

PROJECT ID: 426-4738

COUNTY: WINNEBAGO

ORDER OF SHEETS

Section No.	1	Title
Section No.	2	Typical Sections and Details
Section No.	3	Estimate of Quantities
Section No.	3	Miscellaneous Quantities
Section No.	4	Right of Way Plat
Section No.	5	Plan and Profile
Section No.	6	Standard Detail Drawings
Section No.	7	Sign Plates
Section No.	8	Structure Plans
Section No.	9	Computer Earthwork Data
Section No.	9	Cross Sections

TOTAL SHEETS =

Sheets Revised: 6, 11, 15, 15R, 17



DESIGN DESIGNATION

A.A.D.T.	2019	=	9460	6100
A.A.D.T.	2041	=	14500	9400
D.H.V.		=	1507	992
D.D.		=	60/40	60/40
T.		=	5.3%	4.5%
DESIGN SPEED		=	50 MPH	50 MPH
ESALS		=	2,300,000	

CONVENTIONAL SYMBOLS

PLAN	PROFILE
CORPORATE LIMITS	GRADE LINE
PROPERTY LINE	ORIGINAL GROUND
LOT LINE	MARSH OR ROCK PROFILE (To be noted as such)
LIMITED HIGHWAY EASEMENT	SPECIAL DITCH
EXISTING RIGHT OF WAY	GRADE ELEVATION
PROPOSED OR NEW R/W LINE	CULVERT (Profile View)
SLOPE INTERCEPT	UTILITIES
REFERENCE LINE	ELECTRIC
EXISTING CULVERT	FIBER OPTIC
PROPOSED CULVERT (Box or Pipe)	GAS
COMBUSTIBLE FLUIDS	SANITARY SEWER
	STORM SEWER
	TELEPHONE
	WATER
MARSH AREA	UTILITY PEDESTAL
	POWER POLE
WOODED OR SHRUB AREA	TELEPHONE POLE


WINNEBAGO COUNTY HIGHWAY DEPARTMENT

PLAN OF PROPOSED IMPROVEMENT

CTH JJ AND CTH CB ROUNDABOUT

CTH JJ WINNEBAGO COUNTY

COUNTY PROJECT NUMBER
426-4738

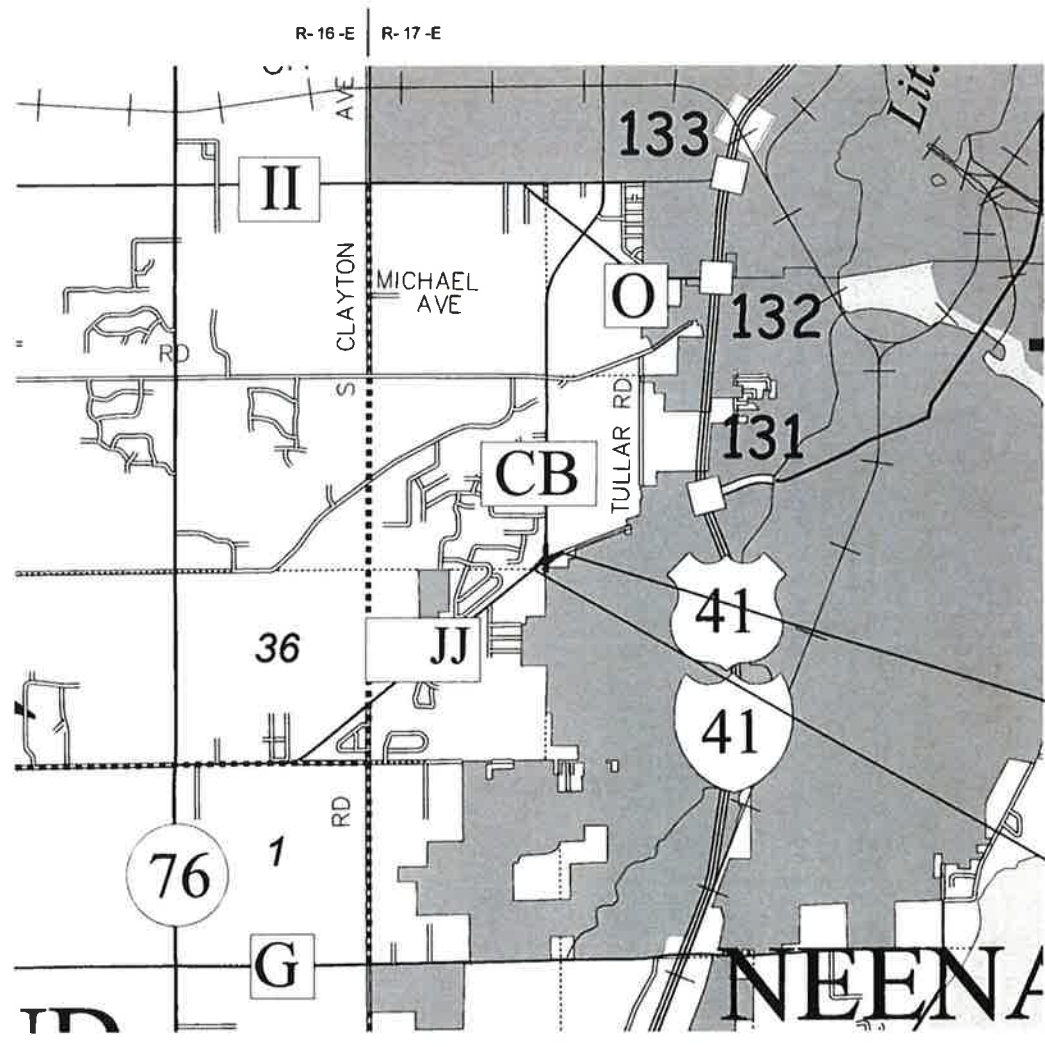

END PROJECT 426-4738
STA. 310+69.70

BEGIN PROJECT 426-4738
STA. 301+23.26
N = 529,018.137
E = 801,297.866

LAYOUT
SCALE 0 1 MI
TOTAL NET LENGTH OF CENTERLINE = 0.179 MILES

HORIZONTAL POSITIONS SHOWN ON THIS PLAN ARE WISCONSIN COORDINATE REFERENCE SYSTEM (WISCRS), (NAME) COUNTY, NAD83 (YEAR), IN U.S. SURVEY FEET. POSITIONS SHOWN ARE GRID COORDINATES, GRID BEARINGS, AND GRID DISTANCES. GRID DISTANCES ARE THE SAME AS GROUND DISTANCES. ELEVATIONS ARE REFERENCED TO NAVD 88 (YEAR). GPS DERIVED ELEVATIONS ARE BASED ON GEOID 12A.

AS-BUILT PLAN

PROJECT LEADER: Bob Williamson
CONTRACTOR: Vinton Construction Company
CONSTRUCTION STARTED 6/27/22
SUBSTANTIALLY COMPLETE 10/3/22

ACCEPTED FOR
WINNEBAGO COUNTY
3/15/2022
HIGHWAY COMMISSIONER

ORIGINAL PLANS PREPARED BY
Westwood
MICHAEL A. MALCOLM
E-30025
PROFESSIONAL ENGINEER
3-14-2022
DATE: (Professional Engineer Signature)

GENERAL NOTES

THE LOCATIONS OF EXISTING AND PROPOSED UTILITY FACILITIES AS SHOWN ON THE PLANS ARE APPROXIMATE. THERE MAY BE OTHER UTILITY FACILITIES WITHIN THE PROJECT AREA THAT ARE NOT SHOWN.

THE CONTRACTOR SHALL NOTIFY DIGGERS HOTLINE AND AFFECTED UTILITIES PRIOR TO THE START OF WORK. ANY UTILITY WHICH IS NOT A MEMBER OF THE DIGGERS HOTLINE MUST BE CONTACTED SEPERATELY.

ENGINEER.

THE EXACT LOCATION OF PRIVATE ENTRANCES IS TO BE DETERMINED IN THE FIELD BY THE ENGINEER.

ALL DISTURBED AREAS, NOT OTHERWISE SURFACED ARE TO BE TOPSOILED, SEEDED, FERTILIZED, AND MULCHED OR E-MATTED AS SHOWN IN THE PLAN.

DISTURBED AREAS ADJACENT TO LAWNS SHALL BE SEEDED WITH MIXTURE NO. 40 AND ALL OTHER AREAS SHALL BE SEEDED WITH MIXTURE NO. 10. SEED MIX NO. 30 SHALL BE USED WITHIN 15 FEET OF SHOULDER POINT IN RURAL SECTIONS THAT ARE NOT ADJACENT TO LAWN TYPE TURF.

CURB AND GUTTER RADII ARE SHOWN TO THE FACE OF CURB, UNLESS OTHERWISE NOTED IN THE PLANS.

THE EXACT LOCATIONS OF ALL EROSION CONTROL ITEMS SHALL BE DETERMINED BY THE ENGINEER IN THE FIELD.

ORDER OF "SECTION 2" SHEETS

SHEET TITLE

- GENERAL NOTES
- PROJECT OVERVIEW
- TYPICAL SECTIONS
- CONSTRUCTION DETAILS
- PAVING DETAILS
- CURB RAMP DETAILS
- EROSION CONTROL
- STORM SEWER
- PAVEMENT MARKING & PERMANENT SIGNING
- TRAIL ACCESS STAGING
- ALIGNMENT PLAN

UTILITIES

ELECTRIC

CONTACTS

WE ENERGIES
 REIJO MURTO (ELECTRIC)
 800 S. LYNNDALE DRIVE
 APPLETON, WI 54914
 TELEPHONE: (920) 380-3369
 CELL: (920) 858-6254
 WE-UTILITY-RELOCATIONS@WE-ENERGIES.COM

SEWER

CITY OF NEENAH
 HEATH KUMMEROW
 211 WALNUT STREET
 P.O. BOX 426
 NEENAH, WI 54957
 PHONE: (920) 886-6245
 EMAIL: HKUMMEROW@CI.NEENAH.WI.US

COMMUNICATION

AT&T WISCONSIN
 CHUCK BARTELT
 70 E DIVISION ST
 FOND DU LAC, WI 54935
 TELEPHONE: (920) 929-1013 (OFFICE)
 MOBILE: 920-410-5104
 EMAIL: cb1461@att.com

WATER

CITY OF NEENAH
 TONY MACH
 211 WALNUT STREET
 P.O. BOX 426
 NEENAH, WI 54957
 PHONE: (920) 886-6182
 EMAIL: AMACH@CI.NEENAH.WI.US

CHARTER
 VINCE ALBIN
 3520 E. DESTINATION DRIVE
 APPLETON, WI 54915

OTHER CONTACTS

WINNEBAGO COUNTY

BOB DOEMEL
 901 W. COUNTY ROAD Y
 OSHKOSH, WI 54903
 TELEPHONE: (920) 232-1713
 EMAIL: RDOEMAL@CO.WINNEBAGO.WI.US

NETLEC (NSIGHT)
 450 SECURITY DRIVE
 GREEN BAY, WI 54313
 ATTN: RICK VINCENT
 PHONE: (920) 617-7316
 EMAIL: RICK.VINCENT@NSIGHT.COM

DESIGN CONSULTANT


MIKE MALCOLM
 ONE SYSTEMS DRIVE
 APPLETON, WI 54914
 TELEPHONE: (920) 830-6175
 EMAIL: MIKE.MALCOLM@WESTWOODPS.COM




US SIGNAL
 HENRY GRAFFENIUS
 7020 SOUTHBELT DRIVE SE
 CALEDONIA, MI 49316
 PHONE: (616) 455-9840
 CELL: (616) 988-5309


GAS

WE ENERGIES
 CODY BECKMAN
 800 S. LYNNDALE DRIVE
 APPLETON, WI 54914
 TELEPHONE: (920) 380-3342
 CODY.BECKMAN@WE-ENERGIES.COM
 WE-UTILITY-RELOCATIONS@WE-ENERGIES.COM




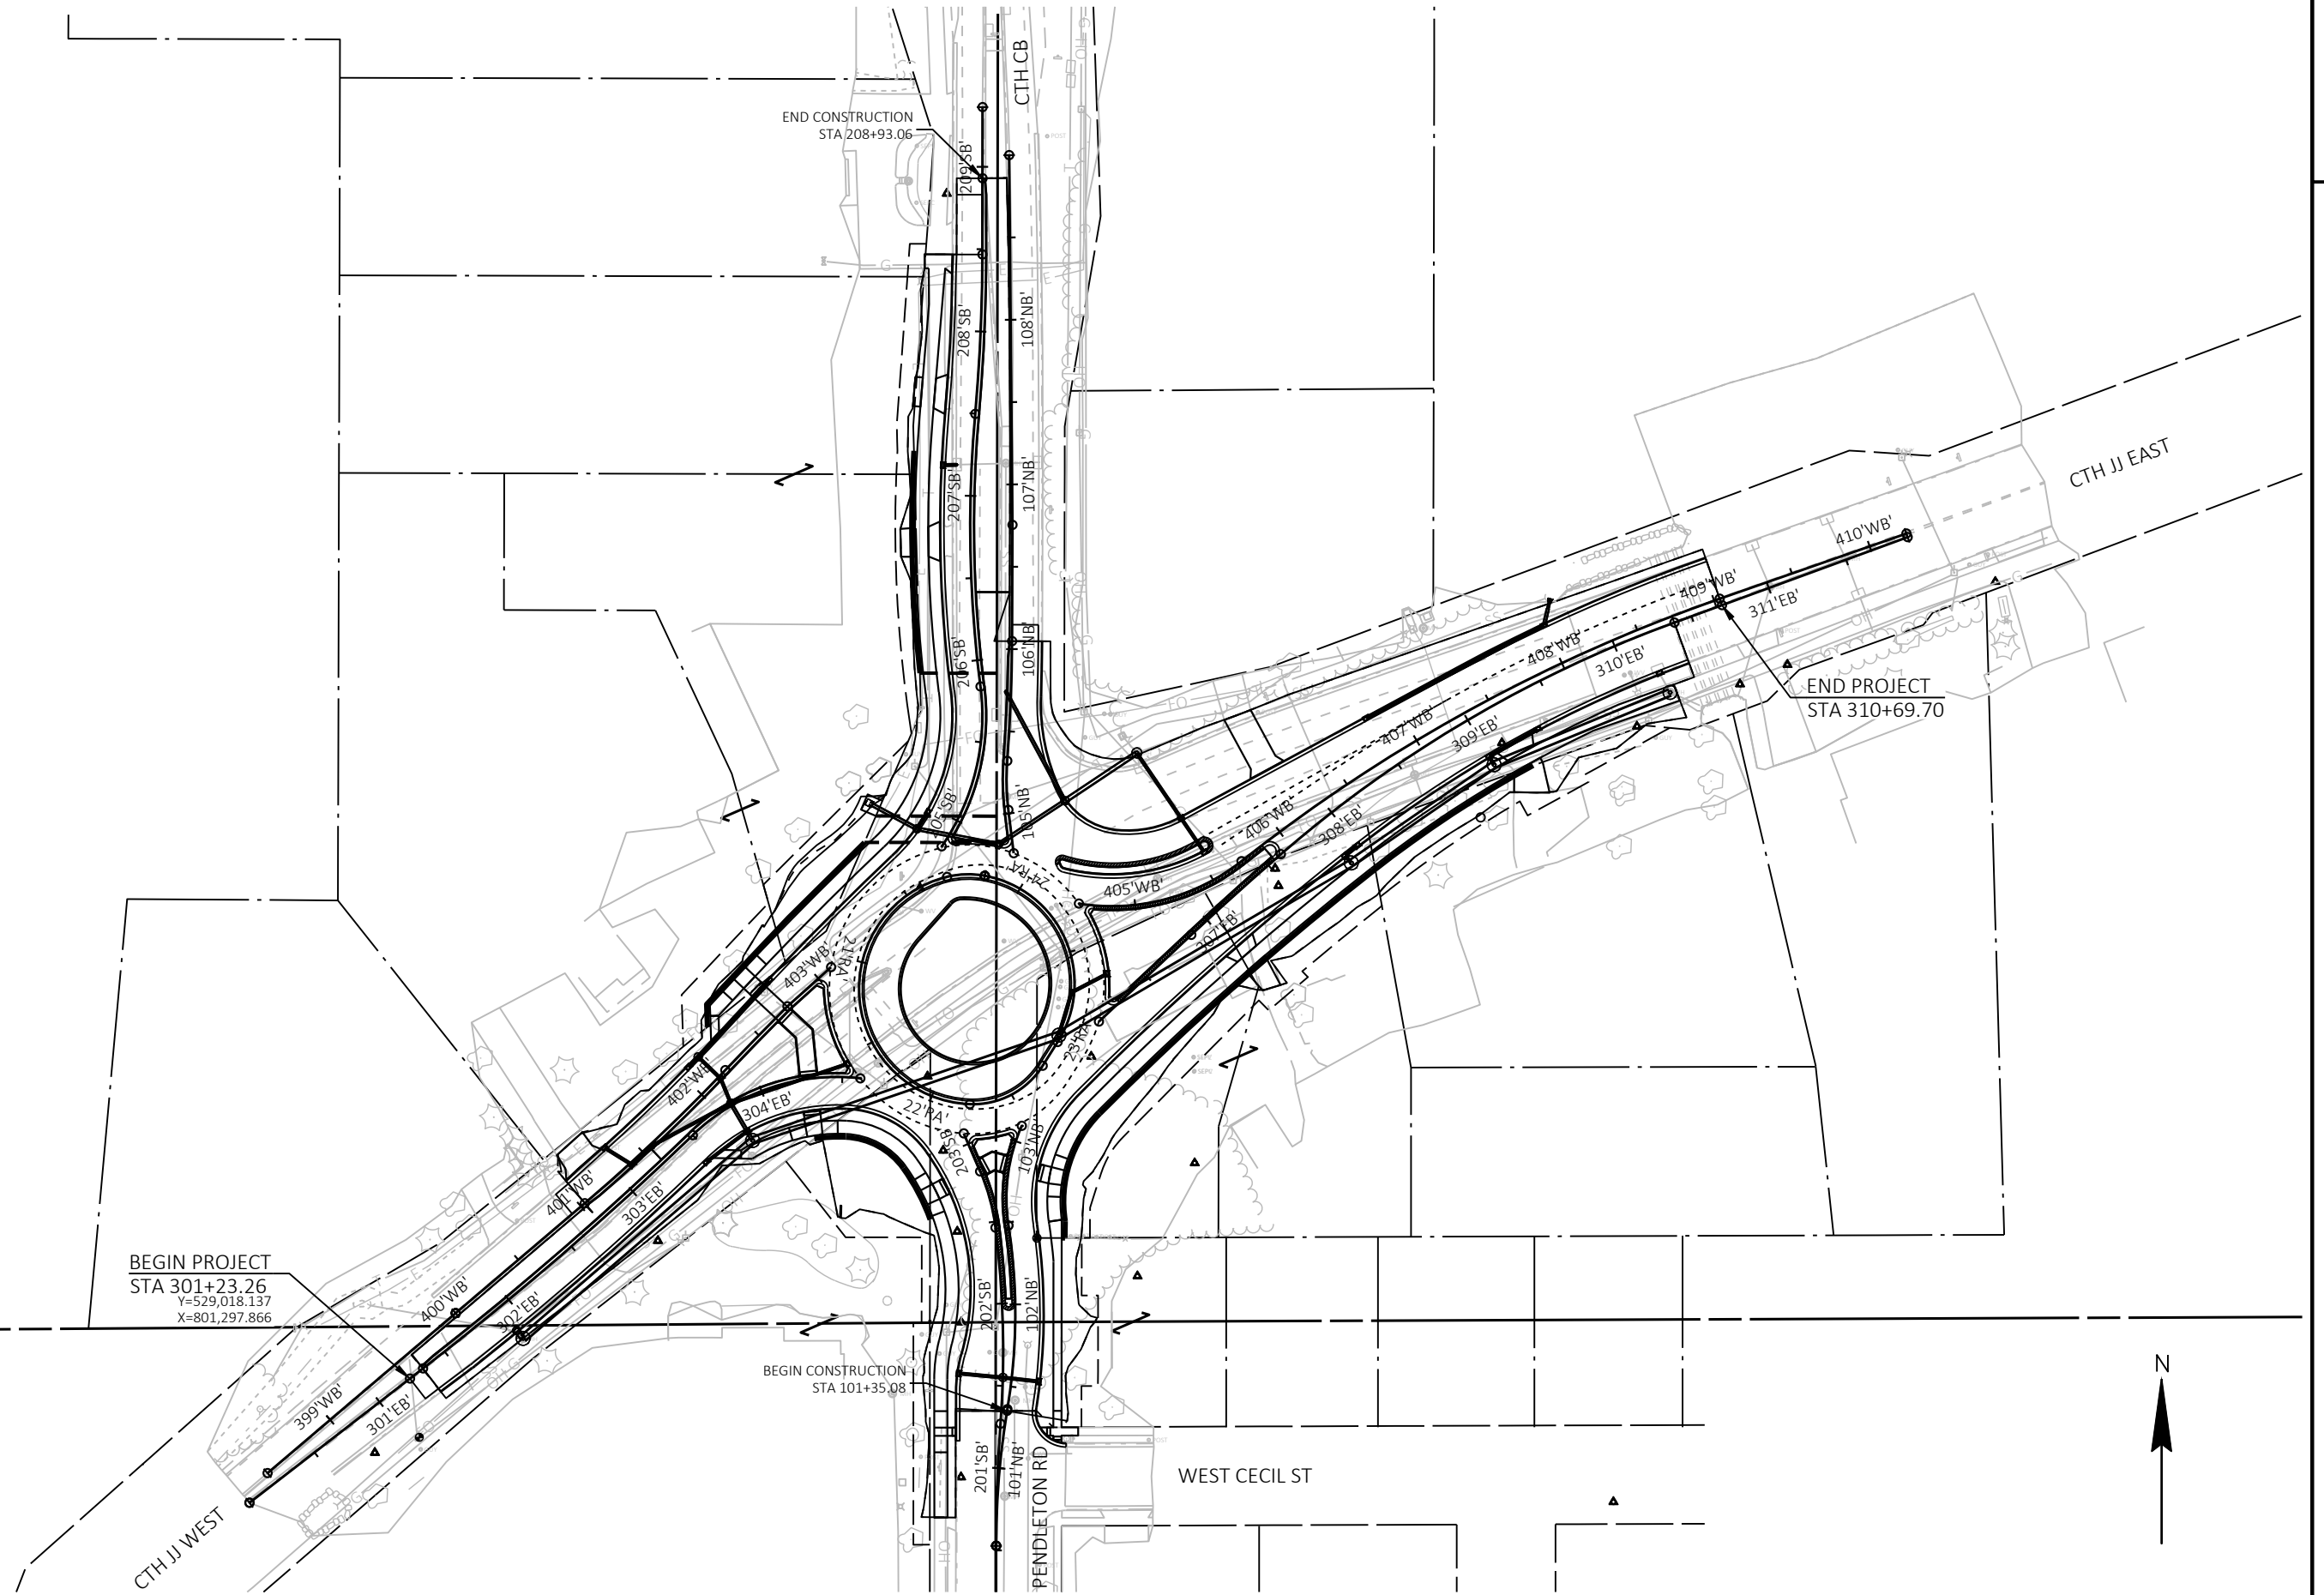

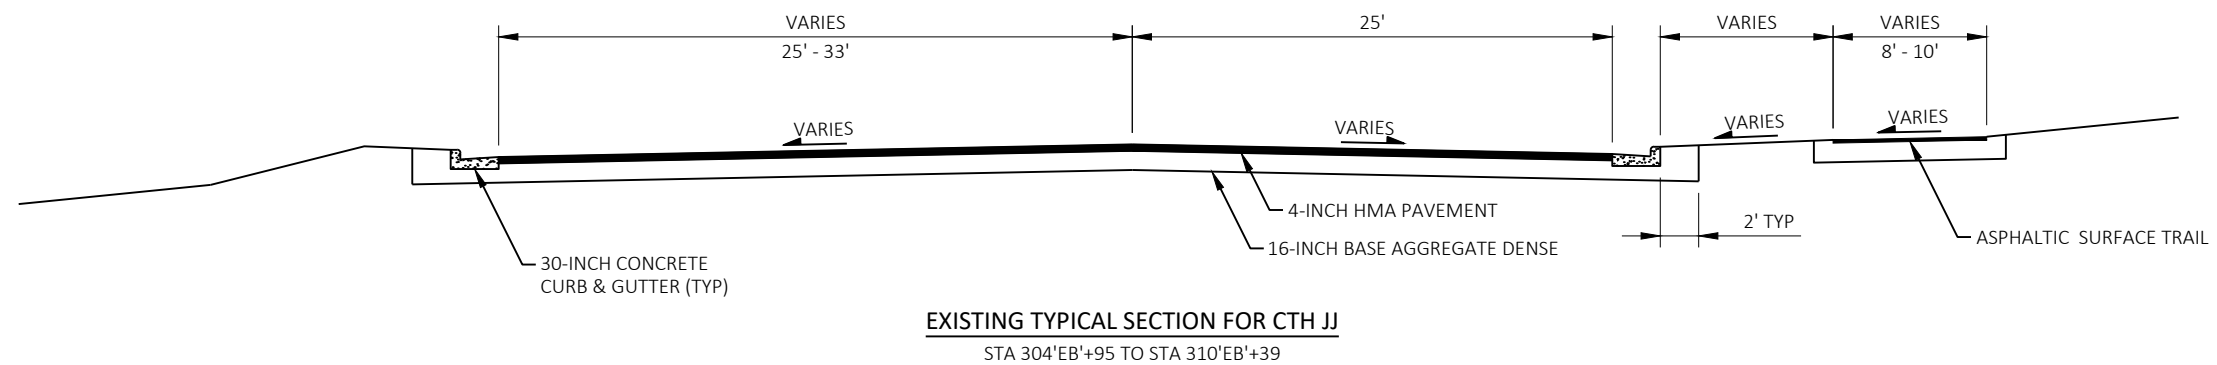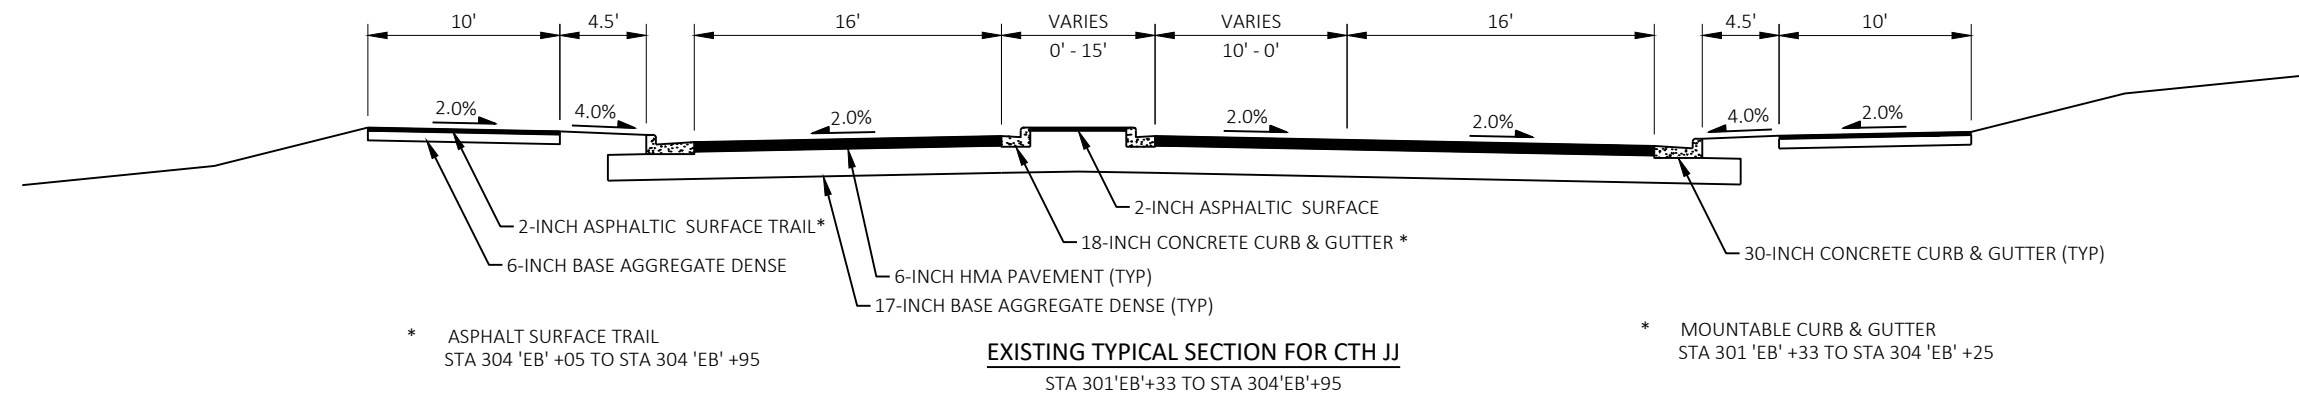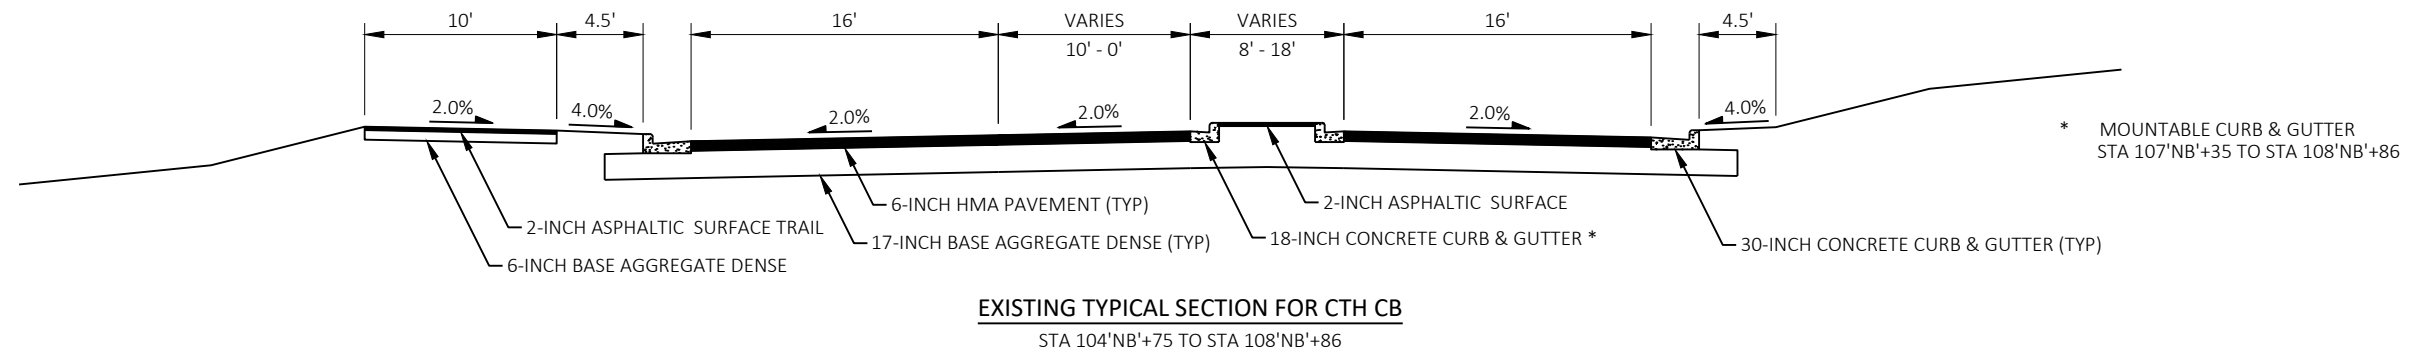


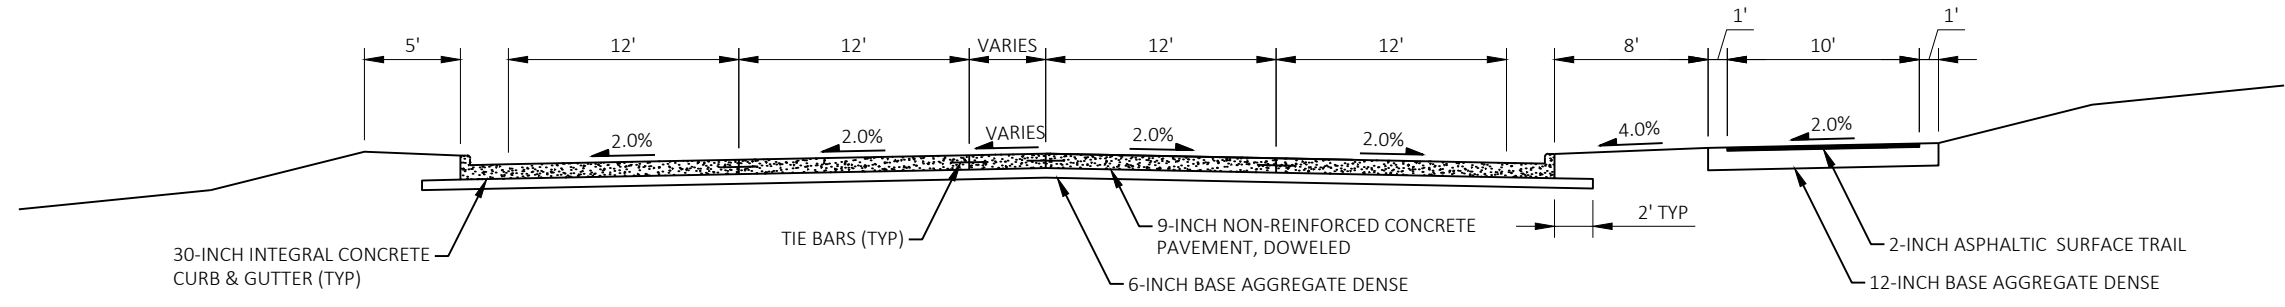


EXISTING TYPICAL SECTION FOR CTH JJ
 STA 310'EB'+39 TO STA 311'EB'+90

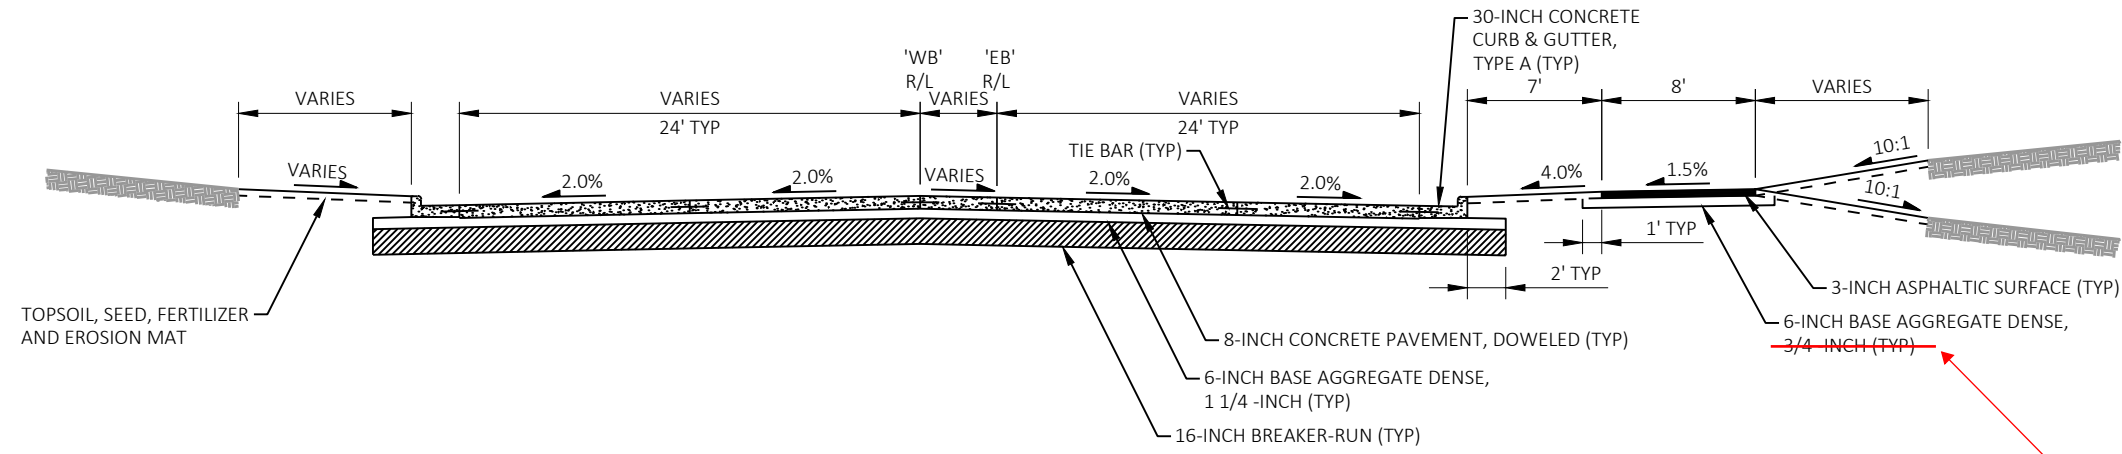

PROPOSED TYPICAL SECTION FOR CTH JJ EAST
 STA 307'EB'+60 TO STA 311'EB'+90

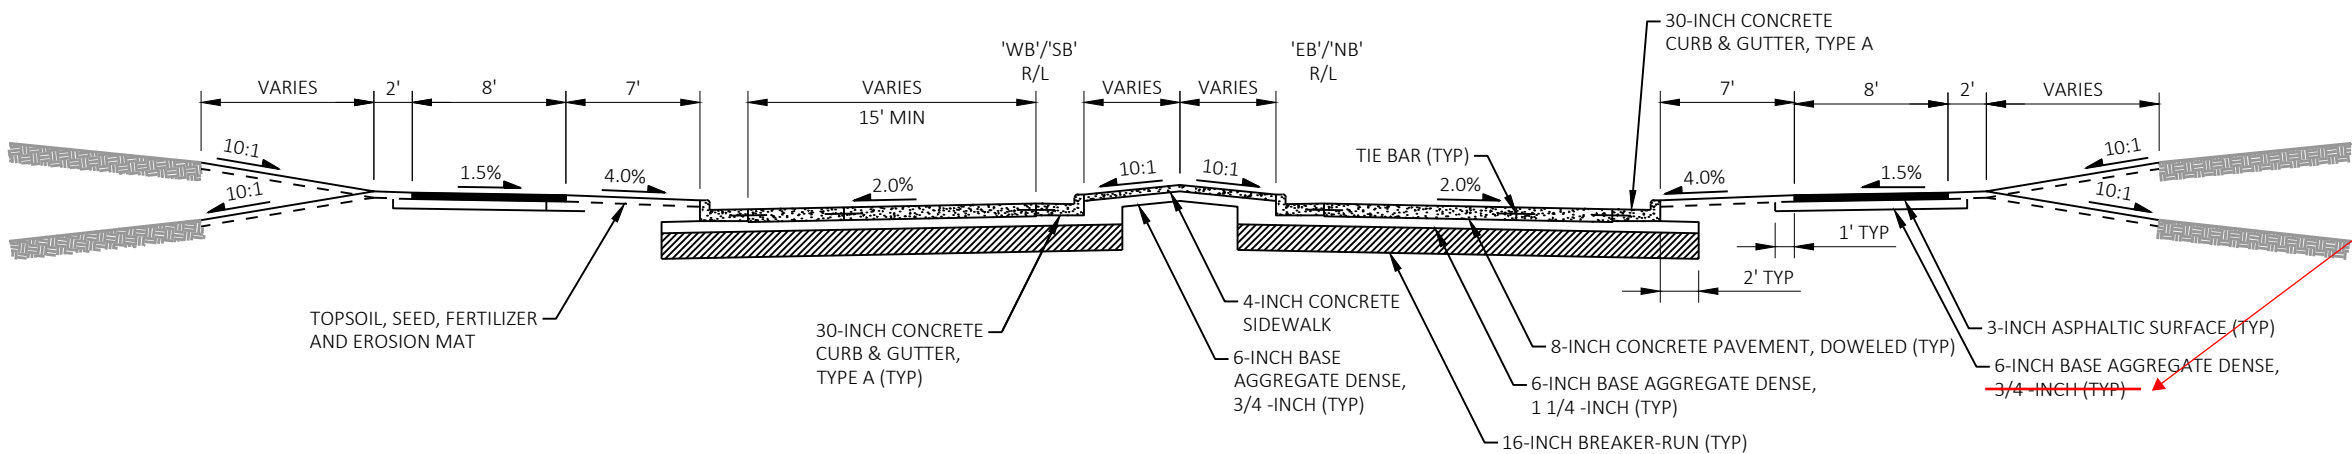


PROPOSED TYPICAL SECTION FOR CTH JJ/PENDELTON RD/CTH CB ROUNDABOUT ENTRANCE
 STA 303EB'+50 TO STA 304'EB'+61
 STA 306'EB'+10 TO STA 307'EB'+60
 STA 101'NB'+35 TO STA 103'NB'+10
 STA 104'NB'+75 TO STA 106'NB'+05

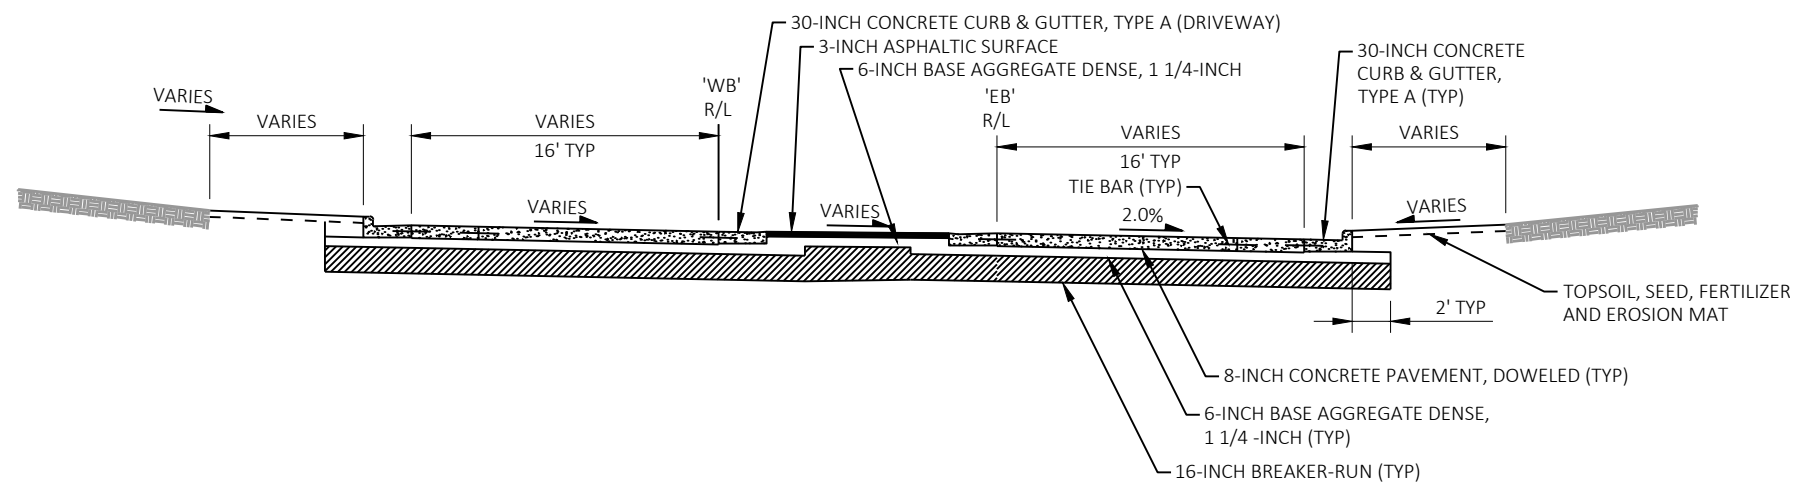


PROPOSED TYPICAL SECTION FOR CTH JJ WEST
 STA 301'EB'+33.26 TO STA 303'EB'+50


1 1/4-IN BAD

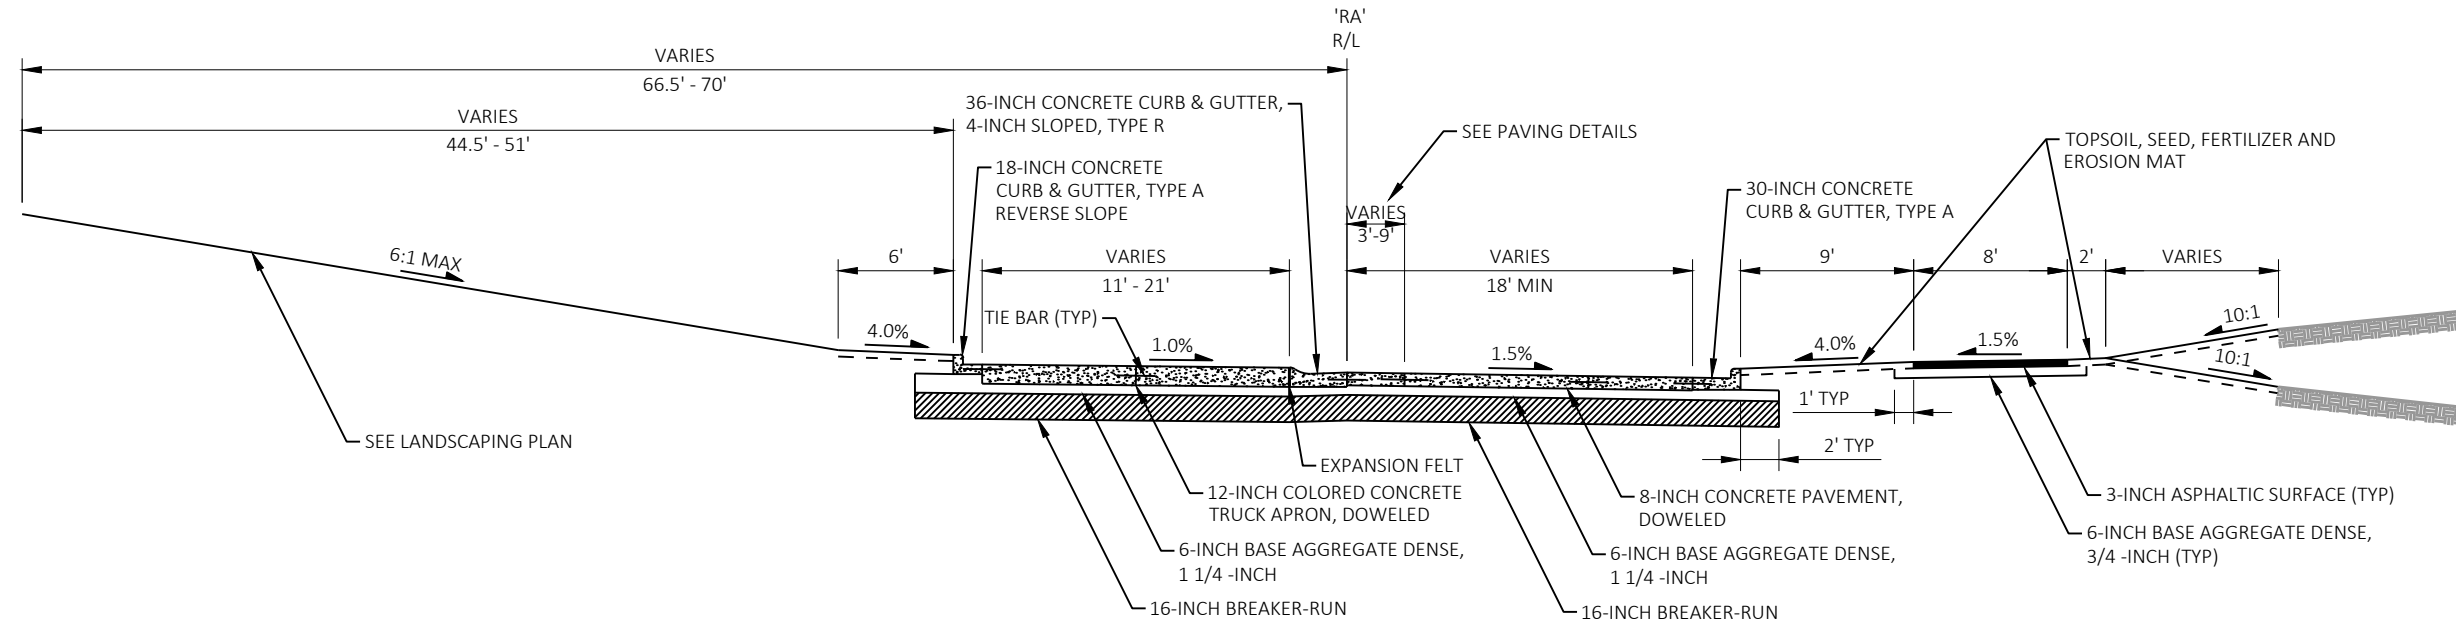


PROPOSED TYPICAL SECTION FOR ROUNDABOUT
 STA 20'RA'+00.00 TO STA 24'RA'+22.83

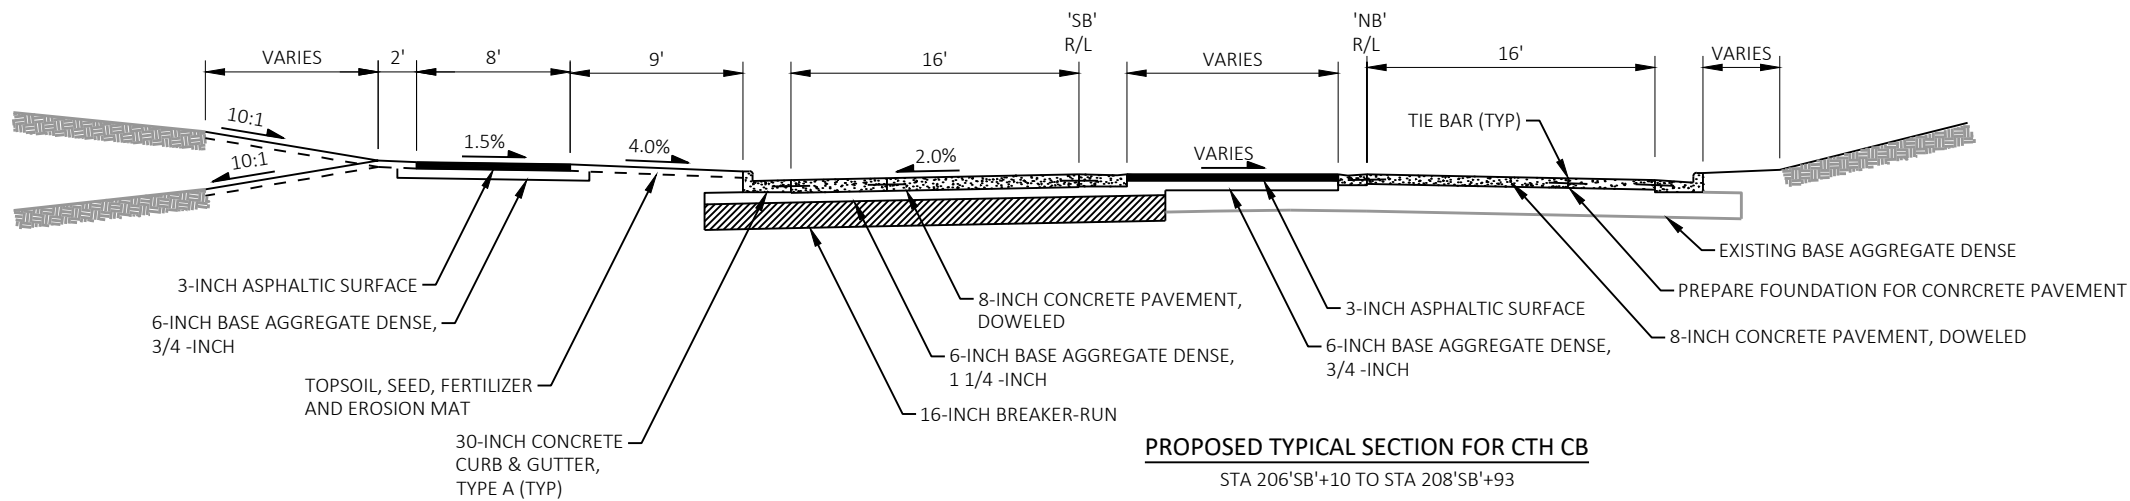


PROPOSED TYPICAL SECTION FOR CTH CB
 STA 206'SB'+10 TO STA 208'SB'+93

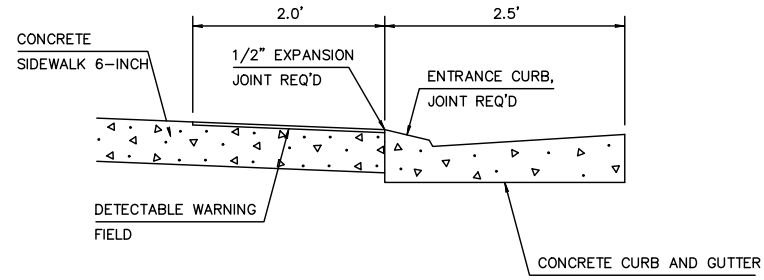


SECTION A-A

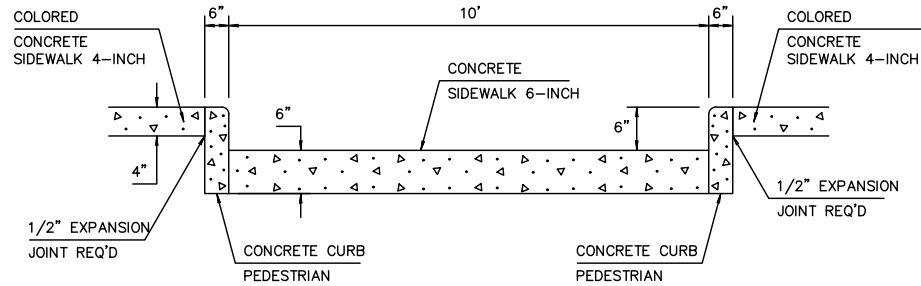

SECTION B-B

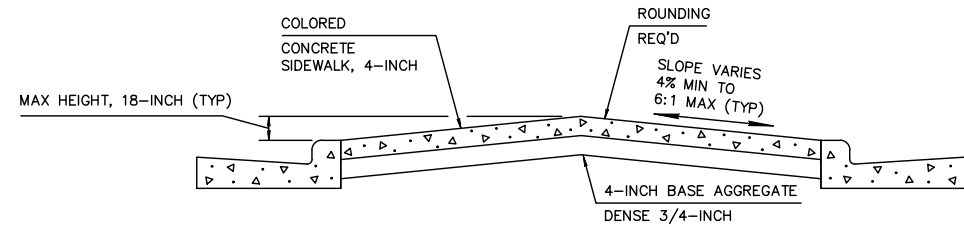


SIDEWALK MEDIAN

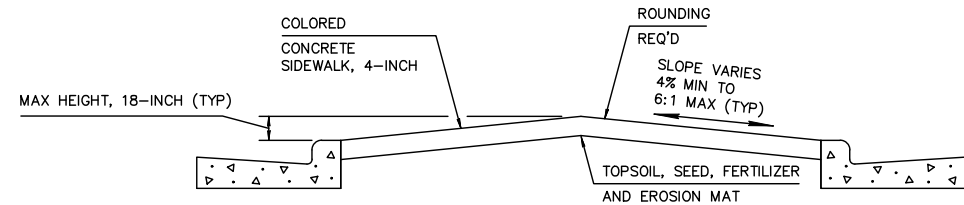


GRASS MEDIAN

SECTION C-C

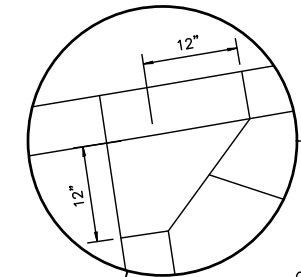

TRANSITION NOSE TYPICAL AT 4 CROSSWALK CORNERS

CONCRETE MEDIAN SLOPED NOSE TYPE 2, REQ'D

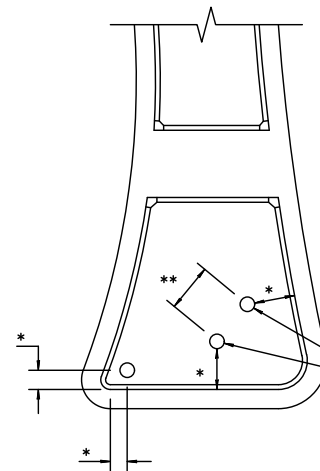

* DISTANCE TO BE LAID OUT IN THE FIELD BASED ON SIGN SIZE. TWO FOOT MINIMUM CLEARANCE BETWEEN THE EDGE OF SIGN AND THE FACE OF CURB.

SEE A4-3 SIGN PLATE FOR "TYPICAL INSTALLATION OF PERMANENT TYPE II SIGNS ON SINGLE POST."


SEE A4-3B SIGN PLATE FOR "SIGN POST BOX-OUTS."

** SEE A4-4 SIGN PLATE FOR POST SPACING REQUIREMENTS.

USE A 18-INCH MINIMUM INSIDE DIAMETER PVC PIPE BOX OUT IN CONCRETE FOR SIGN POST (TYP). THE NUMBER OF BOX OUTS REQUIRED VARIES BY WIDTH OF THE SIGN AND SHALL BE VERIFIED BEFORE PLACING THE CONCRETE IN THE ISLAND.

ISLAND SIGN LOCATION DETAIL (TYP)

NOTIFY THE OUTAGAMIE COUNTY HIGHWAY DEPT. (ANDY ROWELL) AT 920-968-5756 A MINIMUM OF TWO WEEKS PRIOR TO THE NEED FOR SIGN PLACEMENT TO ALLOW FOR STAKING OF ANY PERMANENT SIGNING REQUIRED ON THE PROJECT.


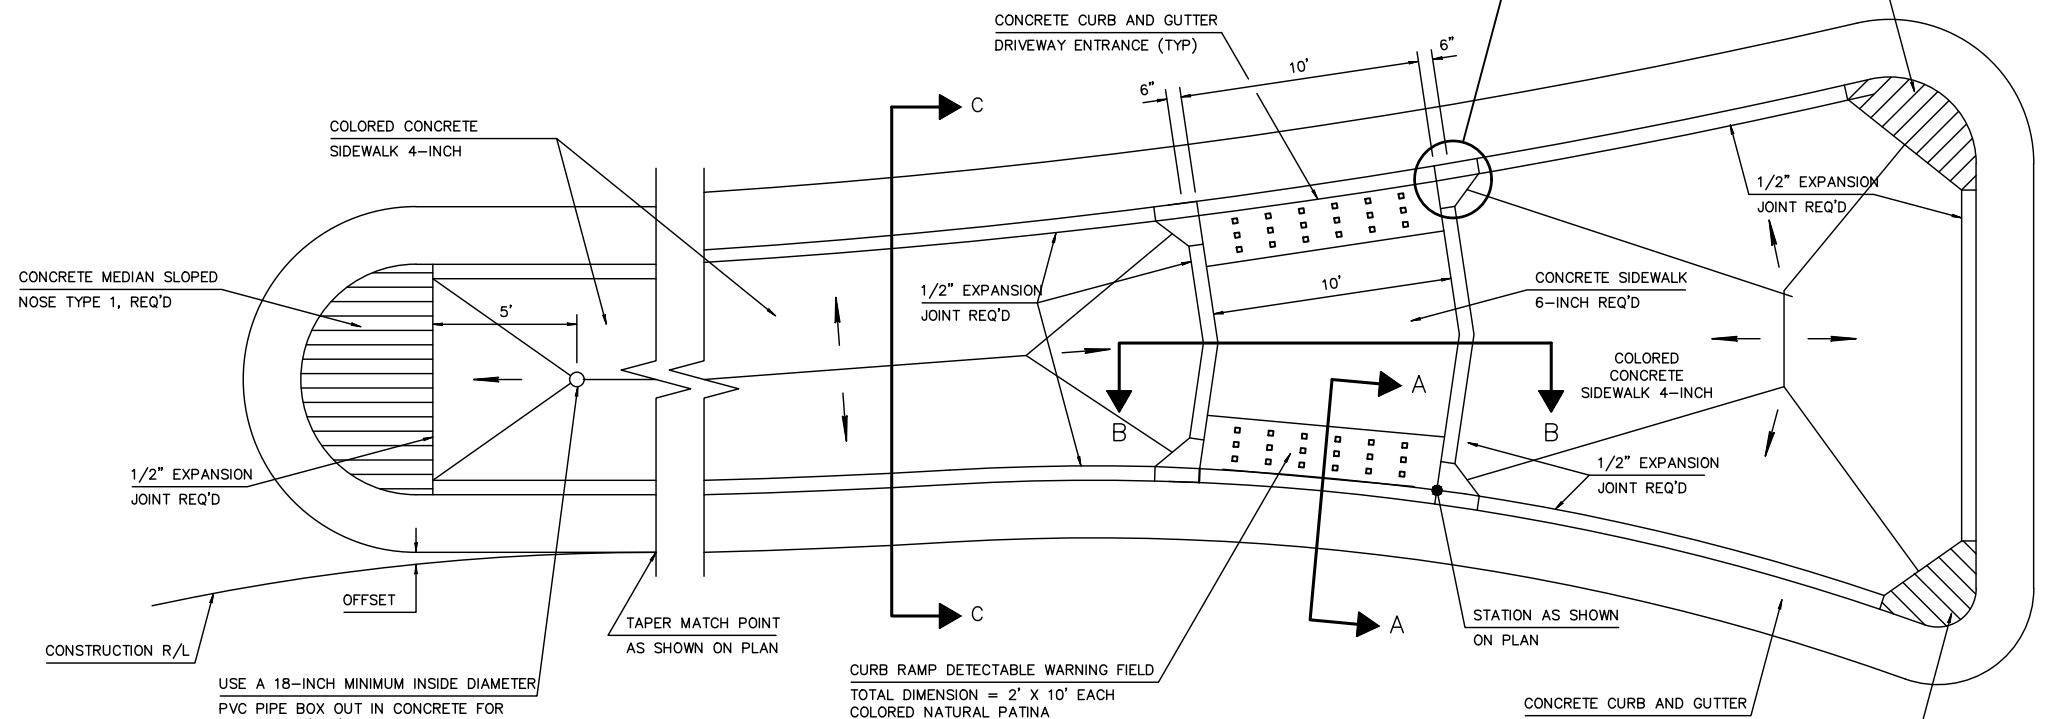


USE A 18-INCH MINIMUM INSIDE DIAMETER PVC PIPE BOX OUT IN CONCRETE FOR SIGN POST (TYP). THE NUMBER OF BOX OUTS REQUIRED VARIES BY WIDTH OF THE SIGN AND SHALL BE VERIFIED BEFORE PLACING THE CONCRETE IN THE ISLAND.


NOTE: INSTALL TRANSITION NOSE. (INCIDENTAL TO OTHER PAY ITEMS.) DO NOT MARK TRANSITION NOSE.

— DRAINAGE BREAK POINT
 ← DIRECTION OF DRAINAGE


SPLITTER ISLAND DETAIL

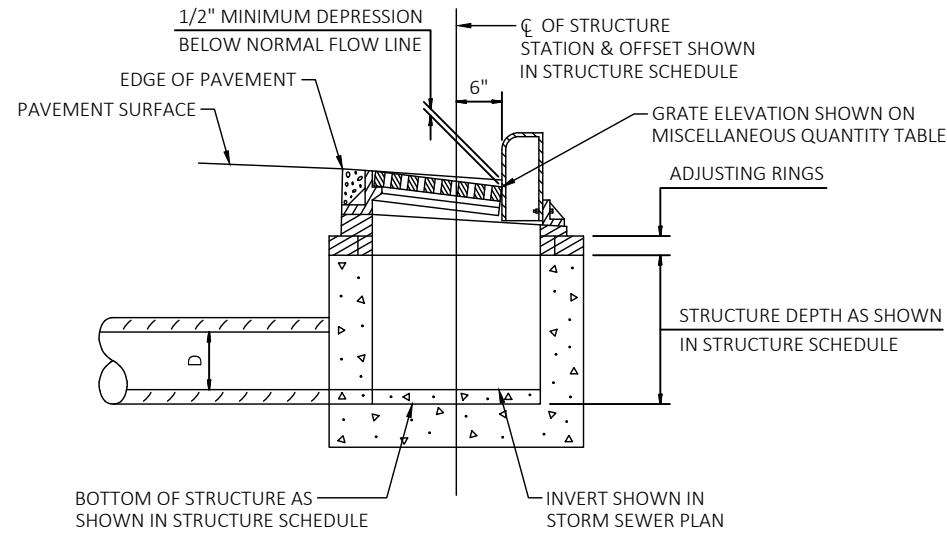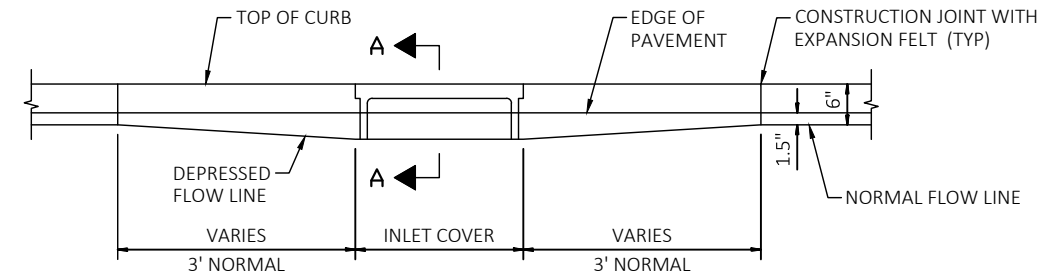

SECTION A-A
DETAIL OF CURB AND GUTTER AT INLETS

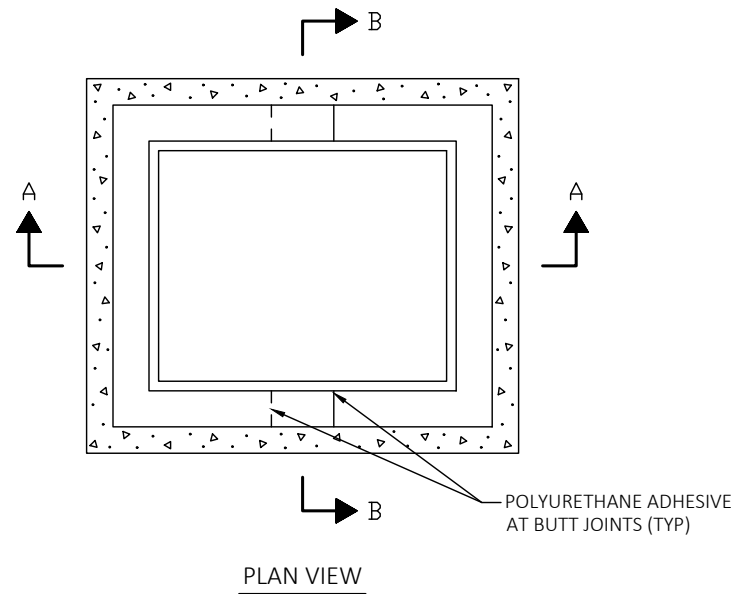


PLAN VIEW

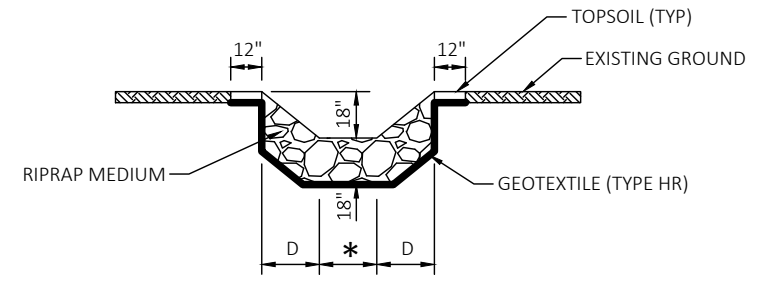


SECTION A-A

* APRON ENDWALL WIDTH
D = PIPE DIAMETER

NOTE:
ALL CUTS MADE TO RUBBER ADJUSTMENT RINGS WILL BE PERPENDICULAR AND PROVIDE A TIGHT JOINT.

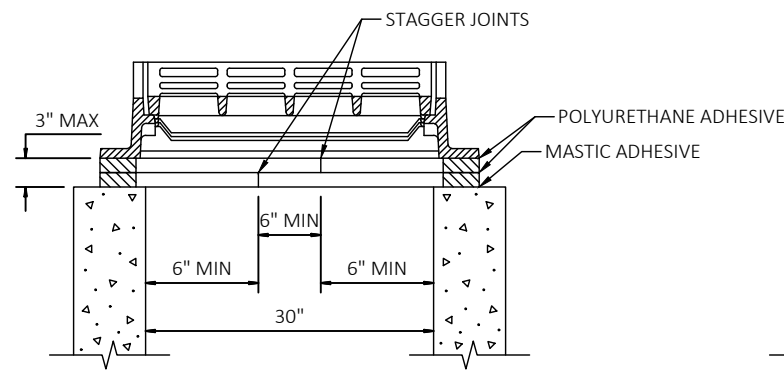


SECTION A-A

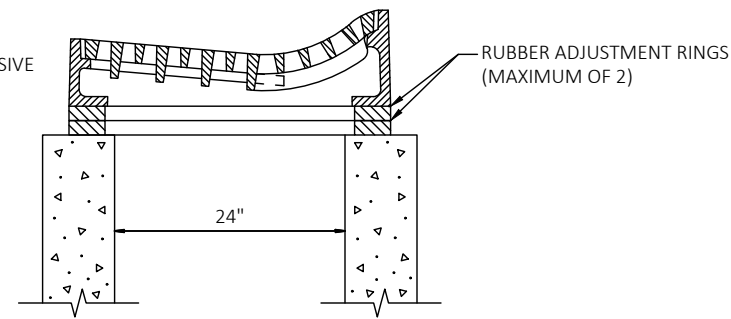

SECTION B-B


RUBBER RING CUTTING DETAIL FOR INLET TYPE 2, SPECIAL

L = 3 TIMES DIAMETER (NORMAL)
OR AS DIRECTED BY THE ENGINEER

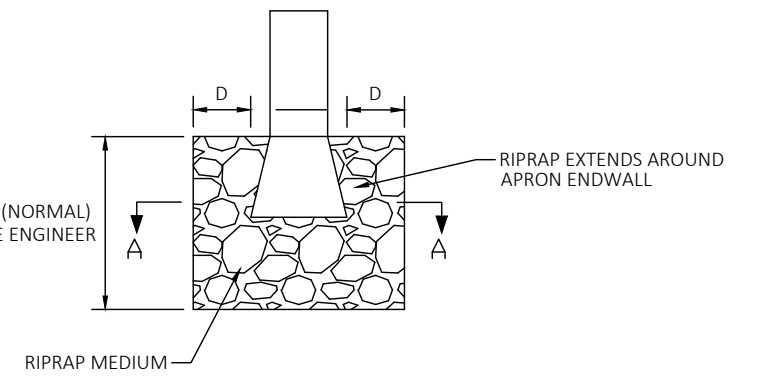


PLAN VIEW

RIPRAP TREATMENT AT STORM SEWER OUTFALLS

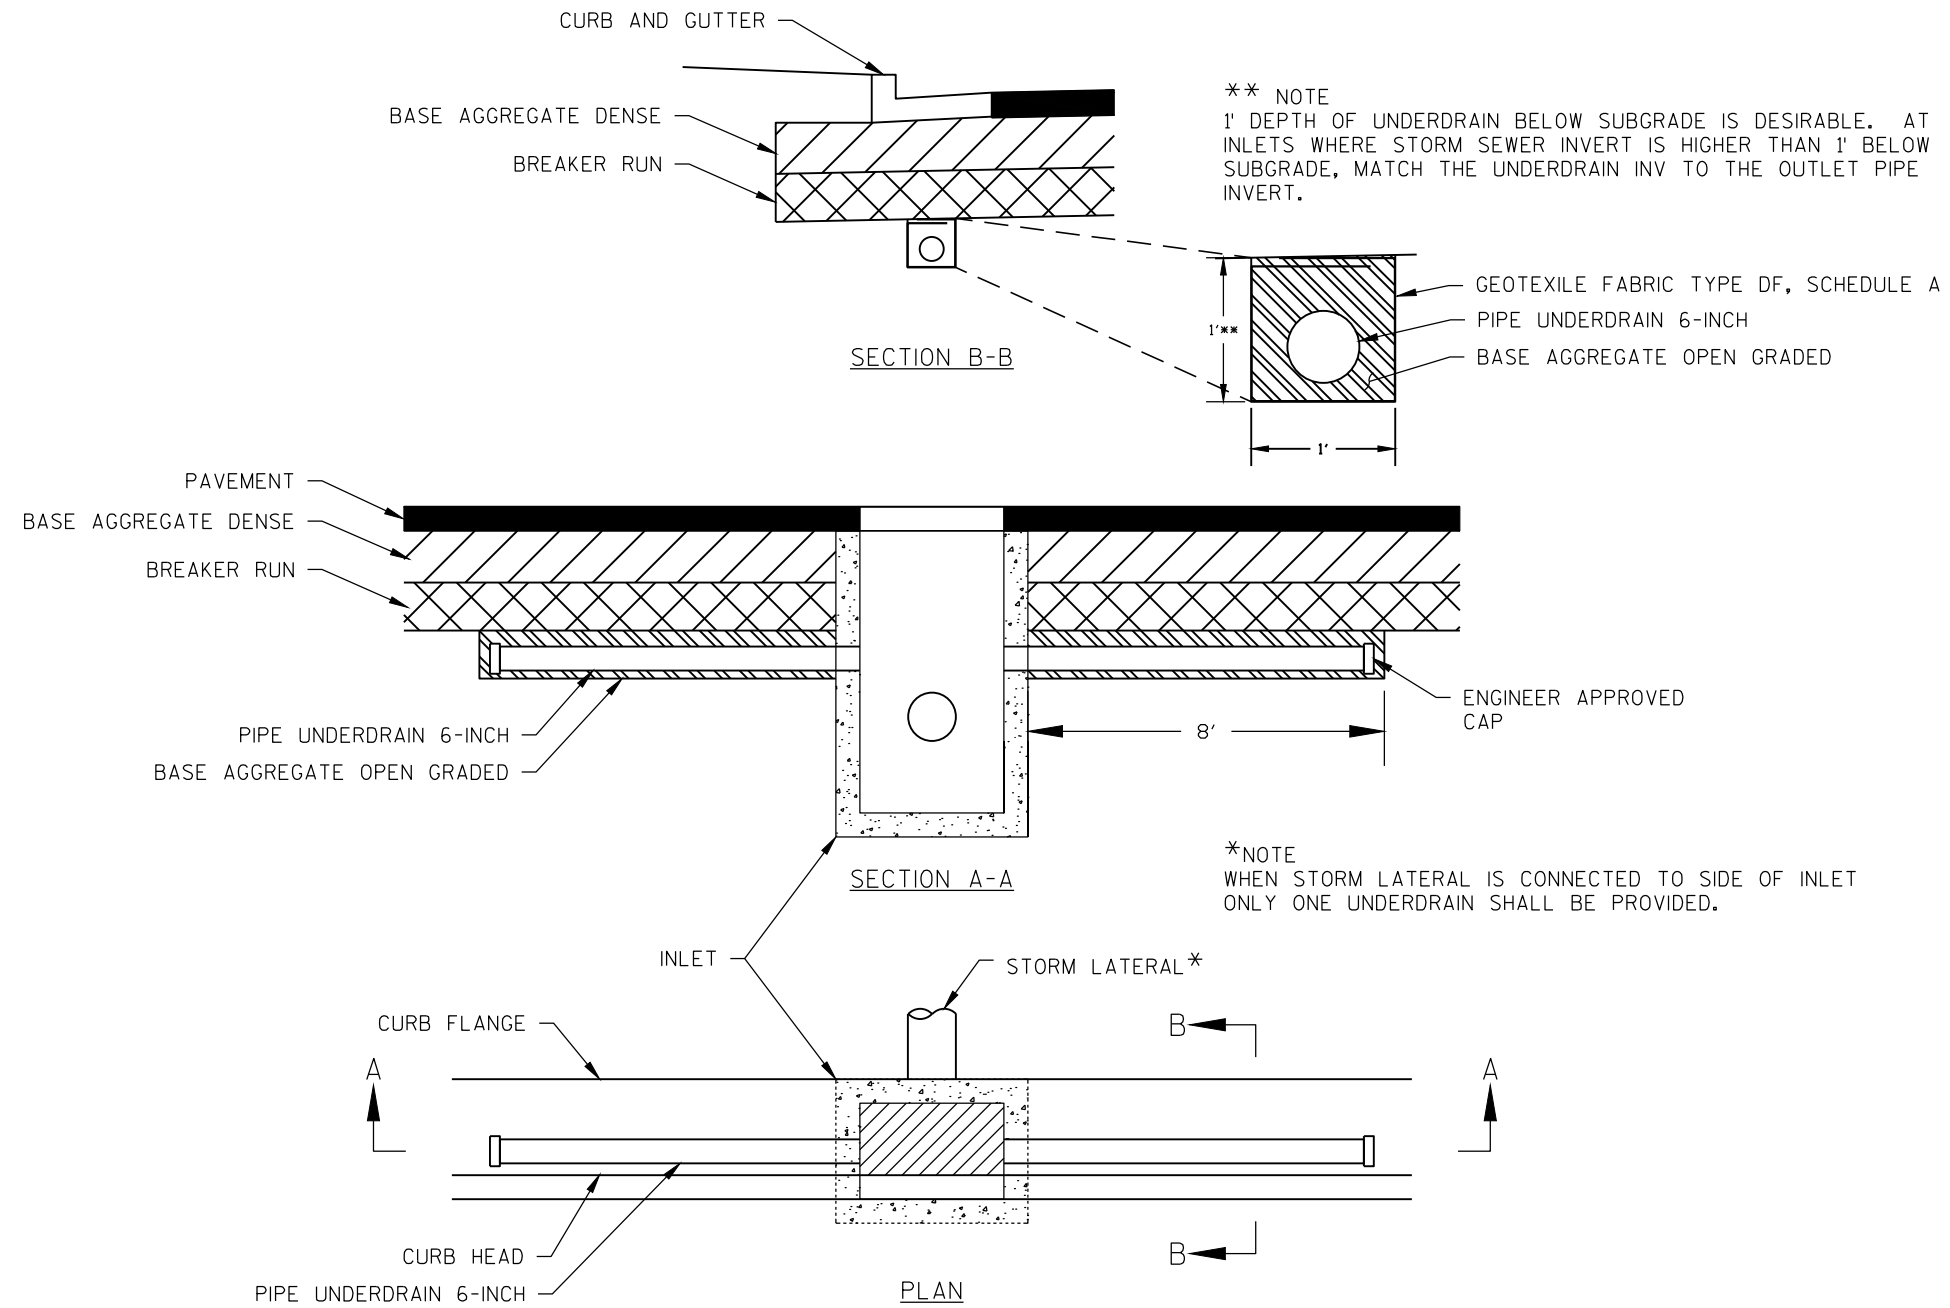


PIPE UNDERDRAIN DETAIL
LOCATED AT PROFILE LOW POINTS: SEE PLAN

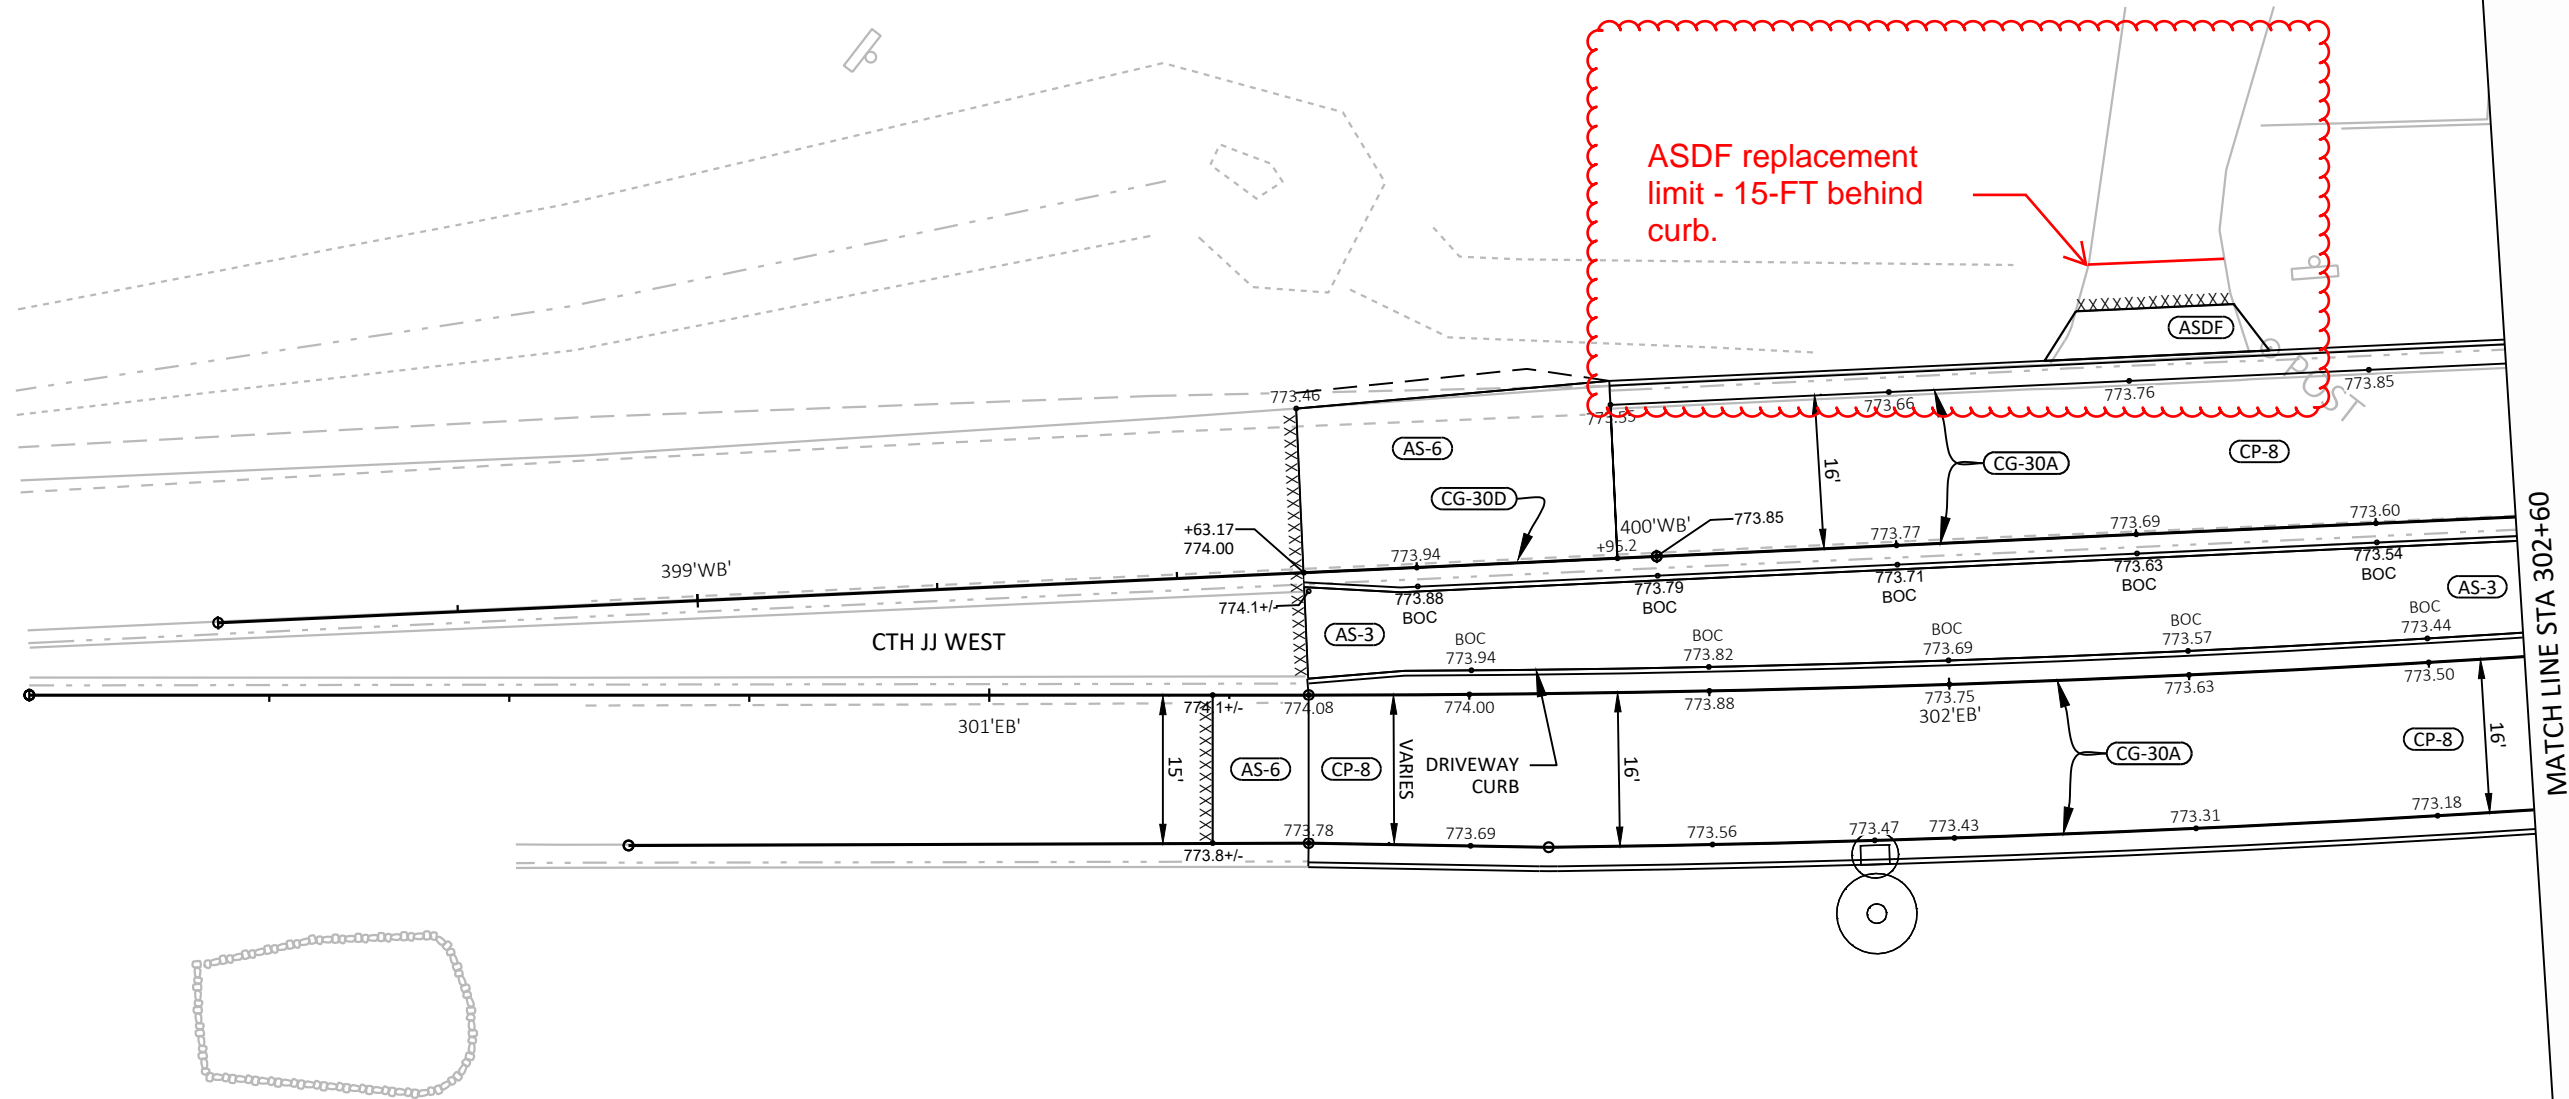


PAVING DETAIL LEGEND

AS-3	ASPHALTIC SURFACE 3-INCH
AS-6	ASPHALTIC SURFACE 6-INCH
ASDF	ASPHALTIC SURFACE DRIVEWAYS AND FIELD ENTRANCES
CABC-6	6-INCH 3/4-INCH BASE AGGREGATE
CD-6	CONCRETE DRIVEWAY 6-INCH
CG-18A	CONCRETE CURB AND GUTTER 18-INCH TYPE A
CG-30A	CONCRETE CURB AND GUTTER 30-INCH TYPE A
CG-30D	CONCRETE CURB AND GUTTER 30-INCH TYPE D
CG-36R4	CONCRETE CURB AND GUTTER 4-INCH SLOPED 36-INCH TYPE R
CMSN1	CONCRETE MEDIAN SLOPE NOSE TYPE 1
CMSN2	CONCRETE MEDIAN SLOPE NOSE TYPE 2
CP-8	CONCRETE PAVEMENT 8-INCH
CP-8C	CONCRETE PAVEMENT 8-INCH COLORED
CCP	CONCRETE CURB PEDESTRIAN
CPTA-12	CONCRETE ROUNDABOUT TRUCK APRON 12-INCH
CS-4	CONCRETE SIDEWALK 4-INCH
CS-6	CONCRETE SIDEWALK 6-INCH
DWF-Y	DETECTABLE WARNING FIELD YELLOW

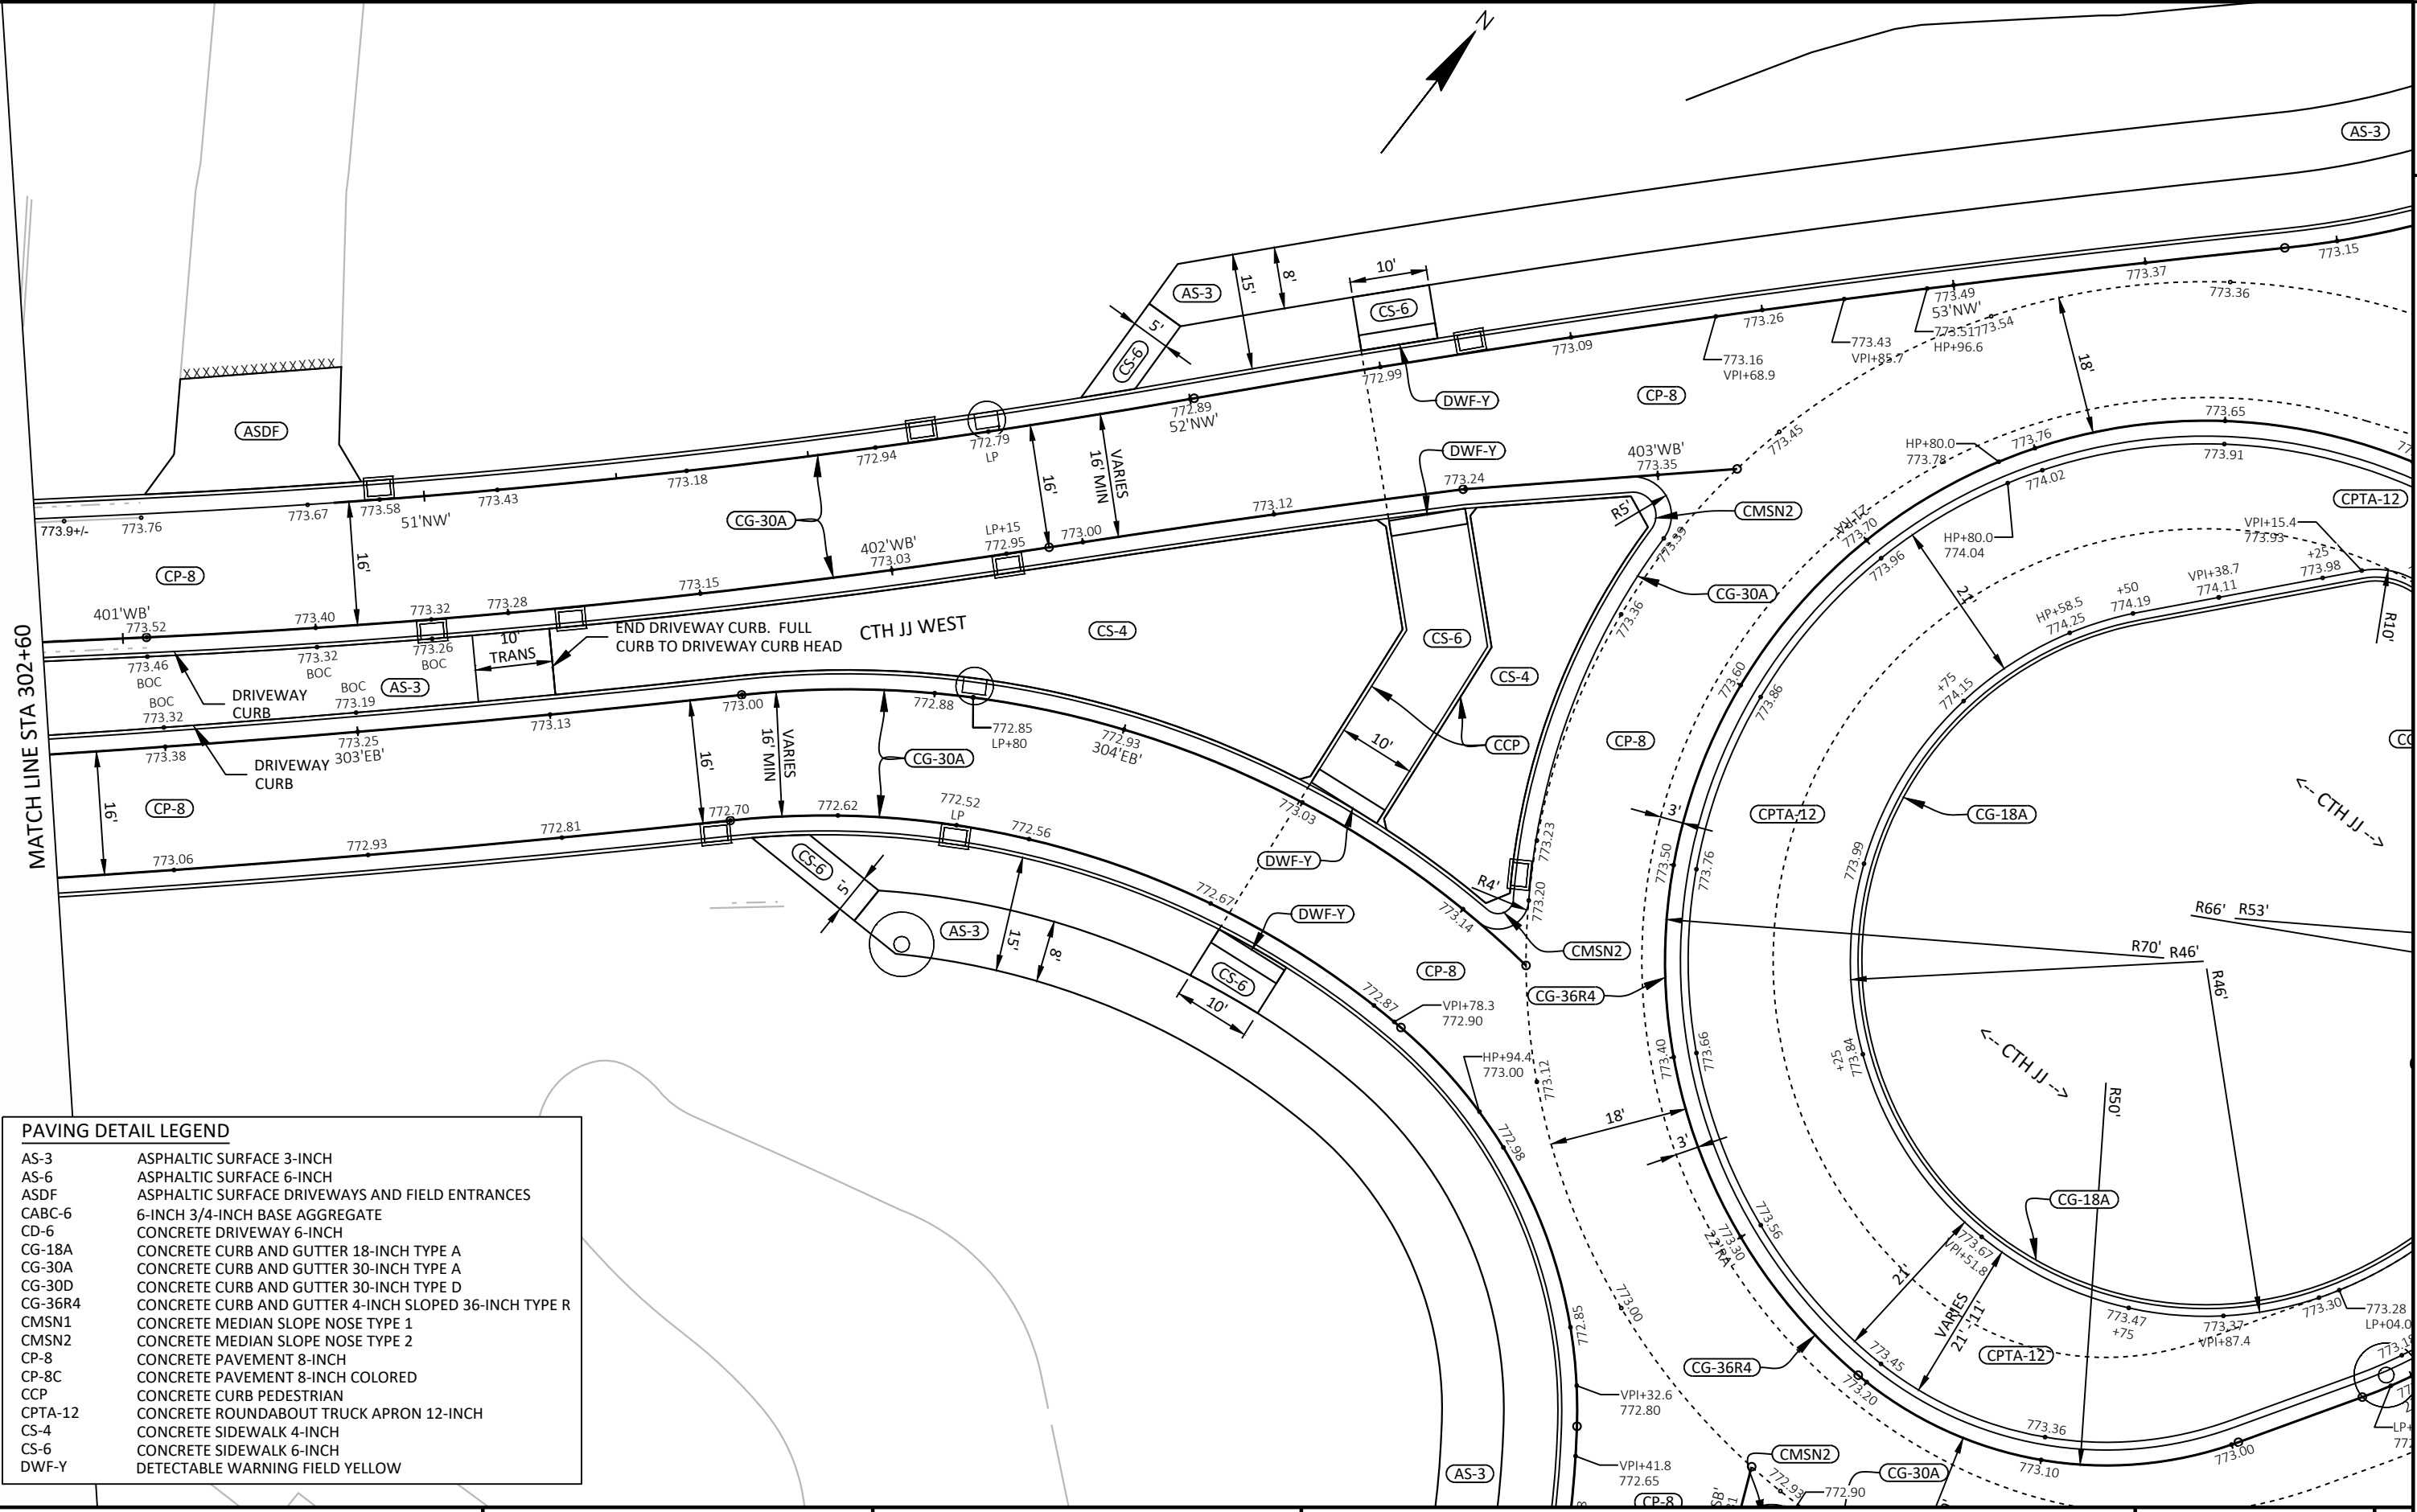

PAVING DETAIL LEGEND

AS-3	ASPHALTIC SURFACE 3-INCH
AS-6	ASPHALTIC SURFACE 6-INCH
ASDF	ASPHALTIC SURFACE DRIVEWAYS AND FIELD ENTRANCES
CABC-6	6-INCH 3/4-INCH BASE AGGREGATE
CD-6	CONCRETE DRIVEWAY 6-INCH
CG-18A	CONCRETE CURB AND GUTTER 18-INCH TYPE A
CG-30A	CONCRETE CURB AND GUTTER 30-INCH TYPE A
CG-30D	CONCRETE CURB AND GUTTER 30-INCH TYPE D
CG-36R4	CONCRETE CURB AND GUTTER 4-INCH SLOPED 36-INCH TYPE R
CMSN1	CONCRETE MEDIAN SLOPE NOSE TYPE 1
CMSN2	CONCRETE MEDIAN SLOPE NOSE TYPE 2
CP-8	CONCRETE PAVEMENT 8-INCH
CP-8C	CONCRETE PAVEMENT 8-INCH COLORED
CCP	CONCRETE CURB PEDESTRIAN
CPTA-12	CONCRETE ROUNDABOUT TRUCK APRON 12-INCH
CS-4	CONCRETE SIDEWALK 4-INCH
CS-6	CONCRETE SIDEWALK 6-INCH
DWF-Y	DETECTABLE WARNING FIELD YELLOW

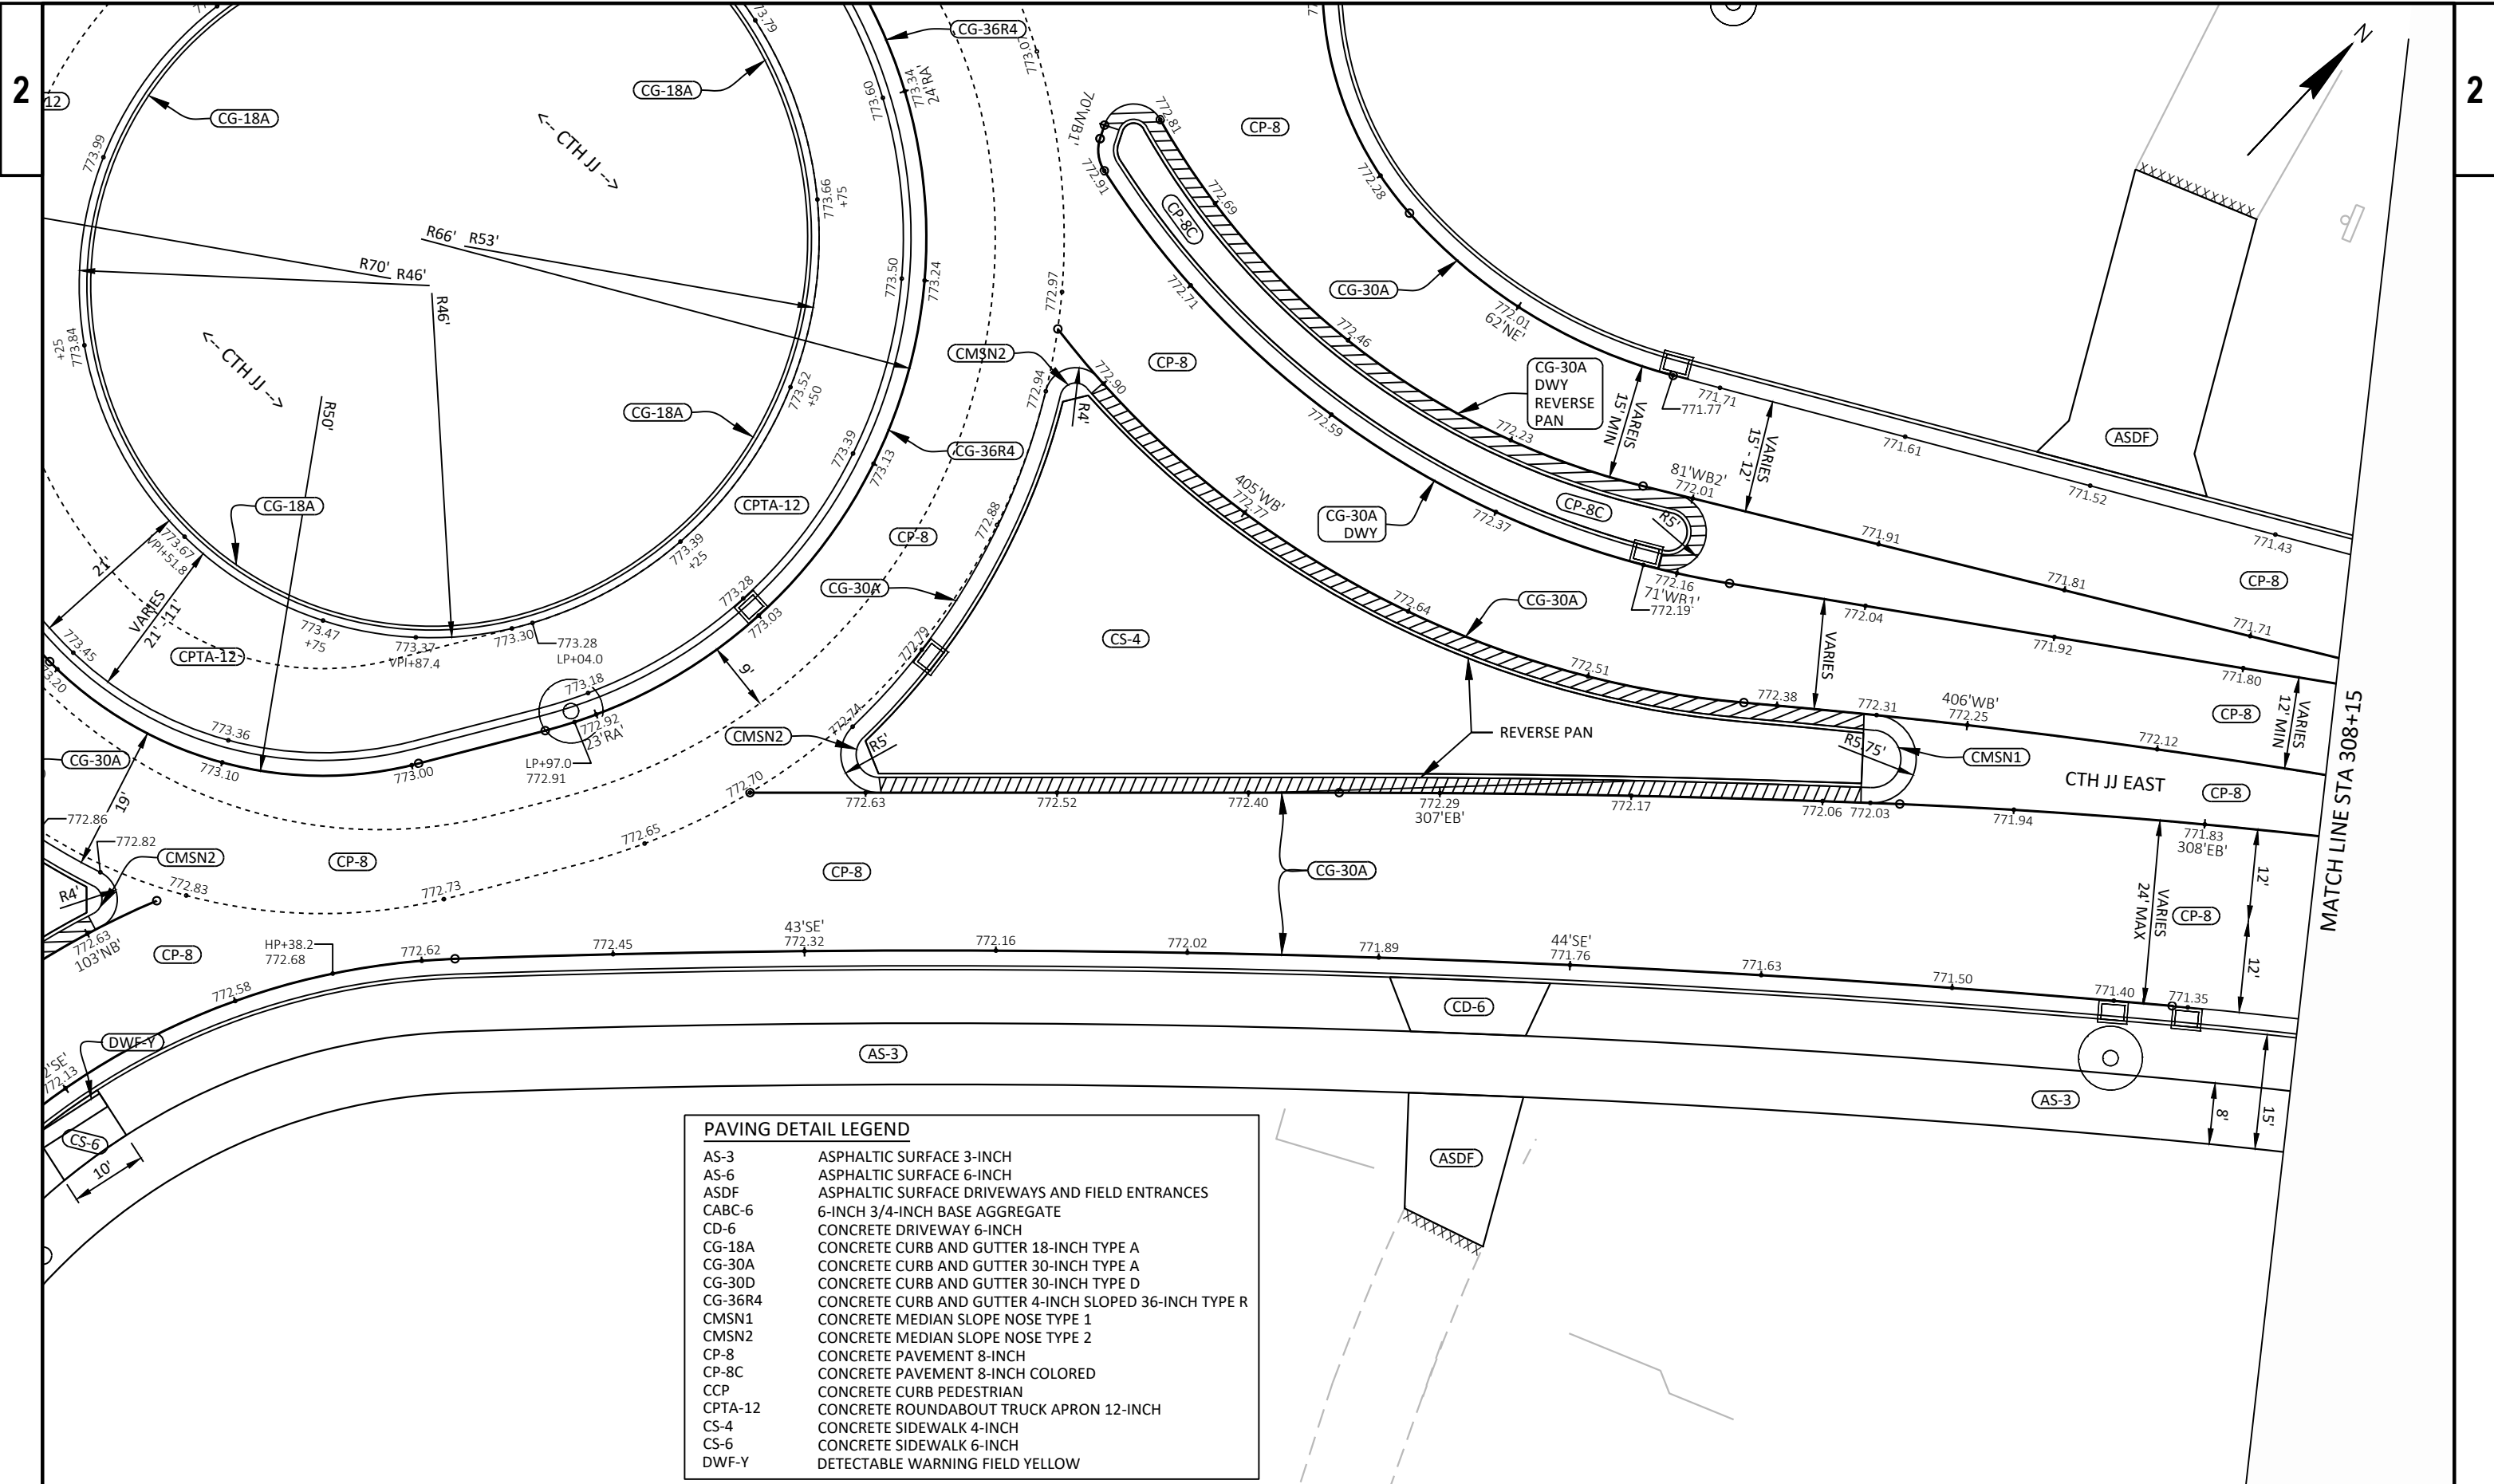

PAVING DETAIL LEGEND

AS-3	ASPHALTIC SURFACE 3-INCH
AS-6	ASPHALTIC SURFACE 6-INCH
ASDF	ASPHALTIC SURFACE DRIVEWAYS AND FIELD ENTRANCES
CABC-6	6-INCH 3/4-INCH BASE AGGREGATE
CD-6	CONCRETE DRIVEWAY 6-INCH
CG-18A	CONCRETE CURB AND GUTTER 18-INCH TYPE A
CG-30A	CONCRETE CURB AND GUTTER 30-INCH TYPE A
CG-30D	CONCRETE CURB AND GUTTER 30-INCH TYPE D
CG-36R4	CONCRETE CURB AND GUTTER 4-INCH SLOPED 36-INCH TYPE R
CMSN1	CONCRETE MEDIAN SLOPE NOSE TYPE 1
CMSN2	CONCRETE MEDIAN SLOPE NOSE TYPE 2
CP-8	CONCRETE PAVEMENT 8-INCH
CP-8C	CONCRETE PAVEMENT 8-INCH COLORED
CCP	CONCRETE CURB PEDESTRIAN
CPTA-12	CONCRETE ROUNDABOUT TRUCK APRON 12-INCH
CS-4	CONCRETE SIDEWALK 4-INCH
CS-6	CONCRETE SIDEWALK 6-INCH
DWF-Y	DETECTABLE WARNING FIELD YELLOW

PROJECT NO: 426-4738

HWY: CTH JJ


COUNTY: WINNEBAGO

PAVING DETAILS - CTH JJ EAST


SHEET

13

E

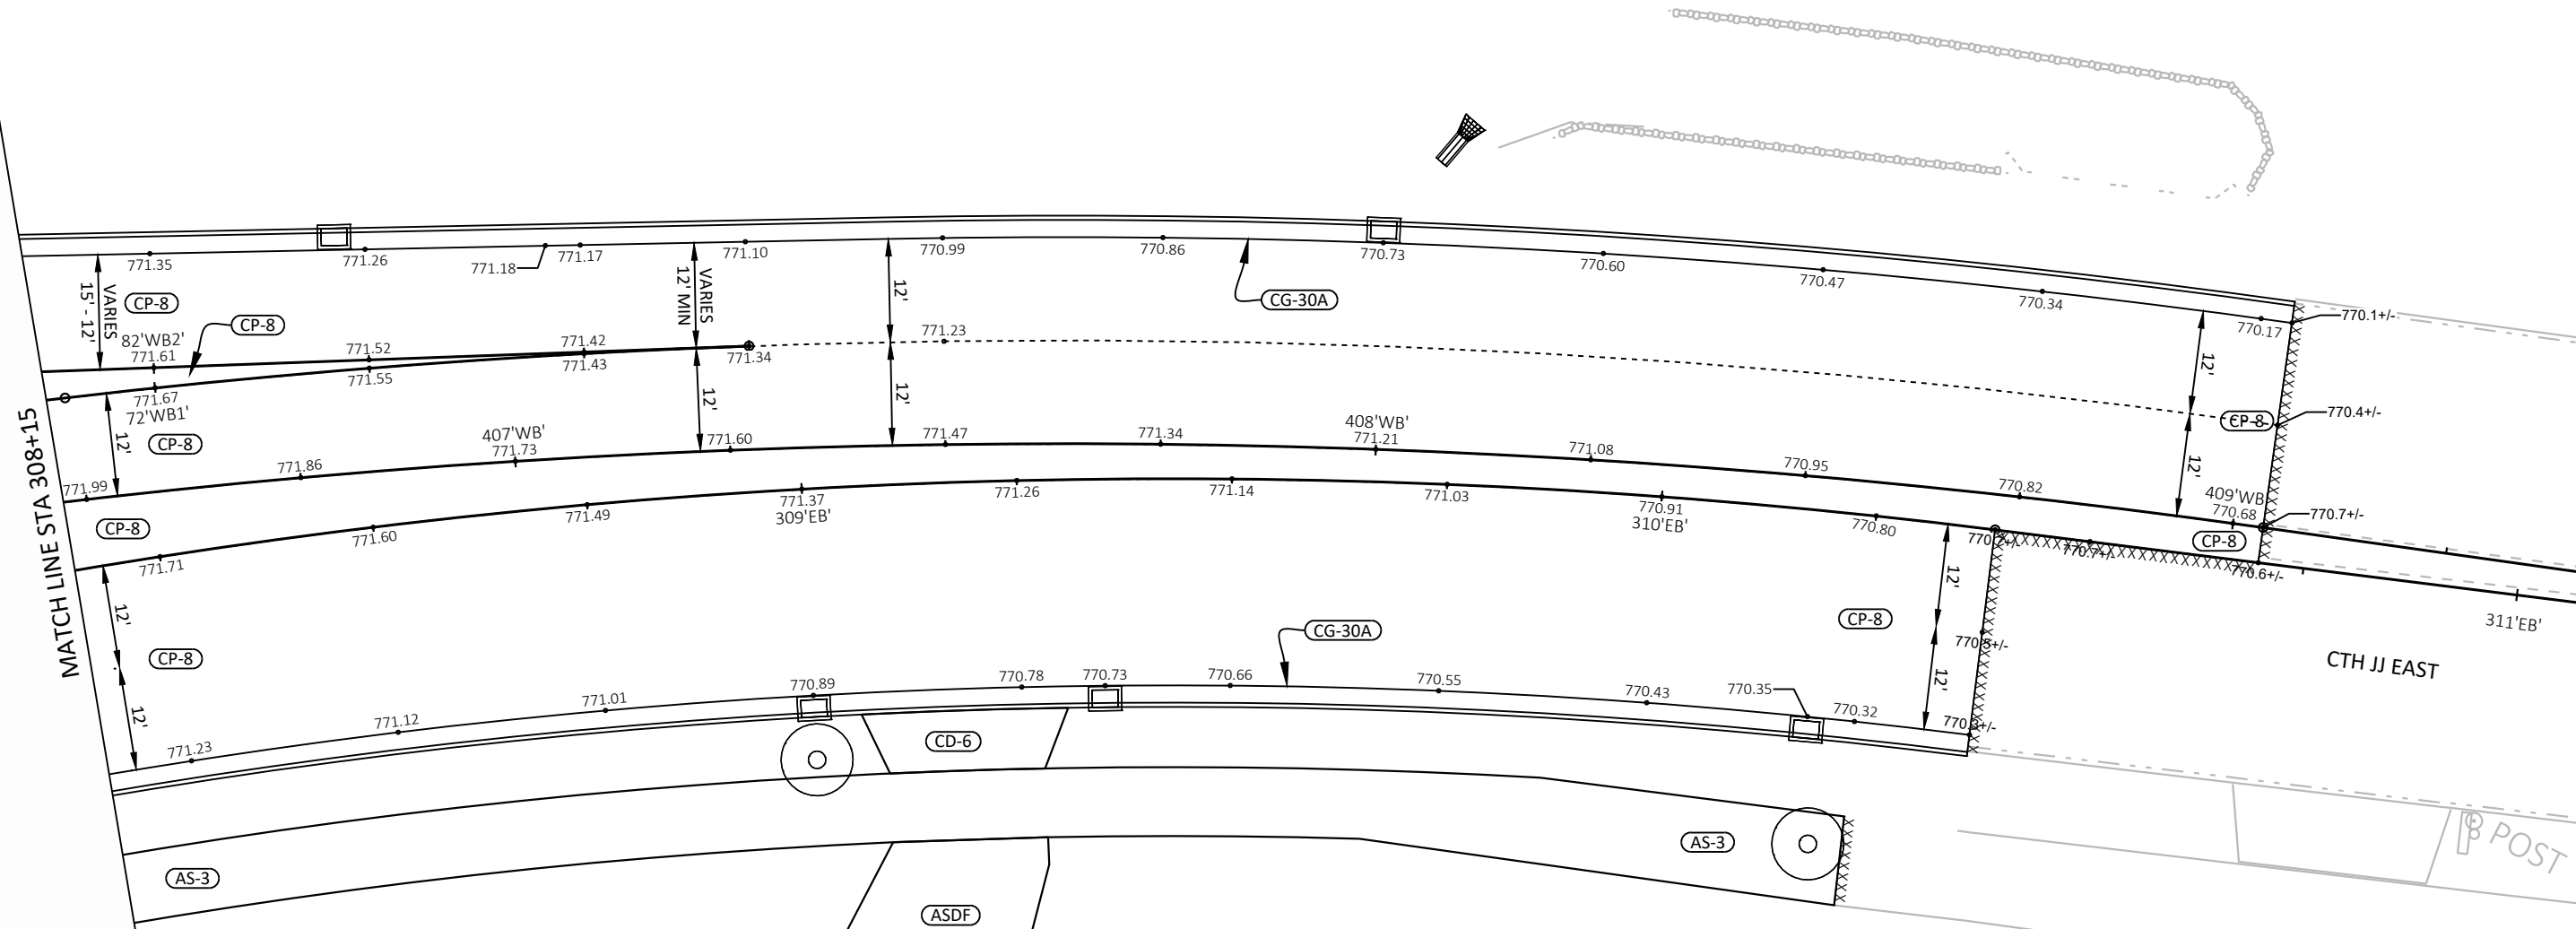

PAVING DETAIL LEGEND	
AS-3	ASPHALTIC SURFACE 3-INCH
AS-6	ASPHALTIC SURFACE 6-INCH
ASDF	ASPHALTIC SURFACE DRIVEWAYS AND FIELD ENTRANCES
CABC-6	6-INCH 3/4-INCH BASE AGGREGATE
CD-6	CONCRETE DRIVEWAY 6-INCH
CG-18A	CONCRETE CURB AND GUTTER 18-INCH TYPE A
CG-30A	CONCRETE CURB AND GUTTER 30-INCH TYPE A
CG-30D	CONCRETE CURB AND GUTTER 30-INCH TYPE D
CG-36R4	CONCRETE CURB AND GUTTER 4-INCH SLOPED 36-INCH TYPE R
CMSN1	CONCRETE MEDIAN SLOPE NOSE TYPE 1
CMSN2	CONCRETE MEDIAN SLOPE NOSE TYPE 2
CP-8	CONCRETE PAVEMENT 8-INCH
CP-8C	CONCRETE PAVEMENT 8-INCH COLORED
CCP	CONCRETE CURB PEDESTRIAN
CPTA-12	CONCRETE ROUNDABOUT TRUCK APRON 12-INCH
CS-4	CONCRETE SIDEWALK 4-INCH
CS-6	CONCRETE SIDEWALK 6-INCH
DWF-Y	DETECTABLE WARNING FIELD YELLOW

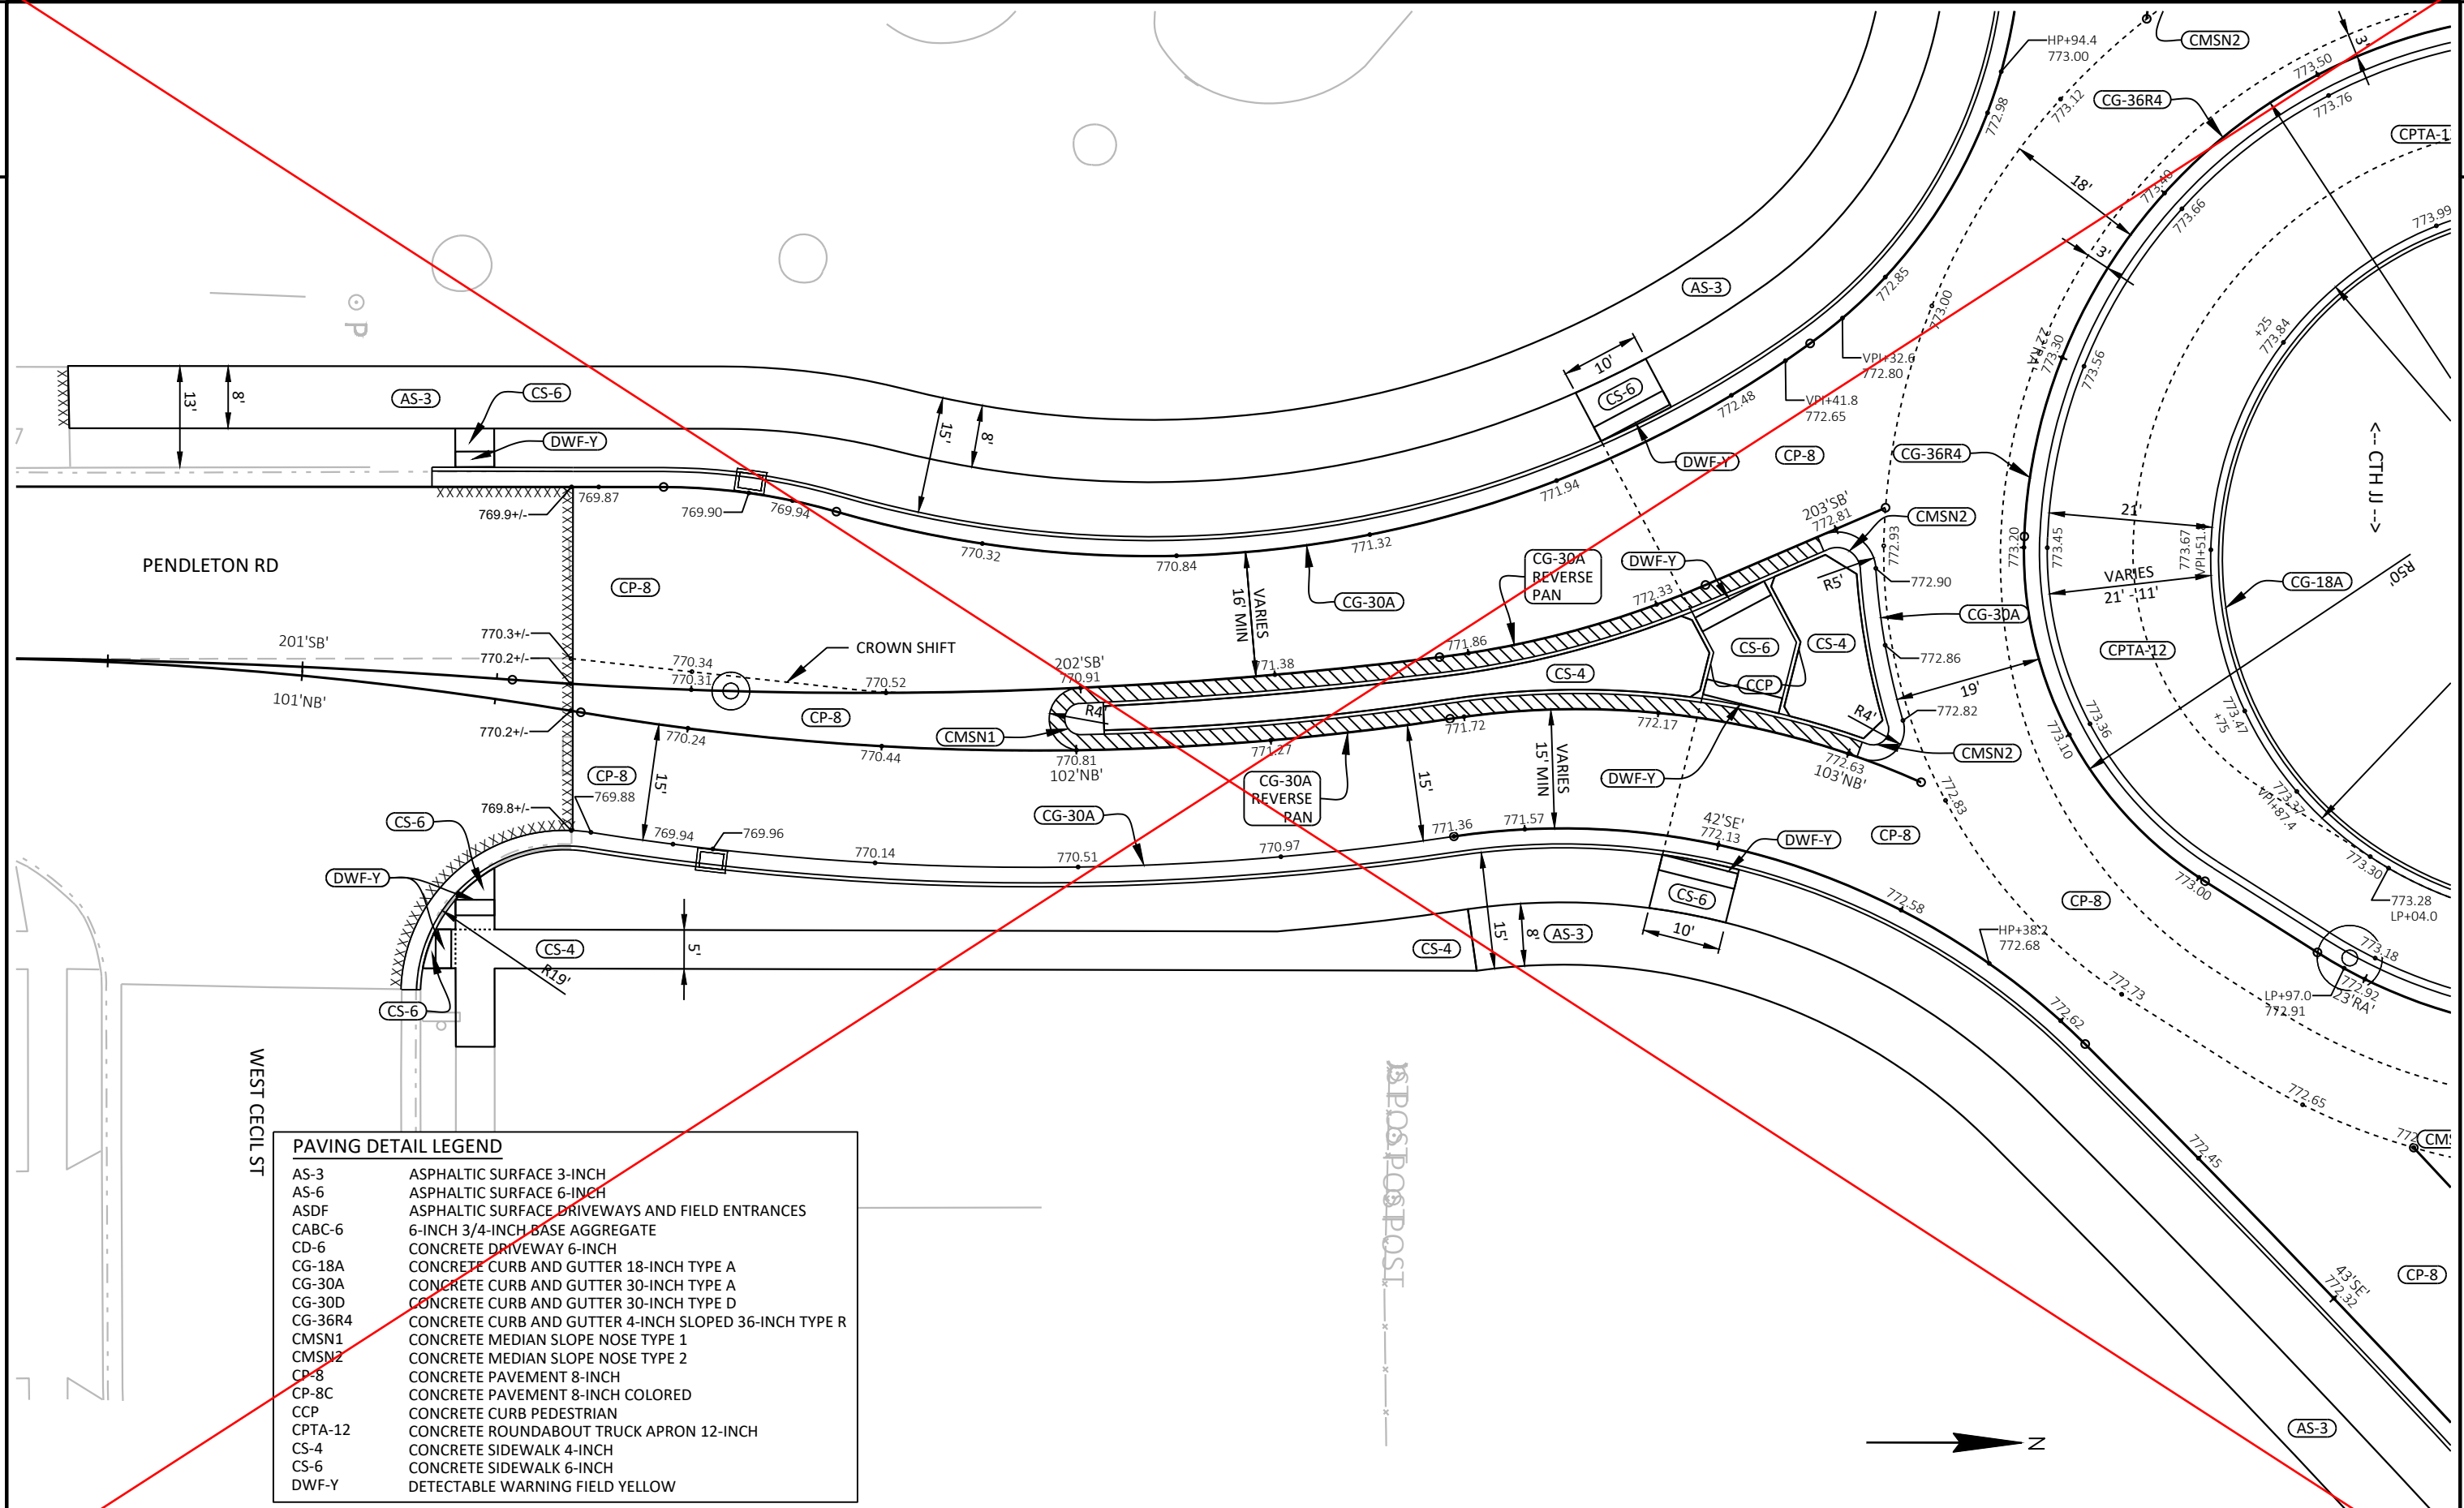


PENDLETON RD


WEST CECIL ST

PAVING DETAIL LEGEND

AS-3	ASPHALTIC SURFACE 3-INCH
AS-6	ASPHALTIC SURFACE 6-INCH
ASDF	ASPHALTIC SURFACE DRIVEWAYS AND FIELD ENTRANCES
CABC-6	6-INCH 3/4-INCH BASE AGGREGATE
CD-6	CONCRETE DRIVEWAY 6-INCH
CG-18A	CONCRETE CURB AND GUTTER 18-INCH TYPE A
CG-30A	CONCRETE CURB AND GUTTER 30-INCH TYPE A
CG-30D	CONCRETE CURB AND GUTTER 30-INCH TYPE D
CG-36R4	CONCRETE CURB AND GUTTER 4-INCH SLOPED 36-INCH TYPE R
CMSN1	CONCRETE MEDIAN SLOPE NOSE TYPE 1
CMSN2	CONCRETE MEDIAN SLOPE NOSE TYPE 2
CP-8	CONCRETE PAVEMENT 8-INCH
CP-8C	CONCRETE PAVEMENT 8-INCH COLORED
CCP	CONCRETE CURB PEDESTRIAN
CPTA-12	CONCRETE ROUNDABOUT TRUCK APRON 12-INCH
CS-4	CONCRETE SIDEWALK 4-INCH
CS-6	CONCRETE SIDEWALK 6-INCH
DWF-Y	DETECTABLE WARNING FIELD YELLOW

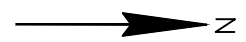


Southbound Pendleton Road revised for left turn lane to W. Cecil St.

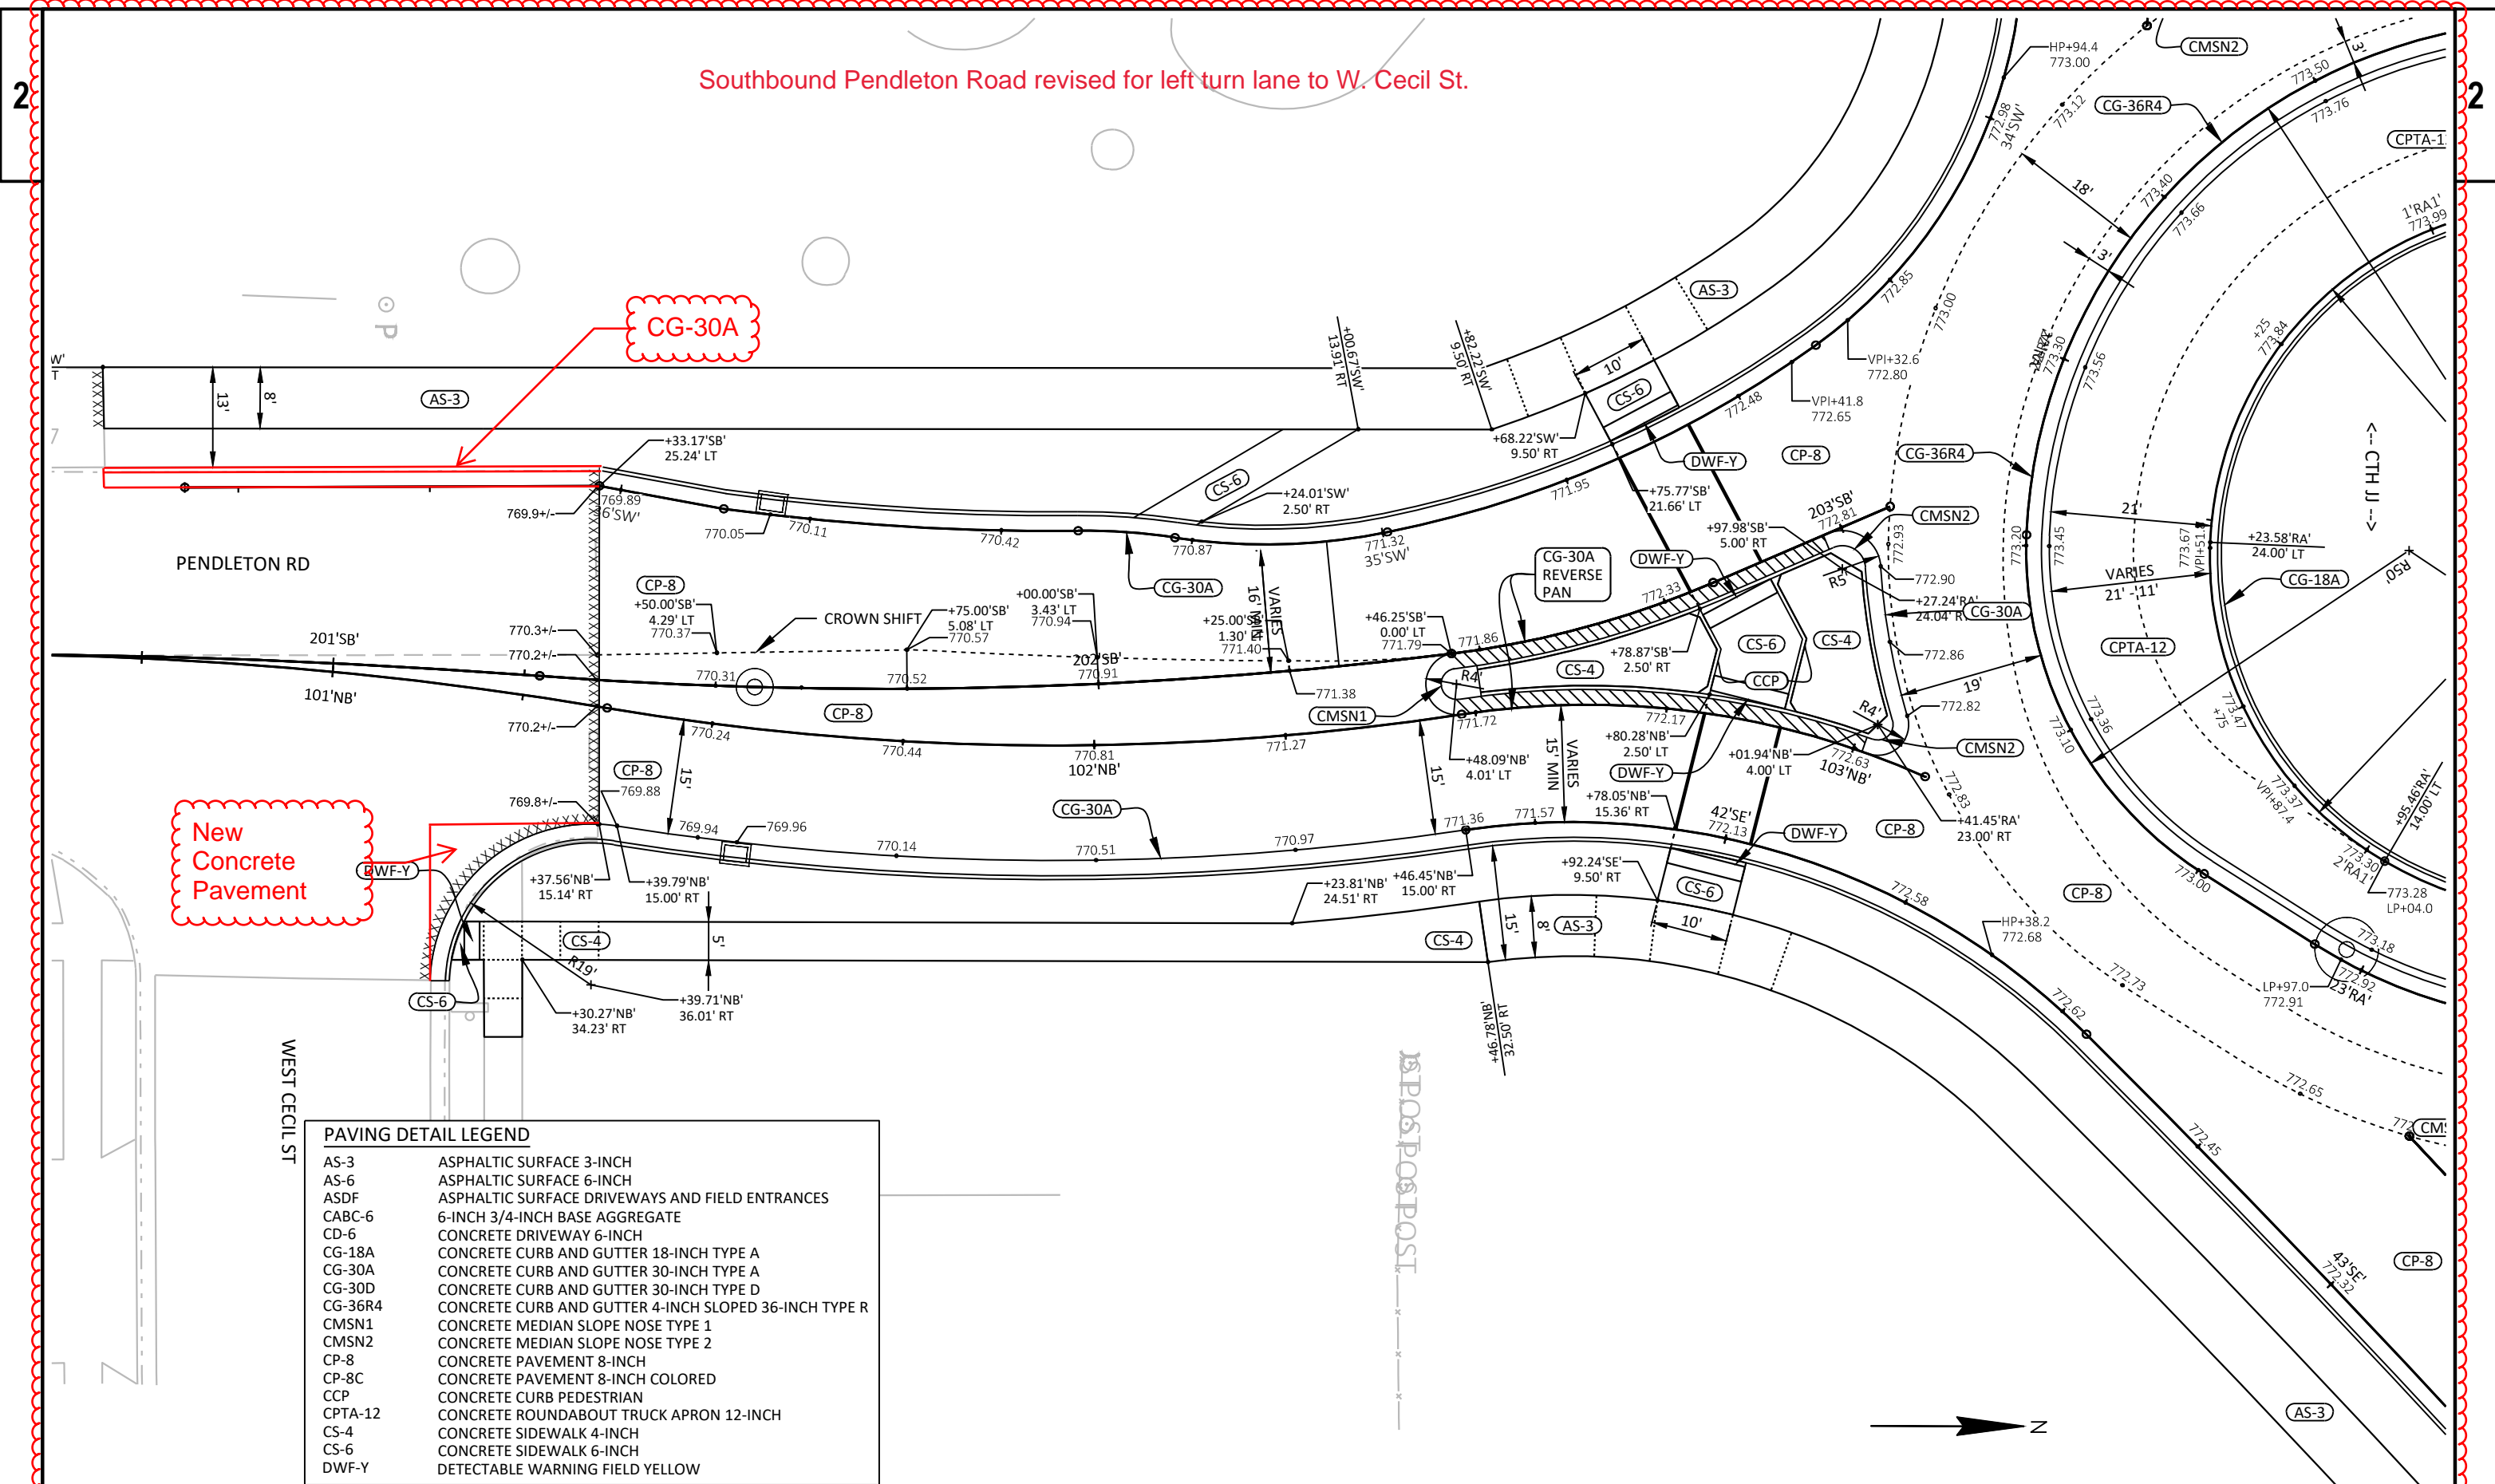

PAVING DETAIL LEGEND


AS-3	ASPHALTIC SURFACE 3-INCH
AS-6	ASPHALTIC SURFACE 6-INCH
ASDF	ASPHALTIC SURFACE DRIVEWAYS AND FIELD ENTRANCES
CABC-6	6-INCH 3/4-INCH BASE AGGREGATE
CD-6	CONCRETE DRIVEWAY 6-INCH
CG-18A	CONCRETE CURB AND GUTTER 18-INCH TYPE A
CG-30A	CONCRETE CURB AND GUTTER 30-INCH TYPE A
CG-30D	CONCRETE CURB AND GUTTER 30-INCH TYPE D
CG-36R4	CONCRETE CURB AND GUTTER 4-INCH SLOPED 36-INCH TYPE R
CMSN1	CONCRETE MEDIAN SLOPE NOSE TYPE 1
CMSN2	CONCRETE MEDIAN SLOPE NOSE TYPE 2
CP-8	CONCRETE PAVEMENT 8-INCH
CP-8C	CONCRETE PAVEMENT 8-INCH COLORED
CCP	CONCRETE CURB PEDESTRIAN
CPTA-12	CONCRETE ROUNDABOUT TRUCK APRON 12-INCH
CS-4	CONCRETE SIDEWALK 4-INCH
CS-6	CONCRETE SIDEWALK 6-INCH
DWF-Y	DETECTABLE WARNING FIELD YELLOW

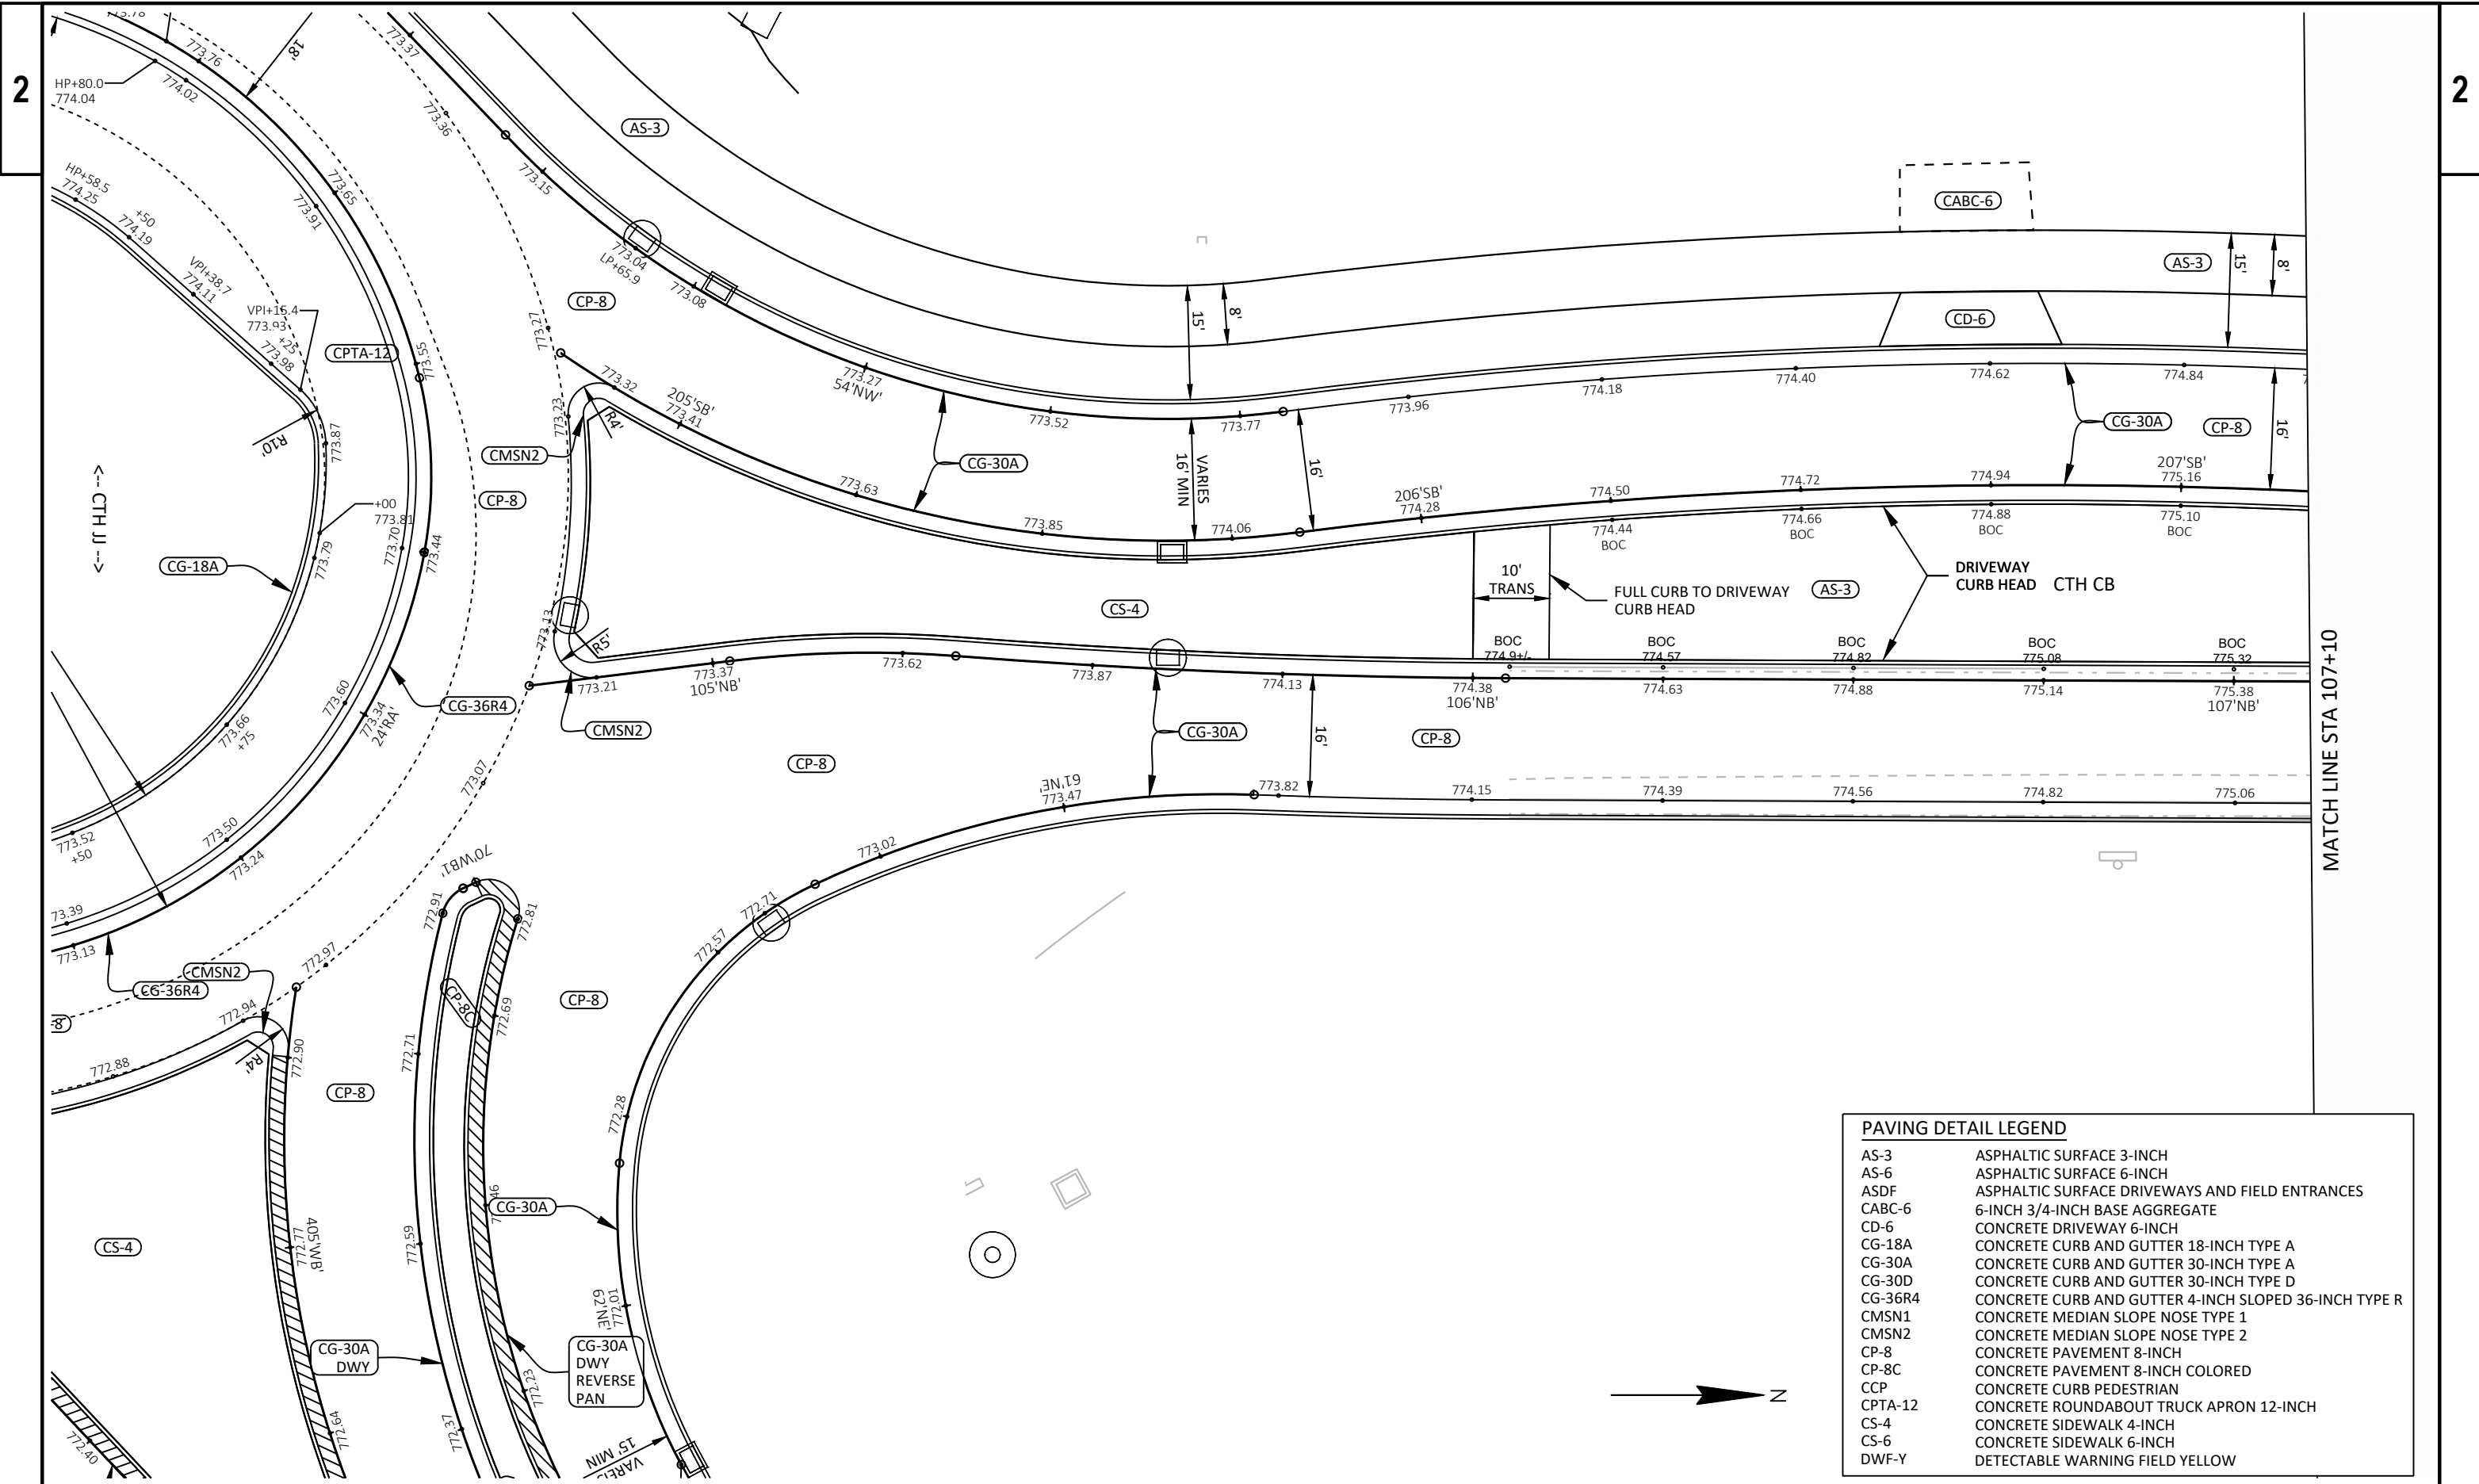

PAVING DETAIL LEGEND


AS-3	ASPHALTIC SURFACE 3-INCH
AS-6	ASPHALTIC SURFACE 6-INCH
ASDF	ASPHALTIC SURFACE DRIVEWAYS AND FIELD ENTRANCES
CABC-6	6-INCH 3/4-INCH BASE AGGREGATE
CD-6	CONCRETE DRIVEWAY 6-INCH
CG-18A	CONCRETE CURB AND GUTTER 18-INCH TYPE A
CG-30A	CONCRETE CURB AND GUTTER 30-INCH TYPE A
CG-30D	CONCRETE CURB AND GUTTER 30-INCH TYPE D
CG-36R4	CONCRETE CURB AND GUTTER 4-INCH SLOPED 36-INCH TYPE R
CMSN1	CONCRETE MEDIAN SLOPE NOSE TYPE 1
CMSN2	CONCRETE MEDIAN SLOPE NOSE TYPE 2
CP-8	CONCRETE PAVEMENT 8-INCH
CP-8C	CONCRETE PAVEMENT 8-INCH COLORED
CCP	CONCRETE CURB PEDESTRIAN
CPTA-12	CONCRETE ROUNDABOUT TRUCK APRON 12-INCH
CS-4	CONCRETE SIDEWALK 4-INCH
CS-6	CONCRETE SIDEWALK 6-INCH
DWF-Y	DETECTABLE WARNING FIELD YELLOW

MATCH LINE STA 107+10

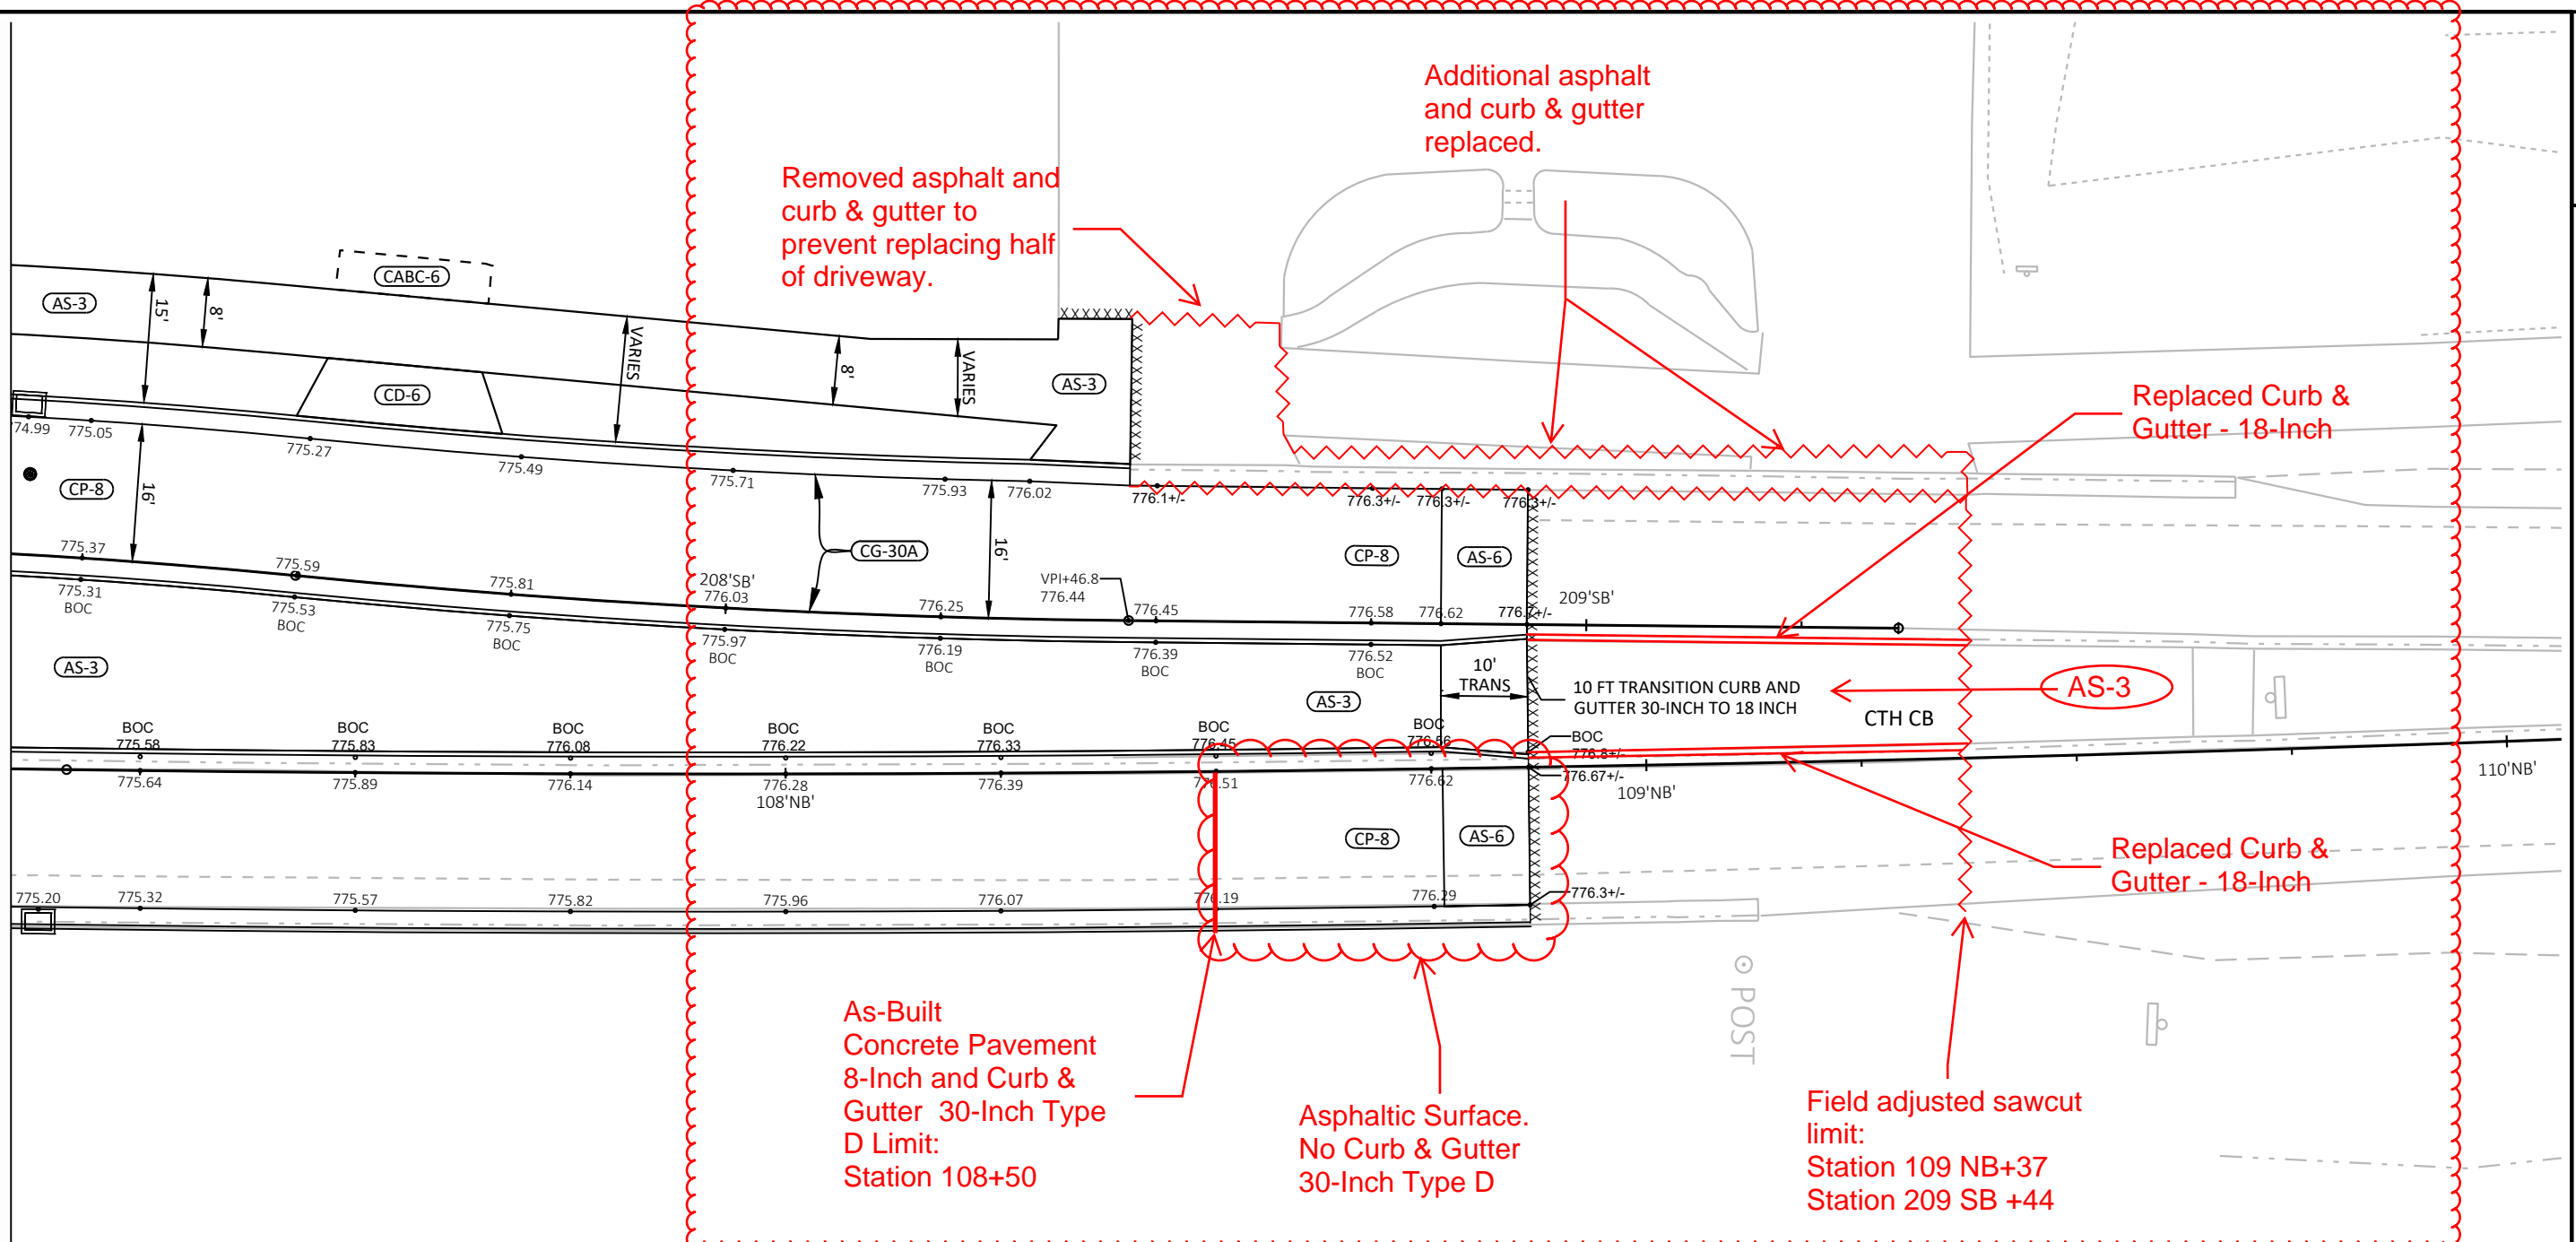


PAVING DETAIL LEGEND

AS-3	ASPHALTIC SURFACE 3-INCH
AS-6	ASPHALTIC SURFACE 6-INCH
ASDF	ASPHALTIC SURFACE DRIVEWAYS AND FIELD ENTRANCES
CAB-6	6-INCH 3/4-INCH BASE AGGREGATE
CD-6	CONCRETE DRIVEWAY 6-INCH
CG-18A	CONCRETE CURB AND GUTTER 18-INCH TYPE A
CG-30A	CONCRETE CURB AND GUTTER 30-INCH TYPE A
CG-30D	CONCRETE CURB AND GUTTER 30-INCH TYPE D
CG-36R4	CONCRETE CURB AND GUTTER 4-INCH SLOPED 36-INCH TYPE R
CMSN1	CONCRETE MEDIAN SLOPE NOSE TYPE 1
CMSN2	CONCRETE MEDIAN SLOPE NOSE TYPE 2
CP-8	CONCRETE PAVEMENT 8-INCH
CP-8C	CONCRETE PAVEMENT 8-INCH COLORED
CCP	CONCRETE CURB PEDESTRIAN
CPTA-12	CONCRETE ROUNDABOUT TRUCK APRON 12-INCH
CS-4	CONCRETE SIDEWALK 4-INCH
CS-6	CONCRETE SIDEWALK 6-INCH
DWF-Y	DETECTABLE WARNING FIELD YELLOW

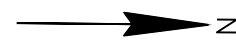


CTH JJ WEST EB						
POINT	ELEVATION	STATION	OFFSET	NORTHING	EASTING	DESCRIPTION
101	773.33	304+26.23	-26.05' LT	529,225.31	801,532.55	SW
102	772.98	304+24.77	-2.50' LT	529,201.81	801,534.88	SW
103	773.03	304+24.58	0.00'	529,199.32	801,535.12	FLAG
104	772.68	304+23.08	17.04' RT	529,182.30	801,536.81	FLAG
105	772.62	304+22.82	19.54' RT	529,179.80	801,537.06	SW
106	773.06	304+22.02	26.54' RT	529,172.81	801,537.75	SW
107	773.18	304+09.33	26.50' RT	529,170.42	801,528.03	SW
108	773.28	304+09.25	34.50' RT	529,162.75	801,530.31	SW
109	773.19	304+22.00	34.54' RT	529,164.96	801,539.29	SW
110	773.26	304+34.75	34.53' RT	529,166.31	801,548.45	SW
111	773.51	304+47.50	34.46' RT	529,166.78	801,557.69	SW
112	773.34	304+47.39	26.46' RT	529,174.78	801,557.66	SW
113	773.14	304+34.71	26.53' RT	529,174.27	801,547.66	SW
114	772.70	304+34.67	19.53' RT	529,181.23	801,546.97	SW
115	772.76	304+34.66	17.03' RT	529,183.72	801,546.72	FLAG
116	773.07	304+34.59	0.00'	529,200.67	801,545.04	FLAG
117	773.02	304+34.58	-2.50' LT	529,203.16	801,544.79	SW
118	773.43	304+34.51	-29.52' LT	529,230.04	801,542.13	SW

CURB RAMP DETAIL LEGEND	
AS-3	ASPHALTIC SURFACE 3-INCH
CG-30A	CONCRETE CURB AND GUTTER 30-INCH TYPE A
CP-8	CONCRETE PAVEMENT 8-INCH
CCP	CONCRETE CURB PEDESTRIAN
CS-4	CONCRETE SIDEWALK 4-INCH
CS-6	CONCRETE SIDEWALK 6-INCH
DWF-Y	DETECTABLE WARNING FIELD YELLOW

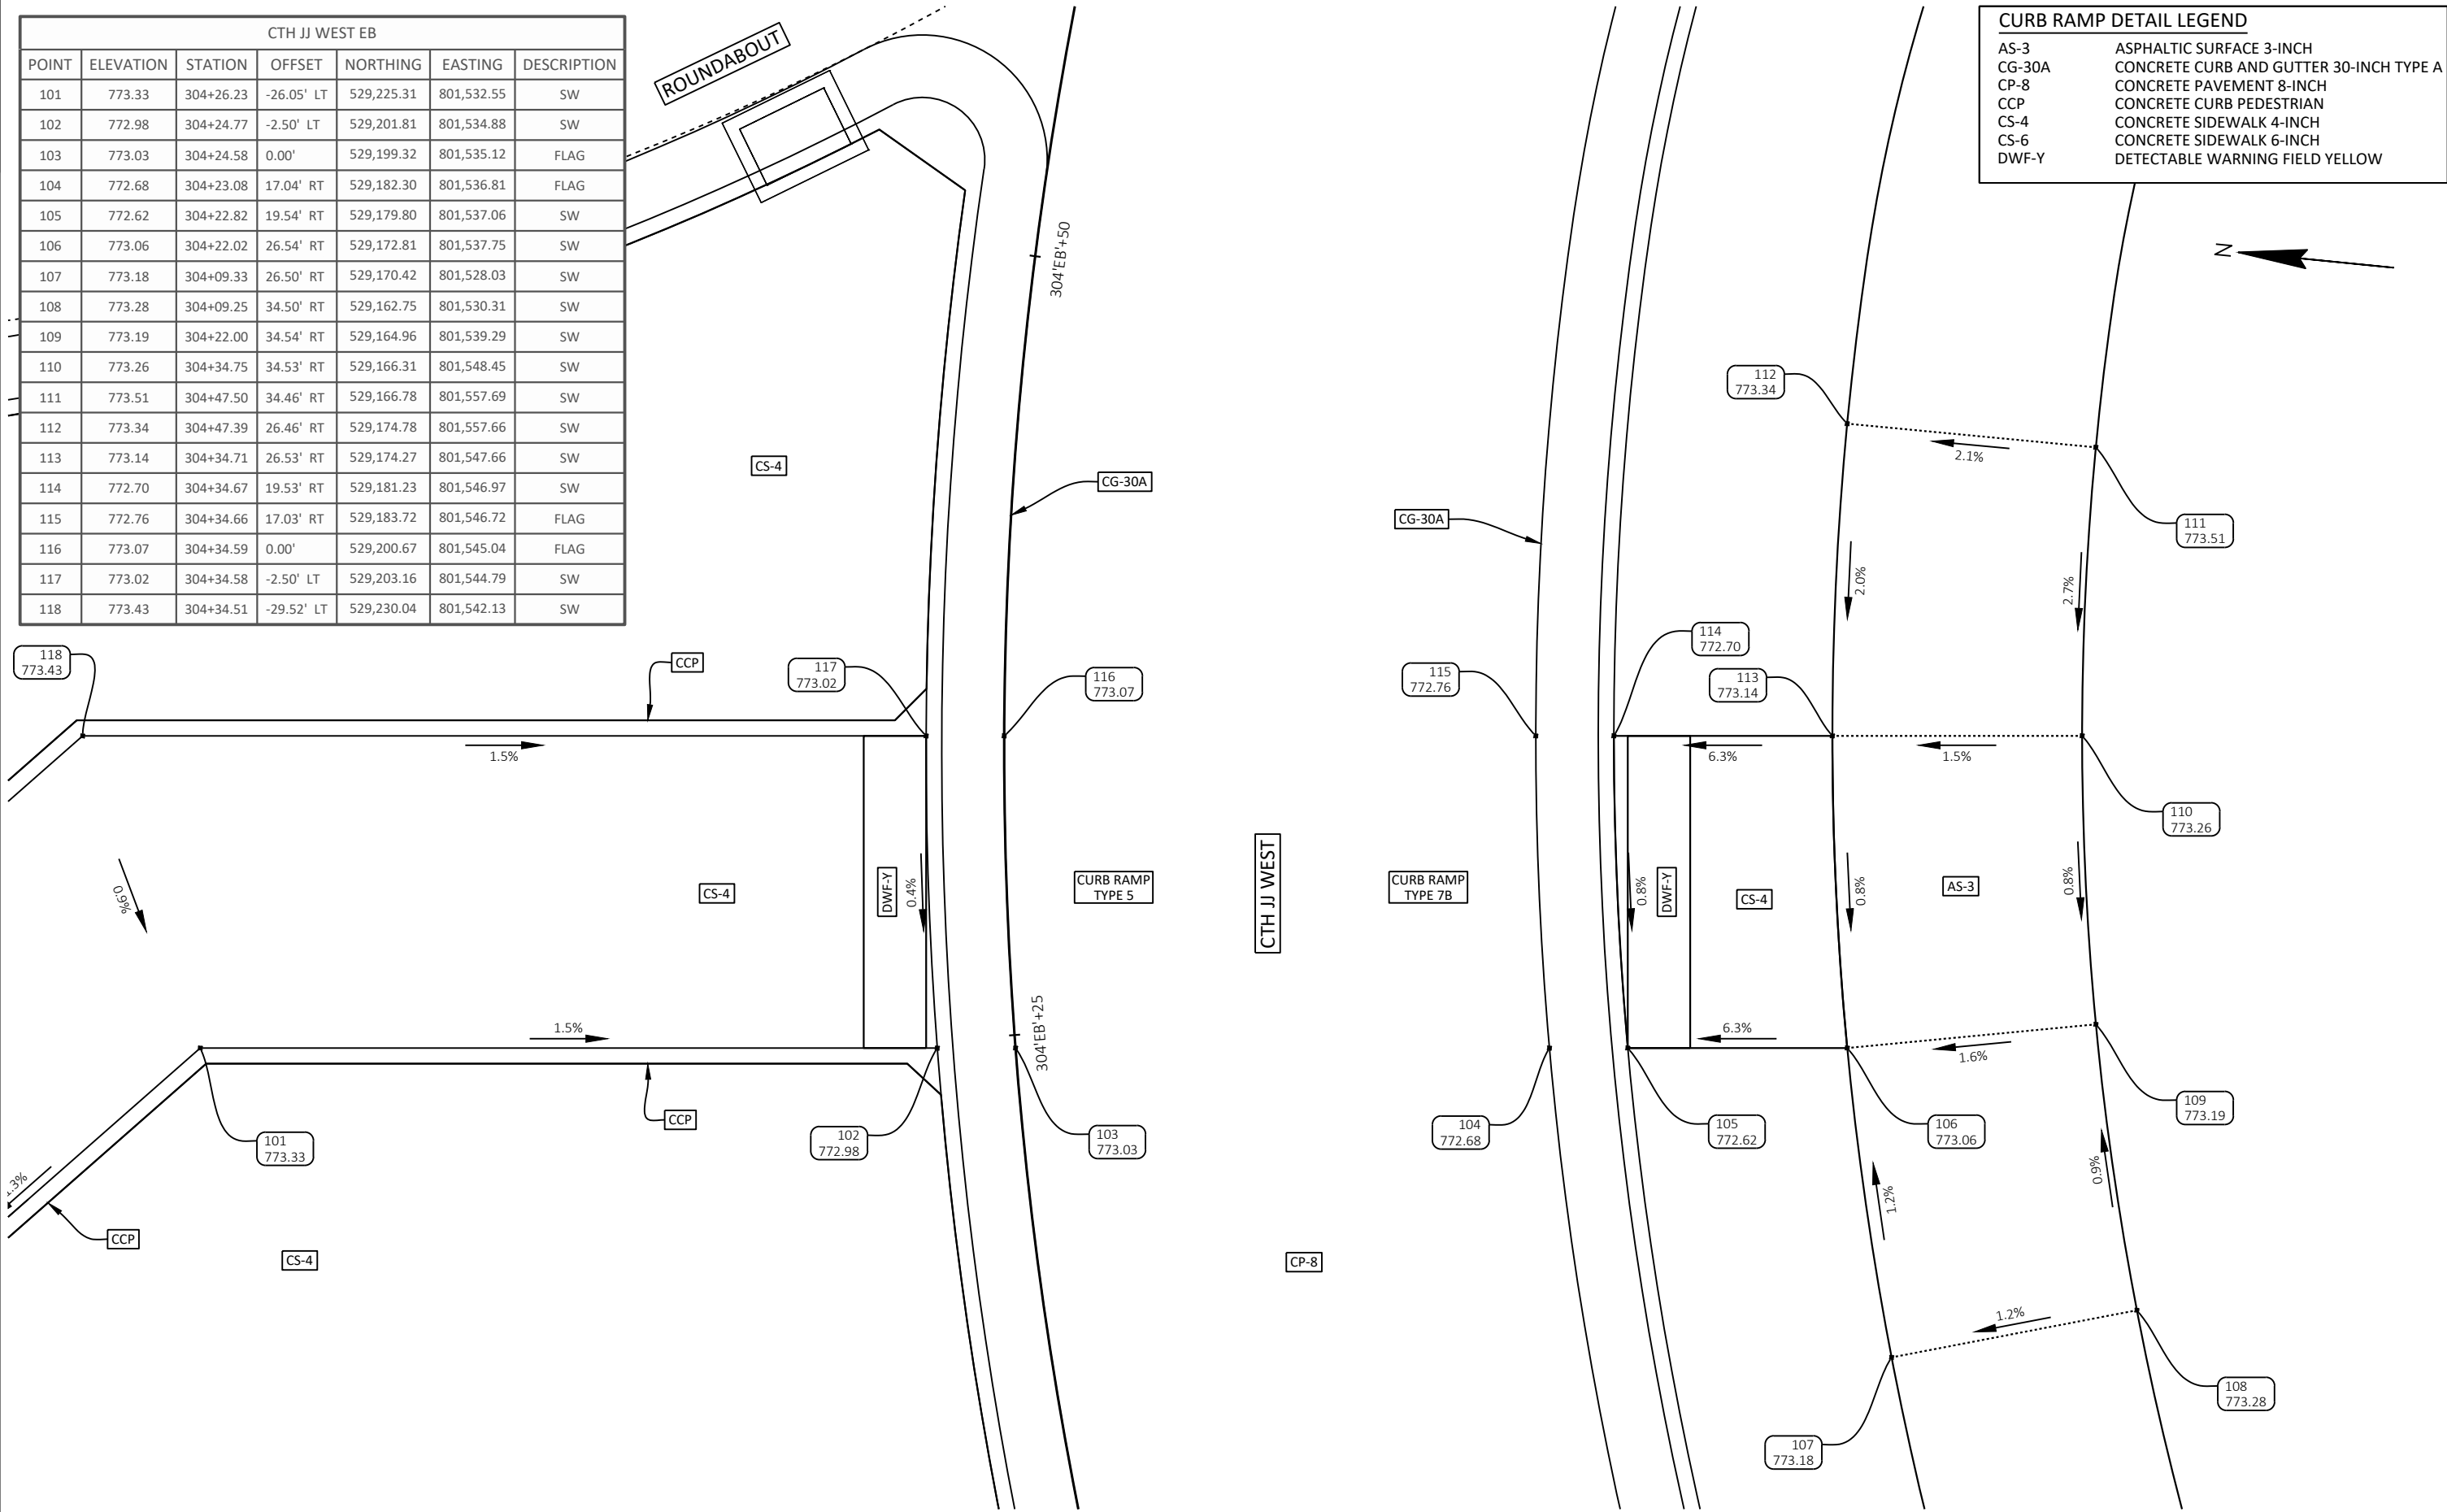

CURB RAMP DETAIL LEGEND



AS-3	ASPHALTIC SURFACE 3-INCH
CG-30A	CONCRETE CURB AND GUTTER 30-INCH TYPE A
CP-8	CONCRETE PAVEMENT 8-INCH
CCP	CONCRETE CURB PEDESTRIAN
CS-4	CONCRETE SIDEWALK 4-INCH
CS-6	CONCRETE SIDEWALK 6-INCH
DWF-Y	DETECTABLE WARNING FIELD YELLOW

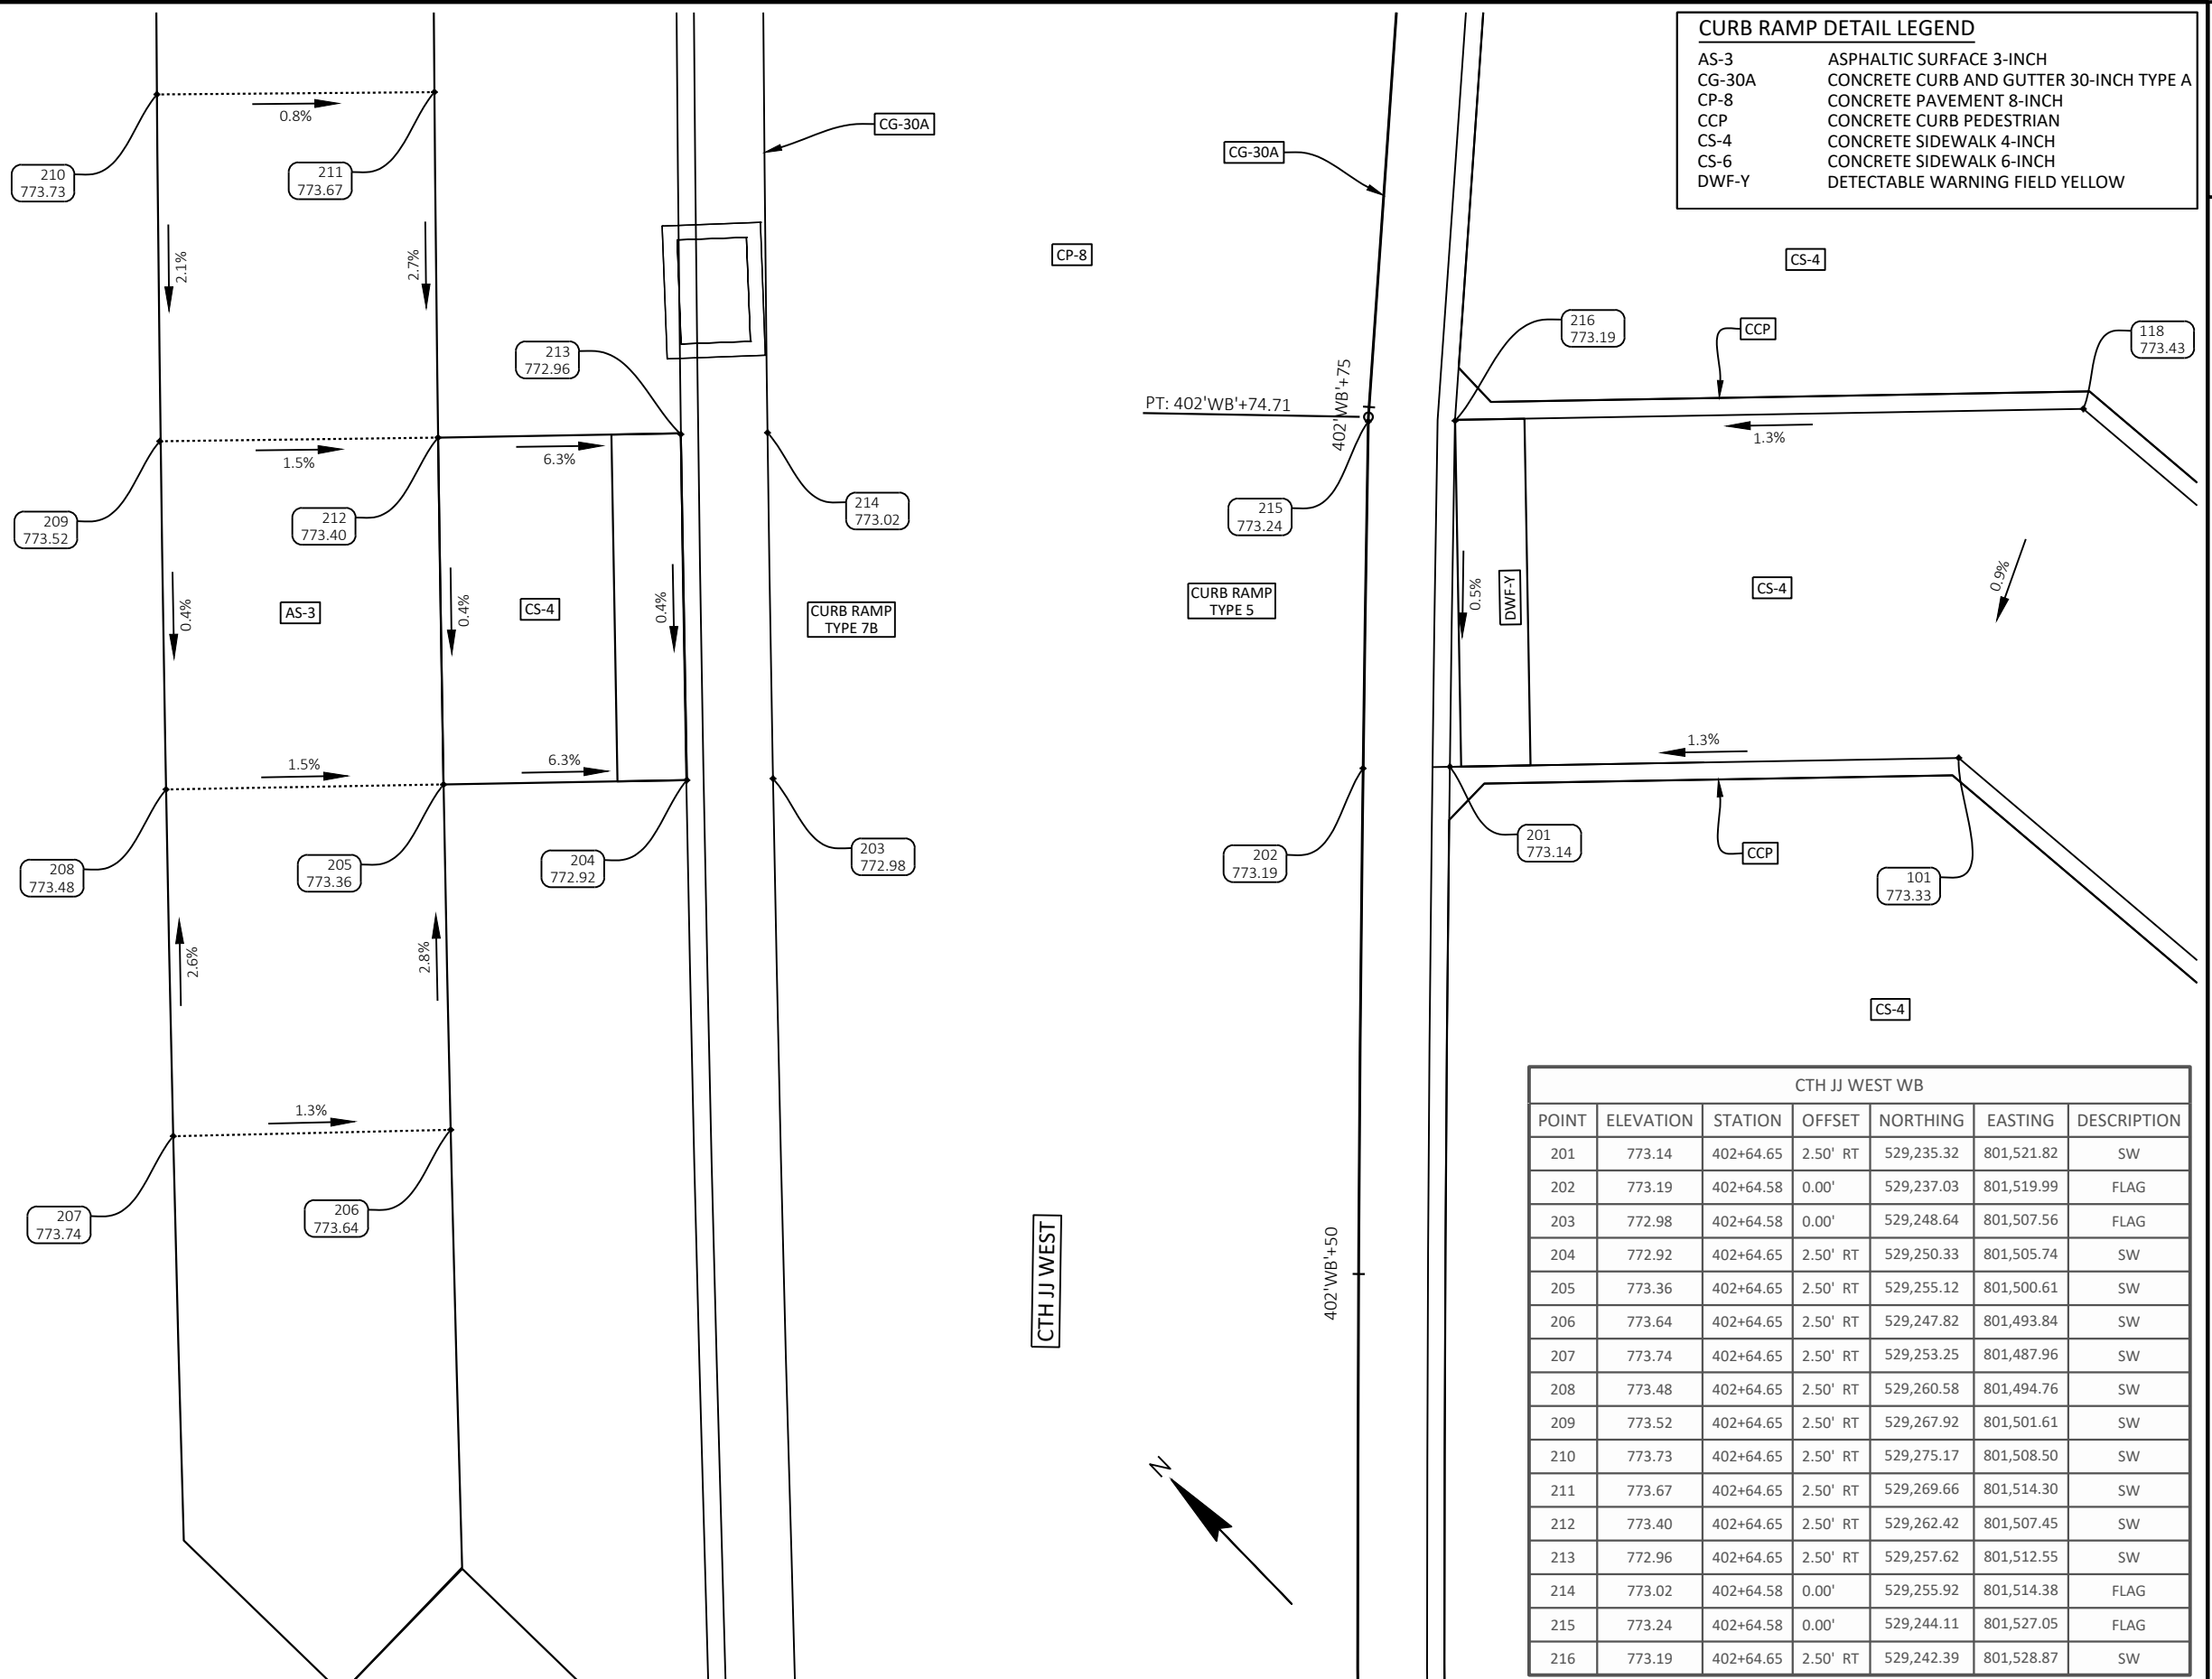

CTH JJ WEST WB


POINT	ELEVATION	STATION	OFFSET	NORTHING	EASTING	DESCRIPTION
201	773.14	402+64.65	2.50' RT	529,235.32	801,521.82	SW
202	773.19	402+64.58	0.00'	529,237.03	801,519.99	FLAG
203	772.98	402+64.58	0.00'	529,248.64	801,507.56	FLAG
204	772.92	402+64.65	2.50' RT	529,250.33	801,505.74	SW
205	773.36	402+64.65	2.50' RT	529,255.12	801,500.61	SW
206	773.64	402+64.65	2.50' RT	529,247.82	801,493.84	SW
207	773.74	402+64.65	2.50' RT	529,253.25	801,487.96	SW
208	773.48	402+64.65	2.50' RT	529,260.58	801,494.76	SW
209	773.52	402+64.65	2.50' RT	529,267.92	801,501.61	SW
210	773.73	402+64.65	2.50' RT	529,275.17	801,508.50	SW
211	773.67	402+64.65	2.50' RT	529,269.66	801,514.30	SW
212	773.40	402+64.65	2.50' RT	529,262.42	801,507.45	SW
213	772.96	402+64.65	2.50' RT	529,257.62	801,512.55	SW
214	773.02	402+64.58	0.00'	529,255.92	801,514.38	FLAG
215	773.24	402+64.58	0.00'	529,244.11	801,527.05	FLAG
216	773.19	402+64.65	2.50' RT	529,242.39	801,528.87	SW

PENDLETON RD SOUTH NB @ W CECIL ST						
POINT	ELEVATION	STATION	OFFSET	NORTHING	EASTING	DESCRIPTION
301	769.59	101+20.47	35.55' RT	528,979.30	801,693.61	SW
302	769.62	101+20.47	35.55' RT	528,980.95	801,693.61	SW
303	769.78	101+24.95	34.96' RT	528,983.50	801,693.60	SW
304	769.90	101+24.95	34.96' RT	528,983.54	801,698.65	SW
305	770.02	101+24.95	34.96' RT	528,983.57	801,703.68	SW
306	770.17	101+24.95	34.96' RT	528,988.54	801,703.68	SW
307	770.00	101+24.95	34.96' RT	528,988.54	801,698.65	SW
308	769.87	101+24.95	34.96' RT	528,988.51	801,693.62	SW
309	770.22	101+24.95	34.96' RT	528,993.50	801,693.62	SW
310	770.58	101+24.95	34.96' RT	528,998.50	801,693.63	SW
311	770.51	101+24.95	34.96' RT	528,998.50	801,688.63	SW
312	770.18	101+24.95	34.96' RT	528,993.50	801,688.62	SW
313	769.84	101+24.95	34.96' RT	528,988.50	801,688.62	SW
314	769.74	101+24.95	34.96' RT	528,988.49	801,684.80	SW
315	769.71	101+24.95	34.96' RT	528,988.48	801,680.73	SW
316	769.65	101+24.95	34.96' RT	528,983.49	801,684.81	SW
317	769.76	101+24.95	34.96' RT	528,983.51	801,688.62	SW
318	769.63	101+24.95	34.96' RT	528,980.96	801,688.61	SW
319	769.76	304+23.08	17.04' RT	528,987.26	801,678.55	FLAG
320	769.70	304+23.08	17.04' RT	528,981.59	801,683.18	FLAG
321	769.68	304+23.08	17.04' RT	528,978.72	801,687.50	FLAG
322	769.64	304+23.08	17.04' RT	528,976.84	801,693.17	FLAG
323	769.60	304+23.08	17.04' RT	528,976.49	801,696.31	FLAG

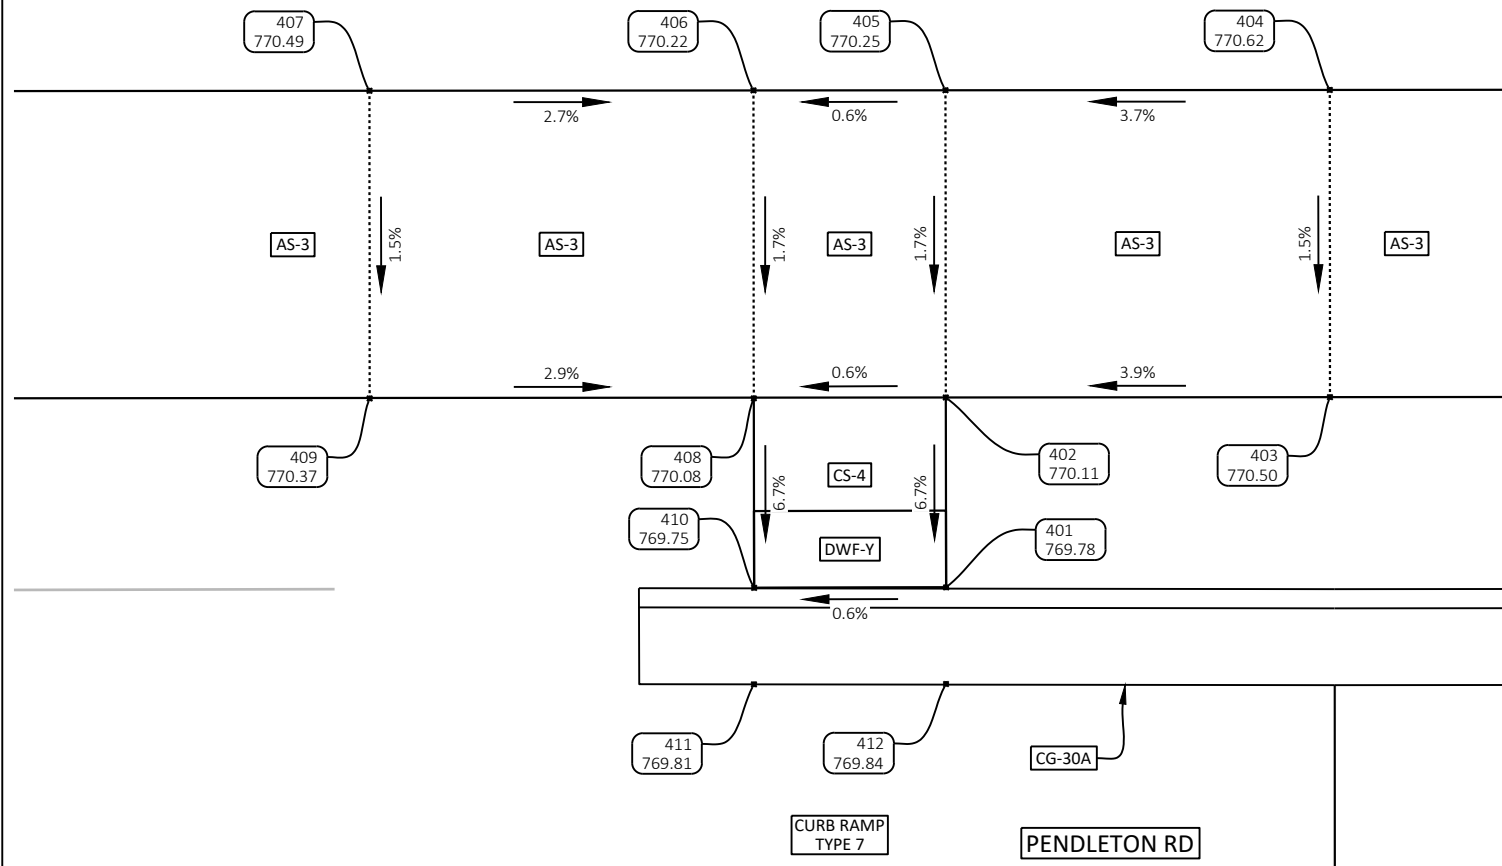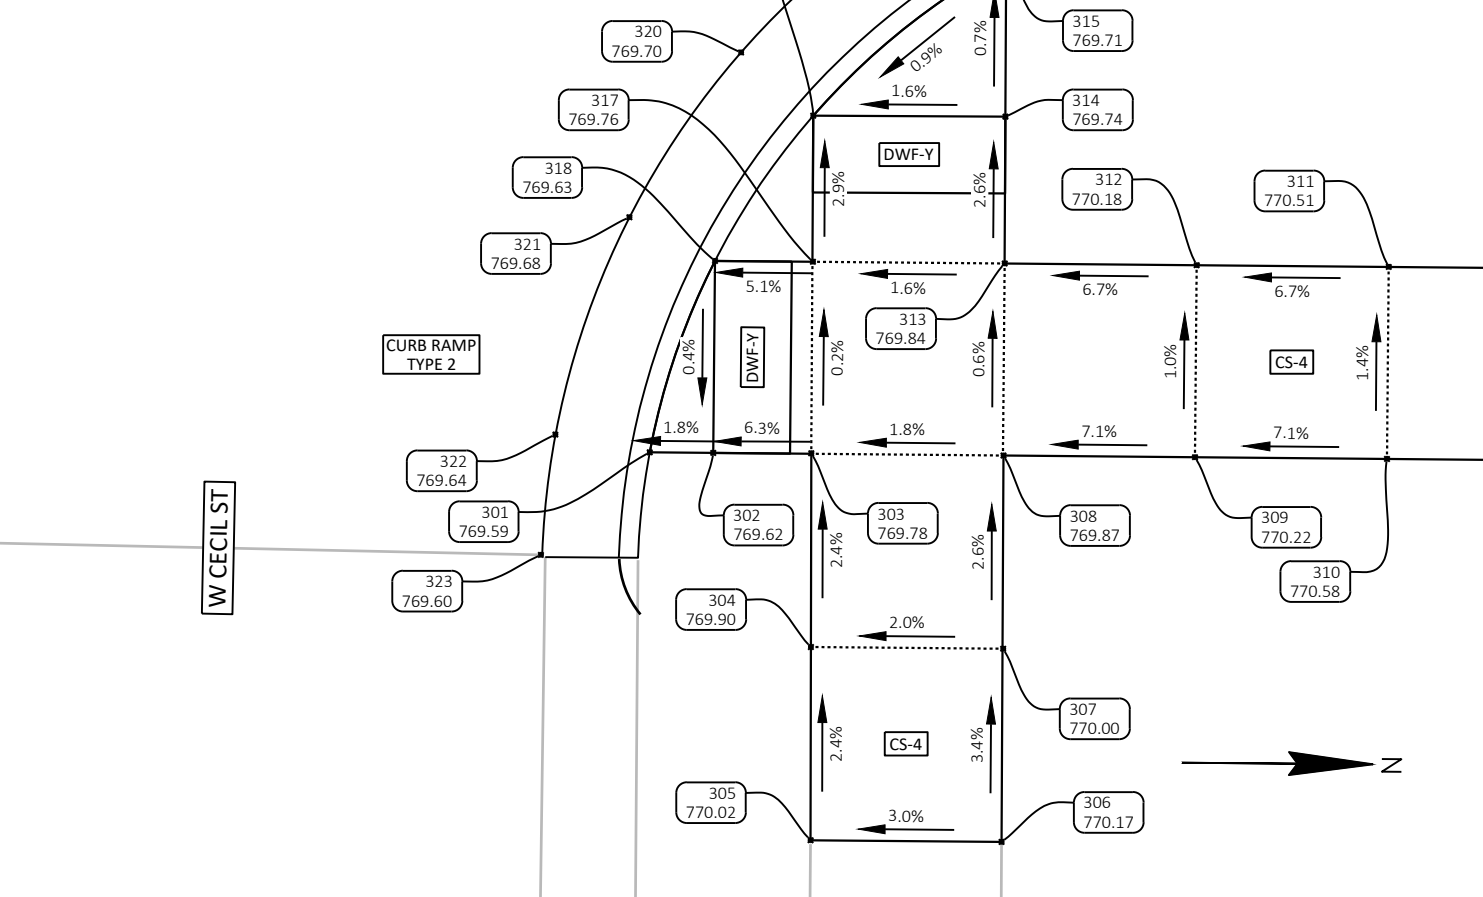

PENDLETON RD SOUTH SB @ W CECIL ST						
POINT	ELEVATION	STATION	OFFSET	NORTHING	EASTING	DESCRIPTION
401	769.78	201+22.75	-27.07' LT	528,988.37	801,629.24	SW
402	770.11	201+22.41	-32.01' LT	528,988.36	801,624.30	SW
403	770.50	201+32.54	-32.71' LT	528,998.37	801,624.29	SW
404	770.62	201+31.98	-40.70' LT	528,998.36	801,616.29	SW
405	770.25	201+21.87	-39.99' LT	528,988.35	801,616.30	SW
406	770.22	201+17.07	-39.65' LT	528,983.35	801,616.30	SW
407	770.49	201+07.47	-39.06' LT	528,973.35	801,616.31	SW
408	770.08	201+17.57	-31.65' LT	528,983.36	801,624.32	SW
409	770.37	201+07.89	-31.06' LT	528,973.36	801,624.32	SW
410	769.75	201+17.89	-26.72' LT	528,983.37	801,629.26	SW
411	769.81	201+18.04	-24.22' LT	528,983.37	801,631.77	FLAG
412	769.84	201+22.91	-24.56' LT	528,988.37	801,631.76	FLAG

CURB RAMP DETAIL LEGEND	
AS-3	ASPHALTIC SURFACE 3-INCH
CG-30A	CONCRETE CURB AND GUTTER 30-INCH TYPE A
CP-8	CONCRETE PAVEMENT 8-INCH
CCP	CONCRETE CURB PEDESTRIAN
CS-4	CONCRETE SIDEWALK 4-INCH
CS-6	CONCRETE SIDEWALK 6-INCH
DWF-Y	DETECTABLE WARNING FIELD YELLOW


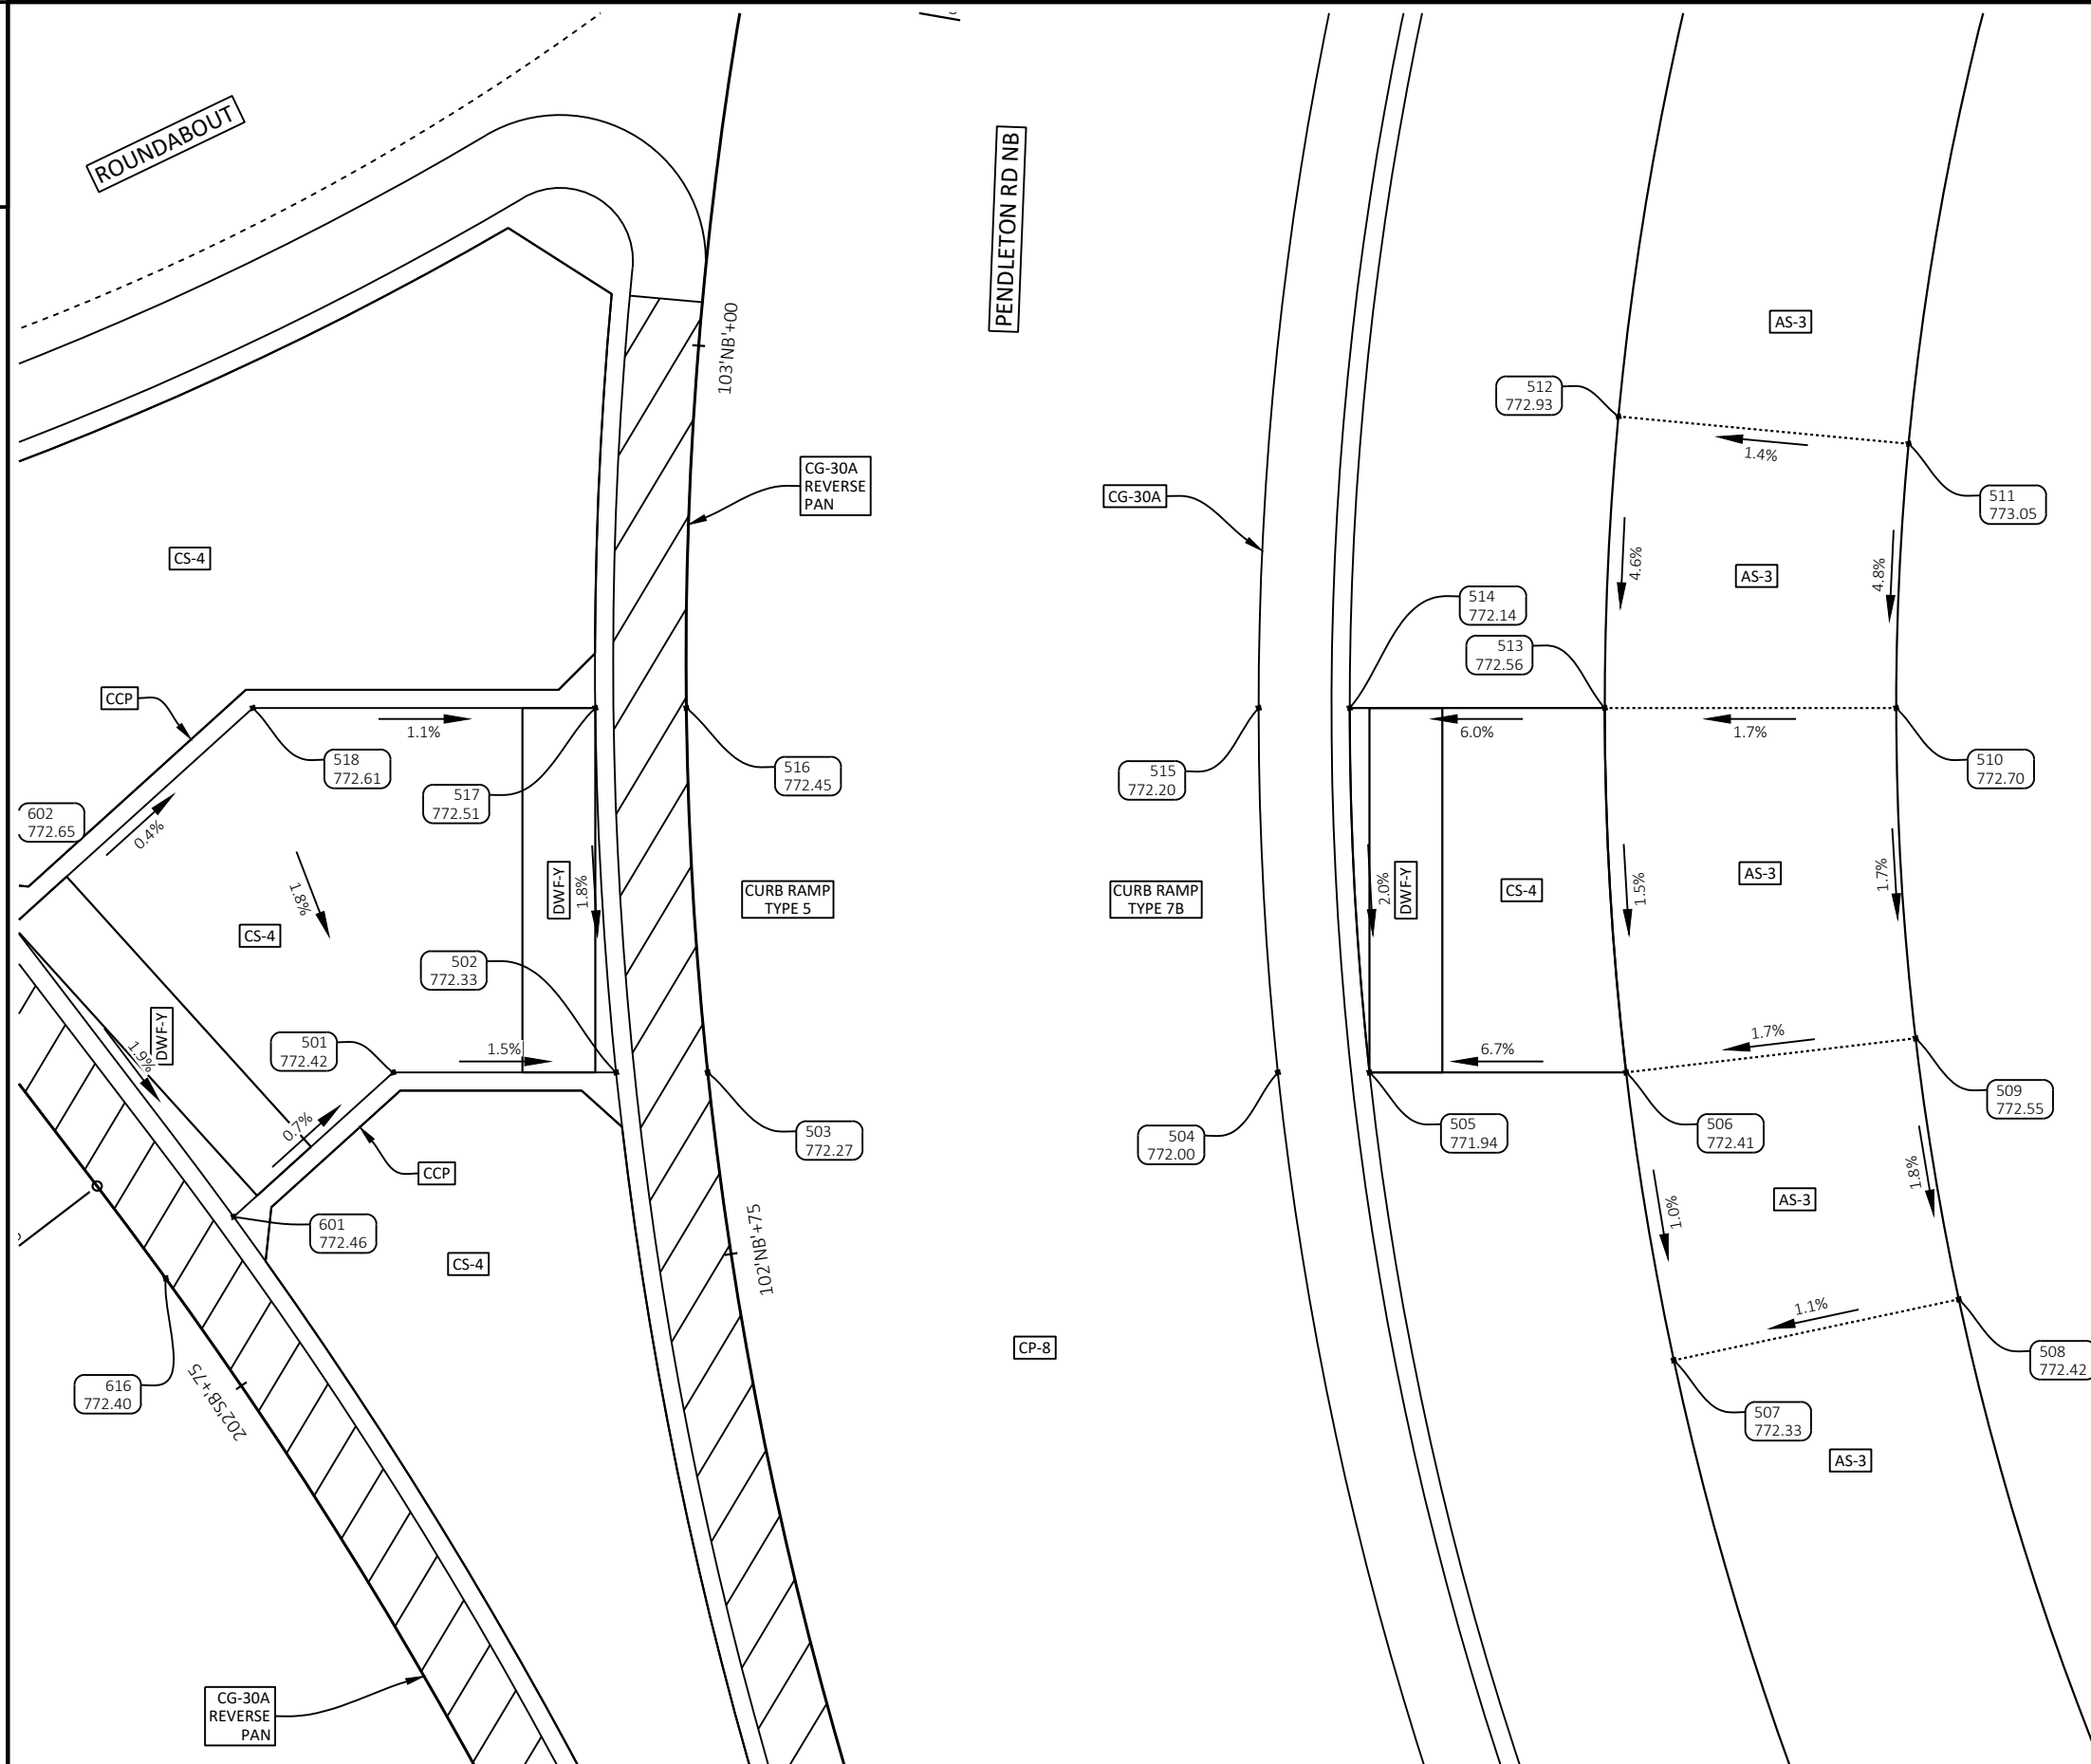



PENDLETON RD NB @ ROUNDABOUT						
POINT	ELEVATION	STATION	OFFSET	NORTHING	EASTING	DESCRIPTION
501	772.42	102+80.86	-8.59' LT	529,144.95	801,652.79	SW
502	772.33	102+80.28	-2.50' LT	529,143.47	801,658.73	SW
503	772.27	102+80.03	0.00'	529,142.85	801,661.16	FLAG
504	772.00	102+78.11	15.55' RT	529,139.05	801,676.35	FLAG
505	771.94	102+77.74	18.04' RT	529,138.44	801,678.78	SW
506	772.41	102+76.59	25.03' RT	529,136.73	801,685.62	SW
507	772.33	102+66.17	24.86' RT	529,128.74	801,684.97	SW
508	772.42	102+65.92	32.86' RT	529,128.47	801,692.96	SW
509	772.55	102+76.37	33.03' RT	529,135.70	801,693.55	SW
510	772.70	102+89.47	33.20' RT	529,144.62	801,695.24	SW
511	773.05	102+99.96	33.32' RT	529,151.58	801,697.33	SW
512	772.93	103+00.11	25.32' RT	529,154.24	801,689.79	SW
513	772.56	102+89.65	25.21' RT	529,146.57	801,687.48	SW
514	772.14	102+89.78	18.21' RT	529,148.27	801,680.69	SW
515	772.20	102+89.82	15.71' RT	529,148.88	801,678.26	FLAG
516	772.45	102+90.05	0.00'	529,152.70	801,663.03	FLAG
517	772.51	102+90.08	-2.50' LT	529,153.30	801,660.60	SW
518	772.61	102+90.18	-11.90' LT	529,155.59	801,651.49	SW

CURB RAMP DETAIL LEGEND	
AS-3	ASPHALTIC SURFACE 3-INCH
CG-30A	CONCRETE CURB AND GUTTER 30-INCH TYPE A
CP-8	CONCRETE PAVEMENT 8-INCH
CCP	CONCRETE CURB PEDESTRIAN
CS-4	CONCRETE SIDEWALK 4-INCH
CS-6	CONCRETE SIDEWALK 6-INCH
DWF-Y	DETECTABLE WARNING FIELD YELLOW

PENDLETON RD SB @ ROUNDABOUT						
POINT	ELEVATION	STATION	OFFSET	NORTHING	EASTING	DESCRIPTION
601	772.46	102+80.86	-8.59' LT	529,142.17	801,647.58	SW
602	772.65	102+80.86	-8.59' LT	529,151.40	801,643.64	SW
603	772.59	102+80.03	0.00'	529,150.22	801,641.42	FLAG
604	772.33	102+80.03	0.00'	529,140.65	801,623.48	FLAG
605	772.28	102+80.86	-8.59' LT	529,139.47	801,621.28	SW
606	772.68	102+80.86	-8.59' LT	529,136.18	801,615.10	SW
607	773.05	102+80.86	-8.59' LT	529,143.13	801,611.13	SW
608	773.14	102+80.86	-8.59' LT	529,138.95	801,604.31	SW
609	772.82	102+80.86	-8.59' LT	529,132.41	801,608.04	SW
610	772.67	102+80.86	-8.59' LT	529,123.95	801,612.17	SW
611	772.53	102+80.86	-8.59' LT	529,116.97	801,615.01	SW
612	772.44	102+80.86	-8.59' LT	529,119.77	801,622.50	SW
613	772.53	102+80.86	-8.59' LT	529,127.18	801,619.48	SW
614	772.07	102+80.86	-8.59' LT	529,130.49	801,625.68	SW
615	772.13	102+80.03	0.00'	529,131.67	801,627.89	FLAG
616	772.40	102+80.03	0.00'	529,140.99	801,645.36	FLAG

CURB RAMP DETAIL LEGEND	
AS-3	ASPHALTIC SURFACE 3-INCH
CG-30A	CONCRETE CURB AND GUTTER 30-INCH TYPE A
CP-8	CONCRETE PAVEMENT 8-INCH
CCP	CONCRETE CURB PEDESTRIAN
CS-4	CONCRETE SIDEWALK 4-INCH
CS-6	CONCRETE SIDEWALK 6-INCH
DWF-Y	DETECTABLE WARNING FIELD YELLOW

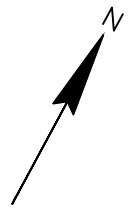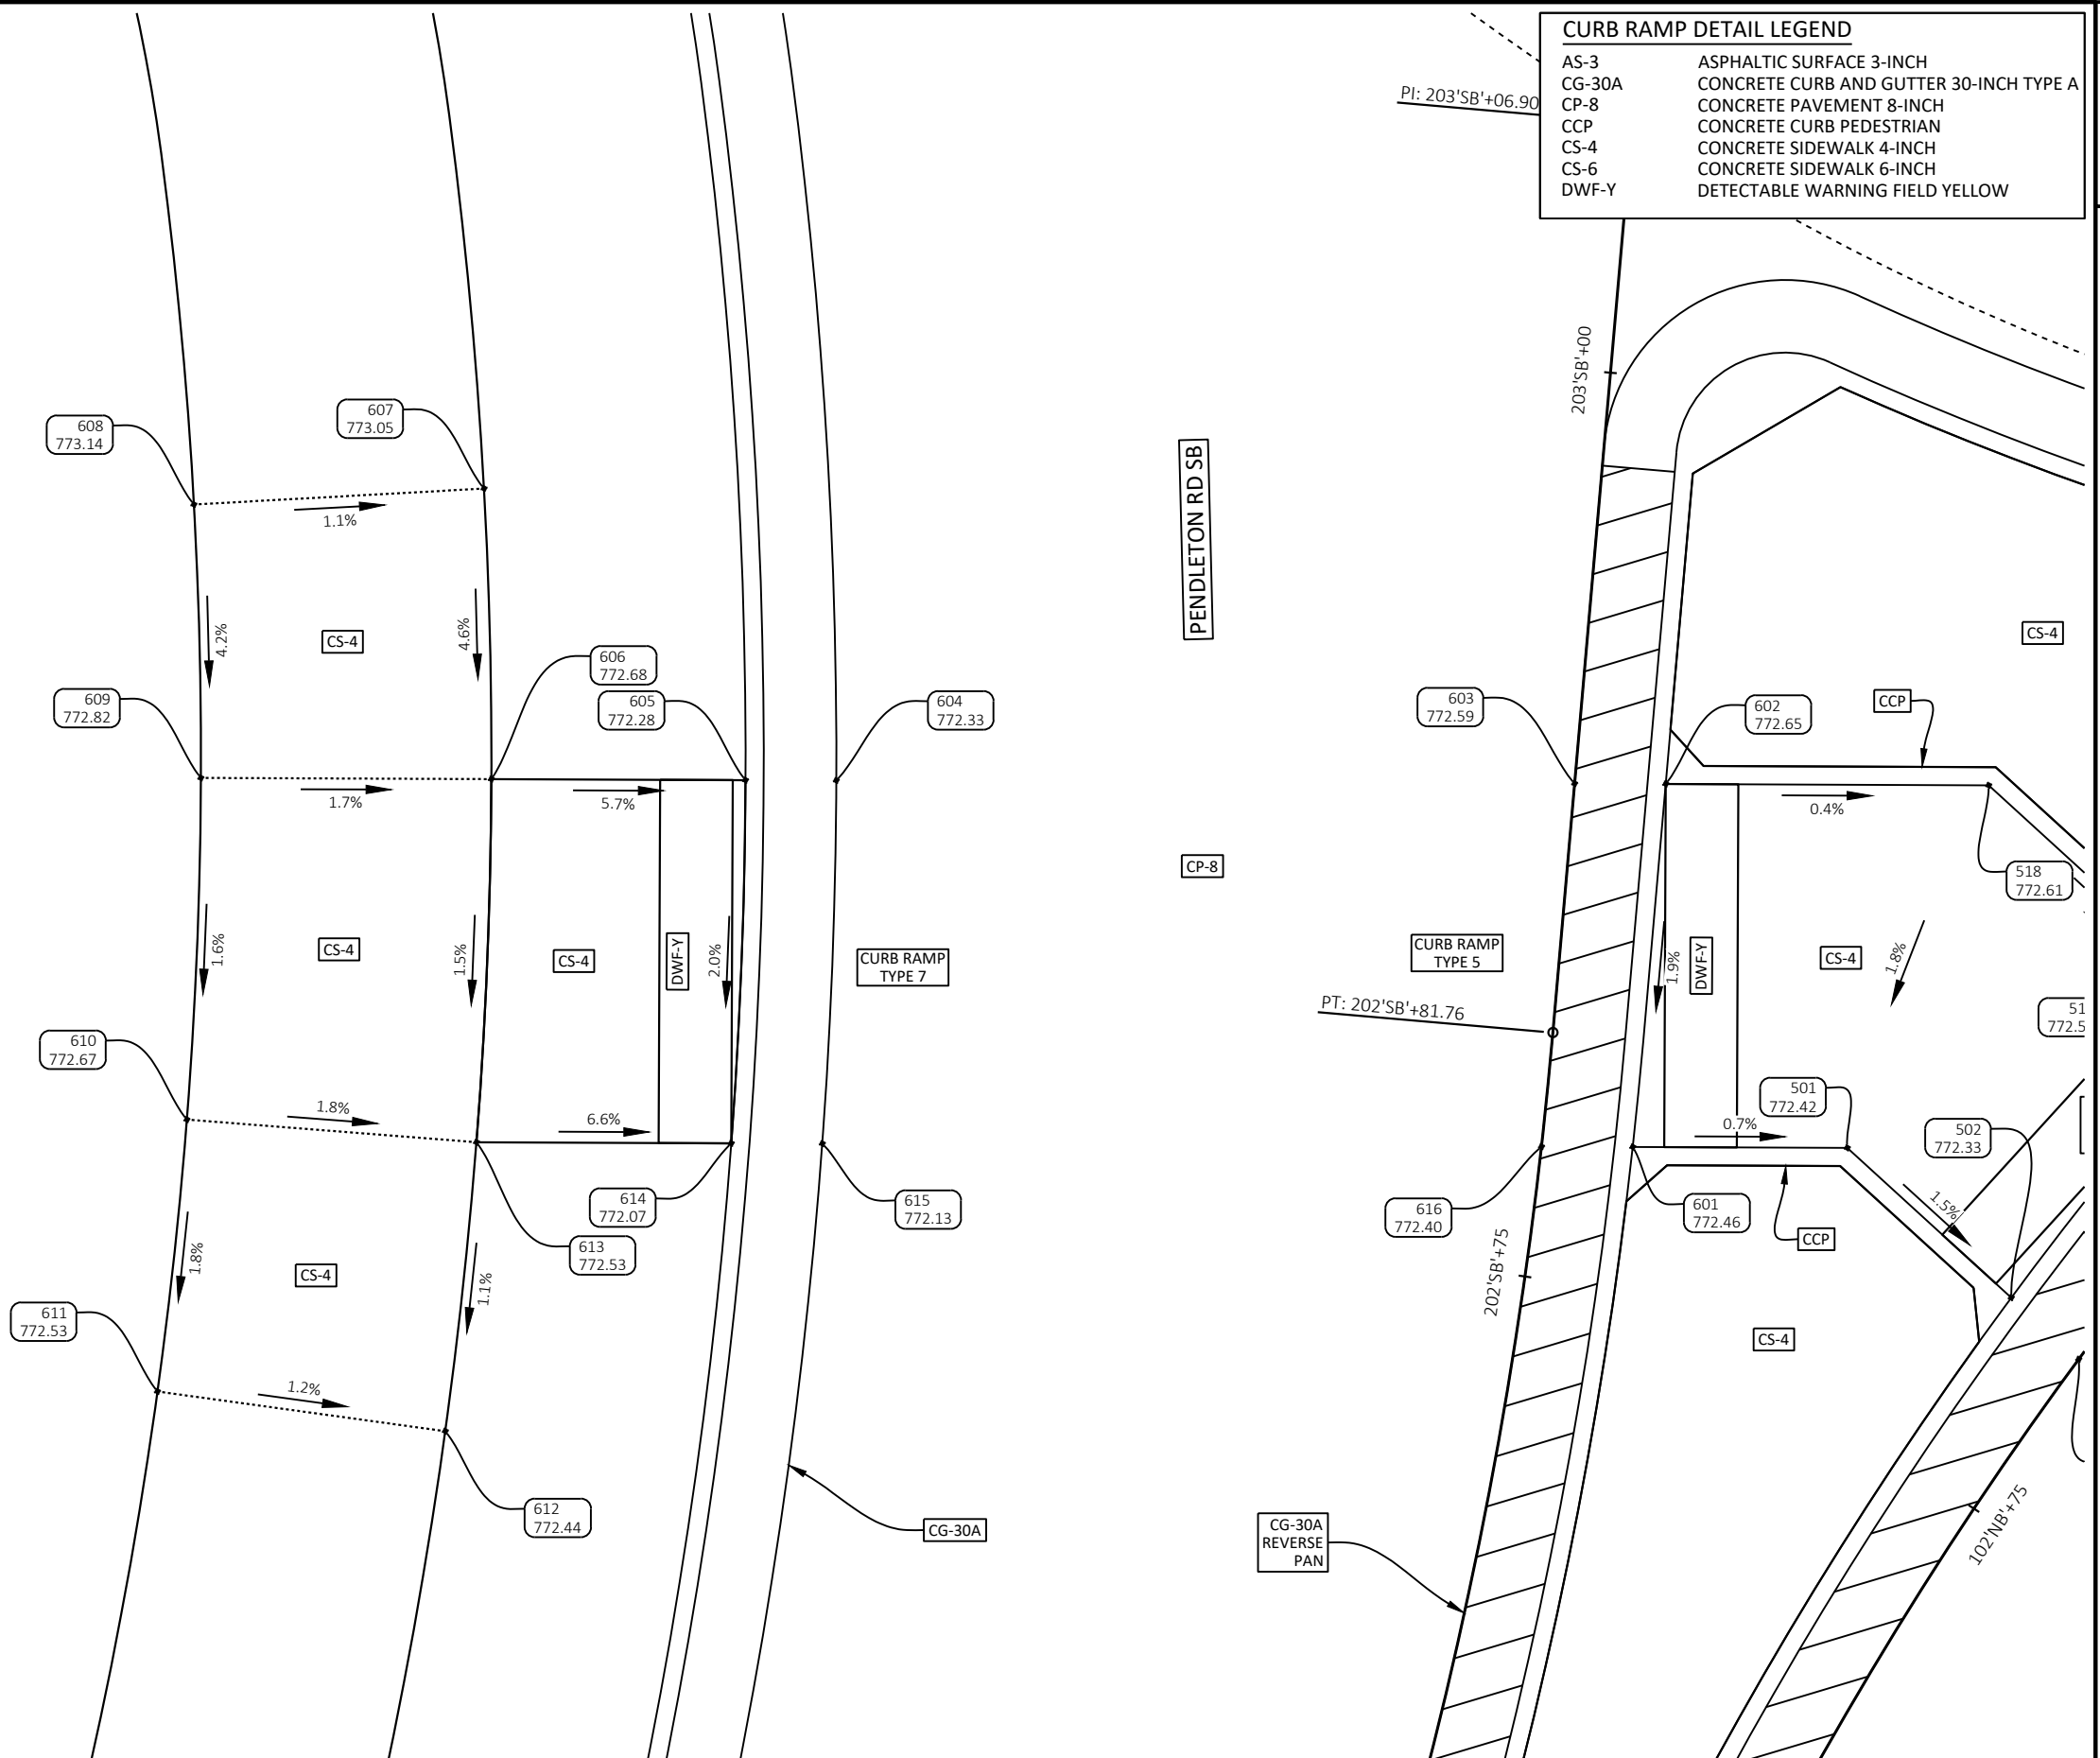


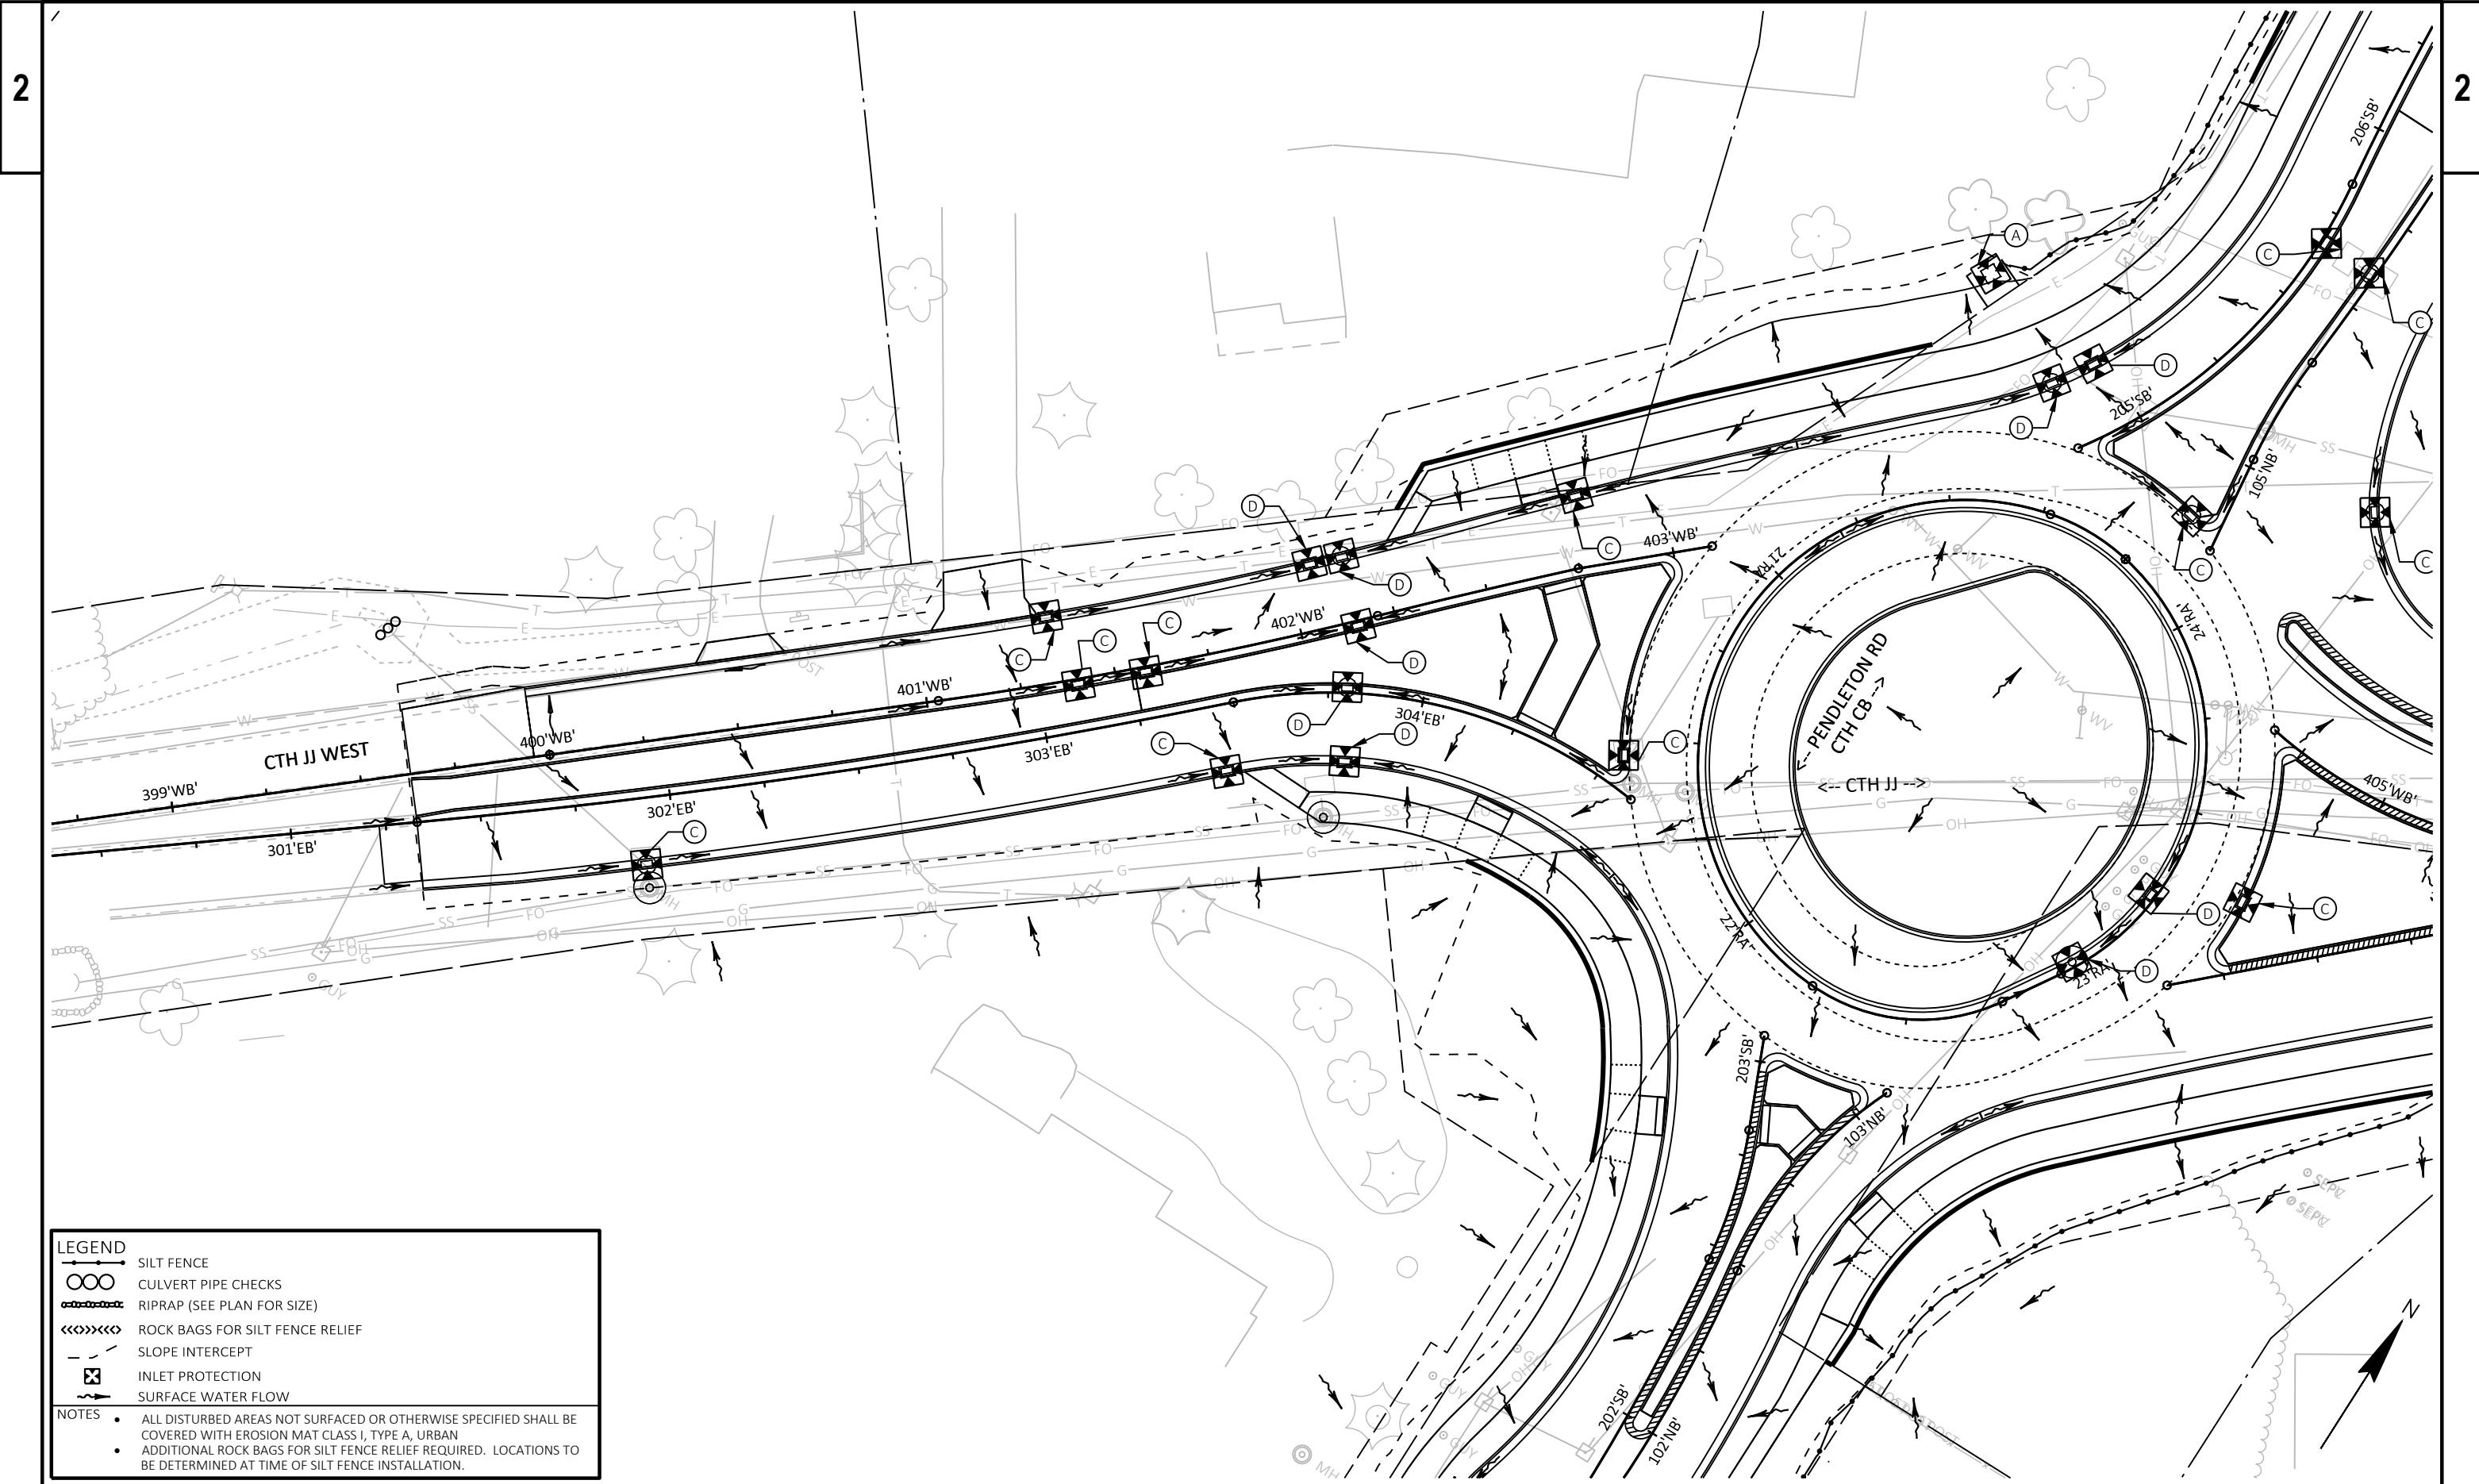



LEGEND

- SILT FENCE
- CULVERT PIPE CHECKS
- RIPRAP (SEE PLAN FOR SIZE)
- ROCK BAGS FOR SILT FENCE RELIEF
- SLOPE INTERCEPT
- INLET PROTECTION
- SURFACE WATER FLOW

NOTES


- ALL DISTURBED AREAS NOT SURFACED OR OTHERWISE SPECIFIED SHALL BE COVERED WITH EROSION MAT CLASS I, TYPE A, URBAN
- ADDITIONAL ROCK BAGS FOR SILT FENCE RELIEF REQUIRED. LOCATIONS TO BE DETERMINED AT TIME OF SILT FENCE INSTALLATION.

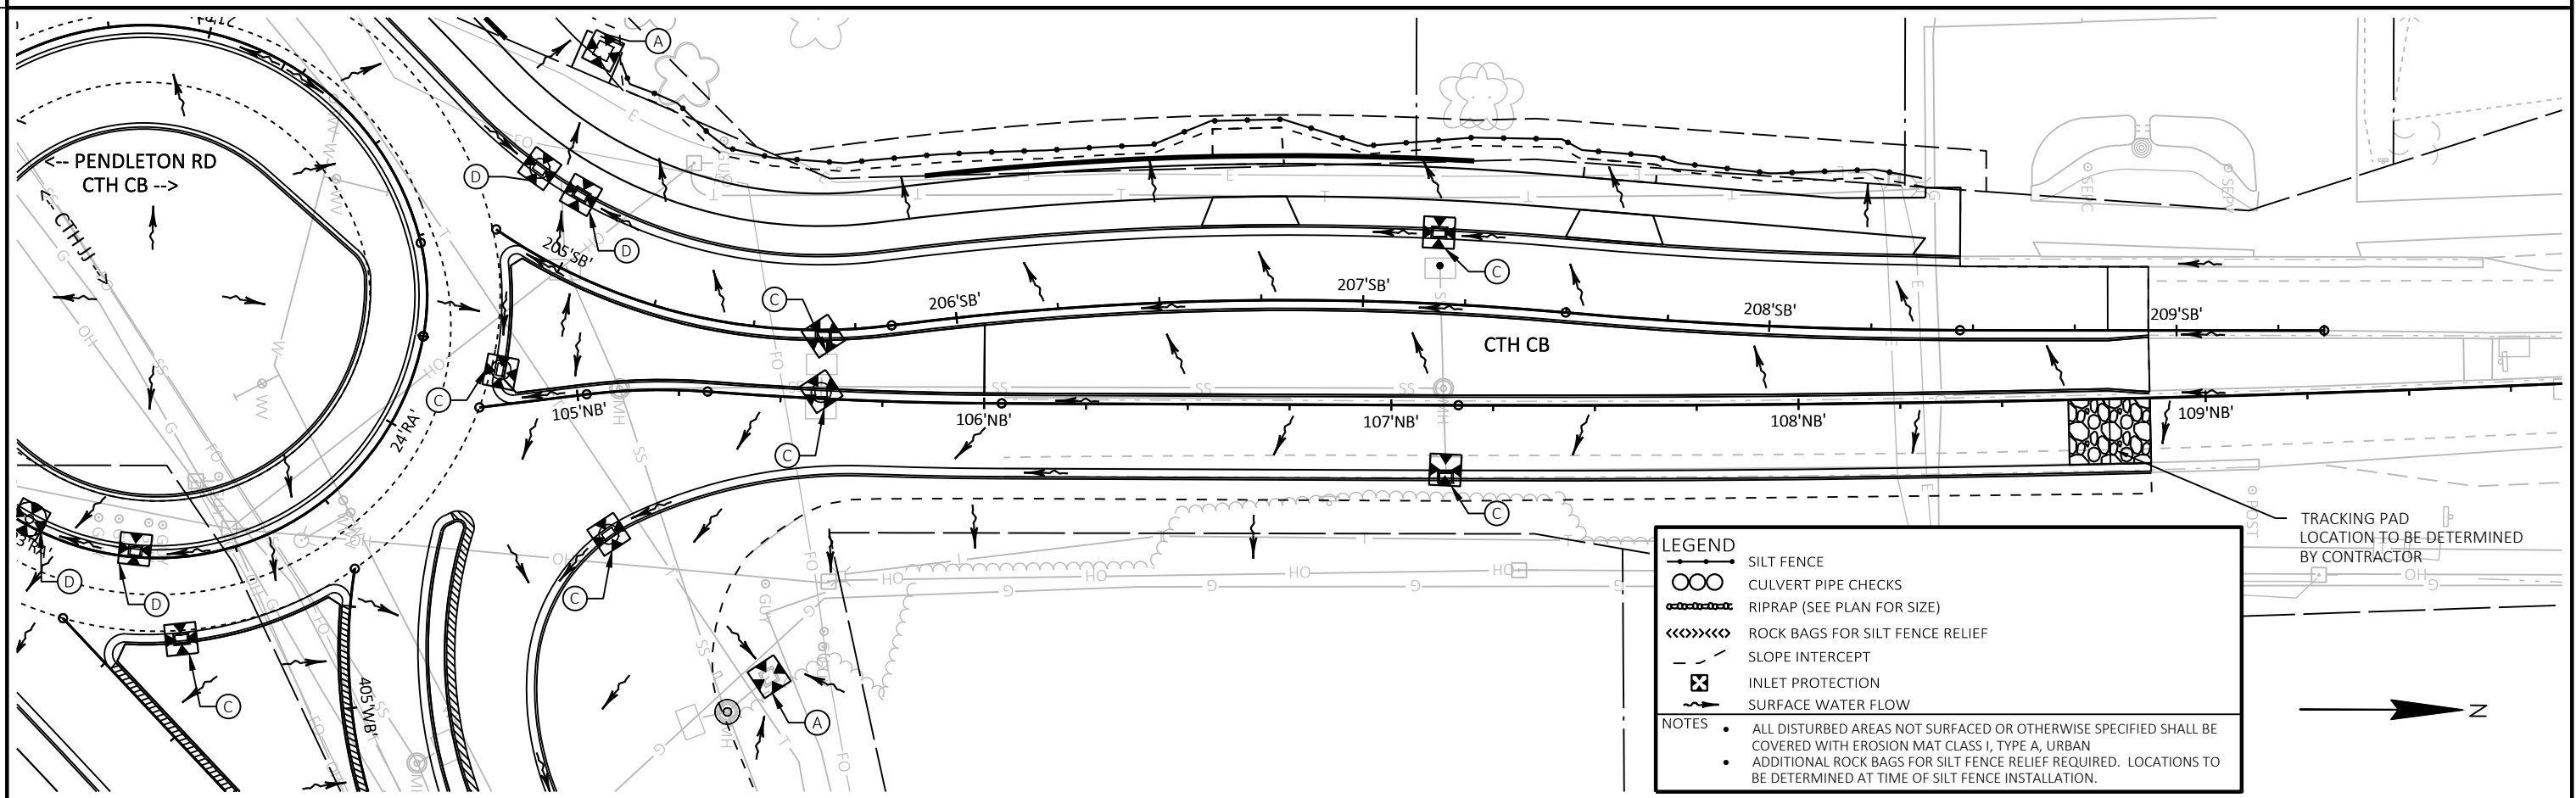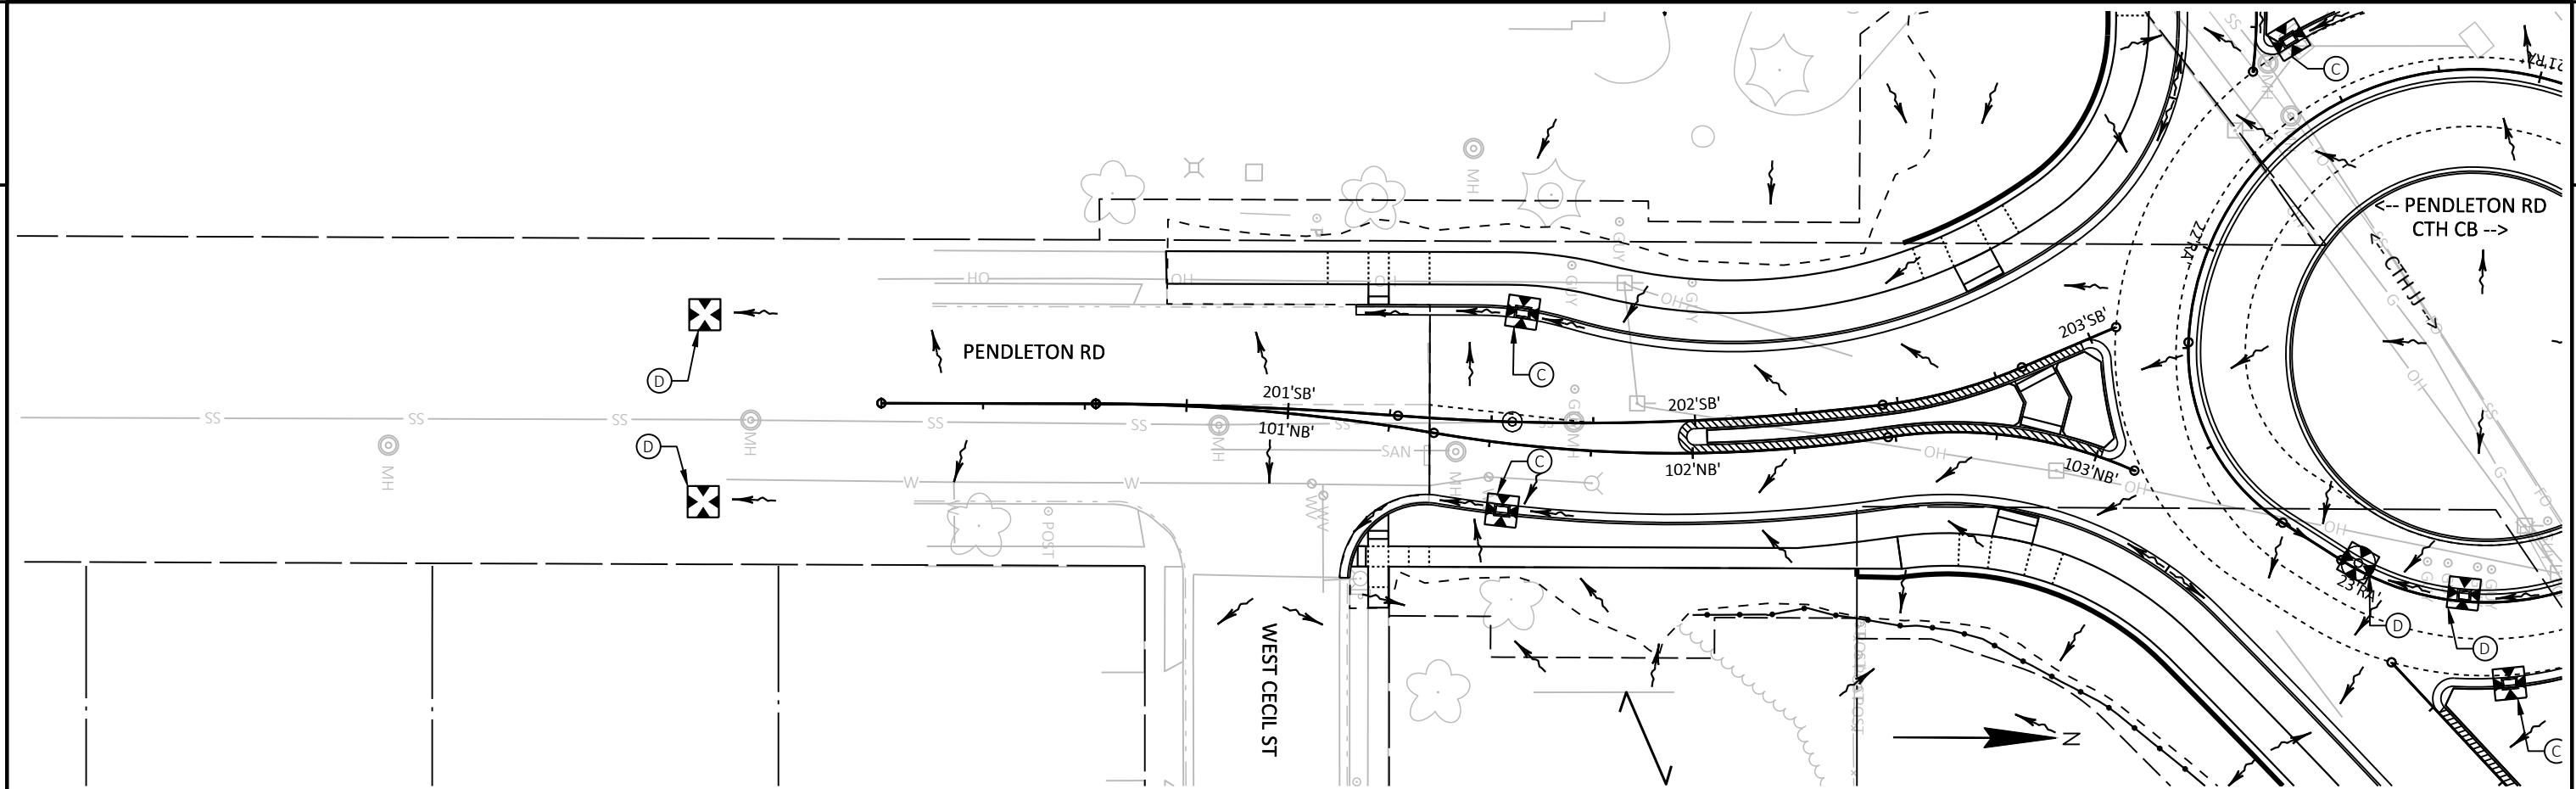


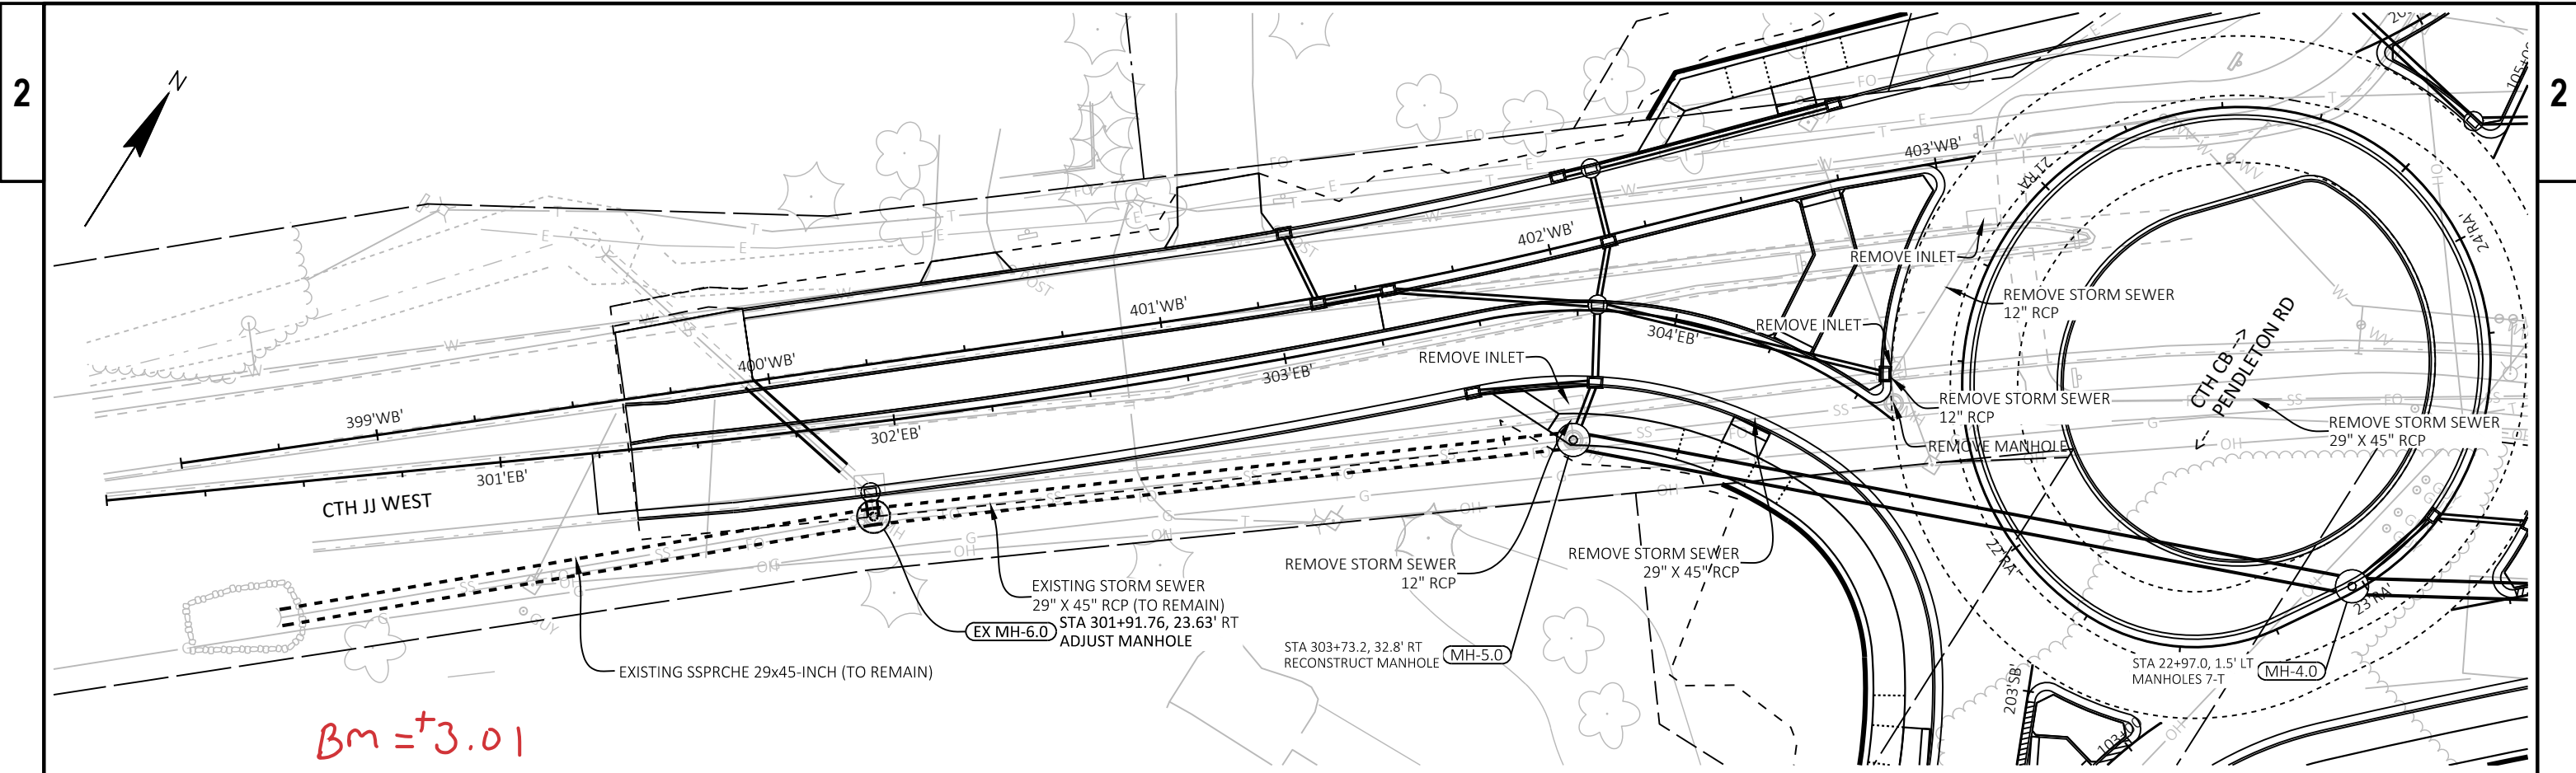


Bm = +3.01
 ELEV. 774.94

NOTE - ADD 0.06' FROM RIM TO GET TO FLANGE GRADE

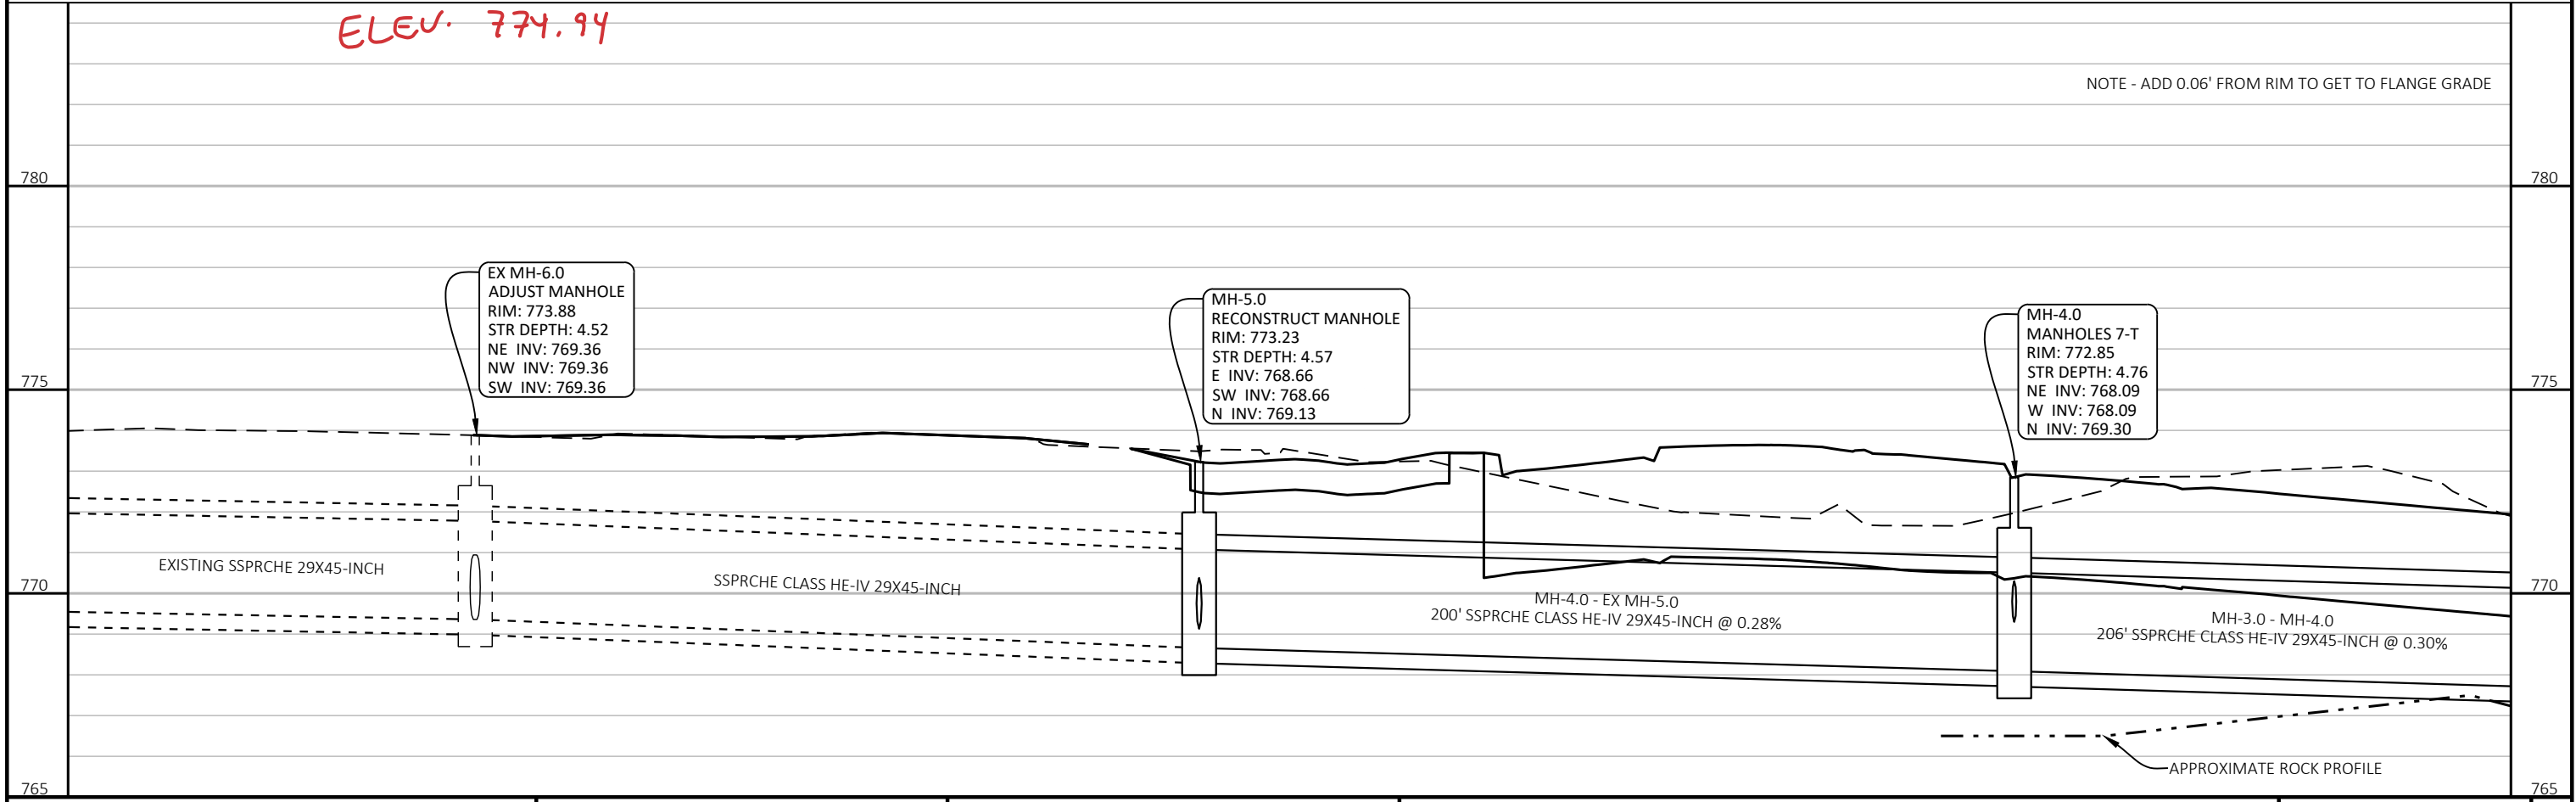


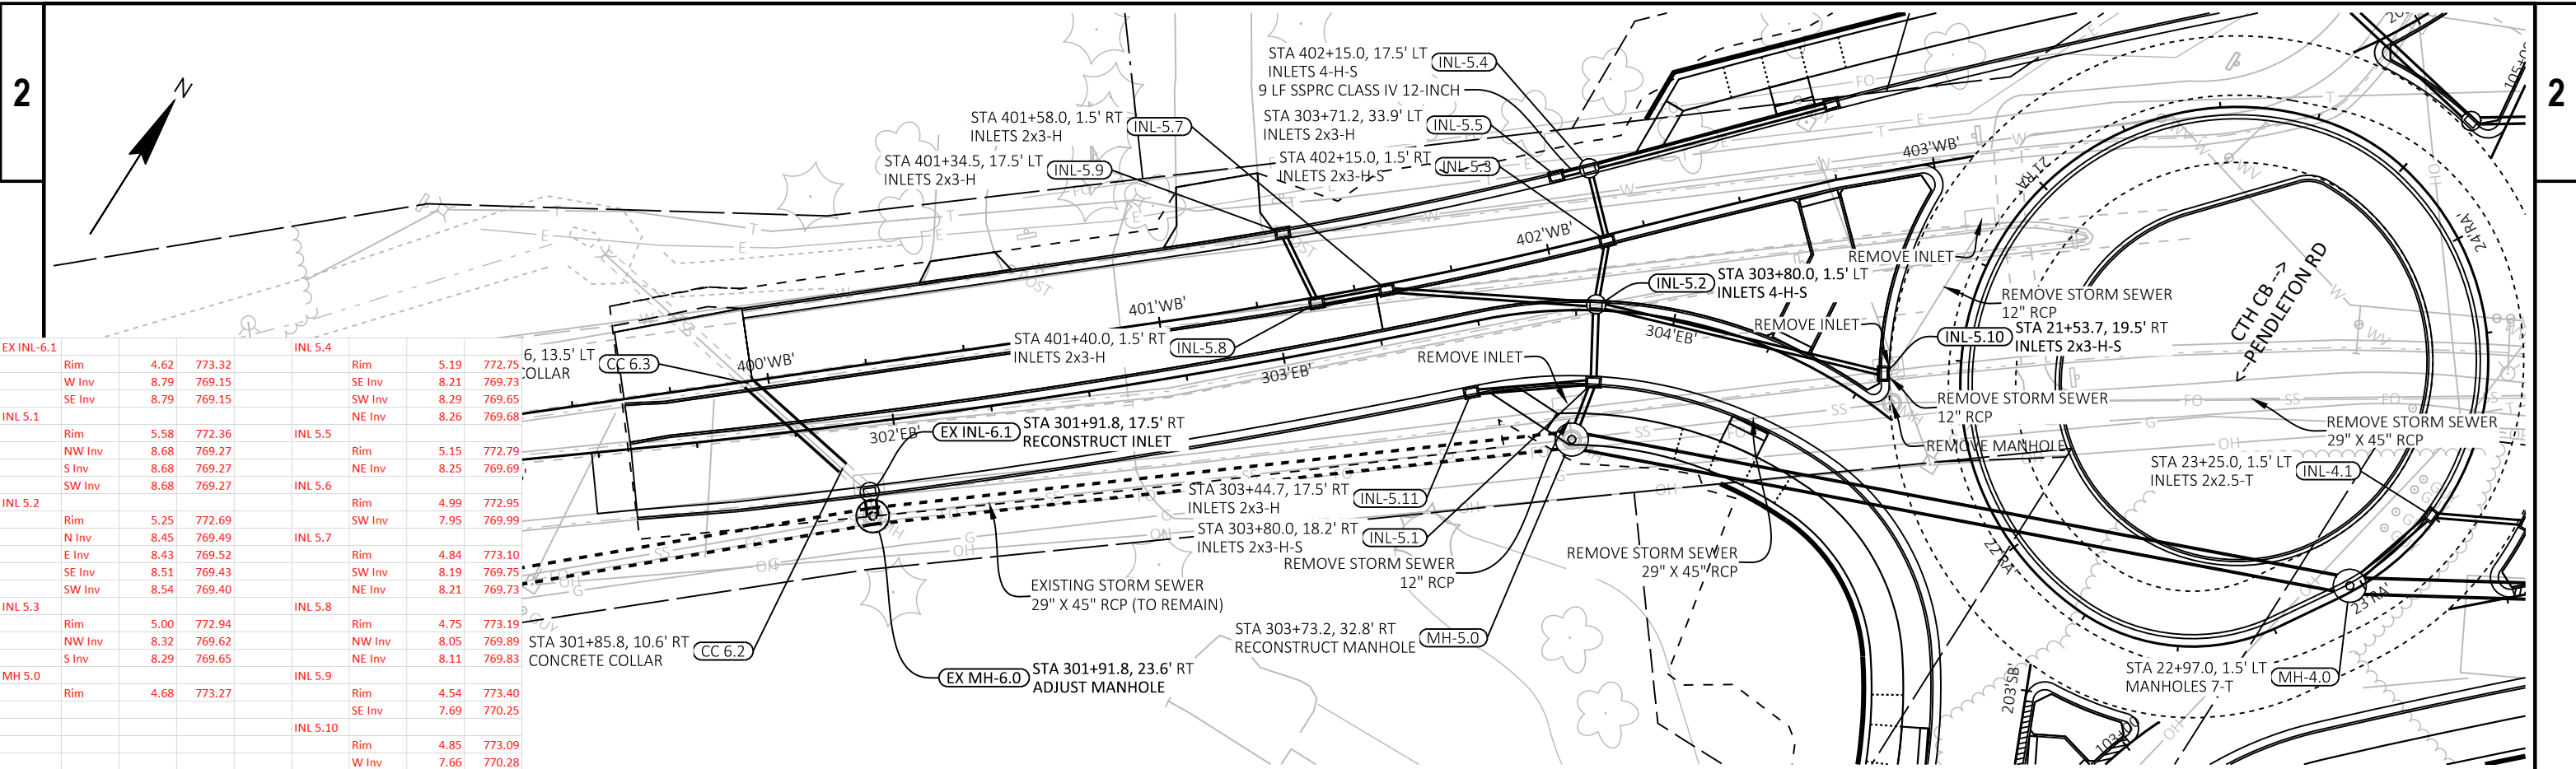


EX INL-6.1	Rim	4.62	773.32	INL 5.4	Rim	5.19	772.75
	W Inv	8.79	769.15		SE Inv	8.21	769.73
	SE Inv	8.79	769.15		SW Inv	8.29	769.65
INL 5.1	Rim	5.58	772.36	INL 5.5	Rim	5.15	772.79
	NW Inv	8.68	769.27		NE Inv	8.25	769.69
	S Inv	8.68	769.27		SW Inv	8.26	769.68
	SW Inv	8.68	769.27	INL 5.6	Rim	4.99	772.95
INL 5.2	Rim	5.25	772.69		SW Inv	7.95	769.99
	N Inv	8.45	769.49	INL 5.7	Rim	4.84	773.10
	E Inv	8.43	769.52		SW Inv	8.19	769.75
	SE Inv	8.51	769.43		NE Inv	8.21	769.73
	SW Inv	8.54	769.40	INL 5.8	Rim	4.75	773.19
INL 5.3	Rim	5.00	772.94		NW Inv	8.05	769.89
	NW Inv	8.32	769.62		NE Inv	8.11	769.83
	S Inv	8.29	769.65	INL 5.9	Rim	4.54	773.40
MH 5.0	Rim	4.68	773.27		SE Inv	7.69	770.25
				INL 5.10	Rim	4.85	773.09
					W Inv	7.66	770.28

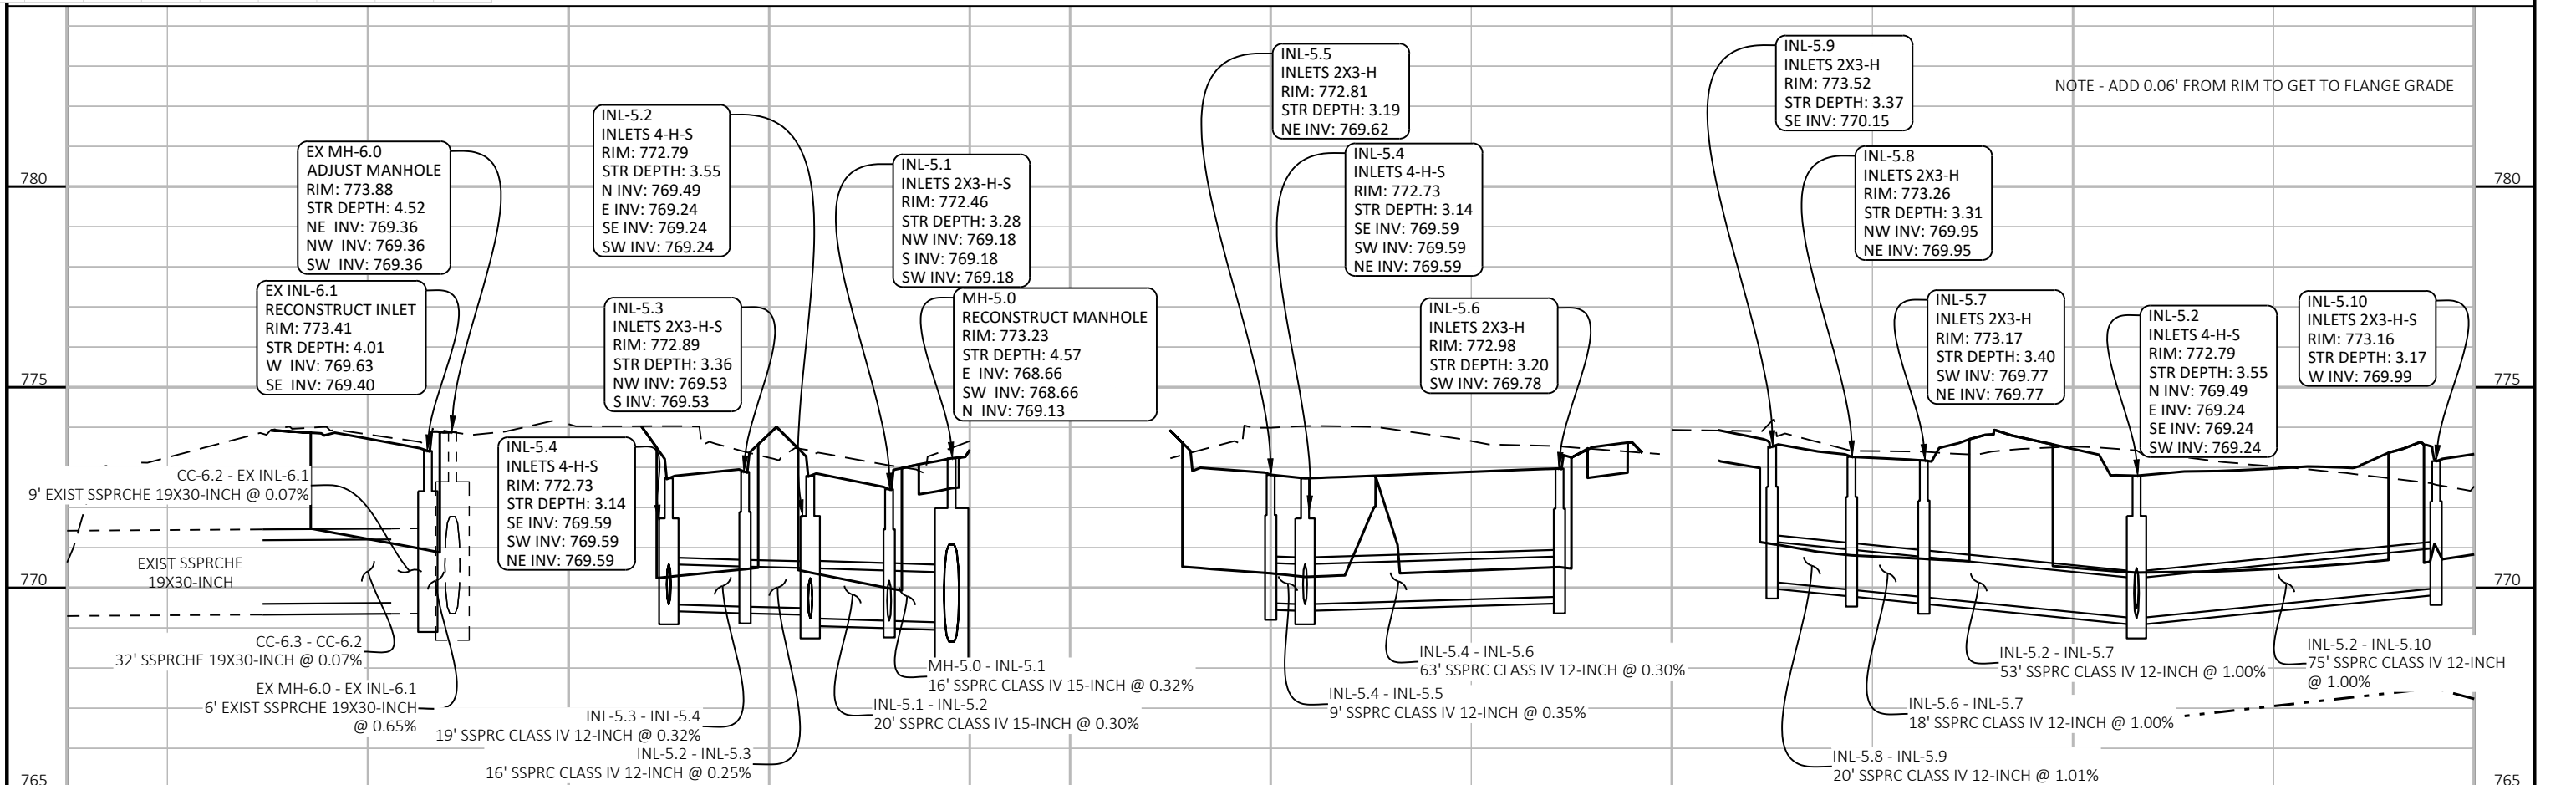

NOTE - ADD 0.06' FROM RIM TO GET TO FLANGE GRADE

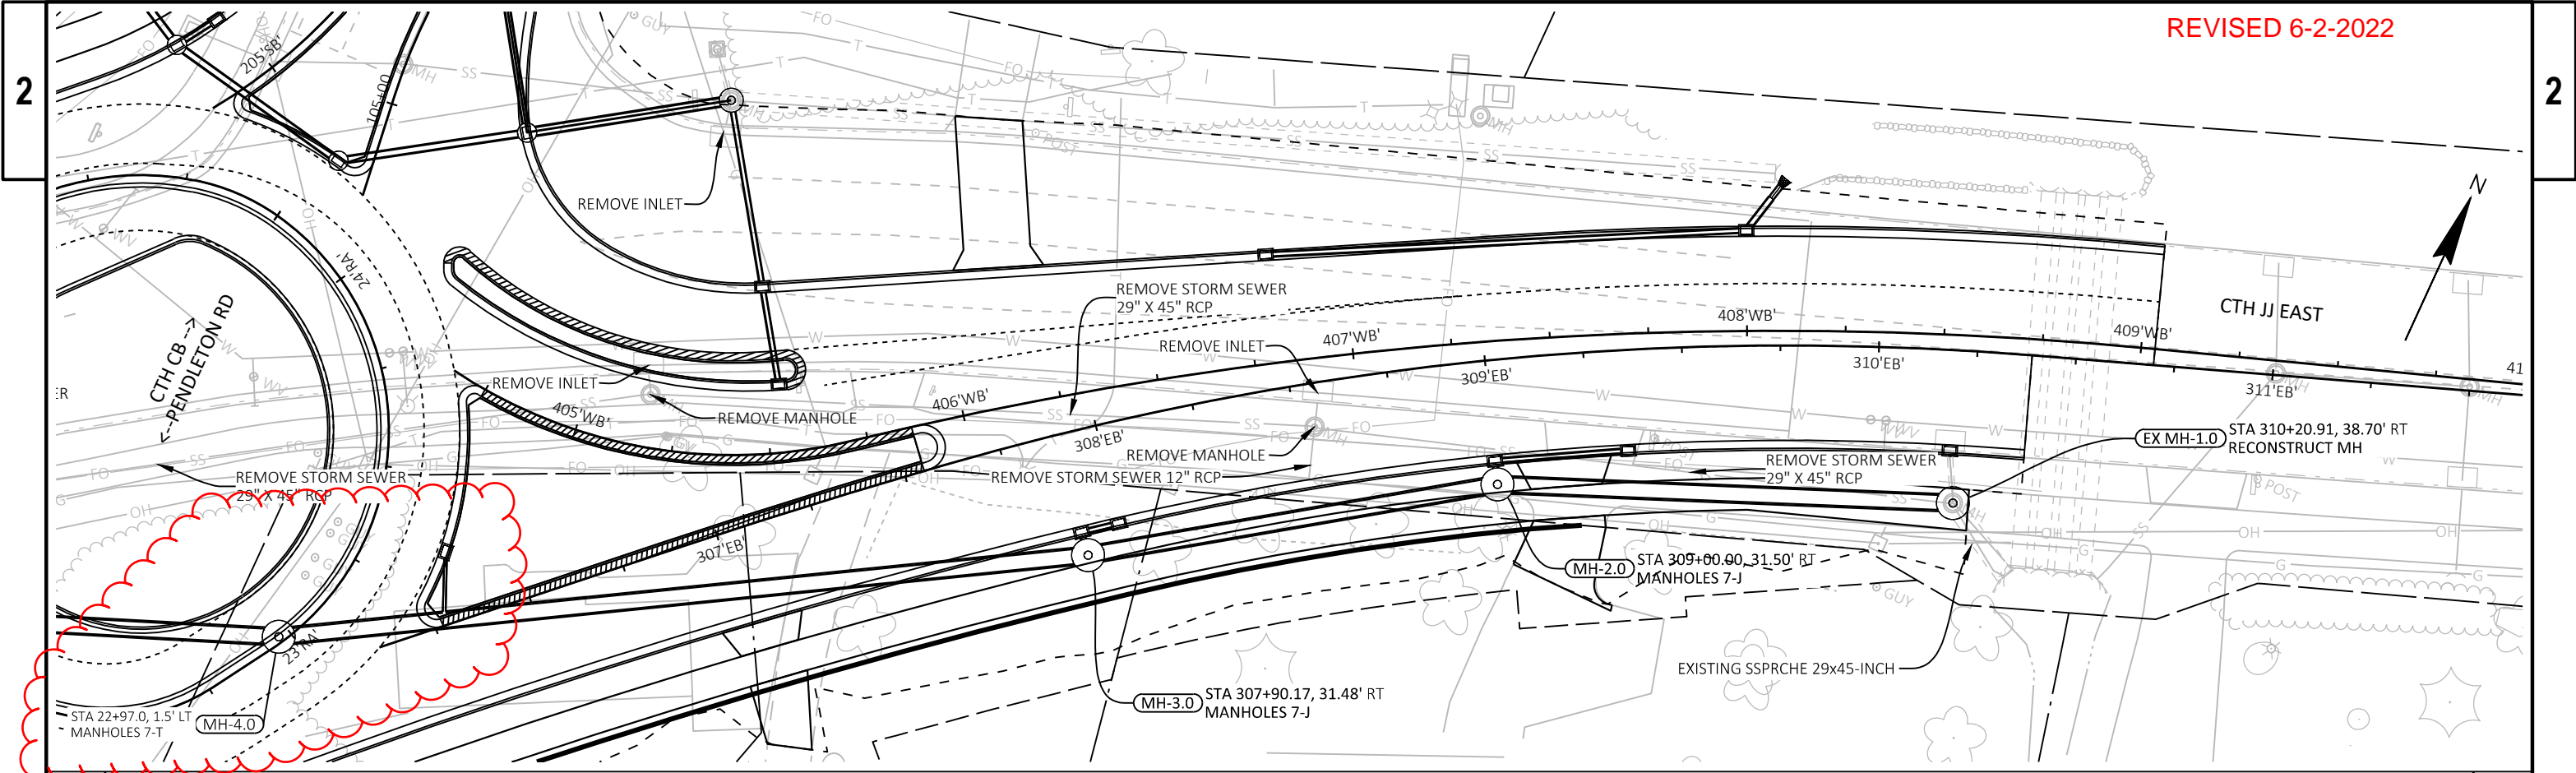

NOTE - ADD 0.06' FROM RIM TO GET TO FLANGE GRADE

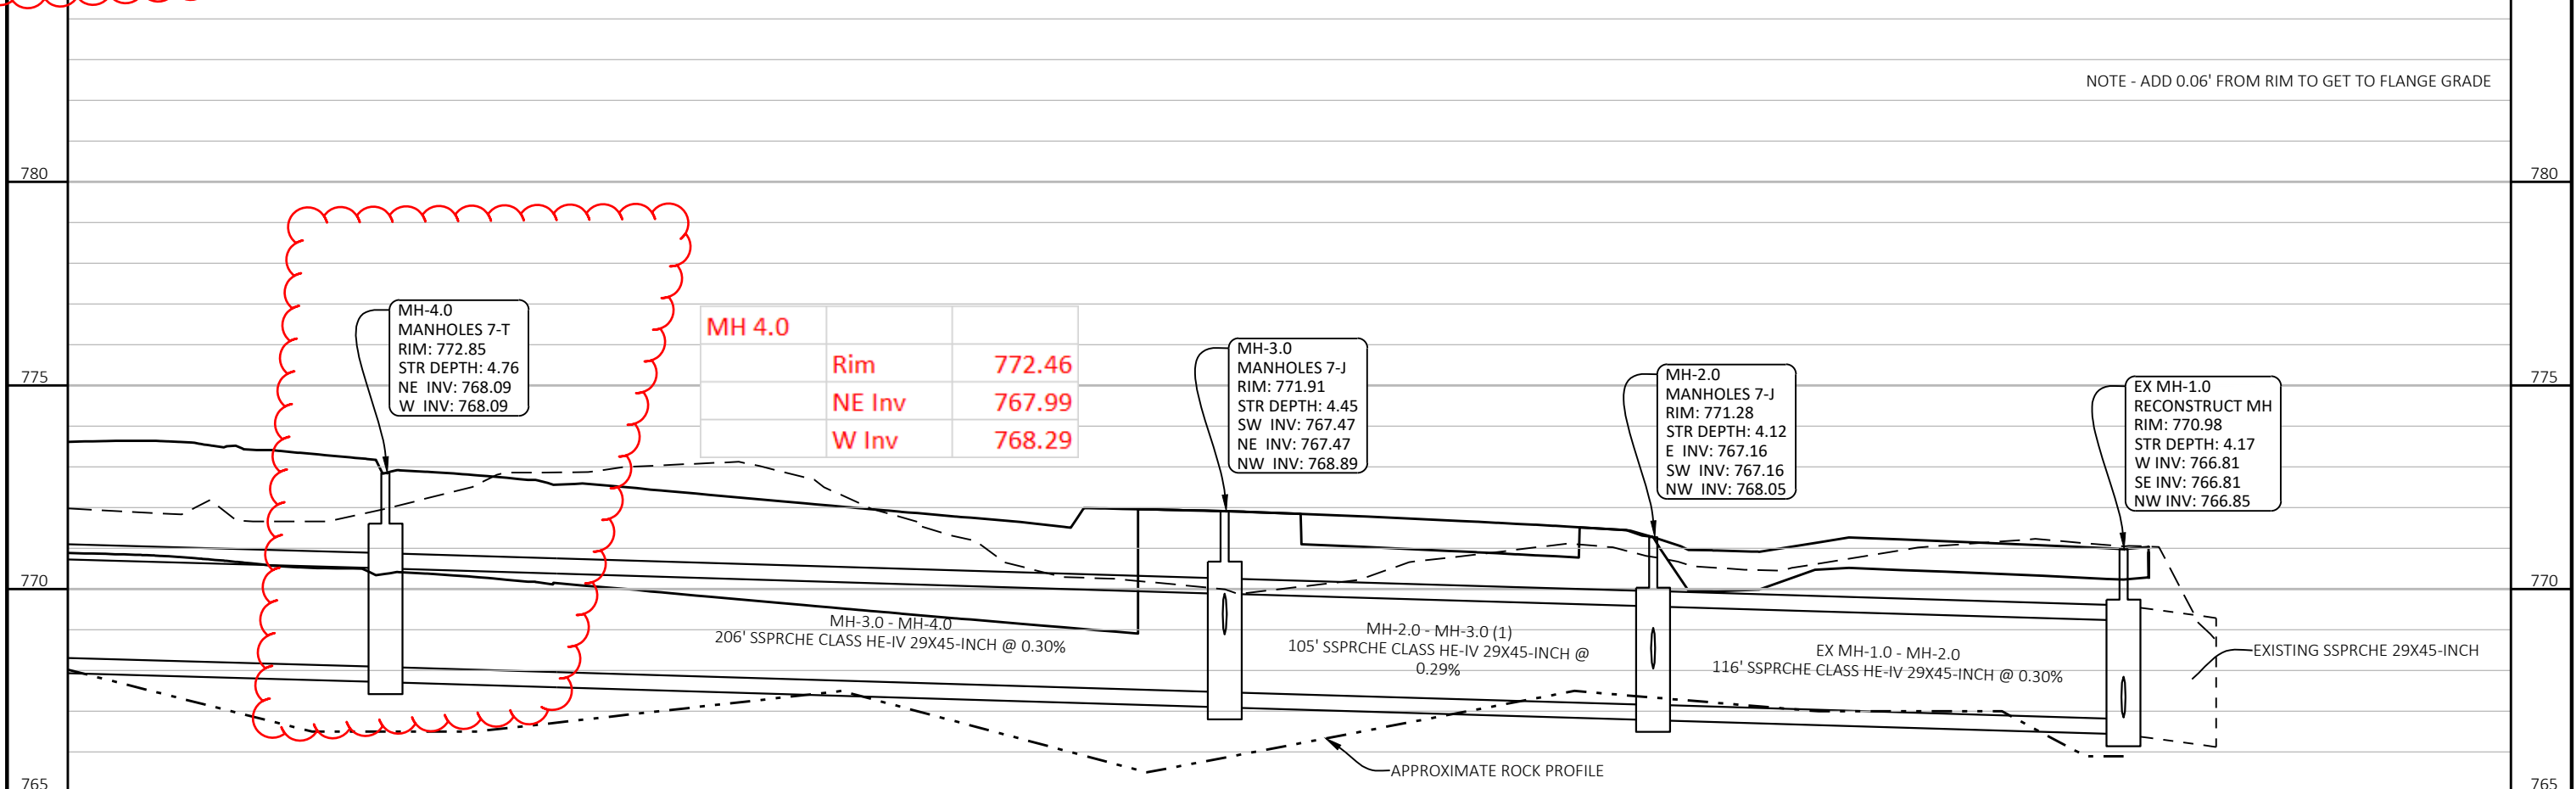


MH 4.0		
Rim		772.46
NE Inv		767.99
W Inv		768.29

MH-4.0
MANHOLES 7-T
RIM: 772.85
STR DEPTH: 4.76
NE INV: 768.09
W INV: 768.09

MH-3.0
MANHOLES 7-J
RIM: 771.91
STR DEPTH: 4.45
SW INV: 767.47
NE INV: 767.47
NW INV: 768.89


MH-2.0
MANHOLES 7-J
RIM: 771.28
STR DEPTH: 4.12
E INV: 767.16
SW INV: 767.16
NW INV: 768.05

EX MH-1.0
RECONSTRUCT MH
RIM: 770.98
STR DEPTH: 4.17
W INV: 766.81
SE INV: 766.81
NW INV: 766.85

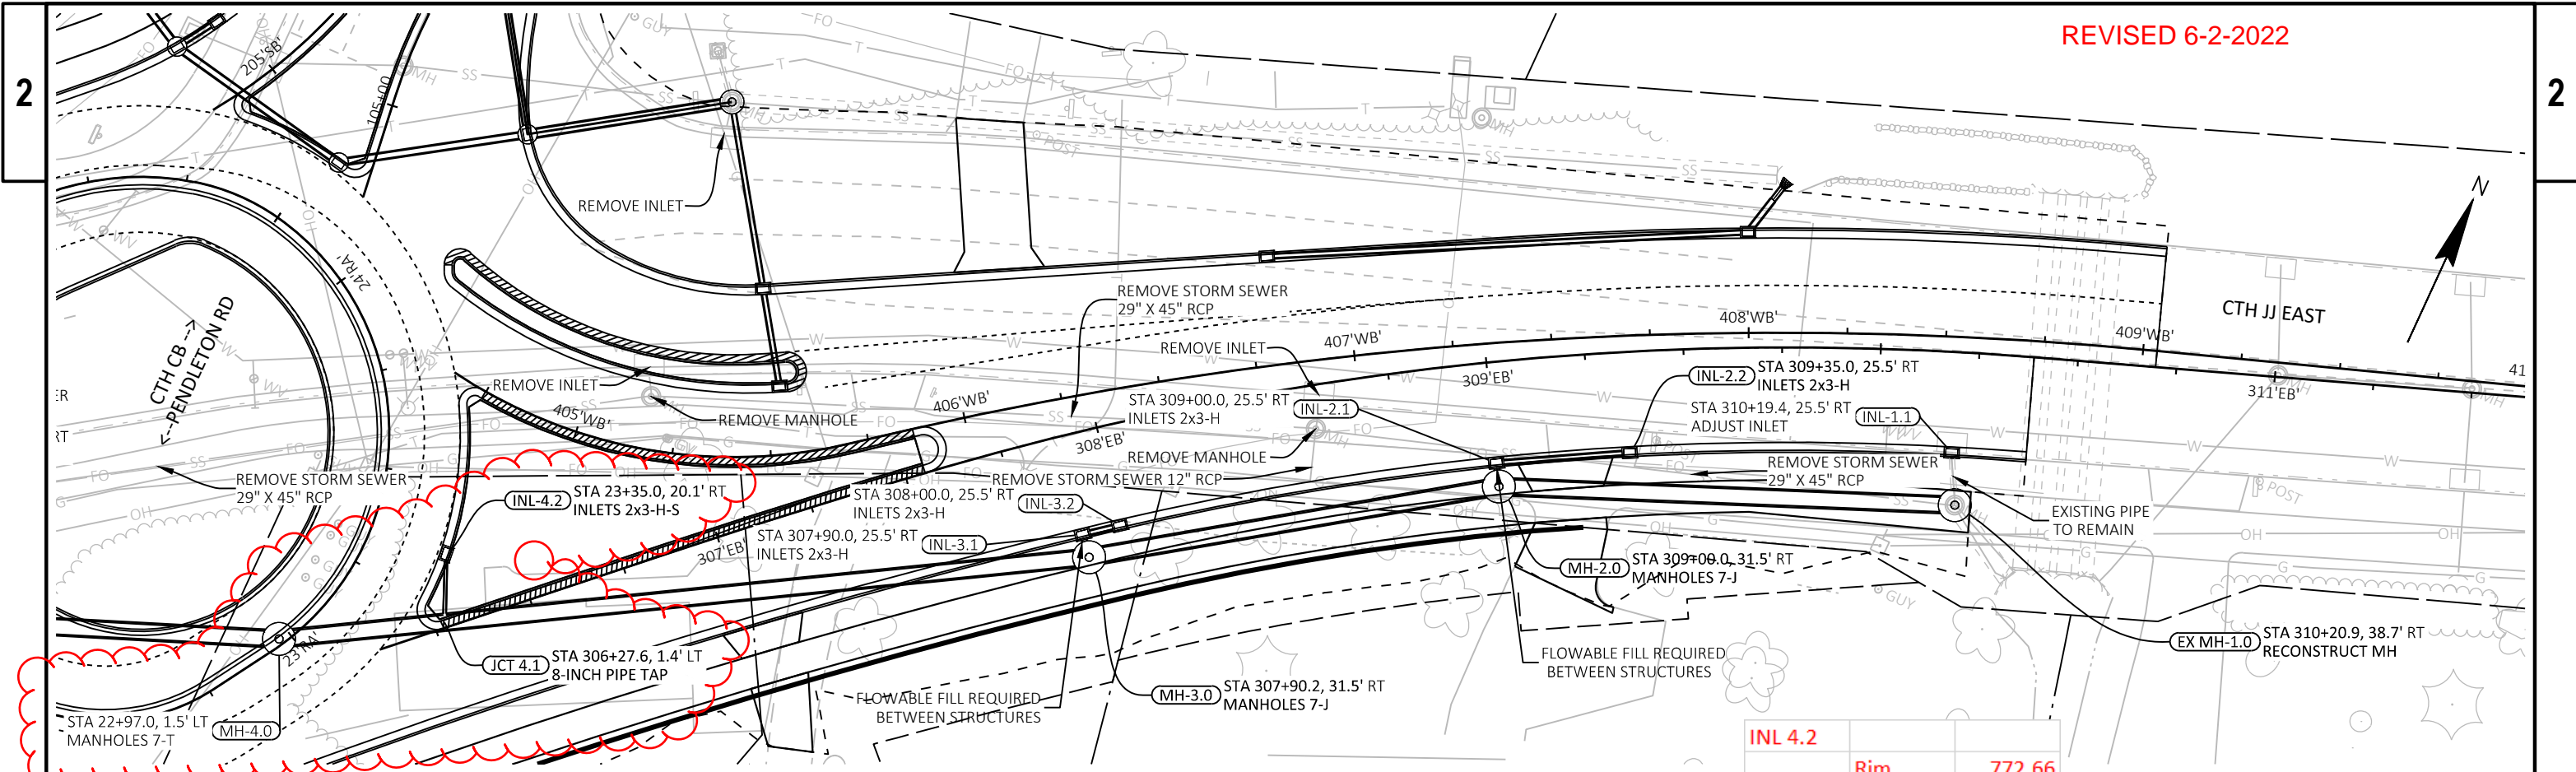

INL 4.2	Rim	772.66
	SE Inv	769.53
MH 3.0	Rim	771.79
INL 3.1	Rim	771.17
	NE Inv	768.92
	SE Inv	768.86
INL 3.2	Rim	771.12
	SW Inv	768.97
MH 2.0	Rim	771.59
INL 2.1	Rim	770.71
	NE Inv	768.16
	SW Inv	768.18
INL 2.2	Rim	770.51
	SW Inv	768.24
EX MH 1.0	Rim	771.17
INL 1.1	Rim	770.12
	SE Inv	766.98



NOTE - ADD 0.06' FROM RIM TO GET TO FLANGE GRADE

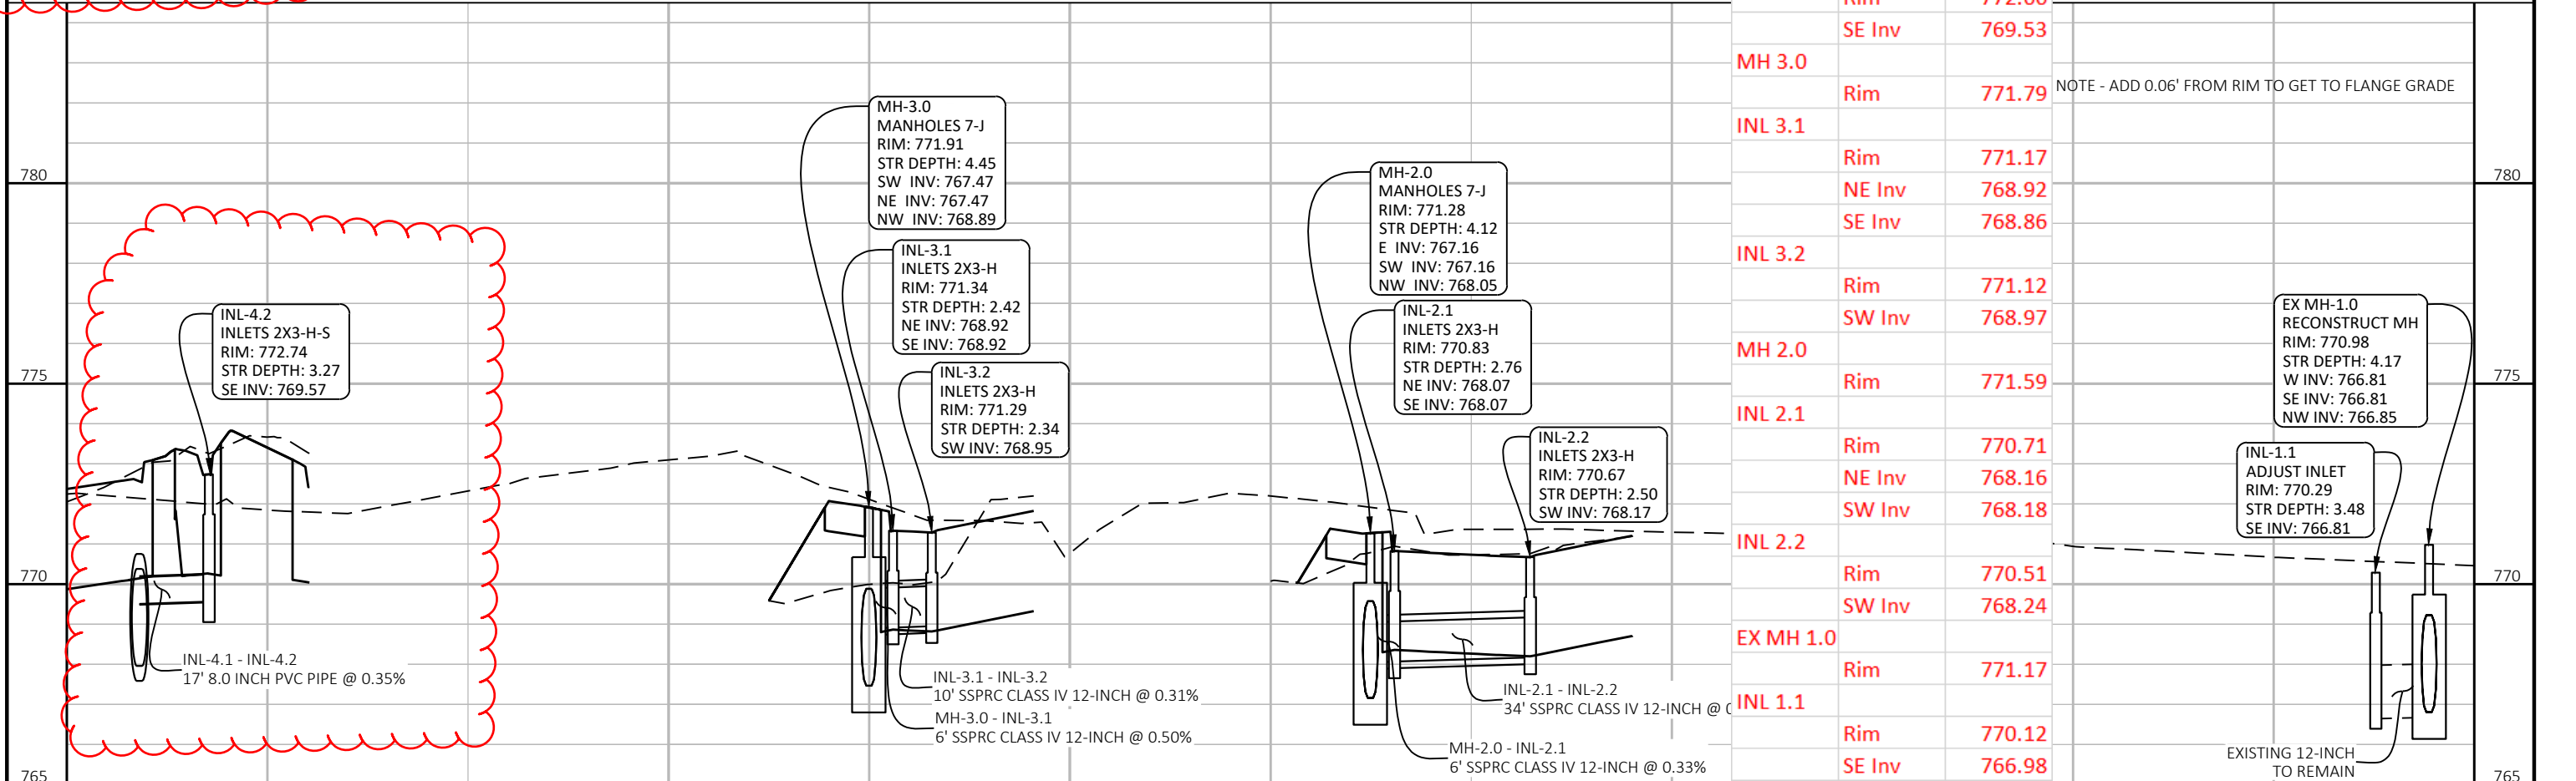

REVISED 6/2/2022



2

2

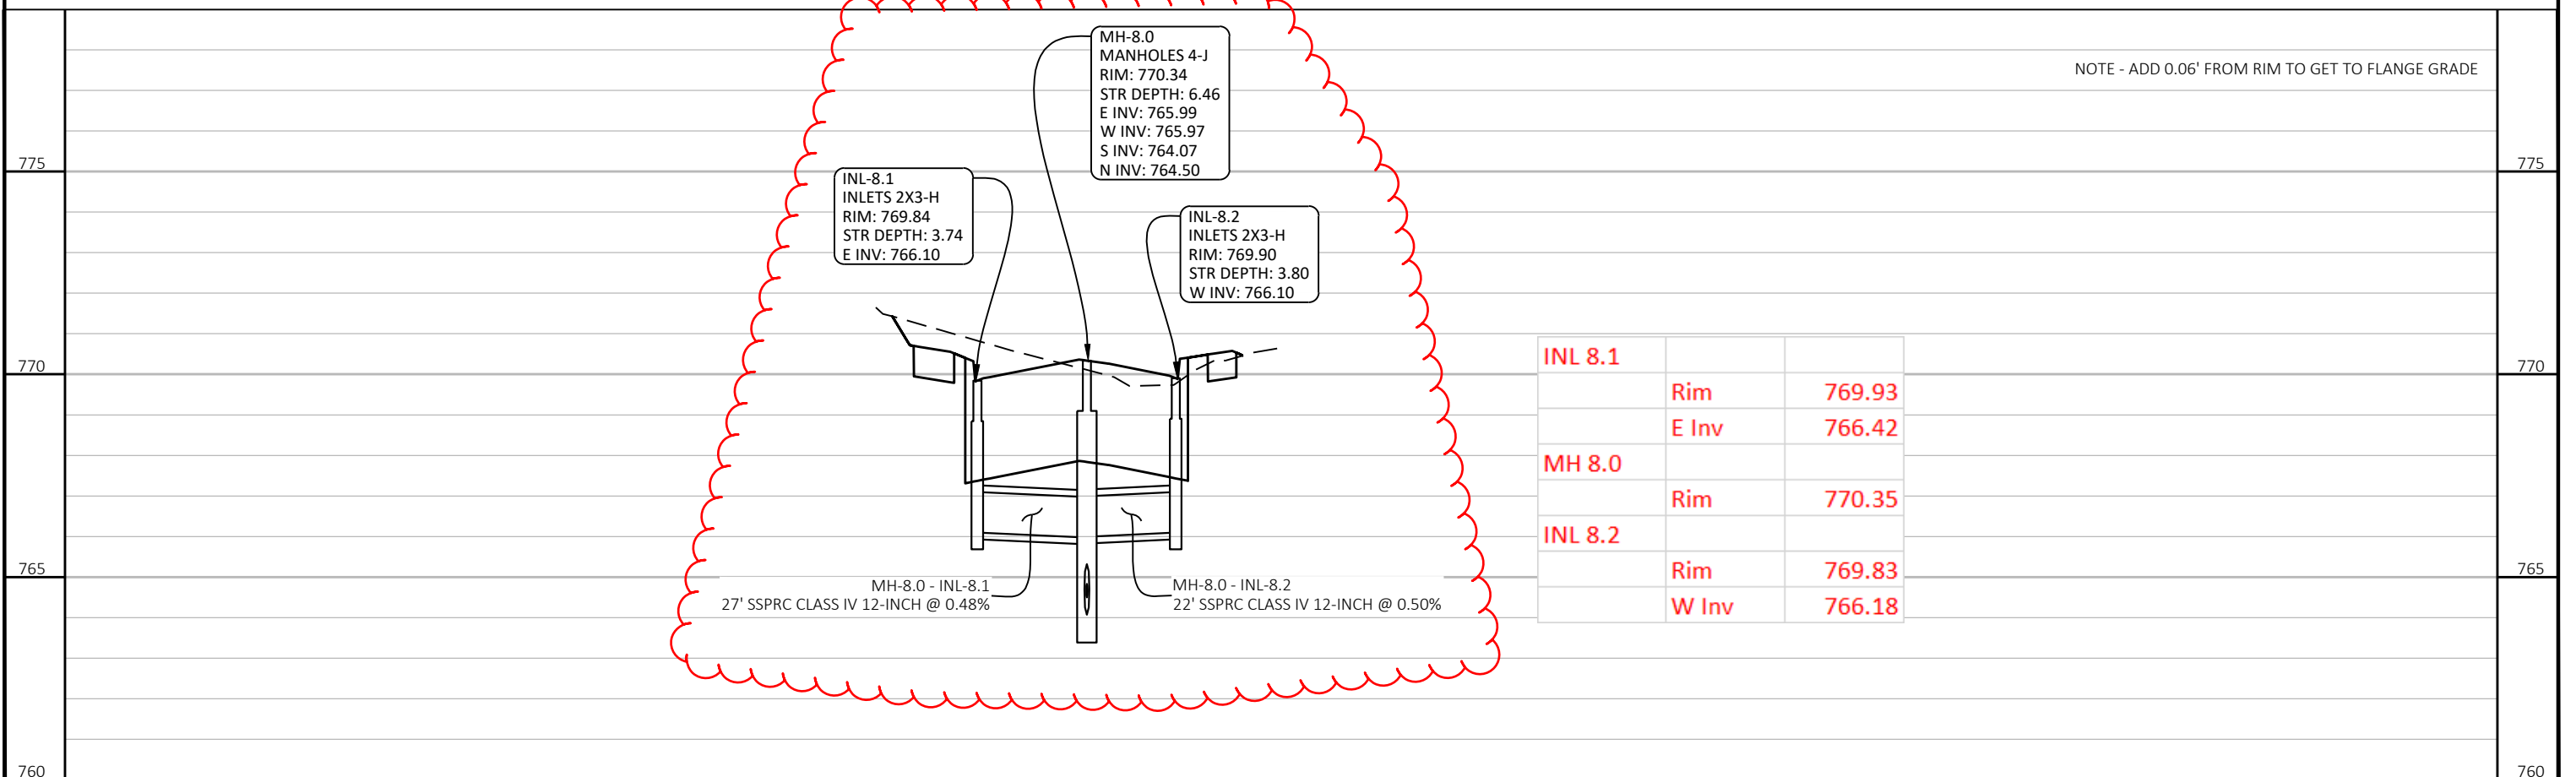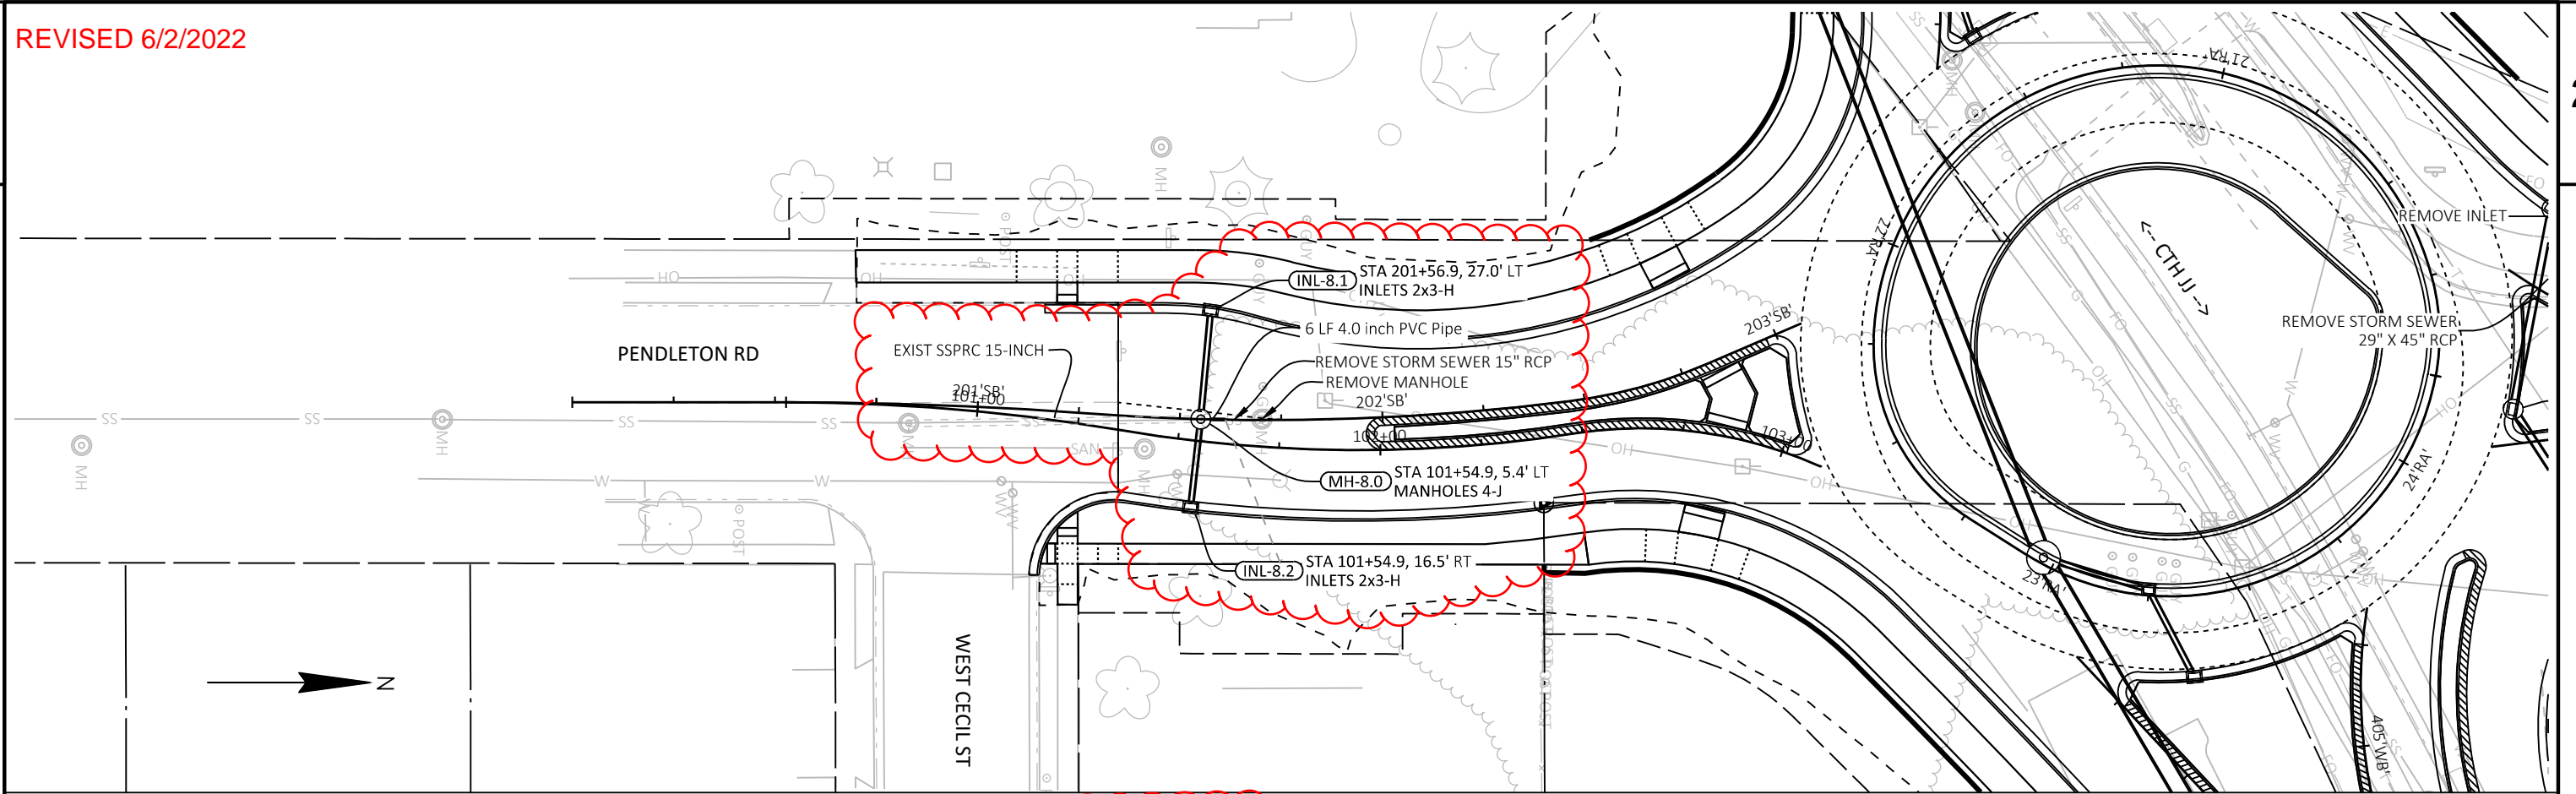

NOTE - ADD 0.06' FROM RIM TO GET TO FLANGE GRADE

INL 8.1	Rim	769.93
	E Inv	766.42
MH 8.0	Rim	770.35
INL 8.2	Rim	769.83
	W Inv	766.18

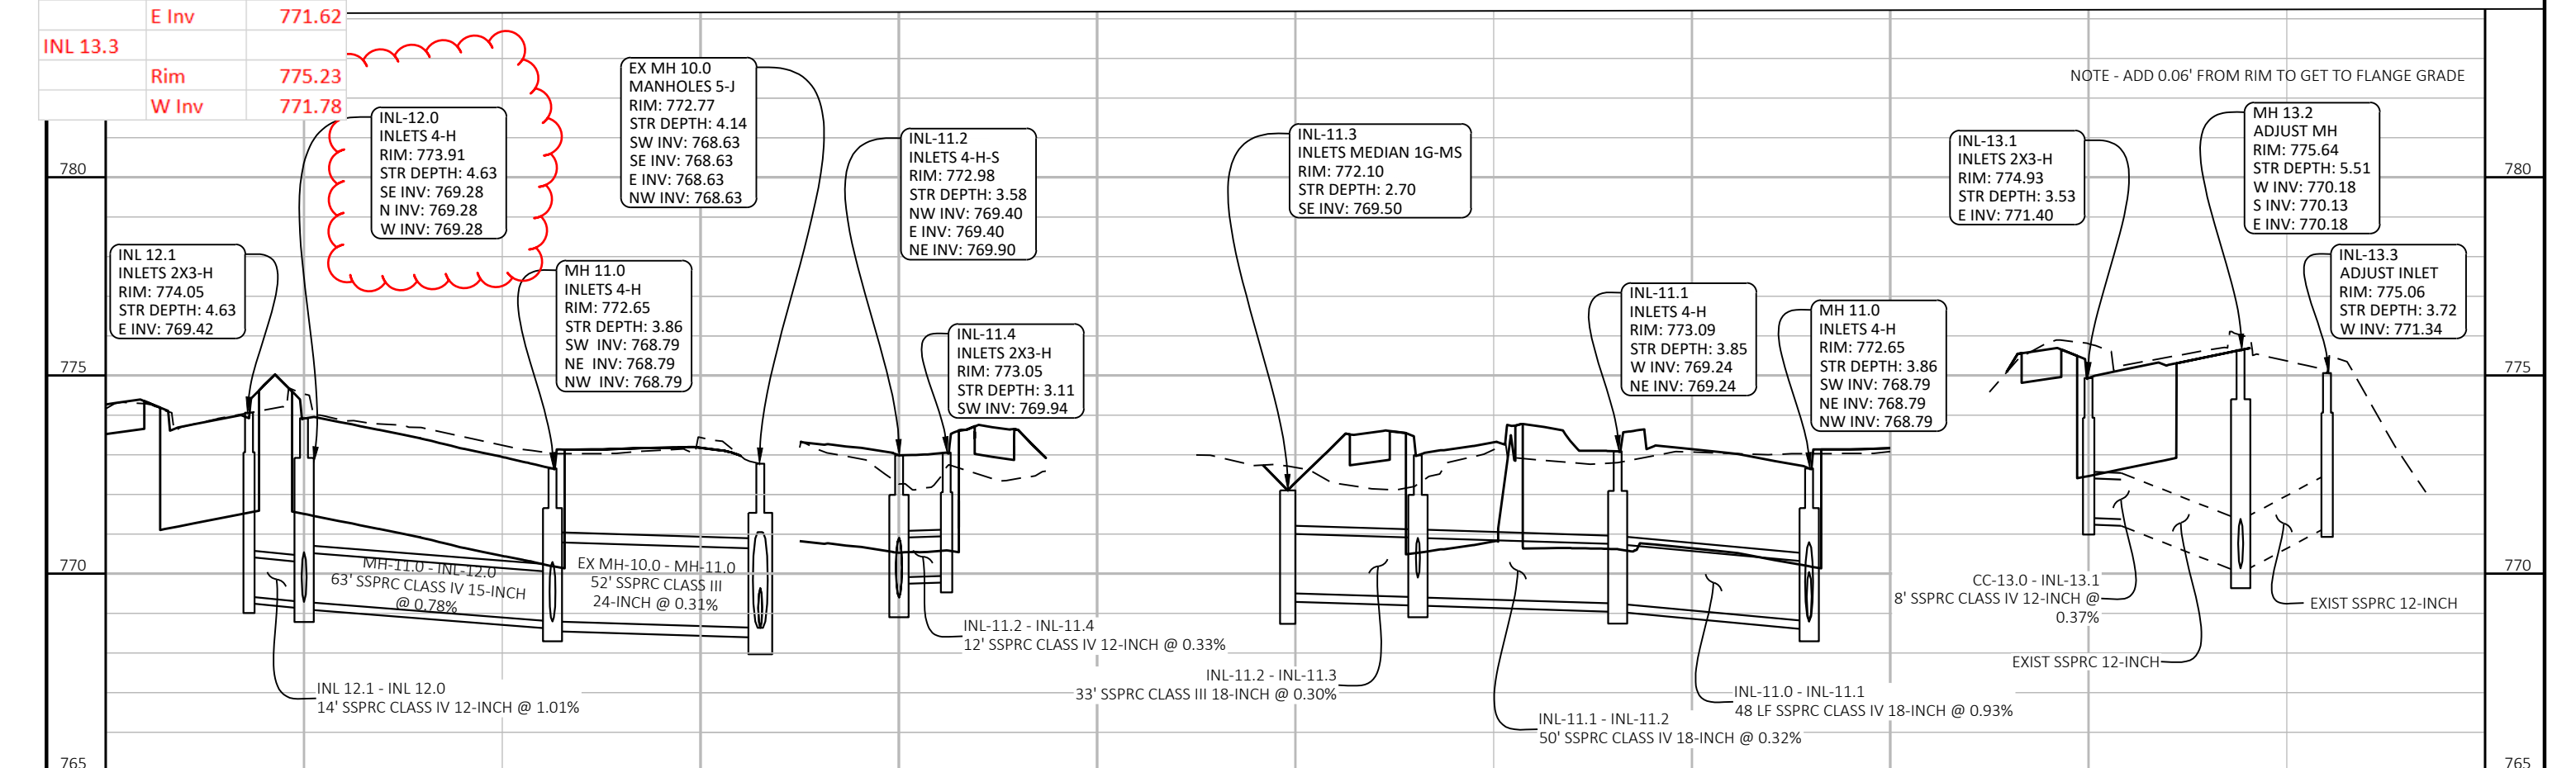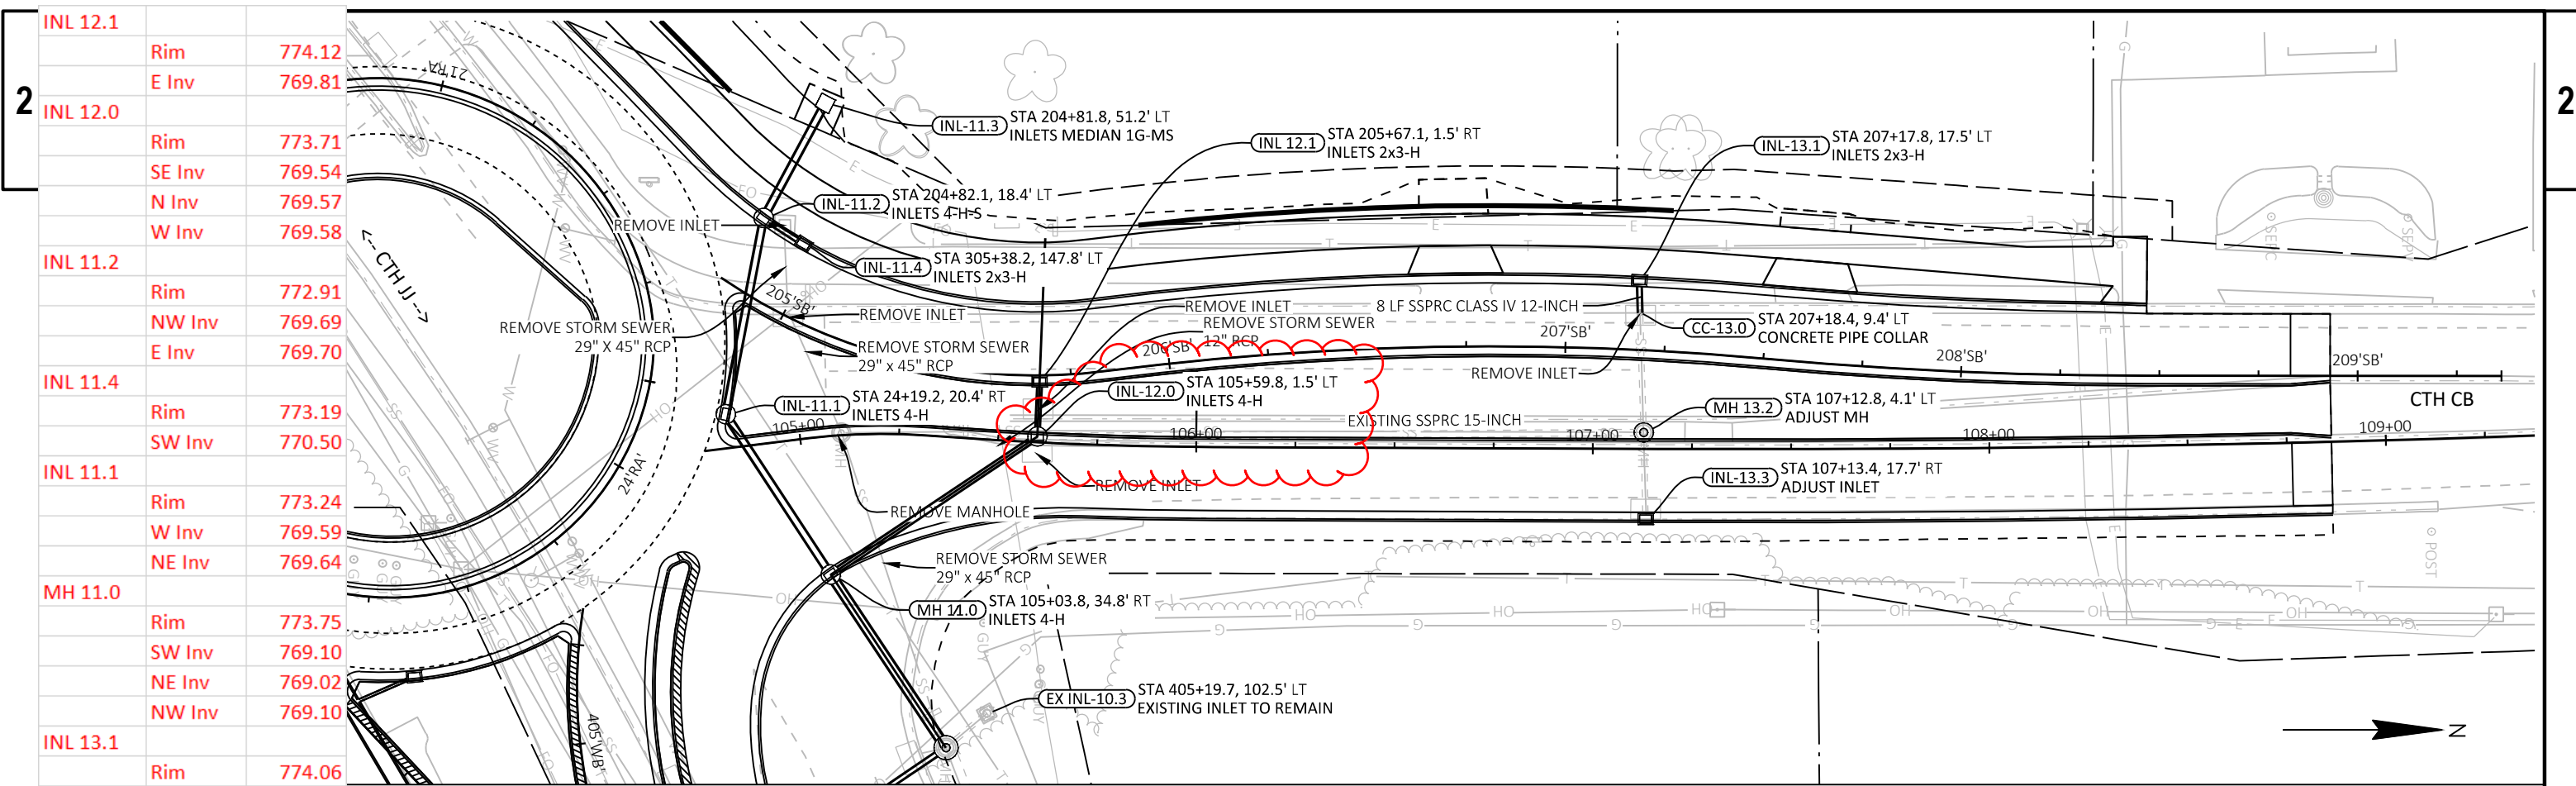


PROJECT NO: 426-4738	HWY: CTH JJ	COUNTY: WINNEBAGO	STORM SEWER - CTH CB	SHEET	E
----------------------	-------------	-------------------	----------------------	-------	---

PAVEMENT MARKING LEGEND - CTH CB and CTH JJ


- (A) MARKING LINE EPOXY 4-INCH (WHITE)
- (B) MARKING LINE EPOXY 4-INCH (WHITE) - 3' LINE, 9' GAP
- (C) MARKING LINE EPOXY 4-INCH (WHITE) - 12.5' LINE, 37.5' GAP
- (D) MARKING LINE EPOXY 4-INCH (YELLOW)
- (E) MARKING LINE EPOXY 8-INCH (WHITE)
- (F) MARKING LINE EPOXY 8-INCH (WHITE) - 3' LINE, 9' GAP
- (G) MARKING ARROWS EPOXY (WHITE)
- (H) MARKING WORD EPOXY
- (I) MARKING DOTTED EXTENSION EPOXY 18-INCH (WHITE)
- (J) MARKING DIAGONAL EPOXY 12-INCH (YELLOW)
- (K) MARKING CHEVRON EPOXY 12-INCH (WHITE)
- (L) MARKING CROSSWALK EPOXY TRANSVERSE LINE 6-INCH (WHITE)
- (M) MARKING CURB EPOXY (YELLOW)
- (N) MARKING ISLAND NOSE EPOXY (YELLOW)

SIGNING LEGEND

- EXISTING SIGN MOUNTED ON POST(S)
- PROPOSED SIGN MOUNTED ON POST(S)
- PROPOSED SIGN
- REMOVE EXISTING SIGN
- MOVE EXISTING SIGN
- EXISTING SIGN TO REMAIN

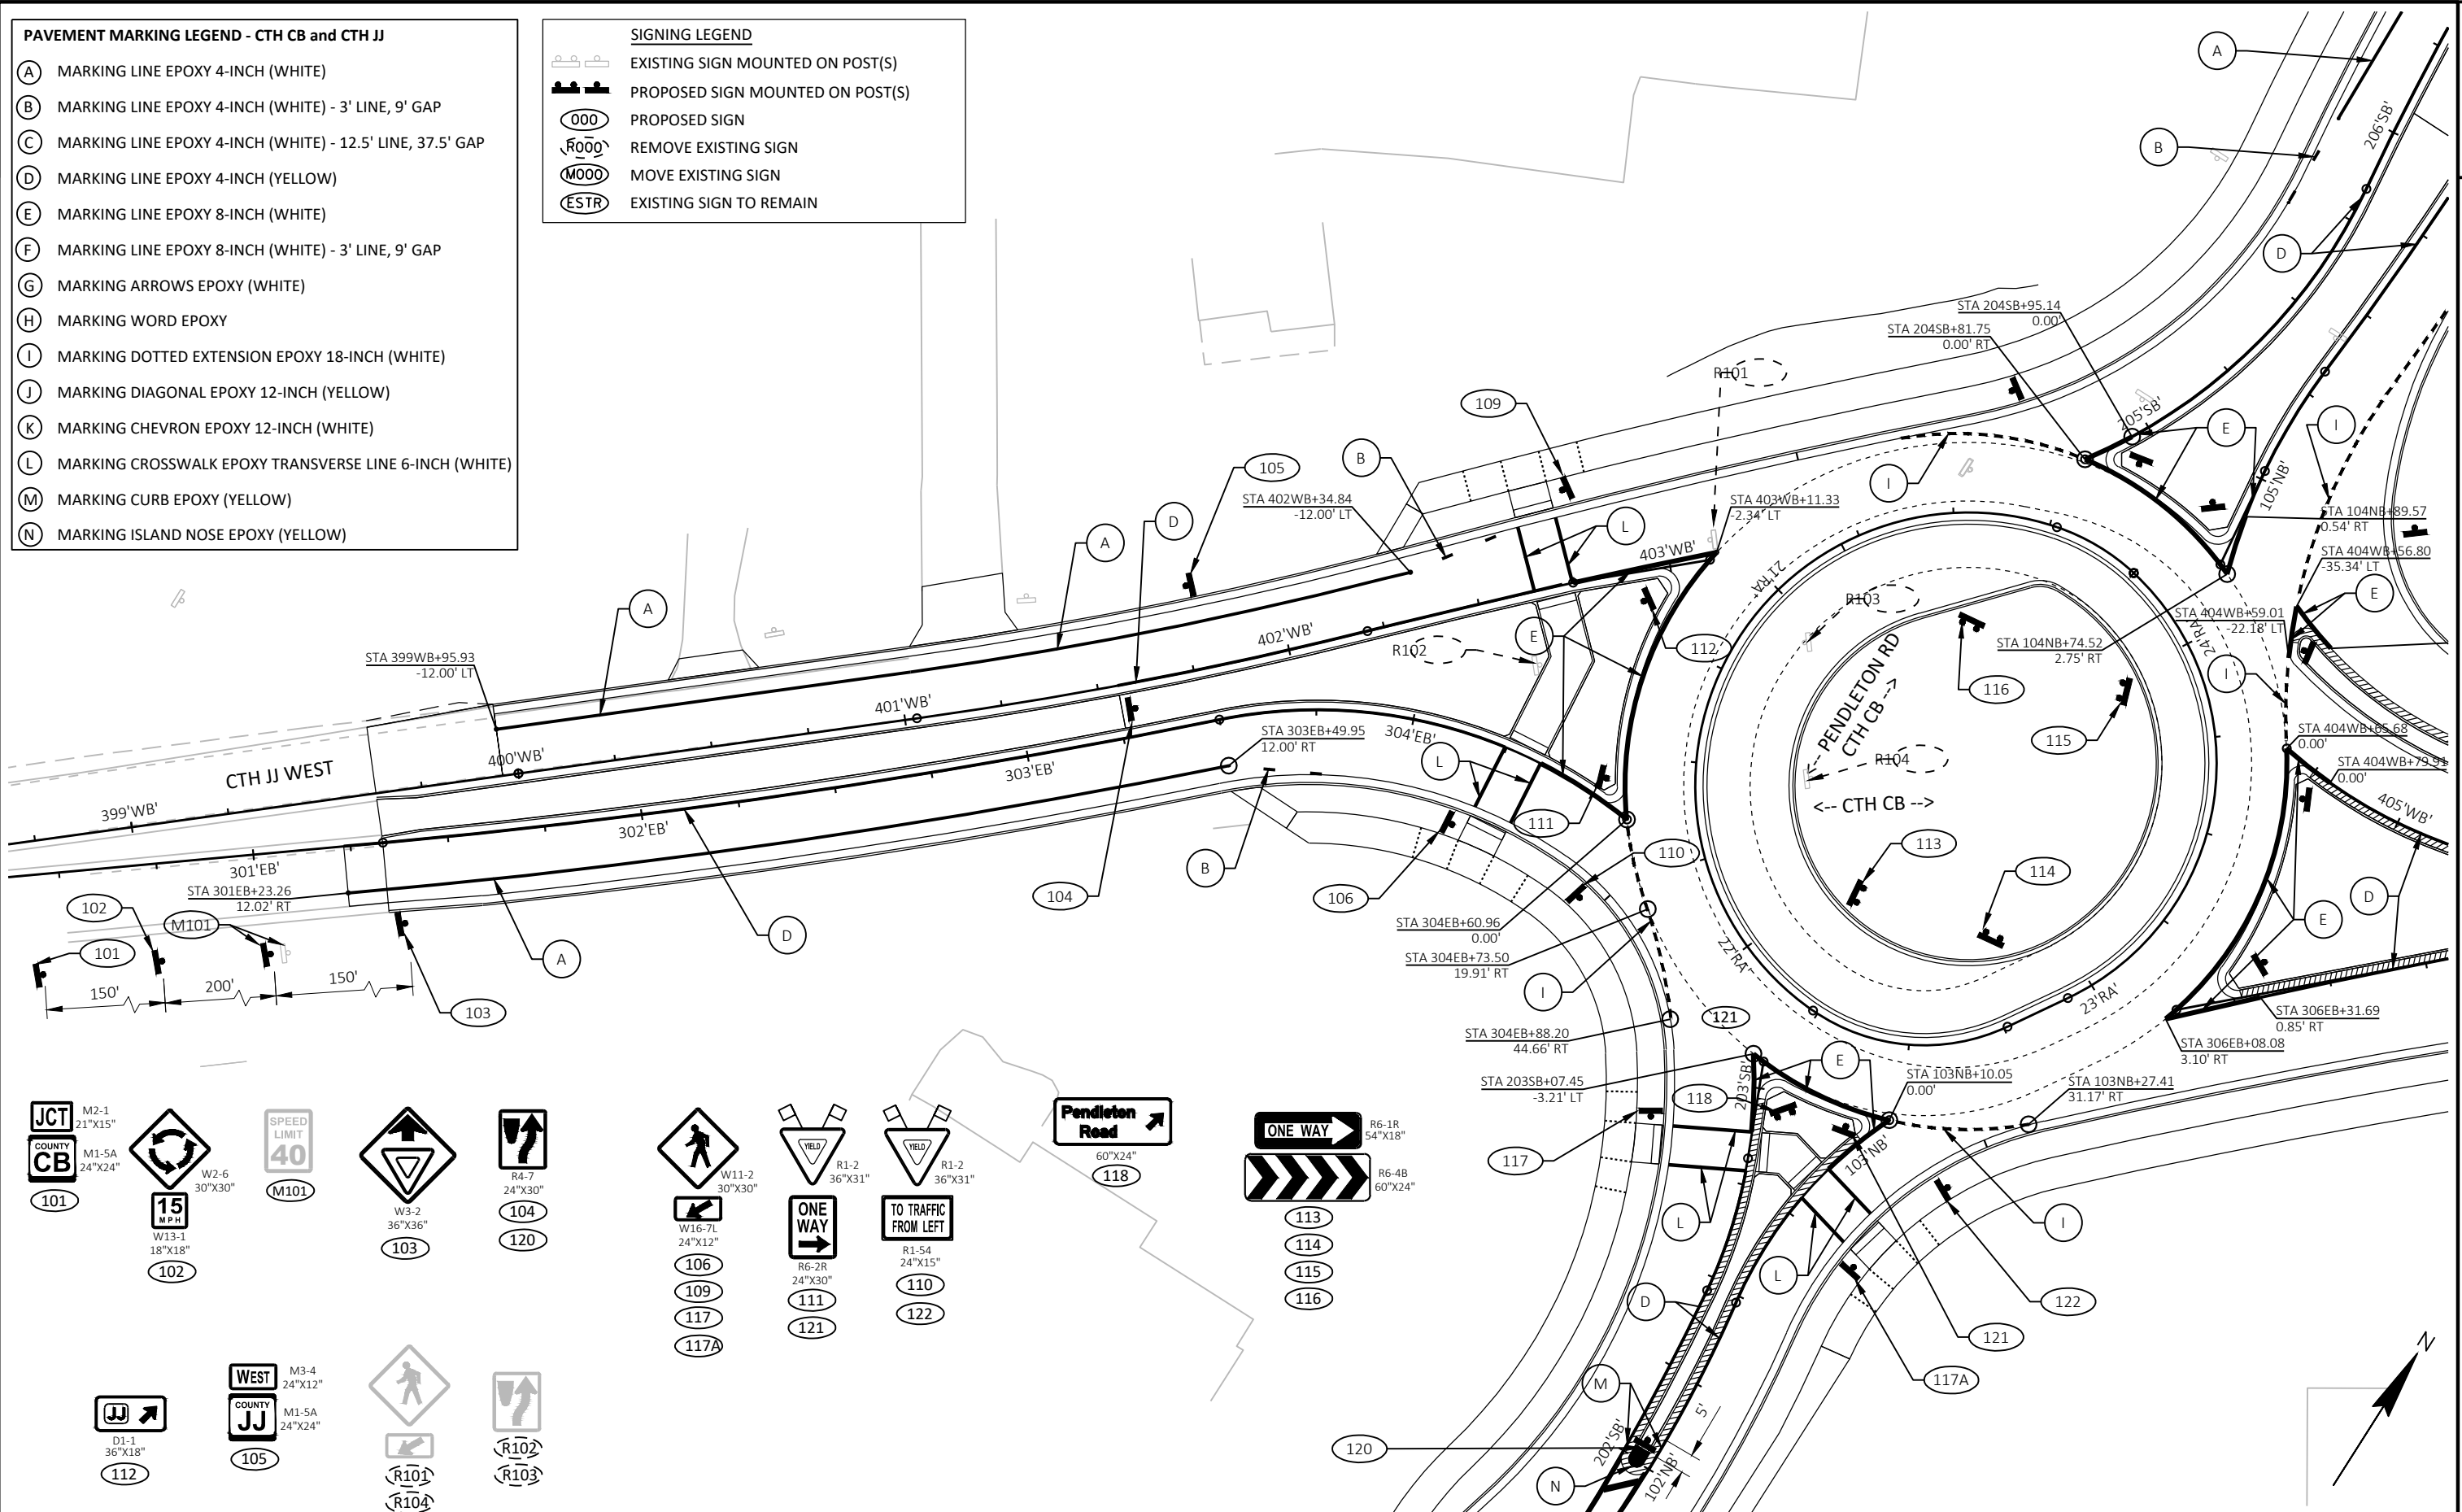

M2-1 21"x15"	M1-5A 24"x24"	W2-6 30"x30"	M101	W3-2 36"x36"	R4-7 24"x30"	W11-2 30"x30"	R1-2 36"x31"	Pendleton Road 60"x24"	ONE WAY R6-1R 54"x18"
101	15 M.P.H. W13-1 18"x18"	102	103	104	120	106	109	110	113
102	103	104	106	109	110	111	112	114	115
105	106	107	108	109	110	111	112	113	114
112	113	114	115	116	117	118	119	120	121
120	121	122	R101	R102	R103	R104	117A	118A	119A

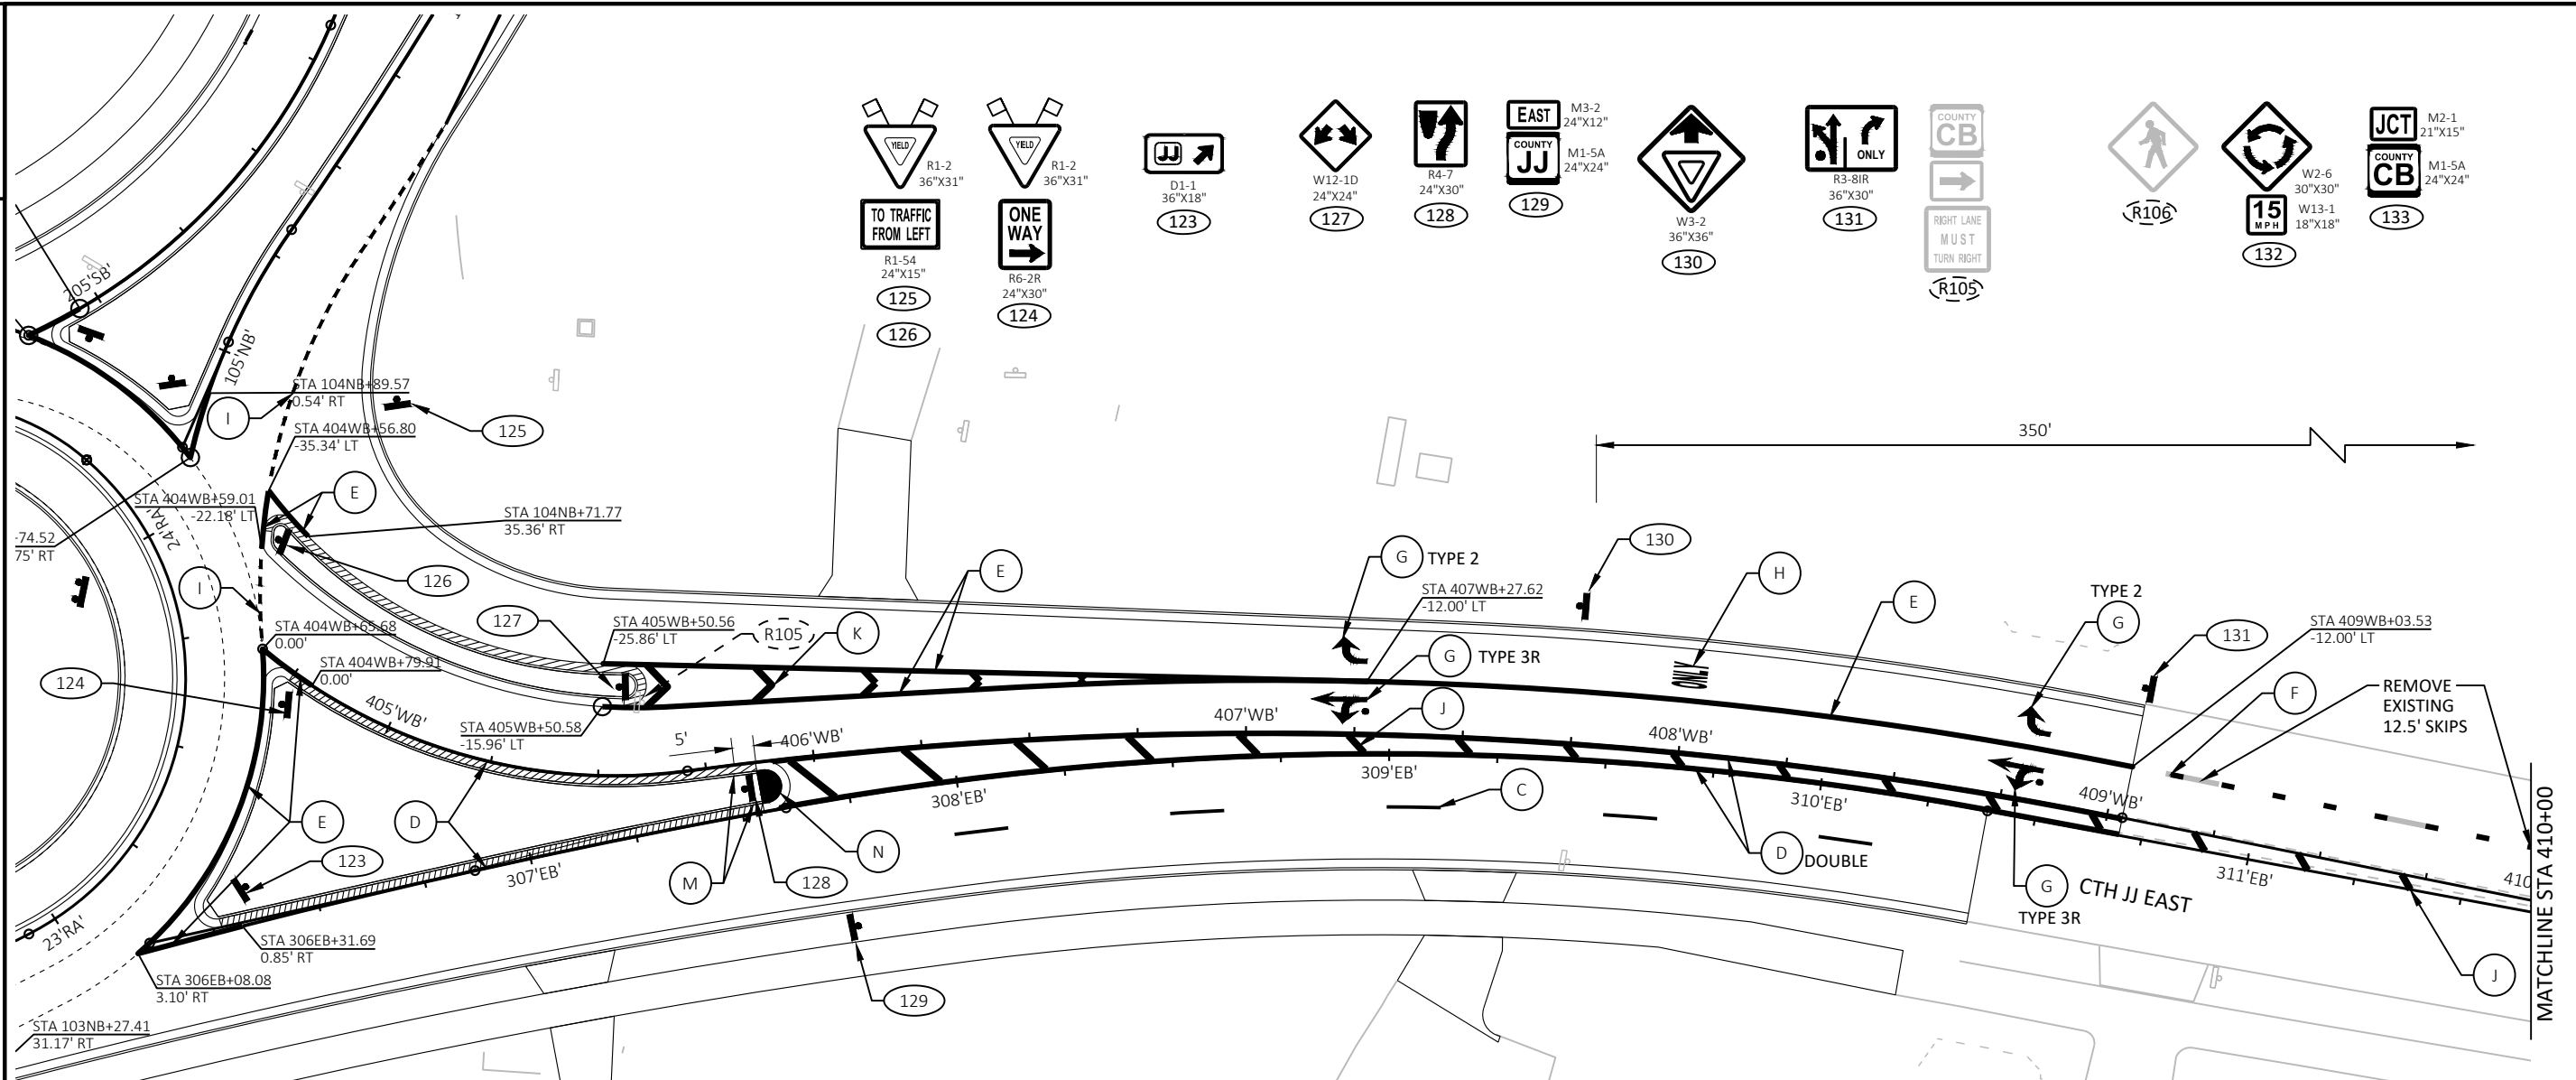


PAVEMENT MARKING LEGEND - CTH CB and CTH JJ

- (A) MARKING LINE EPOXY 4-INCH (WHITE)
- (B) MARKING LINE EPOXY 4-INCH (WHITE) - 3' LINE, 9' GAP
- (C) MARKING LINE EPOXY 4-INCH (WHITE) - 12.5' LINE, 37.5' GAP
- (D) MARKING LINE EPOXY 4-INCH (YELLOW)
- (E) MARKING LINE EPOXY 8-INCH (WHITE)
- (F) MARKING LINE EPOXY 8-INCH (WHITE) - 3' LINE, 9' GAP
- (G) MARKING ARROWS EPOXY (WHITE)
- (H) MARKING WORD EPOXY
- (I) MARKING DOTTED EXTENSION EPOXY 18-INCH (WHITE)
- (J) MARKING DIAGONAL EPOXY 12-INCH (YELLOW)
- (K) MARKING CHEVRON EPOXY 12-INCH (WHITE)
- (L) MARKING CROSSWALK EPOXY TRANSVERSE LINE 6-INCH (WHITE)
- (M) MARKING CURB EPOXY (YELLOW)
- (N) MARKING ISLAND NOSE EPOXY (YELLOW)

SIGNING LEGEND

- EXISTING SIGN MOUNTED ON POST(S)
- PROPOSED SIGN MOUNTED ON POST(S)
- PROPOSED SIGN
- REMOVE EXISTING SIGN
- MOVE EXISTING SIGN
- EXISTING SIGN TO REMAIN

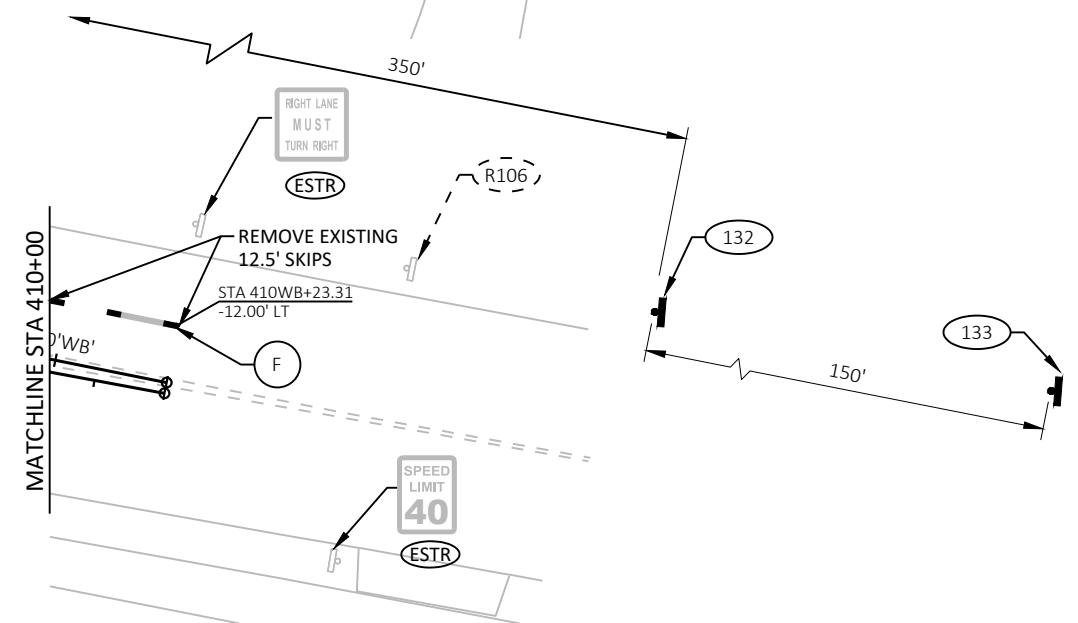

PAVEMENT MARKING LEGEND - CTH CB and CTH JJ



- (A) MARKING LINE EPOXY 4-INCH (WHITE)
- (B) MARKING LINE EPOXY 4-INCH (WHITE) - 3' LINE, 9' GAP
- (C) MARKING LINE EPOXY 4-INCH (WHITE) - 12.5' LINE, 37.5' GAP
- (D) MARKING LINE EPOXY 4-INCH (YELLOW)
- (E) MARKING LINE EPOXY 8-INCH (WHITE)
- (F) MARKING LINE EPOXY 8-INCH (WHITE) - 3' LINE, 9' GAP
- (G) MARKING ARROWS EPOXY (WHITE)
- (H) MARKING WORD EPOXY
- (I) MARKING DOTTED EXTENSION EPOXY 18-INCH (WHITE)
- (J) MARKING DIAGONAL EPOXY 12-INCH (YELLOW)
- (K) MARKING CHEVRON EPOXY 12-INCH (WHITE)
- (L) MARKING CROSSWALK EPOXY TRANSVERSE LINE 6-INCH (WHITE)
- (M) MARKING CURB EPOXY (YELLOW)
- (N) MARKING ISLAND NOSE EPOXY (YELLOW)

SIGNING LEGEND

- EXISTING SIGN MOUNTED ON POST(S)
- PROPOSED SIGN MOUNTED ON POST(S)
- REMOVE EXISTING SIGN
- MOVE EXISTING SIGN
- EXISTING SIGN TO REMAIN

LEGEND

- SIGN NUMBER
- NOTE LETTER

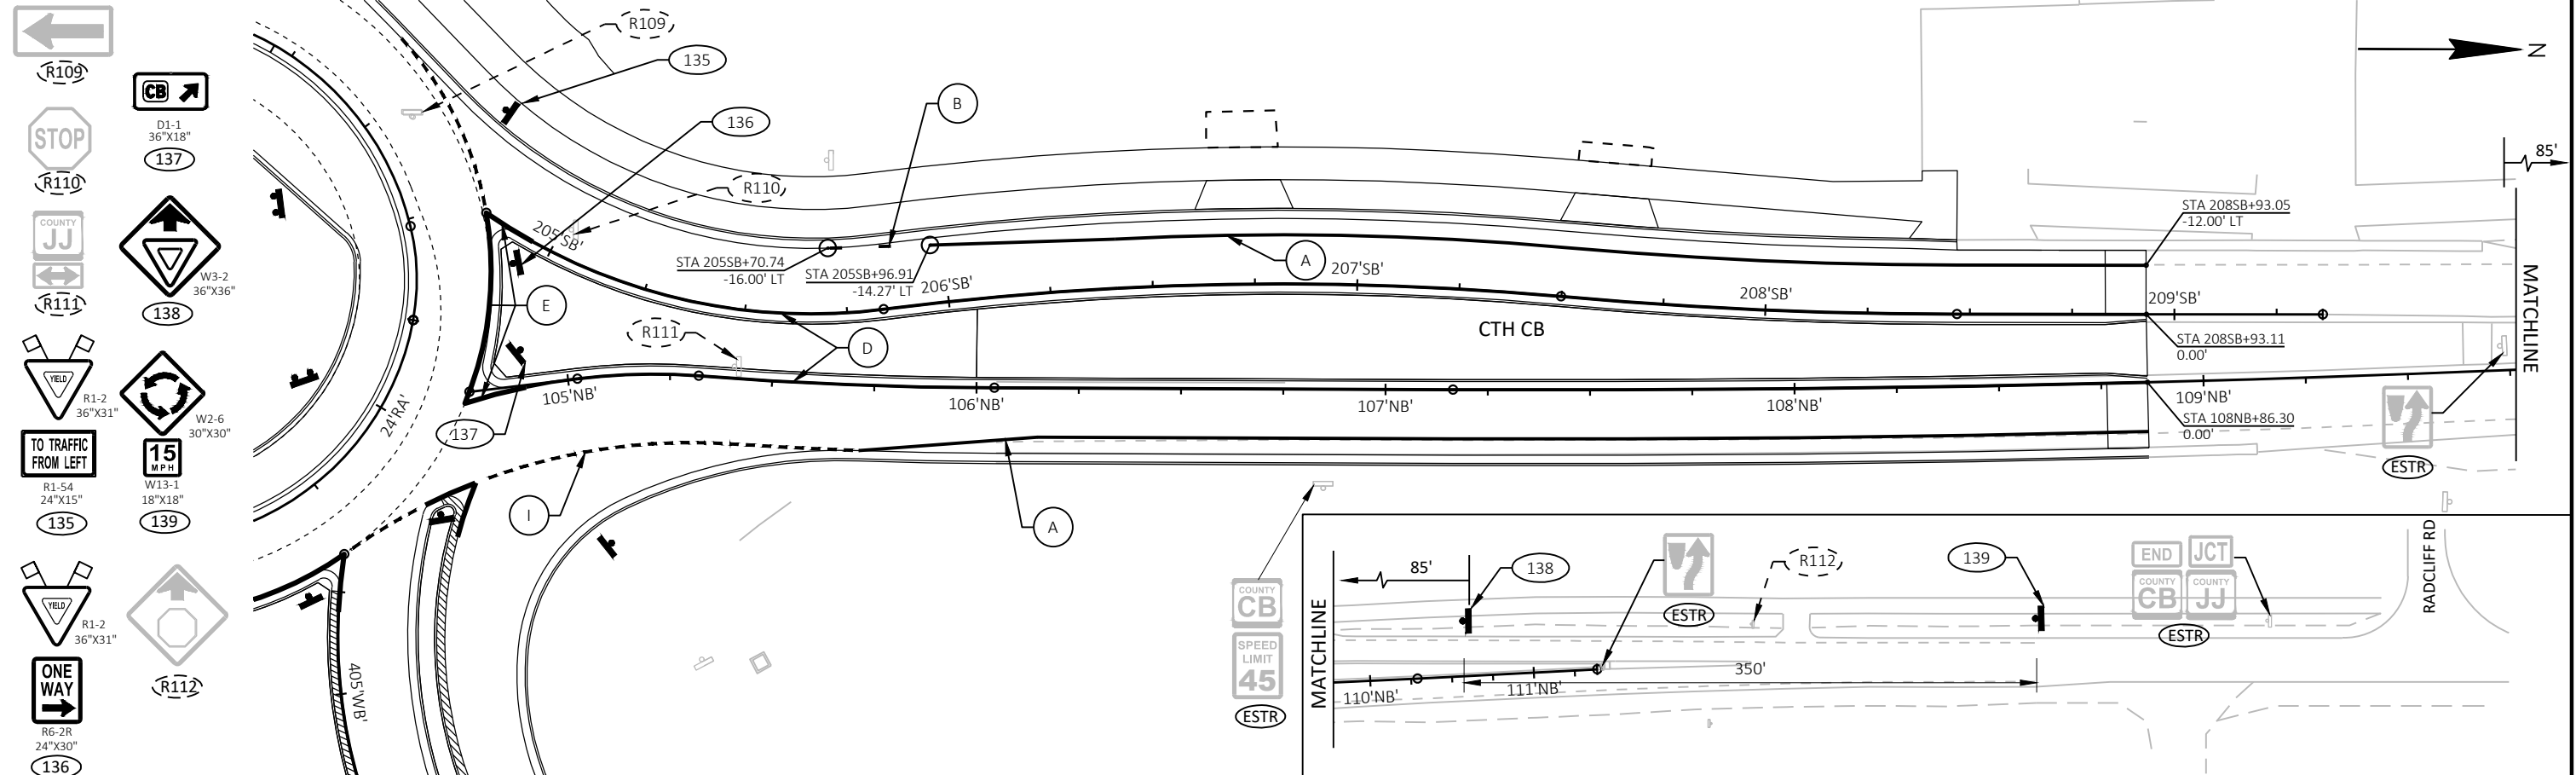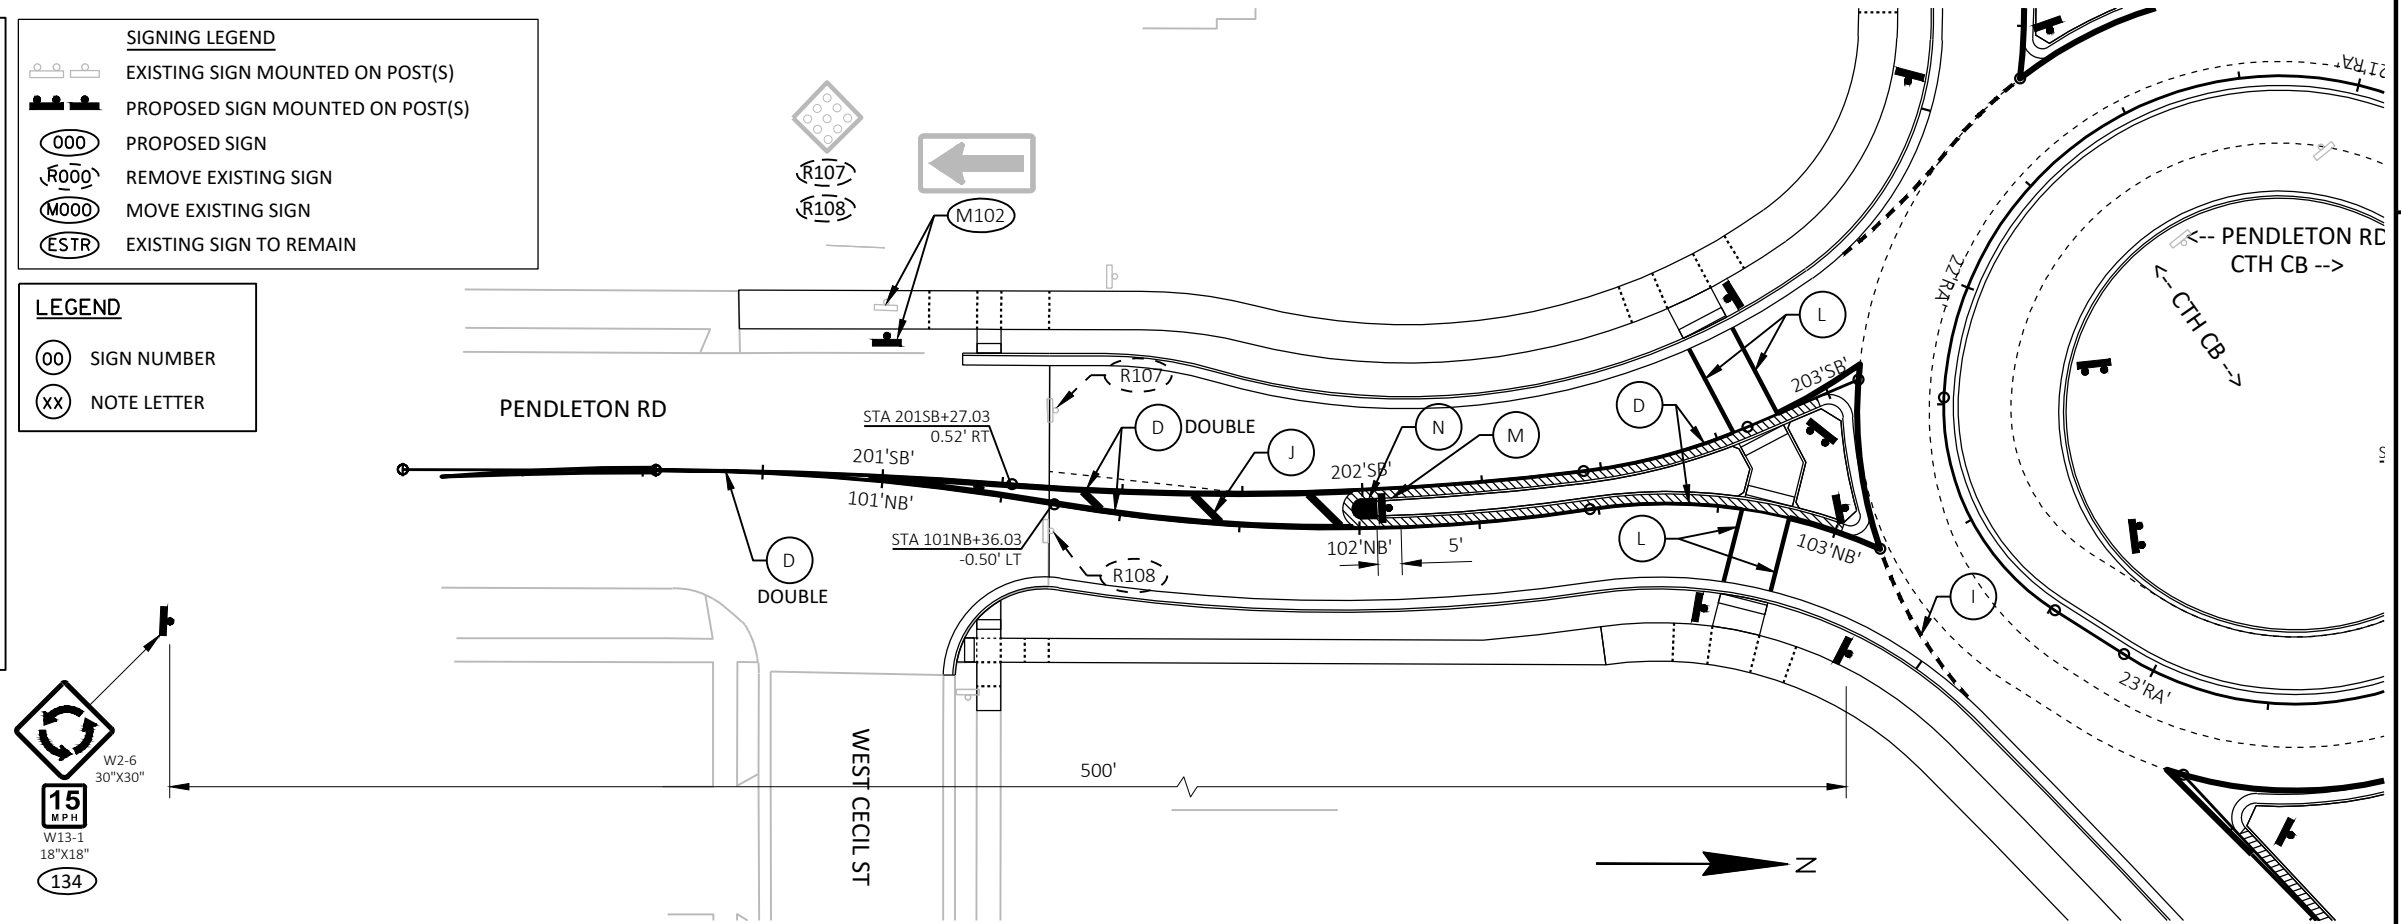

PROJECT NO: 426-4738


HWY: CTH JJ


COUNTY: WINNEBAGO


PAVEMENT MARKING & PERMANENT SIGNING

SHEET

35

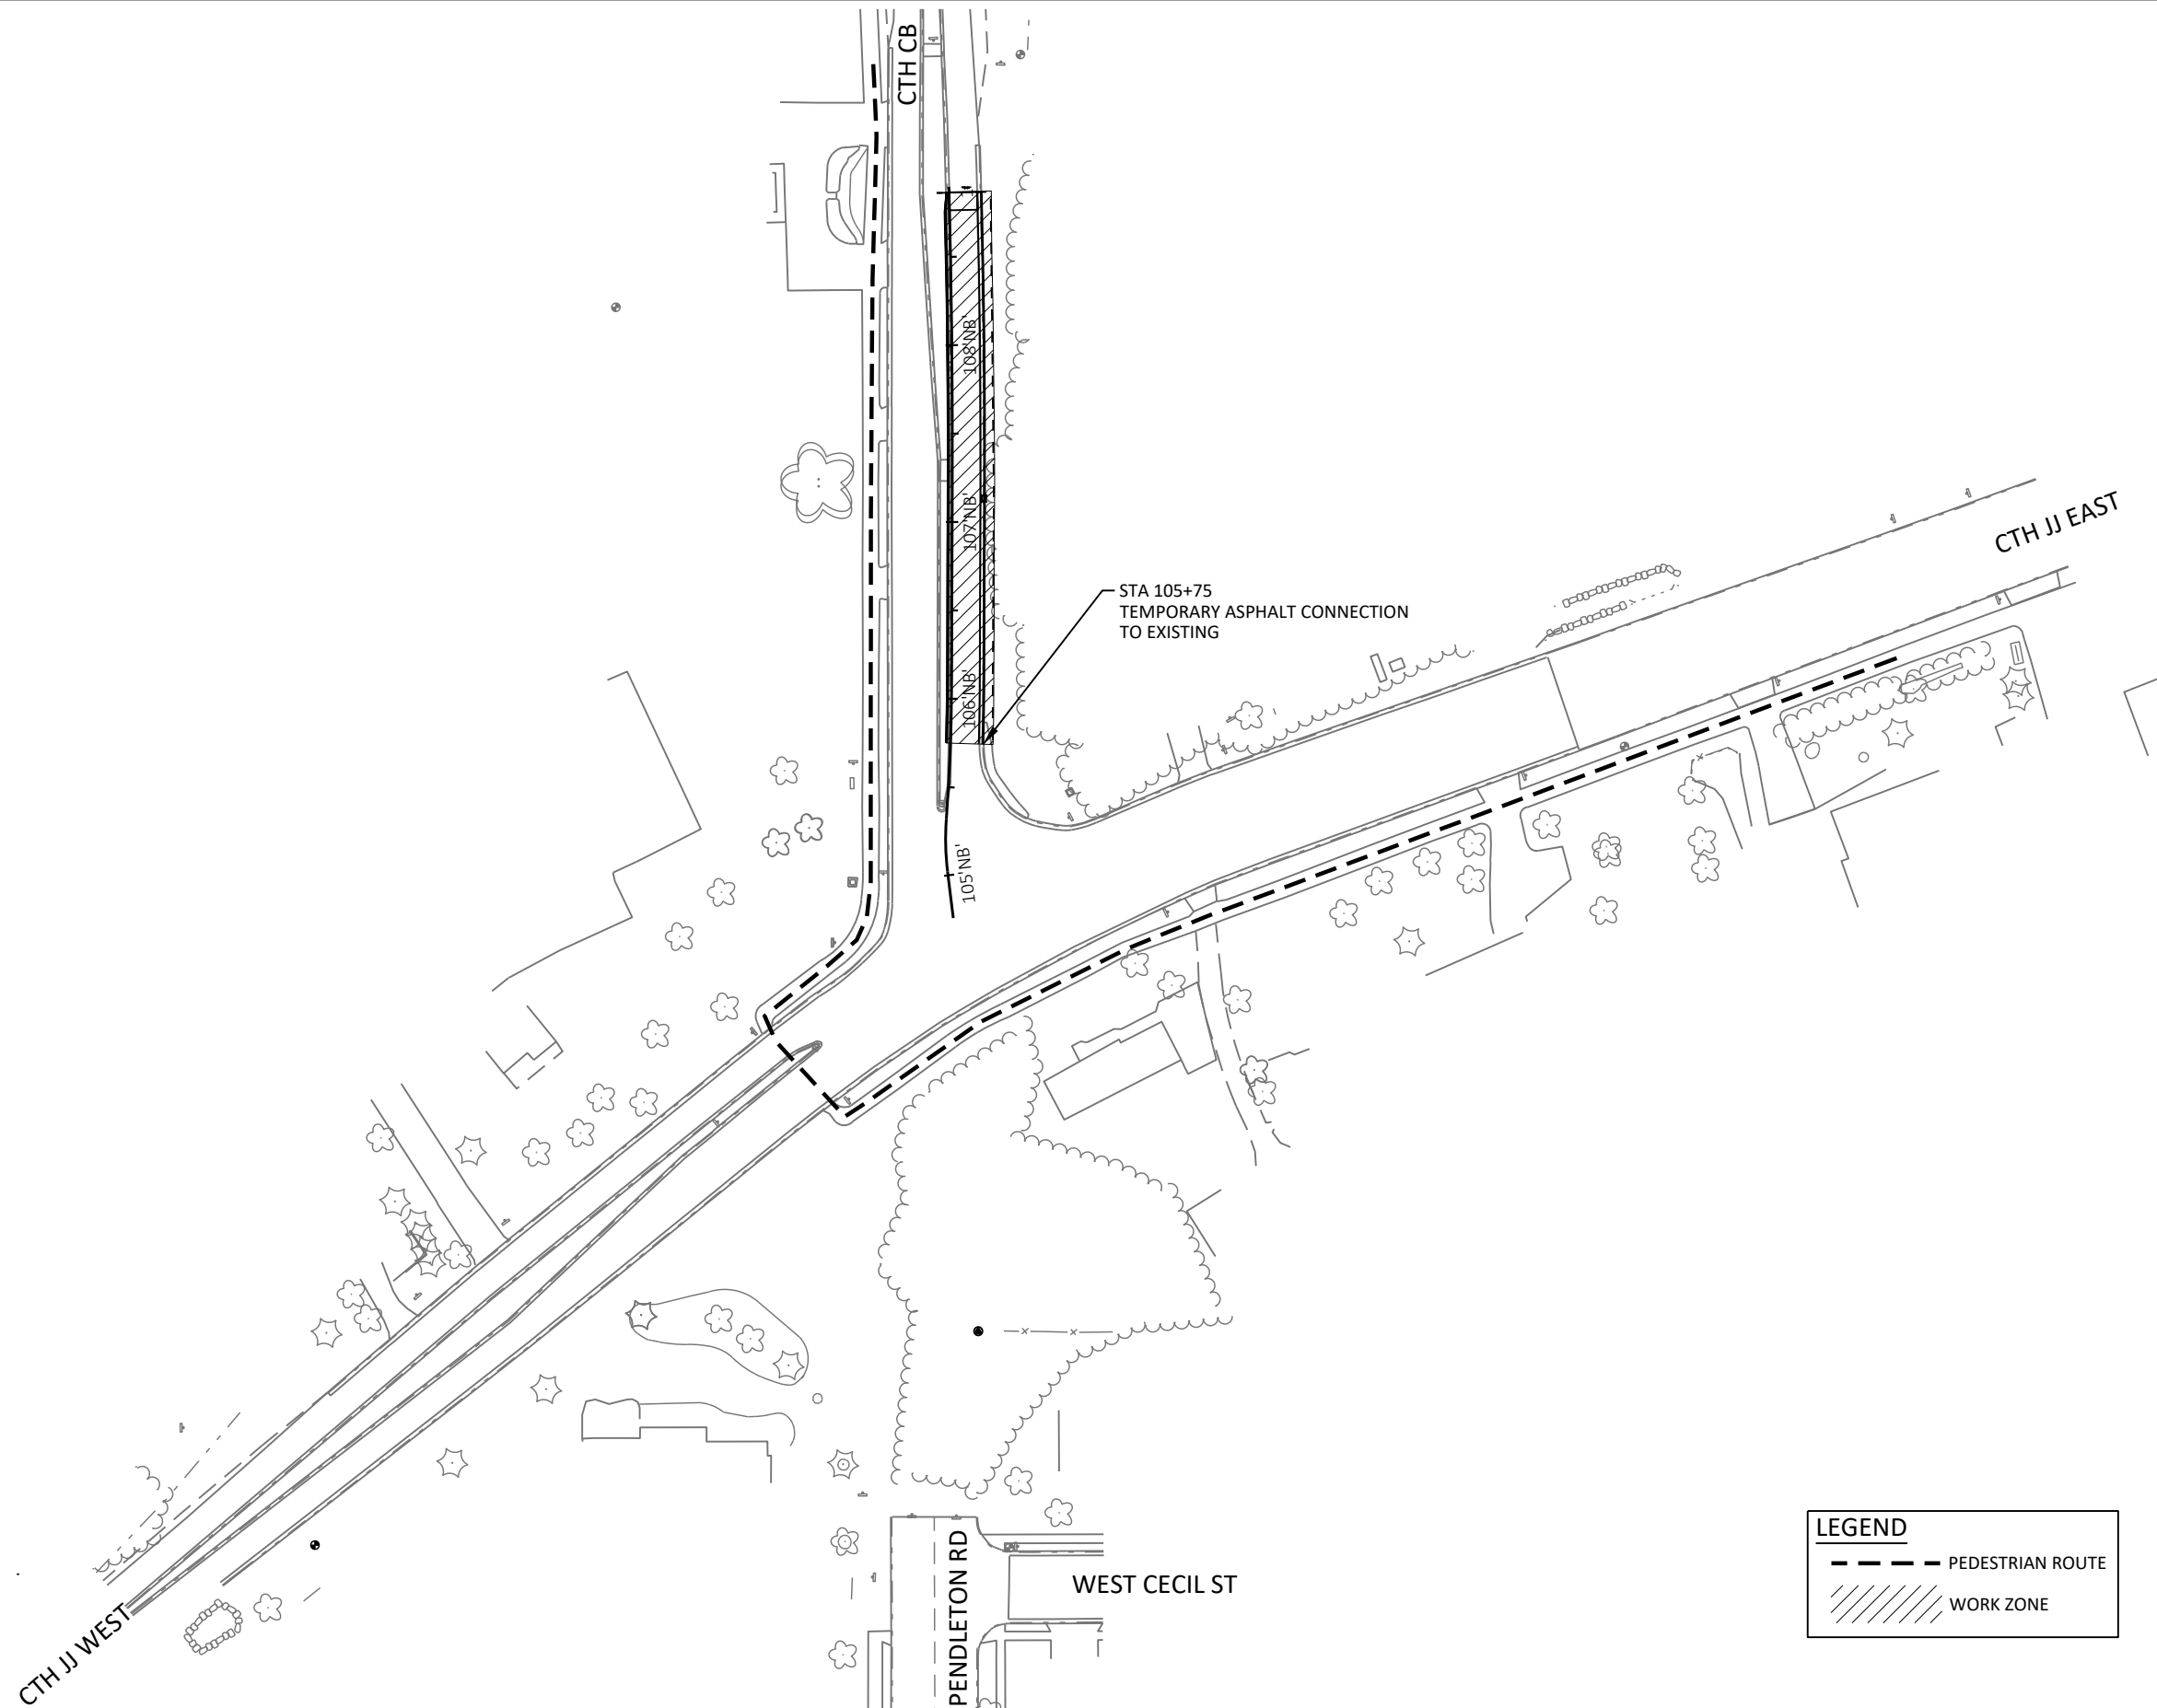

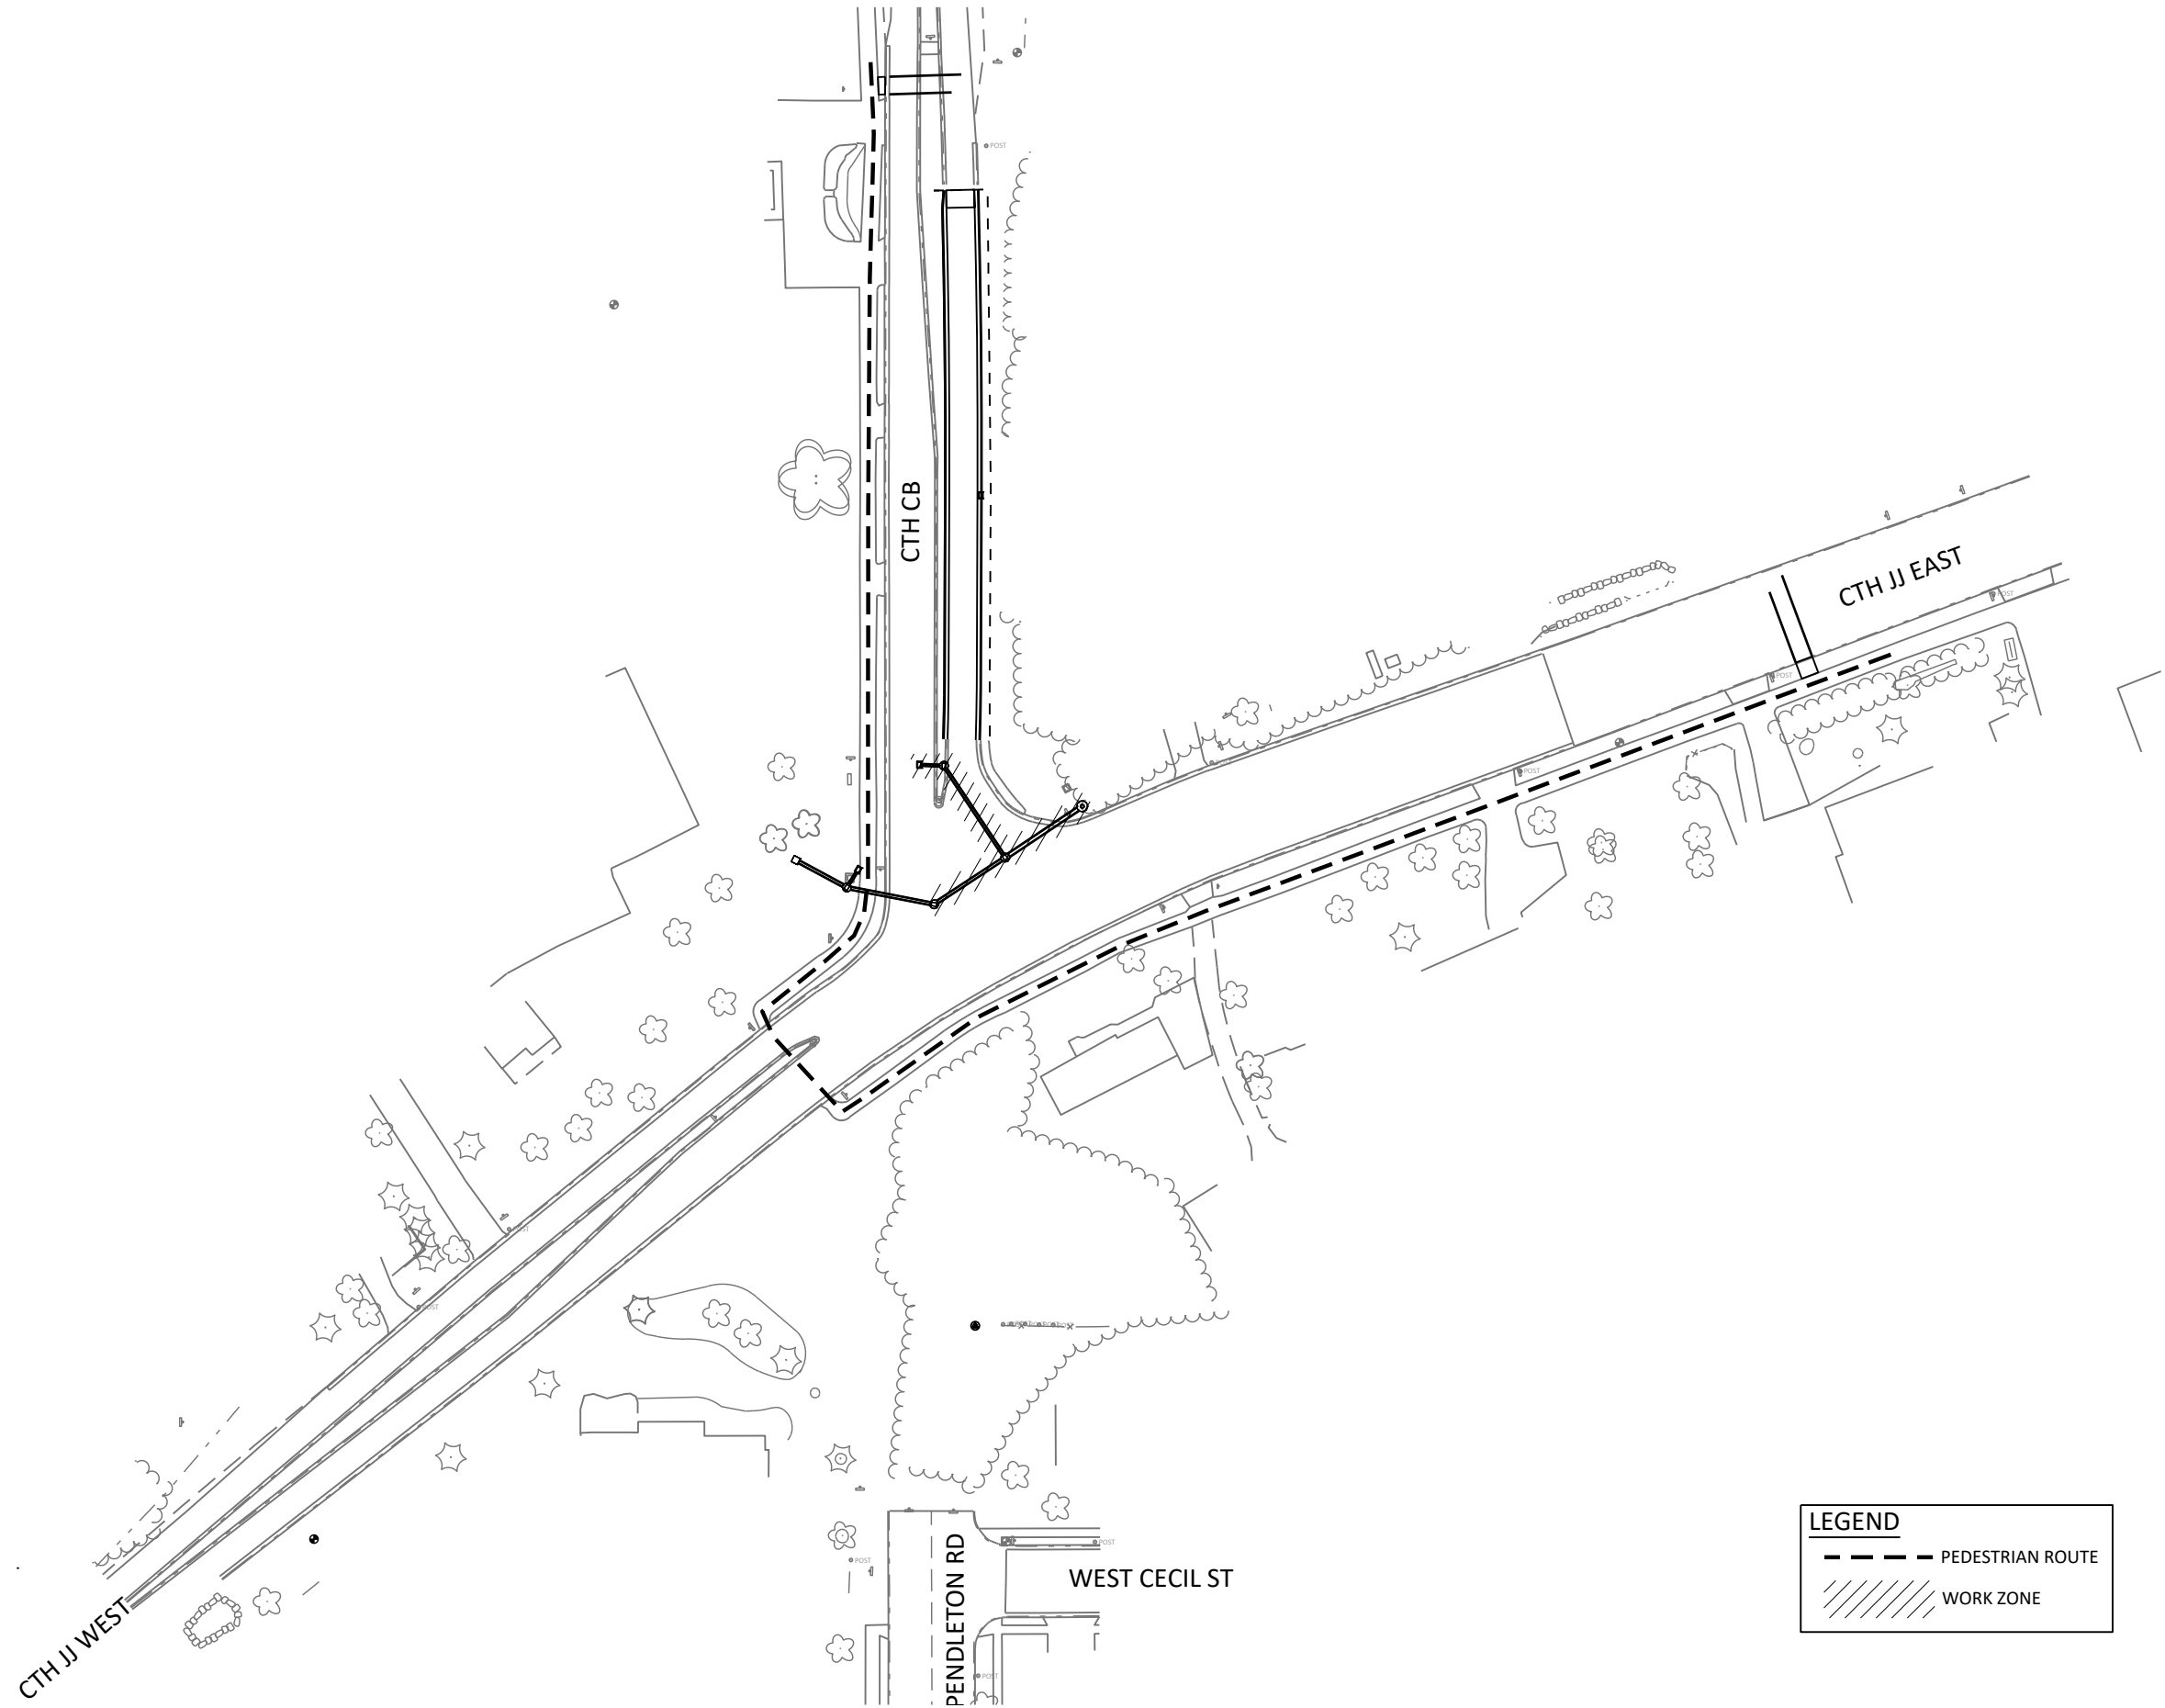


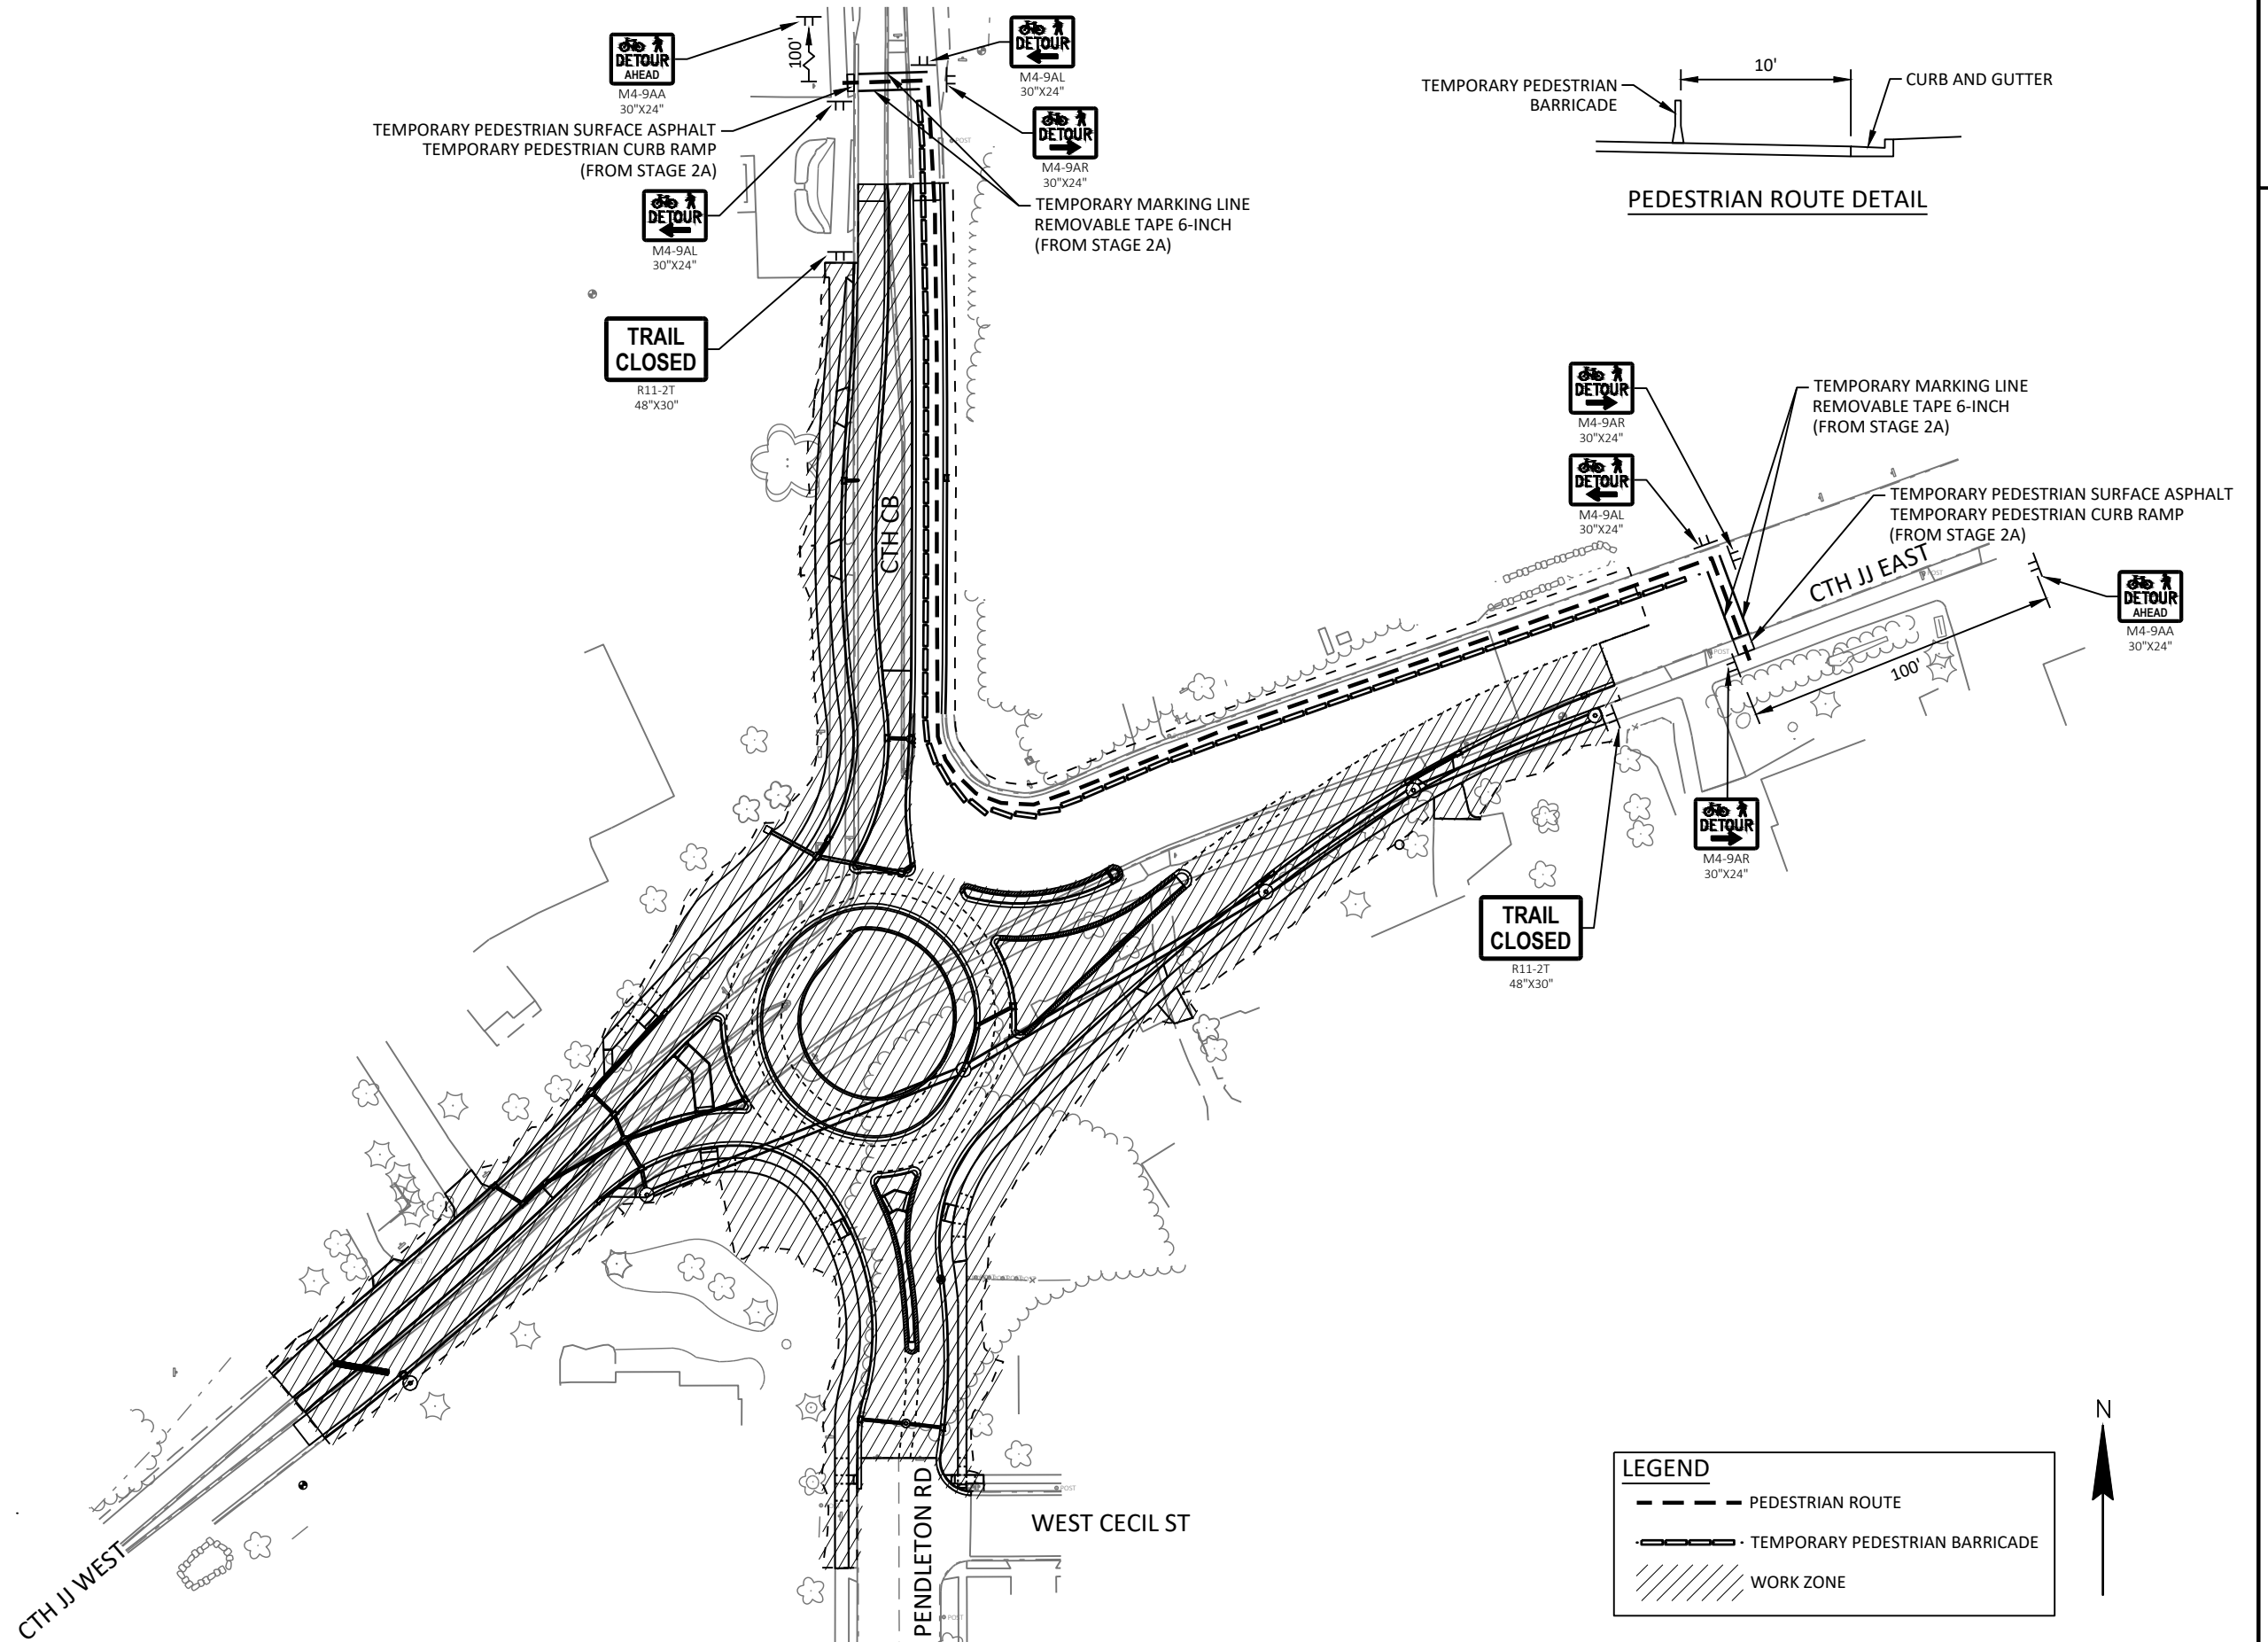

LEGEND

- PEDESTRIAN ROUTE
- == TEMPORARY PEDESTRIAN BARRICADE
- /// WORK ZONE




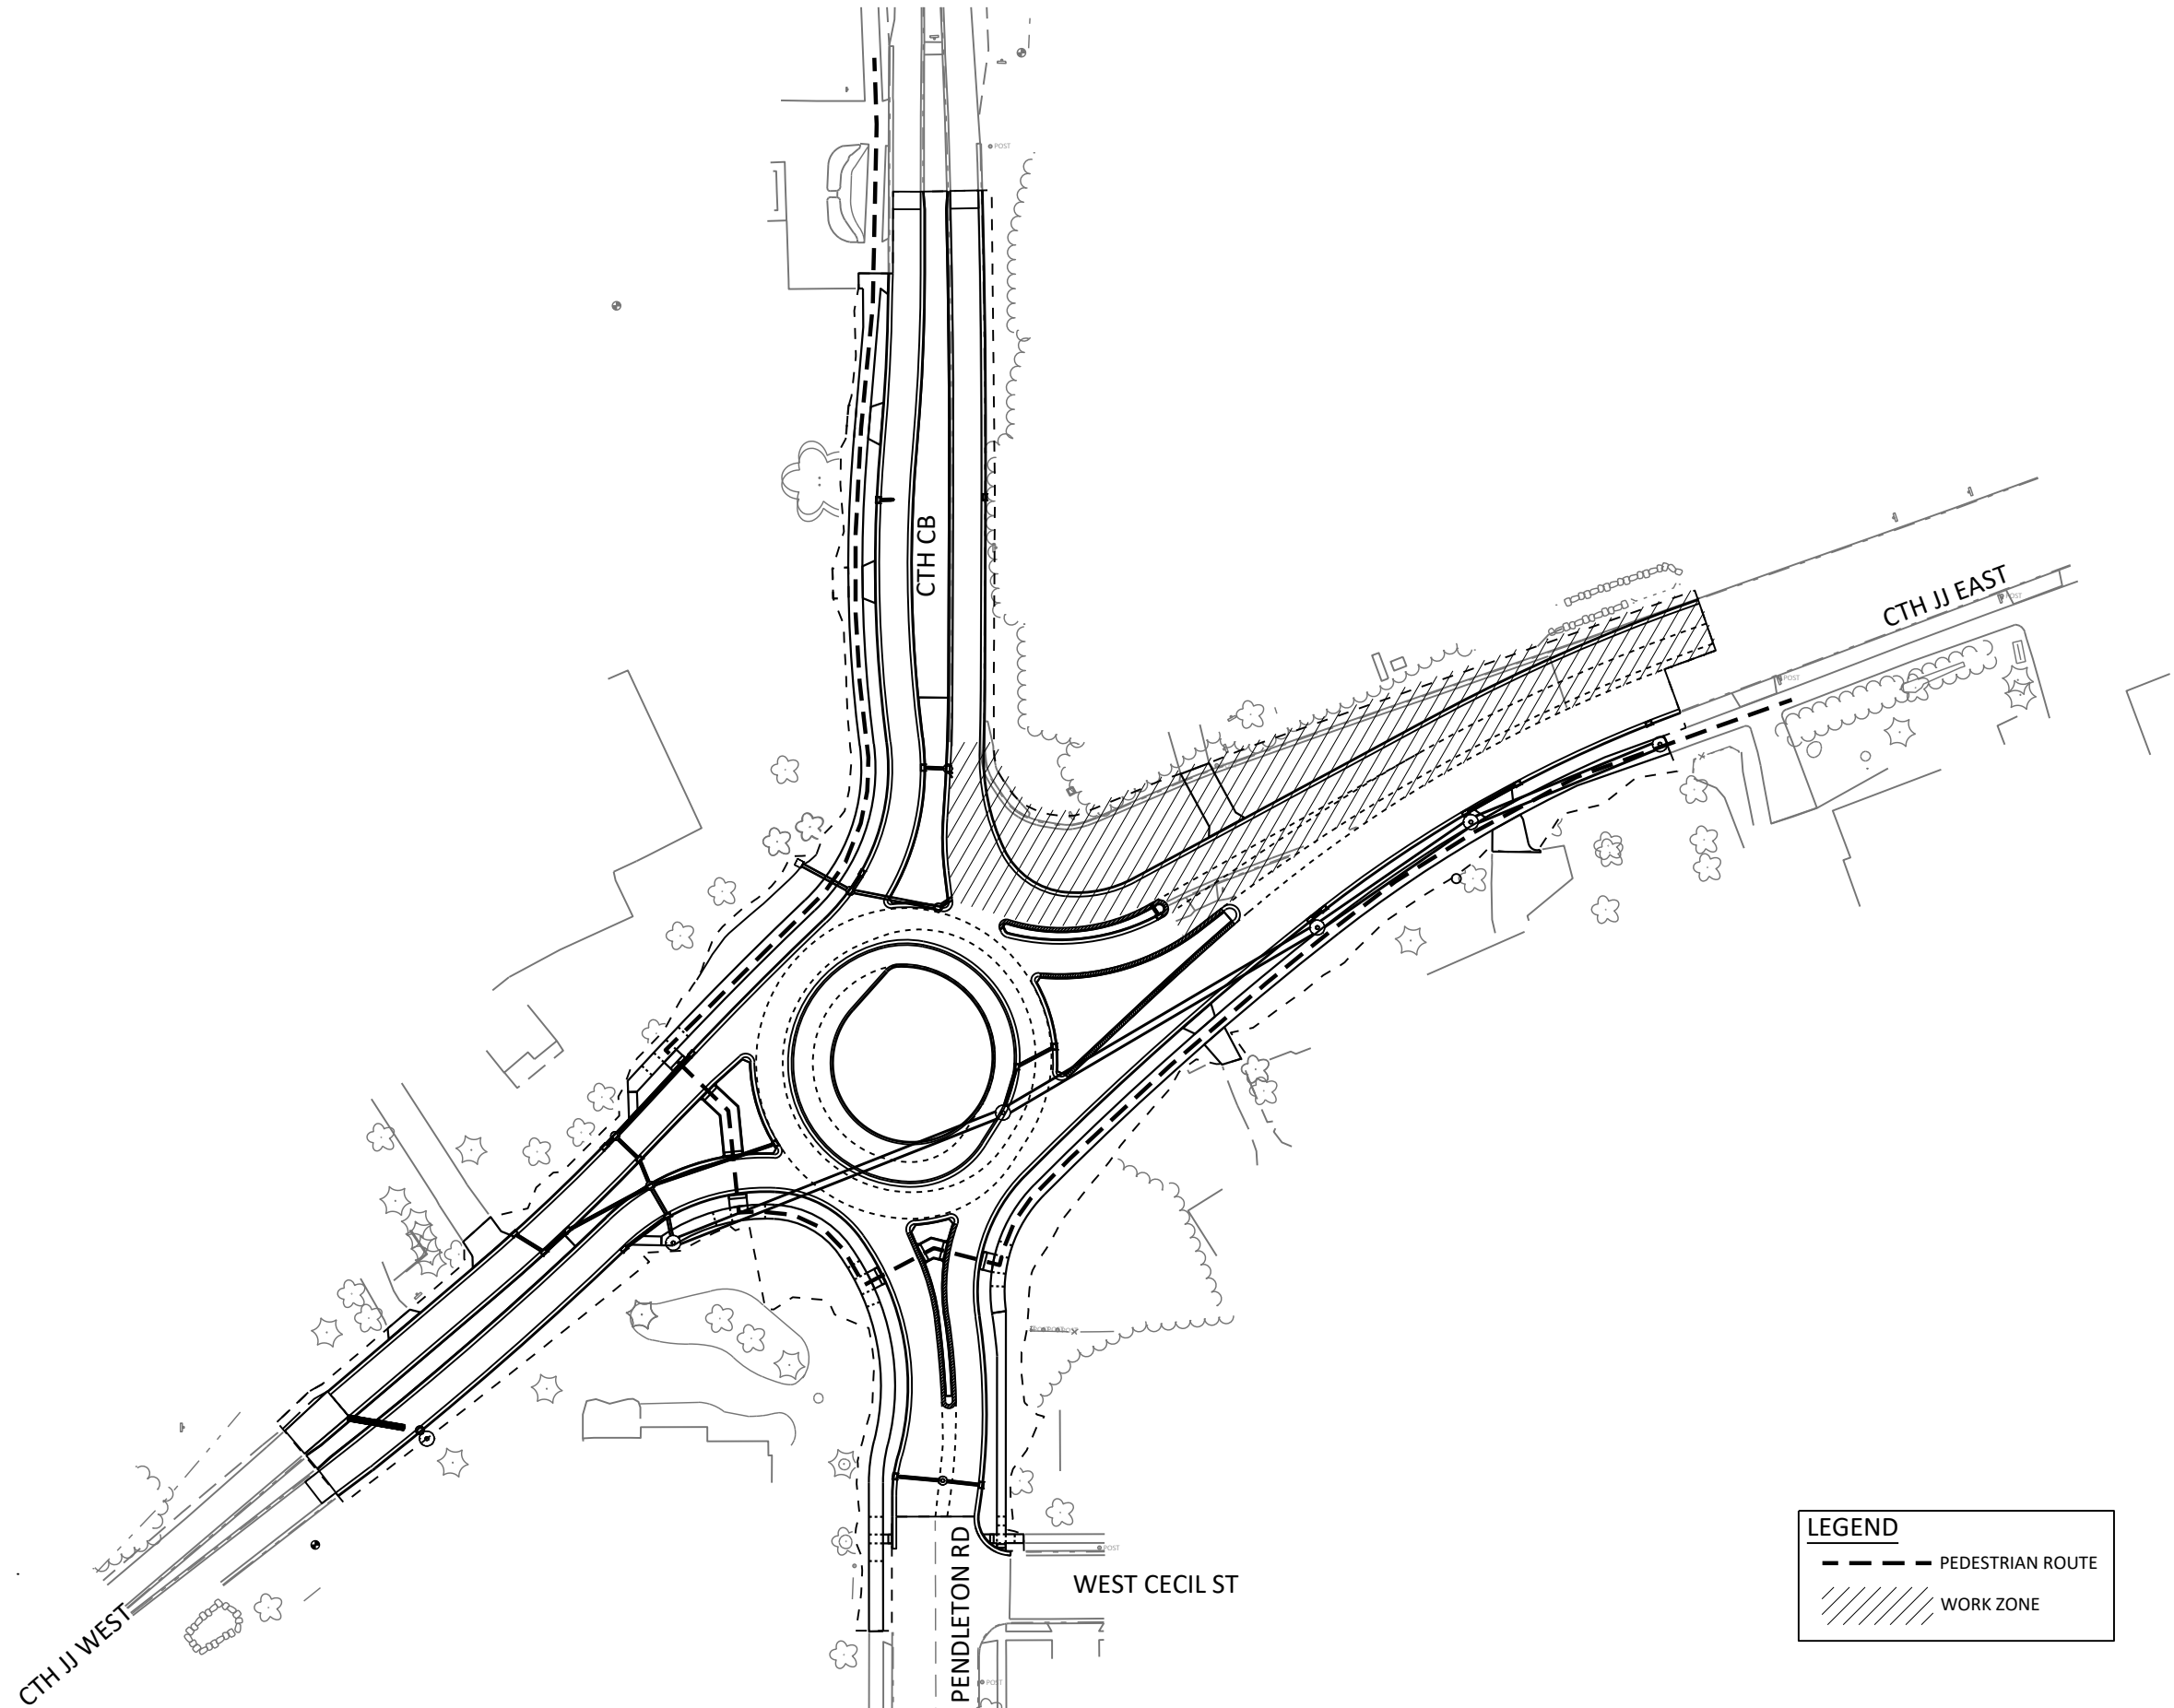

LEGEND

- PEDESTRIAN ROUTE
- /// WORK ZONE



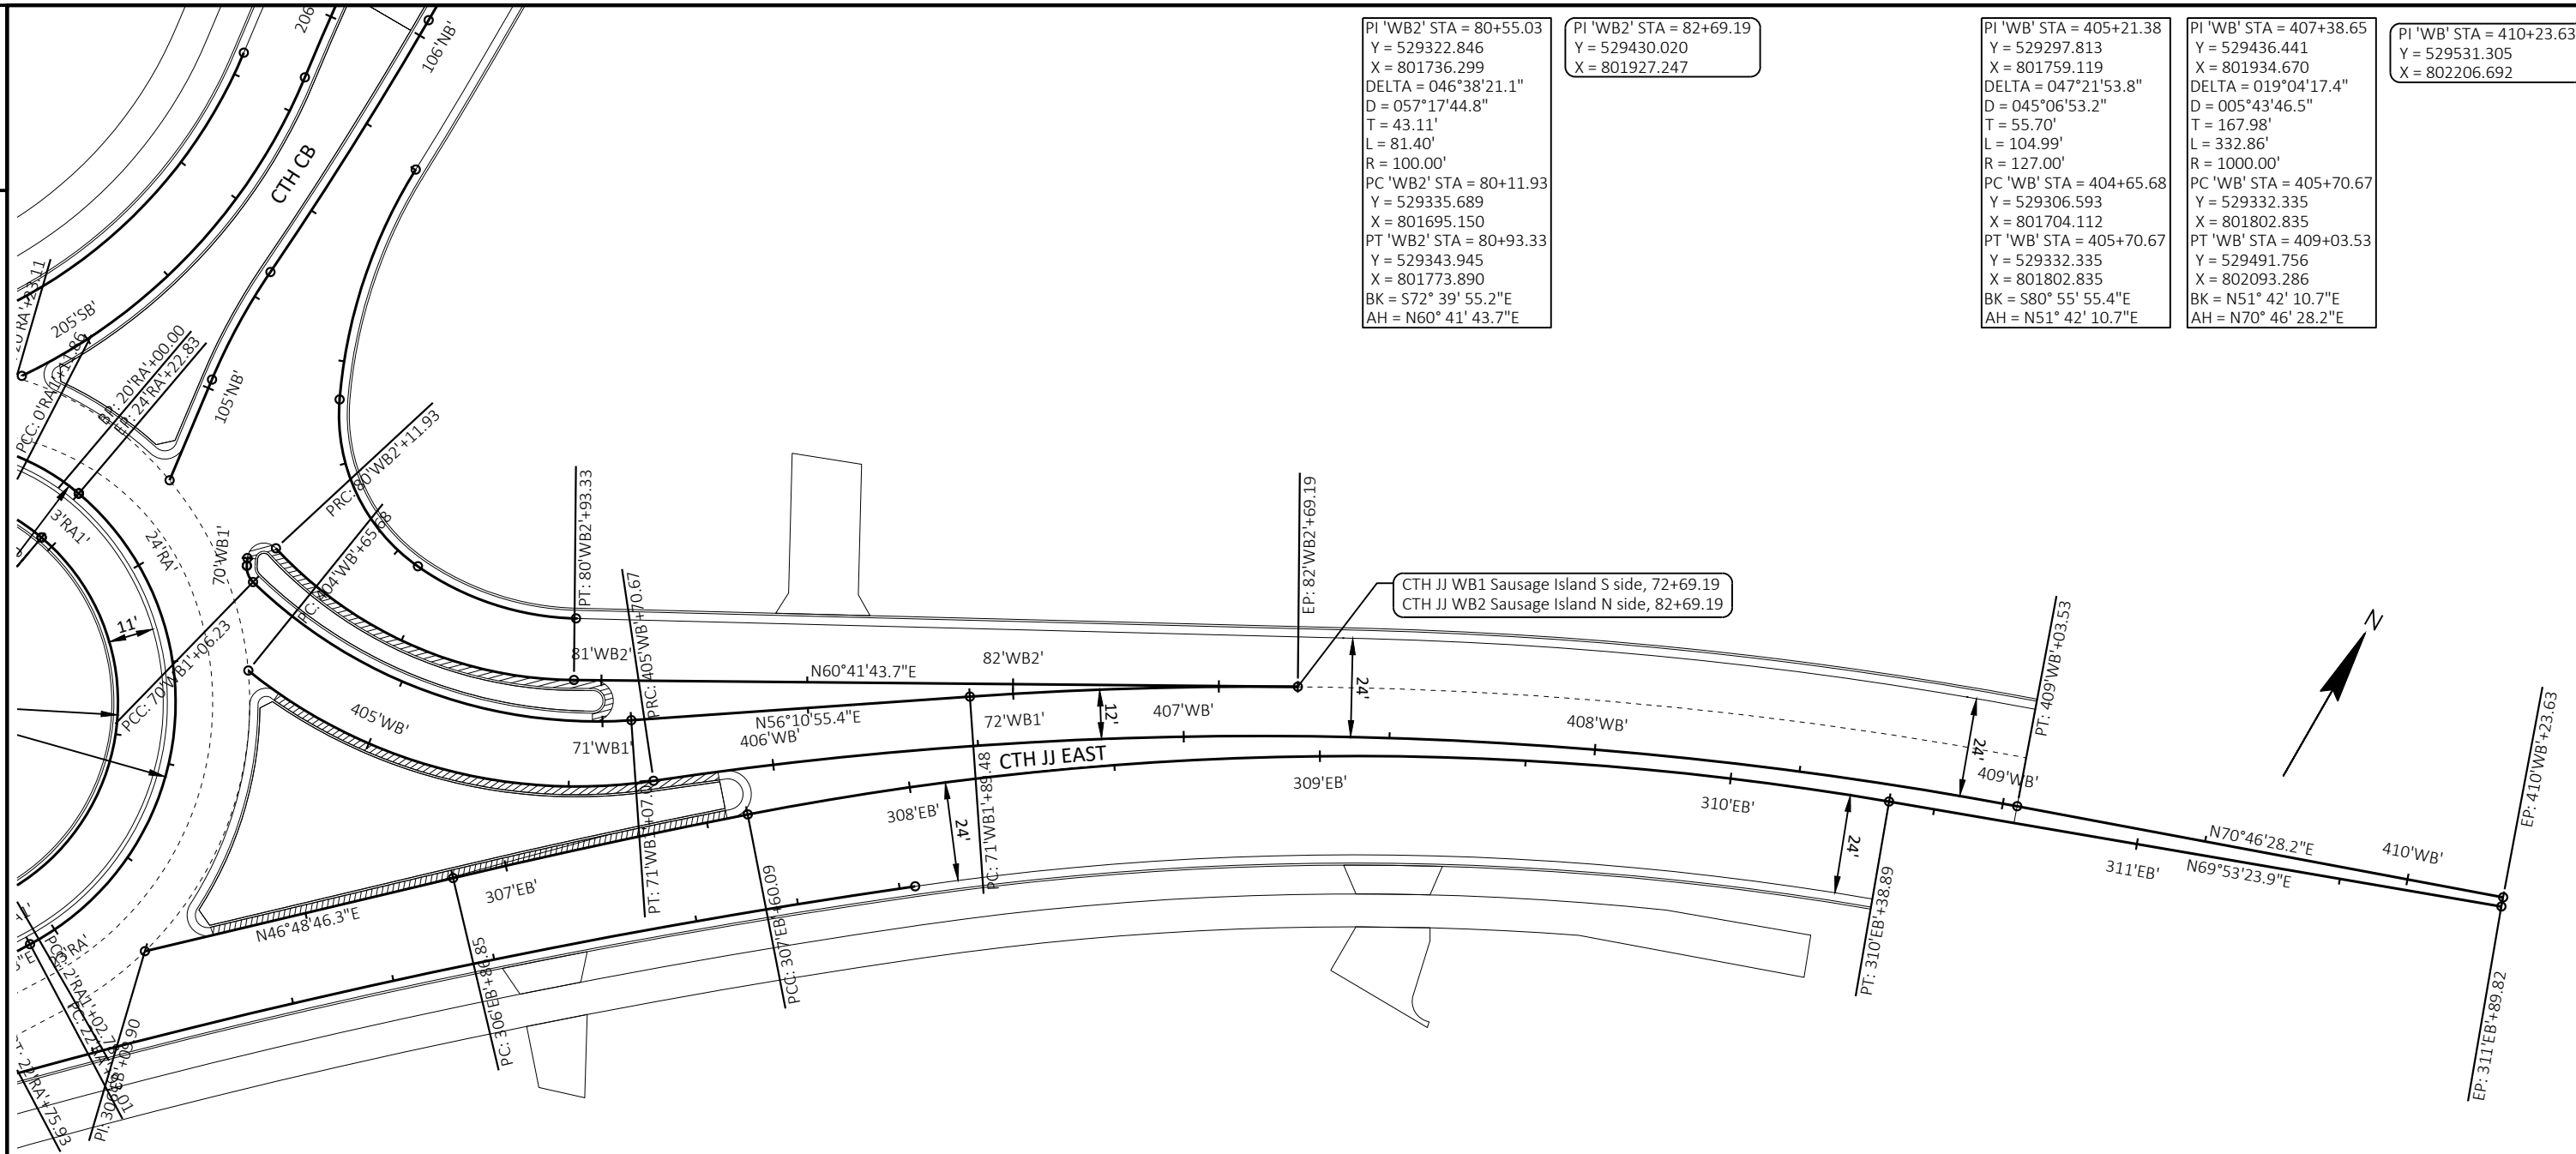

PI 'WB2' STA = 80+55.03
 Y = 529322.846
 X = 801736.299
 DELTA = 046°38'21.1"
 D = 057°17'44.8"
 T = 43.11'
 L = 81.40'
 R = 100.00'
 PC 'WB2' STA = 80+11.93
 Y = 529335.689
 X = 801695.150
 PT 'WB2' STA = 80+93.33
 Y = 529343.945
 X = 801773.890
 BK = S72° 39' 55.2"E
 AH = N60° 41' 43.7"E

PI 'WB2' STA = 82+69.19
 Y = 529430.020
 X = 801927.247

PI 'WB' STA = 405+21.38
 Y = 529297.813
 X = 801759.119
 DELTA = 047°21'53.8"
 D = 045°06'53.2"
 T = 55.70'
 L = 104.99'
 R = 127.00'
 PC 'WB' STA = 404+65.68
 Y = 529306.593
 X = 801704.112
 PT 'WB' STA = 405+70.67
 Y = 529332.335
 X = 801802.835
 BK = S80° 55' 55.4"E
 AH = N51° 42' 10.7"E

PI 'WB' STA = 407+38.65
 Y = 529436.441
 X = 801934.670
 DELTA = 019°04'17.4"
 D = 005°43'46.5"
 T = 167.98'
 L = 332.86'
 R = 1000.00'
 PC 'WB' STA = 405+70.67
 Y = 529332.335
 X = 801802.835
 PT 'WB' STA = 409+03.53
 Y = 529491.756
 X = 802093.286
 BK = N51° 42' 10.7"E
 AH = N70° 46' 28.2"E

PI 'WB' STA = 410+23.63
 Y = 529531.305
 X = 802206.692

PI 'WB1' STA = 70+59.81
 Y = 529312.590
 X = 801746.312
 DELTA = 048°07'04.8"
 D = 047°44'47.3"
 T = 53.58'
 L = 100.78'
 R = 120.00'
 PC 'WB1' STA = 70+06.23
 Y = 529325.823
 X = 801694.396
 PT 'WB1' STA = 71+07.01
 Y = 529342.408
 X = 801790.823
 BK = S75° 41' 59.8"E
 AH = N56° 10' 55.4"E

PI 'WB1' STA = 73+19.05
 Y = 529460.420
 X = 801966.988
 DELTA = 014°35'32.9"
 D = 005°39'41.9"
 T = 129.57'
 L = 257.74'
 R = 1012.00'
 PC 'WB1' STA = 71+89.48
 Y = 529388.306
 X = 801859.338
 PT 'WB1' STA = 74+47.22
 Y = 529503.087
 X = 802089.334
 BK = N56° 10' 55.3"E
 AH = N70° 46' 28.2"E

PI 'EB' STA = 306+09.90
 Y = 529234.930
 X = 801716.251

PI 'EB' STA = 307+23.48
 Y = 529312.656
 X = 801799.058
 DELTA = 002°19'51.8"
 D = 003°10'59.2"
 T = 36.62'
 L = 73.23'
 R = 1800.00'
 PC 'EB' STA = 306+86.85
 Y = 529287.593
 X = 801772.357
 PT 'EB' STA = 307+60.09
 Y = 529336.612
 X = 801826.757
 BK = N46° 48' 46.3"E
 AH = N49° 08' 38.2"E

PI 'EB' STA = 309+01.03
 Y = 529428.814
 X = 801933.363
 DELTA = 020°44'45.7"
 D = 007°26'27.6"
 T = 140.95'
 L = 278.81'
 R = 770.00'
 PC 'EB' STA = 307+60.09
 Y = 529336.612
 X = 801826.757
 PT 'EB' STA = 310+38.89
 Y = 529477.275
 X = 802065.716
 BK = N49° 08' 38.2"E
 AH = N69° 53' 23.9"E

PI 'EB' STA = 311+89.82
 Y = 529529.166
 X = 802207.438


PI 'SB' STA = 200+52.71
 Y = 528916.518
 X = 801653.859

PI 'SB' STA = 200+89.87
 Y = 528953.675
 X = 801653.827
 DELTA = 004°15'21.0"
 D = 005°43'46.5"
 T = 37.16'
 L = 74.28'
 R = 1000.00'
 PC 'SB' STA = 200+52.71
 Y = 528916.518
 X = 801653.859
 PT 'SB' STA = 201+26.99
 Y = 528990.731
 X = 801656.553
 BK = N00° 02' 56.2"W
 AH = N04° 12' 24.8"E

PI 'SB' STA = 201+86.82
 Y = 529050.397
 X = 801660.942
 DELTA = 011°23'19.1"
 D = 009°32'57.5"
 T = 59.83'
 L = 119.26'
 R = 600.00'
 PC 'SB' STA = 201+26.99
 Y = 528990.731
 X = 801656.553
 PT 'SB' STA = 202+46.25
 Y = 529109.756
 X = 801653.462
 BK = N04° 12' 24.8"E
 AH = N07° 10' 54.3"W

PI 'SB' STA = 202+64.12
 Y = 529127.489
 X = 801651.228
 DELTA = 016°08'49.5"
 D = 045°28'22.2"
 T = 17.87'
 L = 35.51'
 R = 126.00'
 PC 'SB' STA = 202+46.25
 Y = 529109.756
 X = 801653.462
 PT 'SB' STA = 202+81.76
 Y = 529143.901
 X = 801644.150
 BK = N07° 10' 54.3"W
 AH = N23° 19' 43.8"W

PI 'SB' STA = 203+06.90
 Y = 529166.989
 X = 801634.193

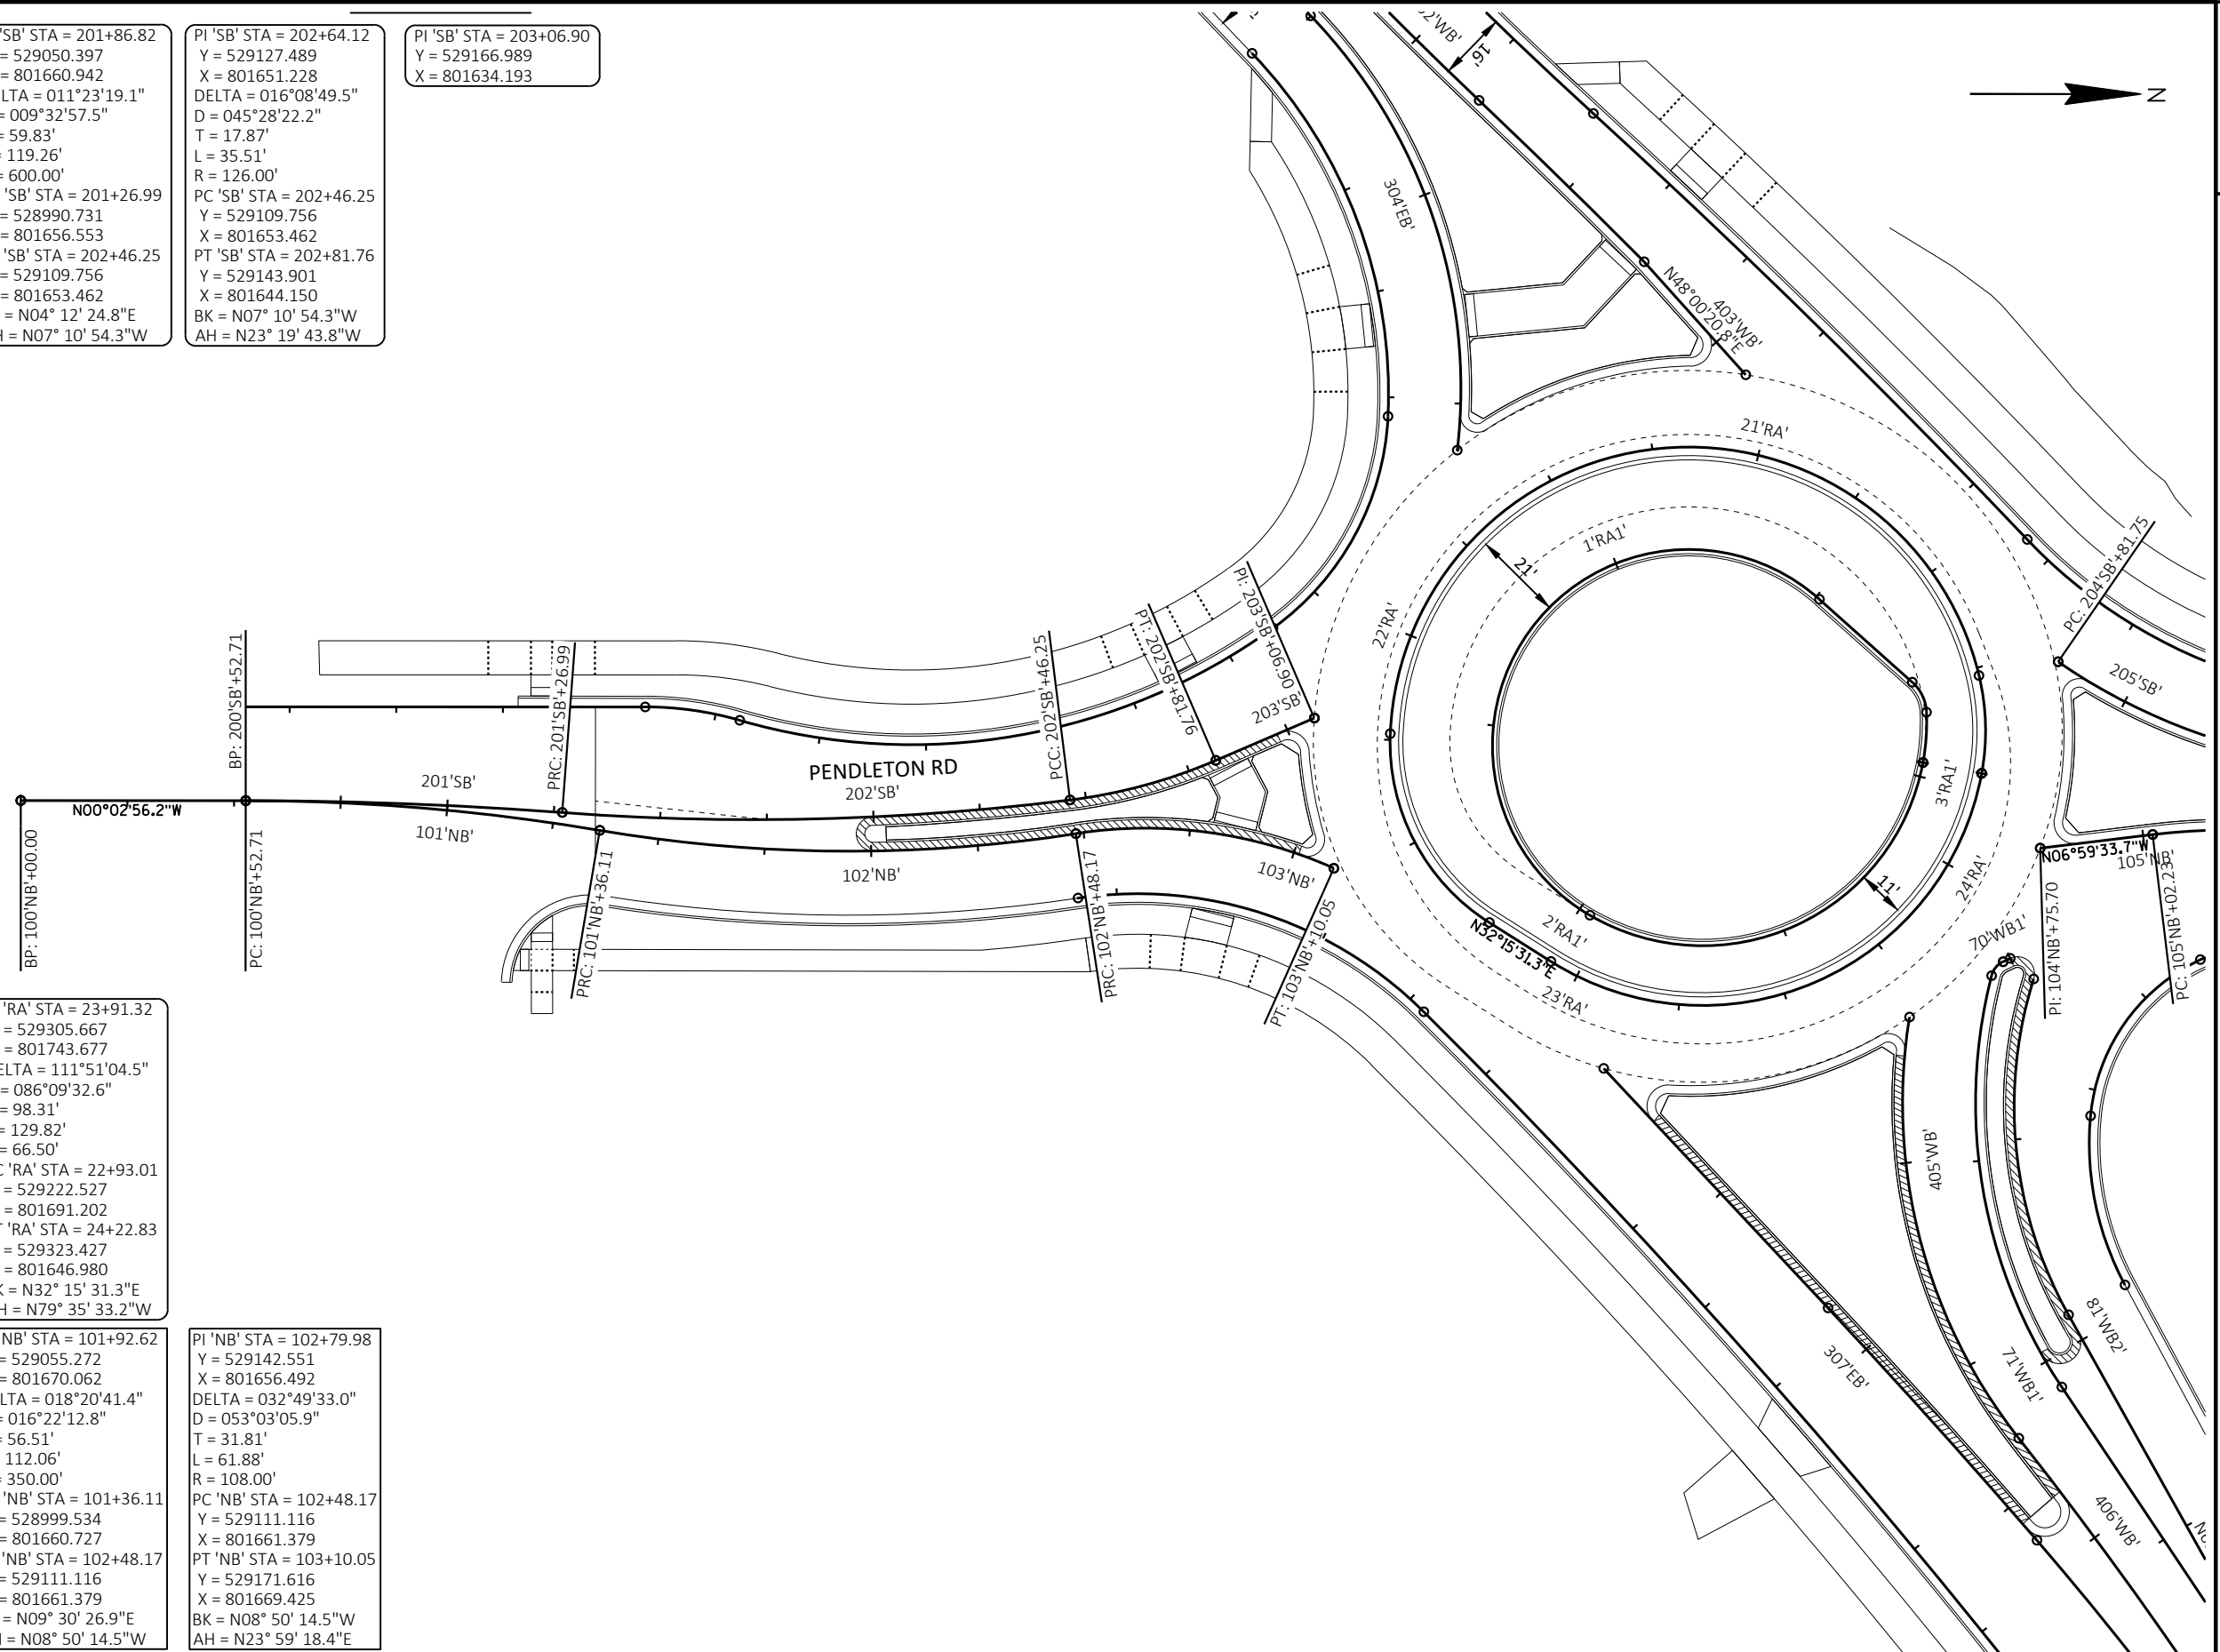

PI 'RA' STA = 20+11.73
 Y = 529325.545
 X = 801635.447
 DELTA = 024°04'14.2"
 D = 104°10'26.9"
 T = 11.73'
 L = 23.11'
 R = 55.00'
 PC 'RA' STA = 20+00.00
 Y = 529323.427
 X = 801646.980
 PT 'RA' STA = 20+23.11
 Y = 529322.775
 X = 801624.053
 BK = N79° 35' 33.2"W
 AH = S76° 20' 12.6"W

PI 'RA' STA = 25+24.12
 Y = 529204.428
 X = 801137.215
 DELTA = 164°05'33.7"
 D = 081°51'04.0"
 T = 501.02'
 L = 200.48'
 R = 70.00'
 PC 'RA' STA = 20+23.11
 Y = 529322.775
 X = 801624.053
 PT 'RA' STA = 22+23.58
 Y = 529184.810
 X = 801637.846
 BK = S76° 20' 12.6"W
 AH = S87° 45' 21.1"E


PI 'RA' STA = 23+91.32
 Y = 529305.667
 X = 801743.677
 DELTA = 111°51'04.5"
 D = 086°09'32.6"
 T = 98.31'
 L = 129.82'
 R = 66.50'
 PC 'RA' STA = 22+93.01
 Y = 529222.527
 X = 801691.202
 PT 'RA' STA = 24+22.83
 Y = 529323.427
 X = 801646.980
 BK = N32° 15' 31.3"E
 AH = N79° 35' 33.2"W

PI 'NB' STA = 100+00.00
 Y = 528863.805
 X = 801653.904

PI 'NB' STA = 100+94.51
 Y = 528958.313
 X = 801653.823
 DELTA = 009°33'23.1"
 D = 011°27'33.0"
 T = 41.79'
 L = 83.40'
 R = 500.00'
 PC 'NB' STA = 100+52.71
 Y = 528916.518
 X = 801653.859
 PT 'NB' STA = 101+36.11
 Y = 528999.534
 X = 801660.727
 BK = N00° 02' 56.2"W
 AH = N09° 30' 26.9"E

PI 'NB' STA = 101+92.62
 Y = 529055.272
 X = 801670.062
 DELTA = 018°20'41.4"
 D = 016°22'12.8"
 T = 56.51'
 L = 112.06'
 R = 350.00'
 PC 'NB' STA = 101+36.11
 Y = 528999.534
 X = 801660.727
 PT 'NB' STA = 102+48.17
 Y = 529111.116
 X = 801661.379
 BK = N09° 30' 26.9"E
 AH = N08° 50' 14.5"W

PI 'NB' STA = 102+79.98
 Y = 529142.551
 X = 801656.492
 DELTA = 032°49'33.0"
 D = 053°03'05.9"
 T = 31.81'
 L = 61.88'
 R = 108.00'
 PC 'NB' STA = 102+48.17
 Y = 529111.116
 X = 801661.379
 PT 'NB' STA = 103+10.05
 Y = 529171.616
 X = 801669.425
 BK = N08° 50' 14.5"W
 AH = N23° 59' 18.4"E

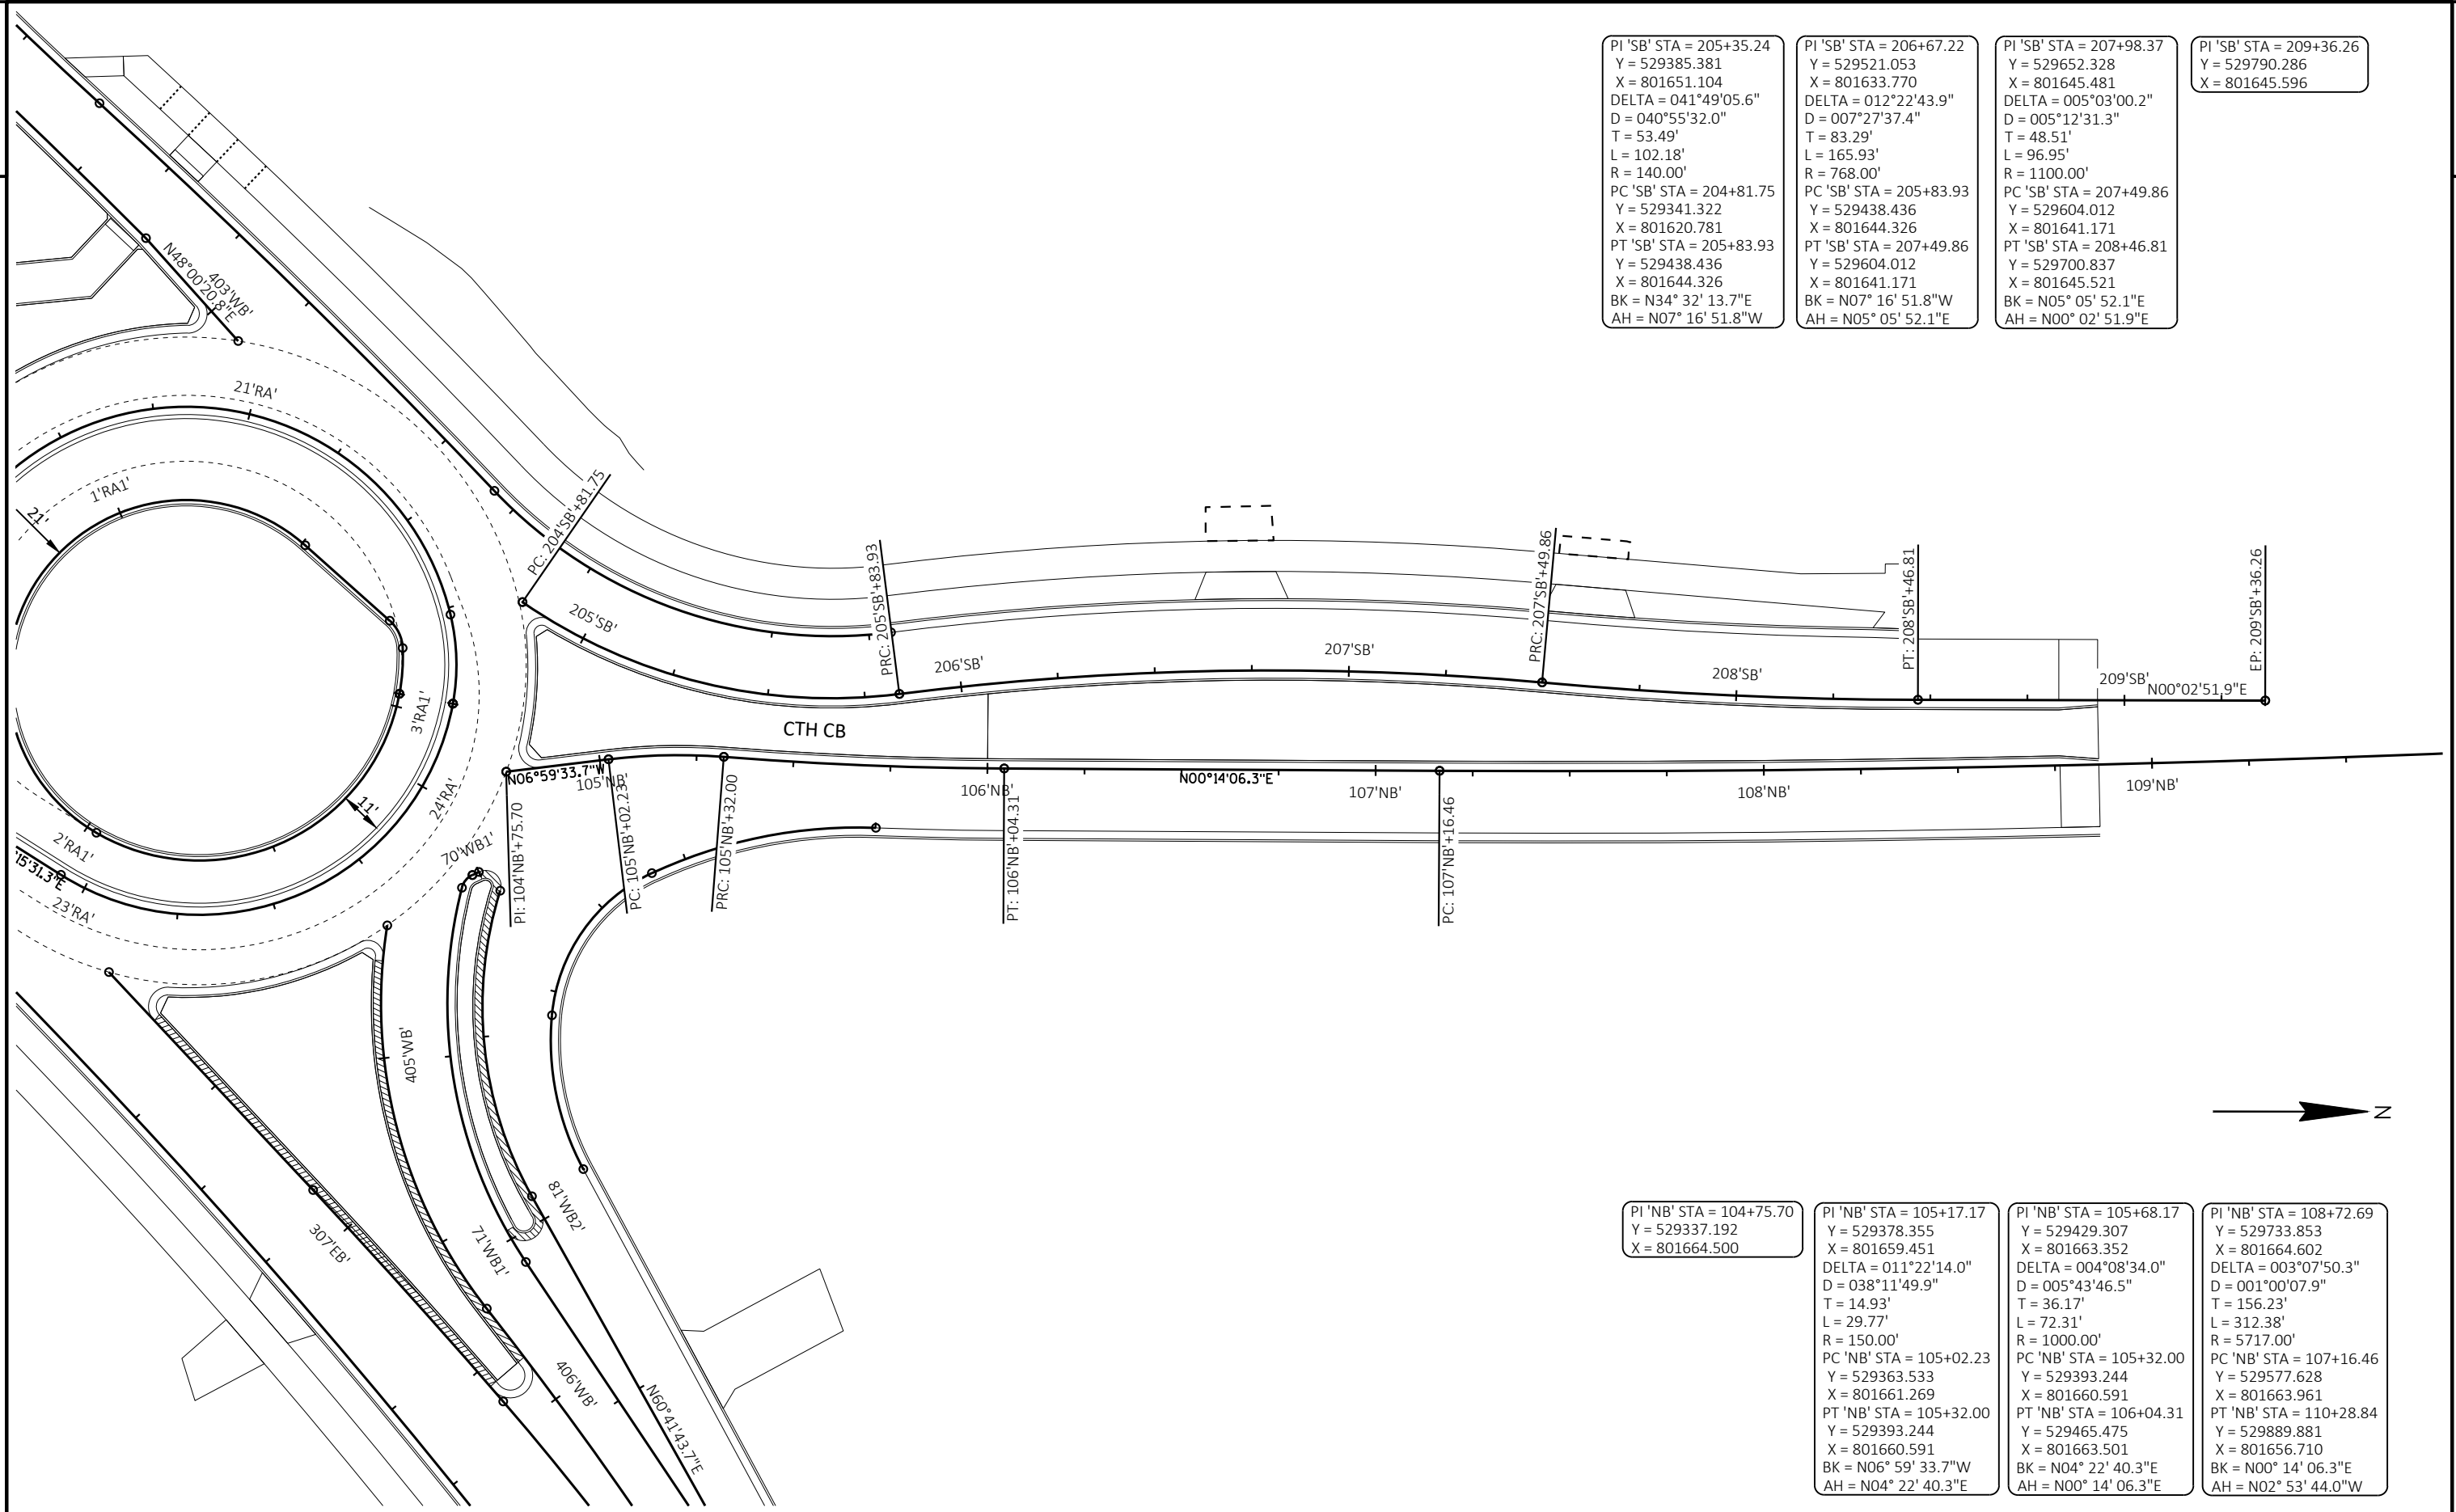

PI 'SB' STA = 205+35.24
 Y = 529385.381
 X = 801651.104
 DELTA = 041°49'05.6"
 D = 040°55'32.0"
 T = 53.49'
 L = 102.18'
 R = 140.00'
 PC 'SB' STA = 204+81.75
 Y = 529341.322
 X = 801620.781
 PT 'SB' STA = 205+83.93
 Y = 529438.436
 X = 801644.326
 BK = N34° 32' 13.7"E
 AH = N07° 16' 51.8"W

PI 'SB' STA = 206+67.22
 Y = 529521.053
 X = 801633.770
 DELTA = 012°22'43.9"
 D = 007°27'37.4"
 T = 83.29'
 L = 165.93'
 R = 768.00'
 PC 'SB' STA = 205+83.93
 Y = 529438.436
 X = 801644.326
 PT 'SB' STA = 207+49.86
 Y = 529604.012
 X = 801641.171
 BK = N07° 16' 51.8"W
 AH = N05° 05' 52.1"E

PI 'SB' STA = 207+98.37
 Y = 529652.328
 X = 801645.481
 DELTA = 005°03'00.2"
 D = 005°12'31.3"
 T = 48.51'
 L = 96.95'
 R = 1100.00'
 PC 'SB' STA = 207+49.86
 Y = 529604.012
 X = 801641.171
 PT 'SB' STA = 208+46.81
 Y = 529700.837
 X = 801645.521
 BK = N05° 05' 52.1"E
 AH = N00° 02' 51.9"E

PI 'SB' STA = 209+36.26
 Y = 529790.286
 X = 801645.596

PI 'NB' STA = 104+75.70
 Y = 529337.192
 X = 801664.500

PI 'NB' STA = 105+17.17
 Y = 529378.355
 X = 801659.451
 DELTA = 011°22'14.0"
 D = 038°11'49.9"
 T = 14.93'
 L = 29.77'
 R = 150.00'
 PC 'NB' STA = 105+02.23
 Y = 529363.533
 X = 801661.269
 PT 'NB' STA = 105+32.00
 Y = 529393.244
 X = 801660.591
 BK = N06° 59' 33.7"W
 AH = N04° 22' 40.3"E

PI 'NB' STA = 105+68.17
 Y = 529429.307
 X = 801663.352
 DELTA = 004°08'34.0"
 D = 005°43'46.5"
 T = 36.17'
 L = 72.31'
 R = 1000.00'
 PC 'NB' STA = 105+32.00
 Y = 529393.244
 X = 801660.591
 PT 'NB' STA = 106+04.31
 Y = 529465.475
 X = 801663.501
 BK = N04° 22' 40.3"E
 AH = N00° 14' 06.3"E

PI 'NB' STA = 108+72.69
 Y = 529733.853
 X = 801664.602
 DELTA = 003°07'50.3"
 D = 001°00'07.9"
 T = 156.23'
 L = 312.38'
 R = 5717.00'
 PC 'NB' STA = 107+16.46
 Y = 529577.628
 X = 801663.961
 PT 'NB' STA = 110+28.84
 Y = 529889.881
 X = 801656.710
 BK = N00° 14' 06.3"E
 AH = N02° 53' 44.0"W

PI 'NW' STA = 50+63.24
 Y = 529136.484
 X = 801394.047

PI 'NW' STA = 51+44.45
 Y = 529190.667
 X = 801454.540
 DELTA = 005°56'07.9"
 D = 005°17'08.1"
 T = 56.20'
 L = 112.30'
 R = 1084.00'
 PC 'NW' STA = 50+88.25
 Y = 529153.273
 X = 801412.587
 PT 'NW' STA = 52+00.55
 Y = 529232.198
 X = 801492.400
 BK = N48° 17' 16.2"E
 AH = N42° 21' 08.3"E


PI 'NW' STA = 52+71.88
 Y = 529284.913
 X = 801540.454
 DELTA = 004°05'06.8"
 D = 002°51'53.2"
 T = 71.33'
 L = 142.60'
 R = 2000.00'
 PC 'NW' STA = 52+00.55
 Y = 529232.198
 X = 801492.400
 PT 'NW' STA = 53+43.15
 Y = 529334.070
 X = 801592.142
 BK = N42° 21' 08.3"E
 AH = N46° 26' 15.0"E

PI 'NW' STA = 54+03.94
 Y = 529375.961
 X = 801636.190
 DELTA = 053°43'47.2"
 D = 047°44'47.3"
 T = 60.79'
 L = 112.53'
 R = 120.00'
 PC 'NW' STA = 53+43.15
 Y = 529334.070
 X = 801592.142
 PT 'NW' STA = 54+55.68
 Y = 529436.257
 X = 801628.474
 BK = N46° 26' 15.0"E
 AH = N07° 17' 32.2"W

PI 'NE' STA = 61+05.20
 Y = 529402.170
 X = 801677.723
 DELTA = 027°14'14.6"
 D = 045°50'11.8"
 T = 30.28'
 L = 59.42'
 R = 125.00'
 PC 'NE' STA = 60+74.92
 Y = 529432.433
 X = 801678.830
 PT 'NE' STA = 61+34.34
 Y = 529374.755
 X = 801690.589
 BK = S02° 05' 42.7"W
 AH = S25° 08' 31.9"E

PI 'NE' STA = 61+60.14
 Y = 529351.400
 X = 801701.550
 DELTA = 059°39'08.7"
 D = 127°19'26.2"
 T = 25.80'
 L = 46.85'
 R = 45.00'
 PC 'NE' STA = 61+34.34
 Y = 529374.755
 X = 801690.589
 PT 'NE' STA = 61+81.19
 Y = 529349.060
 X = 801727.243
 BK = S25° 08' 31.9"E
 AH = S84° 47' 40.7"E

PI 'NE' STA = 62+02.32
 Y = 529347.143
 X = 801748.277
 DELTA = 033°34'48.6"
 D = 081°51'04.0"
 T = 21.12'
 L = 41.03'
 R = 70.00'
 PC 'NE' STA = 61+81.19
 Y = 529349.060
 X = 801727.243
 PT 'NE' STA = 62+22.22
 Y = 529357.181
 X = 801766.860
 BK = S84° 47' 40.7"E
 AH = N61° 37' 30.7"E

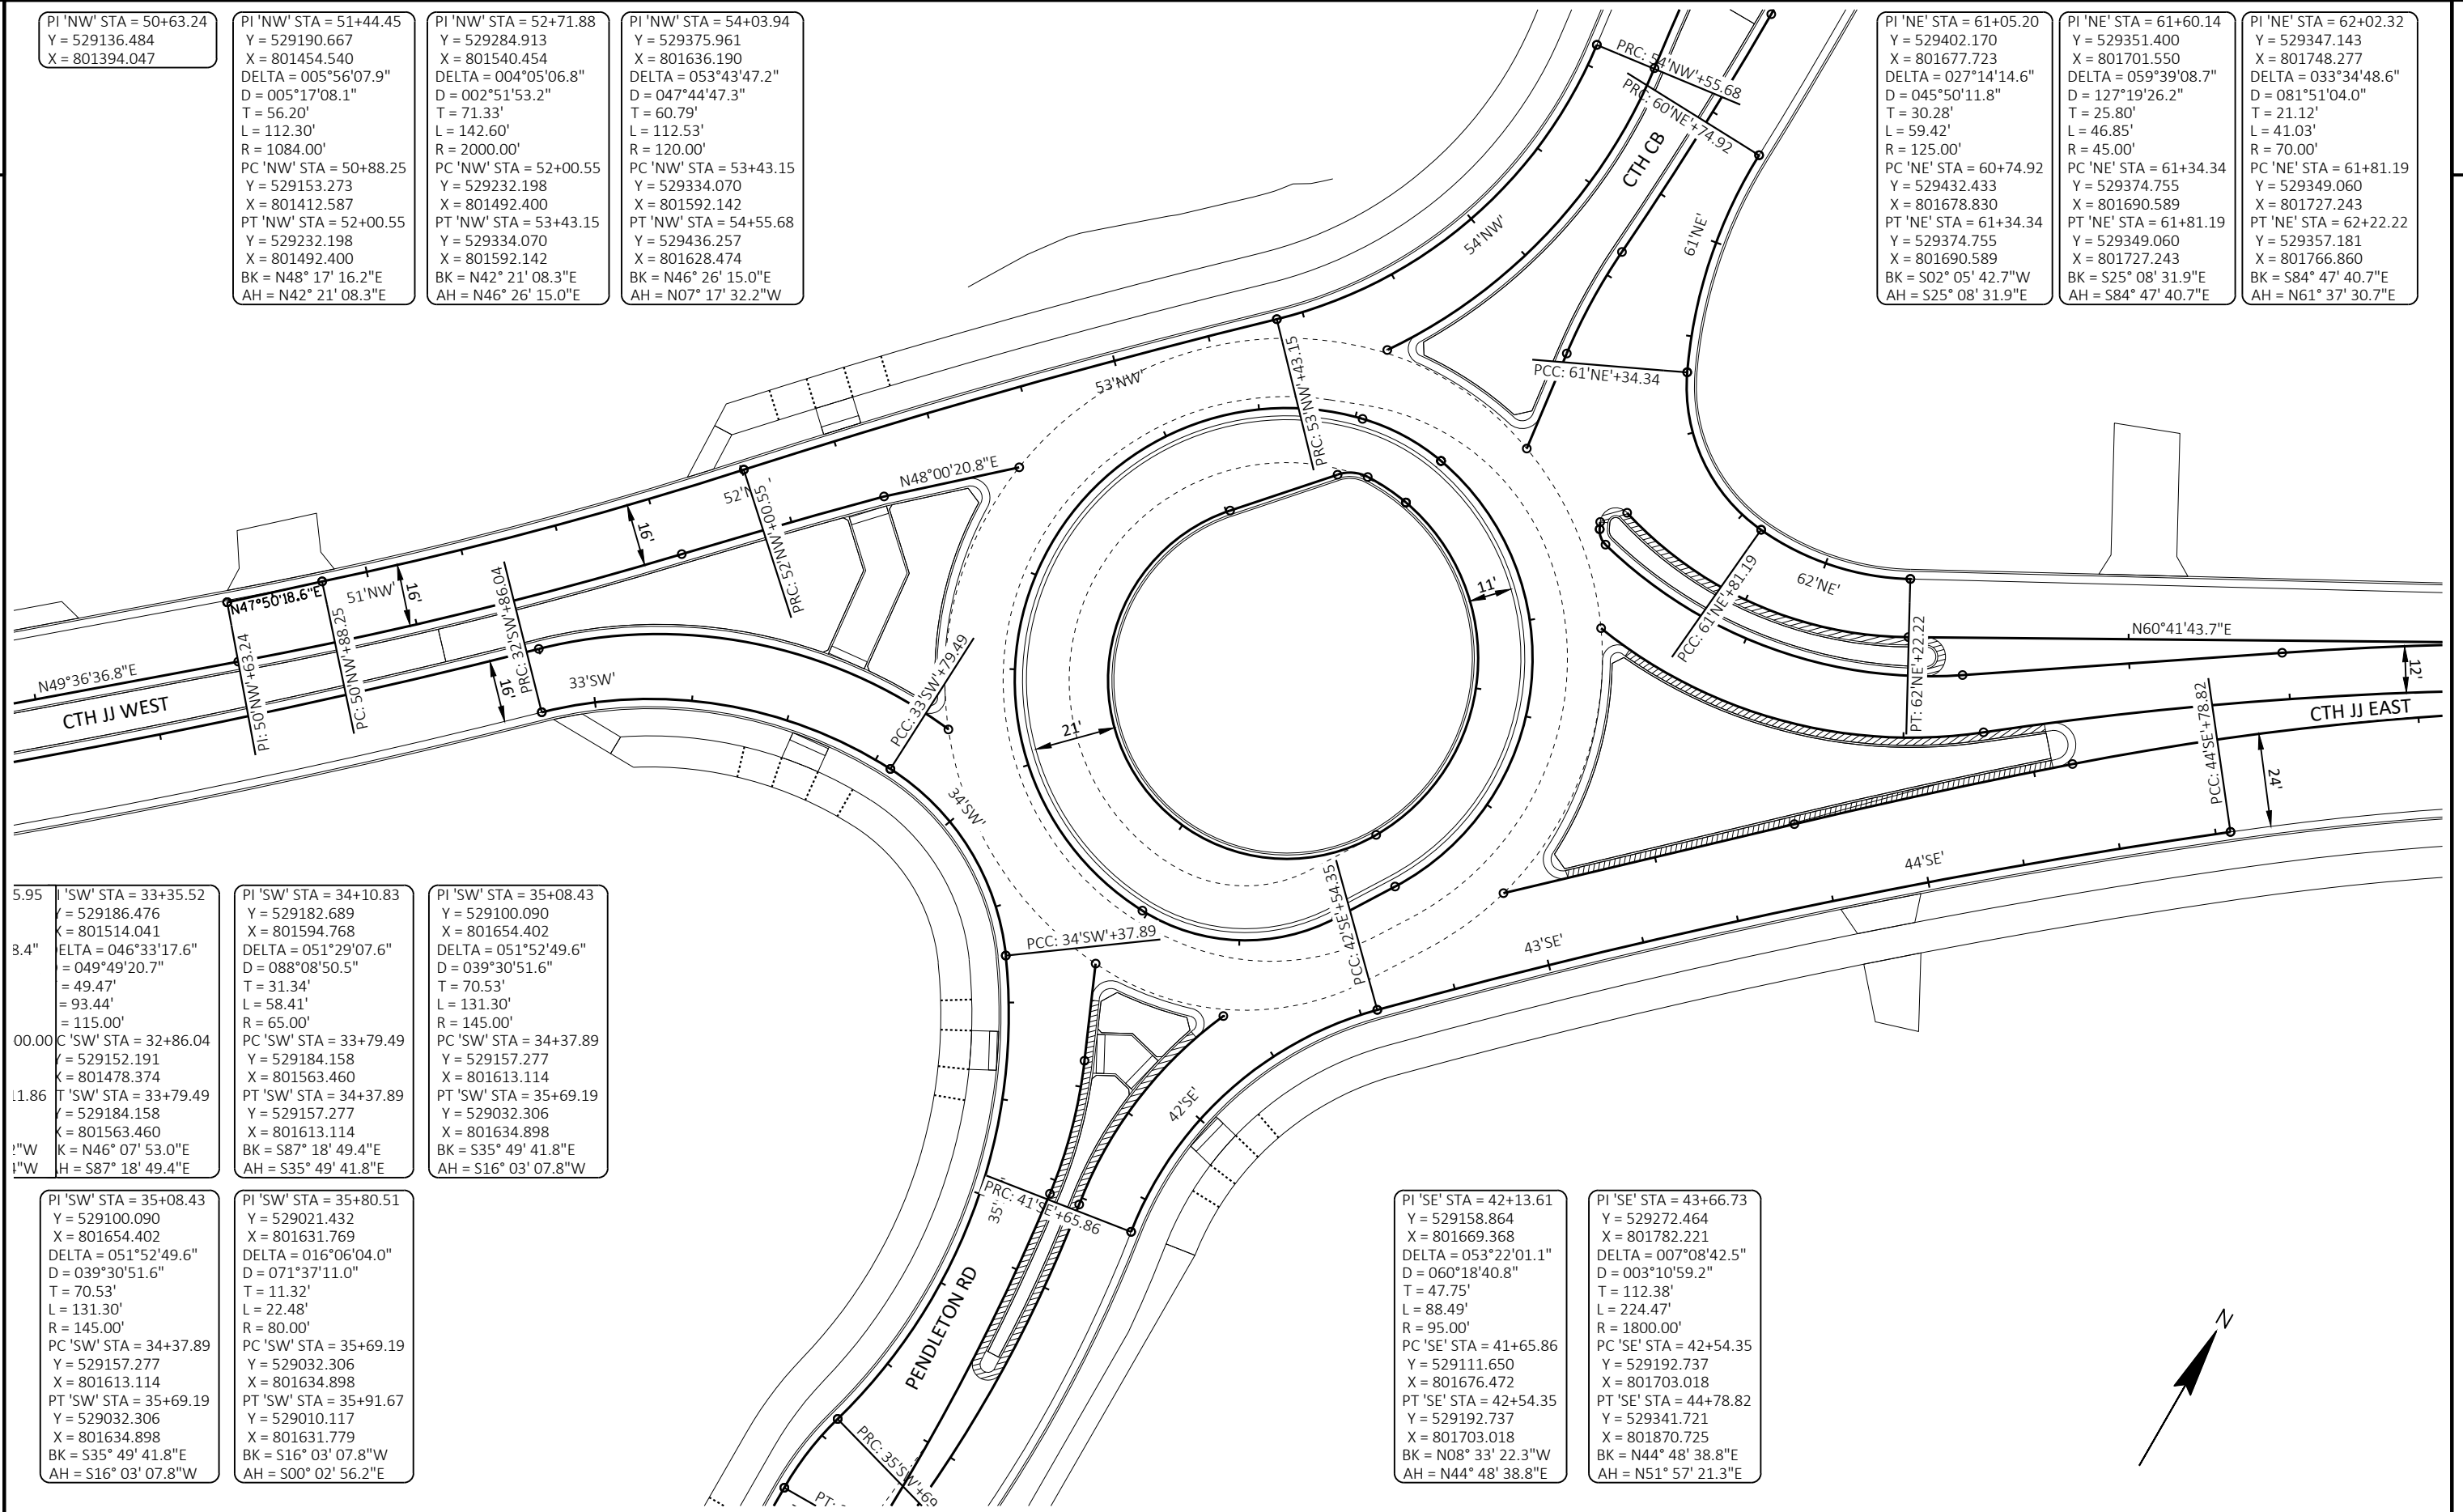

5.95
 8.4"
 00.00
 1.86
 1"
 1"

PI 'SW' STA = 33+35.52
 Y = 529186.476
 X = 801514.041
 DELTA = 046°33'17.6"
 D = 049°49'20.7"
 T = 49.47'
 L = 93.44'
 R = 115.00'
 PC 'SW' STA = 32+86.04
 Y = 529152.191
 X = 801478.374
 PT 'SW' STA = 33+79.49
 Y = 529184.158
 X = 801563.460
 BK = N46° 07' 53.0"E
 AH = S87° 18' 49.4"E

PI 'SW' STA = 34+10.83
 Y = 529182.689
 X = 801594.768
 DELTA = 051°29'07.6"
 D = 088°08'50.5"
 T = 31.34'
 L = 58.41'
 R = 65.00'
 PC 'SW' STA = 33+79.49
 Y = 529184.158
 X = 801563.460
 PT 'SW' STA = 34+37.89
 Y = 529157.277
 X = 801613.114
 BK = S87° 18' 49.4"E
 AH = S35° 49' 41.8"E


PI 'SW' STA = 35+08.43
 Y = 529100.090
 X = 801654.402
 DELTA = 051°52'49.6"
 D = 039°30'51.6"
 T = 70.53'
 L = 131.30'
 R = 145.00'
 PC 'SW' STA = 34+37.89
 Y = 529157.277
 X = 801613.114
 PT 'SW' STA = 35+69.19
 Y = 529032.306
 X = 801634.898
 BK = S35° 49' 41.8"E
 AH = S16° 03' 07.8"W

PI 'SW' STA = 35+08.43
 Y = 529100.090
 X = 801654.402
 DELTA = 051°52'49.6"
 D = 039°30'51.6"
 T = 70.53'
 L = 131.30'
 R = 145.00'
 PC 'SW' STA = 34+37.89
 Y = 529157.277
 X = 801613.114
 PT 'SW' STA = 35+69.19
 Y = 529032.306
 X = 801634.898
 BK = S35° 49' 41.8"E
 AH = S16° 03' 07.8"W

PI 'SW' STA = 35+80.51
 Y = 529021.432
 X = 801631.769
 DELTA = 016°06'04.0"
 D = 071°37'11.0"
 T = 11.32'
 L = 22.48'
 R = 80.00'
 PC 'SW' STA = 35+69.19
 Y = 529032.306
 X = 801634.898
 PT 'SW' STA = 35+91.67
 Y = 529010.117
 X = 801631.779
 BK = S16° 03' 07.8"W
 AH = S00° 02' 56.2"E

PI 'SE' STA = 42+13.61
 Y = 529158.864
 X = 801669.368
 DELTA = 053°22'01.1"
 D = 060°18'40.8"
 T = 47.75'
 L = 88.49'
 R = 95.00'
 PC 'SE' STA = 41+65.86
 Y = 529111.650
 X = 801676.472
 PT 'SE' STA = 42+54.35
 Y = 529192.737
 X = 801703.018
 BK = N08° 33' 22.3"W
 AH = N44° 48' 38.8"E

PI 'SE' STA = 43+66.73
 Y = 529272.464
 X = 801782.221
 DELTA = 007°08'42.5"
 D = 003°10'59.2"
 T = 112.38'
 L = 224.47'
 R = 1800.00'
 PC 'SE' STA = 42+54.35
 Y = 529192.737
 X = 801703.018
 PT 'SE' STA = 44+78.82
 Y = 529341.721
 X = 801870.725
 BK = N44° 48' 38.8"E
 AH = N51° 57' 21.3"E

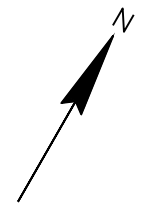

DIVISION	FROM/TO STATION	205.0100 COMMON EXCAVATION (1)		AVAILABLE MATERIAL (5)	UNEXPANDED FILL	EXPANDED FILL (13)	MASS ORDINATE +/- (14)	WASTE	COMMENT
		CUT (2)	EBS EXCAVATION (3)			FACTOR 1.25			
DIVISION 1									
CTH CB & JJ RAB	20+00/23+94	2,017	0	2,017	1,215	1,519	498	498	NOTE 15 and 16
PENDLETON NB	101+35/102+75	689	0	689	83	104	585	585	
CTH CB NB	105+00/106+05	316	0	316	26	33	284	284	
CTH CB NB	106+05/108+86	150	0	150	0	0	150	150	
CTH CB SB	205+00/208+93	1,169	0	1,169	45	56	1,113	1,113	
PENDLETON SB	202+50/202+75	59	0	59	5	6	53	53	
CTH JJ EB	301+33/304+25	1,066	0	1,066	24	30	1,036	1,036	
CTH JJ EB	306+50/310+69	2,245	0	2,245	225	281	1,964	1,964	
CTH JJ WB	399+63/400+93	70	0	70	0	0	70	70	
CTH JJ WB	400+93/402+75	160	0	160	19	24	136	136	
CTH JJ WB	405+00/405+50	204	0	204	24	30	174	174	
	UNDISTRIBUTED	0	200	0	200	250	-250	0	
DIVISION 1 SUBTOTAL		8,145	200	8,145	1,866	2,333	5,813	6,063	
GRAND TOTAL		8,145	200	8,145	1,866	2,333	5,813	6,063	
TOTAL COMMON EXC		8,345							

NOTES:

- (1) COMMON EXCAVATION IS THE SUM OF THE CUT AND EBS EXCAVATION COLUMNS. ITEM NUMBER 205.0100
- (2) SALVAGED/UNSUAABLE PAVEMENT MATERIAL IS INCLUDED IN CUT.
- (5) AVAILABLE MATERIAL = CUT - SALVAGED/UNUSUAABLE PAVEMENT MATERIAL
- (7) ROCK EXCAVATION ITEM NUMBER 205.0200
- (12) EXPANDED ROCK FACTOR = 1.10
- (13) EXPANDED FILL FACTOR = 1.25
- DEPENDING ON SELECTIONS: **EXPANDED FILL = (UNEXPANDED FILL) * FILL FACTOR**
- (14) THE MASS ORDINATE + OR - QTY CALCULATED FOR THE DIVISION. PLUS QUANTITY INDICATES AN EXCESS OF MATERIAL WITHIN THE DIVISION. MINUS INDICATES A SHORTAGE OF MATERIAL WITHIN THE DIVISION.
- (15) FACTORS USED TO COMPUTE ANTICIPATED WASTE AND THE COMPUTED WASTE VOLUME IDENTIFIED ARE FOR GENERAL INFORMATION ONLY.
- (16) EARTHWORK QUANTITIES BASED ON EXISTING AND PROPOSED SURFACE COMPARISON

3

GRUBBING

STATION	TO	STATION	ROADWAY	201.0205 GRUBBING STA
PROJECT 426-4738				
402+00	-	406+00	CTH JJ WB	3
307+00	-	310+00	CTH JJ EB	3
101+00	-	102+00	PENDLETON RD NB	1
201+00	-	203+00	PENDLETON RD SB	2
207+00	-	208+00	CTH CB NB	1
22+00	-	24+00	RAB	2

PROJECT TOTALS 12

REMOVING CURB AND GUTTER

STATION TO STATION	DIR	ROADWAY	204.0150 LF		
PROJECT 426-4738					
NW QUADRANT					
	-	CTH CB/JJ	780		
NE QUADRANT					
	-	CTH CB/JJ	766		
301+33	-	310+39	RT	CTH JJ EB	890
301+33	-	304+93	RT/LT	CTH JJ EB	747
105+36	-	106+35	LT	CTH CB NB	170

PROJECT TOTAL 3,353

REMOVING CONCRETE PAVEMENT

STATION	DIR	ROADWAY	204.0100 SY	COMMENT
PROJECT 426-4738				
405+81	LT	CTH JJ WB	16	DWY APRON
309+27	RT	CTH JJ EB	23	DWY APRON
310+25	LT/RT	CTH JJ EB	488	

PROJECT TOTAL 527

REMOVING STORM SEWER STRUCTURES

STATION	OFFSET FT	DIR	ROADWAY	204.0120 REMOVING MANHOLES EA	204.0220 REMOVING INLETS EA
PROJECT 426-4738					
301+85	17	RT	CTH JJ EB	---	1
303+73	24.0	RT	CTH JJ EB	---	1
303+73	33.0	RT	CTH JJ EB	1	---
304+58	3.5	LT	CTH JJ EB	1	---
304+53	10.0	LT	CTH JJ EB	---	1
304+51	54.0	LT	CTH JJ EB	---	1
306+95	39.0	LT	CTH JJ EB	1	---
306+97	47.0	LT	CTH JJ EB	---	1
308+55	11.0	RT	CTH JJ EB	1	---
308+57	2.0	RT	CTH JJ EB	---	1
101+70	10.0	LT	CTH CB NB	1	---
105+02	52.5	LT	CTH CB NB	---	1
105+00	31.0	LT	CTH CB NB	---	1
105+10	0.5	LT	CTH CB NB	1	---
105+33	81.0	RT	CTH CB NB	---	1
105+60	8.5	LT	CTH CB NB	---	1
105+60	3.0	RT	CTH CB NB	---	1
107+13	33.0	LT	CTH CB NB	---	1

PROJECT TOTAL 6 12

REMOVING STORM SEWER

STATION	DIR	ROADWAY	204.0245.01 REMOVING STORM SEWER 12 TO 18-INCH LF	204.0245.02 REMOVING STORM SEWER 29x45-INCH LF
PROJECT 426-4738				
301+92-310+21	RT & LT	CTH JJ EB	80	810
105+00-105+75	RT & LT	CTH CB NB	222	---

PROJECT TOTALS 302 810

3

3

3

BASE COURSE

STATION TO STATION	DIR	LOCATION	305.0110 BASE AGGREGATE DENSE 3/4-INCH TON	305.0120 BASE AGGREGATE DENSE 1 1/4-INCH TON	311.0110 BREAKER RUN TON	624.0100 WATER MGAL	COMMENT
PROJECT 426-4738							
301+23 - 304+50	R/L	CTH JJ EB (WEST LEG)	0	530	1,310	3	
306+28 - 310+70	R/L	CTH JJ EB (EAST LEG)	0	1120	2,780	7	
101+35 - 103+00	R/L	PENDLETON RD NB	0	320	810	2	
104+88 - 106+15	R/L	CTH CB NB	0	130	330	1	
204+91 - 208+93	R/L	CTH CB SB	10	390	960	2	
		CTH JJ/CTH CB RAB	0	970	2,470	6	
303+28 - 304+51	LT	CTH JJ EB (WEST LEG)	90	0	0	1	SPLITTER ISLAND
306+27 - 307+53	LT	CTH JJ EB (EAST LEG)	80	0	0	0	SPLITTER ISLAND
102+60 - 103+00	LT	PENDLETON RD NB	10	0	0	0	SPLITTER ISLAND
104+85 - 106+35	LT	CTH CB NB	80	0	0	0	SPLITTER ISLAND
402+28 - 208+47	LT	NW QUADRANT TRAIL/SW	200	0	0	1	
303+50 - 100+69	R/L	SW QUADRANT TRAIL/SW	140	0	0	1	
101+21 - 310+25	RT	SE QUADRANT TRAIL/SW	270	0	0	2	
PROJECT TOTALS			880	3,460	8,660	26	

CONCRETE PAVEMENT

STATION TO STATION	DIR	LOCATION	415.0080 CONCRETE PAVEMENT 8-INCH SY	415.4100 CONCRETE PAVEMENT JOINT FILLING SY	416.0512 CONCRETE TRUCK APRON 12-INCH SY	405.0100 COLORING CONCRETE WISDOT RED CY
PROJECT 426-4738						
301+33 - 304+53	RT	CTH JJ EB (WEST LEG)	565	565	0	0
399+96 - 402+96	LT	CTH JJ WB (WEST LEG)	538	538	0	0
306+27 - 310+70	R/L	CTH JJ EB (EAST LEG)	2628	2628	0	10
101+35 - 103+02	R/L	PENDLETON RD NB	667	667	0	0
104+72 - 108+76	RT	CTH CB NB	818	818	0	0
204+90 - 208+83	LT	CTH CB SB	691	691	0	0
		CTH CB/CTH JJ RAB	1426	2061	635	212
PROJECT TOTALS			7,333	7,968	635	222

CONCRETE DRIVEWAY

STATION	DIR	ROADWAY	416.0160 6-INCH SY
PROJECT 426-4738			
206+73	LT	CTH CB SB	16
207+60	LT	CTH CB SB	16
307+04	RT	CTH JJ EB	14
309+18	RT	CTH JJ EB	16
PROJECT TOTAL			63

DRILLED BARS

STATION	DIR	ROADWAY	416.0610 TIE BARS EA	416.0620 DOWEL BARS EA
PROJECT 426-4738				
310+39	RT	CTH JJ EB	---	16
310+39-310+69	LT	CTH JJ EB	10	---
409+04	-	CTH JJ WB	---	19
10135	-	CTH CB NB	---	30
PROJECT TOTAL			10	65

3

ASPHALTIC ITEMS

LOCATION	455.0605 TACK COAT GAL	465.0105 ASPHALTIC SURFACE TON	465.0120 ASPHALTIC SURFACE DRIVEWAYS AND FIELD ENTRANCES TON	465.0125 ASPHALTIC SURFACE TEMPORARY TON	COMMENTS
PROJECT 426-4738					
NW QUADRANT PATH	---	81	---	---	
SW QUADRANT PATH	---	51	---	---	
SE QUADRANT PATH	---	92	---	---	
CTH JJ EB STA 301+33 TO 303+26	---	35	---	---	MEDIAN
CTH CB NB STA 106+35 TO 108+86	---	92	---	---	MEDIAN
CTH JJ EB STA 301+28	1	6	---	---	
CTH JJ WB STA 399+63	5	22	---	---	
CTH CB NB STA 108+76	1	6	---	---	
CTH CB SB STA 208+88	1	6	---	---	
CTH JJ WB STA 400+52 LT	---	---	2	---	DRIVEWAY
CTH JJ WB STA 401+20 LT	---	---	6	---	DRIVEWAY
CTH JJ WB STA 406+16 LT	---	---	13	---	DRIVEWAY
CTH JJ EB STA 307+05 RT			4	---	DRIVEWAY
CTH JJ EB STA 309+20 RT	---	---	6	---	DRIVEWAY
CTH CB NB STA 105+75	---	---	---	4	TEMPORARY CONNECTION
PROJECT TOTALS	8	391	32	4	

PROJECT TOTALS 8 391 32 4

CONCRETE SIDEWALK

LOCATION	602.0405 4-INCH SF	602.0415 6-INCH SF	602.0505 CURB RAMP DETECTABLE WARNING FIELD YELLOW SF
PROJECT 426-4738			
CTH CB (NORTH LEG)	1,932	---	---
PENDLETON RD (SOUTH LEG)	1,260	370	110
CTH JJ WEST LEG	2,480	700	80
CTH JJ EAST LEG	2,654	---	---

PROJECT TOTALS 8,330 1,070 190

CONCRETE CURB AND GUTTER

LOCATION	601.0405 18-INCH TYPE A LF	601.0409 30-INCH TYPE A LF	601.0411 30-INCH TYPE D LF	601.0580 4-INCH SLOPED 36-INCH TYPE R LF	601.0600 CONCRETE CURB PEDESTRIAN LF
PROJECT 426-4738					
NW QUADRANT	---	763	---	---	---
NE QUADRANT	---	815	---	---	---
SW QUADRANT	---	528	---	---	---
SE QUADRANT	---	658	---	---	---
CTH CB MEDIAN	---	804	---	---	---
PENDLETON RD MEDIAN	---	211	---	---	30
CTH JJ WEST LEG MEDIAN	---	620	33	---	83
CTH JJ EAST LEG MEDIAN	---	292	---	---	---
CTH CB/CTH JJ RAB	297	---	---	410	---

PROJECT TOTALS 297 4,691 33 410 113

CONCRETE MEDIAN SLOPED NOSE

STATION	DIR	LOCATION	620.0300 CONCRETE MEDIAN SLOPED NOSE SF
PROJECT 426-4738			
104+82	LT	CTH CB NB	27
204+88	RT	CTH CB SB	24
102+00	LT	PENDLETON RD NB	49
103+04	LT	PENDLETON RD NB	24
203+00	RT	PENDLETON RD SB	27
304+54	LT	CTH JJ EB	24
402+99	RT	CTH JJ WB	28
307+57	LT	CTH JJ EB	66
306+24	LT	CTH JJ EB	28
404+72	RT	CTH JJ WB	24

PROJECT TOTAL 321

3

STORM SEWER PIPE

FROM	-	TO	520.8000 CONCRETE COLLARS FOR PIPE EA	608.0005 STORM SEWER ROCK EXCAVATION CY	608.0315	608.0318	608.0324	608.0412	608.0415	608.0418	608.2319	608.2429	612.0208 PIPE UNDERDRAIN UNPERFORATED (PVC) 8-INCH LF	JOINT TIES (INFORMATION ONLY)
					REINFORCED CONCRETE						REINFORCED CONCRETE HORIZONTAL ELLIPTICAL			
					CLASS III 15-INCH LF	CLASS III 18-INCH LF	CLASS III 24-INCH LF	CLASS IV 12-INCH LF	CLASS IV 15-INCH LF	CLASS IV 18-INCH LF	CLASS HE-III 19X30-INCH LF	CLASS HE-IV 29X45-INCH LF		
PROJECT 426-4738														
EX MH-1.0	-	INL 1.1	---	---	---	---	---	---	---	---	---	---	---	---
EX MH-1.0	-	MH-2.0	---	45	---	---	---	---	---	---	---	116	---	---
MH-2.0	-	INL-2.1	---	---	---	---	6	---	---	---	---	---	---	---
MH-2.0	-	MH-3.0	---	27	---	---	---	---	---	---	---	105	---	---
INL-2.1	-	INL-2.2	---	---	---	---	34	---	---	---	---	---	---	---
MH-3.0	-	INL-3.1	---	---	---	---	6	---	---	---	---	---	---	---
MH-3.0	-	MH-4.0	---	27	---	---	---	---	---	---	---	206	---	---
INL-3.1	-	INL-3.2	---	---	---	---	10	---	---	---	---	---	---	---
MH-4.0	-	INL-4.1	---	---	---	---	---	---	---	---	---	---	---	---
MH-4.0	-	EX MH-5.0	---	26	---	---	---	---	---	---	---	200	---	---
INL-4.2	-	JCT 4.1	---	---	---	---	---	---	---	---	---	---	17	---
EX MH-5.0	-	INL-5.1	---	---	---	---	---	16	---	---	---	---	---	---
INL-5.1	-	INL-5.2	---	---	---	---	---	20	---	---	---	---	---	---
INL-5.1	-	INL-5.11	---	---	---	---	31	---	---	---	---	---	---	---
INL-5.2	-	INL-5.3	---	---	---	---	16	---	---	---	---	---	---	---
INL-5.2	-	INL-5.7	---	---	---	---	53	---	---	---	---	---	---	---
INL-5.2	-	INL-5.10	---	---	---	---	75	---	---	---	---	---	---	---
INL-5.3	-	INL-5.4	---	2	---	---	19	---	---	---	---	---	---	---
INL-5.4	-	INL-5.5	---	1	---	---	9	---	---	---	---	---	---	---
INL-5.4	-	INL-5.6	---	5	---	---	63	---	---	---	---	---	---	---
INL-5.7	-	INL-5.8	---	---	---	---	18	---	---	---	---	---	---	---
INL-5.8	-	INL-5.9	---	---	---	---	20	---	---	---	---	---	---	---
CC-6.3	-	CC-6.2	2	---	---	---	---	---	---	---	32	---	---	---
EX MH-6.0	-	INL-6.1	---	---	---	---	---	---	---	---	6	---	---	---
AEW-7.0	-	INL-7.1	---	---	10	---	---	---	---	---	---	---	---	4
INL-7.1	-	INL-7.2	---	---	---	---	122	---	---	---	---	---	---	---
MH-8.0	-	INL-8.1	---	---	---	---	27	---	---	---	---	---	---	---
MH-8.0	-	INL-8.2	---	---	---	---	22	---	---	---	---	---	---	---
EX MH-10.0	-	INL 10.1	---	---	---	---	48	---	---	---	---	---	---	---
EX MH-10.0	-	MH-11.0	---	---	---	52	---	---	---	---	---	---	---	---
INL-10.1	-	INL 10.2	---	---	---	---	25	---	---	---	---	---	---	---
MH-11.0	-	MH-12.0	---	---	---	---	---	63	---	---	---	---	---	---
MH-12.0	-	INL-12.1	---	---	---	---	14	---	---	---	---	---	---	---
INL-11.0	-	INL-11.1	---	---	---	---	---	---	48	---	---	---	---	---
INL-11.1	-	INL-11.2	---	---	---	---	---	---	51	---	---	---	---	---
INL-11.2	-	INL-11.3	---	3	---	33	---	---	---	---	---	---	---	---
INL-11.2	-	INL-11.4	---	---	---	---	12	---	---	---	---	---	---	---
CC-13.0	-	INL-13.1	1	---	---	---	8	---	---	---	---	---	---	---
UNDISTRIBUTED			---	9	---	---	---	---	---	---	---	---	---	---
PROJECT TOTALS			3	144	10	33	52	638	99	99	38	627	17	4

STORM SEWER STRUCTURES

REVISED 6/2/2022

REVISED 6/23/2022

3

3

STRUCT	STATION	OFFSET	ROADWAY	522.1015 APRON ENDWALLS FOR CULVERT PIPE REINFORCED CONCRETE 15-INCH EACH	611.0420 RECONST. MANHOLES EACH	611.0430 RECONST. INLETS EACH	611.0530 MANHOLE COVERS TYPE J EACH	611.0624 INLET COVERS TYPE H EACH	611.0639 INLET COVERS TYPE H-S EACH	611.0642 INLET COVERS TYPE MS EACH	611.0652 INLET COVERS TYPE T EACH	611.2004 MANHOLES 4-FT DIAMETER EACH	611.2007 MANHOLES 7-FT DIAMETER EACH	611.3004 INLETS 4-FT DIAMETER EACH	611.3230 INLETS 2X3-FT EACH	611.3901 INLETS MEDIAN 1 GRATE EACH	611.8110 ADJUSTING MANHOLE COVERS EACH	611.8115 ADJUSTING INLET COVERS EACH	SPV.0060.01 INLETS 2X2.5-FT SPECIAL EACH	SPV.0060.02 MANHOLES 7-FT DIAMETER EACH	650.4000 CONSTRUCTION STAKING STORM SEWER EACH
--------	---------	--------	---------	---	--	--	---	---	---	--	---	--	--	--	--------------------------------------	---	--	--	--	---	--

PROJECT 426-4738

EX MH-1.0	310+20.91	38.71' RT	CTH JJ EB	---	1	---	---	---	---	---	---	---	---	---	---	---	---	---	---	---	---
INL-1.1	310+19.36	25.50' RT	CTH JJ EB	---	---	---	---	---	---	---	---	---	---	---	---	---	---	1	---	---	---
MH-2.0	309+00.00	31.50' RT	CTH JJ EB	---	---	---	1	---	---	---	---	---	1	---	---	---	---	---	---	---	1
INL-2.1	309+00.00	25.50' RT	CTH JJ EB	---	---	---	---	1	---	---	---	---	---	1	---	---	---	---	---	---	1
INL-2.2	309+35.00	25.50' RT	CTH JJ EB	---	---	---	---	1	---	---	---	---	---	1	---	---	---	---	---	---	1
MH-3.0	307+90.17	31.48' RT	CTH JJ EB	---	---	---	1	---	---	---	---	---	1	---	---	---	---	---	---	---	1
INL-3.1	307+90.00	25.48' RT	CTH JJ EB	---	---	---	---	1	---	---	---	---	---	1	---	---	---	---	---	---	1
INL-3.2	308+00.00	25.50' RT	CTH JJ EB	---	---	---	---	1	---	---	---	---	---	1	---	---	---	---	---	---	1
MH-4.0	22+97.00	1.50' LT	CTH CB & JJ RAB	---	---	---	---	---	---	1	---	---	---	---	---	---	---	---	---	1	1
INL-4.1	23+25.00	1.50' LT	CTH CB & JJ RAB	---	---	---	---	---	---	---	---	---	---	---	---	---	---	---	---	---	---
ACT 4.1	306+27.60	1.40' LT	CTH JJ EB	---	---	---	---	---	---	---	---	---	---	---	---	---	---	---	---	---	1
INL-4.2	23+35.04	20.09' RT	CTH CB & JJ RAB	---	---	---	---	1	---	---	---	---	---	1	---	---	---	---	---	---	1
EX MH-5.0	303+80.00	24.68' RT	CTH JJ EB	---	1	---	---	---	---	---	---	---	---	---	---	---	---	---	---	---	---
INL-5.1	303+80.00	18.18' RT	CTH JJ EB	---	---	---	---	---	1	---	---	---	---	1	---	---	---	---	---	---	1
INL-5.2	303+80.00	1.50' LT	CTH JJ EB	---	---	---	---	---	1	---	---	---	---	1	---	---	---	---	---	---	1
INL-5.3	402+15.00	1.50' RT	CTH JJ WB	---	---	---	---	---	1	---	---	---	---	1	---	---	---	---	---	---	1
INL-5.4	402+15.00	17.50' LT	CTH JJ WB	---	---	---	---	---	1	---	---	---	---	1	---	---	---	---	---	---	1
INL-5.5	303+71.21	33.93' LT	CTH JJ EB	---	---	---	---	1	---	---	---	---	---	1	---	---	---	---	---	---	1
INL-5.6	304+19.14	63.18' LT	CTH JJ EB	---	---	---	---	1	---	---	---	---	---	1	---	---	---	---	---	---	1
INL-5.7	401+58.00	1.50' RT	CTH JJ WB	---	---	---	---	1	---	---	---	---	---	1	---	---	---	---	---	---	1
INL-5.8	401+40.00	1.50' RT	CTH JJ WB	---	---	---	---	1	---	---	---	---	---	1	---	---	---	---	---	---	1
INL-5.9	401+34.50	17.50' LT	CTH JJ WB	---	---	---	---	1	---	---	---	---	---	1	---	---	---	---	---	---	1
INL-5.10	21+54.56	19.53' RT	CTH CB & JJ RAB	---	---	---	---	---	1	---	---	---	---	1	---	---	---	---	---	---	1
INL-5.11	303+44.73	17.50' RT	CTH JJ EB	---	---	---	---	1	---	---	---	---	---	1	---	---	---	---	---	---	1
EX MH-6.0	301+91.76	23.63' RT	CTH JJ EB	---	---	---	---	---	---	---	---	---	---	---	---	---	1	---	---	---	---
INL-6.1	301+91.77	17.50' RT	CTH JJ EB	---	---	1	---	1	---	---	---	---	---	1	---	---	---	---	---	---	1
AEW-7.0	408+06.22	33.64' LT	CTH JJ WB	1	---	---	---	---	---	---	---	---	---	---	---	---	---	---	---	---	1
INL-7.1	408+00.00	25.50' LT	CTH JJ WB	---	---	---	---	1	---	---	---	---	---	1	---	---	---	---	---	---	1
INL-7.2	406+81.15	27.52' LT	CTH JJ WB	---	---	---	---	1	---	---	---	---	---	1	---	---	---	---	---	---	1
MH-8.0	101+54.94	5.41' LT	CTH CB NB	---	---	---	1	---	---	---	---	1	---	---	---	---	---	---	---	---	1
INL-8.1	201+56.93	26.98' LT	CTH CB SB	---	---	---	---	1	---	---	---	---	---	1	---	---	---	---	---	---	1
INL-8.2	101+54.94	16.50' RT	CTH CB NB	---	---	---	---	1	---	---	---	---	---	1	---	---	---	---	---	---	1
EX MH 10.0	405+39.05	89.83' LT	CTH JJ WB	---	1	---	---	---	---	---	---	---	---	---	---	---	---	---	---	---	---
INL-10.1	405+51.76	42.33' LT	CTH JJ WB	---	---	---	---	1	---	---	---	---	---	1	---	---	---	---	---	---	1
INL-10.2	405+54.02	17.33' LT	CTH JJ WB	---	---	---	---	1	---	---	---	---	---	1	---	---	---	---	---	---	1
EX INL-10.3	405+19.67	102.50' LT	CTH JJ WB	---	---	---	---	---	---	---	---	---	---	---	---	---	---	---	---	---	---
MH 11.0	105+03.84	34.78' RT	CTH CB NB	---	---	---	---	1	---	---	---	---	---	1	---	---	---	---	---	---	1
INL-11.1	24+18.84	20.42' RT	CTH CB & JJ RAB	---	---	---	---	1	---	---	---	---	---	1	---	---	---	---	---	---	1
INL-11.2	204+82.14	18.42' LT	CTH CB SB	---	---	---	---	---	1	---	---	---	---	1	---	---	---	---	---	---	1
INL-11.3	204+81.75	51.16' LT	CTH CB SB	---	---	---	---	---	---	1	---	---	---	---	---	1	---	---	---	---	1
INL-11.4	305+38.23	147.83' LT	CTH JJ EB	---	---	---	---	1	---	---	---	---	---	1	---	1	---	---	---	---	1
MH 12.0	105+59.80	1.50' LT	CTH CB NB	---	---	---	---	1	---	---	---	---	---	1	---	---	---	---	---	---	---
INL-12.1	205+67.10	1.50' RT	CTH CB SB	---	---	---	---	1	---	---	---	---	---	1	---	---	---	---	---	---	1
MH 13.2	107+12.83	3.64' LT	CTH CB NB	---	---	---	---	---	---	---	---	---	---	---	---	---	1	---	---	---	---
INL-13.1	207+17.85	17.50' LT	CTH CB SB	---	---	---	---	1	---	---	---	---	---	1	---	---	---	---	---	---	1
INL-13.3	107+13.20	18.20' RT	CTH JJ EB	---	---	---	---	---	---	---	---	---	---	---	---	---	---	1	---	---	---

PROJECT TOTALS

1 3 1 3 23 7 1 1 2 6 24 1 2 2 0 1 36

PROJECT NO: 426-4738

HWY: CTH JJ

COUNTY: WINNEBAGO

MISCELLANEOUS QUANTITIES

SHEET 51

E

3.5

PIPE UNDERDRAIN

STORM SEWER STRUCTURE NUMBER	LOCATION	310.0115 BASE AGGREGATE OPEN GRADED CY	612.0106 PIPE UNDERDRAIN 6-INCH LF	645.0111 GEOTEXTILE TYPE DF SCHEDULE A SY
PROJECT 426-4738				
MH-4.0	CTH CB & CTH JJ RAB	0.50	16.0	9.0
INL-4.1	CTH CB & CTH JJ RAB	---	---	---
INL-4.2	CTH CB & CTH JJ RAB	0.25	8.0	4.5
INL-5.1	CTH JJ WB	0.25	8.0	4.5
INL-5.5	CTH CB & CTH JJ RAB	0.25	8.0	4.5
INL-11.2	CTH JJ WB	0.25	8.0	4.5

PROJECT TOTALS 1.50 48 27.00

LANDMARK REFERENCE MONUMENTS

STATION	DIRECTION	ROADWAY	621.0100 LANDMARK REFERENCE MONUMENTS EACH	621.1200 LANDMAKR REFERENCE MONUMENTS AND ALUMINUM COVERS EACH
PROJECT 426-4738				
201'SB'+89	LT	PENDLETON ROAD	4	1
PROJECT TOTALS			4	1

EROSION CONTROL

LOCATION	628.1504 SILT FENCE LF	628.1520 SILT FENCE MAINTENANCE LF	628.1905 MOBILIZATIONS EROSION CONTROL EA	628.1910 MOBILIZATIONS EMERGENCY EROSION CONTROL EA	628.7005 INLET PROTECTION TYPE A EA	628.7015 INLET PROTECTION TYPE C EA	628.7020 INLET PROTECTION TYPE D EA	628.7555 CULVERT PIPE CHECKS EA	628.7560 TRACKING PADS EA	628.7570 ROCK BAGS EA
PROJECT 426-4738										
CTH CB (NORTH LEG)	352	352	---	---	2	5	2	---	---	---
PENDLETON RD (SOUTH LEG)	---	---	---	---	---	2	2	---	---	---
CTH JJ WEST LEG	---	---	---	---	---	7	4	8	---	---
CTH JJ EAST LEG	532	532	---	---	---	9	3	---	---	---
CTH CB/JJ RAB	---	---	---	---	---	2	2	---	---	---
UNDISTRIBUTED	300	300	4	2	1	7	4	---	2	20

PROJECT TOTALS 1,184 1,184 4 2 3 32 17 8 2 20

RESTORATION

LOCATION	630.0500 SEED WATER MGAL	625.0100 TOPSOIL SY	628.2006 EROSION MAT SY	629.0210 FERTILIZER TYPE B CWT	630.0140 SEEDING MIXTURE #40 LB	SPV.0085.01 LOW MOW SEEDING LB
			URBAN CLASS I TYPE A			
PROJECT 426-4738						
NW QUADRANT	30	1,290	1,290	0.8	23	0
NE QUADRANT	30	1,560	1,560	1.0	28	0
SW QUADRANT	30	1,120	1,120	0.7	20	0
SE QUADRANT	40	1,590	1,590	1.0	29	0
CTH CB/JJ RAB	20	750	750	0.5	0	20
UNDISTRIBUTED	40	1,580	1,580	1.0	30	10

PROJECT TOTALS 190 7,890 7,890 5.0 130 30

FLOWABLE FILL

STATION	DIR	LOCATION	SPV.0035.01 FLOWABLE FILL CY	NOTES
307+90	25.5' RT	EB CTH JJ EAST	2	BETWEEN MH 3.0 - INL 3.1
309+00	25.5' RT	EB CTH JJ EAST	2	BETWEEN MH 2.0 - INL 2.1
PROJECT TOTAL			4	

PERMANENT SIGNS TYPE II AND SIGN SUPPORTS

SIGN NO.	STATION	REFERENCE LINE	FACE DIR.	SIGN CODE	DESCRIPTION	SIGN W X H IN X IN	ASSEMBLY NO.	WIDTH IN	HEIGHT IN	POSTS WOOD 4 X 6-INCH				637.2210 SIGNS TYPE II REFLECTIVE H SF	637.2230 SIGNS TYPE II REFLECTIVE F SF	REMARKS
										634.0612 12-FT EACH	634.0614 14 FT EACH	634.0616 16 FT EACH	634.0618 18 FT EACH			
101	296+35	RT	CTH JJ EB	WB	M2-1 JCT	21 X 15	J1-1	24.00	39.00	---	---	1	---	6.50	---	
					M1-5A CTH CB	24 X 24				---	---	---	---			
102	297+85	RT	CTH JJ EB	WB	W2-6 RAB	30 X 30				---	---	---	1	---	6.25	
					W13-1 15 MPH	18 X 18				---	---	---	---	---	2.25	
103	301+35	RT	CTH JJ EB	WB	W3-2 YIELD AHEAD	36 X 36				---	---	1	---	---	9.00	
104	303+29	LT	CTH JJ EB	WB	R4-7 SPLITTER ISLAND LEFT	24 X 30				---	---	1	---	5.00	---	
105	401+77	LT	CTH JJ WB	EB	M3-4 WEST	24 X 12	J1-1	24.00	36.00	---	---	1	---	6.00	---	
					M1-5A CTH JJ	24 X 24				---	---	---	---			
106	304+17	RT	CTH JJ EB	WB	W11-2 PEDESTRIAN CROSSING	30 X 30				---	---	1	---	---	6.25	
					W16-7L ARROW LEFT	24 X 12				---	---	---	---	---	2.00	
109	402+75	LT	CTH JJ WB	EB	W11-2 PEDESTRIAN CROSSING	30 X 30				---	---	1	---	---	6.25	
					W16-7L ARROW LEFT	24 X 12				---	---	---	---	---	2.00	
110	304+60	RT	CTH JJ EB	WB	R1-2 YIELD	36 X 31				---	---	---	1	3.88	---	
					R1-54 TO TRAFFIC FROM LEFT	24 X 15				---	---	---	---	2.50	---	
111	304+50	LT	CTH JJ EB	WB	R1-2 YIELD	36 X 31				---	---	---	1	3.88	---	
					R6-2R ONE WAY RT ARROW	24 X 30				---	---	---	---	5.00	---	
112	402+91	RT	CTH JJ WB	EB	D1-1 CTH JJ ARROW UP RIGHT	36 X 18				---	1	---	---	4.50	---	
113	22+10	RT	RAB	EB	R6-1R ONE WAY RIGHT	54 X 18				---	---	2	---	6.75	---	
					R6-4B RIGHT CHEVRON	60 X 24				---	---	---	---	10.00	---	MOUNTING HT. 4' TO BOTTOM OF SIGN
114	22+82	RT	RAB	NB	R6-1R ONE WAY RIGHT	54 X 18				---	---	2	---	6.75	---	
					R6-4B RIGHT CHEVRON	60 X 24				---	---	---	---	10.00	---	MOUNTING HT. 4' TO BOTTOM OF SIGN
115	23+95	RT	RAB	WB	R6-1R ONE WAY RIGHT	54 X 18				---	---	2	---	6.75	---	
					R6-4B RIGHT CHEVRON	60 X 24				---	---	---	---	10.00	---	MOUNTING HT. 4' TO BOTTOM OF SIGN
116	20+45	RT	RAB	SB	R6-1R ONE WAY RIGHT	54 X 18				---	---	2	---	6.75	---	
					R6-4B RIGHT CHEVRON	60 X 24				---	---	---	---	10.00	---	MOUNTING HT. 4' TO BOTTOM OF SIGN
117	202+88	LT	CTH CB SB	NB	W11-2 PEDESTRIAN CROSSING	30 X 30				---	---	1	---	---	6.25	
					W16-7L ARROW LEFT	24 X 12				---	---	---	---	---	2.00	
117A	102+73	RT	CTH CB NB	SB	W11-2 PEDESTRIAN CROSSING	30 X 30				---	---	---	---	---	6.25	
					W16-7L ARROW LEFT	24 X 12				---	---	---	---	---	2.00	
118	202+95	RT	CTH CB SB	NB	D1-1 PENDLETON RD	60 X 24				---	---	2	---	10.00	---	
120	202+04	RT	CTH CB SB	SB	R4-7 SPLITTER ISLAND LEFT	24 X 30				---	---	1	---	5.00	---	
121	103+00	LT	CTH CB NB	SB	R1-2 YIELD	36 X 31				---	---	---	1	3.88	---	
					R6-2R ONE WAY RT ARROW	24 X 30				---	---	---	---	5.00	---	
122	103+10	RT	CTH CB NB	SB	R1-2 YIELD	36 X 31				---	---	---	1	3.88	---	
					R1-54 TO TRAFFIC FROM LEFT	24 X 15				---	---	---	---	2.50	---	
123	306+33	LT	CTH JJ EB	WB	D1-1 CTH JJ ARROW UP RIGHT	36 X 18				---	1	---	---	4.50	---	
124	404+78	RT	CTH JJ WB	EB	R1-2 YIELD	36 X 31				---	---	---	1	3.88	---	
					R6-2R ONE WAY RT ARROW	24 X 30				---	---	---	---	5.00	---	
125	105+05	RT	CTH CB NB	SB	R1-2 YIELD	36 X 31				---	---	---	1	3.88	---	
					R1-54 TO TRAFFIC FROM LEFT	24 X 15				---	---	---	---	2.50	---	
126	404+62	LT	CTH JJ WB	EB	R1-2 YIELD	36 X 31				---	---	---	1	3.88	---	
					R1-54 TO TRAFFIC FROM LEFT	24 X 15				---	---	---	---	2.50	---	
127	405+55	LT	CTH JJ WB	EB	W12-1D ARROWS DOWN LT & RT	24 X 24				1	---	---	---	---	4.00	SPECIAL HT. 2'-3" PER SIGN PLATE A4-3
128	405+85	RT	CTH JJ WB	EB	R4-7 SPLITTER ISLAND LEFT	24 X 30				---	---	1	---	5.00	---	
129	307+72	RT	CTH JJ EB	WB	M3-2 EAST	24 X 12	J1-1	24.00	36.00	---	---	1	---	6.00	---	
					M1-5A CTH JJ	24 X 24				---	---	---	---			
130	407+75	LT	CTH JJ WB	EB	W3-2 YIELD AHEAD ARROW	36 X 36				---	---	1	---	---	9.00	
131	409+05	LT	CTH JJ WB	EB	R3-8IR LT LANE STRAIGHT/RIGHT, RIGHT TURN ONLY	36 X 30				---	---	1	---	7.50	---	
132	411+25	LT	CTH JJ WB	EB	W2-6 RAB	30 X 30				---	---	---	1	---	6.25	
					W13-1 15 MPH	18 X 18				---	---	---	---	---	2.25	
133	412+75	LT	CTH JJ WB	EB	M2-1 JCT	21 X 15	J1-1	24.00	39.00	---	---	1	---	6.50	---	
					M1-5A CTH CB	24 X 24				---	---	---	---			
134	98+10	RT	PENDLETON RD	SB	W2-6 RAB	30 X 30				---	---	---	1	---	6.25	
					W13-1 15 MPH	18 X 18				---	---	---	---	---	2.25	
135	204+90	LT	CTH CB SB	NB	R1-2 YIELD	36 X 31				---	---	---	1	3.88	---	
					R1-54 TO TRAFFIC FROM LEFT	24 X 15				---	---	---	---	2.50	---	
136	204+94	RT	CTH CB SB	NB	R1-2 YIELD	36 X 31				---	---	---	1	3.88	---	
					R6-2R ONE WAY RT ARROW	24 X 30				---	---	---	---	5.00	---	
137	104+90	LT	CTH CB NB	SB	D1-1 CTH CB ARROW UP RIGHT	36 X 15				---	1	---	---	3.75	---	
138	210+65	LT	CTH CB NB	SB	W3-2 YIELD AHEAD ARROW	36 X 36				---	---	1	---	---	9.00	
139	214+15	LT	CTH CB NB	SB	W2-6 RAB	30 X 30				---	---	---	1	---	6.25	
					W13-1 15 MPH	18 X 18				---	---	---	---	---	2.25	

PROJECT TOTALS PROJECT TOTALS 1 3 9 10 100.41 49.50

PROJECT NO: 426-4738

HWY: CTH JJ

COUNTY: WINNEBAGO

MISCELLANEOUS QUANTITIES

SHEET

E 3.7

3

MOVING SIGNS TYPE II AND MOVING SMALL SIGN SUPPORTS

SIGN NO.	FROM STATION	TO STATION	LOCATION	DESCRIPTION	638.2102 MOVING SIGNS TYPE II EACH	638.4000 MOVING SMALL SIGN SUPPORTS EACH
PROJECT 426-4738						
M101	301'EB'+05 RT	301'EB'+00 RT	CTH JJ	SPEED LIMIT 40 MPH	1	1
M102	201'SB'+00 LT	201'SB'+00 LT	CTH CB	LEFT ARROW	1	1
PROJECT TOTALS					2	2

REMOVING SIGNS TYPE II AND REMOVING SMALL SIGN SUPPORTS

SIGN NO.	STATION	LOCATION	DESCRIPTION	638.2602 REMOVING SIGNS TYPE II EACH	638.3000 REMOVING SMALL SIGN SUPPORTS EACH
PROJECT 426-4738					
R101	403'WB'+11 LT	CTH JJ WEST	PEDESTRIAN CROSSING	1	1
R102	402'WB'+60 RT	CTH JJ WEST	SPLITTER ISLAND LEFT	1	1
R103	21+04 LT	RAB	SPLITTER ISLAND LEFT	1	1
R104	21+53 LT	RAB	PEDESTRIAN CROSSING	1	1
R105	405'WB'+60 LT	CTH JJ WEST	CTH CB RT LANE MUST TURN RT	1	1
R106	410'WB4+70 LT	CTH JJ WEST	PEDESTRIAN CROSSING	1	1
R107	201'SB'+35 LT	CTH CB SB	END OF ROAD MARKER	1	1
R108	201'SB'+35 RT	CTH CB SB	END OF ROAD MARKER	1	1
R109	20+46 RT	RAB	LEFT ARROW	1	1
R110	205'SB'+05 LT	CTH CB SB	STOP SIGN	1	1
R111	205'SB'+50 RT	CTH CB SB	CTH JJ RT & LEFT ARROW	1	1
R112	LT	CTH CB SB	STOP AHEAD	1	1
PROJECT TOTALS				12	12

3

MARKING

STATION TO STATION	LOCATION	646.9000	646.1020		646.3020	646.5020		646.5120	646.6320	646.7120	SPV.0090.01	646.7420	646.8120	646.8220	SPV.0090.02
		REMOVAL LINE 4-INCH LF	LINE EPOXY 4-INCH (YELLOW) LF (WHITE) LF		LINE EPOXY 8-INCH (WHITE) LF	ARROW EPOXY (TYPE 2) (TYPE 3R) (WHITE) (WHITE) EA EA		WORD EPOXY (ONLY) EA	DOTTED EXTENSION EPOXY 18-INCH (WHITE) LF	DIAGONAL EPOXY 12-INCH (YELLOW) LF	CHEVRON EPOXY 12-INCH (WHITE) LF	CROSSWALK EPOXY TRANSVERSE LINE 6-INCH (WHITE) LF	CURB EPOXY (YELLOW) LF	ISLAND NOSE EPOXY (YELLOW) EACH	TEMPORARY MARKING LINE REMOVABLE TAPE 6-INCH (WHITE) LF
PROJECT 426-4738															
301+23 - 304+62	CTH JJ	--	474	475	138	--	--	--	26	--	--	68	--	--	---
306+08 - 410+25	CTH JJ	40	1,485	63	802	2	2	1	58	95	44	--	10	1	92
100+90 - 103+10	PENDLETON ROAD	--	656	--	79	--	--	--	18	25	--	72	10	1	---
204+82 - 208+93	CTH CB	--	543	638	76	--	--	--	24	--	--	--	--	--	76
PROJECT SUBTOTALS		40	3,158	1,176	1,095	2	2	1	126	120	44	140	20	2	168
PROJECT TOTALS		40	4,334	1,095	4	1	126	120	44	140	20	2	168		

3

3

TEMPORARY PEDESTRIAN TRAFFIC CONTROL

LOCATION	643.0410 TRAFFIC CONTROL BARRICADES TYPE II			643.0900 TRAFFIC CONTROL SIGNS			644.1410 TEMPORARY PEDESTRIAN SURFACE ASPHALT	644.1601 TEMPORARY CURB RAMP			644.1810 TEMPORARY PEDESTRIAN BARRICADES
	NUMBER	CALENDAR DAYS	DAYS	NUMBER	CALENDAR DAYS	DAYS	SF	NUMBER	CALENDAR DAYS	DAYS	LF
PROJECT 426-4738											
CTH CB TRAIL DETOUR	---	---	---	---	---	---	80	---	---	---	882
STAGE 1	---	13	---	---	13	---	---	---	13	---	---
STAGE 2A	11	1	11	11	1	11	---	2	1	2	---
STAGE 2B	---	1	---	---	1	---	---	---	1	---	---
STAGE 3	11	64	704	11	64	704	---	2	64	128	---
STAGE 4	---	14	---	---	14	---	---	---	14	---	---
PROJECT TOTALS		93	715		93	715	80		93	130	882

SAWING

STATION	DIR	ROADWAY	690.0150	690.0250
			SAWING ASPAHLT LF	SAWING CONCRETE LF
PROJECT 426-4738				
208+47	LT	CTH CB SB	25	2.5
208+93	L/R	CTH CB SB	29	2.0
106+05	L/R	CTH CB NB	---	4.0
106+15	RT	CTH CB NB	16	---
101+35	L/R	PENDLETON RD NB	---	49.0
301+23	RT	CTH JJ EB	15	---
301+33	L/R	CTH JJ EB	9	5.0
399+63	LT	CTH JJ WB	17	---
399+63	L/R	CTH JJ WB	---	1.5
400+52	LT	CTH JJ WB	16	---
401+20	LT	CTH JJ WB	21	---
307+01	RT	CTH JJ EB	11	---
406+20	LT	CTH JJ WB	17	---
309+12	RT	CTH JJ EB	22	---
310+25	RT	CTH JJ EB	10	---
310+54	L/R	CTH JJ EB	---	88.0
PROJECT TOTAL			208	152

CONSTRUCTION STAKING

STATION TO STATION	ROADWAY	650.4500	650.7000	650.9000	650.9910	650.9920
		SUBGRADE LF	CONCRETE PAVEMENT LF	CURB RAMPS EA	SUPPLEMENTAL CONTROL LS	SLOPE STAKES LF
PROJECT 426-4738						
101+35 - 108+76	CTH CB NB	480	741	4	---	480
201+34 - 208+93	CTH CB SB	759	759	3	---	759
301+23 - 310+39	CTH JJ EB	916	916	3	---	916
399+63 - 409+04	CTH JJ WB	811	941	3	---	811
20+00 - 24+23	CTH CB/JJ RAB	423	423	---	---	423
UNDISTRIBUTED		---	---	---	1	---
PROJECT TOTALS		3,389	3,780	13	1	3,389

NOTES: CONSTRUCTION STAKING STORM SEWER LOCATED IN STORM SEWER TABLES.
CONSTRUCTION STAKING CURB AND GUTTER LOCATED IN CURB AND GUTTER TABLE.

R/W PROJECT NUMBER 3000994	SHEET NUMBER	TOTAL SHEETS
R/W PROJECT NUMBER	4.01	6
PLAT OF RIGHT OF WAY REQUIRED FOR CTH CB / CTH JJ TOWN OF NEENAH / CITY OF NEENAH		
CTH CB	WINNEBAGO COUNTY	

CONVENTIONAL SYMBOLS

SECTION LINE	---	PARCEL NUMBER	(25)	UTILITY NUMBER	(40)
QUARTER LINE	---	SECTION CORNER	(18, 23, 24, 16, 15, 9)	R/W MONUMENT	●
SIXTEENTH LINE	---	NOTATION FOR COMBUSTIBLE FLUIDS	CAUTION	NON-MONUMENTED R/W POINT	○
NEW REFERENCE LINE	---	NOTATION FOR HIGH VOLTAGE TRANSMISSION LINES	CAUTION	FOUND IRON PIN	IP
NEW R/W LINE	---			VALVE (GAS, WATER, ETC.)	(TYPE)
EXISTING R/W LINE	---			SIGN	SIGN
PROPERTY LINE	---			OFF-PREMISE SIGN	#1-25 SIGN
LOT, TIE, AND OTHER MINOR LINES	---			R/W POINT	(1)
SLOPE INTERCEPT	---			TLE POINT	(1)
CORPORATE LIMITS	---			PLE POINT	(1)
UNDERGROUND FACILITY (COMMUNICATIONS, ELECTRIC, ETC)	---				
FEE ACQUISITION AREA (HATCHING VARIES BY OWNER)	---				
TEMP. LIMITED EASEMENT AREA	---	ACCESS CONTROLLED BY ACQUISITION	---		
EASEMENT AREA (HIGHWAY, PERMANENT LIMITED, OR RESTRICTED DEVELOPMENT)	---	NO ACCESS (BY STATUTORY AUTHORITY)	---		
TRANSMISSION STRUCTURES	---	ACCESS RESTRICTED (BY PREVIOUS PROJECT OR CONTROL)	---		
BUILDING	---	NO ACCESS (NEW HIGHWAY)	---		
BUILDING (TO BE REMOVED)	---	NATIONAL GEODETIC SURVEY MONUMENT	---		
BRIDGE	---	SIXTEENTH CORNER MONUMENT	---		
		PARALLEL OFFSETS	---		

CONVENTIONAL UTILITY SYMBOLS

WATER	---	NON-COMPENSABLE	---	COMPENSABLE	---
GAS	---	POWER POLE	---	TELEPHONE POLE	---
TELEPHONE	---	TELEPHONE PEDESTAL	---	TELEPHONE PEDESTAL	---
OVERHEAD TRANSMISSION LINES	---				
ELECTRIC	---				
CABLE TELEVISION	---				
FIBER OPTIC	---				
SANITARY SEWER	---				
STORM SEWER	---				
ELECTRIC TOWER	---				

CURVE DATA ABBREVIATIONS

LONG CHORD	LCH
LONG CHORD BEARING	LCB
RADIUS	R
DEGREE OF CURVE	D
CENTRAL ANGLE	Δ/DELTA
LENGTH OF CURVE	L
TANGENT	T
DIRECTION AHEAD	DA
DIRECTION BACK	DB

CONVENTIONAL ABBREVIATIONS

ACCESS RIGHTS	AR	OUTLOT	OL
ACRES	AC	PAGE	P
AHEAD	AH	POINT OF TANGENCY	PT
ALUMINUM	ALUM	PROPERTY LINE	PL
AND OTHERS	ET AL	RECORDED AS (100')	
BACK	BK	REEL / IMAGE	R/I
BLOCK	BLK	REFERENCE LINE	R/L
CENTERLINE	C/L	PERMANENT LIMITED EASEMENT	PLE
CERTIFIED SURVEY MAP	CSM	POINT OF BEGINNING	POB
CONCRETE	CONC	POINT OF CURVATURE	PC
COUNTY	CO	POINT OF COMPOUND CURVE	PCC
COUNTY TRUNK HIGHWAY	CTH	POINT OF INTERSECTION	PI
DISTANCE	DIST	REMAINING	REM
CORNER	COR	RESTRICTIVE DEVELOPMENT EASEMENT	RDE
DOCUMENT NUMBER	DOC	RIGHT	RT
EASEMENT	EASE	RIGHT OF WAY	R/W
EXISTING	EX	SECTION	SEC
GAS VALVE	GV	SEPTIC VENT	SEPV
GRID NORTH	GN	SQUARE FEET	SF
HIGHWAY EASEMENT	HE	STATE TRUNK HIGHWAY	STH
IDENTIFICATION	ID	STATION	STA
LAND CONTRACT	LC	TELEPHONE PEDESTAL	TP
LEFT	LT	TEMPORARY LIMITED EASEMENT	TLE
MONUMENT	MON	TRANSPORTATION PROJECT PLAT	TTP
NATIONAL GEODETIC SURVEY	NGS	UNITED STATES HIGHWAY	USH
NUMBER	NO	VOLUME	V

NOTES:

POSITIONS SHOWN ON THIS PLAT ARE WISCONSIN COORDINATE REFERENCE SYSTEM COORDINATES (WISCRS), WINNEBAGO COUNTY, NAD83 1991 IN US SURVEY FEET. VALUES SHOWN ARE GRID COORDINATES, GRID BEARINGS, AND GRID DISTANCES. GRID DISTANCES MAY BE USED AS GROUND DISTANCES.


RIGHT-OF-WAY MONUMENTS ARE 1"X18" IRON PIPE AND ARE PLACED PRIOR TO OR AT THE TIME OF LAND TITLE TRANSFER.

RIGHT-OF-WAY BOUNDARIES ARE DEFINED WITH COURSES OF THE PERIMETER OF THE HIGHWAY LANDS REFERENCED TO THE U.S. PUBLIC LAND SURVEY SYSTEM OR OTHER "SURVEYS" OF PUBLIC RECORD.

PROPERTY LINES SHOWN ON THIS PLAT ARE DRAWN FROM DATA DERIVED FROM MAPS AND DOCUMENTS OF PUBLIC RECORD AND/OR EXISTING OCCUPATIONAL LINES. THIS PLAT MAY NOT BE A TRUE REPRESENTATION OF EXISTING PROPERTY LINES, EXCLUDING RIGHT-OF-WAY, AND SHOULD NOT BE USED AS SUBSTITUTE FOR AN ACCURATE FIELD SURVEY.


A TEMPORARY LIMITED EASEMENT (TLE) IS A RIGHT FOR CONSTRUCTION PURPOSES, AS DEFINED HEREIN, INCLUDING THE RIGHT TO OPERATE NECESSARY EQUIPMENT THEREON, THE RIGHT OF INGRESS AND EGRESS, AS LONG AS REQUIRED FOR SUCH PUBLIC PURPOSE, INCLUDING THE RIGHT TO PRESERVE, PROTECT, REMOVE, OR PLANT THEREON ANY VEGETATION THAT THE HIGHWAY AUTHORITIES MAY DEEM DESIRABLE. ALL (TLE's) ON THIS PLAT EXPIRE AT THE COMPLETION OF THE CONSTRUCTION PROJECT FOR WHICH THIS INSTRUMENT IS GIVEN.

A PERMANENT LIMITED EASEMENT (PLE) IS A RIGHT FOR CONSTRUCTION AND MAINTENANCE PURPOSES, AS DEFINED HEREIN, INCLUDING THE RIGHT TO OPERATE THE NECESSARY EQUIPMENT THEREON AND THE RIGHT OF INGRESS AND EGRESS AS LONG AS REQUIRED FOR SUCH PUBLIC PURPOSE, INCLUDING THE RIGHT TO PRESERVE, PROTECT, REMOVE OR PLANT THEREON ANY VEGETATION THAT THE HIGHWAY AUTHORITIES MAY DEEM NECESSARY OR DESIRABLE, BUT WITHOUT PREJUDICE TO THE OWNERS RIGHT TO MAKE OR CONSTRUCT IMPROVEMENTS ON SAID LANDS OR TO FLATTEN THE SLOPES, PROVIDING SAID ACTIVITIES WILL NOT IMPAIR OR OTHERWISE ADVERSELY AFFECT THE HIGHWAY FACILITIES.

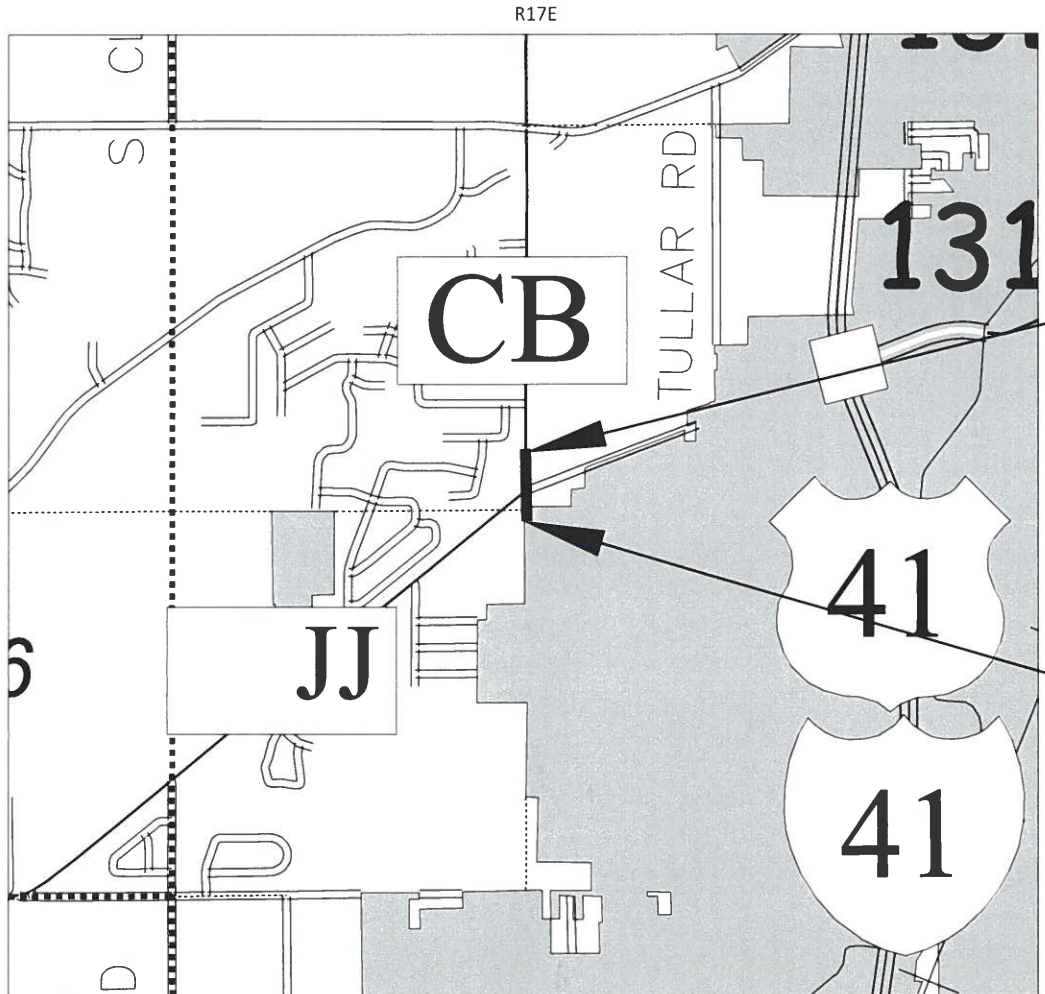

END RELOCATION ORDER
STA 608+30.00
 673.30 FEET NORTH OF AND 1.13 FEET EAST OF SW CORNER OF SECTION 29, T20N, R17E, TOWN OF NEENAH, WINNEBAGO COUNTY WISCONSIN
 Y=529725.700
 X=801654.755

BEGIN RELOCATION ORDER
STA 600+00.00
 156.70 FEET SOUTH OF AND 0.02 FEET WEST OF THE SW CORNER, SECTION 29, T20N, R17E, CITY OF NEENAH, WINNEBAGO COUNTY WISCONSIN
 Y=528895.701
 X=801653.606

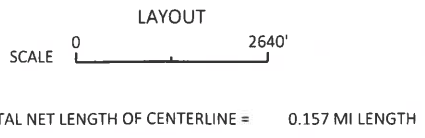

ACCEPTED FOR
 WINNEBAGO COUNTY
 Date: 11/20/20
 (Signature and Title of Official)

ORIGINAL PLANS PREPARED BY
OMNI ASSOCIATES
 a Westwood company



DATE: 11-19-2020 David A. Yurk
 (Signature)
 56


SCHEDULE OF LANDS & INTERESTS REQUIRED

OWNERS NAMES ARE SHOWN FOR REFERENCE PURPOSES ONLY AND ARE SUBJECT TO CHANGE PRIOR TO THE TRANSFER OF LAND INTEREST TO THE COUNTY OF WINNEBAGO.

4

PARCEL NUMBER	PLAT SHEET NUMBER	OWNER	INT. REQD.	TOTAL AREA	AREA ACRES REQUIRED			TOTAL AREA REMAINING	TLE Area	PLE Area
					NEW	EXISTING	TOTAL			
1	1	MATTHEW E. ZODROW & TINA M. ZODROW	FEE TLE	3.56 AC	0.05 AC	----	0.05 AC	3.51 AC	0.16 AC	98 Sq Ft
2	2	PENDLETON PARK LLC	FEE TLE	28.35 AC	0.06 AC	----	0.06 AC	28.29 AC	0.16 AC	----
3	3	HOWARD F. JERSILD & ANGELA J. PARKER	TLE	0.26 AC	----	----	----	0.26 AC	0.05 AC	----
4	4	THE STEVEN E. SMITH REVOCABLE TRUST DATED 10-16-2018	FEE TLE	1.05 AC	0.37 AC	----	0.37 AC	0.68 AC	0.13 AC	----
6	6	MARK R. JENSEN	FEE TLE	1.03 AC	0.03 AC	----	0.03 AC	1.00 AC	0.07 AC	----
7	7	THOMAS G. FOTH & MARY ANN FOTH	TLE	0.97 AC	----	----	----	0.97 AC	200 Sq Ft	----

REVISION DATE:	DATE: 11-19-2020	HWY: CTH CB / CTH JJ	STATE R/W PROJECT : NUMBER 3000994	PLAT SHEET NO: 4.02
		COUNTY: WINNEBAGO	CONSTRUCTION PROJECT NUMBER: 3000994	PS&E SHEET NO: 57 E

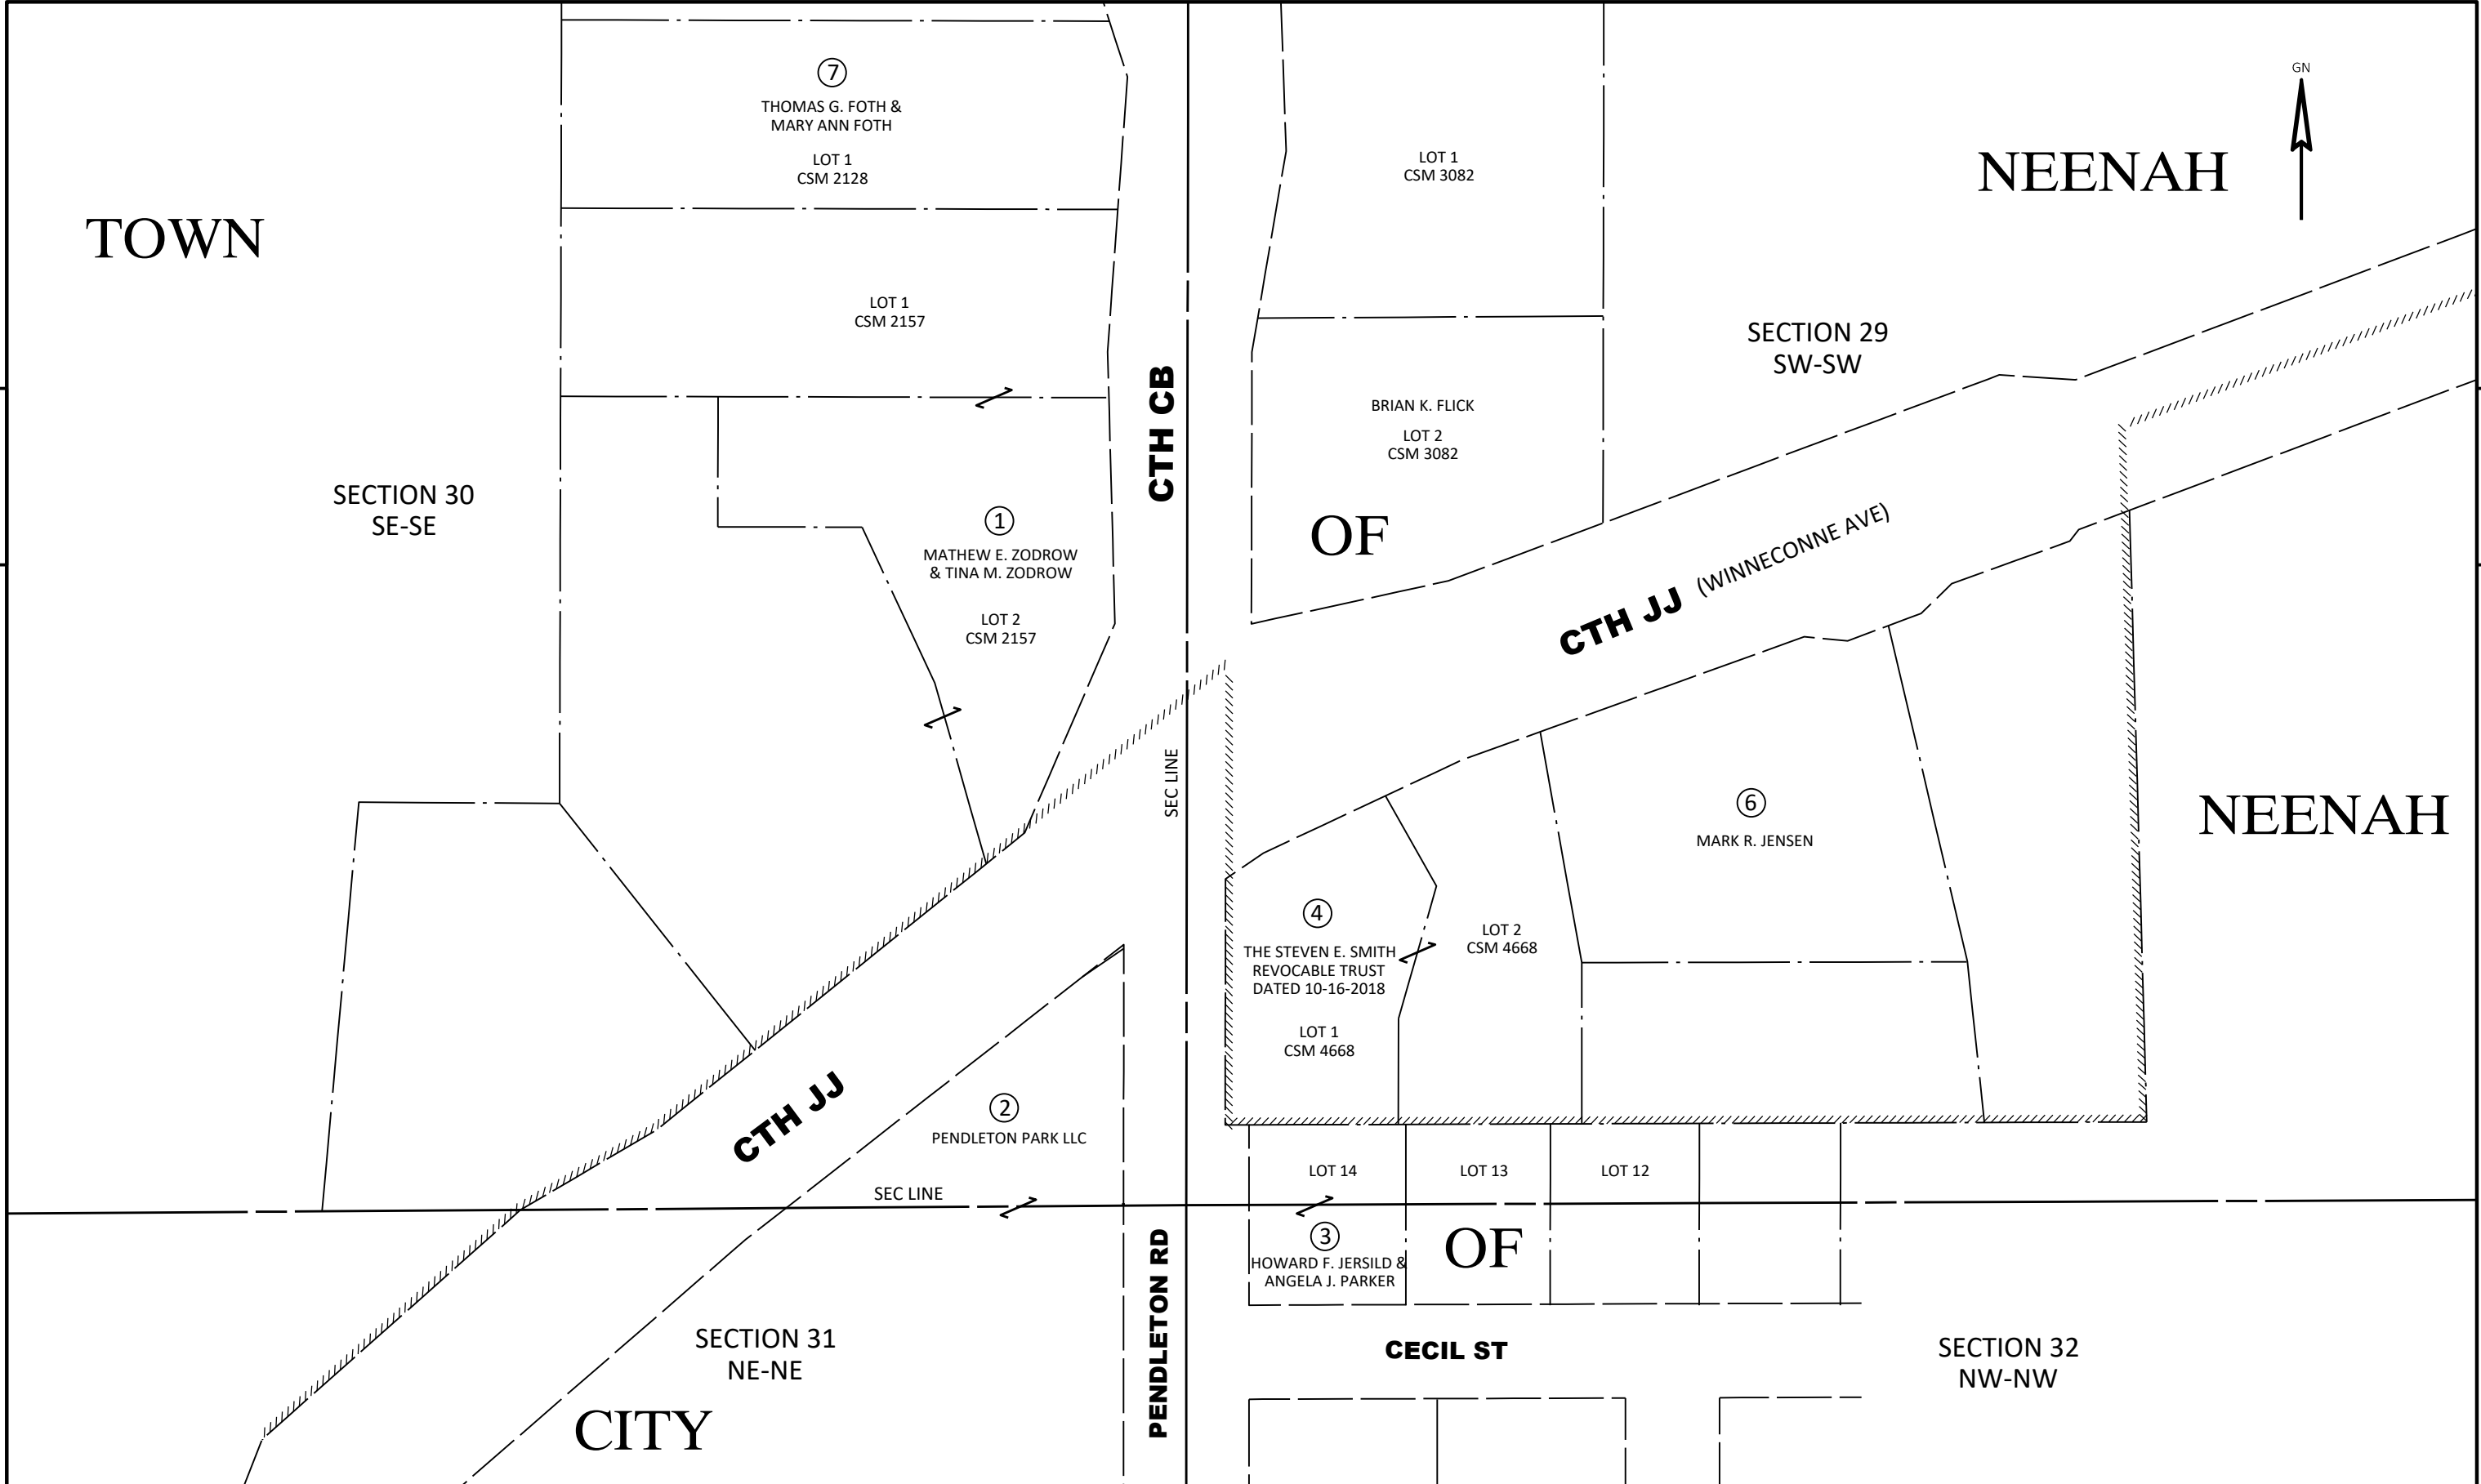

4

4



REVISION DATE	_____	_____	_____	_____
DATE	11-19-2020			
GRID FACTOR	_____			


DATE	11-19-2020
GRID FACTOR	_____



HWY:	CTH CB / CTH JJ
COUNTY:	WINNEBAGO

CONSTRUCTION PROJECT NUMBER	3000994
-----------------------------	---------

PLAT SHEET	4.03
PS&E SHEET	58
	E

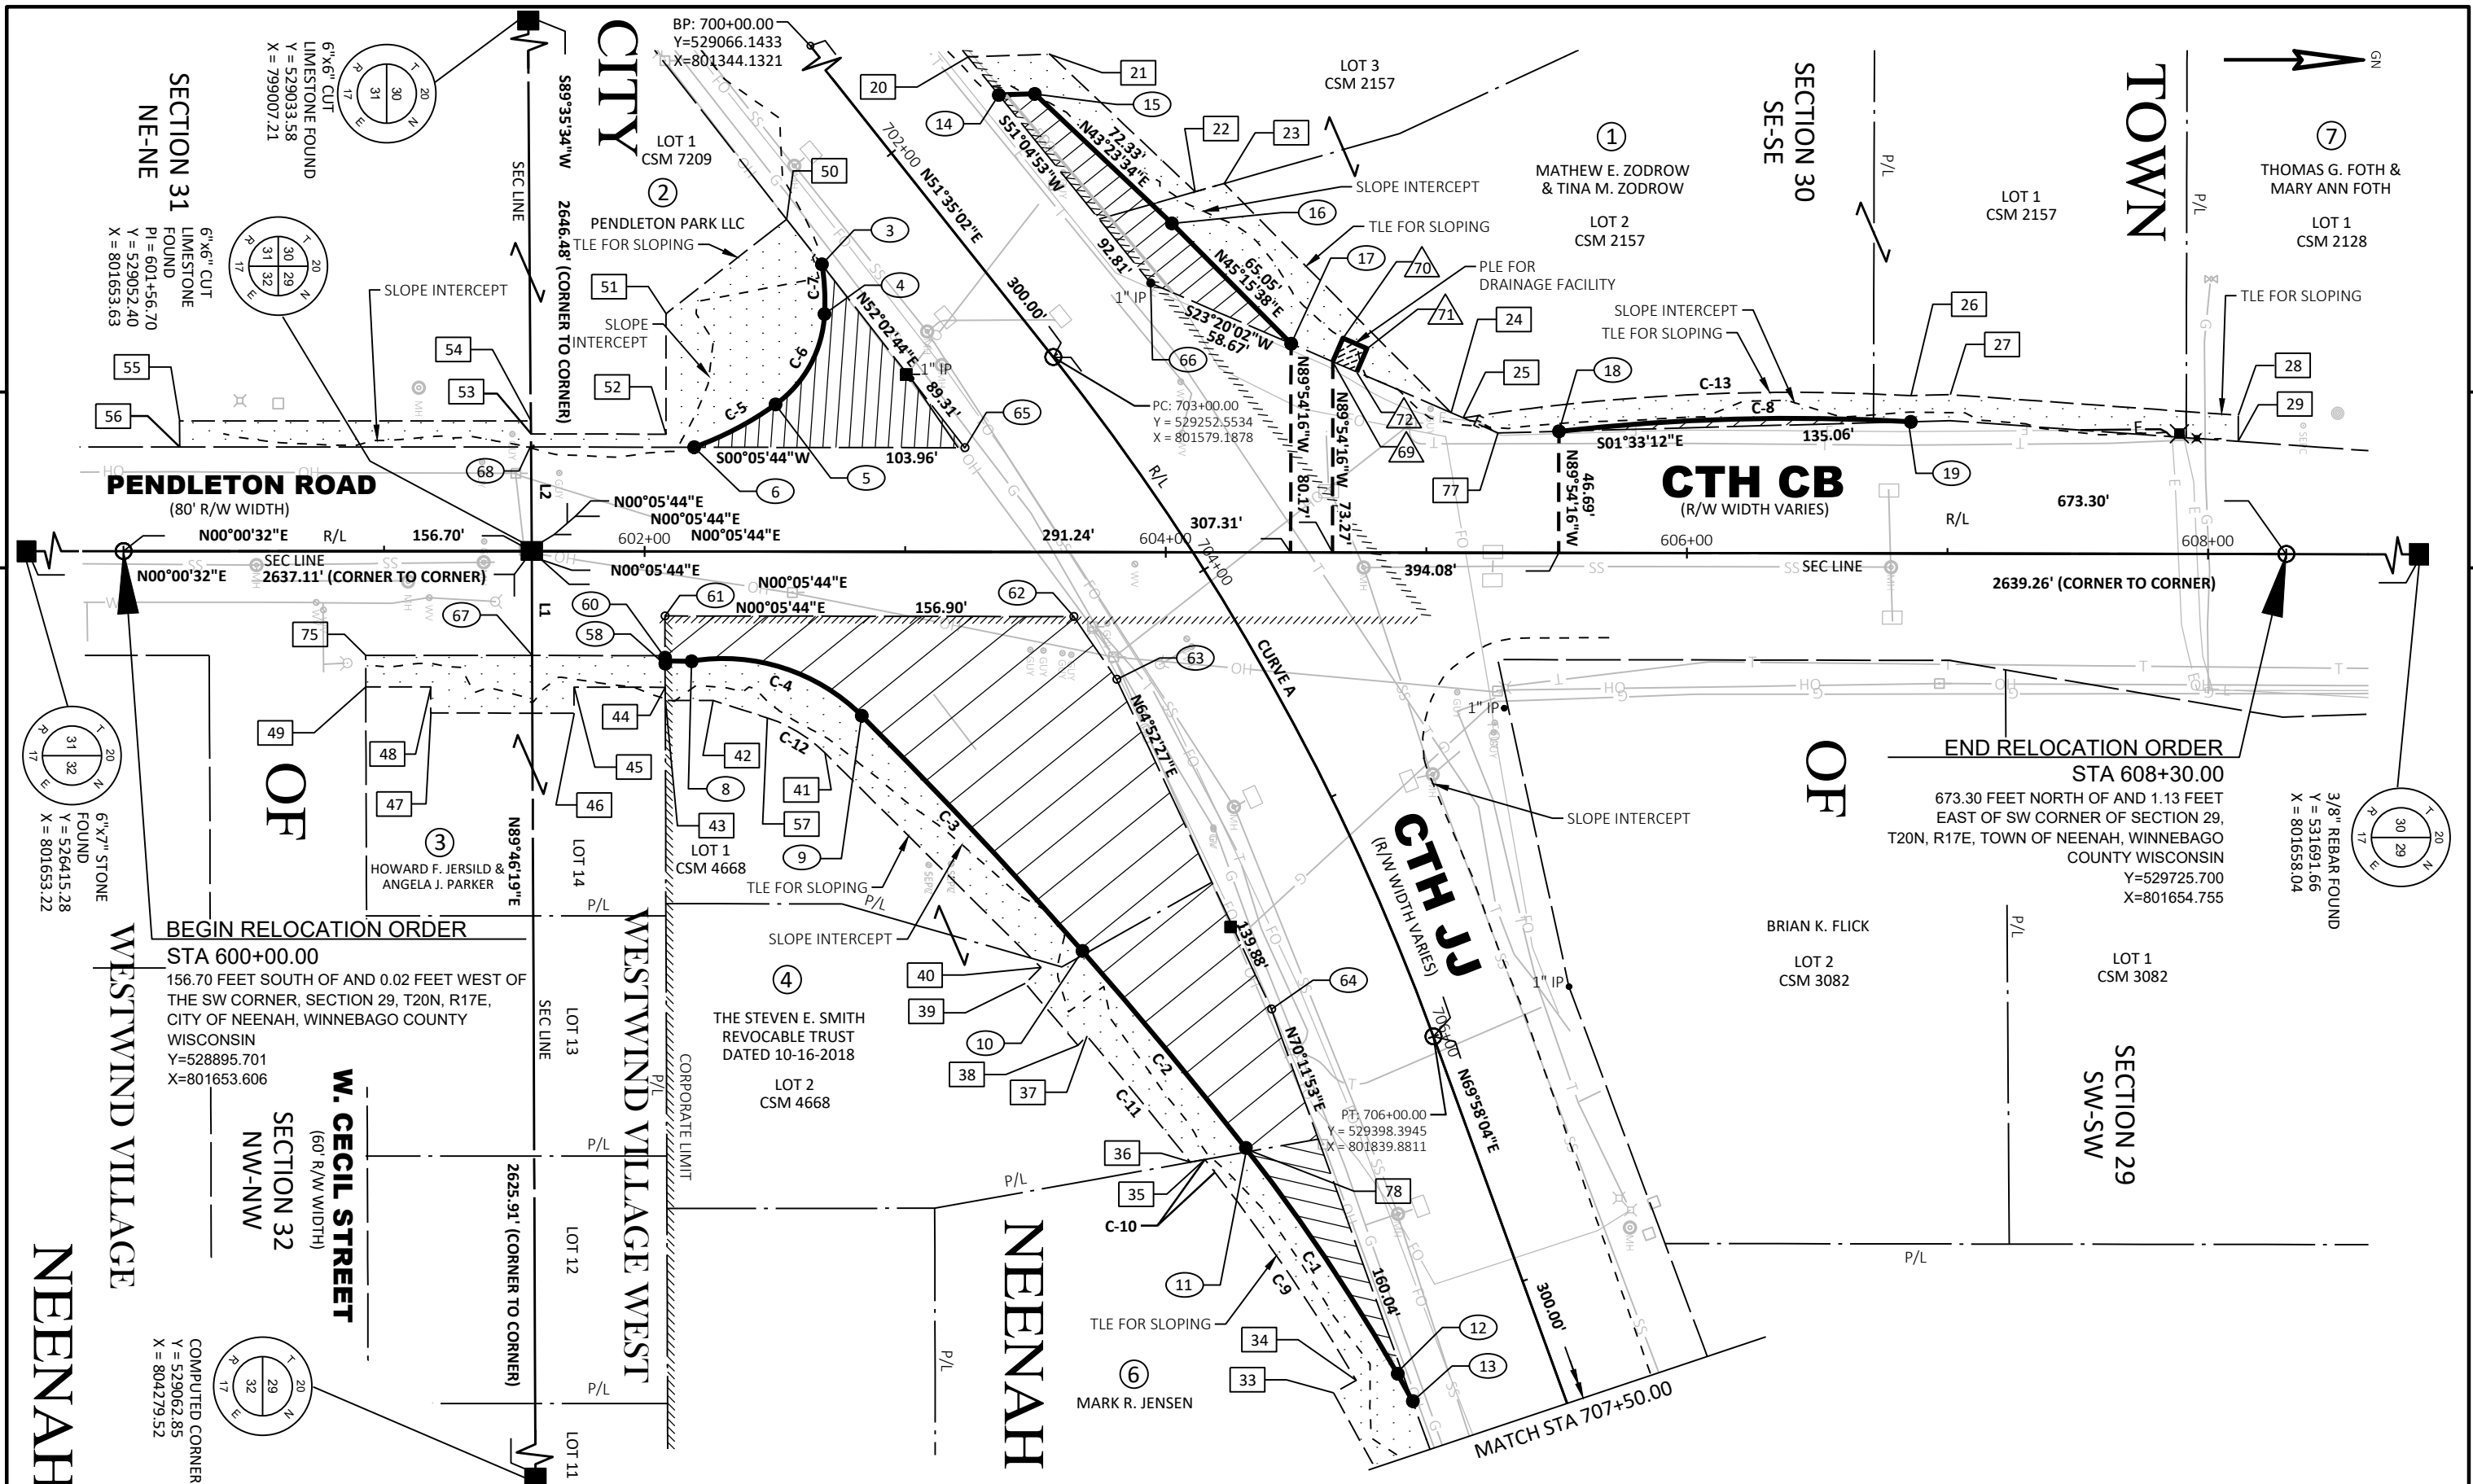


REVISION DATE	DATE	SCALE, FEET	HWY: CTH CB / CTH JJ	PLAT SHEET
	11-19-2020	0 30 60	COUNTY: WINNEBAGO	4.04
	GRID FACTOR		CONSTRUCTION PROJECT NUMBER	PS&E SHEET
			3000994	59

FILE NAME :	N:\3000994.00\CIVIL 3D\RW\RW PLAT.DWG	PLOT DATE :	11/19/2020 3:46 PM	PLOT BY :	JAIRO MAZARIEGOS	PLOT NAME :		PLOT SCALE :	1 IN:60 FT
LAYOUT NAME :	4.04								WISDOT/CADD SHEET 75

CONSTRUCTION PROJECT NUMBER	3000994
-----------------------------	---------

PLAT SHEET	4.04
PS&E SHEET	59

CONSTRUCTION PROJECT NUMBER	3000994
-----------------------------	---------

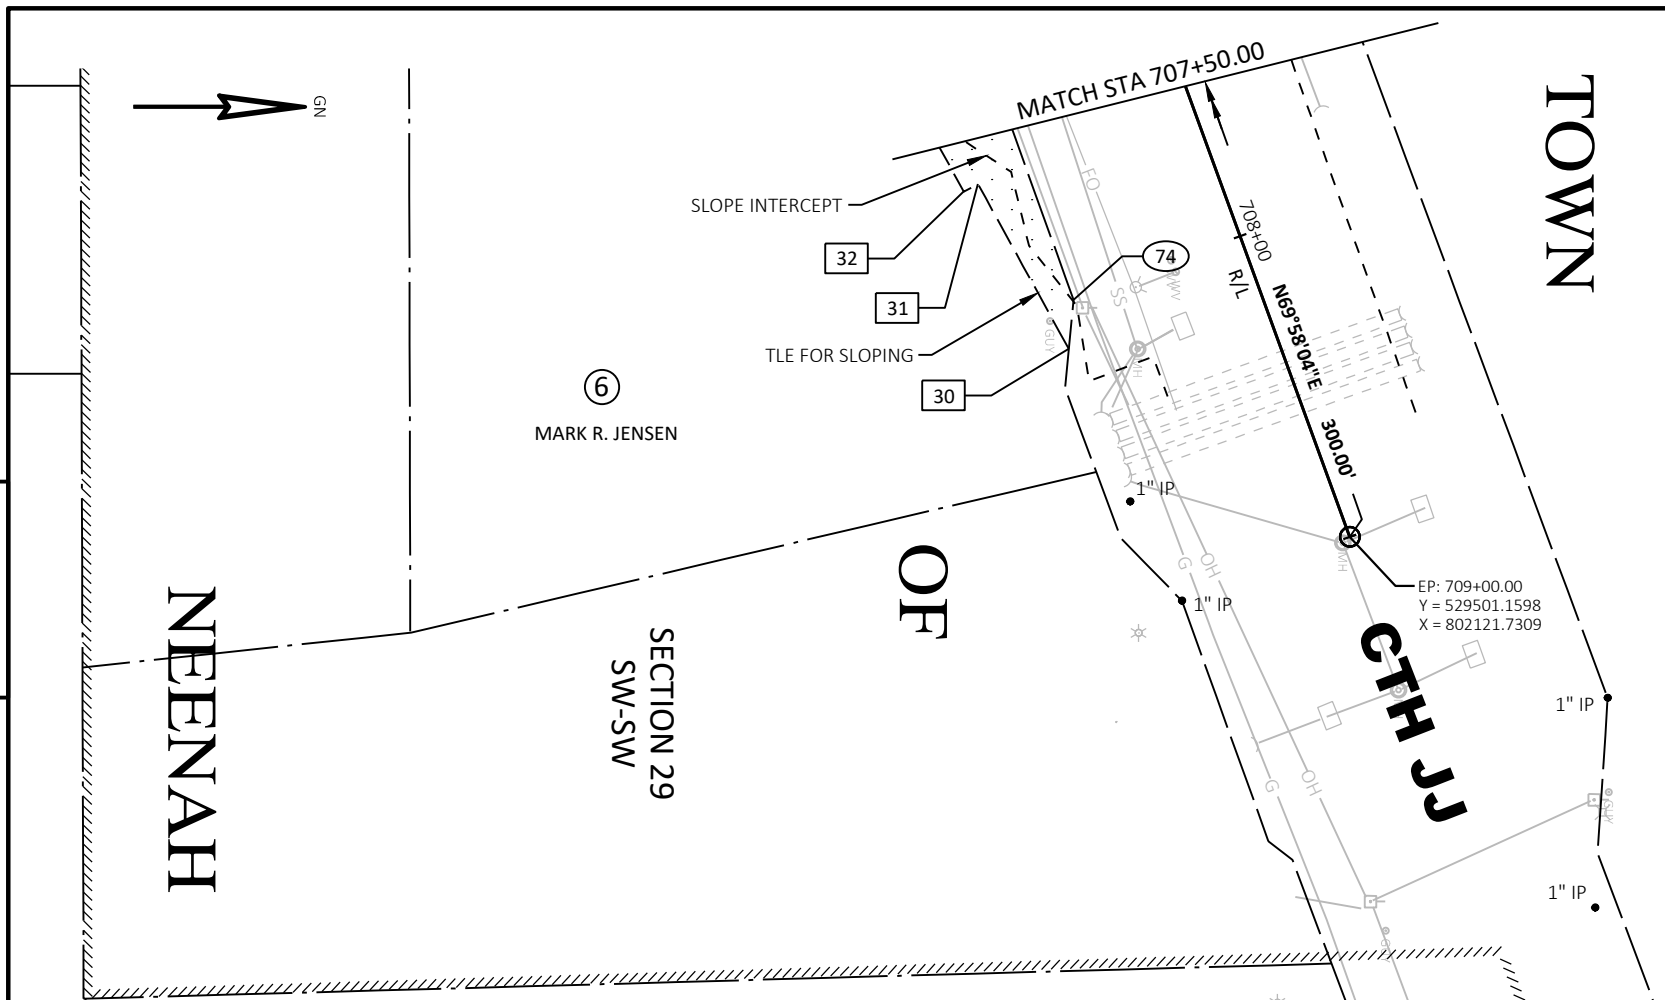

TLE STATION / OFFSET TABLE CTH JJ R/L

POINT #	STA	OFFSET
20	701+89.29	45.98'
21	702+08.00	71.21'
22	702+84.06	82.16'
23	702+88.46	92.78'
30	708+14.74	62.39'
31	707+56.59	71.40'
32	707+57.36	76.34'
33	707+15.41	82.83'
34	707+13.88	73.06'
35	706+14.36	98.54'
36	706+13.39	104.12'
37	705+47.39	123.53'
38	705+49.53	128.13'
39	705+14.59	136.83'
40	705+11.20	128.77'
50	701+94.91	47.28'

RIGHT OF WAY TABLE CTH CB R/L

POINT #	Y	X	STA	OFFSET
5	529145.863	801597.304	602+50.07	56.48'
6	529114.628	801613.734	602+18.86	40.00'
8	529113.680	801695.891	602+18.05	42.16'
9	529178.994	801716.852	602+83.40	63.01'
17	529343.773	801573.949	604+47.94	80.17'
18	529446.560	801607.601	605+50.78	46.69'
19	529581.575	801603.940	606+85.79	50.58'
58	529103.568	801695.680	607+07.94	41.97'
60	529103.561	801693.716	602+07.93	40.00'
61	529103.500	801678.465	602+07.84	24.75'
62	529260.404	801678.728	603+64.74	24.75'
63	529276.857	801702.774	603+81.24	48.77'
65	529218.593	801613.908	603+22.83	40.00'
67	529052.559	801693.630	601+56.93	40.00'
68	529052.116	801613.630	601+56.41	40.00'

TLE STATION / OFFSET TABLE CTH CB R/L

POINT #	STA	OFFSET
24	605+09.46	53.75'
25	605+14.04	51.79'
26	606+85.92	60.58'
27	607+00.99	61.02'
28	608+11.52	53.26'
29	608+11.51	43.24'
41	602+69.33	77.22'
42	602+26.37	57.16'
43	602+08.01	57.16'
44	602+07.99	52.16'
45	601+73.04	52.16'
46	601+73.04	62.16'
47	601+17.94	62.10'
48	601+17.96	52.10'
49	600+93.02	52.06'
51	602+08.12	91.27'
52	602+08.12	45.00'
53	601+56.42	45.00'
54	601+56.34	50.00'
55	600+21.51	50.00'
56	600+21.58	40.00'
57	602+47.15	63.79'
75	600+92.98	40.00'

RIGHT OF WAY TABLE CTH JJ R/L

POINT #	Y	X	STA	OFFSET
3	529163.664	801543.487	702+16.79	47.46'
4	529164.679	801562.546	702+32.36	58.51'
10	529263.733	801807.100	705+12.51	111.68'
11	529326.364	801882.742	706+15.59	82.35'
12	529384.418	801969.003	707+16.52	57.36'
13	529390.467	801979.992	707+28.92	55.44'
14	529231.595	801478.500	702+08.09	46.14'
15	529245.426	801478.052	702+16.33	57.26'
16	529297.988	801527.745	702+87.92	67.56'
64	529336.252	801829.418	705+66.96	54.25'
66	529289.899	801550.709	703+00.85	46.96'

PLE TABLE CTH CB R/L

POINT #	Y	X	STA	OFFSET
69	529359.828	801580.874	604+64.00	73.27'
70	529363.710	801571.873	604+67.87	82.27'
71	529372.892	801575.834	604+77.06	78.33'
72	529369.010	801584.835	604+73.19	69.32'

PLE LINE TABLE

LINE	DIRECTION	LENGTH
69-70	N66°39'58"W	9.80'
70-71	N23°20'02"E	10.00'
71-72	S66°39'58"E	9.80'
72-69	S23°20'02"W	10.00'

LINE TABLE

LINE	DIRECTION	LENGTH
L1	N89°46'19"E	40.00'
67-60	N00°05'44"E	51.00'
60-61	S89°48'32"W	15.25'
62-63	N55°37'08"E	29.14'
13-12	S61°09'54"W	12.54'
8-58	S01°11'43"W	10.11'
58-60	S89°48'32"W	1.97'
L2	S89°35'33"W	40.00'
68-6	N00°05'44"E	62.51'
14-15	N01°51'27"W	13.84'

TLE LINE TABLE PARCEL 1

LINE	DIRECTION	LENGTH
18-77	S01°33'12"E	23.32'
77-25	S23°20'02"W	14.62'
26-27	N01°33'12"W	15.07'
27-28	N04°06'26"E	90.75'
28-29	S89°51'38"E	10.02'
29-76	S04°06'26"W	90.95'
76-19	S01°33'12"E	15.00'

TLE LINE TABLE PARCEL 4

LINE	DIRECTION	LENGTH
78-36	S10°13'31"E	22.64'
37-38	S45°11'21"E	4.95'
38-39	S49°37'07"W	31.23'
39-40	N45°11'21"W	8.57'
40-41	S44°48'39"W	116.87'
57-42	S17°47'34"W	21.81'
42-43	S00°05'48"W	18.36'
43-58	S89°48'32"W	15.19'

TLE LINE TABLE PARCEL 1

LINE	DIRECTION	LENGTH
14-20	S51°04'53"W	18.80'
20-21	N01°51'27"W	31.42'
21-22	N43°23'34"E	76.84'
22-23	N15°52'49"W	11.49'
23-24	N45°15'37"E	123.84'
24-72	S23°20'02"W	39.47'
69-17	S23°20'02"W	17.48'

TLE LINE TABLE PARCEL 6


LINE	DIRECTION	LENGTH
13-74	N70°11'53"E	71.87'
74-30	S84°30'43"E	15.46'
30-31	S61°09'54"W	58.84'
31-32	S28°54'33"E	5.00'
32-33	S61°09'23"W	42.46'
33-34	N68°54'33"W	9.90'
35-78	N10°13'31"W	16.97'

- C-1**
R = 726.50'
L = 104.07'
LC = 103.98'
LCB = S56°03'34"W
- C-2**
R = 1,780.50'
L = 98.22'
LC = 98.21'
LCB = S50°22'32"W
- C-3**
R = 1,780.50'
L = 123.82'
LC = 123.80'
LCB = S46°48'11"W
- C-4**
R = 75.50'
L = 71.21'
LC = 68.60'
LCB = S17°47'34"W
- C-5**
R = 125.50'
L = 35.41'
LC = 35.29'
LCB = N27°44'43"W
- C-6**
R = 45.50'
L = 40.89'
LC = 39.52'
LCB = N61°34'16"W
- C-7**
R = 95.50'
L = 19.12'
LC = 19.09'
LCB = S86°57'05"W
- C-8**
R = 803.50'
L = 135.22'
LC = 135.06'
LCB = N01°33'12"W
- C-9**
R = 711.50'
L = 96.64'
LC = 96.57'
LCB = S55°50'49"W
- C-10**
R = 1765.50'
L = 6.18'
LC = 6.18'
LCB = S51°51'20"W
- C-11**
R = 1760.50'
L = 62.56'
LC = 62.55'
LCB = S50°39'03"W
- C-12**
R = 55.50'
L = 26.17'
LC = 25.93'
LCB = S31°18'06"W
- C-13**
R = 813.50'
L = 172.43'
LC = 172.11'
LCB = N02°50'02"W
- TLE CURVE PT 11-PT 78**
R = 726.50'
L = 1.74'
LCB = N52°01'28"E
- TLE CURVE PT 78-PT 12**
R = 726.50'
L = 102.33'
LC = 102.24'
LCB = N56°07'41"E

CURVE A
PI STA = 704+50.00
Y = 529346.566
X = 801697.735
Δ = 18°23'01"
R = 935.00'
T = 151.30'
L = 300.00'
LC = 298.72'
LCB = N60°46'33"E

REVISION DATE	DATE <u>11-19-2020</u>	SCALE, FEET 0 30 60	HWY: CTH CB / CTH JJ	CONSTRUCTION PROJECT NUMBER <u>3000994</u>	PLAT SHEET <u>4.05</u>
	GRID FACTOR		COUNTY: WINNEBAGO	PS&E SHEET <u>60</u>	E



MATTHEW E. ZODROW &
TINA M. ZODROW

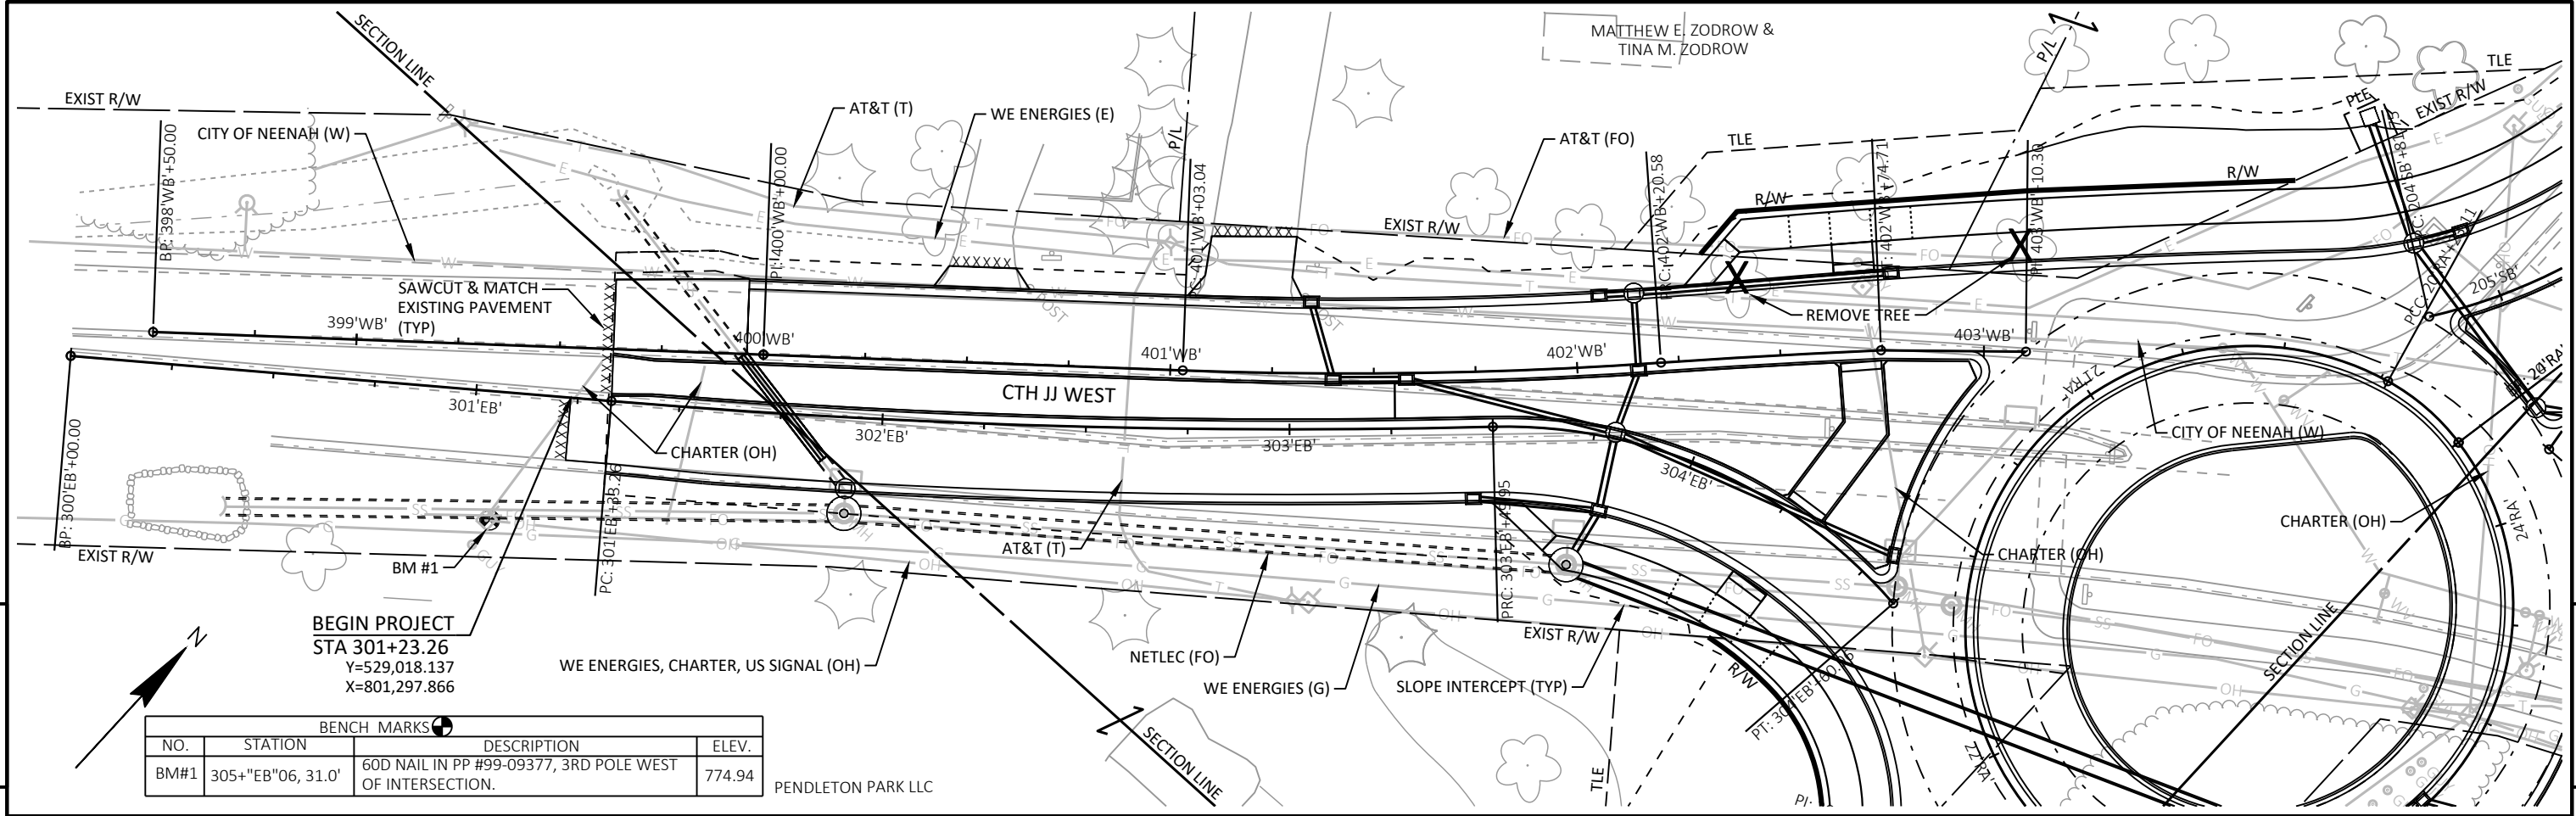


BEGIN PROJECT
STA 301+23.26
Y=529,018.137
X=801,297.866

BENCH MARKS			
NO.	STATION	DESCRIPTION	ELEV.
BM#1	305+''EB''06, 31.0'	60D NAIL IN PP #99-09377, 3RD POLE WEST OF INTERSECTION.	774.94


PENDLETON PARK LLC

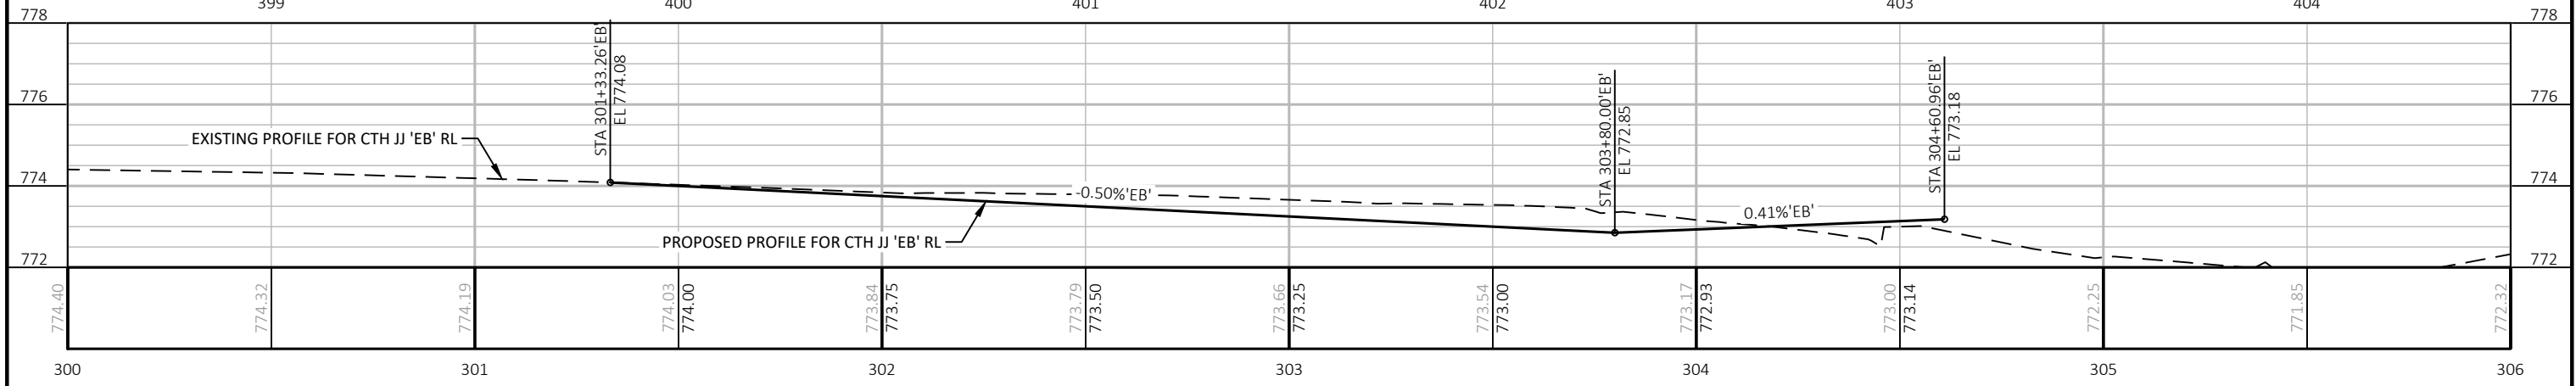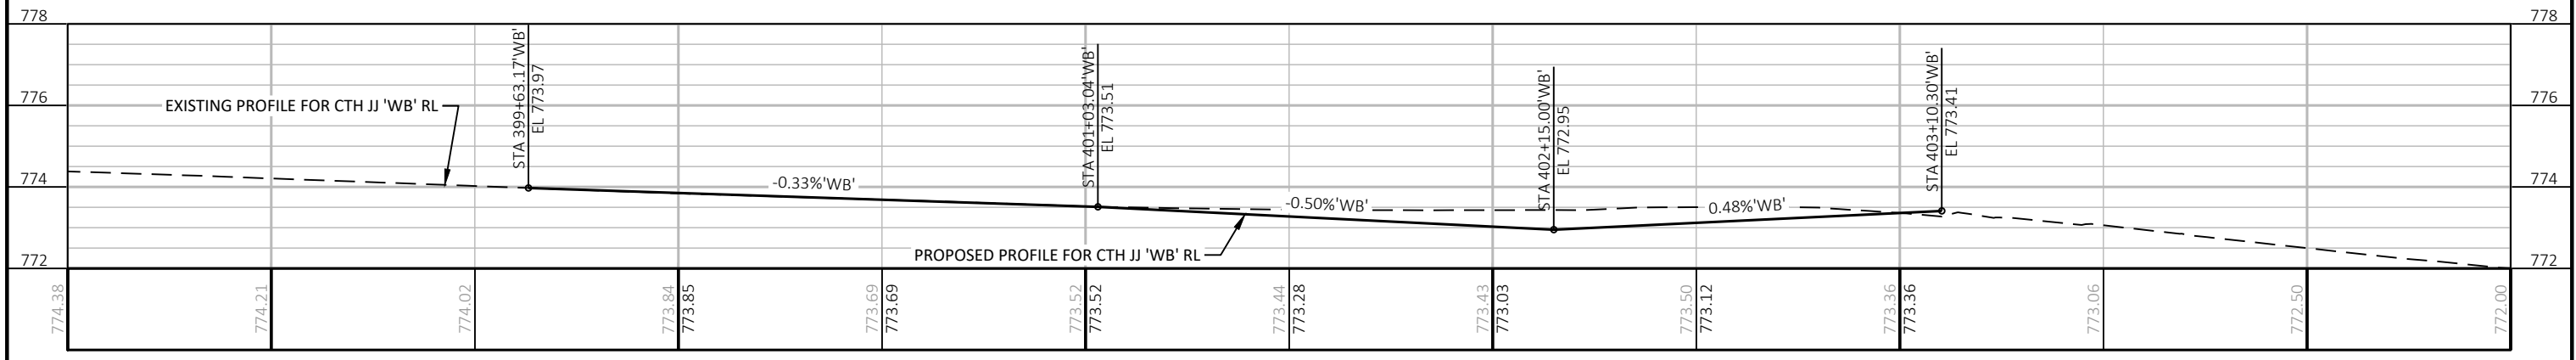

PROJECT NO: 426-4738	HWY: CTH JJ	COUNTY: WINNEBAGO	PLAN AND PROFILE: CTH JJ - WEST	SHEET 62	E
----------------------	-------------	-------------------	---------------------------------	----------	----------

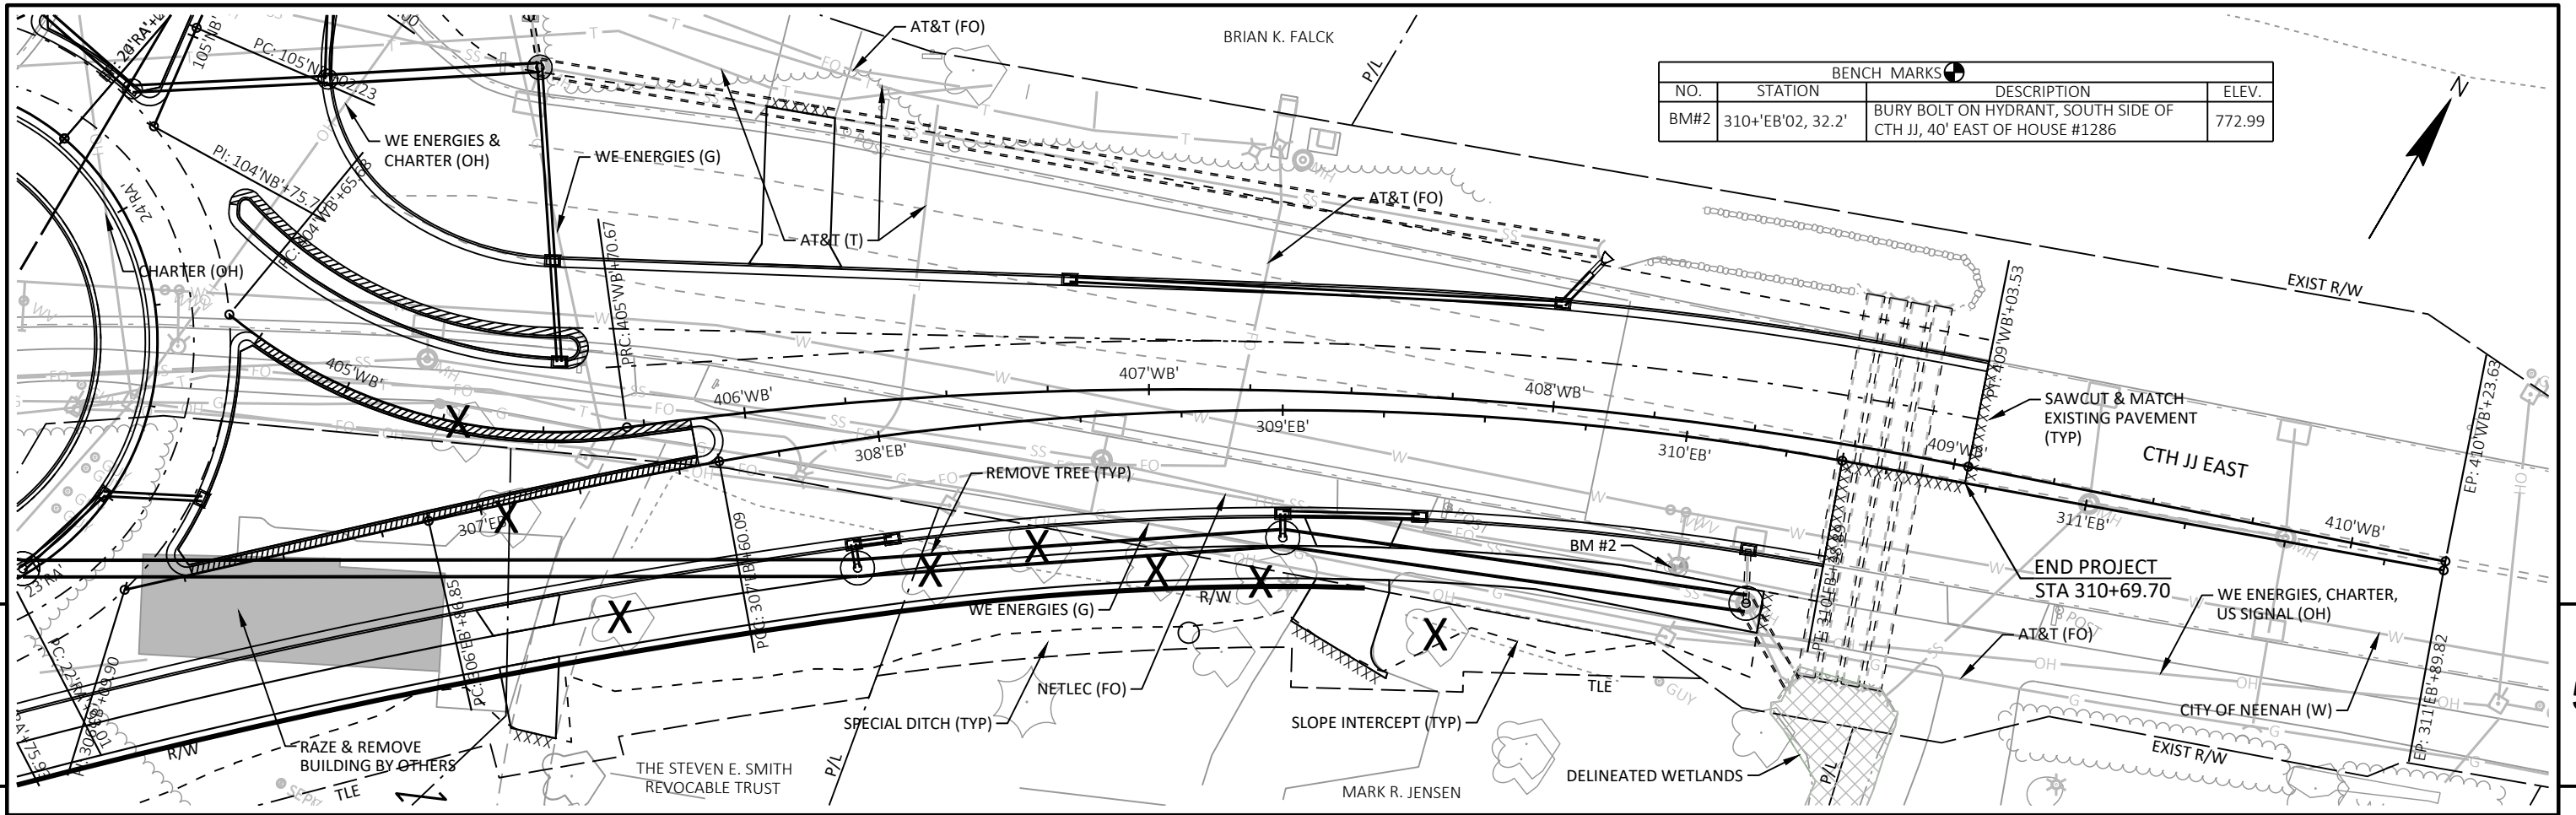

BENCH MARKS			
NO.	STATION	DESCRIPTION	ELEV.
BM#2	310+EB'02, 32.2'	BURY BOLT ON HYDRANT, SOUTH SIDE OF CTH JJ, 40' EAST OF HOUSE #1286	772.99

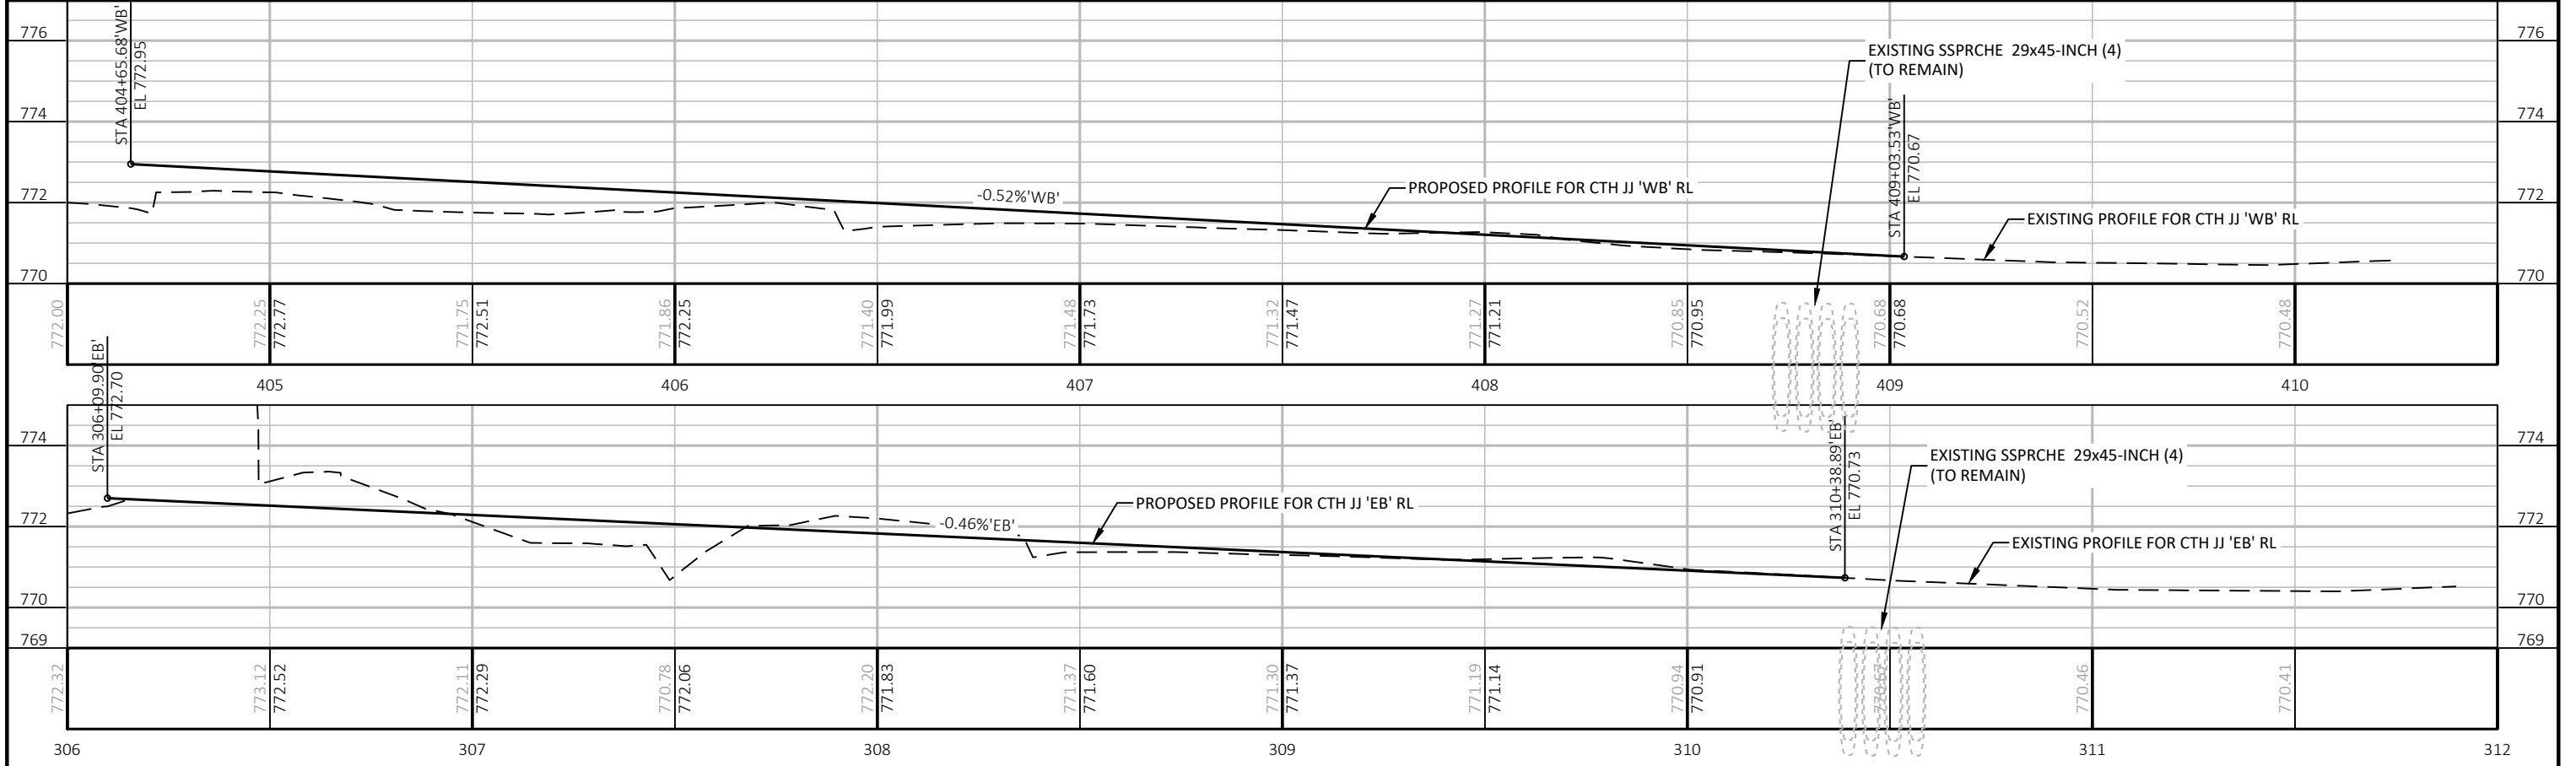

PROJECT NO: 426-4738	HWY: CTH JJ	COUNTY: WINNEBAGO	PLAN AND PROFILE: CTH JJ - EAST	SHEET 63
----------------------	-------------	-------------------	---------------------------------	----------



PENDELTON PARK LLC

BENCH MARKS			
NO.	STATION	DESCRIPTION	ELEV.
BM#3	101+NB'23, 37.7'	ARROW ON HYDRANT, NE CORNER OF PENDELTON & CECIL ST. INTERSECTION	772.09

WE ENERGIES, AT&T, CHARTER (OH)

AT&T (OH)

WE ENERGIES (G)

CITY OF NEENAH (W)

WE ENERGIES, CHARTER, US SIGNAL (OH)

NETLEC (FO)

CHARTER (OH)

CITY OF NEENAH (SS)

PENDELTON ROAD

SAWCUT & MATCH EXISTING PAVEMENT (TYP)

CROWN SHIFT TO MATCH EXISTING

SECTION CORNER MONUMENT

WE ENERGIES, AT&T, CHARTER (OH)

SECTION LINE

CITY OF NEENAH (W)

EXIST R/W

BEGIN CONSTRUCTION 101NB+35.08

EXIST R/W

EXIST R/W

5

WEST CECIL ST


CLEAR & GRUB TO SLOPE INTERCEPTS

HOWARD F. JERSILD & ANGELA J. PARKER


THE STEVEN E. SMITH REVOCABLE TRUST

SLOPE INTERCEPT (TYP)


5

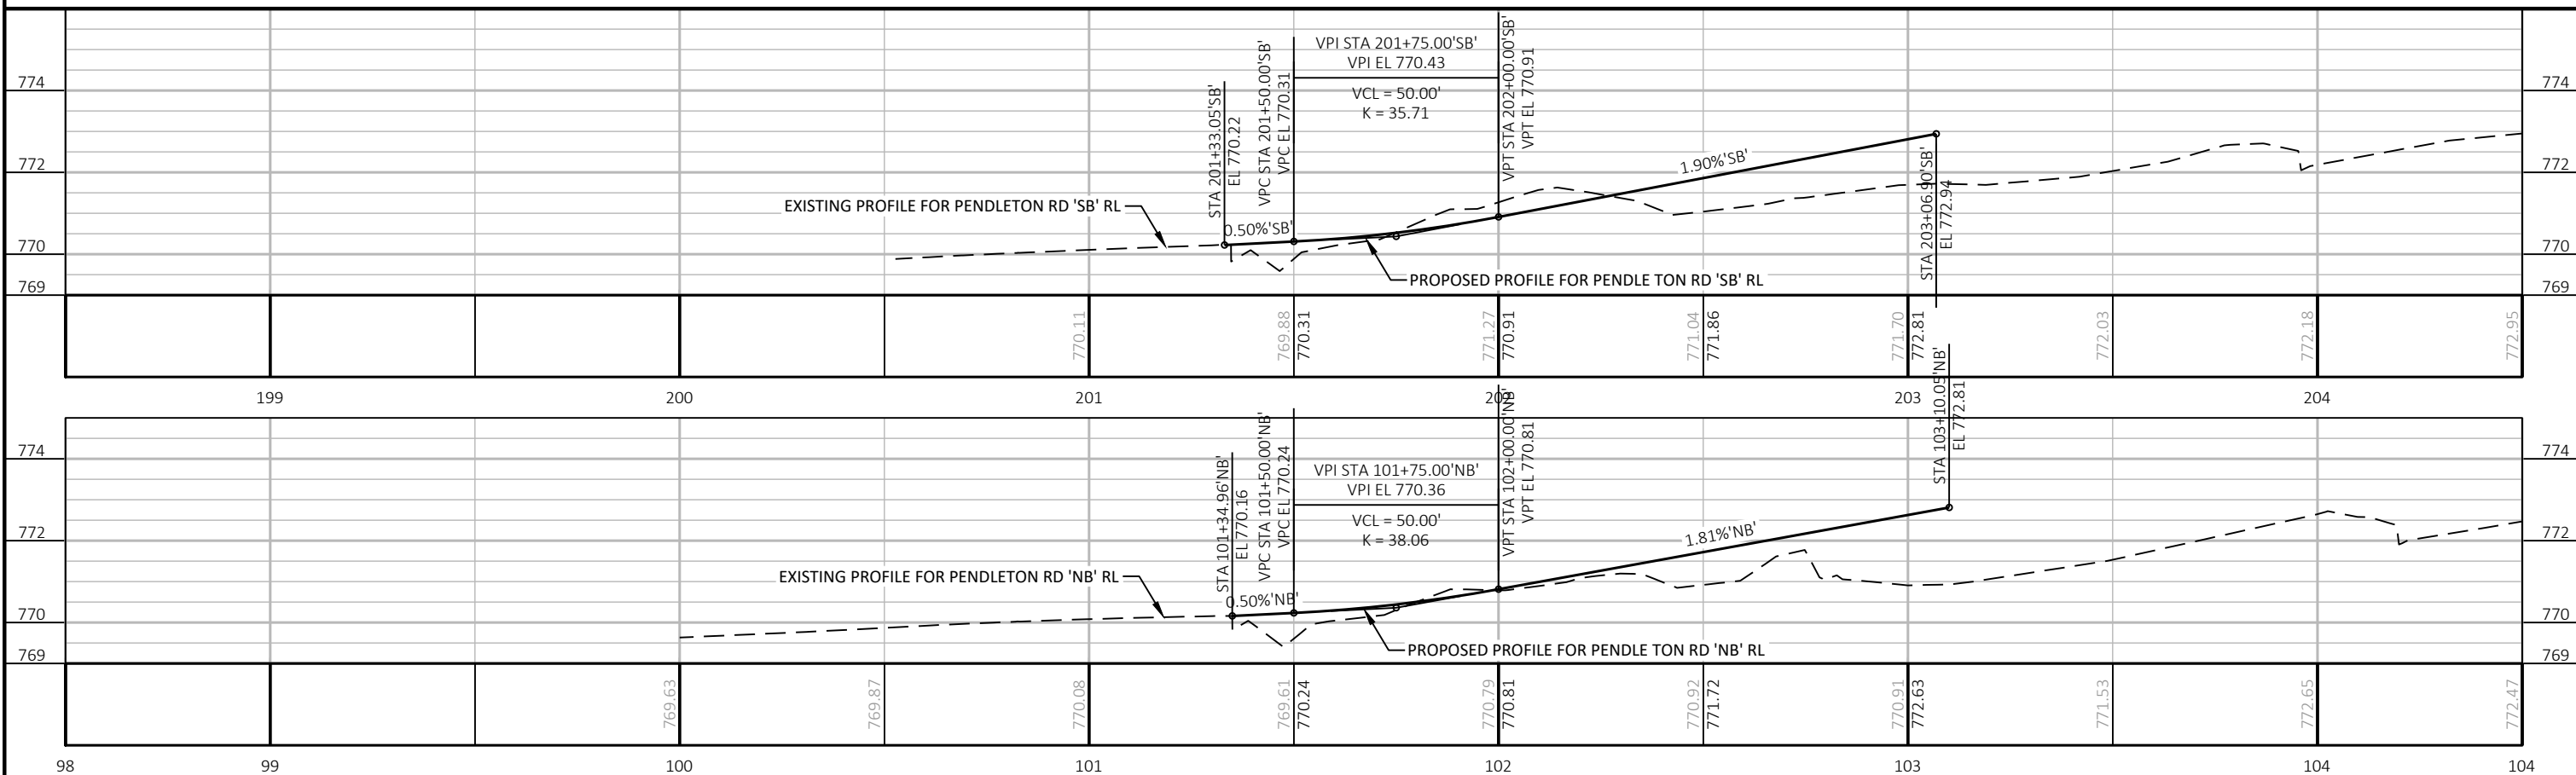


PROJECT NO: 426-4738	HWY: CTH JJ	COUNTY: WINNEBAGO	PLAN AND PROFILE: PENDLETON ROAD	SHEET 64	E
----------------------	-------------	-------------------	----------------------------------	----------	---

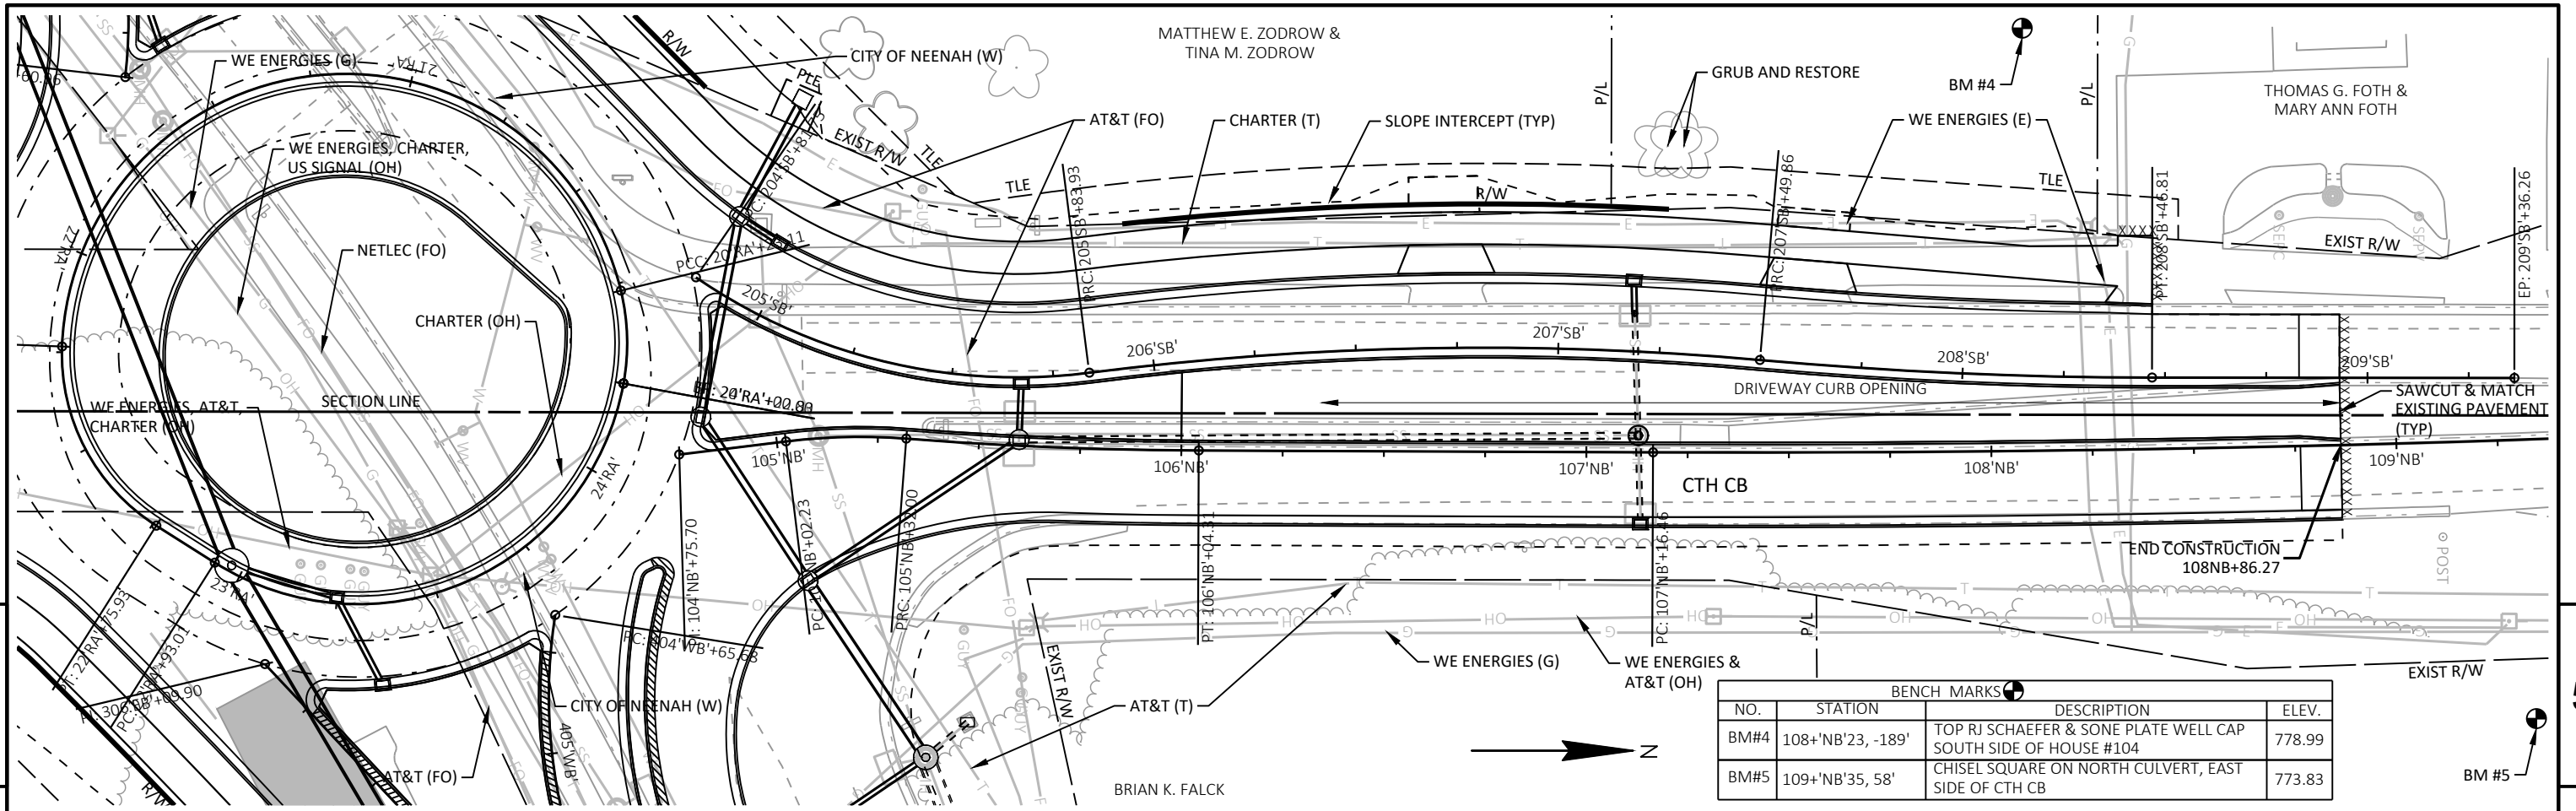


BENCH MARKS			
NO.	STATION	DESCRIPTION	ELEV.
BM#4	108+NB'23, -189'	TOP RJ SCHAEFER & SONE PLATE WELL CAP SOUTH SIDE OF HOUSE #104	778.99
BM#5	109+NB'35, 58'	CHISEL SQUARE ON NORTH CULVERT, EAST SIDE OF CTH CB	773.83

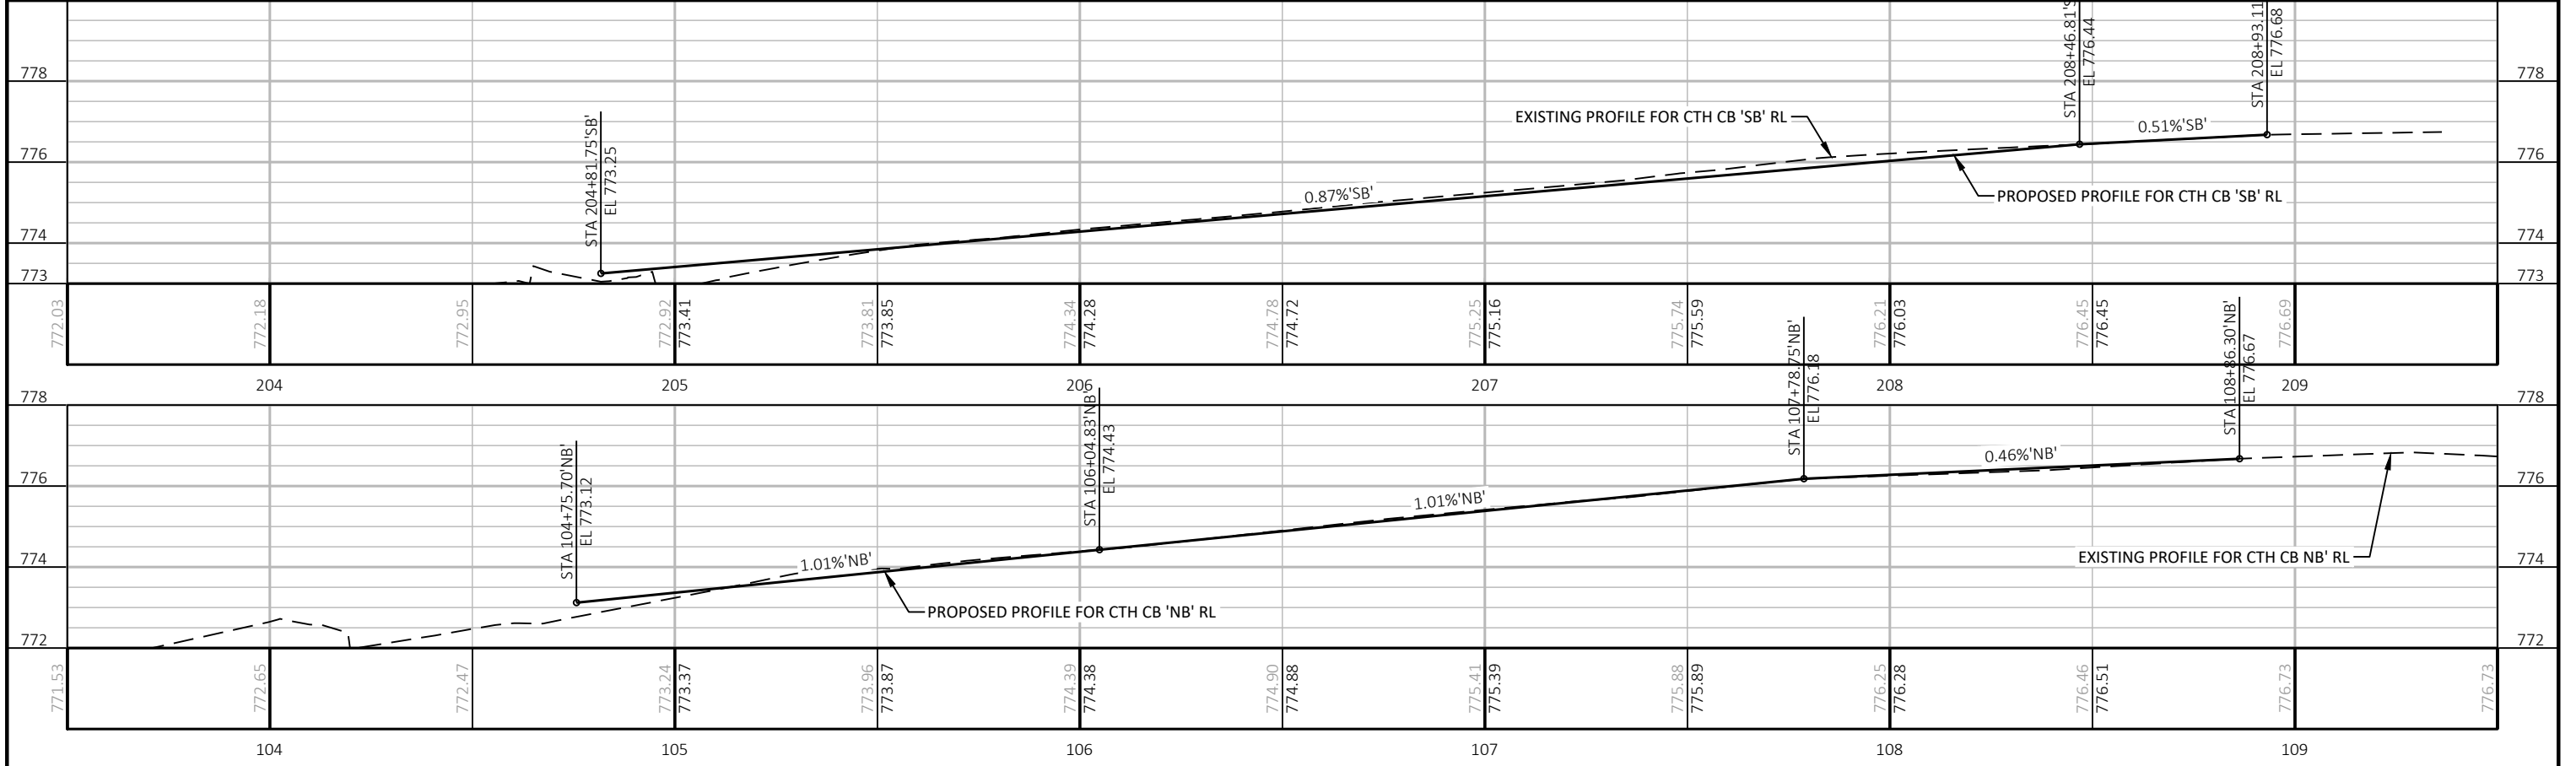






PROJECT NO: 426-4738	HWY: CTH JJ	COUNTY: WINNEBAGO	PLAN AND PROFILE: CTH CB	SHEET 65
----------------------	-------------	-------------------	--------------------------	----------

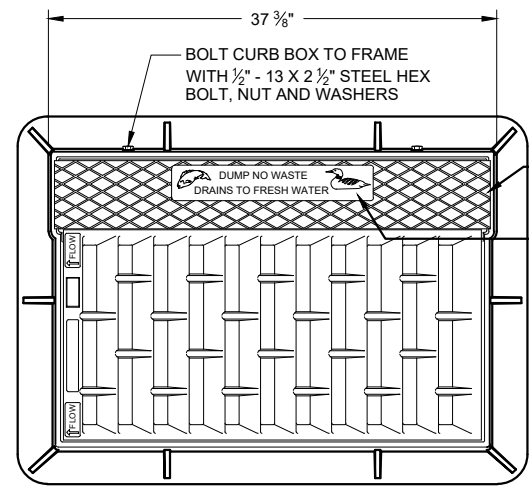

NOTE: EITHER CASTING IS ACCEPTABLE

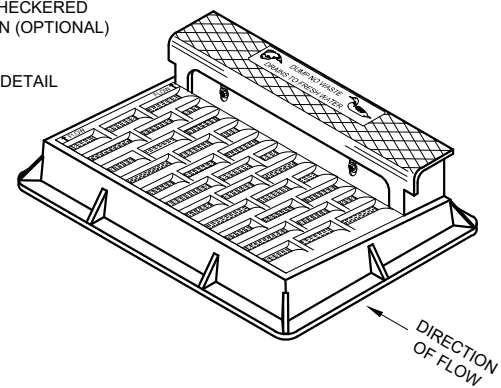


NOTE: CURB BOX HEIGHT ADJUSTABLE 6" - 9"

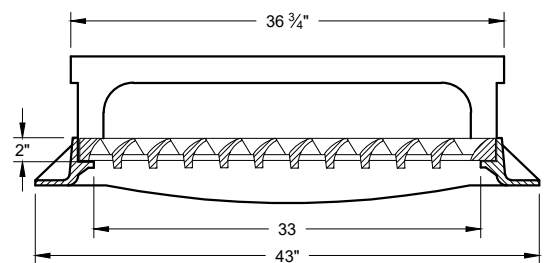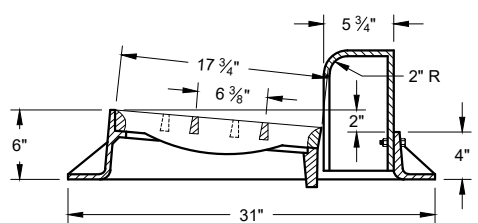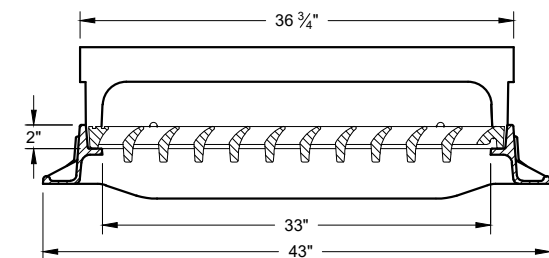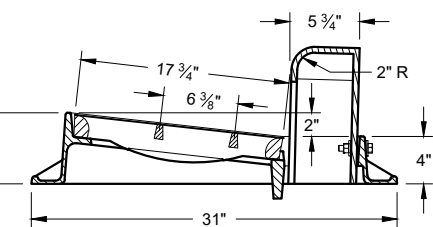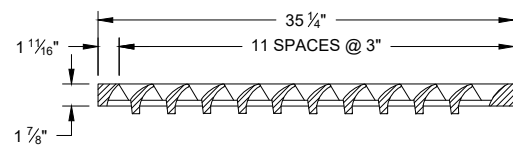


TYPE "H"

NOTE: EITHER CASTING IS ACCEPTABLE

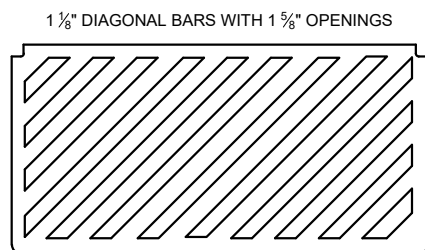


SPECIAL GRATE FOR TYPE "H" COVER

(MEASURES 35" X 17 3/4" X 2")
(NOTED AS TYPE H-S ON DRAINAGE TABLE)

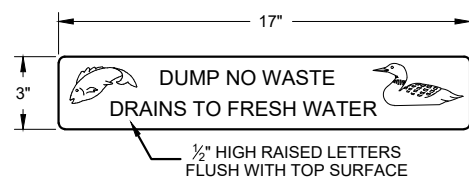


LOGO DETAIL

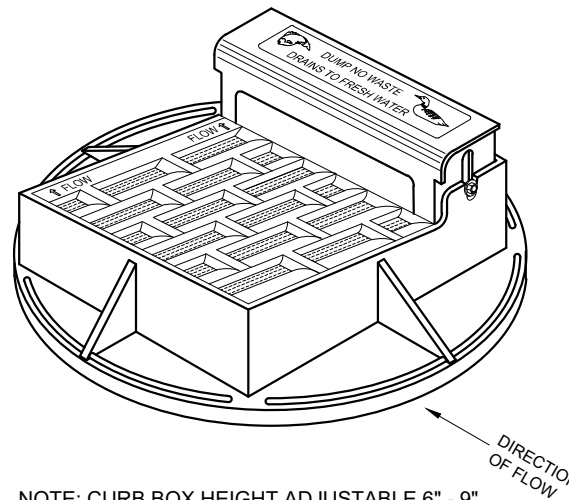

NOTE: CURB BOX HEIGHT ADJUSTABLE 6" - 9"




NOTE: EITHER CASTING IS ACCEPTABLE

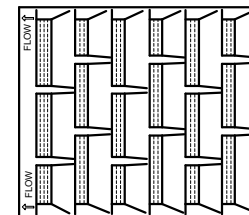



1" DIAGONAL BARS WITH 1 1/2" OPENINGS

SPECIAL GRATE FOR TYPE "A" COVER


(MEASURES 19 7/8" X 17" X 1 7/8")
(NOTED AS TYPE A-S ON DRAINAGE TABLE)

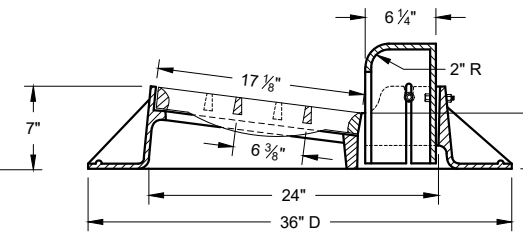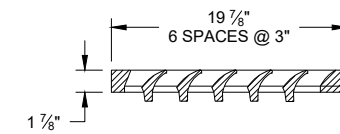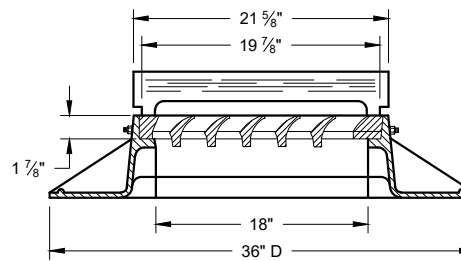

TYPE "A"

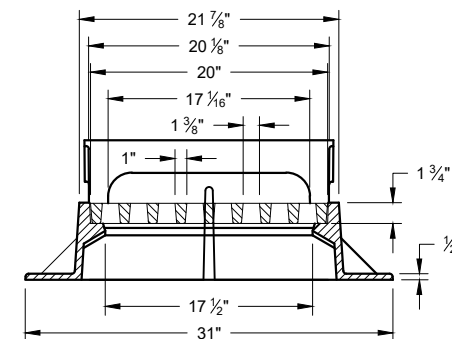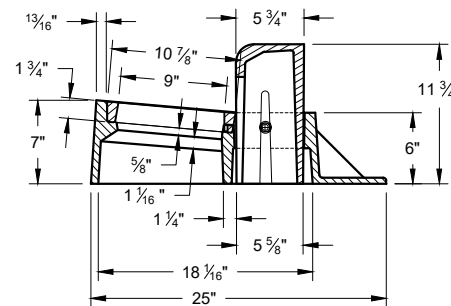

TYPE "Z"

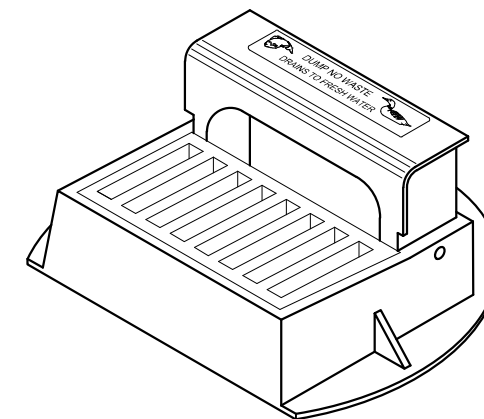

INLET COVERS TYPE A, H, A-S, H-S & Z

STATE OF WISCONSIN
DEPARTMENT OF TRANSPORTATION



APPROVED 11-27-13 /S/ Jerry H. Zogg
DATE APPROVING ENGINEER
FHWA 67

6


6

SDD 08A05-19a

SDD 08A05-19a


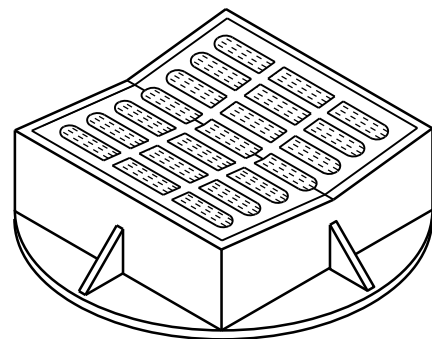
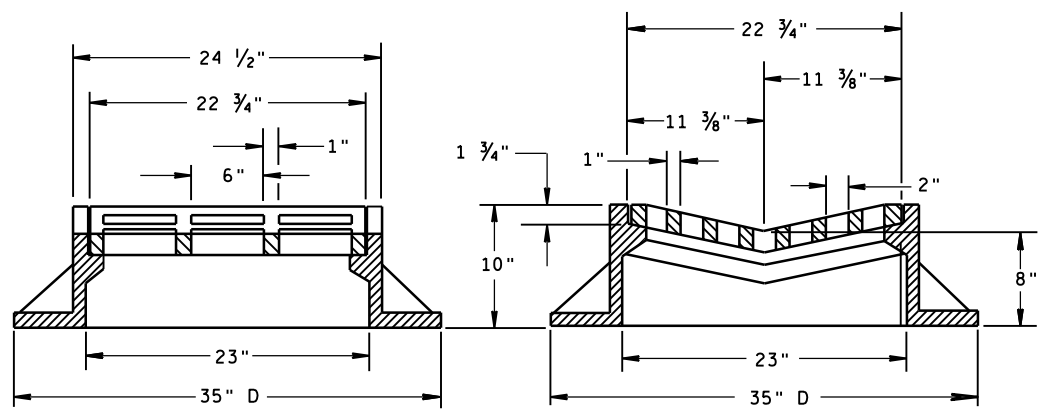


TYPE "B"

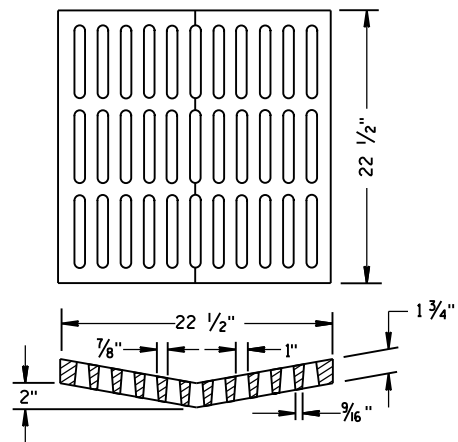

ALTERNATIVE GRATE FOR TYPE "B" COVER

USE WHERE PEDESTRIAN OR BICYCLE TRAFFIC IS POSSIBLE. NOTED AS TYPE B-A ON THE DRAINAGE TABLE

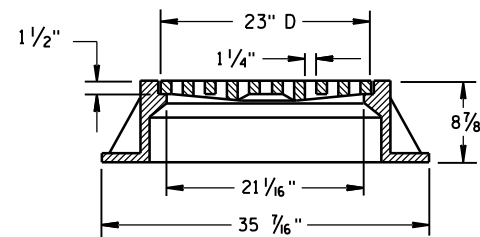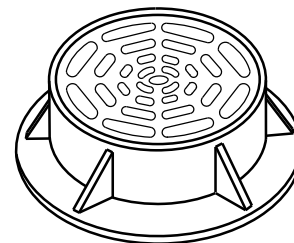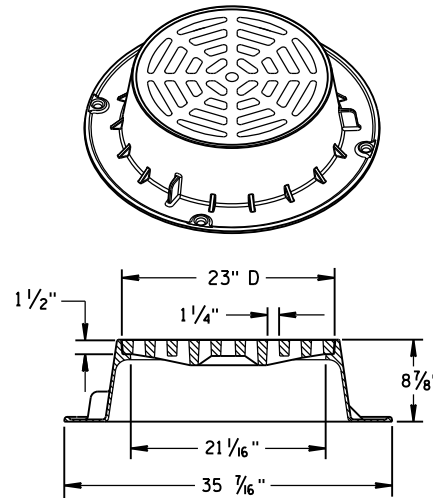

TYPE "C"


NOTE: EITHER CASTING IS ACCEPTABLE

GENERAL NOTES

DETAILS OF CONSTRUCTION, MATERIALS AND WORKMANSHIP NOT SHOWN ON THIS DRAWING SHALL CONFORM TO THE PERTINENT REQUIREMENTS OF THE STANDARD SPECIFICATIONS AND THE APPLICABLE SPECIAL PROVISIONS.


DETAIL DRAWINGS FOR PROPOSED ALTERNATE DESIGNS FOR CATCH BASIN, MANHOLE AND INLET COVERS SHALL BE SUBMITTED TO THE ENGINEER FOR APPROVAL PROVIDING THAT SUCH ALTERNATE DESIGNS MAKE PROVISION FOR EQUIVALENT CAPACITY AND STRENGTH.

ROUND FRAMES AND COVERS SHALL HAVE CONTINUOUSLY MACHINED BEARING SURFACES TO PREVENT ROCKING AND RATTLING.

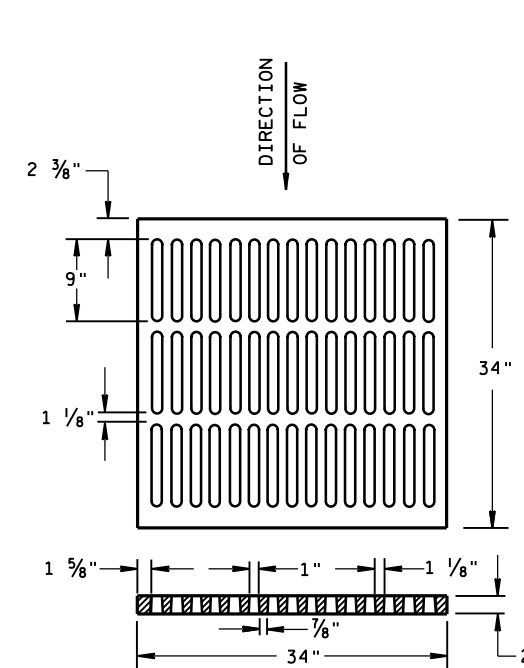



ALTERNATIVE TYPE "MS"

USE WHERE PEDESTRIAN OR BICYCLE TRAFFIC IS PERMITTED NOTED AS TYPE MS-A ON THE DRAINAGE TABLE

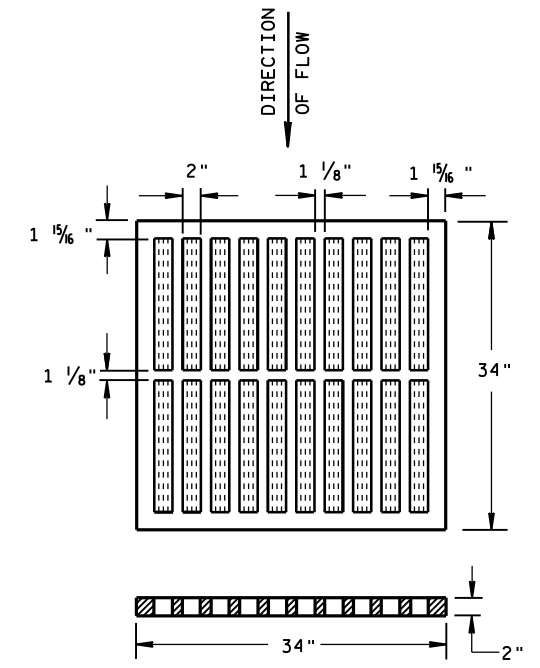

TYPE "MS"

USE ON FREEWAYS AND EXPRESSWAYS NOTED AS TYPE MS ON DRAINAGE TABLE

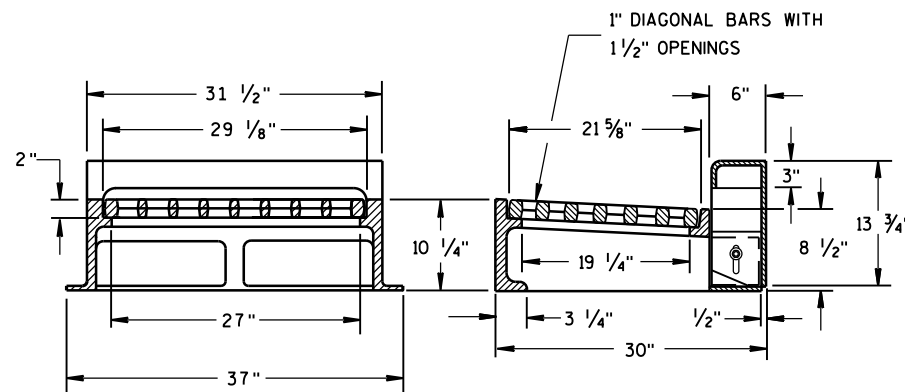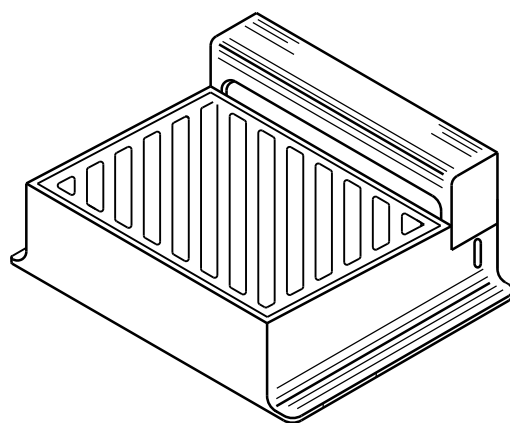

NOTE: CURB BOX HEIGHT ADJUSTABLE 6" TO 9"

TYPE "WM"



DIAGONAL SLOTS, SHALL BE ORIENTED TO THE DIRECTION OF FLOW AS ILLUSTRATED. GRATES ARE MANUFACTURED TO BE REVERSIBLE.

DIRECTION OF FLOW



INLET COVERS
TYPE B, B-A, C,
MS, MS-A, & WM

STATE OF WISCONSIN
DEPARTMENT OF TRANSPORTATION

APPROVED
DATE 11/27/2013 /S/ Jerry H. Zogg
ROADWAY STANDARDS DEVELOPMENT ENGINEER
FHWA

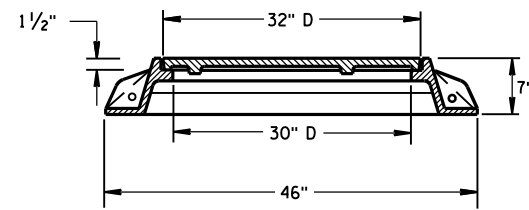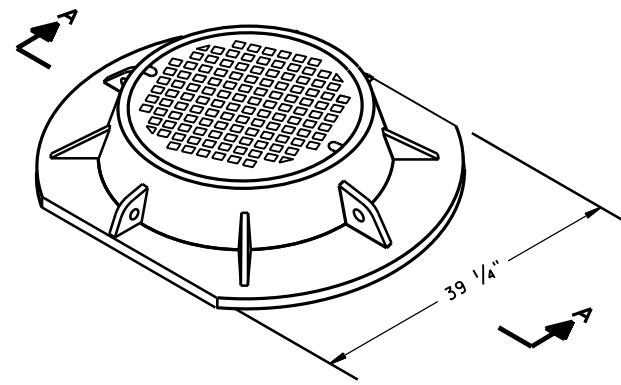

SECTION A-A
TYPE "K"

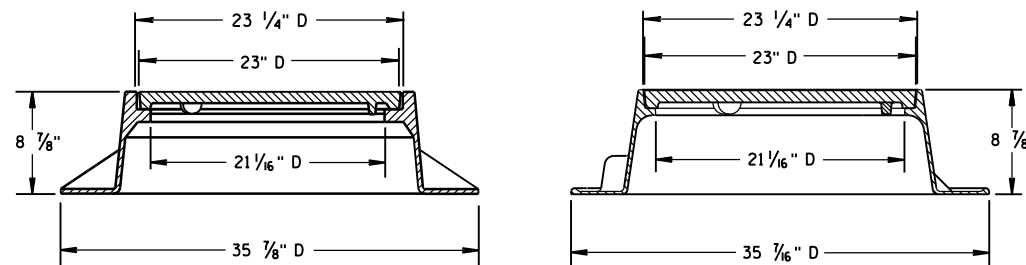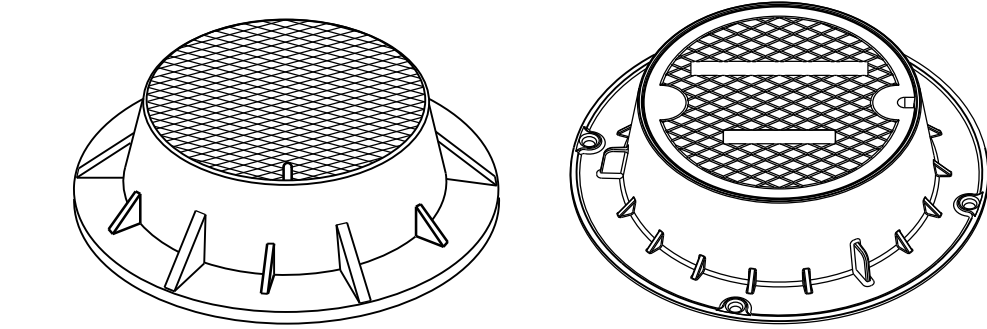

TYPE "J"





NOTE: EITHER CASTING IS ACCEPTABLE

GENERAL NOTES

DETAILS OF CONSTRUCTION, MATERIALS AND WORKMANSHIP NOT SHOWN ON THIS DRAWING SHALL CONFORM TO THE PERTINENT REQUIREMENTS OF THE STANDARD SPECIFICATIONS AND THE APPLICABLE SPECIAL PROVISIONS.

DETAIL DRAWINGS FOR PROPOSED ALTERNATE DESIGNS FOR MANHOLE COVERS SHALL BE SUBMITTED TO THE ENGINEER FOR APPROVAL PROVIDING THAT SUCH ALTERNATE DESIGNS MAKE PROVISION FOR EQUIVALENT CAPACITY AND STRENGTH.

ROUND FRAMES AND COVERS SHALL HAVE CONTINUOUSLY MACHINED BEARING SURFACES TO PREVENT ROCKING AND RATTLING.

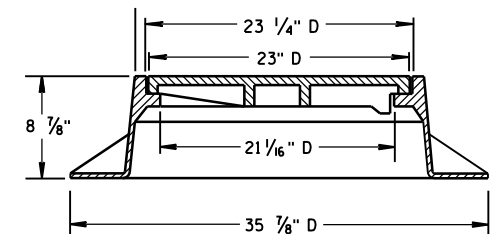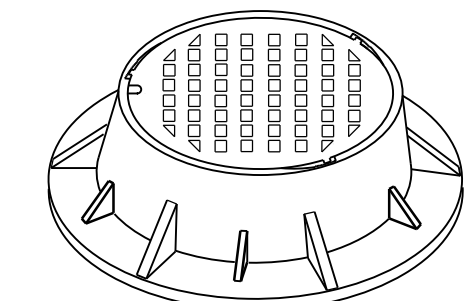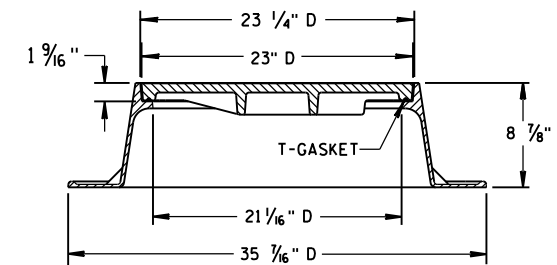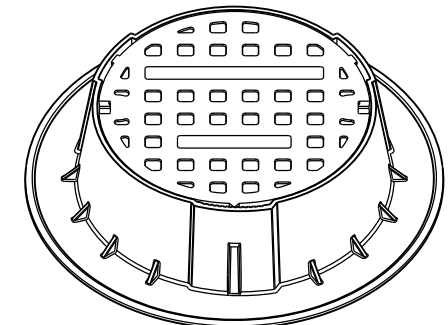



TYPE "J" SPECIAL

TYPE "B" NON-ROCKING SELF-SEAL LID



(NOTED AS TYPE J-S ON THE DRAINAGE TABLE)

NOTE: EITHER CASTING IS ACCEPTABLE




6

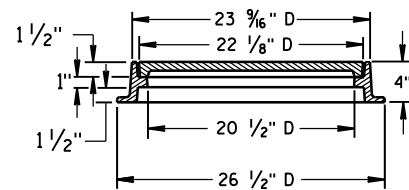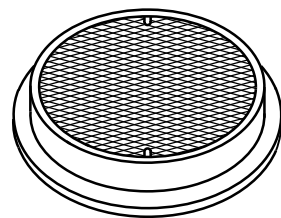

TYPE "L"

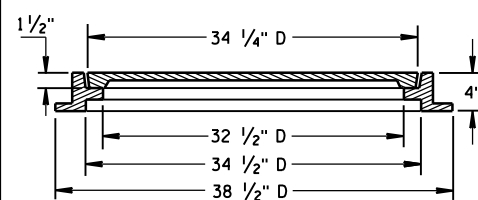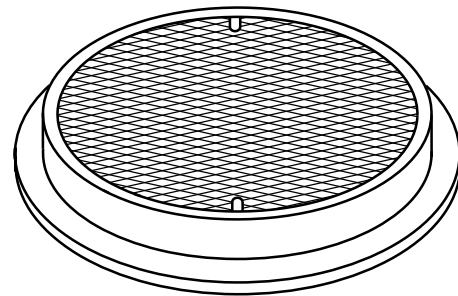

TYPE "M"

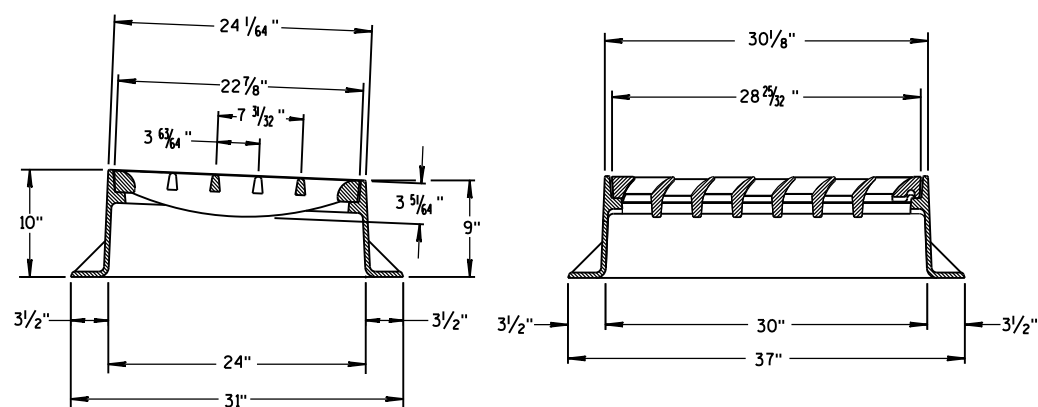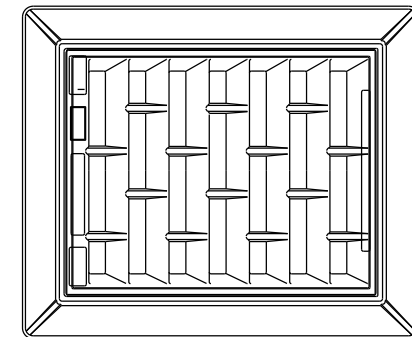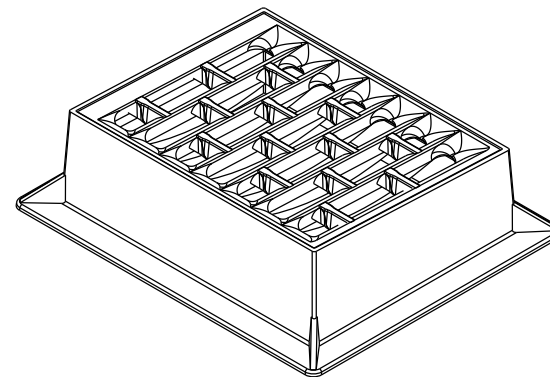

INLET COVER TYPE "BW"

6

INLET COVER TYPE BW
MANHOLE COVERS, TYPE K,
J, J-S, L & M

STATE OF WISCONSIN
DEPARTMENT OF TRANSPORTATION

APPROVED

11/27/2013

DATE

FHWA

/s/ Jerry H. Zogg
ROADWAY STANDARDS DEVELOPMENT
ENGINEER



SDD 08B09 Manholes, 3-FT, 4-FT, 5-FT, 6-FT, 7-FT, 8-FT, 9-FT and 10-FT

GENERAL NOTES

DETAILS OF CONSTRUCTION, MATERIALS AND WORKMANSHIP NOT SHOWN ON THIS DRAWING SHALL CONFORM TO THE PERTINENT REQUIREMENTS OF THE STANDARD SPECIFICATIONS AND THE APPLICABLE SPECIAL PROVISIONS.

UNLESS OTHERWISE AUTHORIZED IN WRITING BY THE ENGINEER, THE CONTRACTOR SHALL NOT ORDER AND DELIVER PRECAST MANHOLE UNITS REQUIRED FOR THE PROJECT UNTIL A LIST OF SIZES IS FURNISHED BY THE ENGINEER.

DETAILED DRAWINGS FOR PROPOSED ALTERNATE DESIGNS FOR UNDERGROUND DRAINAGE STRUCTURES SHALL BE SUBMITTED TO THE ENGINEER FOR APPROVAL PROVIDING THAT SUCH ALTERNATE DESIGNS MAKE PROVISION FOR EQUIVALENT CAPACITY AND STRENGTH.

ALL DRAINAGE STRUCTURES ARE DESIGNATED ON THE PLANS AS "MANHOLES 3X3-L", "CATCH BASINS 4-B", "INLETS 2X3-H", ETC. THE FIRST NUMBERS DESIGNATE THE SIZE OF THE STRUCTURE, AND THE FOLLOWING LETTER DESIGNATES THE TYPE OF COVER TO BE USED TO COMPRISE THE COMPLETE UNIT.

BASES SHALL BE PLACED ON A BED OF MATERIAL AT LEAST 6 INCHES IN DEPTH, WHICH MEETS THE REQUIREMENTS OF FOUNDATION BACKFILL. THIS BEDDING SHALL BE COMPACTED AND PROVIDE UNIFORM SUPPORT FOR THE ENTIRE AREA OF THE BASE.

PRECAST REINFORCED CONCRETE CONE TOPS (ECCENTRIC OR CONCENTRIC) OR PRECAST REINFORCED CONCRETE FLAT SLAB TOPS MAY BE USED ON CONCRETE BLOCK STRUCTURES.

ECCENTRIC CONE TOPS MAY BE USED ON ALL STRUCTURES. CONCENTRIC CONE TOPS SHALL BE USED ONLY ON STRUCTURES 5 FEET OR LESS IN DEPTH UNLESS OTHERWISE DIRECTED BY THE ENGINEER.

STEPS MEETING AASHTO M199 AND THE FOLLOWING REQUIREMENTS SHALL BE INSTALLED IN ALL STRUCTURES OVER 5 FEET IN DEPTH: 16 INCH C-C MAXIMUM SPACING; PROJECT A MINIMUM CLEAR DISTANCE OF 4 INCHES FROM THE WALL AT THE POINT OF EMBEDMENT; MINIMUM LENGTH OF 10 INCHES; MINIMUM WALL EMBEDMENT OF 3 INCHES. FERROUS METAL STEPS NOT PAINTED OR TREATED TO RESIST CORROSION SHALL HAVE A MINIMUM CROSS SECTIONAL DIMENSION OF 1 INCH.

STEPS OF APPROVED POLYPROPYLENE PLASTIC COATED REINFORCEMENT BAR ARE ACCEPTABLE. REINFORCING BAR MUST BE A MINIMUM OF 1/2 INCH AND MEET THE REQUIREMENTS OF ASTM A615.

CERTIFICATION SHALL BE PROVIDED THAT INSTALLED STEPS WHEN TESTED IN ACCORDANCE WITH SECTION 10 OF AASHTO T280 CAN WITHSTAND A VERTICAL LOAD OF 800 LBS. AND A HORIZONTAL LOAD OF 400 LBS.

ALL BAR STEEL REINFORCEMENT SHALL BE EMBEDDED 2 INCHES CLEAR UNLESS OTHERWISE SHOWN OR NOTED.

ALL PRECAST MANHOLE UNITS SHALL CONFORM TO THE PERTINENT REQUIREMENTS OF AASHTO DESIGNATION M199.


PRECAST REINFORCED RISERS SHALL HAVE A TONGUE AND GROOVE JOINT WITH TONGUE UP OR DOWN.

CONCRETE BLOCK WILL NOT BE PERMITTED FOR STRUCTURES GREATER THAN 4 FEET IN DIAMETER.


4" OVERHANGING BASES ARE REQUIRED FOR ALL CONCRETE BLOCK INSTALLATIONS. 4" OVERHANG IS REQUIRED WHEN SEPARATE PRECAST BASE IS PROVIDED. OVERHANG IS NOT REQUIRED ON PRECAST STRUCTURES WITH AN INTEGRAL OR MONOLITHIC BASE.

FOR ADDITIONAL CONFIGURATIONS, MAINTAIN A MINIMUM OF 12 INCHES AS MEASURED FROM THE INSIDE OF THE STRUCTURE WALL BETWEEN THE OUTSIDE PIPE WALLS OF ADJACENT PIPES. SEE DETAIL "D".

- ① FOR PRECAST MANHOLES PROVIDE REINFORCING STEEL IN ACCORDANCE TO AASHTO M199.
- ② SEE PIPE MATRIX TABLE FOR MINIMUM WALL THICKNESS FOR PRECAST MANHOLES
- ③ SEE PIPE MATRIX TABLE FOR MINIMUM THICKNESS OF PRECAST FLAT SLAB TOPS AND BASES.
- ④ JOINTS TO BE SEALED WITH A BUTYL RUBBER SEAL PER SEALANT MANUFACTURERS RECOMMENDATIONS CONFORMING TO ASTM C 990 (TYP.).
- ⑤ SEE MANHOLE COVER OPENING MATRIX.

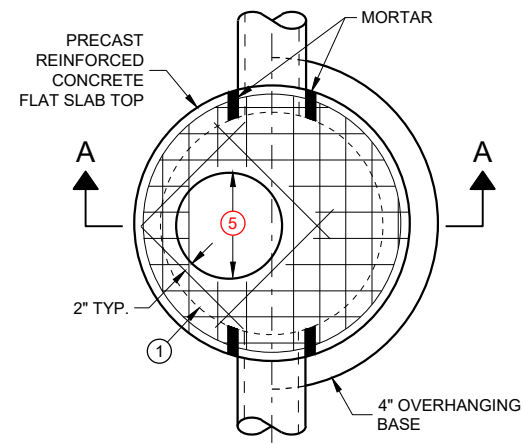

**PLAN VIEW
CIRCULAR OPENING**

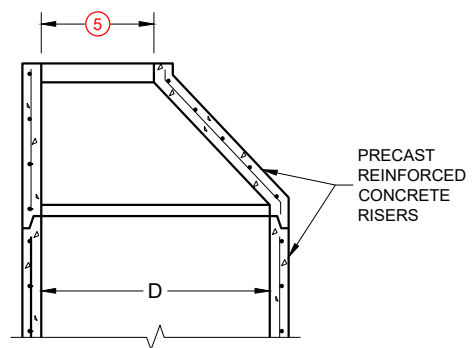

**OPTIONAL PRECAST
REINFORCED CONCRETE
ECCENTRIC TOP**


MANHOLE COVER OPENING MATRIX

MANHOLE COVER TYPE OPENING SIZE (FT.)	C	ALL J'S	K	L	M
2 DIA.	X	X		X	
3 DIA.			X		X


PIPE MATRIX

MANHOLE SIZE (DIA.)	MAXIMUM INSIDE PIPE DIAMETER FOR TWO PIPES		MINIMUM WALL THICKNESS (IN)	MINIMUM PRECAST FLAT SLAB TOP AND BASE THICKNESS
	180° SEPARATION (IN)	90° SEPARATION (IN)		
3-FT	15	12	4	6
4-FT	24	18	5	6
5-FT	36	24	6	8
6-FT	42	36	7	8
7-FT	48	36/42*	8	8
8-FT	60	42	9	8
9-FT	66	54	10	10
10-FT	72	60	11	10

*A 36" PIPE AND A 42" PIPE CAN BE PLACED WITHIN 90 DEGREES. SEE MINIMUM HORIZONTAL PIPE SEPARATION DETAIL.

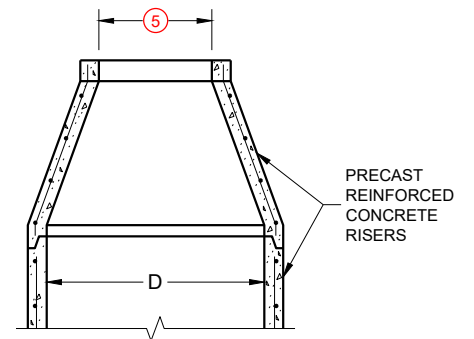


**OPTIONAL PRECAST
REINFORCED CONCRETE
CONCENTRIC TOP**

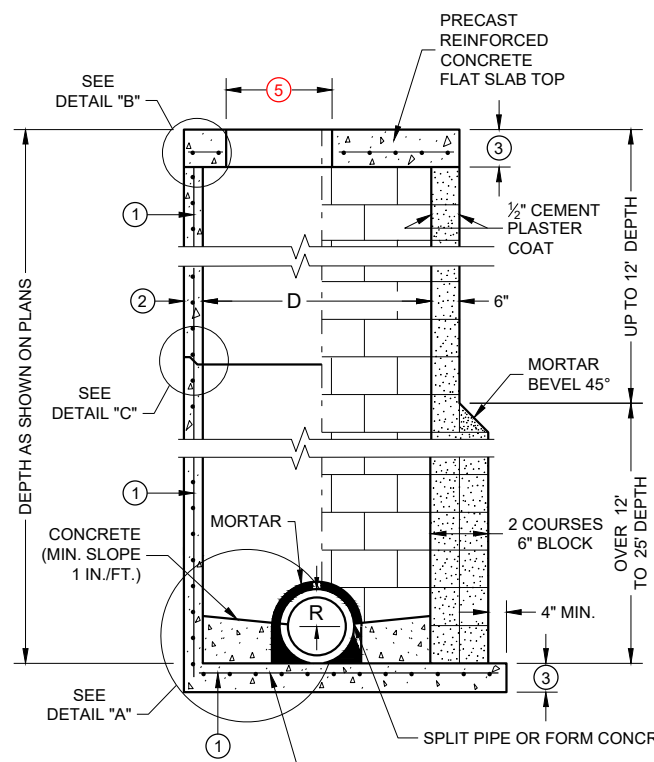


SECTION A - A

PRECAST REINFORCED CONCRETE WITH MONOLITHIC BASE

CONCRETE BLOCK WITH CAST IN PLACE OR PRECAST REINFORCED CONCRETE BASE ①

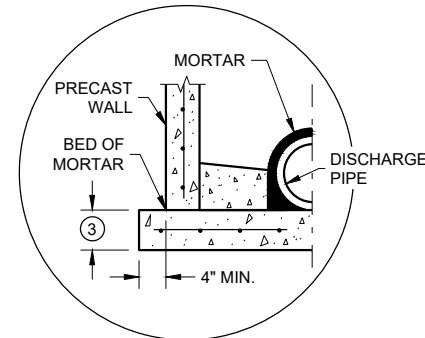


SEPARATE PRECAST REINFORCED CONCRETE BASE OPTION

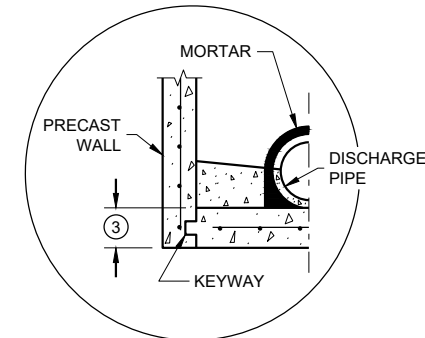


PRECAST REINFORCED CONCRETE WITH INTEGRAL BASE OPTION


DETAIL "A"

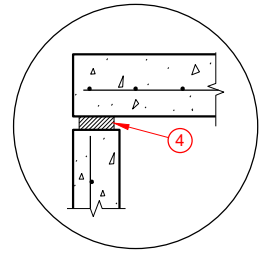

TOP WITH PLAIN END JOINT

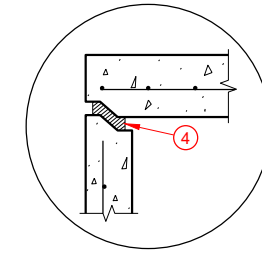


TOP WITH TONGUE AND GROOVE JOINT

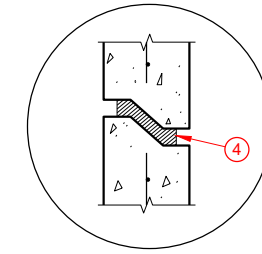

RISER WITH TONGUE AND GROOVE JOINT

DETAIL "B"

DETAIL "C"

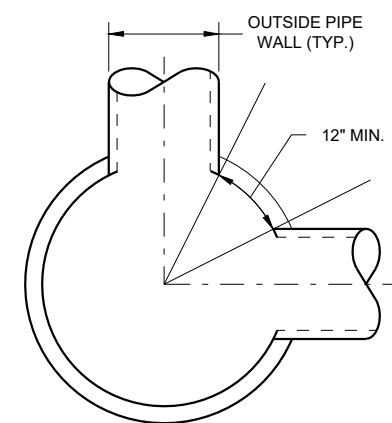

MINIMUM HORIZONTAL PIPE SEPARATION

**MANHOLES, 3-FT, 4-FT
5-FT, 6-FT, 7-FT, 8-FT, 9-FT
AND 10-FT DIAMETER**


STATE OF WISCONSIN
DEPARTMENT OF TRANSPORTATION

APPROVED
November 2021 /S/ Rodney Taylor
DATE ROADWAY STANDARDS DEVELOPMENT ENGINEER
FHWA


SDD 08B09 - 03

SDD 08B09 - 03

MANHOLES 3-FT, 4-FT, 5-FT, 6-FT, 7-FT, 8-FT, 9-FT AND 10-FT DIAMETER

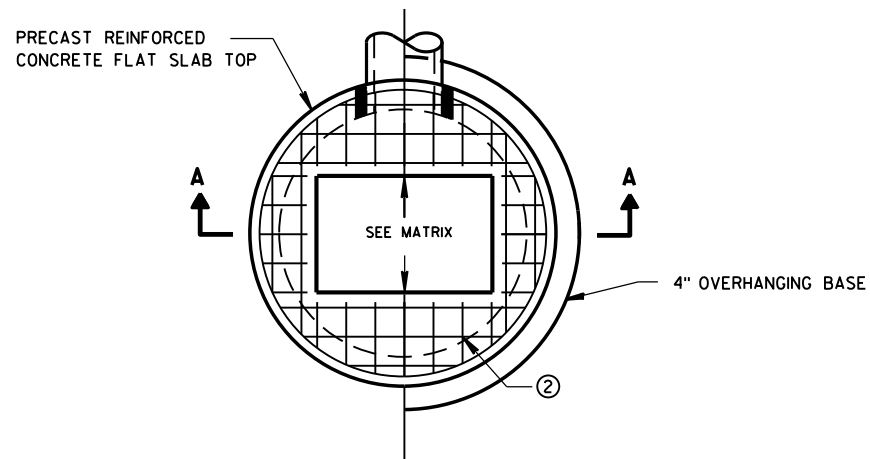

PLAN VIEW RECTANGULAR OPENING

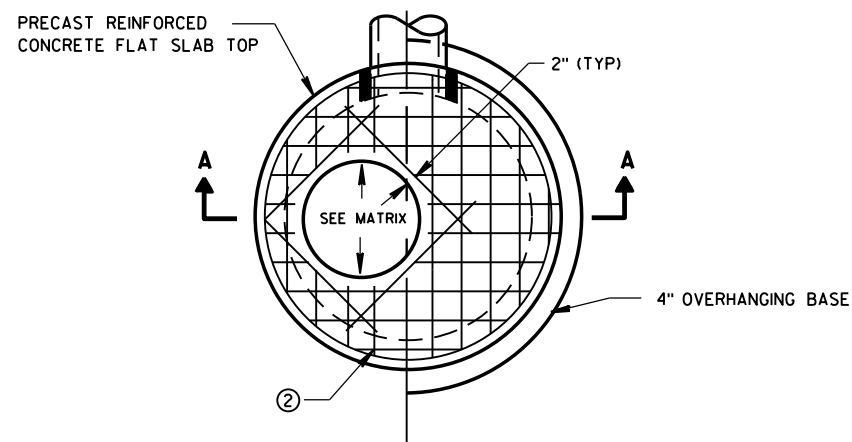

PLAN VIEW CIRCULAR OPENING

GENERAL NOTES

DETAILS OF CONSTRUCTION, MATERIALS AND WORKMANSHIP NOT SHOWN ON THIS DRAWING SHALL CONFORM TO THE PERTINENT REQUIREMENTS OF THE STANDARD SPECIFICATIONS AND THE APPLICABLE SPECIAL PROVISIONS.

UNLESS OTHERWISE AUTHORIZED IN WRITING BY THE ENGINEER, THE CONTRACTOR SHALL NOT ORDER AND DELIVER PRECAST INLET UNITS REQUIRED FOR THE PROJECT UNTIL A LIST OF SIZES IS FURNISHED BY THE ENGINEER.

DETAILED DRAWINGS FOR PROPOSED ALTERNATE DESIGNS FOR UNDERGROUND DRAINAGE STRUCTURES SHALL BE SUBMITTED TO THE ENGINEER FOR APPROVAL PROVIDING THAT SUCH ALTERNATE DESIGNS MAKE PROVISION FOR EQUIVALENT CAPACITY AND STRENGTH.

ALL DRAINAGE STRUCTURES ARE DESIGNATED ON THE PLANS AS "MANHOLES 3X3-L", "CATCH BASINS 4-B", "INLETS 2X3-H", ETC. THE FIRST NUMBERS DESIGNATE THE SIZE OF THE STRUCTURE, AND THE FOLLOWING LETTER DESIGNATES THE TYPE OF COVER TO BE USED TO COMPRISE THE COMPLETE UNIT.

BASES SHALL BE PLACED ON A BED OF MATERIAL AT LEAST 6 INCHES IN DEPTH, WHICH MEETS THE REQUIREMENTS OF FOUNDATION BACKFILL. THIS BEDDING SHALL BE COMPACTED AND PROVIDE UNIFORM SUPPORT FOR THE ENTIRE AREA OF THE BASE.

ALL BAR STEEL REINFORCEMENT SHALL BE EMBEDDED 2 INCHES CLEAR UNLESS OTHERWISE SHOWN OR NOTED.

ALL PRECAST INLET UNITS SHALL CONFORM TO THE PERTINENT REQUIREMENTS OF AASHTO DESIGNATION M199.

PRECAST REINFORCED RISERS SHALL HAVE A TONGUE AND GROOVE JOINT WITH TONGUE UP OR DOWN.

4" OVERHANGING BASES ARE REQUIRED FOR ALL CONCRETE BLOCK INSTALLATIONS. 4" OVERHANG IS REQUIRED WHEN SEPARATE PRECAST BASE IS PROVIDED. OVERHANG IS NOT REQUIRED ON PRECAST STRUCTURES WITH AN INTEGRAL OR MONOLITHIC BASE.


FOR ADDITIONAL CONFIGURATIONS, MAINTAIN A MINIMUM OF 12 INCHES AS MEASURED FROM THE INSIDE OF THE STRUCTURE WALL BETWEEN THE OUTSIDE PIPE WALLS OF ADJACENT PIPES. SEE DETAIL "C".

- ① MINIMUM WALL THICKNESS SHALL BE 4-IN FOR 3-FT DIAMETER AND 5-IN FOR 4-FT DIAMETER PRECAST INLETS.
- ② FOR PRECAST CATCH BASINS PROVIDE REINFORCING STEEL IN ACCORDANCE TO AASHTO M199.


INLET COVER OPENING MATRIX

	INLET COVER TYPE	ALL A'S	ALL B'S	BW	C	F	ALL H'S	S	T	V	WM	Z
3-FT	2 DIA.				X							X
	2X2	X	X					X		X		
4-FT	2 DIA.				X							X
	2X2	X	X					X		X	X	
	2X2.5			X								
	2X3						X					
	2.5X3					X						


JOINTS TO BE SEALED WITH A BUTYL RUBBER SEAL PER SEALANT MANUFACTURERS RECOMMENDATIONS CONFORMING TO ASTM C990 (TYP)

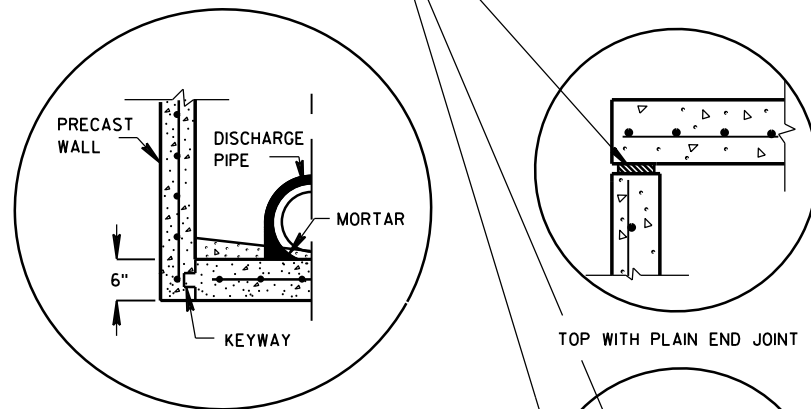


PRECAST REINFORCED CONCRETE WITH INTEGRAL BASE OPTION

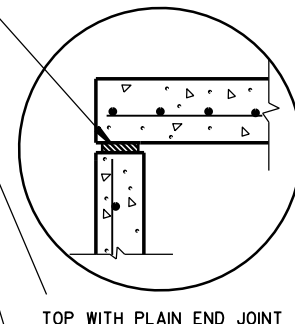


TOP WITH PLAIN END JOINT

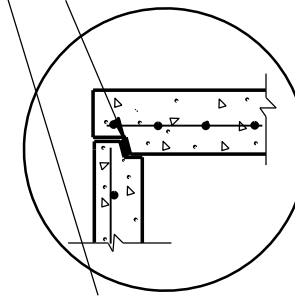

TOP WITH TONGUE AND GROOVE JOINT

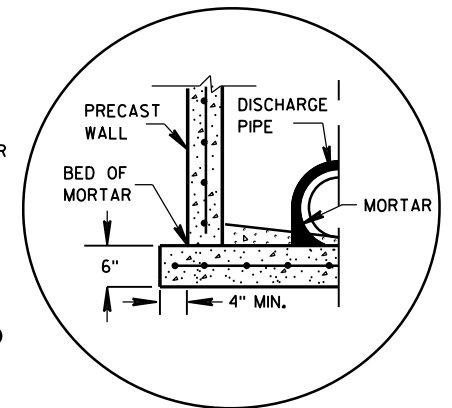

SEPARATE PRECAST REINFORCED CONCRETE BASE OPTION

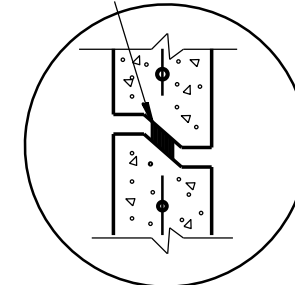


RISER WITH TONGUE AND GROOVE JOINT

DETAIL "A"


DETAIL "B"

INLETS 3-FT AND 4-FT DIAMETER

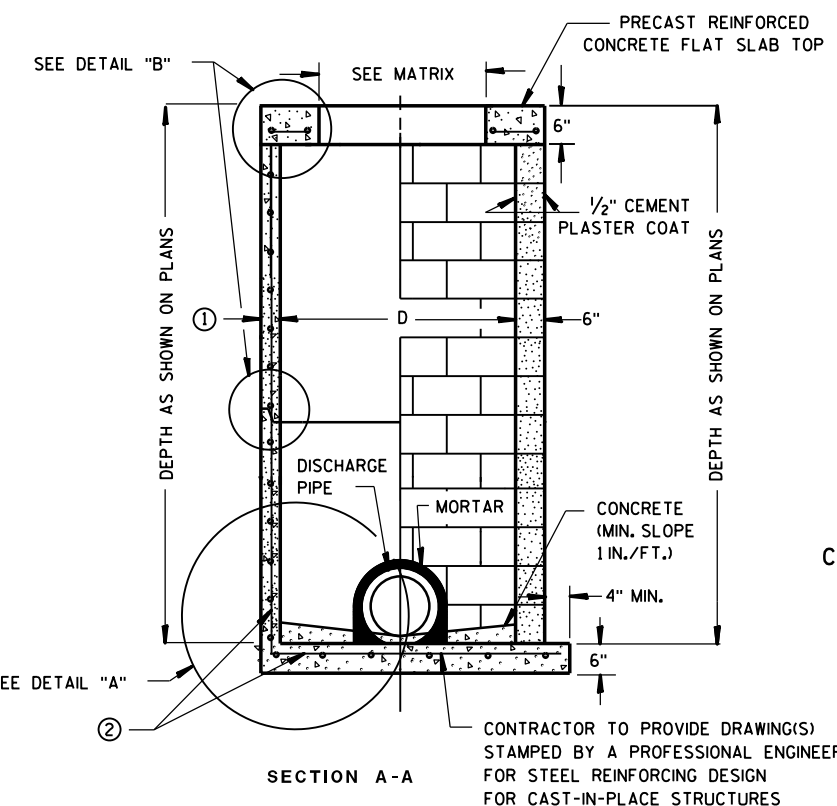

PRECAST REINFORCED CONCRETE WITH MONOLITHIC BASE OR CONCRETE BLOCK WITH CAST-IN-PLACE OR PRECAST REINFORCED CONCRETE BASE ②

CIRCULAR INLETS W/ FLAT TOP

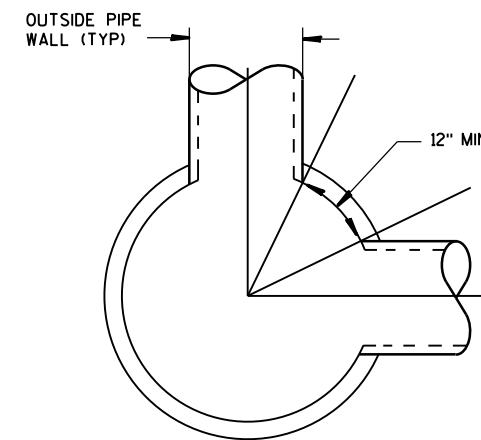

DETAIL "C"


PIPE MATRIX

INLET SIZE	MAXIMUM INSIDE PIPE DIAMETER FOR TWO PIPES	
	180° SEPARATION (IN)	90° SEPARATION (IN)
3-FT	15	12
4-FT	24	18


INLETS 3-FT AND 4-FT DIAMETER

STATE OF WISCONSIN
DEPARTMENT OF TRANSPORTATION


APPROVED
 Sept., 2016 /S/ Rodney Taylor
 DATE ROADWAY STANDARDS DEVELOPMENT UNIT SUPERVISOR
 FHWA

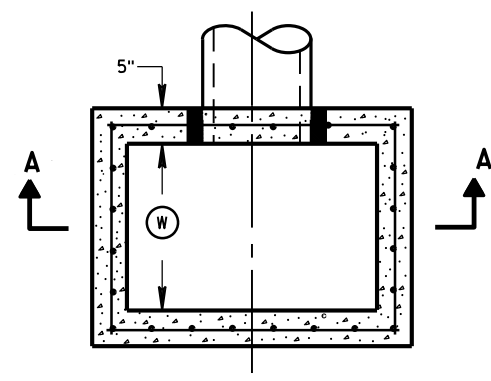


PLAN VIEW

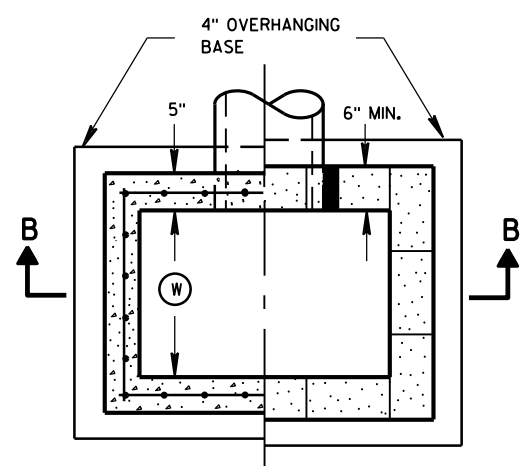


PLAN VIEW

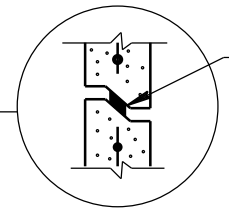

RISER JOINTS TO BE SEALED WITH A BUTYL RUBBER SEAL PER SEALANT MANUFACTURERS RECOMMENDATIONS CONFORMING TO ASTM C 990 (TYP)

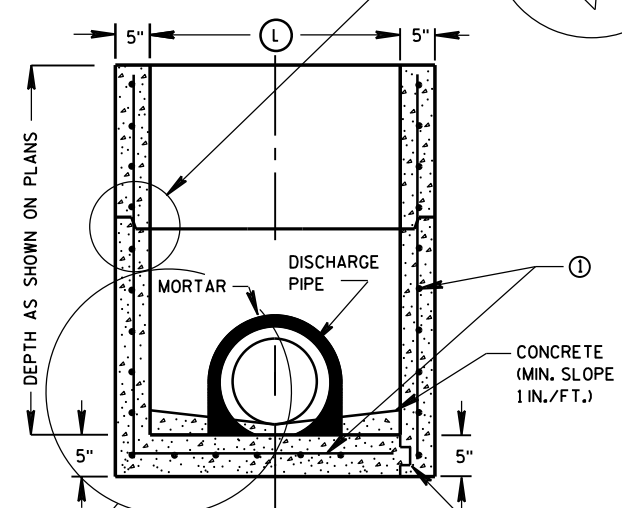


SECTION A-A

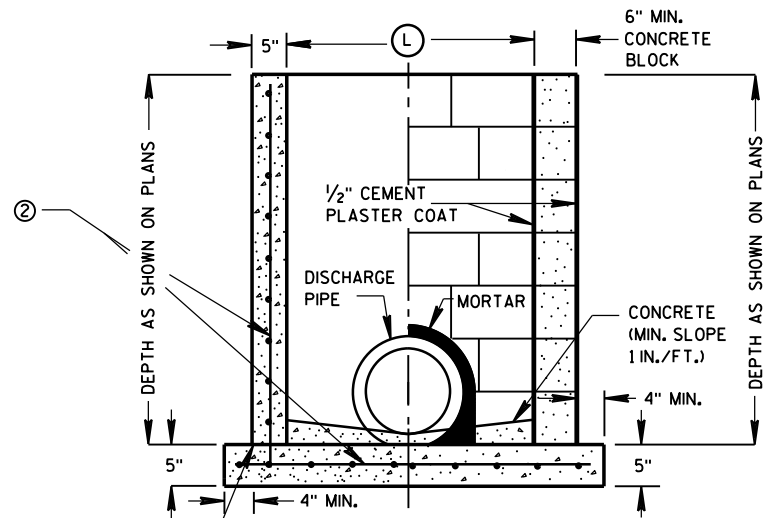

SECTION B-B

PRECAST REINFORCED CONCRETE WITH MONOLITHIC BASE
 PRECAST REINFORCED CONCRETE WITH INTEGRAL BASE
 KEYWAY

CONSTRUCTION JOINT
 CAST-IN-PLACE REINFORCED CONCRETE
 CONCRETE BLOCK WITH CAST-IN-PLACE OR PRECAST REINFORCED CONCRETE BASE ①

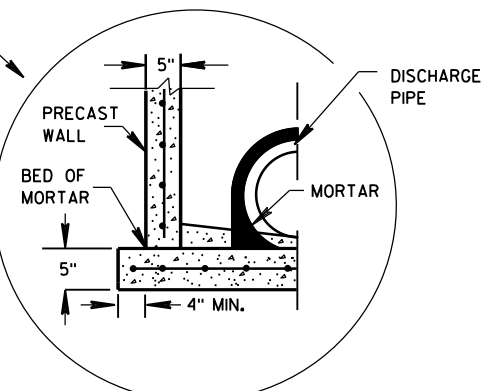

SEPARATE PRECAST REINFORCED CONCRETE BASE OPTION

GENERAL NOTES

DETAILS OF CONSTRUCTION, MATERIALS AND WORKMANSHIP NOT SHOWN ON THIS DRAWING SHALL CONFORM TO THE PERTINENT REQUIREMENTS OF THE STANDARD SPECIFICATIONS AND THE APPLICABLE SPECIAL PROVISIONS.

UNLESS OTHERWISE AUTHORIZED IN WRITING BY THE ENGINEER, THE CONTRACTOR SHALL NOT ORDER AND DELIVER PRECAST INLET UNITS REQUIRED FOR THE PROJECT UNTIL A LIST OF SIZES IS FURNISHED BY THE ENGINEER.

DETAILED DRAWINGS FOR PROPOSED ALTERNATE DESIGNS FOR UNDERGROUND DRAINAGE STRUCTURES SHALL BE SUBMITTED TO THE ENGINEER FOR APPROVAL PROVIDING THAT SUCH ALTERNATE DESIGNS MAKE PROVISION FOR EQUIVALENT CAPACITY AND STRENGTH.

ALL PRECAST INLET UNITS SHALL CONFORM TO THE PERTINENT REQUIREMENTS OF ASTM C 913.

ALL DRAINAGE STRUCTURES ARE DESIGNATED ON THE PLANS AS "MANHOLES 3X3-L", "CATCH BASINS 4-B", "INLETS 2X3-H", ETC. THE FIRST NUMBERS DESIGNATES THE SIZE OF THE STRUCTURE, AND THE FOLLOWING LETTER DESIGNATES THE TYPE OF COVER TO BE USED TO COMPRISE THE COMPLETE UNIT.

BASES SHALL BE PLACED ON A BED OF MATERIAL AT LEAST 6 INCHES IN DEPTH, WHICH MEETS THE REQUIREMENTS OF FOUNDATION BACKFILL. THIS BEDDING SHALL BE COMPACTED AND PROVIDE UNIFORM SUPPORT FOR THE ENTIRE AREA OF THE BASE.

ALL BAR STEEL REINFORCEMENT SHALL BE EMBEDDED 2 INCHES CLEAR UNLESS OTHERWISE SHOWN OR NOTED.

PRECAST REINFORCED RISERS SHALL HAVE A TONGUE AND GROOVE JOINT WITH TONGUE UP OR DOWN.

4" OVERHANGING BASES ARE REQUIRED FOR CAST-IN-PLACE REINFORCED CONCRETE AND CONCRETE BLOCK INSTALLATIONS. 4" OVERHANG IS REQUIRED WHEN SEPARATE PRECAST BASE IS PROVIDED. OVERHANG IS NOT REQUIRED ON PRECAST STRUCTURES WITH AN INTEGRAL OR MONOLITHIC BASE.

MAXIMUM INSIDE PIPE DIAMETER DETERMINED BY 3 INCH CLEARANCE ON EACH SIDE OF THE OUTSIDE WALL OF THE PIPE. SEE DETAIL "A". ASSUMES PIPE ENTERS PERPENDICULAR TO THE STRUCTURE.

① FOR PRECAST INLETS PROVIDE REINFORCING STEEL IN ACCORDANCE TO ASTM C 913.


② CONTRACTOR TO PROVIDE DRAWING(S) STAMPED BY A PROFESSIONAL ENGINEER FOR STEEL REINFORCING DESIGN FOR CAST-IN-PLACE STRUCTURES.

INLET COVER MATRIX

INLET SIZE	INLET COVER TYPE		ALL A'S	ALL B'S	BW	F	ALL H'S	S	T	V	WM
	WIDTH (W) (FT)	LENGTH (L) (FT)									
2X2-FT	2	2	X	X				X		X	
2X2.5-FT	2	2.5			X			X	X	X	X
2X3-FT	2	3					X				
2.5X3-FT	2.5	3				X					

PIPE MATRIX

INLET SIZE	MAXIMUM INSIDE PIPE DIAMETER	
	WIDTH (IN)	LENGTH (IN)
2X2-FT	12	12
2X2.5-FT	12	18
2X3-FT	12	24
2.5X3-FT	18	24

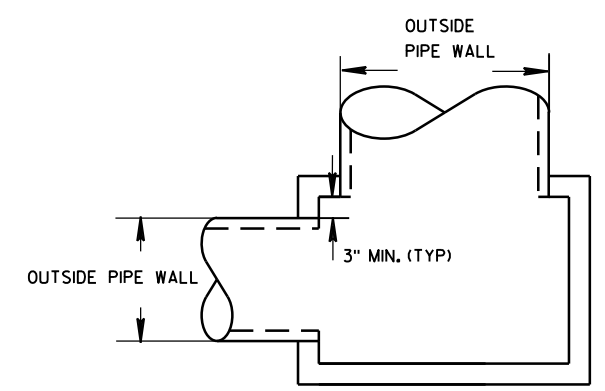

DETAIL "A"

INLETS 2X2-FT, 2X2.5-FT, 2X3-FT AND 2.5X3-FT


INLETS 2X2-FT, 2X2.5-FT, 2X3-FT AND 2.5X3-FT

STATE OF WISCONSIN
 DEPARTMENT OF TRANSPORTATION


APPROVED
 Sept., 2016 /S/ Rodney Taylor
 DATE ROADWAY STANDARDS DEVELOPMENT
 FHWA UNIT SUPERVISOR




SDD 8C8 Inlets Median 1 and 2 Grate

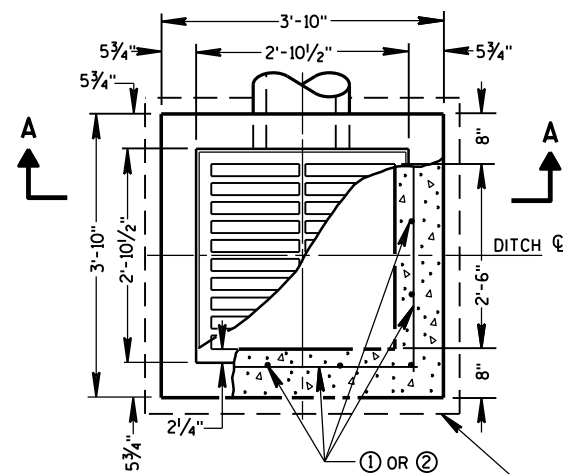


PLAN VIEW

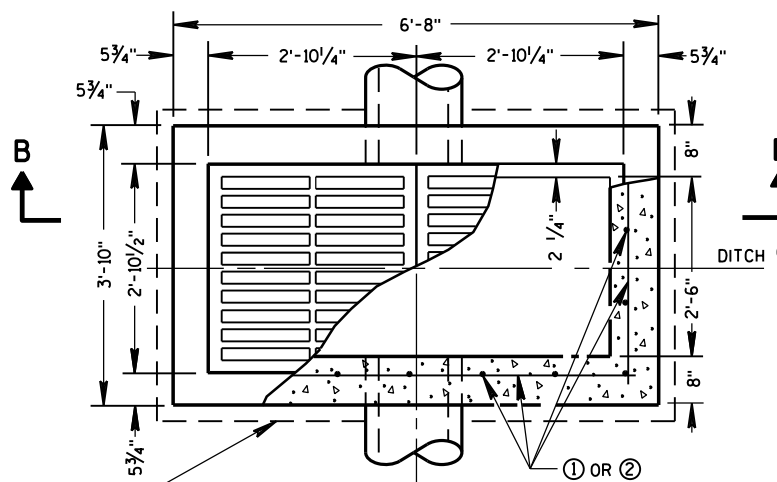


PLAN VIEW

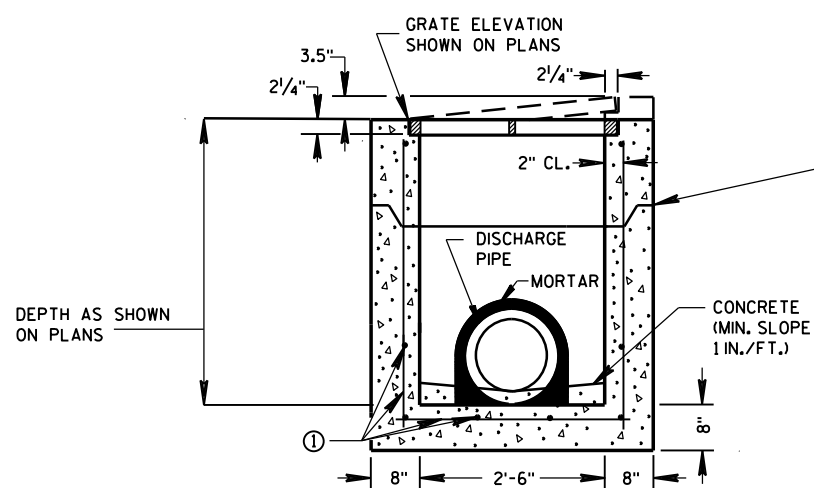

PRECAST REINFORCED CONCRETE SECTION A-A

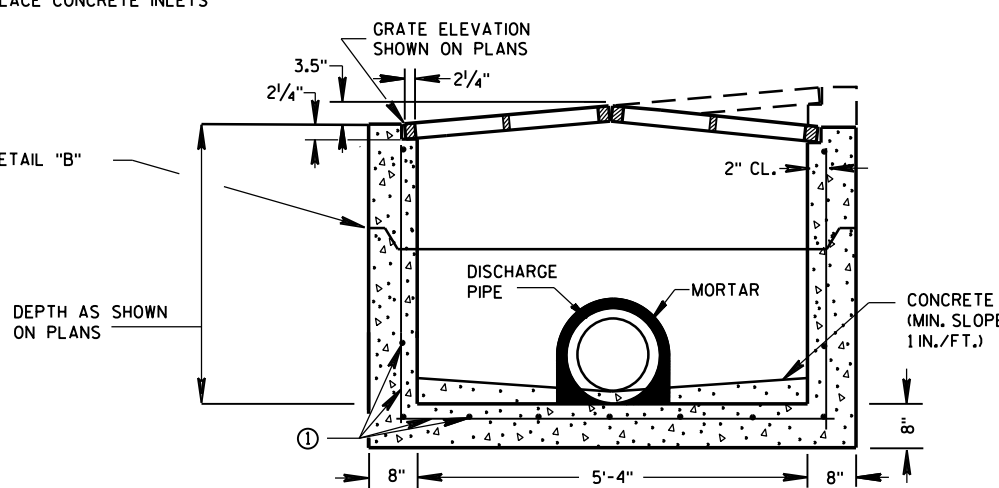


PRECAST REINFORCED CONCRETE SECTION B-B

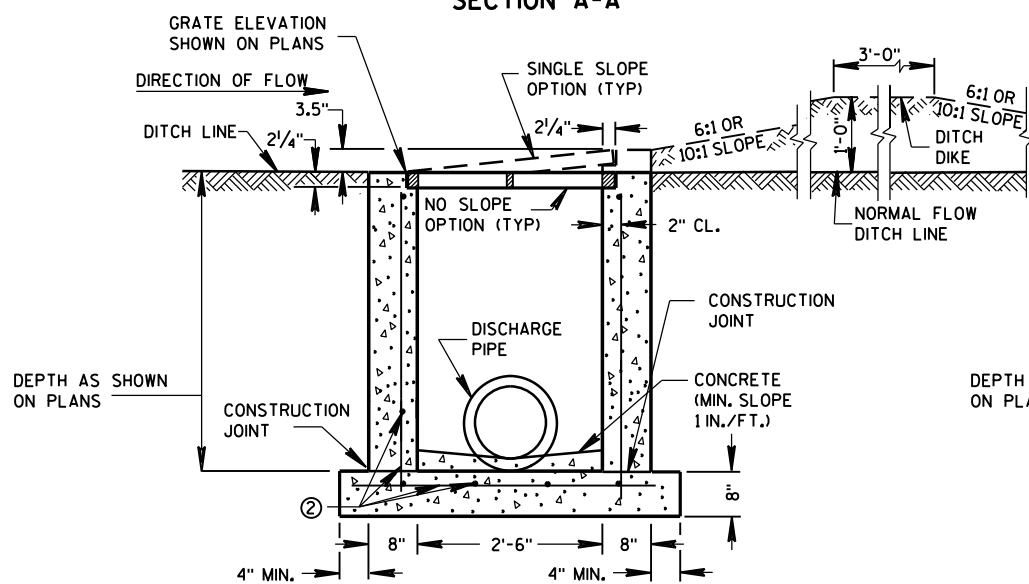

REINFORCED CAST-IN-PLACE CONCRETE SECTION A-A

INLETS MEDIAN 1 GRATE

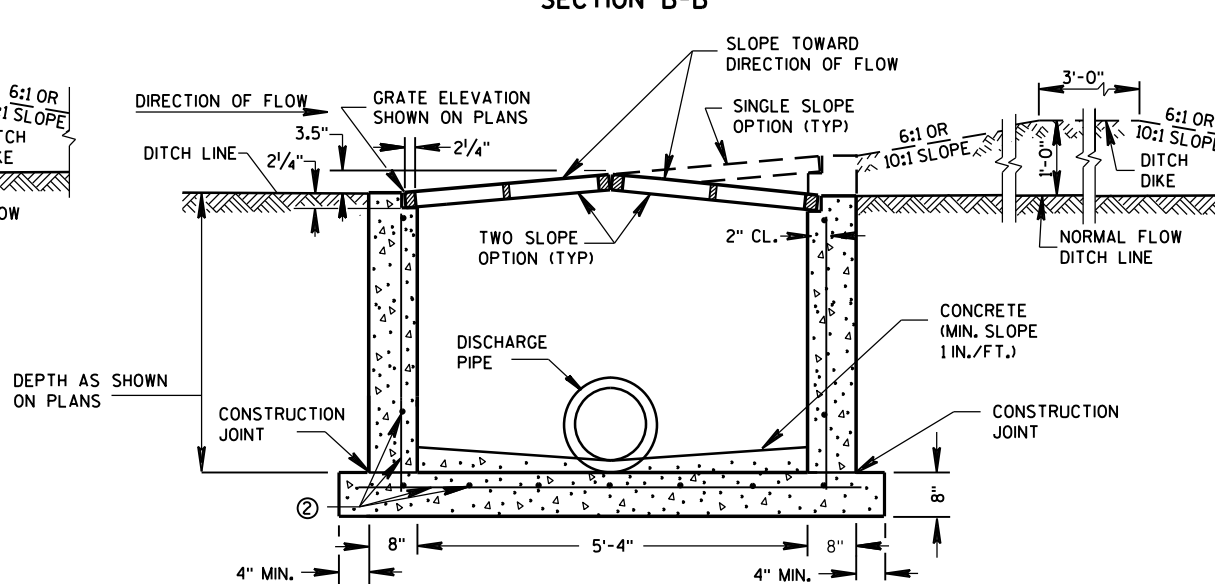

REINFORCED CAST-IN-PLACE CONCRETE SECTION B-B

INLETS MEDIAN 2 GRATE

GENERAL NOTES

DETAILS OF CONSTRUCTION, MATERIALS AND WORKMANSHIP NOT SHOWN ON THIS DRAWING SHALL CONFORM TO THE PERTINENT REQUIREMENTS OF THE STANDARD SPECIFICATIONS AND THE APPLICABLE SPECIAL PROVISIONS.

UNLESS OTHERWISE AUTHORIZED IN WRITING BY THE ENGINEER, THE CONTRACTOR SHALL NOT ORDER AND DELIVER PRECAST INLET UNITS REQUIRED FOR THE PROJECT UNTIL A LIST OF SIZES IS FURNISHED BY THE ENGINEER.

DETAILED DRAWINGS FOR PROPOSED ALTERNATE DESIGNS FOR INLETS WHICH MAY INCLUDE PRECAST REINFORCED CONCRETE INLETS, SHALL BE SUBMITTED TO THE ENGINEER FOR APPROVAL PROVIDING THAT SUCH ALTERNATE DESIGNS MAKE PROVISION FOR EQUIVALENT CAPACITY AND STRENGTH.

ALL MEDIAN INLETS ARE DESIGNATED ON THE PLANS AS "INLETS, IG-MS", ETC. THE FIRST NUMBER AND LETTER DESIGNATE THE TYPE OF STRUCTURE, AND THE FOLLOWING LETTERS DESIGNATE THE TYPE OF COVER TO BE USED TO COMPRISE THE COMPLETE UNIT. BASES SHALL BE PLACED ON A BED OF MATERIAL AT LEAST 6 INCHES IN DEPTH, WHICH MEETS THE REQUIREMENTS OF FOUNDATION BACKFILL. THIS BEDDING SHALL BE COMPACTED AND PROVIDE UNIFORM SUPPORT FOR THE ENTIRE AREA OF THE BASE.

ALL BAR STEEL REINFORCEMENT SHALL BE EMBEDDED 2 INCHES CLEAR UNLESS OTHERWISE SHOWN OR NOTED.

PRECAST REINFORCED RISERS SHALL HAVE A TONGUE AND GROOVE JOINT WITH TONGUE UP OR DOWN.


ALL PRECAST INLET UNITS SHALL CONFORM TO THE PERTINENT REQUIREMENTS OF ASTM C 913.

MAXIMUM INSIDE PIPE DIAMETER DETERMINED BY 3" CLEARANCE ON EACH SIDE OF THE OUTSIDE WALL OF THE PIPE. SEE DETAIL "A". ASSUMES PIPE ENTERS PERPENDICULAR TO THE STRUCTURE.

- ① FOR PRECAST INLETS PROVIDE REINFORCING STEEL IN ACCORDANCE TO ASTM C 913.
- ② CONTRACTOR TO PROVIDE DRAWING(S) STAMPED BY A PROFESSIONAL ENGINEER FOR STEEL REINFORCING DESIGN FOR CAST-IN-PLACE STRUCTURES.


PIPE MATRIX

INLET SIZE	MAXIMUM INSIDE PIPE DIAMETER	
	WIDTH (IN)	LENGTH (IN)
1 GRATE	18	18
2 GRATE	18	42

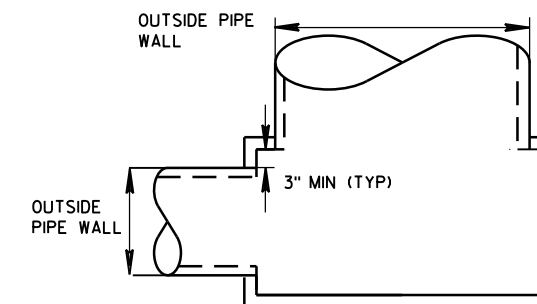

DETAIL "A"

JOINTS TO BE SEALED WITH A BUTYL RUBBER SEAL PER SEALANT MANUFACTURERS RECOMMENDATIONS CONFORMING TO ASTM C 990 (TYP)

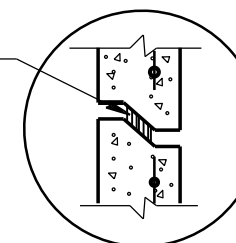

DETAIL "B"


INLETS MEDIAN 1 AND 2 GRATE

STATE OF WISCONSIN
DEPARTMENT OF TRANSPORTATION


APPROVED
Sept., 2016 /S/ Rodney Taylor
DATE ROADWAY STANDARDS DEVELOPMENT
FHWA UNIT SUPERVISOR




SDD 08D01-a Concrete Curb and Gutter

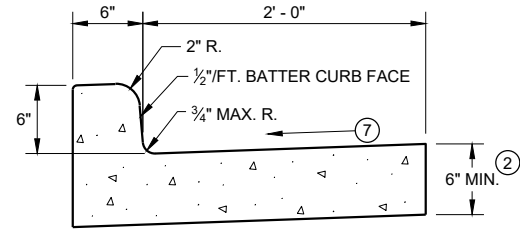


TYPES A¹ & D

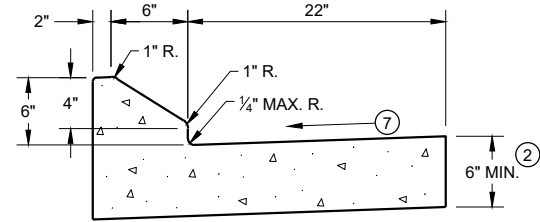


6" SLOPED CURB TYPES G¹ & J

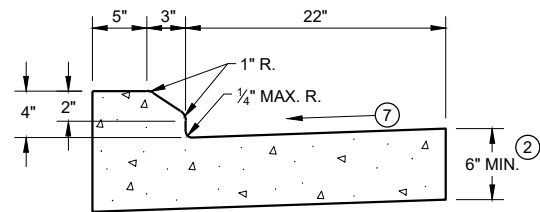


4" SLOPED CURB TYPES G¹ & J

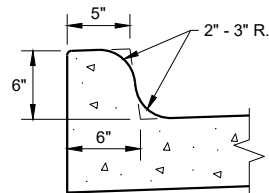

TYPES K¹ & L
(OPTIONAL CURB SHAPE)

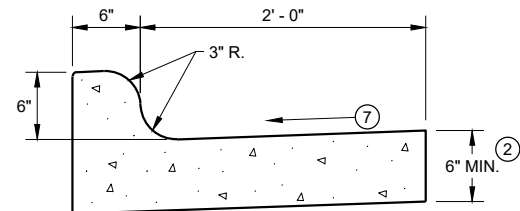


TYPES K¹ & L
CONCRETE CURB AND GUTTER 30"

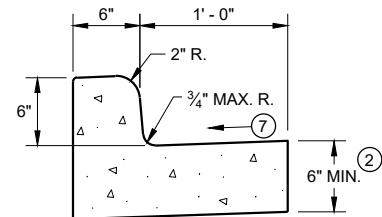


TYPES A¹ & D

CONCRETE CURB AND GUTTER 18"

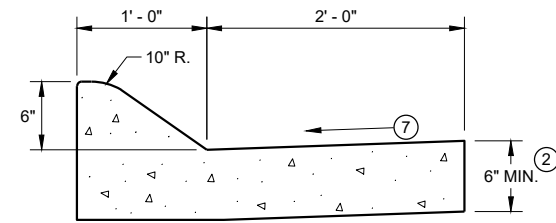


6" SLOPED CURB TYPES A¹ & D

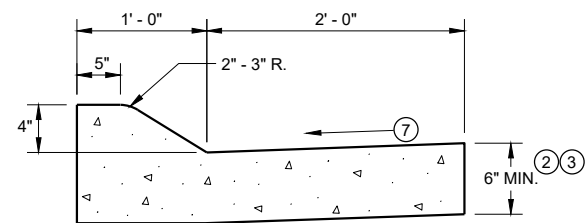


4" SLOPED CURB TYPES A¹ & D

CONCRETE CURB AND GUTTER 36"

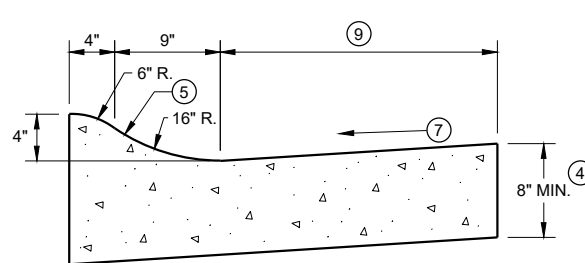

4" SLOPED CURB TYPES R¹ & T

TBT & TBTT	X
30"	22"
36"	28"

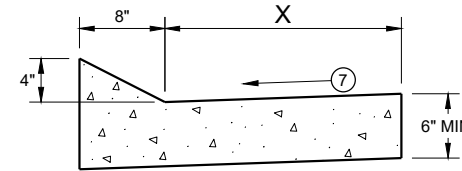


TYPES TBT & TBTT¹

CONCRETE CURB AND GUTTER

PAVEMENT THICKNESS AND MAXIMUM CONCRETE PANEL WIDTH TABLE

PAVEMENT THICKNESS	MAXIMUM PANEL WIDTH
LESS THAN 10"	12'
10" & ABOVE	15'

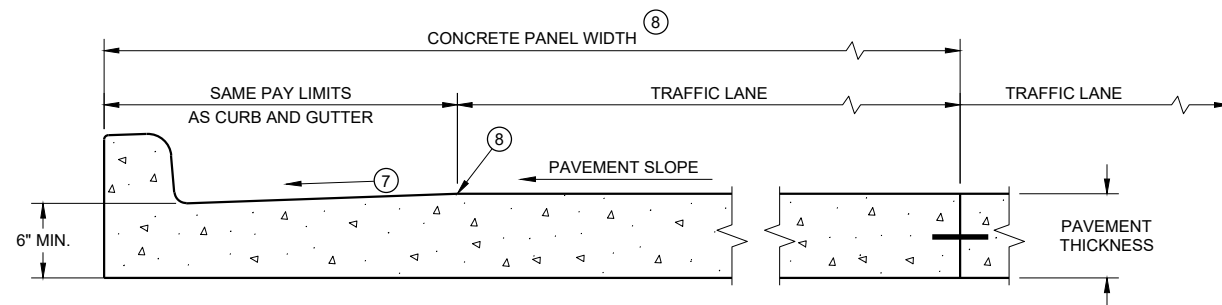

PARTIAL SECTION OF PAVEMENT *
WITH INTEGRAL CURB AND GUTTER

* BIKE LANE IS NOT SHOWN

GENERAL NOTES

DETAILS OF CONSTRUCTION AND WORKMANSHIP NOT SHOWN ON THIS DRAWING SHALL CONFORM TO THE PERTINENT REQUIREMENTS OF THE CONTRACT.

PAVEMENT TIES AND TIE BARS SHALL BE EPOXY COATED IN CONFORMANCE WITH SUBSECTION 505.2.6.2 OF THE STANDARD SPECIFICATIONS.

INTEGRAL CURB AND GUTTER SHALL CONFORM TO THE DETAILS SHOWN FOR CONCRETE CURB AND GUTTER INCLUDING THE TRANSVERSE GUTTER SLOPE.

UNLESS OTHERWISE SHOWN ON THE TYPICAL CROSS SECTIONS, THE BASE AGGREGATE AND COMMON EXCAVATION LIMITS ARE 2' - 0" BEHIND THE BACK OF CURBS.

- ① TIE BARS ARE REQUIRED FOR CURB AND GUTTERS TYPES A, G, K, R, AND TBTT.
- ② THE BOTTOM OF CURB AND GUTTER MAY BE CONSTRUCTED EITHER LEVEL OR PARALLEL TO THE SLOPE OF THE SUBGRADE OR BASE AGGREGATE PROVIDED A 6" MINIMUM GUTTER THICKNESS IS MAINTAINED.
- ③ USE 8" MINIMUM GUTTER THICKNESS WHEN USED WITH AN ADJACENT CONCRETE TRUCK APRON PLACED BEHIND BACK OF CURB.
- ④ THE BOTTOM OF CURB AND GUTTER MAY BE CONSTRUCTED EITHER LEVEL OR PARALLEL TO THE SLOPE OF THE SUBGRADE OR BASE AGGREGATE PROVIDED A 8" MINIMUM GUTTER THICKNESS IS MAINTAINED.
- ⑤ UNLESS OTHERWISE NOTED, FOR STAKING PURPOSES THE FACE OF CURB IS 6" FROM THE BACK OF CURB.
- ⑥ WHEN REVERSE SLOPE GUTTER IS REQUIRED, THE LOCATION(S) WILL BE SHOWN ELSEWHERE IN THE PLAN.
- ⑦ USE 4% GUTTER CROSS SLOPE UNLESS OTHERWISE NOTED IN THE PLANS.
- ⑧ INCLUDE LONGITUDINAL JOINT AND TIE BARS ALONG LANE EDGE WHEN CONCRETE PANEL WIDTH EXCEEDS THE MAXIMUM WIDTH PER TABLE BELOW. LONGITUDINAL JOINT(S) ARE NOT ALLOWED WITHIN TRAFFIC LANES AND BIKE LANES. LONGITUDINAL JOINT MAY BE SAWED.
- ⑨ CONCRETE CURB AND GUTTER 4-INCH SLOPED 30-INCH TYPE "R" AND "T" = 17 INCHES
CONCRETE CURB AND GUTTER 4-INCH SLOPED 36-INCH TYPE "R" AND "T" = 23 INCHES

6

6

SDD 08D01 - 22a


SDD 08D01 - 22a

CONCRETE CURB AND GUTTER


STATE OF WISCONSIN
DEPARTMENT OF TRANSPORTATION 75



SDD 08D01-b Concrete Gutter, Ties, and Curb and Gutter Applications

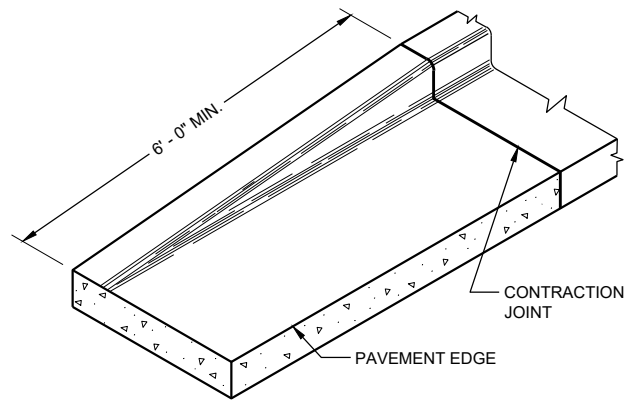

END SECTION CURB AND GUTTER

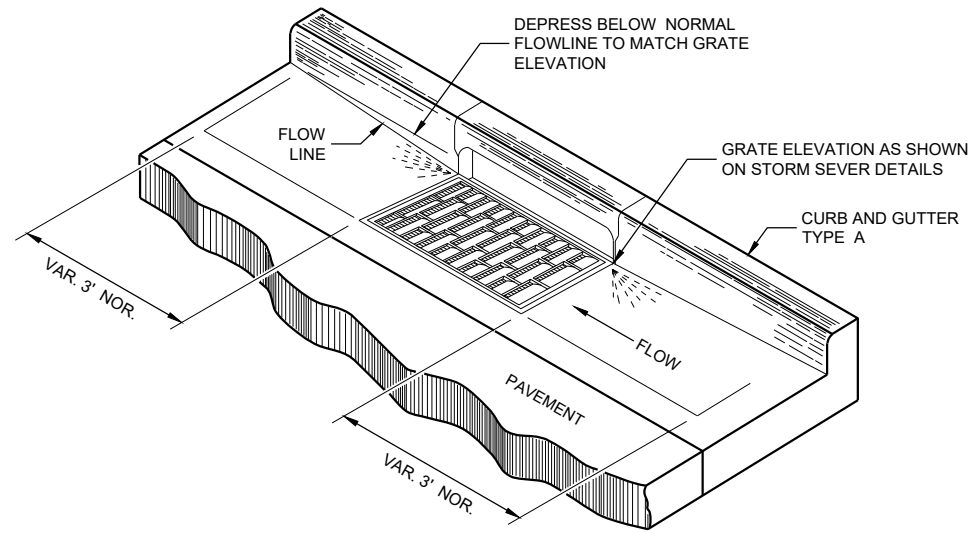

DETAIL OF CURB AND GUTTER AT INLETS
(TYPICAL H INLET COVER SHOWN)


GENERAL NOTES

DETAILS OF CONSTRUCTION AND WORKMANSHIP NOT SHOWN ON THIS DRAWING SHALL CONFORM TO THE PERTINENT REQUIREMENTS OF THE CONTRACT.


PAVEMENT TIES AND TIE BARS SHALL BE EPOXY COATED IN CONFORMANCE WITH SUBSECTION 505.2.6.2 OF THE STANDARD SPECIFICATIONS.

UNLESS OTHERWISE SHOWN ON THE TYPICAL CROSS SECTIONS, THE BASE AGGREGATE AND COMMON EXCAVATION LIMITS ARE 2' - 0" BEHIND THE BACK OF CURBS.


- ① TIE BARS ARE REQUIRED FOR CURB AND GUTTERS TYPES A, G, K, R, AND TBTT.
- ② THE BOTTOM OF CURB AND GUTTER MAY BE CONSTRUCTED EITHER LEVEL OR PARALLEL TO THE SLOPE OF THE SUBGRADE OR BASE AGGREGATE PROVIDED A 6" MINIMUM GUTTER THICKNESS IS MAINTAINED.
- ⑨ REFER TO SDD 08D18 AND 08D19 FOR ADDITIONAL DRIVEWAY ENTRANCE CURB DETAILS.

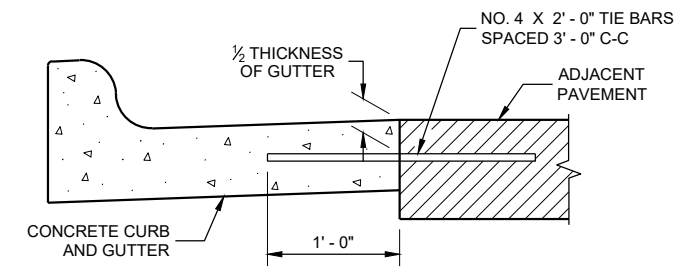

TYPICAL TIE BAR LOCATION ①

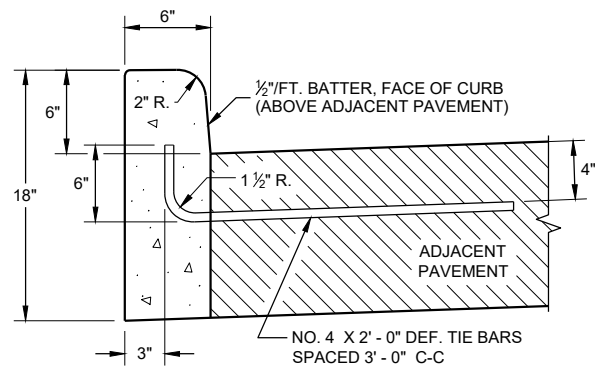


TYPES A ① & D

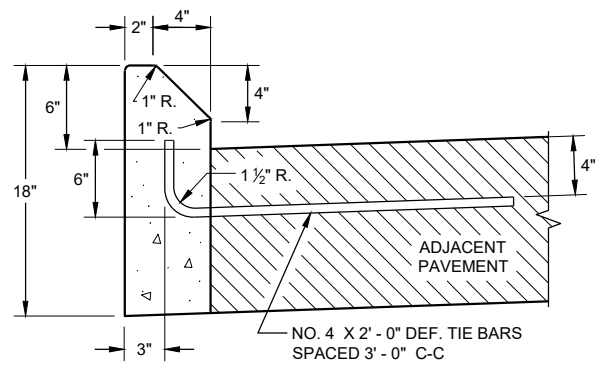


TYPES G ① & J

CONCRETE CURB

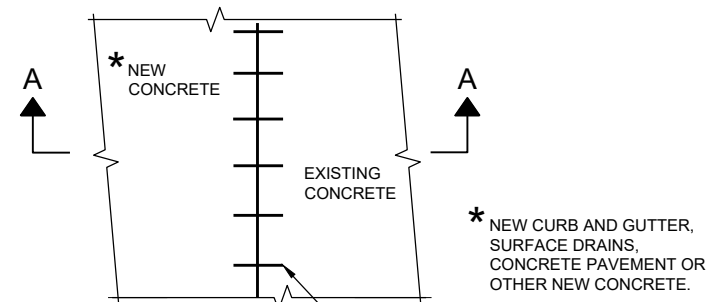


PLAN VIEW

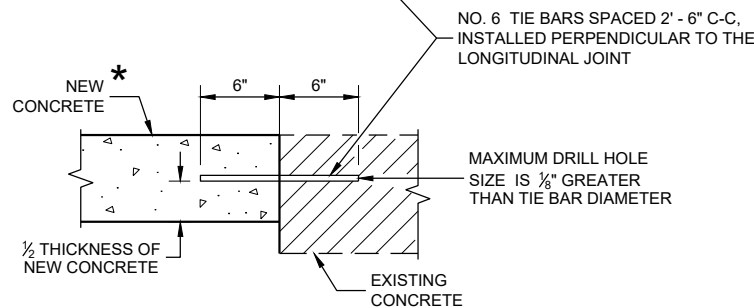

SECTION A - A

TIE BARS DRILLED INTO EXISTING PAVEMENT

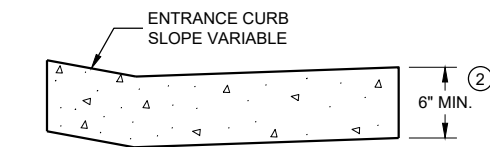

DRIVEWAY ENTRANCE CURB ⑨
(WHEN DIRECTED BY THE ENGINEER)

CONCRETE CURB, TIES AND CURB AND GUTTER APPLICATIONS


STATE OF WISCONSIN
DEPARTMENT OF TRANSPORTATION

APPROVED
February 2021 /S/ Rodney Taylor
DATE ROADWAY STANDARDS DEVELOPMENT ENGINEER


FHWA




SDD 08D05-a: Curb Ramps Types 1 and 1-A

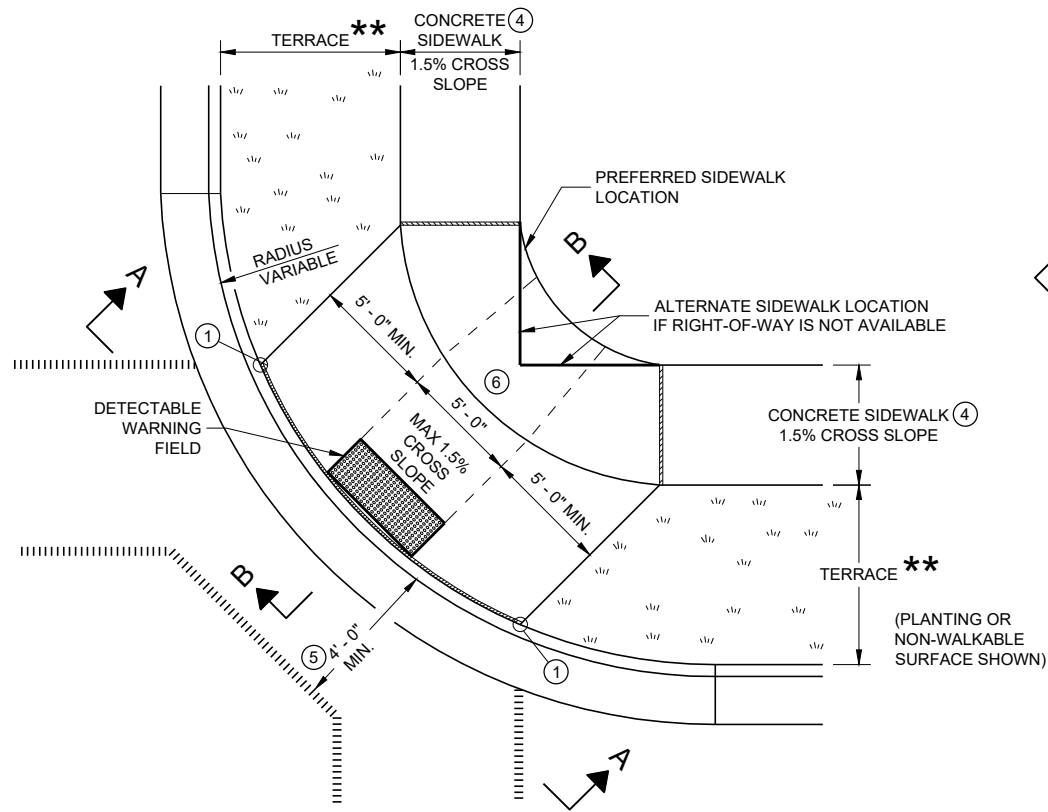


**PLAN VIEW
CURB RAMP TYPE 1
(CENTER OF CORNER RADIUS)**

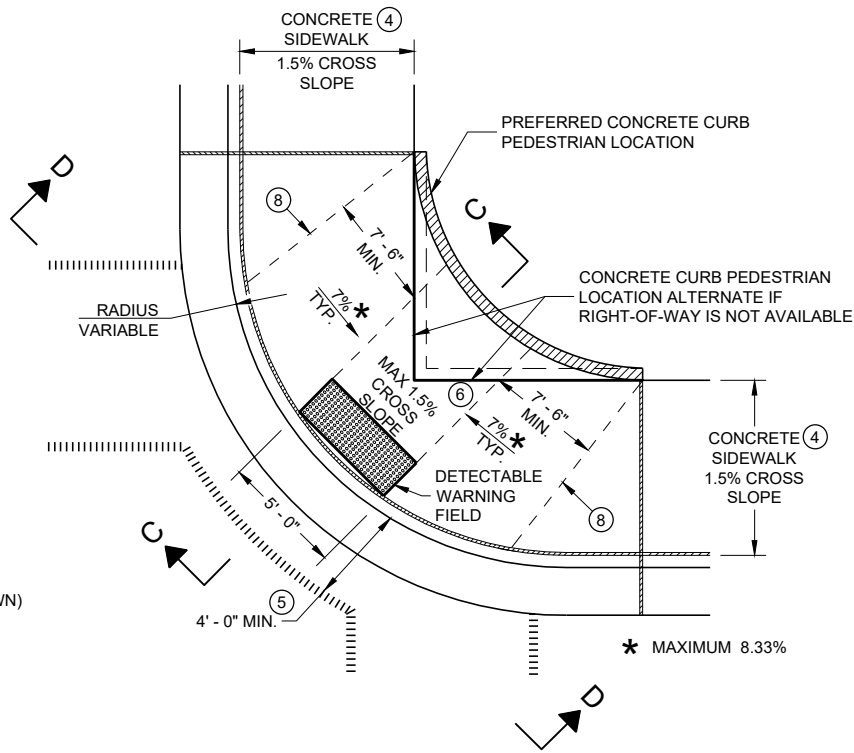


**PLAN VIEW
CURB RAMP TYPE 1 - A
(NO TERRACE)**

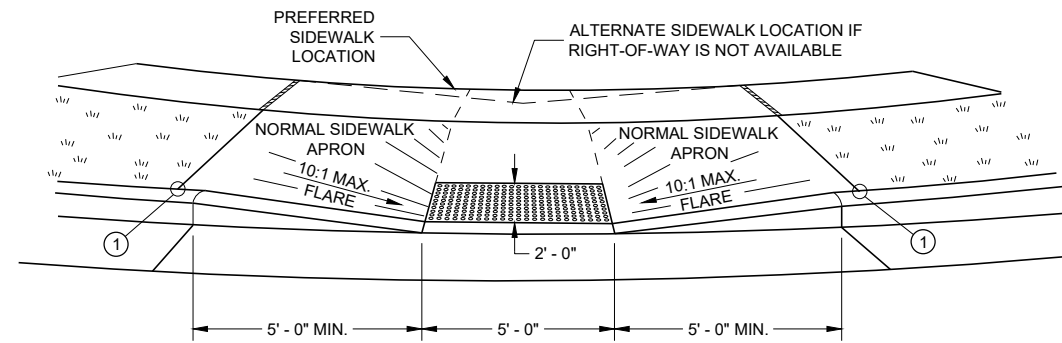


VIEW A - A FOR TYPE 1

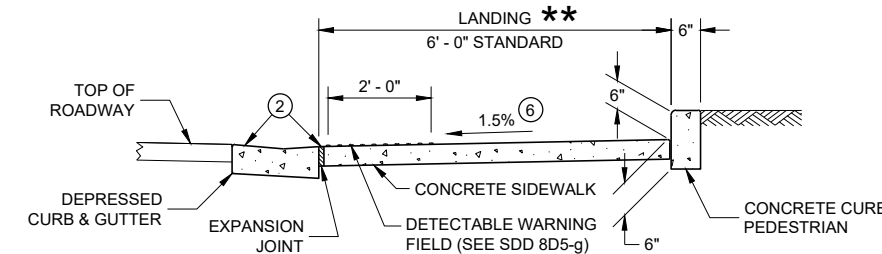

SECTION C - C FOR TYPE 1 - A

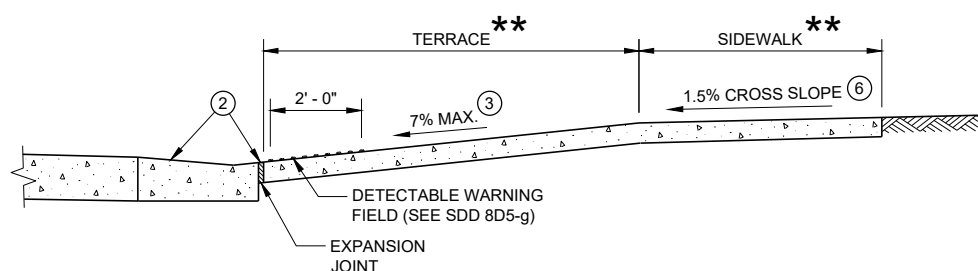

SECTION B - B FOR TYPE 1

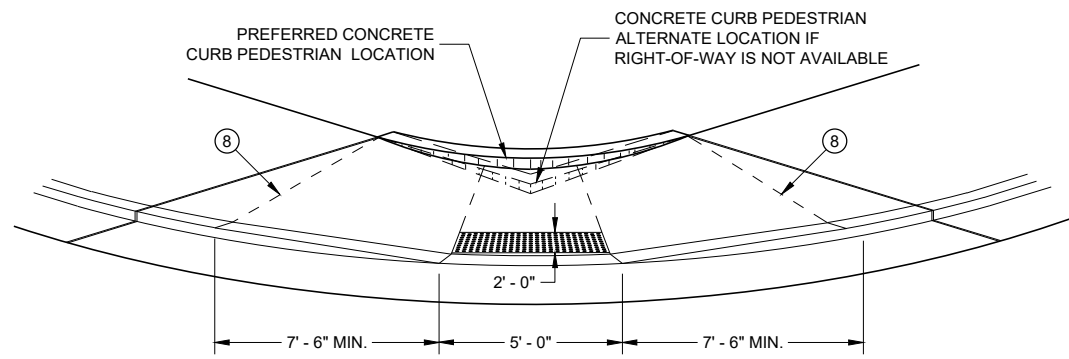

VIEW D - D FOR TYPE 1 - A

GENERAL NOTES

AVOID PLACING DRAINAGE STRUCTURES, JUNCTION BOXES OR OTHER OBSTRUCTIONS IN FRONT OF RAMP ACCESS AREAS.

DETAILS OF CONSTRUCTION, MATERIALS AND WORKMANSHIP NOT SHOWN ON THIS DRAWING SHALL CONFORM TO THE PERTINENT REQUIREMENTS OF THE STANDARD SPECIFICATIONS AND THE APPLICABLE SPECIAL PROVISIONS.

WHEN NECESSARY, THE SIDEWALK ELEVATION MAY BE LOWERED TO MEET THE HIGH POINT ON THE RAMP.

TYPE 1 CURB RAMPS SHALL HAVE A NORMAL SIDEWALK APRON AND CURB ON BOTH SIDES OF RAMP.

DETECTABLE WARNING FIELD SHALL BE MEASURED AND PAID BY THE SQUARE FOOT AS "CURB RAMP DETECTABLE WARNING FIELD". THE CONCRETE PEDESTRIAN CURB, IF NEEDED, SHALL BE MEASURED AND PAID BY THE LINEAR FOOT AS "CONCRETE CURB PEDESTRIAN". CONCRETE SIDEWALK IN THE CURB RAMP AREA SHALL BE MEASURED AND PAID BY THE SQUARE FOOT AS CONCRETE SIDEWALK, INCLUDING THE AREA UNDER THE DETECTABLE WARNING FIELD.

SELECT CURB RAMP DETECTABLE WARNING FIELD MATERIALS AND DEVICES FROM THE DEPARTMENT'S APPROVED MATERIALS LIST. THE COLOR OF THE DETECTABLE WARNING FIELD IS SPECIFIED ELSEWHERE AND IS INCIDENTAL TO THE BID ITEM OF "CURB RAMP DETECTABLE WARNING FIELD"

DETECTABLE WARNING FIELDS THAT ARE INSTALLED AS A GROUP OR SIDE BY SIDE, SHALL BE FROM THE SAME MANUFACTURER.

SURFACE TEXTURE OF THE RAMP SHALL BE OBTAINED BY COARSE BROOMING TRANSVERSE TO THE SLOPE OF THE RAMP.

- ① THIS POINT IS AN EXTENSION OF OUTSIDE EDGE OF APPROACHING SIDEWALK WHERE IT MEETS THE BACK OF CONCRETE CURB. POINT LOCATION MAY BE ADJUSTED TO ALIGN WITH BEGINNING OF FULL-HEIGHT CURB IF THIS DISTANCE IS SHORT.
- ② GRADE CHANGE BETWEEN GUTTER FLAG SLOPE AND THE CURB RAMP SLOPE SHALL NOT EXCEED 11%. MAXIMUM GUTTER FLAG SLOPE IS 4%. PROVIDE LONGITUDINAL DRAINAGE AROUND CURB AND AWAY FROM CURB RAMP. NO VERTICAL LIPS OR DISCONTINUITIES GREATER THAN 1/4" INCH ARE ALLOWED. SLOPE OF CURB HEAD OPENING SHALL MATCH THE RAMP SLOPE, MINIMALLY 1.5% AND NOT TO EXCEED 7%. WHEN ADJACENT TO 1.5% LANDING, CONSTRUCT CURB HEAD OPENING AT 1.5% IN THE DIRECTION OF PEDESTRIAN TRAVEL.
- ③ MAXIMUM 8.33% CURB RAMP SLOPE IS ALLOWABLE WITH FLATTENED GUTTER FLAG SLOPE AND NOT TO EXCEED 11% GRADE CHANGE.
- ④ ±0.5% CONSTRUCTION TOLERANCE IN SIDEWALK CROSS SLOPE. THE SIDEWALK CROSS SLOPE SHALL NOT EXCEED 2% WITHOUT PRIOR APPROVAL FROM THE ENGINEER.
- ⑤ PROVIDE A LEVEL LANDING IN THE STREET AND GUTTER AREA (2% MAXIMUM SLOPE IN ANY DIRECTION). WHEN THE GUTTER SLOPE EXCEEDS 2%, CONSTRUCT THE LEVEL LANDING IN THE STREET AREA.
- ⑥ PROVIDE A LEVEL LANDING (MAXIMUM 2% SLOPE) IN ANY DIRECTION OF PEDESTRIAN TRAVEL. STANDARD LEVEL LANDING SIZE IS 5 FEET BY 5 FEET.
- ⑧ PROVIDE GRADE BREAK PERPENDICULAR TO DIRECTION OF WHEELCHAIR TRAVEL.

LEGEND


- 1/2" EXPANSION JOINT SIDEWALK
- CONTRACTION JOINT FIELD LOCATED
- PAVEMENT MARKING CROSSWALK (WHITE)

CURB RAMPS TYPE 1 AND 1-A


STATE OF WISCONSIN
DEPARTMENT OF TRANSPORTATION 77




SDD 08D05-b Curb Ramps Types 2 and 3

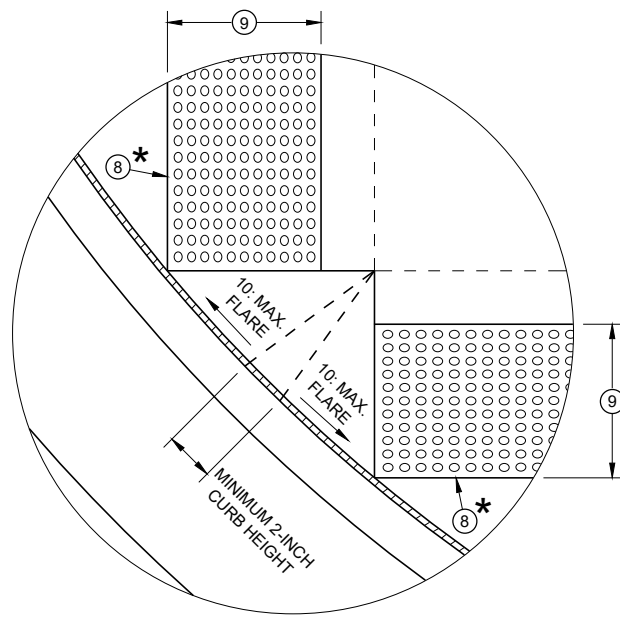


DETAIL A

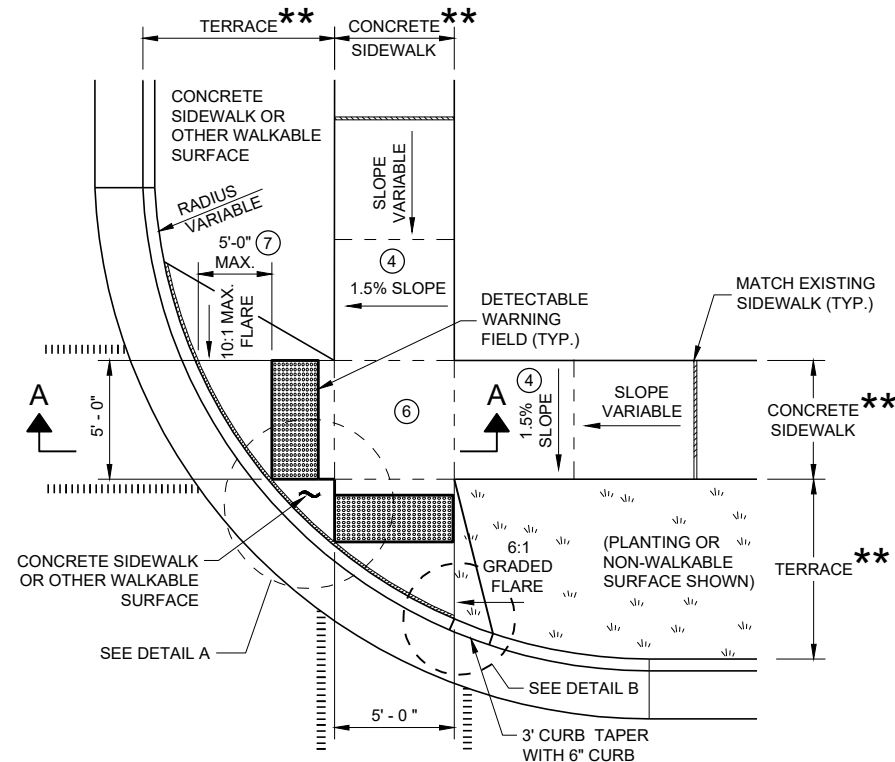


PLAN VIEW CURB RAMP TYPE 2 (CENTER OF CORNER RADIUS)

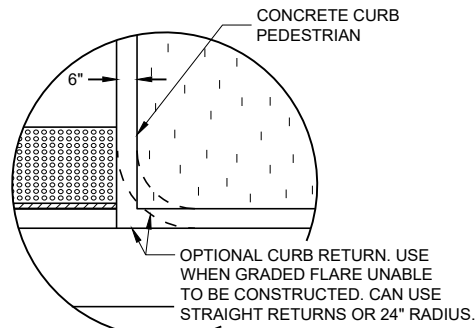


DETAIL B

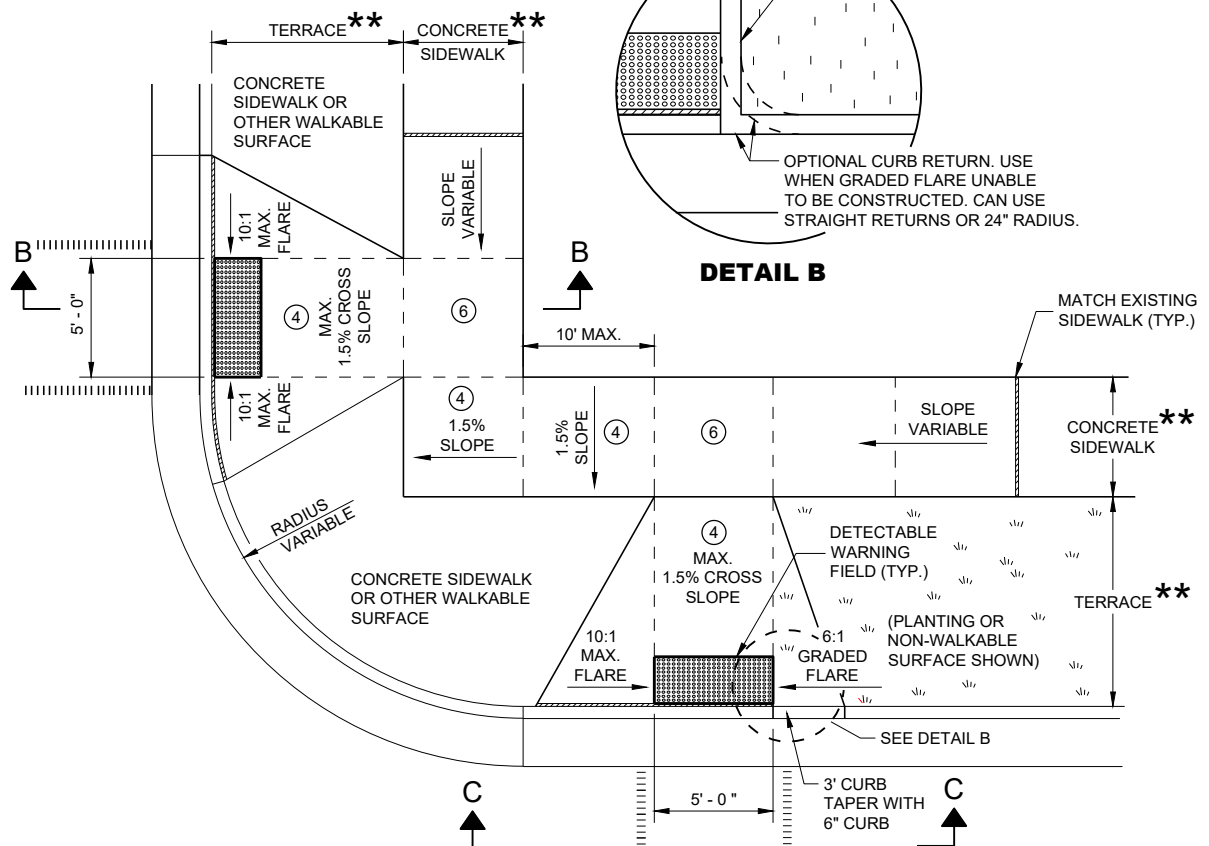


PLAN VIEW CURB RAMP TYPE 3 (OUTSIDE OF CROSSWALK AREA)

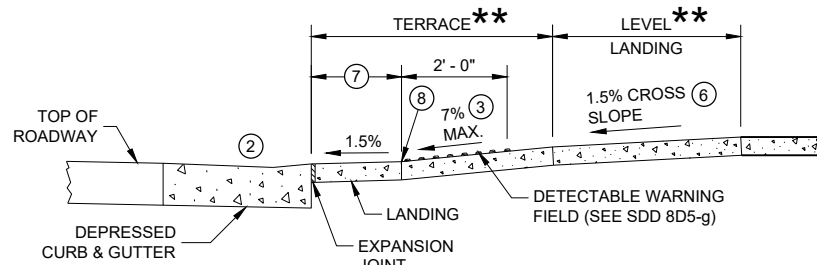

SECTION A - A FOR TYPE 2

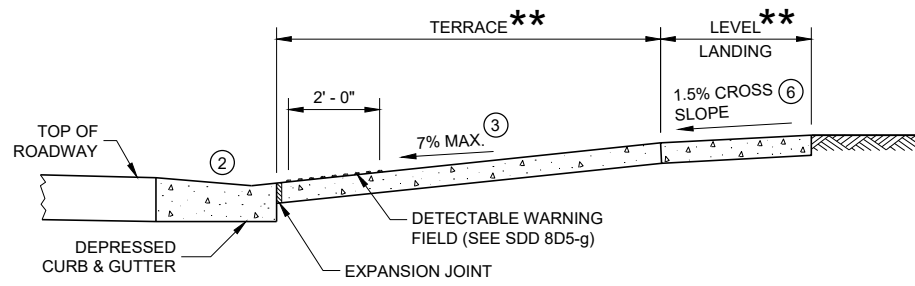

SECTION B - B FOR TYPE 3

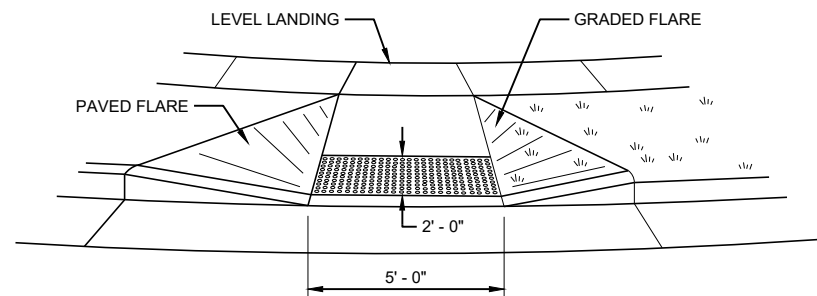

VIEW C - C FOR TYPE 3

GENERAL NOTES

- AVOID PLACING DRAINAGE STRUCTURES, JUNCTION BOXES OR OTHER OBSTRUCTIONS IN FRONT OF RAMP ACCESS AREAS.
- DETAILS OF CONSTRUCTION, MATERIALS AND WORKMANSHIP NOT SHOWN ON THIS DRAWING SHALL CONFORM TO THE PERTINENT REQUIREMENTS OF THE STANDARD SPECIFICATIONS AND THE APPLICABLE SPECIAL PROVISIONS.
- DETECTABLE WARNING FIELDS THAT ARE INSTALLED AS A GROUP OR SIDE BY SIDE SHALL BE FROM THE SAME MANUFACTURER.
- ② GRADE CHANGE BETWEEN GUTTER FLAG SLOPE AND THE CURB RAMP SLOPE SHALL NOT EXCEED 11%. MAXIMUM GUTTER FLAG SLOPE IS 4%. PROVIDE LONGITUDINAL DRAINAGE AROUND CURB AND AWAY FROM CURB RAMP. NO VERTICAL LIPS OR DISCONTINUITIES GREATER THAN 1/4 - INCH ARE ALLOWED. SLOPE OF CURB HEAD OPENING SHALL MATCH THE RAMP SLOPE, MINIMALLY 1.5% AND NOT TO EXCEED 7%. WHEN ADJACENT TO 1.5% LANDING, CONSTRUCT CURB HEAD OPENING AT 1.5% IN THE DIRECTION OF PEDESTRIAN TRAVEL.
- ③ AN 8.33% CURB RAMP SLOPE IS ALLOWABLE WITH FLATTENED GUTTER FLAG SLOPE (2.67% OR LESS) AND NOT TO EXCEED 11% GRADE CHANGE.
- ④ ±0.5% CONSTRUCTION TOLERANCE IN SIDEWALK CROSS SLOPE. THE SIDEWALK CROSS SLOPE SHALL NOT EXCEED 2% WITHOUT PRIOR APPROVAL FROM THE ENGINEER.
- ⑥ PROVIDE A LEVEL LANDING (MAXIMUM 2% SLOPE) IN ANY DIRECTION OF PEDESTRIAN TRAVEL. STANDARD LEVEL LANDING SIZE IS 5 FEET X 5 FEET.
- ⑦ WHEN GRADE BREAK DISTANCE EXCEEDS 5 FEET, USE RADIAL DETECTABLE WARNING FIELD PER SDD 8D5-f.
- ⑧ PROVIDE GRADE BREAK PERPENDICULAR TO DIRECTION OF WHEELCHAIR TRAVEL.
- ⑨ WHEN DISTANCE IS LESS THAN 6' - 0", IT MAY BE DIFFICULT TO ACHIEVE A 7% SLOPE OR FLATTER ALONG THE RAMP. REDUCE CURB HEIGHT IN TRIANGLE AREA TO ACHIEVE 7% SLOPE OR FLATTER ON RAMP. CONSTRUCT 2-INCH MINIMUM CURB HEIGHT BETWEEN 10:1 FLARES.

- * MAXIMUM 2.0% SLOPE IN ALL DIRECTIONS IN FRONT OF GRADE BREAK
- ** WIDTH SHOWN ELSEWHERE IN THE PLANS


LEGEND

- 1/2" EXPANSION JOINT SIDEWALK
- - - - - CONTRACTION JOINT SIDEWALK
- ||||| PAVEMENT MARKING CROSSWALK (WHITE)

CURB RAMPS TYPE 2 AND 3



SDD 08D05-d: Curb Ramps Types 4B and 4B1

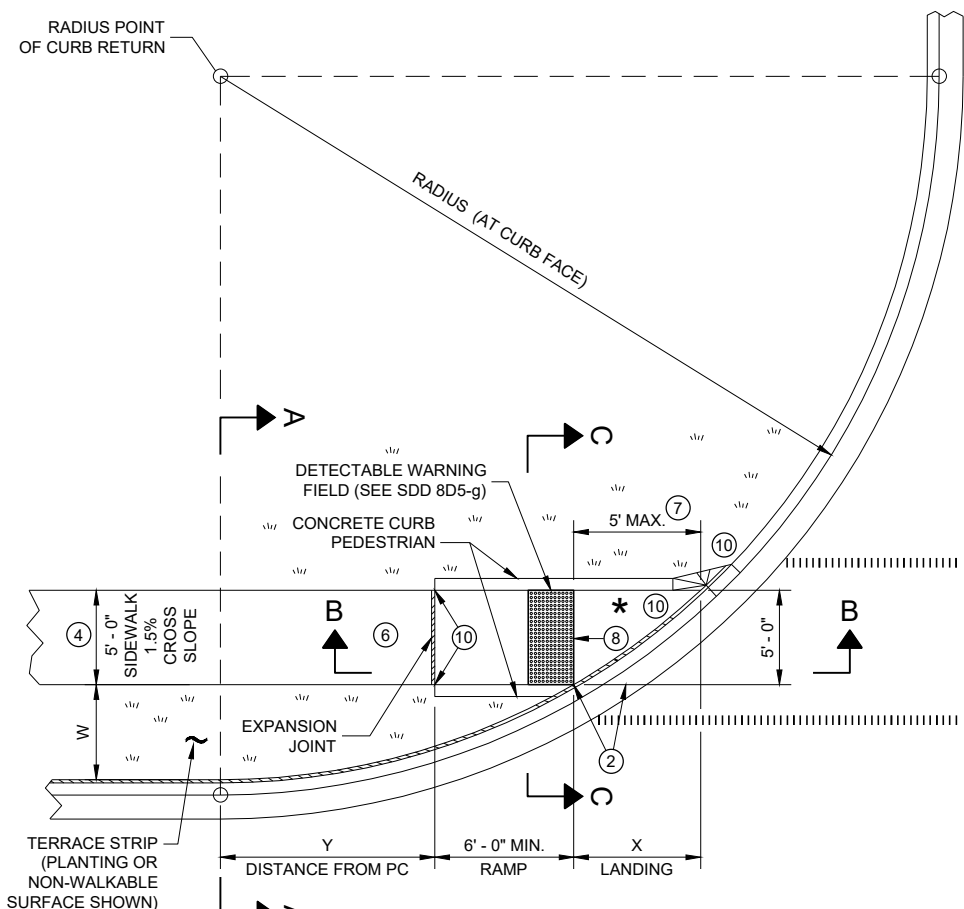

RADIUS (AT CURB FACE)	W = 3' - 0"		W = 4' - 0"		W = 5' - 0"		W = 6' - 0"		W = 7' - 0"		W = 8' - 0"		W = 9' - 0"		W = 10' - 0"	
	X	Y	X	Y	X	Y	X	Y	X	Y	X	Y	X	Y	X	Y
10 FEET	2' - 10 1/4"	0' - 5"	2' - 1"	1' - 4 1/2"	1' - 5"	2' - 1"	0' - 10"	2' - 7 1/2"	0' - 3 1/4"	3' - 0 1/4"						
15 FEET	4' - 6 3/4"	2' - 1 3/4"	3' - 9"	3' - 5 3/4"	3' - 1 1/4"	4' - 6"	2' - 6 3/4"	5' - 4 1/2"	2' - 1"	6' - 1"	1' - 8"	6' - 8 1/2"	1' - 3 1/4"	7' - 2 1/2"	0' - 10 3/4"	7' - 7 1/4"
20 FEET	5' - 9 3/4"	3' - 6 1/2"	4' - 11 1/2"	5' - 1 3/4"	4' - 3 1/4"	6' - 5 1/2"	3' - 8 3/4"	7' - 7"	3' - 3"	8' - 6 1/2"	2' - 10"	9' - 4 1/2"	2' - 5 1/2"	10' - 1 1/4"	2' - 1 1/4"	10' - 9"
30 FEET			6' - 9 1/4"	7' - 11 1/4"	6' - 0 1/4"	9' - 8"	5' - 5"	11' - 1 3/4"	4' - 10 3/4"	12' - 5 3/4"	4' - 5 1/2"	13' - 7 3/4"	4' - 0 3/4"	14' - 8 1/2"	3' - 8 1/2"	15' - 8 1/4"
40 FEET									6' - 1 3/4"	15' - 8 1/2"	5' - 8"	17' - 2"	5' - 3"	18' - 5 3/4"	4' - 10 3/4"	19' - 8 1/4"
50 FEET															5' - 10 1/4"	23' - 2"



INTERMEDIATE RADII CAN BE INTERPOLATED
 DIMENSION "Y" IS CALCULATED BASED ON 6'-0" RAMP LENGTH
 DIMENSION "X" IS CALCULATED BASED ON 5'-0" SIDEWALK WIDTH

LEGEND


- ===== 1/2" EXPANSION JOINT SIDEWALK
- - - - - CONTRACTION JOINT SIDEWALK
- ||||| PAVEMENT MARKING CROSSWALK (WHITE)

GENERAL NOTES




- AVOID PLACING DRAINAGE STRUCTURES, JUNCTION BOXES OR OTHER OBSTRUCTIONS IN FRONT OF RAMP ACCESS AREAS.
- DETAILS OF CONSTRUCTION, MATERIALS AND WORKMANSHIP NOT SHOWN ON THIS DRAWING SHALL CONFORM TO THE PERTINENT REQUIREMENTS OF THE STANDARD SPECIFICATIONS AND THE APPLICABLE SPECIAL PROVISIONS.
- DETECTABLE WARNING FIELDS THAT ARE INSTALLED AS A GROUP OR SIDE BY SIDE, SHALL BE FROM THE SAME MANUFACTURER.
- GRADE CHANGE BETWEEN GUTTER FLAG SLOPE AND THE CURB RAMP SLOPE SHALL NOT EXCEED 11%. MAXIMUM GUTTER FLAG SLOPE IS 4%. PROVIDE LONGITUDINAL DRAINAGE AROUND CURB AND AWAY FROM CURB RAMP. NO VERTICAL LIPS OR DISCONTINUITIES GREATER THAN 1/8" INCH ARE ALLOWED. SLOPE OF CURB HEAD OPENING SHALL MATCH THE RAMP SLOPE, MINIMALLY 1.5% AND NOT TO EXCEED 7%. WHEN ADJACENT TO 1.5% LANDING, CONSTRUCT CURB HEAD OPENING AT 1.5% IN THE DIRECTION OF PEDESTRIAN TRAVEL.
- AN 8.33% CURB RAMP SLOPE IS ALLOWABLE WITH FLATTENED GUTTER FLAG SLOPE AND NOT TO EXCEED 11% GRADE CHANGE.
- ±0.5% CONSTRUCTION TOLERANCE IN SIDEWALK CROSS SLOPE. THE SIDEWALK CROSS SLOPE SHALL NOT EXCEED 2% WITHOUT PRIOR APPROVAL FROM THE ENGINEER.
- PROVIDE A LEVEL LANDING (MAXIMUM 2% SLOPE) IN ANY DIRECTION OF PEDESTRIAN TRAVEL. STANDARD LEVEL LANDING SIZE IS 5 FEET BY 5 FEET.
- WHEN THIS GRADE BREAK DISTANCE EXCEEDS 5 FEET, USE RADIAL DETECTABLE WARNING FIELD PER SDD 8D5-f.
- PROVIDE GRADE BREAK PERPENDICULAR TO DIRECTION OF WHEELCHAIR TRAVEL.
- INSTALL TRANSITION NOSE (INCIDENTAL TO OTHER PAY ITEMS). DO NOT MARK TRANSITION NOSE.

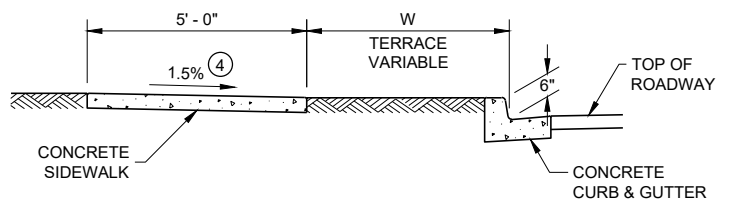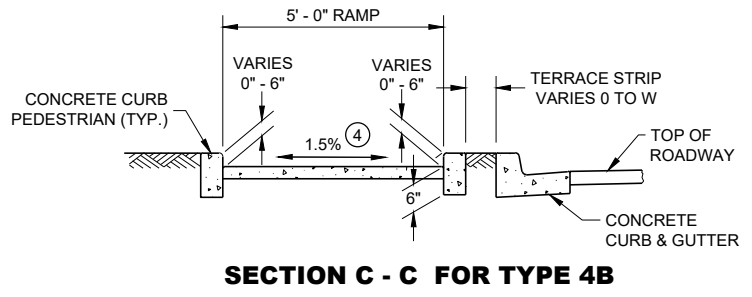

* MAXIMUM 2.0% SLOPE IN ALL DIRECTIONS IF FRONT OF GRADE BREAK

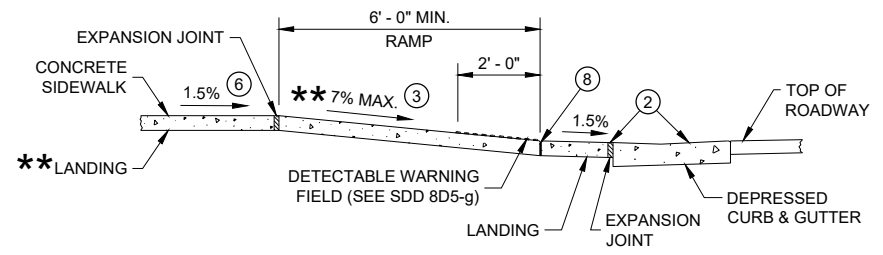

** IF RAMP SLOPE IS LESS THAN 5.0%, THEN NO ADJACENT UPHILL LANDING IS REQUIRED

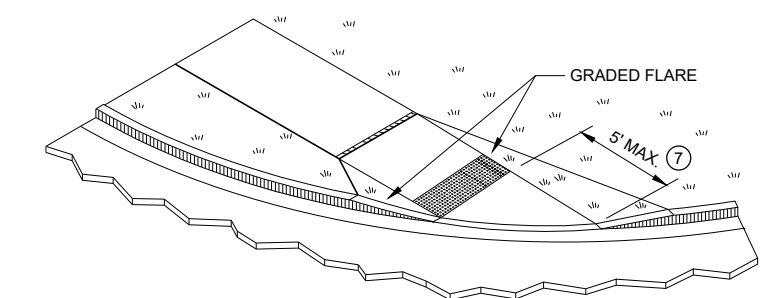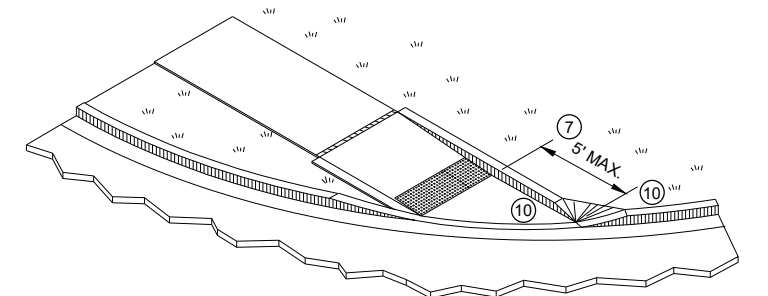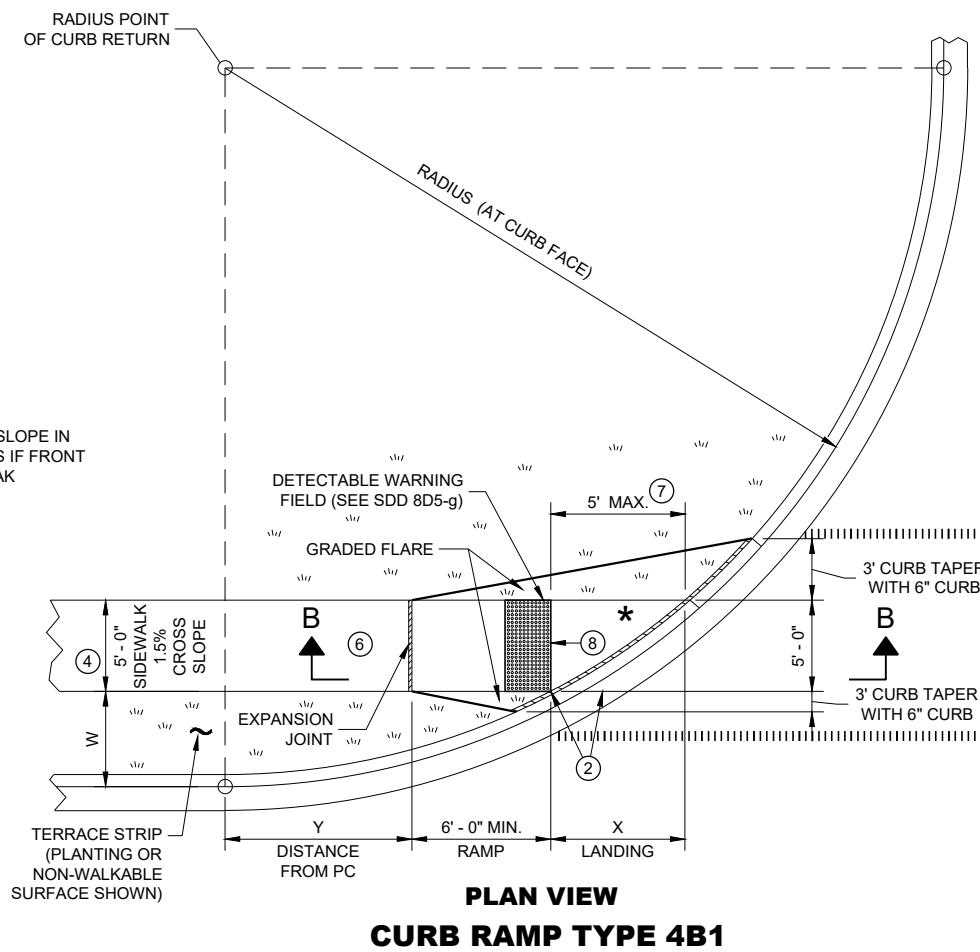

**CURB RAMPS
TYPE 4B AND 4B1**

STATE OF WISCONSIN
DEPARTMENT OF TRANSPORTATION 80

6


6

SDD 08D05 - 20d


SDD 08D05 - 20d



SDD 08D05-e: Curb Ramps Types 5, 6, 7A, 7B and 8

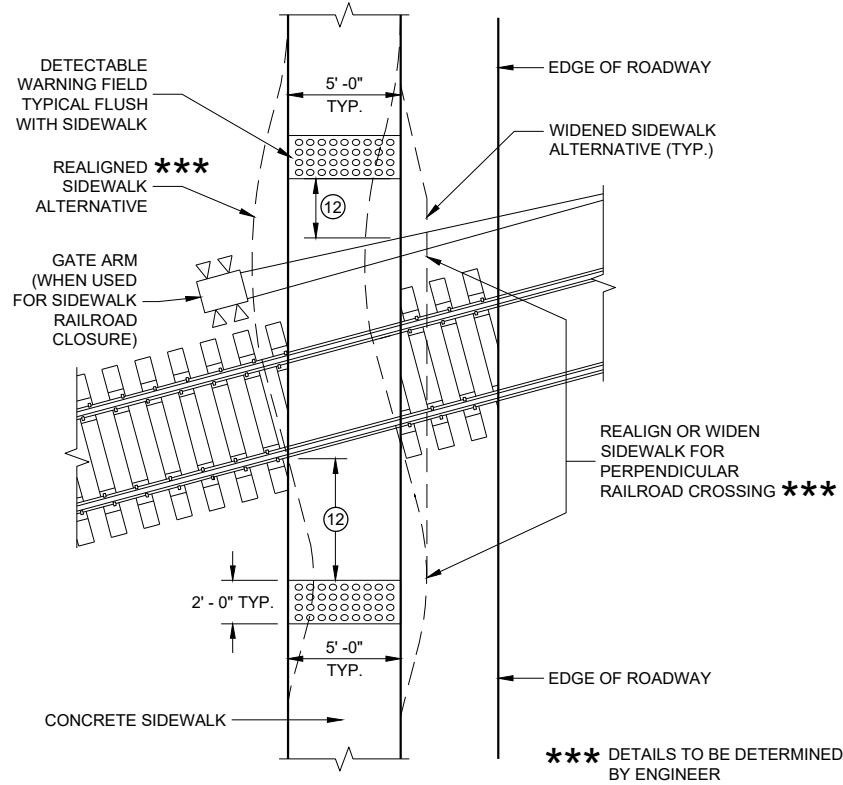


**CURB RAMP TYPE 8
DETECTABLE WARNINGS
AT RAILROAD CROSSING**

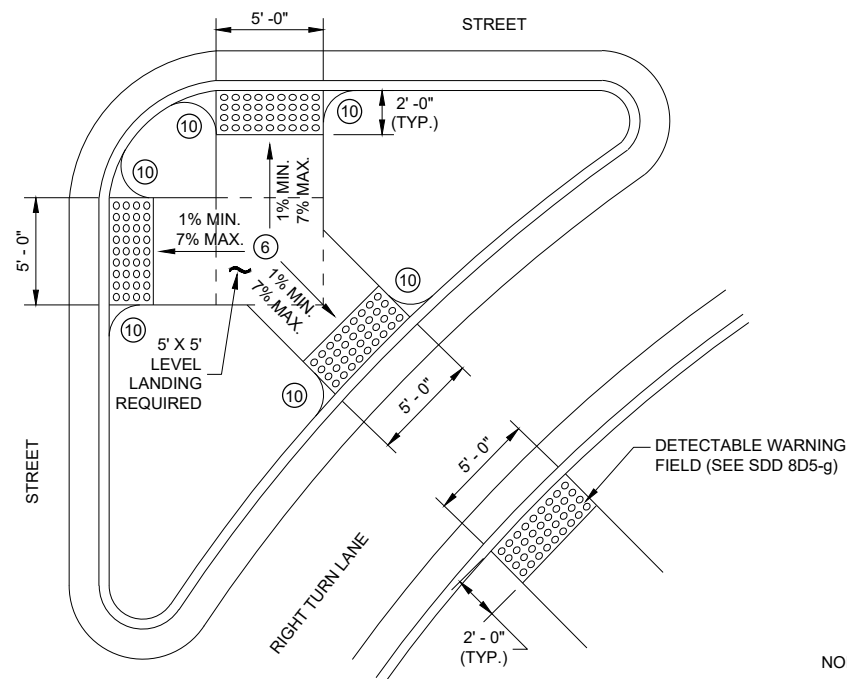


**CURB RAMP TYPE 6
DETECTABLE WARNING AT ISLANDS**


REFER TO GENERAL NOTES (2) AND (3)
FOR ALL ISLAND CURB RAMPS

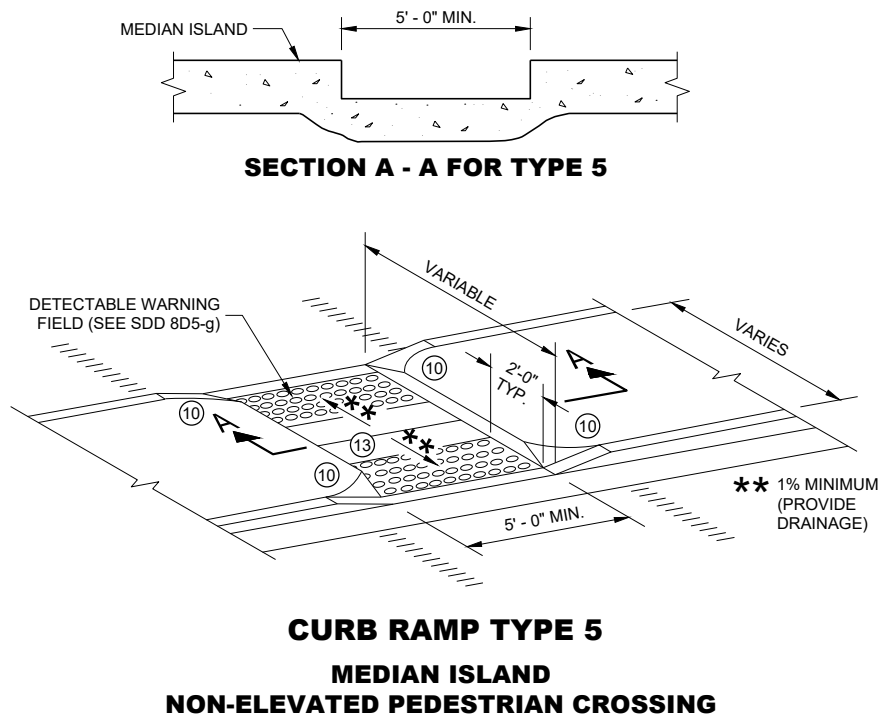

**CURB RAMP TYPE 5
MEDIAN ISLAND
NON-ELEVATED PEDESTRIAN CROSSING**

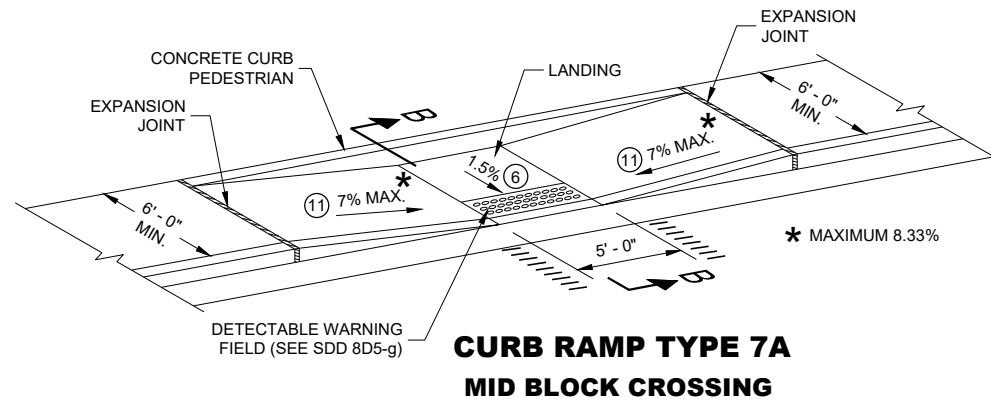

**CURB RAMP TYPE 7A
MID BLOCK CROSSING**

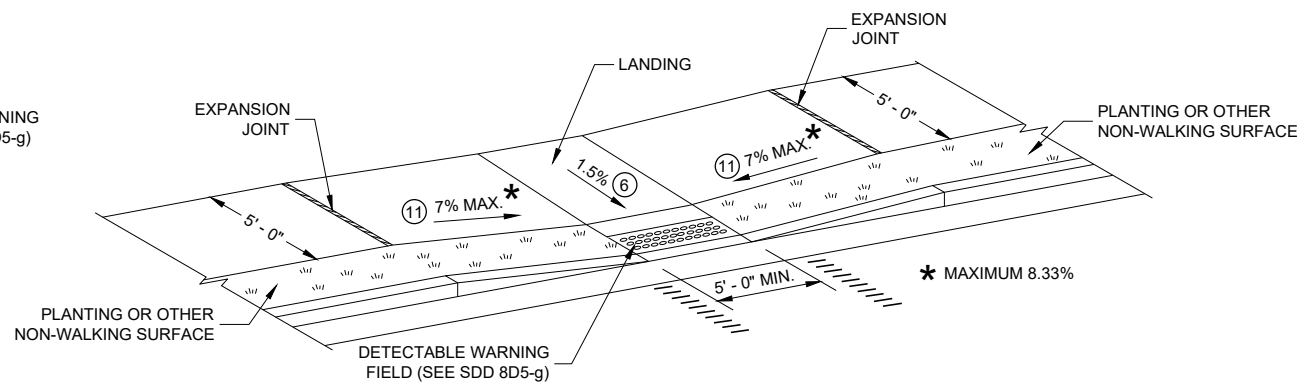

**CURB RAMP TYPE 7B
MID BLOCK CROSSING**

NOTE: THESE PARALLEL AND PARALLEL/PERPENDICULAR CURB RAMPS
MAY BE USED AT INTERSECTIONS AND MID BLOCK LOCATIONS.

GENERAL NOTES

AVOID PLACING DRAINAGE STRUCTURES, JUNCTION BOXES OR OTHER OBSTRUCTIONS IN FRONT OF RAMP ACCESS AREAS.

DETAILS OF CONSTRUCTION, MATERIALS AND WORKMANSHIP NOT SHOWN ON THIS DRAWING SHALL CONFORM TO THE PERTINENT REQUIREMENTS OF THE STANDARD SPECIFICATIONS AND THE APPLICABLE SPECIAL PROVISIONS.


SIDEWALK CROSS SLOPE SHALL NOT EXCEED 2%.

DETECTABLE WARNING FIELDS THAT ARE INSTALLED AS A GROUP OR SIDE BY SIDE, SHALL BE FROM THE SAME MANUFACTURER.

- (2) GRADE CHANGE BETWEEN GUTTER FLAG SLOPE AND THE CURB RAMP SLOPE SHALL NOT EXCEED 11%. MAXIMUM GUTTER FLAG SLOPE IS 4%. PROVIDE LONGITUDINAL DRAINAGE AROUND CURB AND AWAY FROM CURB RAMP. NO VERTICAL LIPS OR DISCONTINUITIES GREATER THAN 1/4 - INCH ARE ALLOWED. SLOPE OF CURB HEAD OPENING SHALL MATCH THE RAMP SLOPE, MINIMALLY 1.5% AND NOT TO EXCEED 7%. WHEN ADJACENT TO 1.5% LANDING, CONSTRUCT CURB HEAD OPENING AT 1.5% IN THE DIRECTION OF PEDESTRIAN TRAVEL.
- (3) AN 8.33% CURB RAMP SLOPE IS ALLOWABLE WITH FLATTENED GUTTER FLAG SLOPE AND NOT TO EXCEED 11% GRADE CHANGE.
- (4) ±0.5% CONSTRUCTION TOLERANCE IN SIDEWALK CROSS SLOPE. THE SIDEWALK CROSS SLOPE SHALL NOT EXCEED 2% WITHOUT PRIOR APPROVAL FROM THE ENGINEER.
- (6) PROVIDE A LEVEL LANDING (MAXIMUM 2% SLOPE) IN ANY DIRECTION OF PEDESTRIAN TRAVEL. STANDARD LEVEL LANDING SIZE IS 5 FEET BY 5 FEET.
- (10) INSTALL TRANSITION NOSE (INCIDENTAL TO OTHER PAY ITEMS). DO NOT MARK TRANSITION NOSE.
- (11) SLOPE SIDEWALK TOWARD LANDING AS SHOWN WHERE THERE IS NO TERRACE OR WHERE THE TERRACE WIDTH IS LESS THAN 6 FEET WIDE.
- (12) THE EDGE OF THE DETECTABLE WARNING FIELD NEAREST TO A RAILROAD CROSSING SHALL BE 1.5 FEET ±0.1' FROM THE FACE OF THE GATE ARM IF THE GATE ARM EXTENDS ACROSS THE SIDEWALK. WHERE THERE IS NO PEDESTRIAN GATE, THE EDGE OF THE DETECTABLE WARNING FIELD NEAREST TO THE RAILROAD CROSSING SHALL BE 15 FEET FROM THE NEAREST RAIL.
- (13) DO NOT INSTALL DETECTABLE WARNING FIELDS AT THE EDGES OF STREET-LEVEL PEDESTRIAN REFUGE ISLANDS IF A MINIMUM 2 FOOT CONCRETE SURFACE WITHOUT DETECTABLE WARNINGS (MEASURED IN THE DIRECTION OF PEDESTRIAN TRAVEL) CANNOT BE ACHIEVED.

LEGEND

- ===== 1/2" EXPANSION JOINT SIDEWALK
- - - - - CONTRACTION JOINT FIELD LOCATED
- ||||||| PAVEMENT MARKING CROSSWALK (WHITE)

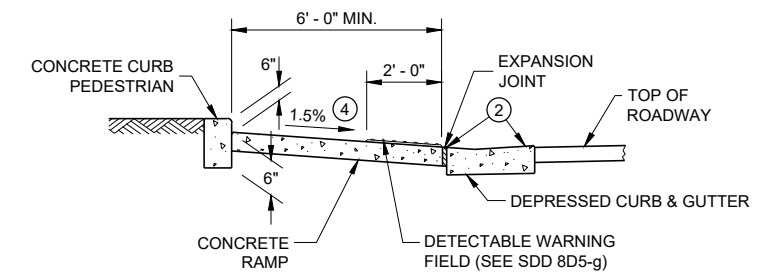

SECTION B - B FOR TYPE 7A


CURB RAMPS TYPE 5, 6, 7A, 7B & 8

STATE OF WISCONSIN
DEPARTMENT OF TRANSPORTATION 81




SDD 08D05-f Curb Ramps Radial Detectable Warning Field Applications

RADIAL DETECTABLE WARNING FIELD PLACEMENT WHEN 5 FOOT GRADE BREAK DISTANCE PER SDD 8D5-c IS EXCEEDED

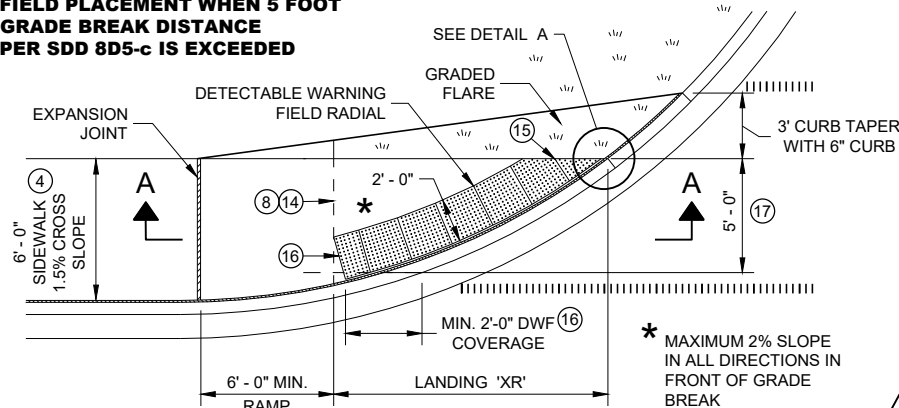

**PLAN VIEW
CURB RAMP TYPE 4A1
(GRADE BREAK DISTANCE GREATER THAN 5 FEET)**

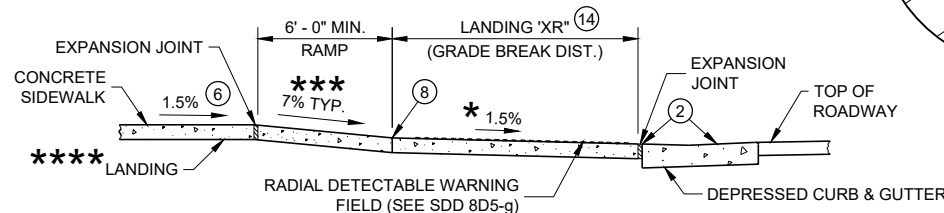


SECTION A - A FOR TYPE 4A1

**** IF RAMP SLOPE IS LESS THAN 5.0%, THEN NO ADJACENT UPHILL LANDING IS REQUIRED

*** MAXIMUM 8.33%

- LEGEND**
- 1/2" EXPANSION JOINT SIDEWALK
 - CONTRACTION JOINT SIDEWALK
 - PAVEMENT MARKING CROSSWALK (WHITE)

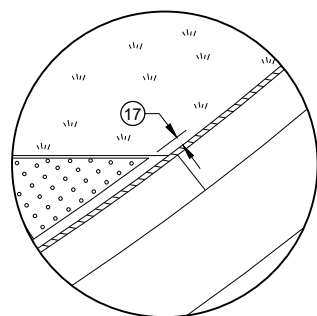


DETAIL A

GENERAL NOTES

- AVOID PLACING DRAINAGE STRUCTURES, JUNCTION BOXES OR OTHER OBSTRUCTIONS IN FRONT OF RAMP ACCESS AREAS.
- DETAILS OF CONSTRUCTION, MATERIALS AND WORKMANSHIP NOT SHOWN ON THIS DRAWING SHALL CONFORM TO THE PERTINENT REQUIREMENTS OF THE STANDARD SPECIFICATIONS AND THE APPLICABLE SPECIAL PROVISIONS.
- DETECTABLE WARNING FIELDS THAT ARE INSTALLED AS A GROUP OR SIDE BY SIDE, SHALL BE FROM THE SAME MANUFACTURER.
- APPLY RADIAL DETECTABLE WARNING PLACEMENT SIMILARLY FOR TYPE 4A AND 4A1 CURB RAMP AND SIMILARLY FOR TYPE 4B AND 4B1 CURB RAMP. TYPE 4A AND 4B RAMP ARE NOT SHOWN.
- REFER TO SDD 8D5-g FOR ADDITIONAL RADIAL PLATE REQUIREMENTS.
- FIELD CUTS AT INTERMEDIATE JOINTS WITHIN THE RADIAL DETECTABLE WARNING FILED ARE PROHIBITED.
- DETERMINE FINAL RADIAL WARNING FIELD CONFIGURATION AND ITS INDIVIDUAL PLATE LOCATIONS. PERFORM PRE-LAYOUT PRIOR TO PLACEMENT IN PLASTIC CONCRETE. FOLLOW MANUFACTURER'S PRODUCT LIST AND INSTALLATION RECOMMENDATIONS.
- 2 GRADE CHANGE BETWEEN GUTTER FLAG SLOPE AND THE CURB RAMP SLOPE SHALL NOT EXCEED 11%. MAXIMUM GUTTER FLAG SLOPE IS 4%. PROVIDE LONGITUDINAL DRAINAGE AROUND CURB AND AWAY FROM CURB RAMP. NO VERTICAL LIPS OR DISCONTINUITIES GREATER THAN 1/4 - INCH ARE ALLOWED. SLOPE OF CURB HEAD OPENING SHALL MATCH THE RAMP SLOPE, MINIMALLY 1.5% AND NOT TO EXCEED 7%. WHEN ADJACENT TO 1.5% LANDING, CONSTRUCT CURB HEAD OPENING AT 1.5% IN THE DIRECTION OF PEDESTRIAN TRAVEL.
 - 3 AN 8.33% CURB RAMP SLOPE IS ALLOWABLE WITH FLATTENED GUTTER FLAG SLOPE AND NOT TO EXCEED 11% GRADE CHANGE.
 - 4 ±0.5% CONSTRUCTION TOLERANCE IN SIDEWALK CROSS SLOPE. THE SIDEWALK CROSS SLOPE SHALL NOT EXCEED 2% WITHOUT PRIOR APPROVAL FROM THE ENGINEER.
 - 6 PROVIDE A LEVEL LANDING (MAXIMUM 2% SLOPE) IN ANY DIRECTION OF PEDESTRIAN TRAVEL. STANDARD LANDING SIZE IS 5 FEET BY 5 FEET.
 - 8 PROVIDE GRADE BREAK PERPENDICULAR TO DIRECTION OF WHEELCHAIR TRAVEL.
 - 14 CONSULT ENGINEER IF GRADE BREAK LOCATION (END OF LANDING DIMENSION "XR") REQUIRES FIELD ADJUSTMENT WHEN ESTABLISHING FINAL RADIAL DETECTABLE WARNING FIELD LOCATION.
 - 15 FIELD SAW CUTS ALONG RADIAL DETECTABLE WARNING PLATES WILL BE NECESSARY TO MATCH EACH CURB RAMP EDGE. AVOID CUTTING THROUGH DOMES WHENEVER POSSIBLE. MAKE FIELD CUTS TRUE TO LINE AND WITHIN 1/8" DEVIATION. SMOOTH EDGES OF FIELD CUT PLATES.
 - 16 USE 1' X 2" RECTANGULAR END PLATE AT END OF TYPE 4A1 RAMP AND PROVIDE MINIMUM 2' - 0" DETECTABLE WARNING FIELD COVERAGE (IN DIRECTION OF PEDESTRIAN TRAVEL) ALONG THE ENTIRE CURB RAMP WIDTH.
 - 17 A MAXIMUM 3 INCH CONCRETE BORDER WITH IS ALLOWABLE IN FROM OF RADIAL DETECTABLE WARNING FIELD FOR CONSTRUCTABILITY PURPOSES. CONCRETE BORDER WIDTH MAY VARY UP TO 1 INCH.


RADIAL DETECTABLE WARNING FIELD PLACEMENT WHEN 5 FOOT GRADE BREAK DISTANCE PER SDD 8D5-d IS EXCEEDED

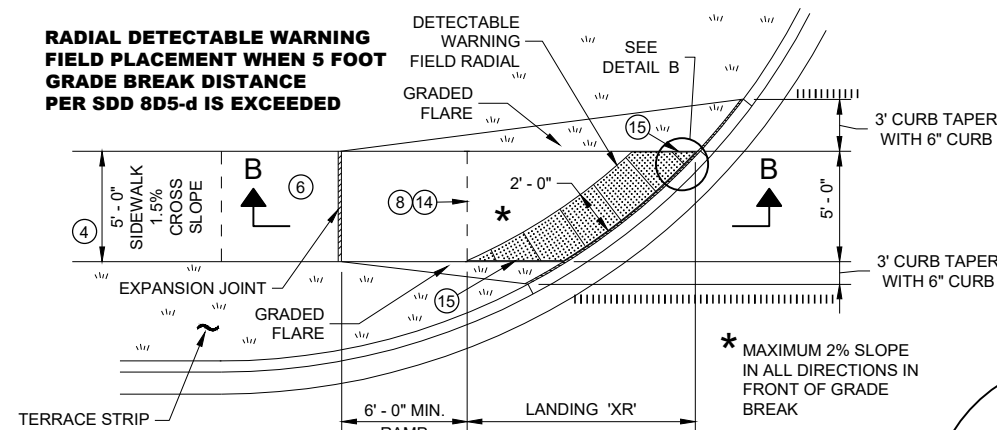

**PLAN VIEW
CURB RAMP TYPE 4B1
(GRADE BREAK DISTANCE GREATER THAN 5 FEET)**


TERRACE STRIP (PLANTING OR NON-WALKABLE SURFACE SHOWN)

* MAXIMUM 2% SLOPE IN ALL DIRECTIONS IN FRONT OF GRADE BREAK

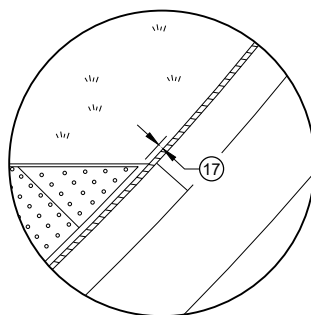


DETAIL B

RADIAL DETECTABLE WARNING FIELD PLACEMENT WHEN 5 FOOT GRADE BREAK DISTANCE PER SDD 8D5-b IS EXCEEDED

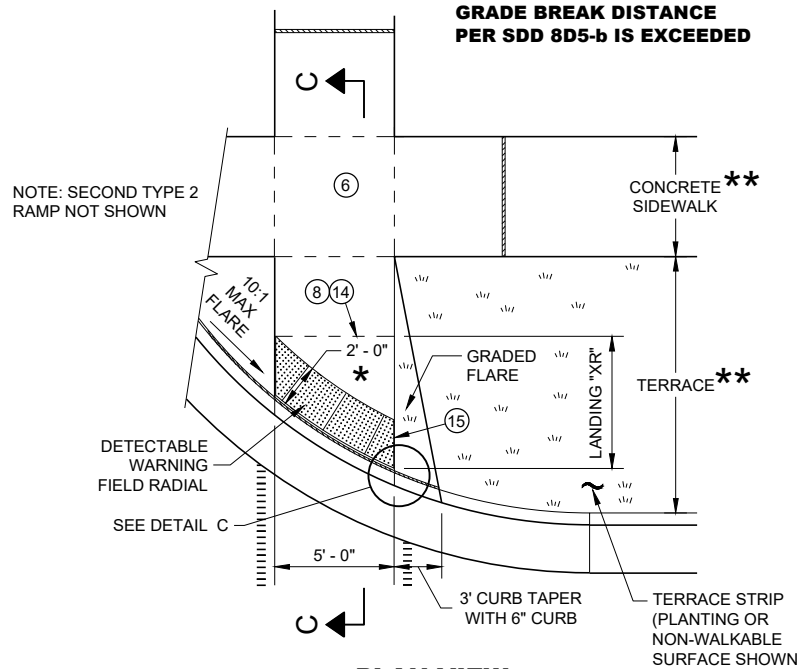

**PLAN VIEW
CURB RAMP TYPE 2
(GRADE BREAK DISTANCE GREATER THAN 5 FEET)
(ON LINE WITH SIDEWALK)**

NOTE: SECOND TYPE 2 RAMP NOT SHOWN

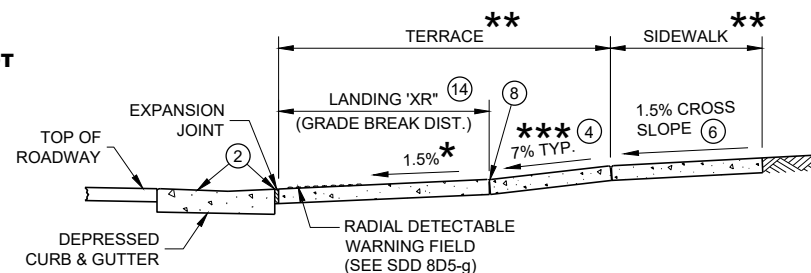


SECTION C - C FOR TYPE 2

* MAXIMUM 2% SLOPE IN ALL DIRECTIONS IN FRONT OF GRADE BREAK

** WIDTH SHOWN ELSEWHERE IN THE PLANS

*** MAXIMUM 8.33%

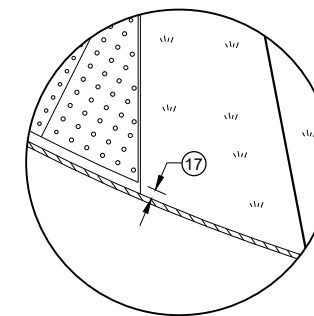

DETAIL C

CURB RAMP RADIAL DETECTABLE WARNING FIELD APPLICATIONS

STATE OF WISCONSIN
DEPARTMENT OF TRANSPORTATION 82

6


6

SDD 08D05 - 20f


SDD 08D05 - 20f




SDD 08D16 Concrete Gutter, Curb and Gutter and Pavement Ties

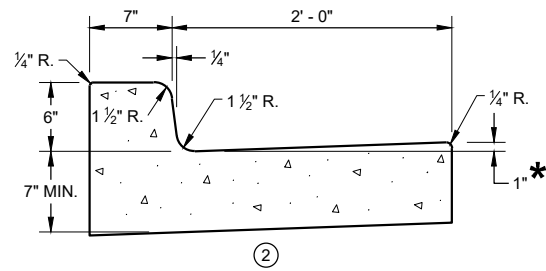


CONCRETE CURB AND GUTTER 31" ①

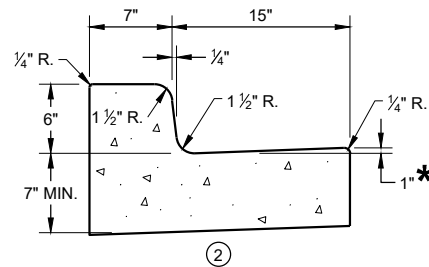

CONCRETE CURB AND GUTTER 22" ①

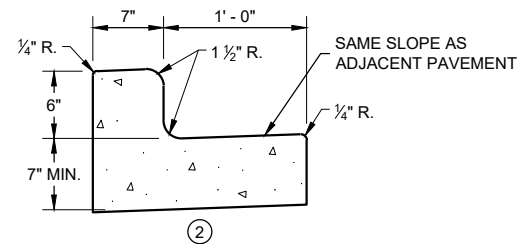


CONCRETE CURB AND GUTTER 19" ①

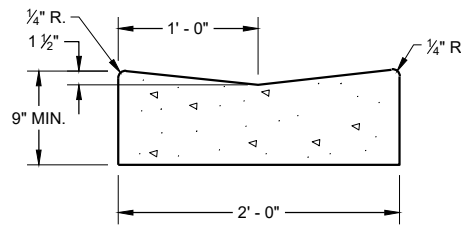


CONCRETE GUTTER 24" ①


* TO BE MEASURED TO A MAXIMUM OF 3" WHERE DRAINAGE PROBLEMS EXIST.

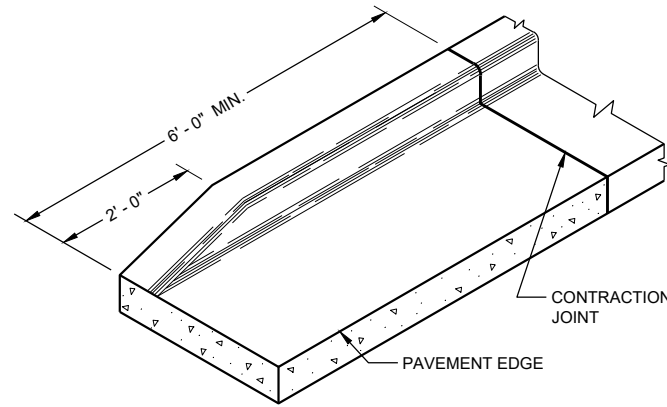


END SECTION CURB AND GUTTER

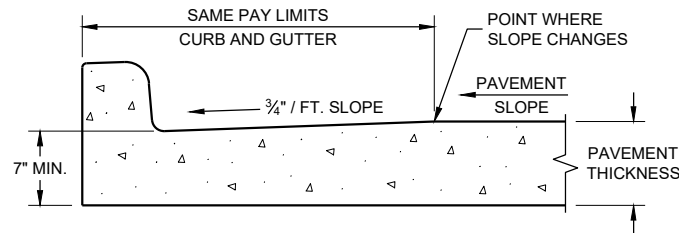

PARTIAL SECTION OF PAVEMENT WITH INTEGRAL CURB AND GUTTER

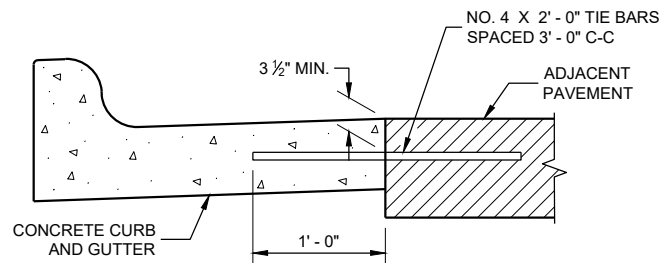

TYPICAL TIE BAR LOCATION ①

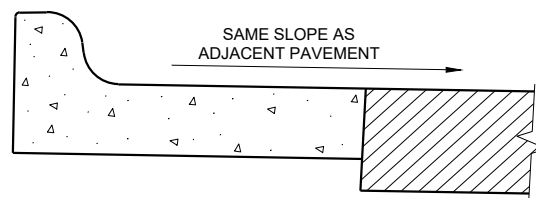

HIGH SIDE SECTION ③
(TYPICAL FOR ALL CURB & GUTTER TYPES)

GENERAL NOTES


DETAILS OF CONSTRUCTION AND WORKMANSHIP NOT SHOWN ON THIS DRAWING SHALL CONFORM TO THE PERTINENT REQUIREMENTS OF THE CONTRACT.

PAVEMENT TIES AND TIE BARS SHALL BE EPOXY COATED IN CONFORMANCE WITH SUBSECTION 505.2.6.2 OF THE STANDARD SPECIFICATIONS.


INTEGRAL CURB AND GUTTER SHALL CONFORM TO THE DETAILS SHOWN FOR CONCRETE CURB AND GUTTER INCLUDING THE TRANSVERSE GUTTER SLOPE. A LONGITUDINAL CONSTRUCTION JOINT IS NOT REQUIRED WITH INTEGRAL CURB AND GUTTER.

UNLESS OTHERWISE SHOWN ON THE TYPICAL CROSS SECTIONS, THE BASE COURSE AND UNCLASSIFIED EXCAVATION LIMITS ARE 2' - 0" BEHIND THE BACK OF CURBS.

- ① WHEN PLACED ADJACENT TO NEW CONCRETE, TIE BARS ARE REQUIRED FOR CURB AND GUTTER 31", 22", 19" AND CONCRETE GUTTER 24".
- ② THE BOTTOM OF CURB AND GUTTER MAY BE CONSTRUCTED EITHER LEVEL OR PARALLEL TO THE SLOPE OF THE SUBGRADE OR BASE COURSE PROVIDED A 7" MINIMUM GUTTER THICKNESS IS MAINTAINED.
- ③ WHEN HIGH SIDE CURB SECTION IS REQUIRED, THE LOCATION(S) WILL BE NOTED ON THE PLANS

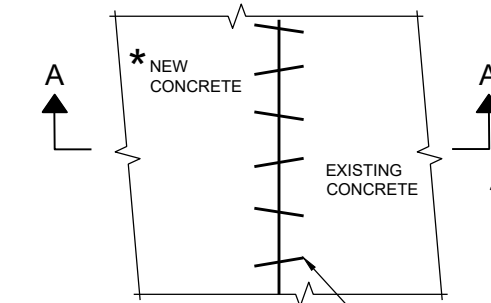

PLAN VIEW

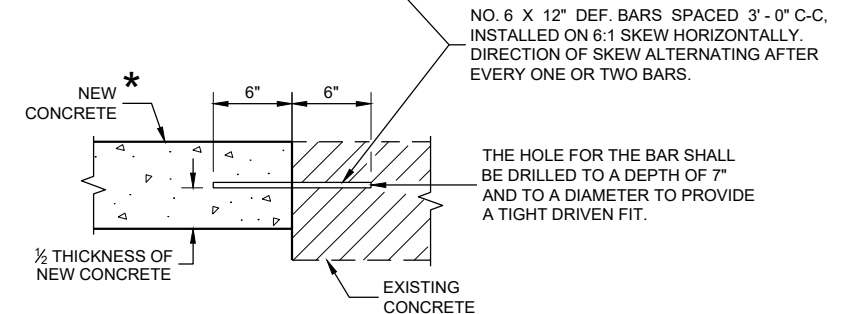

**SECTION A - A
PAVEMENT TIES**

**CONCRETE GUTTER,
CURB AND GUTTER AND
PAVEMENT TIES**
(For Optional use in Milwaukee Co. Only)


STATE OF WISCONSIN
DEPARTMENT OF TRANSPORTATION

APPROVED
February 2020 /S/ Rodney Taylor
DATE ROADWAY STANDARDS DEVELOPMENT ENGINEER

FHWA



SDD 8D19 Driveway and Sidewalk Ramps Type Z

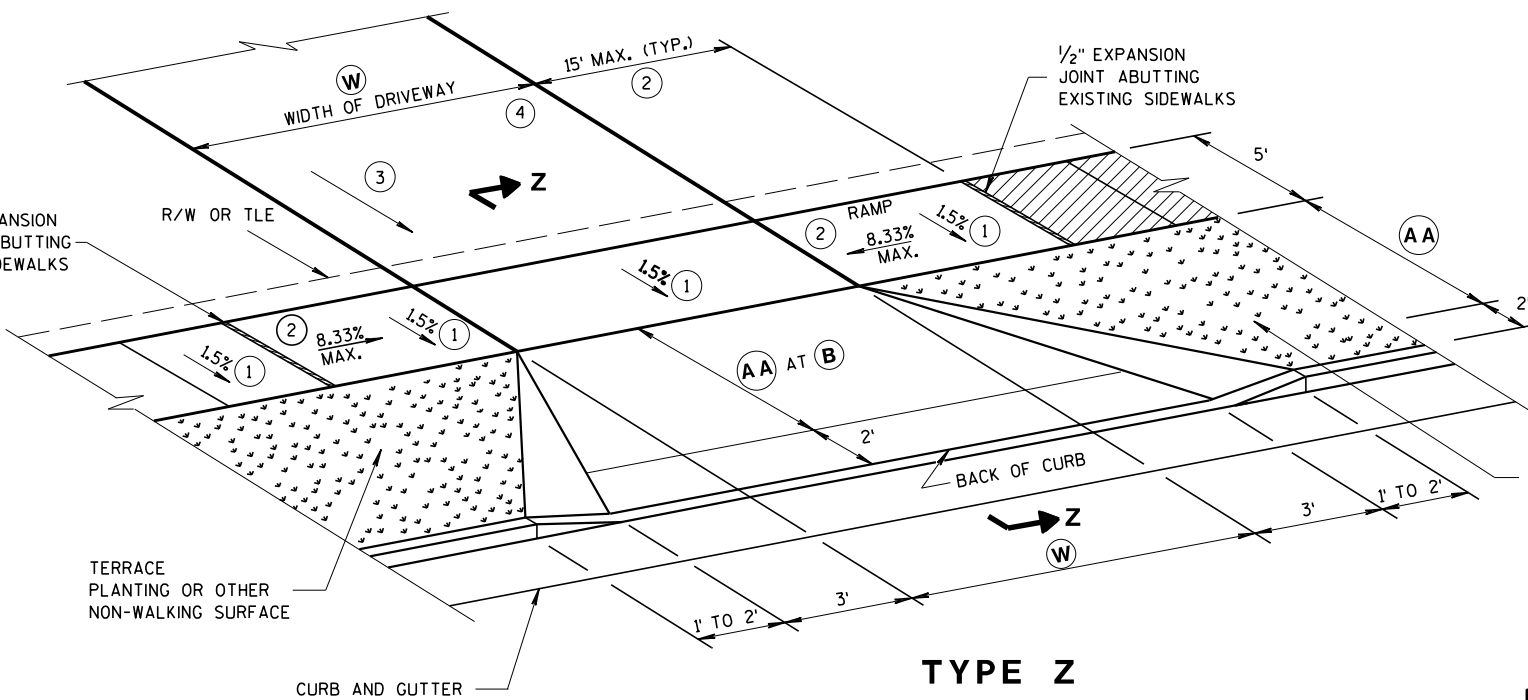

**TYPE Z
SIDEWALK WITH WIDER TERRACE
TERRACE VARIES 7 TO 12 FEET**

TABLE Z

(A A) FEET	(B) %	(B) %
4.5'	6.25% GUTTER	4% GUTTER
5.5'	11.5%	9% TO 11.5%
6.5'	9% TO 11.5%	8% TO 11.5%
7.5'	8% TO 11.5%	6% TO 11.5%
8.5'	7% TO 11.5%	6% TO 11.5%
9.5'	6% TO 11.5%	5% TO 11.5%
	5% TO 11.5%	4% TO 11.5%

GENERAL NOTES


PROVIDE CONSTRUCTION JOINTS ALONG THE CENTER OF THE CONCRETE FOR DRIVEWAYS UNDER 20 FEET IN WIDTH AND AT THE THIRD POINTS OVER 20 FEET IN WIDTH.

(W) IS SHOWN ON PLAN AND PROFILE SHEETS.


OFFSETS, ELEVATIONS, AND PERCENT GRADE ARE SHOWN ON THE CROSS SECTIONS.

- CONSTRUCTION TOLERANCE OF 0.5% ± FOR SIDEWALK CROSS SLOPE. THE SIDEWALK CROSS SLOPE SHALL NOT EXCEED 2%.
- THE SIDEWALK RAMP MAXIMUM RUNNING SLOPE SHALL NOT REQUIRE THE RAMP LENGTH TO EXCEED 15 FEET TO AVOID CHASING THE SLOPE INDEFINITELY WHEN CONNECTING TO STEEP GRADES. WHEN APPLYING THE 15 FOOT MAXIMUM LENGTH, THE RUNNING SLOPE OF THE SIDEWALK SHALL BE AS FLAT AS FEASIBLE AND NOT EXCEED THE LONGITUDINAL GRADE OF THE ROADWAY.
- DRIVEWAY SLOPES: DESIRABLE MAXIMUM**
10.5% UP AWAY FROM SIDEWALK (SAG)
8.5% DOWN AWAY FROM SIDEWALK (CREST)
ABSOLUTE MAXIMUM 15% FOR BOTH CREST AND SAG
- DRIVEWAY TYPES**
 - 6-INCH CONCRETE DRIVEWAY PAVEMENT OVER 6-INCH BASE AGGREGATE
 - 2-INCH TO 3-INCH ASPHALTIC SURFACE OVER 6-INCH BASE AGGREGATE
 - 6-INCH BASE AGGREGATE (MAY BE INCREASED FOR CLAY SUBGRADES)

(W): 12' MIN. - 24' MAX. RESIDENTIAL AND NON-COMMERCIAL (PE & FE)
16' MIN. - 35' MAX. COMMERCIAL (CE)

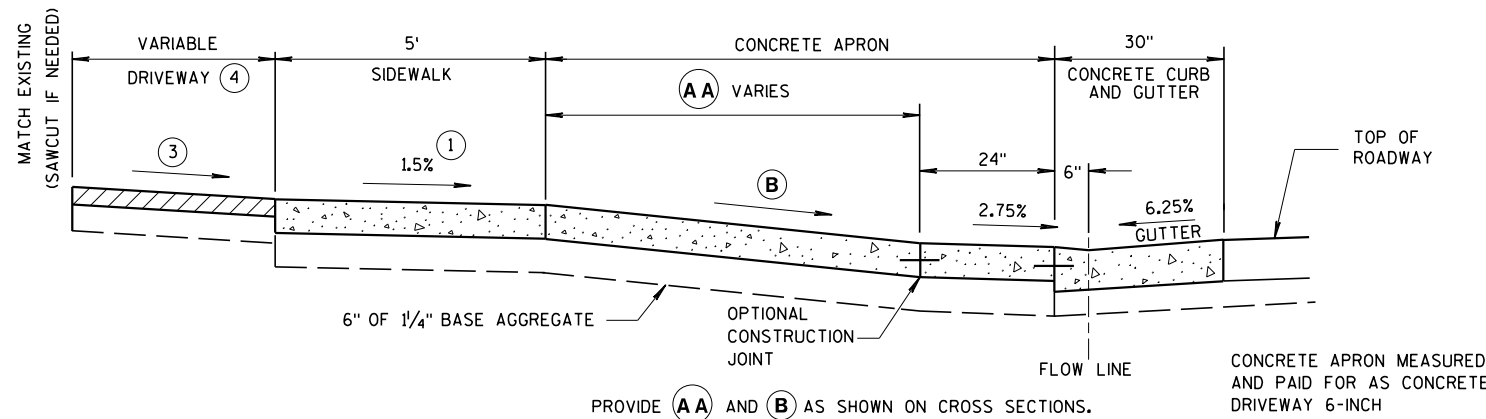

6.25% GUTTER SLOPE

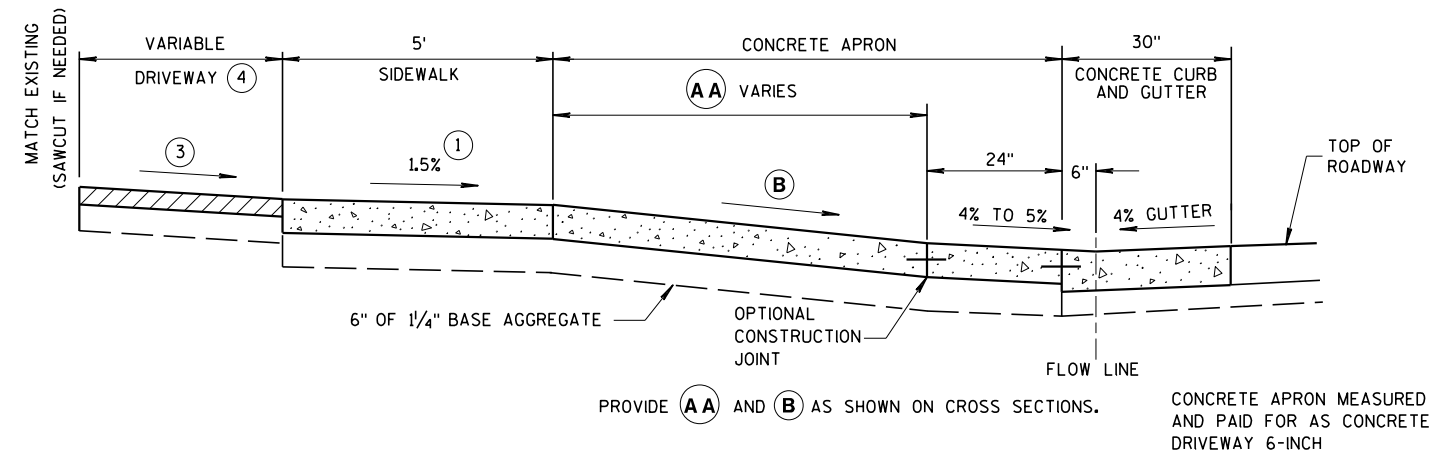

4% GUTTER SLOPE

NOTE: SIDEWALK MAY BE DEPRESSED IN DRIVEWAY AREAS FOR B VALUES NOT SHOWN IN TABLE Z.
SIDEWALK WITHIN THE LIMITS OF THE DRIVEWAY PAID FOR AS CONCRETE DRIVEWAY 6-INCH.
SEPARATE PAYMENT FOR BASE AGGREGATE WILL BE MADE.


**SECTION Z-Z
DRIVEWAY DETAIL WITH CONCRETE CURB & GUTTER
(URBAN AND SUBURBAN)**

NOT TO SCALE


**DRIVEWAY AND SIDEWALK
RAMPS
TYPE Z**

STATE OF WISCONSIN
DEPARTMENT OF TRANSPORTATION

APPROVED
March 2018 /S/ Rodney Taylor
DATE ROADWAY STANDARDS DEVELOPMENT
FHWA UNIT SUPERVISOR

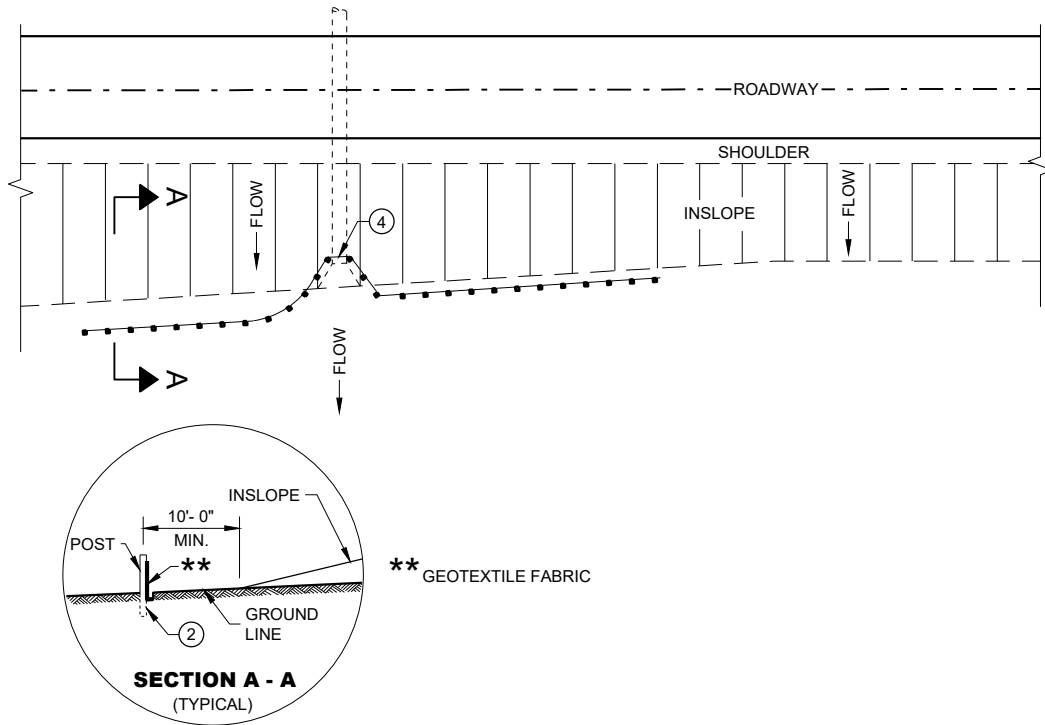

PLAN VIEW
TYPICAL APPLICATION OF SILT FENCE

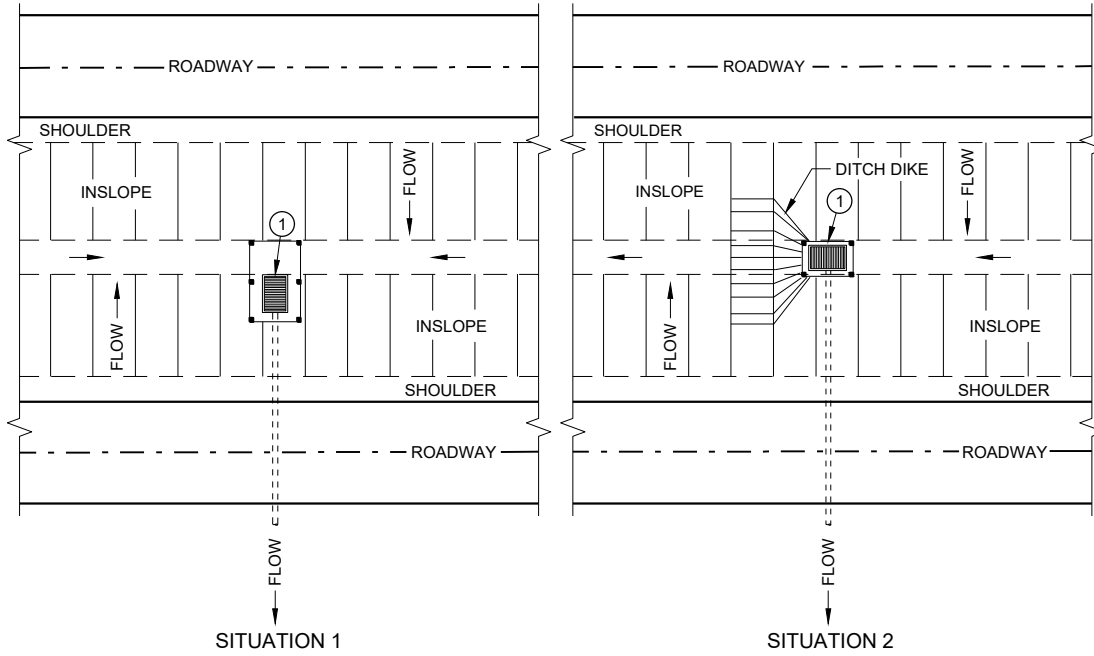


PLAN VIEW
SILT FENCE AT MEDIAN SURFACE DRAINS


GENERAL NOTES

DETAILS OF CONSTRUCTION NOT SHOWN ON THIS DRAWING SHALL CONFORM TO THE PERTINENT REQUIREMENTS OF THE STANDARD SPECIFICATIONS AND APPLICABLE SPECIAL PROVISIONS.


- ① HORIZONTAL BRACE REQUIRED WITH 2" X 4" WOODEN FRAME OR EQUIVALENT AT TOP OF POSTS.
- ② FOR MANUAL INSTALLATIONS THE TRENCH SHALL BE A MINIMUM OF 4" WIDE AND 6" DEEP TO BURY AND ANCHOR THE GEOTEXTILE FABRIC. FOLD MATERIAL TO FIT TRENCH AND BACKFILL AND COMPACT TRENCH WITH EXCAVATED SOIL.
- ③ WOOD POSTS SHALL BE A MINIMUM SIZE OF 1 1/2" X 1 1/2" OF OAK OR HICKORY.
- ④ SILT FENCE TO EXTEND ACROSS THE TOP OF THE PIPE.
- ⑤ CONSTRUCT SILT FENCE FROM A CONTINUOUS ROLL IF POSSIBLE BY CUTTING LENGTHS TO AVOID JOINTS. IF A JOINT IS NECESSARY USE ONE OF THE FOLLOWING TWO METHODS: A) OVERLAP THE END POSTS AND TWIST, OR ROTATE, AT LEAST 180 DEGREES, B) HOOK THE END OF EACH SILT FENCE LENGTH.

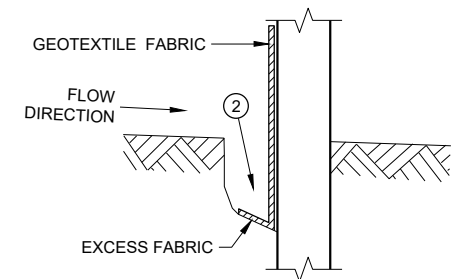


TRENCH DETAIL

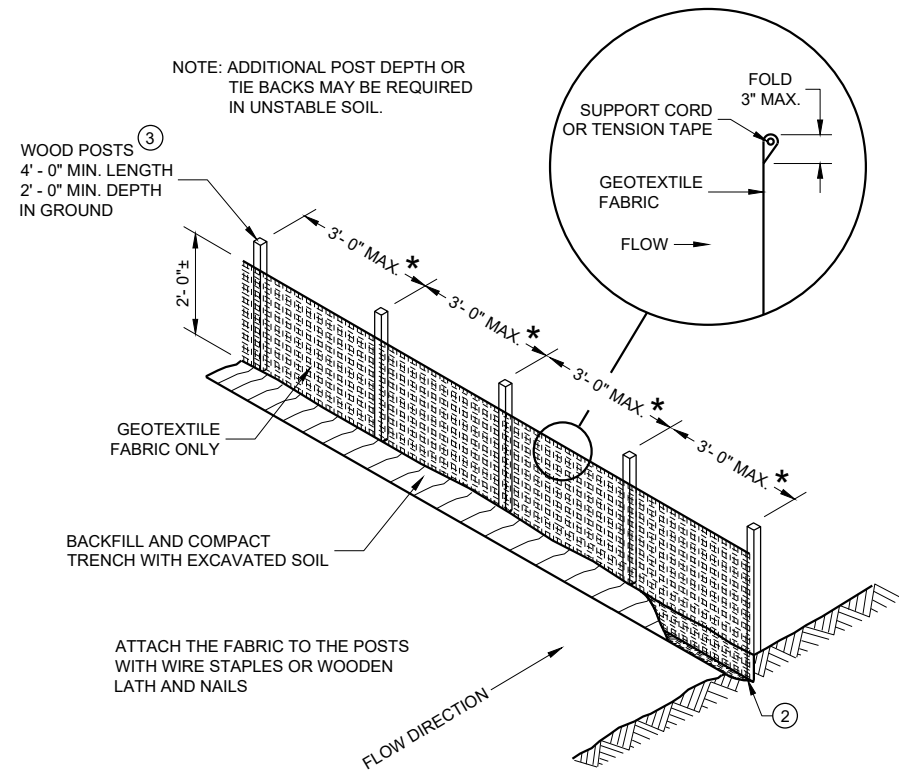

SILT FENCE

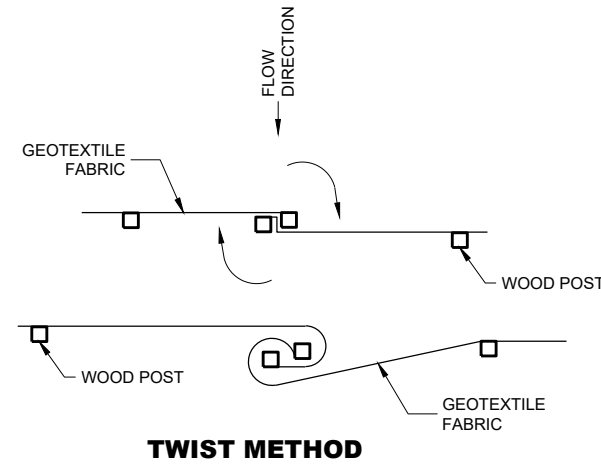


TWIST METHOD

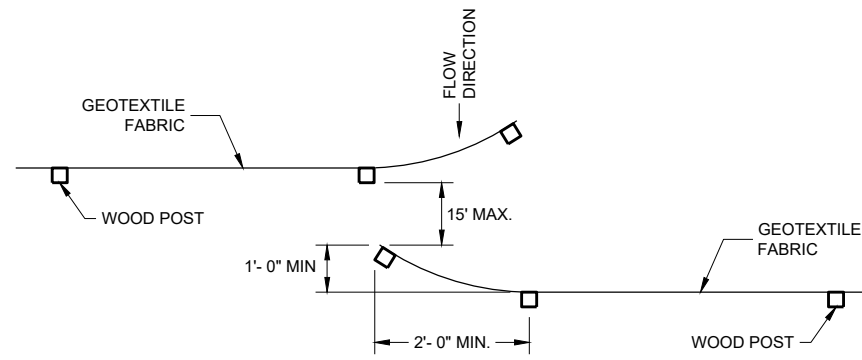

HOOK METHOD

JOINING TWO LENGTHS OF SILT FENCE ⑤

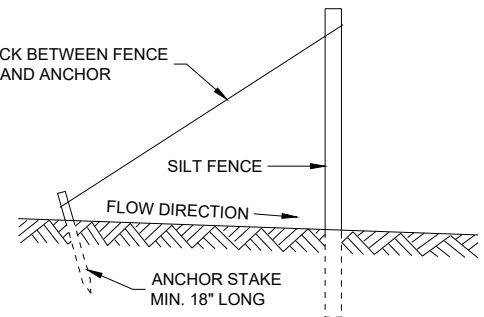

SILT FENCE TIE BACK
(WHEN REQUIRED BY THE ENGINEER)

SILT FENCE



STATE OF WISCONSIN
DEPARTMENT OF TRANSPORTATION

APPROVED
4/29/05 DATE /S/ Beth Cannestra
CHIEF ROADWAY DEVELOPMENT ENGINEER


FHWA



SDD 08E10 Inlet Protection, Types A, B, C and D

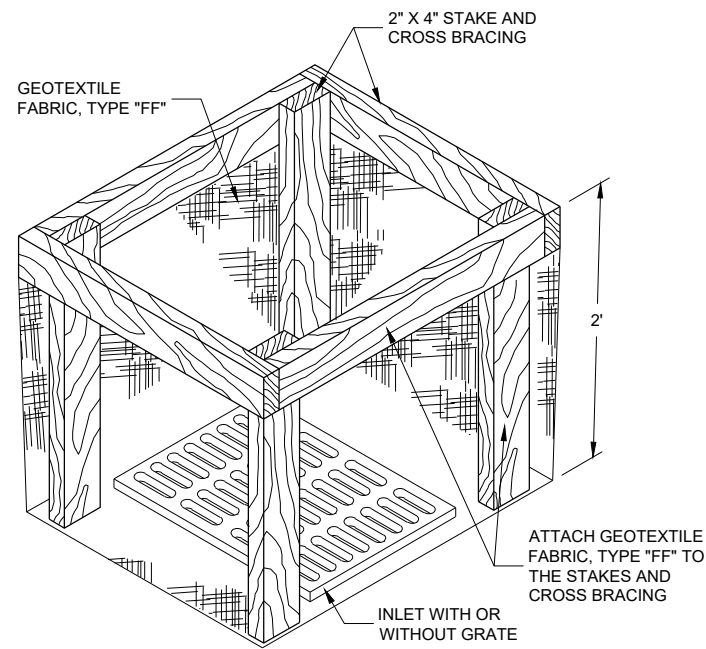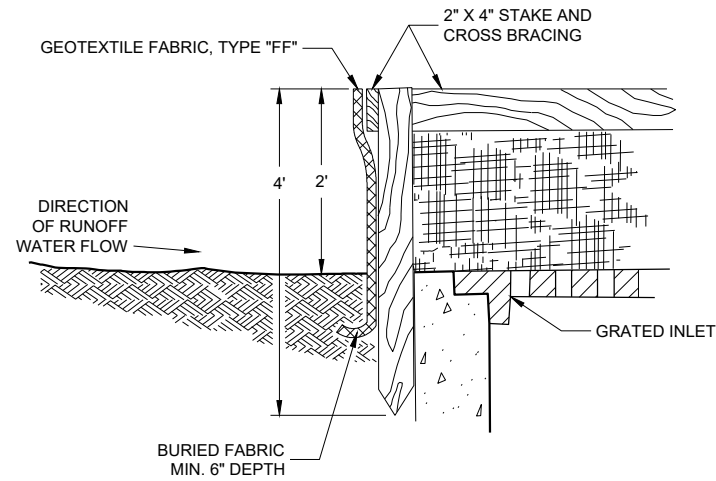


INLET PROTECTION, TYPE "A"

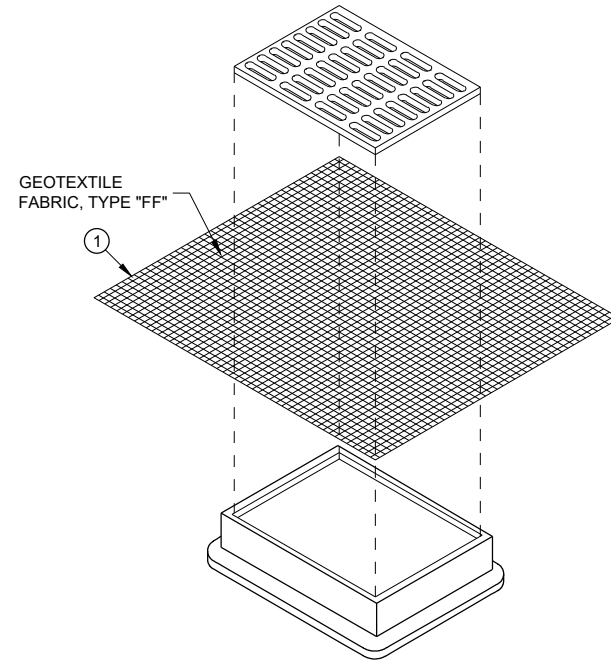

INLET PROTECTION, TYPE "B" (WITHOUT CURB BOX)

(CAN BE INSTALLED IN ANY INLET WITHOUT A CURB BOX)

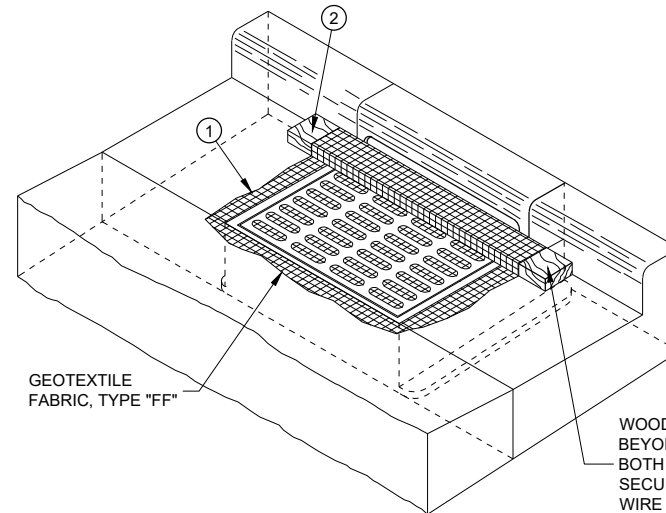

INLET PROTECTION, TYPE "C" (WITH CURB BOX)


INLET SPECIFICATIONS AS PER THE PLAN. DIMENSION LENGTH AND WIDTH TO MATCH

4" x 6" OVAL HOLE SHALL BE HEAT CUT INTO ALL FOUR SIDE PANELS

GEOTEXTILE FABRIC, TYPE "FF"

FRONT, BACK AND BOTTOM TO BE MADE FROM SINGLE PIECE OF FABRIC

MINIMUM DOUBLE STITCHED SEAMS ALL AROUND SIDE PIECES AND ON FLAP POCKETS

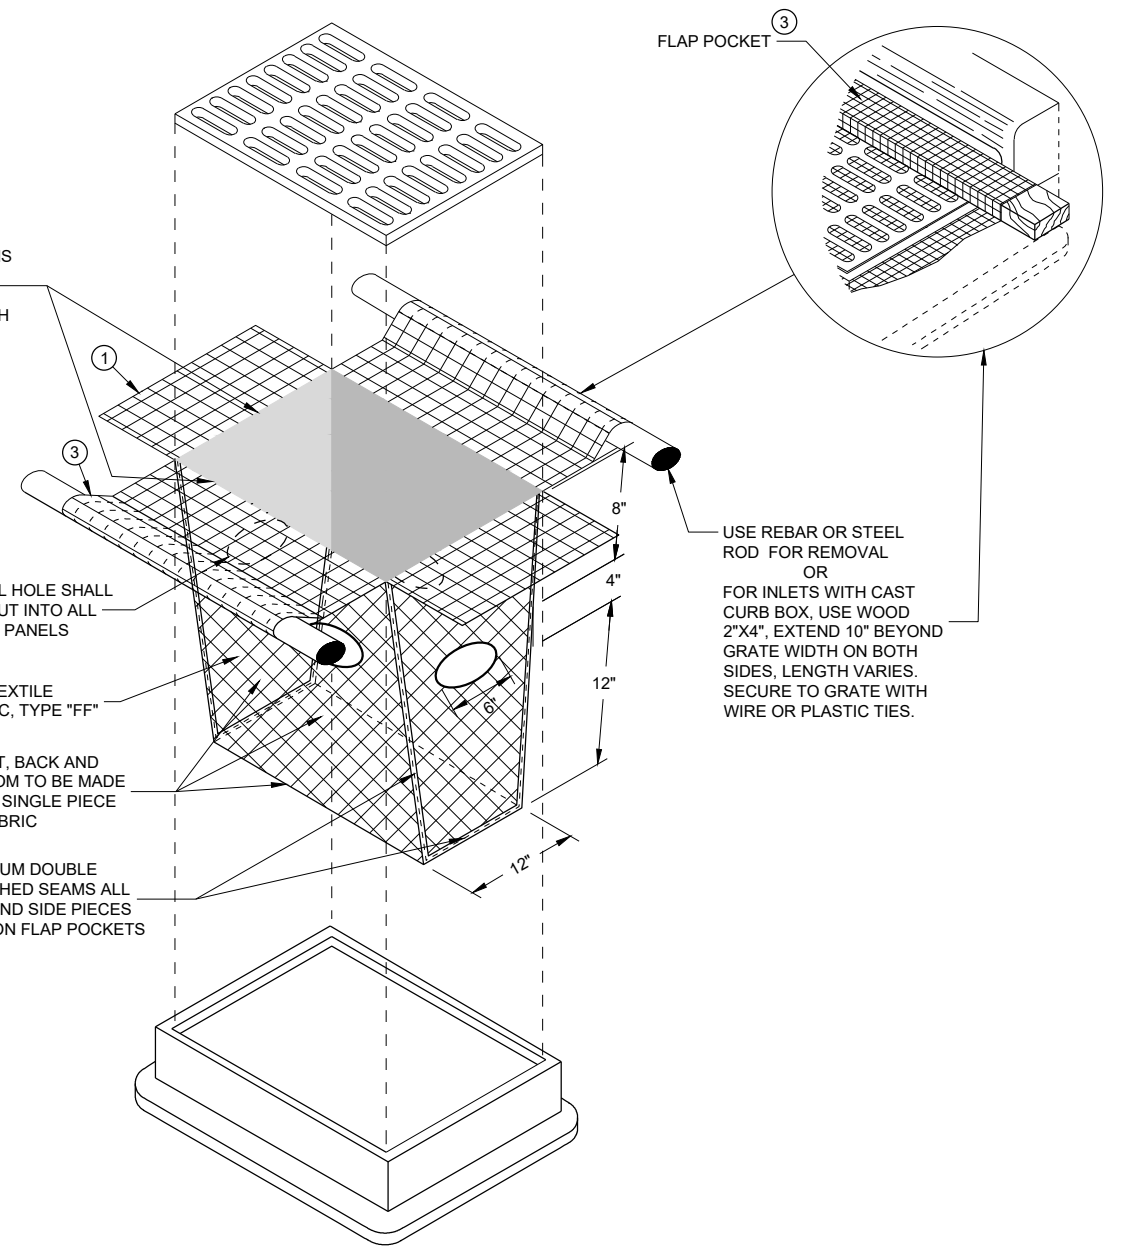

INLET PROTECTION, TYPE "D"

(CAN BE INSTALLED IN ANY INLET WITH OR WITHOUT A CURB BOX AS PER NOTE ②)

GENERAL NOTES

INLET PROTECTION DEVICES SHALL BE MAINTAINED OR REPLACED AT THE DIRECTION OF THE ENGINEER.

MANUFACTURED ALTERNATIVES APPROVED AND LISTED ON THE DEPARTMENT'S EROSION CONTROL PRODUCT ACCEPTABILITY LIST MAY BE SUBSTITUTED.

WHEN REMOVING OR MAINTAINING INLET PROTECTION, CARE SHALL BE TAKEN SO THAT THE SEDIMENT TRAPPED ON THE GEOTEXTILE FABRIC DOES NOT FALL INTO THE INLET. ANY MATERIAL FALLING INTO THE INLET SHALL BE REMOVED IMMEDIATELY.

- ① FINISHED SIZE, INCLUDING FLAP POCKETS WHERE REQUIRED, SHALL EXTEND A MINIMUM OF 10" AROUND THE PERIMETER TO FACILITATE MAINTENANCE OR REMOVAL.
- ② FOR INLET PROTECTION, TYPE C (WITH CURB BOX), AN ADDITIONAL 18" OF FABRIC IS WRAPPED AROUND THE WOOD AND SECURED WITH STAPLES. THE WOOD SHALL NOT BLOCK THE ENTIRE HEIGHT OF THE CURB BOX OPENING.
- ③ FLAP POCKETS SHALL BE LARGE ENOUGH TO ACCEPT WOOD 2X4.

INSTALLATION NOTES

TYPES B & C

TRIM EXCESS FABRIC IN THE FLOW LINE TO WITHIN 3" OF THE GRATE.

THE CONTRACTOR SHALL DEMONSTRATE A METHOD OF MAINTENANCE, USING A SEWN FLAP, HAND HOLDS OR OTHER METHOD TO PREVENT ACCUMULATED SEDIMENT FROM ENTERING THE INLET.

TYPE D

TRIM EXCESS FABRIC IN THE FLOW LINE TO WITHIN 3" OF THE GRATE.

DO NOT INSTALL INLET PROTECTION TYPE D IN INLETS SHALLOWER THAN 30", MEASURED FROM THE BOTTOM OF THE INLET TO THE TOP OF THE GRATE.

THE INSTALLED BAG SHALL HAVE A MINIMUM SIDE CLEARANCE, BETWEEN THE INLET WALLS AND THE BAG, MEASURED AT THE BOTTOM OF THE OVERFLOW HOLES, OF 3". WHERE NECESSARY THE CONTRACTOR SHALL CINCH THE BAG, USING PLASTIC ZIP TIES, TO ACHIEVE THE 3" CLEARANCE. THE TIES SHALL BE PLACED AT A MAXIMUM OF 4" FROM THE BOTTOM OF THE BAG.

6

6

SDD 08E10 - 02

SDD 08E10 - 02

INLET PROTECTION TYPES A, B, C AND D

STATE OF WISCONSIN
DEPARTMENT OF TRANSPORTATION

APPROVED	/s/ Beth Cannestra
10/16/02	DATE
	ROADWAY STANDARDS DEVELOPMENT ENGINEER

FHWA



SDD 08E14 Tracking Pad

GENERAL NOTES

DETAILS OF CONSTRUCTION, MATERIALS AND WORKMANSHIP NOT SHOWN ON THIS DRAWING SHALL CONFORM TO THE PERTINENT REQUIREMENTS OF THE STANDARD SPECIFICATIONS AND THE APPLICABLE SPECIAL PROVISIONS.

TRACKING PAD SHALL BE INSPECTED DAILY. DEFICIENT AREAS SHALL BE REPAIRED OR REPLACED IMMEDIATELY.



TRACKING PAD TO BE REMOVED AFTER CONSTRUCTION IS COMPLETED.

TRACKING PAD SHALL BE THE FULL WIDTH OF THE EGRESS POINT.


SURFACE WATER MUST BE PREVENTED FROM PASSING THROUGH THE TRACKING PAD. FLOWS SHALL BE DIVERTED AWAY, AROUND OR CONVEYED UNDER THE TRACKING PAD.

CULVERT PIPE OR OTHER BMP USED TO DIVERT WATER AWAY, AROUND OR UNDER THE TRACKING PAD SHALL BE DESIGNED TO CONVEY THE 2 YEAR - 24 HOUR EVENT.

THE COST OF ADDITIONAL BMP TO DIVERT WATER ARE INCIDENTAL TO THE TRACKING PAD BID ITEM.

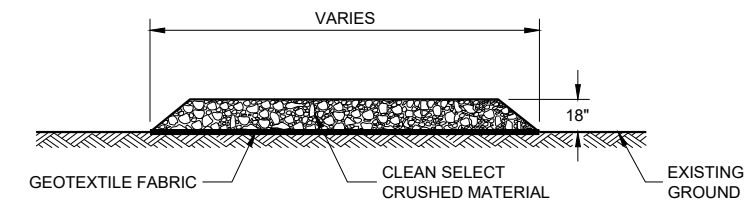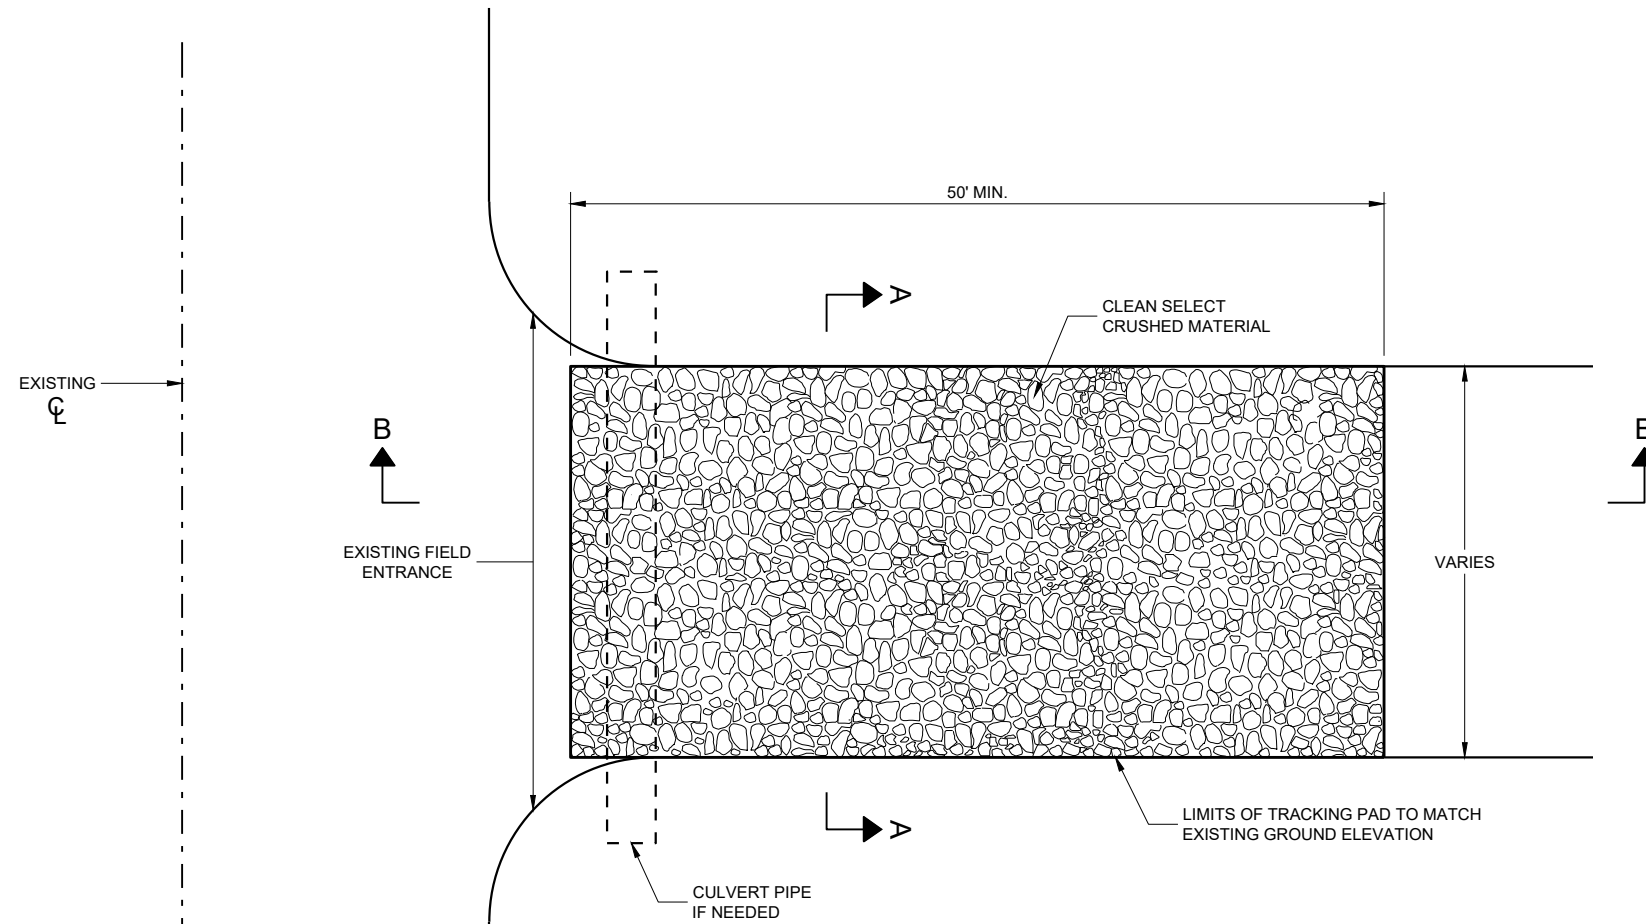

SECTION A - A

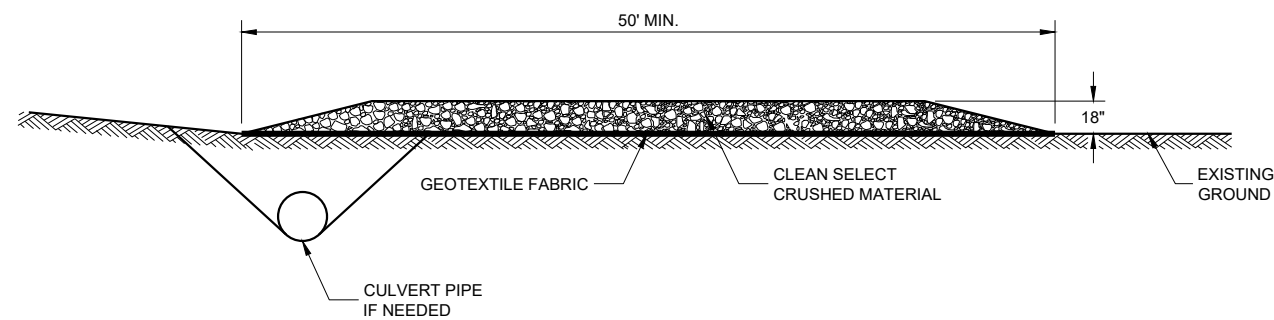

SECTION B - B

TRACKING PAD

STATE OF WISCONSIN
DEPARTMENT OF TRANSPORTATION

APPROVED

3/24/2011

DATE

/s/ Jerry H. Zogg

ROADWAY STANDARDS DEVELOPMENT

ENGINEER


FHWA

6


SDD 08E14 - 01

6

SDD 08E14 - 01

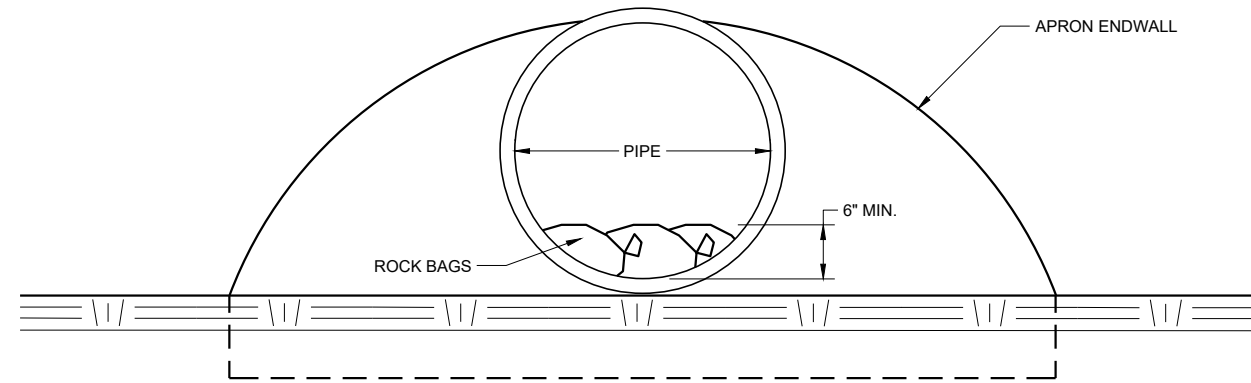

END VIEW

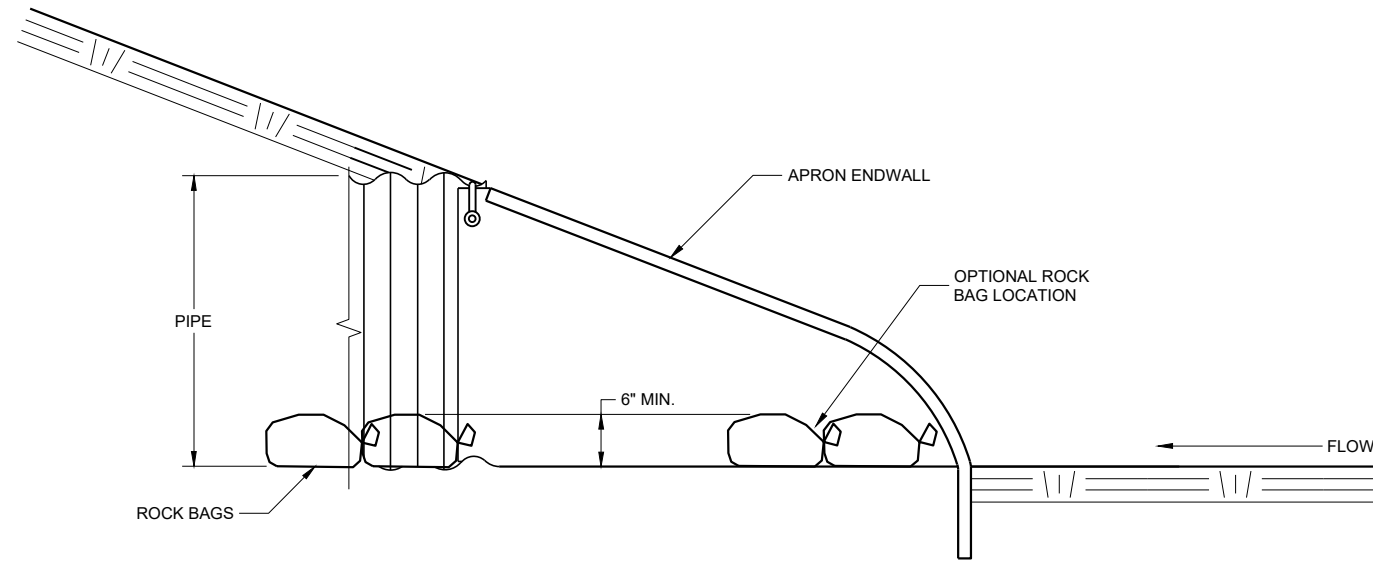

SIDE VIEW

CULVERT PIPE CHECK
 (INSTALL ON INLET END ONLY)

6

6

SDD 08E15 - 01

SDD 08E15 - 01

CULVERT PIPE CHECK	
STATE OF WISCONSIN DEPARTMENT OF TRANSPORTATION	
APPROVED May 2019 DATE	/s/ Daniel Schave EROSION CONTROL ENGINEER

FHWA


88

PIPE DIA. (IN.)	MIN. THICK. (Inches)		DIMENSIONS (Inches)							APPROX. SLOPE	BODY
	STEEL	ALUM.	A	B	H	L	L ₁	L ₂	W		
			(±1")	(MAX.)	(±1")	(±1/2")	①	①			
12	.064	.060	6	6	6	21	12	17 1/2	24	2 1/2 to 1	1 Pc.
15	.064	.060	7	8	6	26	14	21 3/4	30	2 1/2 to 1	1 Pc.
18	.064	.060	8	10	6	31	15	28 1/4	36	2 1/2 to 1	1 Pc.
21	.064	.060	9	12	6	36	18	29 5/8	42	2 1/2 to 1	1 Pc.
24	.064	.075	10	13	6	41	18	37 1/4	48	2 1/2 to 1	1 Pc.
30	.079	.075	12	16	8	51	18	52 1/4	60	2 1/2 to 1	1 Pc.
36	.079	.105	14	19	9	60	24	59 3/4	72	2 1/2 to 1	2 Pc.
42	.109	.105	16	22	8	69	24	75 5/8	84	2 1/2 to 1	2 Pc.
48	.109	.105	18	27	12	78	24	81	90	2 1/4 to 1	3 Pc.
54	.109	.105	18	30	12	84	30	85 1/2	102	2 1/4 to 1	3 Pc.
60	.109x	.105x	18	33	12	87	—	—	114	2 to 1	3 Pc.
66	.109x	.105x	18	36	12	87	—	—	120	2 to 1	3 Pc.
72	.109x	.105x	18	39	12	87	—	—	126	2 to 1	3 Pc.
78	.109x	.105x	18	42	12	87	—	—	132	1 1/2 to 1	3 Pc.
84	.109x	.105x	18	45	12	87	—	—	138	1 1/2 to 1	3 Pc.
90	.109x	.105x	18	37	12	87	—	—	144	1 1/2 to 1	3 Pc.
96	.109x	.105x	18	35	12	87	—	—	150	1 1/2 to 1	3 Pc.

* EXCEPT CENTER PANEL SEE GENERAL NOTES


PIPE DIA. (IN.)	DIMENSIONS (Inches)							APPROX. SLOPE
	T	A	B	C	D	E	G	
	12	2	4	24	48 1/8	72 7/8	24	
15	2 1/4	6	27	46	73	30	2 1/4	3 to 1
18	2 1/2	9	27	46	73	36	2 1/2	3 to 1
21	2 3/4	9	36	37 1/2	73 1/2	42	2 3/4	3 to 1
24	3	9 1/2	43 1/2	30	73 1/2	48	3	3 to 1
27	3 1/4	10 1/2	49 1/2	24	73 1/2	54	3 1/4	3 to 1
30	3 1/2	12	54	19 1/4	73 1/2	60	3 1/2	3 to 1
36	4	15	63	34 3/4	97 3/4	72	4	3 to 1
42	4 1/2	21	63	35	98	78	4 1/2	3 to 1
48	5	24	72	26	98	84	5	3 to 1
54	5 1/2	27	65	33 1/4-35	98 1/4-100	90	5 1/2	2 2/5 to 1
60	6	30-35	60	39	99	96	5	2 to 1
66	6 1/2	24-30	72-78	21-27	99	102	5 1/2	2 to 1
72	7	24-36	78	21	99	108	6	2 to 1
78	7 1/2	24-36	78	21	99	114	6 1/2	2 to 1
84	8	36	90 1/2	21	111 1/2	120	6 1/2	1 1/2 to 1
90	8 1/2	41	87 1/2	24	111 1/2	132	6 1/2	1 1/2 to 1

* MINIMUM
** MAXIMUM

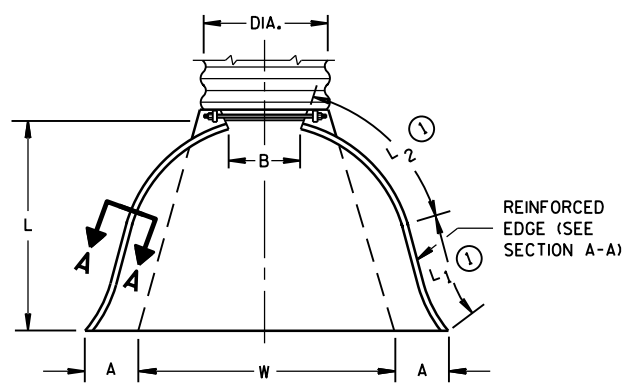


PLAN VIEW

REINFORCED EDGE (SEE SECTION A-A)
END CORNER PLATES MAY BE FASTENED TO APRON PROPER BY BOLTS, RIVETS, OR RESISTANCE SPOT WELDS WHICH WILL HOLD THE SURFACES TIGHTLY TOGETHER

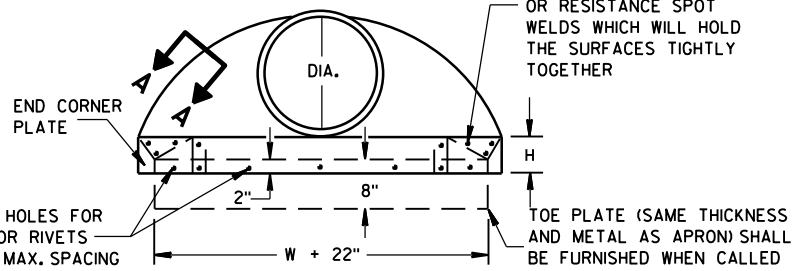


END VIEW


TOE PLATE (SAME THICKNESS AND METAL AS APRON) SHALL BE FURNISHED WHEN CALLED FOR ON THE PLANS

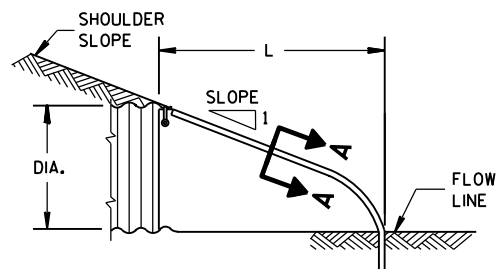


SIDE ELEVATION
METAL ENDWALLS

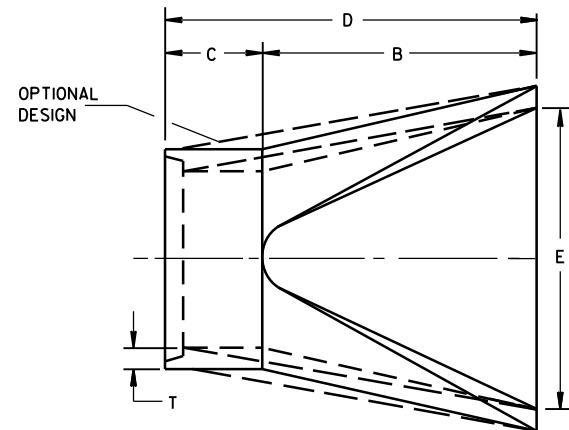

PLAN

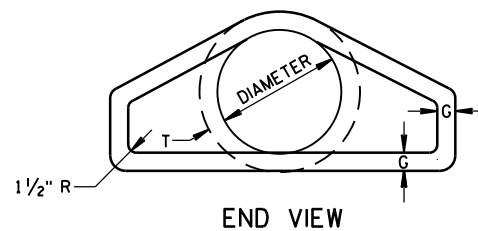


END VIEW

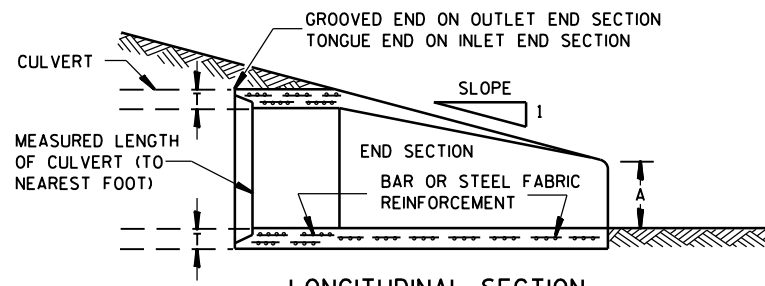


LONGITUDINAL SECTION
CONCRETE ENDWALLS

1" WIDE, 12 GA. (0.109" THICK) GALVANIZED STRAP WITH STANDARD 6" X 1/2" BAND BOLT AND NUT

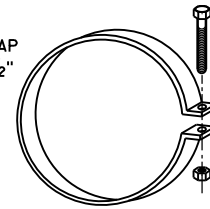

ALTERNATE FOR TYPE 1 CONNECTION
END SECTION CONNECTOR STRAP

THREADED 1/8" DIA. ROD AROUND CULVERT & THROUGH TANK TYPE CONNECTOR LUG OR ALTERNATE CONNECTOR STRAP (SEE DETAIL)

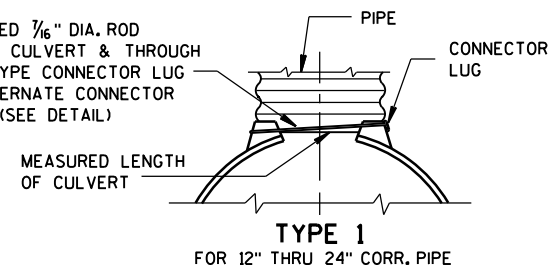


TYPE 1
FOR 12" THRU 24" CORR. PIPE

THREADED 1/8" DIA. ROD OVER TOP OF APRON, SIDE LUGS TO BE RIVETED TO APRON




TYPE 2
FOR 30" THRU 96" CORR. PIPE

MEASURED LENGTH OF CULVERT
CONNECTOR SECTION TO BE PAID FOR AS PART OF END SECTION

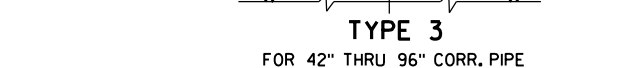

TYPE 3
FOR 42" THRU 96" CORR. PIPE

DIMPLED OR CORRUGATED COUPLING BAND
RIVETED OR BOLTED AT DIMPLES (6" C-C FOR CORRUGATED BAND)

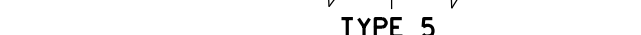

TYPE 5
ALTERNATE FOR:
ALL SIZES CORRUGATED CIRCULAR PIPE


NOTE: DIMPLED BAND FITS OVER OUTSIDE OF ENDWALL, AND CORRUGATED BAND FITS INSIDE ENDWALL. DIMPLED BAND MAY BE USED WITH HELICALLY CORRUGATED PIPE.

FOR CIRCUMFERENTIALLY CORRUGATED PIPE USE ENDWALL CONNECTION DETAILS 1, 2, 3 OR 5 AS APPLICABLE.

FOR HELICALLY CORRUGATED PIPE USE ENDWALL CONNECTION DETAILS 1, 2 OR 5.

FOR HELICALLY CORRUGATED PIPES WITH TWO CIRCUMFERENTIAL CORRUGATIONS AT EACH END USE ENDWALL CONNECTION DETAILS 1, 2 OR 3.

CONNECTION DETAILS

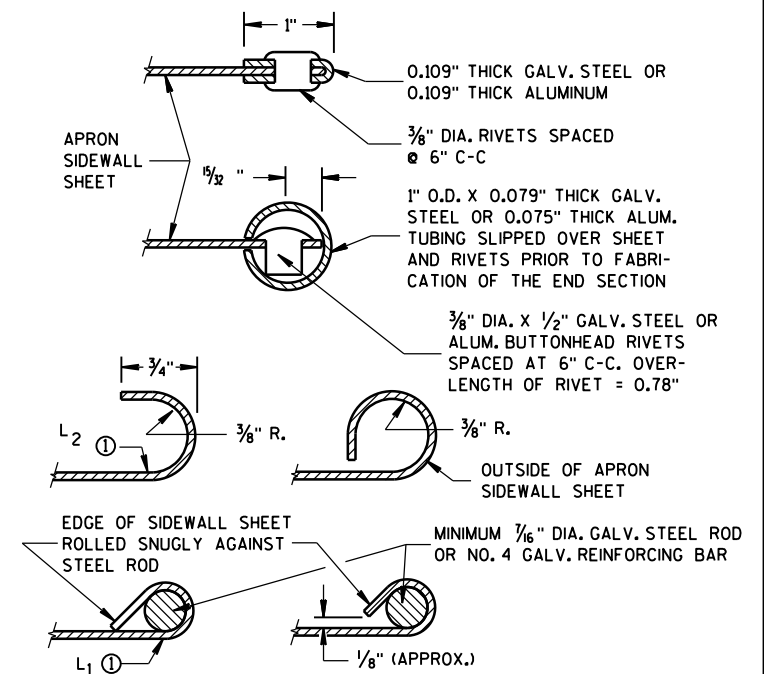

SECTION A-A

GENERAL NOTES

DETAILS OF CONSTRUCTION, MATERIALS AND WORKMANSHIP NOT SHOWN ON THIS DRAWING SHALL CONFORM TO THE PERTINENT REQUIREMENTS OF THE STANDARD SPECIFICATIONS AND THE APPLICABLE SPECIAL PROVISIONS.

CONCRETE CULVERT ENDWALLS MAY NOT BE USED WITH GALVANIZED STEEL OR ALUMINUM CULVERT PIPE OR VICE VERSA. GALVANIZED STEEL OR ALUMINUM ENDWALLS SHALL NORMALLY BE INSTALLED ON CULVERT PIPE OF THE SAME METAL.

ALL THREE PIECE STEEL APRON ENDWALLS FOR 60" DIAMETER PIPE AND LARGER SHALL HAVE 0.109" SIDES AND 0.138" CENTER PANELS. ALL THREE PIECE ALUMINUM APRON ENDWALLS FOR 60" DIAMETER PIPE AND LARGER SHALL HAVE 0.105" SIDES AND 0.134" CENTER PANELS. THE WIDTH OF CENTER PANELS SHALL BE GREATER THAN 20 PERCENT OF THE PIPE PERIMETER.

LAP SEAMS SHALL BE TIGHTLY JOINED BY GALVANIZED RIVETS OR BOLTS FOR STEEL UNITS AND ALUMINUM RIVETS AND BOLTS FOR ALUMINUM UNITS. FOR THE 60" THROUGH 96" DIAMETER APRON ENDWALL SIZES, THE REINFORCED EDGES AND CENTER PANEL SEAMS SHALL BE FURTHER REINFORCED WITH GALVANIZED STEEL OR ALUMINUM STIFFENER ANGLES. THE ANGLES SHALL BE ATTACHED BY GALVANIZED NUTS AND BOLTS FOR STEEL UNITS AND ALUMINUM NUTS AND BOLTS FOR ALUMINUM UNITS.


WHERE TWO OR MORE PIPES WITH APRON ENDWALLS ARE LAID ADJACENT TO EACH OTHER, THEY SHALL BE SEPARATED BY A DISTANCE SUFFICIENT TO PROVIDE A MINIMUM CLEARANCE OF 6 INCHES BETWEEN APRON ENDWALLS.

① FOR PIPE SIZES UP TO 60" DIAMETER, A 180° ROLLED EDGE MAY BE USED INSTEAD OF STEEL ROD REINFORCEMENT. SEE SECTION A-A.


APRON ENDWALLS FOR CULVERT PIPE	
STATE OF WISCONSIN DEPARTMENT OF TRANSPORTATION	
APPROVED 8-30-94 DATE	/s/ Rory L. Rhinesmith CHIEF ROADWAY DEVELOPMENT ENGINEER
FHWA	



SDD 08F04 Joint Ties for Concrete Pipe and Concrete Collar Detail

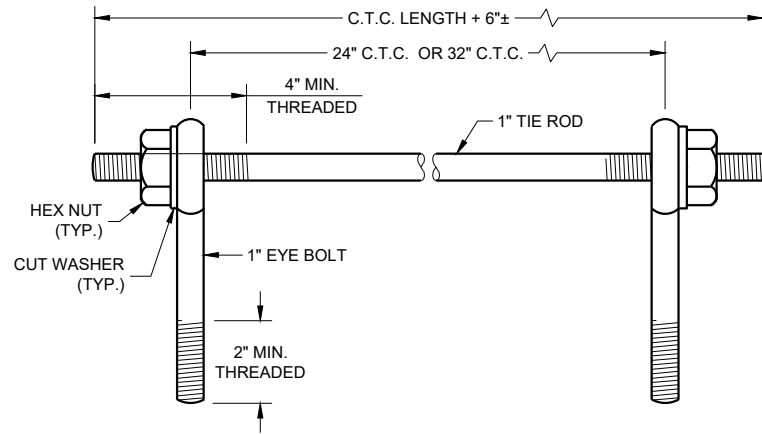

EYE BOLTS AND TIE ROD
EYE BOLT AND TIE ROD ASSEMBLY (ALTERNATE NO. 1)

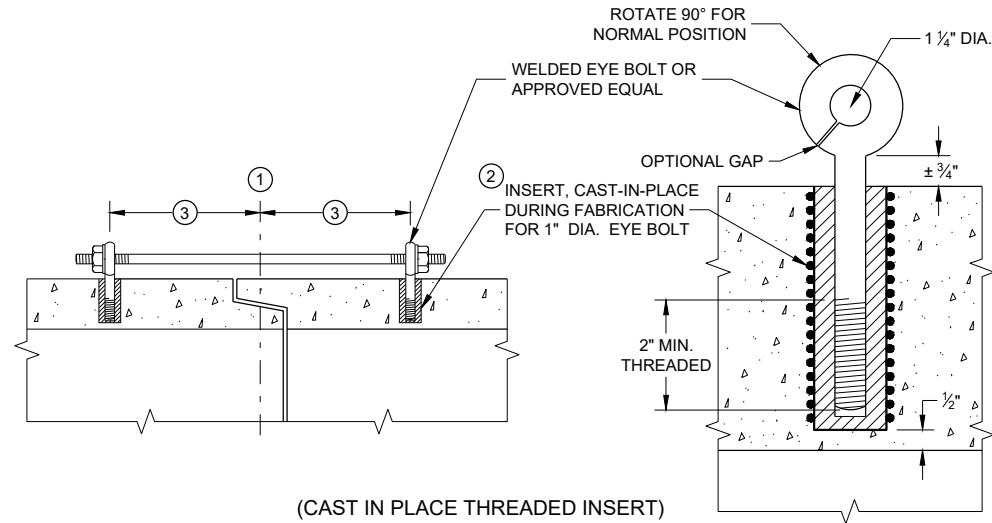

(CAST IN PLACE THREADED INSERT)
LONGITUDINAL SECTIONS

GENERAL NOTES


DETAILS OF CONSTRUCTION, MATERIALS, AND WORKMANSHIP NOT SHOWN ON THIS DRAWING SHALL CONFORM TO THE PERTINENT REQUIREMENTS OF THE STANDARD SPECIFICATIONS AND APPLICABLE SPECIAL PROVISIONS.

CONCRETE CULVERT AND STORM SEWER PIPE SHALL BE TIED TOGETHER IN THE MANNER ILLUSTRATED BY THIS DETAIL AT LOCATIONS DESIGNATED IN THE STANDARD SPECIFICATIONS AND THE PLAN. THE CONTRACTOR MAY USE EITHER ALTERNATE 1, 2 OR 3 FOR DRAINAGE STRUCTURES. ONLY ALTERNATE 1 AND 3 MAY BE USED FOR CATTLE PASSES, UNLESS OTHERWISE STATED IN THE CONTRACT. THE MATERIALS, FABRICATION AND WORK NECESSARY TO TIE THE PIPE BY THIS DETAIL WILL BE CONSIDERED INCIDENTAL TO THE PIPE AND APRON ENDWALLS IF REQUIRED.

DETAILED DRAWINGS FOR PROPOSED ALTERNATE DESIGNS FOR JOINT TIES SHALL BE SUBMITTED TO THE ENGINEER FOR APPROVAL.


JOINT TIES TO BE HOT-DIP GALVANIZED PER ASTM A 153.

- ① CENTER LINE OF TONGUE AND GROOVE OR BELL AND SPIGOT JOINTS.
- ② THE INSIDE OF THE THREADED INSERTS SHALL BE CLEAN TO ALLOW THE INSERTION OF THREADED EYE BOLTS.
- ③ HOLES SHALL BE CAST-IN-PLACE OR DRILLED PER THE APPLICABLE DETAIL, AND EQUAL DISTANCE FROM THE CENTERLINE OF THE JOINT.
- ④ BOLT PROJECTION INSIDE OF PIPE SHALL NOT EXCEED 2 INCHES.
- ⑤ OPENING TO BE ROD DIAMETER PLUS 1 INCH.
- ⑥ LENGTH ADEQUATE TO EXTEND TO WITHIN 1/2 INCH OF THE INNER SURFACE OF THE PIPE.
- ⑦ EYE BOLT LENGTH DETERMINED BY WALL THICKNESS, BELL THICKNESS AND BOLT PROJECTION INSIDE PIPE.

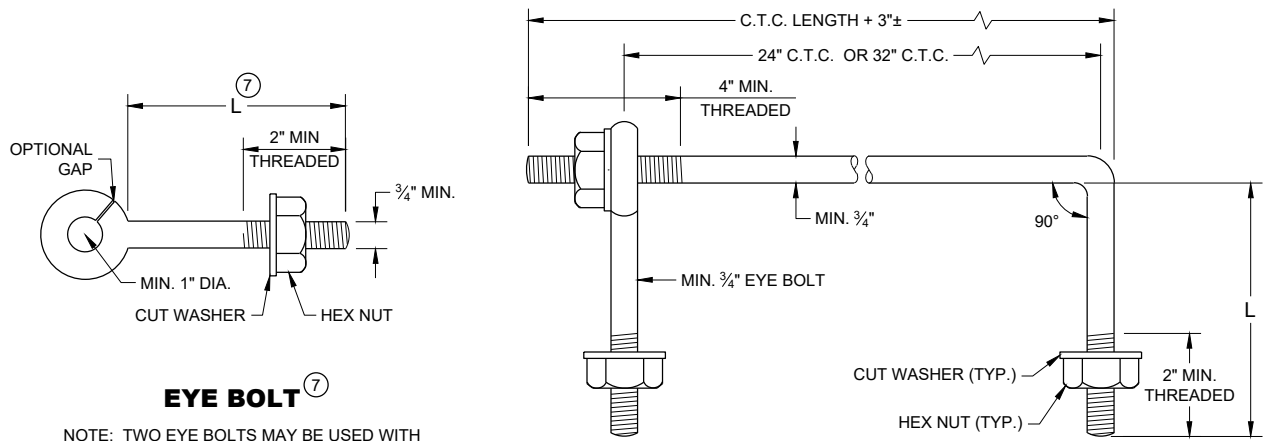

EYE BOLT AND TIE ROD

EYE BOLT ⑦
NOTE: TWO EYE BOLTS MAY BE USED WITH A 30\"/>

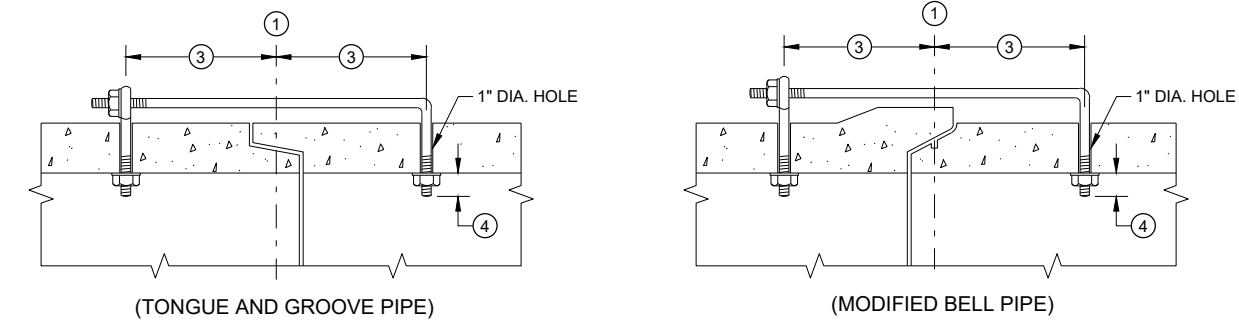


LONGITUDINAL SECTION
(JOINT TIES FOR 18\"/>

EYE BOLT AND TIE ROD ASSEMBLY (ALTERNATE NO. 2)


ADJUSTABLE TIE ROD TABLE

PIPE DIAMETER	TIE ROD DIAMETER	D	L ₁	N
12 - 60	5/8	5/8	5	1/2
66 - 84	3/4	3/4	5	1/2
90 - 144	1	1	7	1 7/16


DIMENSIONS SHOWN ARE IN INCHES

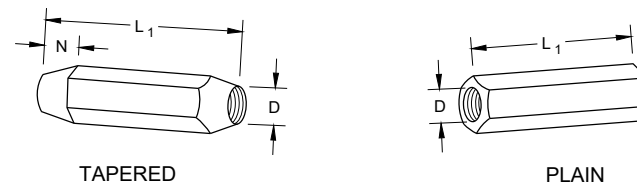

RIGHT AND LEFT THREADS SLEEVE NUTS

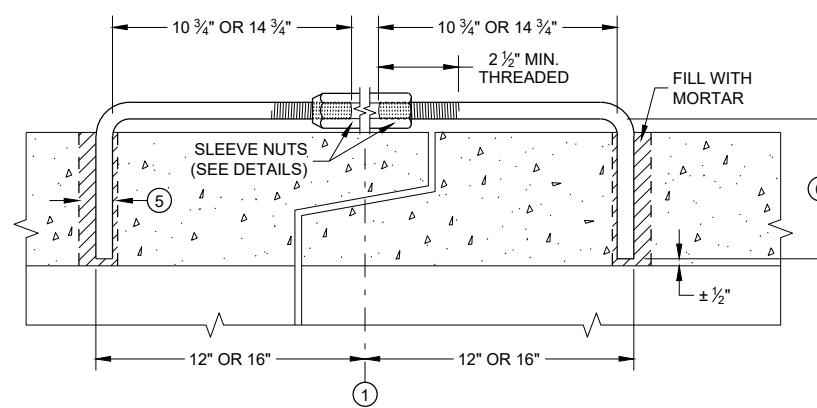


LONGITUDINAL SECTION
ADJUSTABLE TIE ROD (ALTERNATE NO. 3)

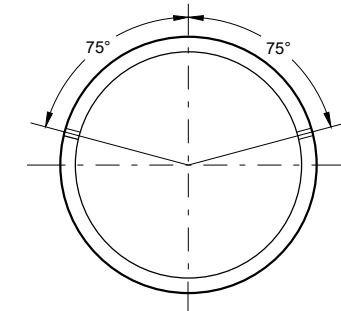

PLACEMENT OF (2) CAST-IN-PLACE INSERTS OR HOLES DURING FABRICATION FOR PIPE SECTIONS REQUIRING TIE RODS

TRANSVERSE SECTION



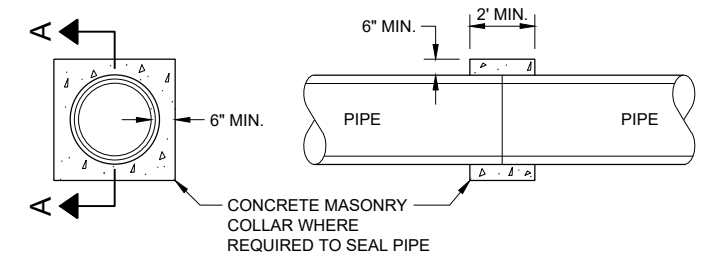


SECTION A - A
CONCRETE COLLAR DETAIL

JOINT TIES FOR CONCRETE PIPE AND CONCRETE COLLAR DETAIL

STATE OF WISCONSIN
DEPARTMENT OF TRANSPORTATION

APPROVED
November 2021 /S/ Rodney Taylor
DATE ROADWAY STANDARDS DEVELOPMENT ENGINEER
FHWA

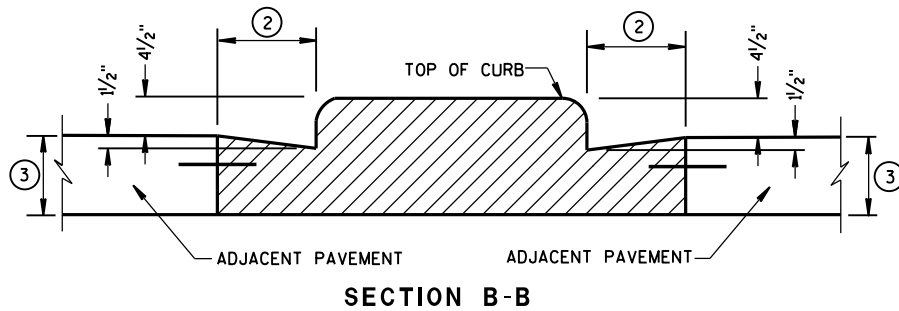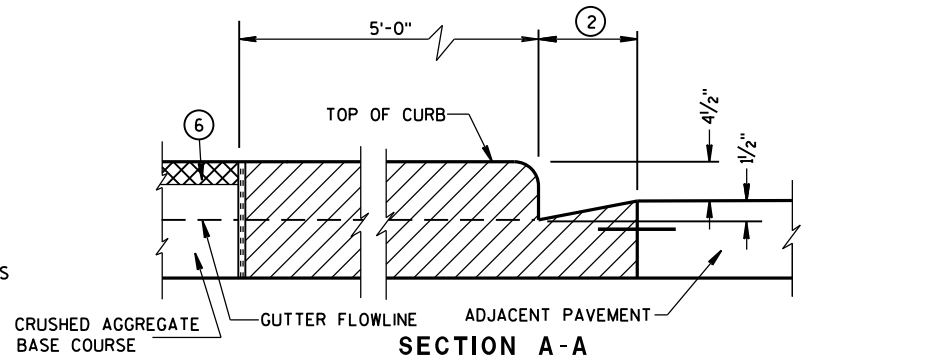
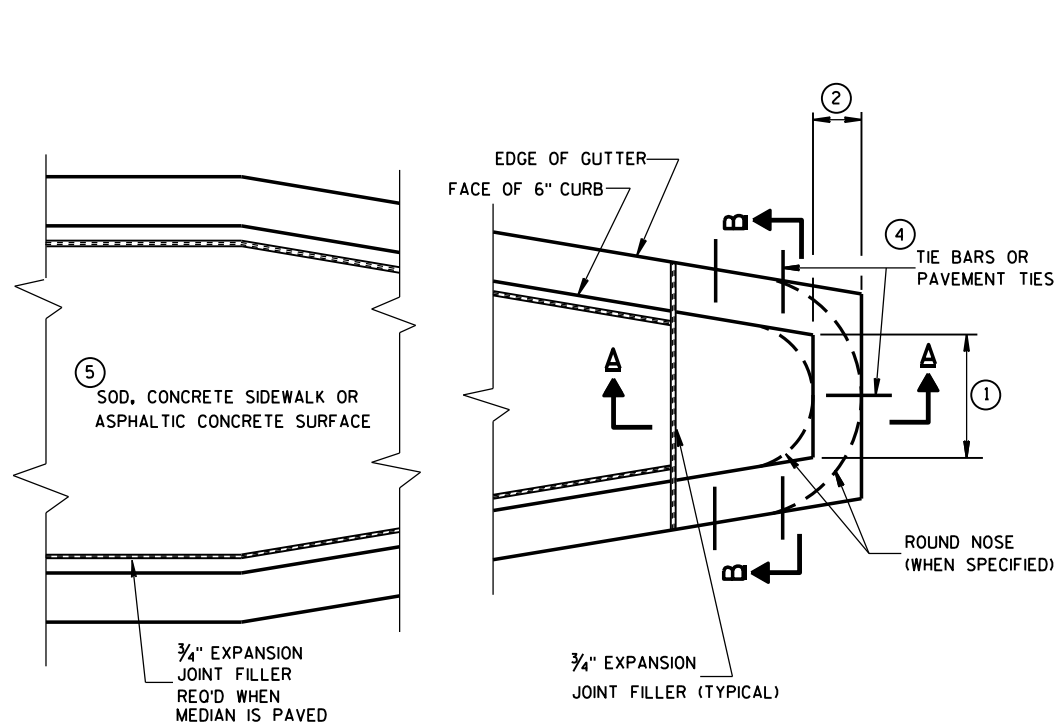


CONCRETE MEDIAN BLUNT NOSE DETAIL



GENERAL NOTES

DETAILS OF CONSTRUCTION, MATERIALS AND WORKMANSHIP NOT SHOWN ON THIS DRAWING SHALL CONFORM TO THE PERTINENT REQUIREMENTS OF THE STANDARD SPECIFICATIONS AND THE APPLICABLE SPECIAL PROVISIONS.


- ① SEE PLAN FOR MEDIAN NOSE WIDTH AND RADIUS (FOR ROUND NOSE ALTERNATE).
- ② WIDTH OF GUTTER TO MATCH EXISTING ADJACENT GUTTER OR AS SPECIFIED ELSEWHERE IN THE PLAN.
- ③ DEPTH EQUAL TO ADJACENT PAVEMENT. ADJACENT PAVEMENT STRUCTURE DETAILS ARE SHOWN ON THE PLAN. TYPICAL OPTIONS ARE:
 - (1) NEW OR EXISTING CONCRETE PAVEMENT.
 - (2) ASPHALTIC CONCRETE PAVEMENT OVER NEW OR EXISTING CONCRETE BASE COURSE.
 - (3) ASPHALTIC CONCRETE PAVEMENT OVER CRUSHED AGGREGATE BASE COURSE.
- ④ TIE BARS OR PAVEMENT TIES REQUIRED IN NEW CONCRETE PAVEMENT OR CONCRETE BASE COURSE. TIE BARS SHALL BE NO. 4 X 2'-0" SPACED AT 2'-0" C-C.
- PAVEMENT TIES REQUIRED IN EXISTING CONCRETE BASE COURSE. PAVEMENT TIES SHALL BE NO. 6 X 1'-0" SPACED AT 3'-0" C-C INSTALLED ON A HORIZONTAL SKEW OF 6:1. THE DIRECTION OF SKEW SHALL ALTERNATE AFTER EVERY ONE OR TWO BARS.
- ⑤ SURFACE TYPE AND DETAILS ARE SHOWN ELSEWHERE IN THE PLAN.

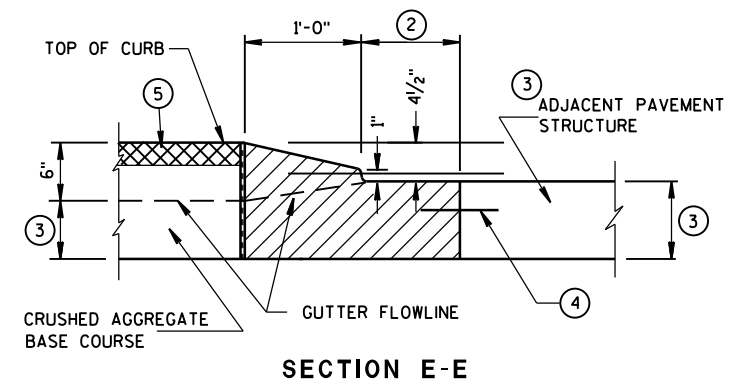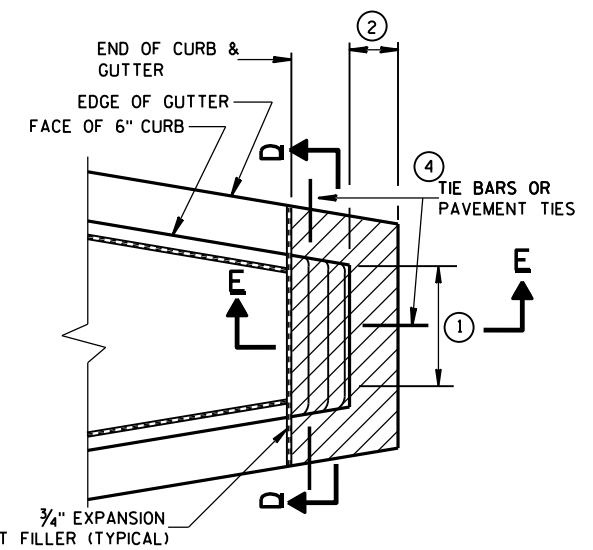

CONCRETE MEDIAN SLOPED NOSE TYPE 2

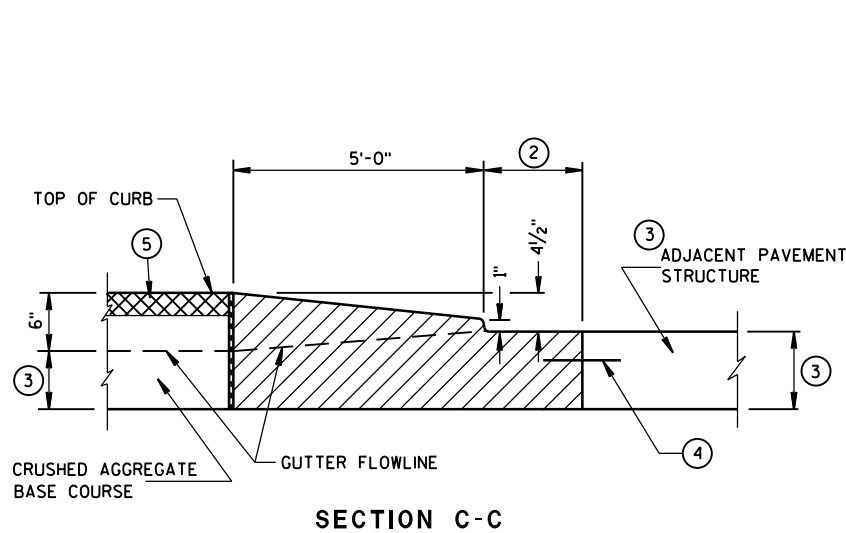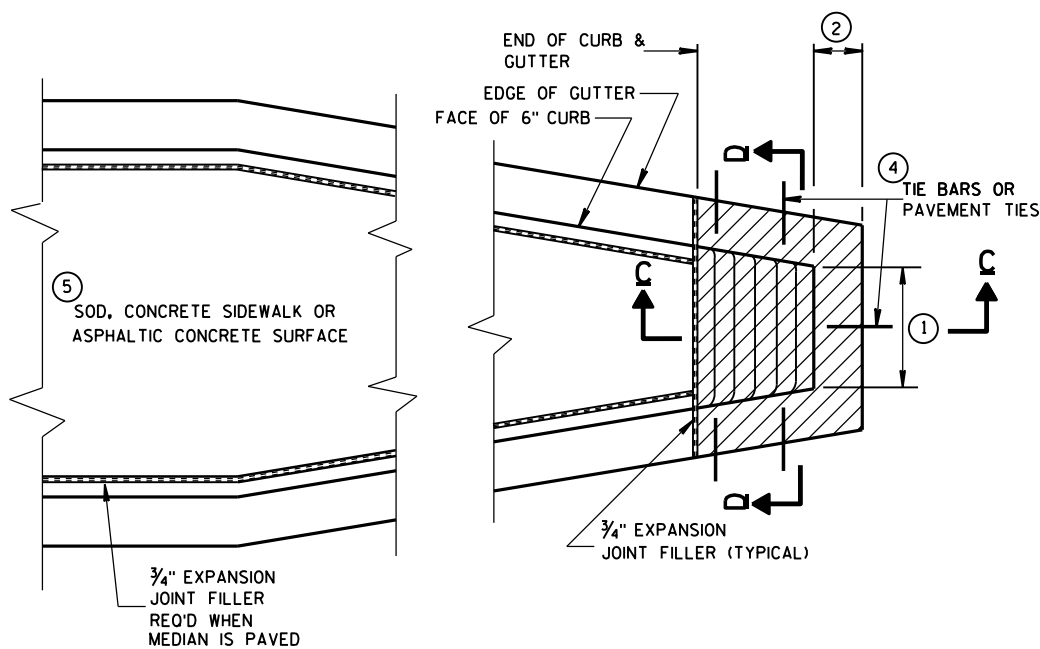

CONCRETE MEDIAN SLOPED NOSE TYPE 1

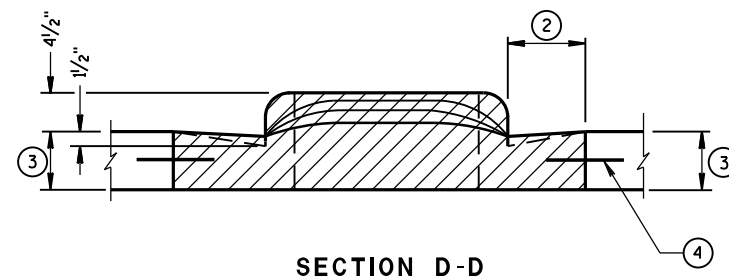


CONCRETE MEDIAN NOSE

STATE OF WISCONSIN
DEPARTMENT OF TRANSPORTATION


APPROVED
6-8-2006 DATE /S/ Jerry H. Zogg
ROADWAY STANDARDS DEVELOPMENT ENGINEER
FHWA

6

6

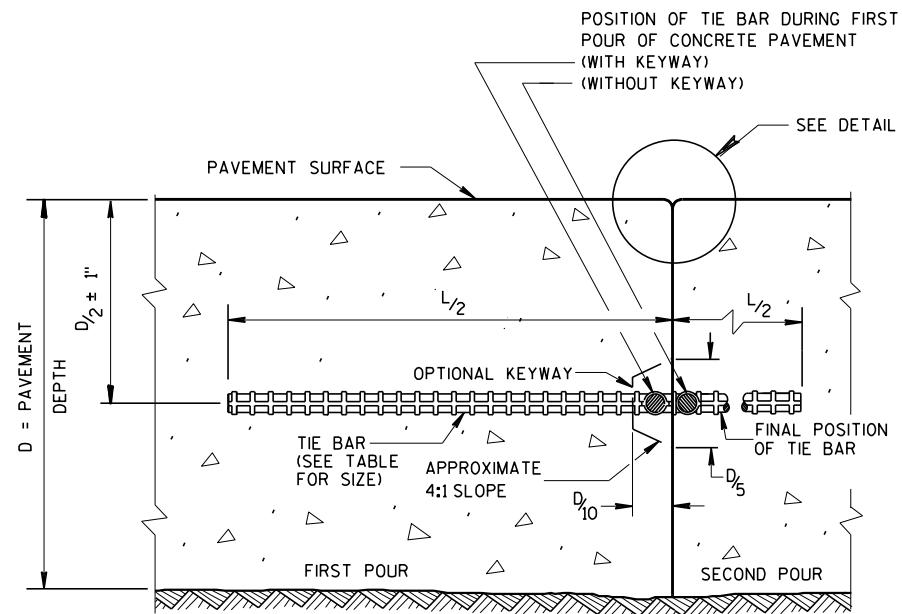


CONSTRUCTION JOINT

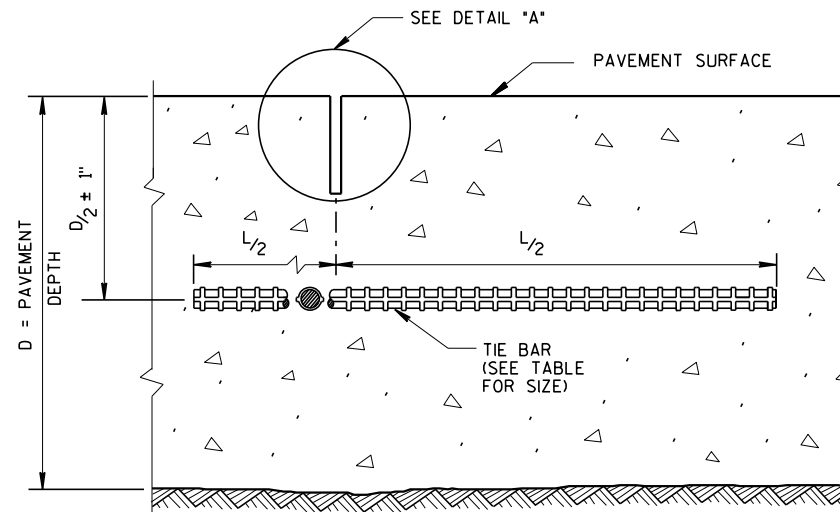

SAWED JOINT


GENERAL NOTES

- CREATE A LONGITUDINAL JOINT FOR PAVEMENT WIDTHS GREATER THAN 15 FEET.
- CORRELATE LONGITUDINAL JOINTS WITH LANE LINES WHEN POSSIBLE.
- ① ANCHOR TIE BARS INTO DRILLED HOLES WITH AN EPOXY.
- ② PAVEMENT THAT WAS IN PLACE PRIOR TO THE CONTRACT.

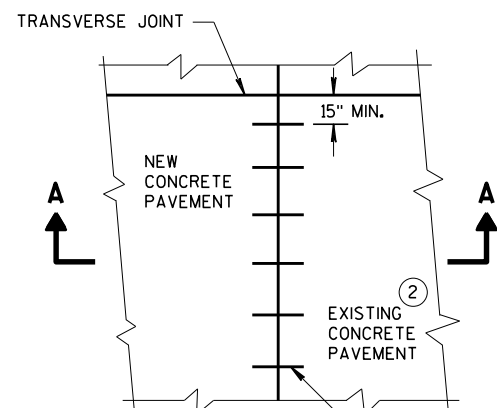


PLAN VIEW


NO. 6 TIE BARS SPACED 30" C-C, INSTALLED PERPENDICULAR TO THE LONGITUDINAL JOINT. ①

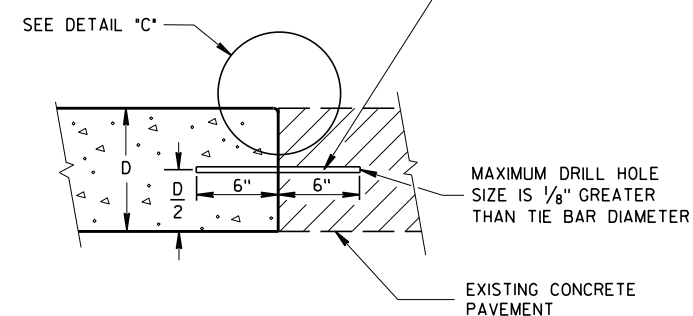


**SECTION A-A
LONGITUDINAL CONSTRUCTION JOINT
TIE BARS ANCHORED
INTO EXISTING PAVEMENT**

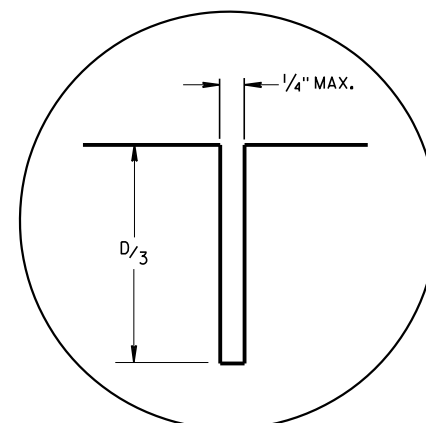

DETAIL "A"

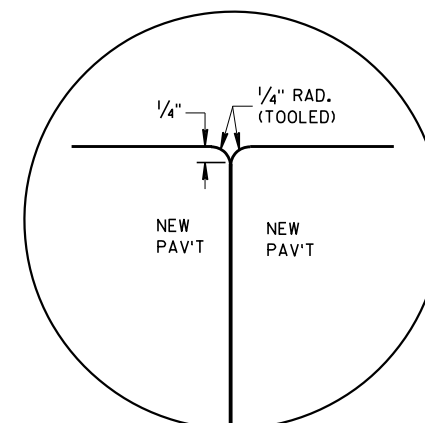

DETAIL "B"

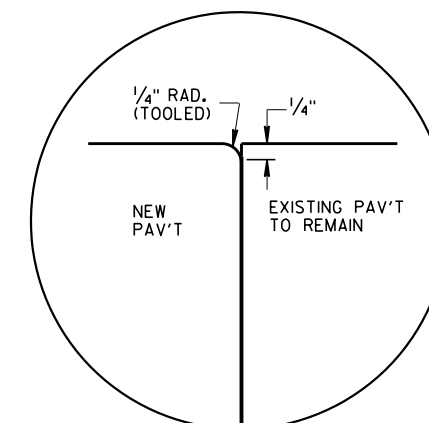


DETAIL "C"

TIE BAR TABLE

PAVEMENT DEPTH (D)	TIE BAR SIZE	TIE BAR LENGTH (L)	MAX. TIE BAR SPACING
< 10 1/2"	NO. 4	30"	36"
≥ 10 1/2"	NO. 5	36"	36"
	NO. 4 *	30"	24" **

* SUBSTITUTE BENT BARS AT LONGITUDINAL JOINTS WHEN EQUIPMENT LIMITATIONS DURING CONSTRUCTION WARRANT (e.g. AUXILIARY LANES OR TURN LANES)

** CONFORM TO 15" MINIMUM SPACING FROM TRANSVERSE JOINTS; SPACING BETWEEN TIE BARS WILL BE 30" AT TRANSVERSE JOINTS.

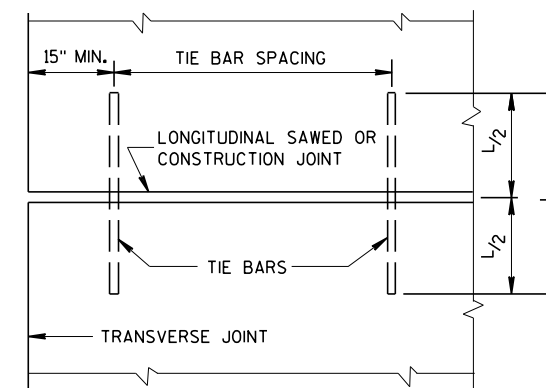


**PLAN VIEW
SHOWING LOCATION OF TIE BARS**


**CONCRETE PAVEMENT
LONGITUDINAL JOINTS AND TIES**

STATE OF WISCONSIN
DEPARTMENT OF TRANSPORTATION

APPROVED
March 2018 /S/ Peter Kemp, P.E.
DATE PAVEMENT SUPERVISOR
FHWA

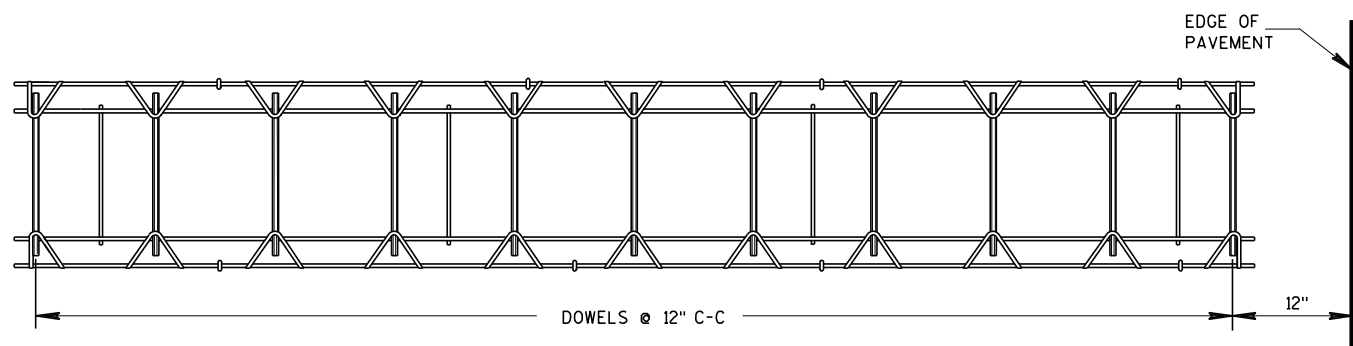

PLAN VIEW

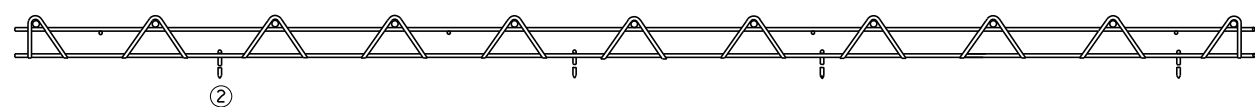

SIDE VIEW
CONTRACTION JOINT DOWEL ASSEMBLY

PAVEMENT DEPTH, DOWEL BAR SIZE AND JOINT SPACING TABLE

PAVEMENT DEPTH (D)	DOWEL BAR DIAMETER	CONTRACTION JOINT SPACING
5 1/2", 6", 6 1/2"	NONE	12'
7", 7 1/2"	1"	14'
8", 8 1/2"	1 1/4"	15'
9", 9 1/2"	1 1/4"	15'
10" & ABOVE	1 1/2"	15'

GENERAL NOTES

CONTRACTION JOINTS

CONSTRUCT TRANSVERSE CONTRACTION JOINTS NORMAL TO THE CENTERLINE. SHOW THE LOCATION OF CONTRACTION JOINTS THROUGH INTERSECTIONS ON THE PLANS OR AS DIRECTED BY THE ENGINEER.


INSTALL DOWEL BARS PARALLEL TO THE PAVEMENT CENTERLINE AND PAVEMENT SURFACE.

FOR PAVEMENT SLABS OF VARYING WIDTHS, LOCATE THE OUTER MOST DOWEL BAR SO THAT THE CENTER OF THE BAR IS A MINIMUM OF 6 INCHES AND A MAXIMUM OF 18 INCHES FROM THE LONGITUDINAL JOINT AND THE FREE EDGE OF PAVEMENT.


CONSTRUCTION JOINTS

LOCATE CONSTRUCTION JOINTS A MINIMUM OF 6 FEET FROM THE NEAREST CONTRACTION JOINT AND ALIGN PARALLEL TO CONTRACTION JOINTS.


- ① OBTAIN THE ENGINEER'S APPROVAL FOR THE USE OF ALTERNATIVE DESIGNS OF THE DOWEL ASSEMBLY. USE MECHANICAL DOWEL BAR INSERTERS OR DOWEL ASSEMBLIES WHEN CONSTRUCTING CONTRACTION JOINTS.
- ② SECURE BASKETS WITH ANCHORS TO HOLD DOWEL BARS IN THE CORRECT POSITION AND ALIGNMENT. TYPE, LOCATION, NUMBER AND LENGTH OF ANCHORS ARE DEPENDENT UPON FIELD CONDITIONS.
- ③ FORM OR SAW CONSTRUCTION JOINTS. PROVIDE A 1/4-INCH RADIUS AT FORMED JOINTS.
- ④ PROVIDE A SMOOTH VERTICAL FACE FOR THE ENTIRE DEPTH OF THE PAVEMENT WHEN FORMING CONSTRUCTION JOINTS.
- ⑤ INSTALL DOWEL BARS AT CONSTRUCTION JOINTS BY FORMING OR DRILLING. INSTALL FORMED DOWEL BARS 12 INCHES C-C AND 12 INCHES FROM PAVEMENT EDGE. REMOVE EXCESS CONCRETE FROM THE FREE END OF THE DOWEL BAR IF DOWEL BARS ARE FORMED THROUGH A HEADER BOARD. INSTALL DRILLED DOWEL BARS ACCORDING TO *DRILLED DOWEL BAR CONSTRUCTION JOINT* DETAIL.
- ⑥ APPLY A THIN UNIFORM COATING OF SURFACE TREATMENT TO THE FREE END OF DOWEL BARS TO PREVENT BONDING.
- ⑦ ANCHOR DOWEL BARS INTO DRILLED HOLES WITH AN EPOXY. MAXIMUM DRILLED HOLE SIZE IS 1/8-INCH GREATER THAN DOWEL BAR DIAMETER, 9 INCHES IN LENGTH.

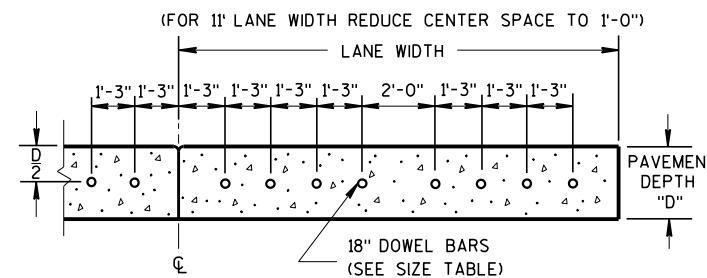


DRILLED DOWEL BAR CONSTRUCTION JOINT

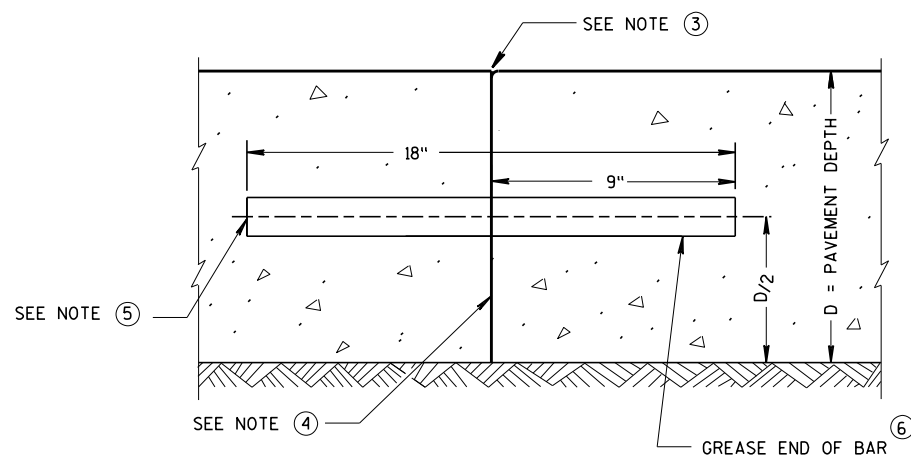


TRANSVERSE CONSTRUCTION JOINT

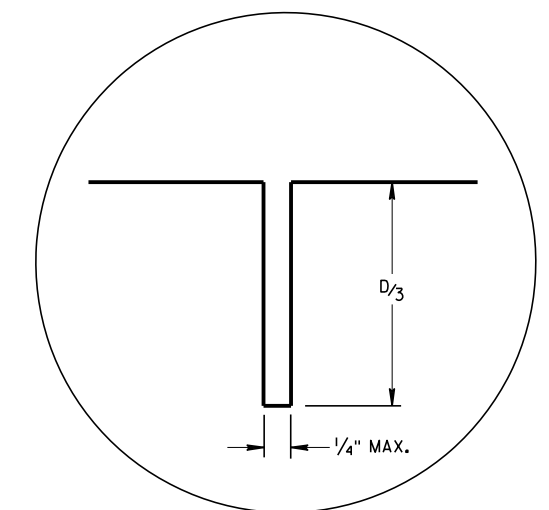

JOINT DETAIL

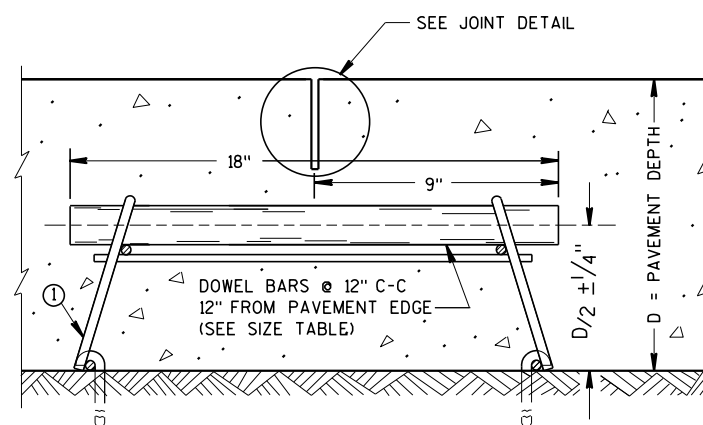

DOWELED CONTRACTION JOINT

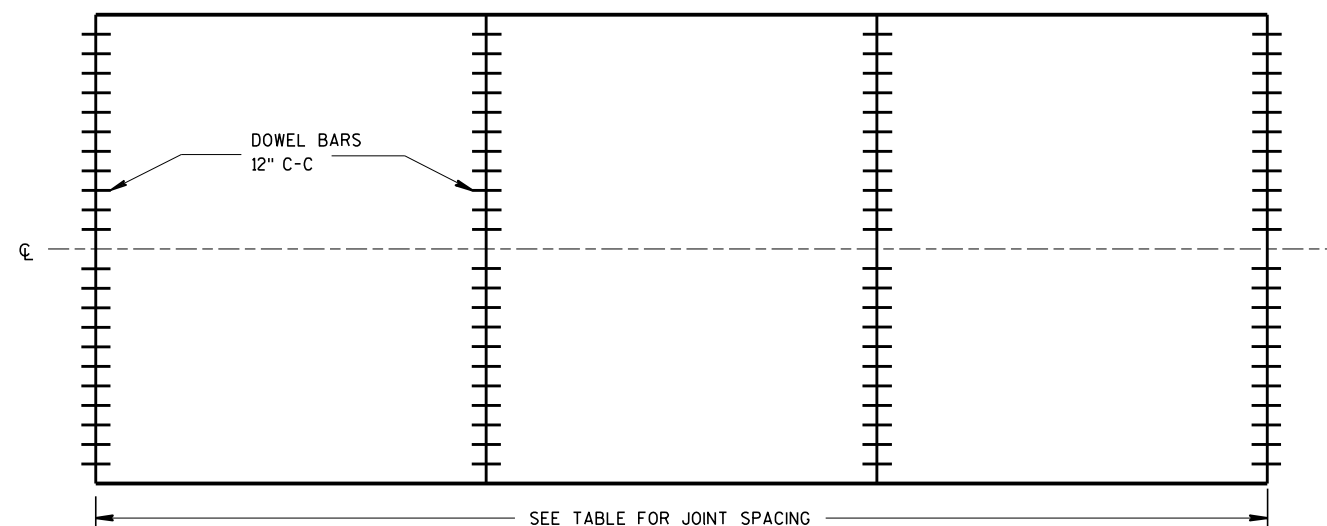


CONTRACTION JOINT LOCATIONS


URBAN DOWELED CONCRETE PAVEMENT	
STATE OF WISCONSIN DEPARTMENT OF TRANSPORTATION	
APPROVED March 2018 DATE	/s/ Peter Kemp, P.E. PAVEMENT SUPERVISOR
FHWA	




SDD 13C18-a Concrete Pavement Jointing

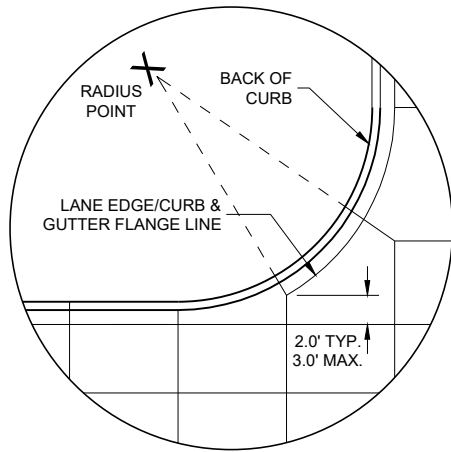


DETAIL "A"

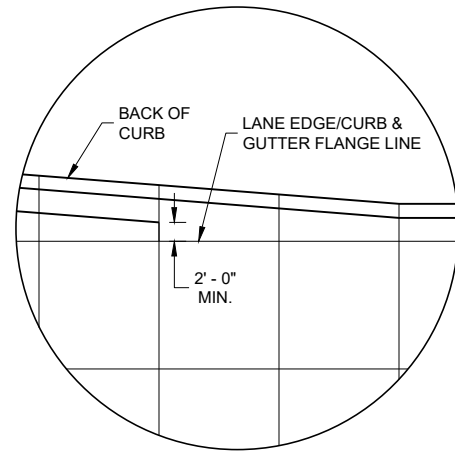

DETAIL "B"

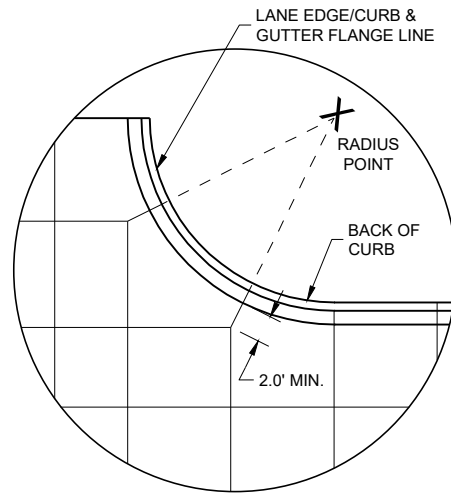

DETAIL "C"

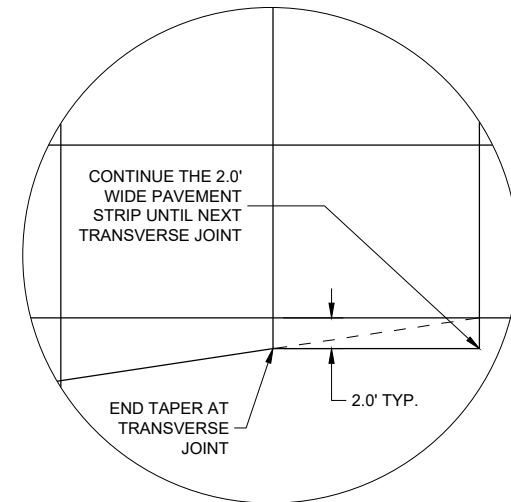


DETAIL "D"

GENERAL NOTES

- THE PRIMARY ROADWAY CONTROLS THE TRANSVERSE JOINT PATTERN.
- ALIGN NEW JOINTS WITH EXISTING JOINTS OR CRACKS.
- CONSTRUCT TRANSVERSE JOINTS PERPENDICULAR TO THE ROADWAY.
- ADJUST TRANSVERSE JOINTS TO ALIGN WITH UTILITY FIXTURES (E.G. MANHOLES AND INLETS) IN THE PAVEMENT STRUCTURE WHEN POSSIBLE. WATER VALVES DO NOT REQUIRE JOINT ADJUSTMENT.
- AVOID SLABS LESS THAN 2 FEET WIDE OR GREATER THAN 15 FEET WIDE.
- SEE TABLE FOR TRANSVERSE JOINT SPACING. JOINT SPACING SPECIFIED IS MAXIMUM AND ACTUAL SPACING CAN BE ADJUSTED TO ACCOMMODATE INTERSECTIONS.
- AVOID ANGLES LESS THAN 60° BY DOGLEGGING JOINTS THROUGH CURVE RADIUS POINTS. USE 90° ANGLES WHEN POSSIBLE.
- CORRELATE LONGITUDINAL JOINTS WITH LANE LINES WHEN POSSIBLE.


- PROVIDE TRANSVERSE JOINTS AT ALL PAVEMENT WIDTH CHANGES.
- CONSTRUCT DOWELED EXPANSION JOINT ON THE SIDE ROAD OF AN INTERSECTION IF THE SIDE ROAD IS CONCRETE PAVEMENT AND GREATER THAN 300 FEET IN LENGTH. ALIGN EXPANSION JOINT WITH EDGE OF RADIUS.
- THE ENGINEER MAY APPROVE SLIGHT VARIATIONS FROM THESE JOINTING DETAILS.

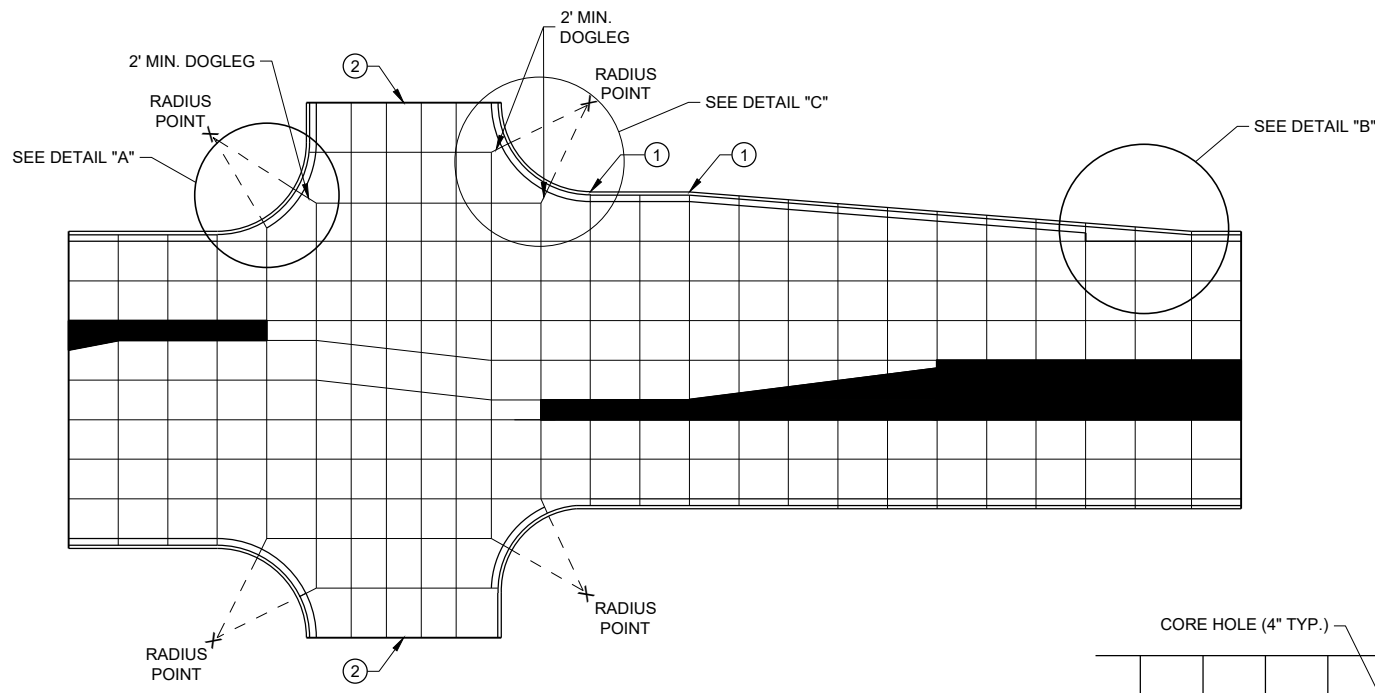


STANDARD INTERSECTION

PAVEMENT DEPTH AND JOINT SPACING TABLE


PAVEMENT DEPTH (D)	CONTRACTION JOINT SPACING
6", 6 1/2"	12'
7", 7 1/2"	14'
8" & ABOVE	15'

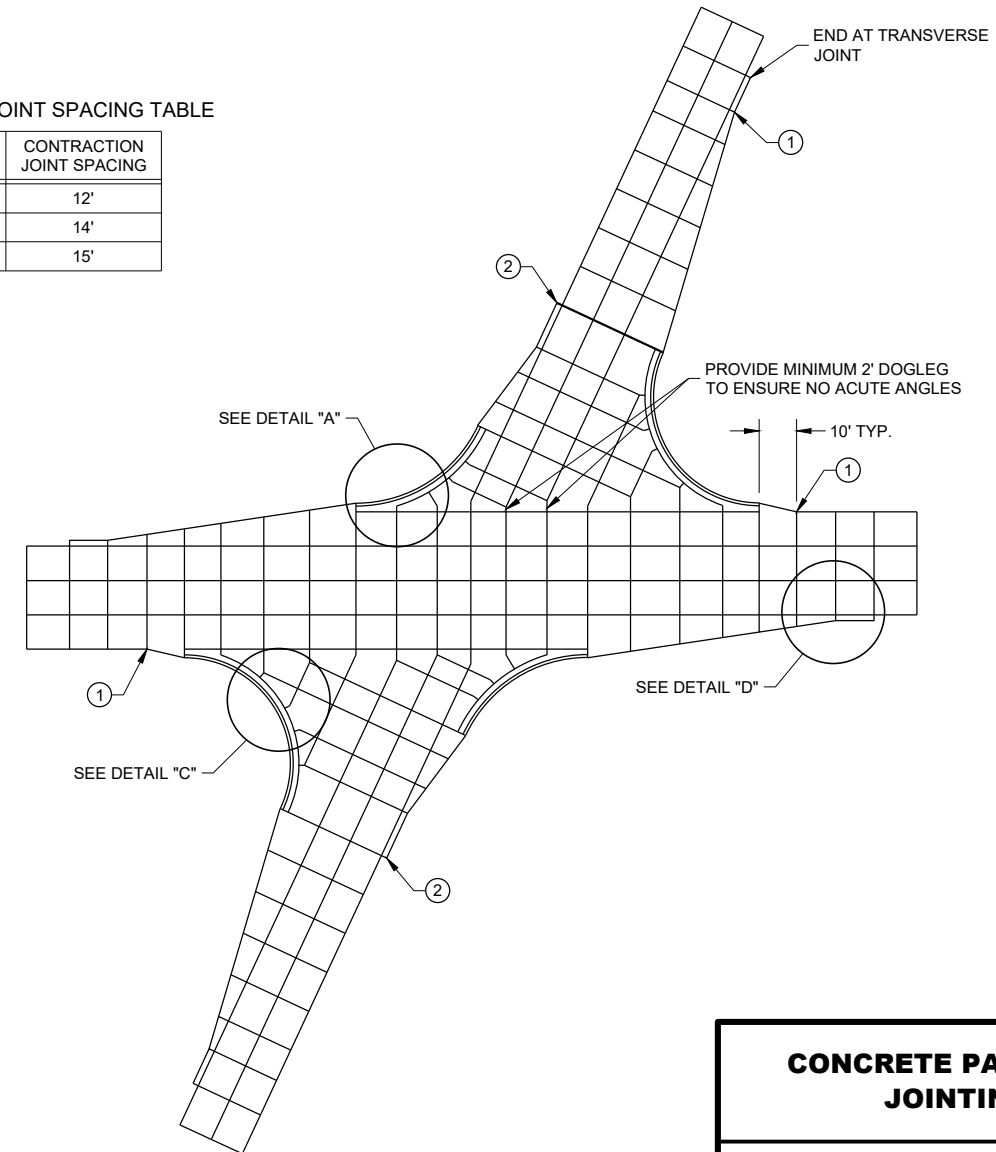

SKEWED INTERSECTION

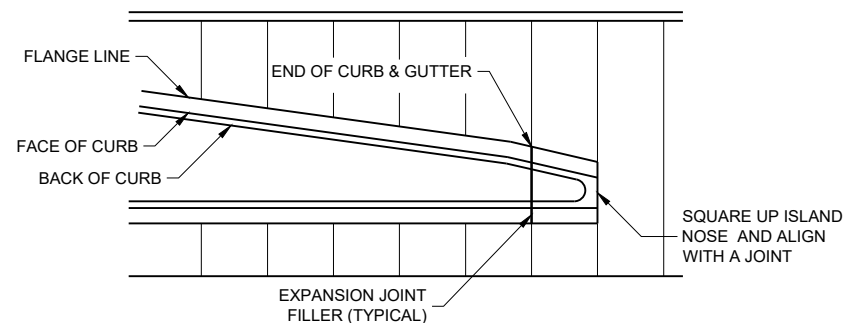

APPROACH TO MEDIAN

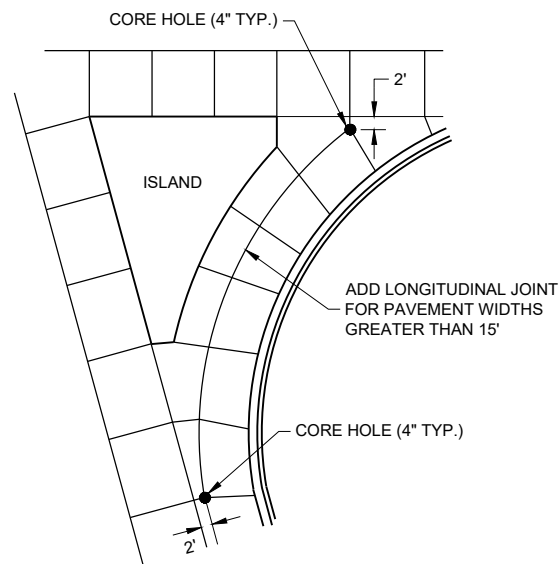

LARGE RIGHT TURN

CONCRETE PAVEMENT JOINTING

STATE OF WISCONSIN DEPARTMENT OF TRANSPORTATION 94



SDD 13C18-b Concrete Pavement Steel Reinforcement


LEGEND

- POTENTIAL DOWELED EXPANSION JOINT
- - - DOWELED JOINT
- TIED JOINT

GENERAL NOTES


USE AN EXPANSION JOINT FILLER MEETING THE REQUIREMENTS OF STANDARD SPECIFICATION 415.

6

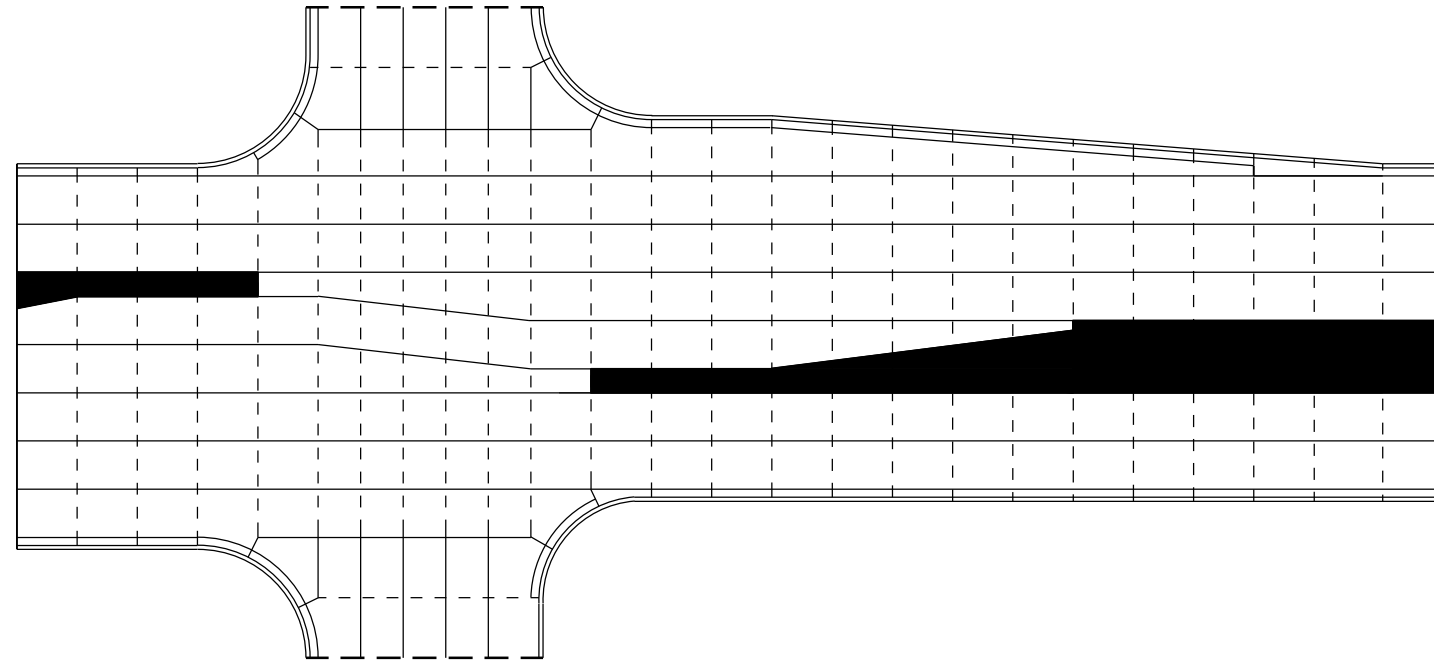

STANDARD INTERSECTION

6

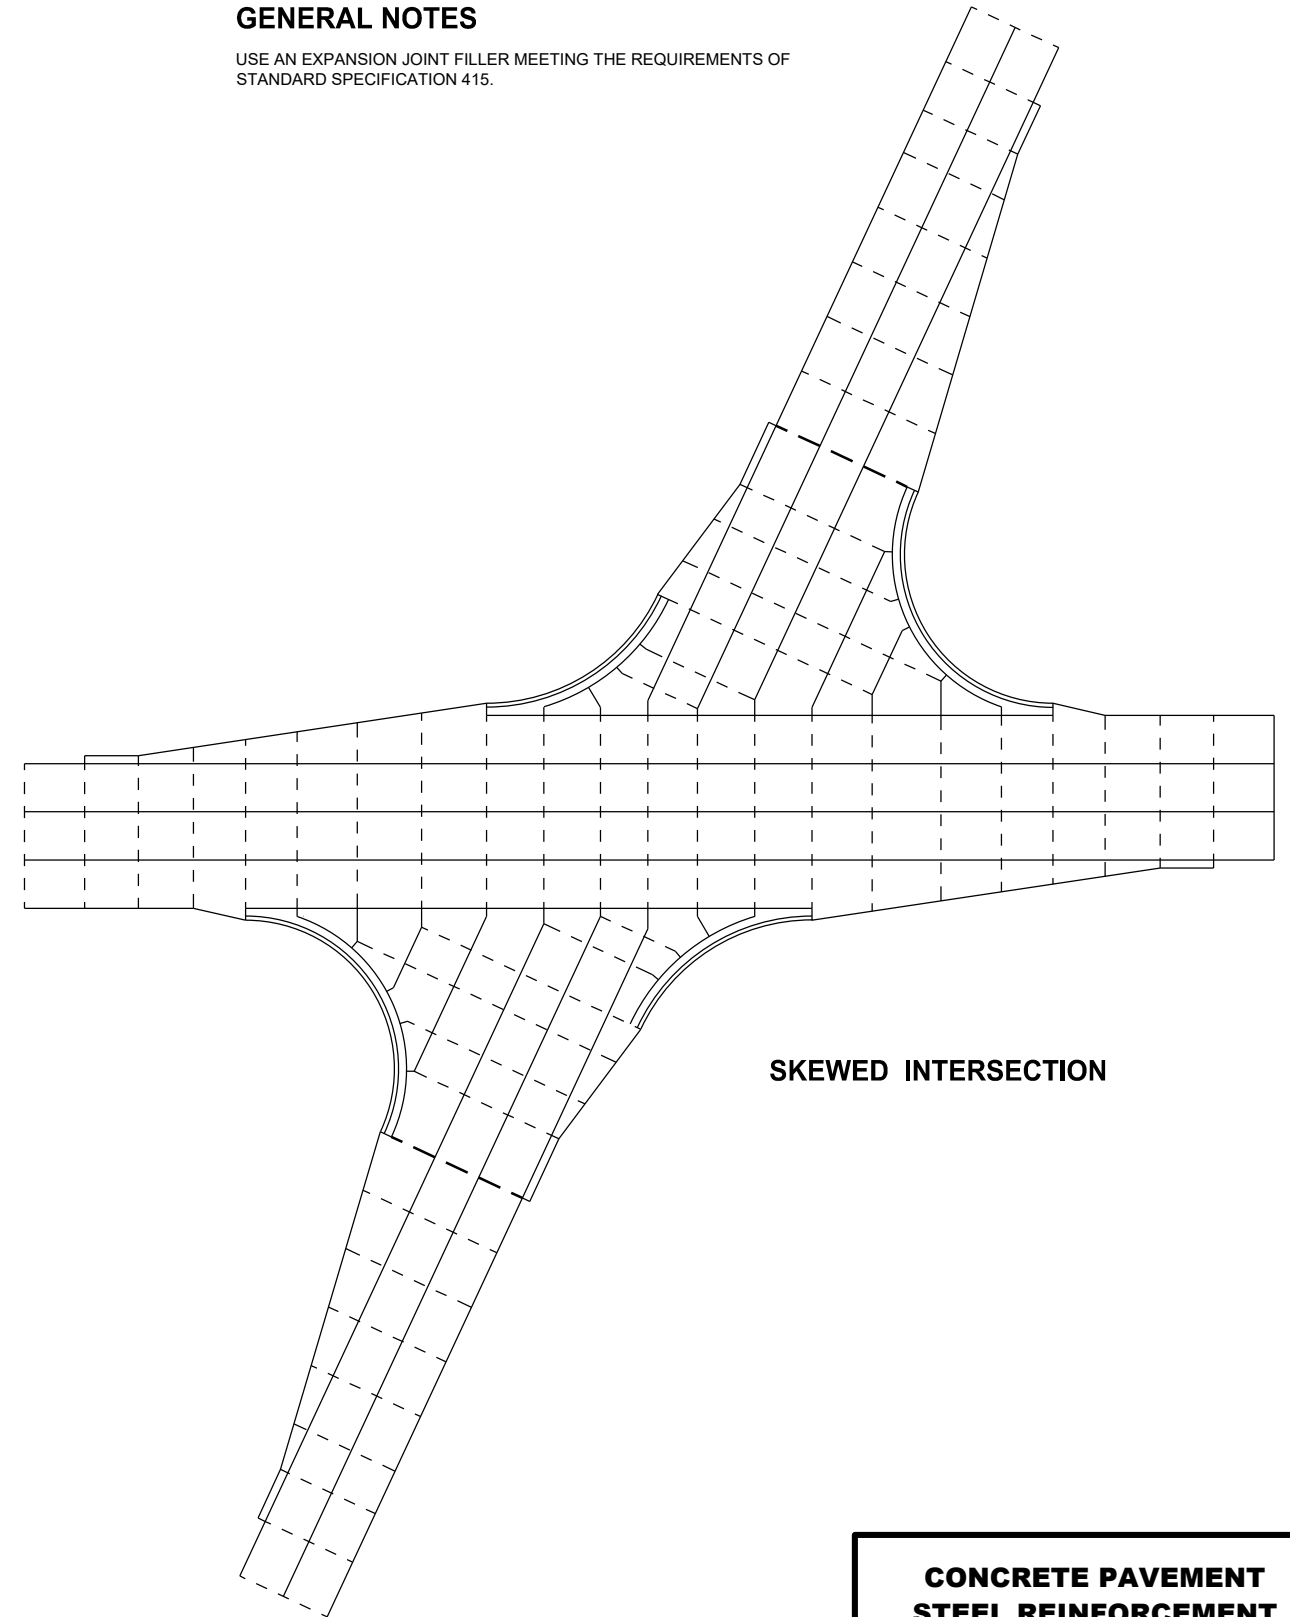

SKewed INTERSECTION

SDD 13C18 - 07b


SDD 13C18 - 07b

**CONCRETE PAVEMENT
STEEL REINFORCEMENT**


STATE OF WISCONSIN
DEPARTMENT OF TRANSPORTATION⁹⁵



SDD 13C18-c Concrete Pavement Joint Types

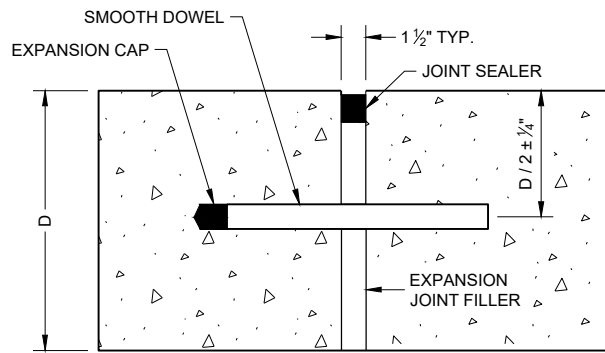

DOWELED TRANSVERSE ①

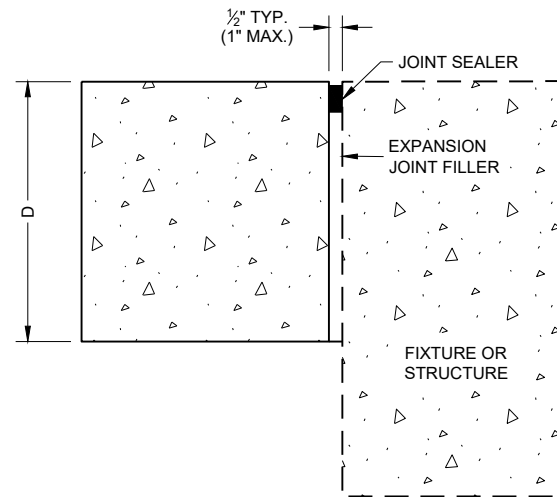

UNTIED - LONGITUDINAL

EXPANSION JOINTS

TIE BAR TABLE


PAVEMENT DEPTH (D)	TIE BAR SIZE	TIE BAR LENGTH (L)	MAX. TIE BAR SPACING
< 10 1/2"	NO. 4	30"	36"
≥ 10 1/2"	NO. 5	36"	36"
	NO. 4*	30"	24" **

* SUBSTITUTE BENT BARS AT LONGITUDINAL JOINTS WHEN EQUIPMENT LIMITATIONS DURING CONSTRUCTION WARRANT (e.g. AUXILIARY LANES OR TURN LANES)


** CONFORM TO 15" MINIMUM SPACING FROM TRANSVERSE JOINTS; SPACING BETWEEN TIE BARS WILL BE 30" AT TRANSVERSE JOINTS.

GENERAL NOTES


- USE DOWELED EXPANSION JOINTS ON SIDE ROADS AT INTERSECTIONS (TO ISOLATE THE SIDE ROAD FROM THE THROUGH STREET) IF THE SIDE ROAD IS CONCRETE PAVEMENT AND GREATER THAN 300 FEET IN LENGTH.
- SPACE CONTRACTION JOINTS IN ACCORDANCE WITH SDD 13C4, 13C11 OR 13C13.
- LOCATE CONSTRUCTION JOINTS A MINIMUM OF 6 FEET FROM THE NEAREST CONTRACTION JOINT AND ALIGN PARALLEL TO CONTRACTION JOINTS.
- CONSTRUCTION JOINTS CAN BE FORMED OR SAWED.
- IF JOINT IS FORMED, PROVIDE A 1/4" RADIUS.
- ANCHOR TIE BARS INTO DRILLED HOLES WITH AN EPOXY.

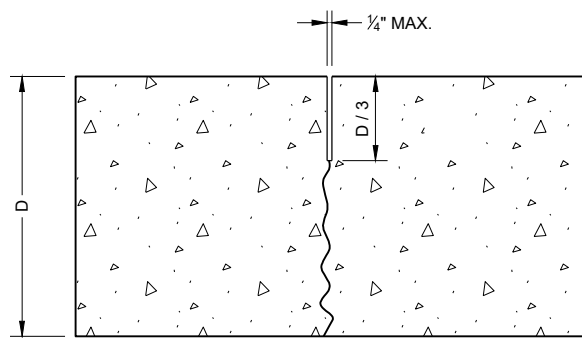


UNDOWELED TRANSVERSE

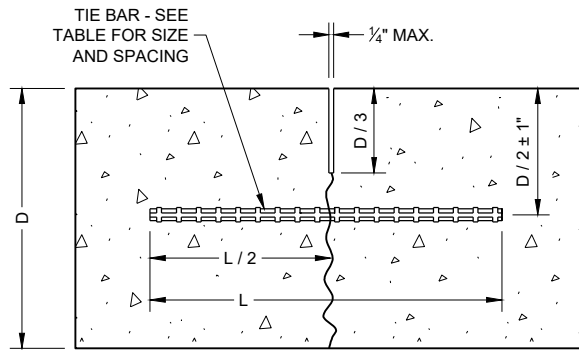


TIED LONGITUDINAL

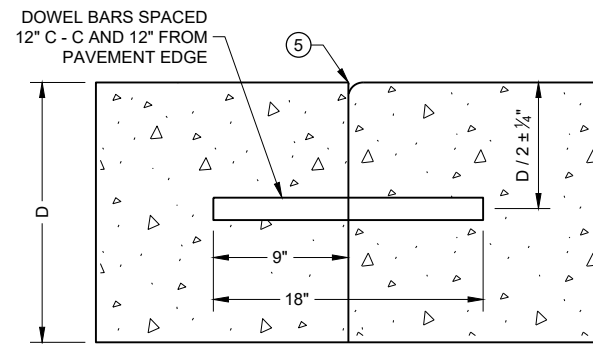


DOWELED TRANSVERSE ③

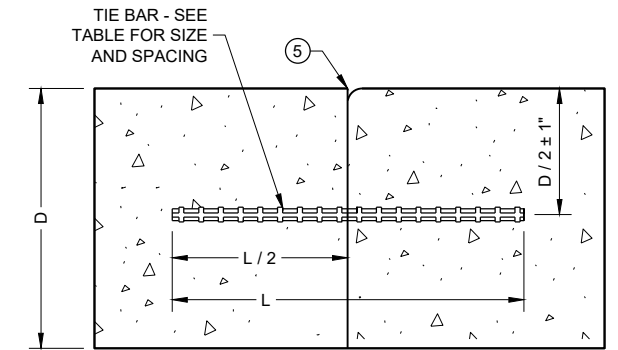


TIED LONGITUDINAL

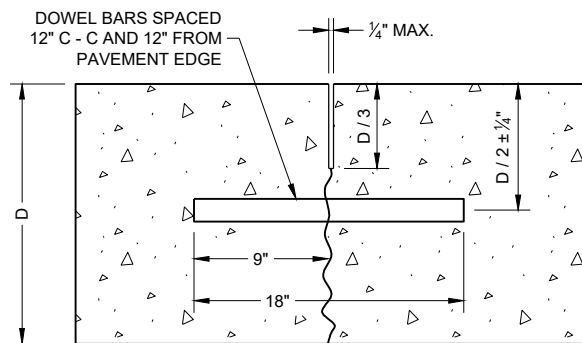

DOWELED TRANSVERSE

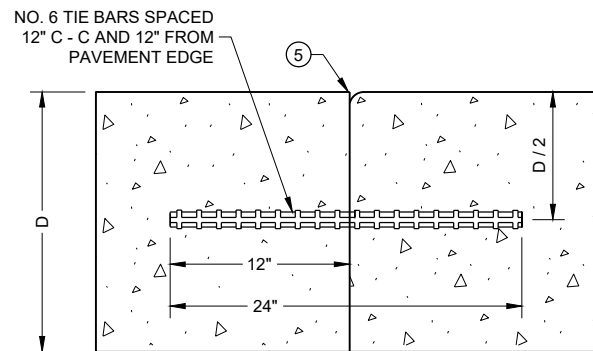

TIED TRANSVERSE ③
(FOR USE ON NON-DOWELED PAVEMENTS ONLY)

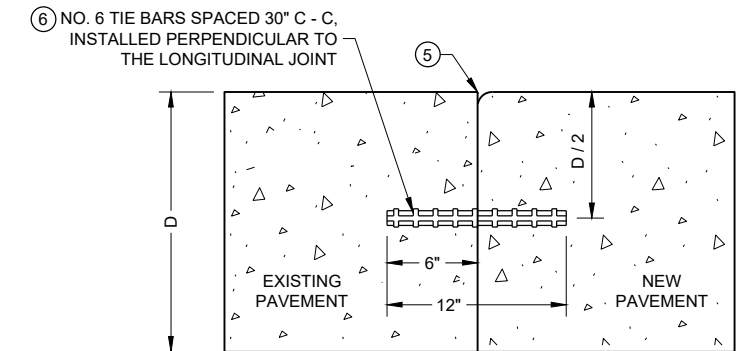

TIED LONGITUDINAL TO EXISTING

CONTRACTION JOINTS

CONSTRUCTION JOINTS

CONCRETE PAVEMENT JOINT TYPES

STATE OF WISCONSIN DEPARTMENT OF TRANSPORTATION 96

6


6

SDD 13C18 - 07c


SDD 13C18 - 07c




SDD 13C18-d Concrete Pavement Jointing at Utility Fixtures

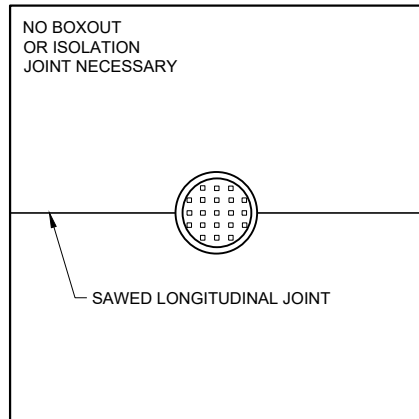

MANHOLE WITH LONGITUDINAL JOINT

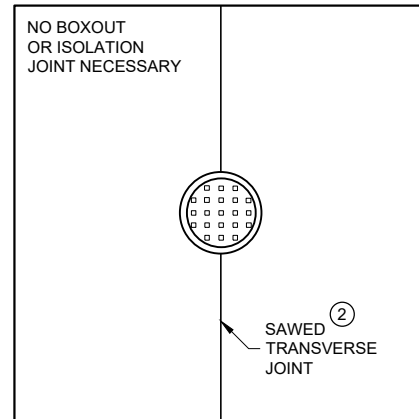

MANHOLE WITH TRANSVERSE JOINT

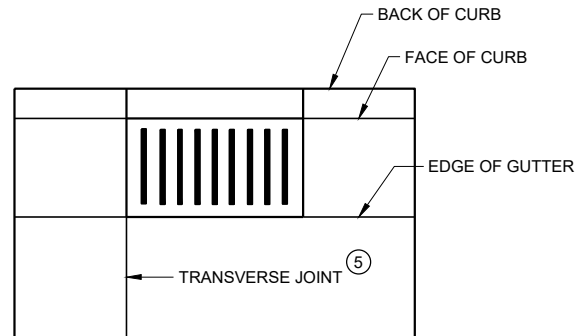


INLET WITH TRANSVERSE JOINT


GENERAL NOTES

- ① USE BOXOUTS WHEN UTILITY STRUCTURE IS IN THE PATH OF CONSTRUCTION JOINTS. PROVIDE A 1 FOOT MINIMUM CLEARANCE BETWEEN THE EXTERIOR LIMIT OF THE STRUCTURE TO THE DIAMOND BOXOUT.
- ② ADJUST TRANSVERSE JOINT TO INTERSECT MANHOLE IF POSSIBLE.
- ③ IF DISTANCE BETWEEN THE LONGITUDINAL JOINT AND THE EDGE OF MANHOLE IS 2 FEET OR LESS, DIVERT THE LONGITUDINAL JOINT AT A 2:1 TAPER RATE TO THE CENTER OF THE MANHOLE. IF THE DISTANCE IS GREATER THAN 2 FEET, DO NOT DIVERT THE JOINT AND SAW AS NORMAL. PLACE REINFORCEMENT REBAR AROUND THE MANHOLE.
- ④ IF THE DISTANCE FROM THE EDGE OF THE MANHOLE TO THE NEAREST TRANSVERSE JOINT IS LESS 4 FEET OR LESS, REDIRECT JOINT TO INTERSECT THE CENTER OF THE MANHOLE. IF DISTANCE IS GREATER THAN 4 FEET, DO NOT DIVERT THE JOINT AND SAW AS NORMAL. PLACE REINFORCEMENT REBAR AROUND THE MANHOLE.
- ⑤ ALIGN TRANSVERSE JOINT WITH ONE EDGE OF INLET WHEN PRACTICAL.


6

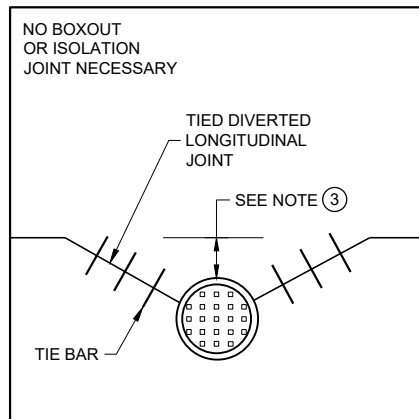

MANHOLE WITH DIVERTED LONGITUDINAL CONTRACTION JOINT

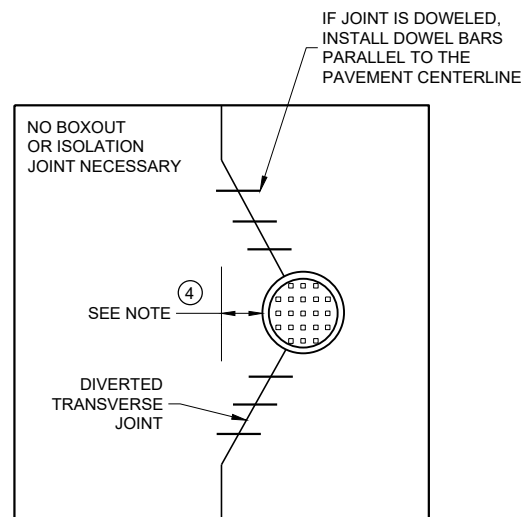

MANHOLE WITH DIVERTED TRANSVERSE CONTRACTION JOINT

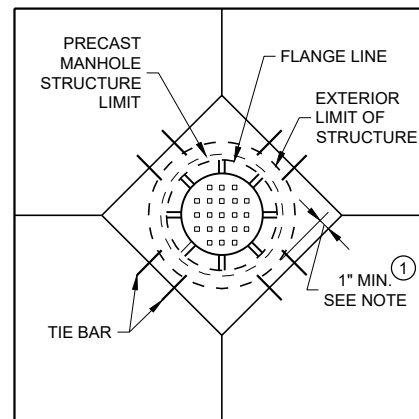

DIAGONAL MANHOLE BOXOUT FOR CONSTRUCTION JOINTS

6


SDD 13C18 - 07d

SDD 13C18 - 07d


CONCRETE PAVEMENT JOINTING AT UTILITY FIXTURES

STATE OF WISCONSIN
DEPARTMENT OF TRANSPORTATION


APPROVED
 November 2018 /S/ Peter Kemp P.E. 97
 DATE PAVEMENT SUPERVISOR
 FHWA

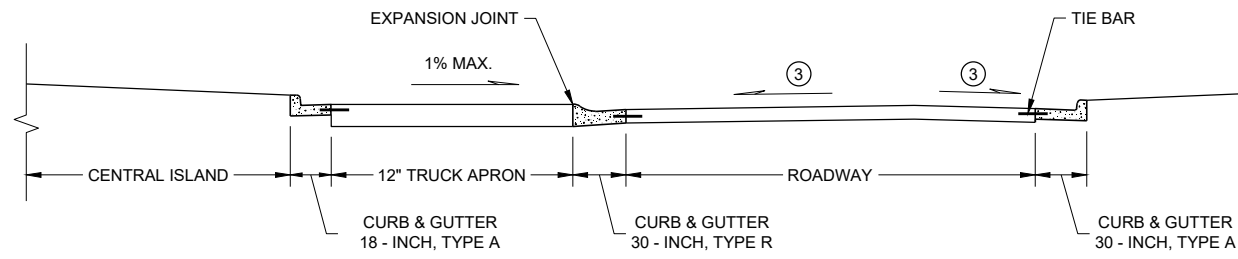


SECTION A - A

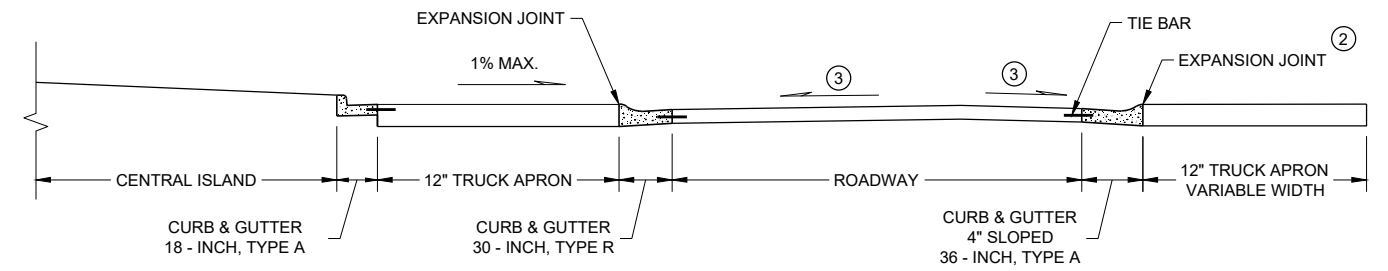

SECTION B - B

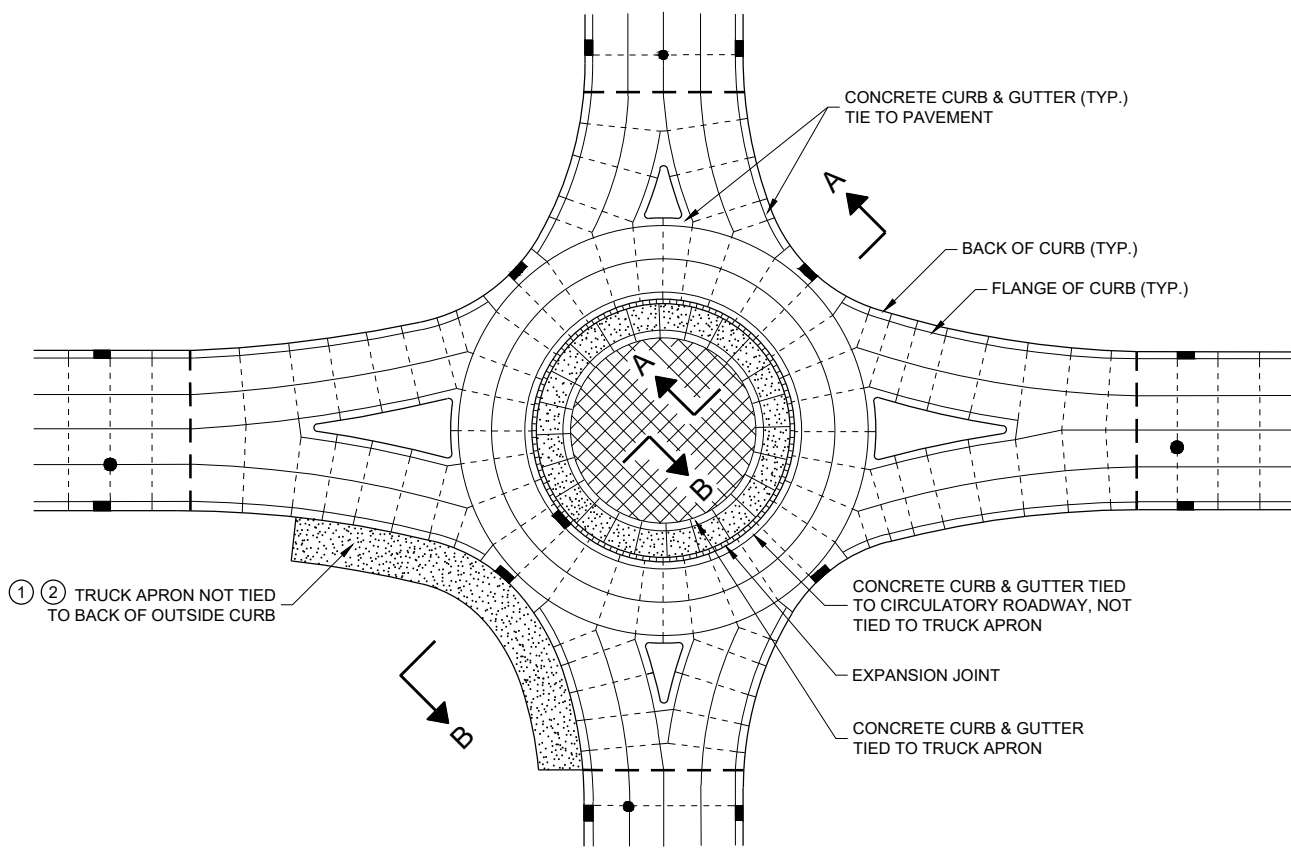

ISOLATED CIRCLE JOINT LAYOUT FOR ROUNDABOUTS

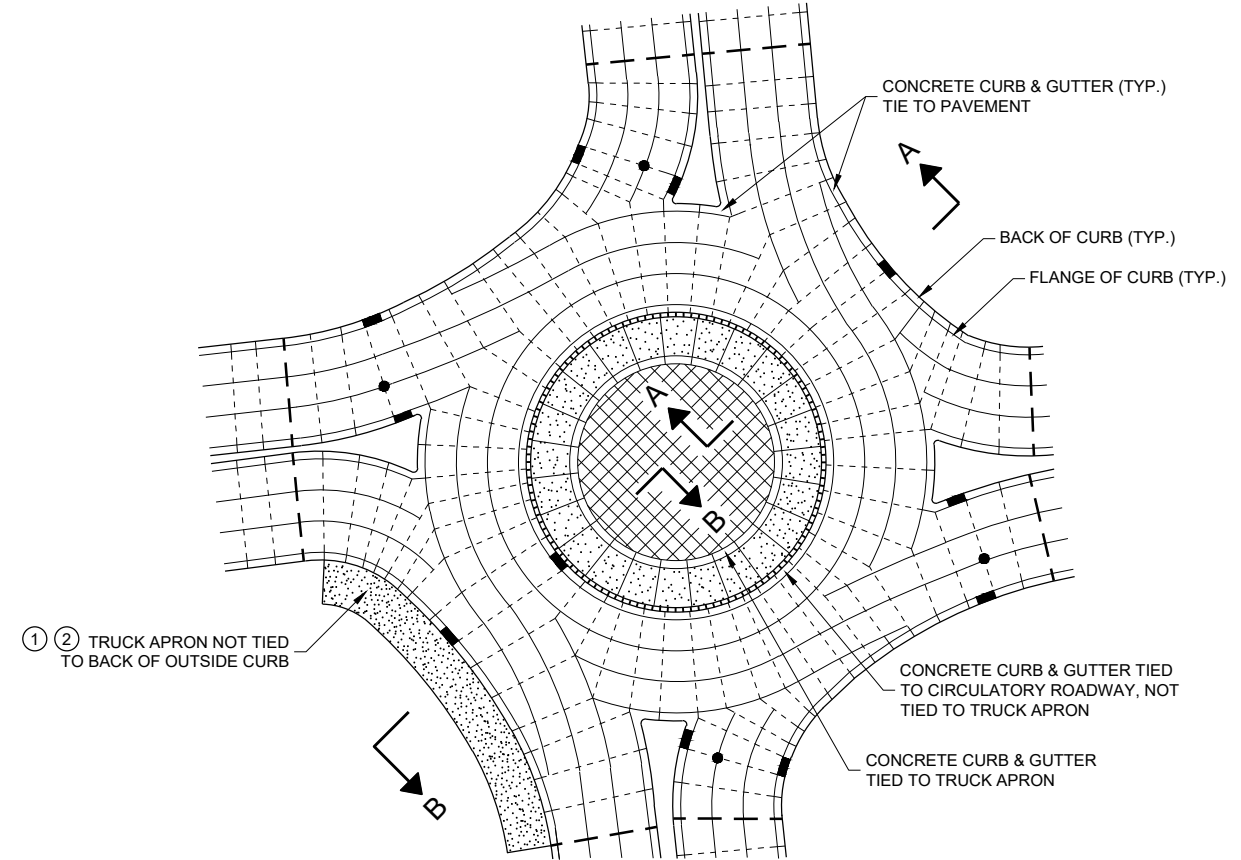




PINWHEEL JOINT LAYOUT FOR ROUNDABOUTS

GENERAL NOTES

MAXIMUM JOINT SPACING IS IN ACCORDANCE WITH THE TABLE SHOWN ON SDD 13C18 - SHEET "a"
USE EXPANSION JOINT FILLER MEETING THE REQUIREMENTS OF STANDARD SPECIFICATION 415.
DO NOT DOWEL OR TIE THE TRUCK APRON TRANSVERSE JOINTS.

- ① DESIGNER DETERMINES SIZE AND LOCATION(S) OF TRUCK APRON TO ACCOMMODATE TRACKING OF OVERSIZE / OVERWEIGHT VEHICLES.
- ② TIE THE OUTSIDE TRUCK APRON TO THE BACK SIDE OF CURB ONLY WHEN ENTIRE TRUCK APRON IS LESS THAN 3 FEET.
- ③ CONFORM TO PLAN CONSTRUCTION DETAILS FOR CIRCULATORY ROADWAY CROSS SLOPE.

LEGEND

- DOWELED JOINT
- TIED JOINT
- ===== EXPANSION JOINT
- — — — — POTENTIAL DOWELED EXPANSION JOINT
-  TRUCK APRON
-  CENTRAL ISLAND
-  UTILITY STRUCTURES

CONCRETE PAVEMENT JOINTING AND STEEL REINFORCEMENT IN ROUNDABOUTS

STATE OF WISCONSIN
DEPARTMENT OF TRANSPORTATION

APPROVED
November 2018 /S/ Peter Kemp P.E.
DATE DATE PAVEMENT SUPERVISOR 98
FHWA




SDD 13C18-f Concrete Pavement Intersection Boxout for Integral Curb and Gutter

LEGEND

- DOWELED JOINT
- TIED JOINT
- ▨▨▨▨ EXPANSION JOINT
- — — — POTENTIAL DOWELED EXPANSION JOINT ①
- ← DIRECTION OF TRAFFIC

GENERAL NOTES

- ① CONSTRUCT DOWELED EXPANSION JOINT ON THE SIDE ROAD OF AN INTERSECTION IF THE SIDE ROAD IS CONCRETE PAVEMENT AND GREATER THAN 300 FEET IN LENGTH. ALIGN EXPANSION JOINT WITH THE EDGE OF RADIUS.
- ② PROVIDE TIED JOINT AT THE FLANGE OF SCAB ON CURB IF SCAB ON CURB AND GUTTER IS USE.

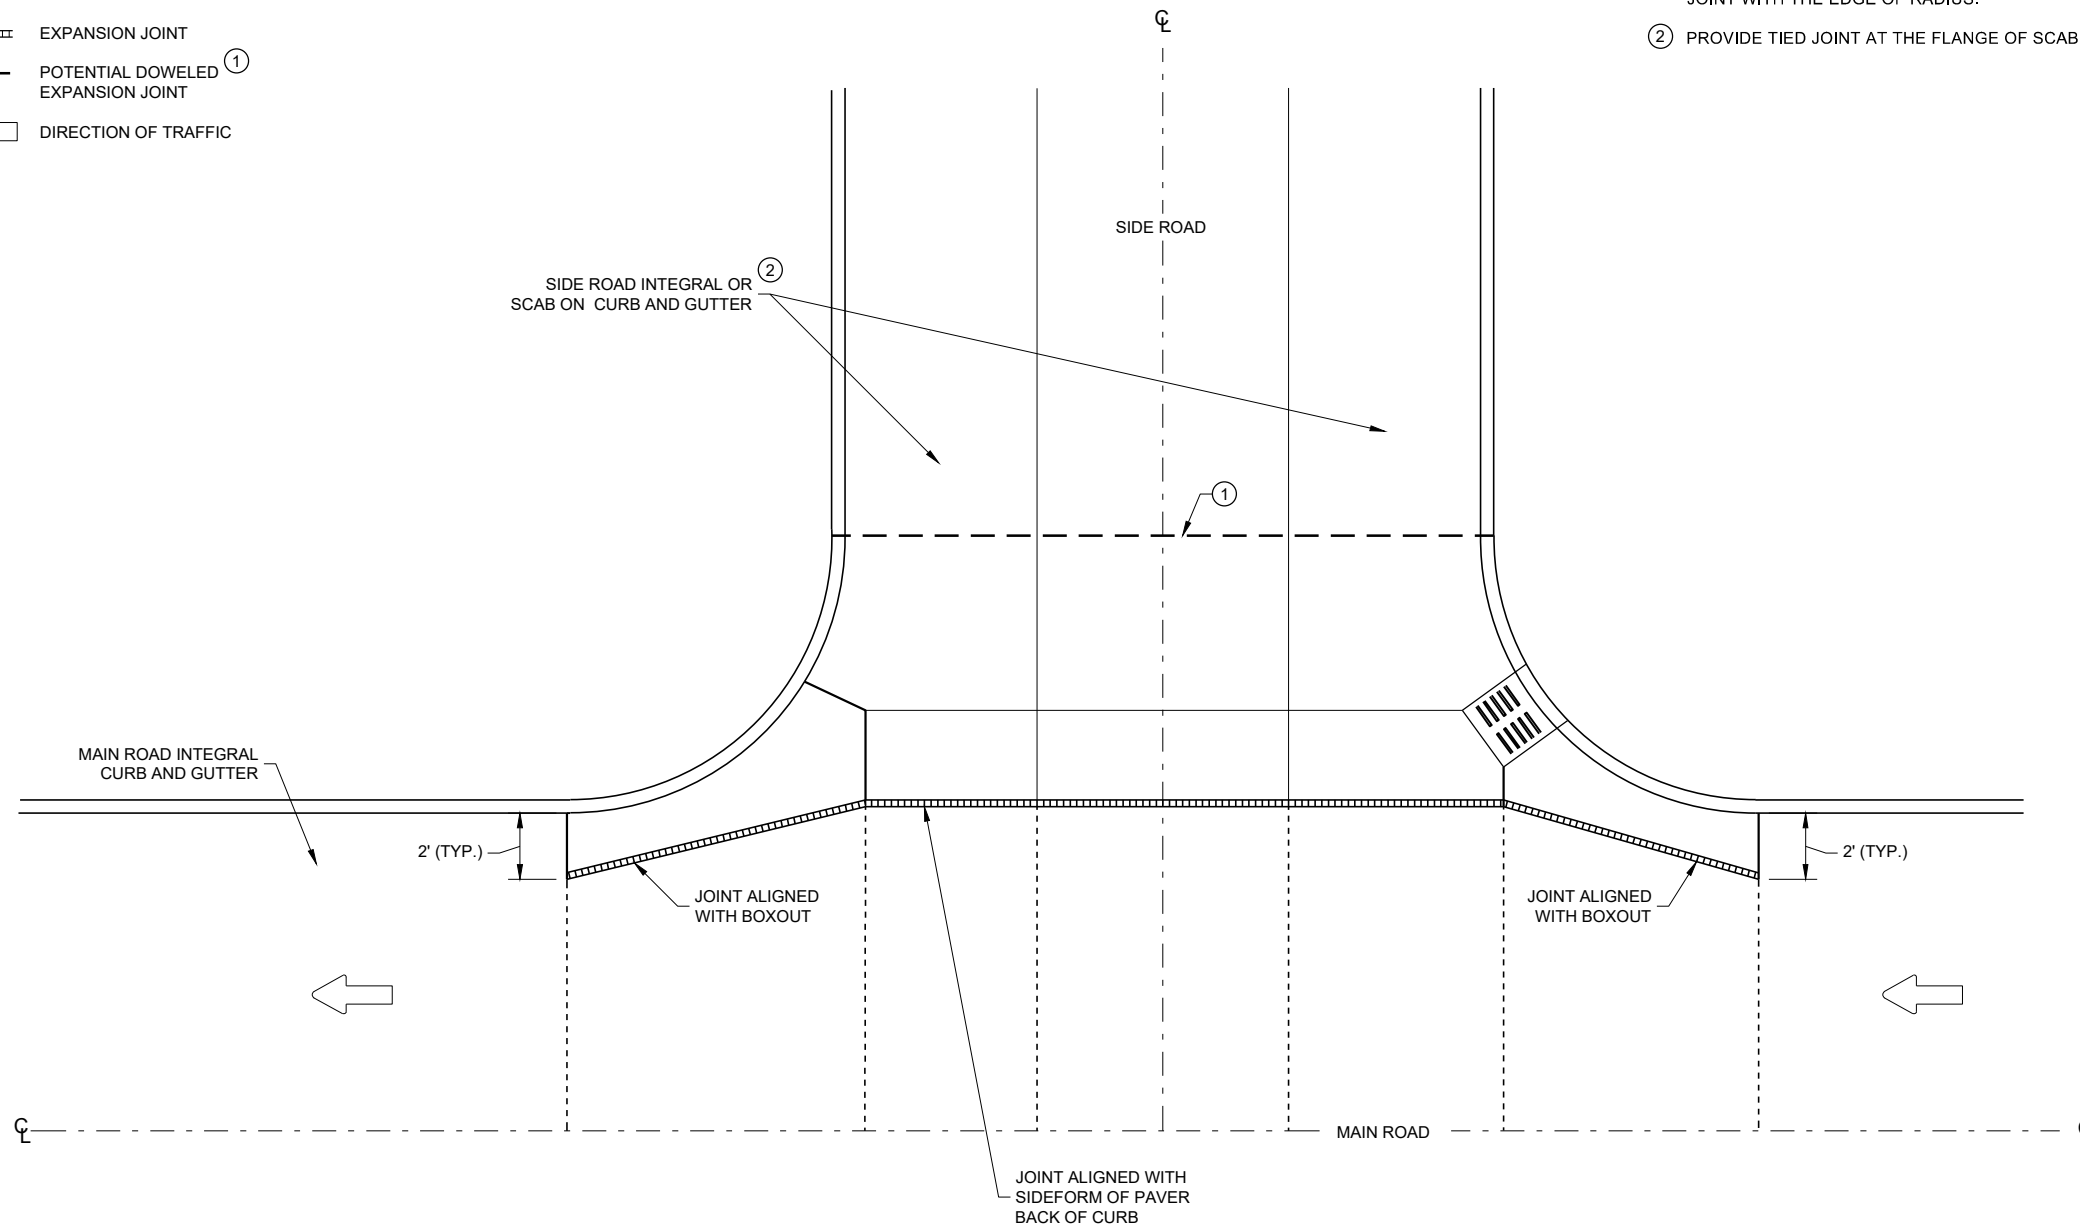

INTERSECTION BOXOUT FOR INTEGRAL CURB AND GUTTER

CONCRETE PAVEMENT INTERSECTION BOXOUT FOR INTEGRAL CURB AND GUTTER	
STATE OF WISCONSIN DEPARTMENT OF TRANSPORTATION	
APPROVED November 2018 DATE	/S/ Peter Kemp P.E. PAVEMENT SUPERVISOR
99	
FHWA	

6



6

SDD 13C18 - 07f

SDD 13C18 - 07f



SDD 13C18-g Concrete Pavement Jointing Acceleration/Deceleration Lane

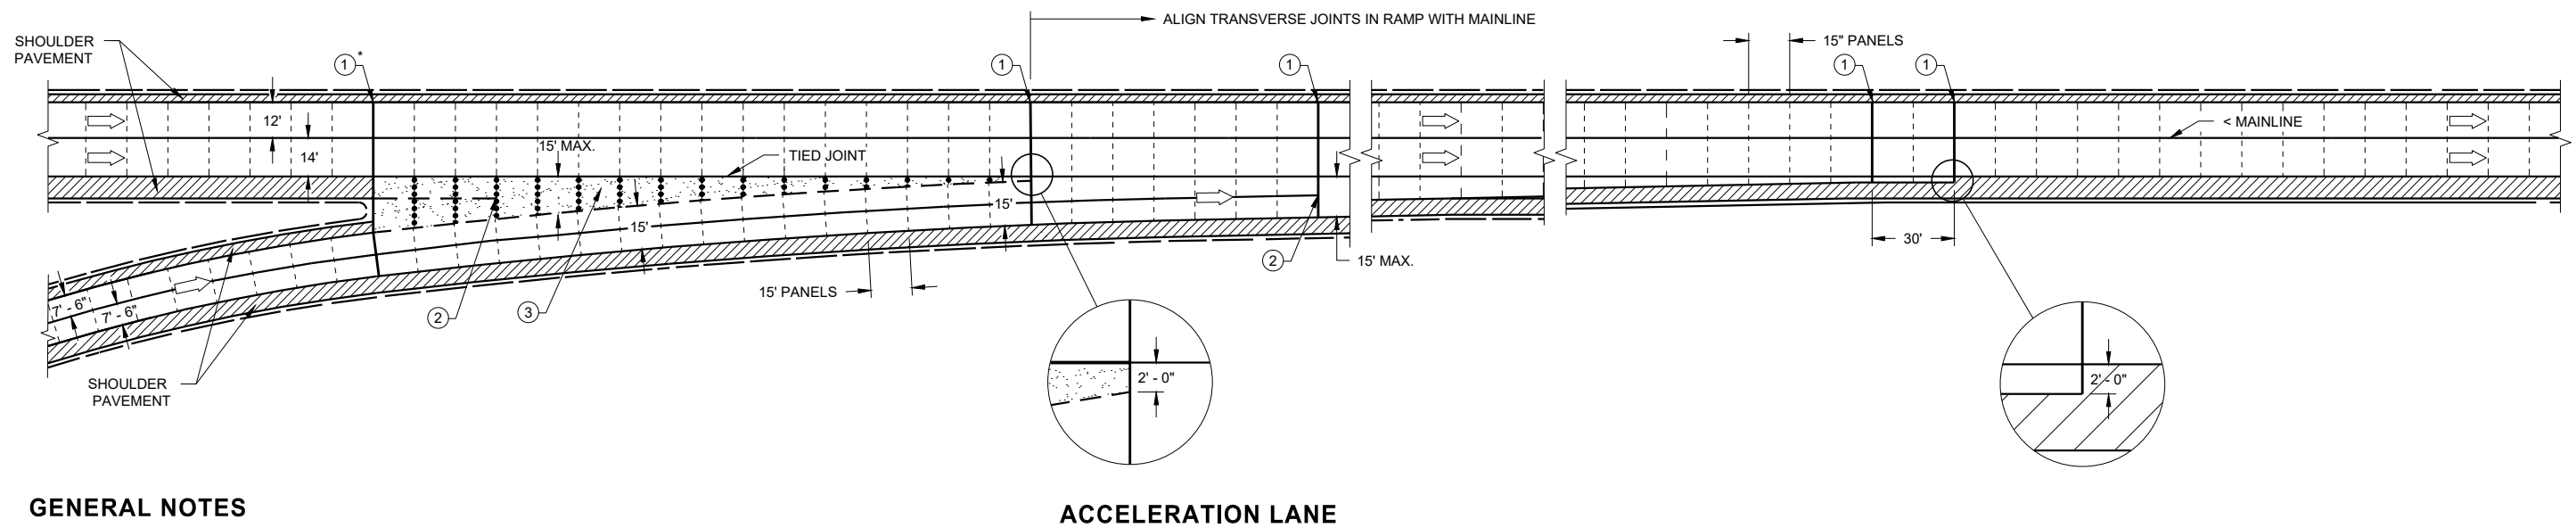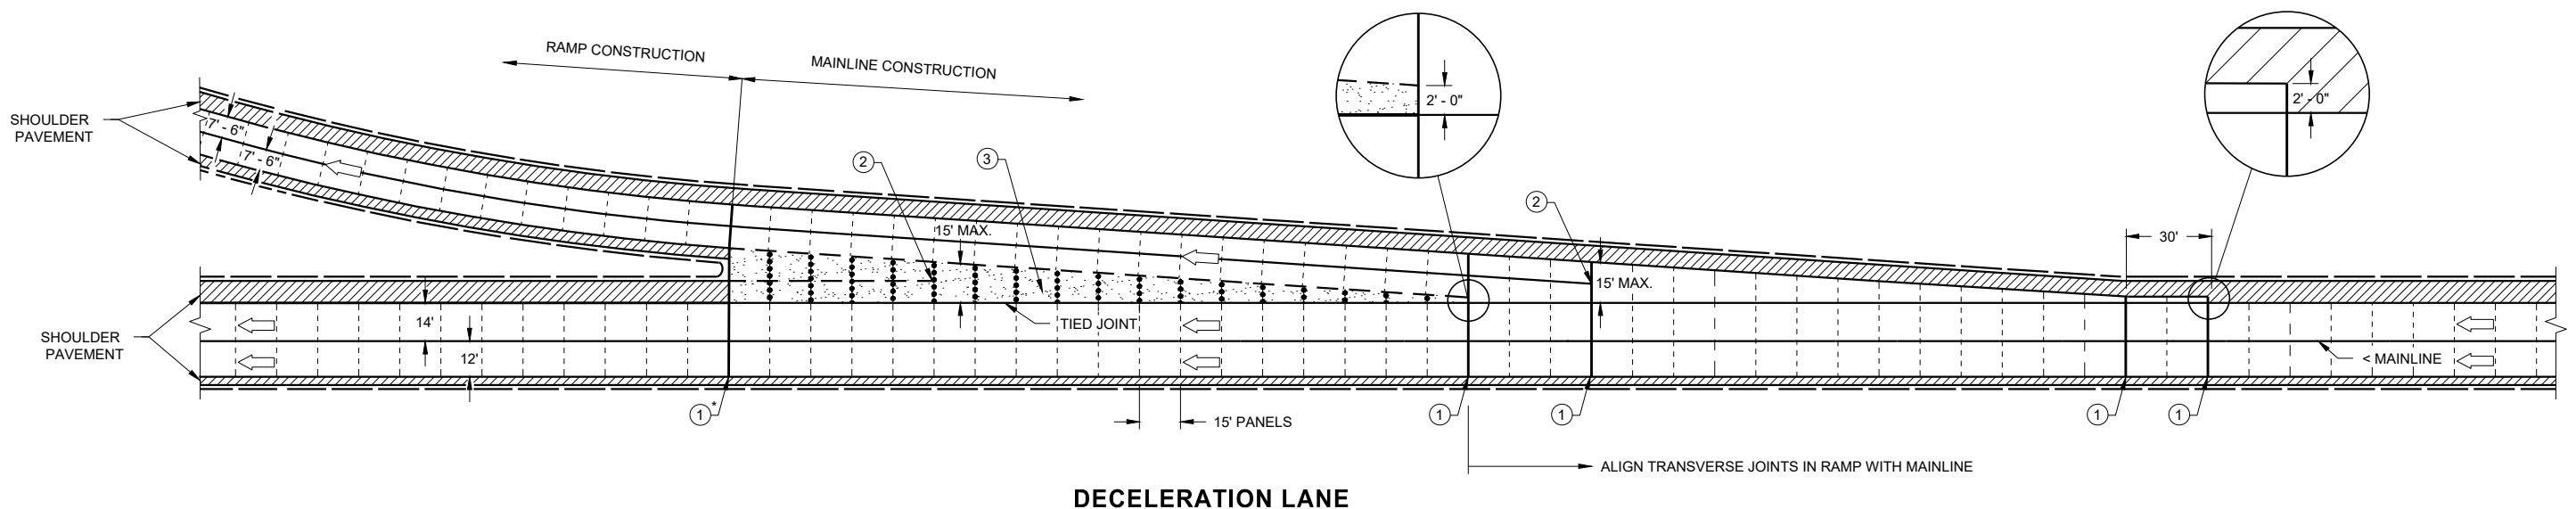

GENERAL NOTES

PAVEMENT AND BASE THICKNESS, PANEL LENGTHS, JOINTS AND REINFORCEMENT FOR THE DECELERATION AND ACCELERATION LANES, INCLUDING TAPERS, SHALL BE THE SAME AS THE MAINLINE, EXCEPT WHERE OTHERWISE NOTED.

ALL REINFORCEMENT BARS SHALL BE EPOXY COATED CONFORMING TO SUBSECTION 505.2.6 OF THE STANDARD SPECIFICATIONS.

LANE AND SHOULDER WIDTHS MAY VARY FROM SHOWN. SEE CONSTRUCTION PLANS FOR ACTUAL PROPOSED WIDTHS.

- ① CRITICAL TRANSVERSE JOINT LOCATIONS AT PAVEMENT WIDTH CHANGES.
(①* IS NOT A CRITICAL TRANSVERSE JOINT WHEN ASPHALTIC GORE IS INSTALLED).
- ② STOP LONGITUDINAL JOINT WITH CORE HOLE (2" TYP.) WHEN IT MEETS THE FIRST TRANSVERSE JOINT LESS THAN 15' WIDE OR STOP LONGITUDINAL JOINT WHEN IT MEETS 2' AWAY FROM THE TIED JOINT OF THE MAINLINE.
- ③ DISREGARD THE JOINT DETAILS IN AND AROUND THE GORE WHEN ASPHALTIC GORE IS INSTALLED.

LEGEND

- DOWELED JOINT
- UNDOWELED JOINT
- TIED JOINT
- - - - UNTIED JOINT
- ▨ GORE
- ➡ DIRECTION OF TRAVEL

CONCRETE PAVEMENT JOINTING ACCELERATION/ DECELERATION LANE	
STATE OF WISCONSIN DEPARTMENT OF TRANSPORTATION	
APPROVED November 2018 DATE	/s/ Peter Kemp P.E. PAVEMENT SUPERVISOR
100	


SDD 13C18 - 07g

SDD 13C18 - 07g




GENERAL NOTES

DETAILS OF INSTALLATION, MATERIALS AND WORKMANSHIP NOT SHOWN ON THIS DRAWING SHALL CONFORM TO THE PERTINENT REQUIREMENTS OF THE STANDARD SPECIFICATIONS AND APPLICABLE SPECIAL PROVISIONS.

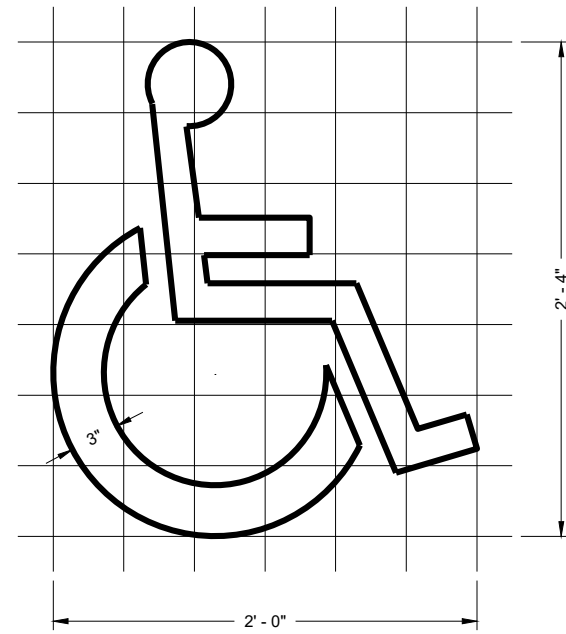

HANDICAP SYMBOL

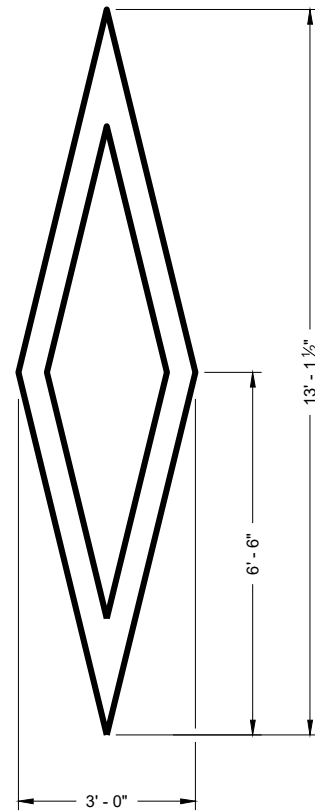

PREFERENTIAL LANE SYMBOL

6

6

SDD 15C07 - 15a

SDD 15C07 - 15a

PAVEMENT MARKING SYMBOLS









STATE OF WISCONSIN
DEPARTMENT OF TRANSPORTATION

APPROVED
November 2019 /S/ Matthew Rauch
DATE STATE SIGNING AND MARKING ENGINEER 101

FHWA



SDD 15C07-b Pavement Marking Words

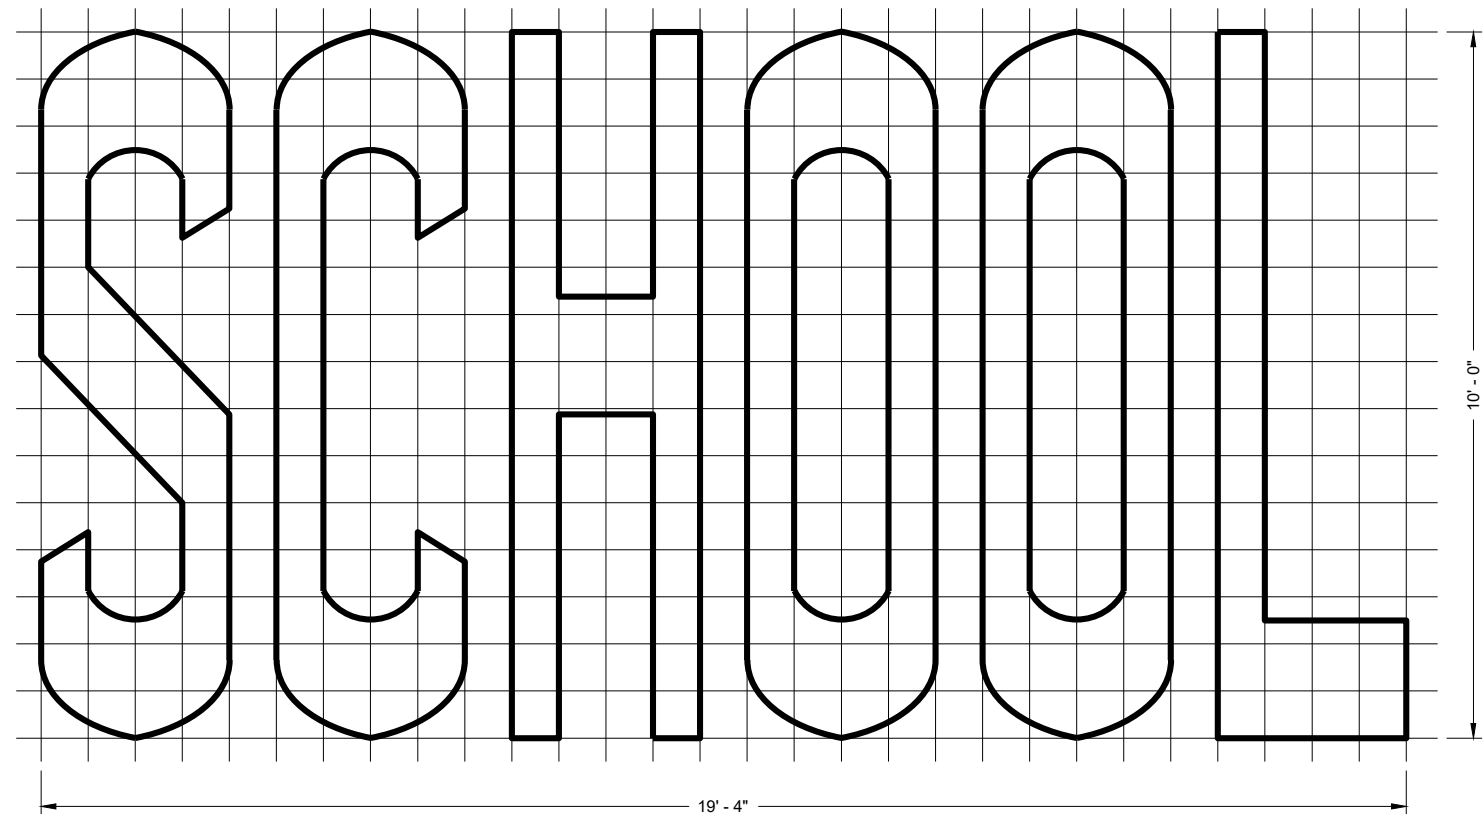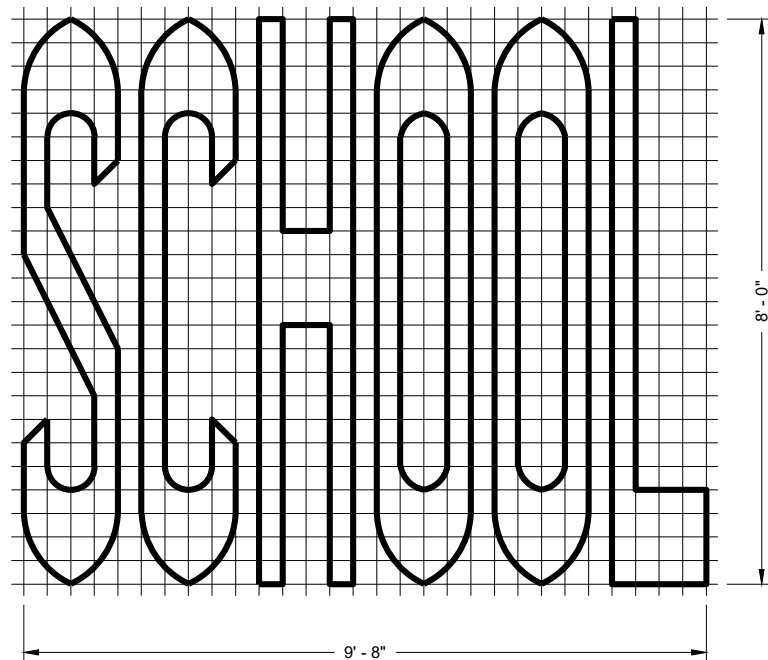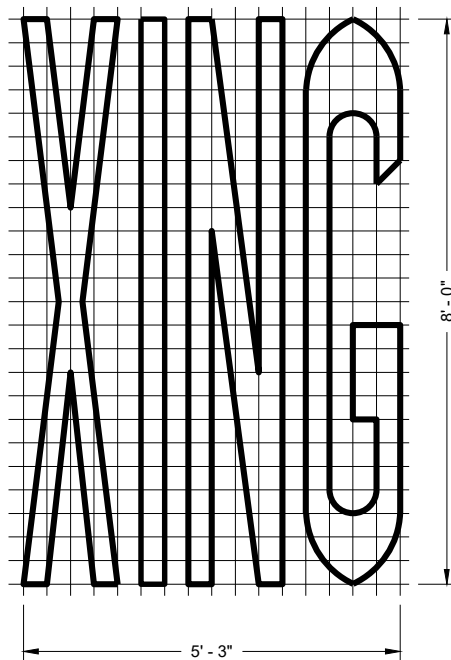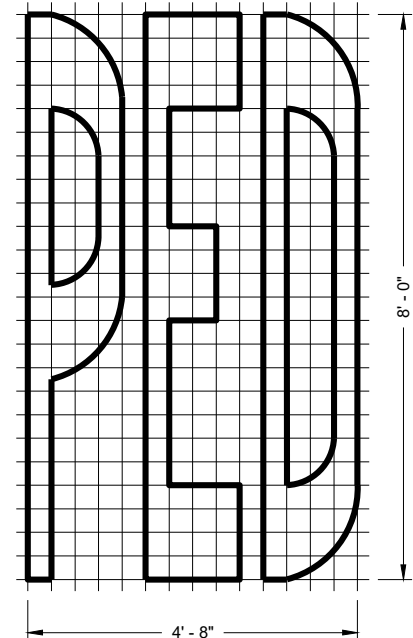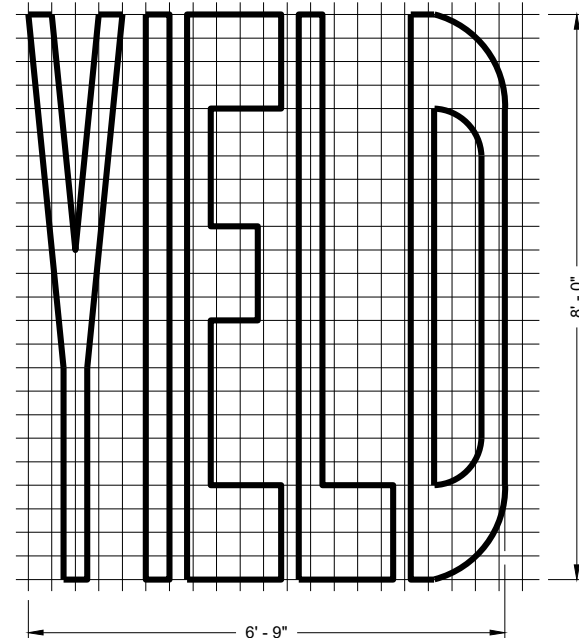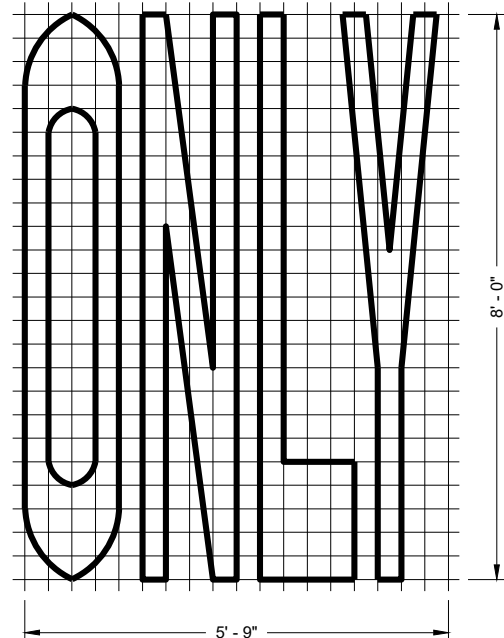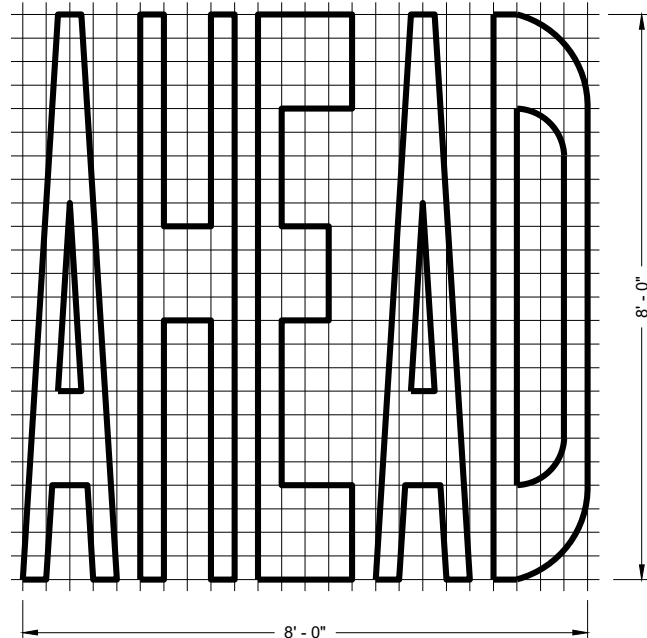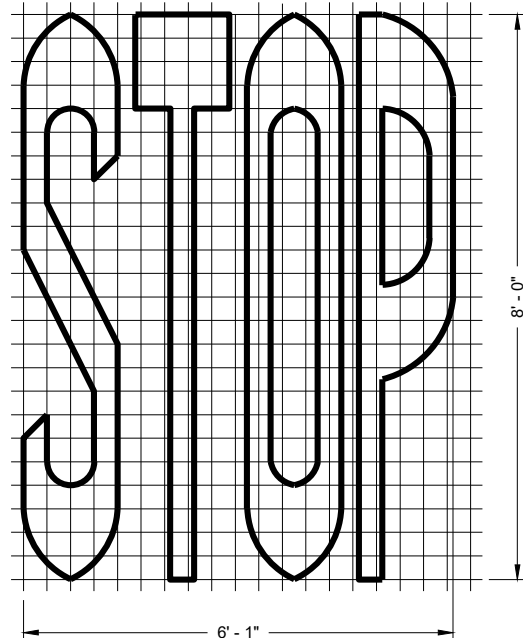

SINGLE LANE

TWO - LANE

GENERAL NOTES

DETAILS OF INSTALLATION, MATERIALS AND WORKMANSHIP NOT SHOWN ON THIS DRAWING SHALL CONFORM TO THE PERTINENT REQUIREMENTS OF THE STANDARD SPECIFICATIONS AND APPLICABLE SPECIAL PROVISIONS.

PAVEMENT MARKING WORDS

STATE OF WISCONSIN
DEPARTMENT OF TRANSPORTATION

APPROVED
November 2019 /S/ Matthew Rauch
DATE STATE SIGNING AND MARKING ENGINEER








FHWA

SDD 15C07 - 15b

SDD 15C07 - 15b



SDD 15C7-c Pavement Marking Arrows

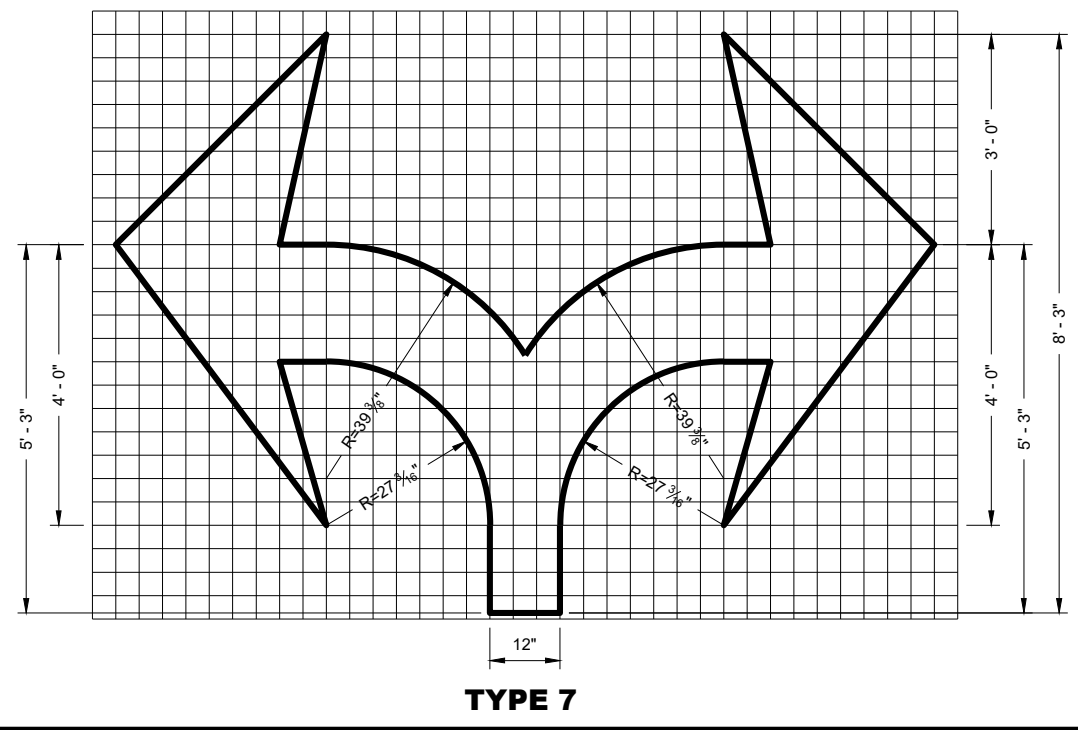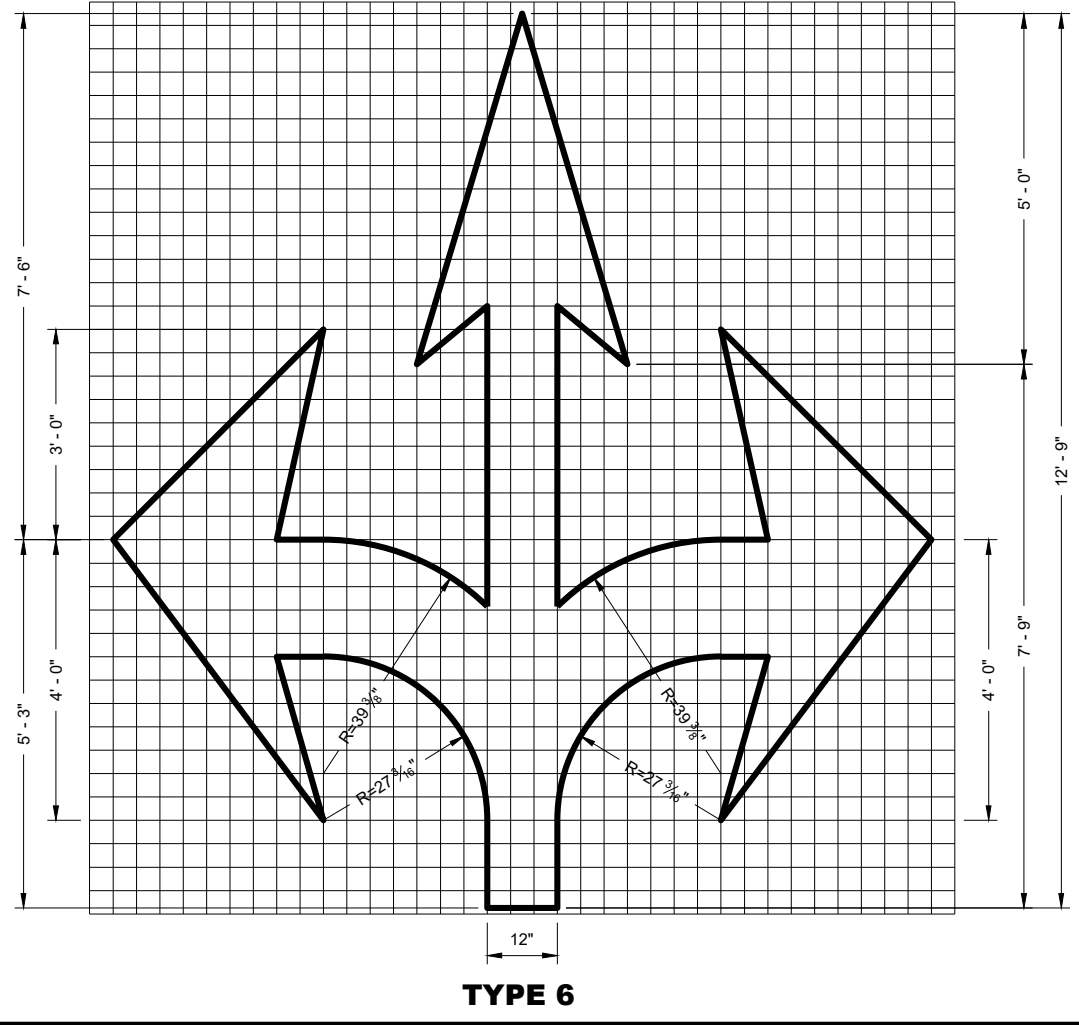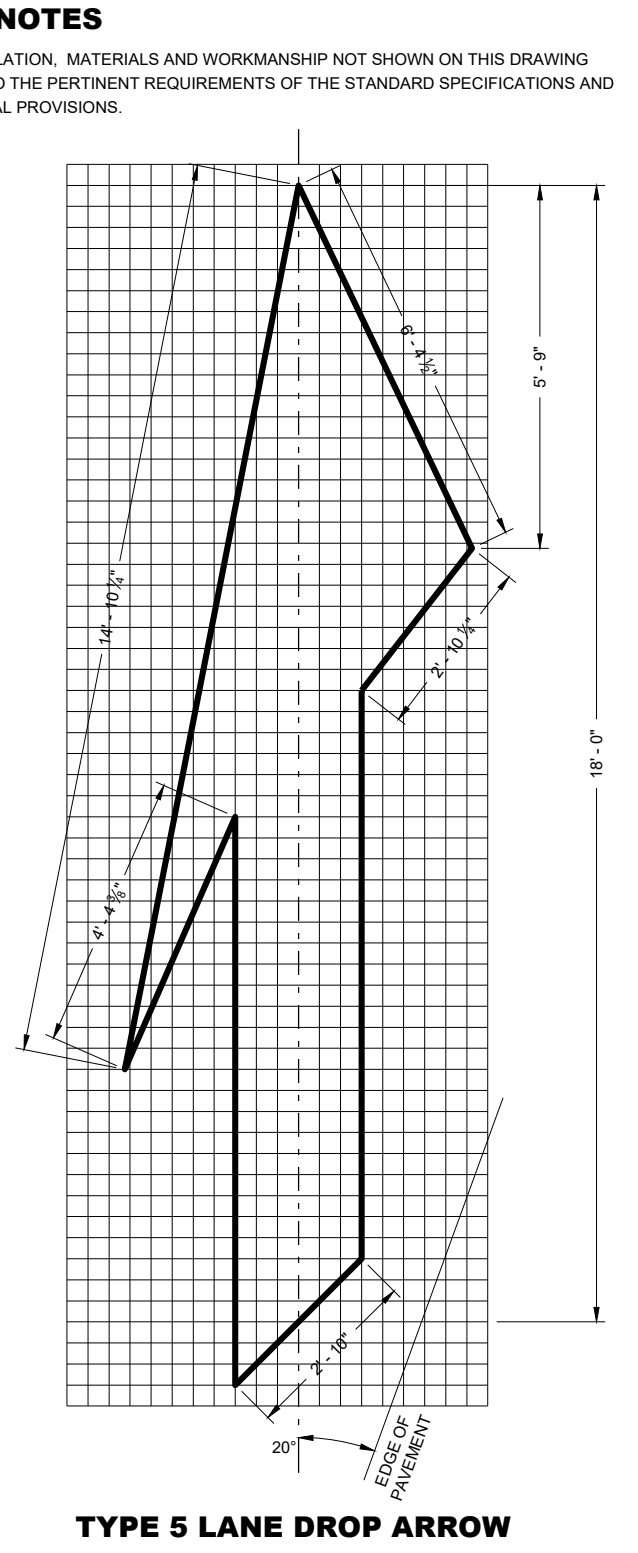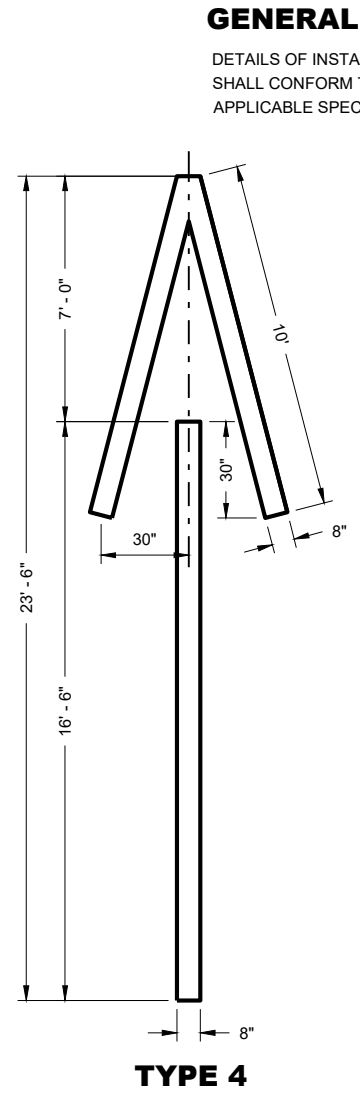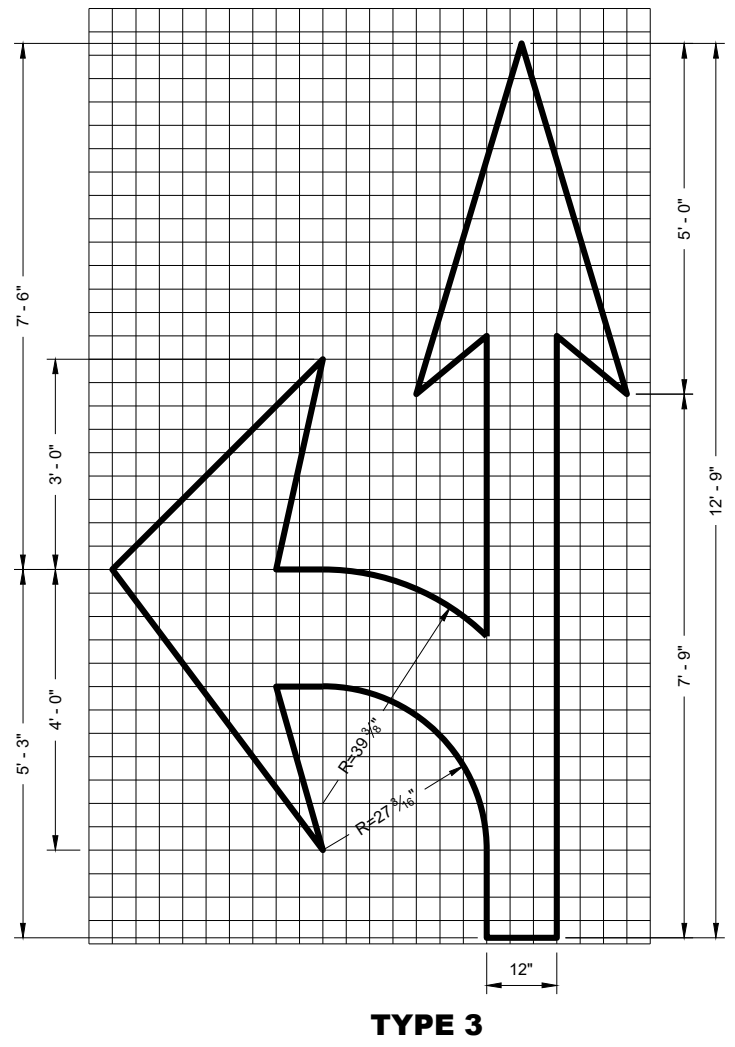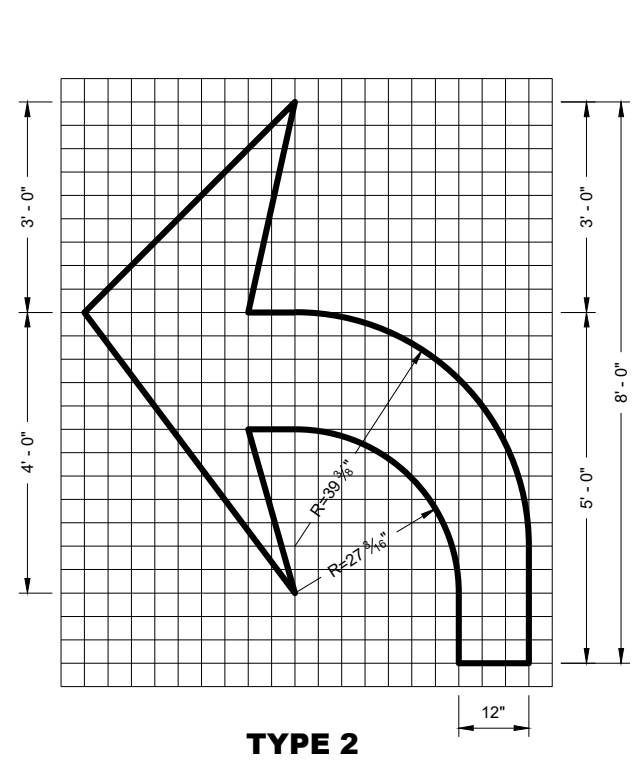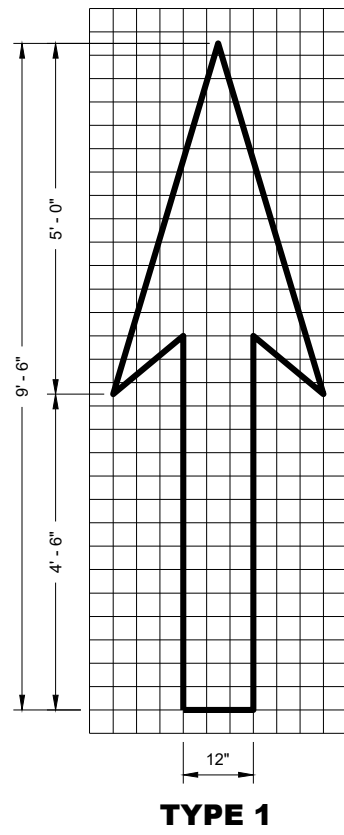

GENERAL NOTES

DETAILS OF INSTALLATION, MATERIALS AND WORKMANSHIP NOT SHOWN ON THIS DRAWING SHALL CONFORM TO THE PERTINENT REQUIREMENTS OF THE STANDARD SPECIFICATIONS AND APPLICABLE SPECIAL PROVISIONS.

6

6

SDD 15C07 - 15c

SDD 15C07 - 15c


PAVEMENT MARKING ARROWS	
STATE OF WISCONSIN DEPARTMENT OF TRANSPORTATION	
APPROVED November 2019 DATE	/s/ Matthew Rauch STATE SIGNING AND MARKING ENGINEER
FHWA	103




SDD 15C7-d Roundabout Marking Arrows

GENERAL NOTES


DETAILS OF INSTALLATION, MATERIALS AND WORKMANSHIP NOT SHOWN ON THIS DRAWING SHALL CONFORM TO THE PERTINENT REQUIREMENTS OF THE STANDARD SPECIFICATIONS AND APPLICABLE SPECIAL PROVISIONS.

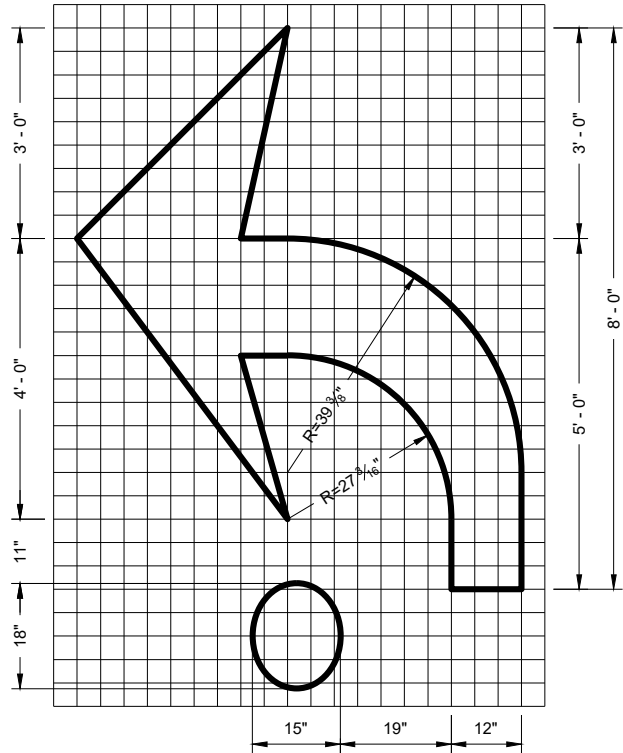


TYPE 2R

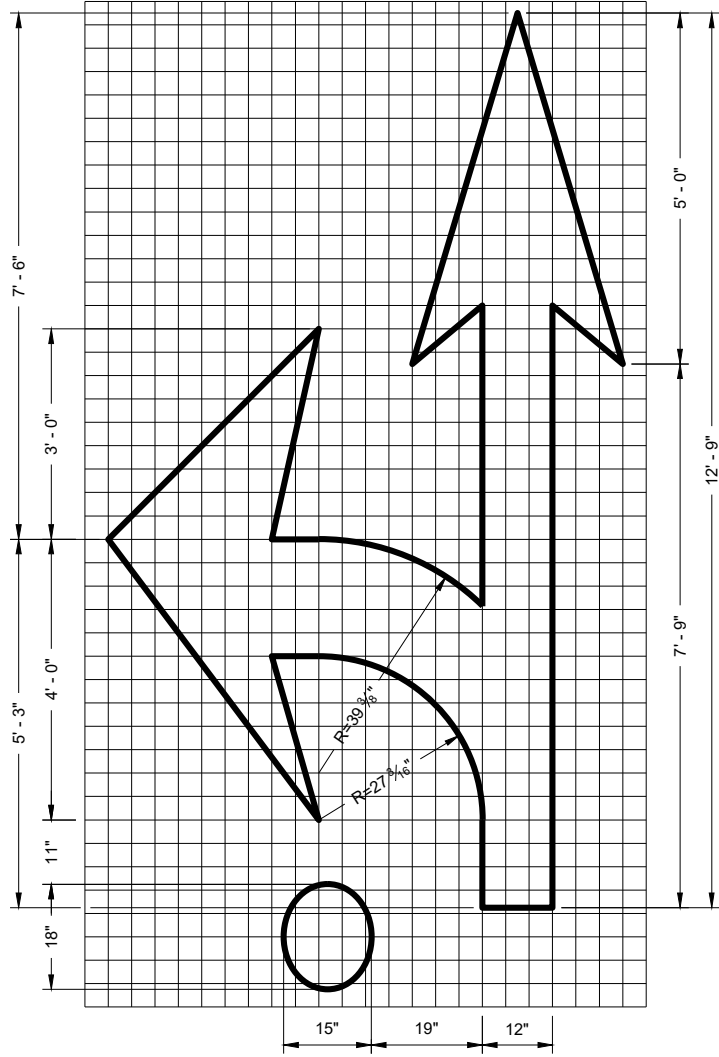

TYPE 3R

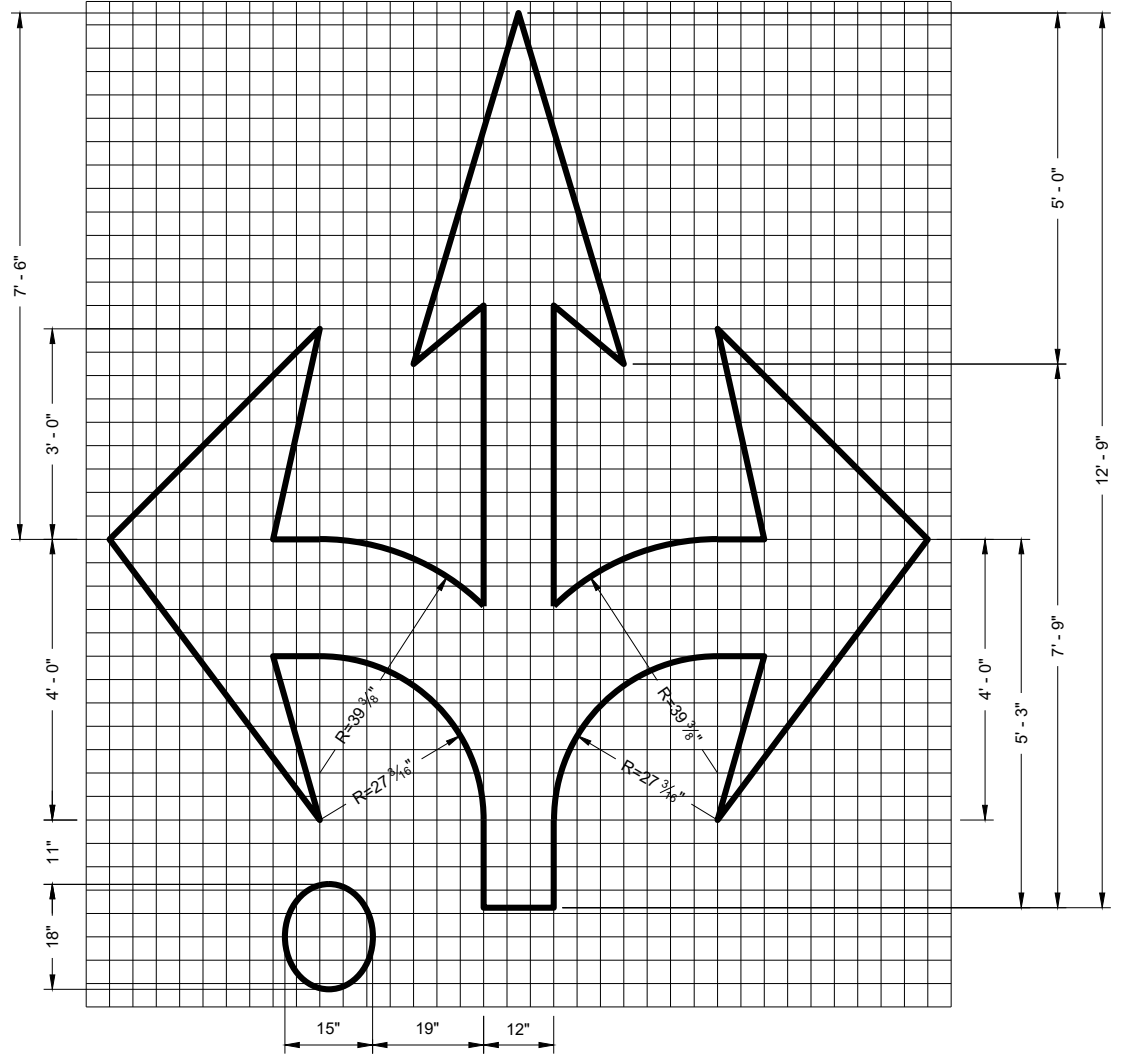

TYPE 6R

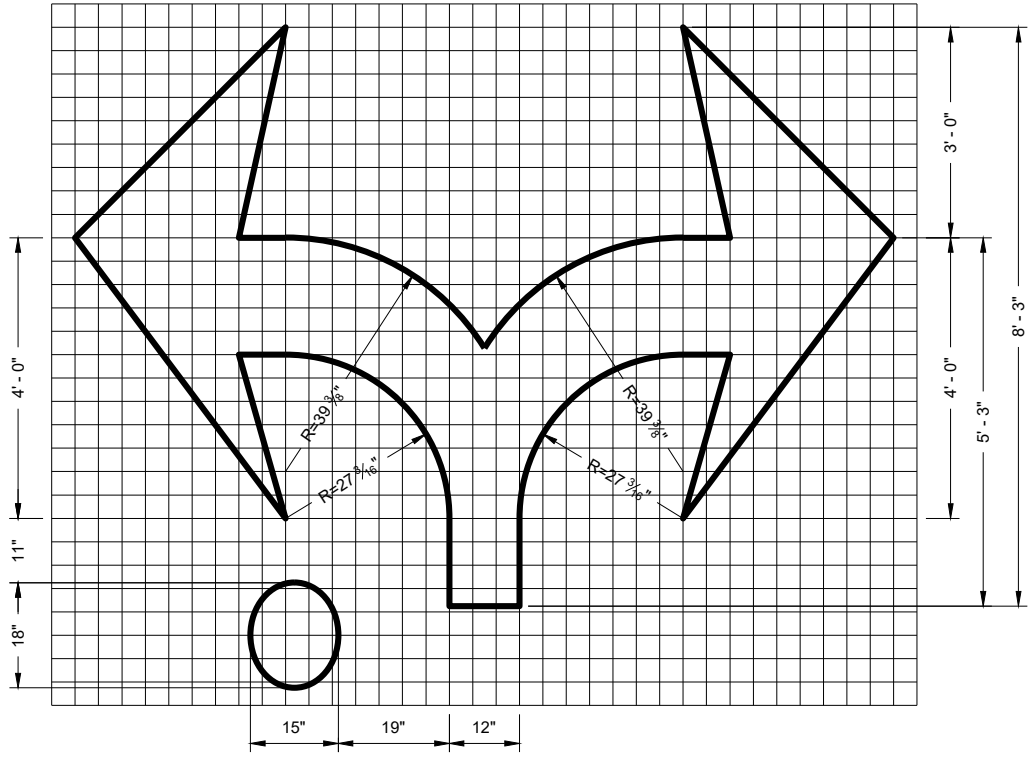

TYPE 7R

6

6


SDD 15C07 - 15d

SDD 15C07 - 15d


ROUNDBOUT MARKING ARROWS	
STATE OF WISCONSIN DEPARTMENT OF TRANSPORTATION	
APPROVED November 2019 DATE	/s/ Matthew Rauch STATE SIGNING AND MARKING ENGINEER
FHWA	104



SDD 15C08-a Longitudinal Marking (Mainline)

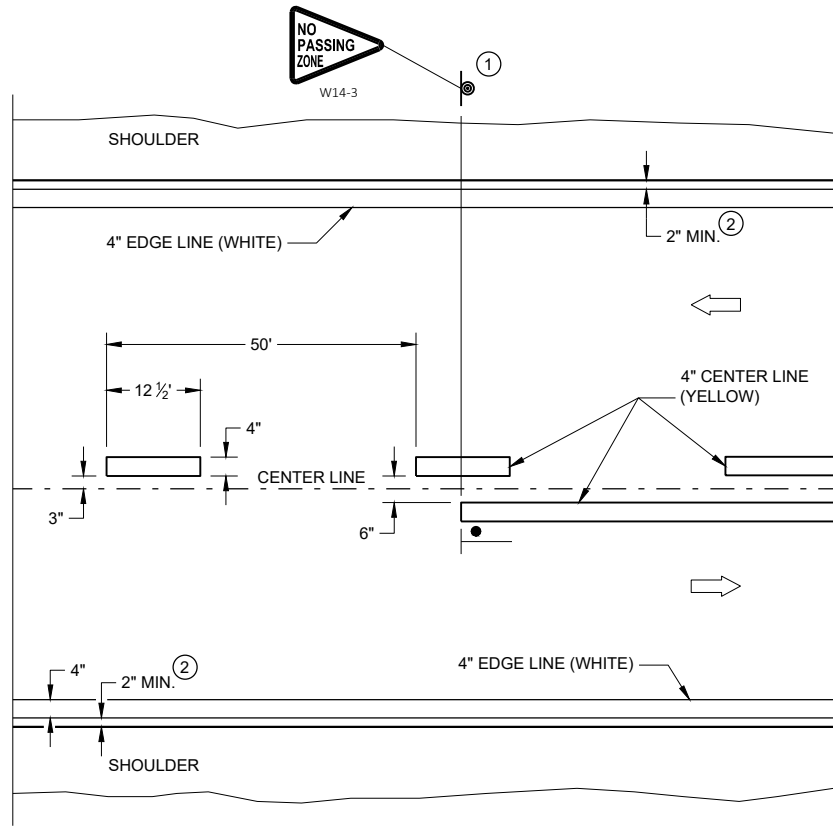


TWO WAY TRAFFIC

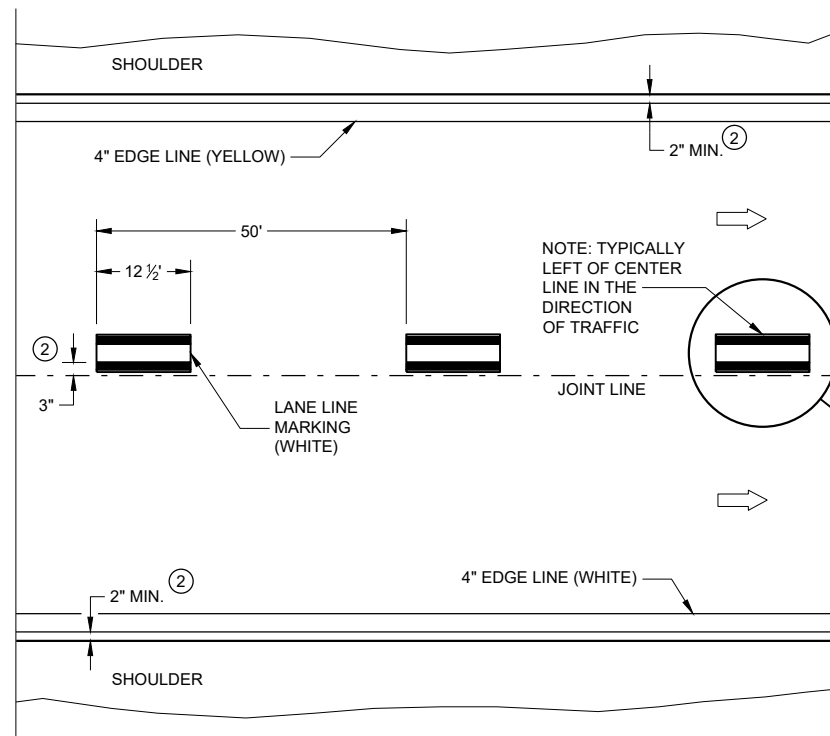


ONE WAY TRAFFIC

PERMANENT PAVEMENT MARKING

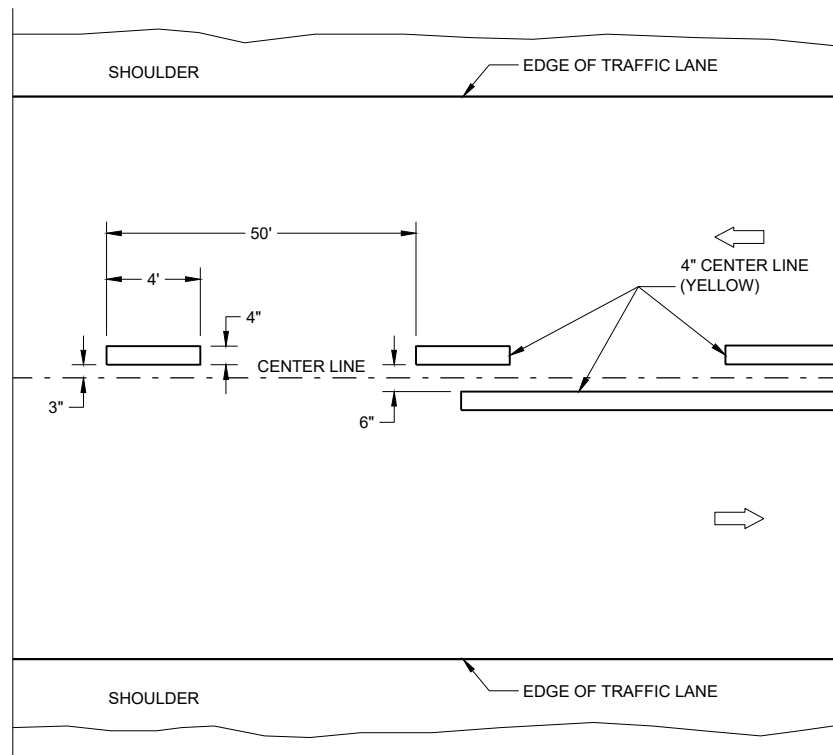

TWO WAY TRAFFIC

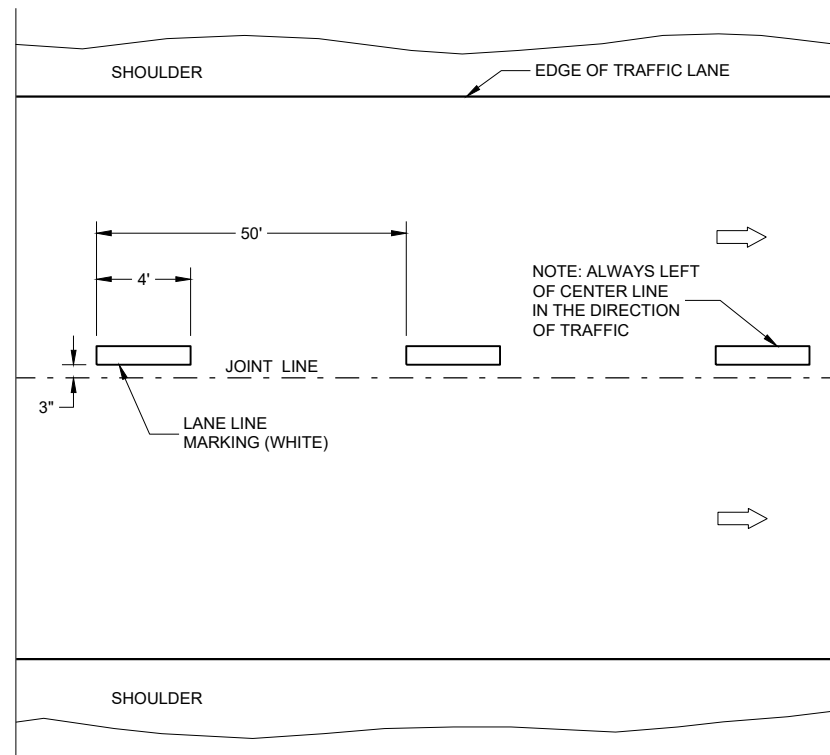

ONE WAY TRAFFIC

TEMPORARY PAVEMENT MARKING


GENERAL NOTES

DETAILS OF CONSTRUCTION NOT SHOWN ON THIS DRAWING SHALL CONFORM TO STANDARD SPECIFICATIONS AND SPECIAL PROVISIONS.

- ① LOCATE THE NO PASSING ZONE W14-3 SIGN WITHIN 50 FEET OF THE "T" MARKING
- ② MEASURE FROM EDGE OF MARKING TO JOINT LINE. THIS DOES NOT INCLUDE SPACE NEEDED FOR GROOVING OPERATIONS.

LEGEND

- "T" MARKING
- SIGN ON PERMANENT SUPPORT
- DIRECTION OF TRAFFIC

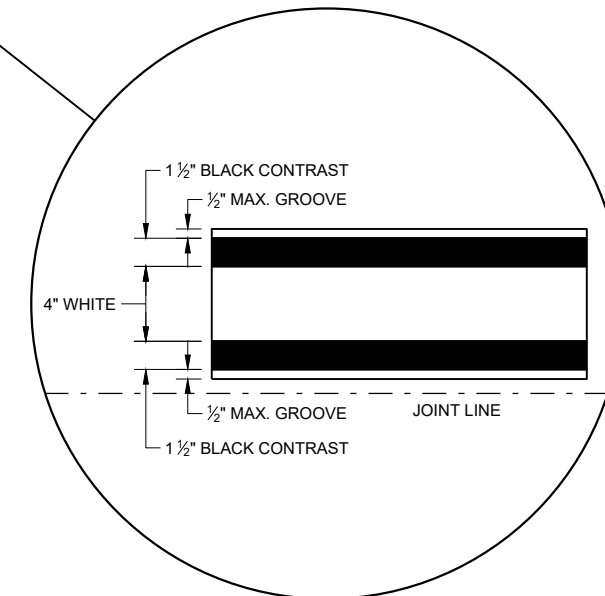

6

6

SDD 15C08 - 20a

SDD 15C08 - 20a

LONGITUDINAL MARKING (MAINLINE)

STATE OF WISCONSIN
DEPARTMENT OF TRANSPORTATION

APPROVED
February 2020 /S/ Matthew Rauch
DATE STATEWIDE SIGNING AND MARKING ENGINEER

FHWA

105




SDD 15C18-a Pavement Markings, Median Islands

GENERAL NOTES


DIAGONALS ARE OPTIONAL WHEN PAINED ISLAND IS LESS THAN 6 FEET AT WIDEST POINT.

➡ DIRECTION OF TRAVEL


* WHEN THE PAINTED MEDIAN LENGTH IS LESS THAN 50 FEET THE SPACING IS 10'.

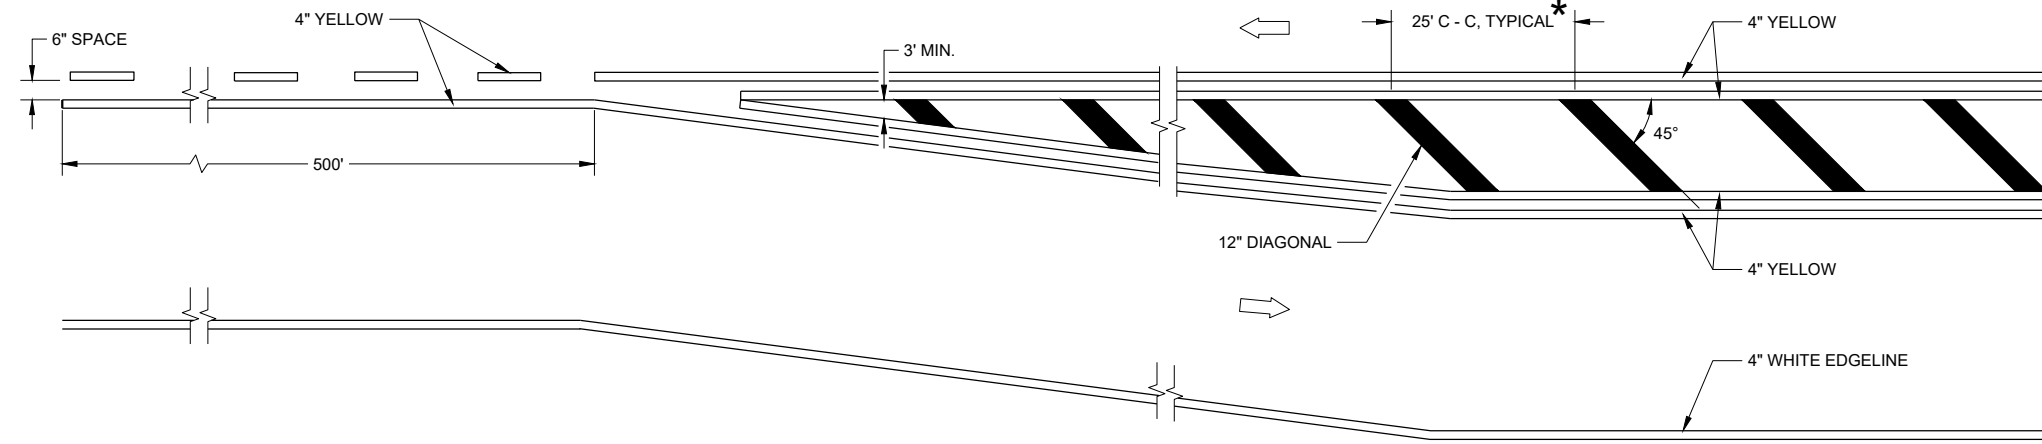

MEDIAN ISLAND DETAIL

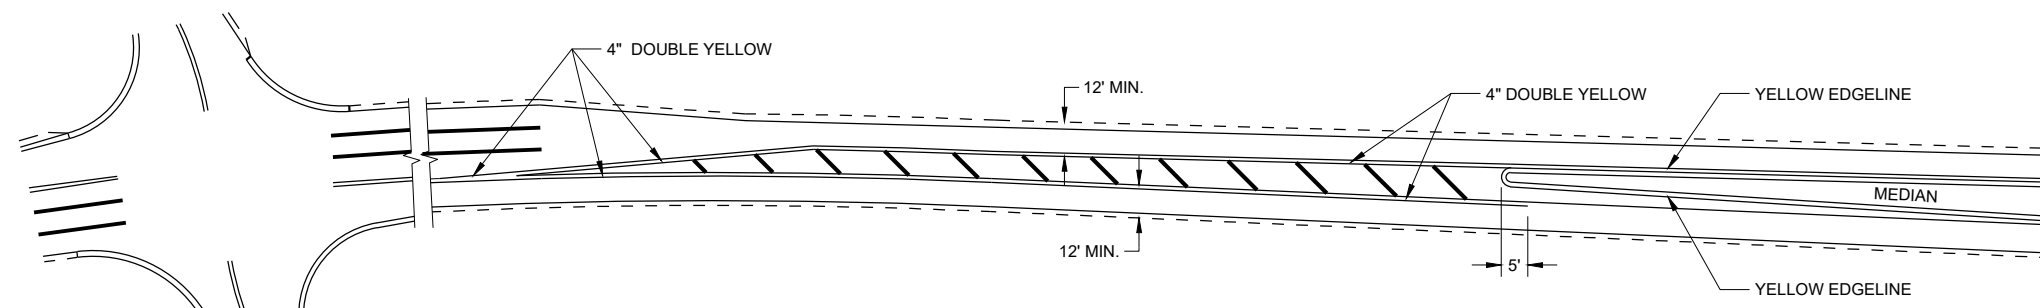

APPROACH MARKINGS FOR OTHER MEDIAN TYPES

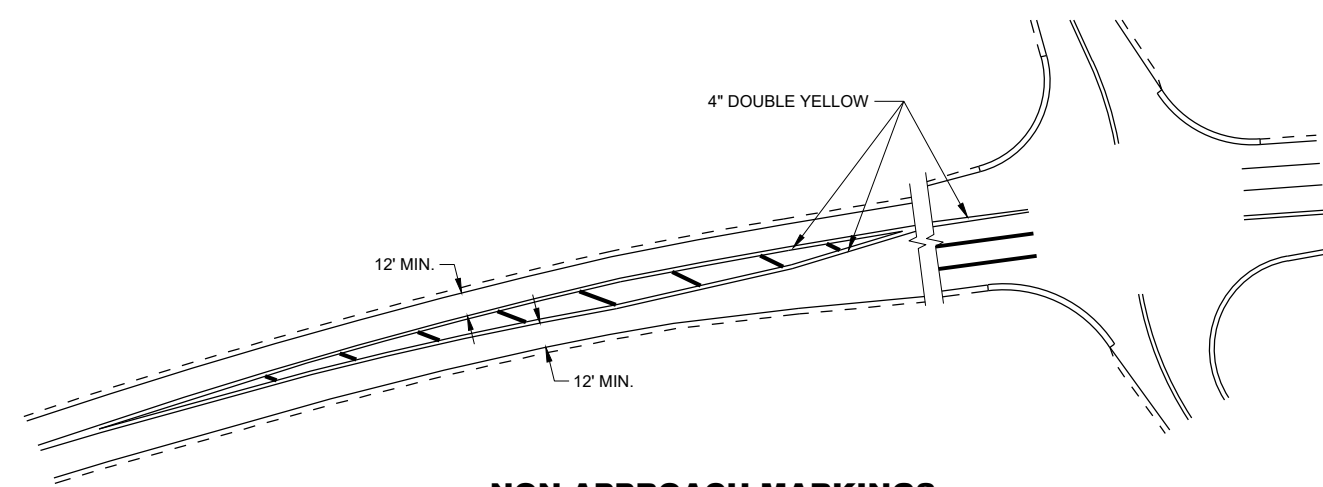

NON-APPROACH MARKINGS

6

6

SDD 15C18 - 05a

SDD 15C18 - 05a

MEDIAN ISLAND PAVEMENT MARKINGS


STATE OF WISCONSIN
DEPARTMENT OF TRANSPORTATION

APPROVED
 February 2021 /S/ Matthew R. Rauch
 DATE STATE SIGNING AND MARKING ENGINEER


FHWA




SDD 15C18-b Pavement Markings, Median Island Nose

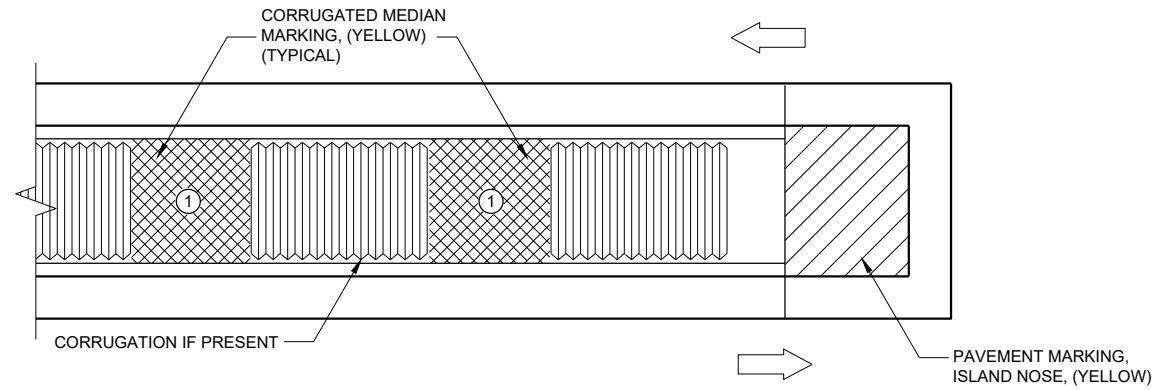

MEDIAN ISLAND WITH SQUARE BLUNT NOSE

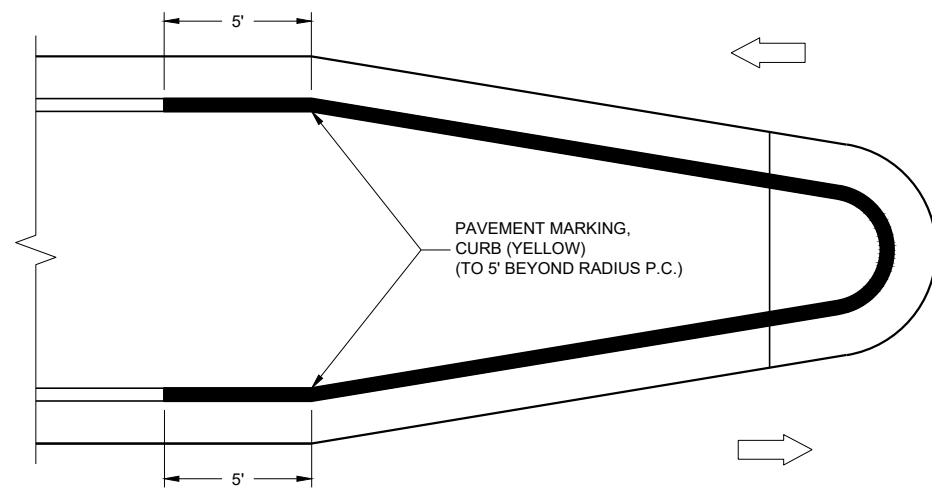

MEDIAN ISLAND WITH ROUND BLUNT NOSE

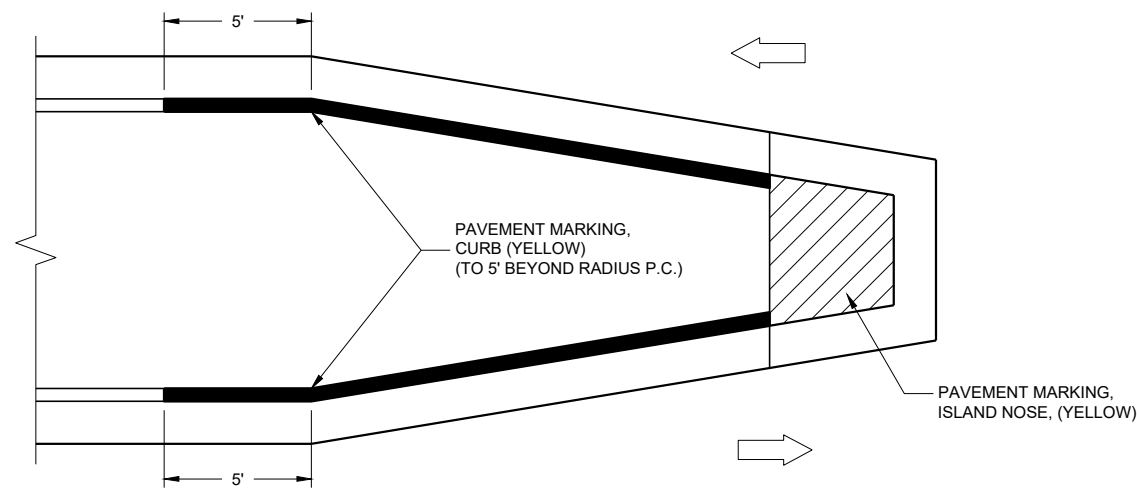





MEDIAN ISLAND WITH SLOPED NOSE

TYPICAL PLACEMENT OF PAVEMENT MARKING ON MEDIAN ISLANDS

GENERAL NOTES

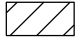WHEN CONCRETE CORRUGATED MEDIAN IS CONSTRUCTED TO SEPARATE TRAFFIC OPERATING IN THE OPPOSING DIRECTION, YELLOW PAVEMENT MARKING SHALL BE APPLIED TO THE FLAT PORTION OF THE CONCRETE CORRUGATED MEDIAN. THE ITEM OF PAVEMENT MARKING, CONCRETE CORRUGATED MEDIAN, WILL BE MEASURED IN PLACE AND ACCEPTED IN ACCORDANCE WITH THE CONTRACT AND PAID FOR AT THE CONTRACT UNIT PRICE PER SQUARE FOOT.

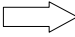-  ISLAND NOSE MARKING
-  CURB MARKING
-  CORRUGATED MEDIAN MARKING
-  DIRECTION OF TRAVEL

6

6

SDD 15C18 - 05b

SDD 15C18 - 05b

PAVEMENT MARKINGS, MEDIAN ISLAND NOSE

STATE OF WISCONSIN
DEPARTMENT OF TRANSPORTATION

APPROVED	/s/ Matthew R. Rauch
February 2021	DATE
	STATE SIGNING AND MARKING ENGINEER


FHWA

REQUIREMENTS FOR EDGE LINES		
POSTED SPEED	IS THERE CONTINUOUS LIGHTING?	
	YES	NO
≤ 30 MPH	NO	OPTIONAL
35 OR 40 MPH	OPTIONAL	RECOMMENDED
≥ 45 MPH	RECOMMENDED	REQUIRED


GENERAL NOTES

APPLIES TO ISLANDS AT LEFT TURNS AT ONE WAY ROADWAYS AS WELL.
SEE MISCELLANEOUS QUANTITIES FOR SIGN SIZE.

- ① MARK CURB NOSES YELLOW.
- ② MARK ACCORDING TO TABLE.

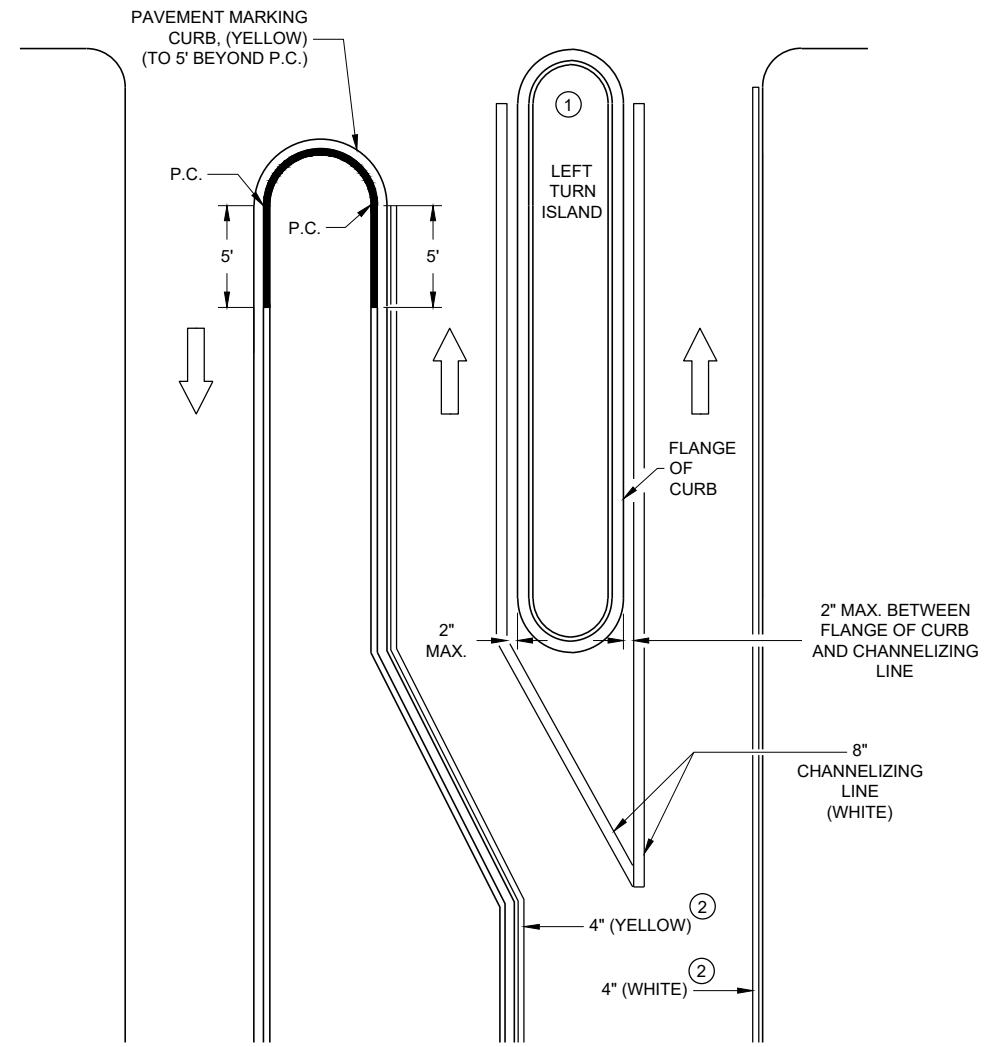

LEFT TURN & MEDIAN ISLAND

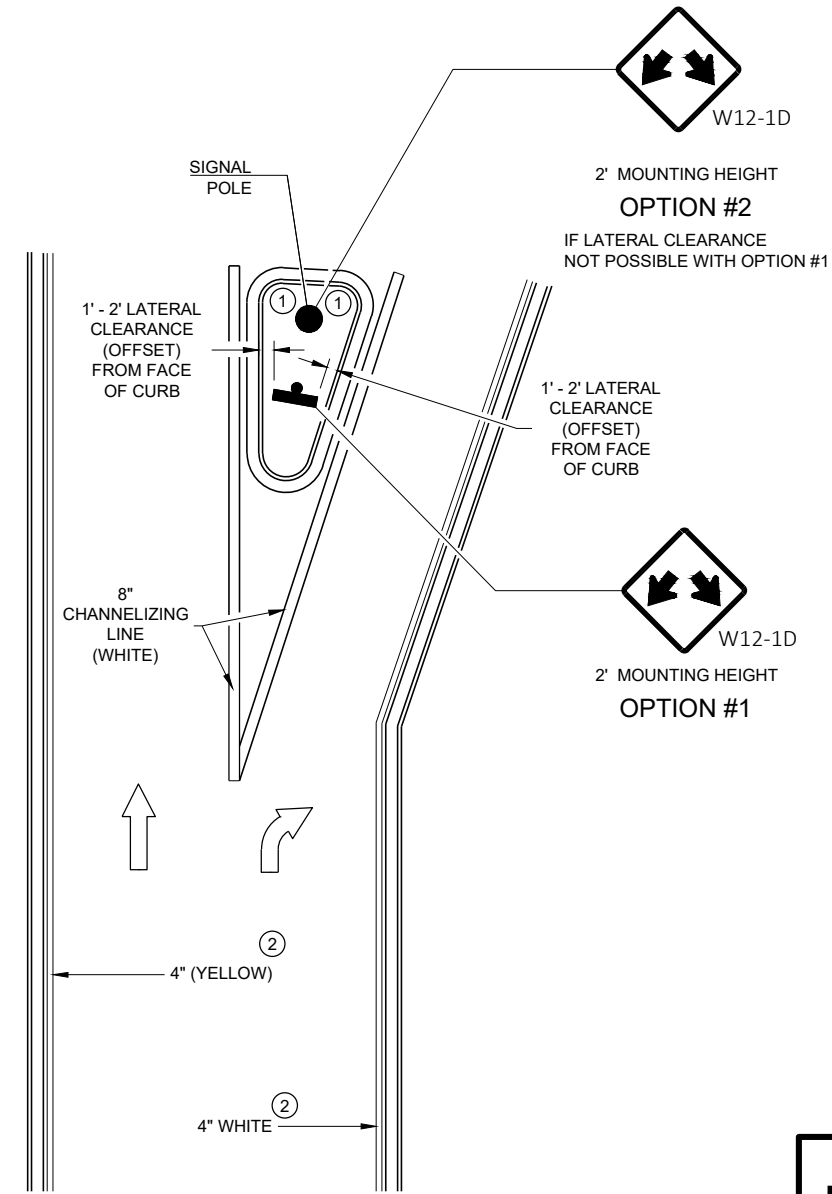

RIGHT TURN ISLAND

6

6

SDD 15C18 - 05c

SDD 15C18 - 05c

MEDIAN PAVEMENT MARKINGS, DOUBLE ARROW WARNING SIGN PLACEMENT

STATE OF WISCONSIN
DEPARTMENT OF TRANSPORTATION

APPROVED
February 2021 DATE /S/ Matthew R. Rauch
STATE SIGNING AND MARKING ENGINEER

FHWA 108




SDD 15C33 Stop Line and Crosswalk Pavement Marking


GENERAL NOTES

STOP SIGN SHALL BE PLACED A MINIMUM OF 6 FEET TO A MAXIMUM OF 50 FEET FROM THE EDGELINE LOCATION.


- ① 18-INCH STOP LINES MAY BE DELETED OR ADDED BY THE REGION MARKING ENGINEER BASED ON VISIBILITY AND SIGHT LINES.
- ② NO STOP LINE IS REQUIRED IF STOP SIGN IS LESS THAN OR EQUAL TO 40 FEET FROM THE EDGELINE.
- ③ NO STOP LINE IS REQUIRED IF STOP SIGN IS LESS THAN OR EQUAL TO 30 FEET FROM THE FLANGE LINE EXTENSION.
- ④ MOVE CLOSER TO THE EDGE OF TRAVEL LINE AS NEEDED FOR VISIBILITY AND SIGHT LINES (NO CLOSER THAN 4 FEET).
- ⑤ LADDER BAR CROSSWALKS SHOULD ONLY BE USED FOR MID BLOCK CROSSINGS. USE 2 - 6" TRANSVERSE LINES INSTEAD.

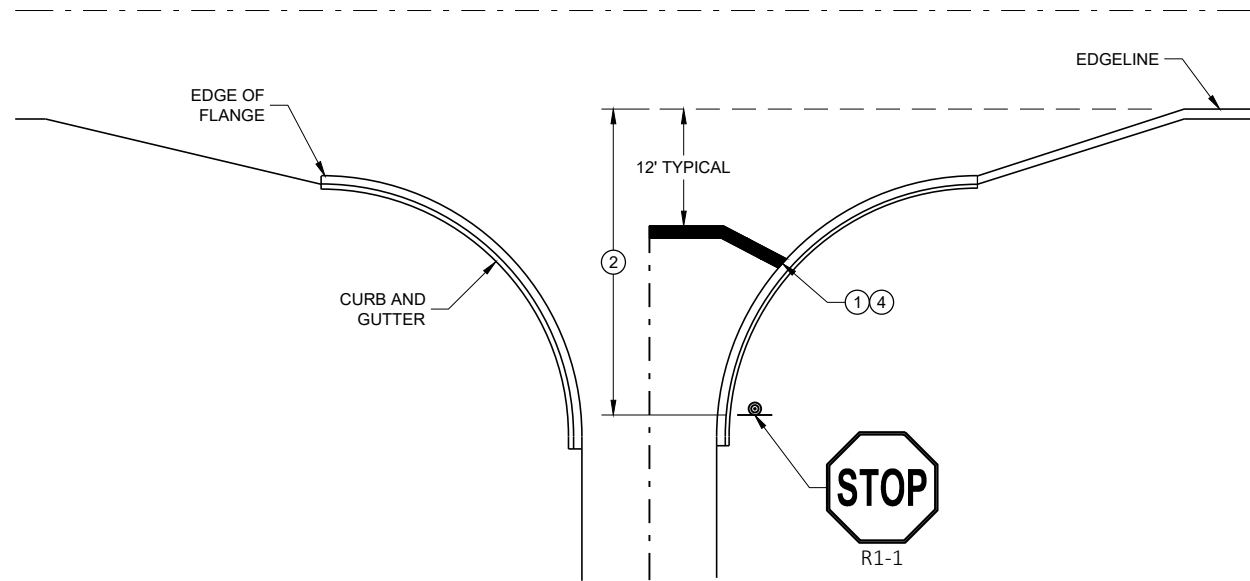


TYPICAL STOP LINE PAVEMENT MARKING WITH CURB AND GUTTER

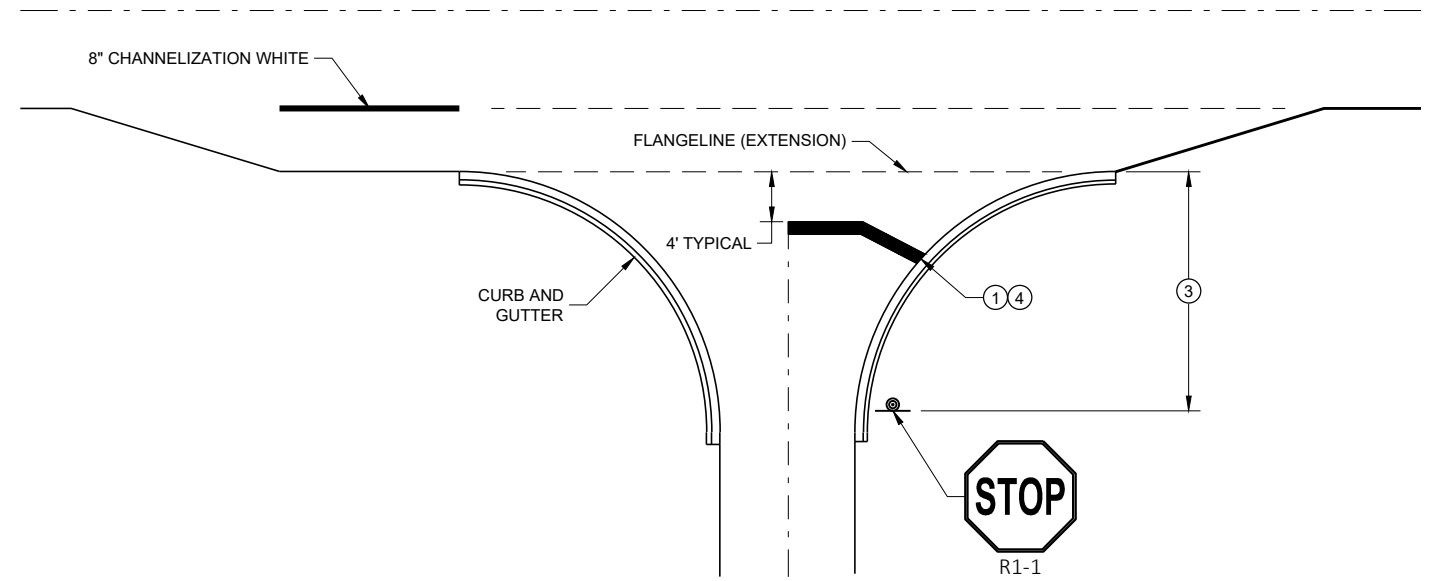

TYPICAL STOP LINE PAVEMENT MARKING FOR SIDE ROADS WITH RIGHT TURN LANE

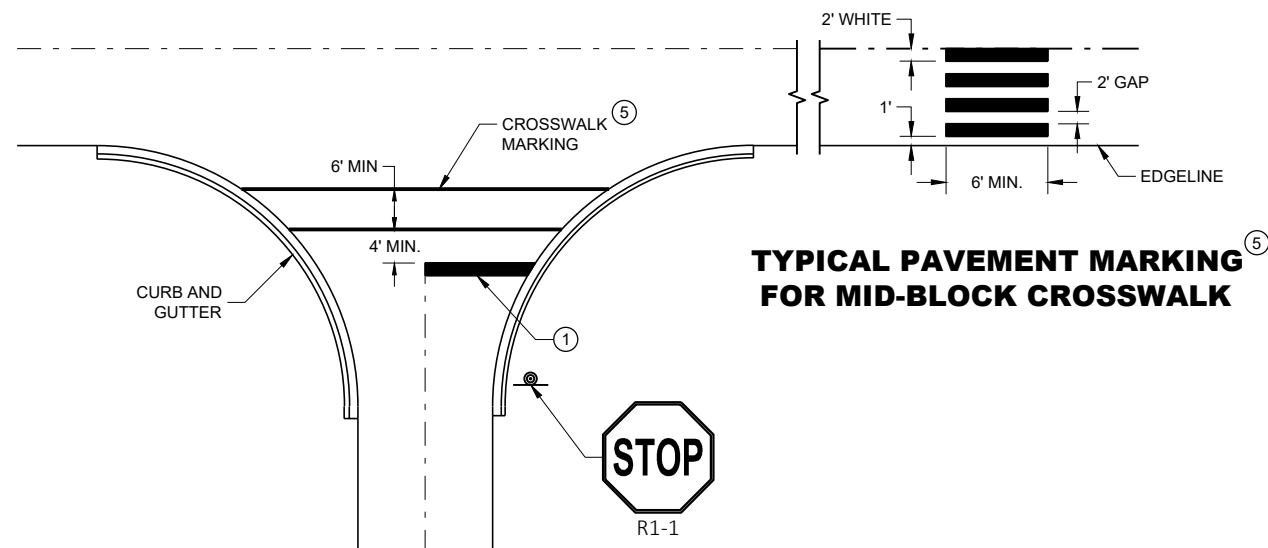

TYPICAL STOP LINE PAVEMENT MARKING FOR SIDE ROADS WITH CROSSWALK MARKING

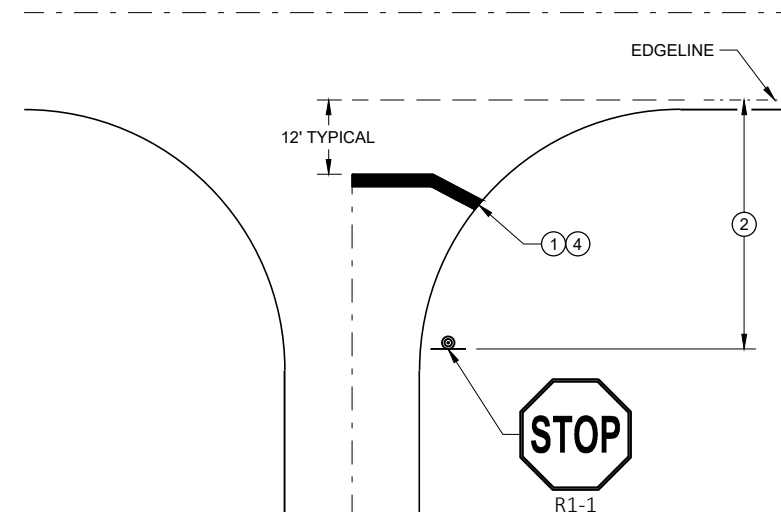

TYPICAL STOP LINE PAVEMENT MARKING WITHOUT CURB AND GUTTER

STOP LINE AND CROSSWALK PAVEMENT MARKING

STATE OF WISCONSIN
DEPARTMENT OF TRANSPORTATION


APPROVED
November 2019 /S/ Matthew Rauch
DATE STATE SIGNING AND MARKING ENGINEER

FHWA




SDD 15D30-a Traffic Control, Pedestrian Accommodation


NOTE: MAY BE USED ON ROADWAY WITH POSTED SPEED OF LESS THAN 40 MPH.

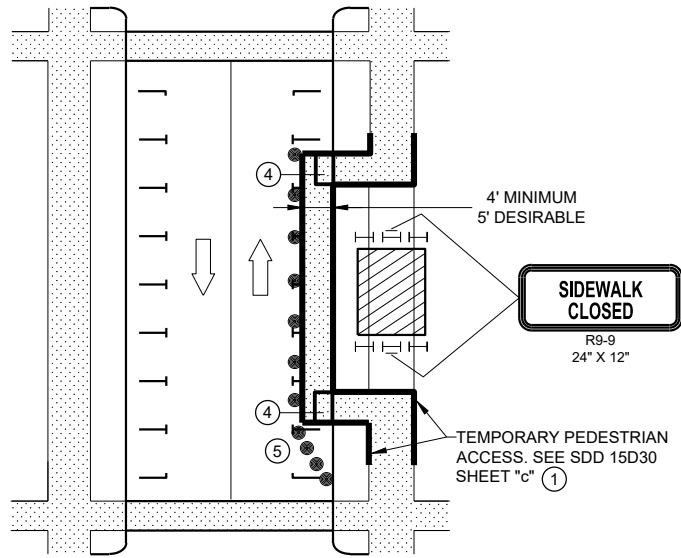

MID-BLOCK SIDEWALK CLOSURE IN PARKING LANE

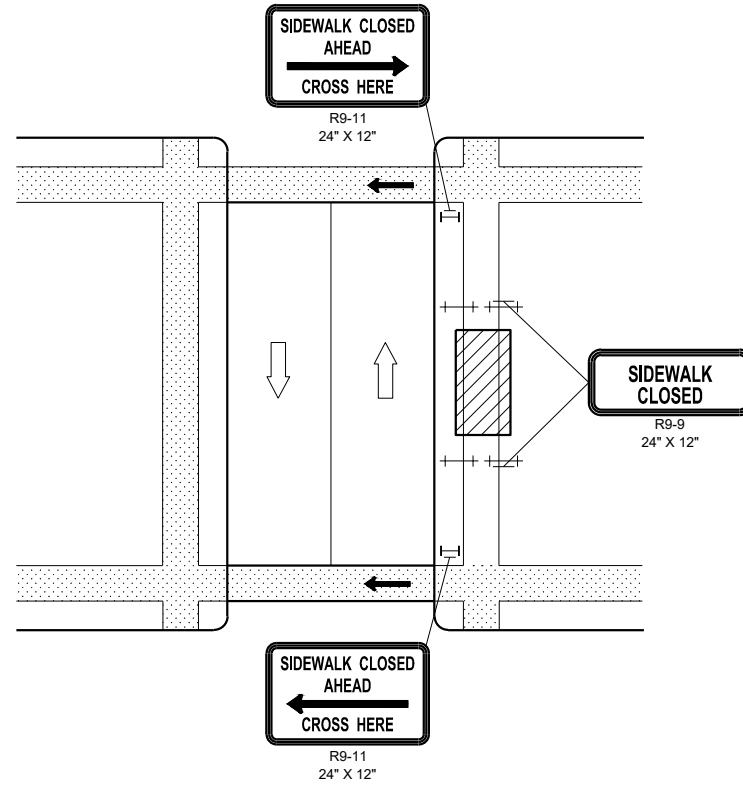


MID-BLOCK SIDEWALK CLOSURE

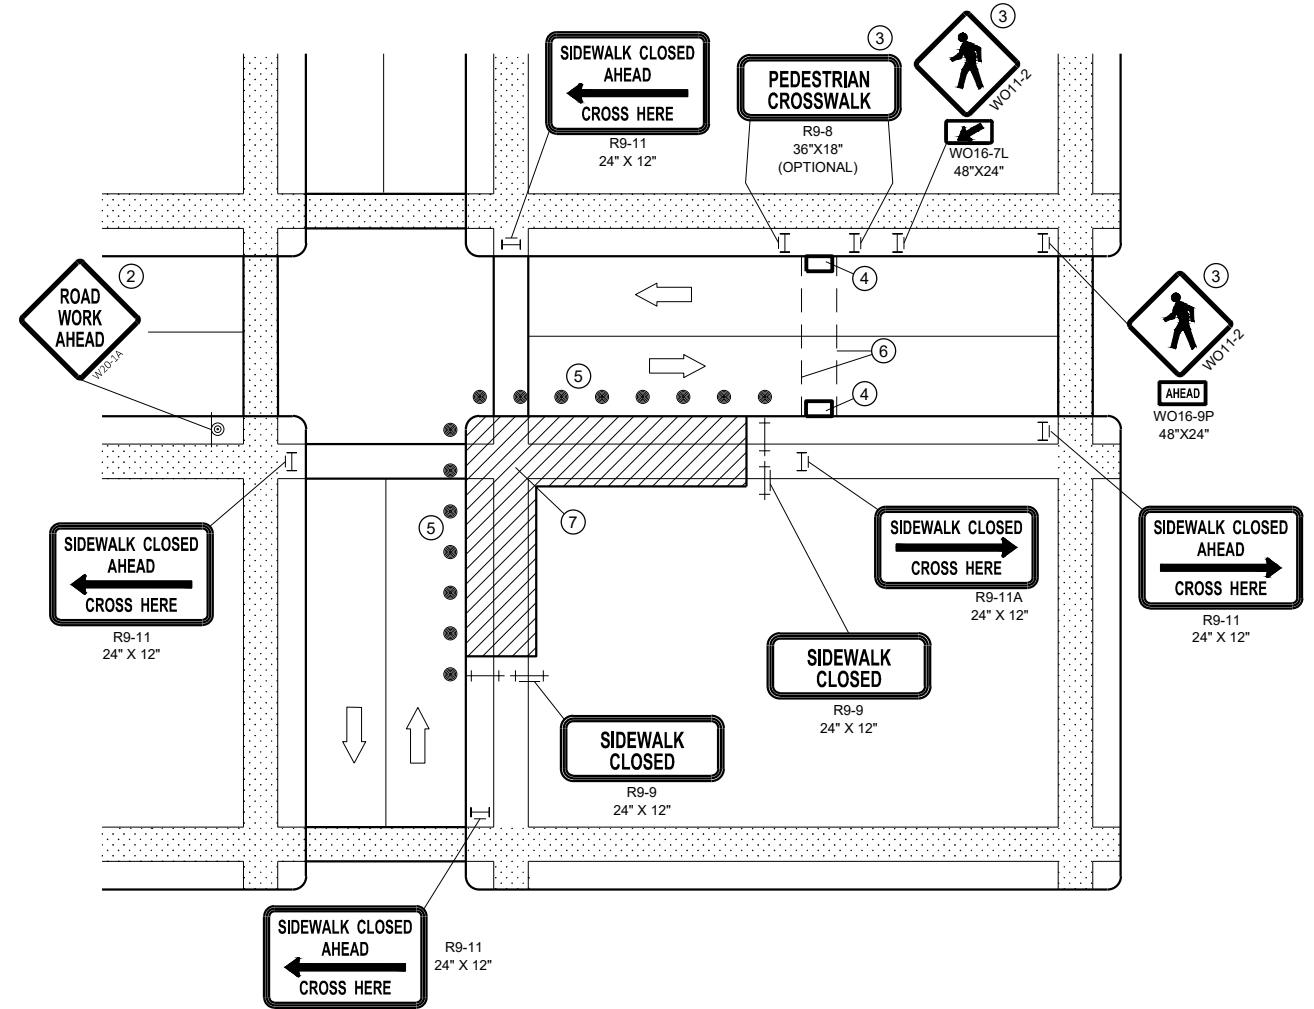

CORNER SIDEWALK CLOSURE WITH TEMPORARY CROSSWALK

NOTE: LAYOUT SAME AS ABOVE.

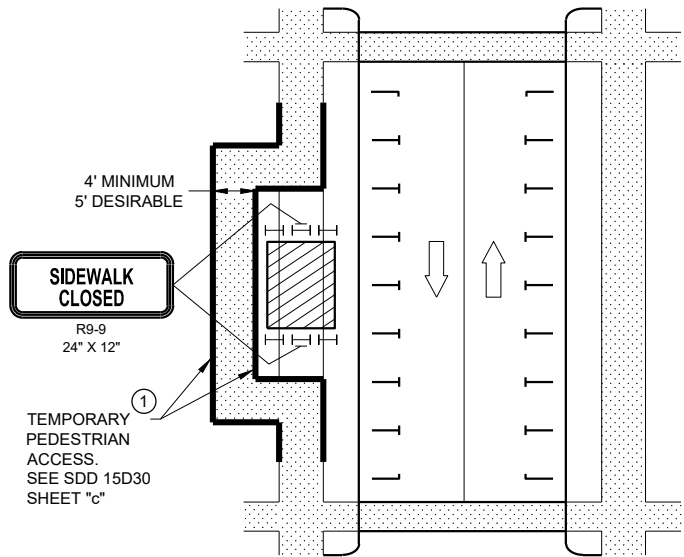

SIDEWALK DIVERSION

GENERAL NOTES

WHEN CLOSING OR RELOCATING CROSSWALKS OR SIDEWALKS, PROVIDE DETECTABLE TEMPORARY FACILITIES AND INCLUDE ACCESSIBILITY FEATURES CONSISTENT WITH EXISTING PEDESTRIAN FACILITIES.

TEMPORARY TRAFFIC CONTROL DEVICES FOR PEDESTRIANS ARE SHOWN. OTHER DEVICES MAY BE NECESSARY TO CONTROL VEHICULAR TRAFFIC. STAGE WORK AS NECESSARY, TO PROVIDE A TEMPORARY PEDESTRIAN ACCESS ROUTE AT ALL TIMES. FOR ROADWAYS WITH NO AVAILABLE DETOURS, MAINTAIN ONE OPEN SIDEWALK AT ALL TIMES.

"WO" SIGN IS THE SAME AS "W" SIGN, EXCEPT THE BACKGROUND IS ORANGE.

FOR NIGHTTIME CLOSURE, USE TYPE "A" FLASHING WARNING LIGHTS ON BARRICADES, SUPPORTING SIGNS AND CLOSING SIDEWALK. USE TYPE "C" STEADY BURN LIGHTS ON CHANNELIZING DEVICES SEPARATING THE WORK AREA FROM VEHICULAR TRAFFIC.

PEDESTRIAN TRAFFIC SIGNAL DISPLAY CONTROLLING CLOSED CROSSWALK SHALL BE COVERED OR DEACTIVATED.

POST MOUNTED SIGNS LOCATED ADJACENT TO A SIDEWALK SHALL HAVE A 7 FOOT MINIMUM CLEARANCE FROM THE BOTTOM OF THE SIGN TO THE SIDEWALK SURFACE.

ALTERNATE SIDEWALK WORK BETWEEN LEFT AND RIGHT SIDE OF ROADWAY TO MAINTAIN PEDESTRIAN ACCESS.

- IF SIDEWALK CLOSURE AFFECTS AN ACCESSIBLE AND DETECTABLE FACILITY, MAINTAIN ACCESSIBILITY AND DETECTABILITY ALONG THE ALTERNATE PEDESTRIAN ROUTE
- "ROAD WORK AHEAD" SIGNS ARE NOT REQUIRED IF THE SIDEWALK CLOSURE OCCURS WITHIN A LARGER WORK ZONE WHERE ADVANCE WARNING SIGNS ARE ALREADY PRESENT, OR IF THE WORK AREA AND EQUIPMENT ARE MORE THAN 2 FEET BEHIND THE CURB.
- IF TEMPORARY PEDESTRIAN CROSSWALK IS NOT PROVIDED, OMIT R9-8 AND WO11-2 SIGN ASSEMBLIES. IF PROVIDED INCLUDE ON BOTH SIDES OF THE CROSSWALK.
- TEMPORARY CURB RAMPS. SEE SDD 15D30 SHEET "b".
- DRUMS OR BARRICADES AT 25 FOOT SPACING. STREET PARKING SHALL BE PROHIBITED FOR AT LEAST 50 FEET IN ADVANCE OF THE MID-BLOCK CROSSWALK.
- TEMPORARY PAVEMENT MARKING FOR CROSSWALK LINES.
- LIMIT WORK TO ONE QUADRANT AT A TIME TO MINIMIZE PEDESTRIAN DISRUPTION.

LEGEND

- SIGN ON PERMANENT SUPPORT
- TRAFFIC CONTROL DRUM
- TYPE II BARRICADE WITH/WITHOUT SIGN (ALL WITH ONE WARNING LIGHT, TYPE A, LOW INTENSITY FLASHING)
- TYPE III BARRICADE WITH/WITHOUT SIGN (ALL WITH ONE WARNING LIGHT, TYPE A, LOW INTENSITY FLASHING)
- UNDER PEDESTRIAN TRAFFIC
- WORK AREA
- PEDESTRIAN CHANNELIZATION DEVICE
- DIRECTION OF TRAFFIC

**TRAFFIC CONTROL,
PEDESTRIAN ACCOMMODATION**

STATE OF WISCONSIN
DEPARTMENT OF TRANSPORTATION 110

6

6

SDD 15D30 - 06a

SDD 15D30 - 06a




GENERAL NOTES


NOTIFY THE BUS COMPANY 7 DAYS IN ADVANCE OF THE BUS STOP RELOCATION.

ALTERNATE SIDEWALK WORK BETWEEN LEFT AND RIGHT SIDE OF ROADWAY TO MAINTAIN PEDESTRIAN ACCESS.


- ① CURB RAMPS SHALL BE 48" MIN. WIDTH WITH A FIRM, STABLE AND SLIP RESISTANT SURFACE. INSTALL CONTRASTING DETECTABLE WARNING FIELD AT PEDESTRIAN STREET CROSSINGS. REFER TO SDD 08D05, SHEET "e".
- ② PROTECTIVE EDGING WITH A 2" MIN. HEIGHT SHALL BE INSTALLED WHEN A CURB RAMP OR LANDING PLATFORM HAS A VERTICAL DROP OF 6" OR GREATER OR HAS A SIDE APRON SLOPE STEEPER THAN 1:3 (33%). PROTECTIVE EDGING SHOULD BE CONSIDERED WHEN CURB RAMPS OR LANDING PLATFORMS HAVE A VERTICAL DROP OF 3" OR MORE.
- ③ DETECTABLE EDGING WITH 6" MIN. HEIGHT AND CONTRASTING COLOR SHALL BE INSTALLED ON ALL CURB RAMP LANDINGS WHERE THE WALKWAY CHANGES DIRECTION (TURNS).
- ④ CURB RAMPS AND LANDINGS SHALL HAVE A 1:50 (2%) MAX. CROSS-SLOPE.
- ⑤ CLEAR SPACE OF 48" X 48" SHALL BE PROVIDED ABOVE AND BELOW THE CURB RAMP.
- ⑥ THE CURB RAMP WALKWAY EDGE SHALL BE MARKED WITH A YELLOW COLOR, 4" WIDE MARKING, UNLESS A CONTRASTING DETECTABLE WARNING FIELD IS PROVIDED.
- ⑦ DO NOT RESTRICT WATER FLOW IN THE GUTTER SYSTEM.
- ⑧ LATERAL JOINTS OR GAPS BETWEEN SURFACES SHALL BE LESS THAN 1/2" WIDTH.
- ⑨ CHANGES BETWEEN SURFACE HEIGHTS SHALL NOT EXCEED 1/2". LATERAL EDGES SHALL BE VERTICAL UP TO 1/4" HIGH AND BEVELED AT 1:2 BETWEEN 1/4" AND 1/2".
- ⑩ 5" WIDE MIN. WITH PEDESTRIAN SAFETY BARRICADE, 10' WIDE MIN. WITHOUT PEDESTRIAN SAFETY BARRICADE.

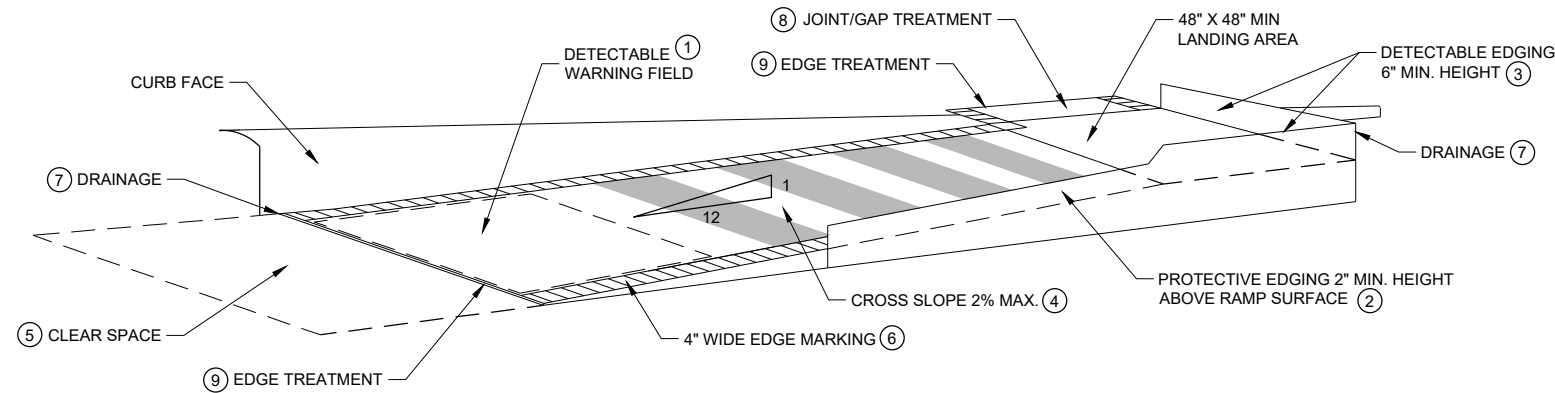

TEMPORARY CURB RAMP PARALLEL TO CURB

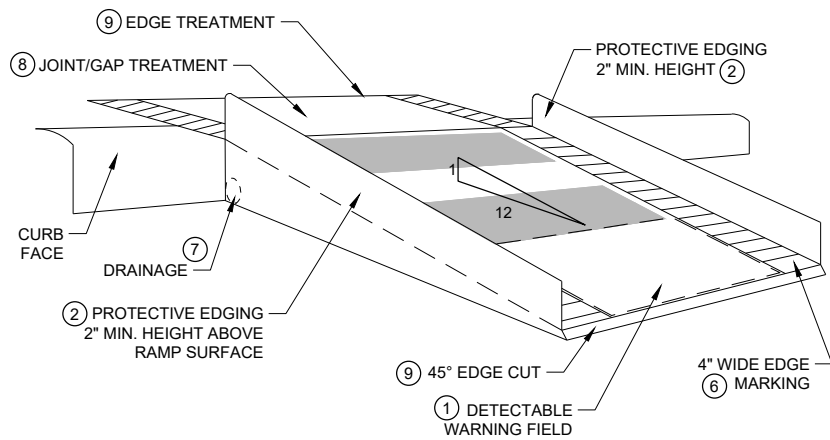


WITH PROTECTIVE EDGE

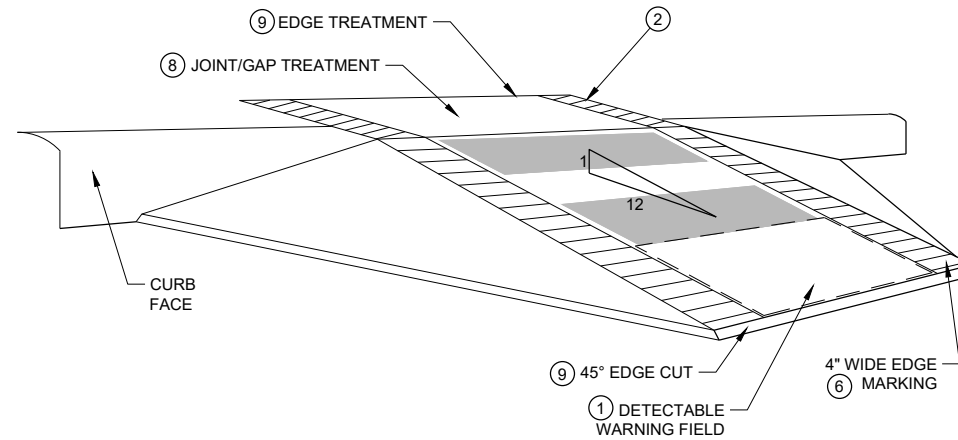


WITH SIDE APRON

TEMPORARY CURB RAMP PERPENDICULAR TO CURB

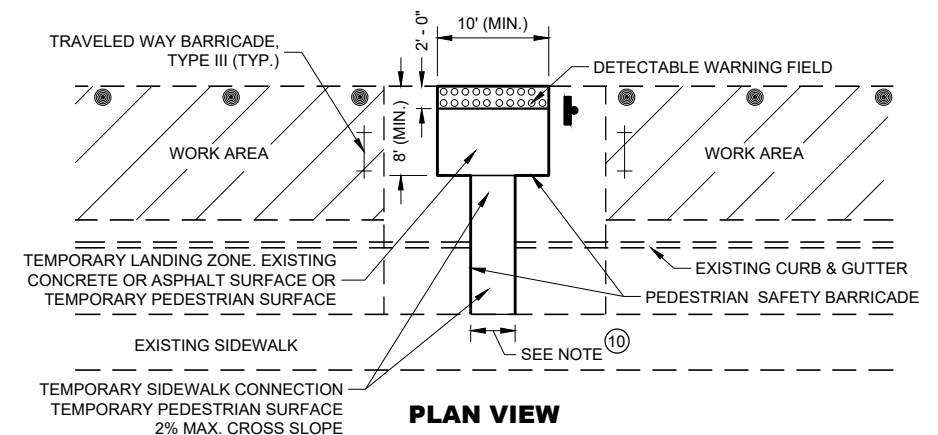

PLAN VIEW

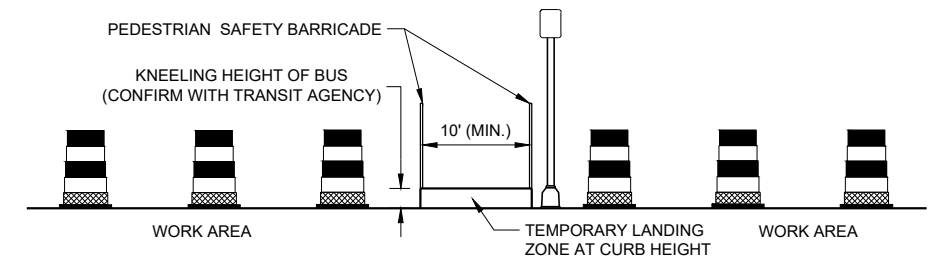

PROFILE VIEW

TEMPORARY BUS STOP PAD

LEGEND

- TRAFFIC CONTROL DRUM
- TYPE III BARRICADE
- WORK AREA

**TRAFFIC CONTROL,
PEDESTRIAN ACCOMMODATION**


STATE OF WISCONSIN
DEPARTMENT OF TRANSPORTATION ¹¹¹

SDD 15D30 - 06b


SDD 15D30 - 06b




SDD 15D30-c Traffic Control, Pedestrian Accommodation

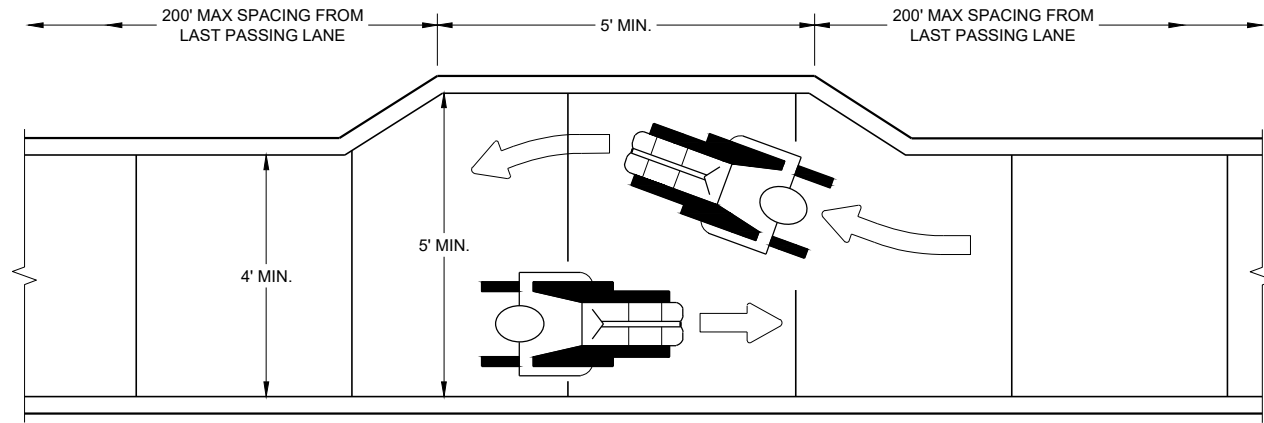


NARROW SIDEWALK PASSING DETAIL

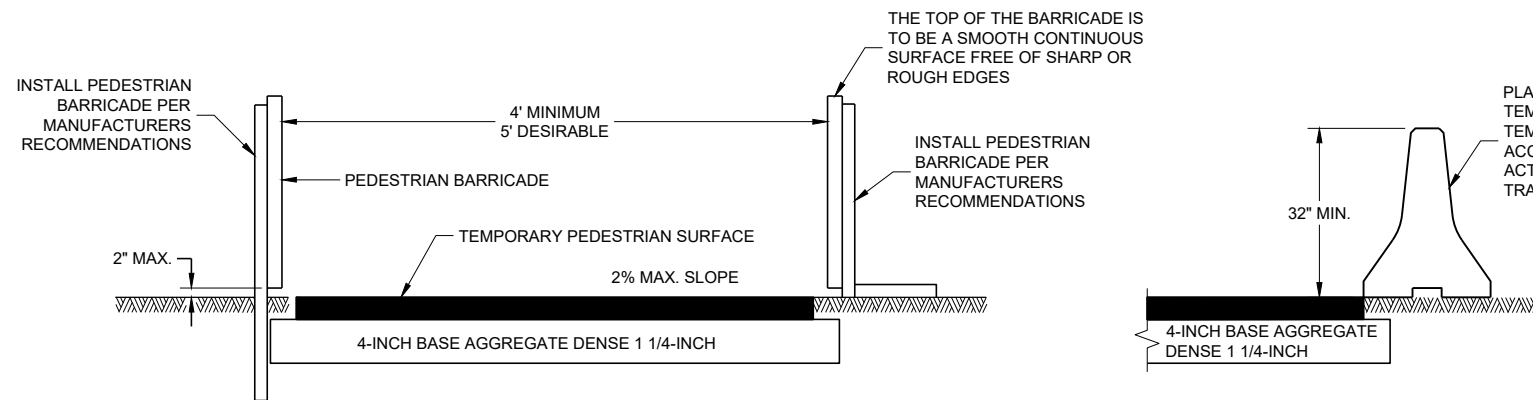


TEMPORARY PEDESTRIAN ACCESS

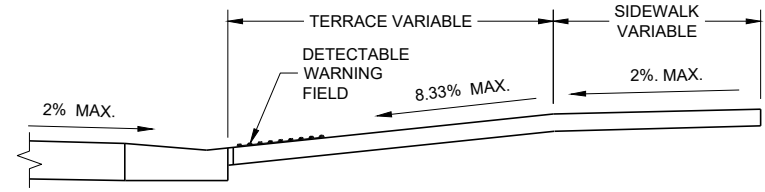


SECTION A - A

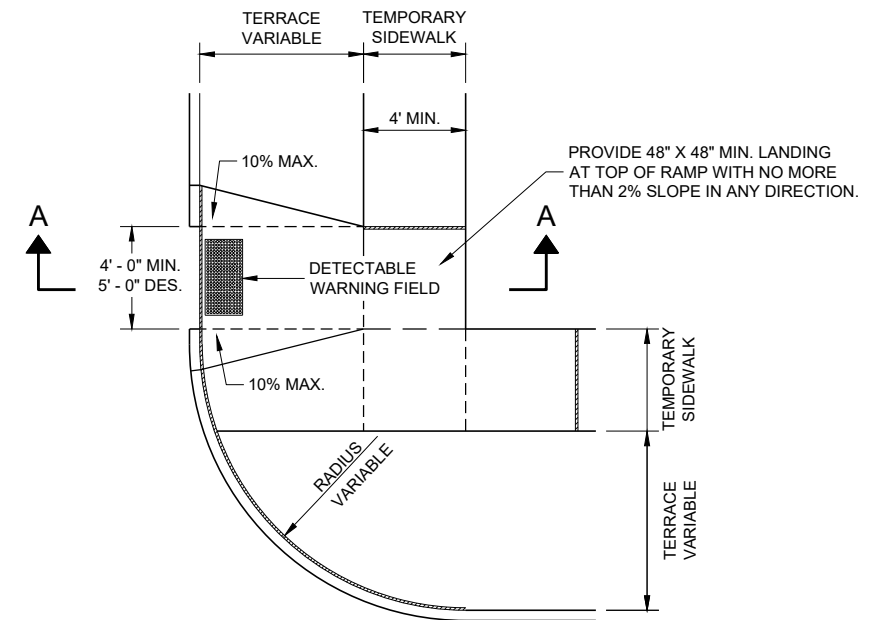

PLAN VIEW TEMPORARY TYPE 3 RAMP (OUTSIDE OF CROSSWALK AREA)

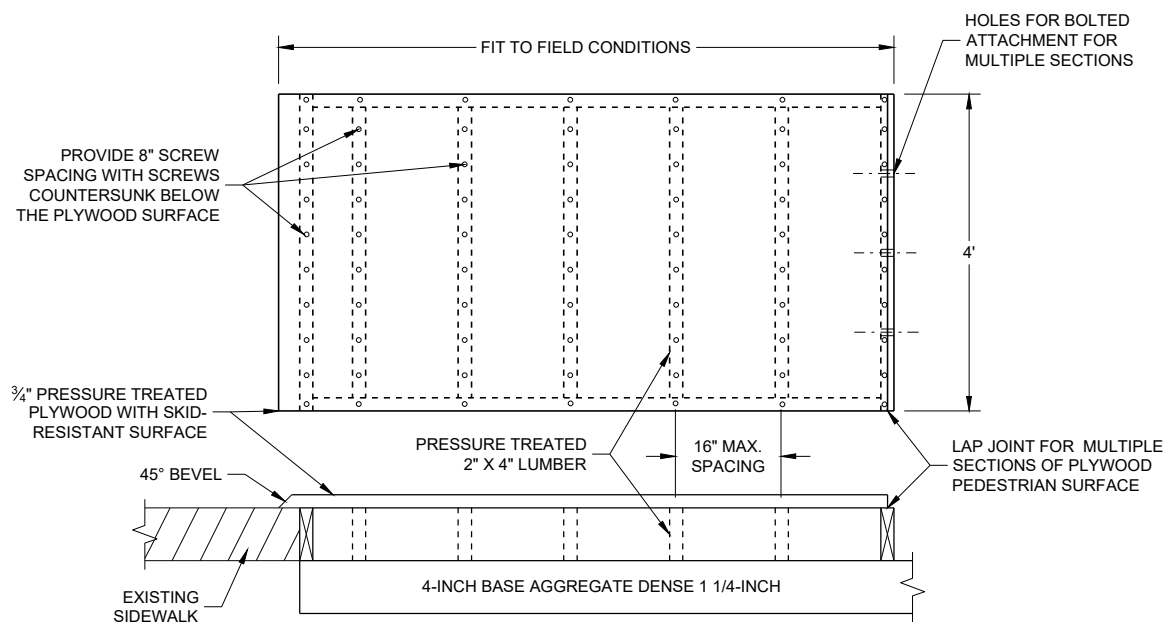

TEMPORARY PEDESTRIAN SURFACE PLYWOOD

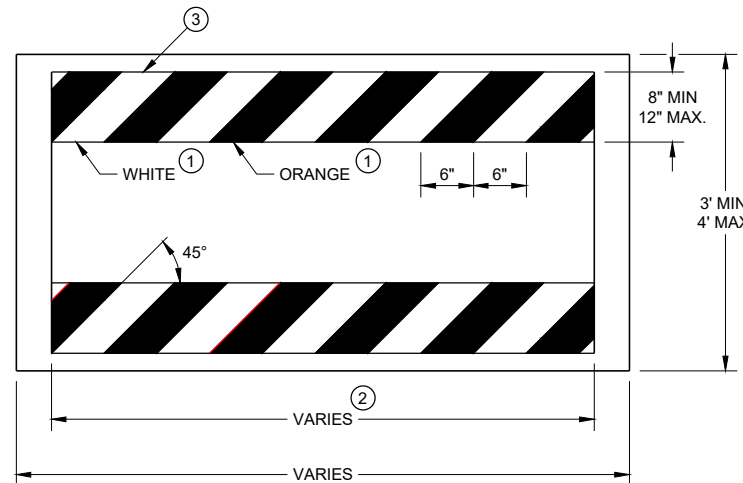

TEMPORARY PEDESTRIAN BARRICADE*

GENERAL NOTES


- BARRICADE DEVICE SELECTED FROM APPROVED PRODUCT LIST
- ① REFLECTIVE SHEETING SHALL FOLLOW THE REQUIREMENTS IN THE APPROVED PRODUCTS LISTING FOR SIGN SHEETING.
- ② SHEETING REQUIRED ON MORE THAN 50% OF BARRICADE WIDTH.
- ③ PLACE SHEETING ON BOTH SIDES OF THE BARRICADE.
- * USE THIS DETAIL FOR SHEETING PLACEMENT REFERENCE.

TRAFFIC CONTROL, PEDESTRIAN ACCOMMODATION

STATE OF WISCONSIN
DEPARTMENT OF TRANSPORTATION


APPROVED
November 2019 /S/ Andrew Heidtke 112
DATE WORK ZONE ENGINEER

FHWA

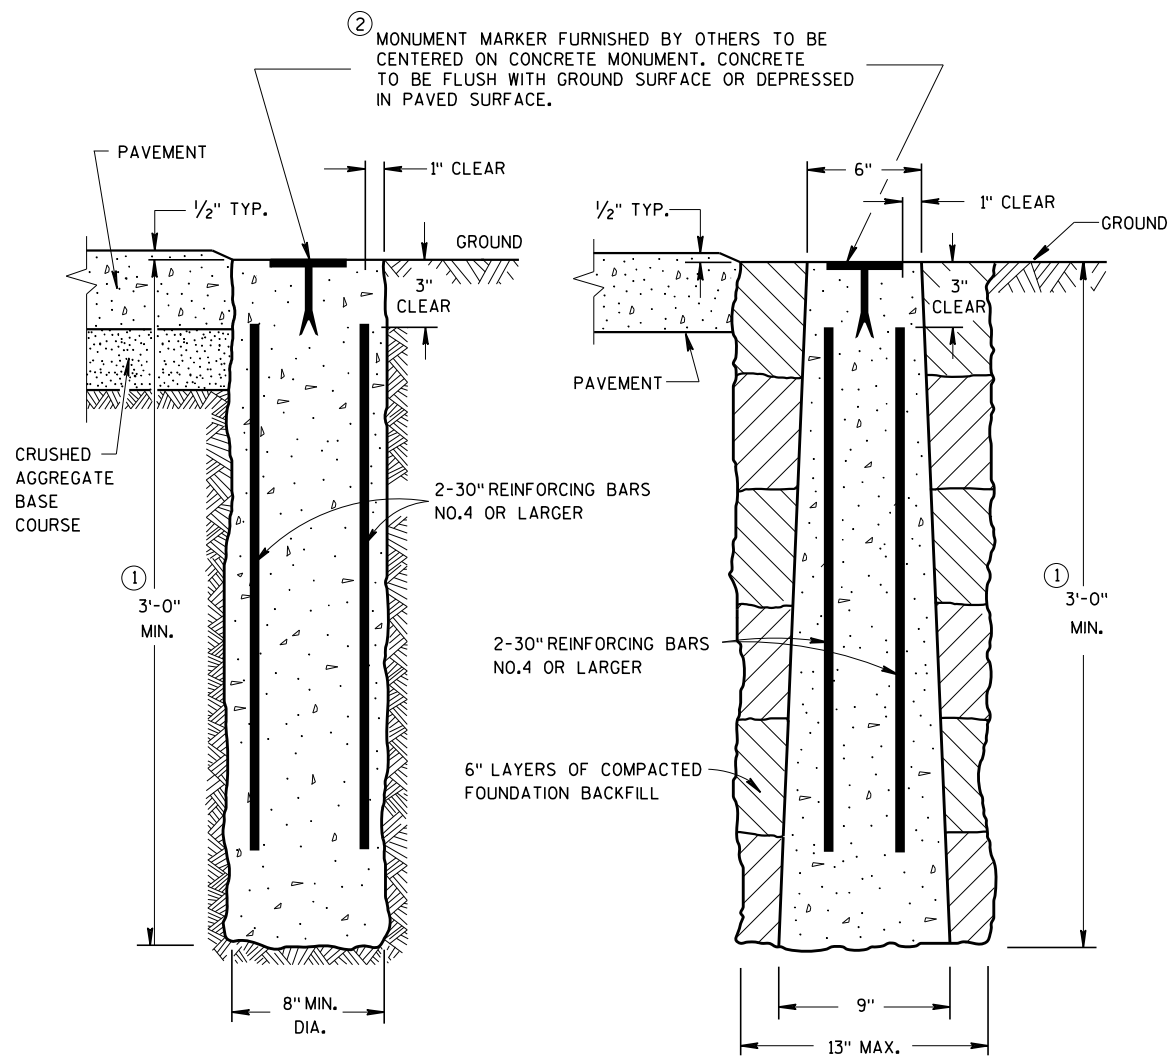


**CAST-IN-PLACE
CONCRETE MONUMENTS
TYPE A**

PRECAST

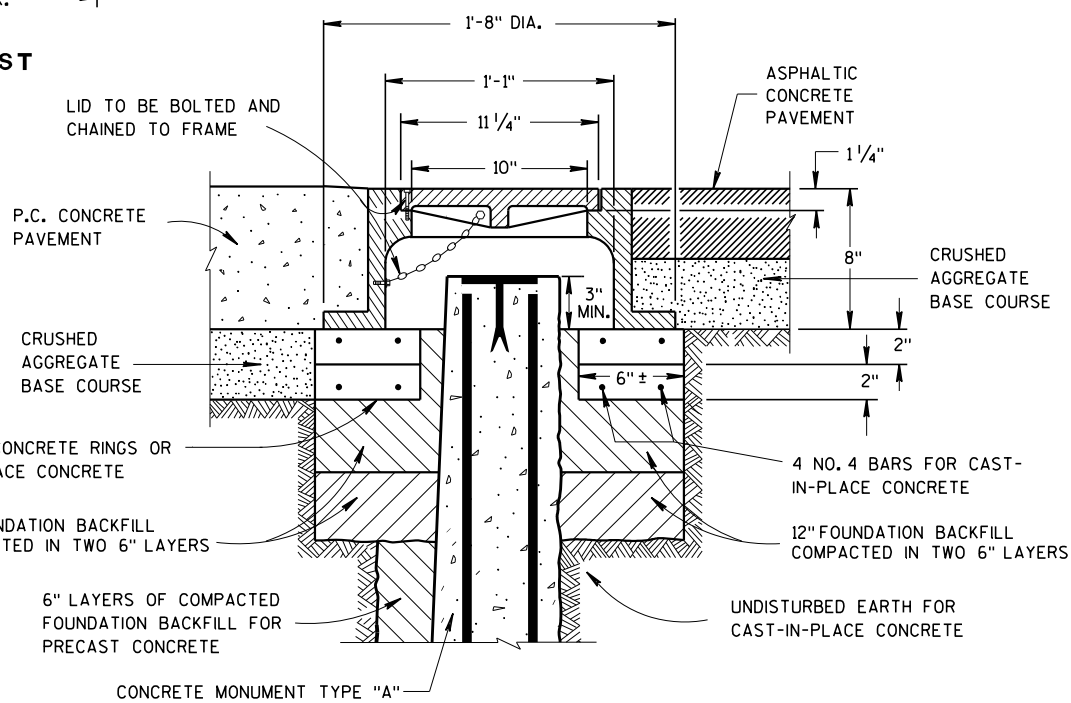



CAST IRON MONUMENT COVER
(APPROXIMATE WEIGHT 95 LBS)

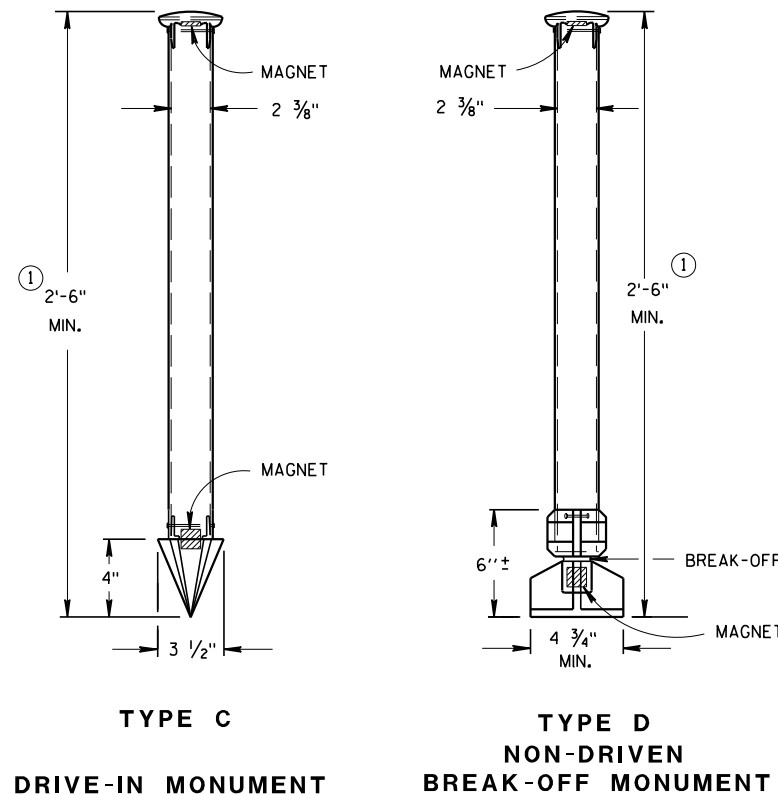

ALUMINUM MONUMENTS
(INCLUDES MARKER)


GENERAL NOTES

- DETAILS OF CONSTRUCTION, MATERIALS AND WORKMANSHIP NOT SHOWN ON THIS DRAWING SHALL CONFORM TO THE PERTINENT REQUIREMENTS OF THE STANDARD SPECIFICATIONS AND THE APPLICABLE SPECIAL PROVISIONS.
- DETAILED DRAWINGS OF PROPOSED ALTERNATE DESIGNS FOR METAL MONUMENTS OR MONUMENT COVERS SHALL BE SUBMITTED TO THE ENGINEER FOR APPROVAL.
- PERMANENT MAGNETS SHALL BE INSERTED NEAR THE TOP AND BOTTOM OF ALL ALUMINUM MONUMENTS SO THE MONUMENT CAN EASILY BE DETECTED BY A METAL DETECTOR.
- THE CAST IRON MONUMENT COVER SHALL BE A "NON-ROCKING" TYPE. ADJUSTMENT OF THE COVER TO GRADE MAY BE ACCOMPLISHED BY THE USE OF MORTAR AND BRICK, OR BY EITHER PRECAST OR CAST-IN-PLACE REINFORCED CONCRETE GRADE RINGS.
- MONUMENTS SHALL BE LOCATED AND PLACED AT THE DIRECTION OF THE ENGINEER.
- ALUMINUM MONUMENTS AND MONUMENT COVERS SHALL BE MADE FROM AN ALUMINUM AND MAGNESIUM ALLOY AS DETERMINED BY THE MANUFACTURER.
- THE MONUMENT COVERS DETAILED ON THIS DRAWING ARE NOT EQUAL ALTERNATES. MONUMENT COVERS SHALL BE CAST IRON UNLESS ALUMINUM IS SPECIFIED ELSEWHERE IN THE CONTRACT.
- MONUMENT SHALL BE CAST-IN-PLACE CONCRETE UNLESS PRECAST CONCRETE OR ALUMINUM MONUMENTS ARE SPECIFIED IN THE CONTRACT OR PERMITTED BY THE ENGINEER
- ① MINIMUM LENGTH SHALL BE 4'-0" FOR MONUMENTS INSTALLED IN PAVED AREAS.
② AN OFFICIAL COUNTY MONUMENT MARKER SUPPLIED BY A COUNTY MAY BE REQUIRED FOR SOME SECTION CORNERS AND WITNESS MONUMENTS INSTEAD OF THIS WIS DOT MARKER.

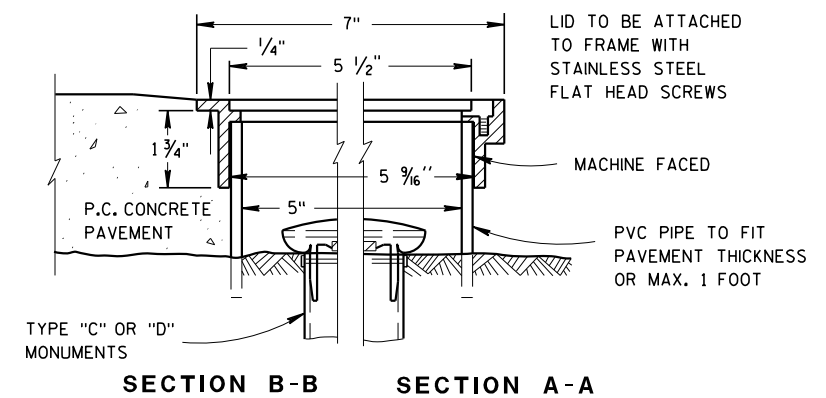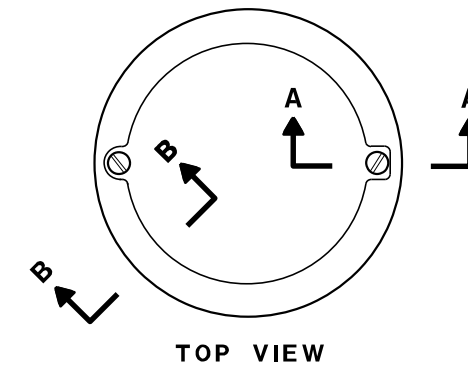

ALUMINUM MONUMENT COVER

(APPROXIMATE WEIGHT 2 LBS)
(FOR CONCRETE PAVEMENT ONLY)



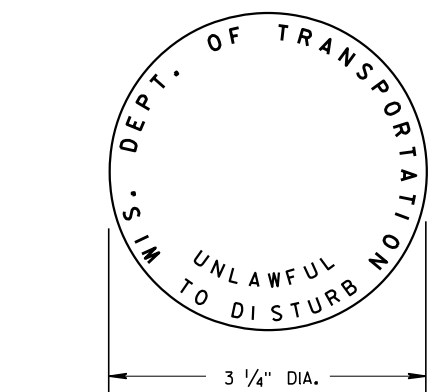


② **WIS DOT MONUMENT MARKER LOGO**
FOR TYPES "A", "C", & "D"

LANDMARK REFERENCE MONUMENTS AND COVERS	
STATE OF WISCONSIN DEPARTMENT OF TRANSPORTATION	
APPROVED March 2018	/s/ Raymond A. Kumpayl DATE CHIEF SURVEYING AND MAPPING ENGINEER
FHWA	

NOTES:


1. ALL SIGNS ARE TYPE II - TYPE H REFLECTIVE. REFERENCE WISDOT STANDARD SPECIFICATIONS FOR ROAD AND BRIDGE CONSTRUCTION, LATEST EDITION.
2. COLOR:
BACKGROUND - GREEN
MESSAGE - WHITE
3. MESSAGE SERIES AS NOTED.
4. ARROWS PER STANDARD SIGN PLATE A1-2.

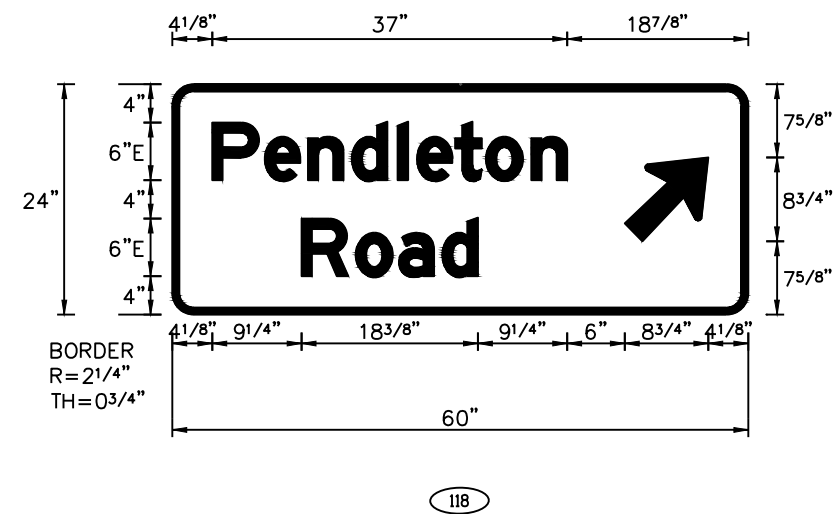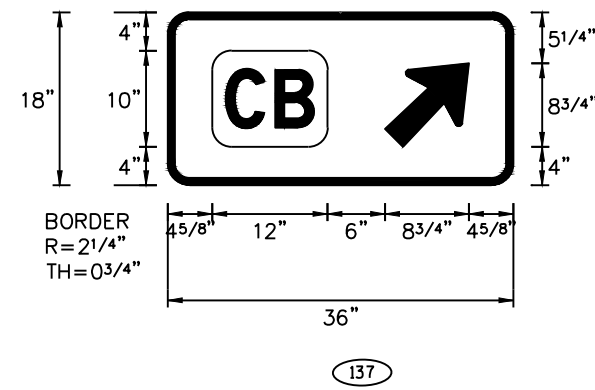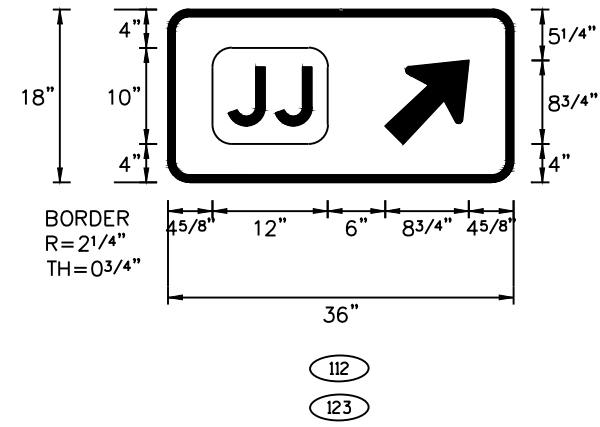


7

7


TYPICAL ASSEMBLIES

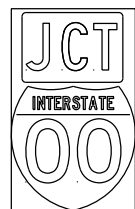


J1-1

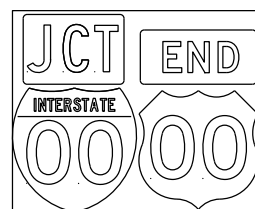


J1-2

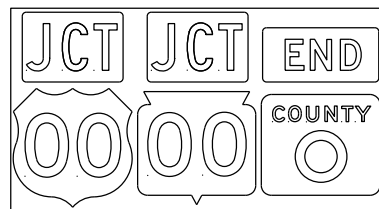


J1-3

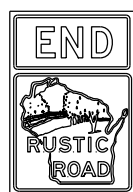


JR1-1

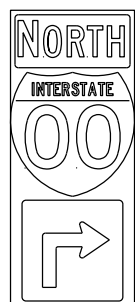


J2-1

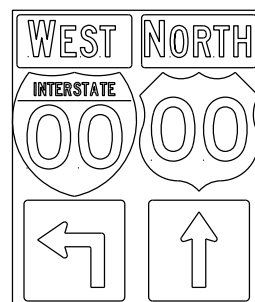


J2-2

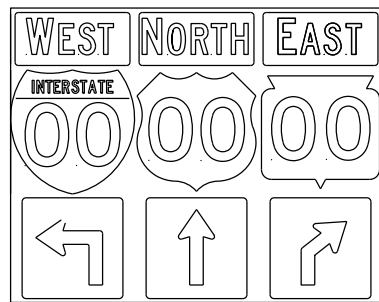


J2-3

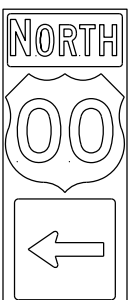


J3-1

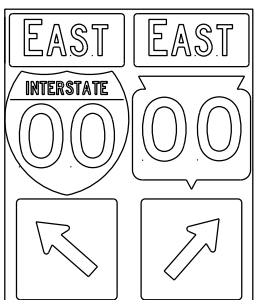


J3-2

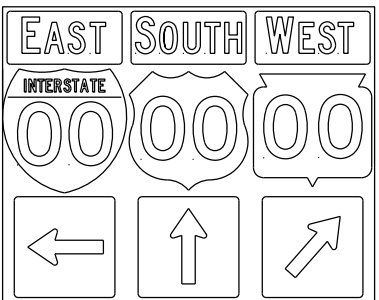


J3-3

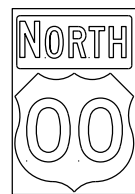


J4-1

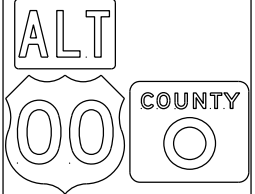


J4-2

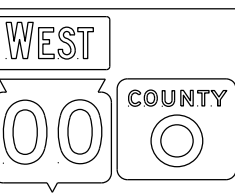


J4-2

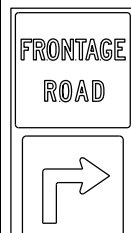


J12-1

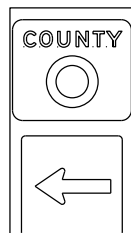


J13-1

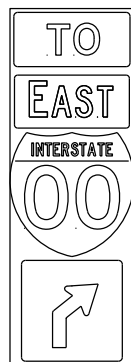


J32-1

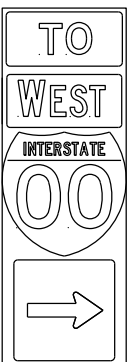


J33-1

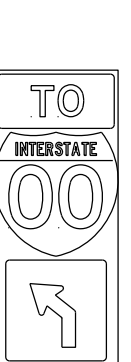

J22-1

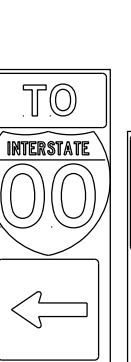

J23-1

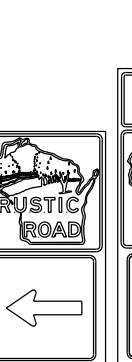


JR13-1



JR23-1




JR99-1

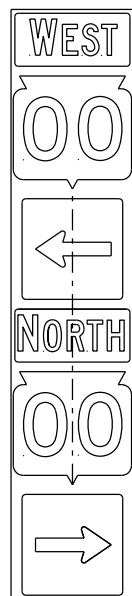

JV




(Typical Vertical J-Assembly See Note 10 and 11)

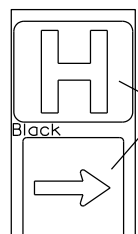

JH-1

Blue Background

blue background with interstate

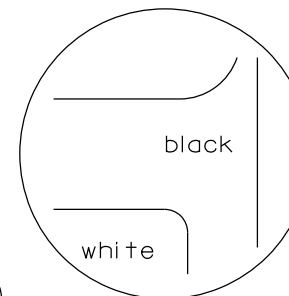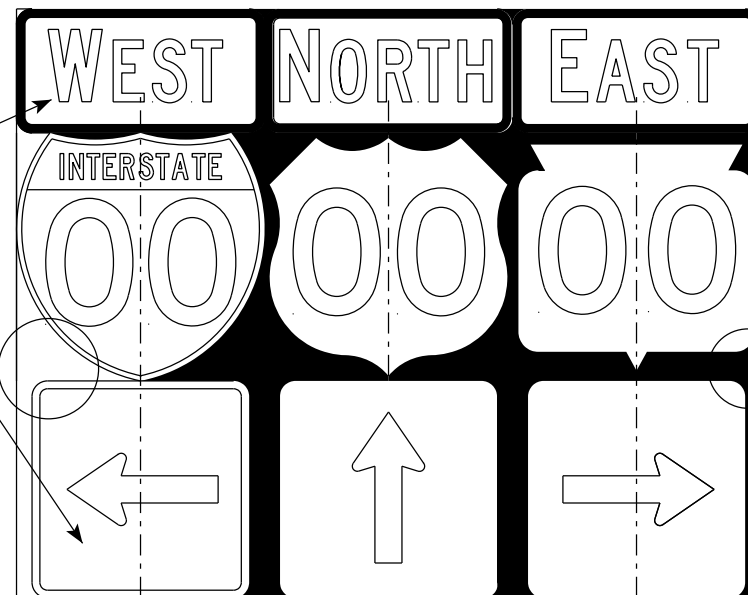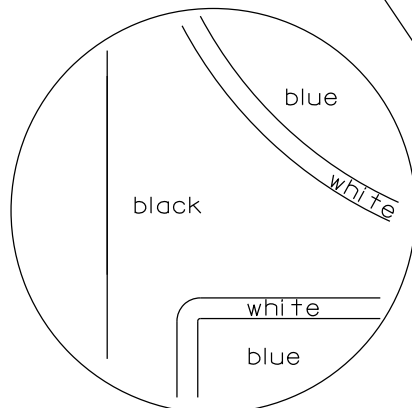

black background

NOTES

- Signs are Type II - Type H Reflective
- Color:
 - Background - Black Non-reflective
 - Message - see Note 5
- Message Series - See Note 5
- Corners shall be square or rounded if base material is plywood. If base material is metal the corners shall be rounded.
- The colors and message spacing on each marker shall be according to the applicable route marker panel specifications.
- Certain marker heads require the component pieces to be the same color. As an example, all the components used with an MI-1 Interstate marker shall be blue.
- Single panel j-assemblies shall only be used with route marker shields that are same size. If the route marker shields are different size use multiple piece component.
- Route assemblies that have 24 inch route shields and have dimensions greater than 48 inches (both vertical and horizontal) shall have one horizontal splice between the arrows and route shields. Vertical splices shall not be used on route assemblies with a horizontal dimension of 144 inches or less. The contractor shall not use more than one vertical joint per sign and the joint shall be between route shields.
- Route assemblies that have 36 inch shields and have dimensions greater than 48 inches (both vertical and horizontal) shall have two horizontal splices. One horizontal splice shall be between the cardinal direction and route shields and the other horizontal splice shall be between the arrows and route shields. Vertical splices shall not be used on route assemblies with a horizontal dimension of 144 or less. The contractor shall not use more than one vertical joint per sign and the joint shall be between route shields.
- All Vertical J Assemblies are given a Sign Code of JV
- For JV Assemblies that have a mixture of Interstate and non Interstate shields, arrows and cardinals shall be white on blue.

ROUTE MARKERS & COMPONENTS IN TYPICAL ASSEMBLIES

WISCONSIN DEPT OF TRANSPORTATION

APPROVED

Matthew R. Rauch
for State Traffic Engineer

DATE 3/18/21

PLATE NO. A2-1S.9


PROJECT NO:

SHEET NO: 115


E

URBAN AREA


RURAL AREA (See Note 2)

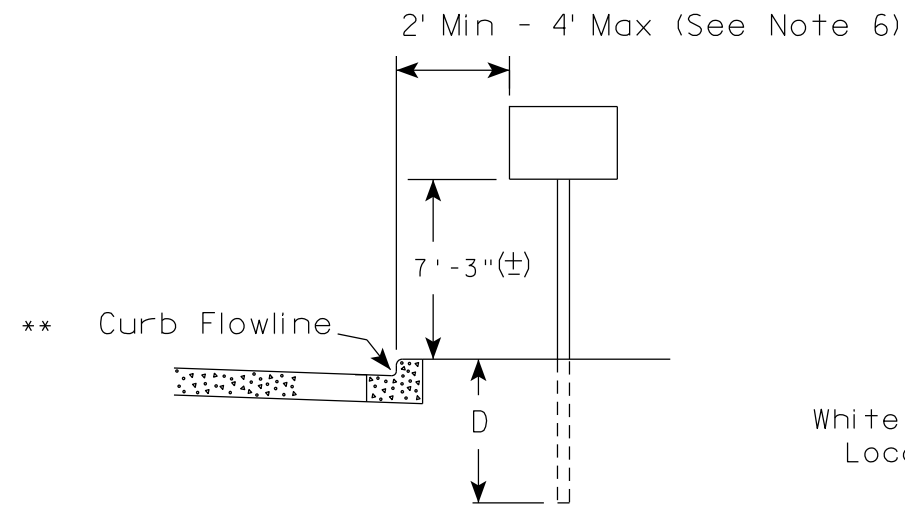


White Edgeline Location

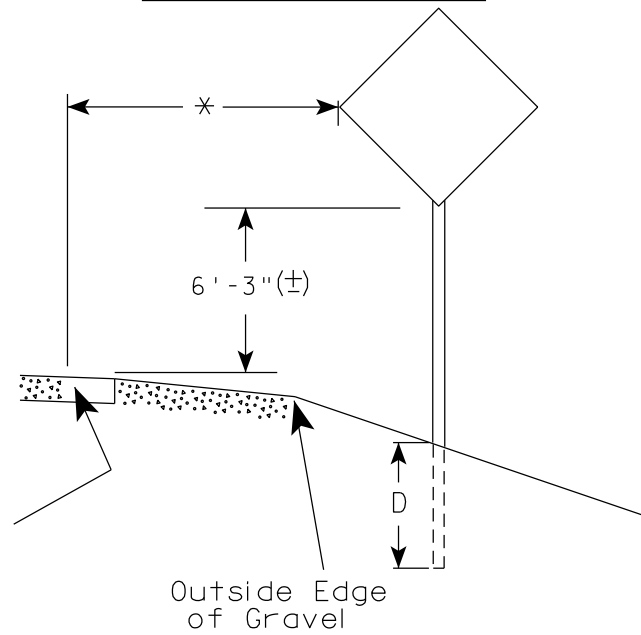

Outside Edge of Gravel

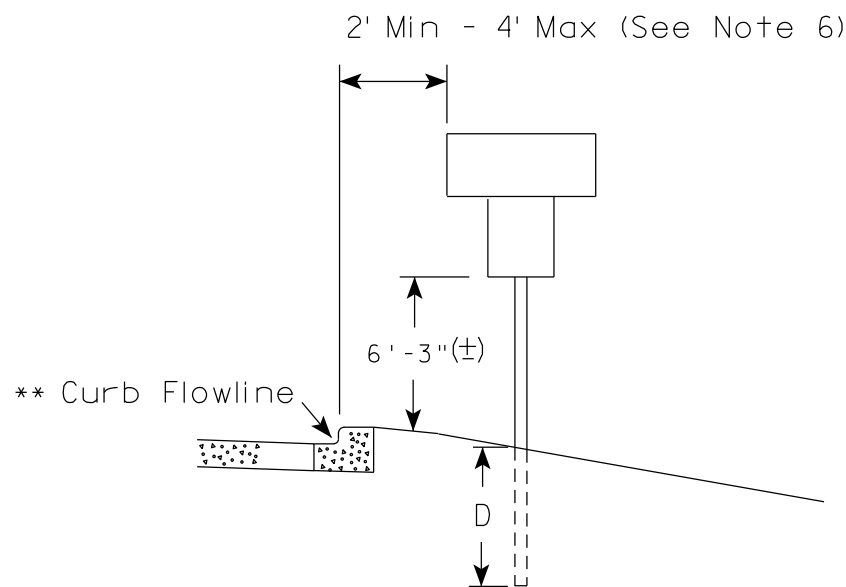

White Edgeline Location

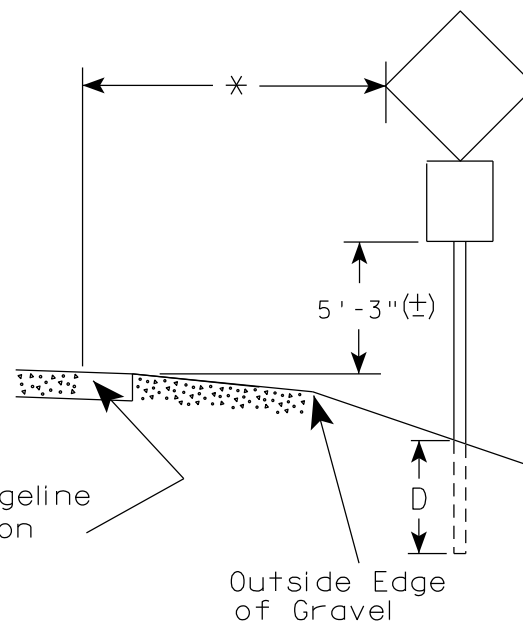

Outside Edge of Gravel

POST EMBEDMENT DEPTH

Area of Sign Installation (Sq. Ft.)	D (Min)
20 or Less	4'
Greater than 20	5'

GENERAL NOTES

1. Signs wider than 4 feet or 20 sq.ft or larger, shall be mounted on multiple posts. Refer to plate A4-4.
2. If signs are mounted on or behind barrier wall, see A4-10 sign plate.
The Double Arrow sign (W12-1D) shall be mounted at a height of 2'-3" (±). The Chevron sign (W1-8), Roundabout Chevron panel (R6-4B), Enhanced Reference Markers, Clearance Markers (W5-52), Mile Markers (D10 series), In Road Object Markers (W5-54) & End of Road Markers (W5-56) shall be mounted at a height of 4'-3" (±).
3. For expressways and freeways, mounting height is 7'- 3" (±) or 6'-3" (±) depending upon existence of a sub-sign.
4. Minimum mounting height for signs mounted on traffic signal poles is 5'- 3" (±).
5. Offset distance shall be consistent with existing signs or consistent throughout length of project.
6. The (±) tolerance for mounting height is 3 inches.
7. Folding signs shall be mounted at a height of 5'-3" (±) or as directed by the Engineer.

* * The existence of curb and gutter does not in itself mandate the vertical clearance illustrated. That height is typically measured where there is sidewalk adjacent to the roadway or parking is permitted. In the absence of sidewalk vertical clearance is measured from the top of the curb. Offset of signs is measured from the flow line.


* 6 feet from edge of a paved shoulder or 12 feet from the edge of pavement (edge line location) or 2 feet from outside edge of gravel, whichever is greater unless directed by project engineer.

TYPICAL INSTALLATION OF PERMANENT TYPE II SIGNS ON SINGLE POSTS

WISCONSIN DEPT OF TRANSPORTATION

APPROVED *Matthew R. Rauch*
for State Traffic Engineer


DATE 5/13/2020 PLATE NO. A4-3.22

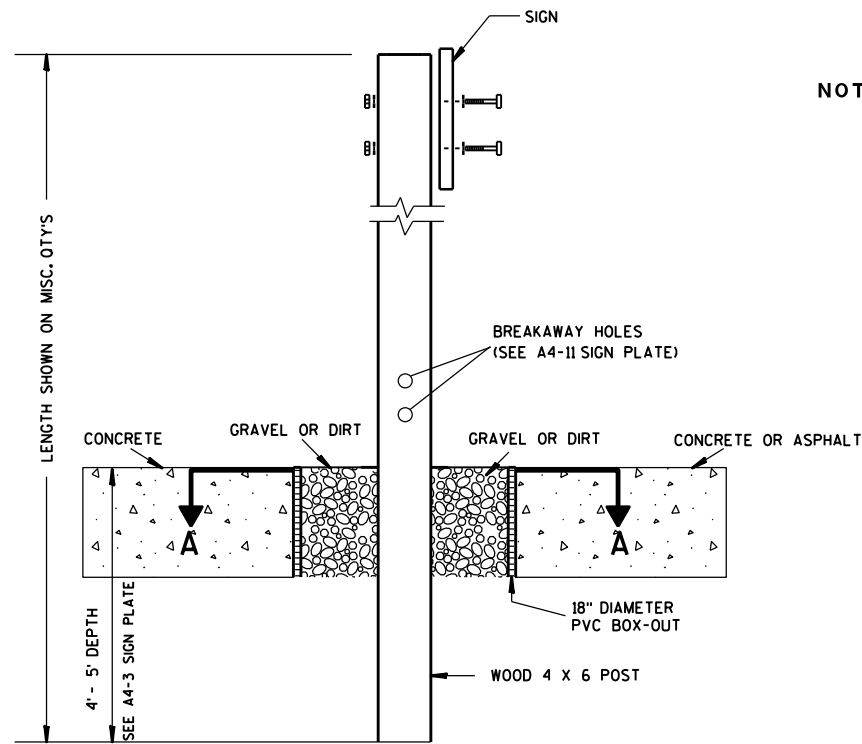

ELEVATION VIEW


DETAIL OF WOOD 4 X 6 SIGN POST IN BOX-OUT

- NOTES:**
1. ALL MATERIAL TO BE APPROVED BY ENGINEER PRIOR TO INSTALLATION
 2. SEE SIGN PLATE A4-8 FOR SIGN HARDWARE REQUIREMENTS
 3. 18 INCH X 18 INCH SQUARE BOX-OUTS MAY BE USED FOR INSTALLATIONS IN EXISTING CONCRETE OR ASPHALT LOCATIONS.

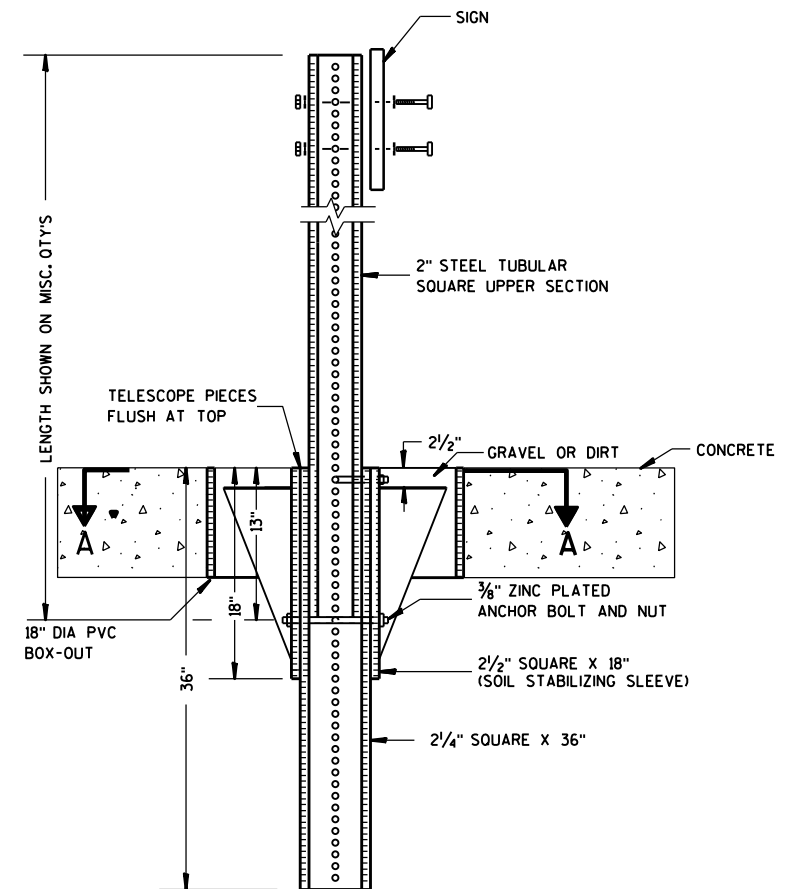

ELEVATION VIEW

DETAIL OF STEEL 2 X 2 SIGN POST IN BOX-OUT

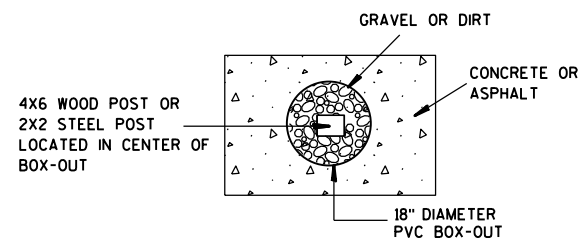

PLAN VIEW


FOR NEW CONCRETE/ASPHALT INSTALLATIONS

SIGN POST BOX-OUTS A4-3B	
<small>WISCONSIN DEPT OF TRANSPORTATION</small>	
APPROVED <i>Matthew R. Rauch</i> <small>for State Traffic Engineer</small>	
<small>DATE 1/27/14</small>	<small>PLATE NO.7 A4-3B.1</small>



GENERAL NOTES

1. For 3 or 4 post installations, individual post spacing shall be greater than 3'-6".
2. See tables below for required number of posts.
3. For expressways and freeways, mounting height is 7'-3" (±) or 6'-3" (±) depending upon existence of sub-sign.
4. The (±) tolerance for mounting height is 3 inches.
5. J-Assemblies are considered to be one sign for mounting height.
6. Offset distance shall be consistent with existing signs or consistent throughout length of project.
7. Folding signs shall be mounted at a height of 5'-3" (±) or as directed by the engineer.
8. The Double Arrow sign (W12-1) shall be mounted at a height of 2'-3" (±). The Chevron sign (W1-8), Roundabout Chevron panel (R6-4B), Clearance Markers (W5-52), Mile Markers (D10 series), In Road Object Markers (W5-54) & End of Road Markers (W5-56) shall be mounted at a height of 4'-3" (±).


URBAN AREA

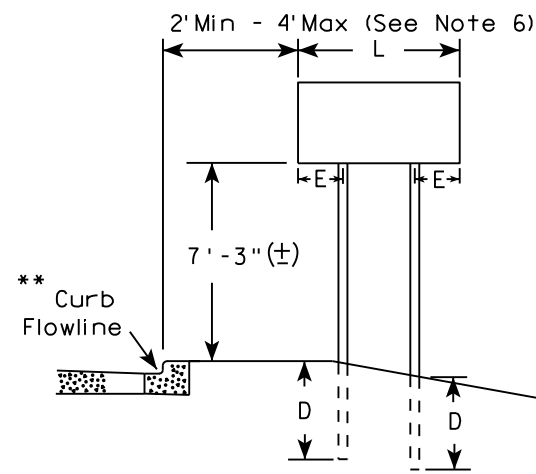


RURAL AREA (See Note 3)

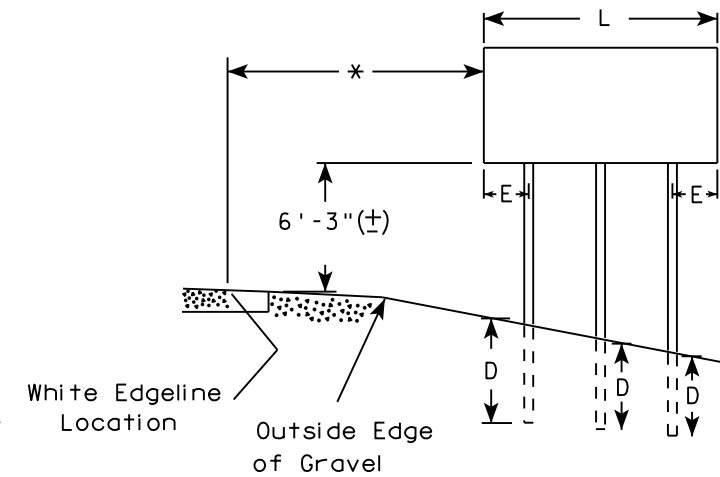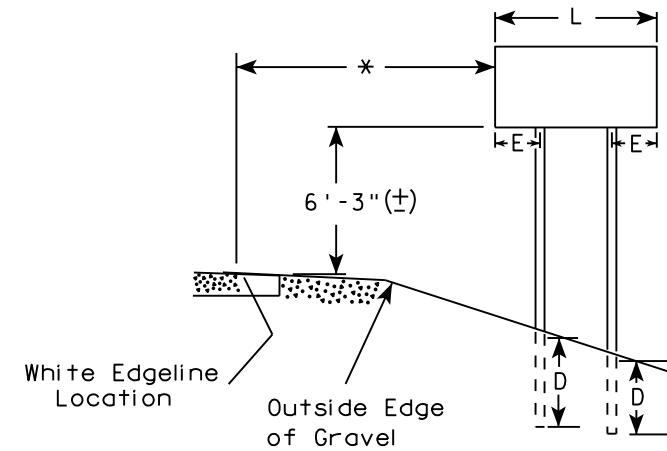

2' Min - 4' Max (See Note 6)

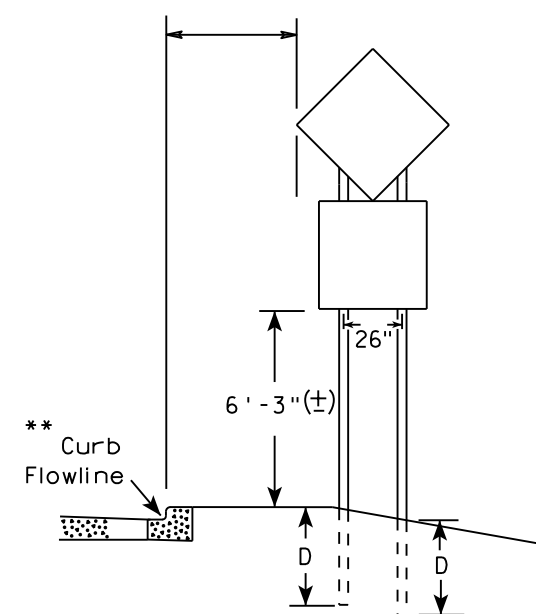

48" DIAMOND WARNING SIGN

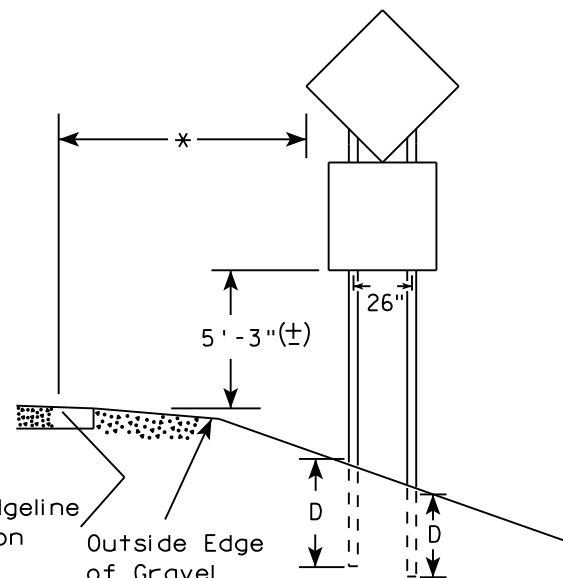

48" DIAMOND WARNING SIGN

* 6 feet from edge of a paved shoulder or 12 feet from the edge of pavement (edge line location) or 2 feet from outside edge of gravel, whichever is greater unless directed by project engineer.

** The existence of curb and gutter does not in itself mandate the vertical clearance illustrated. That height is typically measured where there is sidewalk adjacent to the roadway or parking is permitted. In the absence of sidewalk vertical clearance is measured from the top of the curb. Offset of signs is measured from the flow line.

*** See A4-3 sign plate for signs 4' or less in width and less than 20 S.F. in area.

SIGN SHAPE OTHER THAN DIAMOND (TWO POSTS REQUIRED)	
L	E
Greater than 48" Less than 60"	12"
60" to 108"	L/5


SIGN SHAPE OTHER THAN DIAMOND (THREE POSTS REQUIRED)	
L	E
Greater than 108" to 144"	12"

POST EMBEDMENT DEPTH

Area of Sign Installation (Sq. Ft.)	D (Min)
20 or Less	4'
Greater than 20	5'

TYPICAL INSTALLATION OF TYPE II SIGNS ON MULTIPLE POSTS

WISCONSIN DEPT OF TRANSPORTATION
 APPROVED *Matthew R. Rauch*
 For State Traffic Engineer
 DATE 8/21/17 PLATE NO. A4-4.15

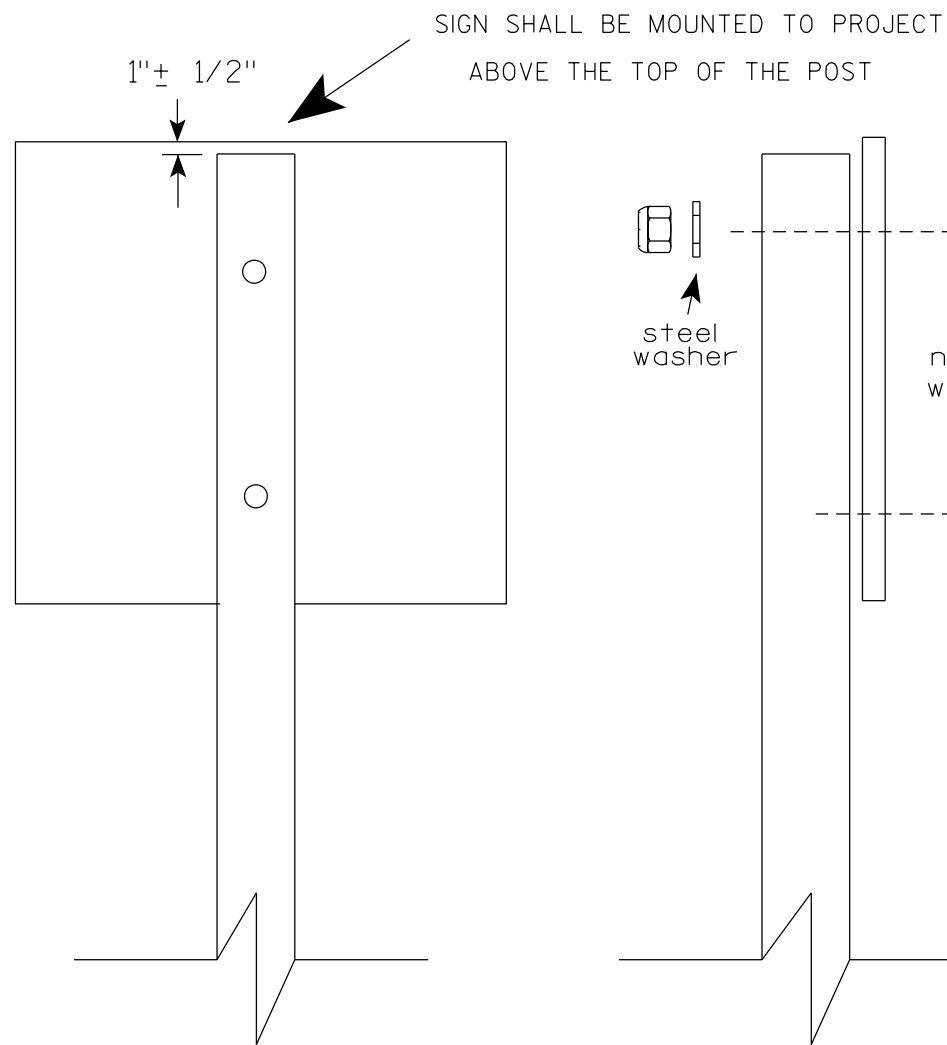

Nuts, bolts and lags used for mounting signs shall have hexagonal heads and shall be either :



- Hot dip galvanized in accordance with ASTM Designation: A 153, Class D, or SC 3
- Electro-galvanized in accordance with ASTM Designation : B 633, TYPE III, SC 3.

Threads on bolts and nuts shall be manufactured with sufficient allowance for the cadmium plate or galvanized coating to permit the nuts to run freely on the bolts.

- STRINGER BOLTING TO ALUMINUM SIGNS (SEE SIGN PLATE A4-18)
- MACHINE BOLTS - 5/16" X 1-3/4" Length w/ lock nuts
- WOOD POSTS (4" x 6")
- LAG SCREWS - 3/8" X 3" (NO STRINGERS ON BACK OF SIGN)
 - 3/8" X 4" (STRINGERS ON BACK OF SIGN)
- SQUARE STEEL POSTS (2" x 2")
- MACHINE BOLTS - 3/8" X 3-1/4" Length w/ nuts (NO STRINGER ON BACK OF SIGN)
 - 3/8" X 5" Length w/ nuts (STRINGERS ON BACK OF SIGN)
- RIVETS - 9/32" (6605-9-6) BULB-TITE, TRI-FOLD, ALUMINUM BODY/MANDREL
- O.D. FLANGE .720-.765 INCH, GRIP RANGE .042-.375 INCH
- WASHERS (ALL POSTS) -
- 1-1/4" O.D. X 3/8" I.D. X 1/16" STEEL
 - 1-1/4" O.D. X 3/8" I.D. X .080 NYLON

* Two different fastening systems are shown for illustration purposes. On any individual sign, either one or the other system shall be used. Actual number of fasteners per sign varies with the sign area, but normally there are two. For a single post installation, all signs greater than 9 sq. ft. require the use of 3 fasteners.

ATTACHMENT OF SIGNS TO POSTS	
WISCONSIN DEPT OF TRANSPORTATION	
APPROVED	<i>Matthew R Rauch</i> For State Traffic Engineer
DATE 4/1/2020	PLATE NO. A4-8.9

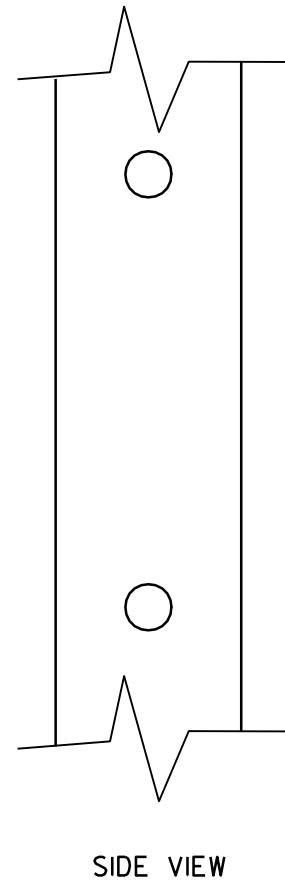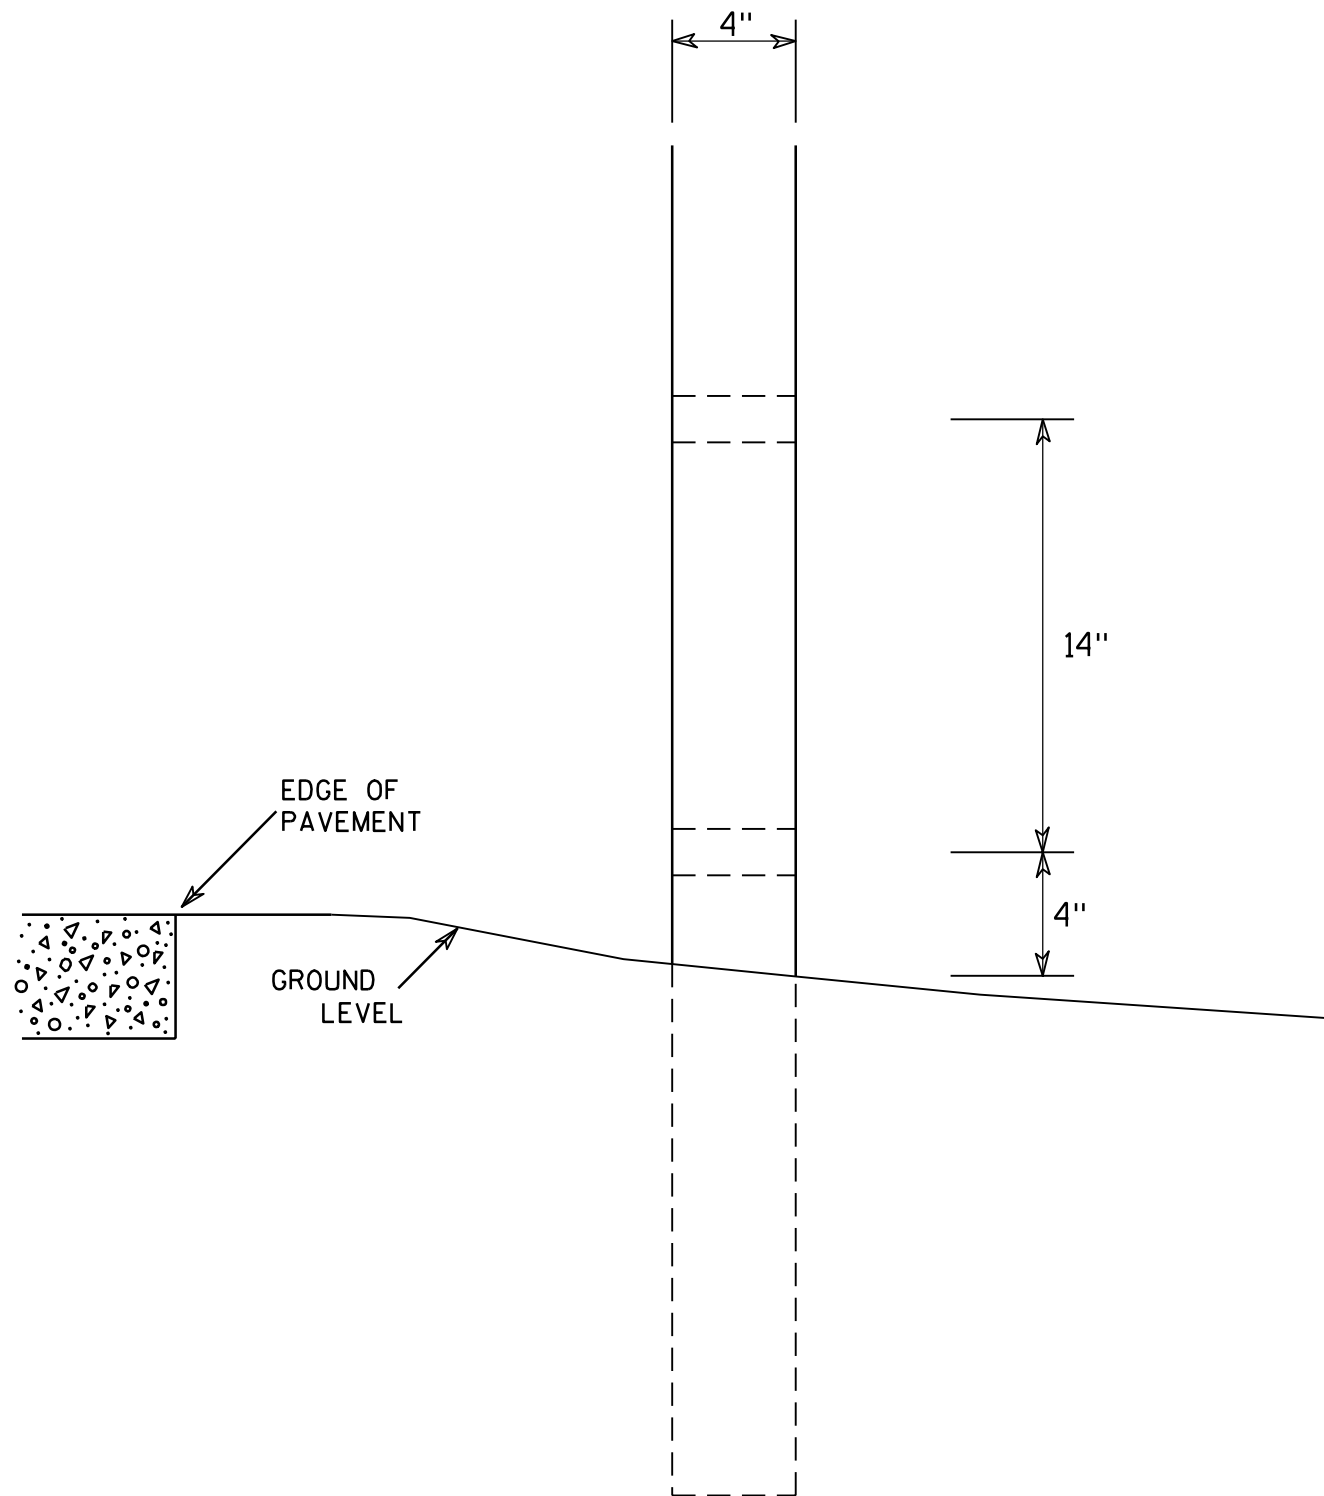

GENERAL NOTES

1. All 4 x 6 Wood Posts shall be modified by having two 1½" diameter holes drilled perpendicular to the roadway centerline.


7

7




4 X 6 WOOD POST MODIFICATIONS	
<i>WISCONSIN DEPT OF TRANSPORTATION</i>	
APPROVED	<i>Chester J Spang</i> for State Traffic Engineer
DATE <u>3/27/97</u>	PLATE NO. <u>A4-11.2</u>

NOTES

1. Sign is Type II - see Note 7 - reference WIS DOT Standard Specification for HIGHWAY and STRUCTURE CONSTRUCTION latest edition.
2. Color:
Background - White & Black - See Note 7
Message - Black
3. Message Series - see Note 5
4. Corners may be square or rounded when base material is plywood but borders shall be rounded as shown. When base material is metal, the corners and borders shall be rounded.
5. Message Series E for 1 letter.
Message Series D for 2 letters unless message is too big then Series C.
Message Series C for 3 letters unless message is too big then Series B.
6. Substitute appropriate letters & optically center to achieve proper balance.
7. Permanent Signs
Background - Type H Reflective
Detour or temporary Signs
Background - Reflective

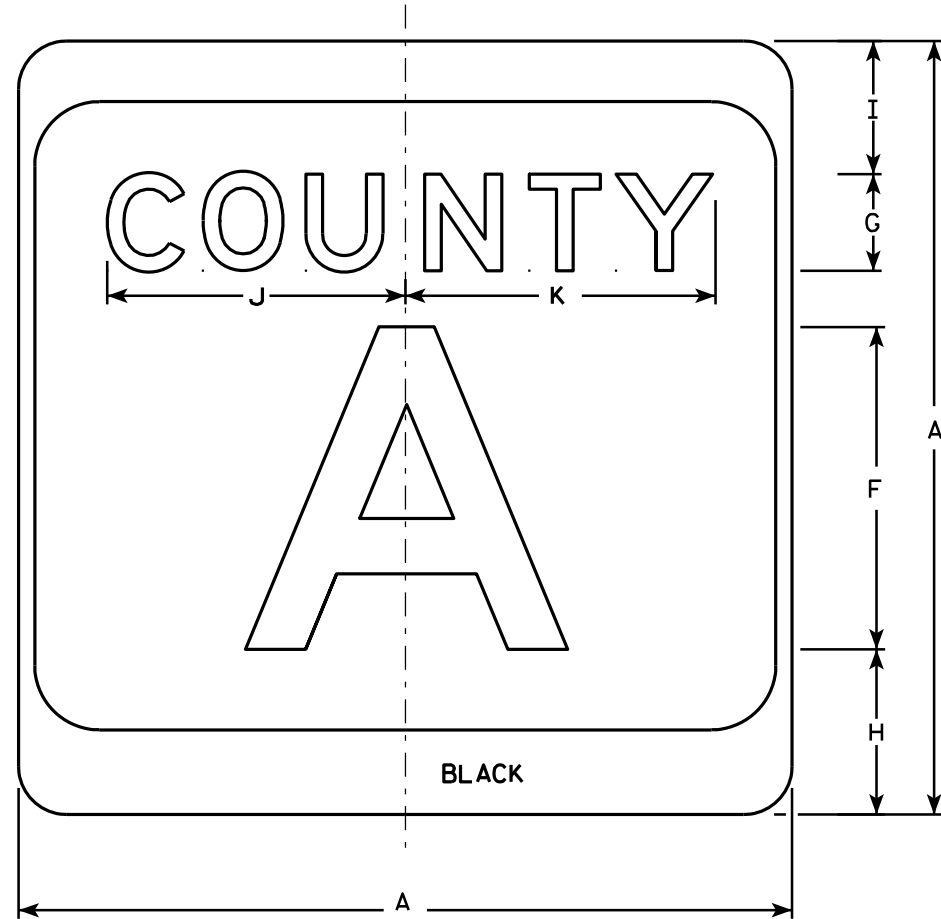

M1-5A

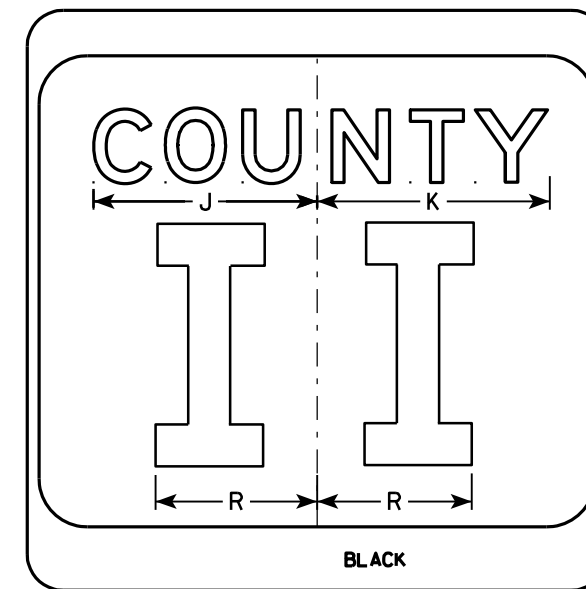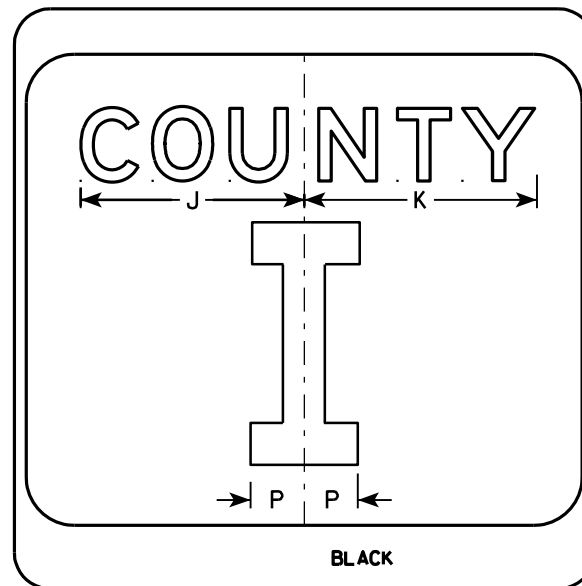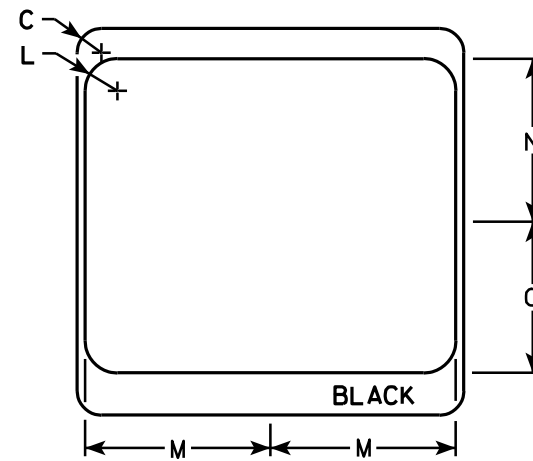

7

7

SIZE	A	B	C	D	E	F	G	H	I	J	K	L	M	N	O	P	Q	R	S	T	U	V	W	X	Y	Z	Area sq. ft.
1																											
2	24		1 1/2			10	3	5 1/8	4 1/8	9 1/4	9 5/8	2	11 1/2	10 1/8	9 3/8	2 1/4		6 5/8									4.0
3	36		2 1/4			16	4	7 5/8	5 5/8	12 1/4	12 7/8	3	17 1/8	15 1/4	14	3 3/8		10									9.0
4	36		2 1/4			16	4	7 5/8	5 5/8	12 1/4	12 7/8	3	17 1/8	15 1/4	14	3 3/8		10									9.0
5	36		2 1/4			16	4	7 5/8	5 5/8	12 1/4	12 7/8	3	17 1/8	15 1/4	14	3 3/8		10									9.0

CTH MARKER
M1-5A FOR ASSEMBLIES

WISCONSIN DEPT OF TRANSPORTATION


APPROVED *Matthew R. Raub*
For State Traffic Engineer

DATE 9/27/11 PLATE NO. MI-5A.8


PROJECT NO: _____ HWY: _____ COUNTY: _____ SHEET NO: 121 **E**

NOTES

1. Sign is Type II - Type H
2. Color:
 - Background - See note 5
 - Message - See note 5
3. Message Series - C
4. Corners may be square or rounded when base material is plywood but borders shall be rounded as shown. When base material is metal, the corners and borders shall be rounded.
5. M2-1 Background - White
 Message - Black
 MB2-1 Background - Blue
 Message - White
 MK2-1 Background - Green
 Message - White
 MM2-1 Background - White
 Message - Green
 MN2-1 Background - Brown
 Message - White
 MP2-1 Background - White
 Message - Blue
 MR2-1 Background - Brown
 Message - Yellow

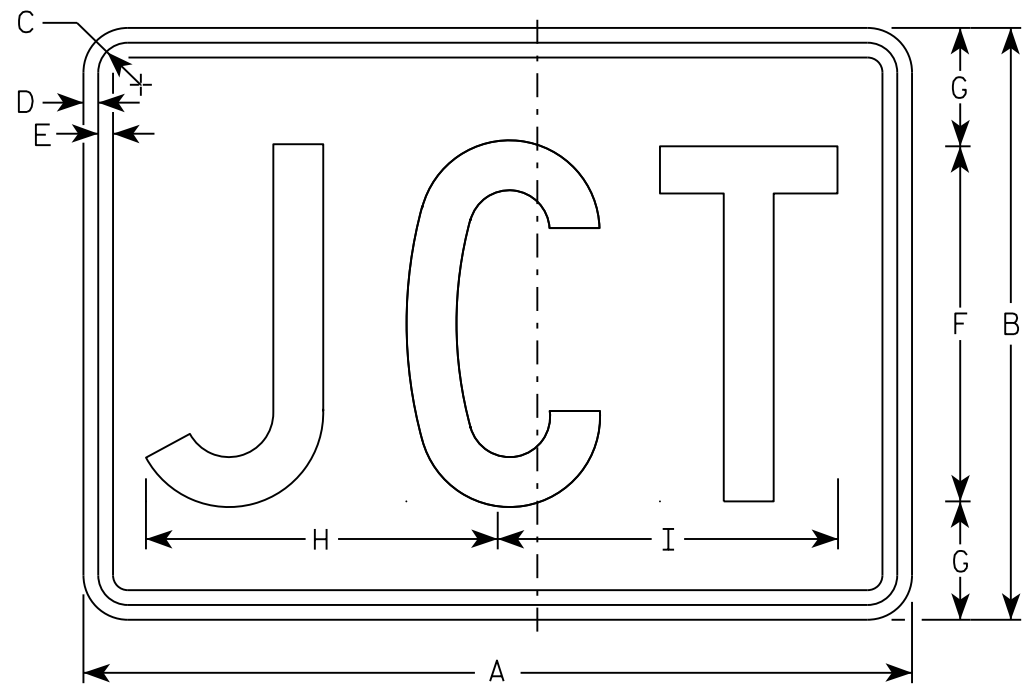

M2-1
MM2-1
MP2-1

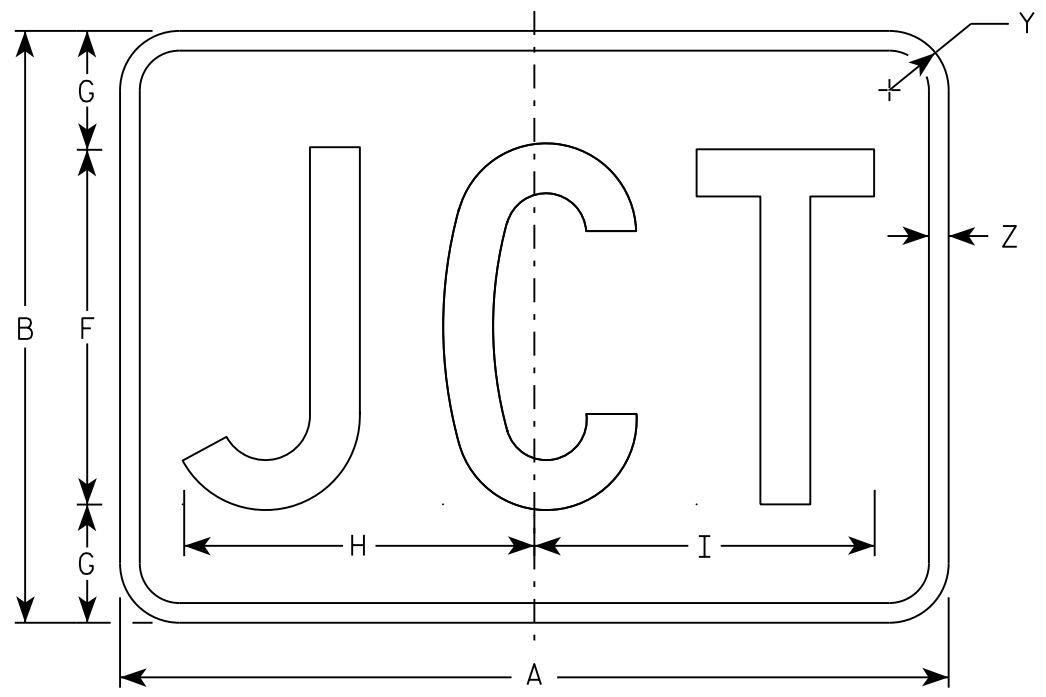

MB2-1
MK2-1
MN2-1
MR2-1

7

SIZE	A	B	C	D	E	F	G	H	I	J	K	L	M	N	O	P	Q	R	S	T	U	V	W	X	Y	Z	Area sq. ft.
1																											
2	21	15	1 1/8	3/8	3/8	9	3	8 7/8	8 5/8																1 1/2	1/2	2.20
3	30	21	1 1/8	3/8	3/8	13	4	12 7/8	12 3/8																1 1/2	1/2	4.40
4	30	21	1 1/8	3/8	3/8	13	4	12 7/8	12 3/8																1 1/2	1/2	4.40
5	30	21	1 1/8	3/8	3/8	13	4	12 7/8	12 3/8																1 1/2	1/2	4.40

STANDARD SIGN
M2-1


WISCONSIN DEPT OF TRANSPORTATION

APPROVED *Matthew R. Rauch*
For State Traffic Engineer


DATE 10/15/15 PLATE NO 22M2-1.12

NOTES


- All Signs Type II - Type H
- Color:
 - Background - See note 5
 - Message - See note 5
- Message Series - C
- Corners may be square or rounded when base material is plywood but borders shall be rounded as shown. When base material is metal, the corners and borders shall be rounded.
- M3-1 thru M3-4 Background - White
 Message - Black
 MB3-1 thru MB3-4 Background - Blue
 Message - White
 MK3-1 thru MK3-4 Background - Green
 Message - White
 MM3-1 thru MM3-4 Background - White
 Message - Green
 MN3-1 thru MN3-4 Background - Brown
 Message - White
 MP3-1 thru MP3-4 Background - White
 Message - Blue
- Note the first letter of each direction is larger than the remainder of the message.

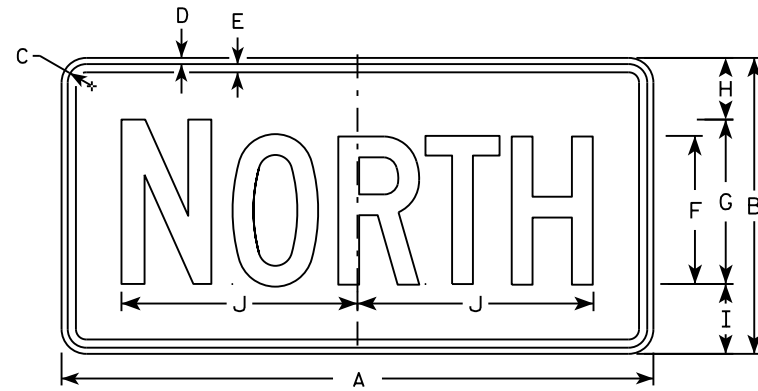


M3-1
MM3-1
MP3-1

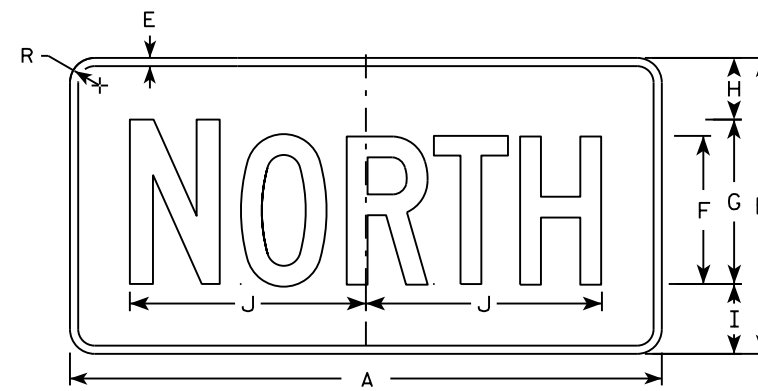


MB3-1
MK3-1
MN3-1

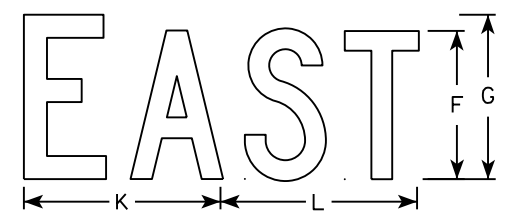


M3-2
MM3-2
MP3-2

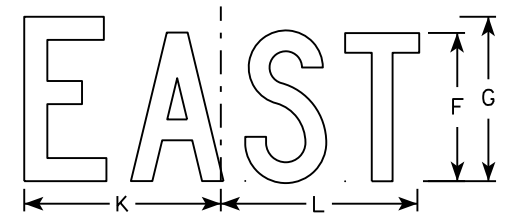


MB3-2
MK3-2
MN3-2

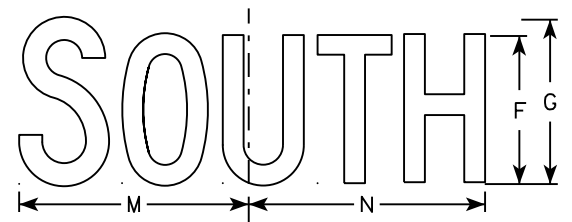


M3-3
MM3-3
MP3-3

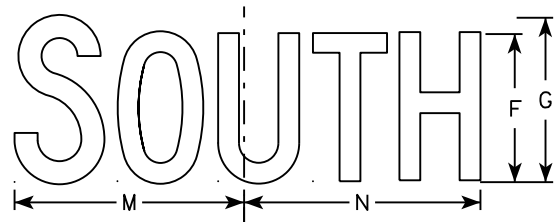

MB3-3
MK3-3
MN3-3

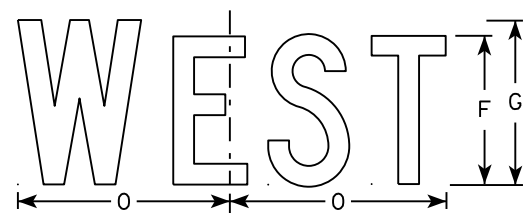

M3-4
MM3-4
MP3-4

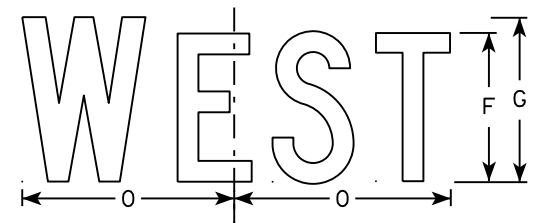

MB3-4
MK3-4
MN3-4

7

SIZE	A	B	C	D	E	F	G	H	I	J	K	L	M	N	O	P	Q	R	S	T	U	V	W	X	Y	Z	Area sq. ft.
1																											
2	24	12	1 1/8	3/8	3/8	6	7	2 1/4	2 3/4	10 1/4	7 7/8	8 3/8	10 1/4	9 3/4	8 3/4			1 1/2									2.00
3	36	18	1 1/8	3/8	1/2	9	10	3 3/4	4 1/4	14 3/8	12	12 1/8	14	14 1/8	13			1 1/2									4.5
4	36	18	1 1/8	3/8	1/2	9	10	3 3/4	4 1/4	14 3/8	12	12 1/8	14	14 1/8	13			1 1/2									4.5
5	36	18	1 1/8	3/8	1/2	9	10	3 3/4	4 1/4	14 3/8	12	12 1/8	14	14 1/8	13			1 1/2									4.5

STANDARD SIGNS
M3-1 thru M3-4
SERIES


WISCONSIN DEPT OF TRANSPORTATION

APPROVED *Matthew R. Rauch*
for State Traffic Engineer

DATE 10/15/15 PLATE NO. M3-1.14

NOTES

1. Sign is Type II - Type H Reflective - reference WIS DOT Standard Specification for HIGHWAY and STRUCTURE CONSTRUCTION latest edition.
2. Color:
Background - White
Message - See note 5
3. Message Series - C
4. Corners may be square or rounded when base material is plywood but borders shall be rounded as shown. When base material is metal, the corners and borders shall be rounded.
5. The border strip and word message are reflectorized red.

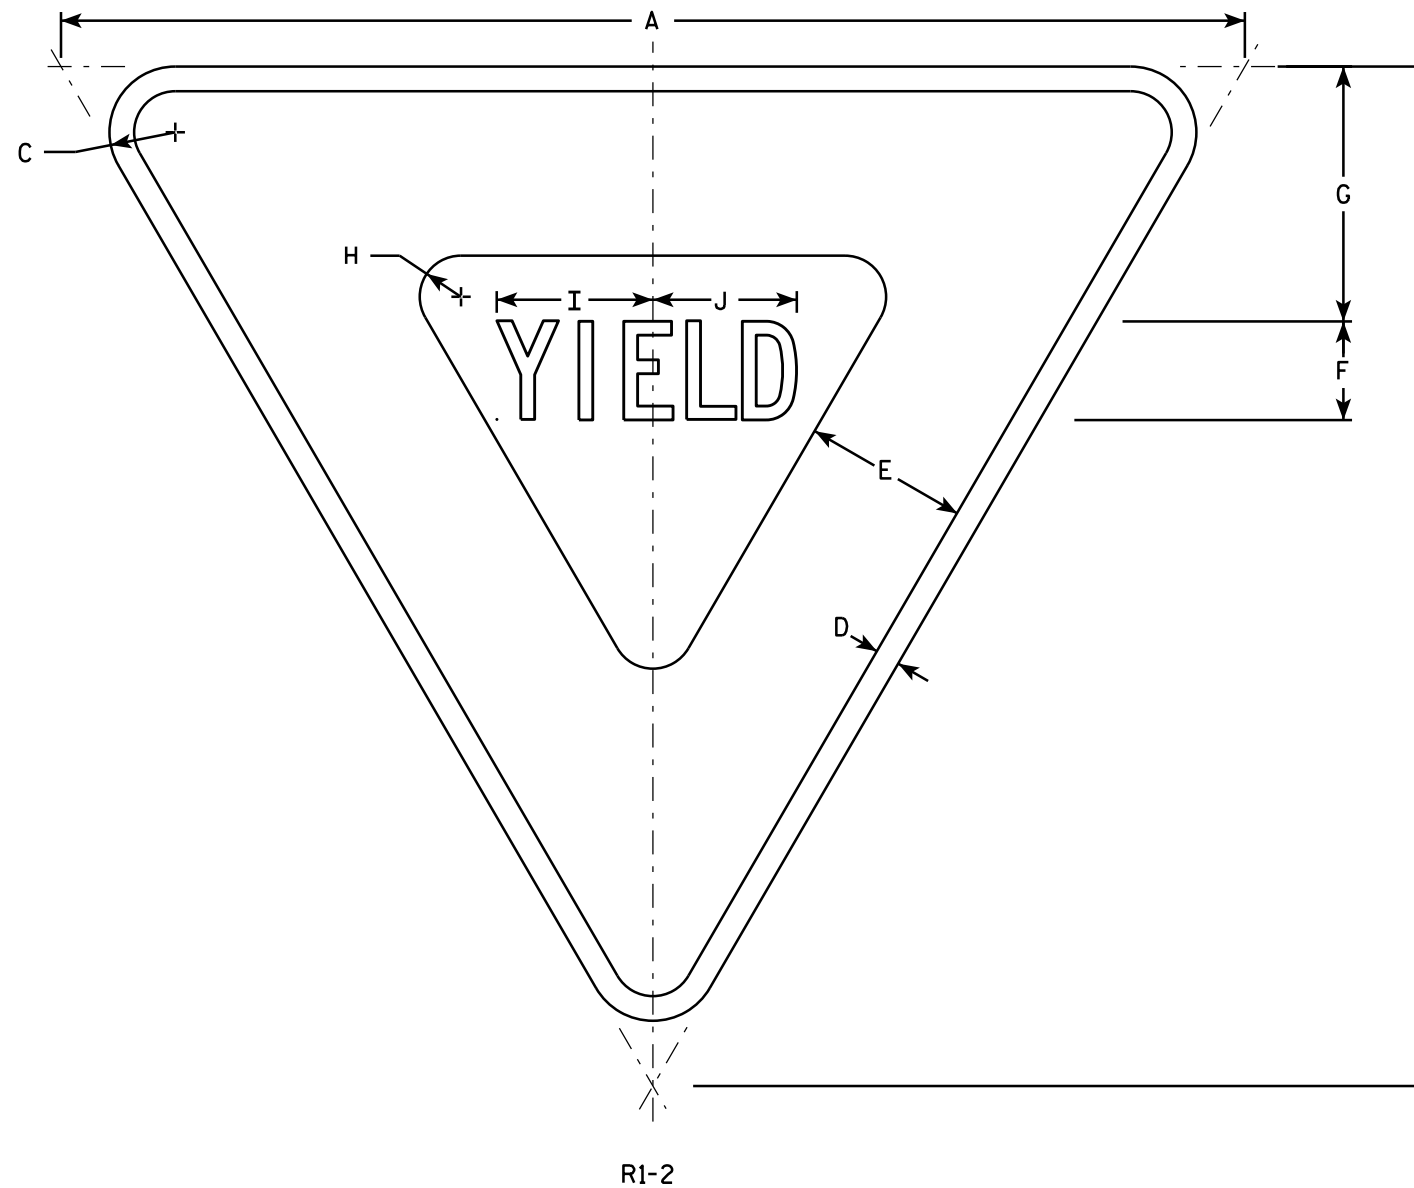

7

7

SIZE	A	B	C	D	E	F	G	H	I	J	K	L	M	N	O	P	Q	R	S	T	U	V	W	X	Y	Z	Area sq. ft.
1	30	26	1 1/2	5/8	4	2 1/2	6 3/8	7/8	4	3 5/8																	2.71
2S	36	31	2	3/4	5	3	7 3/4	1 1/4	4 3/4	4 3/8																	3.88
2M	48	42	3	1	6	4	9 3/4	2	6 1/4	5 7/8																	7.00
3	48	42	3	1	6	4	9 3/4	2	6 1/4	5 7/8																	7.00
4	48	42	3	1	6	4	9 3/4	2	6 1/4	5 7/8																	7.00
5	60	52	3	1 1/2	8	5	13	2 1/2	7 7/8	7 1/4																	10.83
6																											
7	18	15 1/2	1	3/8	2 1/2	1 1/2	3 7/8	5/8	2 3/8	2 1/4																	0.97

STANDARD SIGN
R1-2

WISCONSIN DEPT OF TRANSPORTATION

APPROVED *Matthew R. Rauch*
for State Traffic Engineer

DATE 10/13/14 PLATE NO124R1-2.12

PROJECT NO: _____ HWY: _____ COUNTY: _____ SHEET NO: _____ E

NOTES

1. Sign is Type II - Type H Reflective - reference WIS DOT Standard Specification for HIGHWAY and STRUCTURE CONSTRUCTION latest edition.
2. Color:
Background - White
Message - Black
3. Message Series - B



R1-54

7

7

SIZE	A	B	C	D	E	F	G	H	I	J	K	L	M	N	O	P	Q	R	S	T	U	V	W	X	Y	Z	Area sq. ft.
1																											
2S	24	15	1 1/8	3/8	3/8	4	2 5/8	1 3/4	3 3/4	2	4 1/8	9 3/4	8 7/8	5/8	1 7/8	7 3/4											2.5
2M	24	15	1 1/8	3/8	3/8	4	2 5/8	1 3/4	3 3/4	2	4 1/8	9 3/4	8 7/8	5/8	1 7/8	7 3/4											2.5
3																											
4																											
5																											

STANDARD SIGN
R1-54

WISCONSIN DEPT OF TRANSPORTATION

APPROVED *Matthew R. Rauch*
For State Traffic Engineer

DATE 12/03/10 PLATE NO. R1-54.2

PROJECT NO: _____ HWY: _____ COUNTY: _____ SHEET NO: 125 **E**

NOTES

1. Sigs are Type II - Type H Reflective
2. Color:
Background - White
Message - Black
3. Message Series - D
4. Use appropriate Letter for Sign Code
Each letter added makes sign wider. Example R3-8EAR
5. Square footage of sign varies by letters

1 Letter = 3.75 sq ft for Size 2
6.0 sq ft for Size 3
10.0 sq ft for Size 4 or 5

2 Letters = 7.5 sq ft for Size 2
12.0 sq ft for Size 3
20.0 sq ft for Size 4 or 5

3 Letters = 11.25 sq ft for Size 2
18.0 sq ft for Size 3
30.0 sq ft for Size 4 or 5

4 Letters = 15.0 sq ft for Size 2
24.0 sq ft for Size 3
40.0 sq ft for Size 4 or 5











5 Letters = 18.75 sq ft for Size 2
30.0 sq ft for Size 3
50.0 sq ft for Size 4 or 5

6 Letters = 22.5 sq ft for Size 2
36.0 sq ft for Size 3
60.0 sq ft for Size 4 or 5

6. When letters C,D,G,H are used on the Left or Right end of the sign the Sq.Ft. changes.

Add the amounts when these letters are used:

1.25 sq ft for Size 2
1.5 sq ft for Size 3
2.0 sq ft for Size 4 or 5

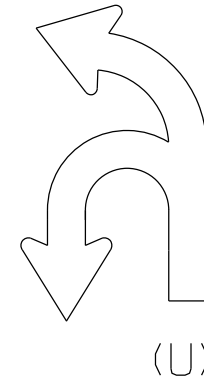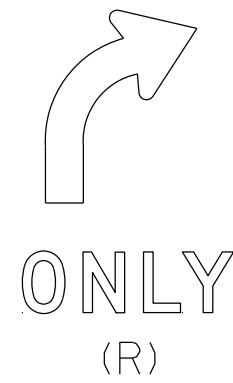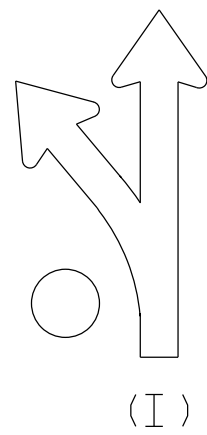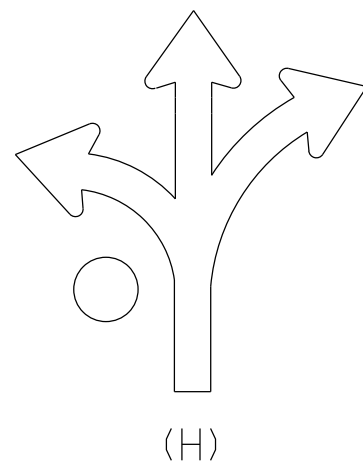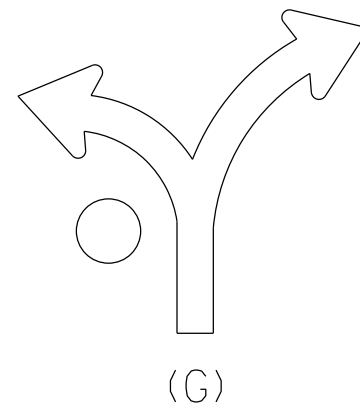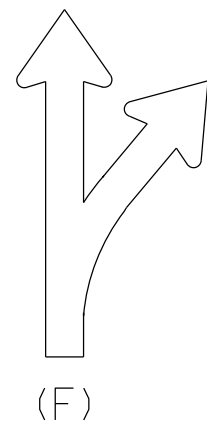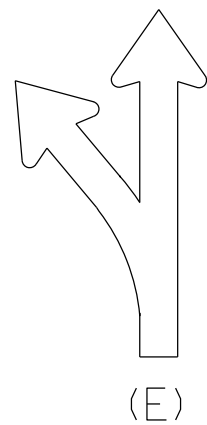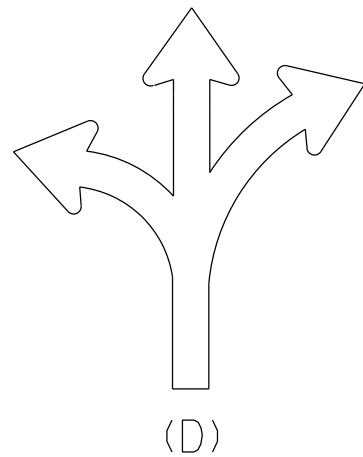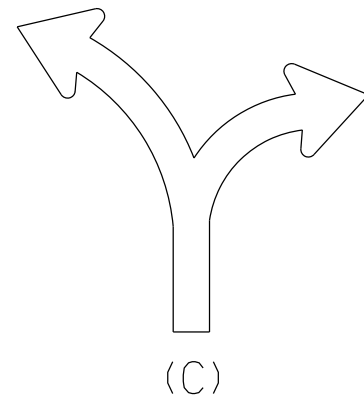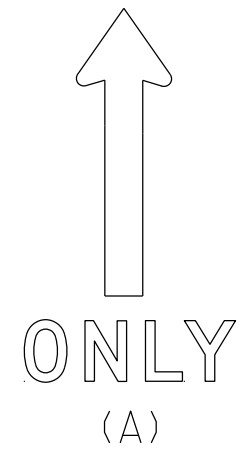

STANDARD SIGN
R3-8 Series





WISCONSIN DEPT OF TRANSPORTATION

APPROVED *Matthew R. Rauch*
for State Traffic Engineer

DATE 5/21/19 PLATE NO. R3-8.1

NOTES

1. Sign is Type II - Type H Reflective
2. Color:
Background - White
Message - Black
3. Message Series - D

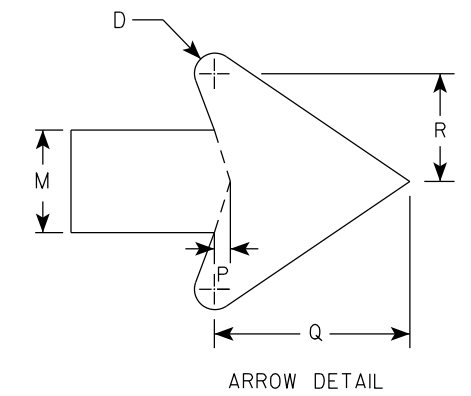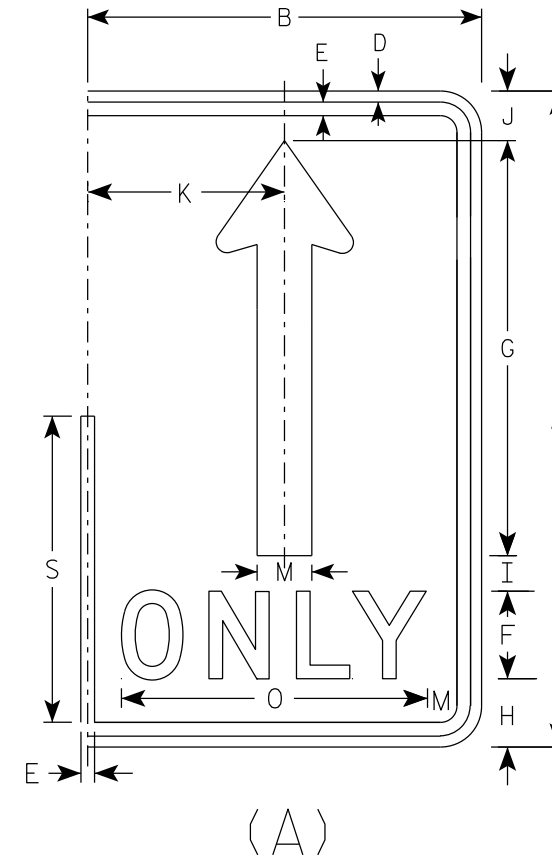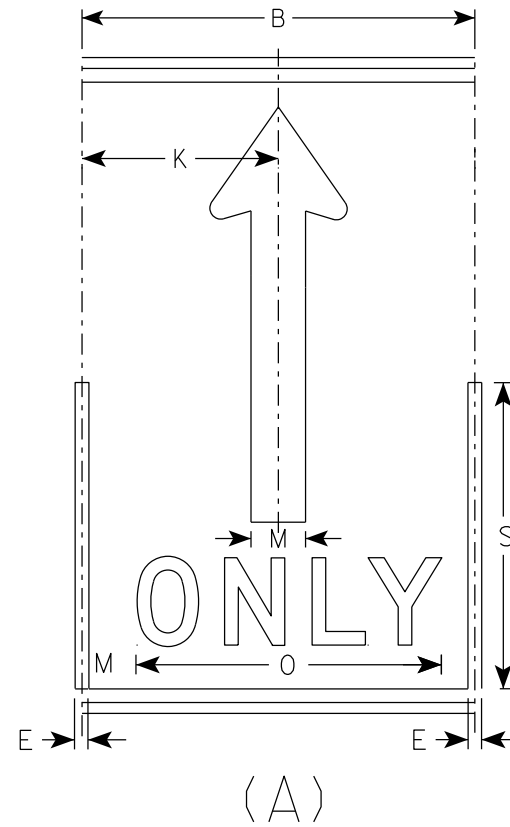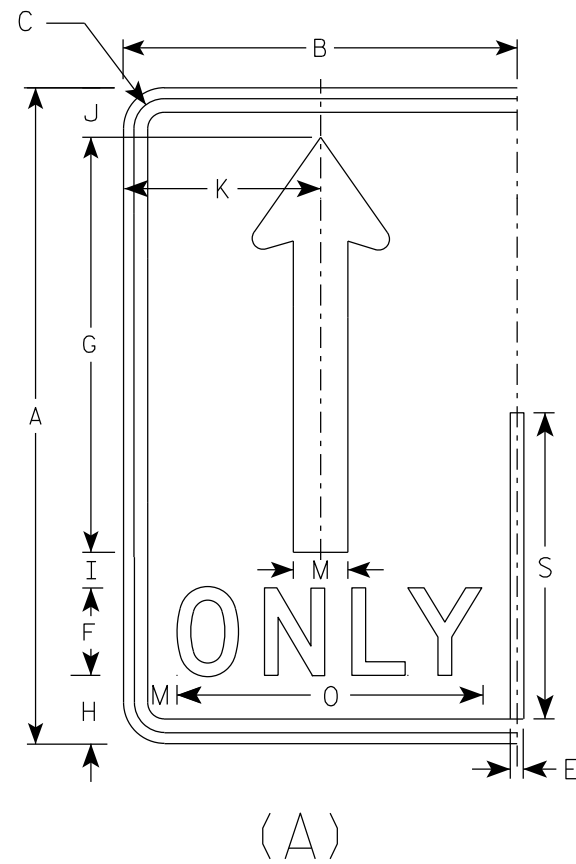

SIZE	A	B	C	D	E	F	G	H	I	J	K	L	M	N	O	P	Q	R	S	T	U	V	W	X	Y	Z	Area sq. ft.
1																											
2S	30	18	1 3/8	1/2	5/8	4	19	3 1/8	1 5/8	2 1/4	9		2 1/2		14	3/8	4 3/4	2 5/8	14								3.75
2M	30	18	1 3/8	1/2	5/8	4	19	3 1/8	1 5/8	2 1/4	9		2 1/2		14	3/8	4 3/4	2 5/8	14								3.75
3	36	24	1 3/8	1/2	5/8	5	22 3/4	3 3/4	1 3/4	2 3/4	12		3		17 5/8	1/2	5 3/4	3 1/8	16 3/4								6.0
4	48	30	2 1/4	3/4	1	6	30 3/8	5 1/8	2 7/8	3 5/8	15		4		21 3/4	5/8	7 5/8	4 1/4	22 3/8								10.0
5	48	30	2 1/4	3/4	1	6	30 3/8	5 1/8	2 7/8	3 5/8	15		4		21 3/4	5/8	7 5/8	4 1/4	22 3/8								10.0

STANDARD SIGN
R3-8 (A) Arrow

WISCONSIN DEPT OF TRANSPORTATION



APPROVED *Matthew R Rauch*
for State Traffic Engineer

DATE 5/21/19 PLATE NO. R3-8.1

PROJECT NO: _____ HWY: _____ COUNTY: _____ SHEET NO: 127 **E**

NOTES

1. Sign is Type II - Type H Reflective
2. Color:
Background - White
Message - Black
Message Series - D

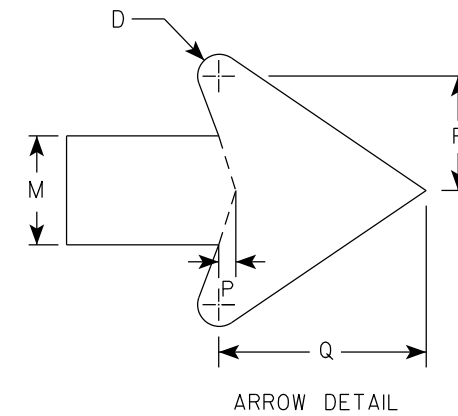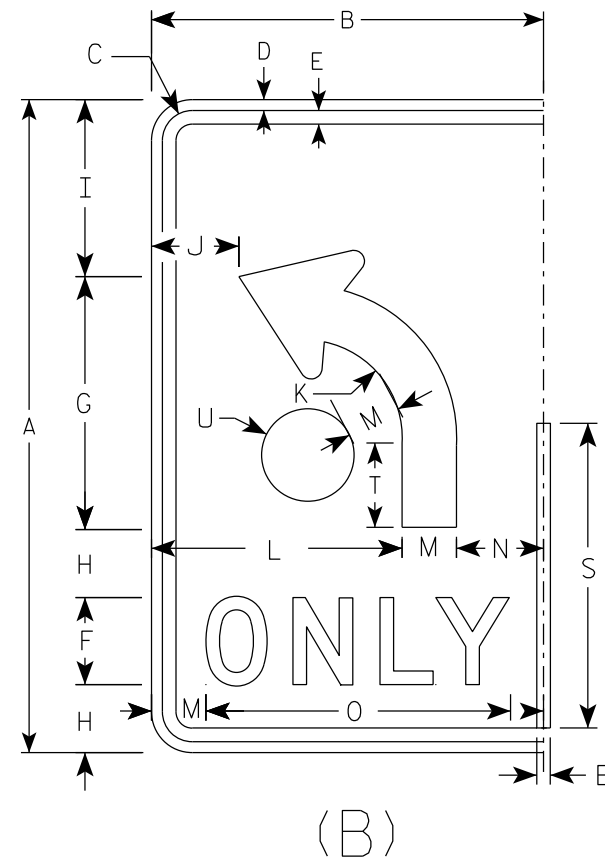

SIZE	A	B	C	D	E	F	G	H	I	J	K	L	M	N	O	P	Q	R	S	T	U	V	W	X	Y	Z	Area sq. ft.
1																											
2S	30	18	1 3/8	1/2	5/8	4	11 5/8	3 1/8	8 1/8	4	4 1/2	11 1/2	2 1/2	4	14	3/8	4 3/4	2 5/8	14	3 7/8	2 1/8						3.75
2M	30	18	1 3/8	1/2	5/8	4	11 5/8	3 1/8	8 1/8	4	4 1/2	11 1/2	2 1/2	4	14	3/8	4 3/4	2 5/8	14	3 7/8	2 1/8						3.75
3	36	24	1 3/8	1/2	5/8	5	14	3 1/2	9 3/4	6	5 3/8	15	3	6	17 5/8	1/2	5 3/4	3 1/8	16 3/4	4 5/8	2 1/2						6.0
4	48	30	2 1/4	3/4	1	6	18 5/8	5 1/8	13 1/8	6 1/8	7 1/4	18	4	8	21 3/4	5/8	7 5/8	4 1/4	22 3/8	6 1/4	3 3/8						10.0
5	48	30	2 1/4	3/4	1	6	18 5/8	5 1/8	13 1/8	6 1/8	7 1/4	18	4	8	21 3/4	5/8	7 5/8	4 1/4	22 3/8	6 1/4	3 3/8						10.0

STANDARD SIGN
R3-8 (B) Arrow


WISCONSIN DEPT OF TRANSPORTATION

APPROVED *Matthew R. Rauch*
for State Traffic Engineer


DATE 5/21/19 PLATE NO. R3-8.1

NOTES


1. Sign is Type II - Type H Reflective
2. Color:
Background - White
Message - Black
3. Message Series - None

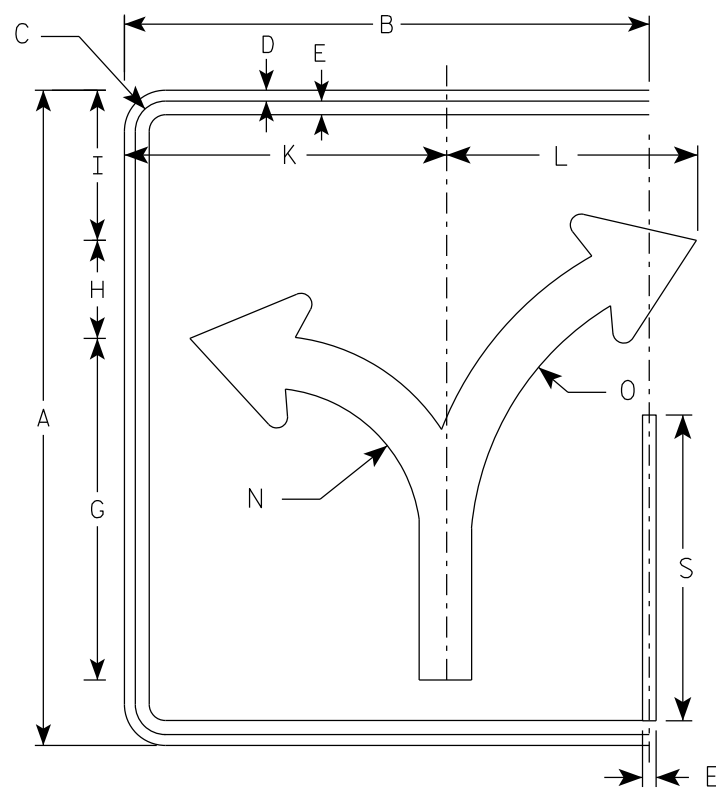


(C)

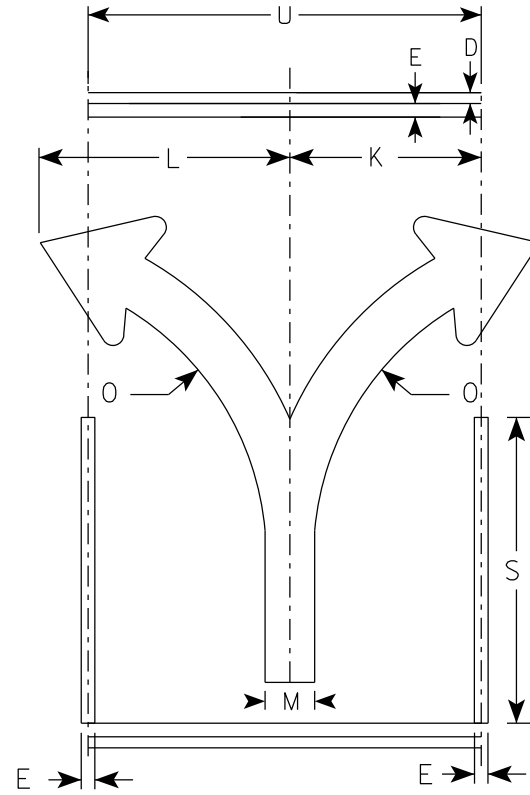

(C)

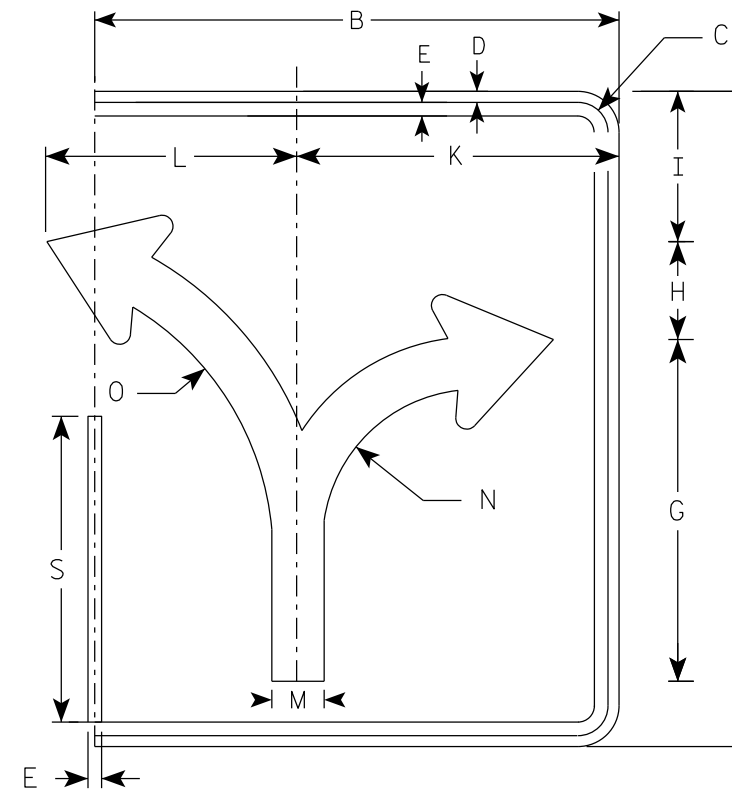

(C)

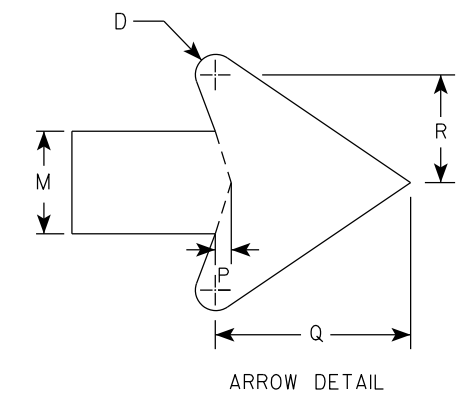

7

7

SIZE	A	B	C	D	E	F	G	H	I	J	K	L	M	N	O	P	Q	R	S	T	U	V	W	X	Y	Z	ENDS	MIDDLE
																											Area sq. ft.	Area sq. ft.
1																												
2S	30	24	1 3/8	1/2	5/8		15 5/8	4 1/2	6 7/8		14 3/4	11 1/2	2 3/8	7	13 1/4	3/8	4 1/2	2 1/2	14		18						5.0	3.75
2M	30	24	1 3/8	1/2	5/8		15 5/8	4 1/2	6 7/8		14 3/4	11 1/2	2 3/8	7	13 1/4	3/8	4 1/2	2 1/2	14		18						5.0	3.75
3	36	30	1 3/8	1/2	5/8		18 3/4	5 1/2	8 1/4		17 1/4	17 1/4	2 7/8	8 3/8	16	1/2	5 1/2	3	16 3/4		24						7.5	6.0
4	48	36	2 1/4	3/4	1		24 7/8	7 1/4	11		23 1/8	18	3 3/4	11 1/8	21 1/4	5/8	7 1/8	4	22 3/8		30						12.0	10.0
5	48	36	2 1/4	3/4	1		24 7/8	7 1/4	11		23 1/8	18	3 3/4	11 1/8	21 1/4	5/8	7 1/8	4	22 3/8		30						12.0	10.0

STANDARD SIGN
R3-8 (C) Arrow

WISCONSIN DEPT OF TRANSPORTATION





APPROVED *Matthew R Rauch*
for State Traffic Engineer

DATE 5/21/19 PLATE NO. R3-8.1

PROJECT NO: _____ HWY: _____ COUNTY: _____ SHEET NO: 129 **E**

NOTES

1. Sign is Type II - Type H Reflective
2. Color:
Background - White
Message - Black
3. Message Series - None

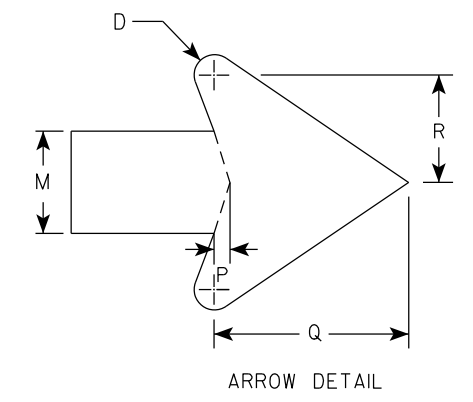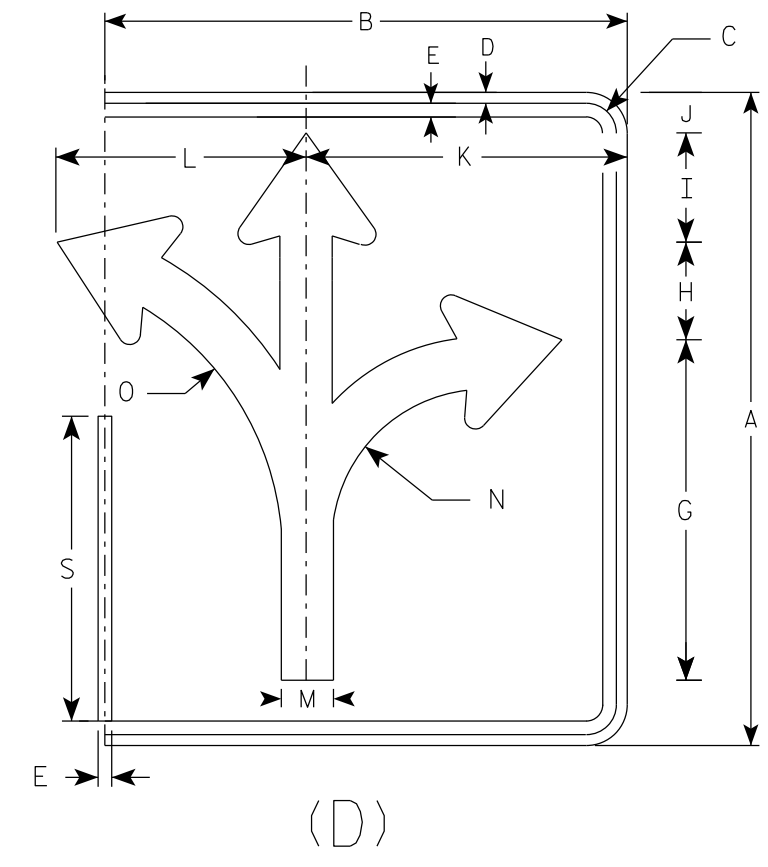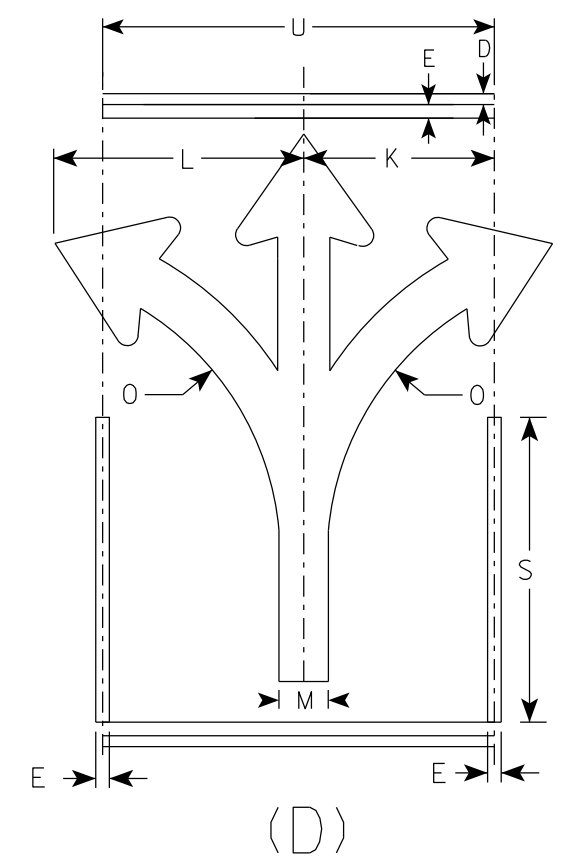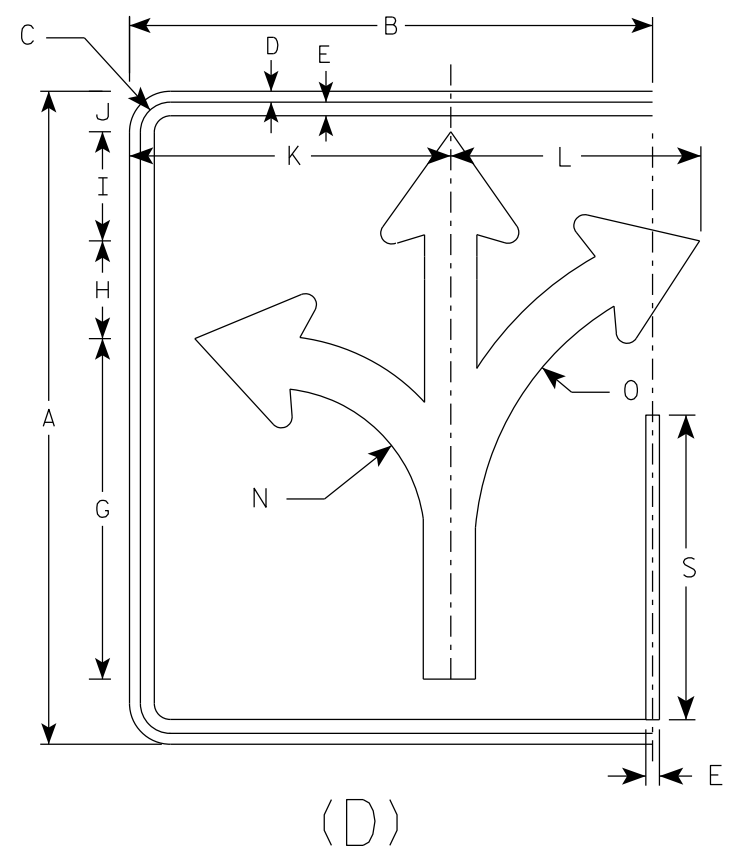

7

7

SIZE	A	B	C	D	E	F	G	H	I	J	K	L	M	N	O	P	Q	R	S	T	U	V	W	X	Y	Z	ENDS	MIDDLE
																											Area sq. ft.	Area sq. ft.
1																												
2S	30	24	1 3/8	1/2	5/8		15 5/8	4 1/2	5	1 7/8	14 3/4	11 1/2	2 3/8	7	13 1/4	3/8	4 1/2	2 1/2	14		18						5.0	3.75
2M	30	24	1 3/8	1/2	5/8		15 5/8	4 1/2	5	1 7/8	14 3/4	11 1/2	2 3/8	7	13 1/4	3/8	4 1/2	2 1/2	14		18					5.0	3.75	
3	36	30	1 3/8	1/2	5/8		18 3/4	5 1/2	6	2 1/4	17 1/4	17 1/4	2 7/8	8 3/8	16	1/2	5 1/2	3	16 3/4		24					7.5	6.0	
4	48	36	2 1/4	3/4	1		24 7/8	7 1/4	7 7/8	3 1/8	23 1/8	18	3 3/4	11 1/8	21 1/4	5/8	7 1/8	4	22 3/8		30					12.0	10.0	
5	48	36	2 1/4	3/4	1		24 7/8	7 1/4	7 7/8	3 1/8	23 1/8	18	3 3/4	11 1/8	21 1/4	5/8	7 1/8	4	22 3/8		30					12.0	10.0	

STANDARD SIGN
R3-8 (D) Arrow



WISCONSIN DEPT OF TRANSPORTATION

APPROVED *Matthew R. Rauch*
for State Traffic Engineer

DATE 5/21/19 PLATE NO. R3-8.1

NOTES

1. Sign is Type II - Type H Reflective
2. Color:
Background - White
Message - Black
3. Message Series - None

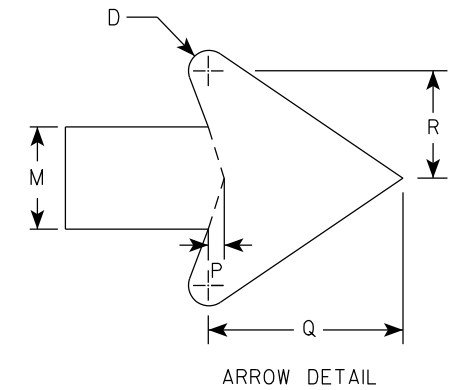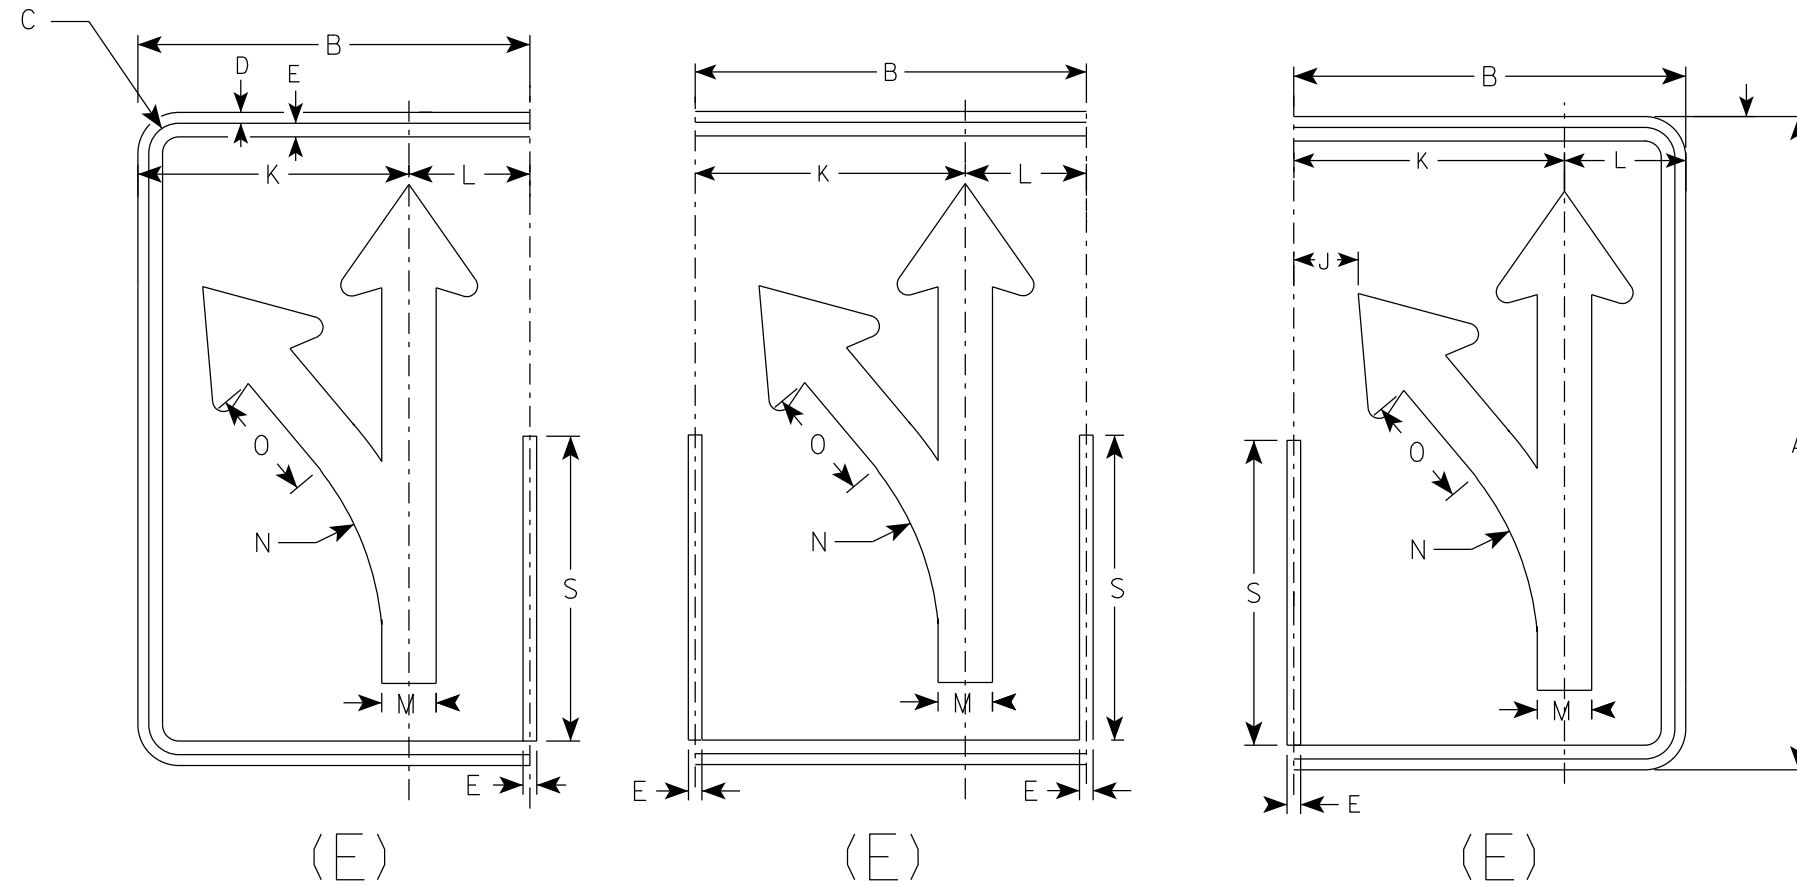

7

7

SIZE	A	B	C	D	E	F	G	H	I	J	K	L	M	N	O	P	Q	R	S	T	U	V	W	X	Y	Z	Area sq. ft.
1																											
2S	30	18	1 3/8	1/2	5/8		18 1/4	4 3/4	3 1/4	3	12 1/2	5 1/2	2 1/2	13 1/4	5 1/8	3/8	4 3/4	2 5/8	14								3.75
2M	30	18	1 3/8	1/2	5/8		18 1/4	4 3/4	3 1/4	3	12 1/2	5 1/2	2 1/2	13 1/4	5 1/8	3/8	4 3/4	2 5/8	14								3.75
3	36	24	1 3/8	1/2	5/8		21 7/8	5 5/8	4	4 7/8	16 1/8	7 3/4	3	15 7/8	6 1/8	1/2	5 3/4	3 1/8	16 3/4								6.0
4	48	30	2 1/4	3/4	1		29 1/8	7 1/2	5 1/4	5 3/8	20 1/2	9 1/2	4	21 1/4	8 1/4	5/8	7 5/8	4 1/4	22 3/8								10.0
5	48	30	2 1/4	3/4	1		29 1/8	7 1/2	5 1/4	5 3/8	20 1/2	9 1/2	4	21 1/4	8 1/4	5/8	7 5/8	4 1/4	22 3/8								10.0

STANDARD SIGN
R3-8 (E) Arrow



WISCONSIN DEPT OF TRANSPORTATION

APPROVED *Matthew R. Rauch*
for State Traffic Engineer

DATE 5/21/19 PLATE NO. R3-8.1

NOTES

1. Sign is Type II - Type H Reflective
2. Color:
Background - White
Message - Black
3. Message Series - None

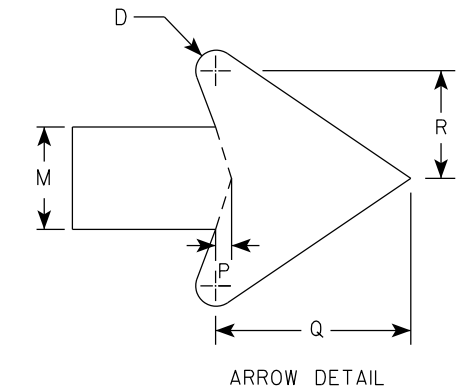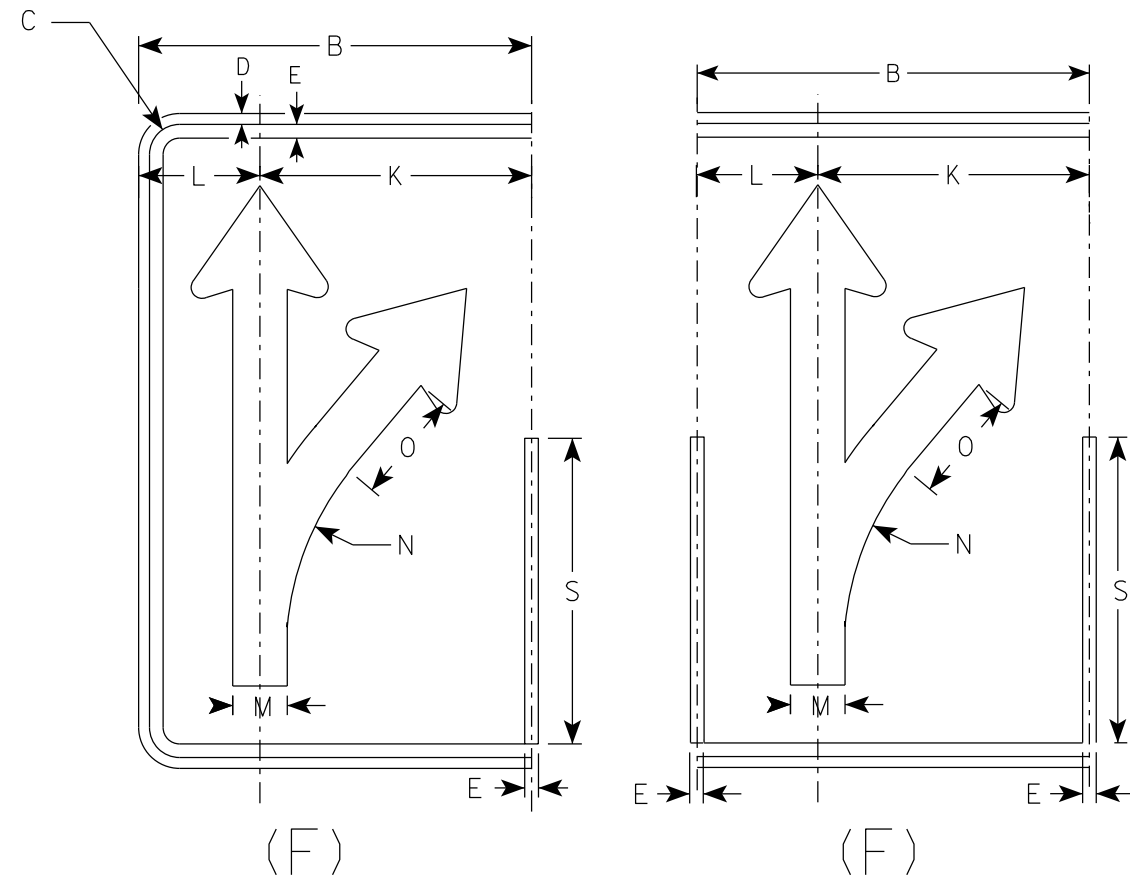

7

7

SIZE	A	B	C	D	E	F	G	H	I	J	K	L	M	N	O	P	Q	R	S	T	U	V	W	X	Y	Z	Area sq. ft.
1																											
2S	30	18	1 3/8	1/2	5/8		18 1/4	4 3/4	3 1/4	3	12 1/2	5 1/2	2 1/2	13 1/4	5 1/8	3/8	4 3/4	2 5/8	14								3.75
2M	30	18	1 3/8	1/2	5/8		18 1/4	4 3/4	3 1/4	3	12 1/2	5 1/2	2 1/2	13 1/4	5 1/8	3/8	4 3/4	2 5/8	14								3.75
3	36	24	1 3/8	1/2	5/8		21 7/8	5 5/8	4	4 7/8	16 1/8	7 3/4	3	15 7/8	6 1/8	1/2	5 3/4	3 1/8	16 3/4								6.0
4	48	30	2 1/4	3/4	1		29 1/8	7 1/2	5 1/4	5 3/8	20 1/2	9 1/2	4	21 1/4	8 1/4	5/8	7 5/8	4 1/4	22 3/8								10.0
5	48	30	2 1/4	3/4	1		29 1/8	7 1/2	5 1/4	5 3/8	20 1/2	9 1/2	4	21 1/4	8 1/4	5/8	7 5/8	4 1/4	22 3/8								10.0

STANDARD SIGN
R3-8 (F) Arrow

WISCONSIN DEPT OF TRANSPORTATION



APPROVED *Matthew R. Rauch*
for State Traffic Engineer

DATE 5/21/19 PLATE NO. R3-8.1

PROJECT NO: _____ HWY: _____ COUNTY: _____ SHEET NO: 132 **E**

NOTES

1. Sign is Type II - Type H Reflective
2. Color:
Background - White
Message - Black
3. Message Series - None

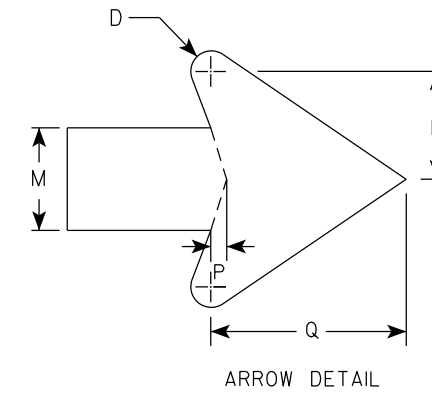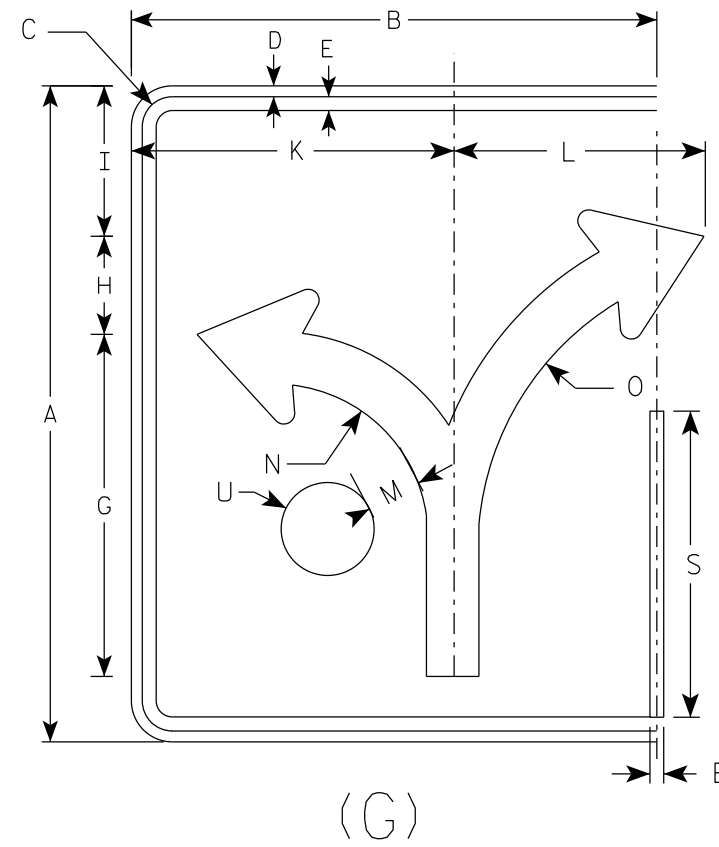

SIZE	A	B	C	D	E	F	G	H	I	J	K	L	M	N	O	P	Q	R	S	T	U	V	W	X	Y	Z	Area sq. ft.
1																											
2S	30	24	1 3/8	1/2	5/8		15 5/8	4 1/2	6 7/8		14 3/4	11 1/2	2 3/8	7	13 1/4	3/8	4 1/2	2 1/2	14		2 1/8						5.0
2M	30	24	1 3/8	1/2	5/8		15 5/8	4 1/2	6 7/8		14 3/4	11 1/2	2 3/8	7	13 1/4	3/8	4 1/2	2 1/2	14		2 1/8						5.0
3	36	30	1 3/8	1/2	5/8		18 3/4	5 1/2	8 1/4		17 1/4	17 1/4	2 7/8	8 3/8	16	1/2	5 1/2	3	16 3/4		2 1/2						7.5
4	48	36	2 1/4	3/4	1		24 7/8	7 1/4	11		23 1/8	18	3 3/4	11 1/8	21 1/4	5/8	7 1/8	4	22 3/8		3 3/8						12.0
5	48	36	2 1/4	3/4	1		24 7/8	7 1/4	11		23 1/8	18	3 3/4	11 1/8	21 1/4	5/8	7 1/8	4	22 3/8		3 3/8						12.0

STANDARD SIGN
R3-8 (G) Arrow

WISCONSIN DEPT OF TRANSPORTATION

APPROVED *Matthew R. Rauch*
For State Traffic Engineer



DATE 5/21/19 PLATE NO. R3-8.1

7

7

NOTES

1. Sign is Type II - Type H Reflective
2. Color:
Background - White
Message - Black
3. Message Series - None

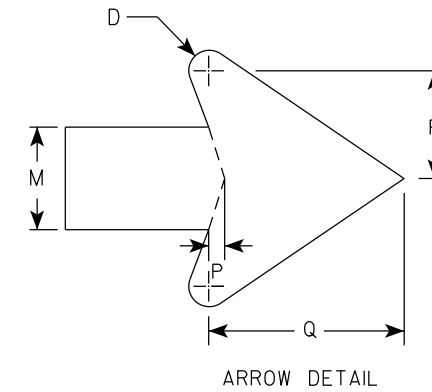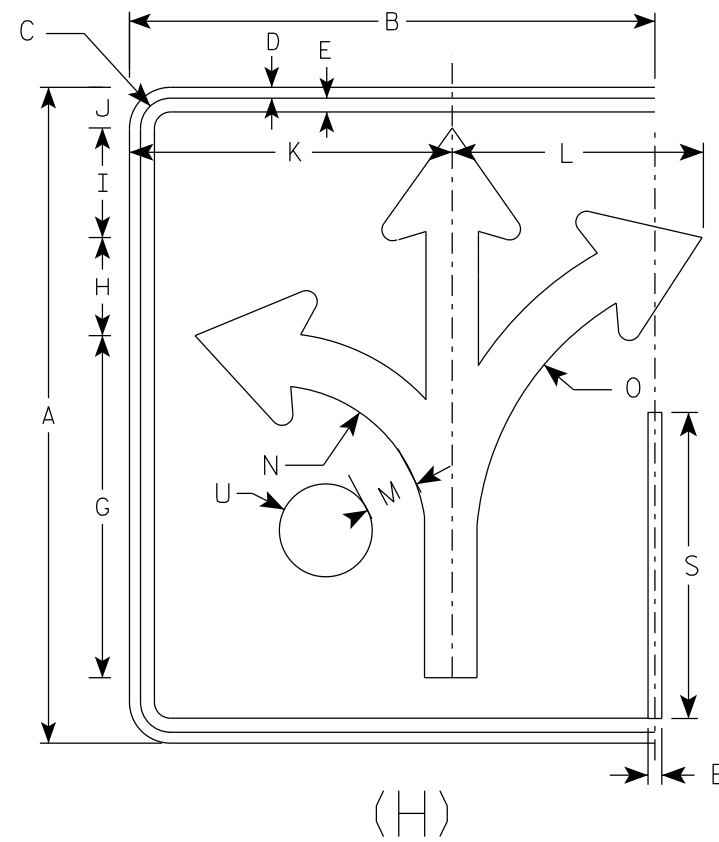

7

7

SIZE	A	B	C	D	E	F	G	H	I	J	K	L	M	N	O	P	Q	R	S	T	U	V	W	X	Y	Z	Area sq. ft.
1																											
2S	30	24	1 3/8	1/2	5/8		15 5/8	4 1/2	5	1 7/8	14 3/4	11 1/2	2 3/8	7	13 1/4	3/8	4 1/2	2 1/2	14		2 1/8						5.0
2M	30	24	1 3/8	1/2	5/8		15 5/8	4 1/2	5	1 7/8	14 3/4	11 1/2	2 3/8	7	13 1/4	3/8	4 1/2	2 1/2	14		2 1/8						5.0
3	36	30	1 3/8	1/2	5/8		18 3/4	5 1/2	6	3 1/8	17 1/4	17 1/4	2 7/8	8 3/8	16	1/2	5 1/2	3	16 3/4		2 1/2						7.5
4	48	36	2 1/4	3/4	1		24 7/8	7 1/4	7 7/8	3 1/8	23 1/8	18	3 3/4	11 1/8	21 1/4	5/8	7 1/8	4	22 3/8		3 3/8						12.0
5	48	36	2 1/4	3/4	1		24 7/8	7 1/4	7 7/8	3 1/8	23 1/8	18	3 3/4	11 1/8	21 1/4	5/8	7 1/8	4	22 3/8		3 3/8						12.0

STANDARD SIGN
R3-8 (H) Arrow


WISCONSIN DEPT OF TRANSPORTATION

APPROVED *Matthew R Rauch*
For State Traffic Engineer


DATE 5/21/19 PLATE NO. R3-8.1

NOTES

1. Sign is Type II - Type H Reflective
2. Color:
Background - White
Message - Black
3. Message Series - None

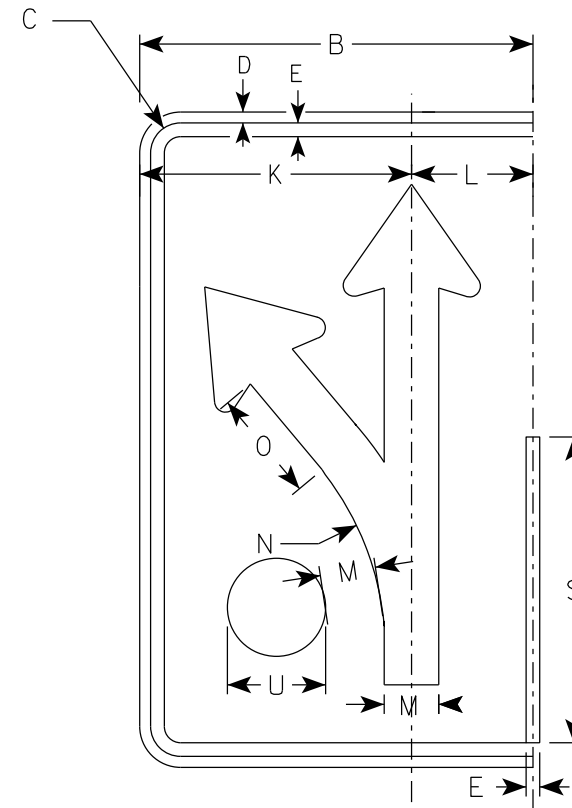

(I)

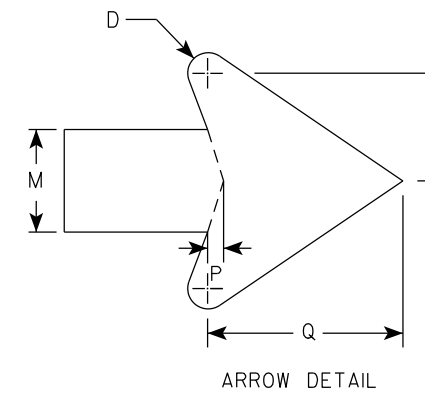

SIZE	A	B	C	D	E	F	G	H	I	J	K	L	M	N	O	P	Q	R	S	T	U	V	W	X	Y	Z	Area sq. ft.
1																											
2S	30	18	1 3/8	1/2	5/8		18 1/4	4 3/4	3 1/4	3	12 1/2	5 1/2	2 1/2	13 1/4	5 1/8	3/8	4 3/4	2 5/8	14		2 1/8						3.75
2M	30	18	1 3/8	1/2	5/8		18 1/4	4 3/4	3 1/4	3	12 1/2	5 1/2	2 1/2	13 1/4	5 1/8	3/8	4 3/4	2 5/8	14		2 1/8						3.75
3	36	24	1 3/8	1/2	5/8		21 7/8	5 5/8	4	4 7/8	16 1/8	7 3/4	3	15 7/8	6 1/8	1/2	5 3/4	3 1/8	16 3/4		2 1/2						6.0
4	48	30	2 1/4	3/4	1		29 1/8	7 1/2	5 1/4	5 3/8	20 1/2	9 1/2	4	21 1/4	8 1/4	5/8	7 5/8	4 1/4	22 3/8		3 3/8						10.0
5	48	30	2 1/4	3/4	1		29 1/8	7 1/2	5 1/4	5 3/8	20 1/2	9 1/2	4	21 1/4	8 1/4	5/8	7 5/8	4 1/4	22 3/8		3 3/8						10.0

STANDARD SIGN
R3-8 (I) Arrow

WISCONSIN DEPT OF TRANSPORTATION



APPROVED *Matthew R. Rauch*
for State Traffic Engineer

DATE 5/21/19 PLATE NO. R3-8.1

PROJECT NO: _____ HWY: _____ COUNTY: _____ SHEET NO: 135 **E**

NOTES

1. Sign is Type II - Type H Reflective
2. Color:
Background - White
Message - Black
3. Message Series - D

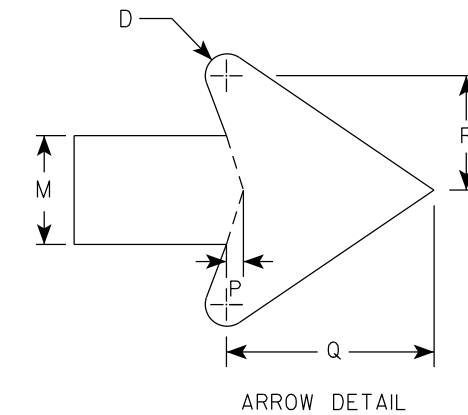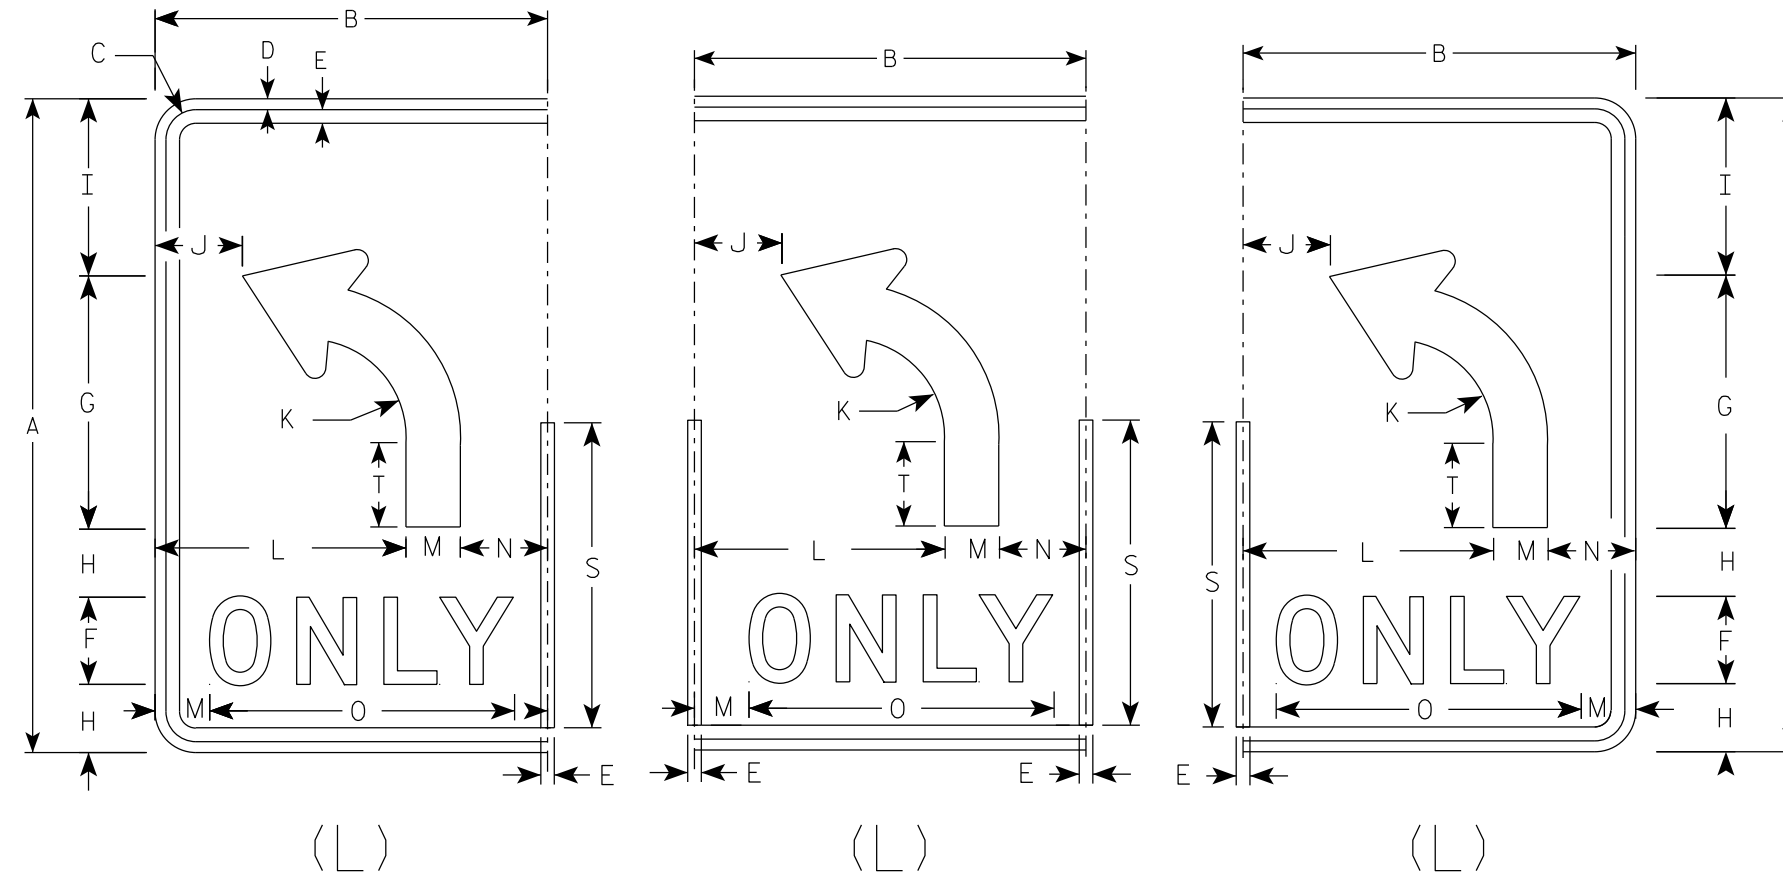

7

7

SIZE	A	B	C	D	E	F	G	H	I	J	K	L	M	N	O	P	Q	R	S	T	U	V	W	X	Y	Z	Area sq. ft.
1																											
2S	30	18	1 3/8	1/2	5/8	4	11 5/8	3 1/8	8 1/8	4	4 1/2	11 1/2	2 1/2	4	14	3/8	4 3/4	2 5/8	14	3 7/8							3.75
2M	30	18	1 3/8	1/2	5/8	4	11 5/8	3 1/8	8 1/8	4	4 1/2	11 1/2	2 1/2	4	14	3/8	4 3/4	2 5/8	14	3 7/8							3.75
3	36	24	1 3/8	1/2	5/8	5	14	3 1/2	9 3/4		5 3/8	15	3	6	17 5/8	1/2	5 3/4	3 1/8	16 3/4	4 5/8							6.0
4	48	30	2 1/4	3/4	1	6	18 5/8	5 1/8	13 1/8	6 1/8	7 1/4	18	4	8	21 3/4	5/8	7 5/8	4 1/4	22 3/8	6 1/4							10.0
5	48	30	2 1/4	3/4	1	6	18 5/8	5 1/8	13 1/8	6 1/8	7 1/4	18	4	8	21 3/4	5/8	7 5/8	4 1/4	22 3/8	6 1/4							10.0

STANDARD SIGN
R3-8 (L) Arrow


WISCONSIN DEPT OF TRANSPORTATION

APPROVED *Matthew R. Rauch*
for State Traffic Engineer

DATE 5/21/19 PLATE NO. R3-8.1

NOTES

1. Sign is Type II - Type H Reflective
2. Color:
Background - White
Message - Black
3. Message Series - D

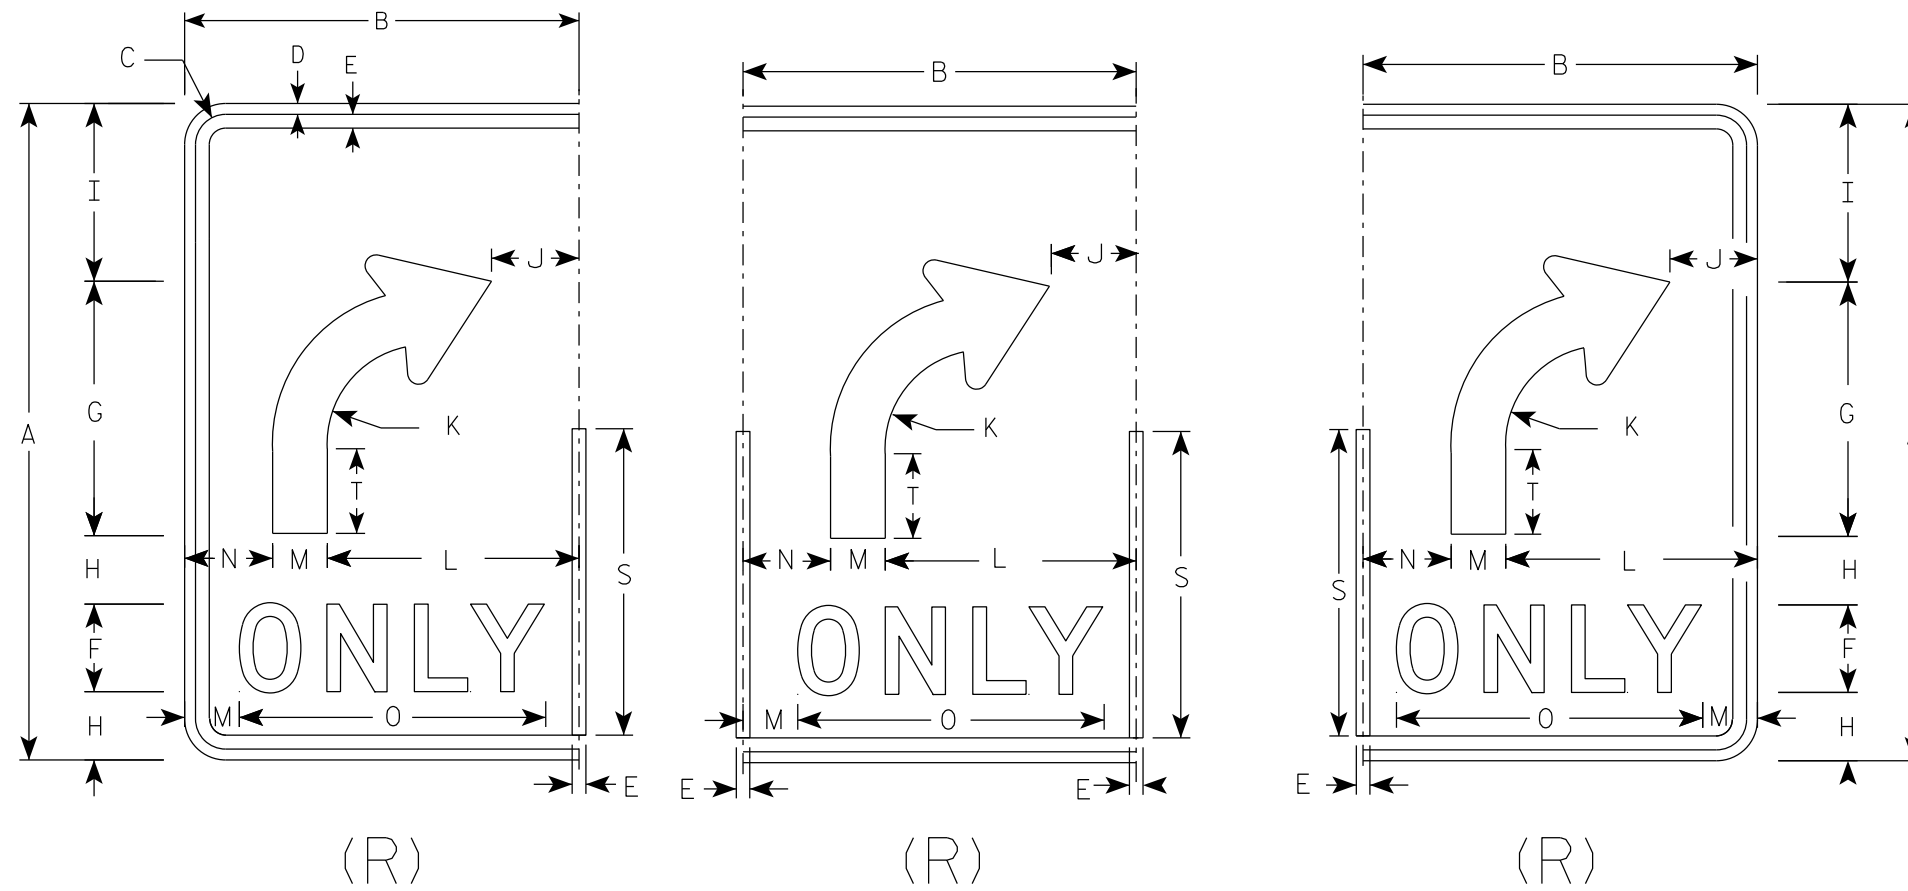

7

7

SIZE	A	B	C	D	E	F	G	H	I	J	K	L	M	N	O	P	Q	R	S	T	U	V	W	X	Y	Z	Area sq. ft.
1																											
2S	30	18	1 3/8	1/2	5/8	4	11 5/8	3 1/8	8 1/8	4	4 1/2	11 1/2	2 1/2	4	14	3/8	4 3/4	2 5/8	14	3 7/8							3.75
2M	30	18	1 3/8	1/2	5/8	4	11 5/8	3 1/8	8 1/8	4	4 1/2	11 1/2	2 1/2	4	14	3/8	4 3/4	2 5/8	14	3 7/8							3.75
3	36	24	1 3/8	1/2	5/8	5	14	3 1/2	9 3/4	6	5 3/8	15	3	6	17 5/8	1/2	5 3/4	3 1/8	16 3/4	4 5/8							6.0
4	48	30	2 1/4	3/4	1	6	18 5/8	5 1/8	13 1/8	6 1/8	7 1/4	18	4	8	21 3/4	5/8	7 5/8	4 1/4	22 3/8	6 1/4							10.0
5	48	30	2 1/4	3/4	1	6	18 5/8	5 1/8	13 1/8	6 1/8	7 1/4	18	4	8	21 3/4	5/8	7 5/8	4 1/4	22 3/8	6 1/4							10.0

STANDARD SIGN
R3-8 (R) Arrow



WISCONSIN DEPT OF TRANSPORTATION

APPROVED *Matthew R. Rauch*
for State Traffic Engineer

DATE 5/21/19 PLATE NO. R3-8.1

NOTES

1. Sign is Type II - Type H Reflective
2. Color:
Background - White
Message - Black
3. Message Series - None

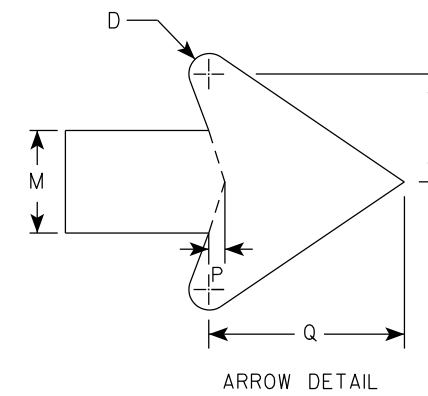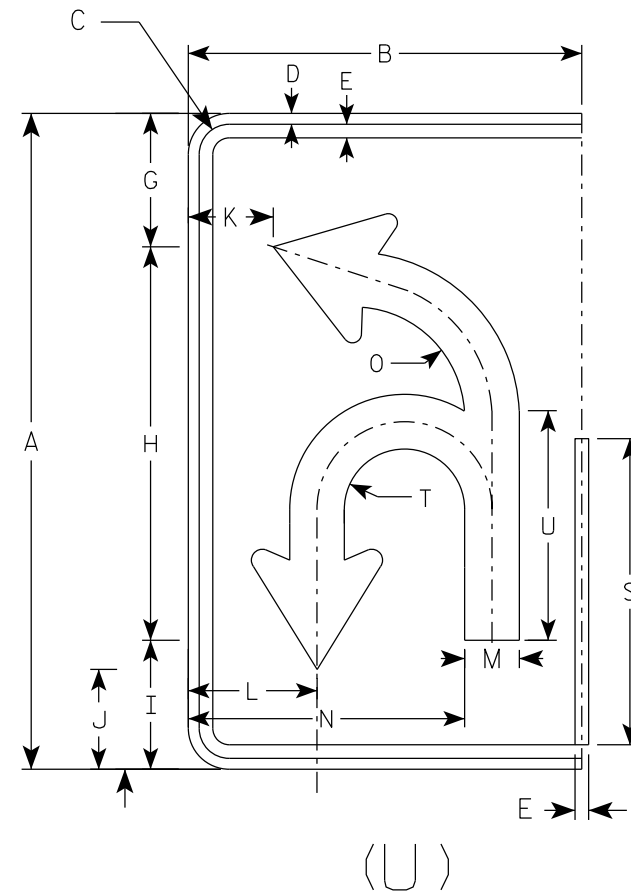

SIZE	A	B	C	D	E	F	G	H	I	J	K	L	M	N	O	P	Q	R	S	T	U	V	W	X	Y	Z	Area sq. ft.
1																											
2S	30	18	1 3/8	1/2	5/8		6 1/8	18	5 7/8	4 5/8	3 7/8	5 7/8	2 1/2	12 5/8	5 1/8	3/8	4 3/4	2 5/8	14	2 3/4	10 1/2						3.75
2M	30	18	1 3/8	1/2	5/8		6 1/8	18	5 7/8	4 5/8	3 7/8	5 7/8	2 1/2	12 5/8	5 1/8	3/8	4 3/4	2 5/8	14	2 3/4	10 1/2						3.75
3	36	24	1 3/8	1/2	5/8		21 7/8	21 5/8	7 1/8	5 1/2	5 7/8	8 1/4	3	16 3/8	6 1/8	1/2	5 3/4	3 1/8	16 3/4	3 1/4	12 5/8						6.0
4	48	30	2 1/4	3/4	1		29 1/8	28 3/4	9 3/8	7 1/4	6 7/8	10	4	20 7/8	8 1/8	5/8	7 5/8	4 1/4	22 3/8	4 3/8	16 3/4						10.0
5	48	30	2 1/4	3/4	1		29 1/8	28 3/4	9 3/8	7 1/4	6 7/8	10	4	20 7/8	8 1/8	5/8	7 5/8	4 1/4	22 3/8	4 3/8	16 3/4						10.0

STANDARD SIGN
R3-8 (U) Arrow

WISCONSIN DEPT OF TRANSPORTATION

APPROVED *Matthew R Rauch*
for State Traffic Engineer



DATE 5/21/19 PLATE NO. R3-8.1

7


7

NOTES

1. Sign is Type II - Type H Reflective - reference WIS DOT Standard Specification for HIGHWAY and STRUCTURE CONSTRUCTION latest edition. material is plywood but borders shall be rounded
2. Color:
Background - White
Message - Black
3. Corners may be square or rounded when base as shown. When base material is metal, the corners and borders shall be rounded.
4. R4-8 is the same as R4-7 except Legend is reversed.

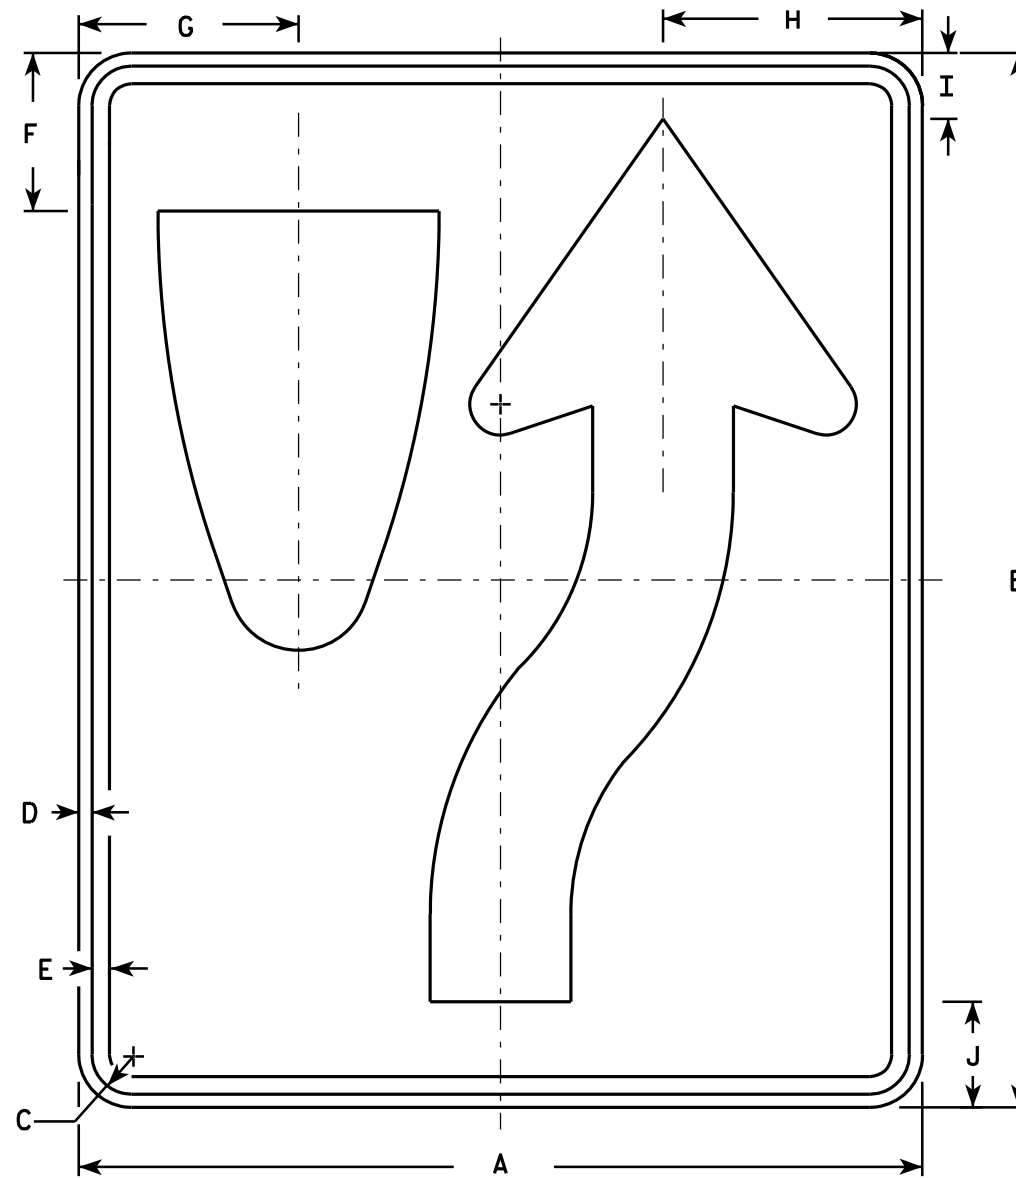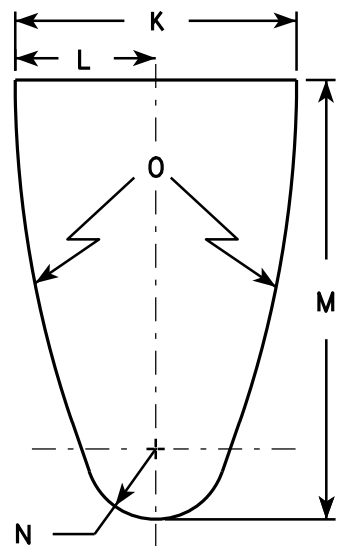

R4-7

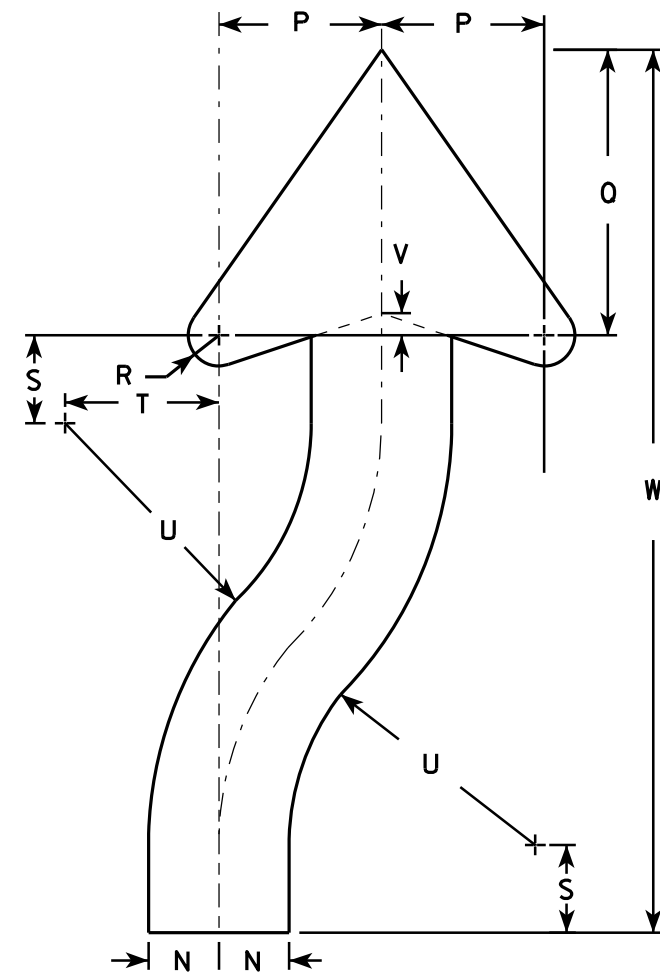

ARROW DETAIL

SIZE	A	B	C	D	E	F	G	H	I	J	K	L	M	N	O	P	Q	R	S	T	U	V	W	X	Y	Z	Area sq. ft.
1	18	24	1 1/8	3/8	1/2	3 3/8	4 3/4	5 1/2	1 3/8	2 1/4	6	3	9 3/8	1 1/2	22 1/2	3 1/2	6 1/8	5/8	1 7/8	3 1/4	6 3/4	1/2	20 3/8				3.0
2S	24	30	1 1/8	3/8	1/2	4 1/2	6 1/4	7 3/8	1 7/8	3	8	4	12 1/2	2	30	4 5/8	8 1/8	7/8	2 1/2	4 3/8	9	5/8	25 1/8				5.0
2M	24	30	1 1/8	3/8	1/2	4 1/2	6 1/4	7 3/8	1 7/8	3	8	4	12 1/2	2	30	4 5/8	8 1/8	7/8	2 1/2	4 3/8	9	5/8	25 1/8				5.0
3	36	48	1 3/4	1/2	5/8	6 3/4	9 3/8	11 1/8	2 7/8	4 1/2	12	6	18 3/4	3	45	6 7/8	12 1/4	1 1/4	3 3/4	6 5/8	13 1/2	1	40 3/4				12.0
4	36	48	1 3/4	1/2	5/8	6 3/4	9 3/8	11 1/8	2 7/8	4 1/2	12	6	18 3/4	3	45	6 7/8	12 1/4	1 1/4	3 3/4	6 5/8	13 1/2	1	40 3/4				12.0
5	48	60	2 1/4	3/4	1	9	12 1/2	14 3/4	3 3/4	6	16	8	25	4	60	9 1/4	16 1/4	1 5/8	5	8 3/4	18	1 1/4	50 1/4				20.0

STANDARD SIGN
R4-7 & R4-8

WISCONSIN DEPT OF TRANSPORTATION



APPROVED *Matthew R. Rauch*
for State Traffic Engineer

DATE 3/25/2011 PLATE NO. R4-7.8

PROJECT NO: _____ HWY: _____ COUNTY: _____ SHEET NO: 139 **E**

NOTES

1. Sign is Type II - Type H Reflective
2. Color:
Background - BLACK
Message - BLACK LEGEND & WHITE ARROW & BORDER
3. Message Series - D

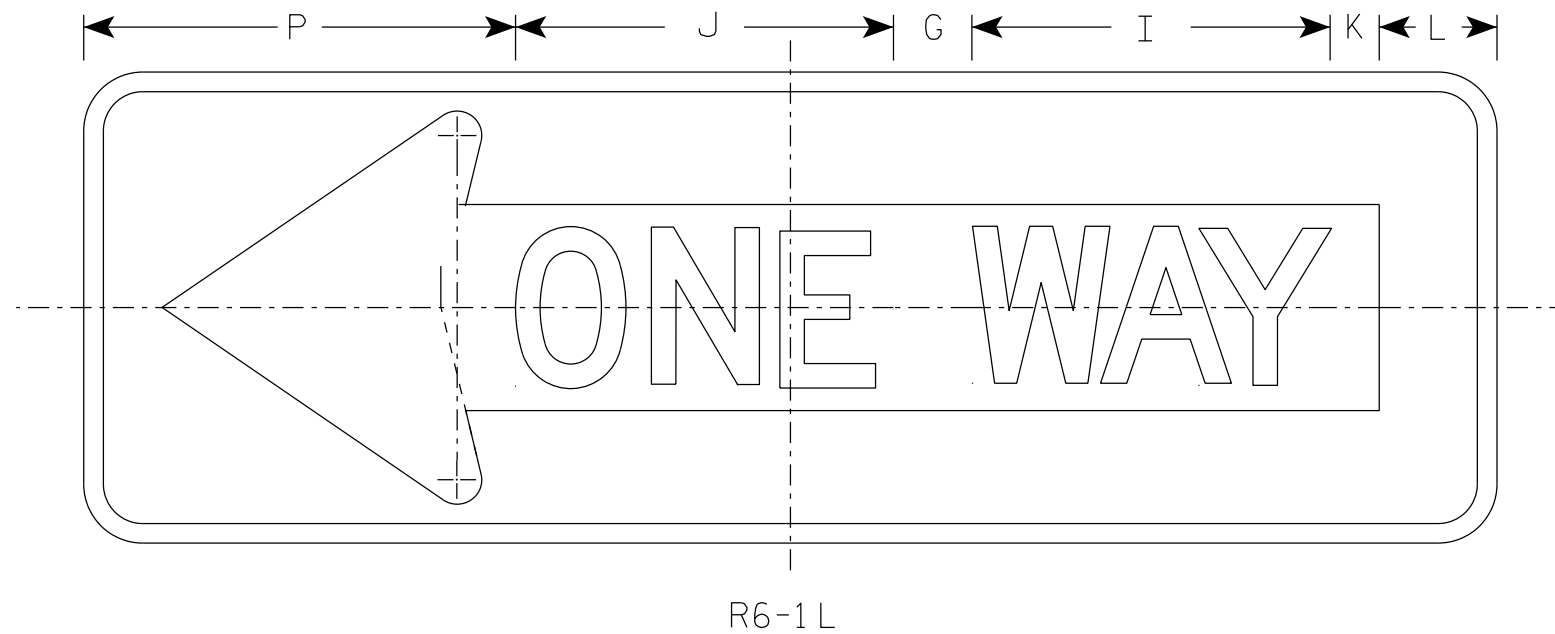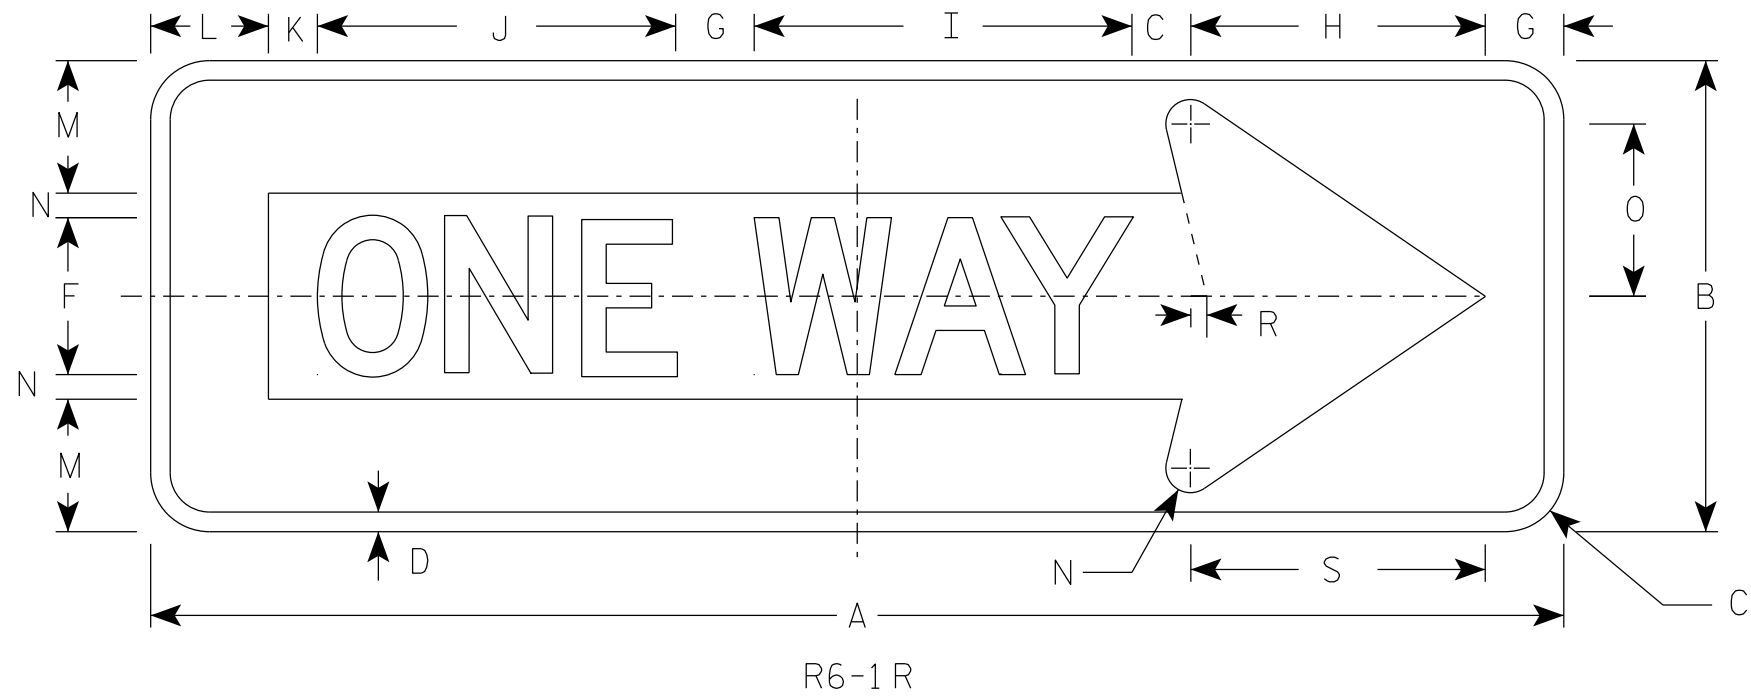

SIZE	A	B	C	D	E	F	G	H	I	J	K	L	M	N	O	P	Q	R	S	T	U	V	W	X	Y	Z	Area sq. ft.
1																											
2S	36	12	1 1/2	1/2		4	2	7 1/2	9 5/8	9 1/8	1 1/4	3	3 3/8	5/8	4 3/8	11		3/8	7 1/2								3.0
2M	54	18	2 1/4	3/4		6	3	11 1/4	13 5/8	14 1/2	1 7/8	4 1/2	5	1	6 1/2	16 1/2		5/8	11 1/4								6.75
3	54	18	2 1/4	3/4		6	3	11 1/4	13 5/8	14 1/2	1 7/8	4 1/2	5	1	6 1/2	16 1/2		5/8	11 1/4								6.75
4	54	18	2 1/4	3/4		6	3	11 1/4	13 5/8	14 1/2	1 7/8	4 1/2	5	1	6 1/2	16 1/2		5/8	11 1/4								6.75
5																											

STANDARD SIGN
R6-1 L & R


WISCONSIN DEPT OF TRANSPORTATION

APPROVED *Matthew R. Rauch*
For State Traffic Engineer

DATE 07/11/18 PLATE NO. R6-1.3

7


7

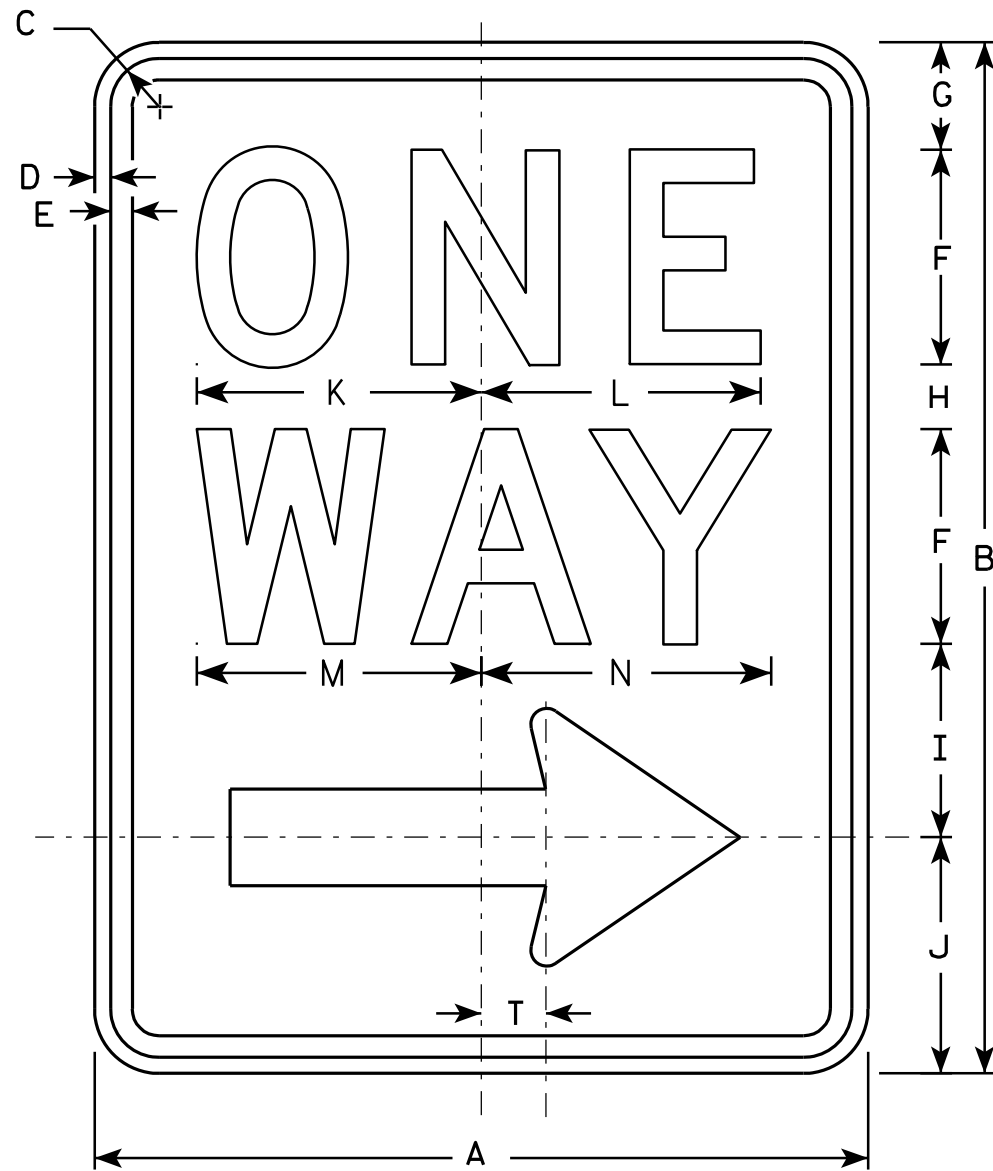

R6-2R

NOTES

1. Sign is Type II - Type H Reflective - reference WIS DOT Standard Specification for HIGHWAY and STRUCTURE CONSTRUCTION latest edition.
2. Color:
Background - White
Message - Black
3. Message Series - D
4. Corners may be square or rounded when base material is plywood but borders shall be rounded as shown. When base material is metal, the corners and borders shall be rounded.
5. R6-2L same as R6-2R except arrow points to the left.

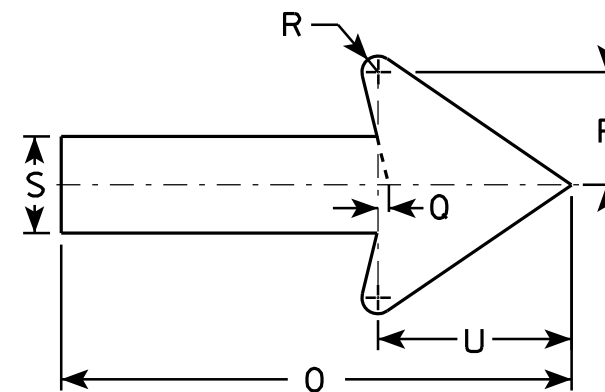

7

7

SIZE	A	B	C	D	E	F	G	H	I	J	K	L	M	N	O	P	Q	R	S	T	U	V	W	X	Y	Z
1	18	24	1 1/8	3/8	1/2	5	2 1/2	1 1/2	4 1/2	5 1/2	6 5/8	6 1/2	6 5/8	6 3/4	11 7/8	2 5/8	1/4	3/8	2 1/4	1 1/2	4 1/2					
2S	24	30	1 1/8	3/8	1/2	6	3	2 1/2	5 1/2	7	8 1/8	8 1/8	8 1/2	8 5/8	16	3 1/2	3/8	1/2	3	2	6					
2M	30	36	1 3/8	1/2	5/8	8	2 1/2	2 5/8	6 7/8	8	10 1/2	10 1/2	11 1/4	11 1/4	20	4 3/8	1/2	5/8	3 3/4	2 1/2	7 1/2					
3	36	48	1 7/8	1/2	5/8	10	5 1/4	3 1/4	9	10 1/2	12 3/4	12 3/4	13 1/4	13 1/2	24	5 5/8	1/2	3/4	4 3/4	3	9					
4	36	48	1 7/8	1/2	5/8	10	5 1/4	3 1/4	9	10 1/2	12 3/4	12 3/4	13 1/4	13 1/2	24	5 5/8	1/2	3/4	4 3/4	3	9					
5																										

STANDARD SIGN
R6-2 R&L

WISCONSIN DEPT OF TRANSPORTATION


APPROVED *Matthew R. Rauch*
For State Traffic Engineer

DATE 11/2/10 PLATE NO. R6-2.8

PROJECT NO: _____ HWY: _____ COUNTY: _____ SHEET NO: 141 **E**

NOTES

1. Sign is Type II - Type H Reflective
2. Color:
Background - WHITE
Message - BLACK
3. Corners may be square or rounded when base material is plywood but borders shall be rounded as shown. When base material is metal, the corners and borders shall be rounded.

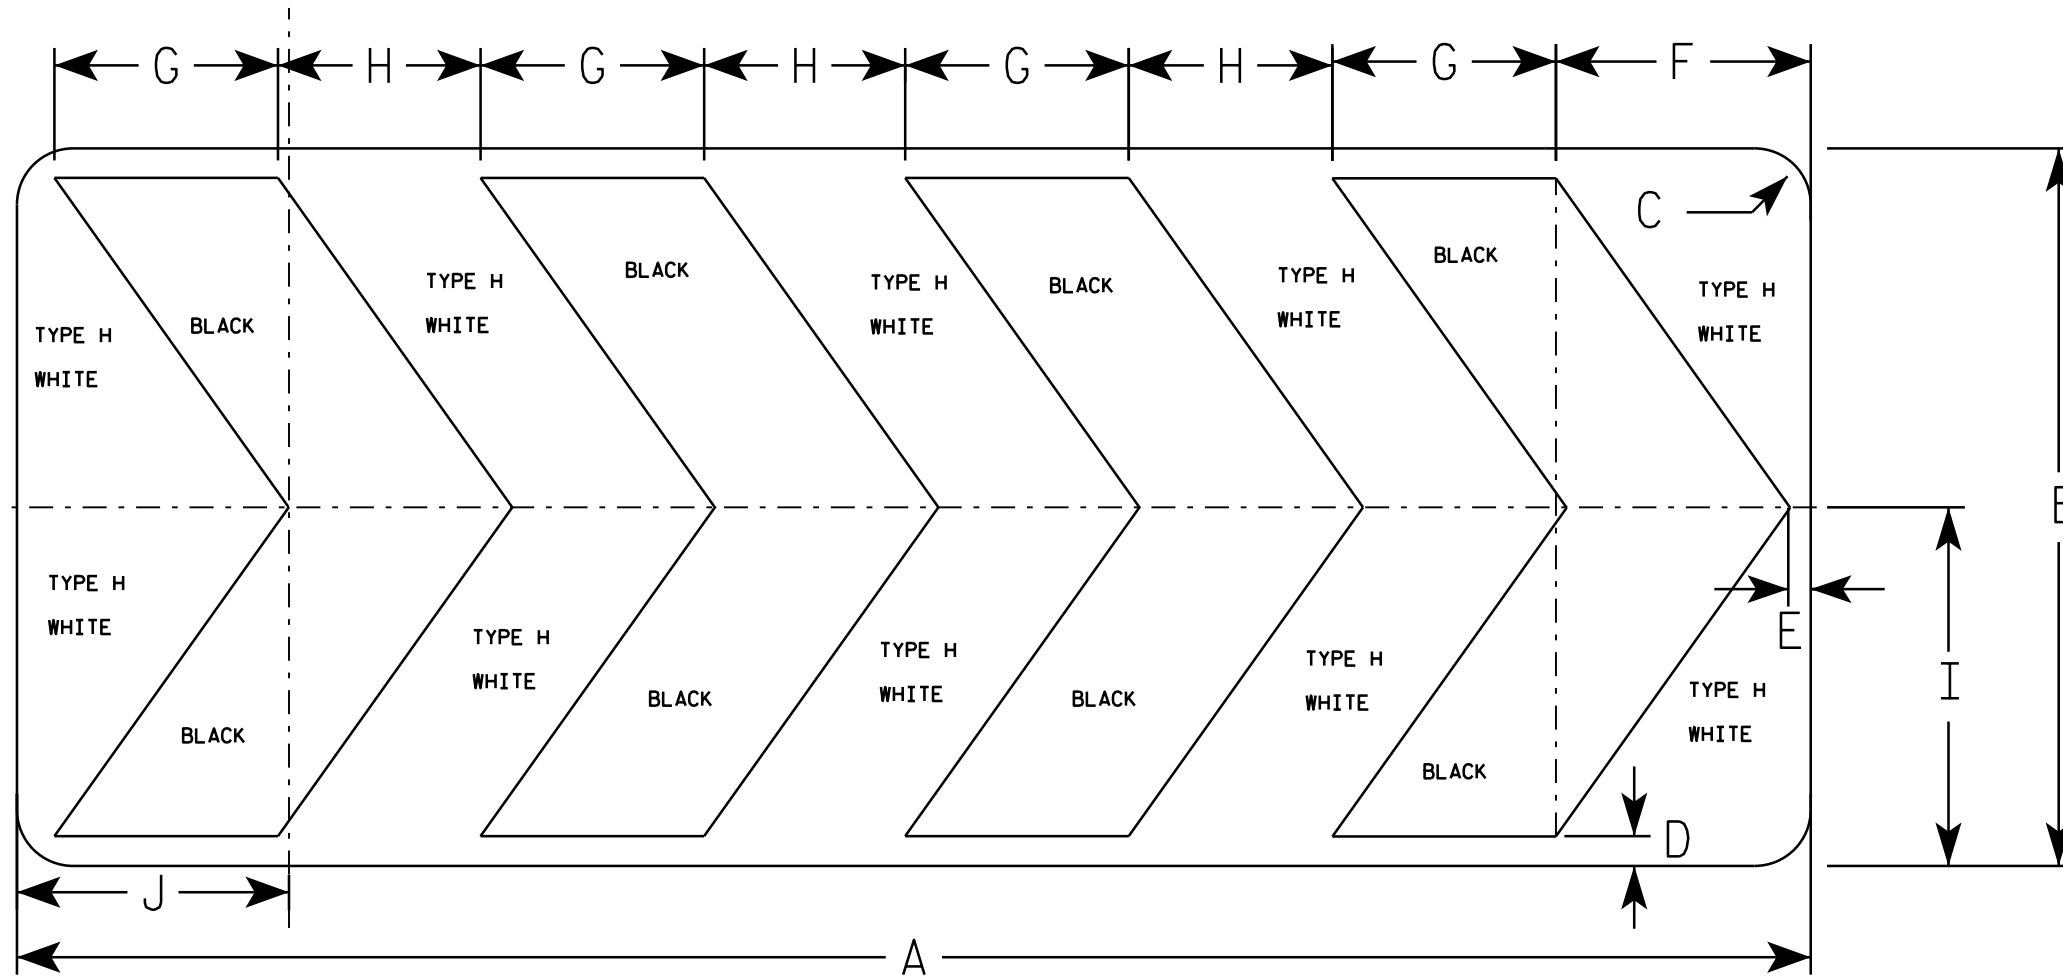

R6-4B

SIZE	A	B	C	D	E	F	G	H	I	J	K	L	M	N	O	P	Q	R	S	T	U	V	W	X	Y	Z	Area sq. ft.
1																											
2S	60	24	1 7/8	1	3/4	8 1/2	7 1/2	6 3/4	12	9 1/8																	10.0
2M	60	24	1 7/8	1	3/4	8 1/2	7 1/2	6 3/4	12	9 1/8																	10.0
3																											
4																											
5																											

STANDARD SIGN
R6-4B


WISCONSIN DEPT OF TRANSPORTATION

APPROVED *Matthew R. Rauch*
for State Traffic Engineer

DATE 8/21/14 PLATE NO. R6-4.3


NOTES

1. Sign is Type II - Type F Reflective
2. Color:
Background - Yellow
Message - Black

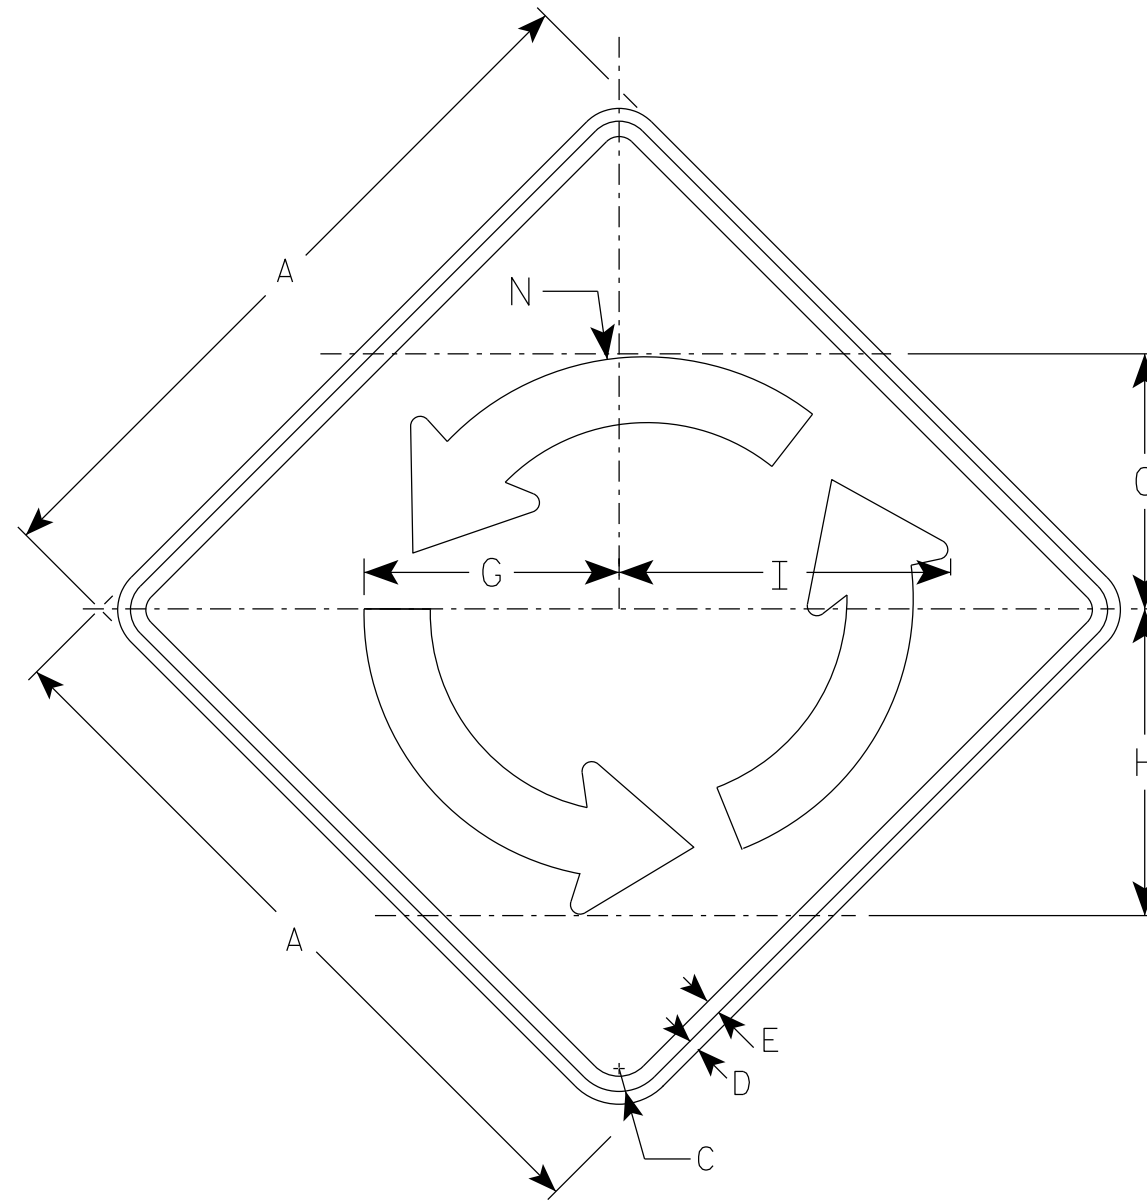

W2-6

Arrow Detail

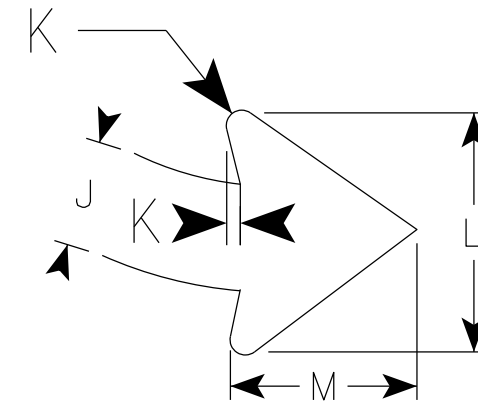

SIZE	A	B	C	D	E	F	G	H	I	J	K	L	M	N	O	P	Q	R	S	T	U	V	W	X	Area sq. ft.
1																									
2S	30		1 3/8	1/2	5/8		10 3/8	12 1/2	13 1/2	2 3/4	3/8	6	4 3/4	11 1/8											6.25
2M	30		1 3/8	1/2	5/8		10 3/8	12 1/2	13 1/2	2 3/4	3/8	6	4 3/4	11 1/8											6.25
3	36		1 5/8	5/8	3/4		12 1/2	15	16 1/4	3 1/4	1/2	7 3/8	5 3/4	13 3/8											9.00
4	48		2 1/4	3/4	1		16 5/8	20	16 1/4	4 3/8	5/8	9 3/4	7 5/8	17 7/8											16.0
5																									

STANDARD SIGN
W2-6

WISCONSIN DEPT OF TRANSPORTATION

APPROVED *Matthew R. Rauch*
for State Traffic Engineer

DATE 3/24/21 PLATE NO. W2-6.7


PROJECT NO:

SHEET NO: 143

E


7

7

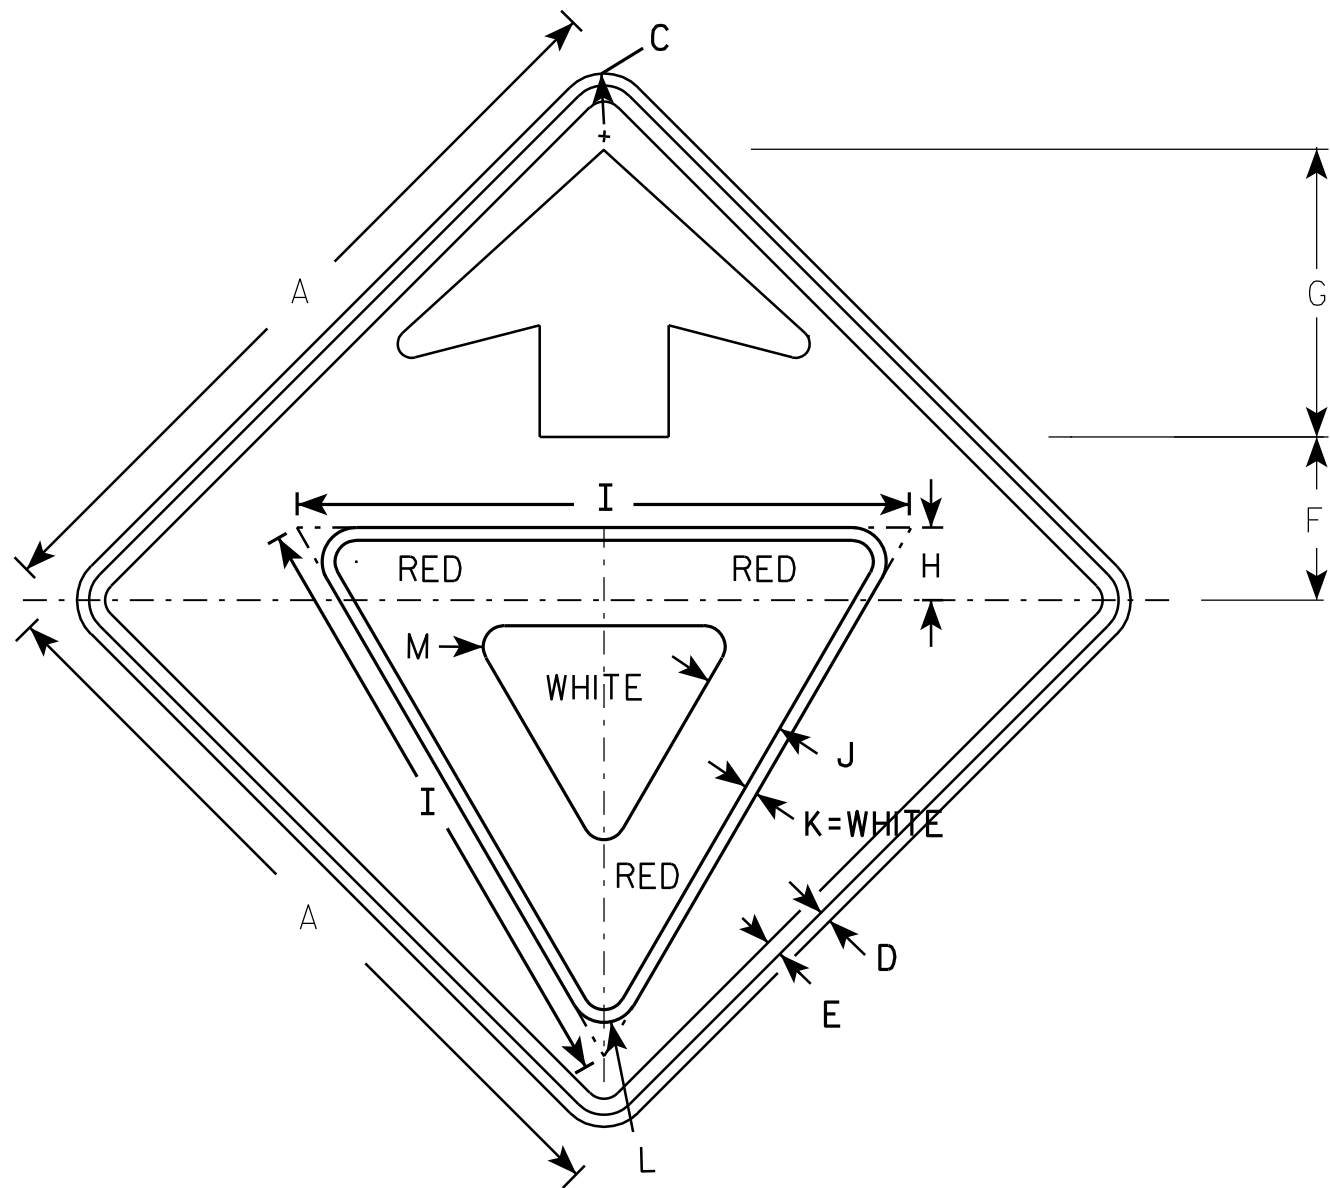

NOTES

1. All Signs Type II - Type F Reflective - reference WIS DOT Standard Specification for HIGHWAY and STRUCTURE CONSTRUCTION latest edition.
2. Color:
 Background - YELLOW
 Arrow & Border - BLACK
 Yield Symbol - WHITE BORDER ON RED BACKGROUND

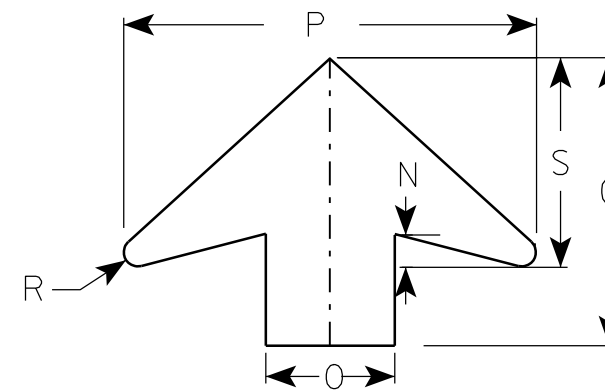

ARROW DETAIL

W3-2

7

7

SIZE	A	B	C	D	E	F	G	H	I	J	K	L	M	N	O	P	Q	R	S	T	U	V	W	X	Y	Z	Area sq. ft.
1	30		1 3/8	1/2	5/8	6 1/4	11 1/4	3	25	3 3/8	1/2	1 3/8	7/8	1 1/4	5	16		1/2	8								6.25
2S	36		1 5/8	5/8	3/4	7 1/2	13 1/2	3 3/8	28	3 3/4	5/8	1 1/2	1	1 5/8	6	19 1/4		5/8	9 3/4								9.0
2M	36		1 5/8	5/8	3/4	7 1/2	13 1/2	3 3/8	28	3 3/4	5/8	1 1/2	1	1 5/8	6	19 1/4		5/8	9 3/4								9.0
3	36		1 5/8	5/8	3/4	7 1/2	13 1/2	3 3/8	28	3 3/4	5/8	1 1/2	1	1 5/8	6	19 1/4		5/8	9 3/4								9.0
4	48		2 1/4	3/4	1	10	17 7/8	4 1/2	38	5	3/4	2 1/8	1 3/8	2	8	25 5/8		7/8	13								16.0
5	48		2 1/4	3/4	1	10	17 7/8	4 1/2	38	5	3/4	2 1/8	1 3/8	2	8	25 5/8		7/8	13								16.0

STANDARD SIGN
W3-2


WISCONSIN DEPT OF TRANSPORTATION

APPROVED *Matthew R. Rauch*
for State Traffic Engineer

DATE 6/7/10 PLATE NO. W3-2..9

NOTES

1. Sign is Type II - Type F Reflective
2. Color:
 Background - Yellow
 Message - Black

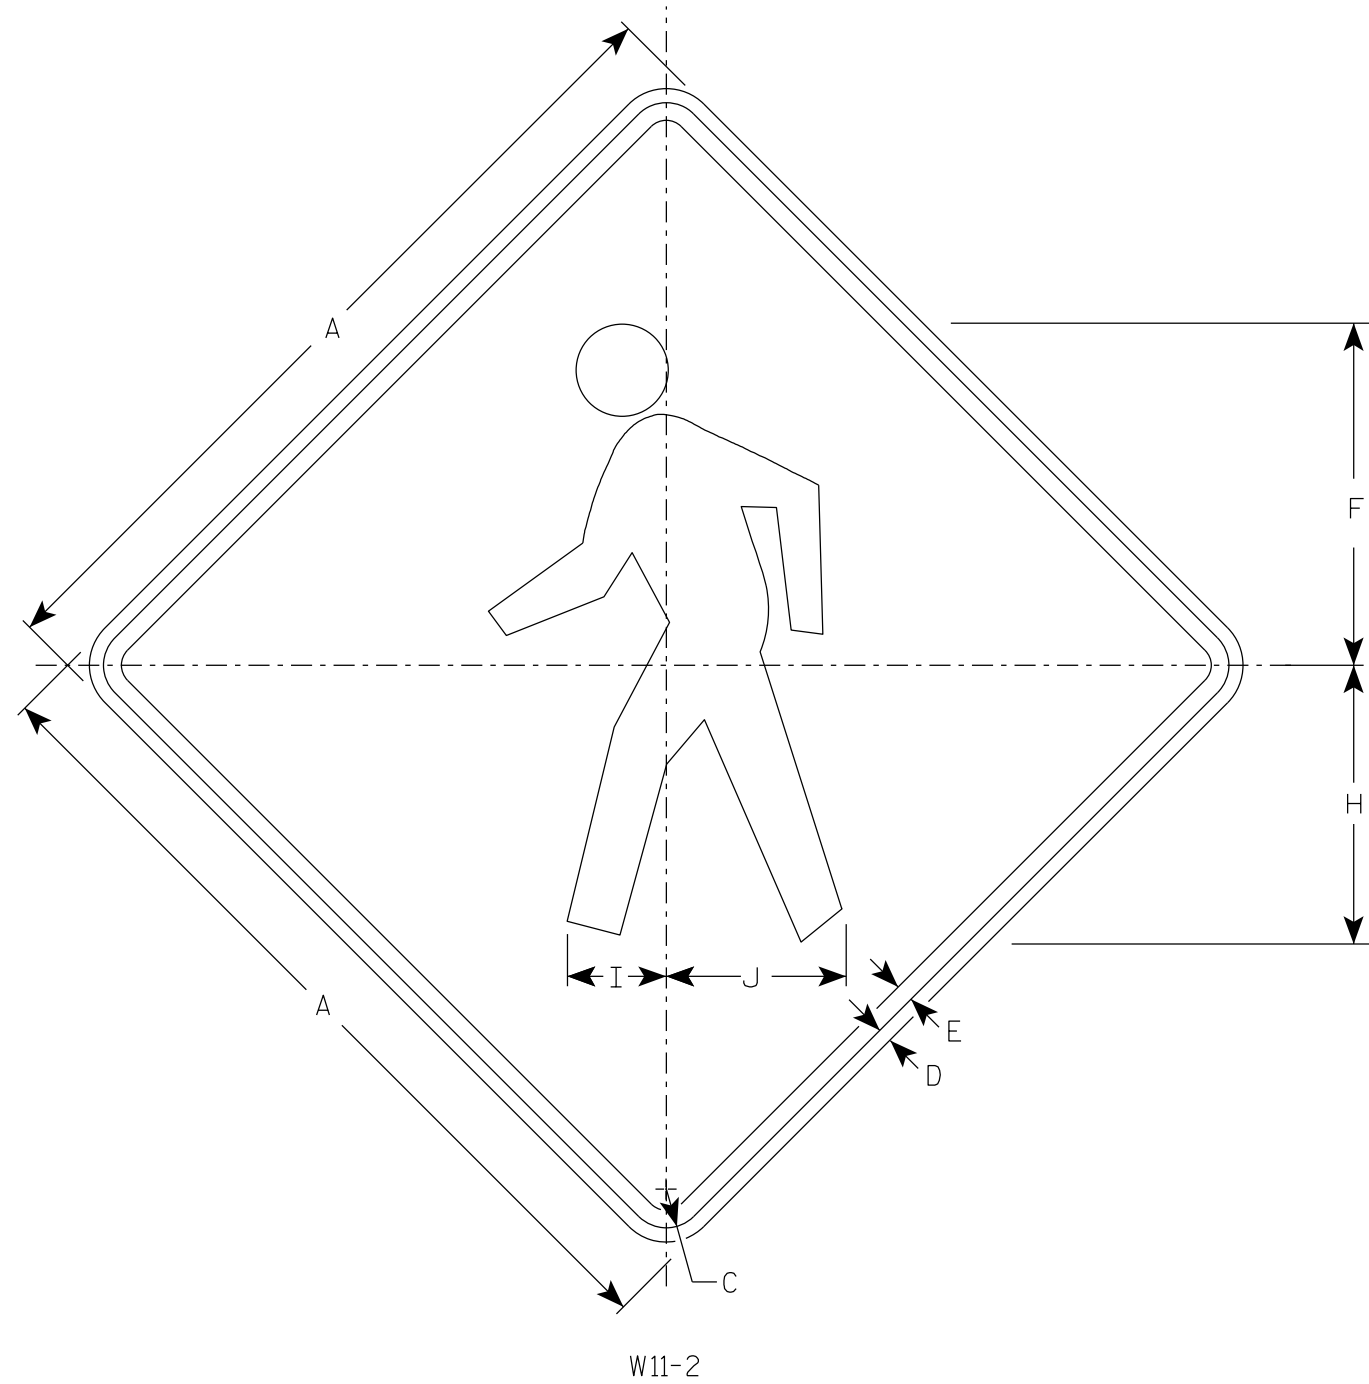

W11-2


SIZE	A	B	C	D	E	F	G	H	I	J	K	L	M	N	O	P	Q	R	S	T	U	V	W	X	Y	Z	Area sq. ft.
1	24		1 1/8	3/8	1/2	9 3/4		7 7/8	2 7/8	5 1/8																	4.0
2S	30		1 3/8	1/2	5/8	12 1/8		9 7/8	3 1/2	6 3/8																	6.25
2M	36		1 5/8	5/8	3/4	14 1/2		11 7/8	4 1/4	7 5/8																	9.0
3	36		1 5/8	5/8	3/4	14 1/2		11 7/8	4 1/4	7 5/8																	9.0
4	48		2 1/4	3/4	1	19 3/8		15 3/4	5 5/8	10 1/4																	16.0
5																											

STANDARD SIGN
W11-2

WISCONSIN DEPT OF TRANSPORTATION


APPROVED *Matthew R Rauch*
 for State Traffic Engineer

DATE 4/8/2020 PLATE NO. W11-2.8

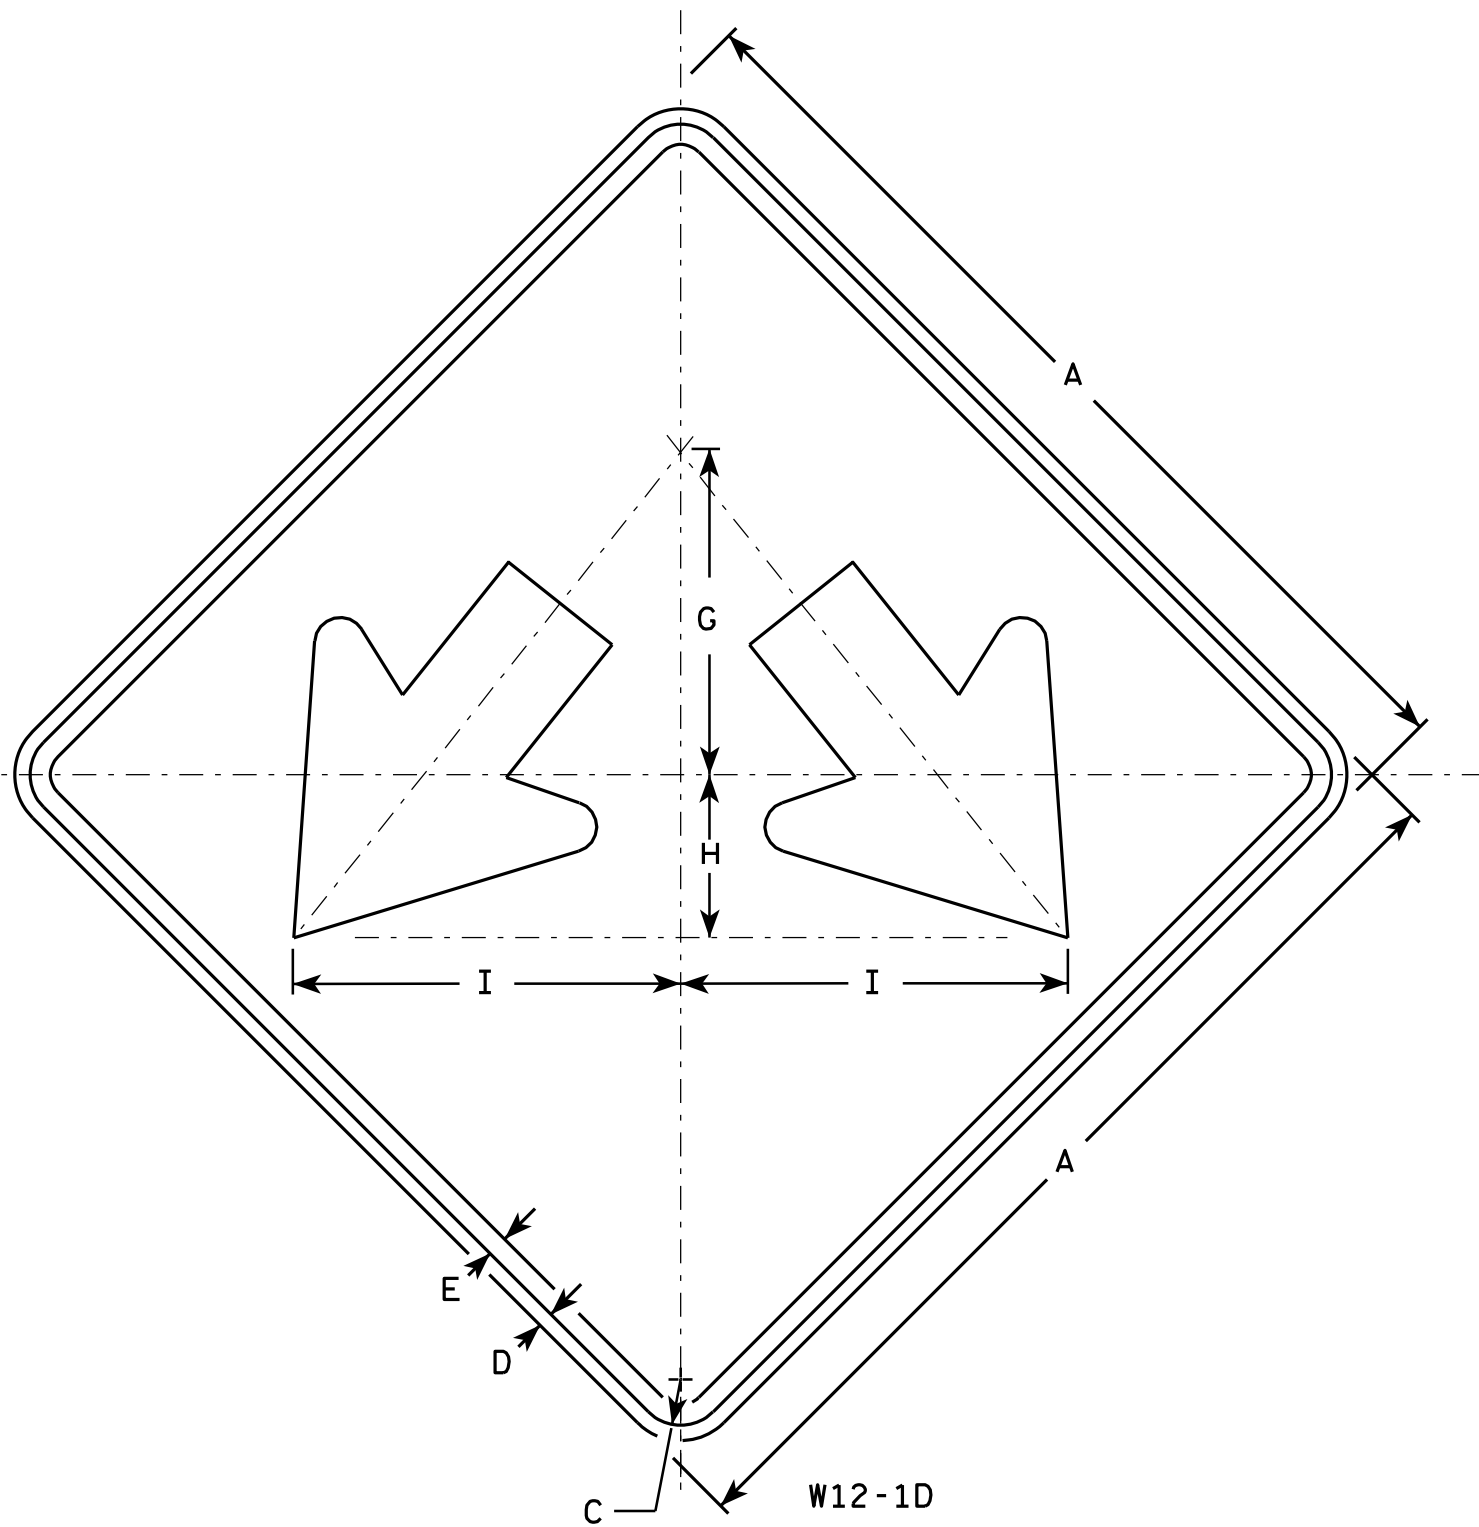

NOTES

1. Sign is Type II - Type F Reflective - reference WIS DOT Standard Specification for HIGHWAY and STRUCTURE CONSTRUCTION latest edition.
2. Color:
Background - Yellow
Message - Black
3. Corners may be square or rounded when base material is plywood but borders shall be rounded as shown. When base material is metal, the corners and borders shall be rounded.

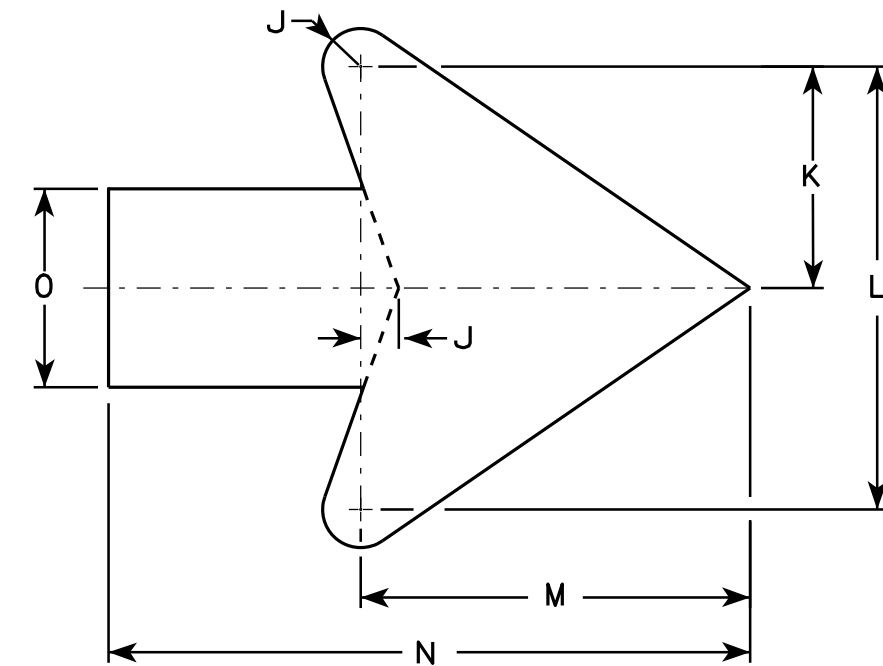

Arrow Detail

SIZE	A	B	C	D	E	F	G	H	I	J	K	L	M	N	O	P	Q	R	S	T	U	V	W	X	Y	Z	Area sq. ft.
1																											
2S	24		1 1/8	1/2	3/8		8	4	9 1/2	3/8	3 3/8	7 1/4	6 3/8	10 3/8	3 1/4												4.0
2M	24		1 1/8	1/2	3/8		8	4	9 1/2	3/8	3 3/8	7 1/4	6 3/8	10 3/8	3 1/4												4.0
3	30		1 3/8	1/2	5/8		10	5	11 7/8	3/4	4 1/2	9	7 7/8	13	4												6.25
4	36		1 3/8	1/2	5/8		12	6	14 1/4	1	5 1/2	10 7/8	9 5/8	15 3/4	4 3/4												9.0
5	48		2 1/4	3/4	1		16	8	19	1 1/4	7 1/4	14 1/2	12 3/4	21	6 1/4												16.0


STANDARD SIGN
W12-1D

WISCONSIN DEPT OF TRANSPORTATION

APPROVED *Matthew R. Rauch*
for State Traffic Engineer

DATE 3/13/13 PLATE NO. W12-1D.15

PROJECT NO: _____ HWY: _____ COUNTY: _____ SHEET NO: 146 **E**

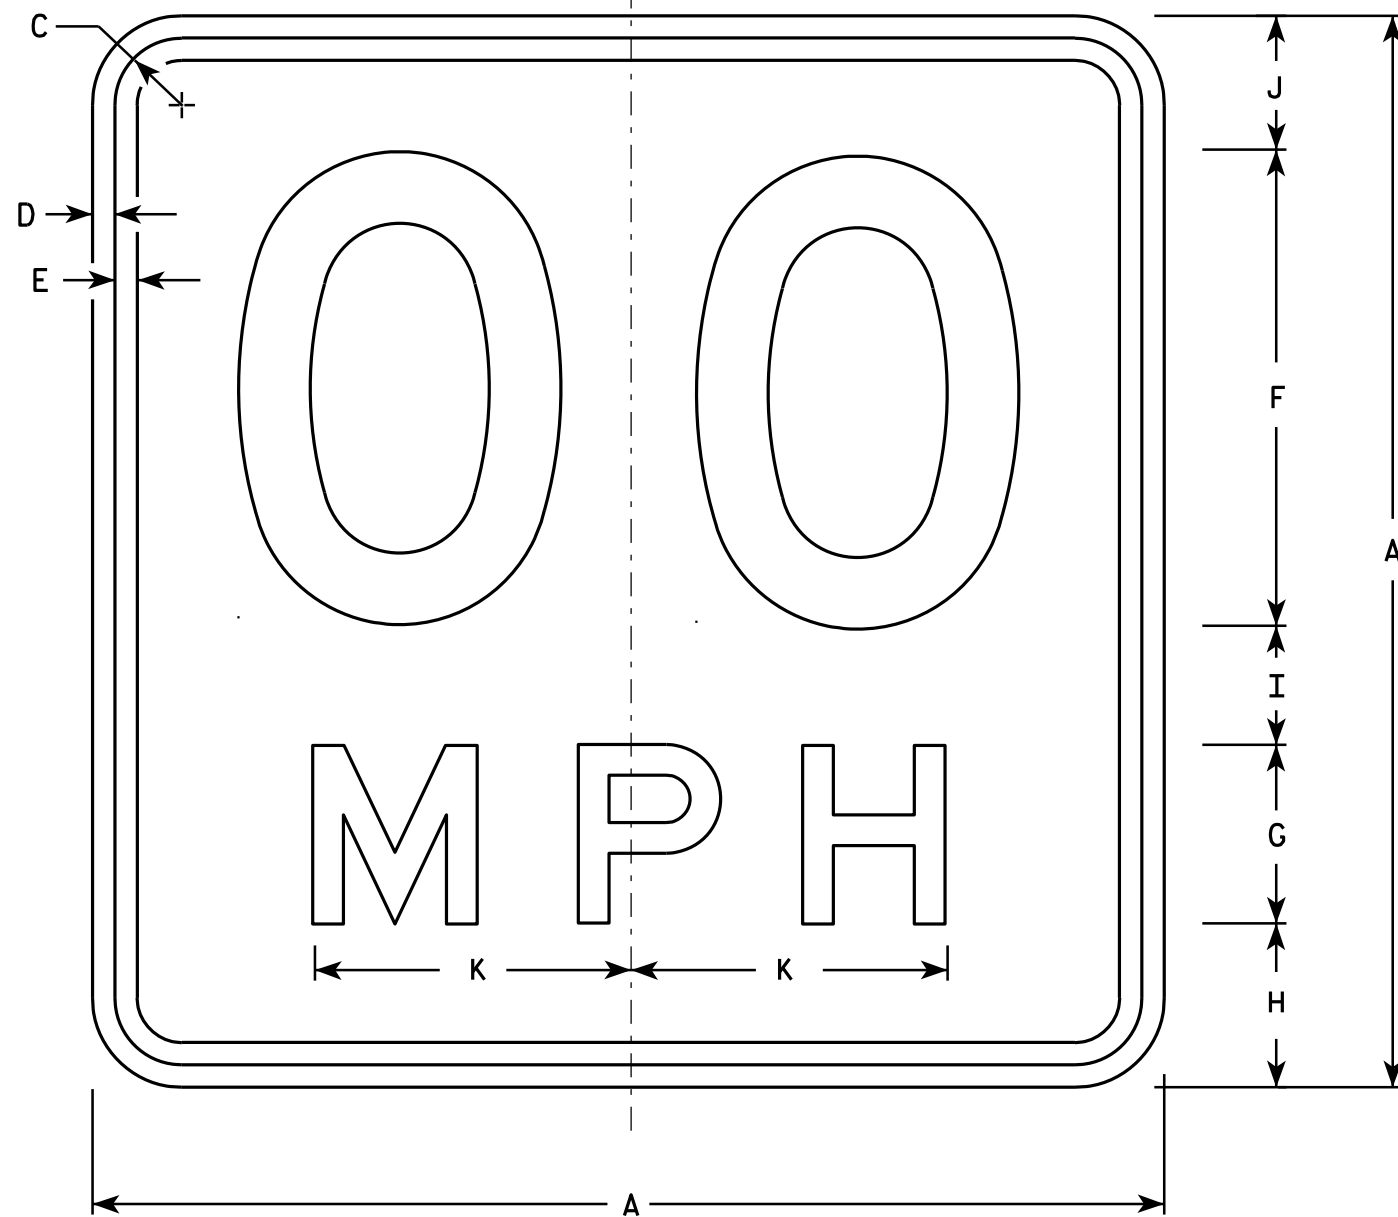

NOTES

1. Sign is Type II - Type F Reflective - reference WIS DOT Standard Specification for HIGHWAY and STRUCTURE CONSTRUCTION latest edition.
2. Color:
Background - Yellow
Message - Black
3. Message Series - See Note 6
4. Corners may be square or rounded when base material is plywood but borders shall be rounded as shown. When base material is metal, the corners and borders shall be rounded.
5. Substitute appropriate numerals and optically space about centerline to achieve proper balance.
6. Line 1 is Series D
Line 2 is Series E

W13-1

* For 30" x 30" Warning Signs, use 18" x 18" W13-1 signs.
For 36" x 36" Warning Signs, use 24" x 24" W13-1 signs.

SIZE	A	B	C	D	E	F	G	H	I	J	K	L	M	N	O	P	Q	R	S	T	U	V	W	X	Y	Z	Area sq. ft.
1	18		1 1/8	3/8	3/8	8	3	2 3/4	2	2 1/4	5 3/8																2.25
* 2S	18		1 1/8	3/8	3/8	8	3	2 3/4	2	2 1/4	5 3/8																2.25
* 2M	18		1 1/8	3/8	3/8	8	3	2 3/4	2	2 1/4	5 3/8																2.25
3	24		1 1/8	3/8	1/2	10	4	4	2 3/4	3 1/4	6 5/8																4.00
4	36		1 5/8	5/8	3/4	16	6	5 1/2	4	4 1/2	10 5/8																9.00
5	36		1 5/8	5/8	3/4	16	6	5 1/2	4	4 1/2	10 5/8																9.00

STANDARD SIGN
W13-1

WISCONSIN DEPT OF TRANSPORTATION

APPROVED *Matthew R. Rauch*
For State Traffic Engineer

DATE 5/31/12 PLATE NO. W13-1.16

PROJECT NO:

HWY:


COUNTY:

SHEET NO: 147

E

NOTES

1. Sign is Type II - Type F Reflective
2. Color:
Background - Yellow
Message - Black
3. W16-7R is the same as W16-7L
except the arrow is reversed along
the vertical centerline.

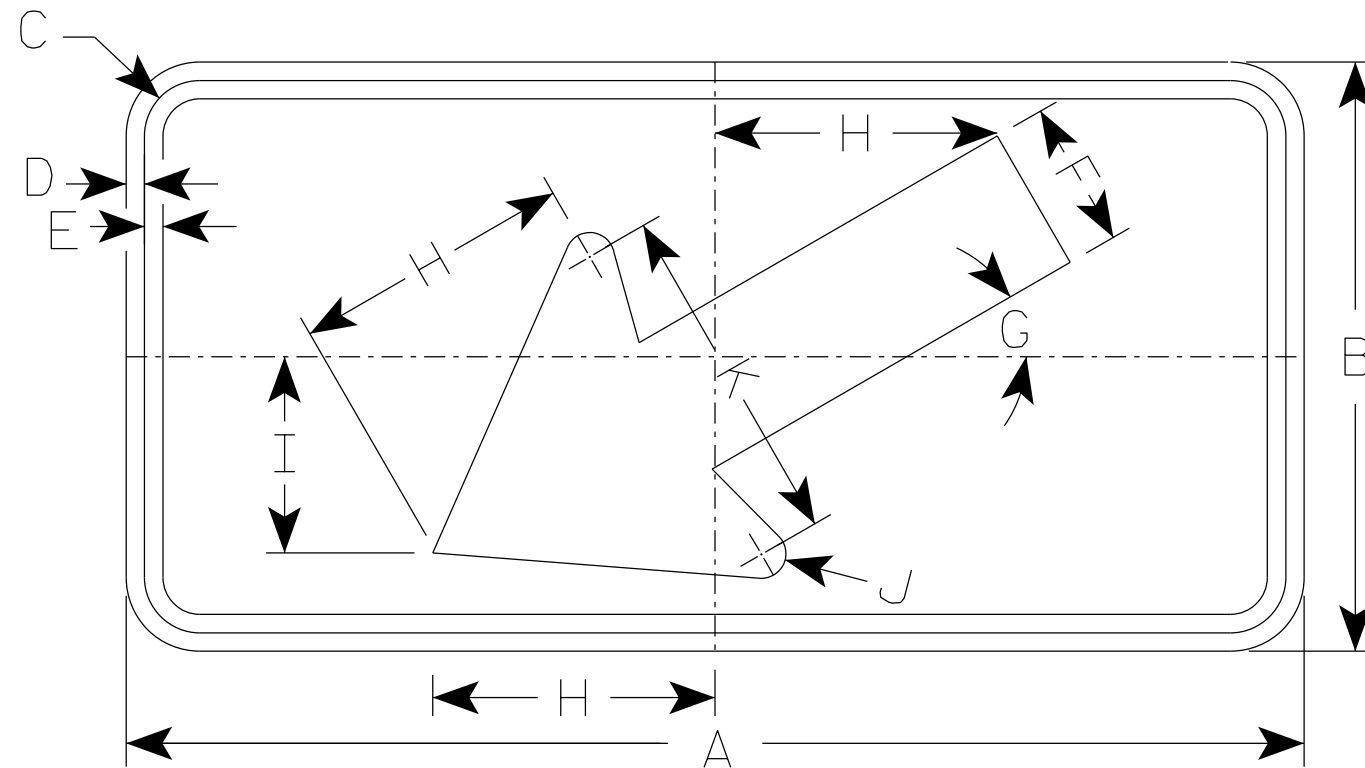

W16-7L

- * For 36" x 36" Warning Signs, use 30" x 18" W16-7L signs.
- * For 48" x 48" Warning Signs, use 48" x 24" W16-7L signs.

SIZE	A	B	C	D	E	F	G	H	I	J	K	L	M	N	O	P	Q	R	S	T	U	V	W	X	Y	Z	Area sq. ft.
1																											
2S	24	12	1 1/8	3/8	3/8	3	30°	5 3/4	4	1/2	7																2.0
* 2M	30	18	1 1/8	3/8	1/2	4 1/2	30°	8 1/2	6	5/8	10 1/4																3.75
* 3	30	18	1 1/8	3/8	1/2	4 1/2	30°	8 1/2	6	5/8	10 1/4																3.75
* 4	48	24	1 3/8	1/2	5/8	6	30°	11 1/2	8	1	14																8.0
5																											

STANDARD SIGN
W16-7

WISCONSIN DEPT OF TRANSPORTATION

APPROVED *Matthew R. Rauch*
for State Traffic Engineer

DATE 3/16/2021 PLATE NO. W16-7.8

DIVISION 1 - CTH JJ EB										
STATION	REAL STATION	DISTANCE	AREA (SF)		INCREMENTAL VOL (CY) (UNADJUSTED)			CUMULATIVE VOL (CY)		
			CUT	FILL	CUT	FILL	CUT	EXPANDED FILL	MASS ORDINATE	
										NOTE 1
301+33	30133.00	0.00	64.74	0.01	0	0	0	0	0	0
302+00	30200.00	67.00	67.67	0.00	164	0	164	0	164	164
302+25	30225.00	25.00	68.72	0.00	63	0	227	0	227	227
302+50	30250.00	25.00	71.10	0.07	65	0	292	0	292	292
303+00	30300.00	50.00	154.22	1.22	209	1	501	1	500	500
303+50	30350.00	50.00	146.97	1.85	279	3	780	5	775	775
304+00	30400.00	50.00	80.41	7.52	211	9	991	16	975	975
304+25	30425.00	25.00	81.79	16.77	75	11	1,066	30	1,036	1,036

DIVISION 1 - CTH JJ WB										
STATION	REAL STATION	DISTANCE	AREA (SF)		INCREMENTAL VOL (CY) (UNADJUSTED)			CUMULATIVE VOL (CY)		
			CUT	FILL	CUT	FILL	CUT	EXPANDED FILL	MASS ORDINATE	
										NOTE 1
402+25	40225.00	0.00	84.19	4.73	0	0	0	0	0	0
402+50	40250.00	25.00	88.82	14.78	80	9	80	11	69	69
402+75	40275.00	25.00	84.20	6.05	80	10	160	24	136	136

DIVISION 1 - CTH JJ EB										
STATION	REAL STATION	DISTANCE	AREA (SF)		INCREMENTAL VOL (CY) (UNADJUSTED)			CUMULATIVE VOL (CY)		
			CUT	FILL	CUT	FILL	CUT	EXPANDED FILL	MASS ORDINATE	
										NOTE 1
306+50	30650.00	0.00	20.40	23.71	0	0	0	0	0	0
307+00	30700.00	50.00	96.40	9.66	108	31	108	39	69	69
307+50	30750.00	50.00	145.97	33.81	224	40	332	89	243	243
307+92	30792.00	42.00	221.40	37.46	286	55	618	158	461	461
308+00	30800.00	8.00	213.65	33.47	64	11	682	171	511	511
308+50	30850.00	50.00	179.87	16.38	364	46	1,046	229	817	817
309+00	30900.00	50.00	162.33	12.72	317	27	1,363	263	1,101	1,101
309+15	30915.00	15.00	165.39	4.59	91	5	1,454	269	1,185	1,185
309+50	30950.00	35.00	163.08	4.12	213	6	1,667	276	1,391	1,391
310+00	31000.00	50.00	168.05	0.01	307	4	1,974	281	1,693	1,693
310+50	31050.00	50.00	70.98	0.00	221	0	2,195	281	1,914	1,914
310+69	31069.00	19.00	72.48	0.00	50	0	2,245	281	1,964	1,964

DIVISION 1 - CTH JJ WB										
STATION	REAL STATION	DISTANCE	AREA (SF)		INCREMENTAL VOL (CY) (UNADJUSTED)			CUMULATIVE VOL (CY)		
			CUT	FILL	CUT	FILL	CUT	EXPANDED FILL	MASS ORDINATE	
										NOTE 1
405+00	40500.00	0.00	111.00	21.83	0	0	0	0	0	0
405+50	40550.00	50.00	109.37	4.59	204	24	204	30	174	174

9

9

DIVISION 1 - PENDLETON NB											
STATION	REAL STATION	DISTANCE	AREA (SF)		INCREMENTAL VOL (CY) (UNADJUSTED)			CUMULATIVE VOL (CY)			
			CUT	FILL	CUT	FILL	CUT	EXPANDED FILL	MASS	ORDINATE	
											NOTE 1
101+35	10135.00	0.00	148.82	1.64	0	0	0	0	0	0	0
101+50	10150.00	15.00	153.57	1.14	84	1	84	1	83		
102+00	10200.00	50.00	159.25	6.54	290	7	374	10	364		
102+50	10250.00	50.00	107.05	33.07	247	37	621	56	565		
102+75	10275.00	25.00	40.46	48.63	68	38	689	104	585		


DIVISION 1 - PENDLETON SB											
STATION	REAL STATION	DISTANCE	AREA (SF)		INCREMENTAL VOL (CY) (UNADJUSTED)			CUMULATIVE VOL (CY)			
			CUT	FILL	CUT	FILL	CUT	EXPANDED FILL	MASS	ORDINATE	
											NOTE 1
202+50	20250.00	0.00	63.58	1.76	0	0	0	0	0	0	0
202+75	20275.00	25.00	64.59	9.10	59	5	59	6	53		

DIVISION 1 - CTH CB SB											
STATION	REAL STATION	DISTANCE	AREA (SF)		INCREMENTAL VOL (CY) (UNADJUSTED)			CUMULATIVE VOL (CY)			
			CUT	FILL	CUT	FILL	CUT	EXPANDED FILL	MASS	ORDINATE	
											NOTE 1
205+00	20500.00	0.00	57.27	30.99	0	0	0	0	0	0	0
205+50	20550.00	50.00	69.63	3.68	118	32	118	40	78		
206+00	20600.00	50.00	74.82	4.97	134	8	252	50	202		
206+50	20650.00	50.00	82.52	0.06	146	5	398	56	342		
206+69.998	20670.00	20.00	107.19	0.00	70	0	468	56	412		
207+00	20700.00	30.00	84.91	0.07	107	0	575	56	519		
207+50	20750.00	50.00	99.37	0.00	171	0	746	56	690		
207+60	20760.00	10.00	97.38	0.00	36	0	782	56	726		
208+00	20800.00	40.00	77.92	0.31	130	0	912	56	856		
208+45	20845.00	45.00	78.52	0.00	147	0	1,059	56	837		
208+46	20846.00	1.00	45.00	0.00	3	0	1,062	56	729		
208+93	20893.00	47.00	45.00	0.00	107	0	1,169	56	963		

DIVISION 1 - CTH CB NB											
STATION	REAL STATION	DISTANCE	AREA (SF)		INCREMENTAL VOL (CY) (UNADJUSTED)			CUMULATIVE VOL (CY)			
			CUT	FILL	CUT	FILL	CUT	EXPANDED FILL	MASS	ORDINATE	
											NOTE 1
105+00	10500.00	0.00	116.66	16.67	0	0	0	0	0	0	0
105+50	10550.00	50.00	72.78	3.73	175	19	175	24	151		
106+05	10605.00	55.00	65.53	3.33	141	7	316	33	284		

9

9

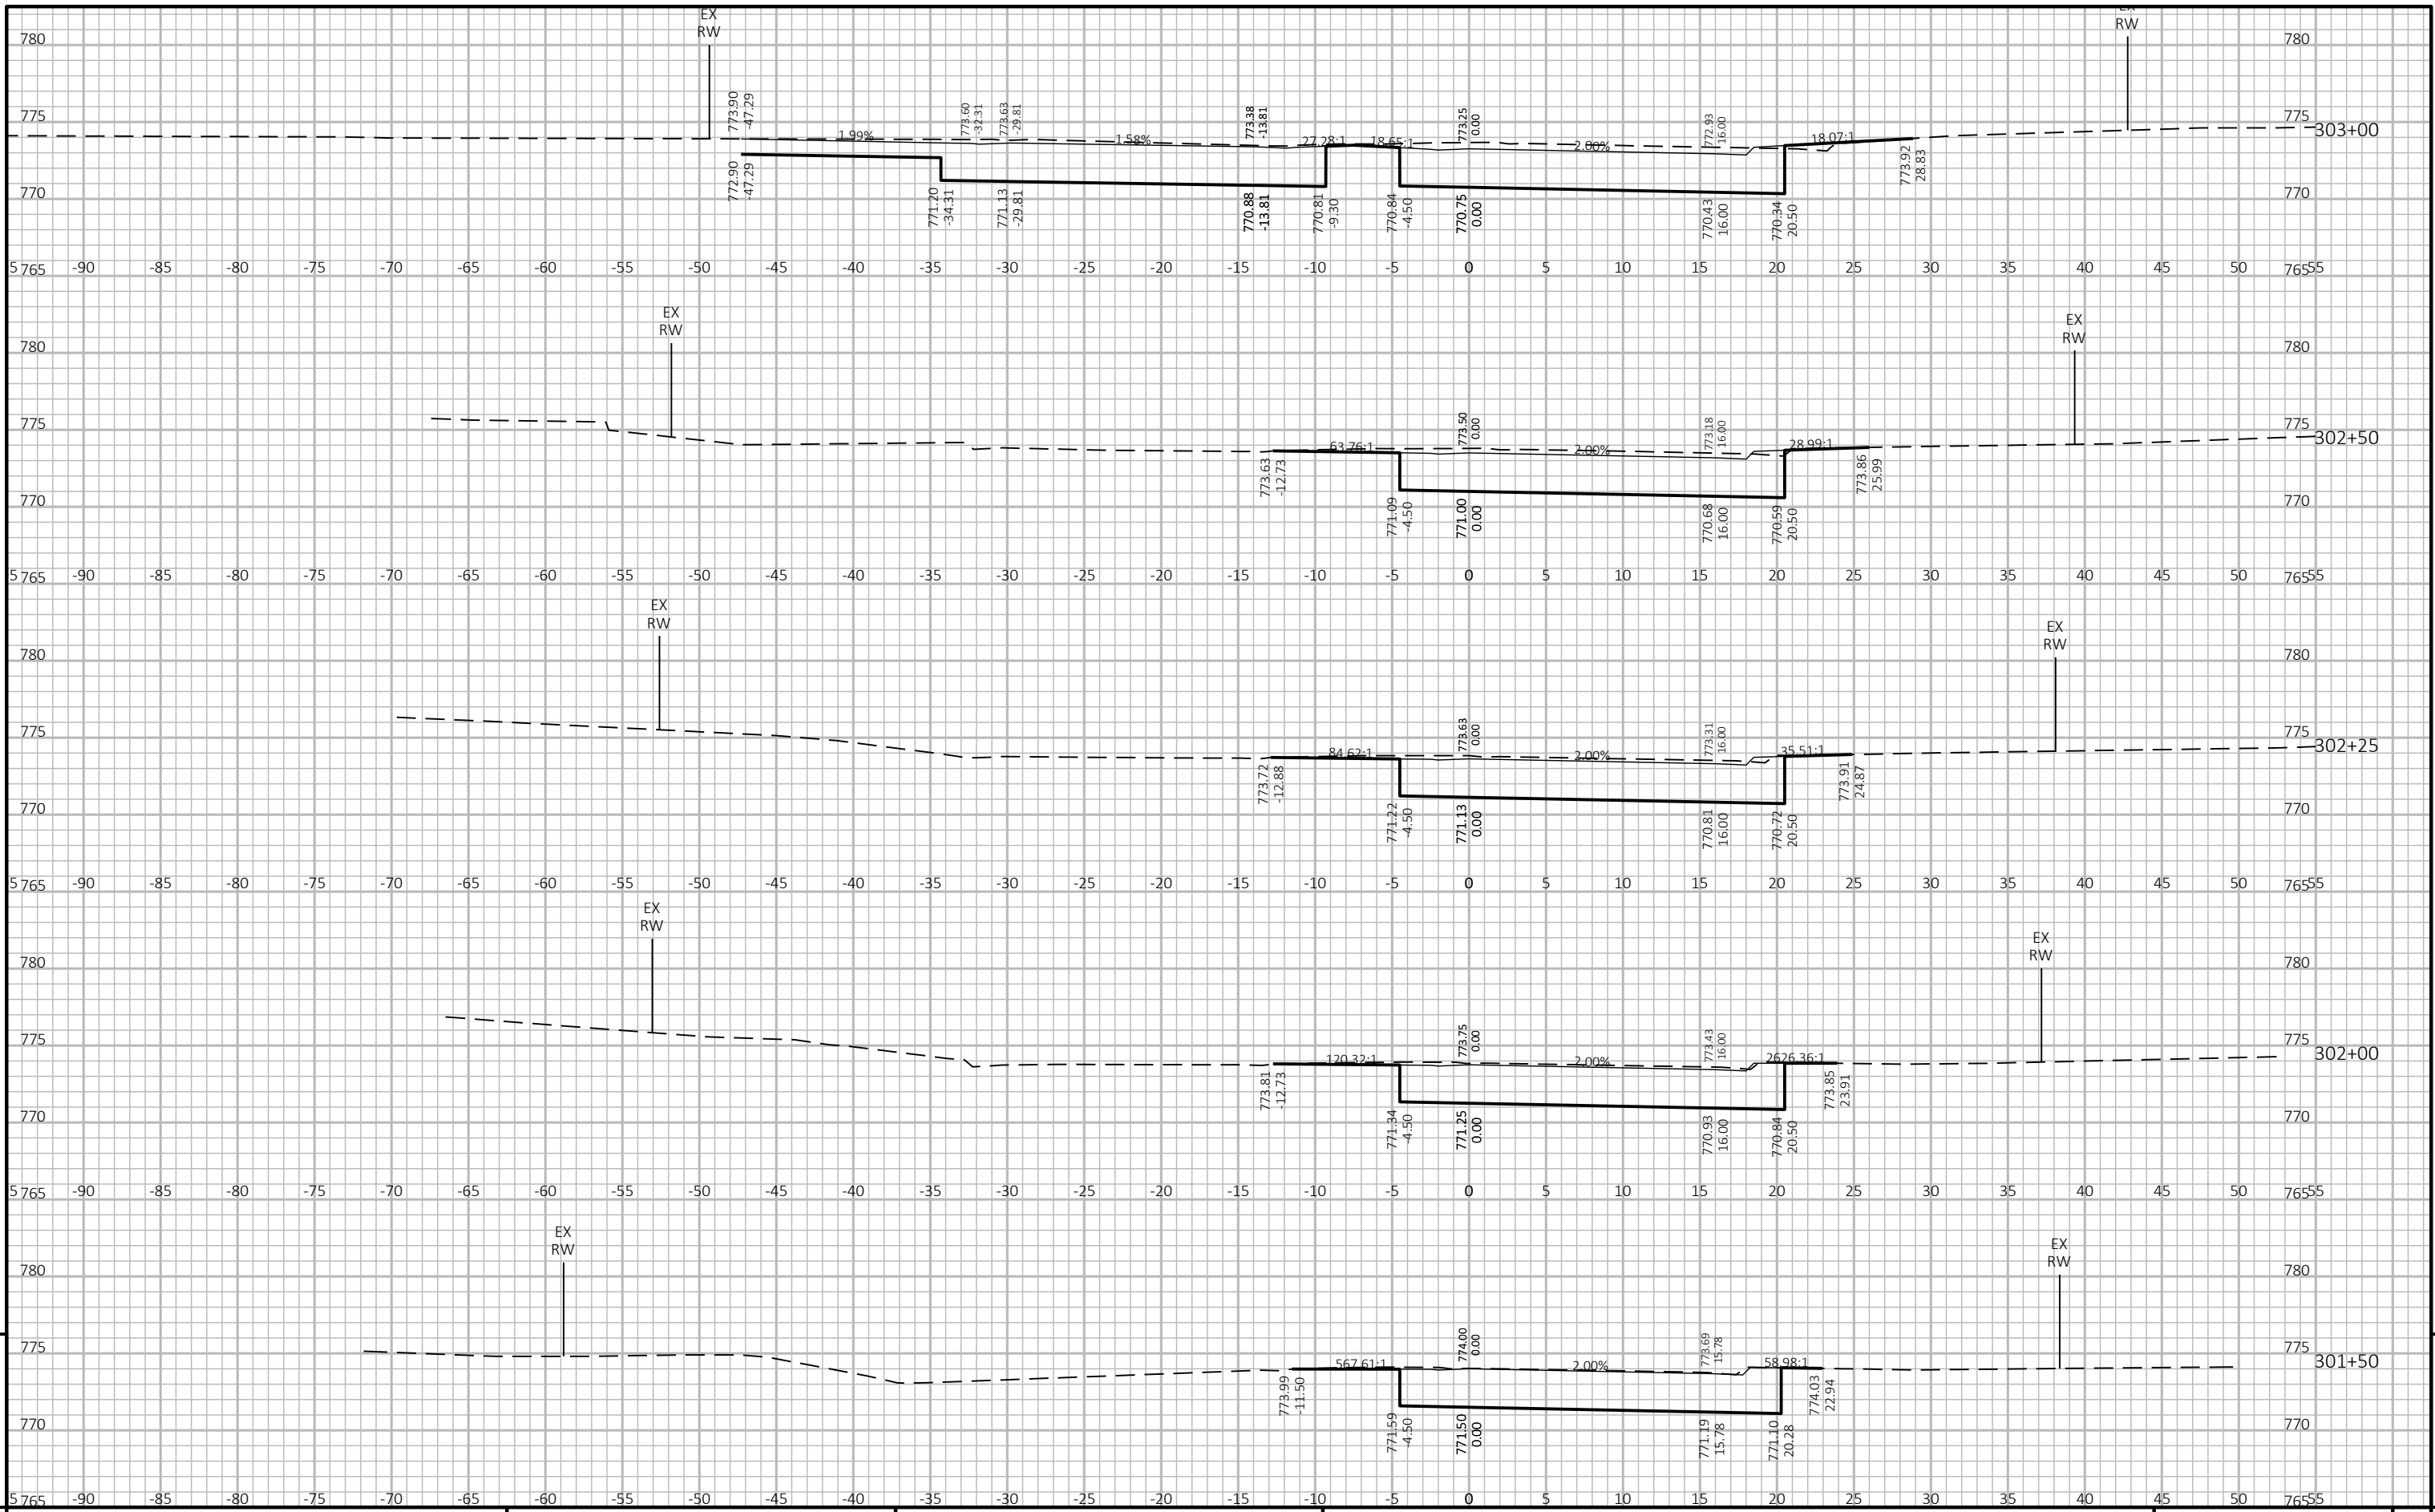


9

9

PROJECT NO: 426-4738 HWY: CTH JJ COUNTY: WINNEBAGO CROSS SECTIONS: CTH JJ WEST EB SHEET 151 E

FILE NAME: N:\3000994.00\CIVIL 3D\SHEETSPLAN\4264738-090200-XS.DWG PLOT DATE: 12/7/2021 11:51 AM PLOT BY: MATT TOMSOVIC PLOT NAME: PLOT SCALE: 1 IN:10 FT HORZ. / 1 IN:10 FT VERT. WISDOT/CADD SHEET 49

LAYOUT NAME: 4264738-090201-xs

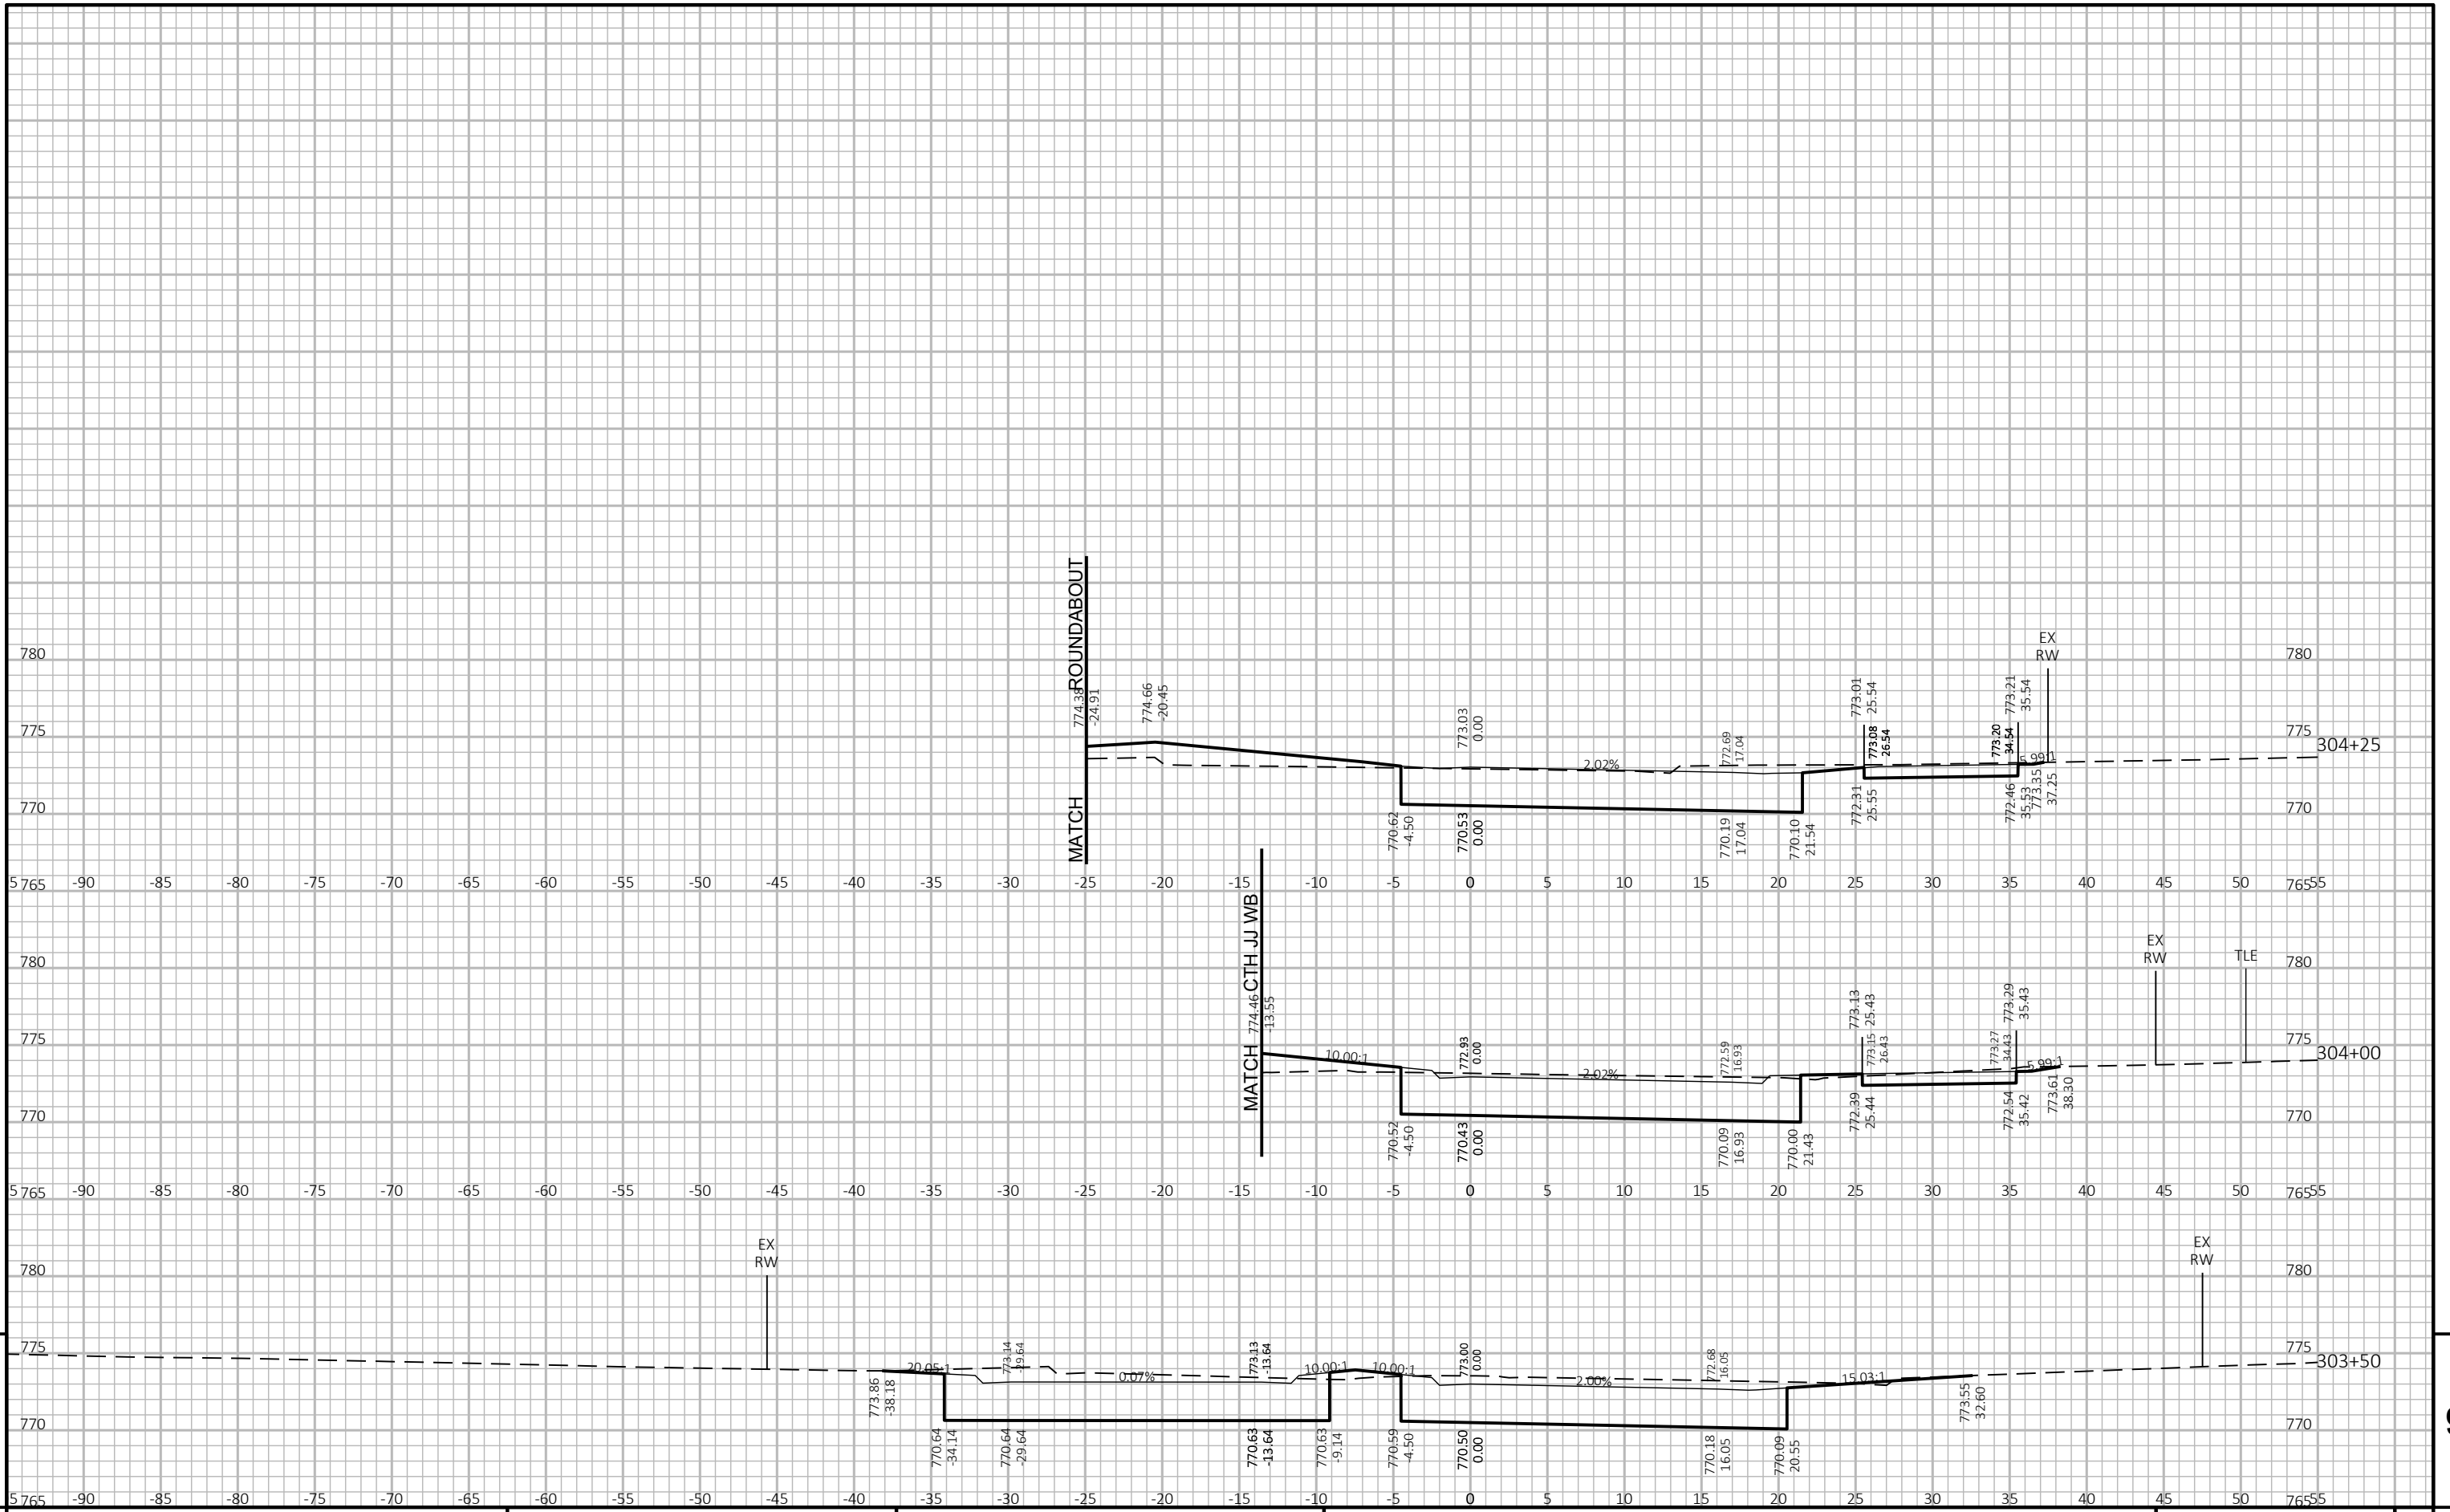

PROJECT NO: 426-4738

HWY: CTH JJ


COUNTY: WINNEBAGO

CROSS SECTIONS: CTH JJ WEST EB

SHEET

152

E

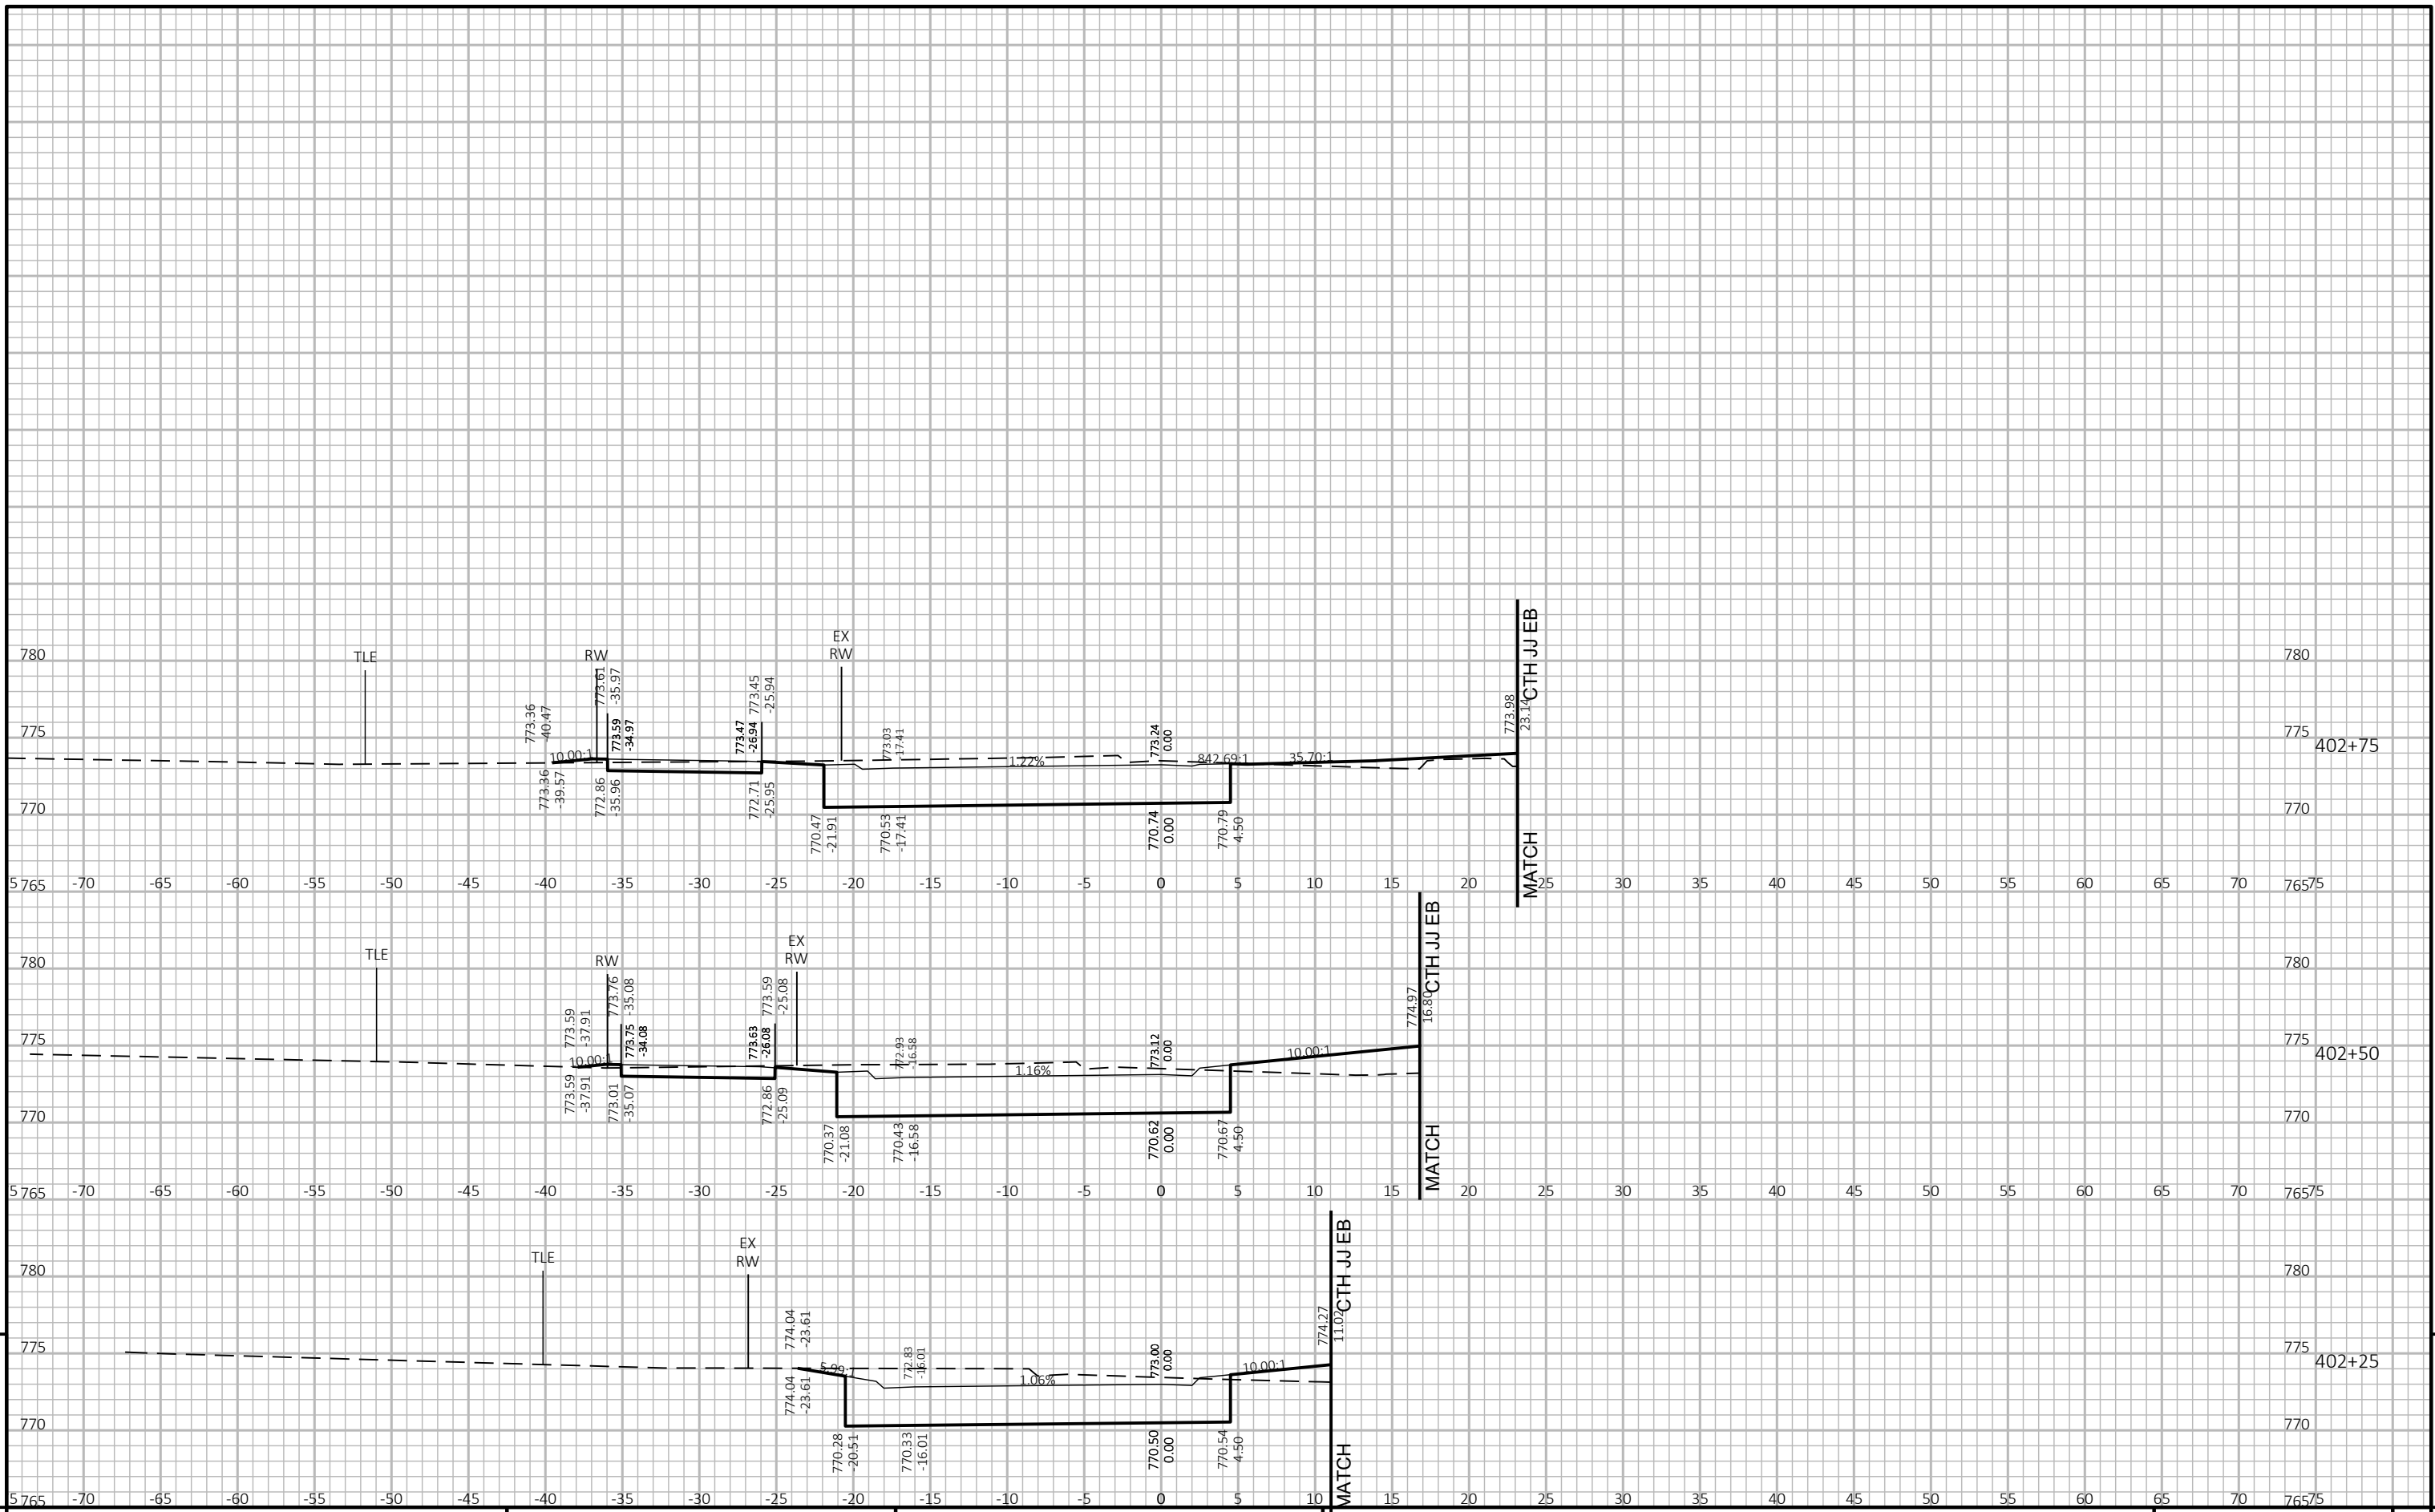

PROJECT NO: 426-4738

HWY: CTH JJ


COUNTY: WINNEBAGO

CROSS SECTIONS: CTH JJ WEST WB

SHEET

153

E

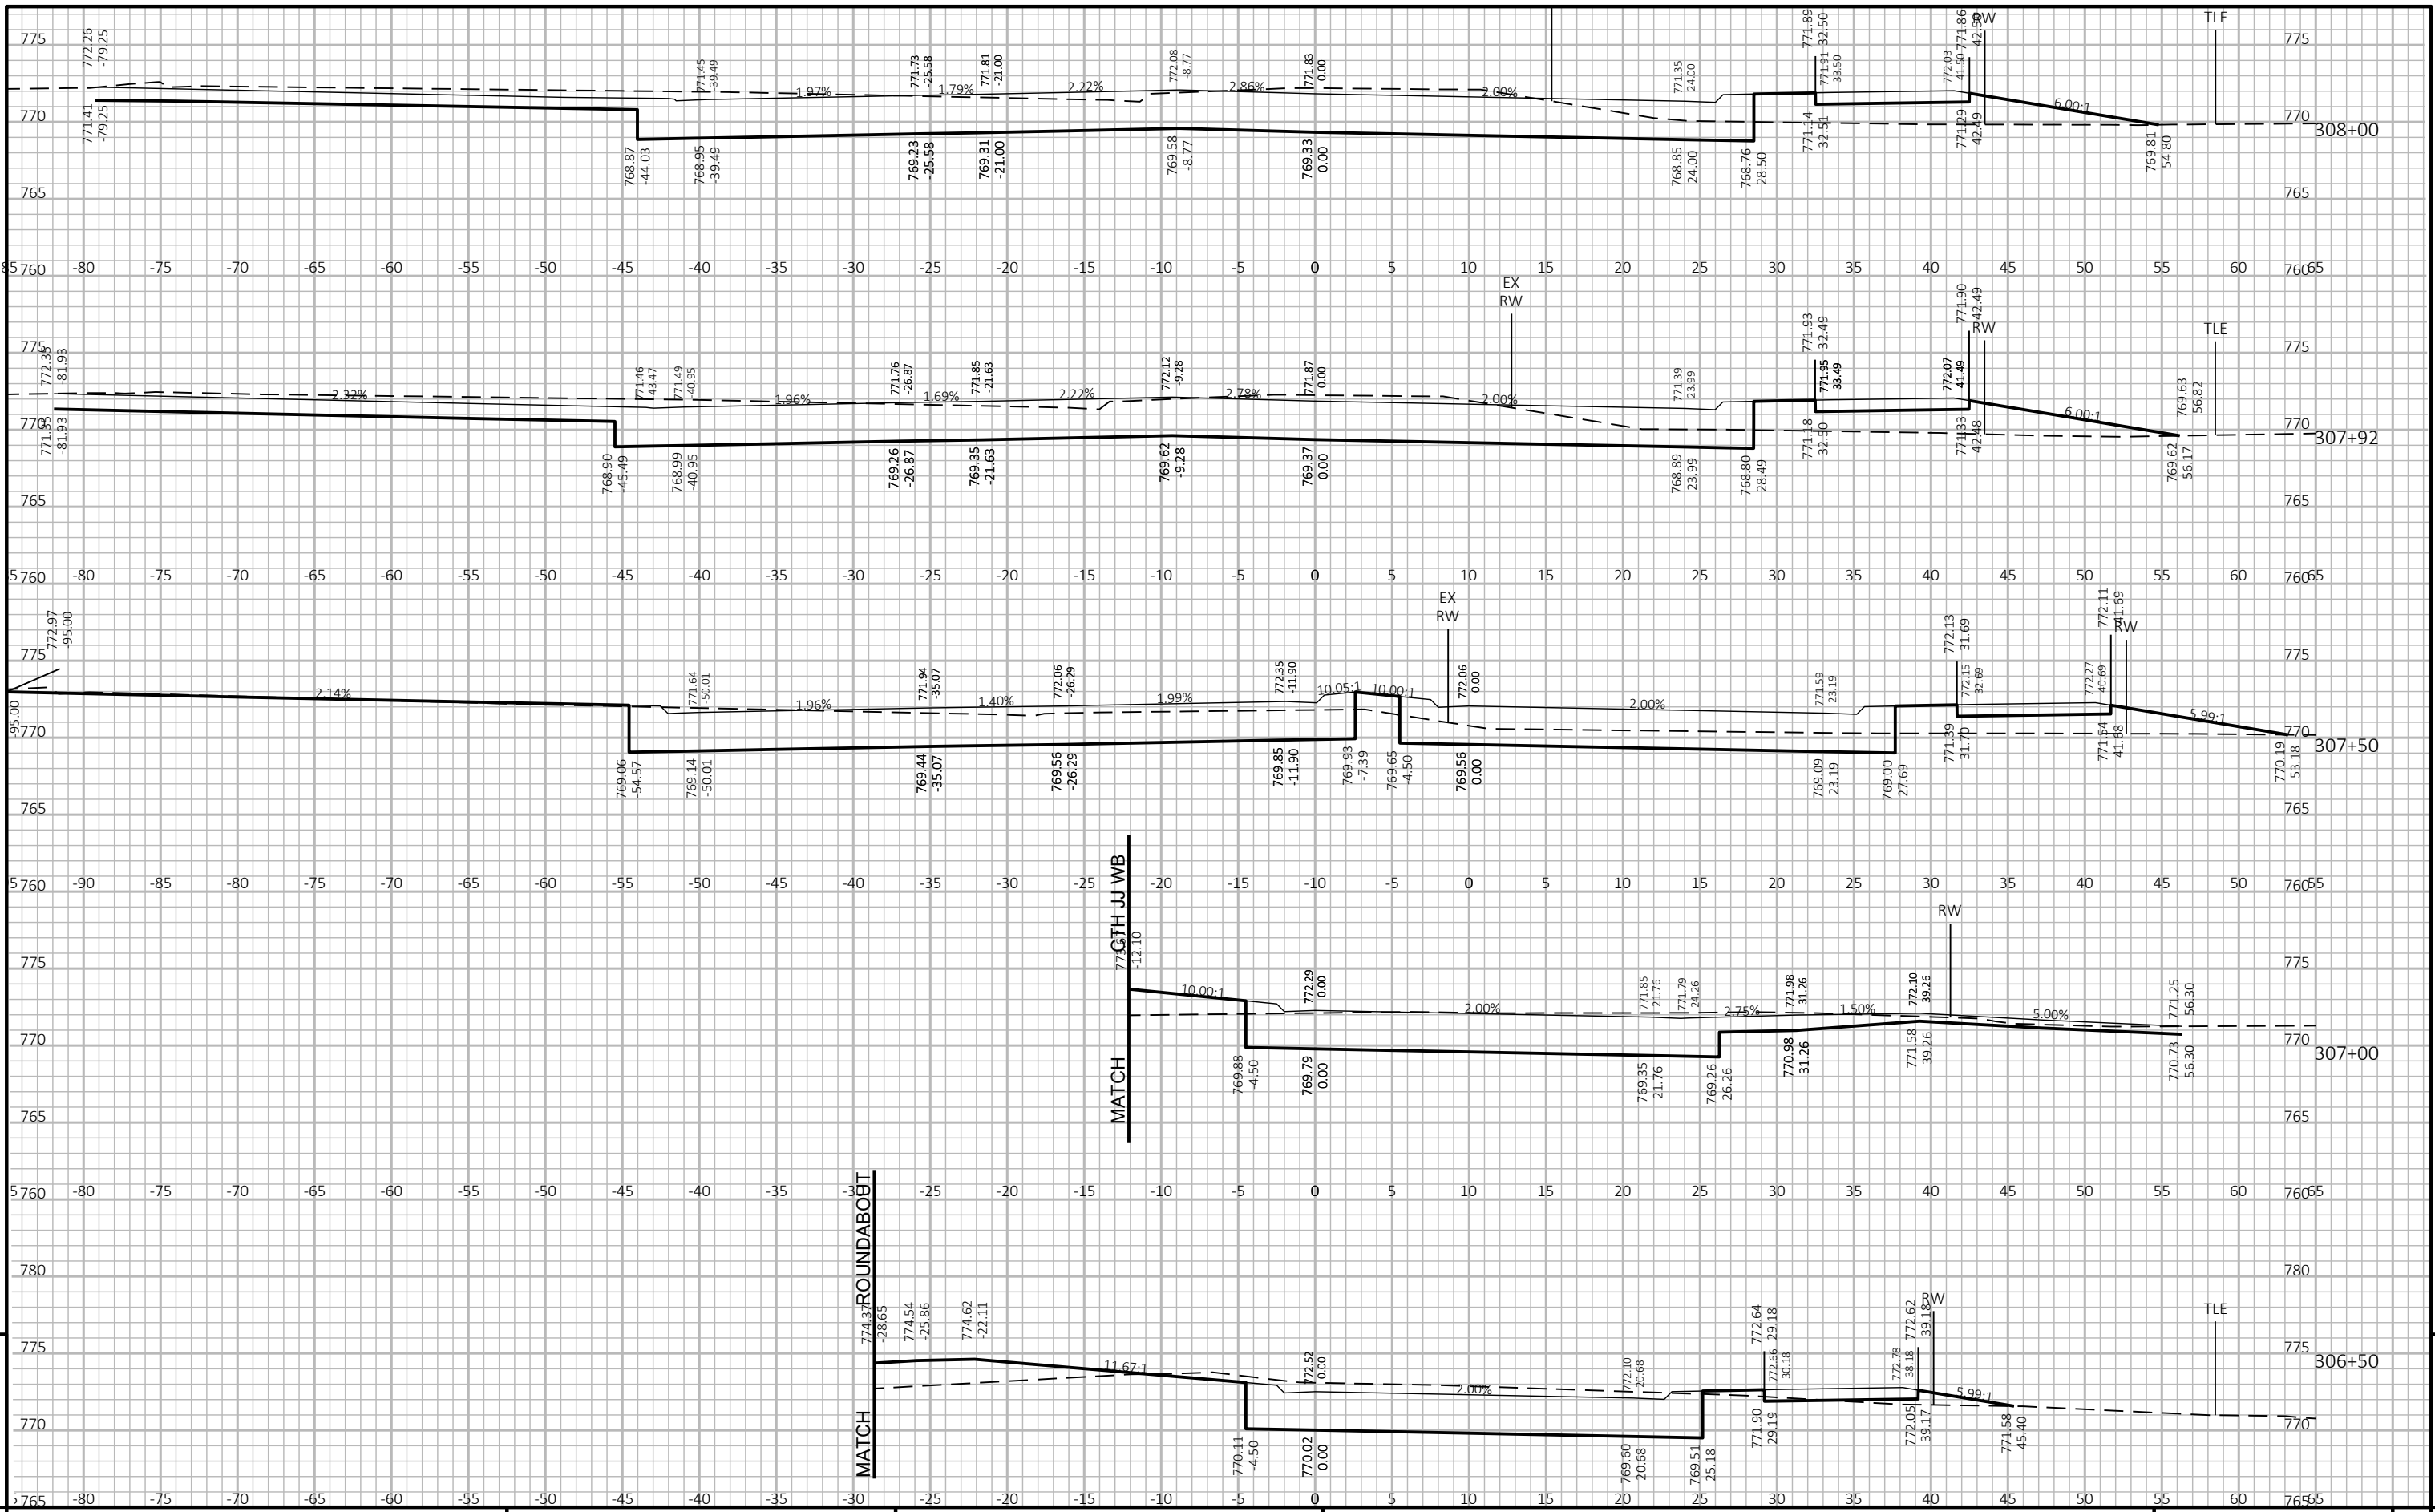


9

9

PROJECT NO: 426-4738 HWY: CTH JJ COUNTY: WINNEBAGO CROSS SECTIONS: CTH JJ EAST EB SHEET 154 E

FILE NAME: N:\3000994.00\CIVIL 3D\SHEETS\PLAN\4264738-090200-XS.DWG PLOT DATE: 12/7/2021 11:51 AM PLOT BY: MATT TOMSOVIC PLOT NAME: PLOT SCALE: 1 IN:10 FT HORZ. / 1 IN:10 FT VERT. WISDOT/CADD SHEET 49

LAYOUT NAME: 4264738-090211-xs

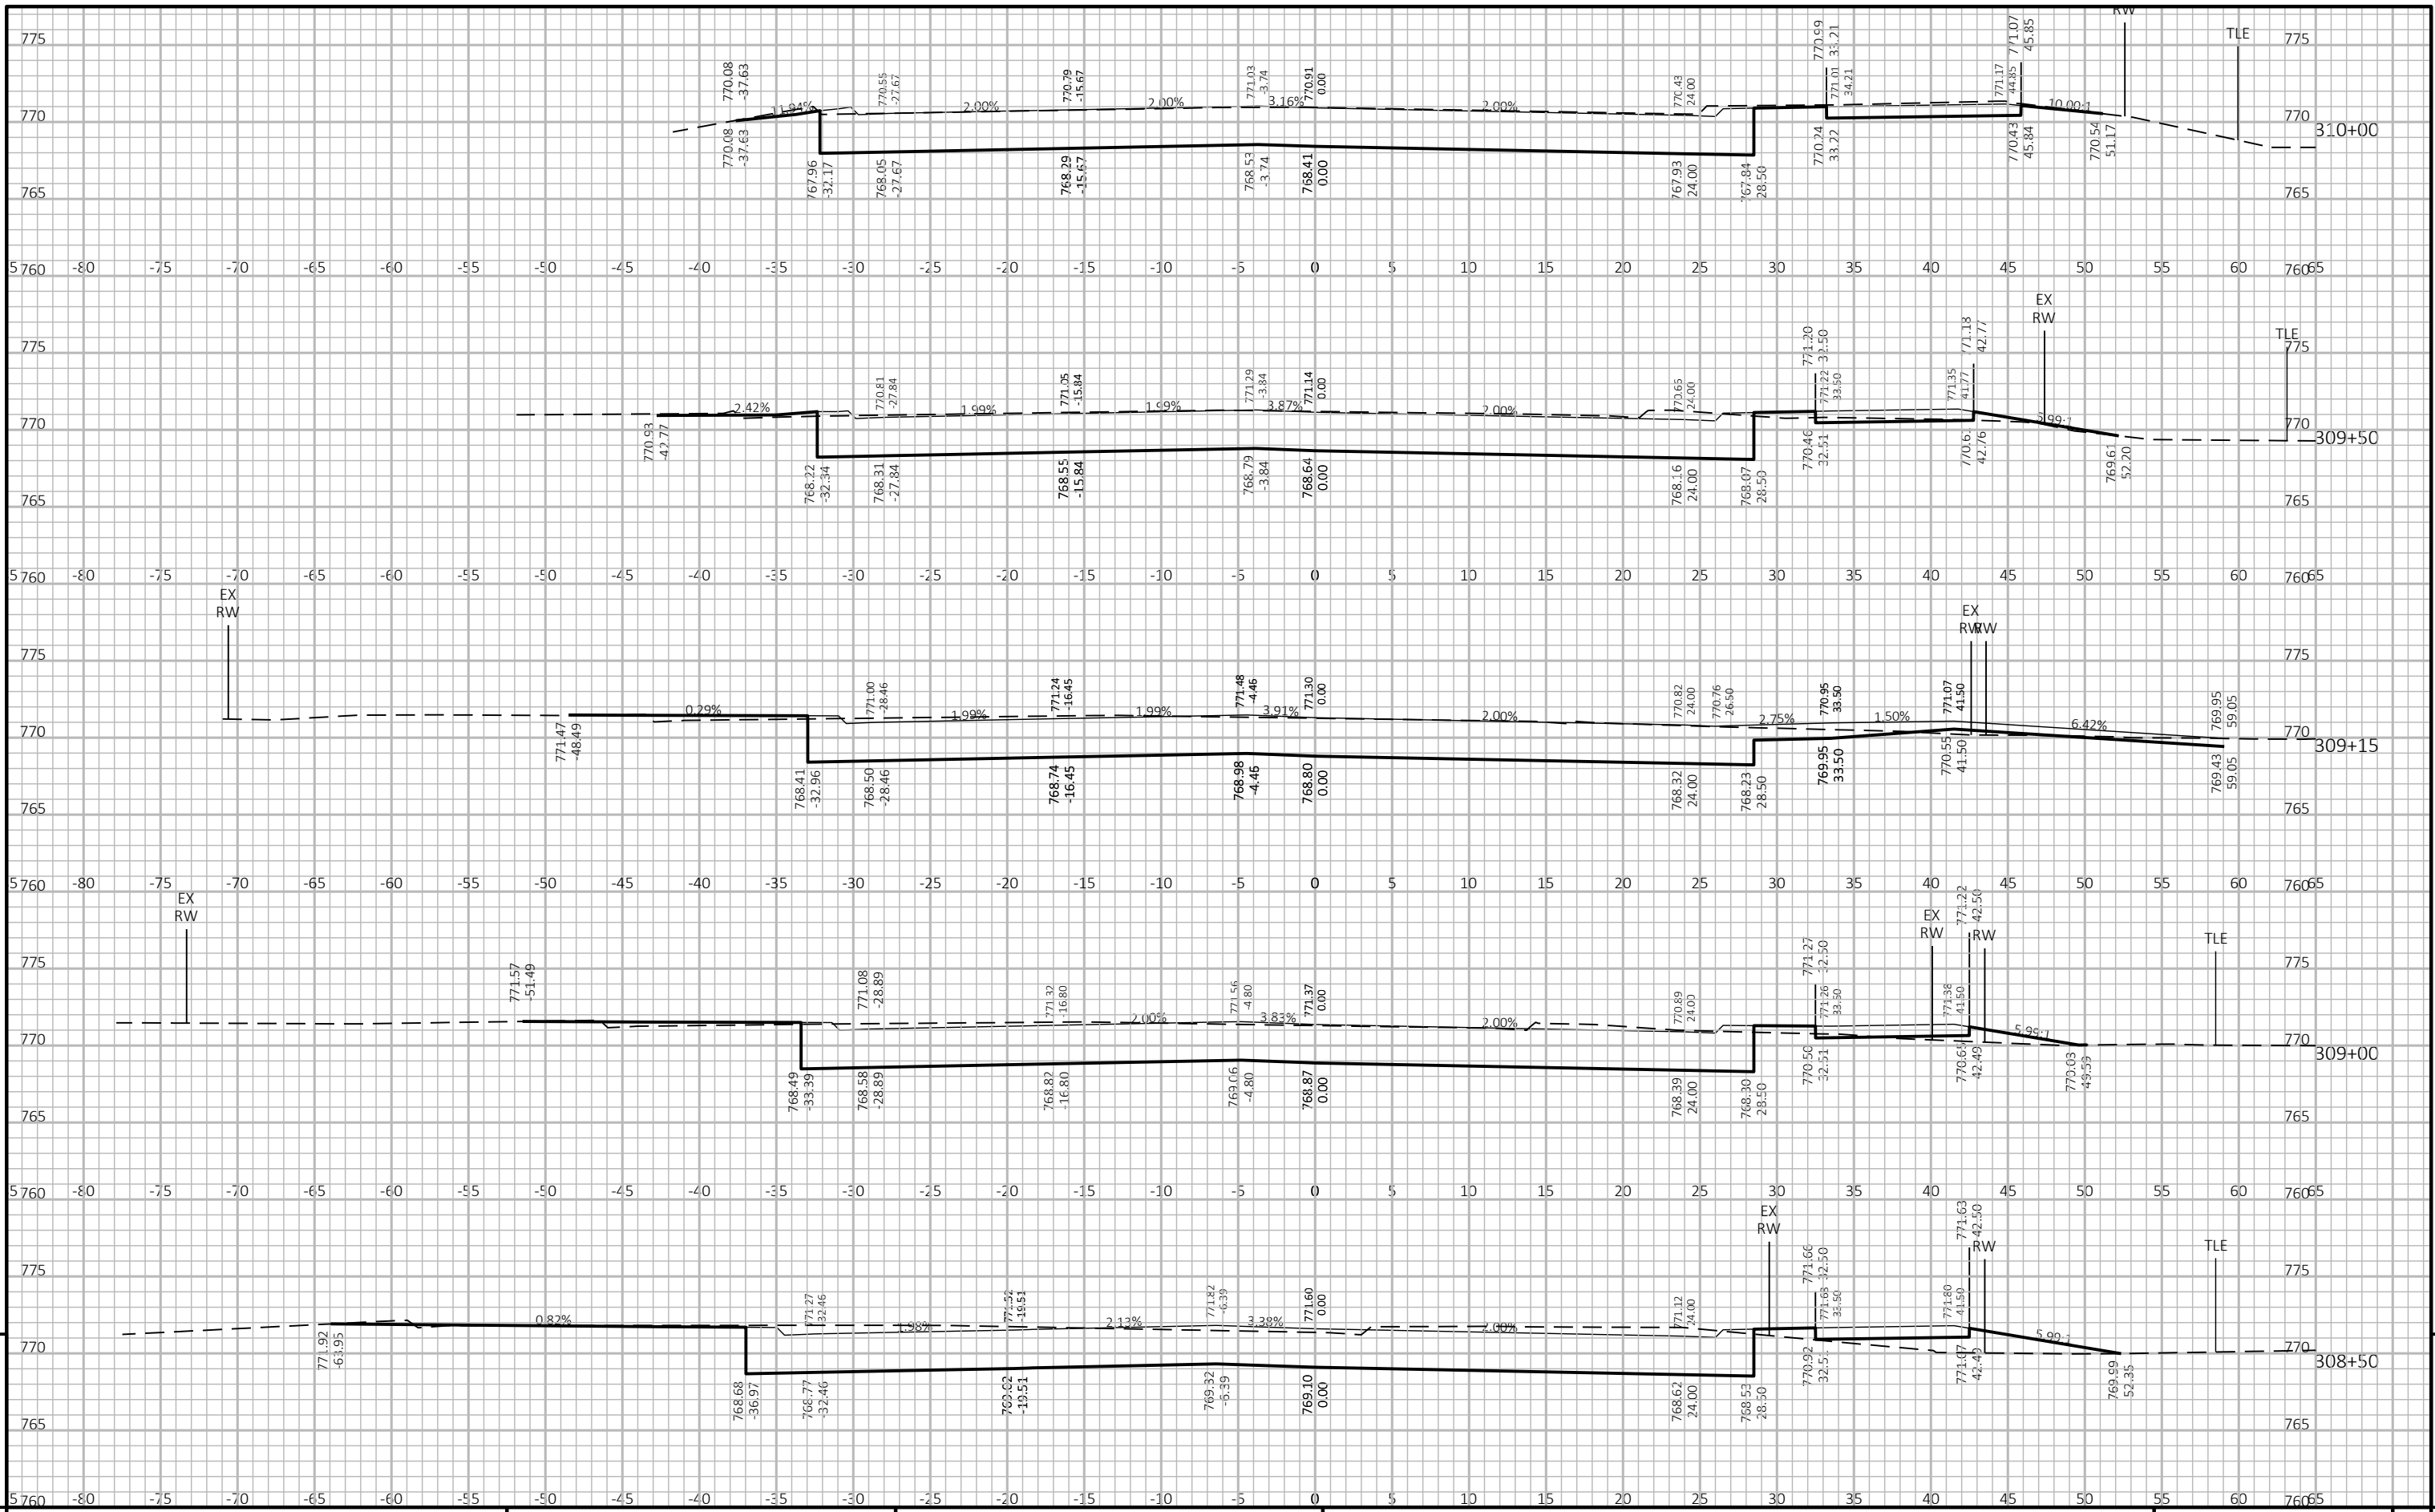


9

9

PROJECT NO: 426-4738 HWY: CTH JJ COUNTY: WINNEBAGO CROSS SECTIONS: CTH JJ EAST EB SHEET 155 E

FILE NAME: N:\3000994.00\CIVIL 3D\SHEETS\PLAN\4264738-090200-XS.DWG PLOT DATE: 12/7/2021 11:51 AM PLOT BY: MATT TOMSOVIC PLOT NAME: PLOT SCALE: 1 IN:10 FT HORZ. / 1 IN:10 FT VERT. WISDOT/CADD SHEET 49

LAYOUT NAME: 4264738-090212-xs

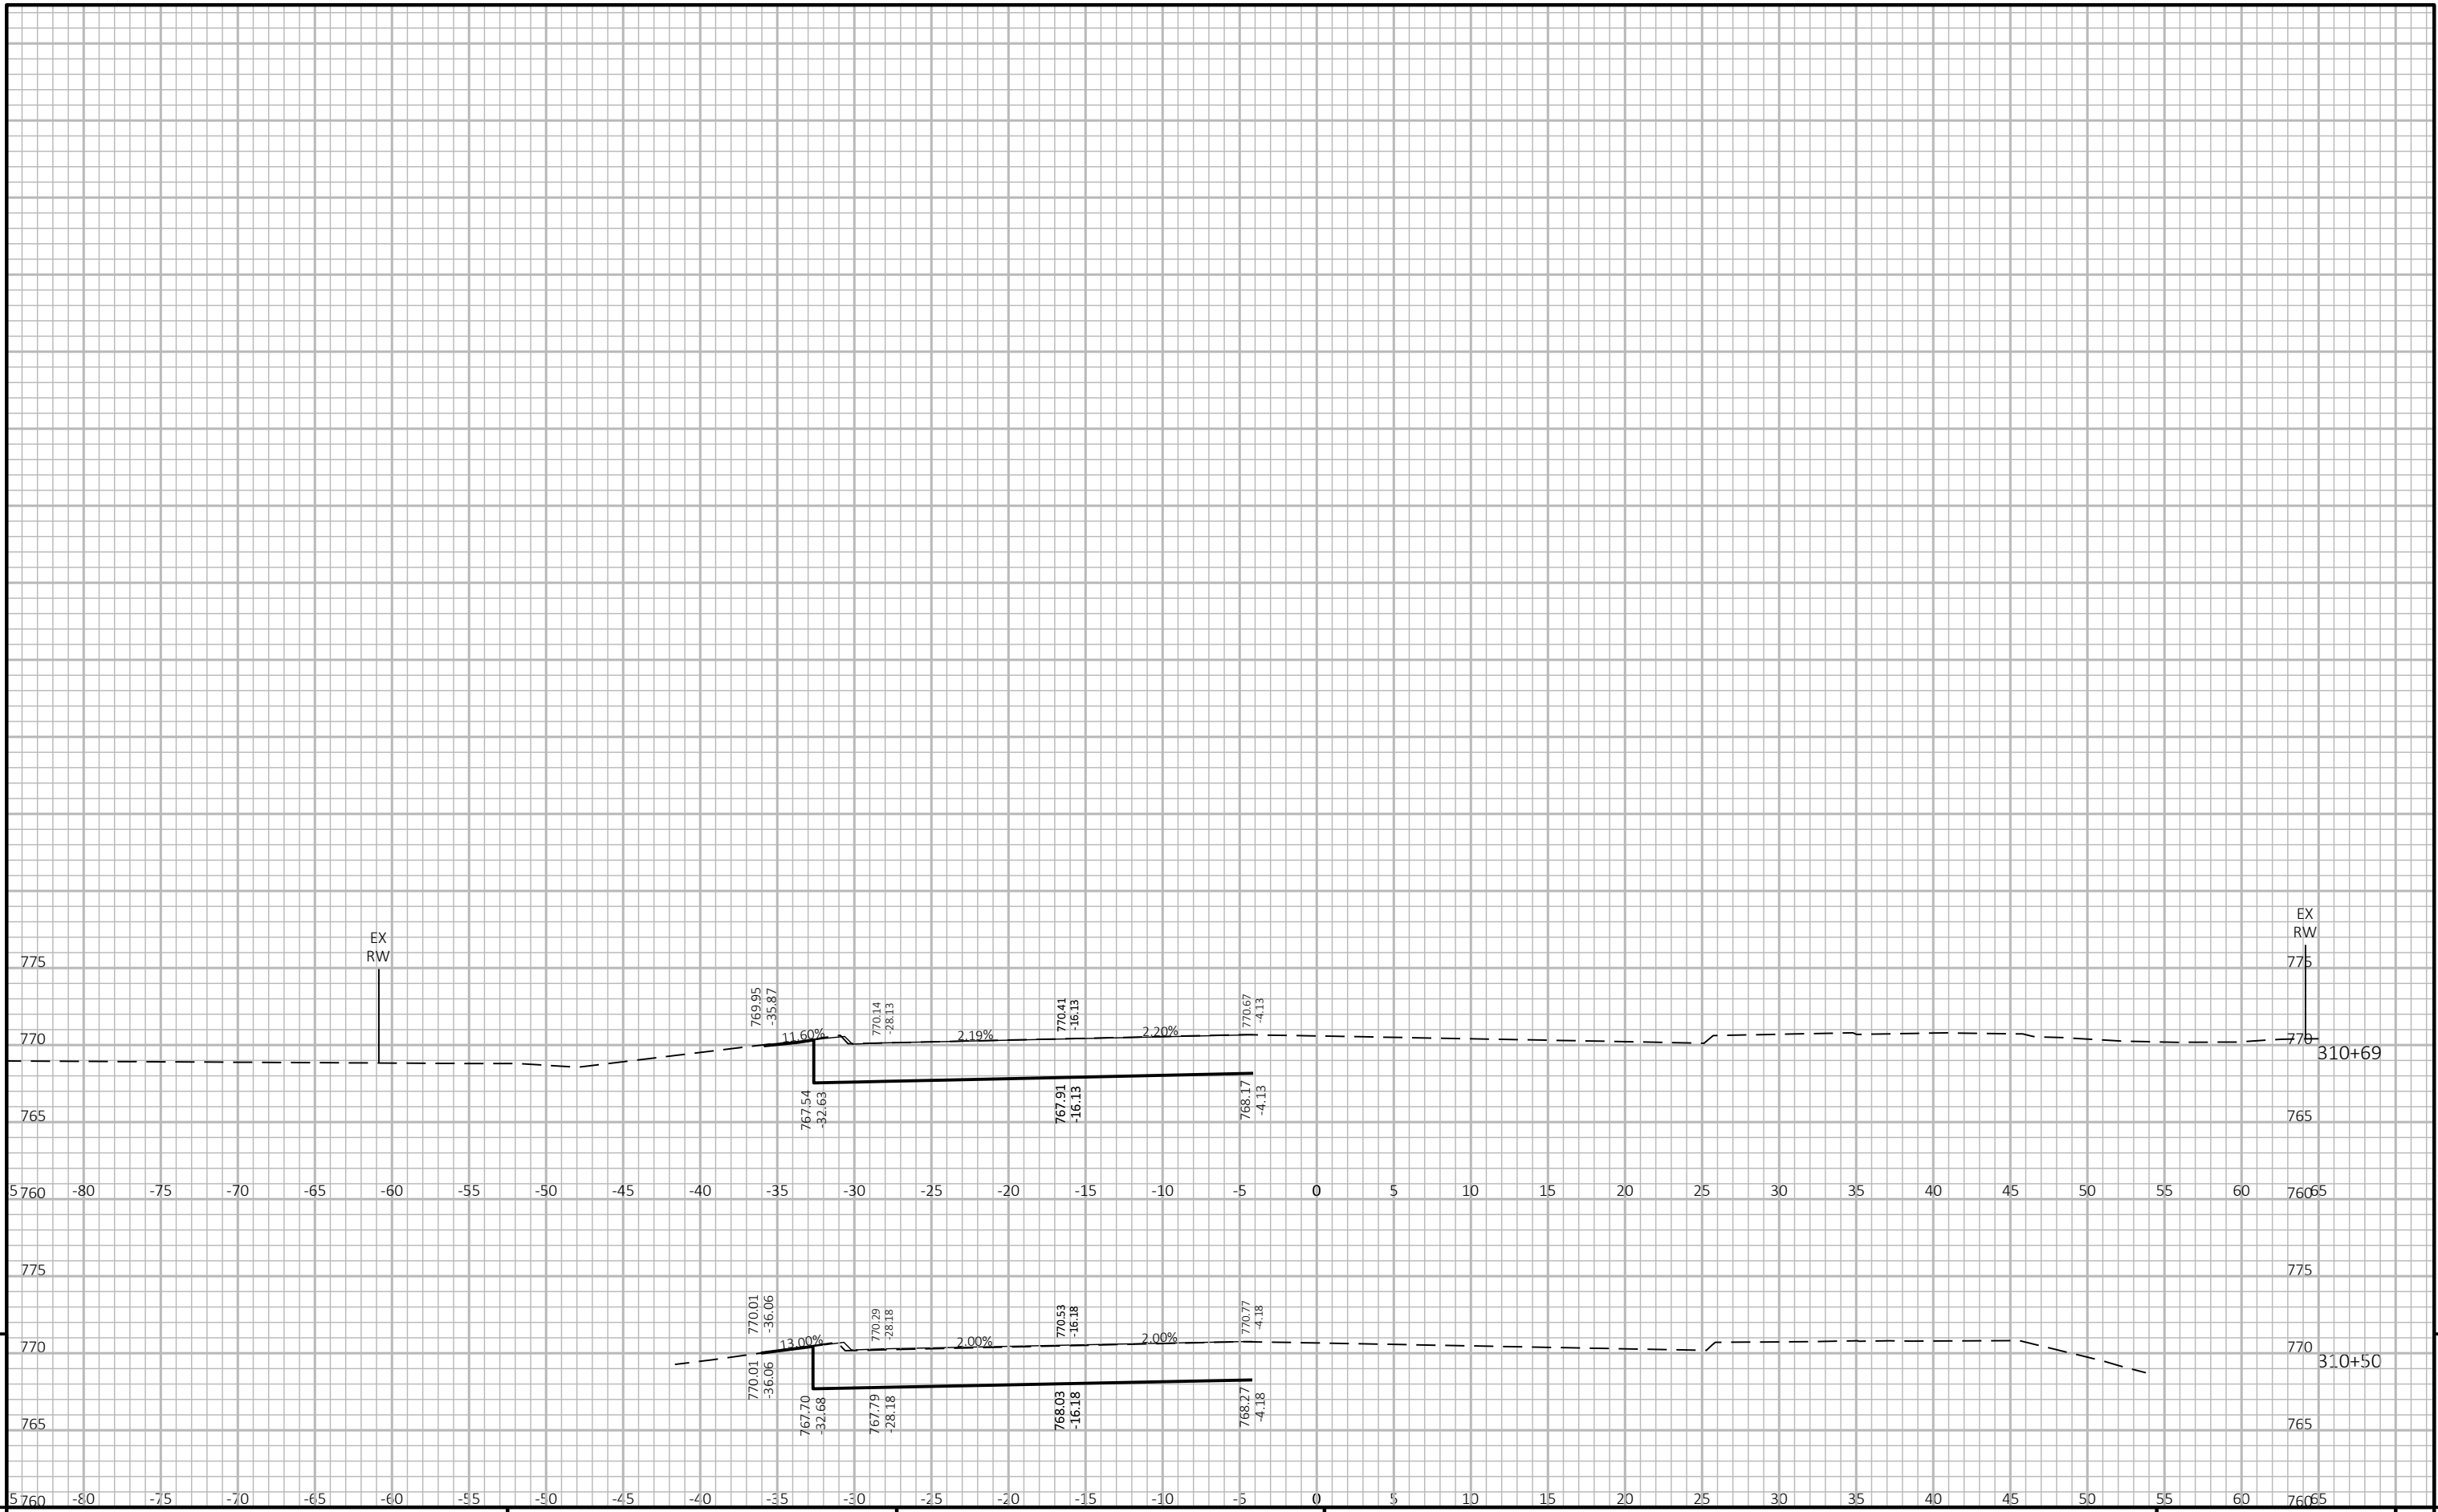


PROJECT NO: 426-4738 HWY: CTH JJ COUNTY: WINNEBAGO CROSS SECTIONS: CTH JJ EAST EB SHEET 156 E

FILE NAME: N:\3000994.00\CIVIL 3D\SHEETS\PLAN\4264738-090200-XS.DWG PLOT DATE: 12/7/2021 11:51 AM PLOT BY: MATT TOMSOVIC PLOT NAME: PLOT SCALE: 1 IN:10 FT HORZ. / 1 IN:10 FT VERT. WISDOT/CADD SHEET 49


9

9

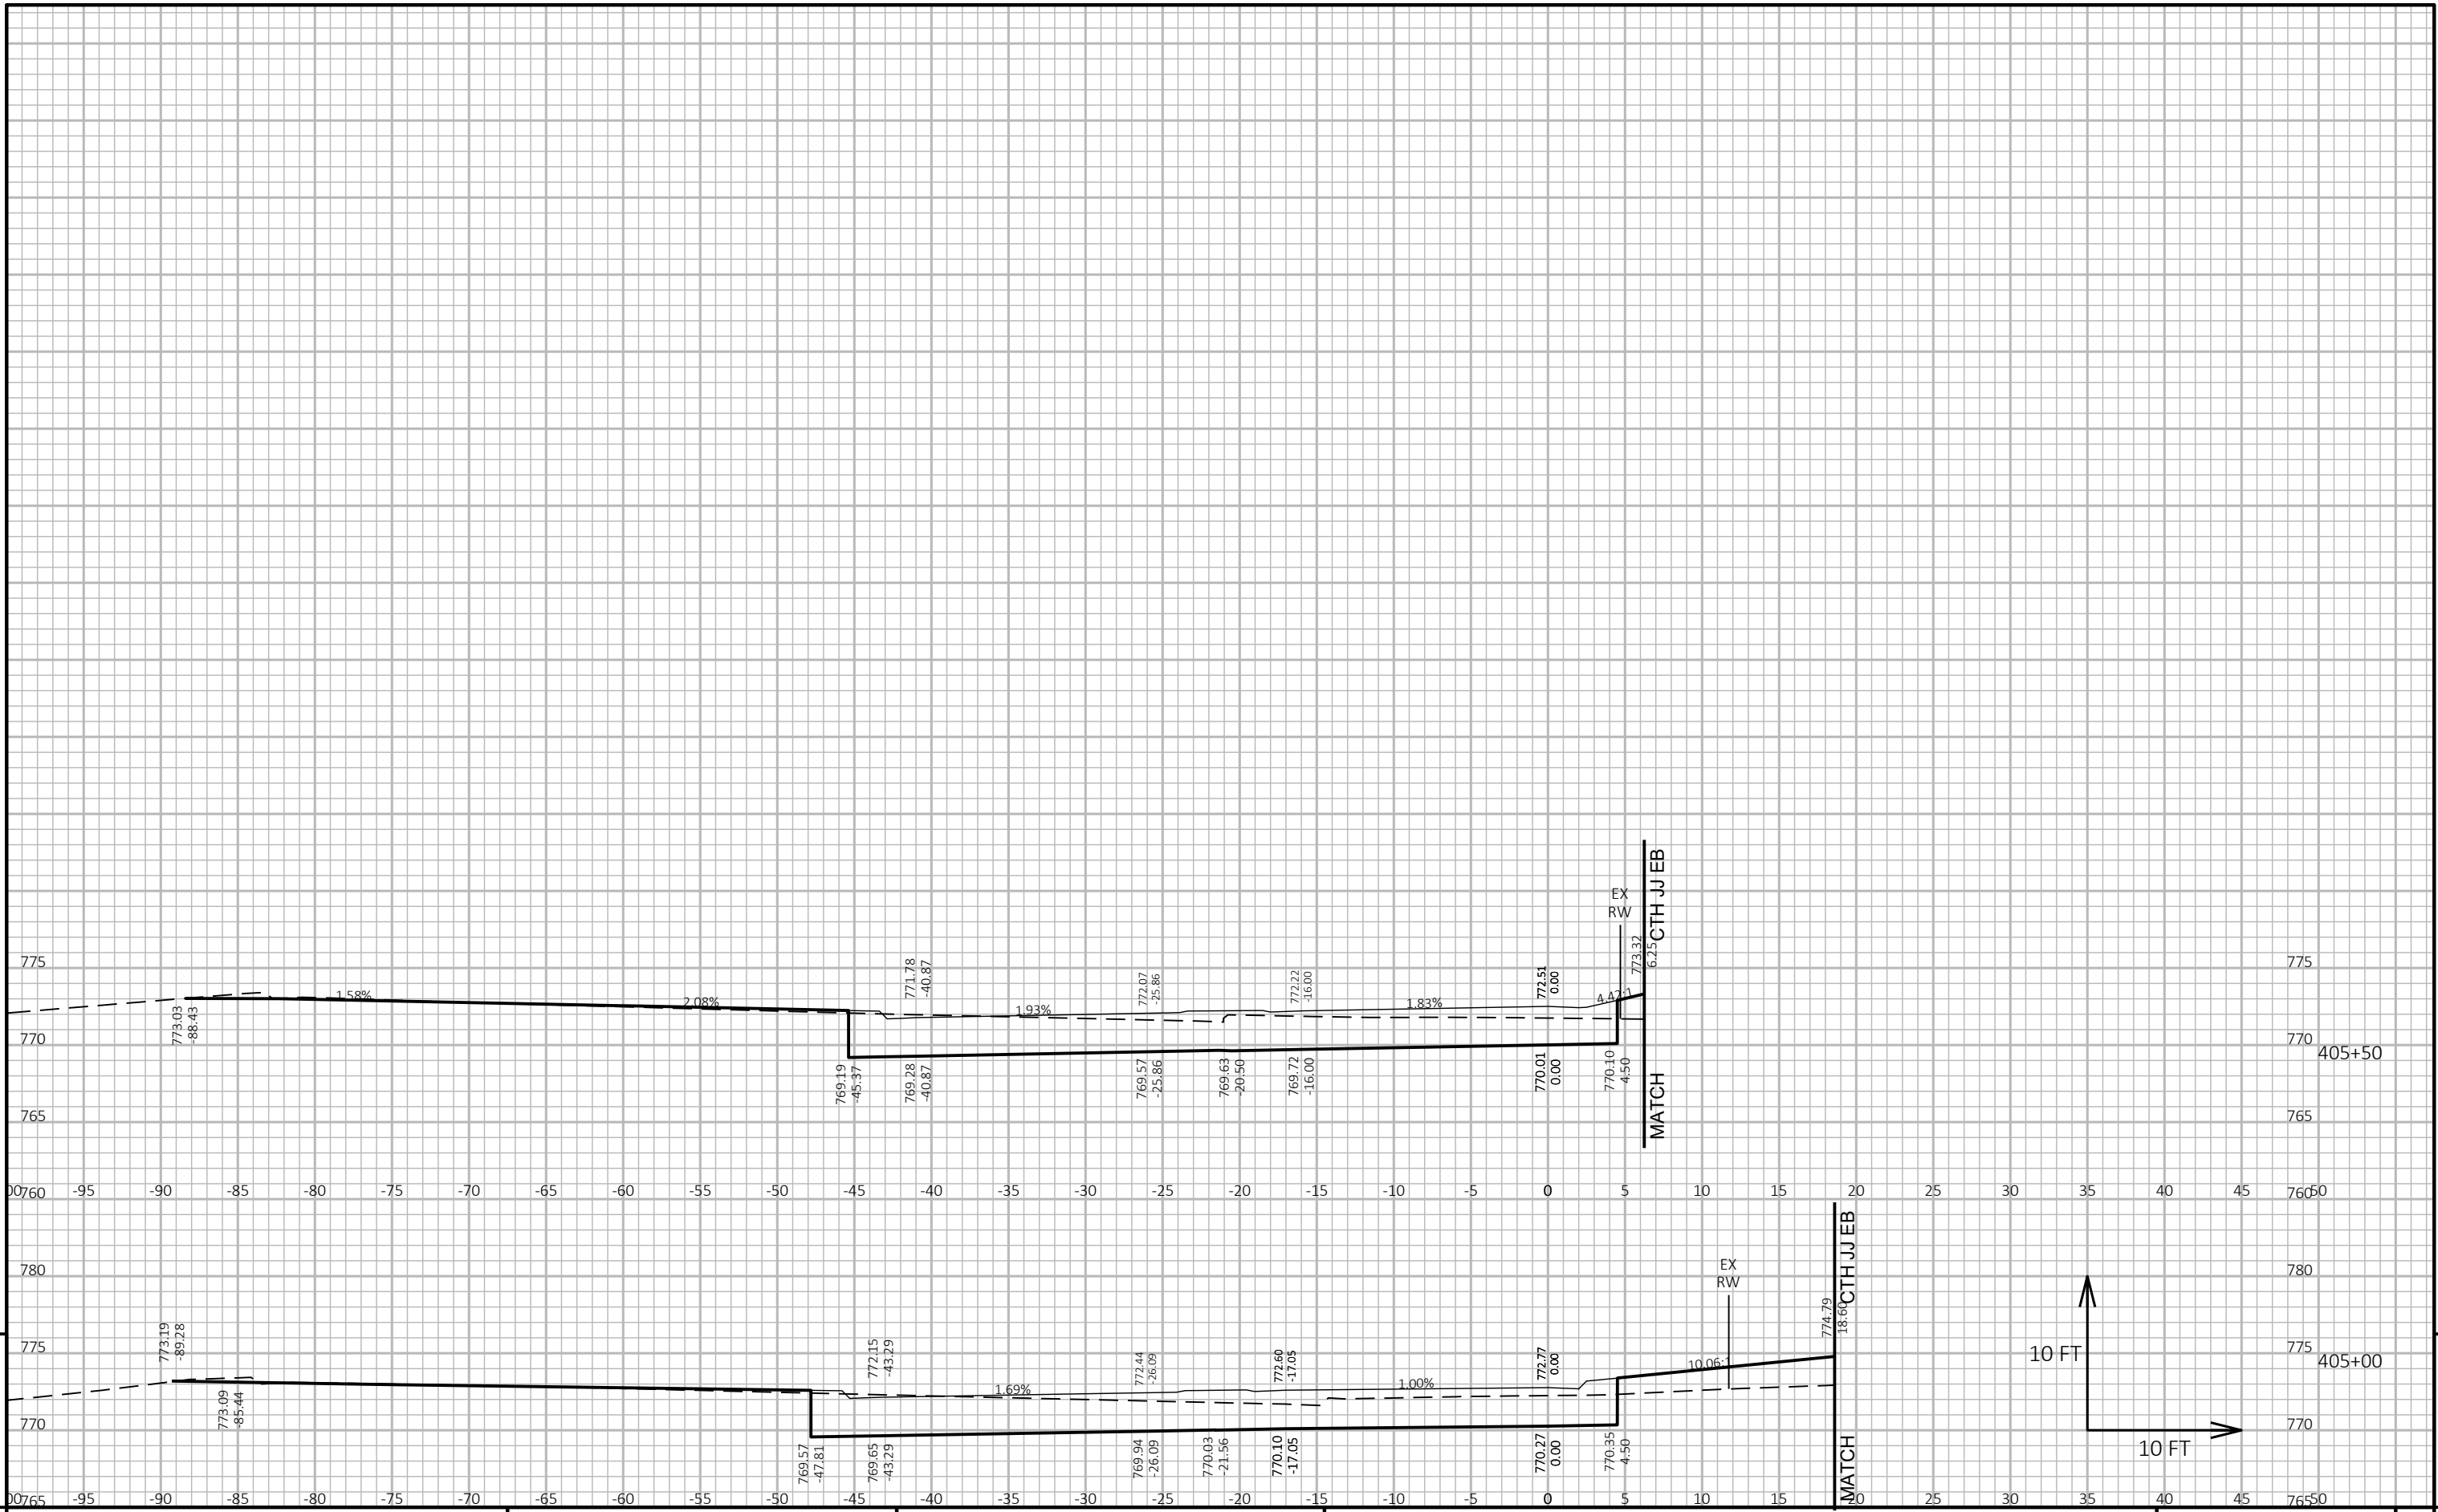

PROJECT NO: 426-4738 HWY: CTH JJ COUNTY: WINNEBAGO CROSS SECTIONS: CTH JJ EAST WB SHEET 157 E

FILE NAME: N:\3000994.00\CIVIL 3D\SHEETS\PLAN\4264738-090200-XS.DWG PLOT DATE: 12/7/2021 11:51 AM PLOT BY: MATT TOMSOVIC PLOT NAME: LAYOUT NAME - 4264738-090215-xs PLOT SCALE: 1 IN:10 FT HORZ. / 1 IN:10 FT VERT. WISDOT/CADD SHEET 49

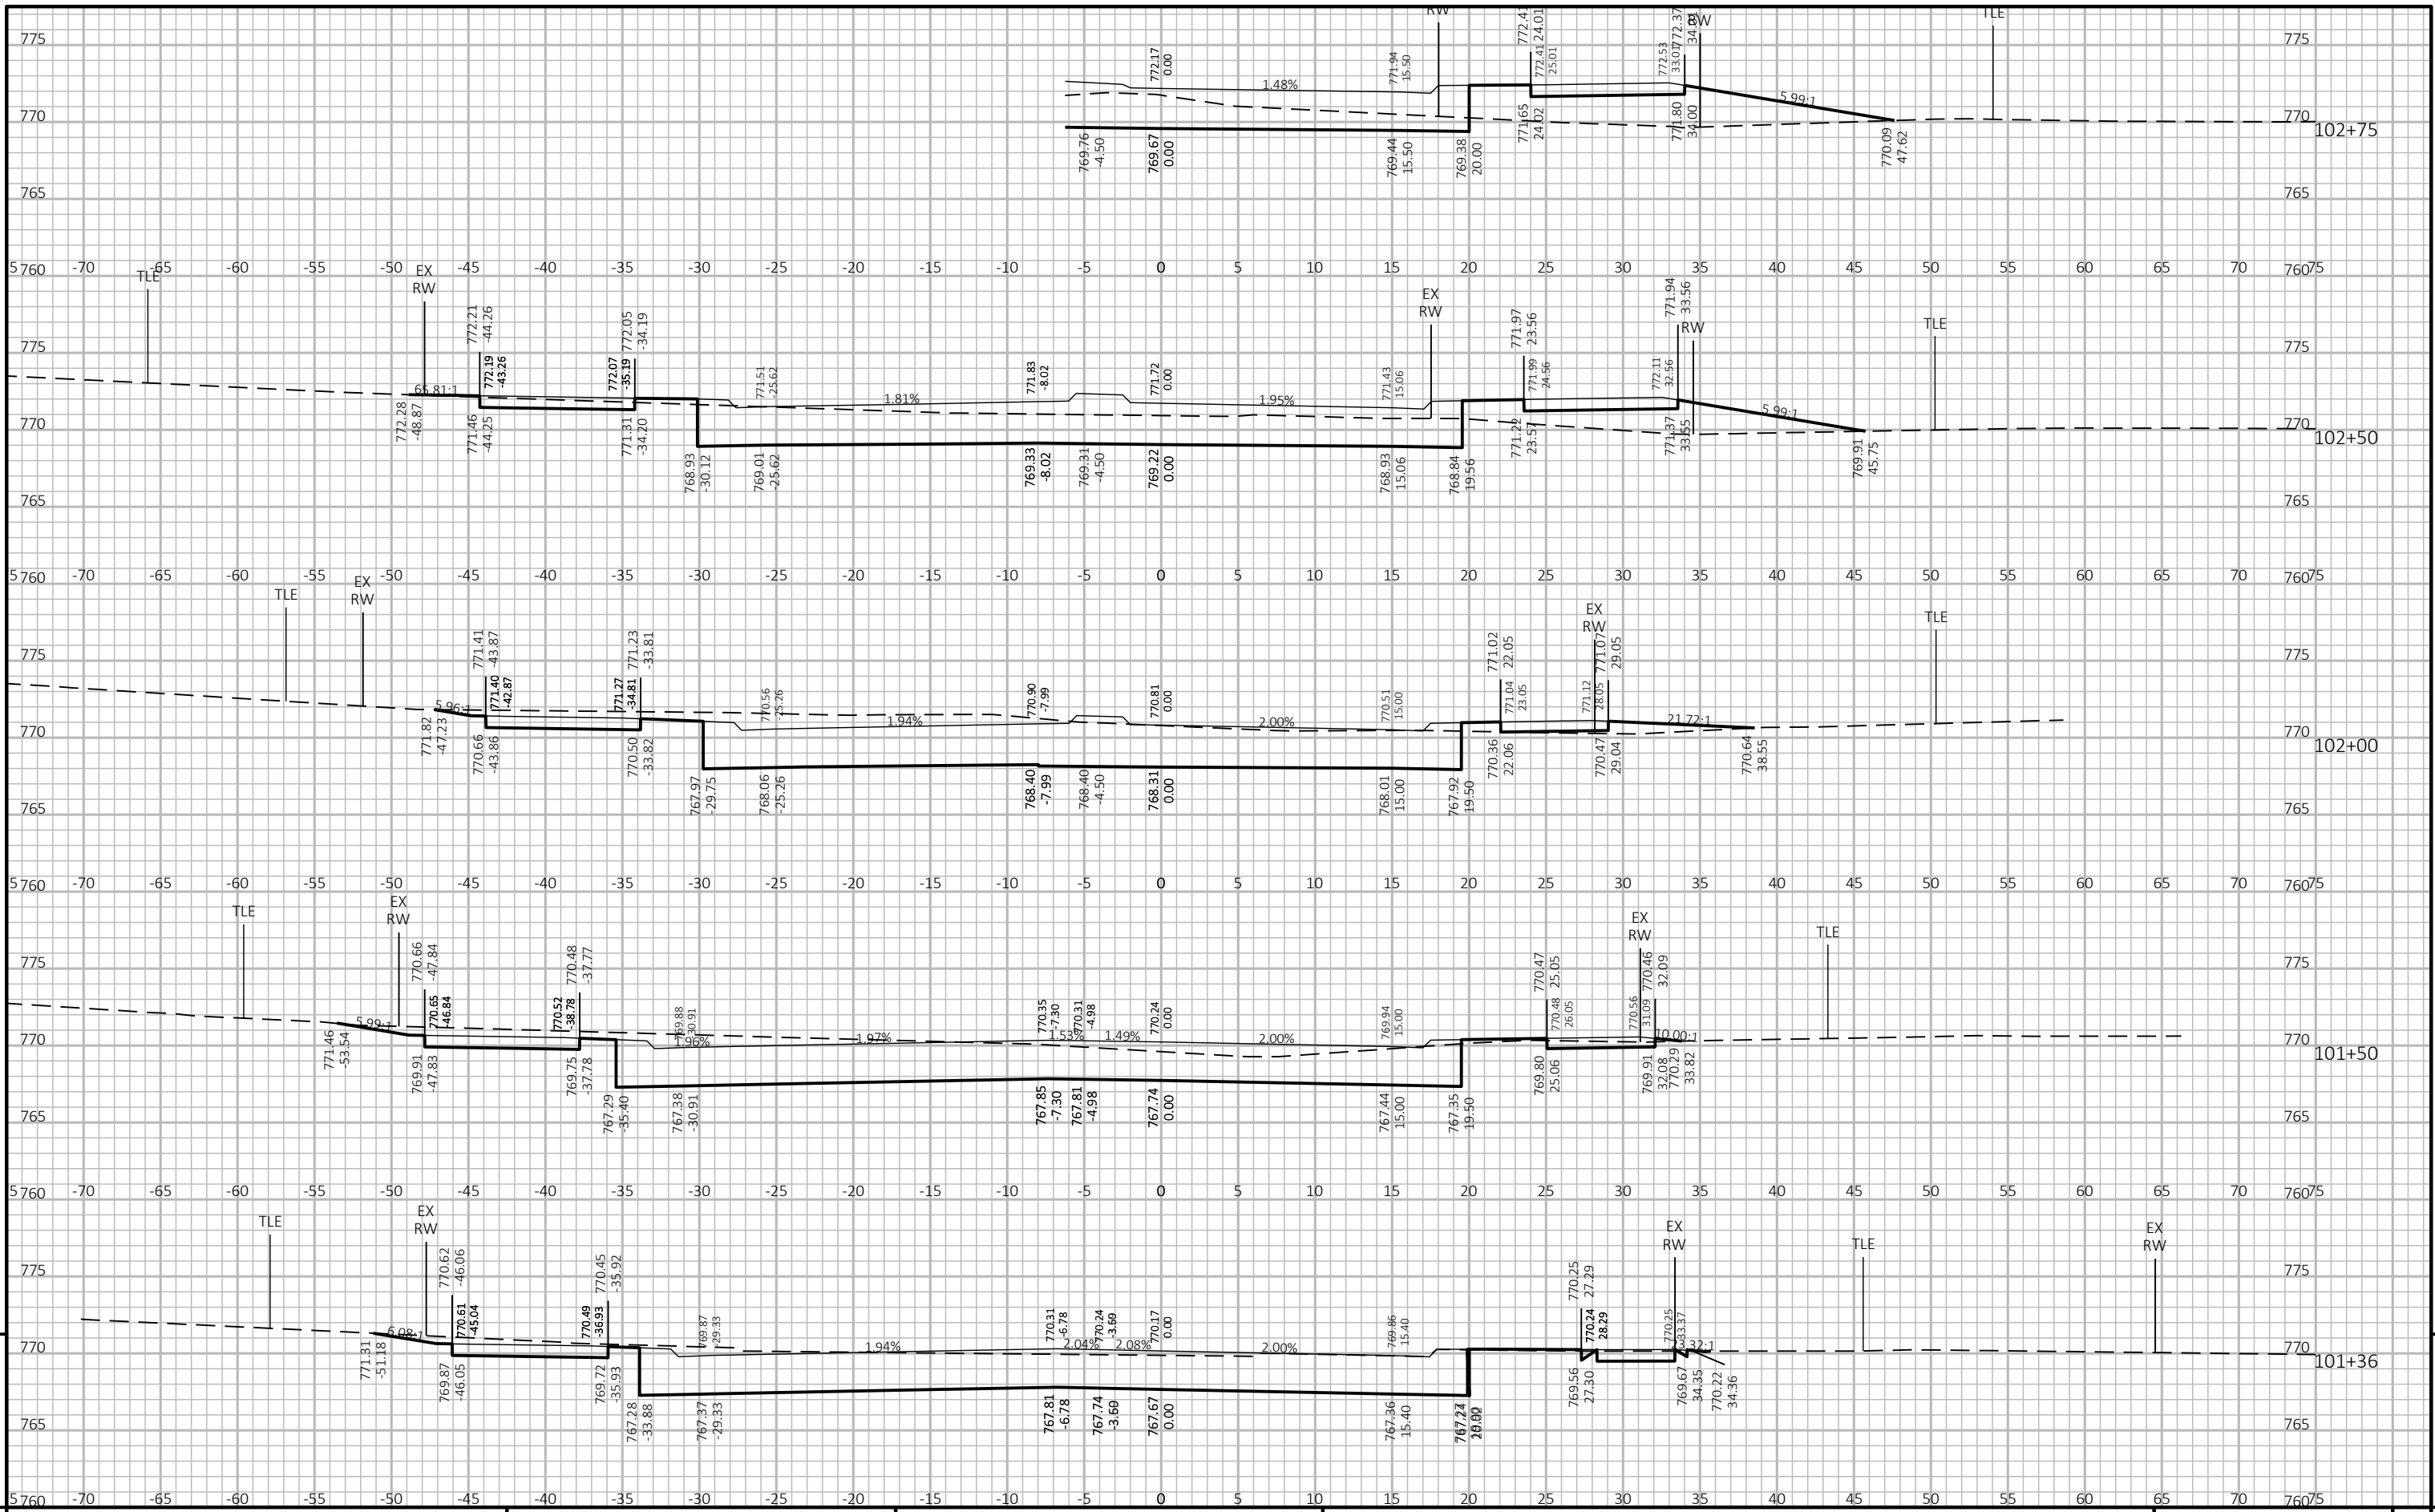

PROJECT NO: 426-4738

HWY: CTH JJ


COUNTY: WINNEBAGO

CROSS SECTIONS: PENDLETON ROAD NB

SHEET

158

E

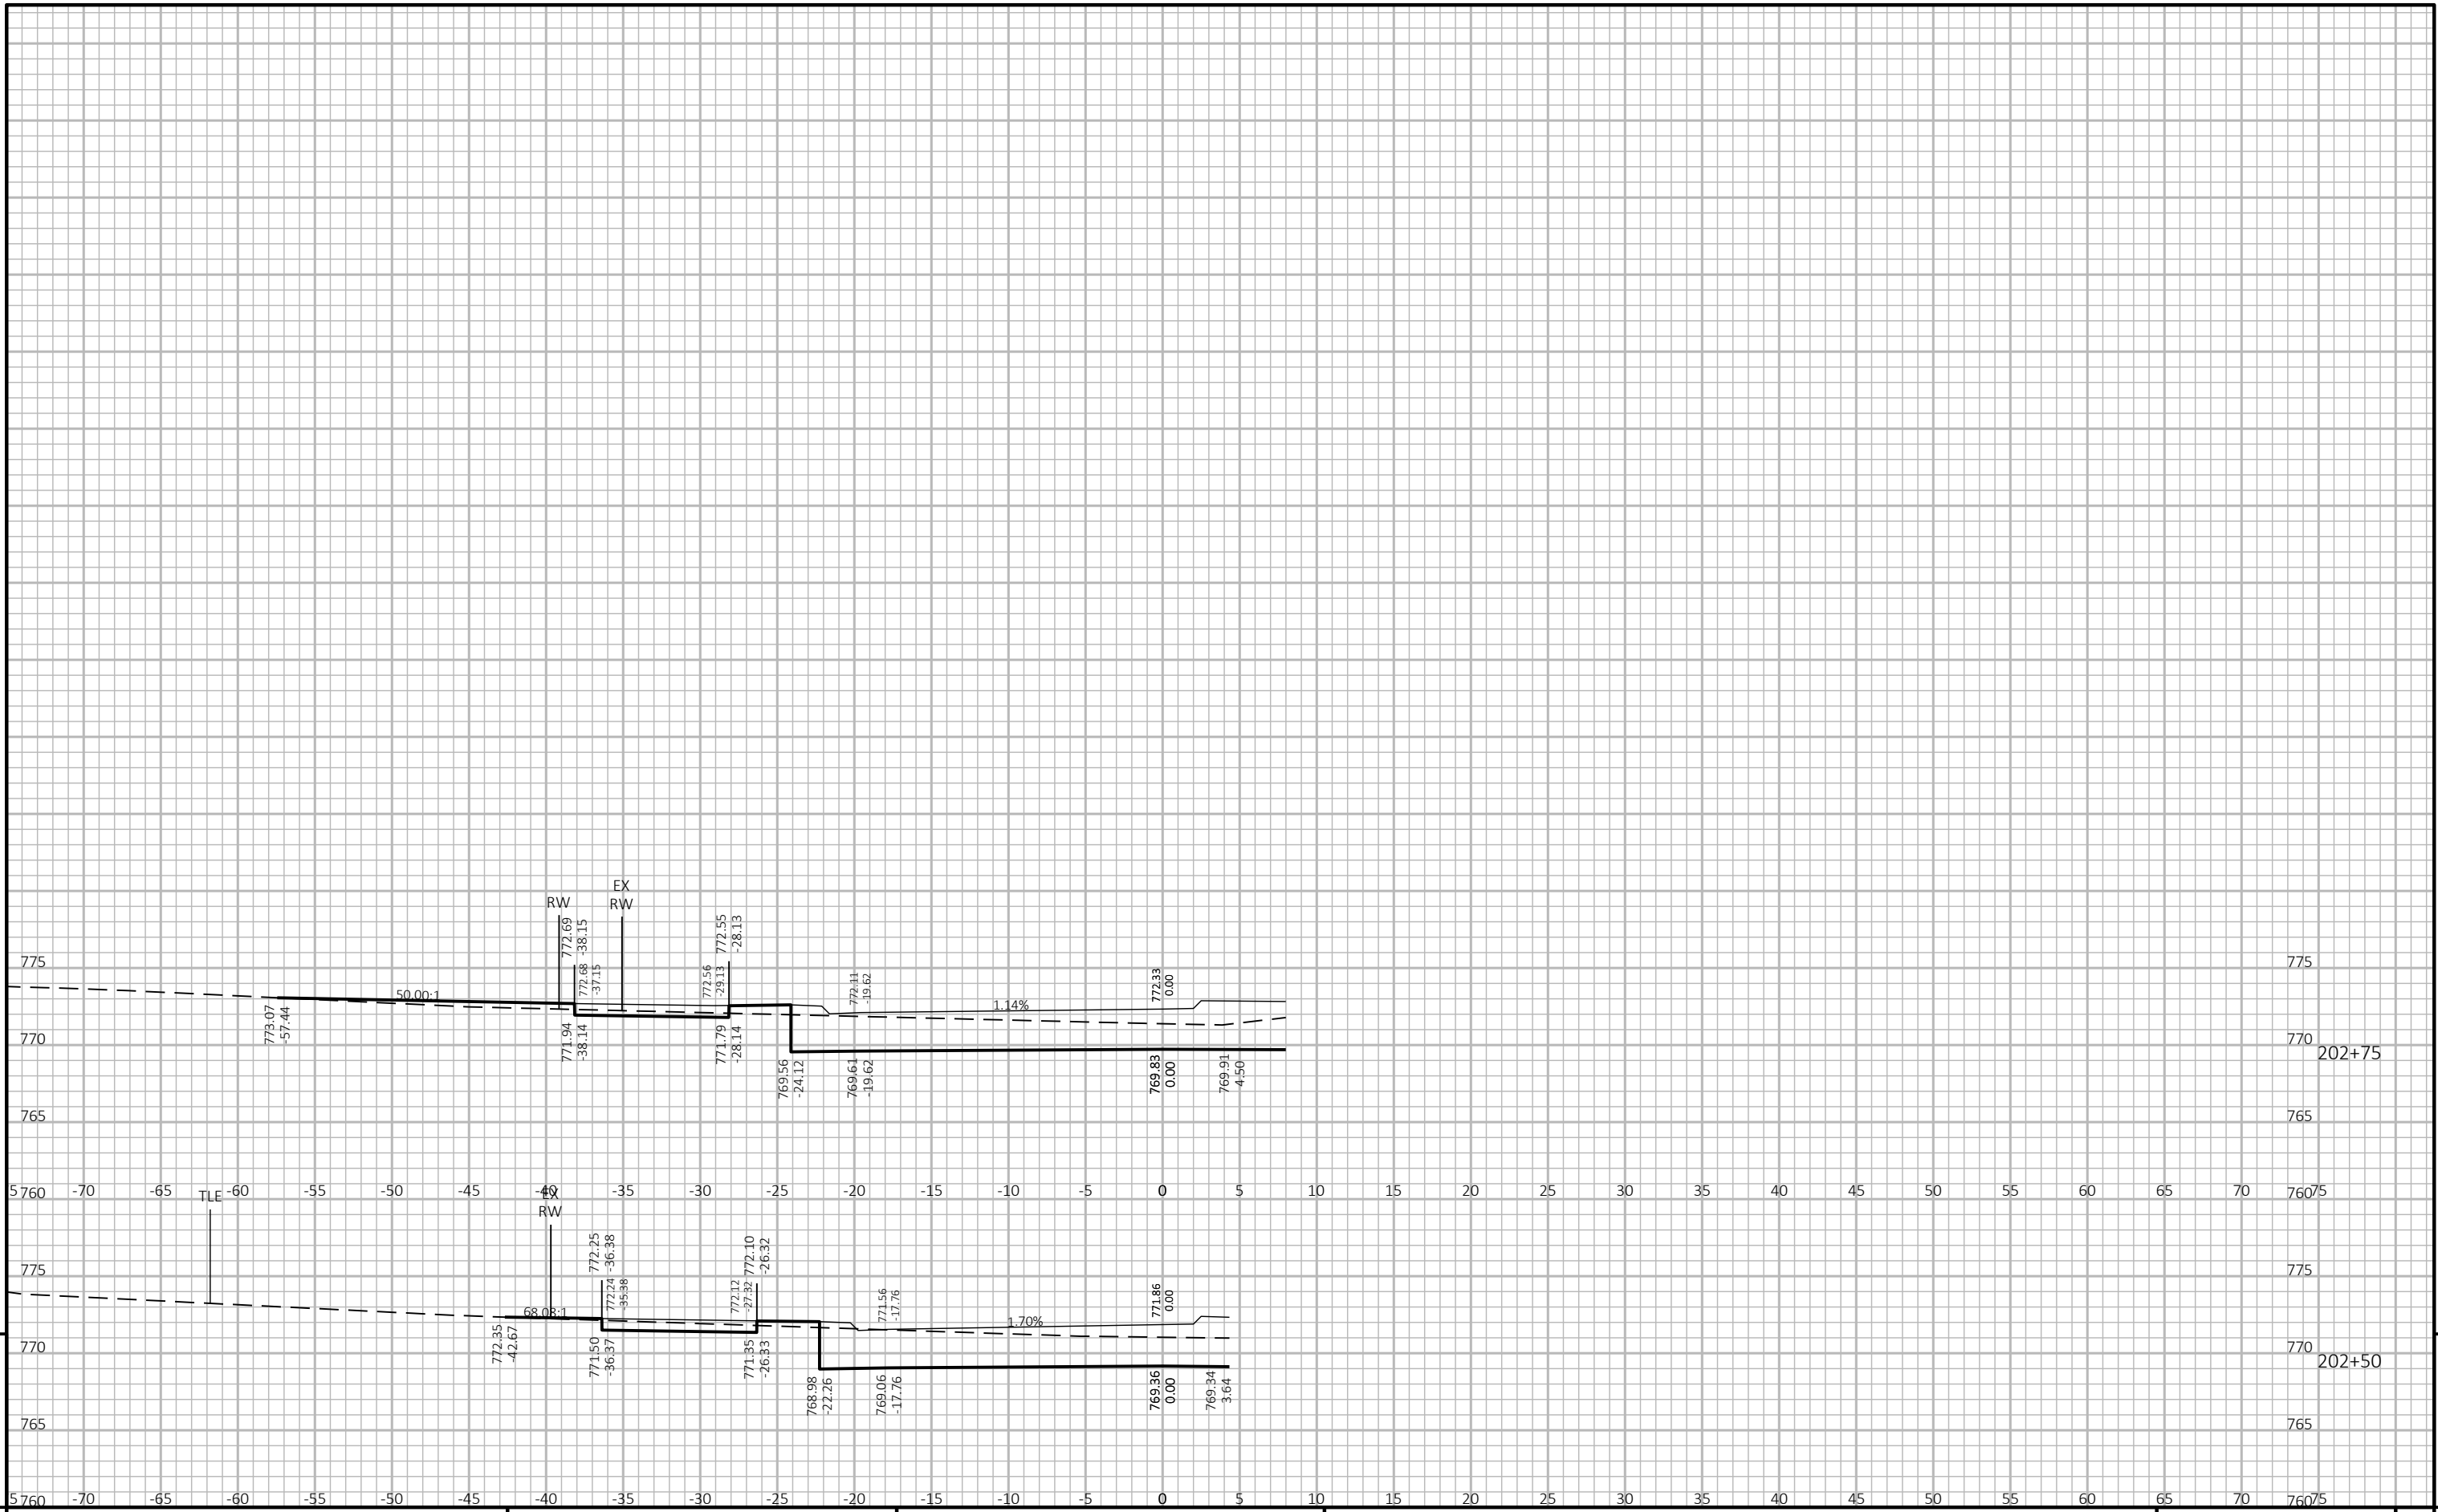


9

9


PROJECT NO: 426-4738 HWY: CTH JJ COUNTY: WINNEBAGO CROSS SECTIONS: PENDLETON ROAD SB SHEET 159 E

FILE NAME: N:\3000994.00\CIVIL 3D\SHEETS\PLAN\4264738-090200-XS.DWG PLOT DATE: 12/7/2021 11:51 AM PLOT BY: MATT TOMSOVIC PLOT NAME: PLOT SCALE: 1 IN:10 FT HORZ. / 1 IN:10 FT VERT. WISDOT/CADD SHEET 49

LAYOUT NAME - 4264738-090225-xs

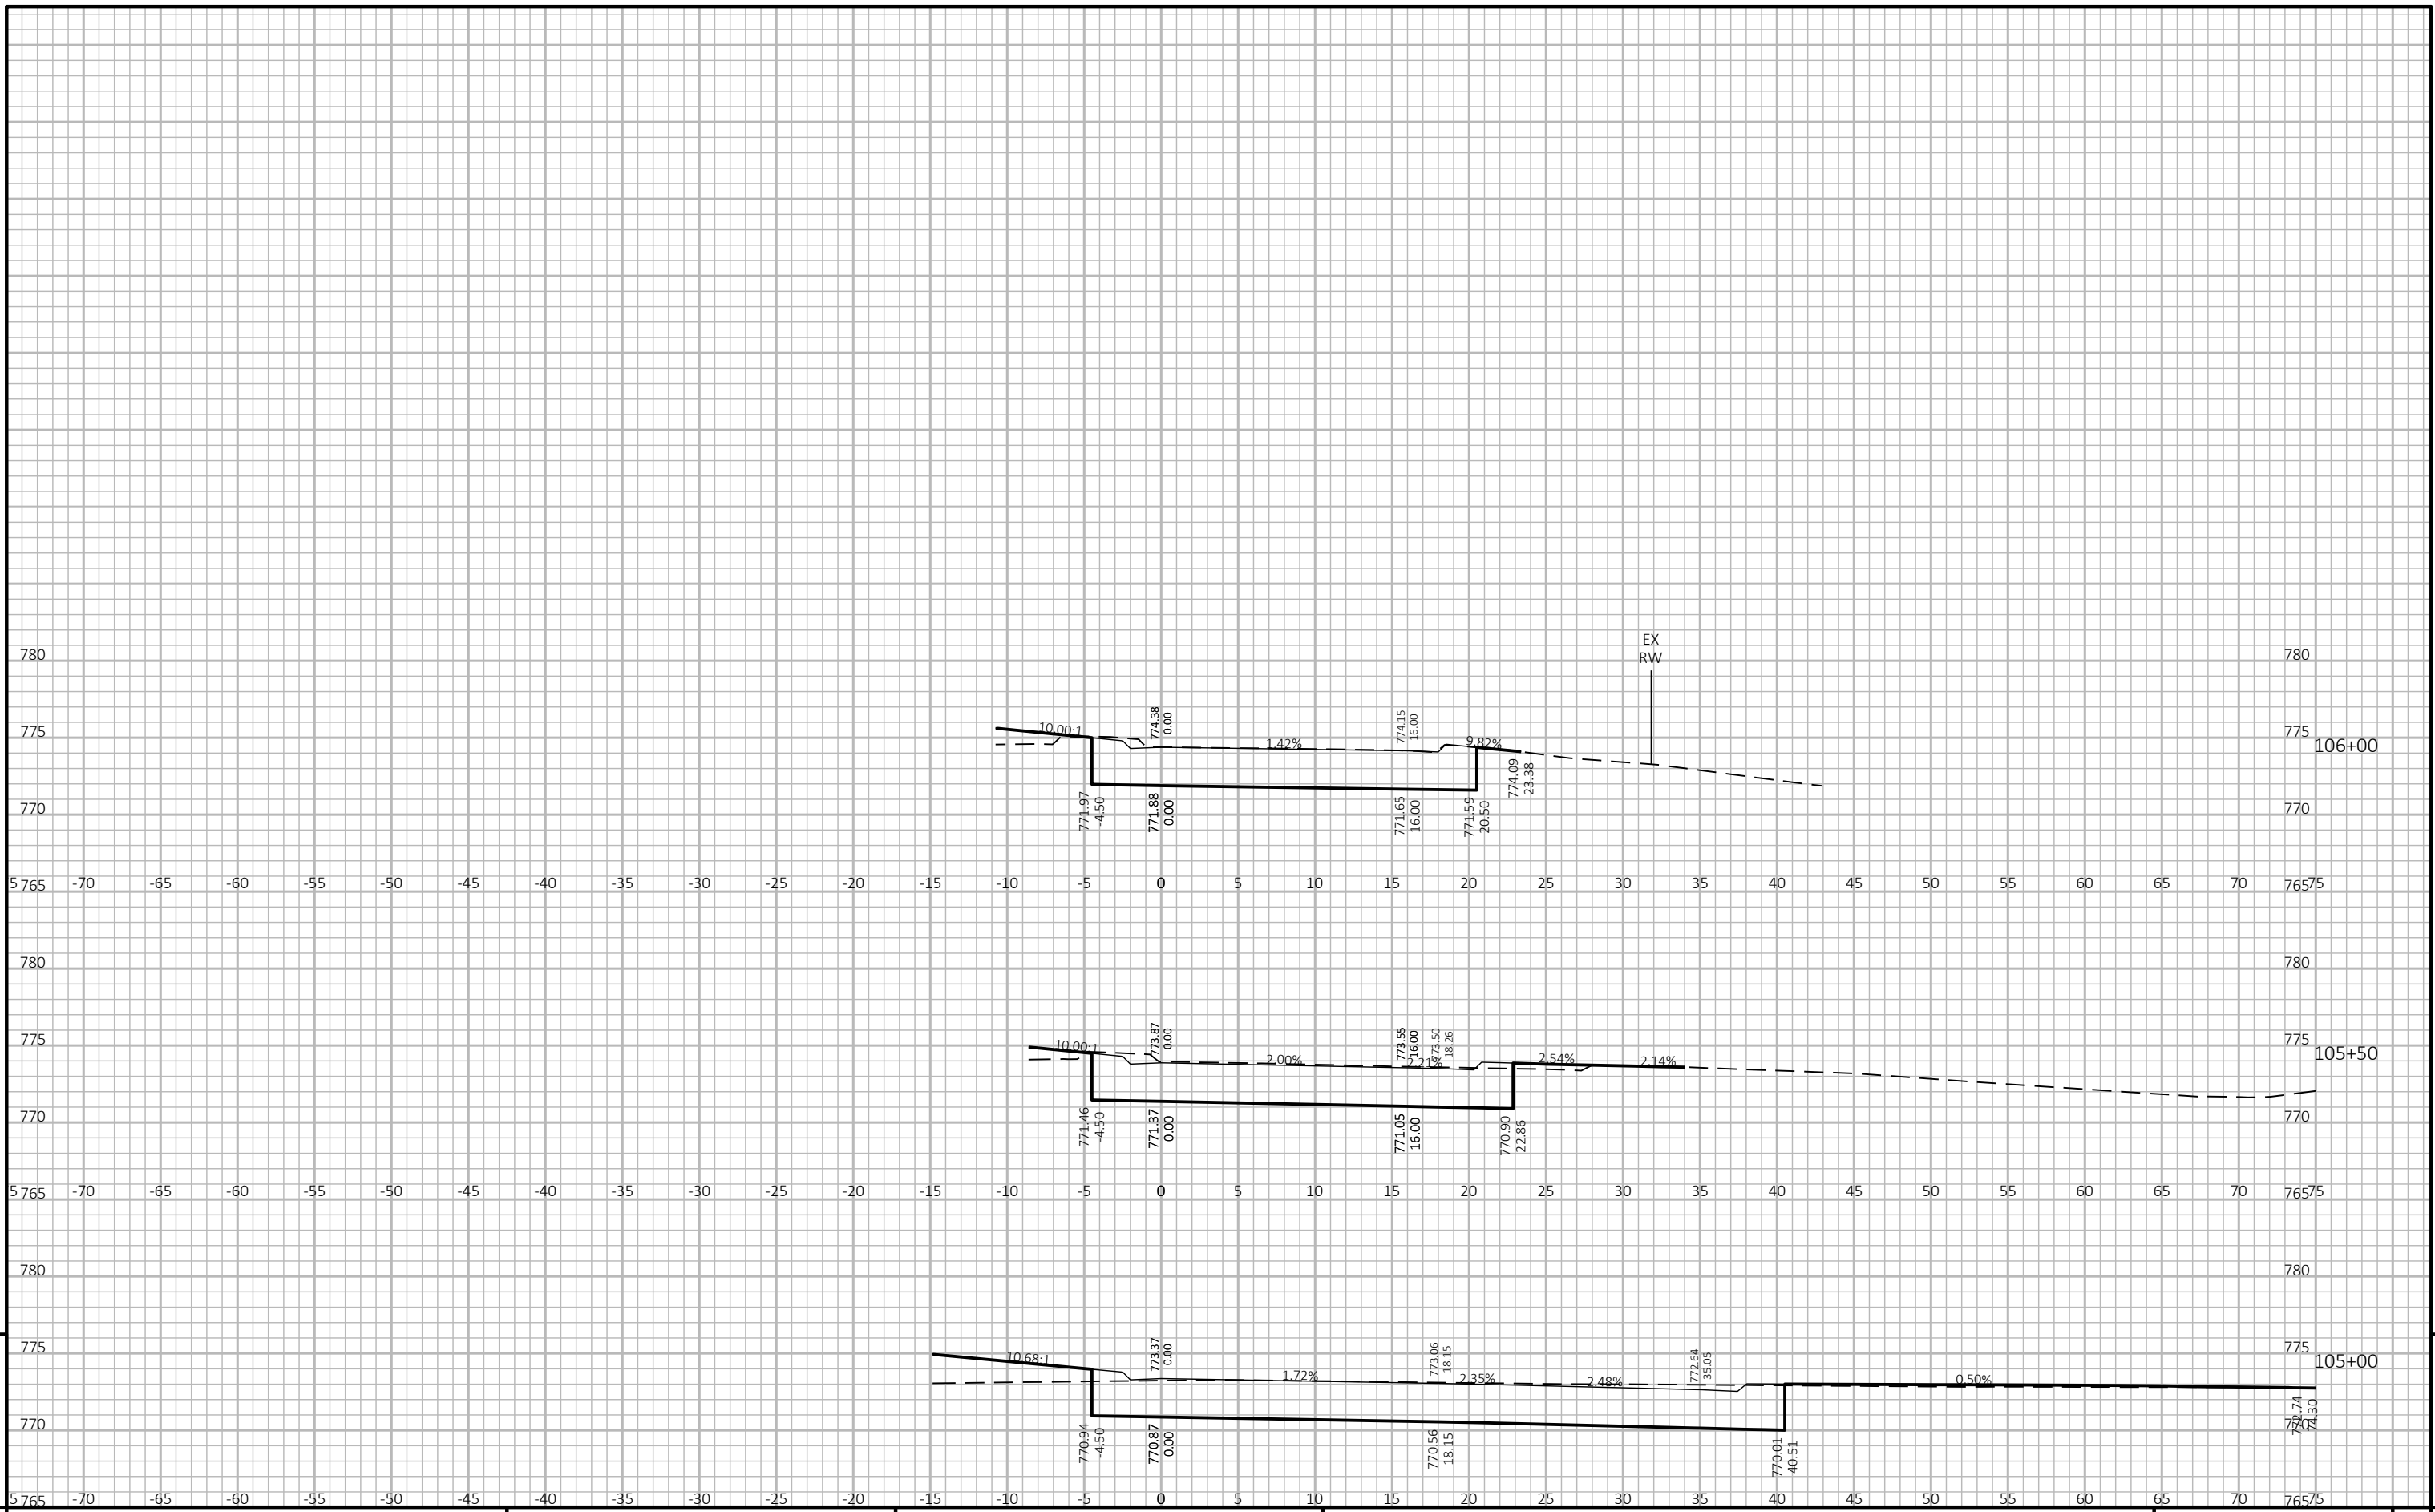

PROJECT NO: 426-4738 HWY: CTH JJ COUNTY: WINNEBAGO CROSS SECTIONS: CTH CB NORTHBOUND SHEET 160 E

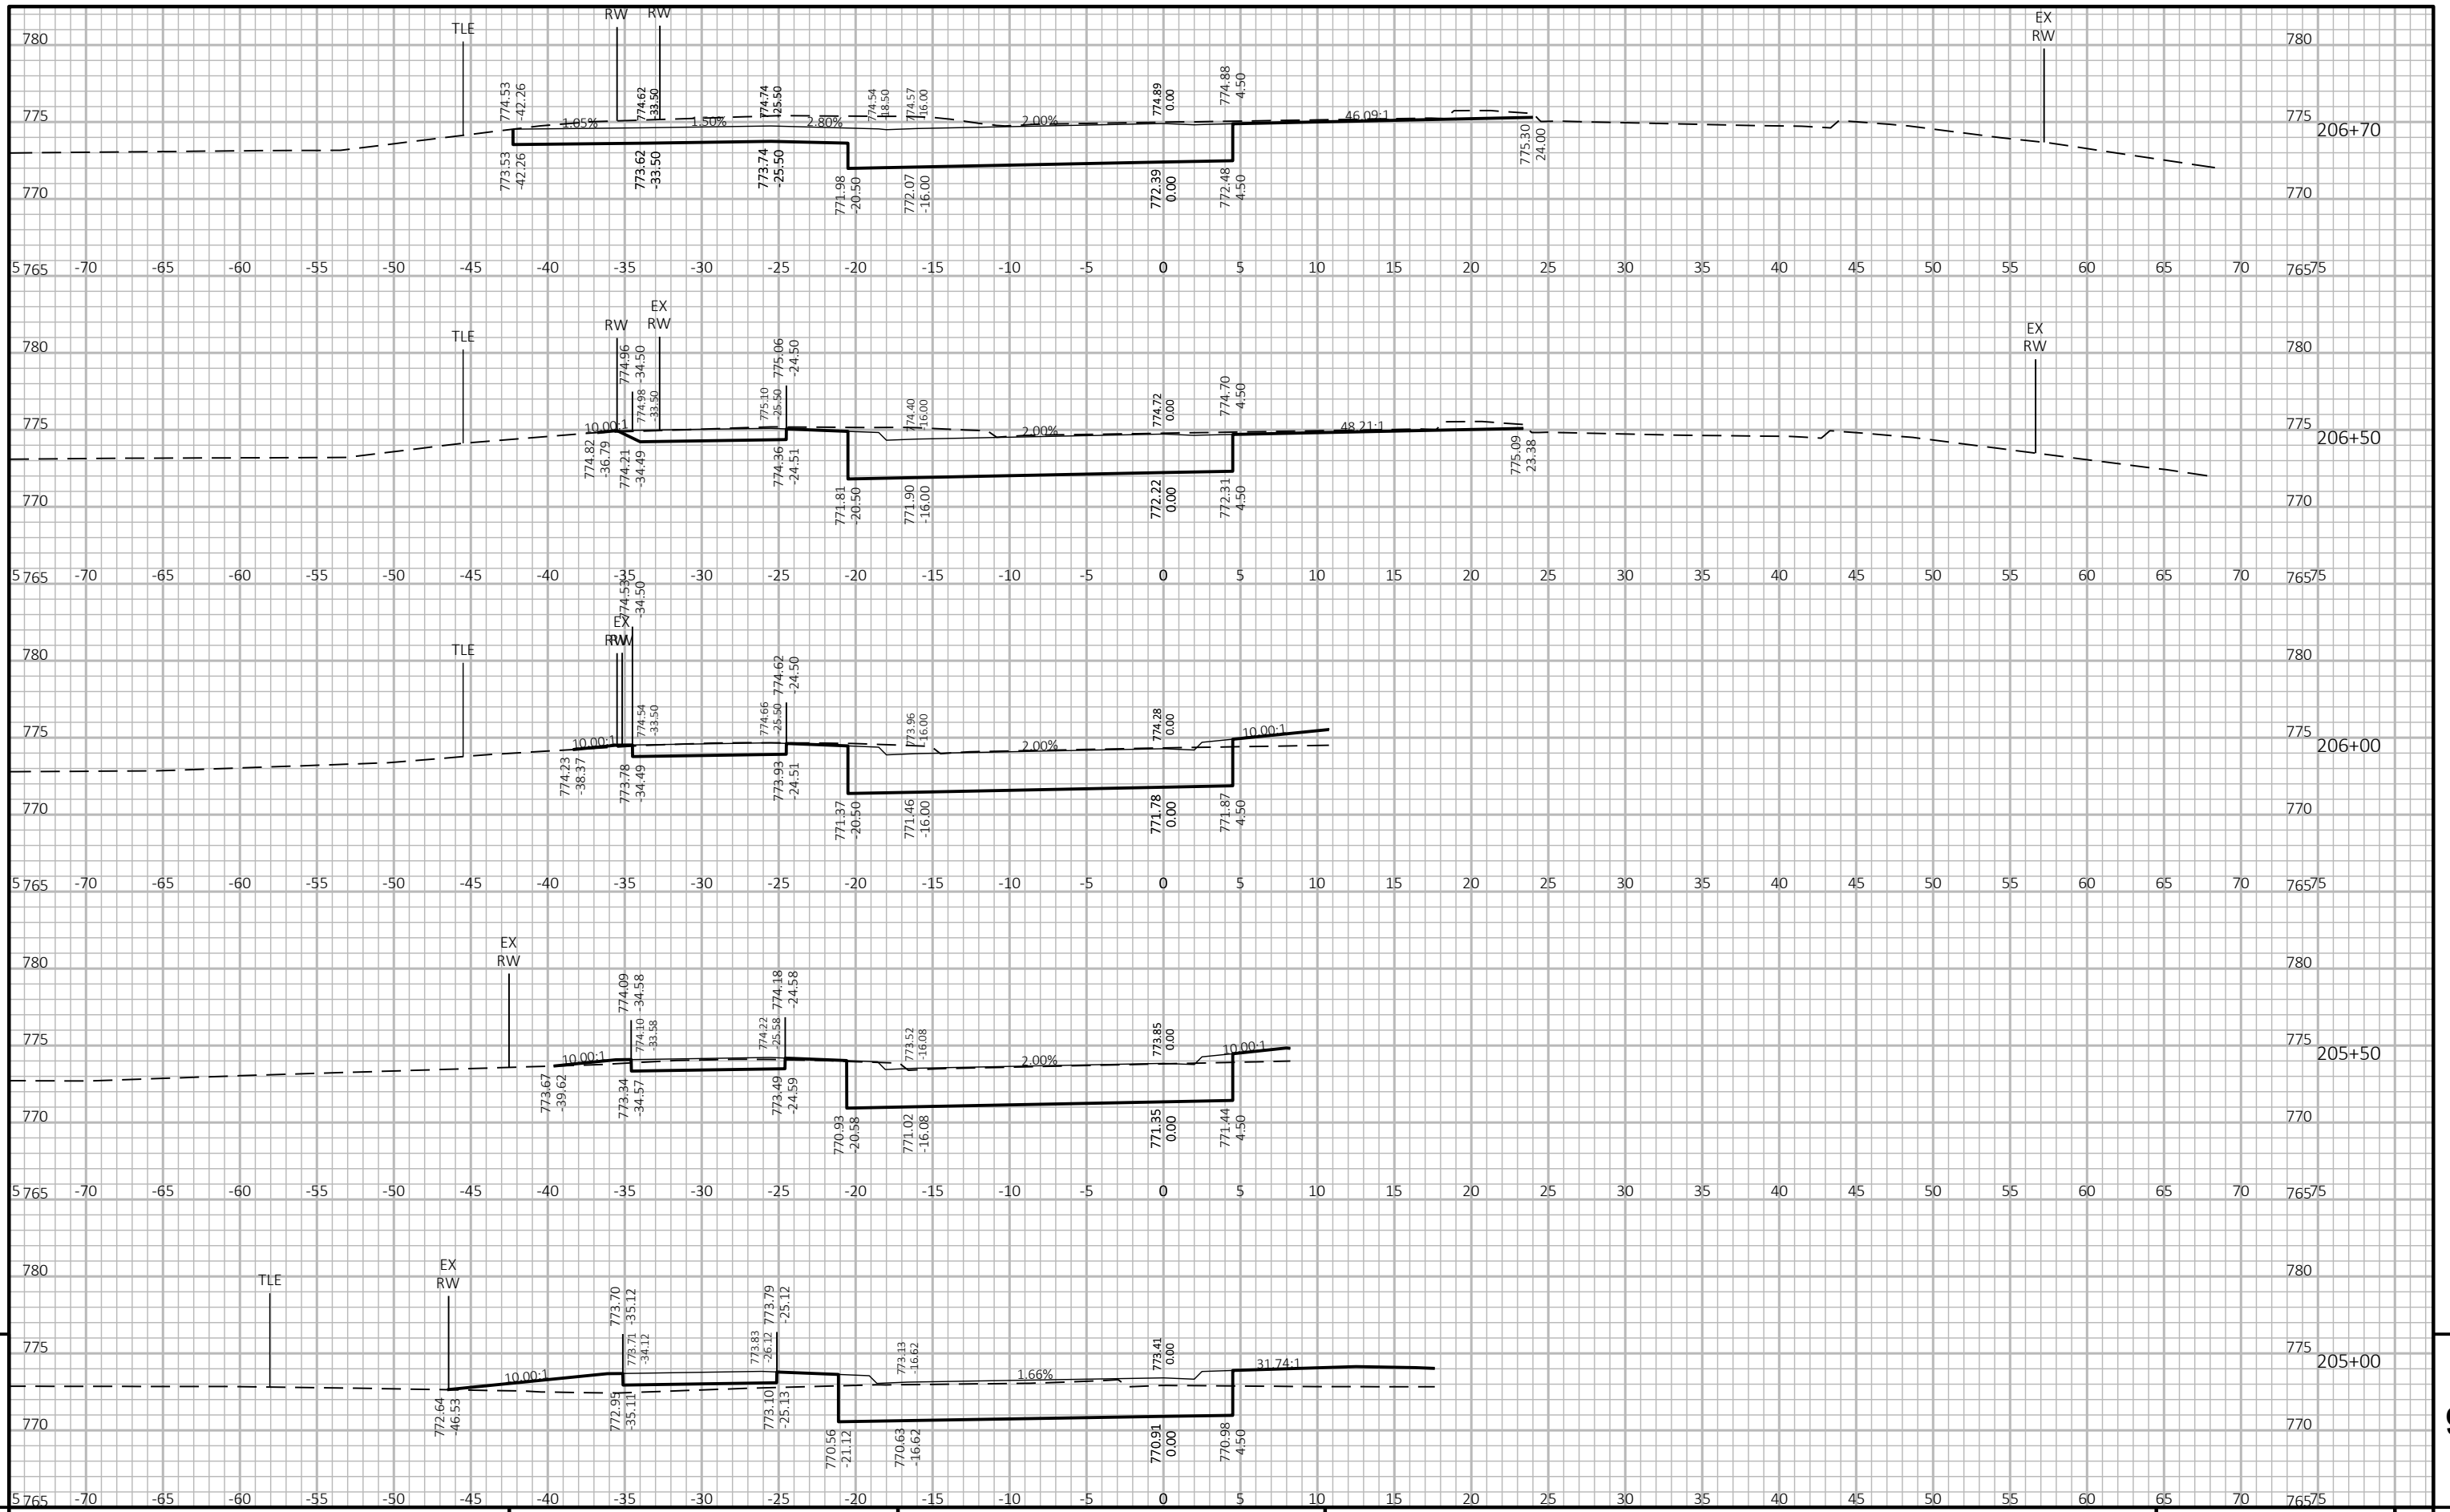


9

9

PROJECT NO: 426-4738 HWY: CTH JJ COUNTY: WINNEBAGO CROSS SECTIONS: CTH CB SOUTHBOUND SHEET 161 E

FILE NAME: N:\3000994.00\CIVIL 3D\SHEETS\PLAN\4264738-090200-XS.DWG PLOT DATE: 12/7/2021 11:52 AM PLOT BY: MATT TOMSOVIC PLOT NAME: PLOT SCALE: 1 IN:10 FT HORZ. / 1 IN:10 FT VERT. WISDOT/CADD SHEET 49

LAYOUT NAME: 4264738-090241-xs

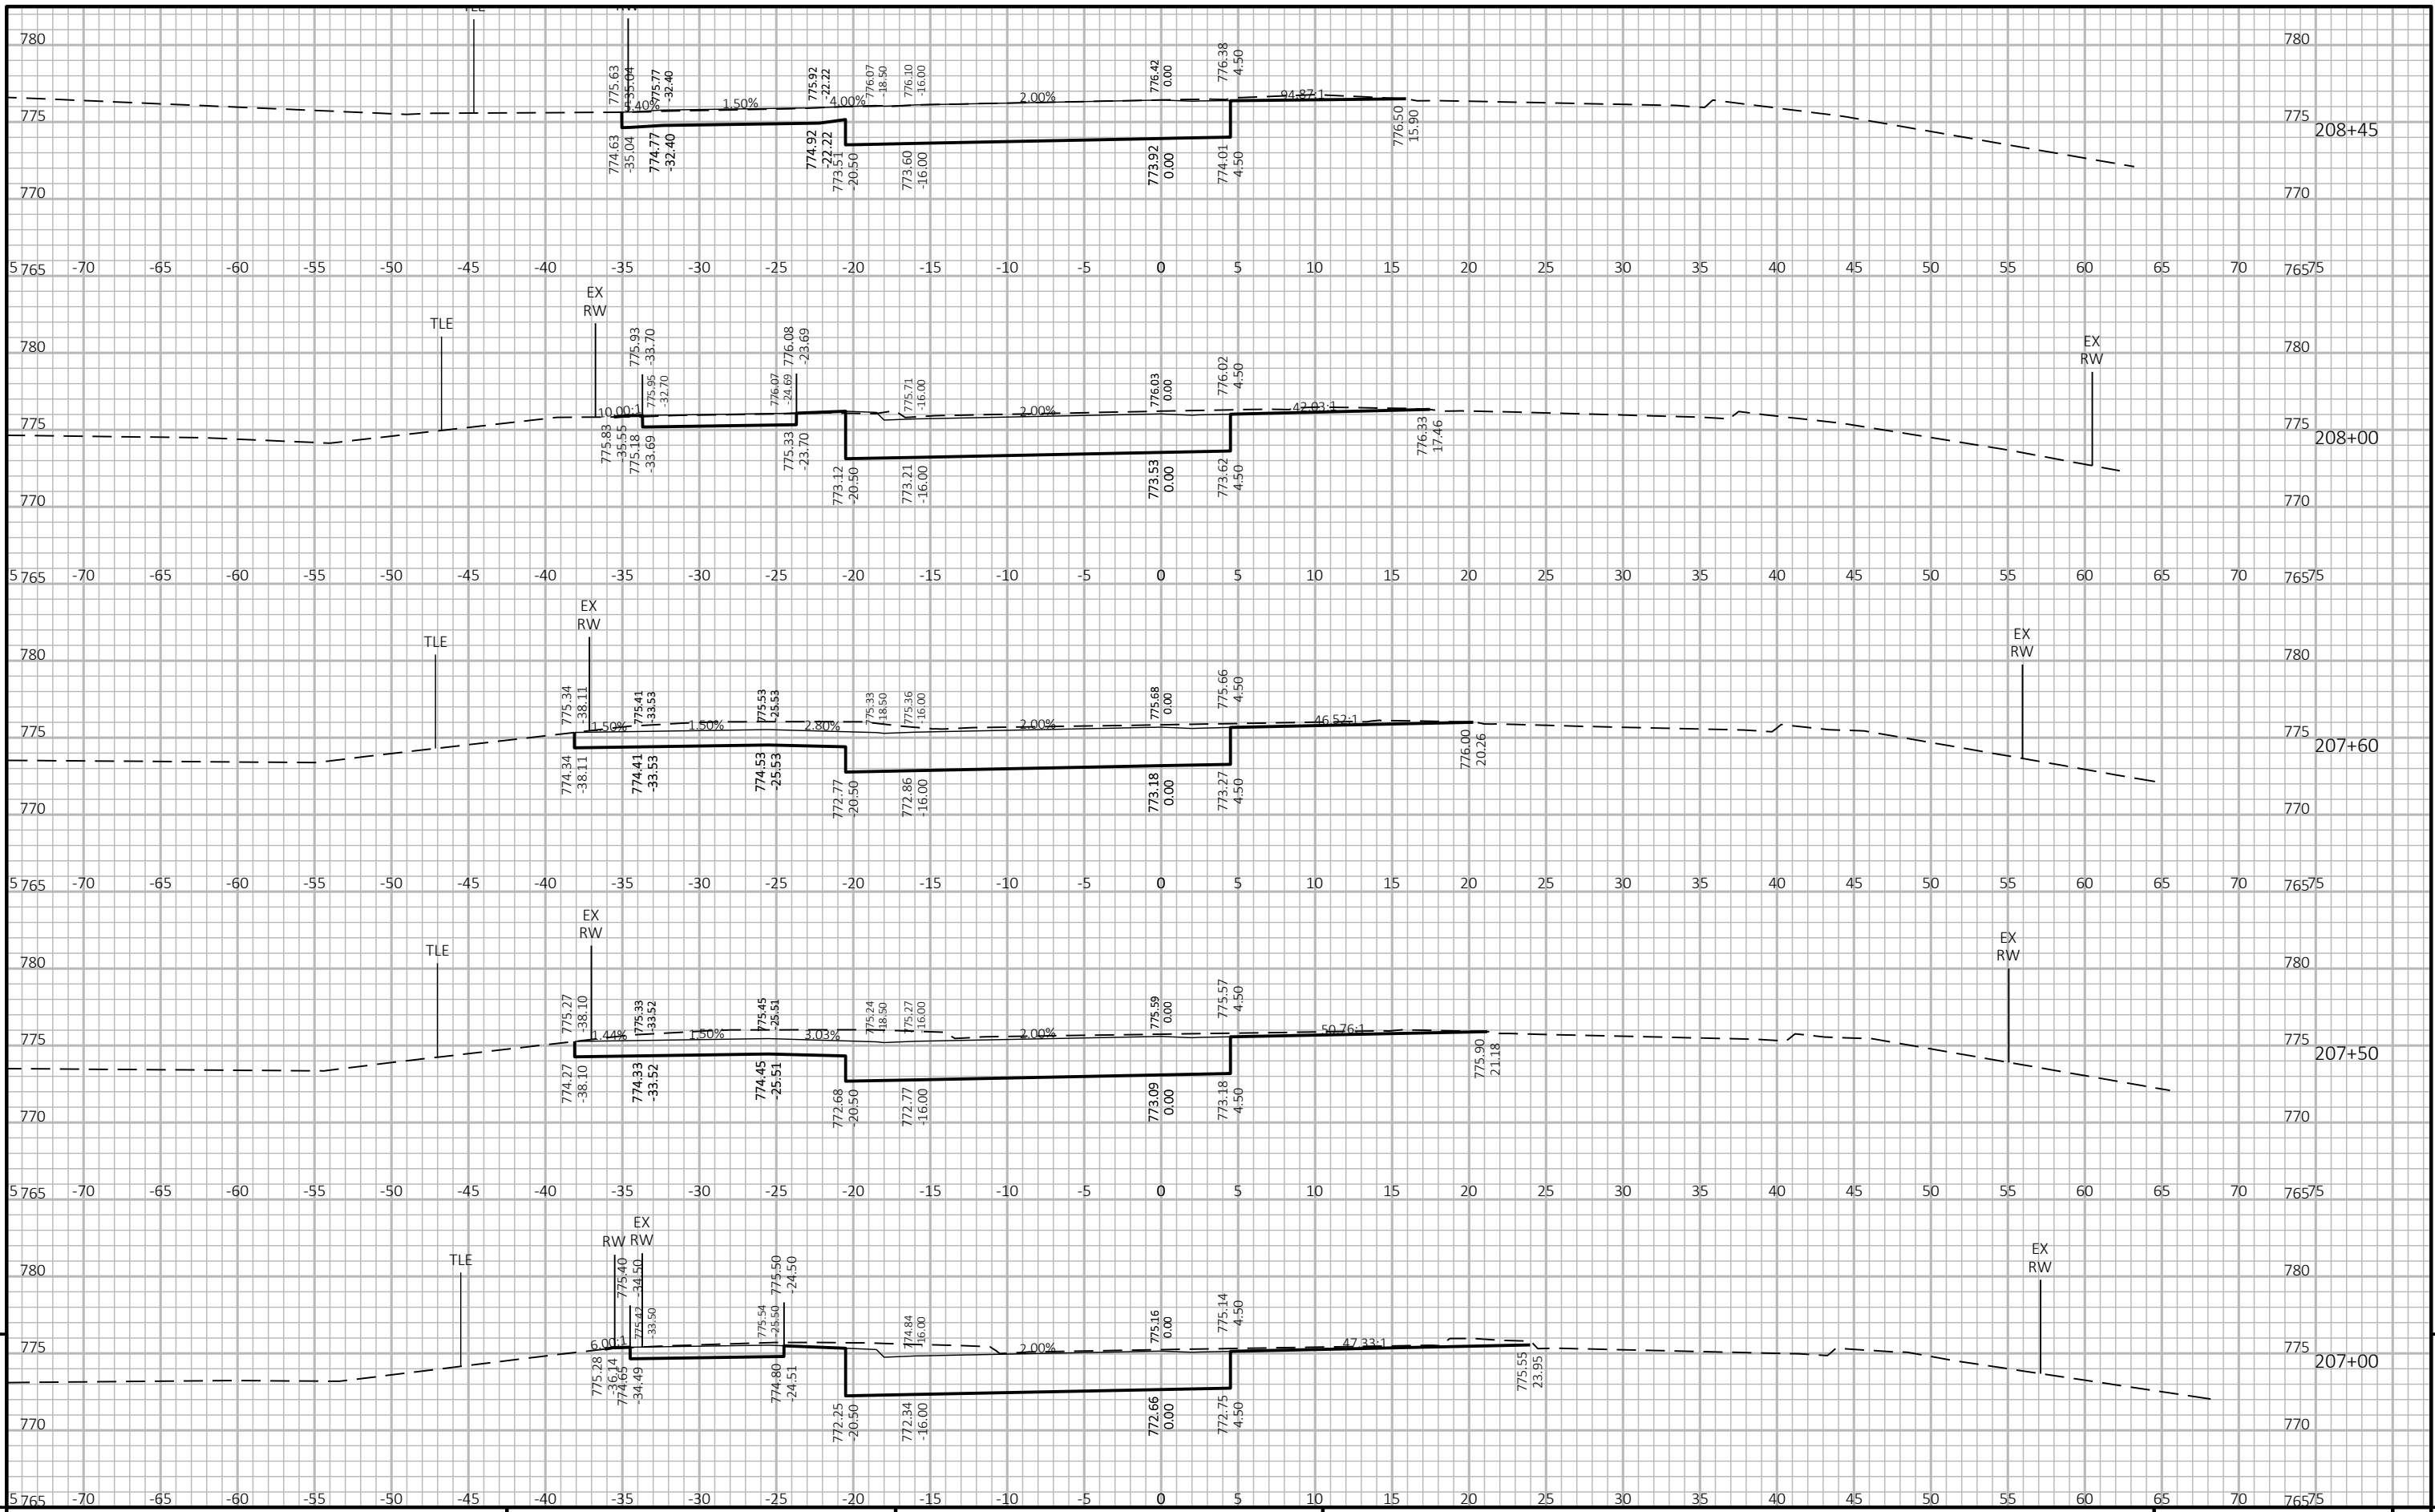


9

9

PROJECT NO: 426-4738 HWY: CTH JJ COUNTY: WINNEBAGO CROSS SECTIONS: CTH CB SOUTHBOUND SHEET 162 E

FILE NAME: N:\3000994.00\CIVIL 3D\SHEETS\PLAN\4264738-090200-XS.DWG PLOT DATE: 12/7/2021 11:52 AM PLOT BY: MATT TOMSOVIC PLOT NAME: PLOT SCALE: 1 IN:10 FT HORZ. / 1 IN:10 FT VERT. WISDOT/CADD SHEET 49

LAYOUT NAME - 4264738-090242-xs

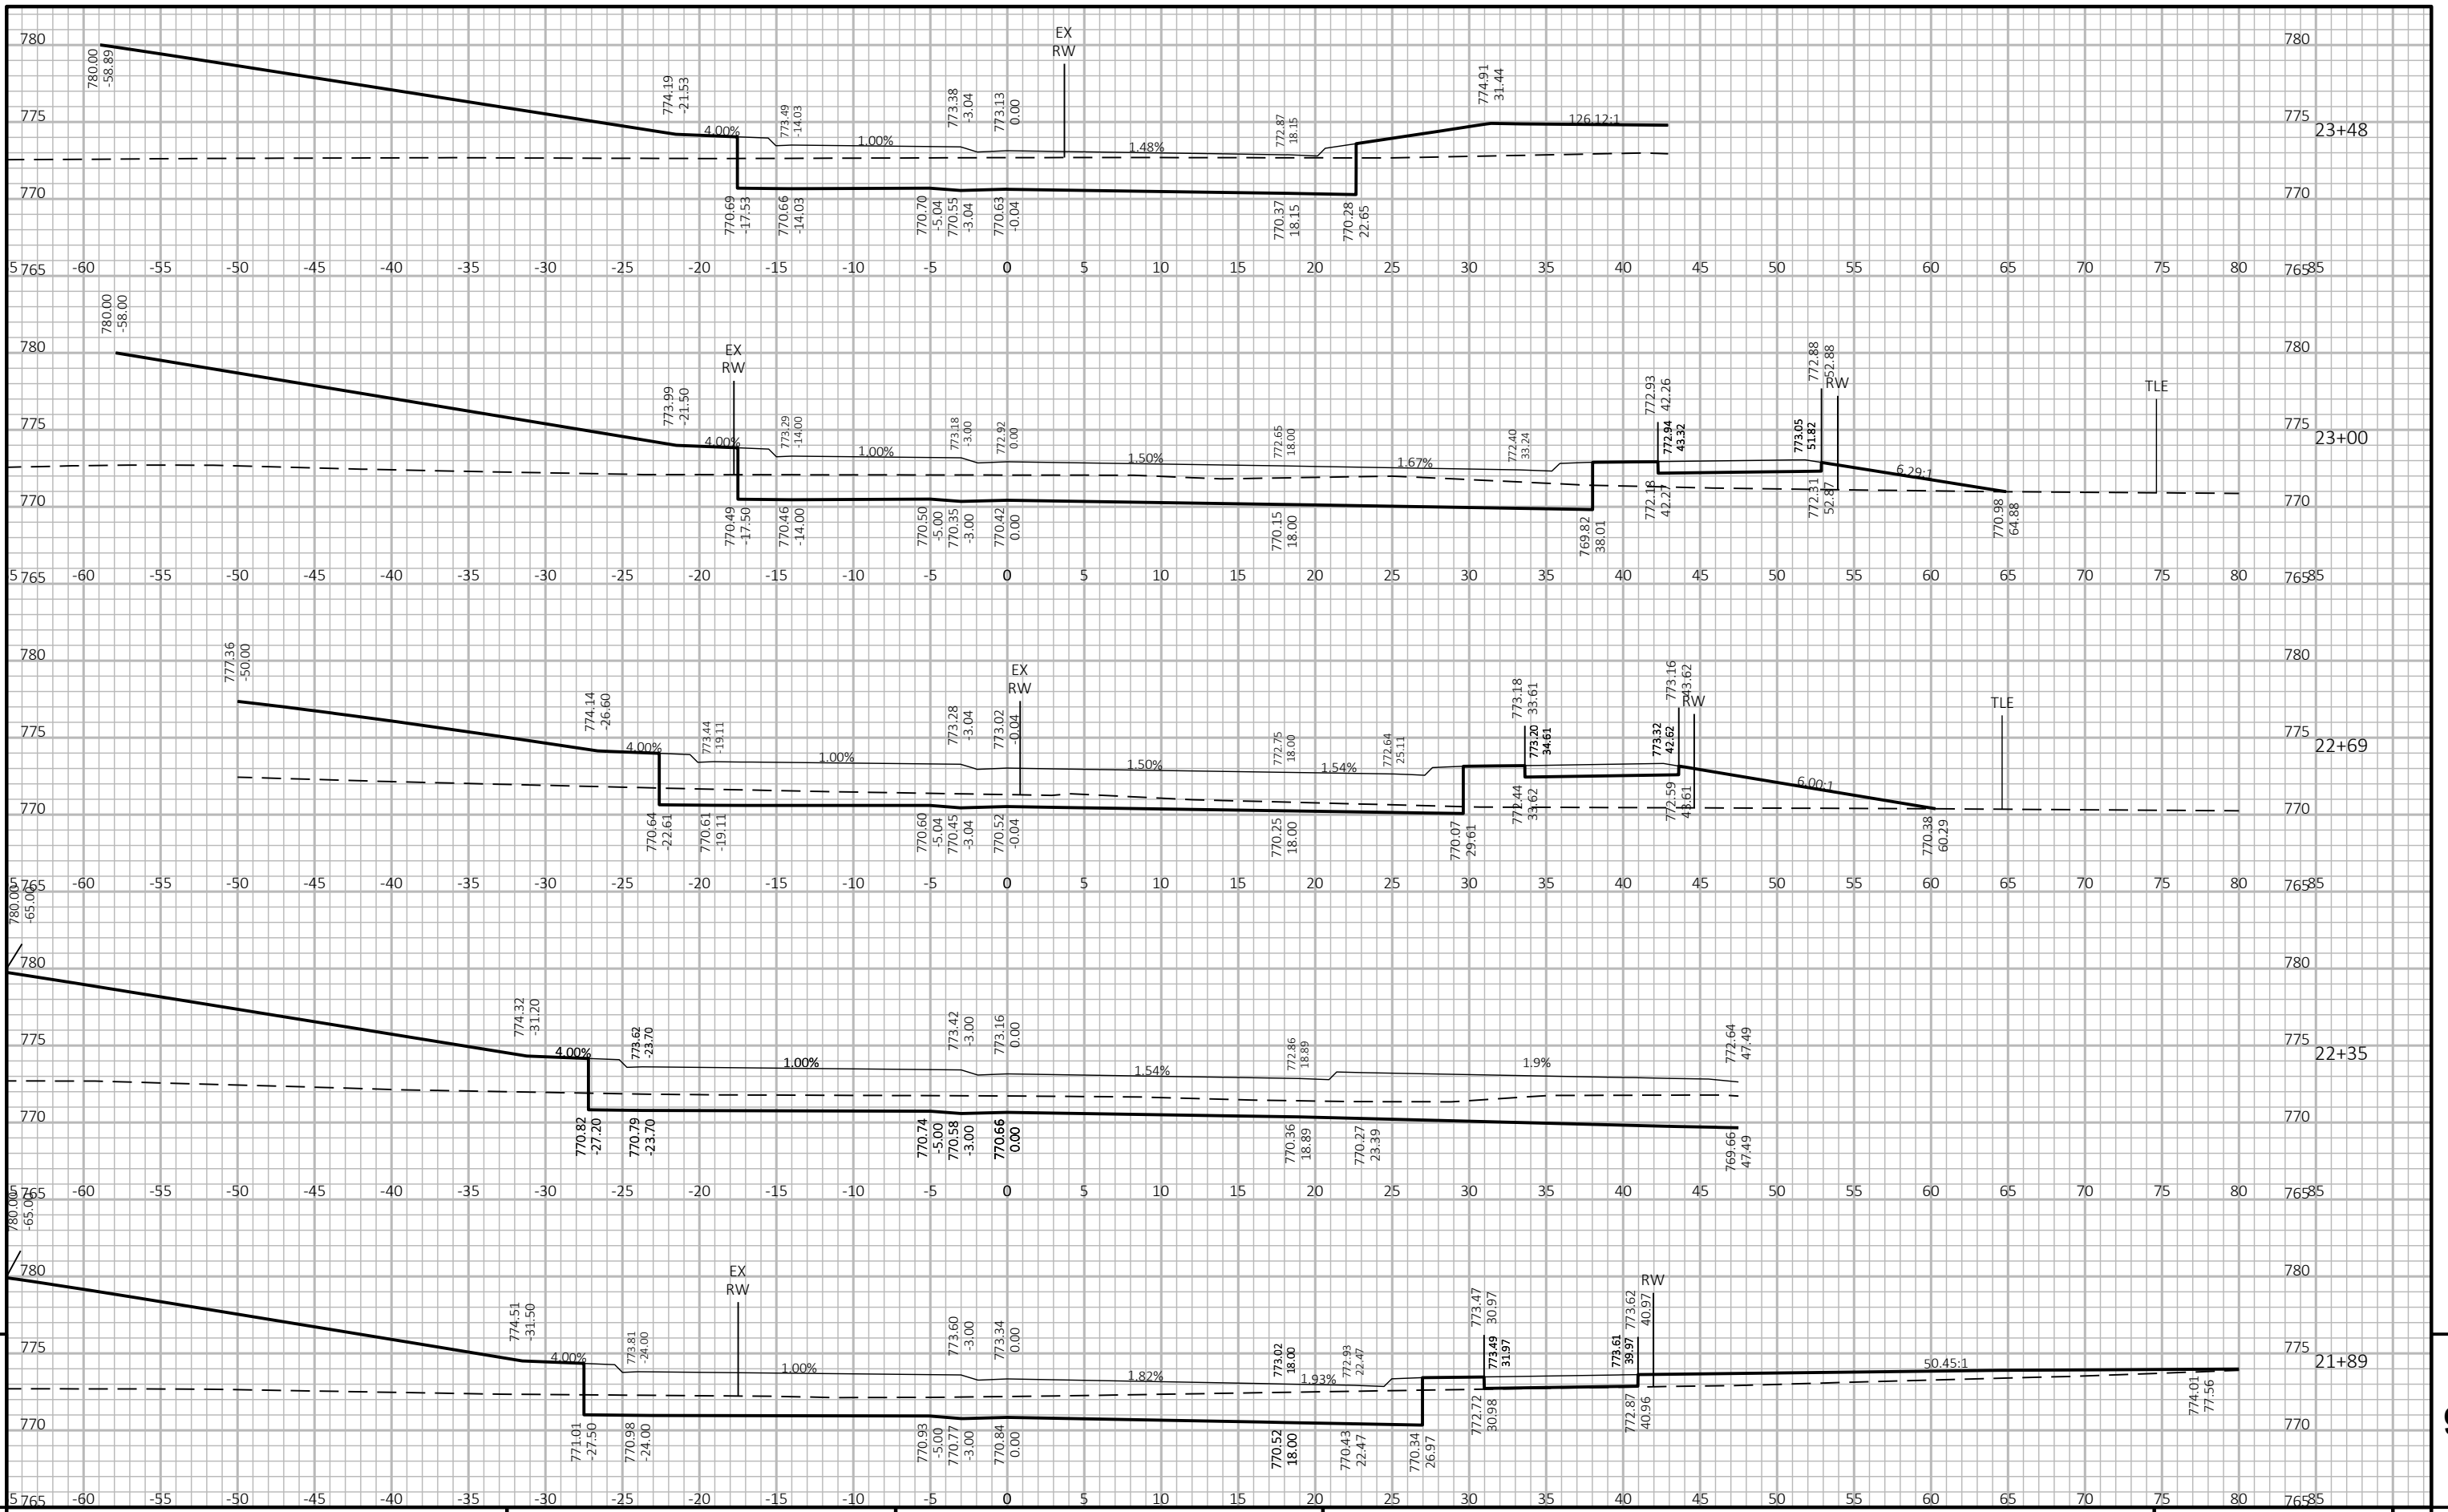


9

9

PROJECT NO: 426-4738 HWY: CTH JJ COUNTY: WINNEBAGO CROSS SECTIONS: ROUNDABOUT SHEET 163 E

FILE NAME: N:\3000994.00\CIVIL 3D\SHEETS\PLAN\4264738-090200-XS.DWG PLOT DATE: 12/7/2021 11:52 AM PLOT BY: MATT TOMSOVIC PLOT NAME: PLOT SCALE: 1 IN:10 FT HORZ. / 1 IN:10 FT VERT. WISDOT/CADD SHEET 49

LAYOUT NAME: 4264738-090252-xs

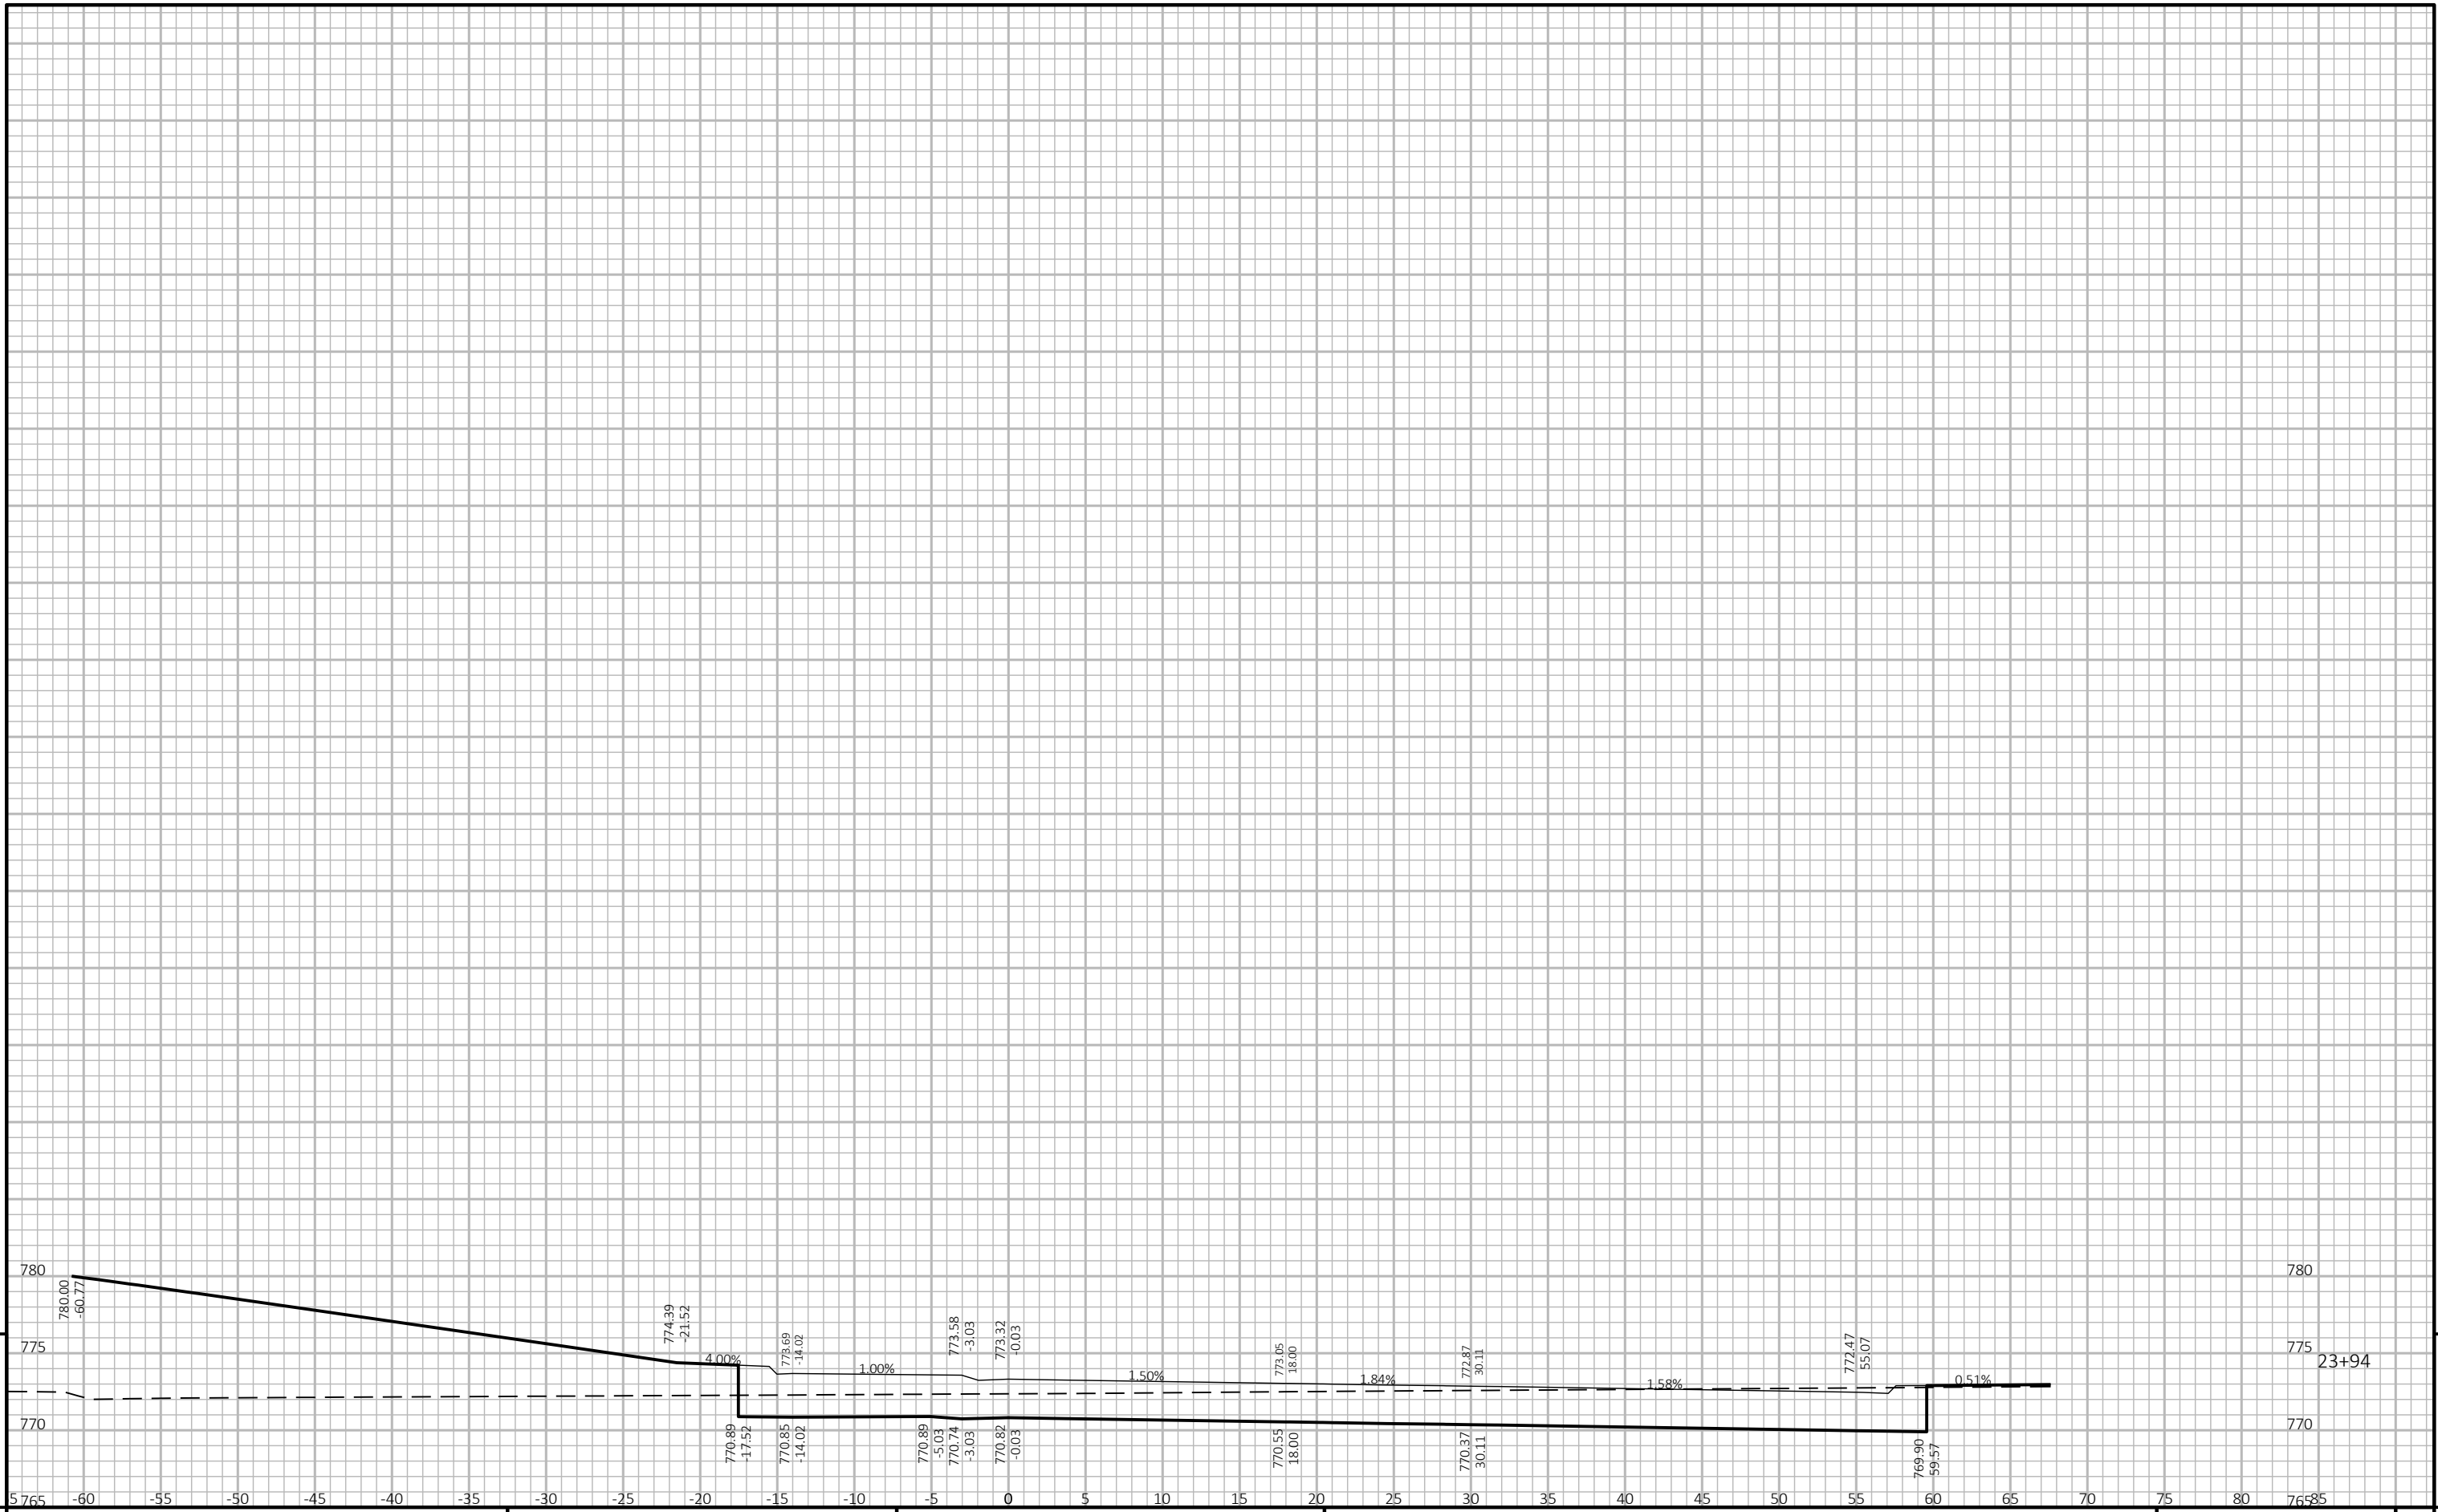

9

9

PROJECT NO: 426-4738 HWY: CTH JJ COUNTY: WINNEBAGO CROSS SECTIONS: ROUNDABOUT SHEET 164 E

FILE NAME: N:\3000994.00\CIVIL 3D\SHEETSPLAN\4264738-090200-XS.DWG PLOT DATE: 12/7/2021 11:52 AM PLOT BY: MATT TOMSOVIC PLOT NAME: PLOT SCALE: 1 IN:10 FT HORZ. / 1 IN:10 FT VERT. WISDOT/CADD SHEET 49

LAYOUT NAME - 4264738-090253-xs