

AS-BUILT PLAN

RECEIVED
DEC 15 2009
WINNEBAGO COUNTY
HIGHWAY COMMISSION

NEL FEB 09
ORDER OF SHEETS

STATE OF WISCONSIN DEPARTMENT OF TRANSPORTATION PLAN OF PROPOSED IMPROVEMENT

STATE PROJECT	FEDERAL PROJECT	
	PROJECT	CONTRACT
4994-00-87	STP 2008486	1
6432-11-71		

PROJECT ID: 4994-00-87, 6432-11-71
WITH N/A

- SECTION NO. 1 TITLE
- SECTION NO. 2 TYPICAL SECTIONS AND DETAILS
- SECTION NO. 3 ESTIMATE OF QUANTITIES
- SECTION NO. 3 MISCELLANEOUS QUANTITIES
- SECTION NO. 4 RIGHT OF WAY PLAT
- SECTION NO. 5 PLAN AND PROFILE
- SECTION NO. 6 STANDARD DETAIL DRAWINGS
- SECTION NO. 7 SIGN PLATES
- SECTION NO. 8 STRUCTURE PLANS
- SECTION NO. 9 COMPUTER EARTHWORK DATA
- SECTION NO. 9 CROSS SECTIONS

CTH Y
STH 76 - CTH A
CTH Y
WINNEBAGO COUNTY

STATE PROJECT NUMBER
4994-00-87

STH 76 & CTH Y INTERSECTION
STH 76 - CTH A
STH 76
WINNEBAGO COUNTY

STATE PROJECT NUMBER
6432-11-71

Addendum Attached to Back

AS BUILT PLAN NO.
SUPERVISOR KEN GORSEGE / DAVE SCHMIDT
RESIDENT MICK HAALSEI
CONTRACTOR ZIGNEGO COMPANIES
COMPLETED 9/16/2009

TOTAL SHEETS = 254



24

DESIGN DESIGNATION

	4994-00-87 CTH Y	6432-11-71 STH 76
A.A.D.T. (2008)	5100	17,500
A.A.D.T. (2028)	7920	26,500
D.H.V. (2028)	790	2650
D.D.	0.50	0.50
T. (% OF ADT)	4.7	4.7
DESIGN SPEED	50 MPH	50 MPH
ESALS	751,900	2,095,100

CONVENTIONAL SYMBOLS



- | | | | |
|--------------------------------|---|---------------|-----------------|
| PLAN | PROFILE | GRADE LINE | ORIGINAL GROUND |
| CORPORATE LIMITS | MARSH OR ROCK PROFILE (To be noted as such) | SPECIAL DITCH | GRADE ELEVATION |
| PROPERTY LINE | CULVERT (Profile View) | UTILITIES | ELECTRIC |
| LOT LINE | FIBER OPTIC | GAS | SANITARY SEWER |
| LIMITED HIGHWAY EASEMENT | STORM SEWER | TELEPHONE | WATER |
| EXISTING RIGHT OF WAY | UTILITY PEDESTAL | POWER POLE | TELEPHONE POLE |
| PROPOSED OR NEW R/W LINE | WOODED OR SHRUB AREA | | |
| SLOPE INTERCEPT | | | |
| REFERENCE LINE | | | |
| EXISTING CULVERT | | | |
| PROPOSED CULVERT (Box or Pipe) | | | |
| COMBUSTIBLE FLUIDS | | | |
| MARSH AREA | | | |
| | | | |

BEGIN PROJECT
6432-11-71
STA 195+01.84
N. 497006.9132
E. 791101.5316

END PROJECT
6432-11-71
STA 200+86.77
N. 497017.1392
E. 791686.3377

BEGIN PROJECT
4994-00-87
STA 200+86.77
N. 497017.1392
E. 791686.3377

END PROJECT
4994-00-87
STA 258+53.16
N. 497080.9279
E. 797452.2513

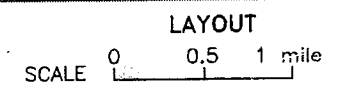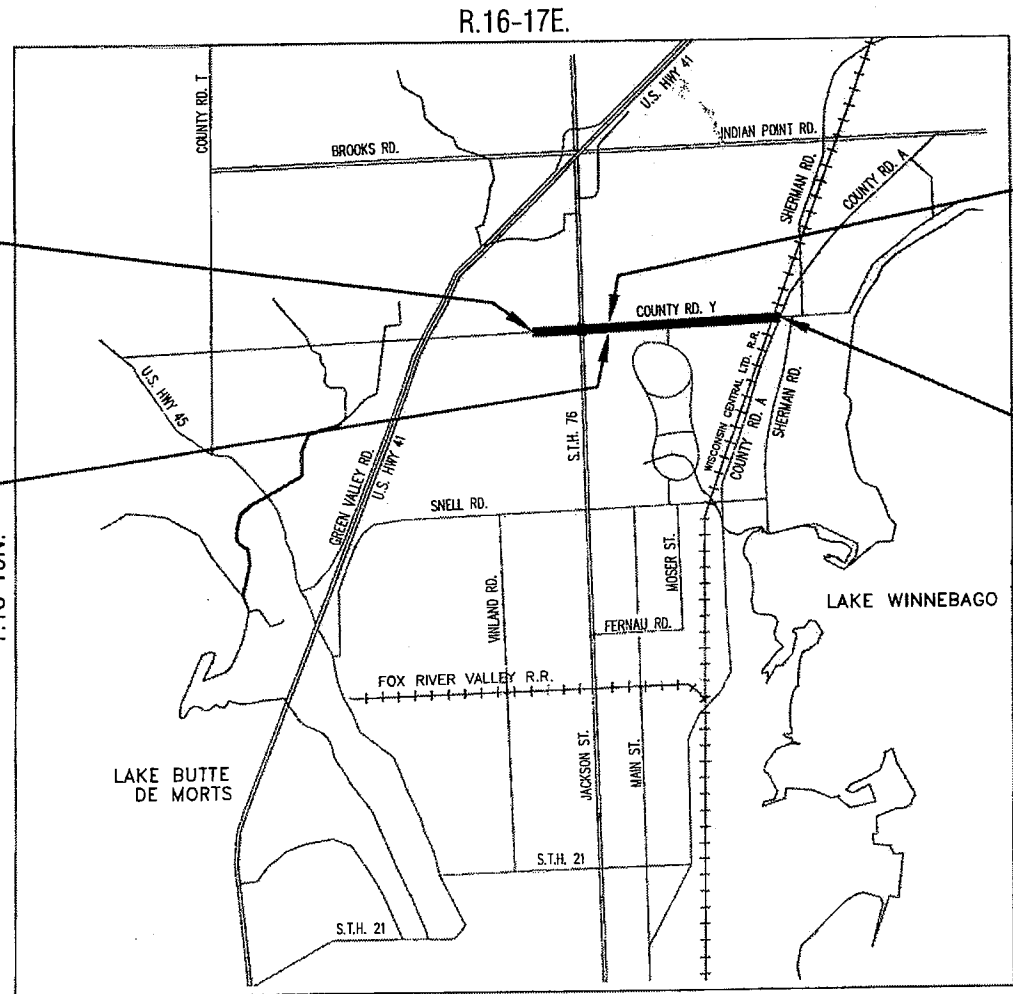

TOTAL NET LENGTH OF CENTERLINE = 1.092 MILES (PROJECT 4994-00-87)
TOTAL NET LENGTH OF CENTERLINE = 0.111 MILES (PROJECT 6432-11-71)

"COORDINATES ON THIS PLAN ARE REFERENCED TO THE WISCONSIN COUNTY COORDINATE SYSTEM," WINNEBAGO COUNTY

PLAN ADDITIONS/DELETIONS: 2, 80, & 96
REVISED PLAN SHEETS: 112

ACCEPTED FOR
WINNEBAGO COUNTY

5/20/08 DATE
John M. Hesse (SIGNATURE)

ORIGINAL PLANS PREPARED BY

WISCONSIN PROFESSIONAL ENGINEER
MICHAEL R. SIMON
E-25860
APPLETON WIS.
5-2008 DATE
Michael R. Simon SIGNATURE

STATE OF WISCONSIN
DEPARTMENT OF TRANSPORTATION

PREPARED BY SURVEYOR McMAHON
DESIGNER McMAHON
MANAGEMENT CONSULTANT SEH
C.O. EXAMINER *Gettwe*

APPROVED FOR THE DEPARTMENT
DATE: *5/20/08*
Gettwe MANAGEMENT CONSULTANT SIGNATURE

COUNTY: WINNEBAGO

GENERAL NOTES

BEARINGS AND COORDINATES SHOWN ON THIS PLAN ARE REFERENCED TO THE WINNEBAGO COUNTY COORDINATE SYSTEM. DISTANCES SHOWN ARE GROUND DISTANCES.

THE LOCATIONS OF EXISTING AND PROPOSED UTILITY FACILITIES AS SHOWN ON THE PLAN AND CROSS SECTIONS ARE APPROXIMATE AND ARE BASED ON UTILITY LOCATES OBTAINED FROM THE UTILITIES WHEN THE SURVEY DATA WAS COLLECTED PRIOR TO THE FINAL DESIGN OF THE PROJECT. IT IS ANTICIPATED THAT UTILITY FACILITIES WILL BE RELOCATED AS PART OF THIS PROJECT AS DESCRIBED IN THE SPECIAL PROVISIONS. LOCATIONS OF THE PROPOSED RELOCATED UTILITY FACILITIES ARE NOT SHOWN ON THE PLAN SHEETS OR CROSS SECTIONS. THERE MAY BE OTHER UTILITY FACILITIES WITHIN THE PROJECT LIMITS THAT ARE NOT SHOWN ON THE PLAN SHEETS OR CROSS SECTIONS.

WHEN THE QUANTITIES OF BASE AGGREGATE DENSE, BREAKER RUN AND HMA PAVEMENT ARE MEASURED FOR PAYMENT BY THE TON, THE THICKNESS AS SHOWN ON THE TYPICAL SECTIONS IS APPROXIMATE AND THE ACTUAL THICKNESS WILL DEPEND UPON THE DISTRIBUTION OF THE MATERIAL AS DIRECTED BY THE ENGINEER IN THE FIELD.

NO TREES OR SHRUBS ARE TO BE REMOVED WITHOUT PRIOR APPROVAL OF THE ENGINEER.

THE EXACT LOCATION OF ALL EROSION CONTROL ITEMS SHALL BE DETERMINED BY THE ENGINEER IN THE FIELD.

ALL RADII SHOWN ON THE PLAN SHEETS ARE TO THE BACK OF CURB.

CONCRETE SIDEWALK AREAS SHALL CONSIST OF 4-INCHES CONCRETE AND 4-INCHES BASE AGGREGATE DENSE 1 1/4-INCH.

CONCRETE PAVEMENT JOINTS IN ADDITION TO THOSE REQUIRED TO MEET THE SPACING REQUIREMENTS OF THE STANDARD DETAIL DRAWING FOR URBAN DOWELED CONCRETE PAVEMENT SHALL BE CONSIDERED INCIDENTAL TO THE ITEM CONCRETE PAVEMENT 8-INCH. THIS INCLUDES ALL ADDITIONAL JOINTS REQUIRED AT INTERSECTIONS, MANHOLES, INLETS, VALVES AND OTHER APPURTENANCES LOCATED WITHIN THE PAVEMENT LIMITS.

THE ELEVATIONS SHOWN ON THE ROADWAY CROSS SECTIONS ARE FINISHED SUBGRADE ELEVATIONS AT THE CENTERLINE AND GUTTER FLANGE LINE, AND FINISHED SURFACE ELEVATIONS AT THE SLOPE INTERCEPTS.

THE EXACT LIMITS OF CONCRETE, ASPHALT OR GRAVEL DRIVEWAY REMOVALS AND REPLACEMENT, AND CONCRETE SIDEWALK REMOVAL AND REPLACEMENT SHALL BE DETERMINED BY THE ENGINEER IN THE FIELD.

ALL CURB RAMPS SHOWN ON THE PLAN SHALL BE TYPE 2 UNLESS OTHERWISE SPECIFIED ON THE PLANS. CURB RAMP DETECTABLE WARNING FIELDS ARE REQUIRED AT ALL CURB RAMP LOCATIONS. REFER TO PAVEMENT MARKING DETAIL FOR CURB RAMP INFORMATION.

CONCRETE DRIVEWAYS SHALL CONSIST OF 7-INCHES CONCRETE AND 6-INCHES BASE AGGREGATE DENSE 1 1/4-INCH.

ALL DISTURBED AREAS NOT OTHERWISE SURFACED SHALL BE RESTORED WITH TOPSOIL, FERTILIZER, SEED, AND MULCH.

FILL AS SHOWN ON THE PLAN PERTAINS TO EMBANKMENT CONSTRUCTED FROM COMMON EXCAVATION. THE FACTOR USED FOR EXPANDING THE FILLS TO COMPLETE THE VOLUME OF MATERIAL REQUIRED IS 30% FOR COMMON EXCAVATION.

EXCAVATION BELOW SUBGRADE (EBS) AREAS ARE CALLED OUT AS UNDISTRIBUTED ON THE PLAN QUANTITIES FOR COMMON EXCAVATION. THESE AREAS ARE TO BE BACKFILLED WITH BREAKER RUN. EXACT LOCATIONS WILL BE DETERMINED BY THE ENGINEER.

THE PER PHASE TOTALS SHOWN ON THE MISCELLANEOUS QUANTITIES SHEETS ARE APPROXIMATE AND WILL VARY ACCORDING TO THE CONTRACTORS OPERATIONS.

STANDARD ABBREVIATIONS AND SYMBOLS

ADJ.	ADJUST	NOR.	NORMAL
ASPH	ASPHALT	P.E.	PRIVATE ENTRANCE
AVE.	AVENUE	P.G.L.	PROFILE GRADE LINE
⊕	BENCH MARK	P.I.	POINT OF INTERSECTION
B-B	BACK TO BACK OF CURB	P.T.	POINT OF TANGENCY
B.A.D.	BASE AGGREGATE DENSE	P.V.C.	POINT OF VERTICAL CURVATURE
B.O.C. or B/C	BACK OF CURB	P.V.I.	POINT OF VERTICAL INTERSECTION
⊕ or CL	CENTERLINE	P.V.T.	POINT OF VERTICAL TANGENCY
CONC.	CONCRETE	P/L	PROPERTY LINE
C.M.P.	CORRUGATED METAL CULVERT PIPE	PVT.	PAVEMENT
C.T.H.	COUNTY TRUNK HIGHWAY	PED.	PEDESTAL
CL	CLASS	R or RAD	RADIUS
△	DELTA	R.C.P.	REINFORCED CONCRETE PIPE
D.	DEGREE OF CURVE	RECON.	RECONSTRUCT
DW	DRIVEWAY	REQ'D	REQUIRED
E.	EAST	R/L	REFERENCE LINE
EB	EASTBOUND	REM.	REMOVE
E-MAT	EROSION MAT	R/W	RIGHT OF WAY
ELEV	ELEVATION	RD.	ROAD
EOP	EDGE OF PAVEMENT	RT.	RIGHT
EOR	END OF RADIUS	S.	SOUTH
EXIST.	EXISTING	SAN	SANITARY SEWER
F-F	FACE TO FACE OF CURB	SB	SOUTH BOUND
FL	FLOWLINE	S.D.D.	STANDARD DETAIL DRAWING
GRAV	GRAVEL	S.I.	SLOPE INTERCEPT
GV	GAS VALVE	STA.	STATION
HDPE	HIGH DENSITY POLYETHYLENE CULVERT PIPE	S.T.H.	STATE TRUNK HIGHWAY
HE	HIGHWAY EASEMENT	STA.	STATION
HMA	HMA	SW	CONCRETE SIDEWALK
H.P.	HIGH POINT	T.I.	TEMPORARY INTEREST
HYD.	HYDRANT	TLE	TEMPORARY LIMITED INTEREST
L.	LENGTH OF CURVE	TYP.	TYPICAL
L.V.C.	LENGTH OF VERTICAL CURVE	V.C.	VERTICAL CURVE
L.S.	LANDSCAPING	WB	WESTBOUND
LT.	LEFT	W	WATERMAIN
MH	MANHOLE	WV	WATER VALVE/SHUTOFF
MAX	MAXIMUM	⊕	HYDRANT W/AUXILIARY VALVE
MIN	MINIMUM	⊕	LIGHT POLE
NB	NORTH BOUND		
NO.	NUMBER		

UTILITIES

AT&T
CHARLES BARTELT
70 E DIVISION STREET
FOND DU LAC, WI 54935
PHONE (920) 929-1013
FAX (920) 929-1064
PAGER (414) 318-0479
CELL (920) 948-2170
cb1461@att.com

MULTIMEDIA COMMUNICATIONS &
ENGINEERING, INC.
JOEL MIKULSKY
PO BOX 11064
GREEN BAY, WI 54307
PHONE (920) 676-0494
FAX (920) 822-4377

CHARTER COMMUNICATIONS
GLEN YOST
165 KNIGHTS WAY
FOND DU LAC, WI 54935
PHONE (920) 907-7720 - EXT 1610
FAX (920) 907-7727

CITY OF OSHKOSH PUBLIC WORKS
DAVID PATEK
215 CHURCH AVENUE
OSHKOSH, WI 54902-1130
(920) 236-5065

TDS TELECOM
STEVE JAKUBIEC
10 COLLEGE AVE
SUITE 218A
APPLETON, WI 54911
(920) 882-4166
steve.jakubiec@tdstelecom.com

SPRINT
JIM BURTON
5600 NORTH RIVER ROAD
SUITE 500
ROSEMONT, IL 60018
PHONE (847) 318-3437
CELL (708) 955-6659
FAX (847) 318-3199
james.m.burton@sprint.com

TIME WARNER CABLE
VINCE ALBIN
1001 KENNEDY AVENUE
PO BOX 145
KIMBERLY, WI 54136-0145
(920) 831-9211

US SIGNAL COMPANY / RVP FIBER
CHRIS LENTINE
201 IONIA, SW
GRAND RAPIDS, MI 49503
PHONE (616) 988-7194
CELL (616) 295-8490
clentine@ussignal.com

WINNEBAGO COUNTY FIBER OPTIC
PATTY FRANCOUR
415 JACKSON STREET
PO BOX 2808
OSHKOSH, WI 54901
(920) 236-4708

WISCONSIN PUBLIC SERVICE ELECTRICAL
DAVE PETERSON
3300 N. MAIN STREET
OSHKOSH, WI 54901
(920) 236-5910

WISCONSIN PUBLIC SERVICE GAS
PAUL SPANGLER
3300 N MAIN ST
OSHKOSH, WI 54901
(920) 236 5908

CANADIAN NATIONAL RAILROAD, WISCONSIN
CENTRAL DIVISION RAILROAD
TERRY LEE
1625 DEPOT STREET
STEVENS POINT, WI 54481
(715) 345-2503

WISCONSIN DOT NE REGION
TRAFFIC SECTION
BOB SCHUURMANS
(920) 492-5710

CANADIAN NATIONAL RAILWAY CONTACTS

RAILROAD FLAGGING CONTACT
TOM TUCKER, TOM.TUCKER@CN.CA
2800 LIVERNOIS, SUITE 330
TROY, MI 48083
OFFICE 248-740-6227
FAX 248-740-6550

MAIN RAILROAD CONTACT
TERRY LEE, MANAGER-ENGR'G SRVC'S
1625 DEPOT STREET
STEVENS POINT, WI 54481
OFFICE 715-345-2503 MOBILE 715-572-7803
FAX 715-345-2507

RAILROAD CROSSING SIGNAL CONTACT
JACK PALACH, SIGNALS DESIGN OFFICER
1625 DEPOT STREET
STEVENS POINT, WI 54481
OFFICE 715-345-2521 MOBILE 715-572-7821
FAX 715-345-2507

24 HOUR EMERGENCY RAILROAD
SIGNAL CONTACT 1-800-616-3432

CALL BEFORE YOU DIG
CANADIAN NATIONAL RAILWAY IS NOT PART OF
THE DIGGERS HOTLINE SYSTEM. CALL CHRISTINE GRZESIAK
715-345-2506 WHEN DIGGING ON RAILROAD R/W

LAND USE:	HYDROLOGIC SOIL GROUP											
	A			B			C			D		
	SLOPE RANGE (PERCENT)			SLOPE RANGE (PERCENT)			SLOPE RANGE (PERCENT)			SLOPE RANGE (PERCENT)		
	0-2	2-6	6 & OVER	0-2	2-6	6 & OVER	0-2	2-6	6 & OVER	0-2	2-6	6 & OVER
ROW CROPS	.08	.16	.22	.12	.20	.27	.15	.24	.33	.19	.28	.38
	.22	.30	.38	.26	.34	.44	.30	.37	.50	.34	.41	.56
MEDIAN STRIP-TURF	.19	.20	.24	.19	.22	.26	.20	.23	.30	.20	.25	.30
	.24	.26	.30	.26	.28	.33	.26	.30	.37	.27	.32	.40
SIDE SLOPE-TURF			.25			.27			.28			.30
			.32			.34			.36			.38
PAVEMENT:												
ASPHALT	.70 - .95											
CONCRETE	.80 - .95											
BRICK	.70 - .80											
DRIVES, WALKS	.75 - .80											
ROOFS	.75 - .95											
GRAVEL ROADS, SHOULDERS	.40 - .60											

TOTAL PROJECT AREA= 12.24 ACRES
TOTAL DISTURBED AREA= 14.86 ACRES

DNR LIAISON


DEPARTMENT OF NATURAL RESOURCES
625 E. COUNTY ROAD Y
SUITE 700
OSHKOSH, WI 54901-9731
ATTENTION: SHELLY ALLNESS
(920) 303-5442

DESIGN CONTACT

MIKE SIMON
McMAHON ASSOCIATES
1445 McMAHON DRIVE
NEENAH, WI 54956
(920) 751-4200




Toll Free (800) 242-8511
Milwaukee Area (414) 258-1181
Hearing Impaired TDD (800) 542-2289
www.DiggersHotline.com

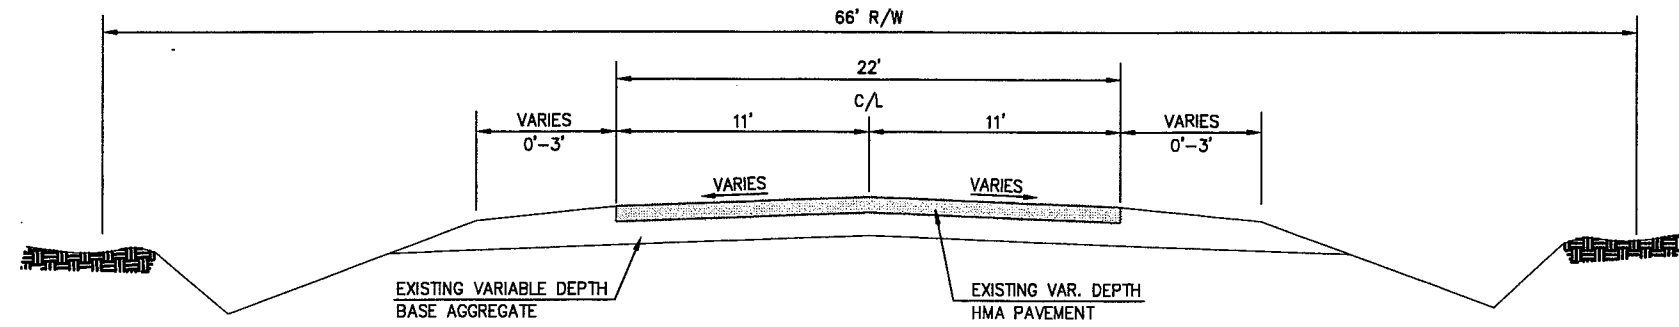


CTH 'Y' EXISTING TYPICAL SECTION

STA. 195+01.84 - STA. 258+53.16

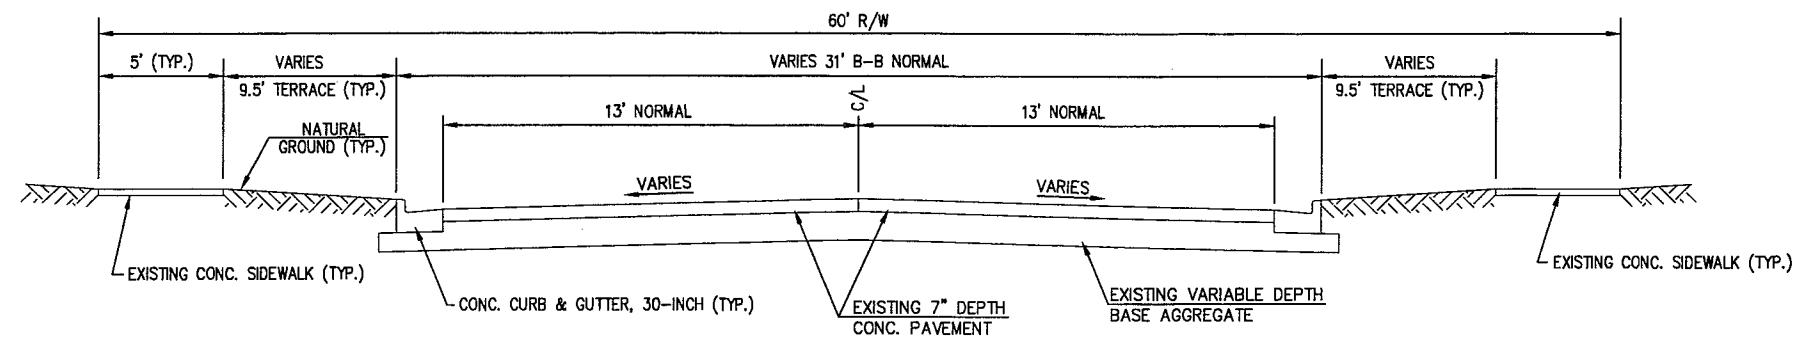


EXISTING TYPICAL SECTION

SODA CREEK RD. AND JACKTAR CT.

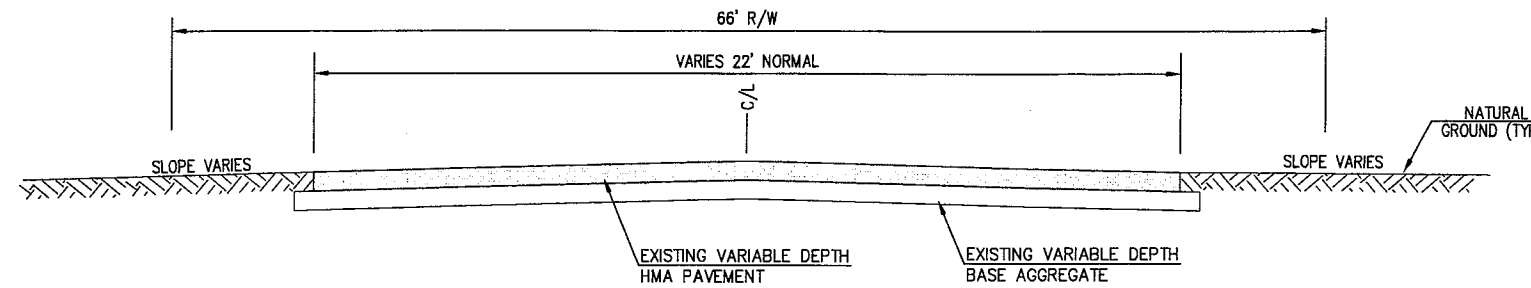

BUTLER AVE. EXISTING TYPICAL SECTION

p:\proj\100\4994\00\TYPICAL SECTIONS\ex_typical_section.dwg 04/28/08 1:53 PM

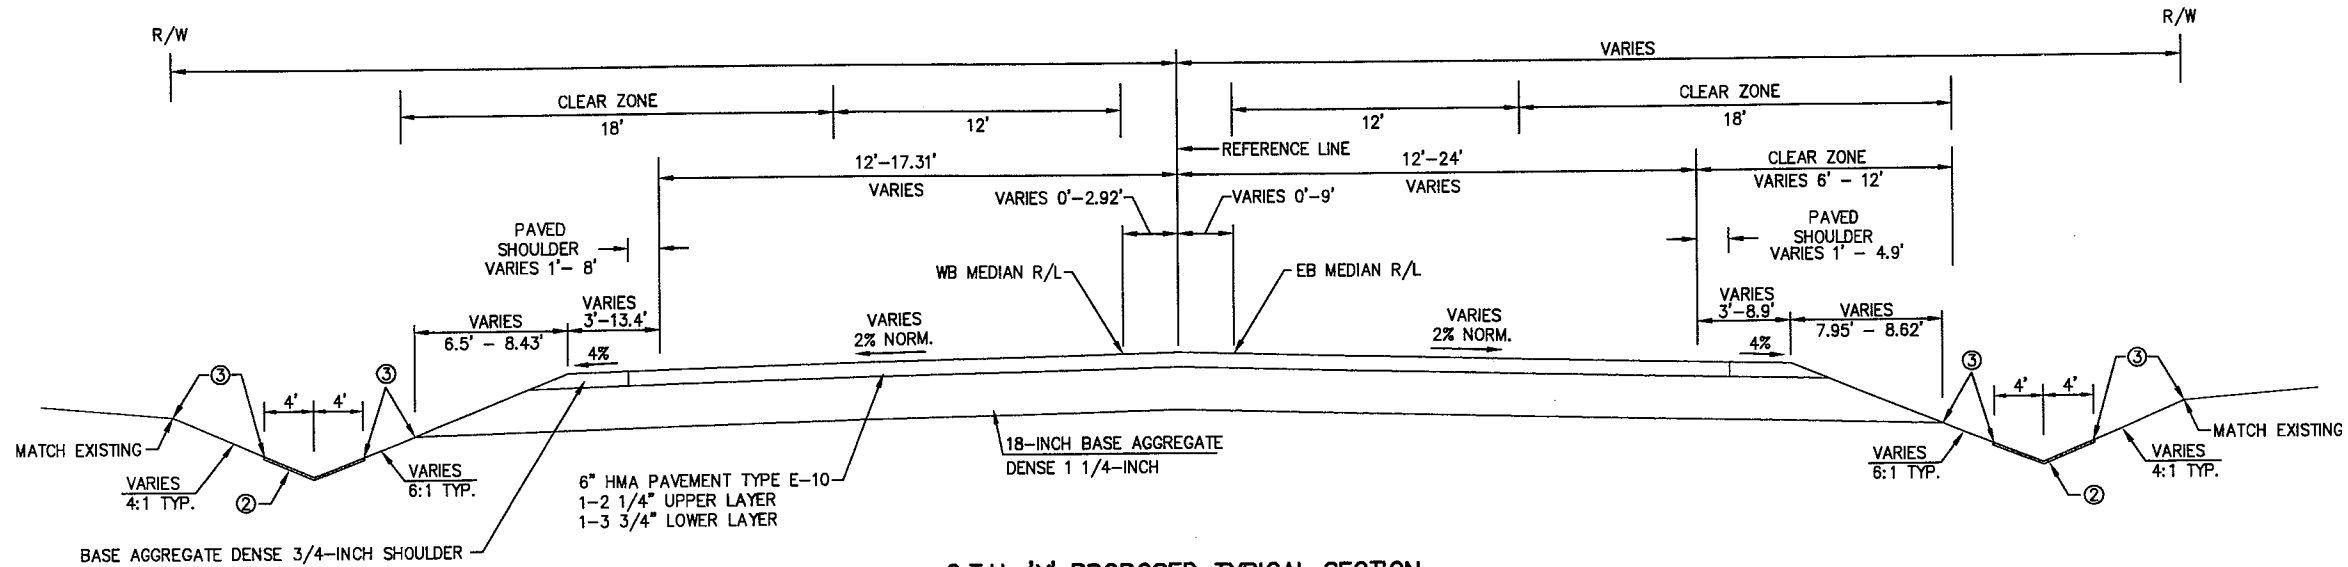


C.T.H. 'Y' PROPOSED TYPICAL SECTION

STA. 195+01.84 TO STA. 197+04.88

NOTE: LIMITS OF RAISED MEDIAN ARE STA. 196+98.93 TO STA. 199+43.41

- KEYED NOTES**
- ① TOPSOIL, SEED, FERTILIZER AND E-MAT. CLASS I, TYPE A.
 - ② TOPSOIL, SEED, FERTILIZER AND E-MAT. CLASS I, TYPE B.
 - ③ TOPSOIL, SEED, FERTILIZER AND MULCH.

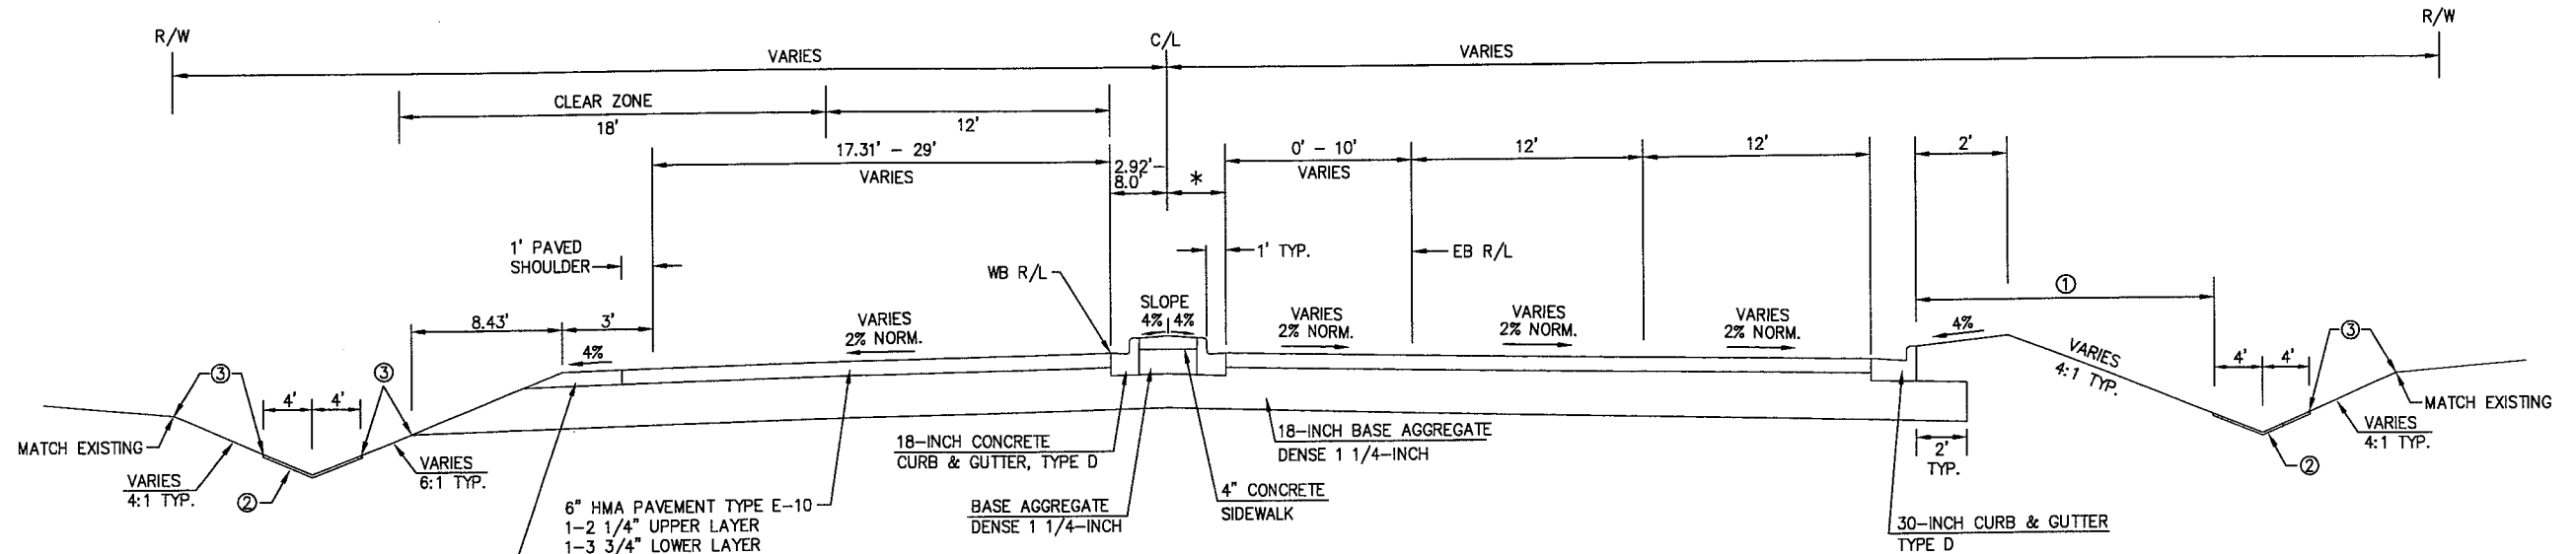

C.T.H. 'Y' PROPOSED TYPICAL SECTION


STA. 197+04.88 - STA. 199+53.51

* C/L TO EB MEDIAN CURB FLANGE VARIES FROM 1' LT. TO 9' RT.

NOTES: LIMITS OF RAISED MEDIAN ARE STA. 196+98.93 TO STA. 199+43.41.

PAVEMENT SECTION FROM STA. 199+05.72 TO STA. 199+53.51 TO CONSIST OF 4-INCHES HMA TYPE E-10 OVER 8-INCH CONCRETE BASE H.E.S. AND 12-INCHES B.A.D. 1 1/4-INCH

W:\DMS\WOODS\970345\01\TYPICAL SECTIONS\TYP PROP.dwg 12/29/08 10:10 AM

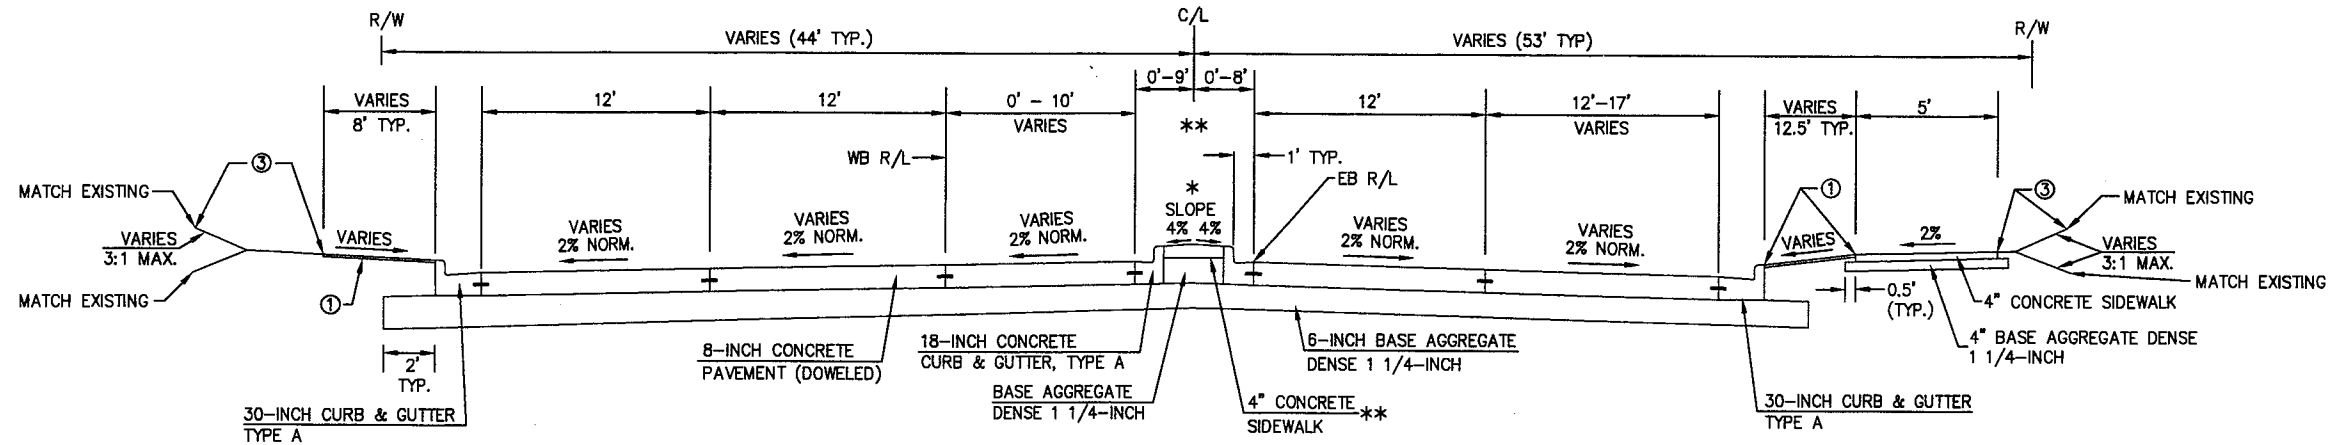

C.T.H. 'Y' PROPOSED TYPICAL SECTION

STA. 200+37.07 - STA. 205+90.21


*LIMITS OF RAISED MEDIAN ARE STA. 200+59.40 TO STA. 205+18.76

** MEDIAN CROSS OVER STA. 203+60 - STA. 204+40
SEE PAVING DETAILS FOR ADDITIONAL INFORMATION

NOTE: PAVEMENT SECTION FROM STA. 200+37.07 TO STA. 200+87.92 TO CONSIST OF 4-INCHES HMA TYPE E-10 OVER 8-INCH CONCRETE BASE H.E.S. AND 12-INCHES B.A.D. 1 1/4-INCH

KEYED NOTES


- ① TOPSOIL, SEED, FERTILIZER AND E-MAT. CLASS I, TYPE A.
- ② TOPSOIL, SEED, FERTILIZER AND E-MAT. CLASS I, TYPE B.
- ③ TOPSOIL, SEED, FERTILIZER AND MULCH.

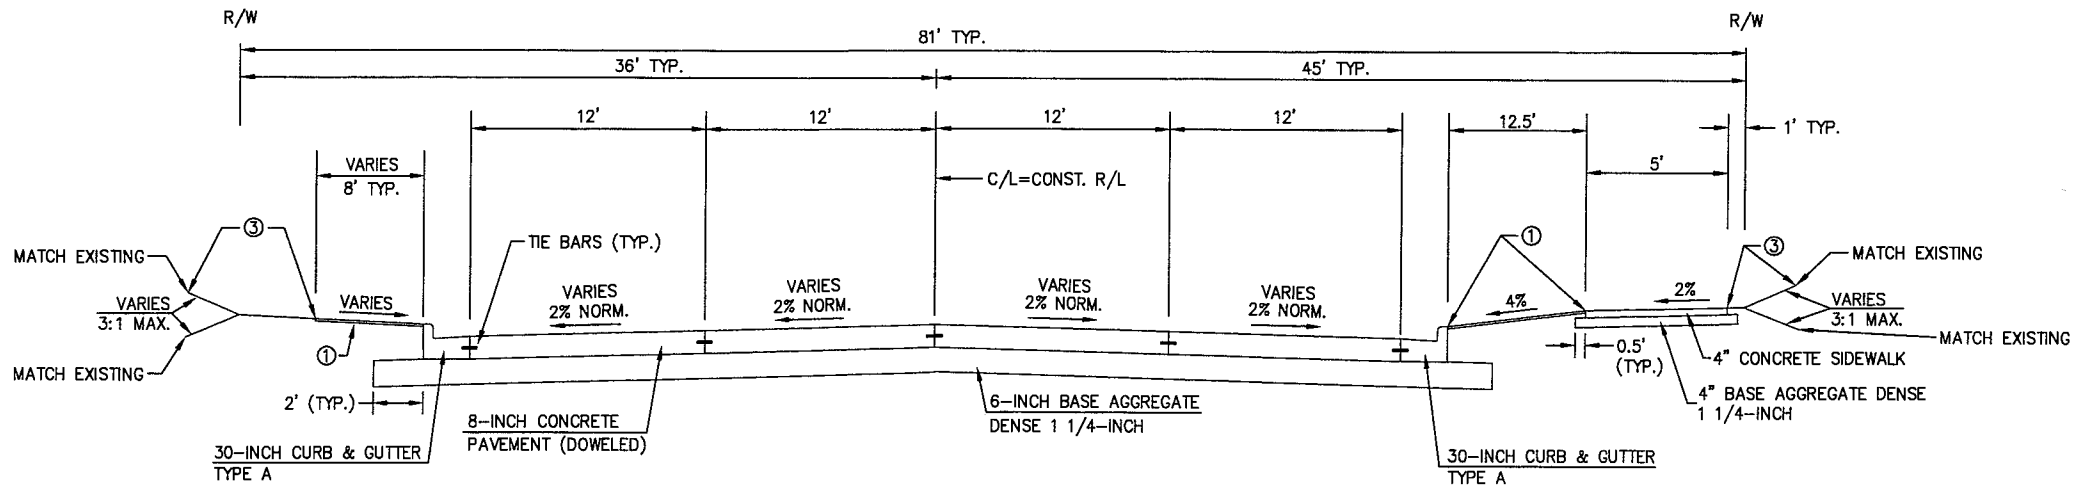

C.T.H. 'Y' PROPOSED TYPICAL SECTION

STA. 205+90.21 - STA. 213+51.55


CROSSING: W:\DMG\W0002\97034\1\00\TYPICAL SECTIONS\TYP PROP.dwg 07/21/08 10:28 AM

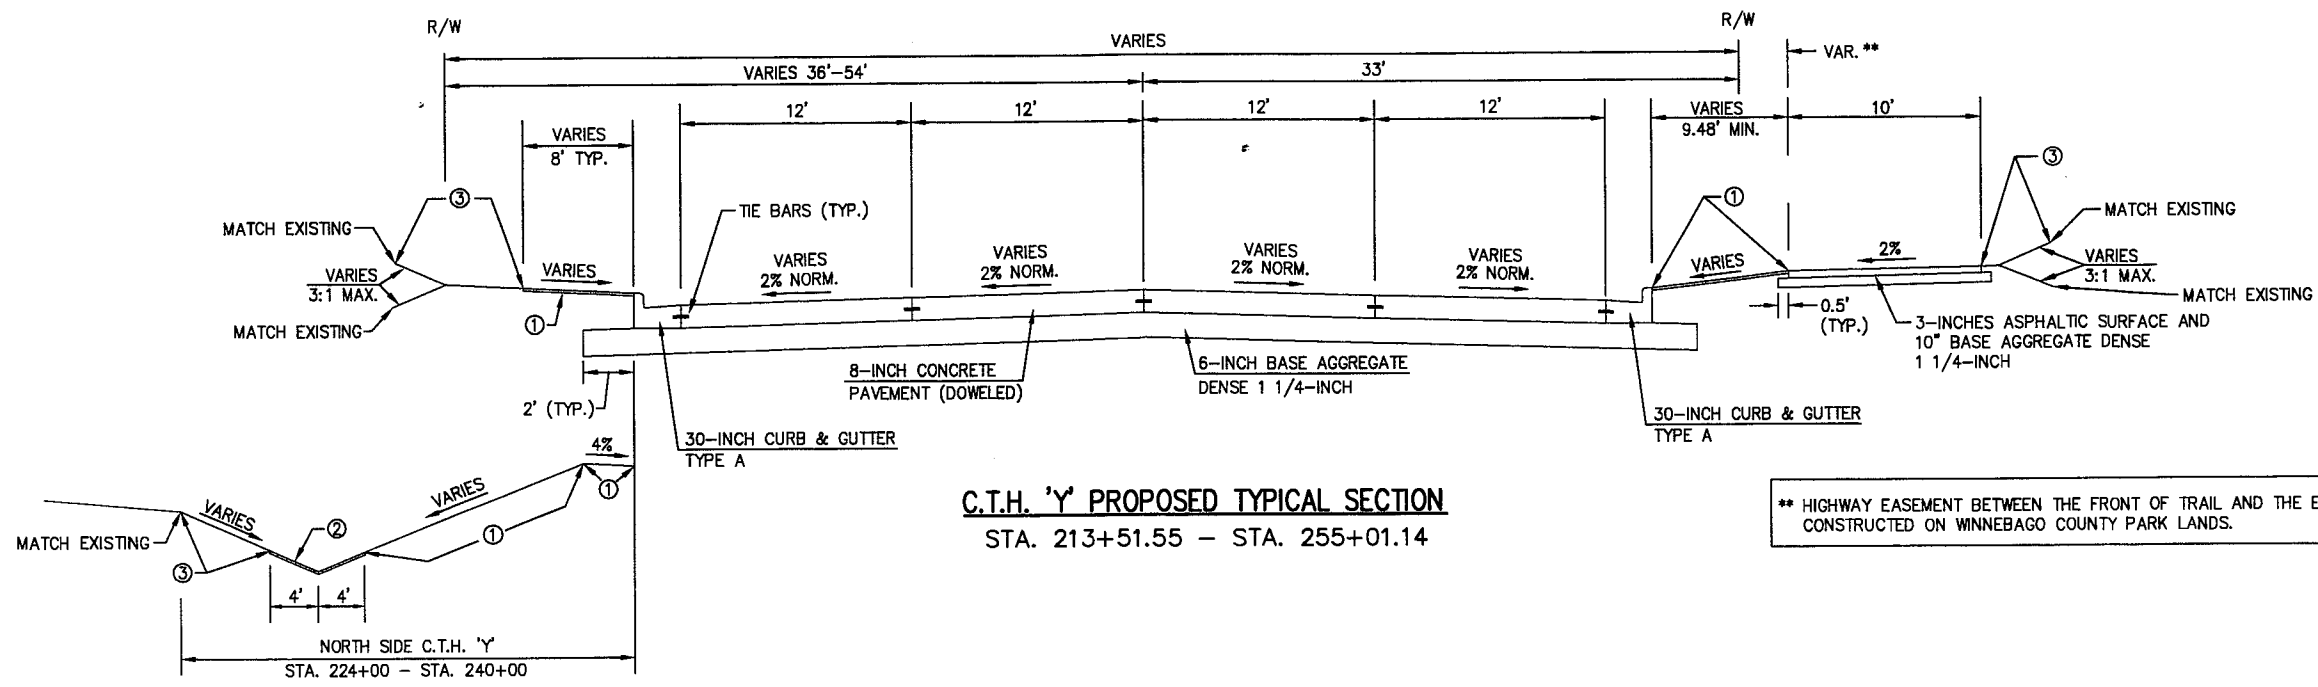

C.T.H. 'Y' PROPOSED TYPICAL SECTION
 STA. 213+51.55 - STA. 255+01.14

** HIGHWAY EASEMENT BETWEEN THE FRONT OF TRAIL AND THE EXISTING R/W. TRAIL TO BE CONSTRUCTED ON WINNEBAGO COUNTY PARK LANDS.

- KEYED NOTES**
- ① TOPSOIL, SEED, FERTILIZER AND E-MAT. CLASS I, TYPE A.
 - ② TOPSOIL, SEED, FERTILIZER AND E-MAT. CLASS I, TYPE B.
 - ③ TOPSOIL, SEED, FERTILIZER AND MULCH.

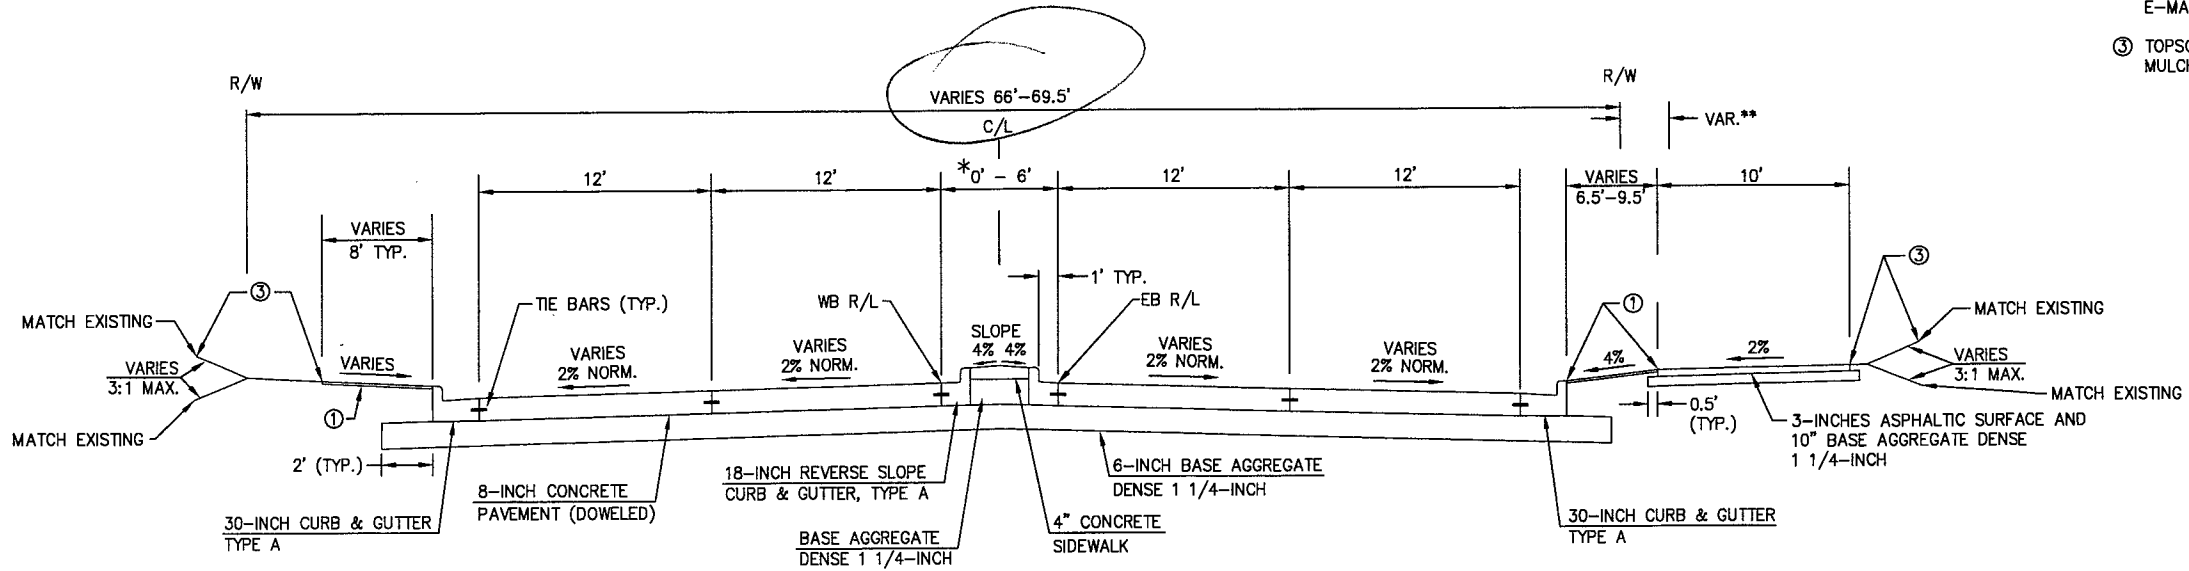

C.T.H. 'Y' PROPOSED TYPICAL SECTION AT CROSSING APPROACHES


STA. 255+01.14 - STA. 258+53.16

*LIMITS OF RAISED MEDIAN ARE STA. 256+01.50 TO STA 256+93.56 AND STA 257+41.48 TO STA 257+97.00

STA. 256+79.07 RT. - STA. 257+44.91 RT. RAILROAD CROSSING TYPICAL SECTION CONSISTS OF 6" HMA TYPE E-10 AND 18" BASE AGGREGATE DENSE 1 1/4-INCH, 6" HMA TO BE CONSTRUCTED IN TWO LAYERS: 1-2 1/4" UPPER LAYER AND 1-3 3/4" LOWER LAYER

STA. 256+90.23 LT. - STA. 257+56.09 LT. RAILROAD CROSSING TYPICAL SECTION CONSISTS OF 6" HMA TYPE E-10 AND 18" BASE AGGREGATE DENSE 1 1/4-INCH, 6" HMA TO BE CONSTRUCTED IN TWO LAYERS: 1-2 1/4" UPPER LAYER AND 1-3 3/4" LOWER LAYER

SECTION TYP. PROP.dwg 07/06/08 12:42 PM

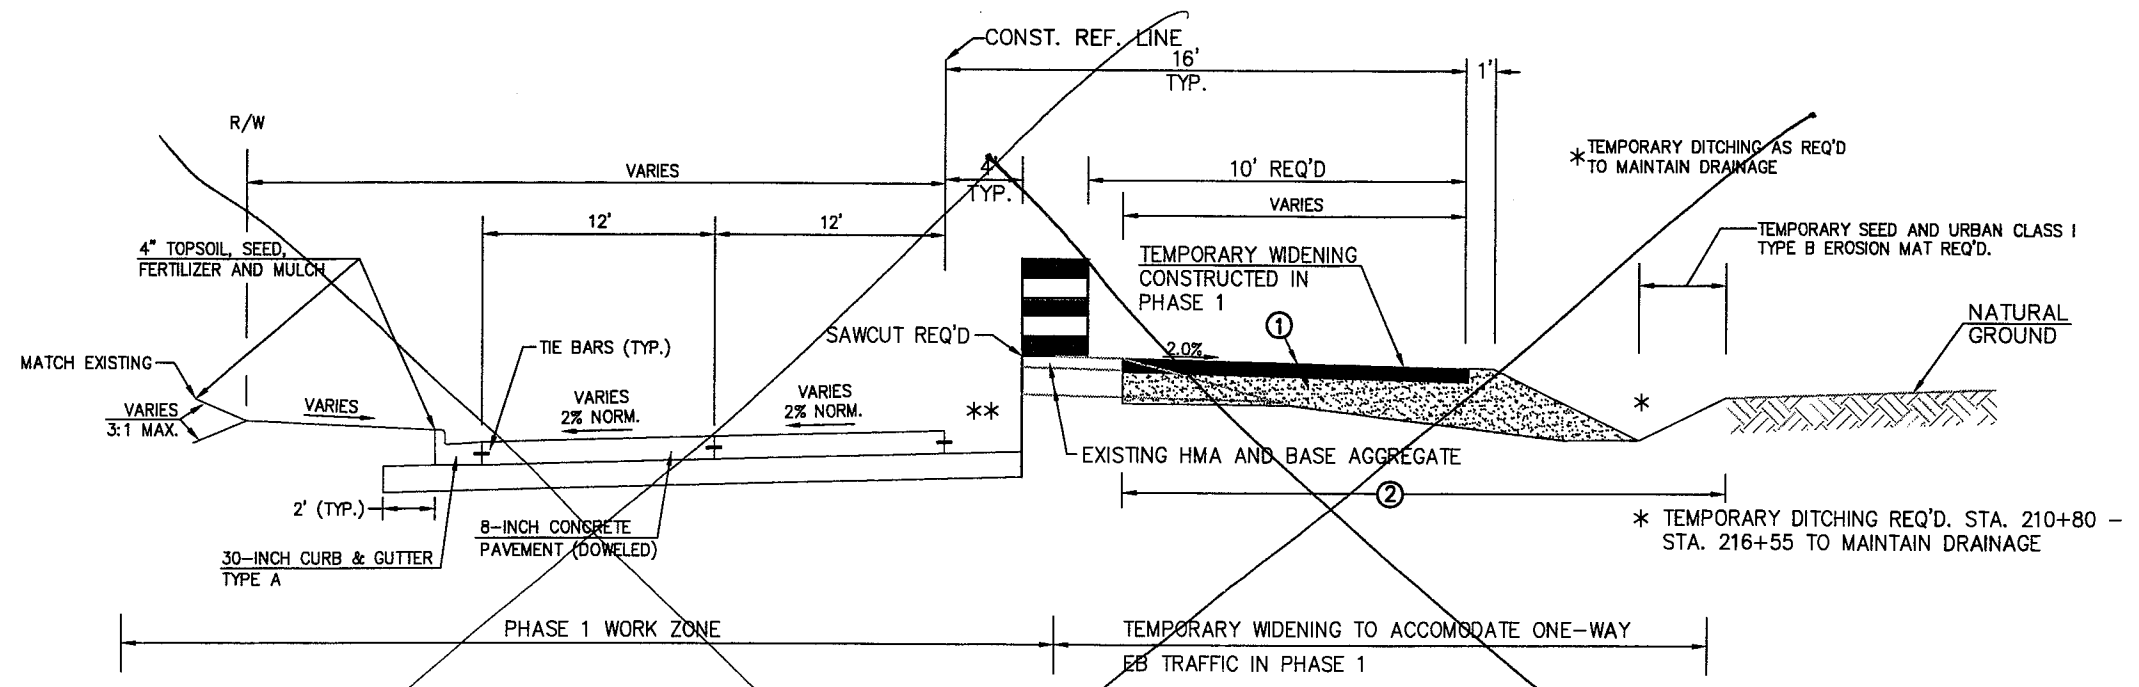

C.T.H.'Y' PROPOSED
TYPICAL SECTIONS ON
SHEETS 6 AND 7.

C.T.H. 'Y' PROPOSED TYPICAL SECTION AND TEMPORARY WIDENING PHASE 1
STA. 200+37.07 - STA. 258+53.16

CONTRACTOR TO VERIFY PROPOSED WIDTH OF WIDENING REQUIRED TO ACCOMMODATE CONSTRUCTION OPERATIONS AND TO MAINTAIN ONE LANE FOR ONE WAY TRAFFIC PRIOR TO CONSTRUCTION. SEE PHASING DIAGRAMS AND TYPICAL SECTIONS TO VERIFY ESTIMATED WIDTHS REQUIRED FOR CONSTRUCTION OPERATIONS.


① WIDEN EXISTING ROADWAY WITH MIN. OF 12-INCHES BASE AGGREGATE DENSE, 1 1/4-INCH AND 3 INCHES ASPHALTIC SURFACE, TEMPORARY TO PROVIDE ONE TRAVEL LANE AS SHOWN IN PHASE 1 TRAFFIC CONTROL DETAILS.

② STRIP ALL TOPSOIL BETWEEN EXISTING EDGE OF PAVEMENT AND PROPOSED MATCH POINT PRIOR TO CONSTRUCTING BASE AGGREGATE DENSE, 1 1/4-INCH. PAYMENT FOR EXCAVATION REQUIRED FOR TEMPORARY ROAD AND TEMPORARY DITCHING WILL BE MEASURED AND PAID FOR AS COMMON EXCAVATION. ENGINEER TO APPROVE SUBGRADE PRIOR TO INSTALLATION OF BASE AGGREGATE DENSE.


TEMP. WIDENING AND
TEMP. DITCHING WAS
ELIMINATED IN CONTRACT
MODIFICATION

170

2

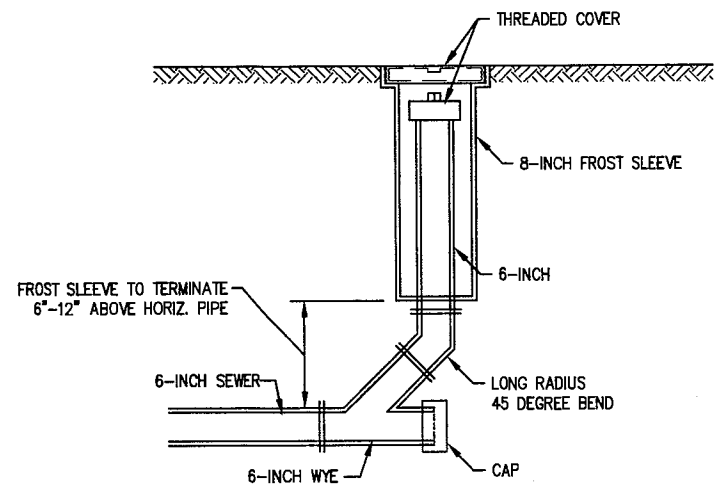


MINI-STORM SEWER CLEANOUT DETAIL

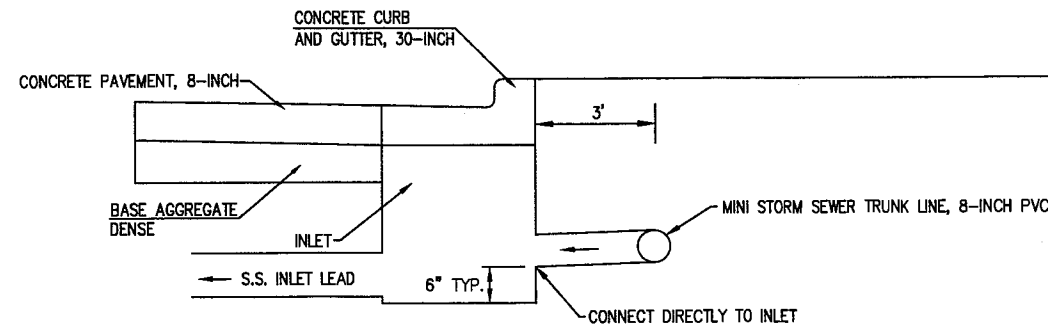

SECTION VIEW


**MINI-STORM SEWER INLET CONNECTION DETAIL
INLET STRUCTURE 19A**

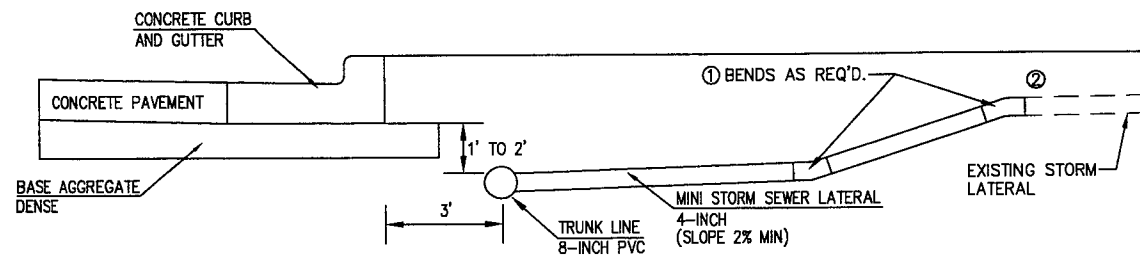


SECTION VIEW

- ① ANY BEND REQ'D. TO MAKE THE CONNECTION TO EXISTING STORM LATERALS WILL BE CONSIDERED INCIDENTAL TO THE ITEM OF MINI-STORM SEWER, 4-INCH.
- ② EXACT LIMITS OF REMOVAL OF EXISTING STORM LATERALS REQ'D. TO MAKE CONNECTION WILL BE DETERMINED BY THE ENGINEER. PAYMENT FOR THIS WORK TO BE CONSIDERED INCIDENTAL TO THE ITEM OF MINI-STORM SEWER, 4-INCH.


**MINI-STORM SEWER LATERAL DETAIL
LATERALS CONNECTED TO EXISTING STORM LATERALS
CTH Y STA. 221+23 LT. STA. 221+58 LT. & 222+06 LT.**

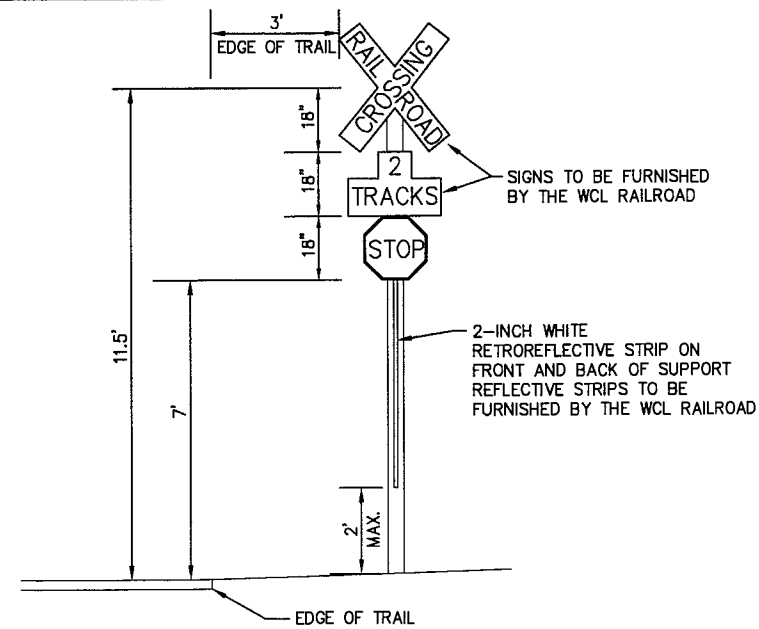

**SIGN MOUNTING DETAIL FOR AT GRADE
CROSSING OF THE RECREATION TRAIL AND
THE WCL RAILROAD**

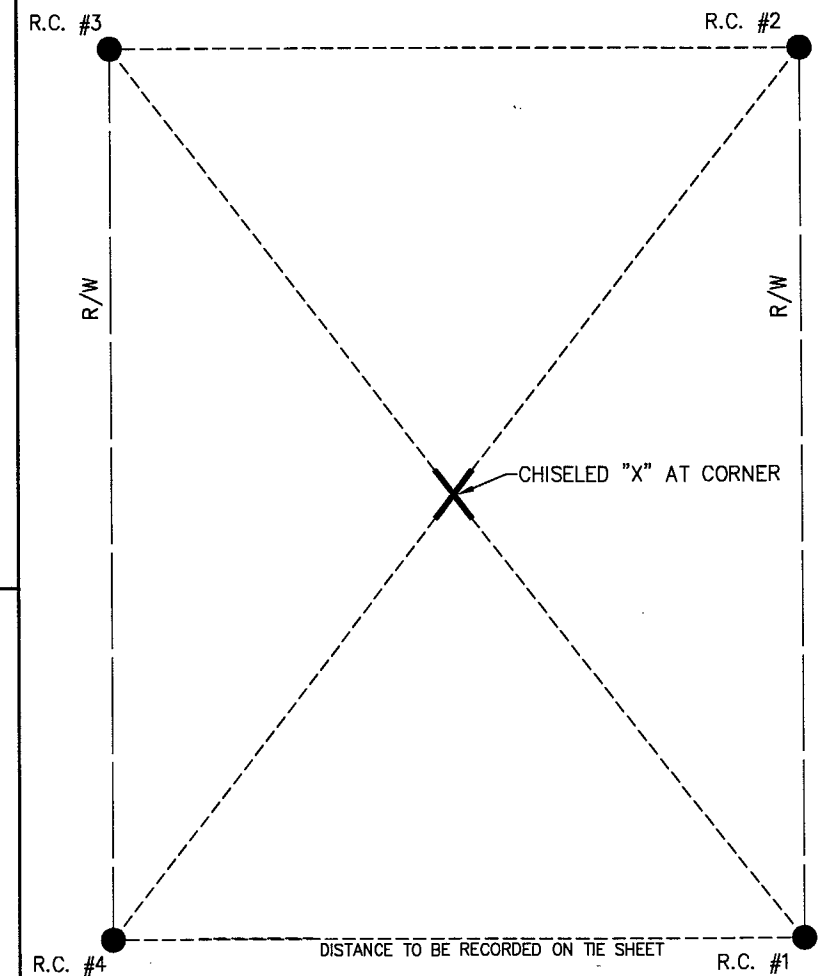


LANDMARK REFERENCE MONUMENT, SPECIAL

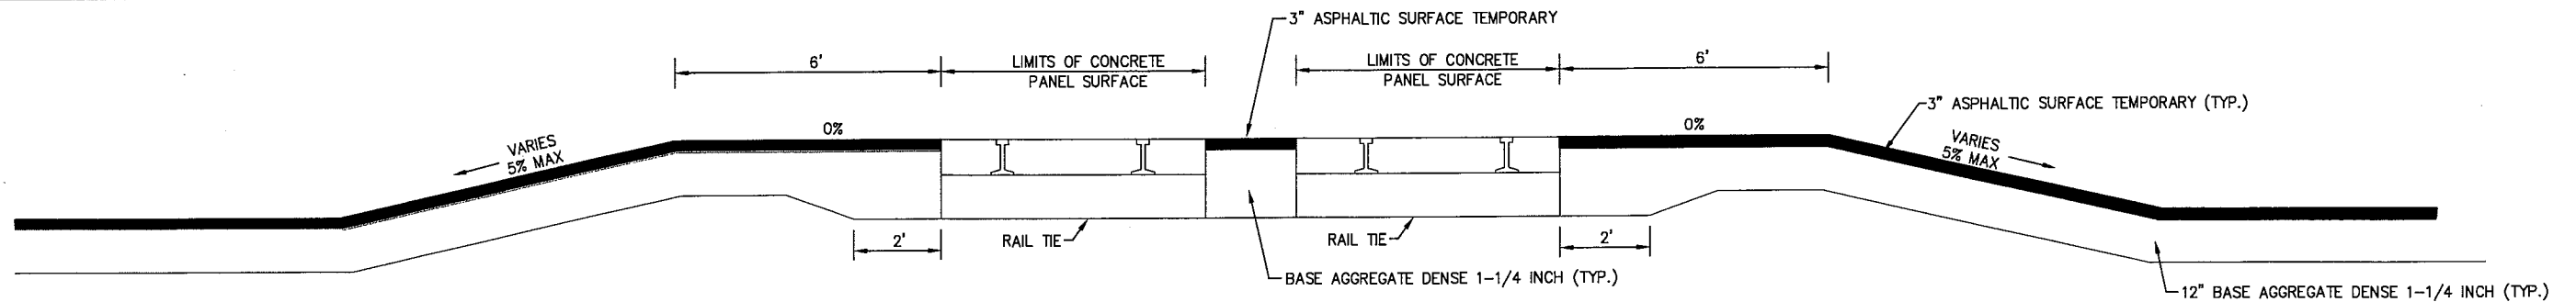


TEMPORARY ASPHALT RAMP AT NEW CONCRETE PANEL SURFACE (CTH Y CROSSING)
NOTE - WIDTH OF RAMP TO VARY IN ACCORDANCE WITH TRAFFIC STAGING AND CONSTRUCTION OPERATIONS


C:\DWG\W002\970543\00\DETAILS - INSTRUCTION\DETAILS\MISC\DETAIL - 01.dwg 19/07/20 9:42 AM

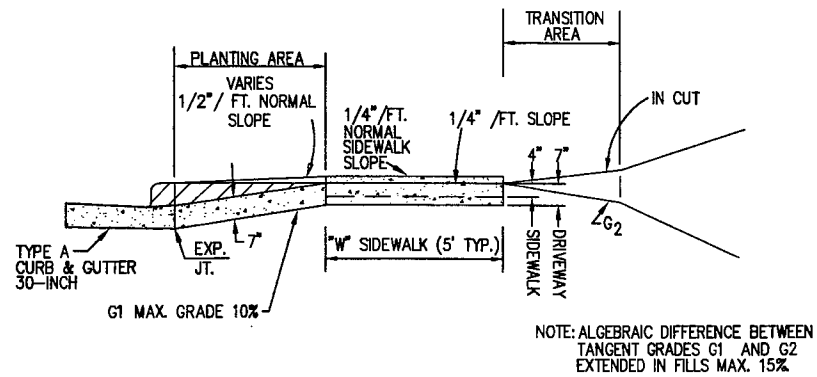

PROFILE PARALLEL TO C/L OF DRIVEWAY

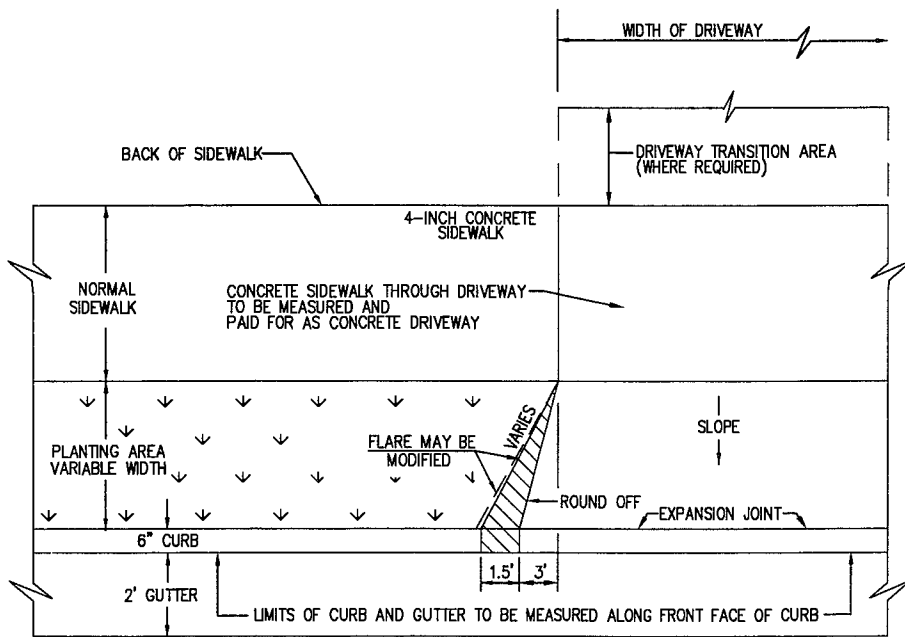


PLAN
CONCRETE DRIVEWAY DETAIL

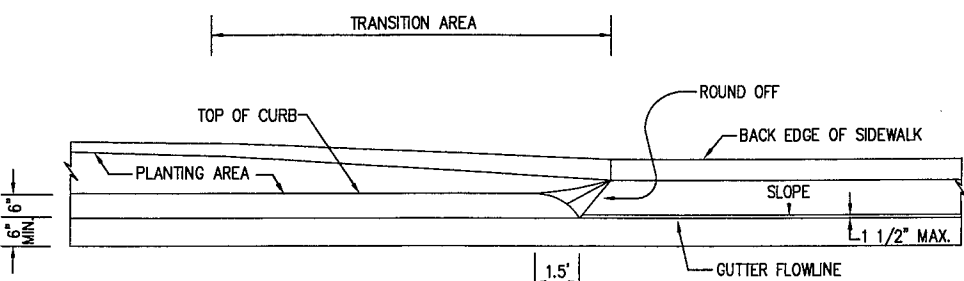


PROFILE PARALLEL TO CENTERLINE OF ROADWAY


DRIVEWAY DETAIL STA. 200+37.07 RT. - 213+51.31 RT.,
WITH 5' CONCRETE SIDEWALK

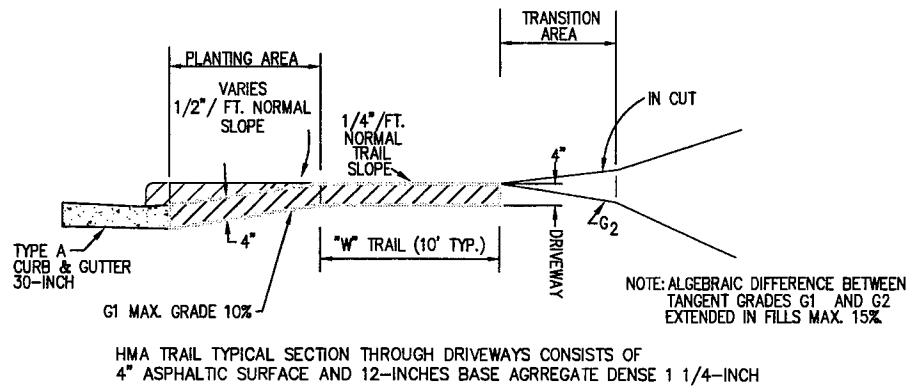

PROFILE PARALLEL TO C/L OF DRIVEWAY

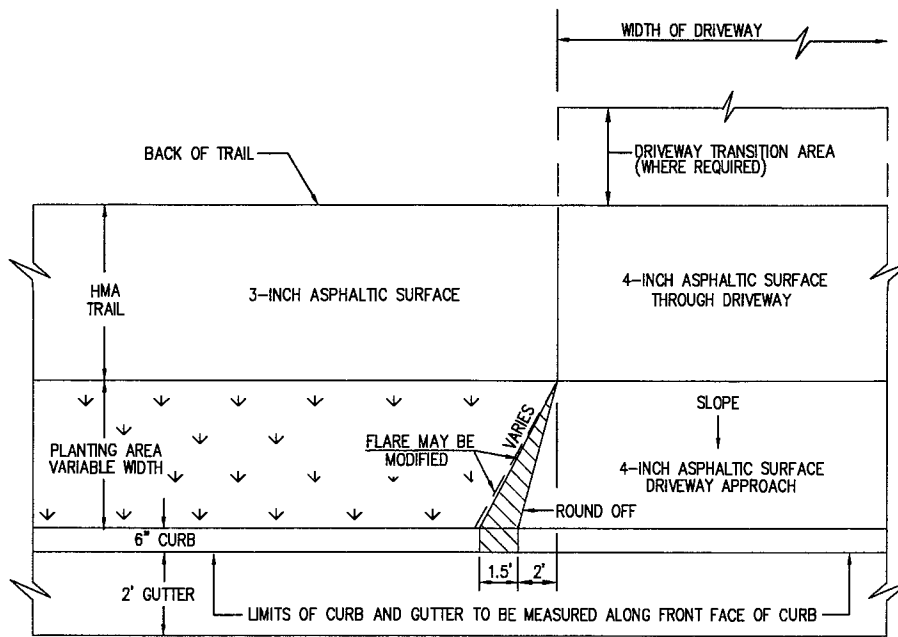


PLAN
HMA DRIVEWAY DETAIL

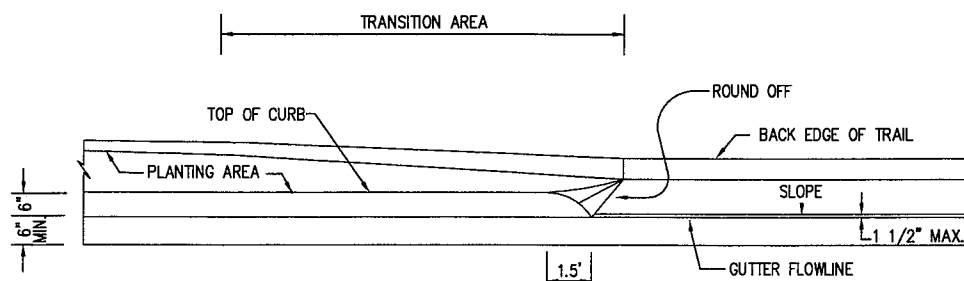


PROFILE PARALLEL TO CENTERLINE OF ROADWAY

DRIVEWAY DETAIL STA. 213+51.31 RT. - 258+53.16 RT.,
WITH 10' ASPHALT TRAIL

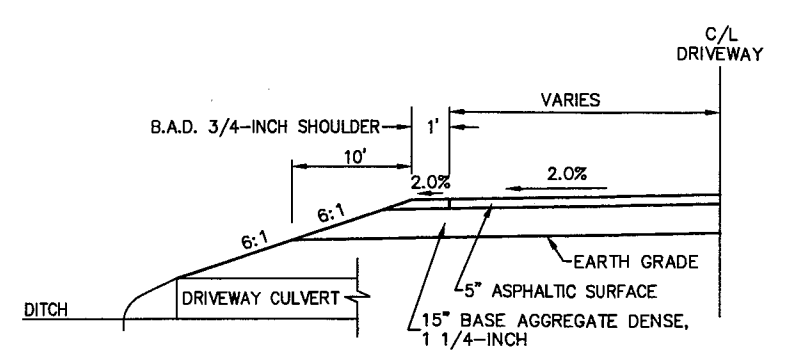

5" ASPHALTIC SURFACE TO BE CONSTRUCTED IN TWO LIFTS,
2-INCH UPPER LAYER AND 3-INCH LOWER LAYER.

1/2 TYPICAL RURAL DRIVEWAY CROSS SECTION (IN CUT)

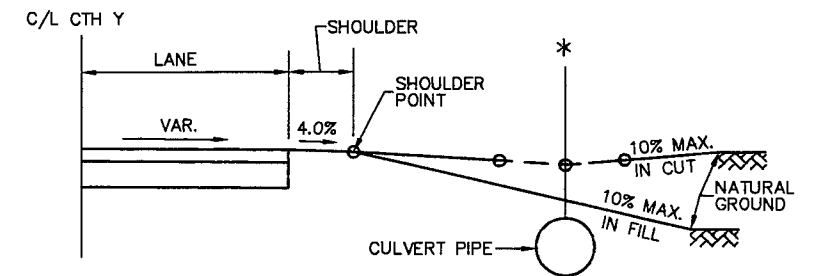

* IN CUT, PLACE THE LOW POINT
OF THE DRIVEWAY OVER THE
NORMAL DITCH LINE

TYPICAL RURAL DRIVEWAY PROFILE

C.T.H. Y
STA. 196+00 LT. AND STA. 196+50 RT.

GENERAL NOTES FOR DRIVEWAYS

MATERIALS FOR DRIVEWAY TRANSITION AREAS TO BE
SAME AS EXISTING.

FOR ASPHALTIC DRIVEWAYS USE 12" BASE AGGREGATE DENSE,
1 1/4-INCH AND 4" ASPHALTIC SURFACE, (PROJECT NUMBER 4994-00-87).
ASPHALTIC SURFACE TO BE CONSTRUCTED IN TWO LIFTS, 2-INCH
UPPER AND 2-INCH LOWER.



FOR ASPHALTIC DRIVEWAYS USE 15" BASE AGGREGATE DENSE,
1 1/4-INCH AND 5" ASPHALTIC SURFACE, (PROJECT NUMBER 6432-11-71).
ASPHALTIC SURFACE TO BE CONSTRUCTED IN TWO LIFTS, 2-INCH
UPPER AND 3-INCH LOWER.

EXISTING AGGREGATE DRIVEWAYS SHALL BE PAVED WITH ASPHALTIC
SURFACE TO THE R/W.



FOR CONCRETE DRIVEWAYS, USE 7" OF CONCRETE AND 6" BASE
AGGREGATE DENSE 1 1/4-INCH.

LENGTH OF TRANSITION AREA TO BE DETERMINED BY THE ENGINEER.

MATCH EXISTING WIDTH OF RESIDENTIAL AND COMMERCIAL DRIVEWAYS AT THE R/W.

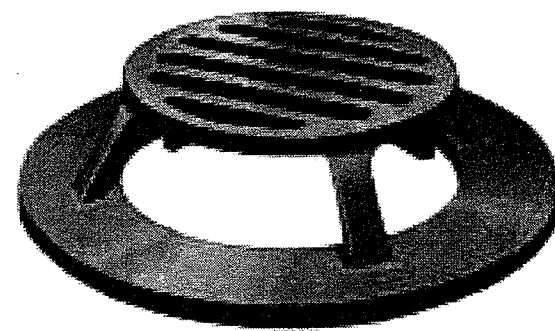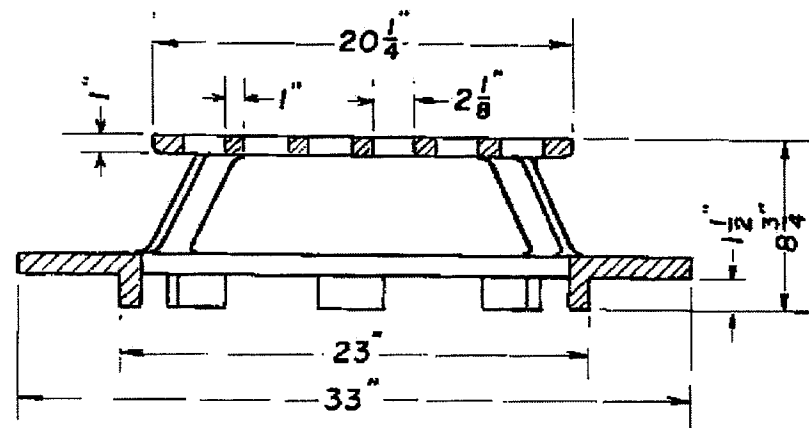


INLET COVER, TYPE A SPECIAL
WEIGHT = 219 LBS.

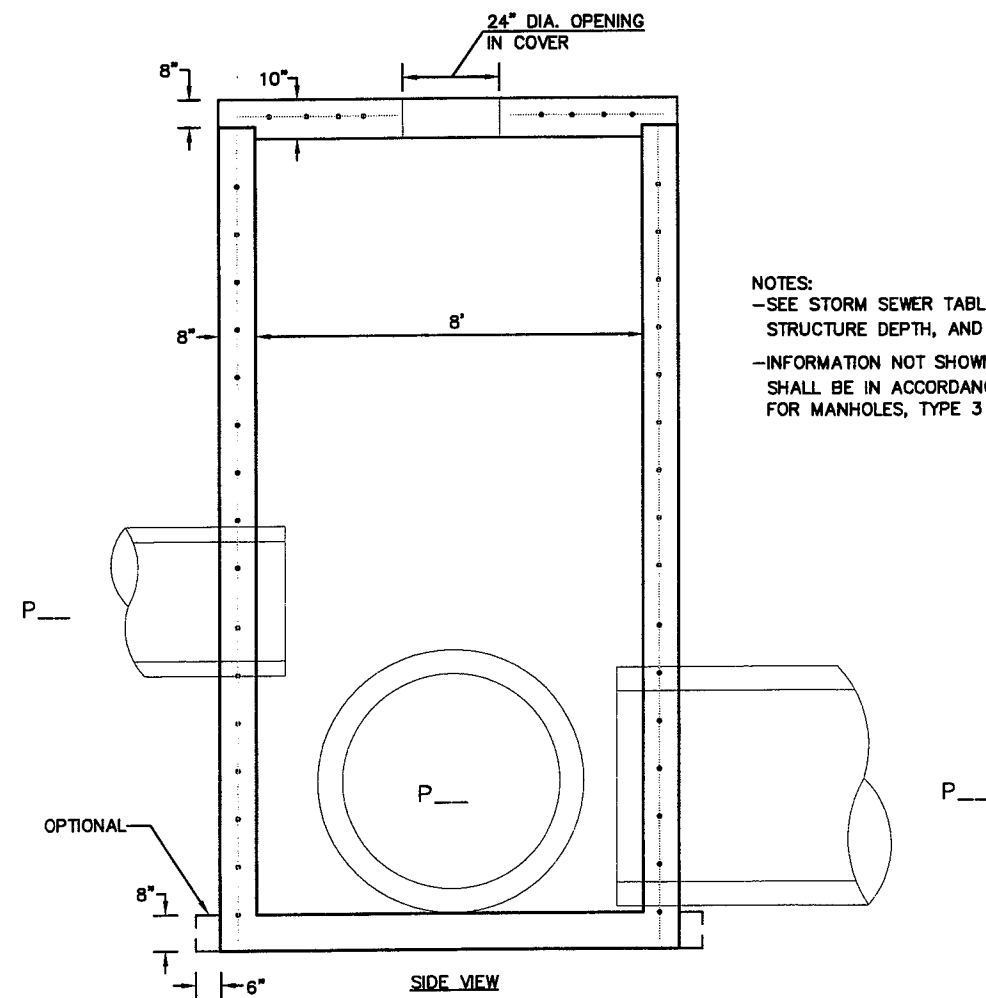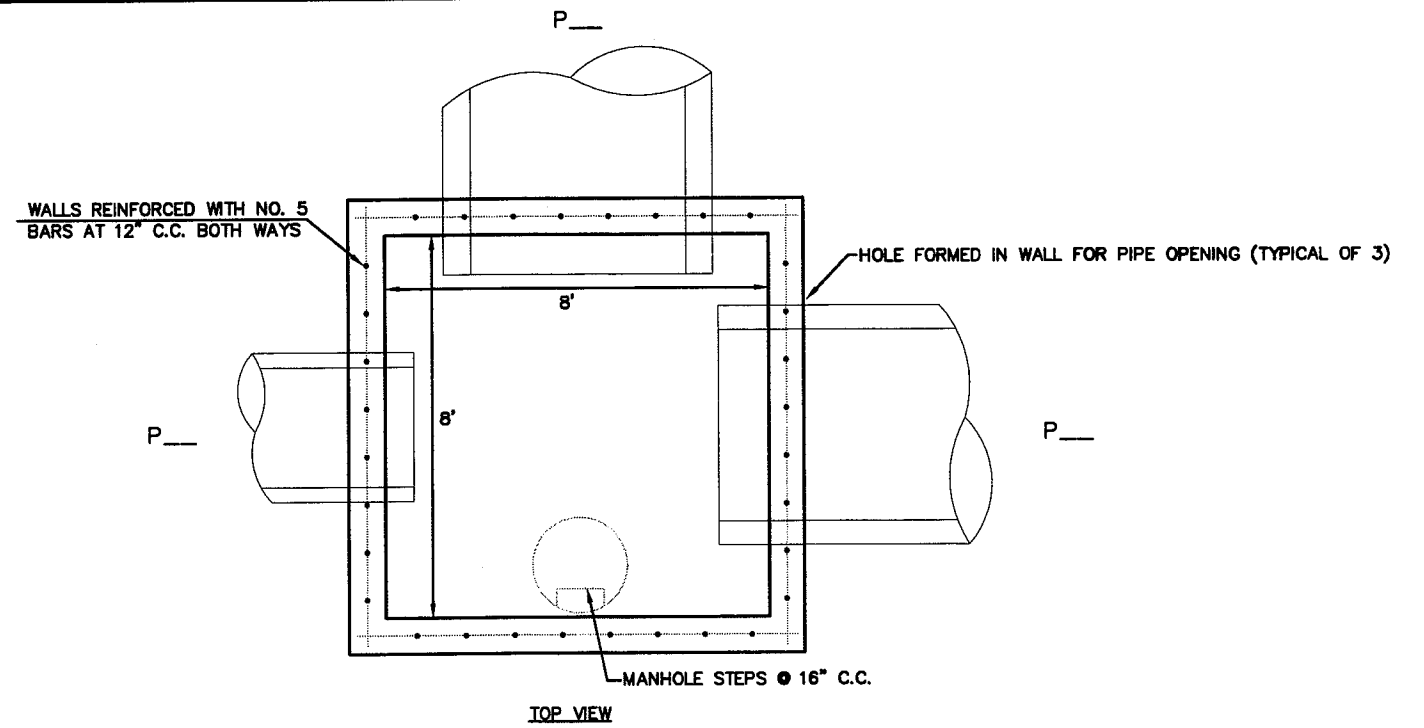


NOTES:
 -SEE STORM SEWER TABLES FOR INVERT ELEVATIONS, STRUCTURE DEPTH, AND PIPE SIZES
 -INFORMATION NOT SHOWN ON THIS DETAIL SHALL BE IN ACCORDANCE WITH THE S.D.D. FOR MANHOLES, TYPE 3

BOX MANHOLE


W:\DWG\WOODS\970341\CONSTRUCTION DETAILS\INLET COVER.dwg, 07/29/08, 9:17 AM

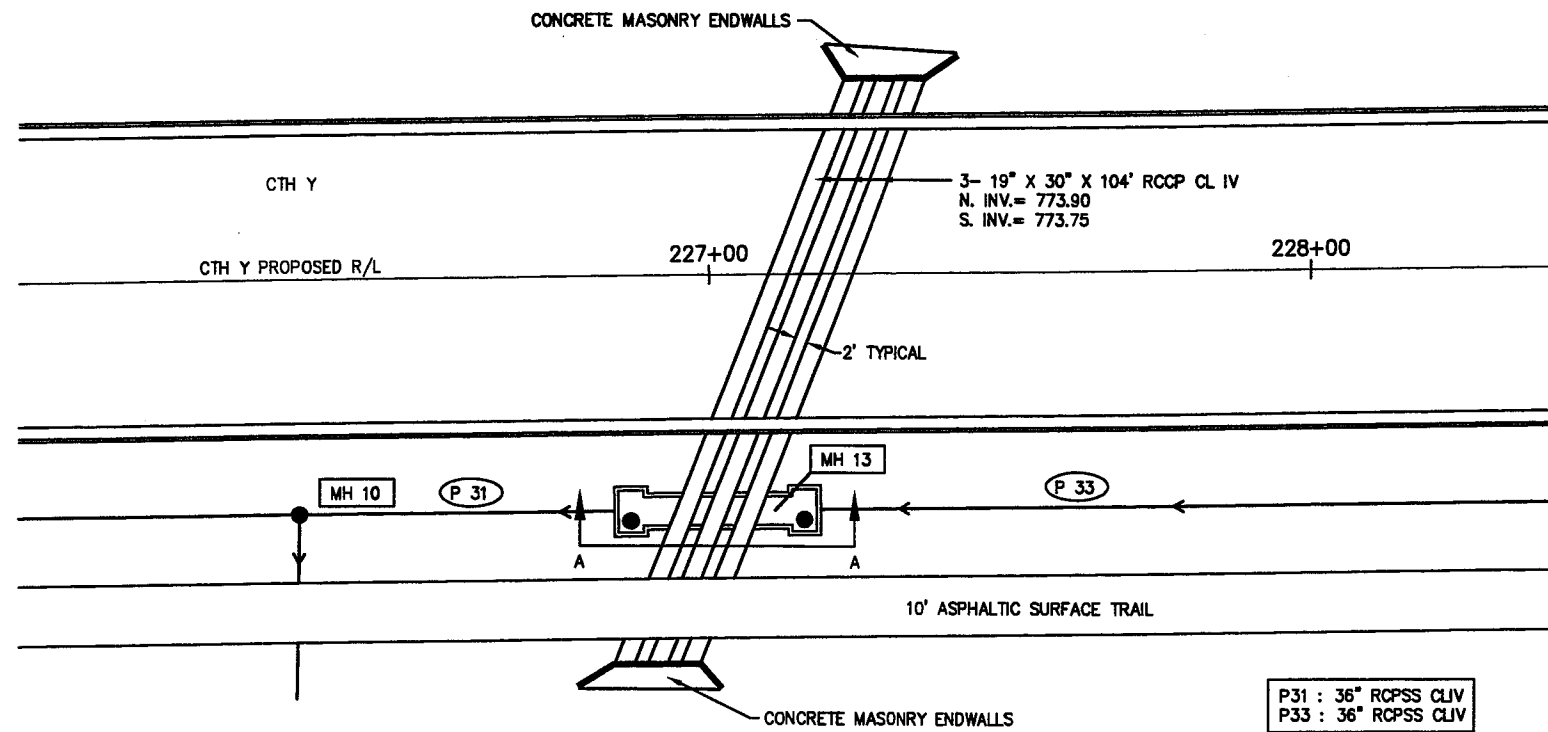

STORM SEWER MH13



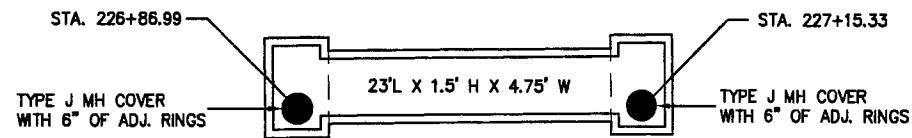



MH 13 PLAN VIEW

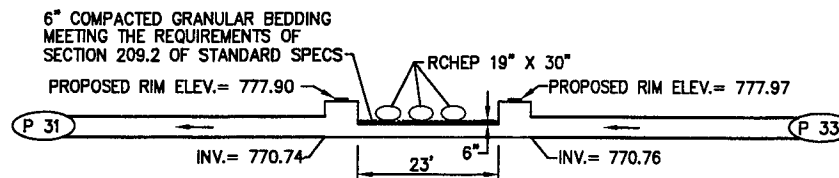


SECTION A-A

w:\dms\w0002\970343\00\DETAILS\CONSTRUCTION\DETAILS\WISC DETAIL -01.dwg 04/28/08 11:59 AM

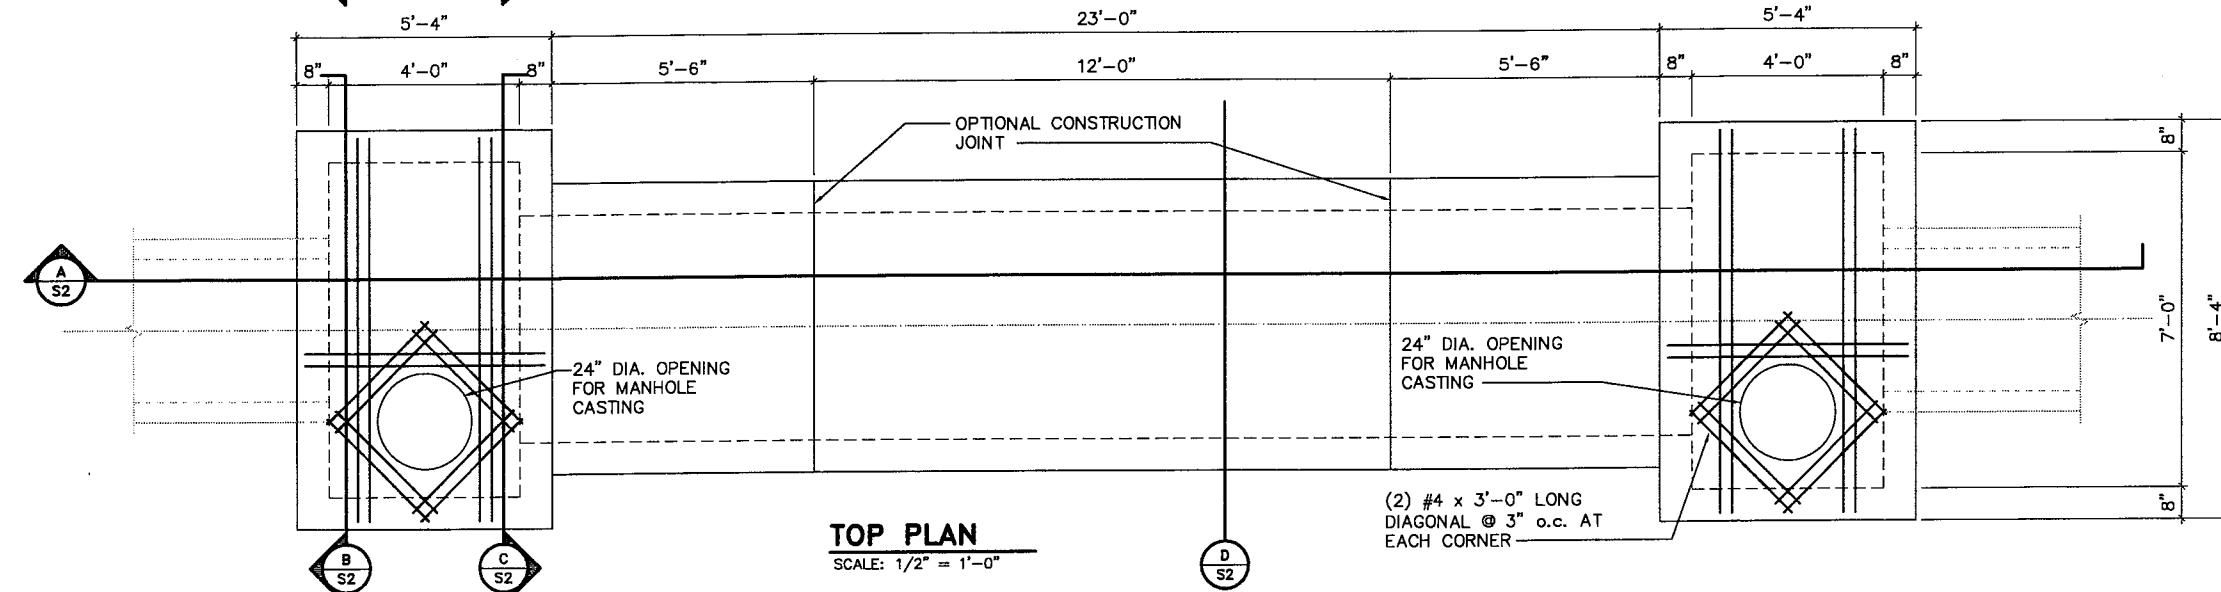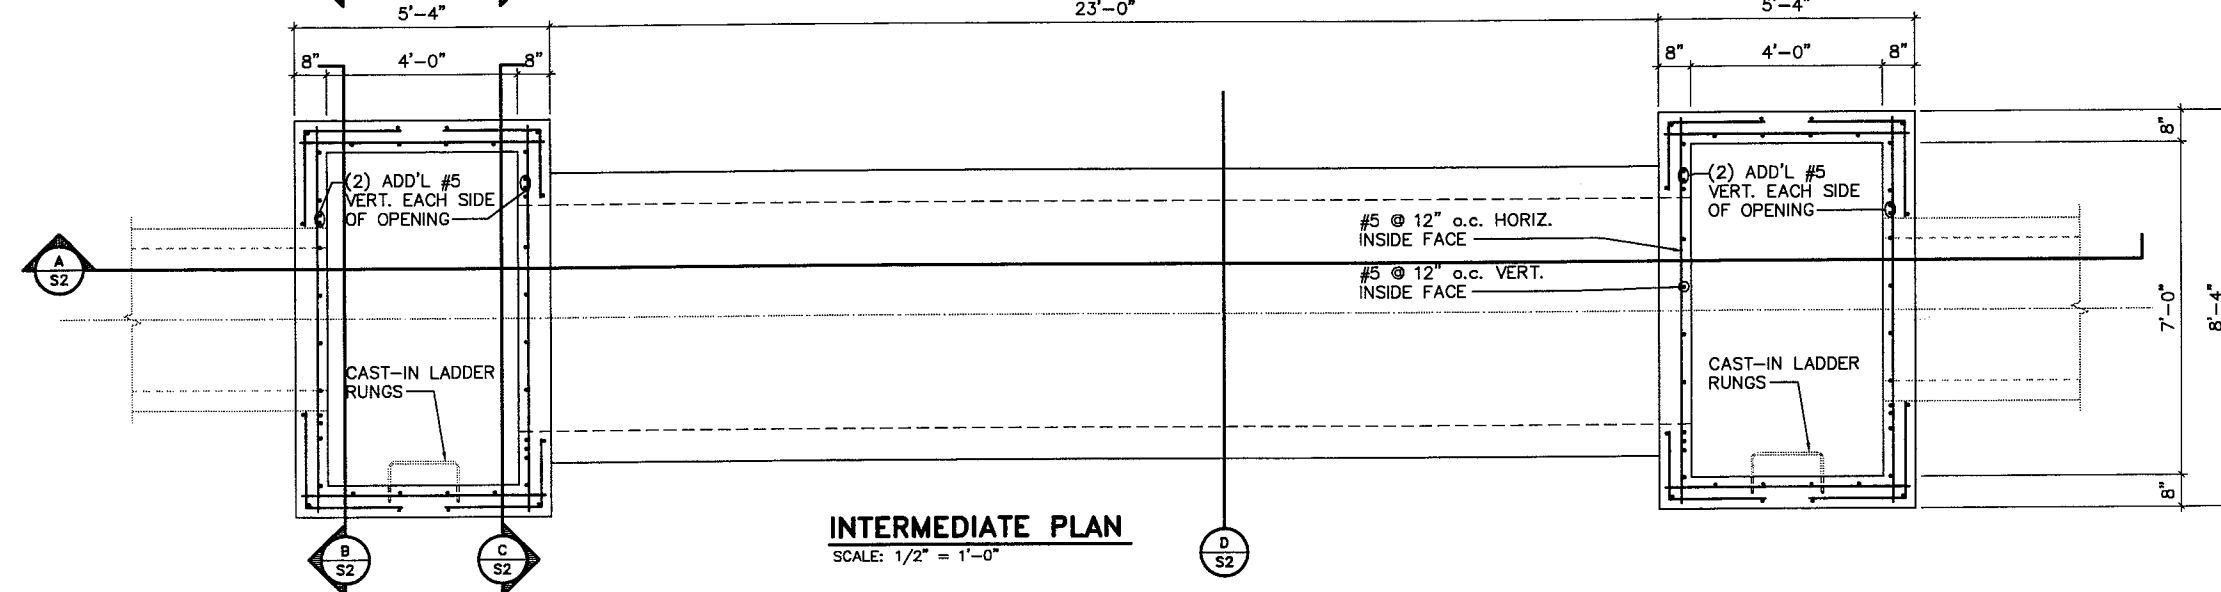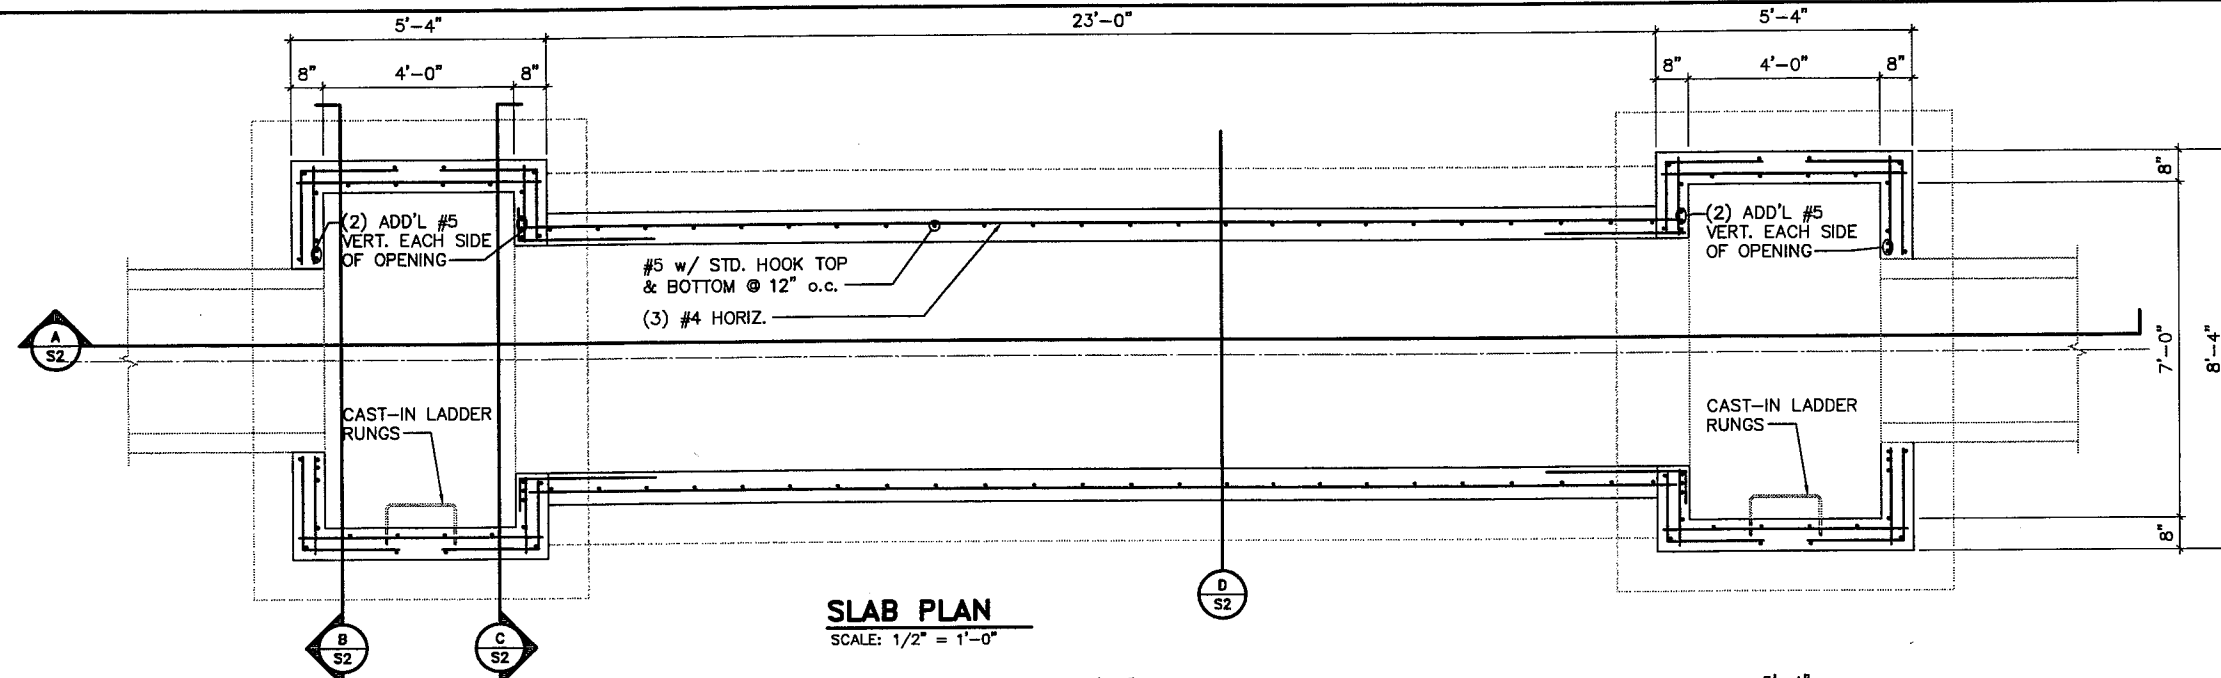


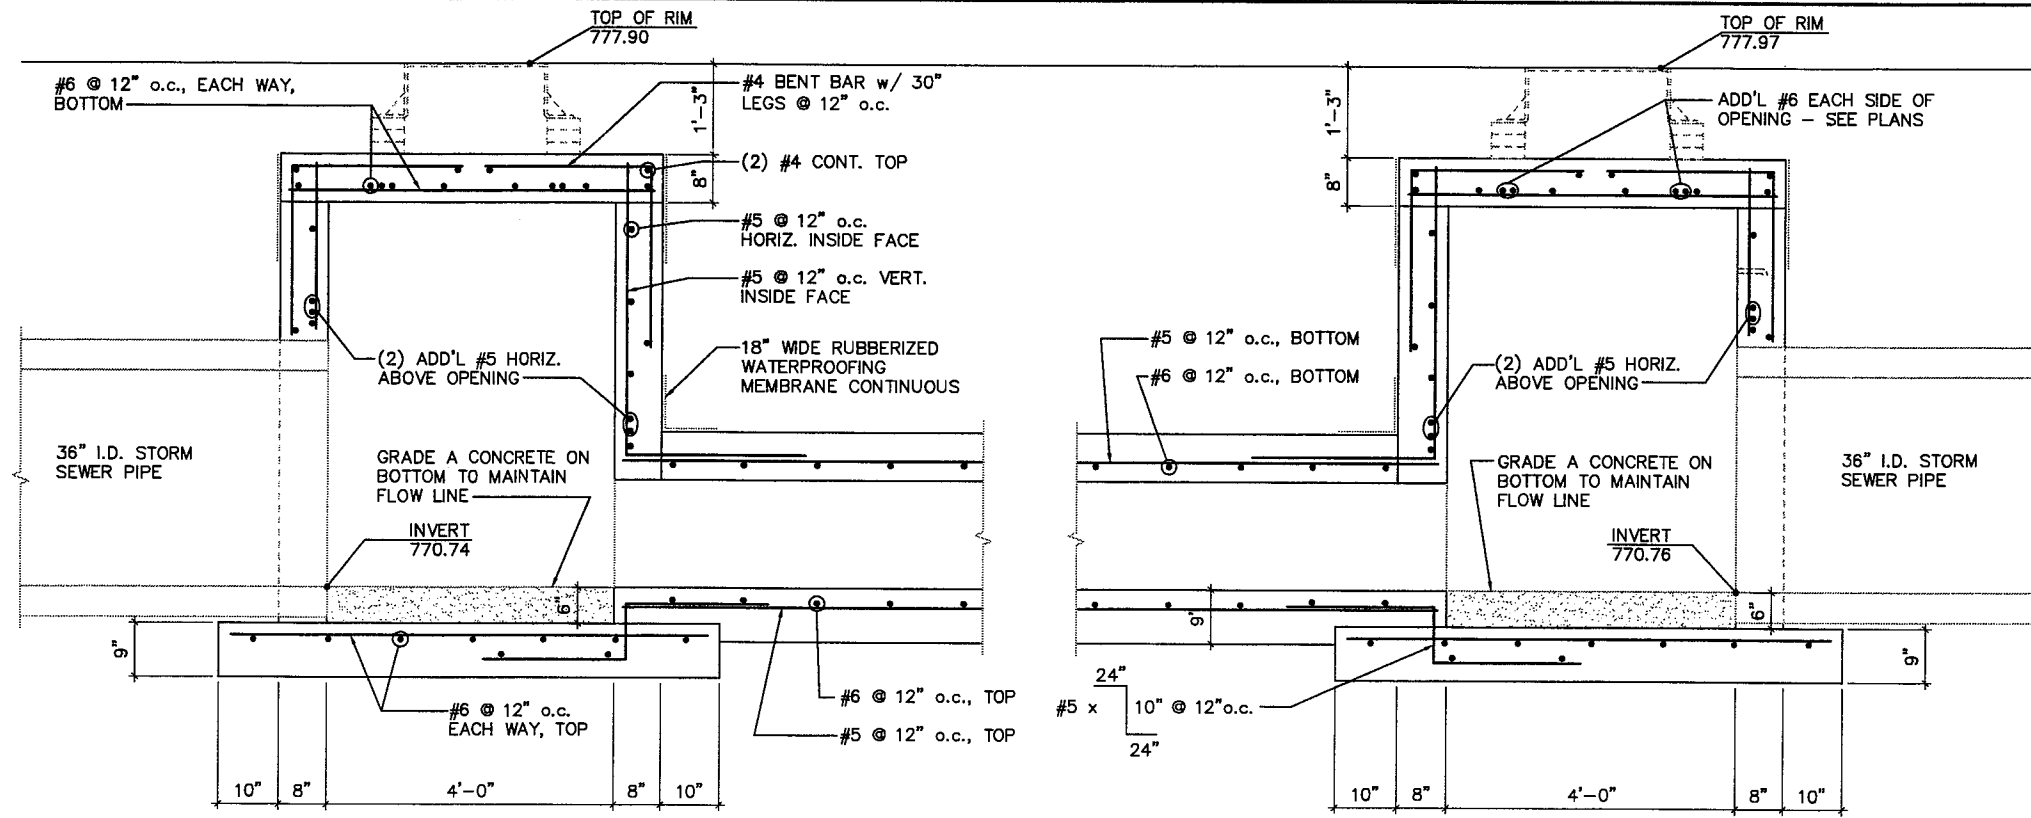


SECTION (LOOKING NORTH)
SCALE: 3/4" = 1'-0"

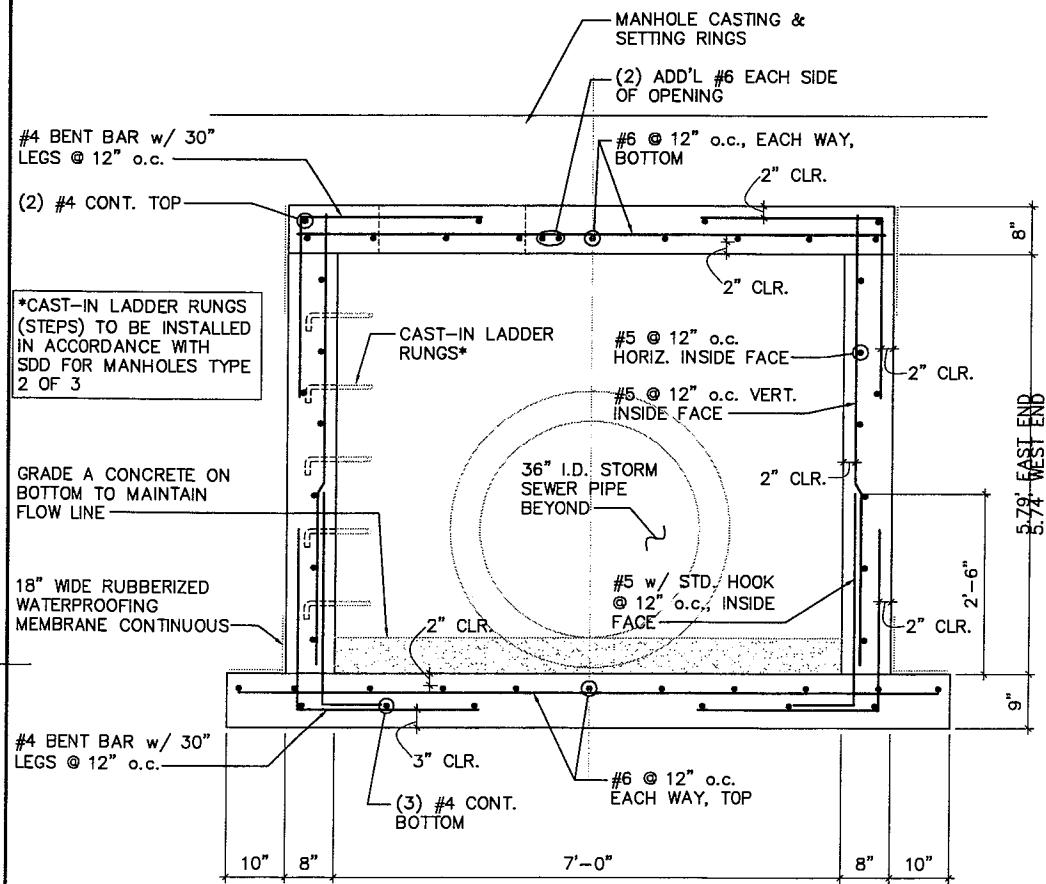

SECTION B
SCALE: 3/4" = 1'-0"

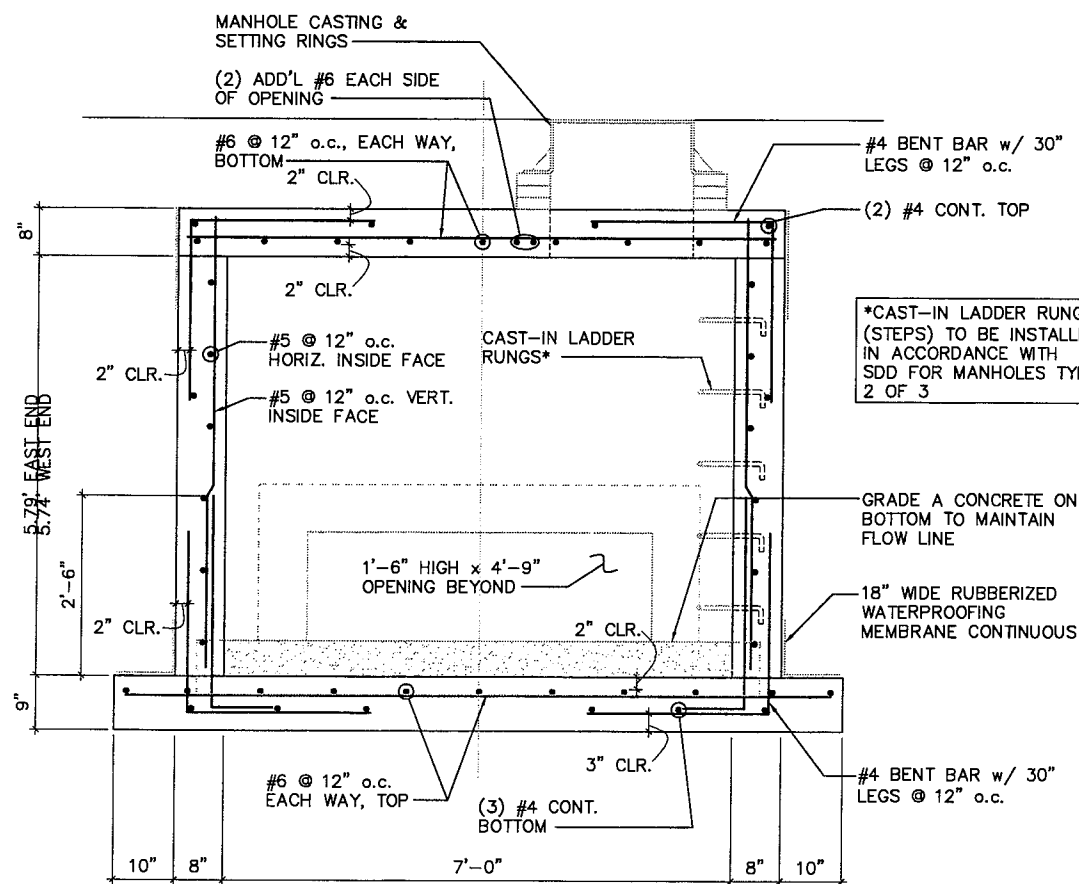



SECTION C
SCALE: 3/4" = 1'-0"

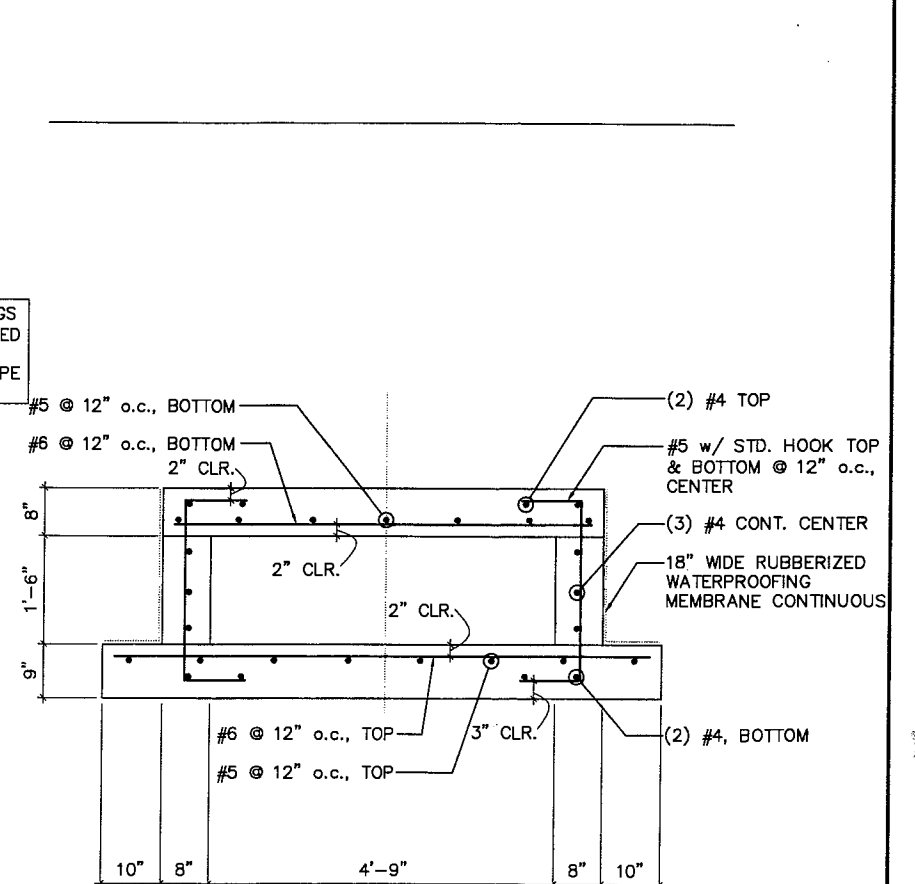

SECTION D
SCALE: 3/4" = 1'-0"

REFER TO PLAN AND PROFILE AND CONSTRUCTION DETAIL SHEETS FOR LOCATIONS OF MANHOLES, INLETS AND OTHER APPURTENANCES LOCATED WITHIN THE PAVEMENT LIMITS

NOTE:
MATCH EXISTING ASPHALTIC PAVEMENT
AND BASE AGGREGATE DENSE SHOULDER
WIDTHS AT MATCH POINT

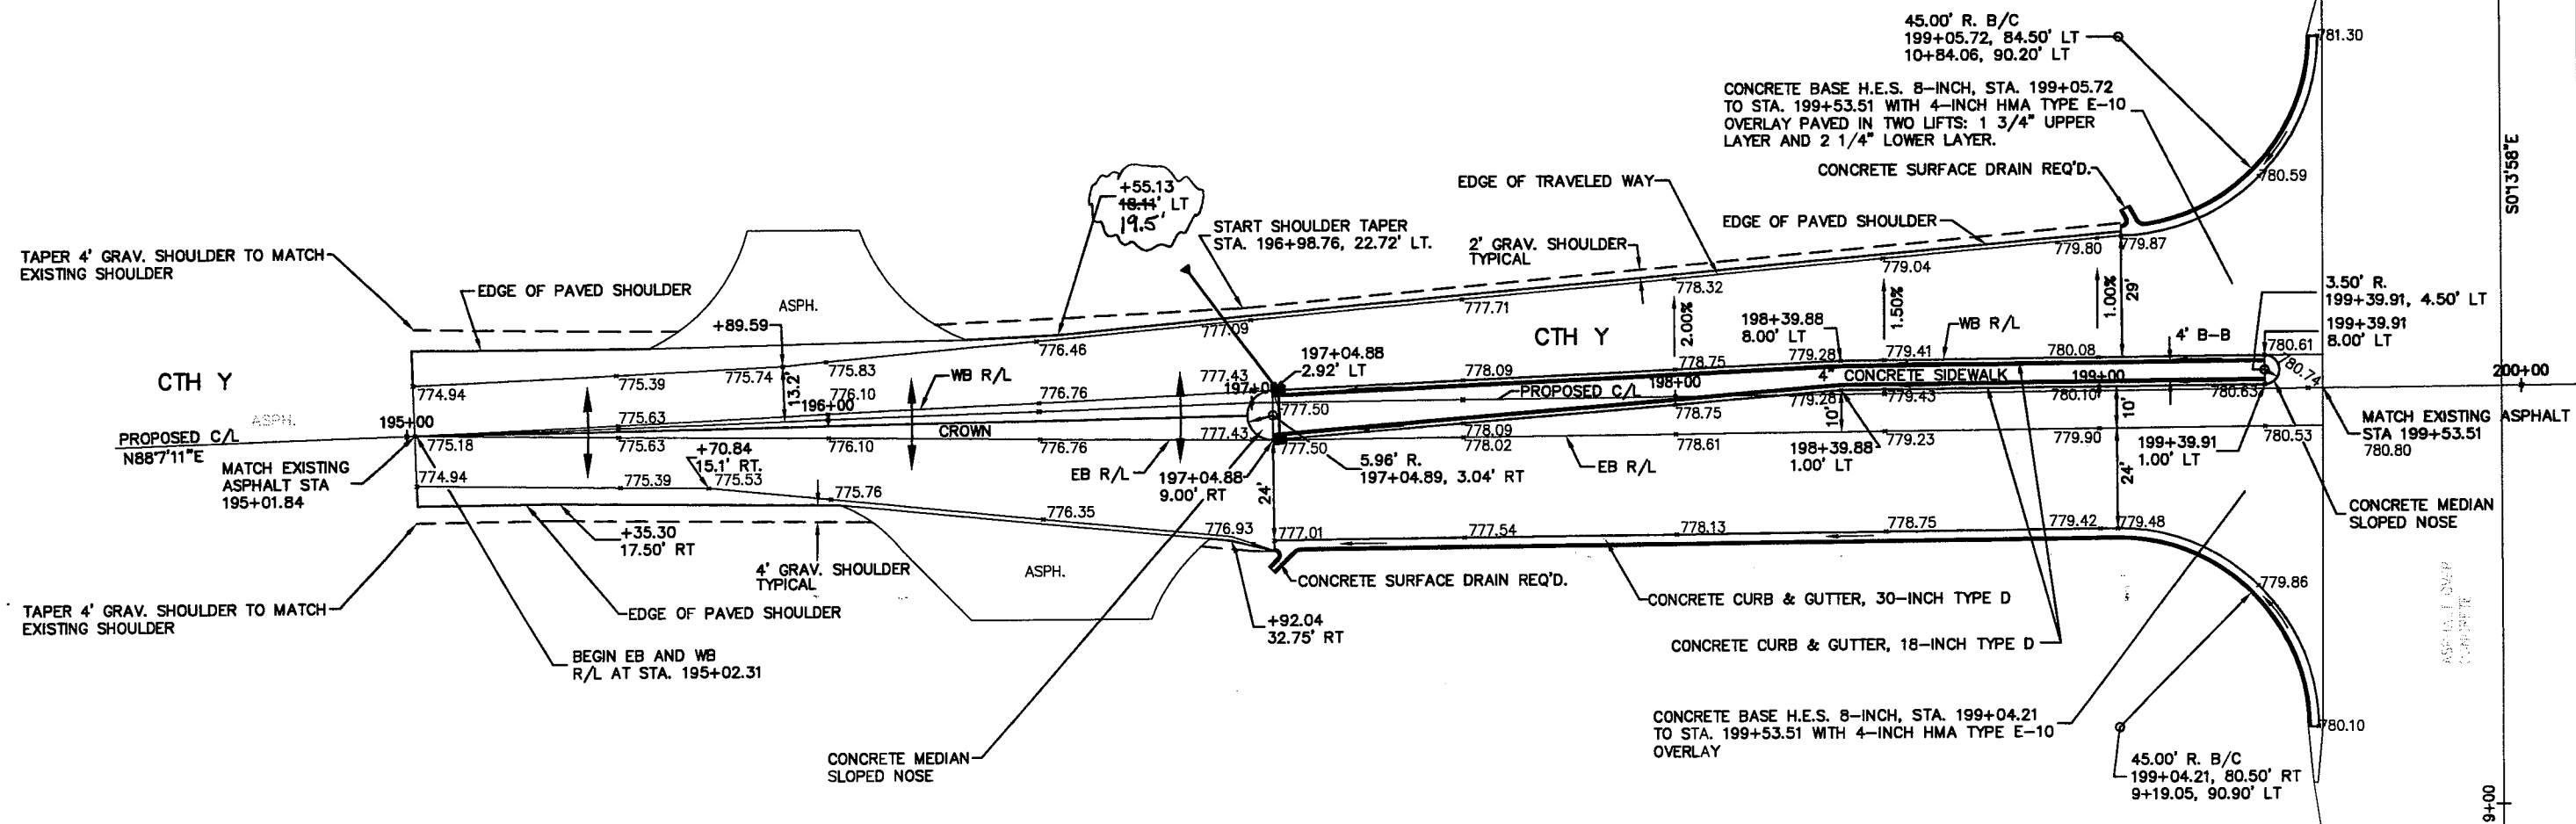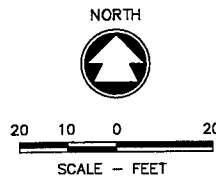

SPOT ELEVATIONS SHOWN ARE FINISHED GRADES AT THE CONSTRUCTION R/L, EB AND WB EDGE OF TRAVELED WAY AND EDGE OF PAVEMENT. SPOT ELEVATIONS ARE LOCATED AT 50' INTERVALS PI'S, PVC'S, C/L - C/L'S, MATCH POINTS, MID POINT OF RADIUS AND AT INLET LOCATIONS.

SPOT ELEVATIONS ON SIDEROAD CENTERLINE ALIGNMENT ARE LOCATED AT 50' INTERVALS, MATCH POINTS, 24' OFF OF MAINLINE C/L, END OF RADIUS, AND EOP. CONTRACTOR IS TO VERIFY MATCH POINT GRADES PRIOR TO GRADING AND PAVING OPERATIONS.

SIDEROAD LONGITUDINAL JOINTS NOT SHOWN ON THIS DETAIL TO BE CONSTRUCTED AT 11' FROM C/L FOR 36' OR GREATER F-F WIDTHS AND 10' FROM C/L ON LESS THAN 36' F-F WIDTHS.



ALL RADIUS DIMENSIONS SHOWN FOR CURB AND GUTTER CONSTRUCTION ARE TO BACK OF CURB

04/22/08 11:25 AM (X-C) Y. FINAL ROW-COMPS (REV)

STH 76 - JACKSON ST.

STH 76 - JACKSON ST.

REFER TO PLAN AND PROFILE AND CONSTRUCTION DETAIL SHEETS FOR LOCATIONS OF MANHOLES, INLETS AND OTHER APPURTENANCES LOCATED WITHIN THE PAVEMENT LIMITS

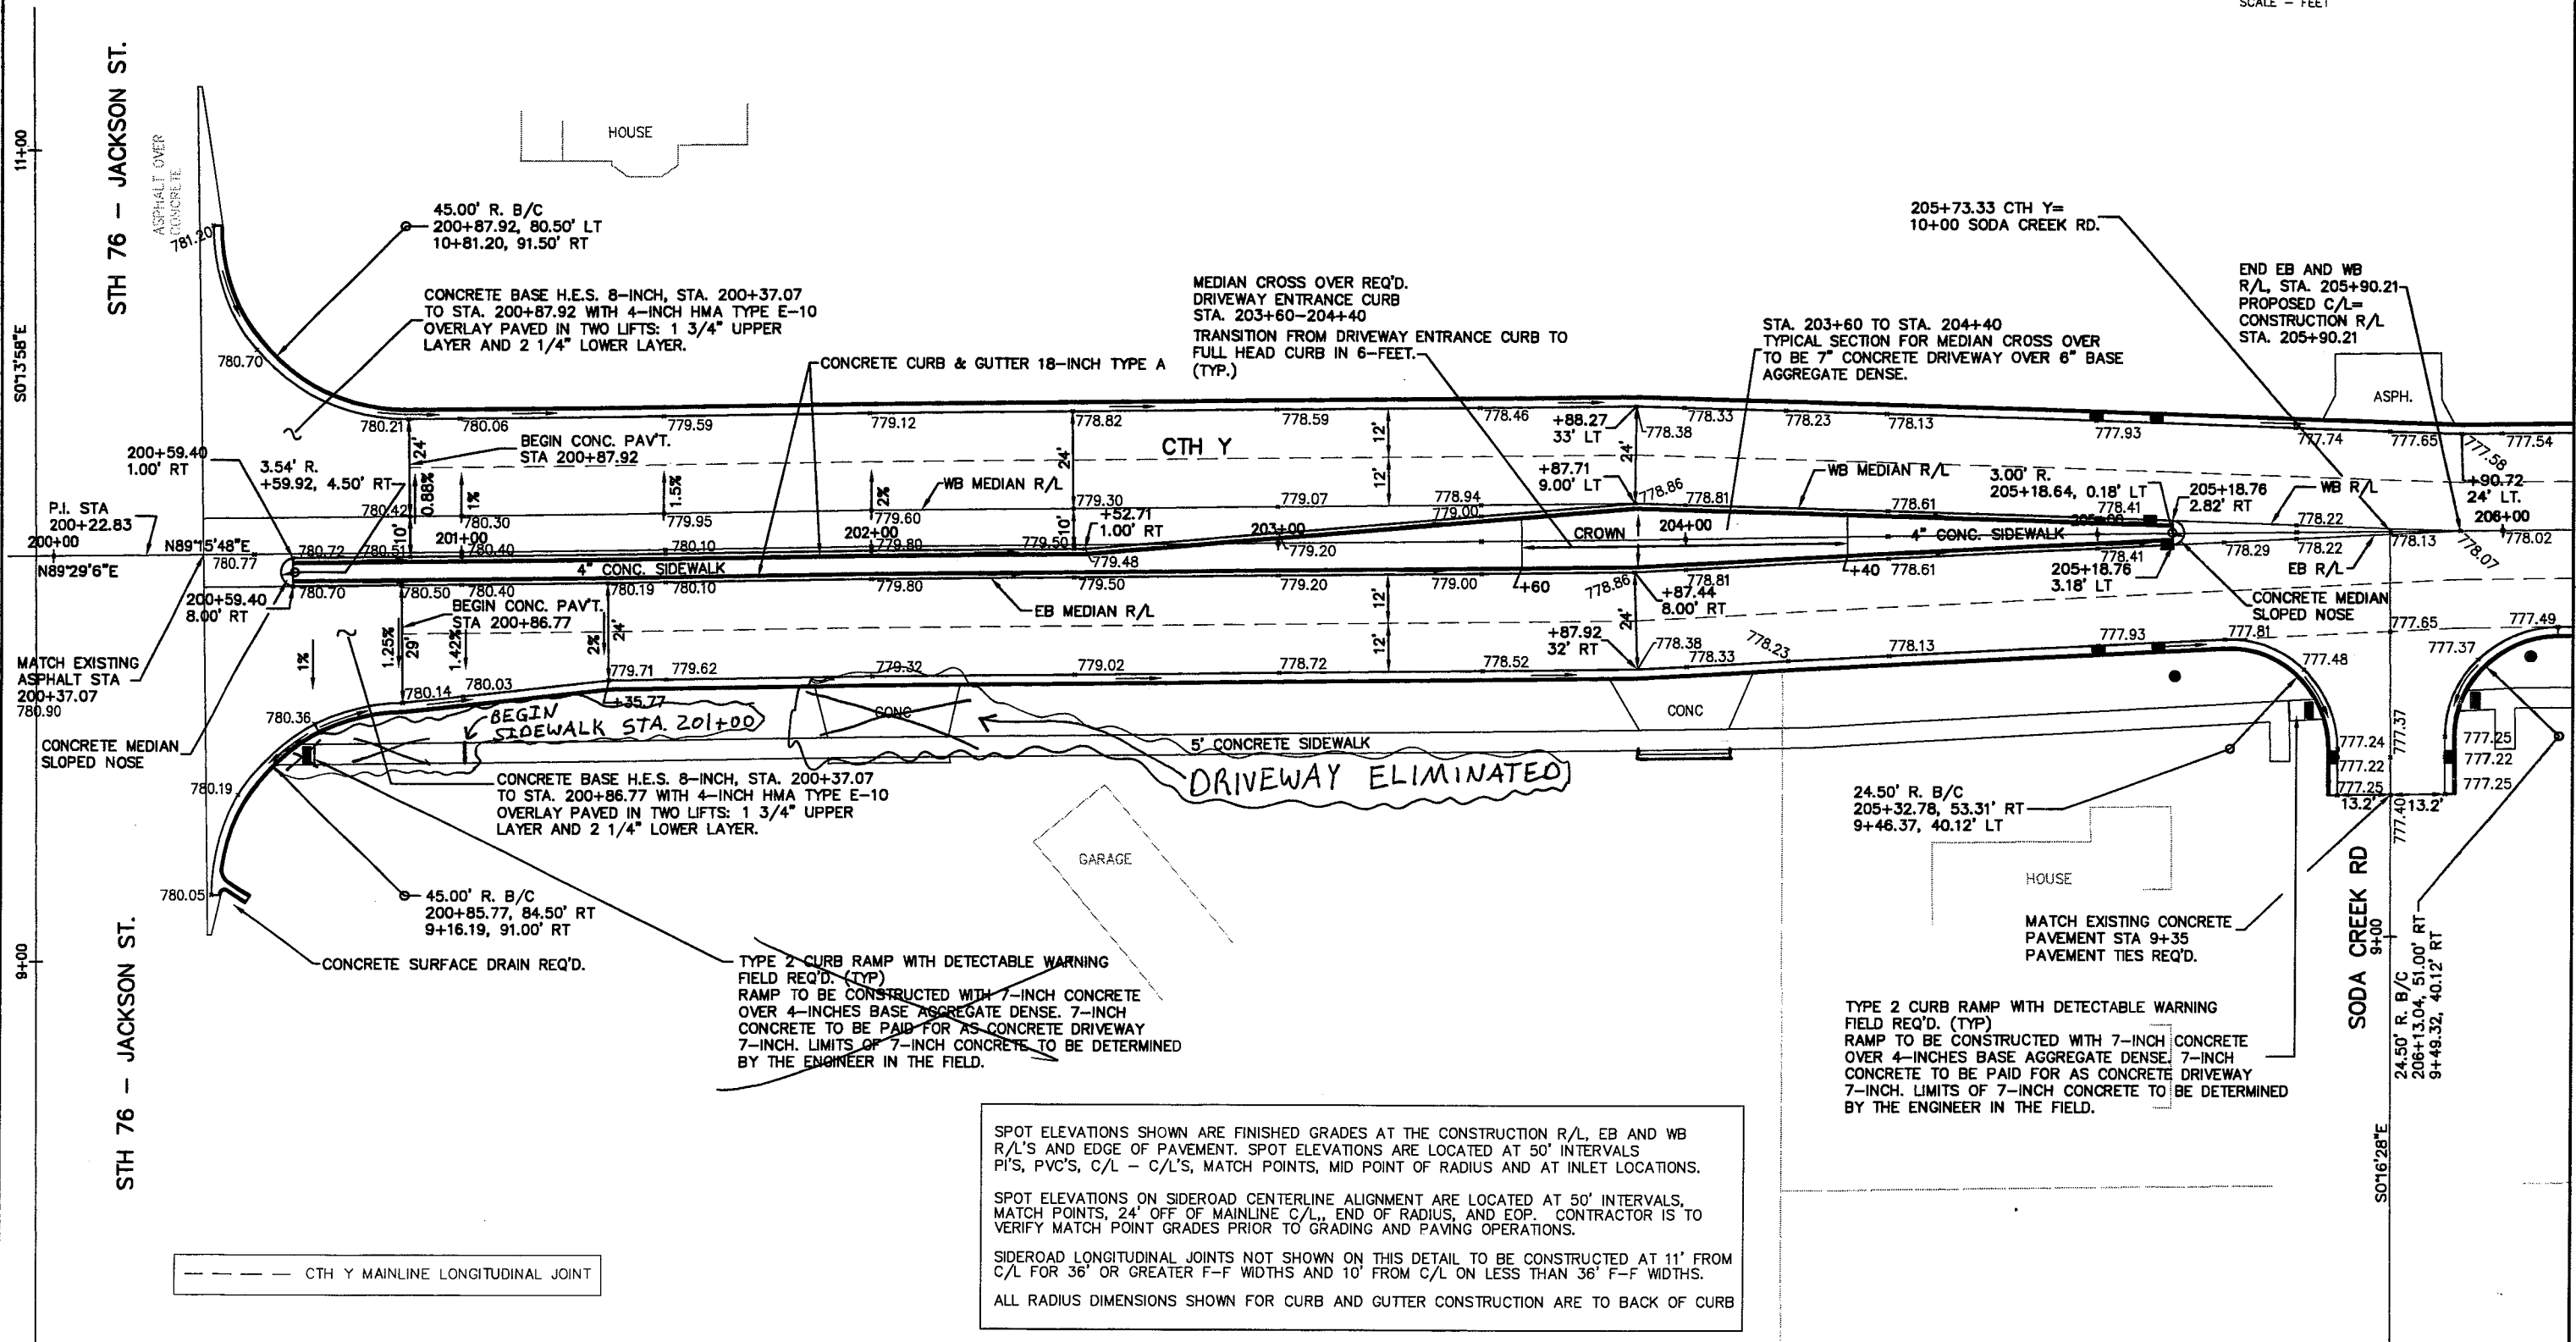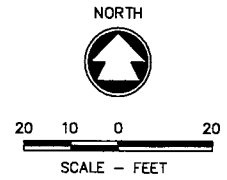


SPOT ELEVATIONS SHOWN ARE FINISHED GRADES AT THE CONSTRUCTION R/L, EB AND WB R/L'S AND EDGE OF PAVEMENT. SPOT ELEVATIONS ARE LOCATED AT 50' INTERVALS P.I.'S, P.V.C.'S, C/L - C/L'S, MATCH POINTS, MID POINT OF RADIUS AND AT INLET LOCATIONS.

SPOT ELEVATIONS ON SIDEROAD CENTERLINE ALIGNMENT ARE LOCATED AT 50' INTERVALS, MATCH POINTS, 24' OFF OF MAINLINE C/L, END OF RADIUS, AND EOP. CONTRACTOR IS TO VERIFY MATCH POINT GRADES PRIOR TO GRADING AND PAVING OPERATIONS.

SIDEROAD LONGITUDINAL JOINTS NOT SHOWN ON THIS DETAIL TO BE CONSTRUCTED AT 11' FROM C/L FOR 36' OR GREATER F-F WIDTHS AND 10' FROM C/L ON LESS THAN 36' F-F WIDTHS.

ALL RADIUS DIMENSIONS SHOWN FOR CURB AND GUTTER CONSTRUCTION ARE TO BACK OF CURB

REFER TO PLAN AND PROFILE AND CONSTRUCTION DETAIL SHEETS FOR LOCATIONS OF MANHOLES, INLETS AND OTHER APPURTENANCES LOCATED WITHIN THE PAVEMENT LIMITS

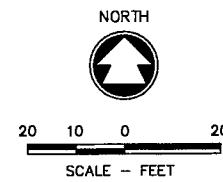


SPOT ELEVATIONS SHOWN ARE FINISHED GRADES AT THE CONSTRUCTION R/L, EB AND WB MEDIAN R/L AND EDGE OF PAVEMENT. SPOT ELEVATIONS ARE LOCATED AT 50' INTERVALS PI'S, PVC'S, C/L - C/L'S, MATCH POINTS, MID POINT OF RADIUS, E.O.R. AND AT INLET LOCATIONS.


SPOT ELEVATIONS ON SIDEROAD CENTERLINE ALIGNMENT ARE LOCATED AT 50' INTERVALS, MATCH POINTS, 24' OFF OF MAINLINE C/L, END OF RADIUS, AND EOP. CONTRACTOR IS TO VERIFY MATCH POINT GRADES PRIOR TO GRADING AND PAVING OPERATIONS.

SIDEROAD LONGITUDINAL JOINTS NOT SHOWN ON THIS DETAIL TO BE CONSTRUCTED AT 11' FROM C/L FOR 36' OR GREATER F-F WIDTHS AND 10' FROM C/L ON LESS THAN 36' F-F WIDTHS.

ALL RADIUS DIMENSIONS SHOWN FOR CURB AND GUTTER CONSTRUCTION ARE TO BACK OF CURB

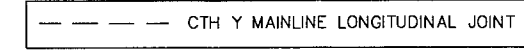

WIDENED ~20' FOR TRUCKS

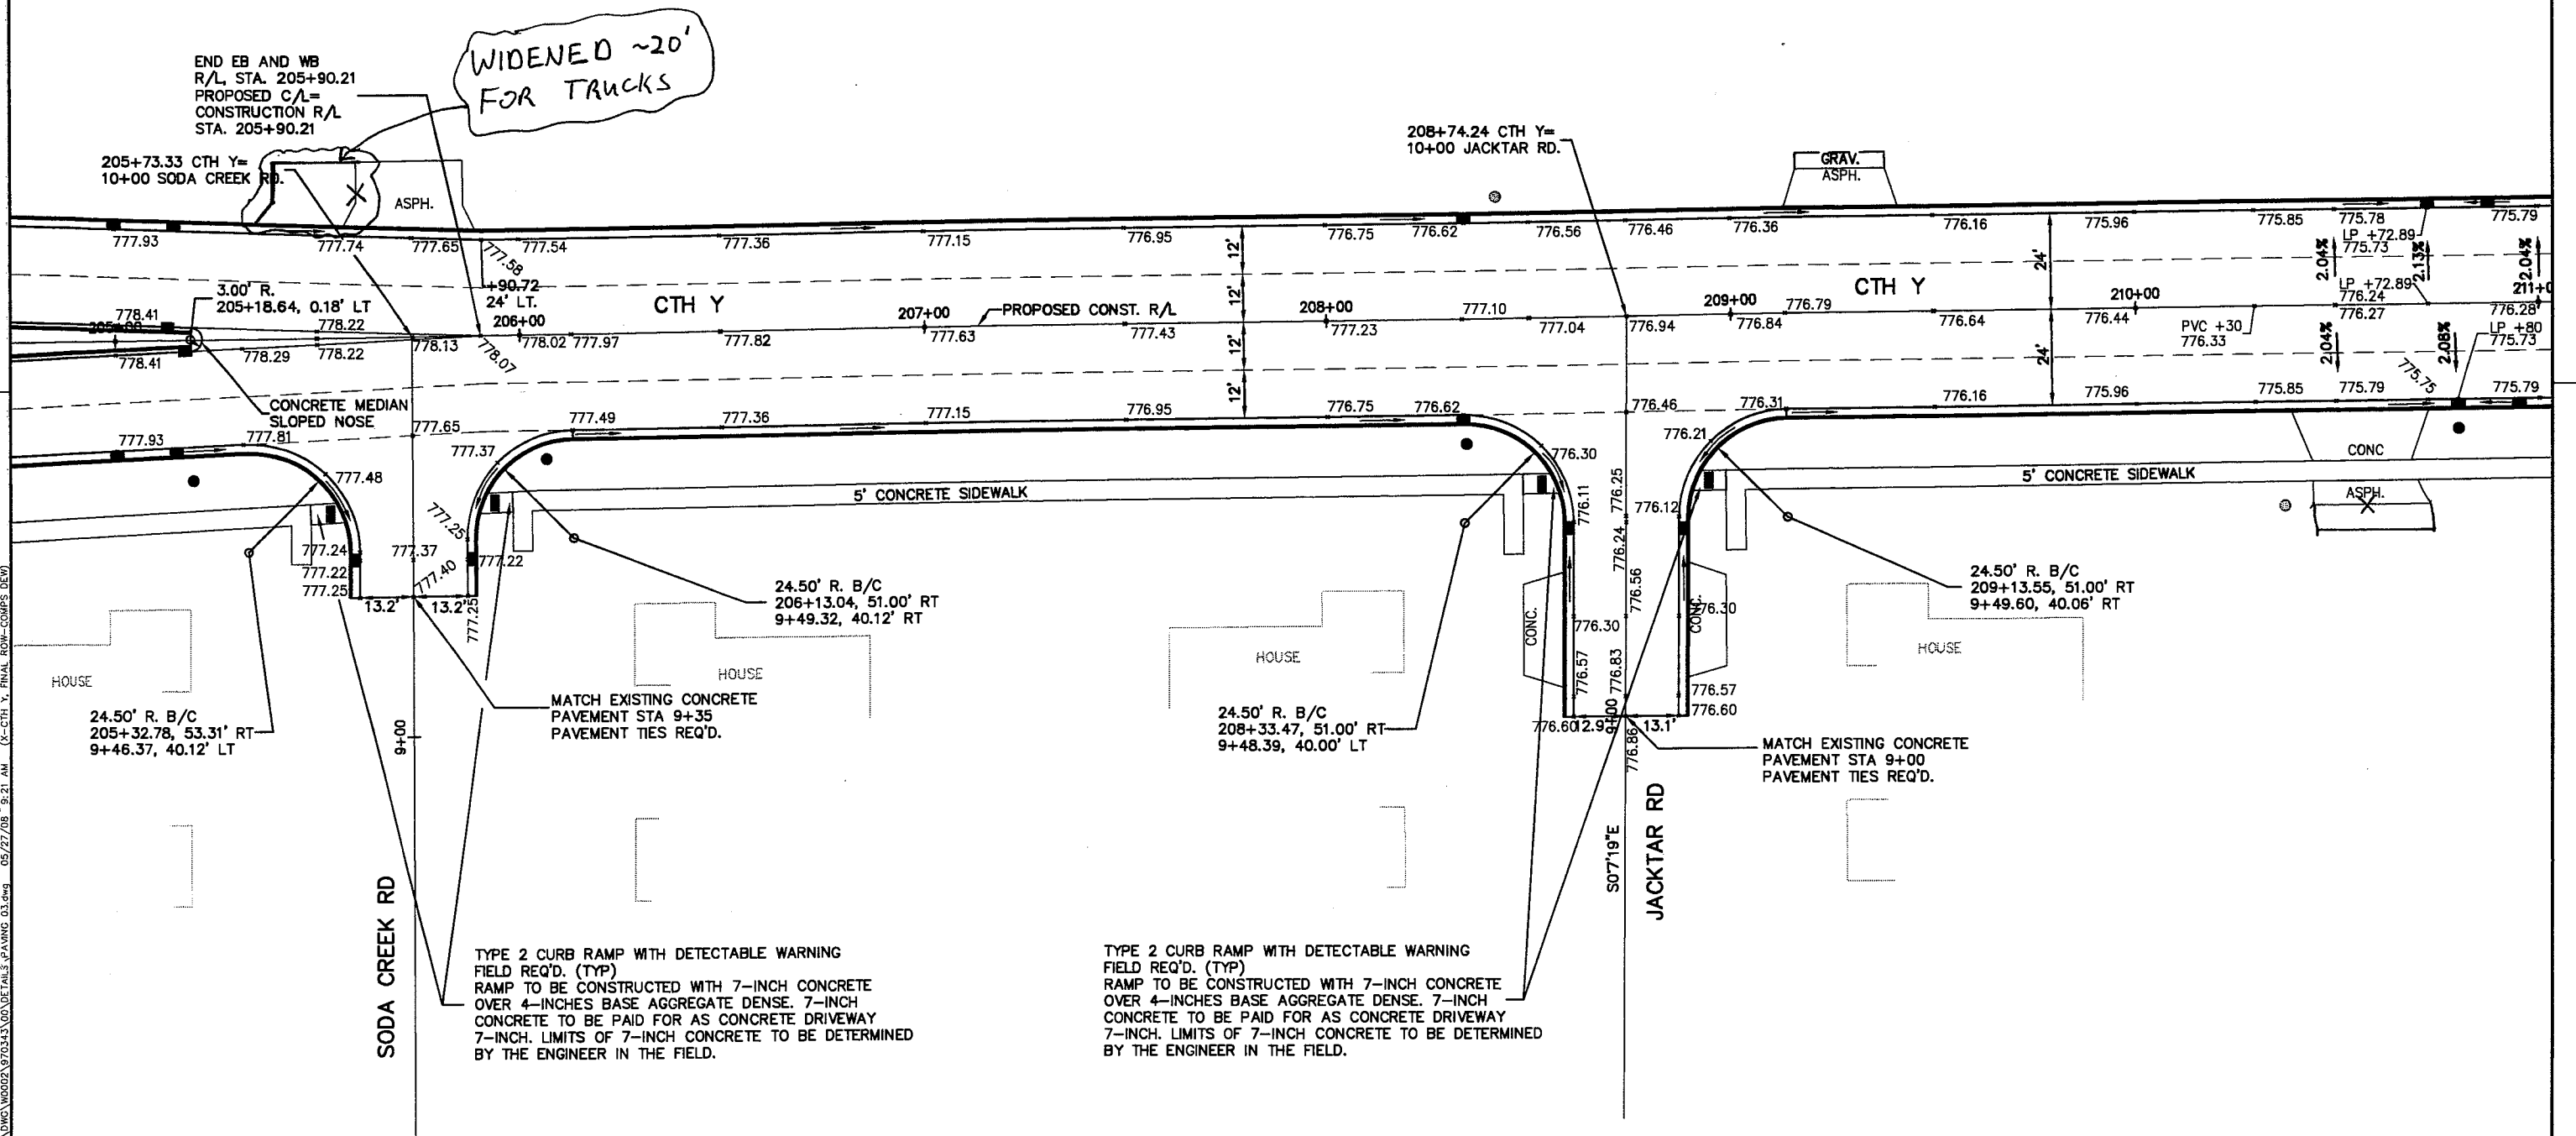

W:\DWG\W0002\970343\00\DETAILS\PAVING 03.dwg 05/27/08 9:21 AM (X-CTH-Y_FINAL ROW-COMPS.DWG)

STATE PROJECT NUMBER: 4994-00-87

HWY: CTH Y

COUNTY: WINNEBAGO







PAVING DETAIL

SHEET NO: 17


E

WSDOT/CADDS SHEET 42

REFER TO PLAN AND PROFILE AND CONSTRUCTION DETAIL SHEETS FOR LOCATIONS OF MANHOLES, INLETS AND OTHER APPURTENANCES LOCATED WITHIN THE PAVEMENT LIMITS

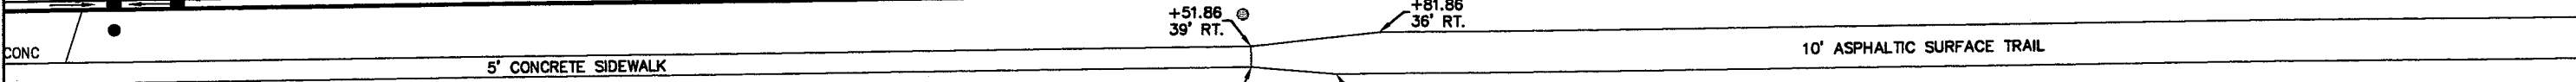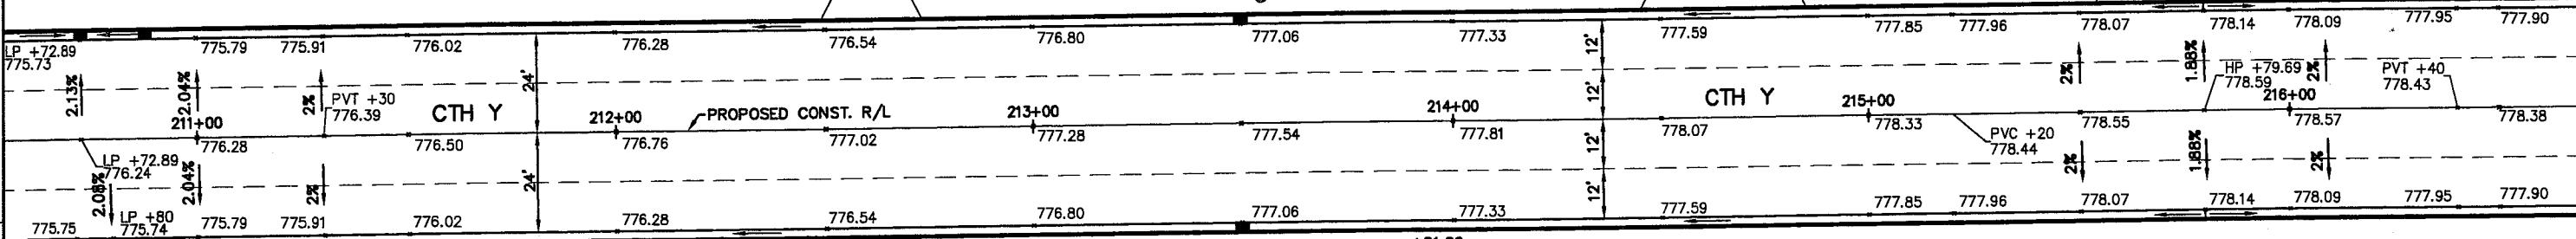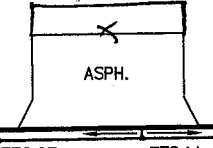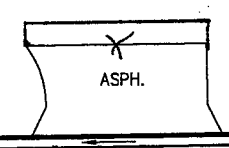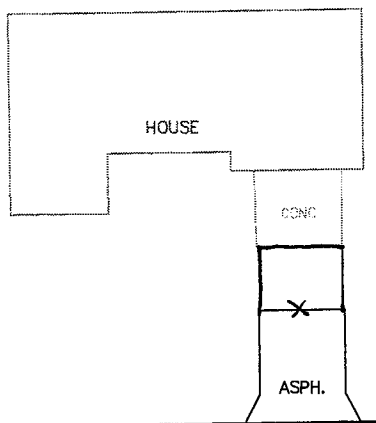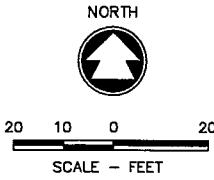

+51.86, 44' RT.,
END 5' CONCRETE SIDEWALK,
TAPER ASPHALTIC SURFACE
TO 10' WIDTH

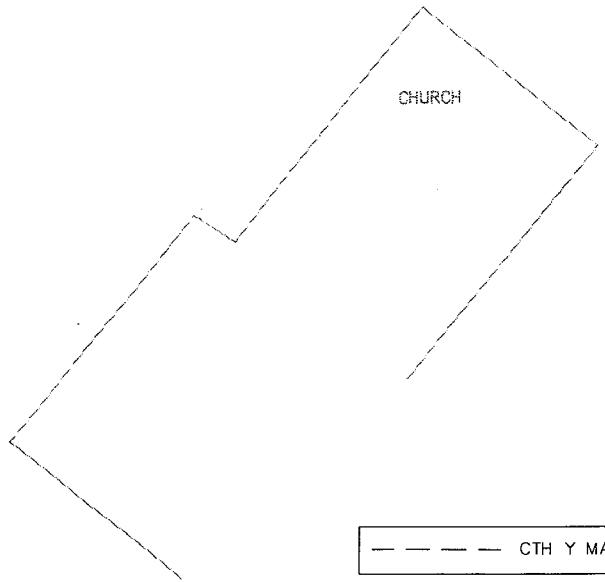

--- CTH Y MAINLINE LONGITUDINAL JOINT

SPOT ELEVATIONS SHOWN ARE FINISHED GRADES AT THE CONSTRUCTION R/L AND AT THE EDGE OF PAVEMENT. SPOT ELEVATIONS ARE LOCATED AT 50' INTERVALS, P.I.'S, PVC'S, H.P.'S, L.P.'S, C/L - C/L'S, MATCH POINTS, MID POINT OF RADIUS, E.O.R.'S AND AT INLET LOCATIONS.


SPOT ELEVATIONS ON SIDEROAD CENTERLINE ALIGNMENT ARE LOCATED AT 50' INTERVALS, MATCH POINTS, 24' OFF OF MAINLINE C/L, END OF RADIUS, AND EOP. CONTRACTOR IS TO VERIFY MATCH POINT GRADES PRIOR TO GRADING AND PAVING OPERATIONS.

SIDEROAD LONGITUDINAL JOINTS NOT SHOWN ON THIS DETAIL TO BE CONSTRUCTED AT 11' FROM C/L FOR 36' OR GREATER F-F WIDTHS AND 10' FROM C/L ON LESS THAN 36' F-F WIDTHS.


ALL RADIUS DIMENSIONS SHOWN FOR CURB AND GUTTER CONSTRUCTION ARE TO BACK OF CURB

C:\DWG\W0002\970443\00\DETAILS\PAVING D1.dwg 05/27/08 9:32 AM (X-CTH Y FINAL ROW-COMPS DEW)

REFER TO PLAN AND PROFILE AND CONSTRUCTION DETAIL SHEETS FOR LOCATIONS OF MANHOLES, INLETS AND OTHER APPURTENANCES LOCATED WITHIN THE PAVEMENT LIMITS

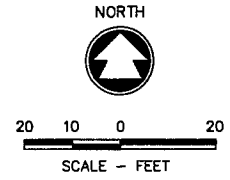

DRIVEWAY ELIMINATED

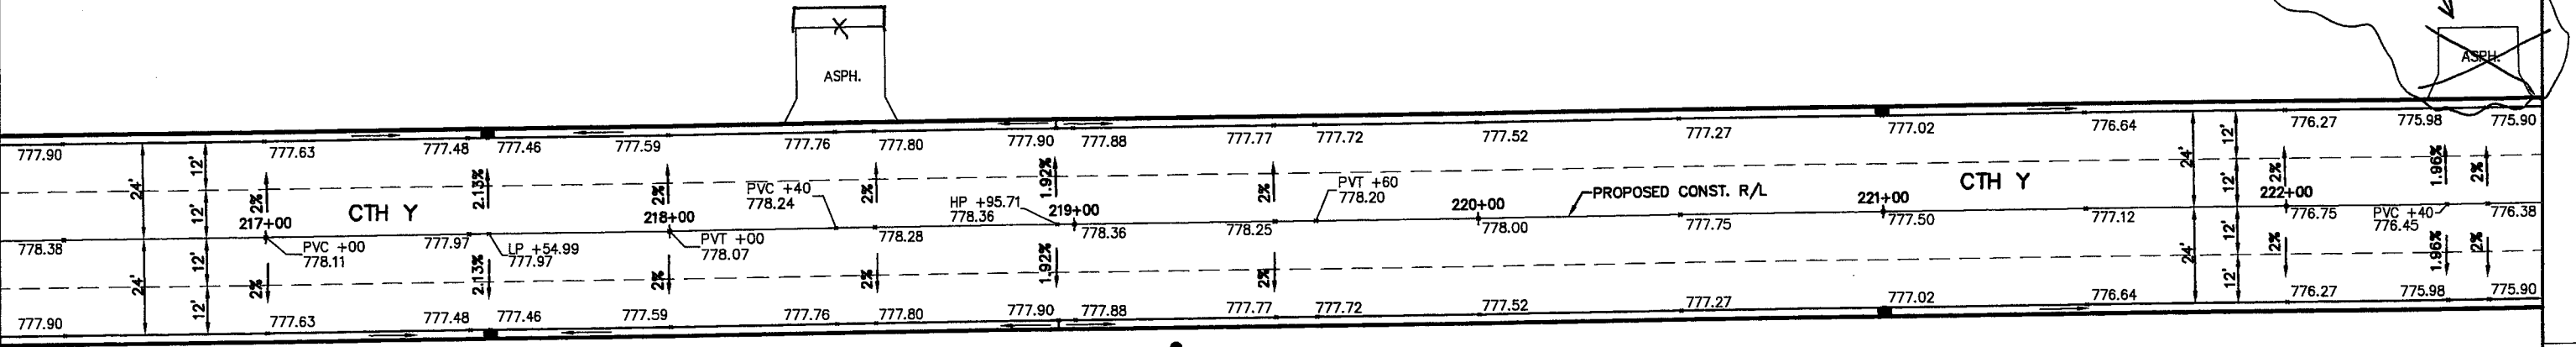

10' ASPHALT TRAIL

10' ASPHALT TRAIL

+19.66
46' RT.

+19.66
54' RT.

--- CTH Y MAINLINE LONGITUDINAL JOINT

SPOT ELEVATIONS SHOWN ARE FINISHED GRADES AT THE CONSTRUCTION R/L AND AT THE EDGE OF PAVEMENT. SPOT ELEVATIONS ARE LOCATED AT 50' INTERVALS, P.I.'S, PVC'S, H.P.'S, L.P.'S, C/L - C/L'S, MATCH POINTS, MID POINT OF RADIUS, E.O.R.'S AND AT INLET LOCATIONS.


SPOT ELEVATIONS ON SIDEROAD CENTERLINE ALIGNMENT ARE LOCATED AT 50' INTERVALS, MATCH POINTS, 24' OFF OF MAINLINE C/L, END OF RADIUS, AND EOP. CONTRACTOR IS TO VERIFY MATCH POINT GRADES PRIOR TO GRADING AND PAVING OPERATIONS.

SIDEROAD LONGITUDINAL JOINTS NOT SHOWN ON THIS DETAIL TO BE CONSTRUCTED AT 11' FROM C/L FOR 36' OR GREATER F-F WIDTHS AND 10' FROM C/L ON LESS THAN 36' F-F WIDTHS.


ALL RADIUS DIMENSIONS SHOWN FOR CURB AND GUTTER CONSTRUCTION ARE TO BACK OF CURB

W:\DWG\W0002\9705\3\03\VE\FILES\PAVING_05.dwg 04/22/06 11:44 AM (X-CTH Y, FINAL ROW-COMPS DEW)

REFER TO PLAN AND PROFILE AND CONSTRUCTION DETAIL SHEETS FOR LOCATIONS OF MANHOLES, INLETS AND OTHER APPURTENANCES LOCATED WITHIN THE PAVEMENT LIMITS

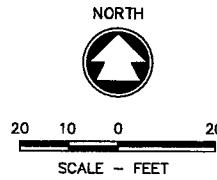

--- CTH Y MAINLINE LONGITUDINAL JOINT

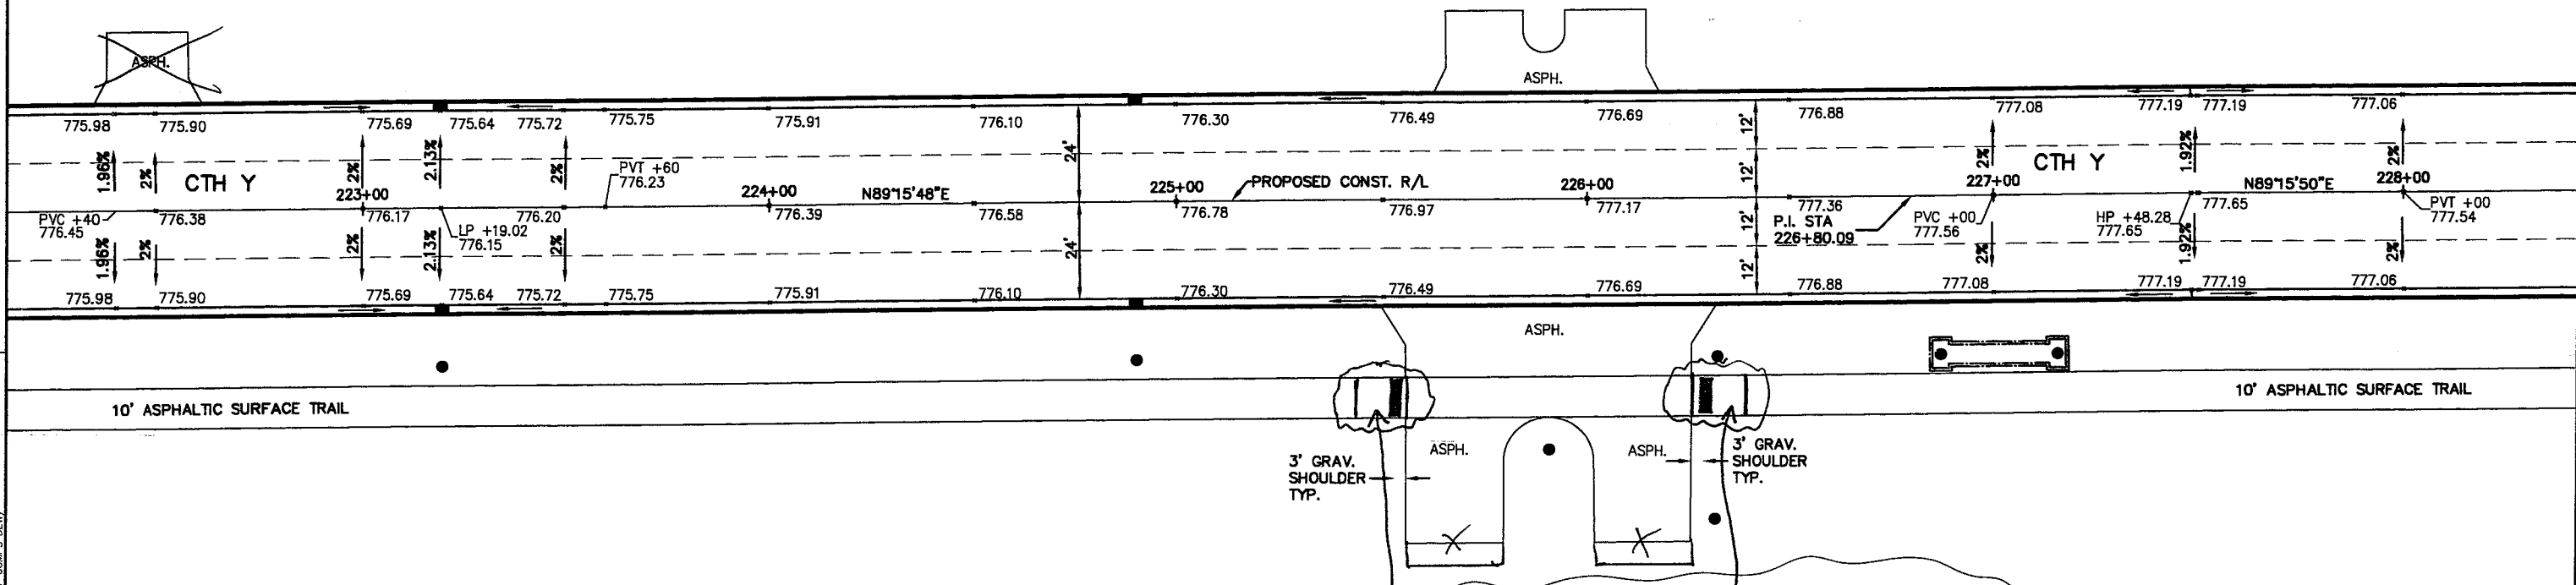

TYPE 2 CURB RAMP WITH DETECTABLE WARNING FIELD REQ'D (TYP)
 RAMP TO BE CONSTRUCTED WITH 7-INCH CONCRETE OVER 4-INCHES BASE AGGREGATE DENSE. 7-INCH CONCRETE TO BE PAID FOR AS CONCRETE DRIVEWAY 7-INCH. LIMITS OF 7-INCH CONCRETE TO BE DETERMINED BY THE ENGINEER IN THE FIELD

SPOT ELEVATIONS SHOWN ARE FINISHED GRADES AT THE CONSTRUCTION R/L AND AT THE EDGE OF PAVEMENT. SPOT ELEVATIONS ARE LOCATED AT 50' INTERVALS, P.I.'S, PVC'S, H.P.'S, L.P.'S, C/L - C/L'S, MATCH POINTS, MID POINT OF RADIUS, E.O.R.'S AND AT INLET LOCATIONS.


SPOT ELEVATIONS ON SIDEROAD CENTERLINE ALIGNMENT ARE LOCATED AT 50' INTERVALS, MATCH POINTS, 24' OFF OF MAINLINE C/L, END OF RADIUS, AND EOP. CONTRACTOR IS TO VERIFY MATCH POINT GRADES PRIOR TO GRADING AND PAVING OPERATIONS.

SIDEROAD LONGITUDINAL JOINTS NOT SHOWN ON THIS DETAIL TO BE CONSTRUCTED AT 11' FROM C/L FOR 36' OR GREATER F-F WIDTHS AND 10' FROM C/L ON LESS THAN 36' F-F WIDTHS.

ALL RADIUS DIMENSIONS SHOWN FOR CURB AND GUTTER CONSTRUCTION ARE TO BACK OF CURB

P:\PROJECTS\4994-00-87\4994-00-87\DETAILS\PAVING DB.dwg 04/22/08 11:45 AM (X-CIT-Y, FINAL ROW-COMPS DEW)

REFER TO PLAN AND PROFILE AND CONSTRUCTION DETAIL SHEETS FOR LOCATIONS OF MANHOLES, INLETS AND OTHER APPURTENANCES LOCATED WITHIN THE PAVEMENT LIMITS

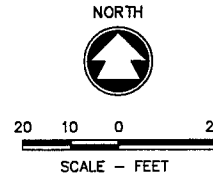


SPOT ELEVATIONS SHOWN ARE FINISHED GRADES AT THE CONSTRUCTION R/L AND AT THE EDGE OF PAVEMENT. SPOT ELEVATIONS ARE LOCATED AT 50' INTERVALS, PI'S, PVC'S, H.P.'S, L.P.'S, C/L - C/L'S, MATCH POINTS, MID POINT OF RADIUS, E.O.R.'S AND AT INLET LOCATIONS.

SPOT ELEVATIONS ON SIDEROAD CENTERLINE ALIGNMENT ARE LOCATED AT 50' INTERVALS, MATCH POINTS, 24' OFF OF MAINLINE C/L, END OF RADIUS, AND EOP. CONTRACTOR IS TO VERIFY MATCH POINT GRADES PRIOR TO GRADING AND PAVING OPERATIONS.

SIDEROAD LONGITUDINAL JOINTS NOT SHOWN ON THIS DETAIL TO BE CONSTRUCTED AT 11' FROM C/L FOR 36' OR GREATER F-F WIDTHS AND 10' FROM C/L ON LESS THAN 36' F-F WIDTHS.


ALL RADIUS DIMENSIONS SHOWN FOR CURB AND GUTTER CONSTRUCTION ARE TO BACK OF CURB

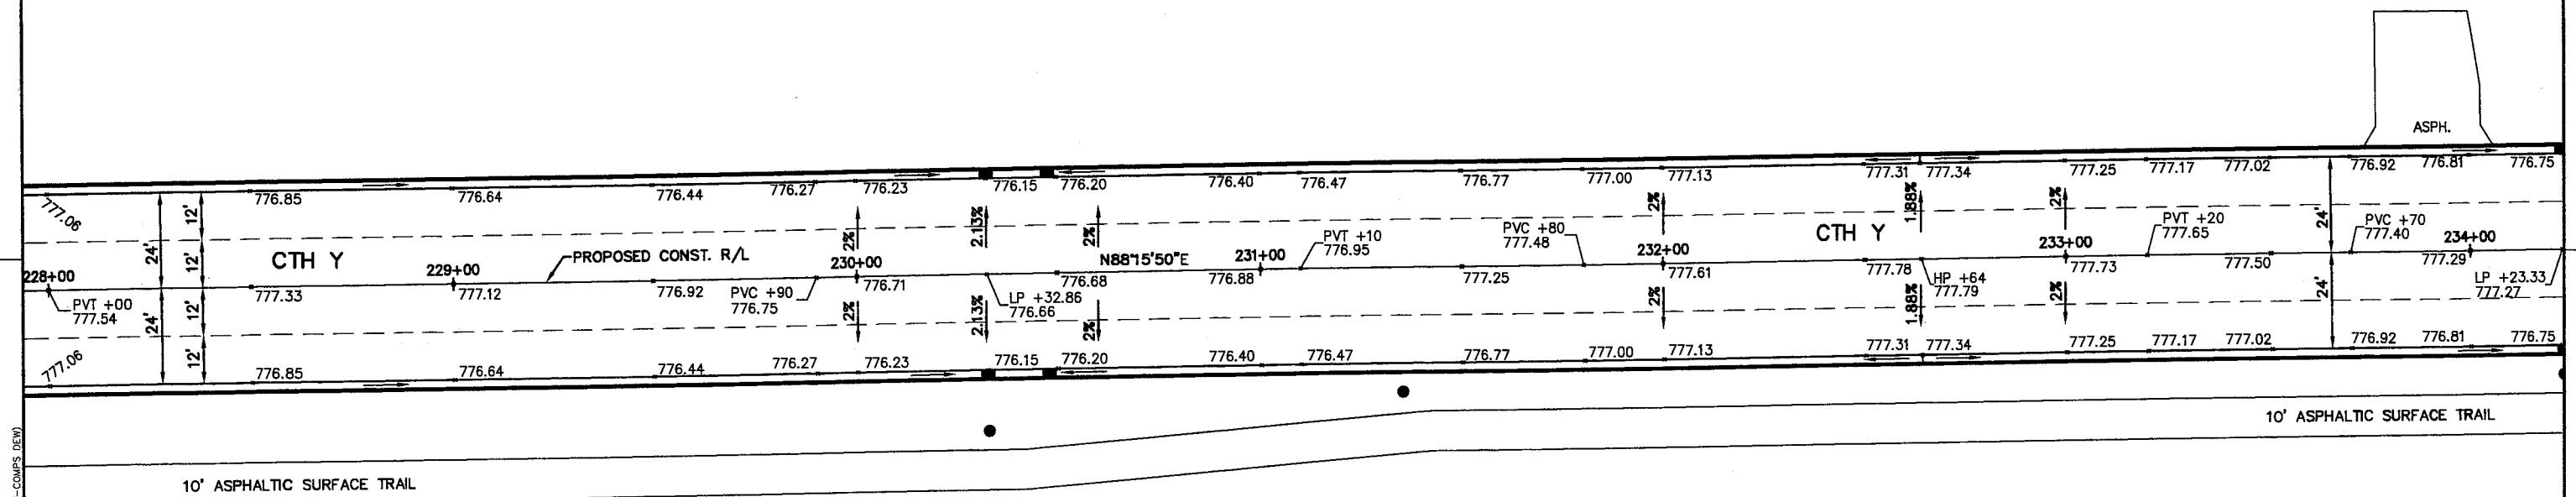

--- CTH Y MAINLINE LONGITUDINAL JOINT

W:\CHW\WOODS\07054\00\DETAILS\PAVING 07.dwg 06/27/08 9:45 AM (X=CTH Y, FINAL ROW-COMPS DEV)

REFER TO PLAN AND PROFILE AND CONSTRUCTION DETAIL SHEETS FOR LOCATIONS OF MANHOLES, INLETS AND OTHER APPURTENANCES LOCATED WITHIN THE PAVEMENT LIMITS

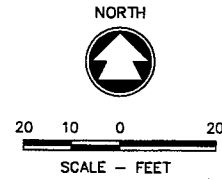


SPOT ELEVATIONS SHOWN ARE FINISHED GRADES AT THE CONSTRUCTION R/L AND AT THE EDGE OF PAVEMENT. SPOT ELEVATIONS ARE LOCATED AT 50' INTERVALS, P.I.'S, P.V.C.'S, H.P.'S, L.P.'S, C/L - C/L'S, MATCH POINTS, MID POINT OF RADIUS, E.O.R.'S AND AT INLET LOCATIONS.

SPOT ELEVATIONS ON SIDEROAD CENTERLINE ALIGNMENT ARE LOCATED AT 50' INTERVALS, MATCH POINTS, 24' OFF OF MAINLINE C/L, END OF RADIUS, AND EOP. CONTRACTOR IS TO VERIFY MATCH POINT GRADES PRIOR TO GRADING AND PAVING OPERATIONS.

SIDEROAD LONGITUDINAL JOINTS NOT SHOWN ON THIS DETAIL TO BE CONSTRUCTED AT 11' FROM C/L FOR 36' OR GREATER F-F WIDTHS AND 10' FROM C/L ON LESS THAN 36' F-F WIDTHS.

ALL RADIUS DIMENSIONS SHOWN FOR CURB AND GUTTER CONSTRUCTION ARE TO BACK OF CURB

--- CTH Y MAINLINE LONGITUDINAL JOINT


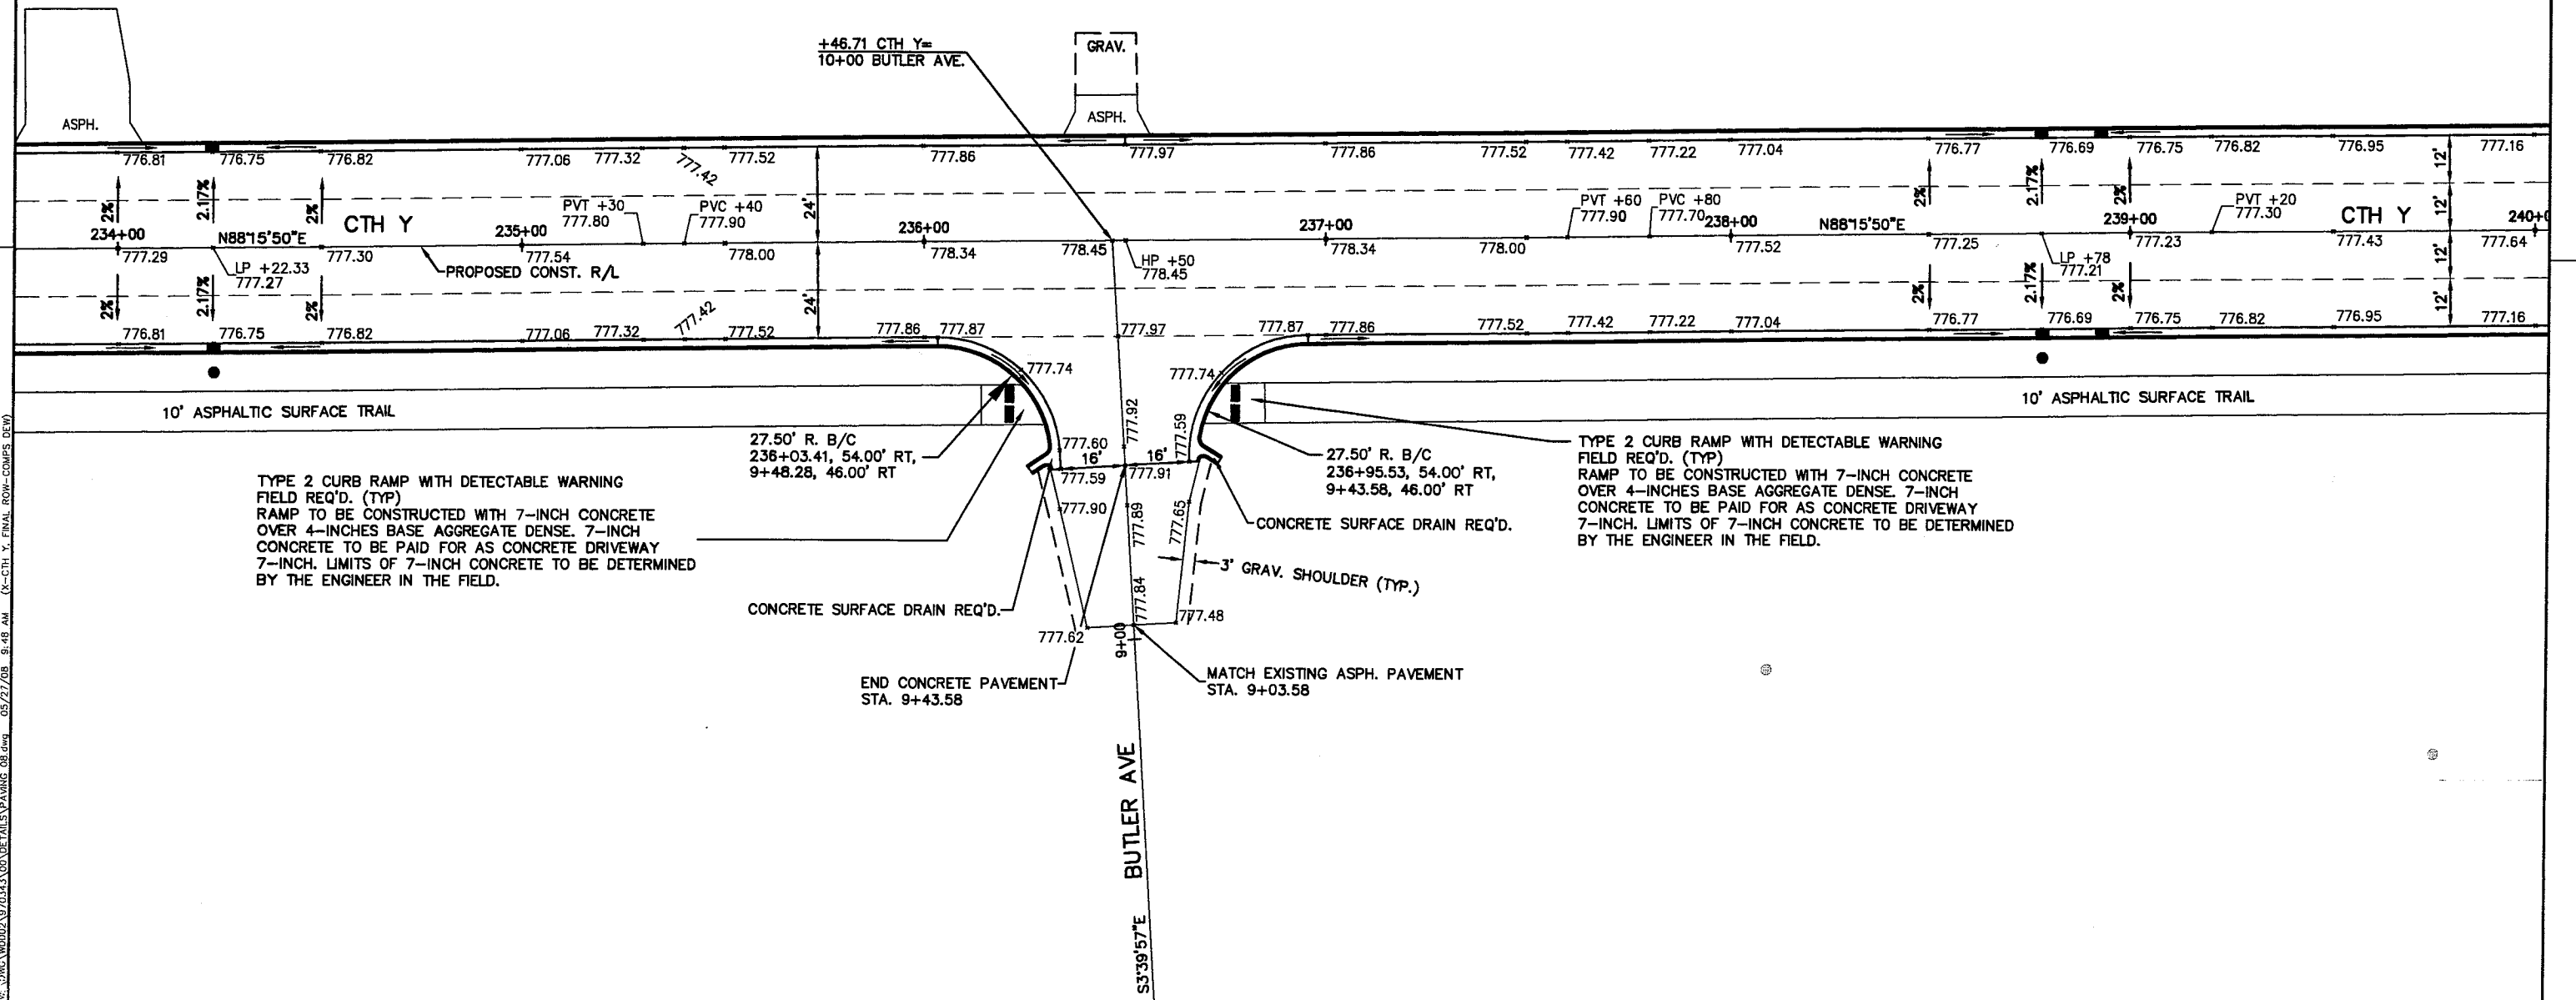


TYPE 2 CURB RAMP WITH DETECTABLE WARNING FIELD REQ'D. (TYP)
RAMP TO BE CONSTRUCTED WITH 7-INCH CONCRETE OVER 4-INCHES BASE AGGREGATE DENSE. 7-INCH CONCRETE TO BE PAID FOR AS CONCRETE DRIVEWAY 7-INCH. LIMITS OF 7-INCH CONCRETE TO BE DETERMINED BY THE ENGINEER IN THE FIELD.

TYPE 2 CURB RAMP WITH DETECTABLE WARNING FIELD REQ'D. (TYP)
RAMP TO BE CONSTRUCTED WITH 7-INCH CONCRETE OVER 4-INCHES BASE AGGREGATE DENSE. 7-INCH CONCRETE TO BE PAID FOR AS CONCRETE DRIVEWAY 7-INCH. LIMITS OF 7-INCH CONCRETE TO BE DETERMINED BY THE ENGINEER IN THE FIELD.

05/27/08 9:48 AM (X-CTH Y FINAL ROW-COMPS.DWG) 1970343\00\DETAILS\PAVING 08.dwg

REFER TO PLAN AND PROFILE AND CONSTRUCTION DETAIL SHEETS FOR LOCATIONS OF MANHOLES, INLETS AND OTHER APPURTENANCES LOCATED WITHIN THE PAVEMENT LIMITS

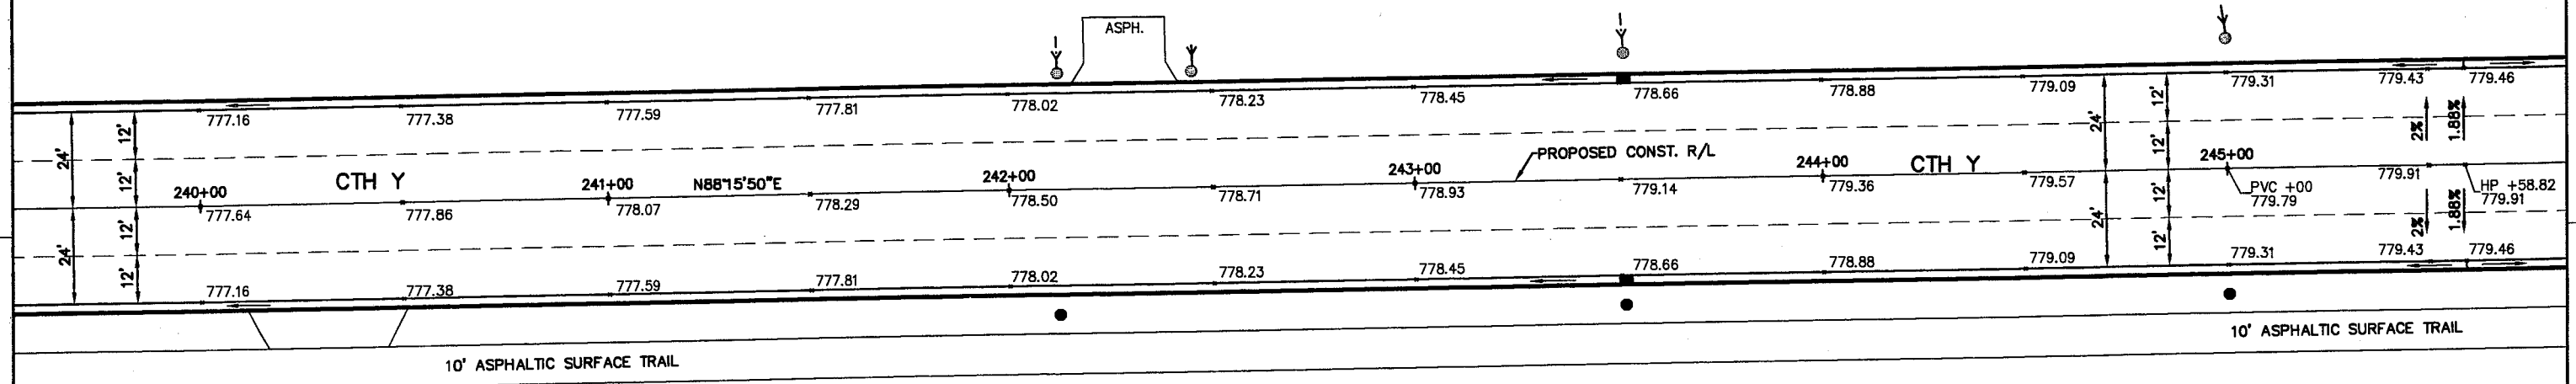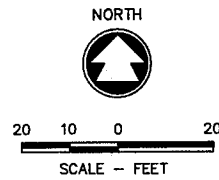

SPOT ELEVATIONS SHOWN ARE FINISHED GRADES AT THE CONSTRUCTION R/L AND AT THE EDGE OF PAVEMENT. SPOT ELEVATIONS ARE LOCATED AT 50' INTERVALS, P.I.'S, PVC'S, H.P.'S, L.P.'S, C/L - C/L'S, MATCH POINTS, MID POINT OF RADIUS, E.O.R.'S AND AT INLET LOCATIONS.

SPOT ELEVATIONS ON SIDEROAD CENTERLINE ALIGNMENT ARE LOCATED AT 50' INTERVALS, MATCH POINTS, 24' OFF OF MAINLINE C/L, END OF RADIUS, AND EOP. CONTRACTOR IS TO VERIFY MATCH POINT GRADES PRIOR TO GRADING AND PAVING OPERATIONS.

SIDEROAD LONGITUDINAL JOINTS NOT SHOWN ON THIS DETAIL TO BE CONSTRUCTED AT 11' FROM C/L FOR 36' OR GREATER F-F WIDTHS AND 10' FROM C/L ON LESS THAN 36' F-F WIDTHS.

ALL RADIUS DIMENSIONS SHOWN FOR CURB AND GUTTER CONSTRUCTION ARE TO BACK OF CURB

W:\DWG\W0002\070313\00\DETAILS\PAVING_08.dwg 04/22/08 11:52 AM (X-CTH Y_FINAL_ROW-COMPS.DWG)

STATE PROJECT NUMBER: 4994-00-87

HWY: CTH Y



COUNTY: WINNEBAGO

PAVING DETAIL

SHEET NO: 23

E

REFER TO PLAN AND PROFILE AND CONSTRUCTION DETAIL SHEETS FOR LOCATIONS OF MANHOLES, INLETS AND OTHER APPURTENANCES LOCATED WITHIN THE PAVEMENT LIMITS

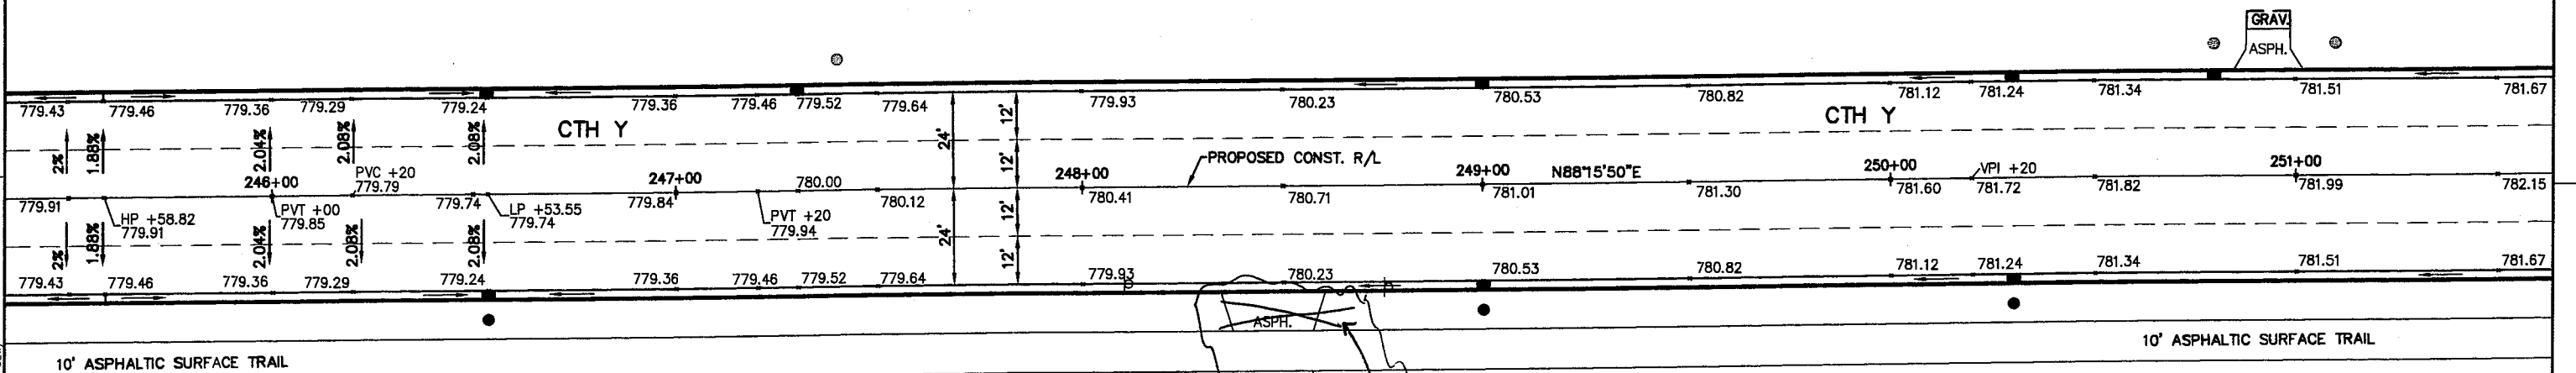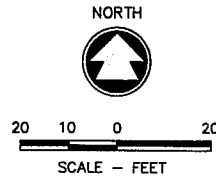

P:\mgs\gsk\p\10w\100002\970343\1000\DETAILS\PAVING 10.dwg 04/22/08 11:54 AM (X-CTH Y FINAL ROW-COMPS DEW)

SPOT ELEVATIONS SHOWN ARE FINISHED GRADES AT THE CONSTRUCTION R/L AND AT THE EDGE OF PAVEMENT. SPOT ELEVATIONS ARE LOCATED AT 50' INTERVALS, P.I.'S, PVC'S, H.P.'S, L.P.'S, C/L - C/L'S, MATCH POINTS, MID POINT OF RADIUS, E.O.R.'S AND AT INLET LOCATIONS.



SPOT ELEVATIONS ON SIDEROAD CENTERLINE ALIGNMENT ARE LOCATED AT 50' INTERVALS, MATCH POINTS, 24' OFF OF MAINLINE C/L,, END OF RADIUS, AND EOP. CONTRACTOR IS TO VERIFY MATCH POINT GRADES PRIOR TO GRADING AND PAVING OPERATIONS.

SIDEROAD LONGITUDINAL JOINTS NOT SHOWN ON THIS DETAIL TO BE CONSTRUCTED AT 11' FROM C/L FOR 36' OR GREATER F-F WIDTHS AND 10' FROM C/L ON LESS THAN 36' F-F WIDTHS.

ALL RADIUS DIMENSIONS SHOWN FOR CURB AND GUTTER CONSTRUCTION ARE TO BACK OF CURB

--- CTH Y MAINLINE LONGITUDINAL JOINT

REFER TO PLAN AND PROFILE AND CONSTRUCTION DETAIL SHEETS FOR LOCATIONS OF MANHOLES, INLETS AND OTHER APPURTENANCES LOCATED WITHIN THE PAVEMENT LIMITS

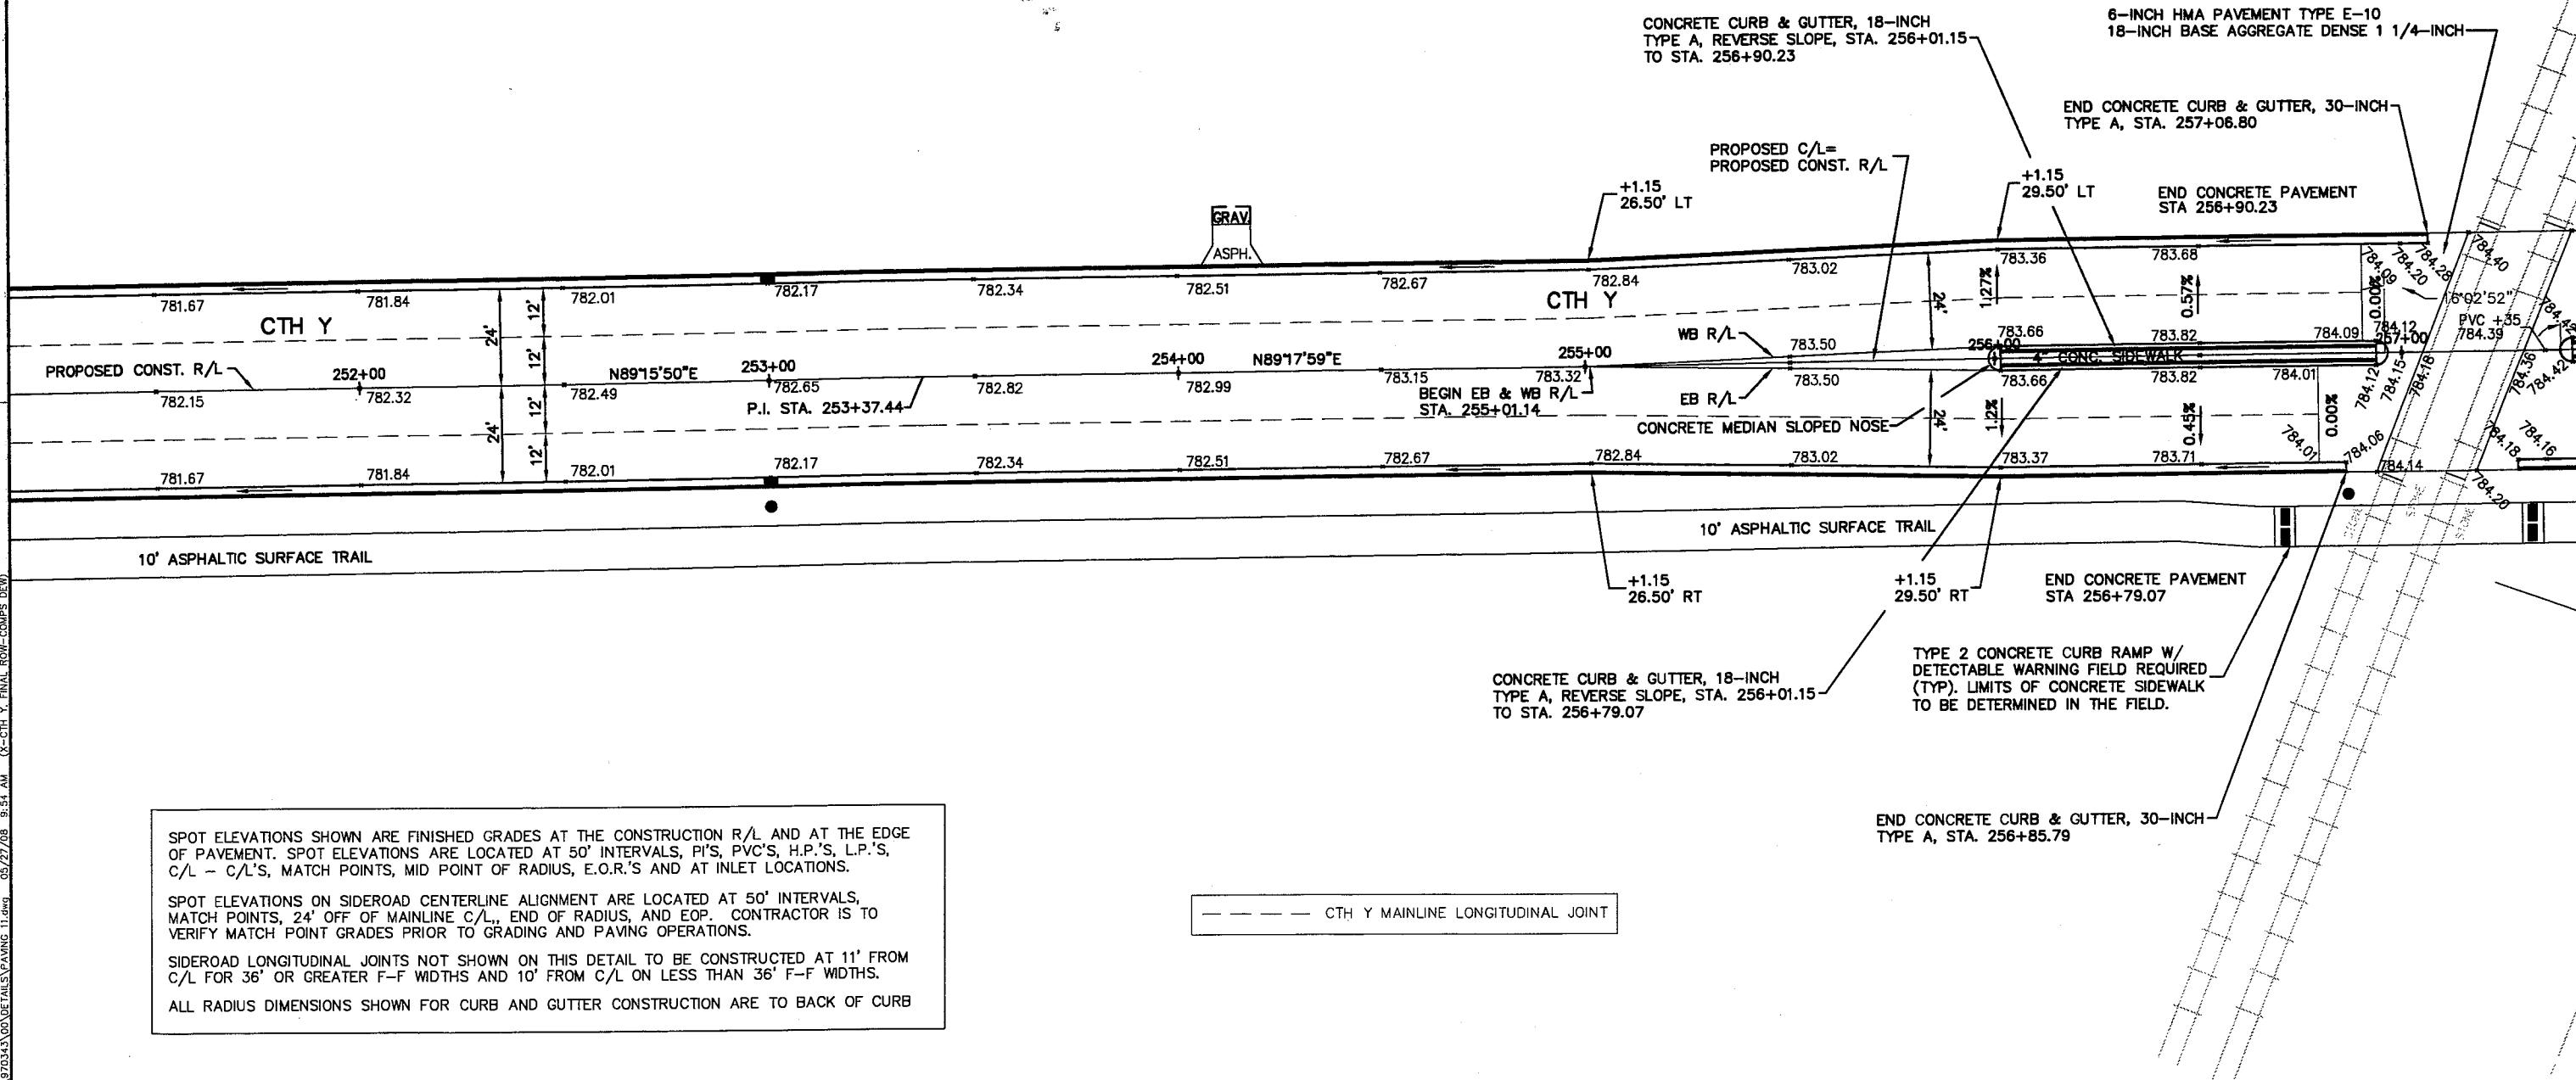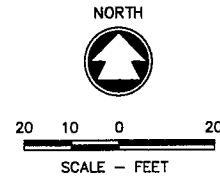

SPOT ELEVATIONS SHOWN ARE FINISHED GRADES AT THE CONSTRUCTION R/L AND AT THE EDGE OF PAVEMENT. SPOT ELEVATIONS ARE LOCATED AT 50' INTERVALS, P.I.'S, PVC'S, H.P.'S, L.P.'S, C/L - C/L'S, MATCH POINTS, MID POINT OF RADIUS, E.O.R.'S AND AT INLET LOCATIONS.

SPOT ELEVATIONS ON SIDEROAD CENTERLINE ALIGNMENT ARE LOCATED AT 50' INTERVALS, MATCH POINTS, 24' OFF OF MAINLINE C/L,, END OF RADIUS, AND EOP. CONTRACTOR IS TO VERIFY MATCH POINT GRADES PRIOR TO GRADING AND PAVING OPERATIONS.

SIDEROAD LONGITUDINAL JOINTS NOT SHOWN ON THIS DETAIL TO BE CONSTRUCTED AT 11' FROM C/L FOR 36' OR GREATER F-F WIDTHS AND 10' FROM C/L ON LESS THAN 36' F-F WIDTHS.

ALL RADIUS DIMENSIONS SHOWN FOR CURB AND GUTTER CONSTRUCTION ARE TO BACK OF CURB

--- CTH Y MAINLINE LONGITUDINAL JOINT

W:\DWG\2002\4994\4994-00\DETAILS\PAVING 1.dwg 08/27/08 9:54 AM X-CTH Y FINAL R/W/COMPS.DWG

REFER TO PLAN AND PROFILE AND CONSTRUCTION DETAIL SHEETS FOR LOCATIONS OF MANHOLES, INLETS AND OTHER APPURTENANCES LOCATED WITHIN THE PAVEMENT LIMITS

SPOT ELEVATIONS SHOWN ARE FINISHED GRADES AT THE CONSTRUCTION R/L AND AT THE EDGE OF PAVEMENT. SPOT ELEVATIONS ARE LOCATED AT 50' INTERVALS, P.I.'S, PVC'S, H.P.'S, L.P.'S, C/L - C/L'S, MATCH POINTS, MID POINT OF RADIUS, E.O.R.'S AND AT INLET LOCATIONS.


SPOT ELEVATIONS ON SIDEROAD CENTERLINE ALIGNMENT ARE LOCATED AT 50' INTERVALS, MATCH POINTS, 24' OFF OF MAINLINE C/L, END OF RADIUS, AND EOP. CONTRACTOR IS TO VERIFY MATCH POINT GRADES PRIOR TO GRADING AND PAVING OPERATIONS.

SIDEROAD LONGITUDINAL JOINTS NOT SHOWN ON THIS DETAIL TO BE CONSTRUCTED AT 11' FROM C/L FOR 36' OR GREATER F-F WIDTHS AND 10' FROM C/L ON LESS THAN 36' F-F WIDTHS.


ALL RADIUS DIMENSIONS SHOWN FOR CURB AND GUTTER CONSTRUCTION ARE TO BACK OF CURB

2


2

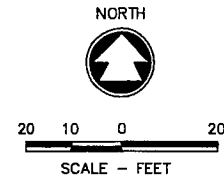

--- CTH Y MAINLINE LONGITUDINAL JOINT

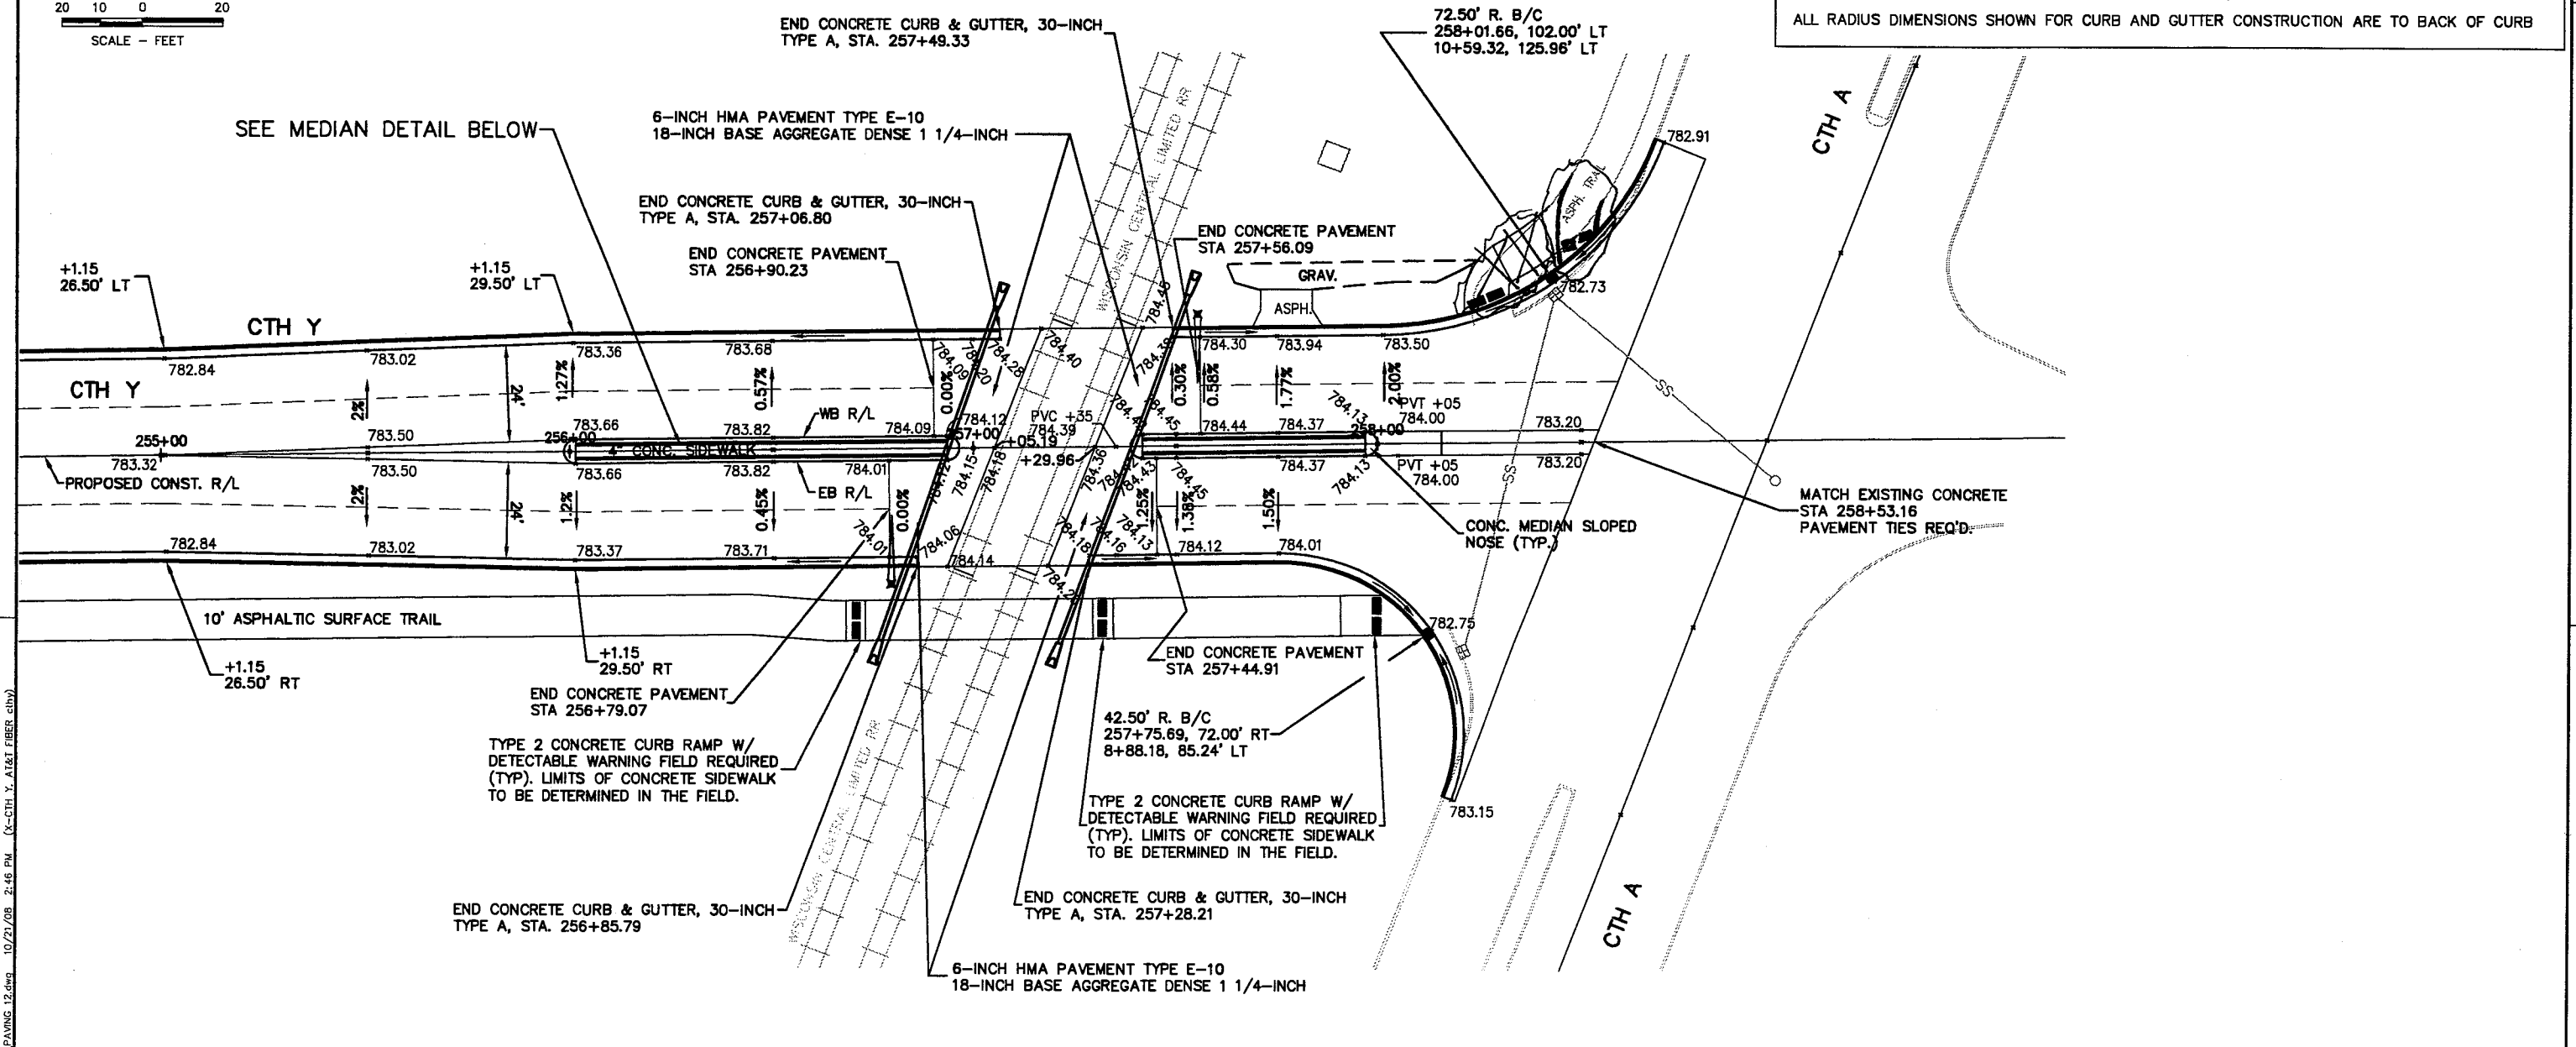


MEDIAN DETAIL

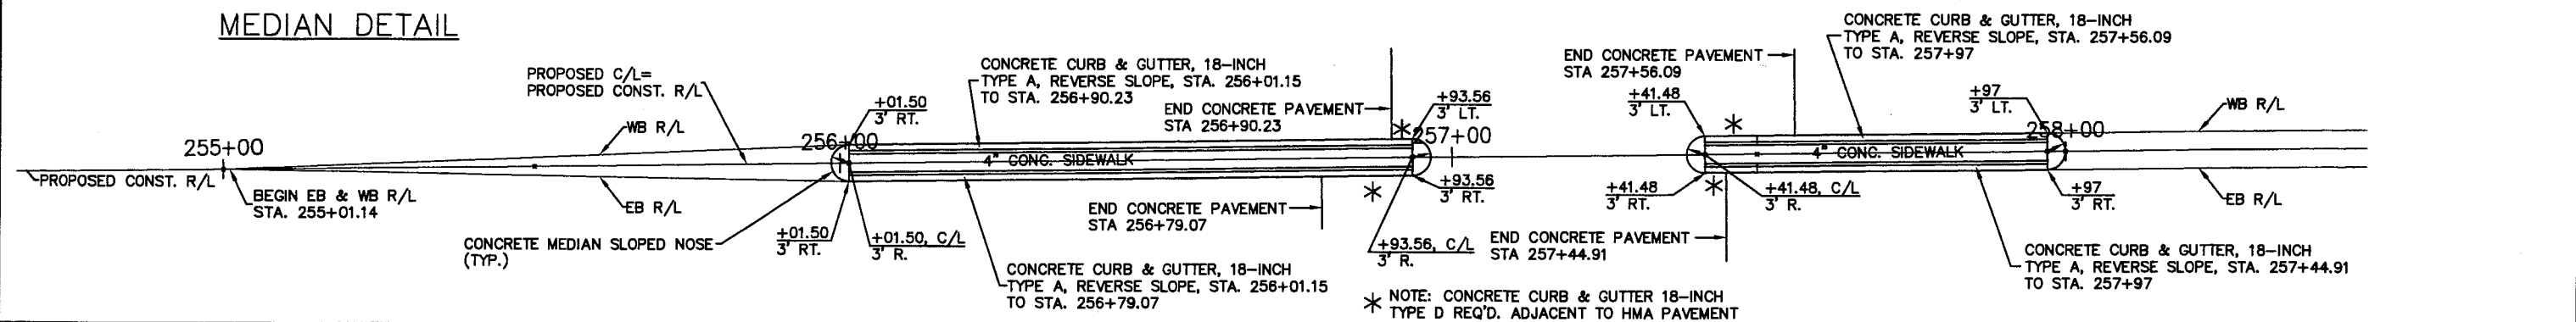


* NOTE: CONCRETE CURB & GUTTER 18-INCH TYPE D REQ'D. ADJACENT TO HMA PAVEMENT


10/22/08 10:21 AM (PROFILE SHEET, UPDATED FINAL ROW-COMPS DEW (2), PROFILE 4-1-08, UPDATED X-CTH Y, FINAL ROW-COMPS DEW, WATERMAIN-1, X-CTH Y, AT&T FIBER CTRY)

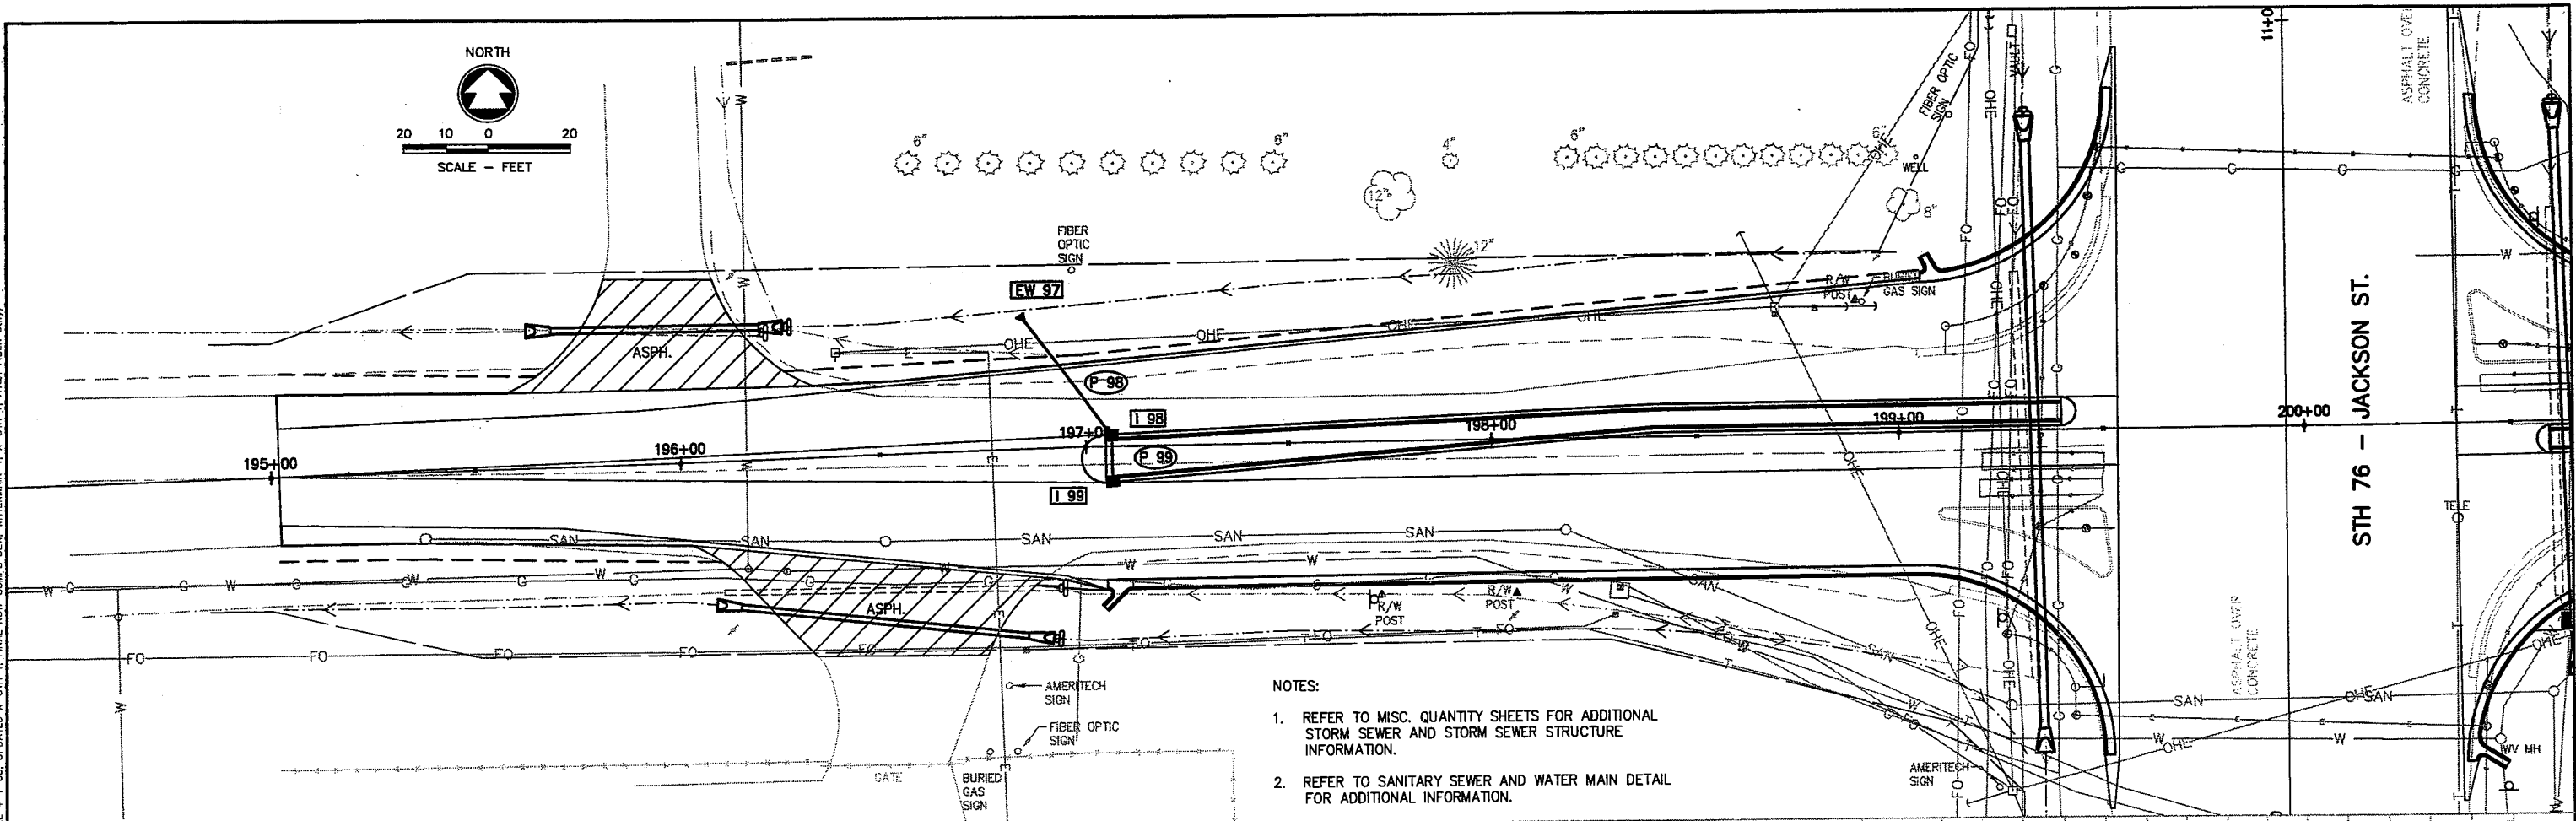


- NOTES:
1. REFER TO MISC. QUANTITY SHEETS FOR ADDITIONAL STORM SEWER AND STORM SEWER STRUCTURE INFORMATION.
 2. REFER TO SANITARY SEWER AND WATER MAIN DETAIL FOR ADDITIONAL INFORMATION.


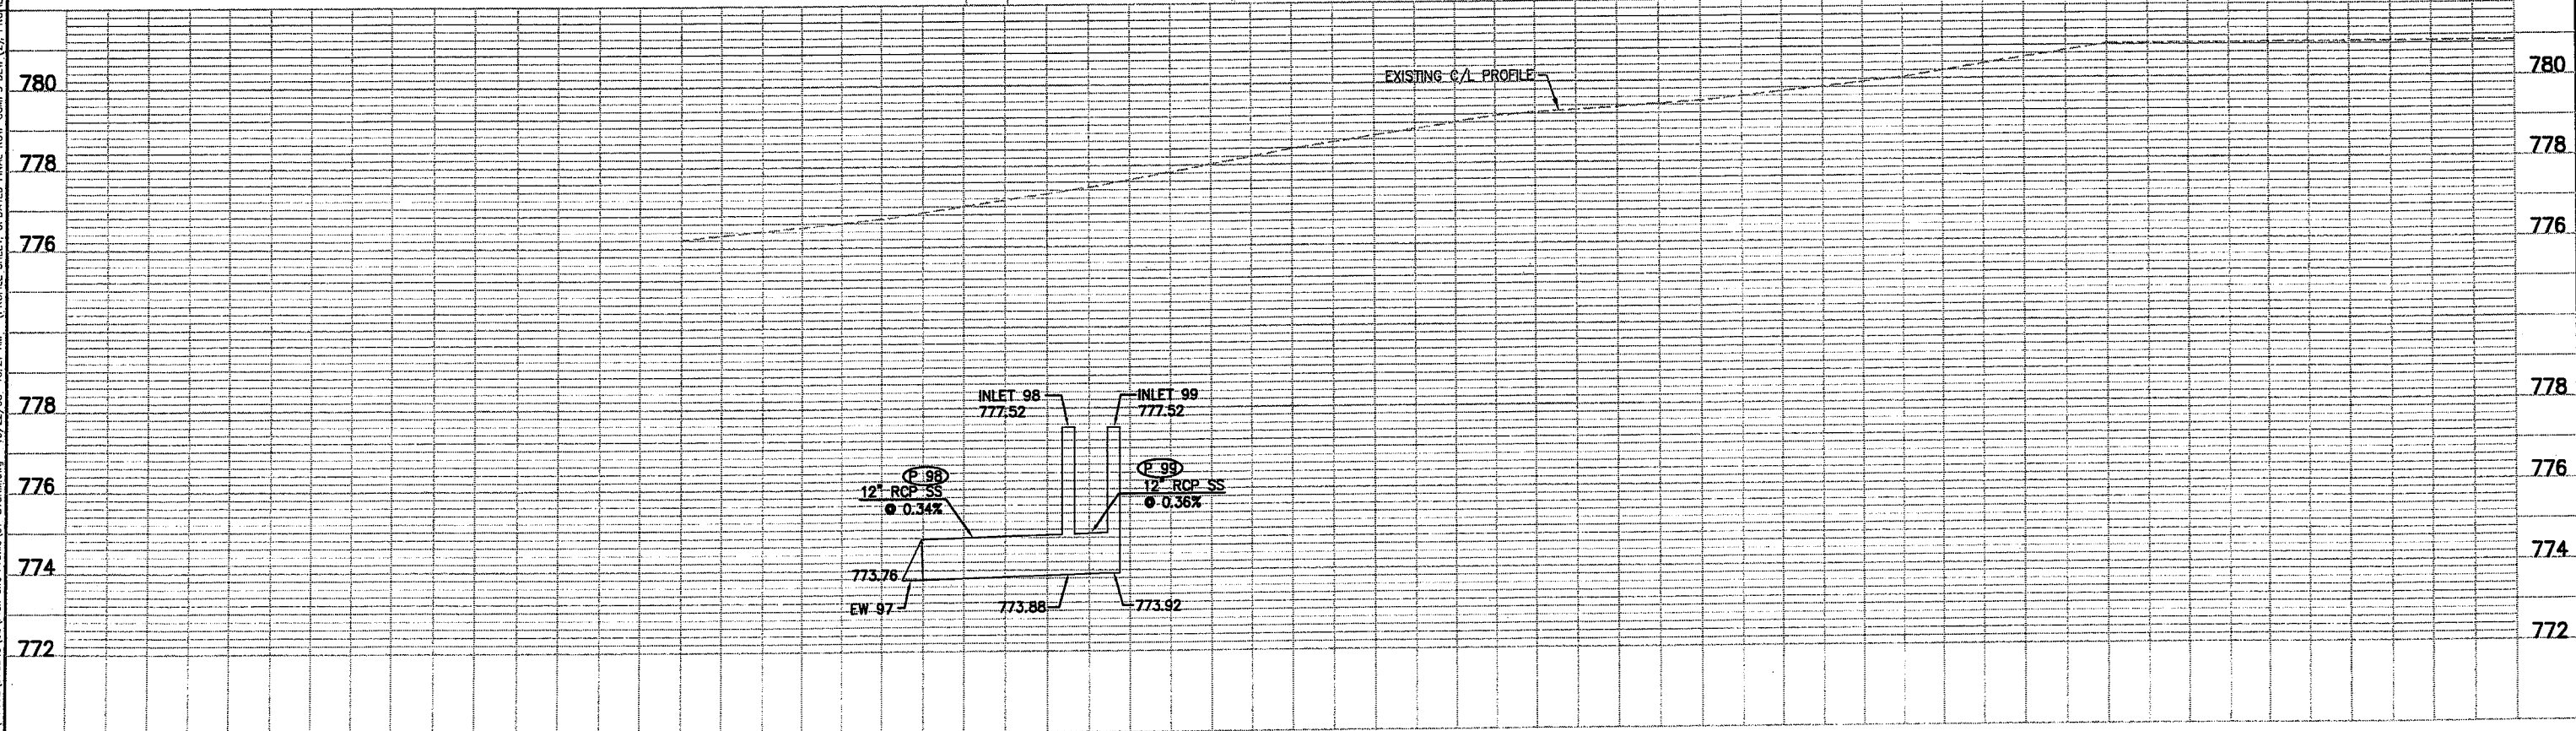


07/16/08 1:32 PM (UPDATED FINAL ROW-COMPS DEW (2), PROFILE 4-1-08, UPDATED X-CTH Y. AT&T FIBER CITY)
 W:\DWG\0002\970343\00\Plan and Profile\02-STORM.dwg

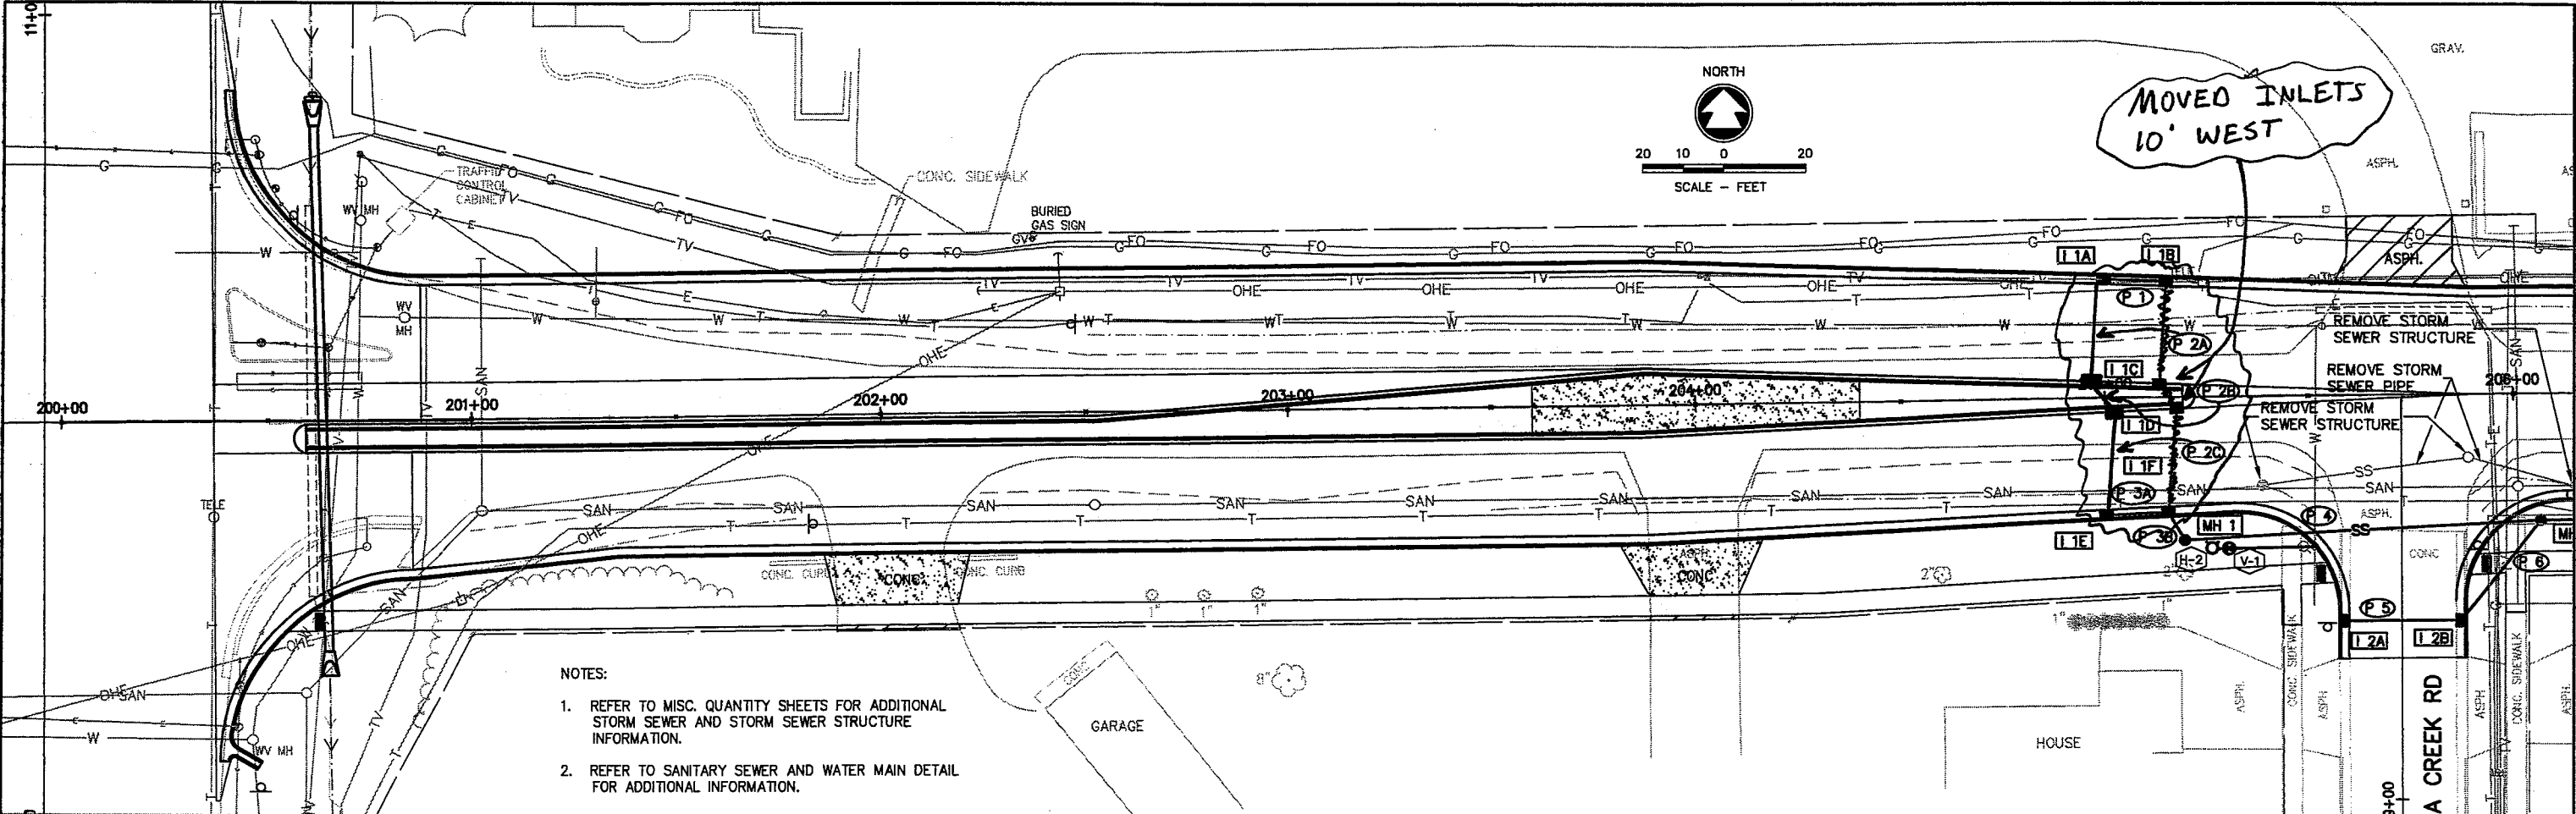


- NOTES:
1. REFER TO MISC. QUANTITY SHEETS FOR ADDITIONAL STORM SEWER AND STORM SEWER STRUCTURE INFORMATION.
 2. REFER TO SANITARY SEWER AND WATER MAIN DETAIL FOR ADDITIONAL INFORMATION.


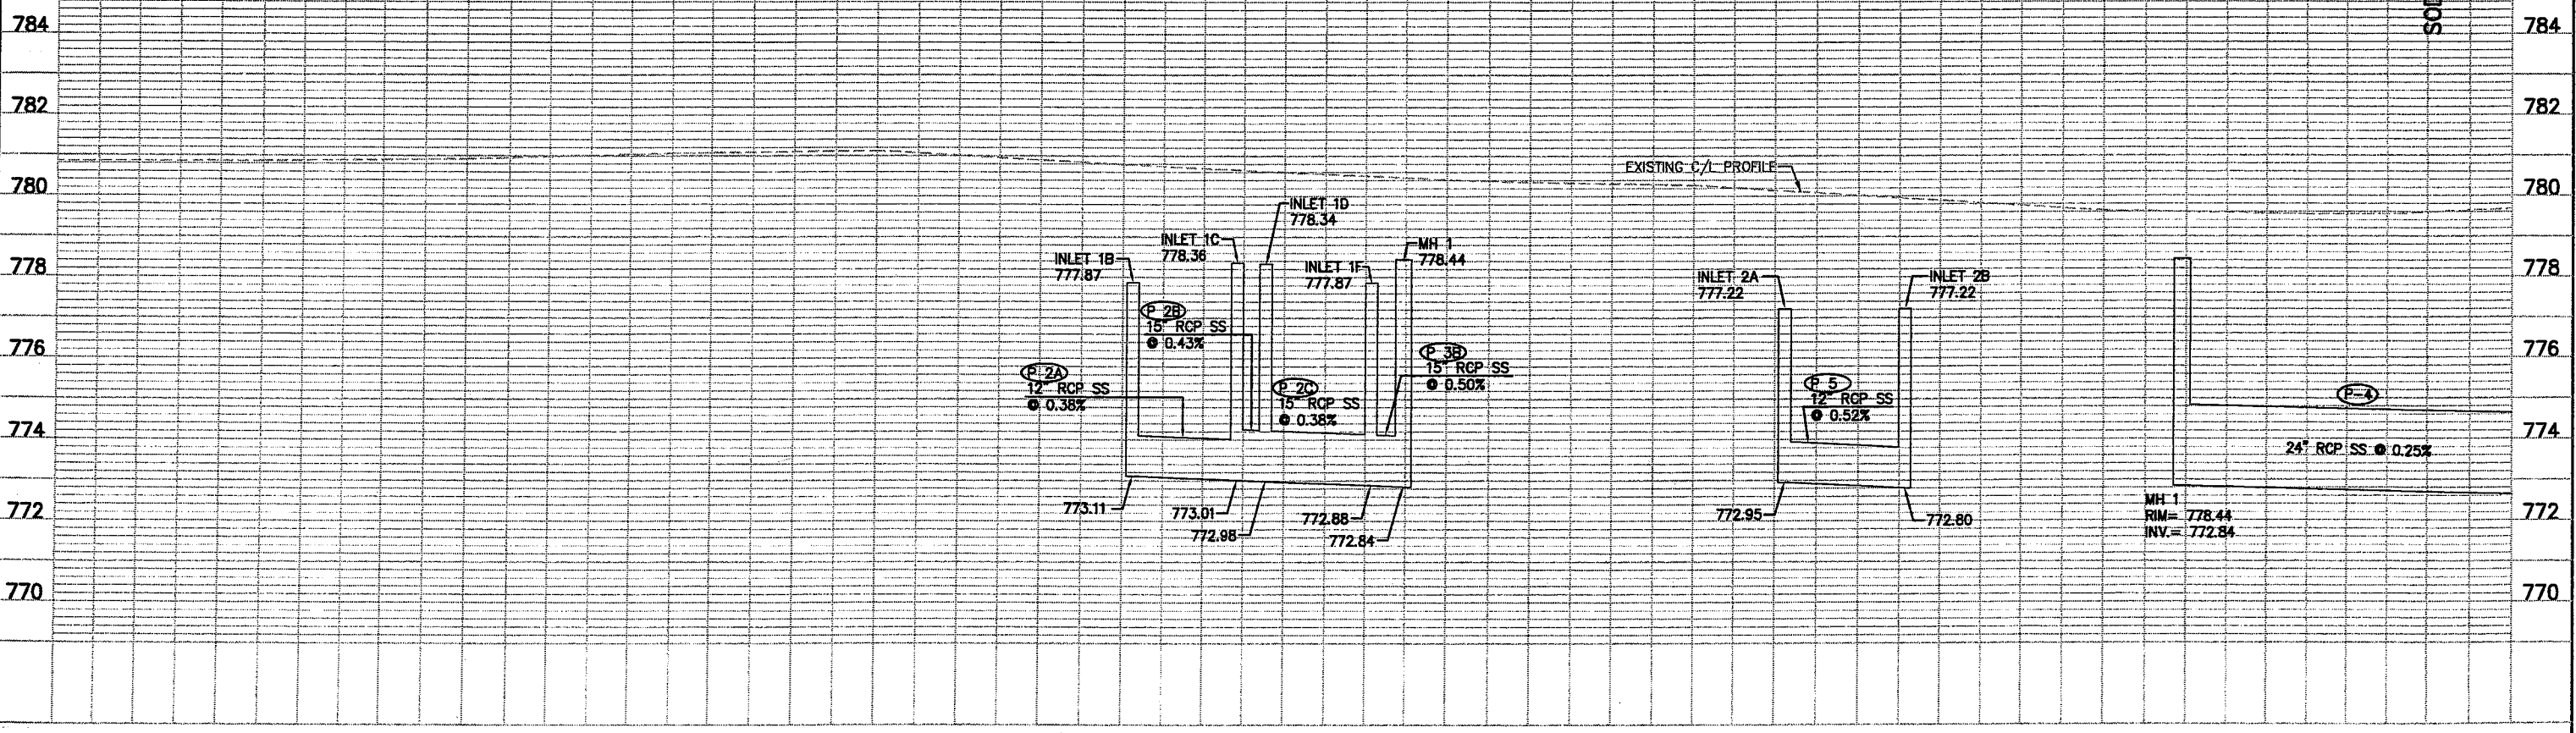


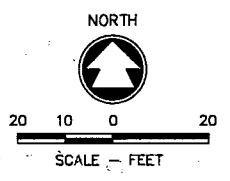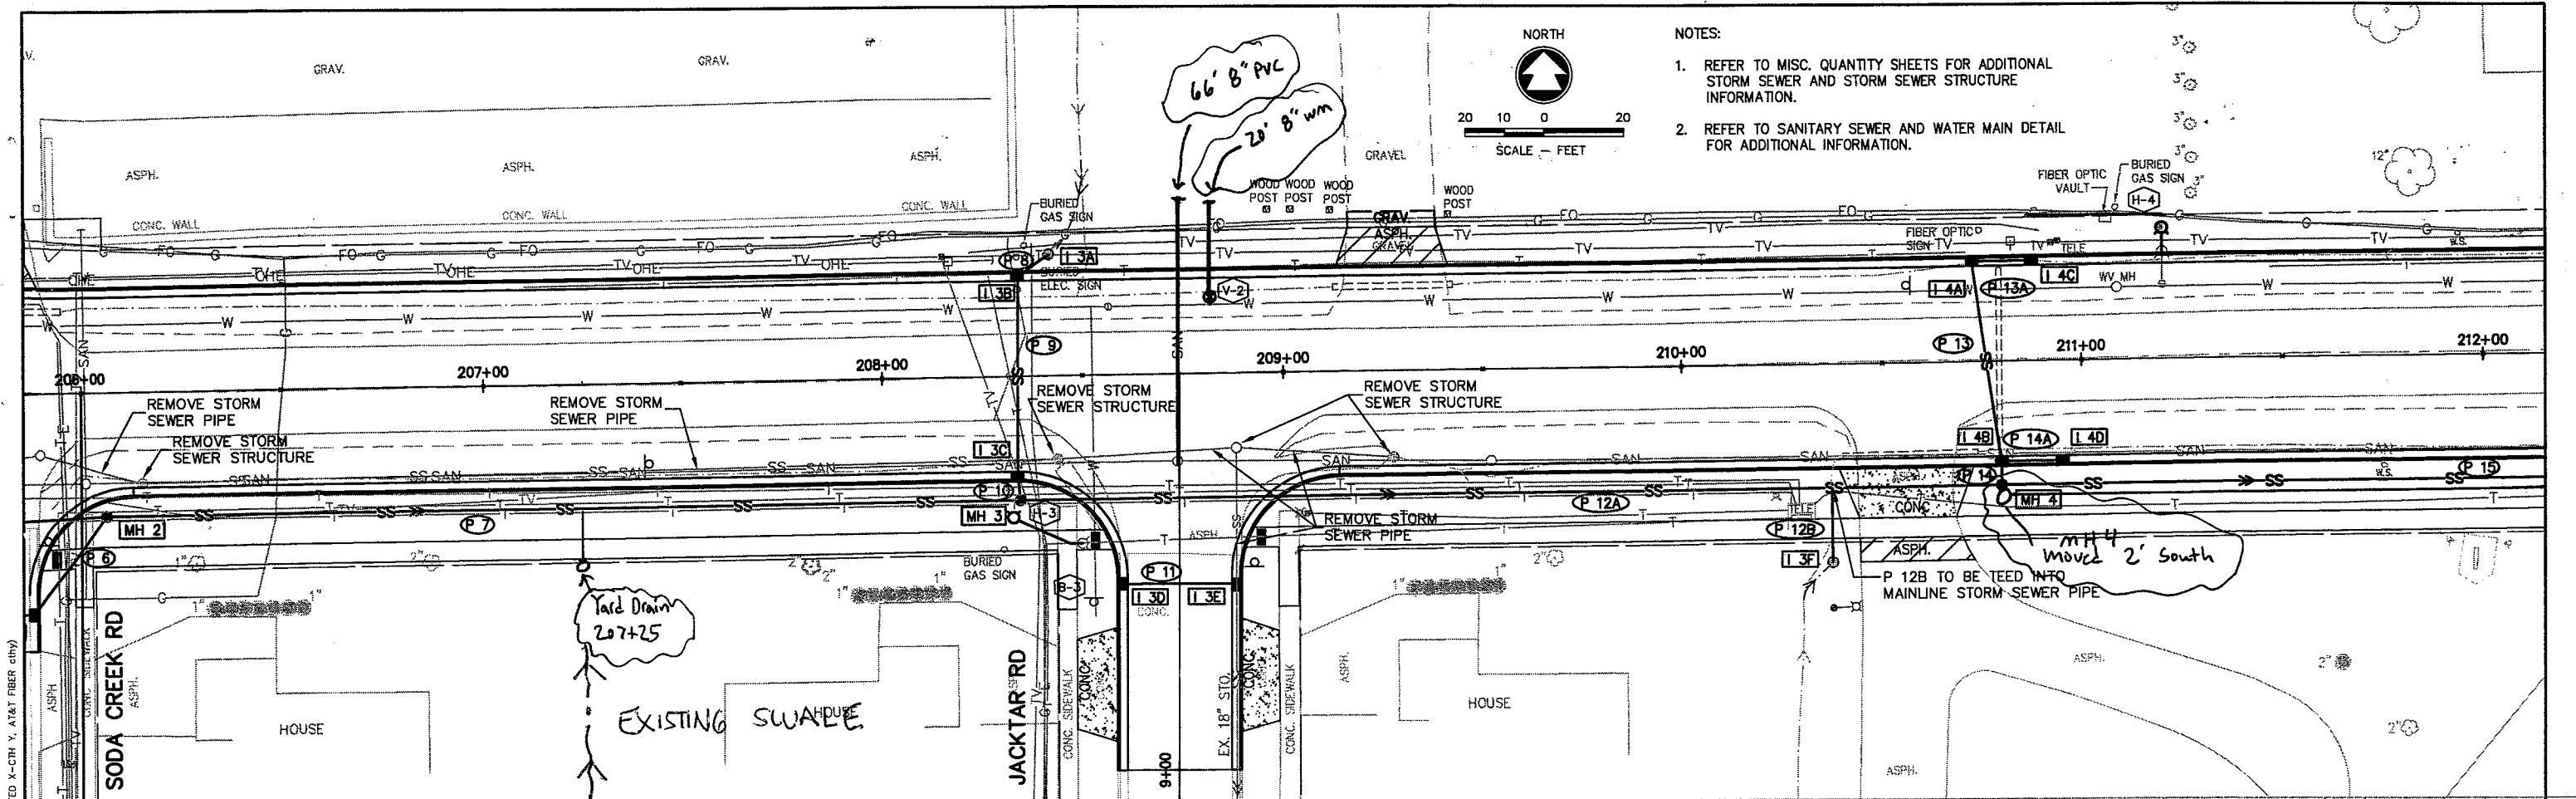


- NOTES:
1. REFER TO MISC. QUANTITY SHEETS FOR ADDITIONAL STORM SEWER AND STORM SEWER STRUCTURE INFORMATION.
 2. REFER TO SANITARY SEWER AND WATER MAIN DETAIL FOR ADDITIONAL INFORMATION.

W:\DWC\002\970343\00\Plan and Profile\03-510R01.dwg 07/19/08 8:42 AM (UPDATED FINAL ROW-COMPS DEW (2), PROFILE 4-1-08, UPDATED X-CTH Y, AT&T FIBER CITY)

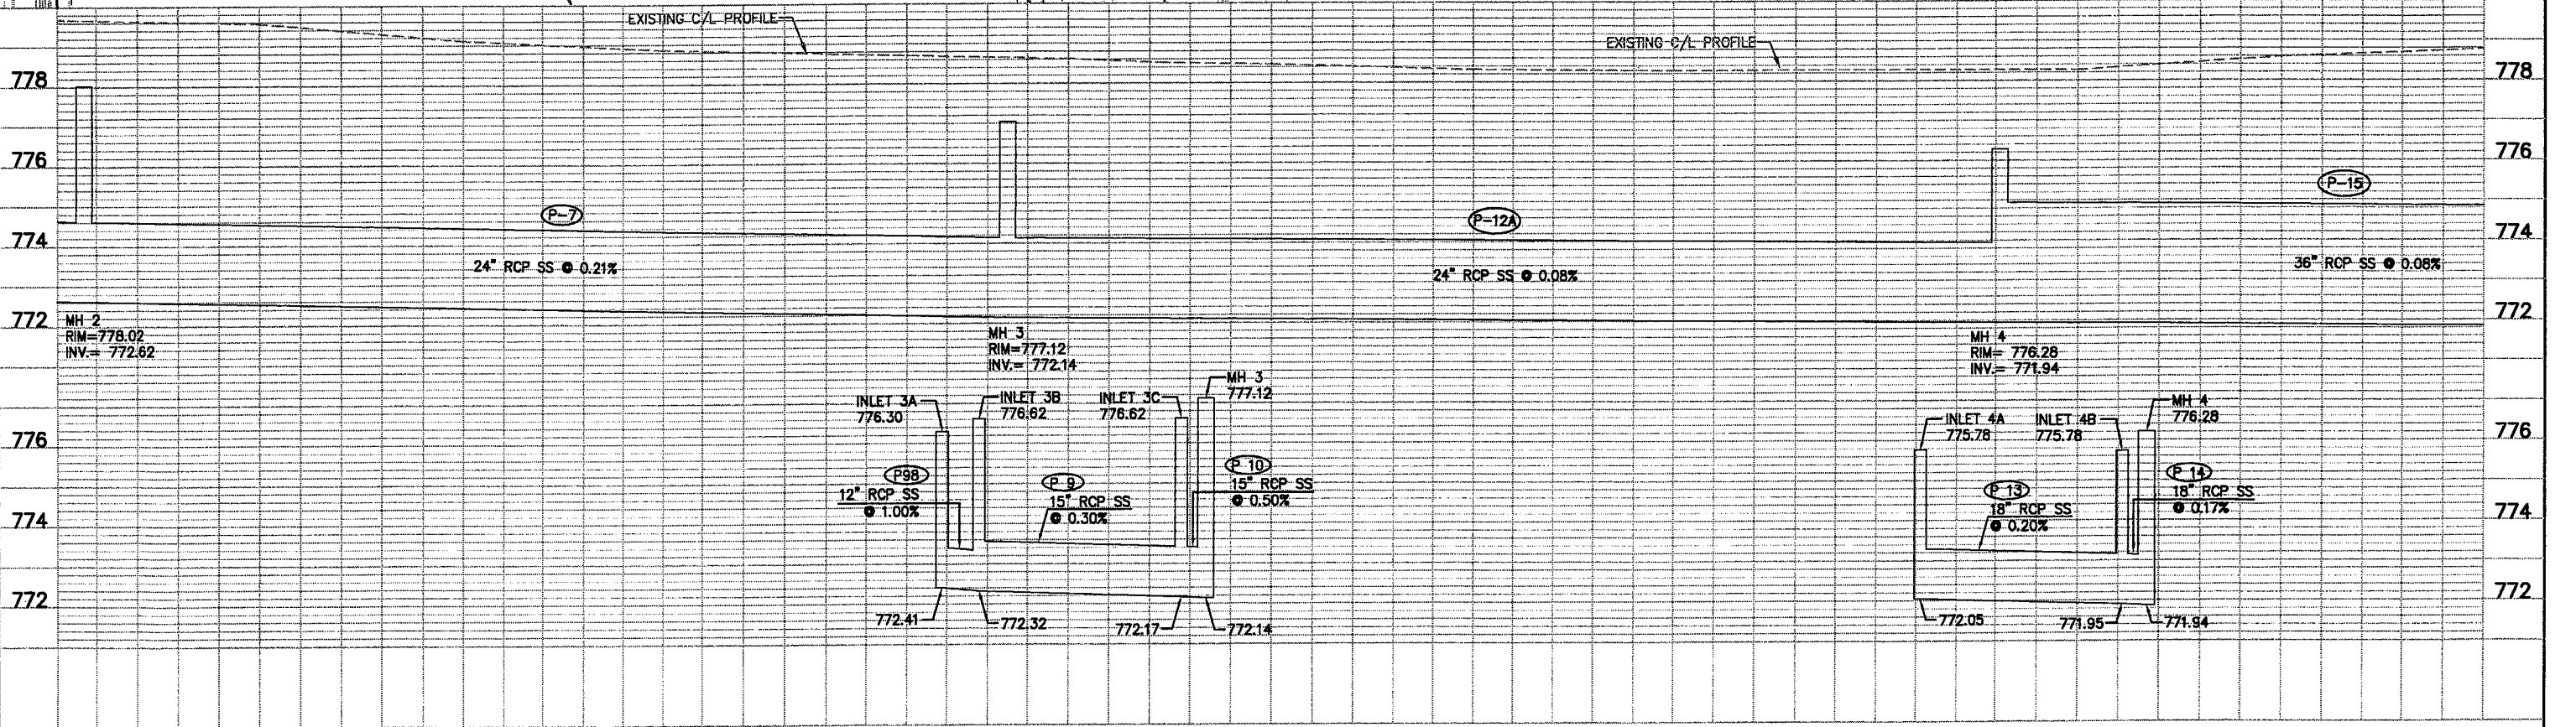

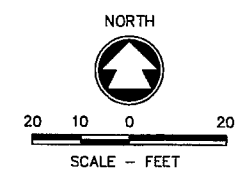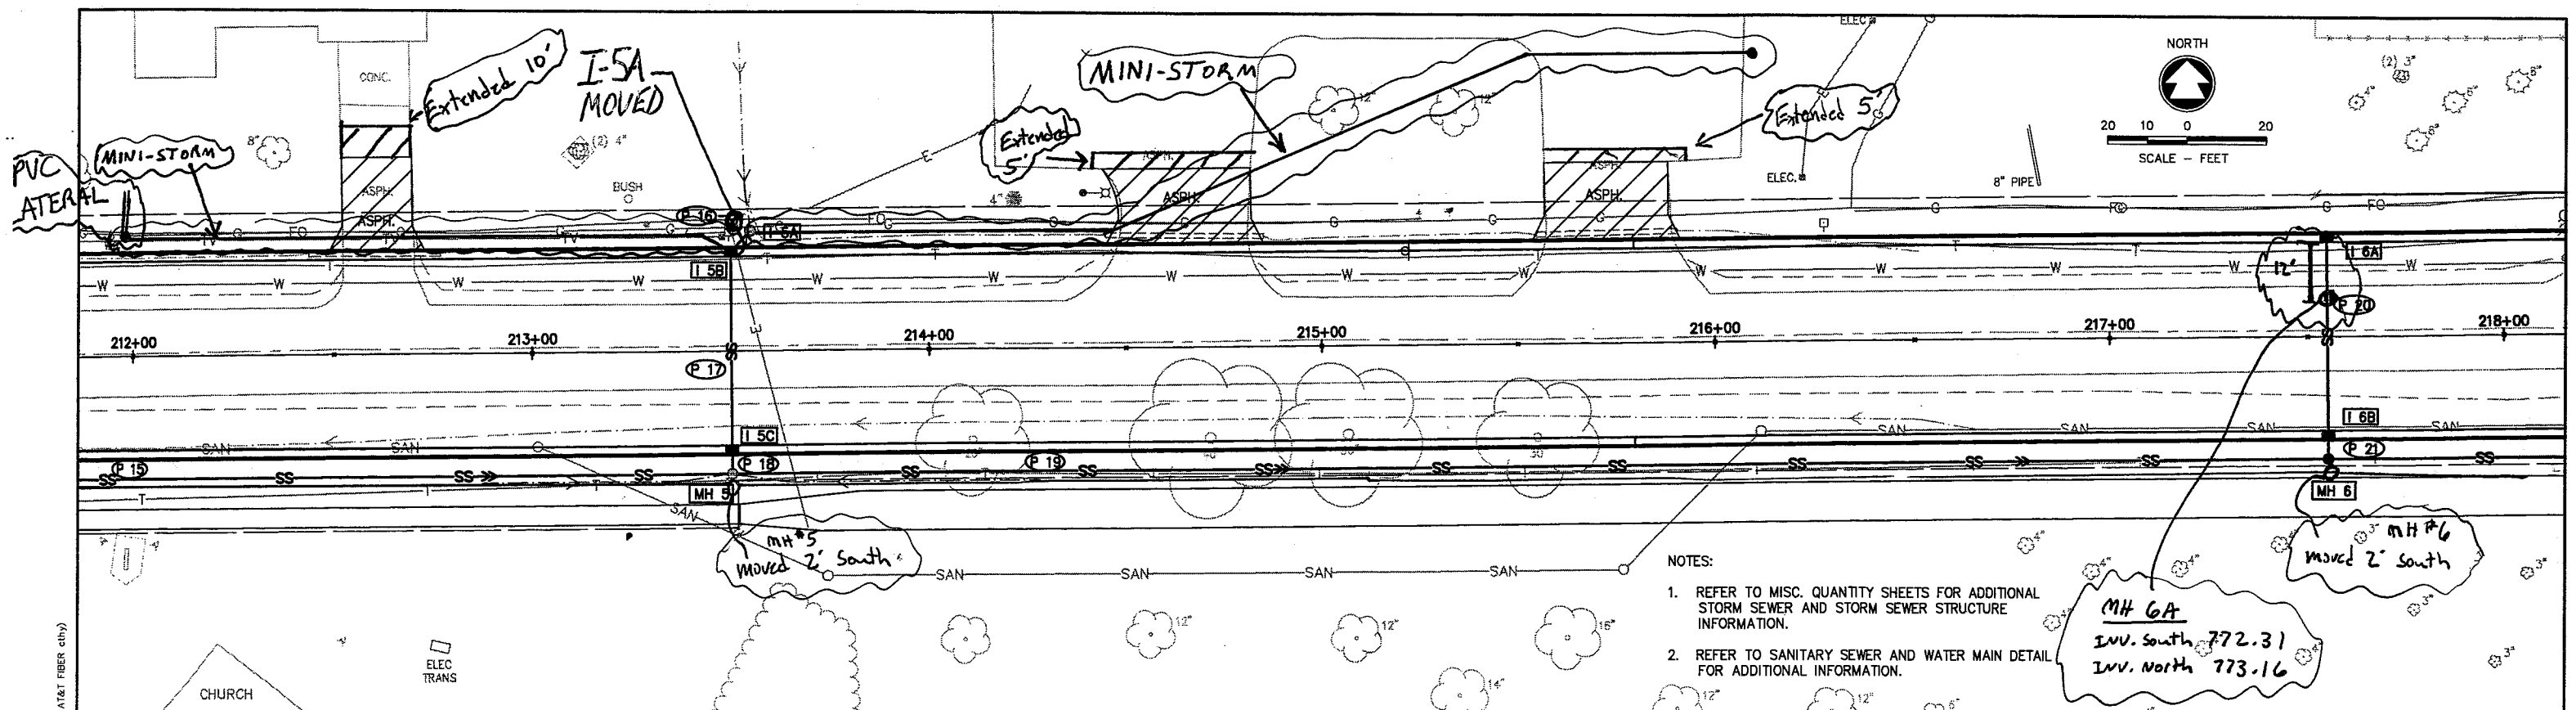


- NOTES:
- REFER TO MISC. QUANTITY SHEETS FOR ADDITIONAL STORM SEWER AND STORM SEWER STRUCTURE INFORMATION.
 - REFER TO SANITARY SEWER AND WATER MAIN DETAIL FOR ADDITIONAL INFORMATION.

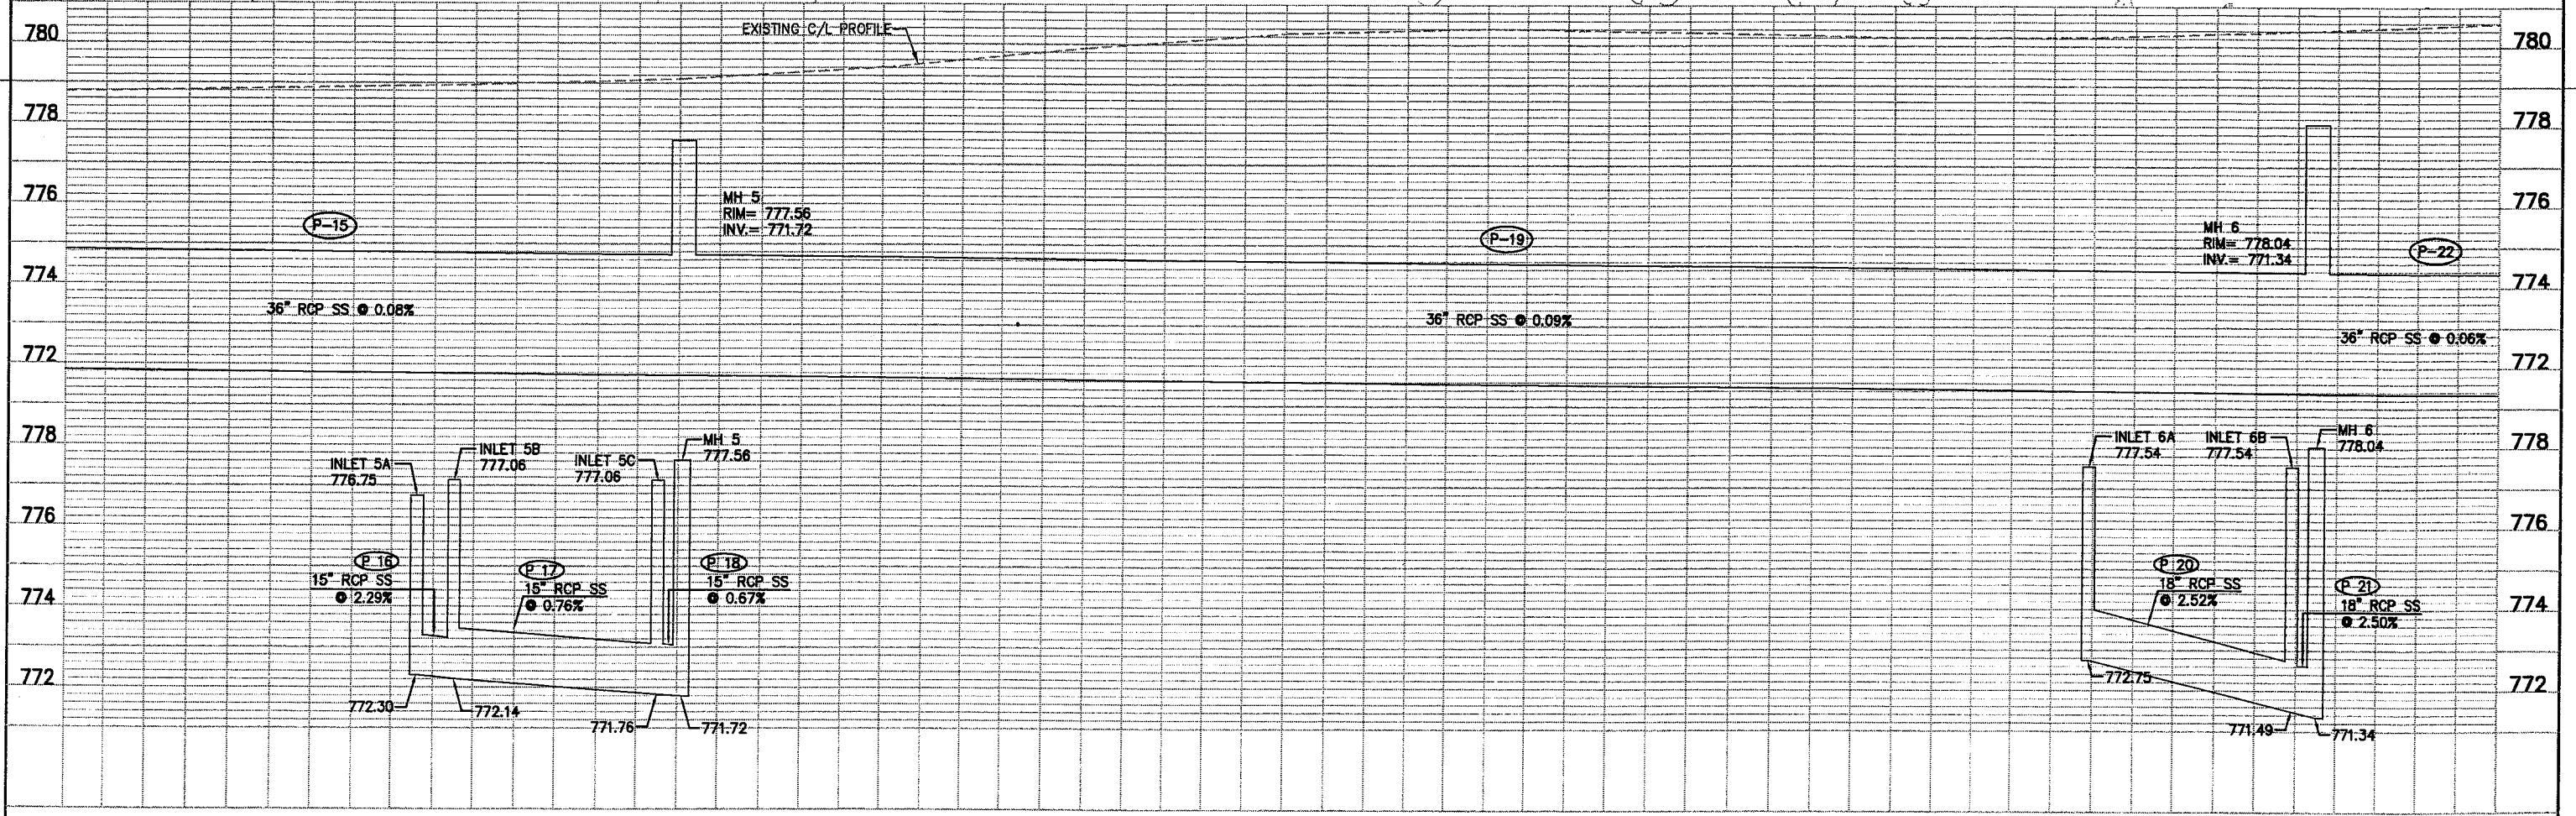


W:\DWG\W0002\970343\00\Plan and Profile\01-SS-STORM.dwg 07/16/08 2:03 PM (UPDATED FINAL ROW-COMPS DEW (2), PROFILE 4-1-08, UPDATED X-CTH Y, A&T FIBER CITY)


W:\GIS\W0002\970343\00\Plan and Profile\05-STORM.dwg 07/16/08 8:58 AM (UPDATED FINAL ROW-COMPS DEW (2), PROFILE 4-1-08, UPDATED X-CTH Y, AT&T FIBER CITY)

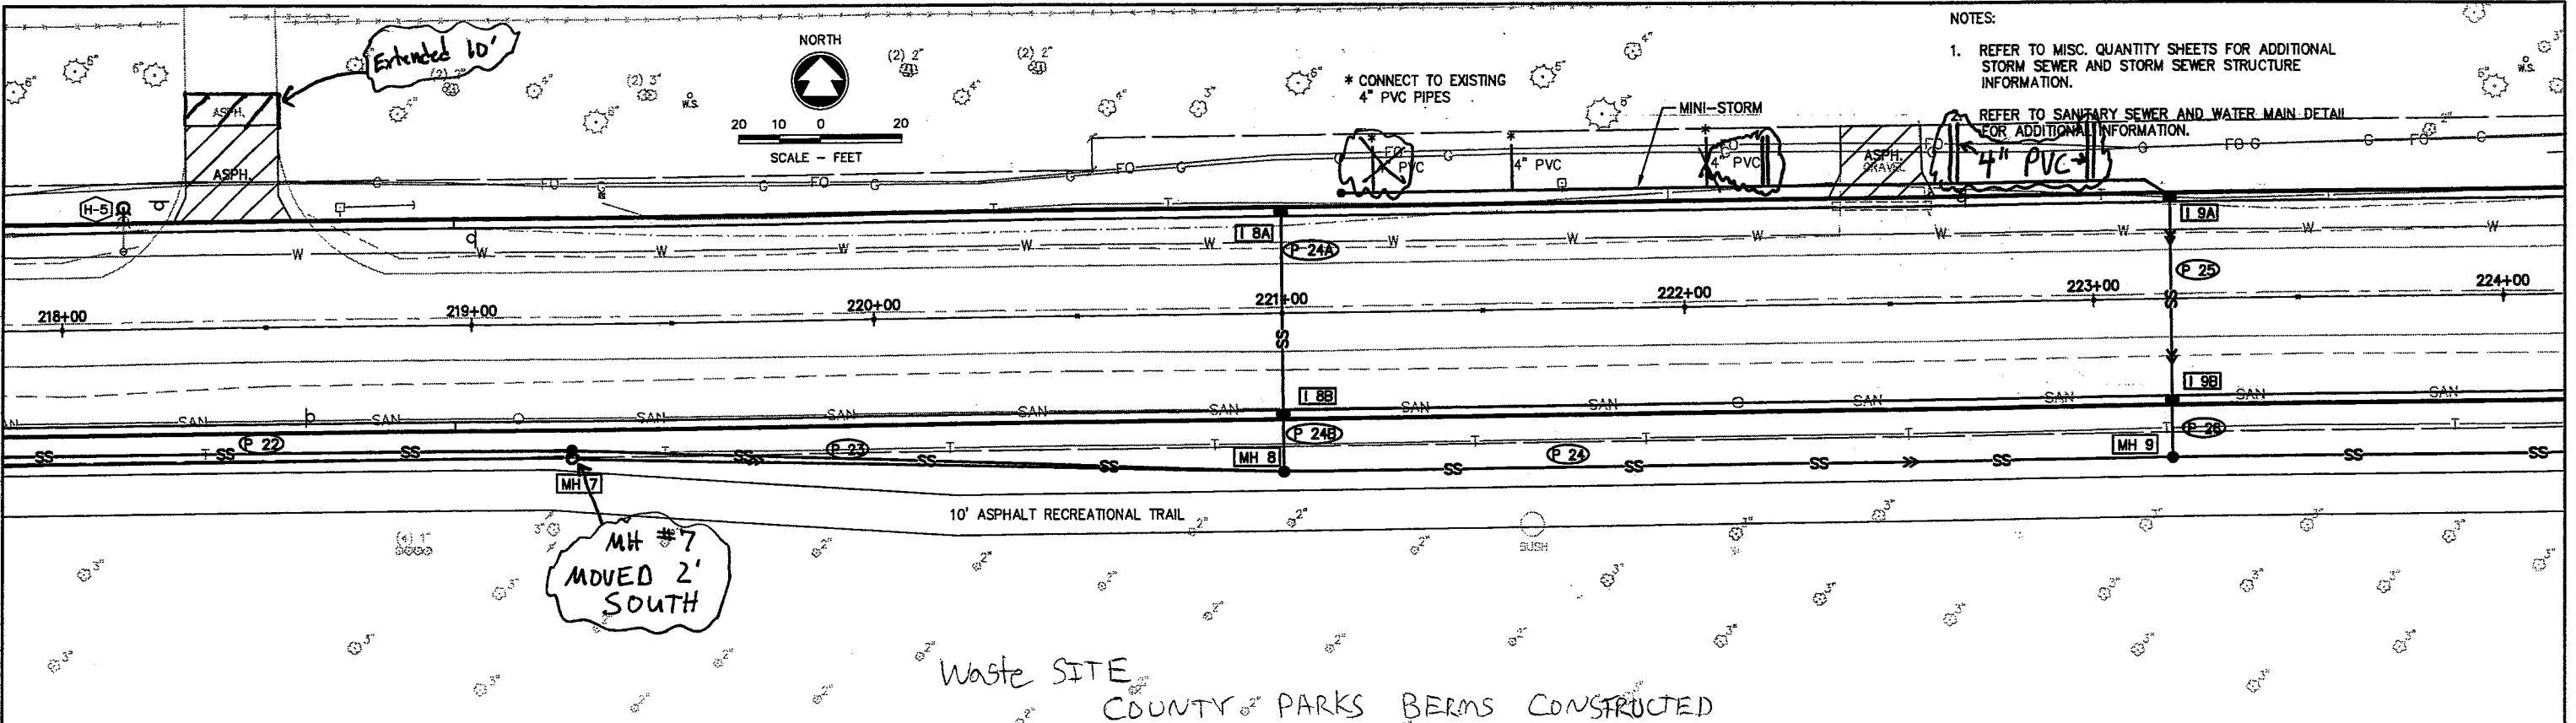

NOTES:



1. REFER TO MISC. QUANTITY SHEETS FOR ADDITIONAL STORM SEWER AND STORM SEWER STRUCTURE INFORMATION.
2. REFER TO SANITARY SEWER AND WATER MAIN DETAIL FOR ADDITIONAL INFORMATION.

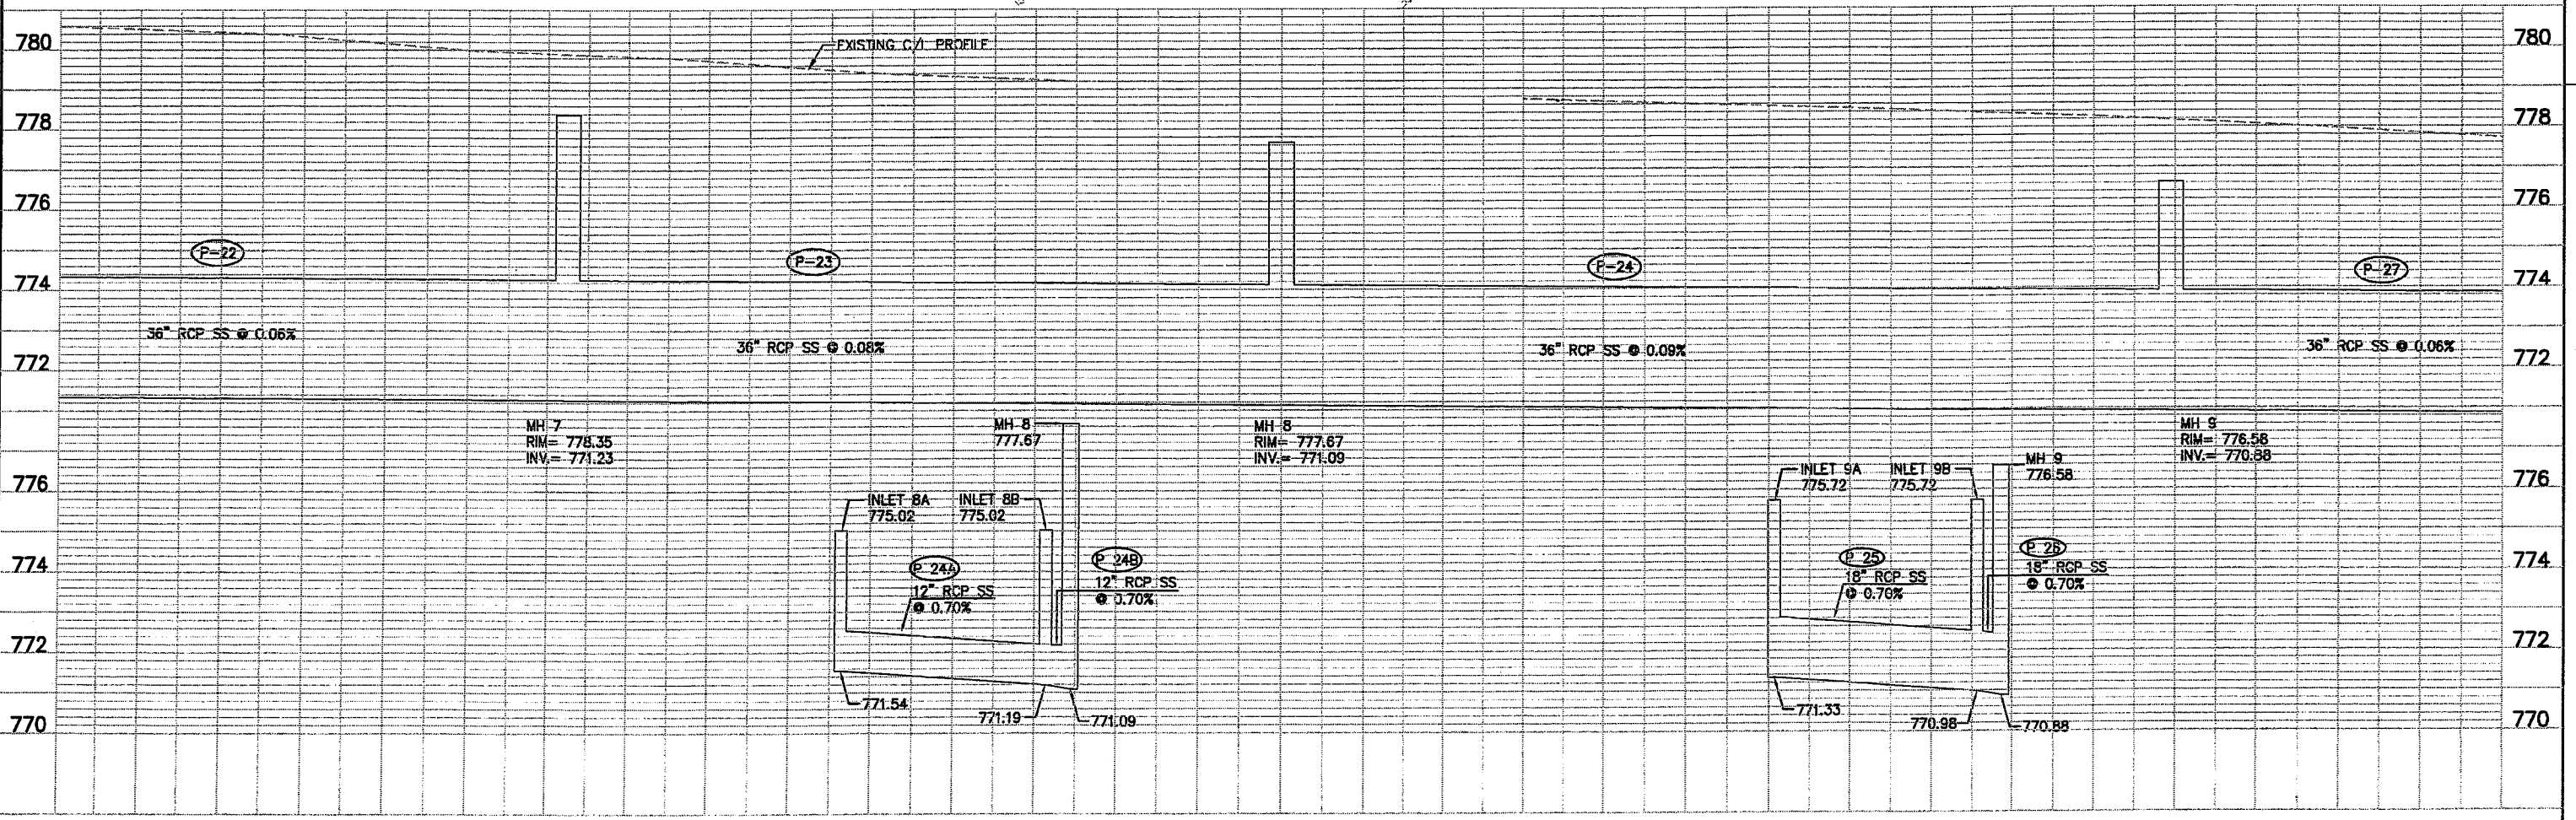


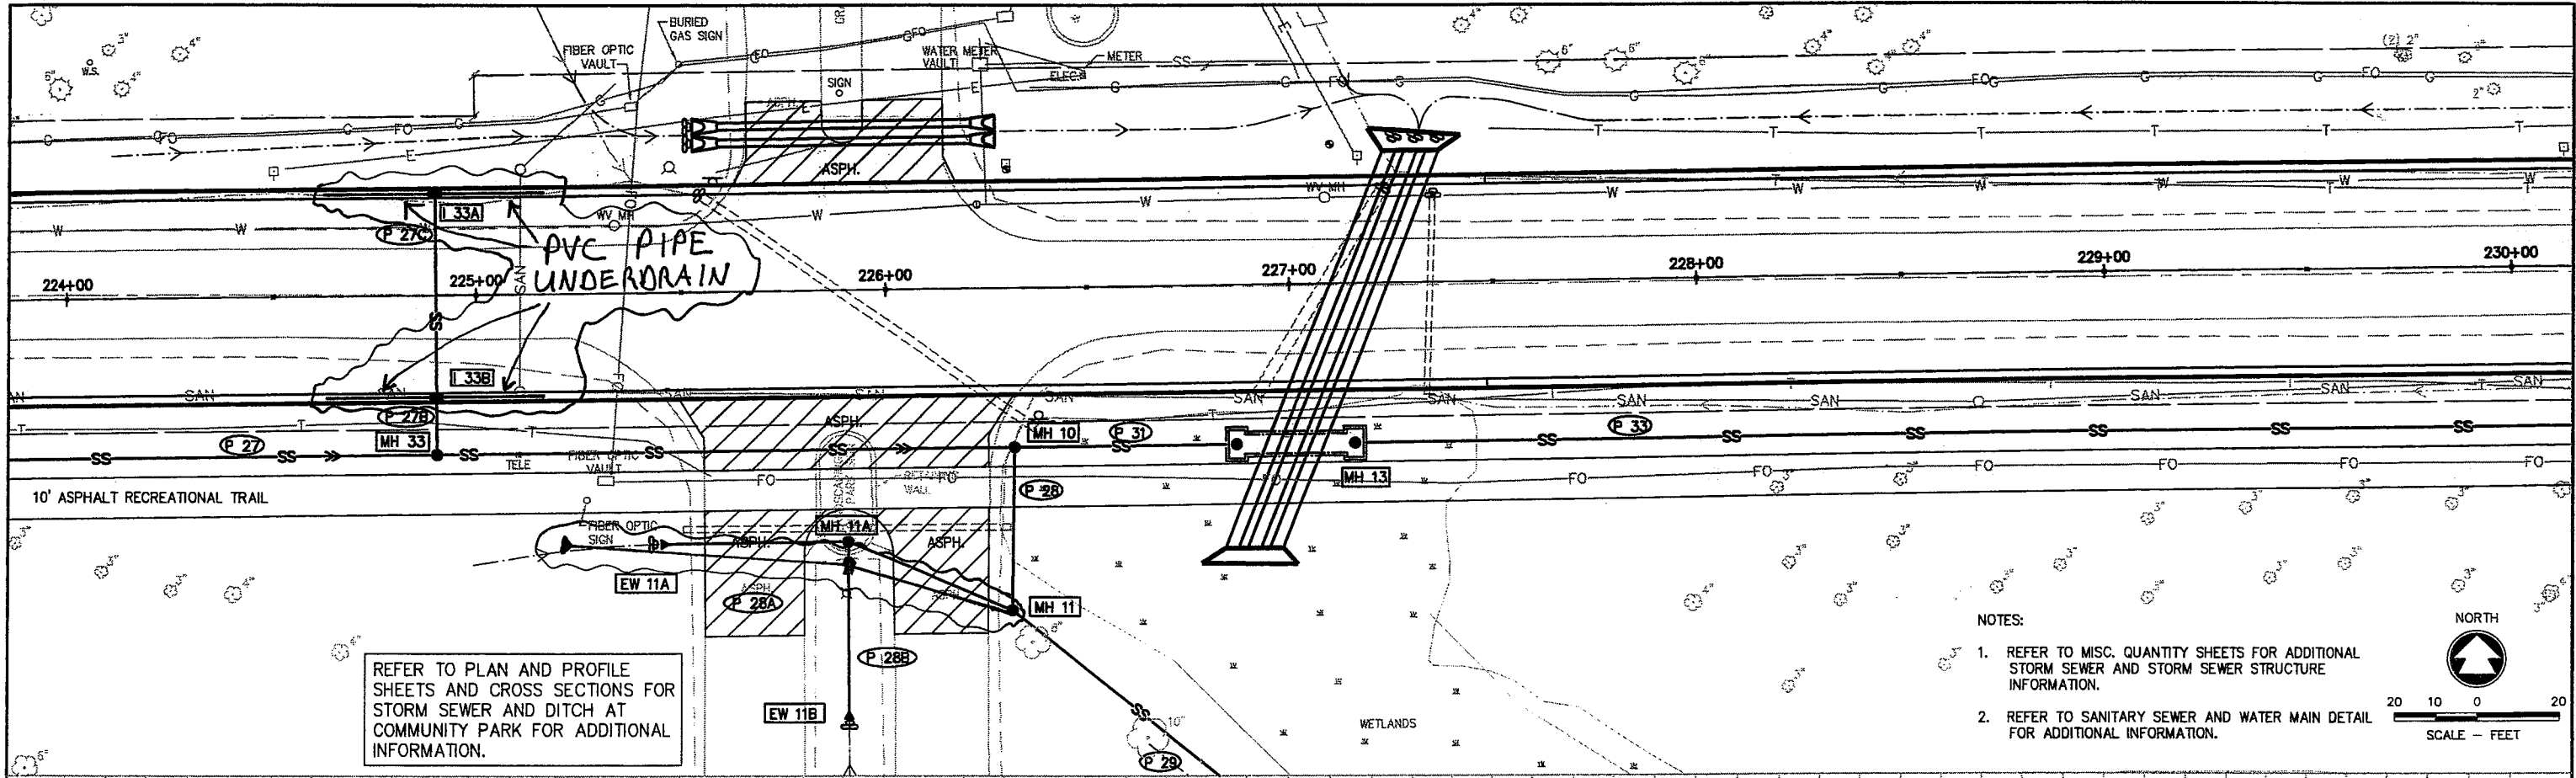


REFER TO PLAN AND PROFILE SHEETS AND CROSS SECTIONS FOR STORM SEWER AND DITCH AT COMMUNITY PARK FOR ADDITIONAL INFORMATION.


- NOTES:
1. REFER TO MISC. QUANTITY SHEETS FOR ADDITIONAL STORM SEWER AND STORM SEWER STRUCTURE INFORMATION.
 2. REFER TO SANITARY SEWER AND WATER MAIN DETAIL FOR ADDITIONAL INFORMATION.

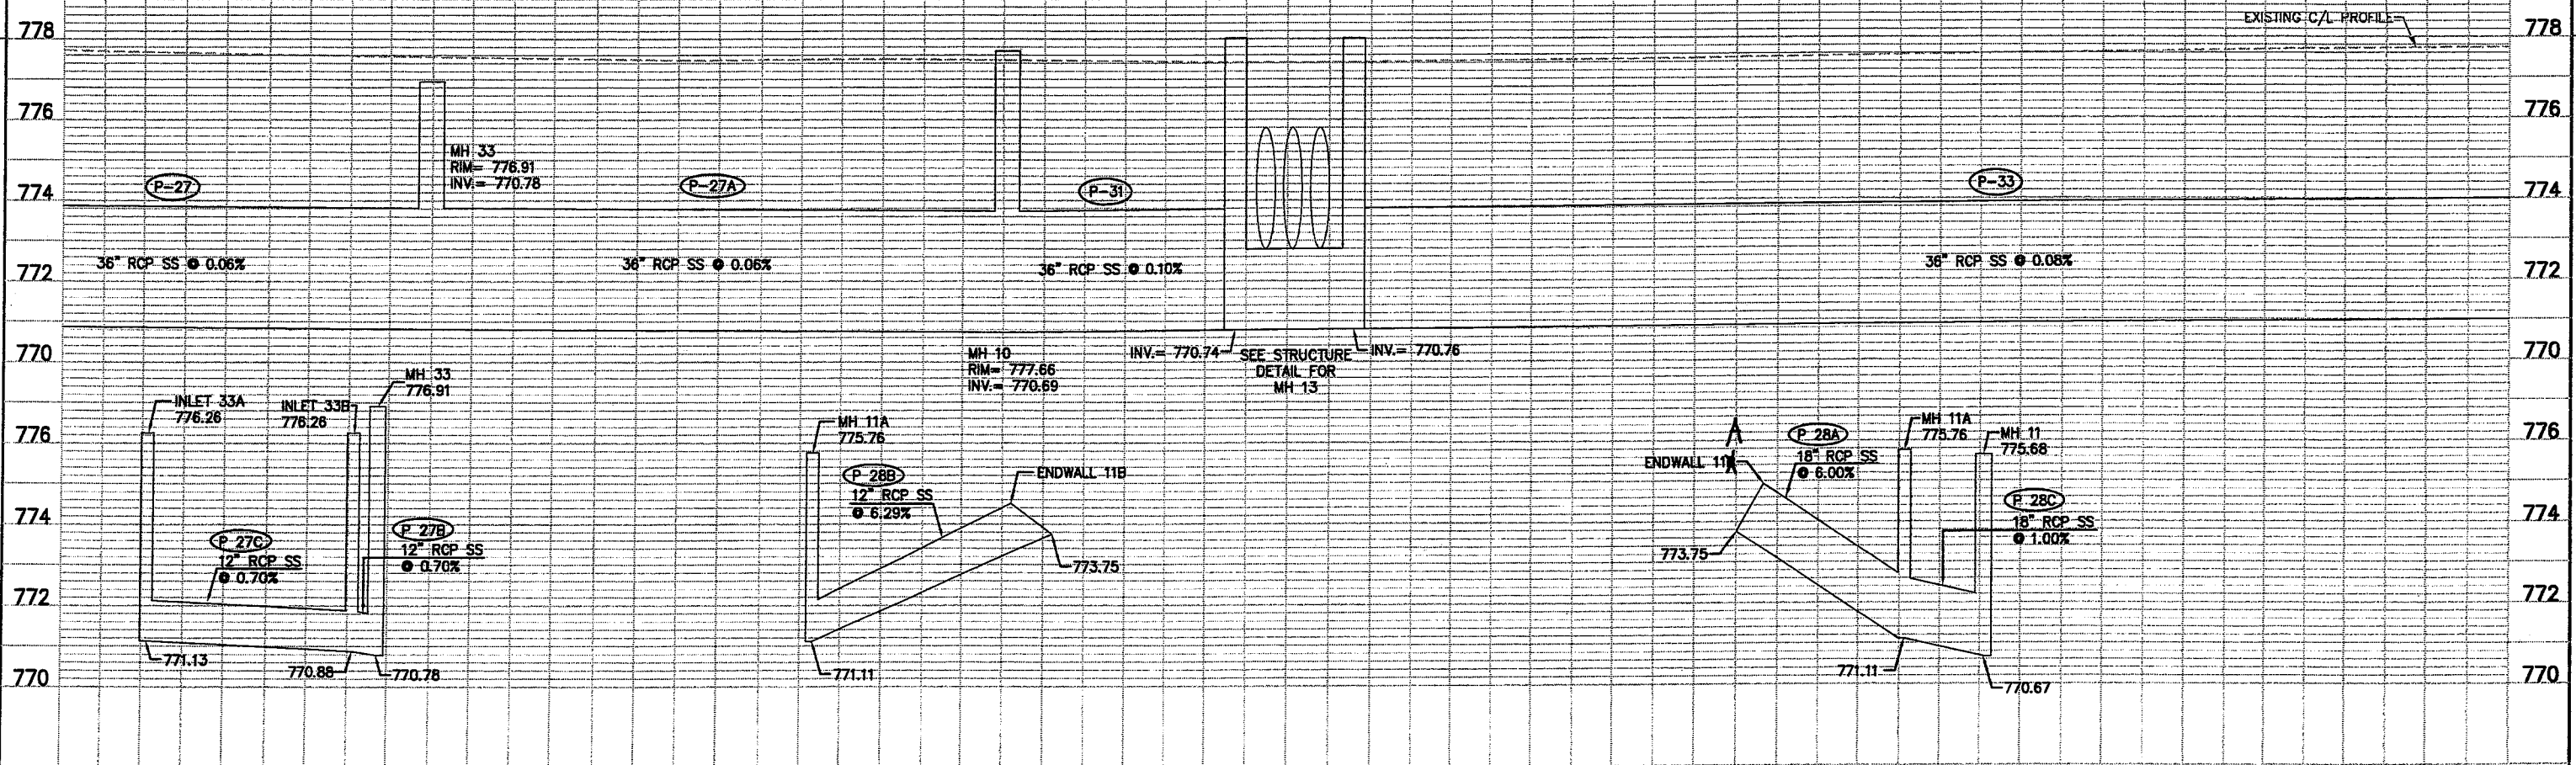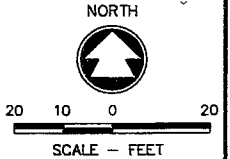


I:\projects\4994\00\4994-00-87\SS\Profile 4-1-08.dwg (UPDATED FINAL ROW-COMPS DEV (2), PROFILE 4-1-08, UPDATED X-CH Y, AT&T FIBER CITY) 07/16/08 3:11 PM

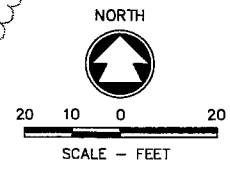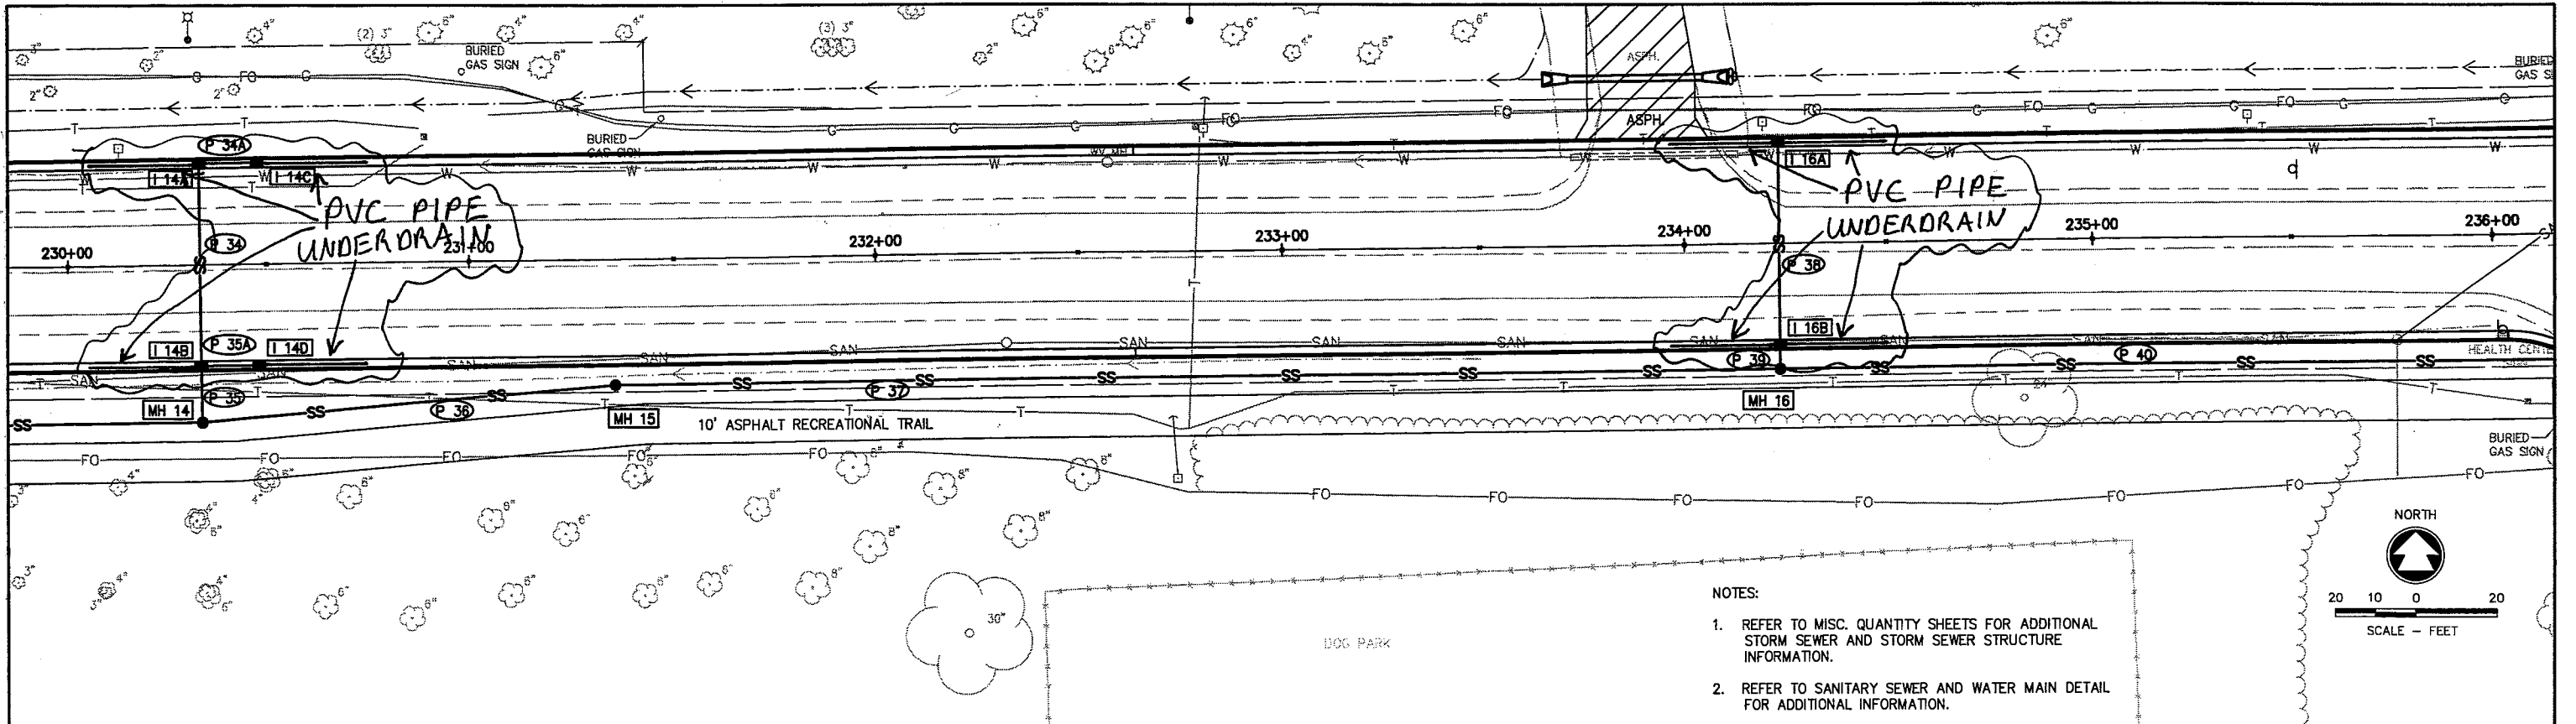



- NOTES:
1. REFER TO MISC. QUANTITY SHEETS FOR ADDITIONAL STORM SEWER AND STORM SEWER STRUCTURE INFORMATION.
 2. REFER TO SANITARY SEWER AND WATER MAIN DETAIL FOR ADDITIONAL INFORMATION.

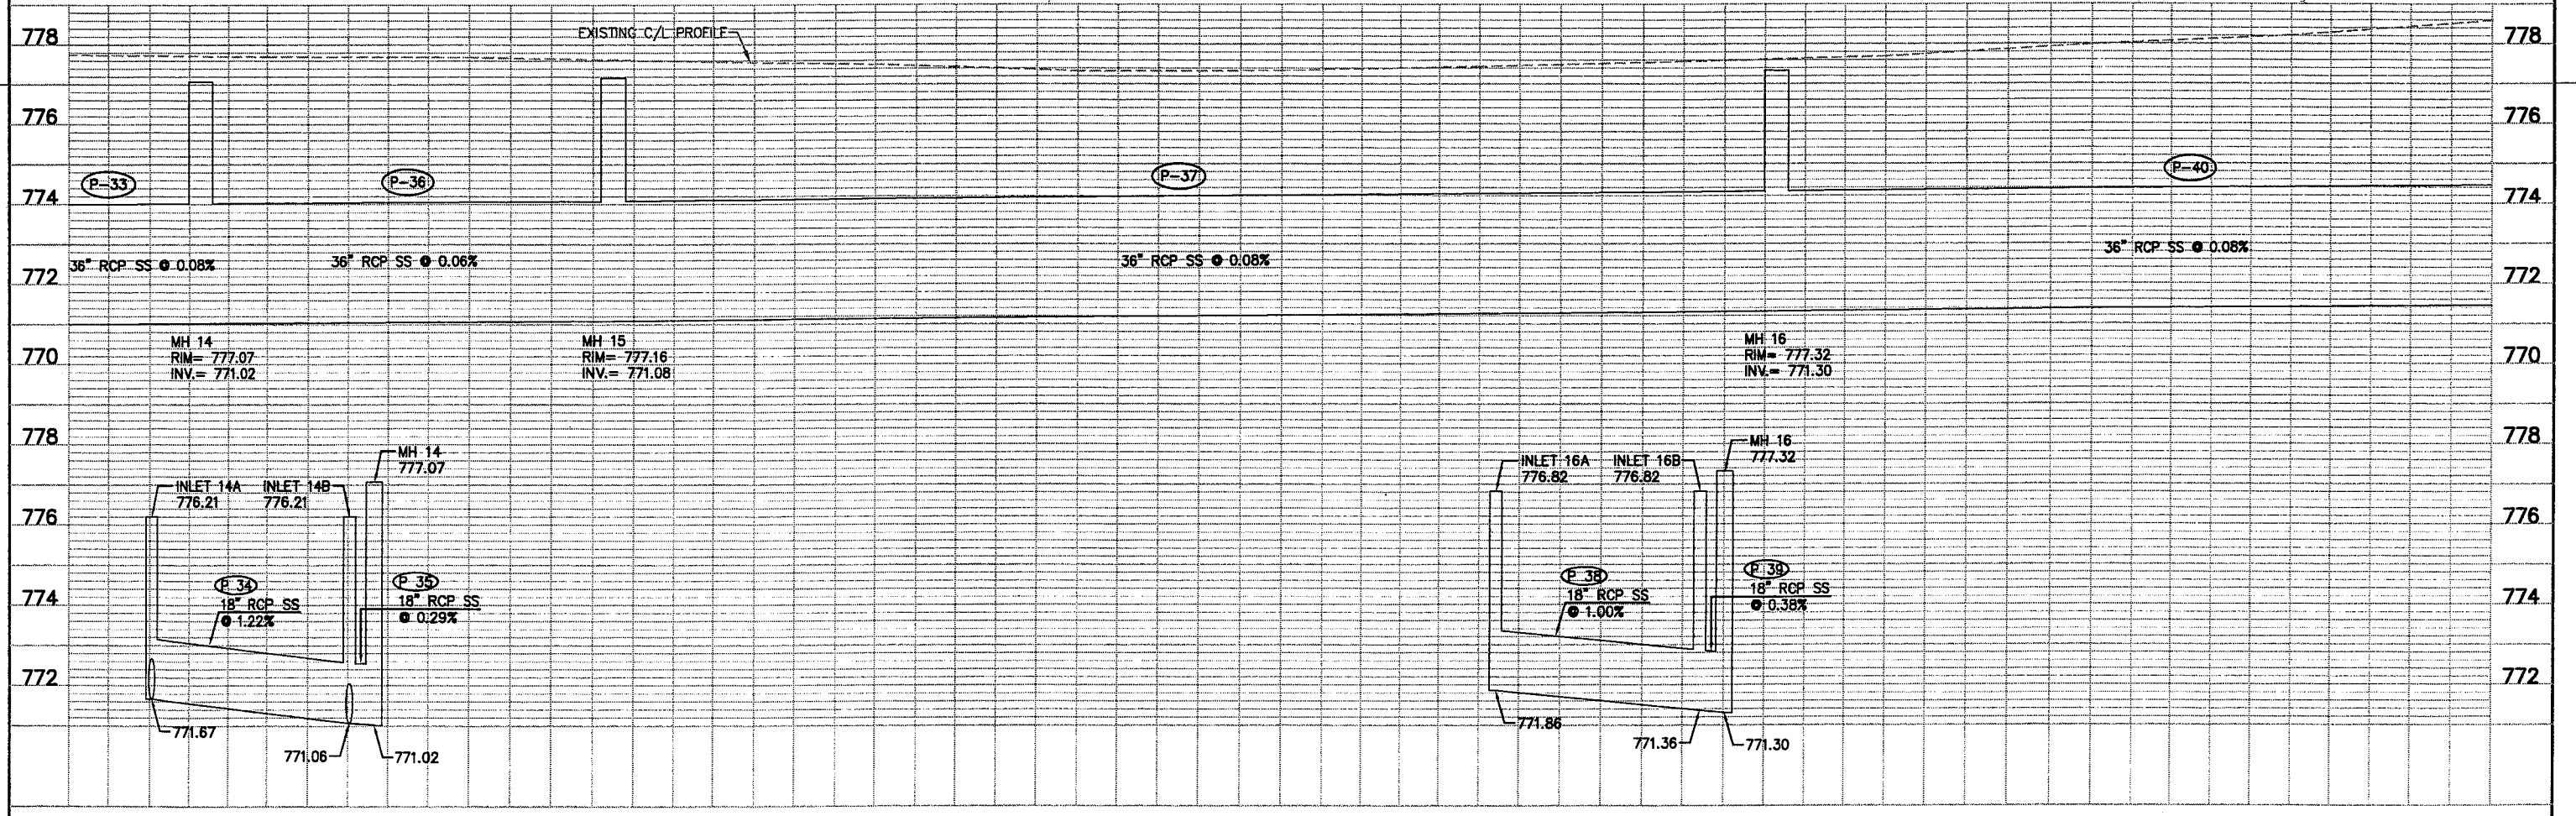

07/18/08 9:00 AM (UPDATED FINAL ROW-COMPS DEW (2), PROFILE 4-1-08, UPDATED X-CTH Y, AT&T FIBER CITY)


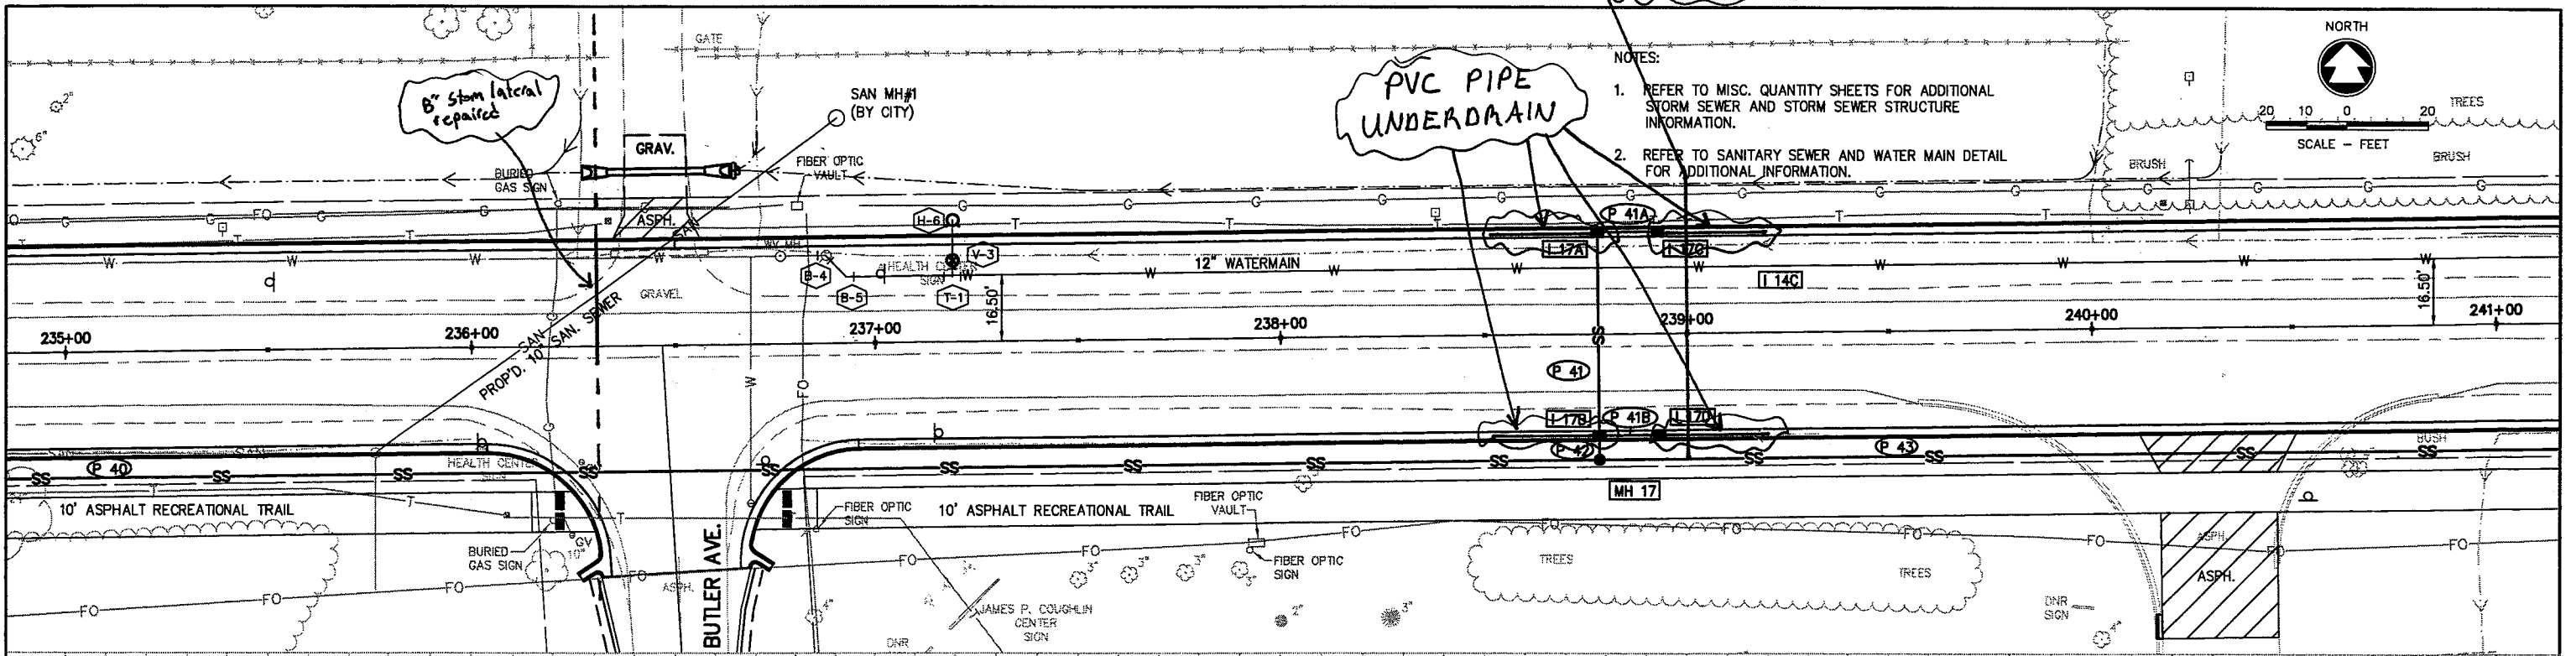


- NOTES:
1. REFER TO MISC. QUANTITY SHEETS FOR ADDITIONAL STORM SEWER AND STORM SEWER STRUCTURE INFORMATION.
 2. REFER TO SANITARY SEWER AND WATER MAIN DETAIL FOR ADDITIONAL INFORMATION.

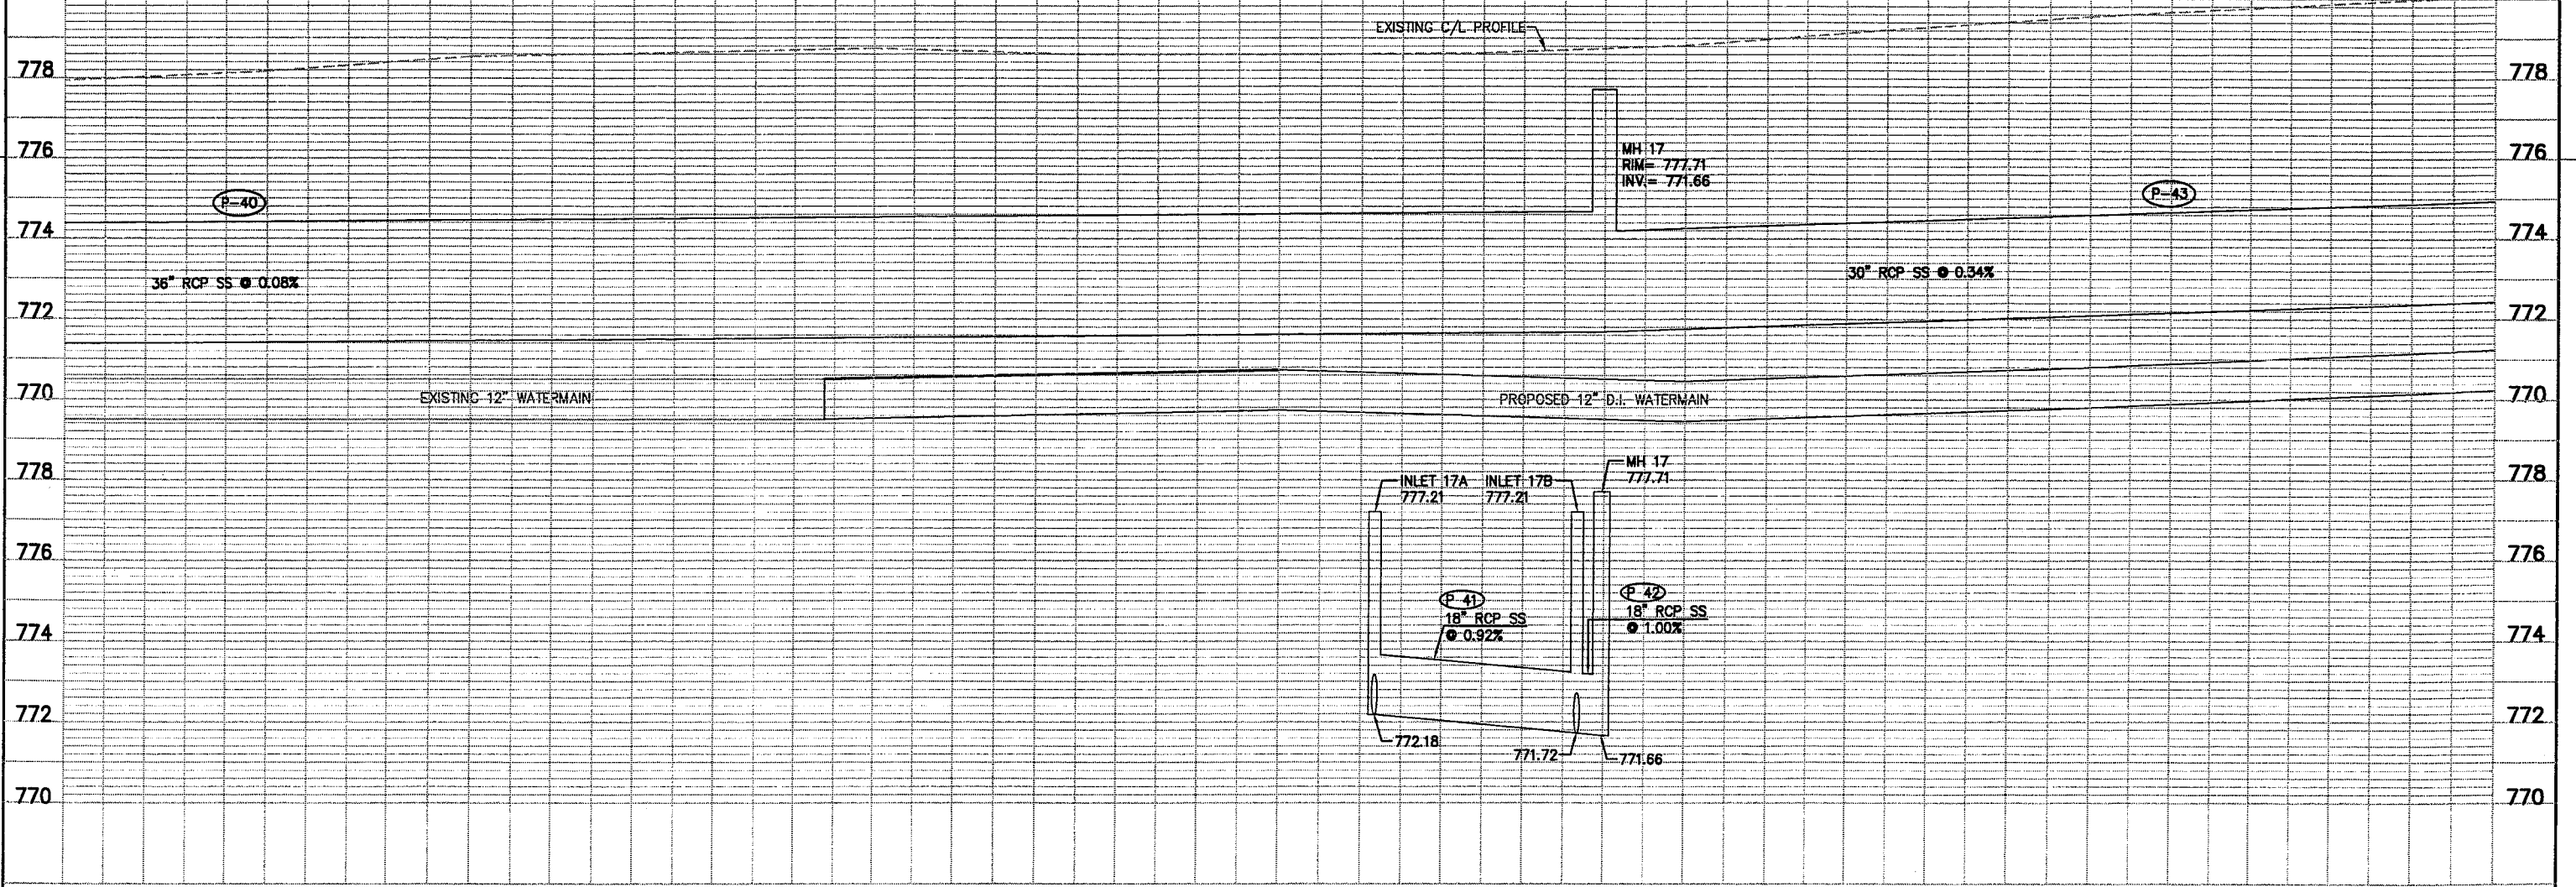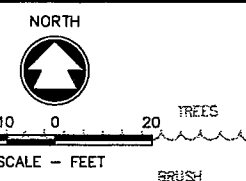


MSDOT/CADDIS SHEET 40

07/18/08 9:03 AM (UP-DATED FINAL ROW-COMPS DEW (2), PROFILE 4-1-08, UPDATED X-CTH Y, AT&T FIBER CITY)
 rpsosen W:\DWG\W0002\970343\00\Plan and Profile\09-STORM.dwg



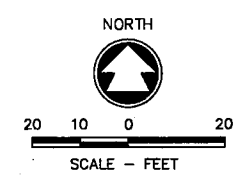
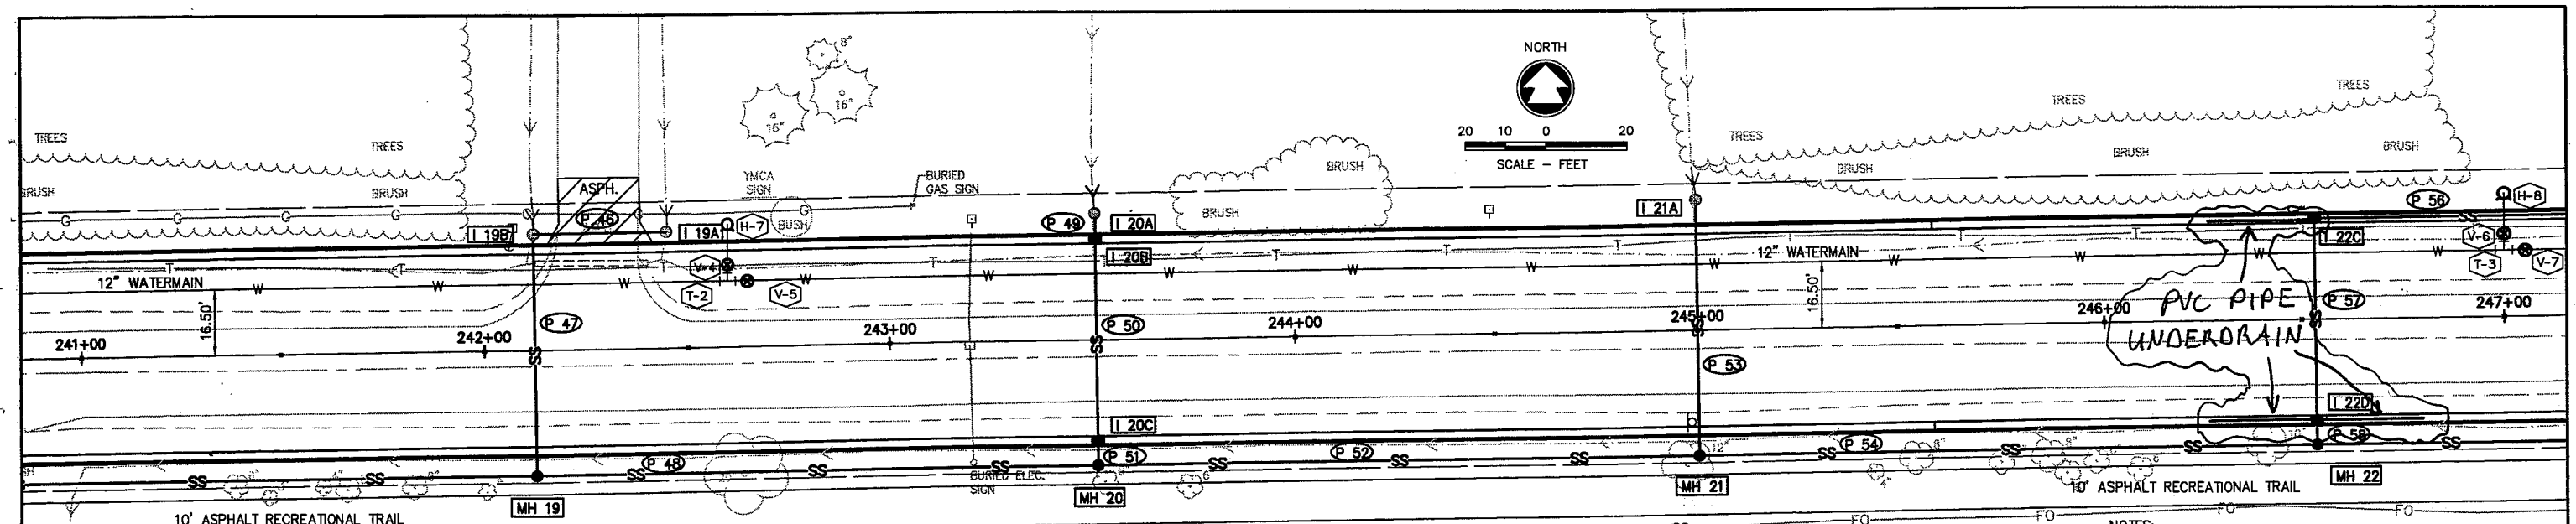


- NOTES:
- REFER TO MISC. QUANTITY SHEETS FOR ADDITIONAL STORM SEWER AND STORM SEWER STRUCTURE INFORMATION.
 - REFER TO SANITARY SEWER AND WATER MAIN DETAIL FOR ADDITIONAL INFORMATION.

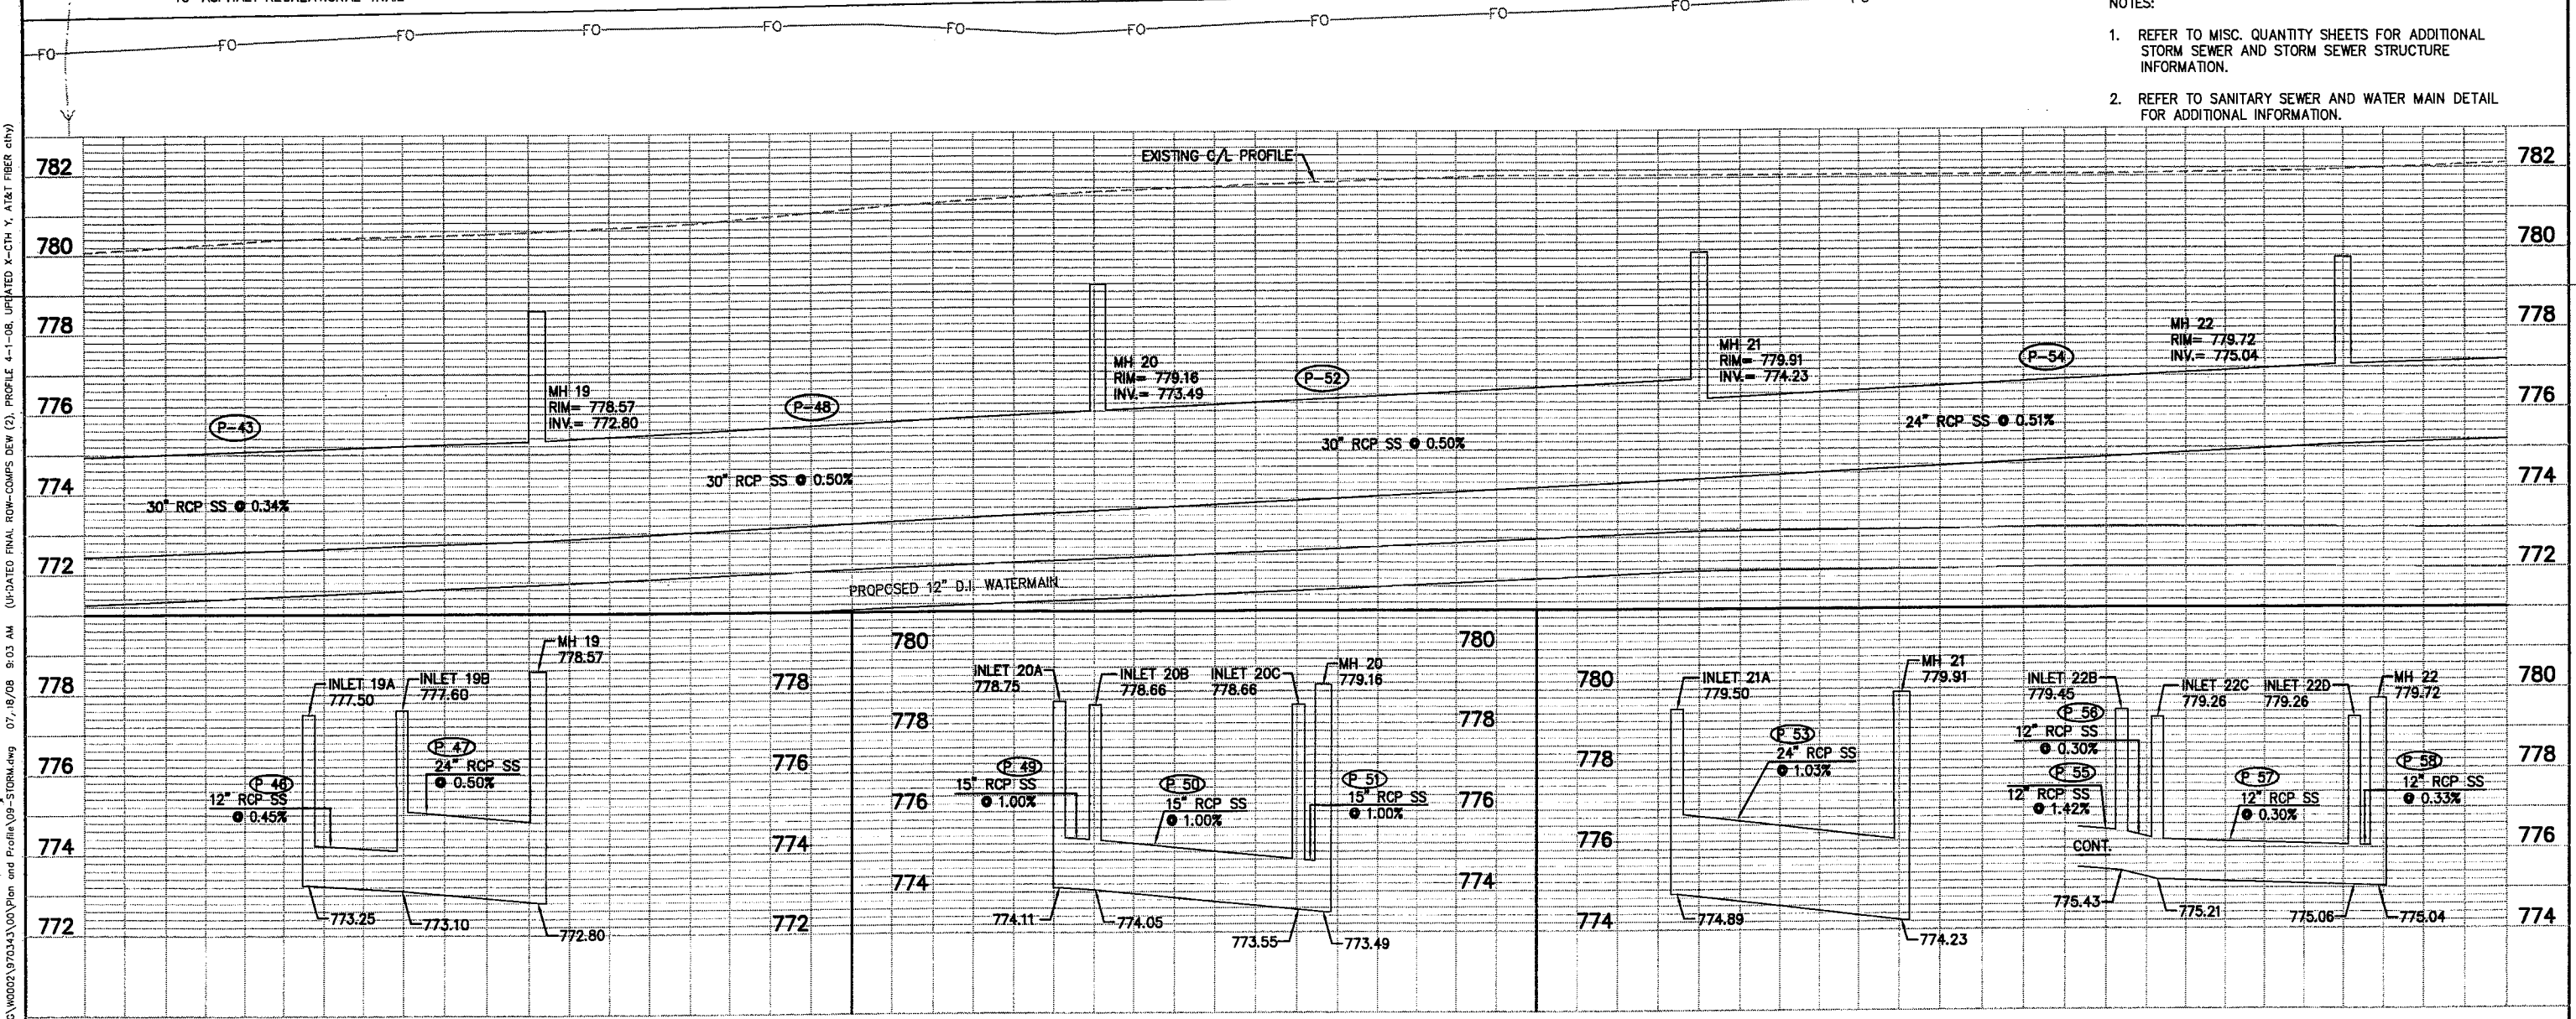



NOTES:

1. REFER TO MISC. QUANTITY SHEETS FOR ADDITIONAL STORM SEWER AND STORM SEWER STRUCTURE INFORMATION.
2. REFER TO SANITARY SEWER AND WATER MAIN DETAIL FOR ADDITIONAL INFORMATION.

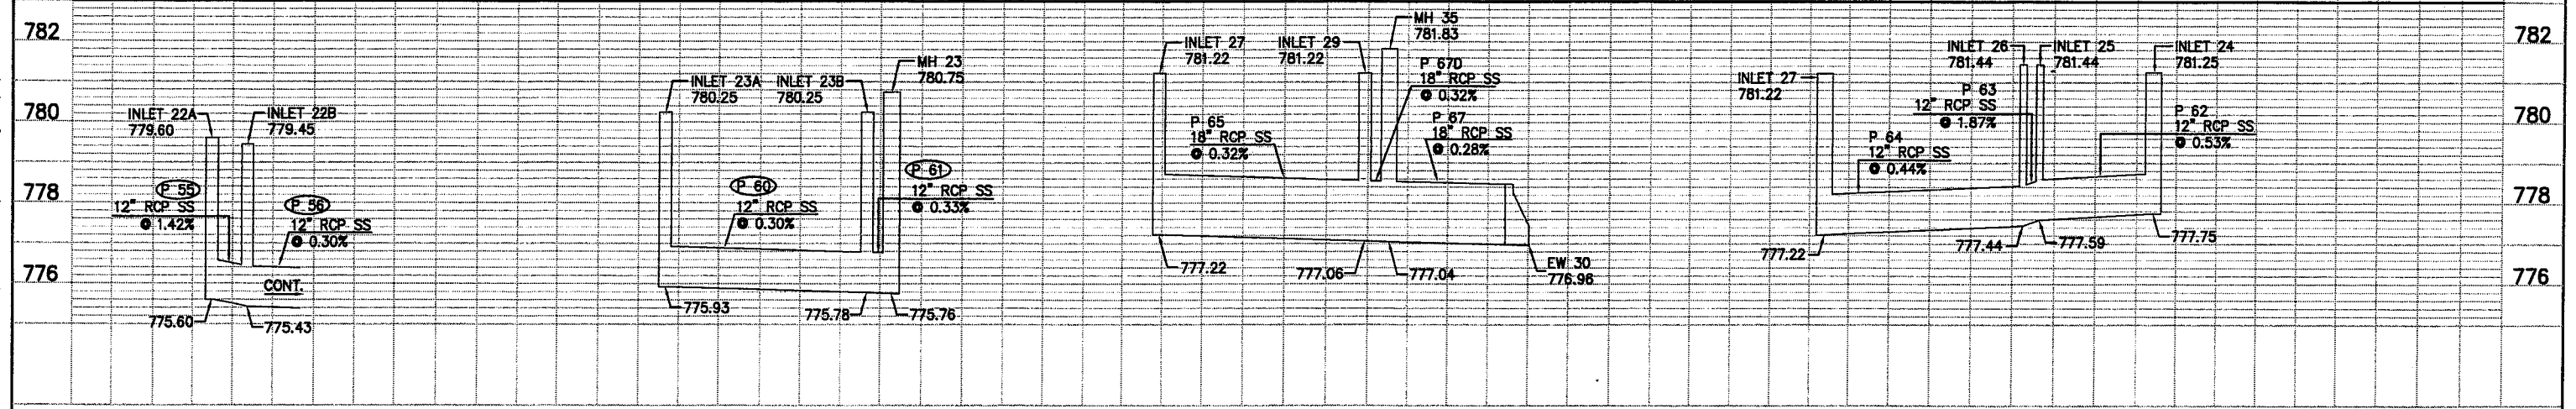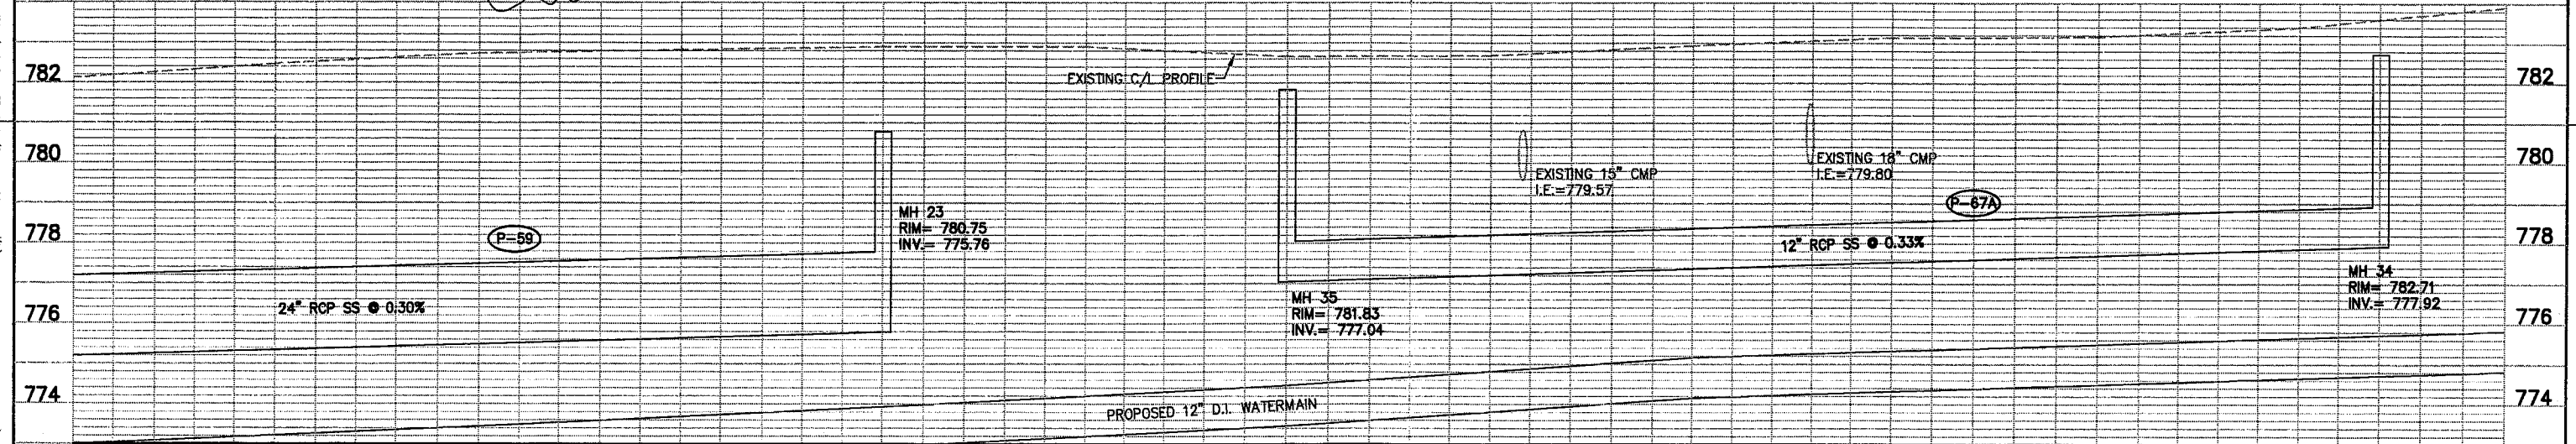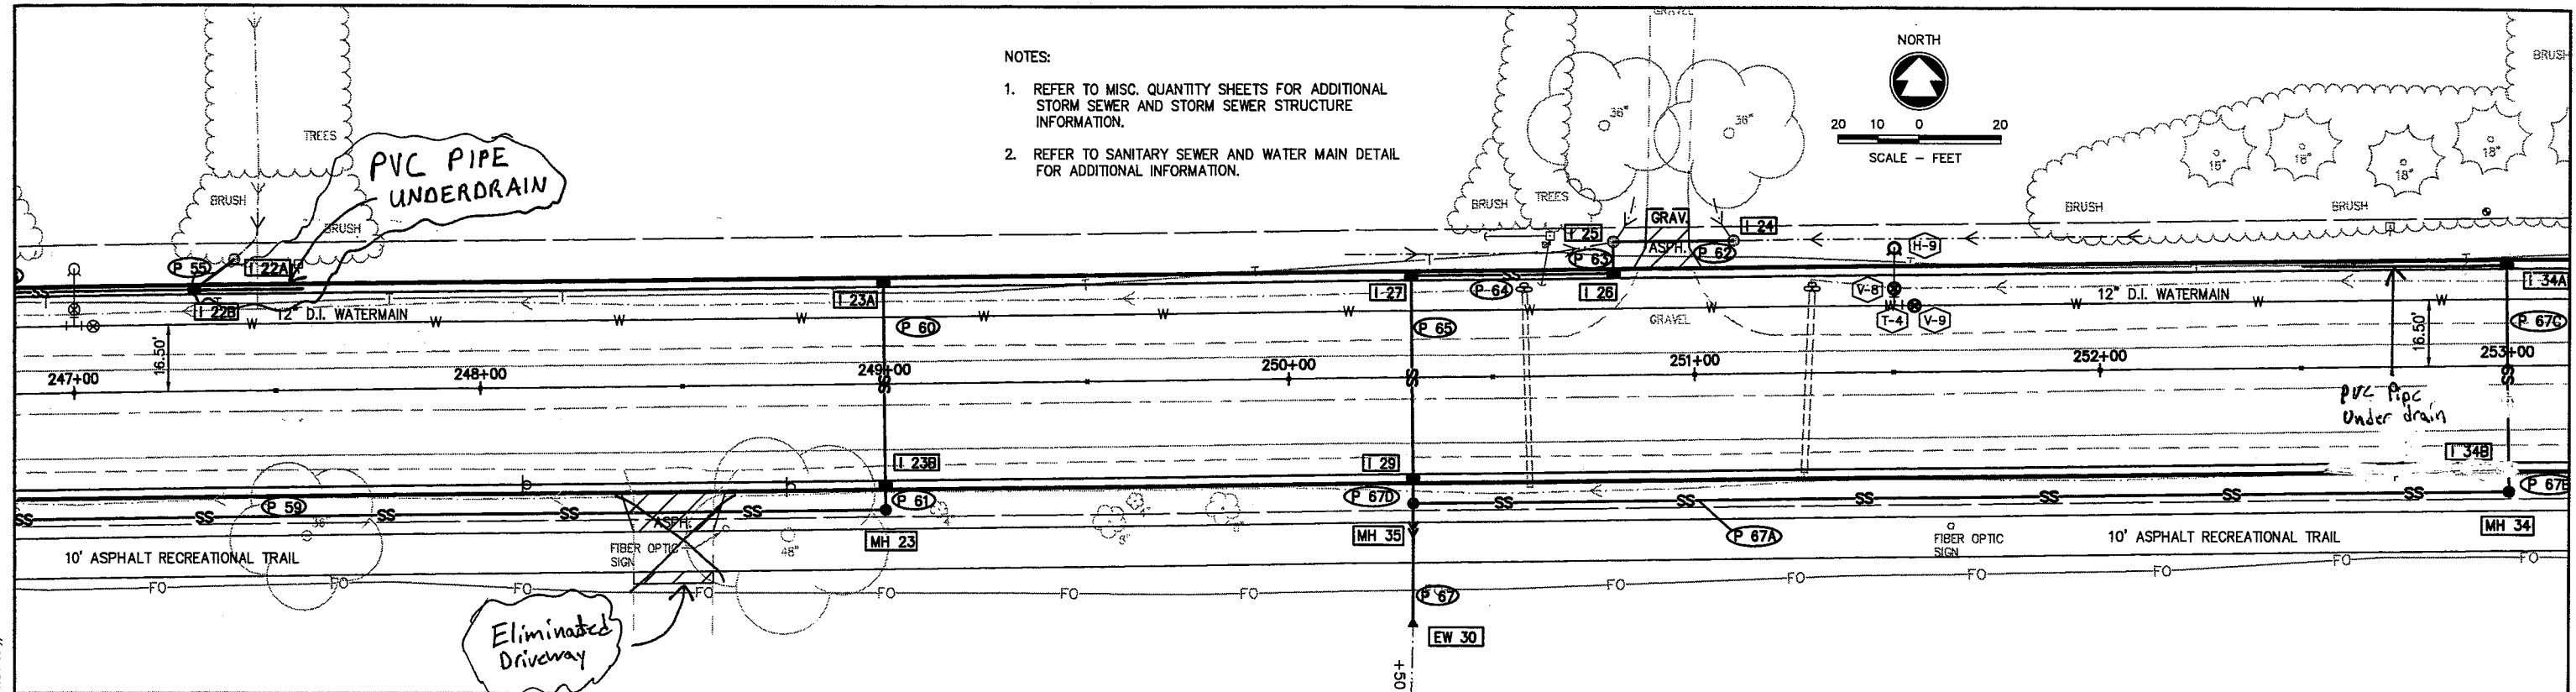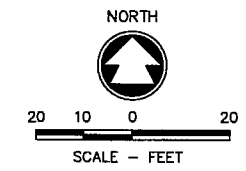


gassen w:\dms\w0002\970343\00\Plan and Profile\10-STORM.dwg 07/18/08 9:05 AM (UPDATED FINAL ROW-COMPS DEW (2), PROFILE 4-1-08, UPDATED X-CTH Y, AT&T FIBER city)

10/27/08 9:46 AM (UPDATED FINAL ROW-COMPS DEW (2), PROFILE 4-1-08, UPDATED X-CTH Y, AT&T FIBER CITY)

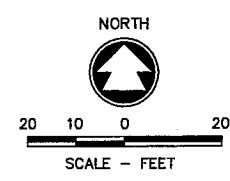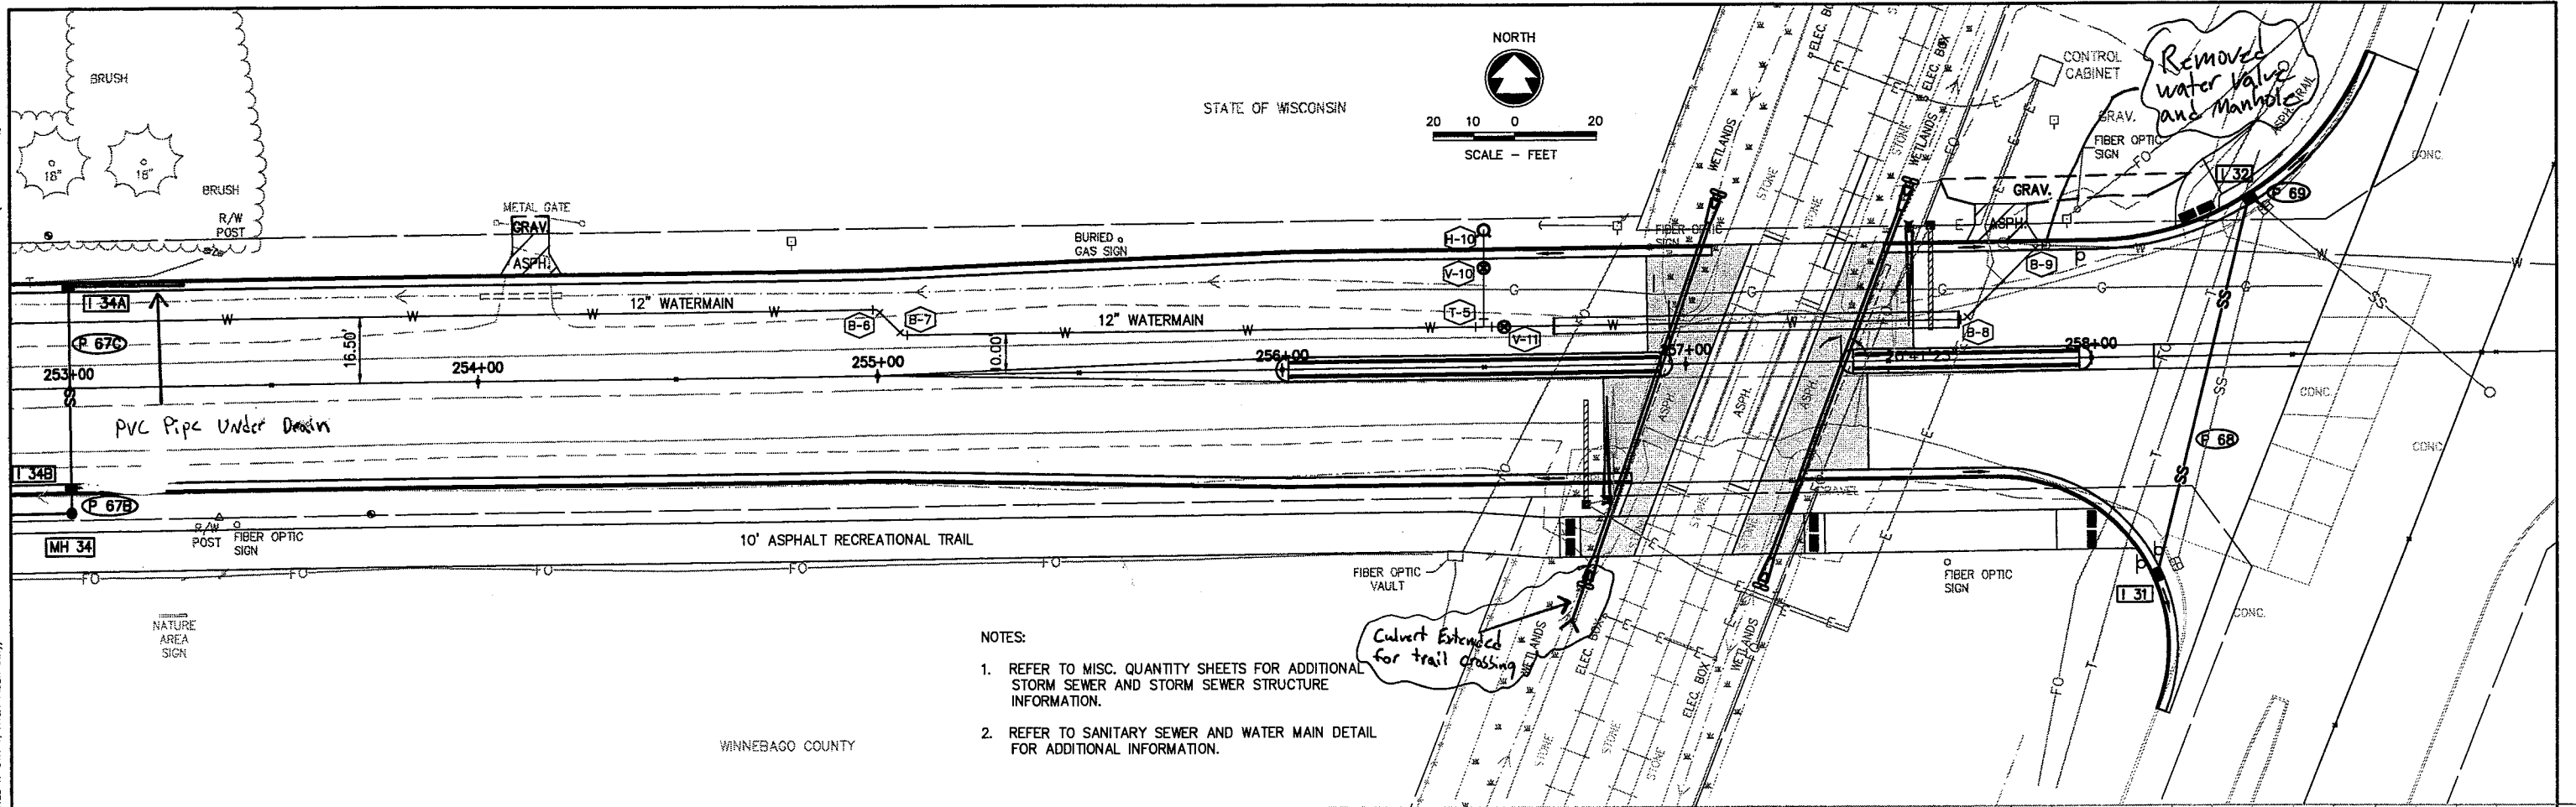

- NOTES:
1. REFER TO MISC. QUANTITY SHEETS FOR ADDITIONAL STORM SEWER AND STORM SEWER STRUCTURE INFORMATION.
 2. REFER TO SANITARY SEWER AND WATER MAIN DETAIL FOR ADDITIONAL INFORMATION.

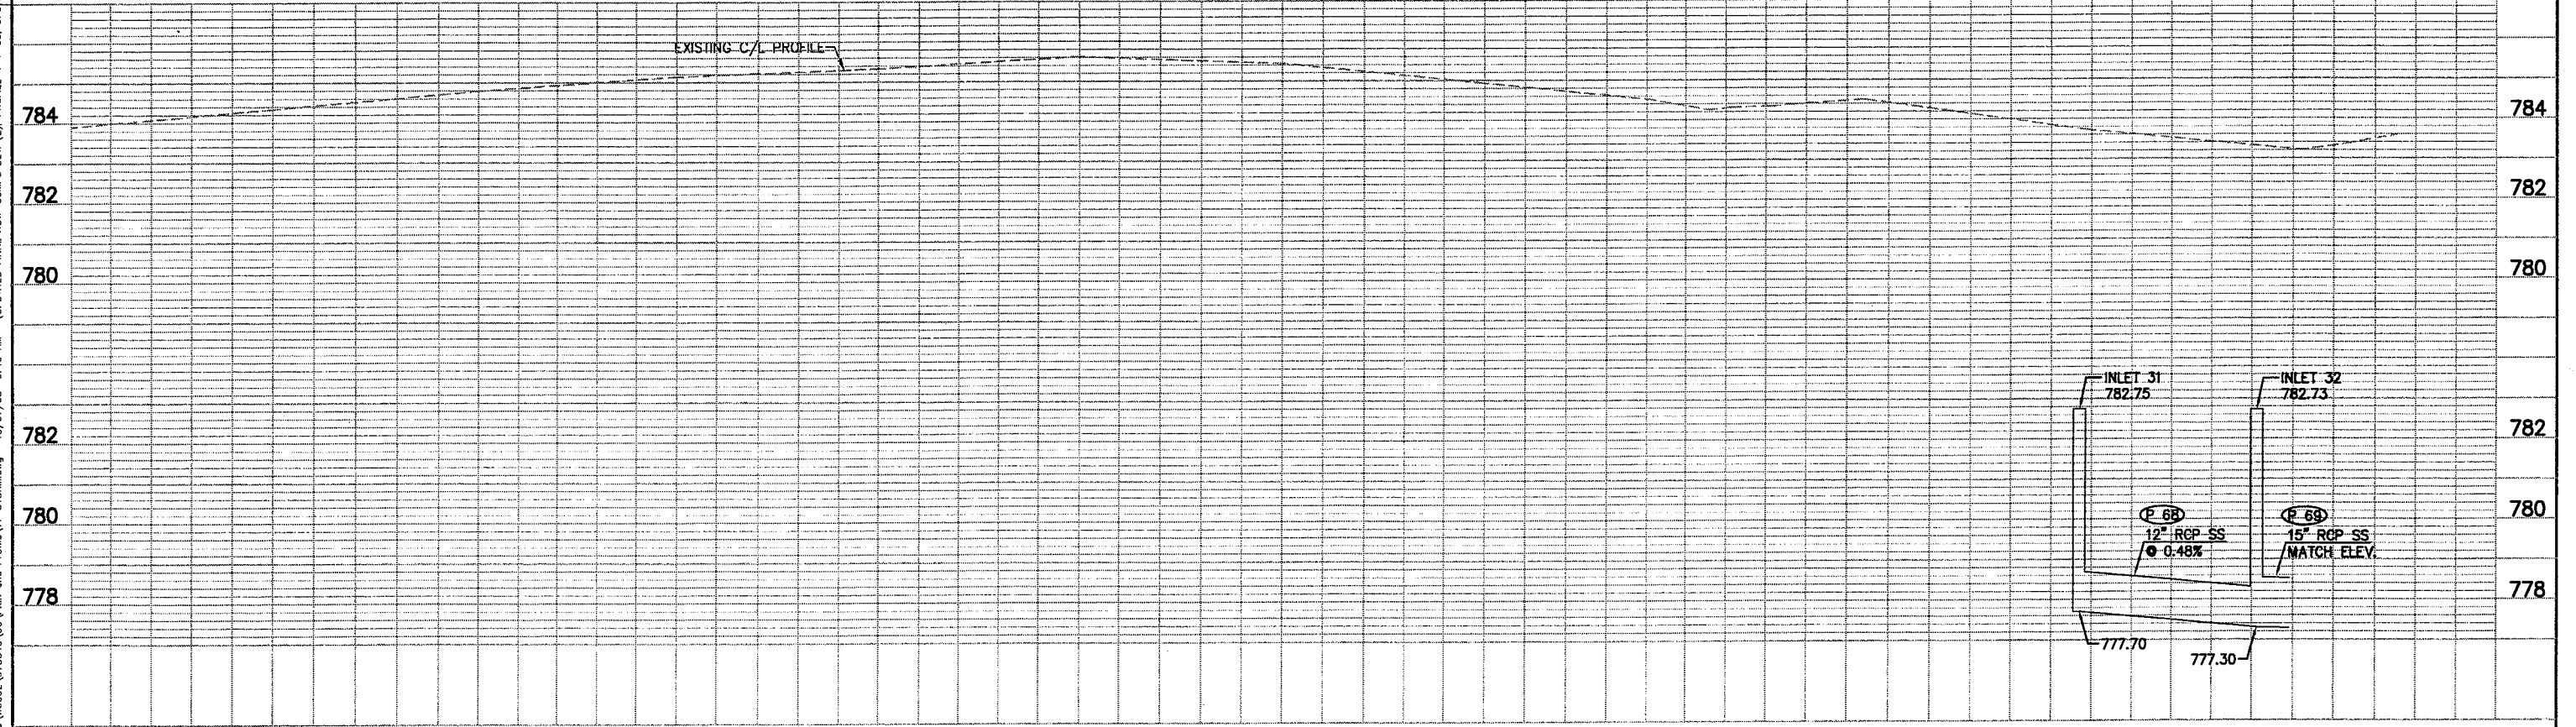

PROJECT ID: 4994-00-87, 6432-11-71
 WITH: N/A

COUNTY: WINNEBAGO

STATE OF WISCONSIN DEPARTMENT OF TRANSPORTATION

PLAN OF PROPOSED IMPROVEMENT SANITARY SEWER AND WATERMAIN


**CTH Y
 STH 76 - CTH A
 CTH Y
 WINNEBAGO COUNTY**

STATE PROJECT NUMBER
4994-00-87

**STH 76 & CTH Y INTERSECTION
 STH 76 - CTH A
 STH 76
 WINNEBAGO COUNTY**

STATE PROJECT NUMBER
6432-11-71

STATE PROJECT	FEDERAL PROJECT	
	PROJECT	CONTRACT
4994-00-87		
6432-11-71		


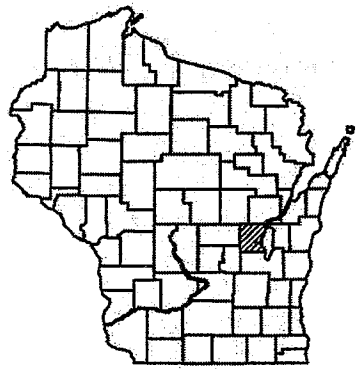


BEGIN PROJECT
 6432-11-71
 STA 195+01.84
 N. 497008.9132
 E. 791101.5318

END PROJECT
 6432-11-71
 STA 200+86.77
 N. 497017.1392
 E. 791688.3377

BEGIN PROJECT
 4994-00-87
 STA 200+86.77
 N. 497017.1392
 E. 791688.3377


END PROJECT
 4994-00-87
 STA 258+53.16
 N. 497090.9279
 E. 797452.2513

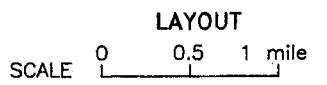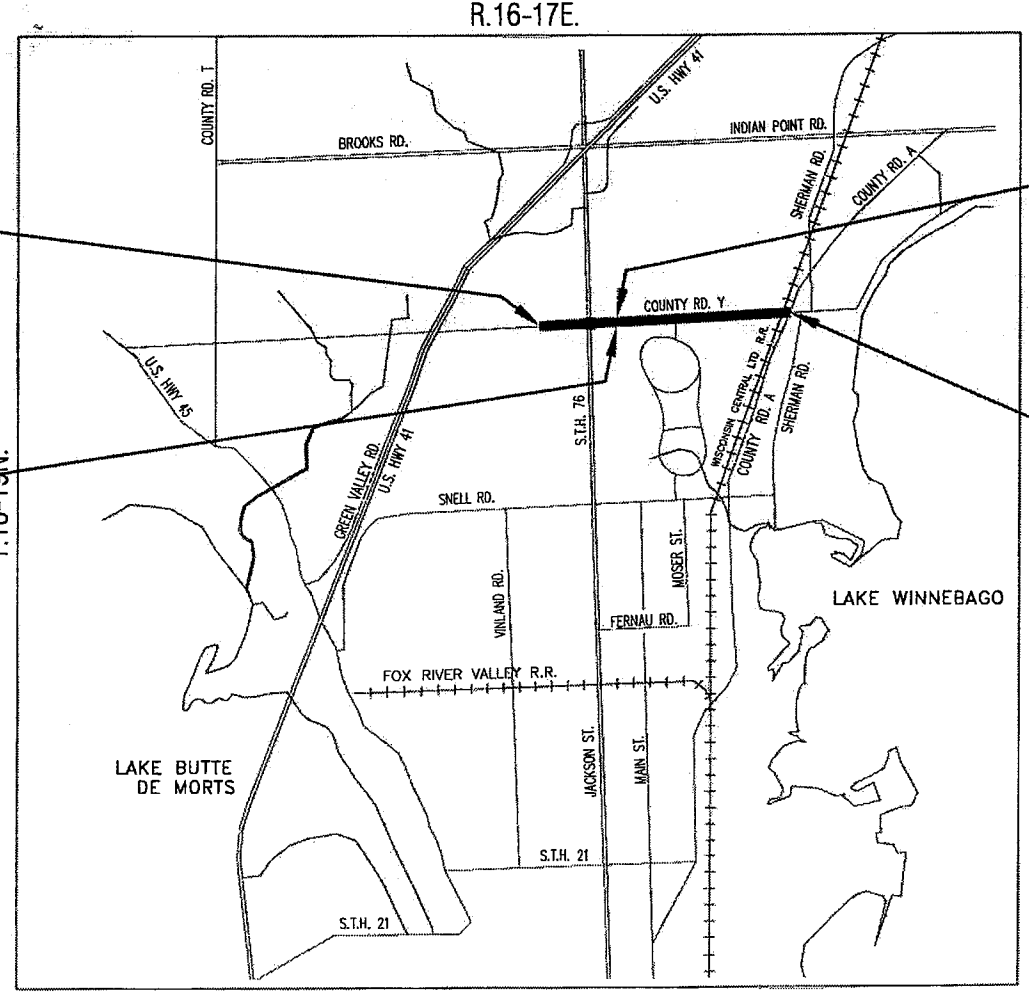


TOTAL NET LENGTH OF CENTERLINE = 1.203 MILES

CONVENTIONAL SYMBOLS

- PLAN
- CORPORATE LIMITS
- PROPERTY LINE
- LOT LINE
- LIMITED HIGHWAY EASEMENT
- EXISTING RIGHT OF WAY
- PROPOSED OR NEW R/W LINE
- SLOPE INTERCEPT
- REFERENCE LINE
- EXISTING CULVERT
- PROPOSED CULVERT (Box or Pipe)
- COMBUSTIBLE FLUIDS
- MARSH AREA
- WOODED OR SHRUB AREA

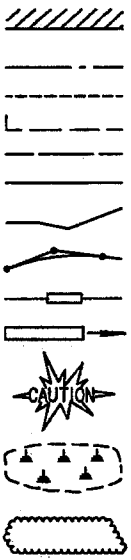

- PROFILE
- GRADE LINE
- ORIGINAL GROUND
- MARSH OR ROCK PROFILE (To be noted as such)
- SPECIAL DITCH
- GRADE ELEVATION
- CULVERT (Profile View)
- UTILITIES
- ELECTRIC
- FIBER OPTIC
- GAS
- SANITARY SEWER
- STORM SEWER
- TELEPHONE
- WATER
- UTILITY PEDESTAL
- POWER POLE
- TELEPHONE POLE

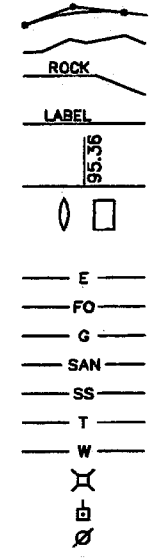

ORIGINAL PLANS PREPARED BY

WISCONSIN


PETER P. GULBRONSON
 E-31578
 KAUKAUNA, WI

PROFESSIONAL ENGINEER


DATE: 8/2/08 SIGNATURE: Peter P. Gulbrunson

SANITARY SEWER DETAILS


NOTE:
FOR REINFORCED CONCRETE PIPE, BEDDING MATERIAL SHALL BE PLACED AND COMPACTED UP TO SPRINGLINE OF PIPE, REMAINING BACKFILL SHALL BE NATIVE MATERIALS FOR TURFED AREAS AND 3/4" CRUSHED STONE IN PAVEMENT AREAS THEN GRANULAR BACKFILL UP TO 12" ABOVE PIPE IS REQUIRED.

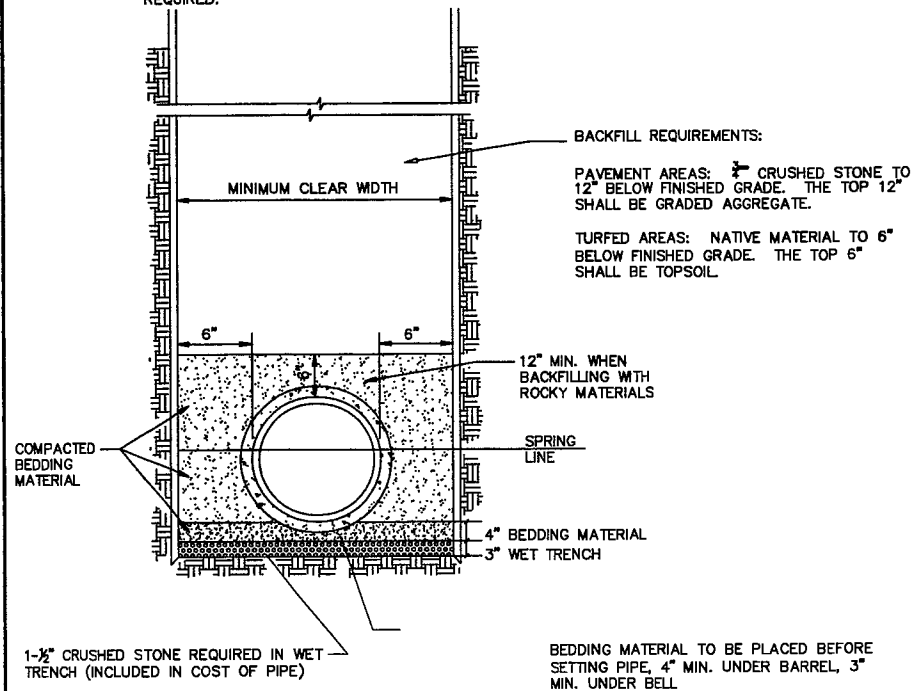


STANDARD SECTION
(CLASS "B" BEDDING)

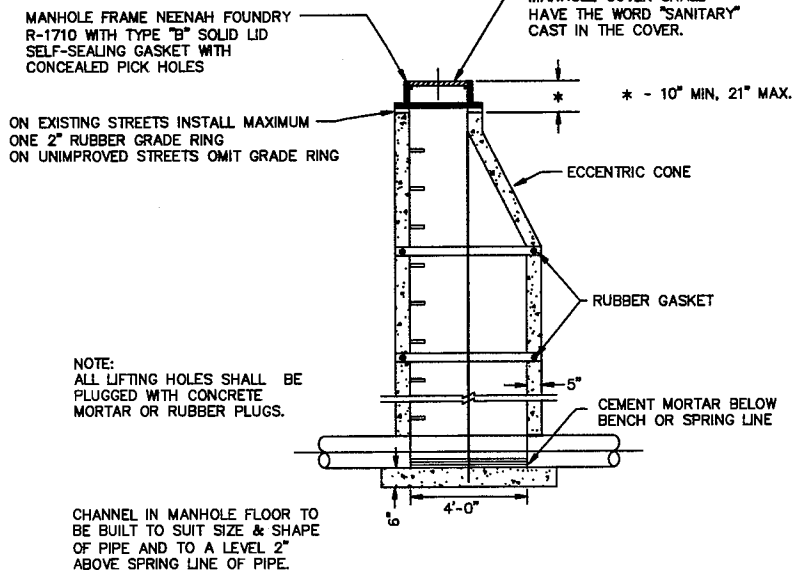


STANDARD PRECAST MANHOLE

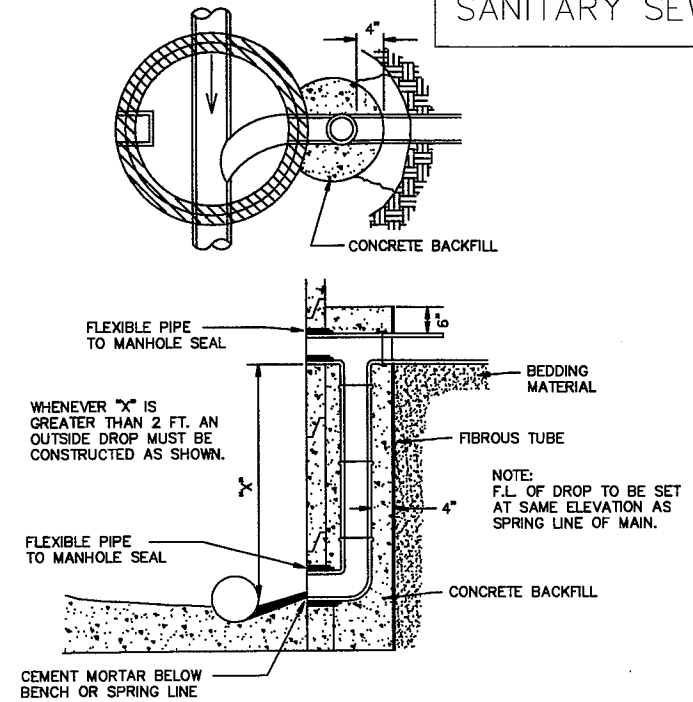


OUTSIDE DROP PRECAST MANHOLE

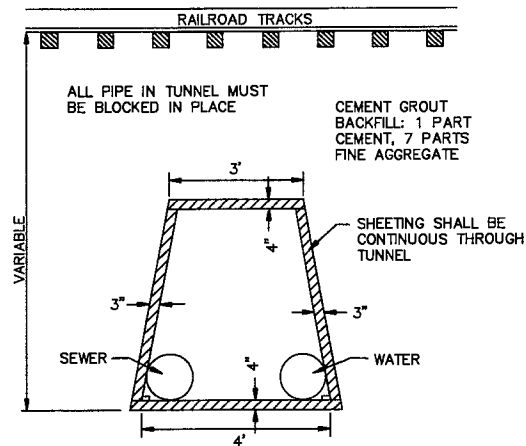

TUNNEL SECTION

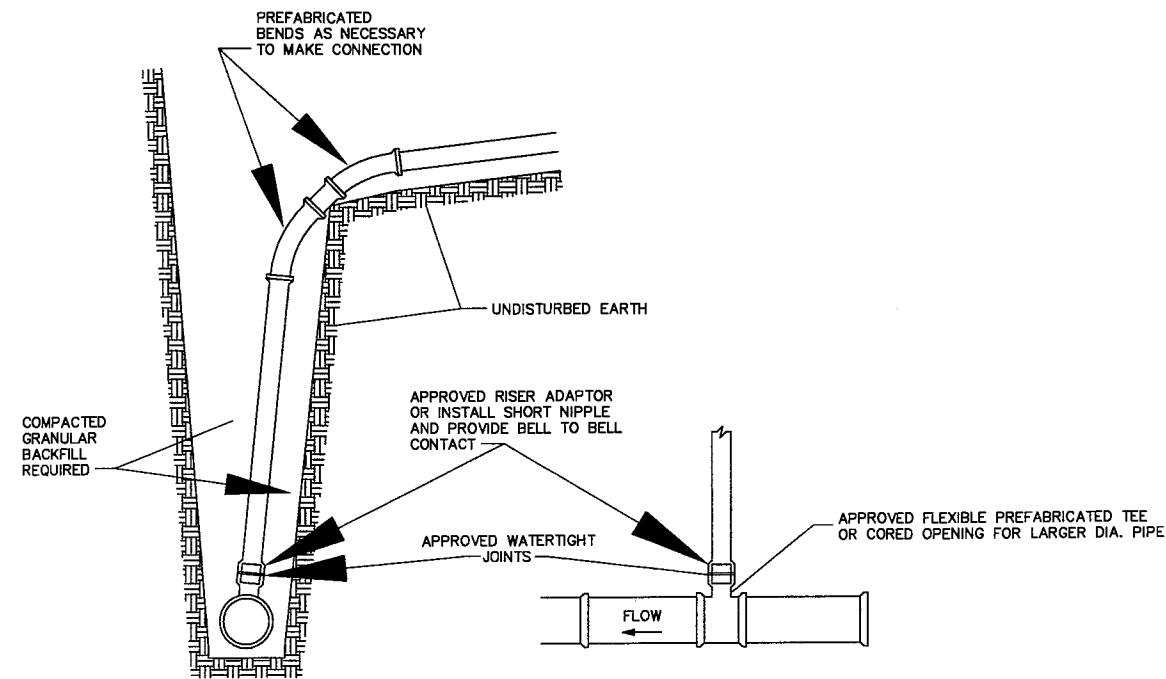

STANDARD RISER DETAIL
(FLEXIBLE RISER TO FLEXIBLE MAIN)

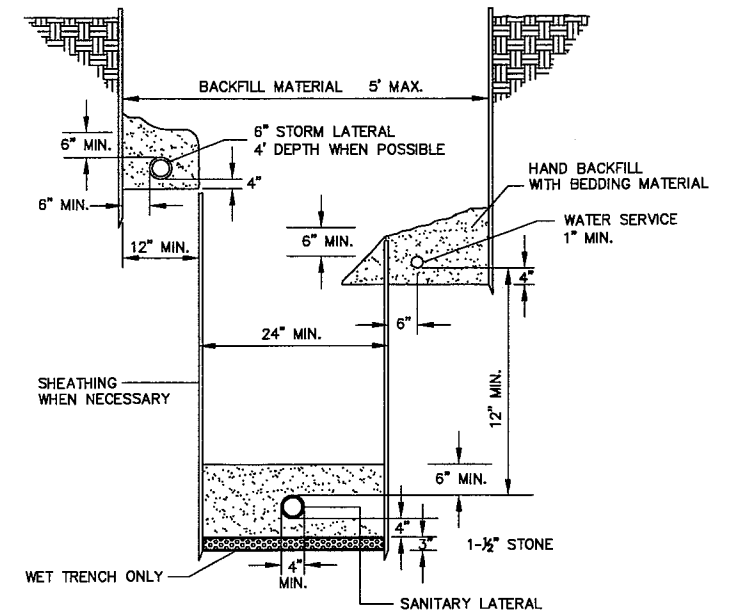


STANDARD SECTION FOR SERVICES
(STORM, SANITARY & WATER)


06/11/08 11:12 AM

WATER MAIN DETAILS
(NOT TO SCALE)


BACKFILL REQUIREMENTS:
PAVEMENT AREAS: 3" CRUSHED STONE TO 12" BELOW FINISHED GRADE. THE TOP 12" SHALL BE GRADED AGGREGATE
TURFED AREAS: NATIVE MATERIALS TO 6" BELOW FINISHED GRADE. THE TOP 6" SHALL BE TOPSOIL.

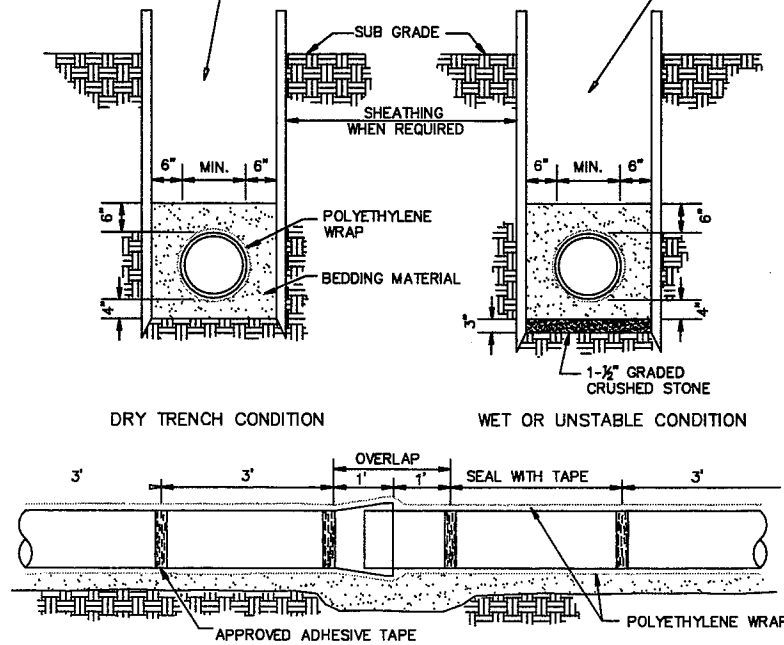


STANDARD WATER MAIN TRENCH SECTION

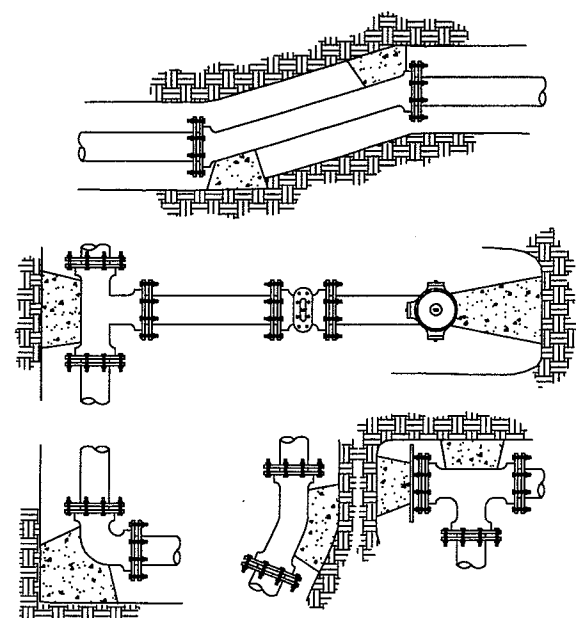

THRUST BLOCK LOCATION

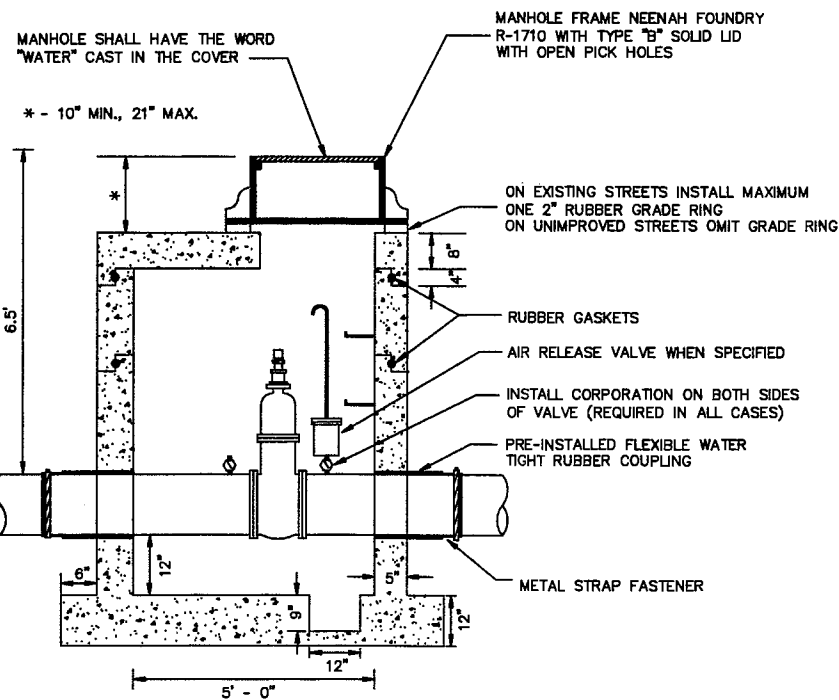


STANDARD WATER VALVE MANHOLE
(5' DIAMETER)

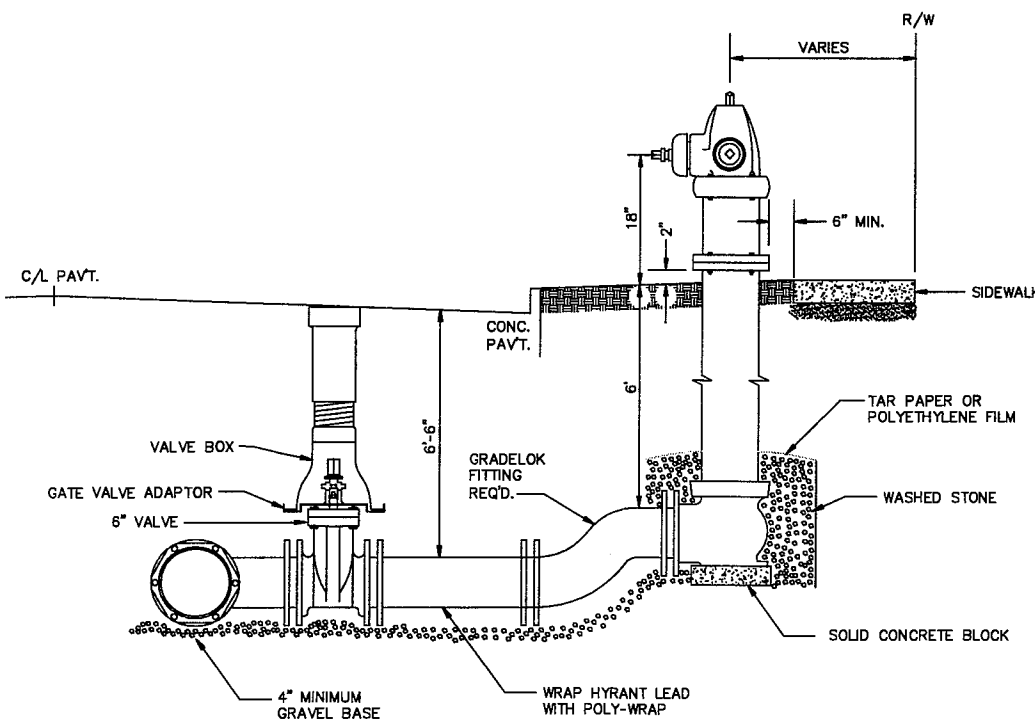

TYPICAL HYDRANT INSTALLATION
MECHANICAL JOINT

p:\mgeplak\w\dwg\w0002\970343\From City\WATERMAIN DETAIL.dwg 05/22/08 7:29 AM

ESTIMATED QUANTITIES
 3 EACH - ADJUST SANITARY MANHOLE
 4.0 VF - RECONSTRUCT SANITARY MANHOLE

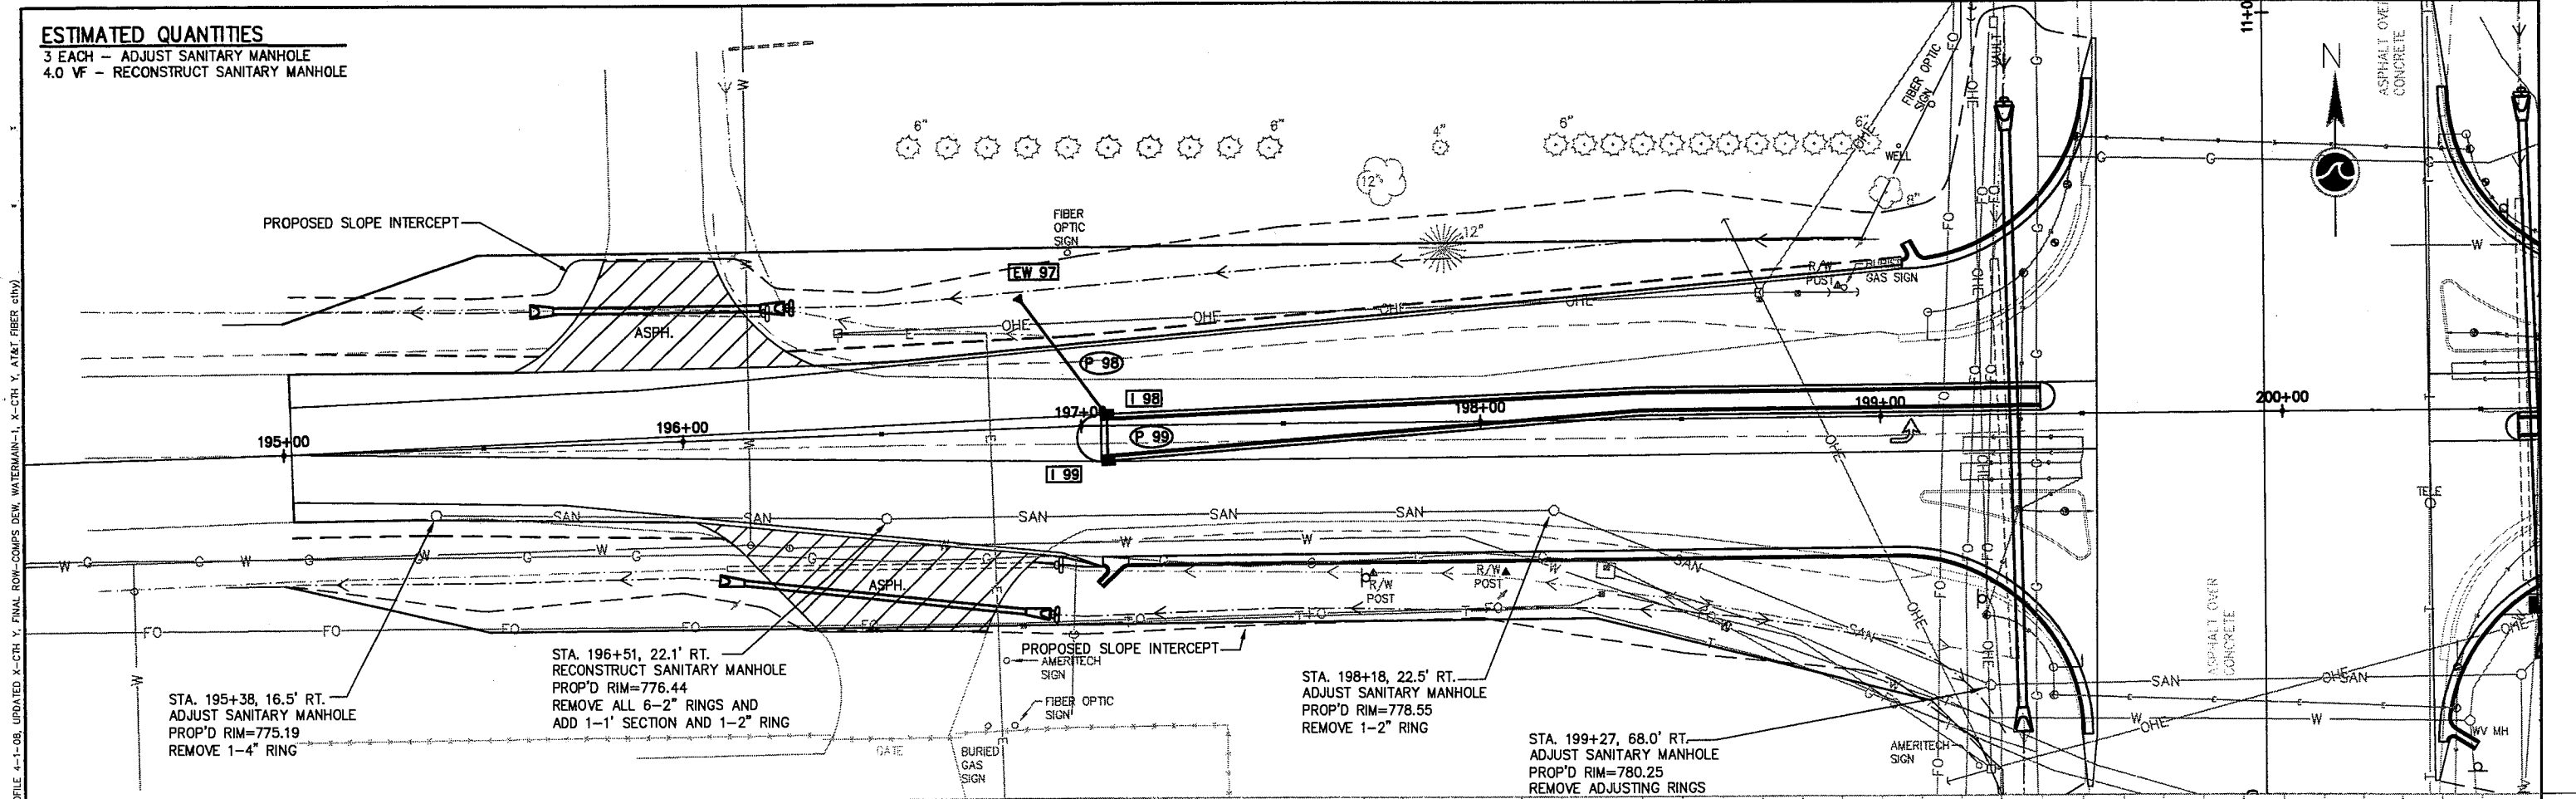


STA. 195+38, 16.5' RT.
 ADJUST SANITARY MANHOLE
 PROP'D RIM=775.19
 REMOVE 1-4" RING

STA. 196+51, 22.1' RT.
 RECONSTRUCT SANITARY MANHOLE
 PROP'D RIM=776.44
 REMOVE ALL 6-2" RINGS AND
 ADD 1-1' SECTION AND 1-2" RING

STA. 198+18, 22.5' RT.
 ADJUST SANITARY MANHOLE
 PROP'D RIM=778.55
 REMOVE 1-2" RING


STA. 199+27, 68.0' RT.
 ADJUST SANITARY MANHOLE
 PROP'D RIM=780.25
 REMOVE ADJUSTING RINGS

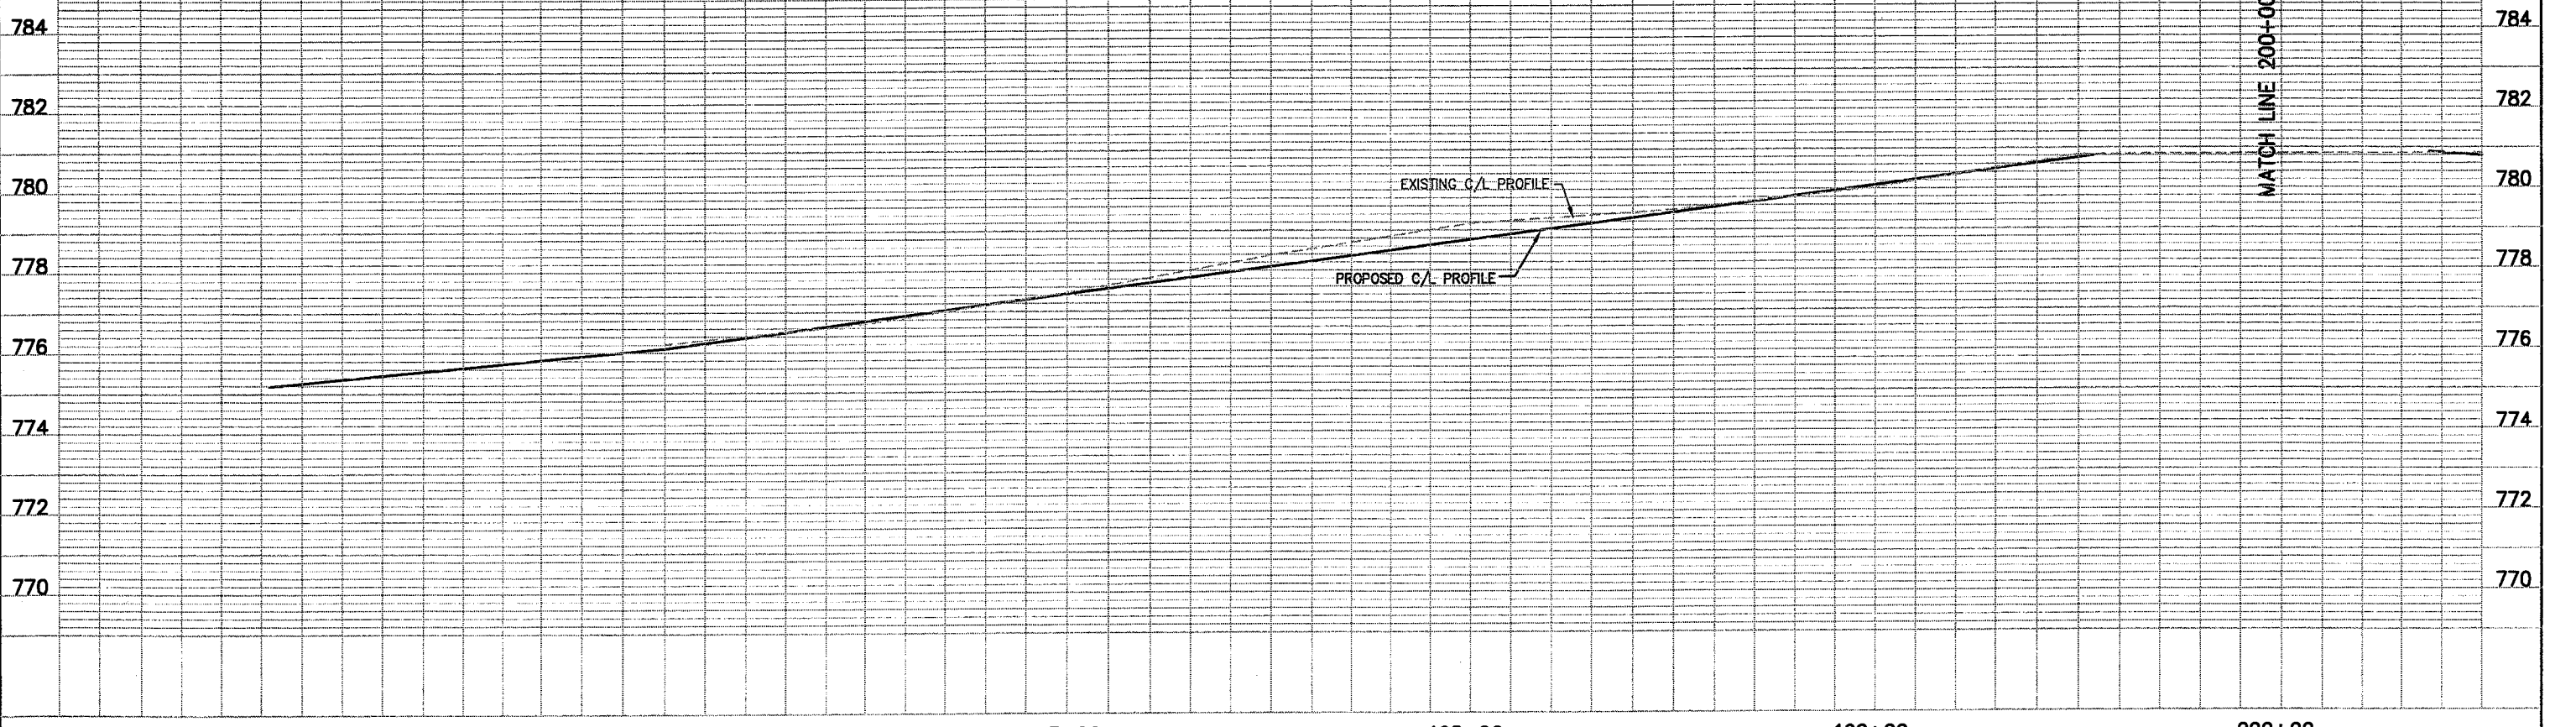

195+00	196+00	197+00	198+00	199+00	200+00
STATE PROJECT NUMBER: 4994-00-87 & 6432-11-71			HWY: CTH Y		COUNTY: WINNEBAGO
SANITARY SEWER & WATER MAIN			4 OF 14		SHEET NO: 41

C:\Users\W00021870343\From City\UPDATED WATERMAIN.dwg 10/22/08 10:14 AM (PROFILE SHEET, UPDATED FINAL ROW-COMPS DEW (2), PROFILE 4-1-08, UPDATED X-CTR Y, FINAL ROW-COMPS DEW, WATERMAIN-1, X-CTR Y, AT&T FIBER CITY)


07/18/08 8:10 AM (UPDATED FINAL ROW-COMPS DEW (2), PROFILE 4-1-08, UPDATED X-CTH Y, AT&T FIBER CITY)
 W:\DWG\W0002\970343\From CIV\UPDATED WATERMAIN2.dwg

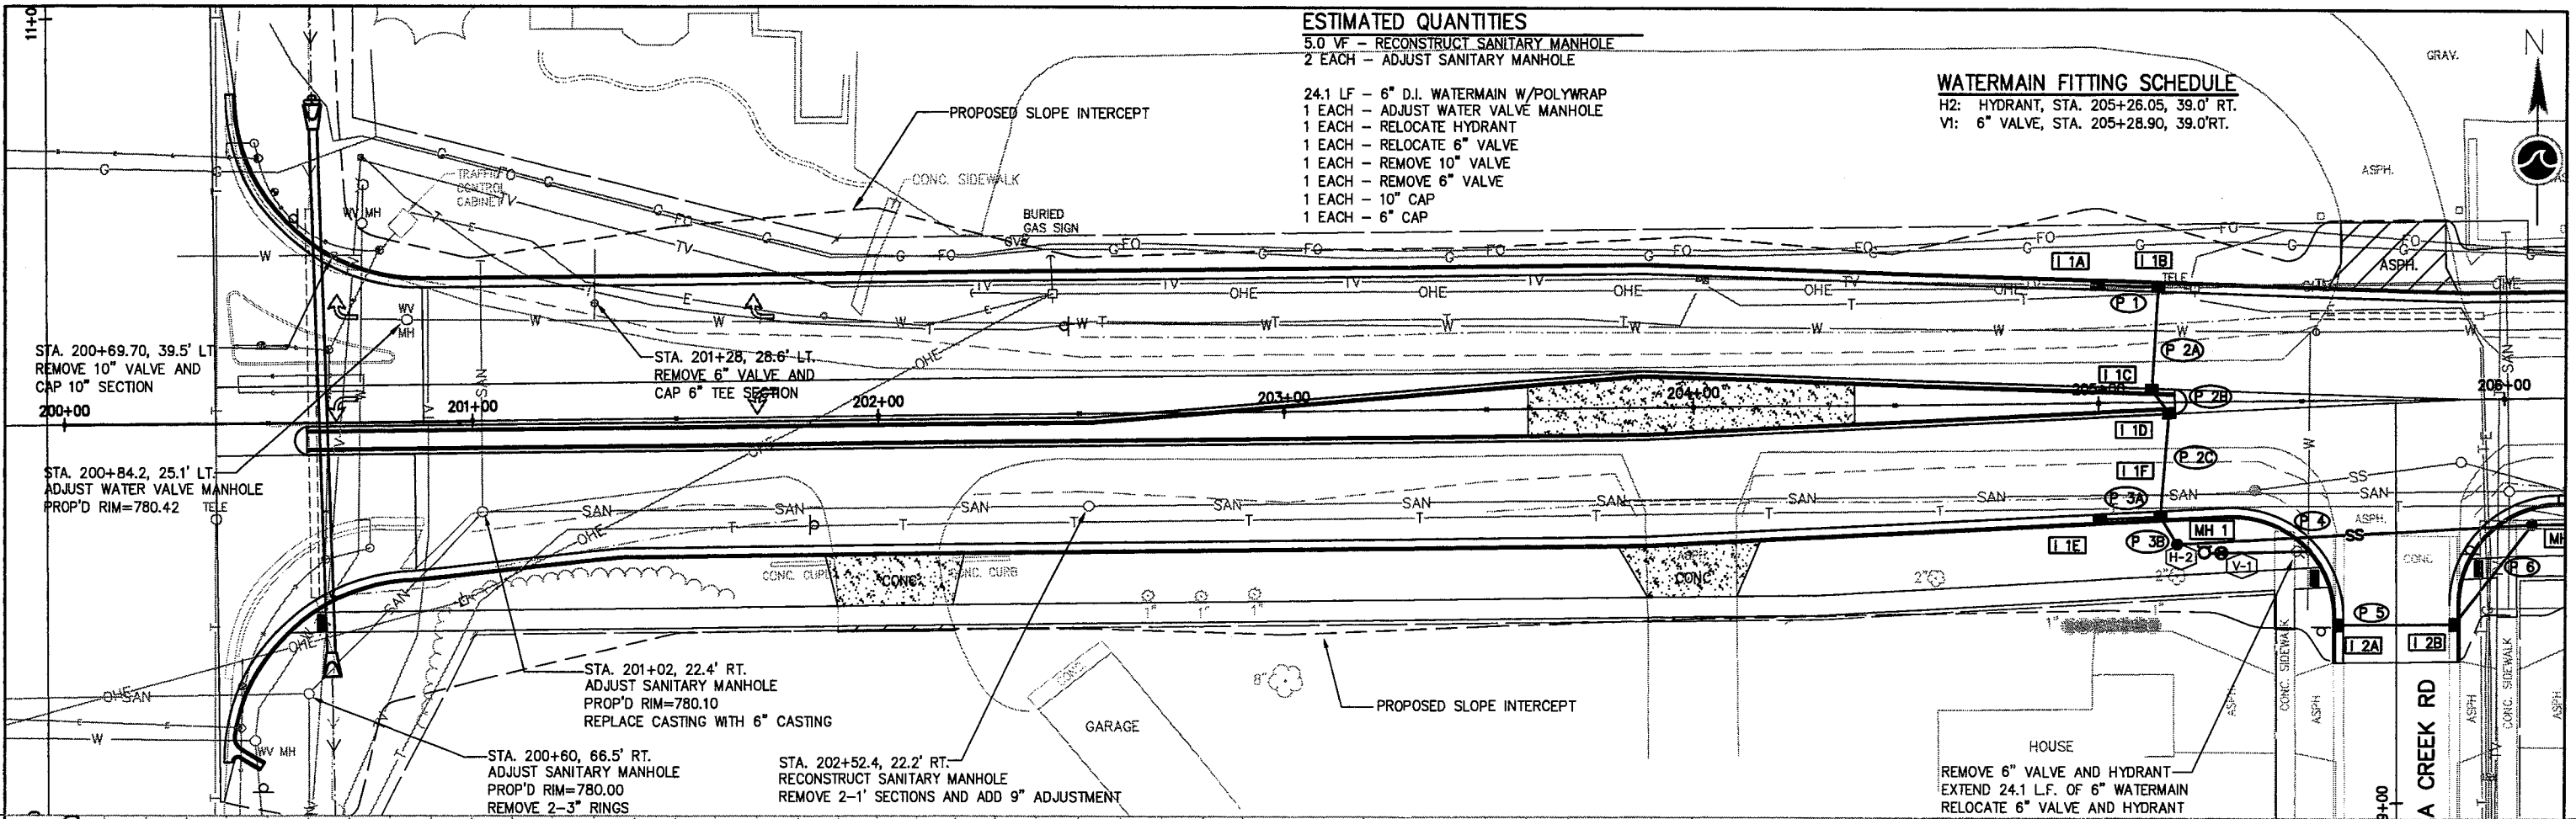

- ESTIMATED QUANTITIES**
- 5.0 VF - RECONSTRUCT SANITARY MANHOLE
 - 2 EACH - ADJUST SANITARY MANHOLE
 - 24.1 LF - 6" D.I. WATERMAIN W/POLYWRAP
 - 1 EACH - ADJUST WATER VALVE MANHOLE
 - 1 EACH - RELOCATE HYDRANT
 - 1 EACH - RELOCATE 6" VALVE
 - 1 EACH - REMOVE 10" VALVE
 - 1 EACH - REMOVE 6" VALVE
 - 1 EACH - 10" CAP
 - 1 EACH - 6" CAP

WATERMAIN FITTING SCHEDULE

H2: HYDRANT, STA. 205+26.05, 39.0' RT.
 V1: 6" VALVE, STA. 205+28.90, 39.0' RT.

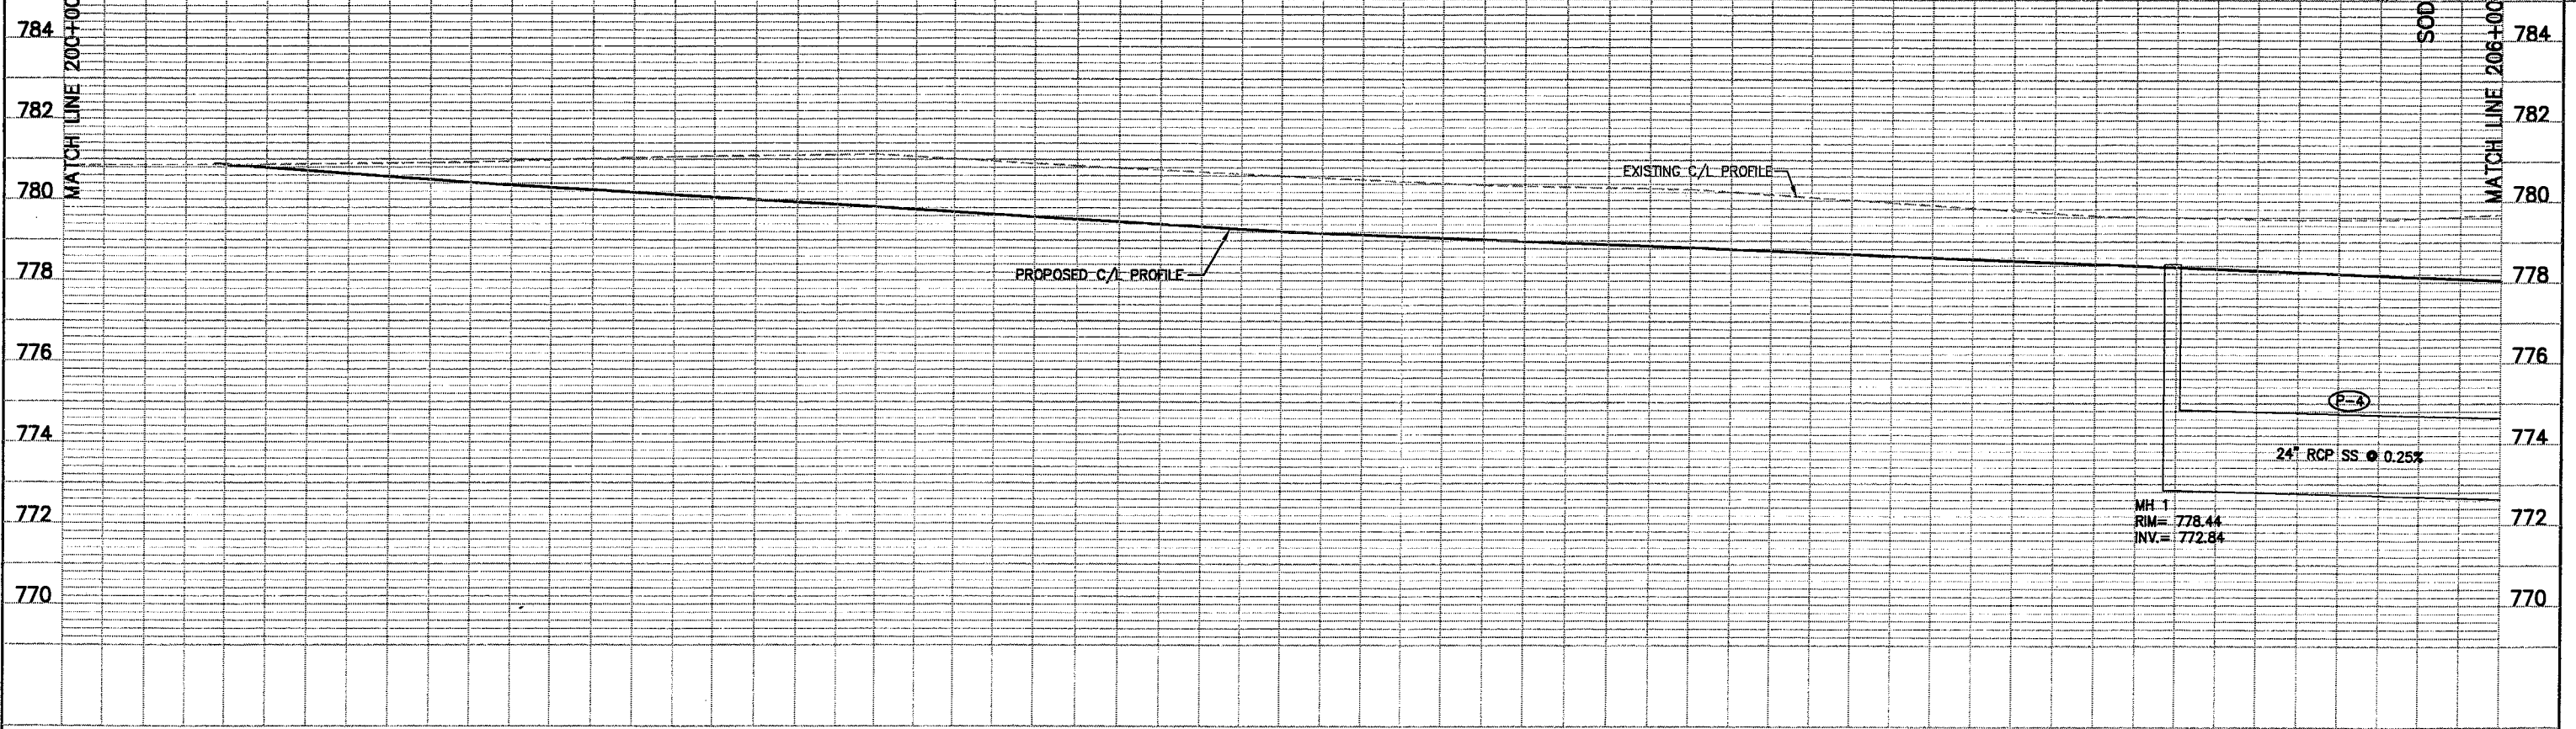

200+00	201+00	202+00	203+00	204+00	205+00	206+00
STATE PROJECT NUMBER: 4994-00-87 & 6432-11-71			HWY: CTH Y	COUNTY: WINNEBAGO	SANITARY SEWER & WATER MAIN	5 OF 14 SHEET NO: 42

WATERMAIN FITTING SCHEDULE

- H3: HYDRANT, STA. 208+31.9, 35.2' RT.
- B3: 6" 45° BEND, STA. 208+46.2, 42.1' RT. REAV.
- V2: 12" X 8" TAPPING SLEEVE & VALVE, STA. 208+81.1, 17.0' LT.
- H4: HYDRANT, STA. 211+20.0, 31.2' LT.

ESTIMATED QUANTITIES

- 57.8 LF - 8" PVC SANITARY SEWER W/ PLUG
- 1 EACH - TAP INTO EXISTING SANITARY MANHOLE
- 1 EACH - ADJUST SANITARY MANHOLE
- 5.2 VF - RECONSTRUCT SANITARY MANHOLE



- 19.0 LF - 8" D.I. WATERMAIN W/ POLYWRAP
- 23.0 LF - 6" D.I. WATERMAIN W/ POLYWRAP
- 1 EACH - 6" 45° BEND
- 1 EACH - 12" X 8" TAPPING SLEEVE & VALVE
- 1 EACH - 8" CAP
- 2 EACH - RELOCATE HYDRANT
- 1 EACH - ADJUST WATER VALVE MANHOLE

STA. 208+73.40, 22.10' RT.
EXTEND 57.8 LF. OF 8" PVC
SANITARY SEWER @ S=0.40%
AND PLUG END!
APPROXIMATE DEPTH 11.6'

STA. 208+81.40, 17.00' LT.
12" X 8" TAPPING SLEEVE & VALVE
EXTEND 19.0 LF. 8" WATERMAIN
AND CAP

STA. 211+09.0, 18.1' LT.
ADJUST WATER VALVE MANHOLE
PROP'D RIM=775.97
REMOVE ALL ADJUSTING RINGS



REMOVE HYDRANT AND EXTEND
4.5 LF. OF 6" WATERMAIN AND
RELOCATE HYDRANT

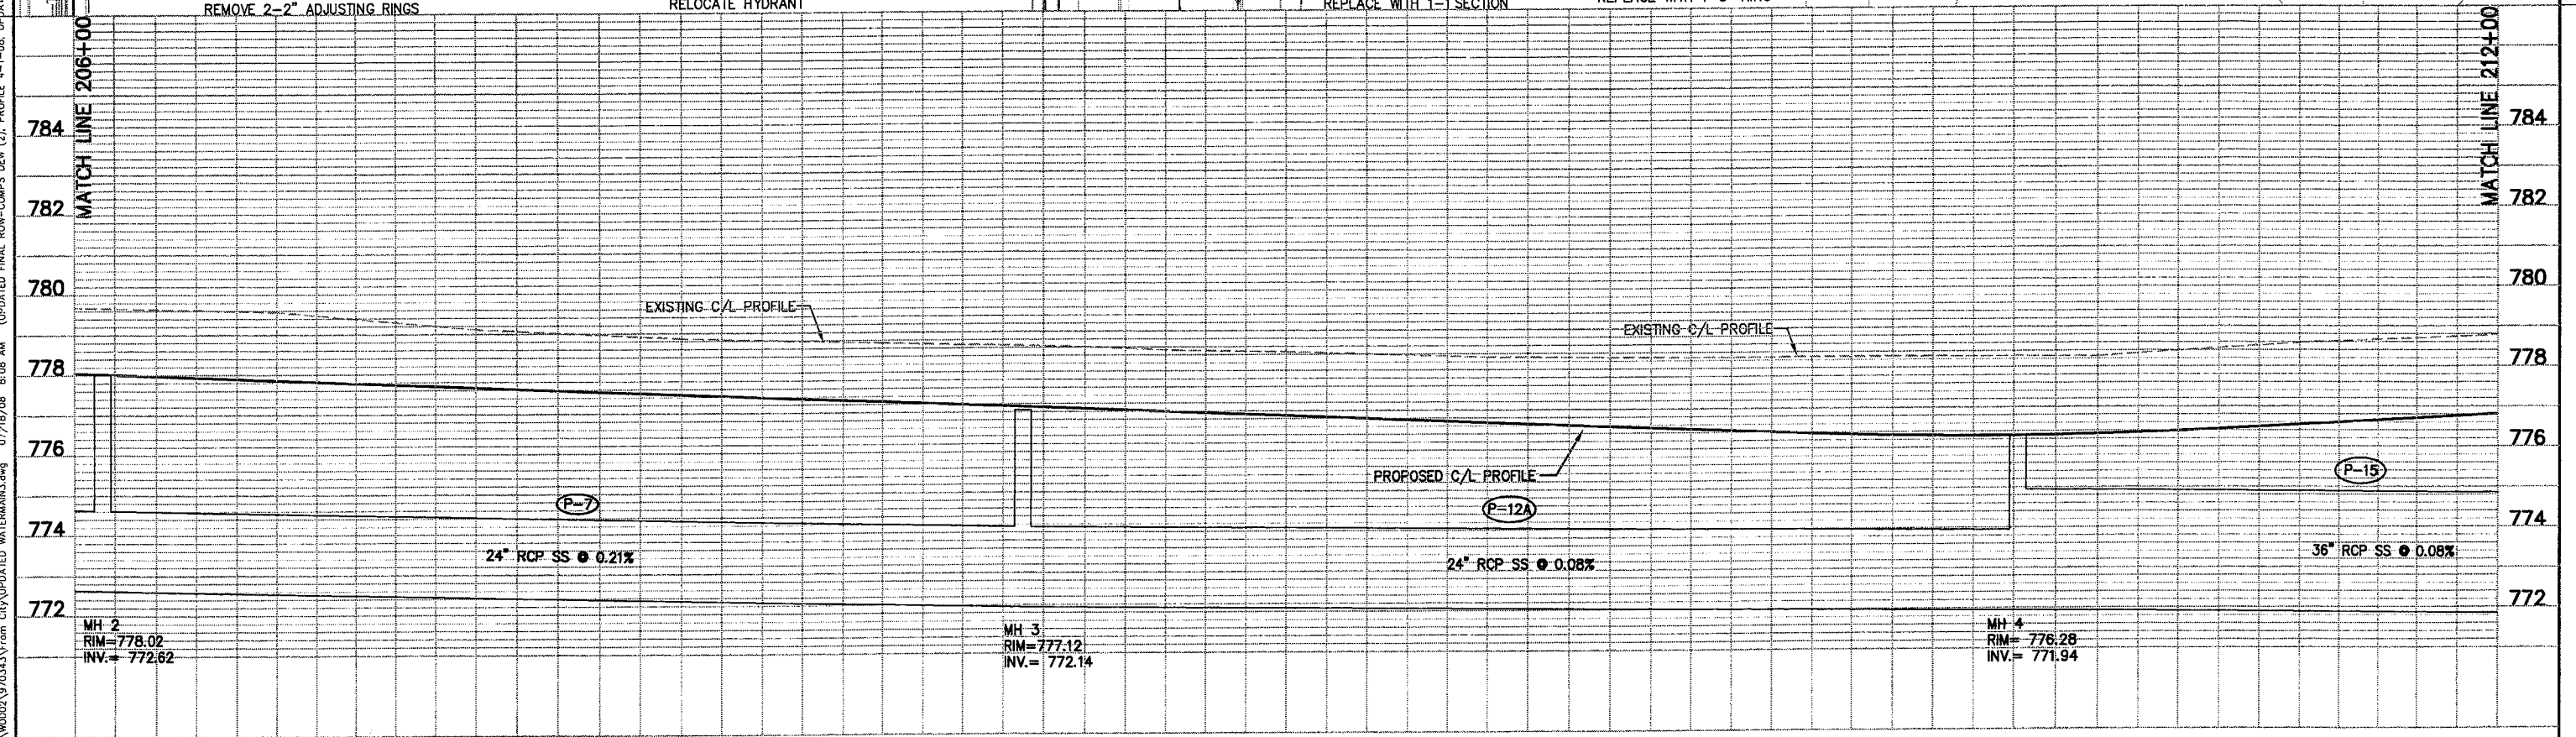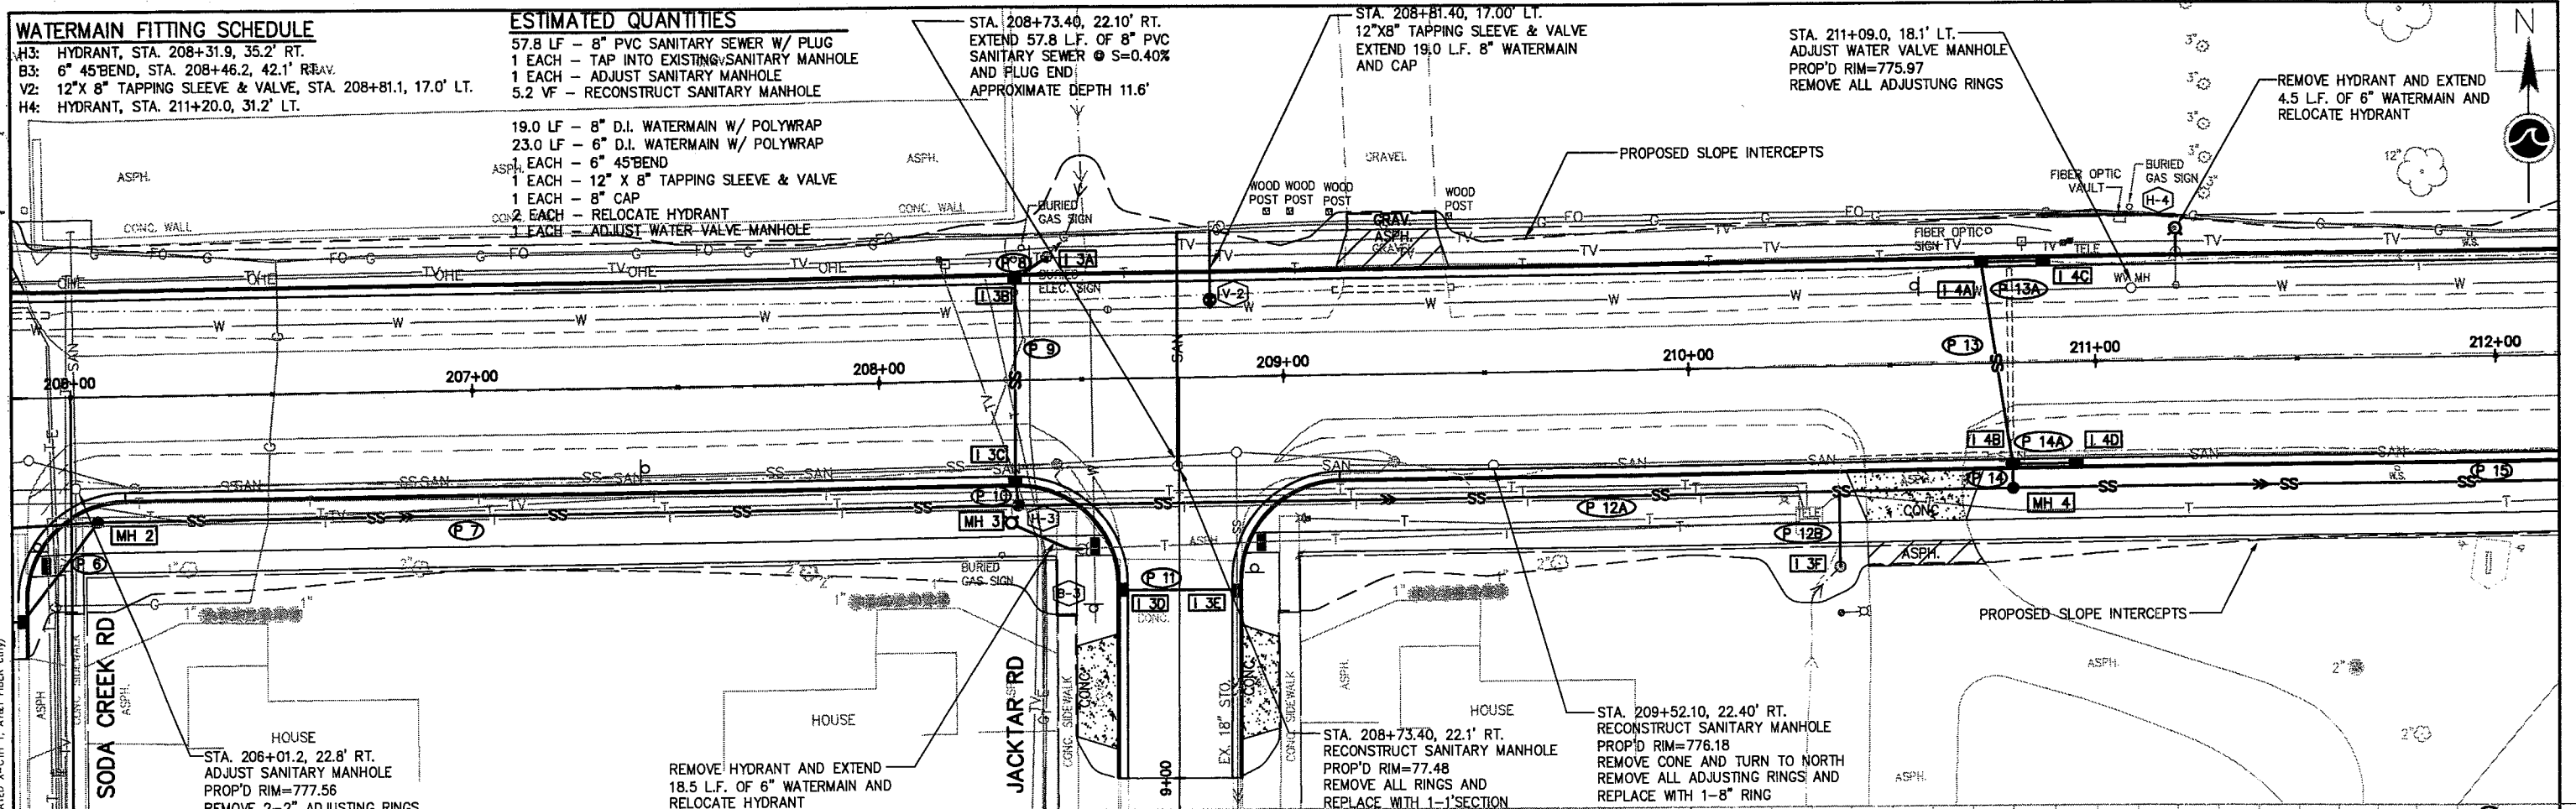

206+00	207+00	208+00	209+00	210+00	211+00	212+00
STATE PROJECT NUMBER: 4994-00-87			HWY: CTH Y		COUNTY: WINNEBAGO	
SANITARY SEWER & WATER MAIN			6 OF 14		SHEET NO: 43	



07/16/08 8:08 AM (UPDATED FINAL ROW-COMPS DEW (2), PROFILE 4-1-08, UPDATED X-CTH Y, AT&T FIBER CITY)
 C:\DWG\0002\970343\From City\UPDATED WATERMAIN.dwg

I:\projects\4994-00-87\4994-00-87.dwg 07/18/08 8:07 AM (UPDATED FINAL ROW-COMPS DEW (2), PROFILE, 4-1-08, UPDATED X-CTR Y, A&T FIBER CITY)

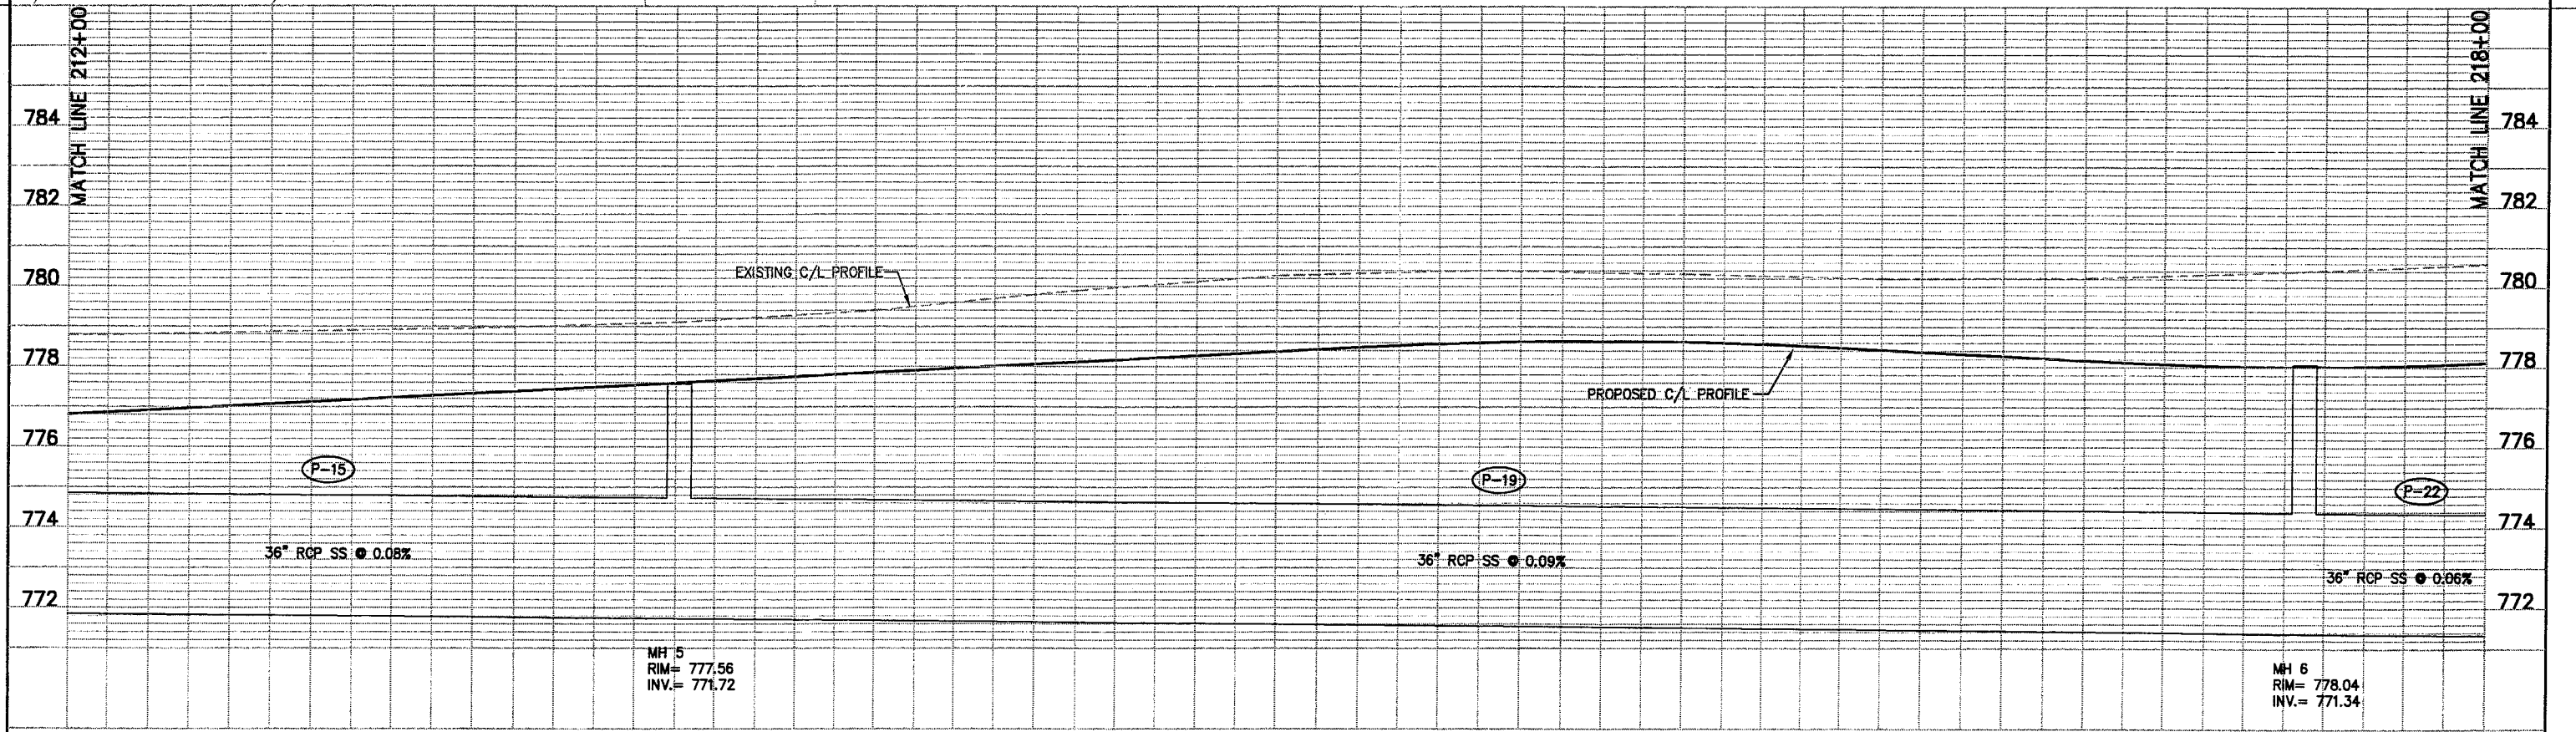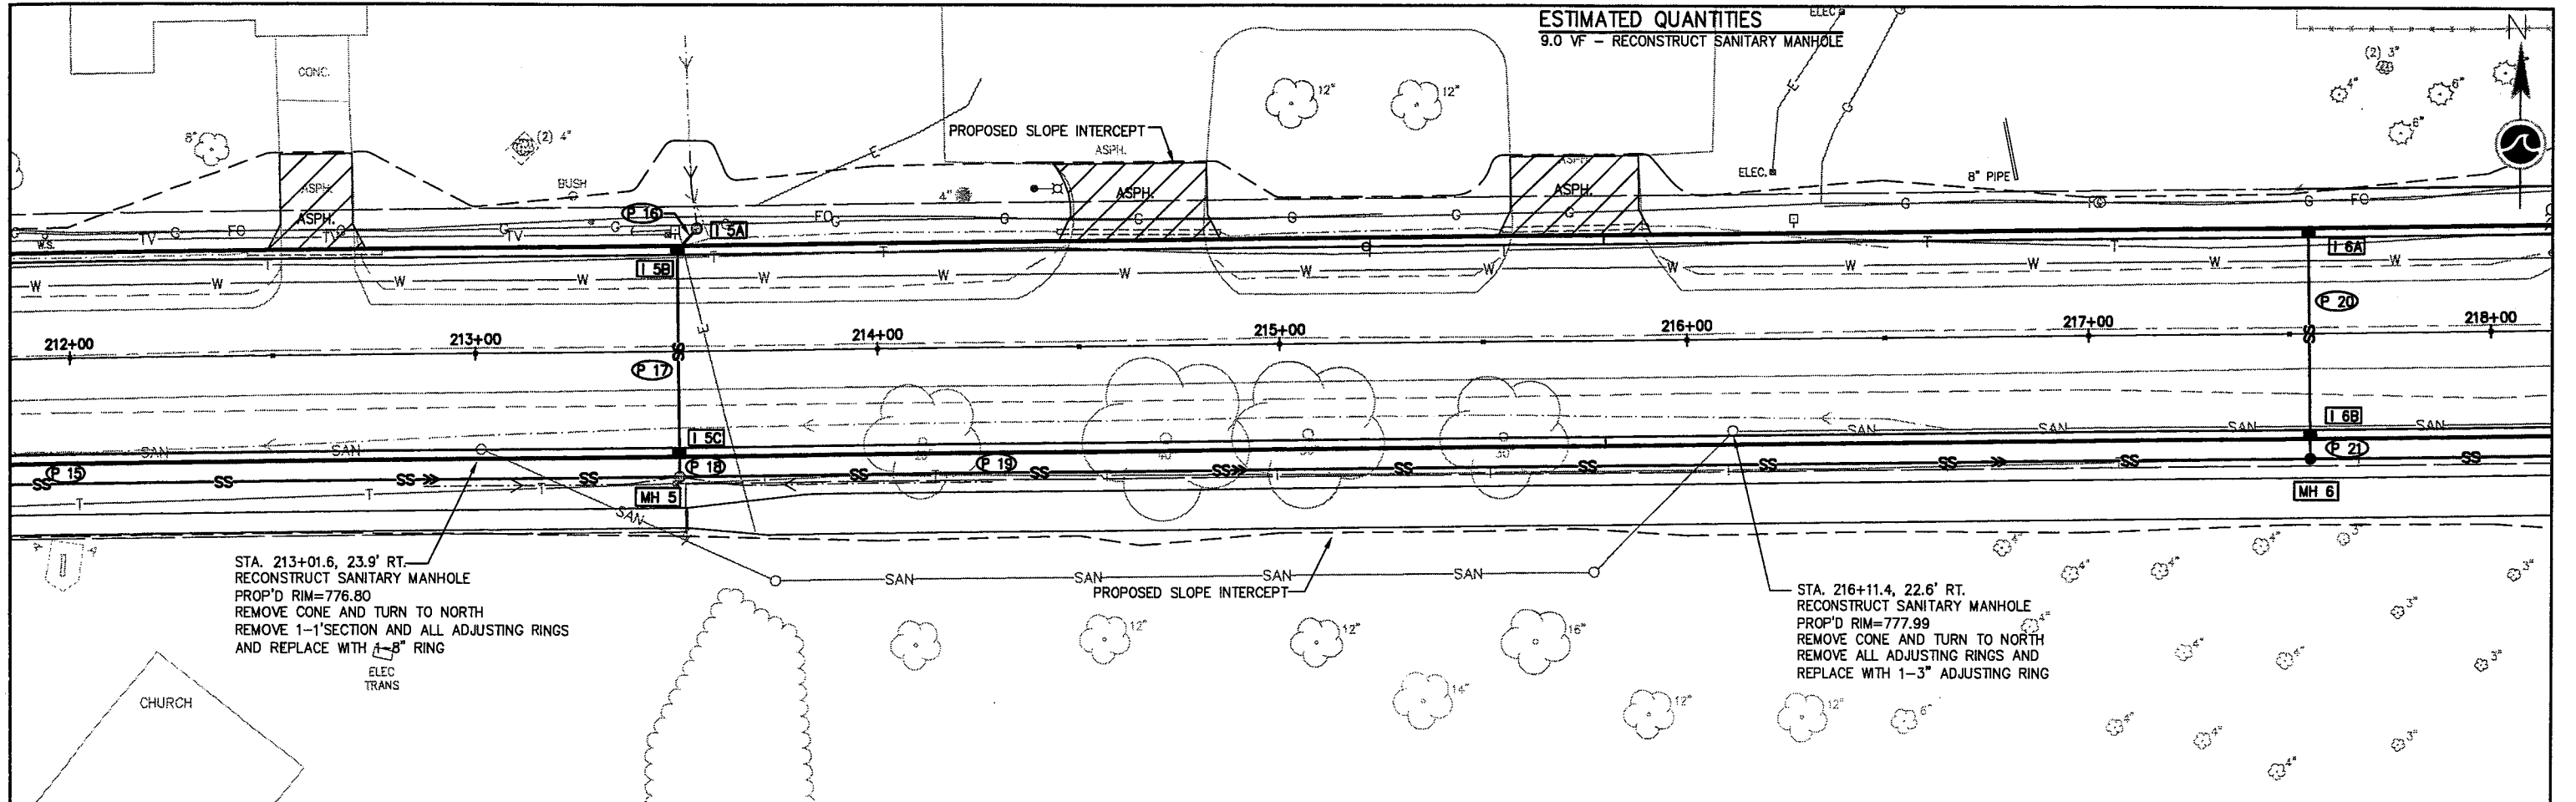


212+00	213+00	214+00	215+00	216+00	217+00	218+00
--------	--------	--------	--------	--------	--------	--------

STATE PROJECT NUMBER: 4994-00-87	HWY: CTH Y	COUNTY: WINNEBAGO	SANITARY SEWER & WATER MAIN	7 OF 14	SHEET NO: 44	E
----------------------------------	------------	-------------------	-----------------------------	---------	--------------	---

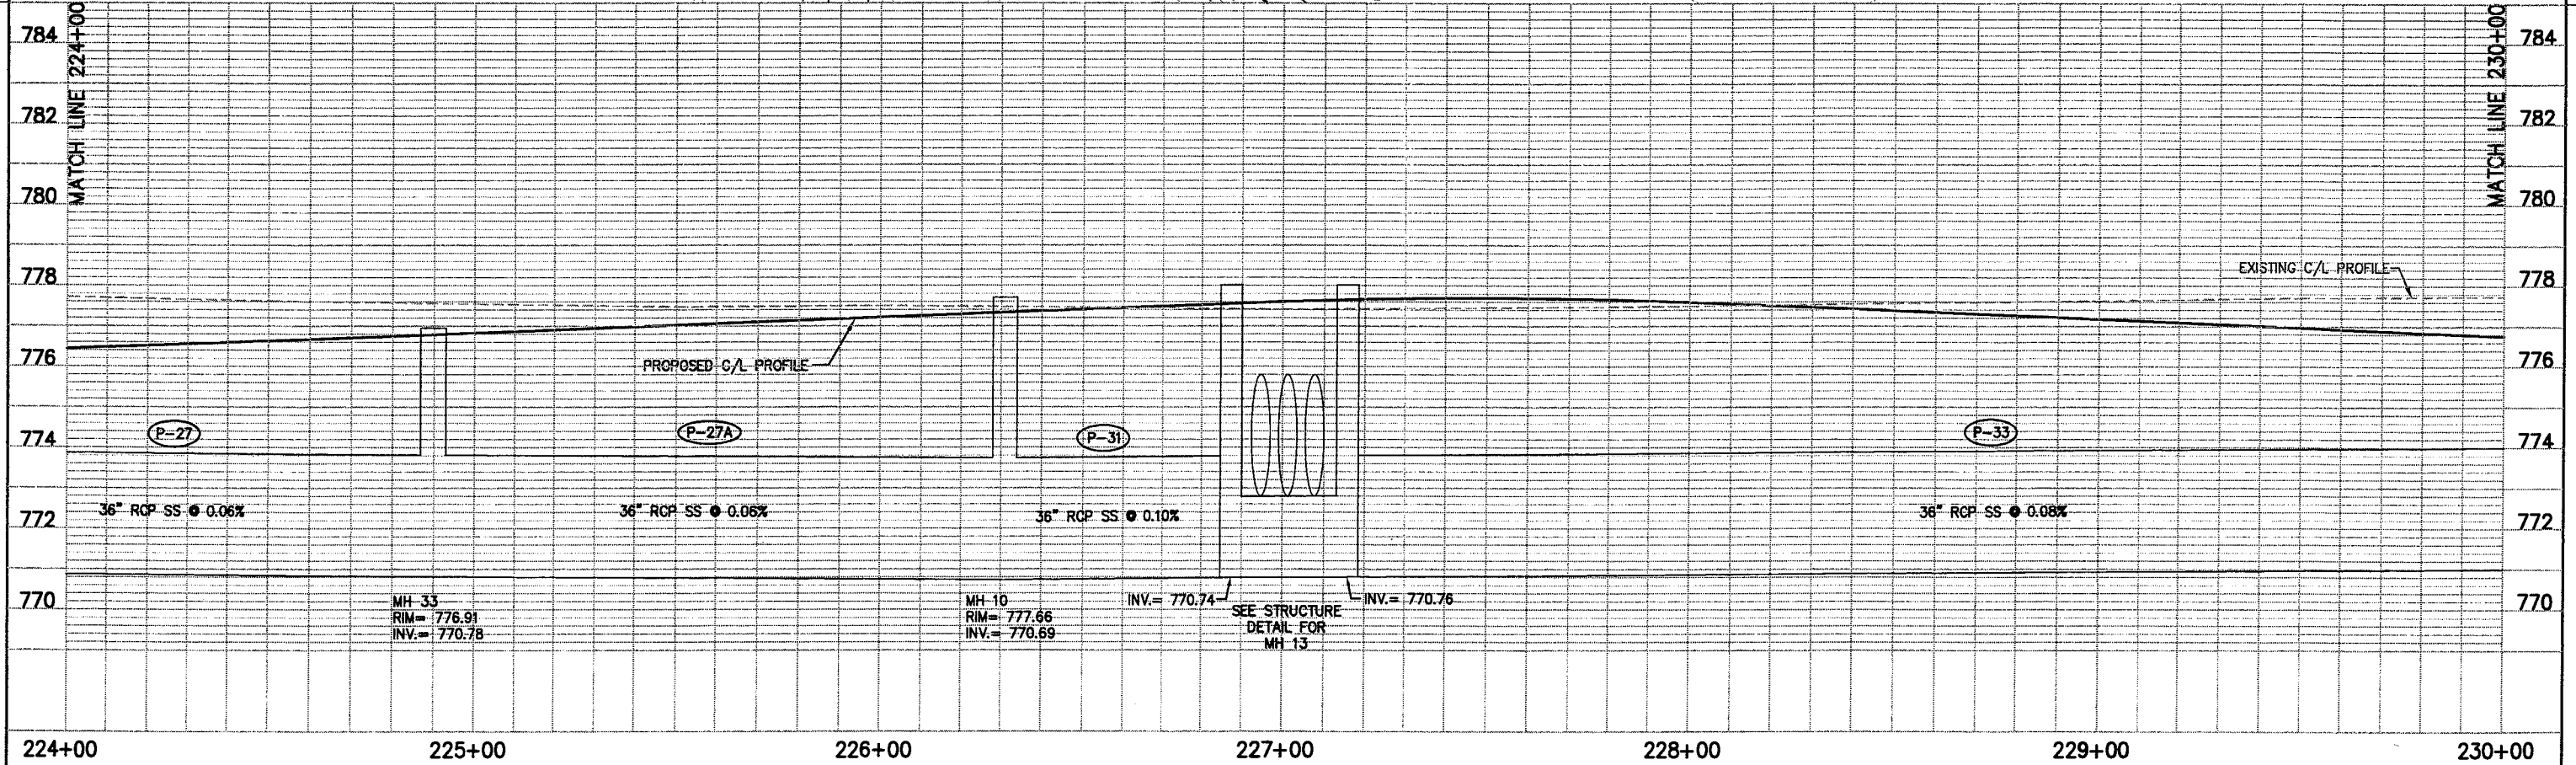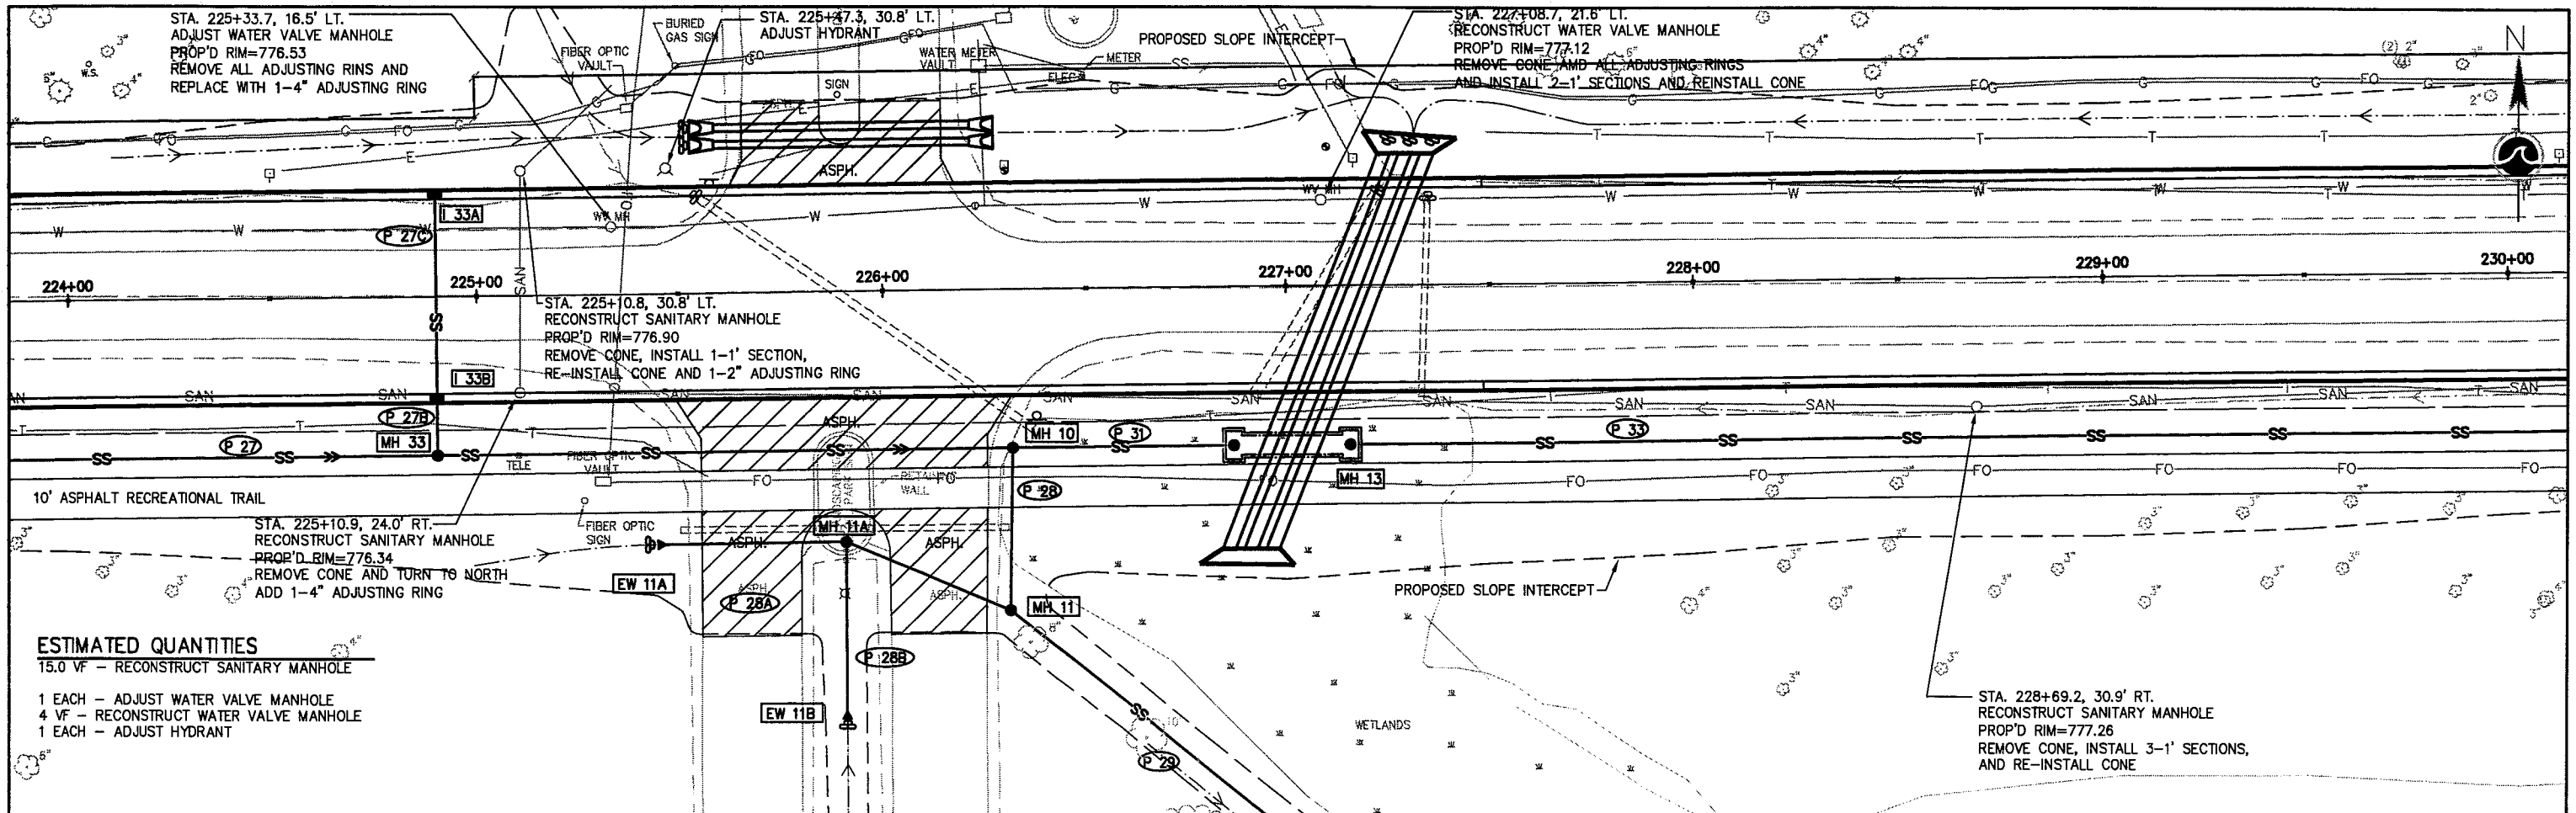

07/18/08 8:13 AM (UPDATED FINAL ROW-COMPS DEW (2), PROFILE 4-1-08, UPDATED X-CITY, AT&T FIBER CITY)


07/18/08 8:15 AM (UPDATED FINAL ROW-COMPS DEW (2), PROFILE 4-1-08, UPDATED X-CTH Y, AT&T FIBER CITY)
 gassen W:\QV\0002\9703\3\3\From City\UPDATED WATERMAIN.dwg

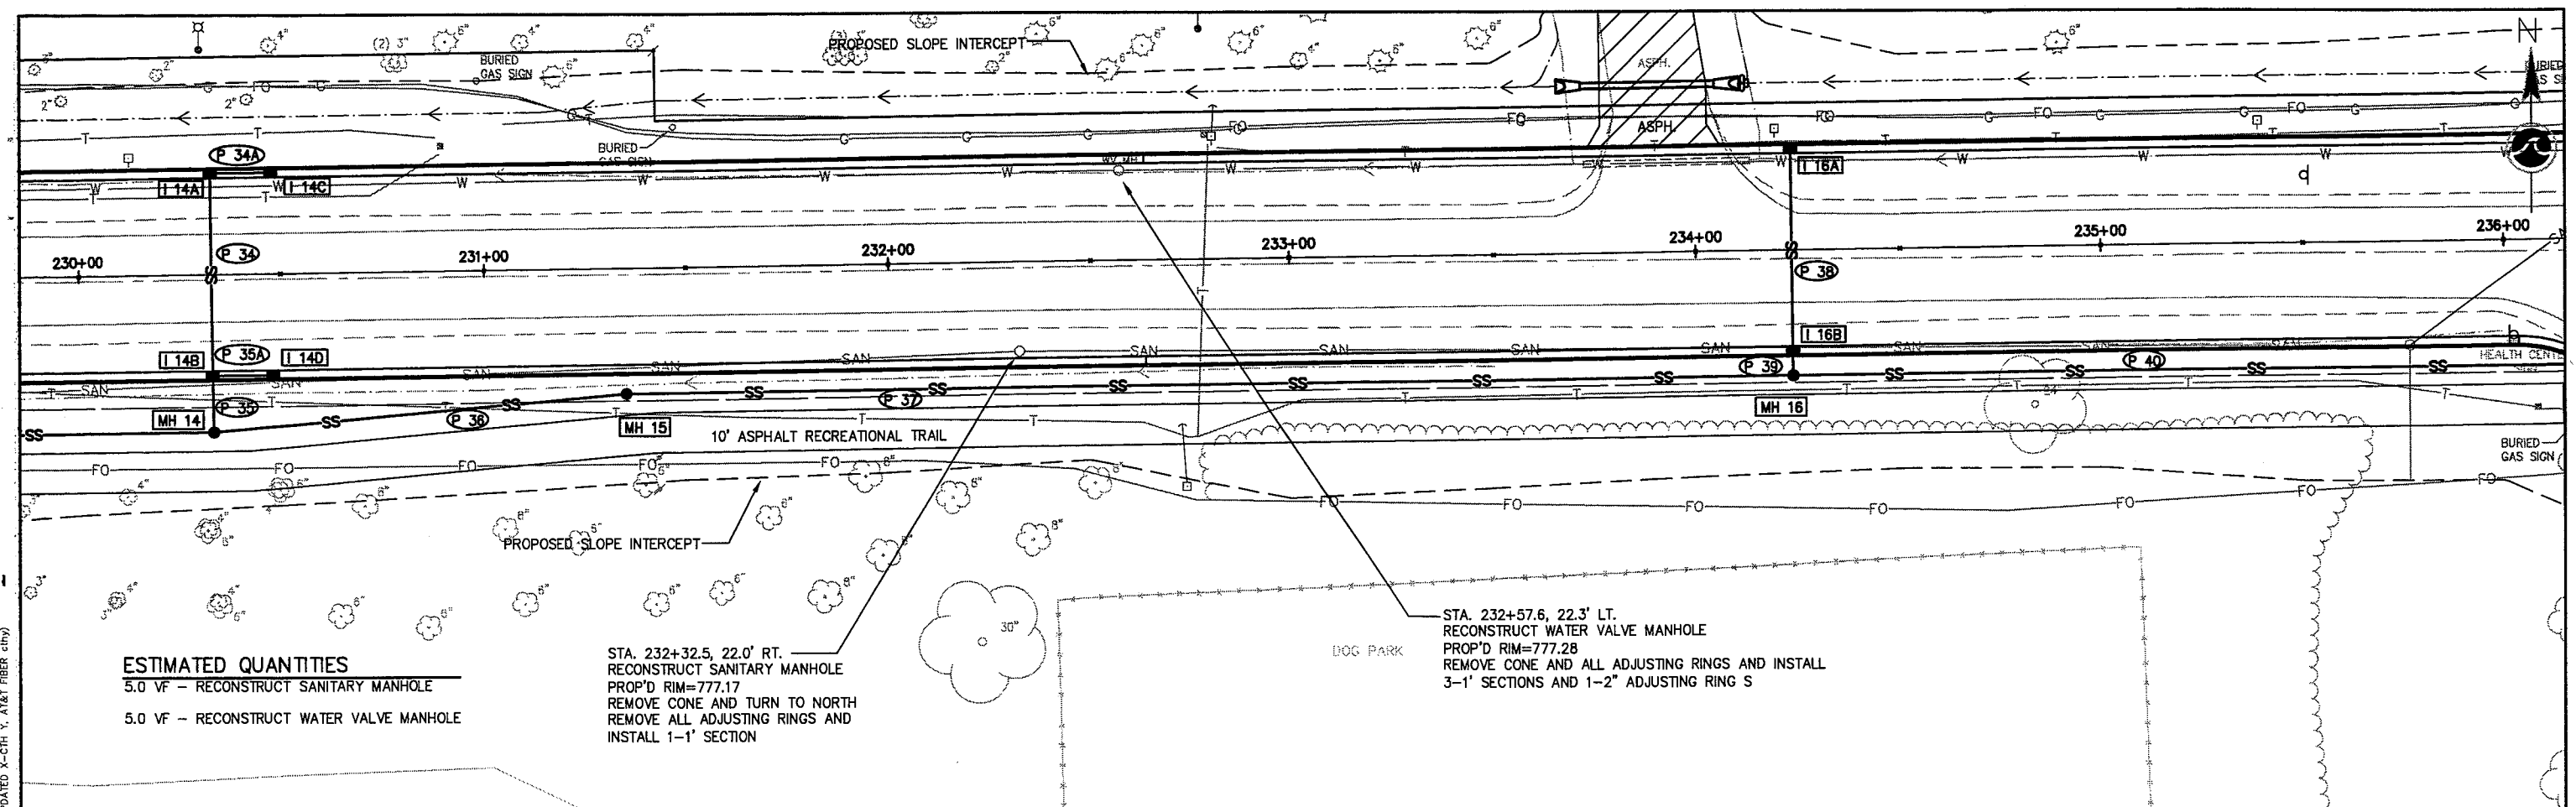



ESTIMATED QUANTITIES
 5.0 VF - RECONSTRUCT SANITARY MANHOLE
 5.0 VF - RECONSTRUCT WATER VALVE MANHOLE

STA. 232+32.5, 22.0' RT.
 RECONSTRUCT SANITARY MANHOLE
 PROP'D RIM=777.17
 REMOVE CONE AND TURN TO NORTH
 REMOVE ALL ADJUSTING RINGS AND
 INSTALL 1-1' SECTION

STA. 232+57.6, 22.3' LT.
 RECONSTRUCT WATER VALVE MANHOLE
 PROP'D RIM=777.28
 REMOVE CONE AND ALL ADJUSTING RINGS AND INSTALL
 3-1' SECTIONS AND 1-2" ADJUSTING RING S

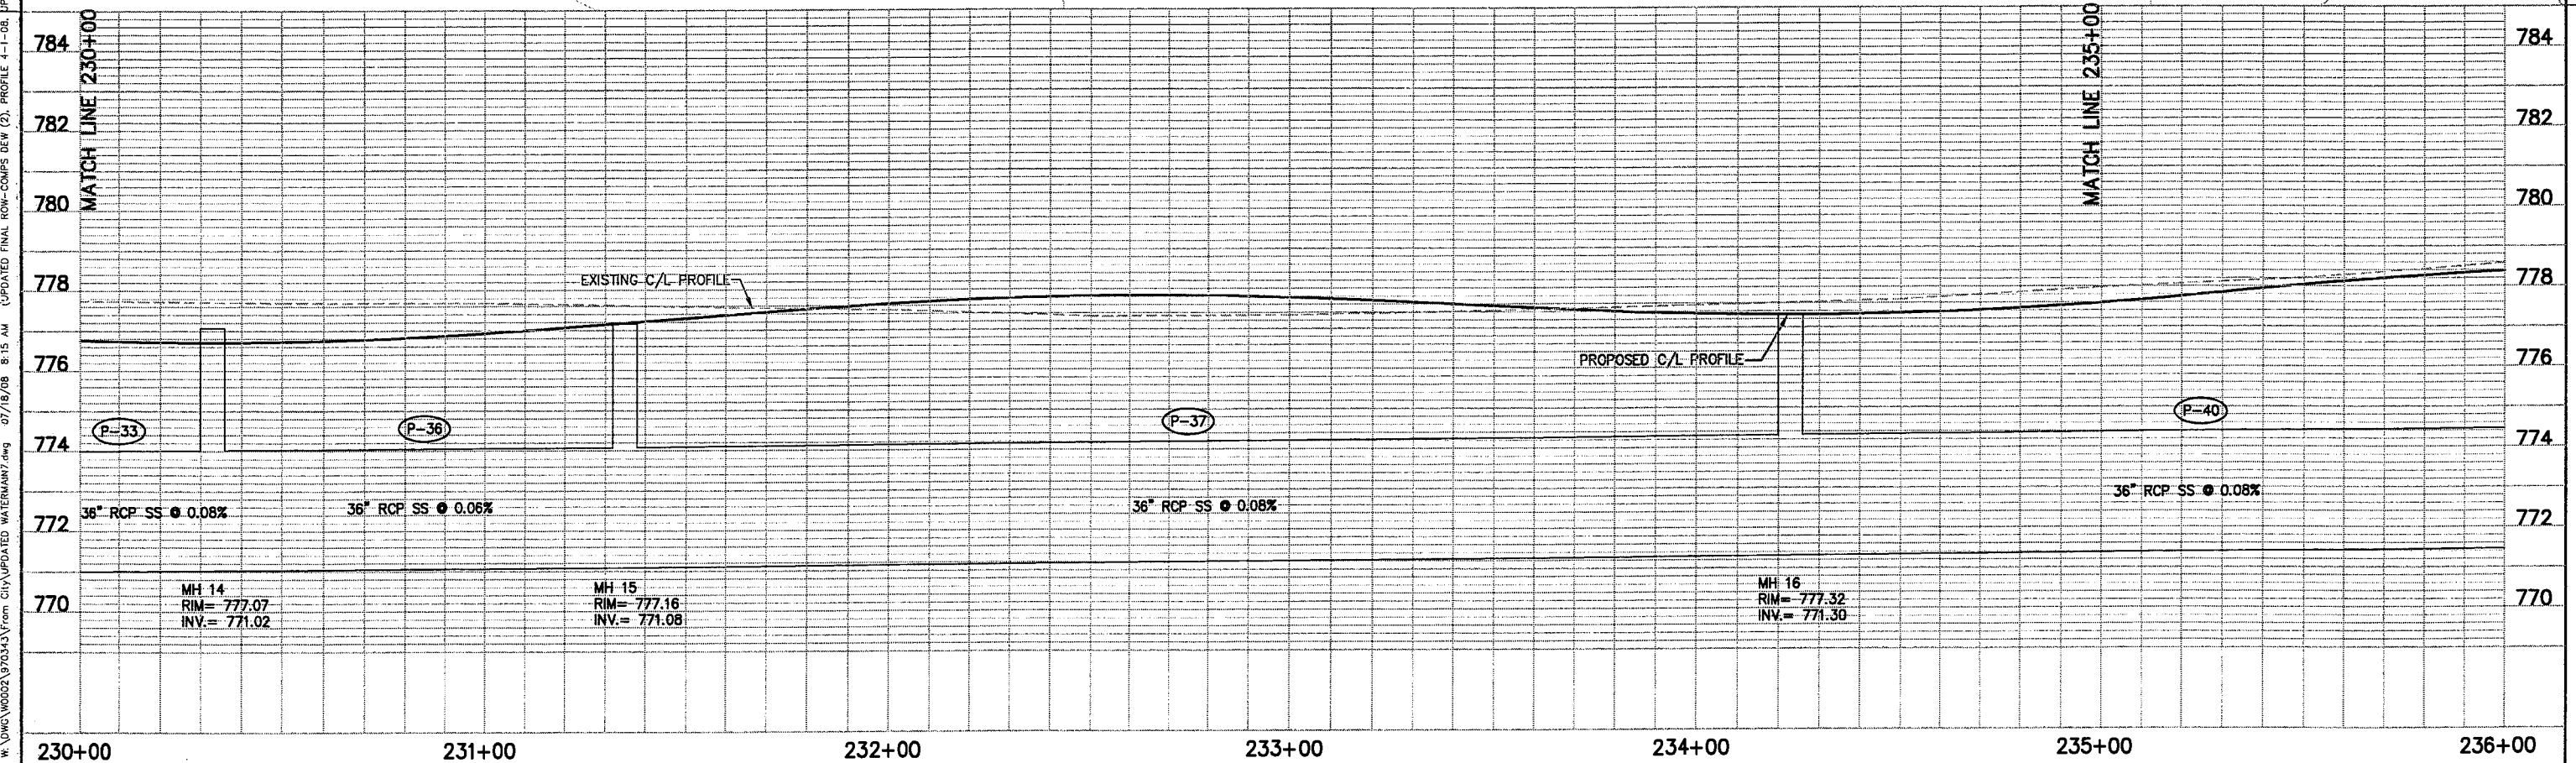

07/18/08 8:17 AM (UPDATED FINAL ROW-COMPS DED (2), PROFILE 4-1-08, UPDATED X-CTH Y, AT&T FIBER CITY)
 rpsaan w:\pvc\w0002\970343\1\from civ\UPDATED WATERMAIN8.dwg

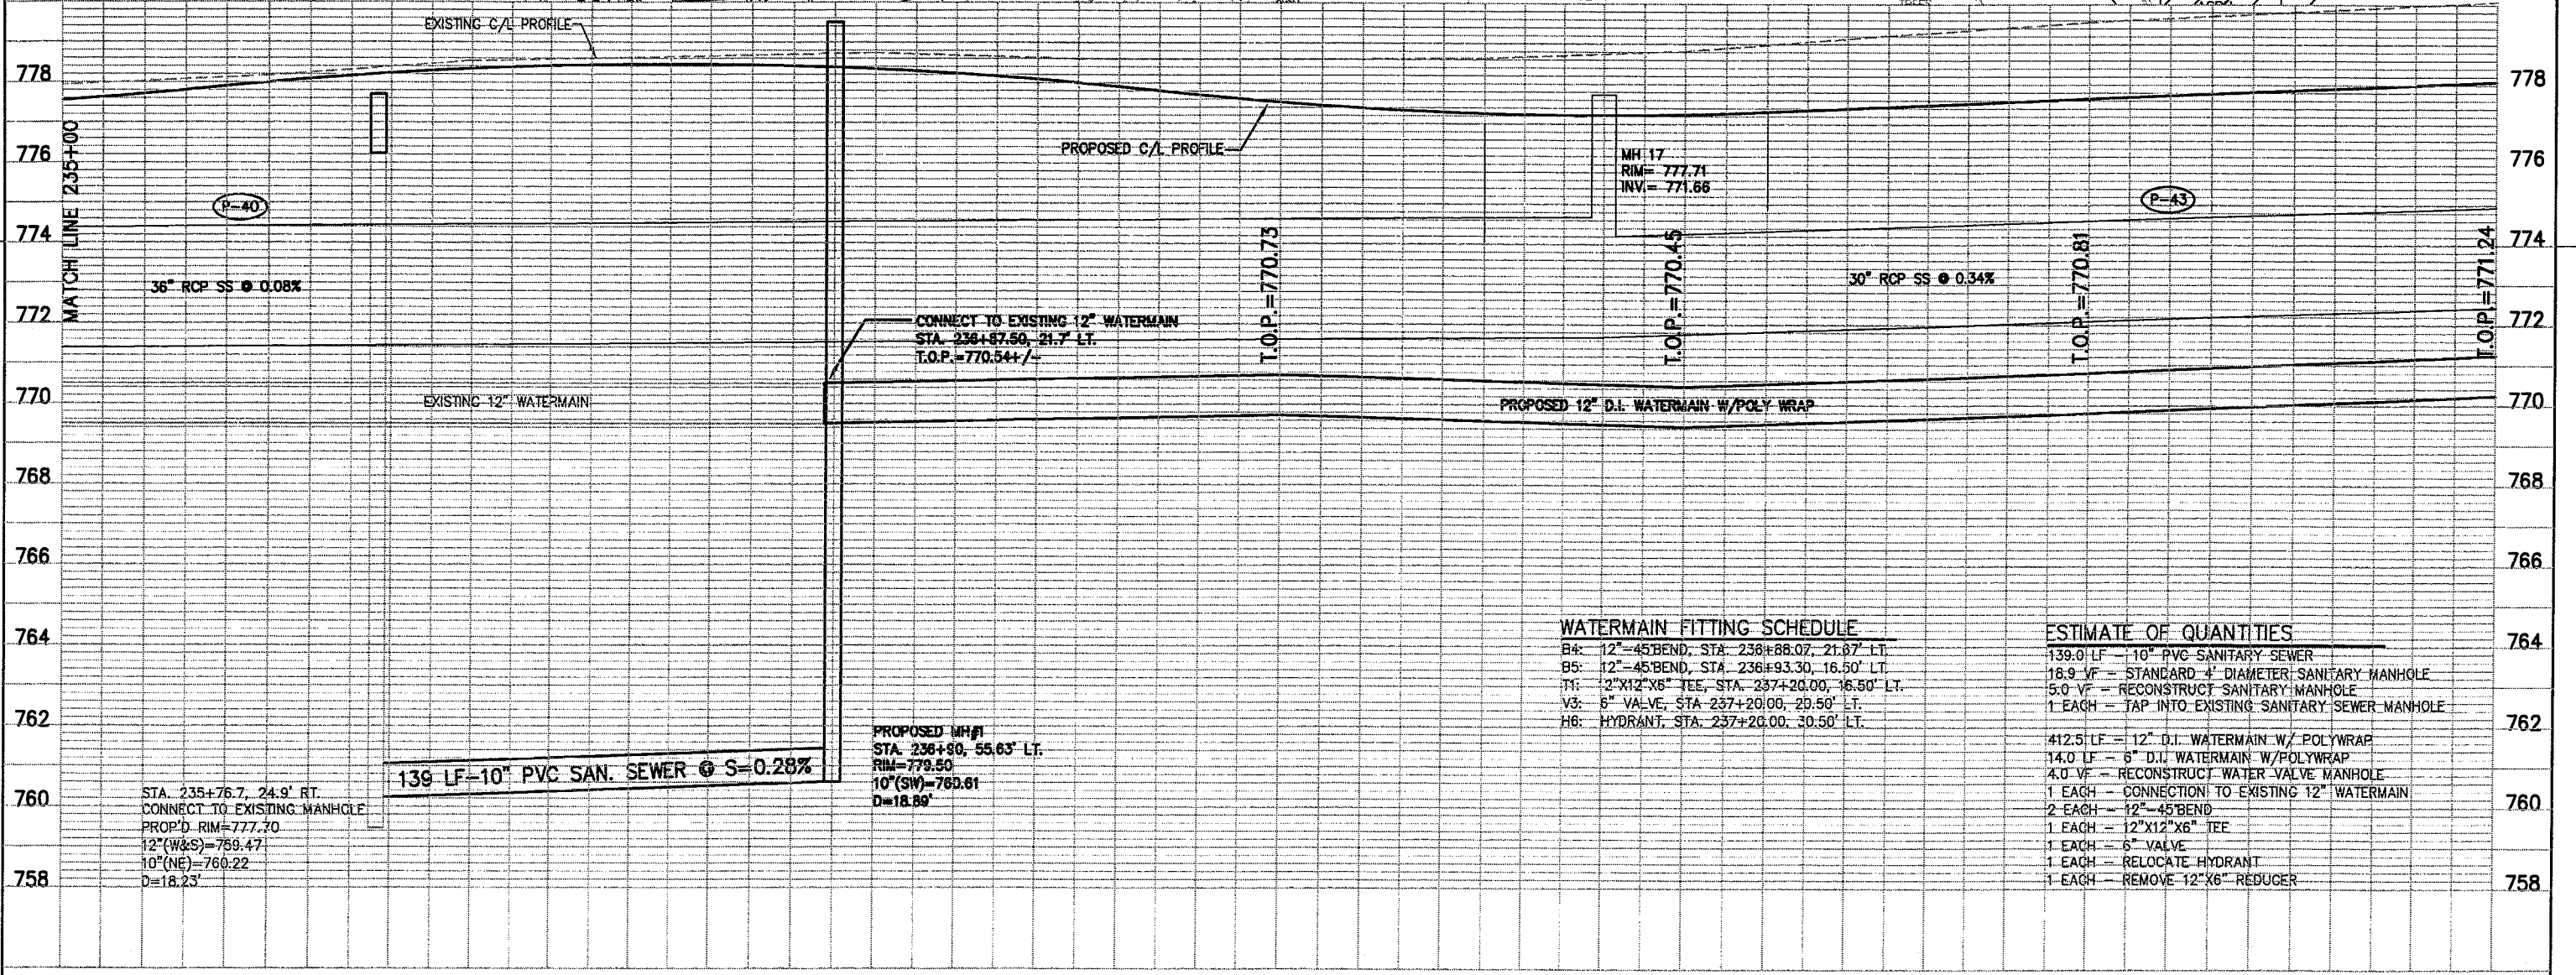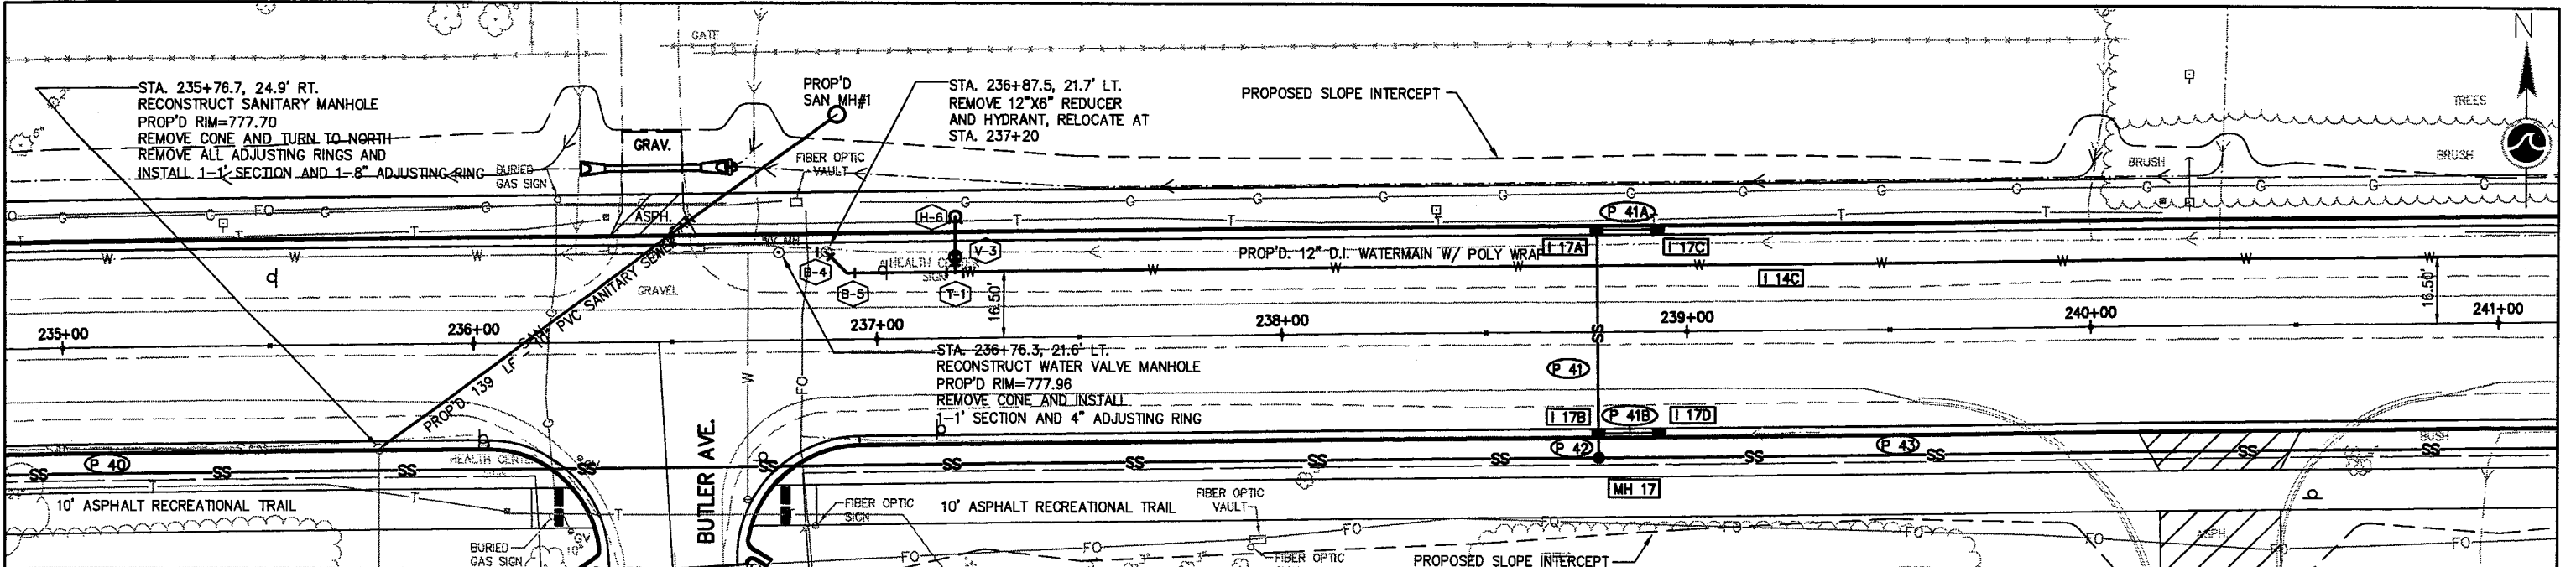


WATERMAIN FITTING SCHEDULE

- B4: 12" 45° BEND, STA. 236+88.07, 21.87' LT.
- B5: 12" 45° BEND, STA. 236+93.30, 16.50' LT.
- T1: 2" X 12" X 6" TEE, STA. 237+20.00, 16.50' LT.
- V3: 6" VALVE, STA. 237+20.00, 20.50' LT.
- H6: HYDRANT, STA. 237+20.00, 30.50' LT.

ESTIMATE OF QUANTITIES


- 139.0 LF - 10" PVC SANITARY SEWER
- 18.9 VF - STANDARD 4' DIAMETER SANITARY MANHOLE
- 5.0 VF - RECONSTRUCT SANITARY MANHOLE
- 1 EACH - TAP INTO EXISTING SANITARY SEWER MANHOLE
- 412.5 LF - 12" D.I. WATERMAIN W/ POLYWRAP
- 14.0 LF - 6" D.I. WATERMAIN W/ POLYWRAP
- 4.0 VF - RECONSTRUCT WATER VALVE MANHOLE
- 1 EACH - CONNECTION TO EXISTING 12" WATERMAIN
- 2 EACH - 12" 45° BEND
- 1 EACH - 12" X 12" X 6" TEE
- 1 EACH - 6" VALVE
- 1 EACH - RELOCATE HYDRANT
- 1 EACH - REMOVE 12" X 6" REDUCER

07/19/08 8:21 AM (UPDATED FINAL ROW-COMPS DEW (2), PROFILE 4-1-08, UPDATED X-CTH Y, A1&T FIBER CITY)
 rpsosen W:\DWG\W0002\970343\From CIV\UPDATED WATERMAIN.dwg

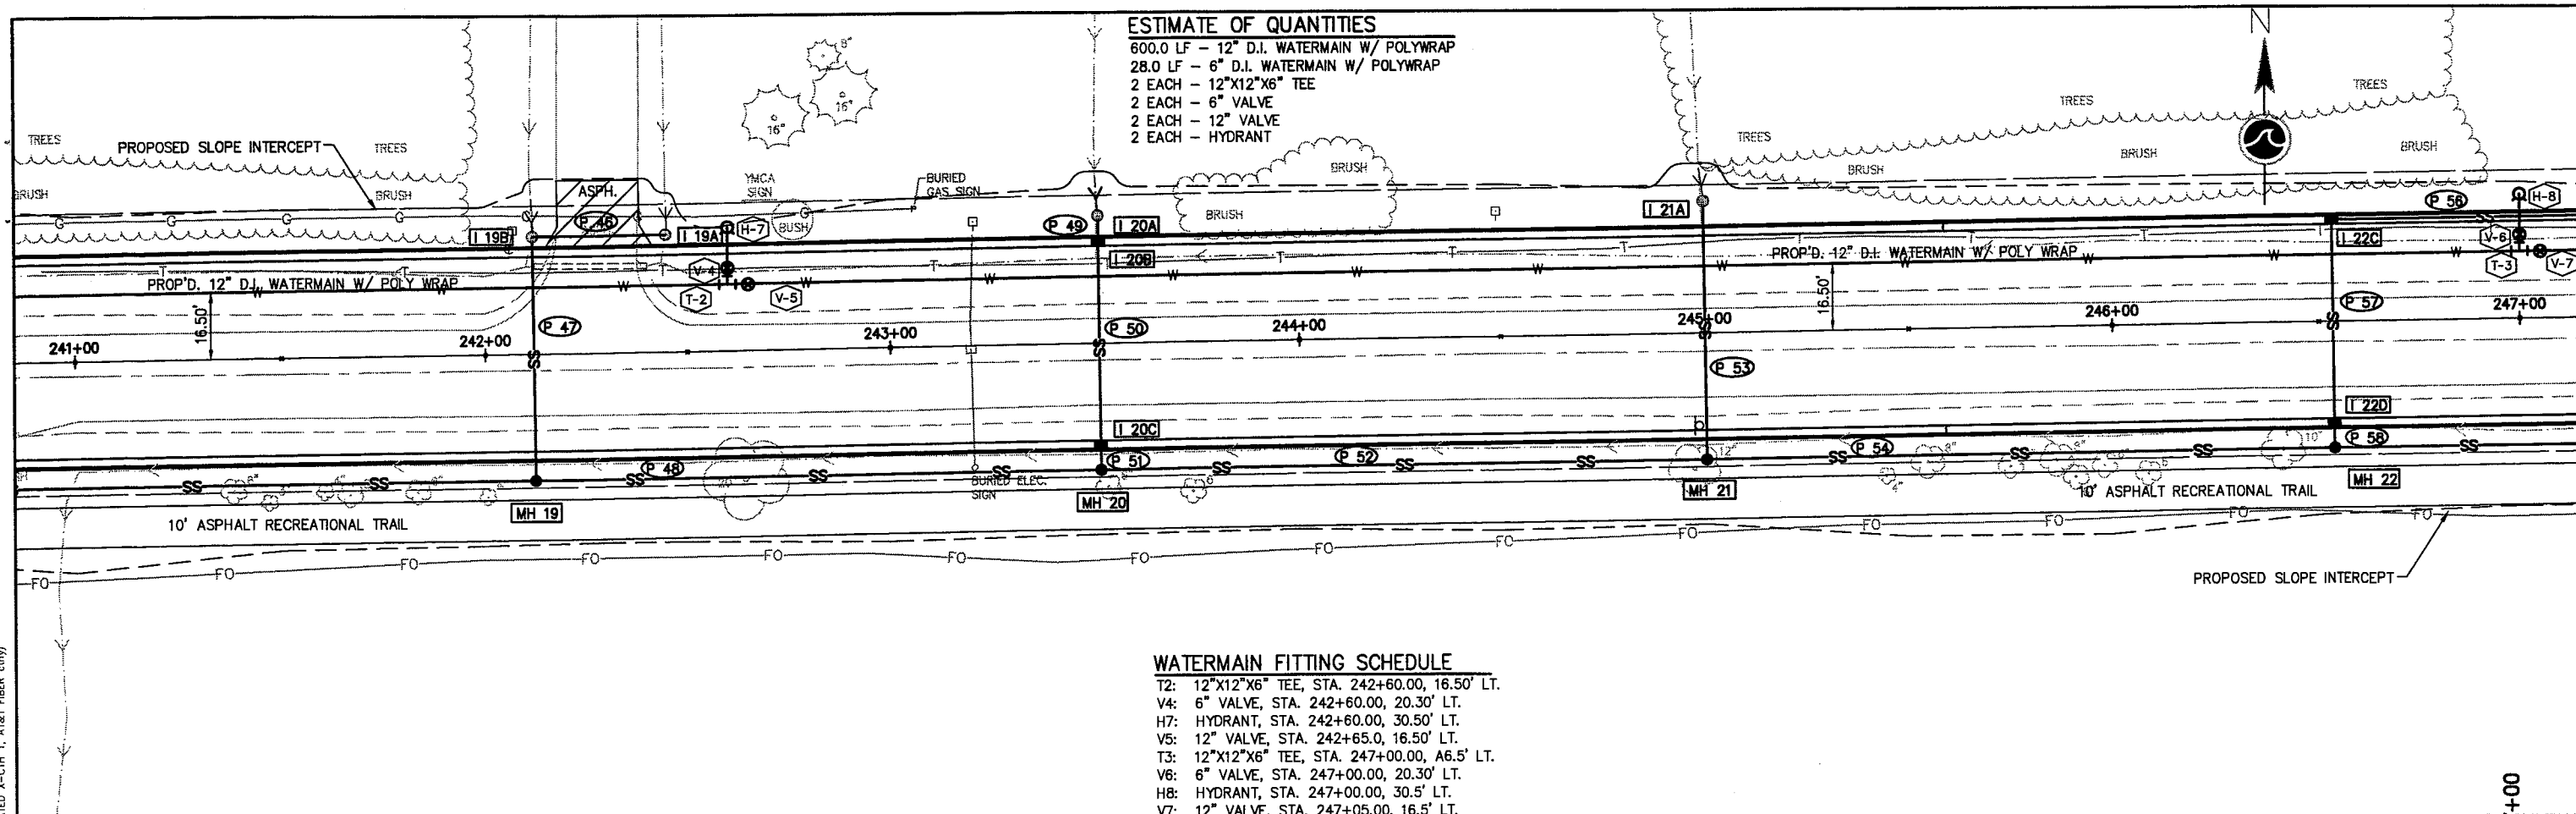

ESTIMATE OF QUANTITIES
 600.0 LF - 12" D.I. WATERMAIN W/ POLYWRAP
 28.0 LF - 6" D.I. WATERMAIN W/ POLYWRAP
 2 EACH - 12"x12"x6" TEE
 2 EACH - 6" VALVE
 2 EACH - 12" VALVE
 2 EACH - HYDRANT

WATERMAIN FITTING SCHEDULE
 T2: 12"x12"x6" TEE, STA. 242+60.00, 16.50' LT.
 V4: 6" VALVE, STA. 242+60.00, 20.30' LT.
 H7: HYDRANT, STA. 242+60.00, 30.50' LT.
 V5: 12" VALVE, STA. 242+65.00, 16.50' LT.
 T3: 12"x12"x6" TEE, STA. 247+00.00, A6.5' LT.
 V6: 6" VALVE, STA. 247+00.00, 20.30' LT.
 H8: HYDRANT, STA. 247+00.00, 30.5' LT.
 V7: 12" VALVE, STA. 247+05.00, 16.5' LT.


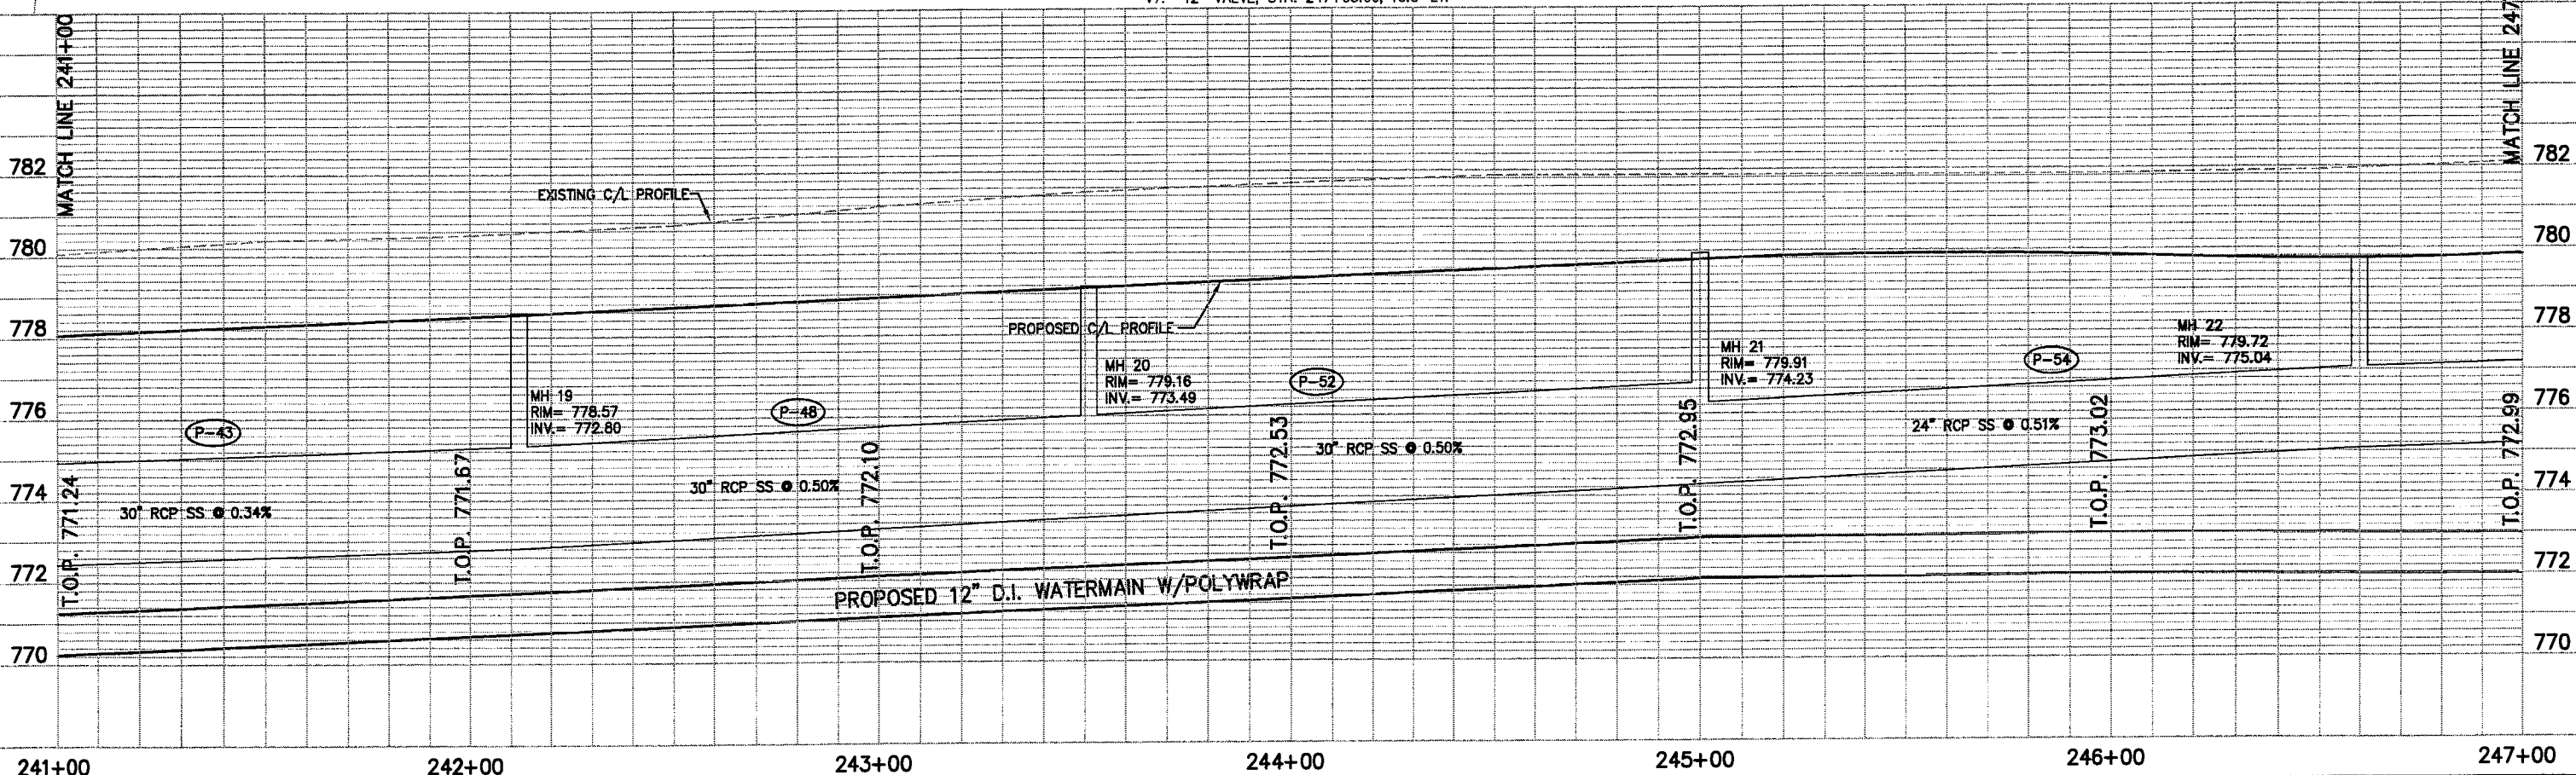


ESTIMATE OF QUANTITIES

- 600.0 LF - 12" D.I. WATERMAIN W/ POLYWRAP
- 14.0 LF - 6" D.I. WATERMAIN W/ POLYWRAP
- 1 EACH - 6" VALVE
- 1 EACH - 12" VALVE
- 1 EACH - HYDRANT
- 1 EACH - 12"X12"X6" TEE


WATERMAIN FITTING SCHEDULE

- T4: 12"X12"X6" TEE, STA. 251+50.00, 16.50' LT.
- V8: 6" VALVE, STA. 251+50.00, 20.30' LT.
- H9: HYDRANT, STA. 251+50.00, 30.50' LT.
- V9: 12" VALVE, STA. 251+55.0, 16.50' LT.

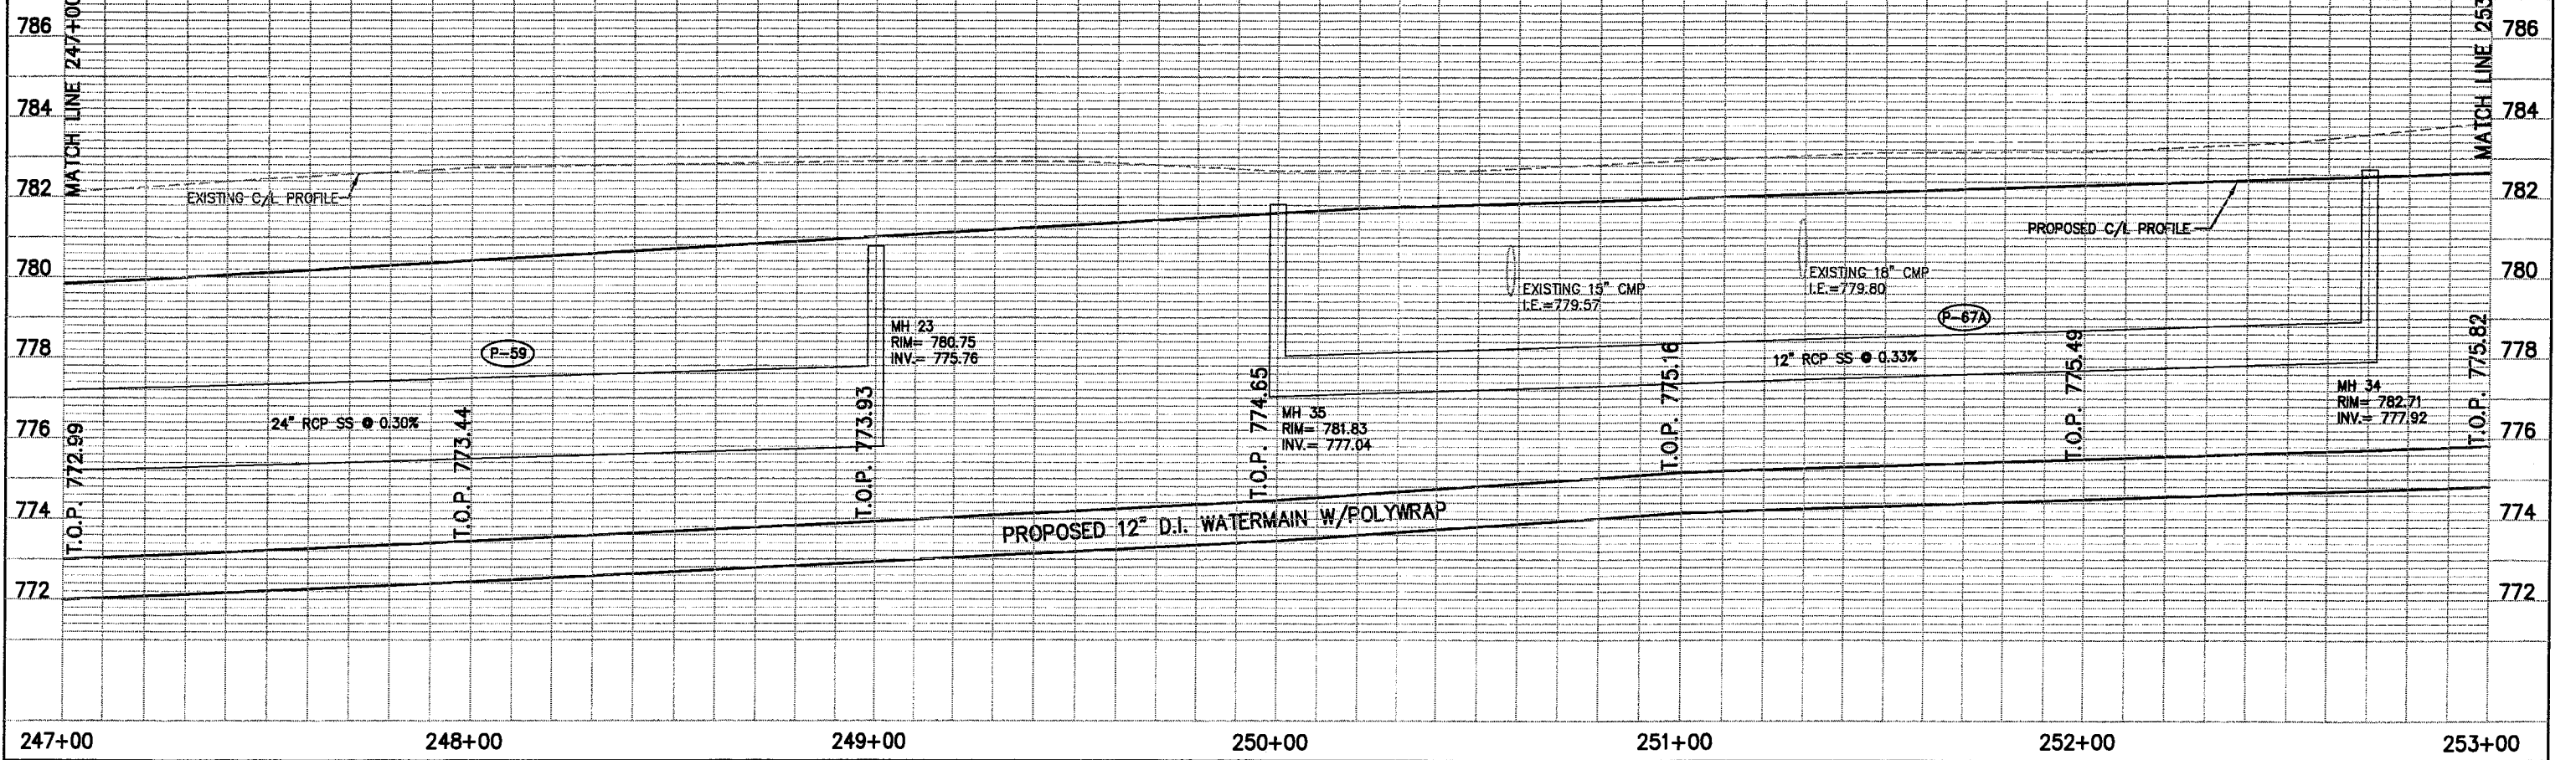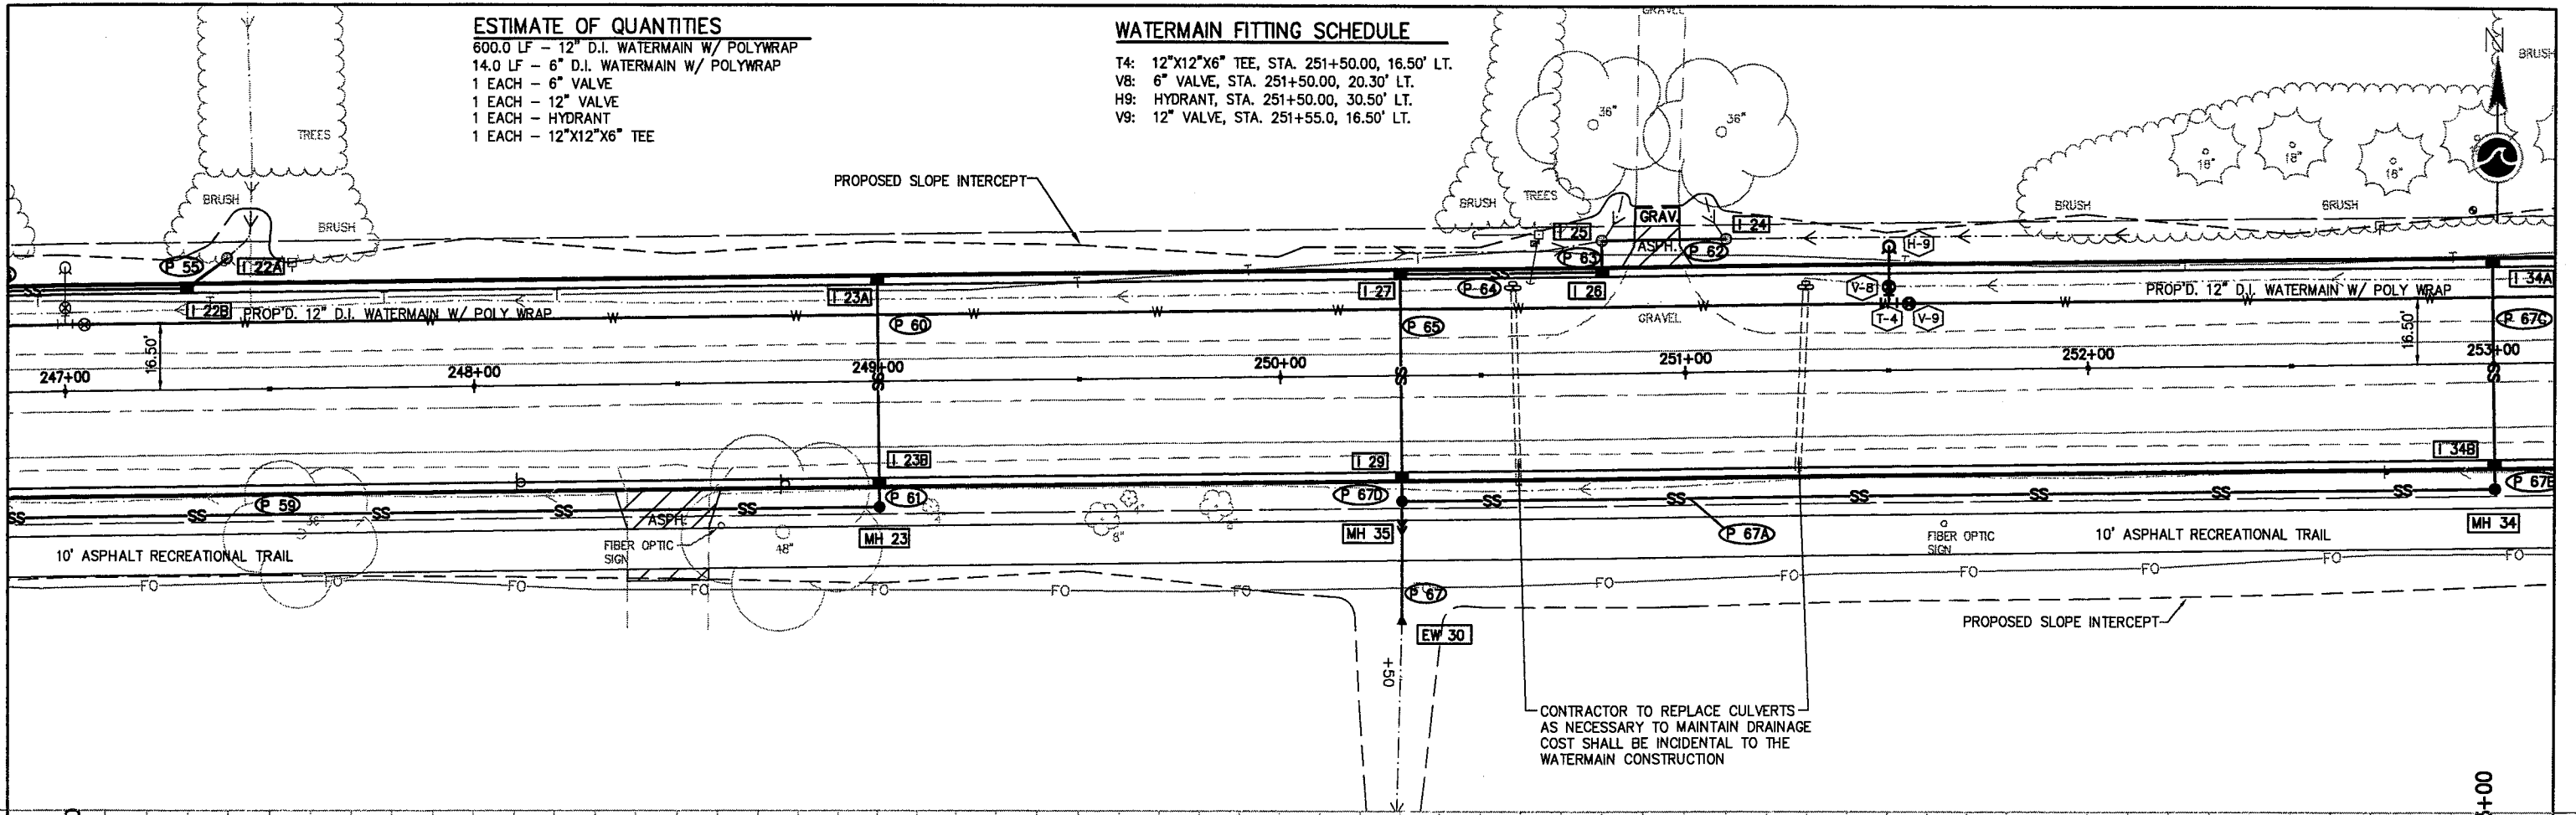

W:\DWG\0002\970343\From City\UPDATED WATERMAIN0.dwg 07/18/08 8:23 AM (UPDATED FINAL ROW-COMPS DEW (2), PROFILE 4-1-08, UPDATED X-CTH Y, AT&T FIBER CITY)

MSDOT/CADD SHEET 40

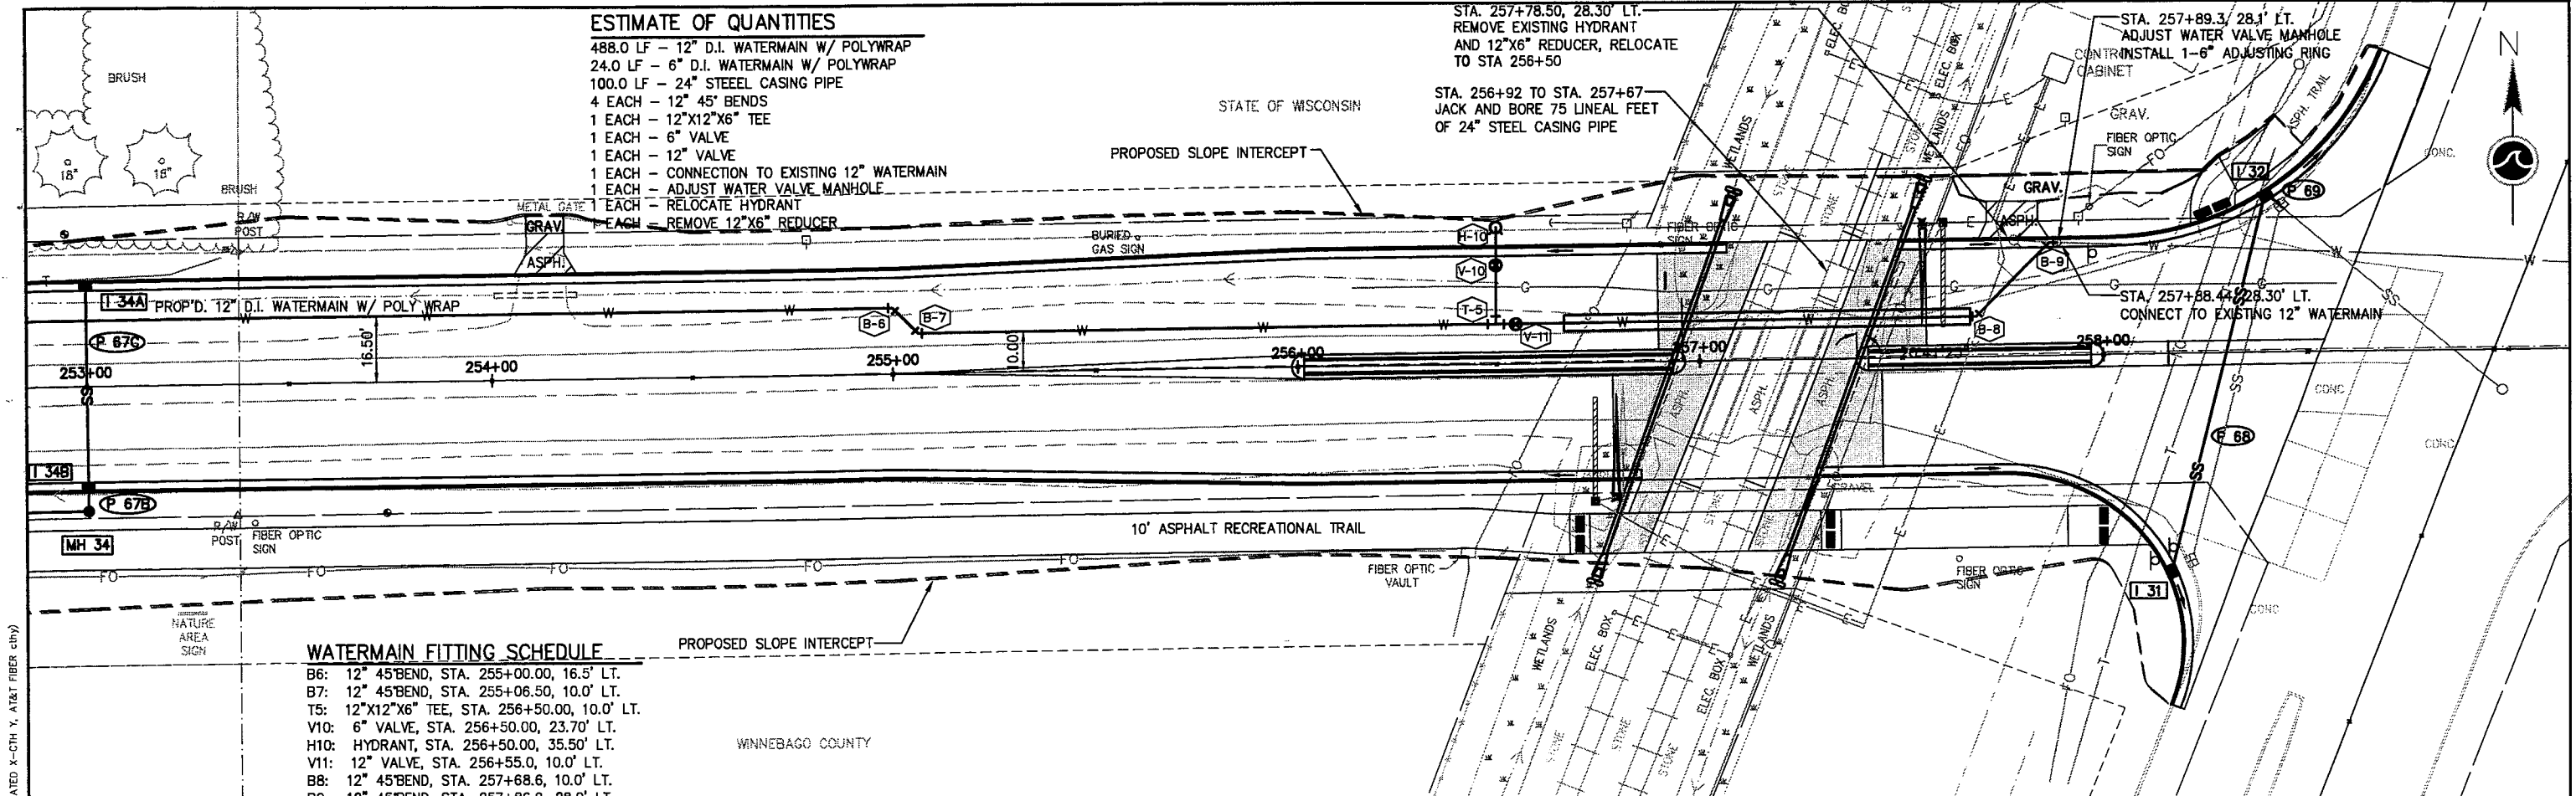

ESTIMATE OF QUANTITIES

- 488.0 LF - 12" D.I. WATERMAIN W/ POLYWRAP
- 24.0 LF - 6" D.I. WATERMAIN W/ POLYWRAP
- 100.0 LF - 24" STEEL CASING PIPE
- 4 EACH - 12" 45° BENDS
- 1 EACH - 12"X12"X6" TEE
- 1 EACH - 6" VALVE
- 1 EACH - 12" VALVE
- 1 EACH - CONNECTION TO EXISTING 12" WATERMAIN
- 1 EACH - ADJUST WATER VALVE MANHOLE
- 1 EACH - RELOCATE HYDRANT
- 1 EACH - REMOVE 12"X6" REDUCER

STA. 257+78.50, 28.30' LT.
REMOVE EXISTING HYDRANT
AND 12"X6" REDUCER, RELOCATE
TO STA 258+50

STA. 256+92 TO STA. 257+67
JACK AND BORE 75 LINEAL FEET
OF 24" STEEL CASING PIPE


STA. 257+89.3 / 28.1' LT.
ADJUST WATER VALVE MANHOLE
AND INSTALL 1-6" ADJUSTING RING

STA. 257+88.44 / 28.30' LT.
CONNECT TO EXISTING 12" WATERMAIN








WATERMAIN FITTING SCHEDULE


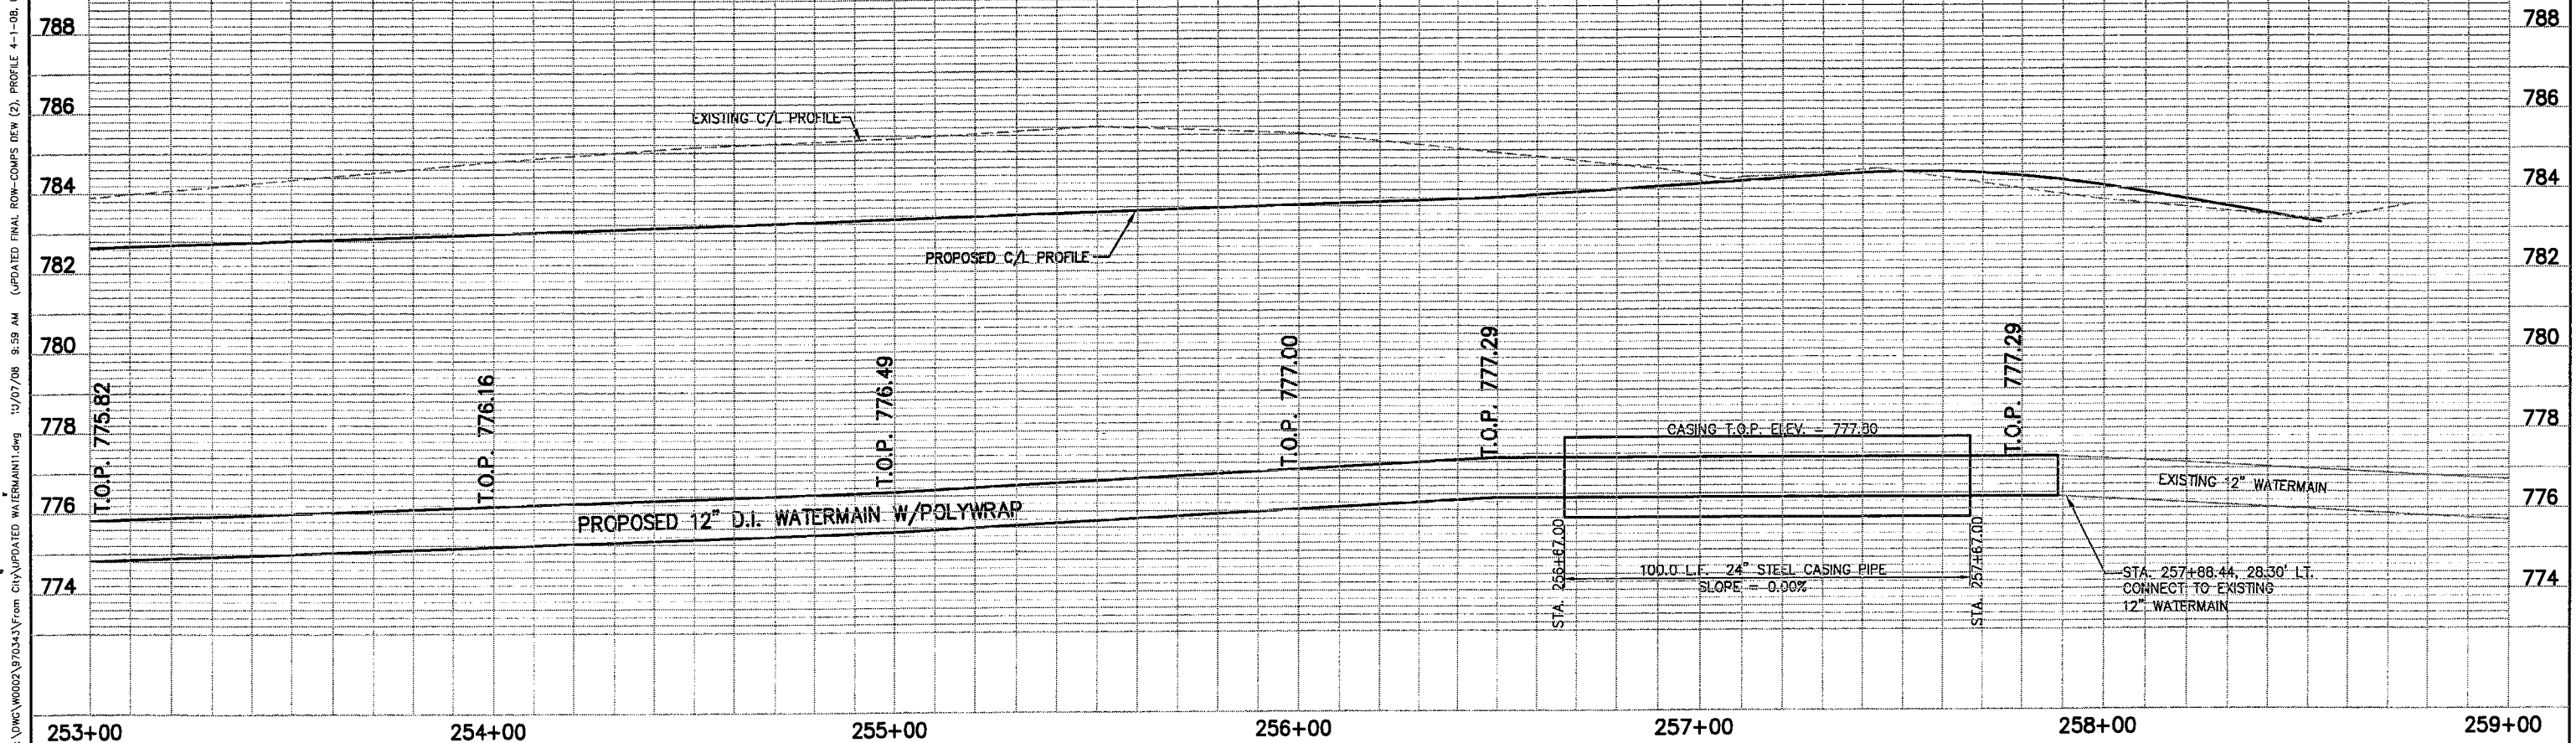
- B6: 12" 45° BEND, STA. 255+00.00, 16.5' LT.
- B7: 12" 45° BEND, STA. 255+06.50, 10.0' LT.
- T5: 12"X12"X6" TEE, STA. 256+50.00, 10.0' LT.
- V10: 6" VALVE, STA. 256+50.00, 23.70' LT.
- H10: HYDRANT, STA. 256+50.00, 35.50' LT.
- V11: 12" VALVE, STA. 256+55.0, 10.0' LT.
- B8: 12" 45° BEND, STA. 257+88.6, 10.0' LT.
- B9: 12" 45° BEND, STA. 257+86.9, 28.0' LT.

10/07/08 9:59 AM (UPDATED FINAL ROW-COMPS DEW (2), PROFILE 4-1-08, UPDATED X-CTH Y, A1&T FIBER CITY)
 W:\DWG\W0002\970343\FROM CITY\UPDATED WATERMAIN1.dwg



WSDOT/CADDS SHEET 40

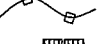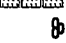LEGEND	
	EROSION MAT, URBAN, CLASS 1, TYPE A
	EROSION MAT, URBAN, CLASS 1, TYPE B
	INLET PROTECTION, TYPE A
	INLET PROTECTION, TYPE C
	SILT FENCE
	TEMPORARY DITCH CHECKS
	CULVERT PIPE DITCH CHECKS

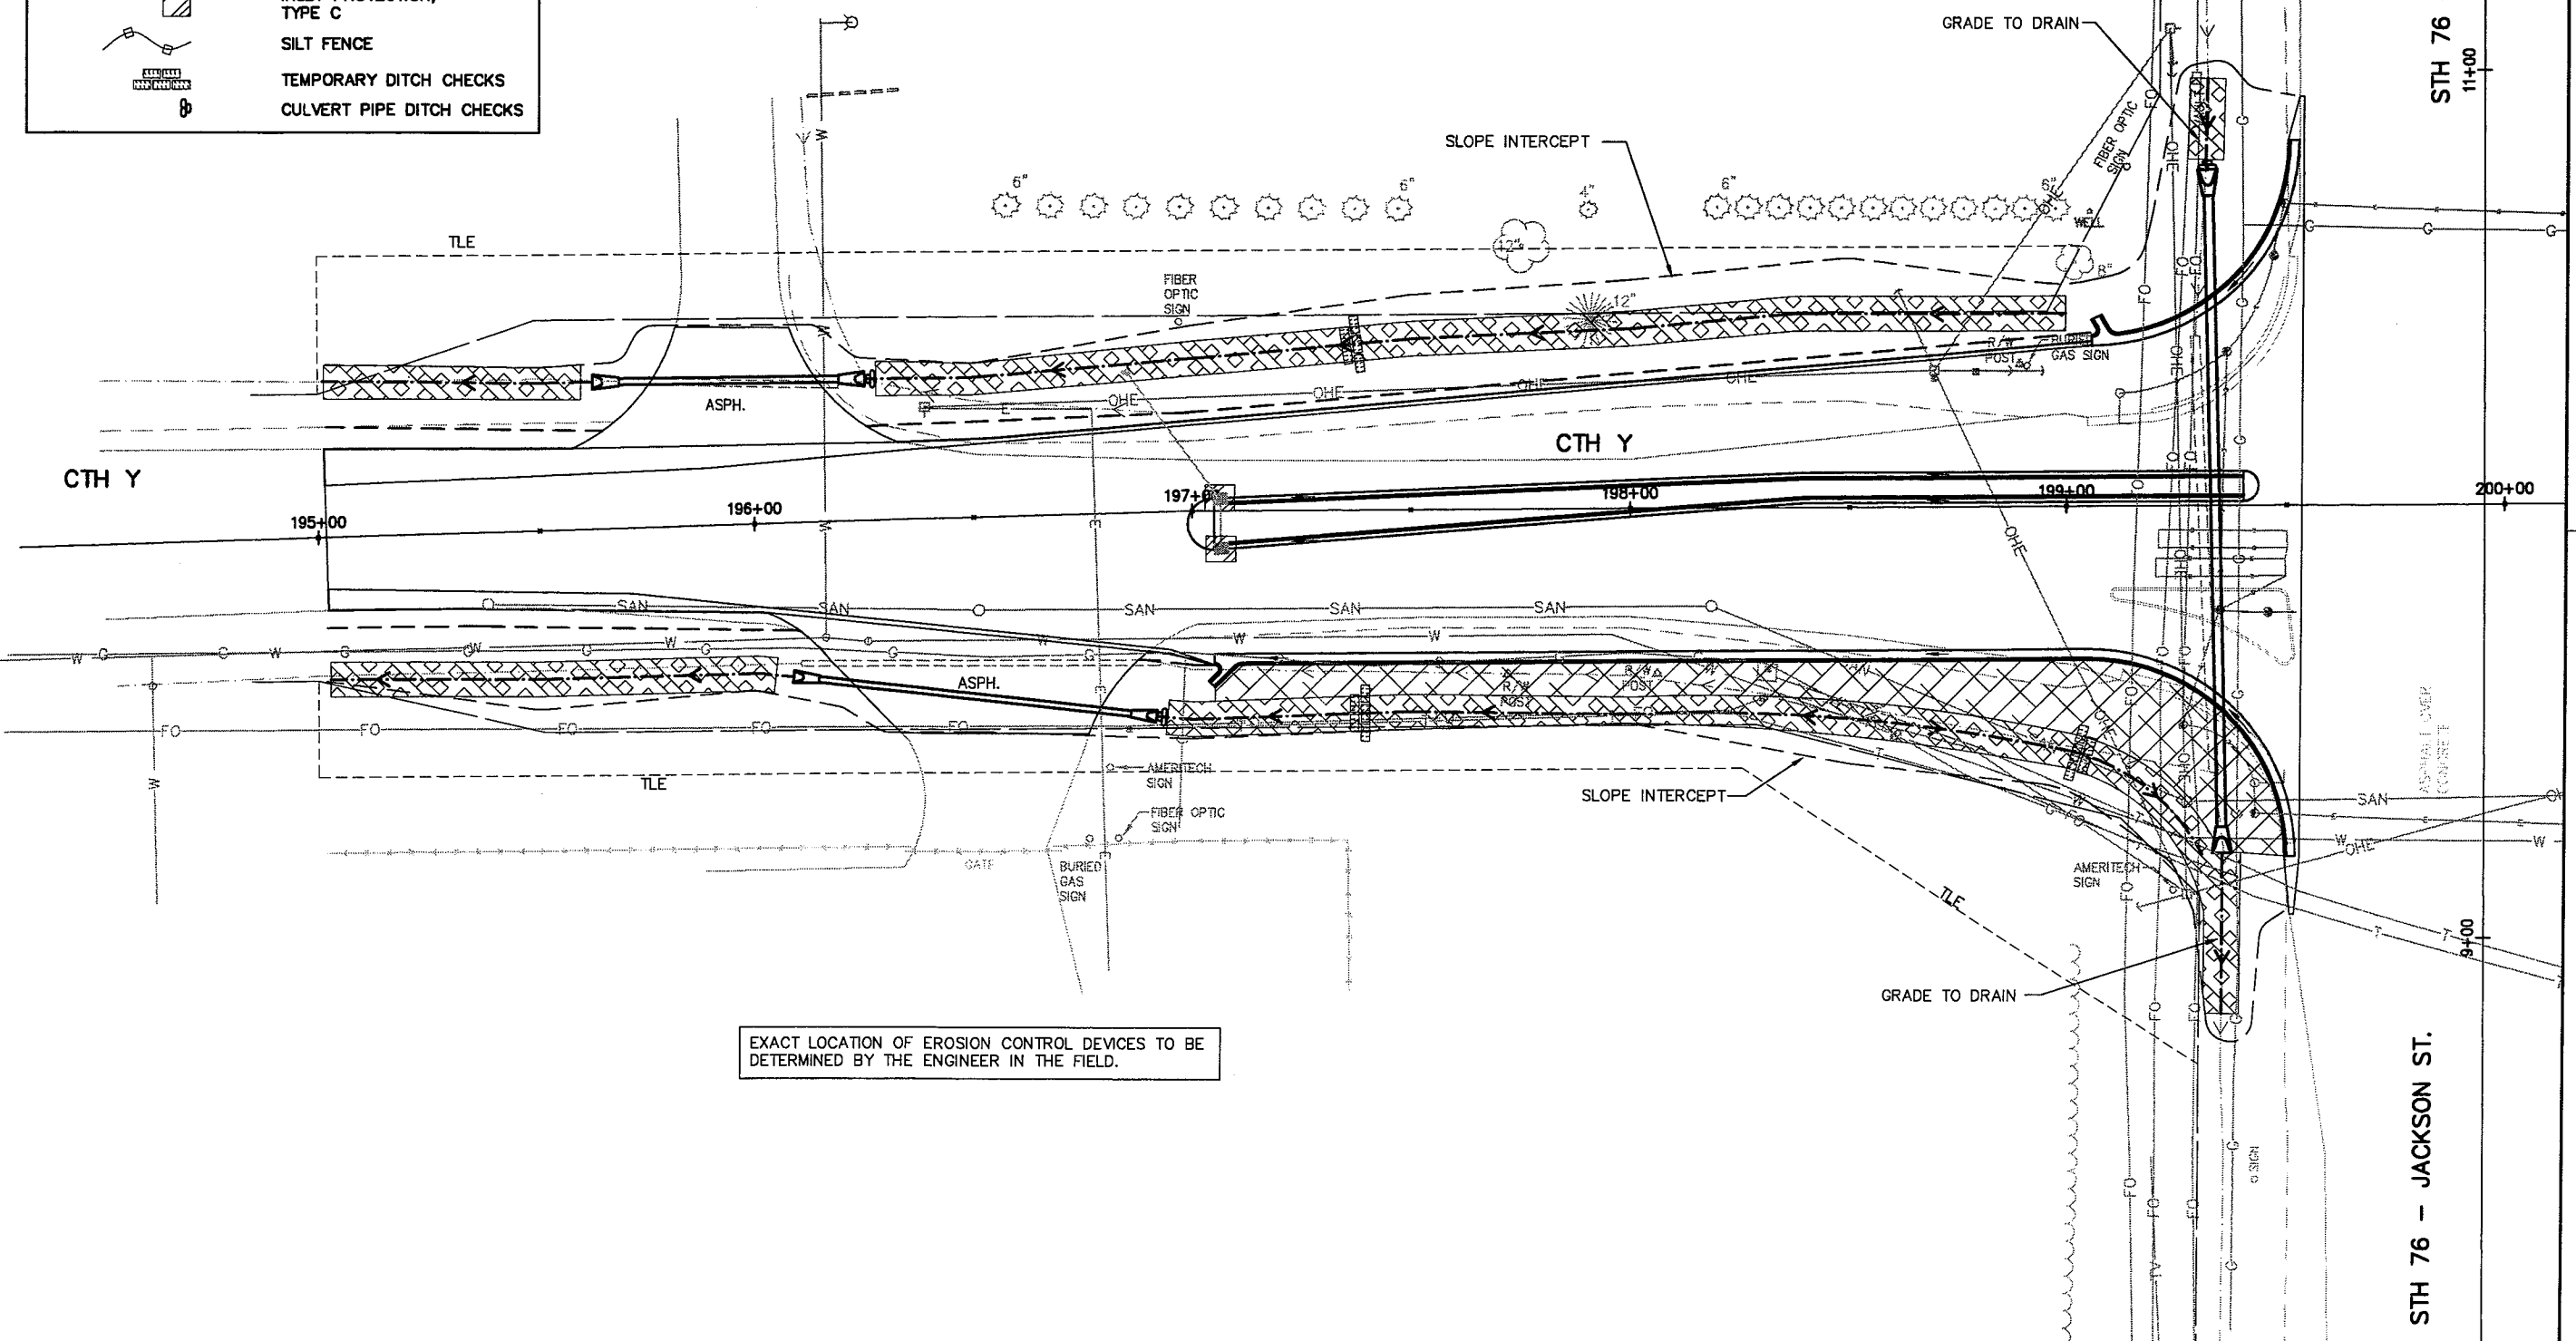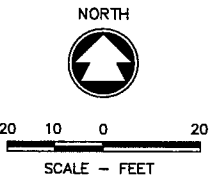

EXACT LOCATION OF EROSION CONTROL DEVICES TO BE DETERMINED BY THE ENGINEER IN THE FIELD.

I:\2008\10\22\08_10_17 AM (X-CTH Y, AT&T FIBER.dwg) 10/22/08 10:17 AM (X-CTH Y, AT&T FIBER.dwg)

STATE PROJECT NUMBER: 6432-11-71

HWY: CTH Y

COUNTY: WINNEBAGO

EROSION CONTROL DETAIL

SHEET NO: 52

E

STH 76 - JACKSON ST.
11+00

STH 76 - JACKSON ST.
9+00



ASPHALT OVER CONCRETE

7+00

8+00

9+00

WS007/CADD SHEET 42

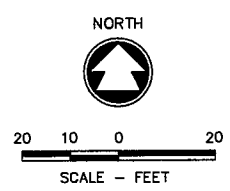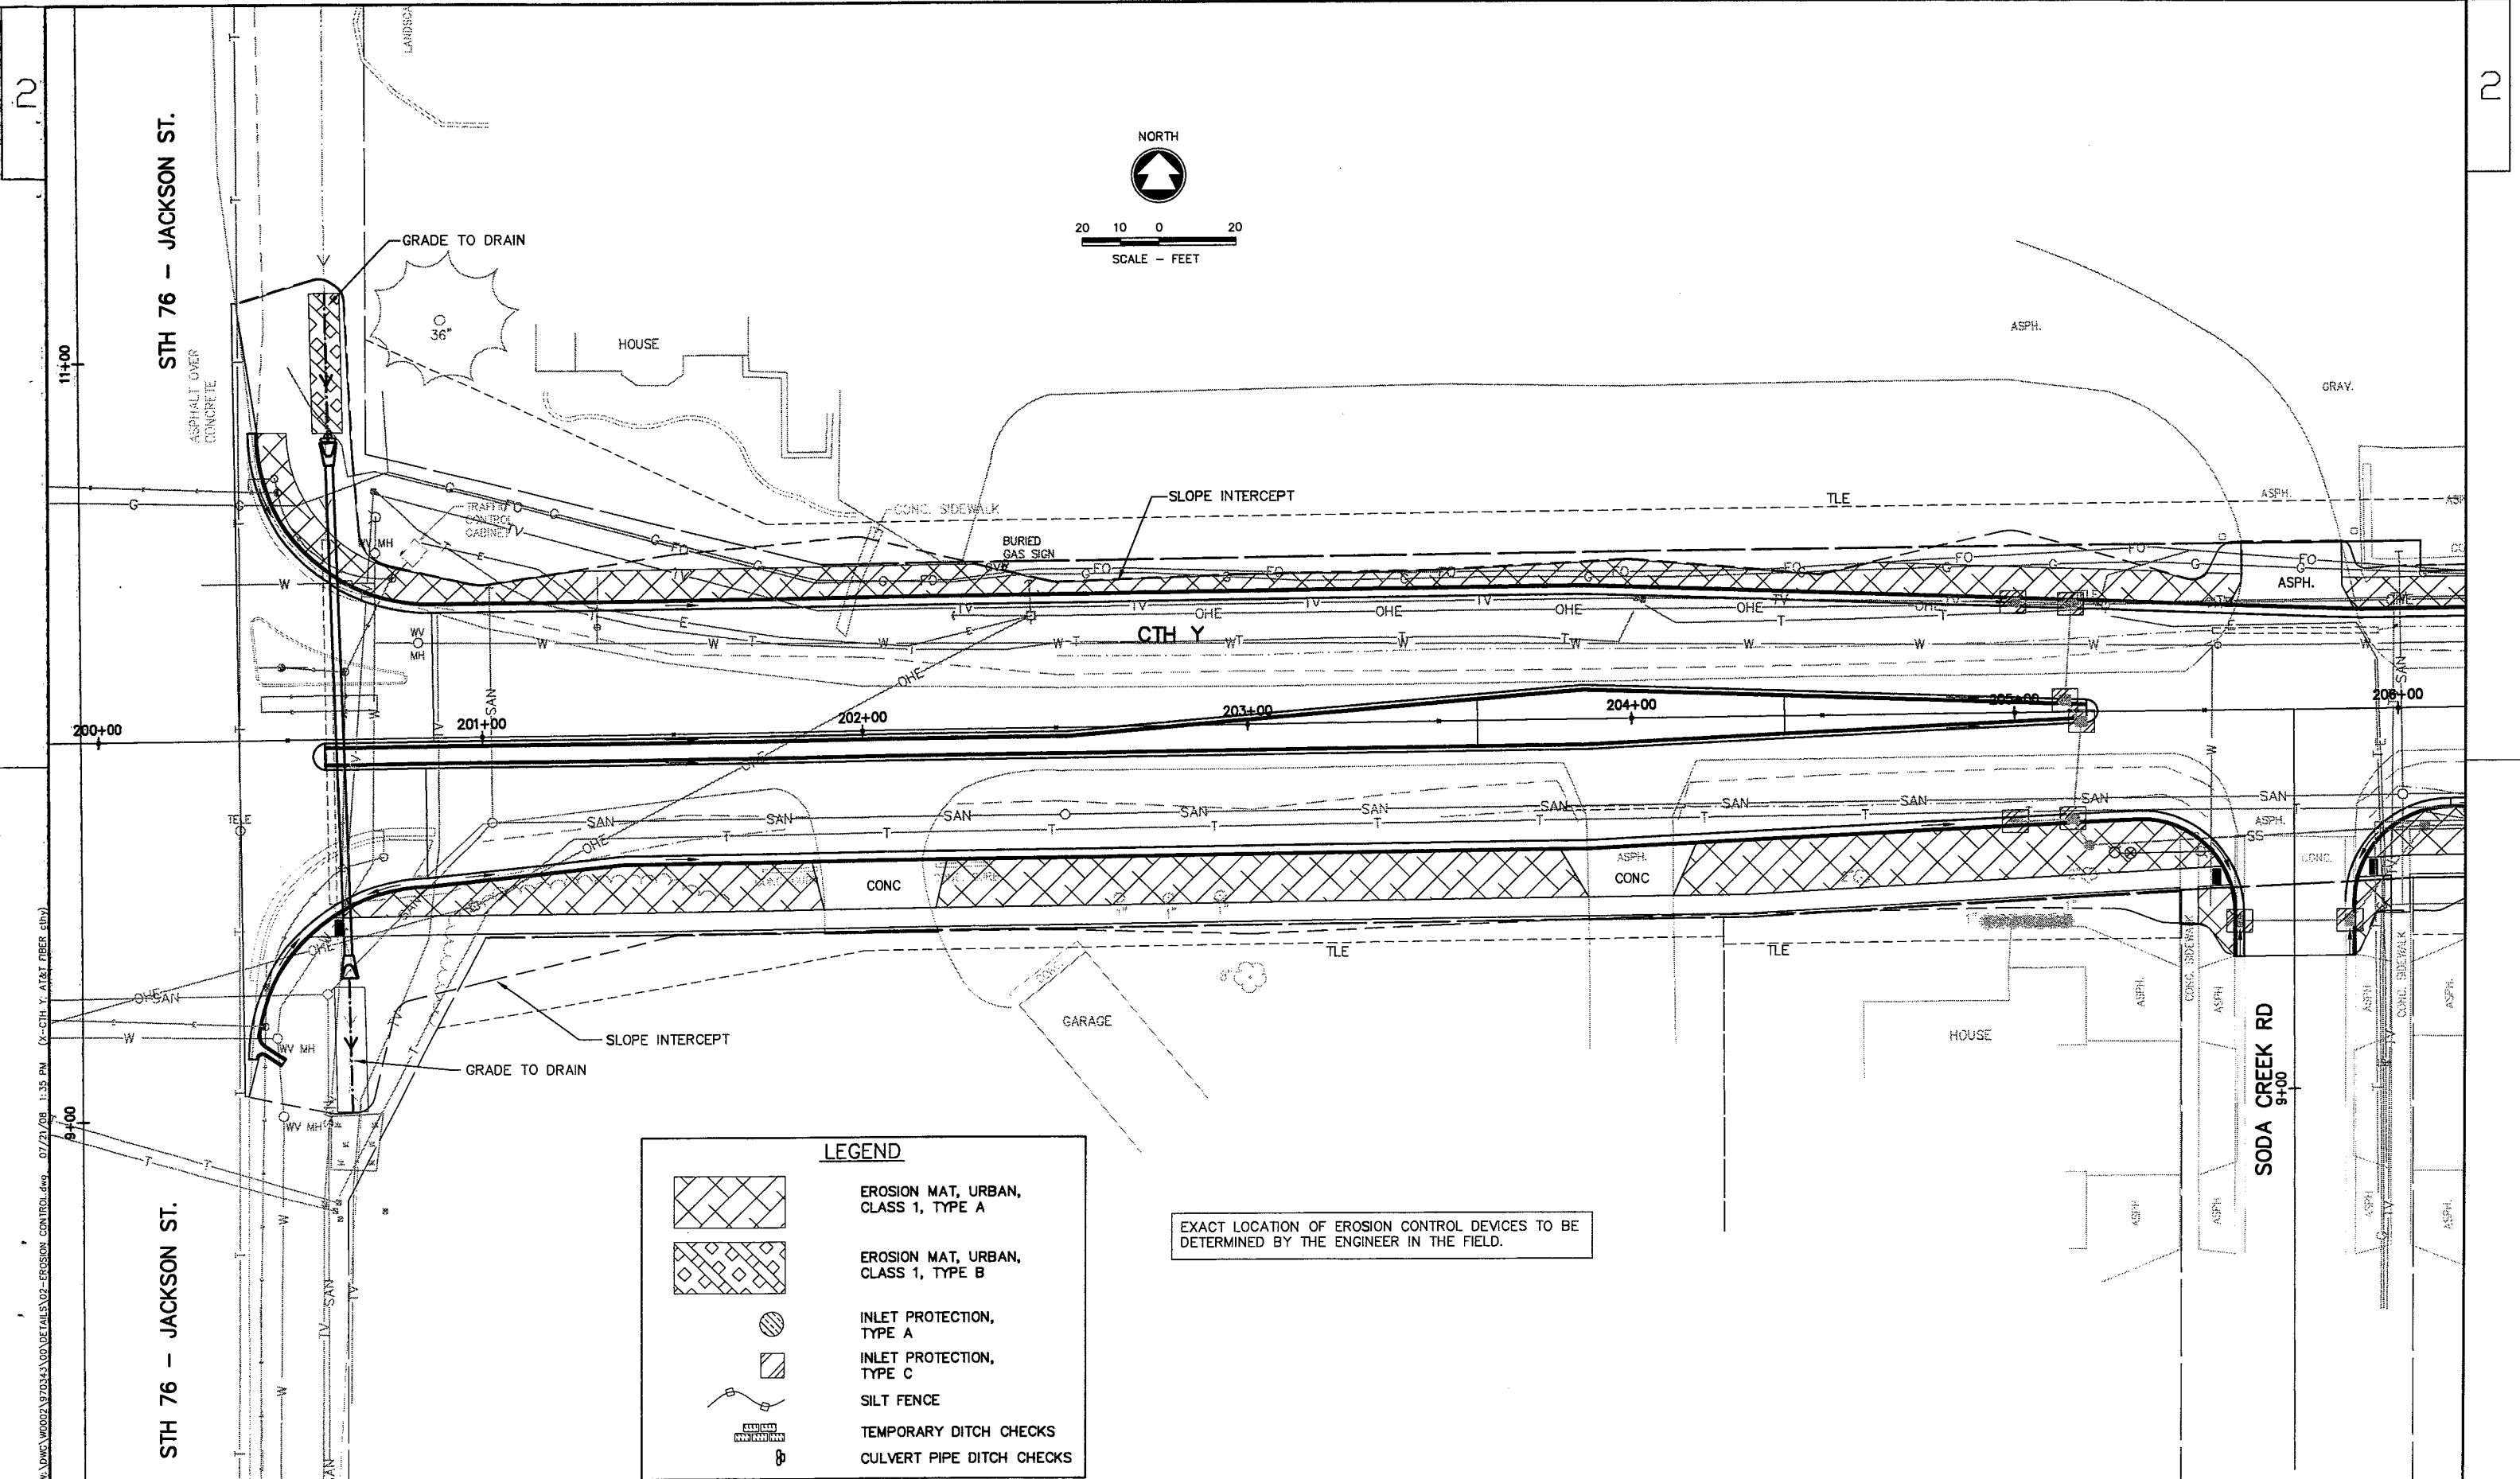

LEGEND








	EROSION MAT, URBAN, CLASS 1, TYPE A
	EROSION MAT, URBAN, CLASS 1, TYPE B
	INLET PROTECTION, TYPE A
	INLET PROTECTION, TYPE C
	SILT FENCE
	TEMPORARY DITCH CHECKS
	CULVERT PIPE DITCH CHECKS

EXACT LOCATION OF EROSION CONTROL DEVICES TO BE DETERMINED BY THE ENGINEER IN THE FIELD.


W:\DWG\WOOD\2002\670343\00\DETAILS\02-EROSION CONTROL.dwg 07/21/08 1:35 PM (X-CTH Y, AT&T, FIBER, etc)

EXACT LOCATION OF EROSION CONTROL DEVICES TO BE DETERMINED BY THE ENGINEER IN THE FIELD.

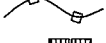LEGEND


-  EROSION MAT, URBAN, CLASS 1, TYPE A
-  EROSION MAT, URBAN, CLASS 1, TYPE B
-  INLET PROTECTION, TYPE A
-  INLET PROTECTION, TYPE C
-  SILT FENCE
-  TEMPORARY DITCH CHECKS
-  CULVERT PIPE DITCH CHECKS

NORTH




20 10 0 20

SCALE - FEET

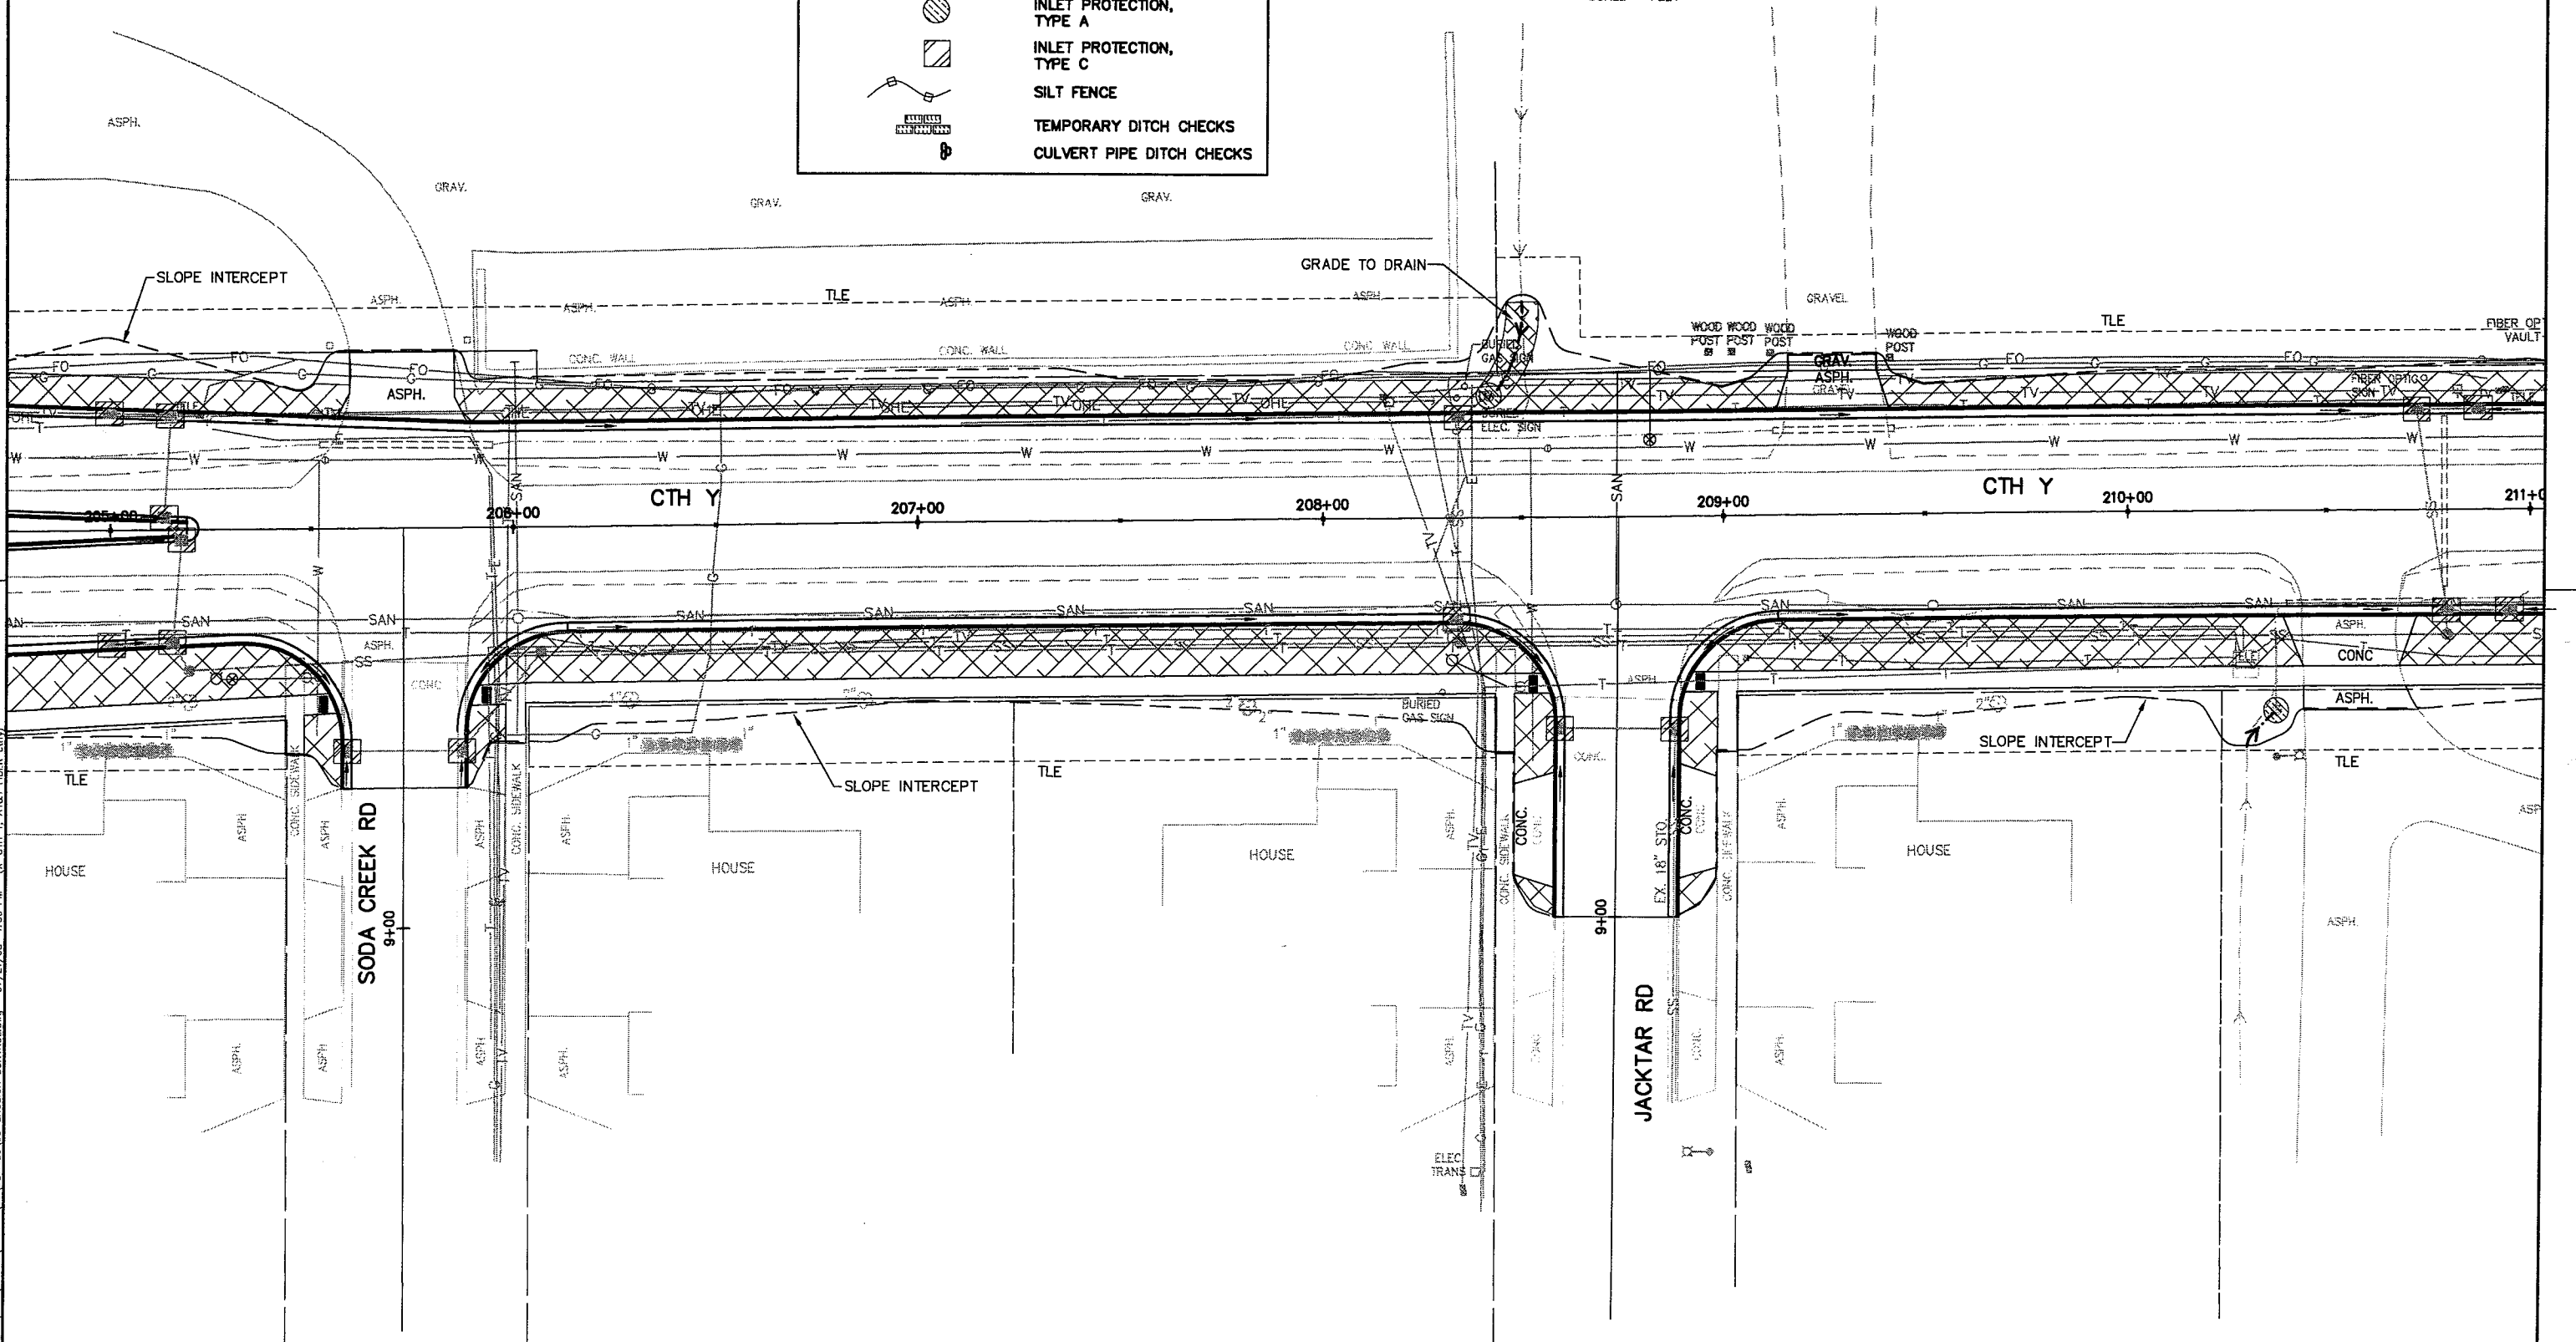

C:\dms\work\21\970343\00\DETAILS\03-EROSION CONTROL.dwg 07/21/08 1:36 PM (X-CTH Y, AT&T FIBER (db))

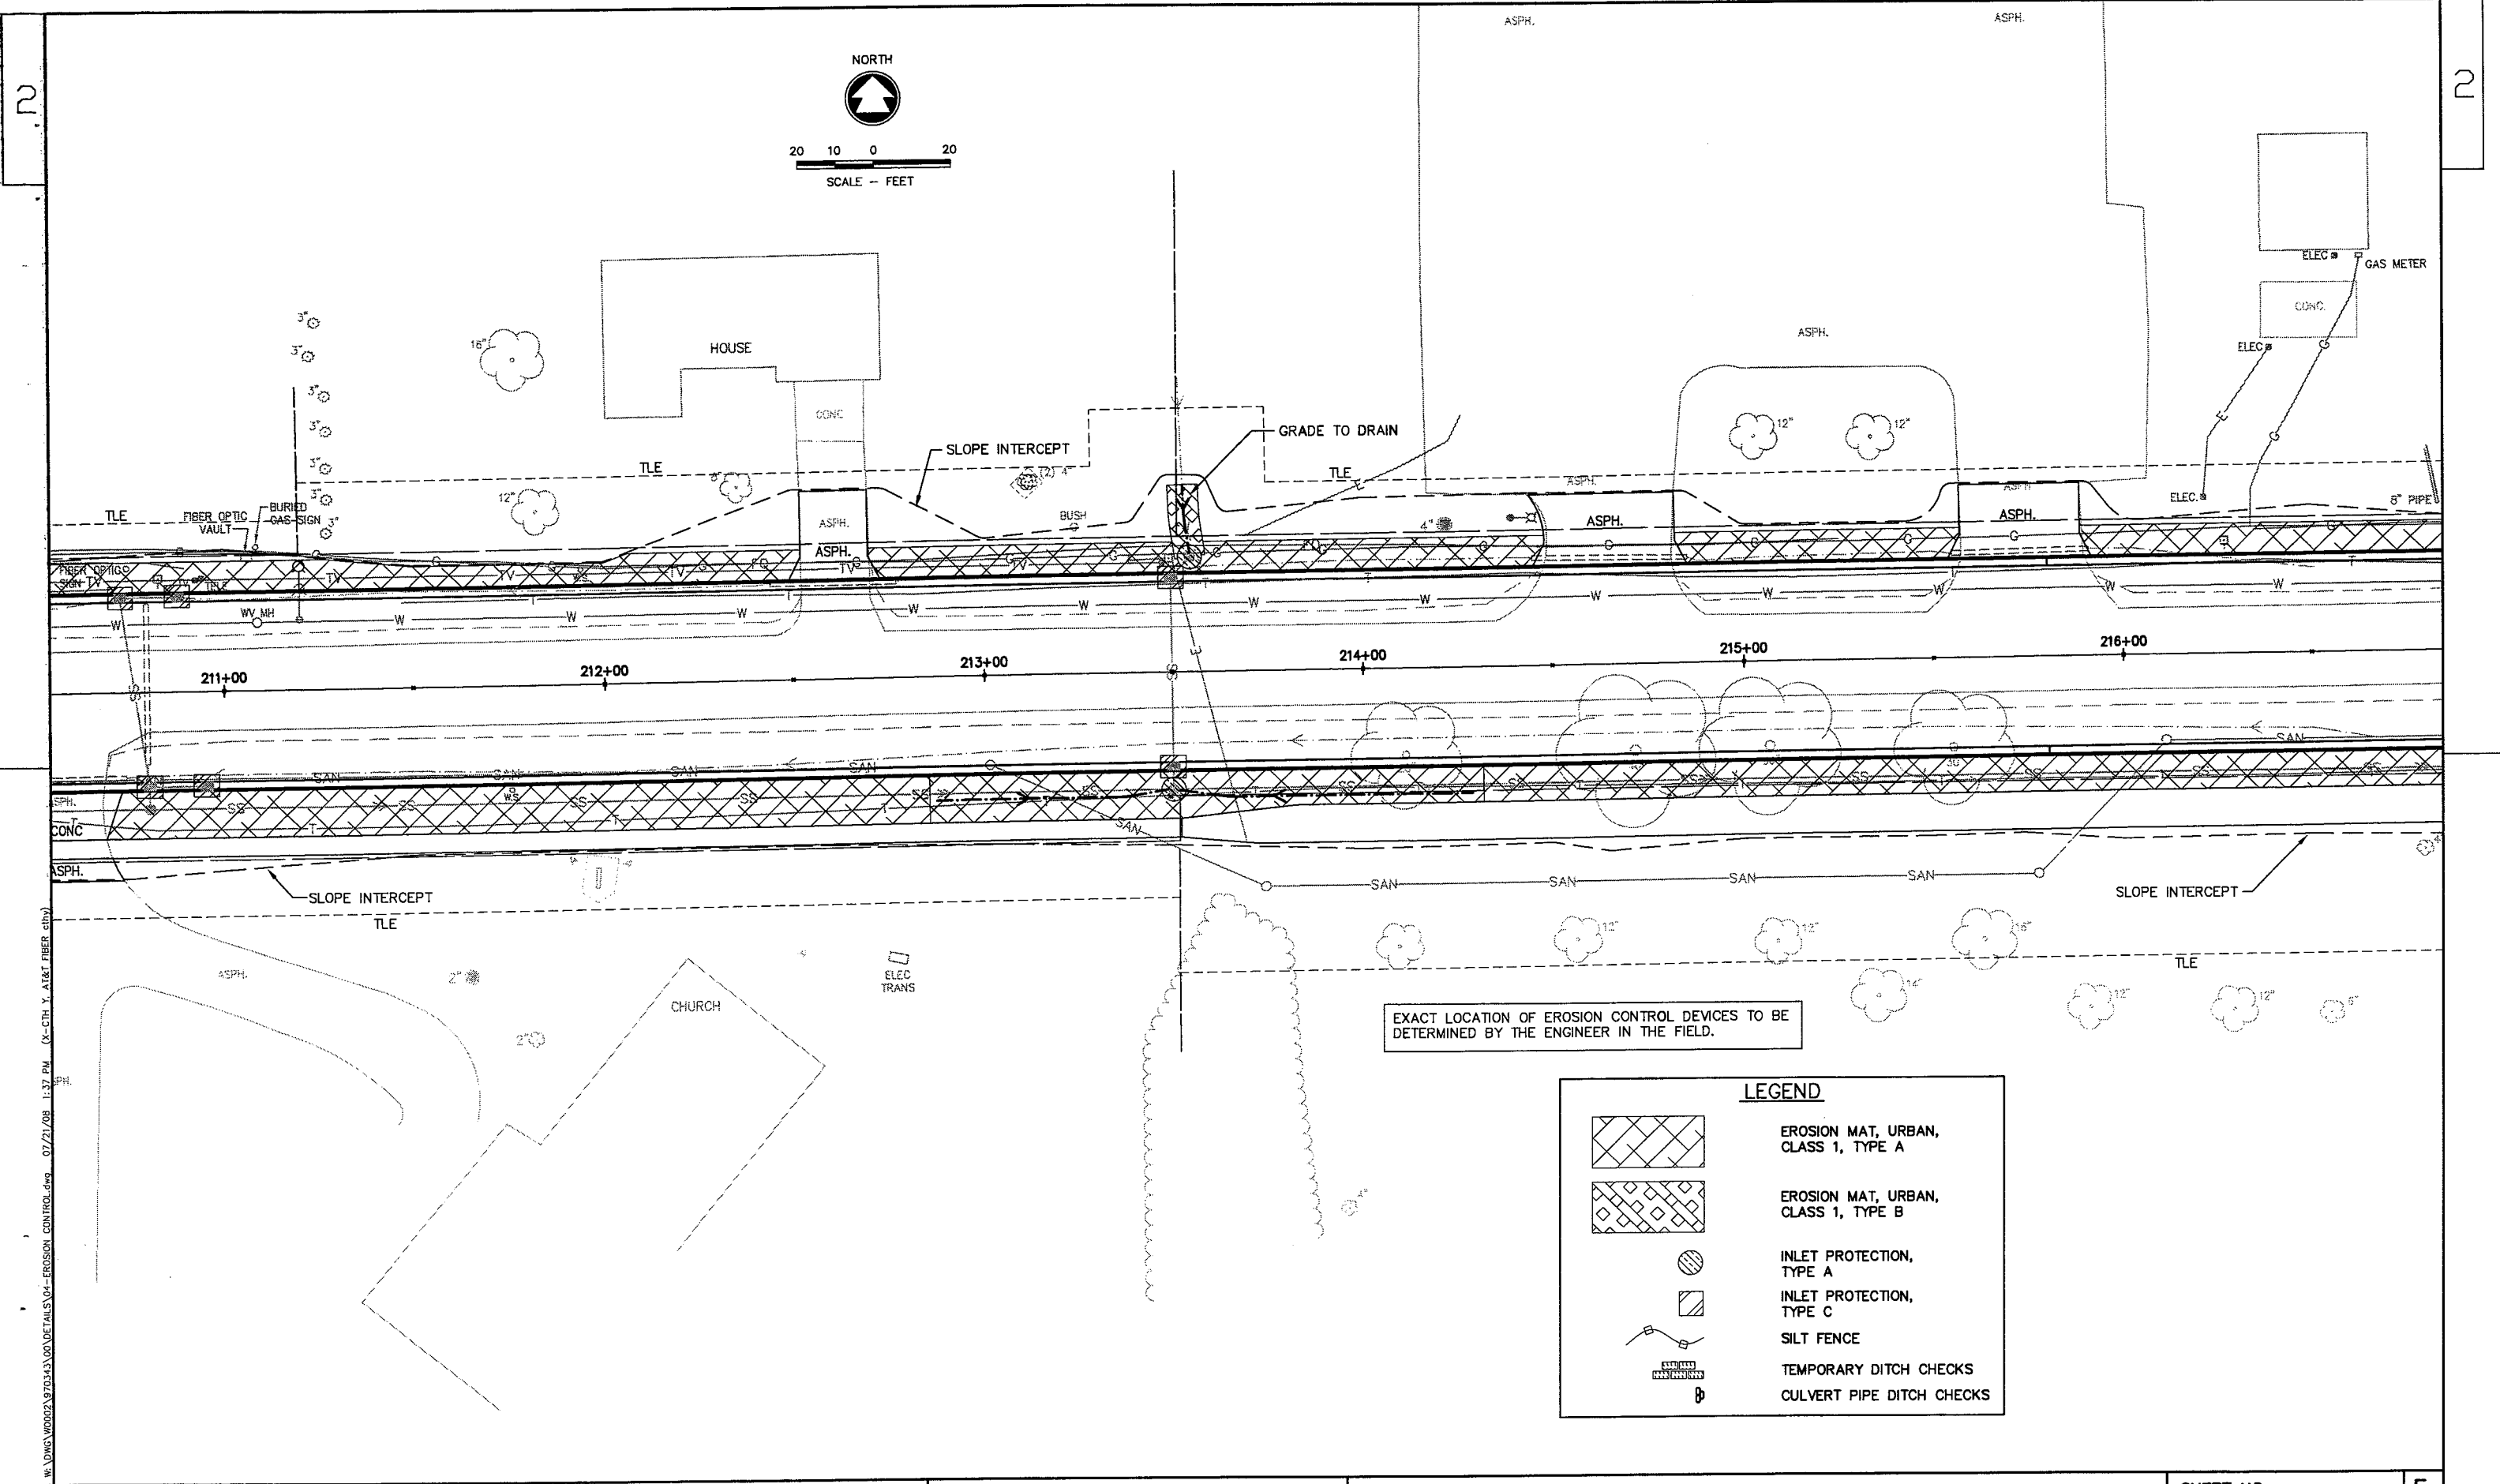

07/21/08 11:37 PM (S-CTH Y, A&T FIBER.cdw)
 W:\DWG\WOODS\970343\00\DETAILS\04-EROSION CONTROL.dwg

STATE PROJECT NUMBER: 4994-00-87

HWY: CTH Y


COUNTY: WINNEBAGO

EROSION CONTROL DETAIL

SHEET NO: 55

E


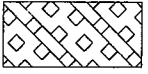



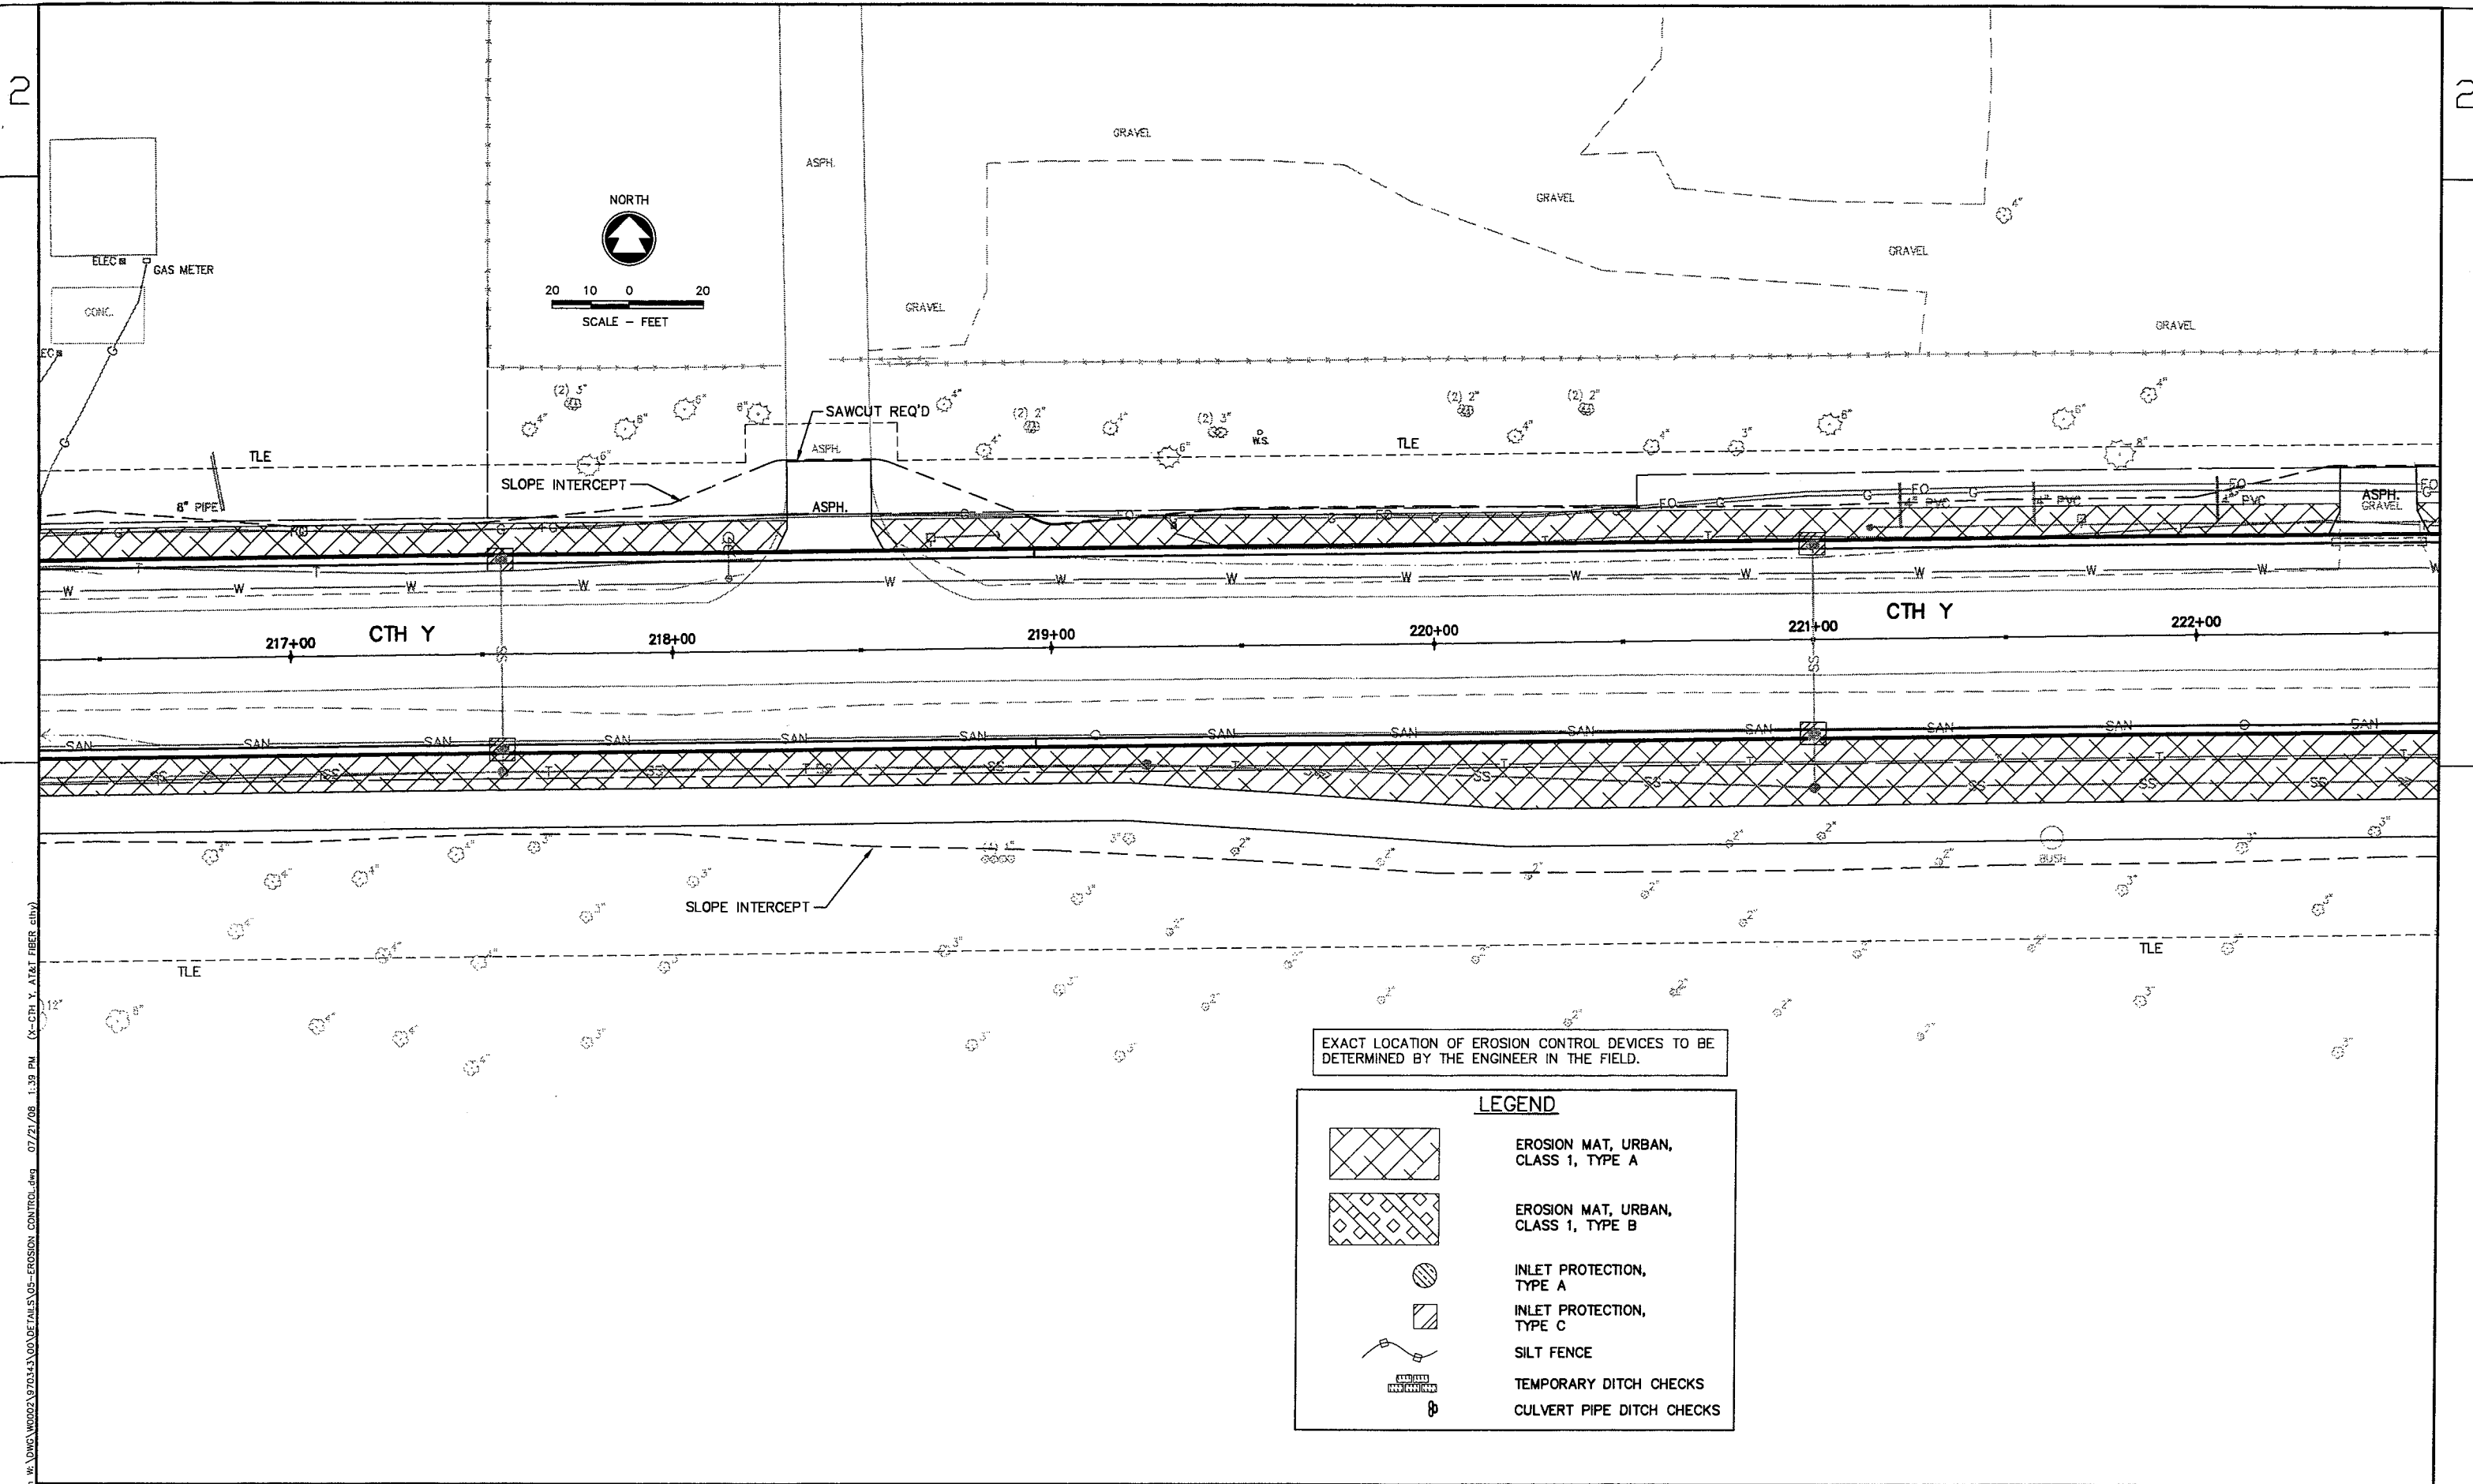

WSDOT/CADD SHEET 42



W:\DWG\W0002\9703\3\00\DETAILS\05-EROSION CONTROL.dwg 07/21/08 1:39 PM (X-CTH Y, AT&T, FIBER, CITY)

EXACT LOCATION OF EROSION CONTROL DEVICES TO BE DETERMINED BY THE ENGINEER IN THE FIELD.

LEGEND

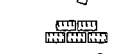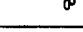	EROSION MAT, URBAN, CLASS 1, TYPE A
	EROSION MAT, URBAN, CLASS 1, TYPE B
	INLET PROTECTION, TYPE A
	INLET PROTECTION, TYPE C
	SILT FENCE
	TEMPORARY DITCH CHECKS
	CULVERT PIPE DITCH CHECKS

STATE PROJECT NUMBER: 4994-00-87


HWY: CTH Y

COUNTY: WINNEBAGO

EROSION CONTROL DETAIL

SHEET NO: 56

E

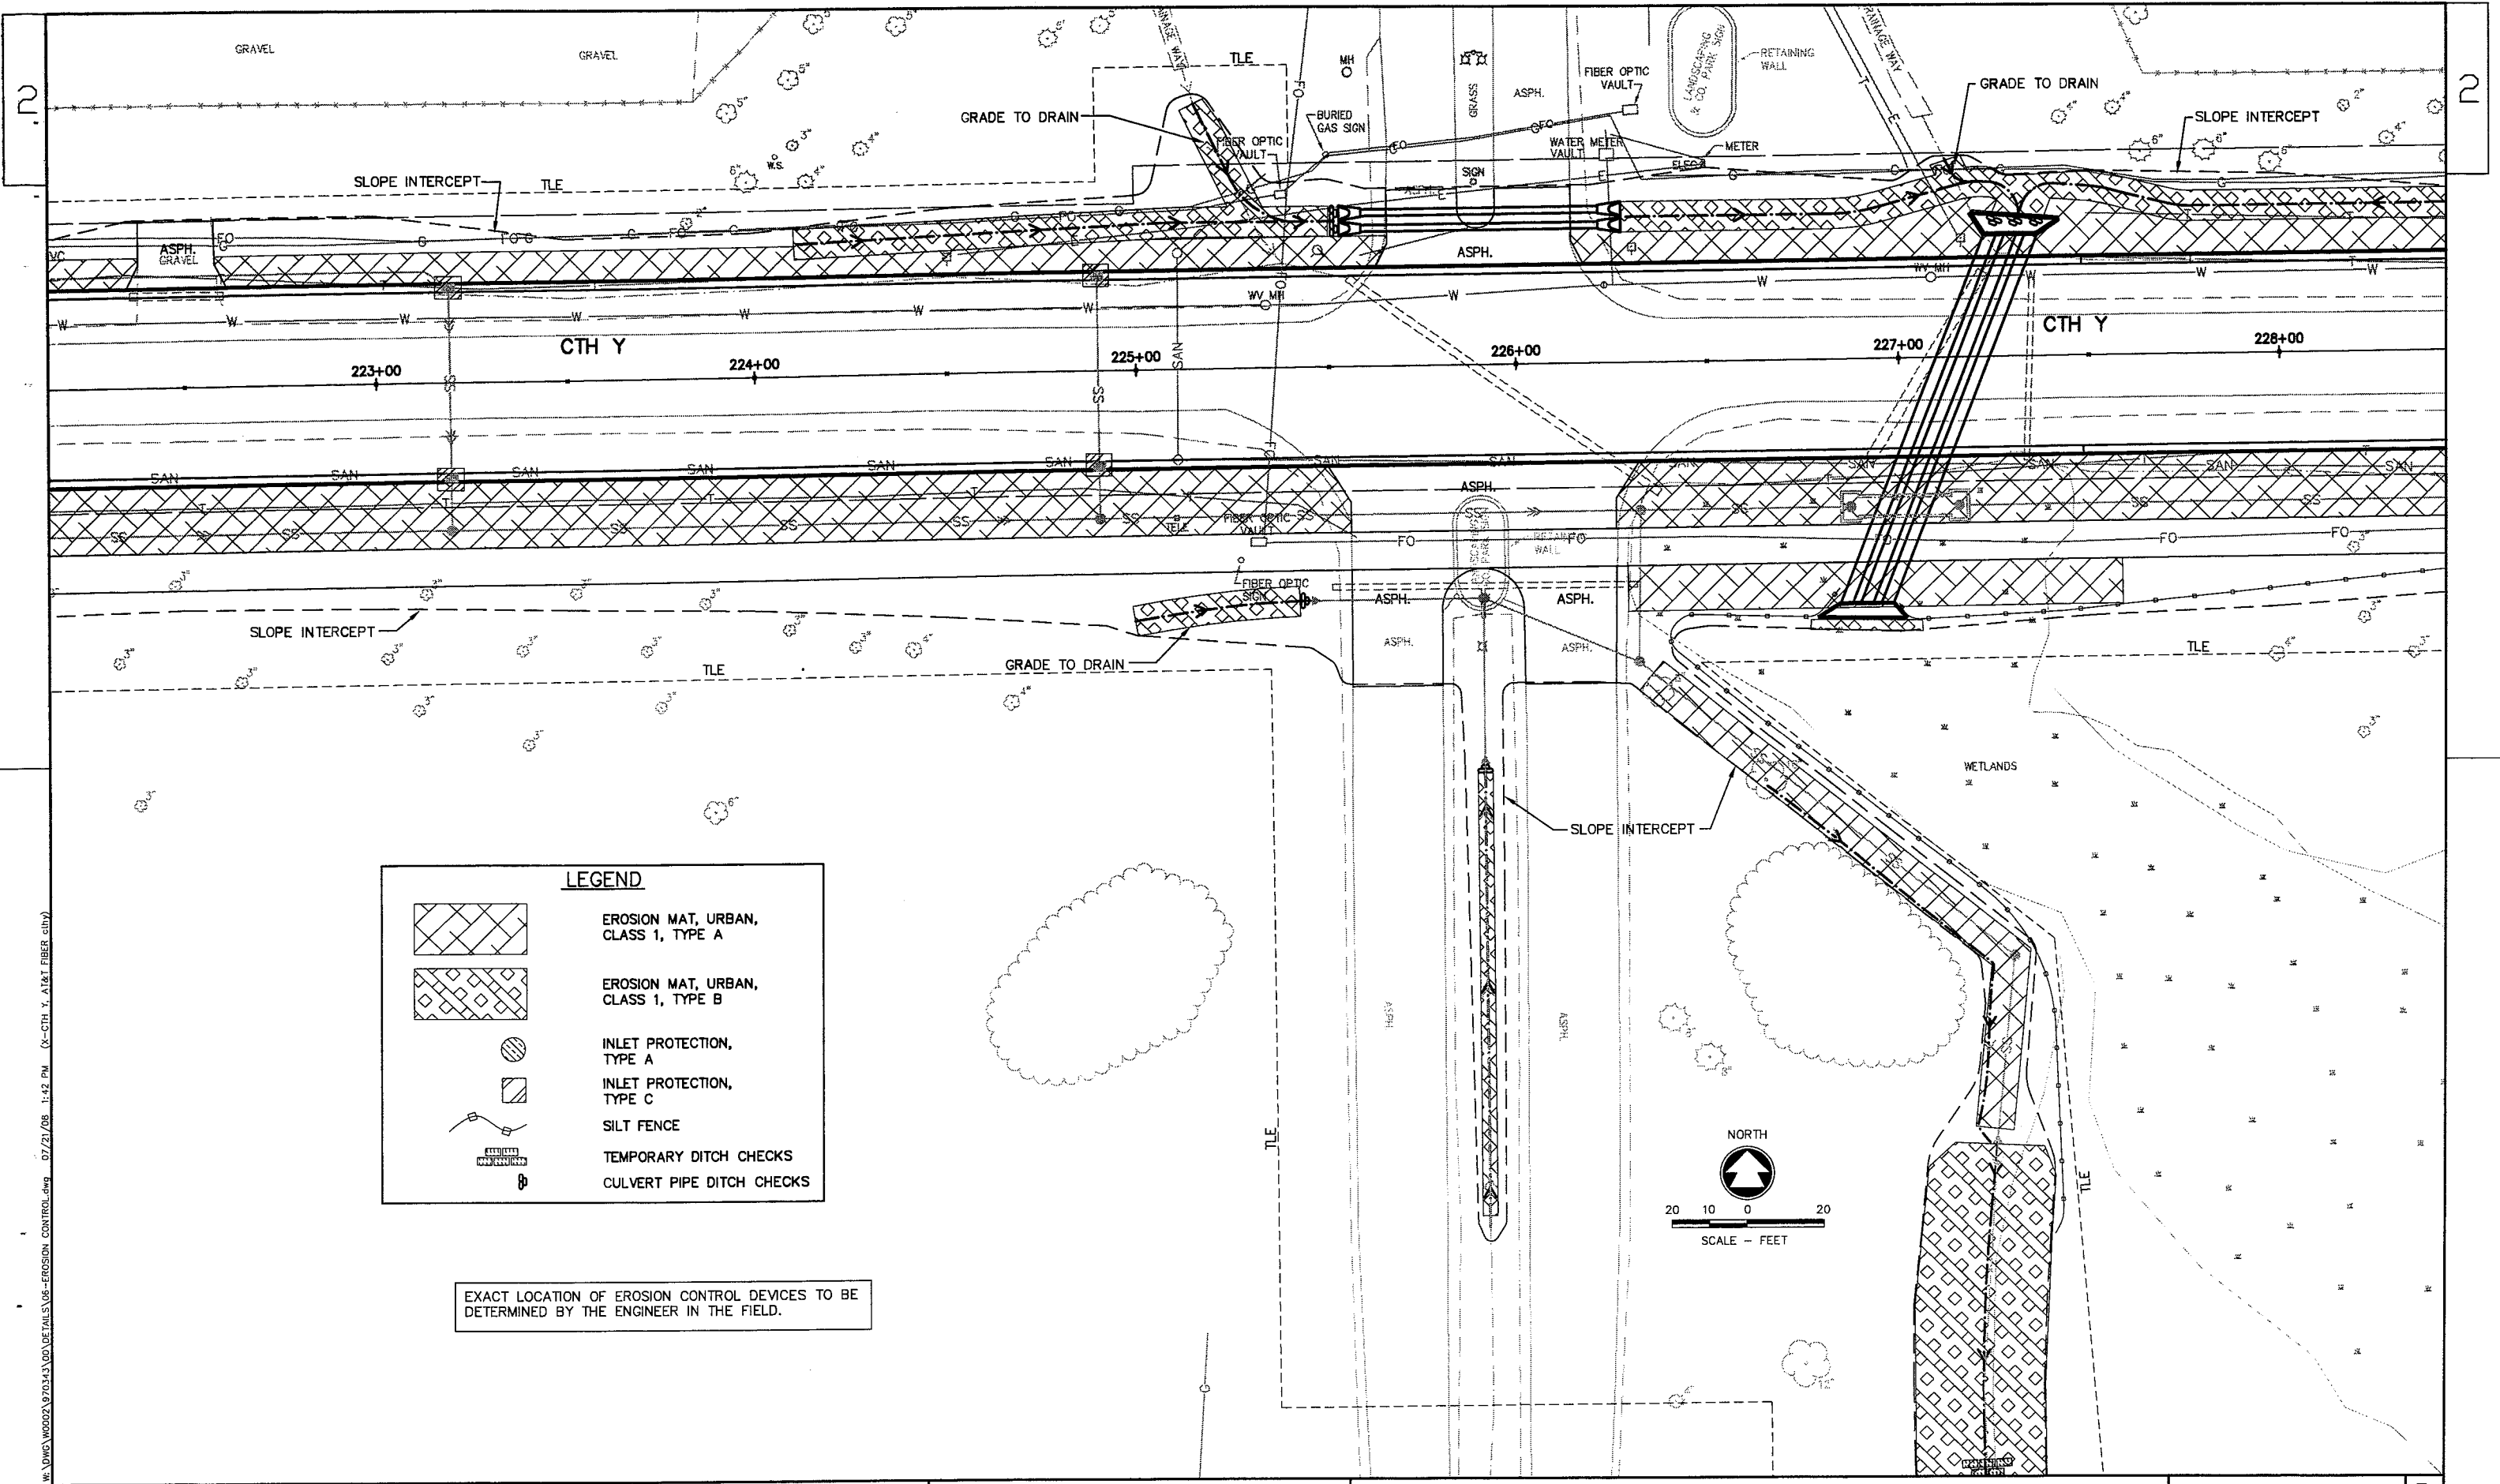

LEGEND








	EROSION MAT, URBAN, CLASS 1, TYPE A
	EROSION MAT, URBAN, CLASS 1, TYPE B
	INLET PROTECTION, TYPE A
	INLET PROTECTION, TYPE C
	SILT FENCE
	TEMPORARY DITCH CHECKS
	CULVERT PIPE DITCH CHECKS



EXACT LOCATION OF EROSION CONTROL DEVICES TO BE DETERMINED BY THE ENGINEER IN THE FIELD.

07/21/08 1:42 PM (X=CTH Y, AT&T FIBER CITY)


EXACT LOCATION OF EROSION CONTROL DEVICES TO BE DETERMINED BY THE ENGINEER IN THE FIELD.

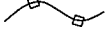LEGEND



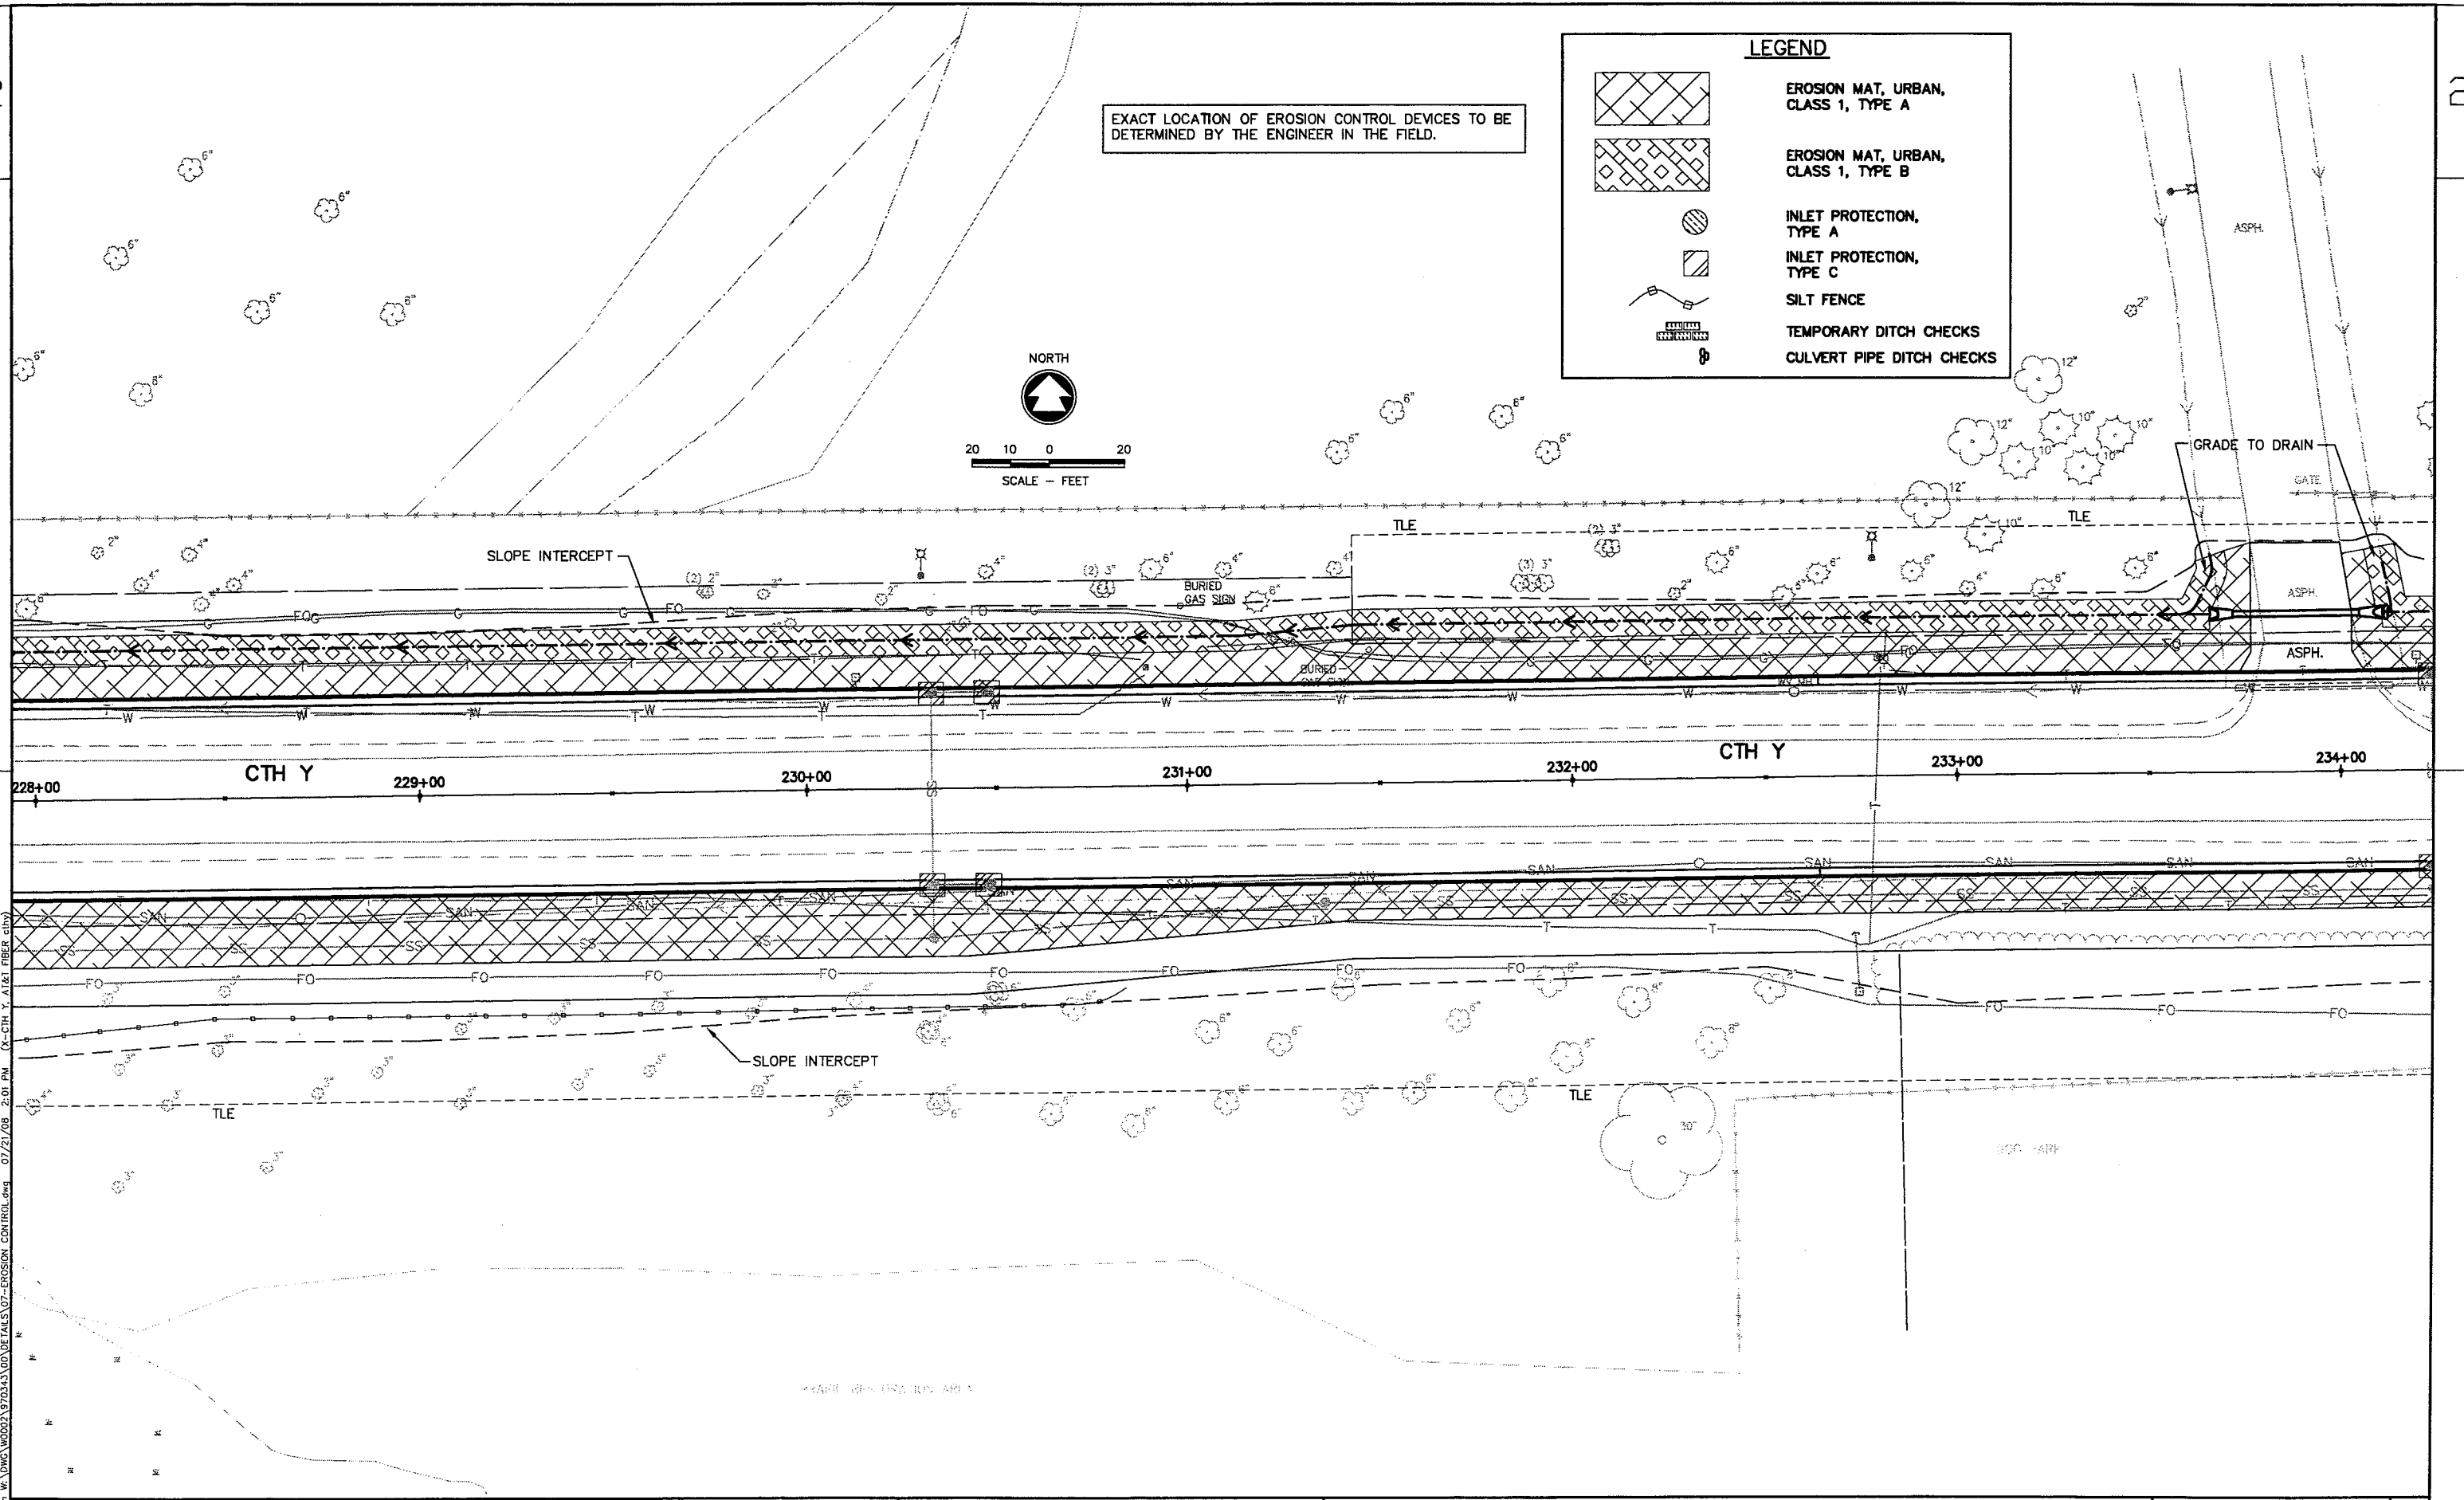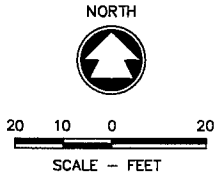

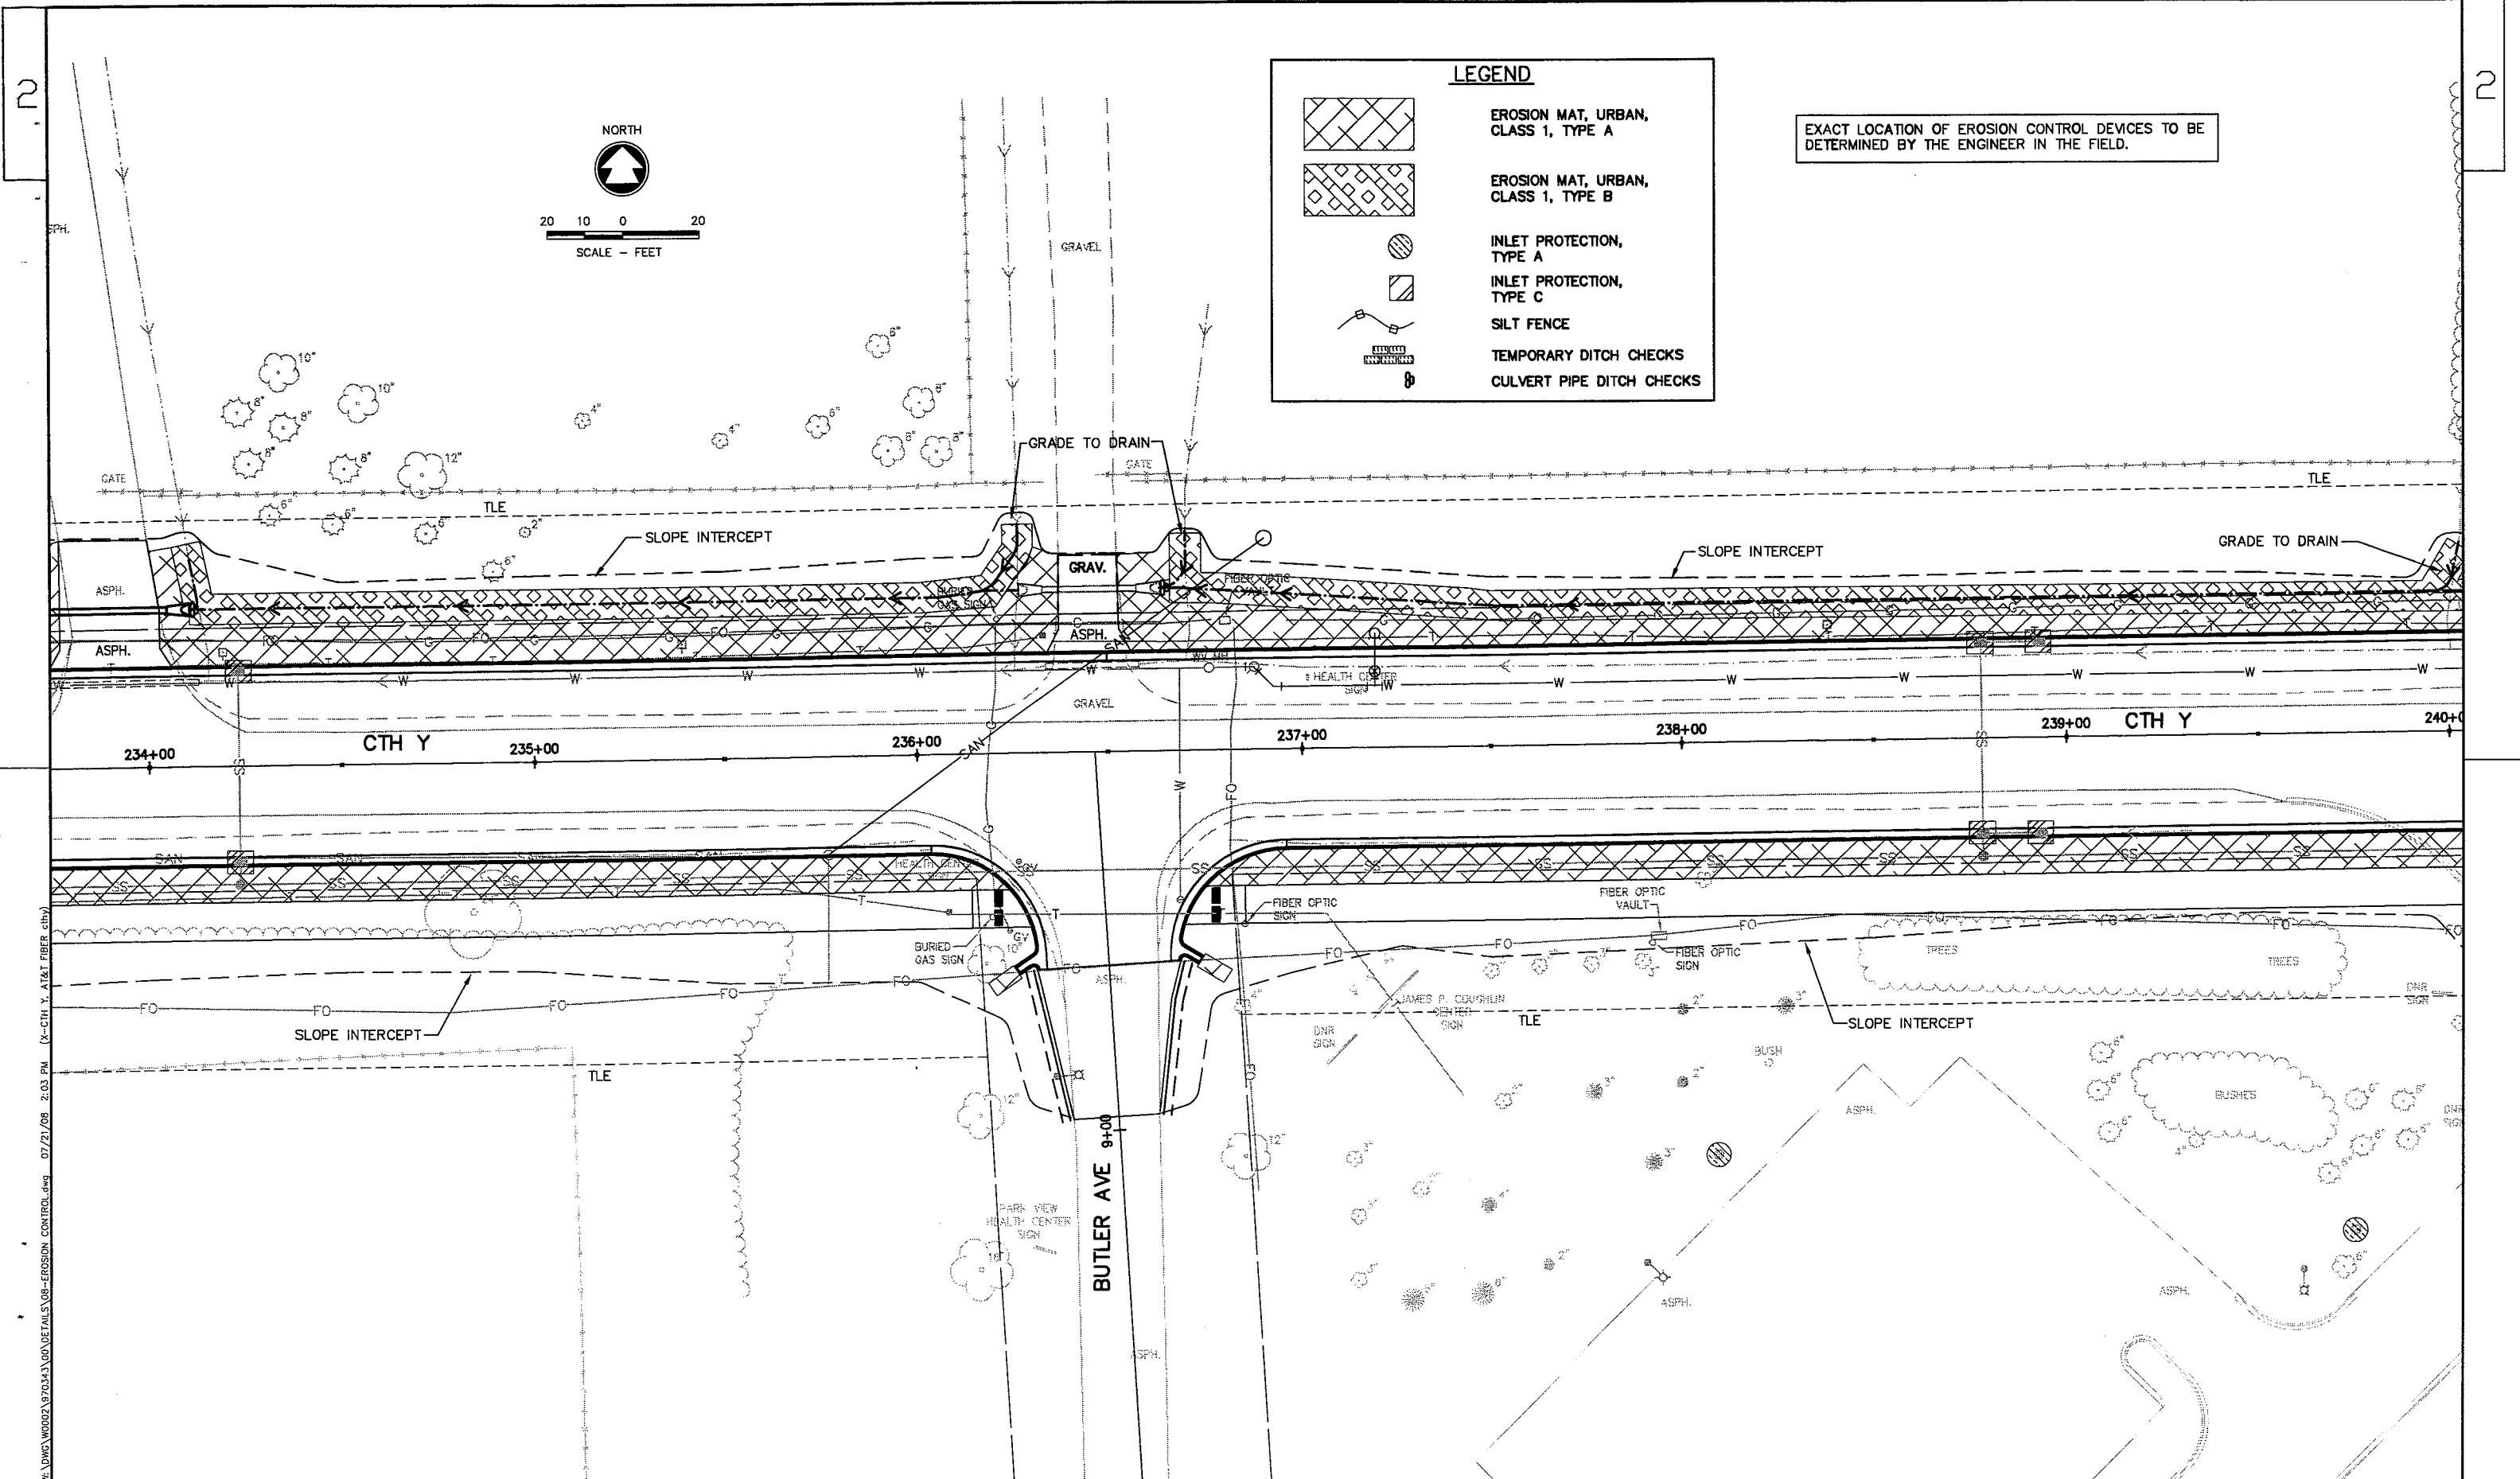


-  EROSION MAT, URBAN, CLASS 1, TYPE A
-  EROSION MAT, URBAN, CLASS 1, TYPE B
-  INLET PROTECTION, TYPE A
-  INLET PROTECTION, TYPE C
-  SILT FENCE
-  TEMPORARY DITCH CHECKS
-  CULVERT PIPE DITCH CHECKS




W:\DWG\0002\970543\00\DETAILS\07-EROSION CONTROL.dwg 07/21/08 2:01 PM (X-CTH Y, AT&T FIBER CITY)

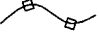

LEGEND

-  EROSION MAT, URBAN, CLASS 1, TYPE A
-  EROSION MAT, URBAN, CLASS 1, TYPE B
-  INLET PROTECTION, TYPE A
-  INLET PROTECTION, TYPE C
-  SILT FENCE
-  TEMPORARY DITCH CHECKS
-  CULVERT PIPE DITCH CHECKS

EXACT LOCATION OF EROSION CONTROL DEVICES TO BE DETERMINED BY THE ENGINEER IN THE FIELD.

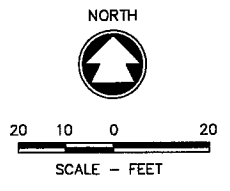

W:\DWG\W0002\1970343\00\DETAILS\08-EROSION CONTROL.dwg 07/21/08 2:03 PM (X-CTH Y, AT&T, FIBER, cth)

STATE PROJECT NUMBER: 4994-00-87



HWY: CTH Y

COUNTY: WINNEBAGO

EROSION CONTROL DETAIL

SHEET NO: 59


E

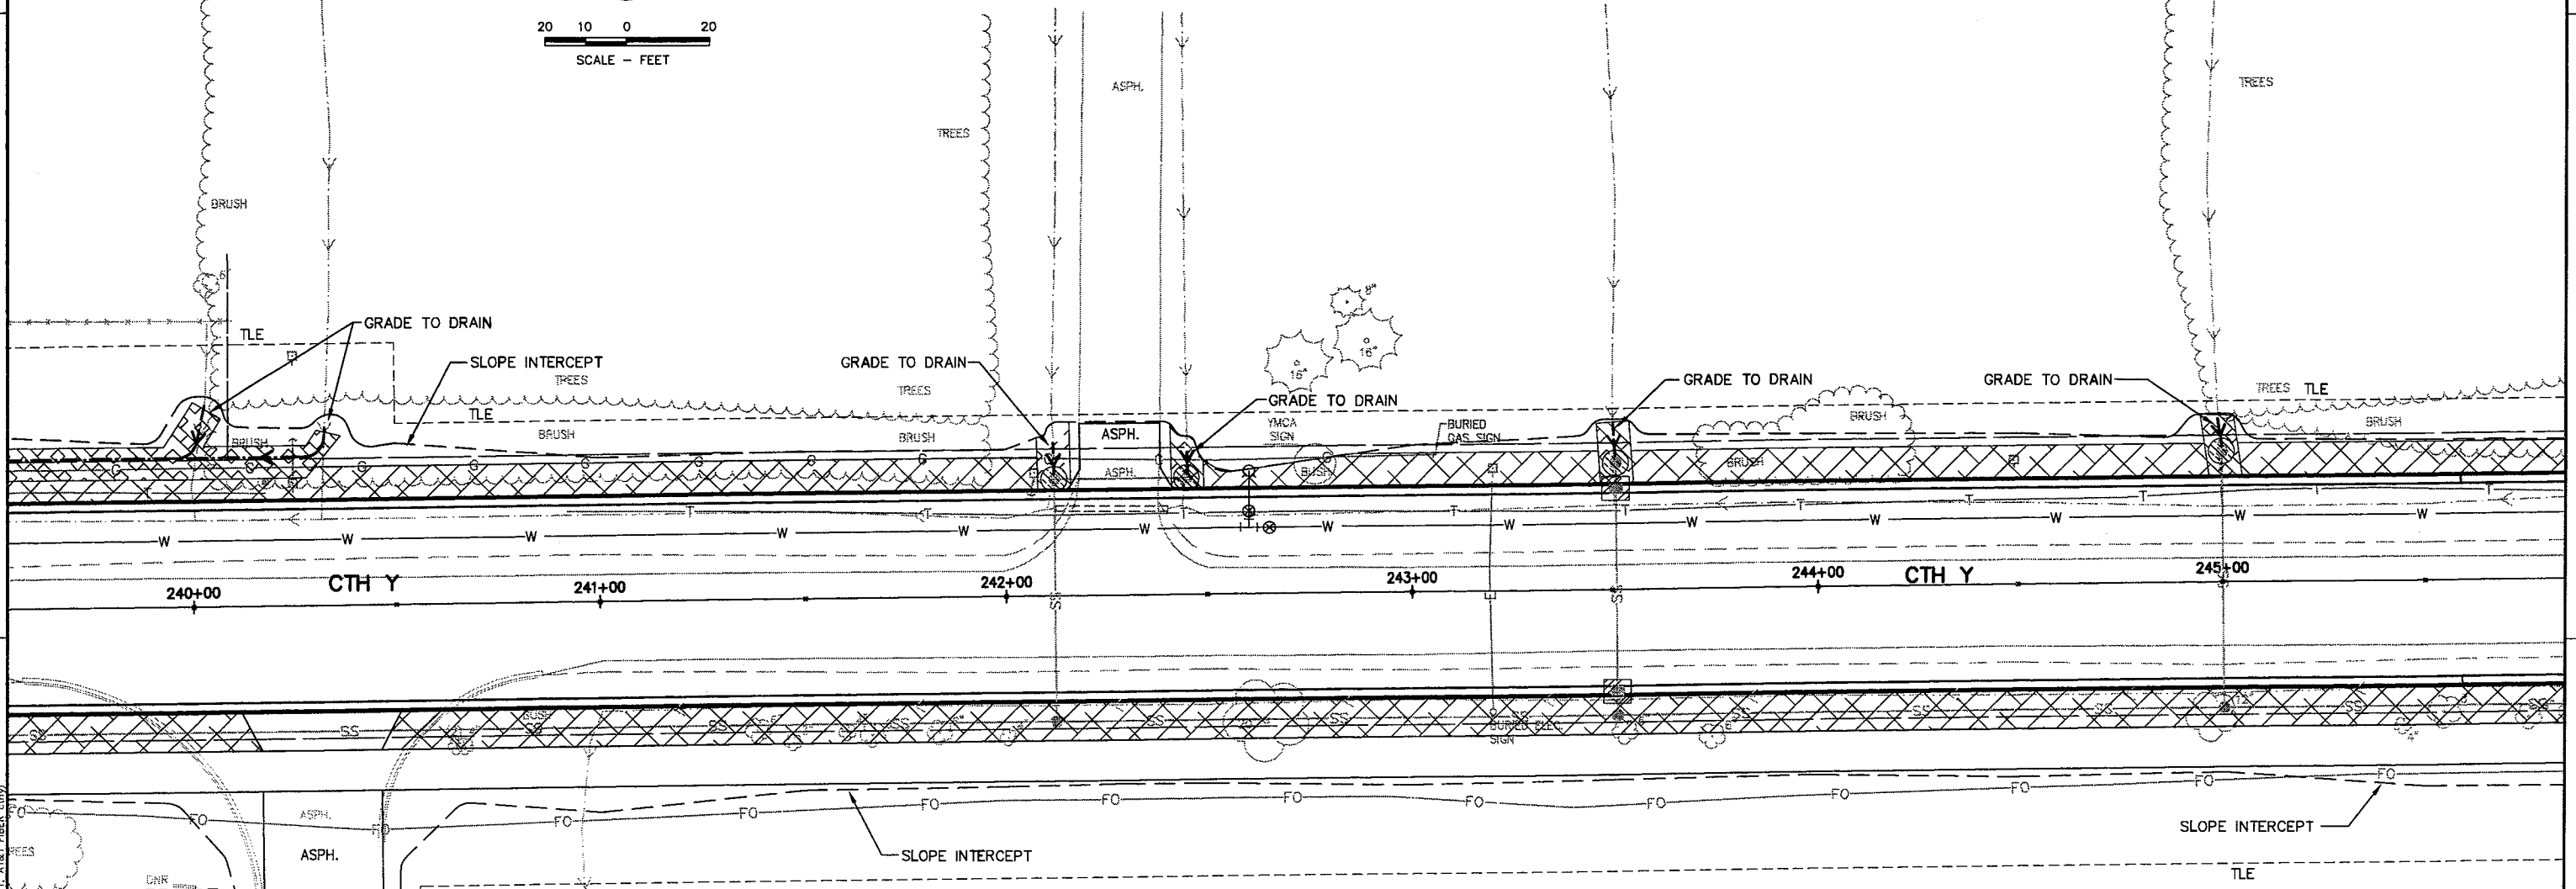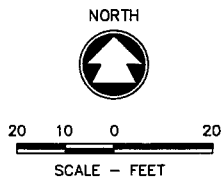

EXACT LOCATION OF EROSION CONTROL DEVICES TO BE DETERMINED BY THE ENGINEER IN THE FIELD.


LEGEND	
	EROSION MAT, URBAN, CLASS 1, TYPE A
	EROSION MAT, URBAN, CLASS 1, TYPE B
	INLET PROTECTION, TYPE A
	INLET PROTECTION, TYPE C
	SILT FENCE
	TEMPORARY DITCH CHECKS
	CULVERT PIPE DITCH CHECKS

C:\WORK\4994\00\DETAILS\00-EROSION_CONTROL.dwg 07/21/08 2:04 PM (X-CTH Y - A187 PAPER.dwg)

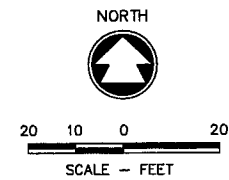


EXACT LOCATION OF EROSION CONTROL DEVICES TO BE DETERMINED BY THE ENGINEER IN THE FIELD.



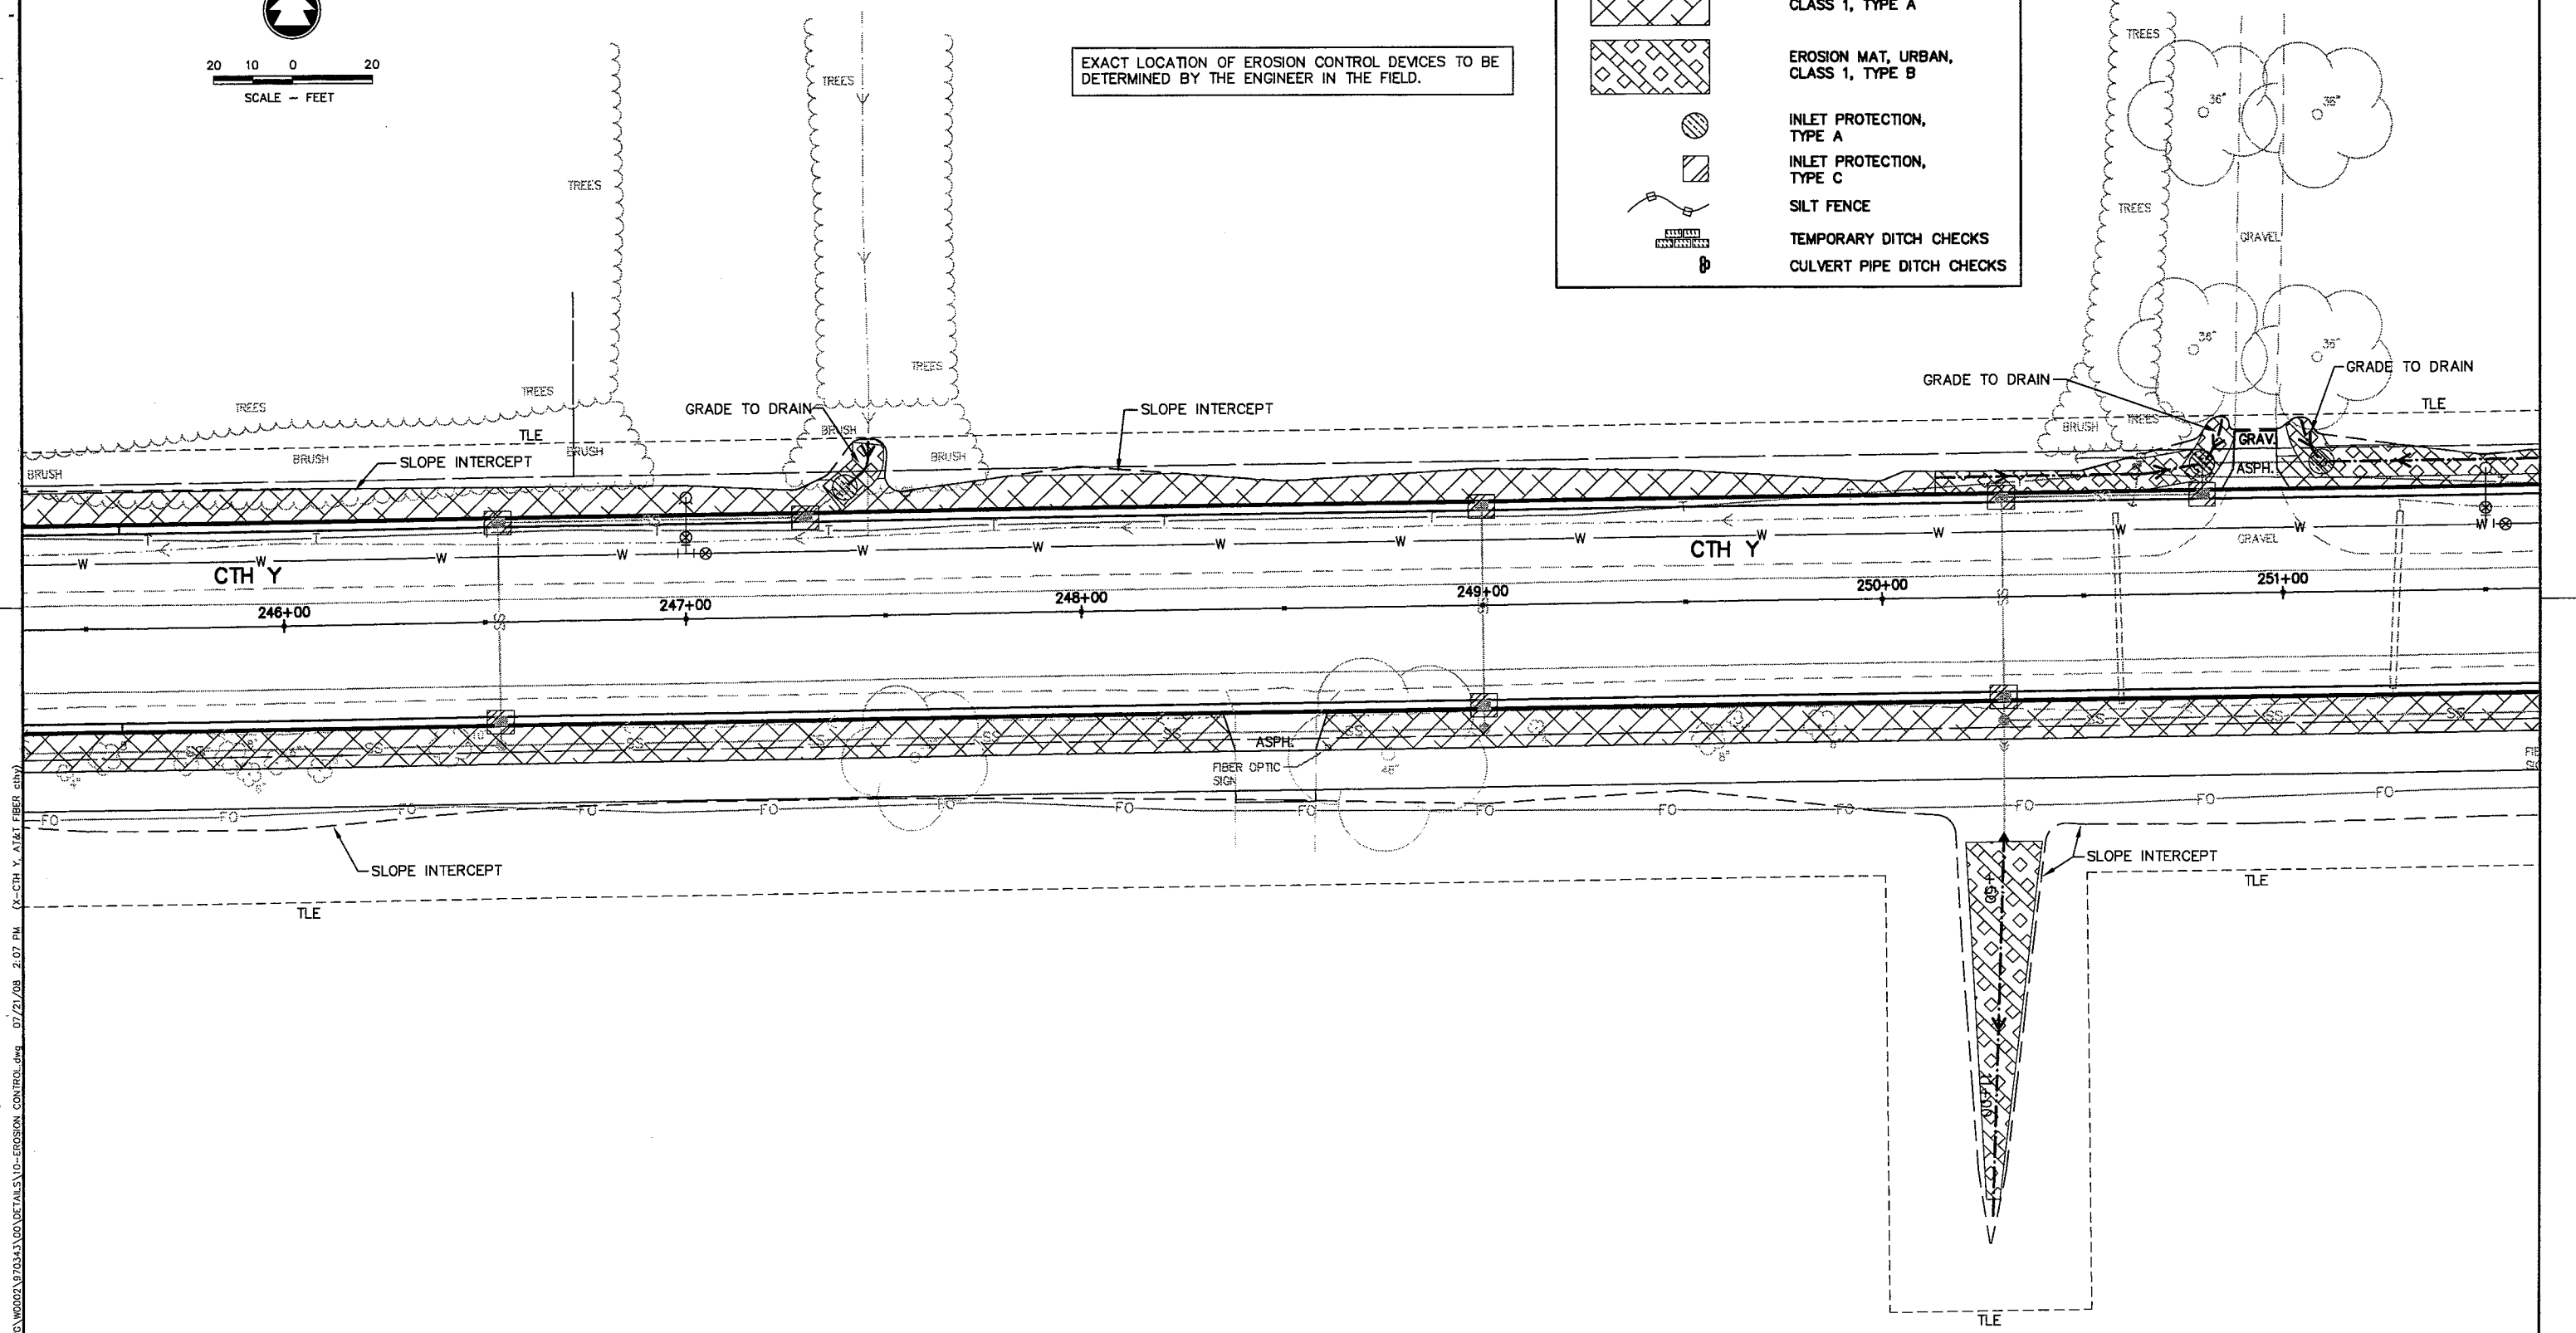




LEGEND	
	EROSION MAT, URBAN, CLASS 1, TYPE A
	EROSION MAT, URBAN, CLASS 1, TYPE B
	INLET PROTECTION, TYPE A
	INLET PROTECTION, TYPE C
	SILT FENCE
	TEMPORARY DITCH CHECKS
	CULVERT PIPE DITCH CHECKS

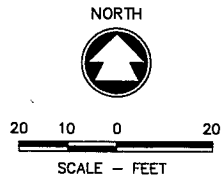


W:\DMS\WOODS\970343\00\DETAILS\10-EROSION CONTROL.dwg 07/21/08 2:07 PM (X-CTH Y-A141-FIBER SIGN)



LEGEND

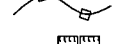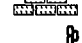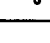-  EROSION MAT, URBAN, CLASS 1, TYPE A
-  EROSION MAT, URBAN, CLASS 1, TYPE B
-  INLET PROTECTION, TYPE A
-  INLET PROTECTION, TYPE C
-  SILT FENCE
-  TEMPORARY DITCH CHECKS
-  CULVERT PIPE DITCH CHECKS

EXACT LOCATION OF EROSION CONTROL DEVICES TO BE DETERMINED BY THE ENGINEER IN THE FIELD.

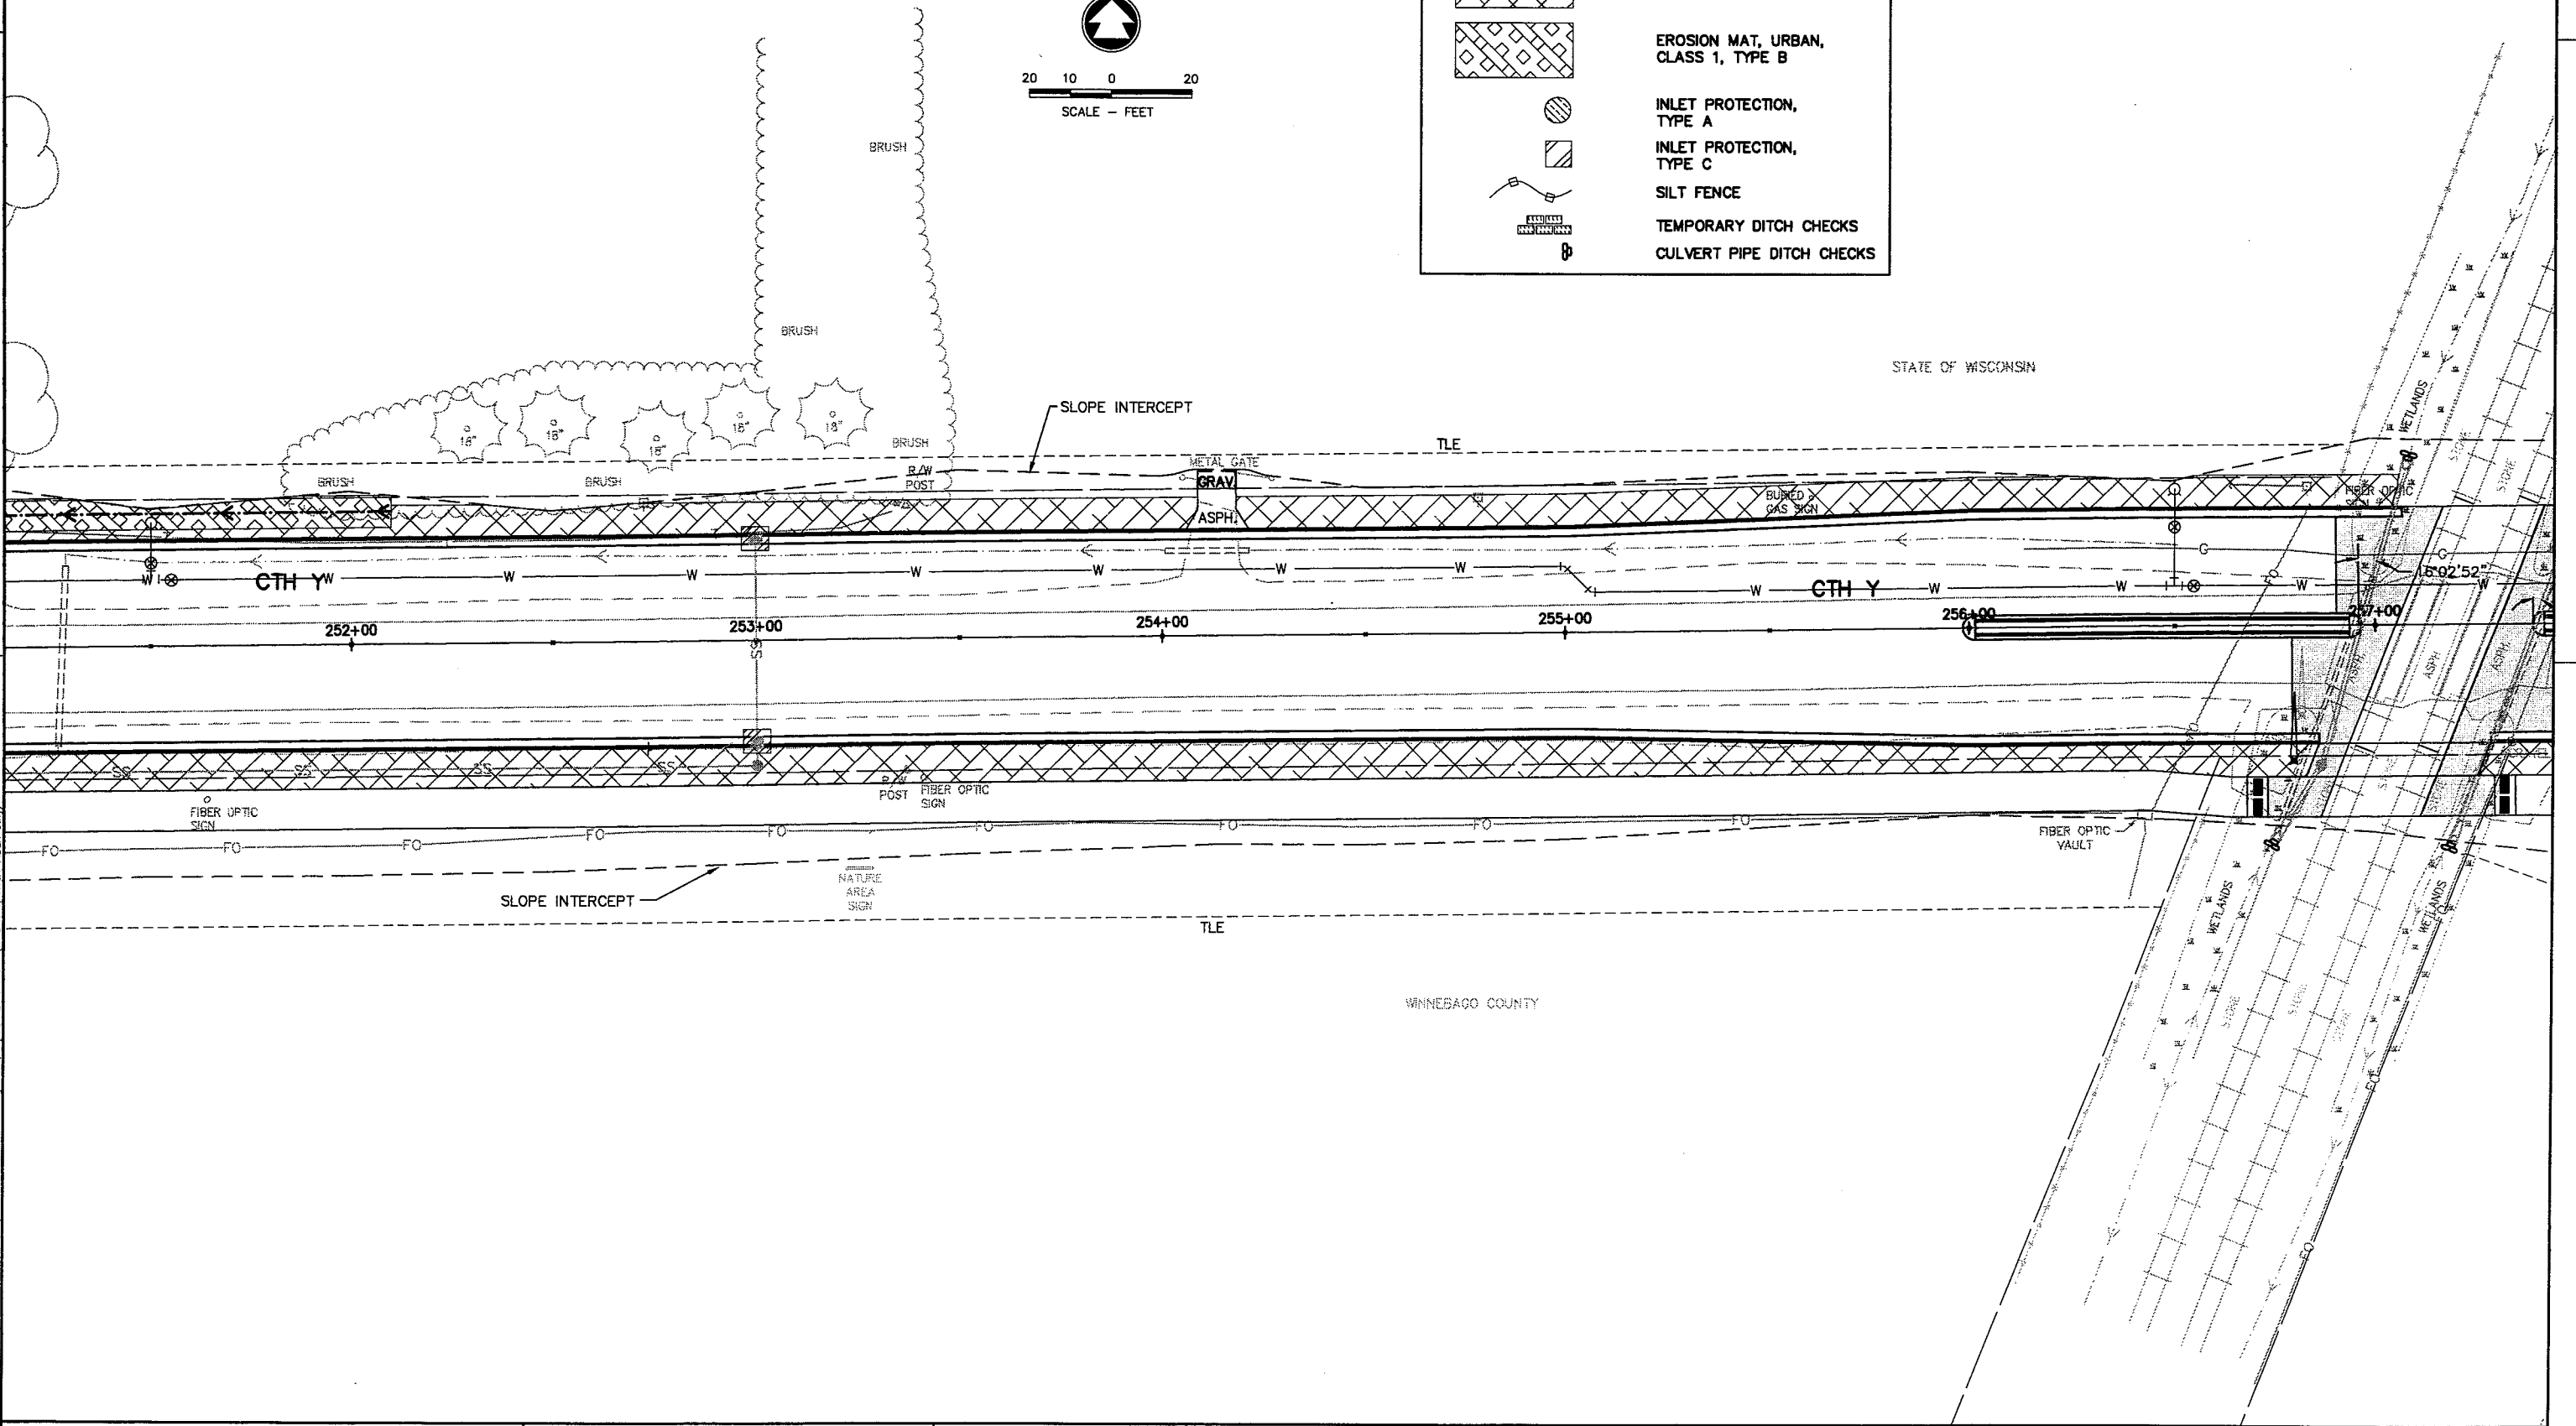

W:\DMS\W0002\970343\00\DETAILS\11-EROSION CONTROL.dwg 07/21/08 2:10 PM (X-CTH Y, AT&T FIBER CITY)

STATE PROJECT NUMBER: 4994-00-87

HWY: CTH Y

COUNTY: WINNEBAGO



EROSION CONTROL DETAIL

SHEET NO:





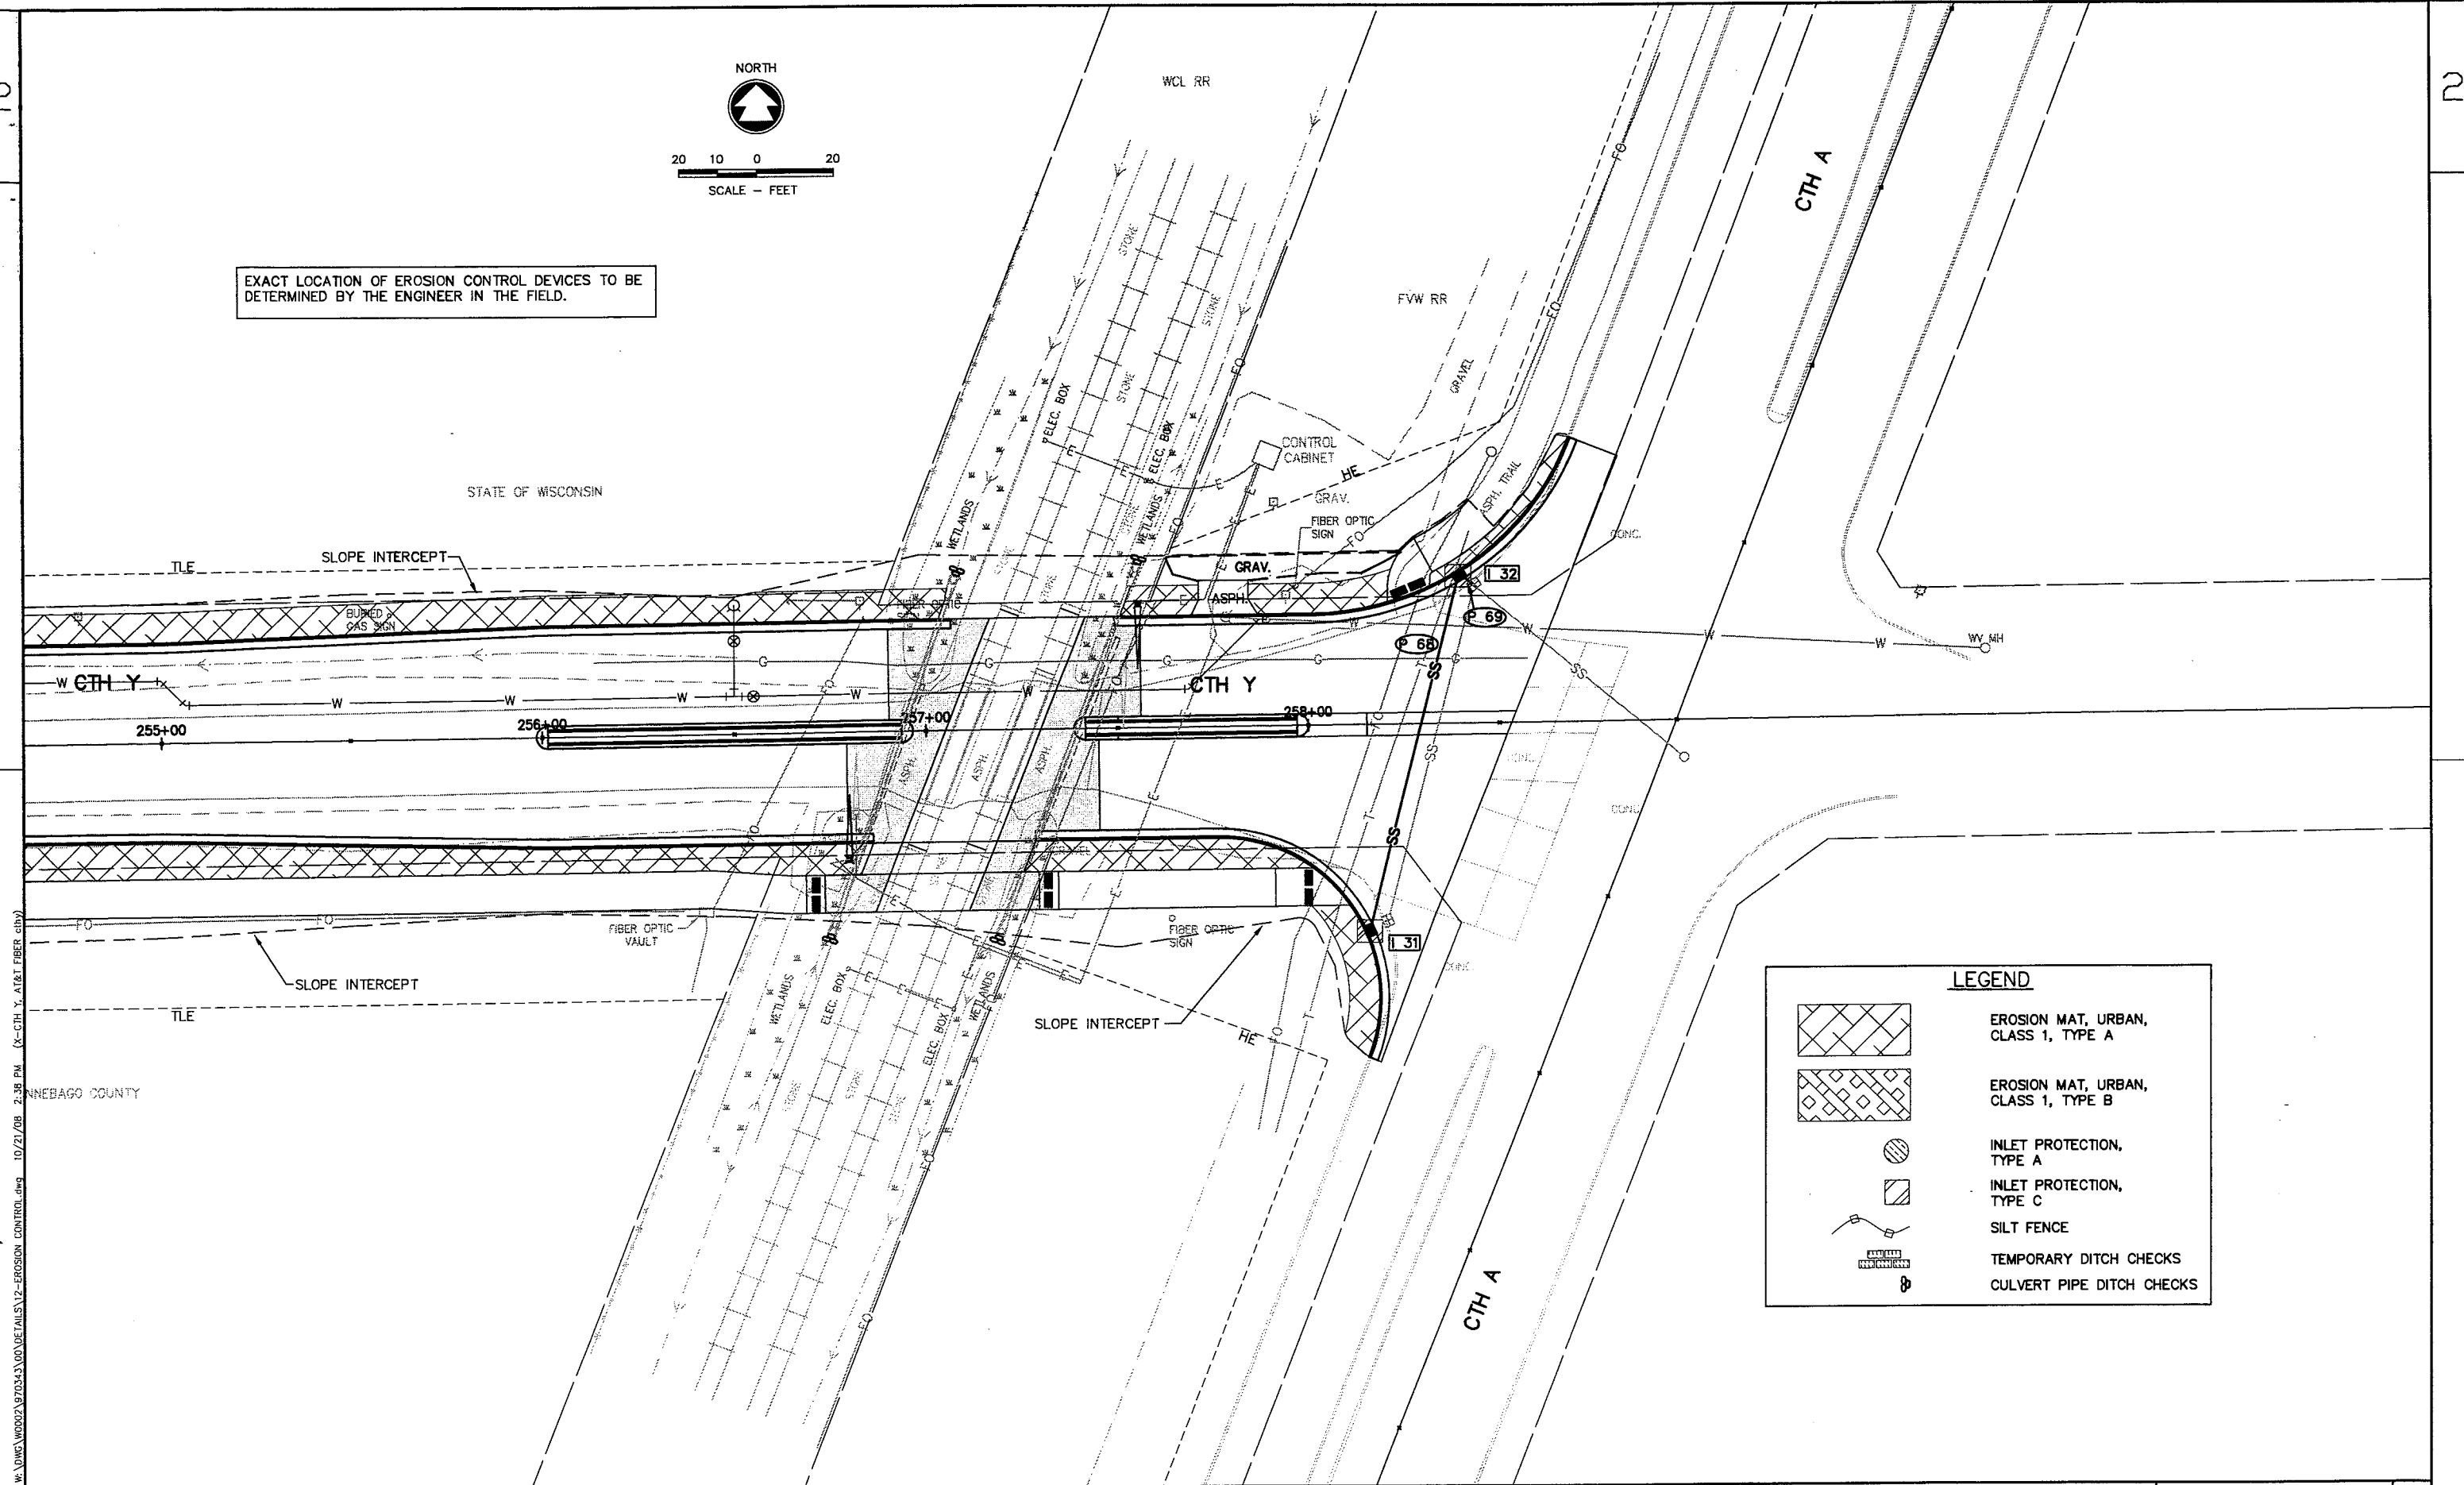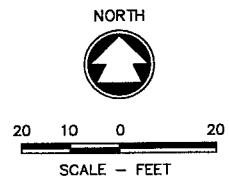


62

E

EXACT LOCATION OF EROSION CONTROL DEVICES TO BE DETERMINED BY THE ENGINEER IN THE FIELD.



LEGEND

-  EROSION MAT, URBAN, CLASS 1, TYPE A
-  EROSION MAT, URBAN, CLASS 1, TYPE B
-  INLET PROTECTION, TYPE A
-  INLET PROTECTION, TYPE C
-  SILT FENCE
-  TEMPORARY DITCH CHECKS
-  CULVERT PIPE DITCH CHECKS

W:\DMS\W0002\97034\3\00\DETAILED\2-EROSION CONTROL.dwg 10/21/08 2:38 PM (X-CTH Y, A1&T FIBER.cdw)

STATE PROJECT NUMBER: 4994-00-87


HWY: CTH Y

COUNTY: WINNEBAGO

EROSION CONTROL DETAIL

SHEET NO: 63

E

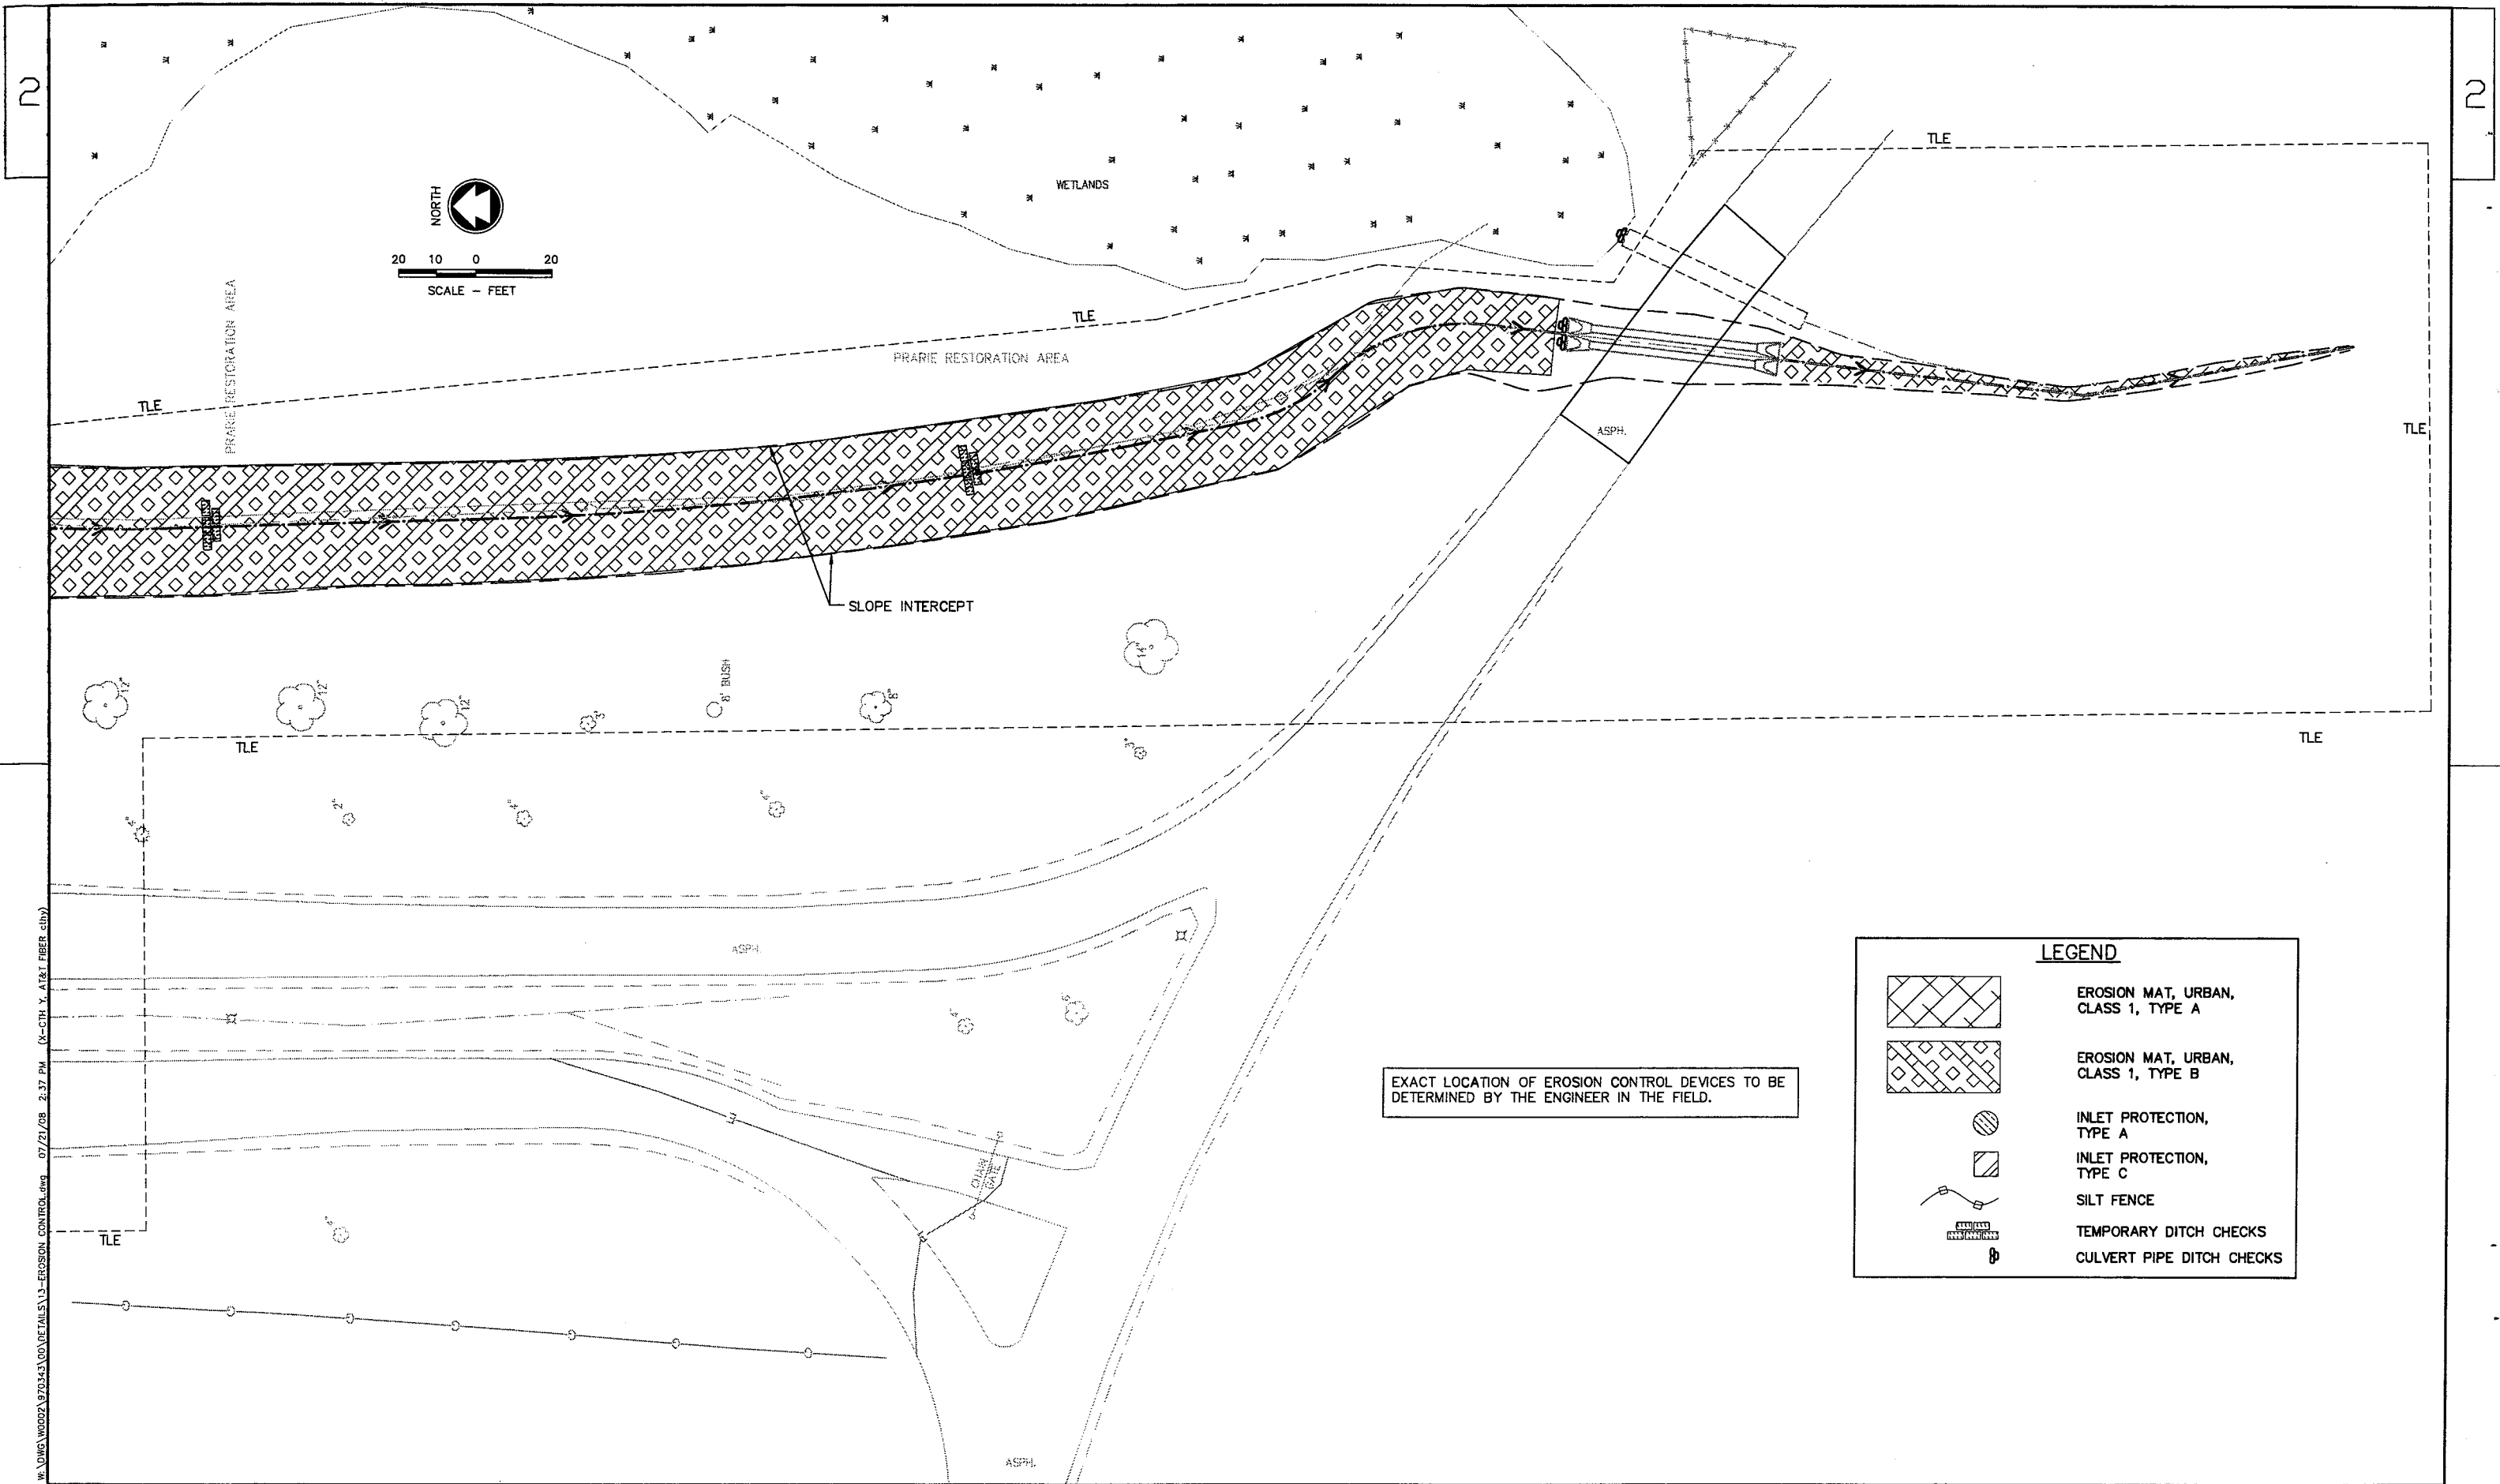

EXACT LOCATION OF EROSION CONTROL DEVICES TO BE DETERMINED BY THE ENGINEER IN THE FIELD.

LEGEND	
	EROSION MAT, URBAN, CLASS 1, TYPE A
	EROSION MAT, URBAN, CLASS 1, TYPE B
	INLET PROTECTION, TYPE A
	INLET PROTECTION, TYPE C
	SILT FENCE
	TEMPORARY DITCH CHECKS
	CULVERT PIPE DITCH CHECKS

c:\msdcs\work\970343\00\DETAILS\13-EROSION_CONTROL.dwg 07/21/08 2:37 PM (X-CITY, Y, A&T, FIBER, GIB)

STATE PROJECT NUMBER: 4994-00-87

HWY: CTH Y


COUNTY: WINNEBAGO

EROSION CONTROL DETAIL


SHEET NO: 64

E

A - EXTENDED 500' WEST OF STA. 195+00

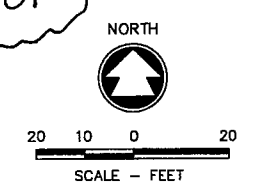


INFORMATION NOT SHOWN ON THIS DETAIL SHALL CONFORM BE IN ACCORDANCE WITH THE PERTINANT STANDARD DETAIL DRAWINGS.
 ALL SIGNS THAT ARE TO BE MOVED SHALL BE MOVED AND RE-ERECTED IN THE SAME LOCATION, IN ACCORDANCE WITH CLEARANCE REQUIREMENTS, ON NEW POSTS UNLESS OTHERWISE NOTED, OR AS THE ENGINEER IN THE FIELD DIRECTS.

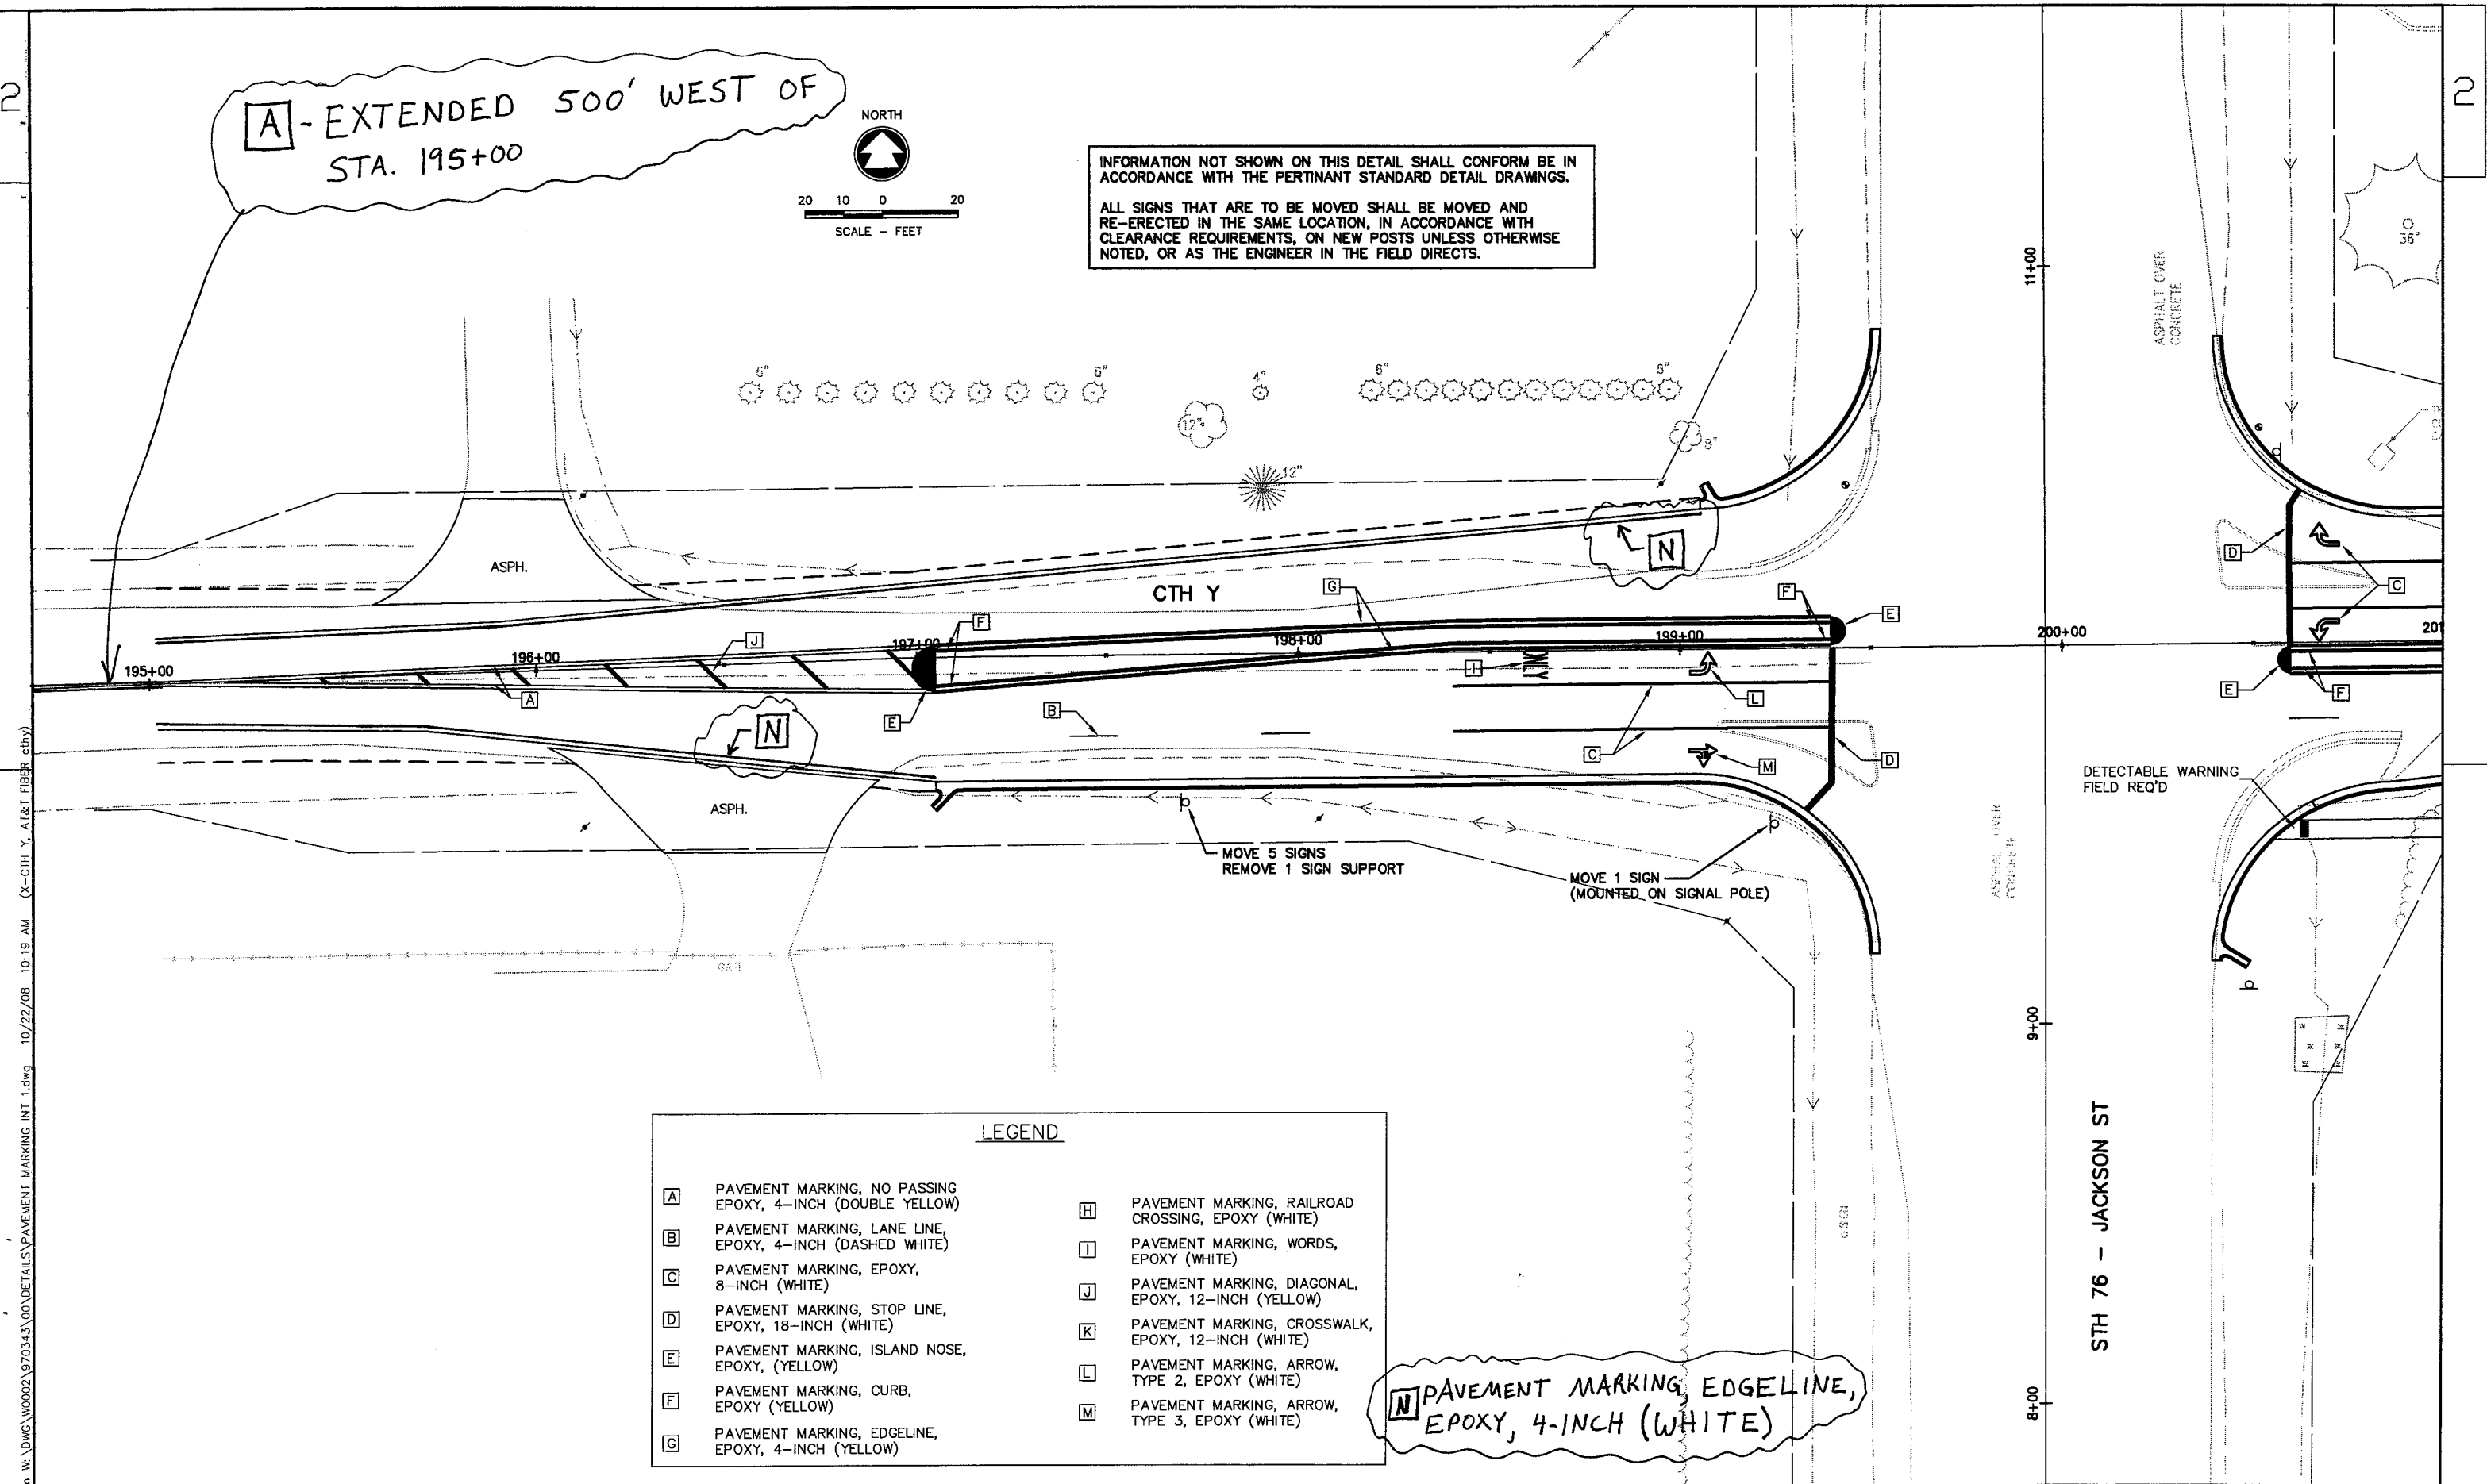


LEGEND	
A	PAVEMENT MARKING, NO PASSING EPOXY, 4-INCH (DOUBLE YELLOW)
B	PAVEMENT MARKING, LANE LINE, EPOXY, 4-INCH (DASHED WHITE)
C	PAVEMENT MARKING, EPOXY, 8-INCH (WHITE)
D	PAVEMENT MARKING, STOP LINE, EPOXY, 18-INCH (WHITE)
E	PAVEMENT MARKING, ISLAND NOSE, EPOXY, (YELLOW)
F	PAVEMENT MARKING, CURB, EPOXY (YELLOW)
G	PAVEMENT MARKING, EDGELINE, EPOXY, 4-INCH (YELLOW)
H	PAVEMENT MARKING, RAILROAD CROSSING, EPOXY (WHITE)
I	PAVEMENT MARKING, WORDS, EPOXY (WHITE)
J	PAVEMENT MARKING, DIAGONAL, EPOXY, 12-INCH (YELLOW)
K	PAVEMENT MARKING, CROSSWALK, EPOXY, 12-INCH (WHITE)
L	PAVEMENT MARKING, ARROW, TYPE 2, EPOXY (WHITE)
M	PAVEMENT MARKING, ARROW, TYPE 3, EPOXY (WHITE)

N PAVEMENT MARKING, EDGELINE, EPOXY, 4-INCH (WHITE)

g:\ssm\w\dwg\w0002\970343\00\DETAILS\PAVEMENT MARKING INT 1.dwg 10/22/08 10:19 AM (X-CTH Y, AT&T FIBER cthy)

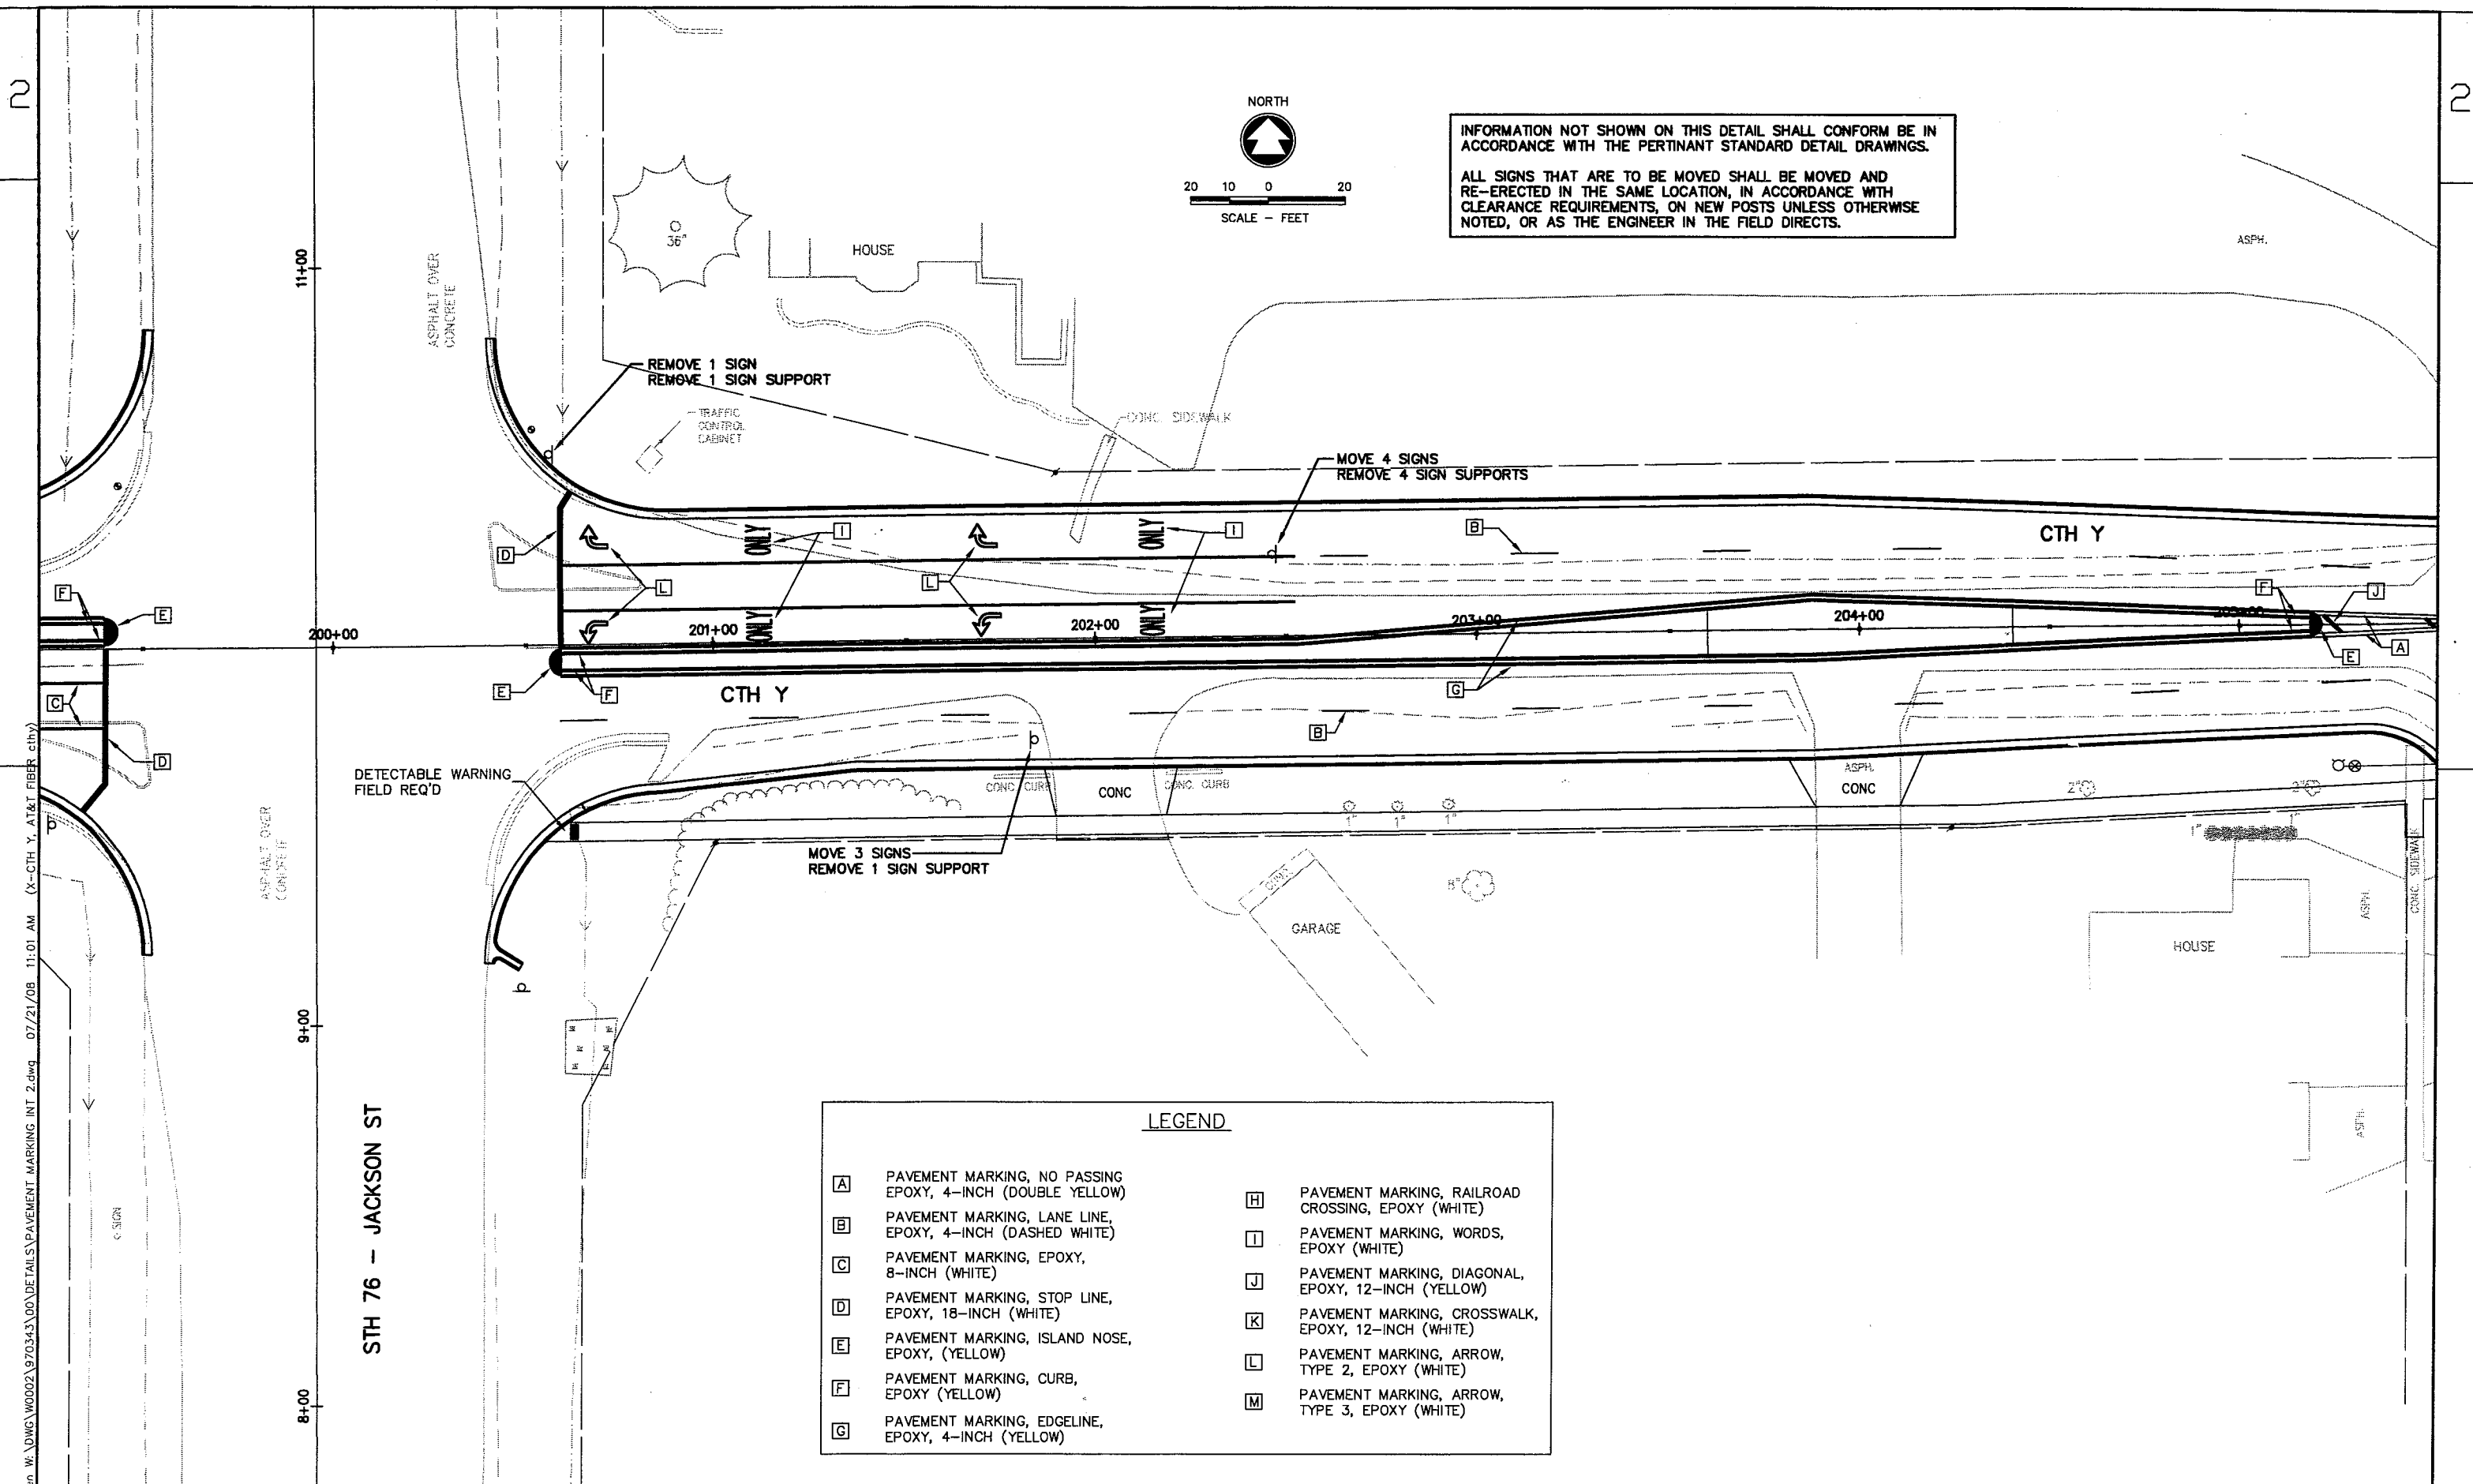

NORTH

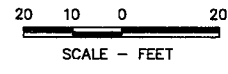

INFORMATION NOT SHOWN ON THIS DETAIL SHALL CONFORM BE IN ACCORDANCE WITH THE PERTINANT STANDARD DETAIL DRAWINGS.

ALL SIGNS THAT ARE TO BE MOVED SHALL BE MOVED AND RE-ERECTED IN THE SAME LOCATION, IN ACCORDANCE WITH CLEARANCE REQUIREMENTS, ON NEW POSTS UNLESS OTHERWISE NOTED, OR AS THE ENGINEER IN THE FIELD DIRECTS.

STH 76 - JACKSON ST

LEGEND	
[A]	PAVEMENT MARKING, NO PASSING EPOXY, 4-INCH (DOUBLE YELLOW)
[B]	PAVEMENT MARKING, LANE LINE, EPOXY, 4-INCH (DASHED WHITE)
[C]	PAVEMENT MARKING, EPOXY, 8-INCH (WHITE)
[D]	PAVEMENT MARKING, STOP LINE, EPOXY, 18-INCH (WHITE)
[E]	PAVEMENT MARKING, ISLAND NOSE, EPOXY, (YELLOW)
[F]	PAVEMENT MARKING, CURB, EPOXY (YELLOW)
[G]	PAVEMENT MARKING, EDGELINE, EPOXY, 4-INCH (YELLOW)
[H]	PAVEMENT MARKING, RAILROAD CROSSING, EPOXY (WHITE)
[I]	PAVEMENT MARKING, WORDS, EPOXY (WHITE)
[J]	PAVEMENT MARKING, DIAGONAL, EPOXY, 12-INCH (YELLOW)
[K]	PAVEMENT MARKING, CROSSWALK, EPOXY, 12-INCH (WHITE)
[L]	PAVEMENT MARKING, ARROW, TYPE 2, EPOXY (WHITE)
[M]	PAVEMENT MARKING, ARROW, TYPE 3, EPOXY (WHITE)

I:\projects\970343\00\DETAILS\PAVEMENT MARKING INT 2.dwg 07/21/08 11:01 AM (X-CTH Y, AT&T FIBER cthy)

STATE PROJECT NUMBER: 4994-00-87 & 6432-11-71

HWY: CTH Y

COUNTY: WINNEBAGO


PAVEMENT MARKING DETAIL

SHEET NO: 66

E


LEGEND

- [A] PAVEMENT MARKING, NO PASSING EPOXY, 4-INCH (DOUBLE YELLOW)
- [B] PAVEMENT MARKING, LANE LINE, EPOXY, 4-INCH (DASHED WHITE)
- [C] PAVEMENT MARKING, EPOXY, 8-INCH (WHITE)
- [D] PAVEMENT MARKING, STOP LINE, EPOXY, 18-INCH (WHITE)
- [E] PAVEMENT MARKING, ISLAND NOSE, EPOXY, (YELLOW)
- [F] PAVEMENT MARKING, CURB, EPOXY (YELLOW)
- [G] PAVEMENT MARKING, EDGE LINE, EPOXY, 4-INCH (YELLOW)
- [H] PAVEMENT MARKING, RAILROAD CROSSING, EPOXY (WHITE)
- [I] PAVEMENT MARKING, WORDS, EPOXY (WHITE)
- [J] PAVEMENT MARKING, DIAGONAL, EPOXY, 12-INCH (YELLOW)
- [K] PAVEMENT MARKING, CROSSWALK, EPOXY, 12-INCH (WHITE)
- [L] PAVEMENT MARKING, ARROW, TYPE 2, EPOXY (WHITE)
- [M] PAVEMENT MARKING, ARROW, TYPE 3, EPOXY (WHITE)

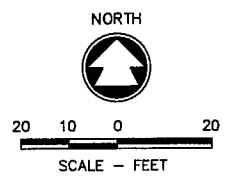

INFORMATION NOT SHOWN ON THIS DETAIL SHALL CONFORM BE IN ACCORDANCE WITH THE PERTINANT STANDARD DETAIL DRAWINGS.

ALL SIGNS THAT ARE TO BE MOVED SHALL BE REMOVED AND RE-ERECTED IN THE SAME LOCATION, IN ACCORDANCE WITH CLEARANCE REQUIREMENTS, ON NEW POSTS UNLESS OTHERWISE NOTED, OR AS THE ENGINEER IN THE FIELD DIRECTS.

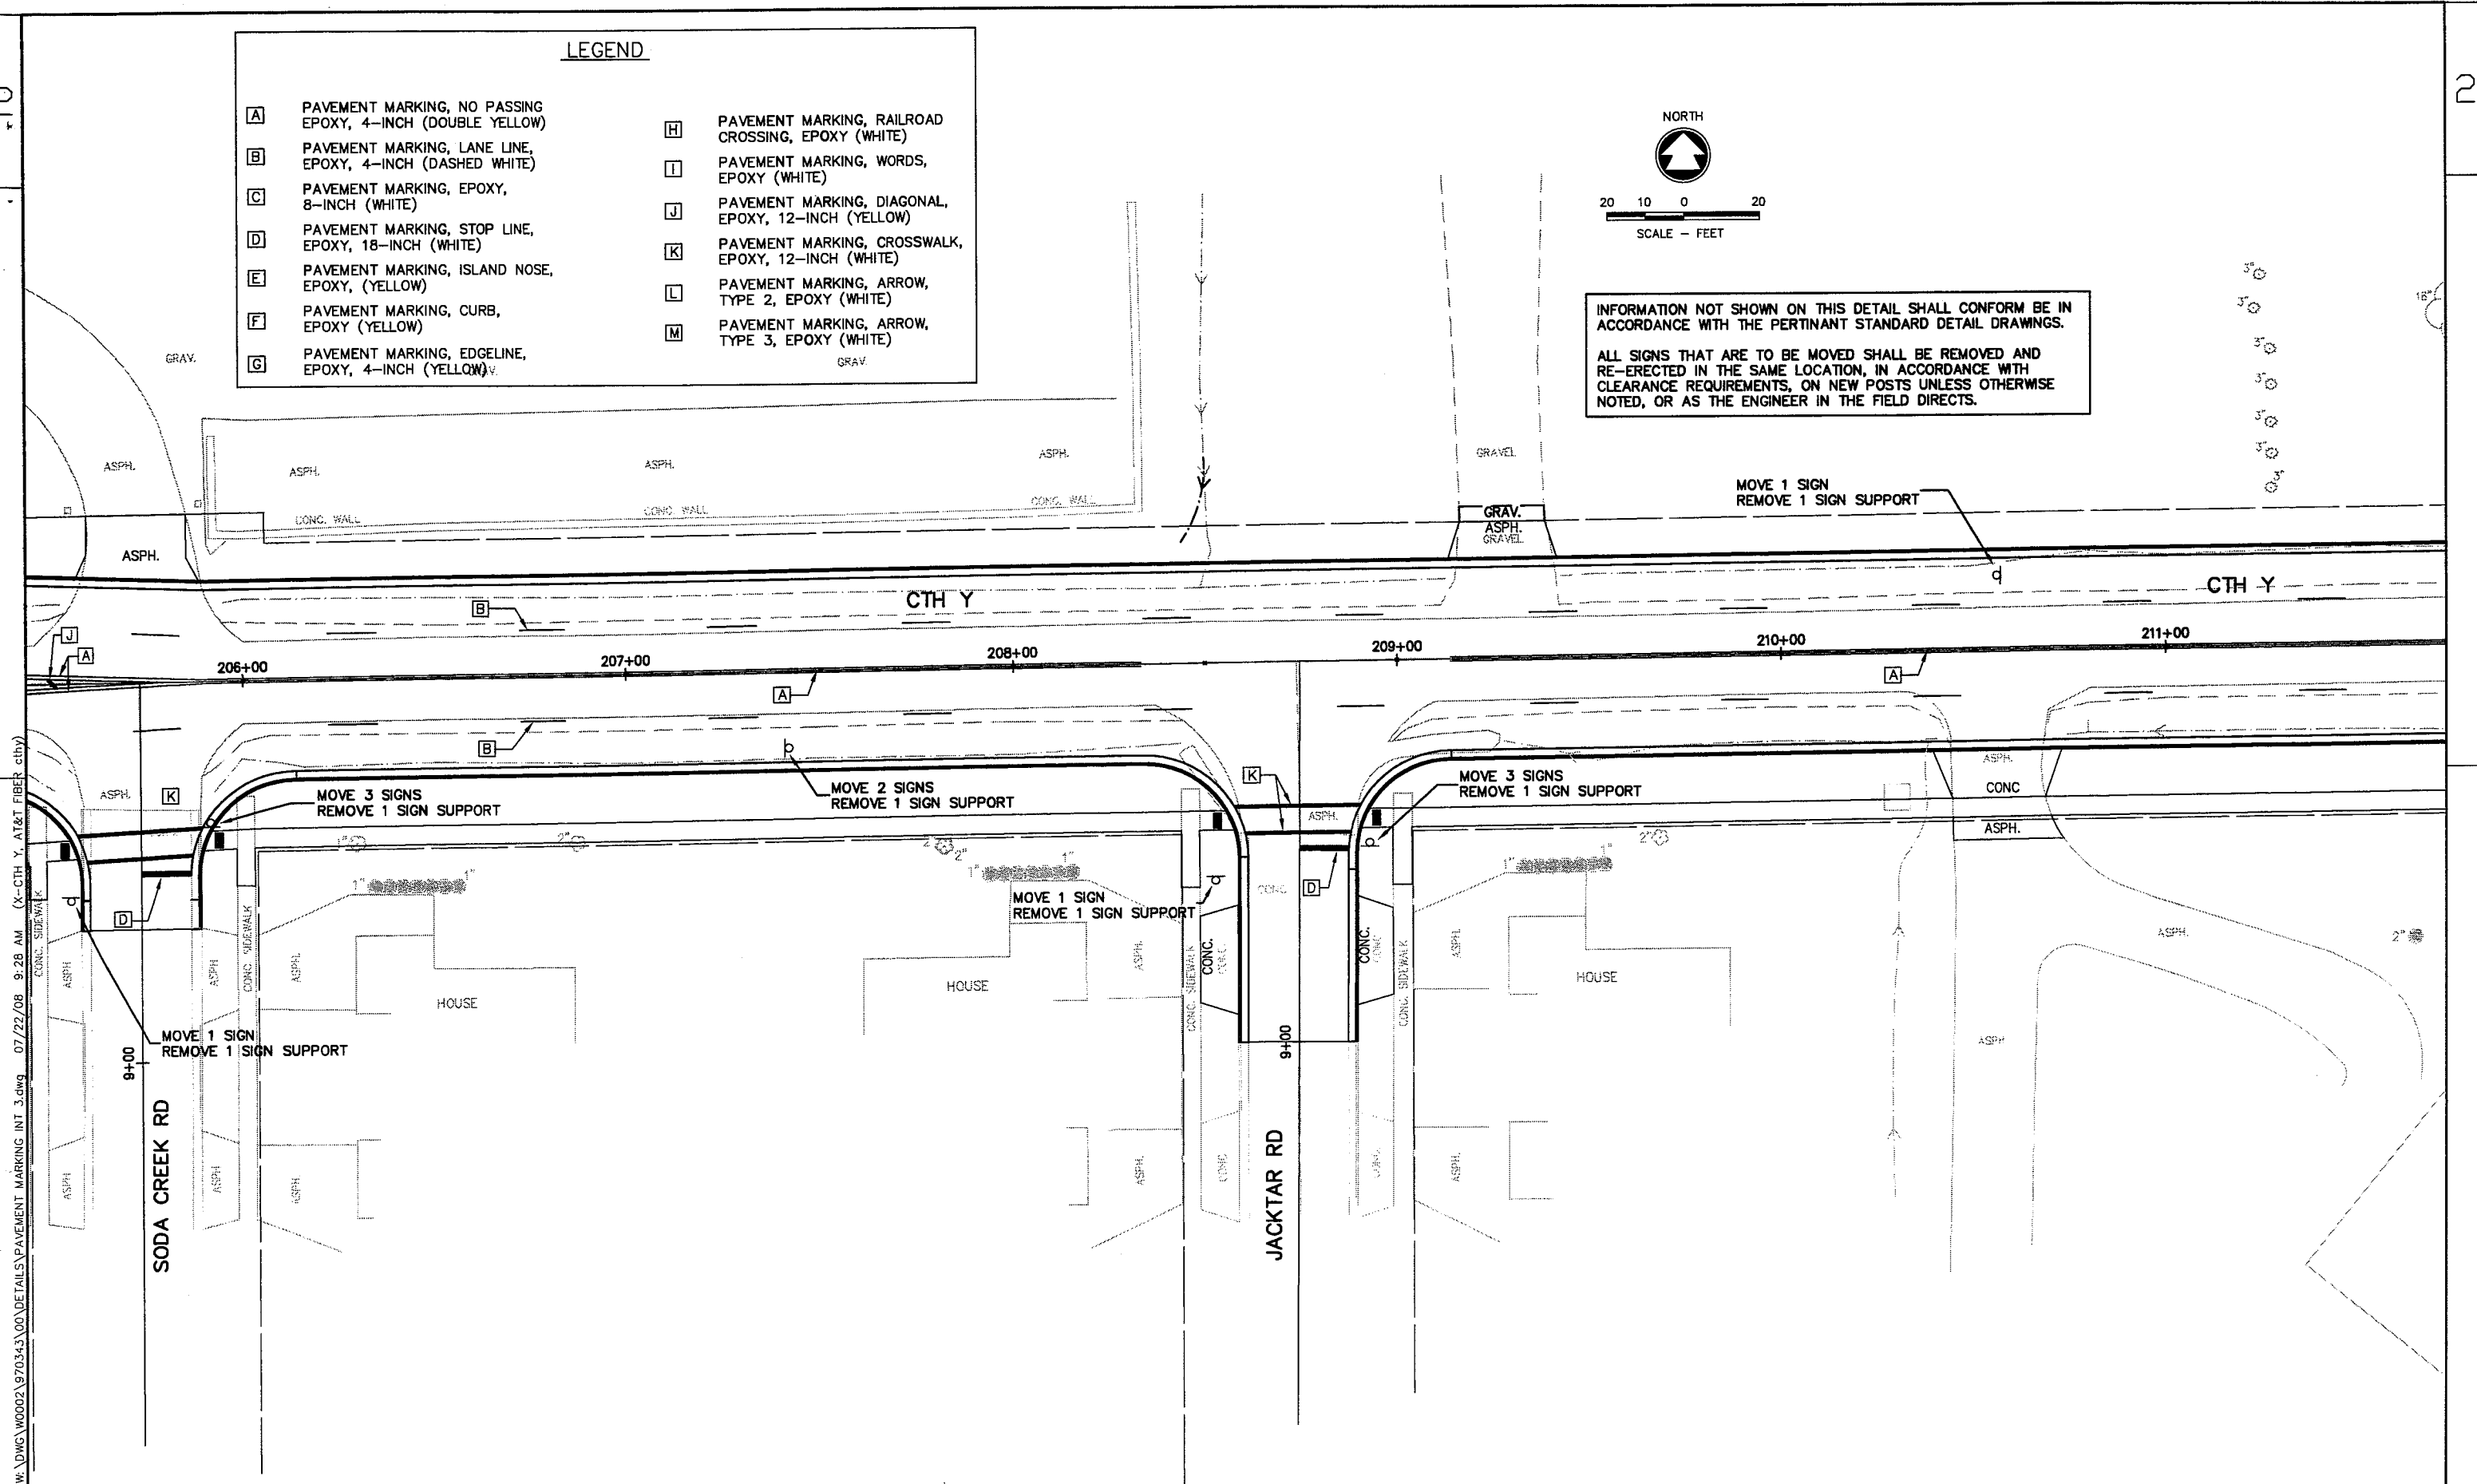

G:\gossen\w\DWG\W0002\970343\00\DETAILS\PAVEMENT MARKING INT 3.dwg 07/22/08 9:28 AM (X-CTH Y, AT&T FIBER cthy)

STATE PROJECT NUMBER: 4994-00-87


HWY: CTH Y

COUNTY: WINNEBAGO

PAVEMENT MARKING AND SIGNING DETAIL


SHEET NO: 67

E

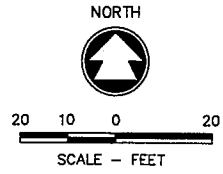

INFORMATION NOT SHOWN ON THIS DETAIL SHALL CONFORM BE IN ACCORDANCE WITH THE PERTINANT STANDARD DETAIL DRAWINGS.


ALL SIGNS THAT ARE TO BE MOVED SHALL BE REMOVED AND RE-ERECTED IN THE SAME LOCATION, IN ACCORDANCE WITH CLEARANCE REQUIREMENTS, ON NEW POSTS UNLESS OTHERWISE NOTED, OR AS THE ENGINEER IN THE FIELD DIRECTS.

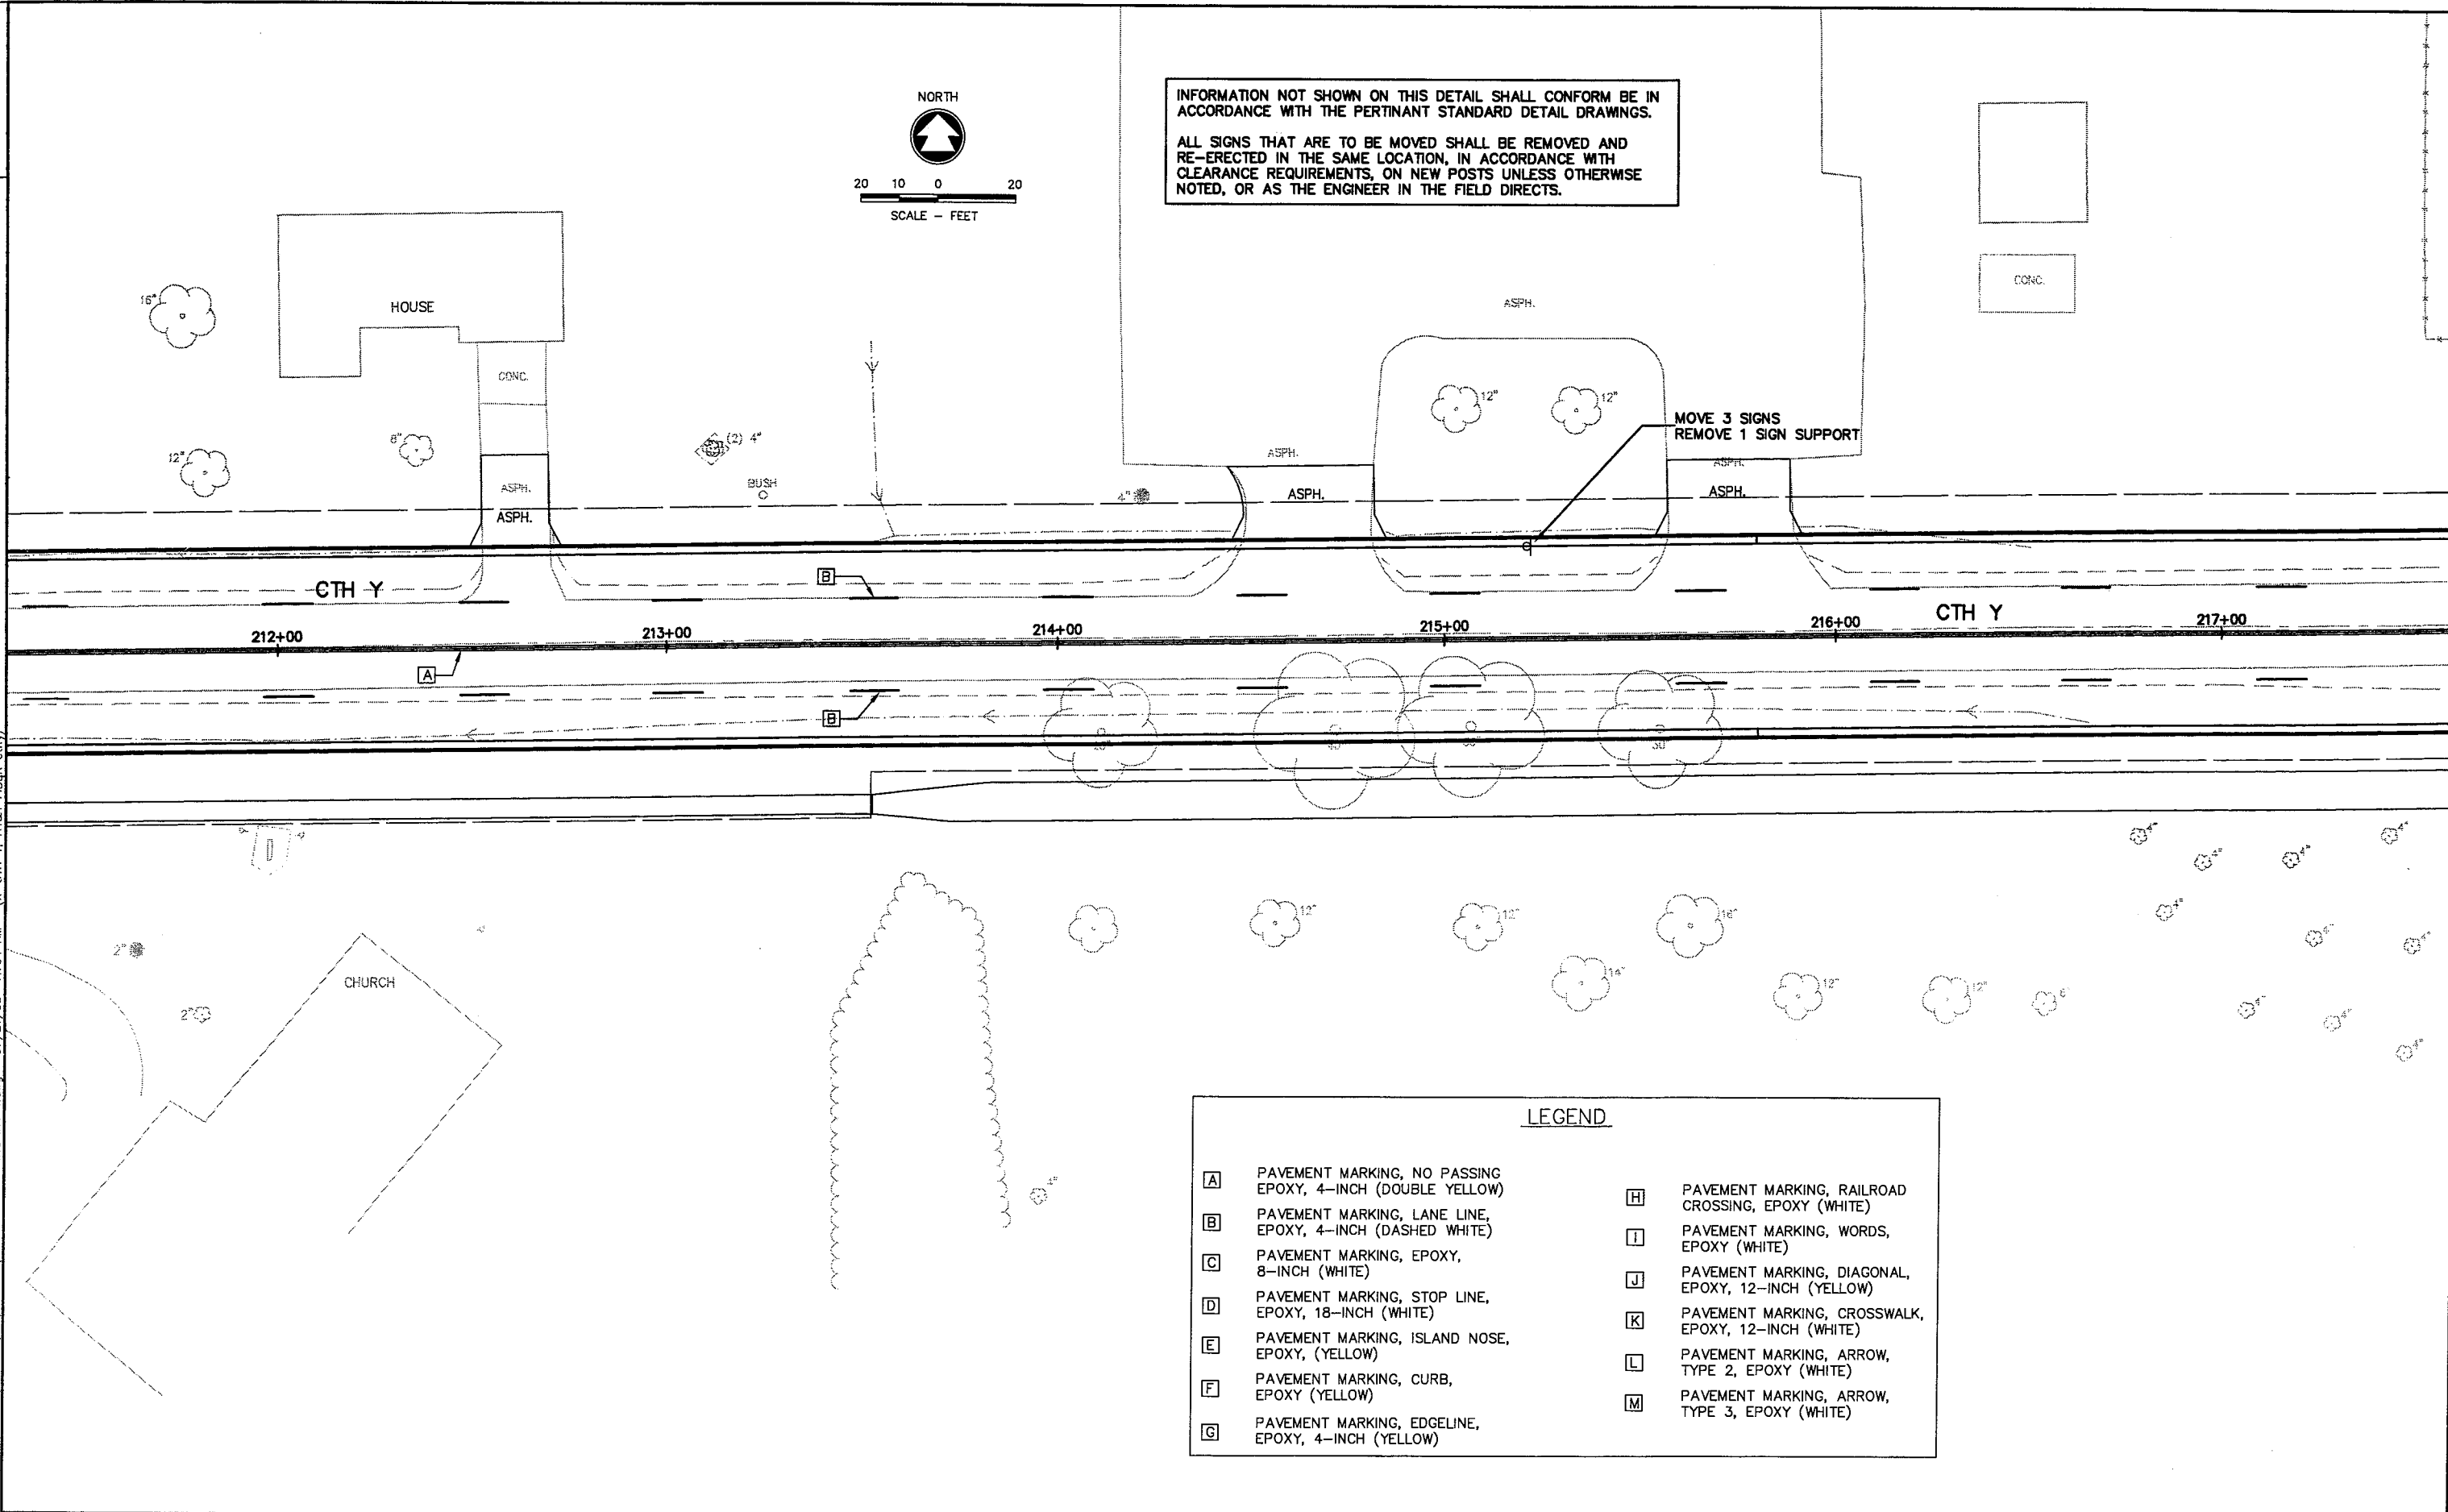

LEGEND

<p>A PAVEMENT MARKING, NO PASSING EPOXY, 4-INCH (DOUBLE YELLOW)</p> <p>B PAVEMENT MARKING, LANE LINE, EPOXY, 4-INCH (DASHED WHITE)</p> <p>C PAVEMENT MARKING, EPOXY, 8-INCH (WHITE)</p> <p>D PAVEMENT MARKING, STOP LINE, EPOXY, 18-INCH (WHITE)</p> <p>E PAVEMENT MARKING, ISLAND NOSE, EPOXY, (YELLOW)</p> <p>F PAVEMENT MARKING, CURB, EPOXY (YELLOW)</p> <p>G PAVEMENT MARKING, EDGELINE, EPOXY, 4-INCH (YELLOW)</p>	<p>H PAVEMENT MARKING, RAILROAD CROSSING, EPOXY (WHITE)</p> <p>I PAVEMENT MARKING, WORDS, EPOXY (WHITE)</p> <p>J PAVEMENT MARKING, DIAGONAL, EPOXY, 12-INCH (YELLOW)</p> <p>K PAVEMENT MARKING, CROSSWALK, EPOXY, 12-INCH (WHITE)</p> <p>L PAVEMENT MARKING, ARROW, TYPE 2, EPOXY (WHITE)</p> <p>M PAVEMENT MARKING, ARROW, TYPE 3, EPOXY (WHITE)</p>
---	---

gossen. W:\DWG\W0002\970343\00\DETAILS\PAVEMENT MARKING INT 4.dwg 07/21/08 11:04 AM (X-CTH Y, AT&T FIBER cthy)

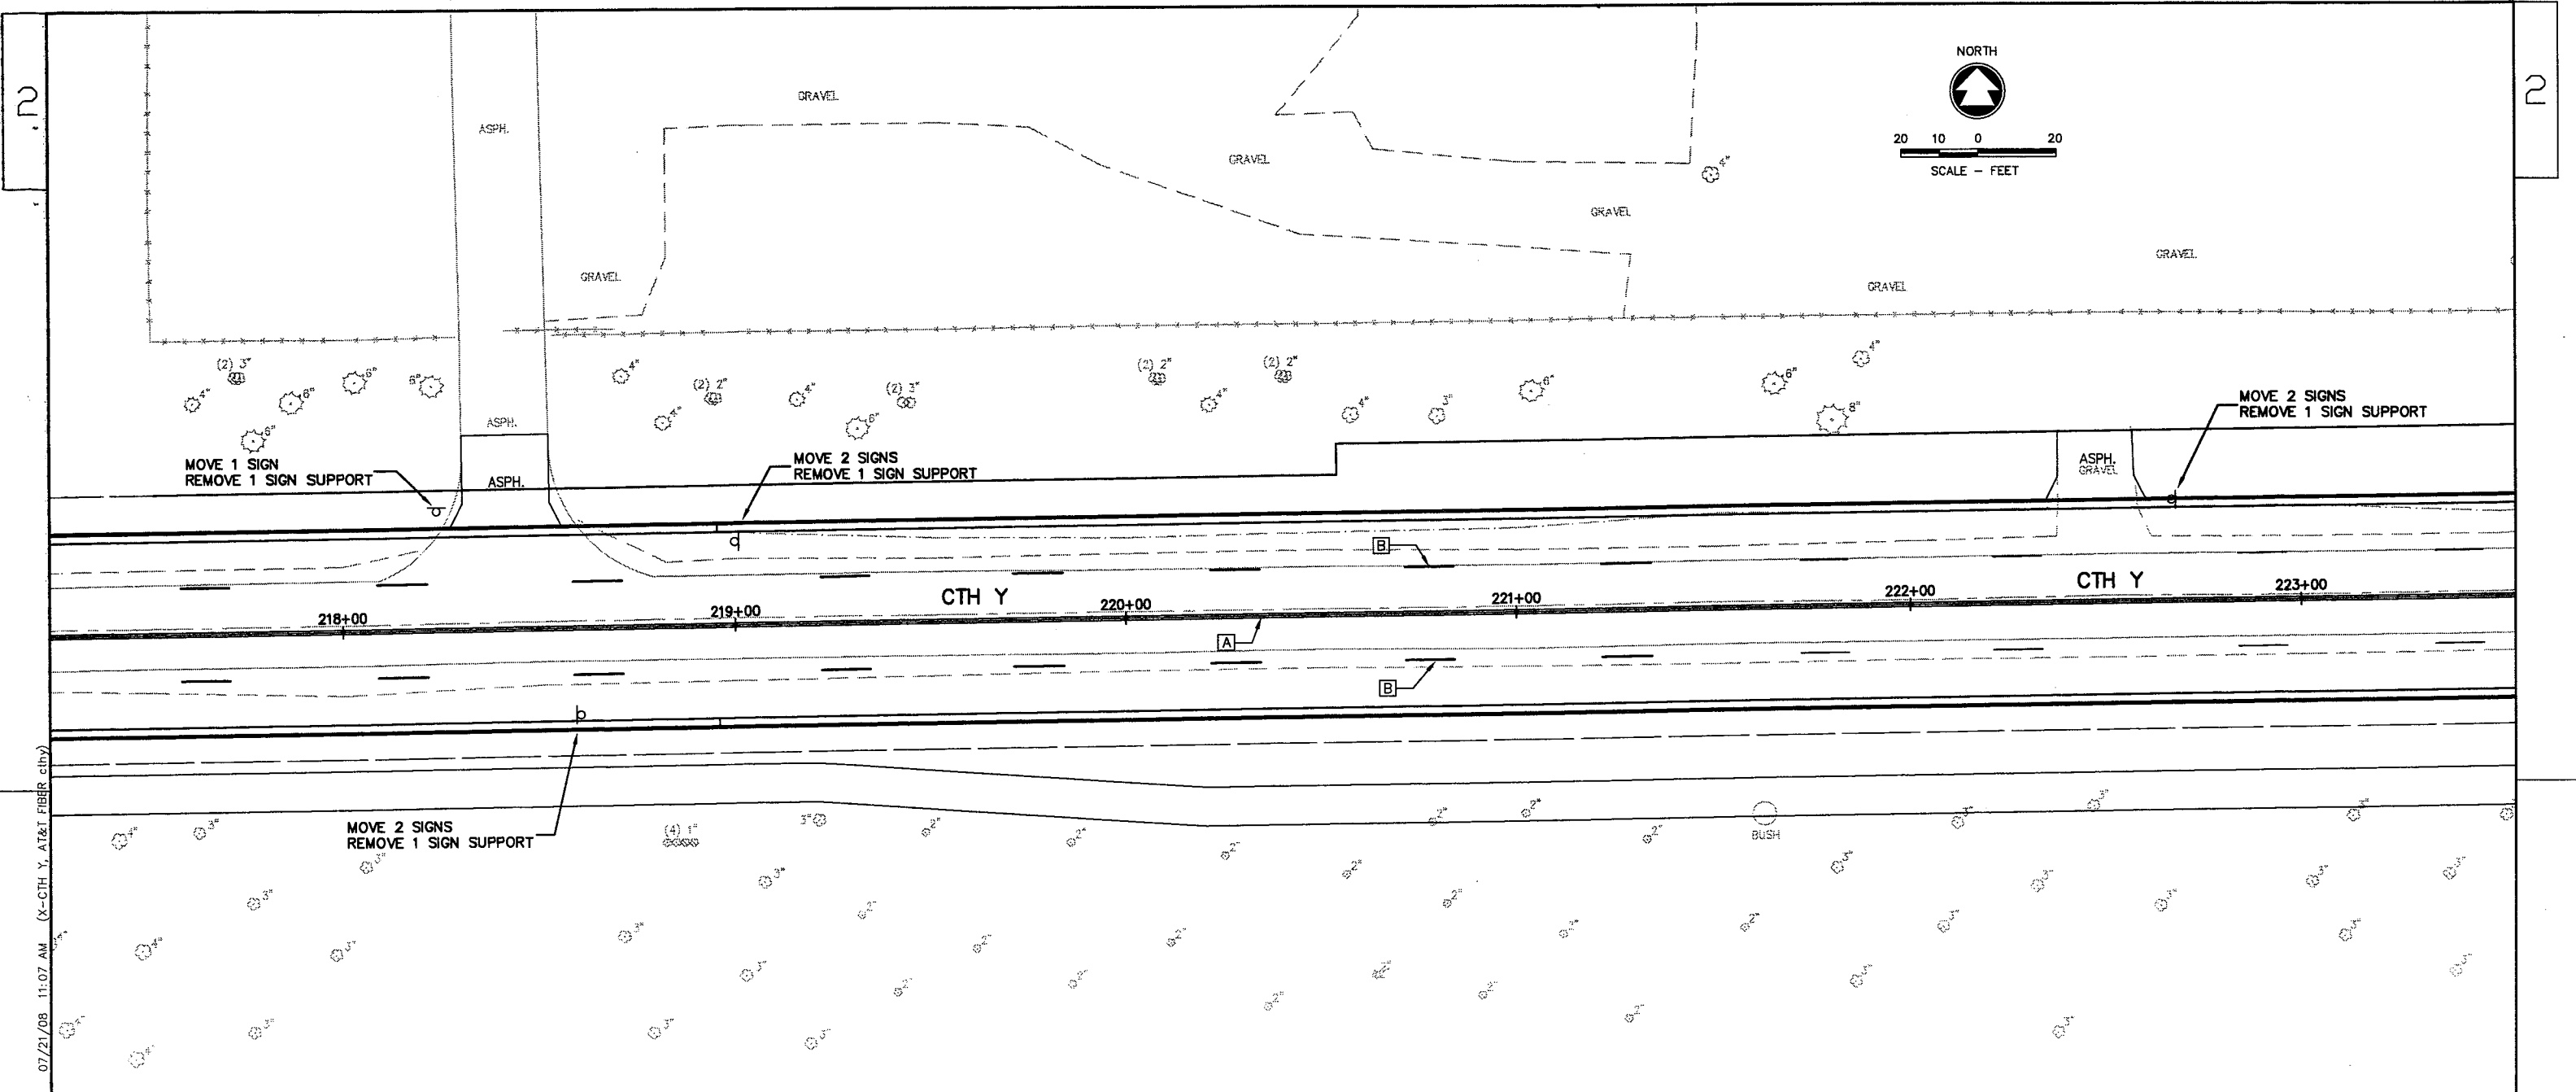

W:\DWG\W0002\970343\00\DETAILS\PAVEMENT MARKING INT 5.dwg 07/21/08 11:07 AM (X-CTH Y, AT&T, FIBER, cth)

LEGEND	
[A]	PAVEMENT MARKING, NO PASSING EPOXY, 4-INCH (DOUBLE YELLOW)
[B]	PAVEMENT MARKING, LANE LINE, EPOXY, 4-INCH (DASHED WHITE)
[C]	PAVEMENT MARKING, EPOXY, 8-INCH (WHITE)
[D]	PAVEMENT MARKING, STOP LINE, EPOXY, 18-INCH (WHITE)
[E]	PAVEMENT MARKING, ISLAND NOSE, EPOXY, (YELLOW)
[F]	PAVEMENT MARKING, CURB, EPOXY (YELLOW)
[G]	PAVEMENT MARKING, EDGELINE, EPOXY, 4-INCH (YELLOW)
[H]	PAVEMENT MARKING, RAILROAD CROSSING, EPOXY (WHITE)
[I]	PAVEMENT MARKING, WORDS, EPOXY (WHITE)
[J]	PAVEMENT MARKING, DIAGONAL, EPOXY, 12-INCH (YELLOW)
[K]	PAVEMENT MARKING, CROSSWALK, EPOXY, 12-INCH (WHITE)
[L]	PAVEMENT MARKING, ARROW, TYPE 2, EPOXY (WHITE)
[M]	PAVEMENT MARKING, ARROW, TYPE 3, EPOXY (WHITE)

INFORMATION NOT SHOWN ON THIS DETAIL SHALL CONFORM BE IN ACCORDANCE WITH THE PERTINANT STANDARD DETAIL DRAWINGS.
 ALL SIGNS THAT ARE TO BE MOVED SHALL BE REMOVED AND RE-ERECTED IN THE SAME LOCATION, IN ACCORDANCE WITH CLEARANCE REQUIREMENTS, ON NEW POSTS UNLESS OTHERWISE NOTED, OR AS THE ENGINEER IN THE FIELD DIRECTS.

STATE PROJECT NUMBER: 4994-00-87



HWY: CTH Y

COUNTY: WINNEBAGO

PAVEMENT MARKING AND SIGNING DETAIL

SHEET NO: 69

E

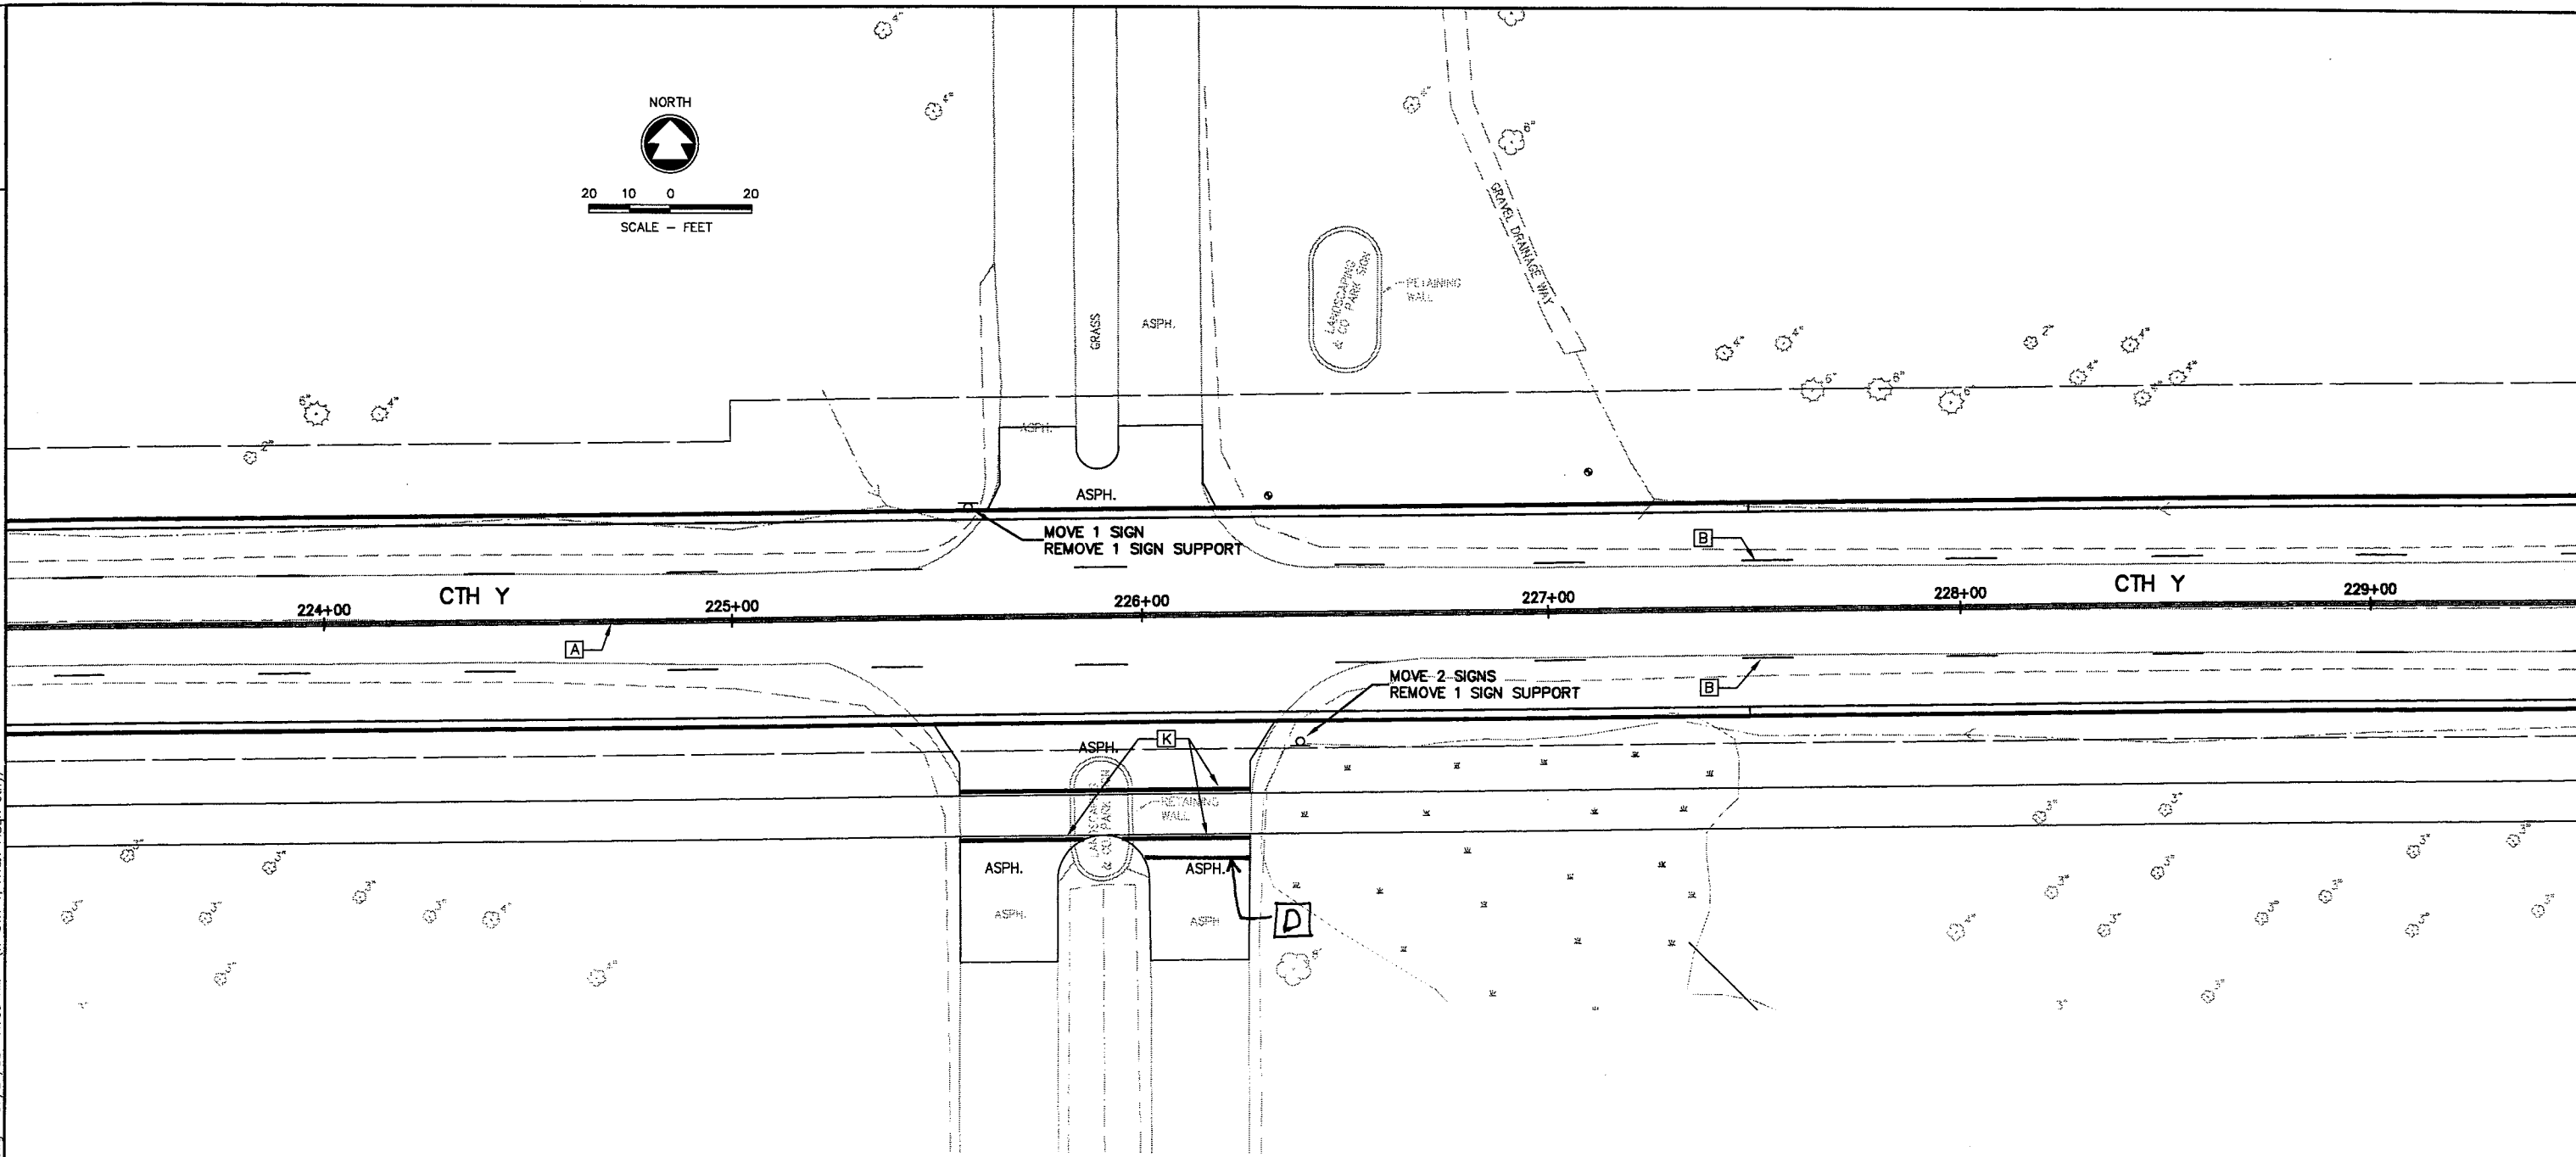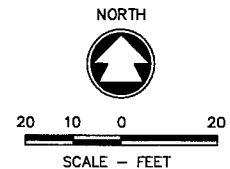


LEGEND

- | | |
|---|--|
| A PAVEMENT MARKING, NO PASSING EPOXY, 4-INCH (DOUBLE YELLOW) | H PAVEMENT MARKING, RAILROAD CROSSING, EPOXY (WHITE) |
| B PAVEMENT MARKING, LANE LINE, EPOXY, 4-INCH (DASHED WHITE) | I PAVEMENT MARKING, WORDS, EPOXY (WHITE) |
| C PAVEMENT MARKING, EPOXY, 8-INCH (WHITE) | J PAVEMENT MARKING, DIAGONAL, EPOXY, 12-INCH (YELLOW) |
| D PAVEMENT MARKING, STOP LINE, EPOXY, 18-INCH (WHITE) | K PAVEMENT MARKING, CROSSWALK, EPOXY, 12-INCH (WHITE) |
| E PAVEMENT MARKING, ISLAND NOSE, EPOXY, (YELLOW) | L PAVEMENT MARKING, ARROW, TYPE 2, EPOXY (WHITE) |
| F PAVEMENT MARKING, CURB, EPOXY (YELLOW) | M PAVEMENT MARKING, ARROW, TYPE 3, EPOXY (WHITE) |
| G PAVEMENT MARKING, EDGELINE, EPOXY, 4-INCH (YELLOW) | |

INFORMATION NOT SHOWN ON THIS DETAIL SHALL CONFORM BE IN ACCORDANCE WITH THE PERTINANT STANDARD DETAIL DRAWINGS.

ALL SIGNS THAT ARE TO BE MOVED SHALL BE REMOVED AND RE-ERECTED IN THE SAME LOCATION, IN ACCORDANCE WITH CLEARANCE REQUIREMENTS, ON NEW POSTS UNLESS OTHERWISE NOTED, OR AS THE ENGINEER IN THE FIELD DIRECTS.



W:\DWC\W0002\970343\00\DETAILS\PAVEMENT MARKING INT 6.dwg 07/21/08 11:09 AM (X-CTH Y, AT&T FIBER cty)

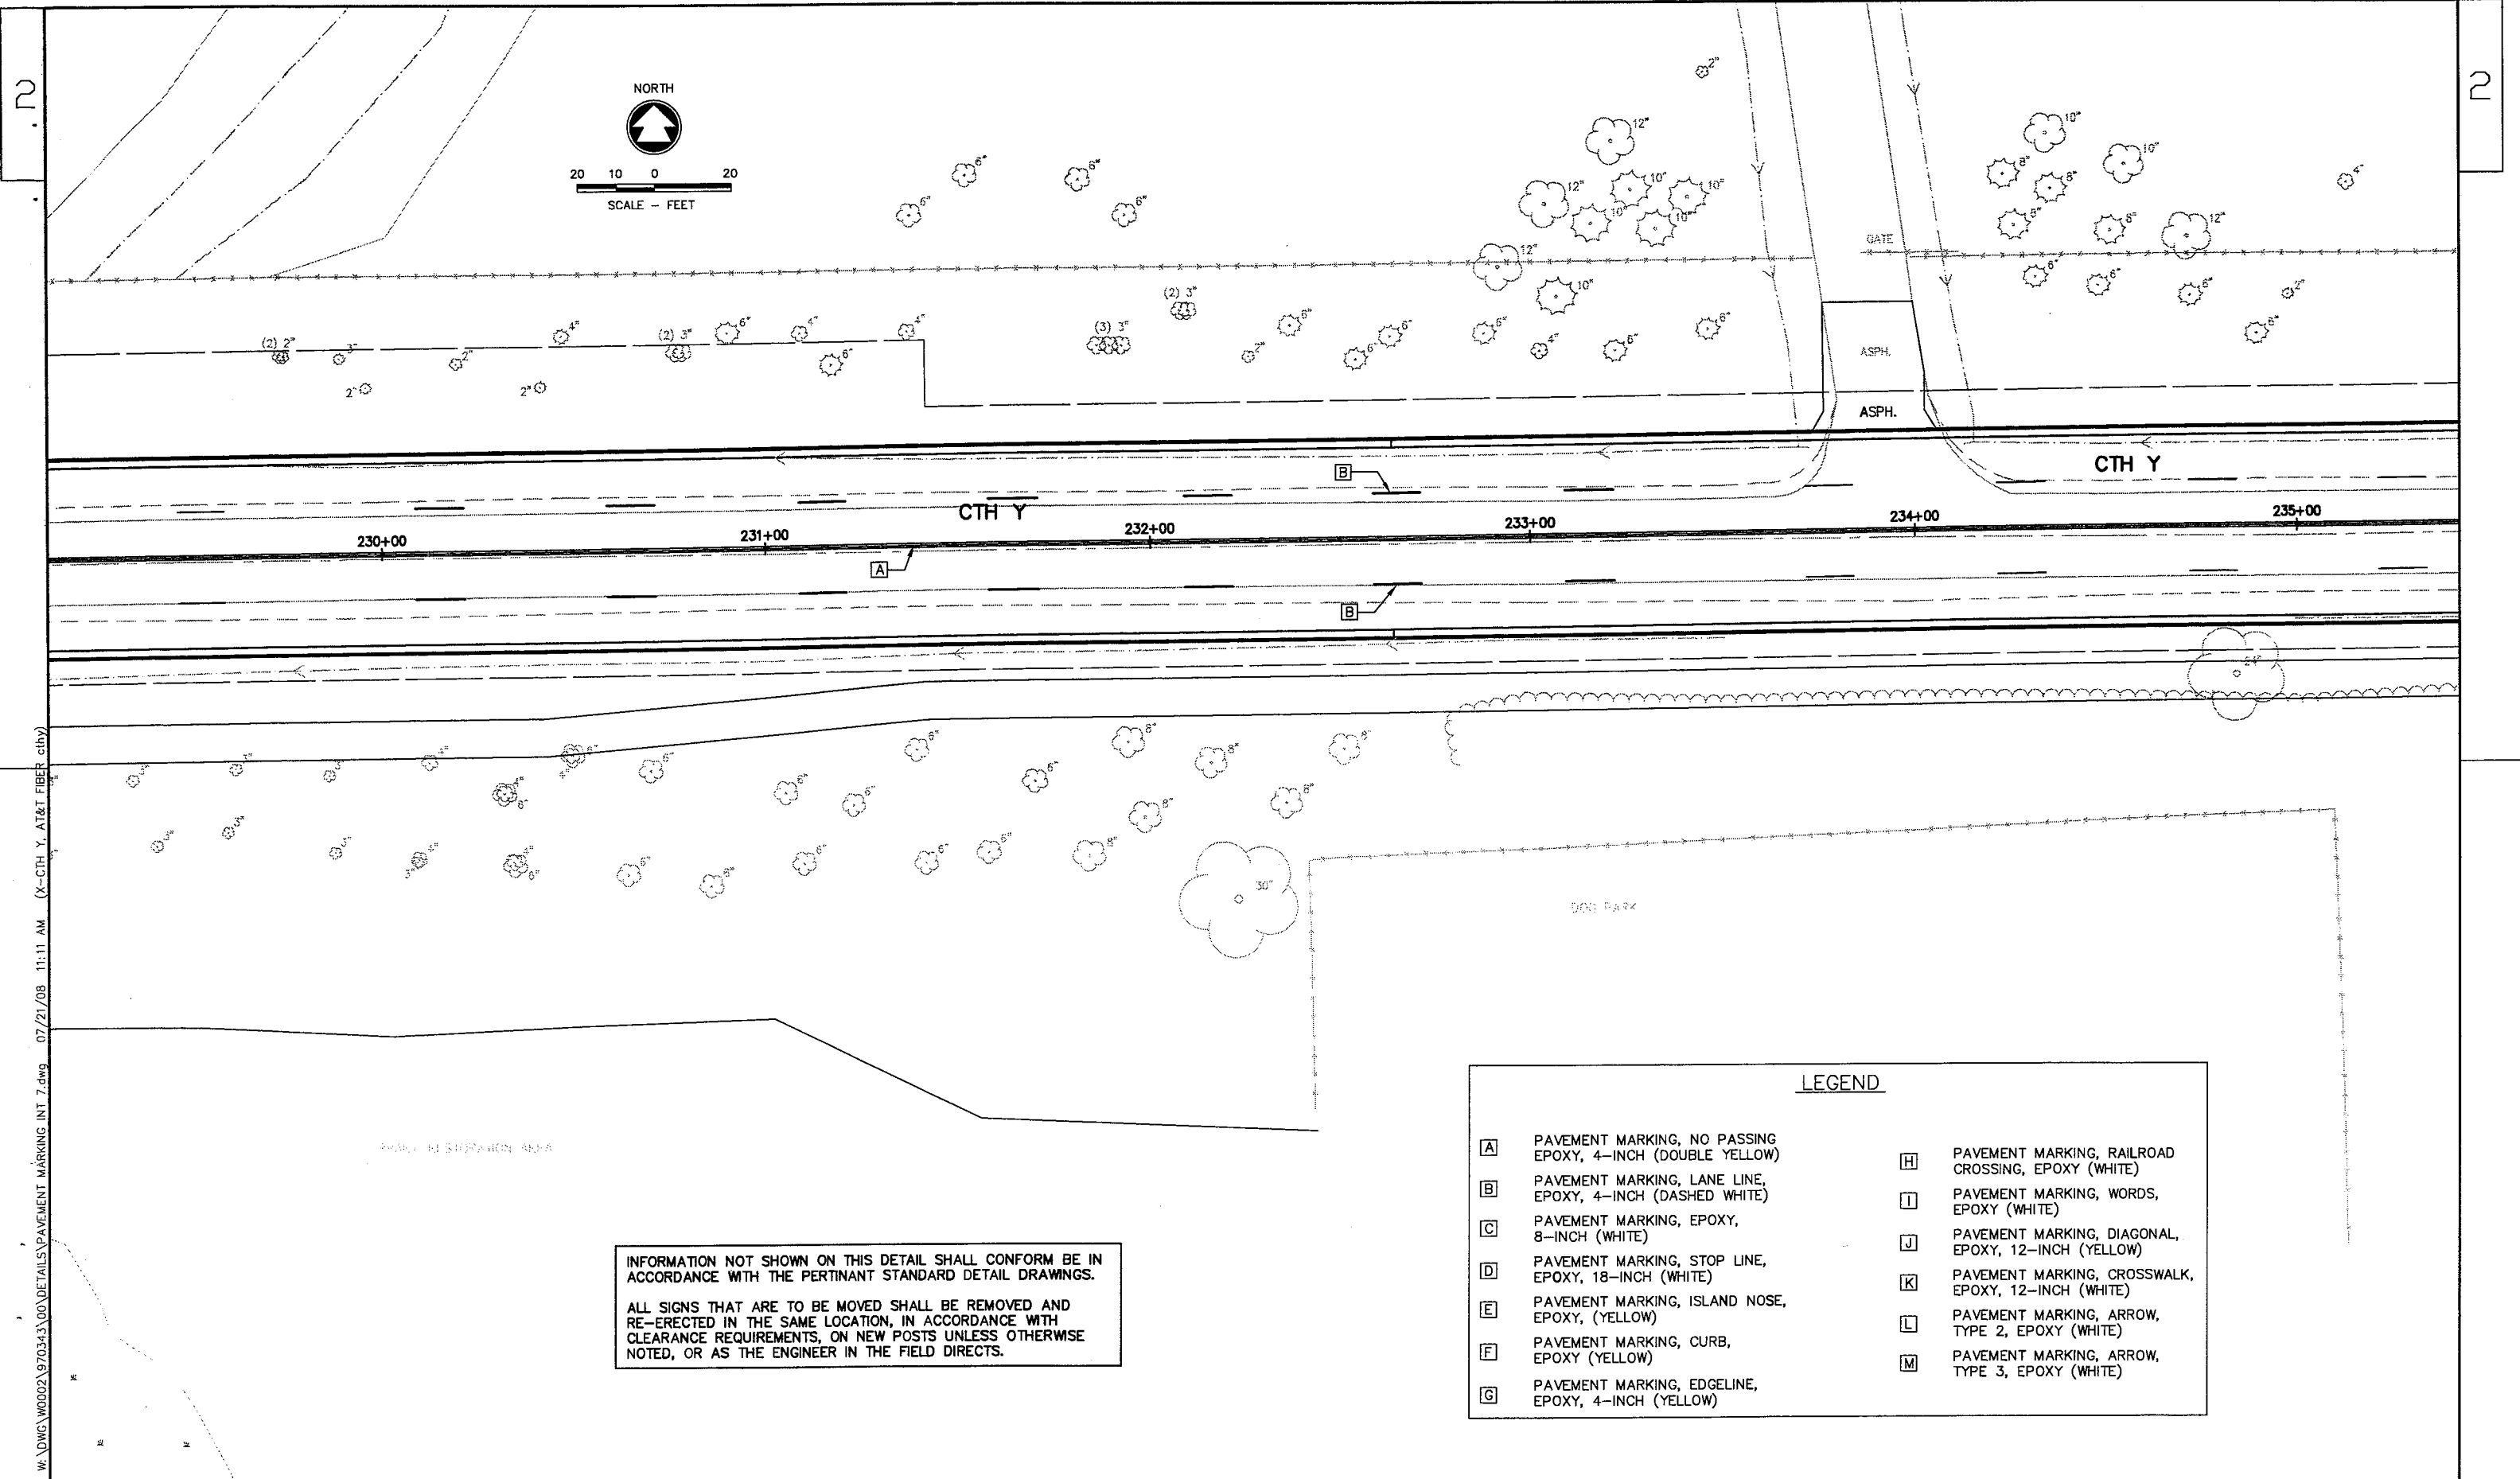

c:\pss\w\0002\970343\00\DETAILS\PAVEMENT MARKING_INT_7.dwg 07/21/08 11:11 AM (X-CTH Y, AT&T FIBER cthv)

INFORMATION NOT SHOWN ON THIS DETAIL SHALL CONFORM BE IN ACCORDANCE WITH THE PERTINANT STANDARD DETAIL DRAWINGS.
 ALL SIGNS THAT ARE TO BE MOVED SHALL BE REMOVED AND RE-ERECTED IN THE SAME LOCATION, IN ACCORDANCE WITH CLEARANCE REQUIREMENTS, ON NEW POSTS UNLESS OTHERWISE NOTED, OR AS THE ENGINEER IN THE FIELD DIRECTS.

LEGEND	
[A]	PAVEMENT MARKING, NO PASSING EPOXY, 4-INCH (DOUBLE YELLOW)
[B]	PAVEMENT MARKING, LANE LINE, EPOXY, 4-INCH (DASHED WHITE)
[C]	PAVEMENT MARKING, EPOXY, 8-INCH (WHITE)
[D]	PAVEMENT MARKING, STOP LINE, EPOXY, 18-INCH (WHITE)
[E]	PAVEMENT MARKING, ISLAND NOSE, EPOXY, (YELLOW)
[F]	PAVEMENT MARKING, CURB, EPOXY (YELLOW)
[G]	PAVEMENT MARKING, EDGELINE, EPOXY, 4-INCH (YELLOW)
[H]	PAVEMENT MARKING, RAILROAD CROSSING, EPOXY (WHITE)
[I]	PAVEMENT MARKING, WORDS, EPOXY (WHITE)
[J]	PAVEMENT MARKING, DIAGONAL, EPOXY, 12-INCH (YELLOW)
[K]	PAVEMENT MARKING, CROSSWALK, EPOXY, 12-INCH (WHITE)
[L]	PAVEMENT MARKING, ARROW, TYPE 2, EPOXY (WHITE)
[M]	PAVEMENT MARKING, ARROW, TYPE 3, EPOXY (WHITE)

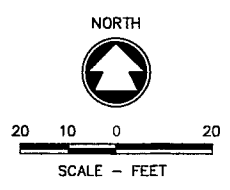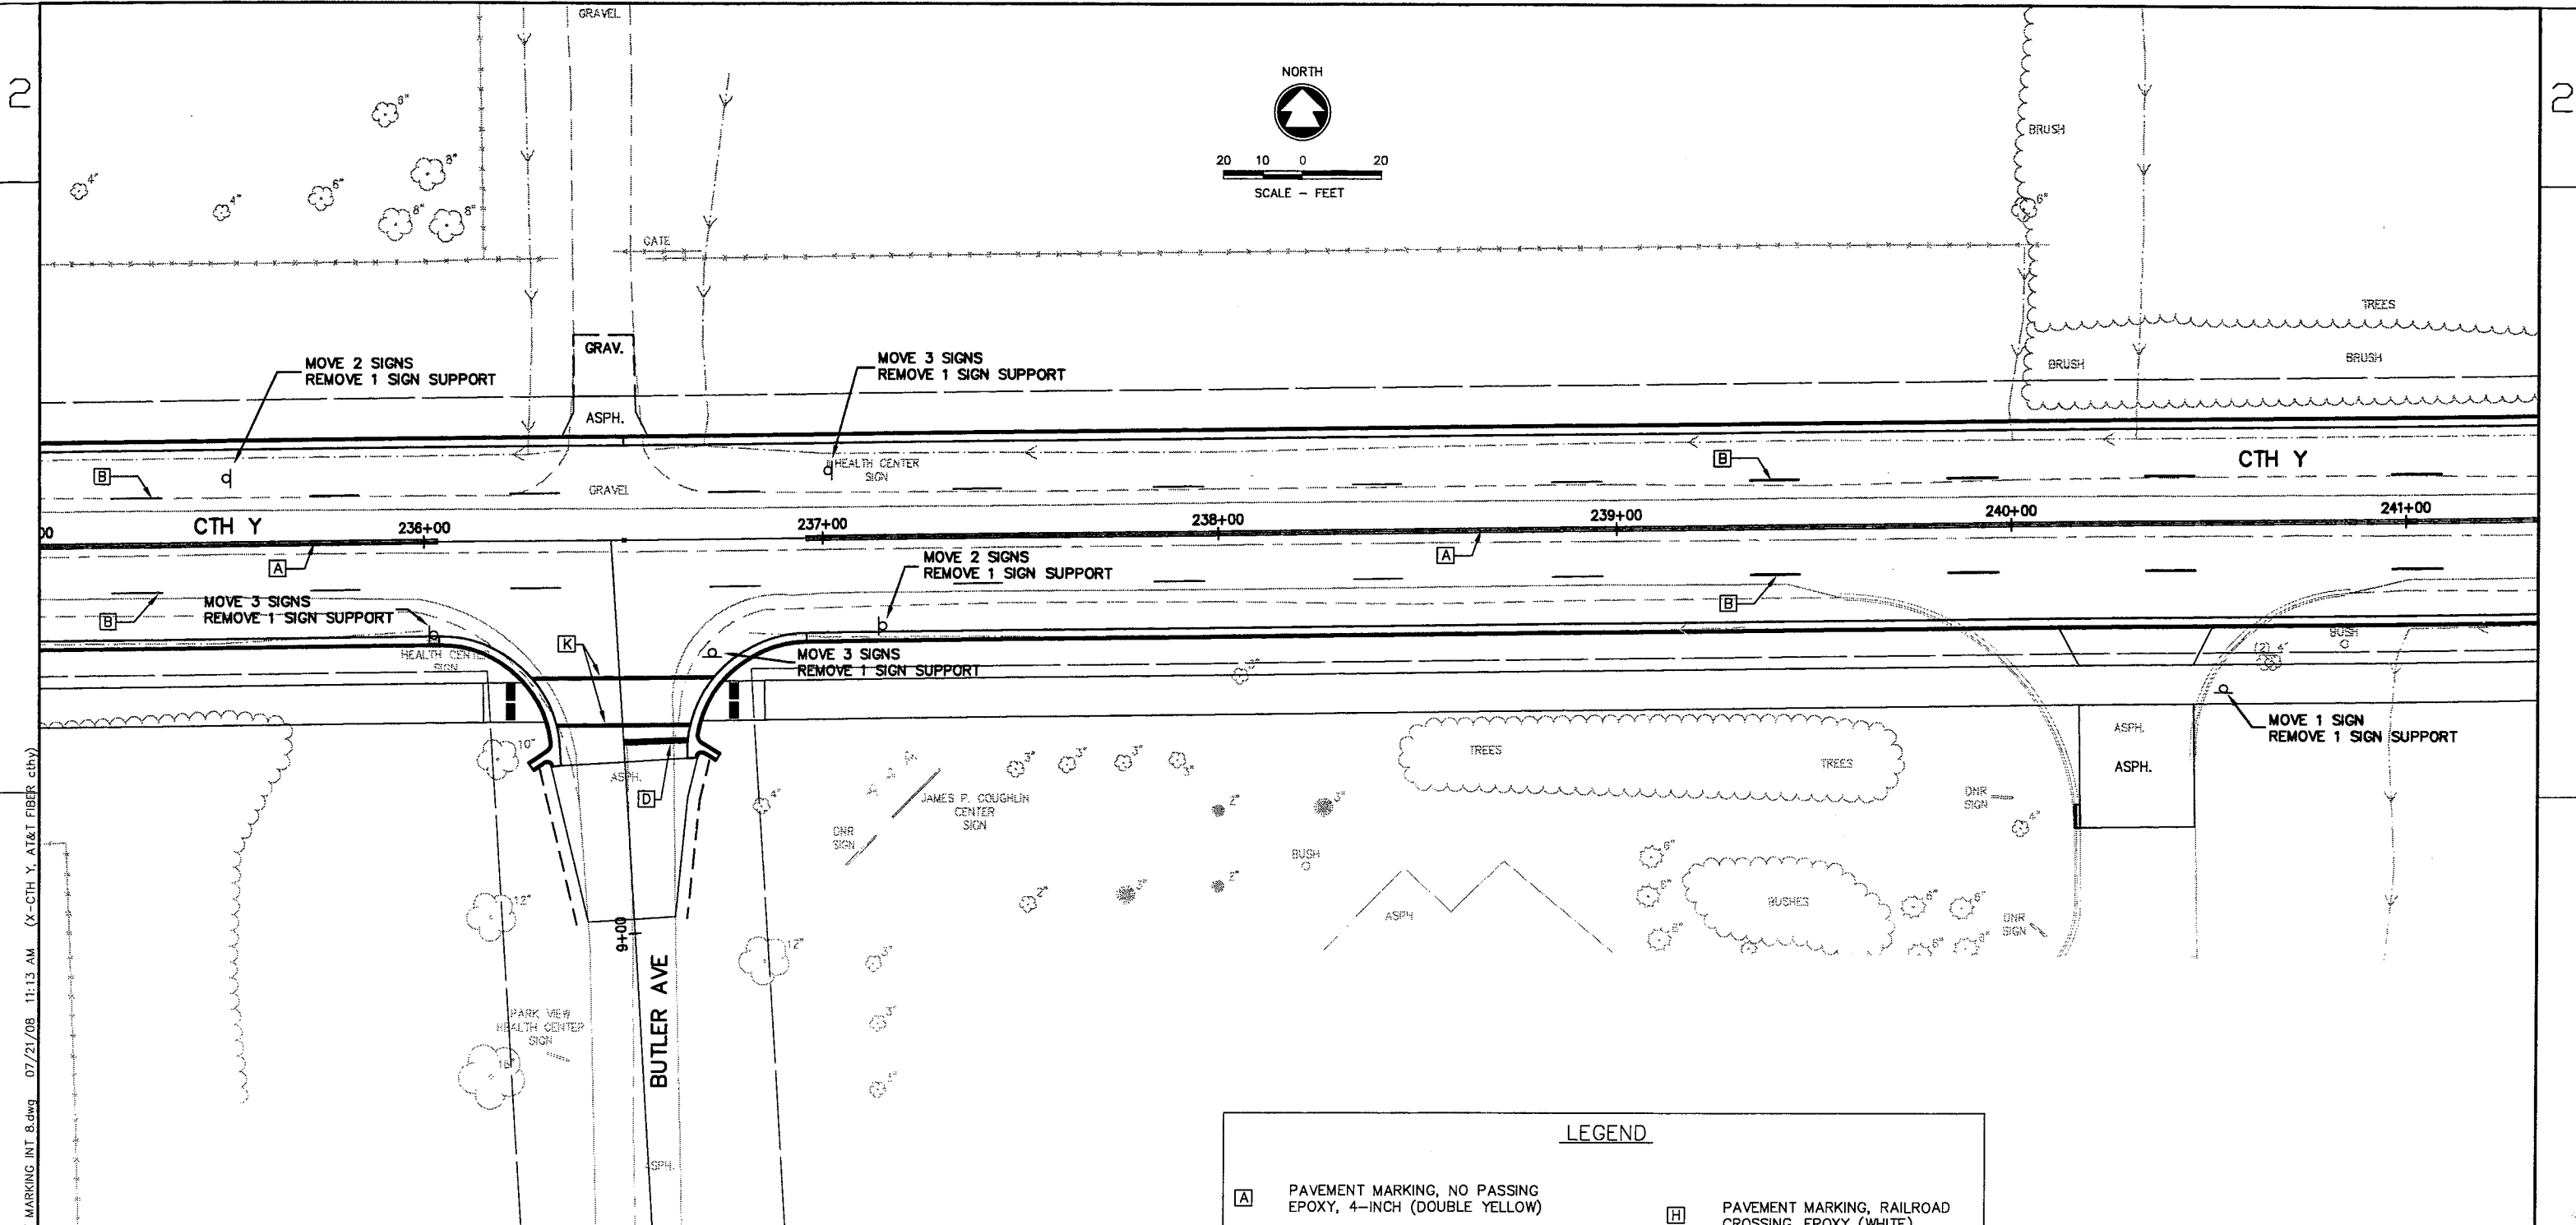


INFORMATION NOT SHOWN ON THIS DETAIL SHALL CONFORM BE IN ACCORDANCE WITH THE PERTINANT STANDARD DETAIL DRAWINGS.

ALL SIGNS THAT ARE TO BE MOVED SHALL BE REMOVED AND RE-ERECTED IN THE SAME LOCATION, IN ACCORDANCE WITH CLEARANCE REQUIREMENTS, ON NEW POSTS UNLESS OTHERWISE NOTED, OR AS THE ENGINEER IN THE FIELD DIRECTS.

LEGEND	
[A]	PAVEMENT MARKING, NO PASSING EPOXY, 4-INCH (DOUBLE YELLOW)
[B]	PAVEMENT MARKING, LANE LINE, EPOXY, 4-INCH (DASHED WHITE)
[C]	PAVEMENT MARKING, EPOXY, 8-INCH (WHITE)
[D]	PAVEMENT MARKING, STOP LINE, EPOXY, 18-INCH (WHITE)
[E]	PAVEMENT MARKING, ISLAND NOSE, EPOXY, (YELLOW)
[F]	PAVEMENT MARKING, CURB, EPOXY (YELLOW)
[G]	PAVEMENT MARKING, EDGELINE, EPOXY, 4-INCH (YELLOW)
[H]	PAVEMENT MARKING, RAILROAD CROSSING, EPOXY (WHITE)
[I]	PAVEMENT MARKING, WORDS, EPOXY (WHITE)
[J]	PAVEMENT MARKING, DIAGONAL, EPOXY, 12-INCH (YELLOW)
[K]	PAVEMENT MARKING, CROSSWALK, EPOXY, 12-INCH (WHITE)
[L]	PAVEMENT MARKING, ARROW, TYPE 2, EPOXY (WHITE)
[M]	PAVEMENT MARKING, ARROW, TYPE 3, EPOXY (WHITE)

C:\Users\W00021\OneDrive\Documents\PAVEMENT MARKING INT 8.dwg 07/21/08 11:13 AM (X-CTH Y, AT&T FIBER cthy)

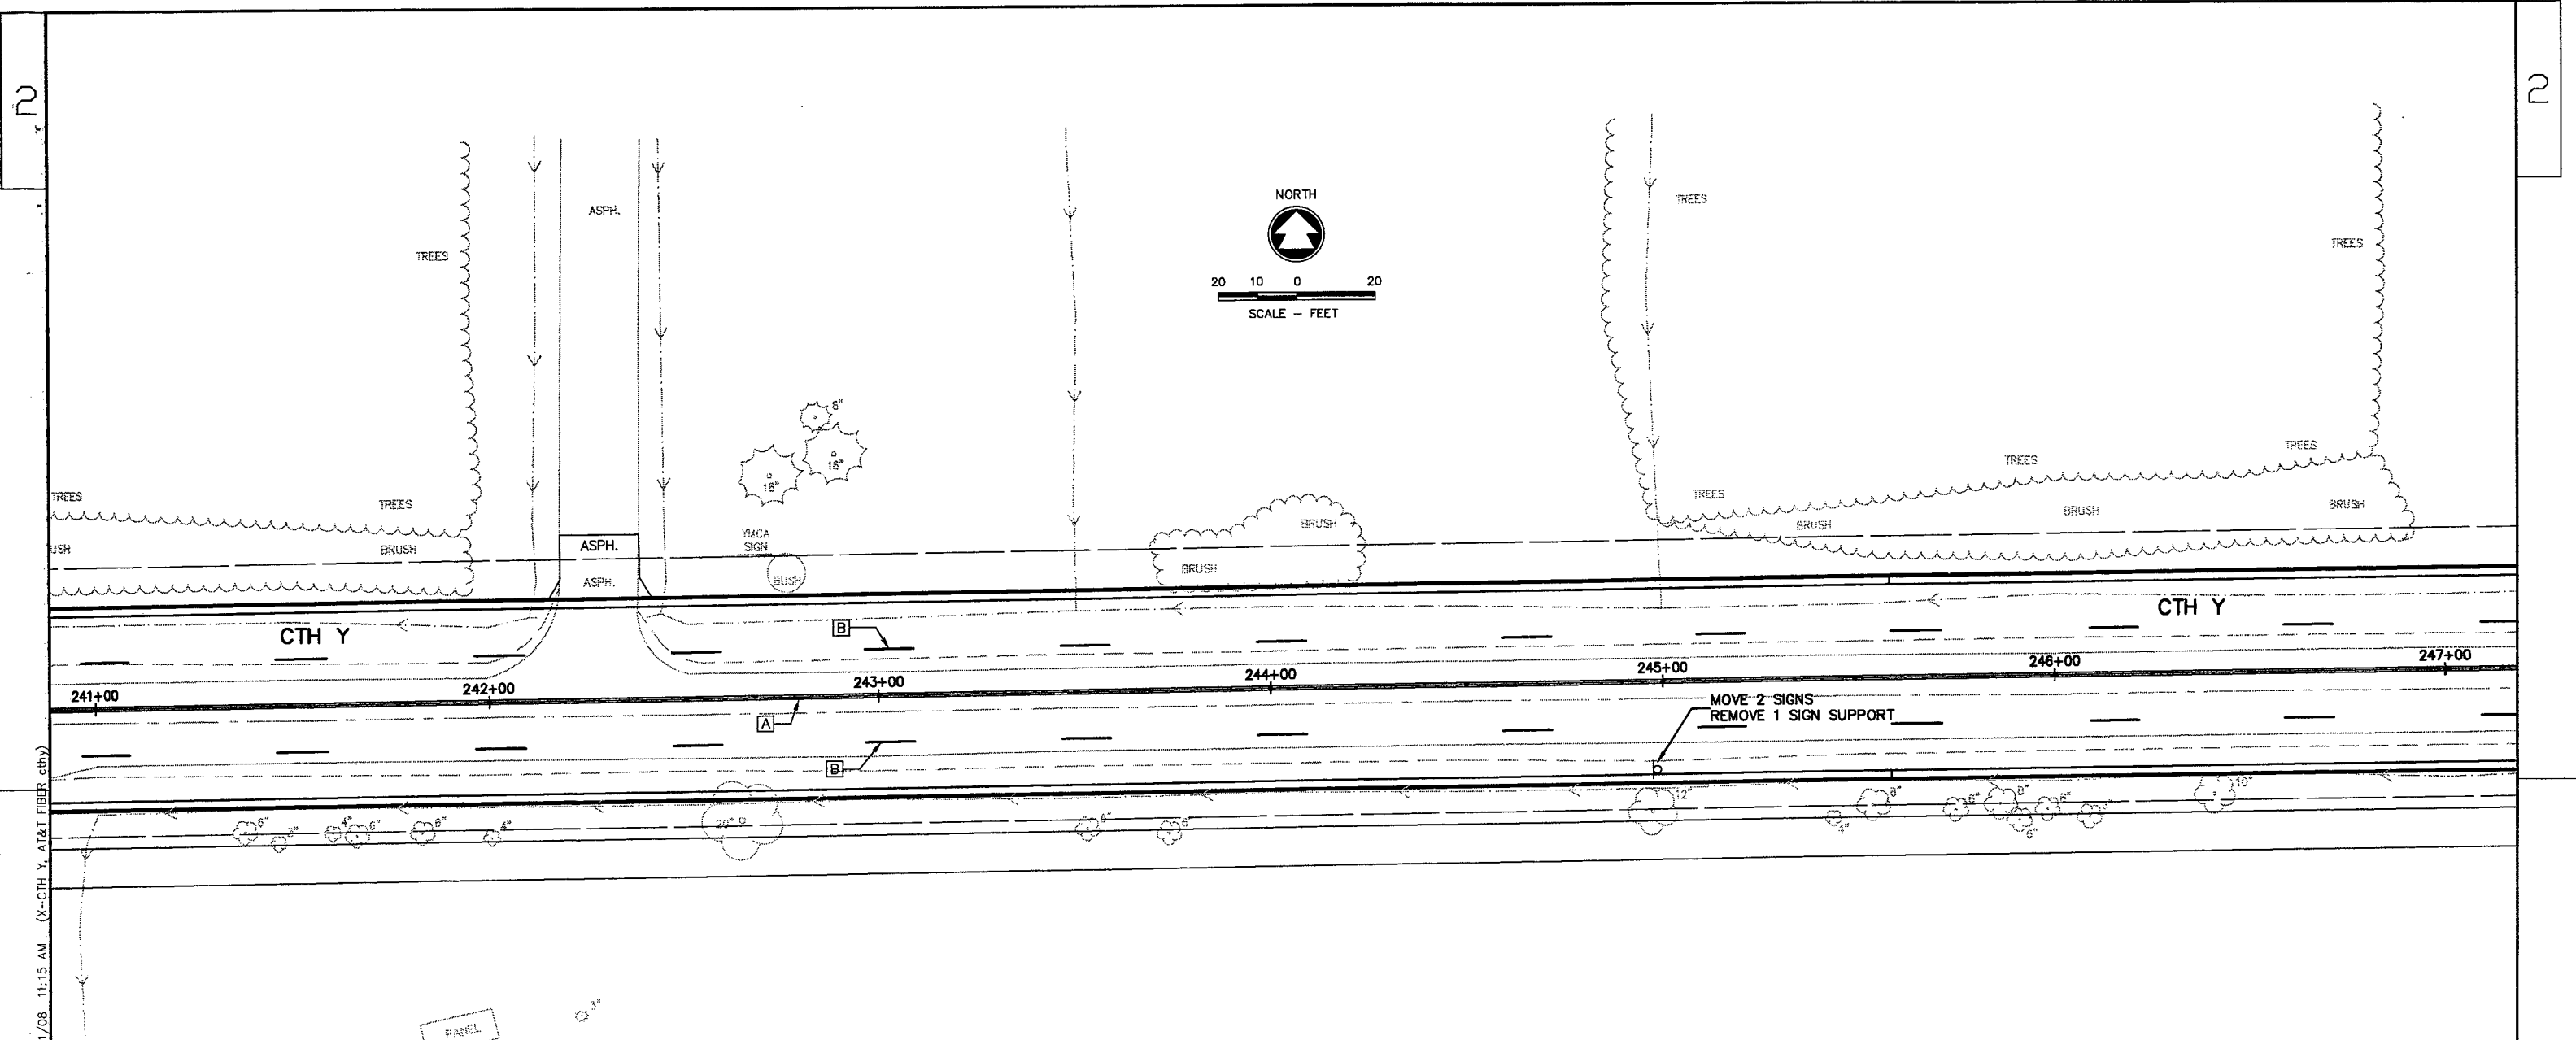

INFORMATION NOT SHOWN ON THIS DETAIL SHALL CONFORM BE IN ACCORDANCE WITH THE PERTINANT STANDARD DETAIL DRAWINGS.

ALL SIGNS THAT ARE TO BE MOVED SHALL BE REMOVED AND RE-ERECTED IN THE SAME LOCATION, IN ACCORDANCE WITH CLEARANCE REQUIREMENTS, ON NEW POSTS UNLESS OTHERWISE NOTED, OR AS THE ENGINEER IN THE FIELD DIRECTS.

LEGEND	
[A]	PAVEMENT MARKING, NO PASSING EPOXY, 4-INCH (DOUBLE YELLOW)
[B]	PAVEMENT MARKING, LANE LINE, EPOXY, 4-INCH (DASHED WHITE)
[C]	PAVEMENT MARKING, EPOXY, 8-INCH (WHITE)
[D]	PAVEMENT MARKING, STOP LINE, EPOXY, 18-INCH (WHITE)
[E]	PAVEMENT MARKING, ISLAND NOSE, EPOXY, (YELLOW)
[F]	PAVEMENT MARKING, CURB, EPOXY (YELLOW)
[G]	PAVEMENT MARKING, EDGELINE, EPOXY, 4-INCH (YELLOW)
[H]	PAVEMENT MARKING, RAILROAD CROSSING, EPOXY (WHITE)
[I]	PAVEMENT MARKING, WORDS, EPOXY (WHITE)
[J]	PAVEMENT MARKING, DIAGONAL, EPOXY, 12-INCH (YELLOW)
[K]	PAVEMENT MARKING, CROSSWALK, EPOXY, 12-INCH (WHITE)
[L]	PAVEMENT MARKING, ARROW, TYPE 2, EPOXY (WHITE)
[M]	PAVEMENT MARKING, ARROW, TYPE 3, EPOXY (WHITE)

W:\DWG\W0002\970343\00\DETAILS\PAVEMENT MARKING INT 9.dwg 07/21/08 11:15 AM (X-CTH Y, AT&T FIBER, cth)

STATE PROJECT NUMBER: 4994-00-87

HWY: CTH Y

COUNTY: WINNEBAGO



PAVEMENT MARKING AND SIGNING DETAIL

SHEET NO: 73

E

2

2

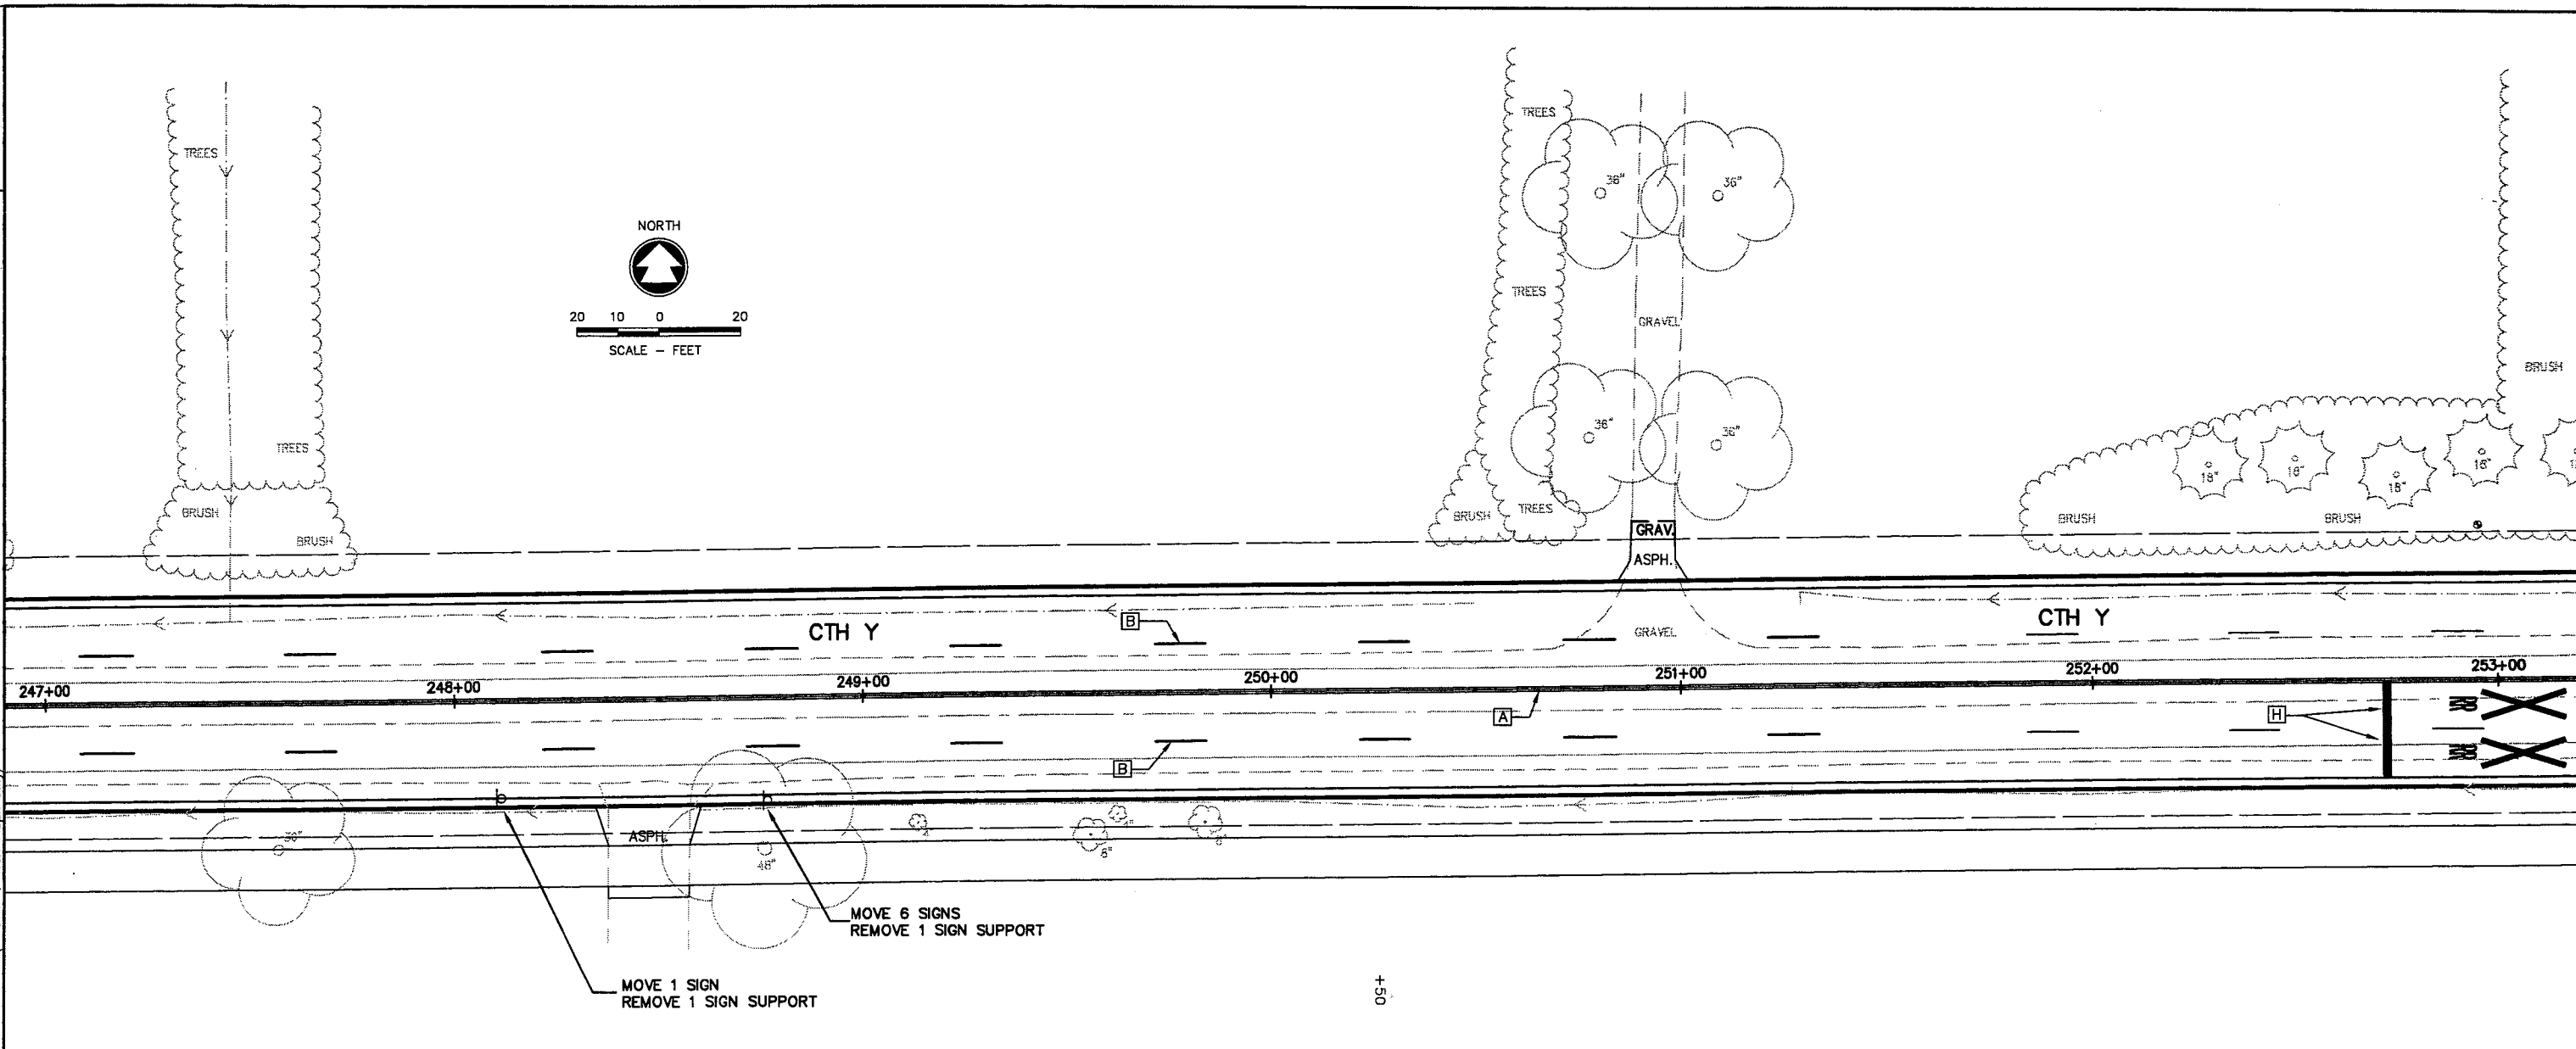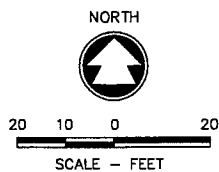

INFORMATION NOT SHOWN ON THIS DETAIL SHALL CONFORM BE IN ACCORDANCE WITH THE PERTINANT STANDARD DETAIL DRAWINGS.

ALL SIGNS THAT ARE TO BE MOVED SHALL BE REMOVED AND RE-ERECTED IN THE SAME LOCATION, IN ACCORDANCE WITH CLEARANCE REQUIREMENTS, ON NEW POSTS UNLESS OTHERWISE NOTED, OR AS THE ENGINEER IN THE FIELD DIRECTS.


LEGEND

[A]	PAVEMENT MARKING, NO PASSING EPOXY, 4-INCH (DOUBLE YELLOW)	[H]	PAVEMENT MARKING, RAILROAD CROSSING, EPOXY (WHITE)
[B]	PAVEMENT MARKING, LANE LINE, EPOXY, 4-INCH (DASHED WHITE)	[I]	PAVEMENT MARKING, WORDS, EPOXY (WHITE)
[C]	PAVEMENT MARKING, EPOXY, 8-INCH (WHITE)	[J]	PAVEMENT MARKING, DIAGONAL, EPOXY, 12-INCH (YELLOW)
[D]	PAVEMENT MARKING, STOP LINE, EPOXY, 18-INCH (WHITE)	[K]	PAVEMENT MARKING, CROSSWALK, EPOXY, 12-INCH (WHITE)
[E]	PAVEMENT MARKING, ISLAND NOSE, EPOXY, (YELLOW)	[L]	PAVEMENT MARKING, ARROW, TYPE 2, EPOXY (WHITE)
[F]	PAVEMENT MARKING, CURB, EPOXY (YELLOW)	[M]	PAVEMENT MARKING, ARROW, TYPE 3, EPOXY (WHITE)
[G]	PAVEMENT MARKING, EDGELINE, EPOXY, 4-INCH (YELLOW)		


g:\gossen_w:\DWG\W0002\970343\00\DETAILS\PAVEMENT MARKING INT 10.dwg 07/21/08 11:17 AM (X-CTH Y, AT&T FIBER CITY)

LEGEND	
[A]	PAVEMENT MARKING, NO PASSING EPOXY, 4-INCH (DOUBLE YELLOW)
[B]	PAVEMENT MARKING, LANE LINE, EPOXY, 4-INCH (DASHED WHITE)
[C]	PAVEMENT MARKING, EPOXY, 8-INCH (WHITE)
[D]	PAVEMENT MARKING, STOP LINE, EPOXY, 18-INCH (WHITE)
[E]	PAVEMENT MARKING, ISLAND NOSE, EPOXY, (YELLOW)
[F]	PAVEMENT MARKING, CURB, EPOXY (YELLOW)
[G]	PAVEMENT MARKING, EDGELINE, EPOXY, 4-INCH (YELLOW)
[H]	PAVEMENT MARKING, RAILROAD CROSSING, EPOXY (WHITE)
[I]	PAVEMENT MARKING, WORDS, EPOXY (WHITE)
[J]	PAVEMENT MARKING, DIAGONAL, EPOXY, 12-INCH (YELLOW)
[K]	PAVEMENT MARKING, CROSSWALK, EPOXY, 12-INCH (WHITE)
[L]	PAVEMENT MARKING, ARROW, TYPE 2, EPOXY (WHITE)
[M]	PAVEMENT MARKING, ARROW, TYPE 3, EPOXY (WHITE)

24-INCH WHITE
(S.D.D. 15C9-7a)

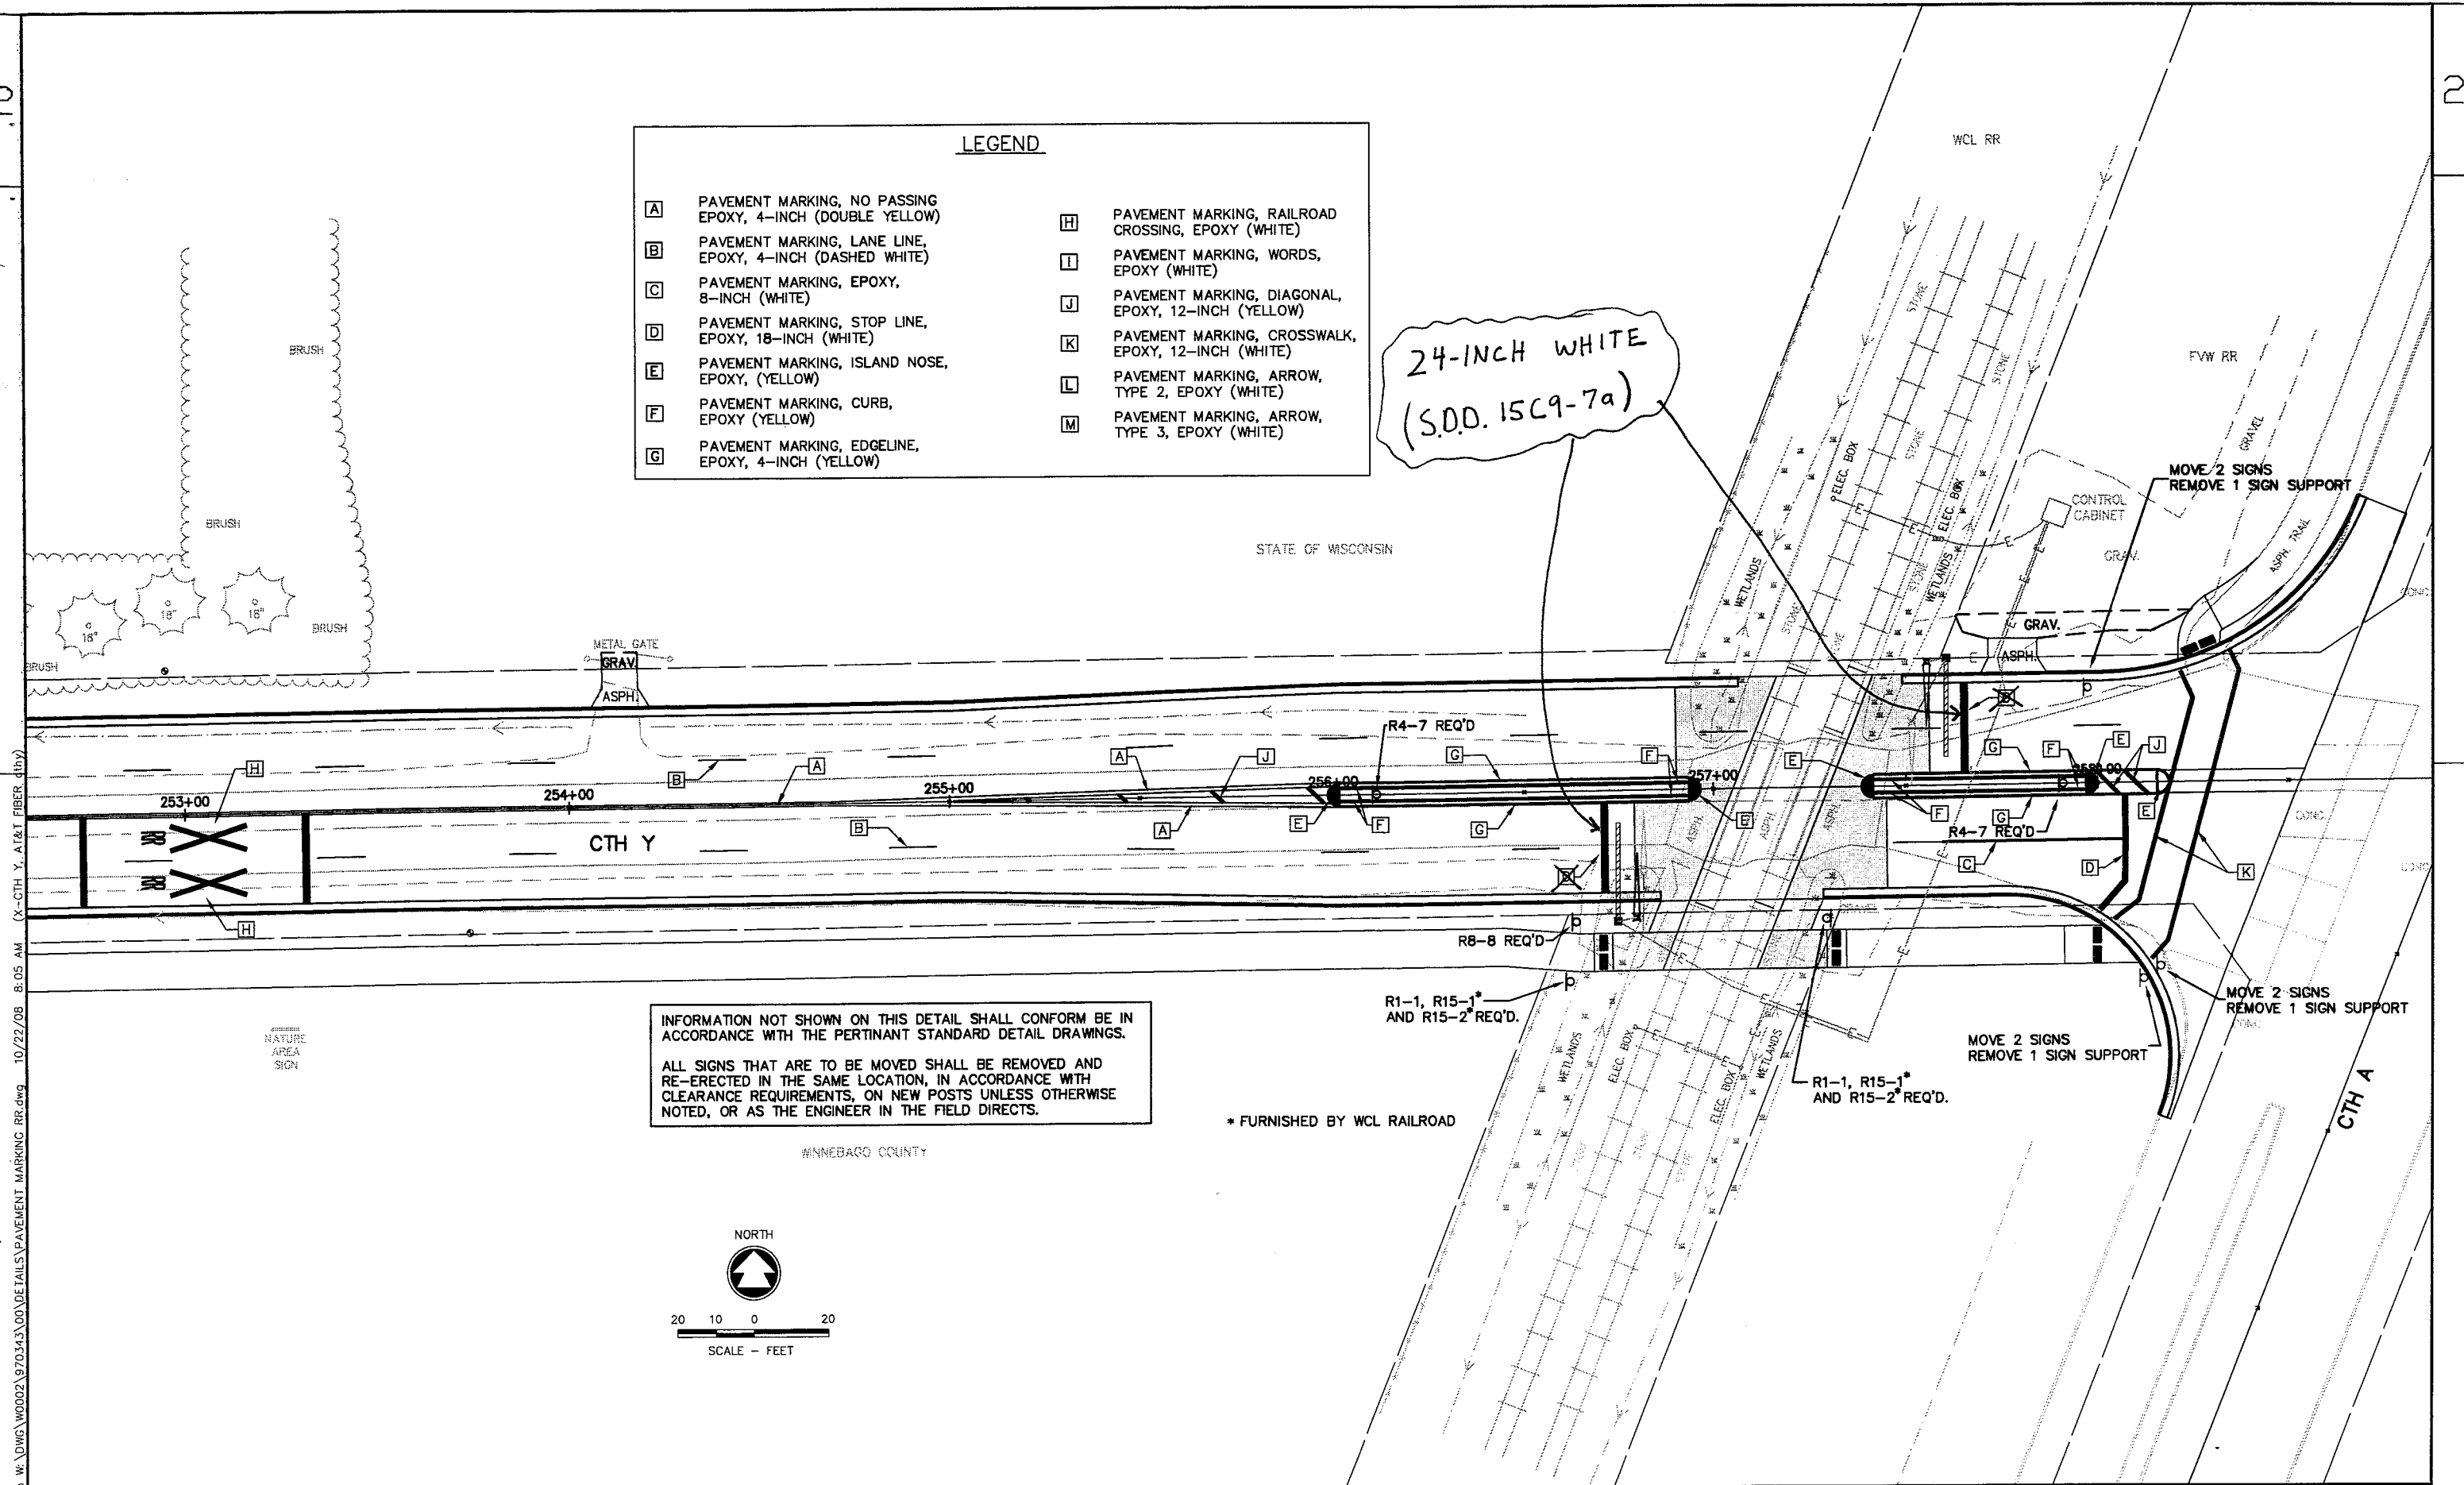


INFORMATION NOT SHOWN ON THIS DETAIL SHALL CONFORM BE IN ACCORDANCE WITH THE PERTINANT STANDARD DETAIL DRAWINGS.
ALL SIGNS THAT ARE TO BE MOVED SHALL BE REMOVED AND RE-ERECTED IN THE SAME LOCATION, IN ACCORDANCE WITH CLEARANCE REQUIREMENTS, ON NEW POSTS UNLESS OTHERWISE NOTED, OR AS THE ENGINEER IN THE FIELD DIRECTS.

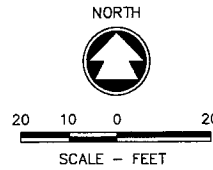


10/22/08 8:05 AM (X-CTH Y, A&T FIBER (b))
 gassen w:\DWG\W0002\970343\00\DETAILS\PAVEMENT MARKING RR.dwg

LEGEND

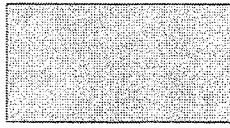

TEMPORARY WIDENING

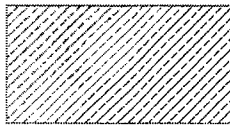

CONSTRUCTION ZONE



SIGN ON PORTABLE OR PERMANENT SUPPORT



TYPE 3 BARRICADE WITH TYPE "A" WARNING LIGHTS



TYPE 3 BARRICADE WITH TYPE "A" WARNING LIGHTS AND SIGN ATTACHED



DIRECTION OF VEHICULAR TRAVEL



NON-METALLIC DRUMS WITH TYPE C WARNING LIGHTS



NON-METALLIC DRUMS



FLEXIBLE TUBULAR MARKER POST



EXISTING CANTILEVERED AUTOMATIC FLASHING SIGNALS FOR RAILROAD CROSSING



EXISTING GATE MECHANISM FOR RAILROAD CROSSING



PROPOSED GATE MECHANISM FOR RAILROAD CROSSING

TRAFFIC CONTROL NOTES:

PORTABLE SUPPORTS ALLOWED FOR SIGN PLACEMENT ON PAVEMENT ONLY.

DETAILS OF TRAFFIC CONTROL DEVICES AND THEIR LOCATION NOT SHOWN ON THE FOLLOWING DETAIL DRAWINGS SHALL CONFORM TO THE PERTINENT REQUIREMENTS OF THE STANDARD DETAIL DRAWINGS AND THE WISCONSIN MANUAL ON UNIFORM TRAFFIC CONTROL DEVICES.

SIGN, BARRICADE, AND DRUM LOCATIONS MAY BE ADJUSTED IN THE FIELD AS DIRECTED BY THE ENGINEER. ANY EXISTING TRAFFIC SIGNS THAT CONFLICT WITH THIS WORK SHALL BE COVERED OR REMOVED AS DIRECTED BY THE ENGINEER.

ALL SIGN SIZES SHALL CONFORM TO THE REQUIREMENTS FOR A CONVENTIONAL ROAD AS DESCRIBED IN THE MUTCD. THE MINIMUM SIZE FOR A DIAMOND SHAPED TEMPORARY TRAFFIC CONTROL SIGN SHALL BE 48" X 48".

ALL PAVEMENT MARKINGS NOT APPROPRIATE TO THE TRAVEL PATH SHALL BE REMOVED.

A MINIMUM OF 10-FOOT WIDE TRAVEL LANES SHALL BE MAINTAINED. TEMPORARY WIDENING MAY BE REQUIRED TO MAINTAIN MINIMUM LANE WIDTHS IN PHASES 1, 3, AND 4.

PAVEMENT GAPS ARE TO BE SUFFICIENT SIZE TO ALLOW TRUCK ACCESS TO BUSINESSES.

ADDITIONAL DRUMS ARE TO BE PLACED AT PRIVATE ENTRANCES AND SIDEROADS AT THE DIRECTION OF THE ENGINEER IN THE FIELD.

TEMPORARY SIGNALS ARE TO BE PLACED AT THE INTERSECTION OF CTH Y AND STH 76. SEE TEMPORARY SIGNAL PLANS FOR MORE INFORMATION.


TRAFFIC CONTROL DURING 2008 CONSTRUCTION SHALL BE CONSISTENT WITH STANDARD DETAIL DRAWING TRAFFIC CONTROL FOR LANE CLOSURE, OR STANDARD DETAIL DRAWING TRAFFIC CONTROL, WORK ON SHOULDER OR PARKING LANE, UNDIVIDED ROADWAY, DEPENDING ON THE LOCATION OF THE WORK ZONE.

W:\DMS\W0002\970343\00\DETAILS\TRAFFIC CONTROL\LEGEND AND NOTES.dwg 10/07/08 10:12 AM

2

2

- Contract Modification #1 combines Phases 1 & 2.
→ Also eliminates ALL temp. widening

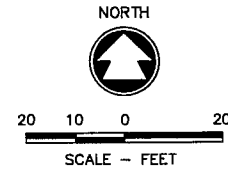


NOTE:
LOCATION OF TEMPORARY SIGNAL POLES TO BE APPROVED BY THE ENGINEER IN THE FIELD. TEMPORARY POLES TO BE LOCATED TO ALLOW FOR THE STAGED CONSTRUCTION OF THE PERMANENT TRAFFIC SIGNALS, STORM SEWER, AND CULVERT PIPES.

TRAFFIC CONTROL NORTH AND SOUTH OF CTH Y ON STH 76 AS WELL AS WEST OF STH 76 ON CTH Y TO BE IN ACCORDANCE WITH STANDARD DETAIL DRAWING FOR BARRICADES AND SIGNS FOR MAINLINE CLOSURES DETAIL B.




EXISTING CONTROLLER CABINET AND BASE TO REMAIN IN CURRENT LOCATION THROUGHOUT CONSTRUCTION. THE EXISTING ELECTRIC SERVICE WILL BE USED FOR THE TEMPORARY CONTROLLER AND TEMPORARY SIGNALS.

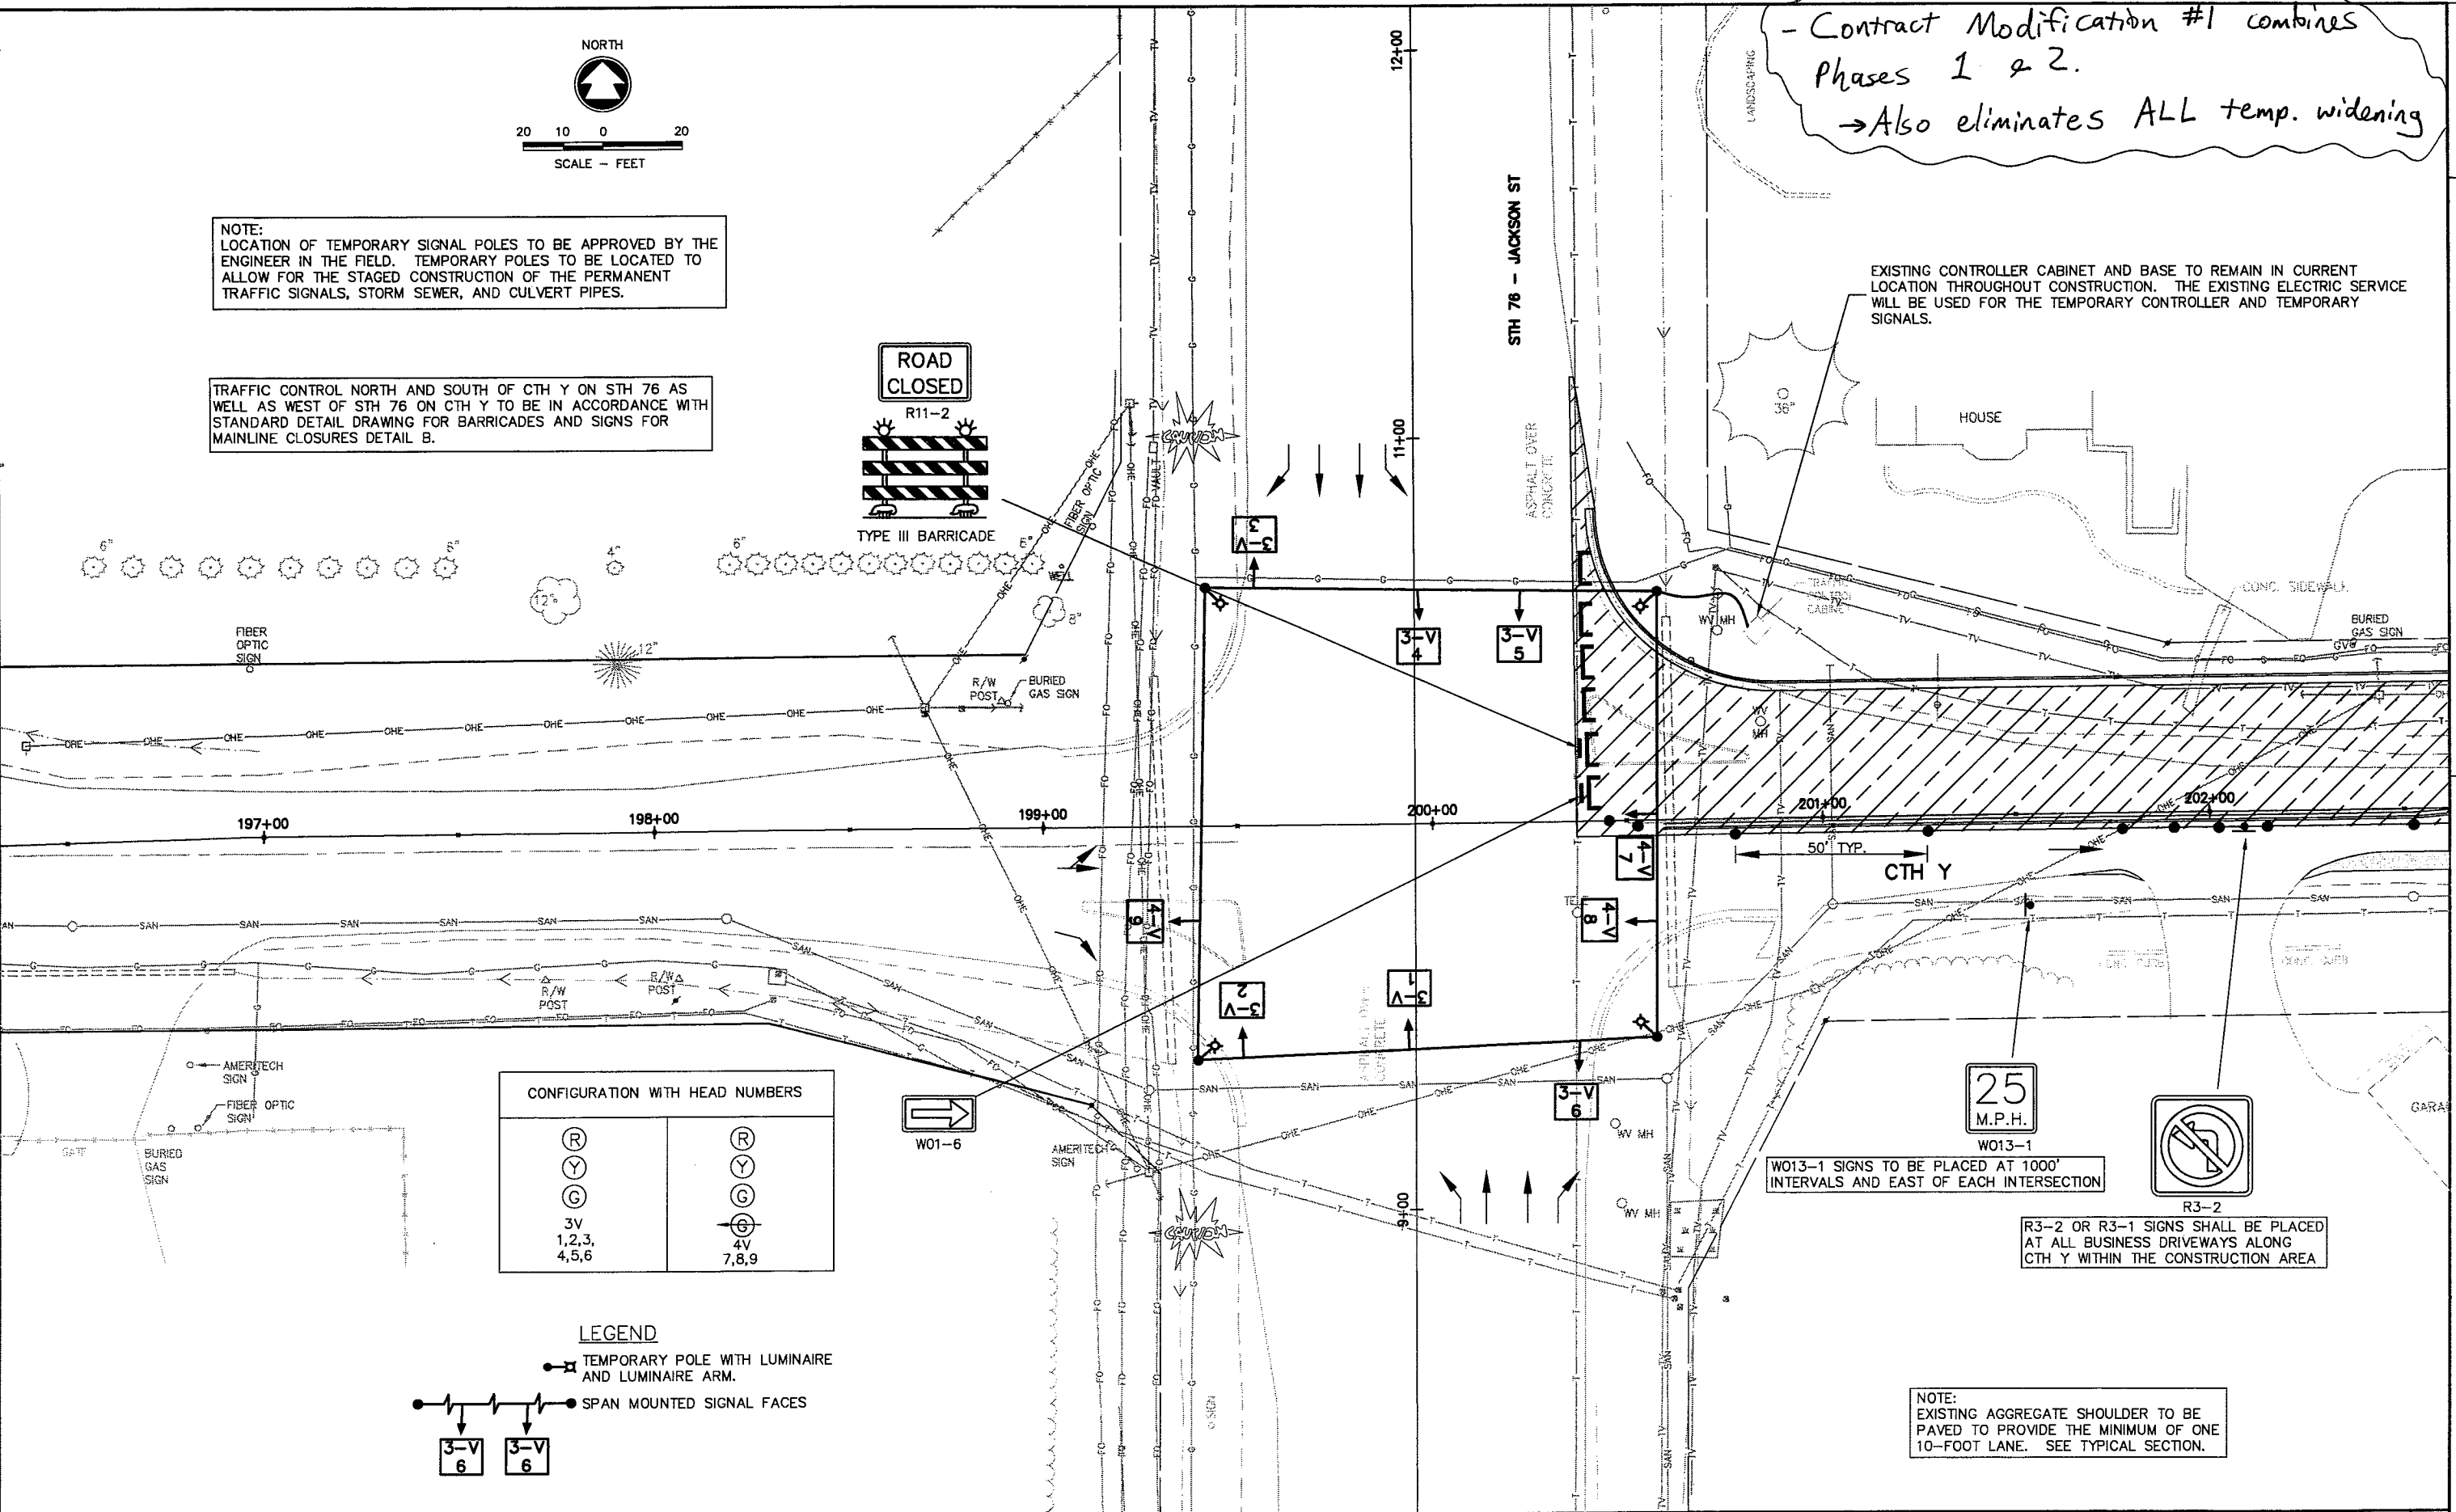

CONFIGURATION WITH HEAD NUMBERS

(R)	(R)
(Y)	(Y)
(G)	(G)
3V 1,2,3, 4,5,6	4V 7,8,9

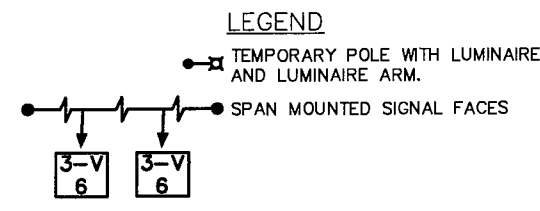



W013-1 SIGNS TO BE PLACED AT 1000' INTERVALS AND EAST OF EACH INTERSECTION

R3-2 OR R3-1 SIGNS SHALL BE PLACED AT ALL BUSINESS DRIVEWAYS ALONG CTH Y WITHIN THE CONSTRUCTION AREA

NOTE:
EXISTING AGGREGATE SHOULDER TO BE PAVED TO PROVIDE THE MINIMUM OF ONE 10-FOOT LANE. SEE TYPICAL SECTION.

gossen_w:\DWG\W0002\970343\00\DETAILS\TC PHASE 1-1.dwg 10/22/08 11:04 AM (X-CTH Y, AT&T FIBER city)

TRAFFIC CONTROL SHOWN FOR THE SODA CREEK RD INTERSECTION IS TYPICAL OF TRAFFIC CONTROL REQUIRED FOR JACKTAR RD AND BUTLER AVE AS WELL. BUTLER AVE TO HAVE A ROAD WORK AHEAD SIGN PLACED AT THE INTERSECTION WITH CTH A.

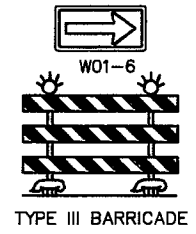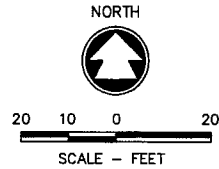

R3-2 OR R3-1 SIGNS SHALL BE PLACED AT ALL BUSINESS DRIVEWAYS ALONG CTH Y WITHIN THE CONSTRUCTION AREA



R5-1a SIGNS TO BE PLACED AT 1000' INTERVALS AND WEST OF EACH INTERSECTION



W013-1 SIGNS TO BE PLACED AT 1000' INTERVALS AND EAST OF EACH INTERSECTION




R3-2 OR R3-1 SIGNS SHALL BE PLACED AT ALL BUSINESS DRIVEWAYS ALONG CTH Y WITHIN THE CONSTRUCTION AREA



NOTE: EXISTING AGGREGATE SHOULDER TO BE PAVED TO PROVIDE THE MINIMUM OF ONE 10-FOOT LANE. SEE TYPICAL SECTION.




p:\mgaalski.w:\DWG\W0002\970343\00\DETAILS\TC PHASE 1-2.dwg 05/22/08 10:51 AM (X-CTH Y, FINAL ROW-COMPS) DEW

TRAFFIC CONTROL SHOWN FOR THE JACKTAR RD INTERSECTION IS TYPICAL OF TRAFFIC CONTROL REQUIRED FOR SODA CREEK RD AND BUTLER AVE AS WELL. BUTLER AVE TO HAVE A ROAD WORK AHEAD SIGN PLACED AT THE INTERSECTION WITH CTH A.

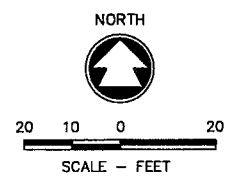

R5-1a SIGNS TO BE PLACED AT 1000' INTERVALS AND WEST OF EACH INTERSECTION

R3-2 OR R3-1 SIGNS SHALL BE PLACED AT ALL BUSINESS DRIVEWAYS ALONG CTH Y WITHIN THE CONSTRUCTION AREA

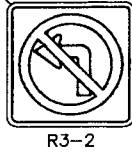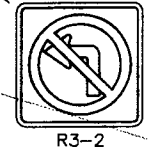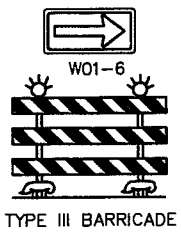


W013-1 SIGNS TO BE PLACED AT 1000' INTERVALS AND EAST OF EACH INTERSECTION



NOTE:
EXISTING AGGREGATE SHOULDER TO BE PAVED TO PROVIDE THE MINIMUM OF ONE 10-FOOT LANE. SEE TYPICAL SECTION.

pma\galski_w\dwg\w0002\970343\00\DETAILS\TC PHASE 1-3.dwg 04/28/08 1:45 PM (X-CTH Y FINAL ROW-COMPS DEV)

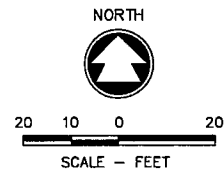

R3-2 OR R3-1 SIGNS SHALL BE PLACED AT ALL BUSINESS DRIVEWAYS ALONG CTH Y WITHIN THE CONSTRUCTION AREA



R3-1
ASPH.

R5-1a SIGNS TO BE PLACED AT 1000' INTERVALS AND WEST OF EACH INTERSECTION



R3-1

WRONG WAY
R5-1a


25
M.P.H.
W013-1

W013-1 SIGNS TO BE PLACED AT 1000' INTERVALS AND EAST OF EACH INTERSECTION

NOTE:
EXISTING AGGREGATE SHOULDER TO BE PAVED TO PROVIDE THE MINIMUM OF ONE 10-FOOT LANE. SEE TYPICAL SECTION.

TEMPORARY DITCHING TO ACCOMMODATE TEMPORARY WIDENING. SEE 2008 CONSTRUCTION DETAIL FOR MORE INFORMATION.

g:\psser\w\dwg\w0002\970343\00\DETAILS\IC_PHASE 1-4.dwg 04/29/08 10:18 AM (X-CTH Y, FINAL ROW-COMPS DEW

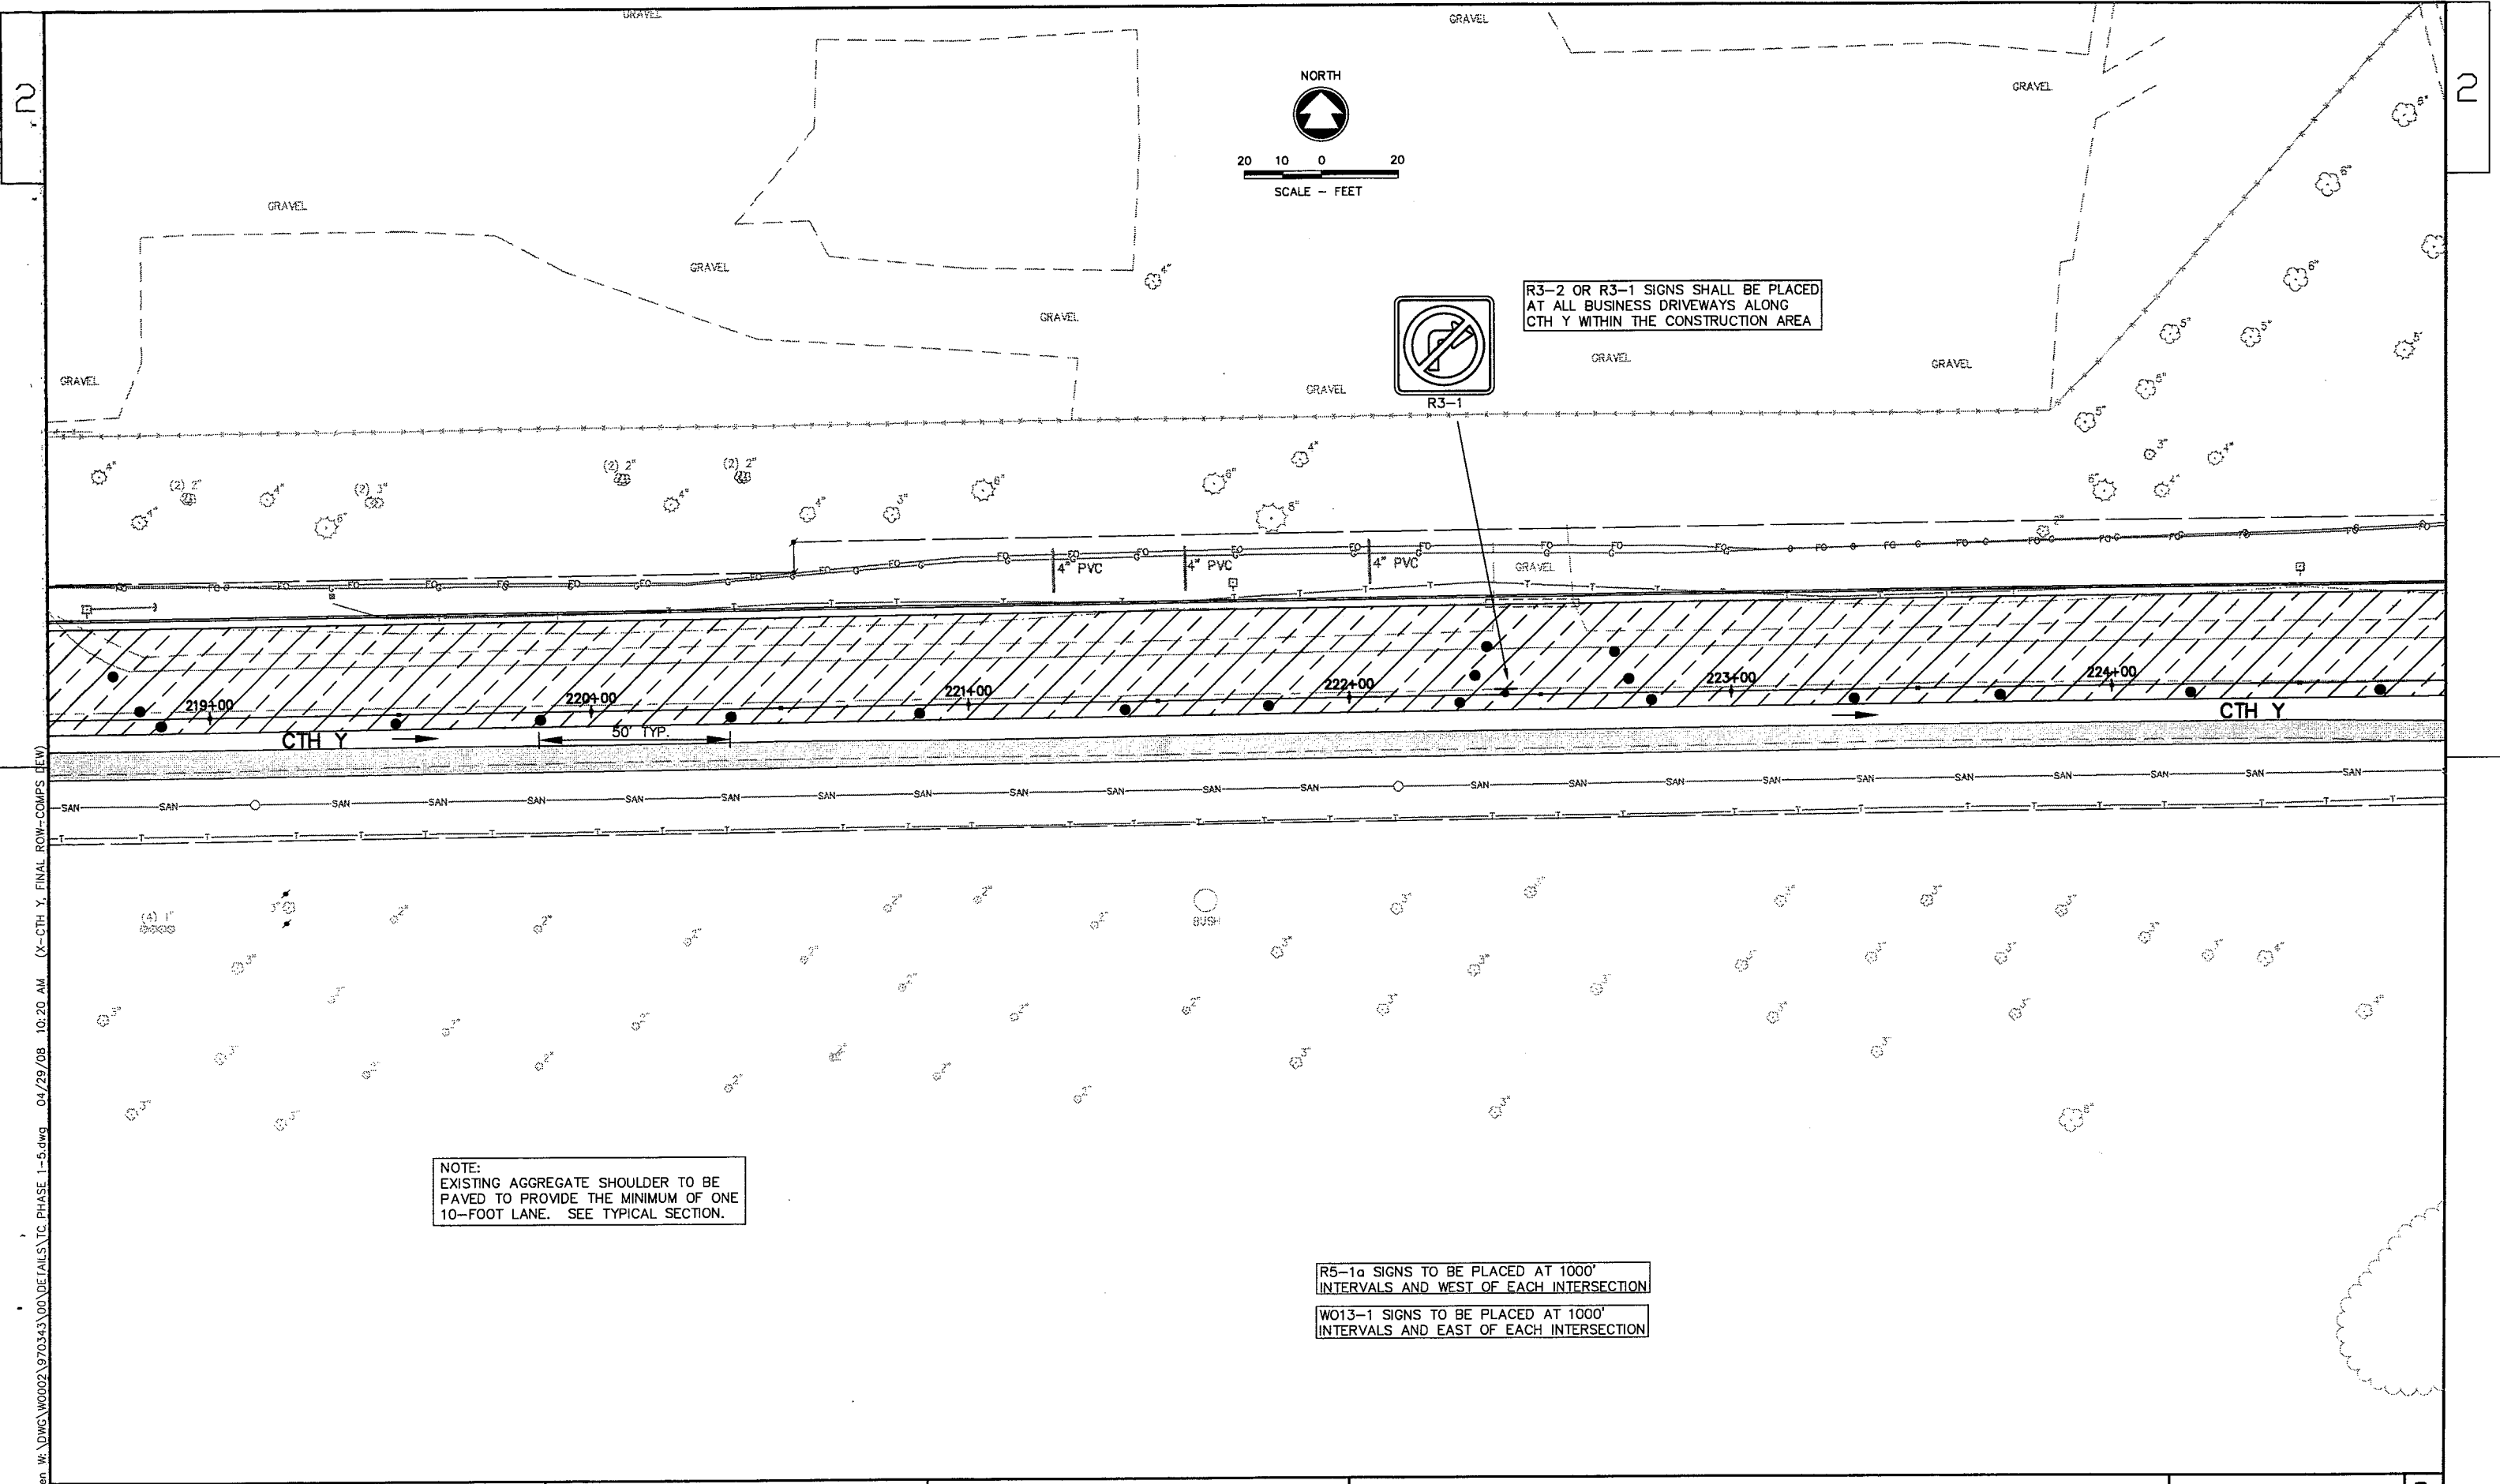

g:\sssen_w\dwg\w0002\970343\00\DETAILS\TC_PHASE 1-5.dwg 04/29/08 10:20 AM (X-CTH Y, FINAL ROW-COMPS (REV)

STATE PROJECT NUMBER: 4994-00-87


HWY: CTH Y

COUNTY: WINNEBAGO


PHASE 1 TRAFFIC CONTROL

SHEET NO: 81

E

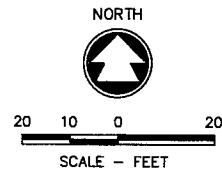

R3-2 OR R3-1 SIGNS SHALL BE PLACED AT ALL BUSINESS DRIVEWAYS ALONG CTH Y WITHIN THE CONSTRUCTION AREA

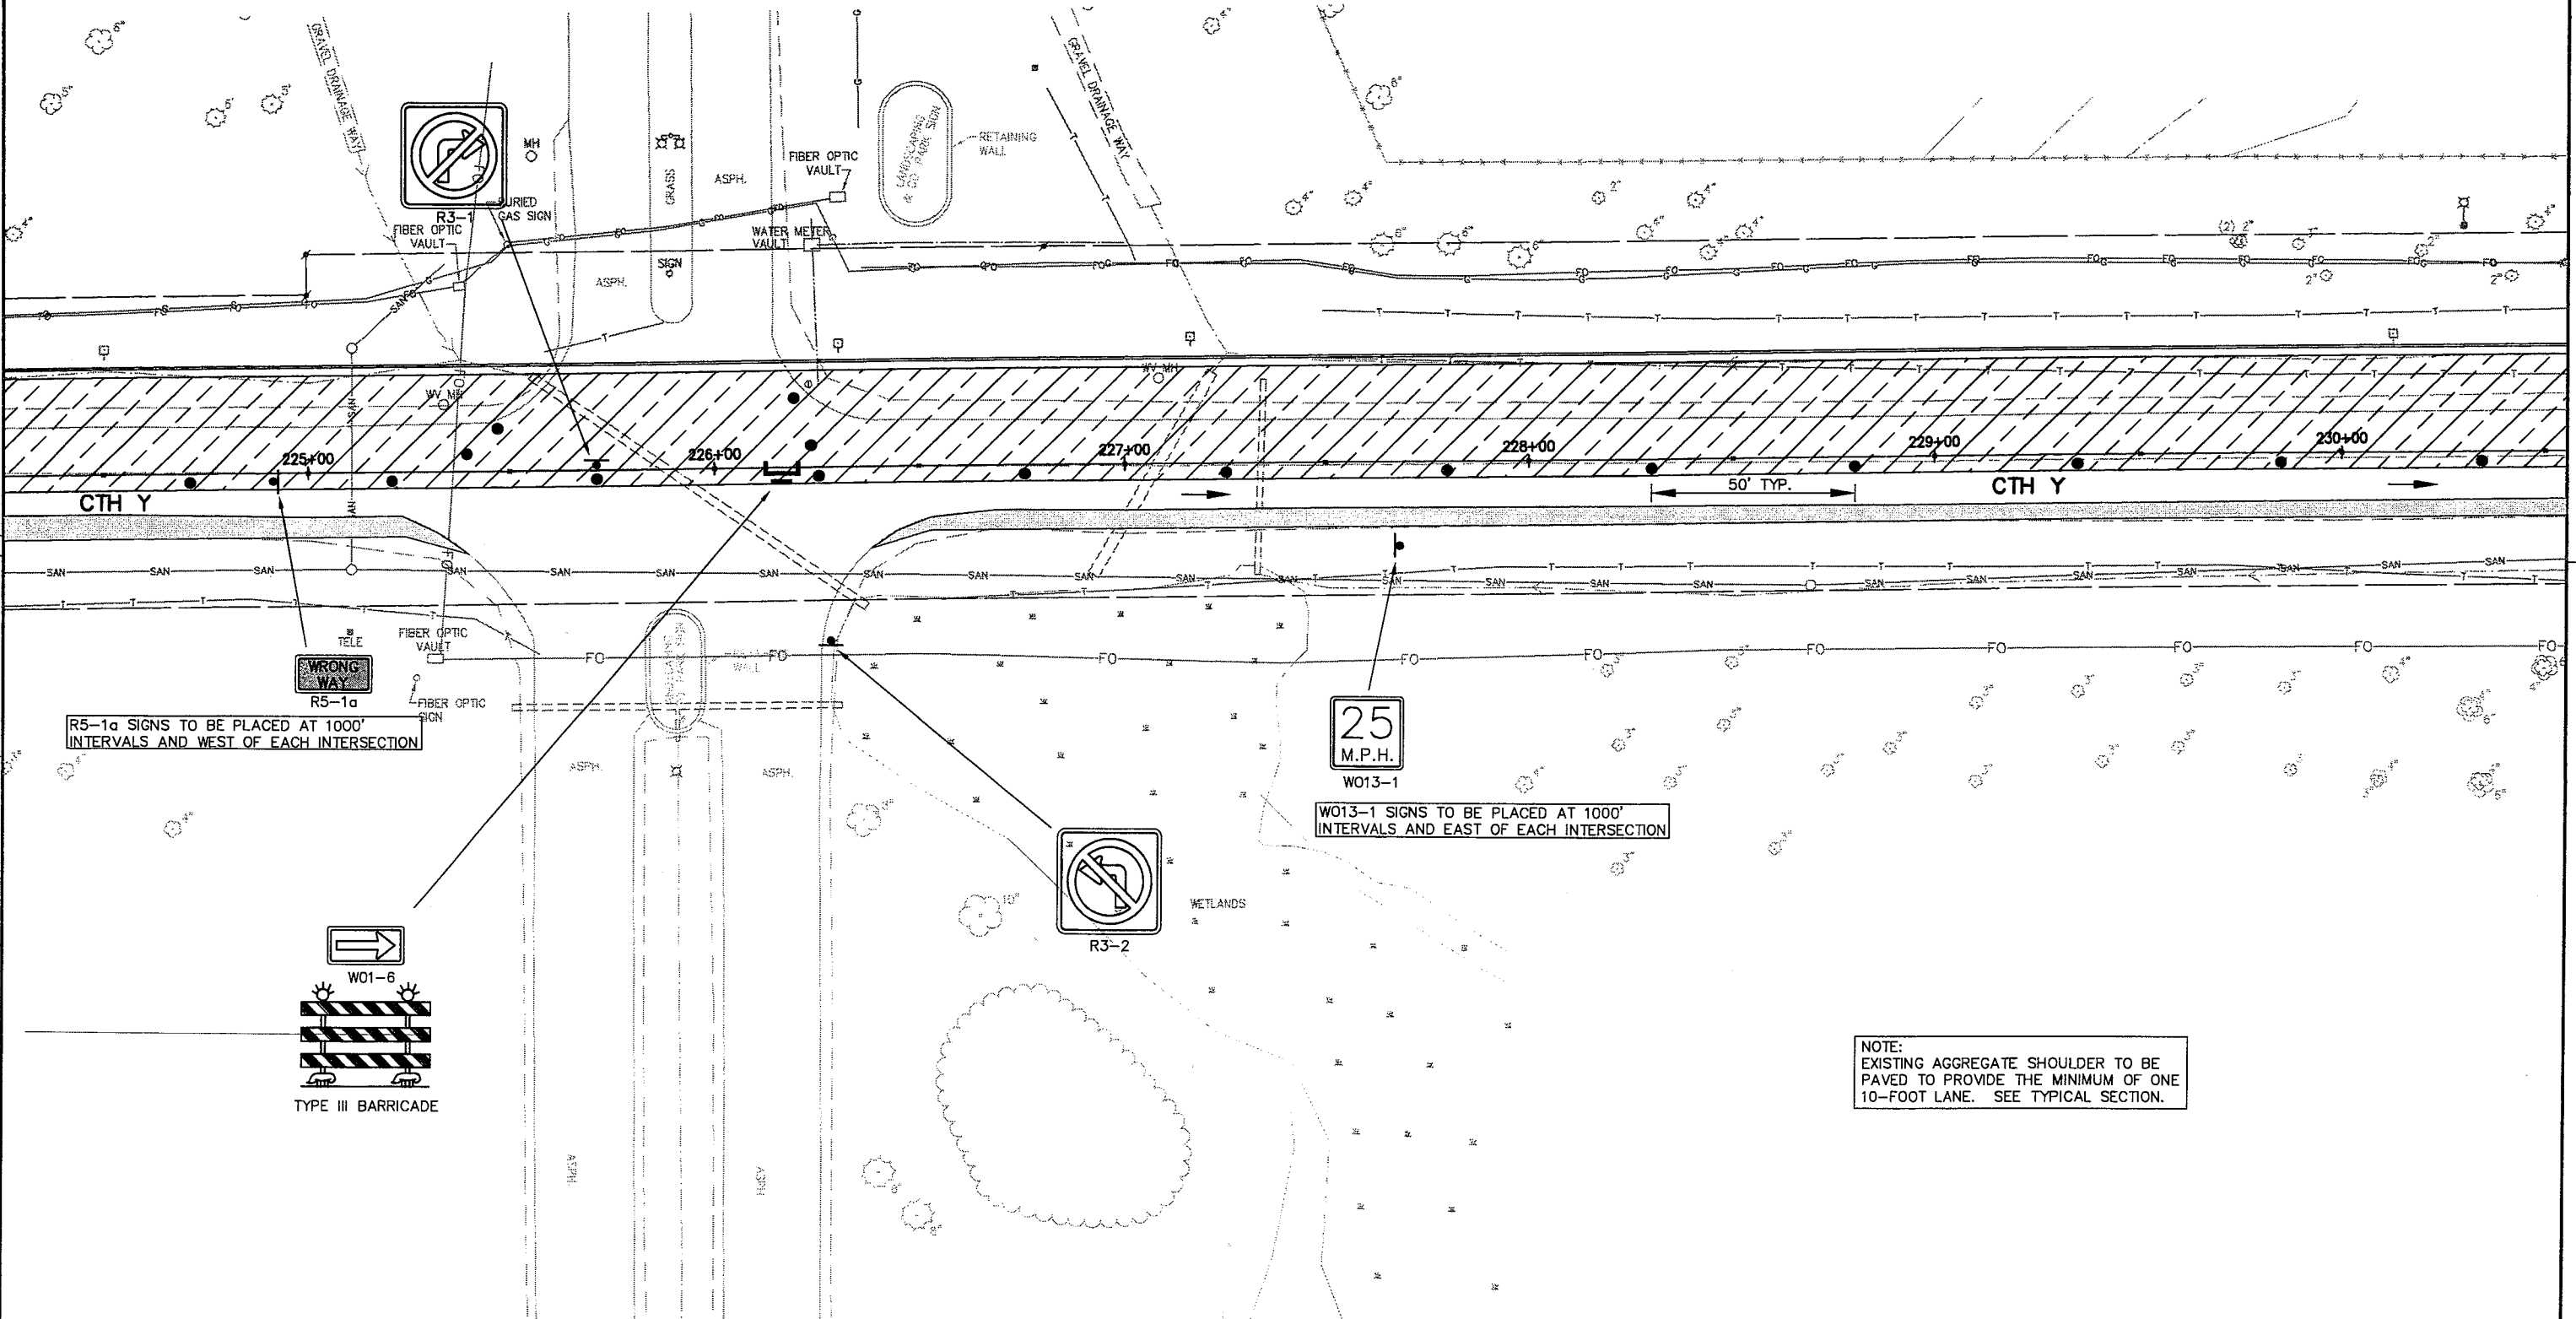


R5-1a SIGNS TO BE PLACED AT 1000' INTERVALS AND WEST OF EACH INTERSECTION

W013-1 SIGNS TO BE PLACED AT 1000' INTERVALS AND EAST OF EACH INTERSECTION

NOTE:
EXISTING AGGREGATE SHOULDER TO BE PAVED TO PROVIDE THE MINIMUM OF ONE 10-FOOT LANE. SEE TYPICAL SECTION.

g:\psssen\w\dwg\w0002\970343\00\DETAILS\1C PHASE 1-6.dwg 04/29/08 10:23 AM (X-CTH Y FINAL ROW-COMPS DEW)

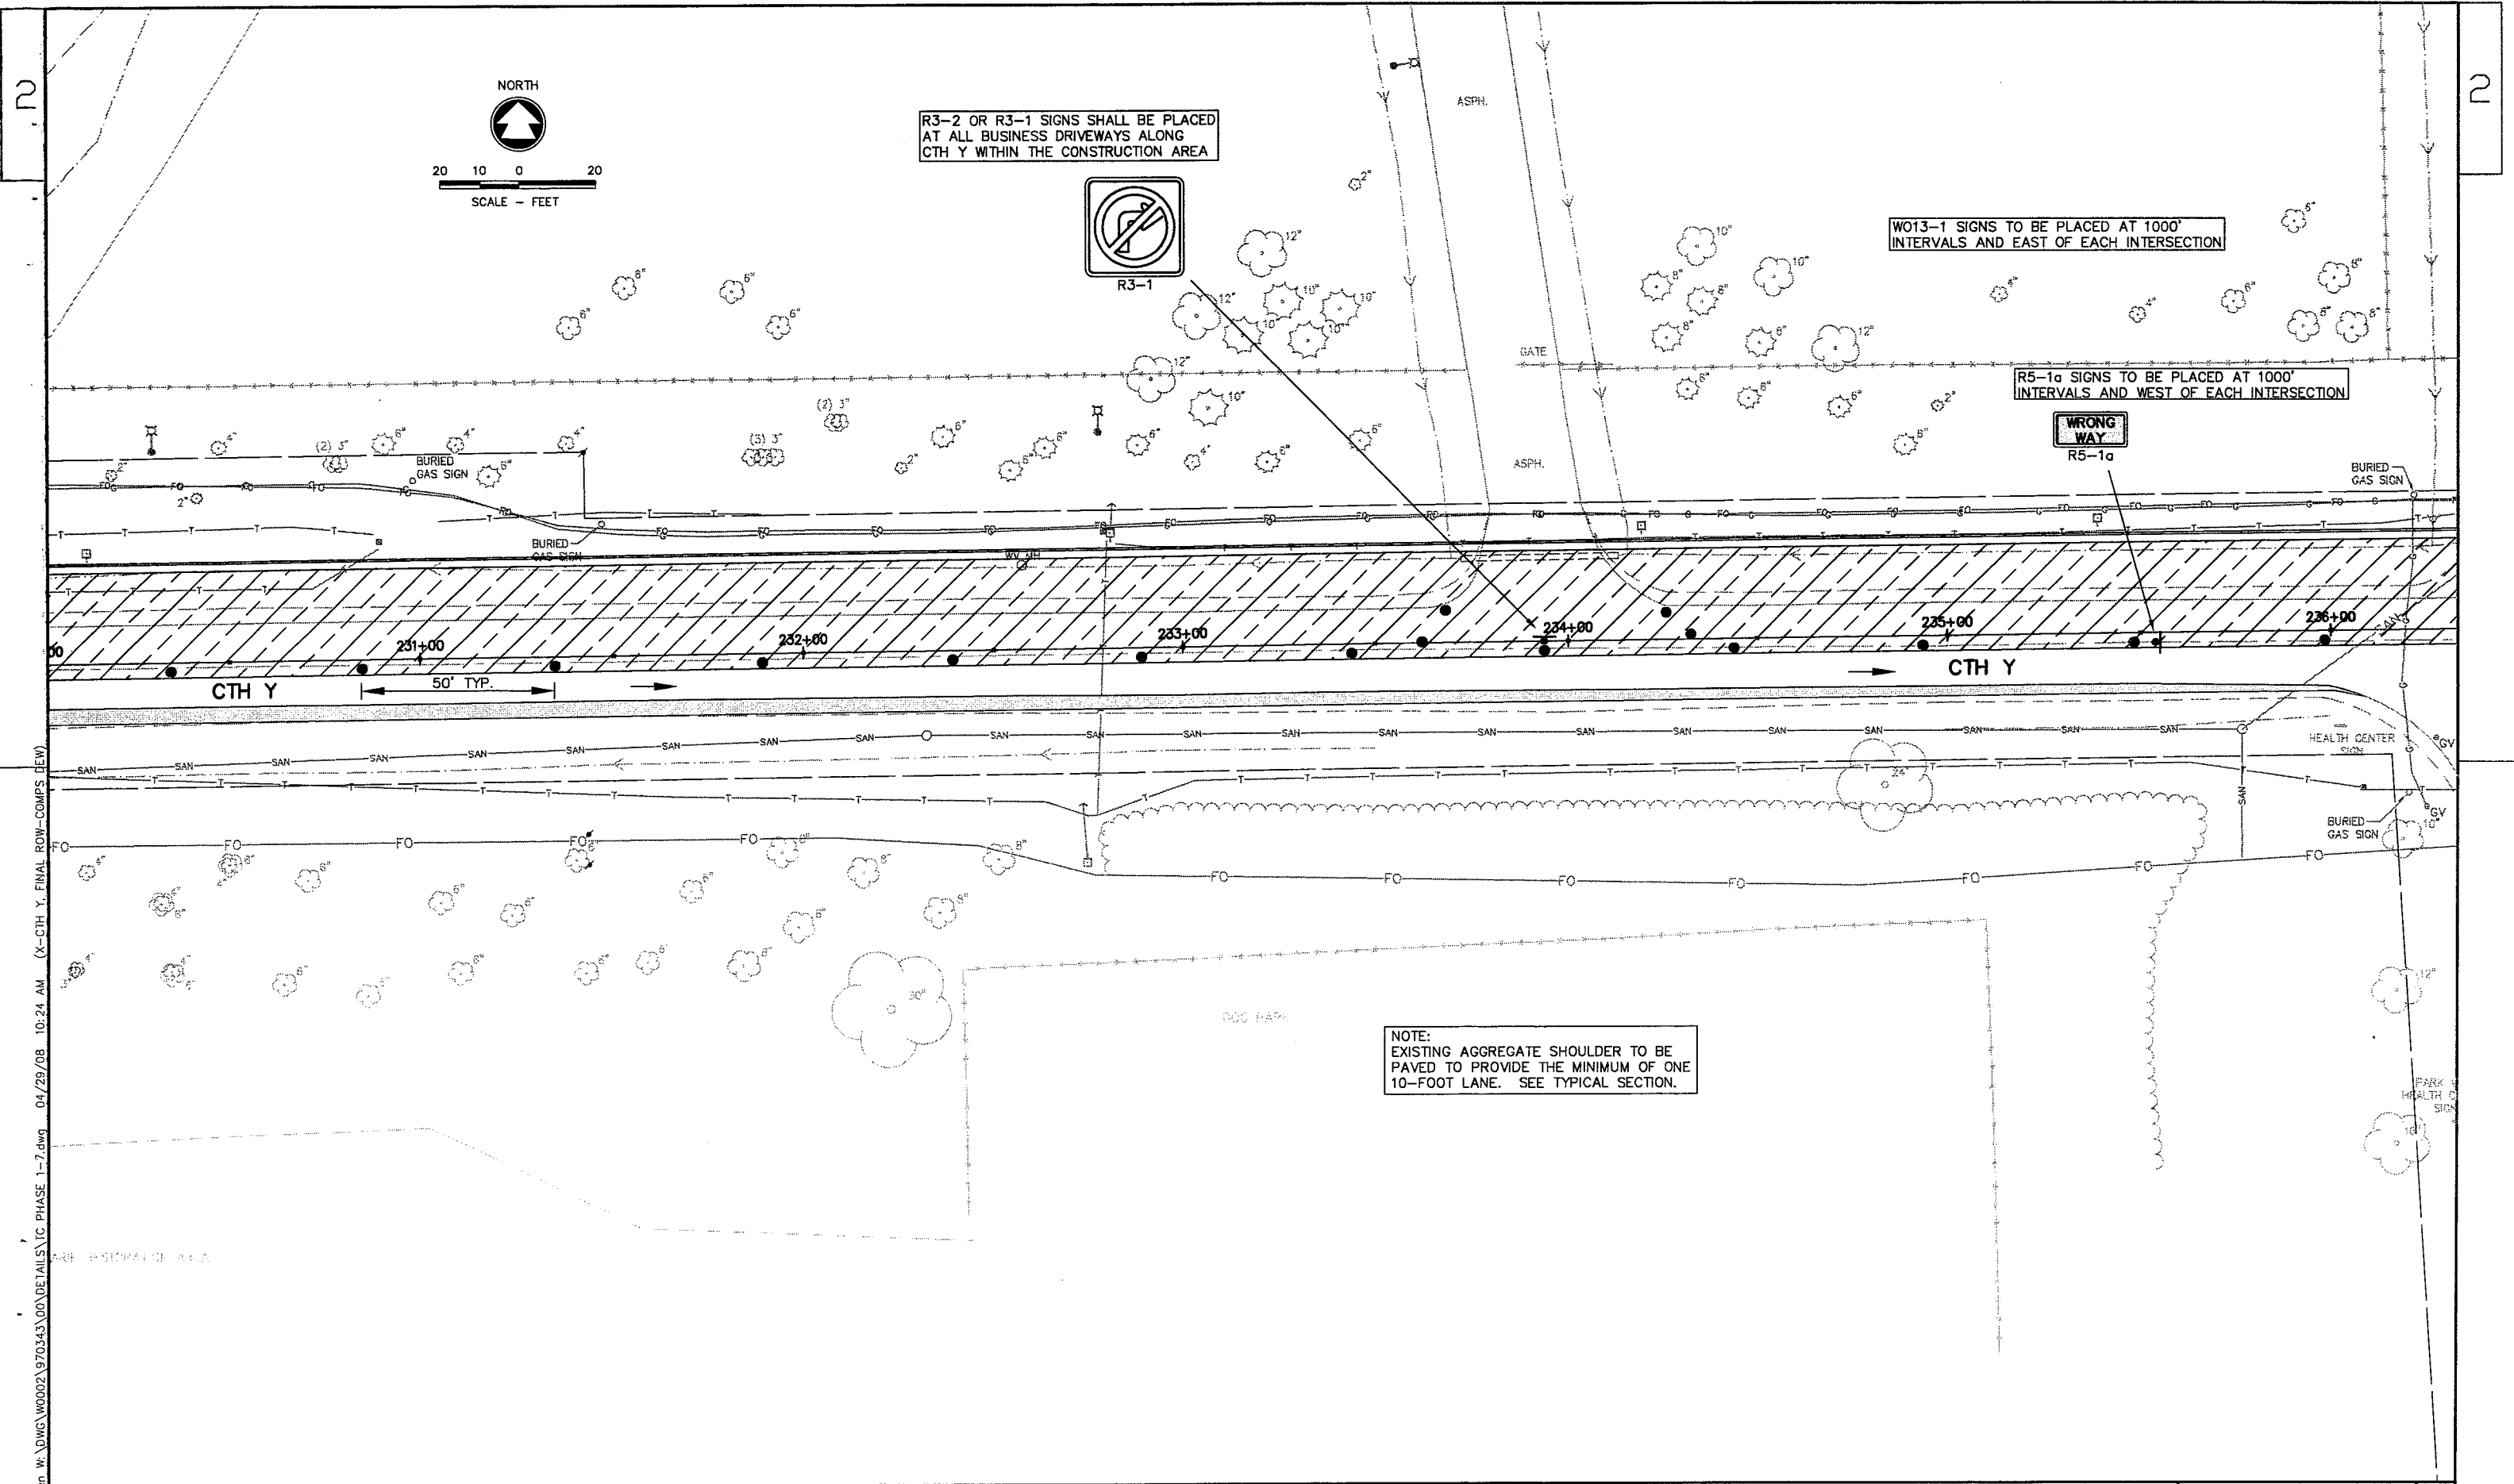

R3-2 OR R3-1 SIGNS SHALL BE PLACED AT ALL BUSINESS DRIVEWAYS ALONG CTH Y WITHIN THE CONSTRUCTION AREA



R3-1

W013-1 SIGNS TO BE PLACED AT 1000' INTERVALS AND EAST OF EACH INTERSECTION

R5-1a SIGNS TO BE PLACED AT 1000' INTERVALS AND WEST OF EACH INTERSECTION



R5-1a

NOTE:
EXISTING AGGREGATE SHOULDER TO BE PAVED TO PROVIDE THE MINIMUM OF ONE 10-FOOT LANE. SEE TYPICAL SECTION.

CROSSING: W:\DWG\WOOD02\970343\00\DETAILS\TC PHASE 1-7.dwg 04/29/08 10:24 AM (X-CTH Y_FINAL ROW-COMPS.DWG)

STATE PROJECT NUMBER: 4994-00-87

HWY: CTH Y


COUNTY: WINNEBAGO

PHASE 1 TRAFFIC CONTROL

SHEET NO: 83

E



TRAFFIC CONTROL SHOWN FOR THE BUTLER AVE INTERSECTION IS TYPICAL OF TRAFFIC CONTROL REQUIRED FOR SODA CREEK RD AND JACKTAR RD AS WELL. BUTLER AVE TO HAVE A ROAD WORK AHEAD SIGN PLACED AT THE INTERSECTION WITH CTH A.

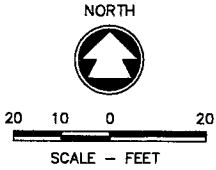

R5-1a SIGNS TO BE PLACED AT 1000' INTERVALS AND WEST OF EACH INTERSECTION


R3-2 OR R3-1 SIGNS SHALL BE PLACED AT ALL BUSINESS DRIVEWAYS ALONG CTH Y WITHIN THE CONSTRUCTION AREA

WRONG WAY R5-1a

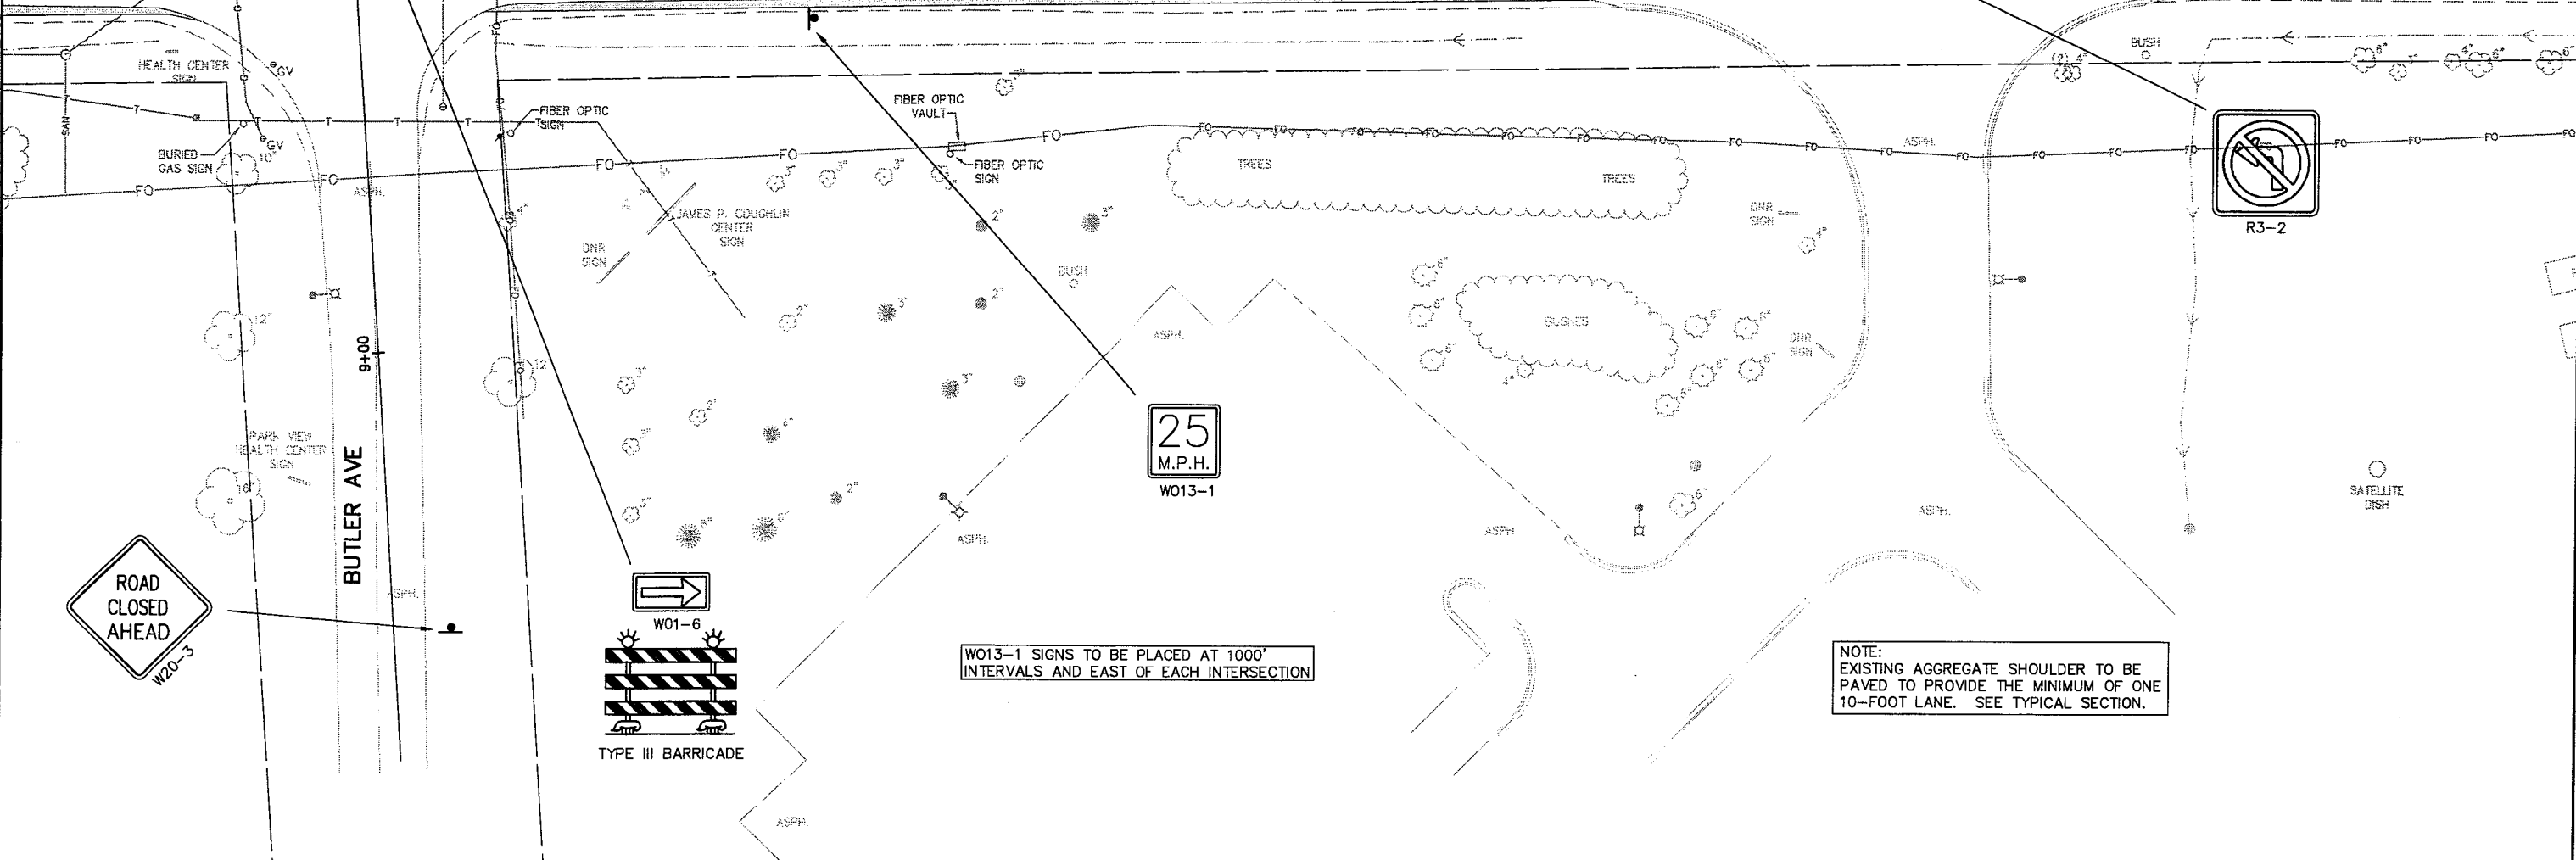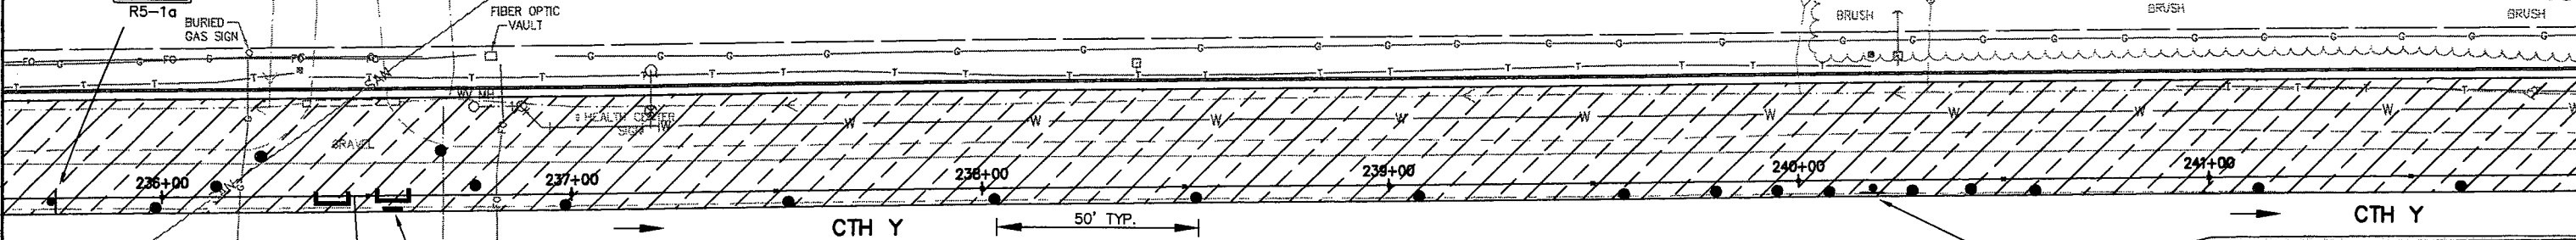

ROAD CLOSED AHEAD W20-3

BUTLER AVE

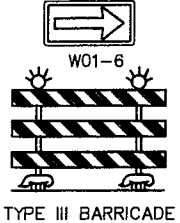

W013-1 SIGNS TO BE PLACED AT 1000' INTERVALS AND EAST OF EACH INTERSECTION

NOTE: EXISTING AGGREGATE SHOULDER TO BE PAVED TO PROVIDE THE MINIMUM OF ONE 10-FOOT LANE. SEE TYPICAL SECTION.

NORTH



20 10 0 20

SCALE - FEET

R3-2 OR R3-1 SIGNS SHALL BE PLACED AT ALL BUSINESS DRIVEWAYS ALONG CTH Y WITHIN THE CONSTRUCTION AREA



R3-1

R5-1a SIGNS TO BE PLACED AT 1000' INTERVALS AND WEST OF EACH INTERSECTION



R5-1a

W013-1 SIGNS TO BE PLACED AT 1000' INTERVALS AND EAST OF EACH INTERSECTION



W013-1

NOTE: EXISTING AGGREGATE SHOULDER TO BE PAVED TO PROVIDE THE MINIMUM OF ONE 10-FOOT LANE. SEE TYPICAL SECTION.

CTH Y

50' TYP.

242+00

243+00

244+00

245+00

246+00

247+00





p:\mge\blak\w\DWG\W0002\970343\00\DETAILS\TC PHASE 1-9.dwg 04/28/08 2:29 PM (X-CTH Y- FINAL ROW-COMPS DEW)

PANE:

PANE:

2

2

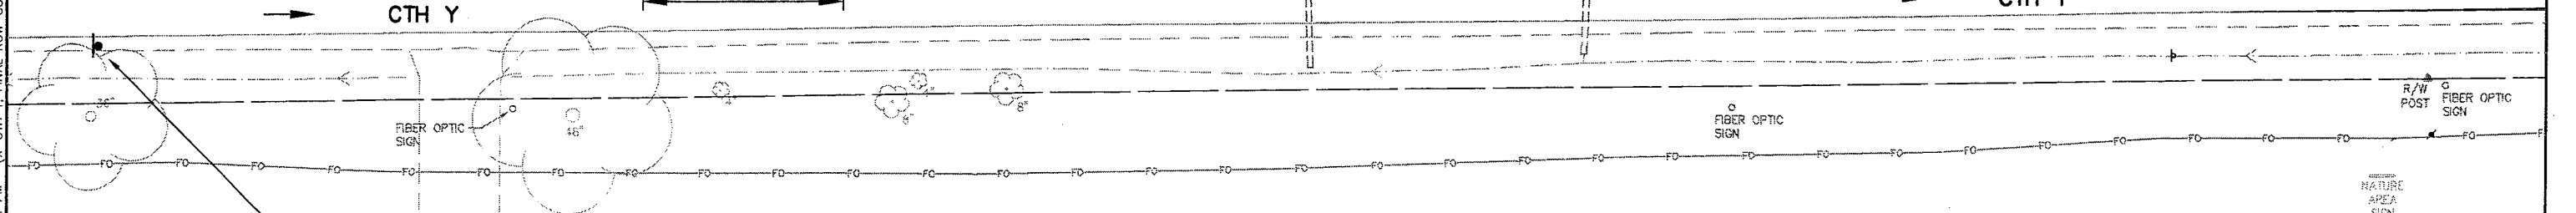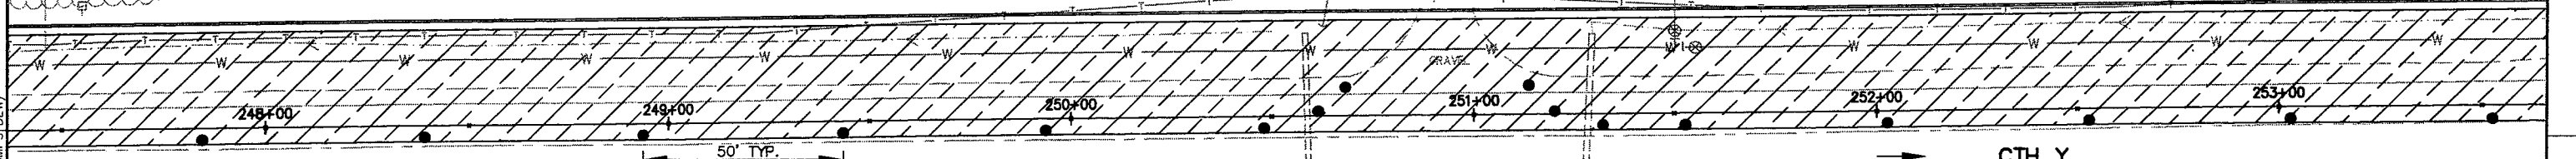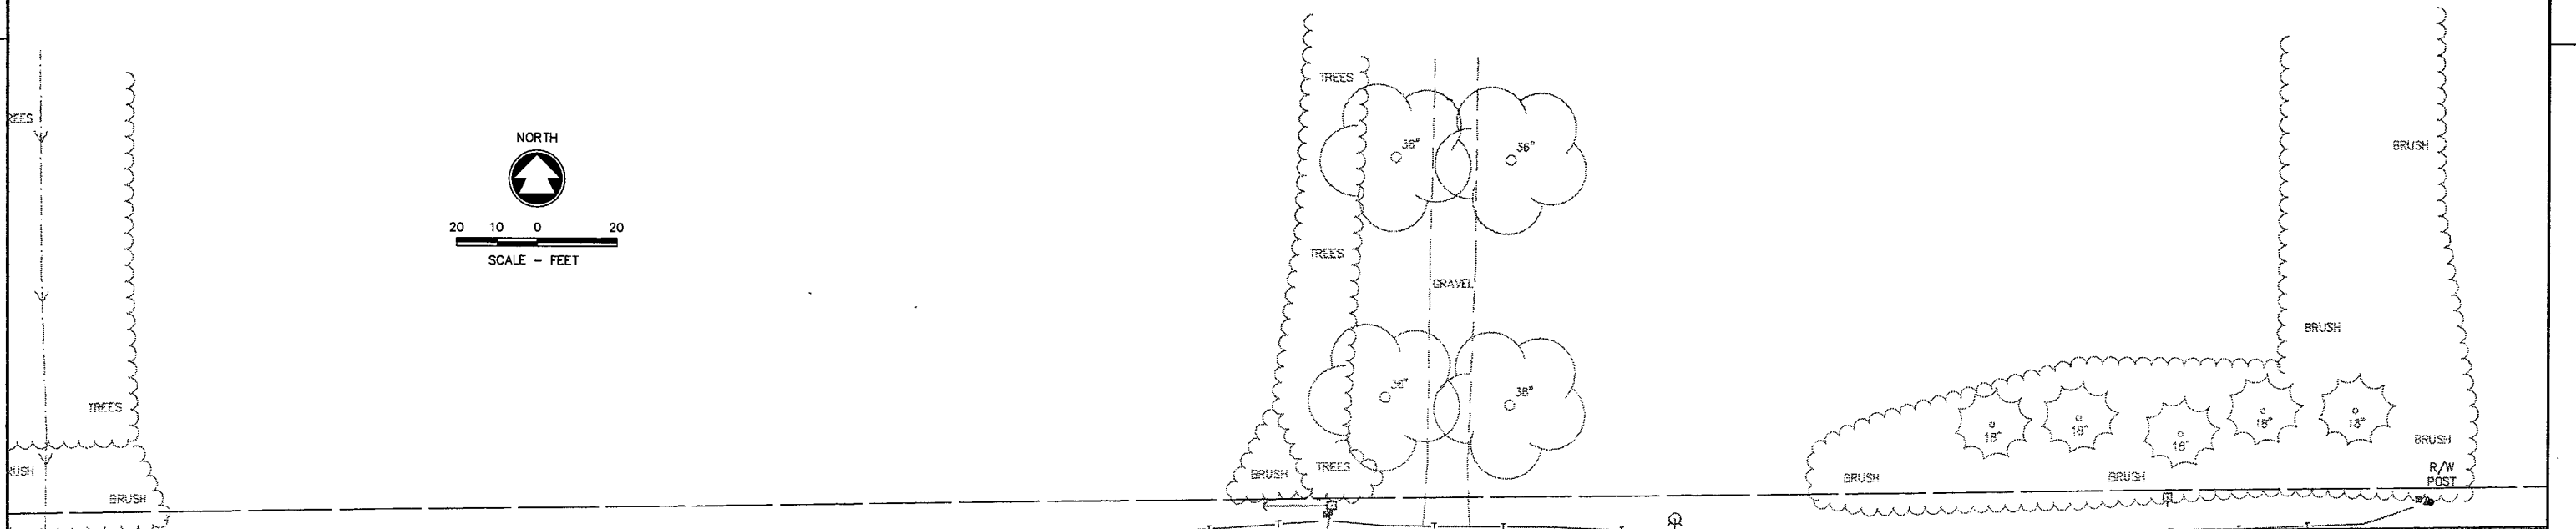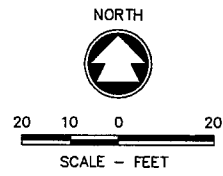

25
M.P.H.
W013-1

W013-1 SIGNS TO BE PLACED AT 1000'
INTERVALS AND EAST OF EACH INTERSECTION

R5-1a SIGNS TO BE PLACED AT 1000'
INTERVALS AND WEST OF EACH INTERSECTION

NOTE:
EXISTING AGGREGATE SHOULDER TO BE
PAVED TO PROVIDE THE MINIMUM OF ONE
10-FOOT LANE. SEE TYPICAL SECTION.

pmgelski.w\dwg\w0002\970343\00\DETAILS\TC PHASE 1-10.dwg 04/28/08 2:31 PM (X-CTH Y, FINAL ROW-COMPS DEW)

STATE PROJECT NUMBER: 4994-00-87

HWY: CTH Y

COUNTY: WINNEBAGO

PHASE 1 TRAFFIC CONTROL






SHEET NO: 86

E

PHASE 1 CROSSING NOTES:

- ONE LANE FOR ONE-WAY EASTBOUND TRAFFIC TO BE LOCATED ON SOUTH SIDE OF EXISTING CENTERLINE. TRAFFIC TO BE MAINTAINED ON EXISTING PAVEMENT WHILE WESTBOUND LANES OF CTH Y ARE CONSTRUCTED.
- EXISTING HIGHWAY - RAIL GRADE CROSSING ADVANCE WARNING SIGNS FOR EASTBOUND TRAFFIC WILL REMAIN IN PLACE.
- FOR THE EASTBOUND RAILROAD SIGNALS, THE EXISTING CANTILEVERED RAILROAD SIGNALS REMAIN IN PLACE AND EXISTING GATE MECHANISM TO REMAIN IN PLACE.
- FOR THE WESTBOUND RAILROAD SIGNALS, THE EXISTING CANTILEVERED RAILROAD SIGNALS REMAIN IN PLACE AND THE RAILROAD WILL REMOVE THE EXISTING GATE MECHANISM EARLY IN TO PHASE 1.
- WISCONSIN CENTRAL LTD. RAILROAD TO INSTALL CROSSING SURFACES EARLY DURING PHASE 1.
- CONTRACTOR TO INSTALL TEMPORARY ASPHALT RAMPS AT THE RAILROAD APPROACHES IN ORDER TO PROTECT THE CONCRETE PANEL SURFACE. REFER TO TEMPORARY ASPHALT RAMP DETAIL FOR ADDITIONAL INFORMATION.
- PRIOR TO THE START OF PHASE 2, THE EXISTING GATE MECHANISM TO BE RELOCATED TO ITS FINAL POSITION.

TRAFFIC CONTROL NORTH AND SOUTH OF CTH Y ON CTH A AS WELL AS EAST OF CTH A ON SUNNYVIEW RD TO BE IN ACCORDANCE WITH STANDARD DETAIL DRAWING FOR BARRICADES AND SIGNS FOR MAINLINE CLOSURES DETAIL B.

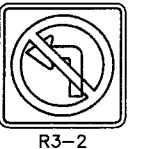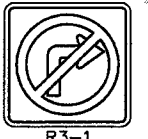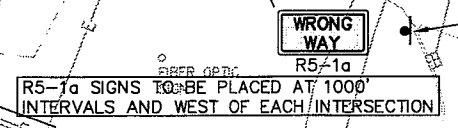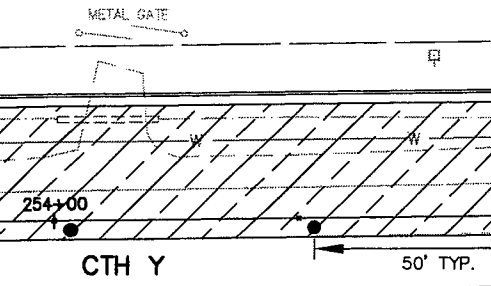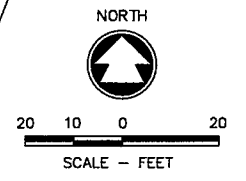

NOTE:
EXISTING AGGREGATE SHOULDER TO BE PAVED TO PROVIDE THE MINIMUM OF ONE 10-FOOT LANE. SEE TYPICAL SECTION.


W:\Dwg\W0002\970343\00\DETAILS\TC PHASE 1 RR.dwg 10/07/08 1:16 PM (X-CTH Y, AT&T FIBER CITY)

SEQUENCE OF OPERATION

RING 1	HEAD NUMBERS	NOT USED				NOT USED				FLASH
		#1		#2		#3		#4		
		R/W	CLEAR TO	R/W	CLEAR TO	R/W	CLEAR TO	R/W	CLEAR TO	
Ø2	1,2,3			G	Y R			R	R R	Y
Ø4	7,8,9			R	R R			G, G	Y R	R
Ø6	4,5,6			R	R R			R	R R	Y

RING 2	HEAD NUMBERS	NOT USED				NOT USED				NOT USED			
		#5		#6		#7		#8					
		R/W	CLEAR TO	R/W	CLEAR TO	R/W	CLEAR TO	R/W	CLEAR TO				
Ø2	1,2,3			R	R R								
Ø4	7,8,9			R	R R								
Ø6	4,5,6			G	Y R								

Sq 11
/

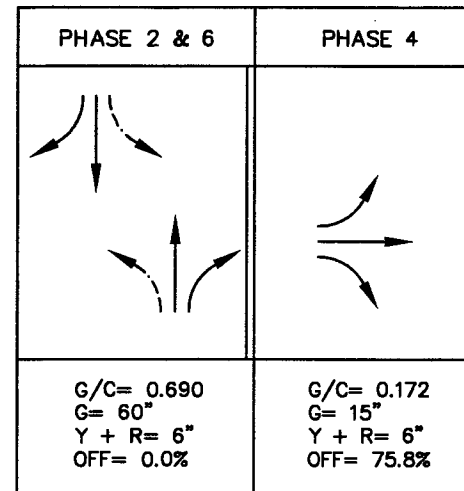


G/C= 0.690
G= 60"
Y + R= 6"
OFF= 0.0%

G/C= 0.172
G= 15"
Y + R= 6"
OFF= 75.8%

Y=4" R=2.0"

C=87 SEC G=75 SEC= 86.2% Y=12.0 SEC = 13.8% PED= 0.0 SEC = 0.0%

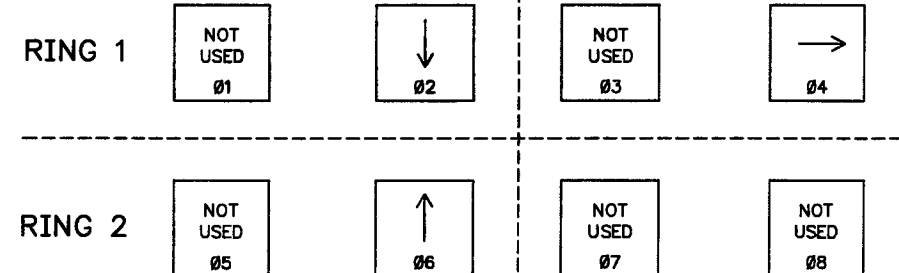

BARRIER

OVERLAPS

CONTROLLER LOGIC

PHASE NUMBER	PHASE LOCKING	DUAL ENTRY W / Ø	PHASE RECALL
1	-	-	-
2	-	6	MAX
3	-	-	-
4	-	-	MAX
5	-	-	-
6	-	2	MAX
7	-	-	-
8	-	-	-

** CLEARANCE TO A PHASE IN CONFLICT WITH THIS PHASE ON (SEE CHART 1 BELOW)

CHART 1

PHASE ON	NON-CONFLICTING PHASE ALLOWED TO TIME CONCURRENTLY	PHASES IN CONFLICT WITH PHASE ON
1	-	-
2	6	4
3	-	-
4	-	2,6
5	-	-
6	2	4
7	-	-
8	-	-


TYPE OF INTERCONNECT	
NONE	<input checked="" type="checkbox"/>
TBC (FUTURE USE)	<input type="checkbox"/>
CLOSED LOOP	<input type="checkbox"/>
HARDWIRE	<input type="checkbox"/>
TONE (FREQ)	<input type="checkbox"/>

TYPE OF PRE-EMPT	
NONE	<input checked="" type="checkbox"/>
RAILROAD	<input type="checkbox"/>
EMERGENCY VEHICLE	<input type="checkbox"/>

TYPE OF LIGHTING	
NONE	<input type="checkbox"/>
IN TRAFFIC CONTROL CABINET	<input checked="" type="checkbox"/>
IN SEPARATE CONTROL CABINET	<input type="checkbox"/>


2

2

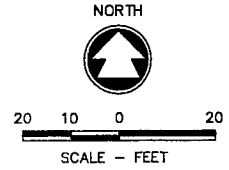

TRAFFIC CONTROL NORTH AND SOUTH OF CTH Y ON STH 76 AS WELL AS WEST OF STH 76 ON CTH Y TO BE IN ACCORDANCE WITH STANDARD DETAIL DRAWING FOR BARRICADES AND SIGNS FOR MAINLINE CLOSURES DETAIL B.

NOTE:
LOCATION OF TEMPORARY SIGNAL POLES TO BE APPROVED BY THE ENGINEER IN THE FIELD.
TEMPORARY POLES TO BE LOCATED TO ALLOW FOR THE STAGED CONSTRUCTION OF THE PERMANENT TRAFFIC SIGNALS, STORM SEWER, AND CULVERT PIPES.

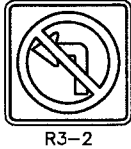

LEFT TURN LANE CLOSED

R3-2 OR R3-1 SIGNS SHALL BE PLACED AT ALL BUSINESS DRIVEWAYS ALONG CTH Y WITHIN THE CONSTRUCTION AREA

EXISTING CONTROLLER CABINET AND BASE TO REMAIN IN CURRENT LOCATION THROUGHOUT CONSTRUCTION. THE EXISTING ELECTRIC SERVICE WILL BE USED FOR THE TEMPORARY CONTROLLER AND TEMPORARY SIGNALS.


R5-1a SIGNS TO BE PLACED AT 1000' INTERVALS AND EAST OF EACH INTERSECTION



STH 76 - JACKSON ST

ASPHALT OVER CONCRETE

HOUSE

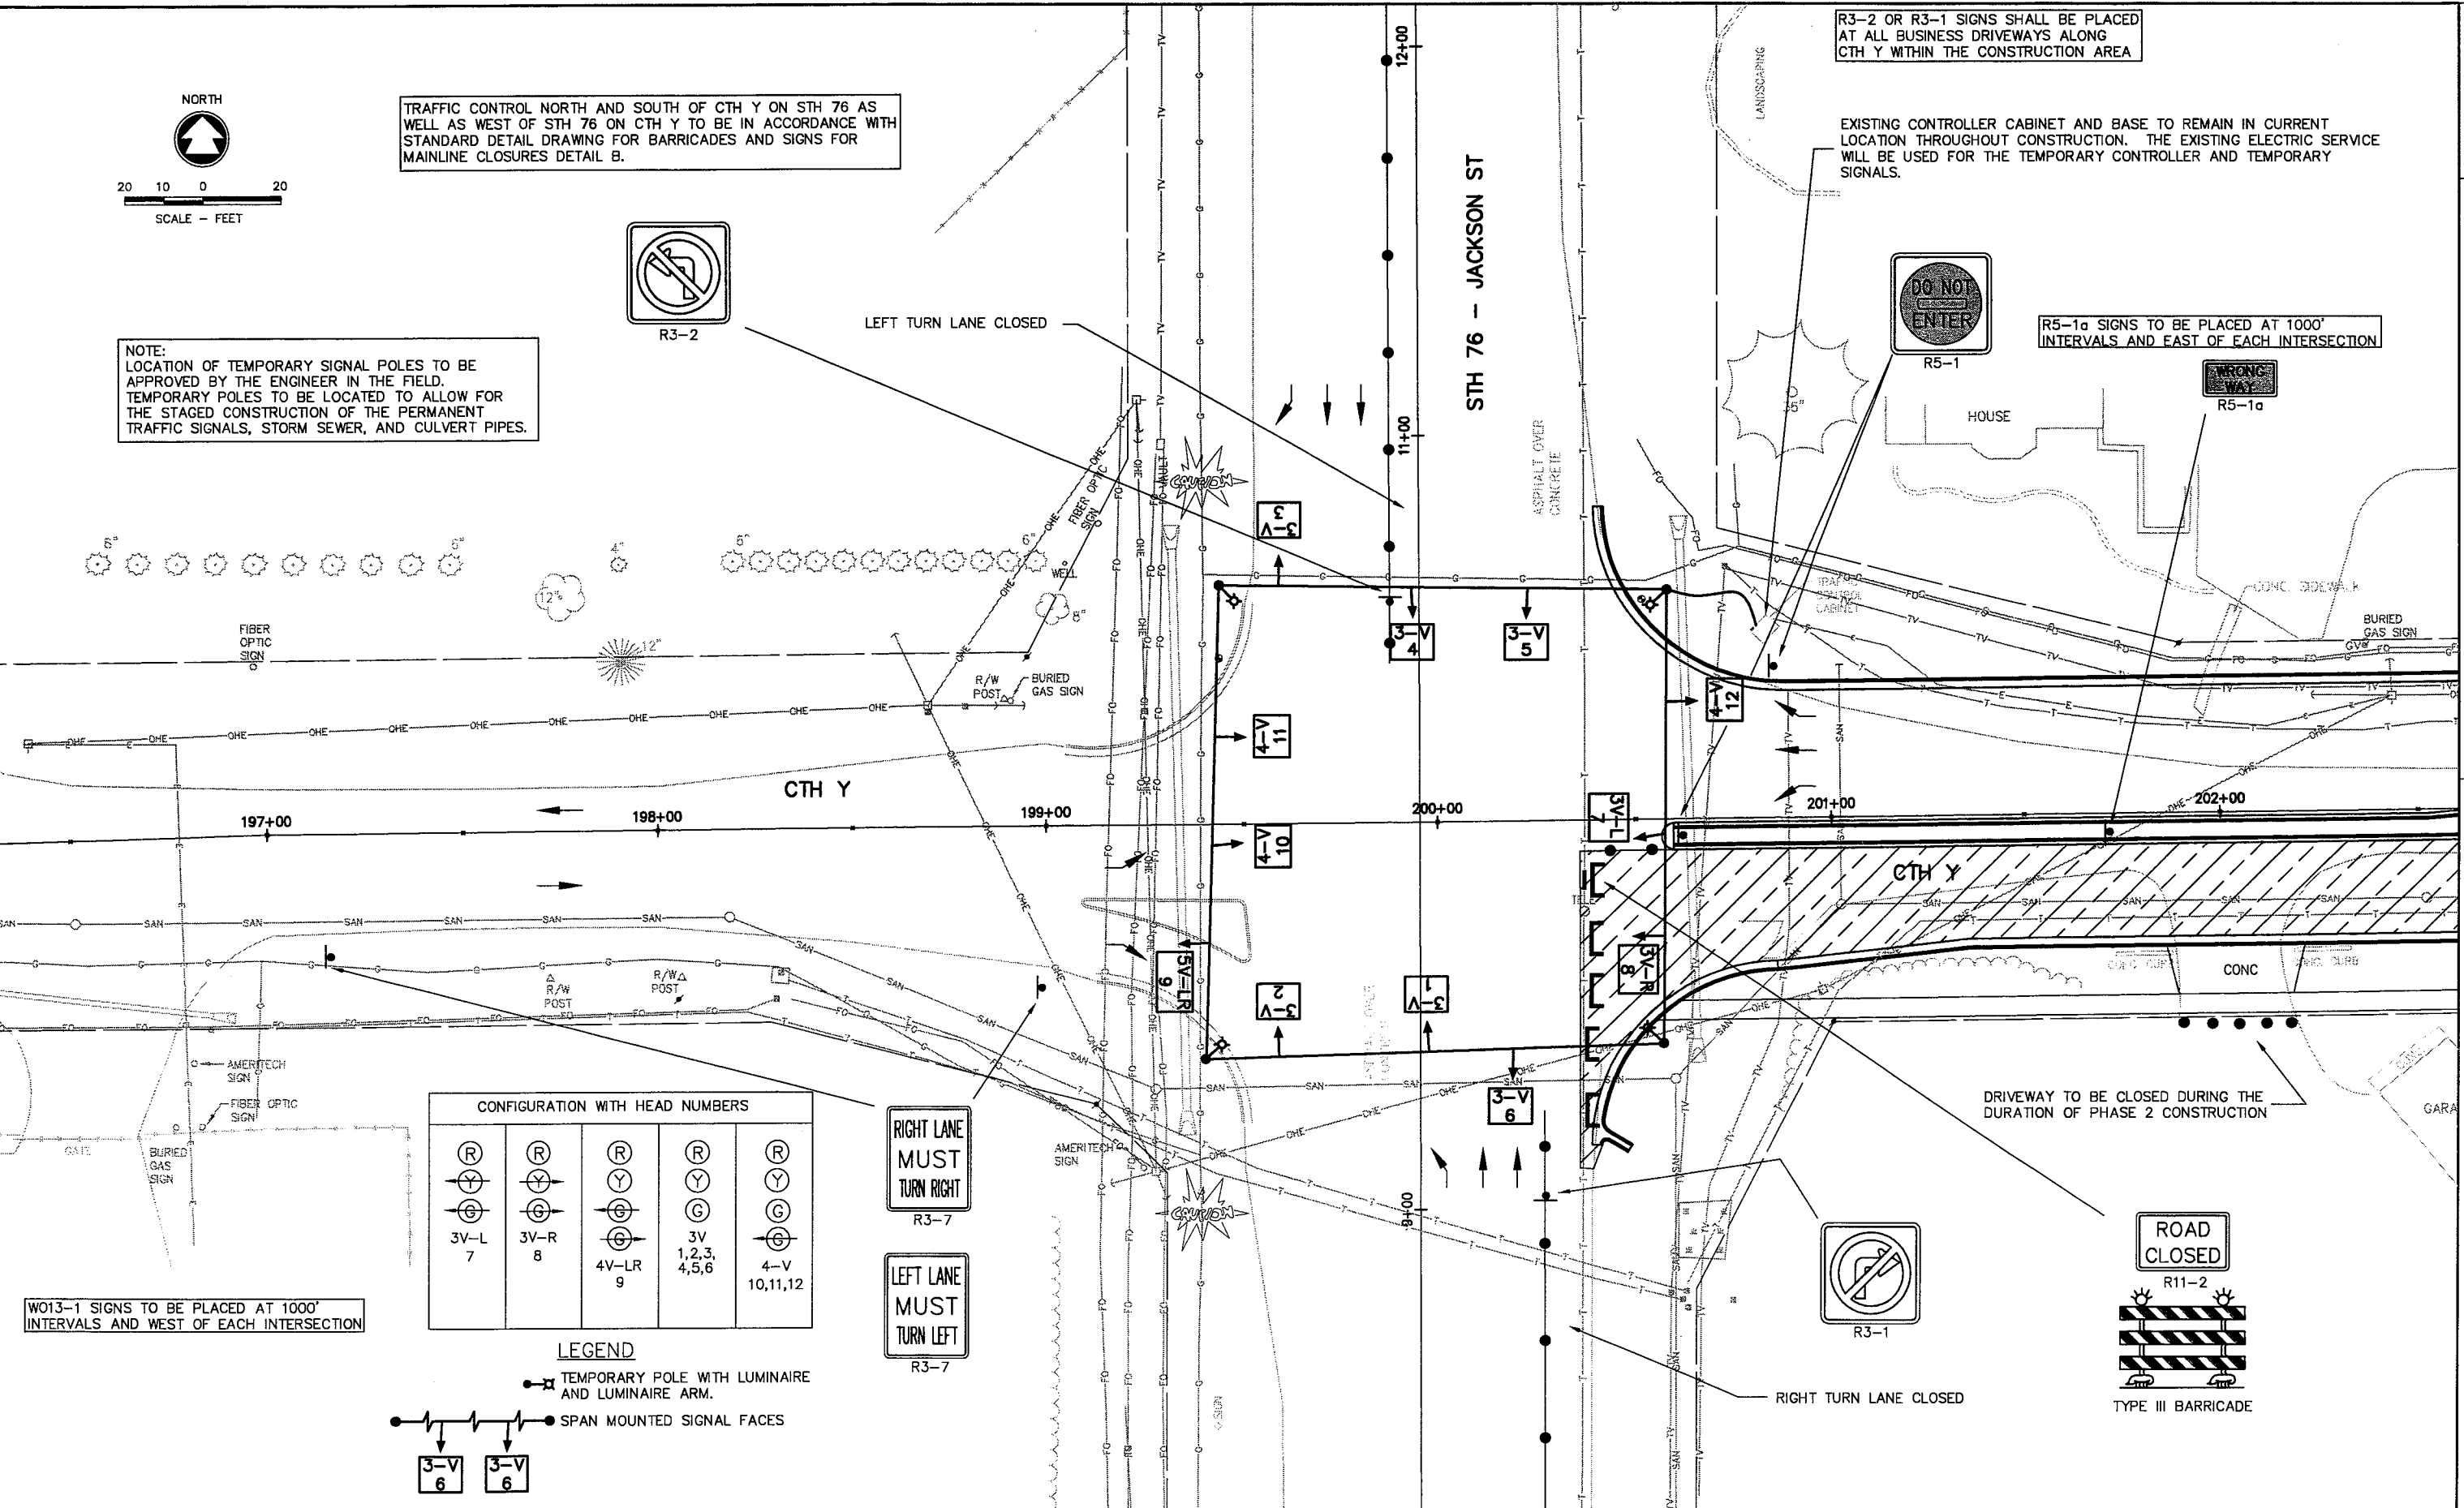


CONFIGURATION WITH HEAD NUMBERS

(R) (Y) (G) 3V-L 7	(R) (Y) (G) 3V-R 8	(R) (Y) (G) 4V-LR 9	(R) (Y) (G) 3V 1,2,3 4,5,6	(R) (Y) (G) 4-V 10,11,12
--------------------------------	--------------------------------	---------------------------------	---	--------------------------------------




W013-1 SIGNS TO BE PLACED AT 1000' INTERVALS AND WEST OF EACH INTERSECTION

LEGEND

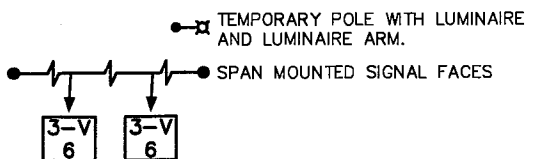

10/22/08 11:07 AM (X-CTH Y, AT&T FIBER CITY) 10/22/08 11:07 AM (X-CTH Y, AT&T FIBER CITY) 10/22/08 11:07 AM (X-CTH Y, AT&T FIBER CITY)

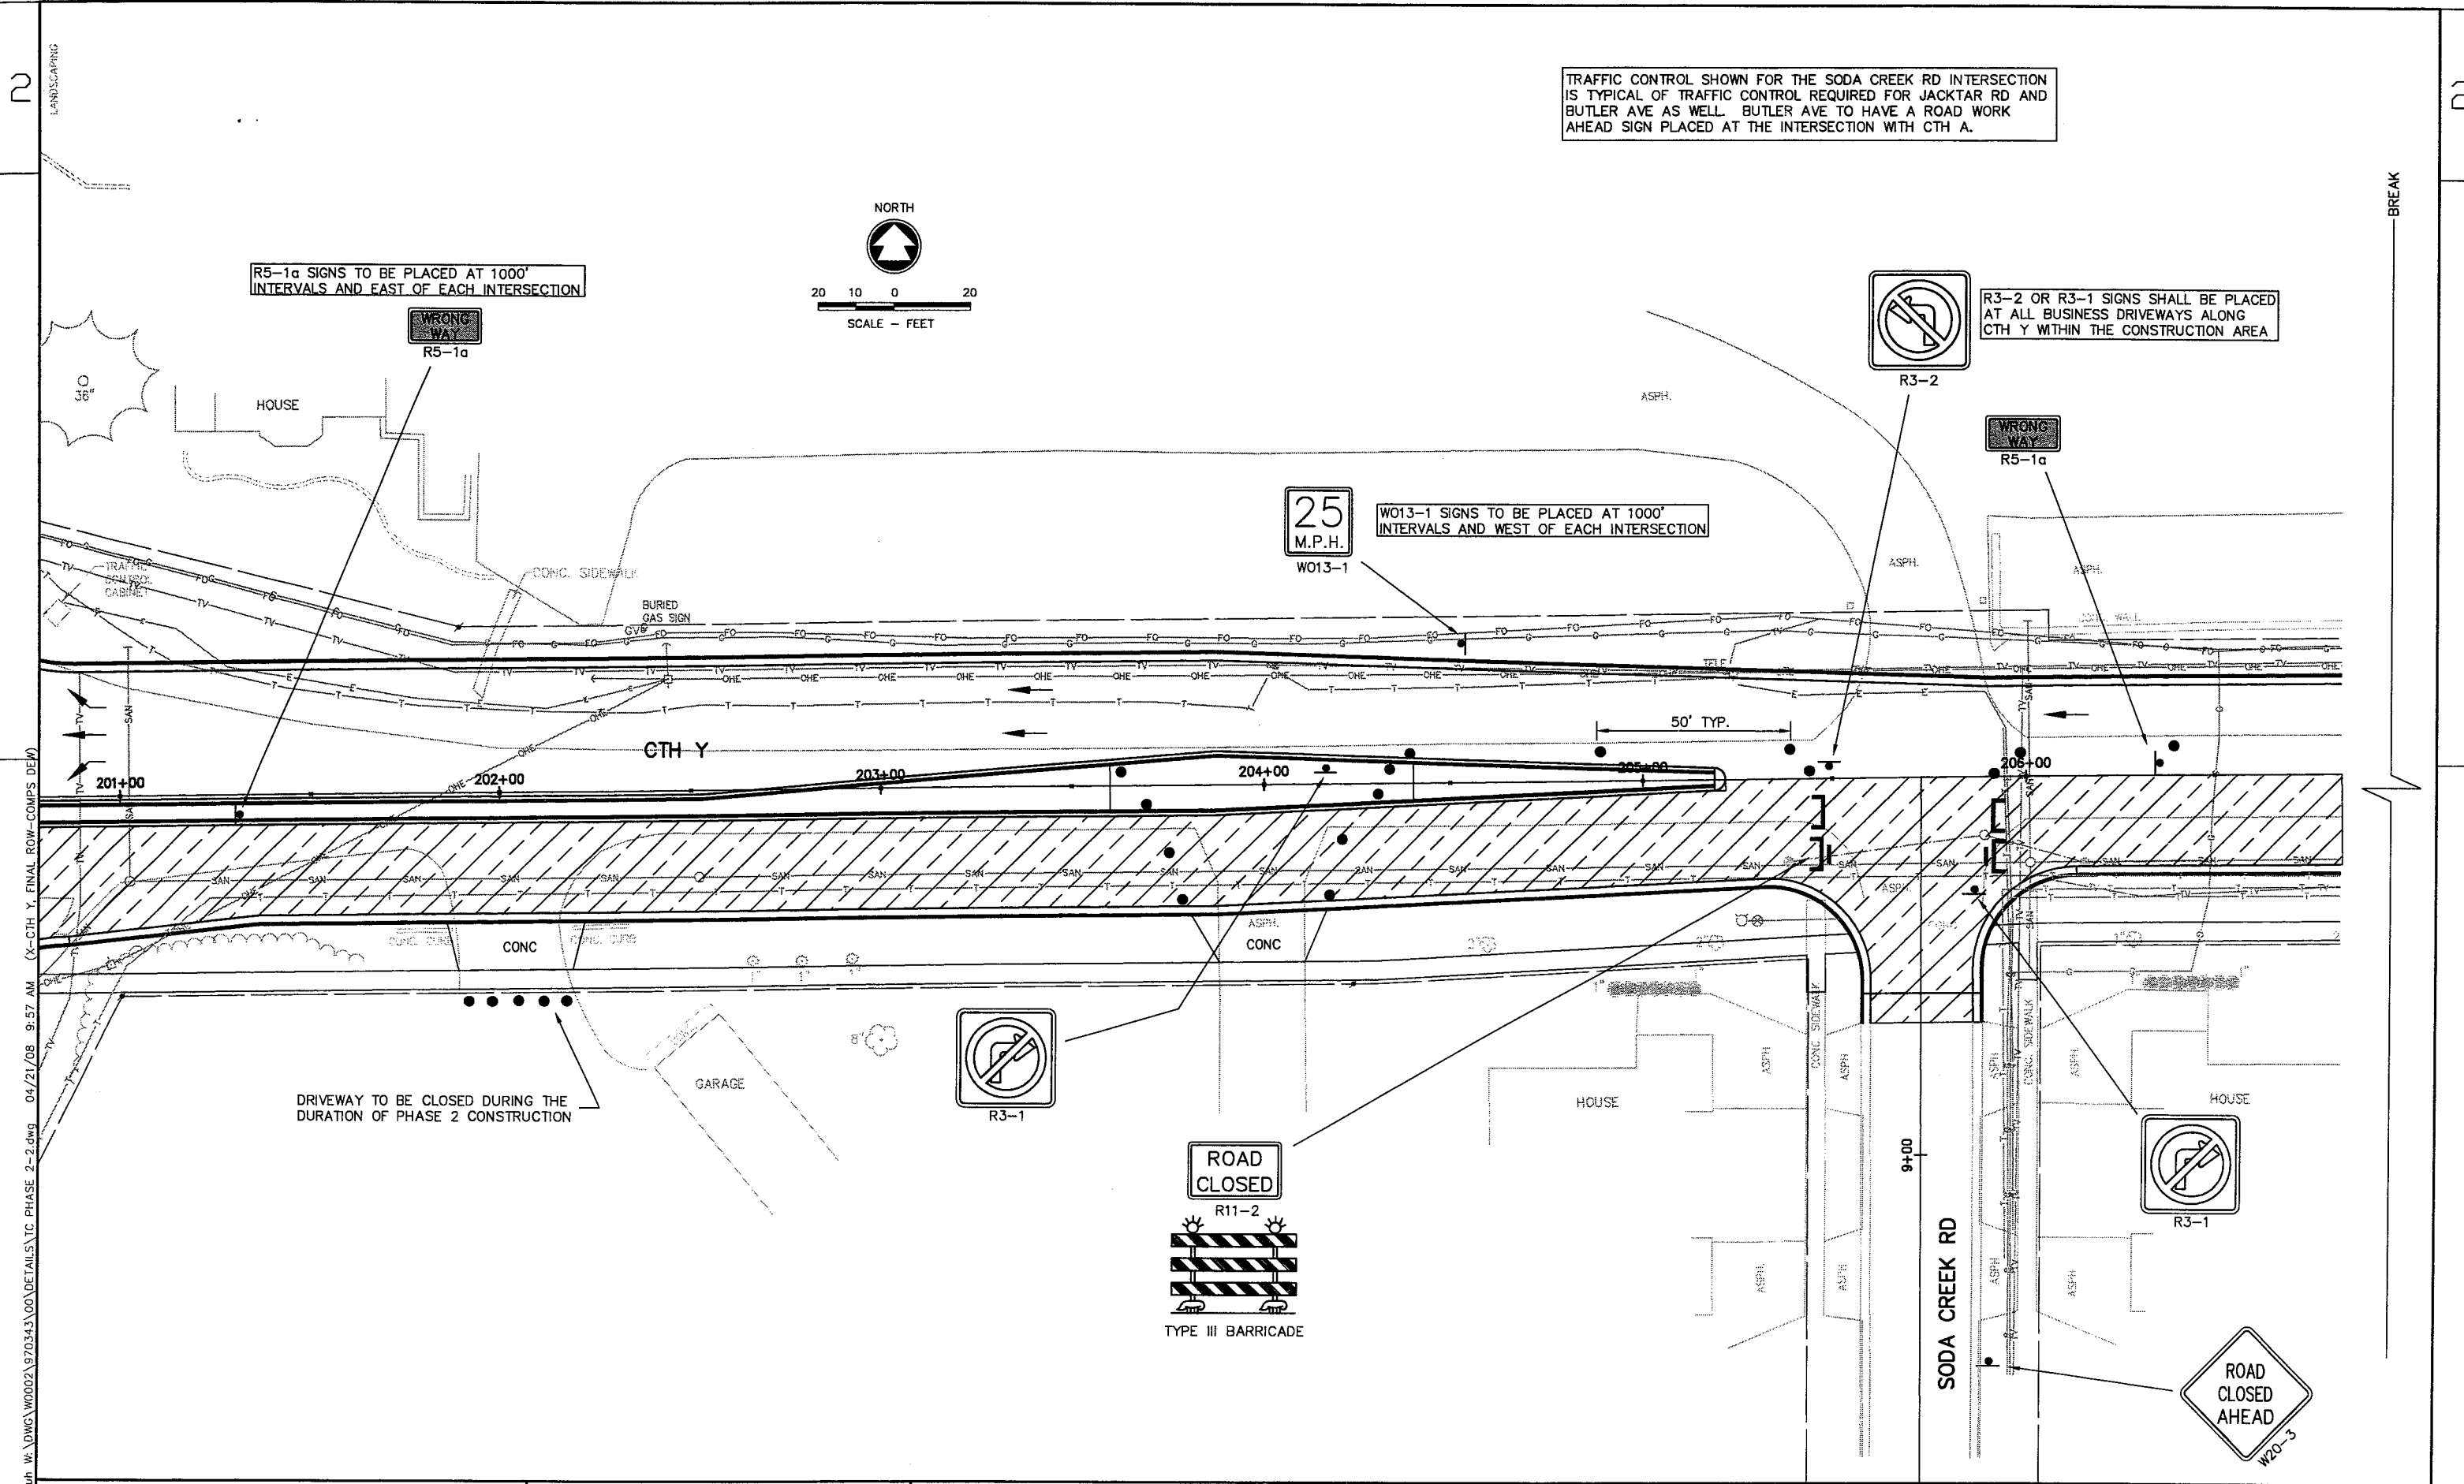

TRAFFIC CONTROL SHOWN FOR THE SODA CREEK RD INTERSECTION IS TYPICAL OF TRAFFIC CONTROL REQUIRED FOR JACKTAR RD AND BUTLER AVE AS WELL. BUTLER AVE TO HAVE A ROAD WORK AHEAD SIGN PLACED AT THE INTERSECTION WITH CTH A.

R5-1a SIGNS TO BE PLACED AT 1000' INTERVALS AND EAST OF EACH INTERSECTION

W013-1 SIGNS TO BE PLACED AT 1000' INTERVALS AND WEST OF EACH INTERSECTION

R3-2 OR R3-1 SIGNS SHALL BE PLACED AT ALL BUSINESS DRIVEWAYS ALONG CTH Y WITHIN THE CONSTRUCTION AREA


DRIVEWAY TO BE CLOSED DURING THE DURATION OF PHASE 2 CONSTRUCTION

04/21/08 9:57 AM (X-CTH Y FINAL ROW-COMPS.DWG) W:\DWG\W0002\970343\00\DETAILS\TC PHASE 2-2.dwg

MSDOT/CADD SHEET 42

PHASE 2 CROSSING NOTES:


- ONE LANE FOR ONE-WAY WESTBOUND TRAFFIC TO BE LOCATED ON NORTH SIDE OF EXISTING CENTERLINE. TRAFFIC TO BE MAINTAINED ON NEW PAVEMENT WHILE EASTBOUND LANES OF CTH Y ARE CONSTRUCTED.
- CONTRACTOR TO INSTALL PERMANENT HIGHWAY - RAIL GRADE CROSSING ADVANCE WARNING SIGNS PRIOR TO OPENING FOR WESTBOUND TRAFFIC.
- FOR THE WESTBOUND RAILROAD SIGNALS, THE EXISTING CANTILEVERED RAILROAD SIGNALS REMAIN IN PLACE AND THE RAILROAD WILL HAVE ALREADY RELOCATED THE EXISTING GATE MECHANISM PRIOR TO OPENING THE CROSSING TO WESTBOUND TRAFFIC.
- FOR THE EASTBOUND RAILROAD SIGNALS, THE EXISTING CANTILEVERED RAILROAD SIGNALS REMAIN IN PLACE. RAILROAD WILL REMOVE THE EXISTING GATE MECHANISM EARLY IN PHASE 2.
- CONTRACTOR TO INSTALL TEMPORARY ASPHALT RAMPS AT THE RAILROAD APPROACHES IN ORDER TO PROTECT THE CONCRETE PANEL SURFACE. REFER TO TEMPORARY ASPHALT RAMP DETAIL FOR ADDITIONAL INFORMATION.
- CONTRACTOR TO INSTALL RAILROAD CROSSBUCK ASSEMBLIES AND STOP SIGNS AT EACH APPROACH TO THE TRAIL CROSSING PRIOR TO PHASE 3.
- CONTRACTOR TO RELOCATE THE EXISTING GATE MECHANISM PRIOR TO THE START OF PHASE 3.

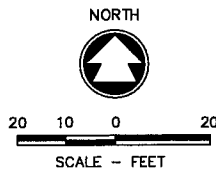

R5-1a SIGNS TO BE PLACED AT 1000' INTERVALS AND EAST OF EACH INTERSECTION



W013-1 SIGNS TO BE PLACED AT 1000' INTERVALS AND WEST OF EACH INTERSECTION

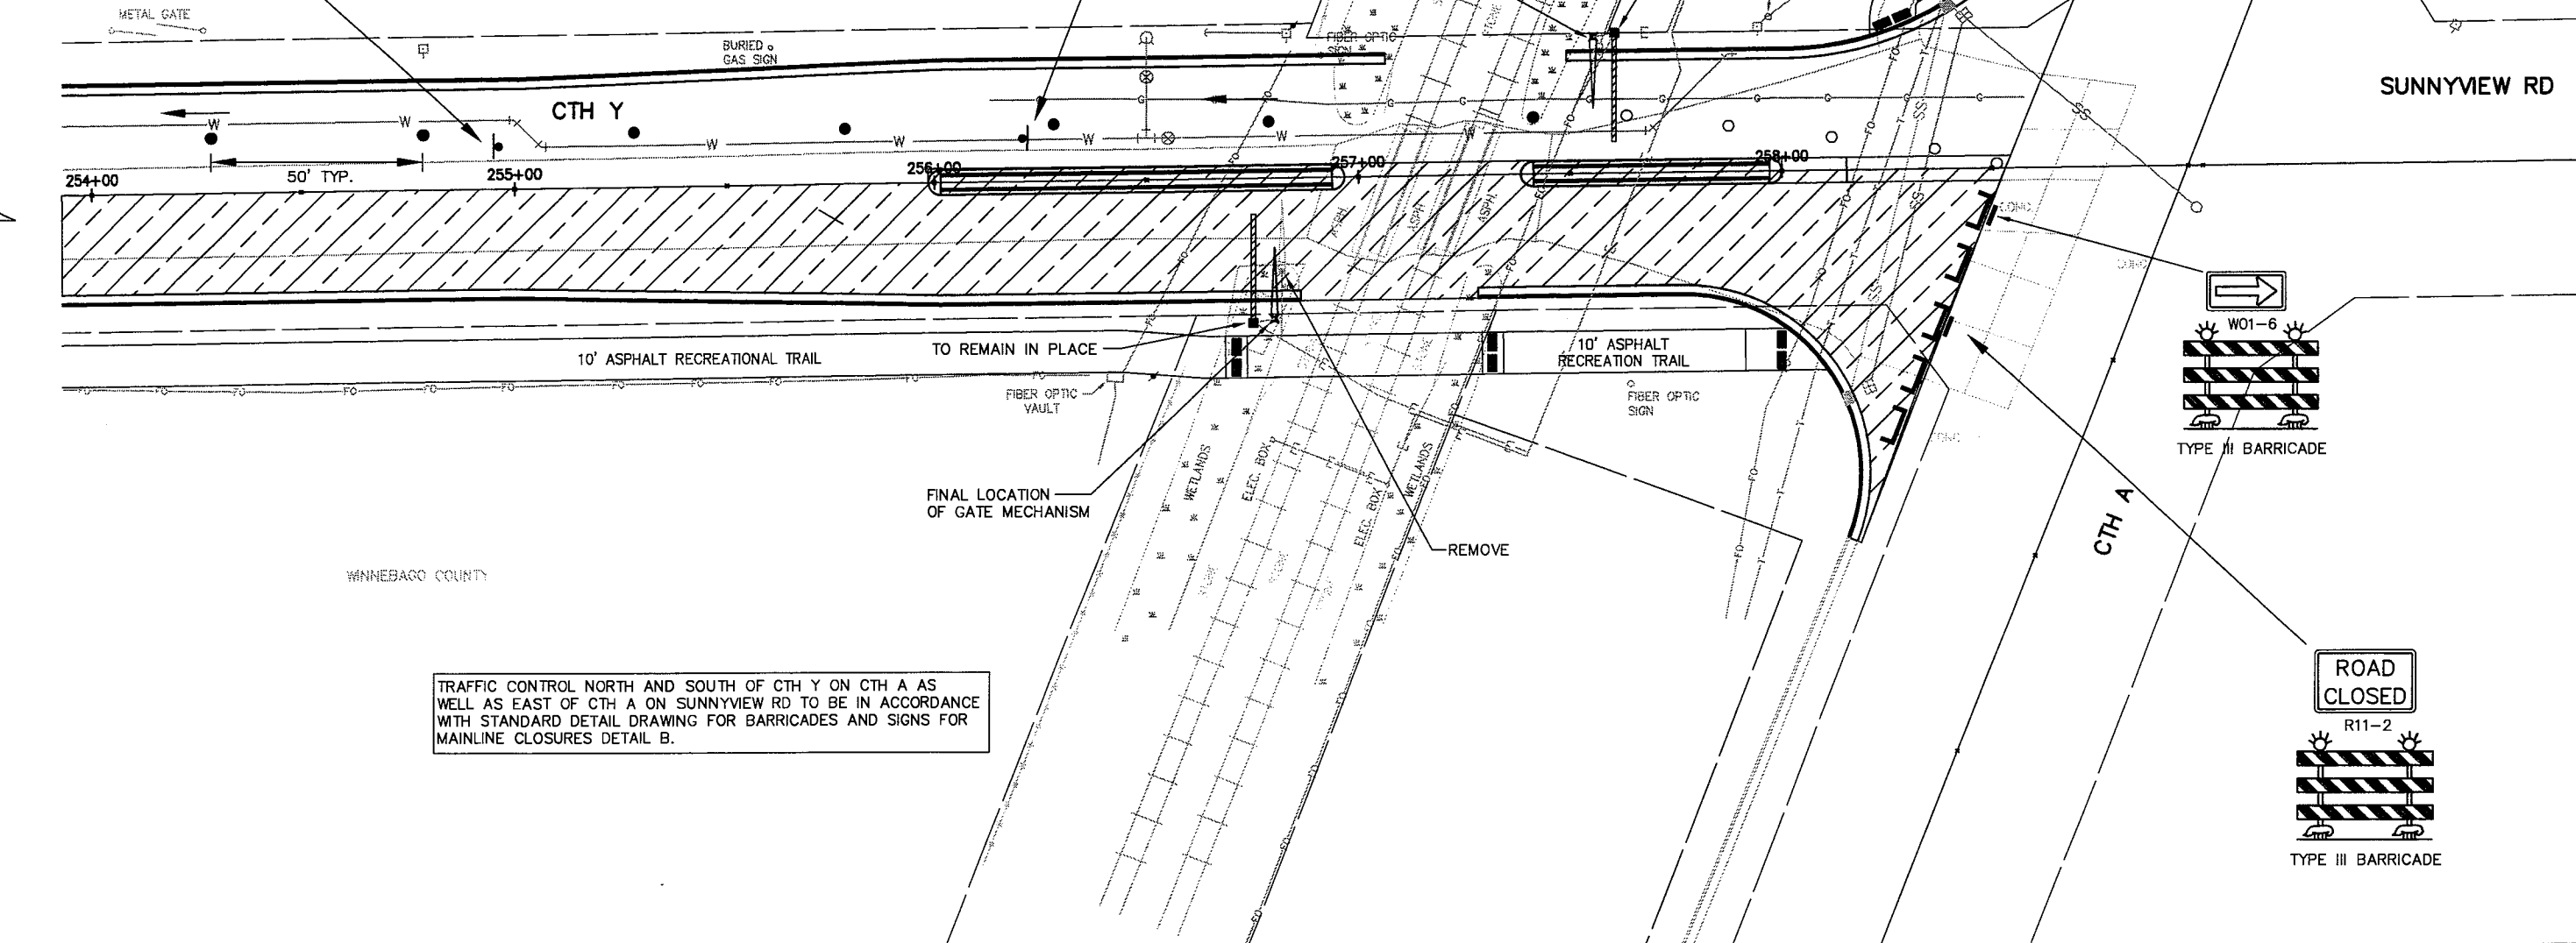

TRAFFIC CONTROL NORTH AND SOUTH OF CTH Y ON CTH A AS WELL AS EAST OF CTH A ON SUNNYVIEW RD TO BE IN ACCORDANCE WITH STANDARD DETAIL DRAWING FOR BARRICADES AND SIGNS FOR MAINLINE CLOSURES DETAIL B.

crossen W:\DWG\W0002\970343\00\DETAILS\TC PHASE 2 RR.dwg 10/07/08 1:45 PM (X-CTH Y, AT&T FIBER cty)

SEQUENCE OF OPERATION

2

NOT USED		#1				#2				#3				#4				FLASH
HEAD NUMBERS		R/W		CLEAR TO		R/W		CLEAR TO		R/W		CLEAR TO		R/W		CLEAR TO		
Ø2	1,2,3					G	Y	R		R	R	R		R	R	R		Y
Ø3	10,11,12					R	R	R		G, G	Y	R		R	R	R		R
Ø4	7,8,9					R	R	R		R	R	R		G, G	Y	R		R
Ø6	4,5,6					R	R	R		R	R	R		R	R	R		Y

RING 1

RING 2

NOT USED		#5				#6				#7				#8			
HEAD NUMBERS		R/W		CLEAR TO		R/W		CLEAR TO		R/W		CLEAR TO		R/W		CLEAR TO	
Ø2	1,2,3					R	R	R									
Ø3	10,11,12					R	R	R									
Ø4	7,8,9					R	R	R									
Ø6	4,5,6					G	Y	R									

BARRIER

** CLEARANCE TO A PHASE IN CONFLICT WITH THIS PHASE ON (SEE CHART 1 BELOW)

CHART 1


PHASE ON	NON-CONFLICTING PHASE ALLOWED TO TIME CONCURRENTLY	PHASES IN CONFLICT WITH PHASE ON
1	-	-
2	6	3,4
3	-	2,4,6
4	-	2,3,6
5	-	-
6	2	3,4
7	-	-
8	-	-

TYPE OF INTERCONNECT	
NONE	<input checked="" type="checkbox"/>
TBC (FUTURE USE)	<input type="checkbox"/>
CLOSED LOOP	<input type="checkbox"/>
HARDWIRE	<input type="checkbox"/>
TONE (FREQ)	<input type="checkbox"/>

TYPE OF PRE-EMPT	
NONE	<input checked="" type="checkbox"/>
RAILROAD	<input type="checkbox"/>
EMERGENCY VEHICLE	<input type="checkbox"/>


TYPE OF LIGHTING	
NONE	<input type="checkbox"/>
IN TRAFFIC CONTROL CABINET	<input checked="" type="checkbox"/>
IN SEPARATE CONTROL CABINET	<input type="checkbox"/>

Sq 17
/

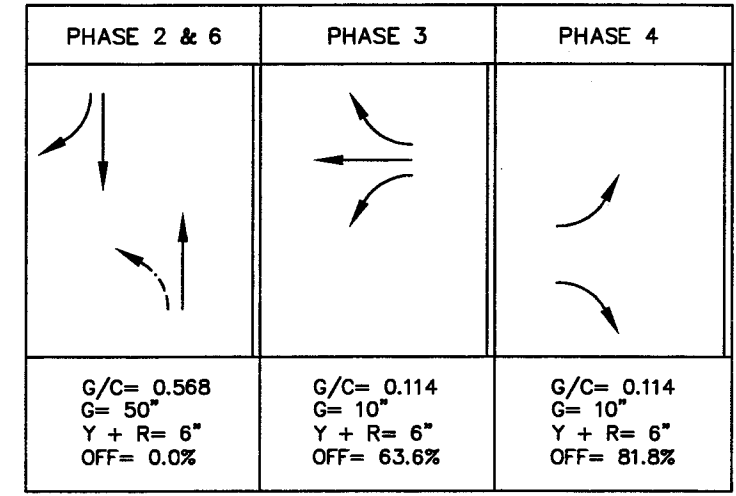


Y=4" R=2.0"

C=88 SEC G=70 SEC= 79.6% Y=18 SEC = 20.4% PED= 0.0 SEC = 0.0%

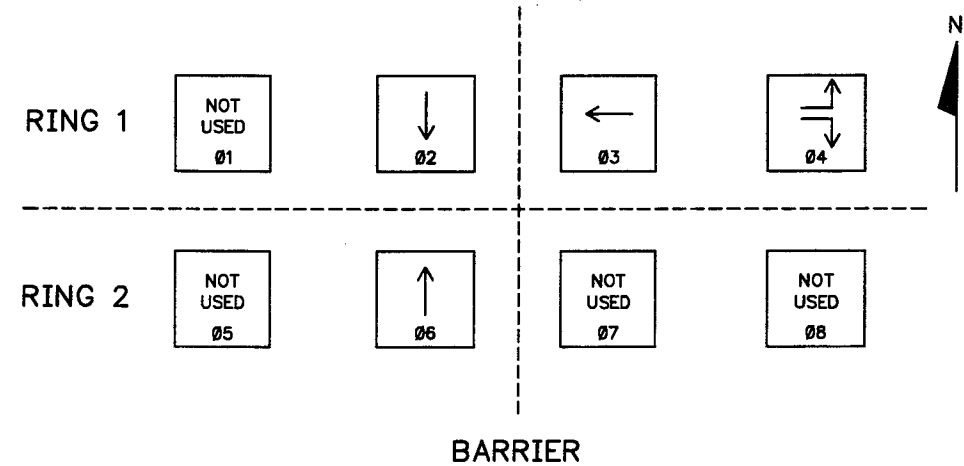

OVERLAPS

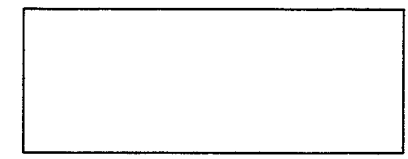

NOTES:


- WHEN ONE PHASE IS ON ALONE, ANY NON-CONFLICTING PHASE MAY START TIMING CONCURRENTLY WITHOUT A CLEARANCE INTERVAL (SEE CHART 1).
- IF ANY OPPOSING THRU PHASES ARE TIMED CONCURRENTLY, THEY SHALL TERMINATE TOGETHER DUE TO PERMISSIVE LEFT TURN CONFLICT.
- PROVIDE FOR HAND CONTROL OPERATION.

CONTROLLER LOGIC

PHASE NUMBER	PHASE LOCKING	DUAL ENTRY W / Ø	PHASE RECALL
1	-	-	-
2	-	6	MAX
3	-	-	MAX
4	-	-	MAX
5	-	-	-
6	-	2	MAX
7	-	-	-
8	-	-	-





m:\proj\4994-00-87\4994-00-87\TRAFFIC SIGNALS\CTH Y PHASE 2 SIGNAL SEQUENCE.dwg 05/27/08 10:59 AM

TRAFFIC CONTROL NORTH AND SOUTH OF CTH Y ON STH 76 AS WELL AS WEST OF STH 76 ON CTH Y TO BE IN ACCORDANCE WITH STANDARD DETAIL DRAWING FOR ADVANCE WARNING SIGNS 45 MPH OR GREATER TWO-WAY UNDIVIDED ROAD OPEN TO TRAFFIC.

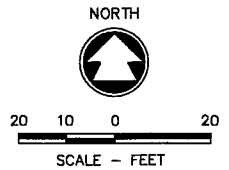


NOTE:
LOCATION OF TEMPORARY SIGNAL POLES TO BE APPROVED BY THE ENGINEER IN THE FIELD. TEMPORARY POLES TO BE LOCATED TO ALLOW FOR THE STAGED CONSTRUCTION OF THE PERMANENT TRAFFIC SIGNALS, STORM SEWER, AND CULVERT PIPES.

ADVANCE WARNING SIGNS ON STH 76 TO BE IN ACCORDANCE WITH THE STANDARD DETAIL DRAWING FOR ROAD CLOSURE.

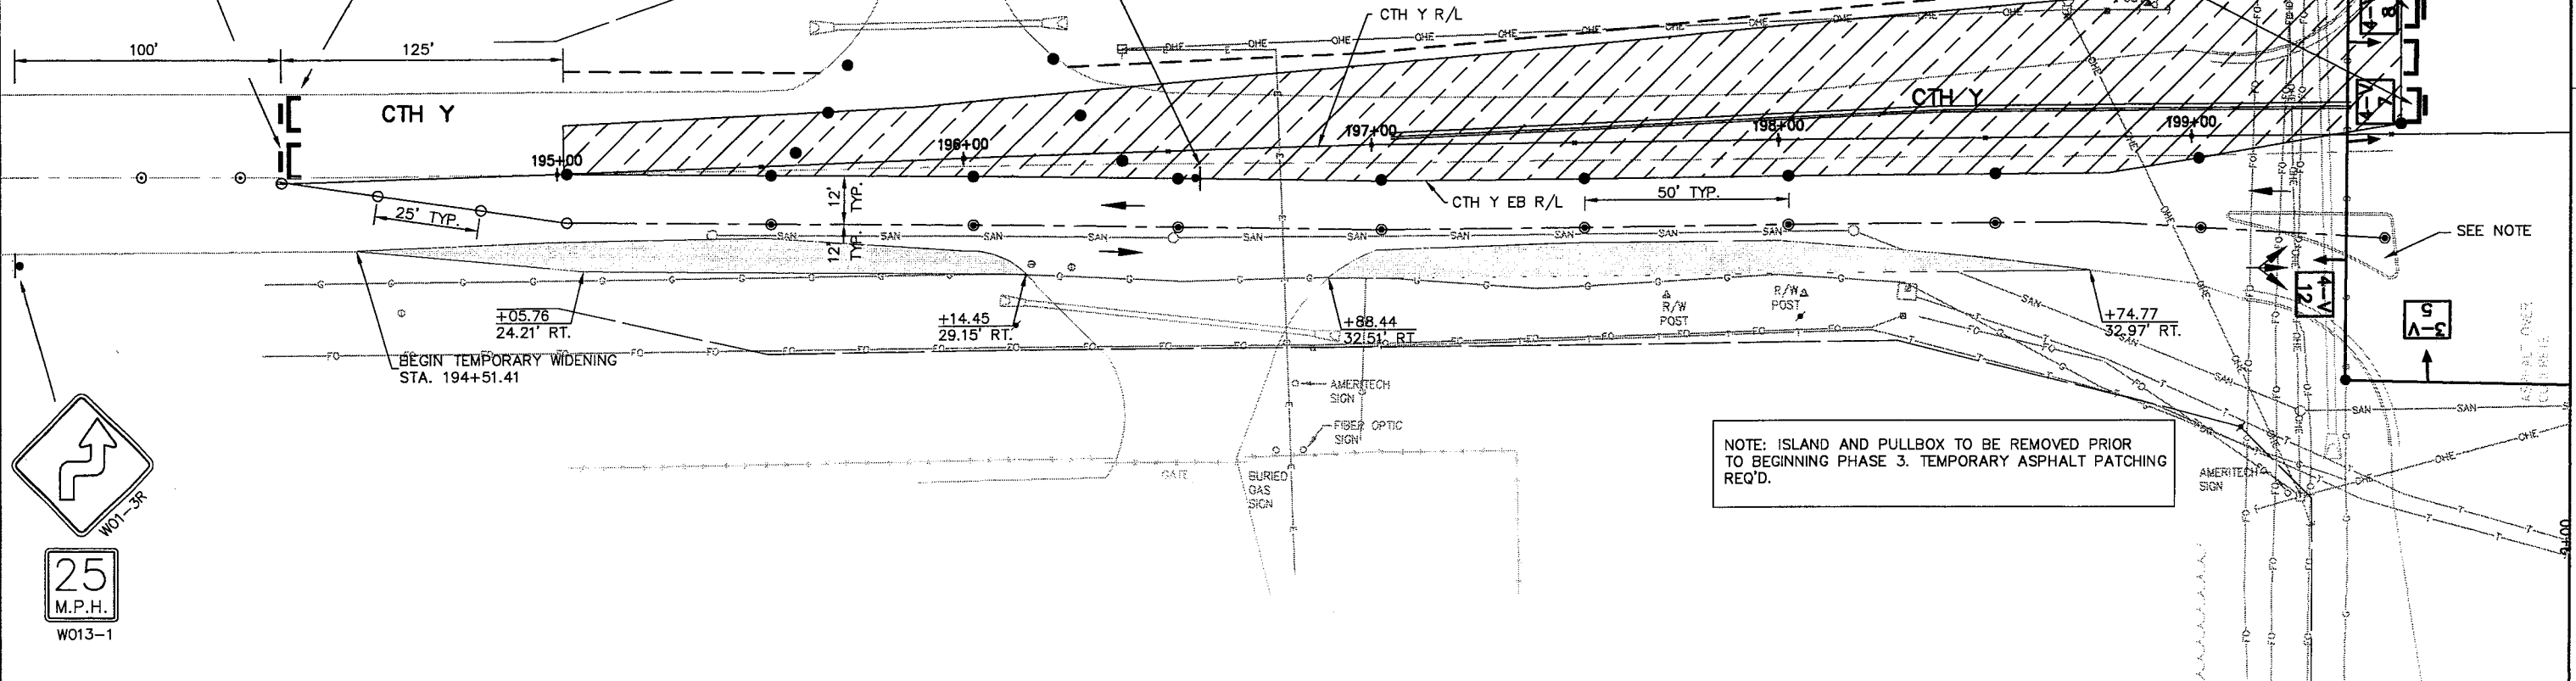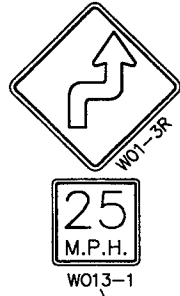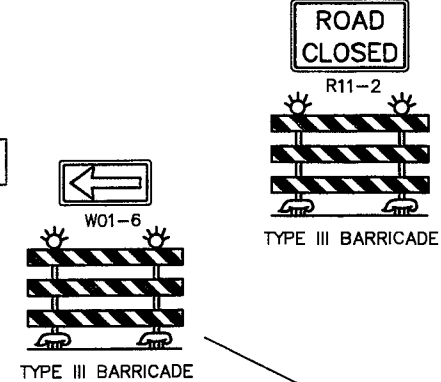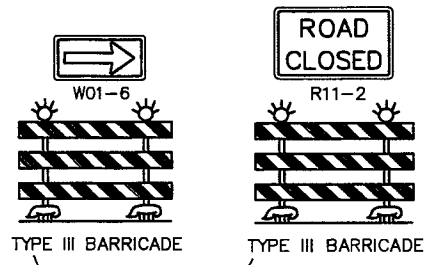

W:\Dwg\W0002\970343\00\DETAILS\TC PHASE 3-1.dwg 10/22/08 11:10 AM (X-CTH Y, AT&T FIBER.cty)

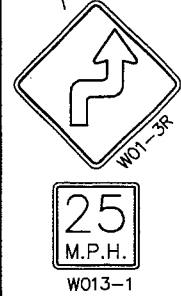

STATE PROJECT NUMBER: 6432-11-71


HWY: CTH Y

COUNTY: WINNEBAGO


PHASE 3 TRAFFIC CONTROL

SHEET NO: 93

E

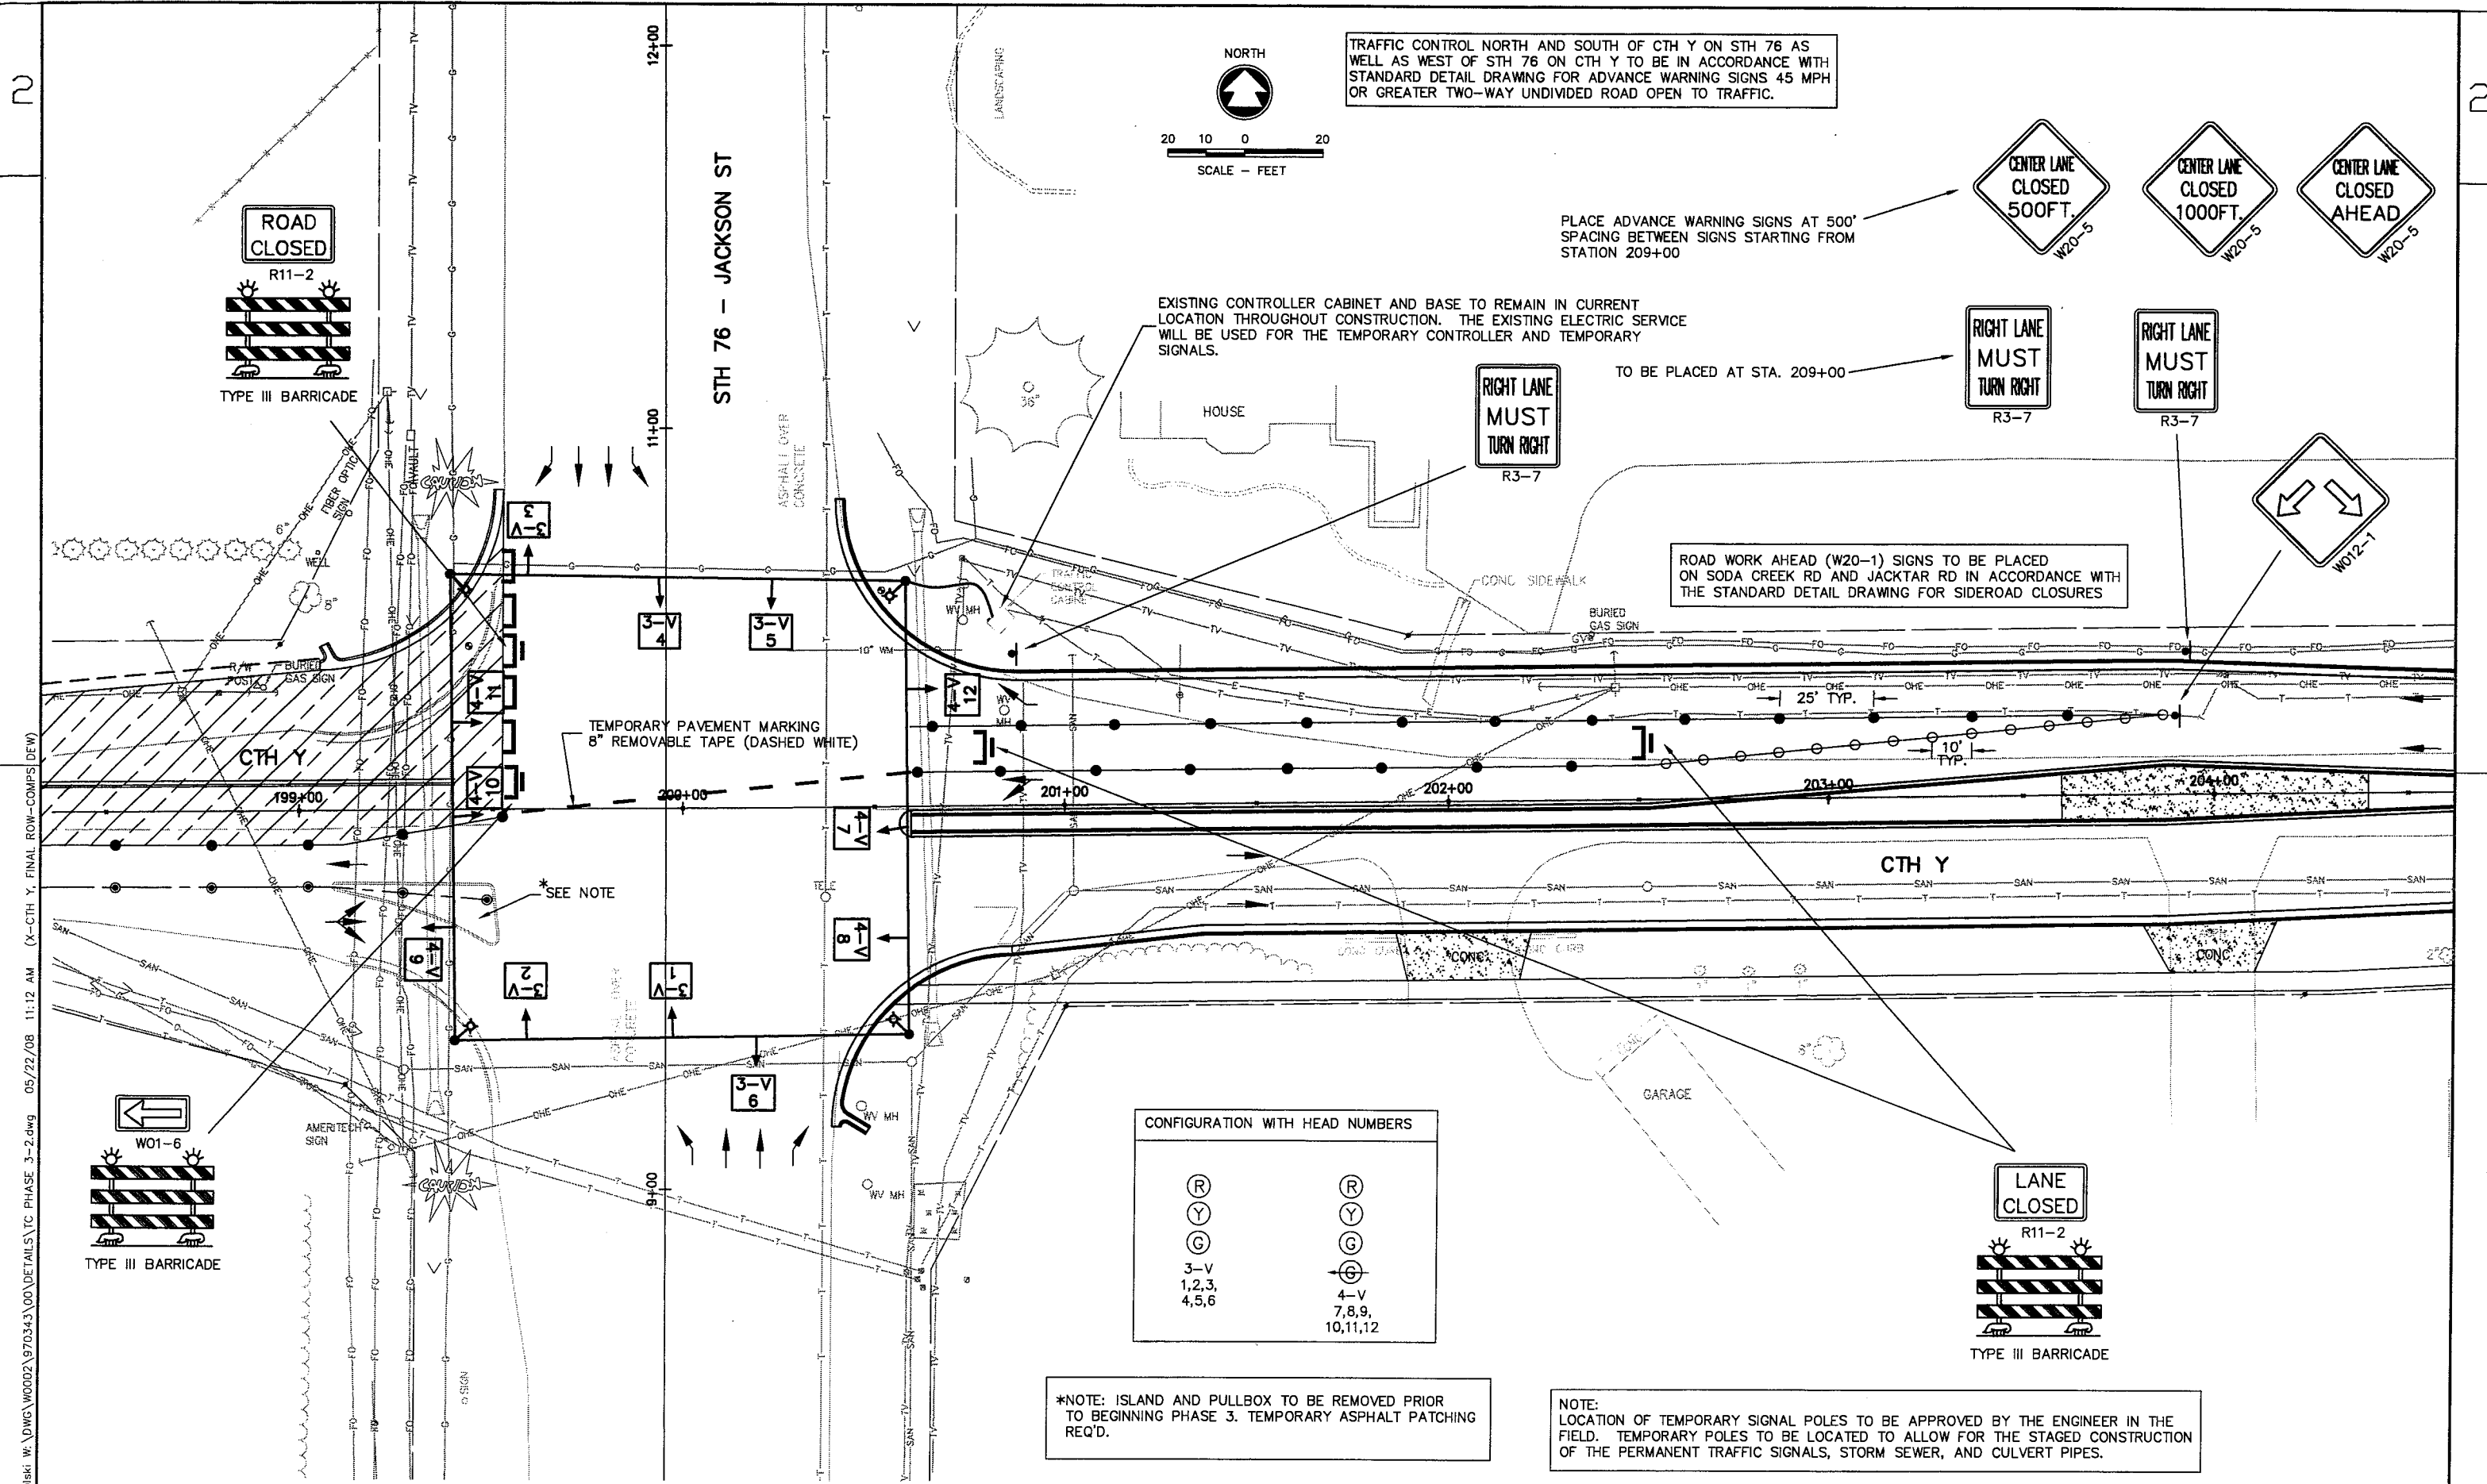

TRAFFIC CONTROL NORTH AND SOUTH OF CTH Y ON STH 76 AS WELL AS WEST OF STH 76 ON CTH Y TO BE IN ACCORDANCE WITH STANDARD DETAIL DRAWING FOR ADVANCE WARNING SIGNS 45 MPH OR GREATER TWO-WAY UNDIVIDED ROAD OPEN TO TRAFFIC.

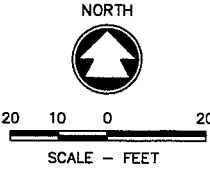

PLACE ADVANCE WARNING SIGNS AT 500' SPACING BETWEEN SIGNS STARTING FROM STATION 209+00




EXISTING CONTROLLER CABINET AND BASE TO REMAIN IN CURRENT LOCATION THROUGHOUT CONSTRUCTION. THE EXISTING ELECTRIC SERVICE WILL BE USED FOR THE TEMPORARY CONTROLLER AND TEMPORARY SIGNALS.



TO BE PLACED AT STA. 209+00



ROAD WORK AHEAD (W20-1) SIGNS TO BE PLACED ON SODA CREEK RD AND JACKTAR RD IN ACCORDANCE WITH THE STANDARD DETAIL DRAWING FOR SIDEROAD CLOSURES

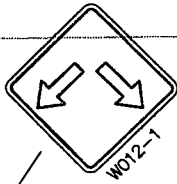

TEMPORARY PAVEMENT MARKING 8" REMOVABLE TAPE (DASHED WHITE)

amapalski.w:\dwc\w0002\970343\00\DETAILS\TC PHASE 3-2.dwg 05/22/08 11:12 AM (X-CTH Y, FINAL ROW-COMPS DEW)

CONFIGURATION WITH HEAD NUMBERS

(R)	(R)
(Y)	(Y)
(G)	(G)
3-V	4-V
1,2,3,4,5,6	7,8,9,10,11,12


*NOTE: ISLAND AND PULLBOX TO BE REMOVED PRIOR TO BEGINNING PHASE 3. TEMPORARY ASPHALT PATCHING REQ'D.

NOTE: LOCATION OF TEMPORARY SIGNAL POLES TO BE APPROVED BY THE ENGINEER IN THE FIELD. TEMPORARY POLES TO BE LOCATED TO ALLOW FOR THE STAGED CONSTRUCTION OF THE PERMANENT TRAFFIC SIGNALS, STORM SEWER, AND CULVERT PIPES.



SEQUENCE OF OPERATION

RING 1	HEAD NUMBERS	NOT USED		#1		#2		#3		#4		FLASH
		CLEAR TO		CLEAR TO		CLEAR TO		CLEAR TO		CLEAR TO		
		R/W	**	R/W	**	R/W	**	R/W	**	R/W	**	
Ø2	1,2,3					G	Y	R				Y
Ø3	10,11,12					R	R	R				R
Ø4	7,8,9					R	R	R				R
Ø6	4,5,6					R	R	R				Y

RING 2	HEAD NUMBERS	NOT USED		#5		#6		#7		#8		FLASH
		CLEAR TO		CLEAR TO		CLEAR TO		CLEAR TO		CLEAR TO		
		R/W	**	R/W	**	R/W	**	R/W	**	R/W	**	
Ø2	1,2,3					R	R	R				
Ø3	10,11,12					R	R	R				
Ø4	7,8,9					R	R	R				
Ø6	4,5,6					G	Y	R				

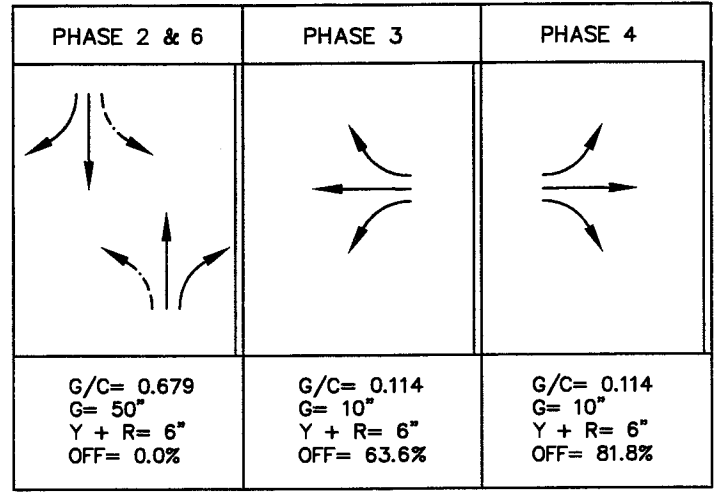

C=88 SEC G=70 SEC= 79.6% Y=18 SEC = 20.4% PED= 0.0 SEC = 0.0%

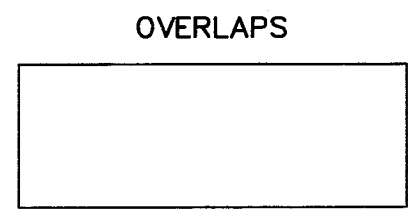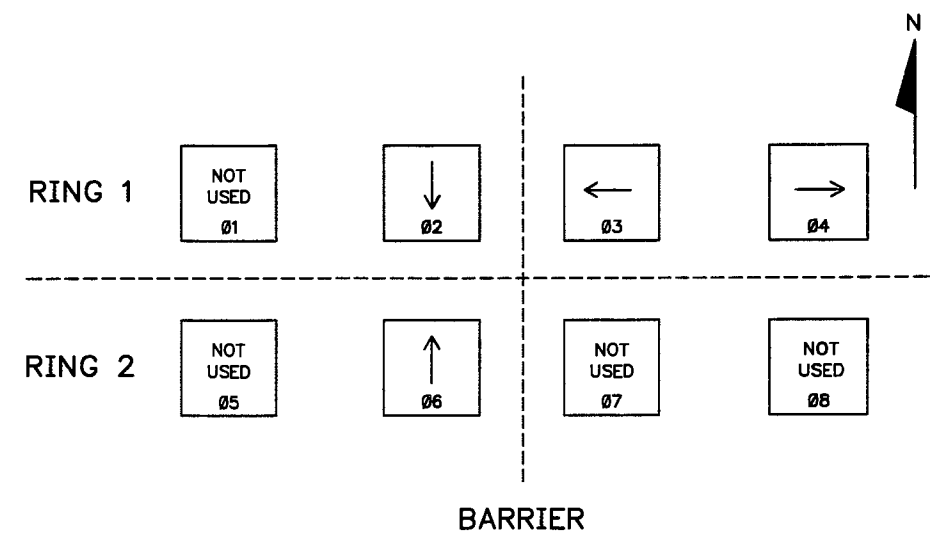

** CLEARANCE TO A PHASE IN CONFLICT WITH THIS PHASE ON (SEE CHART 1 BELOW)

CHART 1

PHASE ON	NON-CONFLICTING PHASE ALLOWED TO TIME CONCURRENTLY	PHASES IN CONFLICT WITH PHASE ON
1	-	-
2	6	3,4
3	-	2,4,6
4	-	2,3,6
5	-	-
6	2	3,4
7	-	-
8	-	-

TYPE OF INTERCONNECT	
NONE	<input checked="" type="checkbox"/>
TBC (FUTURE USE)	<input type="checkbox"/>
CLOSED LOOP	<input type="checkbox"/>
HARDWIRE	<input type="checkbox"/>
TONE (FREQ)	<input type="checkbox"/>

TYPE OF PRE-EMPT	
NONE	<input checked="" type="checkbox"/>
RAILROAD	<input type="checkbox"/>
EMERGENCY VEHICLE	<input type="checkbox"/>

TYPE OF LIGHTING	
NONE	<input type="checkbox"/>
IN TRAFFIC CONTROL CABINET	<input checked="" type="checkbox"/>
IN SEPARATE CONTROL CABINET	<input type="checkbox"/>

NOTES:

- WHEN ONE PHASE IS ON ALONE, ANY NON-CONFLICTING PHASE MAY START TIMING CONCURRENTLY WITHOUT A CLEARANCE INTERVAL (SEE CHART 1).
- IF ANY OPPOSING THRU PHASES ARE TIMED CONCURRENTLY, THEY SHALL TERMINATE TOGETHER DUE TO PERMISSIVE LEFT TURN CONFLICT.
- PROVIDE FOR HAND CONTROL OPERATION.


CONTROLLER LOGIC

PHASE NUMBER	PHASE LOCKING	DUAL ENTRY W / Ø	PHASE RECALL
1	-	-	-
2	-	6	MAX
3	-	-	MAX
4	-	-	MAX
5	-	-	-
6	-	2	MAX
7	-	-	-
8	-	-	-

p:\mop\skt\w\vw\w002\970343\00 TRAFFIC SIGNALS\CTH Y PHASE 3 SIGNAL SEQUENCE.dwg 05/22/08 11:13 AM

2


NOTE: DIMENSIONS FOR THE TEMP. WIDENING ARE FROM THE CTH Y R/L

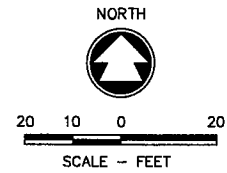

TRAFFIC CONTROL NORTH AND SOUTH OF CTH Y ON STH 76 AS WELL AS WEST OF STH 76 ON CTH Y TO BE IN ACCORDANCE WITH STANDARD DETAIL DRAWING FOR ADVANCE WARNING SIGNS 45 MPH OR GREATER TWO-WAY UNDIVIDED ROAD OPEN TO TRAFFIC.

NOTE: LOCATION OF TEMPORARY SIGNAL POLES TO BE APPROVED BY THE ENGINEER IN THE FIELD. TEMPORARY POLES TO BE LOCATED TO ALLOW FOR THE STAGED CONSTRUCTION OF THE PERMANENT TRAFFIC SIGNALS, STORM SEWER, AND CULVERT PIPES.

NOTE: PROPOSED TYPICAL SECTION TO BE MODIFIED TEMPORARILY TO PROVIDE THE MINIMUM REQUIRED 11-FOOT LANES. REMOVAL OF THE TEMPORARY WIDENING TO BE CONSIDERED INCIDENTAL TO ITEMS OF RESTORATION (TOPSOIL, SEED, FERTILIZER, MULCH, AND EROSION MAT).

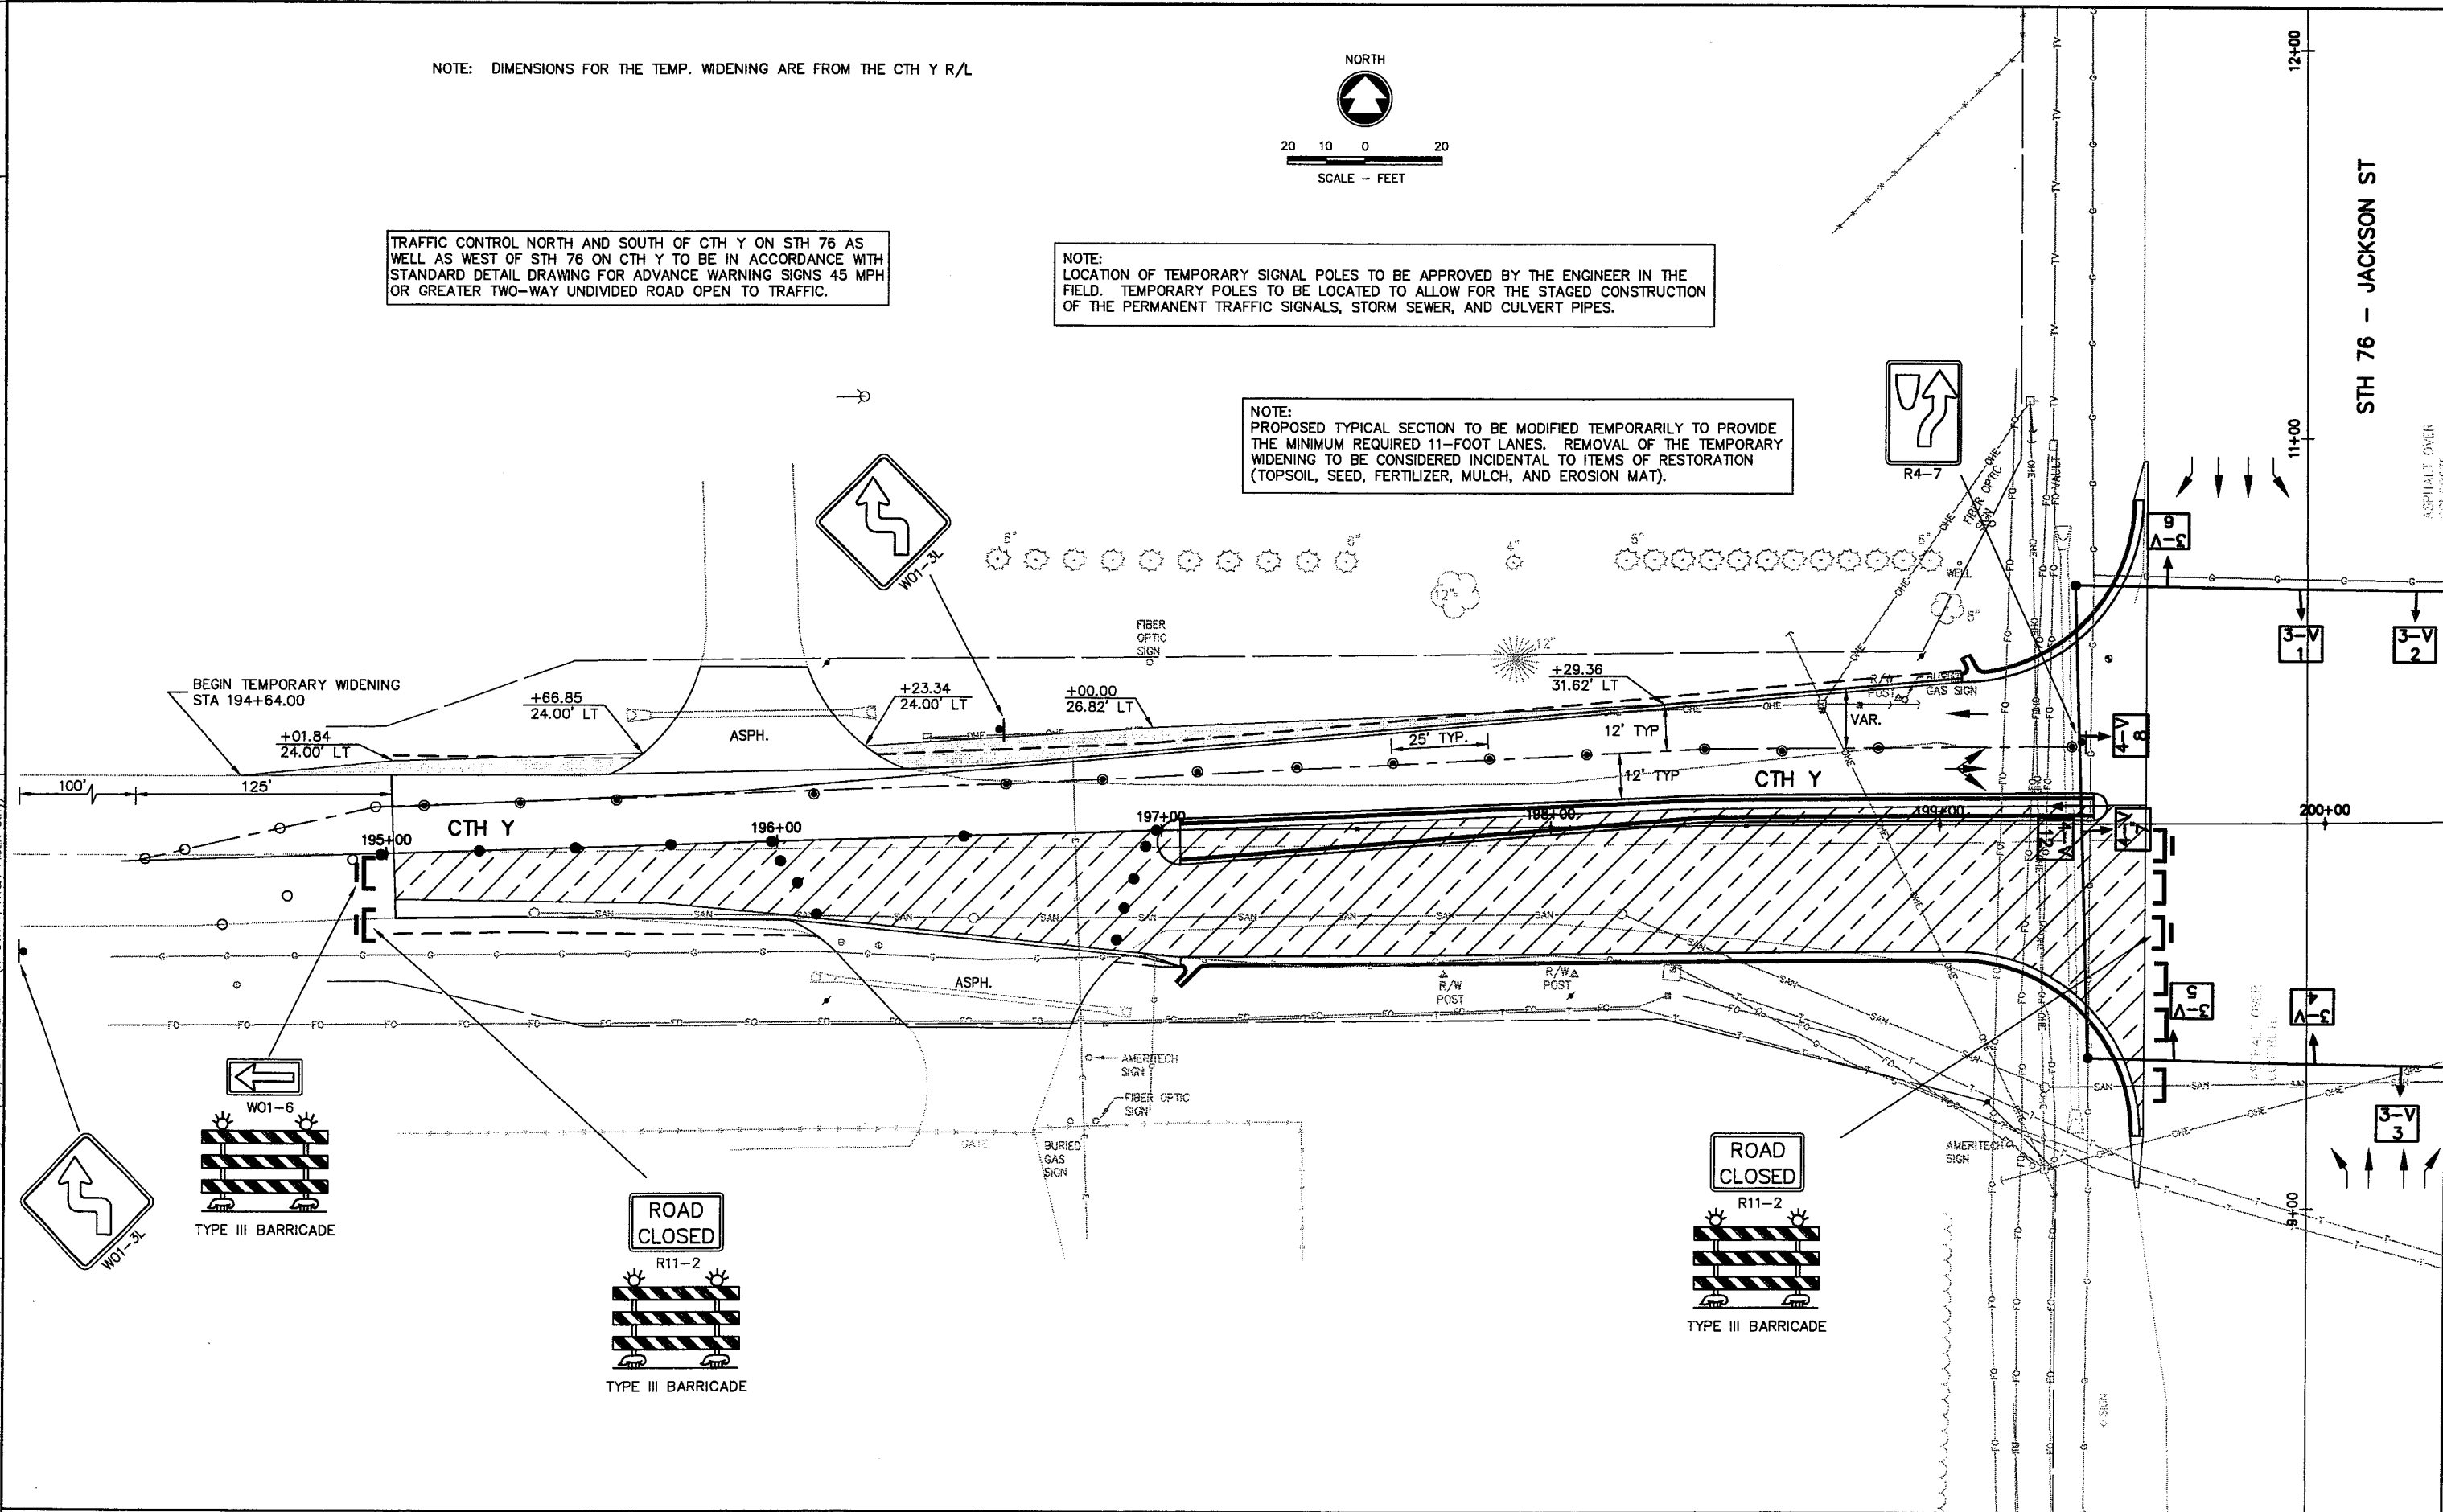

STH 76 - JACKSON ST

ASPHALT OVER

cgossen W:\DWG\W0002\970343\00\DETAILS\TC PHASE 4-1.dwg 10/22/08 11:12 AM (X-CTH Y, AT&T FIBER CITY)

STATE PROJECT NUMBER: 6432-11-71

HWY: CTH Y

COUNTY: WINNEBAGO

PHASE 4 TRAFFIC CONTROL

SHEET NO:

96

E

MSDOT/CADD SHEET 42

NOTE:
LOCATION OF TEMPORARY SIGNAL POLES TO BE APPROVED BY THE ENGINEER IN THE FIELD. TEMPORARY POLES TO BE LOCATED TO ALLOW FOR THE STAGED CONSTRUCTION OF THE PERMANENT TRAFFIC SIGNALS, STORM SEWER, AND CULVERT PIPES.


TRAFFIC CONTROL NORTH AND SOUTH OF CTH Y ON STH 76 AS WELL AS WEST OF STH 76 ON CTH Y TO BE IN ACCORDANCE WITH STANDARD DETAIL DRAWING FOR ADVANCE WARNING SIGNS 45 MPH OR GREATER TWO-WAY UNDIVIDED ROAD OPEN TO TRAFFIC.

PLACE ADVANCE WARNING SIGNS AT 500' SPACING BETWEEN SIGNS STARTING AT STATION 209+00




EXISTING CONTROLLER CABINET AND BASE TO REMAIN IN CURRENT LOCATION THROUGHOUT CONSTRUCTION. THE EXISTING ELECTRIC SERVICE WILL BE USED FOR THE TEMPORARY CONTROLLER AND TEMPORARY SIGNALS.

TO BE PLACED AT STATION 209+00


ROAD WORK AHEAD (W20-1) SIGNS TO BE PLACED ON SODA CREEK RD AND JACKTAR RD

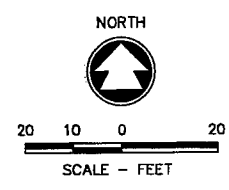

STH 76 - JACKSON ST

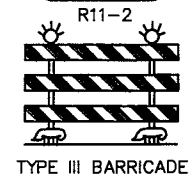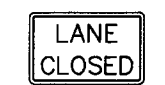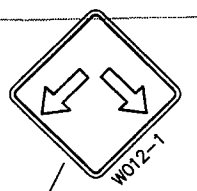

LEGEND

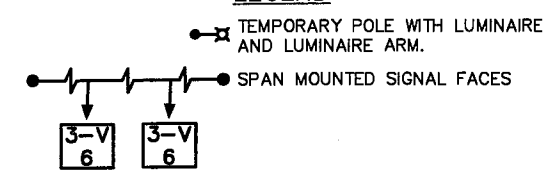

CONFIGURATION WITH HEAD NUMBERS

(R)	(R)
(Y)	(Y)
(G)	(G)
3-V 1,2,3, 4,5,6	4-V 7,8,9, 10,11,12

pmagalski W:\DWC\W0002\970343\00\DETAILS\TC PHASE 4-2.dwg 05/22/08 11:17 AM (X-CTH Y, FINAL ROW-COMPS (DEW))


SEQUENCE OF OPERATION

RING 1



HEAD NUMBERS	#1				#2				FLASH
	R/W	**	*		R/W	**	*		
Ø2	1,2,3				G	Y	R		Y
Ø3	10,11,12				R	R	R		R
Ø4	7,8,9				R	R	R		R
Ø6	4,5,6				R	R	R		Y

RING 2

HEAD NUMBERS	#5				#6				FLASH
	R/W	**	*		R/W	**	*		
Ø2	1,2,3				R	R	R		
Ø4	7,8,9				R	R	R		
Ø6	4,5,6				G	Y	R		
Ø8	10,11,12				R	R	R		

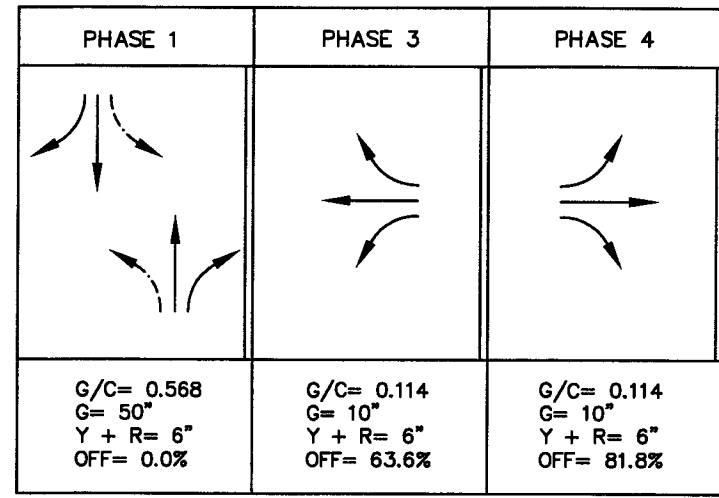

C=88 SEC G=70 SEC= 79.6% Y=18 SEC = 20.4% PED= 0.0 SEC = 0.0%

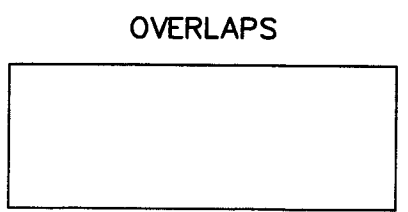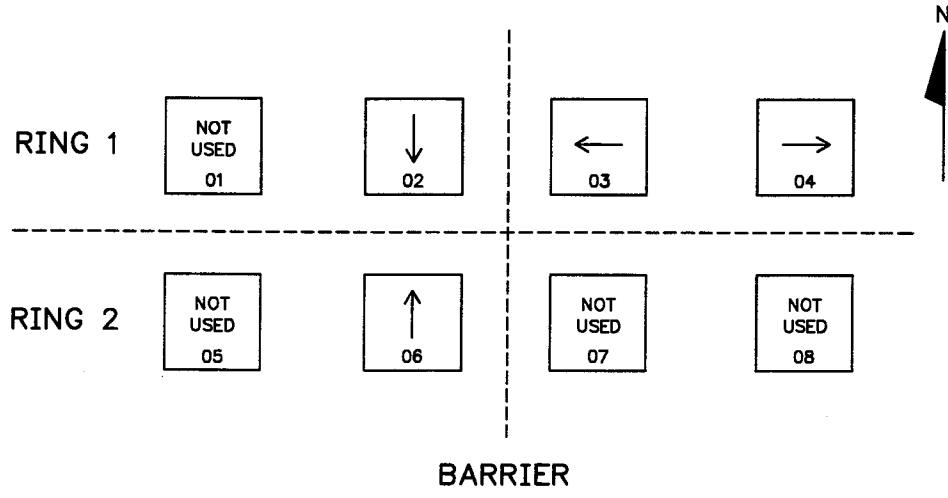

** CLEARANCE TO A PHASE IN CONFLICT WITH THIS PHASE ON (SEE CHART 1 BELOW)

CHART 1

PHASE ON	NON-CONFLICTING PHASE ALLOWED TO TIME CONCURRENTLY	PHASES IN CONFLICT WITH PHASE ON
1	-	-
2	6	3,4
3	-	2,4,6
4	-	2,3,6
5	-	-
6	2	3,4
7	-	-
8	-	-

TYPE OF INTERCONNECT	
NONE	<input checked="" type="checkbox"/>
TBC (FUTURE USE)	<input type="checkbox"/>
CLOSED LOOP	<input type="checkbox"/>
HARDWIRE	<input type="checkbox"/>
tone (FREQ)	<input type="checkbox"/>

TYPE OF PRE-EMPT	
NONE	<input checked="" type="checkbox"/>
RAILROAD	<input type="checkbox"/>
EMERGENCY VEHICLE	<input type="checkbox"/>

TYPE OF LIGHTING	
NONE	<input type="checkbox"/>
IN TRAFFIC CONTROL CABINET	<input checked="" type="checkbox"/>
IN SEPARATE CONTROL CABINET	<input type="checkbox"/>

NOTES:

- WHEN ONE PHASE IS ON ALONE, ANY NON-CONFLICTING PHASE MAY START TIMING CONCURRENTLY WITHOUT A CLEARANCE INTERVAL (SEE CHART 1).
- IF ANY OPPOSING THRU PHASES ARE TIMED CONCURRENTLY, THEY SHALL TERMINATE TOGETHER DUE TO PERMISSIVE LEFT TURN CONFLICT.
- PROVIDE FOR HAND CONTROL OPERATION.

CONTROLLER LOGIC

PHASE NUMBER	PHASE LOCKING	DUAL ENTRY W / 0	PHASE RECALL
1	-	-	-
2	-	6	MAX
3	-	-	MAX
4	-	-	MAX
5	-	-	-
6	-	2	MAX
7	-	-	-
8	-	-	-

SEE REPLACEMENT SHEET 99A

LEGEND


- PULL BOX 12" X 24"
- PULL BOX 24" X 36"
- PULL BOX 24" X 36"
- SIGNAL STANDARD, PEDESTAL MOUNT
- SIGNAL POLE, MAST-ARM, TRANSFORMER MOUNT
- LUMINAIRE (250W, unless otherwise noted)
- CONTROL CABINET BASE
- CONDUIT
- SIGNAL HEAD NUMBER MOUNTING CONFIGURATION
- LOOP DETECTOR (in 1" conduit)
- LOOP DETECTOR (in 1" conduit w/12" PB)
- UTILITY POLE
- SERVICE POLE
- EVP DETECTOR
- PEDESTRIAN PUSH BUTTON
- VIDEO CAMERA
- OVERHEAD LINES
- UNDERGROUND ELECTRIC

CONFIGURATION WITH HEAD NUMBERS		
3-V 	3-H 	EVP DETECTOR
1, 3, 4, 6 7, 9, 10, 12	2, 5, 8, 11	




R1-1F
30" X 30"

Mount under Signal Face numbers 3, 6, 9 & 12.

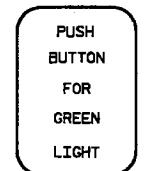

R10-3

MOUNT ON SB1 AND SB6 ABOVE PUSH BUTTON

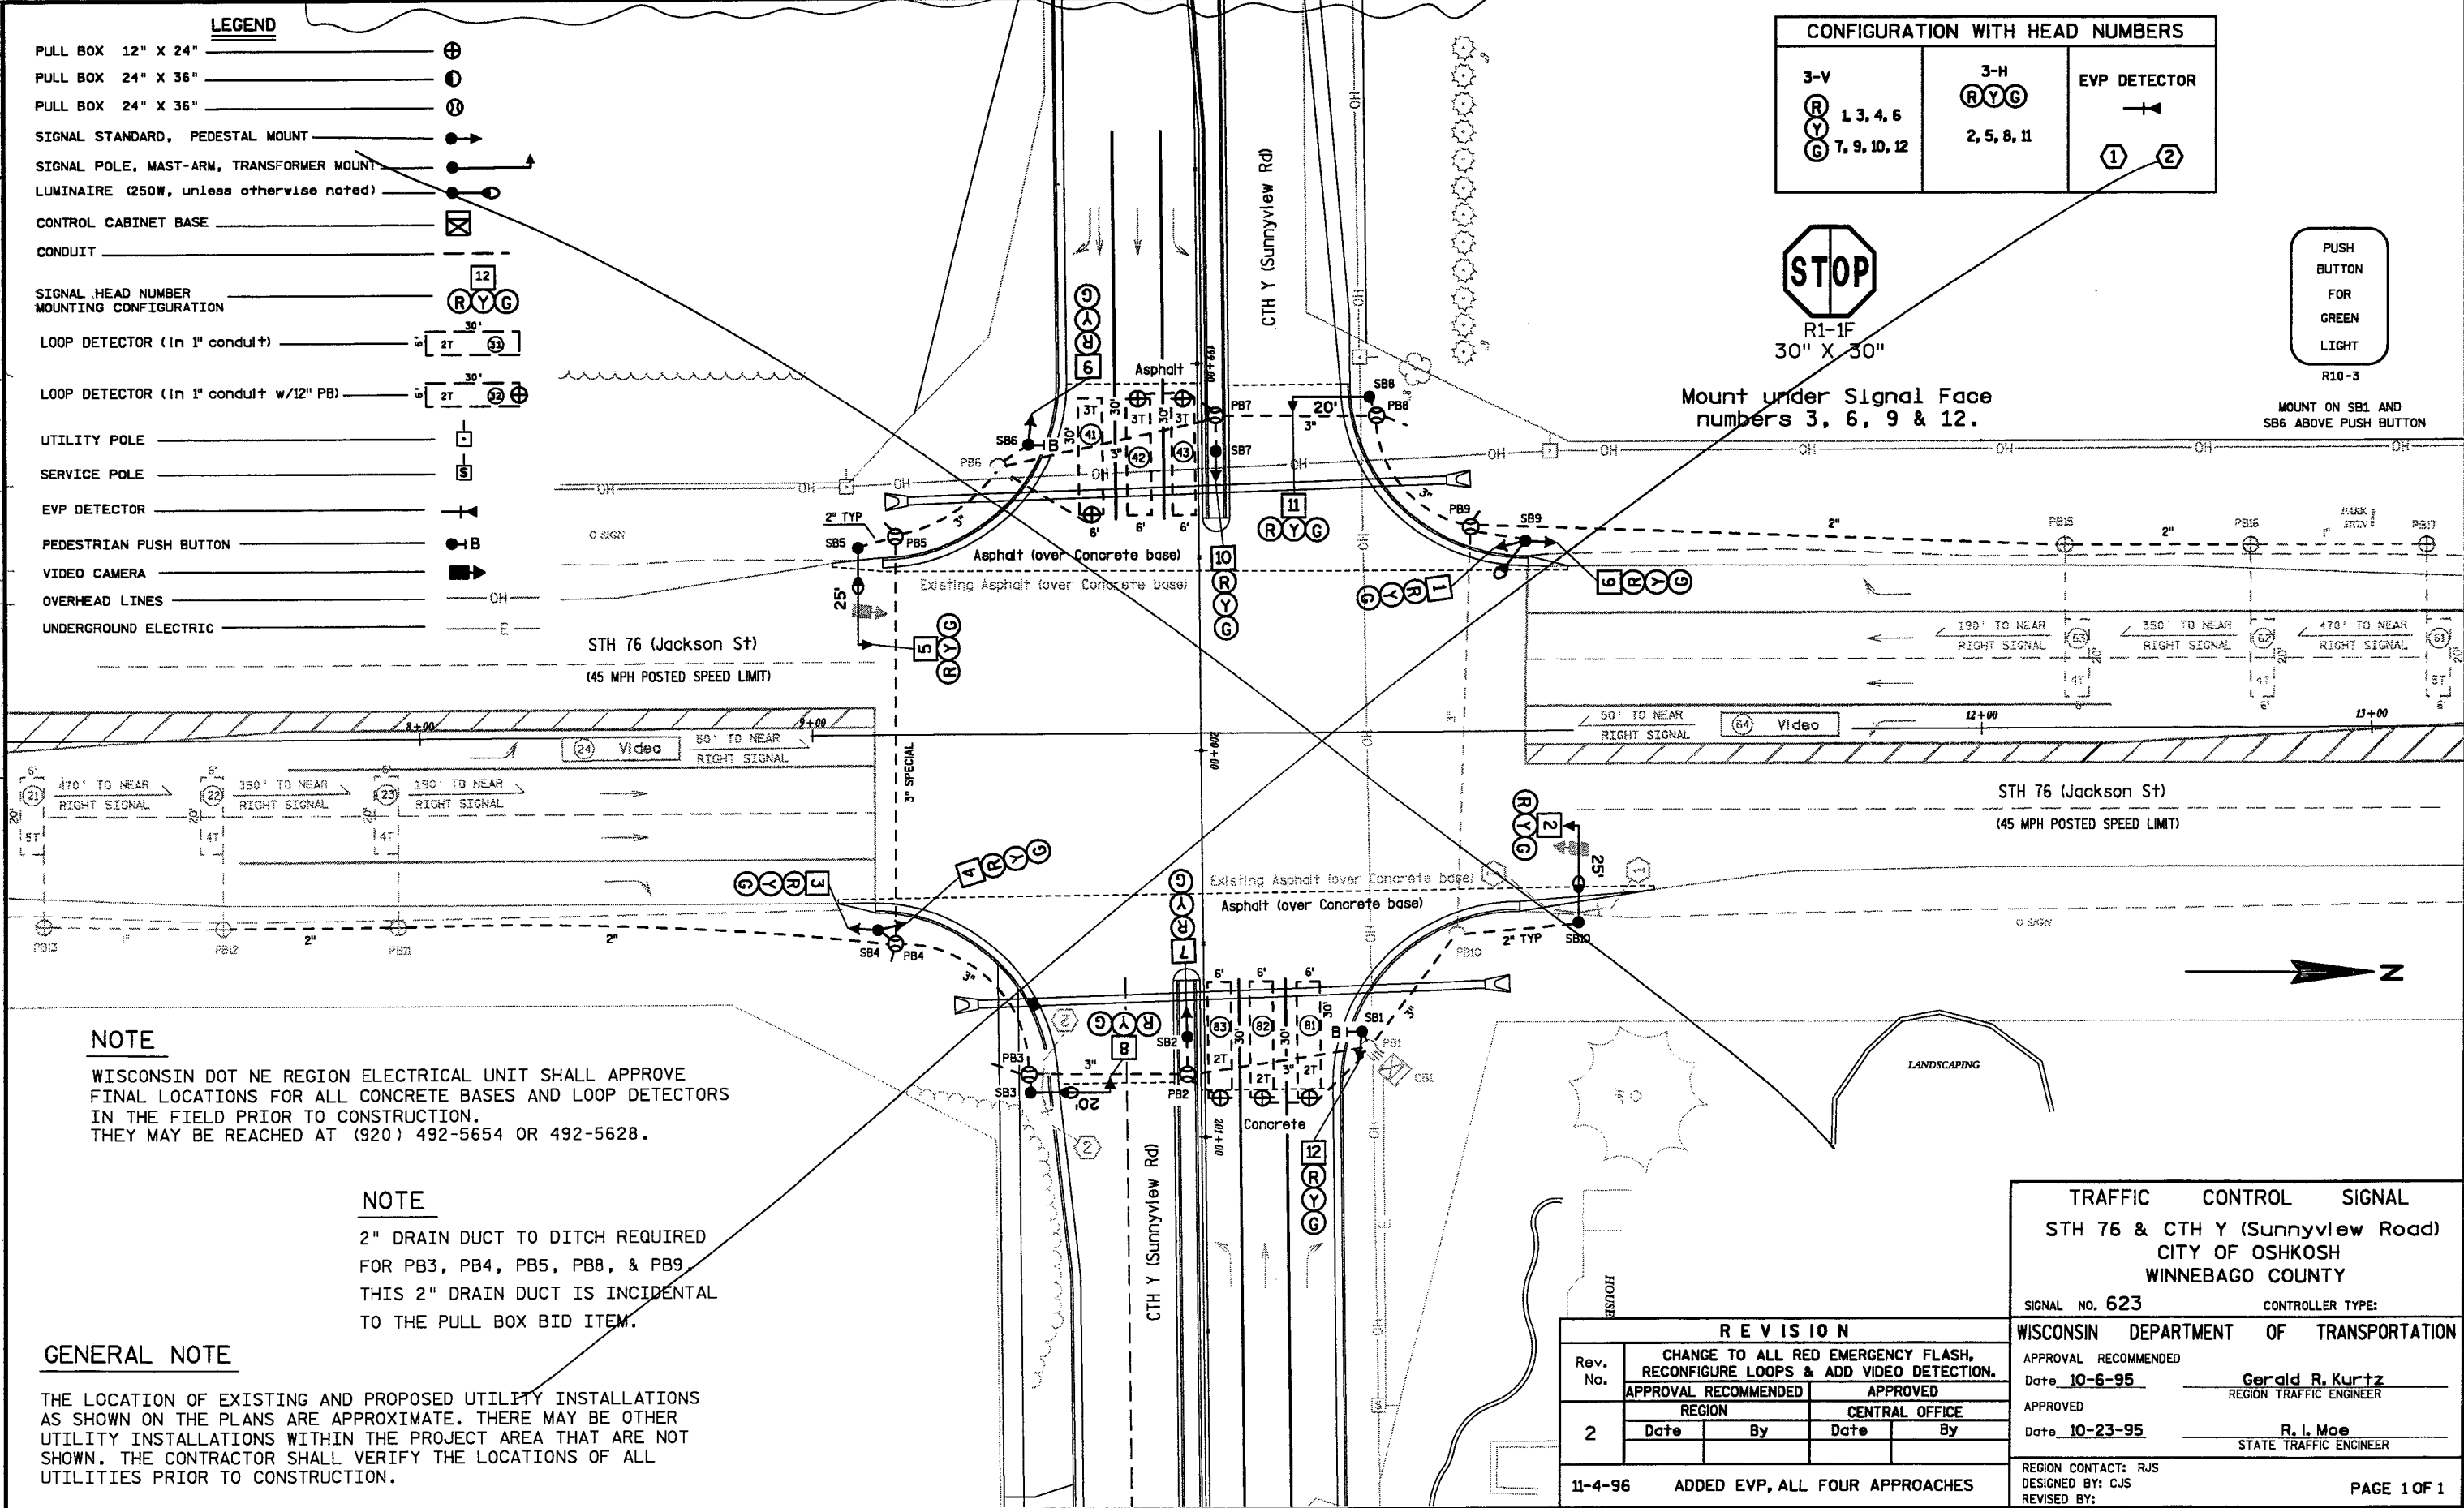

NOTE

WISCONSIN DOT NE REGION ELECTRICAL UNIT SHALL APPROVE FINAL LOCATIONS FOR ALL CONCRETE BASES AND LOOP DETECTORS IN THE FIELD PRIOR TO CONSTRUCTION. THEY MAY BE REACHED AT (920) 492-5654 OR 492-5628.

NOTE

2" DRAIN DUCT TO DITCH REQUIRED FOR PB3, PB4, PB5, PB8, & PB9. THIS 2" DRAIN DUCT IS INCIDENTAL TO THE PULL BOX BID ITEM.




GENERAL NOTE

THE LOCATION OF EXISTING AND PROPOSED UTILITY INSTALLATIONS AS SHOWN ON THE PLANS ARE APPROXIMATE. THERE MAY BE OTHER UTILITY INSTALLATIONS WITHIN THE PROJECT AREA THAT ARE NOT SHOWN. THE CONTRACTOR SHALL VERIFY THE LOCATIONS OF ALL UTILITIES PRIOR TO CONSTRUCTION.

TRAFFIC CONTROL SIGNAL STH 76 & CTH Y (Sunnyview Road) CITY OF OSHKOSH WINNEBAGO COUNTY	
SIGNAL NO. 623	CONTROLLER TYPE:
WISCONSIN DEPARTMENT OF TRANSPORTATION	
APPROVAL RECOMMENDED	APPROVED
Date 10-6-95	Gerald R. Kurtz REGION TRAFFIC ENGINEER
APPROVED	APPROVED
Date 10-23-95	R. I. Moe STATE TRAFFIC ENGINEER
REGION CONTACT: RJS	DESIGNED BY: CJS
REVISED BY:	


REVISION			
Rev. No.	CHANGE TO ALL RED EMERGENCY FLASH, RECONFIGURE LOOPS & ADD VIDEO DETECTION.		
	APPROVAL RECOMMENDED	APPROVED	
	REGION	CENTRAL OFFICE	
2	Date	By	Date By
11-4-96 ADDED EVP, ALL FOUR APPROACHES			

LEGEND

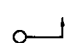- PULL BOX 24" X 36" 
- SIGNAL STANDARD OR TYPE 4 POLE 
- TYPE 2 POLE 

SALVAGE TRAFFIC SIGNALS SUMMARY


- 13' STANDARD (2 TOTAL)
- TYPE 2 POLE (4 TOTAL)
- TYPE 4 POLE (2 TOTAL)

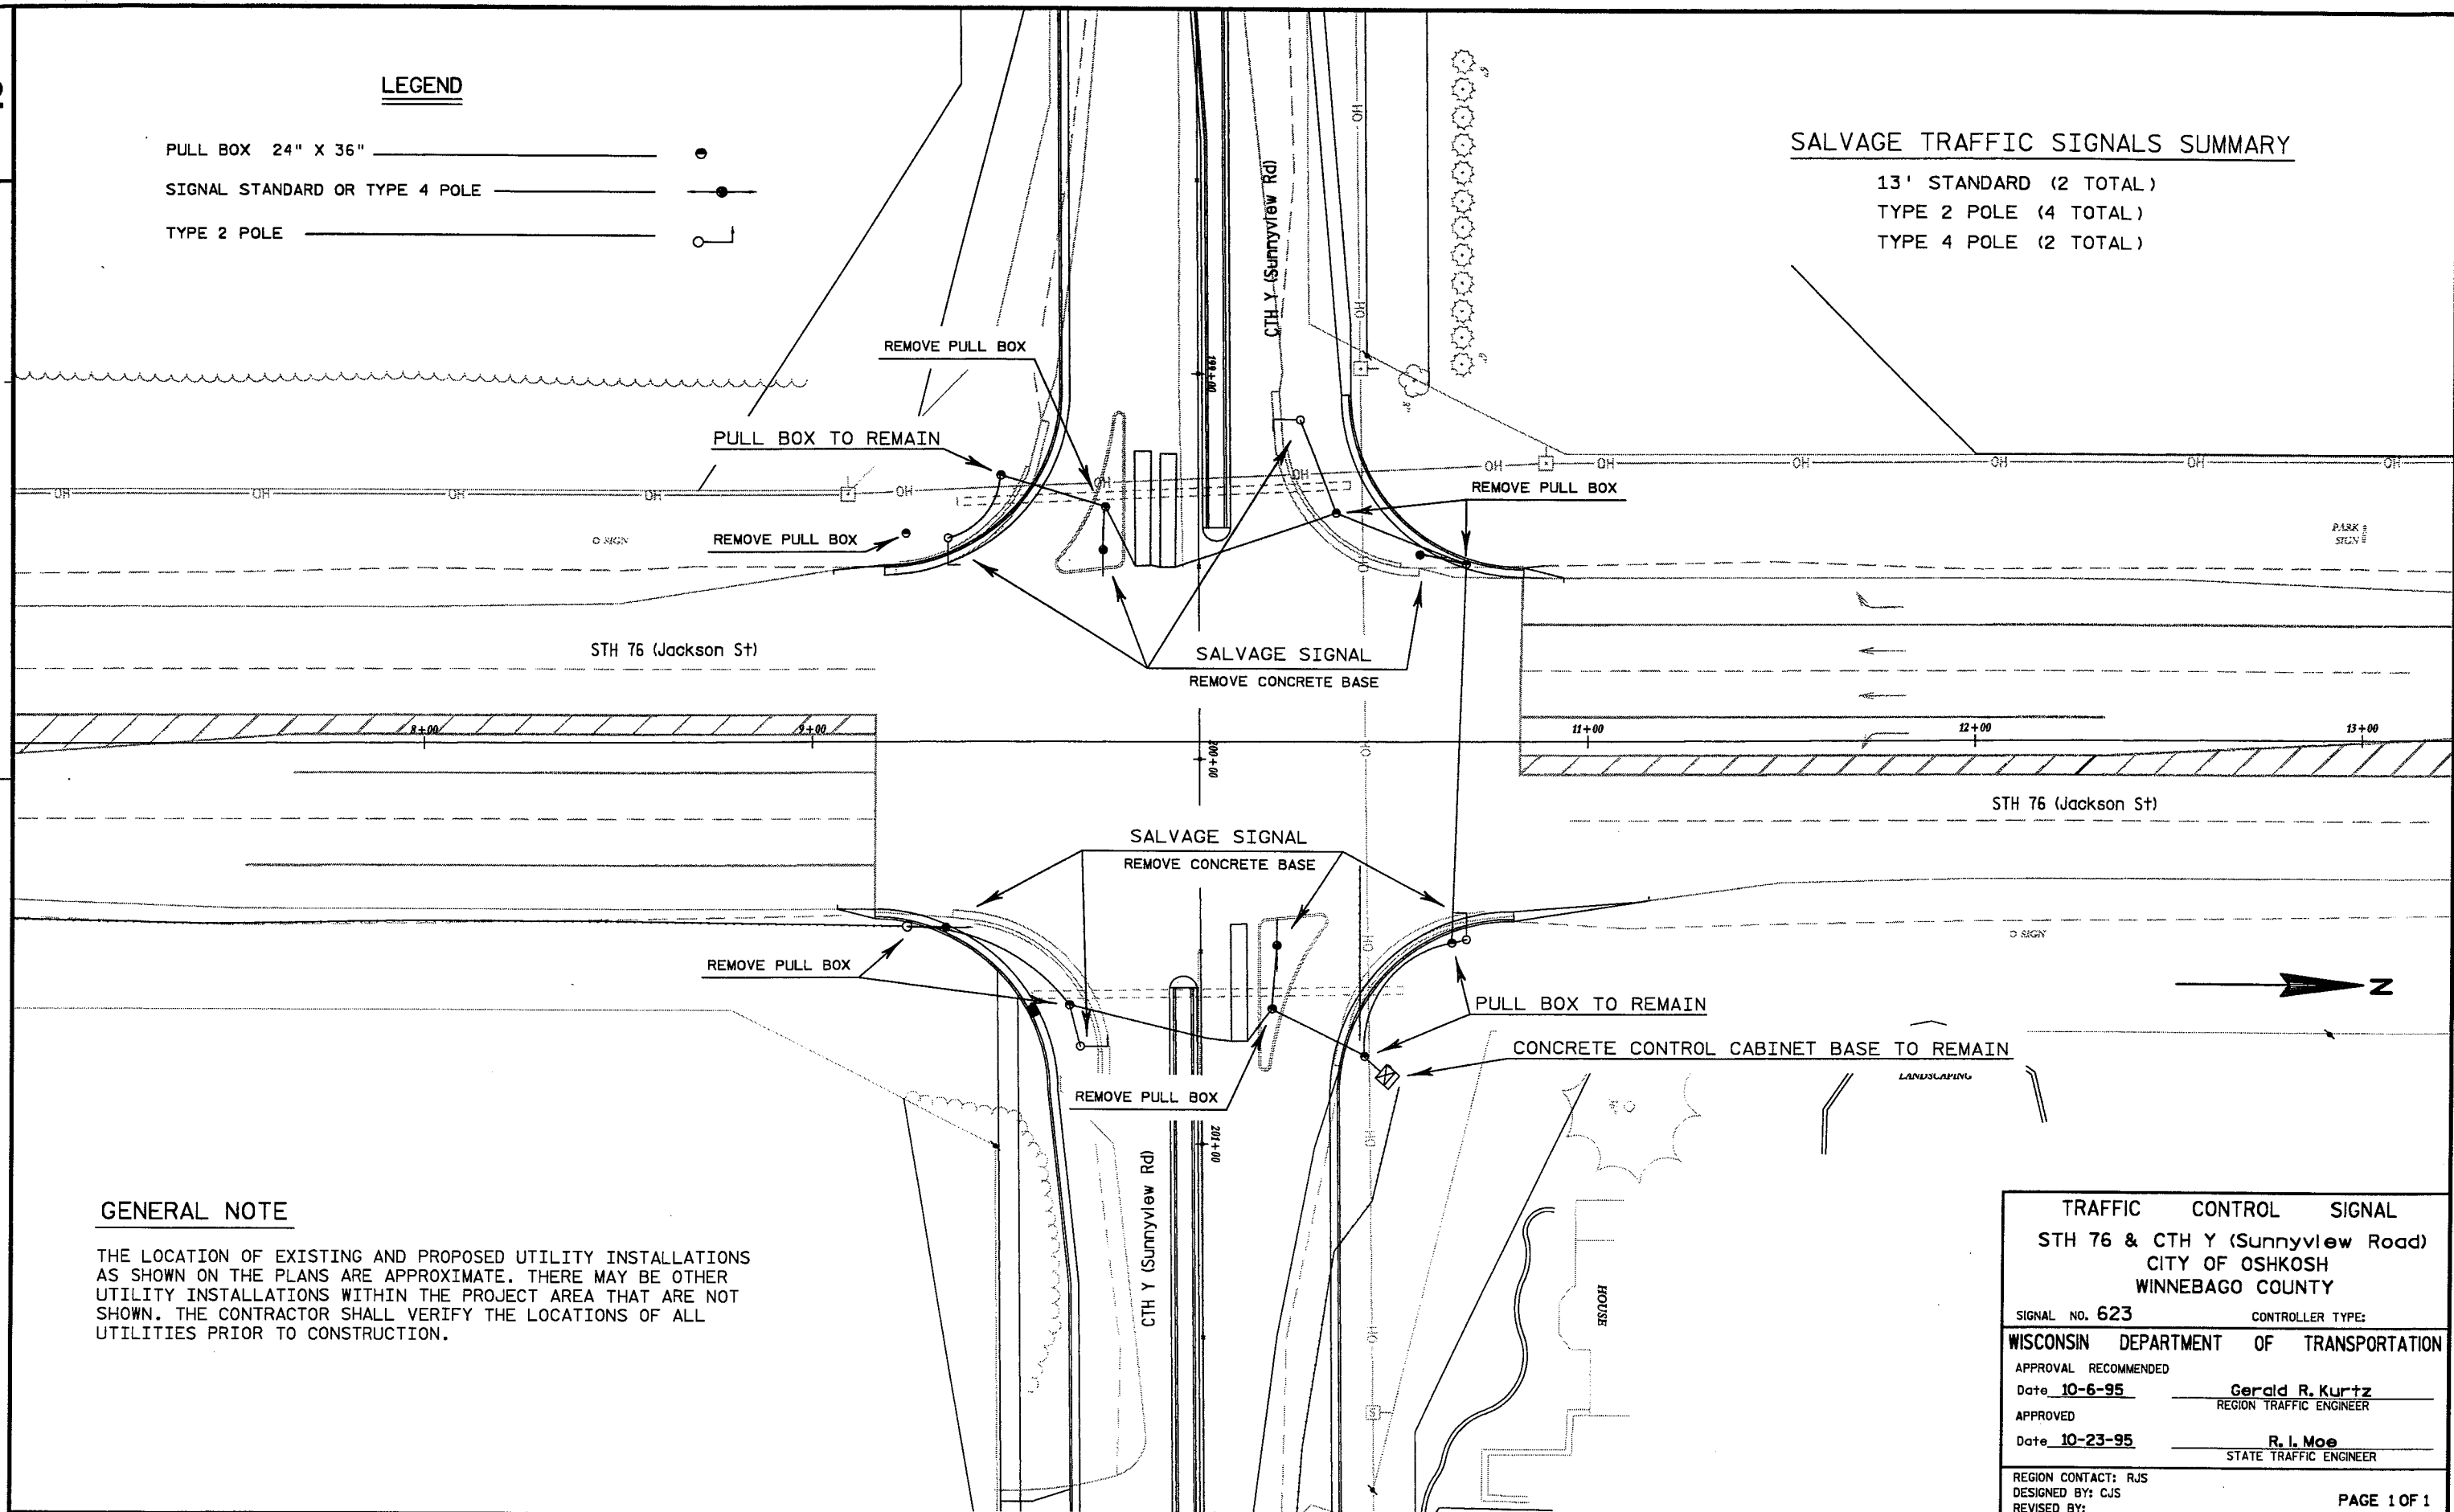

GENERAL NOTE

THE LOCATION OF EXISTING AND PROPOSED UTILITY INSTALLATIONS AS SHOWN ON THE PLANS ARE APPROXIMATE. THERE MAY BE OTHER UTILITY INSTALLATIONS WITHIN THE PROJECT AREA THAT ARE NOT SHOWN. THE CONTRACTOR SHALL VERIFY THE LOCATIONS OF ALL UTILITIES PRIOR TO CONSTRUCTION.


TRAFFIC CONTROL SIGNAL	
STH 76 & CTH Y (Sunnyview Road) CITY OF OSHKOSH WINNEBAGO COUNTY	
SIGNAL NO. 623	CONTROLLER TYPE:
WISCONSIN DEPARTMENT OF TRANSPORTATION	
APPROVAL RECOMMENDED	
Date <u>10-6-95</u>	<u>Gerald R. Kurtz</u> REGION TRAFFIC ENGINEER
APPROVED	
Date <u>10-23-95</u>	<u>R. I. Moe</u> STATE TRAFFIC ENGINEER
REGION CONTACT: RJS	PAGE 1 OF 1
DESIGNED BY: CJS	
REVISED BY:	

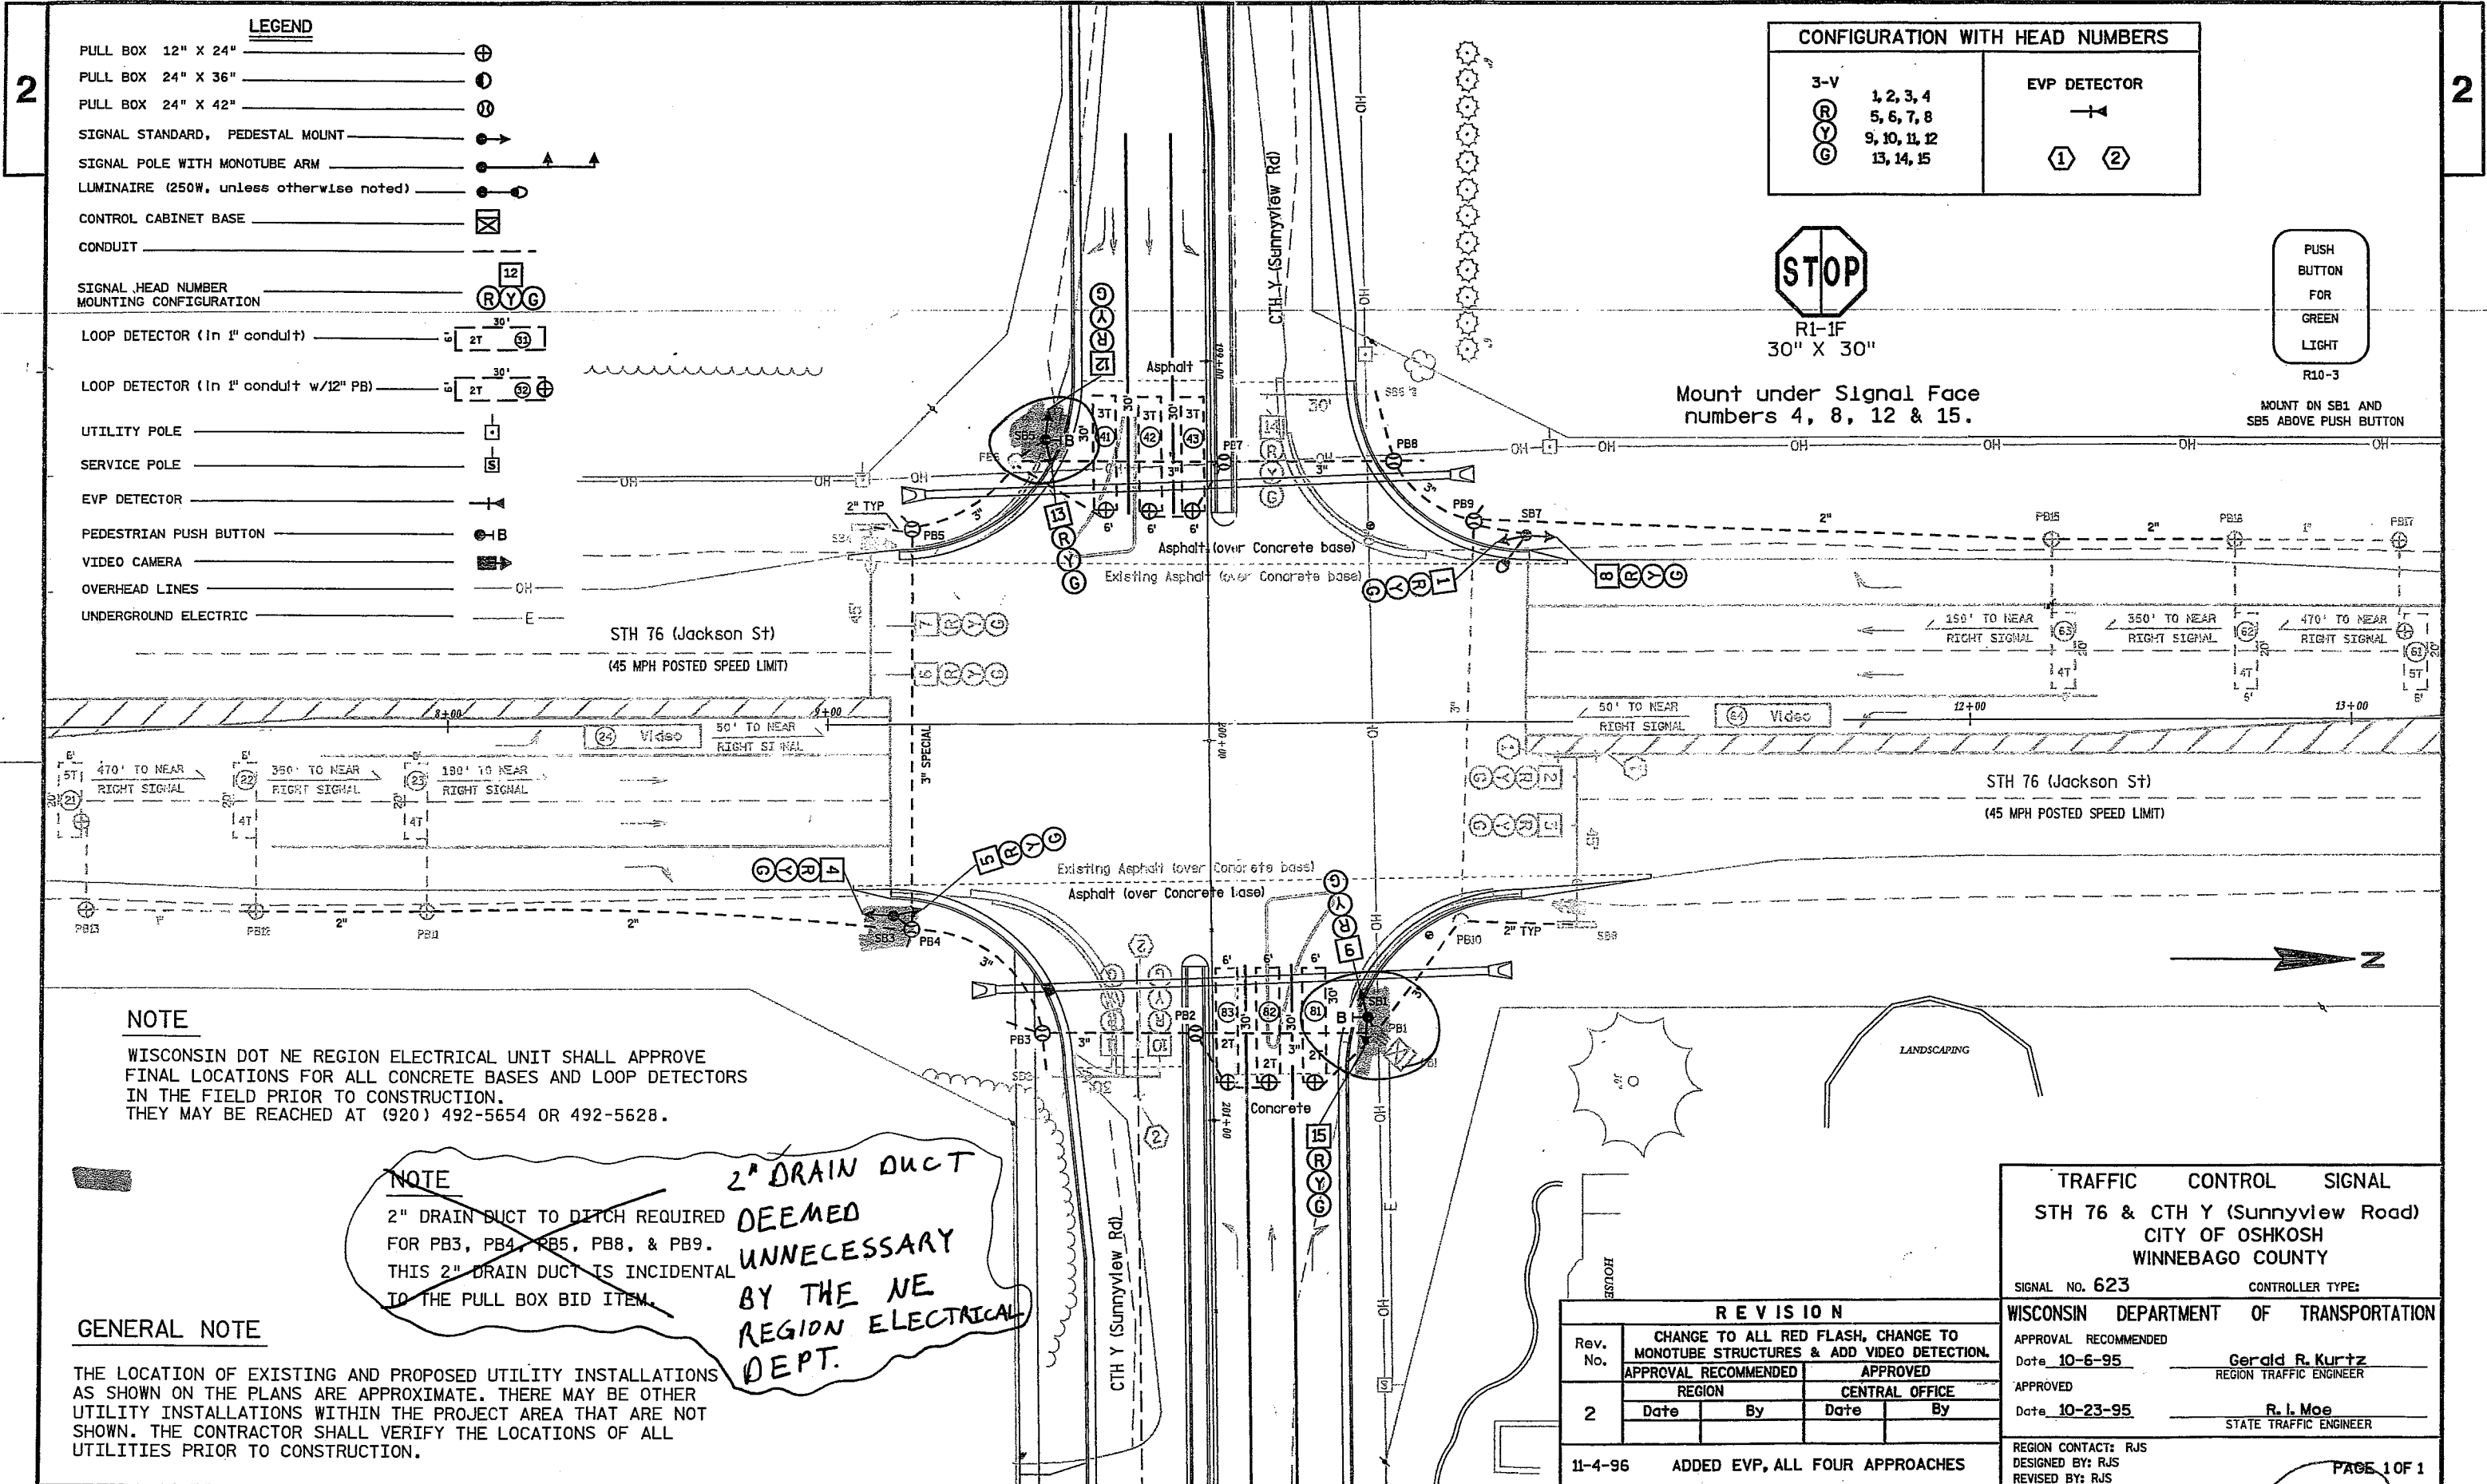


LEGEND

- PULL BOX 12" X 24"
- PULL BOX 24" X 36"
- PULL BOX 24" X 42"
- SIGNAL STANDARD, PEDESTAL MOUNT
- SIGNAL POLE WITH MONOTUBE ARM
- LUMINAIRE (250W, unless otherwise noted)
- CONTROL CABINET BASE
- CONDUIT
- SIGNAL HEAD NUMBER MOUNTING CONFIGURATION
- LOOP DETECTOR (In 1" conduit)
- LOOP DETECTOR (In 1" conduit w/12" PB)
- UTILITY POLE
- SERVICE POLE
- EVP DETECTOR
- PEDESTRIAN PUSH BUTTON
- VIDEO CAMERA
- OVERHEAD LINES
- UNDERGROUND ELECTRIC

CONFIGURATION WITH HEAD NUMBERS		EVP DETECTOR
3-V	1, 2, 3, 4	
	5, 6, 7, 8	
	9, 10, 11, 12	
	13, 14, 15	

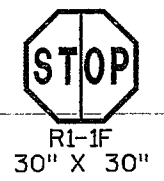

Mount under Signal Face numbers 4, 8, 13 & 15.

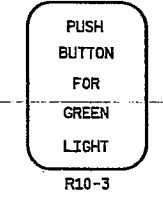

MOUNT ON SB1 AND SB5 ABOVE PUSH BUTTON


NOTE
 WISCONSIN DOT NE REGION ELECTRICAL UNIT SHALL APPROVE FINAL LOCATIONS FOR ALL CONCRETE BASES AND LOOP DETECTORS IN THE FIELD PRIOR TO CONSTRUCTION. THEY MAY BE REACHED AT (920) 492-5654 OR 492-5628.

NOTE
~~2" DRAIN DUCT TO DITCH REQUIRED FOR PB3, PB4, PB5, PB8, & PB9. THIS 2" DRAIN DUCT IS INCIDENTAL TO THE PULL BOX BID ITEM.~~
2" DRAIN DUCT DEEMED UNNECESSARY BY THE NE REGION ELECTRICAL DEPT.


GENERAL NOTE
 THE LOCATION OF EXISTING AND PROPOSED UTILITY INSTALLATIONS AS SHOWN ON THE PLANS ARE APPROXIMATE. THERE MAY BE OTHER UTILITY INSTALLATIONS WITHIN THE PROJECT AREA THAT ARE NOT SHOWN. THE CONTRACTOR SHALL VERIFY THE LOCATIONS OF ALL UTILITIES PRIOR TO CONSTRUCTION.

REVISION			
Rev. No.	CHANGE TO ALL RED FLASH, CHANGE TO MONOTUBE STRUCTURES & ADD VIDEO DETECTION.		
2	Date	By	APPROVED
			REGION
			CENTRAL OFFICE
11-4-96			ADDED EVP, ALL FOUR APPROACHES

TRAFFIC CONTROL SIGNAL	
STH 76 & CTH Y (Sunnyview Road) CITY OF OSHKOSH WINNEBAGO COUNTY	
SIGNAL NO. 623	CONTROLLER TYPE:
WISCONSIN DEPARTMENT OF TRANSPORTATION	
APPROVAL RECOMMENDED Date 10-6-95	Gerald R. Kurtz REGION TRAFFIC ENGINEER
APPROVED Date 10-23-95	R. I. Moe STATE TRAFFIC ENGINEER
REGION CONTACT: RJS DESIGNED BY: RJS REVISED BY: RJS	

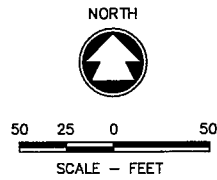

POINT #	NORTHING	EASTING	STATION	LOCATION	ELEVATION	DESCRIPTION
C.P. #1	497033.4186	791168.6442	195+69.79	24.29' LT	775.22	MAG NAIL
C.P. #2	496985.1858	791547.0458	199+47.20	30.45' RT	781.32	MAG NAIL
C.P. #3	497016.3170	791622.4080	200+22.83	0.00' OFFSET	781.14	SEC. COR. / BERSTEIN MON.
C.P. #4	496623.7688	791641.8506	200+37.23	392.77' RT	777.68	MAG NAIL
C.P. #5	497041.7338	791644.8664	200+45.62	25.13' LT	781.62	MAG NAIL
C.P. #6	497367.0099	791641.1663	200+46.10	350.42' LT	780.89	MAG NAIL
C.P. #7	497180.7608	793430.5757	218+32.97	218+32.97	779.97	MAG NAIL
C.P. #8	496655.5697	793726.5239	221+22.14	387.77' RT	776.75	MAG NAIL
C.P. #9	496787.5507	794203.4938	226+00.77	261.94' RT	775.44	MAG NAIL
C.P. #10	497210.1880	794211.3511	226+14.06	160.56' LT	776.71	MAG NAIL
C.P. #11	496452.9097	794245.1125	226+38.08	597.09' RT	774.95	MAG NAIL
C.P. #12	496874.7964	794559.8758	229+58.24	179.28' RT	774.47	NAIL
C.P. #13	497288.9602	794973.5078	233+77.16	229.54' LT	776.62	MAG NAIL
C.P. #14	496943.1883	795051.2663	234+50.47	117.21' RT	775.27	NAIL
C.P. #15	496873.1536	795570.3503	239+68.61	193.90' RT	776.96	MAG NAIL
C.P. #16	497169.2093	795819.4790	242+21.52	98.93' LT	779.20	MAG NAIL
C.P. #17	497215.3842	795820.2604	242+22.90	145.09' LT	779.32	MAG NAIL
C.P. #18	496819.9569	796671.7990	250+69.29	261.24' RT	773.80	MAG NAIL
C.P. #19	497074.7987	797595.2168	253+37.29	0.05' RT	784.17	SEC. COR. / BERSTEIN MON.
C.P. #20	497084.5753	796936.4219	259+95.91	17.88' RT	784.01	MAG NAIL

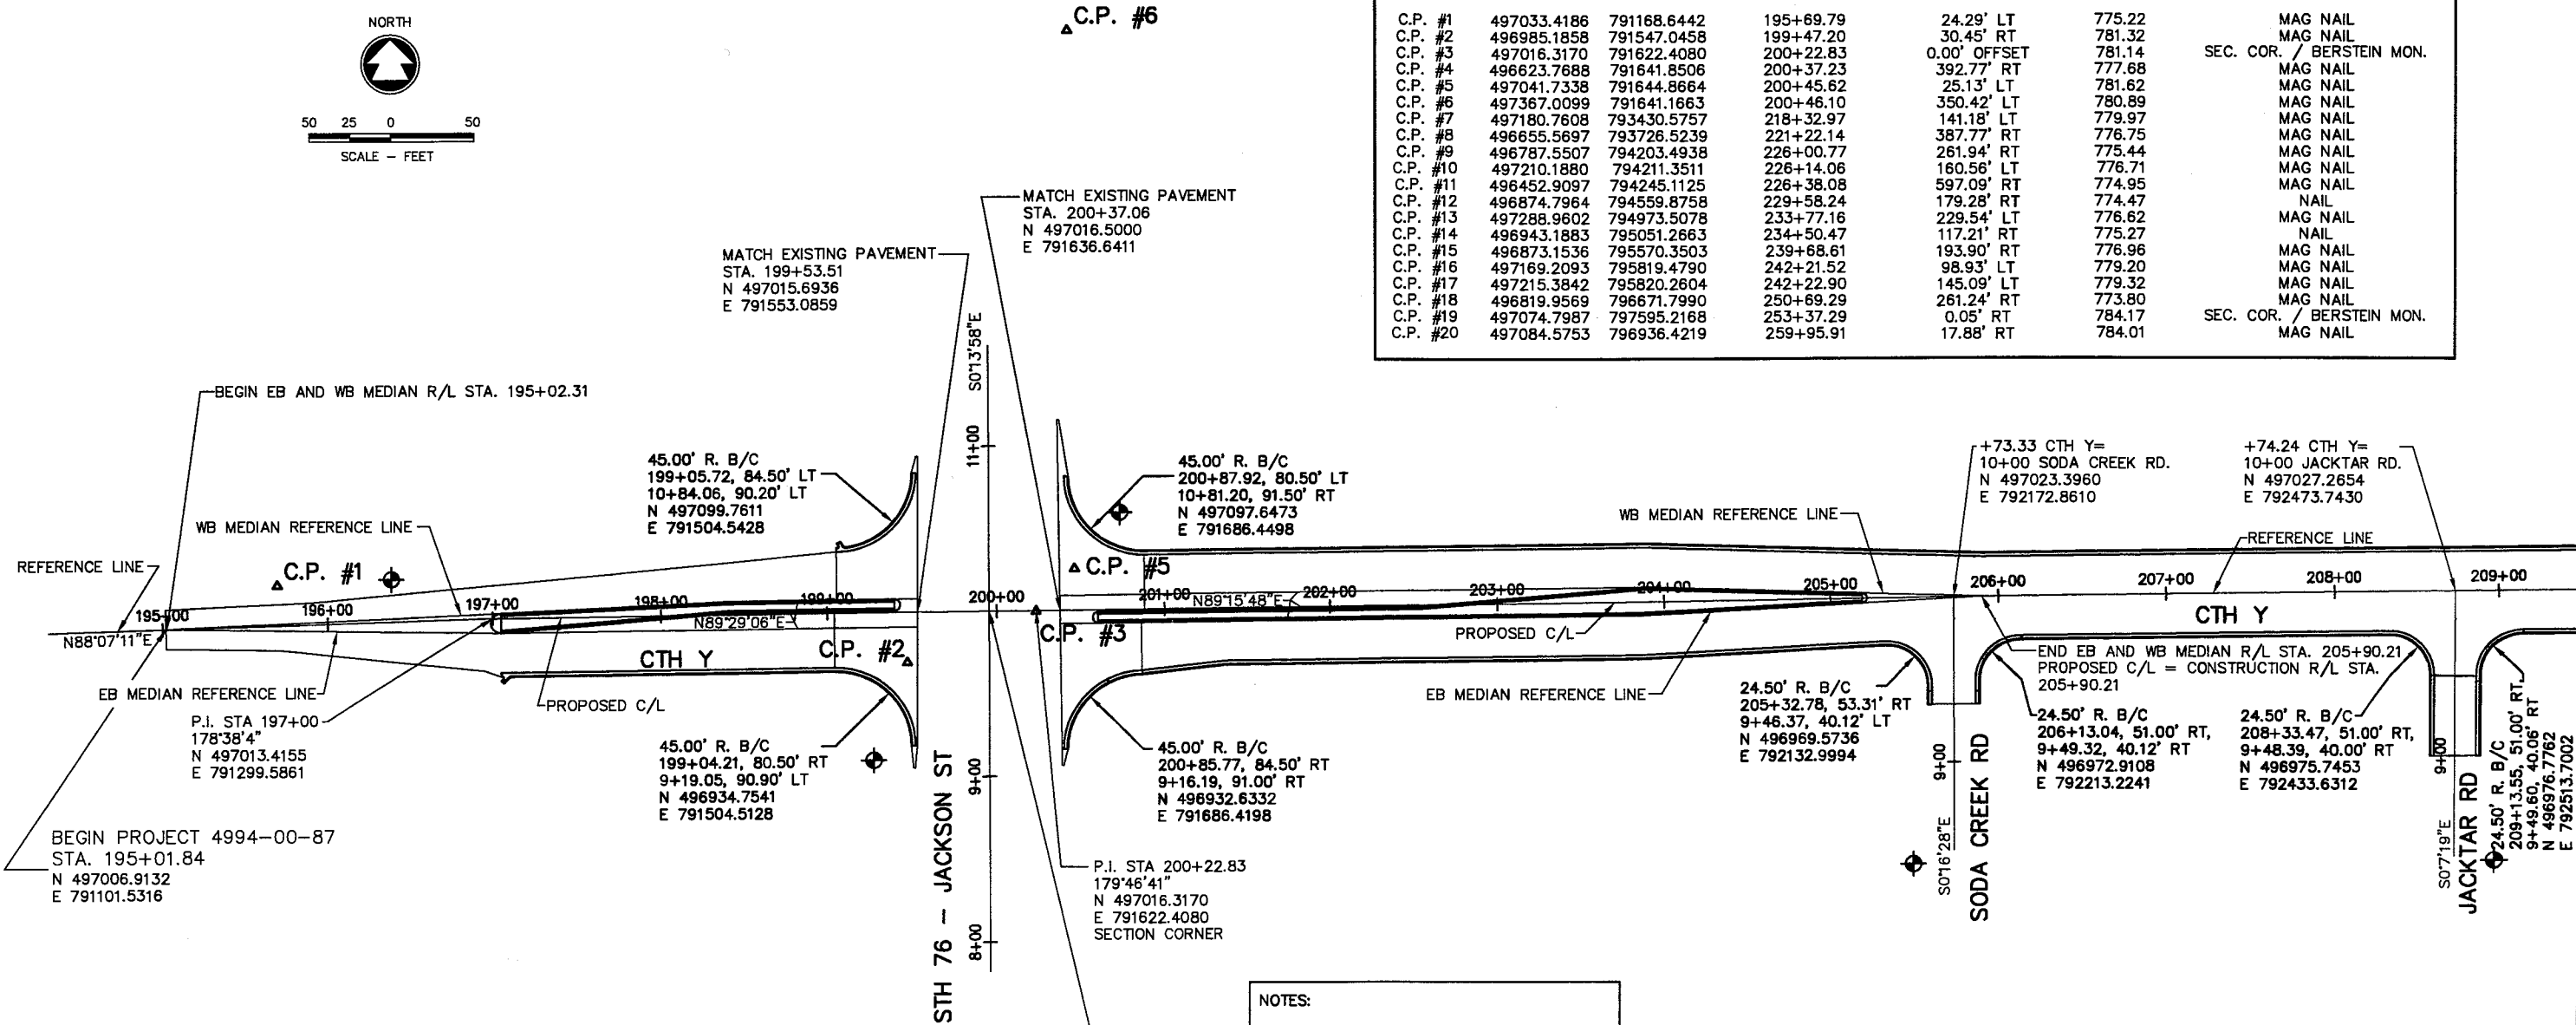

BENCH MARK			
STATION	OFFSET	LOCATION	ELEV.
196+39.79	25.67' LT	NAIL IN PP	775.58
199+26.91	89.37' RT	NAIL IN PP	777.77
200+73.25	58.79' LT	HYD TAG BOLT	782.41
8+38.68	24.21' LT	NAIL IN LP	779.34
SODA CREEK RD			
8+41.60	23.95' RT	NAIL IN LP	777.75
JACKTAR RD			

NOTES:

CTH Y REFERENCE LINE DOES NOT PARALLEL THE SECTION LINE THROUGHOUT THE ALIGNMENT. THE REFERENCE LINE = SECTION LINE FROM STA. 200+22.83 TO STA. 257+37.44.

COORDINATES ARE REFERENCED TO THE WISCONSIN COUNTY COORDINATE SYSTEM, WINNEBAGO COUNTY.


SIDEROAD CENTERLINES ARE BEST FIT ALIGNMENTS BASED UPON A SPLIT OF EXISTING PAVEMENT WIDTH DIMENSIONS.

ALL STATIONS AND OFFSETS LISTED ARE DIMENSIONED OFF THE REFERENCE LINE.

SEE PAVING DETAIL SHEETS FOR MEDIAN LOCATION AND MEDIAN R/L LOCATIONS.



SEE PAVING DETAIL SHEETS FOR MEDIAN AND MEDIAN R/L LOCATIONS.

POINT #	NORTHING	EASTING	STATION	LOCATION	ELEVATION	DESCRIPTION
C.P. #1	497033.4186	791168.6442	195+69.79	24.29' LT	775.22	MAG NAIL
C.P. #2	496985.1858	791547.0458	199+47.20	30.45' RT	781.32	MAG NAIL
C.P. #3	497016.3170	791622.4080	200+22.83	0.00' OFFSET	781.14	SEC. COR. / BERSTEIN MON.
C.P. #4	496623.7688	791641.8506	200+37.23	392.77' RT	777.68	MAG NAIL
C.P. #5	497041.7338	791644.8664	200+45.62	25.13' LT	781.62	MAG NAIL
C.P. #6	497367.0099	791641.1663	200+46.10	350.42' LT	780.89	MAG NAIL
C.P. #7	497180.7608	793430.5757	218+32.97	141.18' LT	779.97	MAG NAIL
C.P. #8	496655.5697	793726.5239	221+22.14	387.77' RT	776.75	MAG NAIL
C.P. #9	496787.5507	794203.4938	226+00.77	261.94' RT	775.44	MAG NAIL
C.P. #10	497210.1880	794211.3511	226+14.06	160.56' LT	776.71	MAG NAIL
C.P. #11	496452.9097	794245.1125	226+38.08	597.09' RT	774.95	MAG NAIL
C.P. #12	496874.7964	794559.8758	229+58.24	179.28' RT	774.47	NAIL
C.P. #13	497288.9602	794973.5078	233+77.16	229.54' LT	776.62	MAG NAIL
C.P. #14	496943.1883	795051.2663	234+50.47	117.21' RT	775.27	NAIL
C.P. #15	496873.1536	795570.3503	239+68.61	193.90' RT	776.96	MAG NAIL
C.P. #16	497169.2093	795819.4790	242+21.52	98.93' LT	779.20	MAG NAIL
C.P. #17	497215.3842	795820.2604	242+22.90	145.09' LT	779.32	MAG NAIL
C.P. #18	496819.9569	796671.7990	250+69.29	261.24' RT	773.80	MAG NAIL
C.P. #19	497074.7987	797595.2168	253+37.29	0.05' RT	784.17	SEC. COR. / BERSTEIN MON.
C.P. #20	497084.5753	796936.4219	259+95.91	17.88' RT	784.01	MAG NAIL

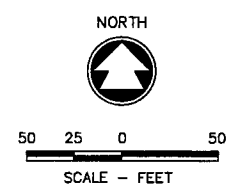

▲C.P. #7

+74.24 CTH Y=
10+00 JACKTAR RD.
N 497027.2654
E 792473.7430

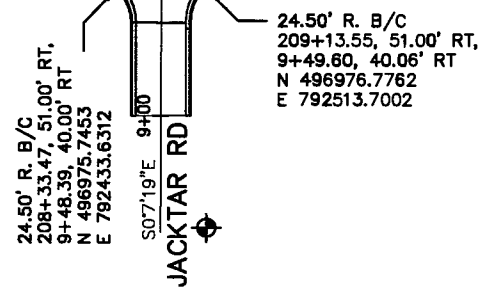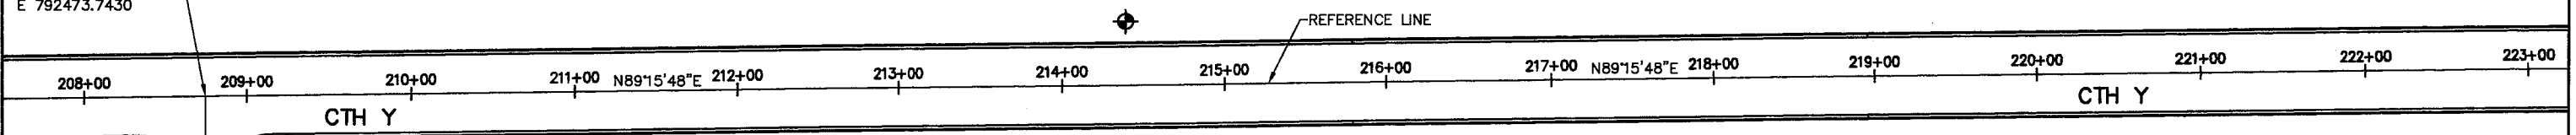


NOTES:
 CTH Y REFERENCE LINE DOES NOT PARALLEL THE SECTION LINE THROUGHOUT THE ALIGNMENT. THE REFERENCE LINE = SECTION LINE FROM STA. 200+22.83 TO STA. 257+37.44.
 COORDINATES ARE REFERENCED TO THE WISCONSIN COUNTY COORDINATE SYSTEM, WINNEBAGO COUNTY.
 SIDEROAD CENTERLINES ARE BEST FIT ALIGNMENTS BASED UPON A SPLIT OF EXISTING PAVEMENT WIDTH DIMENSIONS.
 ALL STATIONS AND OFFSETS LISTED ARE DIMENSIONED OFF THE REFERENCE LINE.
 SEE PAVING DETAIL SHEETS FOR MEDIAN LOCATION AND MEDIAN R/L LOCATIONS.

BENCH MARK			
STATION	OFFSET	LOCATION	ELEV.
8+41.60	23.95' RT	NAIL IN LP	777.75
JACKTAR RD			
214+38.83	39.58' LT	NAIL IN LP	779.51

▲C.P. #8

D:\Projects\4994-00-87\4994-00-87.dwg 04/22/08 2:06 PM

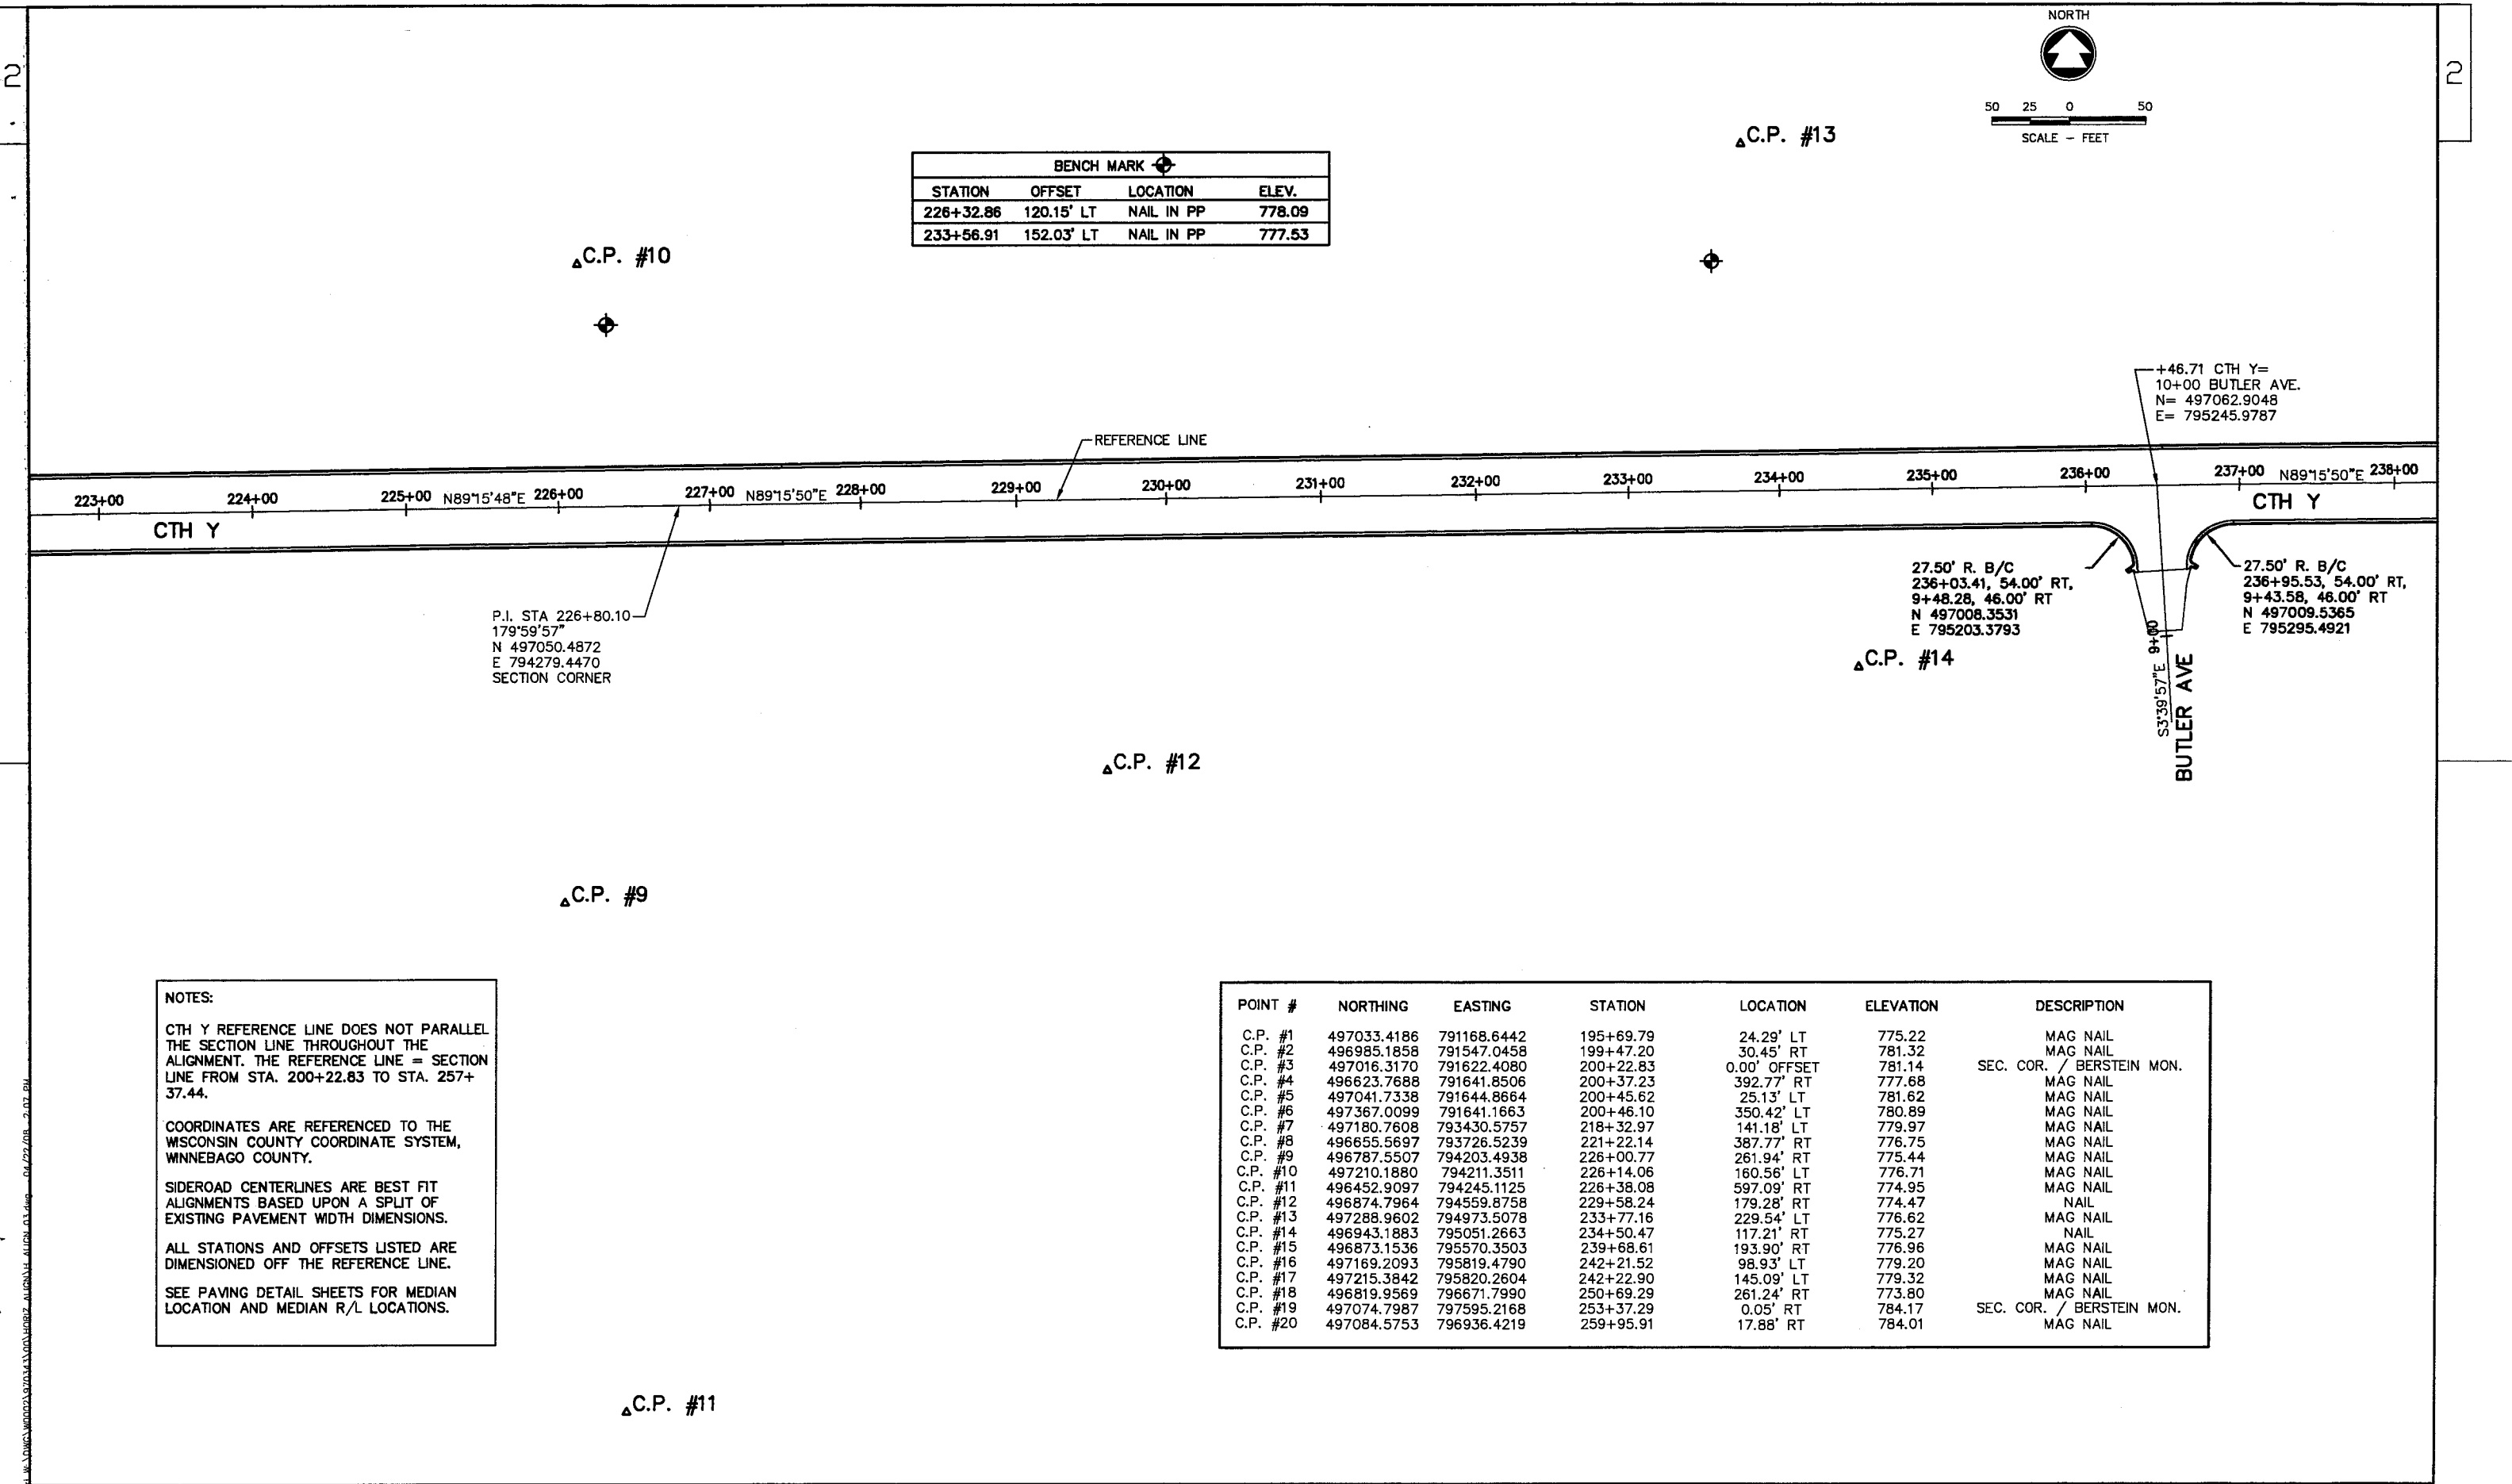

BENCH MARK			
STATION	OFFSET	LOCATION	ELEV.
226+32.86	120.15' LT	NAIL IN PP	778.09
233+56.91	152.03' LT	NAIL IN PP	777.53

P.I. STA 226+80.10
 179°59'57"
 N 497050.4872
 E 794279.4470
 SECTION CORNER

NOTES:

CTH Y REFERENCE LINE DOES NOT PARALLEL THE SECTION LINE THROUGHOUT THE ALIGNMENT. THE REFERENCE LINE = SECTION LINE FROM STA. 200+22.83 TO STA. 257+37.44.


COORDINATES ARE REFERENCED TO THE WISCONSIN COUNTY COORDINATE SYSTEM, WINNEBAGO COUNTY.

SIDEROAD CENTERLINES ARE BEST FIT ALIGNMENTS BASED UPON A SPLIT OF EXISTING PAVEMENT WIDTH DIMENSIONS.

ALL STATIONS AND OFFSETS LISTED ARE DIMENSIONED OFF THE REFERENCE LINE.

SEE PAVING DETAIL SHEETS FOR MEDIAN LOCATION AND MEDIAN R/L LOCATIONS.


POINT #	NORTHING	EASTING	STATION	LOCATION	ELEVATION	DESCRIPTION
C.P. #1	497033.4186	791168.6442	195+69.79	24.29' LT	775.22	MAG NAIL
C.P. #2	496985.1858	791547.0458	199+47.20	30.45' RT	781.32	MAG NAIL
C.P. #3	497016.3170	791622.4080	200+22.83	0.00' OFFSET	781.14	SEC. COR. / BERSTEIN MON.
C.P. #4	496623.7688	791641.8506	200+37.23	392.77' RT	777.68	MAG NAIL
C.P. #5	497041.7338	791644.8664	200+45.62	25.13' LT	781.62	MAG NAIL
C.P. #6	497367.0099	791641.1663	200+46.10	350.42' LT	780.89	MAG NAIL
C.P. #7	497180.7608	793430.5757	218+32.97	141.18' LT	779.97	MAG NAIL
C.P. #8	496655.5697	793726.5239	221+22.14	387.77' RT	776.75	MAG NAIL
C.P. #9	496787.5507	794203.4938	226+00.77	261.94' RT	775.44	MAG NAIL
C.P. #10	497210.1880	794211.3511	226+14.06	160.56' LT	776.71	MAG NAIL
C.P. #11	496452.9097	794245.1125	226+38.08	597.09' RT	774.95	MAG NAIL
C.P. #12	496874.7964	794559.8758	229+58.24	179.28' RT	774.47	NAIL
C.P. #13	497288.9602	794973.5078	233+77.16	229.54' LT	776.62	MAG NAIL
C.P. #14	496943.1883	795051.2663	234+50.47	117.21' RT	775.27	NAIL
C.P. #15	496873.1536	795570.3503	239+68.61	193.90' RT	776.96	MAG NAIL
C.P. #16	497169.2093	795819.4790	242+21.52	98.93' LT	779.20	MAG NAIL
C.P. #17	497215.3842	795820.2604	242+22.90	145.09' LT	779.32	MAG NAIL
C.P. #18	496819.9569	796671.7990	250+69.29	261.24' RT	773.80	MAG NAIL
C.P. #19	497074.7987	797595.2168	253+37.29	0.05' RT	784.17	SEC. COR. / BERSTEIN MON.
C.P. #20	497084.5753	796936.4219	259+95.91	17.88' RT	784.01	MAG NAIL

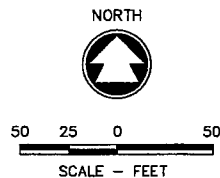

BENCH MARK			
STATION	OFFSET	LOCATION	ELEV.
243+20.46	30.58' LT	NAIL IN PP	780.78

▲ C.P. #17

▲ C.P. #16

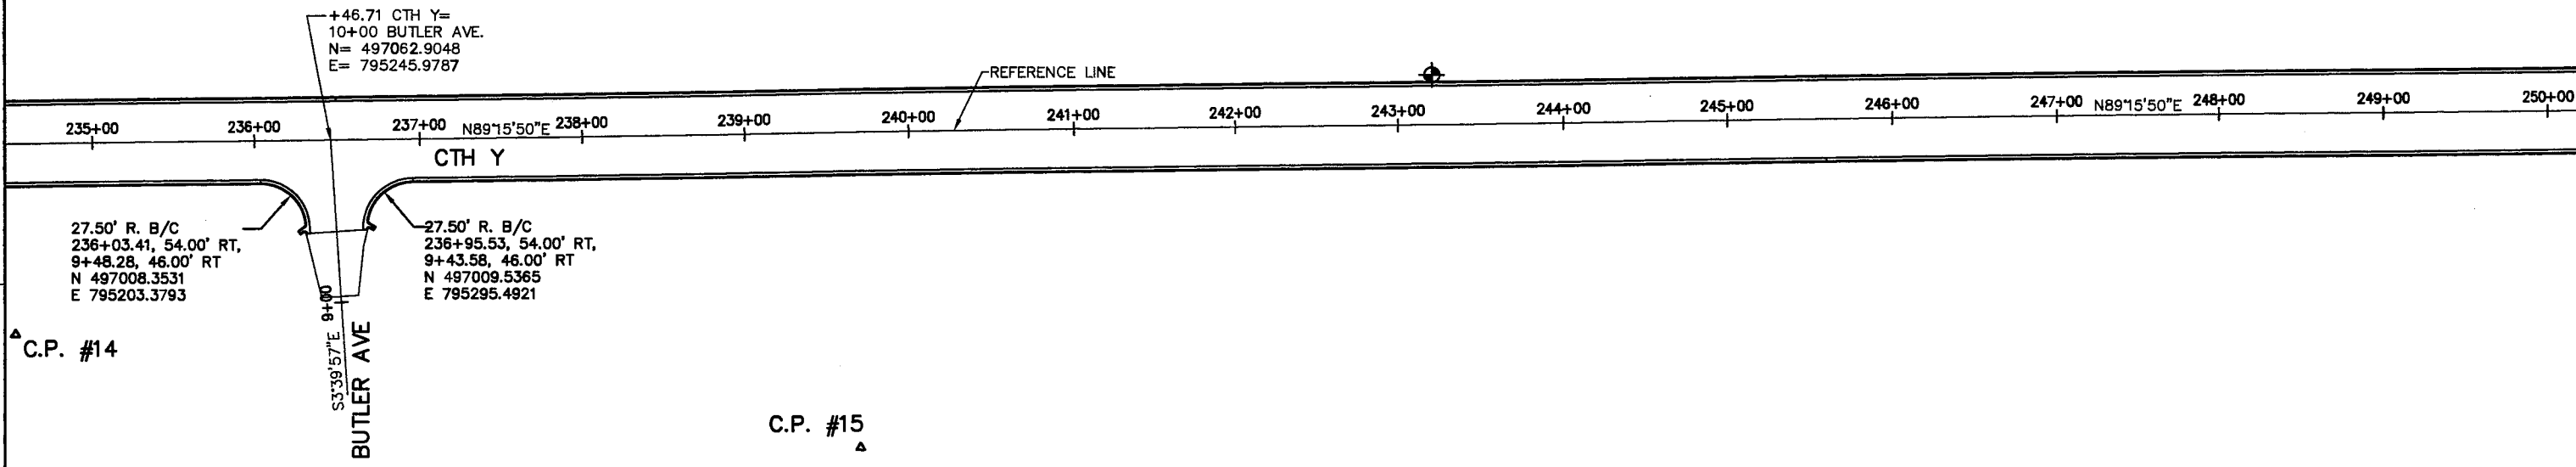

NOTES:

CTH Y REFERENCE LINE DOES NOT PARALLEL THE SECTION LINE THROUGHOUT THE ALIGNMENT. THE REFERENCE LINE = SECTION LINE FROM STA. 200+22.83 TO STA. 257+37.44.

COORDINATES ARE REFERENCED TO THE WISCONSIN COUNTY COORDINATE SYSTEM, WINNEBAGO COUNTY.



SIDEROAD CENTERLINES ARE BEST FIT ALIGNMENTS BASED UPON A SPLIT OF EXISTING PAVEMENT WIDTH DIMENSIONS.

ALL STATIONS AND OFFSETS LISTED ARE DIMENSIONED OFF THE REFERENCE LINE.

SEE PAVING DETAIL SHEETS FOR MEDIAN LOCATION AND MEDIAN R/L LOCATIONS.

POINT #	NORTHING	EASTING	STATION	LOCATION	ELEVATION	DESCRIPTION
C.P. #1	497033.4186	791168.6442	195+69.79	24.29' LT	775.22	MAG NAIL
C.P. #2	496985.1858	791547.0458	199+47.20	30.45' RT	781.32	MAG NAIL
C.P. #3	497016.3170	791622.4080	200+22.83	0.00' OFFSET	781.14	SEC. COR. / BERSTEIN MON.
C.P. #4	496623.7688	791641.8506	200+37.23	392.77' RT	777.68	MAG NAIL
C.P. #5	497041.7338	791644.8664	200+45.62	25.13' LT	781.62	MAG NAIL
C.P. #6	497367.0099	791641.1663	200+46.10	350.42' LT	780.89	MAG NAIL
C.P. #7	497180.7608	793430.5757	218+32.97	141.18' LT	779.97	MAG NAIL
C.P. #8	496655.5697	793726.5239	221+22.14	387.77' RT	776.75	MAG NAIL
C.P. #9	496787.5507	794203.4938	226+00.77	261.94' RT	775.44	MAG NAIL
C.P. #10	497210.1880	794211.3511	226+14.06	160.56' LT	776.71	MAG NAIL
C.P. #11	496452.9097	794245.1125	226+38.08	597.09' RT	774.95	MAG NAIL
C.P. #12	496874.7964	794559.8758	229+58.24	179.28' RT	774.47	NAIL
C.P. #13	497288.9602	794973.5078	233+77.16	229.54' LT	776.62	MAG NAIL
C.P. #14	496943.1883	795051.2663	234+50.47	117.21' RT	775.27	NAIL
C.P. #15	496873.1536	795570.3503	239+68.61	193.90' RT	776.96	MAG NAIL
C.P. #16	497169.2093	795819.4790	242+21.52	98.93' LT	779.20	MAG NAIL
C.P. #17	497215.3842	795820.2604	242+22.90	145.09' LT	779.32	MAG NAIL
C.P. #18	496819.9569	796671.7990	250+69.29	261.24' RT	773.80	MAG NAIL
C.P. #19	497074.7987	797595.2168	253+37.29	0.05' RT	784.17	SEC. COR. / BERSTEIN MON.
C.P. #20	497084.5753	796936.4219	259+95.91	17.88' RT	784.01	MAG NAIL

BENCH MARK			
STATION	OFFSET	LOCATION	ELEV.
252+72.37	34.72' LT	NAIL IN PP	784.16
257+94.43	34.59' LT	NAIL IN PP	784.14

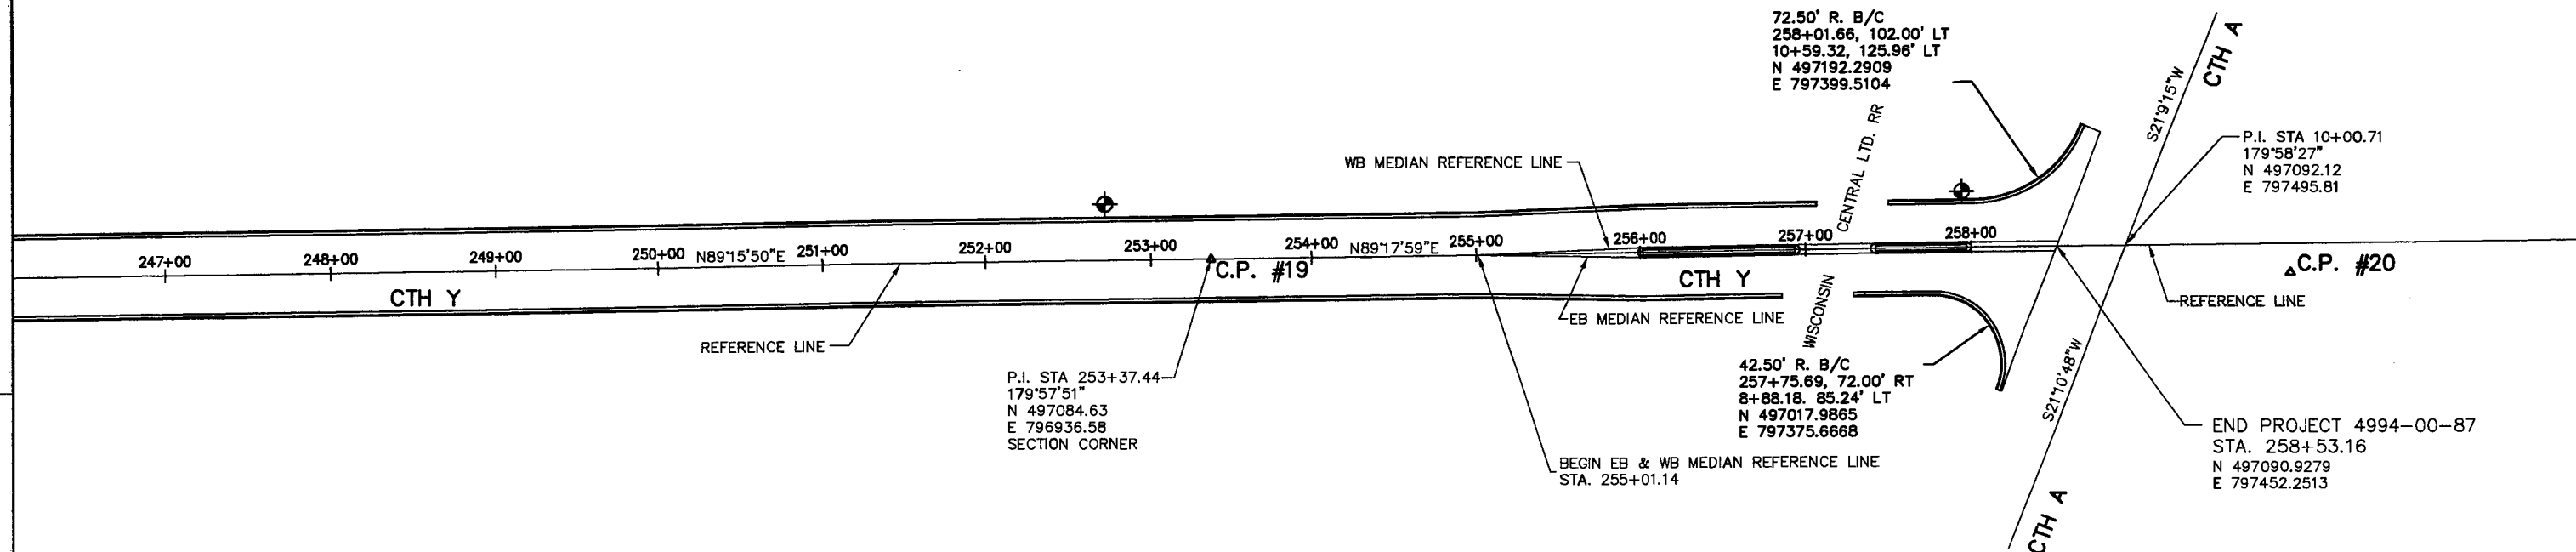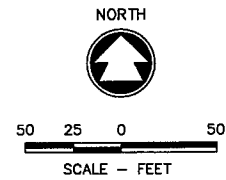

▲C.P. #18

NOTES:

CTH Y REFERENCE LINE DOES NOT PARALLEL THE SECTION LINE THROUGHOUT THE ALIGNMENT. THE REFERENCE LINE = SECTION LINE FROM STA. 200+22.83 TO STA. 257+37.44.

COORDINATES ARE REFERENCED TO THE WISCONSIN COUNTY COORDINATE SYSTEM, WINNEBAGO COUNTY.

SIDEROAD CENTERLINES ARE BEST FIT ALIGNMENTS BASED UPON A SPLIT OF EXISTING PAVEMENT WIDTH DIMENSIONS.

ALL STATIONS AND OFFSETS LISTED ARE DIMENSIONED OFF THE REFERENCE LINE.

SEE PAVING DETAIL SHEETS FOR MEDIAN LOCATION AND MEDIAN R/L LOCATIONS.

SEE PAVING DETAIL SHEETS FOR MEDIAN AND MEDIAN R/L LOCATIONS.

POINT #	NORTHING	EASTING	STATION	LOCATION	ELEVATION	DESCRIPTION
C.P. #1	497033.4186	791168.6442	195+69.79	24.29' LT	775.22	MAG NAIL
C.P. #2	496985.1858	791547.0458	199+47.20	30.45' RT	781.32	MAG NAIL
C.P. #3	497016.3170	791622.4080	200+22.83	0.00' OFFSET	781.14	SEC. COR. / BERSTEIN MON.
C.P. #4	496623.7688	791641.8506	200+37.23	392.77' RT	777.68	MAG NAIL
C.P. #5	497041.7338	791644.8664	200+45.62	25.13' LT	781.62	MAG NAIL
C.P. #6	497367.0099	791641.1663	200+46.10	350.42' LT	780.89	MAG NAIL
C.P. #7	497180.7608	793430.5757	218+32.97	218+32.97	779.97	MAG NAIL
C.P. #8	496655.5697	793726.5239	221+22.14	387.77' RT	776.75	MAG NAIL
C.P. #9	496787.5507	794203.4938	226+00.77	261.94' RT	775.44	MAG NAIL
C.P. #10	497210.1880	794211.3511	226+14.06	160.56' LT	776.71	MAG NAIL
C.P. #11	496452.9097	794245.1125	226+38.08	597.09' RT	774.95	MAG NAIL
C.P. #12	496874.7964	794559.8758	229+58.24	179.28' RT	774.47	NAIL
C.P. #13	497288.9602	794973.5078	233+77.16	229.54' LT	776.62	MAG NAIL
C.P. #14	496943.1883	795051.2663	234+50.47	117.21' RT	775.27	NAIL
C.P. #15	496873.1536	795570.3503	239+68.61	193.90' RT	776.96	MAG NAIL
C.P. #16	497169.2093	795819.4790	242+21.52	98.93' LT	779.20	MAG NAIL
C.P. #17	497215.3842	795820.2604	242+22.90	145.09' LT	779.32	MAG NAIL
C.P. #18	496819.9569	796671.7990	250+69.29	261.24' RT	773.80	MAG NAIL
C.P. #19	497074.7987	797595.2168	253+37.29	0.05' RT	784.17	SEC. COR. / BERSTEIN MON.
C.P. #20	497084.5753	796936.4219	259+95.91	17.88' RT	784.01	MAG NAIL

DATE 17DEC08

ESTIMATE OF QUANTITIES

LINE NUMBER	ITEM	ITEM DESCRIPTION	UNIT	TOTAL	4994-00-87 QUANTITY	6432-11-71 QUANTITY
0010	201.0105	CLEARING	STA	16.000	16.000	
0020	201.0120	CLEARING	ID	472.000	460.000	12.000
0030	201.0205	GRUBBING	STA	16.000	16.000	
0040	201.0220	GRUBBING	ID	472.000	460.000	12.000
0050	203.0100	REMOVING SMALL PIPE CULVERTS	EACH	25.000	21.000	4.000
0060	204.0100	REMOVING PAVEMENT	SY	486.000	486.000	
0070	204.0150	REMOVING CURB & GUTTER	LF	644.000	186.000	458.000
0080	204.0155	REMOVING CONCRETE SIDEWALK	SY	28.000	28.000	
0090	204.0195	REMOVING CONCRETE BASES	EACH	8.000		8.000
0100	204.0210	REMOVING MANHOLES	EACH	2.000	2.000	
0110	204.0215	REMOVING CATCH BASINS	EACH	4.000	4.000	
0120	204.0220	REMOVING INLETS	EACH	2.000	2.000	
0130	204.0245	REMOVING STORM SEWER (SIZE) 01. 12-INCH	LF	282.000	282.000	
0140	204.0245	REMOVING STORM SEWER (SIZE) 02. 15-INCH	LF	8.000	8.000	
0150	204.0245	REMOVING STORM SEWER (SIZE) 03. 18-INCH	LF	34.000	34.000	
0160	204.9060.S	REMOVING (ITEM DESCRIPTION) 01. PULL BOXES	EACH	7.000		7.000
0170	205.0100	EXCAVATION COMMON	CY	36,436.000	33,740.000	2,696.000
0180	213.0100	FINISHING ROADWAY (PROJECT) 01. 4994-00-87	EACH	1.000	1.000	
0190	213.0100	FINISHING ROADWAY (PROJECT) 02. 6432-11-71	EACH	1.000		1.000
0200	305.0110	BASE AGGREGATE DENSE 3/4-INCH	TON	80.000		80.000
0210	305.0120	BASE AGGREGATE DENSE 1 1/4-INCH	TON	20,540.000	16,788.000	3,752.000
0220	311.0110	BREAKER RUN	TON	11,800.000	11,240.000	560.000
0230	320.0345	CONCRETE BASE HES 8-INCH	SY	900.000		900.000
0240	415.0080	CONCRETE PAVEMENT 8-INCH	SY	31,568.000	31,568.000	
0250	415.2000.S	INCENTIVE STRENGTH CONCRETE PAVEMENT	DOL	9,970.000	9,470.000	500.000
0260	416.0170	CONCRETE DRIVEWAY 7-INCH	SY	404.000	404.000	
0270	416.0610	DRILLED TIE BARS	EACH	103.000	103.000	
0280	416.0805	CONCRETE PAVEMENT GAPS	EACH	12.000	12.000	
0290	416.1010	CONCRETE SURFACE DRAINS	CY	5.000	3.000	2.000
0300	455.0115	ASPHALTIC MATERIAL PG64-22	TON	65.400	6.300	59.100
0310	455.0605	TACK COAT	GAL	83.000	7.000	76.000
0320	460.1110	HMA PAVEMENT TYPE E-10	TON	1,091.000	105.000	986.000
0330	465.0105	ASPHALTIC SURFACE	TON	940.000	940.000	
0340	465.0120	ASPHALTIC SURFACE DRIVEWAYS AND FIELD ENTRANCES	TON	365.000	365.000	
0350	465.0125	ASPHALTIC SURFACE TEMPORARY	TON	486.000	420.000	66.000
0360	504.0900	CONCRETE MASONRY ENDWALLS	CY	8.000	8.000	
0370	521.0118	CULVERT PIPE CORRUGATED STEEL 18-INCH	LF	306.000	183.000	123.000
0380	521.1018	APRON ENDWALLS FOR CULVERT PIPE STEEL 18-INCH	EACH	12.000	8.000	4.000
0390	522.0315	CULVERT PIPE REINFORCED CONCRETE CLASS IV 15-INCH	LF	182.000	182.000	
0400	522.0324	CULVERT PIPE REINFORCED CONCRETE CLASS IV 24-INCH	LF	275.000		275.000
0410	522.1012	APRON ENDWALLS FOR CULVERT PIPE REINFORCED CONCRETE 12-INCH	EACH	2.000	1.000	1.000
0420	522.1015	APRON ENDWALLS FOR CULVERT PIPE REINFORCED CONCRETE 15-INCH	EACH	4.000	4.000	
0430	522.1018	APRON ENDWALLS FOR CULVERT PIPE REINFORCED CONCRETE 18-INCH	EACH	2.000	2.000	
0440	522.1024	APRON ENDWALLS FOR CULVERT PIPE REINFORCED CONCRETE 24-INCH	EACH	4.000		4.000

3

3

DATE 17DEC08

ESTIMATE OF QUANTITIES

LINE NUMBER	ITEM	ITEM DESCRIPTION	UNIT	TOTAL	4994-00-87 QUANTITY	6432-11-71 QUANTITY
0450	522.1042	APRON ENDWALLS FOR CULVERT PIPE REINFORCED CONCRETE 42-INCH	EACH	1.000	1.000	
0460	523.0524	APRON ENDWALLS FOR CULVERT PIPE REINFORCED CONCRETE HORIZONTAL ELLIPTICAL 24X38-INCH	EACH	4.000	4.000	
0470	601.0405	CONCRETE CURB & GUTTER 18-INCH TYPE A	LF	1,249.000	1,126.000	123.000
0480	601.0407	CONCRETE CURB & GUTTER 18-INCH TYPE D	LF	443.000	41.000	402.000
0490	601.0409	CONCRETE CURB & GUTTER 30-INCH TYPE A	LF	11,781.000	11,501.000	280.000
0500	601.0411	CONCRETE CURB & GUTTER 30-INCH TYPE D	LF	242.000	48.000	194.000
0510	602.0405	CONCRETE SIDEWALK 4-INCH	SF	9,357.000	7,799.000	1,558.000
0520	602.0505	CURB RAMP DETECTABLE WARNING FIELD YELLOW	SF	136.000	128.000	8.000
0530	608.0412	STORM SEWER PIPE REINFORCED CONCRETE CLASS IV 12-INCH	LF	1,170.000	1,124.000	46.000
0540	608.0415	STORM SEWER PIPE REINFORCED CONCRETE CLASS IV 15-INCH	LF	261.000	261.000	
0550	608.0418	STORM SEWER PIPE REINFORCED CONCRETE CLASS IV 18-INCH	LF	536.000	536.000	
0560	608.0424	STORM SEWER PIPE REINFORCED CONCRETE CLASS IV 24-INCH	LF	1,086.000	1,086.000	
0570	608.0430	STORM SEWER PIPE REINFORCED CONCRETE CLASS IV 30-INCH	LF	622.000	622.000	
0580	608.0436	STORM SEWER PIPE REINFORCED CONCRETE CLASS IV 36-INCH	LF	2,762.000	2,762.000	
0590	608.0442	STORM SEWER PIPE REINFORCED CONCRETE CLASS IV 42-INCH	LF	214.000	214.000	
0600	611.0201	MANHOLES TYPE 1	EACH	10.000	10.000	
0610	611.0210	MANHOLES TYPE 3	EACH	15.000	15.000	
0620	611.0301	INLETS TYPE 1	EACH	11.000	9.000	2.000
0630	611.0303	INLETS TYPE 3	EACH	48.000	48.000	
0640	611.0530	MANHOLE COVERS TYPE J	EACH	26.000	26.000	
0650	611.0612	INLET COVERS TYPE C	EACH	1.000	1.000	
0660	611.0624	INLET COVERS TYPE H	EACH	48.000	48.000	
0670	611.0666	INLET COVERS TYPE Z	EACH	4.000	2.000	2.000
0680	618.0100	MAINTENANCE AND REPAIR OF HAUL ROADS (PROJECT) 01. 4994-00-87	EACH	1.000	1.000	
0690	618.0100	MAINTENANCE AND REPAIR OF HAUL ROADS (PROJECT) 02. 6432-11-71	EACH	1.000		1.000
0700	619.1000	MOBILIZATION	EACH	1.000	0.900	0.100
0710	620.0300	CONCRETE MEDIAN SLOPED NOSE	SF	207.000	94.000	113.000
0720	624.0100	WATER	MGAL	303.000	273.000	30.000
0730	625.0100	TOPSOIL	SY	23,101.000	20,975.000	2,126.000
0740	627.0200	MULCHING	SY	9,877.000	9,877.000	
0750	628.1504	SILT FENCE	LF	595.000	595.000	
0760	628.1520	SILT FENCE MAINTENANCE	LF	595.000	595.000	
0770	628.1905	MOBILIZATIONS EROSION CONTROL	EACH	8.000	4.000	4.000
0780	628.1910	MOBILIZATIONS EMERGENCY EROSION CONTROL	EACH	4.000	2.000	2.000
0790	628.2006	EROSION MAT URBAN CLASS I TYPE A	SY	14,236.000	14,236.000	
0800	628.2008	EROSION MAT URBAN CLASS I TYPE B	SY	6,240.000	4,049.000	2,191.000
0810	628.7005	INLET PROTECTION TYPE A	EACH	14.000	14.000	
0820	628.7015	INLET PROTECTION TYPE C	EACH	51.000	49.000	2.000
0830	628.7504	TEMPORARY DITCH CHECKS	LF	165.000	120.000	45.000
0840	628.7550	CULVERT PIPE DITCH CHECKS	EACH	27.000	24.000	3.000
0850	629.0210	FERTILIZER TYPE B	CWT	14.600	13.200	1.400
0860	630.0140	SEEDING MIXTURE NO. 40	LB	494.000	456.000	38.000

DATE 17DEC08

ESTIMATE OF QUANTITIES

LINE NUMBER	ITEM	ITEM DESCRIPTION	UNIT	TOTAL	4994-00-87 QUANTITY	6432-11-71 QUANTITY
0870	630.0170	SEEDING MIXTURE NO. 70	LB	6.000	6.000	
0880	630.0200	SEEDING TEMPORARY	LB	743.000	683.000	60.000
0890	634.0416	POSTS WOOD 4X4-INCH X 16-FT	EACH	29.000	28.000	1.000
0900	637.0202	SIGNS REFLECTIVE TYPE II	SF	73.000	46.750	26.250
0910	638.2102	MOVING SIGNS TYPE II	EACH	67.000	62.000	5.000
0920	638.2602	REMOVING SIGNS TYPE II	EACH	2.000		2.000
0930	638.3000	REMOVING SMALL SIGN SUPPORTS	EACH	31.000	29.000	2.000
0940	642.5201	FIELD OFFICE TYPE C	EACH	1.000	0.900	0.100
0950	643.0100	TRAFFIC CONTROL (PROJECT) 01. 4994-00-87	EACH	1.000	1.000	
0960	643.0100	TRAFFIC CONTROL (PROJECT) 02. 6432-11-71	EACH	1.000		1.000
0970	643.0300	TRAFFIC CONTROL DRUMS	DAYS	16,732.000	15,548.000	1,184.000
0980	643.0420	TRAFFIC CONTROL BARRICADES TYPE III	DAYS	1,932.000	1,628.000	304.000
0990	643.0500	TRAFFIC CONTROL FLEXIBLE TUBULAR MARKER POSTS	EACH	24.000		24.000
1000	643.0600	TRAFFIC CONTROL FLEXIBLE TUBULAR MARKER BASES	EACH	24.000		24.000
1010	643.0705	TRAFFIC CONTROL WARNING LIGHTS TYPE A	DAYS	3,864.000	3,256.000	608.000
1020	643.0715	TRAFFIC CONTROL WARNING LIGHTS TYPE C	DAYS	1,381.000	1,125.000	256.000
1030	643.0900	TRAFFIC CONTROL SIGNS	DAYS	7,098.000	6,266.000	832.000
1040	643.0905.S	TRAFFIC CONTROL COVERING SIGNS	EACH	14.000	4.000	10.000
1050	646.0106	PAVEMENT MARKING EPOXY 4-INCH	LF	13,981.000	12,072.000	1,909.000
1060	646.0126	PAVEMENT MARKING EPOXY 8-INCH	LF	630.000	376.000	254.000
1070	647.0110	PAVEMENT MARKING RAILROAD CROSSINGS EPOXY	EACH	2.000	2.000	
1080	647.0166	PAVEMENT MARKING ARROWS EPOXY TYPE 2	EACH	5.000	2.000	3.000
1090	647.0176	PAVEMENT MARKING ARROWS EPOXY TYPE 3	EACH	1.000		1.000
1100	647.0356	PAVEMENT MARKING WORDS EPOXY	EACH	5.000	4.000	1.000
1110	647.0456	PAVEMENT MARKING CURB EPOXY	LF	80.000	50.000	30.000
1120	647.0566	PAVEMENT MARKING STOP LINE EPOXY 18-INCH	LF	213.000	128.000	85.000
1130	647.0606	PAVEMENT MARKING ISLAND NOSE EPOXY	EACH	8.000	5.000	3.000
1140	647.0726	PAVEMENT MARKING DIAGONAL EPOXY 12-INCH	LF	102.000	43.000	59.000
1150	647.0776	PAVEMENT MARKING CROSSWALK EPOXY 12-INCH	LF	465.000	465.000	
1160	649.0400	TEMPORARY PAVEMENT MARKING REMOVABLE TAPE 4-INCH	LF	2,100.000		2,100.000
1170	649.0801	TEMPORARY PAVEMENT MARKING REMOVABLE TAPE 8-INCH	LF	100.000		100.000
1180	650.4000	CONSTRUCTION STAKING STORM SEWER SYSTEM	EACH	93.000	90.000	3.000
1190	650.4500	CONSTRUCTION STAKING SUBGRADE	LF	6,529.000	6,027.000	502.000
1200	650.5000	CONSTRUCTION STAKING BASE	LF	620.000	117.000	503.000
1210	650.5500	CONSTRUCTION STAKING CURB GUTTER AND CURB & GUTTER	LF	1,610.000	89.000	1,521.000
1220	650.6000	CONSTRUCTION STAKING PIPE CULVERTS	EACH	15.000	11.000	4.000
1230	650.7000	CONSTRUCTION STAKING CONCRETE PAVEMENT	LF	5,932.000	5,932.000	
1240	650.9910	CONSTRUCTION STAKING SUPPLEMENTAL CONTROL 01. 4994-00-87	LS	1.000	1.000	
1250	650.9910	CONSTRUCTION STAKING SUPPLEMENTAL CONTROL 02. 6432-11-71	LS	1.000		1.000
1260	650.9920	CONSTRUCTION STAKING SLOPE STAKES	LF	7,498.000	6,996.000	502.000
1270	652.0225	CONDUIT RIGID NONMETALLIC SCHEDULE 40 2-INCH	LF	825.000		825.000
1280	652.0235	CONDUIT RIGID NONMETALLIC SCHEDULE 40 3-INCH	LF	380.000		380.000
1290	652.0615	CONDUIT SPECIAL 3-INCH	LF	110.000		110.000
1300	652.0800	CONDUIT LOOP DETECTOR	LF	270.000		270.000
1310	653.0105	PULL BOXES STEEL 12X24-INCH	EACH	6.000		6.000

DATE 17DEC08

E S T I M A T E O F Q U A N T I T I E S

LINE NUMBER	ITEM	ITEM DESCRIPTION	UNIT	TOTAL	4994-00-87 QUANTITY	6432-11-71 QUANTITY
1320	653.0140	PULL BOXES STEEL 24X42-INCH	EACH	7.000		7.000
1330	654.0101	CONCRETE BASES TYPE 1	EACH	5.000		5.000
1340	654.0102	CONCRETE BASES TYPE 2	EACH	5.000		5.000
1350	655.0230	CABLE TRAFFIC SIGNAL 5-14 AWG	LF	750.000		750.000
1360	655.0260	CABLE TRAFFIC SIGNAL 12-14 AWG	LF	1,400.000		1,400.000
1370	655.0305	CABLE TYPE UF 2-12 AWG GROUNDED	LF	690.000		690.000
1380	655.0515	ELECTRICAL WIRE TRAFFIC SIGNALS 10 AWG	LF	2,625.000		2,625.000
1390	655.0610	ELECTRICAL WIRE LIGHTING 12 AWG	LF	600.000		600.000
1400	655.0700	LOOP DETECTOR LEAD IN CABLE	LF	2,770.000		2,770.000
1410	655.0800	LOOP DETECTOR WIRE	LF	1,390.000		1,390.000
1420	657.0100	PEDESTAL BASES	EACH	5.000		5.000
1430	657.0255	TRANSFORMER BASES STANDARD 11 1/2-INCH BOLT CIRCLE	EACH	5.000		5.000
1440	657.0420	TRAFFIC SIGNAL STANDARDS ALUMINUM 13-FT	EACH	5.000		5.000
1450	658.0500	PEDESTRIAN PUSH BUTTONS	EACH	2.000		2.000
1460	658.5069	SIGNAL MOUNTING HARDWARE (LOCATION) 01. CTH Y AND STH 76	LS	1.000		1.000
1470	659.0125	LUMINAIRES UTILITY HPS 250 WATTS	EACH	4.000		4.000
1480	661.0200	TEMPORARY TRAFFIC SIGNALS FOR INTERSECTIONS (LOCATION) 01. CTH Y AND STH 76	LS	1.000		1.000
1490	690.0150	SAWING ASPHALT	LF	7,216.000	6,468.000	748.000
1500	690.0250	SAWING CONCRETE	LF	319.000	319.000	
1510	ASP.1T0A	ON-THE-JOB TRAINING APPRENTICE AT \$5.00/HR	HRS	200.000	200.000	
1520	ASP.1T0G	ON-THE-JOB TRAINING GRADUATE AT \$5.00/HR	HRS	1,000.000	1,000.000	
1530	SPV.0060	SPECIAL 01. MANHOLE BOX	EACH	3.000	3.000	
1540	SPV.0060	SPECIAL 02. MANHOLE BOX CULVERT	EACH	1.000	1.000	
1550	SPV.0060	SPECIAL 03. LANDMARK REFERENCE MONUMENT, SPECIAL	EACH	2.000	2.000	
1560	SPV.0060	SPECIAL 04. GRADING AND SHAPING FOR INLETS	EACH	10.000	10.000	
1570	SPV.0060	SPECIAL 05. INLET COVERS TYPE A SPECIAL	EACH	10.000	10.000	
1580	SPV.0060	SPECIAL 06. UTILITY LINE OPENINGS	EACH	12.000	11.000	1.000
1590	SPV.0060	SPECIAL 07. MINI STORM SEWER CLEANOUTS	EACH	1.000	1.000	
1600	SPV.0060	SPECIAL 08. INSTALL RAILROAD FURNISHED SIGNS	EACH	4.000	4.000	
1610	SPV.0060	SPECIAL 10. POLES TYPE 2 SPECIAL	EACH	1.000		1.000
1620	SPV.0060	SPECIAL 11. POLES TYPE 3 SPECIAL	EACH	3.000		3.000
1630	SPV.0060	SPECIAL 12. POLES TYPE 4 SPECIAL	EACH	1.000		1.000
1640	SPV.0060	SPECIAL 13. TROMBONE ARMS 20-FT SPECIAL	EACH	2.000		2.000
1650	SPV.0060	SPECIAL 14. TROMBONE ARMS 25-FT SPECIAL	EACH	2.000		2.000
1660	SPV.0060	SPECIAL 15. TRAFFIC SIGNAL FACE 3-12 INCH VERTICAL SPECIAL	EACH	8.000		8.000
1670	SPV.0060	SPECIAL 16. TRAFFIC SIGNAL FACE 3-12 INCH HORIZONTAL SPECIAL	EACH	4.000		4.000
1680	SPV.0060	SPECIAL 17. LUMINAIRE ARMS TRUSS TYPE 4-INCH CLAMP 12-FT SPECIAL	EACH	4.000		4.000
1690	SPV.0060	SPECIAL 20. ADJUSTING SANITARY MANHOLES	EACH	6.000	2.000	4.000
1700	SPV.0060	SPECIAL 21. TAP EXISTING SANITARY MANHOLE	EACH	1.000	1.000	
1710	SPV.0060	SPECIAL 30. ADJUST WATER VALVE MANHOLES	EACH	4.000	3.000	1.000
1720	SPV.0060	SPECIAL 31. CONNECTION TO EXISTING WATER MAIN	EACH	2.000	2.000	
1730	SPV.0060	SPECIAL 32. WATER MAIN 6-INCH GATE VALVE	EACH	5.000	5.000	

DATE 17DEC08

E S T I M A T E O F Q U A N T I T I E S

LINE NUMBER	ITEM	ITEM DESCRIPTION	UNIT	TOTAL	4994-00-87 QUANTITY	6432-11-71 QUANTITY
1740	SPV.0060	SPECIAL 33. WATER MAIN 12-INCH GATE VALVE	EACH	4.000	4.000	
1750	SPV.0060	SPECIAL 34. WATER MAIN 12" X 8" TAPPING SLEEVE AND VALVE	EACH	1.000	1.000	
1760	SPV.0060	SPECIAL 35. RELOCATE WATER MAIN 6-INCH GATE VALVE	EACH	1.000	1.000	
1770	SPV.0060	SPECIAL 36. HYDRANTS	EACH	3.000	3.000	
1780	SPV.0060	SPECIAL 37. RELOCATE HYDRANTS	EACH	6.000	6.000	
1790	SPV.0060	SPECIAL 38. ADJUST HYDRANTS	EACH	1.000	1.000	
1800	SPV.0060	SPECIAL 39. REMOVE WATER MAIN 10-INCH VALVE	EACH	1.000		1.000
1810	SPV.0060	SPECIAL 40. REMOVE WATER MAIN 6-INCH VALVE	EACH	1.000	1.000	
1820	SPV.0060	SPECIAL 41. REMOVE WATER MAIN 12" X 6" REDUCER	EACH	2.000	2.000	
1830	SPV.0060	SPECIAL 43. WATER MAIN 6-INCH 45 DEGREE BEND	EACH	1.000	1.000	
1840	SPV.0060	SPECIAL 44. WATER MAIN 12-INCH 45 DEGREE BEND	EACH	6.000	6.000	
1850	SPV.0060	SPECIAL 45. WATER MAIN 12" X 12" X 6" TEES	EACH	5.000	5.000	
1860	SPV.0060	SPECIAL 46. WATER MAIN 6-INCH CAP	EACH	1.000	1.000	
1870	SPV.0060	SPECIAL 47. WATER MAIN 8-INCH CAP	EACH	1.000	1.000	
1880	SPV.0060	SPECIAL 48. WATER MAIN 10-INCH CAP	EACH	1.000		1.000
1890	SPV.0075	SPECIAL 01. STREET SWEEPING	HRS	50.000	50.000	
1900	SPV.0090	SPECIAL 01. SANITARY SEWER 8-INCH	LF	57.800	57.800	
1910	SPV.0090	SPECIAL 02. SANITARY SEWER 10-INCH	LF	139.000	139.000	
1920	SPV.0090	SPECIAL 05. STORM SEWER PIPE PVC SDR 35 6-INCH	LF	19.000	19.000	
1930	SPV.0090	SPECIAL 06. CULVERT PIPE RC HE CLASS HE-IV 19 X 30-INCH	LF	312.000	312.000	
1940	SPV.0090	SPECIAL 07. CULVERT PIPE RC HE CLASS HE-IV 24 X 38-INCH	LF	88.000	88.000	
1950	SPV.0090	SPECIAL 08. MINI STORM SEWER AND LATERALS 4-INCH	LF	12.000	12.000	
1960	SPV.0090	SPECIAL 09. MINI STORM SEWER AND LATERALS 8-INCH	LF	205.000	205.000	
1970	SPV.0090	SPECIAL 10. DUCTILE IRON WATER MAIN 6-INCH	LF	130.600	130.600	
1980	SPV.0090	SPECIAL 11. DUCTILE IRON WATER MAIN 8-INCH	LF	19.000	19.000	
1990	SPV.0090	SPECIAL 12. DUCTILE IRON WATER MAIN 12-INCH	LF	2,101.000	2,101.000	
2000	SPV.0090	SPECIAL 13. 24-INCH STEEL CASING PIPE	LF	100.000	100.000	
2010	SPV.0105	SPECIAL 01. TEMPORARY DITCHING AND GRADING PROJECT 4994-00-87	LS	1.000	1.000	
2020	SPV.0105	SPECIAL 02. SALVAGE TRAFFIC SIGNALS SPECIAL	LS	1.000		1.000
2030	SPV.0200	SPECIAL 01. SANITARY MANHOLES	VF	18.900	18.900	
2040	SPV.0200	SPECIAL 02. RECONSTRUCT SANITARY MANHOLES	VF	58.200	54.200	4.000
2050	SPV.0200	SPECIAL 10. RECONSTRUCT WATER VALVE MANHOLES	VF	13.000	13.000	

ALL ITEMS ARE PROJECT ID 4994-00-87 UNLESS OTHERWISE NOTED

ALL ITEMS ON THIS SHEET ARE CATEGORY 0010 UNLESS OTHERWISE NOTED

CLEARING AND GRUBBING

LOCATION	201.0105 CLEARING STA	201.0120 CLEARING ID	201.0205 GRUBBING STA	201.0220 GRUBBING ID
*198+00 LT		12		12
200+86.77 - 202+00 RT	2		2	
214+10 RT		28		28
214+15 LT		4		4
214+75 RT		40		40
215+05 RT		36		36
215+50 RT		30		30
219+20 RT		3		3
222+10 RT		3		3
222+45 RT		3		3
223+10 RT		3		3
223+50 RT		3		3
223+85 RT		3		3
226+35 RT		8		8
226+65 RT		10		10
228+20 RT		3		3
228+50 RT		3		3
229+10 RT		3		3
229+25 RT		3		3
229+35 RT		3		3
229+60 RT		3		3
229+85 RT		3		3
230+10 RT		4		4
230+49 RT		4		4
230+50 RT		6		6
232+00 - 236+00 RT	4		4	
236+10 RT		10		10
238+00 - 239+00 RT	1		1	
240+00 - 242+00 LT	2		2	
240+60 RT		4		4
240+62 RT		6		6
241+40 RT		6		6
241+45 RT		3		3
241+55 RT		4		4
241+60 RT		6		6
241+80 RT		6		6
242+00 RT		4		4
242+65 RT		20		20
243+00 - 245+00 LT	2		2	
243+50 RT		6		6
243+75 RT		6		6
244+98 RT		12		12
245+00 - 248+00 LT	3		3	
245+40 RT		4		4
245+50 RT		8		8
245+75 RT		6		6
245+80 RT		8		8
245+90 RT		6		6
246+00 RT		6		6
246+10 RT		6		6
246+40 RT		10		10
247+60 RT		36		36
248+75 RT		48		48
249+10 RT		4		4
249+50 RT		6		6
249+60 RT		4		4
249+80 RT		6		6
251+00 - 253+00 LT	2		2	
PROJECT TOTALS	16	472	16	472
*6432-11-71		12		12
4994-00-87	16	460	16	460

REMOVING CONCRETE SIDEWALK
204.0155

STATION TO STATION	LOCATION	S.Y.	PHASE
9+43 - 9+68 LT	SODA CREEK RD	14	2
9+46 - 9+70 RT	SODA CREEK RD	13	2
9+40 - 9+67 LT	JACKTAR RD	15	2
9+41 - 9+65 RT	JACKTAR RD	13	2
PROJECT TOTAL		28	

REMOVING CURB & GUTTER
204.0150

STATION	LOCATION	L.F.	PHASE
*NW QUAD CTH Y / STH 76	STH 76 INT	67	3
*SW QUAD CTH Y / STH 76	STH 76 INT	58	4
*SE QUAD CTH Y / STH 76	STH 76 INT	69	2
*NE QUAD CTH Y / STH 76	STH 76 INT	59	1
*EB RIGHT TURN ISLAND	STH 76 INT	103	3
*WB RIGHT TURN ISLAND	STH 76 INT	102	1
202+04 RT	PE RT	15	2
202+04 RT	PE LT	15	2
240+31 RT	PE RT	92	2
240+31 RT	PE LT	64	2
PROJECT TOTAL		644	
*6432-11-71		458	
4994-00-87		186	

REMOVING SMALL PIPE CULVERTS
203.0100

STATION	LOCATION	EACH	REMARKS	PHASE
*195+94.22	DRIVEWAY LT	1	18" CMP	3
*196+49.37	DRIVEWAY RT	1	15" CMP	4
*199+32.46	CROSS CULVERT	1	24" RCP	3 AND 4
*200+63.39	CROSS CULVERT	1	24" RCP	1 AND 2
203+98	DRIVEWAY RT	1	12" CMP	2
205+74	DRIVEWAY LT	1	18" CMP	1
209+28	DRIVEWAY LT	1	18" CMP	1
210+57	DRIVEWAY RT	1	15" CMP	2
210+80	CROSS CULVERT	1	15" CMP	1 AND 2
212+61	DRIVEWAY LT	1	18" RCP	1
214+65	DRIVEWAY LT	1	15" CMP	1
215+73	DRIVEWAY LT	1	15" CMP	1
222+48	DRIVEWAY LT	1	18" X 24" CMP	1
225+69.97	DRIVEWAY RT	1	18" CMP	2
225+90.38	DRIVEWAY RT	1	12" HDPE	2
227+16.74	CROSS CULVERT	1	24" X 33" CMP	1 AND 2
227+34	CROSS CULVERT	1	18" CMP	1 AND 2
233+88.45	DRIVEWAY LT	1	12" X 18" CMP	1
236+45.66	DRIVEWAY LT	1	18" CMP	2008
242+26	DRIVEWAY LT	1	15" CMP	1
250+59	CROSS CULVERT	1	15" CMP	1 AND 2
251+29	CROSS CULVERT	1	18" CMP	1 AND 2
254+11	DRIVEWAY LT	1	15" CMP	1
256+96.37	CROSS CULVERT	1	12" HDPE	STORM SEWER & UTILITY
257+39.14	CROSS CULVERT	1	15" RCP	STORM SEWER & UTILITY
PROJECT TOTAL		25		
*6432-11-71		4		
4994-00-87		21		

REMOVING PAVEMENT
204.0100

STATION	LOCATION	S.Y.	DESCRIPTION	PHASE
258+00 - 258+53.16	CTH Y	139	MAINLINE	1 AND 2
9+35 - 10+00	SODA CREEK RD	109	MAINLINE	*2
9+00 - 10+00	JACKTAR RD	183	MAINLINE	*2
9+00 - 10+00	JACKTAR RD	55	DRIVEWAY APRONS	2
PROJECT TOTAL		486		

* INCLUDES REMOVAL REQUIRED FOR STORM SEWER INSTALLATION

REMOVING STORM SEWER STRUCTURE

STATION	LOCATION	204.0210 MANHOLE EACH	204.0215 CATCH BASIN EACH	204.0220 INLET EACH	PHASE
205+38.43	21.98' RT		1		STORM SEWER & UTILITY
205+89.31	15.52' RT	1			STORM SEWER & UTILITY
206+15.21	23.03' RT		1		STORM SEWER & UTILITY
208+43.59	21.01' RT		1		STORM SEWER & UTILITY
208+88.13	18.84' RT	1			STORM SEWER & UTILITY
209+27.12	21.78' RT		1		STORM SEWER & UTILITY
258+19.41	52.39' RT			1	2
258+43.12	37.67' LT			1	1
PROJECT TOTAL		2	4	2	

REMOVING STORM SEWER

STATION TO STATION	LOCATION	204.0245.01 12-INCH L.F.	204.0245.02 15-INCH L.F.	204.0245.03 18-INCH L.F.	REMARKS	PHASE
205+38.43 - 205+89.31	CTH Y	51			PVC PIPE	STORM SEWER & UTILITY
205+89.31 - 206+15.21	CTH Y	27			PVC PIPE	STORM SEWER & UTILITY
206+15.21 - 208+43.59	CTH Y	28			PVC PIPE	STORM SEWER & UTILITY
208+43.59 - 208+88.13	CTH Y	45			PVC PIPE	STORM SEWER & UTILITY
208+88.13 - 209+27.12	CTH Y	39			PVC PIPE	STORM SEWER & UTILITY
208+88.13 - I 3E	JACKTAR RD			34	CONC PIPE	STORM SEWER & UTILITY
EXIST I 31 - EXIST I 32	CTH Y	92			CONC PIPE	1 AND 2
I 32	CTH Y		8		CONC PIPE	1
PROJECT TOTALS		282	8	34		

gossen W:\DWG\W0002\970343\Quantities\MISC QUANTITIES.dwg 07/21/08 12:02 PM

BASE AGGREGATE AND BREAKER RUN

STATION TO STATION	LOCATION	305.0110 BASE AGGREGATE DENSE 3/4-INCH TON	305.0120 BASE AGGREGATE DENSE 1 1/4-INCH TON	311.0110 BREAKER RUN TON
*195+01.74 - 199+53.51	CTH Y MAINLINE	80	3282	
*200+37.07 - 200+86.77	CTH Y MAINLINE		470	
200+86.77 - 258+53.16	CTH Y MAINLINE		12405	
9+35 - 9+76	SODA CREEK RD		58	
9+00 - 9+76	JACKTAR RD		108	
9+03.58 - 9+76	BUTLER AVE		206	
200+37.07 - 213+51.86	TRAIL		187	
213+51.86 - 258+53.16	DRIVEWAYS		578	
195+01.84 - 258+53.16	DRIVEWAYS		1000	
195+01.84 - 258+53.16	STORM SEWER & UTILITY CROSSINGS		840	
200+37.07 - 258+53.16	PHASE 1 TEMP WIDENING		1222	
195+51.41 - 198+74.77	PHASE 3 TEMP WIDENING		117	
194+64 - 198+29.36	PHASE 4 TEMP WIDENING		67	
200+86.77 - 258+53.16	UNDISTRIBUTED (EBS AREAS)			11240
195+01.74 - 200+86.77	UNDISTRIBUTED (EBS AREAS)			560
PROJECT TOTALS		80	20540	11800
*6432-11-71		80	3752	560
4994-00-87			16788	11240
PER PHASE				
	STORM SEWER & UTILITY		840	
	PHASE 1		7900	
	PHASE 2		7800	
	PHASE 3	60	2000	
	PHASE 4	20	2000	

EARTHWORK SUMMARY

LOCATION	205.0100 EXCAVATION COMMON C.Y.	FILL C.Y.	*EXPANDED FILL C.Y.	MASS HAUL (WASTE) C.Y.
*CTH Y 195+01.84 - 200+86.77	2696	102	133	2563
CTH Y 200+86.77 - 258+53.16	25178	4617	6002	19176
SODA CREEK RD	114	2	3	111
JACKTAR RD	278	3	3	275
BUTLER AVE	142	15	20	123
STORM SEWER OUTFALL BY WETLANDS	1039	0	0	1039
DITCH AT 250+30 RT	39	0	0	39
TEMPORARY WIDENING	250	0	0	250
** DRIVEWAYS	750	0	0	750
EBS (UNDISTRIBUTED)	5950	0	0	5950
PROJECT TOTALS	36436	4738	6160	30276
*6432-11-71	2696	102	133	2563
4994-00-87	33740	4840	6026	27714
PER PHASE				
	STORM SEWER & UTILITY	1039	0	1039
		13237	1386	11435
	PHASE 2	13710	3250	9485
	PHASE 3	1400	51	1334
	PHASE 4	1100	51	1034
	EBS	5950	0	5950

* EXPANSION FACTOR FOR FILL = 30%
 ** EXCAVATION COMMON FOR DRIVEWAYS REPRESENTS THE VOLUME REQUIRED TO CONSTRUCT THE PAVEMENT SECTION FOR THE DRIVEWAYS

CONCRETE BASE HES, 8-INCH
320.0345

STATION TO STATION	LOCATION	S.Y.	REMARKS
*199+04.21 - 199+53.51	CTH Y	445	PHASE 3 AND 4
*200+37.07 - 200+86.77	CTH Y	455	PHASE 1 AND 2
PROJECT TOTAL		900	
*6432-11-71		900	
4994-00-87		0	
PER PHASE			
	PHASE 1	228	
	PHASE 2	227	
	PHASE 3	223	
	PHASE 4	222	

CONCRETE PAVEMENT, 8-INCH
415.0080

STATION TO STATION	LOCATION	S.Y.	REMARKS	PHASE
200+86.77 - 256+90.23	CTH Y	30185	MAINLINE EB & WB LANES	1 AND 2
257+44.91 - 258+53.16	CTH Y	819	MAINLINE EB & WB LANES	1 AND 2
9+35 - 9+76	SODA CREEK RD	151		2
9+00 - 9+76	JACKTAR RD	255		2
9+43.58 - 9+76	BUTLER AVE	158		2
PROJECT TOTAL		31568		
PER PHASE				
	PHASE 1	15502		
	PHASE 2	16066		

ASPHALTIC ITEMS

STATION TO STATION	LOCATION	460.1110 HMA PAVEMENT TYPE E-10 TON	465.0105 ASPHALTIC SURFACE TON	465.0120 ASPHALTIC SURFACE DRIVEWAYS AND FIELD ENTRANCES TON	465.0125 ASPHALTIC SURFACE TEMPORARY TON	455.0115 ASPHALTIC MATERIAL PG64-22 TON	455.0605 TACK COAT GAL	PHASE
*195+01.84 - 199+05.72	CTH Y	770						1, 2, 3, 4
*195+05.72 - 199+53.51	CTH Y CONC BASE AREA	107				46.2	54	3 AND 4
*200+37.07 - 200+86.77	CTH Y CONC BASE AREA	109				6.4	11	1 AND 2
256+79.07 - 257+56.09	CTH Y RAILROAD APPROACHES	105				6.5	11	1 AND 2
256+79.07 - 257+56.09	TEMPORARY RAMPS AT RAILROAD APPROACHES					6.3	7	1 AND 2
10+44.12 - 11+50	BUTLER AVE		50					2
213+51.86 - 258+53.16	ASPHALT TRAIL		890					2
195+01.84 - 258+53.16	DRIVEWAYS			365				1 AND 2
200+37.07 - 258+53.16	PHASE 1 TEMPORARY WIDENING				350			1
*194+51.41 - 199+53.51	PHASE 3 TEMPORARY WIDENING				42			3
*194+64 - 199+53.51	PHASE 4 TEMPORARY WIDENING				24			4
PROJECT TOTALS		1091	940	365	486	65.4	83	
*6432-11-71		986			66	59.1	76	
4994-00-87		105	940	365	420	6.3	7	
PER PHASE								
	PHASE 1	106		175	350	6.4	9	
	PHASE 2	106	940	170	70	6.4	9	
	PHASE 3	441		10	42	26.3	33	
	PHASE 4	438		10	24	26.3	32	

CONCRETE DRIVEWAY, 7-INCH
416.0170

STATION TO STATION	LOCATION	S.Y.	PHASE
202+04 RT	CTH Y	61	2
203+99 RT	CTH Y	53	2
204+00	CTH Y MEDIAN	109	2
210+57 RT	CTH Y	54	2
9+22 LT	JACKTAR RD	28	2
9+28 RT	JACKTAR RD	27	2
SW QUAD BUTLER AVE	TRAIL	15	2
SE QUAD BUTLER AVE	TRAIL	15	2
WEST RR / TRAIL APPROACH	TRAIL	6	2
EAST RR / TRAIL APPROACH	TRAIL	6	2
SW QUAD CTH A	TRAIL	17	2
NW QUAD CTH A	TRAIL	13	2
PROJECT TOTAL		404	

DRILLED TIE BARS
416.0610

STATION	LOCATION	EACH	PHASE
240+16 RT	CTH Y (CURB IN PE)	2	2
258+53.16	CTH Y	75	1 AND 2
9+35	SODA CREEK RD	13	2
9+00	JACKTAR RD	13	2
PROJECT TOTAL		103	

CONCRETE PAVEMENT GAPS
416.0805

LOCATION	NO. OF LANES	EACH	PHASE
202+00 RT	2	1	PHASE 2
205+80 LT	2	1	PHASE 1
209+25 LT	2	1	PHASE 1
210+60 RT	2	1	PHASE 2
212+60 LT	2	1	PHASE 1
214+60 LT	2	1	PHASE 1
226+00 LT	2	1	PHASE 1
226+10 RT	2	1	PHASE 2
242+15 LT	2	1	PHASE 1
250+90 LT	2	1	PHASE 1
CTH Y AT SODA CREEK RD RT	2	1	PHASE 2
CTH Y AT JACKTAR RD RT	2	1	PHASE 2
PROJECT TOTAL		12	

CONCRETE SURFACE DRAINS
416.1010

STATION	LOCATION	C.Y.	PHASE
*197+04.88 RT	CTH Y	1	4
*199+05.72 LT	CTH Y	1	3
9+16.19 RT	STH 76	1	2
9+43.58 RT	BUTLER AVE	1	2
9+48.28 LT	BUTLER AVE	1	2
PROJECT TOTALS		5	
*6432-11-71		2	
4994-00-87		3	

CONCRETE MASONRY ENDWALLS
504.0900

LOCATION	C.Y.	REMARKS
227+16.74 RT, LT	8	3 - 19"X 30" CONC PIPE
PROJECT TOTALS	8	
PER PHASE		
	PHASE 1	4
	PHASE 2	4

CULVERT PIPES

STATION	LOCATION	CORRUGATED STEEL	REINFORCED CONCRETE	REINFORCED CONCRETE	RC HE	RC HE	THICKNESS	REMARKS	PHASE
		18-INCH 521.0118 LF	CLASS IV 15-INCH 522.0315 LF	CLASS IV 24-INCH 522.0324 LF	CLASS HE-IV 19 X 30-INCH SPV.0090.06 LF	CLASS HE-IV 24 X 38-INCH SPV.0090.07 LF			
*195+94.22 LT	CTH Y	51 58.5					0.064		3
*196+49.37 RT	CTH Y	72 82.5					0.064		4
*199+32.46	CTH Y			146					4
*200+63.39	CTH Y			129 130					1
225+90.38 LT	CTH Y	126 127					0.064	TWIN PIPES	1
227+16.74	CTH Y				312			TRIPLE PIPES, LHF 21039'50"	1
233+88.45 LT	CTH Y	33 34					0.064		1
236+45.66	CTH Y	24					0.064		2008
256+96.37	CTH Y		89 88.3						2008
257+39.14	CTH Y		93 99.4						2008
17+03.48	PARK ENTRANCE RD					88 111.3		TWIN PIPES	2008
PROJECT TOTALS		306	182	275	312	88			
*6432-11-71		123		275					
4994-00-87		183	182		312	88			

APRON ENDWALLS

STATION	LOCATION	STEEL	REINFORCED CONCRETE	REINFORCED CONCRETE	REINFORCED CONCRETE	THICKNESS	REMARKS	PHASE
		18-INCH 521.1018 EACH	15-INCH 522.1015 EACH	CONCRETE 24-INCH 522.1024 EACH	HORIZONTAL ELLIPTICAL 24 X 38-INCH 523.0524 EACH			
*195+94.22 LT	CTH Y	2				0.064		3
*196+49.37 RT	CTH Y	2				0.064		4
*199+32.46	CTH Y			2			JOINT TIES REQ'D **	3
*200+63.39	CTH Y			2			JOINT TIES REQ'D **	1
225+90.38 LT	CTH Y	4				0.064	TWIN PIPES	1
233+88.45 LT	CTH Y	2				0.064		1
236+45.66	CTH Y	2				0.064		1
256+96.37	CTH Y		2				JOINT TIES REQ'D **	1
257+39.14	CTH Y		2				JOINT TIES REQ'D **	1
17+03.48	COMMUNITY PARK				4		JOINT TIES REQ'D **	1
							STORM SEWER & UTILITY	
							STORM SEWER & UTILITY	
							STORM SEWER & UTILITY	
PROJECT TOTALS		12	4	4	4			
*6432-11-71		4		4				
4994-00-87		8	4		4			

** NON-BID ITEM, FOR INFORMATIONAL PURPOSES ONLY

CONCRETE SIDEWALK 4-INCH
602.0405

STATION TO STATION	LOCATION	S.F.	PHASE
*197+04.88 - 199+39.91	MEDIAN	1271	2
*200+59.40 - 200+86.77	MEDIAN	287	2
200+86.77 - 203+60	MEDIAN	1341	2
204+40 - 205+18.76	MEDIAN	496	2
STH 76 - SODA CREEK RD	RT	2237	2
SODA CREEK RD - JACKTAR RD	RT	1448	2
JACKTAR RD - 213+51.86	RT	2277	2
PROJECT TOTAL		9357	
*6432-11-71		1558	
4994-00-87		7799	

CURB RAMP DETECTABLE WARNING FIELD YELLOW
602.0505

LOCATION	S.F.	PHASE
*SE QUAD CTH Y / STH 76	8	2
SW QUAD CTH Y / SODA CREEK RD	8	2
SE QUAD CTH Y / SODA CREEK RD	8	2
SW QUAD CTH Y / JACKTAR RD	8	2
SE QUAD CTH Y / JACKTAR RD	8	2
SW QUAD CTH Y / BUTLER AVE	16	2
SE QUAD CTH Y / BUTLER AVE	16	2
WEST RR APPROACH	16	2
EAST RR APPROACH	16	2
SW QUAD CTH Y / CTH A	16	2
NW QUAD CTH Y / CTH A	16	2
PROJECT TOTAL		136
*6432-11-71		8
4994-00-87		128

CONCRETE CURB & GUTTER, TYPE D

STATION TO STATION	LOCATION	601.0407 18-INCH LF	601.0411 30-INCH LF	PHASE
*197+04.88 - 199+04.64	MEDIAN RT	201		4
*197+04.88 - 199+05.72	MEDIAN LT	201		3
*197+11.14 - 199+04.64	RT		194	4
240+16	DRIVEWAY RT	6		2
256+79.07 - 256+85.79	RT		7	2
256+79.07 - 256+93.56	MEDIAN RT	14		2
256+90.23 - 256+93.56	MEDIAN LT	3		1
256+90.23 - 257+06.80	LT		17	1
257+28.21 - 257+44.91	RT		17	2
257+41.48 - 257+44.91	MEDIAN RT	3		2
257+41.48 - 257+56.09	MEDIAN LT	15		1
257+49.33 - 257+56.09	LT		7	1
PROJECT TOTAL		443	242	
*6432-11-71		402	194	
4994-00-87		41	48	

CONCRETE CURB & GUTTER, TYPE A

STATION TO STATION	LOCATION	601.0405 18-INCH LF	601.0409 30-INCH LF	PHASE
*199+04.64 - 199+39.91	MEDIAN RT	35		4
*199+05.72 - 199+39.91	MEDIAN LT	34		3
-	*SW QUAD CTH Y / STH 76		72	4
-	*NW QUAD CTH Y / STH 76		65	3
-	*SE QUAD CTH Y / STH 76		71	2
-	*NE QUAD CTH Y / STH 76		72	1
*200+59.40 - 200+86.77	MEDIAN RT	27		2
*200+59.40 - 200+86.77	MEDIAN LT	27		1
200+86.77 - 205+18.76	MEDIAN RT	433		2
200+86.77 - 205+18.76	MEDIAN LT	433		1
200+86.77 - 205.31.80	RT		396	2
200+87.92 - 256+90.23	LT		5603	1
-	SW QUAD CTH Y / SODA CREEK RD		41	2
-	SE QUAD CTH Y / SODA CREEK RD		39	2
9+35 - 9+49.32	SODA CREEK RD RT		14	2
9+35 - 9+46.37	SODA CREEK RD LT		11	2
206+13.04 - 208+33.47	RT		220	2
-	SW QUAD CTH Y / JACKTAR RD		39	2
-	SE QUAD CTH Y / JACKTAR RD		39	2
9+00 - 9+49.60	JACKTAR RD RT		50	2
9+00 - 9+48.39	JACKTAR RD LT		48	2
209+13.55 - 236+03.41	RT		2690	2
-	SW QUAD CTH Y / BUTLER AVE		41	2
-	SE QUAD CTH Y / BUTLER AVE		38	2
236+95.53 - 256+79.07	RT		1984	2
256+01.50 - 256+79.07	MEDIAN RT	78		2
256+01.50 - 256+90.23	MEDIAN LT	89		1
257+44.91 - 257+75.69	RT		31	2
257+44.91 - 257+97.00	MEDIAN RT	52		2
257+56.09 - 257+97.00	MEDIAN LT	41		1
257+56.09 - 258+01.66	LT		46	1
-	SW QUAD CTH Y / CTH A		84	2
-	NW QUAD CTH Y / CTH A		87	1
PROJECT TOTAL		1249	11781	
*6432-11-71		123	280	
4994-00-87		1126	11501	

STORM SEWER SUMMARY

PIPE NO.	FROM STRUCTURE	TO STRUCTURE	INLET ELEVATION	OUTLET ELEVATION	SPV.0090.05	608.0412	608.0415	608.0418	608.0424	608.0430	608.0436	608.0442	SLOPE %
					PVC SDR 35 6-INCH L.F.	RCPSS 12-INCH L.F.	RCPSS 15-INCH L.F.	RCPSS 18-INCH L.F.	RCPSS 24-INCH L.F.	RCPSS 30-INCH L.F.	RCPSS 36-INCH L.F.	RCPSS 42-INCH L.F.	
P-1	I 1A	I 1B	773.90	773.17	773.11	773.99	15	11.5					0.40
P-2A	I 1B	I 1C	773.90	773.11	773.01	773.69	26	28.5					0.38
P-2B	I 1C	I 1D	773.68	773.01	772.98	773.62			7	7.5			0.43
P-2C	I 1D	I 1E	773.59	772.98	772.88	773.20			26	2.6			0.36
P-3A	I 1E	I 1F	773.18	772.96	772.88	772.91	15	1.6					0.53
P-3B	I 1F	MH 1	772.90	772.88	772.84	772.84			8	8.0			0.50
P-4	MH 1	MH 2	772.79	772.84	772.62	772.60			88	87.1			0.25
P-5	I 2A	I 2B	772.47	772.95	772.80	772.83	29	29.5					0.52
P-6	I 2B	MH 2	772.83	772.80	772.62	772.66			31	30.6			0.58
P-7	MH 2	MH 3	772.66	772.62	772.14	772.14			228	228.3			0.21
P-8	I 3A	I 3B	772.43	772.41	772.32	772.30	9	7.7					1.00
P-9	I 3B	I 3C	772.30	772.32	772.17	772.20			50	5.2			0.30
P-10	I 3C	MH 3	772.17	772.17	772.14	772.14			6				0.50
P-11	I 3D	I 3E	772.41	772.20	772.08	772.25	28	2.9					0.43
P-12A	MH 3	MH 4	772.16	772.14	771.84	771.94			246	24.7			0.08
P-12B	I 3F	P-12A INLINE TEE	772.17	774.55	771.98	774.33	19						1.00
P-13	I 4A	I 4B	772.02	772.05	771.95	771.95			51	51.7			0.20
P-13A	I 4C	I 4A	772.09	772.11	772.05	772.02	15	15.2					0.40
P-14	I 4B	MH 4	771.94	771.95	771.94	771.94			6	8.6			0.17
P-14A	I 4D	I 4B	772.00	772.01	771.95	771.97	15	14.6					0.40
P-15	MH 4	MH 5	771.94	771.94	771.72	771.71					270	2.64	0.08
P-16	I 5A	I 5B	772.25	772.30	772.14	772.21			7	8.6			2.29
P-17	I 5B	I 5C	772.16	772.14	771.76	771.76			50	5.1			0.76
P-18	I 5C	MH 5	771.76	771.76	771.72	771.72			6	9			0.67
P-19	MH 5	MH 6	771.70	771.72	771.34	771.30					404	4.13	0.09
P-20	I 6A	I 6B	771.52	772.75	771.49	771.49			50	3.8			2.52
P-21	I 6B	MH 6	771.49	771.49	771.34	771.30			6	8			2.50
P-22	MH 6	MH 7	771.25	771.34	771.23	771.20					170	170.3	0.06
P-23	MH 7	MH 8	771.19	771.23	771.09	771.09					176	177.8	0.08
P-24	MH 8	MH 9	771.06	771.09	770.88	770.86					218	22.1	0.10
P-24A	I 8A	I 8B	771.52	771.54	771.19	771.18	50	51.7					0.70
P-24B	I 8B	MH 8	771.18	771.19	771.09	771.10	14	1.5					0.70
P-25	I 9A	I 9B	771.30	771.33	770.98	770.96			50	5.1			0.70
P-26	I 9B	MH 9	770.91	770.98	770.88	770.86			14	1.4			0.71
P-27	MH 9	MH 33	770.86	770.88	770.78	770.79					172	169.4	0.06
P-27A	MH 33	MH 10	770.75	770.78	770.69	770.66					140	145.5	0.06
P-27B	I 33B	MH 33	770.86	770.88	770.78	770.84	14						0.70
P-27C	I 33A	I 33B	771.21	771.13	770.88	770.87	50	51.6					0.70
P-28	MH 10	MH 11	770.62	770.69	770.67	770.66					40	41.5	0.05
P-28A *	EW 11A	MH 11A	773.56	773.75	771.11	771.22			44	6.6			6.00
P-28B *	EW 11B	MH 11A	773.71	773.75	771.11	771.07	42						6.29
P-28C	MH 11A	MH 11	771.07	771.11	770.67	770.64			44	45.2			1.00
P-29	MH 11	MH 12	770.62	770.67	770.57	770.57					126	126.3	0.08
P-30 *	MH 12	EW 12A	770.57	770.57	770.53	770.57					48	39.4	0.08
P-31	MH 13	MH 10	770.74	770.74	770.69	770.62					51	54.2	0.10
P-33	MH 14	MH 13	771.03	771.02	770.76	770.77					317	317.9	0.08
P-34	I 14A	I 14B	771.75	771.62	771.66	771.68			50	51.5			1.22
SUBTOTALS					19	322	191	315	562	0	1918	214	

* JOINT TIES REQ'D - NON-BID ITEM, FOR INFORMATIONAL PURPOSES ONLY

NOTE: ALL STORM SEWER TO BE CONSTRUCTED DURING THE STORM SEWER AND UTILITY PHASE WITH THE EXCEPTION OF PIPE RUN P-68, P-69, P-98 AND P-99
P-68 AND P-69 TO BE CONSTRUCTED DURING PHASES 1 AND 2, P-98 AND P-99 TO BE CONSTRUCTED DURING PHASES 3 AND 4.

STORM SEWER SUMMARY

PIPE NO.	FROM STRUCTURE	TO STRUCTURE	INLET ELEVATION	OUTLET ELEVATION	SPV.0090.05 PVC SDR 35 6-INCH L.F.	608.0412 RCPSS 12-INCH L.F.	608.0415 RCPSS 15-INCH L.F.	608.0418 RCPSS 18-INCH L.F.	608.0424 RCPSS 24-INCH L.F.	608.0430 RCPSS 30-INCH L.F.	608.0436 RCPSS 36-INCH L.F.	608.0442 RCPSS 42-INCH L.F.	SLOPE %
P-34A	I 14C	I 14A	771.80	771.73		15	14.5						0.40
P-35	I 14 B	MH 14	771.02	771.06				14	15				0.29
P-35A	I 14D	I 14B	771.21	771.12		15	14.5						0.40
P-36	MH 15	MH 14	771.06	771.08						102	101.6		0.06
P-37	MH 16	MH 15	771.30	771.30						288			0.08
P-38	I 16A	I 16B	771.80	771.86				50	51.7				1.00
P-39	I 16B	MH 16	771.40	771.36				16	6				0.38
P-40	MH 17	MH 16	771.68	771.66						454	454.7		0.08
P-41	I 17A	I 17B	772.29	772.18				50	51.3				0.92
P-41A	I 17C	I 17A	772.27	772.24		15	15.2						0.40
P-41B	I 17D	I 17B	772.12	771.78		15	15.4						0.40
P-42	I 17B	MH 17	771.77	771.72				6	6.3				1.00
P-43	MH 19	MH 17	772.77	772.80						334	335.5		0.34
P-46	I 19A	I 19B	773.34	773.25		33	33.5						0.45
P-47	I 19B	MH 19	773.07	773.10					60	62.5			0.50
P-48	MH 20	MH 19	773.54	773.49						139	137		0.50
P-49	I 20A	I 20B	774.30	774.14				6	6.5				1.00
P-50	I 20B	I 20C	774.09	774.05				50	52				1.00
P-51	I 20C	MH 20	773.66	773.55				6	7.5				1.00
P-52	MH 21	MH 20	774.29	774.23						149	147		0.50
P-53	I 21A	MH 21	774.81	774.89					64	65			1.03
P-54	MH 22	MH 21	775.04	775.04					160	155			0.51
P-55	I 22A	I 22B	775.25	775.60		12	13						1.42
P-56	I 22B	I 22C	775.55	775.43					74	78			0.30
P-57	I 22C	I 22D	775.25	775.21					50	51			0.30
P-58	I 22D	MH 22	775.04	775.06				8	7				0.33
P-59	MH 23	MH 22	775.77	775.76					240	249			0.30
P-60	I 23A	I 23B	776.03	775.93					50	51			0.30
P-61	I 23B	MH 23	775.84	775.78					6	7			0.33
P-62	I 24	I 25	777.86	777.75					30				1.87
P-63	I 25	I 26	777.54	777.59					-8	7			0.53
P-64	I 26	I 27	777.46	777.44					-60	49			0.44
P-65	I 27	I 29	777.26	777.22						50	51		0.32
P-67 *	MH 35	EW 30	777.04	777.04					29	23			0.28
P-67A	MH 34	MH 35	777.93	777.93		270	271						0.33
P-67B	I 34B	MH 34	777.96	777.97					6				0.70
P-67C	I 34A	I 34B	778.26	778.32					50				0.70
P-67D	I 29	MH 35	777.16	777.06						6	5.5		0.32
P-68	I 31	I 32	777.25	777.77		97	95						0.48
P-69	I 32	EXISTING PIPE	777.24	EXISTING					8	12			-
*P-98	I 98	EW 97	773.86	773.88		35	33.7						0.34
*P-99	I 99	I 98	773.93	773.82		11							0.36

SUBTOTALS	0	848	70	221	524	622	844	0
PROJECT TOTALS	19	1170	261	536	1086	622	2762	214
*6432-11-71	-	46	-	-	-	-	-	-
4994-00-87	19	1,124	261	536	1,086	622	2,762	214

* JOINT TIES REQ'D - NON-BID ITEM, FOR INFORMATIONAL PURPOSES ONLY

NOTE: ALL STORM SEWER TO BE CONSTRUCTED DURING THE STORM SEWER AND UTILITY PHASE WITH THE EXCEPTION OF PIPE RUN P-68, P-69, P-98 AND P-99
P-68 AND P-69 TO BE CONSTRUCTED DURING PHASES 1 AND 2, P-98 AND P-99 TO BE CONSTRUCTED DURING PHASES 3 AND 4.

STORM SEWER STRUCTURES

STRUCTURE NO.	STATION	LOCATION	ENDWALLS		MANHOLES				INLETS		INLET COVERS			MANHOLE COVERS		CONSTRUCTION STAKING	RIM ELEVATION	FLOWLINE OF STRUCTURE	STRUCTURE DEPTH
			522.1012 12-INCH EACH	522.1018 18-INCH EACH	522.1042 42-INCH EACH	611.0201 TYPE 1 EACH	611.0210 TYPE 3 EACH	SPV.0060.01 BOX EACH	SPV.0060.02 BOX CULVERT EACH	611.0301 TYPE 1 EACH	611.0303 TYPE 3 EACH	611.0612 TYPE C EACH	611.0624 TYPE H EACH	611.0666 TYPE Z EACH	SPV.0060.05 TYPE A SPECIAL EACH	611.0530 TYPE J EACH			
*I 99	197+06.40	7.3' RT							1							1	777.52	773.92	2.60
*I 98	197+06.40	1.47' LT							1							1	777.52	773.88	2.64
*EW 97	196+86.44	31.5' LT	1													1		773.76	
MH 1	205+19	35.25' RT				1										1	778.44	772.84	4.35
I 1A	205+00	30.53' LT								1			1			1	777.93	773.17	3.76
I 1B	205+15	29.87' LT								1			1			1	777.87	773.11	3.76
I 1C	205+13	1.93' LT							1				1			1	778.36	773.01	4.35
I 1D	205+17.27	1.38' RT							1				1			1	778.34	772.98	4.36
I 1E	205+00	30.08' RT								1			1			1	777.93	772.96	3.97
I 1F	205+15	29.48' RT								1			1			1	777.87	772.88	3.99
MH 2	206+06.58	31.25' RT					1									1	778.02	772.62	4.15
I 2A	9+44.26 SODA CR	15.63' LT								1			1			1	777.22	772.95	3.27
I 2B	9+44.32 SODA CR	15.63' RT								1			1			1	777.22	772.80	3.42
MH 3	208+34.18	31.25' RT				1										1	777.12	772.14	3.73
I 3A	208+42.22	30.5' LT							1				1			1	776.30	772.41	3.39
I 3B	208+34.18	26.5' LT								1			1			1	776.62	772.32	3.30
I 3C	208+33.47	26.5' RT								1			1			1	776.62	772.17	3.45
I 3D	9+46.82 JACKTAR CT	15.52' RT								1			1			1	776.11	772.20	2.91
I 3E	9+47.10 JACKTAR CT	15.52' LT								1			1			1	776.11	772.08	3.03
I 3F	210+37	50' RT							1				1			1	775.75	772.17	3.08
MH 4	210+80	31.25' RT					1									1	776.28	771.94	3.09
I 4A	210+72.89	26.5' LT								1			1			1	775.78	772.05	2.73
I 4B	210+80	26.5' RT								1			1			1	775.78	771.95	2.83
I 4C	210+87.89	26.5' LT								1			1			1	775.76	772.11	2.65
I 4D	210+95	26.5' RT								1			1			1	775.77	772.01	2.76
MH 5	213+50	31.25' RT					1						1			1	777.56	771.72	4.59
I 5A	213+55	30.5' LT							1				1			1	776.75	772.30	3.95
I 5B	213+50	26.5' LT								1			1			1	777.06	772.14	3.92
I 5C	213+50	26.5' RT								1			1			1	777.06	771.76	4.30
MH 6	217+54.99	31.25' RT					1									1	778.04	771.34	5.45
I 6A	217+54.99	26.5' LT								1			1			1	777.54	772.75	3.79
I 6B	217+54.99	26.5' RT								1			1			1	777.54	771.49	5.05
MH 7	219+25	31.25' RT					1									1	778.35	771.23	5.87
MH 8	221+00	39.25' RT					1									1	777.67	771.09	5.33
I 8A	221+00	26.5 LT								1			1			1	775.02	771.54	2.48
I 8B	221+00	26.5 RT								1			1			1	775.02	771.19	2.83
MH 9	223+19.02	39.25' RT					1									1	776.58	770.88	4.45
I 9A	223+19.02	26.5' LT								1			1			1	775.72	771.33	3.39
I 9B	223+19.02	26.5' RT								1			1			1	775.72	770.98	3.74
I 33A	224+90	26.5' LT								1			1			1	776.26	771.13	4.13
I 33B	224+90	26.50' RT								1			1			1	776.26	770.88	4.38
MH 33	224+90	39.25' RT					1									1	776.91	770.78	4.88
MH 10	226+31.85	39.25' RT						1								1	777.66	770.69	5.72
SUBTOTALS			1	0	0	2	8	1	0	7	24	1	24	4	3	10	43		

LOCATION IS TO CENTER BACK OF CURB FOR TYPE 3 INLETS AND TYPE 1 MANHOLES WITH INLET CASTINGS
 LOCATION IS TO CENTER OF STRUCTURES FOR INLETS BEHIND CURB
 FLOW LINE OF STRUCTURE = LOWEST PIPE FLOWLINE ELEVATION ENTERING STRUCTURE.
 RIM ELEVATION = FINISHED EDGE OF PAVEMENT AT STRUCTURES WITH TYPE H CASTING

STRUCTURE DEPTH = RIM ELEVATION MINUS FLOWLINE OF STRUCTURE MINUS 12" FOR TYPE 3 INLETS WITH TYPE H INLET CASTINGS.
 STRUCTURE DEPTH = RIM ELEVATION MINUS FLOWLINE OF STRUCTURE MINUS 6" FOR INLETS BEHIND CURB
 STRUCTURE DEPTH = RIM ELEVATION MINUS FLOWLINE OF STRUCTURE MINUS 15" FOR MANHOLES WITH TYPE J CASTINGS

NOTE: ALL STRUCTURES TO BE INSTALLED DURING THE STORM SEWER AND UTILITY PHASE
 WITH THE EXCEPTION OF I 99, I 98, EW 97 (PHASES 3 AND 4), AND I 31, I 32 (PHASES 1 & 2).

STORM SEWER STRUCTURES

STRUCTURE NO.	STATION	LOCATION	ENDWALLS			MANHOLES			INLETS		INLET COVERS		MANHOLE COVERS		CONSTRUCTION STAKING 650.4000 EACH	RIM ELEVATION	FLOWLINE OF STRUCTURE	STRUCTURE DEPTH
			522.1012 12-INCH EACH	522.1018 18-INCH EACH	522.1042 42-INCH EACH	611.0201 TYPE 1 EACH	611.0210 TYPE 3 EACH	SPV.0060.01 BOX EACH	SPV.0060.02 BOX CULVERT EACH	611.0301 TYPE 1 EACH	611.0303 TYPE 3 EACH	611.0612 TYPE C EACH	611.0624 TYPE H EACH	611.0666 TYPE Z EACH				
MH 11	10+40.25	DITCH COMMUNITY PARK	0.0'												1	775.68	770.67	3.76
MH 11A	225+90.39	62' RT				1									1	775.76	771.11	3.40
EW 11A	225+44.58	62' RT		1											1	-	773.75	-
EW 11B	225+90.22	105.84' RT	1												1	-	773.75	-
MH 12	11+66.20	DITCH COMMUNITY PARK	0.0'												1	775.95	770.57	4.13
EW 12A	12+18.23	DITCH COMMUNITY PARK	0.0'		1										1	-	770.53	-
MH 13	227+01.16	39.25' RT									1				2	777.97	770.75	5.97
MH 14	230+32.86	39.25' RT						1							1	777.07	771.02	4.80
I 14A	230+32.86	26.5' LT							1				1		1	776.21	771.67	3.54
I 14B	230+32.86	26.5' RT											1		1	776.21	771.06	4.15
I 14C	230+47.86	26.5' LT											1		1	776.67	771.73	3.94
I 14D	230+47.86	26.5' RT											1		1	776.67	771.72	4.55
MH 15	231+35	31.25' RT							1						1	777.16	771.08	4.83
MH 16	234+23.33	31.25' RT							1						1	777.32	771.30	4.77
I 16A	234+23.33	26.5' LT											1		1	776.82	771.86	3.96
I 16B	234+23.33	26.5' RT											1		1	776.82	771.36	4.46
MH 17	238+78	31.25' RT							1						1	777.71	771.66	4.80
I 17A	238+78	26.5' LT											1		1	777.21	772.18	4.03
I 17B	238+78	26.5' RT											1		1	777.21	771.72	4.49
I 17C	238+93	26.5' LT											1		1	776.74	772.24	3.50
I 17D	238+93	26.5' RT											1		1	776.74	771.78	3.96
MH 19	242+12	31.25' RT							1						1	778.57	772.80	4.52
I 19A	242+45	29' LT											1		1	777.50	773.25	3.75
I 19B	242+12	29' LT											1		1	777.60	773.10	4.00
MH 20	243+51	31.25' RT							1						1	779.16	773.49	4.42
I 20A	243+51	31.5' LT											1		1	778.75	774.11	4.14
I 20B	243+51	26.5' LT											1		1	778.66	774.05	3.61
I 20C	243+51	26.5' RT											1		1	778.66	773.55	4.11
MH 21	245+00	31.25' RT							1						1	779.91	774.23	4.43
I 21A	245+00	32.5' LT											1		1	779.50	774.89	4.11
MH 22	246+53.55	31.25' RT							1						1	779.72	775.04	3.43
I 22A	247+40	32.5' LT											1		1	779.60	775.60	3.50
I 22B	247+30	26.5' LT											1		1	779.45	775.43	3.02
I 22C	246+53.55	26.5' LT											1		1	779.26	775.21	3.05
I 22D	246+53.55	26.5' RT											1		1	779.26	775.06	3.20
MH 23	249+00	31.25' RT							1						1	780.75	775.76	3.74
I 23A	249+00	26.5' LT											1		1	780.25	775.93	3.32
I 23B	249+00	26.5' RT											1		1	780.25	775.78	3.47
I 24	251+10	33' LT											1		1	781.44	777.75	3.00
I 25	250+80	33' LT											1		1	781.44	777.59	3.35
I 26	250+80	26.5' LT											1		1	781.44	777.44	3.00
I 27	250+30	26.5' LT											1		1	781.22	777.22	3.00
I 29	250+30	26.5' RT											1		1	781.22	777.06	3.16
EW 30	250+30	61.75' RT		1											1	-	776.96	-
MH 35	250+30	31.25' RT													1	781.83	777.04	3.54
MH 34	253+00	31.25' RT													1	782.71	777.93	3.53
I 34A	253+00	26.5' LT											1		1	782.17	778.32	3.85
I 34B	253+00	26.5' RT											1		1	782.17	777.97	4.20
I 31	258+14.63	54.99' RT											1		1	782.75	777.77	3.98
I 32	258+39.41	40.10' LT											1		1	782.73	777.24	4.49
SUBTOTALS			1	2	1	8	7	2	1	3	24	0	24	0	7	16	50	
PROJECT TOTALS			2	2	1	10	15	3	1	11	48	1	48	4	10	26	93	
6432-11-71			1	-	-	-	-	-	-	2	-	-	-	2	-	3		
4994-00-87			1	2	1	10	15	3	1	9	48	1	48	2	10	26	90	

LOCATION IS TO CENTER BACK OF CURB FOR TYPE 3 INLETS AND TYPE 1 MANHOLES WITH INLET CASTINGS
 LOCATION IS TO CENTER OF STRUCTURES FOR INLETS BEHIND CURB
 FLOW LINE OF STRUCTURE = LOWEST PIPE FLOWLINE ELEVATION ENTERING STRUCTURE.
 RIM ELEVATION = FINISHED EDGE OF PAVEMENT AT STRUCTURES WITH TYPE H CASTING

STRUCTURE DEPTH = RIM ELEVATION MINUS FLOWLINE OF STRUCTURE MINUS 12" FOR TYPE 3 INLETS WITH TYPE H INLET CASTINGS.
 STRUCTURE DEPTH = RIM ELEVATION MINUS FLOWLINE OF STRUCTURE MINUS 6" FOR INLETS BEHIND CURB
 STRUCTURE DEPTH = RIM ELEVATION MINUS FLOWLINE OF STRUCTURE MINUS 15" FOR MANHOLES WITH TYPE J CASTINGS

NOTE: ALL STRUCTURES TO BE INSTALLED DURING THE STORM SEWER AND UTILITY PHASE
 WITH THE EXCEPTION OF I 99, I 98, EW 97 (PHASES 3 AND 4), AND I 31, I 32 (PHASES 1 & 2).

ALL ITEMS ARE PROJECT ID 4994-00-87 UNLESS OTHERWISE NOTED

ALL ITEMS ON THIS SHEET ARE CATEGORY 0010 UNLESS OTHERWISE NOTED

LANDSCAPING SUMMARY

STATION	LOCATION	625.0100 TOPSOIL	627.0200 MULCHING	628.2006 EROSION MAT URBAN, CLASS I TYPE A S.Y.	628.2008 EROSION MAT URBAN, CLASS I TYPE B S.Y.	629.0210 FERTILIZER TYPE B CWT.	630.0140 SEEDING MIXTURE NO. 40 LB.	630.0170 SEEDING MIXTURE NO. 70 LB.	630.0200 SEEDING TEMPORARY LB.	PHASE
*195+01.84 - 200+86.77	CTH Y	2126			2126	1.4	38		57	2
200+86.77 - 258+53.16	CTH Y	19140	9877	8597	666	12.1	326	4	141	2 AND 4
200+86.77 - 258+53.16		1835		5639	2872	1.1	31	1	382	STORM SEWER & UTILITY
210+80 - 216+55	PHASE 1 WIDENING UNDISTRIBUTED				511				14	1
							99	1	146	
PROJECT TOTALS		23101	9877	14236	6240	14.6	494	6	743	
*6432-11-71		2126			2191	1.4	38		60	
4994-00-87		20975	9877	14236	4049	13.2	456	6	683	
PER PHASE										
2008		1835		5639	2937	1.1	31	1	385	
PHASE 1		9000	4180	4100	1693	5.7	154		98	
PHASE 2		10750	4993	4000	1411	6.8	184	4	100	
PHASE 3		696	323	297	91	0.4	12		6	
PHASE 4		820	381	200	108	0.5	14		8	

NOTE: TEMPORARY SEEDING REQUIRED ON ALL AREAS DISTURBED THE STORM SEWER AND UTILITY PHASE CONSTRUCTION

INLET PROTECTION

STATION TO STATION	STRUCTURE	628.7005 TYPE A EACH	628.7015 TYPE C EACH
*197+06.40	I 99		1
*197+06.40	I 98		1
205+00	I 1A		1
205+15	I 1B		1
205+13	I 1C		1
205+17.27	I 1D		1
205+00	I 1E		1
205+15	I 1F		1
9+44.26 SODA CR	I 2A		1
9+44.32 SODA CR	I 2B		1
208+42.22	I 3A	1	
208+34.18	I 3B		1
208+33.47	I 3C		1
9+46.82 JACKTAR CT	I 3D		1
9+47.10 JACKTAR CT	I 3E		1
210+37	I 3F	1	
210+72.89	I 4A		1
210+80	I 4B		1
210+87.89	I 4C		1
210+95	I 4D		1
213+55	I 5A	1	
213+50	I 5B		1
213+50	I 5C		1
213+50	MH 5	1	
217+54.99	I 6B		1
217+54.99	I 6A		1
221+00	I 8A		1
221+00	I 8B		1
223+19.02	I 9A		1
223+19.02	I 9B		1
224+90	I 33A		1
224+90	I 33B		1
230+32.86	I 14A		1
230+32.86	I 14B		1
230+47.86	I 14C		1
230+47.86	I 14D		1
234+23.33	I 16A		1
234+23.33	I 16B		1
238+08	EXISTING, 109' RT	1	
238+86	I 17A		1
238+86	I 17B		1
238+93	I 17C		1
238+93	I 17D		1
239+74	EXISTING, 131' RT	1	
240+94	EXISTING, 148' RT	1	
242+45	I 19A		1
242+12	I 19B		1
243+51	I 20A	1	
243+51	I 20B		1
243+51	I 20C		1
245+00	I 21A	1	
246+60.55	I 22C		1
246+60.55	I 22D		1
247+40	I 22A	1	
247+30	I 22B		1
249+00	I 23A		1
249+00	I 23B		1
251+10	I 24	1	
250+80	I 25	1	
250+80	I 26		1
250+30	I 27		1
250+30	I 29		1
253+00	I 34A		1
253+00	I 34B		1
258+14.63	I 31		1
258+39.41	I 32		1
PROJECT TOTAL		14	51
*6432-11-71		-	2
4994-00-87		14	49

NOTE: INLET PROTECTION TO BE INSTALLED CONCURRENTLY WITH STRUCTURE INSTALLATION.

WATER
624.0100

STATION TO STATION	LOCATION	MGAL	REMARKS
*195+01.84 - 200+86.77	CTH Y	17	FOR DUST CONTROL
*195+01.84 - 200+86.77	CTH Y	13	FOR SEEDING
200+86.77 - 258+53.16	CTH Y	156	FOR DUST CONTROL
200+86.77 - 258+53.16	CTH Y	117	FOR SEEDING
PROJECT TOTALS		303	
*6432-11-71		30	
4994-00-87		273	

SILT FENCE

STATION TO STATION	LOCATION	628.1504 SILT FENCE L.F.	628.1520 SILT FENCE MAINTENANCE L.F.	PHASE
200+86.77 - 258+53.16	CTH Y UNDISTRIBUTED	470	470	STORM SEWER & UTILITY
		125	125	
PROJECT TOTALS		595	595	

CONCRETE MEDIAN SLOPED NOSE
620.0300

STATION TO STATION	LOCATION	S.F.	PHASE
*197+04.89	MEDIAN	69	4
*199+39.91	MEDIAN	22	4
*200+59.92	MEDIAN	22	2
205+18.64	MEDIAN	22	2
256+01.50	MEDIAN	18	2
256+93.56	MEDIAN	18	2
257+41.48	MEDIAN	18	2
257+97.00	MEDIAN	18	2
PROJECT TOTAL		207	
*6432-11-71		113	
4994-00-87		94	

DITCH CHECKS

LOCATION	628.7504 TEMPORARY L.F.	628.7550 CULVERT PIPE EACH	REMARKS	PHASE
*196+25 LT		1	PROPOSED PIPE	3
*196+95 RT		1	PROPOSED PIPE	4
*197+40 LT	15		PROPOSED DITCHING	3
*197+40 RT	15		PROPOSED DITCHING	4
*199+00 RT	15		PROPOSED DITCHING	4
*199+32 LT		1	PROPOSED PIPE	3
*200+63 LT		1	PROPOSED PIPE	1
225+45 RT		1	PROPOSED PIPE	2
225+50 LT		2	PROPOSED PIPE	1
225+90 RT		1	PROPOSED PIPE	2
227+25 LT		3	PROPOSED PIPE	1
234+10 LT		1	PROPOSED PIPE	1
236+65 LT		1	PROPOSED PIPE	1
257+05 LT		2	PROPOSED PIPE	1
257+50 LT		2	PROPOSED PIPE	1
13+00 DITCH @ COMMUNITY PARK	15		PROPOSED DITCHING	STORM SEWER & UTILITY
15+00 DITCH @ COMMUNITY PARK	15		PROPOSED DITCHING	STORM SEWER & UTILITY
16+00 DITCH @ COMMUNITY PARK		2	PROPOSED PIPE	STORM SEWER & UTILITY
250+30 RT	15		PROPOSED DITCHING	STORM SEWER & UTILITY
UNDISTRIBUTED **	75	8		
PROJECT TOTAL	165	27		
*6432-11-71	45	3		
4994-00-87	120	24		

** INCLUDES PHASE 1 TEMPORARY WIDENING

ALL ITEMS ARE PROJECT ID 4994-00-87 UNLESS OTHERWISE NOTED

ALL ITEMS ON THIS SHEET ARE CATEGORY 0010 UNLESS OTHERWISE NOTED

TRAFFIC CONTROL

LOCATION	SERVICE PERIOD (DAYS)	643.0900		643.0420		643.0300		643.0705		643.0715		FLEXIBLE TUBULAR MARKER		TEMPORARY PAVEMENT MARKING		REMOVABLE TAPE
		(NO.)	(DAYS)	(NO.)	(DAYS)	(NO.)	(DAYS)	(NO.)	(DAYS)	(NO.)	(DAYS)	POSTS 643.0500 EACH	BASES 643.0600 EACH	4-INCH 649.0400 L.F.	8-INCH 649.0801 L.F.	
2008 CONSTRUCTION	40	29	1160			15	600			5	200					
PHASE 1	37	67	2479	19	703	204	7548	38	1406	10	370					
PHASE 2	37	71	2627	25	925	200	7400	50	1850	15	555					
*PHASE 3	16	30	480	11	176	50	800	22	352	10	160	12	12	1050		50
*PHASE 4	16	22	352	8	128	24	384	16	256	6	96	12	12	1050		50
PROJECT TOTALS			7098		1932		16732		3864		1381			2100		100
*6432-11-71			832		304		1184		608		256			2100		100
4994-00-87			6266		1628		15548		3256		1125					

NOTE: DRUMS QUANTITY INCLUDES ADDITIONAL DRUMS TO BE PLACED AS NEEDED IN PAVEMENT GAPS AND OTHER APPROPRIATE LOCATIONS

MOVING AND REMOVING SIGNS, SUPPORTS

STATION	LOCATION	638.2102 MOVING SIGNS, TYPE II EACH	638.2602 REMOVING SIGNS TYPE II EACH	638.3000 REMOVING SMALL SIGN SUPPORTS EACH	634.0416 POSTS WOOD 4X4-INCH X 16-FT EACH	DESCRIPTION	PHASE
*197+50 RT	CTH Y	5		1	1	CTH Y, STH 76, ARROWS, NO PARKING	4
*199+25 RT	CTH Y		1			YIELD	4
*200+60 LT	CTH Y		1	1		YIELD	1
201+80 RT	CTH Y	3		1		ADOPT A HIGHWAY, NO PARKING	2
202+50 LT	CTH Y	4		1		CTH Y, STH 76, ARROWS	1
207+40 RT	CTH Y	2		1		FIRE STATION, NO PARKING	2
210+55 LT	CTH Y	1		1		SIGNALS AHEAD	1
215+20 LT	CTH Y	3		1		STH 76, NO PARKING	1
218+20 LT	CTH Y	1		1		STOP SIGN	1
218+55 RT	CTH Y	2		1		SPEED LIMIT, NO PARKING	2
219+00 LT	CTH Y	2		1		SPEED LIMIT, NO PARKING	1
222+70 LT	CTH Y	2		1		FIRE STATION, NO PARKING	1
225+55 LT	CTH Y	1		1		STOP SIGN	1
226+35 RT	CTH Y	2		1		STOP SIGN, DO NOT ENTER	2
235+50 LT	CTH Y	2		1		SPEED LIMIT, NO PARKING	1
236+00 RT	CTH Y	3		1		HEALTH CENTER SIGNS	2
237+00 LT	CTH Y	3		1		HEALTH CENTER SIGNS	1
237+15 RT	CTH Y	2		1		SPEED LIMIT, NO PARKING	2
240+50 RT	CTH Y	1		1		STOP SIGN	2
245+00 RT	CTH Y	2		1		RR ADVANCE WARNING, NO PARKING	2
248+10 RT	CTH Y	1		1		STOP SIGN AHEAD	2
248+75 RT	CTH Y	6		1		CTH Y, CTH A, NO PARKING, WIN CO HEALTH DEPT	2
258+00 LT	CTH Y	2		1		STOP SIGN, RR ADVANCE WARNING	1
258+10 RT	CTH Y	2		1		CTH A, ARROWS	2
258+15 RT	CTH Y	2		1		STOP SIGN, CROSS TRAFFIC DOES NOT STOP	2
9+15 RT	CTH Y	2		1		CTH Y, ARROW	2
9+42 LT	SODA CREEK RD	1		1		DEAD END	2
9+65 RT	SODA CREEK RD	3		1		STOP SIGN, STREET SIGNS	2
9+40 LT	JACKTAR RD	1		1		DEAD END	2
9+55 RT	JACKTAR RD	3		1		STOP SIGN, STREET SIGNS	2
9+70 RT	BUTLER AVE	3		1		STOP SIGN, STREET SIGNS	2
PROJECT TOTALS		67	2	30	29*		
*6432-11-71		5	2	1	1		
4994-00-87		62		29	28		

* ADDITIONAL QUANTITIES SHOWN ELSEWHERE

TRAFFIC CONTROL COVERING SIGNS
643.0905.S

LOCATION	DESCRIPTION	EACH	DESCRIPTION	TIME FRAME
CTH A	SOUTH OF CTH Y	2	CTH Y, ARROW	DURING PHASE 1
CTH A	NORTH OF CTH Y	2	CTH Y, ARROW	DURING PHASE 1
*197+50 RT	CTH Y	2	CTH Y, ARROW	DURING PHASE 2
*STH 76	SOUTH OF CTH Y	4	CTH Y (2), ARROW (2)	DURING PHASE 2
*STH 76	NORTH OF CTH Y	4	CTH Y (2), ARROW (2)	DURING PHASE 2
PROJECT TOTALS		14		
*6432-11-71		10		
4994-00-87		4		

TYPE II SIGNS AND SUPPORTS

STATION	LOCATION	INSTALL RAILROAD FURNISHED SIGNS SPV.0060.08 EACH	SIGNS, REFLECTIVE TYPE II 637.0202 SF	SIZE	SIGN CODE	POSTS WOOD 4X4-INCH X 16 FT 634.0416 EACH	DESCRIPTION	PHASE
*197+10	CTH Y		5.00	24 X 30	R4-7	1	KEEP RIGHT	4
*197+10 RT	CTH Y		11.25	54 X 30	R3-8-W	1	LEFT ONLY, AHEAD ONLY, RIGHT AND THRU	4
*199+35	CTH Y		5.00	24 X 30	R4-7	1	KEEP RIGHT	4
*200+60	CTH Y		5.00	24 X 30	R4-7	1	KEEP RIGHT	2
202+00	CTH Y		4.00	24 X 24	R3-2	1	NO LEFT TURN	2
203+55	CTH Y		4.00	24 X 24	R3-4	1	NO U TURN	2
204+00 LT	CTH Y		11.25	54 X 30	R3-8-W	1	LEFT ONLY, AHEAD ONLY, RIGHT ONLY	1
204+50	CTH Y		4.00	24 X 24	R3-4	1	NO U TURN	2
205+10	CTH Y		5.00	24 X 30	R4-7	1	KEEP RIGHT	2
256+10	CTH Y		5.00	24 X 30	R4-7	1	KEEP RIGHT	2
256+60 RT	CTH Y		5.00	24 X 30	R4-7	1	KEEP RIGHT	2
257+95	CTH Y		5.00	24 X 30	R8-8	1	DO NOT STOP ON TRACKS	2
256+85	CTH Y		1.75	18X48	R1-1		STOP	2
256+85	CTH Y	1		48X9	R15-1	1**	CROSSBUCKS	2
256+85	CTH Y	1		27X18	R15-2		NUMBER OF TRACKS	2
257+25	CTH Y		1.75	18X48	R1-1		STOP	2
257+25	CTH Y	1		48X9	R15-1	1**	CROSSBUCKS	2
257+25	CTH Y	1		27X18	R15-2		NUMBER OF TRACKS	2
PROJECT TOTALS			73.00			14		
*6432-11-71			26.25			4		
4994-00-87		4	46.75			10		

** R1-1, R15-1, AND R15-2 TO BE MOUNTED ON A COMMON SUPPORT AT EACH APPROACH TO THE TRAIL CROSSING. R15-1 AND R15-2 SIGNS TO BE FURNISHED BY RAILROAD AND INSTALLED BY CONTRACTOR

SAWING CONCRETE
690.0250

STATION	LOCATION	L.F.	DESCRIPTION	REMARKS
258+53.16	CTH Y	189	MATCH POINT	PHASE 1 AND 2
240+35 RT	CTH Y	1.5	DRIVEWAY CURB	PHASE 2
9+35	SODA CREEK RD	31.5	MATCH POINT	PHASE 2
9+45 RT,LT	SODA CREEK RD	10	SIDEWALK	PHASE 2
9+00	JACKTAR RD	31	MATCH POINT	PHASE 2
9+22 LT	JACKTAR RD	23	DRIVEWAY	PHASE 2
9+26 RT	JACKTAR RD	23	DRIVEWAY	PHASE 2
9+45 RT,LT	JACKTAR RD	10	SIDEWALK	PHASE 2
PROJECT TOTAL		319		

UTILITY LINE OPENING
SPV.0060.06

STATION	LOCATION	EACH	REMARKS
*199+25, 55' LT	CTH Y	1	STORM SEWER & UTILITY PHASE
205+96, 32' LT	CTH Y	1	STORM SEWER & UTILITY PHASE
225+33, 39' RT	CTH Y	1	STORM SEWER & UTILITY PHASE
226+32, 47' RT	CTH Y	1	STORM SEWER & UTILITY PHASE
231+20, 40' LT	CTH Y	1	STORM SEWER & UTILITY PHASE
258+36, 36' LT	CTH Y	1	STORM SEWER & UTILITY PHASE
195+01.84 - 258+53.16	CTH Y	6	UNDISTRIBUTED
PROJECT TOTAL		12	
		*6432-11-71	1
		4994-00-87	11

MINI STORM SEWER AND LATERALS

STATION	LOCATION	L.F.		COMMENTS
		SPV.0090.08 4-INCH	SPV.0090.09 8-INCH	
221+14 - 223+19.02	CTH Y		205	CONNECT TO I 9A
221+23 LT	CTH Y	4		CONNECT TO EXISTING 4"
221+58 LT	CTH Y	4		CONNECT TO EXISTING 4"
222+06 LT	CTH Y	4		CONNECT TO EXISTING 4"
PROJECT TOTAL		12	205	

MINI STORM SEWER CLEANOUTS
SPV.0060.07

STATION	LOCATION	EACH
221+14 LT	CTH Y	1
PROJECT TOTAL		1

SAWING ASPHALT
690.0150

STATION	LOCATION	L.F.	DESCRIPTION	REMARKS
17+00	COUNTY PARK ENT	44	STORM SEWER OUTFALL	PHASE 1
*195+01.84 - 199+53.51	CTH Y	452	LONGITUDINAL CUT	PHASE 3
*195+01.84	CTH Y	37	MATCH POINT	PHASE 3 AND 4
*196+00 LT	CTH Y	27	DRIVEWAY	PHASE 3
*196+50 RT	CTH Y	42	DRIVEWAY	PHASE 4
*199+53.51	CTH Y	190	MATCH POINT	PHASE 3 AND 4
200+37.07 - 200+86.77	CTH Y	50	LONGITUDINAL CUT 4' RT	PHASE 1
200+86.77 - 258+53.16	CTH Y	5766	LONGITUDINAL CUT 4' RT	PHASE 1
200+37.07	CTH Y	209	MATCH POINT	PHASE 1 AND 2
202+04 RT	CTH Y	30	DRIVEWAY	PHASE 2
204+00 RT	CTH Y	22	DRIVEWAY	PHASE 2
205+75 LT	CTH Y	26	DRIVEWAY	PHASE 1
210+58 RT	CTH Y	29	DRIVEWAY	PHASE 2
212+60 LT	CTH Y	18	DRIVEWAY	PHASE 1
214+60 LT	CTH Y	38	DRIVEWAY	PHASE 1
215+80 LT	CTH Y	31	DRIVEWAY	PHASE 1
218+40 LT	CTH Y	22	DRIVEWAY	PHASE 1
225+60 RT	CTH Y	24	DRIVEWAY	PHASE 2
225+70 LT	CTH Y	20	DRIVEWAY	PHASE 1
226+00 LT	CTH Y	20	DRIVEWAY	PHASE 1
226+10 RT	CTH Y	24	DRIVEWAY	PHASE 2
233+90 LT	CTH Y	24	DRIVEWAY	PHASE 1
240+35 RT	CTH Y	29	DRIVEWAY	PHASE 2
242+25 LT	CTH Y	20	DRIVEWAY	PHASE 1
9+03.58	BUTLER AVE	22	MATCH POINT	PHASE 2
PROJECT TOTAL		7216		
		*6432-11-71	748	
		4994-00-87	6468	

GRADING AND SHAPING FOR INLETS
SPV.0060.04

STRUCTURE	EACH	PHASE
I 3A	1	1
I 3F	1	2
I 5A	1	1
I 19A	1	1
I 19B	1	1
I 20A	1	1
I 21A	1	1
I 22A	1	1
I 24	1	1
I 25	1	1
PROJECT TOTAL		10

LANDMARK REFERENCE MONUMENT SPECIAL
SPV.0060.03

STATION	LOCATION	EACH	DESCRIPTION
226+80.10	0' OFFSET, CTH Y	1	T19N, R16E
253+37.45	0' OFFSET, CTH Y	1	T19N, R16E / R17E
PROJECT TOTAL		2	

PAVEMENT MARKING

STATION TO STATION	LOCATION	PHASE	646.0106 CENTERLINE EPOXY 4-INCH L.F.	646.0106 LANE LINE EPOXY 4-INCH L.F.	646.0106 EDGELINE EPOXY 4-INCH L.F.	646.0126 EPOXY 8-INCH L.F.	647.0166 ARROWS EPOXY TYPE 2 EACH	647.0176 ARROWS EPOXY TYPE 3 EACH	647.0356 WORDS EPOXY EACH	647.0456 CURB EPOXY L.F.	647.0566 STOP LINE EPOXY 18-INCH L.F.	647.0606 ISLAND NOSE EPOXY EACH	647.0726 DIAGONAL EPOXY 12-INCH L.F.	647.0776 CROSSWALK 12-INCH EPOXY L.F.	647.0110 RAILROAD CROSSING EPOXY EACH
*195+01.84 - 199+53.51	CTH Y	4	800	38	1059	200	1	1	1	20	45	2	59		
*200+37.07 - 200+86.77	CTH Y	4		12		54	2			10	40	1			
200+37.07 - 258+53.16	CTH Y	2	9836	978	1258	376	2		4	50	86	5	43	136	2
10+00 - 10+50.24	SODA CREEK RD	2									13			60	
9+21.22 - 10+00	JACKTAR RD	2									13			60	
10+00 - 10+75	BUTLER AVE	2									16			79	
9+45.63 - 10+00	COUNTY PARK ENT	2												130	
PROJECT TOTALS			10636	1028	2317	630	5	1	5	80	213	8	102	465	2
*6432-11-71			800	50	1059	254	3	1	1	30	85	3	59		
4994-00-87			9836	978	1258	376	2		4	50	128	5	43	465	2
646.0106 TOTAL PAVEMENT MARKING EPOXY 4-INCH=			13981												

CONSTRUCTION STAKING SUBGRADE
650.4500

STATION TO STATION	LOCATION	L.F.	PHASE
*195+01.84 - 199+53.51	CTH Y	452	3 AND 4
*200+37.87 - 200+86.77	CTH Y	50	1 AND 2
200+86.77 - 258+53.16	CTH Y	5766	1 AND 2
9+35 - 10+00	SODA CREEK RD	65	2
9+00 - 10+00	JACKTAR RD	100	2
9+03.58 - 10+00	BUTLER AVE	96	2
PROJECT TOTAL		6529	
*6432-11-71		502	
4994-00-87		6027	

CONSTRUCTION STAKING, BASE
650.5000

STATION TO STATION	LOCATION	L.F.	PHASE
*195+01.84 - 199+53.51	CTH Y	452	3 AND 4
200+37.07 - 200+86.77	CTH Y	51	1 AND 2
256+79.07 - 257+56.09	CTH Y	77	1 AND 2
9+03.58 - 9+43.58	BUTLER AVE	40	2
PROJECT TOTAL		620	
*6432-11-71		503	
4994-00-87		117	

CONSTRUCTION STAKING, PIPE CULVERTS
650.6000

STATION	LOCATION	EACH	REMARKS	PHASE
*195+94.22 LT	CTH Y	1		3
*196+49.37 RT	CTH Y	1		4
*199+32.46	CTH Y	1	CONC REQ'D	3 AND 4
*200+63.39	CTH Y	1	CONC REQ'D	1 AND 2
225+90.38 LT	CTH Y	2	TWIN PIPES	1
227+16.74	CTH Y	3	TRIPLE PIPES, CONC REQ'D	1 AND 2
233+88.45 LT	CTH Y	1		1
236+45.66	CTH Y	1		2008
256+96.37	CTH Y	1	CONC REQ'D	2008
257+39.14	CTH Y	1	CONC REQ'D	2008
17+03.48	OUTFALL BY WETLANDS	2	TWIN PIPES, CONC REQ'D	2008
PROJECT TOTALS		15		
*6432-11-71		4		
4994-00-87		11		

CONSTRUCTION STAKING, CONCRETE PAVEMENT
650.7000

STATION TO STATION	LOCATION	L.F.	PHASE
200+86.77 - 256+90.23	CTH Y	5603	1 AND 2
257+44.91 - 258+53.16	CTH Y	108	1 AND 2
9+35 - 10+00	SODA CREEK RD	65	2
9+00 - 10+00	JACKTAR RD	100	2
9+43.58 - 10+00	BUTLER AVE	56	2
PROJECT TOTAL		5932	

CONSTRUCTION STAKING SLOPE STAKES
650.9920

STATION TO STATION	LOCATION	L.F.	PHASE
*195+01.84 - 199+53.51	CTH Y	452	3 AND 4
*200+37.07 - 200+86.77	CTH Y	50	1 AND 2
200+86.77 - 258+53.16	CTH Y	5766	1 AND 2
9+35 - 10+00	SODA CREEK RD	65	2
9+00 - 10+00	JACKTAR RD	100	2
9+03.58 - 10+00	BUTLER AVE	96	2
10+00 - 18+75	STORM SEWER OUTFALL	875	2008
10+36 - 11+30	DITCH AT 250+30 RT	94	2008
PROJECT TOTAL		7498	
*6432-11-71		502	
4994-00-87		6996	

ALL STAKING TO BE DONE DURING THE STORM SEWER AND UTILITY PHASE EXCEPT FOR STRUCTURES I 99, I 98, EW 97 (PHASES 3 & 4) AND I 31, I 32 (PHASES 1 & 2)

SANITARY SEWER

STATION - STATION	OFFSET	8-INCH SPV.0090.01 LF	10-INCH SPV.0090.02 LF
208 + 73	LT	57.8	
235+76 - 236+90	RT & LT		139
TOTAL		57.8	139

SANITARY MANHOLES

STATION	OFFSET	ADJUST SPV.0060.20 EACH	RECONSTRUCT SPV.0200.02 VF	SPV.0200.01 VF
*195 + 38	RT	1		
*196 + 51	RT		4.0	
*198 + 18	RT	1		
*199 + 27	RT	1		
*200 + 60	RT	1		
201 + 02	RT	1		
202 + 52	RT		5.0	
206 + 01	RT	1		
208 + 73	RT		1.2	
209 + 52	RT		4.0	
213 + 01	RT		5.0	
216 + 11	RT		4.0	
219 + 11	RT		4.0	
222 + 12	RT		5.0	
225 + 10	RT		4.0	
225 + 10	LT		5.0	
228 + 69	RT		6.0	
232 + 32	RT		5.0	
235 + 76	RT		6.0	
236 + 87	LT			18.9
TOTAL		6	58.2	18.9
*6432-11-71		4	4	
4994-00-87		2	54.2	18.9

DUCTILE IRON WATER MAIN

STATION - STATION	OFFSET	6-INCH SPV.0090.10 LF	8-INCH SPV.0090.11 LF	12-INCH SPV.0090.12 LF
205+26 - 205+50	RT	24.1		
208+31 - 208+46	RT	18.5		
208 + 81	LT		19.0	
211 + 20	LT	4.5		
218 + 15	LT	3.5		
236+87 - 241+00	LT			413.0
237 + 20	LT	14.0		
241+00 - 247+00	LT			600.0
242 + 60	LT	14.0		
247 +00	LT	14.0		
247+00 - 253+00	LT			600.0
251 + 50	LT	14.0		
253+00 - 257+89	LT			488.0
256 + 50	LT	24.0		
TOTAL		130.6	19.0	2101.0

CONNECTION TO EXISTING WATER MAIN
SPV.0060.31

STATION	OFFSET	12-INCH EACH
236 + 87	LT	1
257 + 88	LT	1
TOTAL		2

WATER VALVE MANHOLES

STATION	OFFSET	ADJUST SPV.0060.30 EACH	RECONSTRUCT SPV.0200.10 VF
*200 + 84	LT	1	
211 + 09	LT	1	
225 + 33	LT	1	
227 + 08	LT		4.0
232 + 57	LT		5.0
236 + 76	LT		4.0
257 + 89	LT	1	
TOTAL		4	13
*6432-11-71		1	
4994-00-87		3	13.0

WATER MAIN BENDS

STATION	OFFSET	6-INCH 45 DEGREE SPV.0060.43 EACH	12-INCH 45 DEGREE SPV.0060.44 EACH
208 + 46	RT	1	
236 + 88	LT		1
236 + 93	LT		1
255 + 00	LT		1
255 + 06	LT		1
257 + 68	LT		1
257 + 86	LT		1
TOTAL		1	6

WATER MAIN CAPS

STATION	OFFSET	6-INCH SPV.0060.46 EACH	8-INCH SPV.0060.47 EACH	10-INCH SPV.0060.48 EACH
*200 + 69	LT			1
201 + 28	LT	1		
208 + 81	LT		1	
TOTAL		1	1	1
*6432-11-71				1
4994-00-87		1	1	

HYDRANTS

STATION	OFFSET	RELOCATE SPV.0060.37 EACH	ADJUST SPV.0060.38 EACH	SPV.0060.36 EACH
205 + 26	RT	1		
208 + 31	RT	1		
212 + 20	LT	1		
218 + 15	LT	1		
225 + 47	LT		1	
237 + 20	LT	1		
242 + 60	LT			1
247 + 00	LT			1
251 + 50	LT			1
256 + 50	LT	1		
TOTAL		6	1	3

WATER MAIN GATE VALVES

STATION	OFFSET	RELOCATE 6-INCH SPV.0060.35 EACH	6-INCH SPV.0060.32 EACH	12-INCH SPV.0060.33 EACH	12"X8" TAPPING SLEEVE AND VALVE SPV.0060.34 EACH
205 + 28	LT	1			
208 + 81	LT				1
237 + 20	LT		1		
242 + 60	LT		1		
242 + 65	LT			1	
247 + 00	LT		1		
247 + 05	LT			1	
251 + 50	LT		1		
251 + 55	LT			1	
256 + 50	LT		1		
256 + 55	LT			1	
TOTAL		1	5	4	1

WATER MAIN TEES
SPV.0060.45

STATION	OFFSET	12"X12"X6" EACH
237 + 20	LT	1
242 + 50	LT	1
247 + 00	LT	1
251 + 50	LT	1
256 + 50	LT	1
TOTAL		5

TAP EXISTING SANITARY MANHOLE
SPV.0060.21

STATION	OFFSET	EACH
235 + 76	RT	1
TOTAL		1

REMOVE WATER MAIN

STATION	OFFSET	6-INCH VALVE SPV.0060.40 EACH	10-INCH VALVE SPV.0060.39 EACH	12"X6" REDUCER SPV.0060.41 EACH
*200 + 69	LT		1	
201 + 28	LT	1		
236 + 87	LT			1
257 + 78	LT			1
TOTAL		1	1	2
*6432-11-71			1	
4994-00-87		1		2

24-INCH STEEL CASING PIPE
SPV.0090.13

STATION - STATION	OFFSET	24-INCH LF
256+67 - 257+67	LT	100
TOTAL		100

✓ REMOVING PULL BOXES SPECIAL
204.9060.S

LOCATION	EACH
STH 76 & CTH Y	7
TOTALS	7

✓ Removing Concrete Bases
204.0195

LOCATION	EACH
STH 76 & CTH Y	8
TOTALS	8

✓ PULL BOXES STEEL

LOCATION	653.0105 12x24-Inch EACH	653.0140 24x42-Inch EACH
STH 76 & CTH Y	6	7
TOTALS	6	7

Concrete Bases

LOCATION	654.0101 Type 1 EACH	654.0102 Type 2 EACH
STH 76 & CTH Y	5	1
TOTALS	5	1

CONDUIT RIGID NONMETALLIC SCHEDULE 40

FROM	TO	652.0225 2-Inch LF	652.0235 3-Inch LF	652.0615 3-Inch Special LF
PB1	SB1	5		
PB1	PB2		50	
PB2	SB2	10		
PB2	PB3		40	
PB3	SB3 SB2	510		
PB3	SB4		50	
PB4	PB11	200		
PB11	PB12	160		
PB4	SB4 SB3	5		
PB4	PB5			110
PB5	SB5 SB4	10		
PB5	PB6		40	
PB6	SB6 SB5	10		
PB6	PB7		55	
PB7	SB7	10		
PB7	PB8		45	
PB8	SB8 SB6	520		
PB8	PB9		40	
PB9	PB15	200		
PB15	PB16	160		
PB9	SB9 SB7	15		
PB9	PB10		15	
PB10	SB10 SB8	30		
PB10	PB1		35	
TOTALS		825	380	110
			360	

Loop Detectors

LOCATION	LOOP NO.	Standard Detail Drawing	# of Turns	652.0800 Conduit LF	655.0700 Lead In Cable LF	655.0800 Wire LF
STH 76 & CTH Y	22				540	
STH 76 & CTH Y	23				380	
STH 76 & CTH Y	41	9F7-3	3	100	320	280
STH 76 & CTH Y	42	9F7-3	3	85	260	270
STH 76 & CTH Y	43	9F7-3	3	85	260	250
STH 76 & CTH Y	62				530	
STH 76 & CTH Y	63				370	
STH 76 & CTH Y	81	9F9-3	2	95	20	200
STH 76 & CTH Y	82	9F9-3	2	85	20	220
STH 76 & CTH Y	83	9F9-3	2	85	70	170
TOTALS				270	2,770	1,390
					2,820	

Electrical Wire Lighting 12 AWG

(120 Volt System)		655.0610 (Black) LF	655.0610 (White) LF	655.0610 (Green) LF
FROM	TO			
SB3	Luminaire	50	50	50
SB5	Luminaire	50	50	50
SB9	Luminaire	50	50	50
SB10	Luminaire	50	50	50
Subtotals		200	200	200
Total		600	600	600

Cable Type UF 2-12 AWG Grounded
655.0305

FROM	TO	LF
CB1	SB3 SB2	150
SB3 SB2	SB5 SB4	230
CB1	SB10 SB8	110
SB10 SB8	SB9 SB7	200
TOTAL		690

TRAFFIC SIGNALS

LOCATION	657.0100 Pedestal Bases EACH	657.0255 Transformer Bases Standard 11 1/2-Inch Bolt Circle EACH	SPV.0060.10 Poles Type 2 SPECIAL EACH	SPV.0060.11 Poles Type 3 SPECIAL EACH	SPV.0060.12 Poles Type 4 SPECIAL EACH	657.0420 Standards Aluminum 13-FT EACH	658.0500 Pedestrian Push Buttons EACH	SPV.0060.13 Trombone 20-FT SPECIAL EACH	SPV.0060.14 Arms 25-FT SPECIAL EACH	SPV.0060.15 3-12 Inch vertical SPECIAL EACH	SPV.0060.16 Traffic Signal Face 3-12 Inch horizontal SPECIAL EACH	658.5069 Mounting Hardware LS
STH 76 & CTH Y	83	81	10	10	1	83	2	20	20	8	10	1
TOTALS	83	81	10	10	1	83	2	20	20	8	10	1

✓ Salvage Traffic Signals Special
SPV.0105.02
Discuss
e
P&E Con

LOCATION	LS
STH 76 & CTH Y	1
TOTALS	1

TRAFFIC SIGNAL CABLE

LOCATION	FROM	TO	655.0230		HEAD NO.	655.0260		655.0230 Base to Head	
			5-14 AWG LF	12-14 AWG LF		5-14 AWG LF	5-14 AWG LF		
STH 76 (North Side)	CB1	SB10	400	110	2	50			
			508	200	1	15			
CTH Y (East Side)	CB1	SB1	40	40	12	15			
			110	110	7	15			
STH 76 (South Side)	CB1	SB4	230	230	3	15			
			4	160	5	50			
CTH Y (West Side)	CB1	SB8	260	260	14	15			
			110	110	10	15			
Peds (east side)	CB1	SB1	40						
Peds (west side)	CB1	SB6	400						
Subtotals			440	1,400	1360				
Totals			750	560	1,400	1360		310	

NB & EB
 RED LED = RED CONDUCTOR
 YELLOW LED = ORANGE CONDUCTOR
 GREEN LED = GREEN CONDUCTOR

SB & WB
 RED LED = RED W/BLACK CONDUCTOR
 YELLOW LED = ORANGE W/ BLACK CONDUCTOR
 GREEN LED = GREEN W/ BLACK CONDUCTOR

PEDS
 PUSH BUTTON = BLACK CONDUCTOR

Electrical Wire Traffic Signals 10 AWG
655.0515


FROM	TO	(Grounded Conductor) (White) LF	(Equipment Grounding Conductor) (Green) LF
CB1	SB1	40	40
SB1	PB1	15	15
SB1	SB2	110	160
SB2	PB2	120	90
SB2	SB3	120	120
SB3	PB3	170	170
SB3	SB4	170	170
SB4	PB4	15	15
SB4	SB5	100	100
SB5	PB5	15	20
SB5	SB6	100	190
SB6	PB6	20	20
SB6	SB7	110	110
SB7	PB7	110	30
SB7	SB8	210	210
SB8	PB8	15	40
SB8	SB9	100	120
SB9	PB9	25	25
SB9	SB10	200	200
SB10	PB10	40	80
SB10	CB1	110	110
Subtotals		1,210	1,415
Totals		1,225	1,790

Lighting Summary

LOCATION	659.0125 Luminaire Utility HPS 250 Watts EACH	SPV.0060.17 Luminaire Arms Truss Type 4-Inch Clamp 12-FT EACH
STH 76 & CTH Y	1	1
TOTAL	1	1

STATE PROJECT NUMBER 4994-00-87	SHEET NUMBER 4.0R	TOTAL SHEETS 9
FEDERAL PROJECT NUMBER		

PLAT OF RIGHT OF WAY REQUIRED FOR
STH 76 - C.T.H. A
 C.T.H. Y
 WINNEBAGO COUNTY

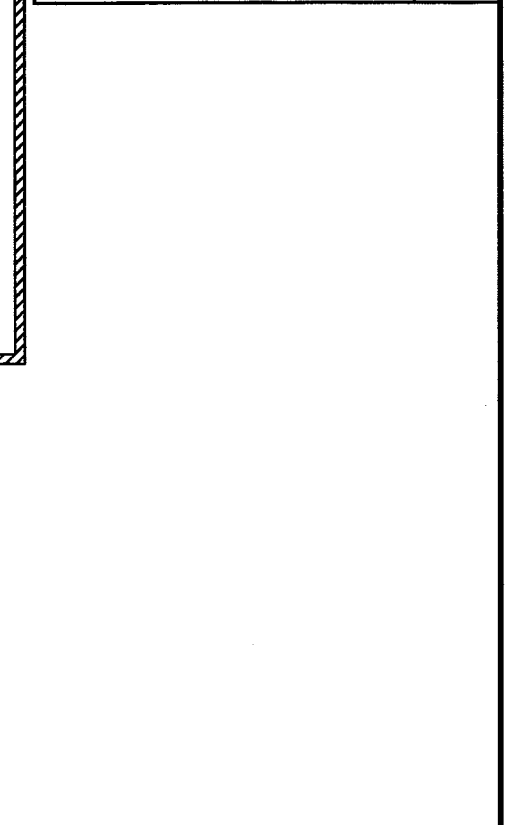

AMENDED PLAT NOTE
 THIS C.T.H. Y RIGHT-OF-WAY PLAT PREPARED AS STATE PROJECT 4994-00-87 IS AN AMENDMENT TO A RIGHT-OF-WAY PLAT PREPARED AS STATE PROJECT 4994-00-87 BY CPC CIVIL PROFESSIONAL CONSULTANTS, INC. ORIGINALLY SIGNED 12/12/2000.

THIS AMENDED PLAT IS PREPARED TO BEST MATCH THE PREVIOUS RIGHT-OF-WAY PLAT PREPARED BY CPC DATED 12/12/2000 WITH SOME DIFFERENCES FOUND AND NOTED ON THE INDIVIDUAL SHEETS. PREVIOUS PLAT INFORMATION FROM THE CPC PLAT OF RIGHT-OF-WAY ARE FADED BACK WITH A LIGHT SHADING AND LINETYPES. ADDITIONAL ACQUISITIONS/EASEMENTS THAT NEED TO BE ACQUIRED AS WELL AS ADDITIONAL DATA RELATED TO THIS AMENDED PROJECT 4994-00-87 ARE NOTED WITH DARKER TEXT AND LINE TYPES.


ALL BEARINGS AS NOTED ON THIS AMENDED PLAT ARE ORIENTED TO THE WINNEBAGO COUNTY COORDINATE SYSTEM. THE PREVIOUS PLAT PREPARED BY CPC CIVIL PROFESSIONAL CONSULTANTS WAS ORIENTATED TO THE WISCONSIN COORDINATE SYSTEM CENTRAL ZONE.

ALL PREVIOUS DEEDS AND EASEMENTS SIGNED AND RECORDED IN RELATION TO THE PREVIOUS RIGHT-OF-WAY PLAT CAN BE FOLLOWED WITH THE SHOWN RECORDED AS BEARINGS AND DISTANCES SHOWN ON THIS PLAT.

CONVENTIONAL SIGNS AND ABBREVIATIONS

- | | | | |
|----------|---|-------|-----------------------|
| ▲ | ANGLE | ----- | CORPORATE LIMITS |
| AC | ACRE | ----- | PROPERTY LINE |
| ⊙ | BENCH MARK | ----- | SECTION LINE |
| BLDG | BUILDING | ----- | EXISTING RIGHT OF WAY |
| ⊕ or CL | CENTERLINE | ----- | NEW RIGHT OF WAY |
| CONC. | CONCRETE | ----- | |
| C.M.C.P. | CORRUGATED METAL CULVERT PIPE | ----- | |
| C.T.H. | COUNTY TRUNK HIGHWAY | ----- | |
| △ | DELTA | ----- | |
| D. | DEGREE OF CURVE | ----- | |
| E. | EAST | ----- | |
| E | EXTERNAL DISTANCE | ----- | |
| ELEV | ELEVATION | ----- | |
| EXIST. | EXISTING | ----- | |
| F.E. | FIELD ENTRANCE | ----- | |
| FL | FLOWLINE | ----- | |
| GN | GRID NORTH | ----- | |
| GV | GAS VALVE | ----- | |
| ha | HECTARE | ----- | |
| H.S.E. | HOUSE | ----- | |
| km | KILOMETER | ----- | |
| LT. | LEFT | ----- | |
| MH | MANHOLE | ----- | |
| MAX | MAXIMUM | ----- | |
| MIN | MINIMUM | ----- | |
| m | METER | ----- | |
| N | NORTH | ----- | |
| NO. | NUMBER | ----- | |
| NOR. | NORMAL | ----- | |
| P.E. | PRIVATE ENTRANCE | ----- | |
| P.I. | POINT OF INTERSECTION | ----- | |
| P.C. | POINT OF CURVATURE | ----- | |
| P.T. | POINT OF TANGENCY | ----- | |
| P.L.E. | PERMANENT LIMITED EASEMENT | ----- | |
| P/L | PROPERTY LINE | ----- | |
| PED. | PEDESTAL | ----- | |
| R | RADIUS | ----- | |
| R.C.C.P. | REINFORCED CONCRETE CULVERT PIPE | ----- | |
| REM. | REMAINING | ----- | |
| REQ'D | REQUIRED | ----- | |
| R/L | REFERENCE LINE | ----- | |
| R/W | RIGHT OF WAY | ----- | |
| ● | 3/4" x 24" ROUND IRON REBAR WEIGHING 1.5 LBS/LINEAL FT SET | ----- | |
| ● | 3/4" REBAR FOUND | ----- | |
| RD. | ROAD | ----- | |
| RT. | RIGHT | ----- | |
| S | SLOPE | ----- | |
| S. | SOUTH | ----- | |
| STA. | STATION | ----- | |
| S.T.H. | STATE TRUNK HIGHWAY | ----- | |
| T.I. | TEMPORARY INTEREST | ----- | |
| T.L.E. | TEMPORARY LIMITED EASEMENT | ----- | |
| TYP. | TYPICAL | ----- | |
| WV | WATER VALVE/SHUTOFF | ----- | |
| ⊕ B-9 | MONITORING WELLS | ----- | |
| ⊕ VEX-21 | VAPOR EXTRACTION WELLS | ----- | |
| () | RECORDED AS BEARING/DISTANCE BY RIGHT-OF-WAY PLAT PREPARED BY CPC CIVIL PROFESSIONAL CONSULTANTS INC. | ----- | |
| ○ | EDGE OF TREES/BUSH | ----- | |
| —G— | EXISTING UNDERGROUND GAS | ----- | |
| —T— | EXISTING UNDERGROUND TELEPHONE | ----- | |
| —TV— | EXISTING UNDERGROUND TELEVISION | ----- | |
| —E— | EXISTING UNDERGROUND ELECTRIC | ----- | |

BEGIN RELOCATION ORDER
 STA 195+01.84
 520.88' WEST AND 9.40' SOUTH OF THE
 NORTHEAST CORNER OF SECTION 35,
 TOWNSHIP 19 NORTH, RANGE 16 EAST

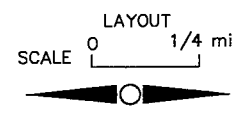

END RELOCATION ORDER
 STA 258+53.16
 515.67' EAST AND 6.91' SOUTH OF THE
 NORTHEAST CORNER OF SECTION 36,
 TOWNSHIP 19 NORTH, RANGE 16 EAST

TOTAL NET LENGTH OF CENTERLINE = 1.203 MILES

NOTES


DIMENSIONING FOR THE NEW RIGHT-OF-WAY IS MEASURED ALONG AND PERPENDICULAR TO THE NEW REFERENCE LINE.

RIGHT-OF-WAY BOUNDARIES ARE DEFINED WITH COURSES REFERENCED TO CURRENT DEEDS OF RECORD OR OTHER SURVEYS OF PUBLIC RECORD.

COORDINATES AND BEARINGS ON THIS PLAT ARE ORIENTED TO WINNEBAGO COUNTY COORDINATES.

RIGHT OF WAY MONUMENTS WILL BE SET PRIOR TO COMPLETION OF THE PROJECT BY McMAHON ASSOCIATES, INC.

THE AREAS SHOWN IN THE TOTAL ACRES COLUMN OF THE SCHEDULE OF LANDS AND INTERESTS REQUIRED MAY BE APPROXIMATE AND DERIVED FROM TAX ROLLS OR OTHER AVAILABLE SOURCES AND MAY NOT INCLUDE LANDS OF THE OWNERS WHICH ARE NOT CONTIGUOUS TO THE AREA TO BE ACQUIRED.

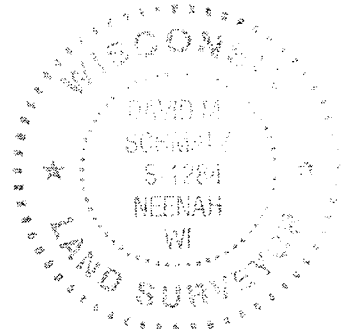

SURVEYOR'S CERTIFICATE

The property as shown and described on this map was surveyed under my direction and control according to the Wisconsin Administrative Code, Chapter A-E7 of Minimum Standards for Property Surveys, and is a correct representation of said survey, to the best of my knowledge and belief.

3-7-08
 date
 David M. Schmalz
 Registered Land Surveyor

APPROVED FOR
 WINNEBAGO COUNTY

 DIRECTOR OF PUBLIC WORKS

 DATE

PLAT PREPARED
 BY
 McMAHON ASSOCIATES, INC.
 NEENAH, WISCONSIN

REVISION DATE
 6/2008-ADD
 UNDERGROUND
 UTILITIES

REVISION DATE	ROUTE	COUNTY	DATE	STATE PROJECT NUMBER	SHEET NUMBER
	C.T.H. Y	WINNEBAGO	2/2008	4994-00-87	
	SCALE, FT.	GRID FACTOR		FEDERAL PROJECT NUMBER	
	0				4.1R

SCHEDULE OF LANDS & INTEREST REQUIRED

PARCEL NO.	PARCEL ID	SHEET NO.	OWNERSHIP	INTEREST REQUIRED	TOTAL EXISTING ACRES	INTEREST ACQUIRED BY ORIGINAL PLAT	NEW R/W ACQUIRED ACRES	EXISTING R/W ACQUIRED ACRES	TOTAL ACQUIRED ACRES	REMAINING ACRES	T.L.E. REQUIRED SQUARE FEET	HIGHWAY EASEMENT REQUIRED SQUARE FEET	P.L.E. EXISTING SQUARE FEET
1	91268510000	4.3R	WINNEBAGO COUNTY	QUIT CLAIM, TLE	-		0.14	0.18	0.32	-	6,410		
2	91268500000	4.3R	WINNEBAGO COUNTY	QUIT CLAIM, TLE	92.51		0.11	0.18	0.29	92.22	6,734		
3	91529020000	4.3R	JACKSON HIGHLAND APARTMENT, LLC	TLE	5.25	0.13			0.00	5.12	2,575		
4	18027602	4.3R	BRET MAR LLC	TLE	5.01	0.87			0.00	4.14	11,172		
5	91529032000	4.3R	NICOLET APARTMENTS I II LLC	TLE	0.44	0.14				0.30	1,136		
6	91529031100	4.3R	NICOLET APARTMENTS I II LLC	TLE	0.44	0.12			0.00	0.32	1,800		
7	91529031000	4.4R	NICOLET APARTMENTS I II LLC	TLE	0.44	0.12			0.56	0.32	1,800		
8	91529030100	4.4R	NICOLET APARTMENTS I II LLC	TLE	0.44	0.12			0.00	0.32	1,800		
9	18027604	4.4R	MARY L. RUPNOW	TLE	16.46	0.25			0.00	16.21	3,704		
10	91530100000	4.4R	WILLIAM E. RUPNOW & MARY L. RUPNOW	TLE	0.84	0.17				0.67	3,965		
11	91529010000	4.4R	CHURCH OF CHRIST IN OSHKOSH, INC.	TLE	4.77	0.34			0.00	4.43	4,920	216	
12	18027701	4.4R	TOWN OF OSHKOSH	TLE	5.00	0.33			0.00	4.67	6,051		
13	91530000000	4.4R-4.5R	WINNEBAGO COUNTY FAIRGROUNDS	QUIT CLAIM, TLE	153.30		0.51	1.71	2.22	151.08	33,379		
14	91529000000	4.4R-4.5R	WINNEBAGO COUNTY PARK	HIGHWAY EASEMENT, TLE	-		0.81	1.45	2.26	-	184,140	19,361	
15	91529500000	4.5R-4.7R	WINNEBAGO COUNTY	HIGHWAY EASEMENT, TLE	-		0.74	1.76	-	-	88,527	7,045	
16	18028201 & 18028202	4.6R	OSHKOSH COMMUNITY YOUNG MEN'S CHRISTIAN ASSOCIATION, INC.	TLE	19.99	0.55			0.00	19.44	6,412		
17	180282	4.6R-4.7R	BERNADETTE M. NETZER	TLE	20.00	0.55			0.00	19.45	5,642		
18	180583	4.7R	FOX VALLEY TECHNICAL COLLEGE	TLE	39.29	29.00			0.00	10.29	2,927		
19	91529600000 & 180584	4.7R & 4.8	WISCONSIN CENTRAL LIMITED RAILROAD	PLE	-								2,738
20		4.4R, 4.6R	WISCONSIN PUBLIC SERVICE - ELECTRIC	RELEASE OF RIGHTS									
21		4.3R-4.6R	WISCONSIN PUBLIC SERVICE - GAS	RELEASE OF RIGHTS									
22		4.3R, 4.4R, 4.6R	CITY OF OSHKOSH	RELEASE OF RIGHTS									
23		4.3R, 4.5R, 4.7R	AMELIA SYSTEMS - WINNEBAGO COUNTY FIBER OPTICS	RELEASE OF RIGHTS									
24		4.3R-4.6R	AMERITECH	RELEASE OF RIGHTS									
25		4.7R, 4.8	SPRINT	TEMPOARY CONSTRUCTION EASEMENT									
26		4.7R, 4.8	TDS TELECOM	TEMPOARY CONSTRUCTION EASEMENT									
27	180585 & 91529610000	4.8	WISCONSIN CENTRAL LTD	HIGHWAY EASEMENT	-							25,908	
					-								
					-								
							2.31				373,094	52,530	2,738


NOTES:

THE PARCEL NUMBERS USED ON THIS PLAT CORRESPOND TO THE SAME PARCEL NUMBERS USED ON THE ORIGINAL PLAT PREPARED BY CPC, INC.

CURRENT OWNERSHIPS AS SHOWN ON THIS PLAT HAVE CHANGED FOR SOME PARCELS THAT WERE SHOWN ON THE ORIGINAL PLAT.

THE "INTEREST REQUIRED" COLUMN INDICATES INTERESTS TO BE ACQUIRED BY THIS AMENDED PLAT. INTERESTS THAT HAVE BEEN PREVIOUSLY ACQUIRED BY THE ORIGINAL PLAT PREPARED BY CPC, INC IN 2001 ARE SHOWN IN THE "INTEREST ACQUIRED BY ORIGINAL PLAT" COLUMN.





REVISION DATE	ROUTE	COUNTY	DATE	STATE PROJECT NUMBER	SHEET NUMBER
	C.T.H. Y	WINNEBAGO	2/2008	4994-00-87	4.2R
	SCALE, FT.		GRID FACTOR	FEDERAL PROJECT NUMBER	
	0 250 500				

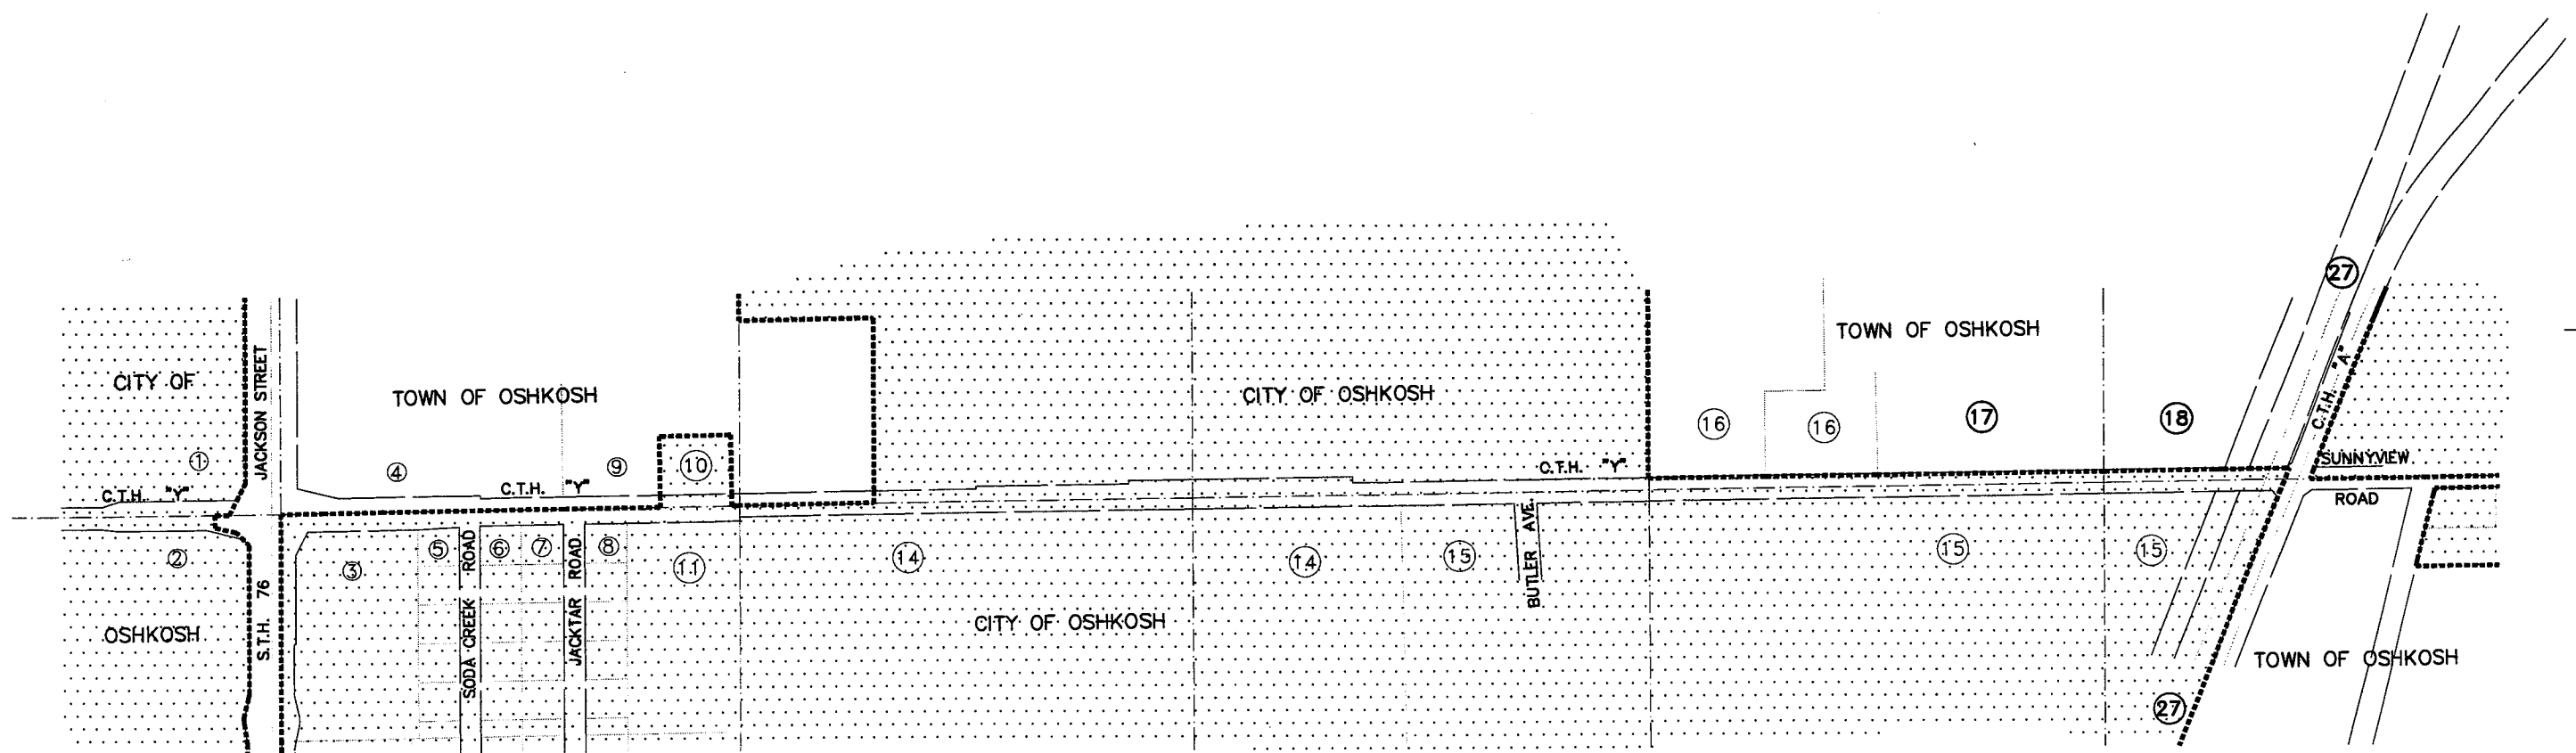

REVISION DATE	ROUTE	COUNTY	DATE	STATE PROJECT NUMBER	SHEET NUMBER
	C.T.H. Y	WINNEBAGO	2/2008	4994-00-87	4.3R
	SCALE, FT.	GRID FACTOR		FEDERAL PROJECT NUMBER	
	0 50 100				

PT. NO.	BEARING	DISTANCE	PT. NO.	BEARING	DISTANCE
1000			1000		
104	N89°15'48"E	1329.03'	119	S89°28'55"W	522.84'
15	S00°09'01"E	45.00'	40	N00°31'05"W	28.28'
12	S89°15'48"W	747.99'	41	N70°35'56"E	51.67'
11	S86°37'15"W	60.09'	45	N89°28'55"E	346.87'
10	S86°37'15"W	113.43'	102	N89°28'55"E	127.36'
9	S89°15'48"W	330.02'	1000	S00°09'19"E	45.00'
105	S89°15'48"W	77.82'			
1000	N00°03'53"W	53.00'			

PT. NO.	BEARING	DISTANCE
1000		
106	N00°09'19"W	75.62'
107	N89°50'41"E	47.90'
6	S76°01'03"E	122.36'
7	N89°15'48"E	416.32'
8	S00°44'12"E	8.02'
108	N89°15'48"E	746.14'
104	S00°04'35"E	36.00'
1000	S89°15'48"W	1329.03'

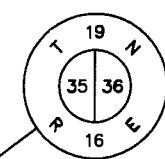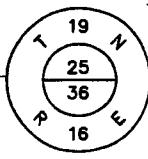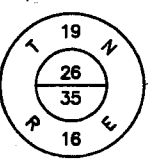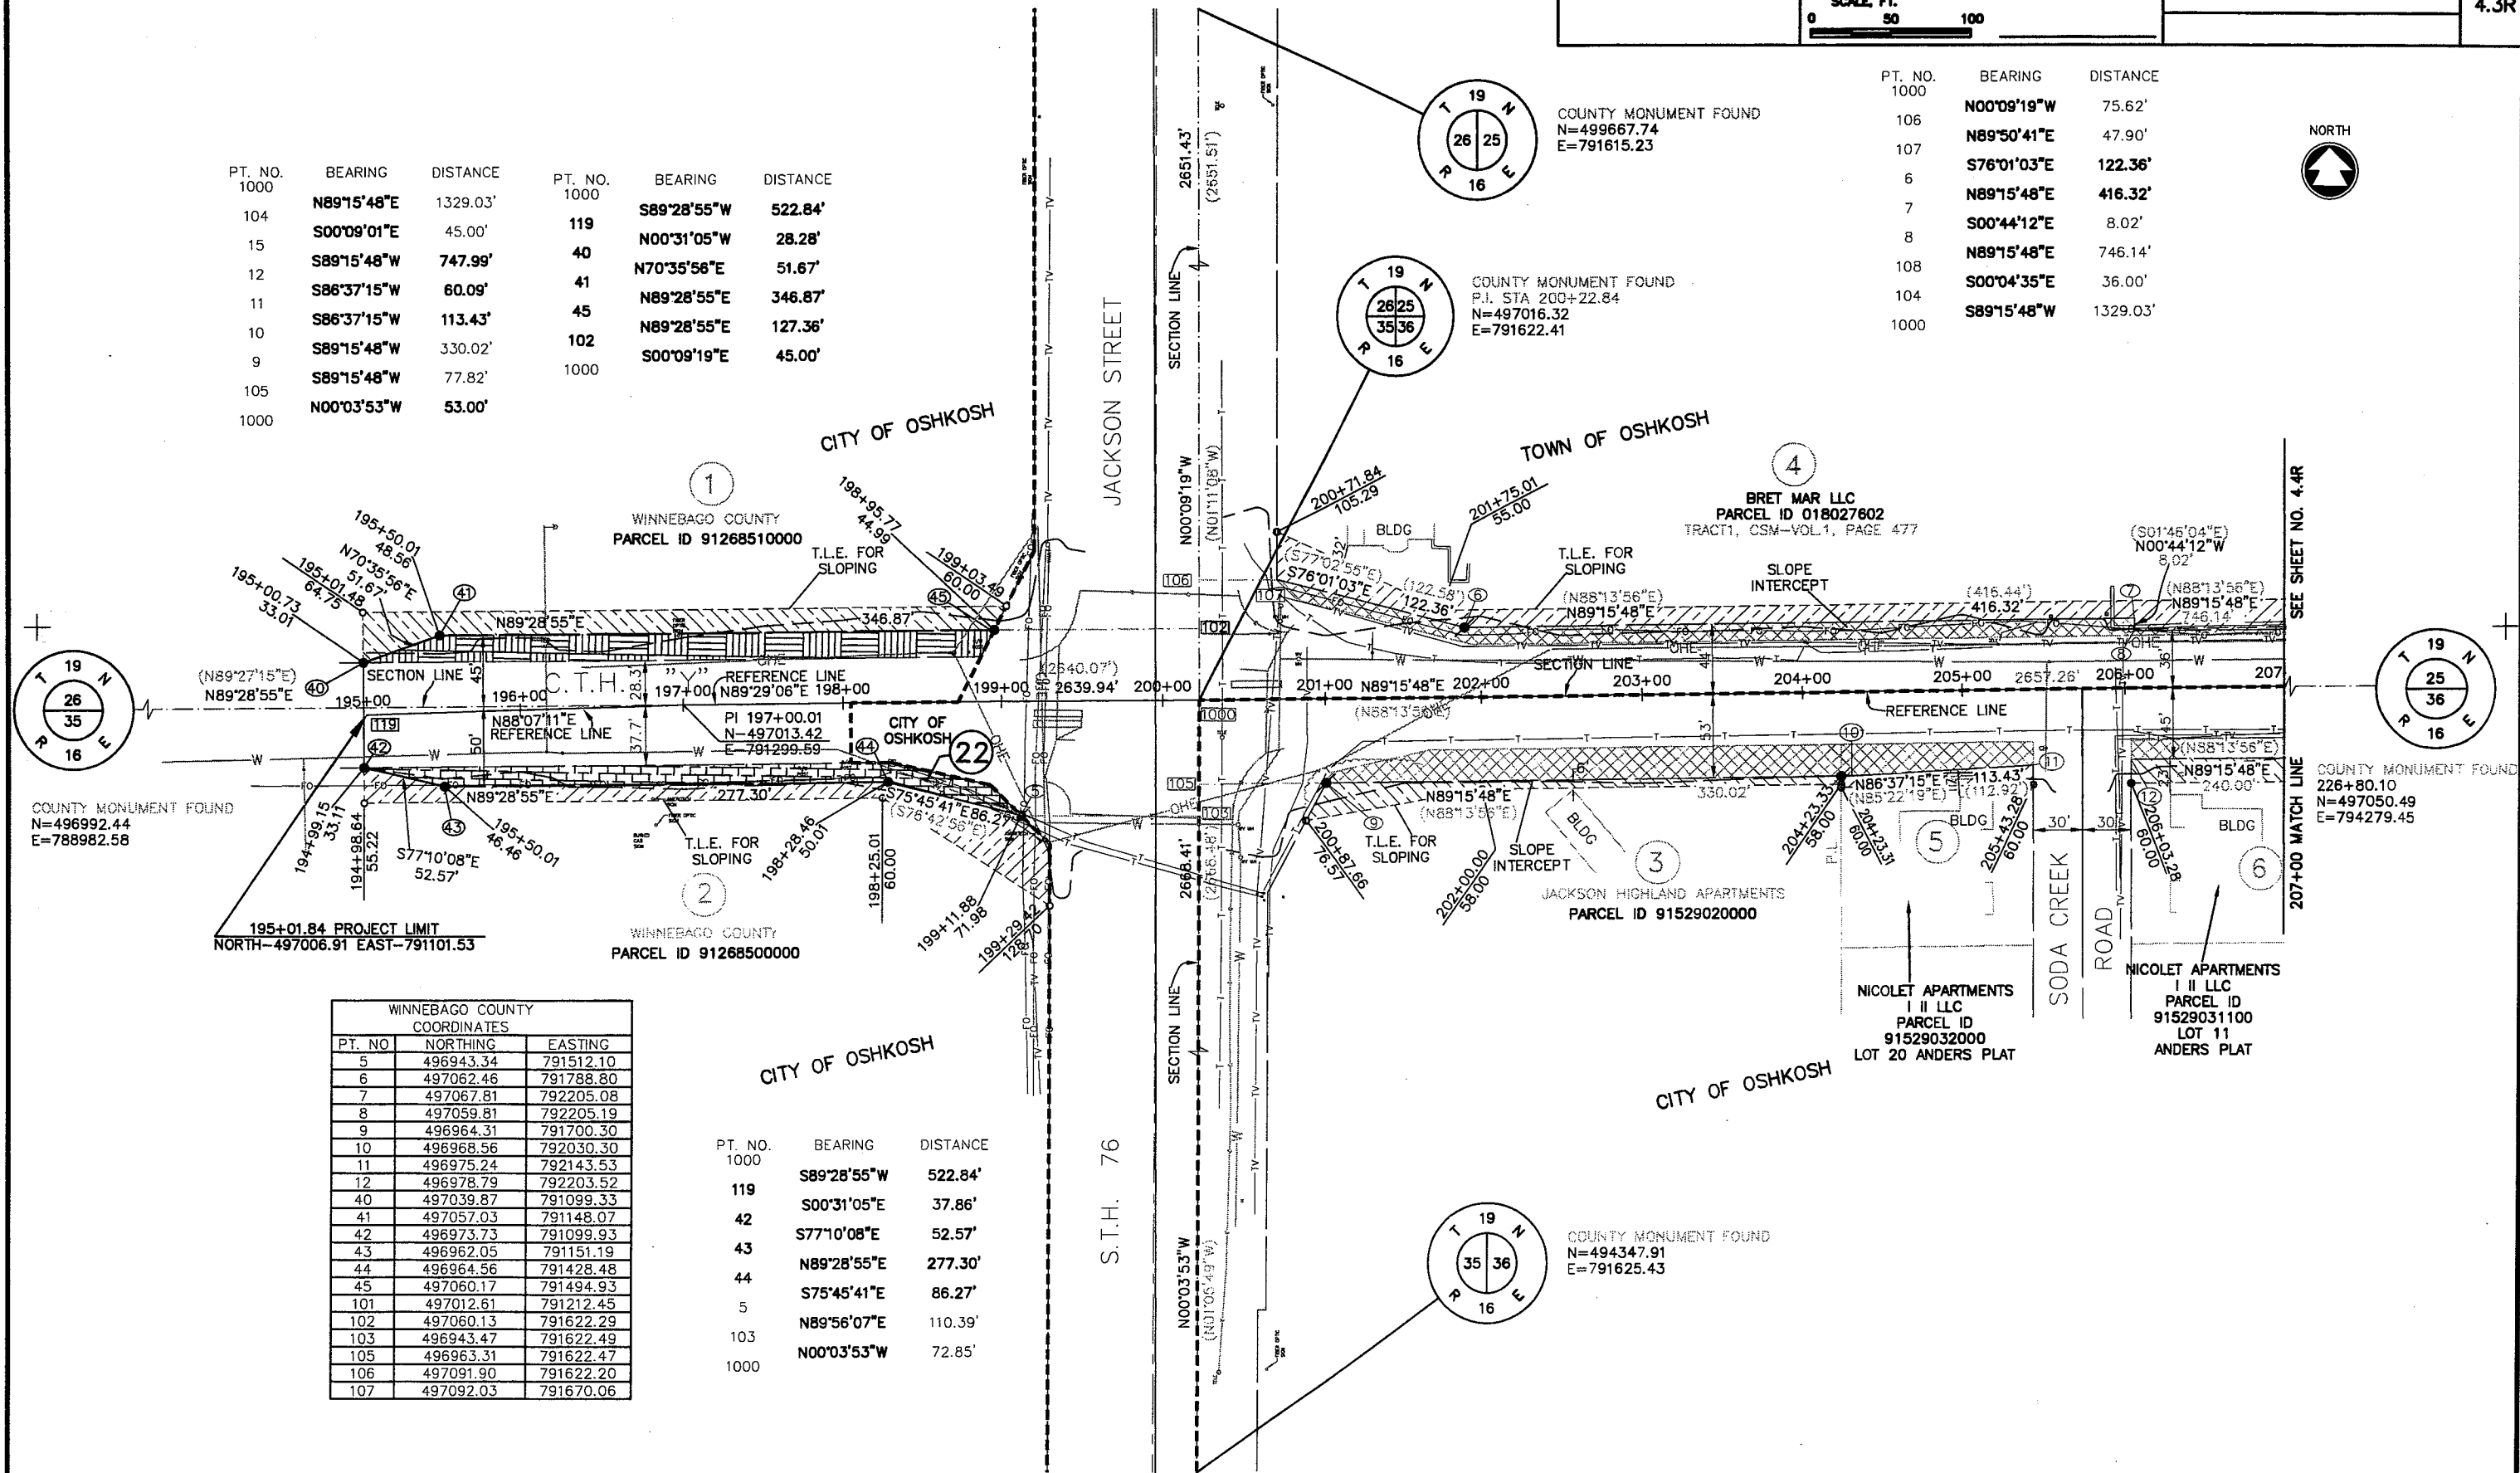

WINNEBAGO COUNTY COORDINATES		
PT. NO.	NORTHING	EASTING
5	496943.34	791512.10
6	497062.46	791788.80
7	497067.81	792205.08
8	497059.81	792205.19
9	496964.31	791700.30
10	496968.56	792030.30
11	496975.24	792143.53
12	496978.79	792203.52
40	497039.87	791099.33
41	497057.03	791148.07
42	496973.73	791099.93
43	496962.05	791151.19
44	496964.56	791428.48
45	497060.17	791494.93
101	497012.61	791212.45
102	497060.13	791622.29
103	496943.47	791622.49
105	496963.31	791622.47
106	497091.90	791622.20
107	497092.03	791670.06

PT. NO.	BEARING	DISTANCE
1000		
119	S89°28'55"W	522.84'
40	S00°31'05"E	37.86'
42	S77°10'08"E	52.57'
43	N89°28'55"E	277.30'
44	S75°45'41"E	86.27'
5	N89°56'07"E	110.39'
103		
1000	N00°03'53"W	72.85'


COUNTY MONUMENT FOUND
N=496992.44
E=788982.58

COUNTY MONUMENT FOUND
N=497050.49
E=794279.45

COUNTY MONUMENT FOUND
N=494347.91
E=791625.43

REVISION DATE	ROUTE	COUNTY	DATE	STATE PROJECT NUMBER	SHEET NUMBER
	C.T.H. Y	WINNEBAGO	2/2008	4994-00-87	4.4R
	SCALE, FT.	GRID FACTOR		FEDERAL PROJECT NUMBER	
	0 50 100				

PT. NO.	BEARING	DISTANCE
1001	S89°15'48"W	1328.23'
104	N00°04'35"W	36.00'
108	N89°15'48"E	400.15
109	S00°05'44"E	36.00'
110	N89°15'48"E	928.06'


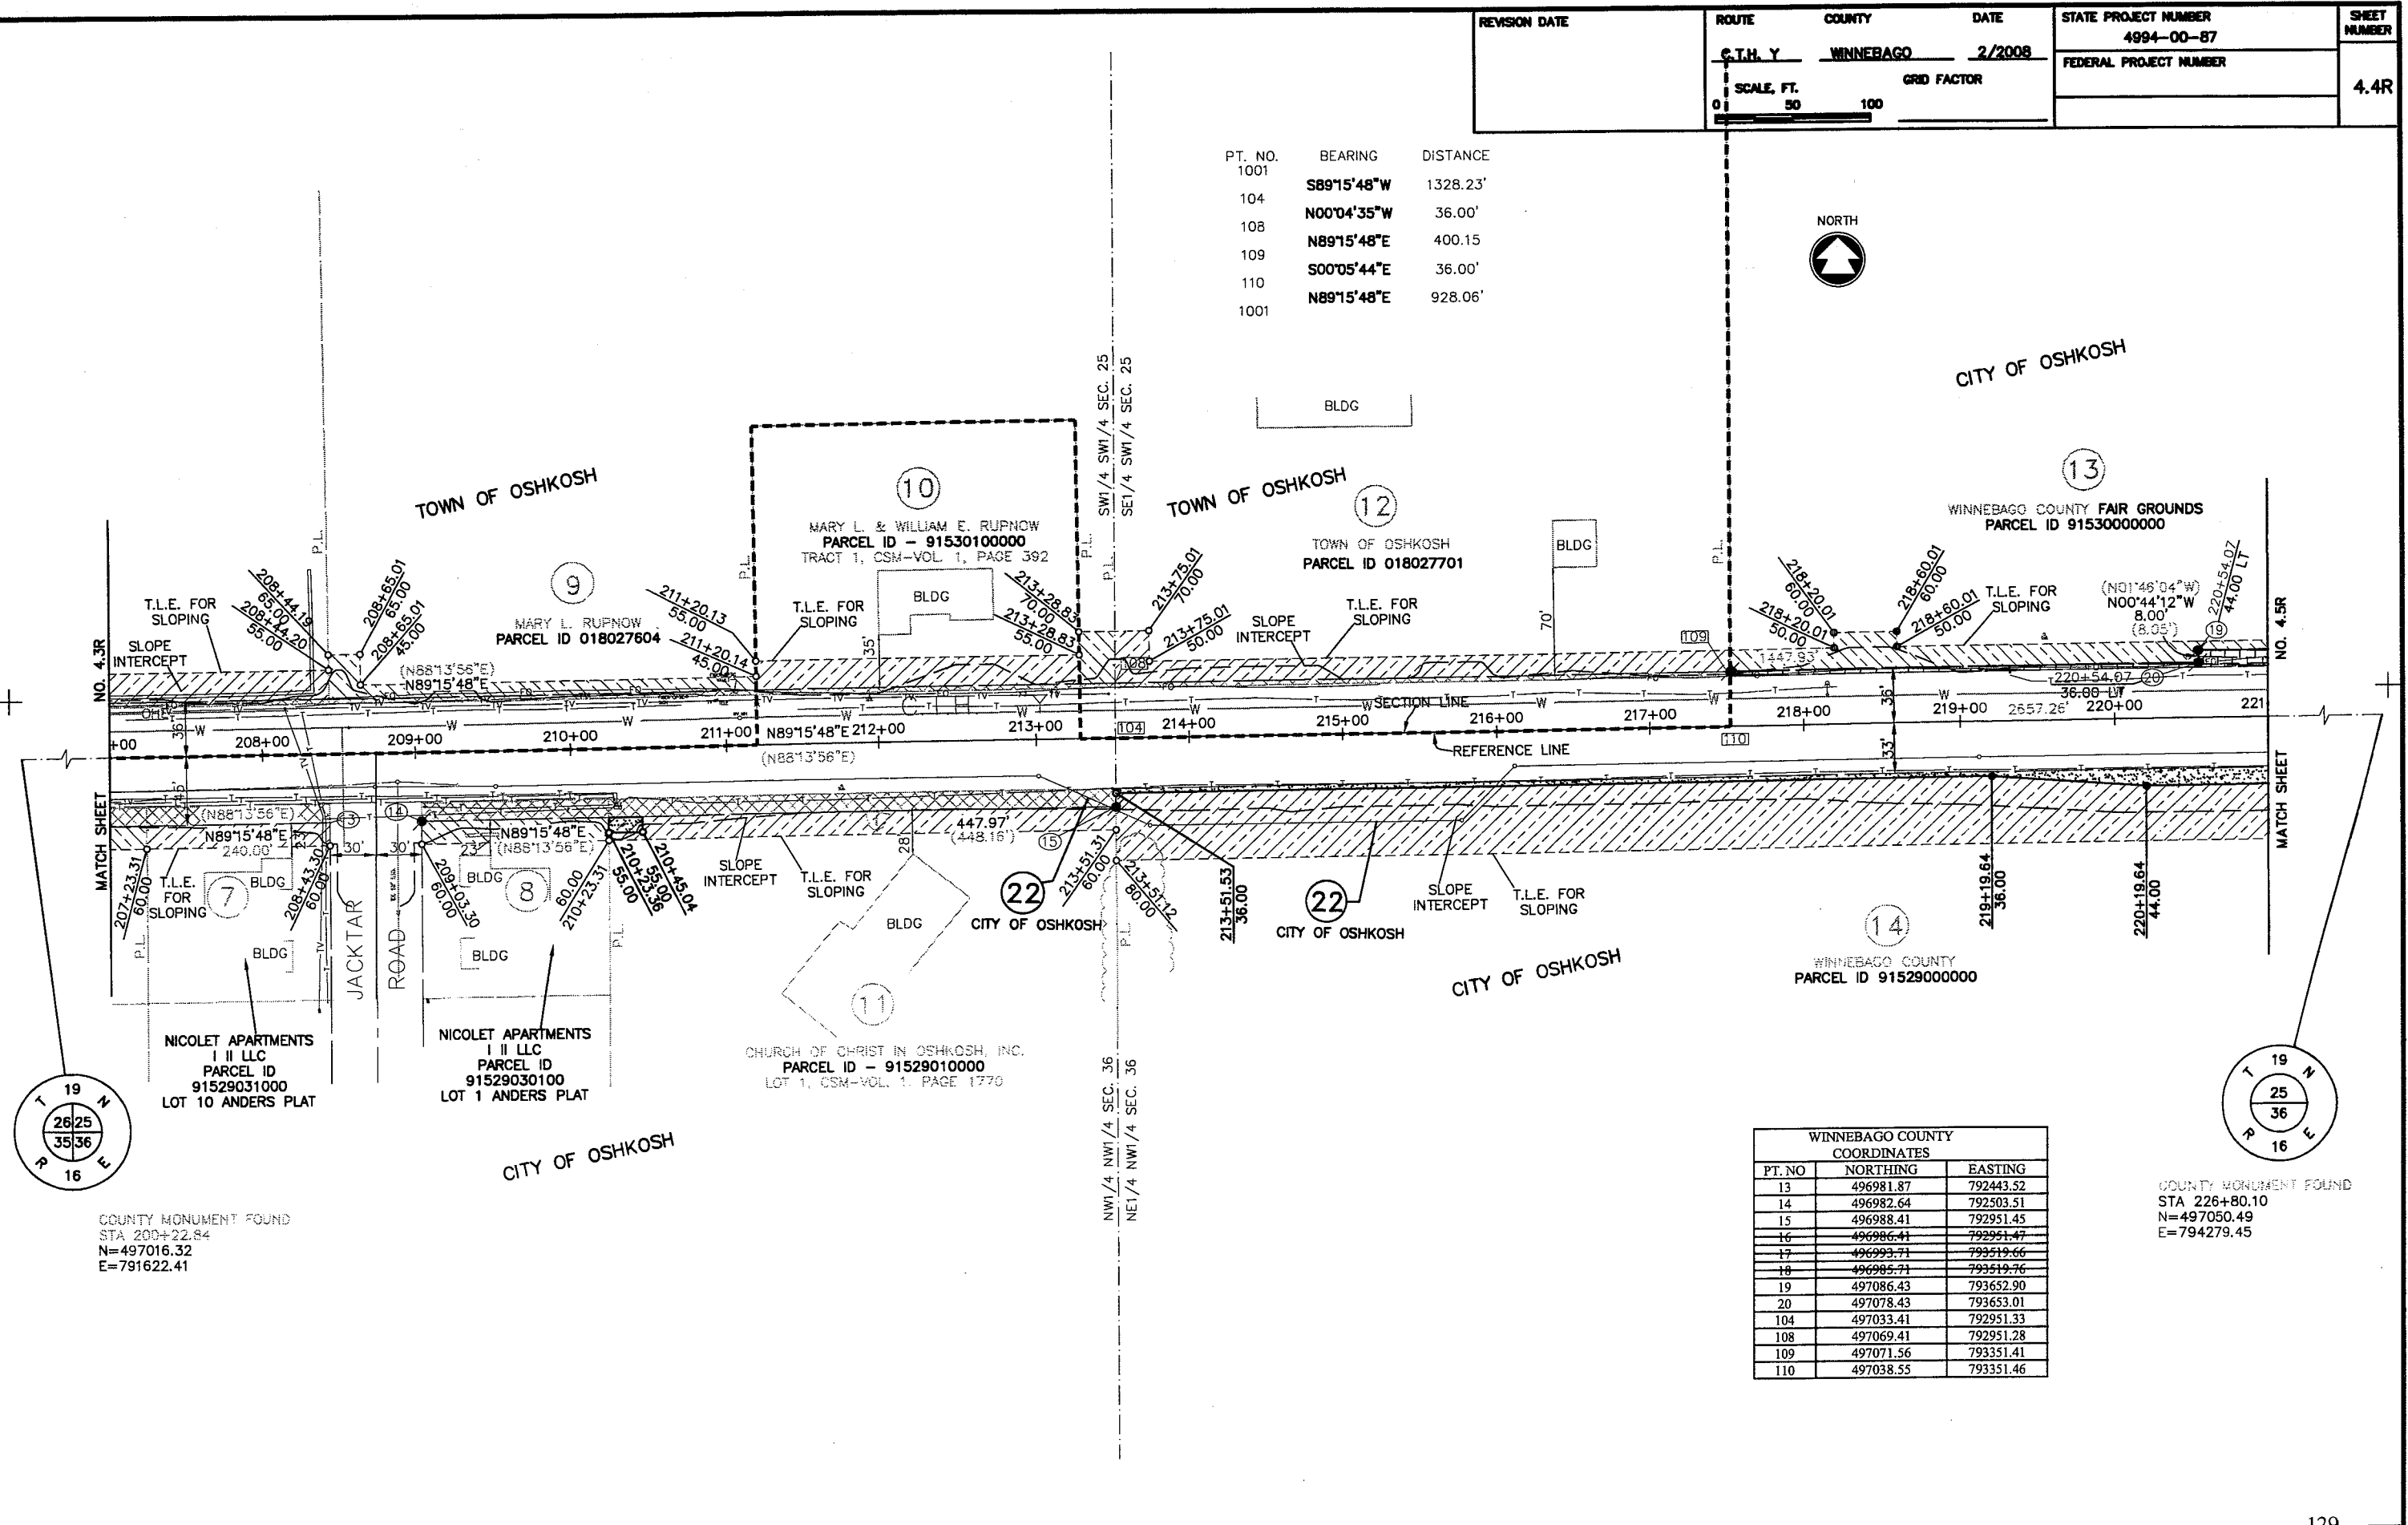


PT. NO	NORTHING	EASTING
13	496981.87	792443.52
14	496982.64	792503.51
15	496988.41	792951.45
16	496986.41	792951.47
17	496993.71	793519.66
18	496985.71	793519.76
19	497086.43	793652.90
20	497078.43	793653.01
104	497033.41	792951.33
108	497069.41	792951.28
109	497071.56	793351.41
110	497038.55	793351.46

COUNTY MONUMENT FOUND
 STA 226+80.10
 N=497050.49
 E=794279.45

COUNTY MONUMENT FOUND
 STA 200+22.84
 N=497016.32
 E=791622.41

REVISION DATE	ROUTE	COUNTY	DATE	STATE PROJECT NUMBER	SHEET NUMBER
	C.T.H. Y	WINNEBAGO	2/2008	4994-00-87	4.5R
	SCALE, FT. 0 50 100			FEDERAL PROJECT NUMBER	

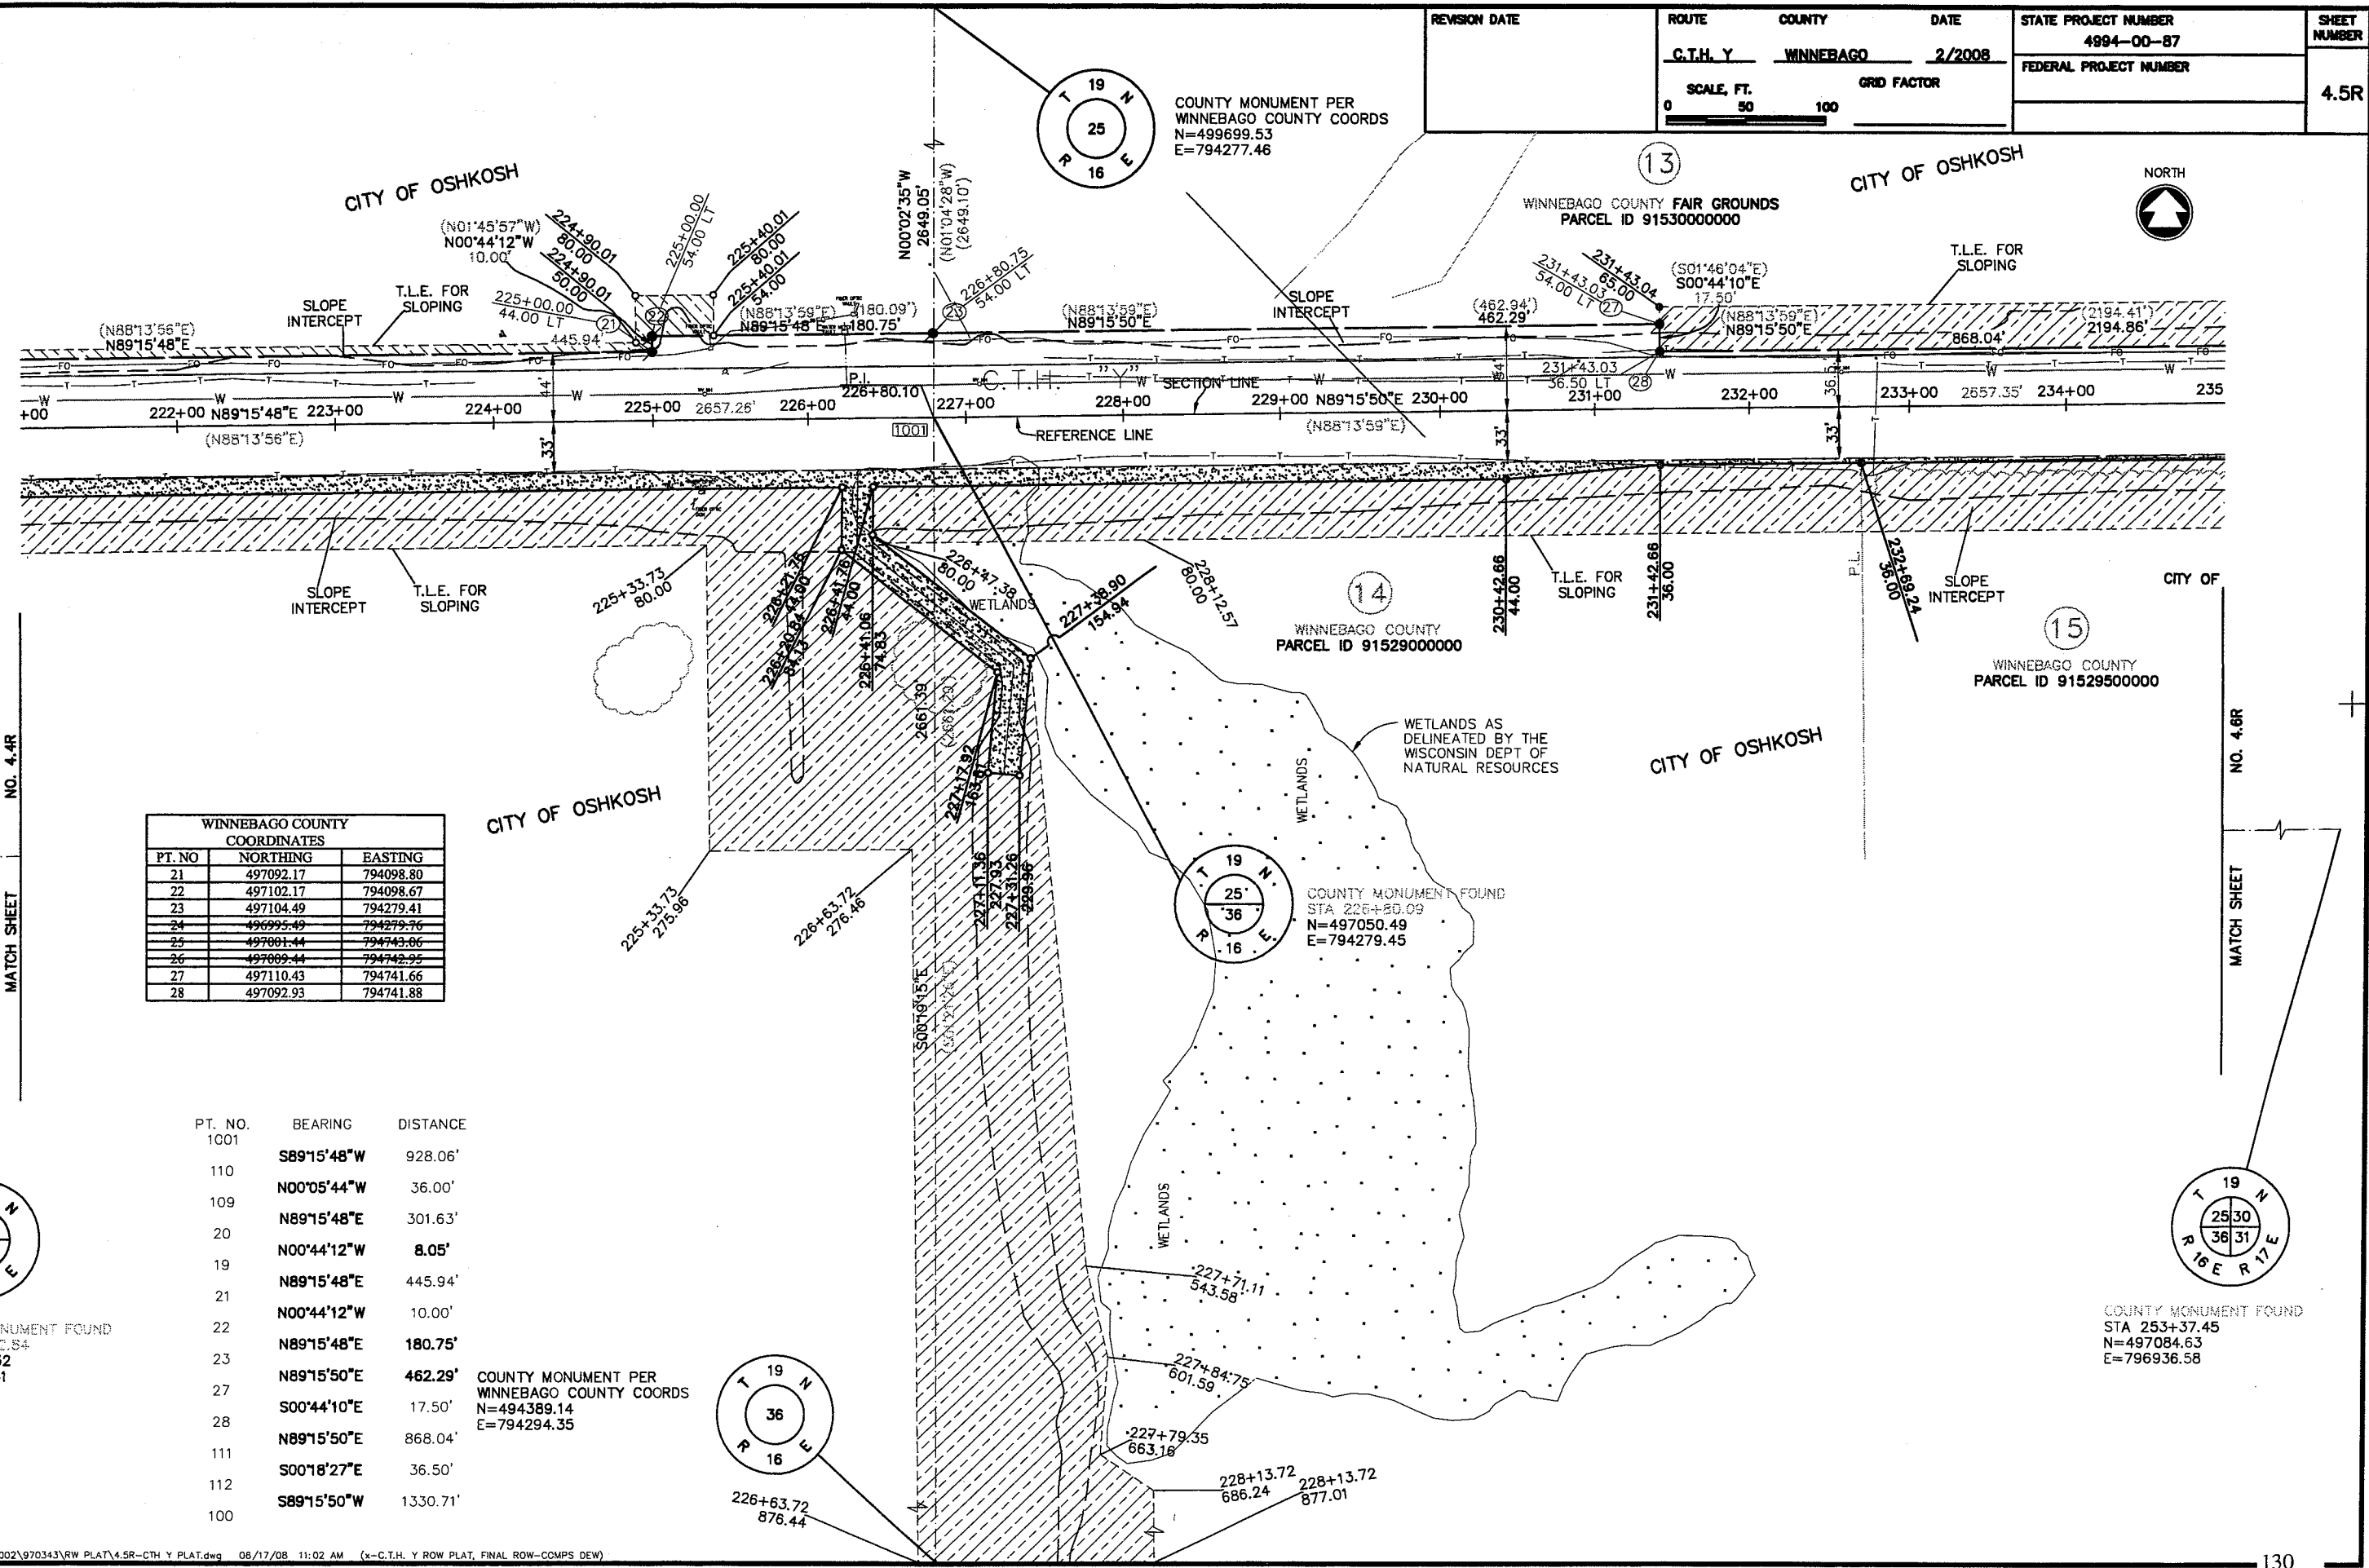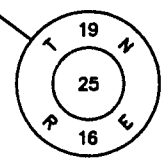

WINNEBAGO COUNTY COORDINATES		
PT. NO	NORTHING	EASTING
21	497092.17	794098.80
22	497102.17	794098.67
23	497104.49	794279.41
24	496995.49	794279.76
25	497081.44	794743.86
26	497089.44	794742.95
27	497110.43	794741.66
28	497092.93	794741.88

PT. NO.	BEARING	DISTANCE
1001		
110	S89°15'48"W	928.06'
109	N00°05'44"W	36.00'
20	N89°15'48"E	301.63'
19	N00°44'12"W	8.05'
21	N89°15'48"E	445.94'
22	N00°44'12"W	10.00'
23	N89°15'48"E	180.75'
27	N89°15'50"E	462.29'
28	S00°44'10"E	17.50'
111	N89°15'50"E	868.04'
112	S00°18'27"E	36.50'
100	S89°15'50"W	1330.71'

COUNTY MONUMENT PER WINNEBAGO COUNTY COORDS
N=494389.14
E=794294.35

COUNTY MONUMENT FOUND
STA 200+22.54
N=497016.32
E=791622.41



COUNTY MONUMENT FOUND
STA 253+37.45
N=497084.63
E=796936.58

MATCH SHEET NO. 4.4R

MATCH SHEET NO. 4.6R


REVISION DATE	ROUTE	COUNTY	DATE	STATE PROJECT NUMBER	SHEET NUMBER
	C.T.H. Y	WINNEBAGO	2/2008	4994-00-87	4.6R
	SCALE, FT.	GRID FACTOR		FEDERAL PROJECT NUMBER	
	0 50 100				

PT. NO.	BEARING	DISTANCE
1002		
112	S89°15'50"W	1326.64'
111	N00°18'27"W	36.50'
32	N89°15'50"E	1326.82'
35	N89°13'57"E	351.33'
117	N21°11'47"E	11.01'
118	N89°13'57"E	71.17'
116	S21°11'47"W	50.38'
1002	S89°13'57"W	408.24'

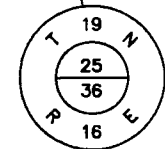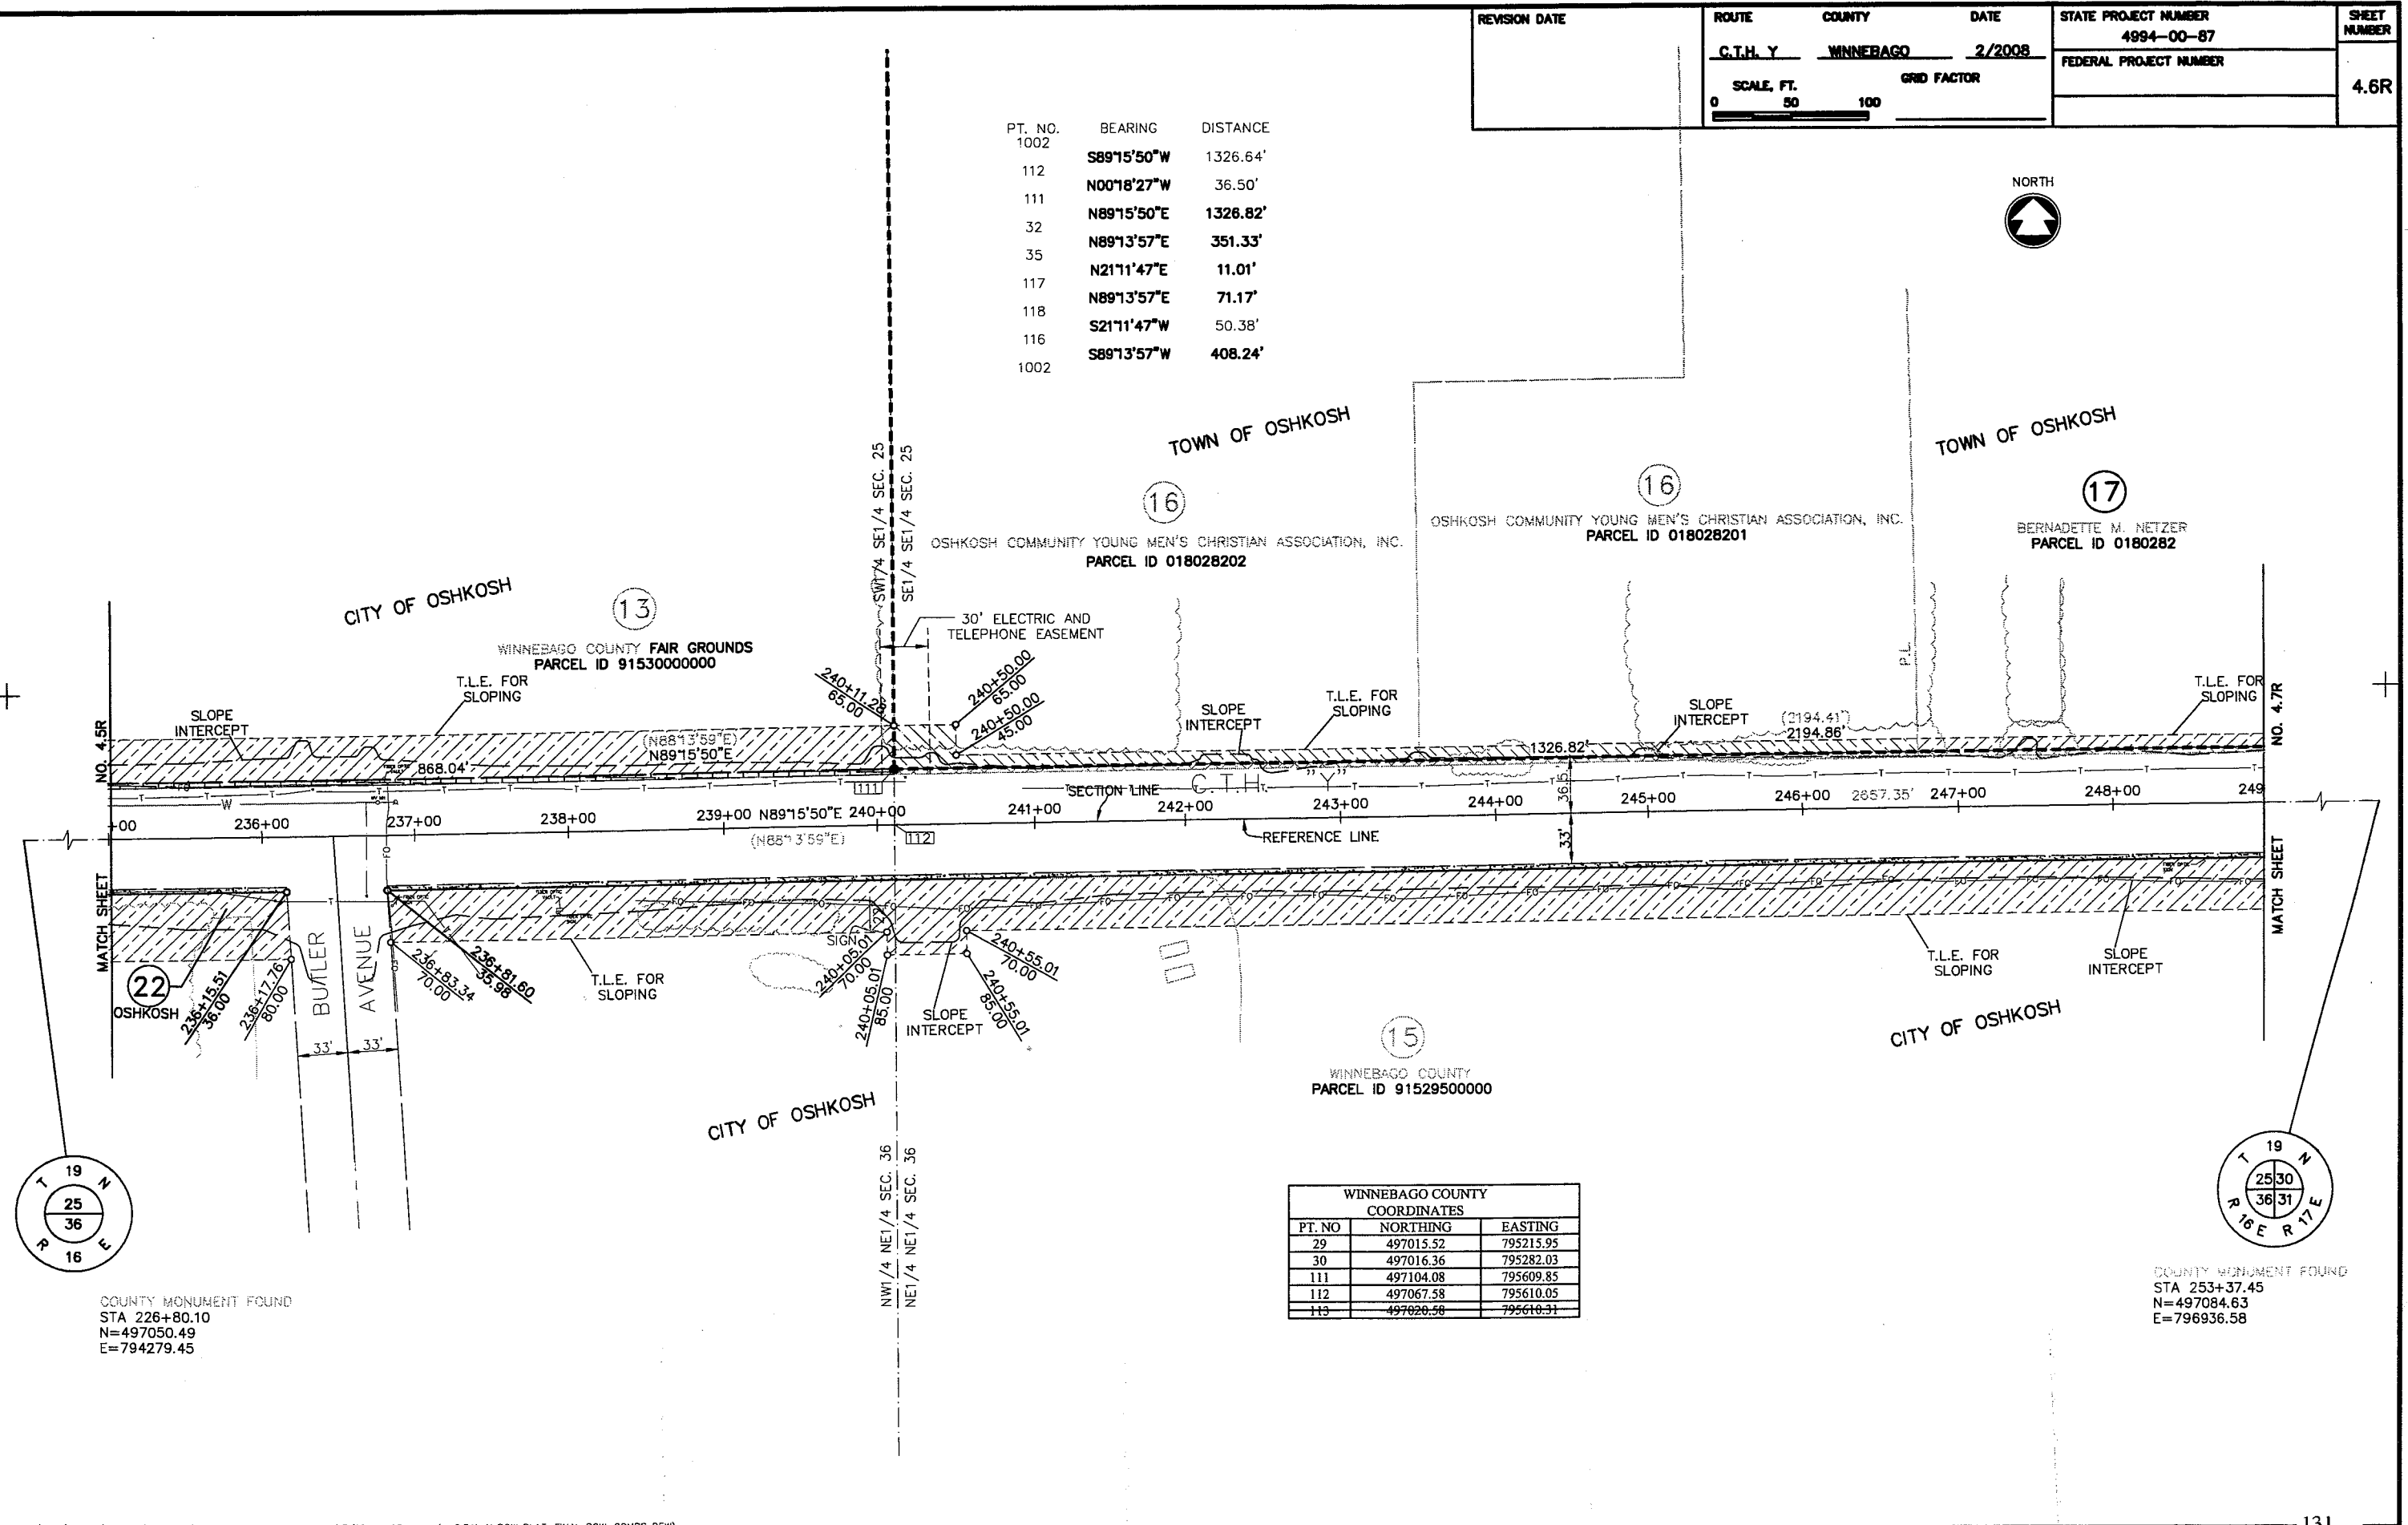

COUNTY MONUMENT FOUND
 STA 226+80.10
 N=497050.49
 E=794279.45


WINNEBAGO COUNTY COORDINATES		
PT. NO	NORTHING	EASTING
29	497015.52	795215.95
30	497016.36	795282.03
111	497104.08	795609.85
112	497067.58	795610.05
113	497020.58	795610.31

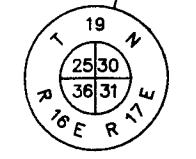

COUNTY MONUMENT FOUND
 STA 253+37.45
 N=497084.63
 E=796936.58

REVISION DATE	ROUTE	COUNTY	DATE	STATE PROJECT NUMBER	SHEET NUMBER
	C.T.H. Y	WINNEBAGO	2/2008	4994-00-87	4.7R
	SCALE, FT.	GRID FACTOR		FEDERAL PROJECT NUMBER	
	0 50 100				



COUNTY MONUMENT PER WINNEBAGO COUNTY COORDS
N=499731.63
E=796935.34

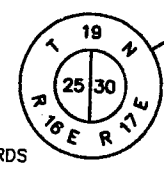

WINNEBAGO COUNTY COORDINATES		
PT. NO	NORTHING	EASTING
31	497037.62	796936.78
32	497121.13	796936.56
33	497042.84	797326.46
34	497126.79	797359.02
35	497125.83	797287.86
36	497041.89	797255.30
114	497031.11	797251.12
115	497032.00	797322.26
116	497090.09	797344.79
117	497136.10	797291.84
118	497137.05	797362.99




PT. NO.	BEARING	DISTANCE
1002	N89°13'57"E	408.24'
116	S21°11'47"W	62.33'
115	S89°16'59"W	71.14'
114	N21°11'47"E	62.24'
113	S89°13'57"W	337.08'

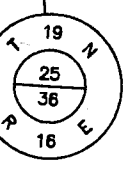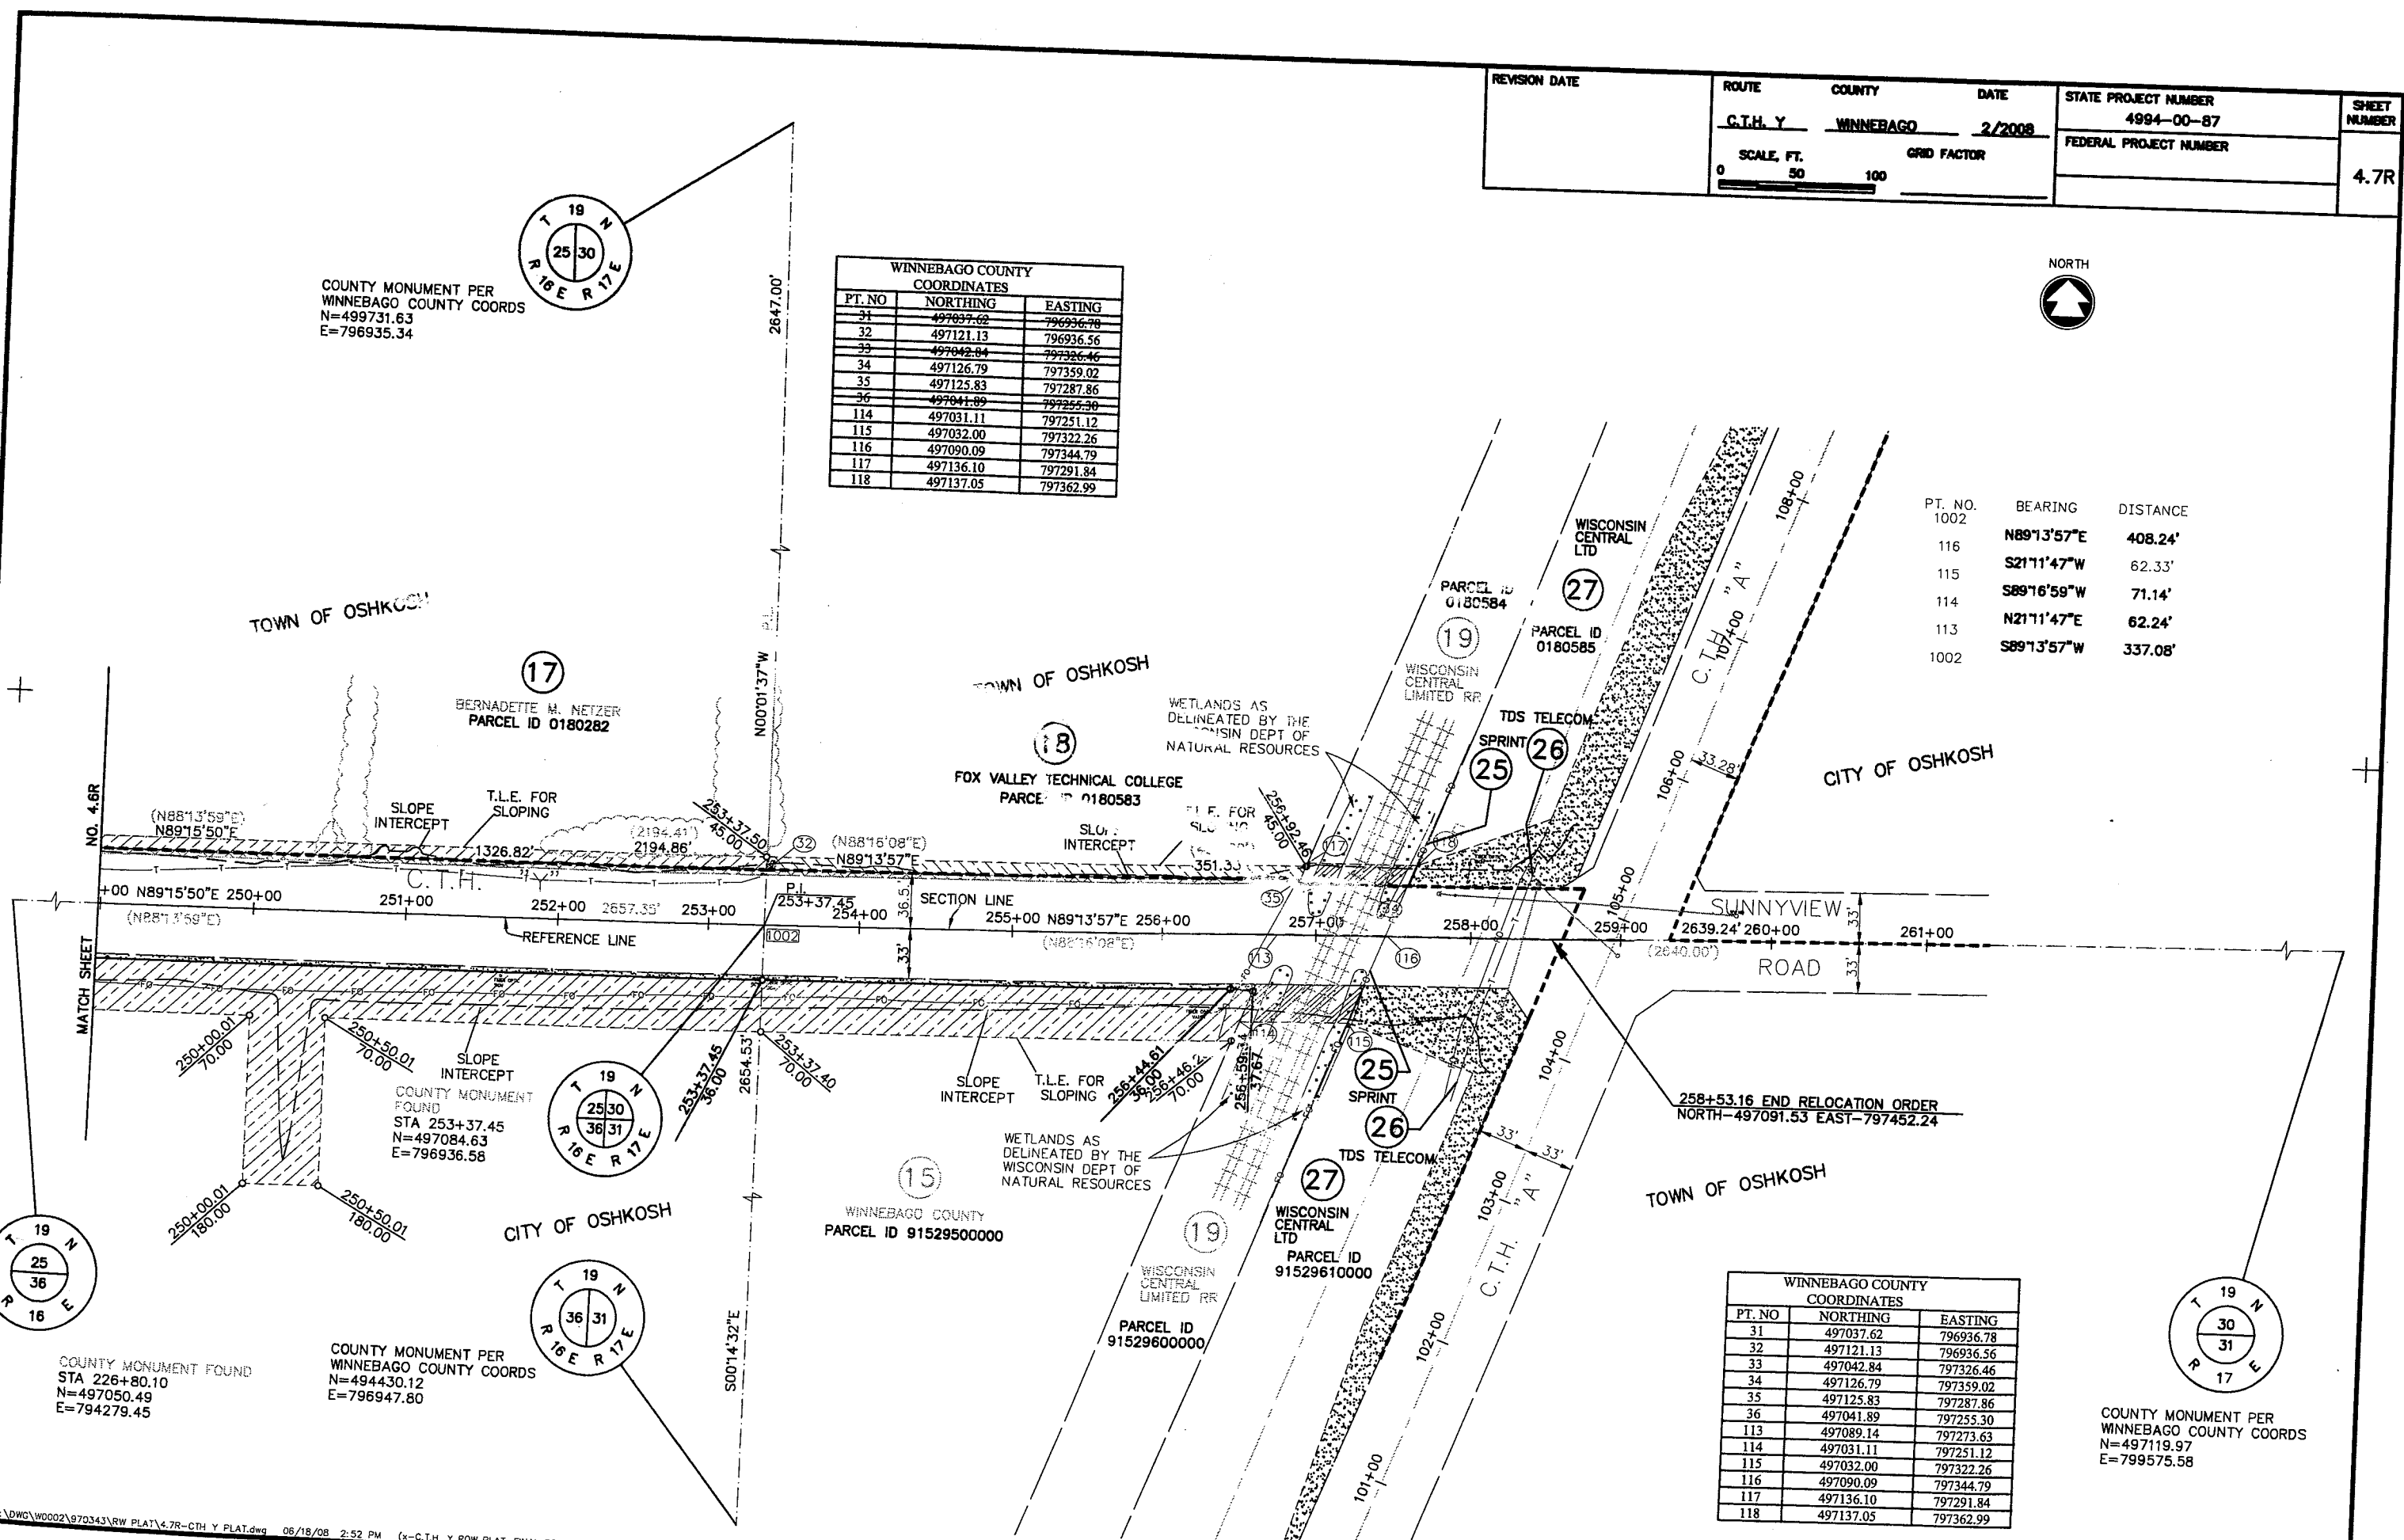


COUNTY MONUMENT FOUND
STA 226+80.10
N=497050.49
E=794279.45

COUNTY MONUMENT PER WINNEBAGO COUNTY COORDS
N=494430.12
E=796947.80

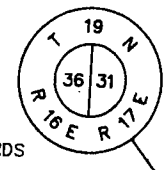




WINNEBAGO COUNTY COORDINATES		
PT. NO	NORTHING	EASTING
31	497037.62	796936.78
32	497121.13	796936.56
33	497042.84	797326.46
34	497126.79	797359.02
35	497125.83	797287.86
36	497041.89	797255.30
113	497089.14	797273.63
114	497031.11	797251.12
115	497032.00	797322.26
116	497090.09	797344.79
117	497136.10	797291.84
118	497137.05	797362.99

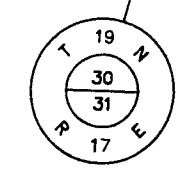

COUNTY MONUMENT PER WINNEBAGO COUNTY COORDS
N=497119.97
E=799575.58

REVISION DATE	ROUTE	COUNTY	DATE	STATE PROJECT NUMBER	SHEET NUMBER
	C.T.H. Y	WINNEBAGO	2/2008	4994-00-87	4.8
	SCALE, FT.		GRID FACTOR		
	0 50 100				

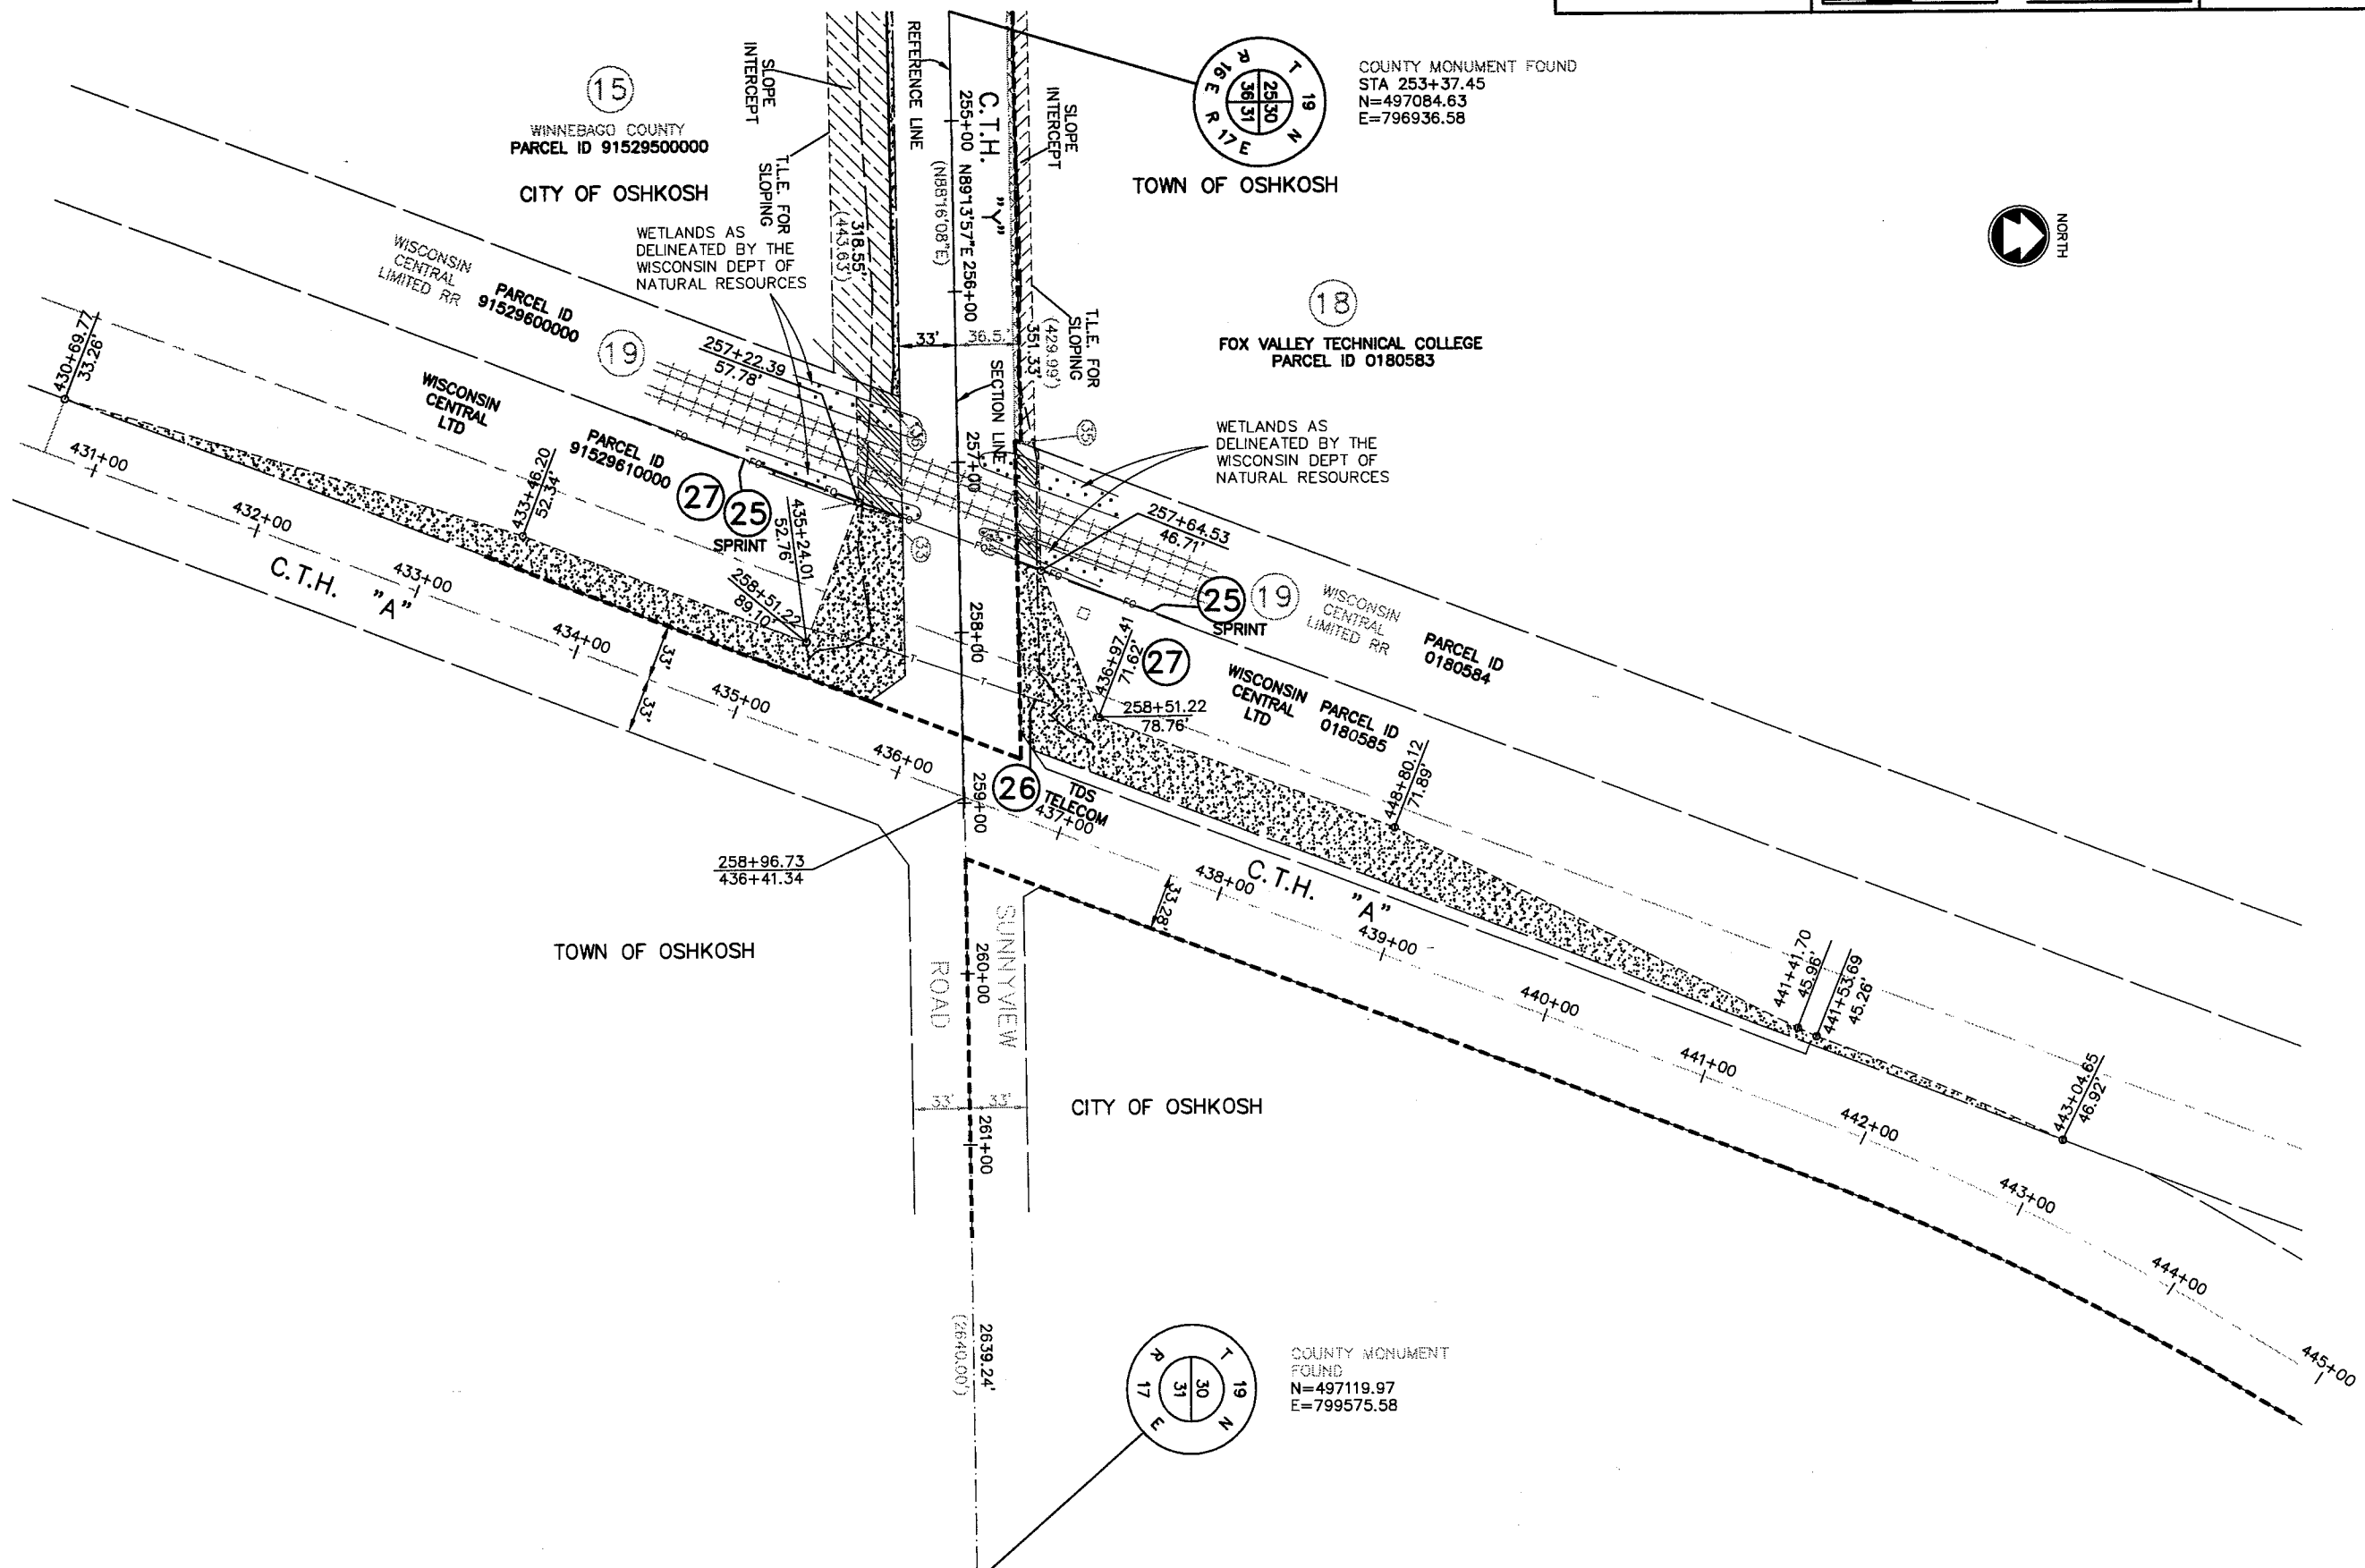

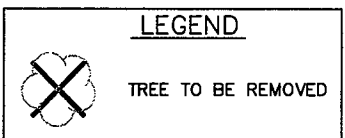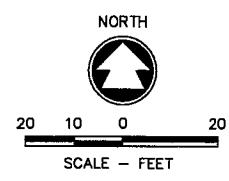

STA 199+32.46
 REMOVE EXIST 24" RCP
 24" X 146' RCCP REQ'D
 NORTH INV. = 776.75
 SOUTH INV. = 776.00


STA 195+94.22 LT
 REMOVE EXIST 18" CMP
 18" X 51' CMP REQ'D
 WEST INV. = 771.89
 EAST INV. = 772.48

STA 196+49.37 RT
 REMOVE EXIST 15" CMP
 15" X 72' CMP REQ'D
 WEST INV. = 772.58
 EAST INV. = 773.40

BENCH MARK			
STATION	OFFSET	LOCATION	ELEV.
196+39.79	26.57' LT	NAIL IN PP	775.58
199+26.91	89.37' RT	NAIL IN PP	777.77


5

5

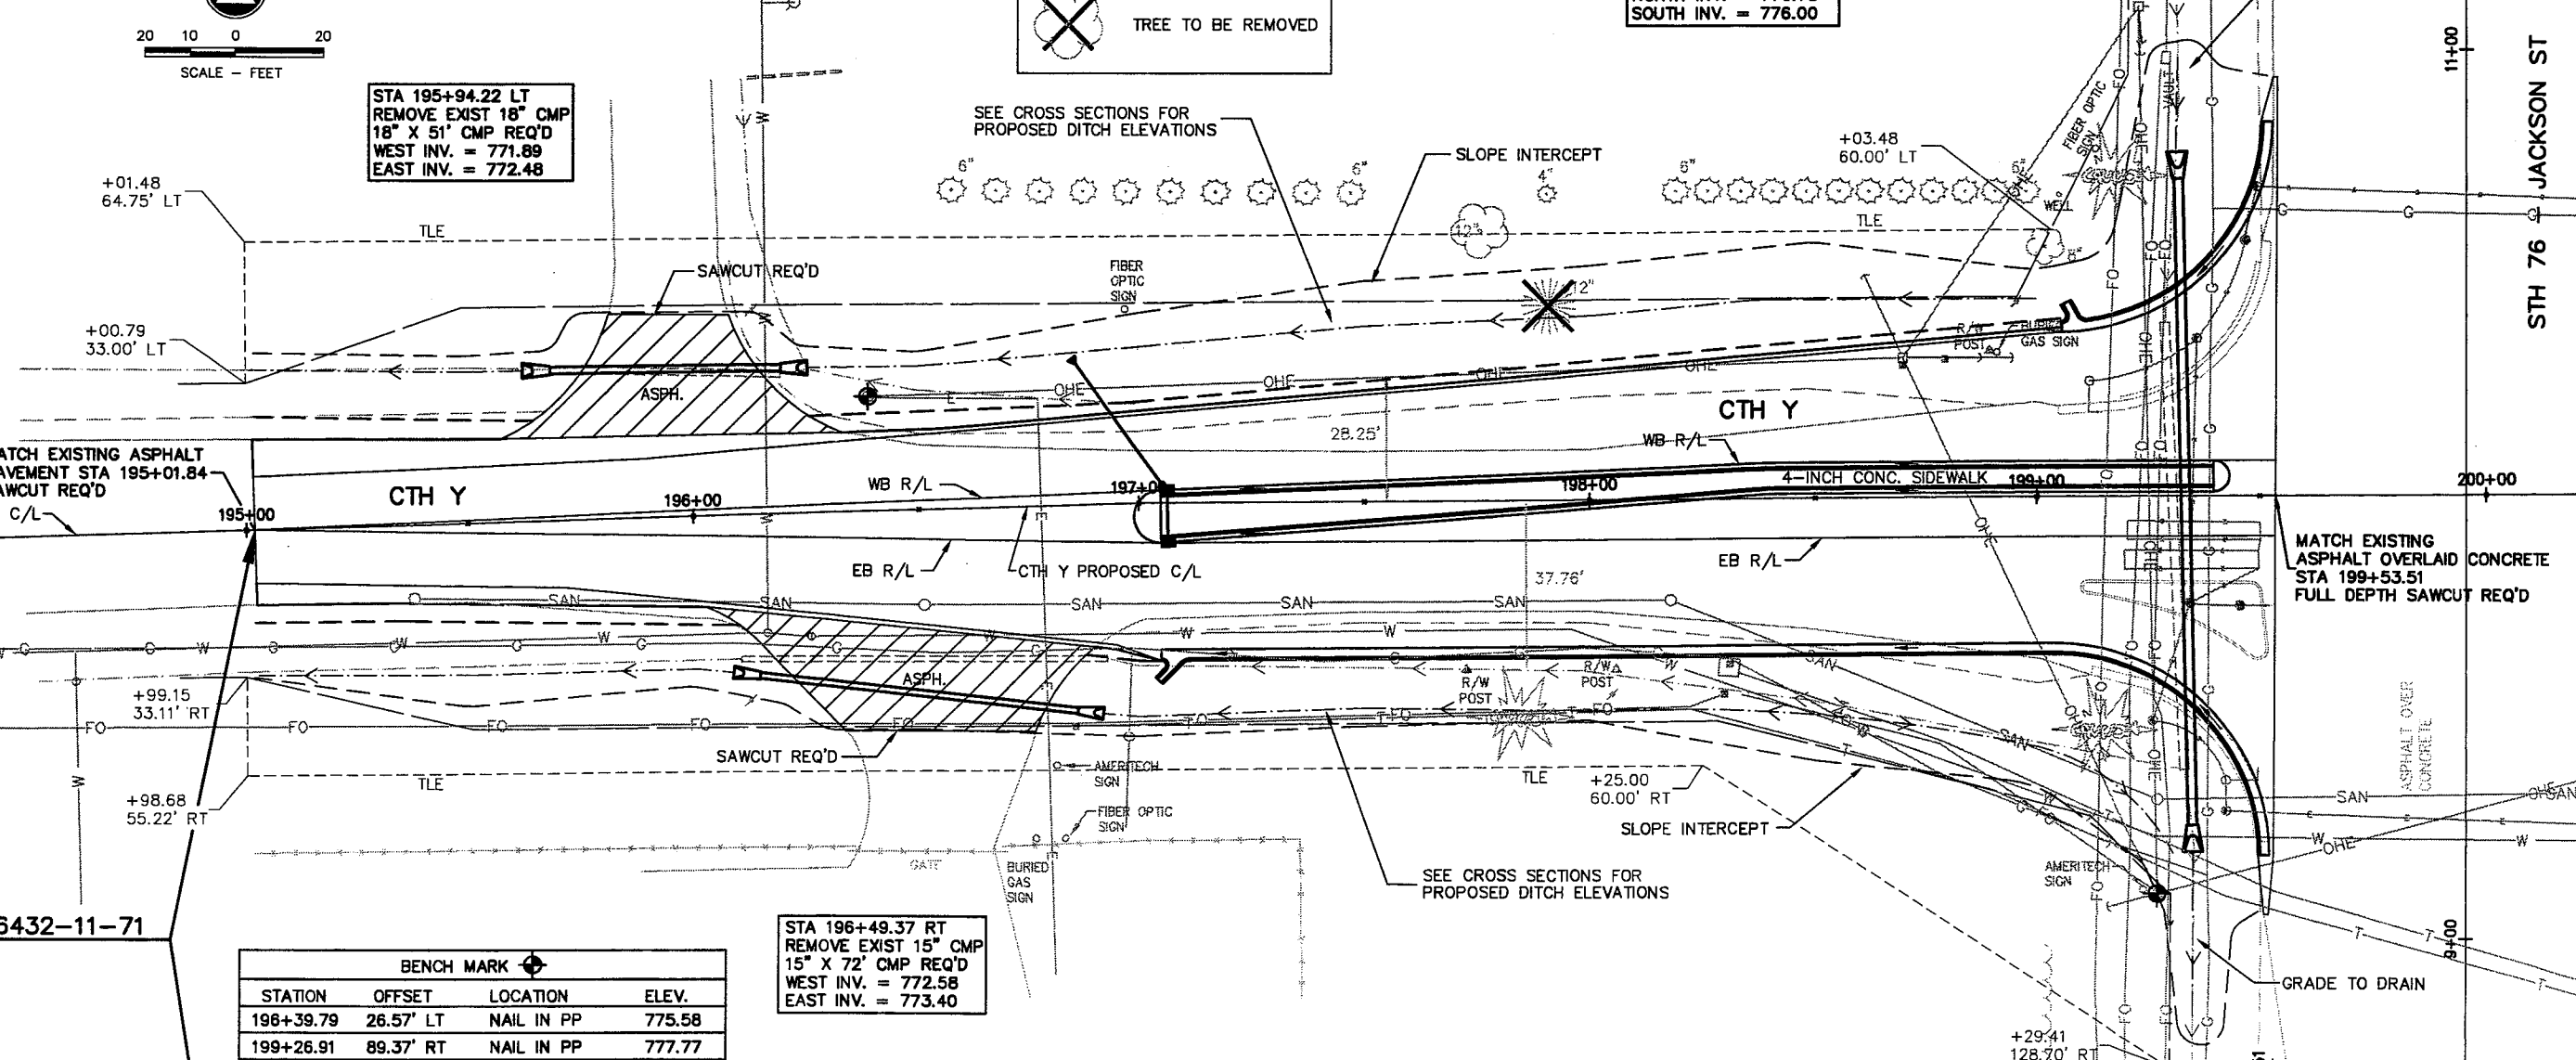

BEGIN PROJECT 6432-11-71
 STA. 195+01.84

W:\DMS\W0002\970343\00\Plan and Profile\CTH Y 01.dwg 10/22/08 9:40 AM (X-CTH Y, A1&T FIBER cth)

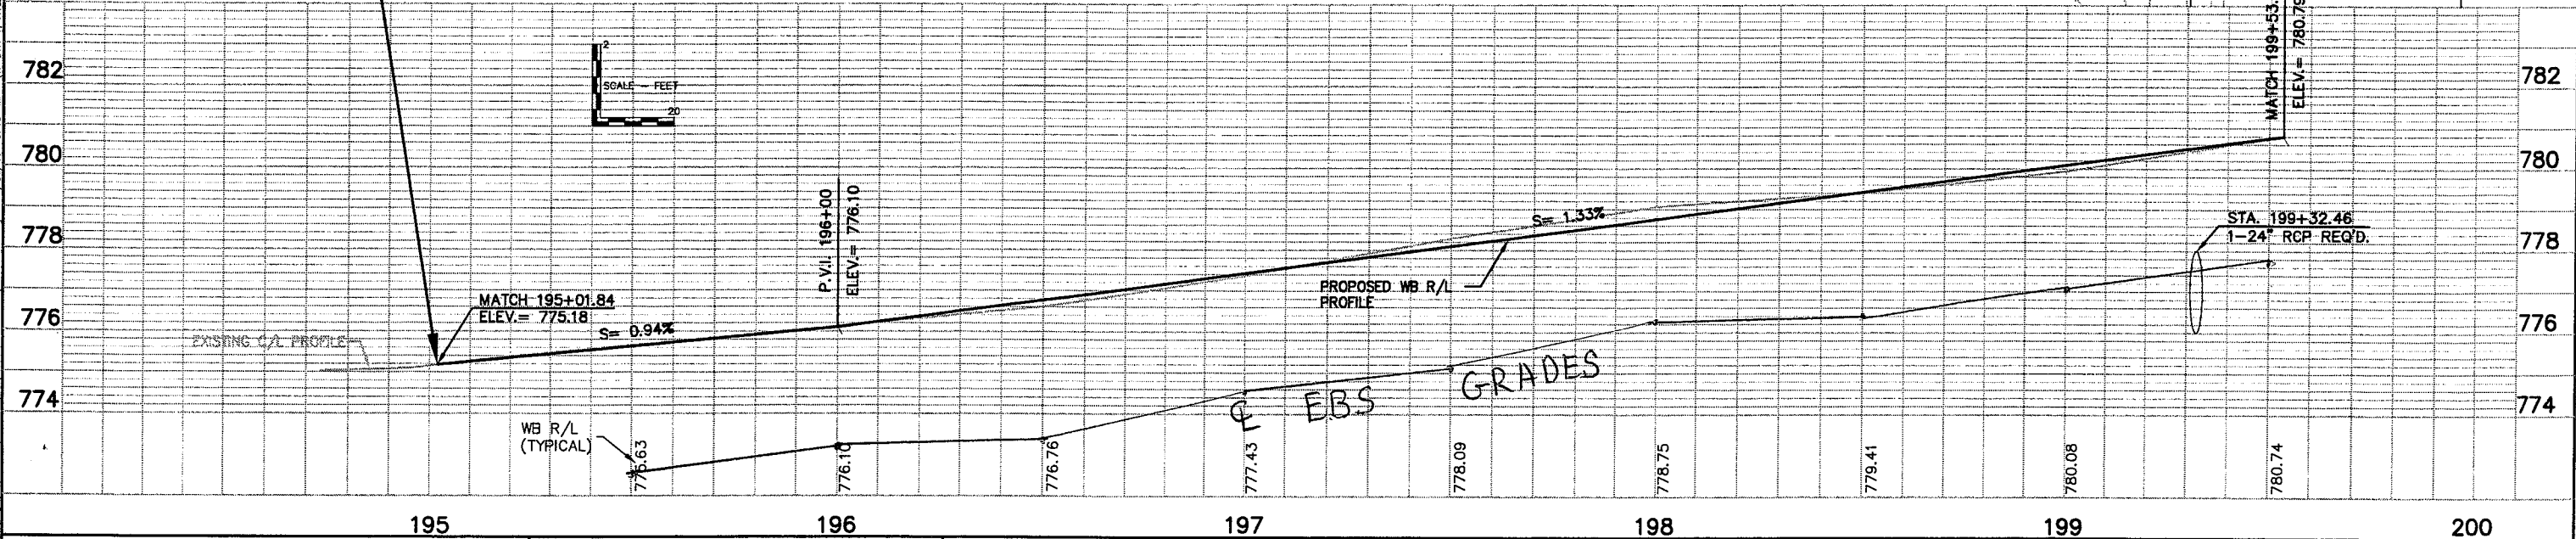

STH 76 - JACKSON ST

200

END PROJECT 6432-11-71
STA. 200+86.77


BEGIN PROJECT 4994-00-87
STA. 200+86.77

STA 200+63.39
REMOVE EXIST 24" RCP
24" X 129" RCCP REQ'D
NORTH INV. = 777.00
SOUTH INV. = 776.40

BENCH MARK			
STATION	OFFSET	LOCATION	ELEV.
200+73.25	58.79' LT	HYD TAG BOLT	782.41

STA 205+74 LT
REMOVE EXIST 18" CMP

STA 203+98 RT
REMOVE EXIST 12" CMP

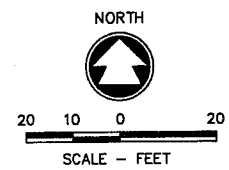


LEGEND

TREE TO BE REMOVED

MATCH EXISTING ASPHALT OVERLAID CONCRETE STA 200+37.07 FULL DEPTH SAWCUT REQ'D.

MATCH EXISTING CONCRETE PAVEMENT STA 9+35 FULL DEPTH SAWCUT REQ'D PAVEMENT TIES REQ'D.

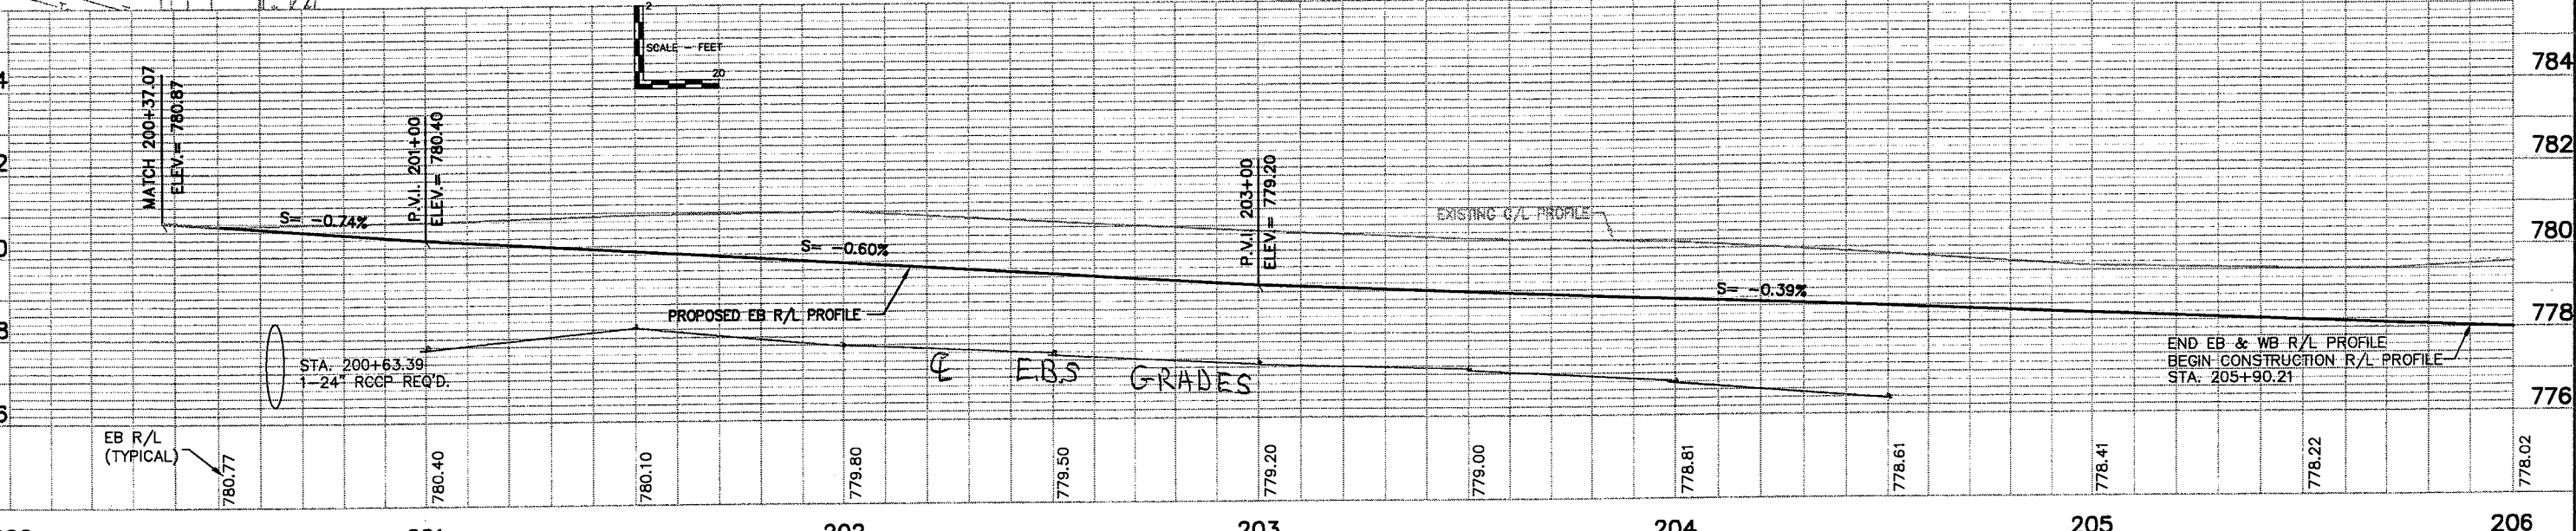

STATE PROJECT NUMBER: 4994-00-87 & 6432-11-71

HWY: CTH Y

COUNTY: WINNEBAGO


PLAN AND PROFILE

SHEET NO: 135

E

WSDOT/CADD SHEET 40



p:\projects\1970343\00\Plan and Profile\CTH Y 02.dwg 05/22/08 11:25 AM (X-CTH Y, FINAL ROW-COMPS.DWG)

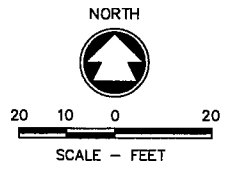

LEGEND


TREE TO BE REMOVED

BENCH MARK			
STATION	OFFSET	LOCATION	ELEV.
8+38.88	24.21' LT	NAIL IN LP	779.34
8+41.60	23.95' RT	NAIL IN LP	777.75

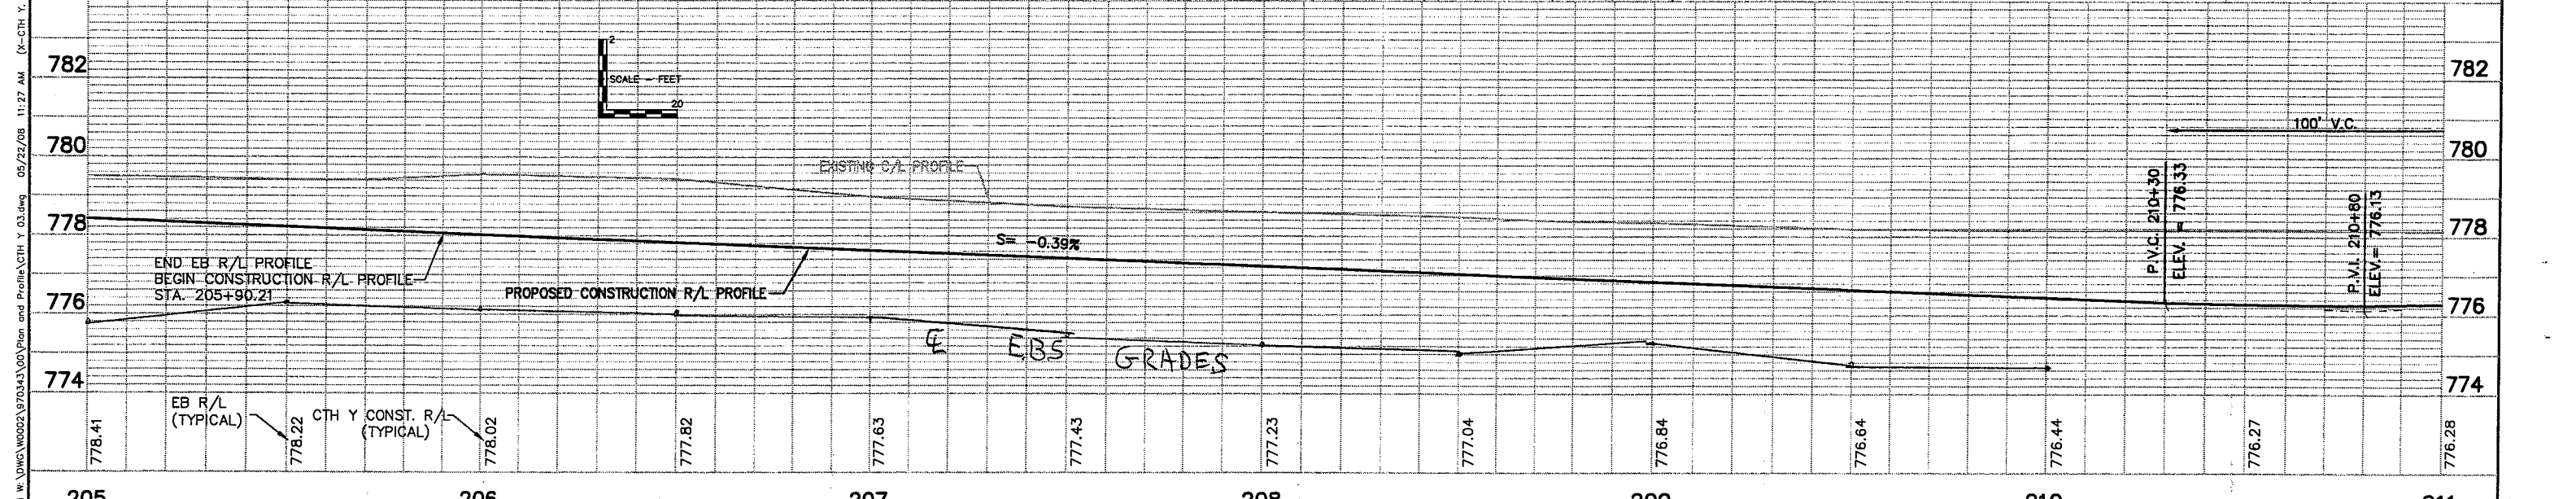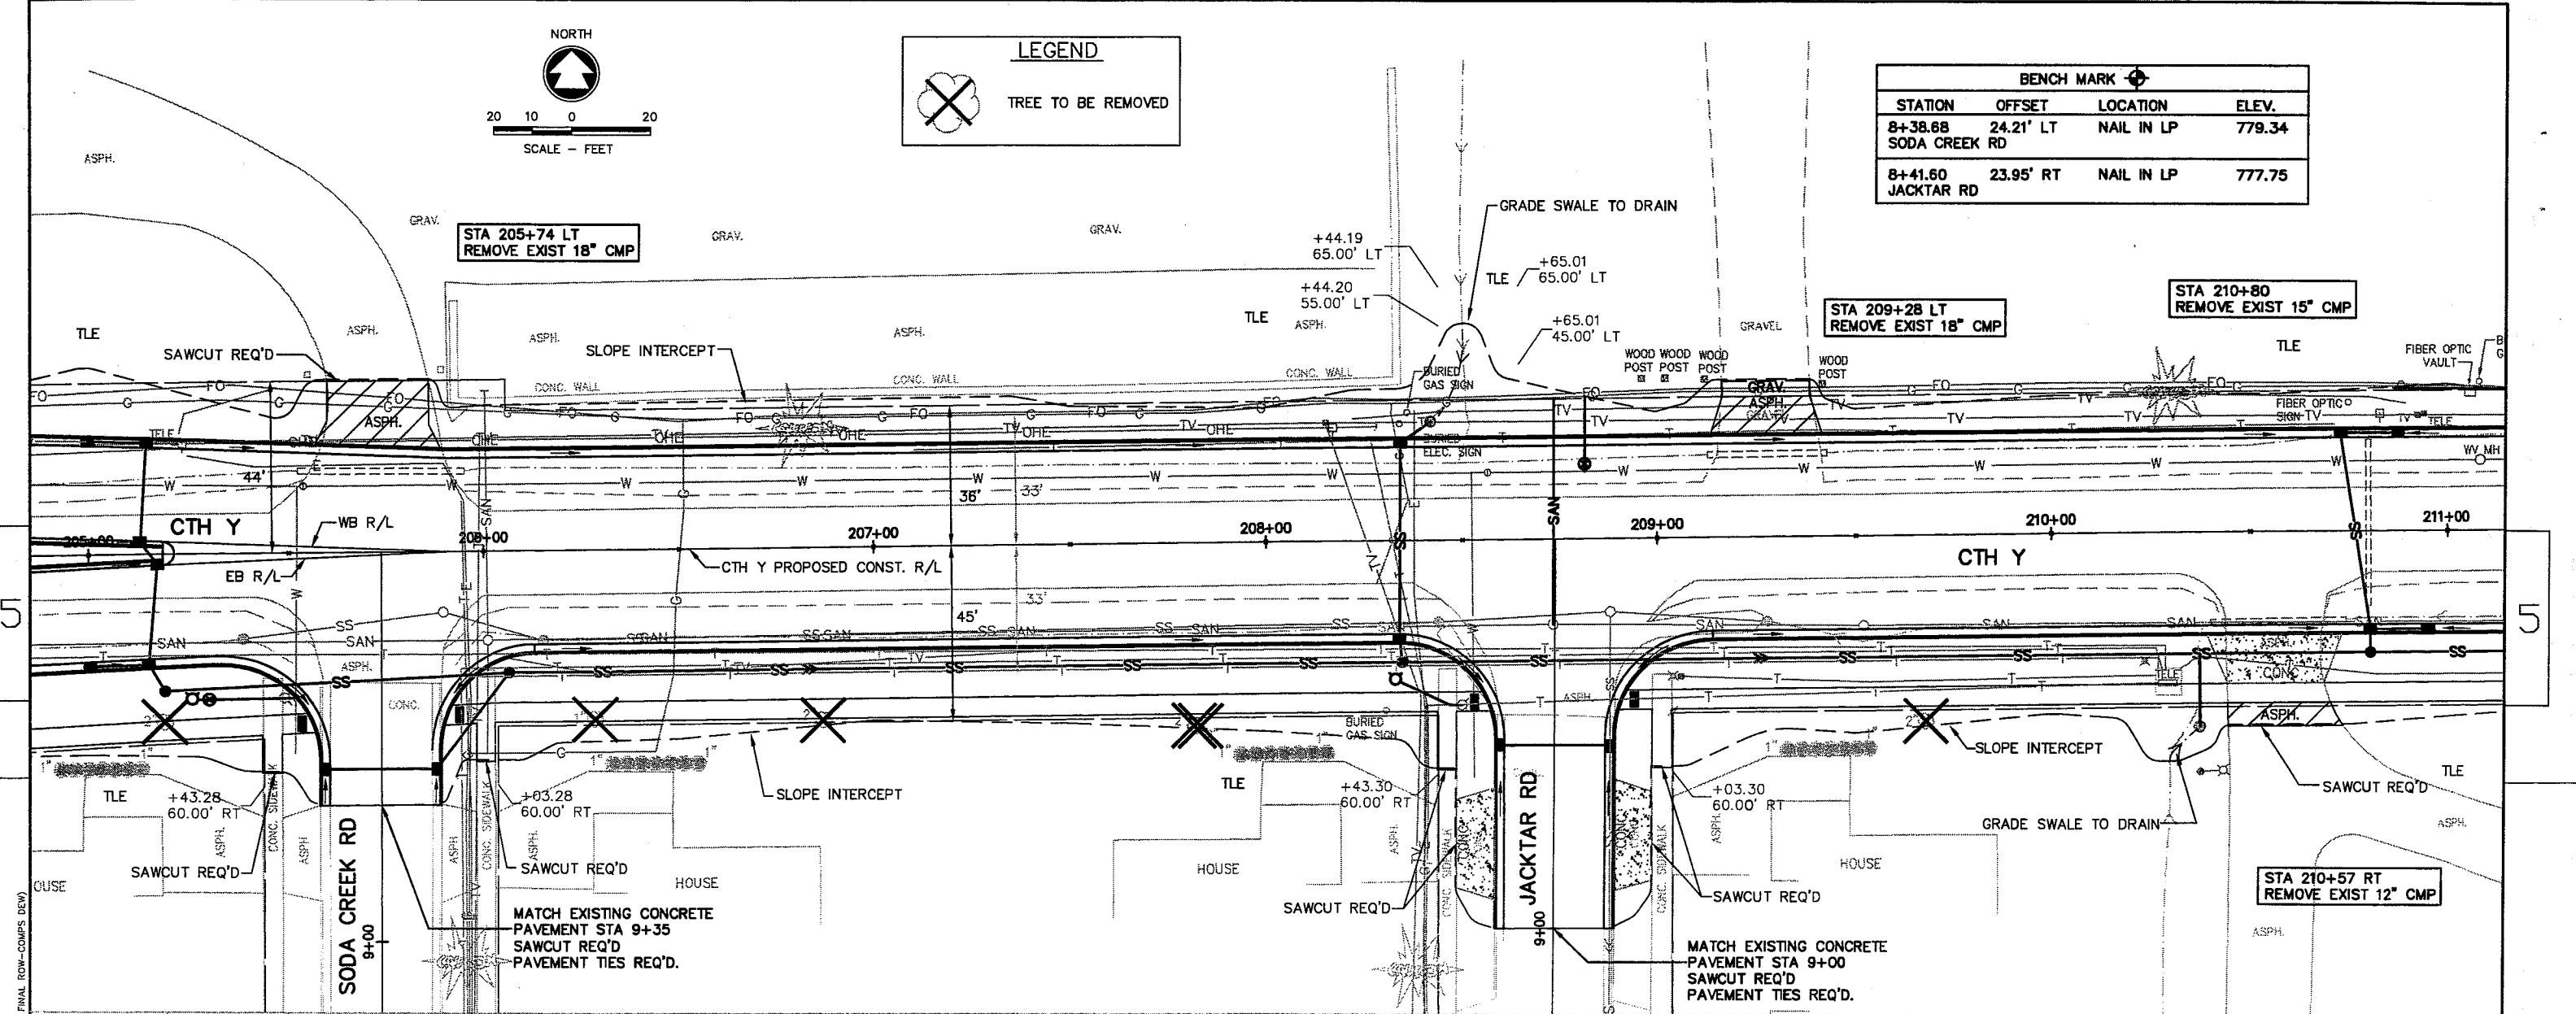


D:\Projects\4994-00-87\4994-00-87.dwg 05/22/08 11:27 AM (X-CTH Y, FINAL ROW-COMPS DEW)

p:\magnaki.w\dwg\002\970343\00\Plan and Profile\CTH Y.dwg 05/22/08 11:31 AM (X-CTH Y, FINAL ROW-CMPS.DWG)

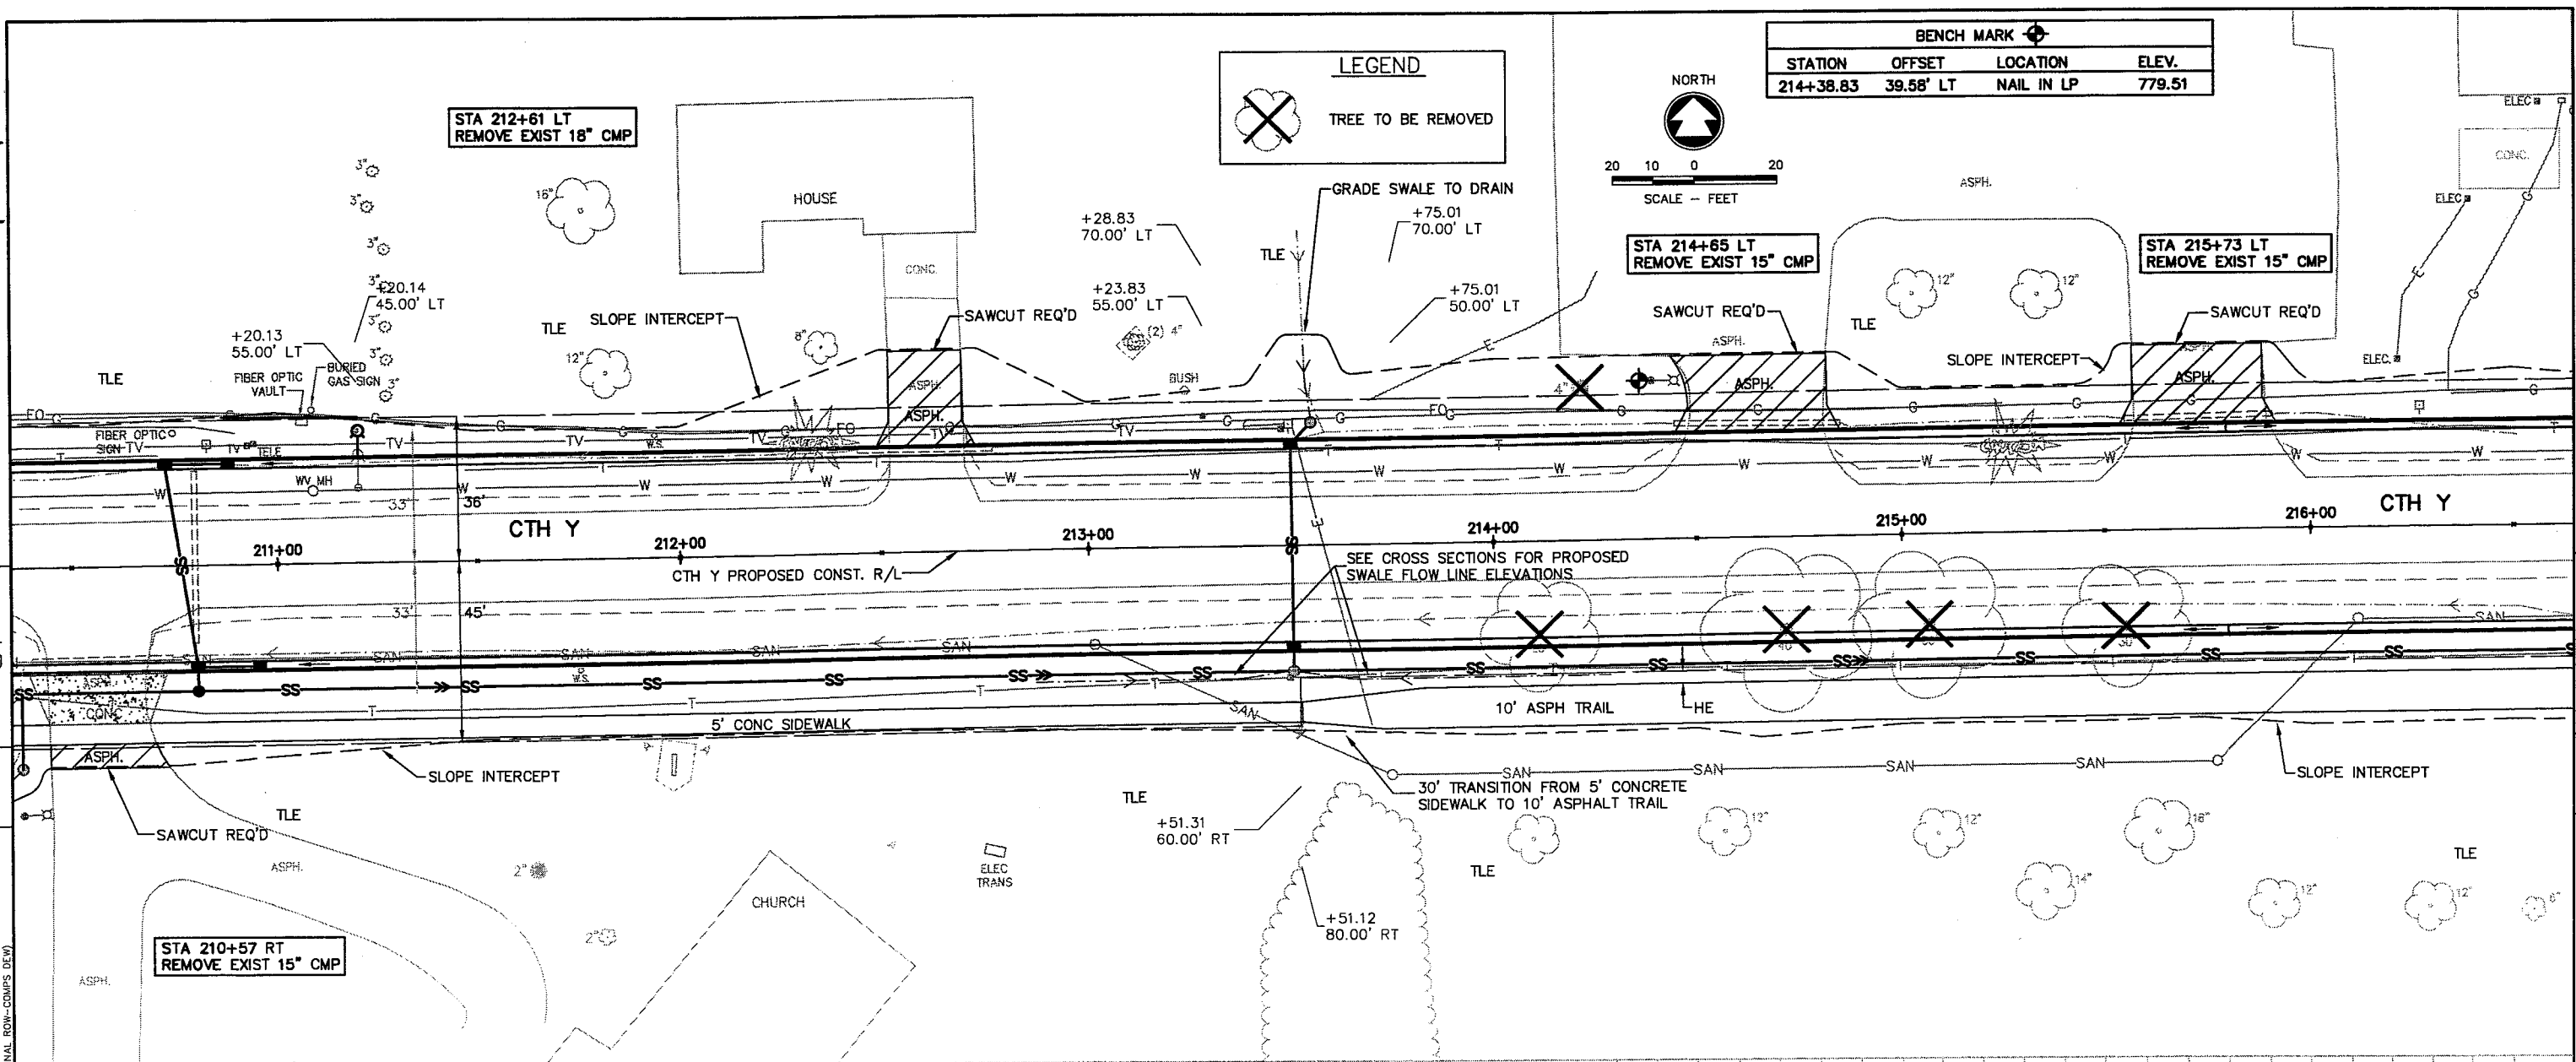

LEGEND

 TREE TO BE REMOVED


BENCH MARK


STATION	OFFSET	LOCATION	ELEV.
214+38.83	39.58' LT	NAIL IN LP	779.51

NORTH

SCALE - FEET

20 10 0 20

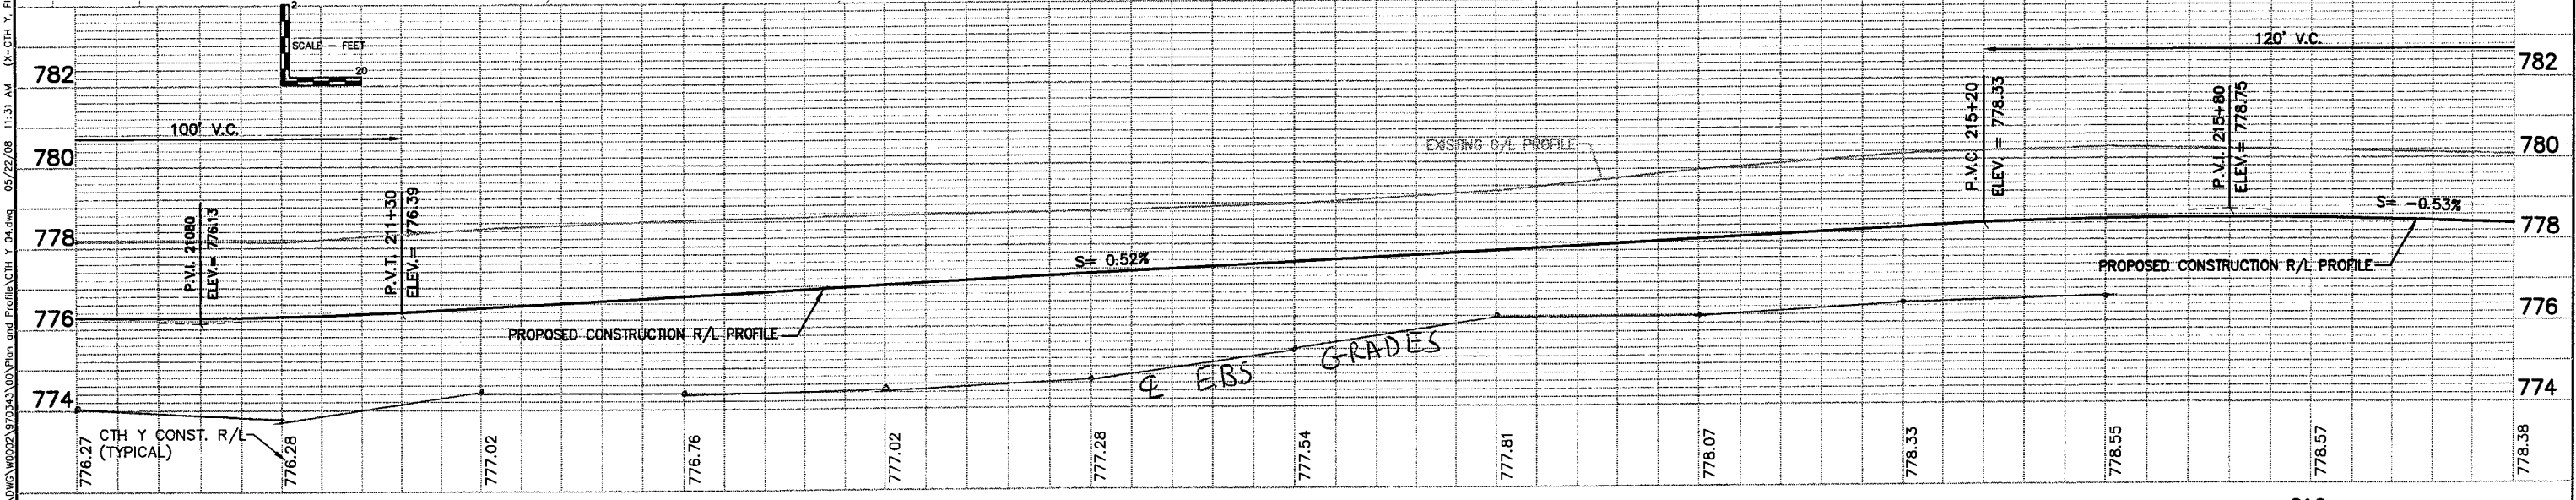

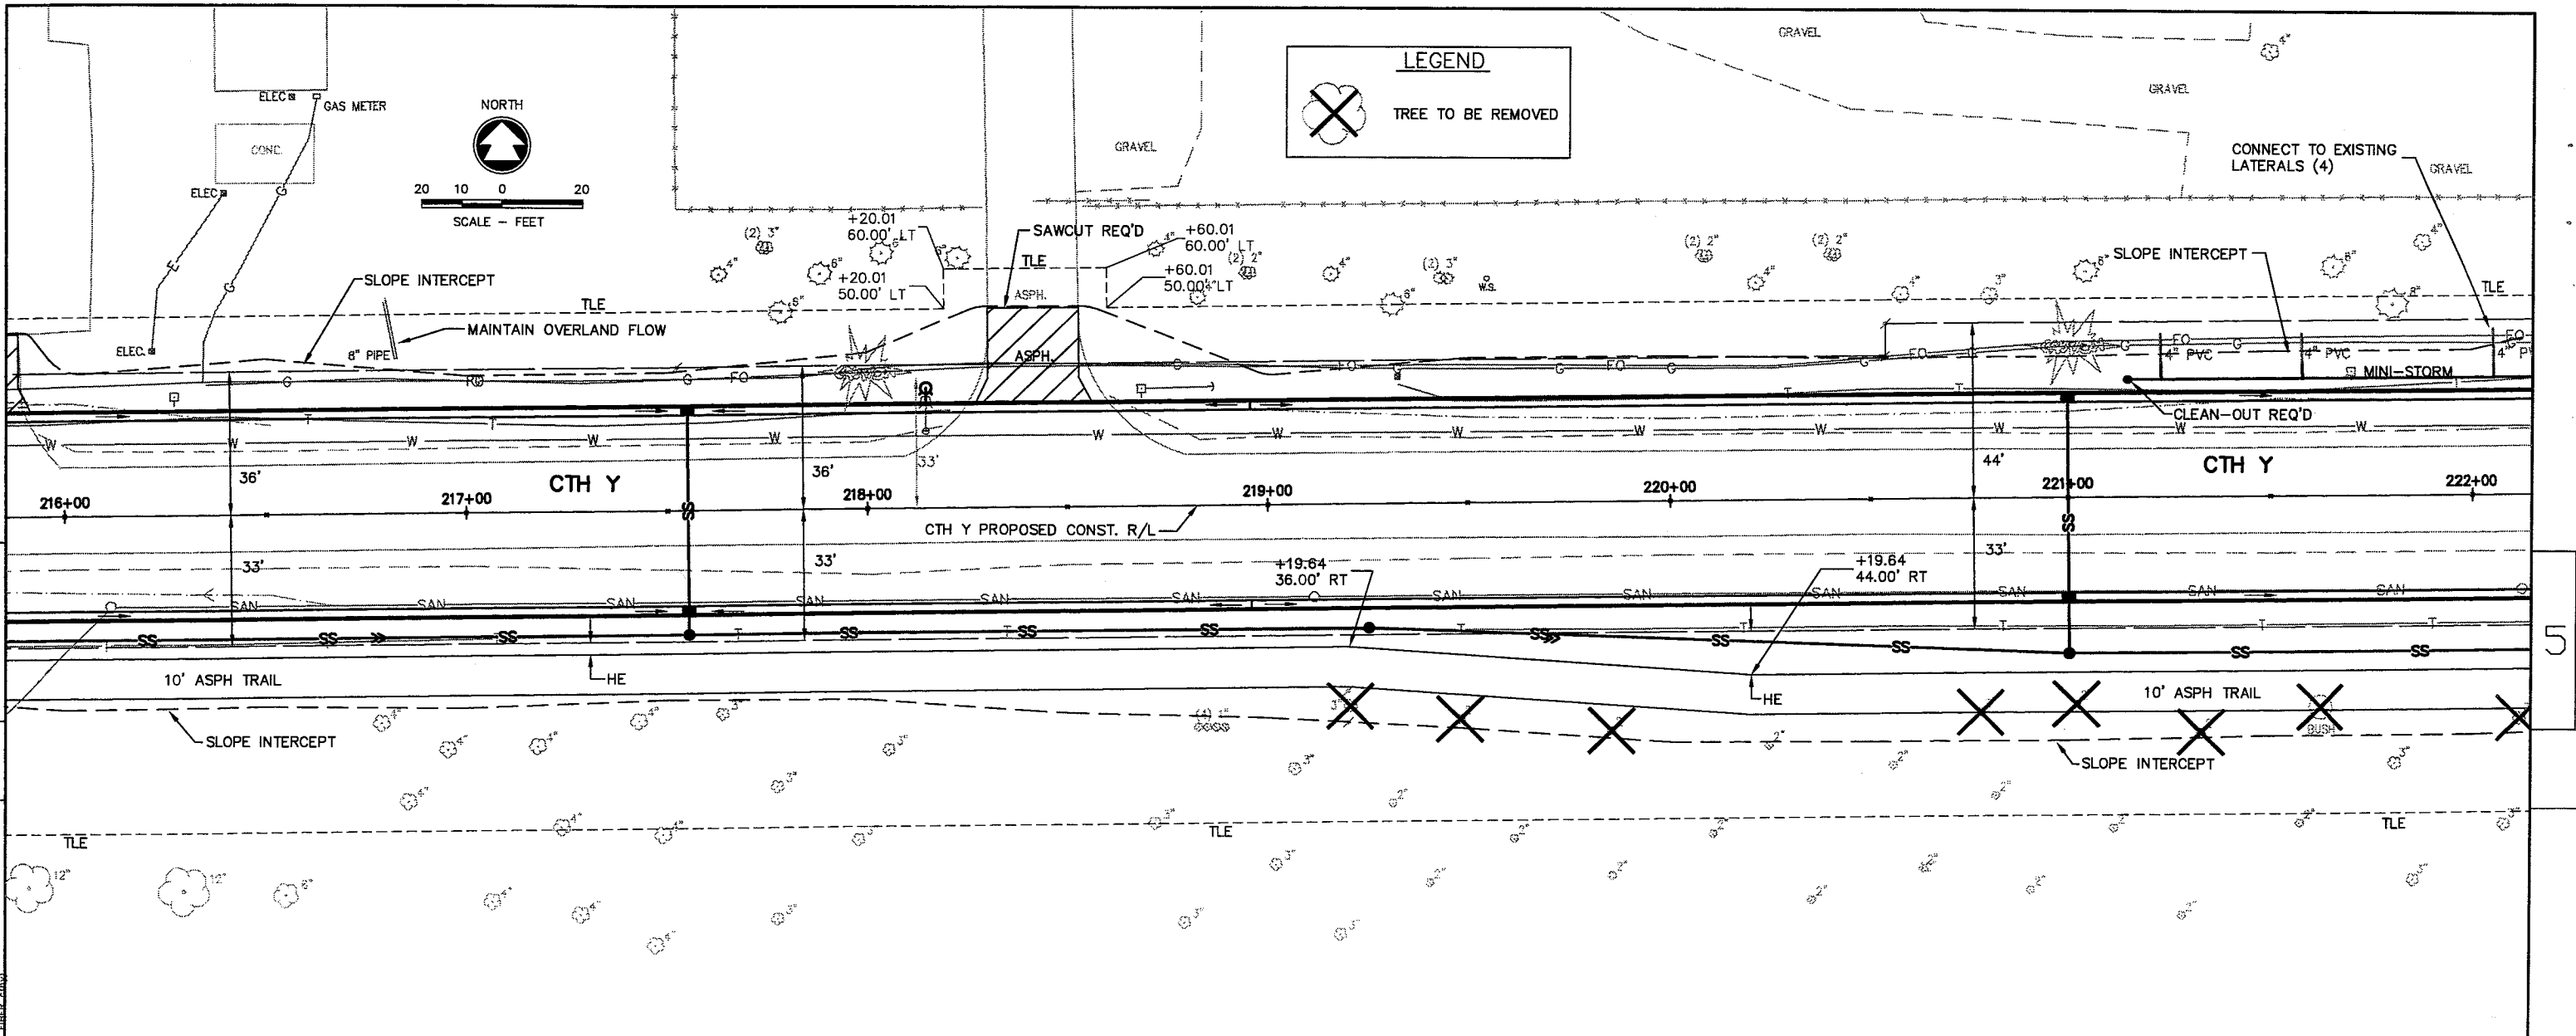


LEGEND

TREE TO BE REMOVED

NORTH


SCALE - FEET

20 10 0 20

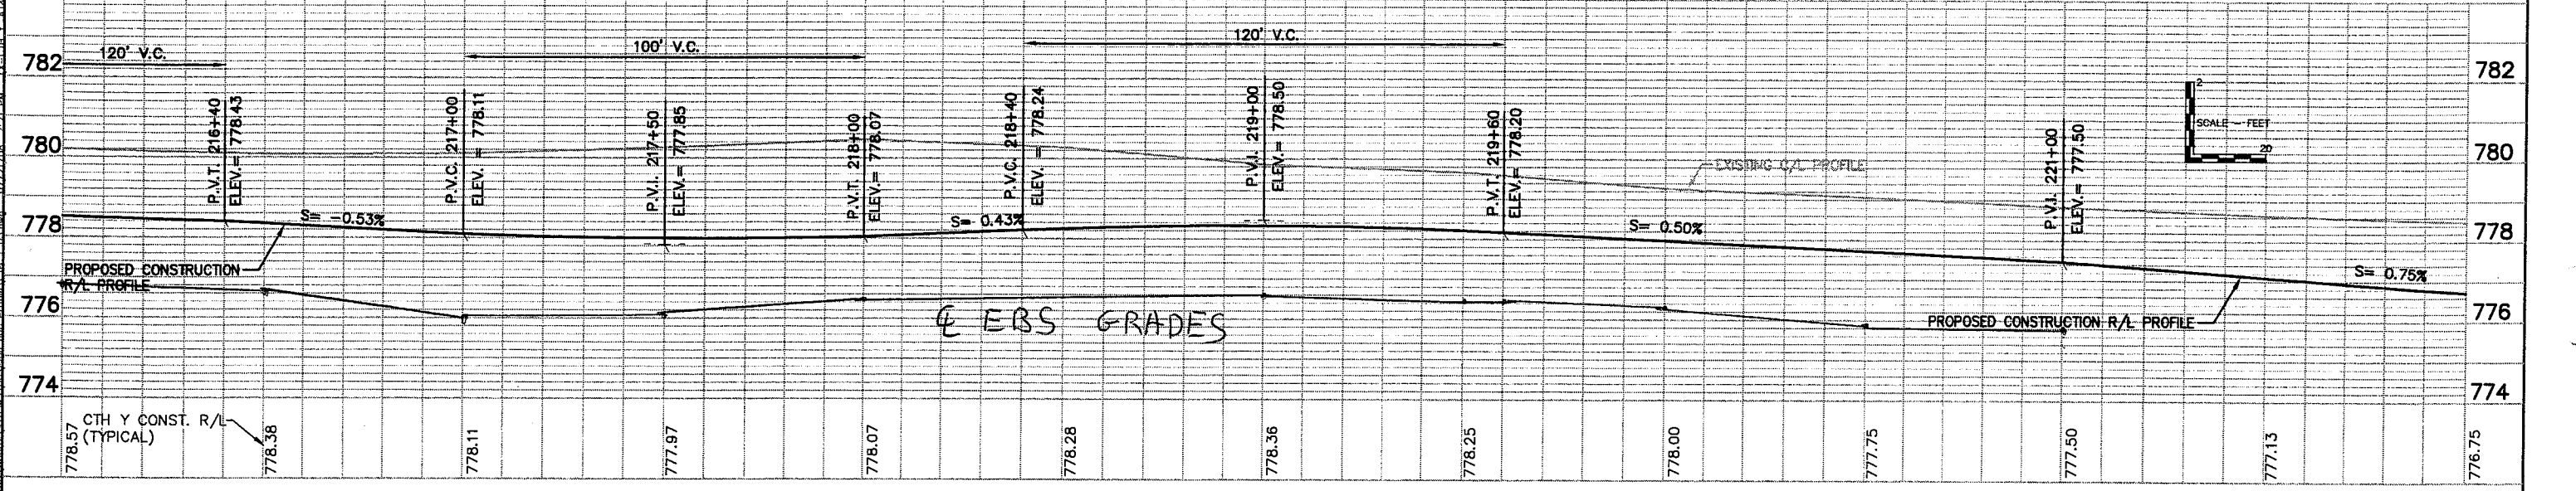


STATE PROJECT NUMBER: 4994-00-87	HWY: CTH Y	COUNTY: WINNEBAGO	PLAN AND PROFILE	SHEET NO: 138	E
----------------------------------	------------	-------------------	------------------	---------------	---

p:\mgs\10022\9703\3\00\Plan and Profile\CTH Y 06.dwg 05/22/08 11:41 AM (X-CTH Y FINAL ROW-COMPS DEW)

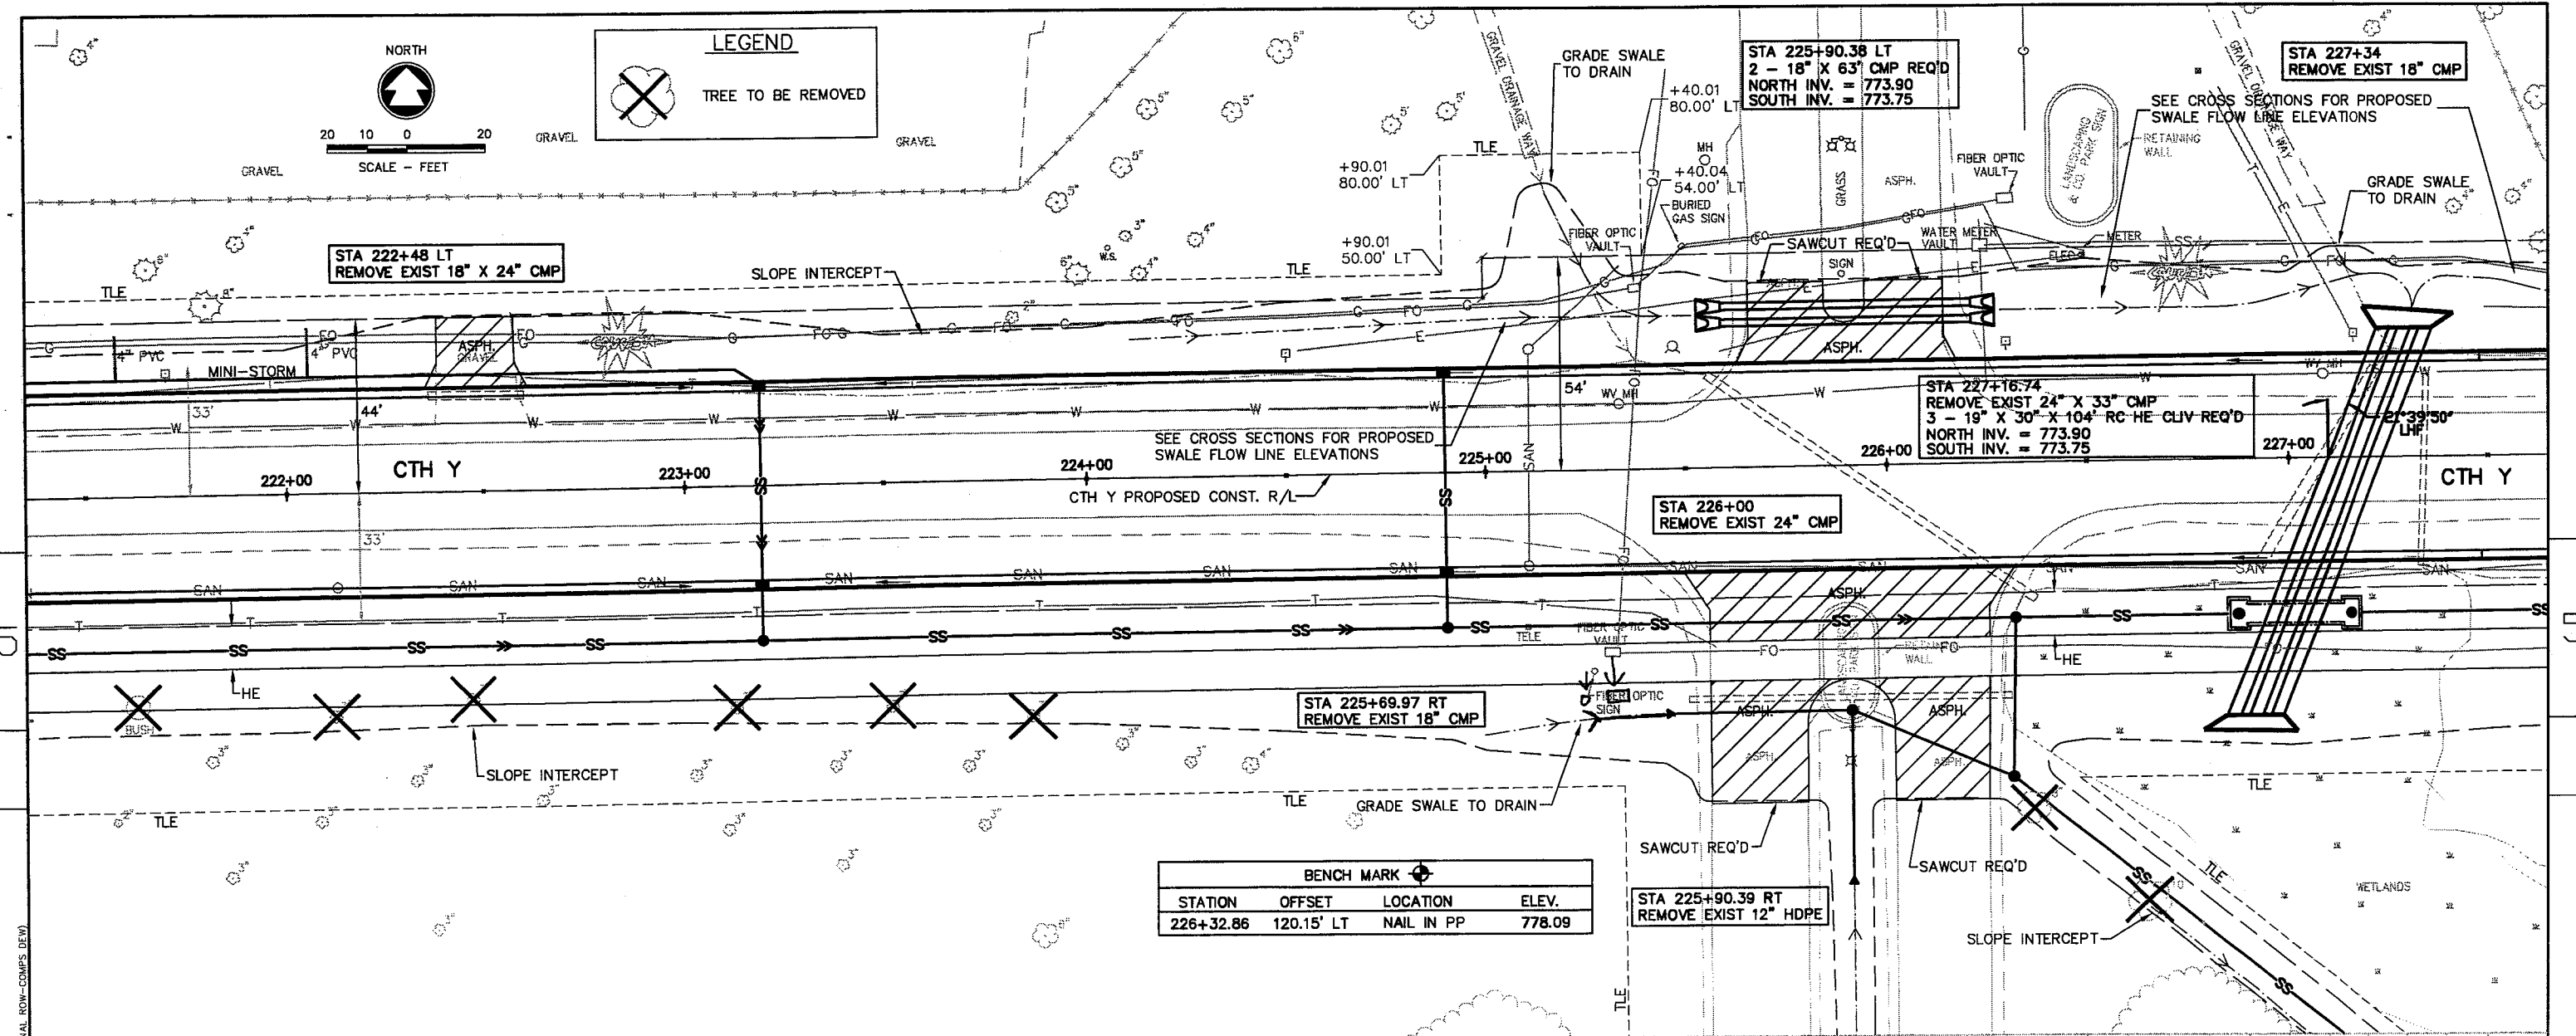


LEGEND

TREE TO BE REMOVED




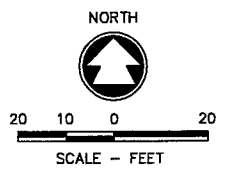


BENCH MARK

STATION	OFFSET	LOCATION	ELEV.
226+32.86	120.15' LT	NAIL IN PP	778.09

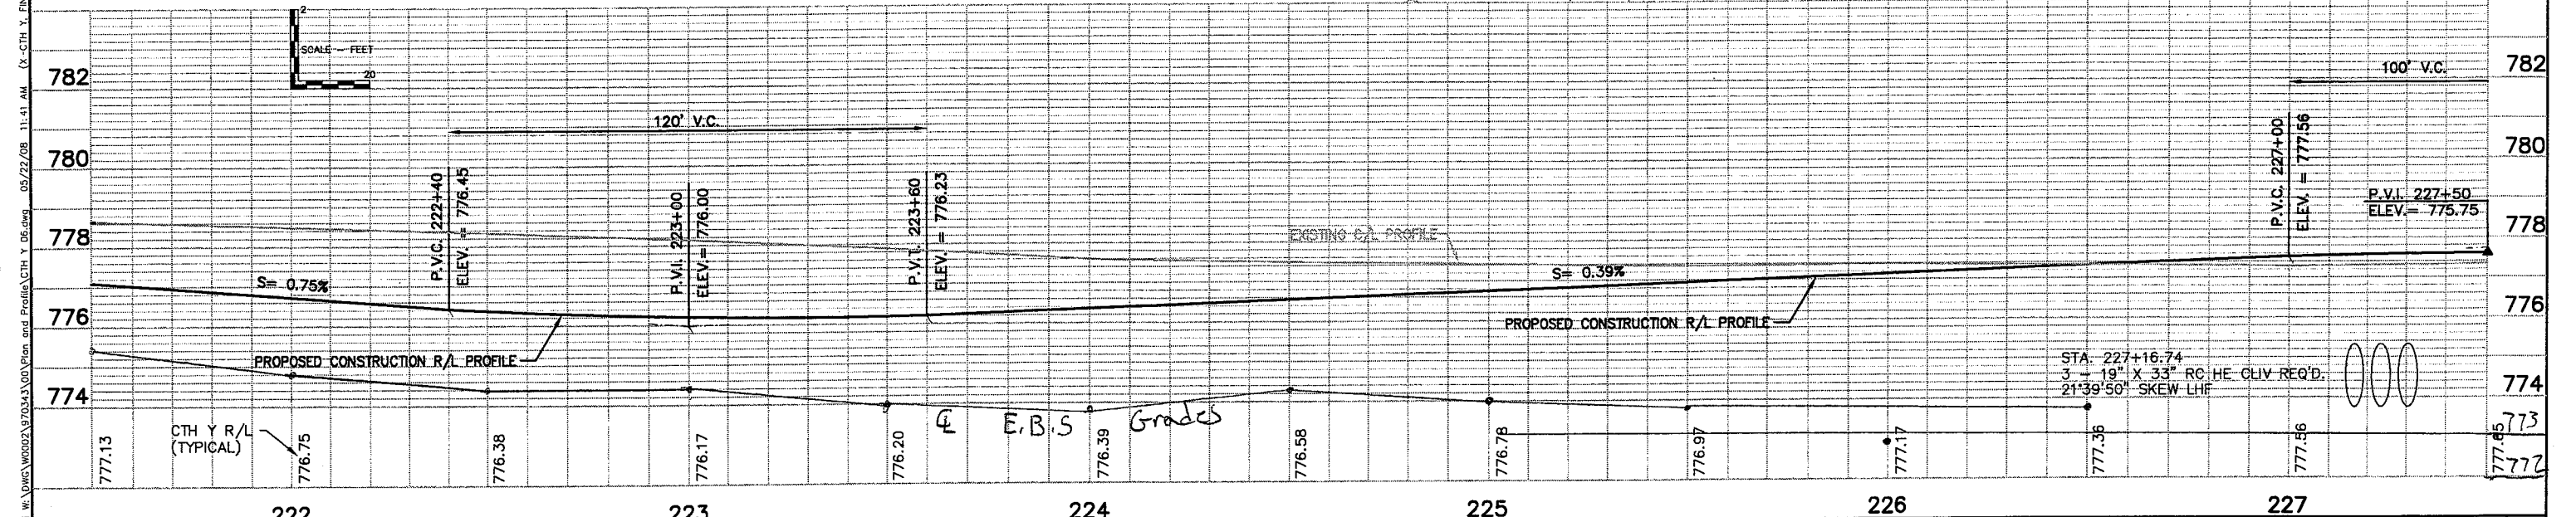


STA 227+16.74
 REMOVE EXIST 24" X 33" CMP
 3 - 19" X 30" X 104' RCCP REQ'D
 NORTH INV. = 773.90
 SOUTH INV. = 773.75

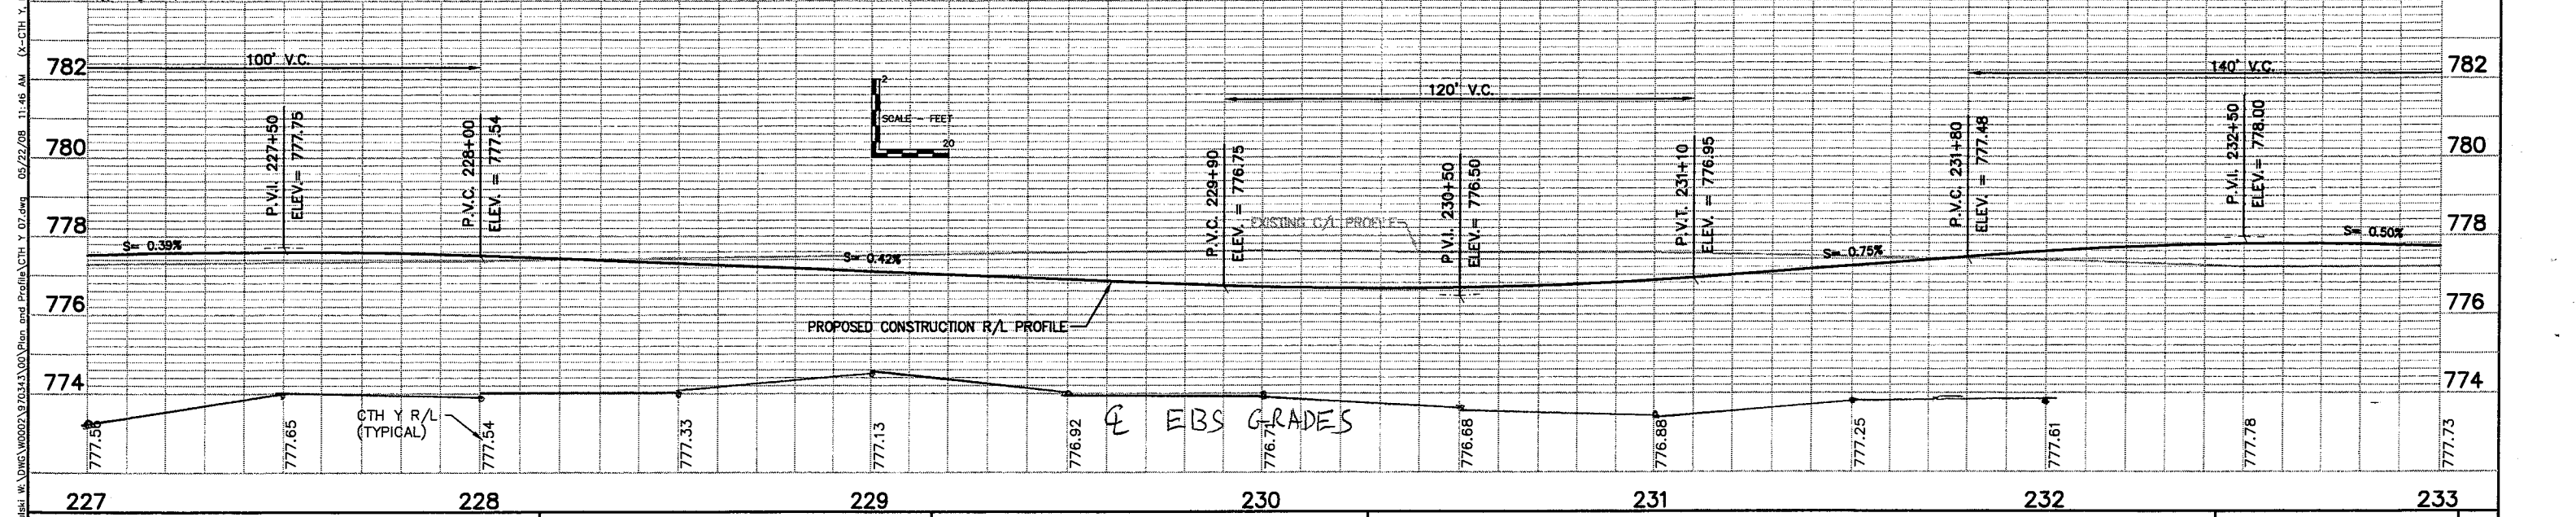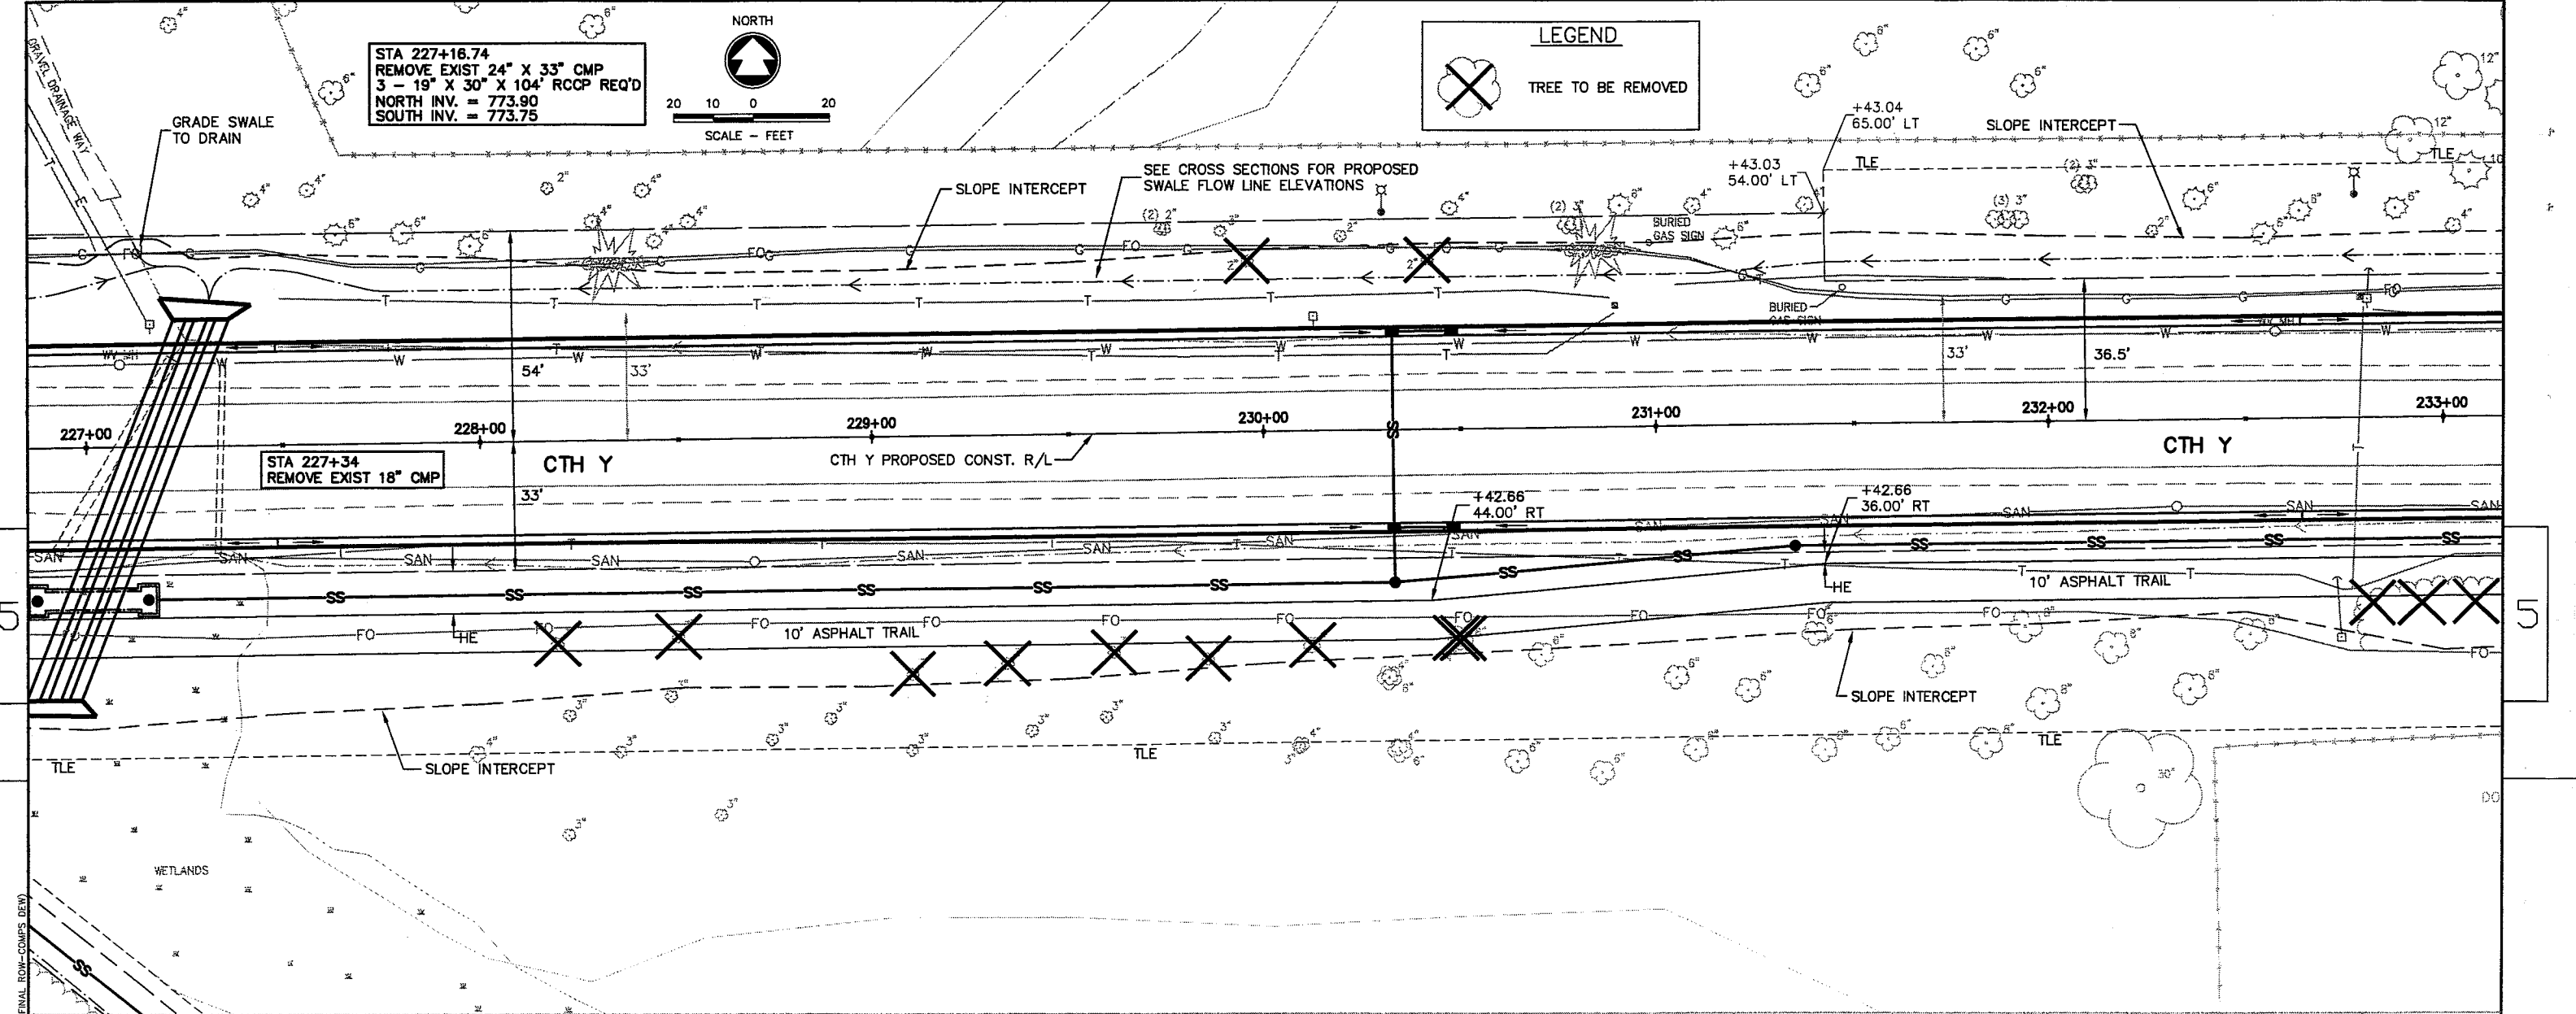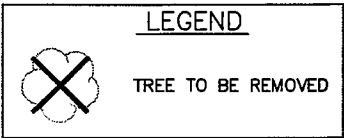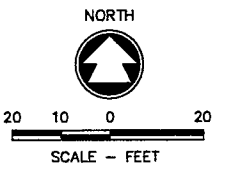

05/22/08 11:46 AM (X-CTH Y_FINAL ROW-COMPS DEV)

WSDOT/CADD SHEET 40

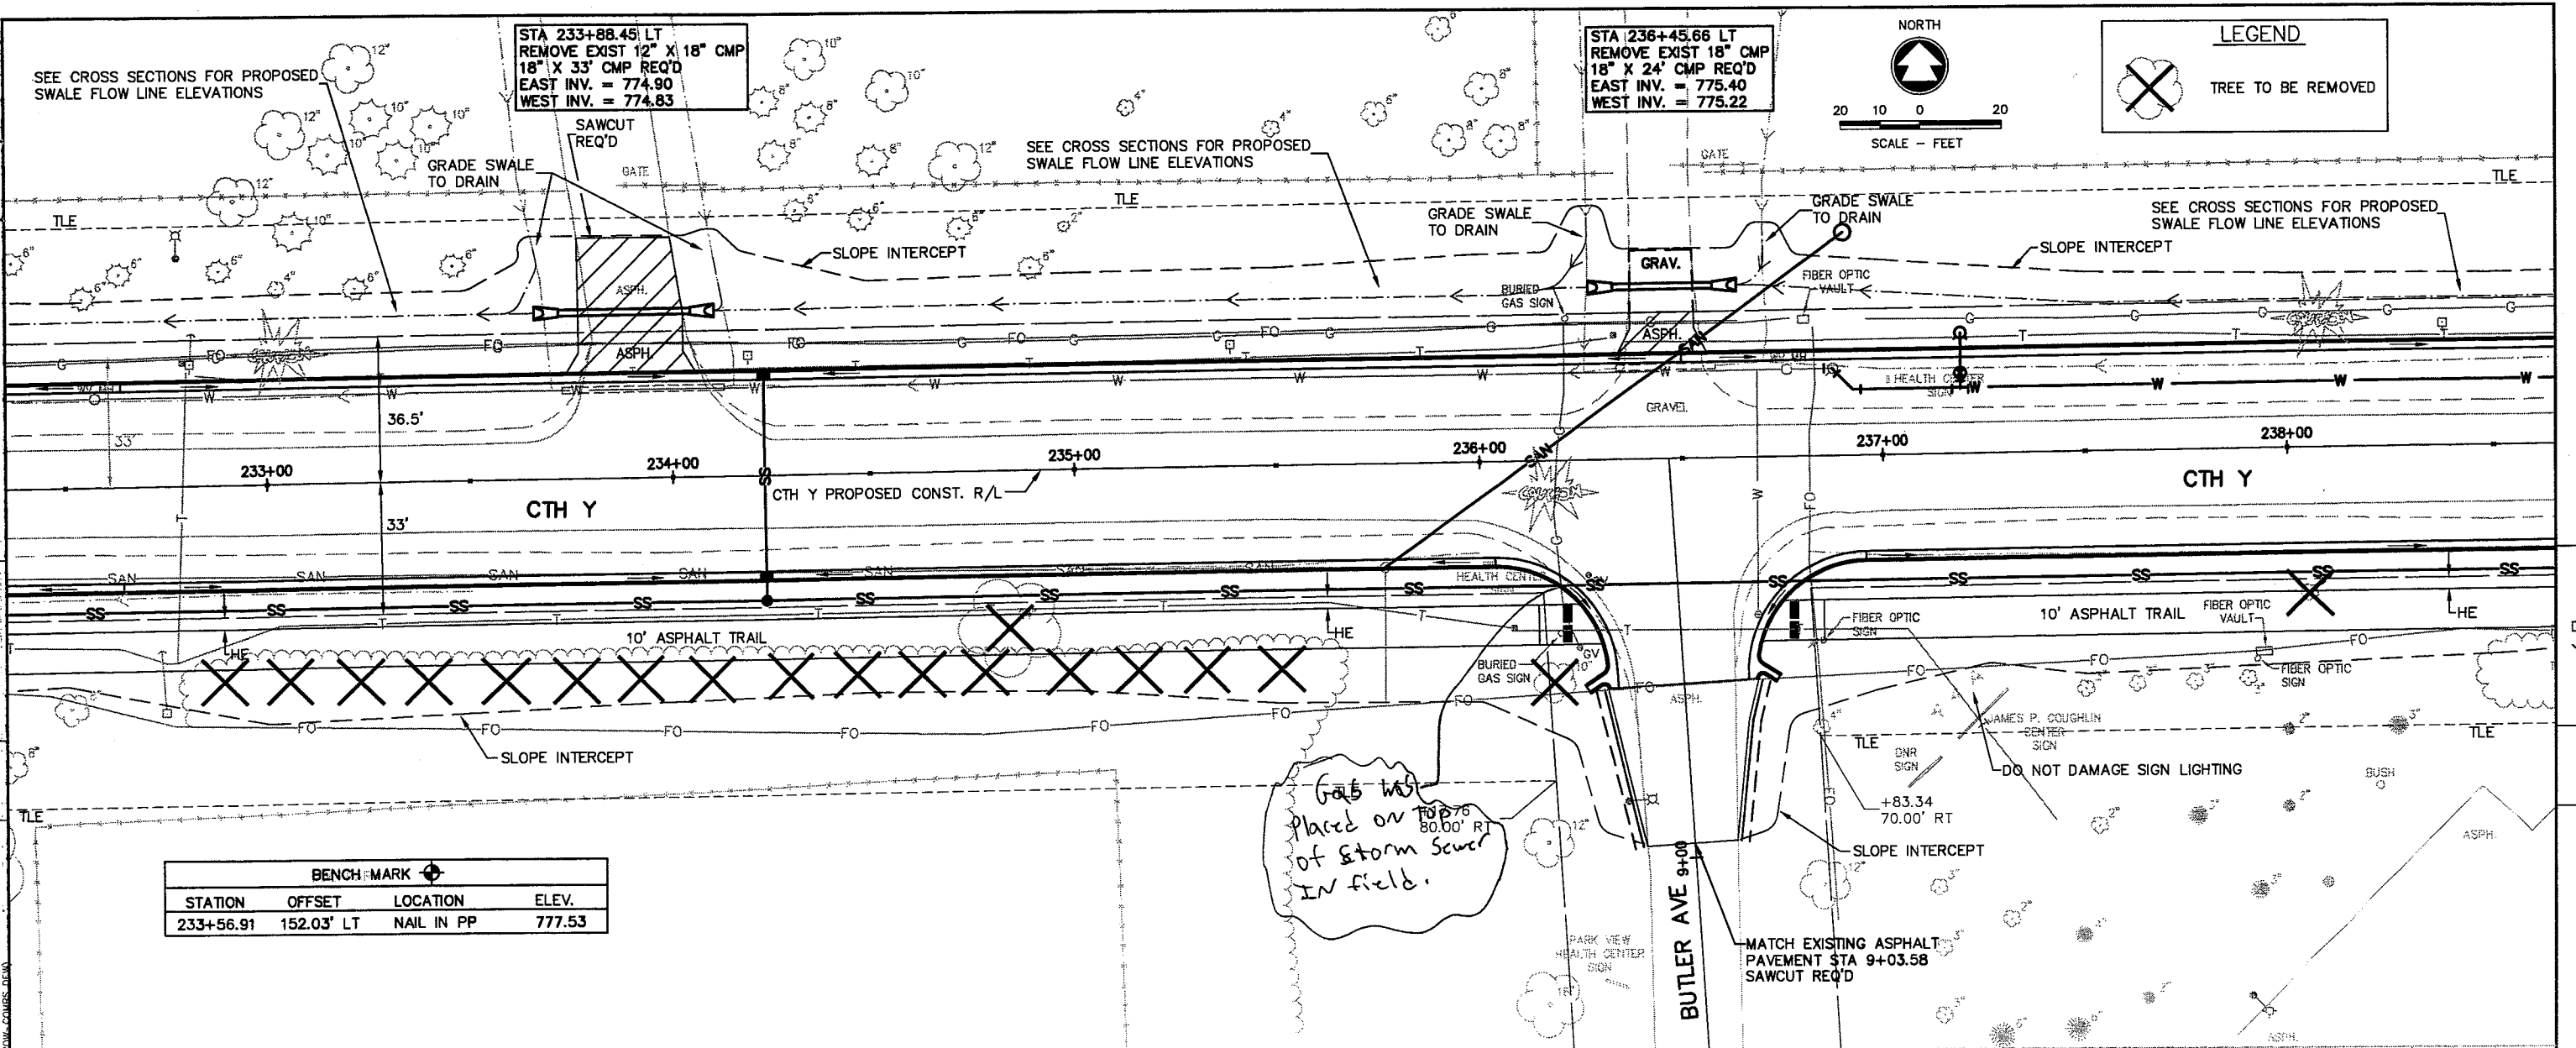

STA 233+88.45 LT
 REMOVE EXIST 12" X 18" CMP
 18" X 33" CMP REQ'D
 EAST INV. = 774.90
 WEST INV. = 774.83

STA 236+45.66 LT
 REMOVE EXIST 18" CMP
 18" X 24" CMP REQ'D
 EAST INV. = 775.40
 WEST INV. = 775.22


LEGEND

TREE TO BE REMOVED

BENCHMARK

STATION	OFFSET	LOCATION	ELEV.
233+56.91	152.03' LT	NAIL IN PP	777.53

Gas was placed on of storm sewer in field.

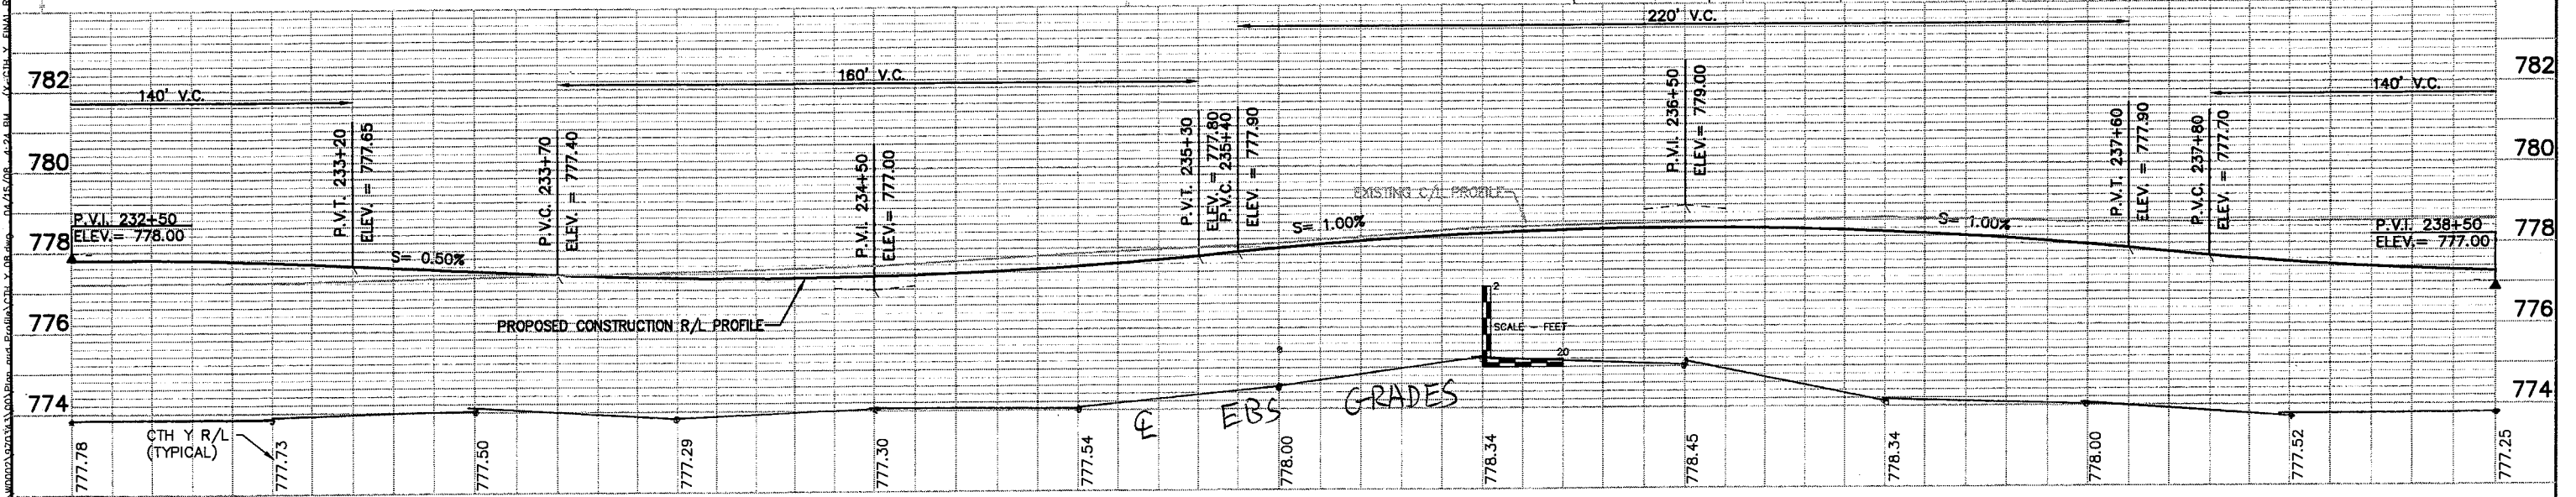


WSDOT/CADD SHEET 40



SCALE - FEET
20 10 0 20


STA 242+26 LT
REMOVE EXIST 15" CMP



STATION	OFFSET	LOCATION	ELEV.
233+56.91	152.03' LT	NAIL IN PP	777.53

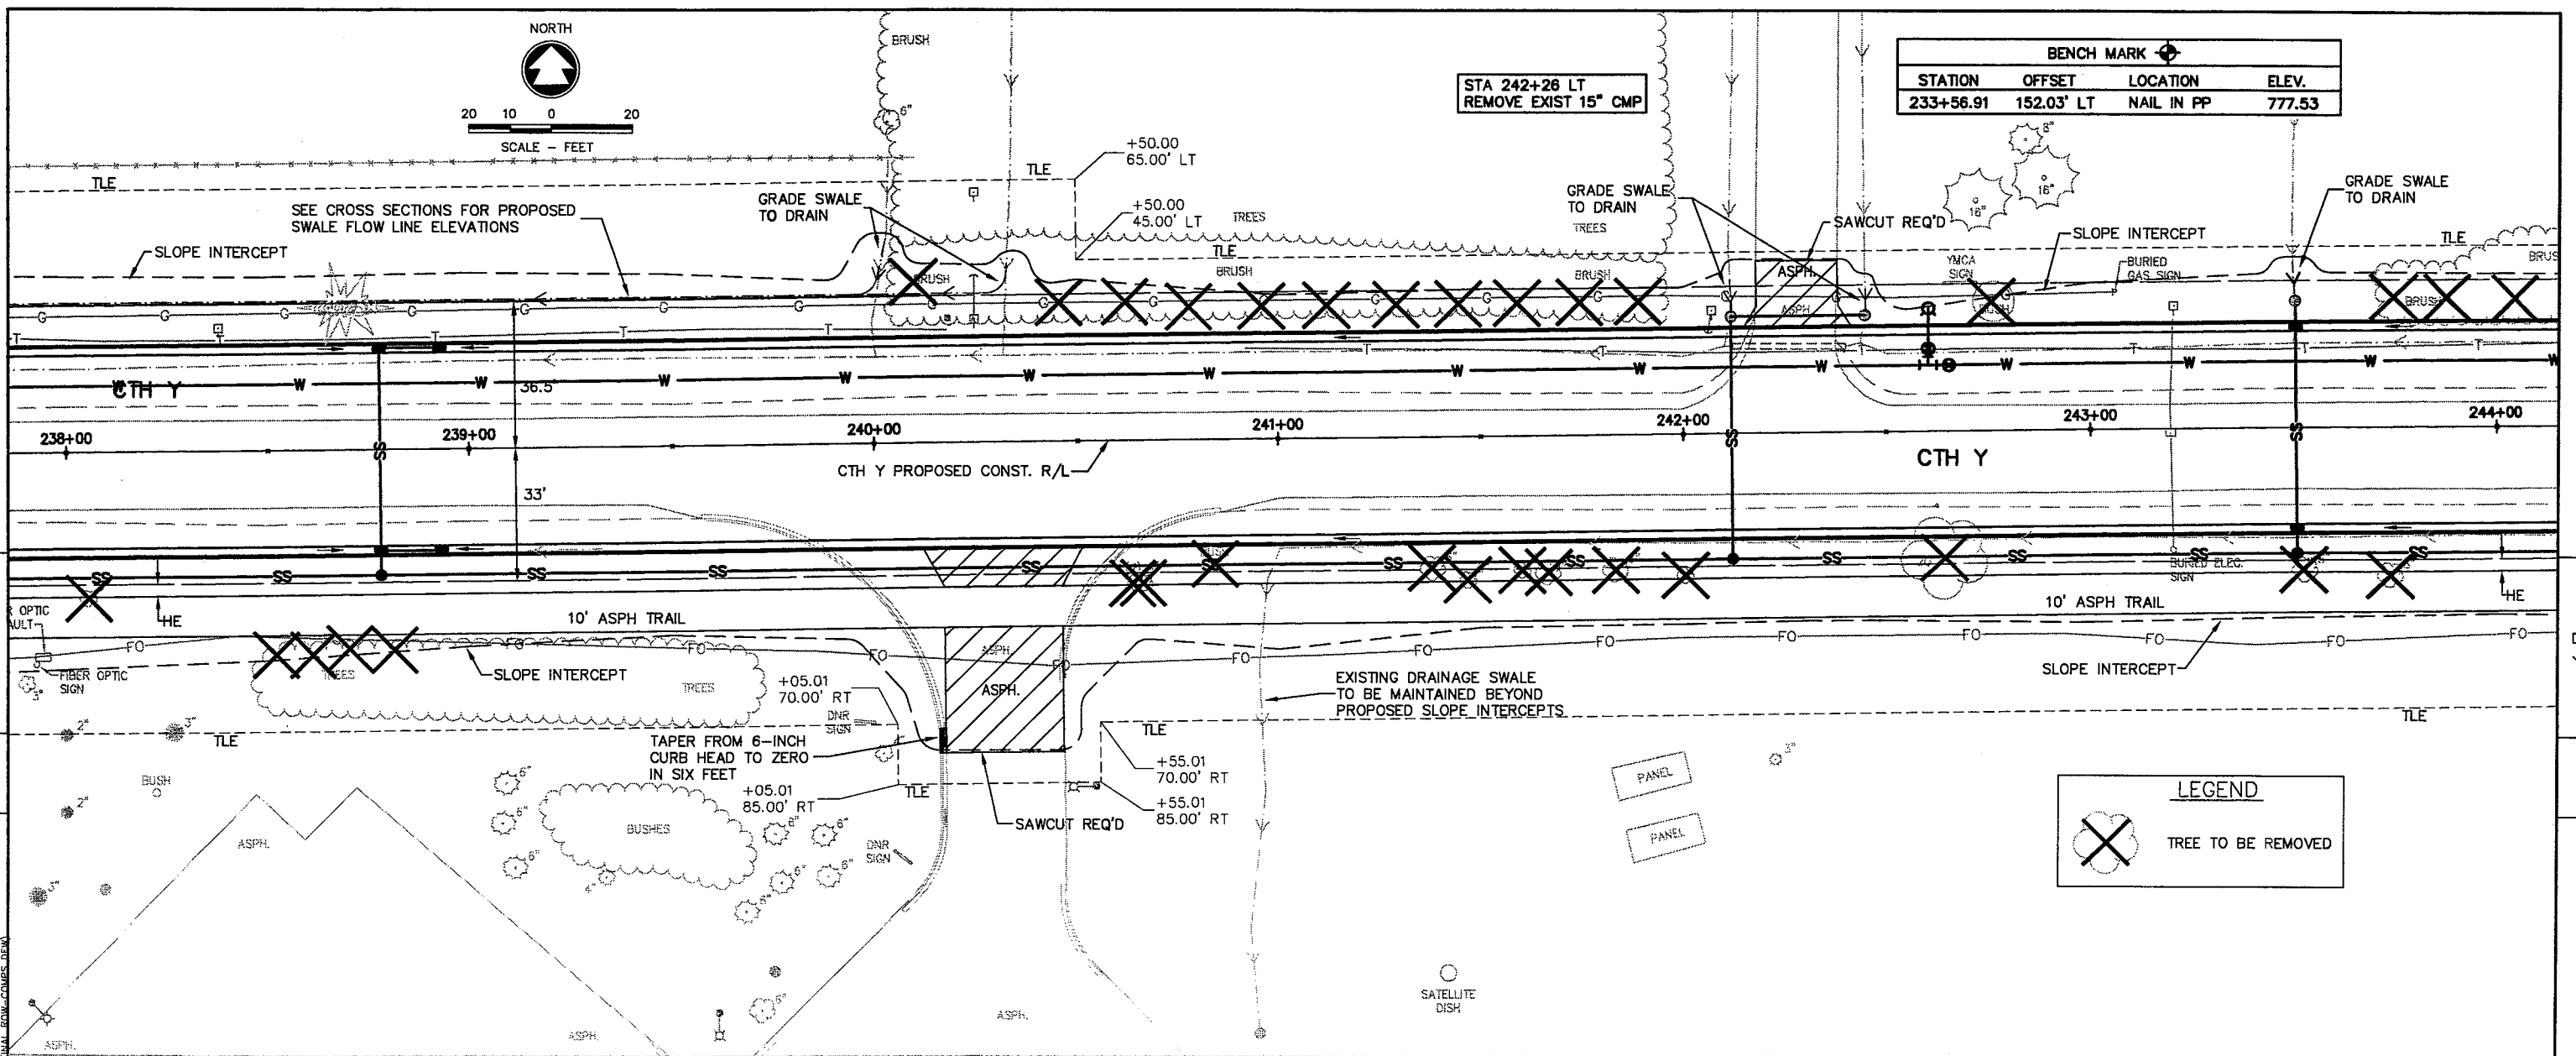

LEGEND


TREE TO BE REMOVED

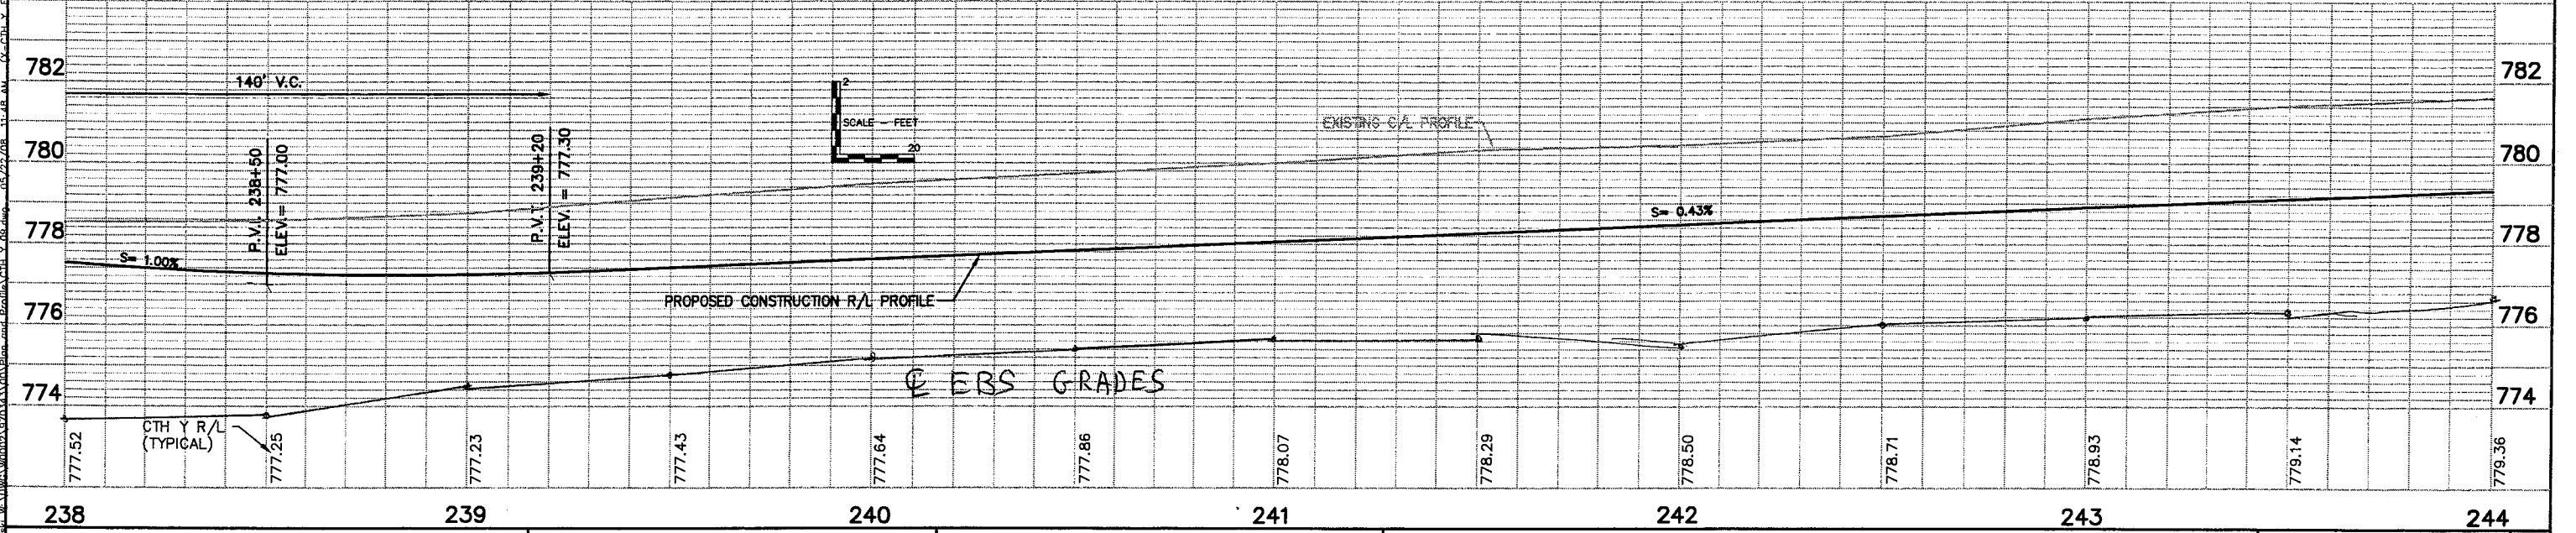

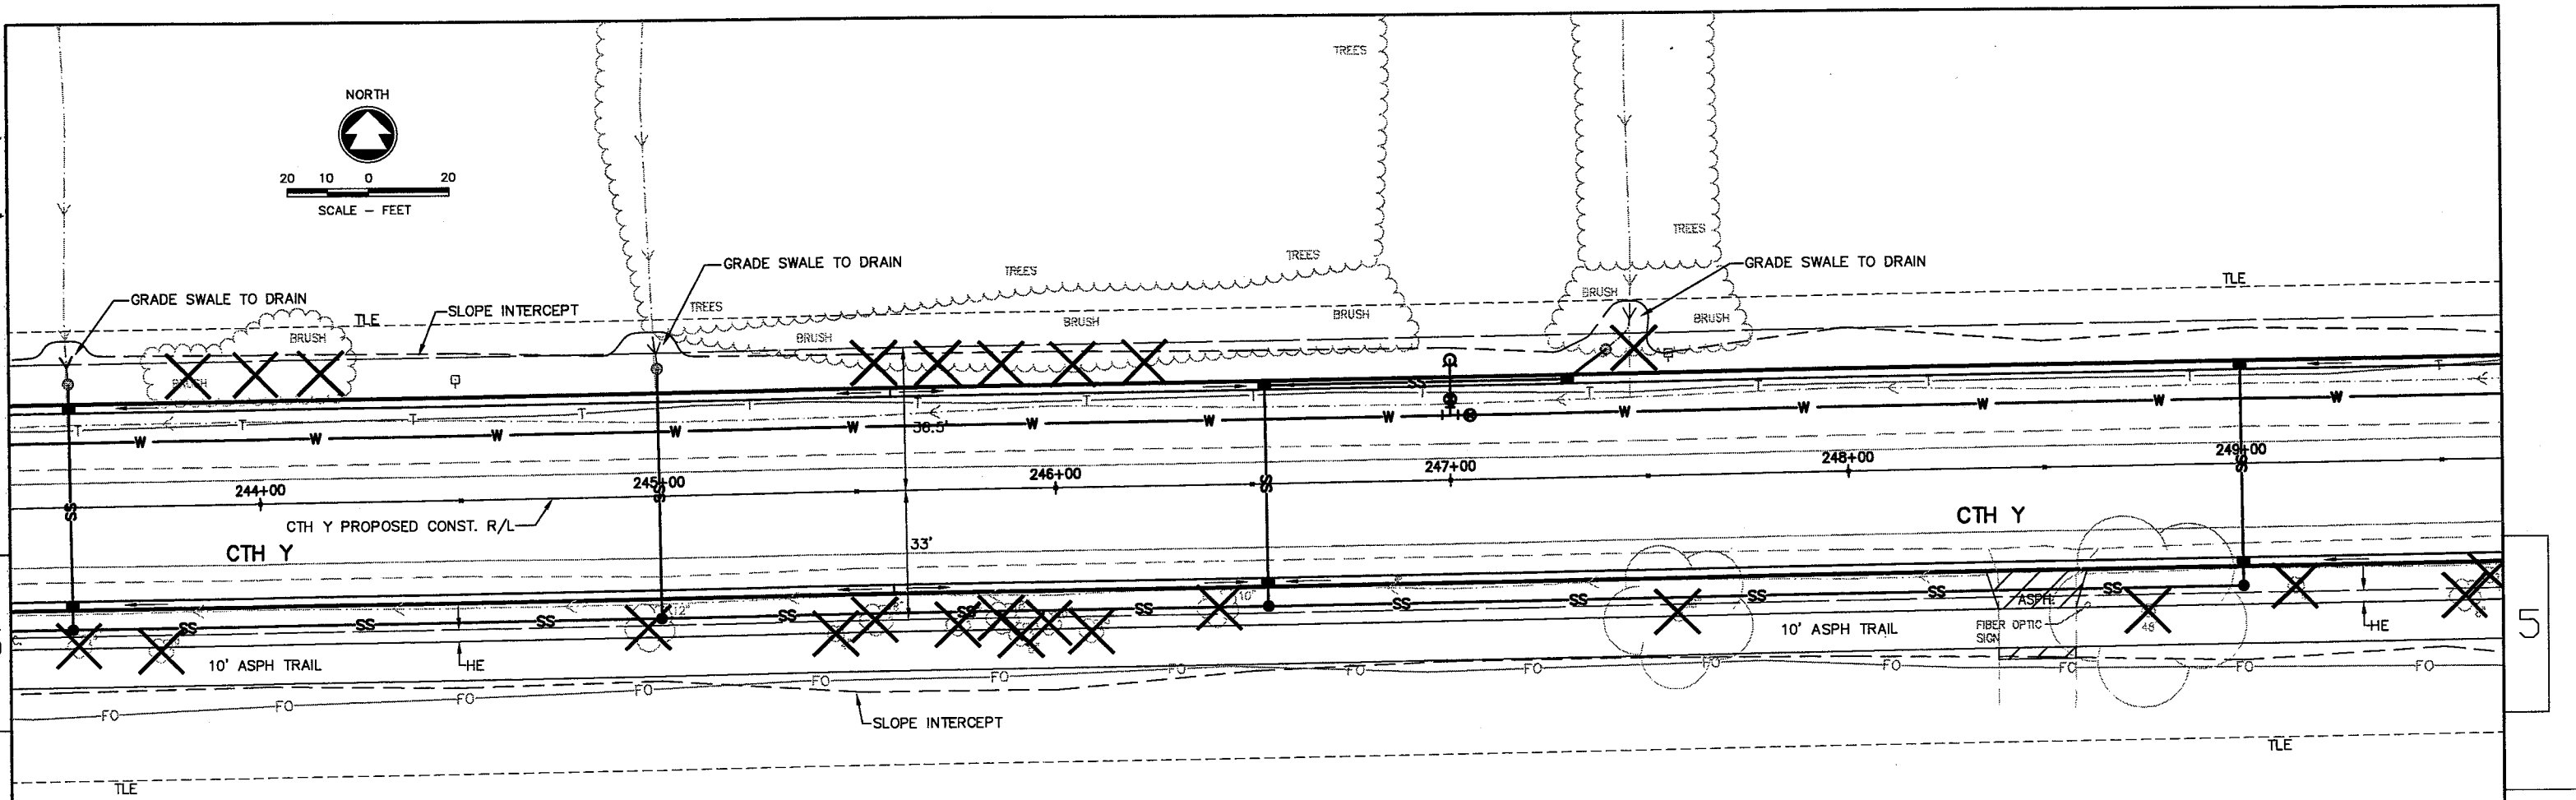
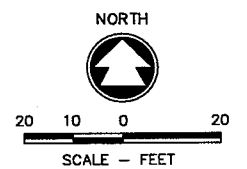


LEGEND

TREE TO BE REMOVED

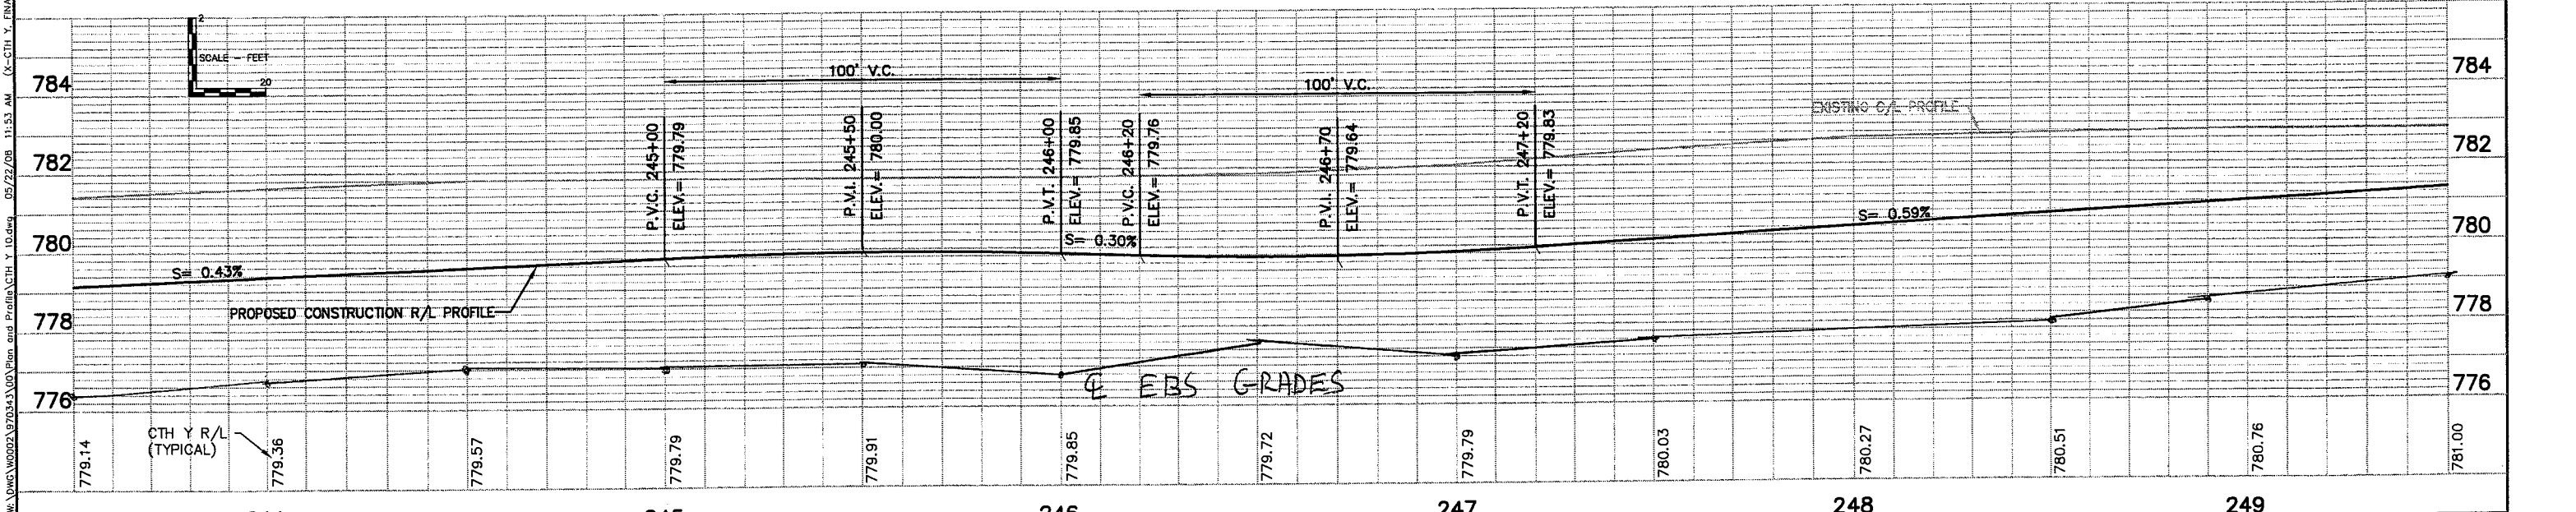


p:\mshaki\w\dmw\0002\9703\31\00\Plan and Profile\CTH Y 10.dwg 05/22/08 11:53 AM (X-CTH Y_FINAL ROW-COMPS.DWG)

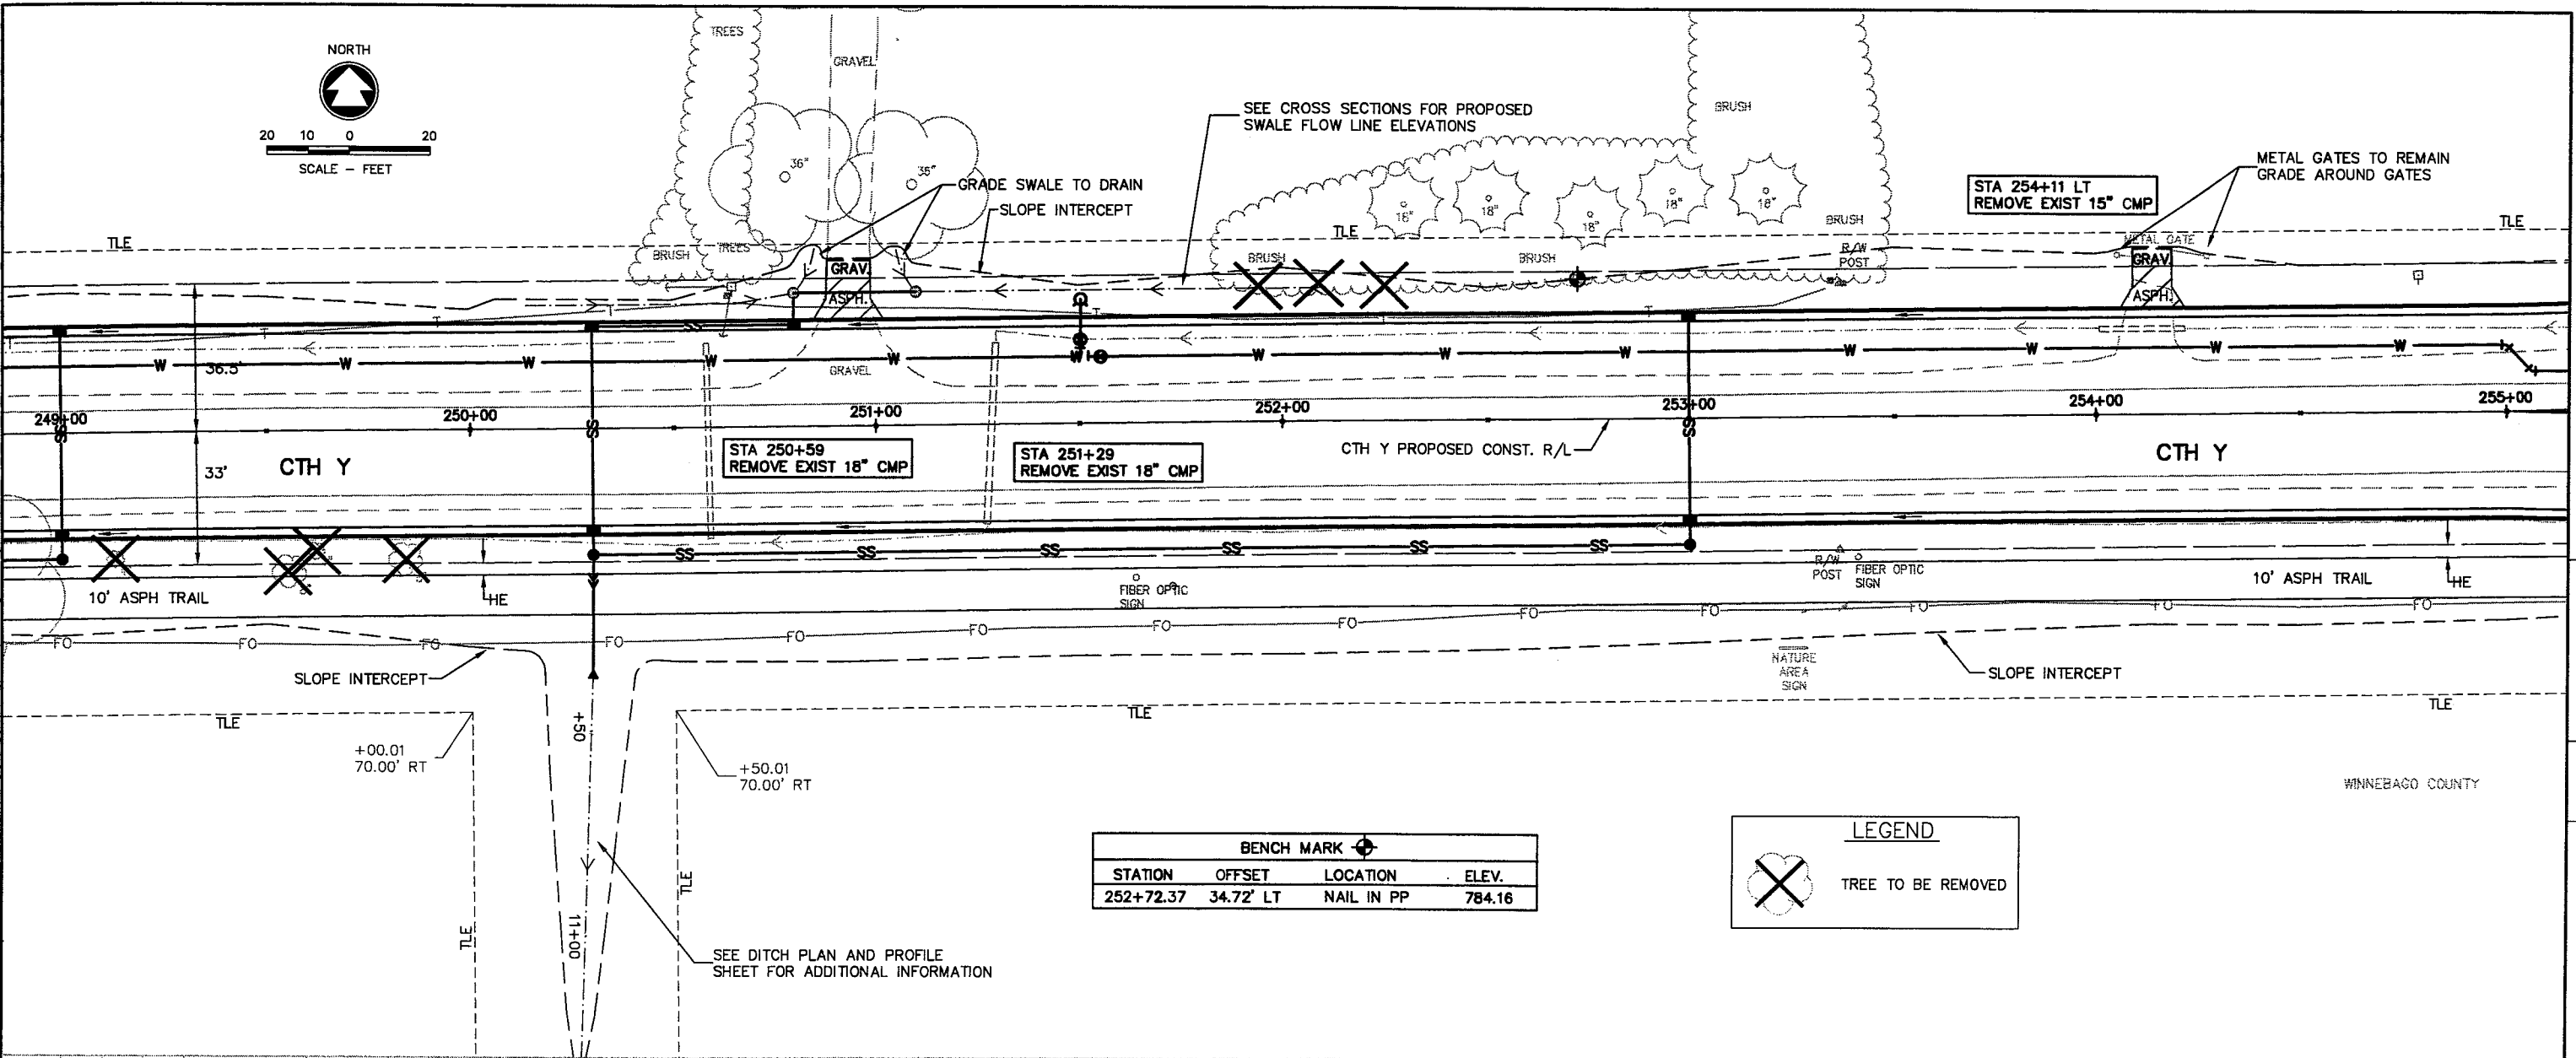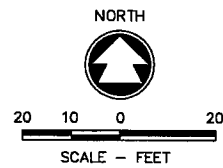

BENCH MARK			
STATION	OFFSET	LOCATION	ELEV.
252+72.37	34.72' LT	NAIL IN PP	784.16

LEGEND

TREE TO BE REMOVED


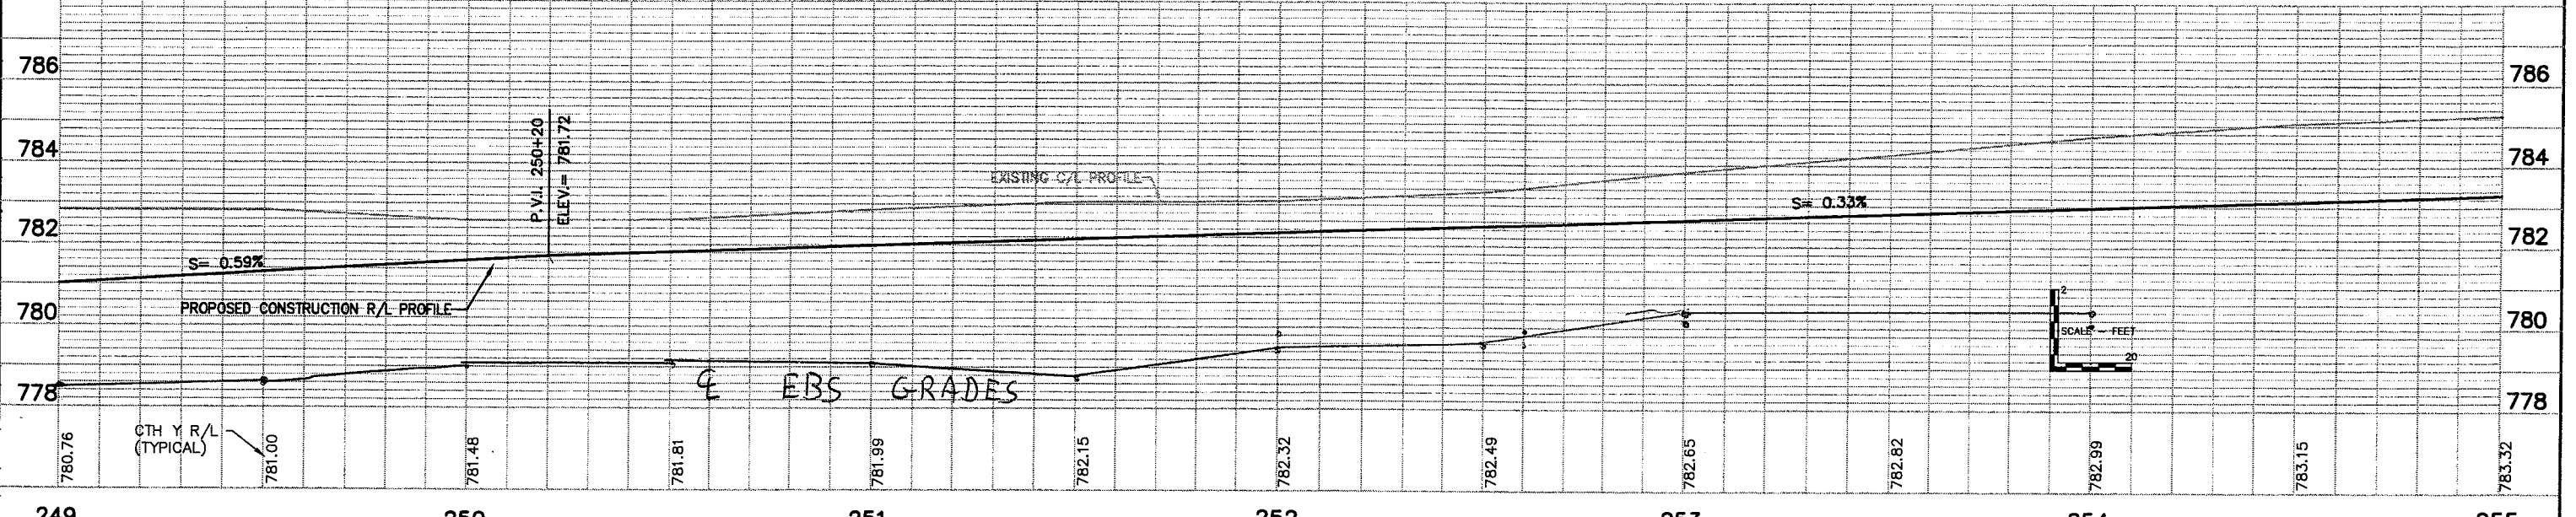


LEGEND

 TREE TO BE REMOVED

STA 256+96.37
 REMOVE EXIST 12" HDPE
 15" X 89" RCCP REQ'D
 NORTH INV. = 781.00
 SOUTH INV. = 780.25

RAILROAD CROSSING TO BE
 CONSTRUCTED BY OTHERS

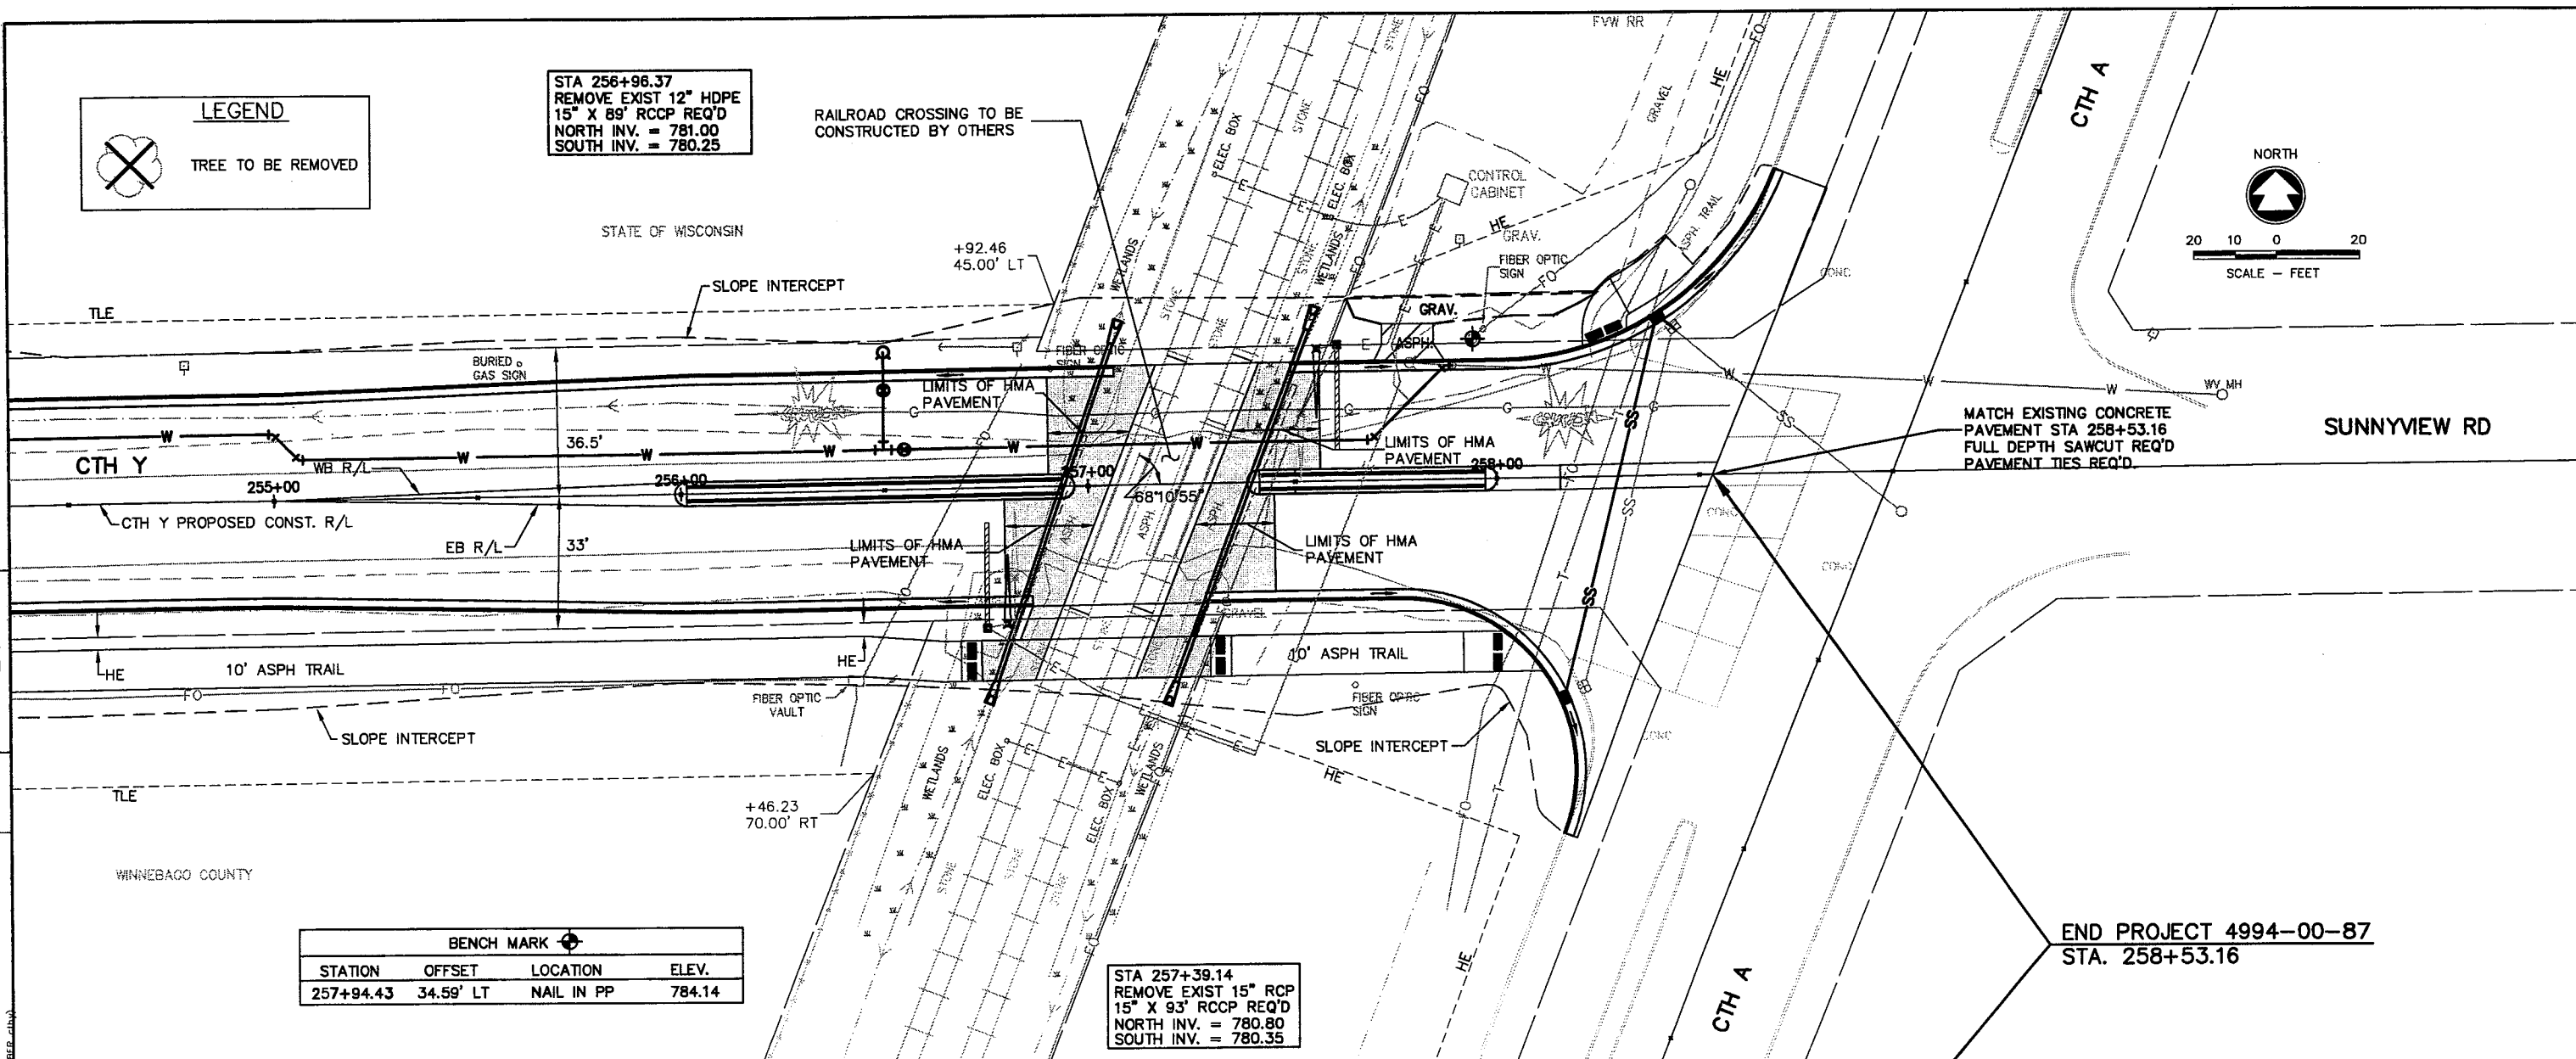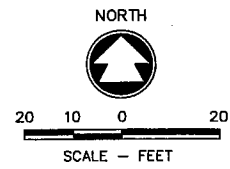


BENCH MARK


STATION	OFFSET	LOCATION	ELEV.
257+94.43	34.59' LT	NAIL IN PP	784.14

STA 257+39.14
 REMOVE EXIST 15" RCP
 15" X 93" RCCP REQ'D
 NORTH INV. = 780.80
 SOUTH INV. = 780.35

END PROJECT 4994-00-87
 STA. 258+53.16


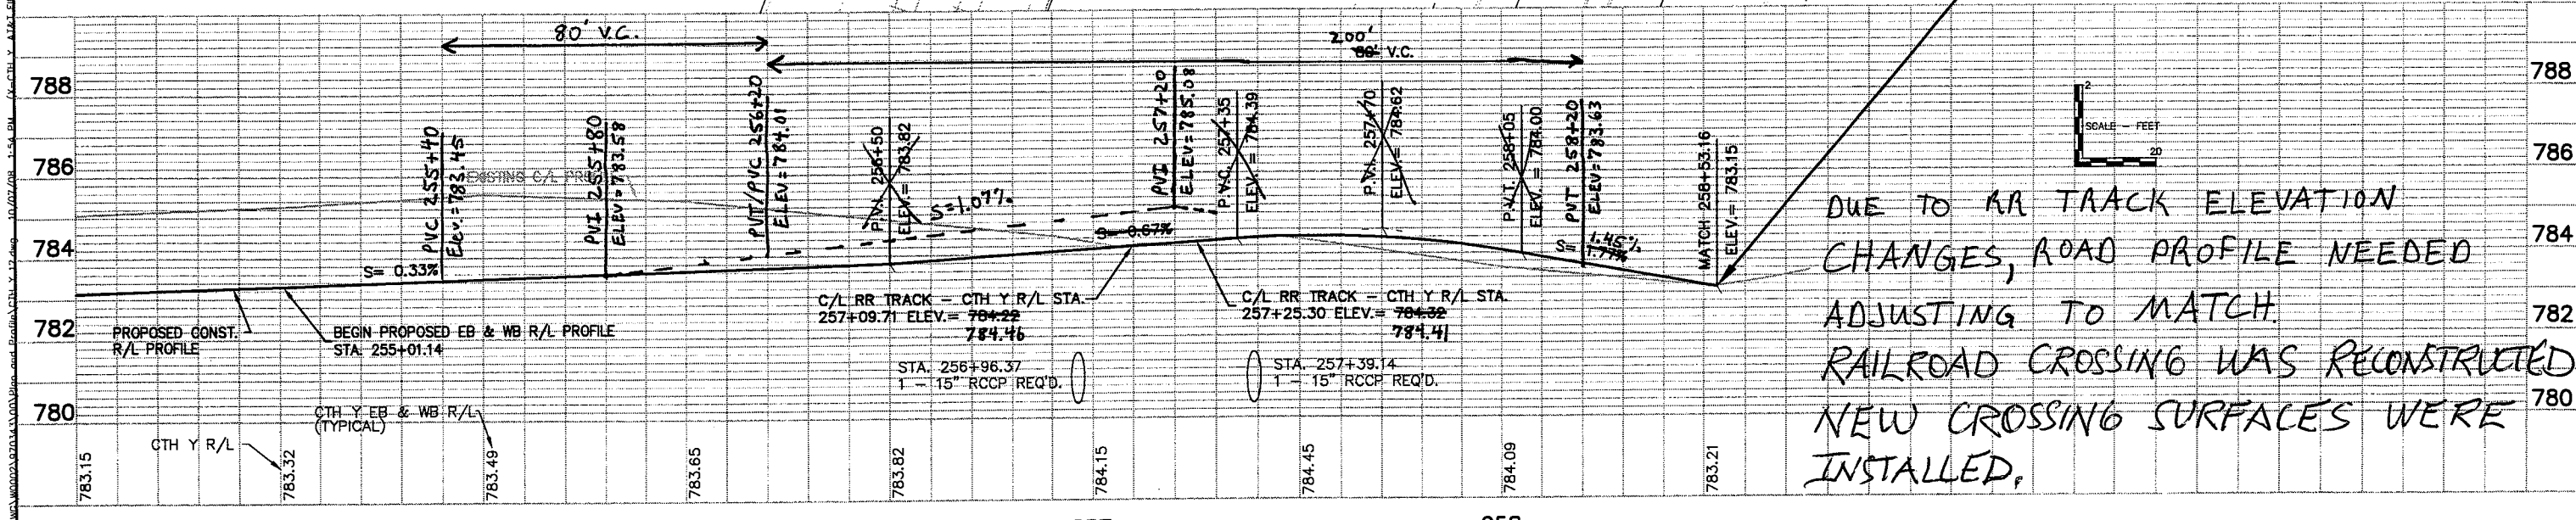


DUE TO RR TRACK ELEVATION
 CHANGES, ROAD PROFILE NEEDED
 ADJUSTING TO MATCH.
 RAILROAD CROSSING WAS RECONSTRUCTED.
 NEW CROSSING SURFACES WERE
 INSTALLED.

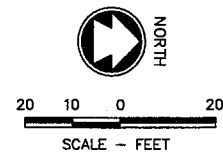


LEGEND

TREE TO BE REMOVED

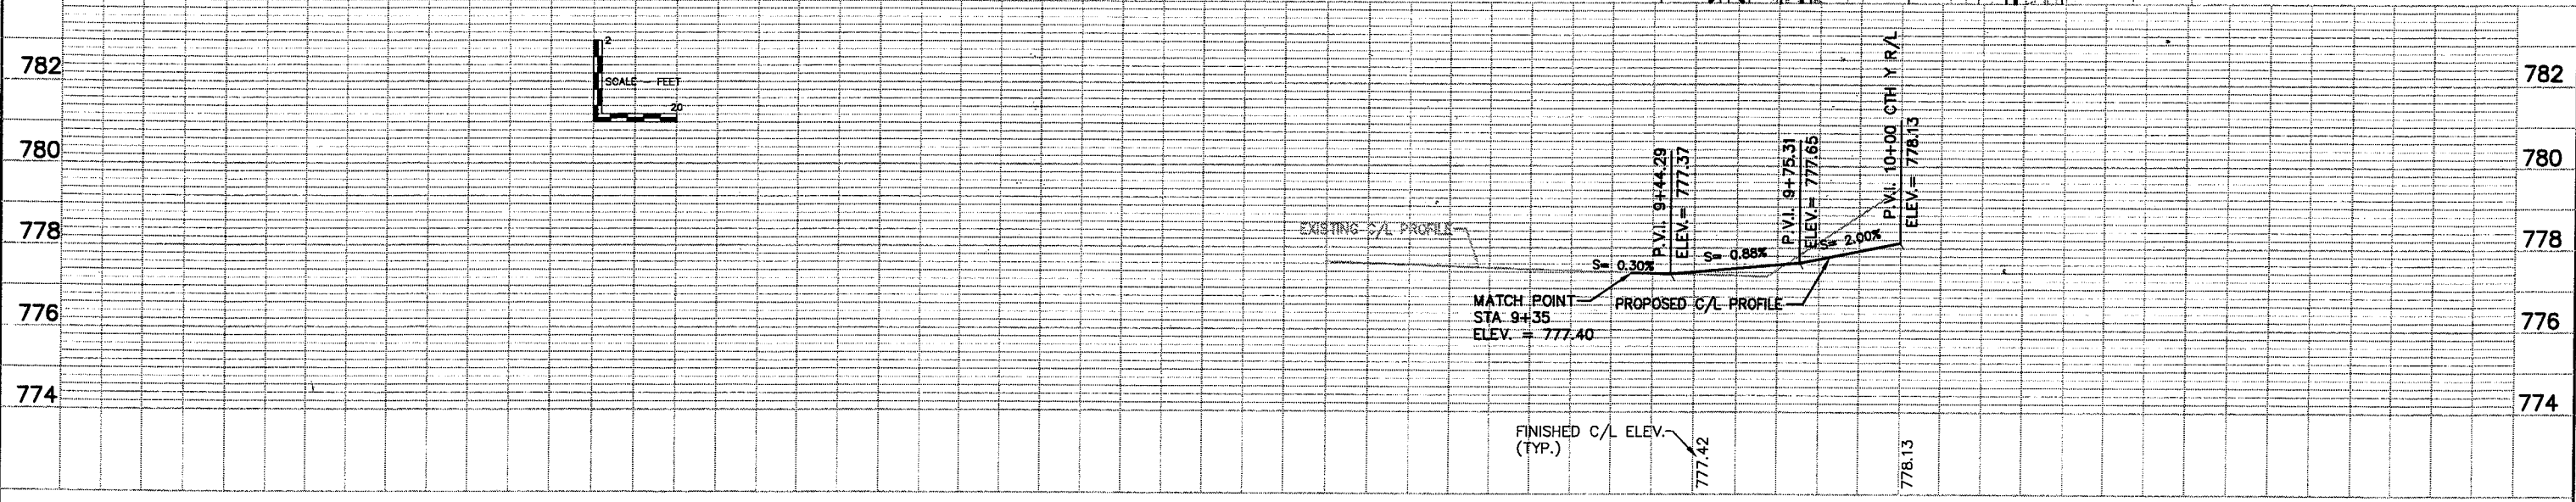
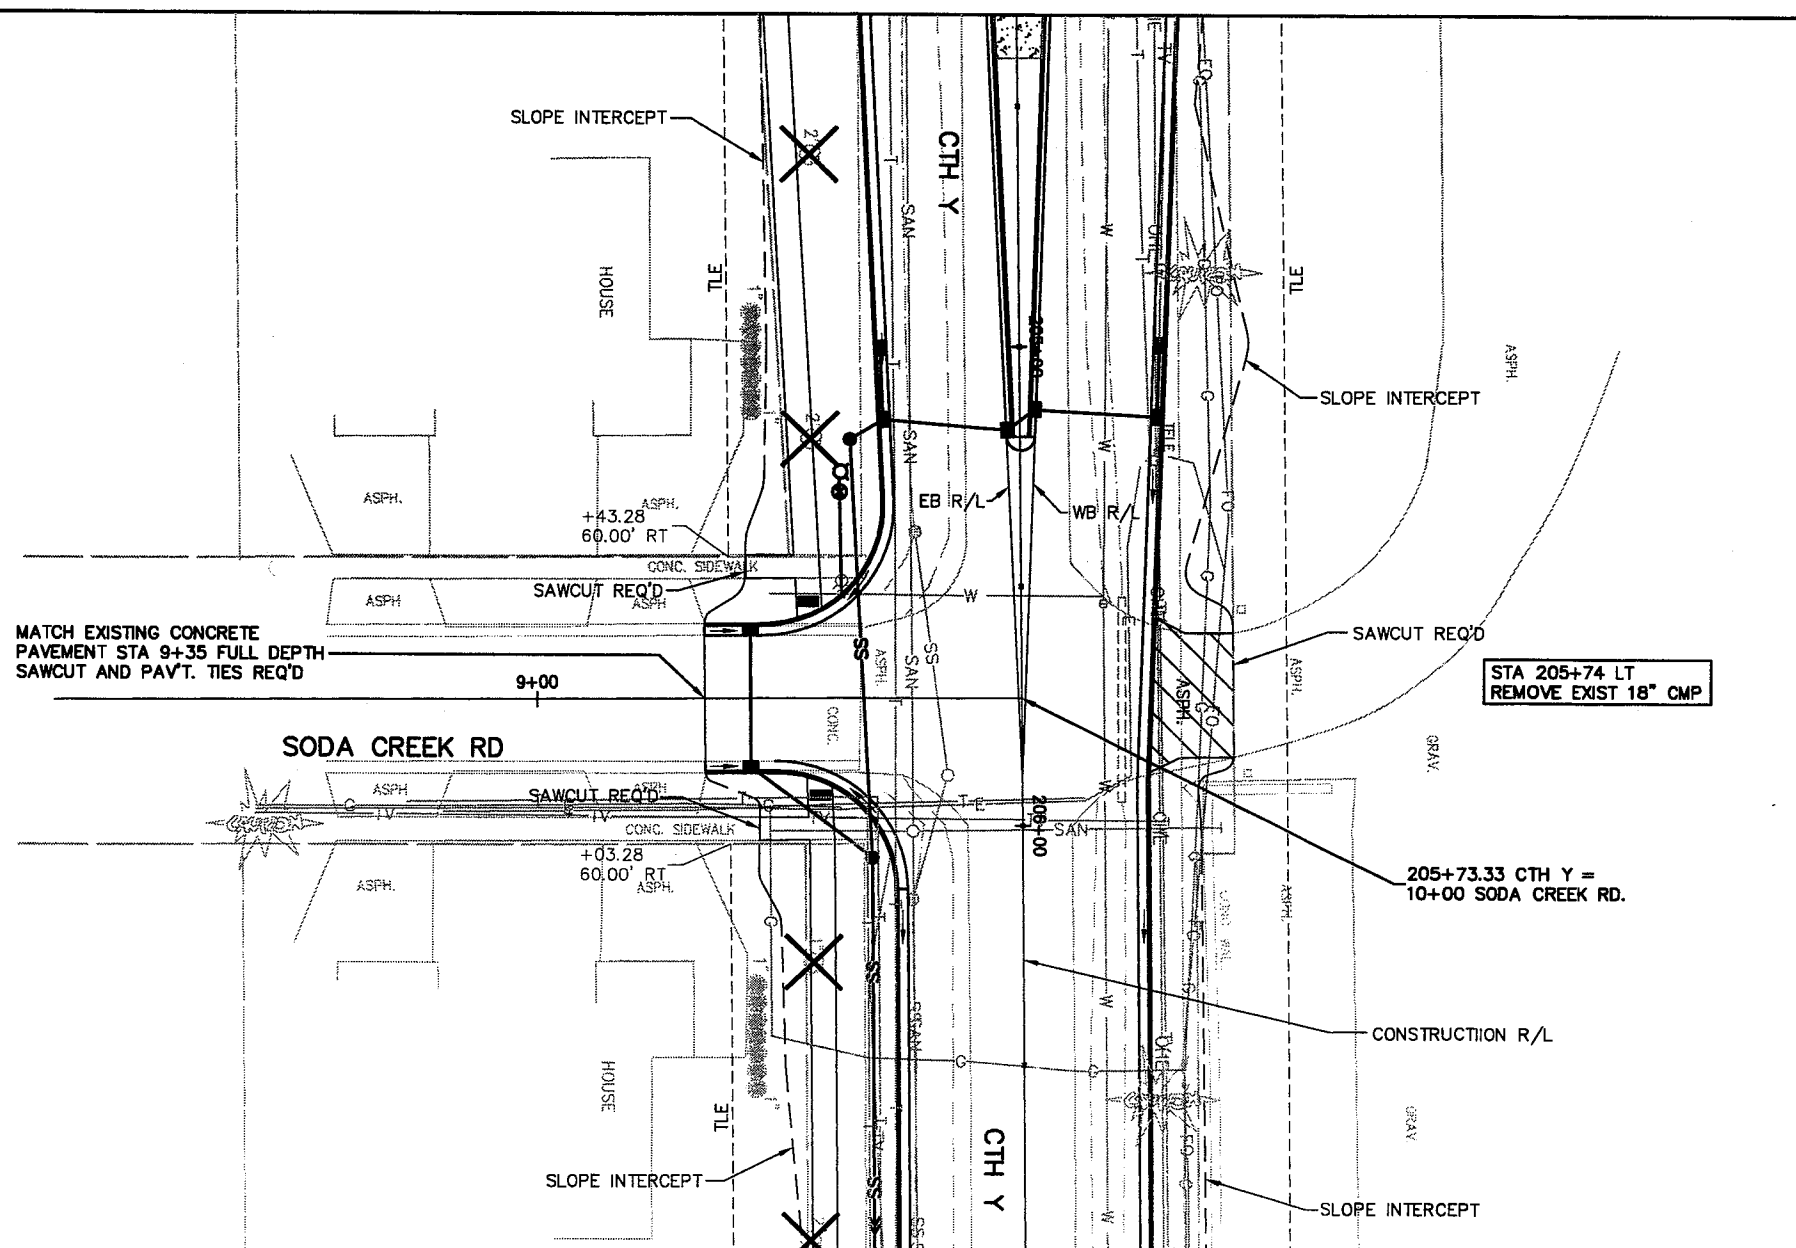


W:\06002\970343\00\Plan and Profile\CTH Y SODA CREEK.dwg 04/22/08 2:19 PM (X-CTH Y FINAL ROW-COMPS DEW)

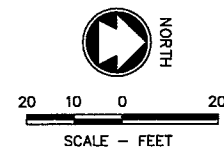

LEGEND

TREE TO BE REMOVED

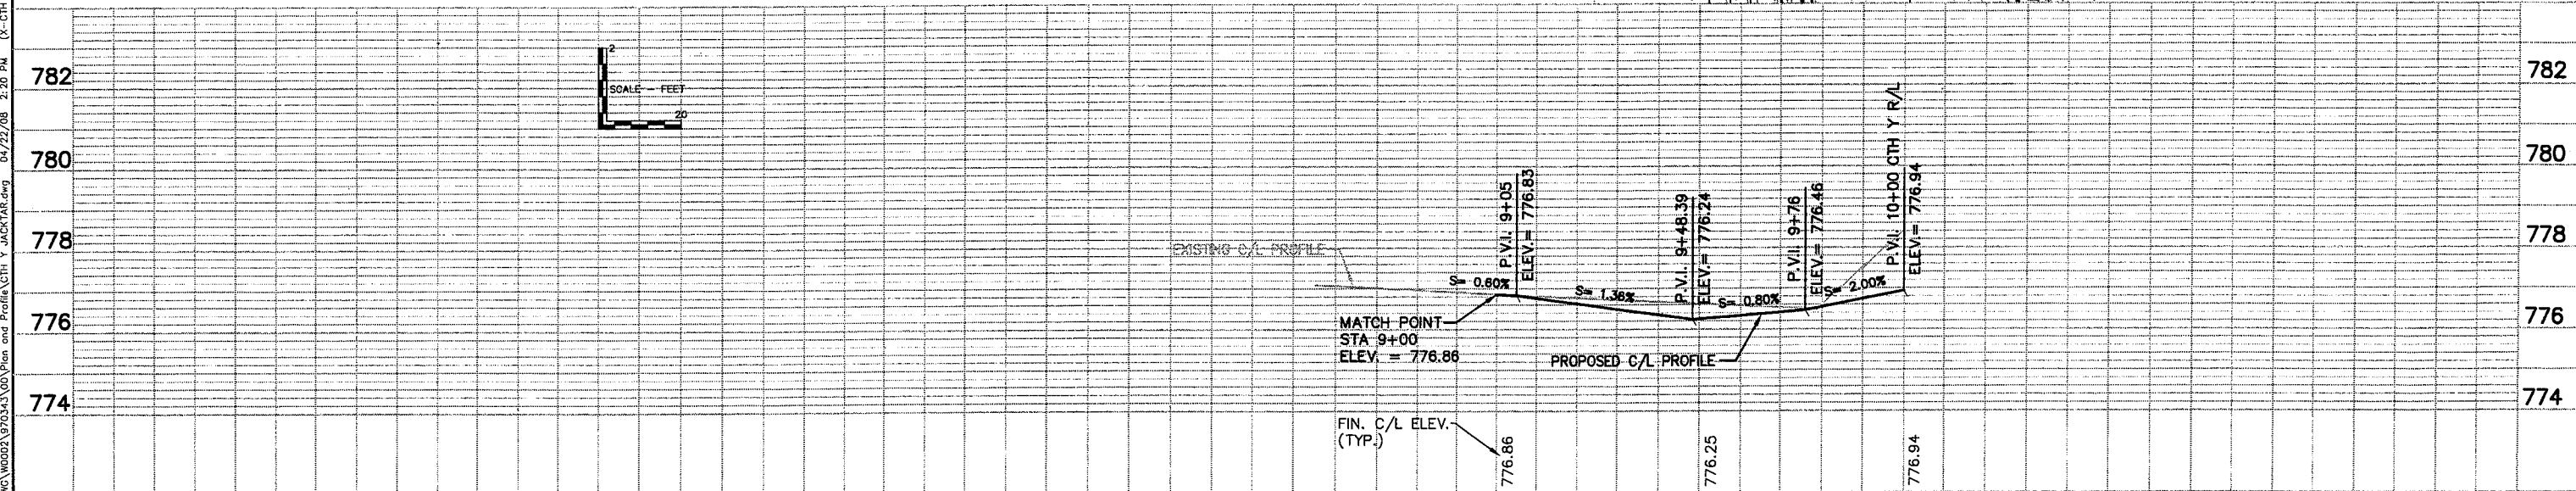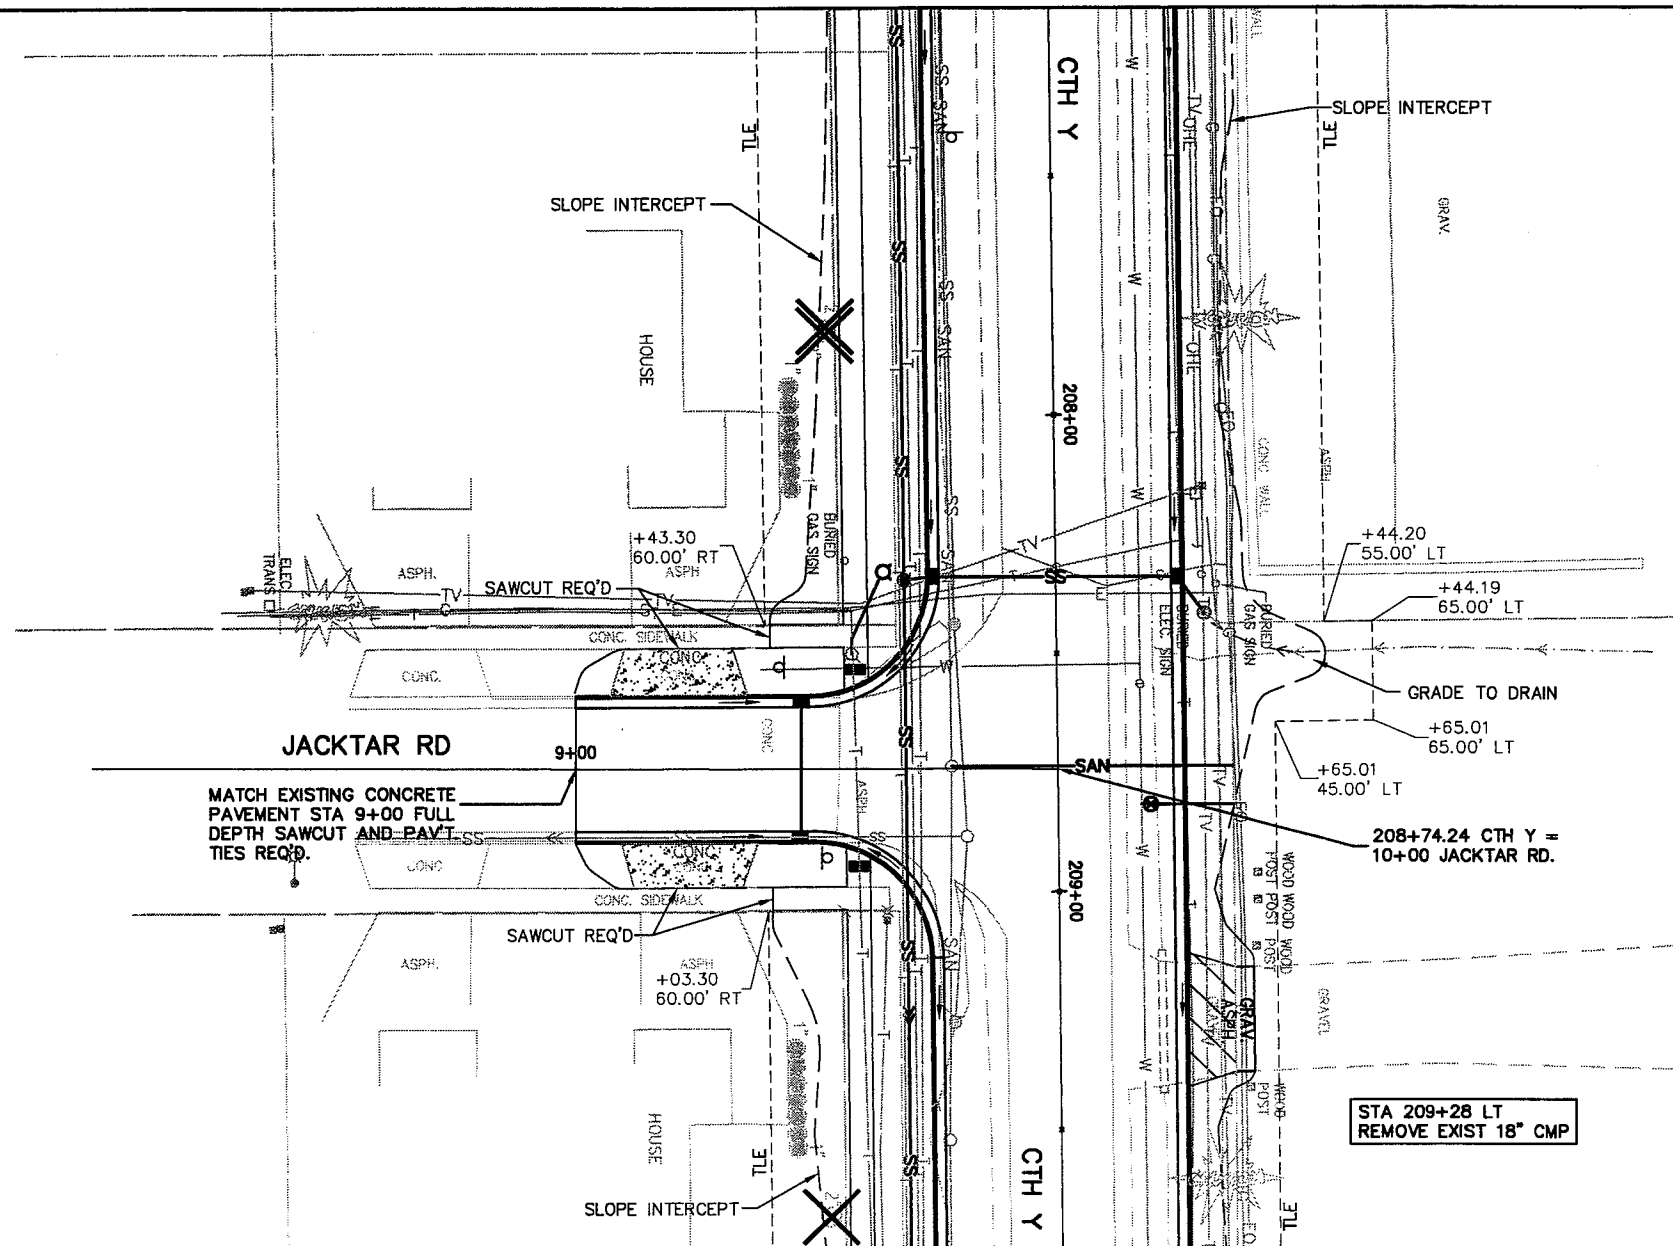

W:\DWC\WOOD2\97034\3\00\Plan and Profile\CTH Y JACKTAR.dwg 04/22/08 2:20 PM (X-CTH Y FINAL ROW-COMPS DEW)

STATE PROJECT NUMBER: 4994-00-87


HWY: CTH Y

COUNTY: WINNEBAGO

PLAN AND PROFILE


SHEET NO: 147

E


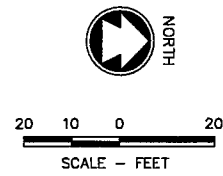


LEGEND

TREE TO BE REMOVED

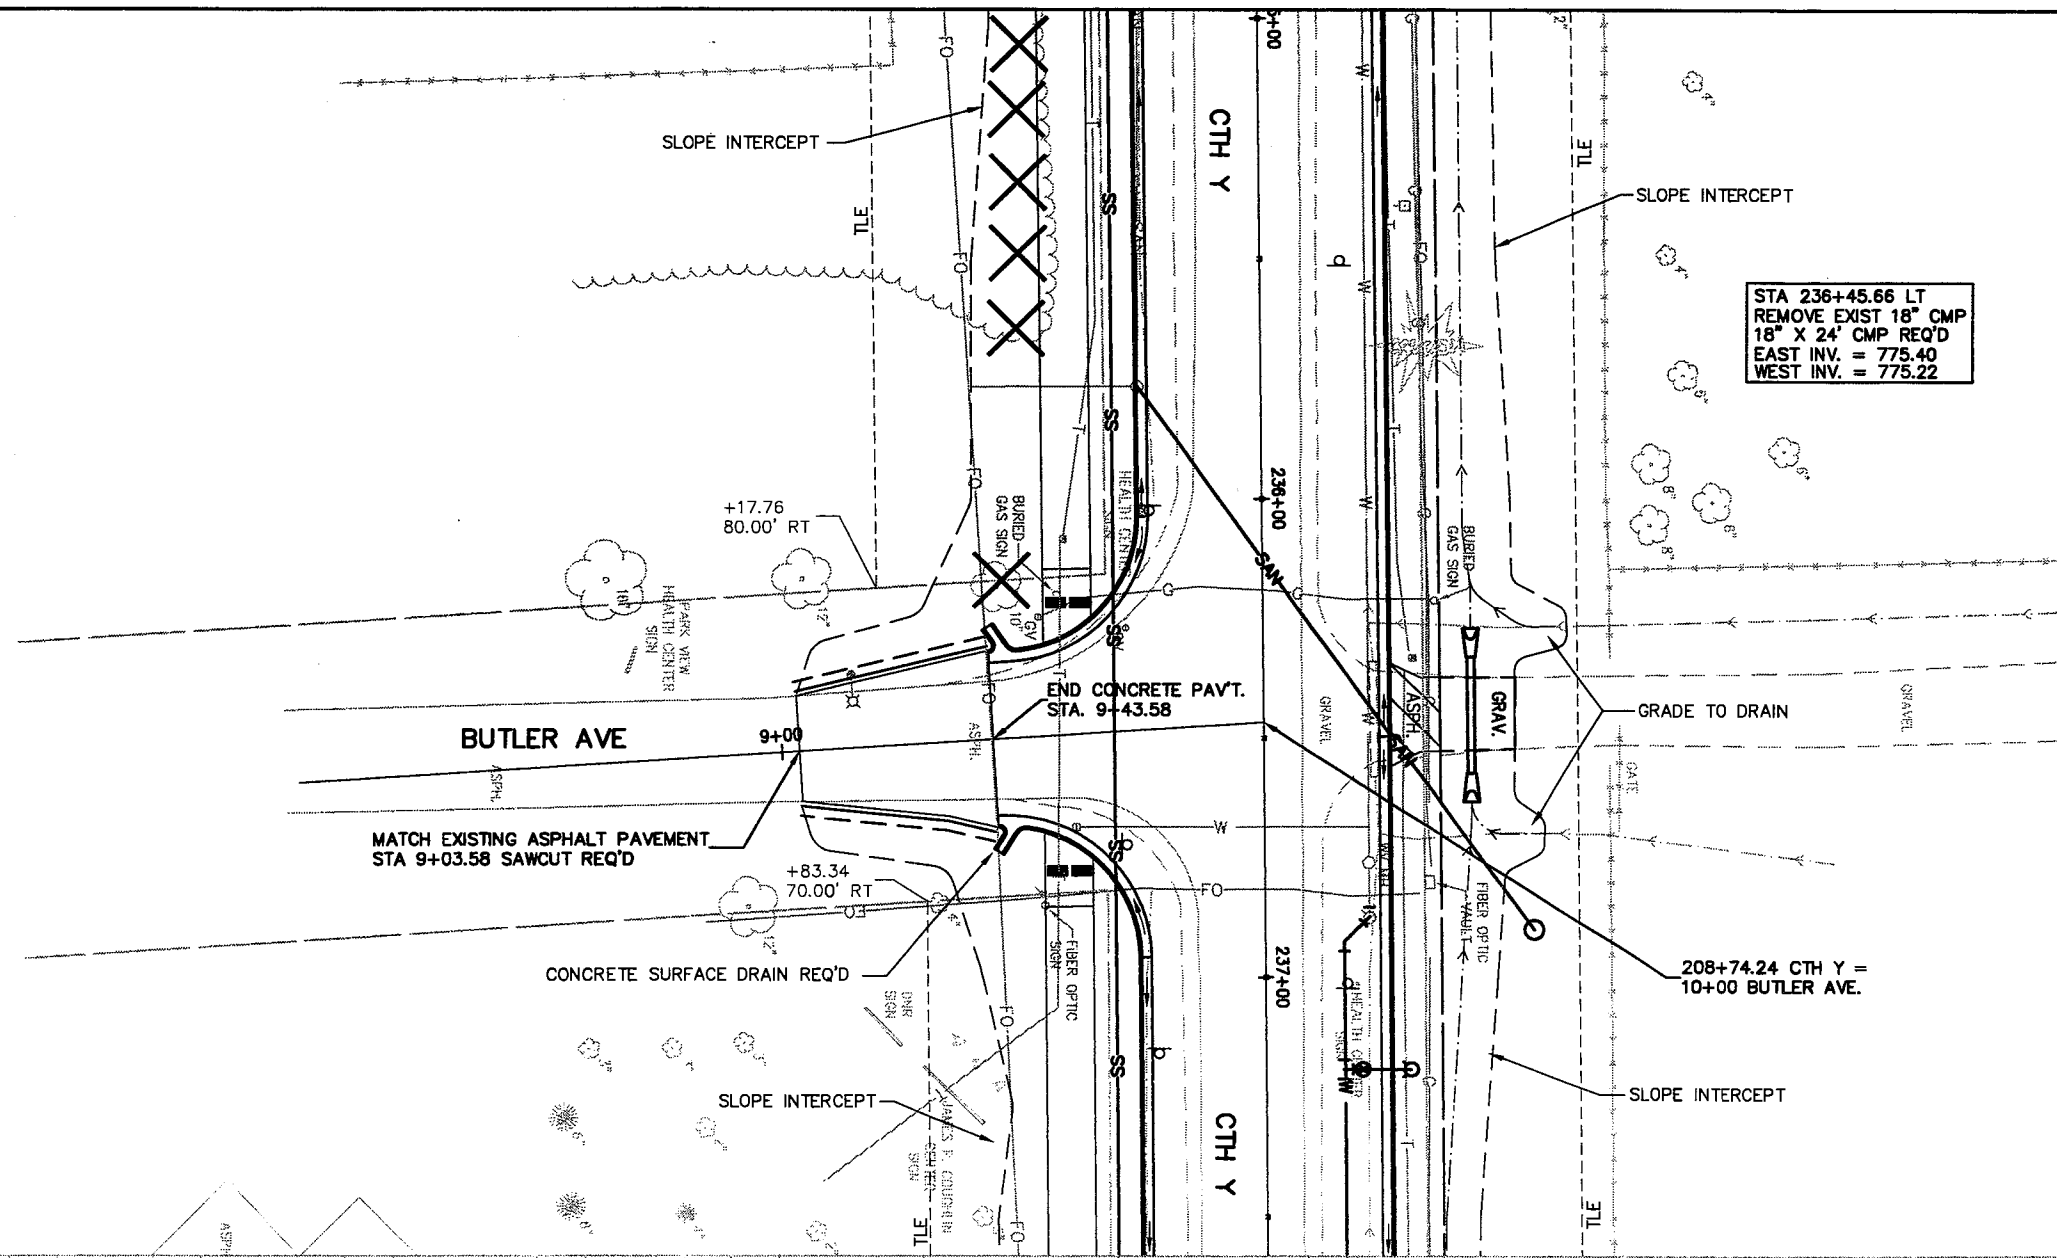

STA 236+45.66 LT
 REMOVE EXIST 18" CMP
 18" X 24' CMP REQ'D
 EAST INV. = 775.40
 WEST INV. = 775.22


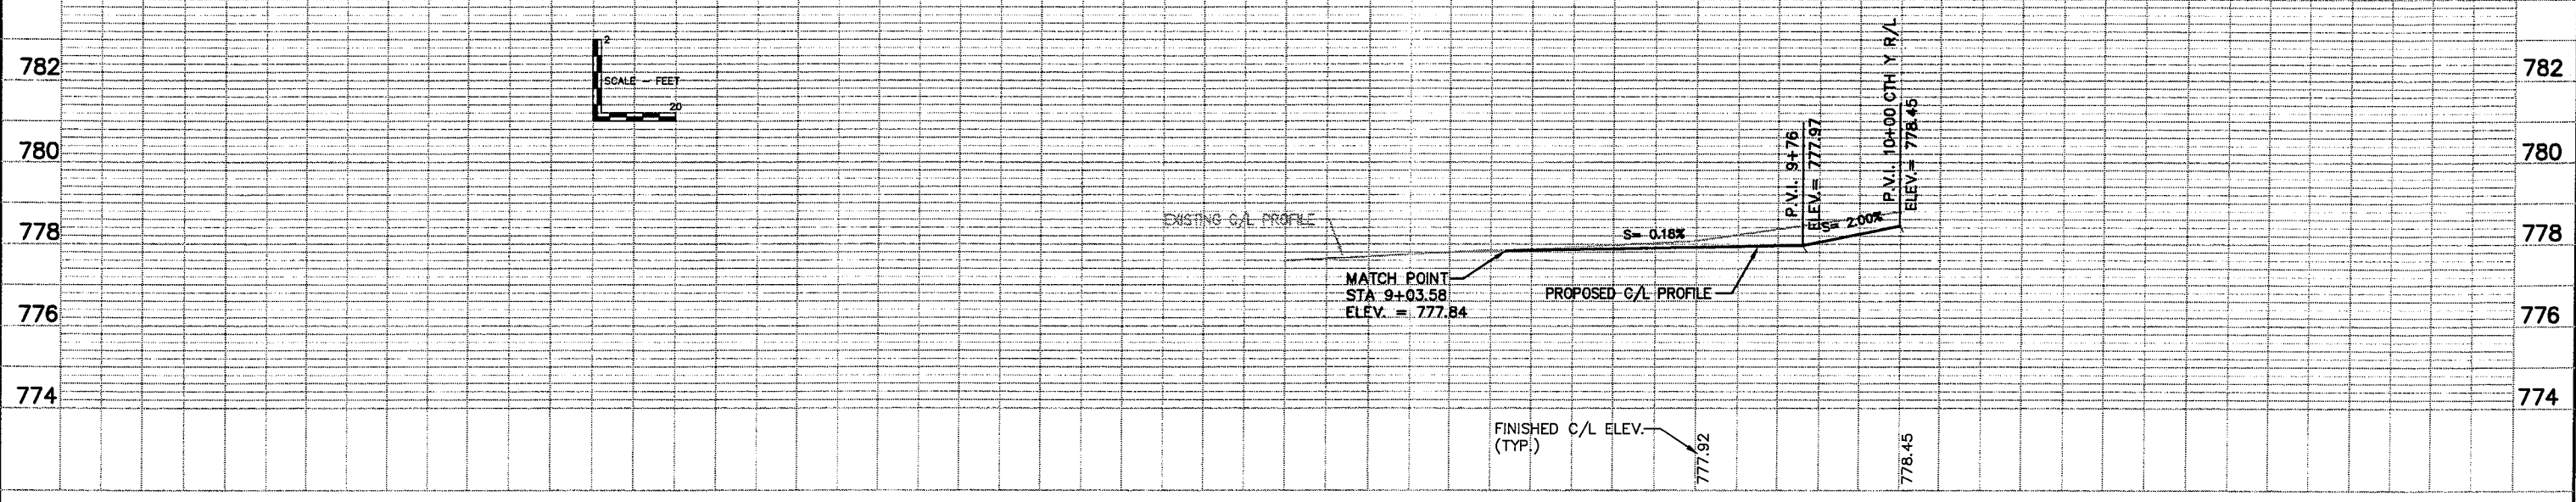
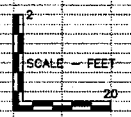


W:\GIS\W0002\9703\3\100\Plan and Profile\CTH Y BUTLER.dwg 04/28/08 4:22 PM (X-CTH Y, FINAL ROW-COMPS DEW)



PROPOSED DITCH C/L COORDINATE INFORMATION

STA	NORTHING	EASTING
10+00	497010.63	794231.72
10+40.25	496970.39	794231.33
10+66.20	496891.85	794329.80
12+14.48	496843.84	794325.58
12+81.28	496777.04	794322.11
14+57.38	496601.12	794329.70
15+75.39	496485.07	794351.17
PC 16+18.64	496447.21	794372.06
PI 16+30.31	496436.98	794377.70
PT 16+40.64	496426.72	794376.55
18+03.07	496264.64	794357.65
18+75	496194.06	794370.65




R. = 36.85'

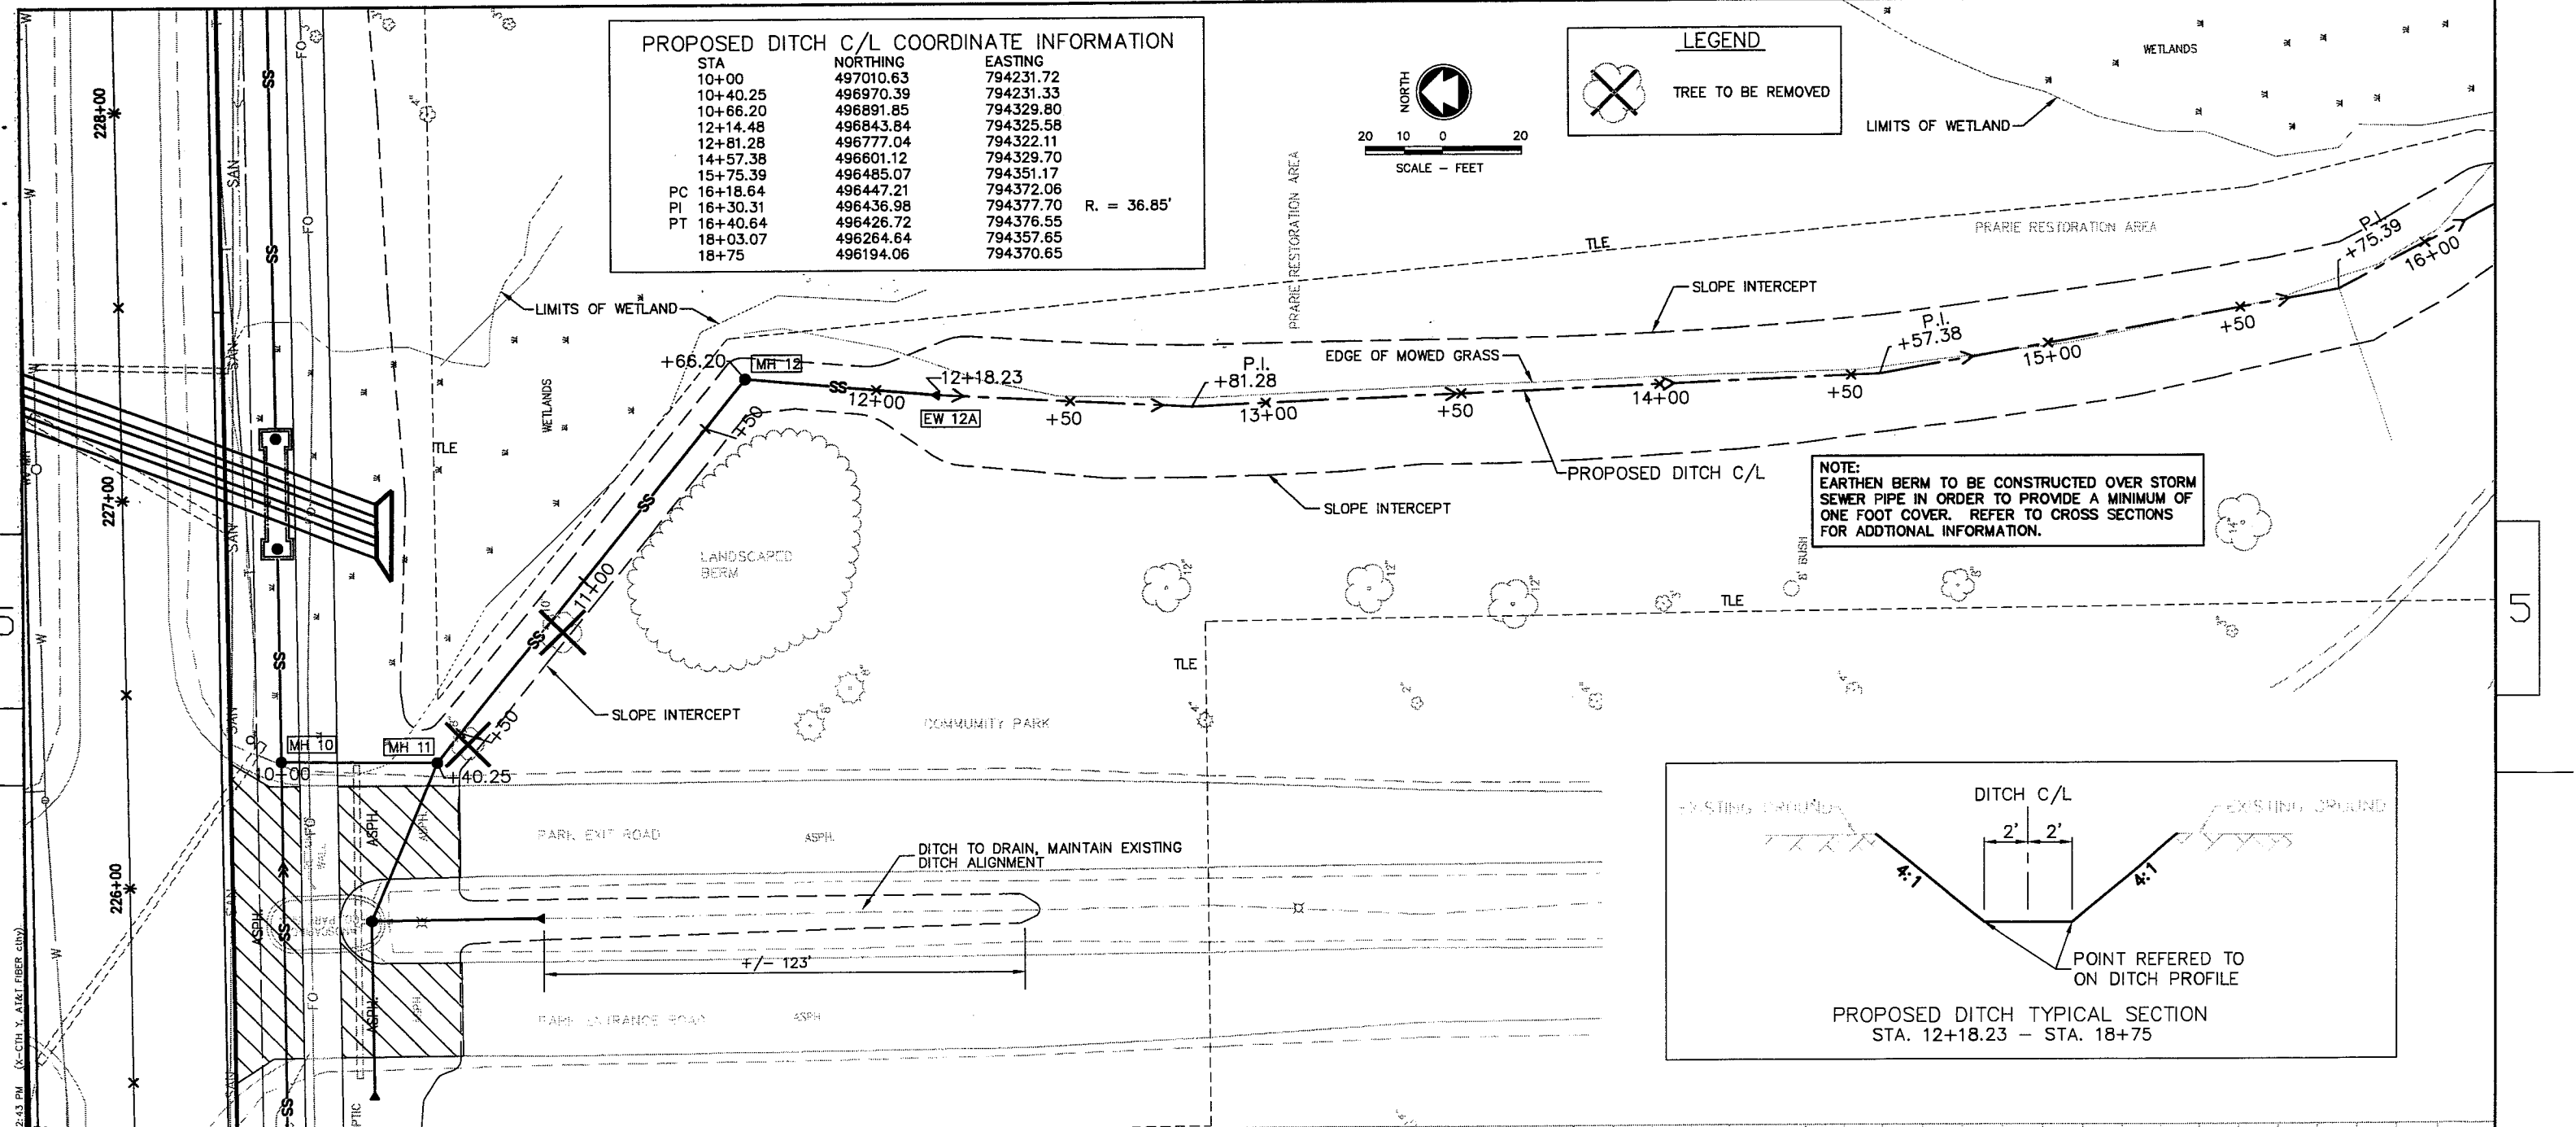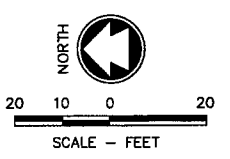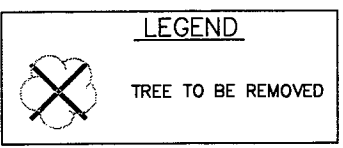

NOTE:
 EARTHEN BERM TO BE CONSTRUCTED OVER STORM SEWER PIPE IN ORDER TO PROVIDE A MINIMUM OF ONE FOOT COVER. REFER TO CROSS SECTIONS FOR ADDITIONAL INFORMATION.

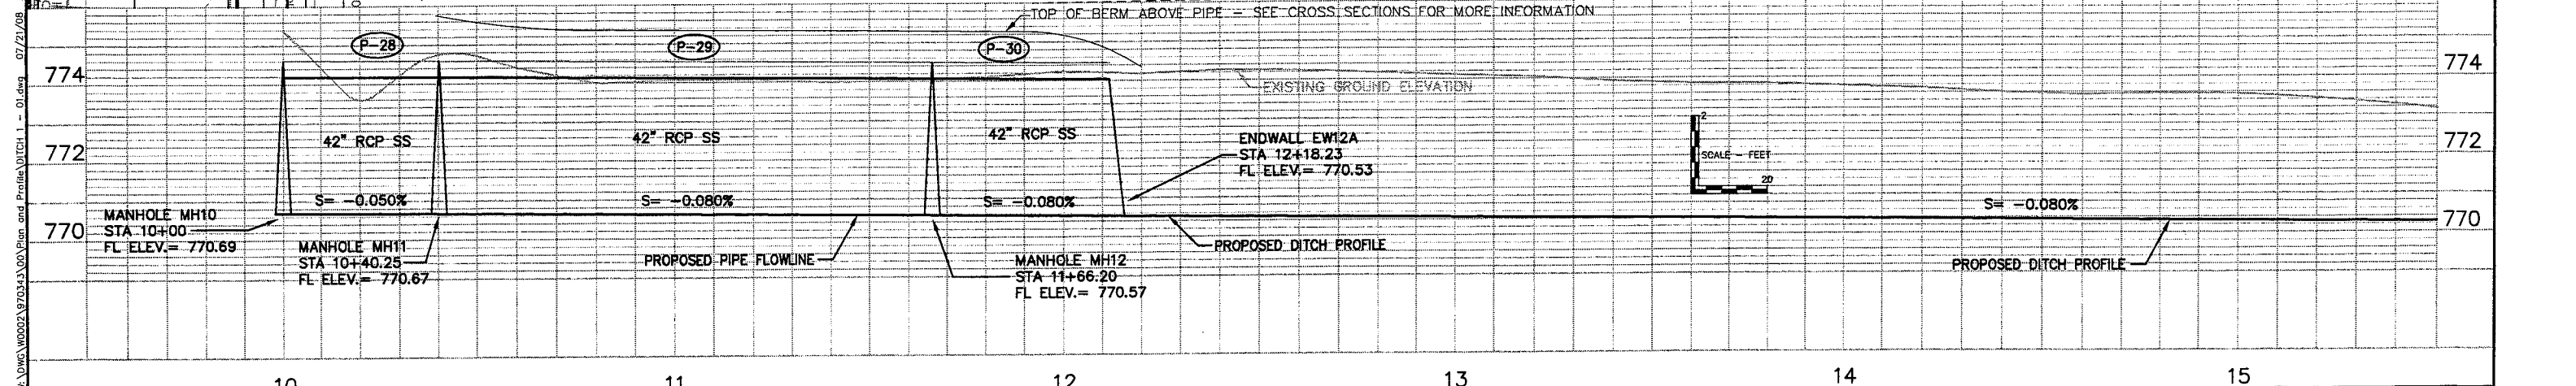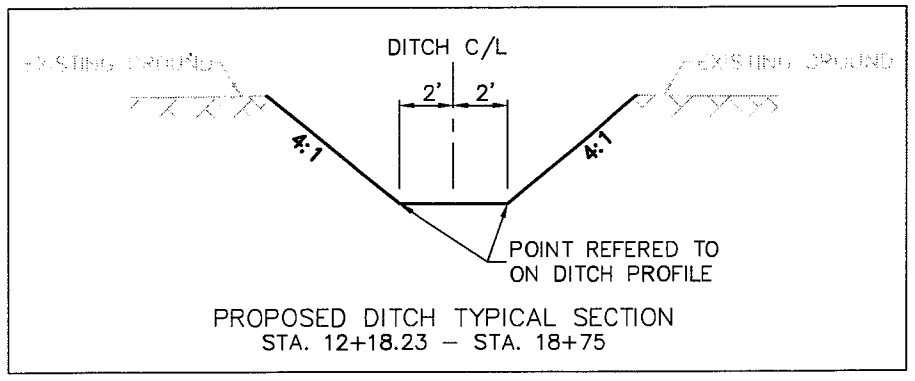


07/21/08 2:43 PM (X-CITY.Y.AIKI.FEER.ctb) W:\DWG\W0002\970343\00\Plan and Profile\DT01_1_01.dwg

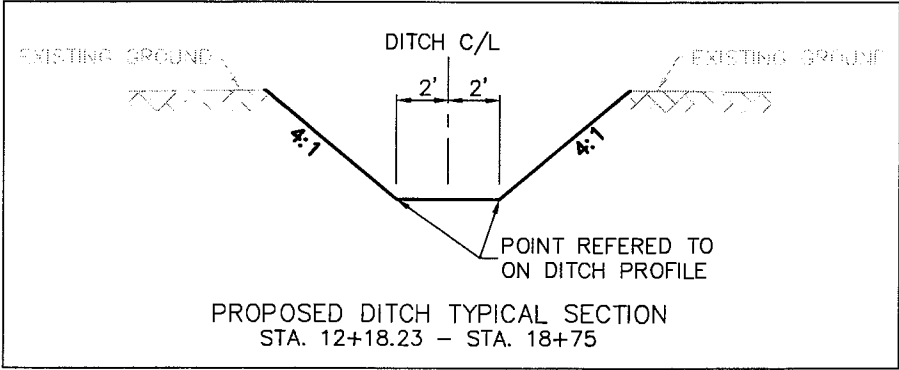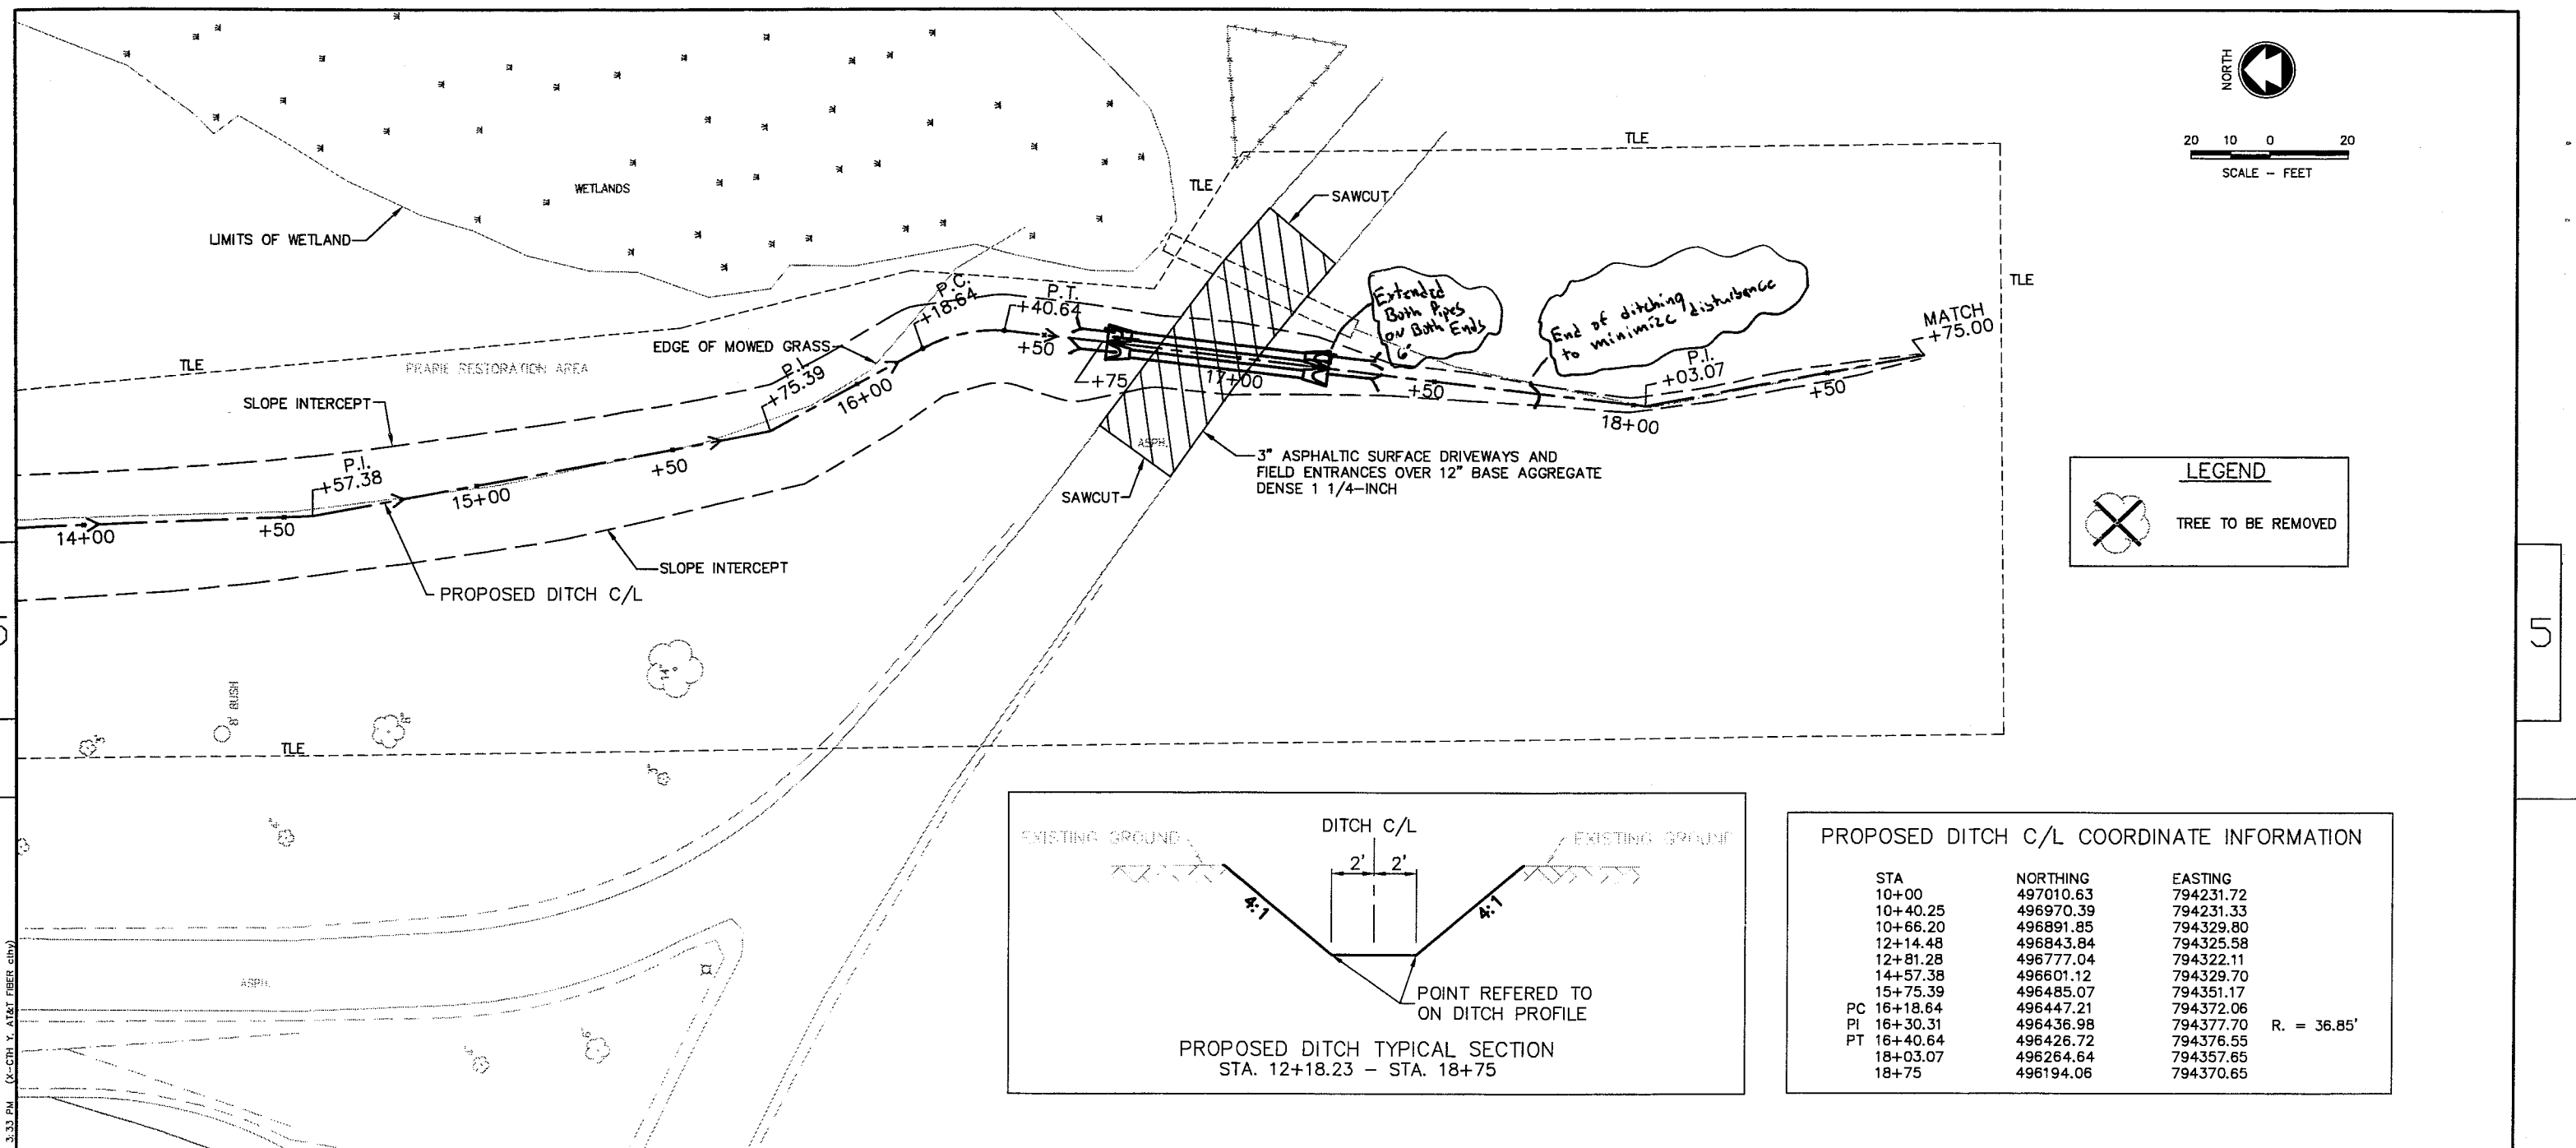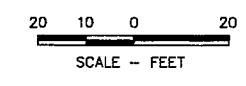

PROPOSED DITCH C/L COORDINATE INFORMATION




STA	NORTHING	EASTING
10+00	497010.63	794231.72
10+40.25	496970.39	794231.33
10+66.20	496891.85	794329.80
12+14.48	496843.84	794325.58
12+81.28	496777.04	794322.11
14+57.38	496601.12	794329.70
15+75.39	496485.07	794351.17
PC 16+18.64	496447.21	794372.06
PI 16+30.31	496436.98	794377.70
PT 16+40.64	496426.72	794376.55
18+03.07	496264.64	794357.65
18+75	496194.06	794370.65

R. = 36.85'

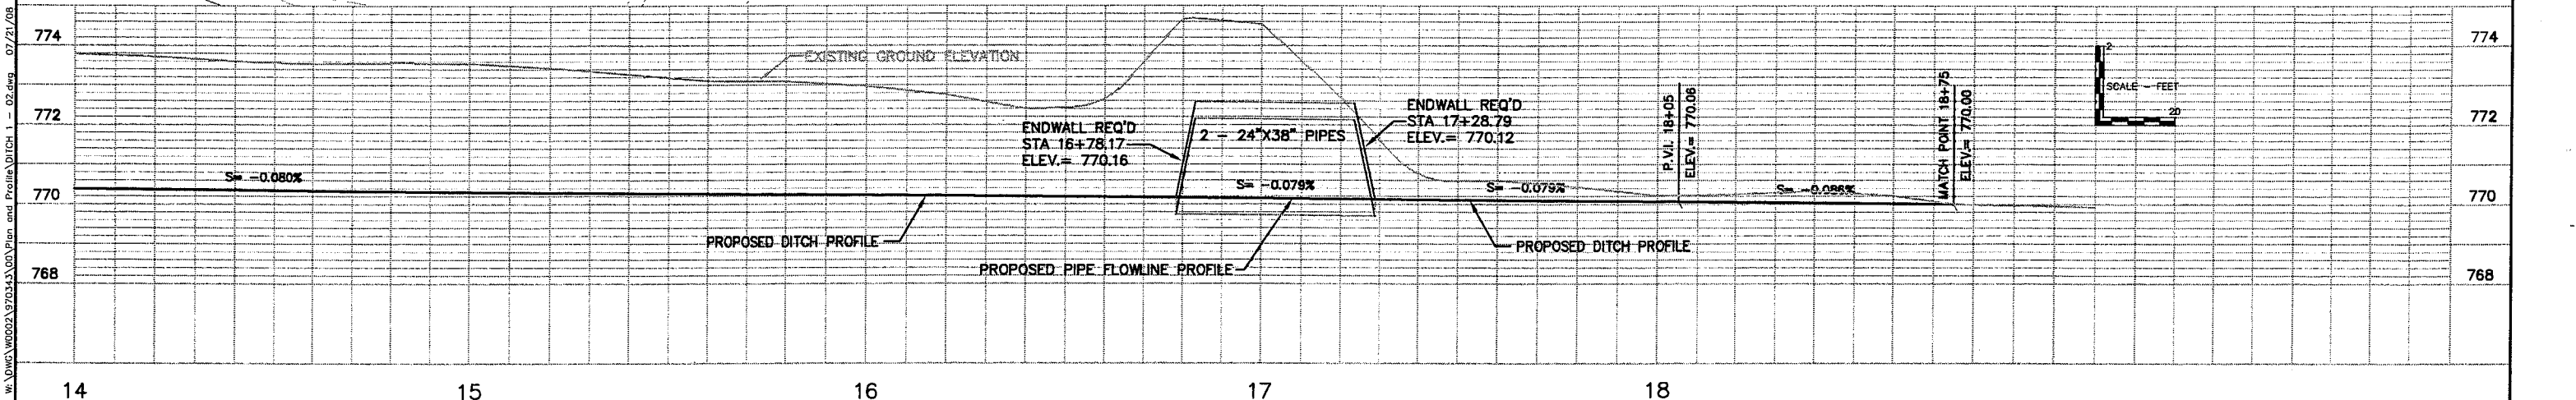

W:\DMS\WOODS\970343\00\Plan and Profile\DITCH 1 - 02.dwg 07/21/08 3:33 PM (X-CTH Y, AT&T FIBER cty)

p:\mgs\skt_w_dwg\0002\97034\00\Plan and Profile\DITCH 2 - 01.dwg 05/22/08 12:08 PM (X-CTH Y, FINAL ROW-COMPS DEW)

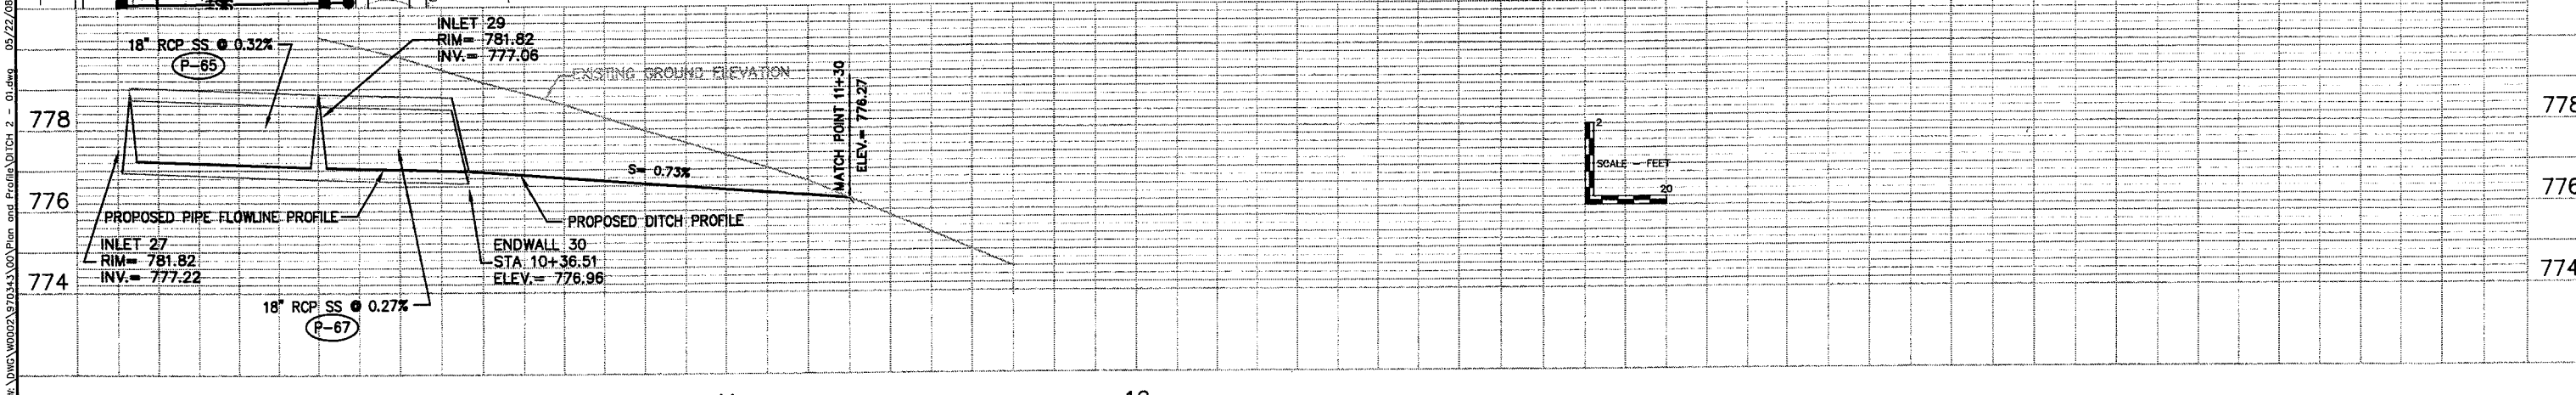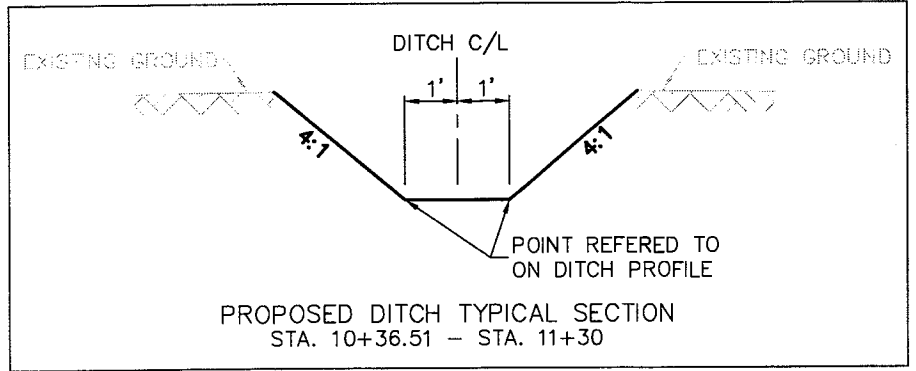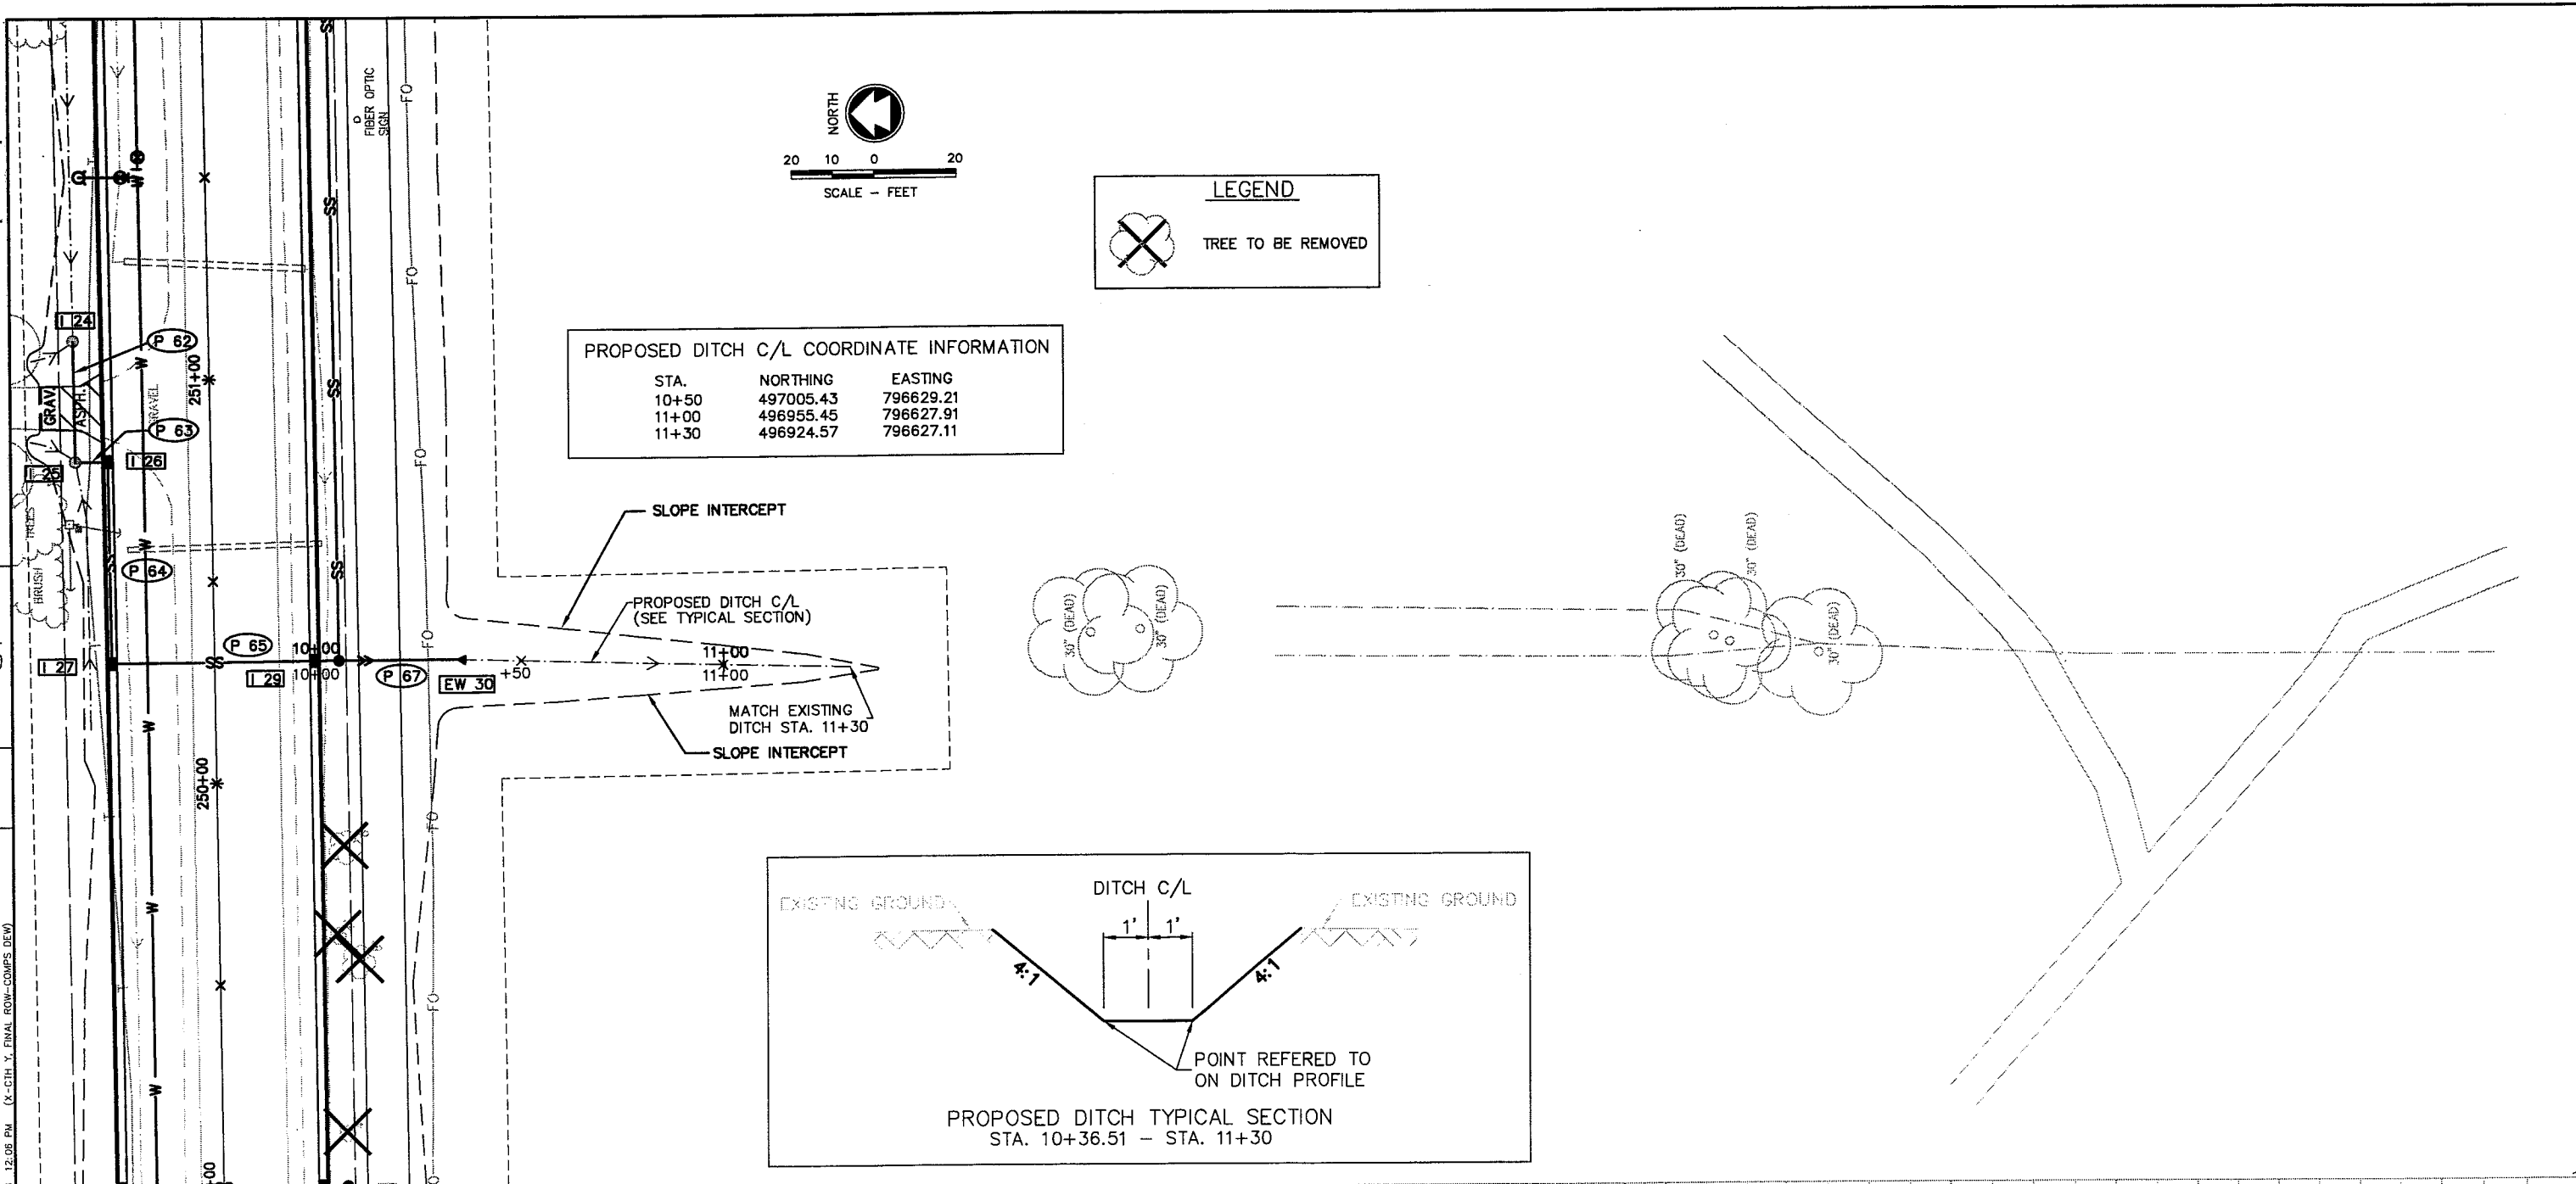


Standard Detail Drawing List


08A5-16A	INLET COVERS TYPE A, H, A-S, & H-S
08A5-16B	INLET COVERS TYPE B, B-A, C, MS, MS-A, & WM
08A5-17D	INLET COVER, TYPE Z MANHOLE COVERS, TYPE K, J, J-S, J-H, J-H-S, L & M
08B6-4	MANHOLES TYPE 1
08B7-4	MANHOLES TYPE 2 & 3
08C1-5	INLETS TYPE 1, 2, 3 & 4
08D1-16	CONCRETE CURB, CONCRETE CURB AND GUTTER & PAVEMENT TIES
08D4-4	CONCRETE SURFACE DRAINS & ASPHALTIC FLUMES
08D5-11A	CURB RAMPS TYPES 1 AND 1-A
08D5-11B	CURB RAMPS TYPES 2 AND 3
08D5-11C	CURB RAMPS TYPE 4A
08D5-11D	CURB RAMPS TYPE 4B
08D5-11E	CURB RAMPS TYPES 5, 6, 7A, 7B & 8
08E8-3	TYPICAL INSTALLATIONS OF EROSION BALES / TEMPORARY DITCH CHECKS
08E9-6	SILT FENCE
08E10-2	INLET PROTECTION TYPE A, B, C AND D
08F1-11	APRON ENDWALLS FOR CULVERT PIPE
08F2-1	APRON ENDWALLS FOR PIPE ARCH AND ELLIPTICAL PIPE
08F4-6	JOINT TIES FOR CONCRETE PIPE
08F10-1	CONCRETE MASONRY ENDWALLS FOR CULVERT PIPE AND PIPE ARCH
09B2-7	CONDUIT
09B4-9	PULL BOX
09C2-4	CONCRETE BASES, TYPES 1, 2 & 5
09C3-2	TRANSFORMER/PEDESTAL BASES
09E1-6A	POLE MOUNTINGS FOR TRAFFIC SIGNALS TYPE 2
09E1-6B	POLE MOUNTINGS FOR TRAFFIC SIGNALS AND LIGHTING UNITS, TYPE 3 (HEAVY DUTY)
09E1-8C	POLE MOUNTINGS FOR TRAFFIC SIGNALS AND LIGHTING UNITS, TYPE 4
09E1-4G	HARDWARE DETAILS FOR POLE MOUNTINGS
09E3-2	NON-FREEWAY LIGHTING UNIT POLE WIRING
09E6-2	TRAFFIC SIGNAL STANDARD POLY BRACKET MOUNTINGS (TYPICAL) 13 FT. OR 15 FT.
09F7-3	LOOP DETECTOR INSTALLED IN NEW CONCRETE BASE WITH NEW ASPHALTIC OVERLAY ROUND CSCP PULLBOX
09F9-3	LOOP DETECTOR PLACED IN CRUSHED AGGREGATE BASE (NEW CONCRETE PAVEMENT)
09G1-2A	SPAN WIRE TEMPORARY TRAFFIC SIGNAL
09G1-2B	SPAN WIRE TEMPORARY TRAFFIC SIGNAL
09G1-2D	SPAN WIRE TEMPORARY TRAFFIC SIGNAL
09G1-2E	SPAN WIRE TEMPORARY TRAFFIC SIGNAL
09G1-2F	SPAN WIRE TEMPORARY TRAFFIC SIGNAL
09G1-2G	SPAN WIRE TEMPORARY TRAFFIC SIGNAL
11B2-2	CONCRETE MEDIAN NOSE
13B1-9	PAVEMENT DETAILS FOR RAILROAD APPROACH
13C1-12	CONCRETE PAVEMENT LONGITUDINAL JOINTS AND PAVEMENT TIES
13C13-5	URBAN DOWELED CONCRETE PAVEMENT
15C2-4A	BARRICADES AND SIGNS FOR MAINLINE CLOSURES
15C2-4B	BARRICADES AND SIGNS FOR MAINLINE CLOSURES
15C3-1	BARRICADES AND SIGNS FOR SIDEROAD CLOSURES
15C4-1	TRAFFIC CONTROL, ADVANCE WARNING SIGNS 45 M.P.H. OR GREATER TWO-WAY UNDIVIDED ROAD OPEN TO TRAFFIC
15C7-8A	PAVEMENT MARKING SYMBOLS
15C7-8B	PAVEMENT MARKING WORDS
15C8-10A	PAVEMENT MARKING (MAINLINE)
15C8-10D	PAVEMENT MARKING (LEFT TURN LANE)
15C8-11E	PAVEMENT MARKING (ISLANDS, STOP LINE & CROSS WALK)
15C9-7A	SIGNING AND PAVEMENT MARKING DETAILS FOR RAILROAD-HIGHWAY GRADE CROSSINGS
15C11-5	FLEXIBLE TUBULAR MARKER POST, ANCHOR & BASES
15C12-3	TRAFFIC CONTROL FOR LANE CLOSURE (SUITABLE FOR MOVING OPERATIONS)
15C18-2	MEDIAN ISLAND MARKING
15D28-1	TRAFFIC CONTROL, WORK ON SHOULDER OR PARKING LANE, UNDIVIDED ROADWAY

Section Corner lies

By tie
pipes


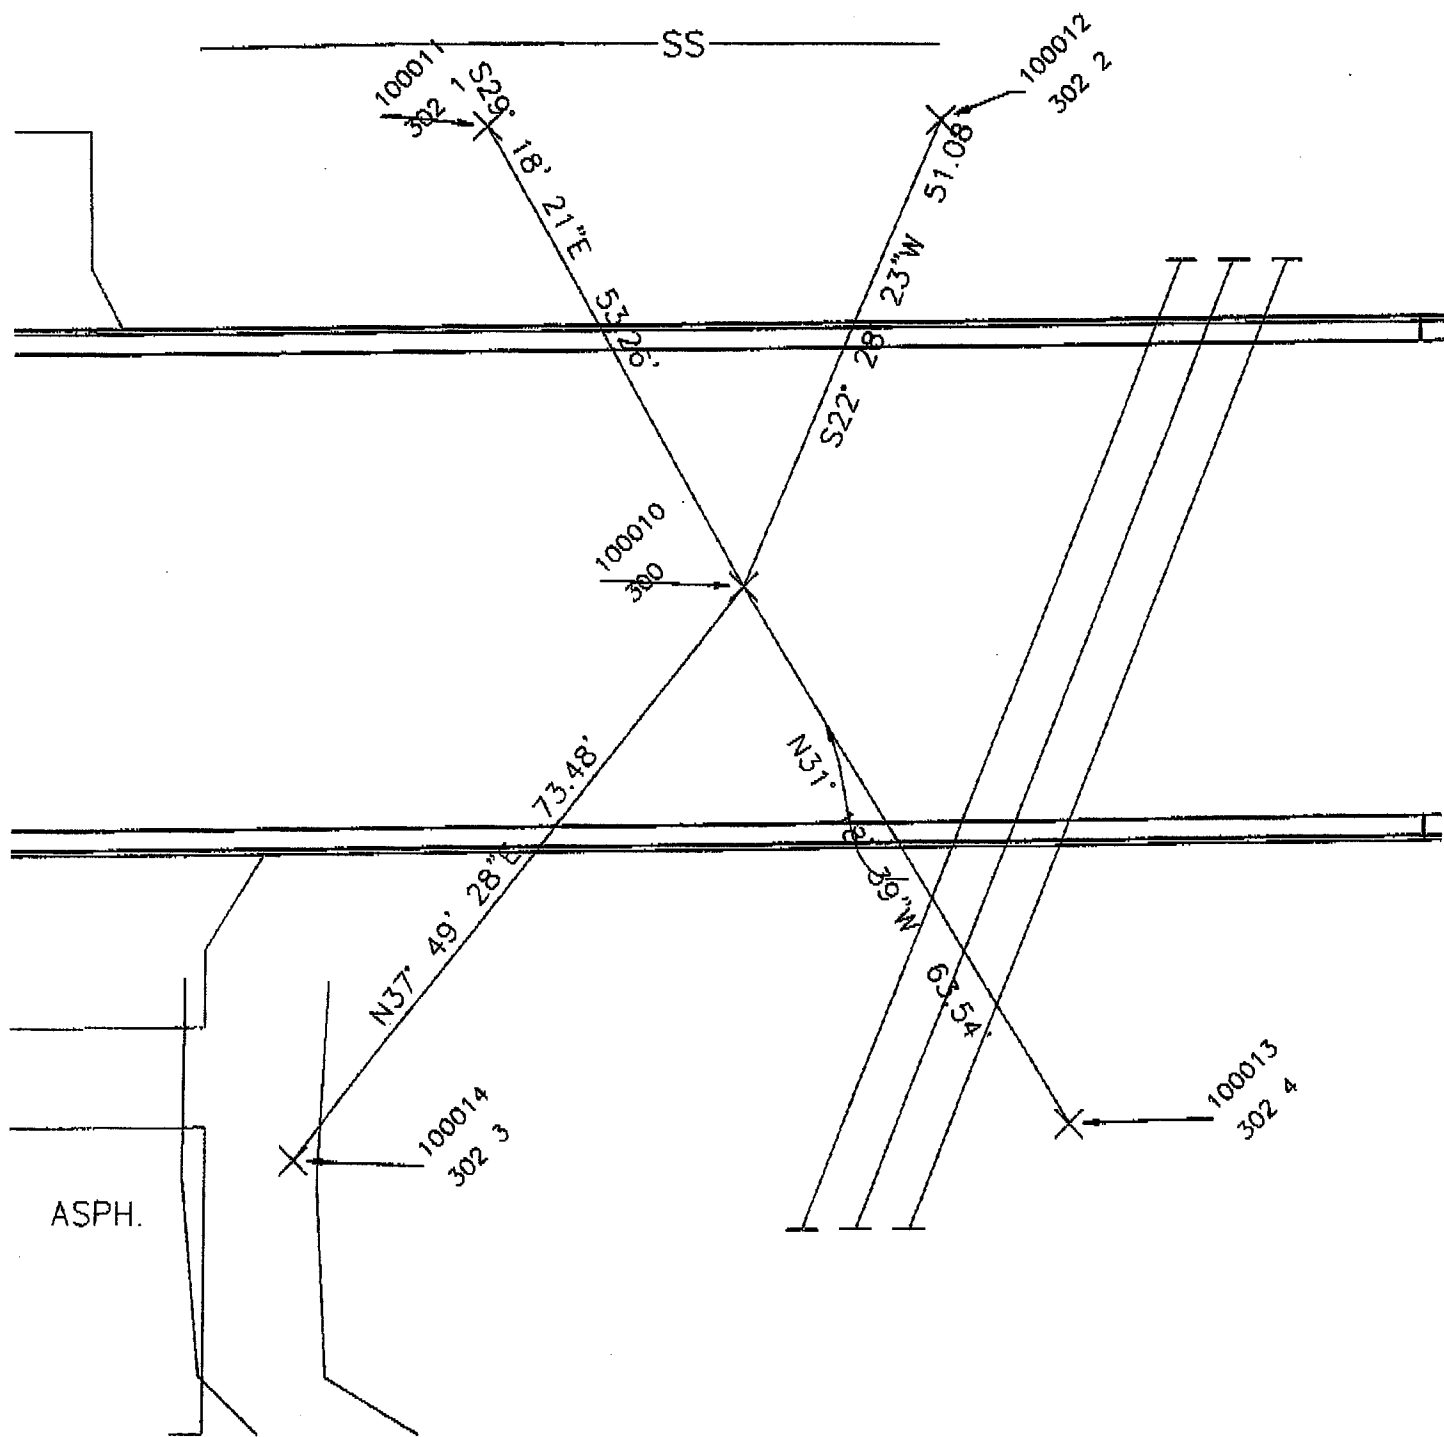


East
East


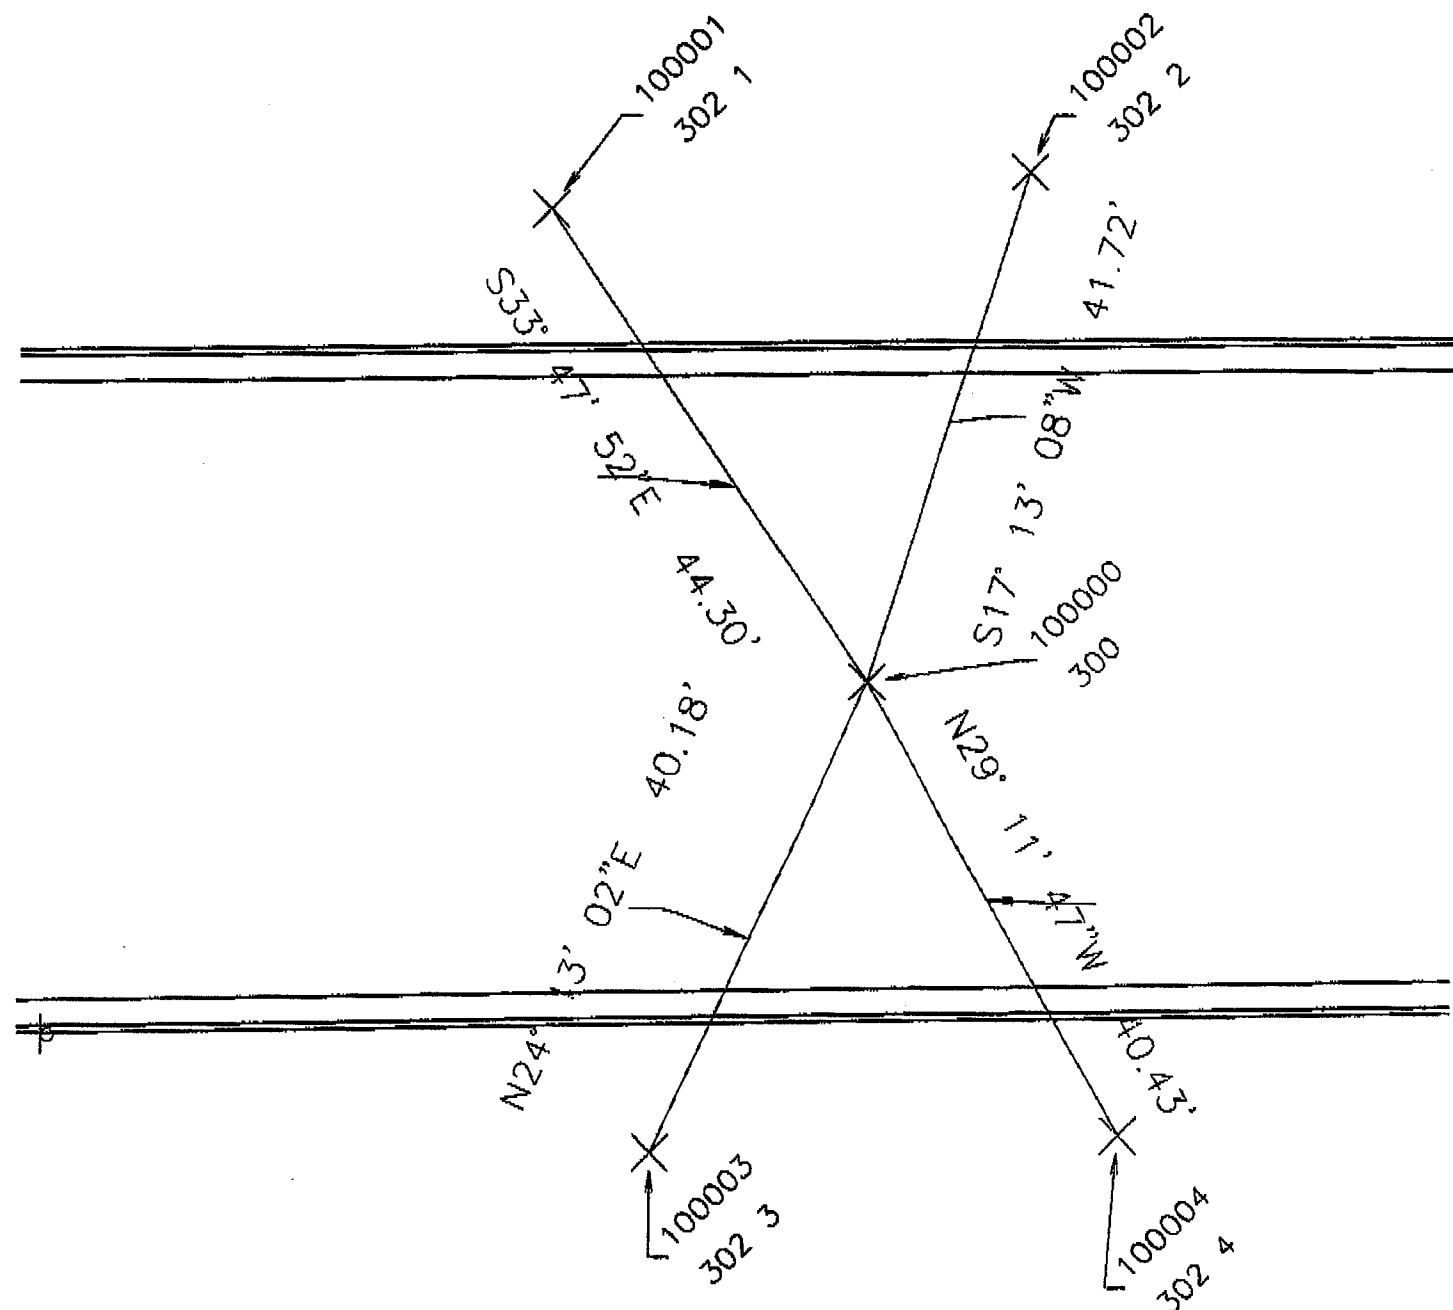


6

NOTE:
GRATE IS REVERSIBLE.

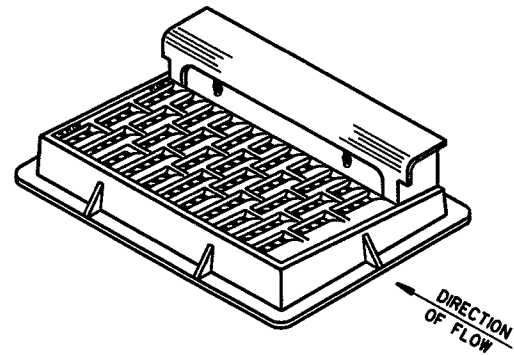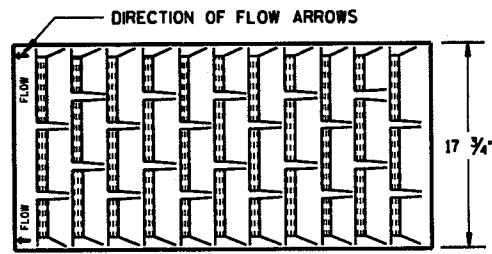


NOTE: CURB BOX HEIGHT ADJUSTABLE 6" TO 9"

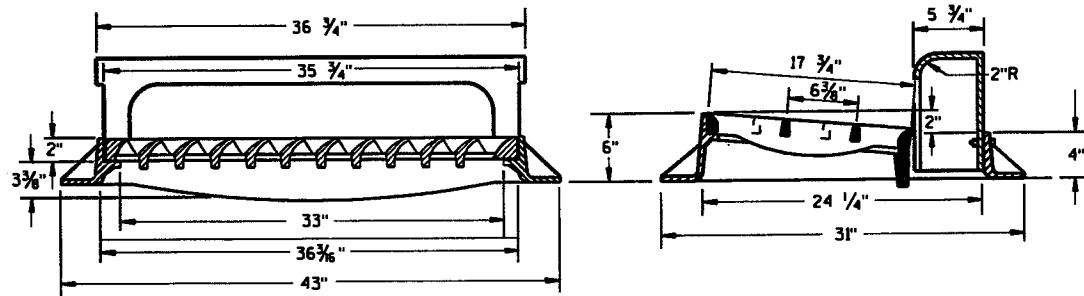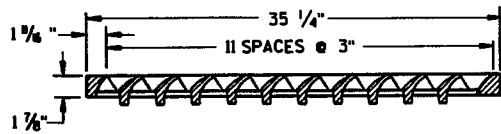

TYPE "H"

(APPROXIMATE WEIGHT 422 LBS.)

FRAME..... 175 LBS.
 GRATE..... 138 LBS.
 CURB BOX..... 109 LBS.

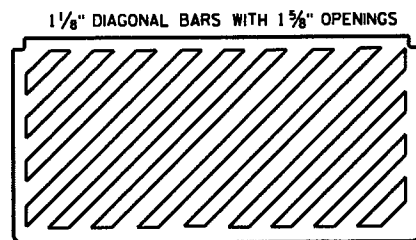

SPECIAL GRATE FOR TYPE "H" COVER

(MEASURES 35 1/4" X 17 3/4" X 2")

(APPROXIMATE WEIGHT 172 LBS.)

GRATE..... 172 LBS.

(NOTED AS TYPE H-S ON DRAINAGE TABLE)



GENERAL NOTES

DETAILS OF CONSTRUCTION, MATERIALS AND WORKMANSHIP NOT SHOWN ON THIS DRAWING SHALL CONFORM TO THE PERTINENT REQUIREMENTS OF THE STANDARD SPECIFICATIONS AND THE APPLICABLE SPECIAL PROVISIONS.



DETAIL DRAWINGS FOR PROPOSED ALTERNATE DESIGNS FOR CATCH BASIN, MANHOLE AND INLET COVERS SHALL BE SUBMITTED TO THE ENGINEER FOR APPROVAL PROVIDING THAT SUCH ALTERNATE DESIGNS MAKE PROVISION FOR EQUIVALENT CAPACITY AND STRENGTH.

ROUND FRAMES AND COVERS SHALL HAVE CONTINUOUSLY MACHINED BEARING SURFACES TO PREVENT ROCKING AND RATTLING.

THE ACTUAL WEIGHT OF COVERS MAY VARY WITHIN 5 PERCENT, PLUS OR MINUS, OF THE APPROXIMATE WEIGHT.

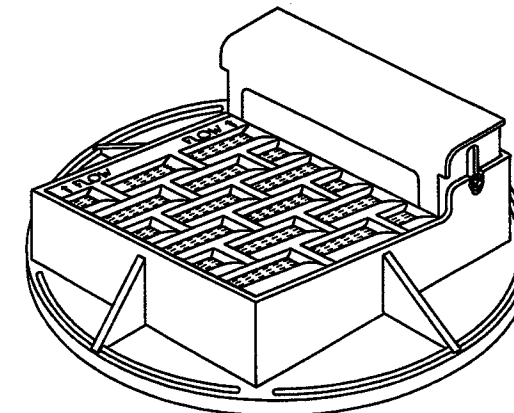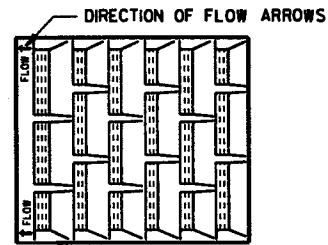

NOTE: CURB BOX ADJUSTABLE 4" TO 9"

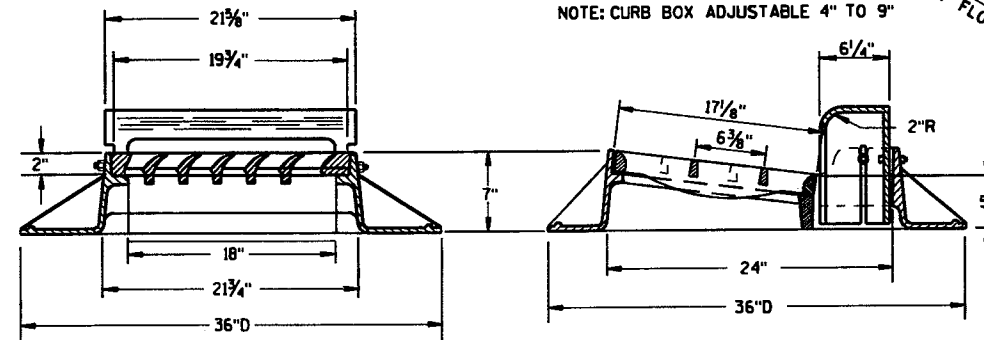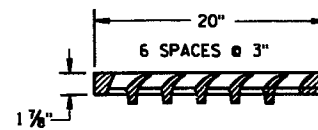


TYPE "A"

(APPROXIMATE WEIGHT 325 LBS.)

FRAME..... 157 LBS.
 GRATE..... 84 LBS.
 CURB BOX..... 84 LBS.

NOTE:
GRATE IS REVERSIBLE.

1" DIAGONAL BARS
WITH 1 1/2" OPENINGS

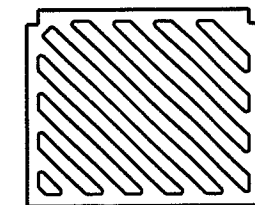

SPECIAL GRATE FOR TYPE "A" COVER

(MEASURES 19 3/4" X 17" X 1 7/8")

GRATE..... 84 LBS.

(NOTED AS TYPE A-S ON DRAINAGE TABLE)

6

INLET COVERS
TYPE A, H, A-S, & H-S



STATE OF WISCONSIN
DEPARTMENT OF TRANSPORTATION

APPROVED


10/4/99
DATE

Paul J. [Signature]
 CHIEF ROADWAY DEVELOPMENT ENGINEER



FHWA

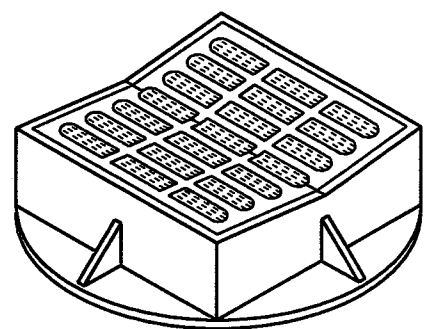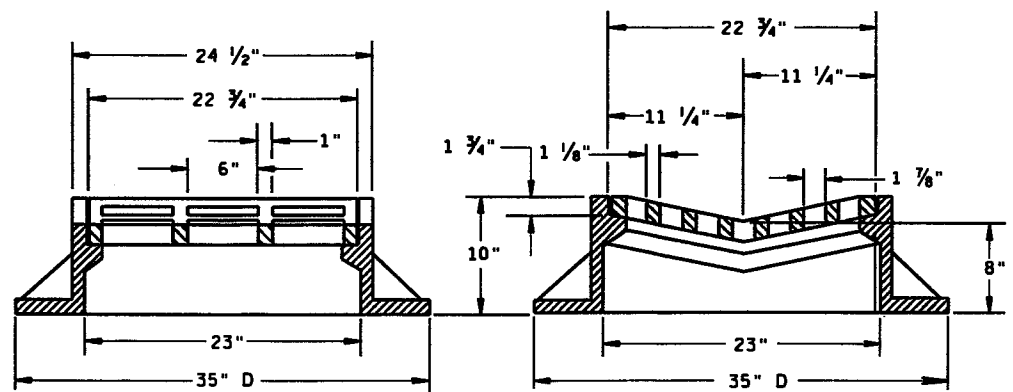

TYPE "B"
 (APPROXIMATE WEIGHT 395 LBS.)
 FRAME..... 285 LBS.
 GRATE..... 110 LBS.

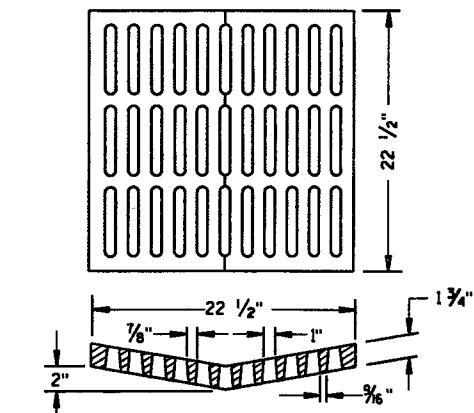


ALTERNATIVE GRATE FOR TYPE "B" COVER
 (APPROXIMATE GRATE WEIGHT 125 LBS.)
 GRATE..... 125 LBS.
 USE WHERE PEDESTRIAN OR BICYCLE TRAFFIC IS POSSIBLE.
 NOTED AS TYPE B-A ON THE DRAINAGE TABLE

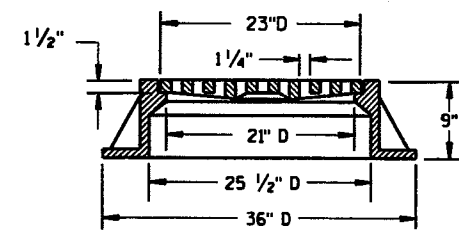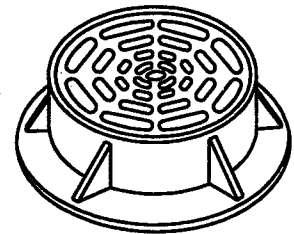


TYPE "C"
 (APPROXIMATE WEIGHT 340 LBS.)
 FRAME..... 235 LBS.
 GRATE..... 105 LBS.

GENERAL NOTES



DETAILS OF CONSTRUCTION, MATERIALS AND WORKMANSHIP NOT SHOWN ON THIS DRAWING SHALL CONFORM TO THE PERTINENT REQUIREMENTS OF THE STANDARD SPECIFICATIONS AND THE APPLICABLE SPECIAL PROVISIONS.
 DETAIL DRAWINGS FOR PROPOSED ALTERNATE DESIGNS FOR CATCH BASIN, MANHOLE AND INLET COVERS SHALL BE SUBMITTED TO THE ENGINEER FOR APPROVAL PROVIDING THAT SUCH ALTERNATE DESIGNS MAKE PROVISION FOR EQUIVALENT CAPACITY AND STRENGTH.
 ROUND FRAMES AND COVERS SHALL HAVE CONTINUOUSLY MACHINED BEARING SURFACES TO PREVENT ROCKING AND RATTLING.
 THE ACTUAL WEIGHT OF COVERS MAY VARY WITHIN 5 PERCENT, PLUS OR MINUS, OF THE APPROXIMATE WEIGHT.

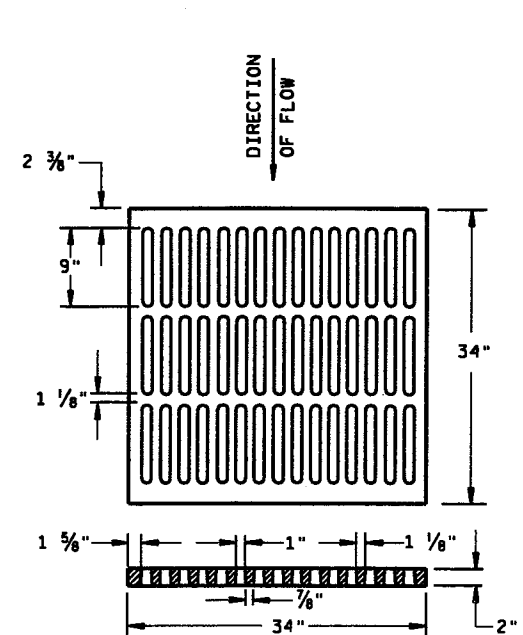

ALTERNATIVE TYPE "MS"
 (APPROXIMATE GRATE WEIGHT 365 LBS.)
 GRATE..... 365 LBS.
 USE WHERE PEDESTRIAN OR BICYCLE TRAFFIC IS PERMITTED
 NOTED AS TYPE MS-A ON THE DRAINAGE TABLE

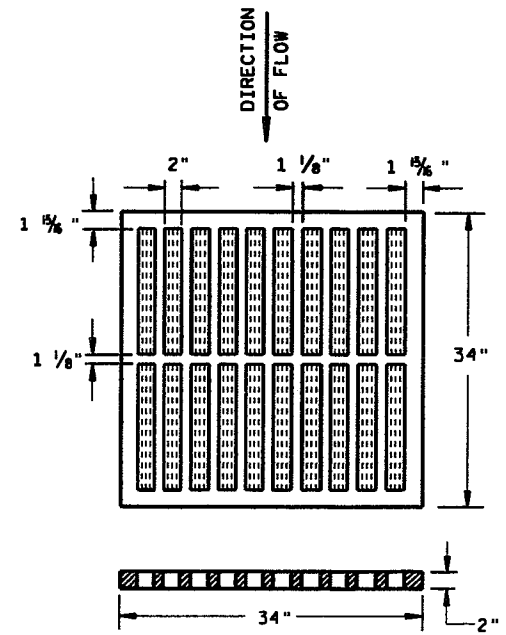

TYPE "MS"
 (APPROXIMATE GRATE WEIGHT 270 LBS.)
 GRATE..... 270 LBS.
 USE ON FREEWAYS AND EXPRESSWAYS
 NOTED AS TYPE MS ON DRAINAGE TABLE

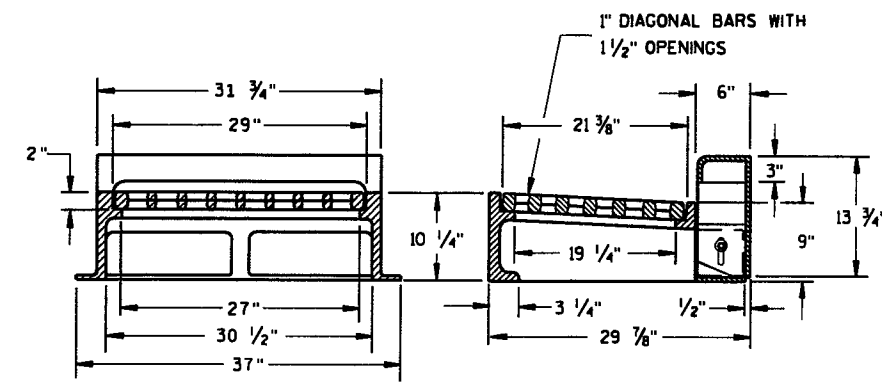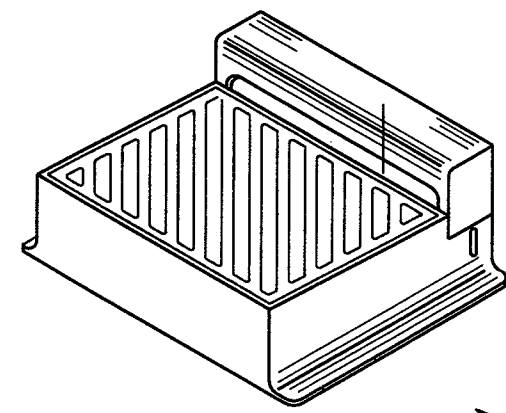

NOTE: CURB BOX HEIGHT ADJUSTABLE 6" TO 9"

TYPE "WM"
 (APPROXIMATE WEIGHT 670 LBS.)
 FRAME..... 360 LBS.
 GRATE..... 160 LBS.
 CURB BOX..... 150 LBS.

DIAGONAL SLOTS, SHALL BE ORIENTED TO THE DIRECTION OF FLOW AS ILLUSTRATED. GRATES ARE MANUFACTURED TO BE REVERSIBLE.

6

6

S.D.D. 8 A 5-16b



S.D.D. 8 A 5-16b

INLET COVERS
 TYPE B, B-A, C, MS, MS-A, & WM




STATE OF WISCONSIN
 DEPARTMENT OF TRANSPORTATION

APPROVED
 10/4/99
 DATE
 FHWA


Paul J. Williams
 CHIEF ROADWAY DEVELOPMENT ENGINEER

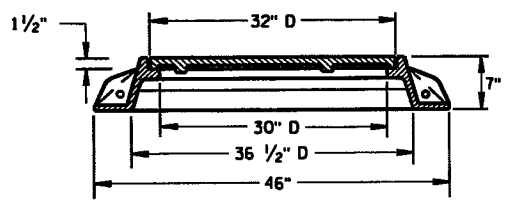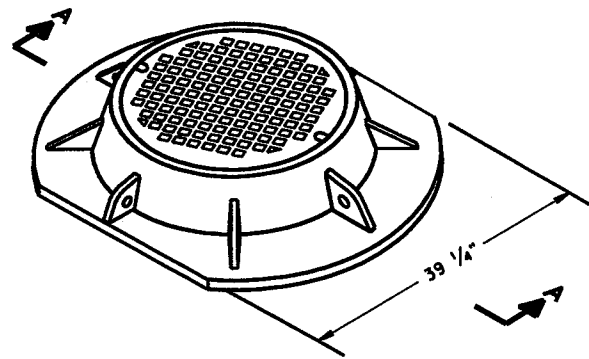

SECTION A-A
TYPE "K"
(APPROXIMATE WEIGHT 415 LBS.)
FRAME.....210 LBS.
LID.....205 LBS.

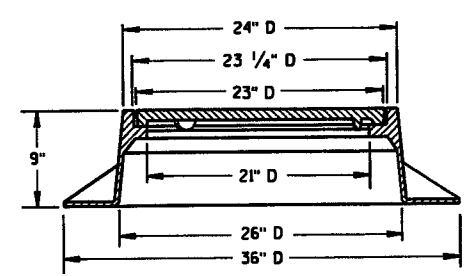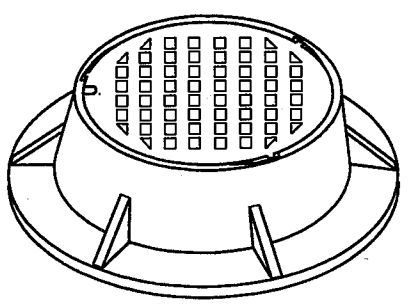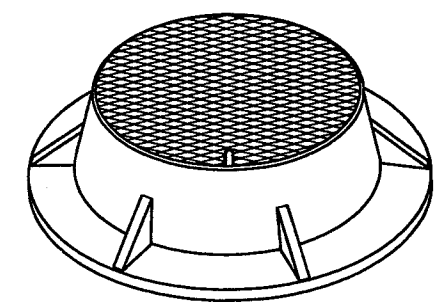

TYPE "J"
(APPROXIMATE WEIGHT 250 LBS.)
FRAME.....135 LBS.
LID.....115 LBS.

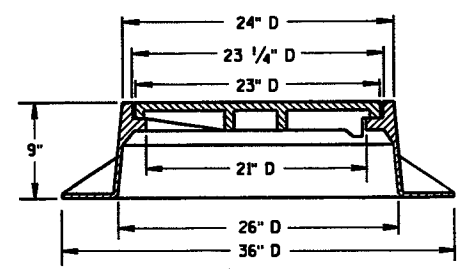

TYPE "J" SPECIAL
TYPE "B" NON-ROCKING SELF-SEAL LID
(APPROXIMATE WEIGHT 245 LBS.)
FRAME.....145 LBS.
LID.....100 LBS.
(NOTED AS TYPE J-S ON THE DRAINAGE TABLE)

GENERAL NOTES


DETAILS OF CONSTRUCTION, MATERIALS AND WORKMANSHIP NOT SHOWN ON THIS DRAWING SHALL CONFORM TO THE PERTINENT REQUIREMENTS OF THE STANDARD SPECIFICATIONS AND THE APPLICABLE SPECIAL PROVISIONS.

DETAIL DRAWINGS FOR PROPOSED ALTERNATE DESIGNS FOR MANHOLE COVERS SHALL BE SUBMITTED TO THE ENGINEER FOR APPROVAL PROVIDING THAT SUCH ALTERNATE DESIGNS MAKE PROVISION FOR EQUIVALENT CAPACITY AND STRENGTH.



ROUND FRAMES AND COVERS SHALL HAVE CONTINUOUSLY MACHINED BEARING SURFACES TO PREVENT ROCKING AND RATTLING.

THE ACTUAL WEIGHT OF COVERS MAY VARY WITHIN 5 PERCENT, PLUS OR MINUS, OF THE APPROXIMATE WEIGHT.

① MANUFACTURER MAY PROVIDE ADDITIONAL SEALS OR GASKETS.


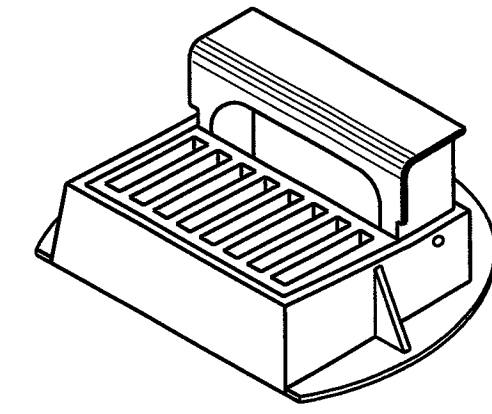


CURB BOX ADJUSTABLE 4" TO 10"

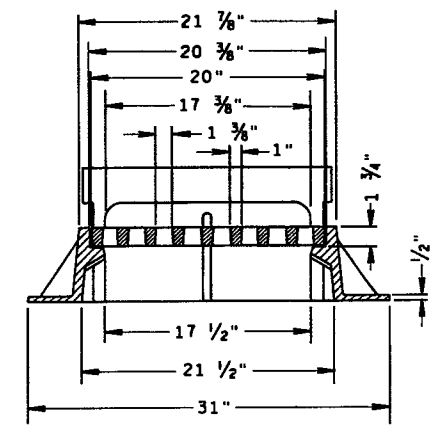
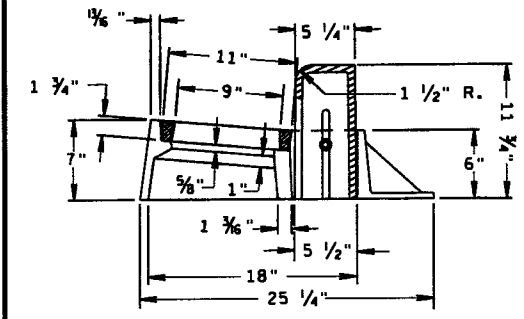


INLET COVER TYPE "Z"



(APPROXIMATE WEIGHT 340 LBS.)
FRAME.....198 LBS.
GRATE.....50 LBS.
CURB BOX.....92 LBS.

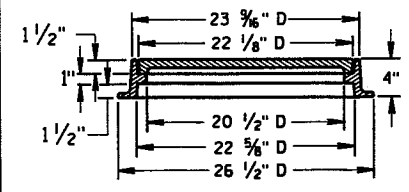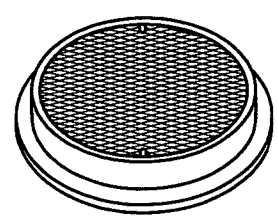


TYPE "L"
(APPROXIMATE WEIGHT 145 LBS.)
FRAME.....75"
LID.....70"

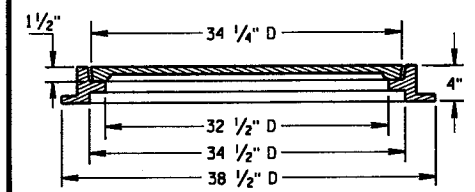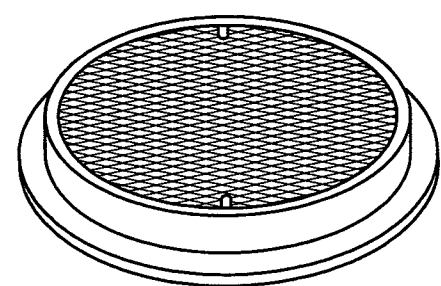


TYPE "M"
(APPROXIMATE WEIGHT 385 LBS.)
FRAME.....125"
LID.....260"

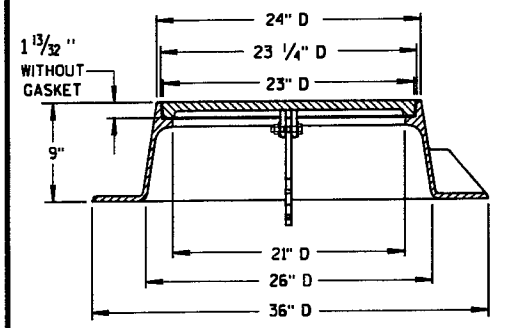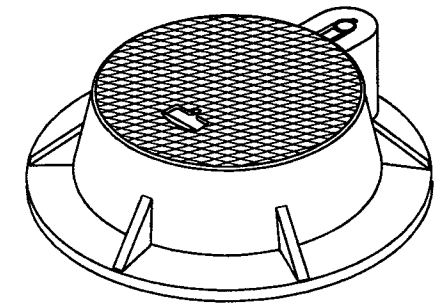

TYPE "J" HINGED
LID WITHOUT "T SEAL" GASKET
(APPROXIMATE WEIGHT 310 LBS.)
FRAME.....190 LBS.
LID.....120 LBS.
(NOTED AS TYPE J-H ON THE DRAINAGE TABLE)

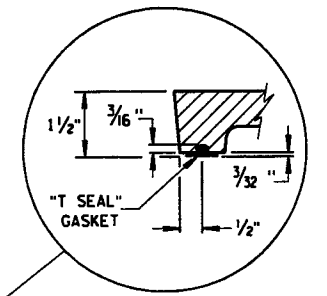

"T SEAL" GASKET DETAIL

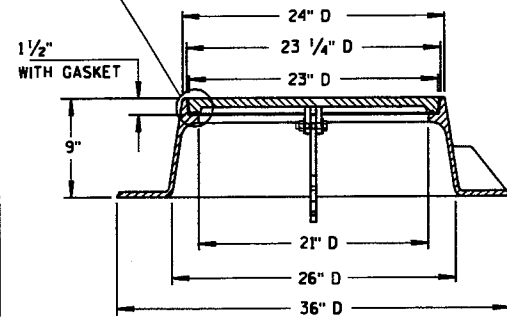

TYPE "J" HINGED-SPECIAL ①
LID WITH "T SEAL" GASKET
(APPROXIMATE WEIGHT 310 LBS.)
FRAME.....190 LBS.
LID.....120 LBS.
(NOTED AS TYPE J-S-H ON THE DRAINAGE TABLE)

INLET COVER, TYPE Z
MANHOLE COVERS, TYPE
K, J, J-S, J-H, J-H-S, L & M

STATE OF WISCONSIN
DEPARTMENT OF TRANSPORTATION

APPROVED
4-29-05
DATE
FHWA


[Signature]
CHIEF ROADWAY DEVELOPMENT ENGINEER

6


6

S.D.D. 8 A 5-17d

S.D.D. 8 A 5-17d

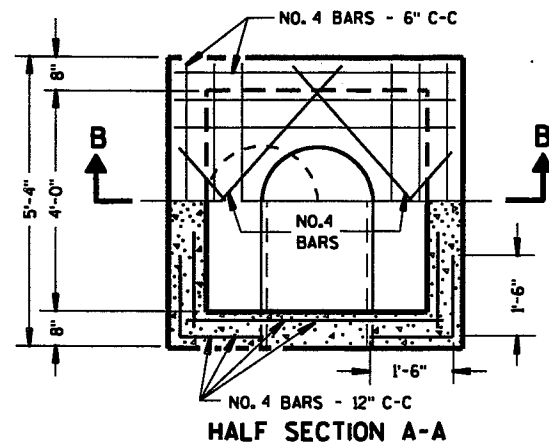

HALF SECTION A-A

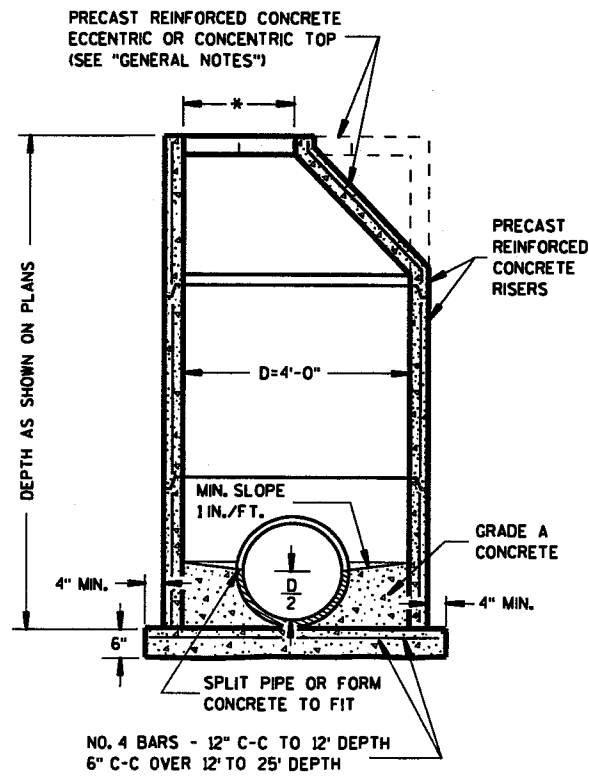

NO. 4 BARS - 12" C-C TO 12' DEPTH
6" C-C OVER 12' TO 25' DEPTH

PRECAST REINFORCED CONCRETE

GENERAL NOTES

DETAILS OF CONSTRUCTION, MATERIALS AND WORKMANSHIP NOT SHOWN ON THIS DRAWING SHALL CONFORM TO THE PERTINENT REQUIREMENTS OF THE STANDARD SPECIFICATIONS AND THE APPLICABLE SPECIAL PROVISIONS. DETAILED DRAWINGS FOR PROPOSED ALTERNATE DESIGNS FOR UNDERGROUND DRAINAGE STRUCTURES SHALL BE SUBMITTED TO THE ENGINEER FOR APPROVAL PROVIDING THAT SUCH ALTERNATE DESIGNS MAKE PROVISION FOR EQUIVALENT CAPACITY AND STRENGTH.

ALL DRAINAGE STRUCTURES ARE DESIGNATED ON THE PLANS AS "MANHOLES 1-C", "CATCH BASINS 1-B", "INLETS 3-H", ETC. THE FIRST DIGIT DESIGNATES THE MASONRY PORTION OF THE STRUCTURE, AND THE FOLLOWING LETTER DESIGNATES THE TYPE OF COVER TO BE USED TO COMPRISE THE COMPLETE UNIT.

PRECAST REINFORCED BASES SHALL BE PLACED ON A BED OF MATERIAL AT LEAST 6 INCHES IN DEPTH, WHICH MEETS THE REQUIREMENTS OF GRANULAR BACKFILL. THIS BEDDING SHALL BE COMPACTED AND PROVIDE UNIFORM SUPPORT FOR THE ENTIRE AREA OF THE BASE.

PRECAST REINFORCED CONE TOPS (ECCENTRIC OR CONCENTRIC) MAY BE USED ON CONCRETE BLOCK STRUCTURES. THE CONE TOPS SHALL BE INSTALLED ON A BED OF MORTAR.

ECCENTRIC CONE TOPS MAY BE USED ON ALL STRUCTURES, AND CONCENTRIC CONE TOPS SHALL BE USED ONLY ON STRUCTURES 5 FEET OR LESS IN DEPTH, UNLESS OTHERWISE DIRECTED BY THE ENGINEER.

STEPS CONFORMING TO AASHTO M 199 SHALL BE INSTALLED IN ALL STRUCTURES OVER 5 FEET IN DEPTH.

SOLID ALUMINUM STEPS SHALL HAVE A MINIMUM CROSS SECTIONAL DIMENSION OF 0.75 INCH. ALUMINUM SURFACES TO BE EMBEDDED IN CONCRETE SHALL BE GIVEN ONE COAT OF SUITABLE QUALITY PAINT, SUCH AS ZINC CHROMATE PRIMER CONFORMING TO FEDERAL SPECIFICATION TT-P-645 OR EQUIVALENT.


ALL BAR STEEL REINFORCEMENT SHALL BE EMBEDDED 2 INCHES CLEAR UNLESS OTHERWISE SHOWN OR NOTED.

PRECAST REINFORCED CONCRETE RISERS MAY BE PLACED WITH TONGUE UP OR DOWN.


ALL PRECAST INLET UNITS AND MANHOLES SHALL CONFORM TO THE PERTINENT REQUIREMENTS OF AASHTO DESIGNATION M 199.

* USE 2'-0" DIAMETER OPENING WITH TYPE "C", "L" AND "J" COVERS, OR 3'-0" DIAMETER WITH TYPE "K" AND "M" COVERS.

① 2 COURSES 6" BLOCK.

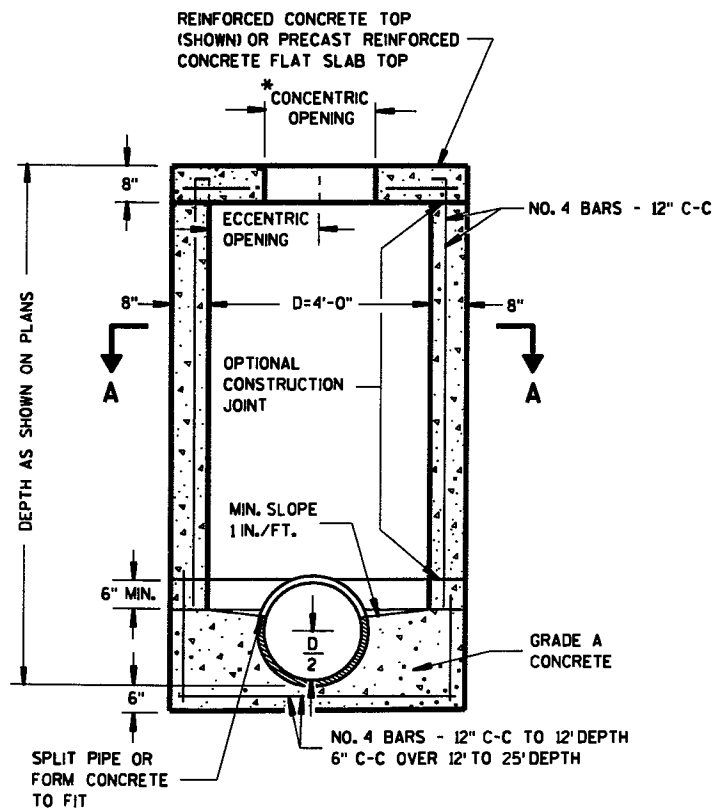

SECTION B-B
REINFORCED CONCRETE

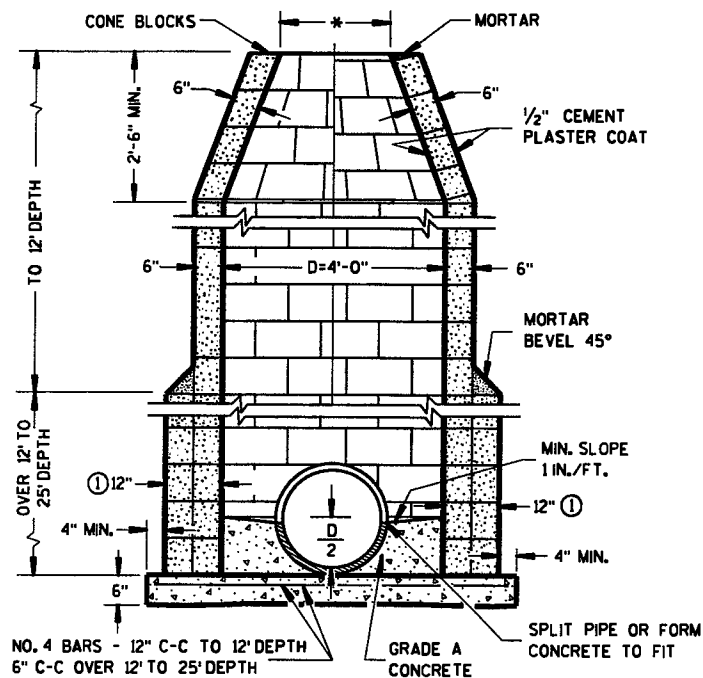

NO. 4 BARS - 12" C-C TO 12' DEPTH
6" C-C OVER 12' TO 25' DEPTH

CONCRETE BLOCK

6


6

S.D.D. 8 B 6-4


S.D.D. 8 B 6-4

MANHOLES TYPE 1


MANHOLES TYPE 1	
STATE OF WISCONSIN DEPARTMENT OF TRANSPORTATION	
APPROVED 9/9/05 DATE	/S/ Jerry M. Zogg ROADWAY STANDARDS DEVELOPMENT ENGINEER
FHWA	

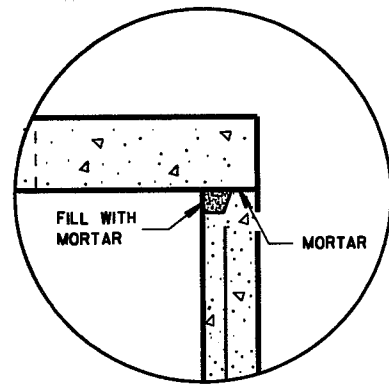

DETAIL "A"

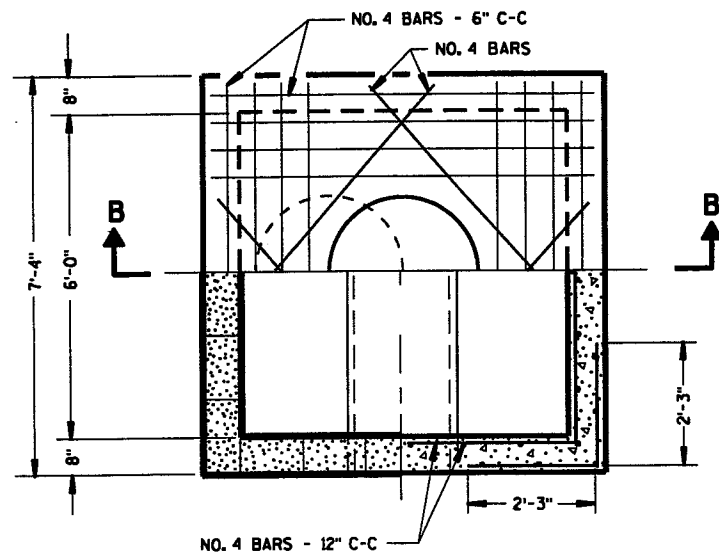


HALF SECTION A-A

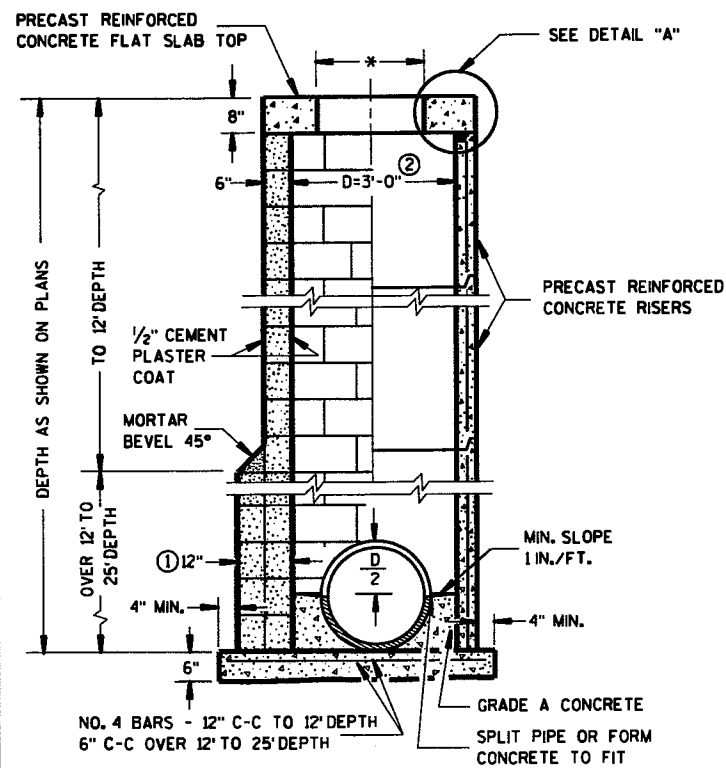

CONCRETE BLOCK

② PRECAST REINFORCED CONCRETE


MANHOLES TYPE 2

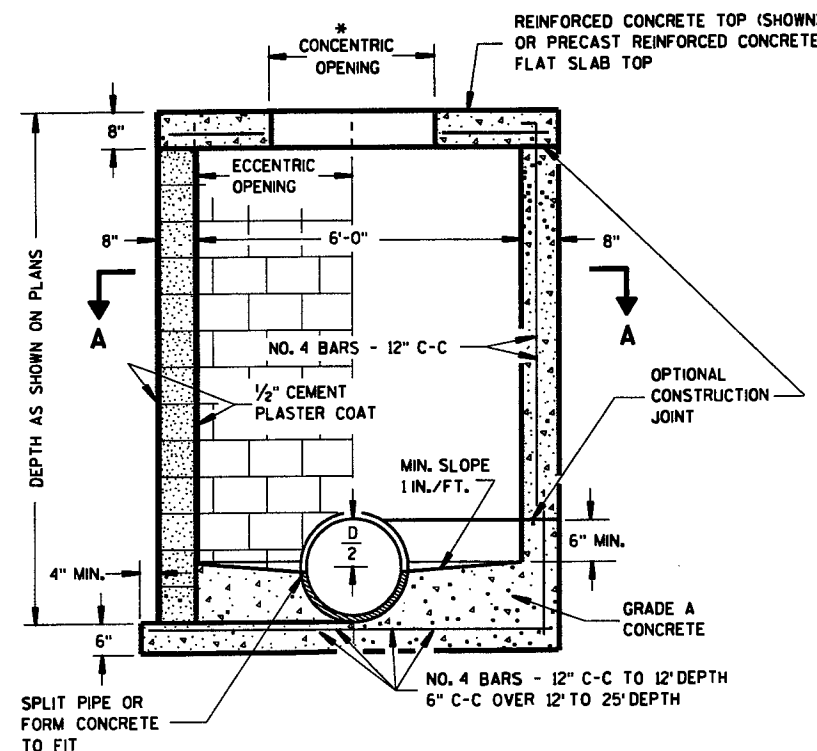

CONCRETE BLOCK

REINFORCED CONCRETE

MANHOLES TYPE 3

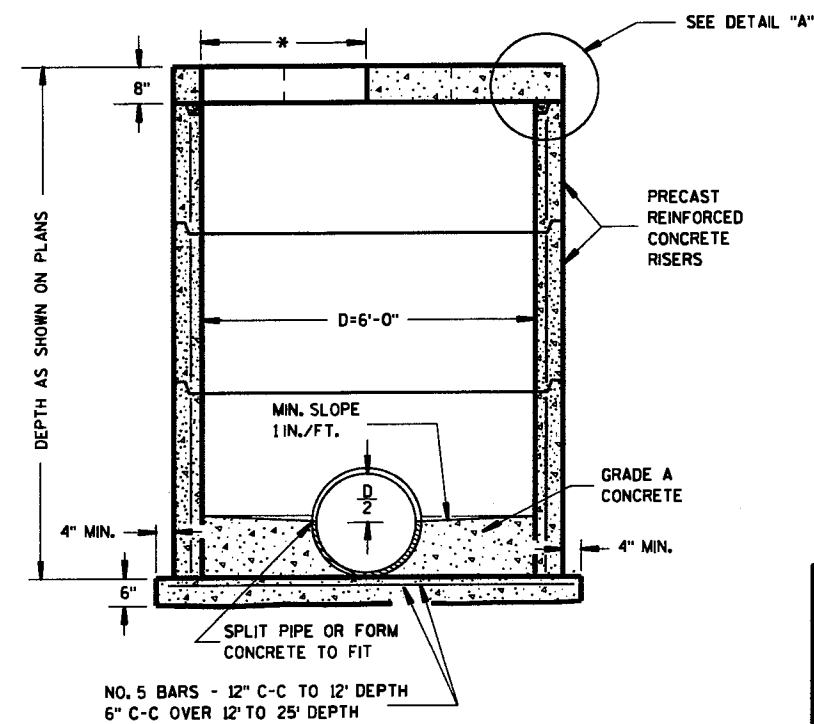

PRECAST REINFORCED CONCRETE

MANHOLES TYPE 2 & 3

STATE OF WISCONSIN
DEPARTMENT OF TRANSPORTATION

APPROVED
9/9/05 /S/ Jerry H. Zogg
DATE ROADWAY STANDARDS DEVELOPMENT
ENGINEER
FHWA

GENERAL NOTES

DETAILS OF CONSTRUCTION, MATERIALS AND WORKMANSHIP NOT SHOWN ON THIS DRAWING SHALL CONFORM TO THE PERTINENT REQUIREMENTS OF THE STANDARD SPECIFICATIONS AND THE APPLICABLE SPECIAL PROVISIONS.

DETAILED DRAWINGS FOR PROPOSED ALTERNATE DESIGNS FOR UNDERGROUND DRAINAGE STRUCTURES SHALL BE SUBMITTED TO THE ENGINEER FOR APPROVAL PROVIDING THAT SUCH ALTERNATE DESIGNS MAKE PROVISION FOR EQUIVALENT CAPACITY AND STRENGTH.

ALL DRAINAGE STRUCTURES ARE DESIGNATED ON THE PLANS AS "MANHOLES 1-C", "CATCH BASINS 1-B", "INLETS 3-H", ETC. THE FIRST DIGIT DESIGNATES THE MASONRY PORTION OF THE STRUCTURE, AND THE FOLLOWING LETTER DESIGNATES THE TYPE OF COVER TO BE USED TO COMPRISE THE COMPLETE UNIT.

PRECAST REINFORCED BASES SHALL BE PLACED ON A BED OF MATERIAL AT LEAST 6 INCHES IN DEPTH, WHICH MEETS THE REQUIREMENTS OF GRANULAR BACKFILL. THIS BEDDING SHALL BE COMPACTED AND PROVIDE UNIFORM SUPPORT FOR THE ENTIRE AREA OF THE BASE.

STEPS CONFORMING TO AASHTO M 199 SHALL BE INSTALLED IN ALL STRUCTURES OVER 5 FEET IN DEPTH.

SOLID ALUMINUM STEPS SHALL HAVE A MINIMUM CROSS SECTIONAL DIMENSION OF 0.75 INCH. ALUMINUM SURFACES TO BE EMBEDDED IN CONCRETE SHALL BE GIVEN ONE COAT OF SUITABLE QUALITY PAINT, SUCH AS ZINC CHROMATE PRIMER CONFORMING TO FEDERAL SPECIFICATION TT-P-645 OR EQUIVALENT.

ALL BAR STEEL REINFORCEMENT SHALL BE EMBEDDED 2 INCHES CLEAR UNLESS OTHERWISE SHOWN OR NOTED.

PRECAST REINFORCED CONCRETE RISERS MAY BE PLACED WITH TONGUE UP OR DOWN.

ALL PRECAST INLET UNITS AND MANHOLES SHALL CONFORM TO THE PERTINENT REQUIREMENTS OF AASHTO DESIGNATION M 199.

* USE 2'-0" DIAMETER OPENING WITH TYPE "C", "L" AND "J" COVERS, OR 3'-0" DIAMETER WITH TYPE "K" AND "M" COVERS.

① 2 COURSES 6" BLOCK.

② WHEN CONNECTING PIPES ARE 24" OR LARGER THE PRECAST MANHOLES MAY BE INCREASED TO 42" DIAMETER.


6

6


S.D.D. 8 B 7-4

S.D.D. 8 B 7-4

*SELECTION OF SQUARE OR CIRCULAR DESIGN WILL BE BASED ON THE PIPE SIZES AND THE INLET COVER BEING UTILIZED

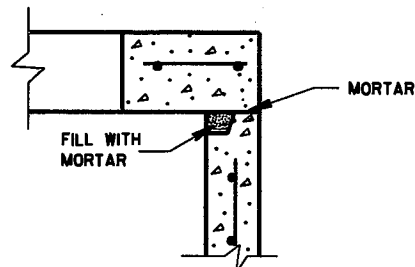

DETAIL "A"

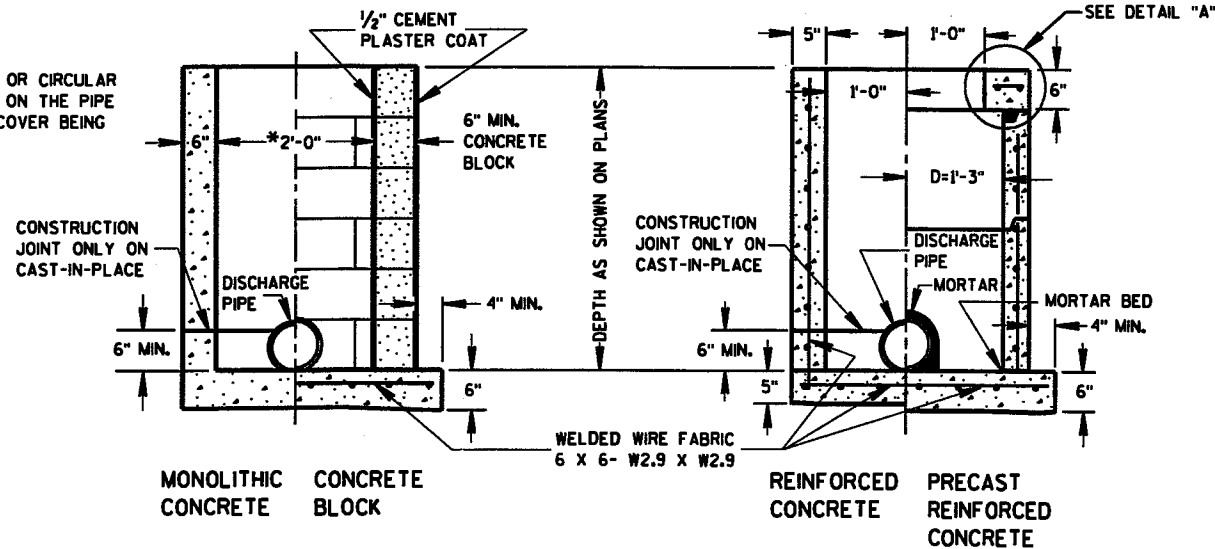

INLETS TYPE 1

GENERAL NOTES

DETAILS OF CONSTRUCTION, MATERIALS AND WORKMANSHIP NOT SHOWN ON THIS DRAWING SHALL CONFORM TO THE PERTINENT REQUIREMENTS OF THE STANDARD SPECIFICATIONS AND THE APPLICABLE SPECIAL PROVISIONS.

DETAILED DRAWINGS FOR PROPOSED ALTERNATE DESIGNS FOR UNDERGROUND DRAINAGE STRUCTURES SHALL BE SUBMITTED TO THE ENGINEER FOR APPROVAL PROVIDING THAT SUCH ALTERNATE DESIGNS MAKE PROVISION FOR EQUIVALENT CAPACITY AND STRENGTH.

ALL PRECAST INLET UNITS SHALL CONFORM TO THE PERTINENT REQUIREMENTS OF AASHTO DESIGNATION M 199.

ALL DRAINAGE STRUCTURES ARE DESIGNATED ON THE PLANS AS "MANHOLES I-C", "CATCH BASINS I-B", "INLETS 3-H", ETC. THE FIRST DIGIT DESIGNATES THE MASONRY PORTION OF THE STRUCTURE, AND THE FOLLOWING LETTER DESIGNATES THE TYPE OF COVER TO BE USED TO COMPRISE THE COMPLETE UNIT.


PRECAST REINFORCED BASES SHALL BE PLACED ON A BED OF MATERIAL AT LEAST 6 INCHES IN DEPTH, WHICH MEETS THE REQUIREMENTS OF GRANULAR BACKFILL. THIS BEDDING SHALL BE COMPACTED AND PROVIDE UNIFORM SUPPORT FOR THE ENTIRE AREA OF THE BASE.

PRECAST REINFORCED CONCRETE FLAT SLAB TOPS MAY BE USED ON THE STRUCTURES. THE TOPS SHALL BE INSTALLED ON A BED OF MORTAR.

ALL BAR STEEL REINFORCEMENT SHALL BE EMBEDDED 2 INCHES CLEAR UNLESS OTHERWISE SHOWN OR NOTED.


PRECAST REINFORCED CONCRETE RISERS SHALL BE PLACED WITH TONGUE DOWN.

- ① USE 2'-6" OPENING FOR TYPE 2 INLETS, 3'-0" OPENING FOR TYPE 3 INLETS, AND 2'-11" FOR TYPE 4 INLETS.
- ② USE 2'-0" OPENING FOR TYPE 1, 2 & 3 INLETS, 2'-6 1/2" OPENING FOR TYPE 4 INLETS.

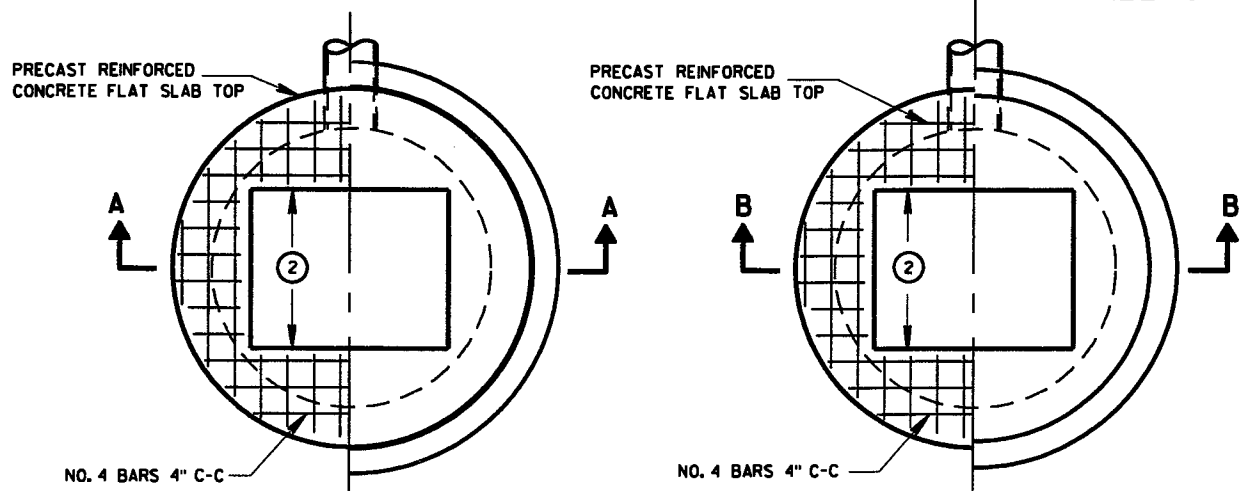


PLAN VIEW

PLAN VIEW

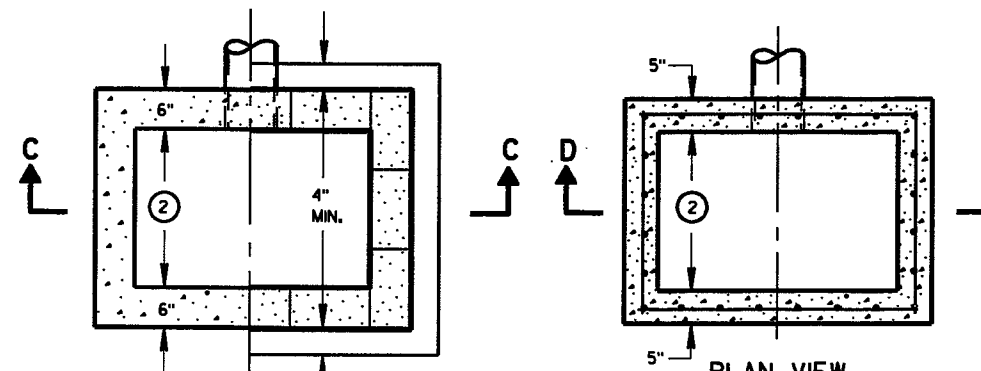


PLAN VIEW

PLAN VIEW

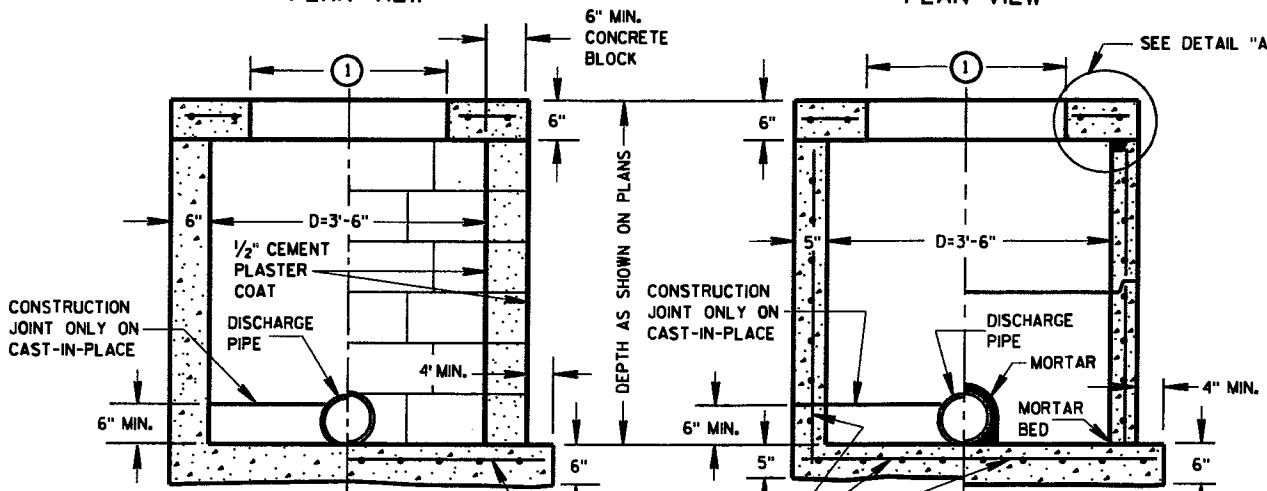

SECTION A-A

SECTION B-B

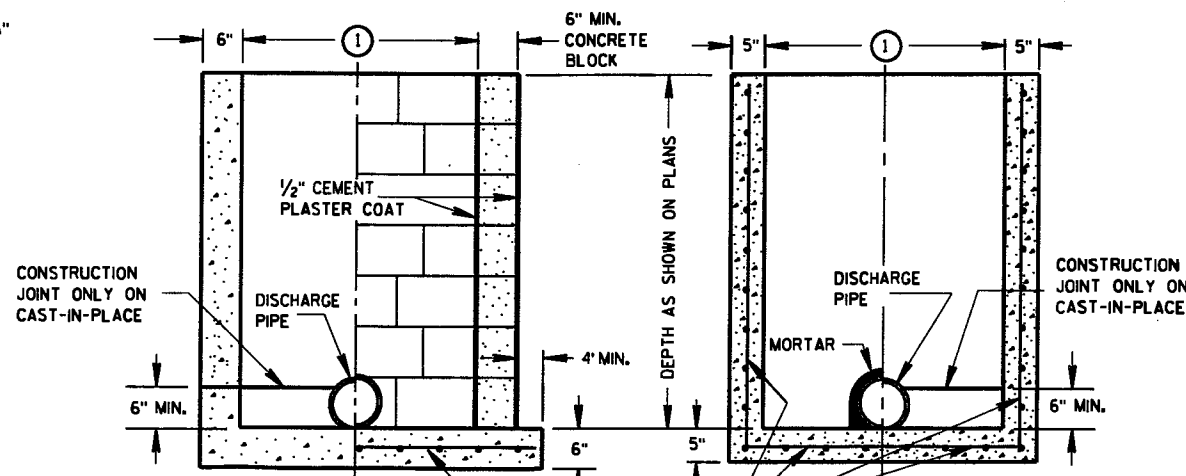

SECTION C-C

SECTION D-D

INLETS TYPE 2, 3 & 4

INLETS TYPE 1, 2, 3 & 4


STATE OF WISCONSIN
DEPARTMENT OF TRANSPORTATION

APPROVED
8/26/94
DATE
[Signature]
CHIEF ROADWAY DEVELOPMENT ENGINEER
FHWA


S.D.D. 8 C 1-5

S.D.D. 8 C 1-5


ASPHALTIC FLUME

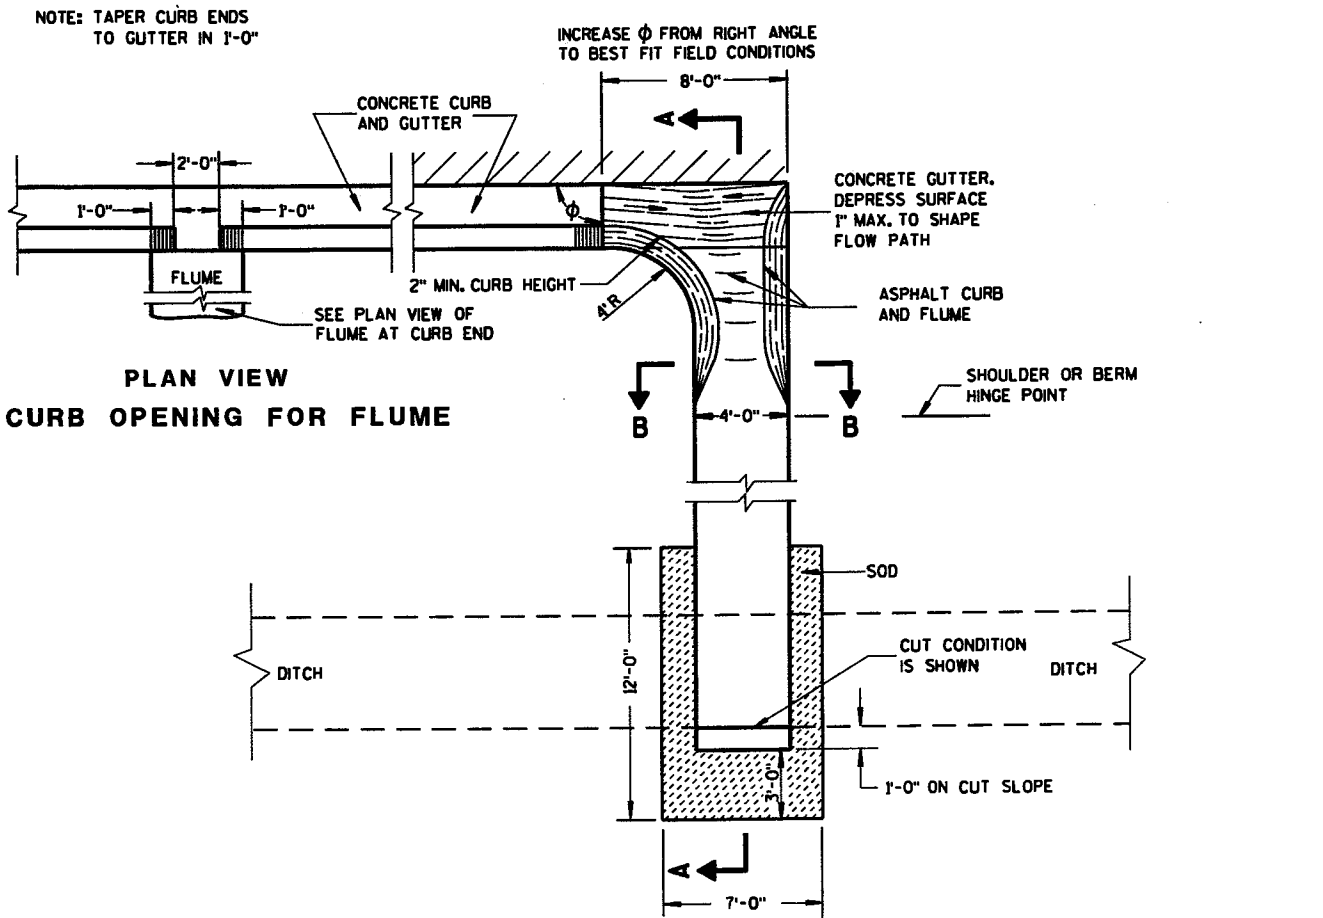

PLAN VIEW FLUME AT CURB END

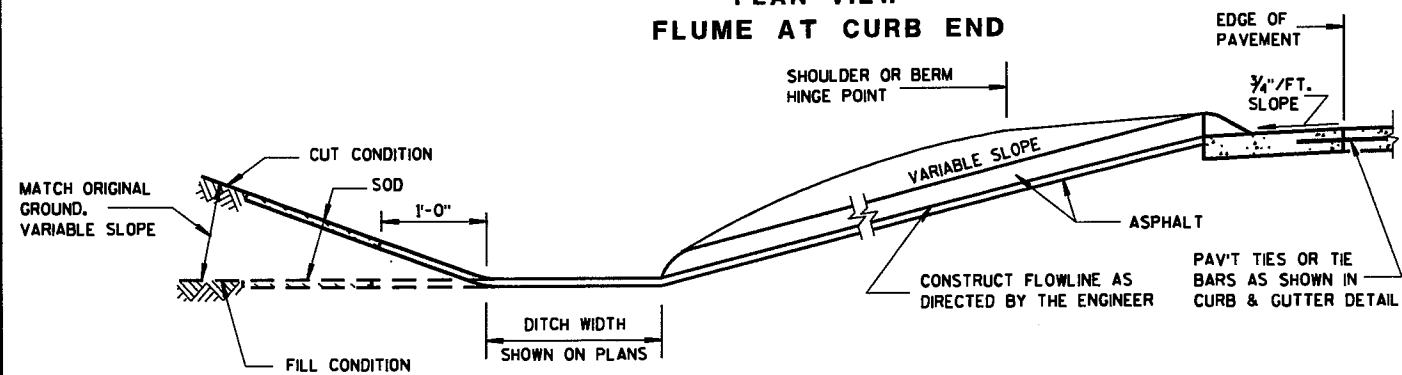

SECTION A-A

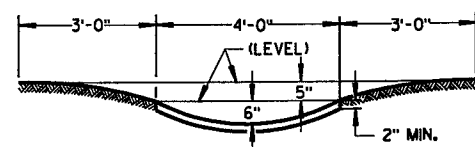

SECTION B-B


GENERAL NOTES

DETAILS OF CONSTRUCTION, MATERIALS AND WORKMANSHIP NOT SHOWN ON THIS DRAWING SHALL CONFORM TO PERTINENT REQUIREMENTS OF THE STANDARD SPECIFICATIONS AND APPLICABLE SPECIAL PROVISIONS.


WELDED STEEL WIRE FABRIC SHALL BE IN ACCORDANCE WITH AASHTO SPECIFICATION M55.

- ① JOINTS SHALL BE 1/8 TO 1/4 INCH WIDE BY 1/2 INCHES DEEP AND SPACED AT UNIFORM INTERVALS OF APPROXIMATELY 4 FEET.
- ② GEOTEXTILE FABRIC TYPE "R" SHALL UNDERLAY THE FULL LENGTH AND WIDTH OF THE CONCRETE SURFACE DRAIN AND RIPRAP.
- ③ CONCRETE SURFACE DRAIN WITHOUT CURB AND GUTTER MAY BE USED ON BACKSLOPES WHEN SPECIFIED


③ CONCRETE SURFACE DRAIN

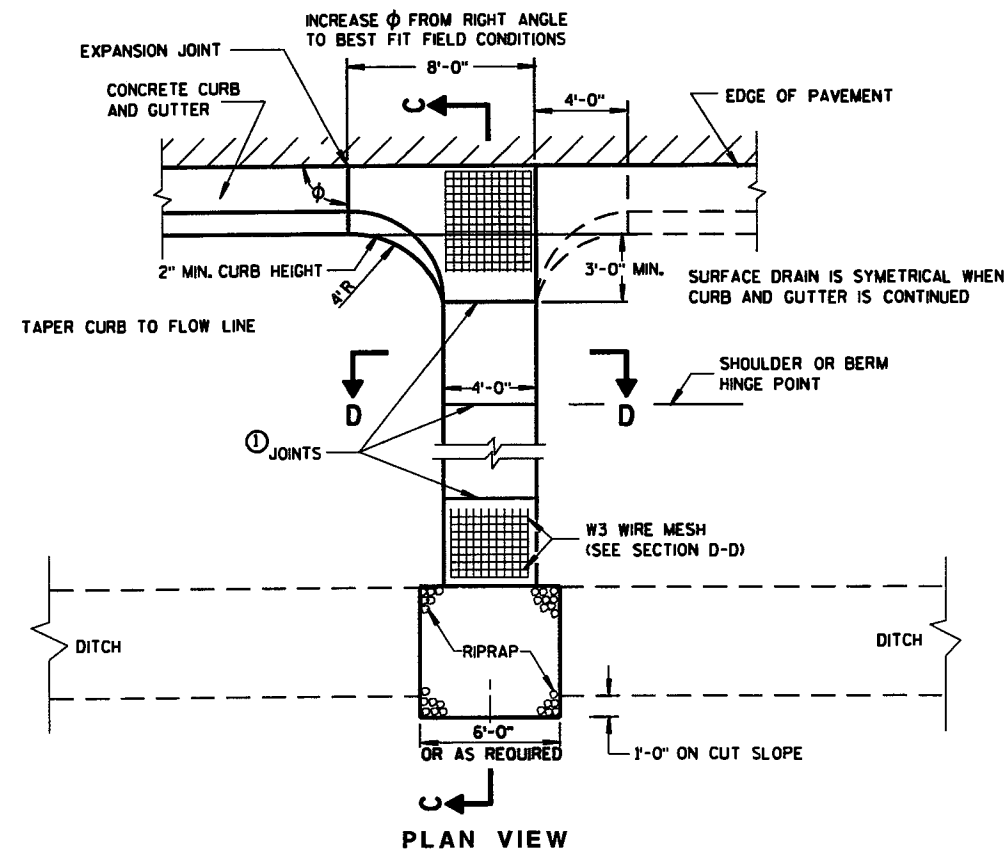

PLAN VIEW

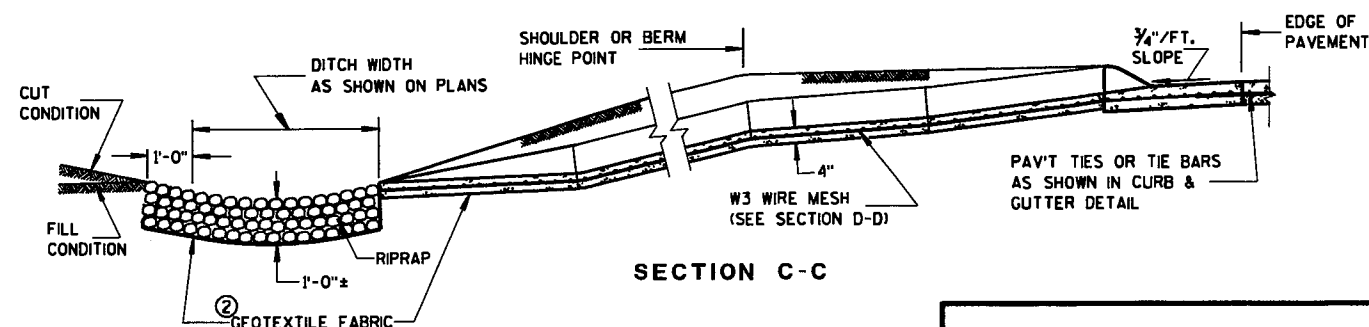

SECTION C-C

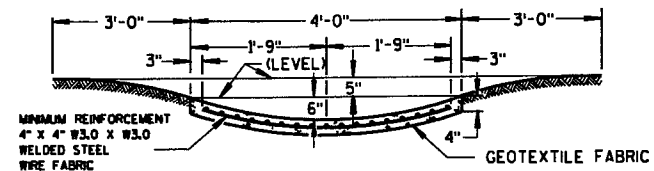

SECTION D-D

CONCRETE SURFACE DRAINS & ASPHALTIC FLUMES

STATE OF WISCONSIN
DEPARTMENT OF TRANSPORTATION

APPROVED

12-17-07


DATE

FHWA


/S/ Jerry H. Zogg

ROADWAY STANDARDS DEVELOPMENT

ENGINEER

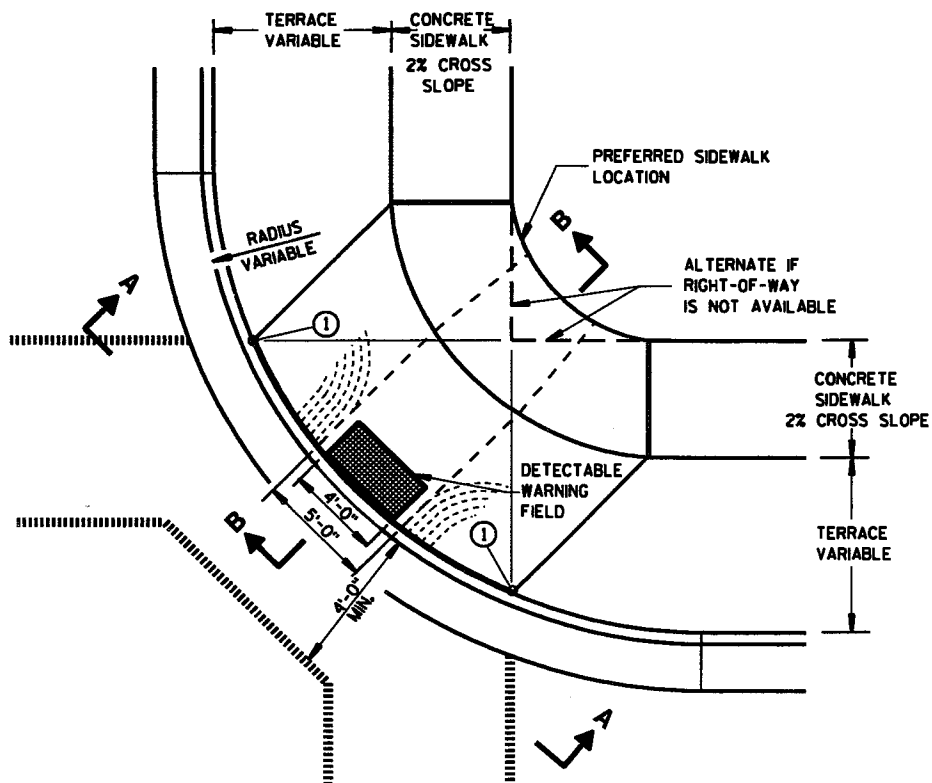

**PLAN VIEW
TYPE 1 RAMP
(CENTER OF CORNER RADIUS)**

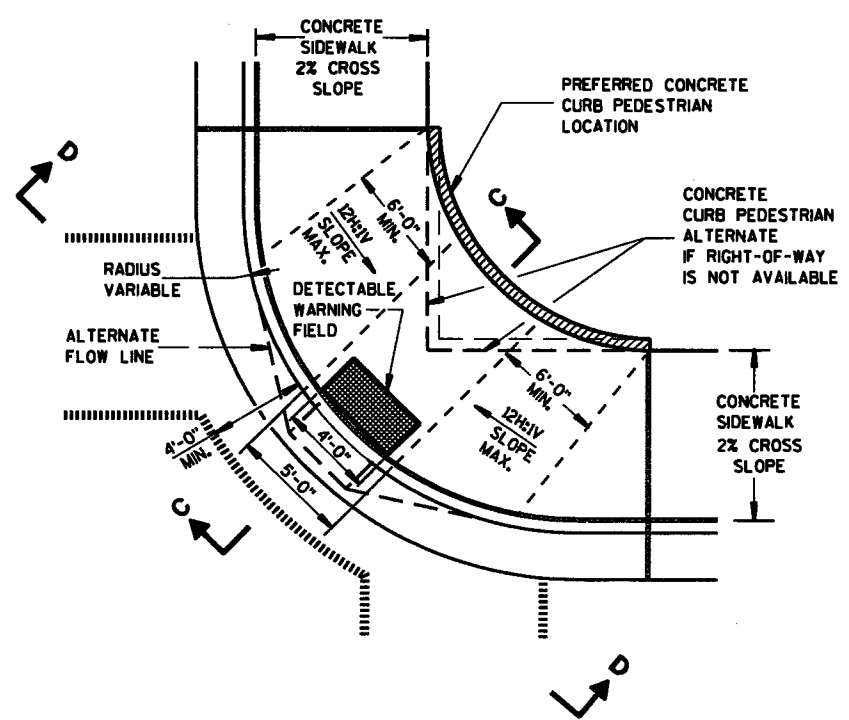


**PLAN VIEW
TYPE 1-A RAMP
(NO TERRACE)**

GENERAL NOTES


- DETAILS OF CONSTRUCTION, MATERIALS AND WORKMANSHIP NOT SHOWN ON THIS DRAWING SHALL CONFORM TO THE PERTINENT REQUIREMENTS OF THE STANDARD SPECIFICATIONS AND THE APPLICABLE SPECIAL PROVISIONS.
- RAMPS SHALL BE BUILT AT 12H:1V OR FLATTER. WHEN NECESSARY, THE SIDEWALK ELEVATION MAY BE LOWERED TO MEET THE HIGH POINT ON THE RAMP.
- TYPE 1 RAMPS SHALL HAVE A NORMAL SIDEWALK APRON AND CURB ON BOTH SIDES OF RAMP.
- DETECTABLE WARNING FIELD SHALL BE MEASURED AND PAID BY THE SQUARE FOOT AS "CURB RAMP DETECTABLE WARNING FIELD". THE CONCRETE PEDESTRIAN CURB, IF NEEDED, SHALL BE MEASURED AND PAID BY THE LINEAL FOOT AS "CONCRETE CURB PEDESTRIAN". CONCRETE SIDEWALK IN THE CURB RAMP AREA SHALL BE MEASURED AND PAID BY THE SQUARE FOOT AS CONCRETE SIDEWALK, INCLUDING THE AREA UNDER THE DETECTABLE WARNING FIELD.
- SELECT CURB RAMP DETECTABLE WARNING FIELD MATERIALS AND DEVICES FROM THE DEPARTMENT'S APPROVED MATERIALS LIST. THE COLOR OF THE DETECTABLE WARNING FIELD IS SPECIFIED ELSEWHERE AND IS INCIDENTAL TO THE BID ITEM OF "CURB RAMP DETECTABLE WARNING FIELD".
- SURFACE TEXTURE OF THE RAMP SHALL BE OBTAINED BY COARSE BROOMING TRANSVERSE TO THE SLOPE OF THE RAMP.
- ① THIS POINT IS AN EXTENSION OF OUTSIDE EDGE OF APPROACHING SIDEWALK WHERE IT MEETS THE BACK OF CONCRETE CURB.
 - ② GRADE CHANGE BETWEEN GUTTER FLAG SLOPE AND THE CURB RAMP SLOPE SHALL NOT EXCEED 1%. PROVIDE DRAINAGE AWAY FROM CURB RAMP AT GUTTER FLAG INTERFACE.

LEGEND


- 1/2" EXPANSION JOINT-SIDEWALK
- - - CONTRACTION JOINT FIELD LOCATED
- ▤ PAVEMENT MARKING CROSSWALK (WHITE)
- - - ALTERNATIVE LAYOUT

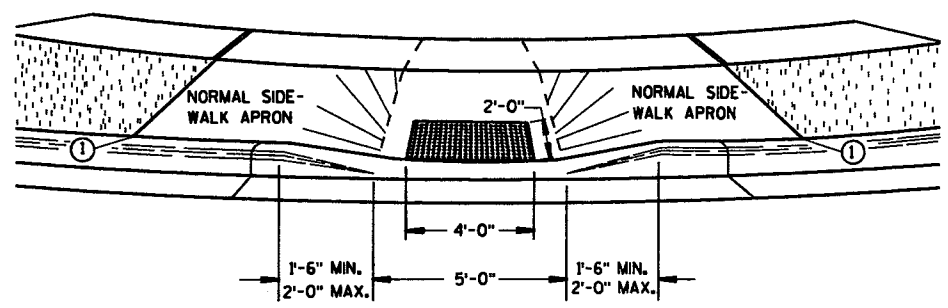


VIEW A-A

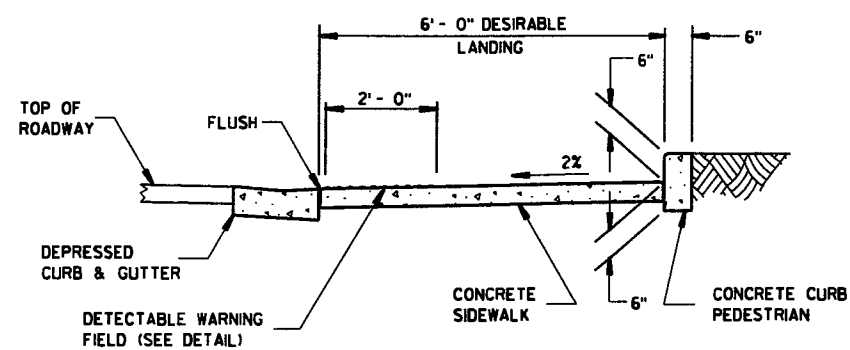

SECTION C-C

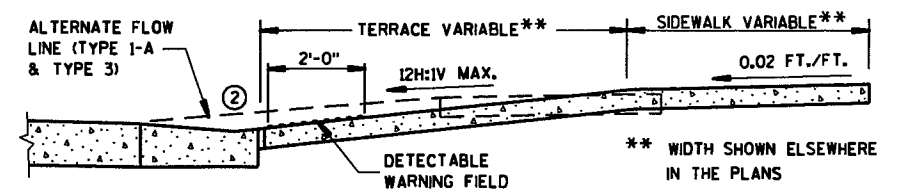

SECTION B-B

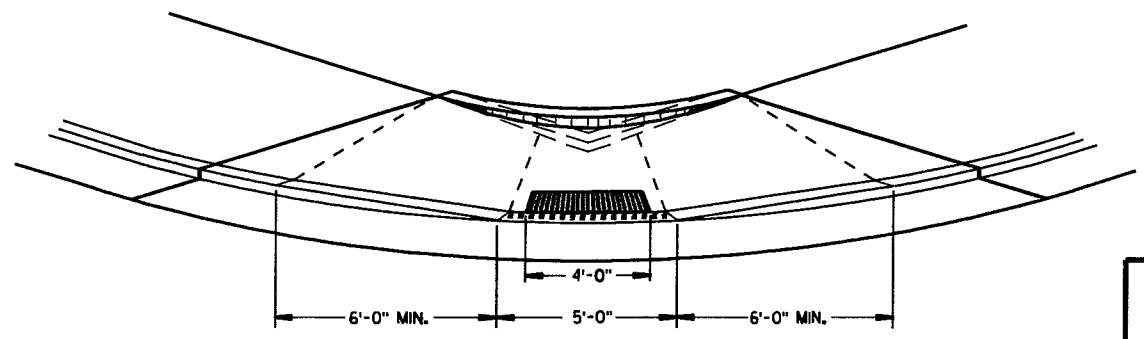

VIEW D-D

**CURB RAMPS
TYPES 1 AND 1-A**


STATE OF WISCONSIN
DEPARTMENT OF TRANSPORTATION

6


6

S.D.D. 8 D 5-110


S.D.D. 8 D 5-110

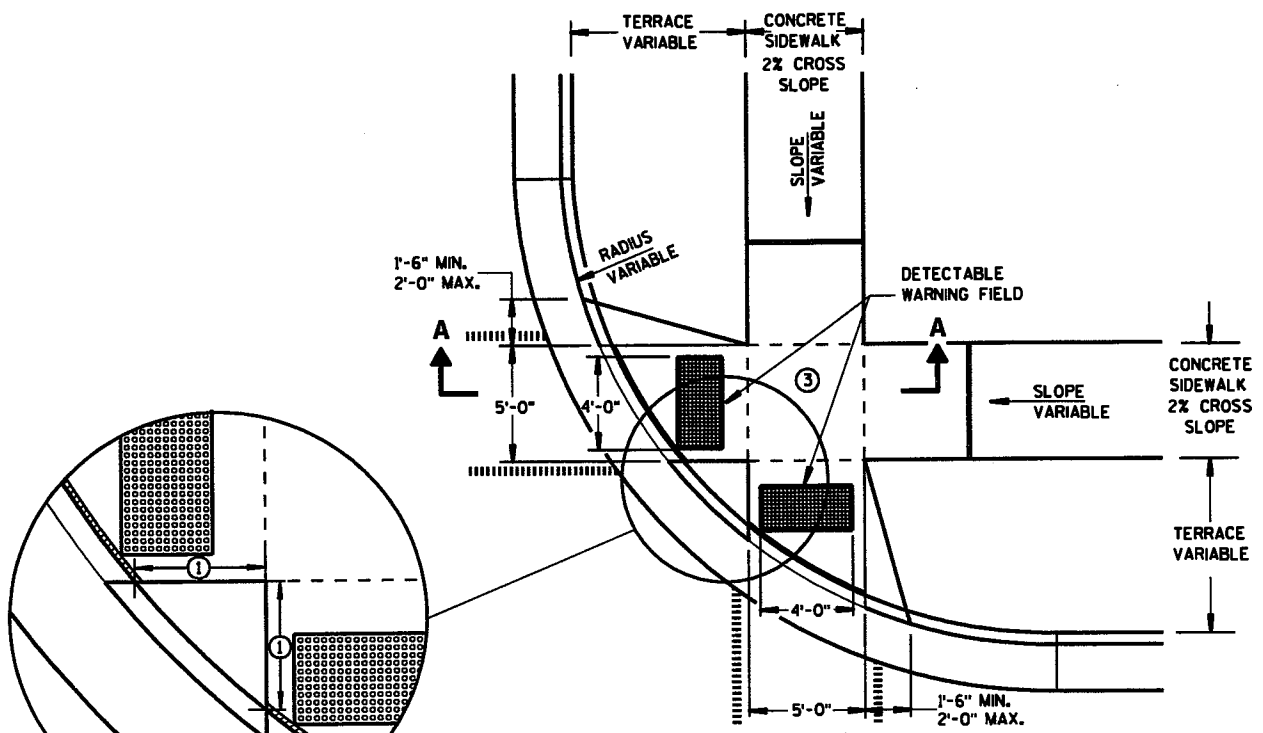

**PLAN VIEW
TYPE 2 RAMP
(ON LINE WITH SIDEWALK)**

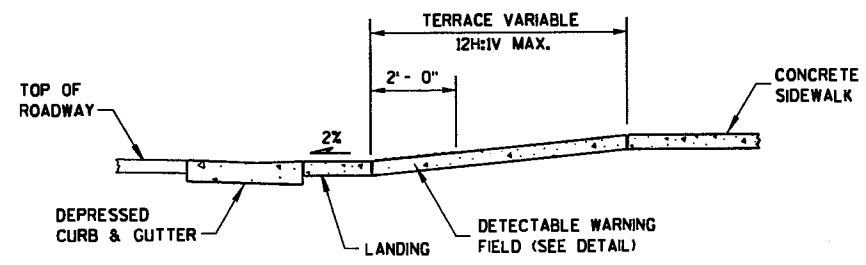

SECTION A-A

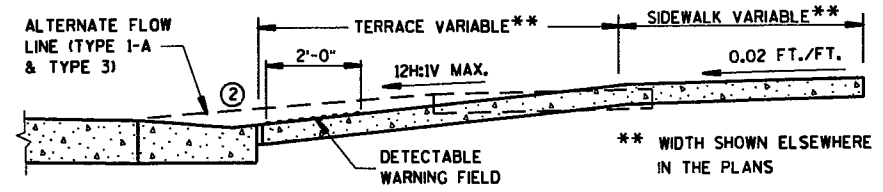


SECTION B-B

GENERAL NOTES

- USE THE TYPE 3 RAMP ONLY WHEN A TYPE 1 OR TYPE 2 CANNOT BE ACHIEVED BECAUSE OF FIELD CONDITIONS.
- ① WHEN THIS DISTANCE IS LESS THAN 6'-0" IT MAY BE DIFFICULT TO ACHIEVE A 12H:1V SLOPE, OR FLATTER, ON THE RAMP. REDUCE CURB HEIGHT IN TRIANGLE AREA TO ACHIEVE 12H:1V SLOPE, OR FLATTER, ON RAMP. 2" MINIMUM CURB HEIGHT.
- ② GRADE CHANGE BETWEEN GUTTER FLAG SLOPE AND THE CURB RAMP SLOPE SHALL NOT EXCEED 11%. PROVIDE DRAINAGE AWAY FROM CURB RAMP AT GUTTER FLAG INTERFACE.
- ③ PROVIDE LANDING AT TOP OF RAMP WITH NO MORE THAN 2% SLOPE IN ANY DIRECTION.

LEGEND

- 1/2" EXPANSION JOINT-SIDEWALK
- - - CONTRACTION JOINT FIELD LOCATED
- ||||| PAVEMENT MARKING CROSSWALK (WHITE)
- - - ALTERNATIVE LAYOUT

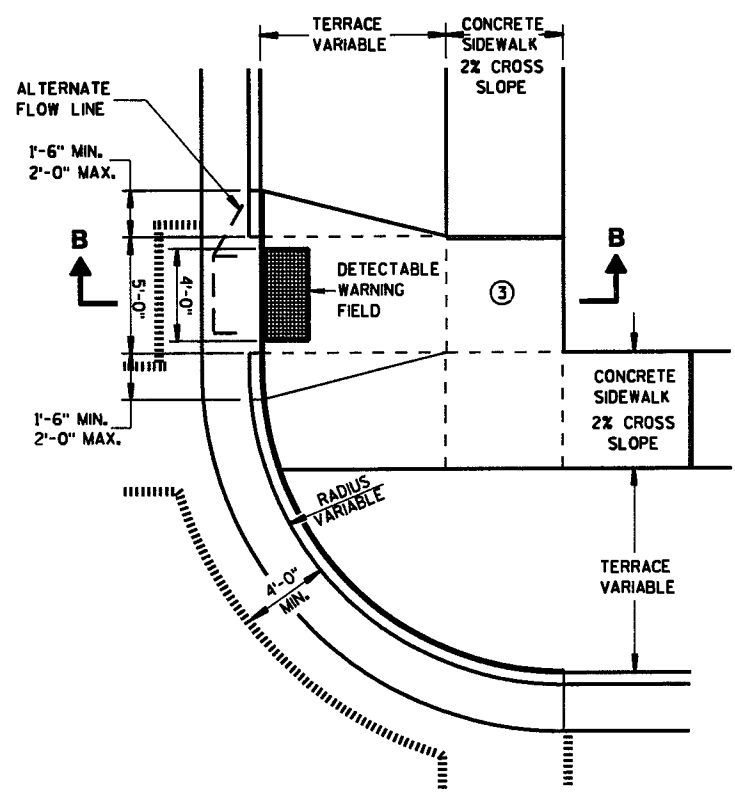


**PLAN VIEW
TYPE 3 RAMP
(OUTSIDE OF CROSSWALK AREA)**


**CURB RAMPS
TYPES 2 AND 3**

STATE OF WISCONSIN
DEPARTMENT OF TRANSPORTATION

6

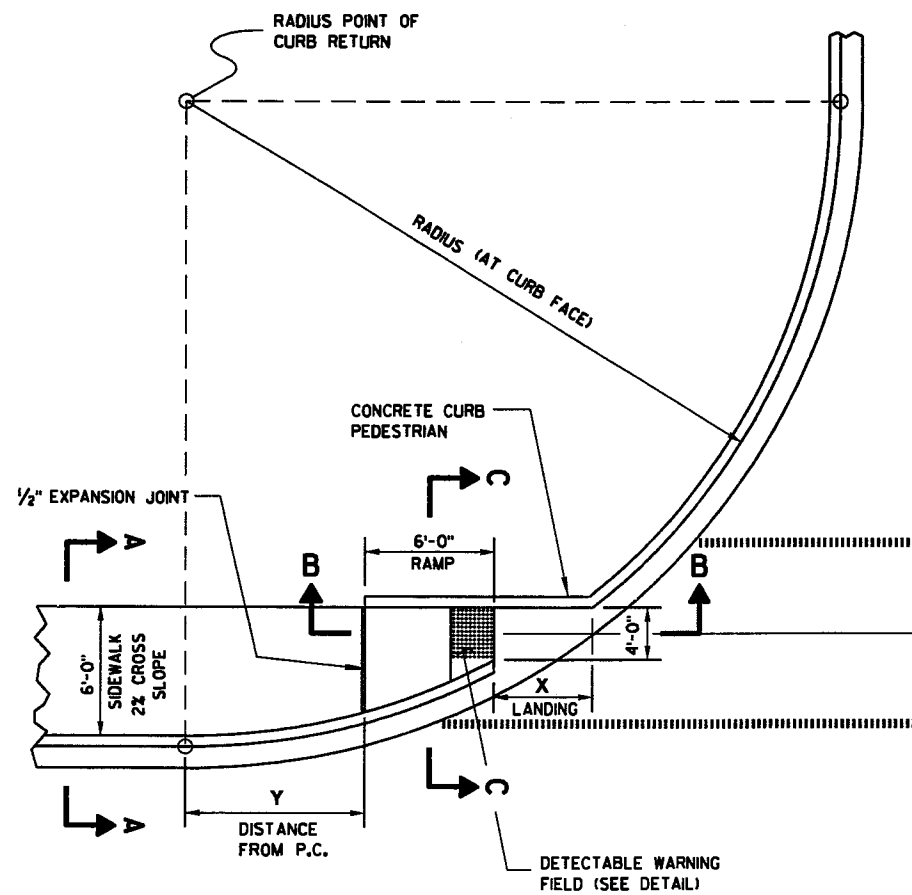


**CURB RAMP TYPE 4A
PLAN VIEW**

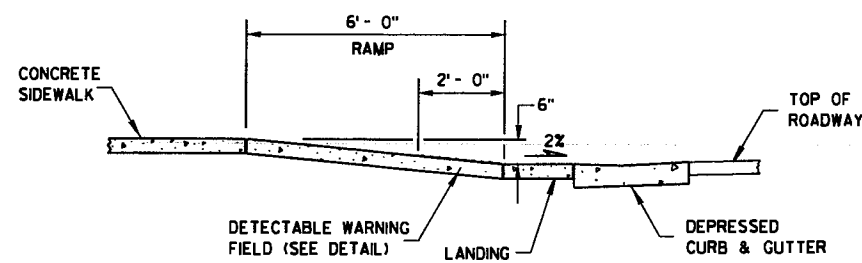


SECTION B-B

RADIUS (AT CURB FACE)	X	Y
20 FEET	6'-1 ³ / ₄ "	2'-7 ¹ / ₄ "
30 FEET	7'-11 ³ / ₄ "	4'-8 ¹ / ₄ "
40 FEET	9'-5 ¹ / ₄ "	6'-5"
50 FEET	10'-8 ³ / ₄ "	7'-11 ¹ / ₄ "
60 FEET	11'-10 ¹ / ₄ "	9'-3 ¹ / ₂ "

INTERMEDIATE RADII CAN BE INTERPOLATED

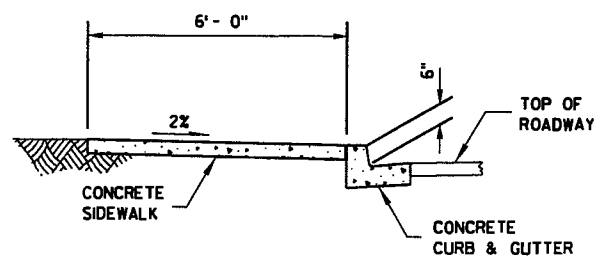

SECTION A-A

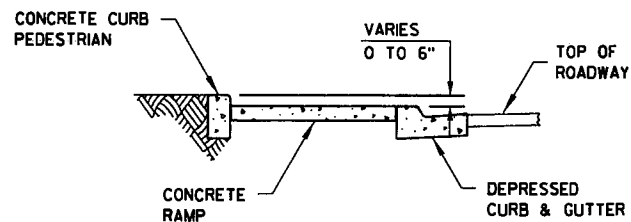


SECTION C-C

GENERAL NOTES

AVOID PLACING DRAINAGE STRUCTURES, JUNCTION BOXES OR OTHER OBSTRUCTIONS IN FRONT OF RAMP ACCESS AREAS.

RAMP SLOPES SHALL NOT BE STEEPER THAN 12:1

SIDEWALK CROSS SLOPE SHALL NOT EXCEED 2%.

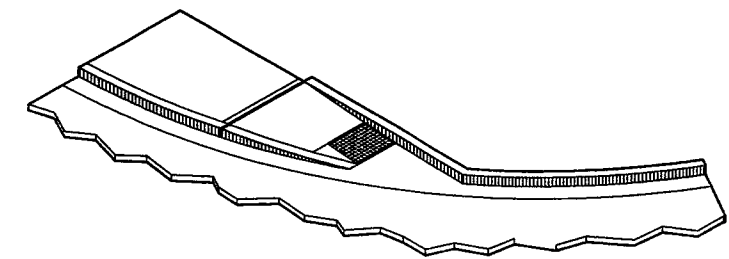

ISOMETRIC VIEW

LEGEND


- 1/2" EXPANSION JOINT-SIDEWALK
- - - CONTRACTION JOINT FIELD LOCATED
- ||||| PAVEMENT MARKING CROSSWALK (WHITE)

**CURB RAMPS
TYPE 4A**


STATE OF WISCONSIN
DEPARTMENT OF TRANSPORTATION

S.D.D. 8 D 5-11c


S.D.D. 8 D 5-11c

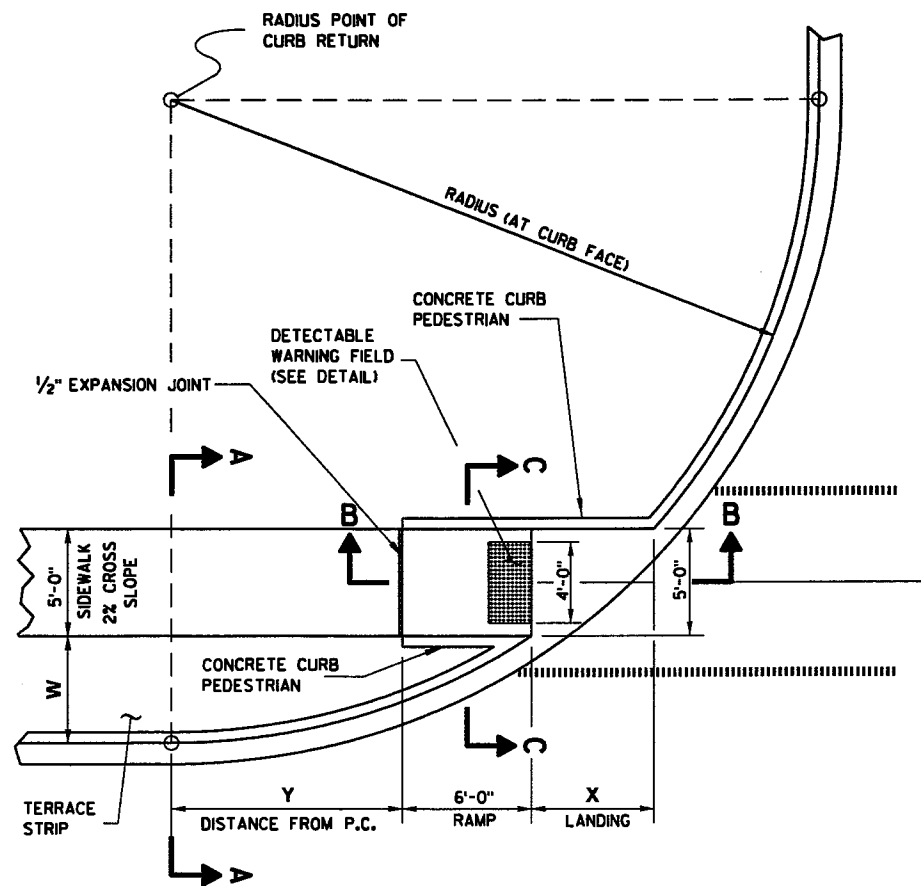


**CURB RAMP TYPE 4B
PLAN VIEW**

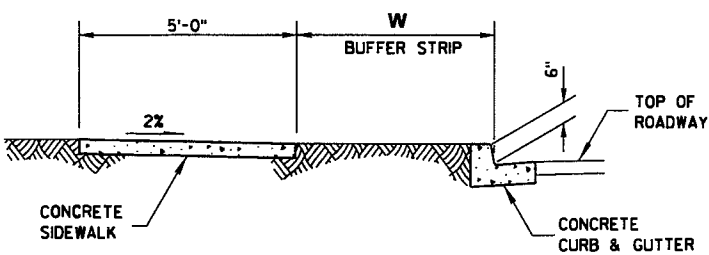

SECTION A-A

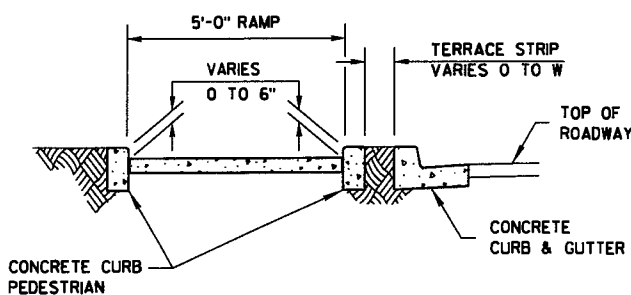

SECTION C-C

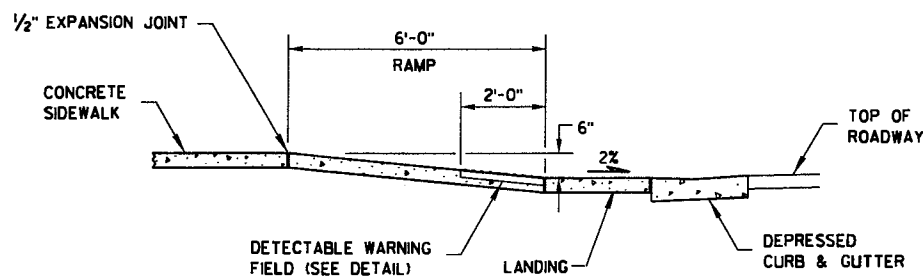

SECTION B-B

GENERAL NOTES


AVOID PLACING DRAINAGE STRUCTURES, JUNCTION BOXES OR OTHER OBSTRUCTIONS IN FRONT OF RAMP ACCESS AREAS.

RAMP SLOPES SHALL NOT BE STEEPER THAN 12:1

SIDEWALK CROSS SLOPE SHALL NOT EXCEED 2%.

RADIUS (AT CURB FACE)	W = 3' - 0"		W = 4' - 0"		W = 5' - 0"		W = 6' - 0"		W = 7' - 0"	
	X	Y	X	Y	X	Y	X	Y	X	Y
20 FEET	5'-5 1/2"	4'-6 1/2"	4'-8 1/2"	6'-0"	4'-1"	7'-2 3/4"	3'-7"	8'-3 1/2"	3'-1 1/2"	9'-2 1/2"
30 FEET	7'-3 3/4"	7'-1"	6'-5 1/2"	8'-11 1/2"	5'-9 1/4"	10'-7"	5'-2 1/2"	12'-0"	4'-8 3/4"	13'-3 1/4"
40 FEET	8'-9 1/2"	9'-2 1/2"	7'-10"	11'-5 1/4"	7'-1"	13'-4 1/2"	6'-5 3/4"	15'-3 1/4"	5'-11 1/2"	16'-7 1/4"
50 FEET	10'-3 1/4"	11'-3 1/4"	9'-1 1/4"	13'-7 1/4"	8'-2 1/2"	15'-9 1/2"	7'-6 1/2"	17'-9"	6'-11 3/4"	19'-6 1/4"
60 FEET	11'-2 1/2"	12'-8 3/4"	10'-3 1/4"	15'-6 1/2"	9'-2 1/4"	17'-11 3/4"	8'-5 3/4"	20'-1 1/4"	7'-10 1/2"	22'-1 1/2"
70 FEET	12'-2 3/4"	14'-3 1/4"	11'-1 1/4"	17'-4"	10'-1"	19'-11 3/4"	9'-3 3/4"	22'-4 1/4"	8'-8 1/4"	24'-6 1/4"
80 FEET	13'-2"	15'-8 1/2"	11'-10 1/2"	18'-11 3/4"	10'-10 3/4"	21'-10"	10'-1"	24'-4 3/4"	9'-5"	26'-8 3/4"
90 FEET	14'-1 1/2"	17'-1 1/2"	12'-8 1/4"	20'-6 1/2"	11'-7 3/4"	23'-7"	10'-9 3/4"	26'-3 3/4"	10'-1 1/4"	28'-9 1/2"
100 FEET	14'-10 1/2"	18'-3 3/4"	13'-5 1/2"	22'-0"	12'-4 1/4"	25'-2 3/4"	11'-5 3/4"	28'-1 1/2"	10'-9"	30'-9"

INTERMEDIATE RADII CAN BE INTERPOLATED

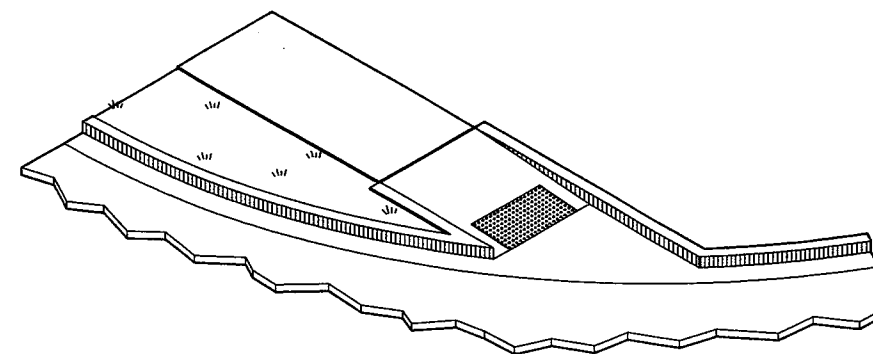


ISOMETRIC VIEW

LEGEND


- 1/2" EXPANSION JOINT-SIDEWALK
- - - CONTRACTION JOINT FIELD LOCATED
- ||||| PAVEMENT MARKING CROSSWALK (WHITE)

**CURB RAMPS
TYPE 4B**


STATE OF WISCONSIN
DEPARTMENT OF TRANSPORTATION

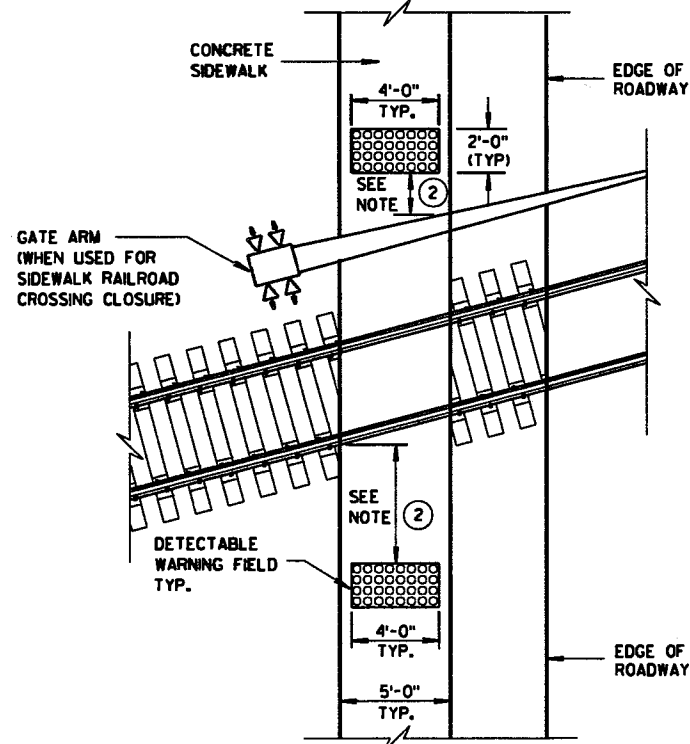


TYPE 8
DETECTABLE WARNINGS
AT RAILROAD CROSSING

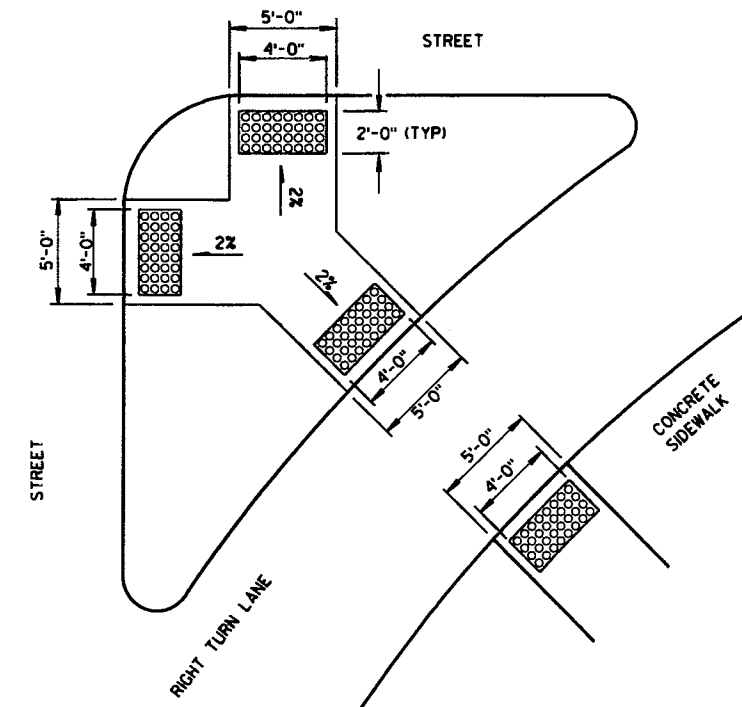


TYPE 6
DETECTABLE WARNING AT ISLANDS

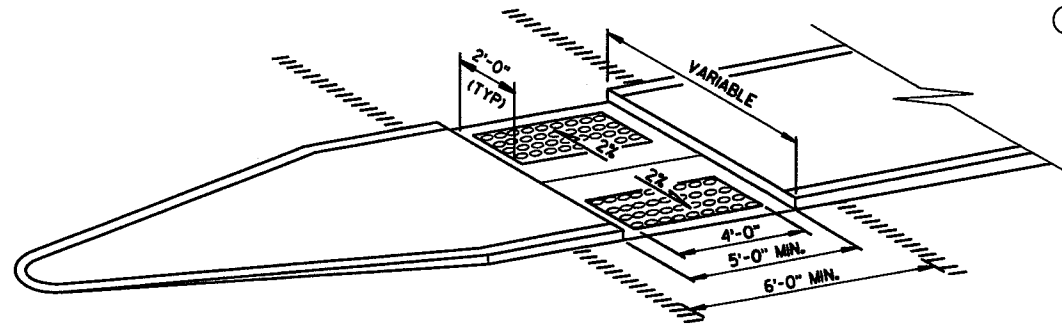

MEDIAN ISLAND
NON-ELEVATED CROSSING
TYPE 5

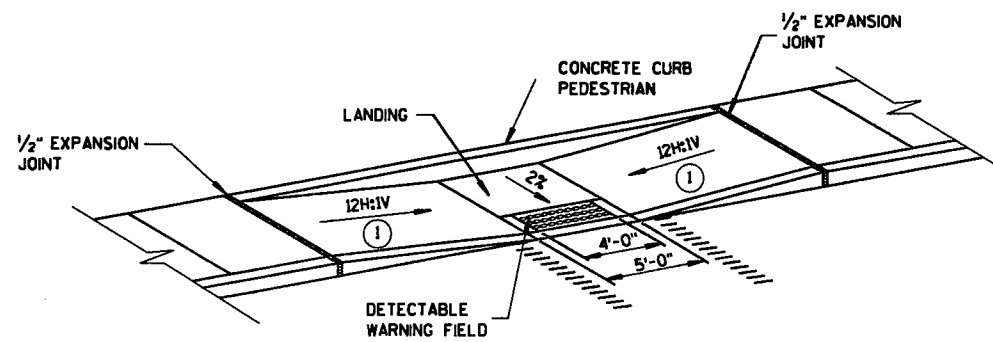

MID-BLOCK CROSSING
TYPE 7A

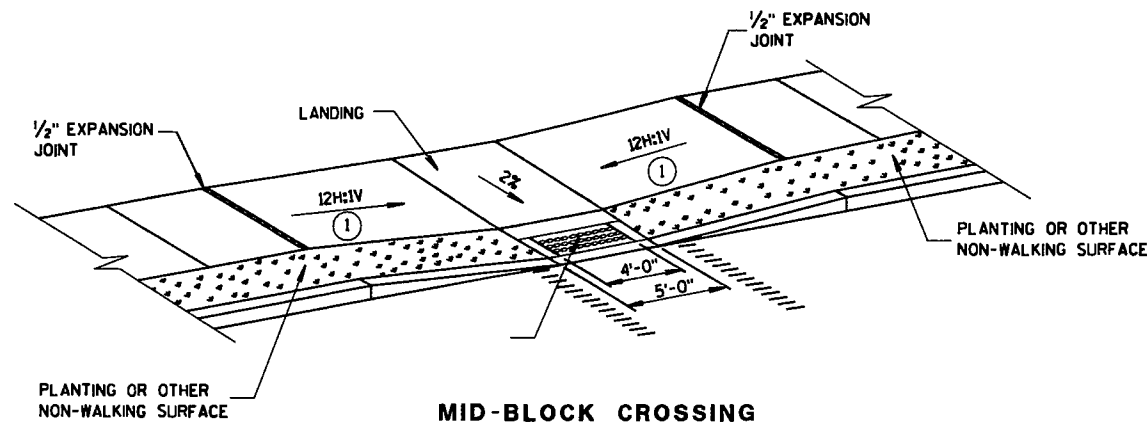

MID-BLOCK CROSSING
TYPE 7B

NOTE: THESE PARALLEL AND PARALLEL/PERPENDICULAR CURB RAMPS
MAY BE USED AT INTERSECTIONS AND MID BLOCK LOCATIONS.


GENERAL NOTES

SIDEWALK CROSS SLOPE SHALL NOT EXCEED 2%.

- ① SLOPE SIDEWALK TOWARD LANDING AS SHOWN WHERE THERE IS NO TERRACE OR WHERE THE TERRACE WIDTH IS LESS THAN 6 FEET WIDE.
- ② THE EDGE OF THE DETECTABLE WARNING FIELD NEAREST TO A RAILROAD CROSSING SHALL BE 15 FEET ± 0.1' FROM THE FACE OF THE GATE ARM IF THE GATE ARM EXTENDS ACROSS THE SIDEWALK. WHERE THERE IS NO PEDESTRIAN GATE, THE EDGE OF THE DETECTABLE WARNING FIELD NEAREST TO THE RAILROAD CROSSING SHALL BE 15 FEET FROM THE NEAREST RAIL.

LEGEND


- 1/2" EXPANSION JOINT-SIDEWALK
- - - CONTRACTION JOINT FIELD LOCATED
- ▤ PAVEMENT MARKING CROSSWALK (WHITE)

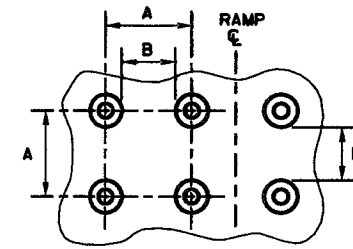

PLAN VIEW


	MIN.	MAX.
A	1.6"	2.4"
B	0.65"	1.5"
C	*	*
D	0.9"	1.4"

* THE C DIMENSION IS 50% TO 65% OF THE D DIMENSION.

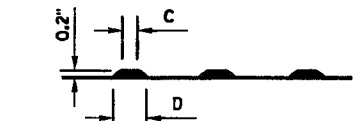

ELEVATION VIEW

TRUNCATED DOMES
DETECTABLE WARNING
PATTERN DETAIL

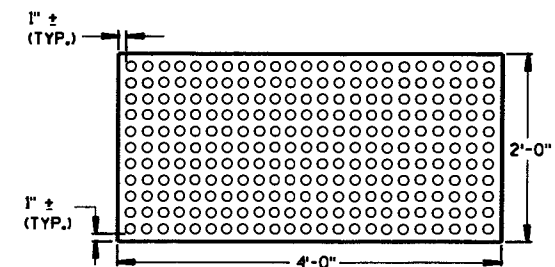

PLAN VIEW
DETECTABLE WARNING
FIELD (TYPICAL)

CURB RAMPS
TYPES 5, 6, 7A, 7B & 8


STATE OF WISCONSIN
DEPARTMENT OF TRANSPORTATION

APPROVED

9/9/05
DATE
FHWA


/s/ Jerry H. Zogg
ROADWAY STANDARDS DEVELOPMENT
ENGINEER

WOOD STAKES (2 PER BALE)
NOMINAL 2" X 2" X 30" MIN.
LENGTH OR EQUIVALENT

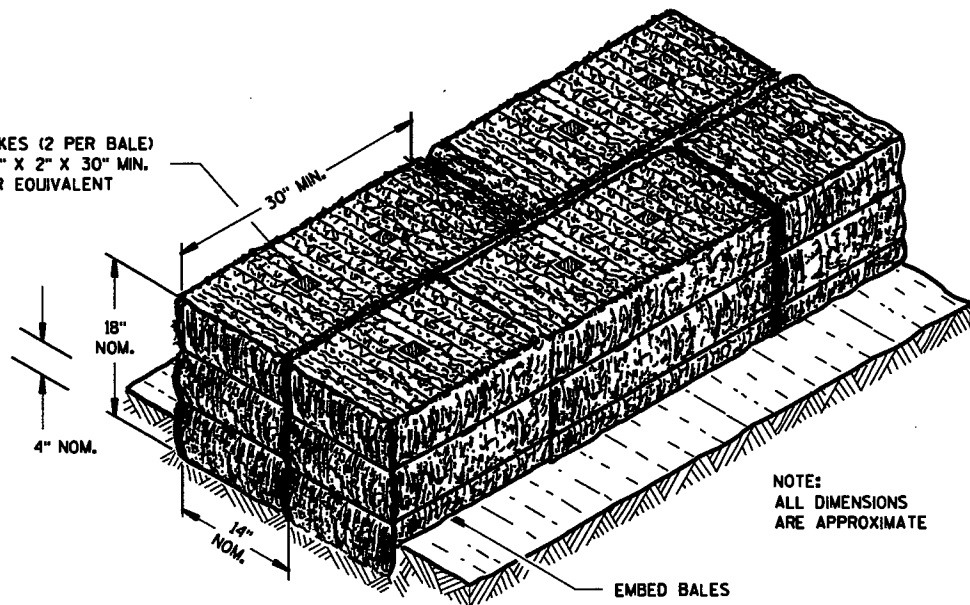

SECTION A-A


NOTE:
ALL DIMENSIONS
ARE APPROXIMATE

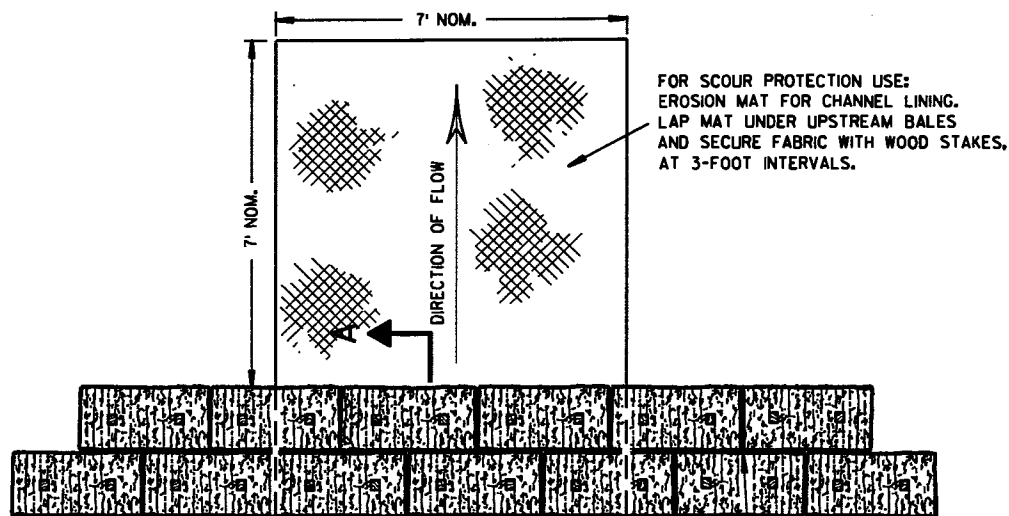

PLAN VIEW

STAGGER JOINTS BETWEEN ADJACENT
ROWS OF BALES.

BOTTOM ELEVATION OF END BALE SHALL
BE EQUAL TO OR GREATER THAN TOP OF
LOWEST MIDDLE BALE.

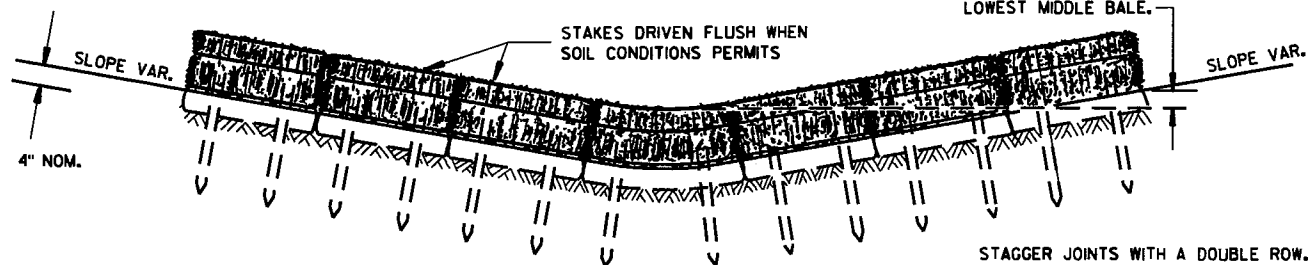


FRONT ELEVATION

TEMPORARY DITCH CHECK USING EROSION BALES ①

GENERAL NOTES


DETAILS OF CONSTRUCTION, MATERIALS AND WORKMANSHIP NOT SHOWN ON THIS DRAWING SHALL CONFORM TO THE PERTINENT REQUIREMENTS OF THE STANDARD SPECIFICATIONS AND THE APPLICABLE SPECIAL PROVISIONS.

- ① TEMPORARY DITCH CHECKS EITHER EROSION BALES OR MANUFACTURED SHALL BE PAID FOR UNDER THE BID ITEM OF TEMPORARY DITCH CHECK. THE DEPARTMENT WILL NOT PAY FOR TEMPORARY DITCH CHECKS CONSTRUCTED OF A SINGLE ROW OF EROSION BALES.

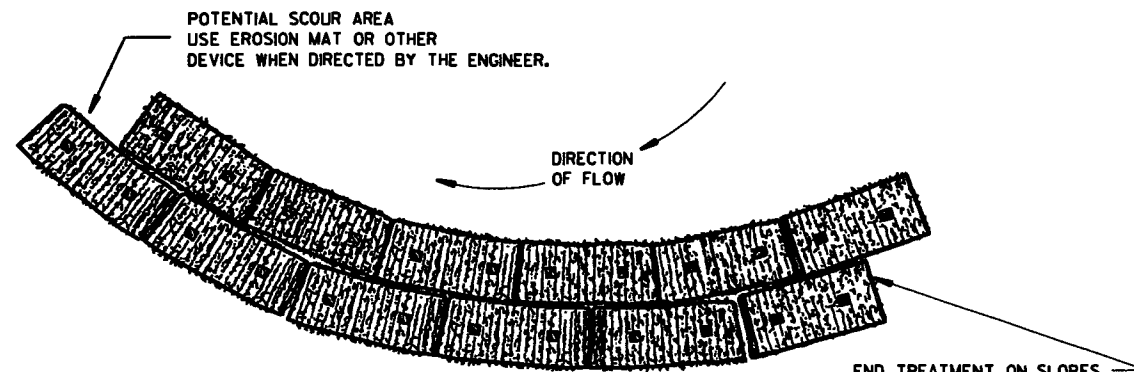


PLAN VIEW

WHEN ALTERING THE DIRECTION OF FLOW

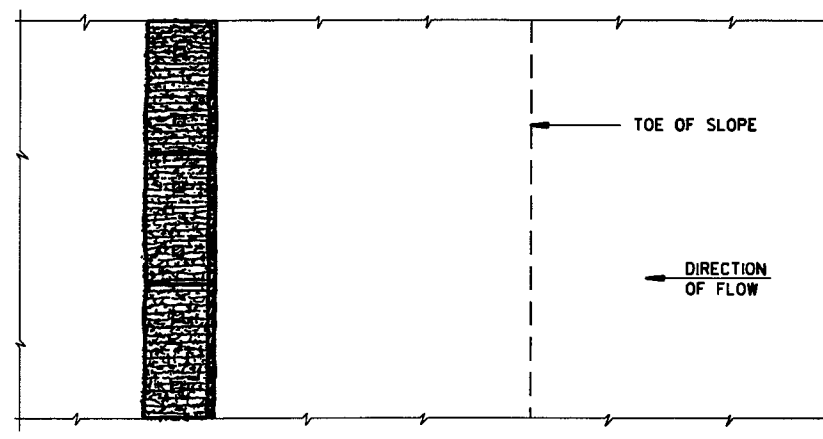

PLAN VIEW

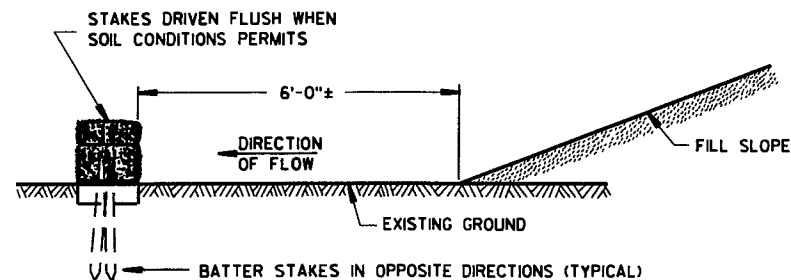

FRONT ELEVATION

WHEN EXISTING GROUND SLOPES AWAY FROM FILL SLOPE


EROSION BALES FOR SHEET FLOW

**TYPICAL INSTALLATIONS OF
EROSION BALES / TEMPORARY
DITCH CHECKS**


STATE OF WISCONSIN
DEPARTMENT OF TRANSPORTATION

APPROVED
DATE 6/04/02
DATE
CHIEF ROADWAY DEVELOPMENT ENGINEER

FHWA

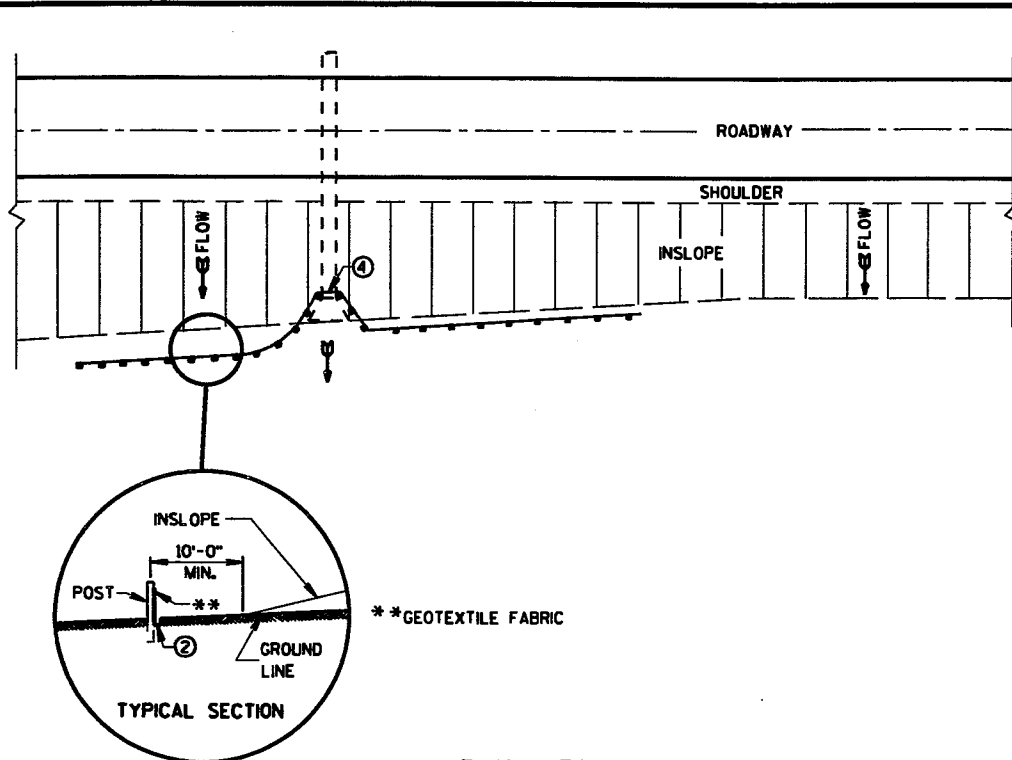

PLAN VIEW
TYPICAL APPLICATION OF SILT FENCE

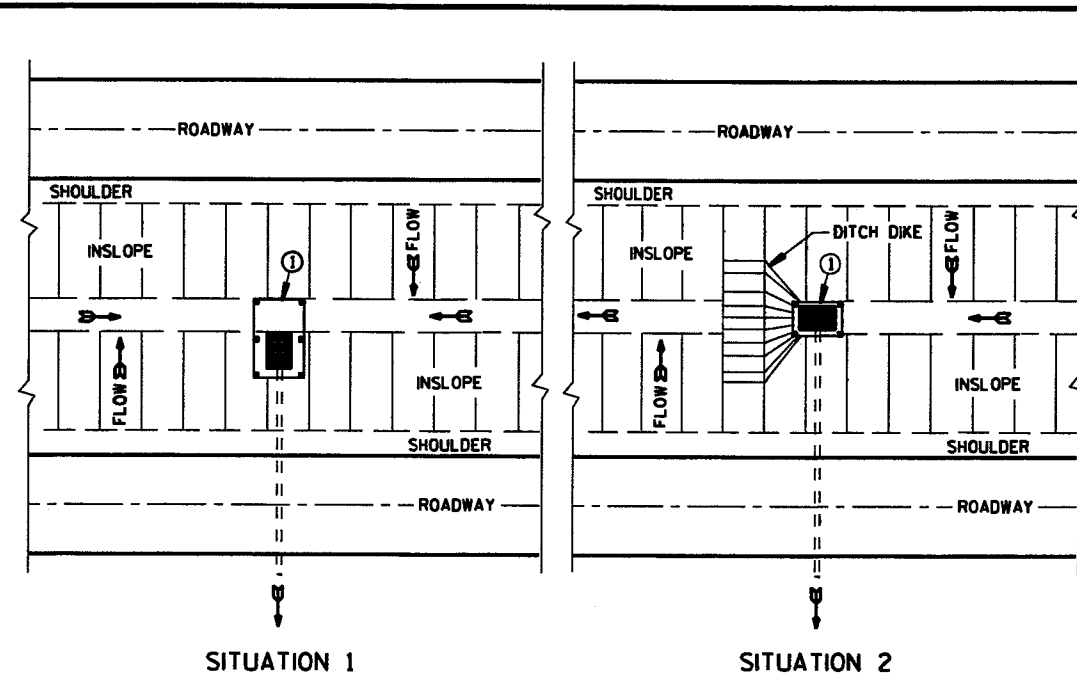


SITUATION 1 SITUATION 2
PLAN VIEW
SILT FENCE AT MEDIAN SURFACE DRAINS


GENERAL NOTES

DETAILS OF CONSTRUCTION NOT SHOWN ON THIS DRAWING SHALL CONFORM TO THE PERTINENT REQUIREMENTS OF THE STANDARD SPECIFICATIONS AND APPLICABLE SPECIAL PROVISIONS.

- ① HORIZONTAL BRACE REQUIRED WITH 2" X 4" WOODEN FRAME OR EQUIVALENT AT TOP OF POSTS.
- ② FOR MANUAL INSTALLATIONS THE TRENCH SHALL BE A MINIMUM OF 4" WIDE & 6" DEEP TO BURY AND ANCHOR THE GEOTEXTILE FABRIC. FOLD MATERIAL TO FIT TRENCH AND BACKFILL & COMPACT TRENCH WITH EXCAVATED SOIL.
- ③ WOOD POSTS SHALL BE A MINIMUM SIZE OF 1/8" X 1/8" OF OAK OR HICKORY.
- ④ SILT FENCE TO EXTEND ACROSS THE TOP OF THE PIPE.
- ⑤ CONSTRUCT SILT FENCE FROM A CONTINUOUS ROLL IF POSSIBLE BY CUTTING LENGTHS TO AVOID JOINTS. IF A JOINT IS NECESSARY USE ONE OF THE FOLLOWING TWO METHODS: A) OVERLAP THE END POSTS AND TWIST, OR ROTATE, AT LEAST 180 DEGREES, B) HOOK THE END OF EACH SILT FENCE LENGTH.

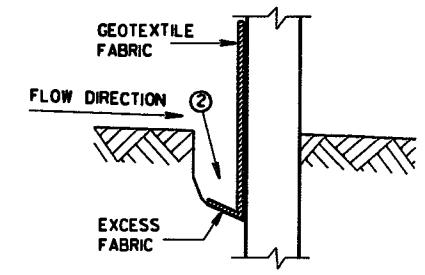


TRENCH DETAIL

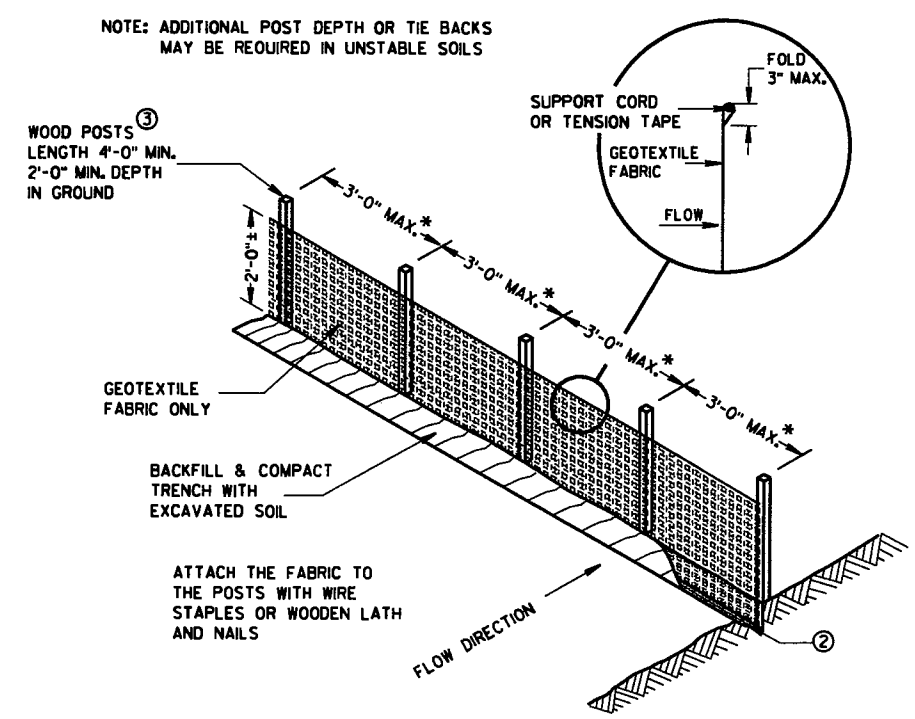


NOTE: ADDITIONAL POST DEPTH OR TIE BACKS MAY BE REQUIRED IN UNSTABLE SOILS

* NOTE: 8'-0" POST SPACING ALLOWED IF A WOVEN GEOTEXTILE FABRIC IS USED.


SILT FENCE

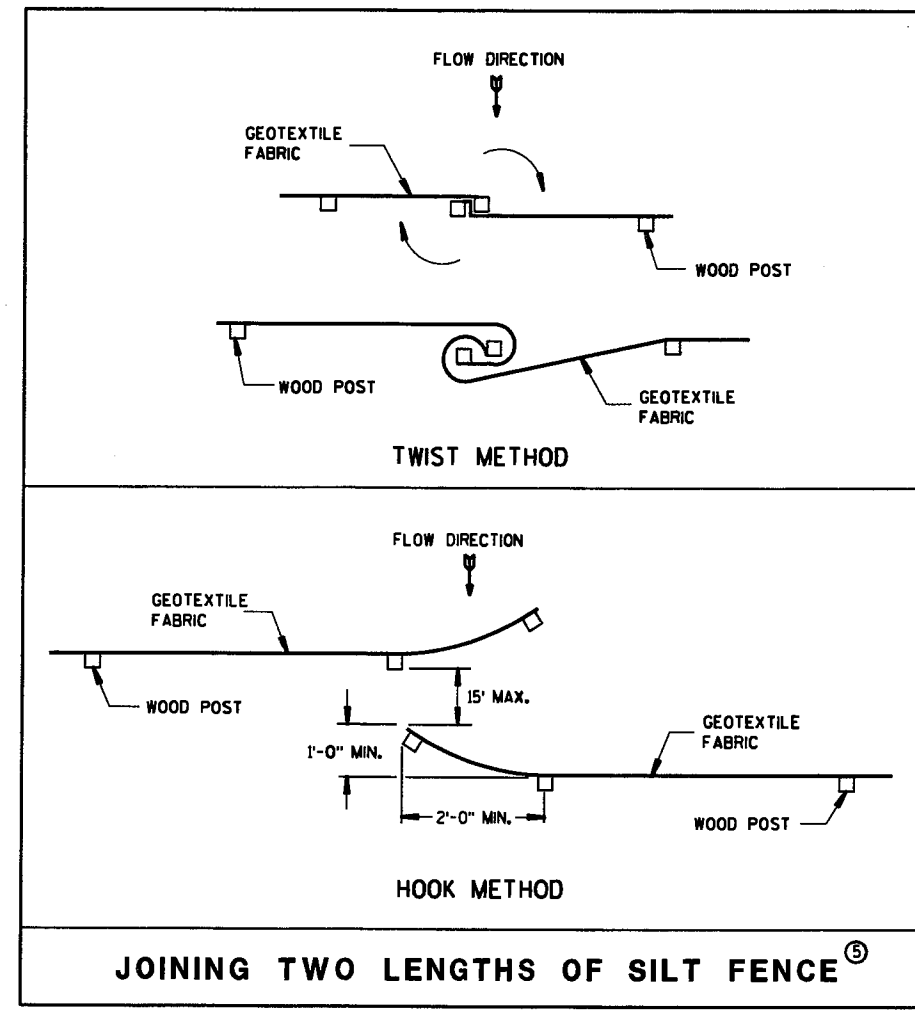

JOINING TWO LENGTHS OF SILT FENCE ⑤

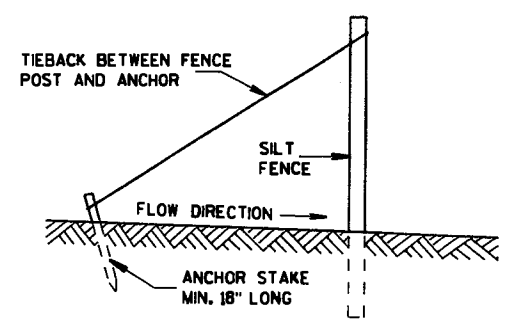



SILT FENCE TIE BACK
(WHEN REQUIRED BY THE ENGINEER)

SILT FENCE	
STATE OF WISCONSIN DEPARTMENT OF TRANSPORTATION	
APPROVED 4-29-05 DATE	 CHIEF ROADWAY DEVELOPMENT ENGINEER
FHWA	

S.D.D. 8 E 9-6

6

S.D.D. 8 E 9-6

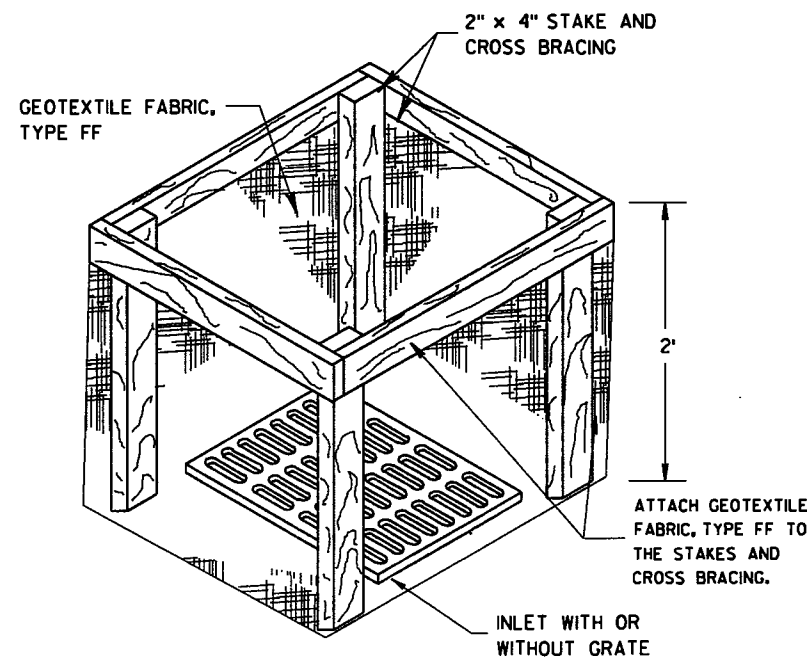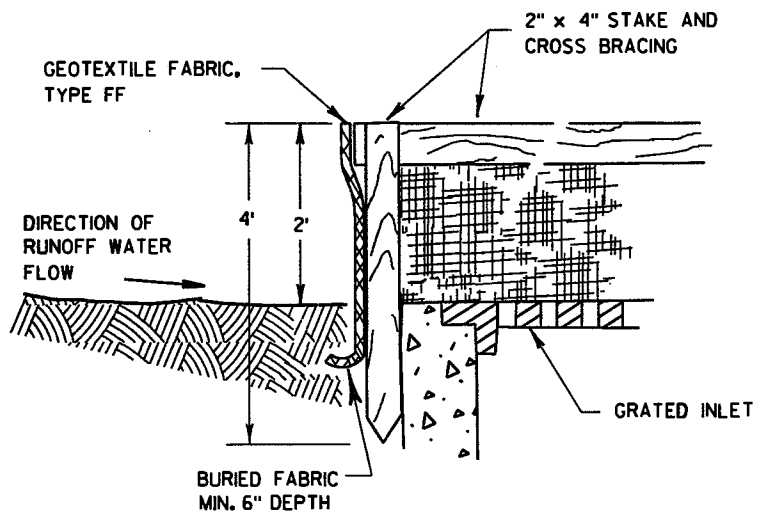

INLET PROTECTION, TYPE A


GENERAL NOTES

INLET PROTECTION DEVICES SHALL BE MAINTAINED OR REPLACED AT THE DIRECTION OF THE ENGINEER.

MANUFACTURED ALTERNATIVES APPROVED AND LISTED ON THE DEPARTMENT'S EROSION CONTROL PRODUCT ACCEPTABILITY LIST MAY BE SUBSTITUTED.


WHEN REMOVING OR MAINTAINING INLET PROTECTION, CARE SHALL BE TAKEN SO THAT THE SEDIMENT TRAPPED ON THE GEOTEXTILE FABRIC DOES NOT FALL INTO THE INLET. ANY MATERIAL FALLING INTO THE INLET SHALL BE REMOVED IMMEDIATELY.

- ① FINISHED SIZE, INCLUDING FLAP POCKETS WHERE REQUIRED, SHALL EXTEND A MINIMUM OF 10" AROUND THE PERIMETER TO FACILITATE MAINTENANCE OR REMOVAL.
- ② FOR INLET PROTECTION, TYPE C (WITH CURB BOX), AN ADDITIONAL 18" OF FABRIC IS WRAPPED AROUND THE WOOD AND SECURED WITH STAPLES. THE WOOD SHALL NOT BLOCK THE ENTIRE HEIGHT OF THE CURB BOX OPENING.
- ③ FLAP POCKETS SHALL BE LARGE ENOUGH TO ACCEPT WOOD 2X4.

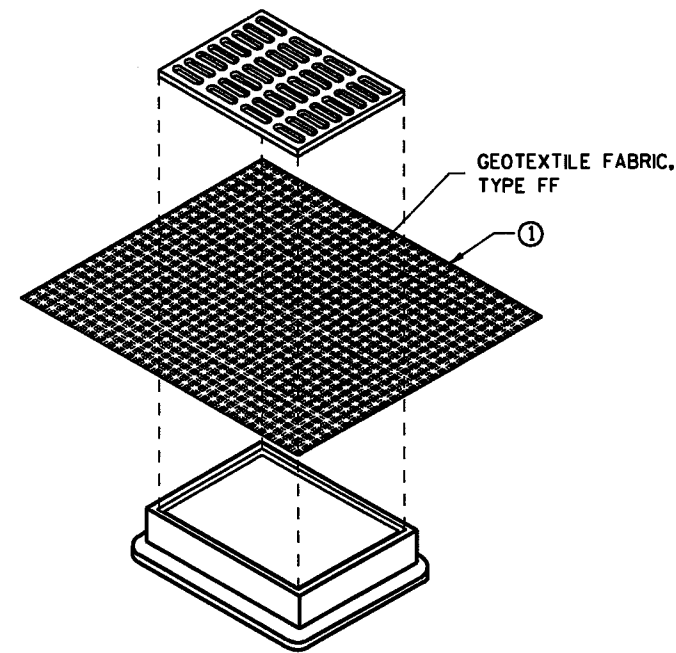

INLET PROTECTION, TYPE B (WITHOUT CURB BOX)

(CAN BE INSTALLED IN ANY INLET WITHOUT A CURB BOX)

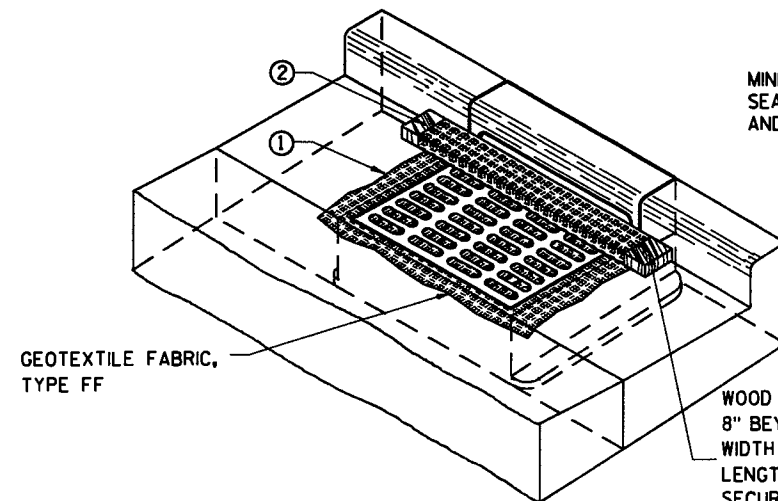

INLET PROTECTION, TYPE C (WITH CURB BOX)

INSTALLATION NOTES

TYPE B & C

TRIM EXCESS FABRIC IN THE FLOW LINE TO WITHIN 3" OF THE GRATE.


THE CONTRACTOR SHALL DEMONSTRATE A METHOD OF MAINTENANCE, USING A SEWN FLAP, HAND HOLDS OR OTHER METHOD TO PREVENT ACCUMULATED SEDIMENT FROM ENTERING THE INLET.

TYPE D

DO NOT INSTALL INLET PROTECTION TYPE D IN INLETS SHALLOWER THAN 30", MEASURED FROM THE BOTTOM OF THE INLET TO THE TOP OF THE GRATE.

TRIM EXCESS FABRIC IN THE FLOW LINE TO WITHIN 3" OF THE GRATE.

THE INSTALLED BAG SHALL HAVE A MINIMUM SIDE CLEARANCE, BETWEEN THE INLET WALLS AND THE BAG, MEASURED AT THE BOTTOM OF THE OVERFLOW HOLES, OF 3". WHERE NECESSARY THE CONTRACTOR SHALL CINCH THE BAG, USING PLASTIC ZIP TIES, TO ACHIEVE THE 3" CLEARANCE. THE TIES SHALL BE PLACED AT A MAXIMUM OF 4" FROM THE BOTTOM OF THE BAG.

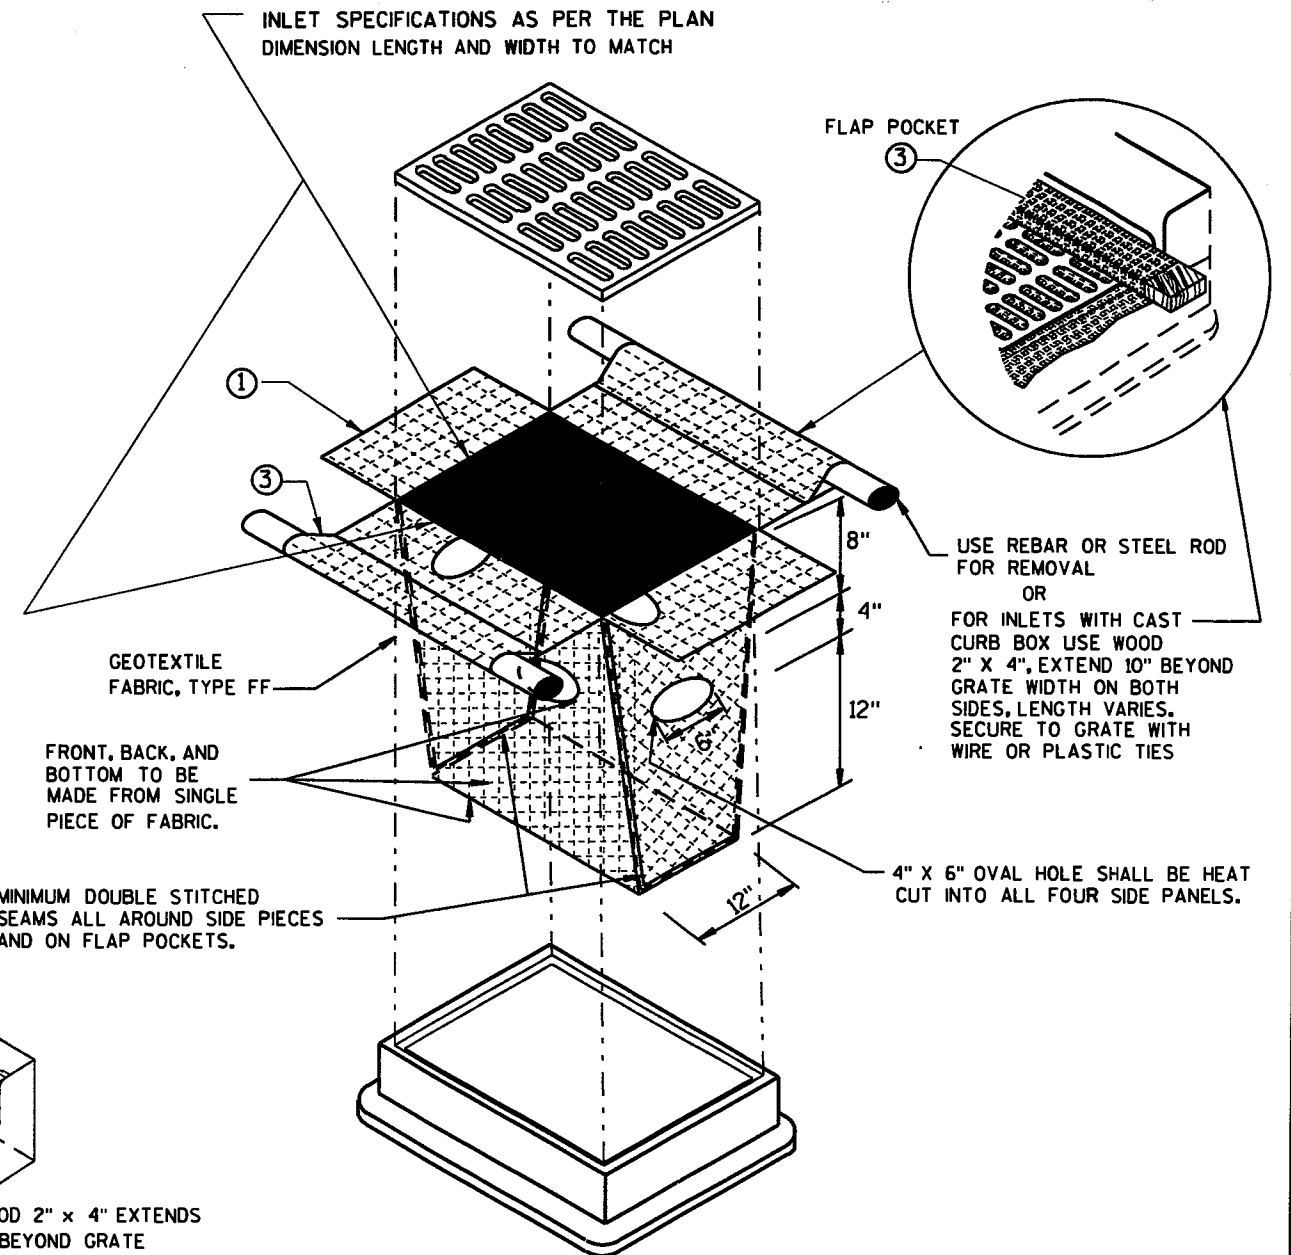

INLET PROTECTION, TYPE D

(CAN BE INSTALLED IN ANY INLET TYPE WITH OR WITHOUT A CURB BOX AS PER NOTE ②)

INLET PROTECTION TYPE A, B, C, AND D	
STATE OF WISCONSIN DEPARTMENT OF TRANSPORTATION	
APPROVED 10/16/02 DATE FHWA	 CHIEF ROADWAY DEVELOPMENT ENGINEER

6


6

S.D.D. 8 E 10-2

S.D.D. 8 E 10-2


METAL APRON ENDWALLS											
PIPE DIA. (IN.)	MIN. THICK. (Inches)		DIMENSIONS (Inches)						APPROX. SLOPE	BODY	
	STEEL	ALUM.	A (±1")	B (MAX.)	H (±1")	L (±1 1/2")	L1	L2			W (±2")
12	.064	.060	6	6	6	21	12	17 1/2	24	2 1/2 to 1	1 Pc.
15	.064	.060	7	8	6	26	14	21 1/4	30	2 1/2 to 1	1 Pc.
18	.064	.060	8	10	6	31	15	28 1/4	36	2 1/2 to 1	1 Pc.
21	.064	.060	9	12	6	36	18	29 5/8	42	2 1/2 to 1	1 Pc.
24	.064	.075	10	13	6	41	18	37 1/4	48	2 1/2 to 1	1 Pc.
30	.079	.075	12	16	8	51	18	52 1/4	60	2 1/2 to 1	1 Pc.
36	.079	.105	14	19	9	60	24	59 3/4	72	2 1/2 to 1	2 Pc.
42	.109	.105	16	22	8	69	24	75 3/4	84	2 1/2 to 1	2 Pc.
48	.109	.105	18	27	12	78	24	81	90	2 1/2 to 1	3 Pc.
54	.109	.105	18	30	12	84	30	85 1/2	102	2 1/2 to 1	3 Pc.
60	.109*	.105*	18	33	12	87	—	—	114	2 to 1	3 Pc.
66	.109*	.105*	18	36	12	87	—	—	120	2 to 1	3 Pc.
72	.109*	.105*	18	39	12	87	—	—	126	2 to 1	3 Pc.
78	.109*	.105*	18	42	12	87	—	—	132	1 1/2 to 1	3 Pc.
84	.109*	.105*	18	45	12	87	—	—	138	1 1/2 to 1	3 Pc.
90	.109*	.105*	18	37	12	87	—	—	144	1 1/2 to 1	3 Pc.
96	.109*	.105*	18	35	12	87	—	—	150	1 1/2 to 1	3 Pc.

* EXCEPT CENTER PANEL SEE GENERAL NOTES

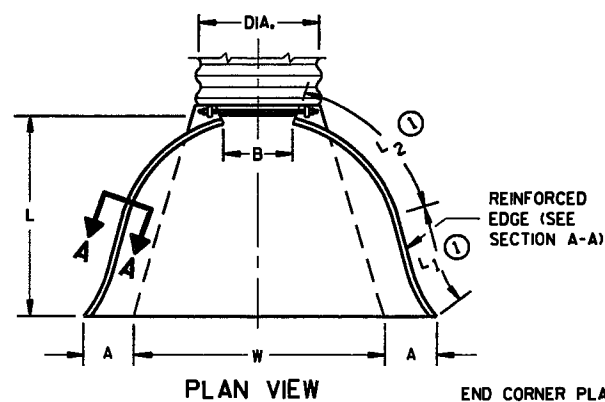


PLAN VIEW

END CORNER PLATES MAY BE FASTENED TO APRON PROPER BY BOLTS, RIVETS, OR RESISTANCE SPOT WELDS WHICH WILL HOLD THE SURFACES TIGHTLY TOGETHER

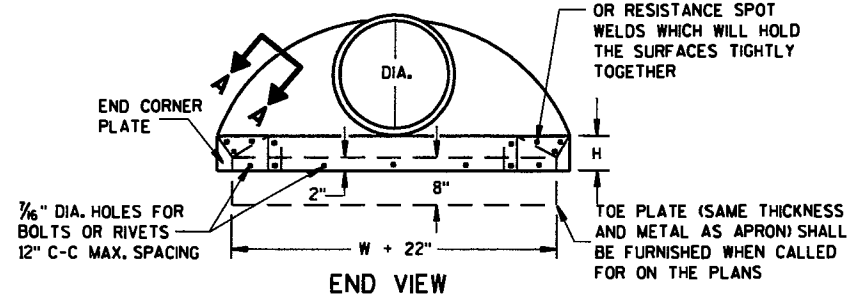


END VIEW

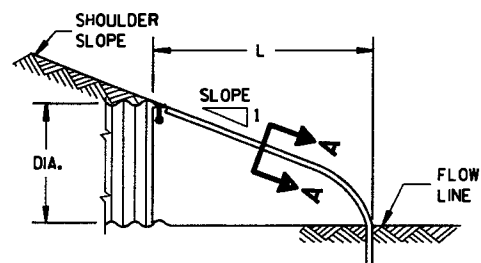


SIDE ELEVATION METAL ENDWALLS

REINFORCED CONCRETE APRON ENDWALLS										
PIPE DIA. (IN.)	DIMENSIONS (Inches)							APPROX. SLOPE		
	T	A	B	C	D	E	G			
12	2	4	24	48 1/4	72 1/4	24	2	3 to 1		
15	2 1/4	6	27	46	73	30	2 1/4	3 to 1		
18	2 1/2	9	27	46	73	36	2 1/2	3 to 1		
21	2 3/4	9	36	37 1/2	73 1/2	42	2 3/4	3 to 1		
24	3	9 1/2	43 1/2	30	73 1/2	48	3	3 to 1		
27	3 1/4	10 1/2	49 1/2	24	73 1/2	54	3 1/4	3 to 1		
30	3 1/2	12	54	19 1/4	73 1/2	60	3 1/2	3 to 1		
36	4	15	63	34 1/4	97 1/4	72	4	3 to 1		
42	4 1/2	21	63	35	98	78	4 1/2	3 to 1		
48	5	24	72	26	98	84	5	3 to 1		
54	5 1/2	27	65	33 1/4 - 35	98 1/4 - 100	90	5 1/2	2 1/2 to 1		
60	6	30 - 35	60	39	99	96	5	2 to 1		
66	6 1/2	24 - 30	72 - 78	21 - 27	99	102	5 1/2	2 to 1		
72	7	24 - 36	78	21	99	108	6	2 to 1		
78	7 1/2	24 - 36	78	21	99	114	6 1/2	2 to 1		
84	8	36	90 1/2	21	111 1/2	120	6 1/2	1 1/2 to 1		
90	8 1/2	41	87 1/2	24	111 1/2	132	6 1/2	1 1/2 to 1		


* MINIMUM
** MAXIMUM

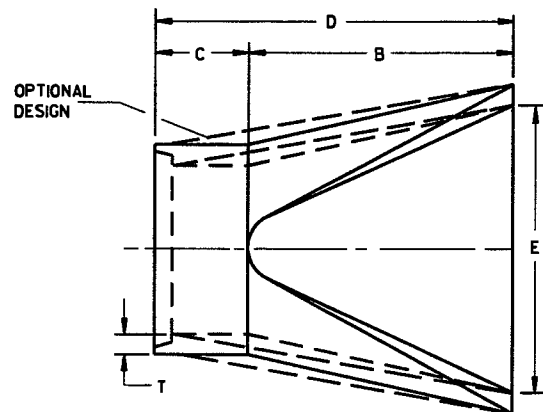

PLAN

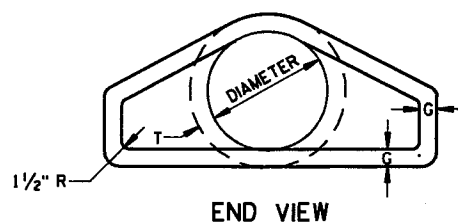


END VIEW

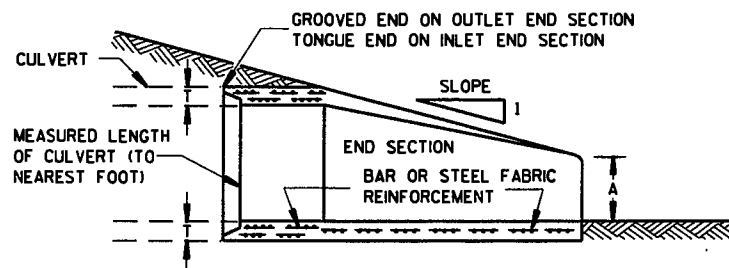


LONGITUDINAL SECTION CONCRETE ENDWALLS

1" WIDE, 12 GA. (0.109" THICK) GALVANIZED STRAP WITH STANDARD 6" X 1/2" BAND BOLT AND NUT

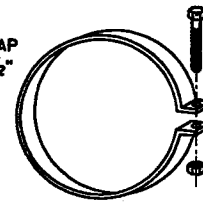

ALTERNATE FOR TYPE 1 CONNECTION END SECTION CONNECTOR STRAP

THREADED 3/8" DIA. ROD AROUND CULVERT & THROUGH TANK TYPE CONNECTOR LUG OR ALTERNATE CONNECTOR STRAP (SEE DETAIL)

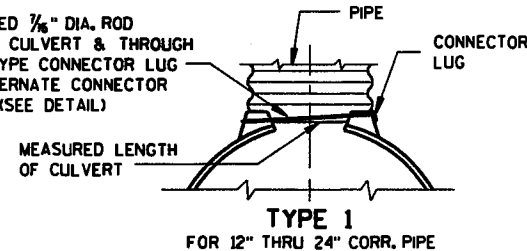


TYPE 1 FOR 12" THRU 24" CORR. PIPE


THREADED 3/8" DIA. ROD OVER TOP OF APRON, SIDE LUGS TO BE RIVETED TO APRON



TYPE 2 FOR 30" THRU 96" CORR. PIPE

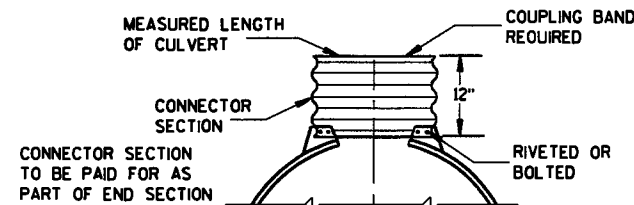

TYPE 3 FOR 42" THRU 96" CORR. PIPE

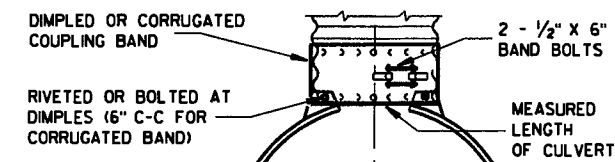

TYPE 5 ALTERNATE FOR: ALL SIZES CORRUGATED CIRCULAR PIPE


NOTE: DIMPLED BAND FITS OVER OUTSIDE OF ENDWALL, AND CORRUGATED BAND FITS INSIDE ENDWALL. DIMPLED BAND MAY BE USED WITH HELICALLY CORRUGATED PIPE.

FOR CIRCUMFERENTIALLY CORRUGATED PIPE USE ENDWALL CONNECTION DETAILS 1, 2, 3 OR 5 AS APPLICABLE.

FOR HELICALLY CORRUGATED PIPE USE ENDWALL CONNECTION DETAILS 1, 2 OR 5.

FOR HELICALLY CORRUGATED PIPES WITH TWO CIRCUMFERENTIAL CORRUGATIONS AT EACH END USE ENDWALL CONNECTION DETAILS 1, 2 OR 3.

CONNECTION DETAILS

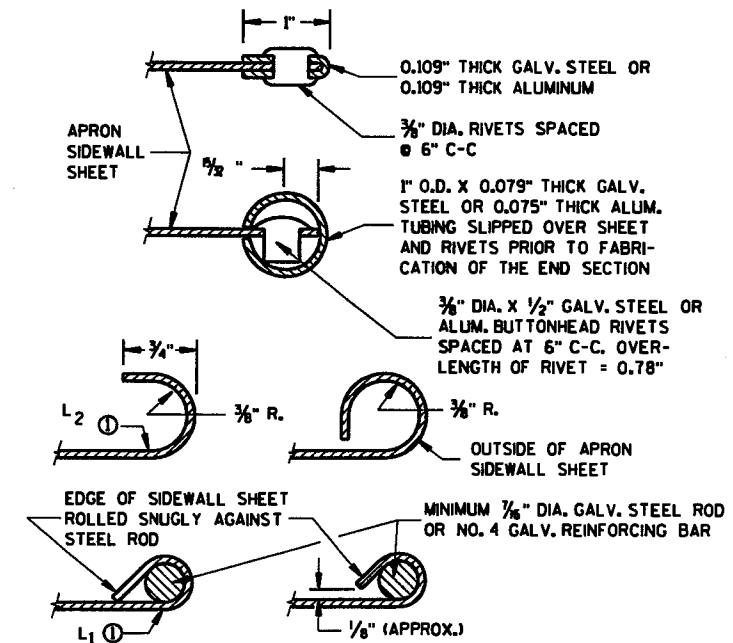

SECTION A-A

GENERAL NOTES

DETAILS OF CONSTRUCTION, MATERIALS AND WORKMANSHIP NOT SHOWN ON THIS DRAWING SHALL CONFORM TO THE PERTINENT REQUIREMENTS OF THE STANDARD SPECIFICATIONS AND THE APPLICABLE SPECIAL PROVISIONS.

CONCRETE CULVERT ENDWALLS MAY NOT BE USED WITH GALVANIZED STEEL OR ALUMINUM CULVERT PIPE OR VICE VERSA. GALVANIZED STEEL OR ALUMINUM ENDWALLS SHALL NORMALLY BE INSTALLED ON CULVERT PIPE OF THE SAME METAL.

ALL THREE PIECE STEEL APRON ENDWALLS FOR 60" DIAMETER PIPE AND LARGER SHALL HAVE 0.109" SIDES AND 0.138" CENTER PANELS. ALL THREE PIECE ALUMINUM APRON ENDWALLS FOR 60" DIAMETER PIPE AND LARGER SHALL HAVE 0.105" SIDES AND 0.134" CENTER PANELS. THE WIDTH OF CENTER PANELS SHALL BE GREATER THAN 20 PERCENT OF THE PIPE PERIMETER.

LAP SEAMS SHALL BE TIGHTLY JOINED BY GALVANIZED RIVETS OR BOLTS FOR STEEL UNITS AND ALUMINUM RIVETS AND BOLTS FOR ALUMINUM UNITS. FOR THE 60" THROUGH 96" DIAMETER APRON ENDWALL SIZES, THE REINFORCED EDGES AND CENTER PANEL SEAMS SHALL BE FURTHER REINFORCED WITH GALVANIZED STEEL OR ALUMINUM STIFFENER ANGLES. THE ANGLES SHALL BE ATTACHED BY GALVANIZED NUTS AND BOLTS FOR STEEL UNITS AND ALUMINUM NUTS AND BOLTS FOR ALUMINUM UNITS.

WHERE TWO OR MORE PIPES WITH APRON ENDWALLS ARE LAID ADJACENT TO EACH OTHER, THEY SHALL BE SEPARATED BY A DISTANCE SUFFICIENT TO PROVIDE A MINIMUM CLEARANCE OF 6 INCHES BETWEEN APRON ENDWALLS.

① FOR PIPE SIZES UP TO 60" DIAMETER, A 180° ROLLED EDGE MAY BE USED INSTEAD OF STEEL ROD REINFORCEMENT. SEE SECTION A-A.


APRON ENDWALLS FOR CULVERT PIPE

STATE OF WISCONSIN DEPARTMENT OF TRANSPORTATION


APPROVED 11/30/94 DATE

CHIEF ROADWAY DEVELOPMENT ENGINEER

FHWA

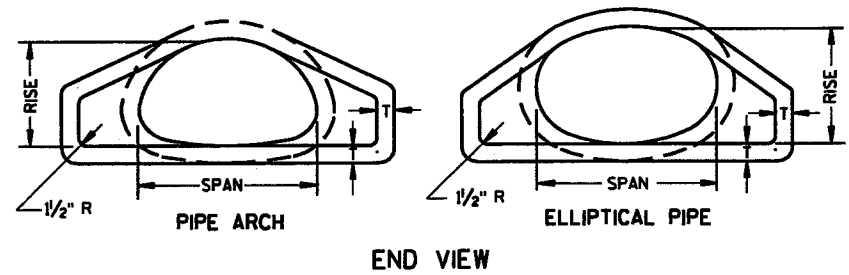


END VIEW

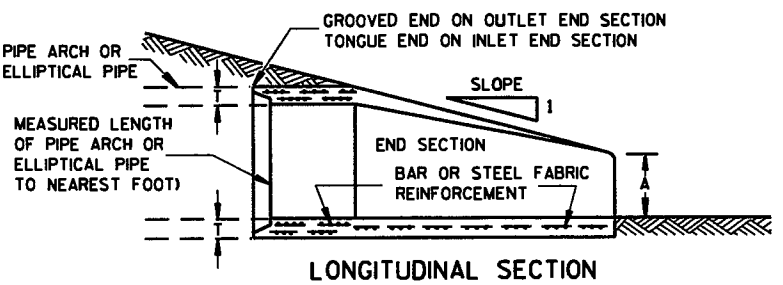


LONGITUDINAL SECTION

CONCRETE ENDWALLS

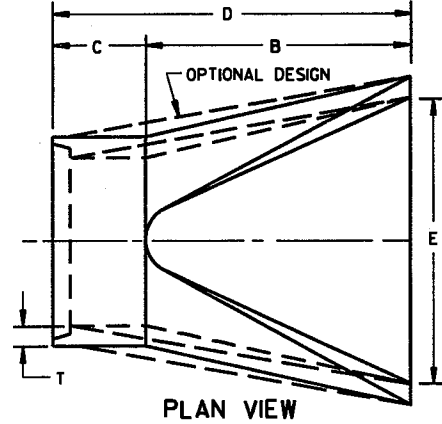


PLAN VIEW

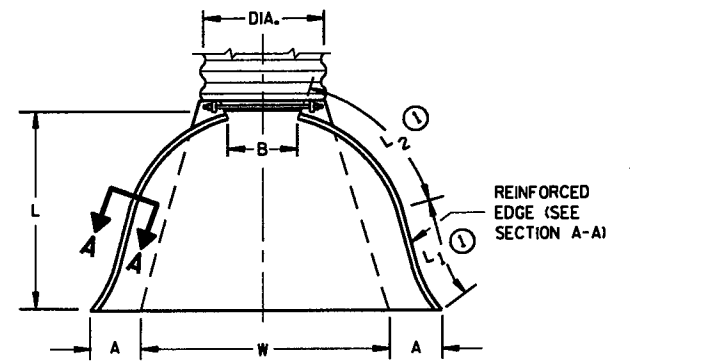


PLAN VIEW


REINFORCED EDGE (SEE SECTION A-A)
END CORNER PLATES MAY BE FASTENED TO APRON PROPER BY BOLTS, RIVETS, OR RESISTANCE SPOT WELDS WHICH WILL HOLD THE SURFACES TIGHTLY TOGETHER

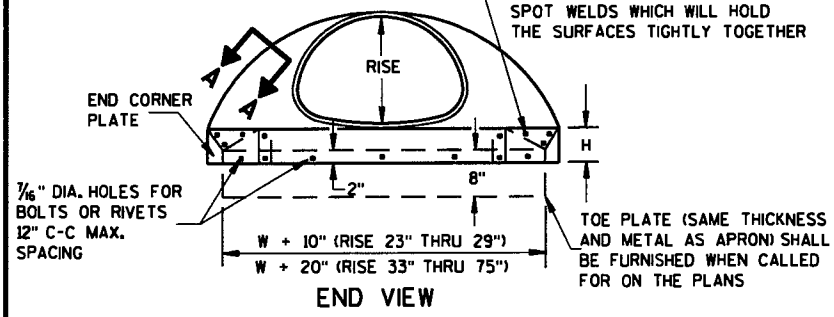

END VIEW

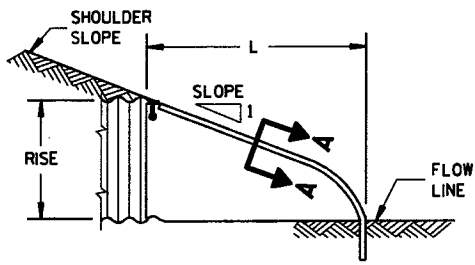

SIDE ELEVATION
METAL ENDWALLS

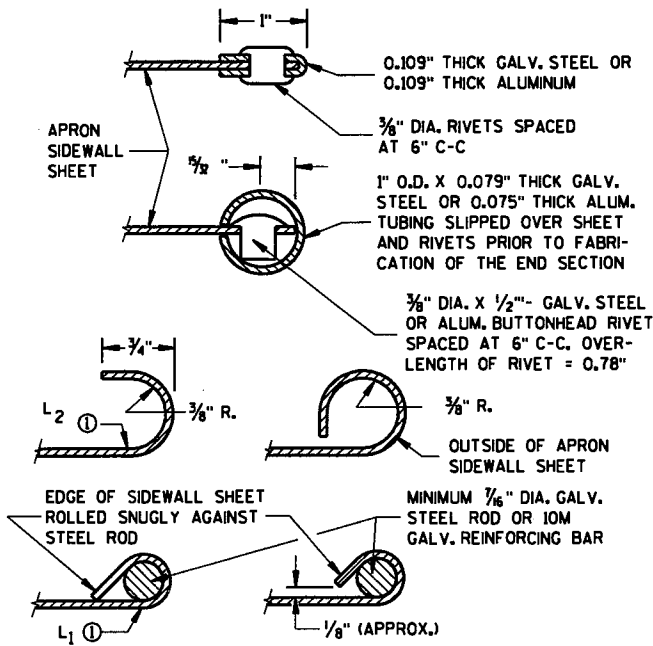

SECTION A-A

2- 2 1/3" x 1/2" CORRUGATIONS

EQUIV. DIA. (Inches)	(Inches)		MIN. THICK. (Inches)		DIMENSIONS (Inches)							APPROX. SLOPE	BODY
	SPAN	RISE	STEEL	ALUM.	A (±1")	B (MAX.)	H (±1")	L (±1 1/2")	L1 (±1")	L2 (±1")	W (±2")		
15	17	13	.064	.060	7	9	6	19	14	15	30	2 1/2 to 1	1 Pc.
18	21	15	.064	.060	7	10	6	23	14	19 3/8	36	2 1/2 to 1	1 Pc.
21	24	18	.064	.060	8	12	6	28	18	21 3/4	42	2 1/2 to 1	1 Pc.
24	28	20	.064	.060	9	14	6	32	18	27 1/2	48	2 1/2 to 1	1 Pc.
30	35	24	.079	.075	10	16	6	39	18	37 3/8	60	2 1/2 to 1	1 Pc.
36	42	29	.079	.075	12	18	8	46	24	45 3/8	75	2 1/2 to 1	1 Pc.
42	49	33	.109	.105	13	21	9	53	24	54 3/4	85	2 1/2 to 1	2 Pc.
48	57	38	.109	.105	18	26	12	63	24	68	90	2 1/2 to 1	3 Pc.
54	64	43	.109	.105	18	30	12	70	24	72 3/4	102	2 1/2 to 1	3 Pc.
60	71	47	.109*	.105*	18	33	12	77	30	82 1/4	114	2 1/2 to 1	3 Pc.
66	77	52	.109*	.105*	18	36	12	77	—	—	126	2 to 1	3 Pc.
72	83	57	.109*	.105*	18	39	12	77	—	—	138	2 to 1	3 Pc.

3" x 1" CORRUGATIONS

EQUIV. DIA. (Inches)	(Inches)		MIN. THICK. (Inches)		DIMENSIONS (Inches)							APPROX. SLOPE	BODY
	SPAN	RISE	STEEL	ALUM.	A (±1")	B (MAX.)	H (±1")	L (±1 1/2")	L1 (±1")	L2 (±1")	W (±2")		
48	53	41	.109	.105	18	26	12	63	24	72 3/4	90	2 1/2 to 1	2 Pc.
54	60	46	.109	.105	18	30	12	70	30	82 1/4	102	2 to 1	2 Pc.
60	66	51	.109*	.105*	18	33	12	77	—	—	114	1 1/2 to 1	3 Pc.
66	73	55	.109*	.105*	18	36	12	77	—	—	126	1 1/2 to 1	3 Pc.
72	81	59	.109*	.105*	18	39	12	77	—	—	138	2 to 1	3 Pc.
78	87	63	.109*	.105*	22	38	12	77	—	—	148	1 1/2 to 1	3 Pc.
84	95	67	.109*	.105*	22	34	12	77	—	—	162	1 1/2 to 1	3 Pc.
90	103	71	.109*	.105*	22	38	12	77	—	—	174	1 1/2 to 1	3 Pc.
96	112	75	.109*	.105*	24	40	12	77	—	—	174	1 1/2 to 1	3 Pc.

NOTE: ALL SPLICES TO BE LAP RIVETED OR BOLTED. * EXCEPT CENTER PANEL SEE GENERAL NOTES

REINFORCED CONCRETE PIPE ARCH

EQUIV. DIA. (Inches)	DIMENSIONS (Inches)							APPROX. SLOPE	
	**SPAN	**RISE	T	A	B	C	D		E
24	29	18	3	8 1/2	39	33	72	48	3 to 1
30	36	22	3 1/2	9 1/2	50	46	96	60	3 to 1
36	44	27	4	11 1/8	60	36	96	72	3 to 1
42	51	31	4 1/2	15 3/8	60	36	96	78	3 to 1
48	58	36	5	21	60	36	96	84	3 to 1
54	65	40	5 1/2	25 1/2	60	36	96	90	3 to 1
60	73	45	6	31	60	36	96	96	3 to 1
72	88	54	7	31	60	39	99	120	2 to 1
84	102	62	8	28 1/2	83	19	102	144	2 to 1

REINFORCED CONCRETE ELLIPTICAL PIPE

EQUIV. DIA. (Inches)	DIMENSIONS (Inches)							APPROX. SLOPE	
	**SPAN	**RISE	T	A	B	C	D		E
24	30	19	3 1/4	8 1/2	39	33	72	48	3 to 1
30	38	24	3 3/4	9 1/2	54	18	72	60	3 to 1
36	45	29	4 1/2	11 1/8	60	24	84	72	2 1/2 to 1
42	53	34	5	15 1/4	60	36	96	78	2 1/2 to 1
48	60	38	5 1/2	21	60	36	96	84	2 1/2 to 1
54	68	43	6	25 1/2	60	36	96	90	2 1/2 to 1
60	76	48	6 1/2	30	60	36	96	96	2 1/2 to 1

**NOMINAL SIZE

GENERAL NOTES

DETAILS OF CONSTRUCTION, MATERIALS AND WORKMANSHIP NOT SHOWN ON THIS DRAWING SHALL CONFORM TO THE PERTINENT REQUIREMENTS OF THE STANDARD SPECIFICATIONS AND THE APPLICABLE SPECIAL PROVISIONS.


CONCRETE APRON ENDWALLS MAY NOT BE USED WITH GALVANIZED STEEL OR ALUMINUM CULVERT PIPE OR VISE VERSA. GALVANIZED STEEL OR ALUMINUM APRON ENDWALLS SHALL NORMALLY BE INSTALLED ON CULVERT PIPE OF THE SAME METAL.

ALL THREE PIECE STEEL APRON ENDWALLS FOR 66" X 51" PIPE ARCH AND LARGER SHALL HAVE 0.109" SIDES AND 0.138" CENTER PANELS. ALL THREE PIECE ALUMINUM APRON ENDWALLS FOR 66" X 51" PIPE ARCH AND LARGER SHALL HAVE 0.105" SIDES AND 0.134" CENTER PANELS. THE WIDTH OF CENTER PANELS SHALL BE GREATER THAN 20 PERCENT OF THE PIPE ARCH PERIMETER.


LAP SEAMS SHALL BE TIGHTLY JOINED BY GALVANIZED RIVETS OR BOLTS FOR STEEL UNITS AND ALUMINUM RIVETS AND BOLTS FOR ALUMINUM UNITS. FOR THE 77" X 52" THROUGH 112" X 75" APRON ENDWALL SIZES, THE REINFORCED EDGES AND CENTER PANEL SEAMS SHALL BE FURTHER REINFORCED WITH GALVANIZED STEEL OR ALUMINUM STIFFENER ANGLES. THE ANGLES SHALL BE ATTACHED BY GALVANIZED NUTS AND BOLTS FOR STEEL UNITS AND ALUMINUM NUTS AND BOLTS FOR ALUMINUM UNITS.

WHERE TWO OR MORE PIPES WITH APRON ENDWALLS ARE LAID ADJACENT TO EACH OTHER, THEY SHALL BE SEPARATED BY A DISTANCE SUFFICIENT TO PROVIDE A MINIMUM CLEARANCE OF 6 INCHES BETWEEN APRON ENDWALLS.


① FOR PIPE ARCH SIZES UP TO 73" X 55" A 180° ROLLED EDGE MAY BE USED INSTEAD OF STEEL ROD REINFORCEMENT. SEE SECTION A-A.

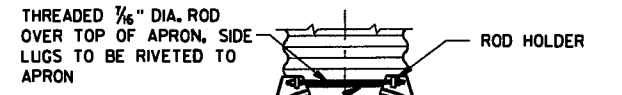

TYPE 2
FOR 17" X 13" THRU 112" X 75" PIPE ARCH

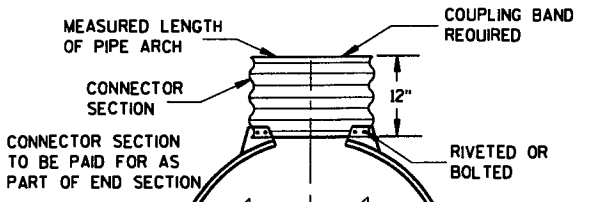

TYPE 3
FOR 64" X 43" THRU 112" X 75" PIPE ARCH

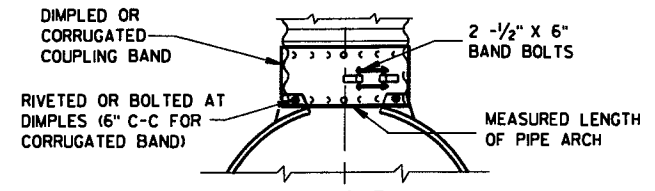

TYPE 5
ALTERNATE FOR:
ALL SIZES CORRUGATED PIPE ARCHES

NOTE: DIMPLED BAND FITS OVER OUTSIDE OF ENDWALL, AND CORRUGATED BAND FITS INSIDE ENDWALL.

CONNECTION DETAILS

**APRON ENDWALLS FOR
PIPE ARCH AND
ELLIPTICAL PIPE**

STATE OF WISCONSIN
DEPARTMENT OF TRANSPORTATION

APPROVED
11/30/94
DATE
FHW


Paul J. ...
CHIEF ROADWAY DEVELOPMENT ENGINEER

6

6


S.D.D. 8 F 2-1

S.D.D. 8 F 2-1

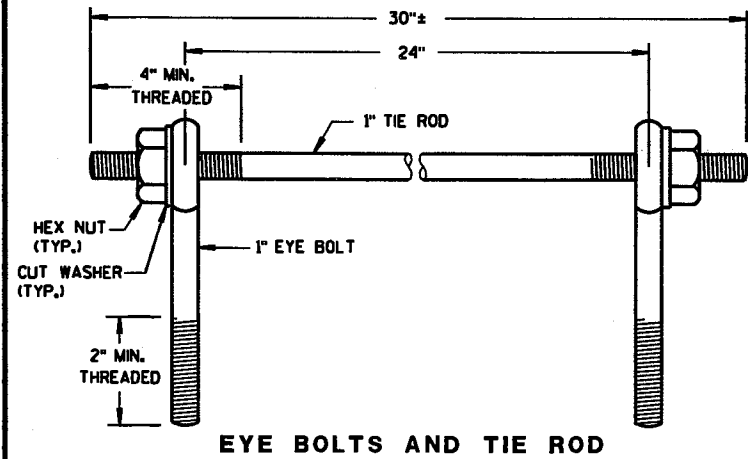

EYE BOLTS AND TIE ROD

EYE BOLT AND TIE ROD ASSEMBLY (ALTERNATE NO. 1)

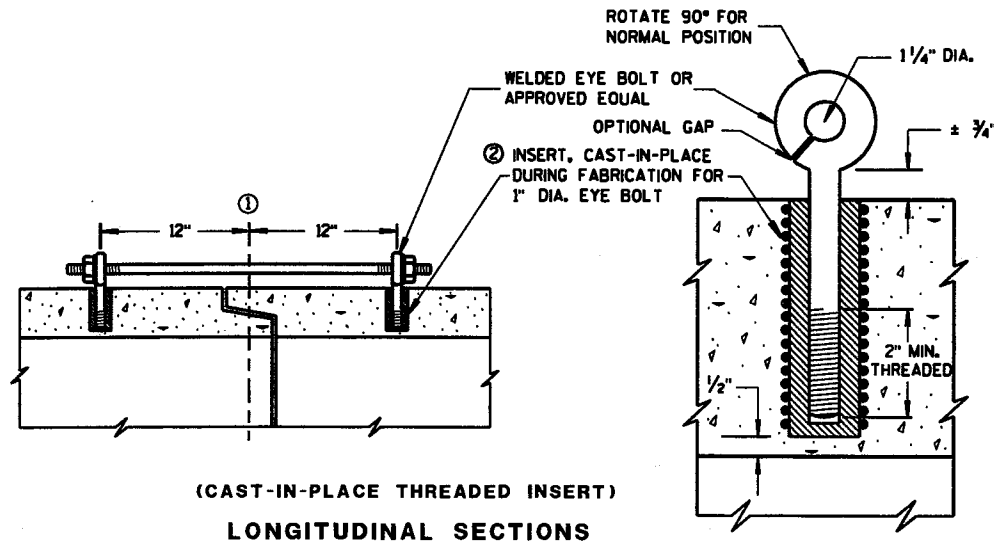

(CAST-IN-PLACE THREADED INSERT)
LONGITUDINAL SECTIONS


GENERAL NOTES

DETAILS OF CONSTRUCTION, MATERIALS, AND WORKMANSHIP NOT SHOWN ON THIS DRAWING SHALL CONFORM TO THE PERTINENT REQUIREMENTS OF THE STANDARD SPECIFICATIONS AND APPLICABLE SPECIAL PROVISIONS.


CONCRETE CULVERT PIPE SHALL BE TIED TOGETHER IN THE MANNER ILLUSTRATED BY THIS DETAIL AT LOCATIONS DESIGNATED ON THE PLAN. THE CONTRACTOR MAY USE EITHER ALTERNATE 1, 2 OR 3 FOR DRAINAGE STRUCTURES. ONLY ALTERNATE 1 AND 3 MAY BE USED FOR CATTLE PASSES, UNLESS OTHERWISE STATED IN THE CONTRACT THE MATERIALS, FABRICATION AND WORK NECESSARY TO TIE CULVERT PIPE AS INDICATED ON THE PLANS AND BY THIS DETAIL WILL BE CONSIDERED INCIDENTAL TO CULVERT PIPE, REINFORCED CONCRETE CULVERT PIPE, OR REINFORCED CONCRETE PIPE CATTLE PASS.

DETAILED DRAWINGS FOR PROPOSED ALTERNATE DESIGNS FOR JOINT TIES SHALL BE SUBMITTED TO THE ENGINEER FOR APPROVAL.

- ① C. OF TONGUE AND GROOVE OR BELL AND SPIGOT JOINTS.
- ② THE INSIDE OF THE THREADED INSERTS SHALL BE CLEAN TO ALLOW THE INSERTION OF THREADED EYE BOLTS.
- ③ HOLES SHALL BE CAST-IN-PLACE OR DRILLED 12 INCHES FROM C. OF TONGUE AND GROOVE.
- ④ BOLT PROJECTION INSIDE OF PIPE SHALL NOT EXCEED 2 INCHES.
- ⑤ OPENING TO BE ROD DIAMETER PLUS 1 INCH.
- ⑥ LENGTH ADEQUATE TO EXTEND TO WITHIN 1/2 INCH OF THE INNER SURFACE OF THE PIPE.

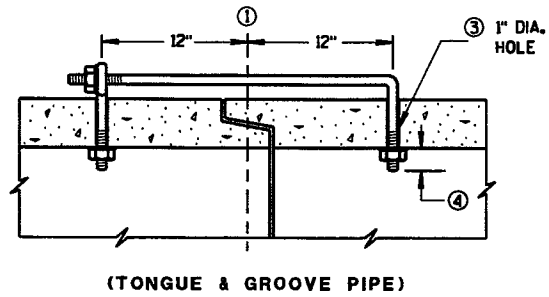

(TONGUE & GROOVE PIPE)

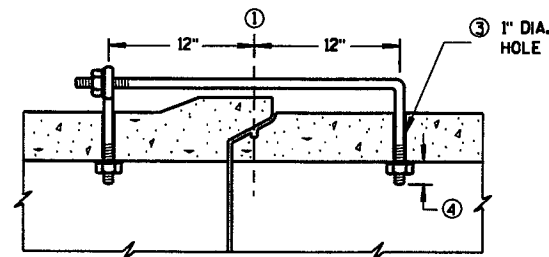

(MODIFIED BELL PIPE)
LONGITUDINAL SECTION


EYE BOLT DIMENSION TABLE

PIPE SIZE	L = LENGTH	
	TONGUE & GROOVE PIPE	MODIFIED BELL PIPE
18" TO 24"	4 1/2"	6 1/4"
30"	5"	7"
36"	5 1/2"	7"
42"	6"	
48"	6 1/2"	
60"	7 1/2"	
66"	8"	


ADJUSTABLE TIE ROD TABLE

PIPE DIAMETER	TIE ROD DIAMETER	D	L ₁	N
12-60	3/8	3/8	5	1/2
66-84	3/4	3/4	5	1/2
90-108	1	1	7	1 1/8


DIMENSIONS SHOWN ARE IN INCHES

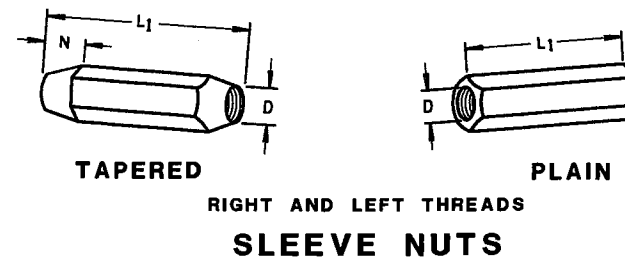

TAPERED PLAIN
RIGHT AND LEFT THREADS
SLEEVE NUTS

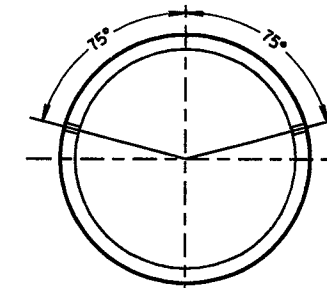


PLACEMENT OF (2) CAST-IN-PLACE INSERTS OR HOLES DURING FABRICATION FOR PIPE SECTIONS REQUIRING TIE RODS
TRANSVERSE SECTION

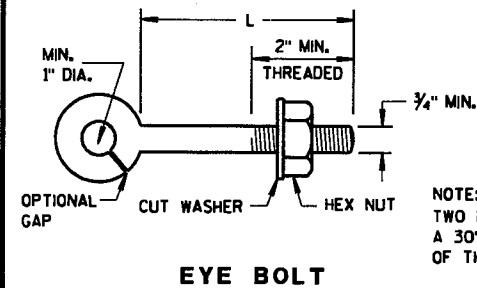


EYE BOLT

NOTE:
TWO EYE BOLTS MAY BE USED WITH A 30" LONG THREADED ROD IN LIEU OF THE 90° BENT TIE ROD.

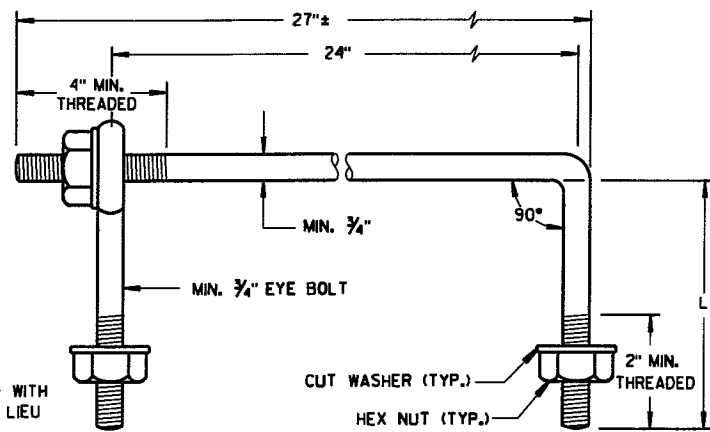

EYE BOLT AND TIE ROD


(JOINT TIES FOR 18" TO 66" DIA. CONCRETE PIPE)
EYE BOLT AND TIE ROD ASSEMBLY (ALTERNATE NO. 2)

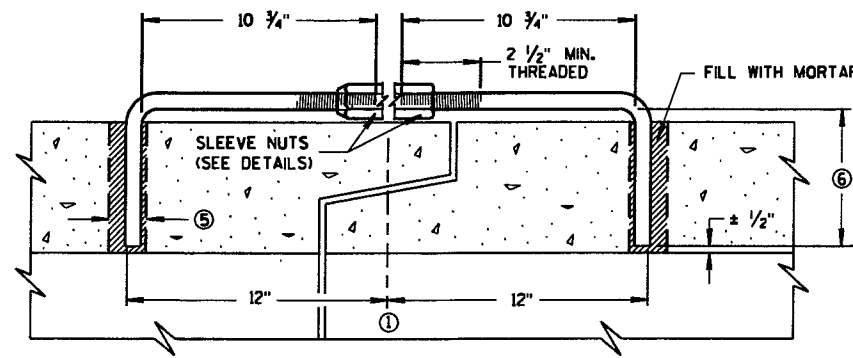

LONGITUDINAL SECTION

(JOINT TIES FOR 12" TO 108" DIA. CONCRETE PIPE)
ADJUSTABLE TIE ROD (ALTERNATE NO. 3)

JOINT TIES FOR CONCRETE PIPE	
STATE OF WISCONSIN DEPARTMENT OF TRANSPORTATION	
APPROVED 12/17/07 DATE	/s/ Jerry H. Zogg ROADWAY STANDARDS DEVELOPMENT ENGINEER
FHWA	

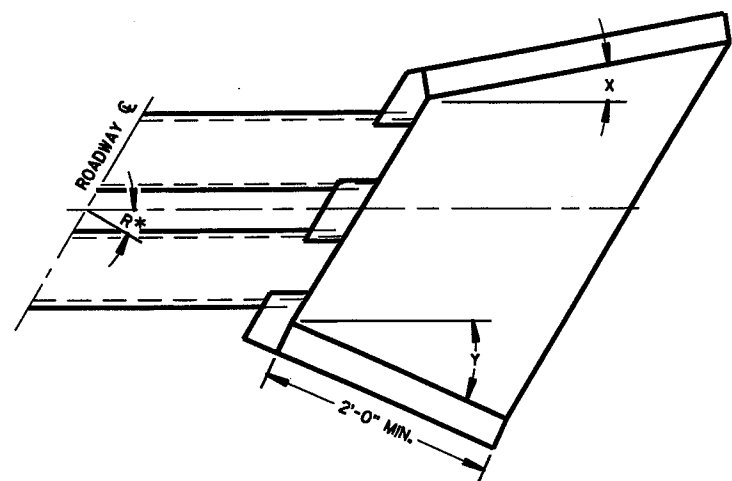

WINGWALL ANGLE DETAILS

INLET			OUTLET		
R*	X	Y	R*	X	Y
0 - 7°	30"	30"	0 - 15°	15°	15°
8 - 22°	25°	"	16 - 45°	10°	"
23 - 37°	20°	"	46 - 75°	5°	"
38 - 52°	15°	"	OVER 75°	0°	"
53 - 67°	10°	"			
68 - 82°	5°	"			
OVER 82°	0°	"			

*R = NUMBER OF DEGREES RIGHT OR LEFT HAND FORWARD

GENERAL NOTES

DETAILS OF CONSTRUCTION, MATERIALS AND WORKMANSHIP NOT SHOWN ON THIS DRAWING SHALL CONFORM TO THE PERTINENT REQUIREMENTS OF THE STANDARD SPECIFICATIONS AND THE APPLICABLE SPECIAL PROVISIONS.


FILL SLOPES FLATTER THAN 2 1/2:1 SHALL BE WARPED TO MEET THE TOP OF THE WINGWALLS.

ALL STEEL REINFORCEMENT AND WELDED STEEL WIRE FABRIC SHALL BE EMBEDDED 2 INCHES CLEAR UNLESS OTHERWISE NOTED.


① MINIMUM REINFORCEMENT SHALL BE 6" X 6" - W4.0 X W4.0 OR NO. 3 BARS SPACED 12" C-C IN BOTH DIRECTIONS.

② THE SPACE BETWEEN PIPES SHALL BE AS FOLLOWS:


DIAMETER OR SPAN	SPACE
UP TO AND INCLUDING 48"	2'-0"
OVER 48" TO 72"	1/2 DIA. OR SPAN
OVER 72"	3'-0"

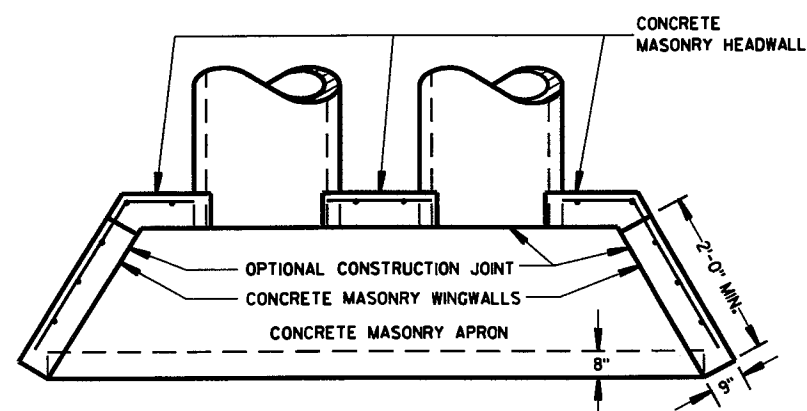


PLAN VIEW
CULVERT PIPE AND PIPE ARCH

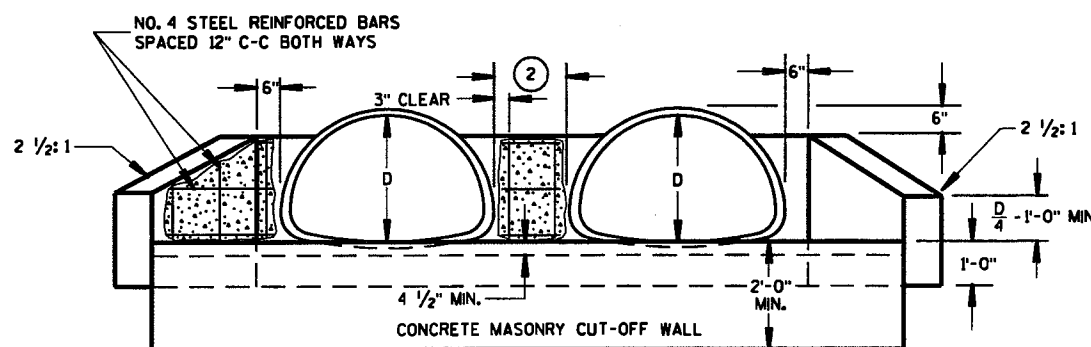

END ELEVATION
PIPE ARCH

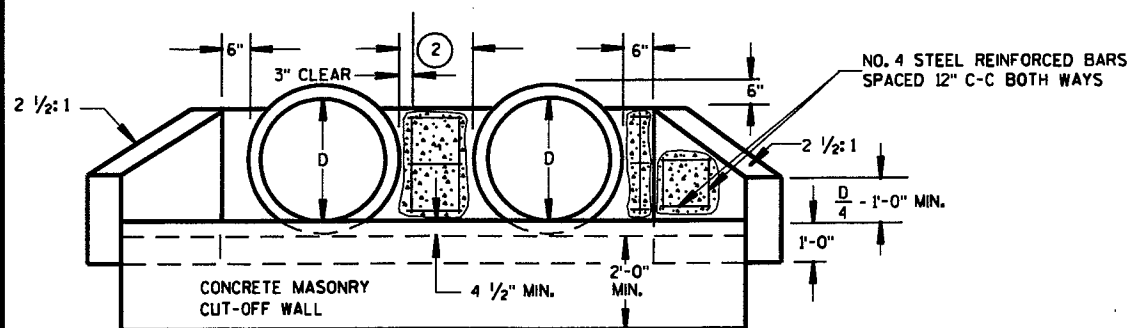

END ELEVATION
CULVERT PIPE

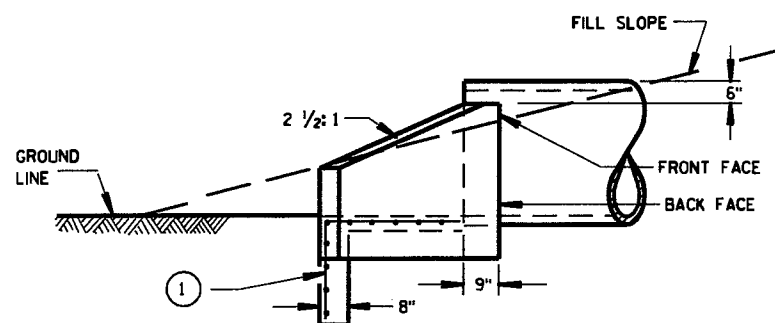

SIDE ELEVATION
CULVERT PIPE AND PIPE ARCH

CONCRETE MASONRY ENDWALLS FOR
CULVERT PIPE AND PIPE ARCH

STATE OF WISCONSIN
DEPARTMENT OF TRANSPORTATION


APPROVED
9/14/98
DATE

Paul J. Anderson
CHIEF ROADWAY DEVELOPMENT ENGINEER


FHWA

S.D.D. 8 F 10-1

S.D.D. 8 F 10-1

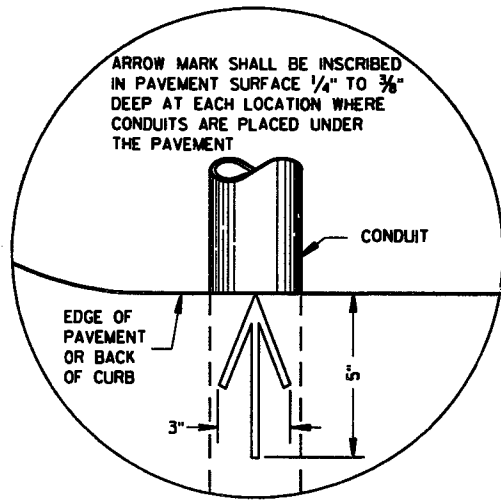


PLAN VIEW
ARROW MARK

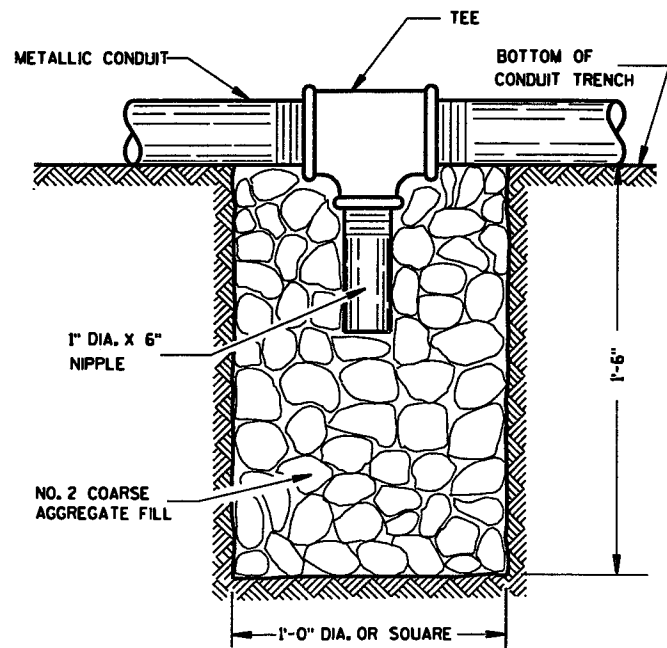

NOTE: INSTALL AT LOCATIONS WHERE METALLIC CONDUITS CANNOT BE PITCHED TO DRAIN INTO A PULL BOX.

DRAIN SUMP FOR METALLIC CONDUIT

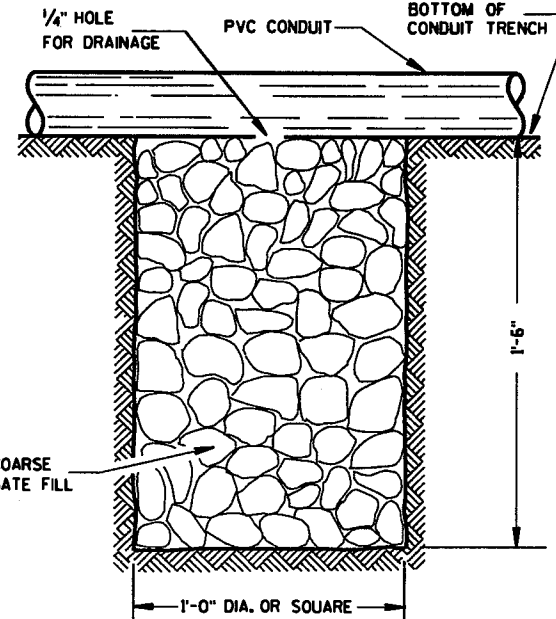

NOTE: INSTALL AT LOCATIONS WHERE PVC CONDUITS CANNOT BE PITCHED TO DRAIN INTO A PULL BOX.

DRAIN SUMP FOR PVC CONDUIT

GENERAL NOTES

DETAILS OF CONSTRUCTION, MATERIALS AND WORKMANSHIP NOT SHOWN ON THIS DRAWING SHALL CONFORM TO THE PERTINENT REQUIREMENTS OF THE CONTRACT.

METALLIC (STANDARD SPECIFICATION 652.2.2) OR NONMETALLIC (STANDARD SPECIFICATION 652.2.3) CONDUIT SHALL BE FURNISHED AND PLACED AS SHOWN.

DEPTH OF CONDUIT INSTALLED BELOW THE TRAVELED WAY SHALL BE 24 INCHES MINIMUM AND 36 INCHES MAXIMUM.

DEPTH OF CONDUIT INSTALLED THAT IS NOT BELOW THE TRAVELED WAY SHALL BE 18 INCHES MINIMUM AND 36 INCHES MAXIMUM.

ANY EXCEPTION TO THE MAXIMUM DEPTH SHALL BE ONLY WITH THE WRITTEN APPROVAL OF THE ENGINEER.

THE TRENCH SHALL NOT BE BACKFILLED PRIOR TO INSPECTION OF THE CONDUIT.

ALL METALLIC CONDUIT RACEWAY ENDS SHALL BE REAMED AND THREADED.

ALL METALLIC CONDUIT IN WHICH WIRE OR CABLE IS TO BE INSTALLED SHALL BE BUSHED WITH APPROVED THREADED BUSHINGS BEFORE INSTALLATION OF THE WIRE OR CABLE.

ALL METALLIC CONDUITS IN WHICH WIRE OR CABLE IS NOT TO BE INSTALLED SHALL BE CAPPED WITH THREADED PROTECTIVE CAPS, AS APPROVED BY THE ENGINEER.

ALL NONMETALLIC CONDUIT SHALL BE CAPPED OR PLUGGED IMMEDIATELY AFTER INSTALLATION AND SHALL REMAIN CAPPED OR PLUGGED UNTIL WIRE/CABLES ARE INSTALLED.

NONMETALLIC CONDUITS IN WHICH WIRE OR CABLE IS NOT BEING INSTALLED SHALL REMAIN CAPPED OR PLUGGED.

BENDING OF PVC ELECTRICAL CONDUIT SHALL BE ACCOMPLISHED BY USING A BLANKET OR EMERSON TYPE TANK DESIGNED FOR THE PURPOSE OF BENDING PVC ELECTRICAL CONDUIT.

ALL CUT ENDS SHALL BE TRIMMED INSIDE AND OUTSIDE TO REMOVE ALL ROUGH EDGES ON NONMETALLIC CONDUIT. (SEE NEC 347.5)

WHEN REQUIRED TO CONNECT NONMETALLIC CONDUIT TO METALLIC CONDUIT, ONLY U.L. LISTED ADAPTER FITTINGS SHALL BE USED.


PRIOR TO CONDUIT ACCEPTANCE, CONDUIT CAPS OR PLUGS SHALL BE REMOVED, AND THE CAPS, PLUGS AND CONDUIT ENDS SHALL BE THOROUGHLY CLEANED AND THEN THE CAPS OR PLUGS REINSTALLED TO ENSURE THAT THE CAPS OR PLUGS CAN BE EASILY REMOVED IN THE FUTURE.

ALL CONDUIT BEING FURNISHED AND INSTALLED SHALL HAVE THE U.L. LABEL FIRMLY ATTACHED.

CONDUIT RUNS SHALL BE THE SAME SIZE OF CONDUIT FROM ONE END TO THE OTHER (FROM PULL BOX TO PULL BOX-OR-JUNCTION BOX TO JUNCTION BOX-OR-BASE TO BASE, ETC.).

POLY ROPE OR A PULL WIRE SHALL BE INSTALLED AS STATED IN THE STANDARD SPECIFICATION, ITEM 652.3.1.1.

ALL CONDUIT RUNS SHALL BE STRAIGHT (WITHOUT BENDS) FROM PULL BOX TO PULL BOX, PULL BOX TO BASE AND BASE TO BASE AS SHOWN ON THE PLANS.

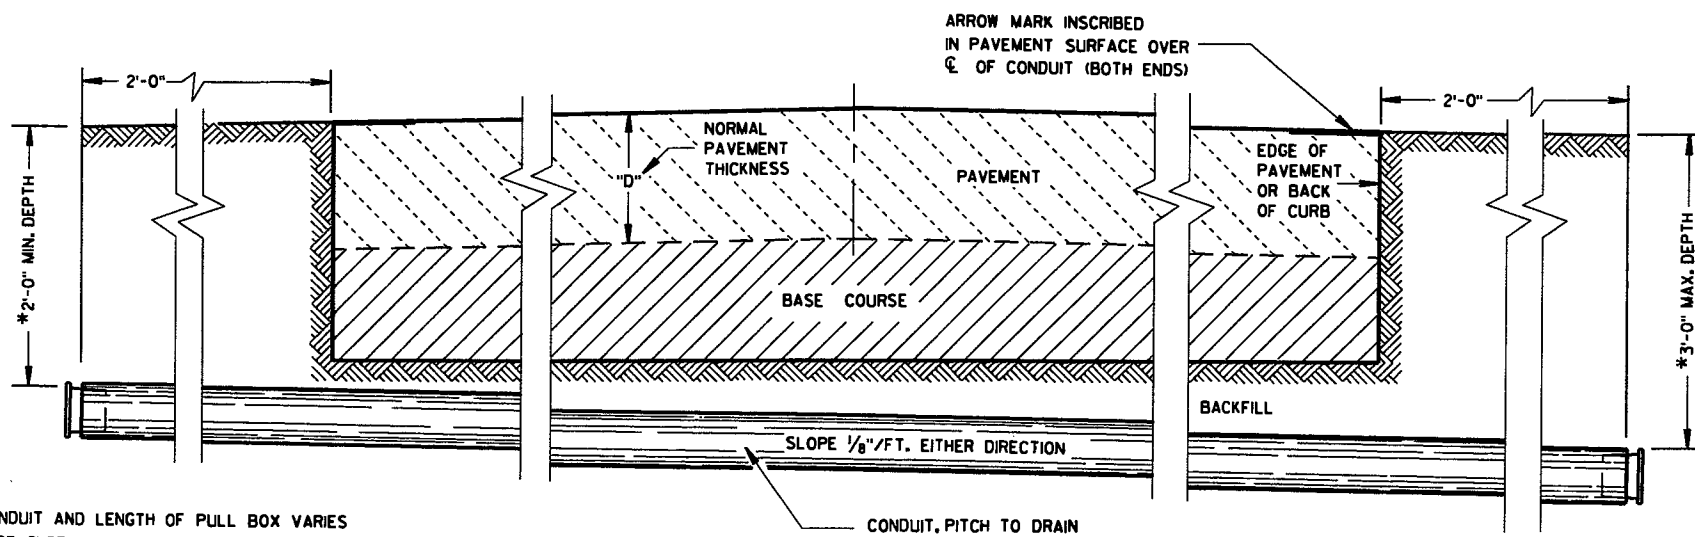

*DEPTH OF CONDUIT AND LENGTH OF PULL BOX VARIES WITH HEIGHT OF CURB USED. ALSO SEE PULL BOX S.D.D. 9B4

SIDE ELEVATION
DETAIL FOR CONDUIT UNDER PAVED HIGHWAYS

CONDUIT	
STATE OF WISCONSIN DEPARTMENT OF TRANSPORTATION	
APPROVED 10/23/03 DATE	 STATE ELECTRICAL ENGINEER FOR HIGHWAYS
FHWA	

6

6

S.D.D. 9 B 2-7

S.D.D. 9 B 2-7

TABLE OF NOMINAL DIMENSIONS AND WEIGHTS

DIMENSION IN INCHES		CORRUGATED STEEL PIPE								
		A	12	12	12	18	18	18	24	24
PIPE DIAMETER (INSIDE)	A	12	12	12	18	18	18	24	24	24
PIPE LENGTH **	B	24	30	36	24	30	36	36	42	48
WALL THICKNESS	C	0.064	0.064	0.064	0.064	0.064	0.064	0.064	0.064	0.064
COVER	D	10 1/4	10 1/4	10 1/4	16 1/4	16 1/4	16 1/4	22 1/4	22 1/4	22 1/4
FRAME	E	14 1/2	14 1/2	14 1/2	20 1/2	20 1/2	20 1/2	26 1/2	26 1/2	26 1/2
FRAME	F	8 1/2	8 1/2	8 1/2	14 1/2	14 1/2	14 1/2	20 1/2	20 1/2	20 1/2
FRAME	G	11 1/2	11 1/2	11 1/2	17 1/2	17 1/2	17 1/2	23 1/2	23 1/2	23 1/2
		WEIGHT IN POUNDS *								
FRAME AND COVER		60	60	60	110	110	110	155	155	155

* THE ACTUAL WEIGHT OF THE MANHOLE FRAME AND COVER MAY VARY WITHIN 5 PERCENT PLUS OR MINUS OF THE WEIGHTS SHOWN.

** NORMALLY USED LENGTHS. THE PROJECT ENGINEER SHALL DETERMINE IF PIPE LENGTHS, OTHER THAN THOSE SPECIFIED, SHALL BE USED, TO A MAXIMUM OF 48" (CONTINUOUS LENGTH, NON-SPLICED). THE ADDITIONAL LENGTH SHALL BE INCIDENTAL TO THE PULL BOX BID PRICE.

GENERAL NOTES

DETAILS OF CONSTRUCTION, MATERIALS AND WORKMANSHIP NOT SHOWN ON THIS DRAWING SHALL CONFORM TO THE PERTINENT REQUIREMENTS OF THE CONTRACT.

ALL FRAMES AND COVERS SHALL BE HEAVY DUTY TYPE, SUITABLE FOR VEHICULAR TRAFFIC LOADS.

PULL BOXES LOCATED IN THE ROADWAYS SHALL HAVE LOCKING COVERS.

ENTRANCE HOLES INTO PULL BOXES SHALL BE CUT WITH A CIRCULAR HOLE SAW OR HYDRAULIC CONDUIT PUNCH. HOLE SIZE SHALL BE THE OUTSIDE DIAMETER OF THE CONDUIT THAT IS TO FIT IN THE OPENING PLUS NO MORE THAN 1/4".

THE CONTRACTOR SHALL NOT INSTALL WIRE IN ANY PULL BOX UNTIL ITS INSTALLATION HAS BEEN INSPECTED AND ACCEPTED BY THE ENGINEER.

GROUNDING LUGS (MECHANICAL CONNECTORS) SHALL BE U.L. LISTED AND APPROVED FOR USE WITH COPPER WIRE. THE MECHANICAL CONNECTION (INSIDE AND OUTSIDE) TO THE PULL BOX, SHALL BE TOTALLY AND PERMANENTLY SEALED WITH A SILICONE OR RUBBERIZED CAULKING COMPOUND AS APPROVED BY THE ENGINEER.


GROUNDING LUGS ARE NOT REQUIRED IN PULL BOXES WHEN VOLTAGES OF LESS THAN 50 VOLTS AC ARE THE ONLY VOLTAGES ENCOUNTERED IN THE BOXES.

ALL METALLIC CONDUIT IN WHICH WIRE AND/OR CABLE IS TO BE INSTALLED, SHALL BE BUSHED BEFORE INSTALLATION OF THE WIRE AND/OR CABLE.


S.D.D. 9B2, "CONDUIT", APPLIES TO THIS DRAWING.

WHEN PULL BOXES ARE INSTALLED FOR FUTURE USE, DO NOT INSTALL THE EQUIPMENT GROUNDING LUG. THE EQUIPMENT GROUNDING LUG, THE EQUIPMENT GROUNDING ELECTRODE AND THE EQUIPMENT GROUNDING CONDUCTOR SHALL BE REQUIRED AND INSTALLED UNDER A FUTURE WIRING CONTRACT.

IF PULL BOX EQUIPMENT GROUNDING IS REQUIRED USING AN EQUIPMENT GROUNDING ELECTRODE IN EACH PULL BOX, THE EQUIPMENT GROUNDING ELECTRODE SHALL BE 5/8" X 8'-0", COPPERCLAD AND BE EXOTHERMICALLY WELDED TO A #4 AWG, COPPER, STRANDED WIRE (BARE OR GREEN INSULATED). THE #4 AWG WIRE SHALL BE 4 FEET IN LENGTH, NEATLY COILED, TAPED AND AVAILABLE FOR USE WHEN REQUIRED.

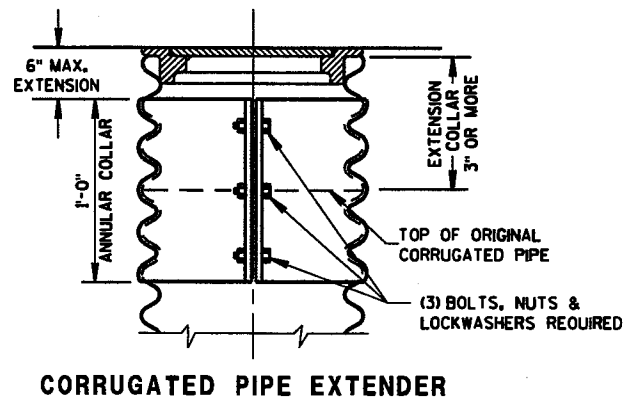


CORRUGATED PIPE EXTENDER

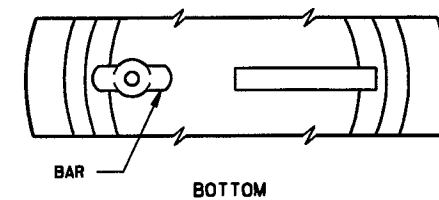


ALTERNATE COVER (LOCKING)

TIGHTENING BAR TYPE

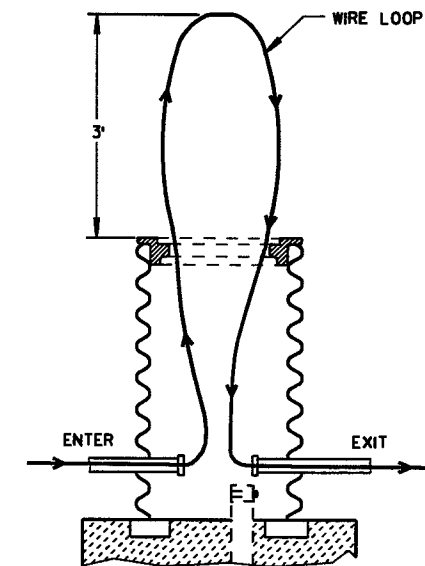


MEASUREMENT DETAIL FOR WIRE/CABLE IN THE PULL BOX

WHEN A PULL BOX IS INSTALLED IN CRUSHED AGGREGATE SHOULDERS, PLACE IT 2-3 INCHES BELOW GRADE AND COVER IT WITH 2-3 INCHES OF CRUSHED AGGREGATE

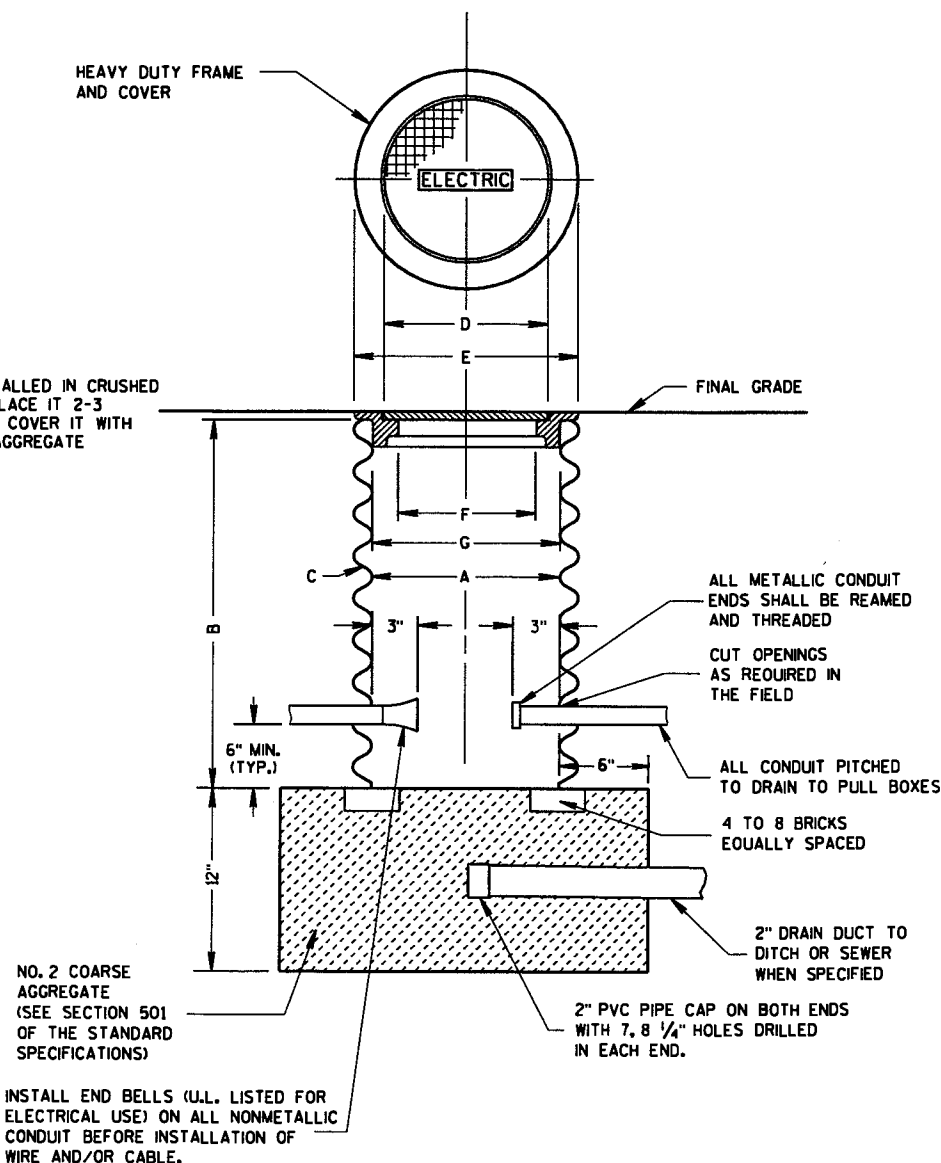

PULL BOX

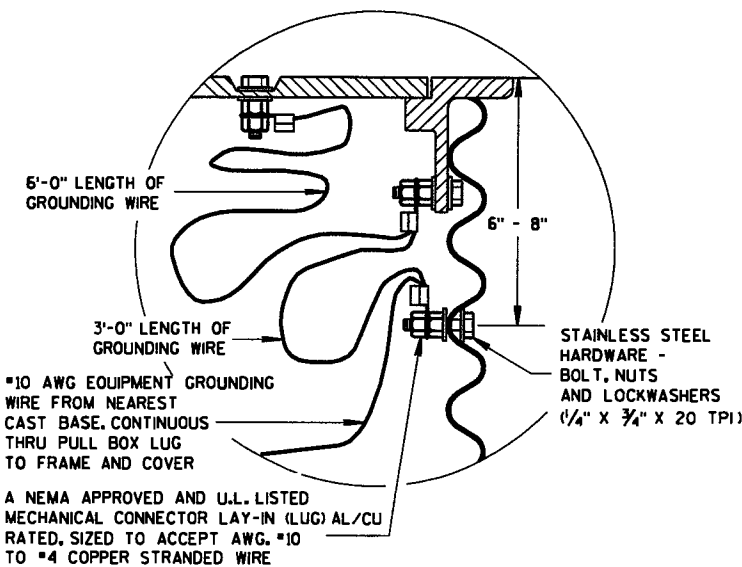


EQUIPMENT GROUNDING LUG AND LOCATION IN STEEL PULL BOXES

PULL BOX

STATE OF WISCONSIN
DEPARTMENT OF TRANSPORTATION

APPROVED
9/27/06 /S/ Balu Ananthanarayanan
DATE STATE ELECTRICAL ENGINEER FOR
FHWA HIGHWAYS

FORM DEPTH SHALL BE NO MORE THAN 6" BELOW GRADE ON THE LOWER SIDE OF BASE

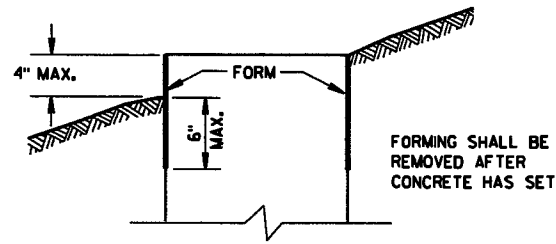

FORMING DETAIL

QUANTITY REQUIREMENTS	CONCRETE BASE TYPE		
	1	2	5
APPROX. CUBIC YARDS OF CONCRETE	0.40	0.57	0.40
LBS. OF HOOP BAR STEEL	NONE	23	16
LBS. OF VERTICAL BAR STEEL	NONE	60	18

GENERAL NOTES

DETAILS OF CONSTRUCTION, MATERIALS AND WORKMANSHIP NOT SHOWN ON THIS DRAWING SHALL CONFORM TO THE PERTINENT REQUIREMENTS OF THE CONTRACT.

BASES SHALL BE EXCAVATED BY USE OF A CIRCULAR AUGER.

TOP SURFACES OF CONCRETE BASES SHALL BE TROWEL FINISHED SMOOTH AND LEVEL.

CONDUIT SIZES AND LOCATIONS SHALL BE AS SHOWN ON THE PLANS.

THE FINAL OR TERMINATING CONCRETE BASE IN A CONDUIT RUN SHALL HAVE A 6" EXIT STUB INSTALLED FOR FUTURE CABLING USE. THE EXIT STUB SHALL BE SIZED AS USED THROUGHOUT THE CONDUIT RUN AS SHOWN AT THE ENTRANCE OF THE BASE.

MINIMUM BENDING RADIUS OF CONDUIT IS EQUAL TO 6 X THE DIAMETER.

CONDUIT HEIGHT ABOVE CONCRETE BASES SHALL BE 1 INCH. ALL METALLIC CONDUIT ENDS SHALL BE REAMED AND THREADED.

ALL CONDUIT ENDS AT THE TOP OF CONCRETE BASES SHALL BE CAPPED IF METALLIC OR PLUGGED IF NONMETALLIC IMMEDIATELY AFTER PLACEMENT AND BEFORE CONCRETE IS POURED. CONDUITS IN WHICH WIRE OR CABLE IS NOT INSTALLED SHALL REMAIN CAPPED OR PLUGGED.

GENERAL NOTES (CONTINUED)

BELL ENDS SHALL BE INSTALLED ON ALL PVC CONDUIT EXPOSED AT THE TOP OF CONCRETE BASES BEFORE INSTALLATION OF CABLE OR WIRE.

ENDS OF CONDUIT INSTALLED BELOW GRADE FOR FUTURE USE SHALL BE CAPPED IF METALLIC OR PLUGGED IF NONMETALLIC.

WHEN REQUIRED TO CONNECT NONMETALLIC CONDUIT TO METALLIC CONDUIT, ONLY ADAPTER FITTINGS, U.L. LISTED FOR ELECTRICAL USE, SHALL BE USED.

IF A BASE REQUIRES A DEEP FORM BECAUSE OF LOOSE DIRT OR FILL, THE FORM SHALL BE REMOVED BEFORE BACKFILLING AROUND THE BASE. BACKFILL SHALL BE TAMPED TIGHT AGAINST THE BARE CONCRETE BASE IN LAYERS OF 1 FOOT OR LESS.

A NO. 4 AWG, STRANDED COPPER EQUIPMENT GROUNDING CONDUCTOR SHALL BE EXOTHERMICALLY WELDED TO THE EQUIPMENT GROUNDING ELECTRODE (GROUND ROD) FOR TYPE 2 AND TYPE 5 BASES.

THE EQUIPMENT GROUNDING CONDUCTOR SHALL BE FURNISHED AND INSTALLED TO ENTER THE BASE OF THE TYPE 2 AND TYPE 5 BASES THROUGH A 1 INCH CONDUIT INSTALLED FOR GROUNDING PURPOSES, LEAVING A 4 FOOT COIL OF WIRE ABOVE THE CONCRETE BASE. THE EQUIPMENT GROUNDING CONDUCTOR SHALL BE NEATLY COILED AND THE COILS TIED TOGETHER.

ANCHOR RODS SHALL BE THREADED 12" IN LENGTH ON EACH END OF THE ROD. ANCHOR RODS SHALL BE MANUFACTURED IN ACCORDANCE WITH SECTION 654.2.1 AND 641.2.2 OF THE STANDARD SPECIFICATIONS, ASTM A-449, OR ASTM A-687 (GRADE 105).

WASHERS AND LOCK WASHERS ARE REQUIRED ON ALL ANCHOR RODS.




WHEN ANCHOR RODS USING THE ALTERNATE "L" BEND ARE FURNISHED, THE 4" "L" BEND SHALL BE IN ADDITION TO THE SPECIFIED ANCHOR ROD BAR LENGTH. THE "L" BEND END SHALL NOT BE THREADED.

ANCHOR RODS SHALL BE INSTALLED WITH MISALIGNMENTS OF LESS THAN 1:40 FROM VERTICAL PER SECTION 5.17.6.3, AASHTO 2001 4TH EDITION STANDARD SPECIFICATIONS FOR STRUCTURAL SUPPORTS FOR HIGHWAY SIGNS, LUMINARIES AND TRAFFIC SIGNALS.

WELDING OF THE ANCHOR RODS TO THE CAGE IS UNACCEPTABLE. TIE WIRES SHALL BE USED.

BAR STEEL REINFORCEMENT SHALL BE COATED WITH POWDERED EPOXY RESIN IN ACCORDANCE WITH SECTION 505 OF THE STANDARD SPECIFICATIONS (LATEST EDITION).




- ① THE MINIMUM DEPTH OF CONDUIT EXITING THE CONCRETE BASE AND INSTALLED BELOW THE TRAVELED WAY SHALL BE 24 INCHES. THE MINIMUM DEPTH OF CONDUIT EXITING THE CONCRETE BASE THAT IS NOT INSTALLED BELOW THE TRAVELED WAY SHALL BE 18 INCHES. THE MAXIMUM DEPTH OF ALL CONDUIT SHALL BE 36 INCHES EXCEPT WITH WRITTEN APPROVAL BY THE ENGINEER.
- ② (4) 1" DIA. X 3'-6" ANCHOR RODS.
- ③ (4) 1" DIA. X 5'-0" ANCHOR RODS.
- ④ (6) NO. 6 X 6'-8" BAR STEEL REINFORCEMENT.
- ⑤ (7) NO. 4 X 5'-1" BAR STEEL REINFORCEMENT @ 1'-0" C-C.
- ⑥ (4) 1" DIA. X 3'-6" ANCHOR RODS.
- ⑦ (6) NO. 4 X 4'-8" BAR STEEL REINFORCEMENT
- ⑧ (5) NO. 4 X 5'-1" BAR STEEL REINFORCEMENT @ 1'-0" C-C.

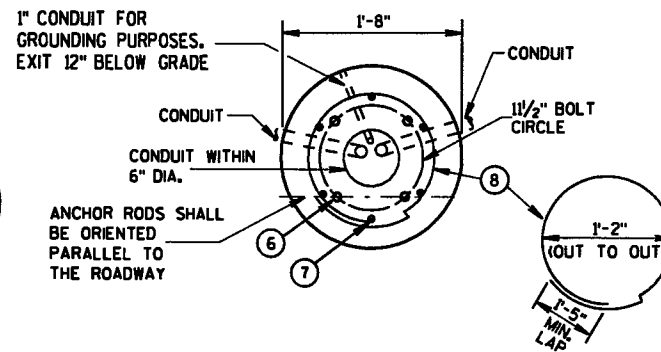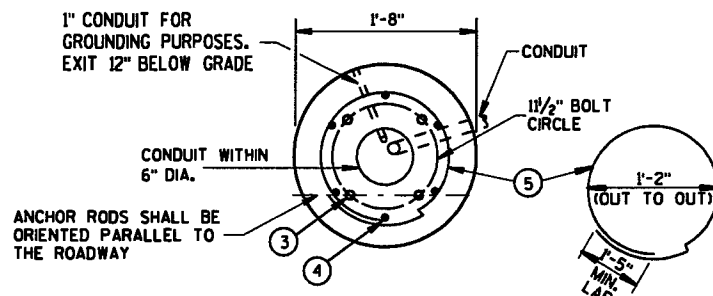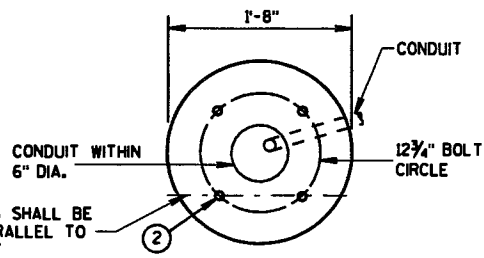

FORM ALL EXPOSED CONCRETE. PROVIDE 1" CHAMFER ALL AROUND

HALF SECTION IN UNPAVED AREA (TYPICAL FOR TYPES 1, 2 & 5)

HALF SECTION IN PAVEMENT (TYPICAL FOR TYPES 1, 2 & 5)

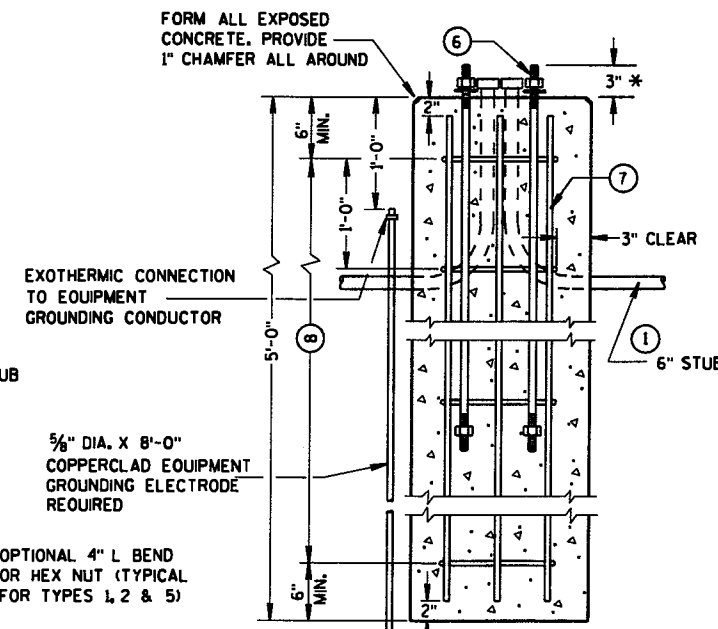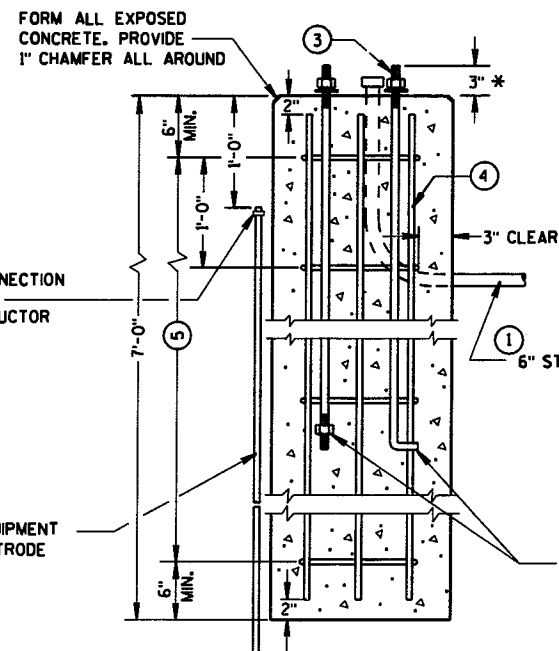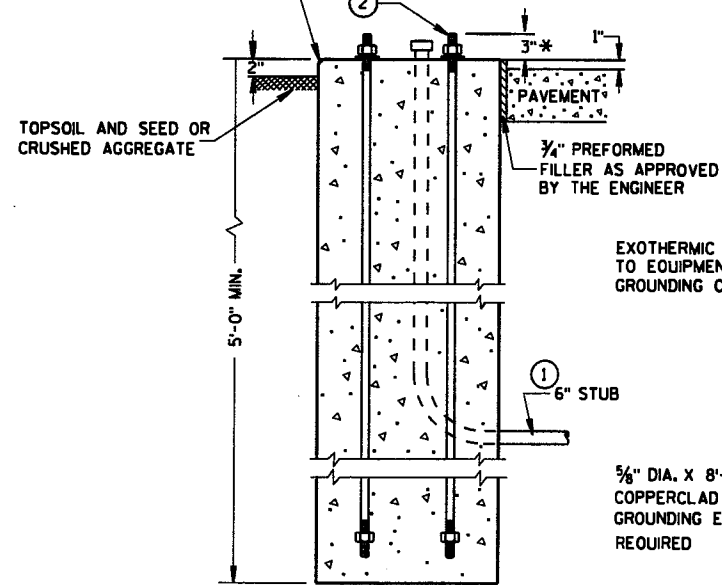

TYPE 1

TYPE 2

TYPE 5

CONCRETE BASES

* ANY ANCHOR ROD PROJECTION SHORTER THAN 2 3/4" OR LONGER THAN 3 1/4" SHALL REQUIRE THE BASE TO BE REMOVED AND REPLACED AT THE CONTRACTORS EXPENSE.

CONCRETE BASES, TYPES 1, 2 & 5	
STATE OF WISCONSIN DEPARTMENT OF TRANSPORTATION	
APPROVED 1/12/05 DATE	 STATE ELECTRICAL ENGINEER FOR HIGHWAYS
FHWA	

6

S.D.D. 9 C 2-4

GENERAL NOTES

DETAILS OF CONSTRUCTION, MATERIALS AND WORKMANSHIP NOT SHOWN ON THIS DRAWING SHALL CONFORM TO THE PERTINENT REQUIREMENTS OF THE CONTRACT.

FOUR (4) BOLTS SHALL BE FURNISHED WITH EACH TRANSFORMER BASE. BOLTS SHALL BE 1" DIAMETER, 4" IN LENGTH, WITH WASHERS, LOCK WASHERS AND NUTS. BOLTS, NUTS AND WASHERS SHALL BE MANUFACTURED IN ACCORDANCE WITH SECTION 641.2.2 OF THE STANDARD SPECIFICATIONS, ASTM A-325, (92,000 YIELD) HEAVY HEX NUT AND BE GALVANIZED IN ACCORDANCE WITH ASTM A-153, CLASS C.

LEVELING SHIMS, IF NEEDED, SHALL BE DESIGNED FOR THE PURPOSE AND USED UNDER CAST BASES WHEN PLUMBING POLES OR STANDARDS DURING INSTALLATION. THE USE OF WASHERS IN LIEU OF PROPER LEVELING SHIMS IS NOT ACCEPTABLE.

SHIM LENGTH SHALL BE LONG ENOUGH TO COMPLETELY COVER THE AREA UNDER THE LENGTH AND WIDTH OF THE BASE MOUNTING FLANGE.

DOUBLE NUTTING IS NOT ACCEPTABLE FOR LEVELING OR MOUNTING PURPOSES.

A NEMA APPROVED AND U.L. LISTED MECHANICAL CONNECTOR (LUG) AL/CU RATED AND SIZED TO ACCEPT #10 AWG STRANDED WIRE, SHALL BE FURNISHED AND INSTALLED IN THE PEDESTAL AND TRANSFORMER BASES.



THE MECHANICAL CONNECTOR SHALL BE INSTALLED USING A 1/4" - 20 (TPI) STAINLESS STEEL HEX HEAD BOLT OF SUFFICIENT LENGTH TO FIRMLY ATTACH THE LUG TO THE BASE.

SHOULD THE MANNER OF ATTACHMENT OF THE LUG REQUIRE WASHERS, HEX NUTS, LOCK WASHER - THEY SHALL BE STAINLESS STEEL AS IS THE BOLT. THE MANNER OF ATTACHMENT SHALL NOT BLOCK ACCESSIBILITY TO WIRE PLACEMENT IN THE CONNECTOR.


PEDESTAL BASE COLLAR THREADING SHALL BE TAPERED AND IN ACCORDANCE WITH NATIONAL PIPE THREADING DIMENSIONS.

BASE COLLAR THREADING SHALL EXTEND INTO THE BASE COLLAR WITH SUFFICIENT DEPTH TO ACCEPT THE INSTALLATION OF TRAFFIC SIGNAL STANDARDS TO A DEPTH OF 1/2", THEN TIGHTENING TO A POINT OF BEING IMMOVABLE.


THE ACCESS DOOR SHALL BE OF THE SAME MATERIAL AS THE BASE.

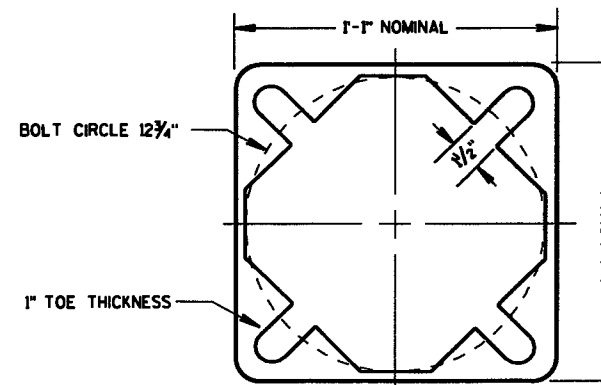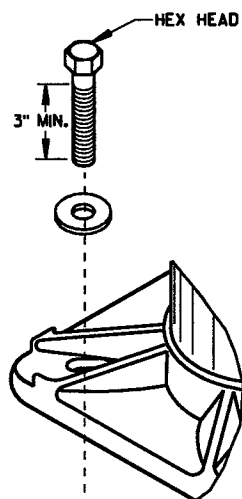


**BOTTOM VIEW
(PEDESTAL BASE)**

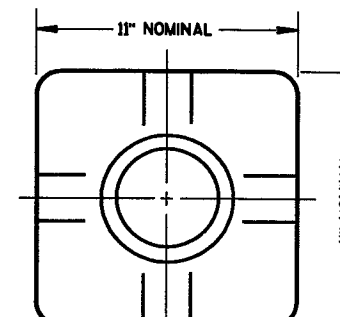


**TOP VIEW
(PEDESTAL BASE)**

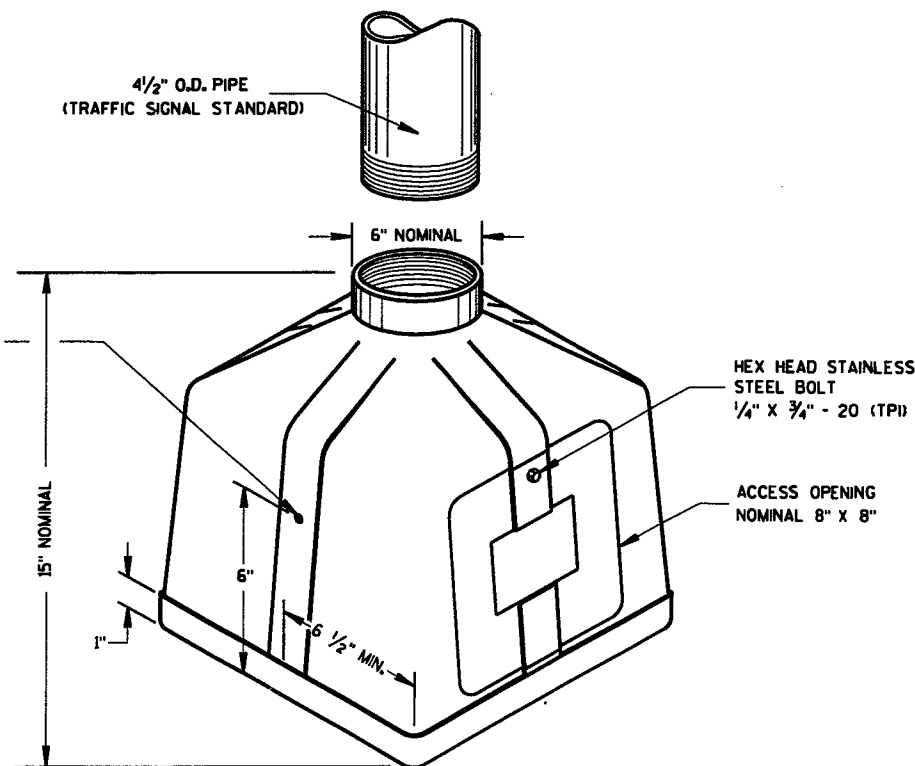


**ISOMETRIC VIEW
PEDESTAL BASE**

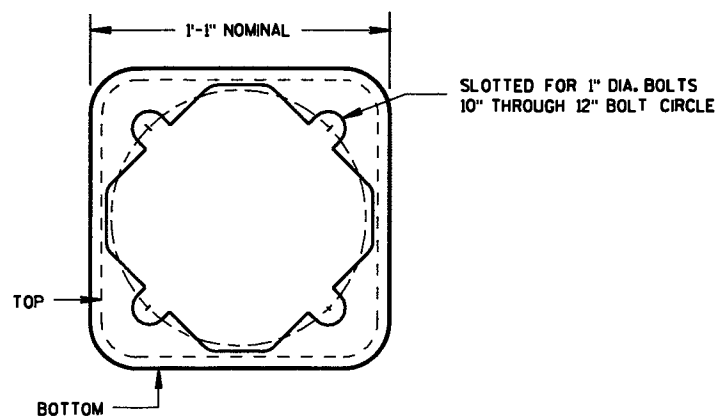


**BOTTOM VIEW
(TRANSFORMER BASE)**

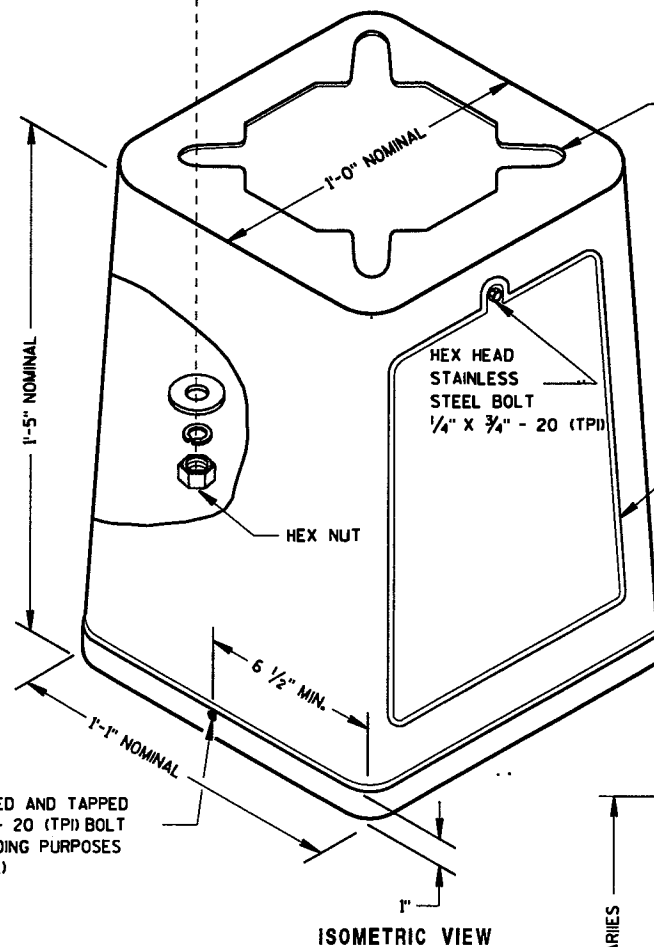

ISOMETRIC VIEW

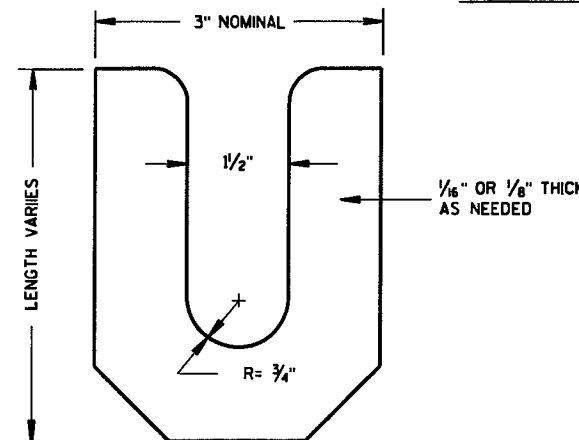

LEVELING SHIM

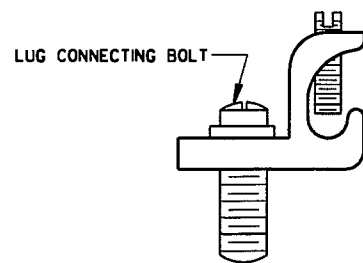

**TYPICAL MECHANICAL
CONNECTOR LUG**
TO BE FURNISHED WITH EACH BASE

TRANSFORMER BASE
INTENDED FOR USE WITH TYPE 2, 3, 4, 5 & 6 POLES

TRANSFORMER/PEDESTAL BASES

STATE OF WISCONSIN
DEPARTMENT OF TRANSPORTATION


APPROVED
10/21/96
DATE

Bob Stuss
STATE ELECTRICAL ENGINEER FOR
HIGHWAYS


FHWA

S.D.D. 9 C 3-2


S.D.D. 9 C 3-2

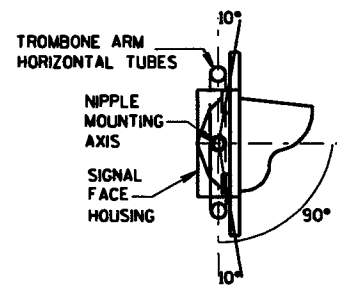

SECTION A-A
(10 DEGREES TILT REQUIREMENT OF FACE(S) IN THE TROMBONE MOUNTING)

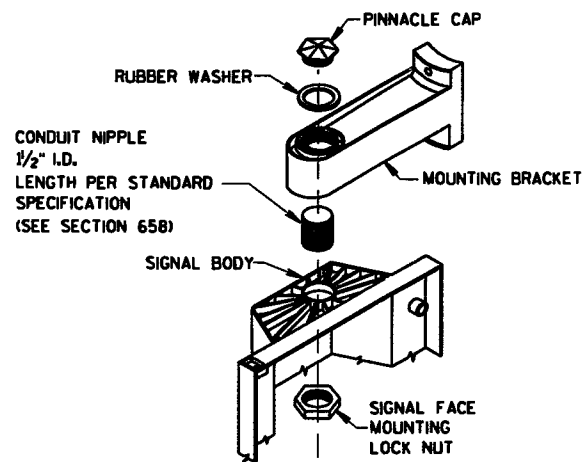


SIGNAL FACE MOUNTING DETAIL
(BANDED)

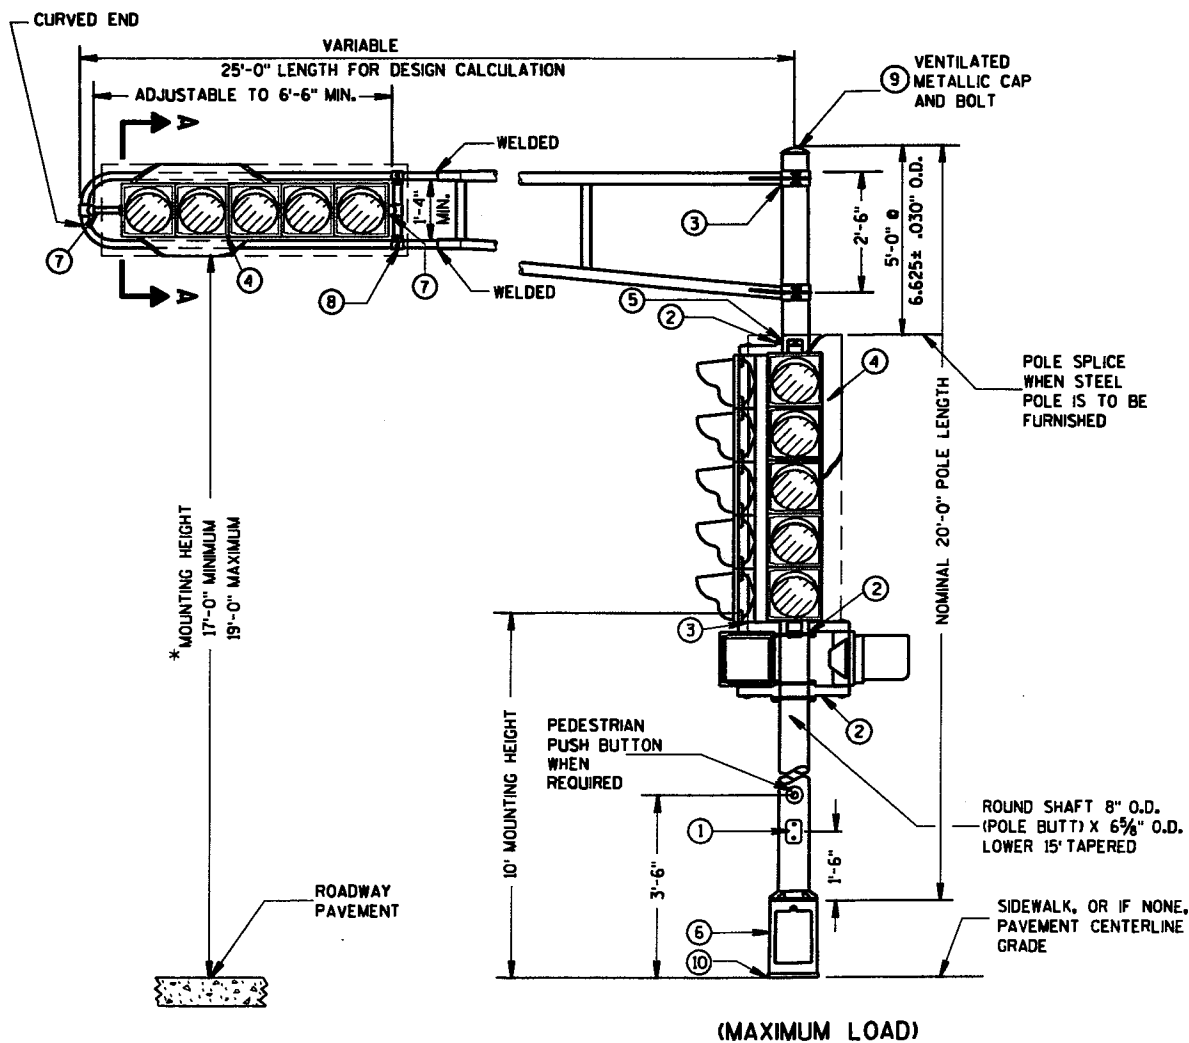

(MAXIMUM LOAD)



TYPICAL MOUNTING OF BACK TO BACK
3 AND 5 SECTION SIGNAL FACES

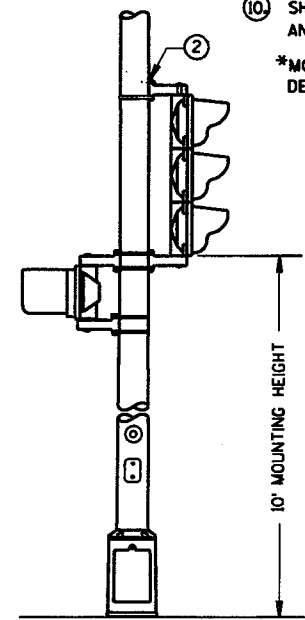

TYPICAL MOUNTING OF 3 SECTION
SIGNAL FACE

TYPE 2 POLE MOUNTING CONFIGURATION

GENERAL NOTES

DETAILS OF CONSTRUCTION, MATERIALS AND WORKMANSHIP NOT SHOWN ON THIS DRAWING SHALL CONFORM TO THE PERTINENT REQUIREMENTS OF THE CONTRACT. POLES SHALL BE EITHER ALUMINUM OR GALVANIZED STEEL AS CALLED FOR IN THE CONTRACT.

SECTION 657, POLES, OF THE STANDARD SPECIFICATIONS SHALL APPLY TO THIS DRAWING.

A PULL WIRE/ROPE IN ACCORDANCE WITH STANDARD SPECIFICATION 652 SHALL BE INSTALLED IN EACH TROMBONE ARM RACEWAY DURING THE MANUFACTURING PROCESS.

TYPE 2 ALUMINUM POLES SHALL BE CONSTRUCTED OF 6063-T6 ALUMINUM ALLOY. SLEEVING INSIDE THE POLE IS NOT ACCEPTABLE.


WHEN TRANSFORMER BASES ARE USED, WIRE CONNECTIONS SHALL BE MADE IN THE TRANSFORMER BASE.

- ① 4" X 6" REINFORCED HANDHOLE & COVER ASSEMBLY WITH 2 (TWO) 1/4" X 3/4" - 20 TPI HEX HEAD STAINLESS STEEL BOLTS.
- ② SIGNAL FACE MOUNTING BRACKETS. MOUNT WITH CAP SCREWS AND BANDING. (SEE STANDARD SPECIFICATIONS - SEC. 658)
- ③ GROMMETS, 1" CHASE NIPPLES OR 1" CLOSE CONDUIT NIPPLES WITH BUSHINGS SHALL BE PROVIDED FOR 1 3/8" HOLE IN POLE SHAFT FOR WIRING.
- ④ SECURELY MOUNT DULL BLACK POLYCARBONATE BACKPLATES, PROJECTING 5" BEYOND ALL SIDES OF THE SIGNAL FACE HOUSING, PER MANUFACTURER'S RECOMMENDATIONS.
- ⑤ POLE MOUNTED SIGNAL FACES SHALL REQUIRE 1 OR MORE MOUNTING SPACERS UNDER THE TOP MOUNTING BRACKET(S) AS REQUIRED, TO PLUMB THE SIGNAL FACES.
- ⑥ CAST ALUMINUM TRANSFORMER BASE, WHEN REQUIRED.
- ⑦ MOUNTING BRACKET NIPPLES FOR THE SIGNAL FACE(S) SHALL BE 2 INCHES IN LENGTH AND 1/2 INCHES IN DIAMETER. (SEE STANDARD SPECIFICATION - SECTION 658).
- ⑧ VERTICAL STRUT (ADJUSTABLE), ONE (1) SET SCREW (1/4" X 3/4" LONG-20 TPI, STAINLESS STEEL, HEX HEAD) INTO EACH ARM MEMBER IF STRUT IS THE SLIDING TYPE.
- ⑨ FURNISH AND INSTALL VENTILATED, CAST, METALLIC (ALUMINUM ALLOY) CAPS. FASTEN CAPS WITH ONE (1) 1/4" X 3/4" - 20 TPI STAINLESS STEEL, HEX HEAD BOLT.
- ⑩ SHIMMING, IF NEEDED, SHALL BE LOCATED BETWEEN THE CONCRETE FOUNDATION AND THE TRANSFORMER BASE.

*MOUNTING HEIGHT LIMITATION DIMENSIONS OF THE TROMBONE MAST ARM WILL BE DEPENDENT UPON THE USE/NON-USE OF A TRANSFORMER BASE.

FOR MANUFACTURERS USE ONLY

WELD TO BE 100% R.T. OR U.T. TESTED AS PER THE REQUIREMENTS OF AWS D 15-88. RECORDS OF COMPLIANCE OF SUCH TESTING SHALL BE FURNISHED TO THE OFFICE OF DESIGN/BRIDGE FOR VERIFICATION AND APPROVAL.

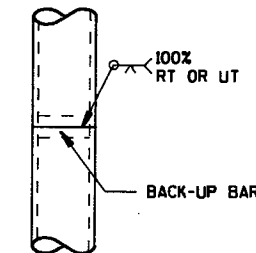

POLE SPLICE DETAIL

POLE MOUNTINGS FOR
TRAFFIC SIGNALS
TYPE 2

STATE OF WISCONSIN
DEPARTMENT OF TRANSPORTATION



6

6

S.D.D. 9 E 1-60



S.D.D. 9 E 1-60

*RISE FOR 4' ARM SHALL BE 2'-0".

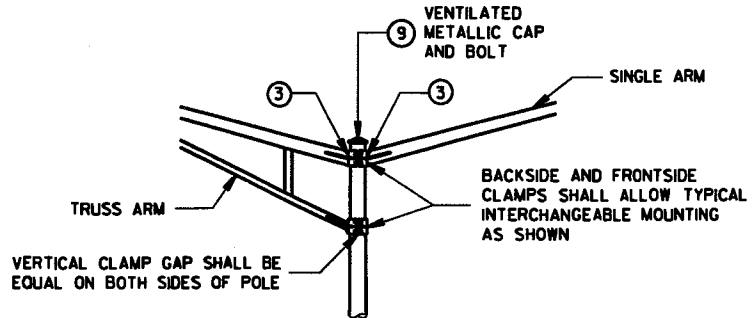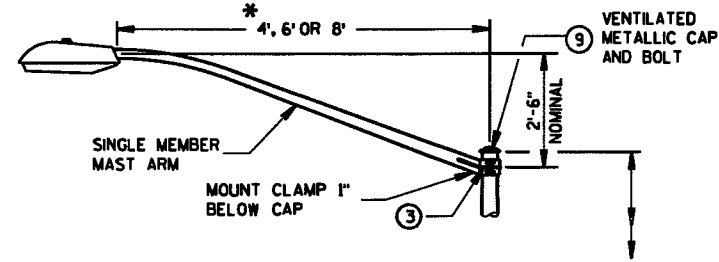


INTERCHANGEABLE MOUNTING DETAIL

LUMINAIRE
WT. - 50 LBS.
EFFECTIVE PROJECTED
AREA FOR WIND
LOADING = 15 SQ. FT.

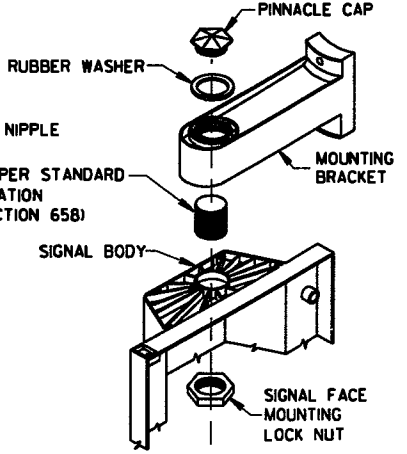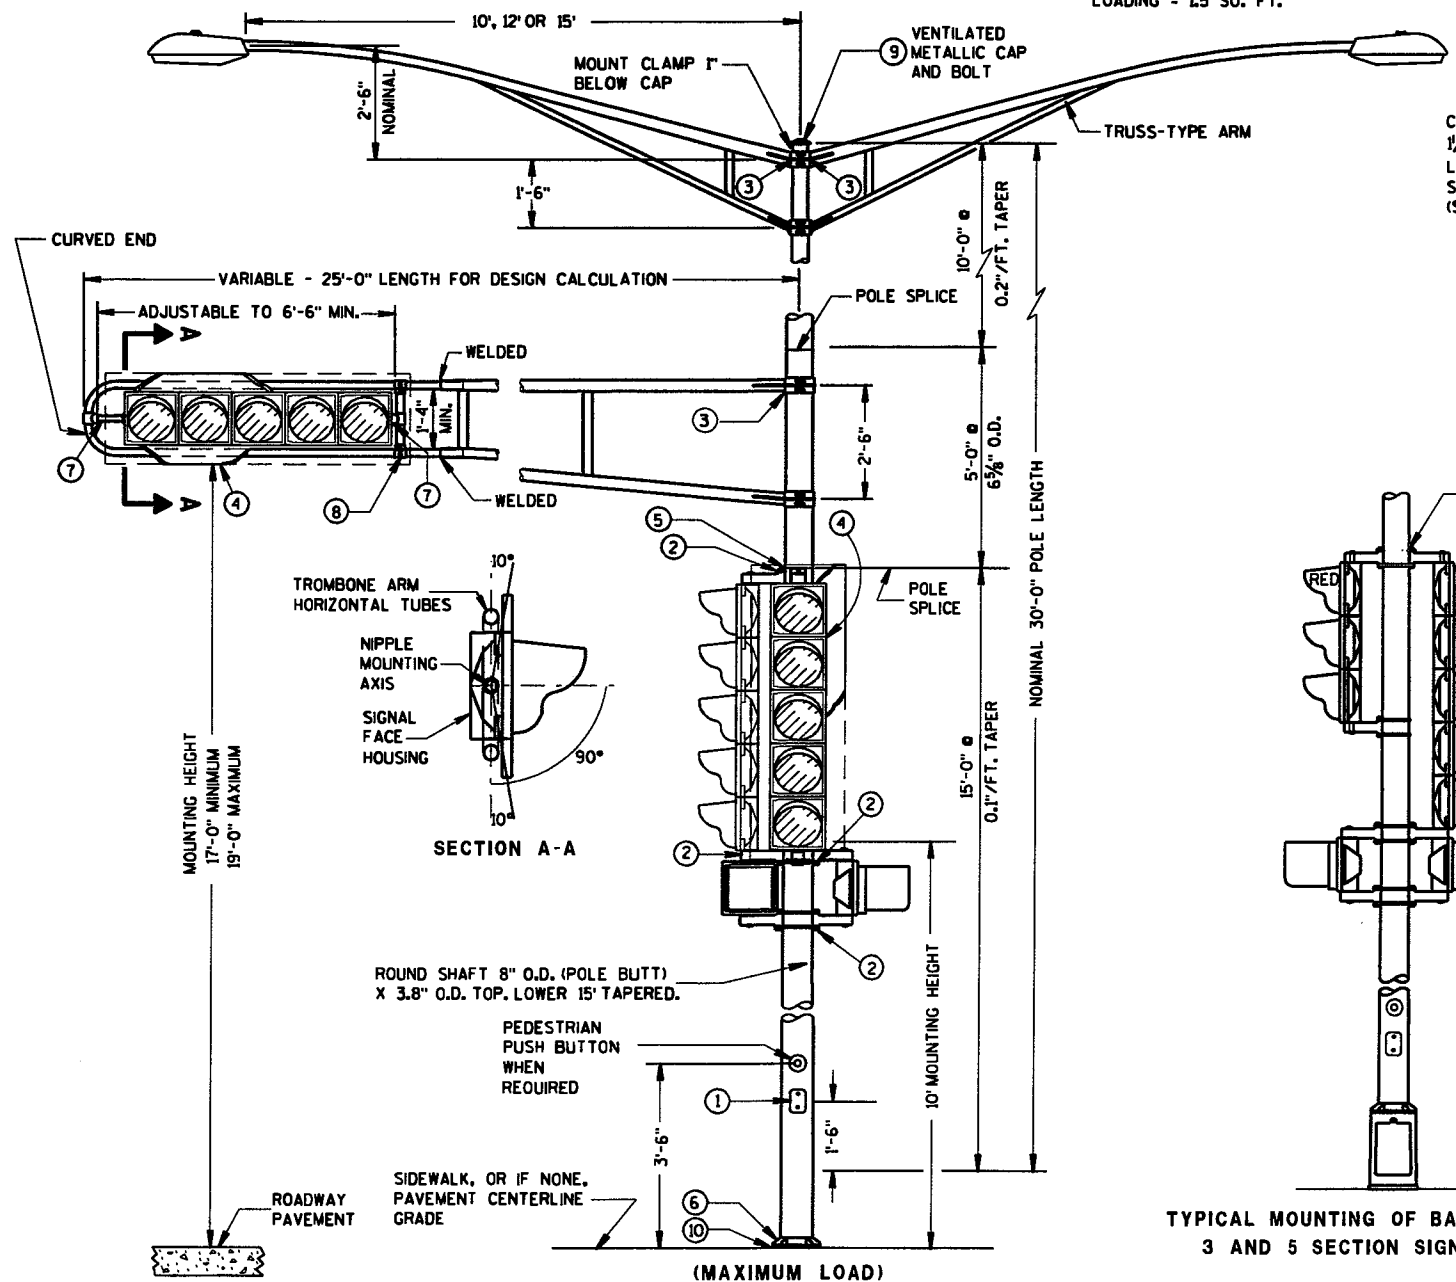

SIGNAL FACE MOUNTING DETAIL (BANDED)

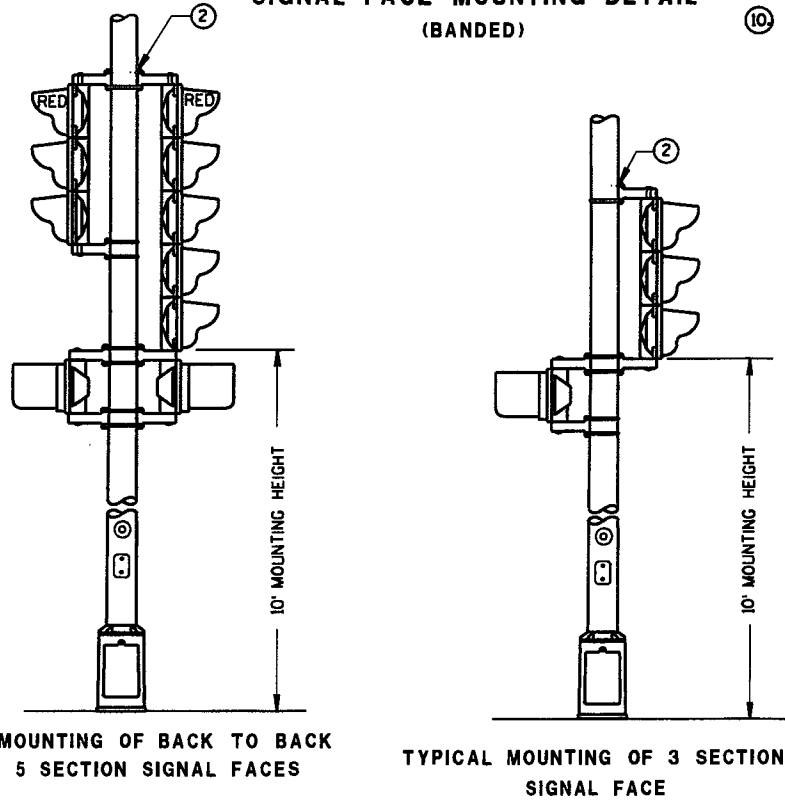


TYPE 3 POLE MOUNTING CONFIGURATION

GENERAL NOTES


- 1. DETAILS OF CONSTRUCTION, MATERIALS AND WORKMANSHIP NOT SHOWN ON THIS DRAWING SHALL CONFORM TO THE PERTINENT REQUIREMENTS OF THE CONTRACT.
- 2. ALL TYPE 3 POLE MOUNTINGS SHALL BE DESIGNED TO INCLUDE TWIN 15' ARMS WITH LUMNAIRES.
- 3. POLES SHALL BE GALVANIZED STEEL.
- 4. SECTION 657, POLES, OF THE STANDARD SPECIFICATIONS SHALL APPLY TO THIS DRAWING.
- 5. A PULL WIRE/ROPE IN ACCORDANCE WITH STANDARD SPECIFICATION 652, SHALL BE INSTALLED IN EACH TROMBONE ARM RACEWAY DURING THE MANUFACTURING PROCESS.
- 6. THE SLIPFITTER END OF THE LUMINAIRE MAST ARM SHALL BE A NOMINAL 2 3/8 INCHES IN OUTSIDE DIAMETER. THE STRAIGHT PORTION OF THE SLIPFITTER END OF THE LUMINAIRE MAST ARM SHALL BE A NOMINAL 12 INCHES IN LENGTH.
- 7. WHEN TRANSFORMER BASES ARE USED, WIRE CONNECTIONS SHALL BE MADE IN THE TRANSFORMER BASE.
- 8. 4" X 6" REINFORCED HANDHOLE & COVER ASSEMBLY WITH 2 (TWO) 1/4" X 3/4" - 20 TPI HEX HEAD STAINLESS STEEL BOLTS.
- 9. SIGNAL FACE MOUNTING BRACKETS, MOUNT WITH CAP SCREWS AND BANDING. (SEE STANDARD SPECIFICATIONS - SEC. 658)
- 10. GROMMETS, 1" CHASE NIPPLES OR 1" CLOSE CONDUIT NIPPLES WITH BUSHINGS SHALL BE PROVIDED FOR 1 3/8" HOLE IN POLE SHAFT FOR WIRING.
- 11. SECURELY MOUNT DULL BLACK POLYCARBONATE BACKPLATES, PROJECTING 5" BEYOND ALL SIDES OF THE SIGNAL FACE HOUSING, PER MANUFACTURER'S RECOMMENDATIONS.
- 12. POLE MOUNTED SIGNAL FACES SHALL REQUIRE 1 OR MORE MOUNTING SPACERS UNDER THE TOP MOUNTING BRACKET(S) AS REQUIRED, TO PLUMB THE SIGNAL FACE.
- 13. TYPE 3 POLE CONFIGURATIONS SHALL BE MOUNTED DIRECTLY TO THEIR CONCRETE BASES.
- 14. MOUNTING BRACKET NIPPLES FOR THE SIGNAL FACE(S) SHALL BE 2 INCHES IN LENGTH AND 1/2 INCHES IN DIAMETER. (SEE STANDARD SPECIFICATION - SECTION 658)
- 15. VERTICAL STRUT (ADJUSTABLE), ONE (1) SET SCREW (1/4" X 3/4" - 20 TPI, STAINLESS STEEL, HEX HEAD) INTO EACH ARM MEMBER IF STRUT IS THE SLIDING TYPE.
- 16. FURNISH AND INSTALL VENTILATED, CAST, METALLIC (ALUMINUM ALLOY) CAPS. FASTEN CAPS WITH ONE (1) 1/4" X 3/4" - 20 TPI STAINLESS STEEL, HEX HEAD BOLT.
- 17. SHIMMING, IF NEEDED, SHALL BE LOCATED BETWEEN THE CONCRETE FOUNDATION AND POLE.

FOR MANUFACTURERS USE ONLY
WELD TO BE 100% R.T. OR U.T. TESTED AS PER THE REQUIREMENTS OF AWS D 1.5-88. RECORDS OF COMPLIANCE OF SUCH TESTING SHALL BE FURNISHED TO THE OFFICE OF DESIGN/BRIDGE FOR VERIFICATION AND APPROVAL.


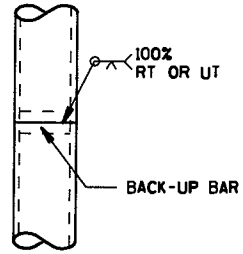


POLE SPLICE DETAIL

POLE MOUNTINGS FOR TRAFFIC SIGNALS AND LIGHTING UNITS, TYPE 3 (HEAVY DUTY)
STATE OF WISCONSIN
DEPARTMENT OF TRANSPORTATION




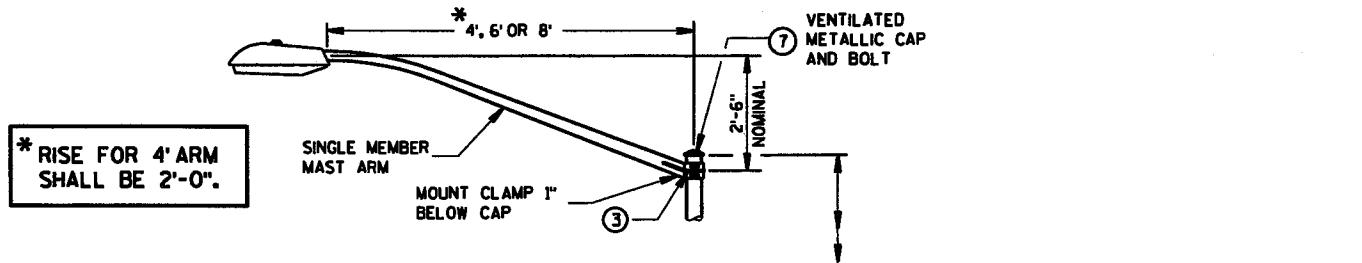


*RISE FOR 4' ARM SHALL BE 2'-0".

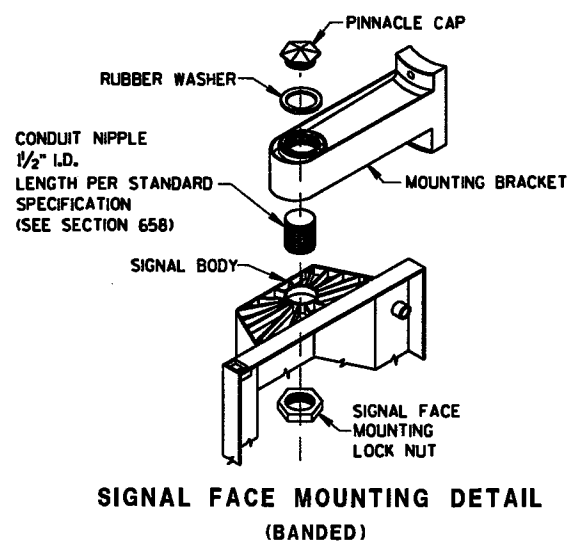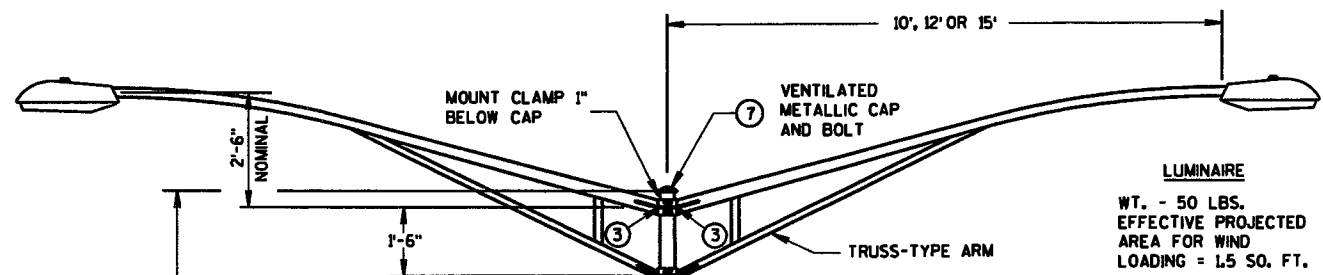

GENERAL NOTES

- DETAILS OF CONSTRUCTION, MATERIALS AND WORKMANSHIP NOT SHOWN ON THIS DRAWING SHALL CONFORM TO THE PERTINENT REQUIREMENTS OF THE CONTRACT.
- ALL TYPE 4 POLE MOUNTINGS SHALL BE DESIGNED TO INCLUDE TWIN 15' ARMS WITH LUMINAIRES.
- POLES SHALL BE GALVANIZED STEEL WITH A MINIMUM WALL THICKNESS OF U.S. STANDARD II GAGE (.1196").
- SECTION 657, POLES, OF THE STANDARD SPECIFICATIONS SHALL APPLY TO THIS DRAWING.
- THE SLIPFITTER END OF THE LUMINAIRE MAST ARM SHALL BE A NOMINAL 2 3/8 INCHES IN OUTSIDE DIAMETER. THE STRAIGHT PORTION OF THE SLIPFITTER END OF THE LUMINAIRE MAST ARM SHALL BE A NOMINAL 12 INCHES IN LENGTH. WHEN TRANSFORMER BASES ARE USED, CONNECTIONS SHALL BE MADE IN THE TRANSFORMER BASE.
- *TYPE 4" SHALL BE INDENT PRINTED WITH 1/2-INCH HIGH FIGURES ON TWO OPPOSITE EDGES OF POLE PLATE.
- ① 4" X 6" REINFORCED HANDHOLE & COVER ASSEMBLY WITH 2 (TWO) 1/4" X 3/4" - 20 TPI HEX HEAD STAINLESS STEEL BOLTS.
 - ② SIGNAL FACE MOUNTING BRACKETS, MOUNT WITH CAP SCREWS AND BANDING. (SEE STANDARD SPECIFICATIONS - SEC. 658).
 - ③ GROMMETS, 1" CHASE NIPPLES OR 1" CLOSE CONDUIT NIPPLES WITH BUSHINGS SHALL BE PROVIDED FOR 1 3/8" HOLE IN POLE SHAFT FOR WIRING.
 - ④ SECURELY MOUNT DULL BLACK POLYCARBONATE BACKPLATES, PROJECTING 5" BEYOND ALL SIDES OF THE SIGNAL FACE HOUSING, PER MANUFACTURER'S RECOMMENDATIONS.
 - ⑤ POLE MOUNTED SIGNAL FACES SHALL REQUIRE 1 OR MORE MOUNTING SPACERS UNDER THE TOP MOUNTING BRACKET(S) AS REQUIRED, TO PLUMB THE SIGNAL FACE.
 - ⑥ CAST ALUMINUM TRANSFORMER BASE, WHEN REQUIRED.
 - ⑦ FURNISH AND INSTALL VENTILATED, CAST, METALLIC (ALUMINUM ALLOY) CAPS, FASTEN CAPS WITH ONE (1) 1/4" X 3/4" - 20 TPI STAINLESS STEEL, HEX HEAD BOLT.
 - ⑧ SHIMMING, IF NEEDED, SHALL BE LOCATED BETWEEN THE CONCRETE FOUNDATION AND THE TRANSFORMER BASE.

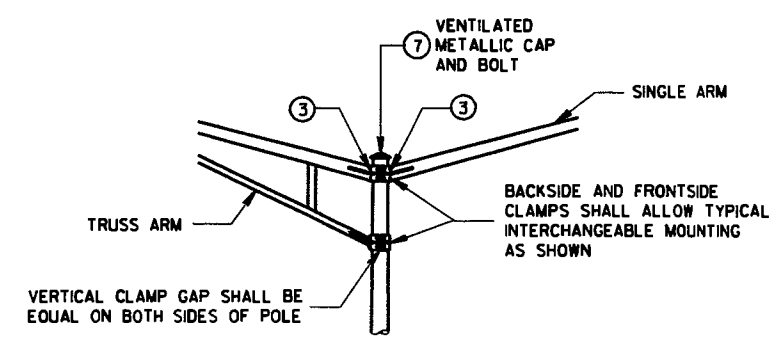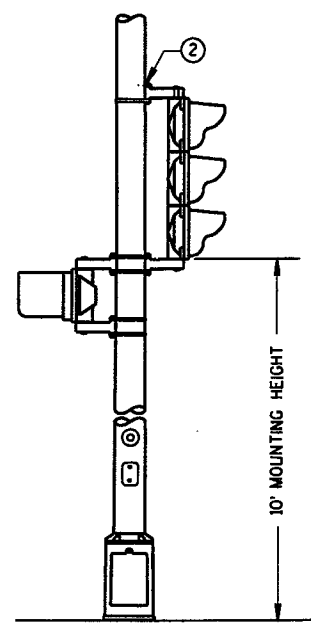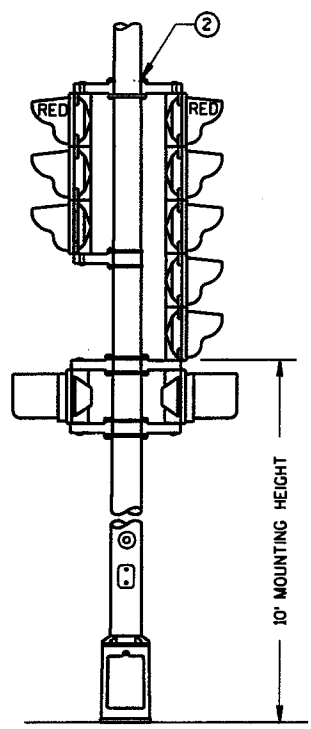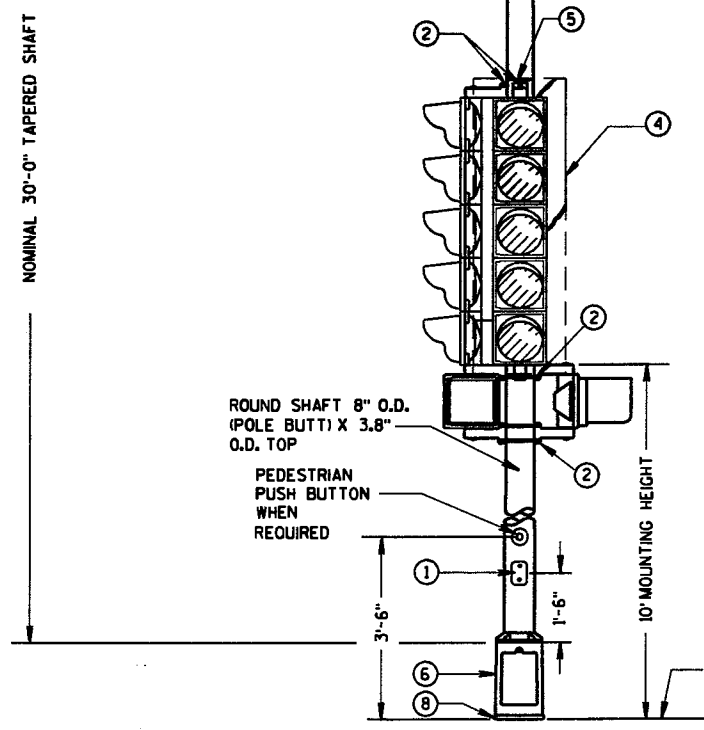

(MAXIMUM LOAD)

TYPICAL MOUNTING OF BACK TO BACK 3 AND 5 SECTION SIGNAL FACES

TYPICAL MOUNTING OF 3 SECTION SIGNAL FACE

INTERCHANGEABLE MOUNTING DETAIL

TYPE 4 POLE MOUNTING CONFIGURATION

POLE MOUNTINGS FOR TRAFFIC SIGNALS AND LIGHTING UNITS, TYPE 4


STATE OF WISCONSIN
DEPARTMENT OF TRANSPORTATION

6


6

S.D.D. 9 E 1-8C


S.D.D. 9 E 1-8C

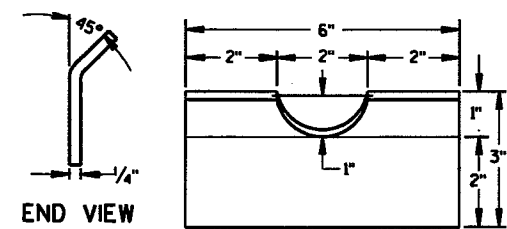


**FRONT VIEW
RECTANGULAR CLAMP SHIM**
(4 TO A SET)

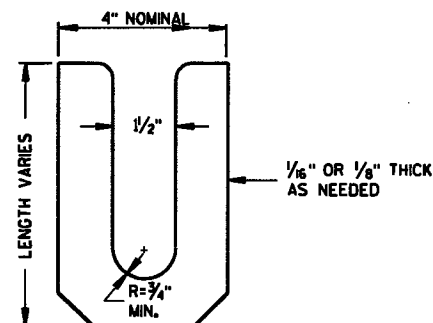


LEVELING SHIM
SHALL BE ALUMINUM

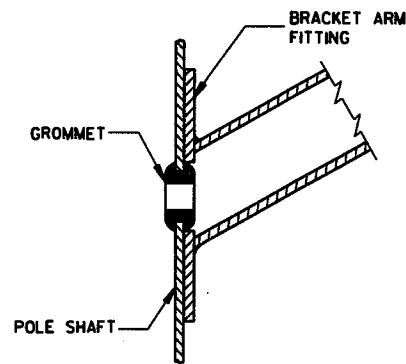


**TYPICAL APPLICATION OF
GROMMET IN POLE SHAFT**

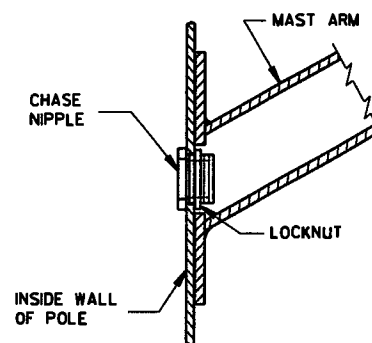


**TYPICAL APPLICATION OF
CHASE NIPPLE IN POLE SHAFT**

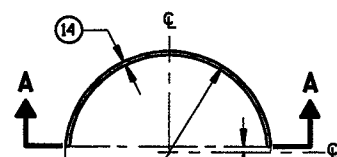


PLAN VIEW

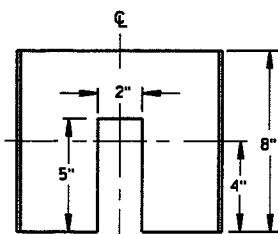


**SECTION A-A
CIRCULAR CLAMP SHIM**
(2 TO A SET)

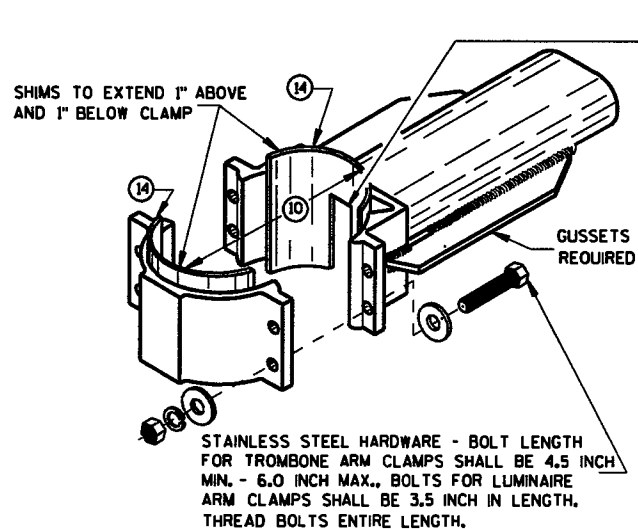


**TYPICAL TROMBONE MAST ARM AND SINGLE
LUMINAIRE MAST ARM MOUNTING CLAMP**

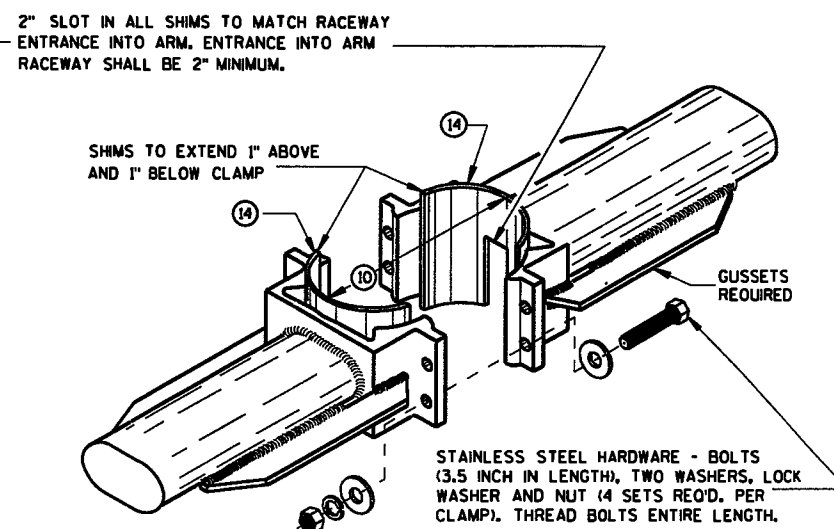



**TYPICAL LUMINAIRE MAST ARM
(DOUBLE) MOUNTING BRACKETS**

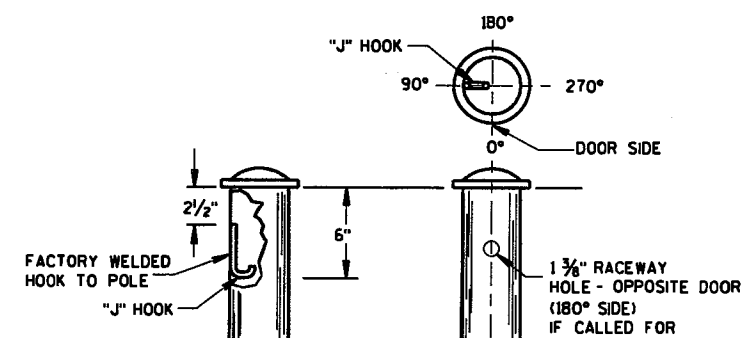


TYPICAL "J" HOOK LOCATION

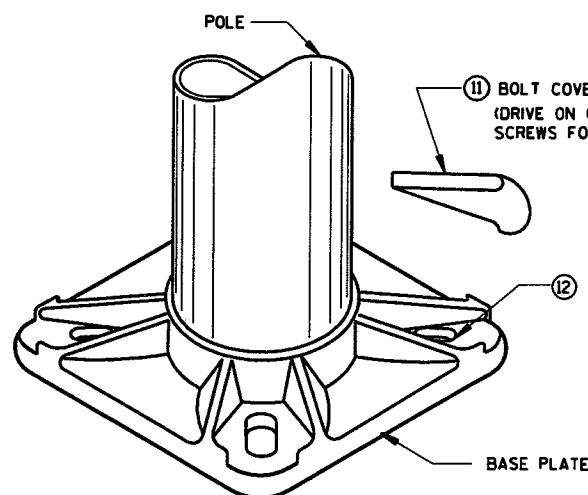

BASE PLATE

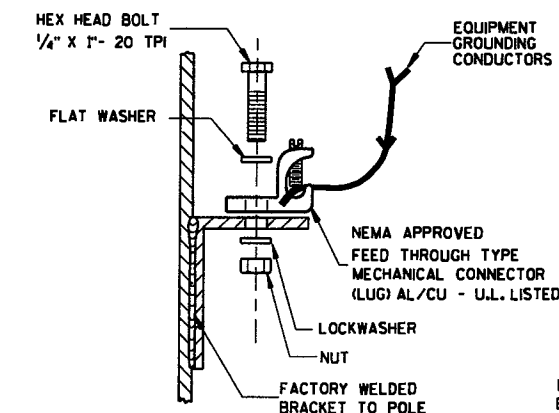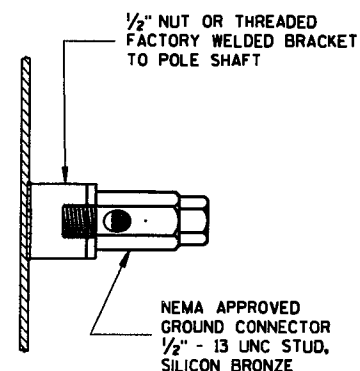

TYPICAL GROUNDING CONNECTIONS
NUT, BOLT AND WASHERS SHALL
BE STAINLESS STEEL

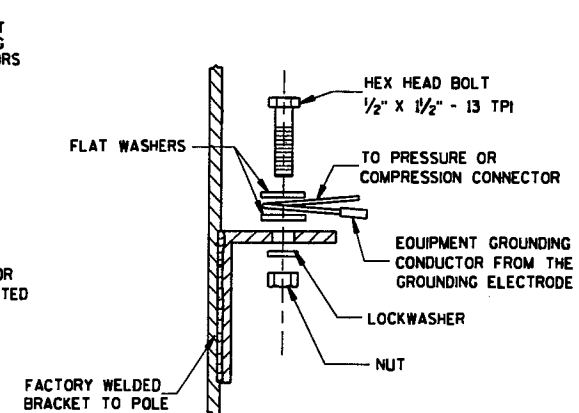

**HARDWARE DETAILS FOR
POLE MOUNTINGS**

STATE OF WISCONSIN
DEPARTMENT OF TRANSPORTATION

APPROVED
3/5/01
DATE

Paul J. Smith
STATE ELECTRICAL ENGINEER FOR
HIGHWAYS

GENERAL NOTES

CLAMP BOLT-NUT TIGHTENING TORQUE SHALL BE INDICATED BY INDENT STAMPING (1/2 INCH NUMERALS AND LETTERS) OR WEATHERPROOF PRINTING ON THE INSIDE OF THE CLAMP THAT IS WELDED TO THE ARM MEMBER.

- (10) 4.5" I.D. FOR LUMINAIRE MAST ARM CLAMP.
6.625" I.D. FOR TROMBONE MAST ARM CLAMP.
- (11) INDIVIDUAL BASE PLATE ANCHOR ROD COVERS. (4 REQUIRED)
- (12) BASE PLATE SLOTTED TO ACCEPT 1" THROUGH 12" BOLT CIRCLE USING 1" DIAMETER ANCHOR RODS.
- (13) OUTSIDE SHIM DIAMETER - (4.5" O.D. FOR LUMINAIRE MAST ARM)
(6.625" O.D. FOR TROMBONE MAST ARM)
- (14) VARIABLE SHIM THICKNESS - (0.10", 0.25", 0.35", 0.53" OR 0.70")
SHIM THICKNESS FOR TROMBONE MAST ARMS MAY BE TYPICALLY 0.25", 0.35", 0.53" OR 0.70".
SHIM THICKNESS FOR LUMINAIRE MAST ARMS MAY BE TYPICALLY 0.10", 0.25" OR 0.35".

SHIM MATERIAL SHALL BE ALUMINUM ALLOY.

SHIM THICKNESS SHALL BE IMPRESSED INTO EACH SHIM. NUMERALS SHALL BE 1/4" HIGH AND LEGIBLE.


THE CONTRACTOR SHALL SUBMIT TWO COPIES OF ALL SHIM SHOP DRAWINGS TO THE ENGINEER FOR APPROVAL.

- (15) LEVELING SHIMS, DESIGNED FOR THE PURPOSE, SHALL BE USED WHEN PLUMBING POLES. THE USE OF WASHERS IN LIEU OF PROPER LEVELING SHIMS IS NOT ACCEPTABLE. LEVELING SHIMS SHALL BE USED ONLY BETWEEN THE TOP OF THE CONCRETE BASE AND A METALLIC BASE PLATE.


SHIMS SHALL BE LONG ENOUGH AND WIDE ENOUGH TO COMPLETELY COVER THE AREA UNDER THE LENGTH AND WIDTH OF THE BASE MOUNTING FLANGE.

6


6

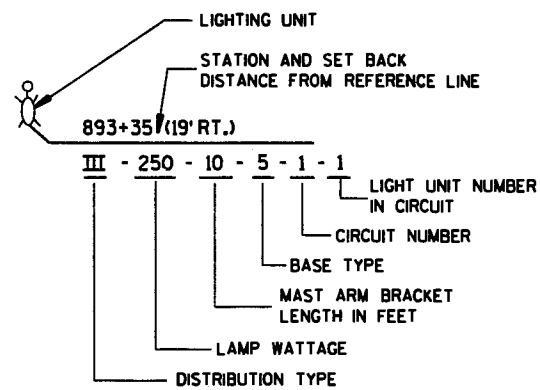



LIGHTING UNIT CODE
(TYPICAL)

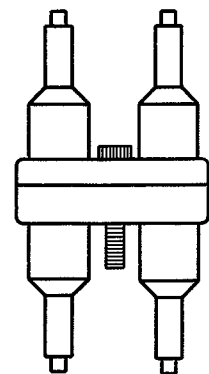


DETAIL "A"
DOUBLE POLE

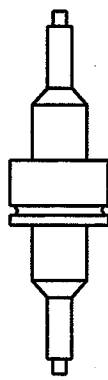

DETAIL "B"
SINGLE POLE

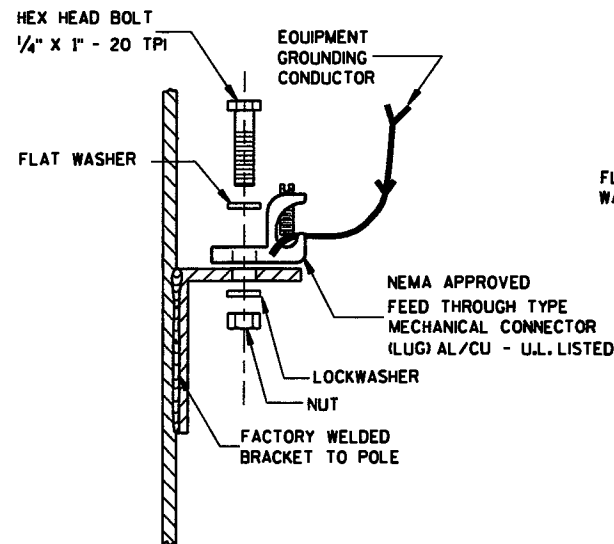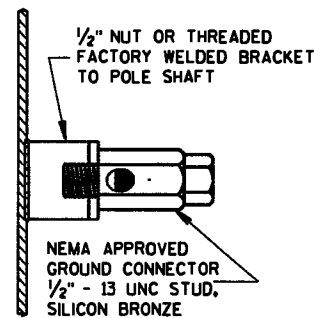


TYPICAL GROUNDING CONNECTIONS
NUT, BOLT, WASHERS AND LOCKWASHERS SHALL BE STAINLESS STEEL

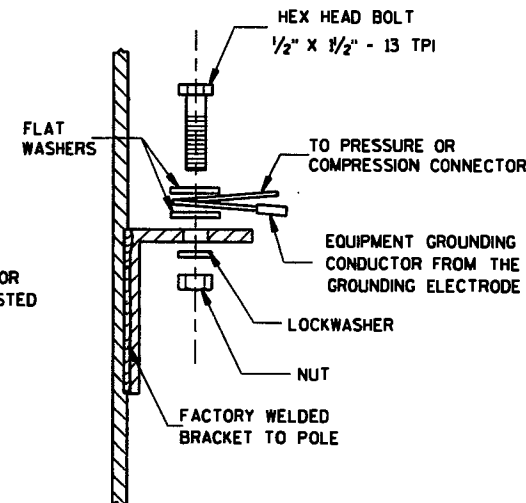


GENERAL NOTES

DETAILS OF CONSTRUCTION, MATERIALS AND WORKMANSHIP NOT SHOWN ON THIS DRAWING SHALL CONFORM TO THE PERTINENT REQUIREMENTS OF THE CONTRACT.
THE EQUIPMENT GROUNDING CONNECTOR SHALL BE TAPED WITH 3 WRAPS (MINIMUM) OF APPROVED RUBBER TAPE AND THEN 3 WRAPS (MINIMUM) OF APPROVED VINYL TAPE TO COVER SHARP WIRE ENDS AFTER THE CONNECTION IS COMPLETED.

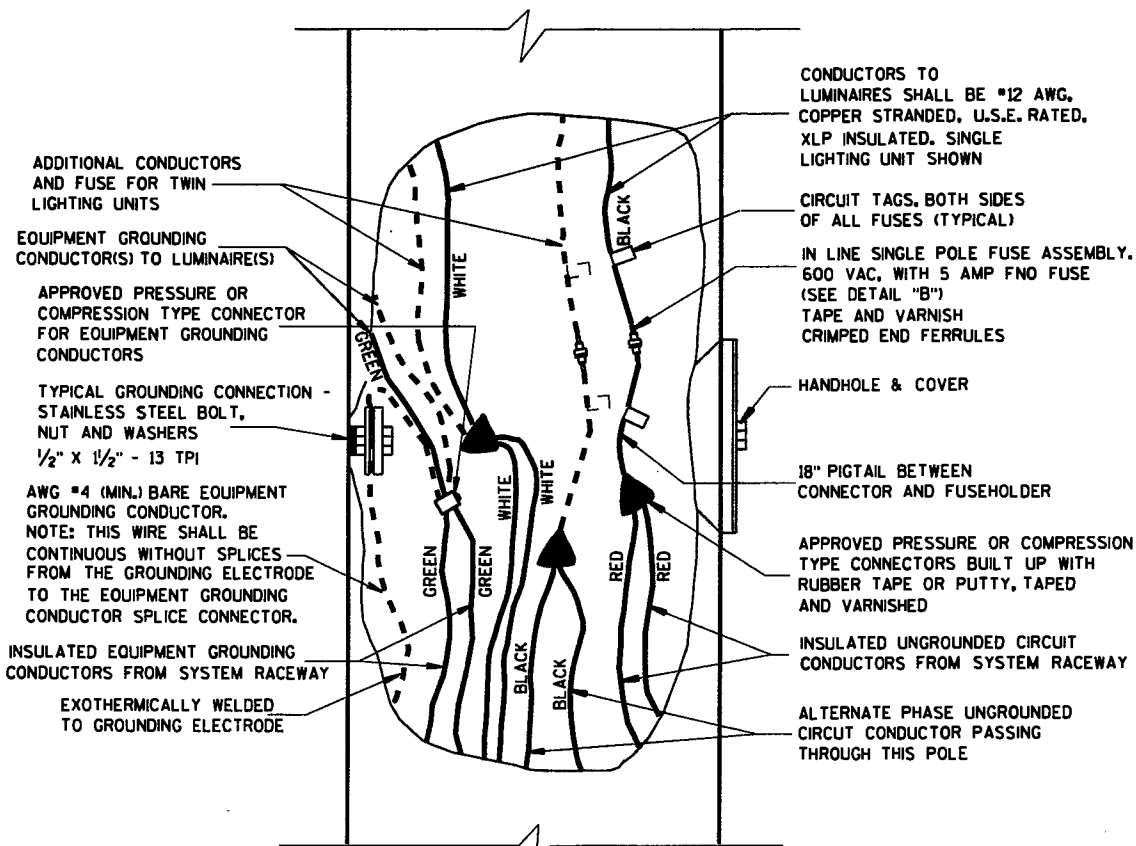

3 WIRE - 120, 240 OR 480 VAC (UNGROUNDING CONDUCTOR) WITH GROUNDING CONDUCTOR AND WITH EQUIPMENT GROUNDING CONDUCTOR

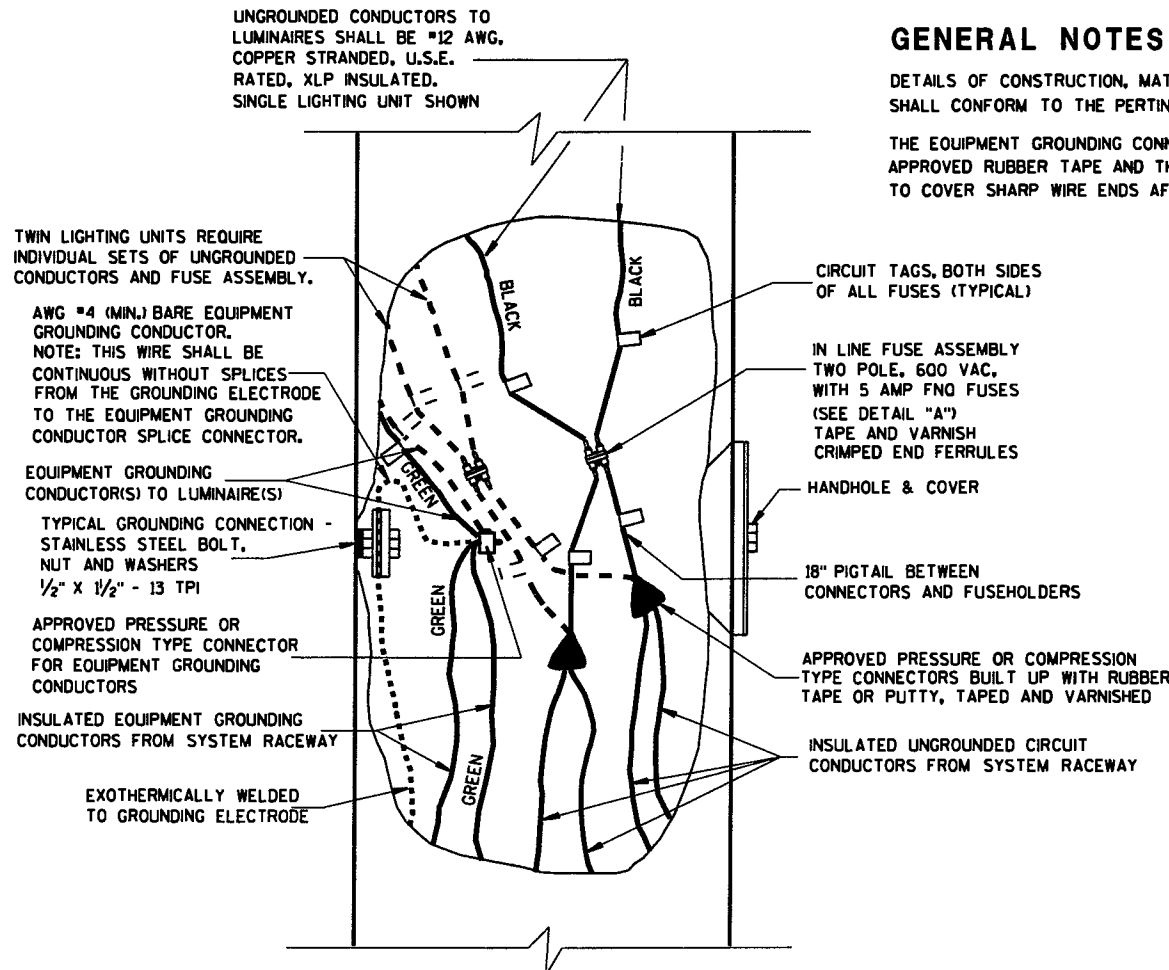

2 WIRE - 240 OR 480 VAC (UNGROUNDING CONDUCTORS) WITH EQUIPMENT GROUNDING CONDUCTOR

NON-FREWAY LIGHTING UNIT POLE WIRING

STATE OF WISCONSIN
DEPARTMENT OF TRANSPORTATION

APPROVED
10/21/96
DATE

Bob Stued
STATE ELECTRICAL ENGINEER FOR
HIGHWAYS


FHWA

S.D.D. 9 E 3-2

S.D.D. 9 E 3-2

6

6

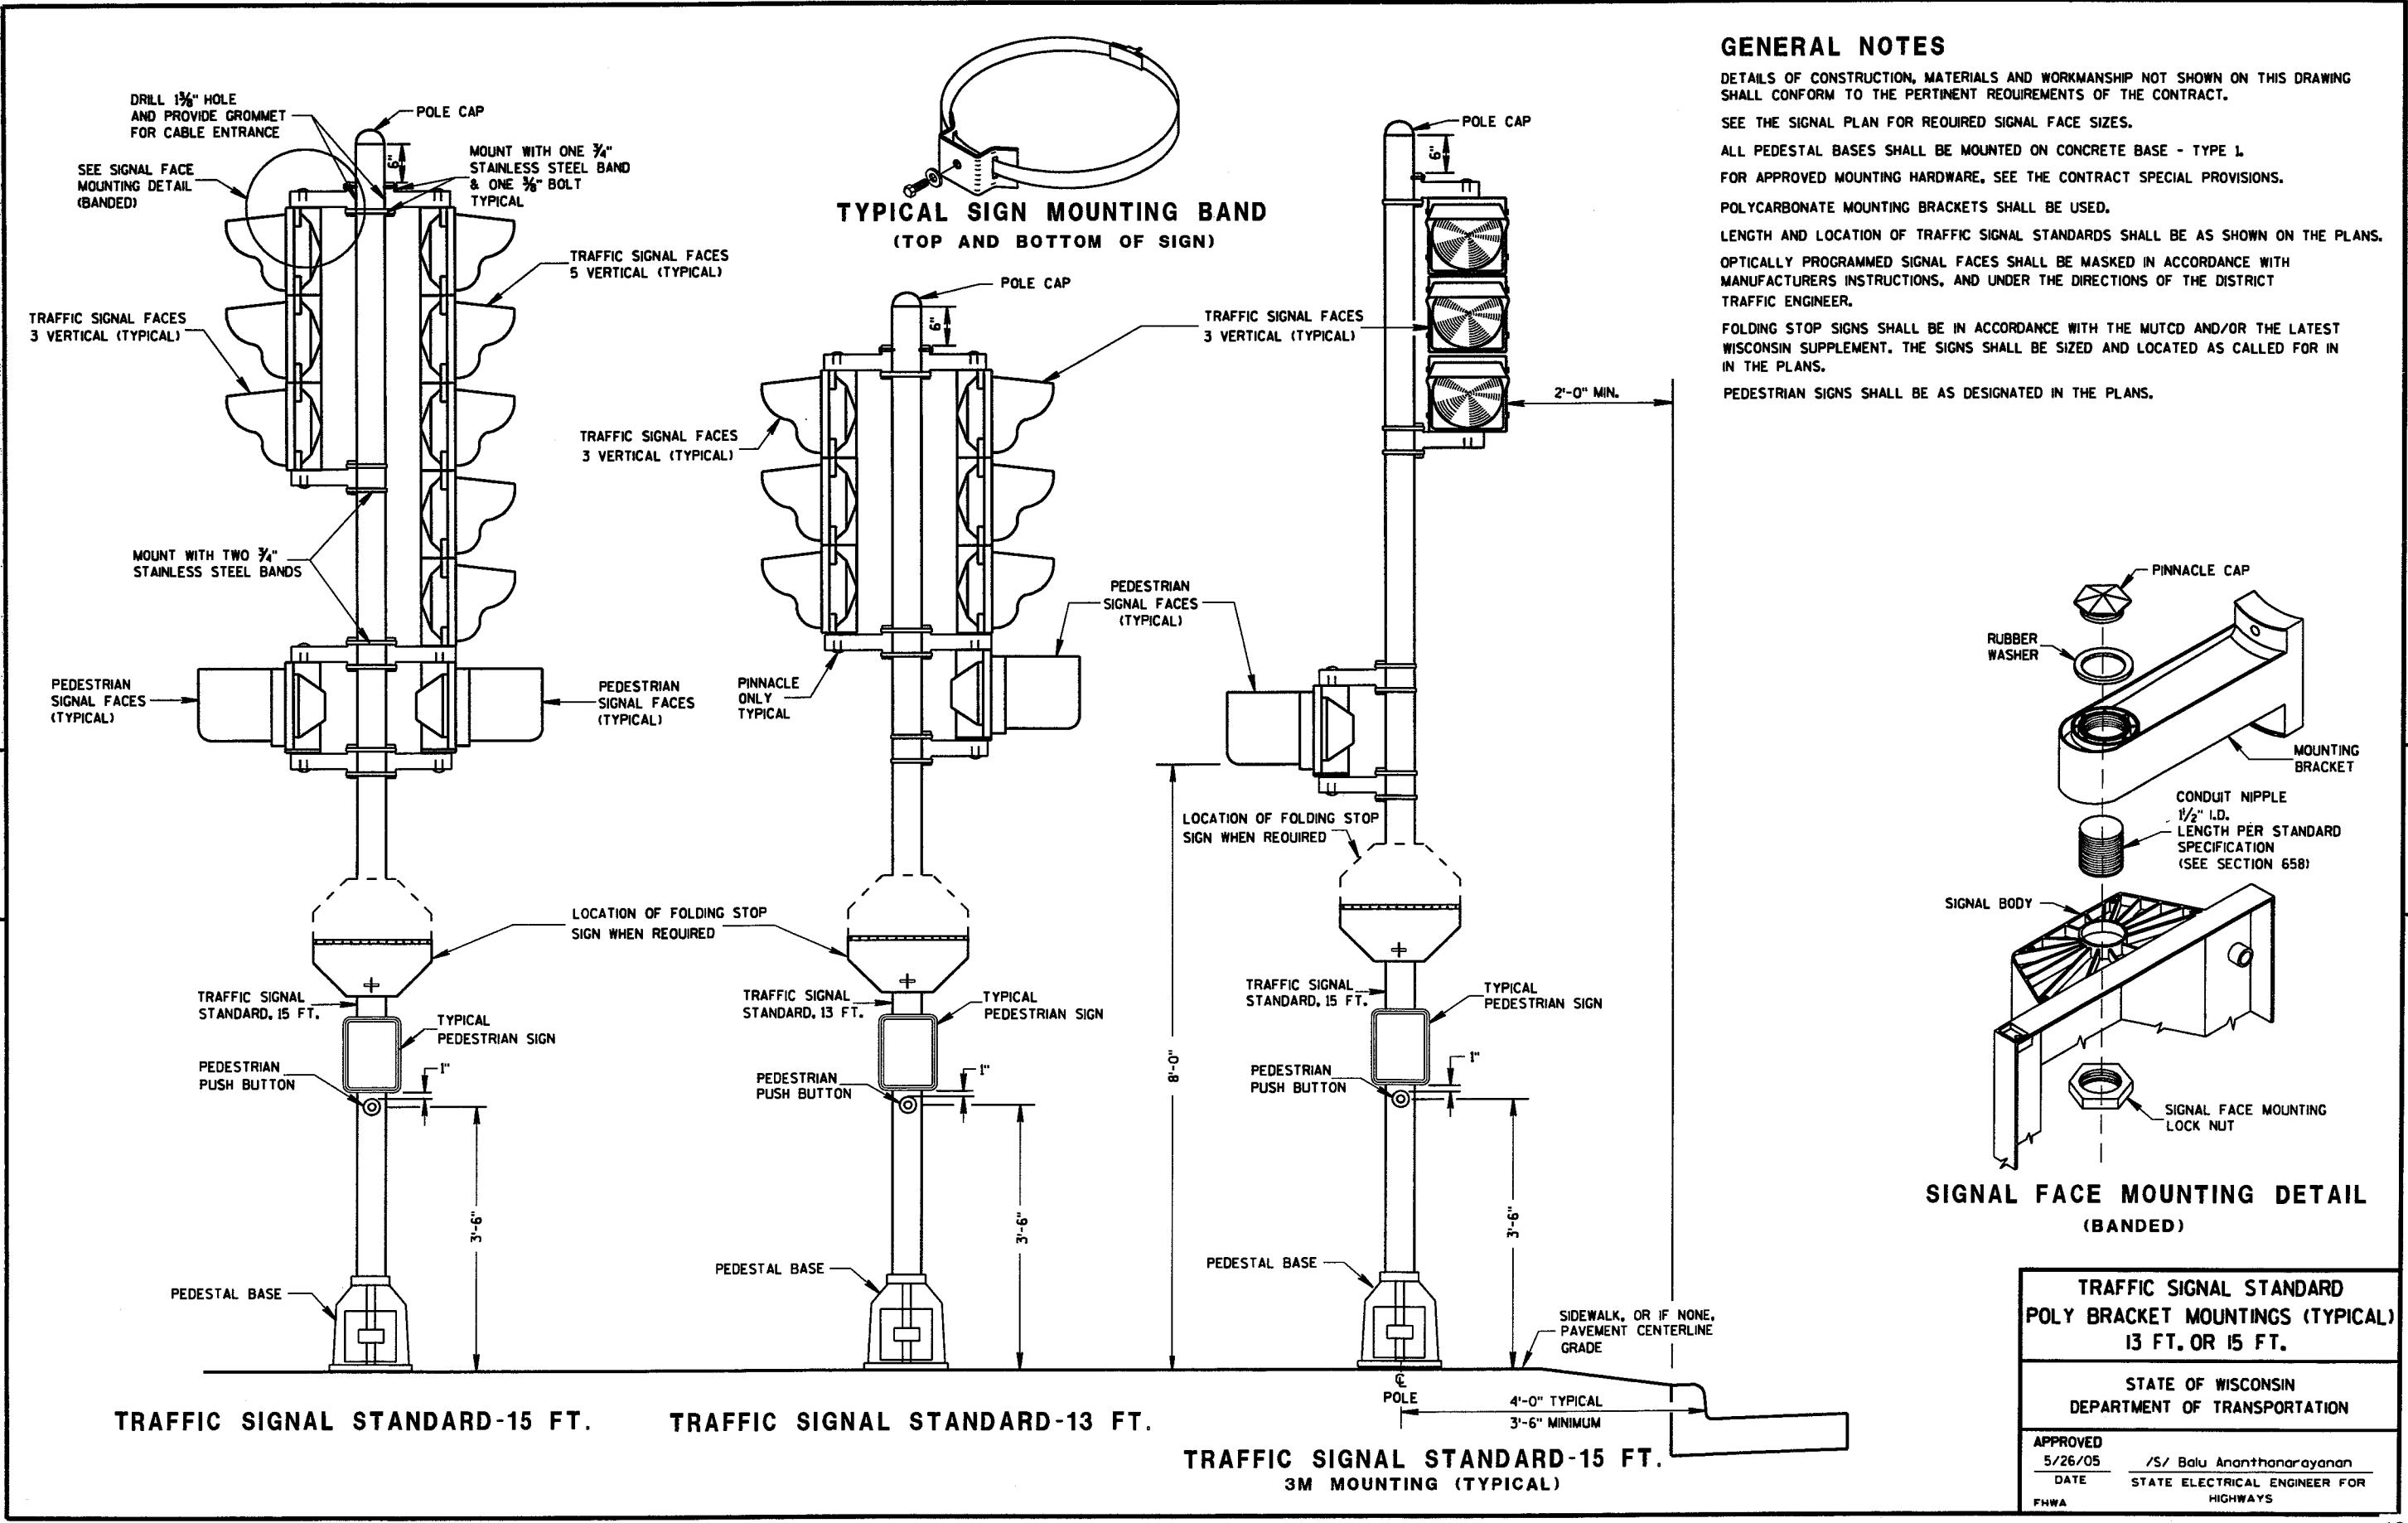

S.D.D. 9 E 6-2

S.D.D. 9 E 6-2

TRAFFIC SIGNAL STANDARD POLY BRACKET MOUNTINGS (TYPICAL) 13 FT. OR 15 FT.	
STATE OF WISCONSIN DEPARTMENT OF TRANSPORTATION	
APPROVED 5/26/05	/S/ Balu Ananthanarayanan
DATE	STATE ELECTRICAL ENGINEER FOR HIGHWAYS
FHWA	

GENERAL NOTES

DETAILS OF CONSTRUCTION, MATERIALS AND WORKMANSHIP NOT SHOWN ON THIS DRAWING SHALL CONFORM TO THE PERTINENT REQUIREMENTS OF THE CONTRACT.

LOOP SIZE, LOCATION, NUMBER OF TURNS OF WIRE AND ASSOCIATED SIGNAL PHASE SHALL BE AS SHOWN ON THE PLANS.

PITCH LEAD OUT CONDUIT TO DRAIN TO ROADSIDE PULL BOX.

SPLICES SHALL BE INSTALLED BY USING CAST IN PLACE SPLICE KITS SUCH AS 3M TYPE 82A1 OR APPROVED EQUAL. NON-INSULATED BUTT SPLICES TO FIT #12 AWG STRANDED WIRE SHALL BE USED. SPLICES SHALL BE SOLDERED AND INSULATED FROM EACH OTHER AS PER INSTRUCTIONS INCLUDED IN THE SPLICE KIT.

MEASURE GROUND RESISTANCE USING A MEGGER. REPLACE LOOP WIRE NOT ATTAINING A READING OF INFINITY TO GROUND.

AFTER SPLICING THE LOOP WIRE TO THE LOOP LEAD-IN CABLE, THE CONTRACTOR SHALL MEASURE INDUCTANCE, GROUND RESISTANCE AND WIRE RESISTANCE AT THE CABINET END OF THE LEAD-IN CABLE AND FURNISH A COPY OF THE READINGS TO THE PROJECT ENGINEER FOR EVALUATION.

VERIFY THICKNESS OF NEW ASPHALTIC OVERLAY BEFORE INSTALLING PULL BOX AND RELATED CONDUIT.

CONDUIT SHALL BE FULLY ENCASED IN NEW CONCRETE BASE (2" MINIMUM COVER).

ANTI-SIEZE LUBRICATING MATERIAL SHALL BE USED ON ALL THREADS OF THREADED ASSEMBLIES BEFORE INSTALLATION.

LOOP DETECTOR LEADS SHALL BE IDENTIFIED WITH THEIR ASSOCIATED LOOP BY USE OF WATERPROOF TAGS AT BOTH ENDS OF THE CABLE. A LISTING OF THE CABLE IDENTIFICATION PER INDIVIDUAL LOOP LEAD-IN SHALL BE PLACED IN THE CABINET.

ANY PVC LEAD-OUT CONDUIT CONTAINING MORE THAN ONE TWISTED PAIR OF LOOP LEAD WIRE SHALL BE 2".

THE #12 AWG LOOP WIRE FROM THE LOOP TO THE ROADSIDE PULL BOX, SHALL BE HAND TWISTED AT LEAST 3 TWISTS PER FOOT BEFORE INSTALLATION.


SPLICES OF LOOP WIRE TO LEAD-IN CABLE SHALL BE MADE ONLY IN PULL BOXES AT THE SIDE OF THE ROAD.

THE #12 AWG LOOP WIRE SHALL BE INSTALLED FROM THE ROADSIDE PULL BOX, INTO THE PULL BOX IN THE PAVEMENT, THROUGH THE LOOP CONDUIT, BACK TO THE ROADSIDE PULL BOX, AND BE INSTALLED IN ONE, NON-SPLICED CONTINUOUS LENGTH.

PROTECTION OF THE PULL BOX AND RELATED CONDUITS SHALL BE REQUIRED AFTER INSTALLATION AND BEFORE THE NEW CONCRETE BASE IS POURED.

PROTECTION OF THE PULL BOX SHALL BE REQUIRED AFTER THE NEW CONCRETE BASE IS POURED AND BEFORE THE NEW ASPHALTIC OVERLAY IS PLACED.


12" PULL BOXES IN PAVEMENT SHALL BE CORRUGATED STEEL ONLY.

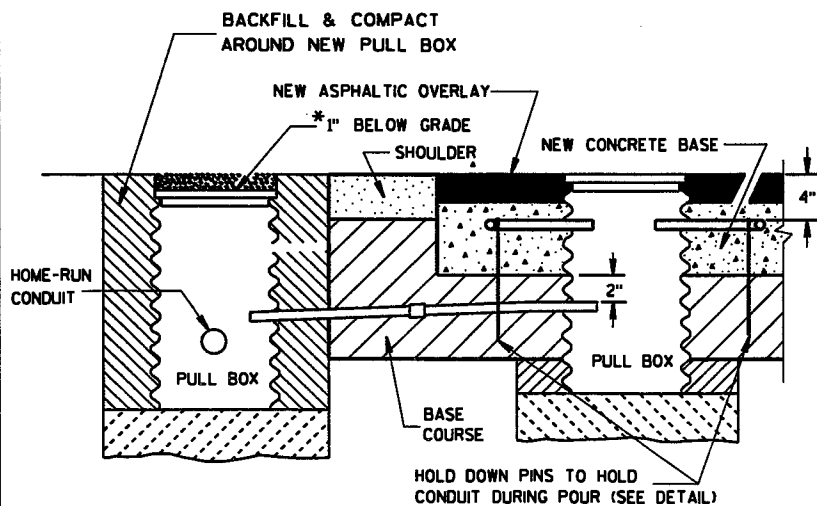

**SECTION A-A
NO CURB & GUTTER**

LOOP DETECTOR INSTALLATION DETAIL


*RECESS PULL BOX SO THAT THE COVER IS 3" BELOW GRADE IN SHOULDER AREAS OF CRUSHED AGGREGATE. BACKFILL OVER COVER WITH THE CRUSHED AGGREGATE TO BRING THE AREA TO GRADE LEVEL.

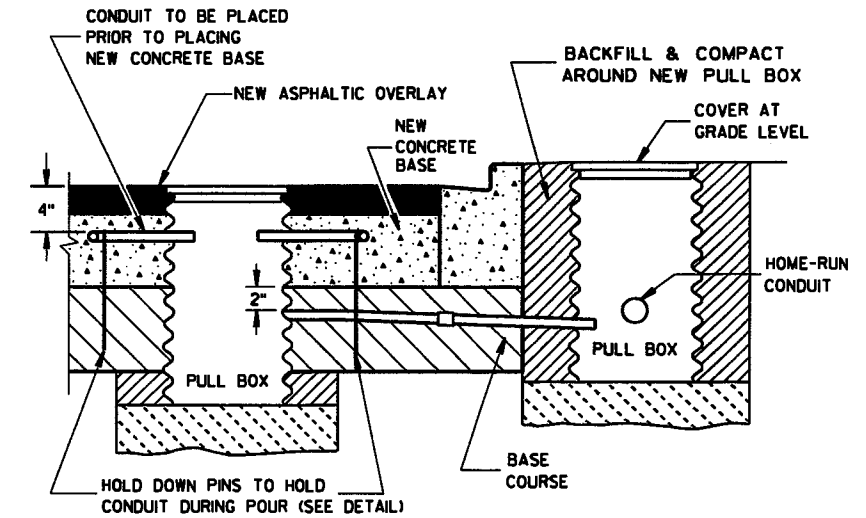


**SECTION B-B
CURB & GUTTER**

LOOP DETECTOR INSTALLATION DETAIL


6

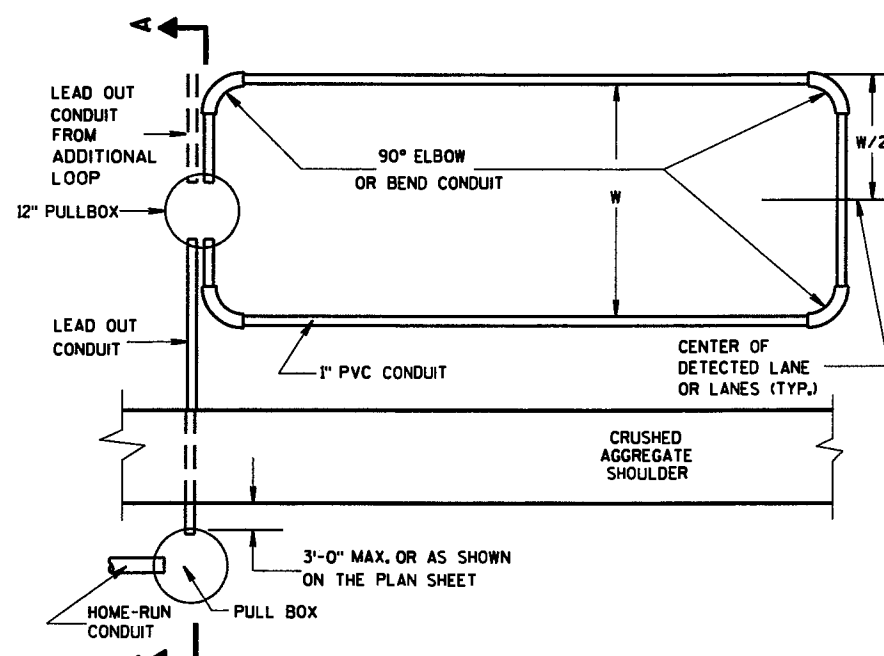

**TYPICAL PLAN OF LOOP DETECTOR
WITH 12" PULLBOX**

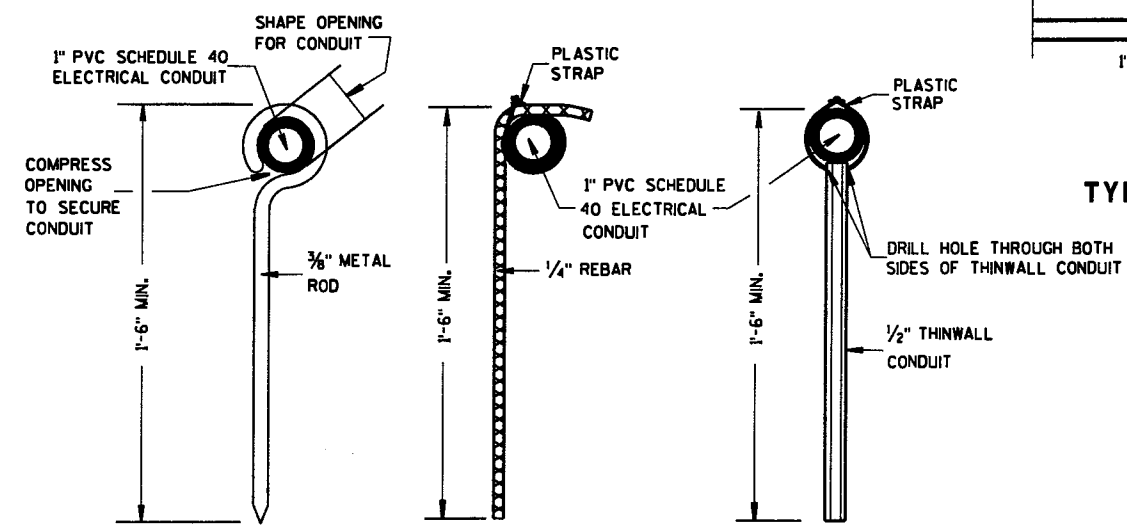

TYPICAL DETAILS FOR HOLD DOWN PINS

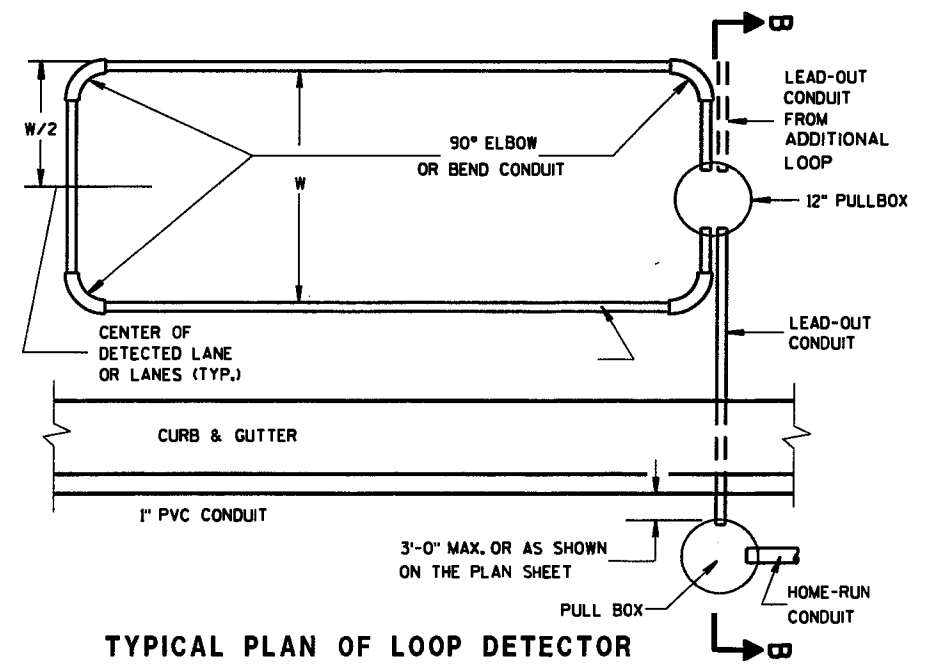


**TYPICAL PLAN OF LOOP DETECTOR
WITH 12" PULLBOX**

6

LOOP DETECTOR INSTALLED IN NEW CONCRETE BASE WITH NEW ASPHALTIC OVERLAY ROUND CSCP PULLBOX	
STATE OF WISCONSIN DEPARTMENT OF TRANSPORTATION	
APPROVED 6/7/06 DATE	/S/ Balu Ananthanarayanan STATE ELECTRICAL ENGINEER FOR HIGHWAYS
FHWA	

S.D.D. 9 F 7-3

S.D.D. 9 F 7-3

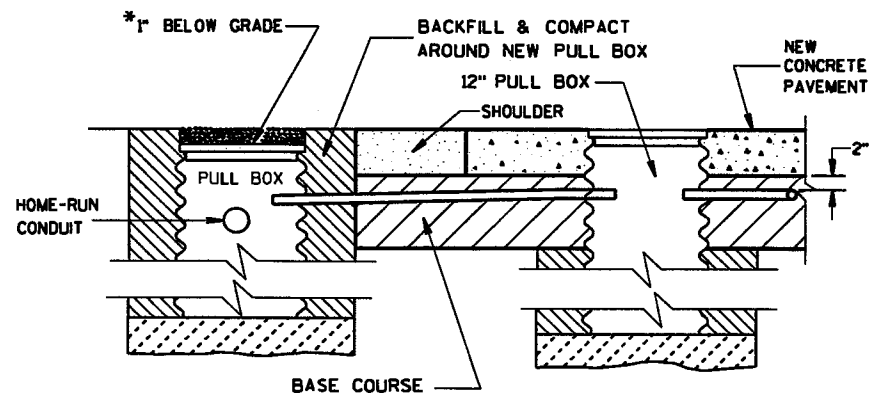

SECTION A-A
NO CURB & GUTTER

LOOP DETECTOR INSTALLATION DETAILS

*RECESS PULL BOX SO THAT THE COVER IS 3" BELOW GRADE IN SHOULDER AREAS OF CRUSHED AGGREGATE. BACKFILL OVER COVER WITH THE CRUSHED AGGREGATE TO BRING THE AREA TO GRADE LEVEL.

GENERAL NOTES

DETAILS OF CONSTRUCTION, MATERIALS AND WORKMANSHIP NOT SHOWN ON THIS DRAWING SHALL CONFORM TO THE PERTINENT REQUIREMENTS OF THE CONTRACT.

LOOP SIZE, LOCATION, NUMBER OF TURNS OF WIRE AND ASSOCIATED SIGNAL PHASE SHALL BE AS SHOWN ON THE PLANS.

PITCH LEAD OUT CONDUIT TO DRAIN TO ROADSIDE PULL BOX.

SPLICES SHALL BE INSTALLED BY USING CAST IN PLACE SPLICE KITS SUCH AS 3M TYPE 82A1 OR APPROVED EQUAL. NON-INSULATED BUTT SPLICES TO FIT #12 AWG STRANDED WIRE SHALL BE USED. SPLICES SHALL BE SOLDERED AND INSULATED FROM EACH OTHER AS PER INSTRUCTIONS INCLUDED IN THE SPLICE KIT.

MEASURE GROUND RESISTANCE USING A MEGGER. REPLACE LOOP WIRE NOT ATTAINING A READING OF INFINITY TO GROUND.

AFTER SPLICING THE LOOP WIRE TO THE LOOP LEAD-IN CABLE, THE CONTRACTOR SHALL MEASURE INDUCTANCE, GROUND RESISTANCE AND WIRE RESISTANCE AT THE CABINET END OF THE LEAD-IN CABLE AND FURNISH A COPY OF THE READINGS TO THE PROJECT ENGINEER FOR EVALUATION.

ANTI-SIEZE LUBRICATING MATERIAL SHALL BE USED ON ALL THREADS OF THREADED ASSEMBLIES BEFORE INSTALLATION.

LOOP DETECTOR LEADS SHALL BE IDENTIFIED WITH THEIR ASSOCIATED LOOP BY USE OF WATERPROOF TAGS AT BOTH ENDS OF THE CABLE. A LISTING OF THE CABLE IDENTIFICATION PER INDIVIDUAL LOOP LEAD-IN SHALL BE PLACED IN THE CABINET.


THE #12 AWG LOOP WIRE FROM THE LOOP TO THE ROADSIDE PULL BOX, SHALL BE HAND TWISTED AT LEAST 3 TWISTS PER FOOT BEFORE INSTALLATION.

SPLICES OF LOOP WIRE TO LEAD-IN CABLE SHALL BE MADE ONLY IN PULL BOXES AT THE SIDE OF THE ROAD.

THE #12 AWG LOOP WIRE SHALL BE INSTALLED FROM THE ROADSIDE PULL BOX, THROUGH THE LOOP DUCT, BACK TO THE ROADSIDE PULL BOX, AND BE INSTALLED IN ONE, NON-SPLICED, CONTINUOUS LENGTH.


PROTECTION OF THE CONDUIT, CONDULET AND PULL BOX SHALL BE REQUIRED AFTER INSTALLATION AND BEFORE THE NEW CONCRETE PAVEMENT IS PLACED.

12" PULL BOXES IN PAVEMENT SHALL BE CORRUGATED STEEL ONLY.

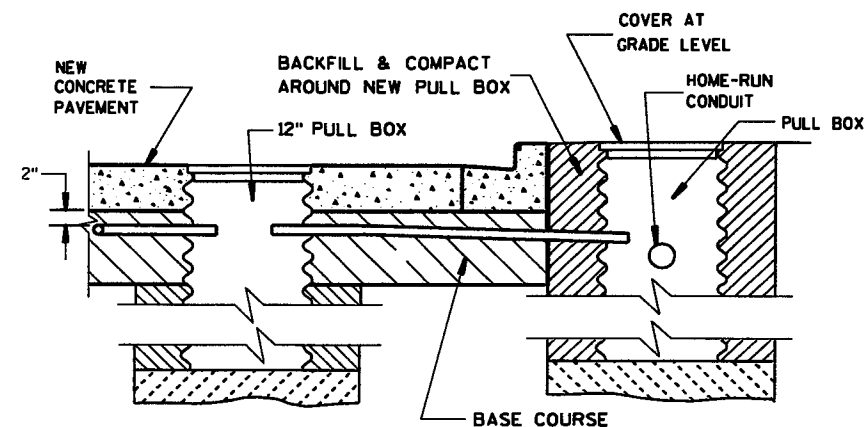


SECTION B-B
CURB & GUTTER

LOOP DETECTOR INSTALLATION DETAILS

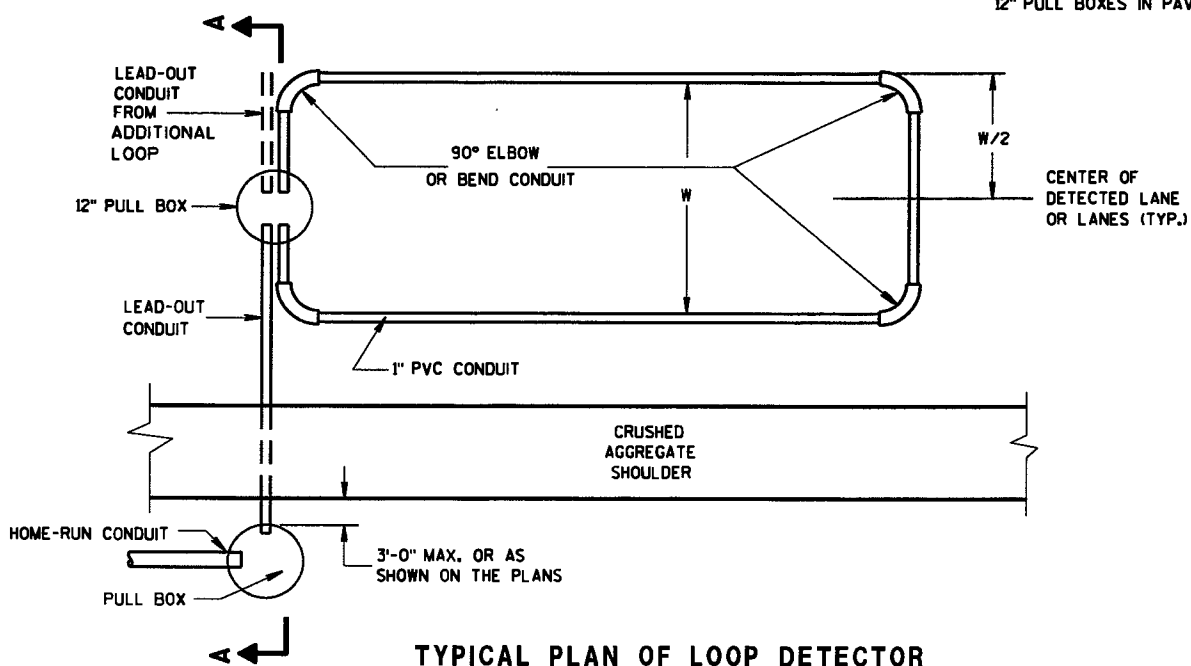

TYPICAL PLAN OF LOOP DETECTOR
WITH 12" PULLBOX

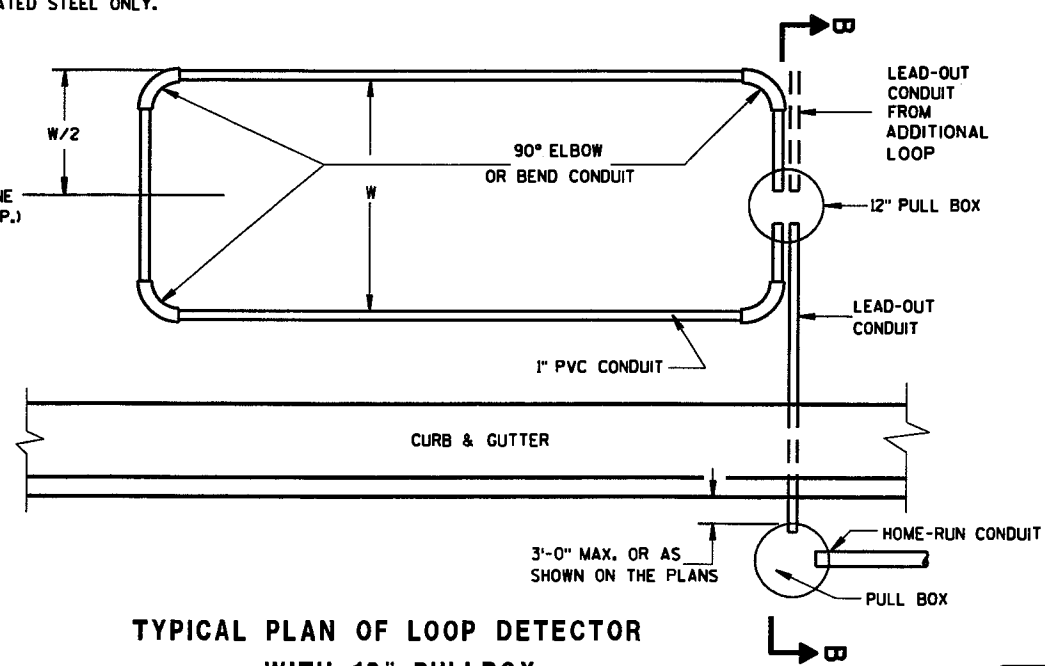

TYPICAL PLAN OF LOOP DETECTOR
WITH 12" PULLBOX

LOOP DETECTOR PLACED IN CRUSHED AGGREGATE BASE (NEW CONCRETE PAVEMENT)	
STATE OF WISCONSIN DEPARTMENT OF TRANSPORTATION	
APPROVED 6/7/06 DATE	/S/ Balu Ananthanarayanan STATE ELECTRICAL ENGINEER FOR HIGHWAYS
FHWA	

6

6

S.D.D. 9 F 9-3

S.D.D. 9 F 9-3

GENERAL NOTES

DETAILS OF CONSTRUCTION, MATERIALS AND WORKMANSHIP NOT SHOWN ON THIS DRAWING SHALL CONFORM TO THE PERTINENT REQUIREMENTS OF THE CONTRACT.

1. WOOD POLES SHALL BE CLASS 4. LENGTH DETERMINED BY SIGNAL PLAN.

2. SIGNAL FACES:

A. ALL SECTIONS SHALL BE 12" AND POLYCARBONATE.

B. EACH SHALL CONTAIN A 5" WIDE DULL BLACK POLYCARBONATE BACKPLATE.

C. EACH SHALL BE WIRED FROM THE TOP SIGNAL MOUNTING BRACKET.


D. NEAR RIGHT SIGNAL FACE SUSPENDED ON THE TETHER (NO BACKPLATE) SHALL NOT BE OVER THE TRAVELED WAY. IF THE POLE IS WITHIN 5 FEET OF THE TRAVELED WAY MOUNT THE SIGNAL FACE ON THE WOOD POLE WITH BACKPLATE.

3. SPAN WIRE:

A. EACH SPAN WIRE SHALL BE INDIVIDUALLY DOWN GUYED.

B. SIGNAL AND LIGHTING CABLES SHALL ONLY BE ATTACHED TO THE UPPER SPAN WIRE.

C. THE SIGNAL ASSEMBLY SHALL HAVE A 17' MIN. HEIGHT ABOVE THE ROADWAY. THIS SHALL BE MEASURED AFTER THE SPAN WIRE INSTALLATION IS COMPLETED WITH ALL CABLES AND SIGNAL FACES IN PLACE. MAINTAIN MINIMUM AND MAXIMUM HEIGHTS AS ROADWAY WORK PROGRESSES.

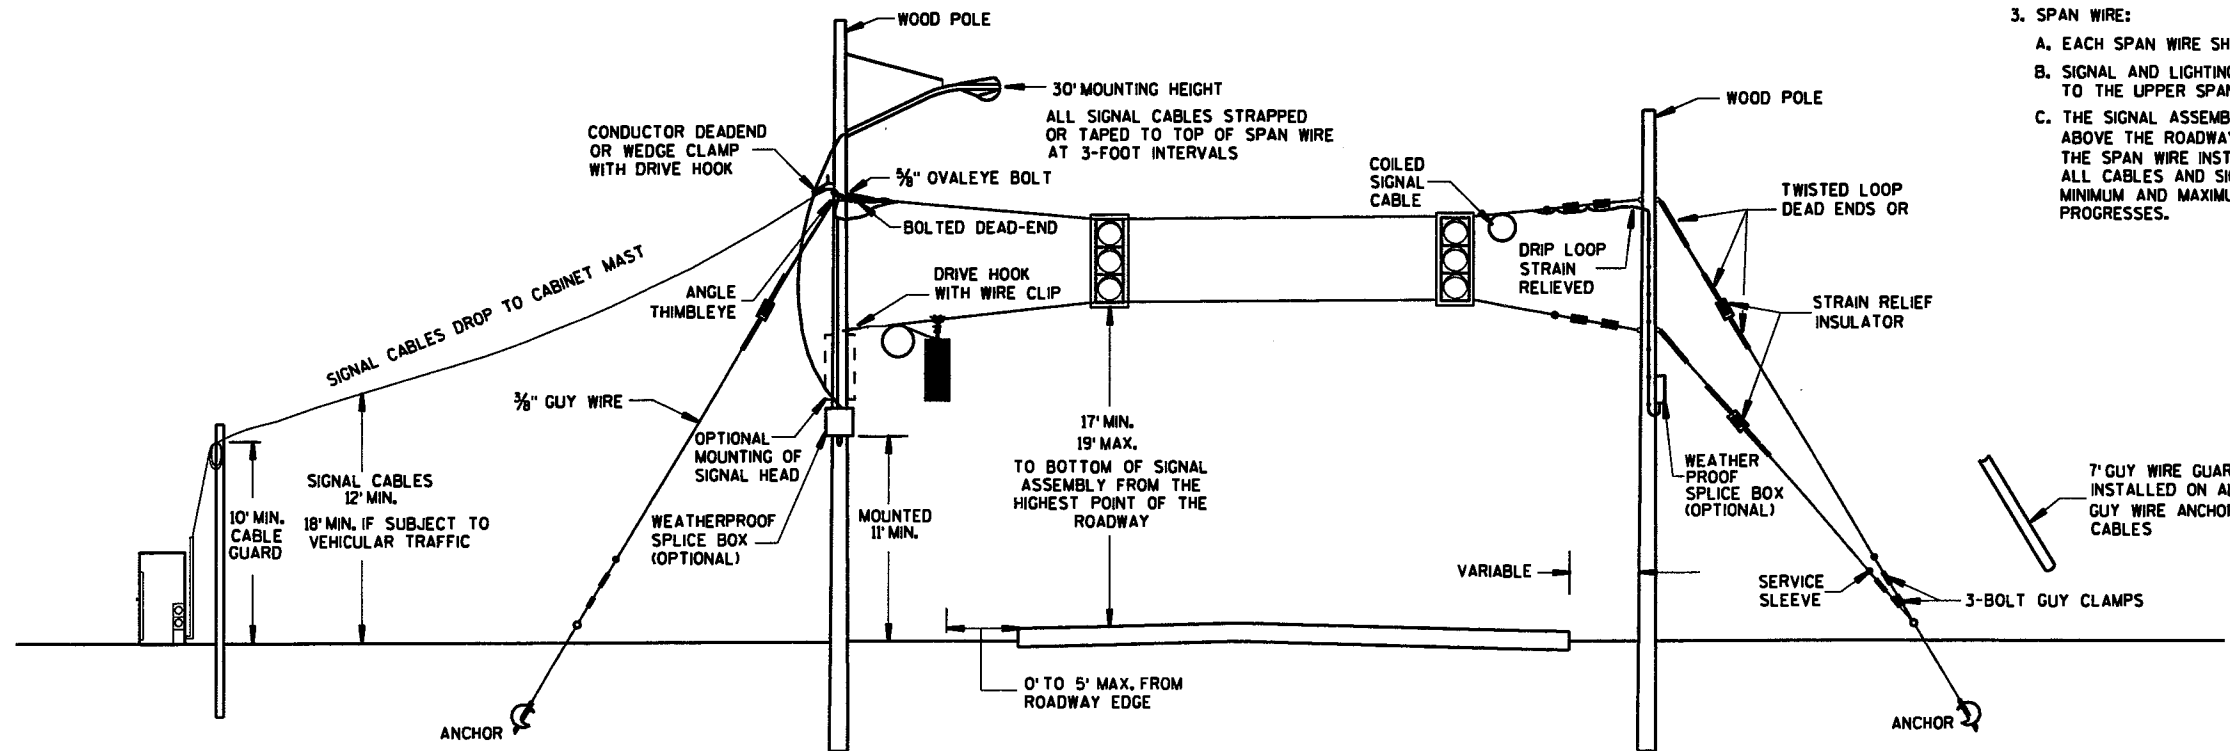

**SPAN WIRE
TEMPORARY SIGNALS**

MINIMUM POLE LENGTHS	POLE BURIEL DEPTHS
25'	5'
30'	6'
35'	7'
40'	8'
45'	9'



SPAN WIRE TEMPORARY TRAFFIC SIGNAL	
STATE OF WISCONSIN DEPARTMENT OF TRANSPORTATION	
APPROVED 5-24-07 DATE	/S/ Balu Ananthanarayanan CHIEF ELECTRICAL ENGINEER FOR HIGHWAYS
FHWA	

6

6

S.D.D. 9 C 1-20

S.D.D. 9 C 1-20

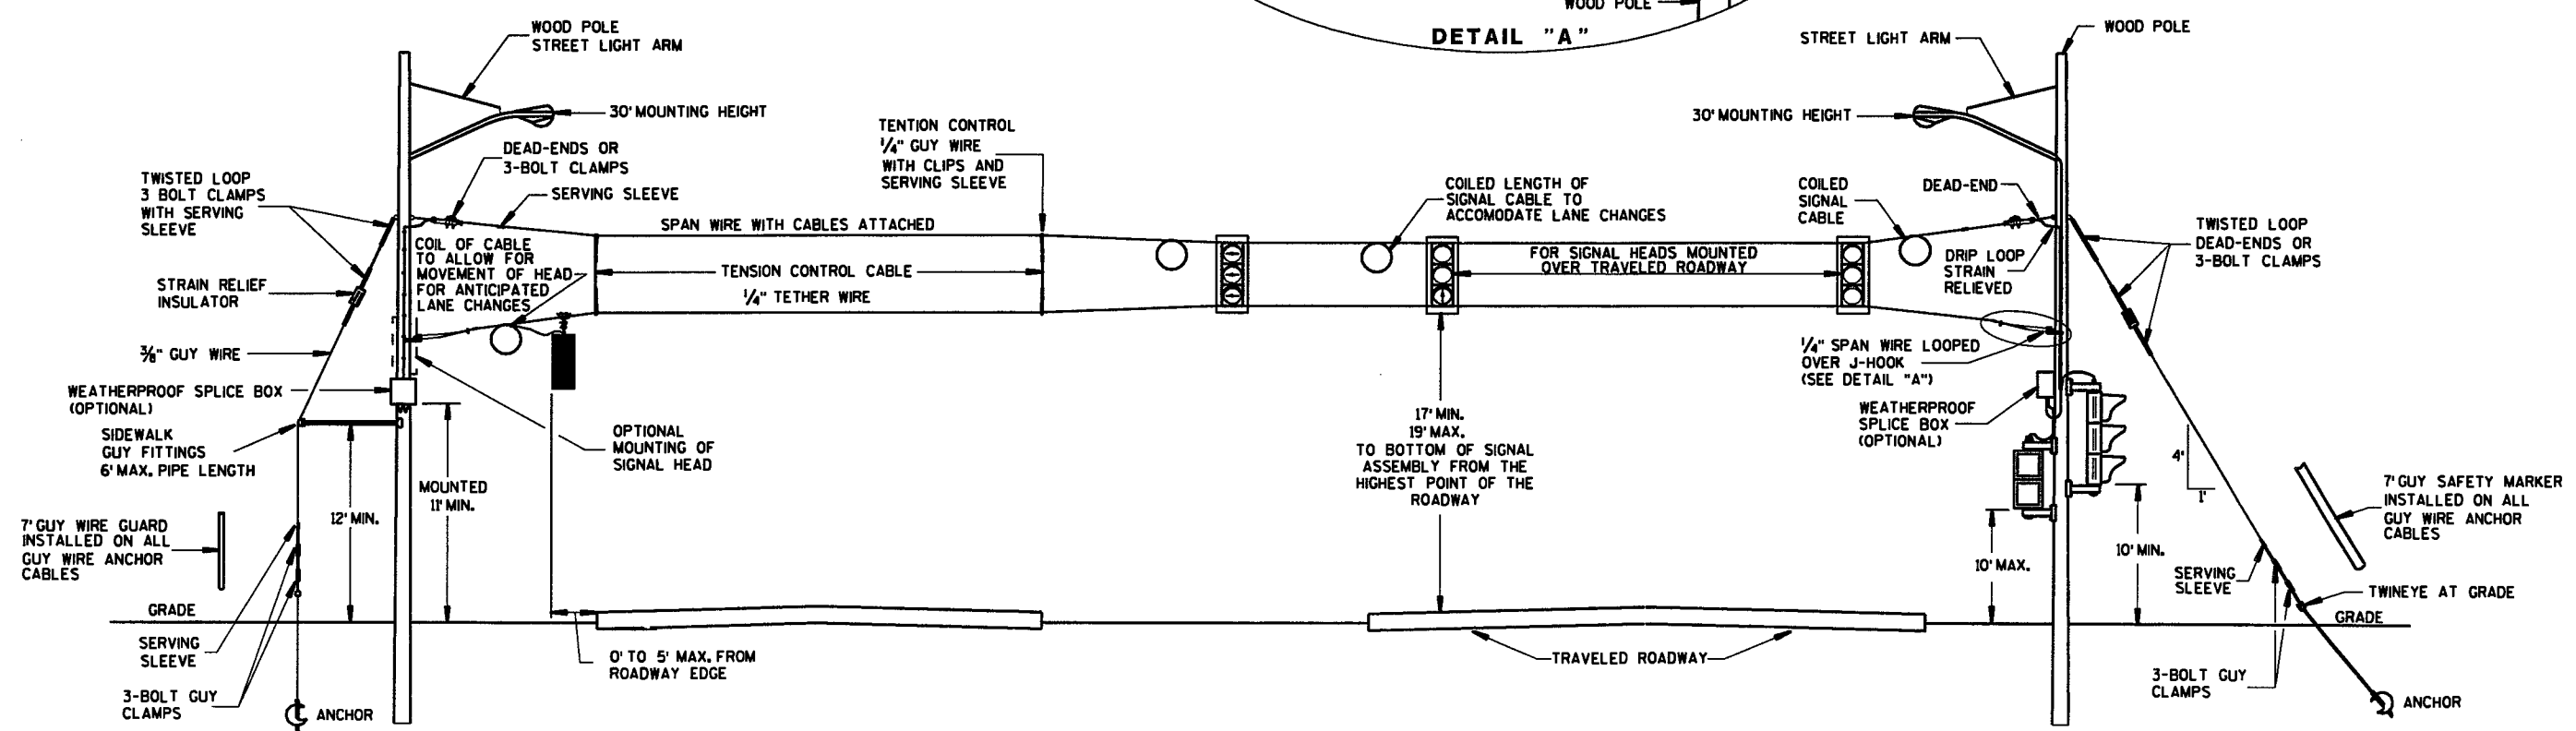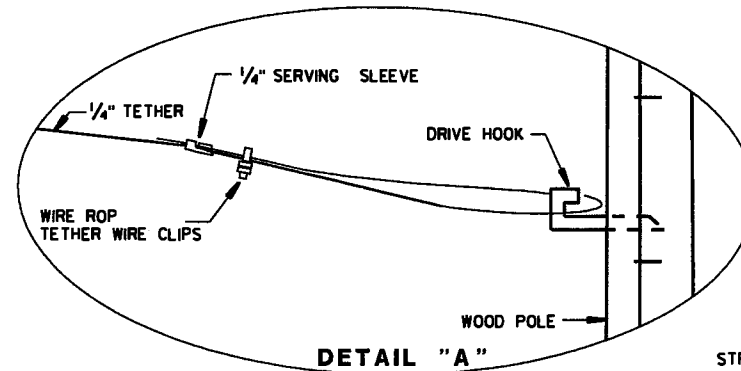

GENERAL NOTES

DETAILS OF CONSTRUCTION, MATERIALS AND WORKMANSHIP NOT SHOWN ON THIS DRAWING SHALL CONFORM TO THE PERTINENT REQUIREMENTS OF THE CONTRACT.

1. WOOD POLES SHALL BE CLASS 4. LENGTH DETERMINED BY SIGNAL PLAN.
2. SIGNAL FACES:
 - A. ALL SECTIONS SHALL BE 12" AND POLYCARBONATE.
 - B. EACH SHALL CONTAIN A 5" WIDE DULL BLACK POLYCARBONATE BACKPLATE.
 - C. EACH SHALL BE WIRED FROM THE TOP SIGNAL MOUNTING BRACKET.
 - D. NEAR RIGHT SIGNAL FACE SUSPENDED ON THE TETHER (NO BACKPLATE) SHALL NOT BE OVER THE TRAVELED WAY. IF THE POLE IS WITHIN 5 FEET OF THE TRAVELED WAY MOUNT THE SIGNAL FACE ON THE WOOD POLE WITH BACKPLATE.
 - E. FAR INDICATION SHALL BE MAINTAINED OVER CENTER OF TRAFFIC LANE.
3. SPAN WIRE:
 - A. EACH SPAN WIRE SHALL BE INDIVIDUALLY DOWN GUYED.
 - B. SIGNAL AND LIGHTING CABLES SHALL ONLY BE ATTACHED TO THE UPPER SPAN WIRE.
 - C. THE SIGNAL ASSEMBLY SHALL HAVE A 17' MIN. HEIGHT ABOVE THE ROADWAY. THIS SHALL BE MEASURED AFTER THE SPAN WIRE INSTALLATION IS COMPLETED WITH ALL CABLES AND SIGNAL FACES IN PLACE. MAINTAIN MINIMUM AND MAXIMUM HEIGHTS AS ROADWAY WORK PROGRESSES.

**SPAN WIRE
TEMPORARY SIGNALS
4 LANE ROADWAYS**

MINIMUM POLE LENGTHS	CLASS	MIN. BURIAL DEPTHS
25'	V	5'
30'	VI	6'
35'	VII	7'
40'	VIII	8'
45'	IX	9'

**SPAN WIRE
TEMPORARY TRAFFIC SIGNAL**

STATE OF WISCONSIN
DEPARTMENT OF TRANSPORTATION

APPROVED
5-24-07 /S/ Balu Ananthanarayanan
DATE CHIEF ELECTRICAL ENGINEER FOR
FHWA HIGHWAYS


6

6


S.D.D. 9 C 1-2b

S.D.D. 9 C 1-2b

6

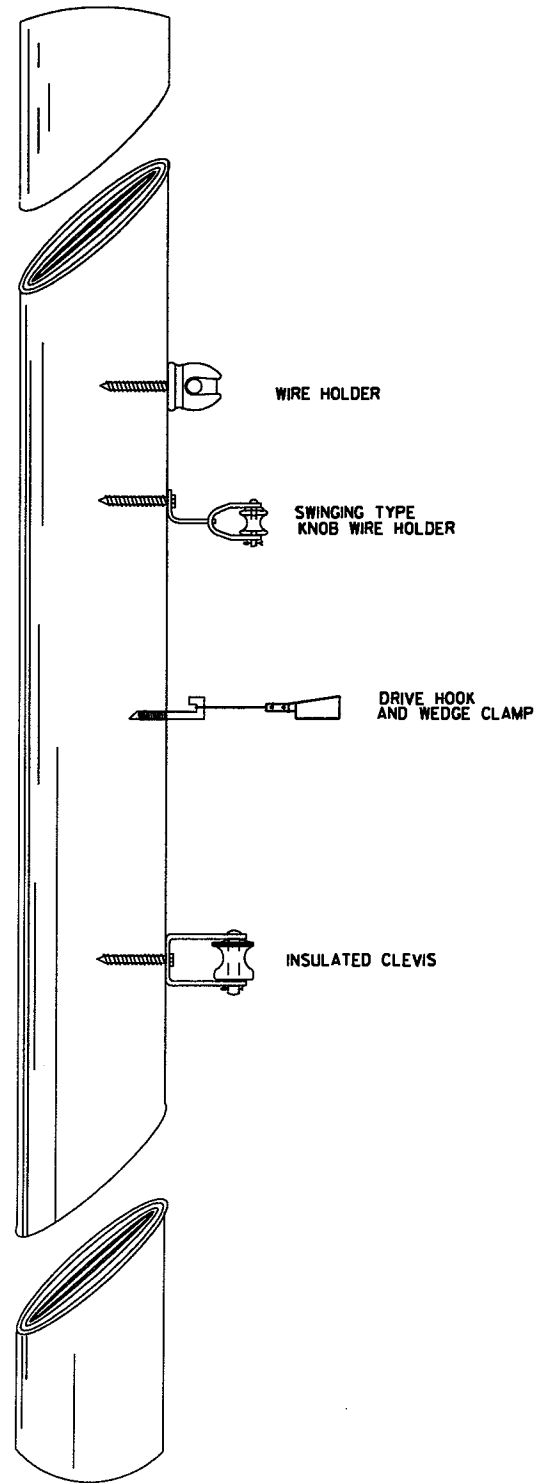

TYPICAL CABLE HANGERS

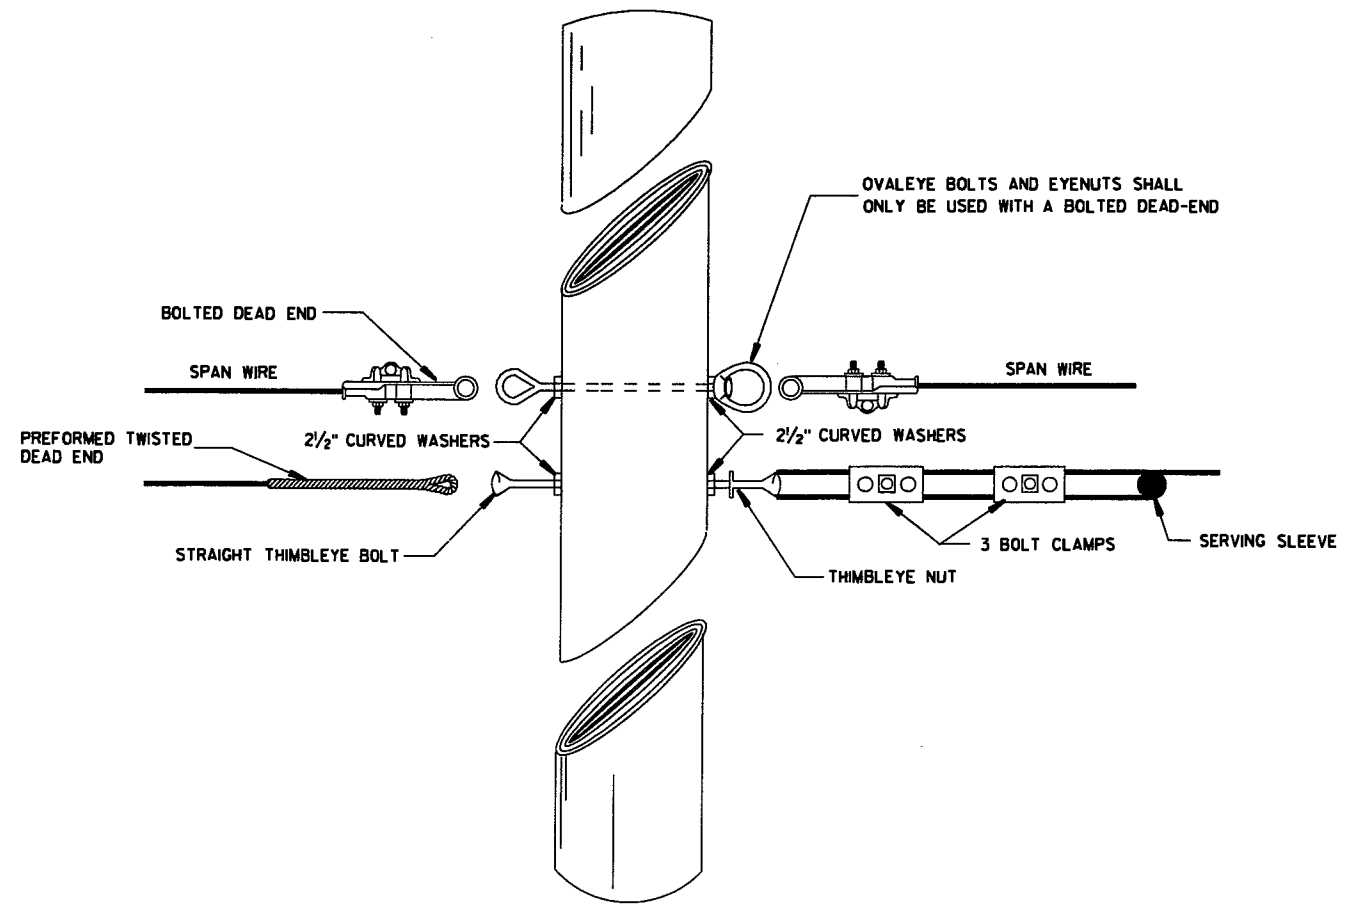

TYPICAL DEAD-ENDING

6


S.D.D. 9 C 1-2d

S.D.D. 9 C 1-2d

SPAN WIRE TEMPORARY TRAFFIC SIGNAL	
STATE OF WISCONSIN DEPARTMENT OF TRANSPORTATION	
APPROVED 5-24-07 DATE	/S/ Balu Ananthanarayanan CHIEF ELECTRICAL ENGINEER FOR HIGHWAYS
FHWA	

6

6

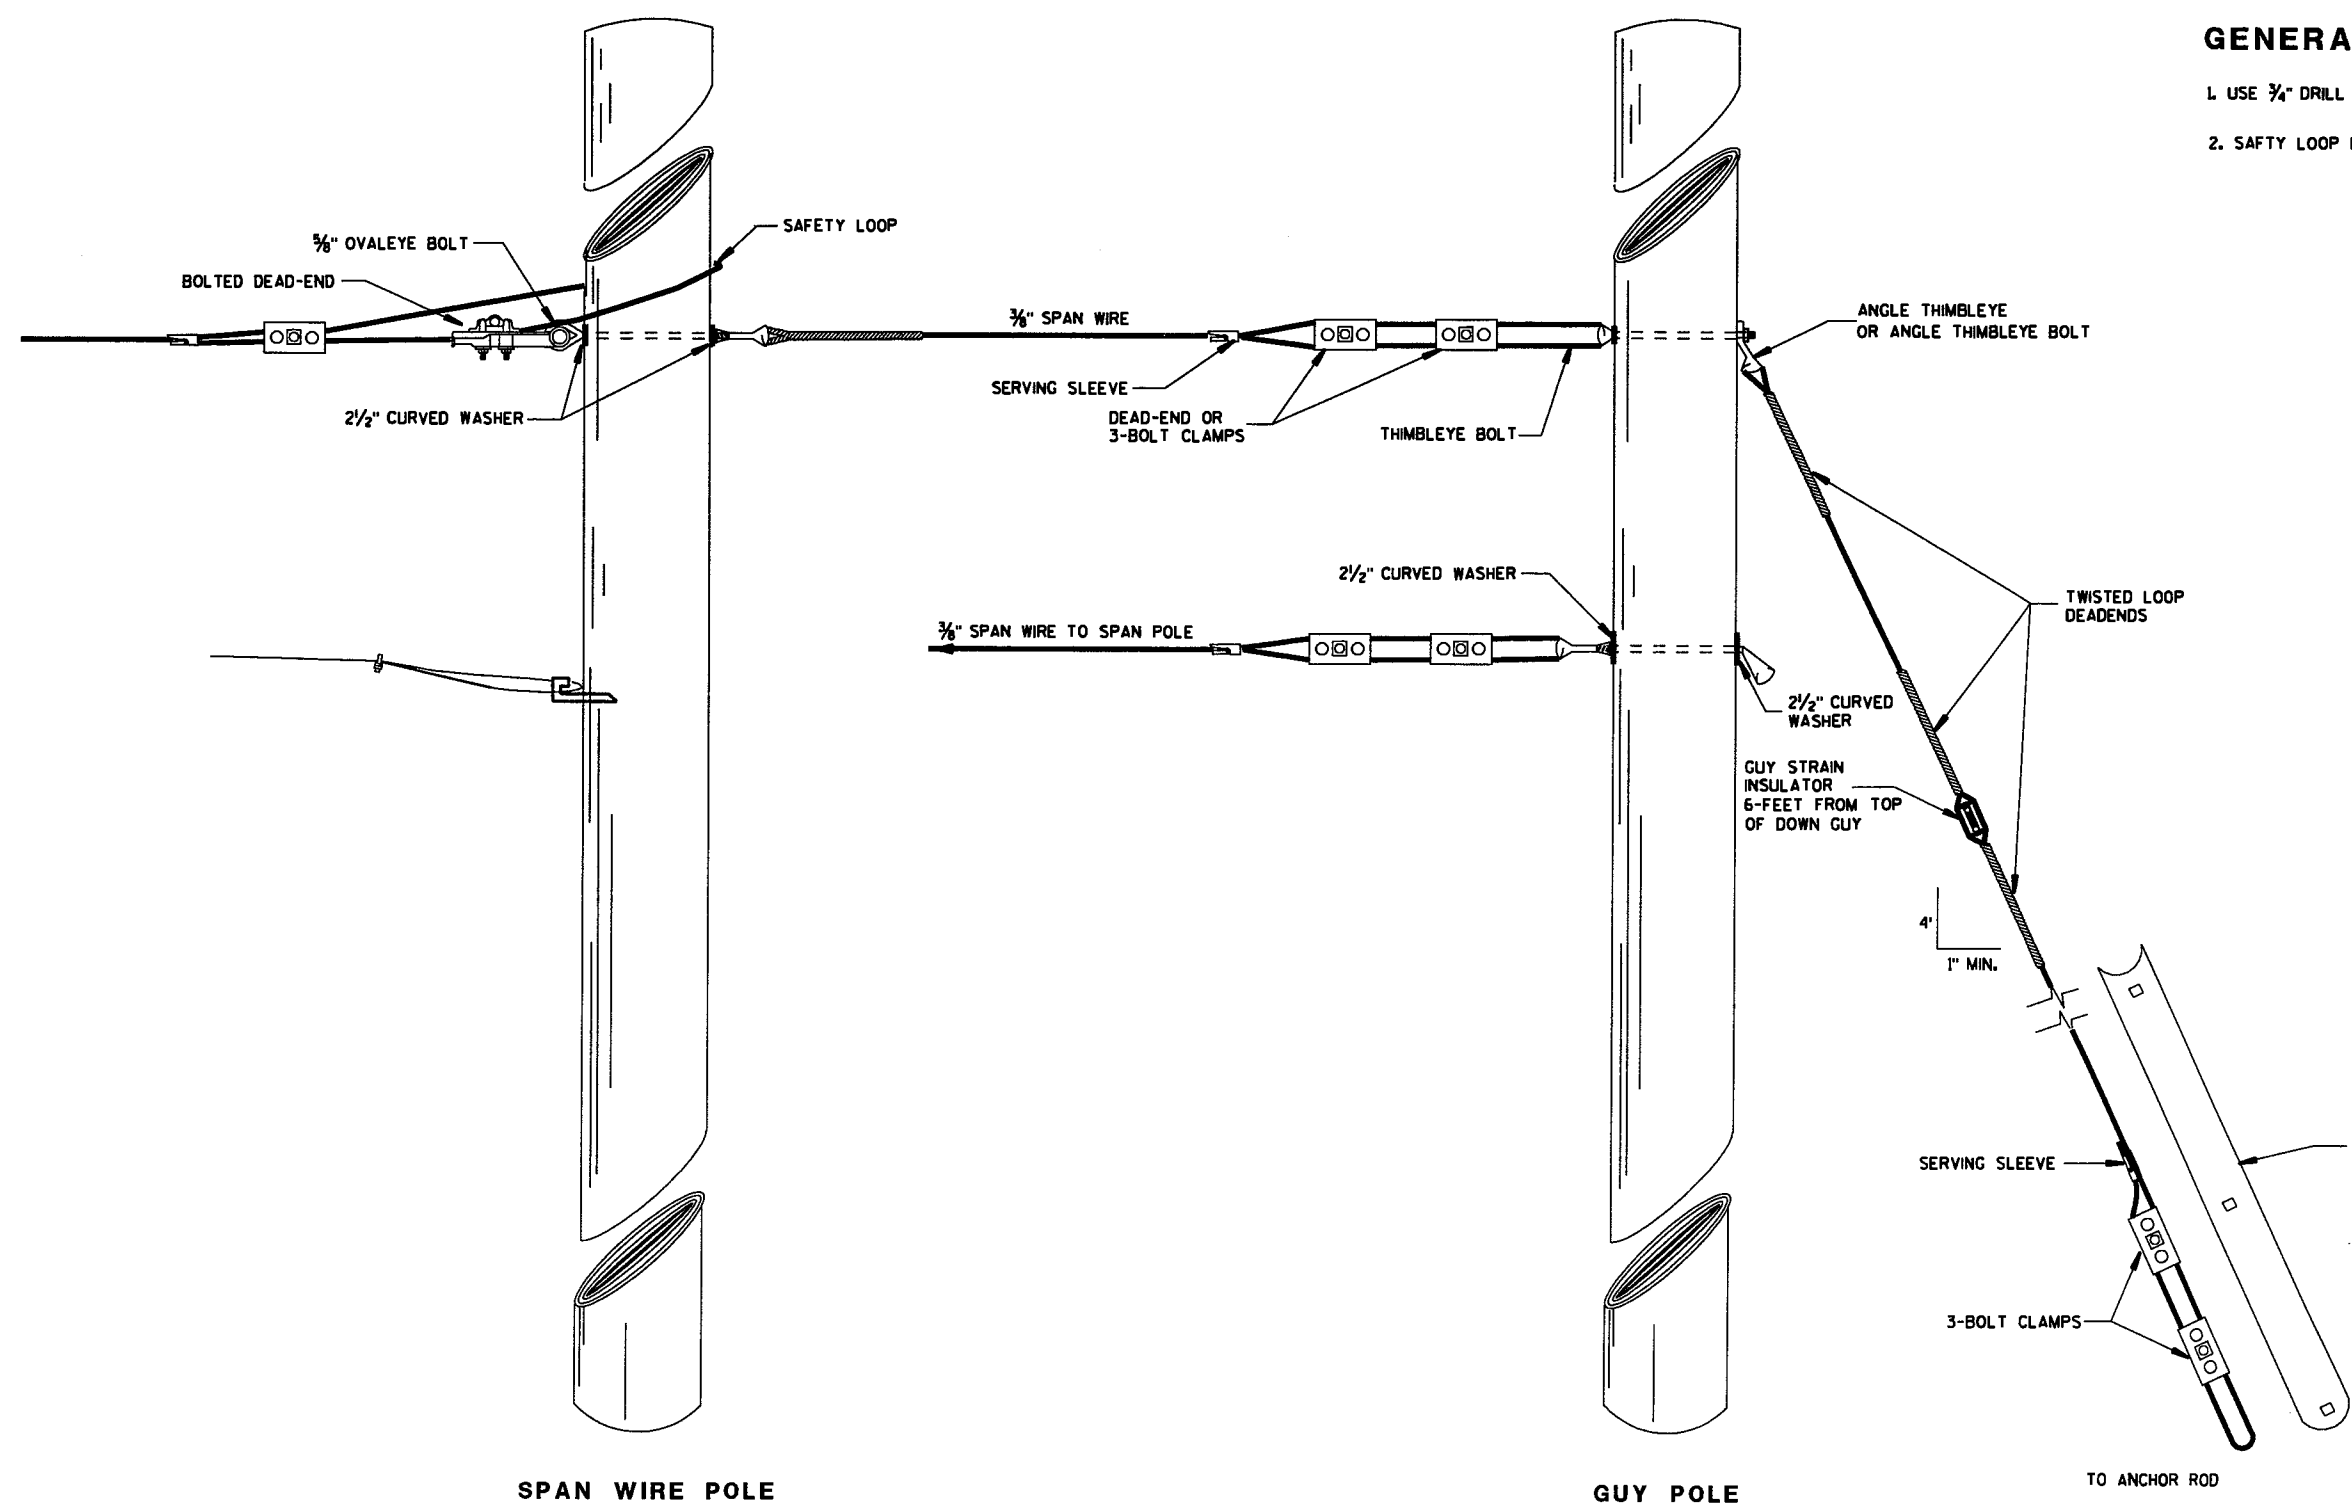

GENERAL NOTES

- 1. USE 3/4" DRILL IN WOOD POLE TO PROVIDE HOLE FOR 5/8" BOLTS.
- 2. SAFTY LOOP REQUIRED ON EACH END OF ALL SPAN WIRES.

SPAN WIRE POLE

GUY POLE

TO ANCHOR ROD


TYPICAL DEAD-ENDINGS OR GUYING

SPAN WIRE TEMPORARY TRAFFIC SIGNAL	
STATE OF WISCONSIN DEPARTMENT OF TRANSPORTATION	
APPROVED 5-24-07 DATE	/S/ Balu Ananthanarayanan CHIEF ELECTRICAL ENGINEER FOR HIGHWAYS
FWA	


S.D.D. 9 G 1-2e

S.D.D. 9 G 1-2e


6

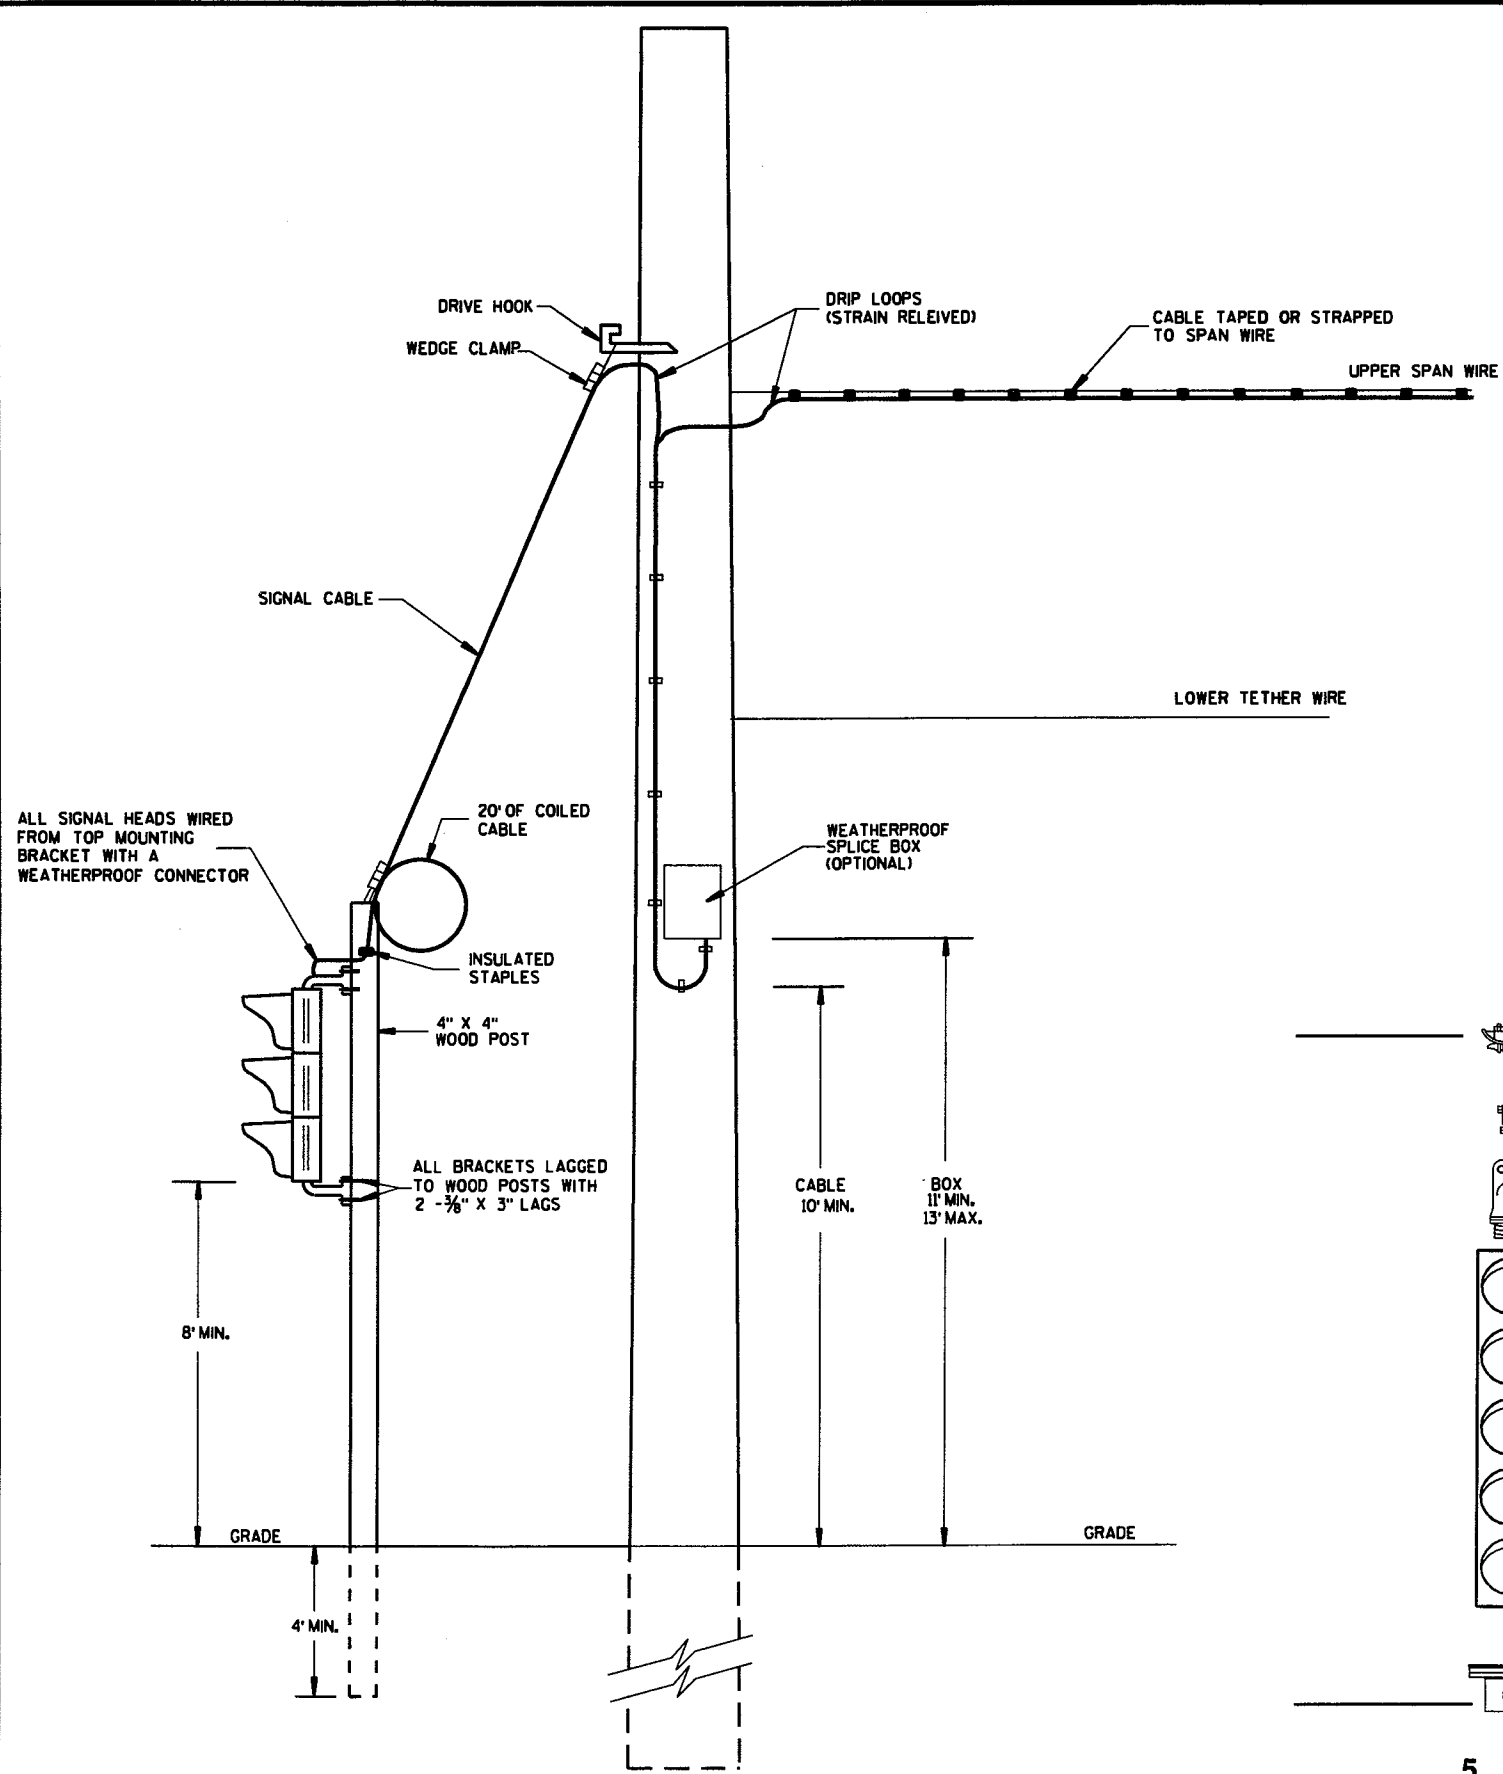

TYPICAL DROP TO TEMPORARY MOVEABLE SIGNAL

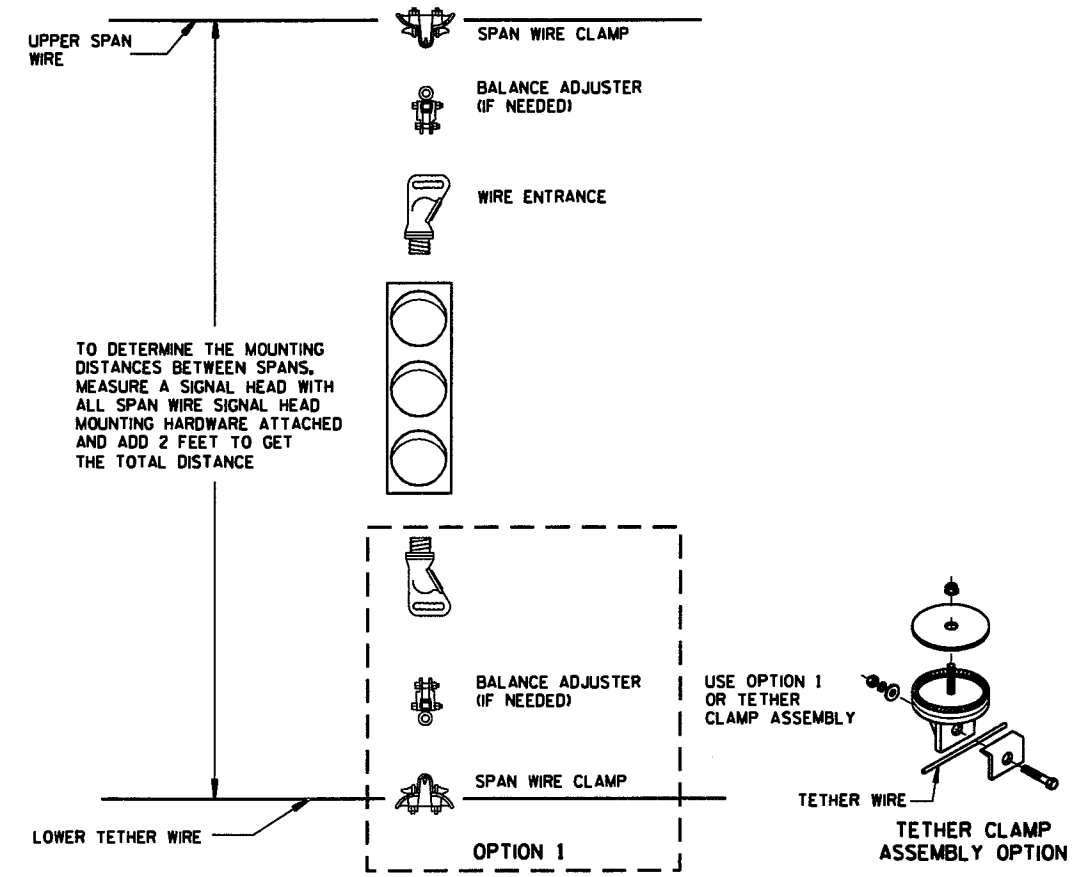

TYPICAL SPAN WIRE MOUNTING HARDWARE


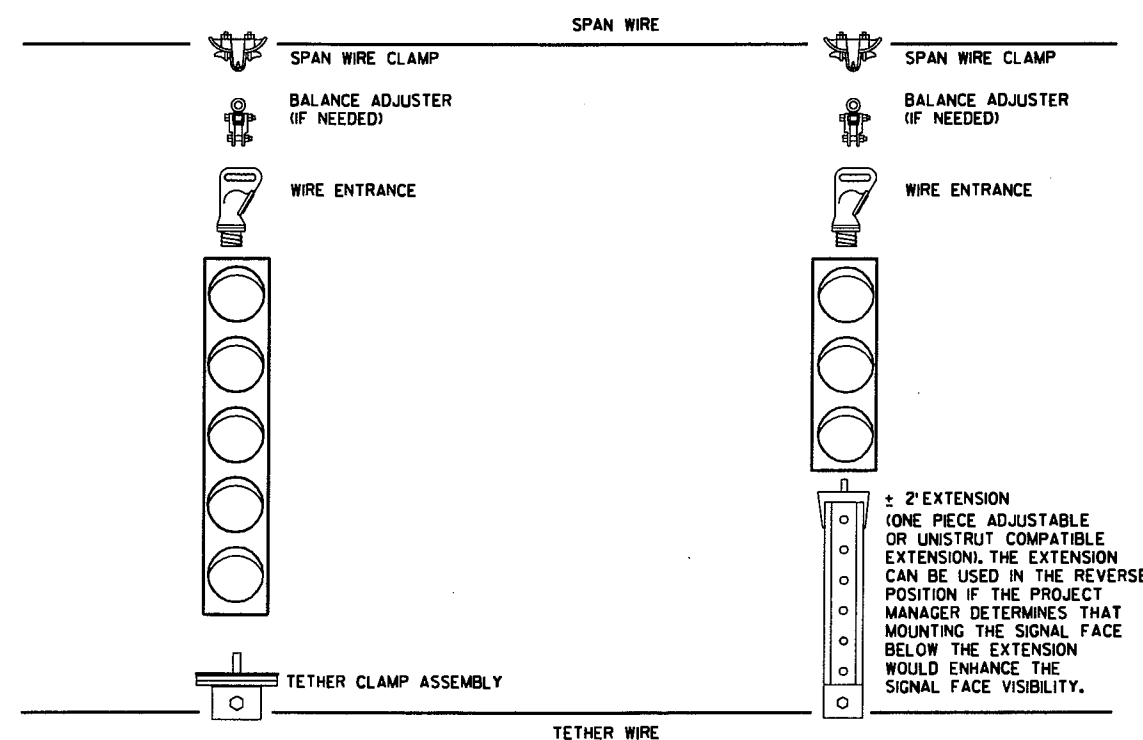


5 SECTION VERTICAL WITH 3 SECTION VERTICAL ON ONE SPAN WIRE


SPAN WIRE TEMPORARY TRAFFIC SIGNAL	
STATE OF WISCONSIN DEPARTMENT OF TRANSPORTATION	
APPROVED 5-24-07 DATE	/S/ Balu Ananthanarayanan CHIEF ELECTRICAL ENGINEER FOR HIGHWAYS
FHWA	

S.D.D. 9 C 1-2f


S.D.D. 9 C 1-2f

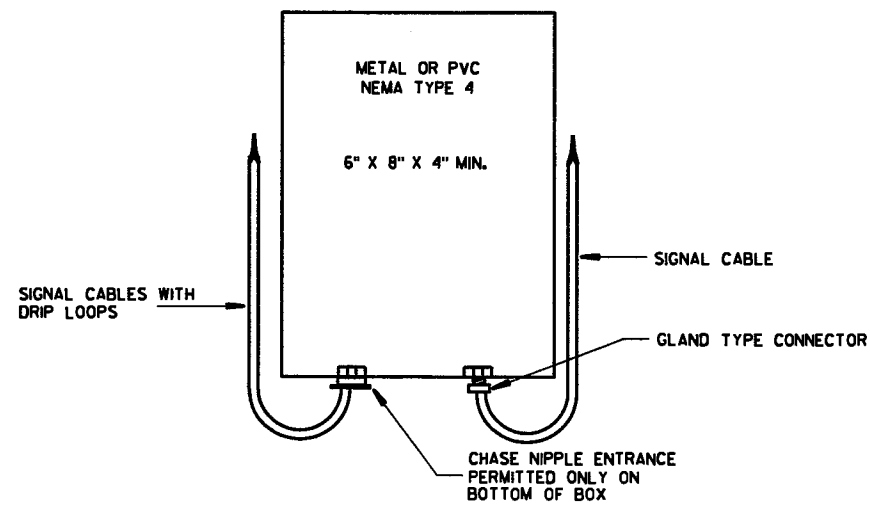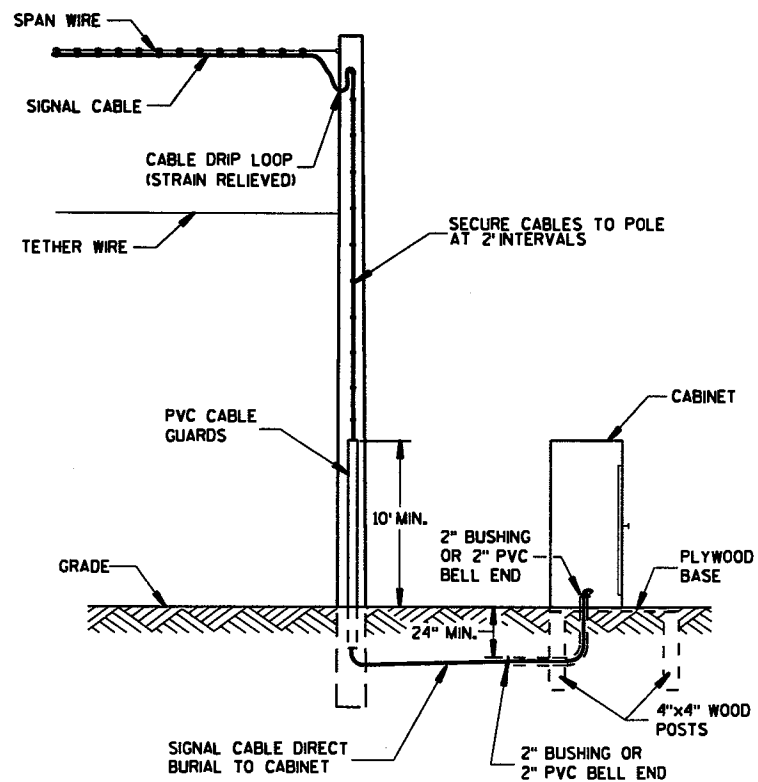

SPLICE BOX

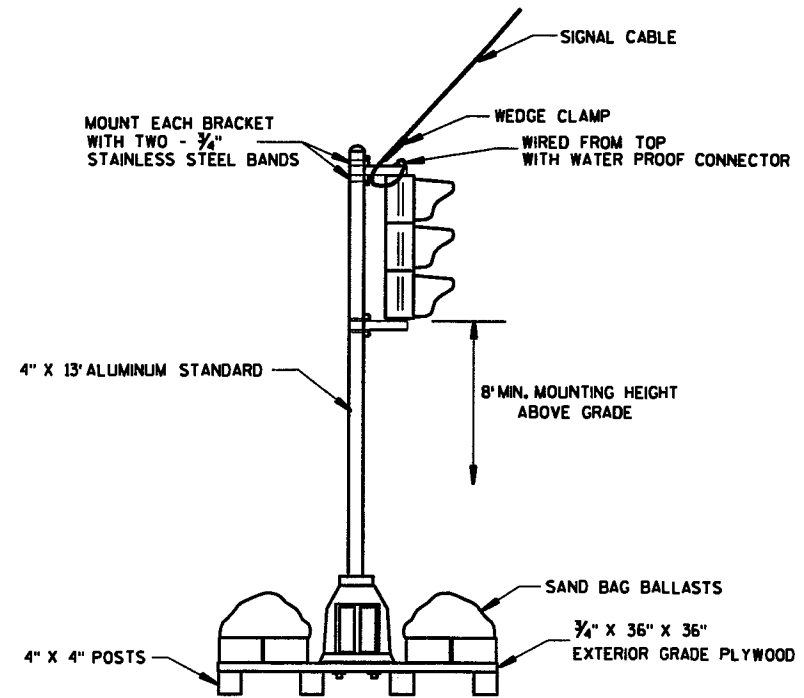


TYPICAL SKID TYPE TEMPORARY

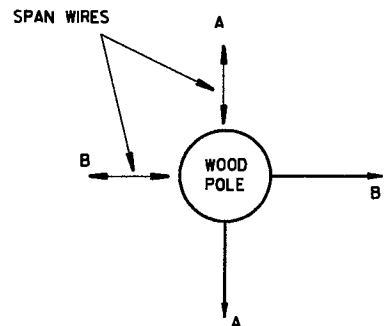


ALL DOWN OR SIDEWALK GUYS SHALL BE INSTALLED IN THE OPPOSITE DIRECTION OF THE STRAIN OF THE SPAN WIRE

CORNER POLES



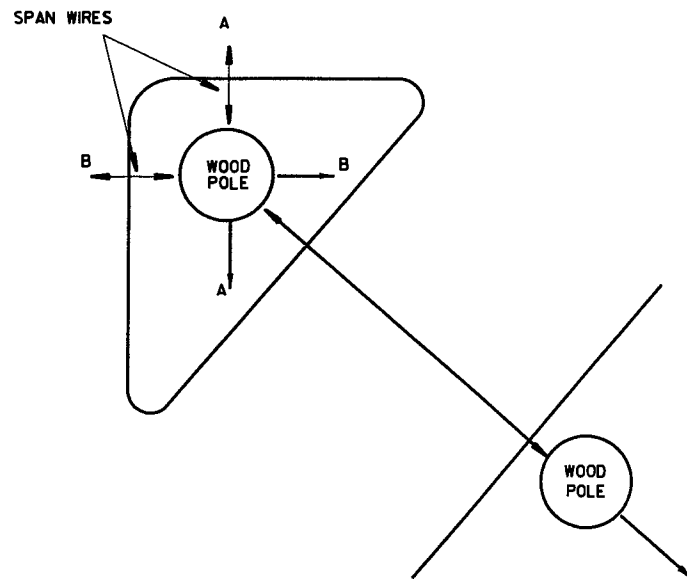


ISLAND POLES



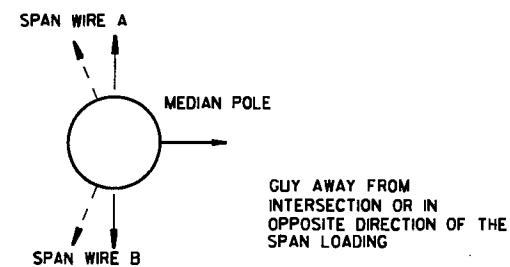


MEDIAN POLES

SPAN WIRE TEMPORARY TRAFFIC SIGNAL	
STATE OF WISCONSIN DEPARTMENT OF TRANSPORTATION	
APPROVED 5-24-07 DATE	/S/ Balu Ananthanarayanan CHIEF ELECTRICAL ENGINEER FOR HIGHWAYS
FHWA	

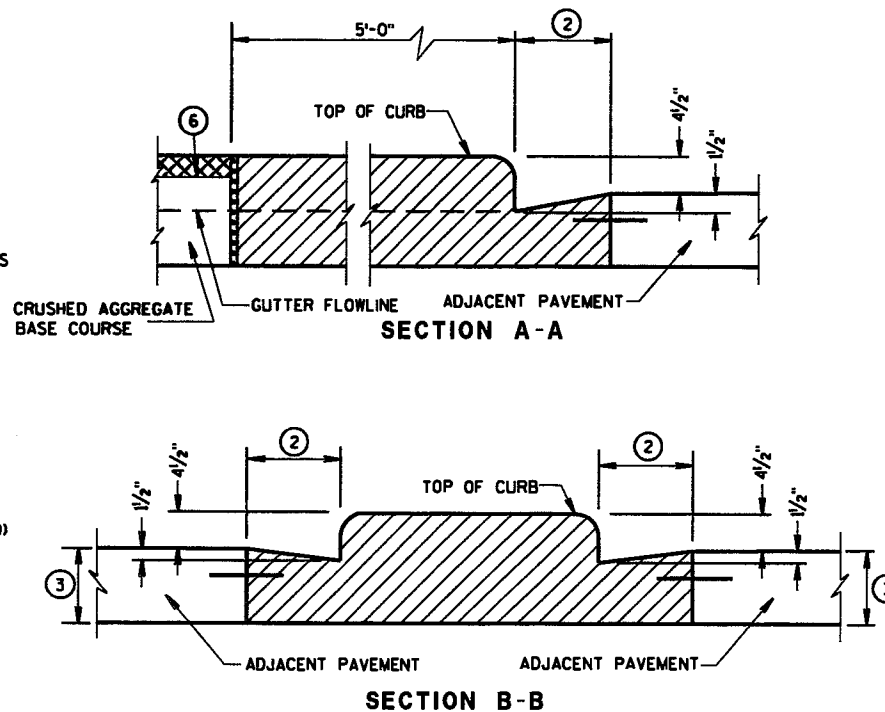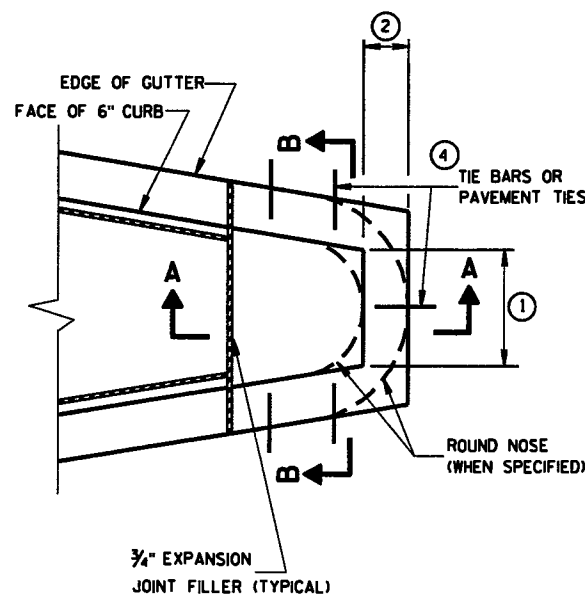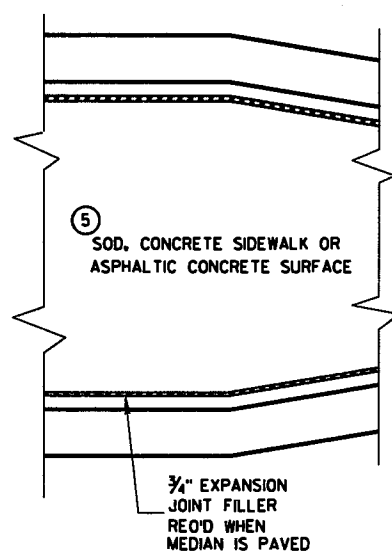

CONCRETE MEDIAN BLUNT NOSE DETAIL

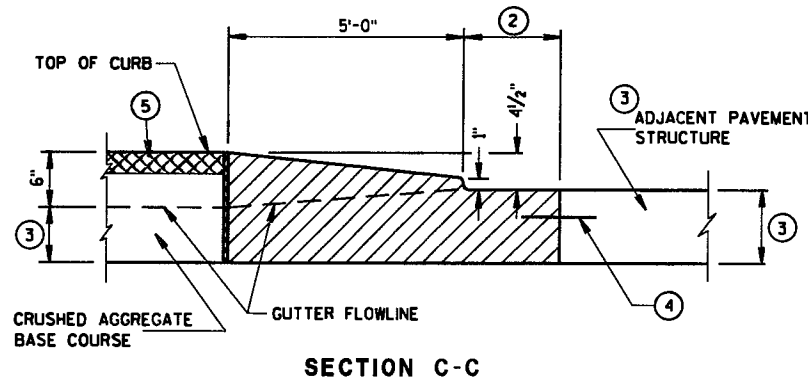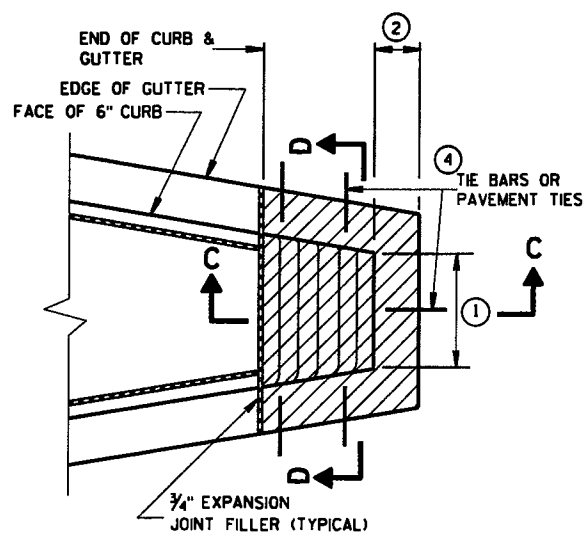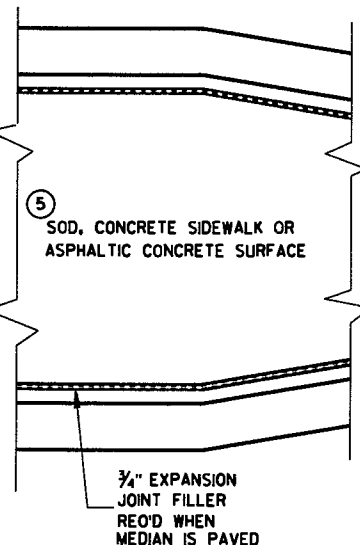


CONCRETE MEDIAN SLOPED NOSE TYPE 1


GENERAL NOTES

DETAILS OF CONSTRUCTION, MATERIALS AND WORKMANSHIP NOT SHOWN ON THIS DRAWING SHALL CONFORM TO THE PERTINENT REQUIREMENTS OF THE STANDARD SPECIFICATIONS AND THE APPLICABLE SPECIAL PROVISIONS.

- ① SEE PLAN FOR MEDIAN NOSE WIDTH AND RADIUS (FOR ROUND NOSE ALTERNATE).
 - ② WIDTH OF GUTTER TO MATCH EXISTING ADJACENT GUTTER OR AS SPECIFIED ELSEWHERE IN THE PLAN.
 - ③ DEPTH EQUAL TO ADJACENT PAVEMENT. ADJACENT PAVEMENT STRUCTURE DETAILS ARE SHOWN ON THE PLAN. TYPICAL OPTIONS ARE:
 - (1) NEW OR EXISTING CONCRETE PAVEMENT.
 - (2) ASPHALTIC CONCRETE PAVEMENT OVER NEW OR EXISTING CONCRETE BASE COURSE.
 - (3) ASPHALTIC CONCRETE PAVEMENT OVER CRUSHED AGGREGATE BASE COURSE.
 - ④ TIE BARS OR PAVEMENT TIES REQUIRED IN NEW CONCRETE PAVEMENT OR CONCRETE BASE COURSE. TIE BARS SHALL BE NO. 4 X 2'-0" SPACED AT 2'-0" C-C.
- PAVEMENT TIES REQUIRED IN EXISTING CONCRETE BASE COURSE. PAVEMENT TIES SHALL BE NO. 6 X 1'-0" SPACED AT 3'-0" C-C INSTALLED ON A HORIZONTAL SKEW OF 6:1 THE DIRECTION OF SKEW SHALL ALTERNATE AFTER EVERY ONE OR TWO BARS.
- ⑤ SURFACE TYPE AND DETAILS ARE SHOWN ELSEWHERE IN THE PLAN.

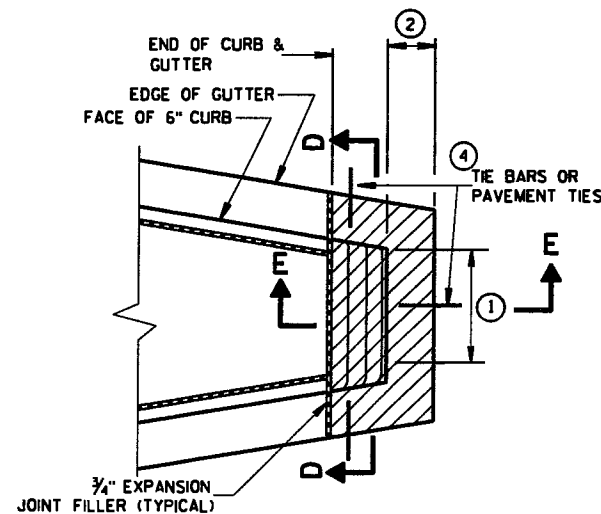


CONCRETE MEDIAN SLOPED NOSE TYPE 2

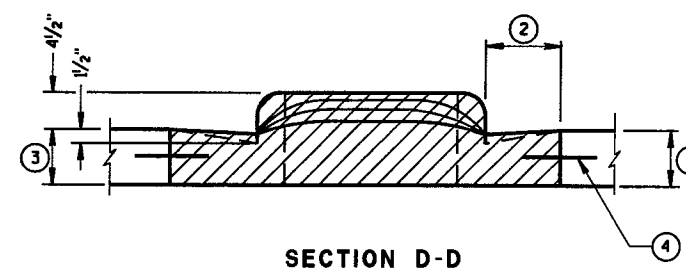

CONCRETE MEDIAN NOSE

STATE OF WISCONSIN
DEPARTMENT OF TRANSPORTATION

APPROVED
6/8/06 /S/ Jerry H. Zogg
DATE ROADWAY STANDARDS DEVELOPMENT ENGINEER
FHWA

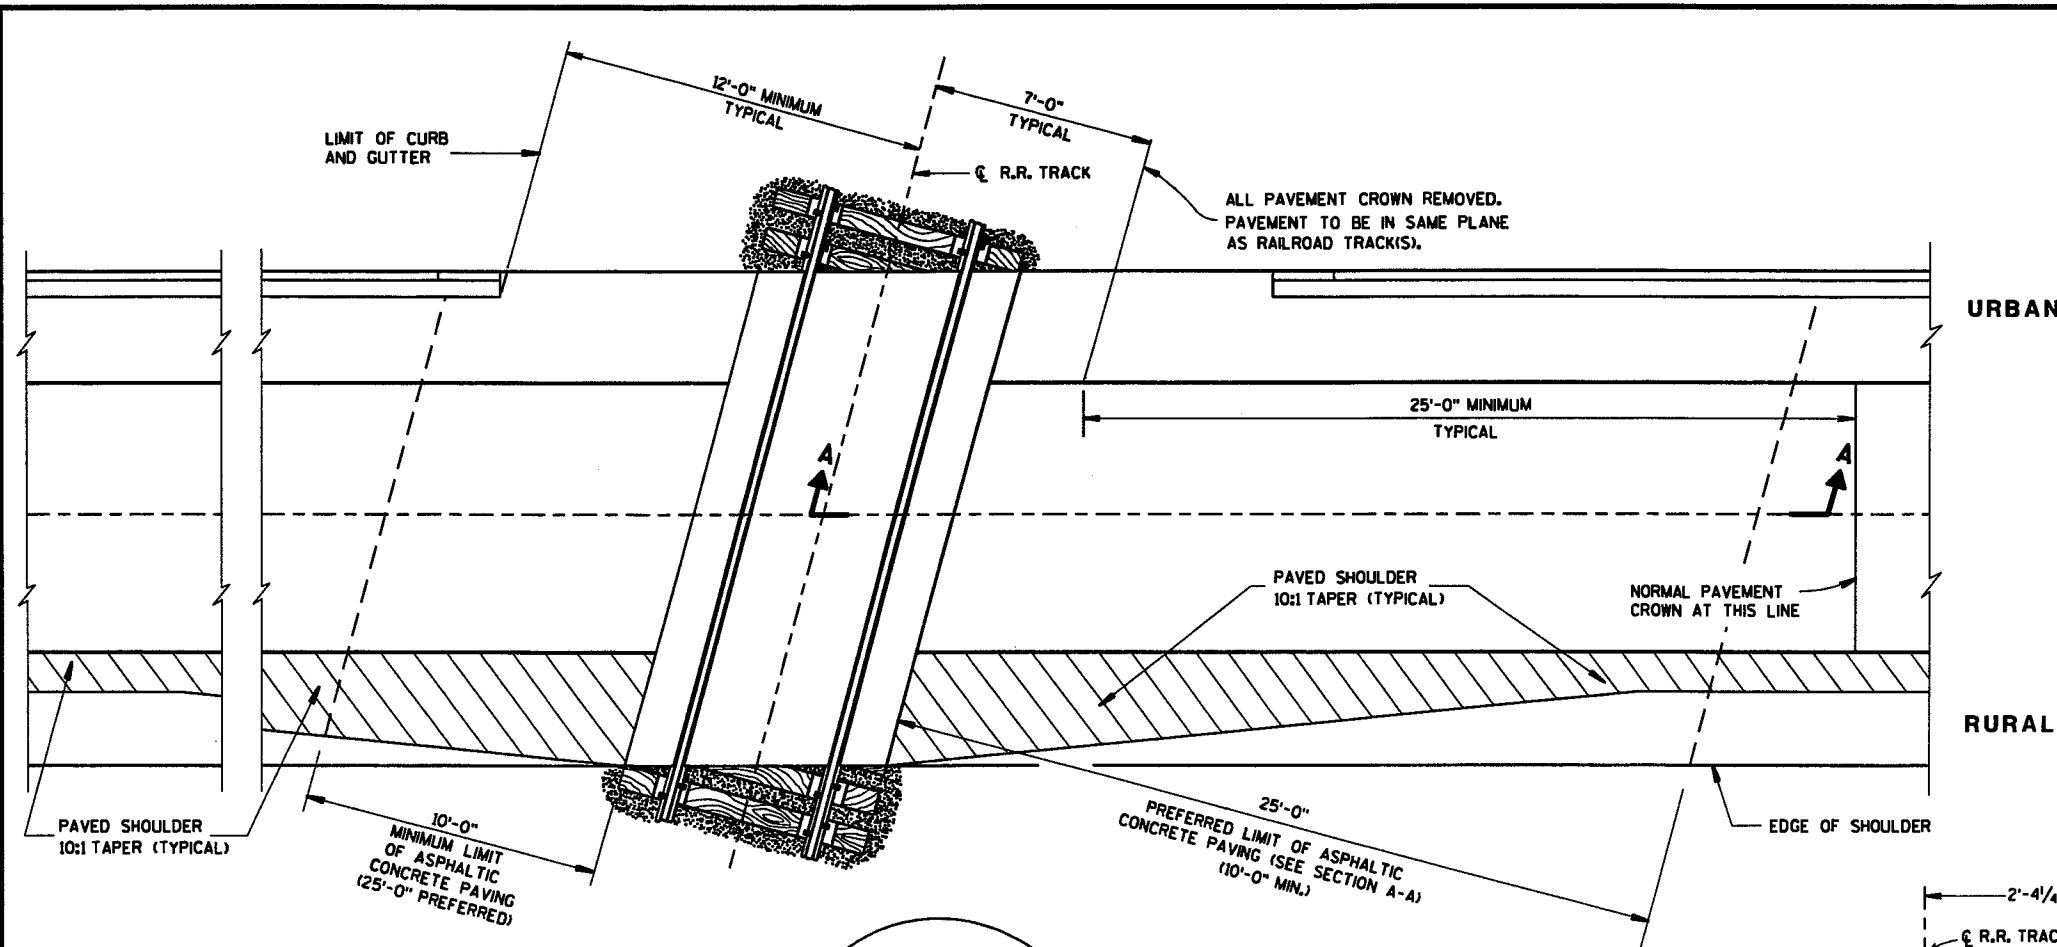

GENERAL NOTES

DETAILS OF CONSTRUCTION, MATERIALS AND WORKMANSHIP NOT SHOWN ON THIS DRAWING SHALL CONFORM TO THE PERTINENT REQUIREMENTS OF THE STANDARD SPECIFICATIONS AND THE APPLICABLE SPECIAL PROVISIONS.


TIMBER, CONCRETE OR RUBBER CROSSING SURFACE MATERIAL, RAILS, TIES, BALLAST, GEOTEXTILE FABRIC AND CROSSING DRAINAGE SYSTEM BY OTHERS UNLESS OTHERWISE PROVIDED.

ASPHALTIC CONCRETE APPROACHES AND ASPHALTIC CONCRETE CROSSING SURFACES ** TO BE PLACED BY CONTRACTOR UNLESS OTHERWISE PROVIDED.


ASPHALTIC CONCRETE FLANGEWAY AND FIELD FILLERS TO BE PLACED AND THOROUGHLY HAND COMPACTED BY THE CONTRACTOR WHEN NOT PROVIDED BY OTHERS, SEE DETAIL B. ASPHALTIC FILLERS NOT REQUIRED WHEN RUBBER FILLERS ARE PROVIDED.

ASPHALTIC CONCRETE PAVEMENT SHALL BE ROLLED PARALLEL TO THE TRACK.

** CROSSING SURFACE MAY BE TIMBER, RUBBER, CONCRETE, ASPHALTIC CONCRETE OR A COMBINATION OF SUCH MATERIALS.

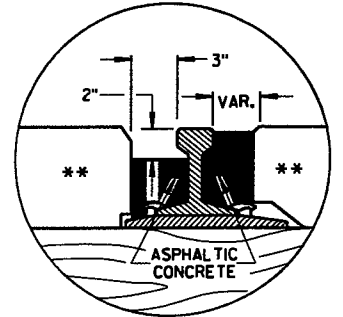


**DETAIL B
ASPHALTIC CONCRETE
FLANGEWAY AND FIELD FILLERS**

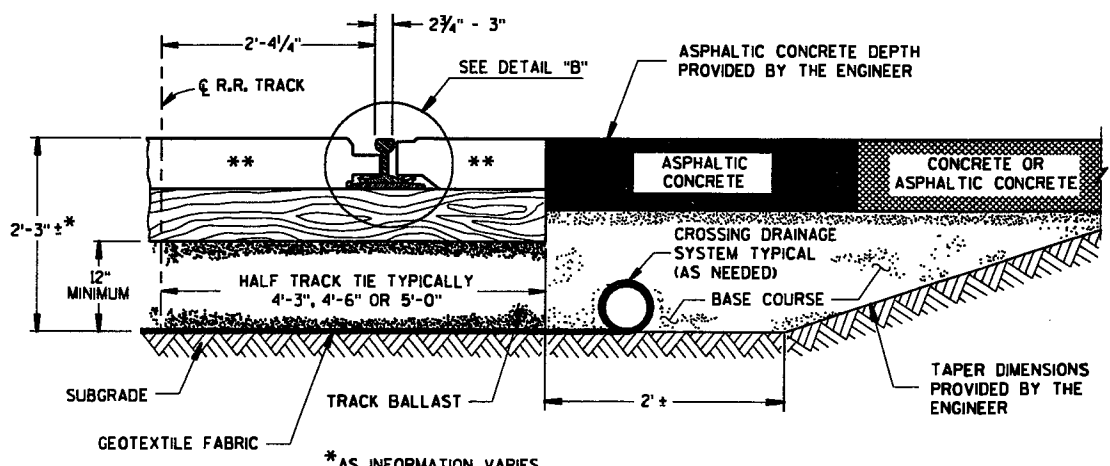


*AS INFORMATION, VARIES WITH TRACK STRUCTURE AND SOIL CONDITIONS

TYPICAL HALF SECTION

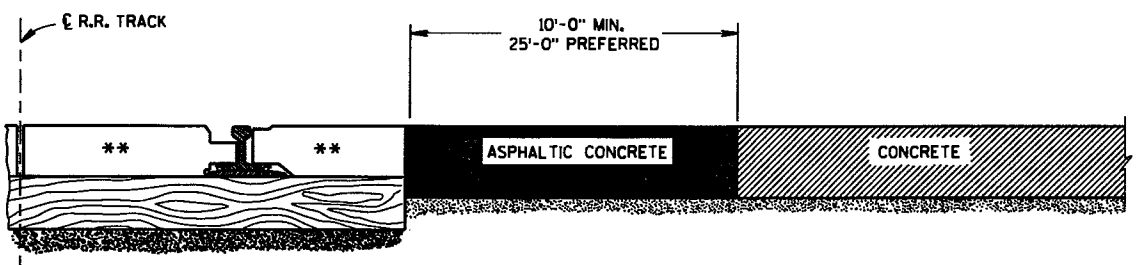

**SECTION A-A
CONCRETE PAVEMENT APPROACH**

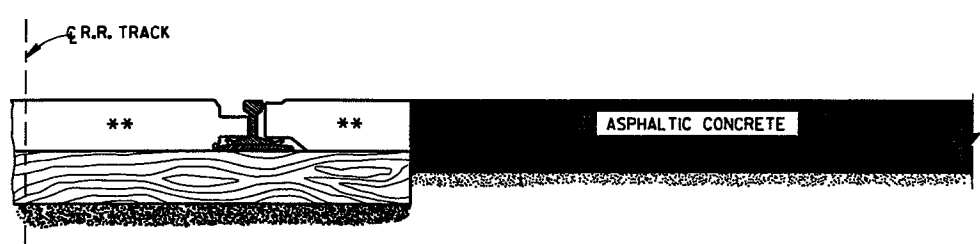

**SECTION A-A
ASPHALTIC CONCRETE PAVEMENT APPROACH**

EXAMPLES OF PAVEMENT APPROACHES


PAVEMENT DETAILS FOR RAILROAD APPROACH	
STATE OF WISCONSIN DEPARTMENT OF TRANSPORTATION	
APPROVED 5-12-06 DATE	/S/ Ronald E. Adams CHIEF, RAILROADS & HARBORS SECTION
FHWA	

6


6

S.D.D. 13 B 1-9


S.D.D. 13 B 1-9

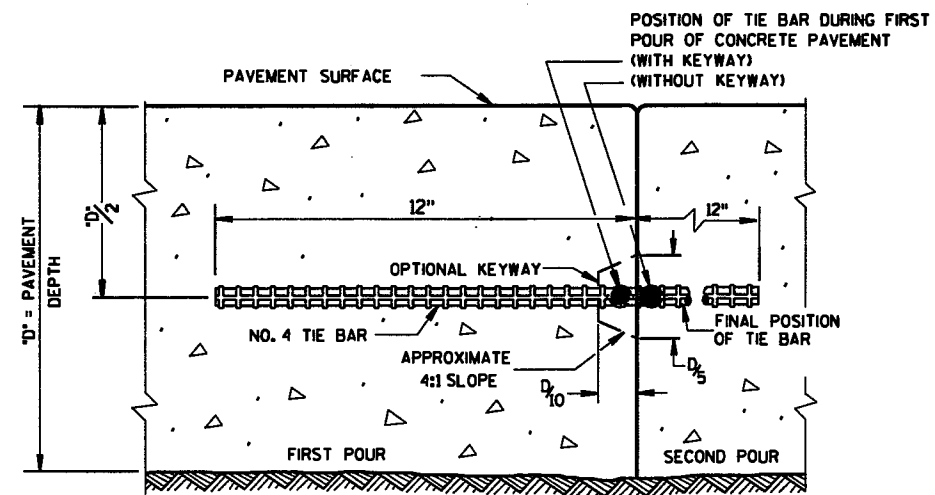

CONSTRUCTION JOINT

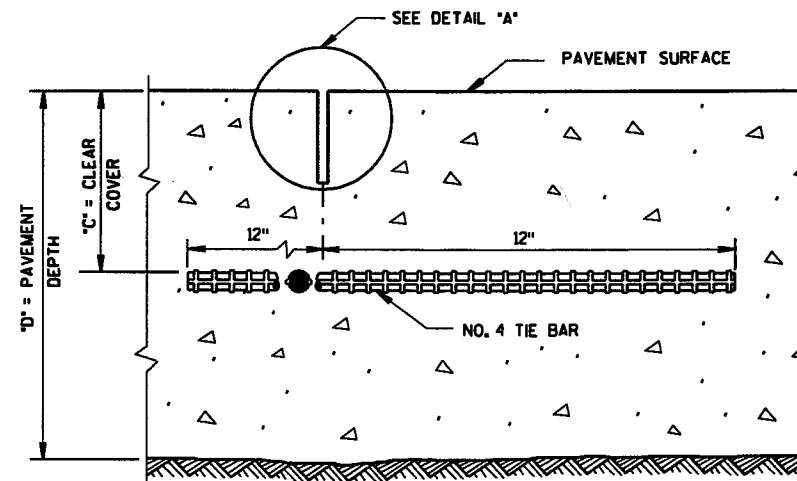

SAWED JOINT

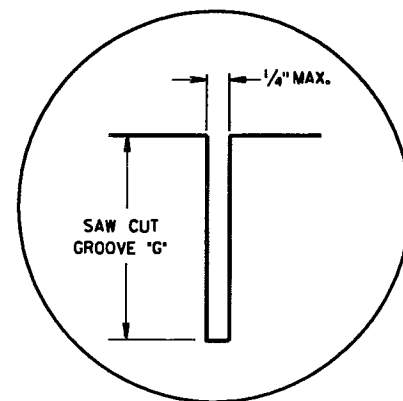


DETAIL "A"

GENERAL NOTES

DETAILS OF CONSTRUCTION NOT SHOWN ON THIS DRAWING SHALL CONFORM TO THE PERTINENT REQUIREMENTS OF THE STANDARD SPECIFICATIONS AND THE APPLICABLE SPECIAL PROVISIONS.


LONGITUDINAL JOINTS SHALL NOT BE SEALED OR FILLED.

TIE BAR SPACINGS ARE VALID ONLY FOR PAVEMENT WIDTHS IN THE TABLE. FOR WIDER PAVEMENTS, TIED CONCRETE SHOULDERS OR RAMPS, THE TIE BAR SPACING SHALL BE AS SHOWN ON THE PLANS.

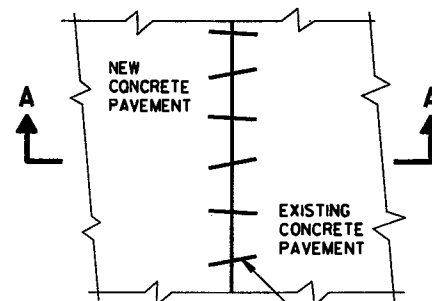

PLAN VIEW

NO. 6 TIE BARS SPACED 3'-0" C-C, INSTALLED ON 6:1 SKEW HORIZONTALLY, DIRECTION OF SKEW ALTERNATING AFTER EVERY ONE OR TWO BARS.

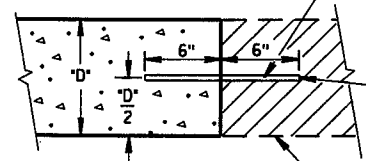


THE HOLE FOR THE BAR SHALL BE DRILLED TO A DEPTH OF 7" AND TO SUCH A DIAMETER AS TO PROVIDE A TIGHT DRIVEN FIT.

EXIST. CONC. PAVEMENT


SECTION A-A PAVEMENT TIES

PAVEMENT DEPTH "D"	CLEAR COVER "C"	SAW CUT GROOVE "G"	MAXIMUM TIE BAR SPACING "S"	
			PAVEMENT WIDTH 24' OR 26'	30'
6, 6 1/2"	3" ± 1/2"	2"	48"	42"
7, 7 1/2"	3 1/4" ± 1"	2 1/4"	45"	36"
8, 8 1/2"	3 3/4" ± 1"	2 1/2"	39"	30"
9, 9 1/2"	4 1/4" ± 1"	3"	33"	27"
10, 10 1/2"	4 3/4" ± 1"	3 1/4"	30"	24"
11, 11 1/2"	5 1/4" ± 1"	3 3/4"	27"	21"
12"	5 3/4" ± 1"	4"	24"	21"

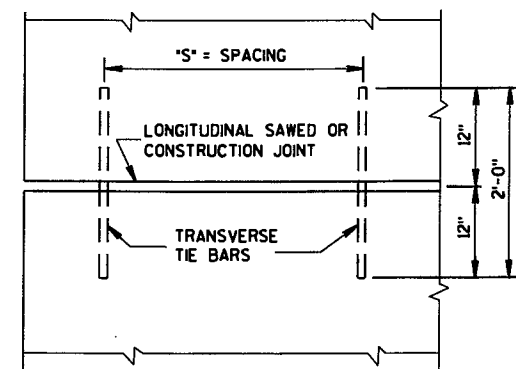

PLAN VIEW SHOWING LOCATION OF TIE BARS


CONCRETE PAVEMENT LONGITUDINAL JOINTS AND PAVEMENT TIES	
STATE OF WISCONSIN DEPARTMENT OF TRANSPORTATION	
APPROVED 3/21/07 DATE	/S/ Steven W. Krebs CHIEF MATERIALS MANAGEMENT ENGINEER
FHWA	

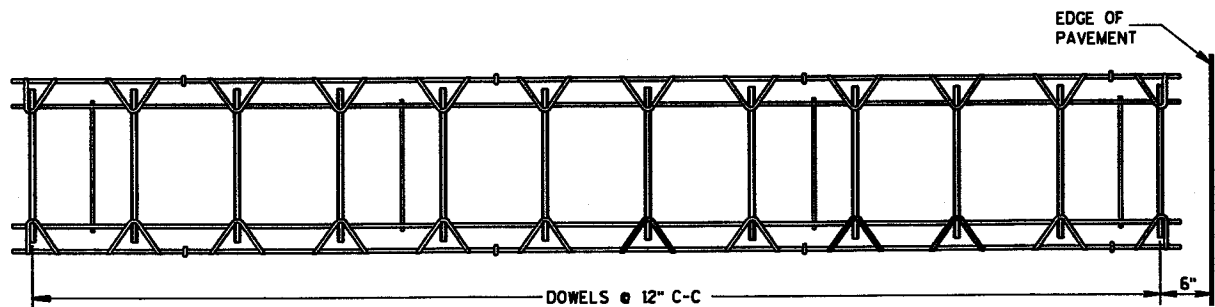


PLAN VIEW



SIDE VIEW
CONTRACTION JOINT DOWEL ASSEMBLY ①

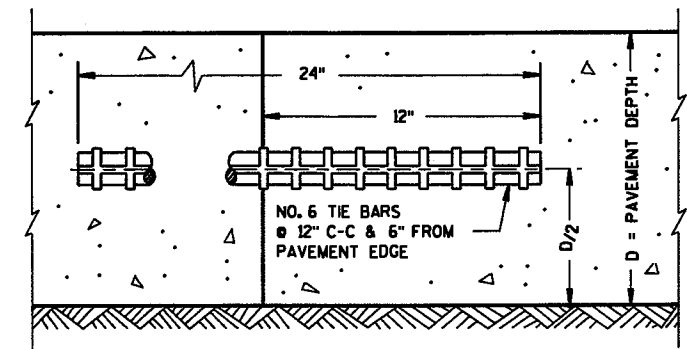

CONSTRUCTION JOINT

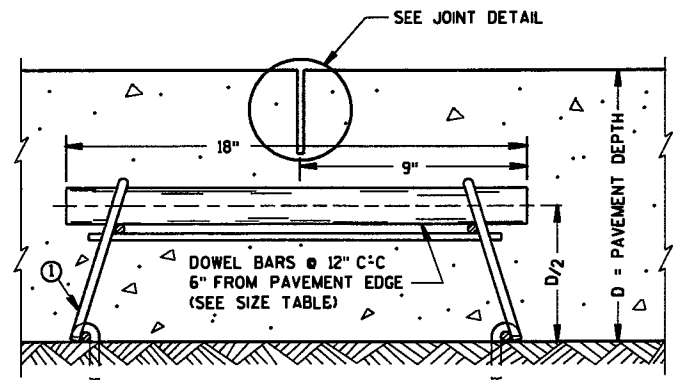

DOWELED CONTRACTION JOINT

PAVEMENT DEPTH, DOWEL BAR SIZE AND JOINT SPACING TABLE

PAVEMENT DEPTH (D)	DOWEL BAR DIAMETER	CONTRACTION JOINT SPACING
6", 6 1/2"	1 1/4"	12'
7", 7 1/2"	1 1/4"	14'
8", 8 1/2"	1 1/4"	15'
9", 9 1/2"	1 1/4"	15'
10" & ABOVE	1 1/2"	15'

GENERAL NOTES

DETAILS OF CONSTRUCTION NOT SHOWN ON THIS DRAWING SHALL CONFORM TO THE STANDARD SPECIFICATIONS AND SPECIAL PROVISIONS.

CONTRACTION JOINTS

CONTRACTION JOINTS SHALL BE NORMAL TO THE CENTERLINE. THE LOCATION OF CONTRACTION JOINTS THROUGH INTERSECTIONS SHALL BE SHOWN ON THE PLANS OR AS DIRECTED BY THE ENGINEER.

CONTRACTION JOINTS SHALL NOT BE SEALED OR FILLED.

DOWEL BARS SHALL BE INSTALLED PARALLEL TO THE PAVEMENT CENTERLINE AND SURFACE.

CONSTRUCTION JOINTS


CONSTRUCTION JOINTS SHALL BE A MINIMUM OF 4 FEET FROM THE NEAREST CONTRACTION JOINT AND ALIGNED PARALLEL TO CONTRACTION JOINTS.

TIE BARS MAY BE INSERTED THROUGH THE HEADER BOARD AFTER THE CONCRETE HAS BEEN PLACED.


- ① ALTERNATIVE DESIGNS OF THE DOWEL ASSEMBLY MAY BE USED WHEN APPROVED BY THE ENGINEER. MECHANICAL DOWEL BAR IMPLANTERS MAY BE USED INSTEAD OF DOWEL ASSEMBLIES.
- ② DOWEL BARS SHALL BE ANCHORED INTO DRILL HOLES WITH AN APPROVED EPOXY GROUT.
- ③ THE FREE END OF DOWEL BARS SHALL RECEIVE A THIN UNIFORM COATING OF BOND BREAKING GREASE.
- ④ DOWEL BARS INSTALLED BY DRILLING SHALL BE SPACED 1'-3" ON CENTER. THE GROUPING OF DOWEL BARS SHALL BE CENTERED INSIDE THE SLAB BASED ON ALL THE FOLLOWING SITUATIONS:

BETWEEN THE EDGES OF PAVEMENTS WITHOUT LONGITUDINAL JOINTS OR BETWEEN THE EDGE OF PAVEMENT AND NEAREST LONGITUDINAL JOINT OR BETWEEN TWO ADJACENT LONGITUDINAL JOINTS.

THE DISTANCE FROM THE EDGE OF PAVEMENT OR LONGITUDINAL JOINT TO THE CENTER OF THE DOWEL BAR NEAREST THAT EDGE OR JOINT SHALL BE A MINIMUM OF 6 INCHES AND A MAXIMUM OF 14 INCHES.

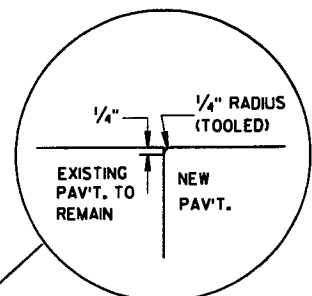


1 1/4" DIA. X 18" DOWEL BARS ANCHORED INTO EXISTING PAV'T. (SEE NOTE 2)

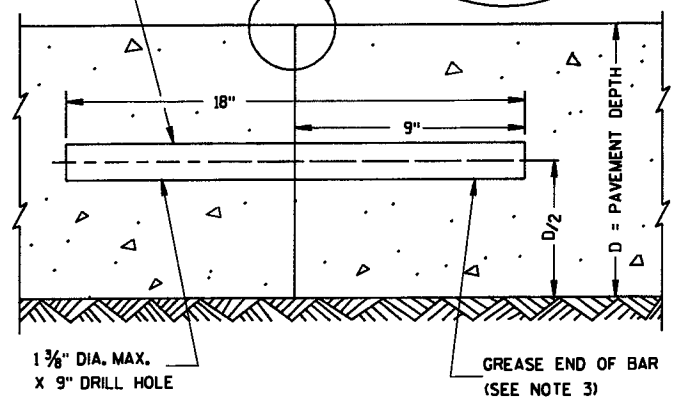


1 3/8" DIA. MAX. X 9" DRILL HOLE
GREASE END OF BAR (SEE NOTE 3)

TRANSVERSE CONTRACTION JOINTS ABUTTING EXISTING PAVEMENT
DOWEL BAR DETAIL ④

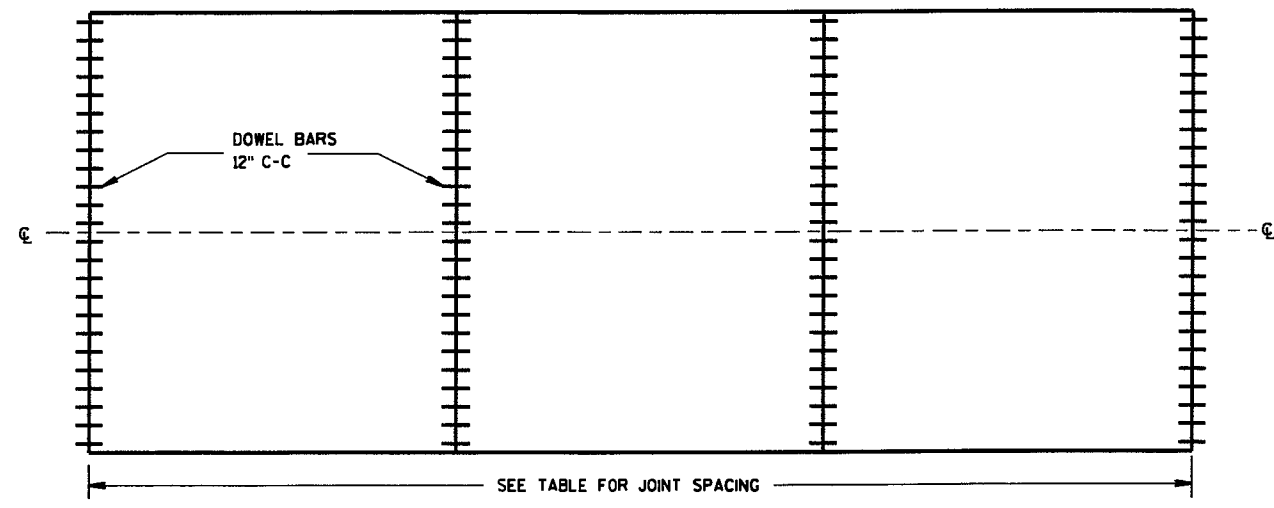

CONTRACTION JOINT LOCATIONS

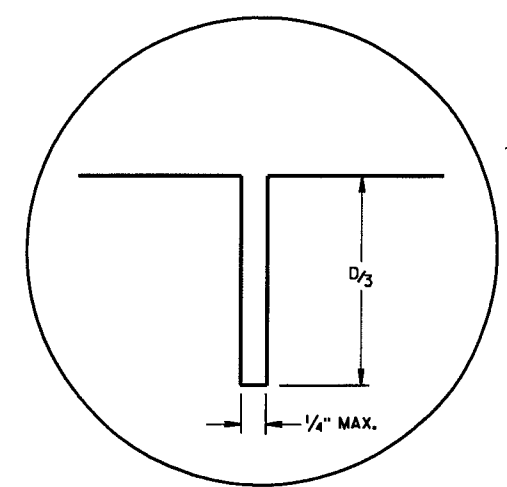

JOINT DETAIL

URBAN DOWELED CONCRETE PAVEMENT

STATE OF WISCONSIN
DEPARTMENT OF TRANSPORTATION

APPROVED
3/21/07 /S/ Steven W. Krebs
DATE CHIEF MATERIALS MANAGEMENT ENGINEER
FHWA

6


6

S.D.D. 13 C 13-5

S.D.D. 13 C 13-5


SPEED LIMIT (MPH)	"STOP AHEAD" ADVANCE WARNING DISTANCE (FT)
25	200
30	200
35	350
40	350
45	500
50	550
55	750

SEE SDD 15C2-4b FOR GENERAL NOTES AND FOOTNOTES ① THROUGH ⑦

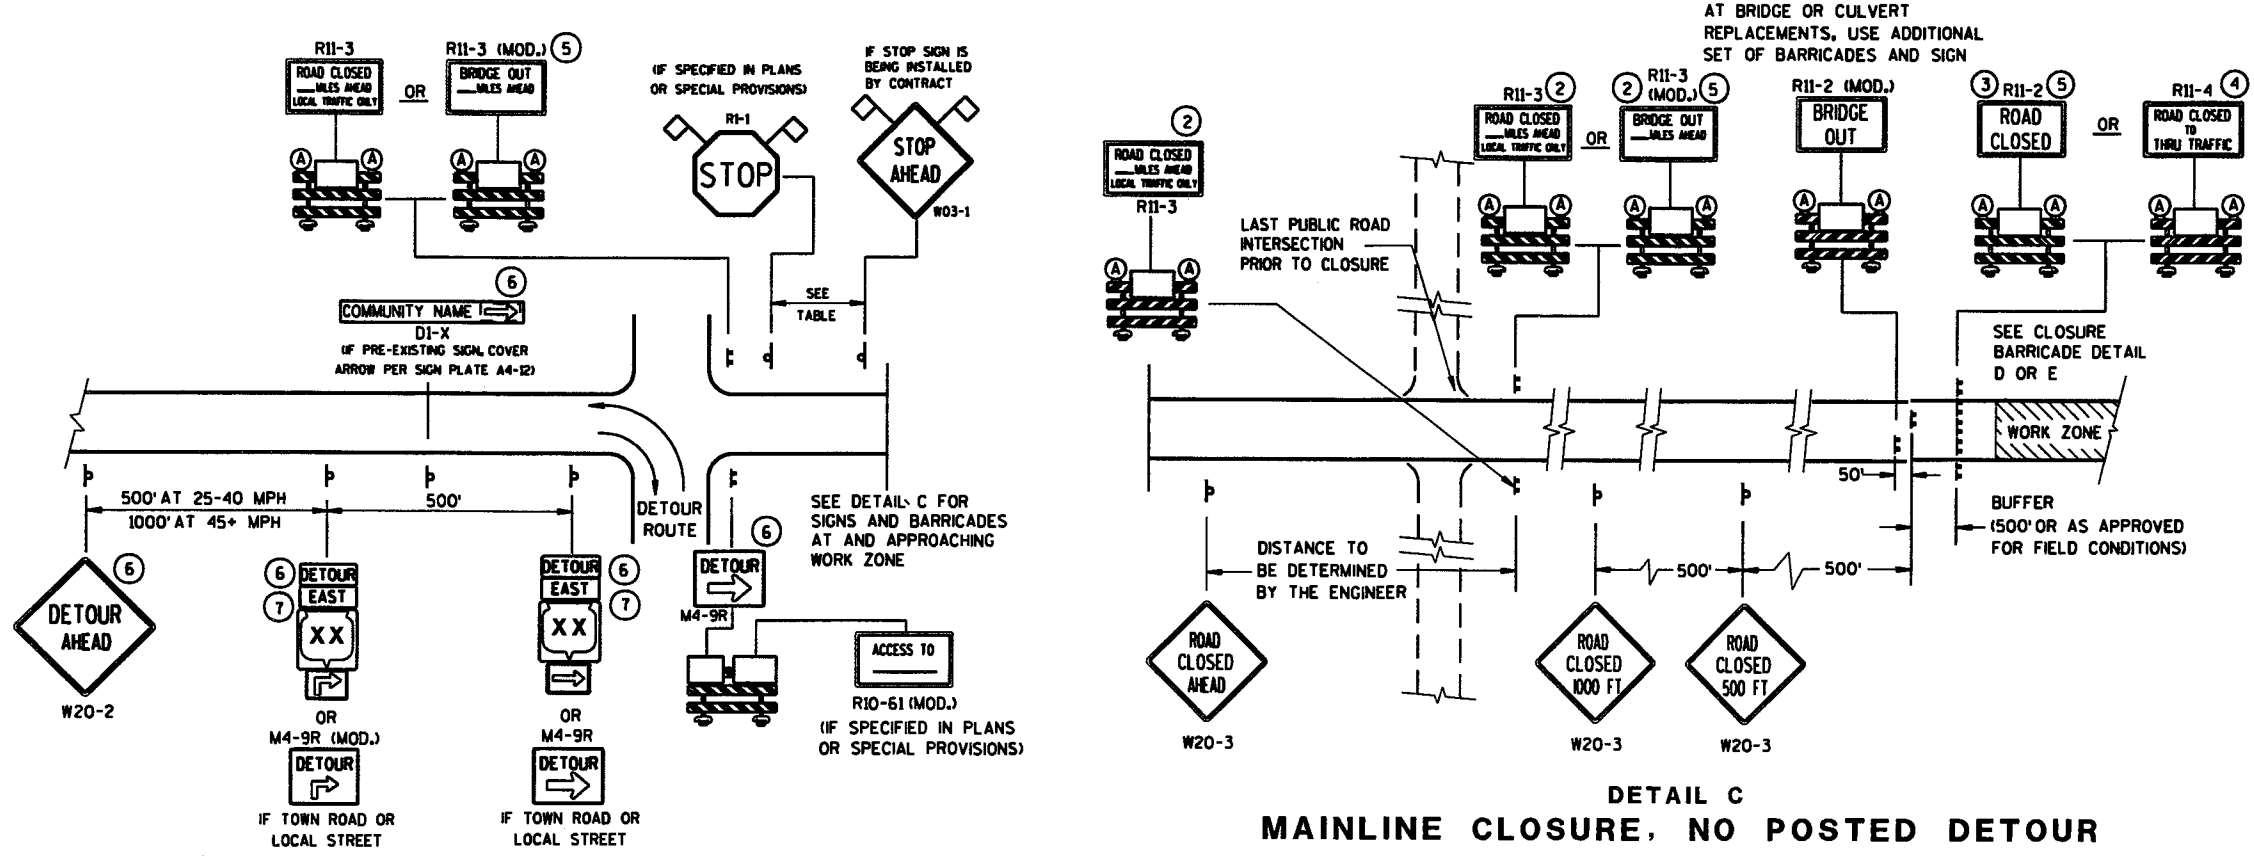

DETAIL C
MAINLINE CLOSURE, NO POSTED DETOUR

DETAIL A
MAINLINE CLOSURE WITH POSTED DETOUR
WORK ZONE GREATER THAN 1/2 MILE FROM DETOUR ROUTE (1000 FEET IF URBAN)

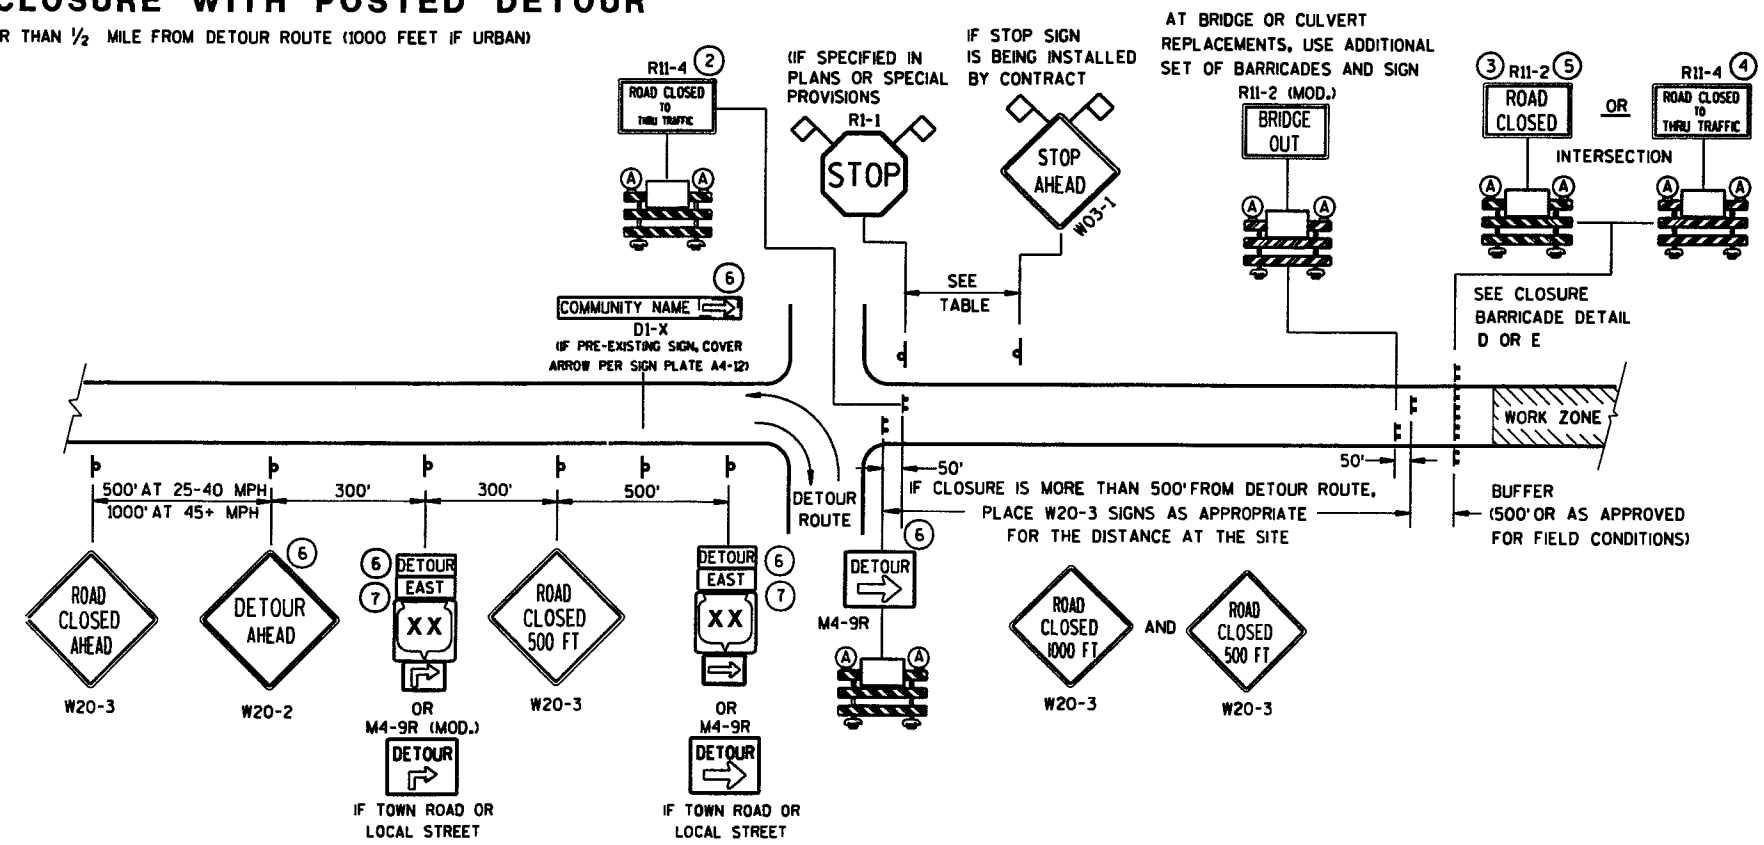

DETAIL B
MAINLINE CLOSURE WITH POSTED DETOUR
WORK ZONE LESS THAN 1/2 MILE FROM DETOUR ROUTE (1000 FEET IF URBAN)

- LEGEND**
- ⊥ POST MOUNTED SIGN
 - ⊥ TYPE III BARRICADES
 - Ⓐ TYPE "A" LOW INTENSITY FLASHING WARNING LIGHT (FOR NIGHT USE)
 - ▨ WORK ZONE
 - DETOUR EAST M4-8 M3-x
 - XX OR COUNTY XX OR MI-4 MI-5A MI-6
 - OR MOS-1 MO6-1
 - ◇ FLAGS, 16" X 16" MIN., (ORANGE)

BARRICADES AND SIGNS FOR MAINLINE CLOSURES


STATE OF WISCONSIN
DEPARTMENT OF TRANSPORTATION

6


6

S.D.D. 15 C 2-40

S.D.D. 15 C 2-40

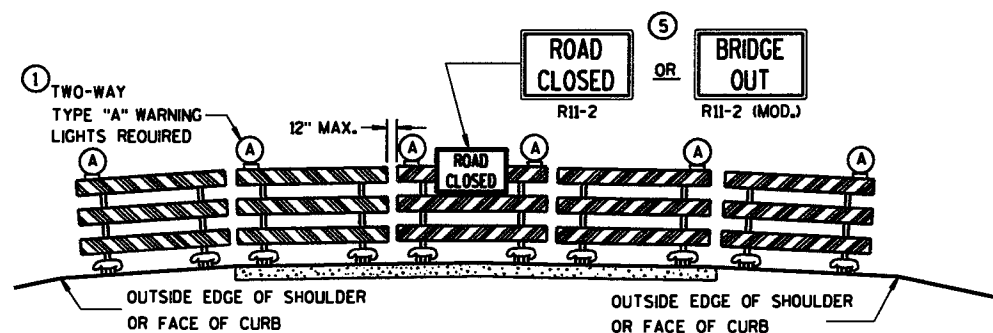

DETAIL D
ROAD CLOSURE BARRICADE DETAIL
 APPROACH VIEW

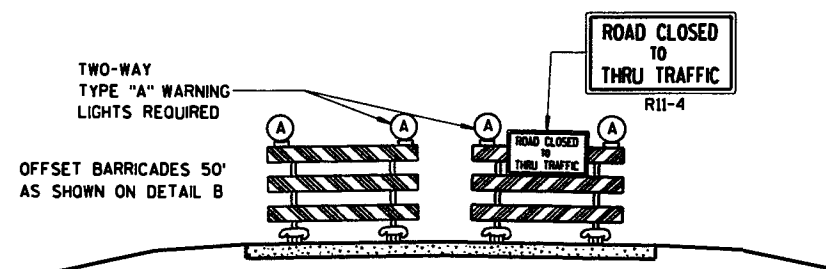

DETAIL E
LANE CLOSURE BARRICADE DETAIL
 APPROACH VIEW

SEE SDD 15C2-4a FOR LEGEND

GENERAL NOTES

THE EXACT NUMBER, LOCATION, AND SPACING OF ALL SIGNS AND BARRICADES SHALL BE ADJUSTED TO FIT FIELD CONDITIONS AS APPROVED BY THE ENGINEER.

ANY SIGNS TEMPORARY OR EXISTING, WHICH CONFLICT WITH TRAFFIC CONTROL "IN USE" SHALL BE REMOVED OR COVERED AS NEEDED AND AS APPROVED BY THE ENGINEER.

THE SPACING BETWEEN TRAFFIC CONTROL SIGNS SHOULD BE ADJUSTED TO NOT CONFLICT WITH AND SHOULD PROVIDE A DESIRABLE MINIMUM OF 200 FEET CLEARANCE TO EXISTING SIGNS THAT WILL REMAIN IN PLACE.

BARRICADES THAT MUST BE MOVED FOR A WORK OPERATION SHALL BE IMMEDIATELY RE-ESTABLISHED UPON COMPLETION OF THE OPERATION OR, FOR CONTINUING OPERATIONS, AT THE END OF EACH WORKING DAY.

SIGNS THAT WILL BE IN PLACE LESS THAN 7 CONTINUOUS DAYS AND NIGHTS MAY BE MOUNTED ON PORTABLE SUPPORTS.

ALL TYPE III BARRICADES SHALL HAVE RAILS REFLECTORIZED ON BOTH FACES. STRIPES SHALL BE PROPERLY SLOPED DOWN TOWARD THE TRAFFIC SIDE OR AS SHOWN IN THE ROAD CLOSURE BARRICADE DETAIL D FOR FULL ROAD CLOSURES.

TYPE "A" LOW-INTENSITY FLASHING WARNING LIGHTS SHALL BE VISIBLE ON BOTH SIDES OF THE BARRICADE.

THE R11-2, R11-3, M4-9, R11-4 AND R10-61 SIGNS PLACED ON BARRICADES SHALL COVER NO MORE THAN THE TOP RAIL. THE SIGNS SHALL NOT COVER ANY PORTION OF THE MIDDLE OR BOTTOM RAILS.

THE REFLECTIVE SHEETING USED ON R11-2, R11-3, R11-4, R10-61 AND R1-1 SIGNS SHALL COMPLY WITH SUBSECTION 637.2.2.2 OF THE STANDARD SPECIFICATIONS.

"WO AND "MO" SIGNS ARE THE SAME AS "W" AND "M" SIGNS EXCEPT THE BACKGROUND IS ORANGE.

ALL SIGNS SHALL BE 48" X 48" UNLESS OTHERWISE NOTED BELOW:

- R11-2 SHALL BE 48" X 30".
- R11-3, R11-4 AND R10-61 SHALL BE 60" X 30".
- M4-9 SHALL BE 30" X 24".
- M3-X AND M4-8 SHALL BE 24" X 12". (30" X 15" IF NEEDED TO MATCH EXISTING SIGNS.)
- M1-4, M1-5A, AND M1-6 SHALL BE 24" X 24". (36" X 36" IF NEEDED TO MATCH EXISTING SIGNS.)
- M05-1 AND M06-1 SHALL BE 21" X 21". (30" X 30" IF NEEDED TO MATCH EXISTING SIGNS.)
- D1-X SHALL BE AS SHOWN ON SPECIFIC PROJECT SIGNING DETAIL SHEETS.
- R1-1 SHALL BE 36" X 36".

- 1 TWO WARNING LIGHTS SHALL BE PROVIDED ON THE CENTER BARRICADE AND A MINIMUM OF ONE WARNING LIGHT SHALL BE PROVIDED ON EACH OF THE OTHER BARRICADES WITHIN THE ROADWAY LIMITS. SPACING OF THE WARNING LIGHTS SHALL BE UNIFORM TO THE EDGE OF ROADWAY AS SHOWN (APPROX. 8-FOOT LIGHT SPACING).
- 2 THESE SIGNS AND BARRICADES ARE NOT REQUIRED IF ROAD CLOSURE BEGINS AT INTERSECTION.
- 3 FOR ROAD CLOSURE WITHOUT LOCAL ACCESS TO PROJECT, SEE ROAD CLOSURE BARRICADE DETAIL D.
- 4 FOR ROAD CLOSURE WITH LOCAL ACCESS TO PROJECT, SEE LANE CLOSURE BARRICADE DETAIL E.
- 5 FOR BRIDGE OR CULVERT REPLACEMENTS, SUBSTITUTE "BRIDGE OUT" INSTEAD OF "ROAD CLOSED" ON R11-2 AND R11-3 SIGNS.
- 6 INSTALL DETOUR AND COMMUNITY GUIDE SIGNS AND ARROWS ONLY IF SPECIFIED IN THE CONTRACT. IF THERE ARE EXISTING ROUTE MARKER ASSEMBLIES THAT WILL REMAIN IN PLACE, ADJUST THE LOCATION OF THE DETOUR ROUTE SIGNS TO CORRESPOND WITH THE EXISTING ASSEMBLIES. MODIFY EXISTING SIGNS WHERE POSSIBLE. SEE SPECIFIC PROJECT DETOUR SIGNING DETAIL SHEETS. IF DETOUR SIGNS ARE BEING INSTALLED BY OTHERS, PLACE THE CONTRACTED TRAFFIC CONTROL SIGNS TO ALLOW FOR PLACEMENT OF ALL WARNING, DETOUR AND GUIDE SIGNS AS SHOWN.
- 7 "EAST" CARDINAL DIRECTION MARKERS AND RIGHT TURN ARROWS ARE SHOWN. USE OTHER CARDINAL DIRECTIONS AND ARROWS AS APPROPRIATE.


6

6


S.D.D. 15 C 2-4b

S.D.D. 15 C 2-4b


BARRICADES AND SIGNS FOR MAINLINE CLOSURES	
STATE OF WISCONSIN DEPARTMENT OF TRANSPORTATION	
APPROVED 9/16/03 DATE	<i>Thomas N. Nottbohm for</i> CHIEF SIGNS AND MARKING ENGINEER
FHWA	

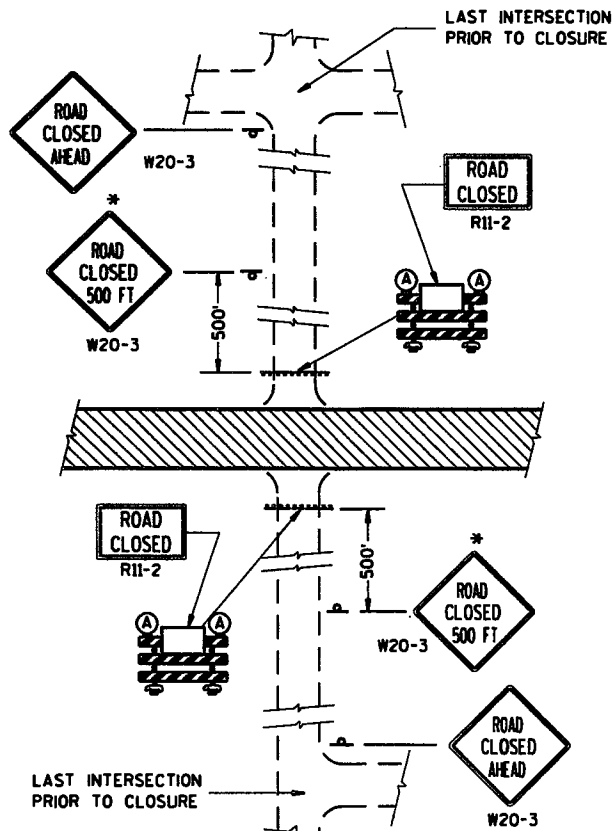


DETAIL 1
(NO ACCESS TO PROJECT)

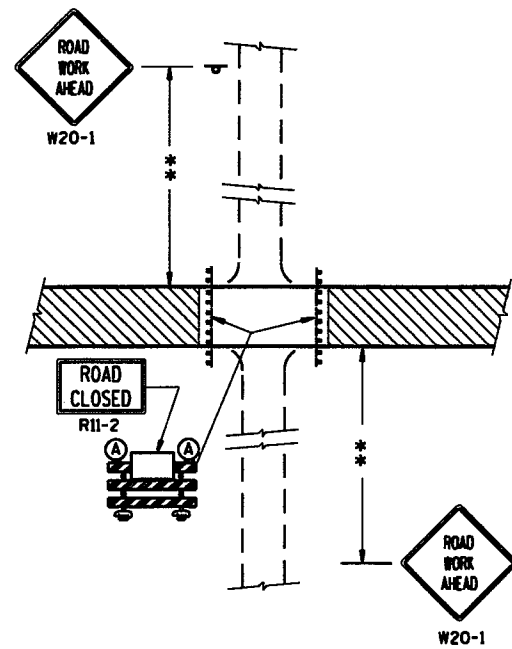

DETAIL 2
(PUBLIC CROSS-TRAFFIC MAINTAINED.
NO ACCESS TO PROJECT).

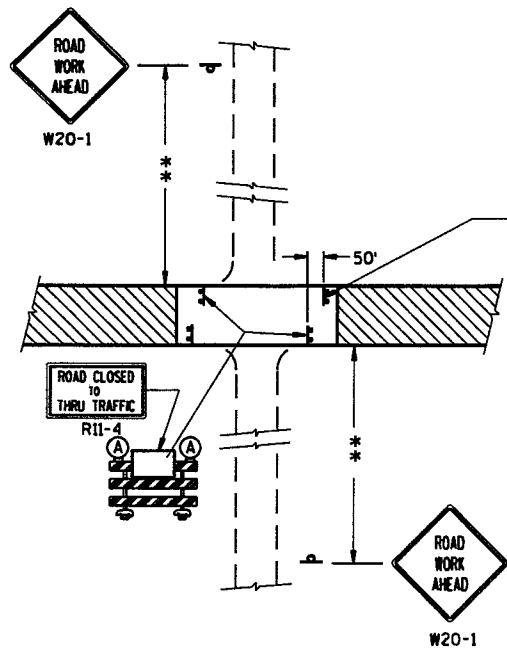

DETAIL 3
(PUBLIC CROSS-TRAFFIC MAINTAINED. CONTRACTOR,
LOCAL BUSINESS AND RESIDENT ACCESS).

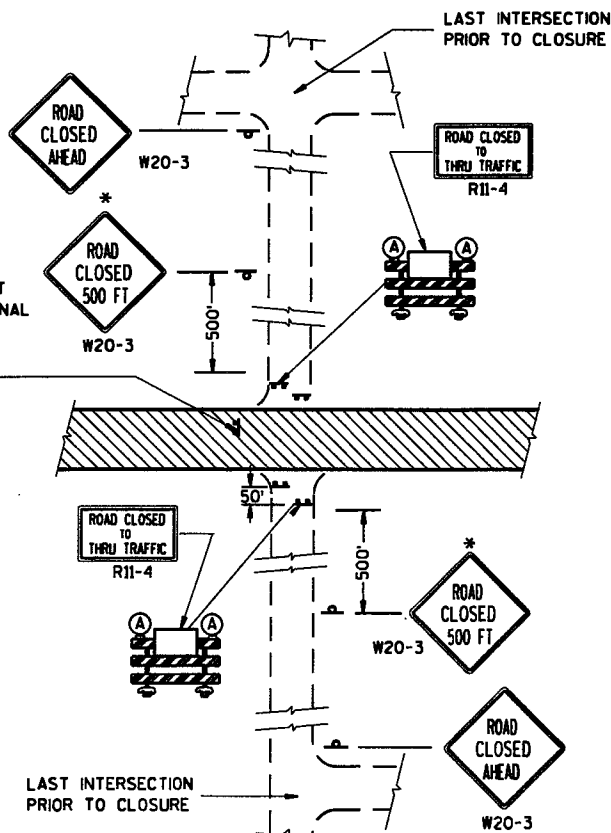

DETAIL 4
(CONTRACTOR, LOCAL BUSINESS AND
RESIDENT ACCESS TO PROJECT)

GENERAL NOTES

THE EXACT NUMBER, LOCATION, AND SPACING OF ALL SIGNS AND BARRICADES SHALL BE ADJUSTED TO FIT FIELD CONDITIONS AS APPROVED BY THE ENGINEER.

ANY SIGNS TEMPORARY OR EXISTING, WHICH CONFLICT WITH TRAFFIC CONTROL "IN USE" SHALL BE REMOVED OR COVERED AS NEEDED AND AS APPROVED BY THE ENGINEER.

THE SPACING BETWEEN TRAFFIC CONTROL SIGNS SHOULD BE ADJUSTED TO NOT CONFLICT WITH AND SHOULD PROVIDE A DESIRABLE MINIMUM OF 200 FEET CLEARANCE TO EXISTING SIGNS THAT WILL REMAIN IN PLACE.

IF A "STOP" SIGN MUST BE REMOVED FOR A WORK OPERATION, A TEMPORARY "STOP" SIGN SHALL BE PLACED PRIOR TO THE SIGN REMOVAL, OR A FLAGGER SHALL BE PROVIDED UNTIL THE SIGN IS RE-ESTABLISHED.

BARRICADES THAT MUST BE MOVED FOR A WORK OPERATION SHALL BE IMMEDIATELY RE-ESTABLISHED UPON COMPLETION OF THE OPERATION OR, FOR CONTINUING OPERATIONS, AT THE END OF EACH WORKING DAY.

SIGNS THAT WILL BE IN PLACE LESS THAN 7 CONTINUOUS DAYS AND NIGHTS MAY BE MOUNTED ON PORTABLE SUPPORTS.

ALL TYPE III BARRICADES SHALL HAVE RAILS REFLECTORIZED ON BOTH FACES. STRIPES SHALL BE PROPERLY SLOPED DOWN TOWARD THE TRAFFIC SIDE OR AS SHOWN IN THE ROAD CLOSURE BARRICADE DETAIL D FOR FULL ROAD CLOSURES.

TYPE "A" LOW-INTENSITY FLASHING WARNING LIGHTS SHALL BE VISIBLE ON BOTH SIDES OF THE BARRICADE.

THE R11-2, R11-3 AND R11-4 SIGNS PLACED ON BARRICADES SHALL COVER NO MORE THAN THE TOP RAIL. THE SIGNS SHALL NOT COVER ANY PORTION OF THE MIDDLE OR BOTTOM RAILS.

THE REFLECTIVE SHEETING USED ON R11-2, R11-3 AND R11-4 SIGNS SHALL COMPLY WITH SUBSECTION 637.2.2.2 OF THE STANDARD SPECIFICATIONS.

ALL SIGNS SHALL BE 48" X 48" UNLESS OTHERWISE NOTED BELOW:
R11-2 SHALL BE 48" X 30".
R11-4 AND R11-3 SHALL BE 60" X 30".

*OMIT THE "ROAD CLOSED 500 FT." SIGN IF THE LAST INTERSECTION IS 500 FT. OR LESS FROM THE WORK ZONE.

**500' MAX. OR AT LAST INTERSECTION WHICHEVER IS CLOSER.

LEGEND

- ⊥ POST MOUNTED WARNING SIGN
- ▬ TYPE III BARRICADES
- Ⓐ TYPE "A" LOW INTENSITY FLASHING WARNING LIGHT (FOR NIGHT USE)
- ▨ WORK AREA


**BARRICADES AND SIGNS
FOR
SIDEROAD CLOSURES**

STATE OF WISCONSIN
DEPARTMENT OF TRANSPORTATION

APPROVED
9-16-03
DATE
Thomas N. Nottbohm for
CHIEF SIGNS AND MARKING ENGINEER
FHWA

6

6

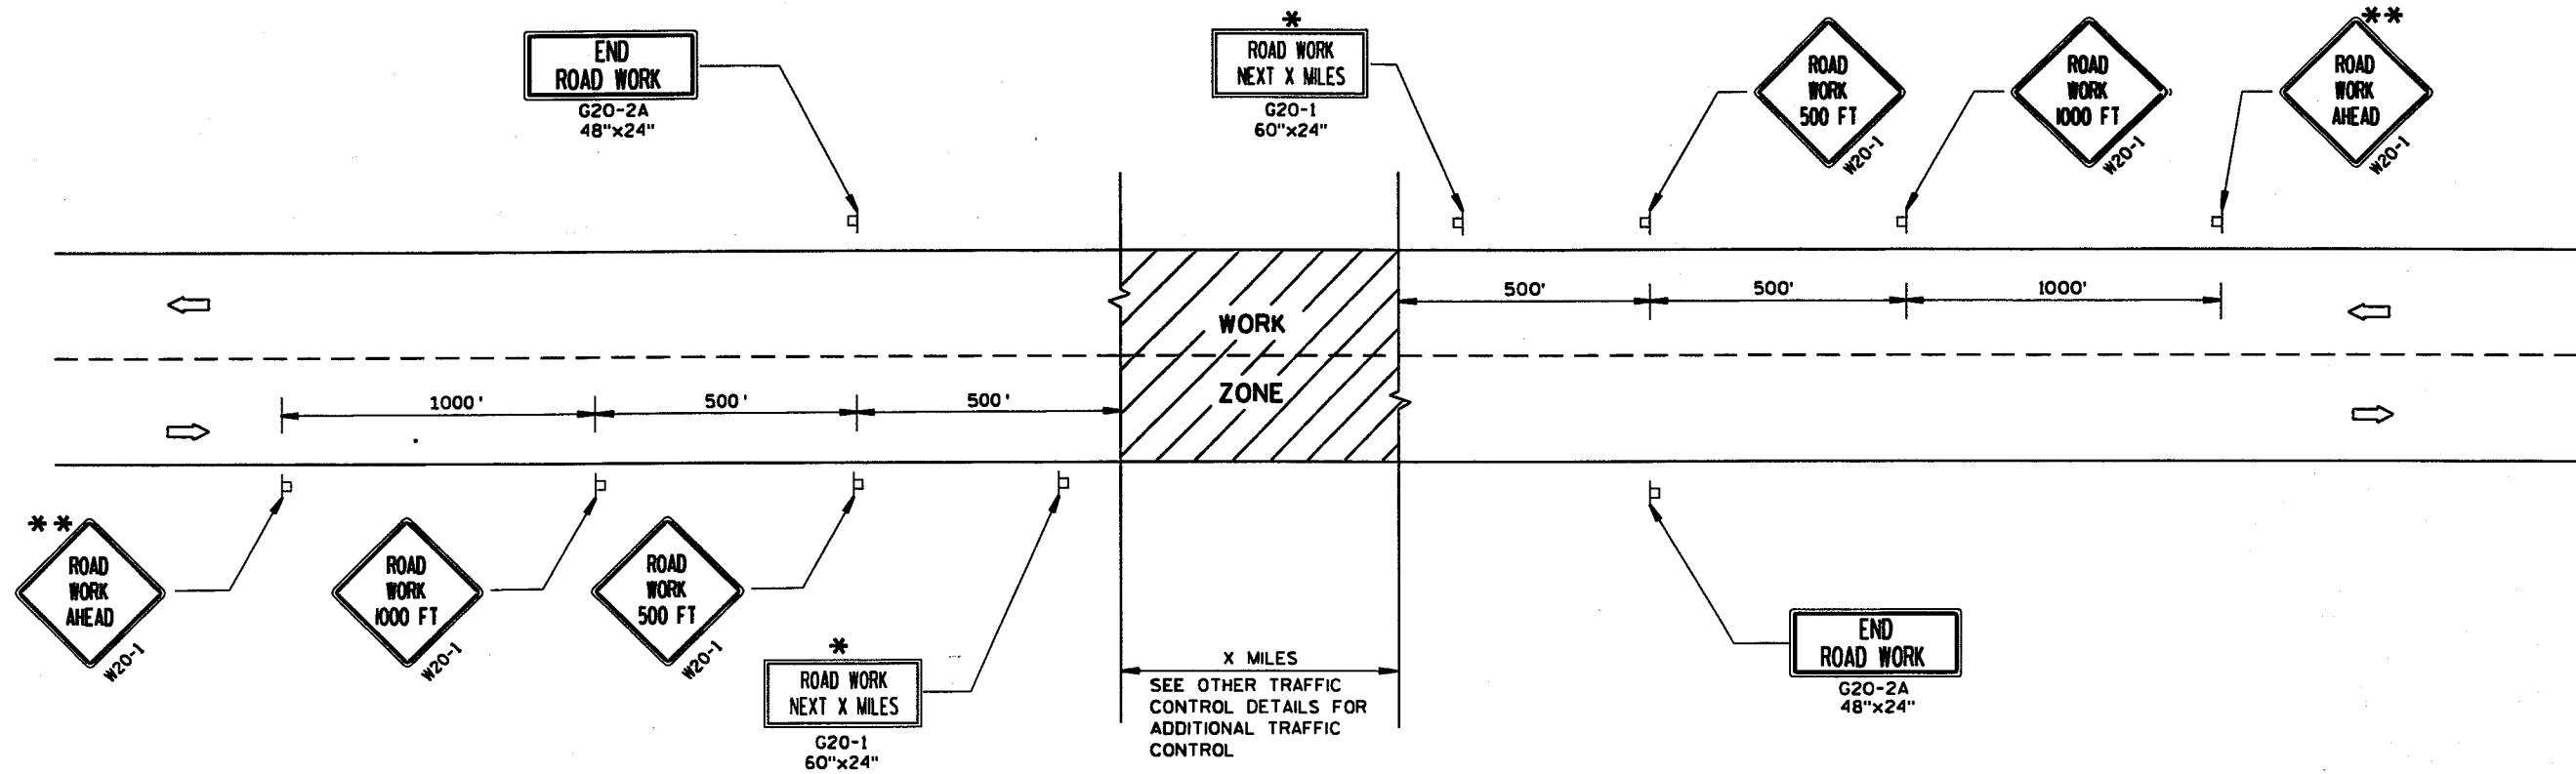

TYPICAL SIDEROAD APPROACH WARNING SIGN DETAIL

GENERAL NOTES

THE EXACT NUMBER, LOCATION, AND SPACING OF ALL SIGNS AND DEVICES SHALL BE ADJUSTED TO FIT FIELD CONDITIONS.

THE SPACING BETWEEN TRAFFIC CONTROL SIGNS SHOULD BE ADJUSTED TO NOT CONFLICT WITH AND SHOULD PROVIDE A MINIMUM OF 200 FEET (500 FEET DESIRABLE) CLEARANCE TO EXISTING SIGNS THAT WILL REMAIN IN PLACE.


ALL SIGNS ARE 48"x48" UNLESS OTHERWISE NOTED.

SIGNS THAT WILL BE IN PLACE LESS THAN 7 CONTINUOUS DAYS AND NIGHTS MAY BE MOUNTED ON PORTABLE SUPPORTS.

IF A "STOP" SIGN MUST BE REMOVED FOR A WORK OPERATION, A TEMPORARY "STOP" SIGN SHALL BE PLACED PRIOR TO THE SIGN REMOVAL, OR A FLAGGER SHALL BE PROVIDED UNTIL THE SIGN IS RE-ESTABLISHED.

* OMIT G20-1 SIGNS IF LENGTH OF WORK AREA IS 2 MILES OR LESS.

** PLACE ADDITIONAL W20-1 "ROAD WORK AHEAD" SIGN IF WORK AREA WITHIN THE PROJECT IS SEPARATED BY MORE THAN 2 MILES FROM PREVIOUS WORK AREA OR SIGNING.

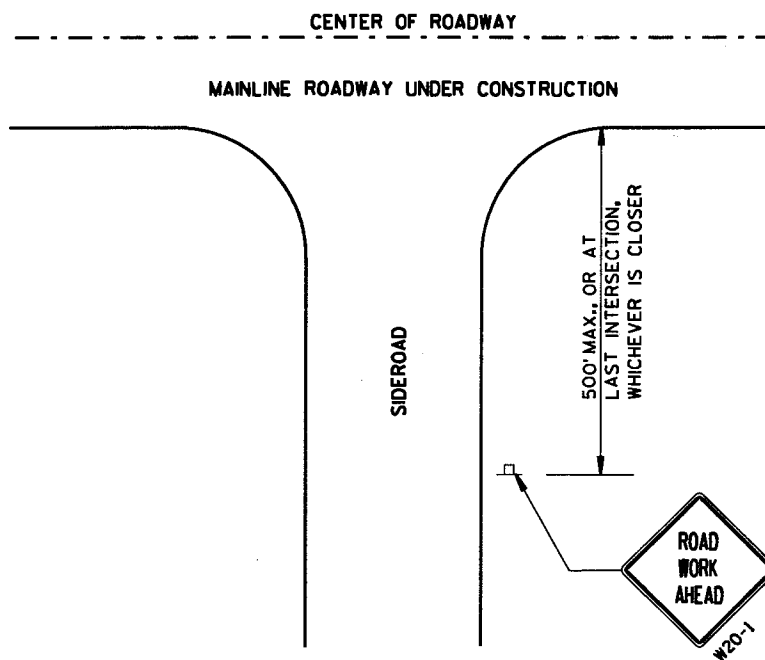


LEGEND

- POST MOUNTED SIGN
- ⇒ DIRECTION OF TRAFFIC FLOW


TRAFFIC CONTROL, ADVANCE WARNING SIGNS 45 M.P.H. OR GREATER TWO-WAY UNDIVIDED ROAD OPEN TO TRAFFIC	
STATE OF WISCONSIN DEPARTMENT OF TRANSPORTATION	
APPROVED 5/23/00 DATE	<i>Cheta J. Spang</i> CHIEF SIGNS AND MARKING ENGINEER
FHWA	

S.D.D. 15 C 4-1


S.D.D. 15 C 4-1

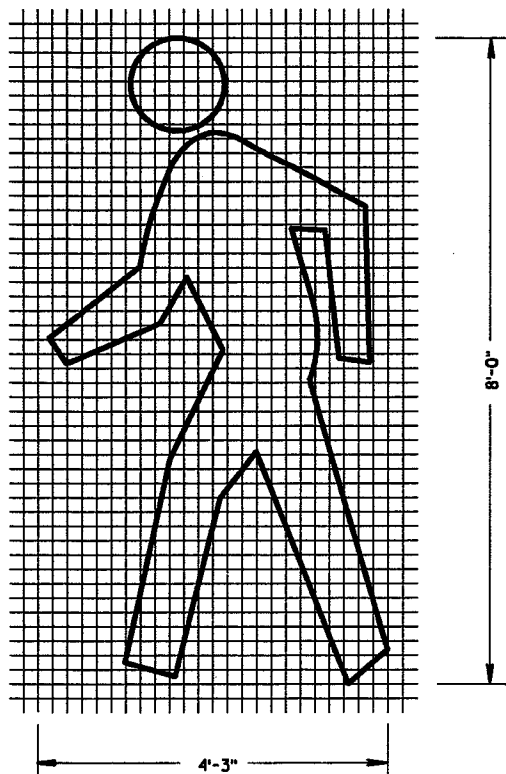

PEDESTRIAN SYMBOL

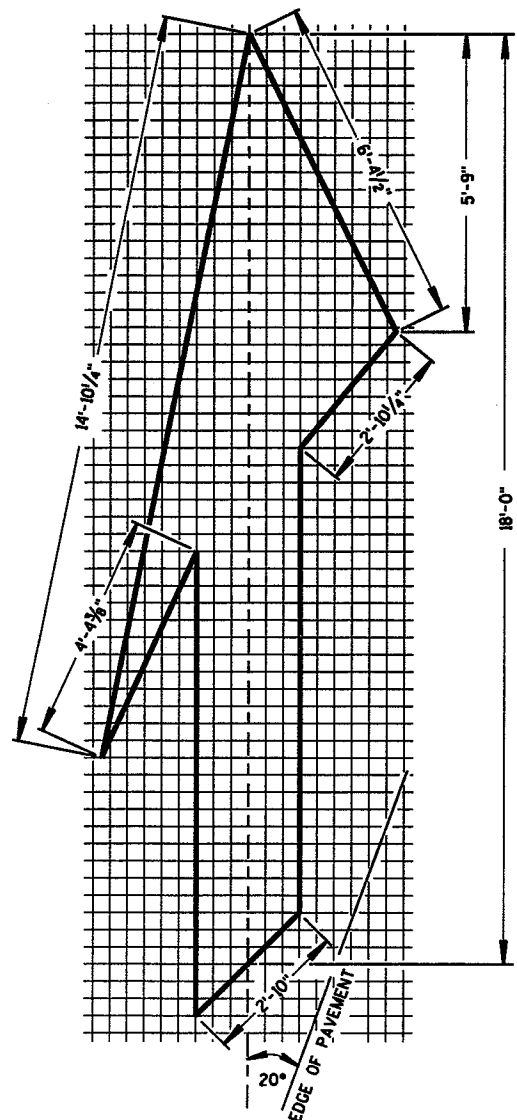


TYPE 5 LANE DROP ARROW

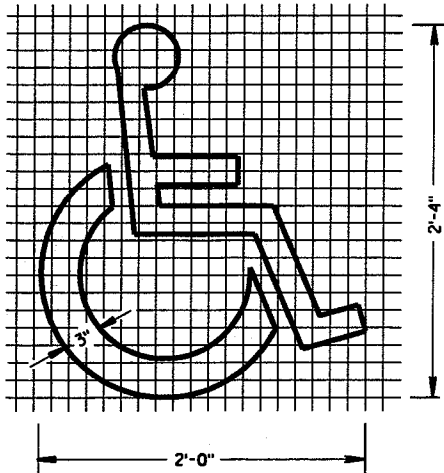


2'-0"


2'-4"

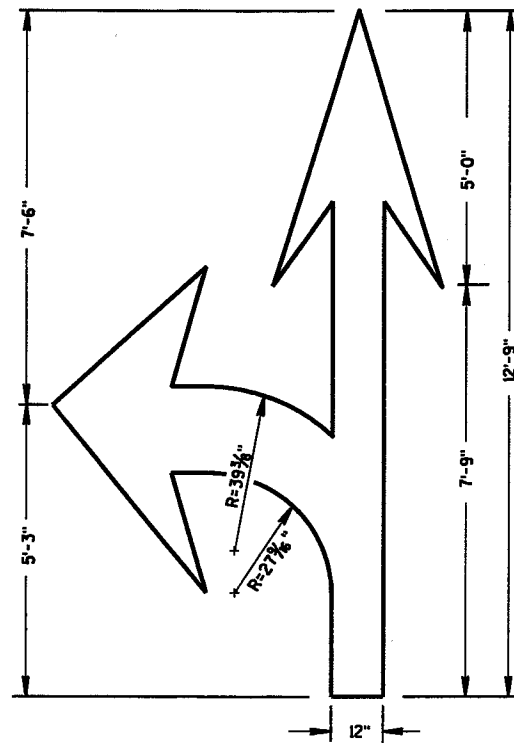

TYPE 3

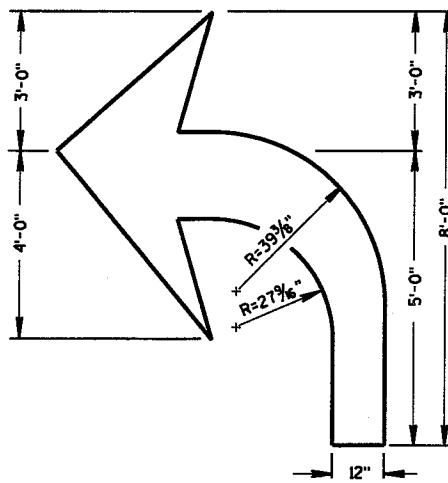

TYPE 2

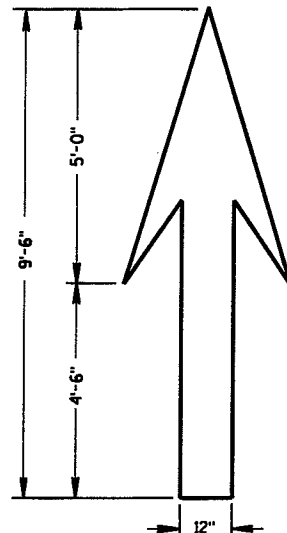


TYPE 1

GENERAL NOTES


DETAILS OF INSTALLATION, MATERIALS AND WORKMANSHIP NOT SHOWN ON THIS DRAWING SHALL CONFORM TO THE PERTINENT REQUIREMENTS OF THE STANDARD SPECIFICATIONS AND APPLICABLE SPECIAL PROVISIONS.

ALL LETTERS AND SYMBOLS SHALL BE IN CONFORMANCE WITH REQUIREMENTS INCLUDED IN "STANDARD ALPHABETS FOR HIGHWAY SIGNS AND PAVEMENT MARKING" BY THE FEDERAL HIGHWAY ADMINISTRATION. ALL LETTERS, ARROWS AND SYMBOLS SHALL BE WHITE AND REFLECTORIZED.

A DETAILED DRAWING OF THE HANDICAPPED PARKING SYMBOL IS ILLUSTRATED IN THE "STANDARD HIGHWAY SIGNS MANUAL" BY THE FEDERAL HIGHWAY ADMINISTRATION.

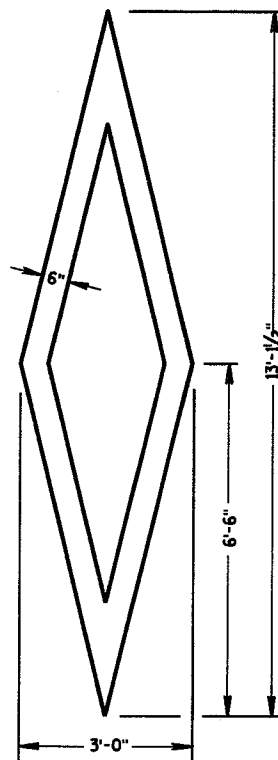

PREFERENTIAL LANE SYMBOL

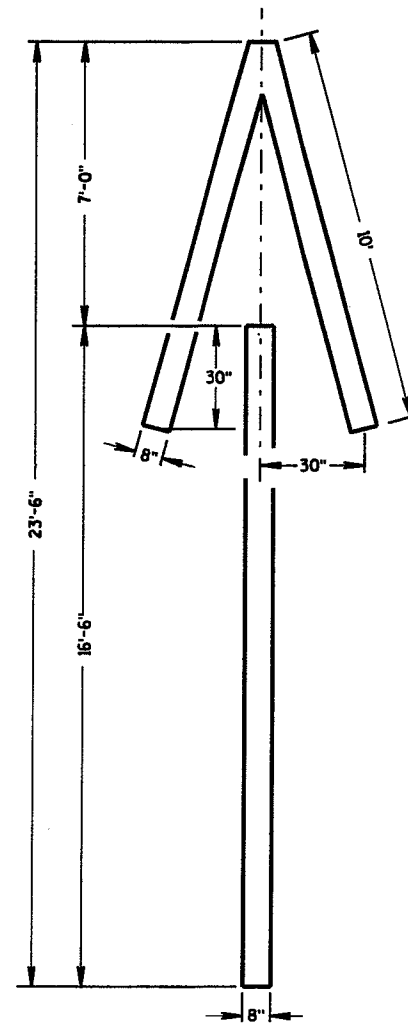

TYPE 4

PAVEMENT MARKING SYMBOLS

STATE OF WISCONSIN
DEPARTMENT OF TRANSPORTATION




APPROVED
2/22/05
DATE
FHWA

Thomas N. Notbush
STATE TRAFFIC ENGINEER OF DESIGN




GENERAL NOTES

DETAILS OF INSTALLATION, MATERIALS AND WORKMANSHIP NOT SHOWN ON THIS DRAWING SHALL CONFORM TO THE PERTINENT REQUIREMENTS OF THE STANDARD SPECIFICATIONS AND APPLICABLE SPECIAL PROVISIONS.

ALL LETTERS, ARROWS AND SYMBOLS SHALL BE IN CONFORMANCE WITH REQUIREMENTS INCLUDED IN "STANDARD ALPHABETS FOR HIGHWAY SIGNS AND PAVEMENT MARKING" BY THE FEDERAL HIGHWAY ADMINISTRATION. ALL LETTERS, ARROWS AND SYMBOLS SHALL BE WHITE AND REFLECTORIZED.

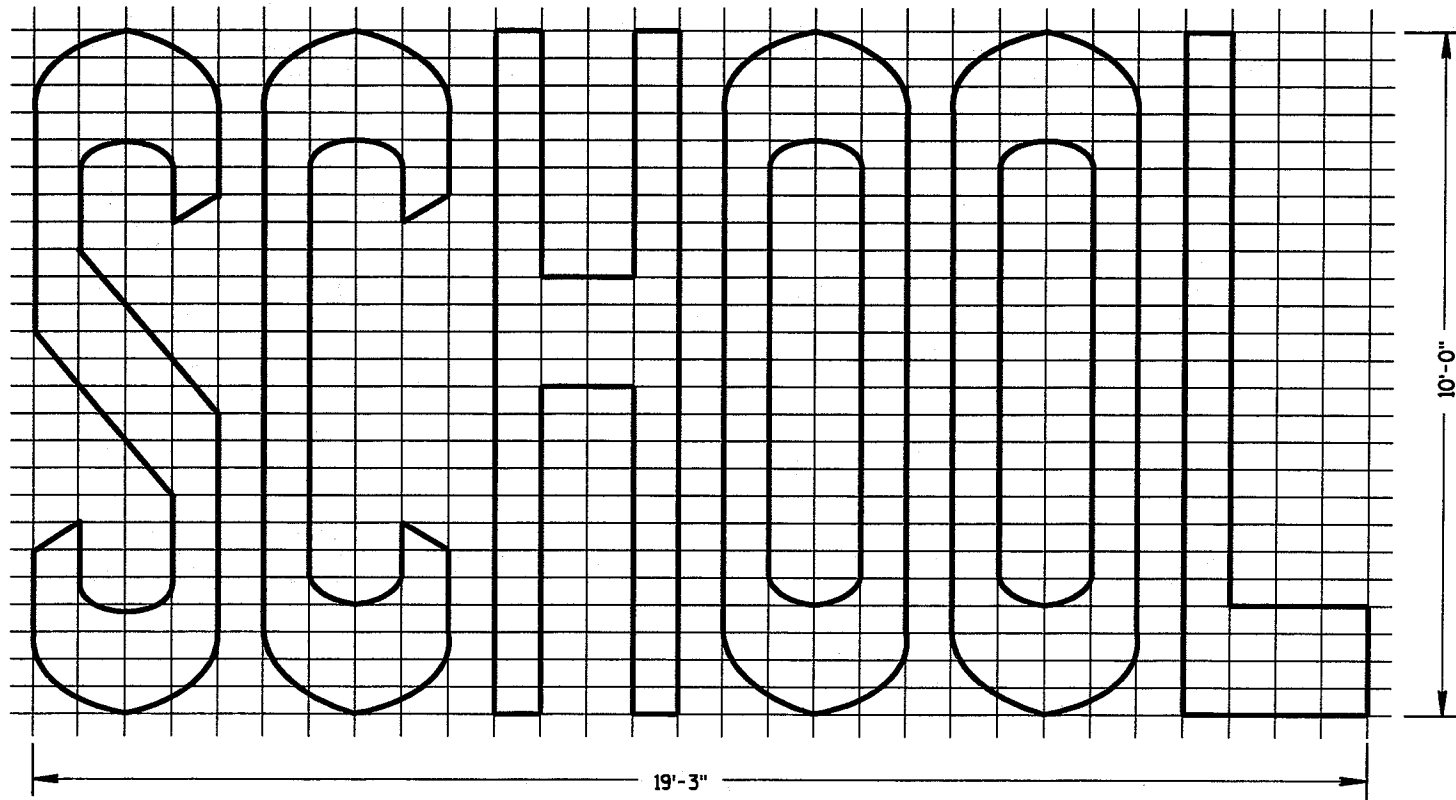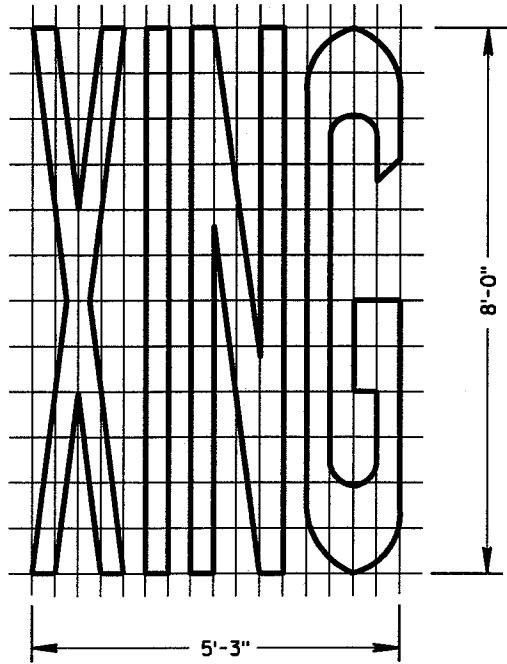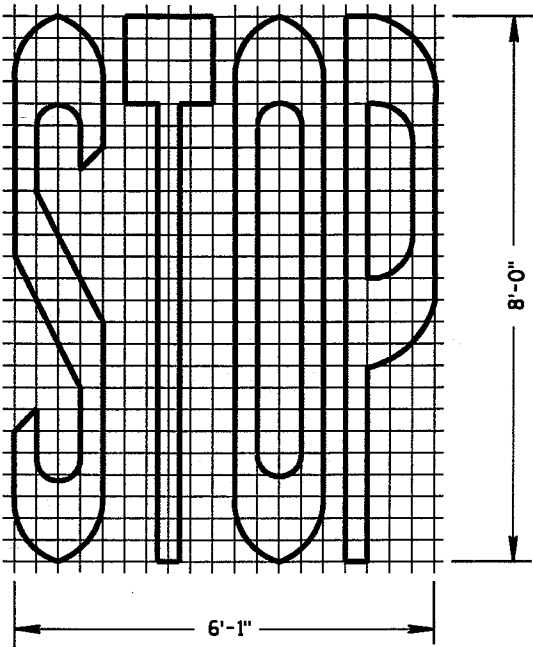

TWO-LANE

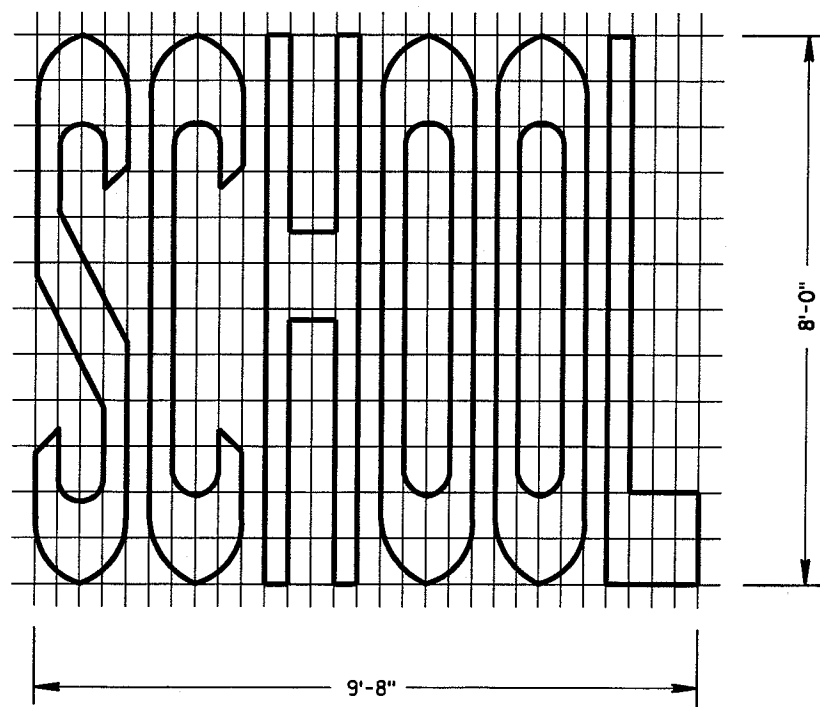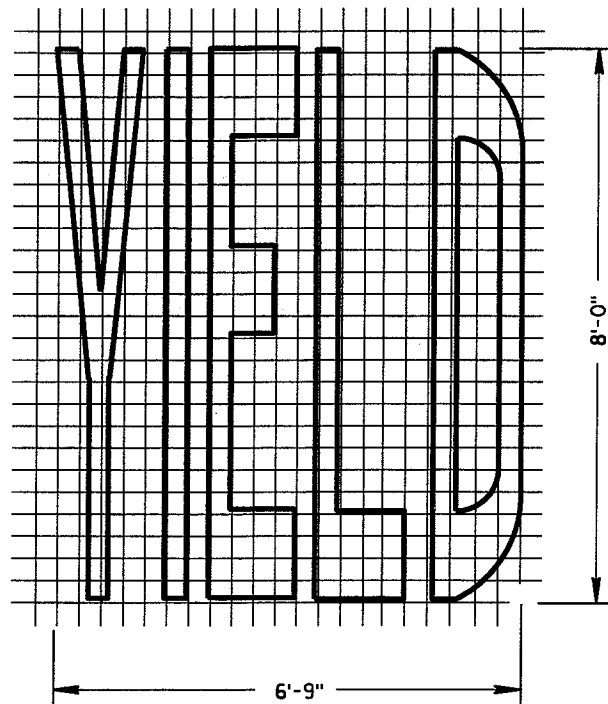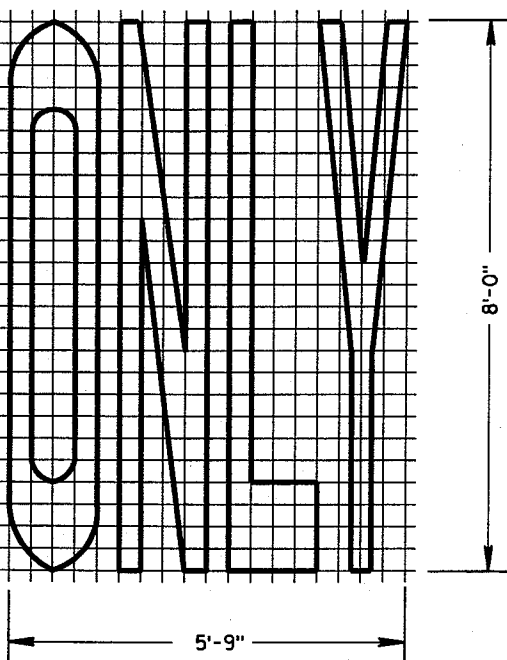

SINGLE-LANE


PAVEMENT MARKING WORDS	
STATE OF WISCONSIN DEPARTMENT OF TRANSPORTATION	
APPROVED 2-22-05 DATE	<i>Thomas N. Notbohm</i> STATE TRAFFIC ENGINEER OF DESIGN
FHWA	

6


6

S.D.D. 15 C 7-8b

S.D.D. 15 C 7-8b

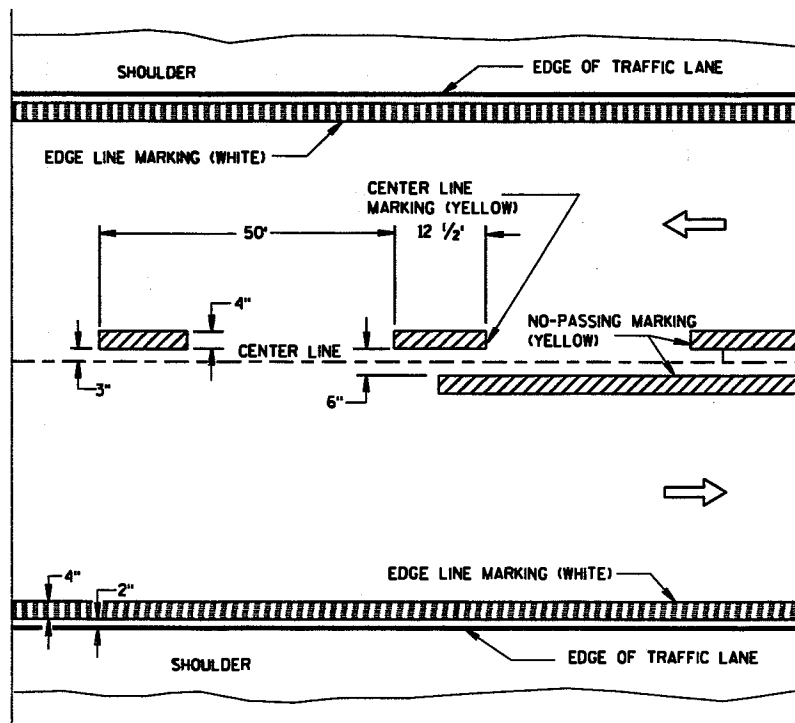


TWO WAY TRAFFIC

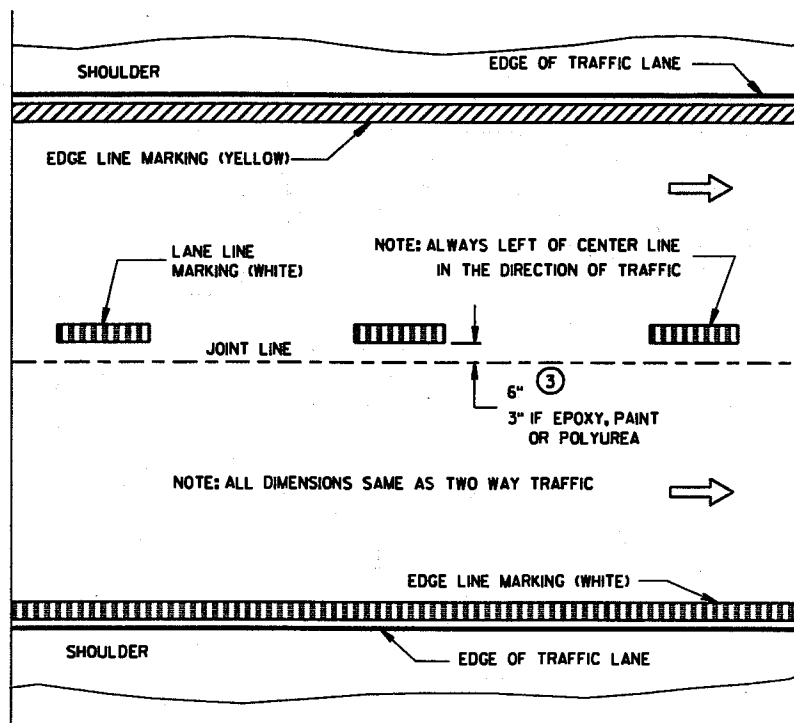


ONE WAY TRAFFIC

PERMANENT PAVEMENT MARKING

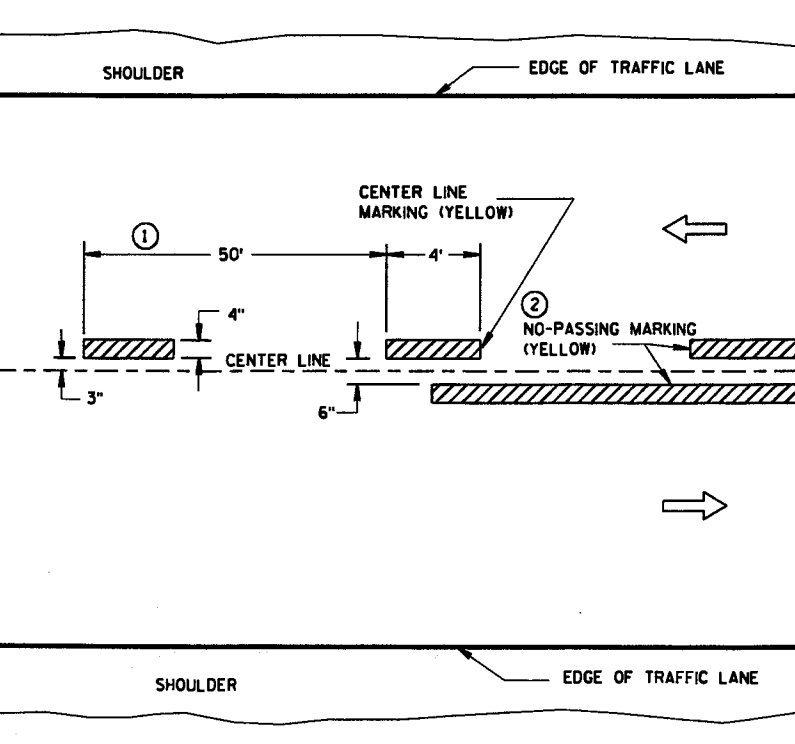

TWO WAY TRAFFIC

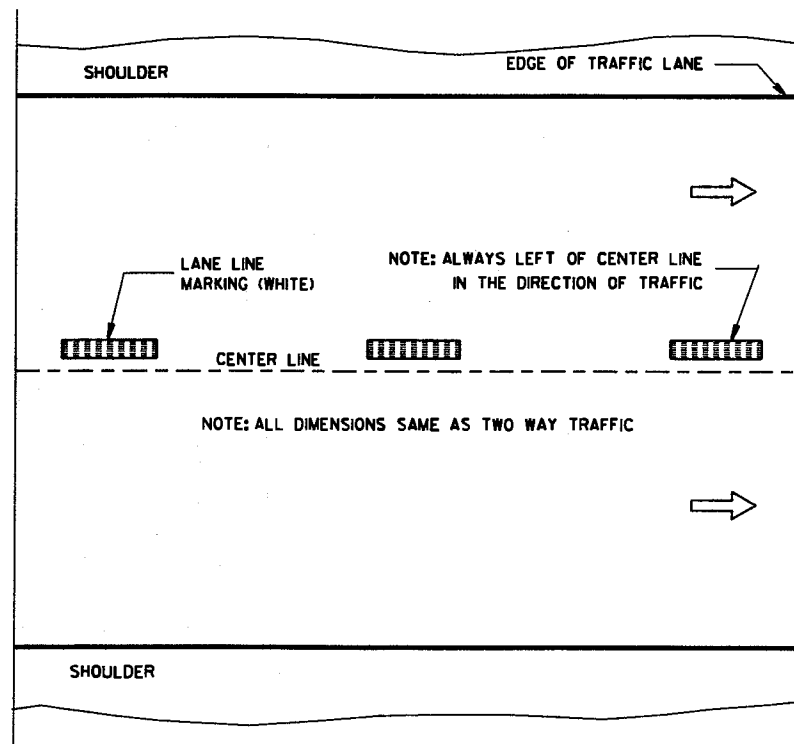

ONE WAY TRAFFIC

TEMPORARY (INTERMEDIATE) PAVEMENT MARKING
(SHOWS CYCLE FOR TEMPORARY CENTER LINE OR TEMPORARY LANE LINE MARKING)


GENERAL NOTES

DETAILS OF CONSTRUCTION NOT SHOWN ON THIS DRAWING SHALL CONFORM TO STANDARD SPECIFICATIONS AND SPECIAL PROVISIONS.

- ① HALF CYCLE LENGTHS (25'±) WITH 2' MINIMUM STRIPE LENGTHS SHALL BE PROVIDED ON ROADWAYS (INCLUDING TEMPORARY TRAVELED WAYS) WITH REVERSE CURVATURE, CURVATURE OF OVER 5 DEGREES OR WHEN DIRECTED BY THE ENGINEER TO MARK UNUSUAL ALIGNMENT OF THE TRAVELED WAY.
- ② NO PASSING ZONE TEMPORARY PAVEMENT MARKING IS REQUIRED TO BE PLACED, WHERE APPROPRIATE, ALONG WITH CENTERLINE TEMPORARY PAVEMENT MARKING WHEN A SAME DAY PERMANENT PAVEMENT MARKING ITEM IS INCLUDED IN THE CONTRACT.
- ③ DIMENSION FROM THE WHITE REFLECTIVE EDGE FOR WET REFLECTIVE TAPE PLACEMENT ONLY.

NOTE

ARROW SYMBOL (→) SHOWS DIRECTION OF TRAVEL

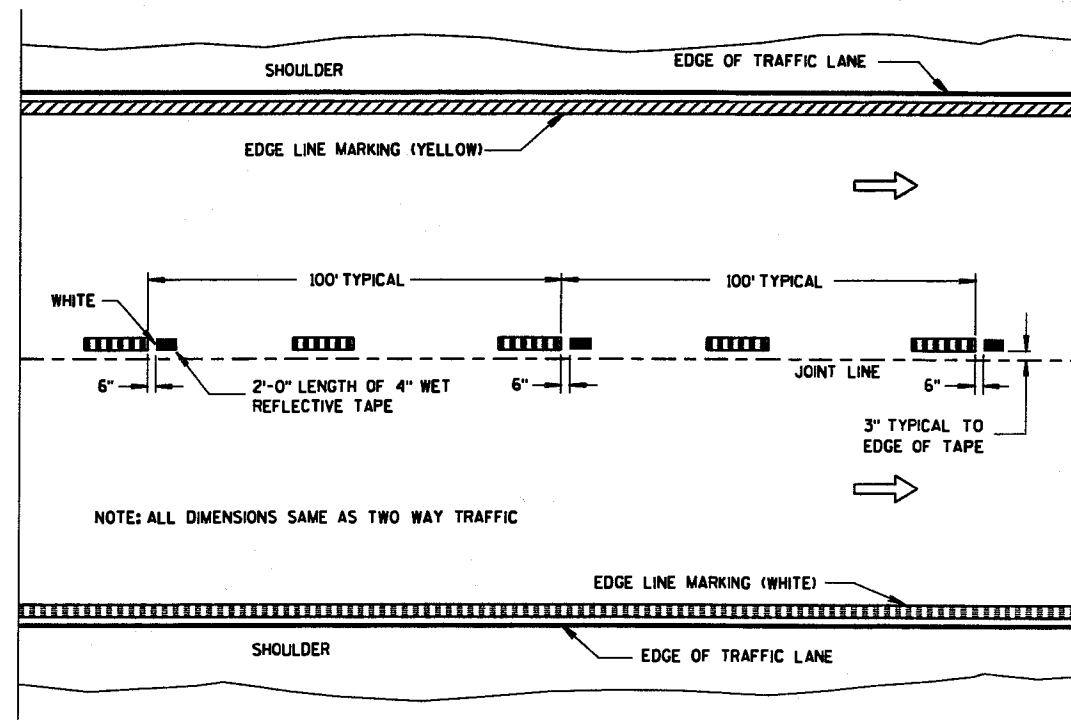

WET REFLECTIVE TAPE SUPPLEMENT TO
SPRAYED OR NON WET REFLECTIVE TAPE LANE LINE

PAVEMENT MARKING
(MAINLINE)

STATE OF WISCONSIN
DEPARTMENT OF TRANSPORTATION

APPROVED
1-16-07 /S/ Thomas N. Notbohm
DATE STATE TRAFFIC ENGINEER OF DESIGN
FHWA


6

6

S.D.D. 15 C 8-100

S.D.D. 15 C 8-100


NOTE:
ARROW SYMBOL (→)
SHOWS DIRECTION OF TRAVEL

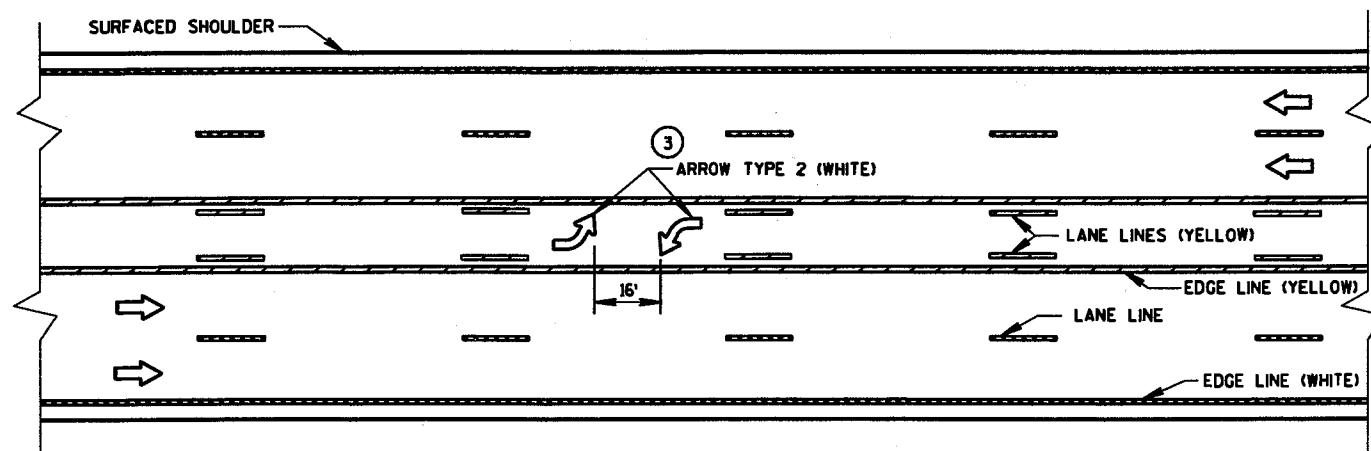

TWO WAY LEFT TURN LANE


NOTES:

- ① STOP BAR IS REQUIRED ONLY WHEN SPECIFIED IN THE CONTRACT.
- ② DISTANCE MAY BE ADJUSTED TO ACCOMMODATE SHORT LEFT TURN LANES. AS APPROVED BY THE ENGINEER.
- ③ A SET OF ARROWS IS REQUIRED EVERY 400' OR NEAR INTERSECTIONS OR DRIVEWAYS WITH TURNING TRAFFIC.

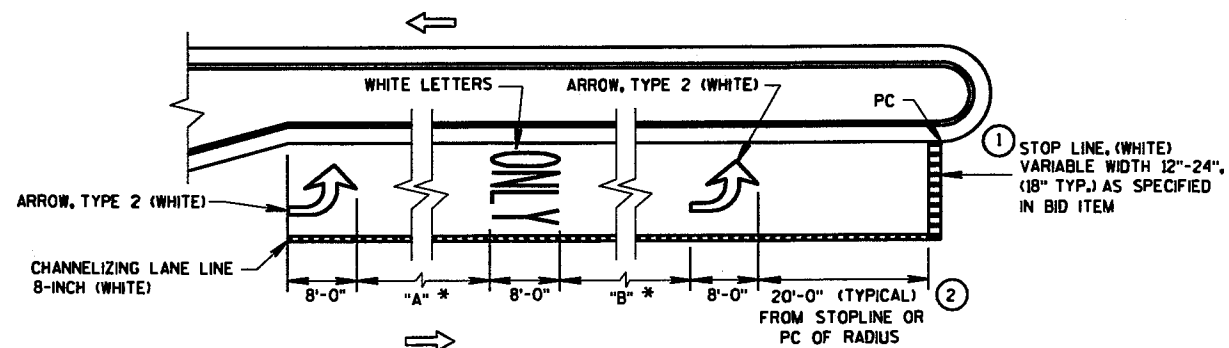


LEFT TURN LANE
(LENGTH 108' TO 167')

* VARIABLE, 32' MIN.
"A" = "B" (TYPICAL)

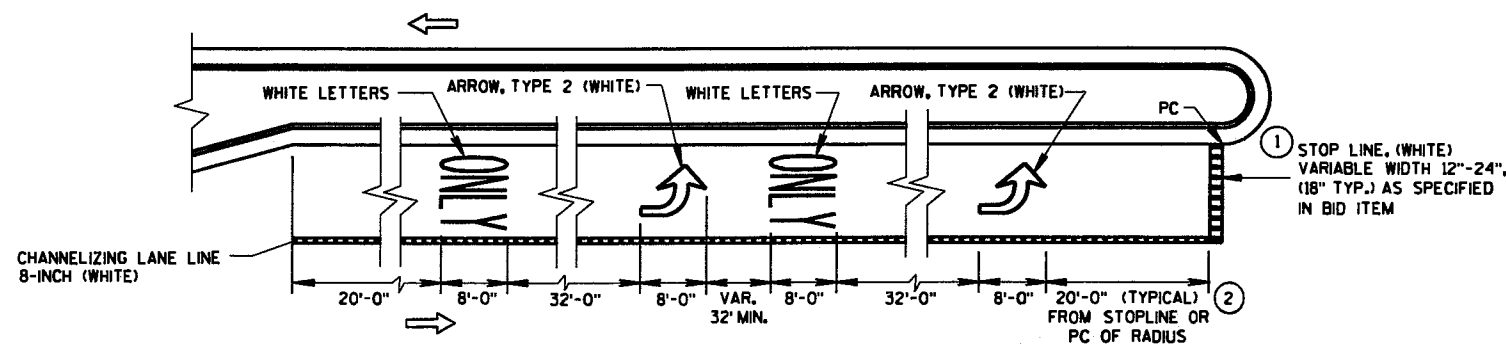

LEFT TURN LANE
(LENGTH OVER 167')

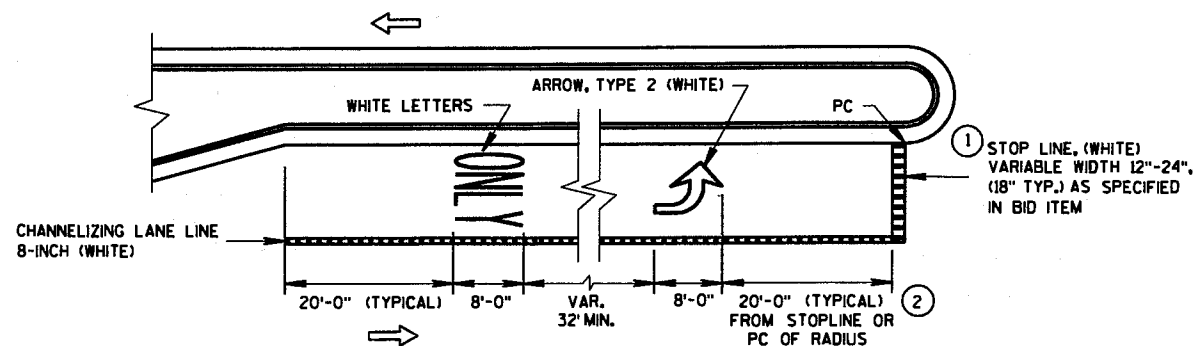

LEFT TURN LANE
(LENGTH UNDER 108')

PAVEMENT MARKING
(LEFT TURN LANE)

STATE OF WISCONSIN
DEPARTMENT OF TRANSPORTATION


APPROVED
8/1/05 DATE /S/ Thomas N. Notbohm
STATE TRAFFIC ENGINEER OF DESIGN
FHWA

6


6

S.D.D. 15 C 8-10d


S.D.D. 15 C 8-10d

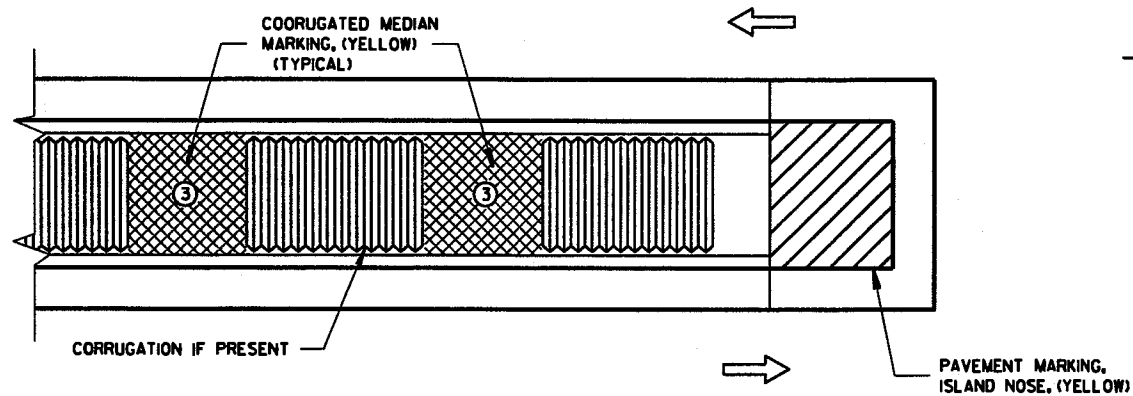

MEDIAN ISLAND WITH SQUARE BLUNT NOSE

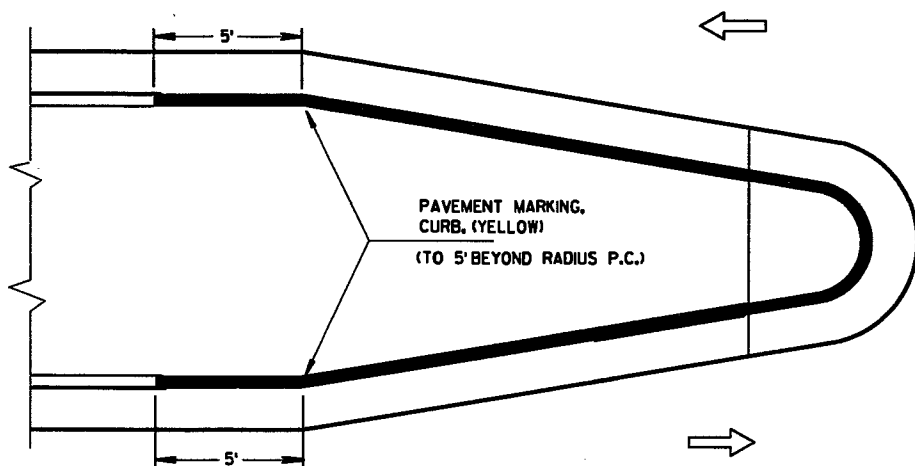


MEDIAN ISLAND WITH ROUND BLUNT NOSE

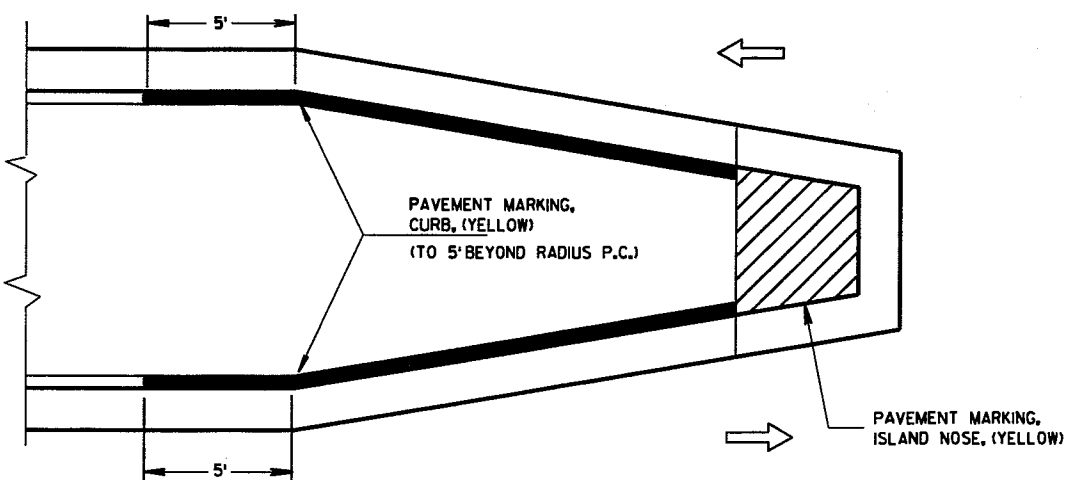

MEDIAN ISLAND WITH SLOPED NOSE


TYPICAL PLACEMENT OF PAVEMENT MARKING ON MEDIAN ISLANDS

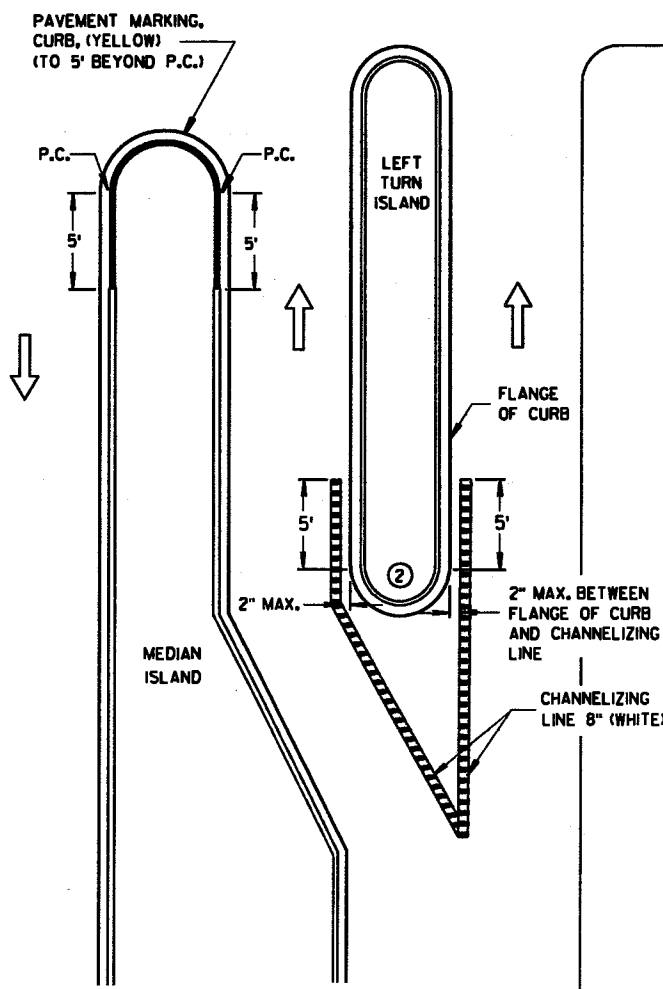


LEFT TURN & MEDIAN ISLAND

GENERAL NOTES

- ① STOP LINE IS REQUIRED ONLY WHEN SPECIFIED IN THE CONTRACT.
- ② DO NOT MARK CURB NOSES THAT SEPARATE LANES OF TRAFFIC TRAVELING IN THE SAME DIRECTION.
- ③ WHEN CONCRETE CORRUGATED MEDIAN IS CONSTRUCTED TO SEPARATE TRAFFIC OPERATING IN THE OPPOSING DIRECTION YELLOW PAVEMENT MARKING SHALL BE APPLIED TO THE FLAT PORTION OF THE CONCRETE CORRUGATED MEDIAN. THE ITEM OF PAVEMENT MARKING, CONCRETE CORRUGATED MEDIAN, WILL BE MEASURED IN PLACE AND ACCEPTED IN ACCORDANCE WITH THE CONTRACT AND PAID FOR AT THE CONTRACT UNIT PRICE PER SQUARE FOOT.

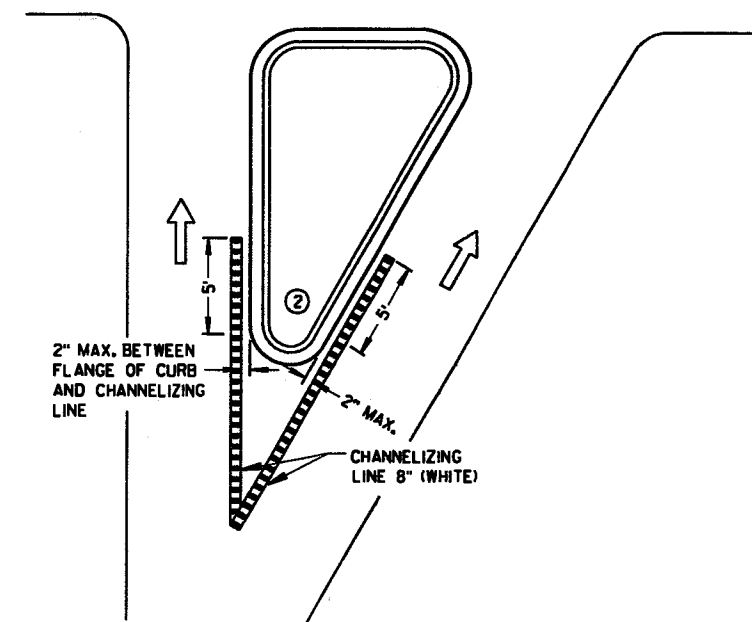

RIGHT TURN ISLAND

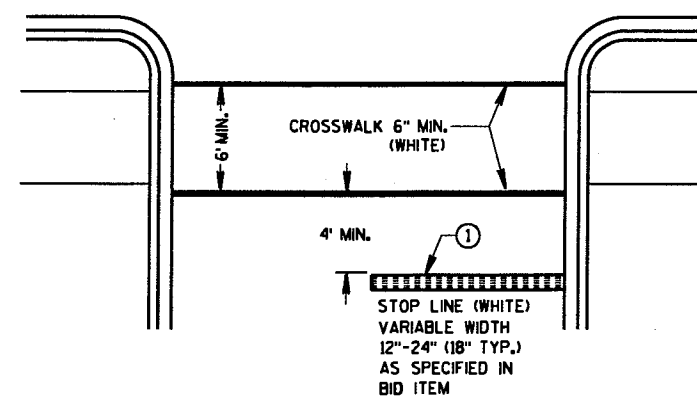

STOP LINE AND CROSSWALK

LEGEND

- ISLAND NOSE MARKING
- CURB MAKING
- CORRUGATED MEDIAN MARKING
- DIRECTION OF TRAVEL

PAVEMENT MARKING (ISLANDS, STOP LINE & CROSS WALK)

STATE OF WISCONSIN
DEPARTMENT OF TRANSPORTATION

APPROVED
9-21-07 /S/ Thomas N. Netbohm
DATE STATE TRAFFIC ENGINEER OF DESIGN
FHWA




W14-3

500'

CENTERLINE OR LANE LINE (4)
(3)

NO-PASSING ZONE MARKING (4)

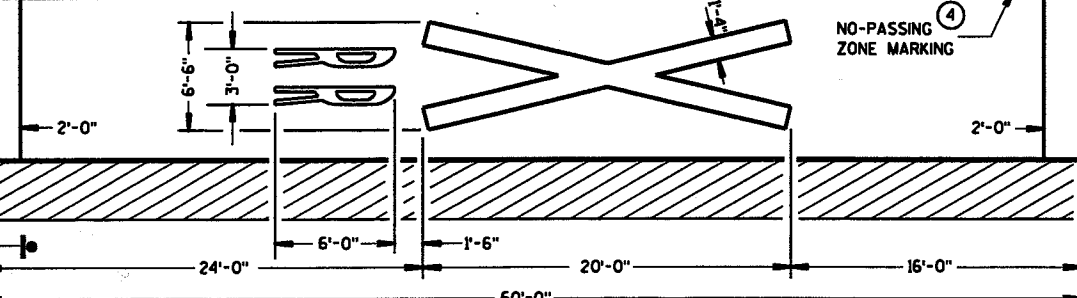

(5) (SEE TABLE)

PREFERRED PAVEMENT MARKING (3)




W10-1

MATCH LINE


CENTERLINE OR LANE LINE (4)
(3)

NO-PASSING ZONE MARKING (4)

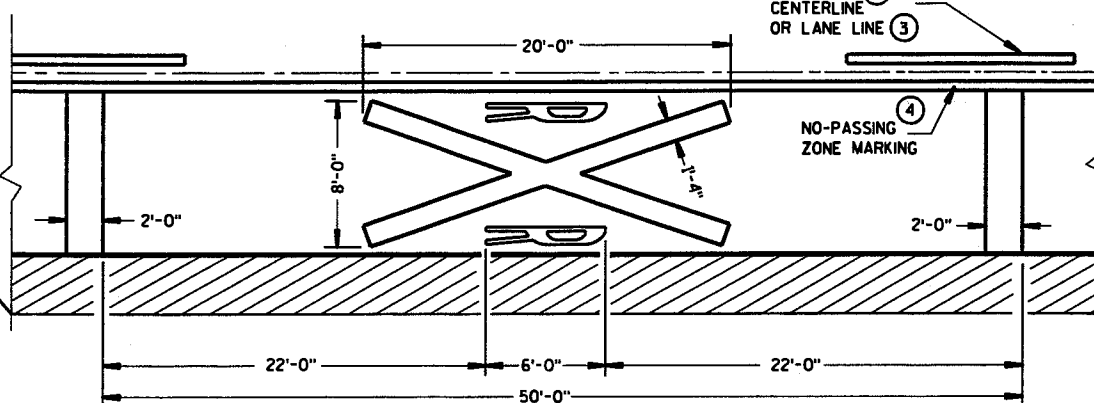

(5) (SEE TABLE)

ALTERNATE PAVEMENT MARKING (3)

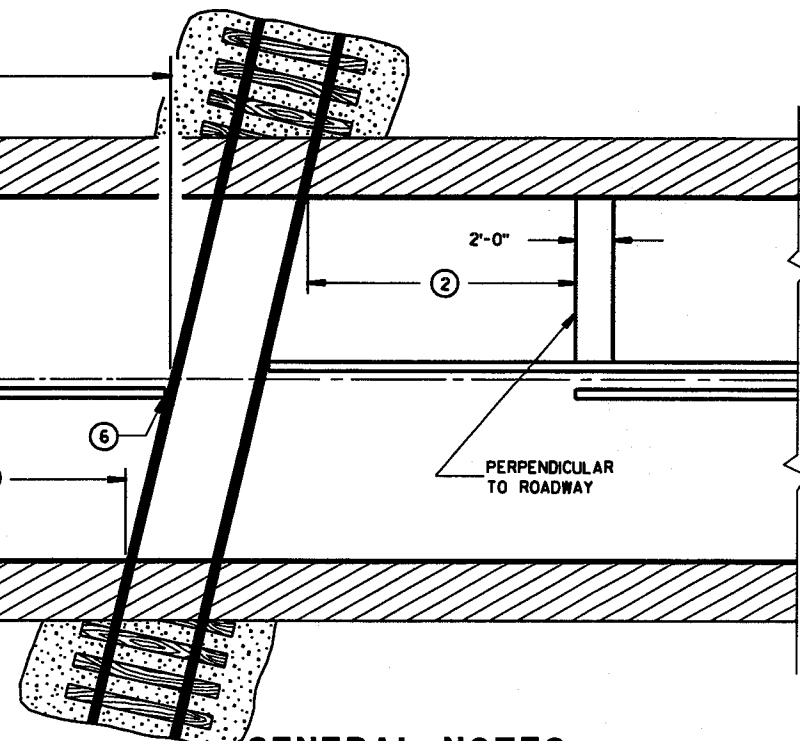

GENERAL NOTES


DETAILS OF CONSTRUCTION, MATERIALS, AND WORKMANSHIP NOT SHOWN ON THIS DRAWING SHALL CONFORM TO THE PERTINENT REQUIREMENTS OF THE STANDARD SPECIFICATIONS AND THE APPLICABLE SPECIAL PROVISIONS.

A THREE-LANE ROADWAY SHOULD BE MARKED WITH A CENTERLINE FOR TWO-LANE APPROACH OPERATION ON THE APPROACH TO A CROSSING.

ON MULTI-LANE ROADS THE TRANSVERSE BANDS SHOULD EXTEND ACROSS ALL APPROACH LANES, AND INDIVIDUAL R X R SYMBOLS SHOULD BE USED IN EACH APPROACH LANE. ALL LETTERS AND SYMBOLS SHALL BE IN CONFORMANCE WITH THE "STANDARD ALPHABETS FOR HIGHWAY SIGNS AND PAVEMENT MARKINGS" (ADOPTED BY THE FEDERAL HIGHWAY ADMINISTRATION).

CENTER OR LANE LINES AND NO-PASSING ZONE MARKINGS SHOWN ON THIS DRAWING ARE REQUIRED AND PAID FOR UNDER OTHER ITEMS IN THE CONTRACT.

- (1) A PORTION OF THE PAVEMENT MARKING SYMBOL SHOULD BE DIRECTLY OPPOSITE THE ADVANCE WARNING SIGN (W10-1).
- (2) MINIMUM 8' FROM ANY RAILROAD WARNING DEVICES (SIGNALS, GATES, ETC.) OR 25' FROM THE NEAREST RAIL, WHICHEVER DISTANCE IS GREATER.
- (3) REFLECTIVE WHITE.
- (4) REFLECTIVE YELLOW 500' MINIMUM. MARKING LIMITS MAY BE EXTENDED AS DIRECTED BY THE ENGINEER TO MEET ADJACENT NO-PASSING ZONE MARKINGS.
- (5) TABLE BASED UPON 2C-4 WISCONSIN SUPPLEMENT OF MANUAL ON UNIFORM TRAFFIC CONTROL DEVICES.
- (6) FOR MULTIPLE TRACK CROSSINGS, THE BARRIER LINE SHALL EXTEND TO THE NEAR RAIL OF THE FURTHEST TRACK IN THE DIRECTION OF HIGHWAY TRAVEL.

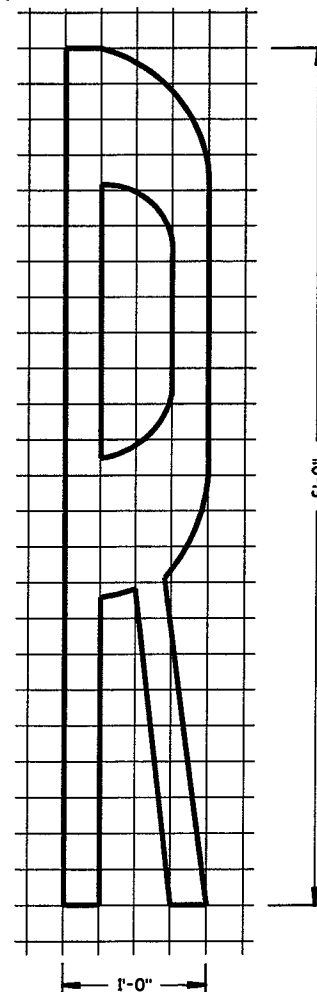

Posted Speed (M.P.H.)	Minimum Dimension (Feet)
25	150
30	200
35	250
40	300
45	400
50	550
55	750
60	1000
65	1000


**SIGNING AND PAVEMENT MARKING
DETAILS FOR RAILROAD-HIGHWAY
GRADE CROSSINGS**

STATE OF WISCONSIN
DEPARTMENT OF TRANSPORTATION


APPROVED
6/7/06 /S/ Thomas N. Notbohm
DATE STATE TRAFFIC ENGINEER OF DESIGN
FHWA

S.D.D. 15 C 9-70


S.D.D. 15 C 9-70

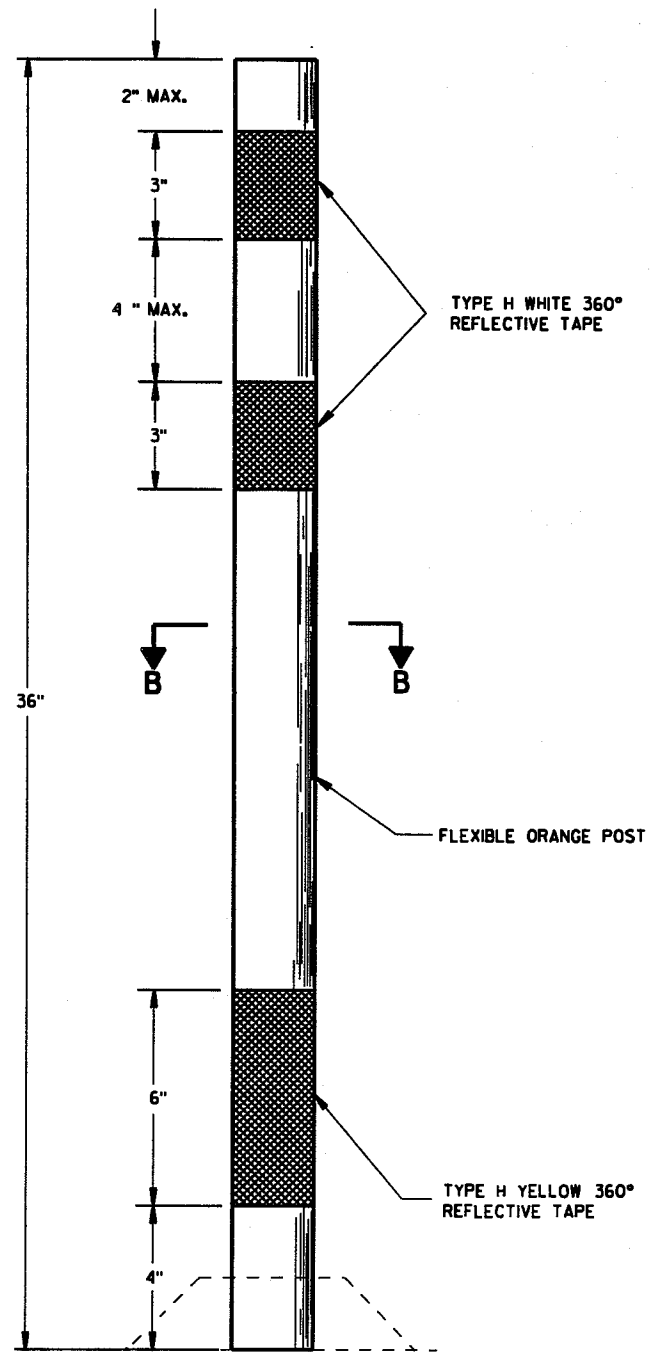

FLEXIBLE TUBULAR MARKER POST

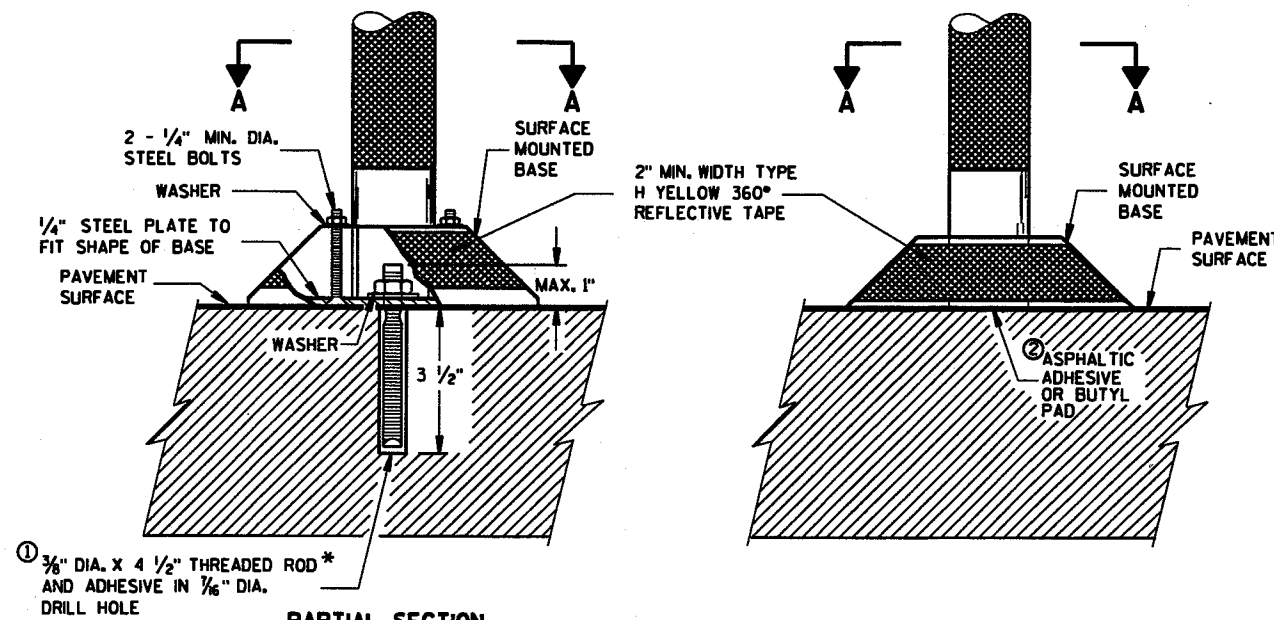


PARTIAL SECTION TO SHOW BOLTS
POST BASES ON NEW OR EXISTING PAVEMENT

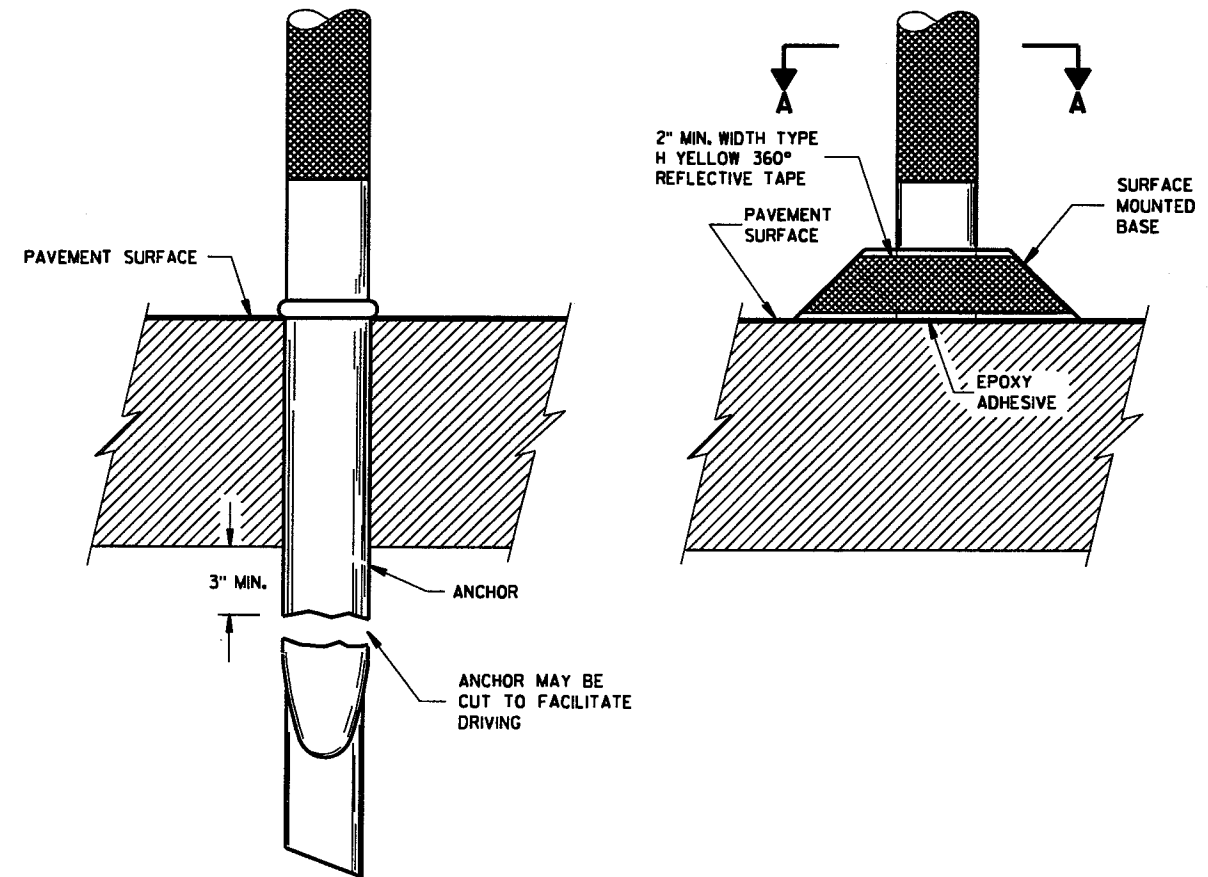


POST ANCHOR AND BASE ON PAVEMENT WHICH WILL BE REMOVED

GENERAL NOTES

- DETAILS OF CONSTRUCTION NOT SHOWN ON THIS DRAWING SHALL CONFORM TO THE PERTINENT REQUIREMENTS OF THE STANDARD SPECIFICATIONS AND APPLICABLE SPECIAL PROVISIONS.
- SURFACE MOUNTED BASES SHALL BE FURNISHED IN ACCORDANCE WITH MANUFACTURERS RECOMMENDATIONS TO BE COMPATIBLE WITH FLEXIBLE TUBULAR MARKER POSTS TO A SIZE AND SHAPE THAT WILL PROVIDE A STABLE POST FOUNDATION WHEN SECURED TO THE PAVEMENT.
- ① THREADED ROD SHALL BE MACHINED DOWN TO 0.280 INCH DIA. 1 1/4 INCHES FROM THE TOP.
 - ② THE ASPHALTIC ADHESIVE OR BUTYL PAD FURNISHED SHALL BE IN ACCORDANCE WITH MANUFACTURERS RECOMMENDATIONS.

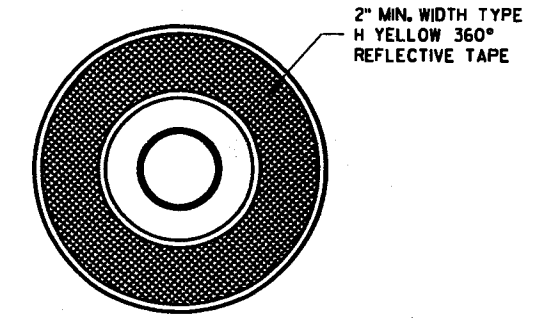

SECTION A-A
SURFACE MOUNTED BASE

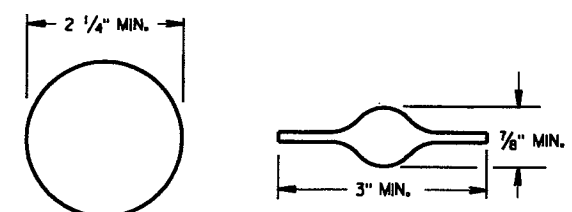

SECTION B-B
ALTERNATIVE SHAPES

FLEXIBLE TUBULAR MARKER POST, ANCHOR & BASES	
STATE OF WISCONSIN DEPARTMENT OF TRANSPORTATION	
APPROVED 2/17/94 DATE	<i>Robert F. Ruesch</i> STATE TRAFFIC ENGINEER FOR HWYS
FHWA	

S.D.D. 15 C 11-5

S.D.D. 15 C 11-5


TWO-LANE ROADWAY

SYMBOLS

- WORK AREA
- FLAGGER, EQUIPPED WITH STOP/SLOW PADDLE FASTENED ON SUPPORT STAFF
- SIGN ON PORTABLE OR PERMANENT SUPPORT



USE OF THE "BE PREPARED TO STOP" SIGN IS OPTIONAL. WHEN USED, THIS SIGN SHALL BE LOCATED BETWEEN THE W20-7a AND W20-4 SIGNS. A 500' TYPICAL SPACING SHALL BE PROVIDED BETWEEN THE SIGNS.

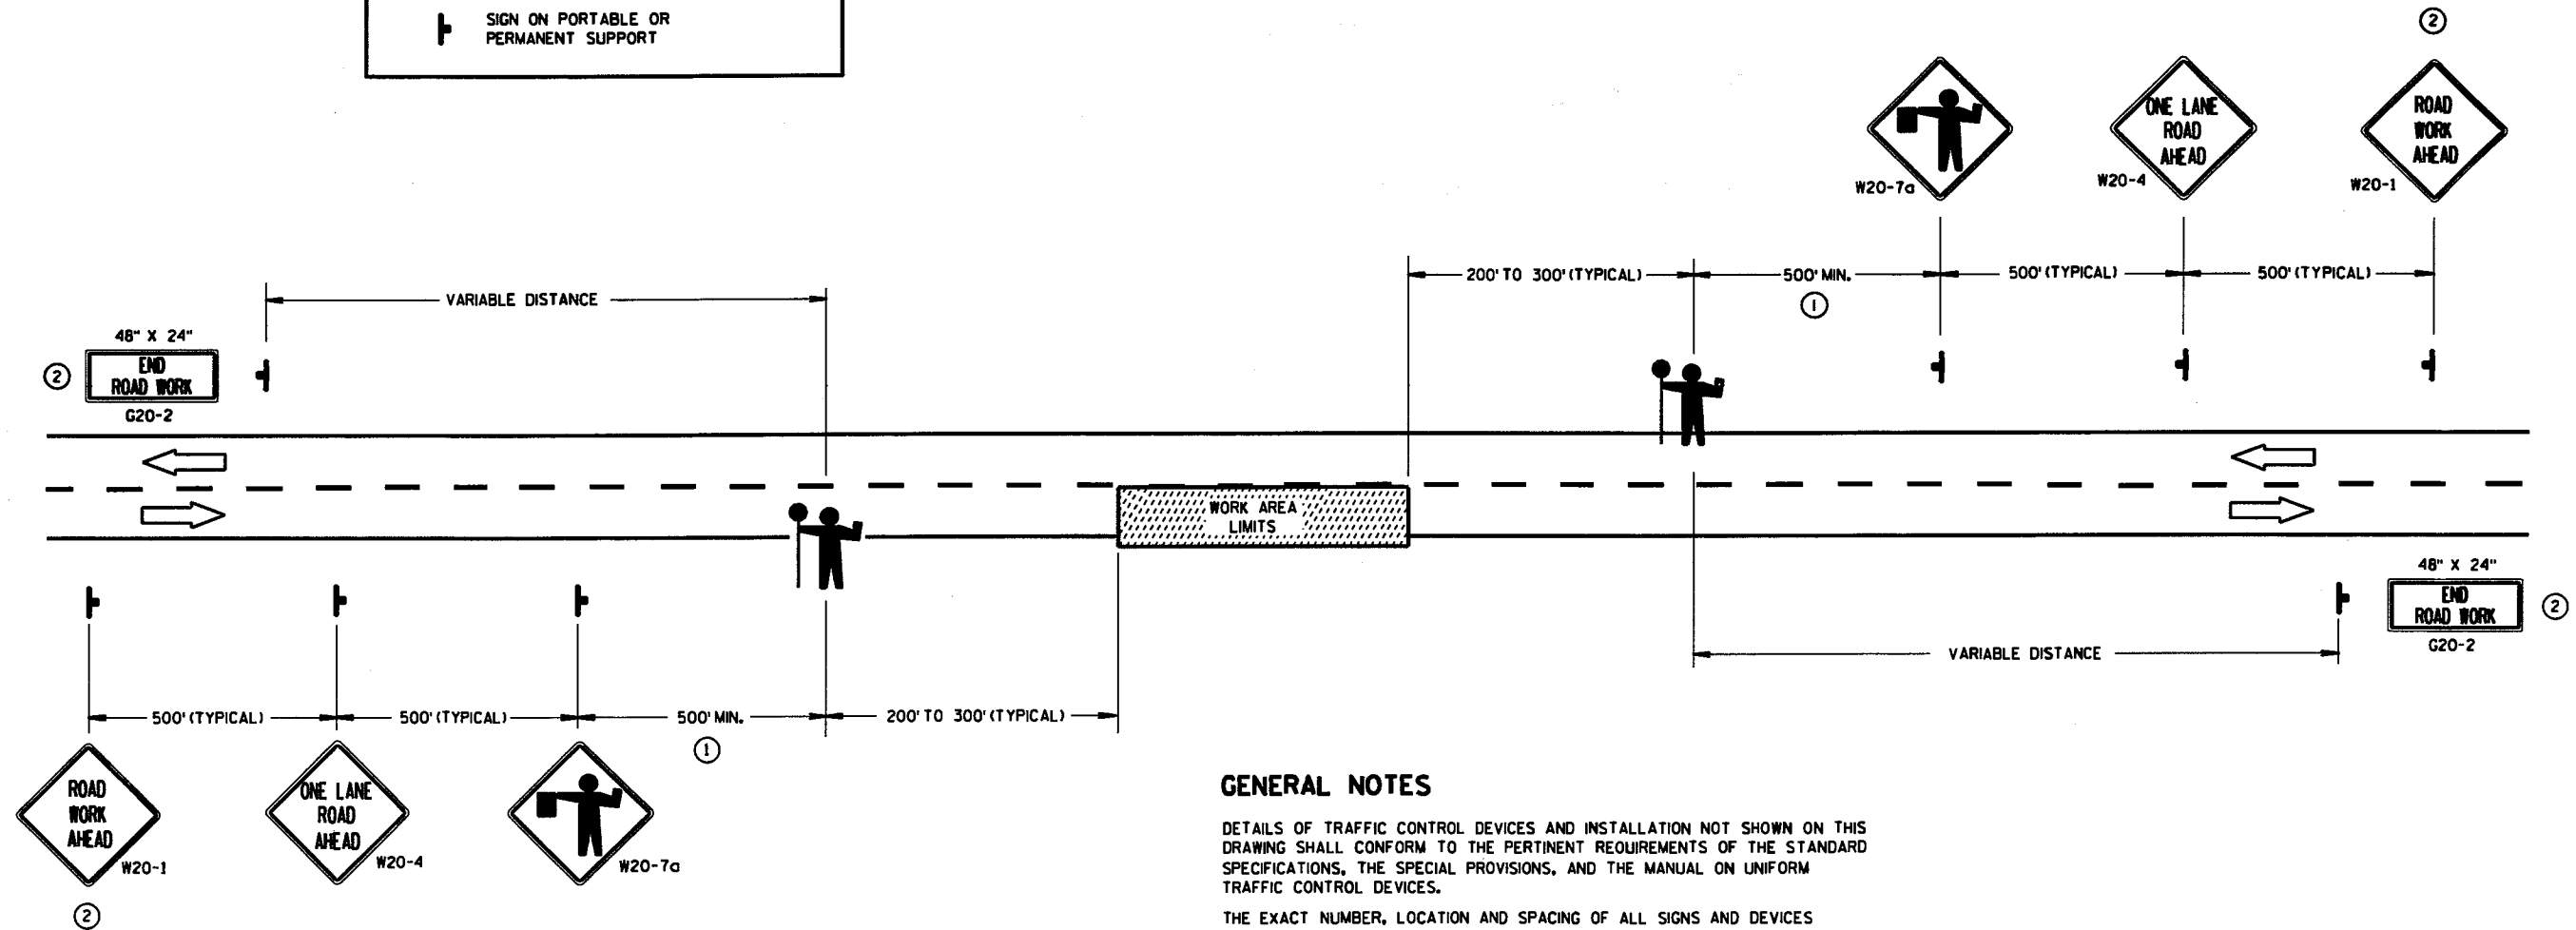

GENERAL NOTES

DETAILS OF TRAFFIC CONTROL DEVICES AND INSTALLATION NOT SHOWN ON THIS DRAWING SHALL CONFORM TO THE PERTINENT REQUIREMENTS OF THE STANDARD SPECIFICATIONS, THE SPECIAL PROVISIONS, AND THE MANUAL ON UNIFORM TRAFFIC CONTROL DEVICES.

THE EXACT NUMBER, LOCATION AND SPACING OF ALL SIGNS AND DEVICES (AND THE LOCATION OF ALL FLAGGERS) SHALL BE ADJUSTED TO FIT FIELD CONDITIONS AS APPROVED BY THE ENGINEER.

THE FIRST ADVANCE WARNING SIGN SHOULD TYPICALLY BE LOCATED IN ADVANCE OF THE ANTICIPATED TRAFFIC BACKUP OR QUEUE.

WHEN A SIDE ROAD OR RAMP INTERSECTS THE FACILITY ON WHICH THE WORK IS BEING PERFORMED, ADDITIONAL TRAFFIC CONTROLS SHALL BE PROVIDED AS SPECIFIED IN THE PLANS AND/OR THE SPECIAL PROVISIONS OR AS APPROVED BY THE ENGINEER.

FLAGGERS SHALL BE IN SIGHT OF EACH OTHER OR IN DIRECT COMMUNICATION AT ALL TIMES. THEY SHALL BE EQUIPPED WITH STOP/SLOW PADDLES FASTENED ON SUPPORT STAFFS. WHEN THE FLAGGING OPERATION IS NOT IN EFFECT, THE "FLAGGER AHEAD", THE "ROAD WORK AHEAD" AND THE ONE LANE ROAD AHEAD" SIGNS SHALL BE COVERED OR REMOVED AND THE HIGHWAY RESTORED TO NORMAL OPERATION.


ALL SIGNS ARE 48" X 48" UNLESS OTHERWISE NOTED.

- ① FOR A MOVING WORK OPERATION, SIGNING FOR BOTH DIRECTIONS SHALL BE REESTABLISHED (AS SIMULTANEOUSLY AS PRACTICAL) AT APPROXIMATELY 3500 FOOT INTERVALS IN THE MOVING WORK OPERATION OR AS APPROVED BY THE ENGINEER.
- ② SIGN NOT REQUIRED IF FLAGGING OPERATION OCCURS WITHIN A SIGNED ROAD WORK ZONE AREA.

TRAFFIC CONTROL FOR LANE CLOSURE (SUITABLE FOR MOVING OPERATIONS)	
STATE OF WISCONSIN DEPARTMENT OF TRANSPORTATION	
APPROVED 9/5/06 DATE	/S/ Thomas N. Notbohm STATE TRAFFIC ENGINEER OF DESIGN
FHWA	

6

6

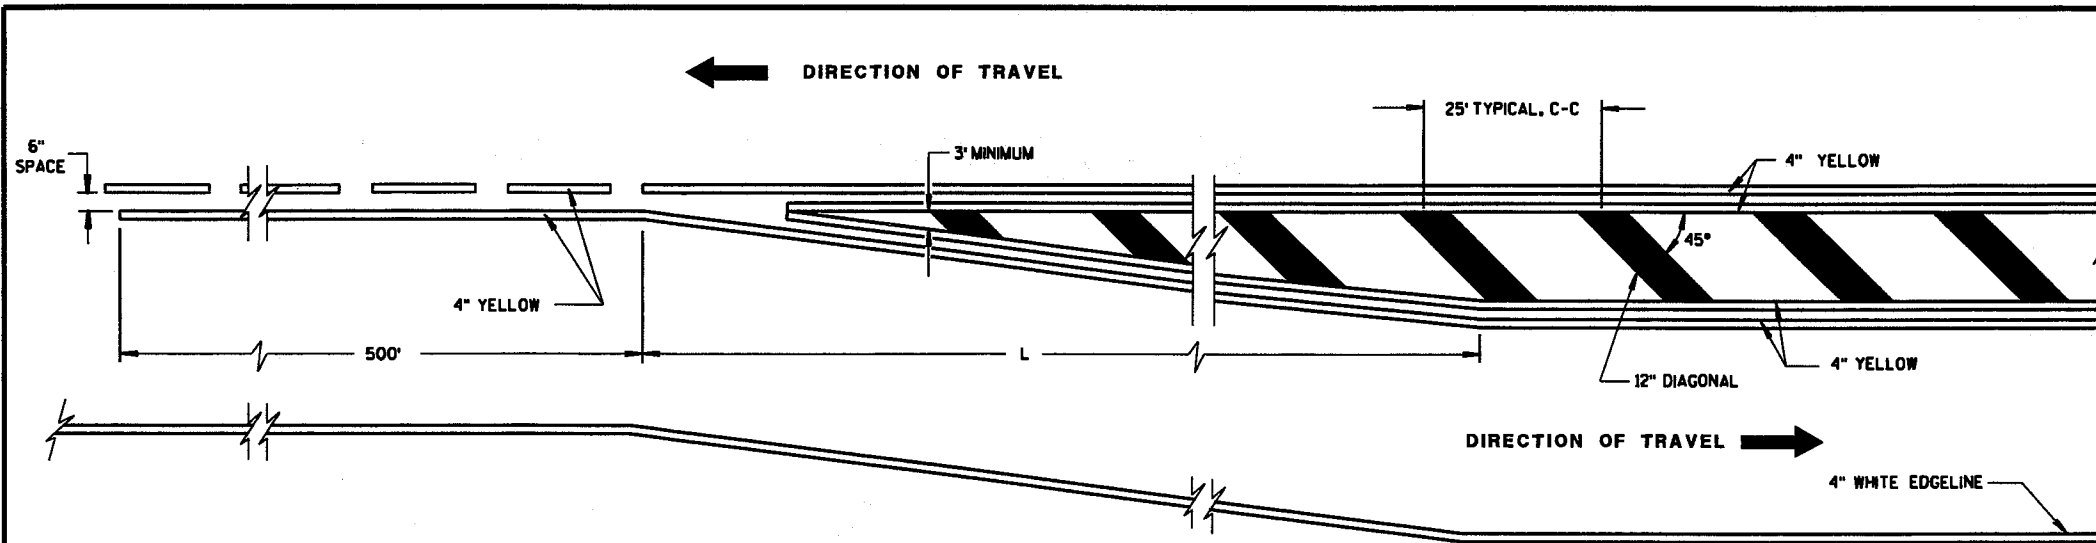


MEDIAN ISLAND DETAIL

GENERAL NOTE


DIAGONALS ARE OPTIONAL WHEN PAINTED ISLAND IS LESS THAN 6 FEET AT WIDEST POINT.

MINIMUM SHIFTING TAPER LENGTH TABLE

POSTED SPEED (S)	TAPER LENGTH (L)
25	100'
30	100'
35	125'
40	165'
45	270'
50	300'
55	330'
65	390'

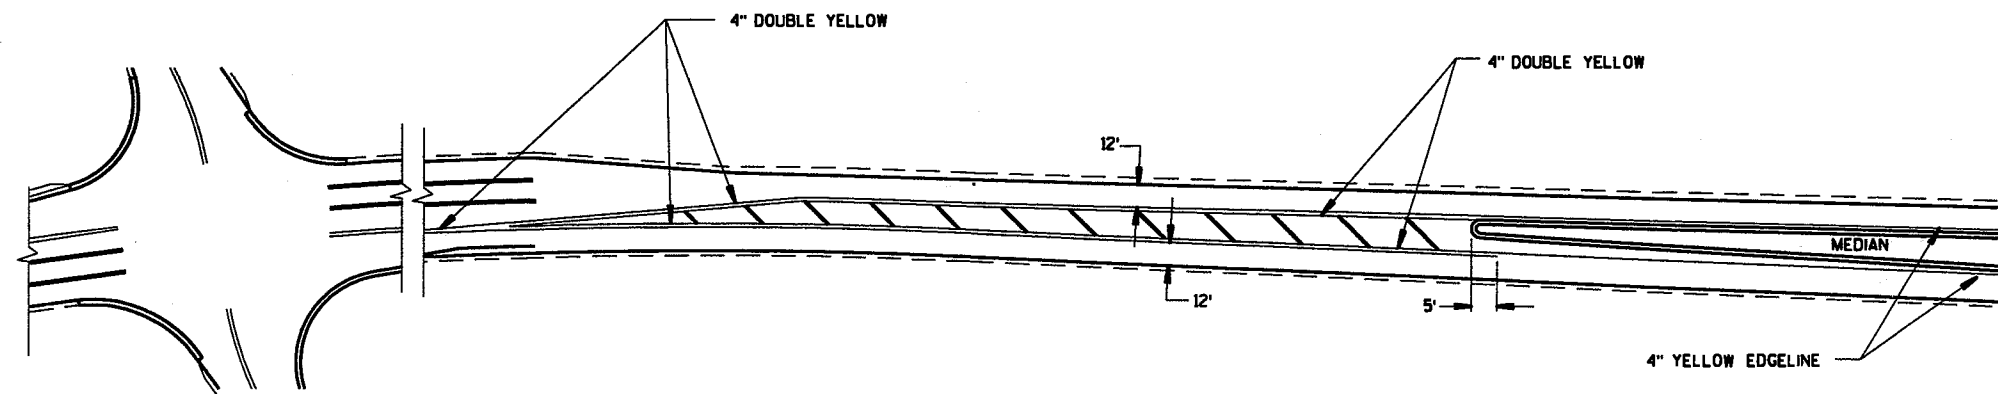

APPROACH MARKINGS FOR OTHER MEDIAN TYPES

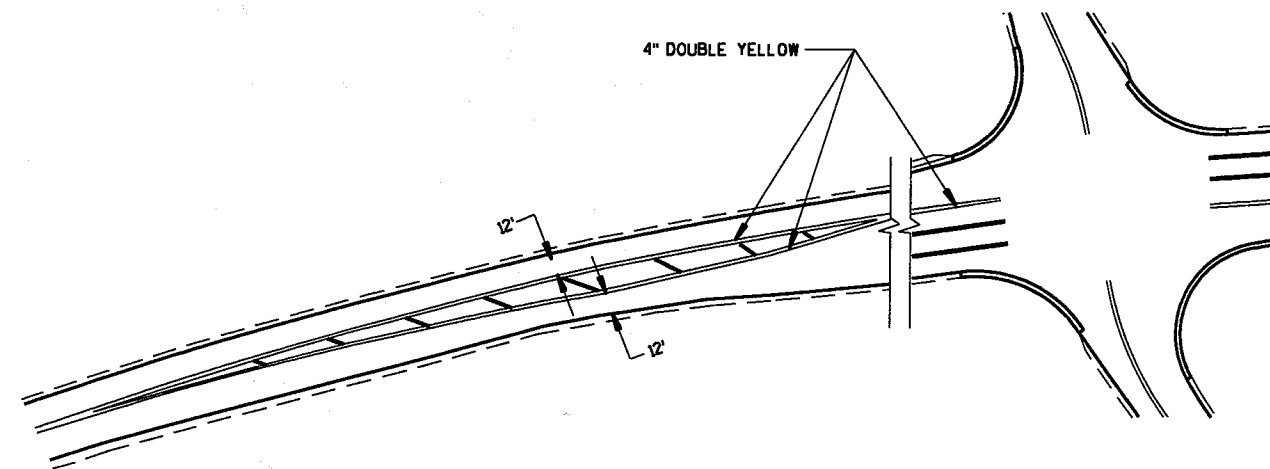

NON APPROACH MARKINGS

MEDIAN ISLAND MARKING	
STATE OF WISCONSIN DEPARTMENT OF TRANSPORTATION	
APPROVED 10-16-07 DATE	/S/ Thomas N. Notbohm STATE TRAFFIC ENGINEER OF DESIGN
FHWA	

6

6

GENERAL NOTES

THE EXACT NUMBER, LOCATION AND SPACING OF ALL SIGNS AND DEVICES SHALL BE ADJUSTED TO FIT FIELD CONDITIONS AS APPROVED BY THE ENGINEER.

ALL SIGNS ARE 48" X 48" UNLESS OTHERWISE NOTED. IF NECESSARY DUE TO SPACE CONSTRAINTS IN URBAN AREAS, 36" X 36" SIGNS MAY BE USED IF APPROVED BY DISTRICT TRAFFIC UNIT.

"WO" SIGNS ARE THE SAME AS "W" SIGNS EXCEPT THE BACKGROUND IS ORANGE.

SIGNS THAT WILL BE IN PLACE LESS THAN 7 CONTINUOUS DAYS AND NIGHTS MAY BE MOUNTED ON PORTABLE SUPPORTS.

ANY SIGNS TEMPORARY OR EXISTING, WHICH CONFLICT WITH TRAFFIC CONTROL "IN USE" SHALL BE REMOVED OR COVERED AS NEEDED AND AS APPROVED BY THE ENGINEER.

W20-1 AND G20-2A SIGNS ARE NOT REQUIRED IF THE WORK AREA IS WITHIN A LARGER WORK ZONE WHERE THESE SIGNS ARE ALREADY PRESENT. G20-2A SIGNS MAY ALSO BE OMITTED IF DURATION OF WORK IS LESS THAN 7 CONTINUOUS DAYS AND NIGHTS.


CHANNELIZING DEVICES PLACED ADJACENT TO THE WORK AREA SHALL BE PULLED BACK FROM THE TRAVEL LANE WHEN WORK IS NOT IN PROGRESS.

TABLE A

S	SHOULDER TAPER LENGTH (FEET)					BUFFER SPACE (FEET)
	4	6	8	10	10	
30	20	30	40	50	85	
35	30	45	55	70	120	
40	40	55	75	90	170	
45	60	90	120	150	220	
50	70	100	135	170	280	
55	75	110	150	185	335	

W = SHOULDER WIDTH (FEET)
S = NON-CONSTRUCTION SPEED LIMIT (MPH)

SHOULDER TAPER LENGTH
 $= \frac{WS}{3}$ AT 45 MPH OR GREATER
 $= \frac{WS^2}{180}$ AT 40 MPH OR LESS

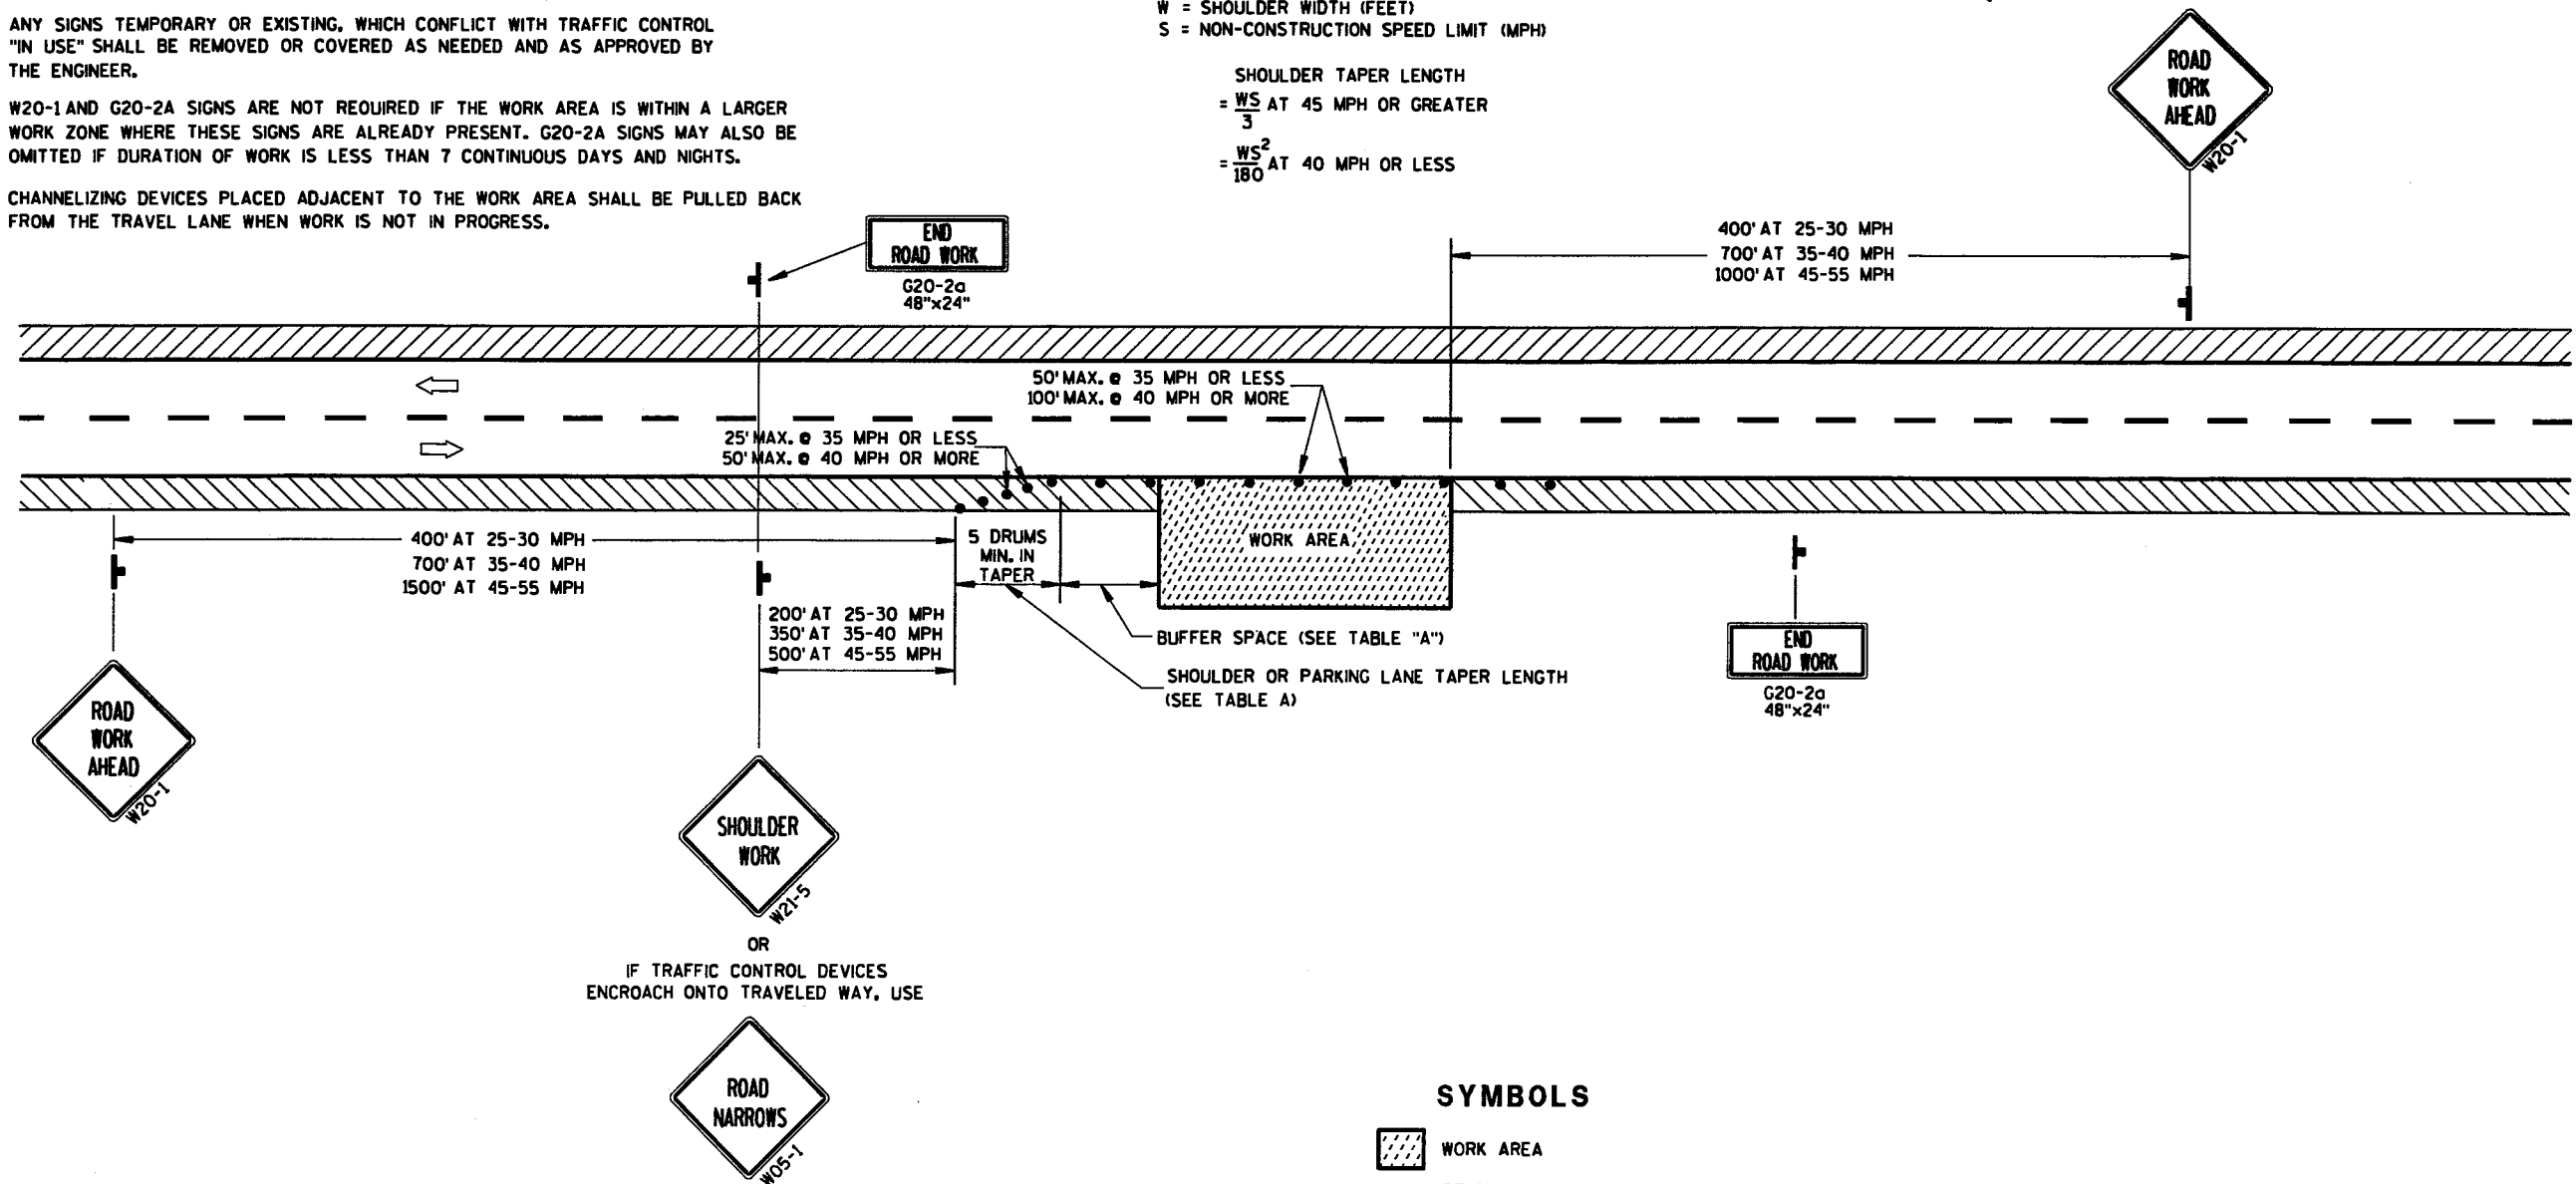

SYMBOLS

- WORK AREA
- DRUM
- POST MOUNTED SIGN
- DIRECTION OF TRAFFIC FLOW

**TRAFFIC CONTROL,
WORK ON SHOULDER OR
PARKING LANE,
UNDIVIDED ROADWAY**

STATE OF WISCONSIN
DEPARTMENT OF TRANSPORTATION





APPROVED
5/23/00
DATE

Chetan J. Sengupta
CHIEF SIGNS AND MARKING ENGINEER

FHWA

URBAN AREA

RURAL AREA (See Note 2)

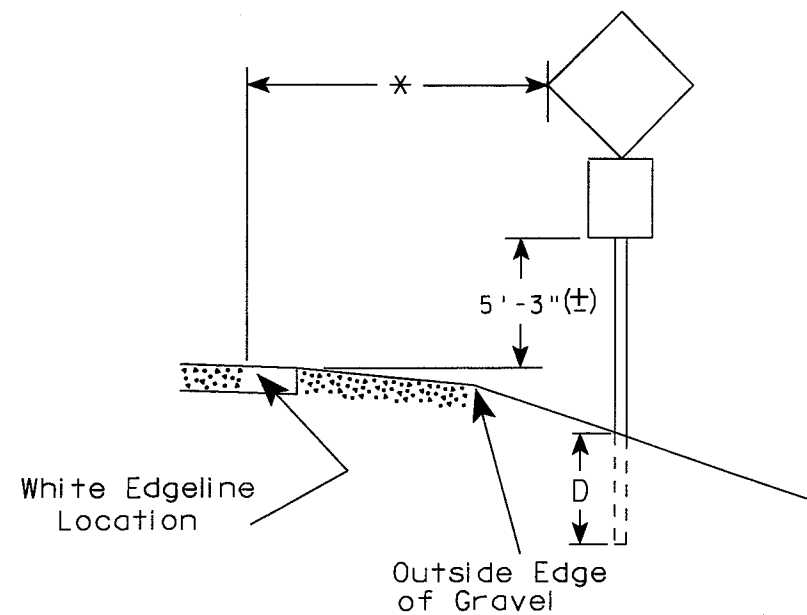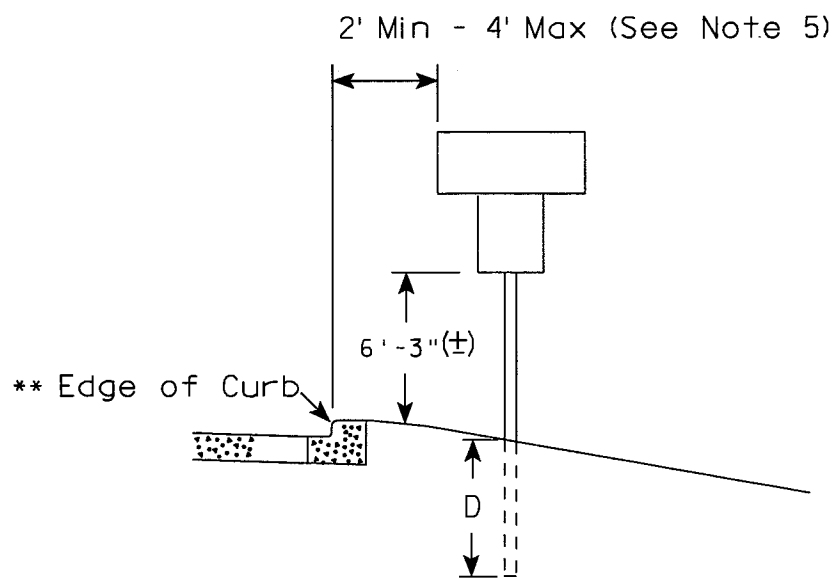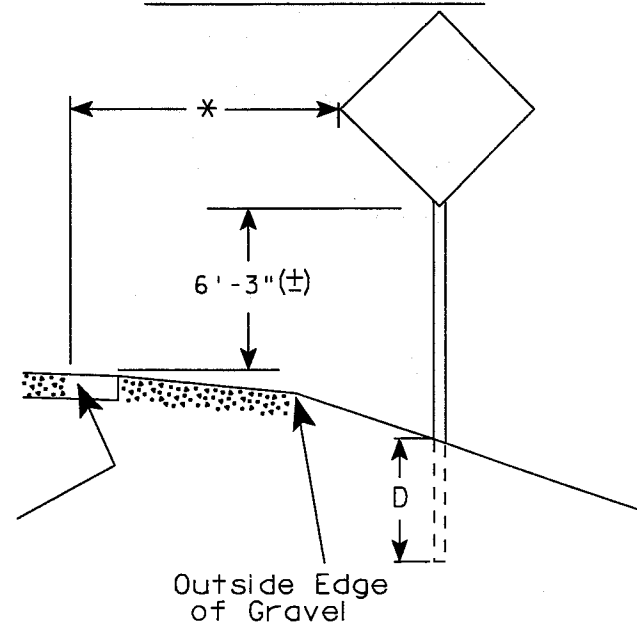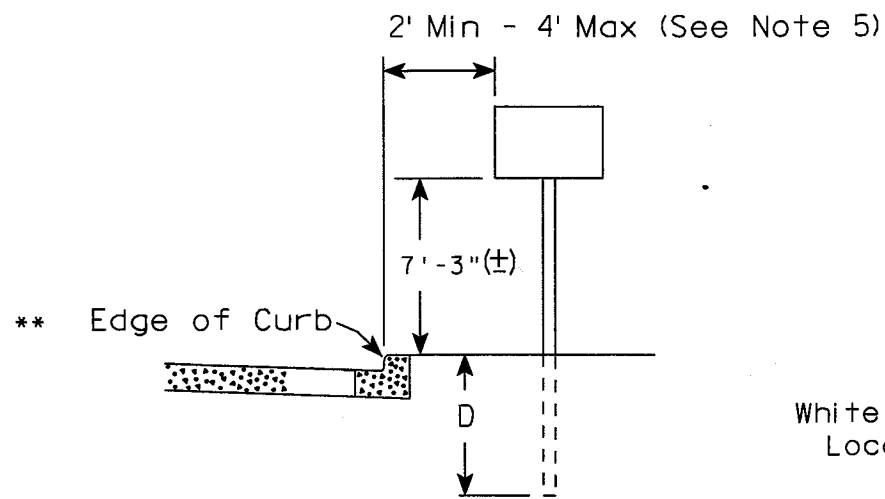

- GENERAL NOTES
1. Signs wider than 4 feet or larger than 20 sq. ft. shall be mounted on multiple posts. Refer to plate A4-4.
 2. For expressways and freeways, mounting height is 7'-3" (±) or 6'-3" (±) depending upon existence of a sub-sign.
 3. Minimum mounting height for J assemblies (A4-5) is 7'-3" (±) or 6'-3" (±) per urban or rural detail respectively.
 4. Minimum mounting height for signs mounted on traffic signal poles is 5'-3" (±).
 5. Offset distance shall be consistent with existing signs or consistent throughout length of project.
 6. The (±) tolerance for mounting height is 3 inches.
 7. Folding stop signs (R1-1F) shall be mounted at a height of 5'-3" (±) or as directed by the Engineer.
 8. The Double Arrow sign (W12-1) shall be mounted at a height of 2'-3" (±). The Chevron sign (W1-8), Roundabout Chevron panel (W1-8A), Clearance Markers (W5-52), Mile Markers (D10 series) & End of Road Markers (W5-56 & W5-56A) shall be mounted at a height of 4'-3" (±).

POST EMBEDMENT DEPTH

Area of Sign Installation (Sq. Ft.)	D (Min)
20 or Less	4'
Greater than 20	5'

** The existence of curb and gutter does not in itself mandate the vertical clearance illustrated. That height is typically measured where there is sidewalk adjacent to the roadway or parking is permitted. In the absence of sidewalk vertical clearance is measured from the top of the curb. Offset of signs is measured from the flow line.

* 6 feet from edge of a paved shoulder or 12 feet from the edge of pavement (edge line location) or 2 feet from outside edge of gravel, whichever is greater unless directed by project engineer.

TYPICAL INSTALLATION OF PERMANENT TYPE II SIGNS ON SINGLE POSTS

WISCONSIN DEPT OF TRANSPORTATION

APPROVED *Matthew R. Rauch*
for State Traffic Engineer

DATE 12/12/07 PLATE NO. A4-3.14


GENERAL NOTES

1. For 3 post installations, spacing is $S/2$ and S must be greater than 7'-0".
2. For 4 post installations, spacing is $S/3$ and S must be greater than 10'-6".
3. For expressways and freeways, mounting height is 7'-3" (\pm) or 6'-3" (\pm) depending upon existence of sub-sign.
4. The (\pm) tolerance for mounting height is 3 inches.
5. Minimum mounting height for J assemblies (A4-5) is 7'-3" (\pm) or 6'-3" (\pm) per urban or rural detail respectively.
6. Offset distance shall be consistent with existing signs or consistent throughout length of project.
7. Folding stop signs (R1-1F) shall be mounted at a height of 5'-3" (\pm) or as directed by the engineer.
8. The Double Arrow sign (W12-1) shall be mounted at a height of 2'-3" (\pm). The Chevron sign (W1-8), Roundabout Chevron panel (W1-8A), Clearance Markers (W5-52), Mile Markers (D10 series) & End of Road Markers (W5-56 & W5-56A) shall be mounted at a height of 4'-3" (\pm).



* 6 feet from edge of a paved shoulder or 12 feet from the edge of pavement (edge line location) or 2 feet from outside edge of gravel, whichever is greater unless directed by project engineer.

** The existence of curb and gutter does not in itself mandate the vertical clearance illustrated. That height is typically measured where there is sidewalk adjacent to the roadway or parking is permitted. In the absence of sidewalk vertical clearance is measured from the top of the curb. Offset of signs is measured from the flow line.



URBAN AREA

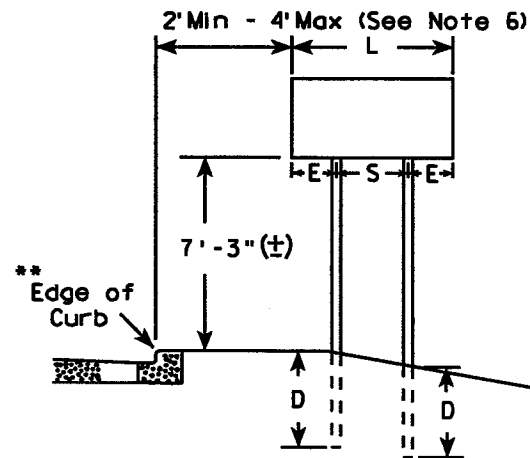

RURAL AREA (See Note 3)

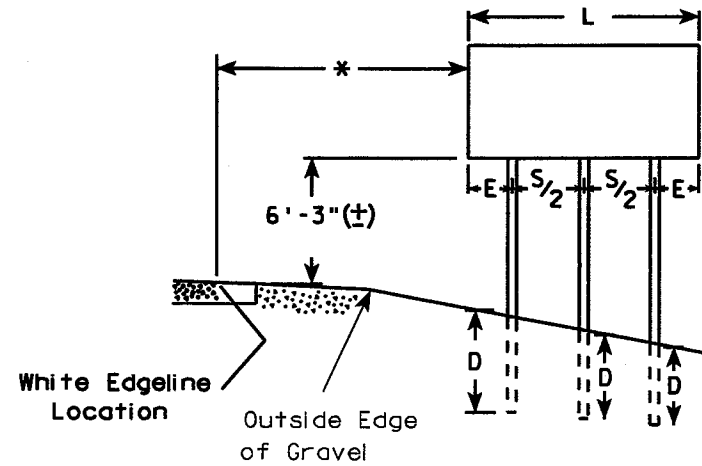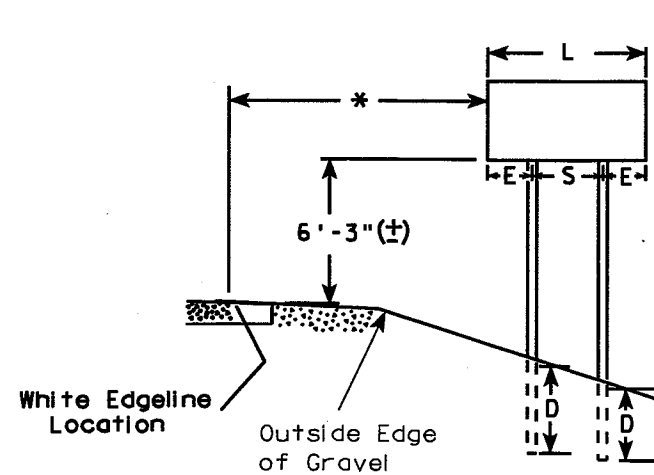

URBAN AREA

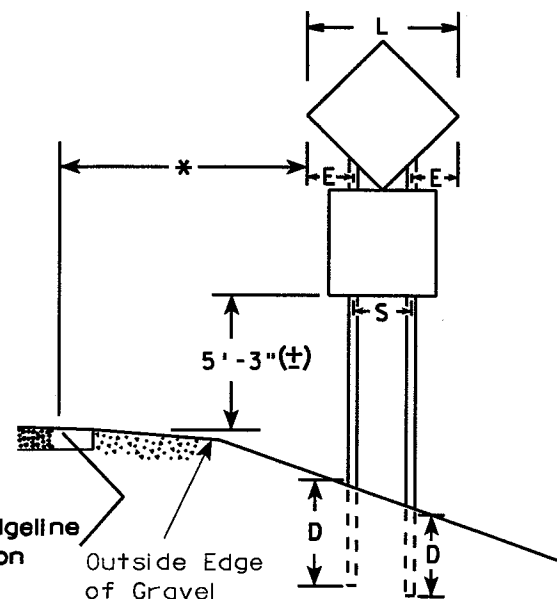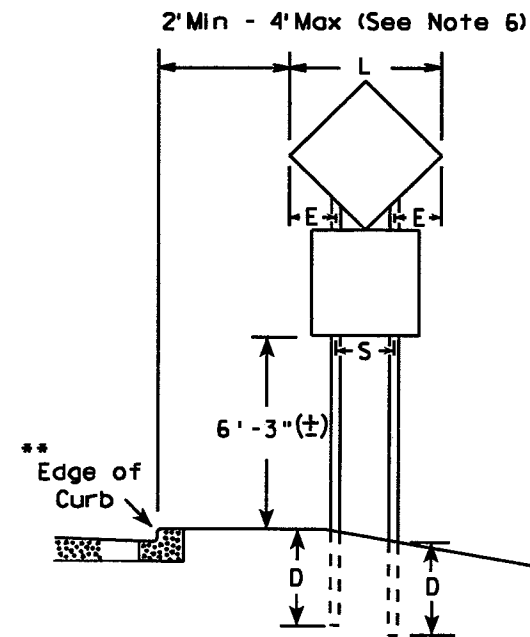

DIAMOND SHAPED SIGNS

L	S	E
Less than 60"	20"	L/2 - 10
60"--72"	32"	L/2 - 16
Greater than 72"	3 L/5	L/5

SIGN SHAPE OTHER THAN DIAMOND (Two Post Installations)

L	S	E
Less than 60"	L-24"	12"
60" or more	3 L/5	L/5

POST EMBEDMENT DEPTH

Area of Sign Installation (Sq. Ft.)	D (Min)
20 or Less	4'
Greater than 20	5'

TYPICAL INSTALLATION OF TYPE II SIGNS ON MULTIPLE POSTS

WISCONSIN DEPT OF TRANSPORTATION

APPROVED *Matthew R. Rauch*
For State Traffic Engineer

DATE 12/12/07 PLATE NO. A4-4.9



PROJECT NO:

HWY:

COUNTY:

SHEET NO: 209

E

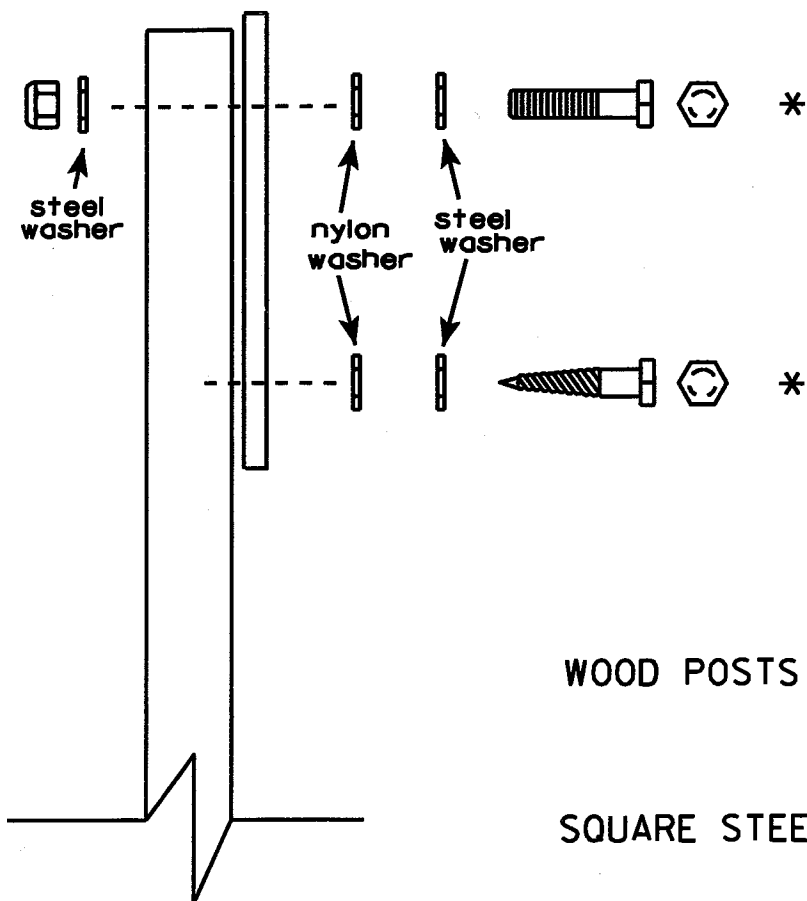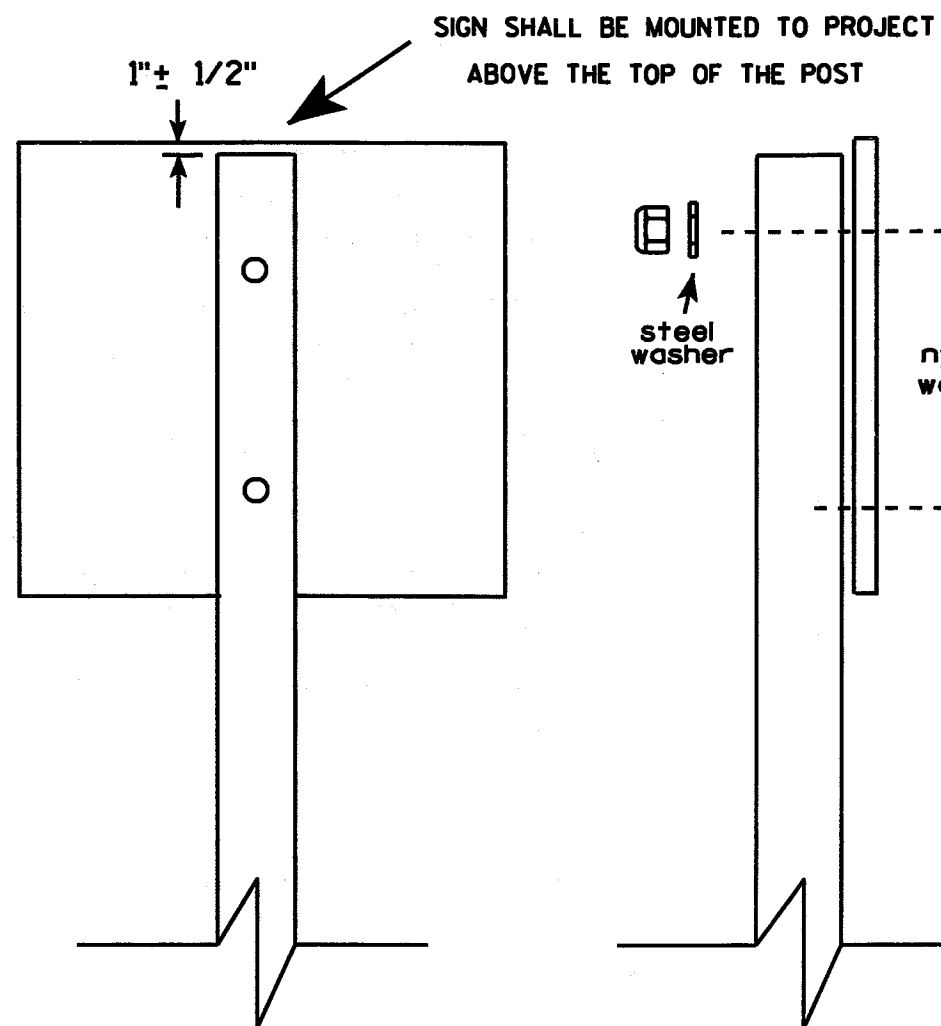


Nuts, bolts and lags used for mounting signs shall have hexagonal heads and shall be either :

- Hot dip or mechanically galvanized in accordance with ASTM Designation: A 153, Class D, or
- Cadmium plated in accordance with ASTM Designation : B 766 TYPE 3, Class 12, or
- Electro-galvanized in accordance with ASTM Designation : B 633, TYPE III, SC 3.

Threads on bolts and nuts shall be manufactured with sufficient allowance for the cadmium plate or galvanized coating to permit the nuts to run freely on the bolts.

WOOD POSTS (4" x 4" or 4" x 6")
LAG SCREWS - 3/8" X 3"
MACHINE BOLTS - 5/16" X 6-1/2" or 7" Length w/ nuts
SQUARE STEEL POSTS (2" x 2")
MACHINE BOLTS - 3/8" X 3-1/4" Length w/ nuts
WASHERS (ALL POSTS) -

1-1/4" O.D. X 3/8" I.D. X 1/16" STEEL
1-1/4" O.D. X 3/8" I.D. X .080 NYLON for all Type H signs.

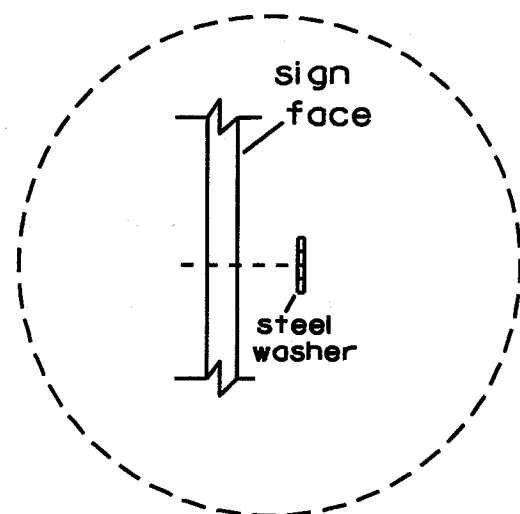

Washer Placement when Sign Has Other Than Type H or Type F Face

* Two different fastening systems are shown for illustration purposes. On any individual sign, either one or the other system shall be used. Actual number of fasteners per sign varies with the sign area, but normally there are two. For a single post installation, all signs greater than 9 sq. ft. require the use of 3 fasteners.


ATTACHMENT OF SIGNS
TO POSTS

WISCONSIN DEPT OF TRANSPORTATION


APPROVED *Matthew R. Rauch*
For State Traffic Engineer

DATE 8/30/06 PLATE NO. A4-8.6


BRACE BANDING

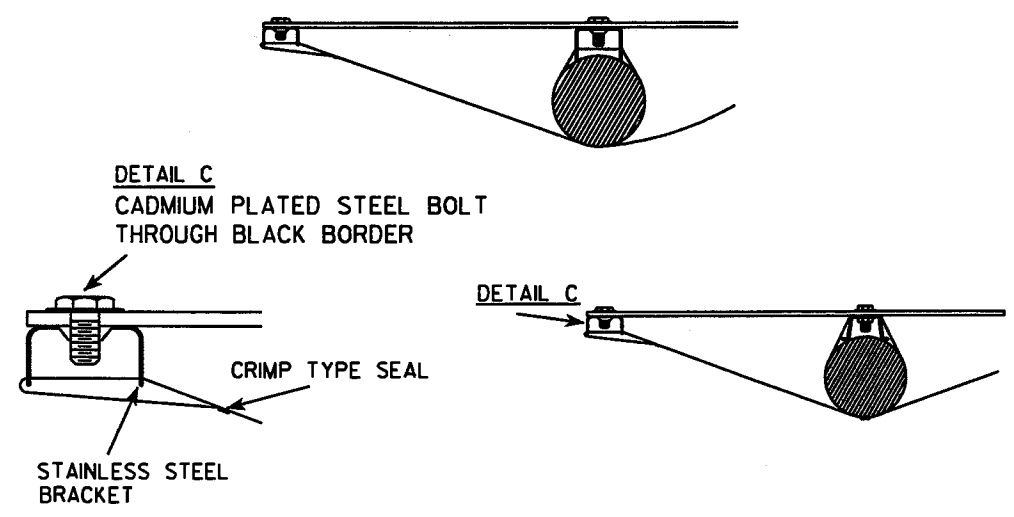




SINGLE SIGN

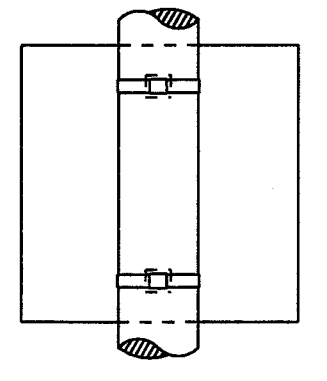

BRACKET BANDING

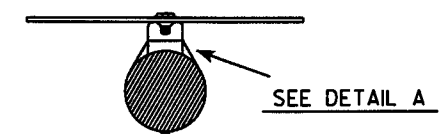


"J" ASSEMBLY

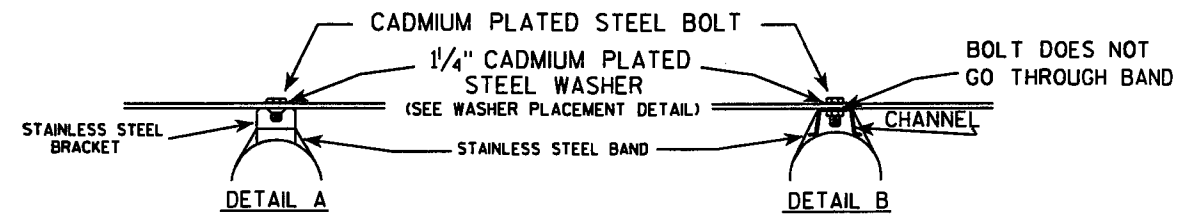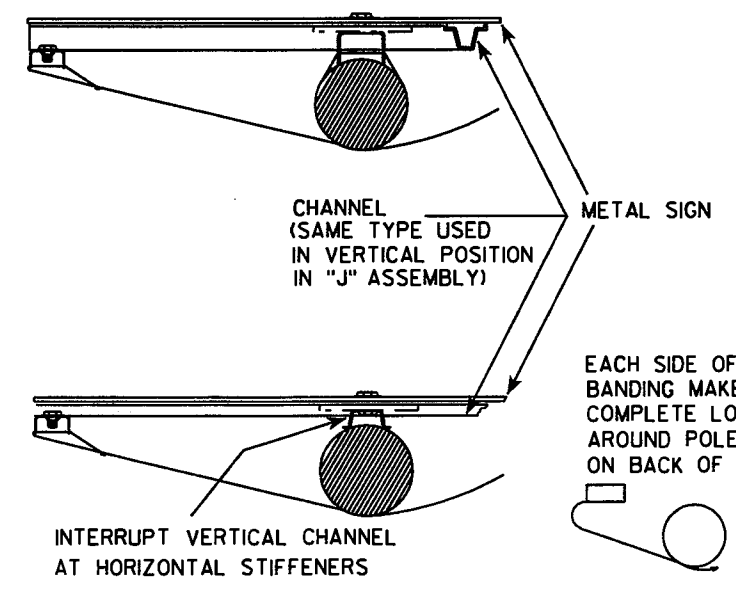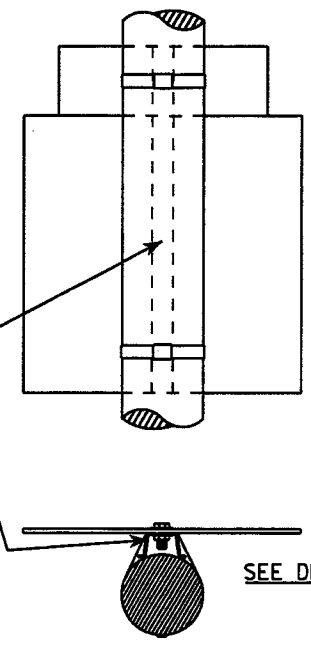


GENERAL NOTES

1. Signs 4' or greater in width shall have one brace band installed at the center of the sign.
2. Signs 3' or greater in height shall have three bracket bands installed. Signs less than 3' in height shall have two bracket bands installed.
3. Banding and assembly bracket shall be stainless steel. All bands shall be 3/4" in width and 0.025" thickness.

WASHER PLACEMENT

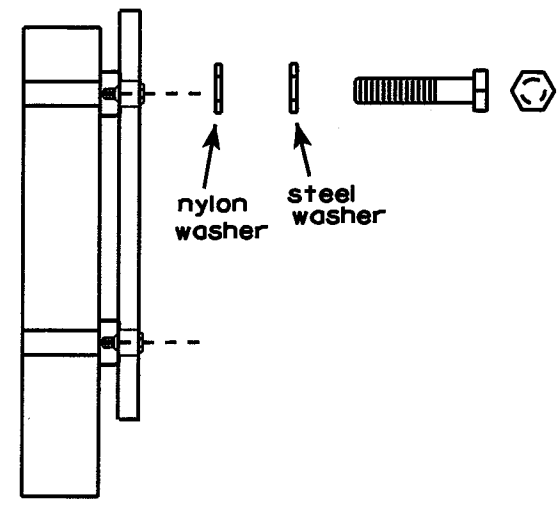


WASHERS (ALL POSTS) -
1-1/4" O.D. X 3/8" I.D. X 1/16" STEEL
1-1/4" O.D. X 3/8" I.D. X .080 NYLON
FOR ALL TYPE H SIGNS

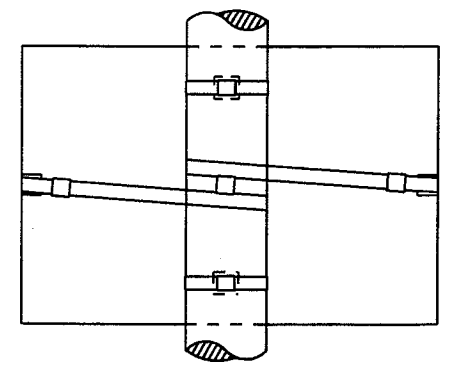

BRACE BANDING

BRACE BANDING SHALL BE TIGHTENED FIRMLY
BUT NOT SO TIGHT AS TO APPRECIABLY
CURVE FACE OF SIGN.

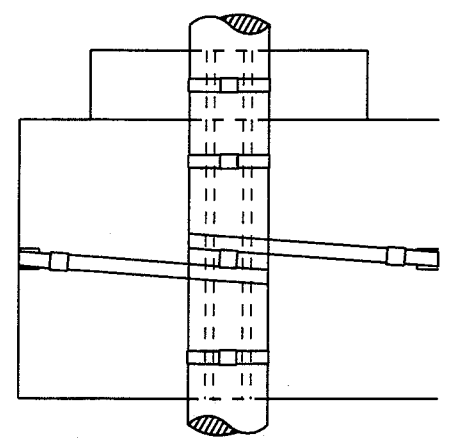

**STANDARD SIGN
SIGN BANDING DETAILS**



WISCONSIN DEPT OF TRANSPORTATION

APPROVED *Matthew R. Raub*
For State Traffic Engineer

DATE 11/08/05 PLATE NO. A5-9.2

NOTES

1. Sign is Type II - Type H Reflective - reference WIS DOT Standard Specification for HIGHWAY and STRUCTURE CONSTRUCTION latest edition. material is plywood but borders shall be rounded
2. Color:
Background - White
Message - Black
3. Corners may be square or rounded when base as shown. When base material is metal, the corners and borders shall be rounded.
4. R4-8 is the same as R4-7 except Legend is reversed.

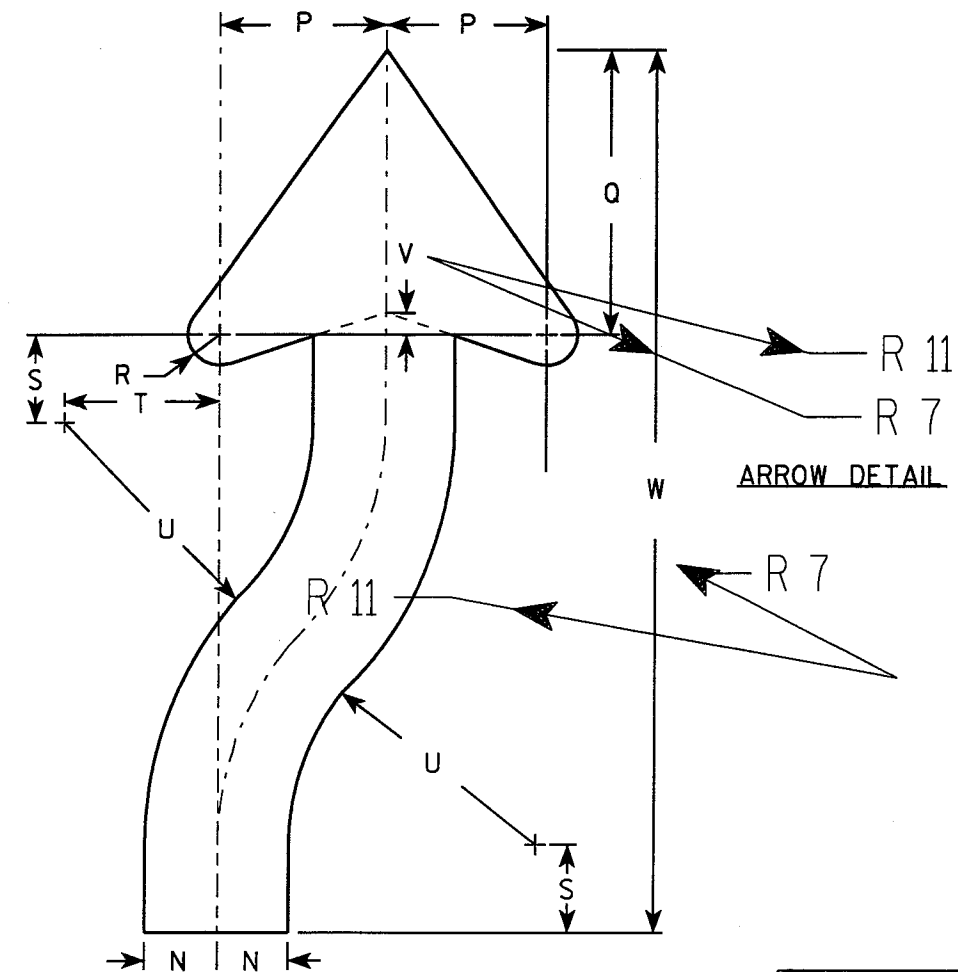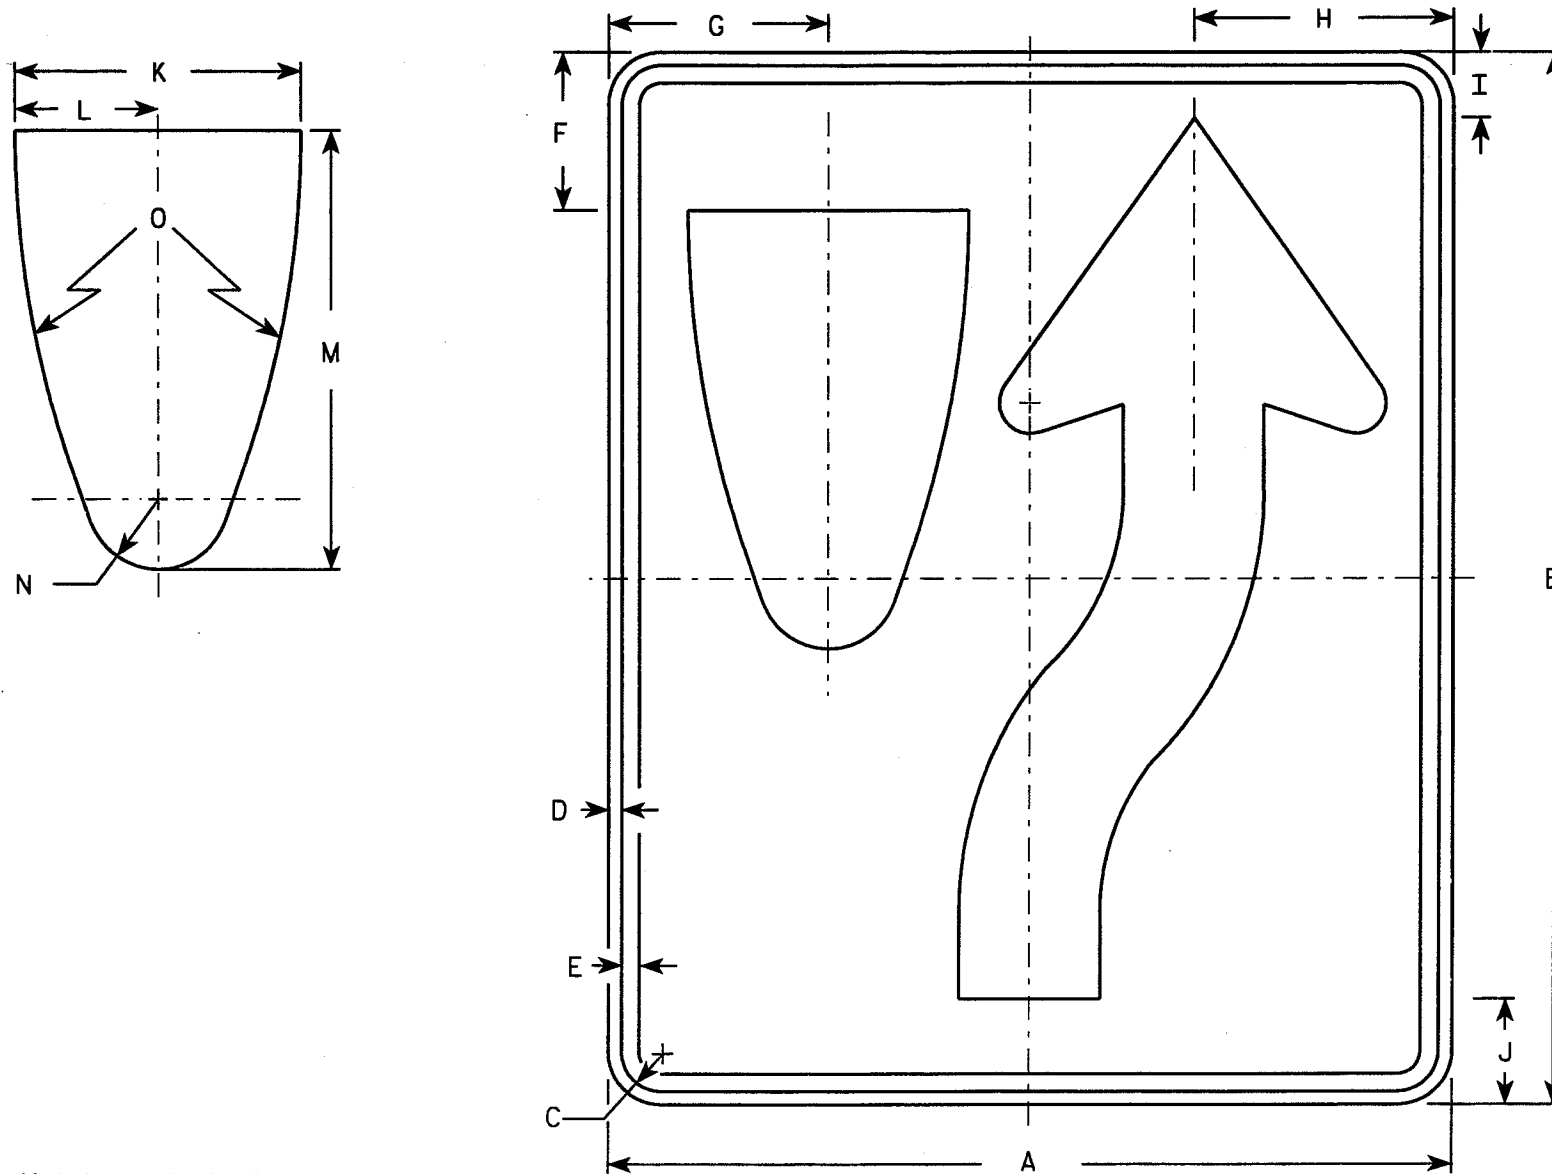

Metric equivalent for this sign is:

SIZE	
1	450 mm X 600 mm
2	600 mm X 750 mm
3	900 mm X 1200 mm
4	900 mm X 1200 mm
5	900 mm X 1200 mm

SIZE	A	B	C	D	E	F	G	H	I	J	K	L	M	N	O	P	Q	R	S	T	U	V	W	X	Y	Z	Area sq. ft.	Area m ²
1	18	24	1 1/8	3/8	1/2	3 3/8	4 3/4	5 1/2	1 3/8	2 1/4	6	3	9 3/8	1 1/2	22 1/2	3 1/2	6 1/8	5/8	1 7/8	3 1/4	6 3/4	1/2	20 3/8			3.0	.27	
2	24	30	1 1/8	3/8	1/2	4 1/2	6 1/4	7 3/8	1 7/8	3	8	4	12 1/2	2	30	4 5/8	8 1/8	7/8	2 1/2	4 3/8	9	5/8	25 1/8			5.0	.45	
3	36	48	1 3/4	1/2	5/8	6 3/4	9 3/8	11 1/8	2 7/8	4 1/2	12	6	18 3/4	3	45	6 7/8	12 1/4	1 1/4	3 3/4	6 5/8	13 1/2	1	40 3/4			12.0	1.08	
4	36	48	1 3/4	1/2	5/8	6 3/4	9 3/8	11 1/8	2 7/8	4 1/2	12	6	18 3/4	3	45	6 7/8	12 1/4	1 1/4	3 3/4	6 5/8	13 1/2	1	40 3/4			12.0	1.08	
5	48	60	2 1/4	3/4	1	9	12 1/2	14 3/4	3 3/4	6	16	8	25	4	60	9 1/4	16 1/4	1 5/8	5	8 3/4	18	1 1/4	50 1/4			20.0	1.08	

STANDARD SIGN
R4-7 & R4-8



WISCONSIN DEPT OF TRANSPORTATION

APPROVED *Chetan J. Spony*
State Traffic Engineer

DATE 2/6/02 PLATE NO. R4-7.7

NOTES

1. Sign is Type II - Type H Reflective - reference WIS DOT Standard Specification for HIGHWAY and STRUCTURE CONSTRUCTION latest edition.
2. Color:
Background - WHITE
Message - BLACK
3. Message Series - D
4. Corners may be square or rounded when base material is plywood but borders shall be rounded as shown. When base material is metal, the corners and borders shall be rounded.

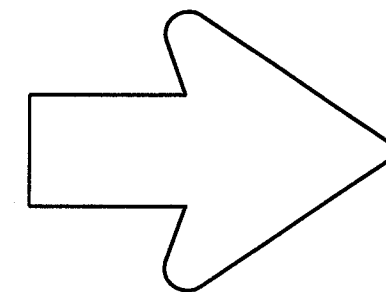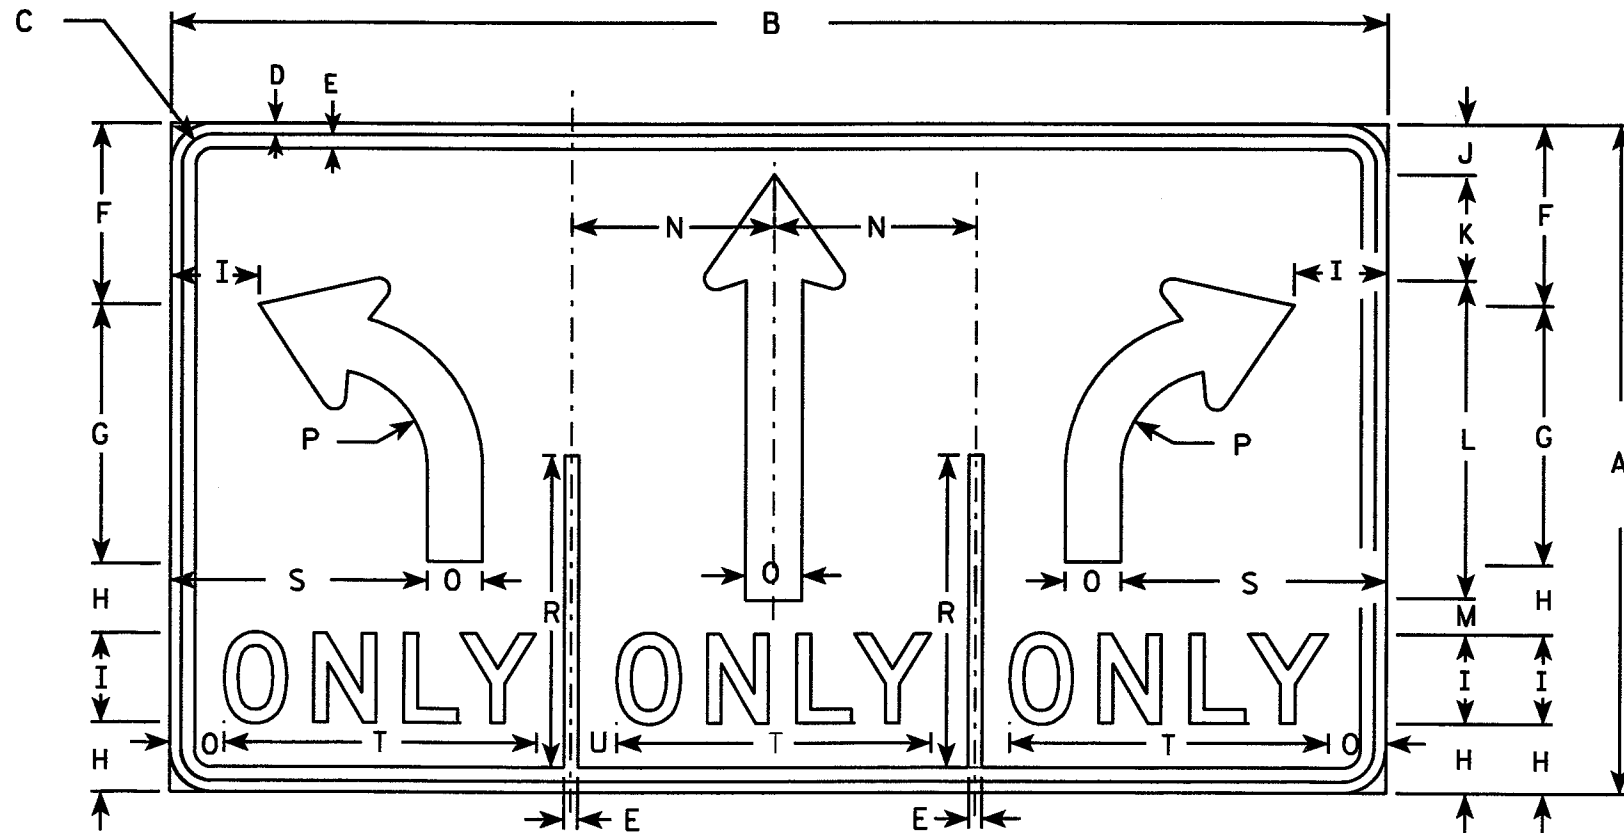

SEE R3-8 FOR ARROW DETAIL

R3-8W

Metric equivalent for this sign is:

SIZE	
1	
2	750 mm X 1350 mm
3	
4	1200 mm X 2100 mm
5	1200 mm X 2100 mm

SIZE	A	B	C	D	E	F	G	H	I	J	K	L	M	N	O	P	Q	R	S	T	U	V	W	X	Y	Z	Area sq. ft.	Area sq. m.
1																												
2	30	54	1 3/8	1/2	5/8	8 1/8	11 5/8	3 1/8	4	2 1/4	4 3/4	14 1/4	1 5/8	9	2 1/2	4 1/2		14	11 1/2	14	2						11.25	1.01
3																												
4	48	84	2 1/4	3/4	1	13	18 1/2	5 1/4	6	3 3/4	7	29 1/8	2 3/8	14	3 3/4	7 1/4		22 3/8	17 1/4	20 1/2	3 1/4						28.0	2.52
5	48	84	2 1/4	3/4	1	13	18 1/2	5 1/4	6	3 3/4	7	29 1/8	2 7/8	14	3 3/4	7 1/4		22 3/8	17 1/4	20 1/2	3 1/4						28.0	2.52

STANDARD SIGN
R3-8W


WISCONSIN DEPT OF TRANSPORTATION

APPROVED
Matthew R. Rauch
For State Traffic Engineer

DATE 3/14/07 PLATE NO. R3-8W.3

PROJECT NO:


SHEET NO: 213

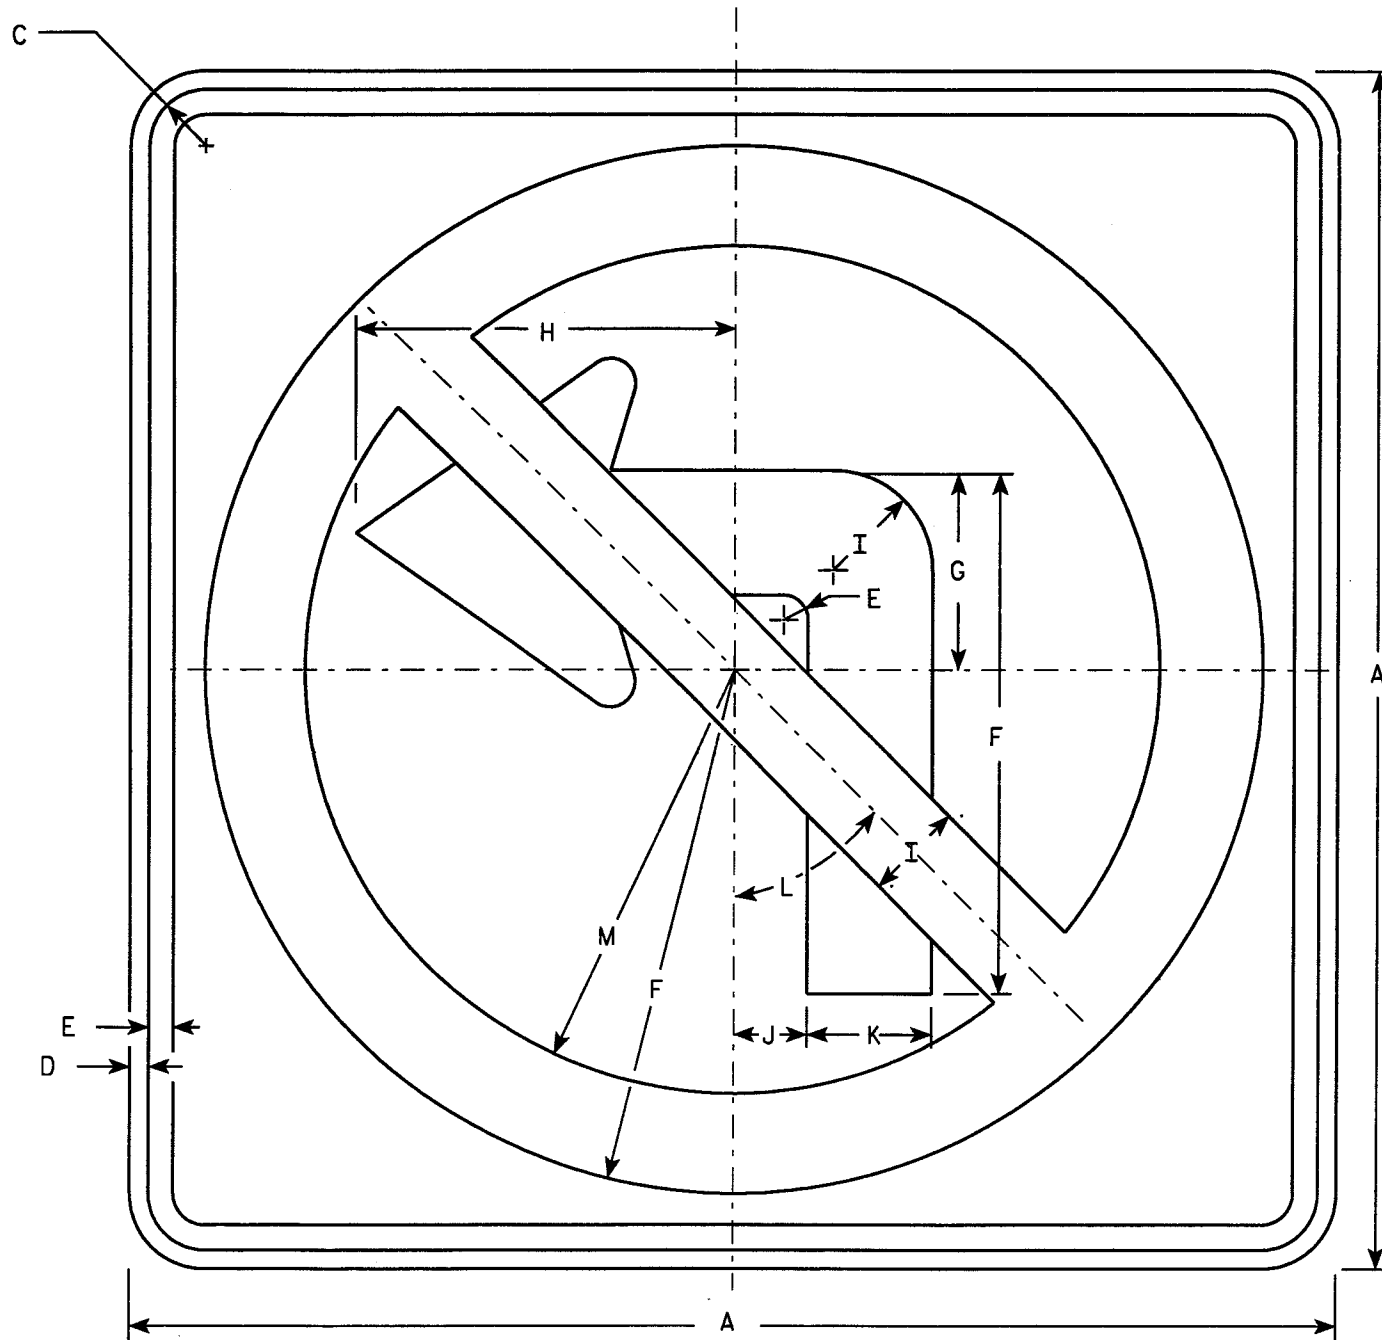

R3-2

NOTES

1. Sign is Type II - Type H Reflective - reference WIS DOT Standard Specification for HIGHWAY and STRUCTURE CONSTRUCTION latest edition.
2. Color:
Background - White
Message - See note 4
3. Corners may be square or rounded when base material is plywood but borders shall be rounded as shown. When base material is metal, the corners and borders shall be rounded.
4. Border & Arrow are non reflective black, the circle with diagonal bar is reflective red.

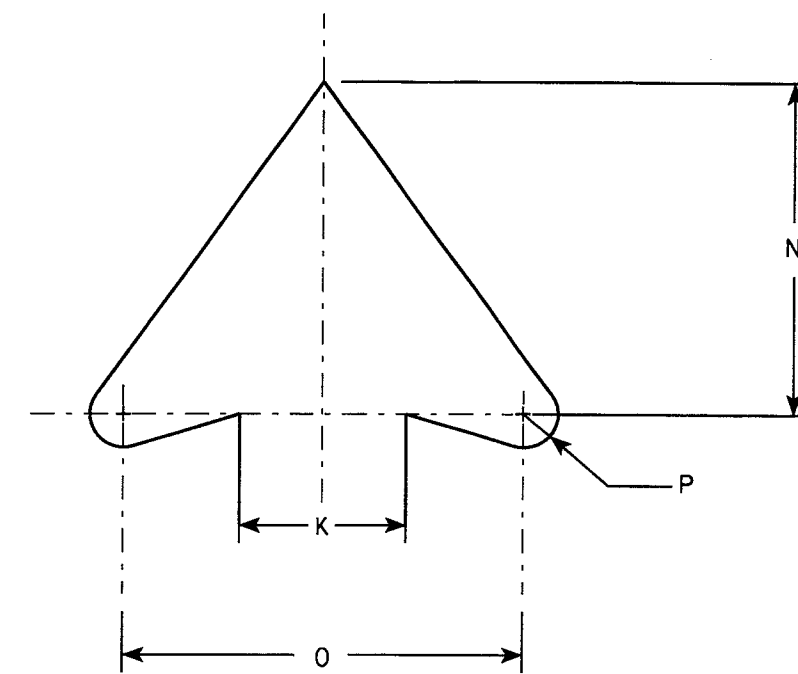

ARROW DETAIL

Metric equivalent for this sign is:

SIZE	
1	600 mm X 600 mm
2	600 mm X 600 mm
3	750 mm X 750 mm
4	900 mm X 900 mm
5	1200 mm X 1200 mm

SIZE	A	B	C	D	E	F	G	H	I	J	K	L	M	N	O	P	Q	R	S	T	U	V	W	X	Y	Z	Area sq. ft.	Area sq. m.
1	24		1 1/8	3/8	1/2	10 1/2	4	7 1/2	2	1 1/2	2 1/2	45°	8 1/2	5	6	1/2											4.0	0.36
2	24		1 1/8	3/8	1/2	10 1/2	4	7 1/2	2	1 1/2	2 1/2	45°	8 1/2	5	6	1/2											4.0	0.36
3	30		1 3/8	1/2	5/8	13 1/8	5	9 1/2	2 1/2	1 7/8	3 1/8	45°	10 5/8	6 1/4	7 1/2	5/8											6.25	0.56
4	36		1 5/8	5/8	3/4	15 3/4	6	11 1/4	3	2 1/4	3 3/4	45°	12 3/4	7 1/2	9	3/4											9.0	0.81
5	48		2 1/4	3/4	1	21	8	15	4	3	5	45°	17	10	12	1											16.0	1.44

STANDARD SIGN
R3-2

WISCONSIN DEPT OF TRANSPORTATION

APPROVED

Chester J. Spang
for State Traffic Engineer

DATE 2/01/02

PLATE NO. R3-2.9

PROJECT NO:

HWY:



COUNTY:

SHEET NO: 214

E

NOTES

1. Sign is Type II - Type H Reflective - reference WIS DOT Standard Specification for HIGHWAY and STRUCTURE CONSTRUCTION latest edition.
2. Color:
Background - White
Message - See note 4
3. Corners may be square or rounded when base material is plywood but borders shall be rounded as shown. When base material is metal, the corners and borders shall be rounded.
4. Border & Arrow are non reflective black, the circle with diagonal bar is reflective red.

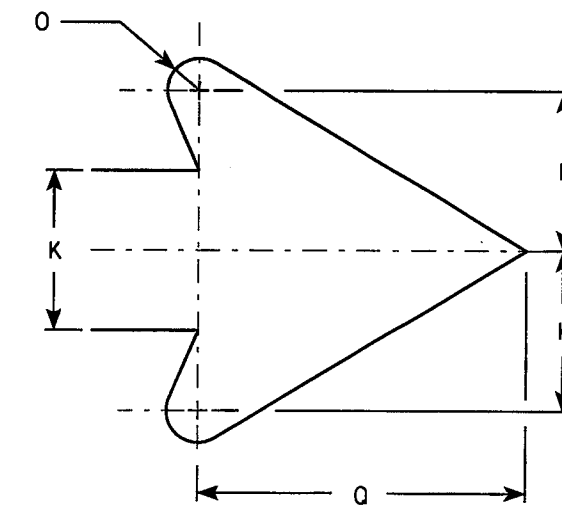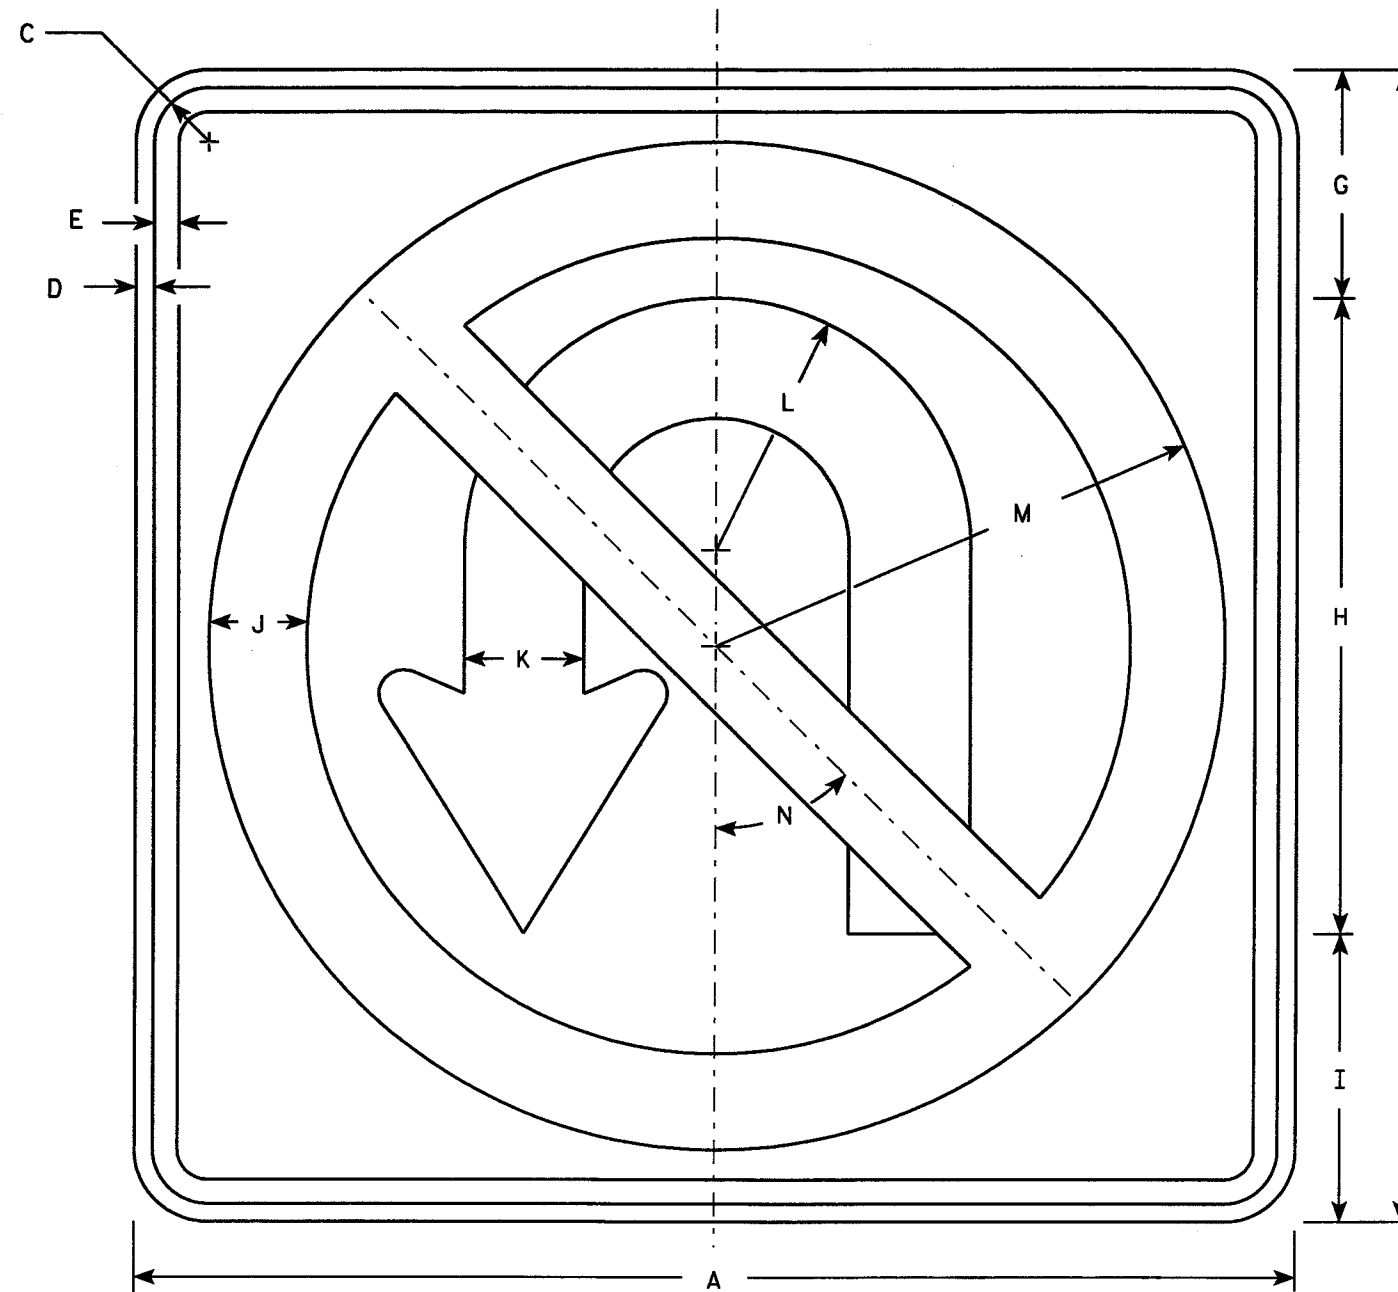

ARROW DETAIL

Metric equivalent for this sign is:

SIZE	
1	
2	600 mm X 600 mm
3	750 mm X 750 mm
4	900 mm X 900 mm
5	900 mm X 900 mm

SIZE	A	B	C	D	E	F	G	H	I	J	K	L	M	N	O	P	Q	R	S	T	U	V	W	X	Y	Z	A _{req} sq. ft.	A _{req} sq. m
1																												
2	24		1 1/8	3/8	1/2		4 3/4	13 1/4	6	2	2 1/2	5 1/4	10 1/2	45°	1/2		5										4.0	0.36
3	30		1 3/8	1/2	5/8		6	16 5/8	7 1/2	2 1/2	3 1/8	6 5/8	13 1/8	45°	5/8		6 1/2										6.25	0.56
4	36		1 5/8	5/8	3/4		7 1/8	19 7/8	9	3	3 3/4	7 7/8	15 3/4	45°	3/4		7 5/8										9.0	0.81
5	36		1 5/8	5/8	3/4		7 1/8	19 7/8	9	3	3 3/4	7 7/8	15 3/4	45°	3/4		7 5/8										9.0	0.81

STANDARD SIGN
R3-4

WISCONSIN DEPT OF TRANSPORTATION

APPROVED *Christa J. Spang*
for State Traffic Engineer

DATE 2/01/02 PLATE NO. R3-4.10



NOTES

1. Sign is Type II - Type H Reflective - reference WIS DOT Standard Specification for HIGHWAY and STRUCTURE CONSTRUCTION latest edition.
2. Color:
Background - White
Message - Black
3. Message Series - D
4. Corners may be square or rounded when base material is plywood but borders shall be rounded as shown. When base material is metal, the corners and borders shall be rounded.

7

Metric equivalent for this sign is:

SIZE	
1	
2	600 mm X 750 mm
3	900 mm X 1200 mm
4	1200 mm X 1500 mm
5	

SIZE	A	B	C	D	E	F	G	H	I	J	K	L	M	N	O	P	Q	R	S	T	U	V	W	X	Y	Z	Area sq. ft.	Area sq. m.
1																												
2	24	30	1 1/8	3/8	1/2	4	3 5/8	2 1/4	9 1/4	9 5/8	6 5/8	3 5/8	10														5.0	0.45
3	36	48	1 3/8	1/2	5/8	6	6	4	13 7/8	14 3/8	9 7/8	5 3/8	15														12.0	1.08
4	48	60	2 1/4	3/4	1	8	7 1/4	4 1/2	18 1/2	19 1/4	13 1/4	7 1/4	20														20.0	1.80
5																												

STANDARD SIGN

R8-8

WISCONSIN DEPT OF TRANSPORTATION

APPROVED *Chester J. Spang*
for State Traffic Engineer

DATE 2/8/02 PLATE NO. R8-8.3

PROJECT NO: _____ HWY: _____ COUNTY: _____ SHEET NO: 216 **E**

CTH Y EARTHWORK DATA

Station	Area Type	Area	Inc. Vol.	Cum. Vol.	MassHaul
Station 195+01.84	CUT	98.24	3.64	3.64	
	FILL	2.56	0.09	0.09	3.54
Station 195+50.00	CUT	110.76	185.77	189.41	
	FILL	0.75	2.94	3.03	186.38
Station 196+00.00	CUT	121.79	215.32	404.74	
	FILL	0.12	0.81	3.84	400.90
Station 196+50.00	CUT	117.51	221.58	626.31	
	FILL	3.05	2.94	6.78	619.53
Station 197+00.00	CUT	101.70	202.97	829.29	
	FILL	4.00	6.52	13.30	815.98
Station 197+50.00	CUT	138.99	222.86	1052.15	
	FILL	15.99	18.50	31.81	1020.34
Station 198+00.00	CUT	128.12	247.33	1299.48	
	FILL	16.71	30.28	62.09	1237.39
Station 198+50.00	CUT	168.27	274.44	1573.91	
	FILL	12.11	26.69	88.78	1485.14
Station 199+00.00	CUT	172.05	315.11	1889.02	
	FILL	0.91	12.06	100.84	1788.19
Station 199+50.00	CUT	280.51	419.03	2308.06	
	FILL	0.00	0.84	101.68	2206.37
Station 200+00.00	CUT	0.00	259.73	2567.78	
	FILL	0.00	0.00	101.68	2466.10
Station 200+50.00	CUT	137.82	127.61	2695.40	
	FILL	0.00	0.00	101.68	2593.72
Station 201+00.00	CUT	77.62	199.49	2894.88	
	FILL	16.96	15.70	117.38	2777.50
Station 201+50.00	CUT	138.86	200.45	3095.33	
	FILL	0.14	15.83	133.21	2962.13
Station 202+00.00	CUT	184.12	299.06	3394.39	
	FILL	0.00	0.13	133.33	3261.06
Station 202+50.00	CUT	135.61	296.04	3690.44	
	FILL	0.03	0.03	133.36	3557.07
Station 203+00.00	CUT	166.29	279.53	3969.97	
	FILL	0.00	0.03	133.39	3836.57
Station 203+50.00	CUT	141.73	285.20	4255.17	
	FILL	0.13	0.12	133.51	4121.66
Station 204+00.00	CUT	156.84	276.45	4531.62	
	FILL	0.00	0.12	133.63	4398.00
Station 204+50.00	CUT	111.44	248.40	4780.03	
	FILL	0.81	0.75	134.37	4645.65
Station 205+00.00	CUT	99.83	195.62	4975.65	
	FILL	3.23	3.74	138.11	4837.53

Station	Area Type	Area	Inc. Vol.	Cum. Vol.	MassHaul
Station 205+50.00	CUT	99.53	184.59	5160.23	
	FILL	0.00	2.99	141.10	5019.13
Station 206+00.00	CUT	111.94	195.80	5356.03	
	FILL	0.00	0.00	141.10	5214.93
Station 206+50.00	CUT	139.15	232.49	5588.52	
	FILL	0.31	0.29	141.39	5447.13
Station 207+00.00	CUT	122.51	242.28	5830.80	
	FILL	1.69	1.85	143.25	5687.55
Station 207+50.00	CUT	106.38	211.94	6042.73	
	FILL	1.10	2.58	145.83	5896.90
Station 208+00.00	CUT	121.65	211.13	6253.87	
	FILL	0.38	1.37	147.21	6106.66
Station 208+50.00	CUT	107.65	212.31	6466.18	
	FILL	1.48	1.72	148.93	6317.25
Station 209+00.00	CUT	111.47	202.89	6689.07	
	FILL	0.36	1.70	150.63	6518.44
Station 209+28.00	CUT	133.64	127.10	6796.16	
	FILL	2.30	1.38	152.01	6644.16
Station 209+50.00	CUT	128.26	106.70	6902.86	
	FILL	4.69	2.85	154.86	6748.01
Station 210+00.00	CUT	121.88	231.61	7134.47	
	FILL	2.95	7.08	161.94	6972.54
Station 210+50.00	CUT	166.88	267.37	7401.84	
	FILL	0.41	3.11	165.05	7236.80
Station 210+58.00	CUT	169.13	49.78	7451.62	
	FILL	0.63	0.15	165.20	7286.42
Station 211+00.00	CUT	142.64	242.49	7694.11	
	FILL	0.00	0.49	165.69	7528.42
Station 211+50.00	CUT	140.06	261.75	7955.86	
	FILL	0.07	0.06	165.75	7790.11
Station 212+00.00	CUT	137.92	257.38	8213.25	
	FILL	0.19	0.24	166.00	8047.25
Station 212+50.00	CUT	156.78	272.87	8486.12	
	FILL	0.00	0.18	166.17	8319.94
Station 212+61.00	CUT	163.50	65.24	8551.36	
	FILL	0.00	0.00	166.17	8385.18
Station 213+00.00	CUT	133.35	214.39	8765.75	
	FILL	0.49	0.35	166.53	8599.22
Station 213+50.00	CUT	130.35	244.17	9009.92	
	FILL	0.01	0.46	166.98	8842.94
Station 214+00.00	CUT	139.63	249.99	9259.91	
	FILL	4.91	4.55	171.54	9088.37

p:\mgalski\w\proj\w0002\970343\Quantities\Earthwork Summary.dwg 05/22/08 12:12 PM

9

9

CTH Y EARTHWORK DATA cont.

Station	Area Type	Area	Inc.Vol.	Cum.Vol.	MassHaul
Station 214+50.00	CUT FILL	176.45 0.00	292.67 4.55	9552.58 176.08	
Station 214+65.00	CUT FILL	191.97 0.00	102.34 0.00	9654.92 176.08	9376.49
Station 215+00.00	CUT FILL	165.14 1.21	231.47 0.78	9886.38 176.87	9478.83
Station 215+50.00	CUT FILL	158.43 0.88	297.78 1.93	10184.14 178.80	9709.52
Station 215+73.00	CUT FILL	159.42 0.10	134.53 0.42	10318.67 179.22	10005.34
Station 216+00.00	CUT FILL	129.97 5.02	144.69 2.56	10463.36 181.77	10139.45
Station 216+50.00	CUT FILL	139.86 2.62	249.85 7.07	10713.21 188.84	10281.59
Station 217+00.00	CUT FILL	157.93 3.10	275.73 5.29	10988.94 194.14	10524.36
Station 217+50.00	CUT FILL	191.06 0.13	323.14 2.99	11312.08 197.12	10794.81
Station 218+00.00	CUT FILL	198.83 0.26	361.01 0.36	11673.09 197.48	11114.95
Station 218+42.00	CUT FILL	203.07 2.88	312.59 2.44	11985.68 199.92	11475.61
Station 218+50.00	CUT FILL	195.69 3.76	59.08 0.98	12044.76 200.91	11785.76
Station 219+00.00	CUT FILL	117.29 18.40	289.80 20.52	12334.56 221.43	11843.85
Station 219+50.00	CUT FILL	107.63 30.24	208.26 45.03	12542.82 266.46	12113.13
Station 220+00.00	CUT FILL	102.14 34.15	194.23 59.62	12737.05 326.08	12276.36
Station 220+50.00	CUT FILL	100.02 38.55	187.19 67.31	12924.24 393.39	12410.98
Station 221+00.00	CUT FILL	100.99 35.34	186.12 68.41	13110.36 461.80	12530.85
Station 221+50.00	CUT FILL	111.38 31.30	196.64 61.71	13307.00 523.51	12648.56
Station 222+00.00	CUT FILL	121.52 27.95	215.65 54.86	13522.64 578.37	12783.49
Station 222+50.00	CUT FILL	169.19 23.43	269.18 47.57	13791.82 625.94	12944.27
					13165.88

Station	Area Type	Area	Inc.Vol.	Cum.Vol.	MassHaul
Station 223+00.00	CUT FILL	147.65 23.56	293.37 43.51	14085.19 669.45	
Station 223+50.00	CUT FILL	123.85 30.45	251.40 50.01	14336.59 719.46	13415.74
Station 224+00.00	CUT FILL	99.72 41.31	207.01 66.45	14543.60 785.91	13617.13
Station 224+50.00	CUT FILL	93.98 48.76	179.36 83.40	14722.96 869.31	13757.69
Station 225+00.00	CUT FILL	79.15 72.80	160.31 112.55	14883.27 981.88	13853.65
Station 225+50.00	CUT FILL	83.70 36.86	150.78 101.53	15034.05 1083.39	13901.41
Station 226+00.00	CUT FILL	78.35 46.78	150.04 77.43	15184.09 1160.82	13950.66
Station 226+50.00	CUT FILL	61.54 129.11	129.52 162.84	15313.61 1323.66	14023.27
Station 227+00.00	CUT FILL	33.29 153.21	87.81 261.40	15401.42 1585.06	13989.96
Station 227+50.00	CUT FILL	29.15 158.87	57.81 288.96	15459.23 1874.01	13816.36
Station 228+00.00	CUT FILL	31.78 138.07	56.42 274.94	15515.65 2148.96	13585.22
Station 228+50.00	CUT FILL	41.93 99.26	68.26 219.75	15583.91 2368.71	13366.69
Station 229+00.00	CUT FILL	52.87 82.57	87.78 168.37	15671.69 2537.08	13215.20
Station 229+50.00	CUT FILL	65.41 56.89	109.51 129.13	15781.20 2666.21	13134.61
Station 230+00.00	CUT FILL	83.77 37.25	138.12 87.17	15919.32 2753.38	13114.99
Station 230+50.00	CUT FILL	92.10 31.45	162.84 63.61	16082.16 2816.99	13165.94
Station 231+00.00	CUT FILL	78.55 26.73	158.00 53.87	16240.16 2870.86	13265.17
Station 231+50.00	CUT FILL	51.92 38.58	120.80 60.48	16360.97 2931.34	13369.30
Station 232+00.00	CUT FILL	32.05 50.06	77.75 82.07	16438.72 3013.41	13429.63
Station 232+50.00	CUT FILL	19.37 46.50	47.61 89.40	16486.32 3102.81	13425.30
Station 233+00.00	CUT FILL	21.10 68.18	37.47 106.18	16523.79 3209.00	13383.51
					13314.80

CTH Y EARTHWORK DATA cont.

Station	Area Type	Area	Inc.Vol.	Cum.Vol.	MassHaul
233+50.00	CUT	33.79	50.82	16574.61	13255.61
	FILL	50.63	110.01	3319.01	
233+89.58	CUT	57.80	67.13	16641.75	13256.16
	FILL	40.21	66.58	3385.59	
234+00.00	CUT	82.23	23.16	16664.91	13264.41
	FILL	37.08	14.91	3400.50	
234+50.00	CUT	57.20	110.58	16775.49	13318.43
	FILL	24.01	56.56	3457.06	
235+00.00	CUT	58.25	106.89	16882.38	13379.91
	FILL	25.04	45.41	3502.47	
235+50.00	CUT	46.24	96.75	16979.13	13409.03
	FILL	48.00	67.63	3570.10	
236+00.00	CUT	55.35	94.07	17073.20	13420.95
	FILL	40.71	82.15	3652.25	
236+50.00	CUT	64.44	110.92	17184.12	13484.19
	FILL	10.78	47.68	3699.93	
237+00.00	CUT	56.90	112.36	17296.48	13547.36
	FILL	42.35	49.19	3749.12	
237+50.00	CUT	65.14	113.00	17409.48	13596.59
	FILL	26.53	63.77	3812.89	
238+00.00	CUT	90.75	144.35	17553.83	13704.64
	FILL	12.67	36.30	3849.19	
238+50.00	CUT	112.38	188.09	17741.92	13873.40
	FILL	8.20	19.33	3868.52	
239+00.00	CUT	126.92	221.58	17963.50	14083.22
	FILL	4.50	11.76	3880.28	
239+50.00	CUT	161.07	266.65	18230.16	14345.65
	FILL	0.07	4.23	3884.51	
240+00.00	CUT	164.29	301.25	18531.41	14645.47
	FILL	1.47	1.43	3885.94	
240+50.00	CUT	174.03	313.25	18844.66	14957.36
	FILL	0.00	1.37	3887.30	
241+00.00	CUT	138.07	288.97	19133.64	15237.21
	FILL	9.85	9.12	3896.43	
241+50.00	CUT	150.41	267.11	19400.75	15492.29
	FILL	3.15	12.04	3908.46	
242+00.00	CUT	150.26	278.40	19679.15	15765.80
	FILL	2.13	4.88	3913.34	
242+28.28	CUT	169.12	167.26	19846.41	15929.37
	FILL	4.93	3.69	3917.04	

Station	Area Type	Area	Inc.Vol.	Cum.Vol.	MassHaul
242+50.00	CUT	150.89	128.72	19975.12	16055.50
	FILL	1.50	2.58	3919.62	
243+00.00	CUT	168.27	295.52	20270.64	16349.13
	FILL	0.54	1.89	3921.51	
243+50.00	CUT	181.14	323.53	20594.17	16672.15
	FILL	0.00	0.50	3922.02	
244+00.00	CUT	181.82	336.08	20930.24	17008.17
	FILL	0.07	0.08	3922.08	
244+50.00	CUT	170.66	326.38	21256.62	17333.97
	FILL	0.55	0.57	3922.65	
245+00.00	CUT	156.81	303.22	21559.84	17636.27
	FILL	0.45	0.92	3923.57	
245+50.00	CUT	142.90	277.51	21837.35	17908.81
	FILL	4.92	4.97	3928.54	
246+00.00	CUT	150.95	272.08	22109.43	18171.78
	FILL	4.93	9.12	3937.66	
246+50.00	CUT	159.76	287.69	22397.12	18453.86
	FILL	1.12	5.60	3943.26	
247+00.00	CUT	170.34	305.65	22702.77	18757.08
	FILL	1.50	2.42	3945.69	
247+50.00	CUT	176.70	321.34	23024.11	19076.98
	FILL	0.06	1.45	3947.13	
248+00.00	CUT	176.72	327.25	23351.36	19403.28
	FILL	0.96	0.95	3948.08	
248+50.00	CUT	163.14	314.69	23666.04	19716.37
	FILL	0.76	1.59	3949.67	
249+00.00	CUT	148.46	288.52	23954.56	20003.51
	FILL	0.73	1.38	3951.06	
249+50.00	CUT	125.77	253.92	24208.49	20253.90
	FILL	3.08	3.53	3954.59	
250+00.00	CUT	86.49	196.54	24405.03	20426.15
	FILL	23.15	24.29	3978.88	
250+50.00	CUT	74.71	149.26	24554.28	20512.37
	FILL	44.94	63.04	4041.92	
250+93.43	CUT	107.98	146.93	24701.21	20585.71
	FILL	46.56	73.59	4115.51	
251+00.00	CUT	109.55	26.47	24727.68	20601.26
	FILL	43.15	10.92	4126.42	
251+50.00	CUT	76.48	172.25	24899.93	20692.34
	FILL	44.51	81.17	4207.59	

CTH Y EARTHWORK DATA cont.

Station	Area Type	Area	Inc.Vol.	Cum.Vol.	MassHaul
252+00.00	CUT	78.72	143.70	25043.63	20747.92
	FILL	50.66	88.12	4295.71	
252+50.00	CUT	88.20	154.55	25198.17	20816.12
	FILL	42.59	86.35	4382.05	
253+00.00	CUT	109.93	183.45	25381.63	20927.99
	FILL	34.71	71.58	4453.63	
253+50.00	CUT	127.63	219.96	25601.59	21089.68
	FILL	28.22	58.27	4511.91	
254+00.00	CUT	138.98	246.86	25848.45	21294.20
	FILL	17.51	42.34	4554.25	
254+13.76	CUT	165.92	77.69	25926.14	21363.64
	FILL	14.85	8.25	4562.50	
254+50.00	CUT	150.17	212.13	26138.27	21558.43
	FILL	11.00	17.35	4579.84	
255+00.00	CUT	156.98	284.40	26422.67	21825.98
	FILL	7.19	16.84	4596.68	
255+50.00	CUT	182.71	314.53	26737.19	22132.24
	FILL	1.74	8.27	4604.95	
256+00.00	CUT	170.10	326.68	27063.87	22456.79
	FILL	0.56	2.13	4607.09	
256+50.00	CUT	118.40	267.13	27331.00	22720.79
	FILL	2.82	3.13	4610.22	
257+00.00	CUT	46.67	152.84	27483.85	22857.82
	FILL	14.25	15.81	4626.03	
257+50.00	CUT	72.01	109.89	27593.74	22916.06
	FILL	41.53	51.65	4677.68	
258+00.00	CUT	68.85	43.74	27695.21	22979.86
	FILL	4.51	8.07	4715.35	
258+50.00	CUT	62.18	121.33	27816.53	23097.01
	FILL	0.00	4.18	4719.52	
258+53.16	CUT	0.00	57.58	27874.11	23154.59
	FILL	0.00	0.00	4719.52	

SIDEROAD EARTHWORK DATA

SODA CREEK RD

Station	Area Type	Area	Inc.Vol.	Cum.Vol.	MassHaul
9+35.00	CUT	43.06	27.91	27.91	27.91
	FILL	0.00	0.00	0.00	
9+50.00	CUT	50.18	25.90	53.81	53.00
	FILL	2.90	0.81	0.81	
9+75.31	CUT	78.85	60.48	114.29	112.12
	FILL	0.00	1.36	2.17	

JACKTAR RD

Station	Area Type	Area	Inc.Vol.	Cum.Vol.	MassHaul
9+00.00	CUT	42.44	39.30	39.30	39.29
	FILL	0.01	0.01	0.01	
9+50.00	CUT	58.83	93.77	133.07	131.62
	FILL	1.55	1.45	1.46	
9+76.00	CUT	125.64	88.82	221.89	219.69
	FILL	0.00	0.75	2.20	
10+00.00	CUT	0.00	55.84	277.73	275.53
	FILL	0.00	0.00	2.20	

BUTLER AVE

Station	Area Type	Area	Inc.Vol.	Cum.Vol.	MassHaul
9+03.58	CUT	38.93	2.58	2.58	2.57
	FILL	0.11	0.01	0.01	
9+50.00	CUT	49.44	75.96	78.54	68.63
	FILL	11.41	9.91	9.92	
9+76.00	CUT	82.32	63.44	141.98	126.57
	FILL	0.00	5.49	15.41	


STORM SEWER OUTFALL AT COMMUNITY PARK

Station	Area Type	Area	Inc.Vol.	Cum.Vol.	MassHaul
Station 12+20.00	CUT	68.51			
	FILL	0.00			
Station 12+40.00	CUT	70.48	51.48	51.48	
	FILL	0.00	0.00	0.00	51.48
Station 12+60.00	CUT	72.68	53.02	104.50	
	FILL	0.00	0.00	0.00	104.50
Station 12+80.00	CUT	70.43	53.00	157.51	
	FILL	0.00	0.00	0.00	157.51
Station 13+00.00	CUT	69.31	51.75	209.26	
	FILL	0.00	0.00	0.00	209.26
Station 13+20.00	CUT	67.16	50.55	259.81	
	FILL	0.00	0.00	0.00	259.81
Station 13+40.00	CUT	62.82	48.14	307.95	
	FILL	0.00	0.00	0.00	307.95
Station 13+60.00	CUT	62.90	46.56	354.51	
	FILL	0.00	0.00	0.00	354.51
Station 13+80.00	CUT	61.62	46.12	400.63	
	FILL	0.00	0.00	0.00	400.63
Station 14+00.00	CUT	60.12	45.09	445.72	
	FILL	0.00	0.00	0.00	445.72
Station 14+20.00	CUT	58.70	44.01	489.72	
	FILL	0.00	0.00	0.00	489.72
Station 14+40.00	CUT	56.84	42.79	532.51	
	FILL	0.00	0.00	0.00	532.51
Station 14+60.00	CUT	54.72	41.32	573.83	
	FILL	0.00	0.00	0.00	573.83
Station 14+80.00	CUT	55.21	40.71	614.54	
	FILL	0.00	0.00	0.00	614.54
Station 15+00.00	CUT	55.40	40.97	655.51	
	FILL	0.00	0.00	0.00	655.51
Station 15+20.00	CUT	52.65	40.02	695.53	
	FILL	0.00	0.00	0.00	695.53
Station 15+40.00	CUT	48.20	37.35	732.88	
	FILL	0.00	0.00	0.00	732.88
Station 15+60.00	CUT	43.66	34.02	766.90	
	FILL	0.00	0.00	0.00	766.90
Station 15+80.00	CUT	44.11	32.51	799.41	
	FILL	0.00	0.00	0.00	799.41
Station 16+00.00	CUT	40.76	31.43	830.85	
	FILL	0.00	0.00	0.00	830.85
Station 16+20.00	CUT	36.25	28.52	859.37	
	FILL	0.00	0.00	0.00	859.37


Station	Area Type	Area	Inc.Vol.	Cum.Vol.	MassHaul
Station 16+40.00	CUT	28.50	23.98	883.35	
	FILL	0.00	0.00	0.00	883.35
Station 16+60.00	CUT	34.10	23.19	906.54	
	FILL	0.00	0.00	0.00	906.54
Station 16+80.00	CUT	62.37	35.73	942.27	
	FILL	0.00	0.00	0.00	942.27
Station 17+00.00	CUT	60.78	45.61	987.88	
	FILL	0.00	0.00	0.00	987.88
Station 17+20.00	CUT	30.24	33.71	1021.59	
	FILL	0.00	0.00	0.00	1021.59
Station 17+40.00	CUT	2.76	12.22	1033.81	
	FILL	0.00	0.00	0.00	1033.81
Station 17+60.00	CUT	2.49	1.95	1035.75	
	FILL	0.00	0.00	0.00	1035.75
Station 17+80.00	CUT	1.11	1.34	1037.09	
	FILL	0.00	0.00	0.00	1037.09
Station 18+00.00	CUT	0.48	0.59	1037.68	
	FILL	0.00	0.00	0.00	1037.68
Station 18+20.00	CUT	0.59	0.40	1038.08	
	FILL	0.00	0.00	0.00	1038.08
Station 18+40.00	CUT	1.00	0.59	1038.66	
	FILL	0.00	0.00	0.00	1038.66
Station 18+60.00	CUT	0.48	0.55	1039.21	
	FILL	0.00	0.00	0.00	1039.21
Station 18+75.00	CUT	0.01	0.14	1039.35	
	FILL	0.00	0.00	0.00	1039.35

DITCH AT 250+30 RT


Station	Area Type	Area	Inc.Vol.	Cum.Vol.	MassHaul
Station 10+40.00	CUT	27.89			
	FILL	0.00			
Station 10+60.00	CUT	19.81	17.67	17.67	
	FILL	0.00	0.00	0.00	17.67
Station 10+80.00	CUT	12.18	11.85	29.52	
	FILL	0.00	0.00	0.00	29.52
Station 11+00.00	CUT	6.19	6.80	36.32	
	FILL	0.00	0.00	0.00	36.32
Station 11+20.00	CUT	1.98	3.03	39.35	
	FILL	0.00	0.00	0.00	39.35

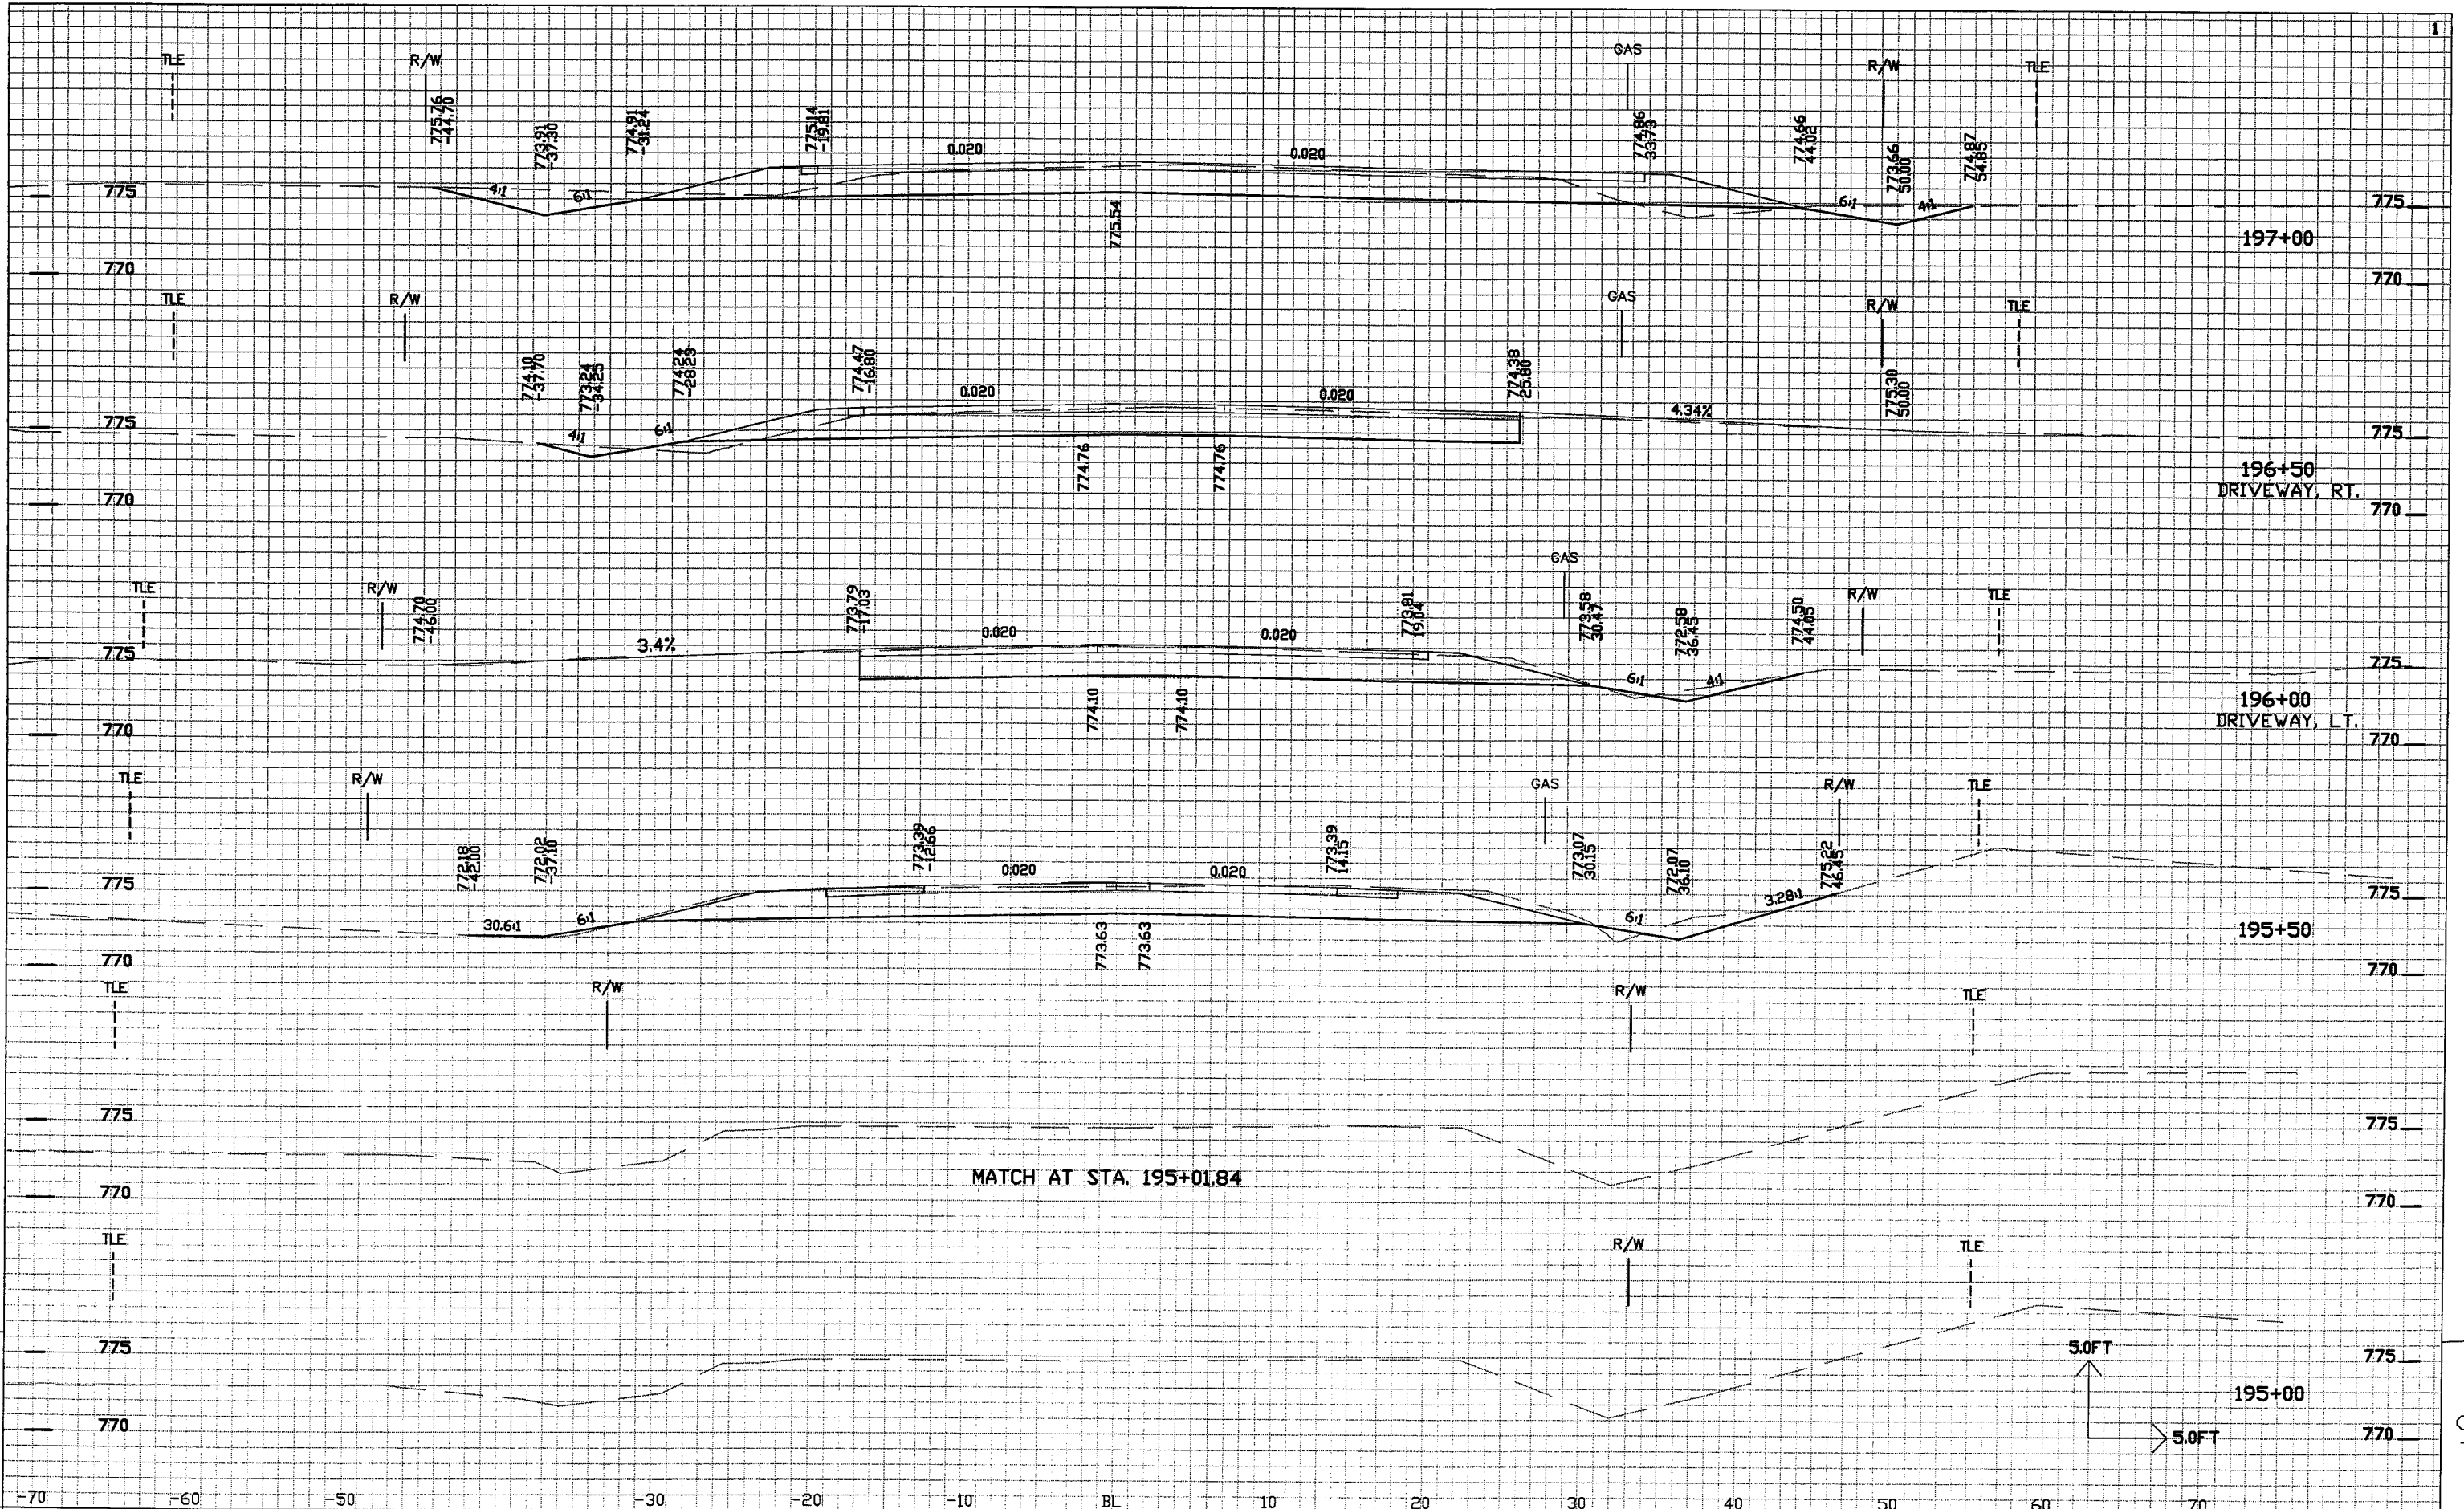

g:\essen_w\DWG\W0002\970343\Cross_Section\CTH Y 4-1-08.dwg 06/18/08 11:57 AM

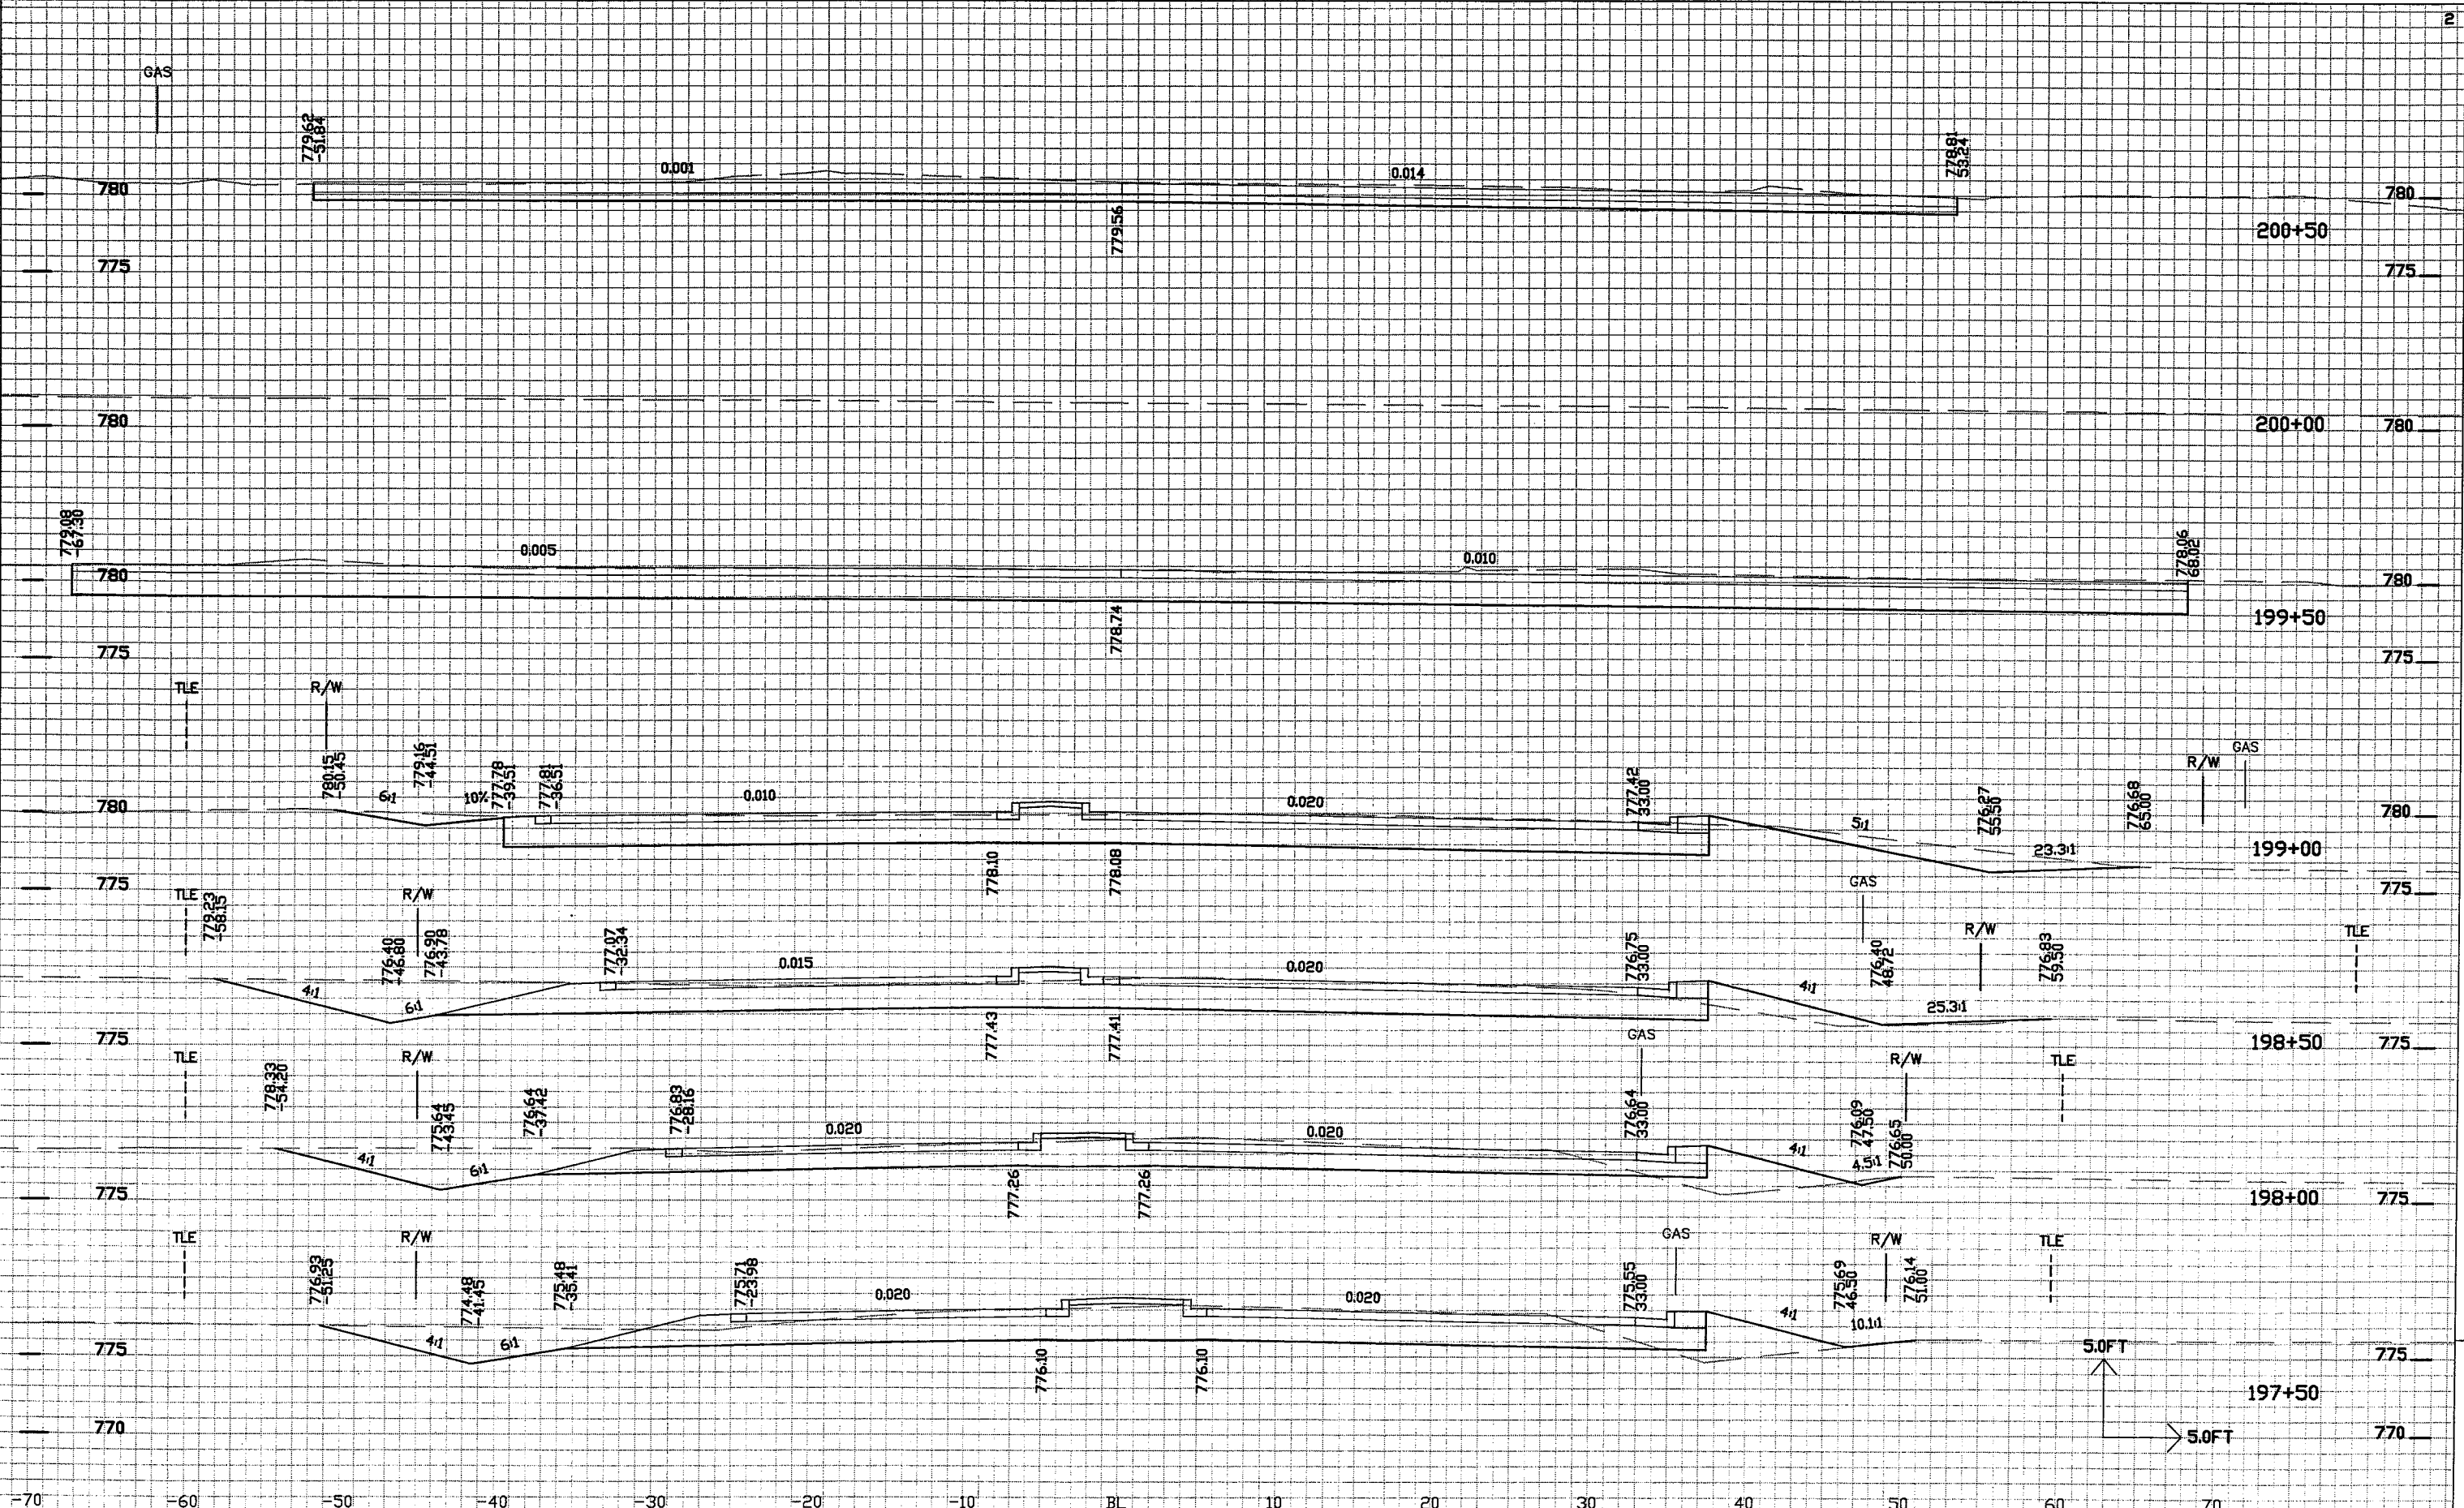

PROJECT NO: 4994-00-87 & 6432-11-71 | HWY: CTH Y | COUNTY: WINNEBAGO | CROSS SECTIONS | SHEET NO: 223 | E

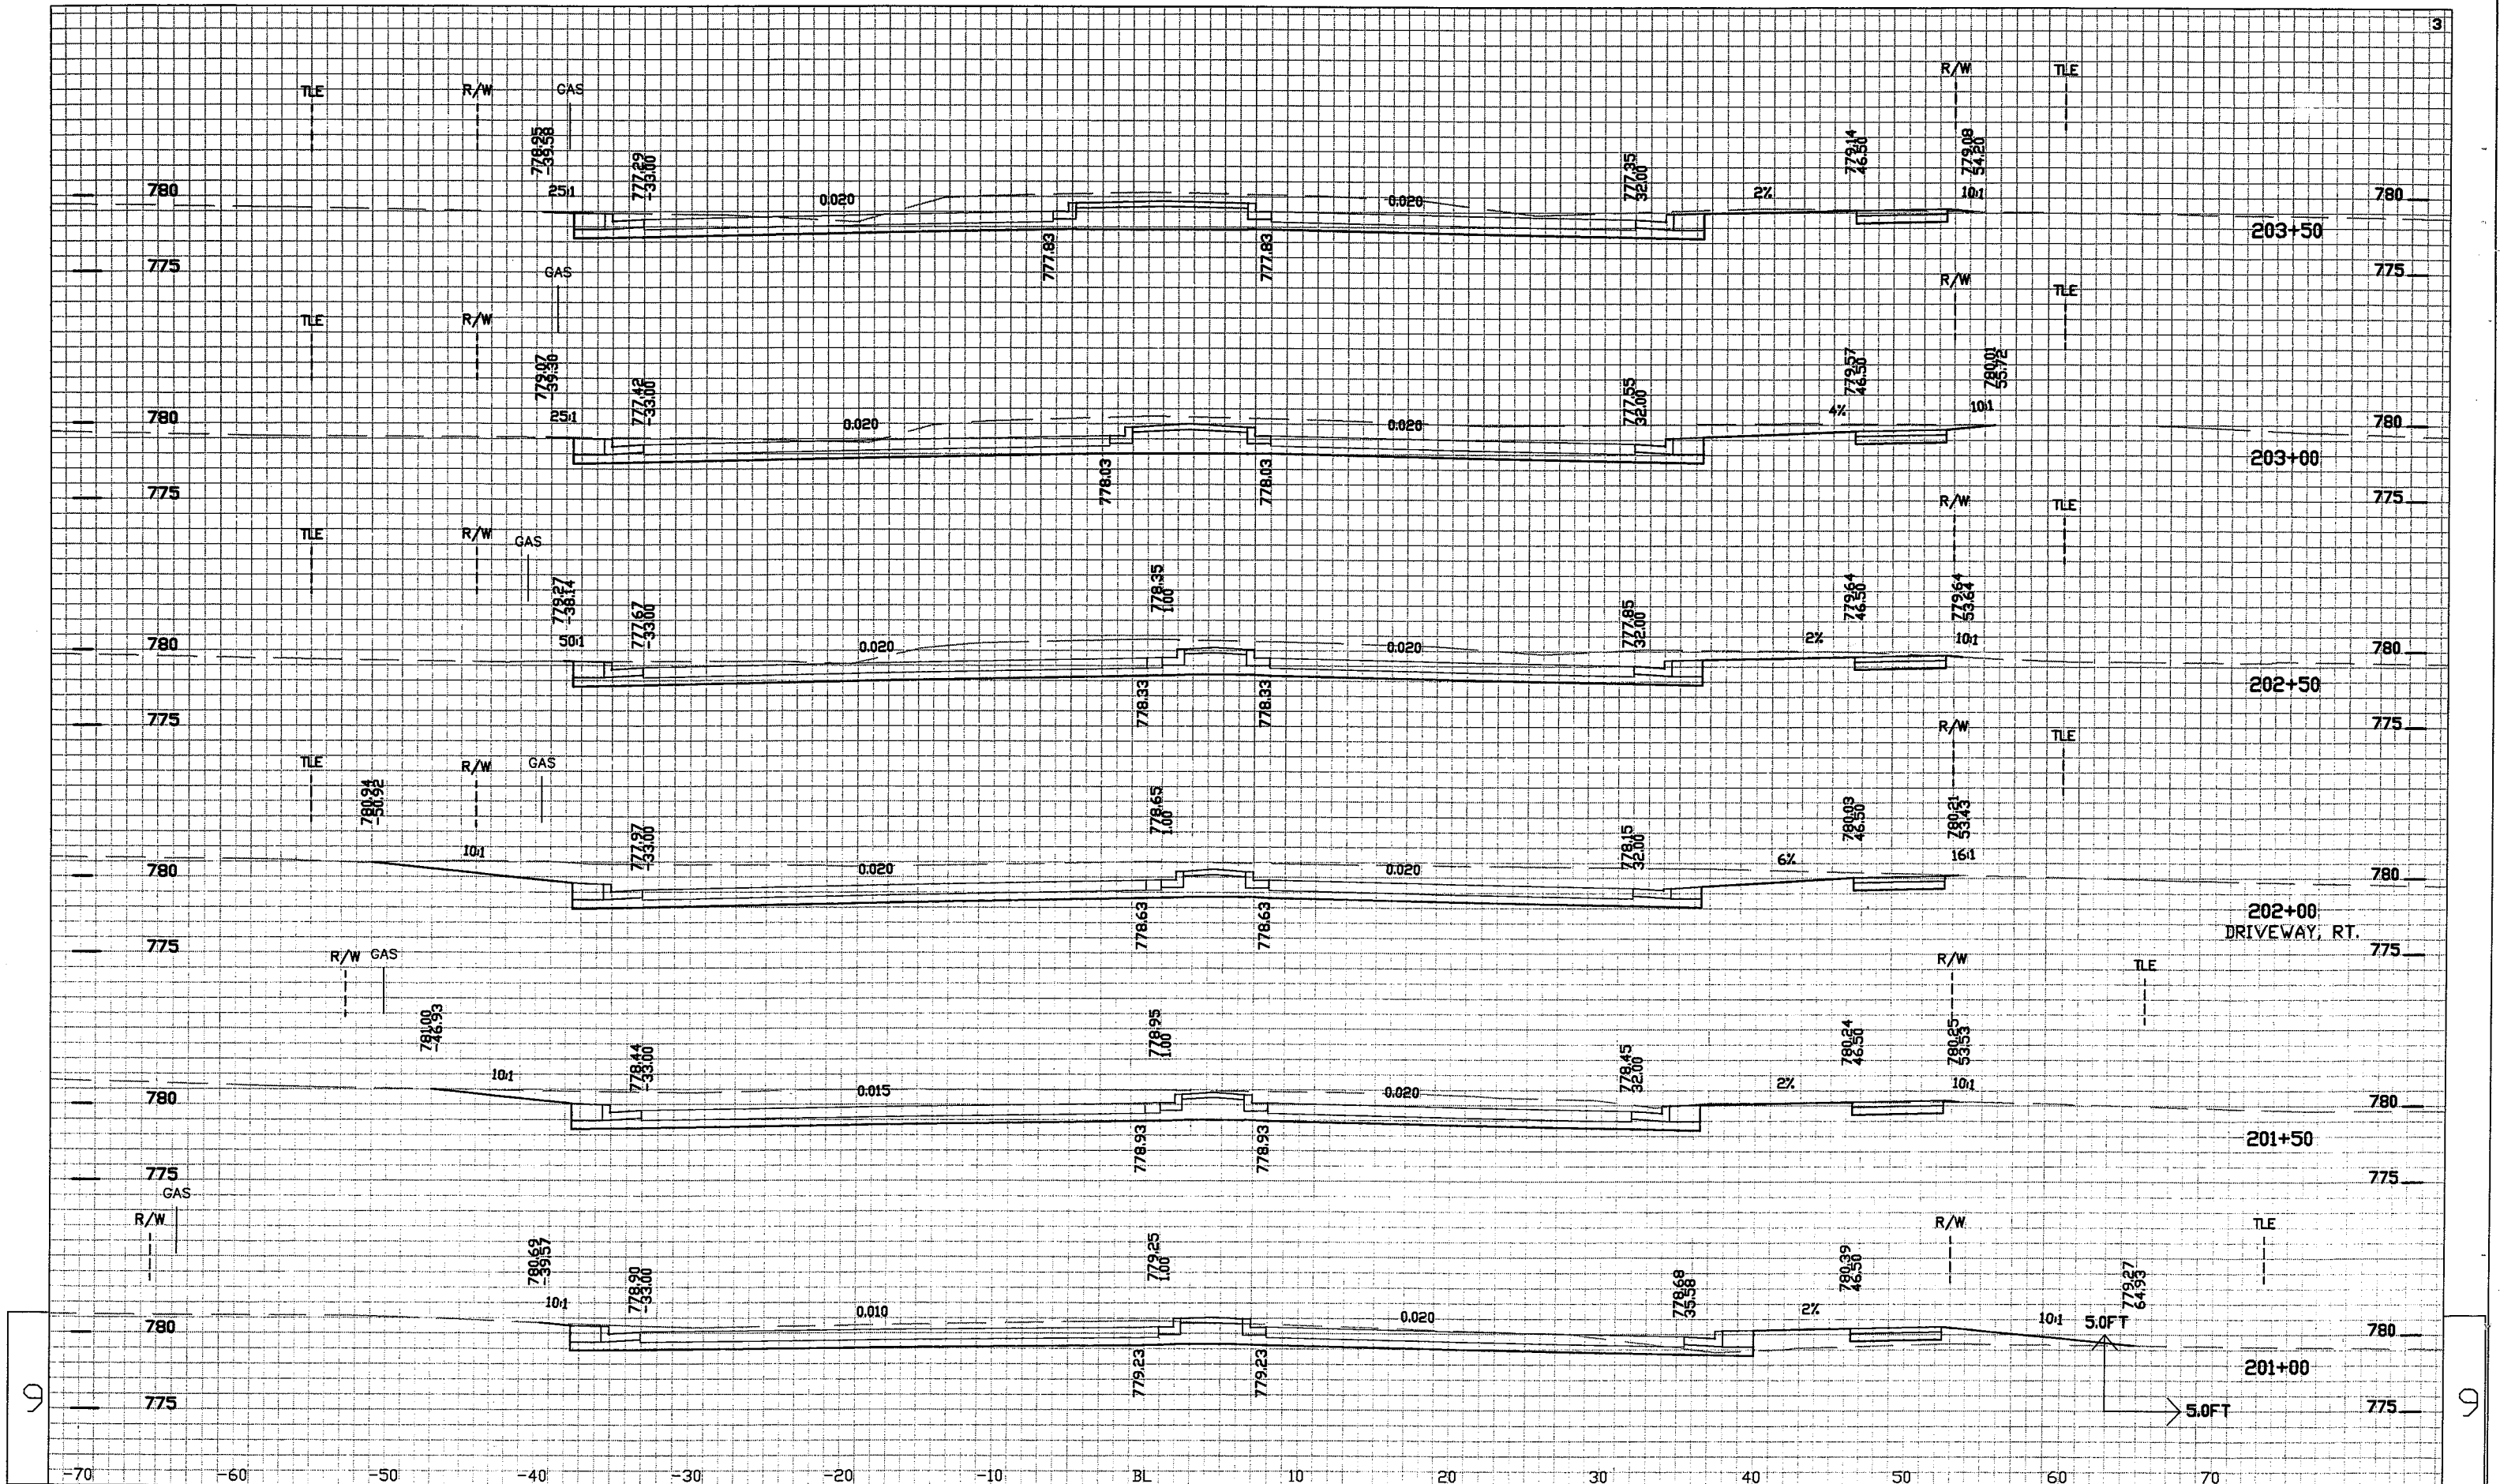

PROJECT NO: 4994-00-87 & 6432-11-71

HWY: CTH Y

COUNTY: WINNEBAGO

CROSS SECTIONS

SHEET NO: 224

E


FILE NAME : \$\$...designfile...\$\$

PLOT DATE : \$\$...plottingdate...\$\$

PLOT BY : \$\$...plotuser...\$\$

PLOT NAME :

PLOT SCALE : \$\$...plotscale...\$\$

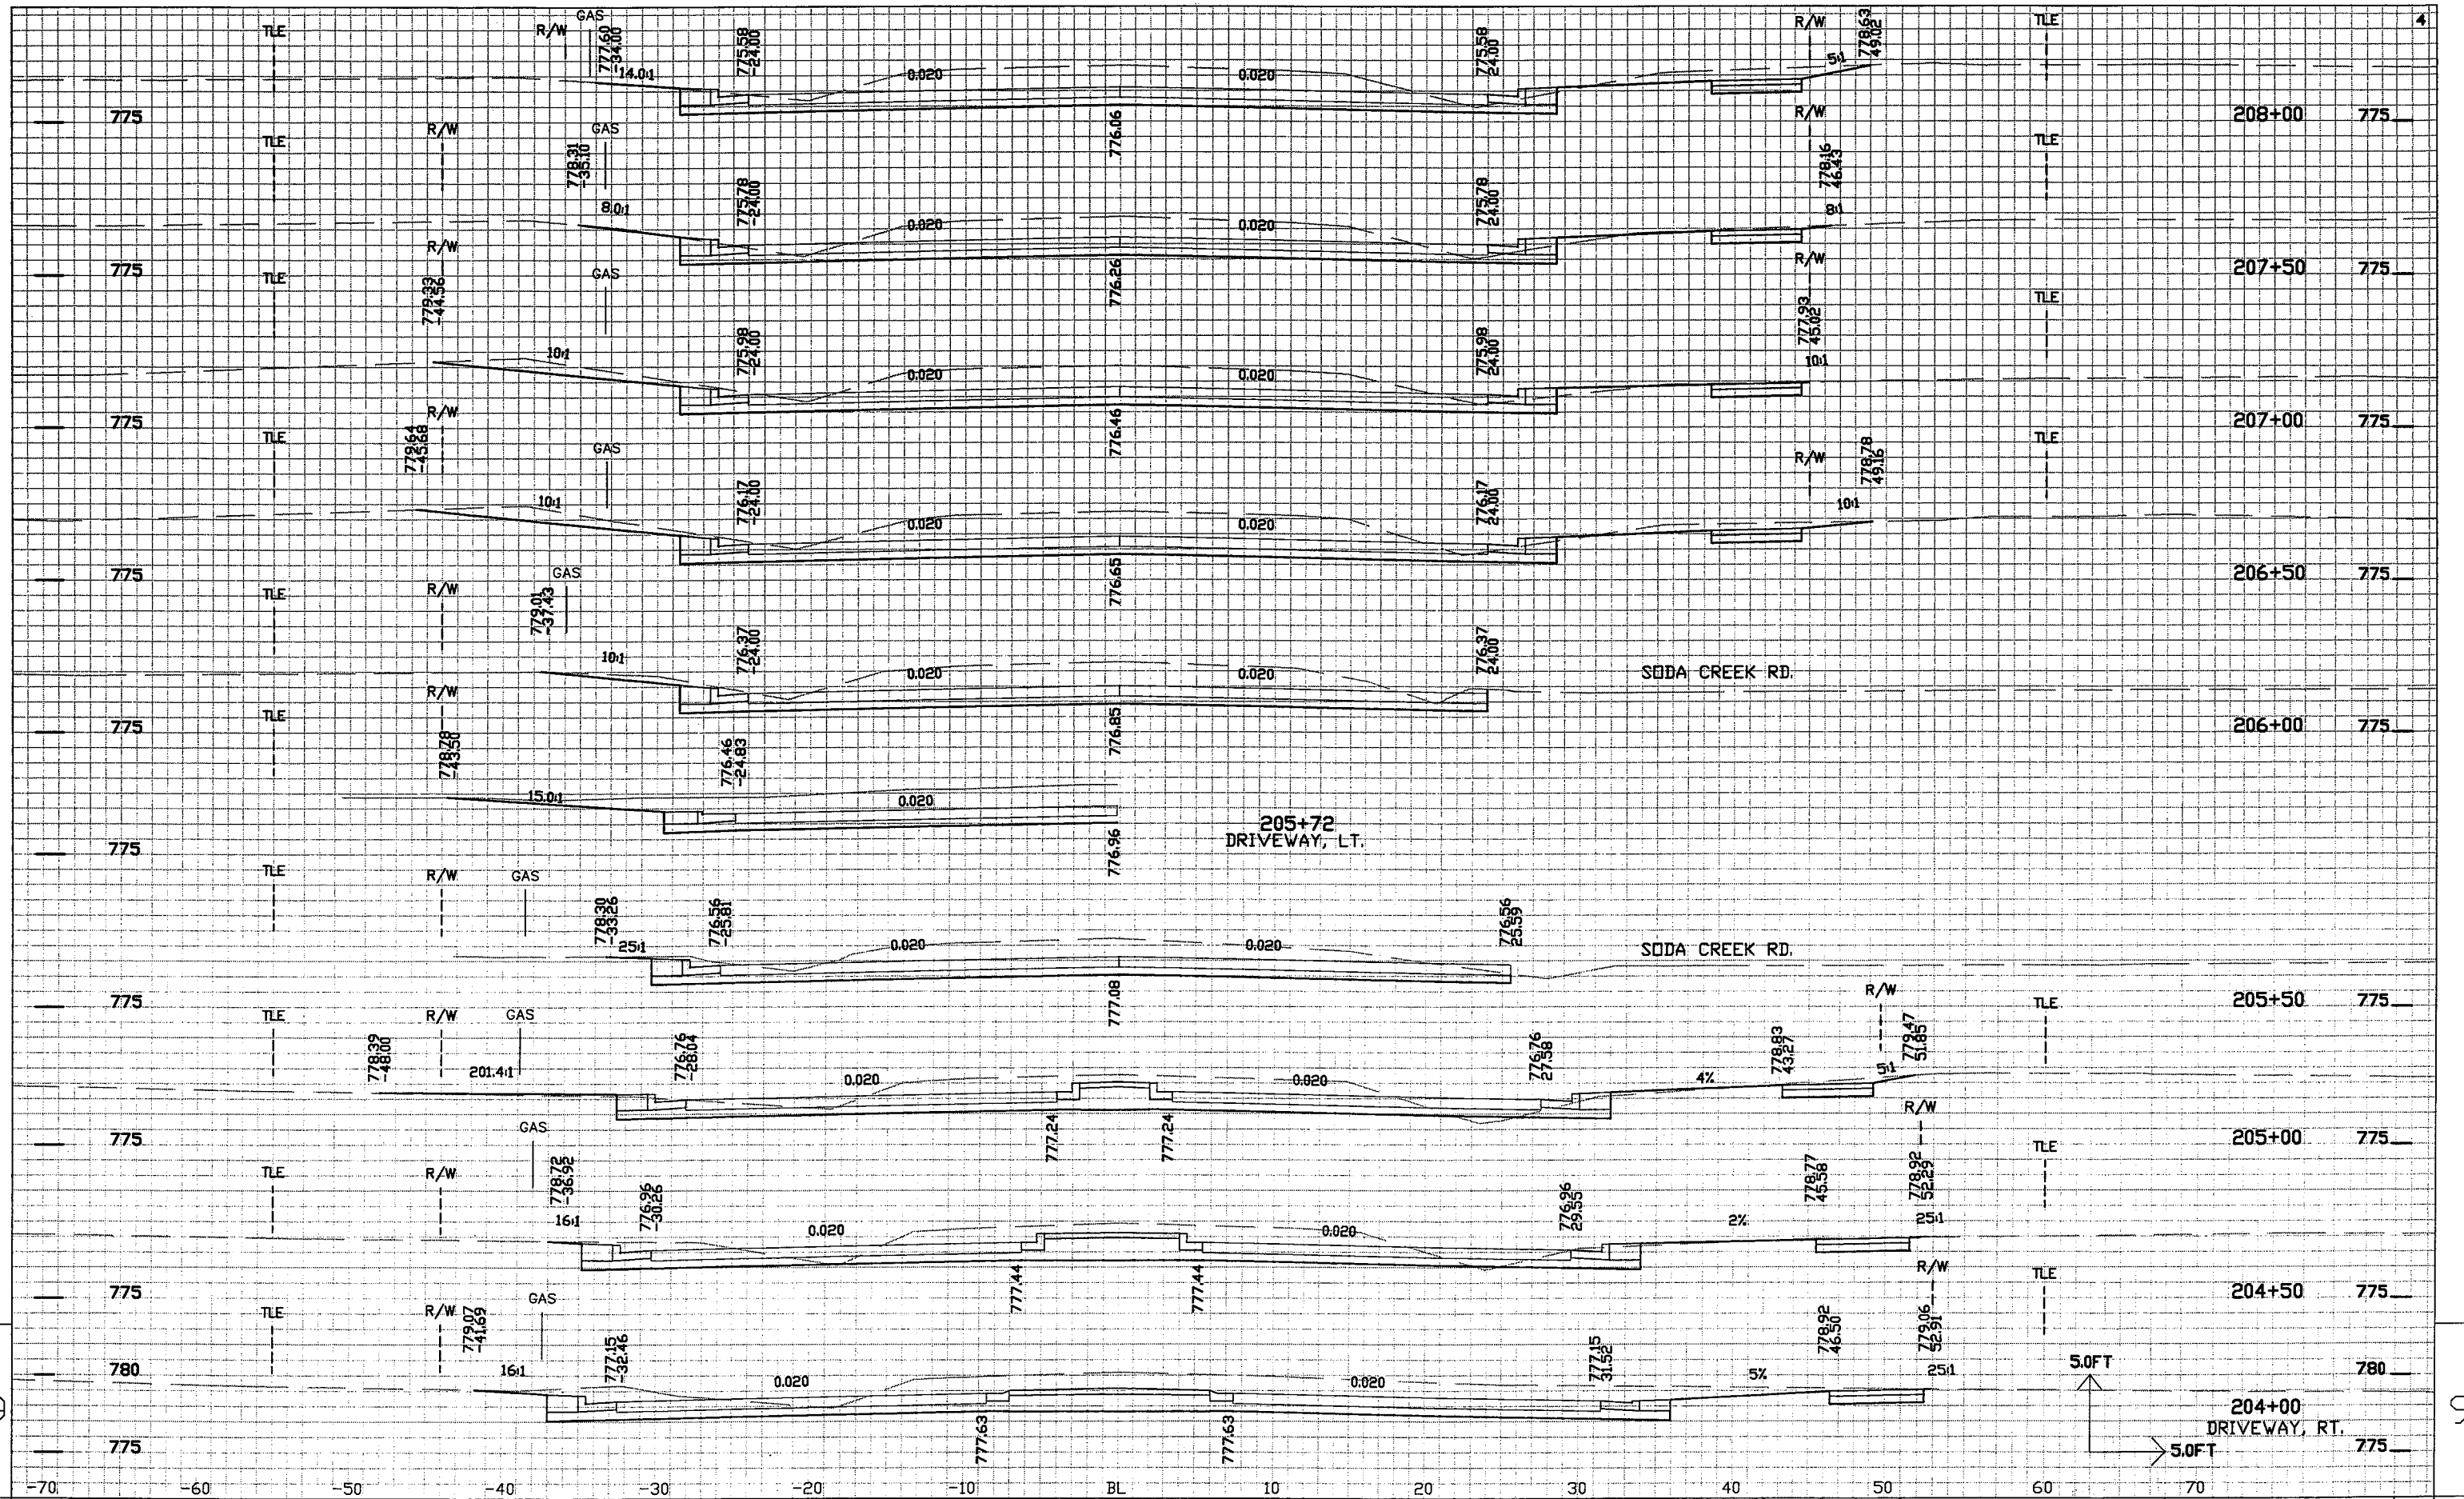

PROJECT NO: 4994-00-87

HWY: CTH Y

COUNTY: WINNEBAGO

CROSS SECTIONS

SHEET NO: 225

E


FILE NAME : \$\$...designfile...\$\$

PLOT DATE : \$\$...plottingdate...\$\$

PLOT BY : \$\$...plotuser...\$\$

PLOT NAME :

PLOT SCALE : \$\$...plotscale...\$\$

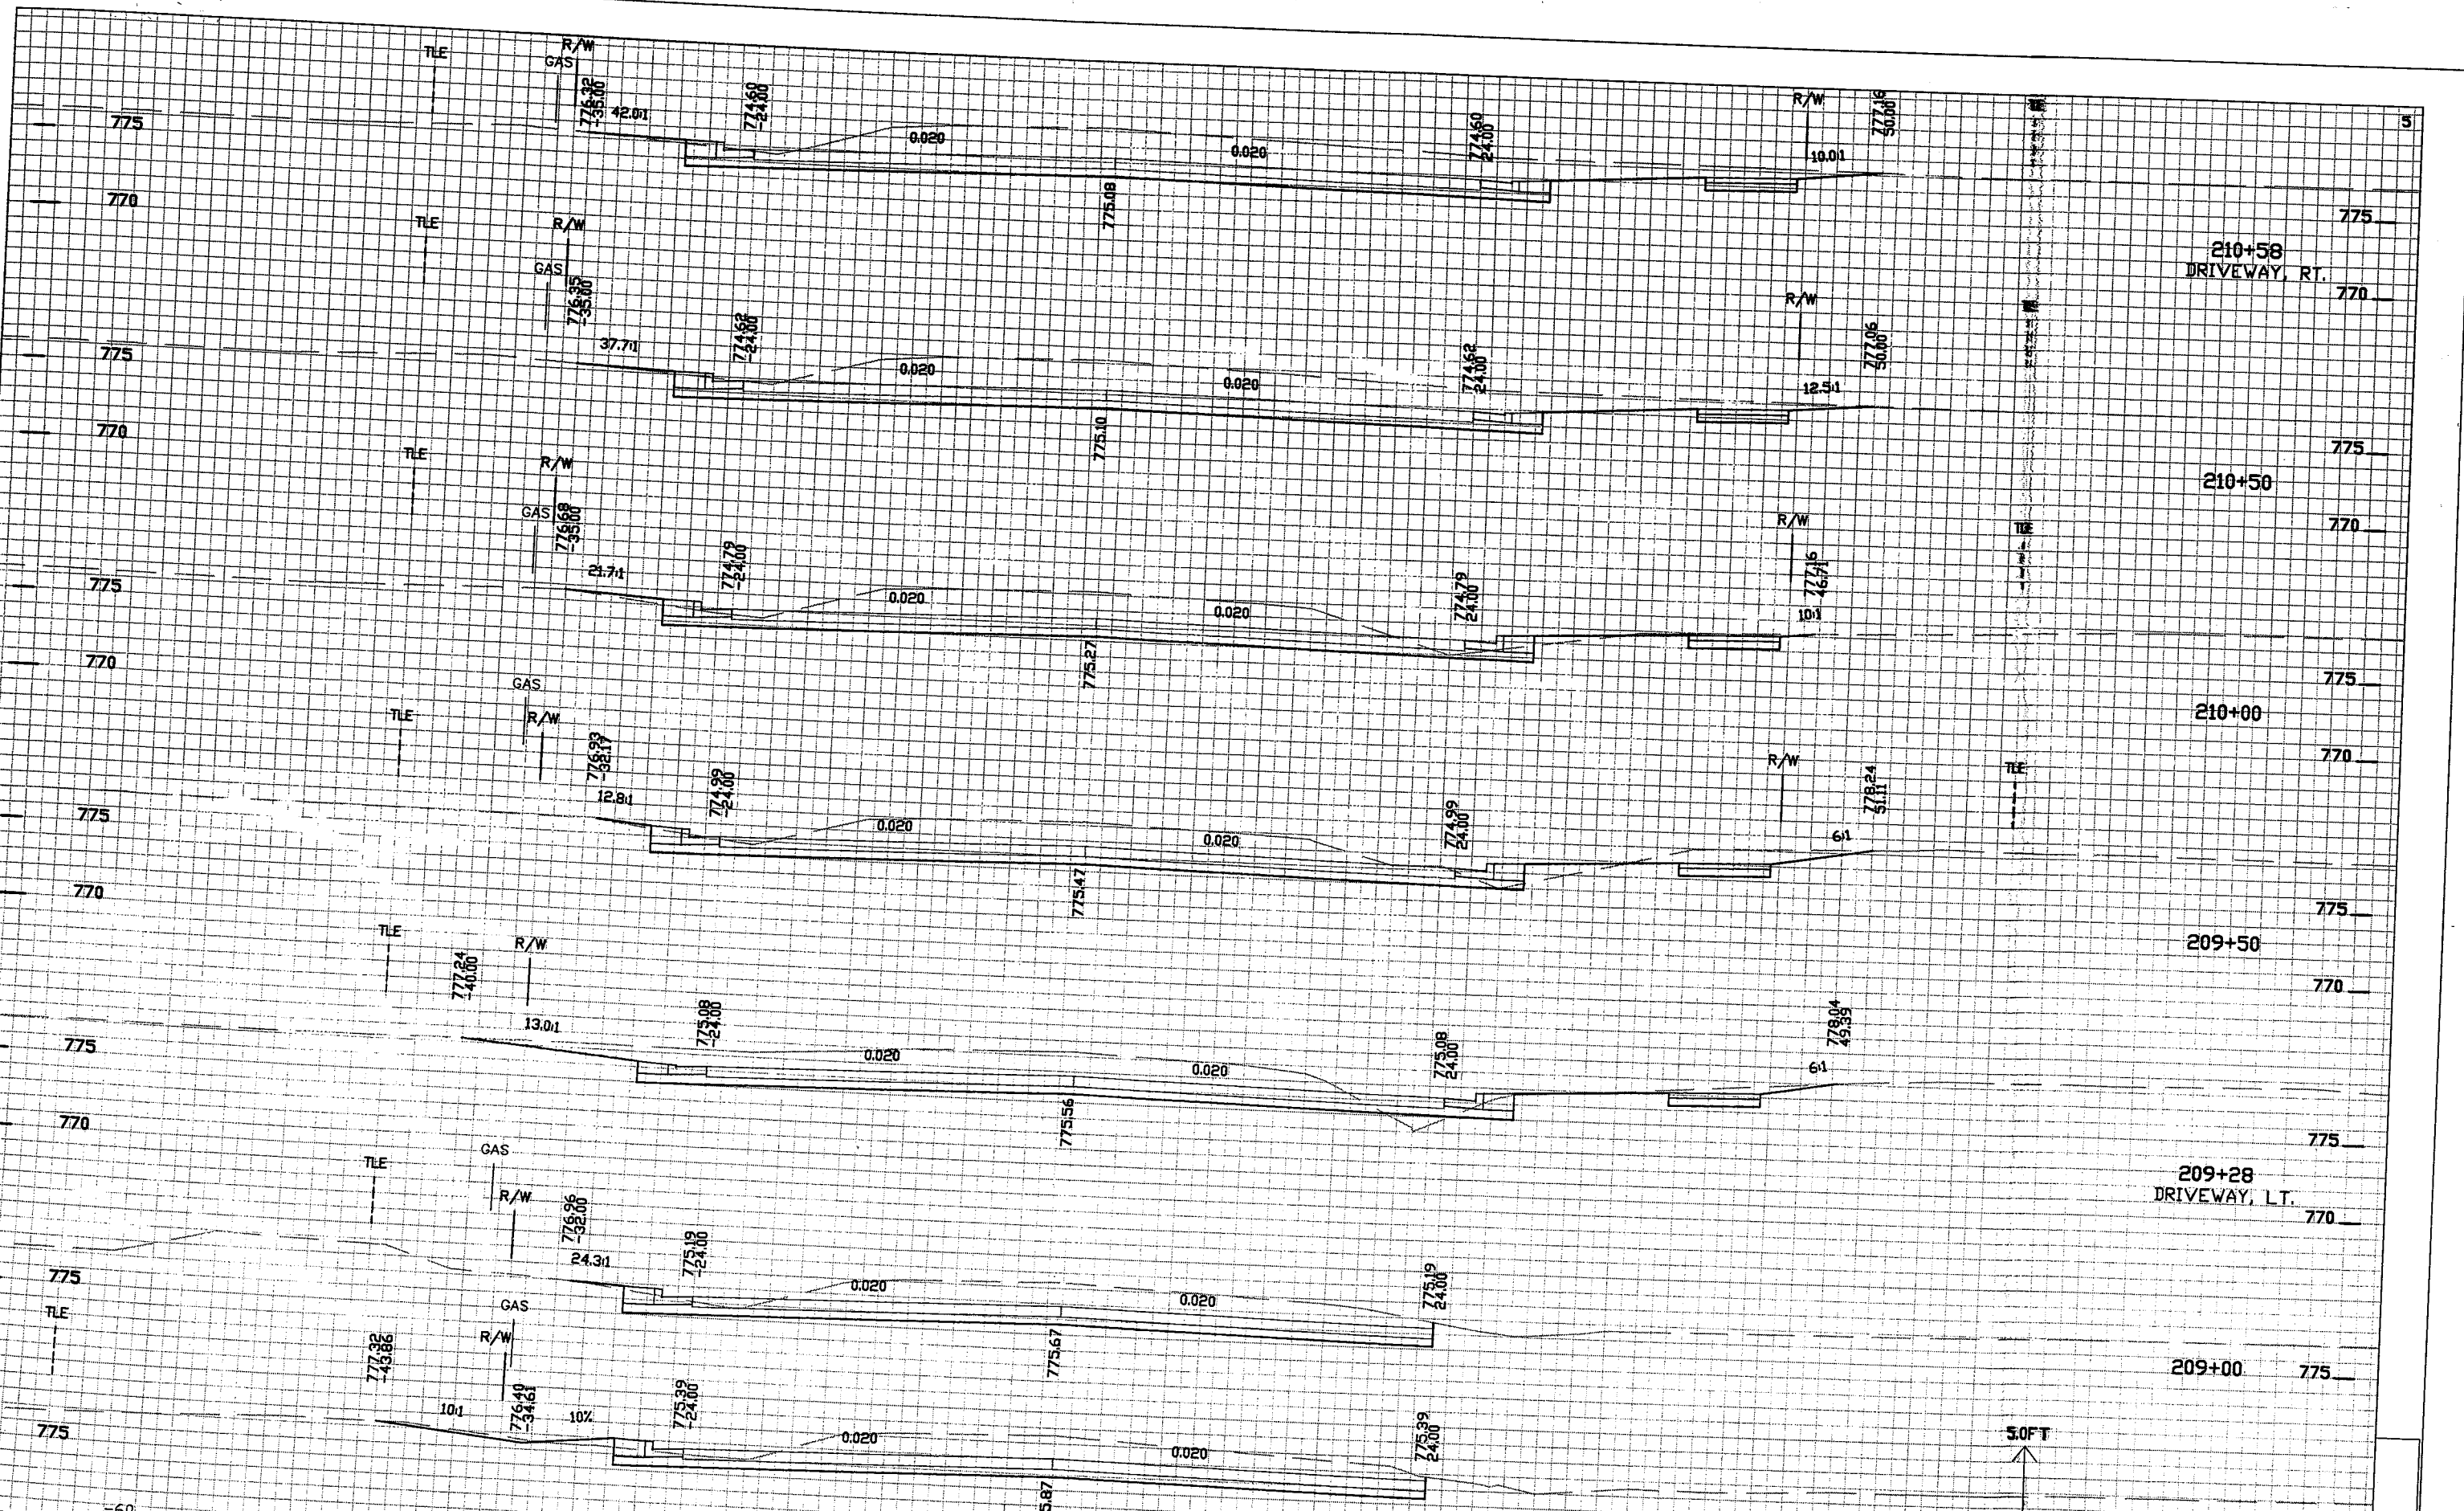

PROJECT NO: 4994-00-87

HWY: CTH Y

COUNTY: WINNEBAGO

CROSS SECTIONS


PLT DATE: \$\$\$..plottingdate...\$\$

PLT BY: \$\$\$..platuser...\$\$

PLT NAME:

SHEET NO: 226

E

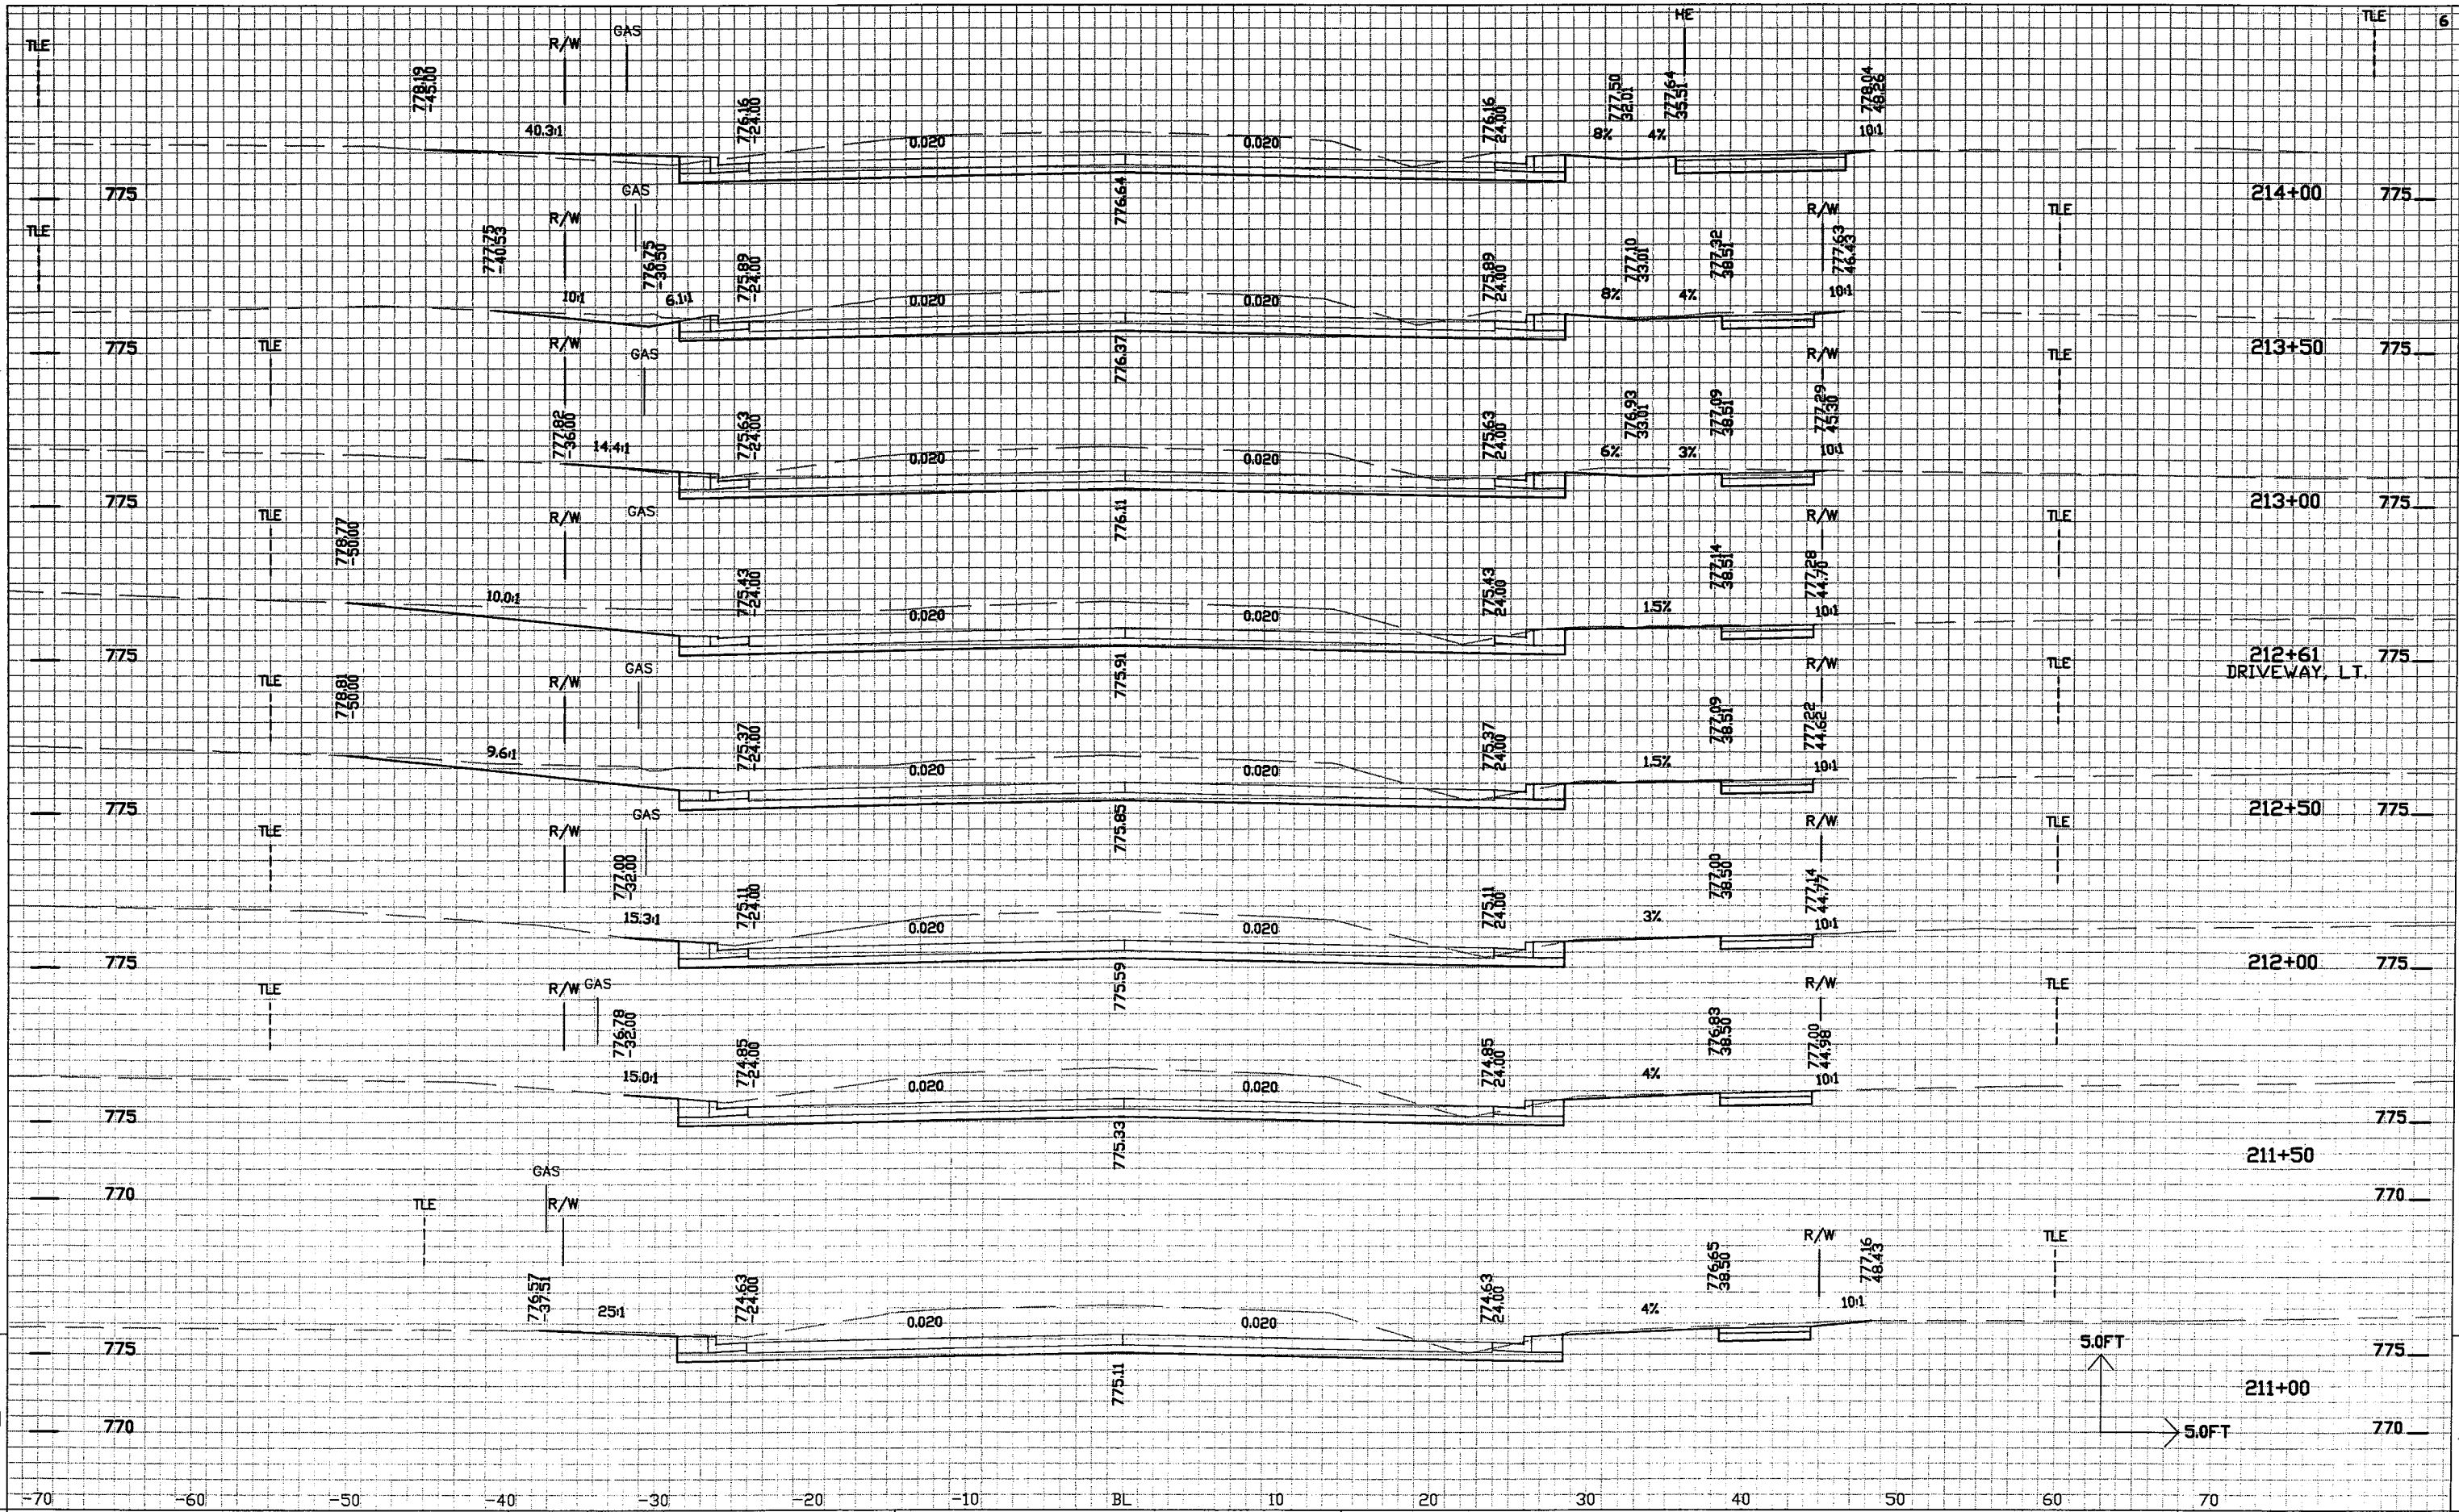

PROJECT NO: 4994-00-87

HWY: CTH Y

COUNTY: WINNEBAGO

CROSS SECTIONS

SHEET NO: 227

E


FILE NAME: \$\$\$designfile\$\$\$

PLOT DATE: \$\$\$plottingdate\$\$\$

PLOT BY: \$\$\$plotuser\$\$\$

PLOT NAME:

PLOT SCALE: \$\$\$plotscale\$\$\$

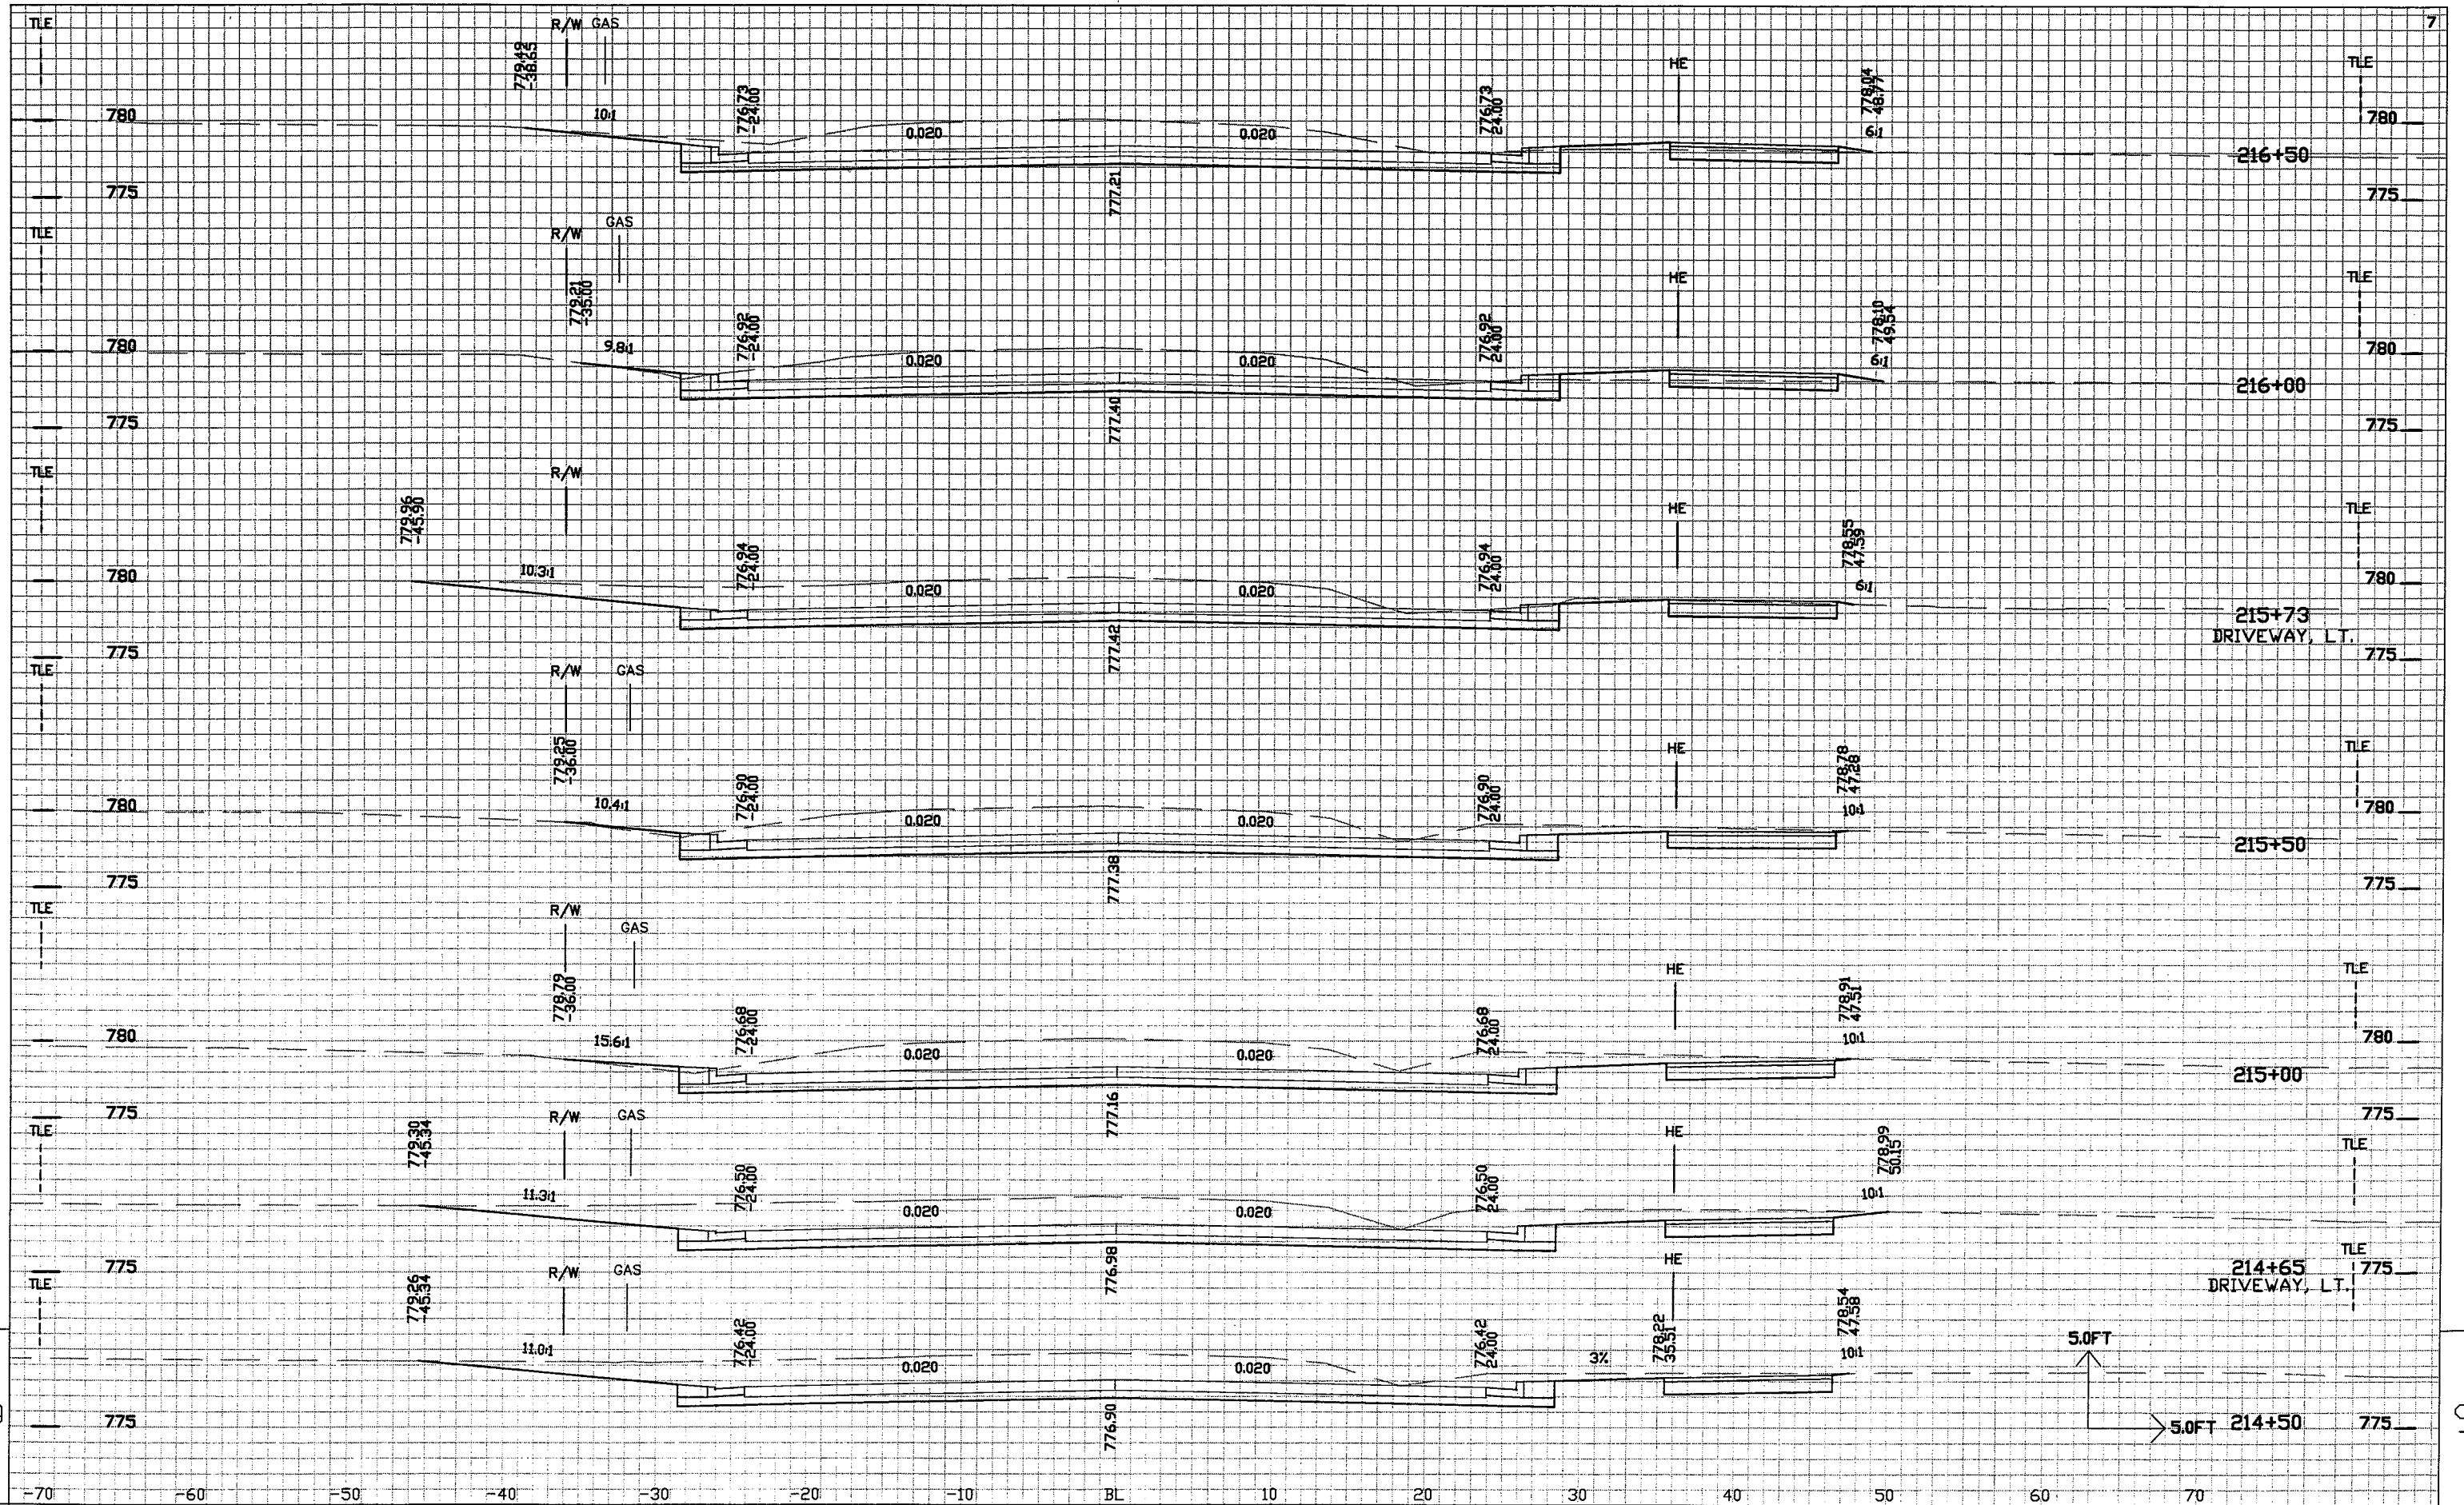

PROJECT NO: 4994-00-87

HWY: CTH Y

COUNTY: WINNEBAGO

CROSS SECTIONS

SHEET NO: 228

E


FILE NAME : \$\$...designfile...\$\$


PLOT DATE : \$\$...plottingdate...\$\$

PLOT BY : \$\$...plotuser...\$\$

PLOT NAME :

PLOT SCALE : \$\$...plotscale...\$\$

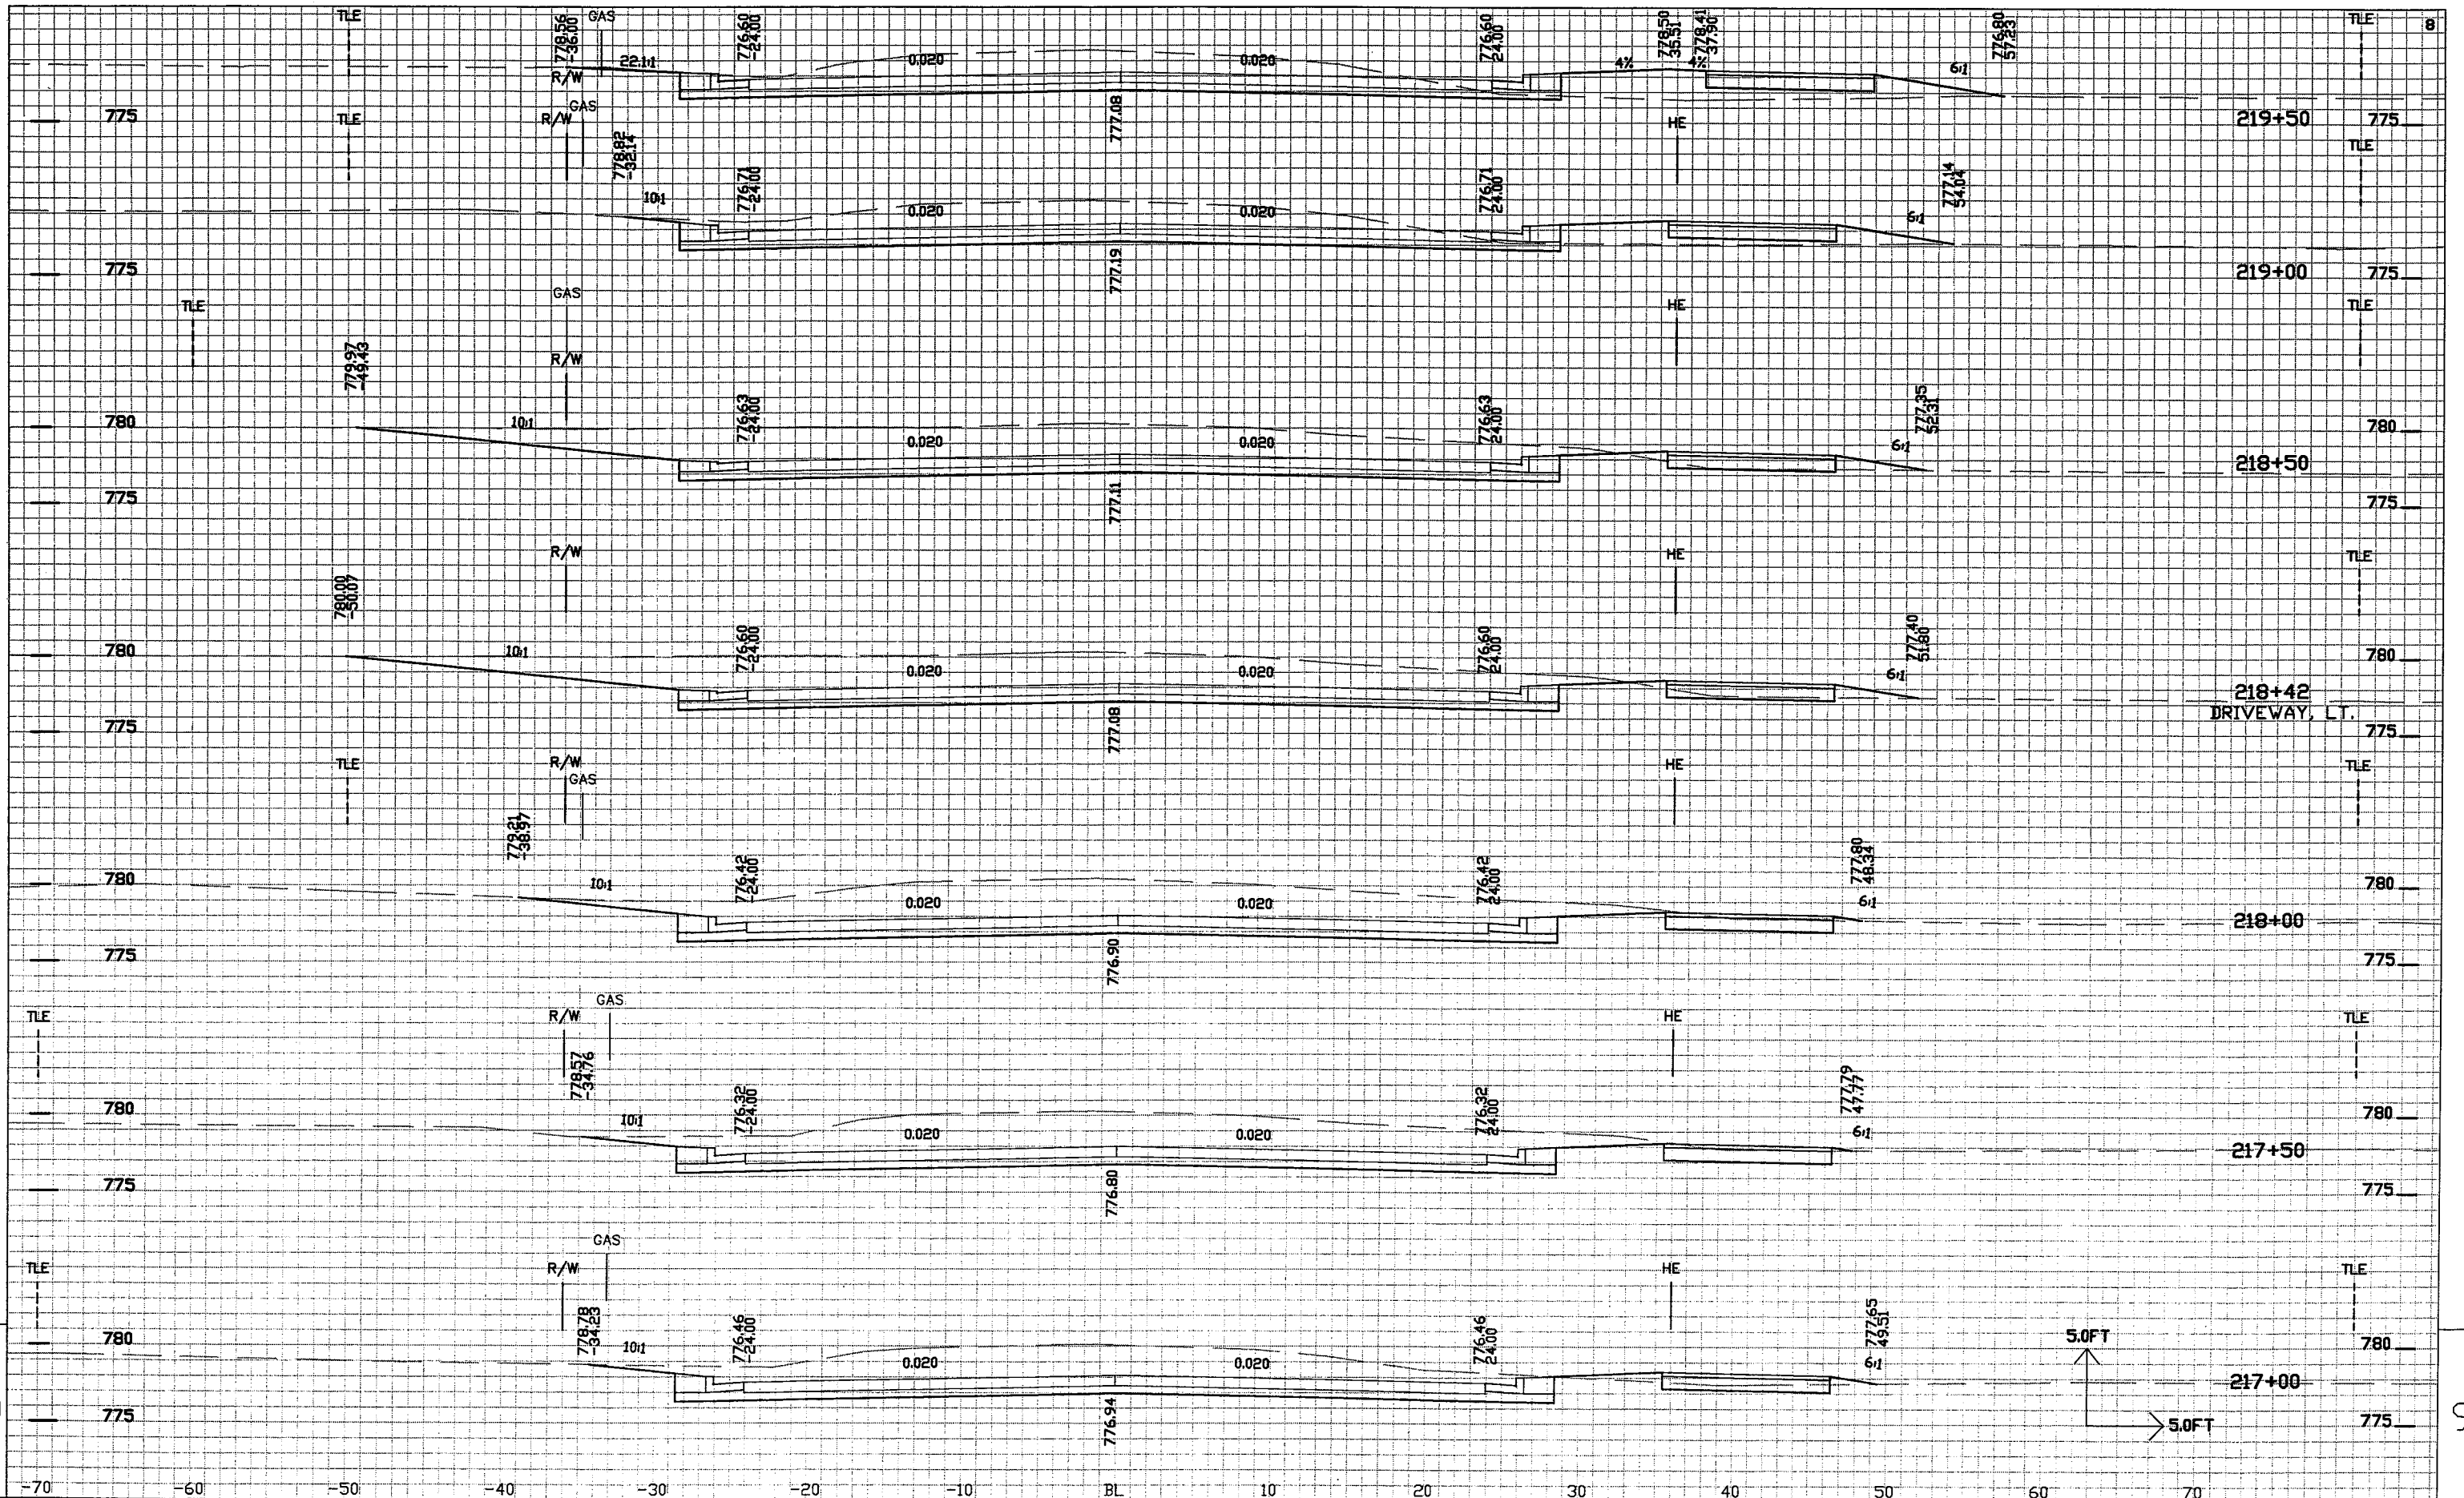

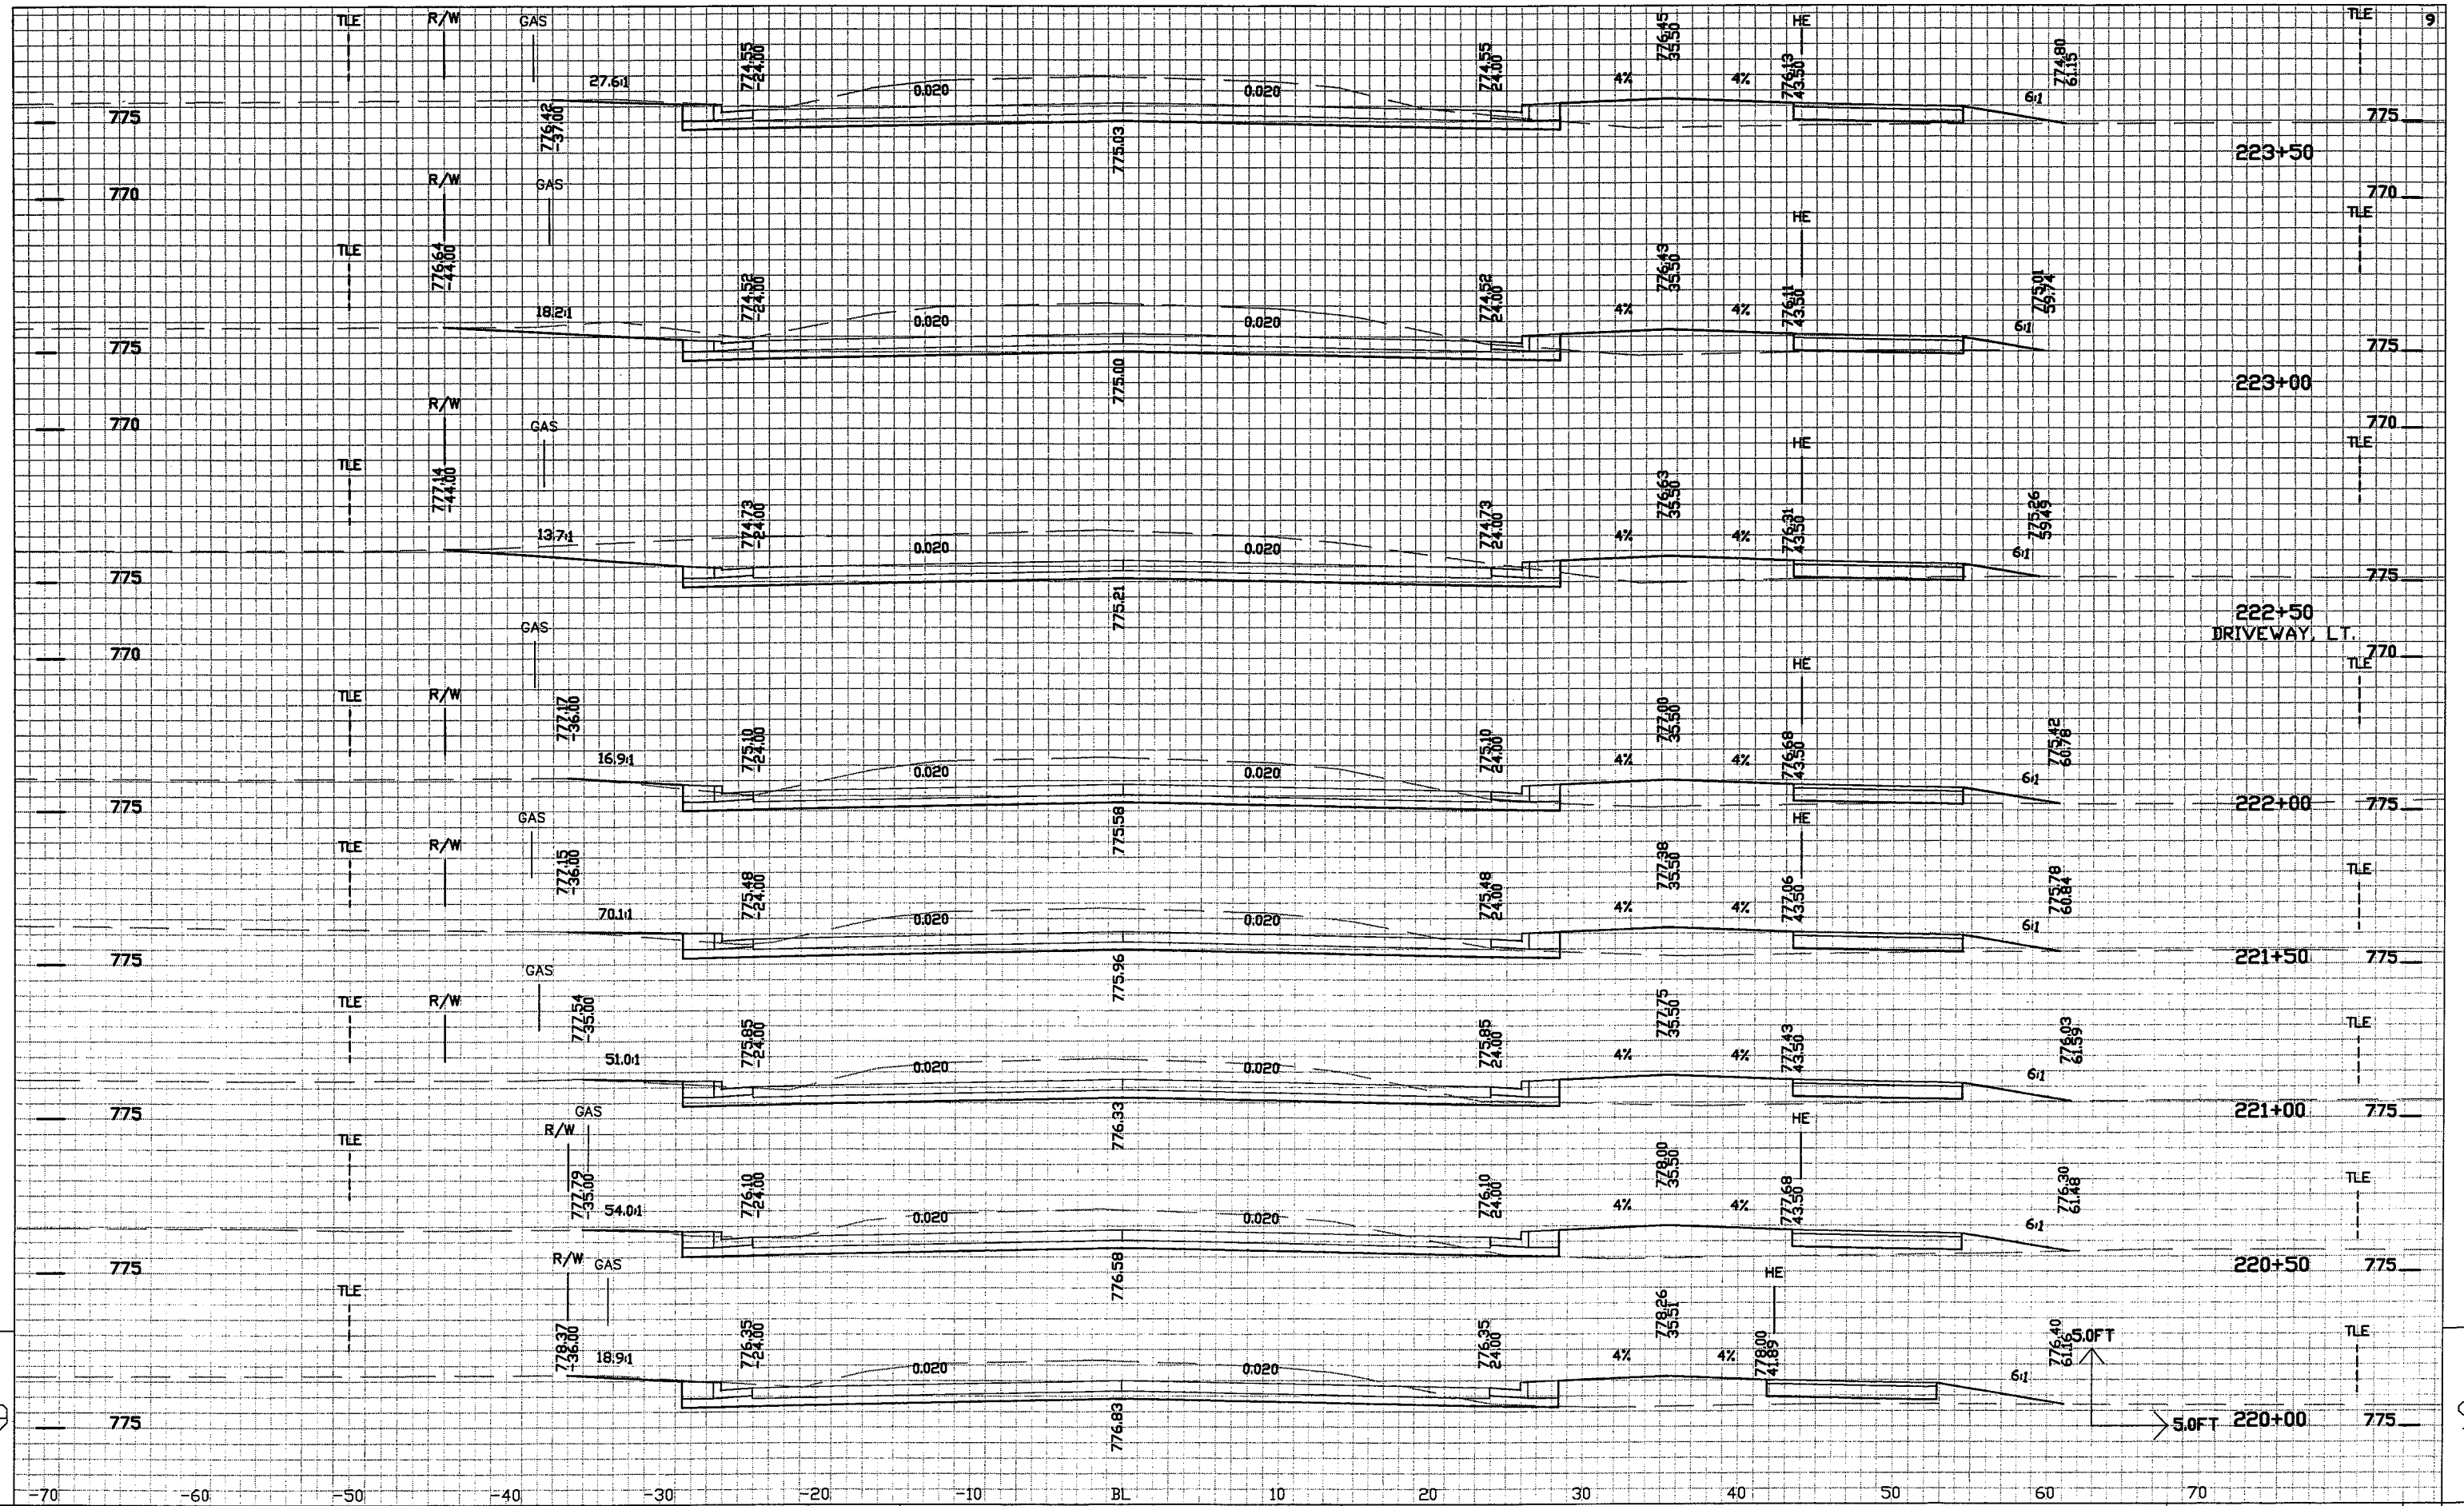

PROJECT NO: 4994-00-87

HWY: CTH Y

COUNTY: WINNEBAGO

CROSS SECTIONS

SHEET NO: 230

E


FILE NAME: \$\$\$...designfile...\$\$

PLOT DATE: \$\$\$...plottingdate...\$\$

PLOT BY: \$\$\$...plotuser...\$\$

PLOT NAME:

PLOT SCALE: \$\$\$...plotscale...\$\$

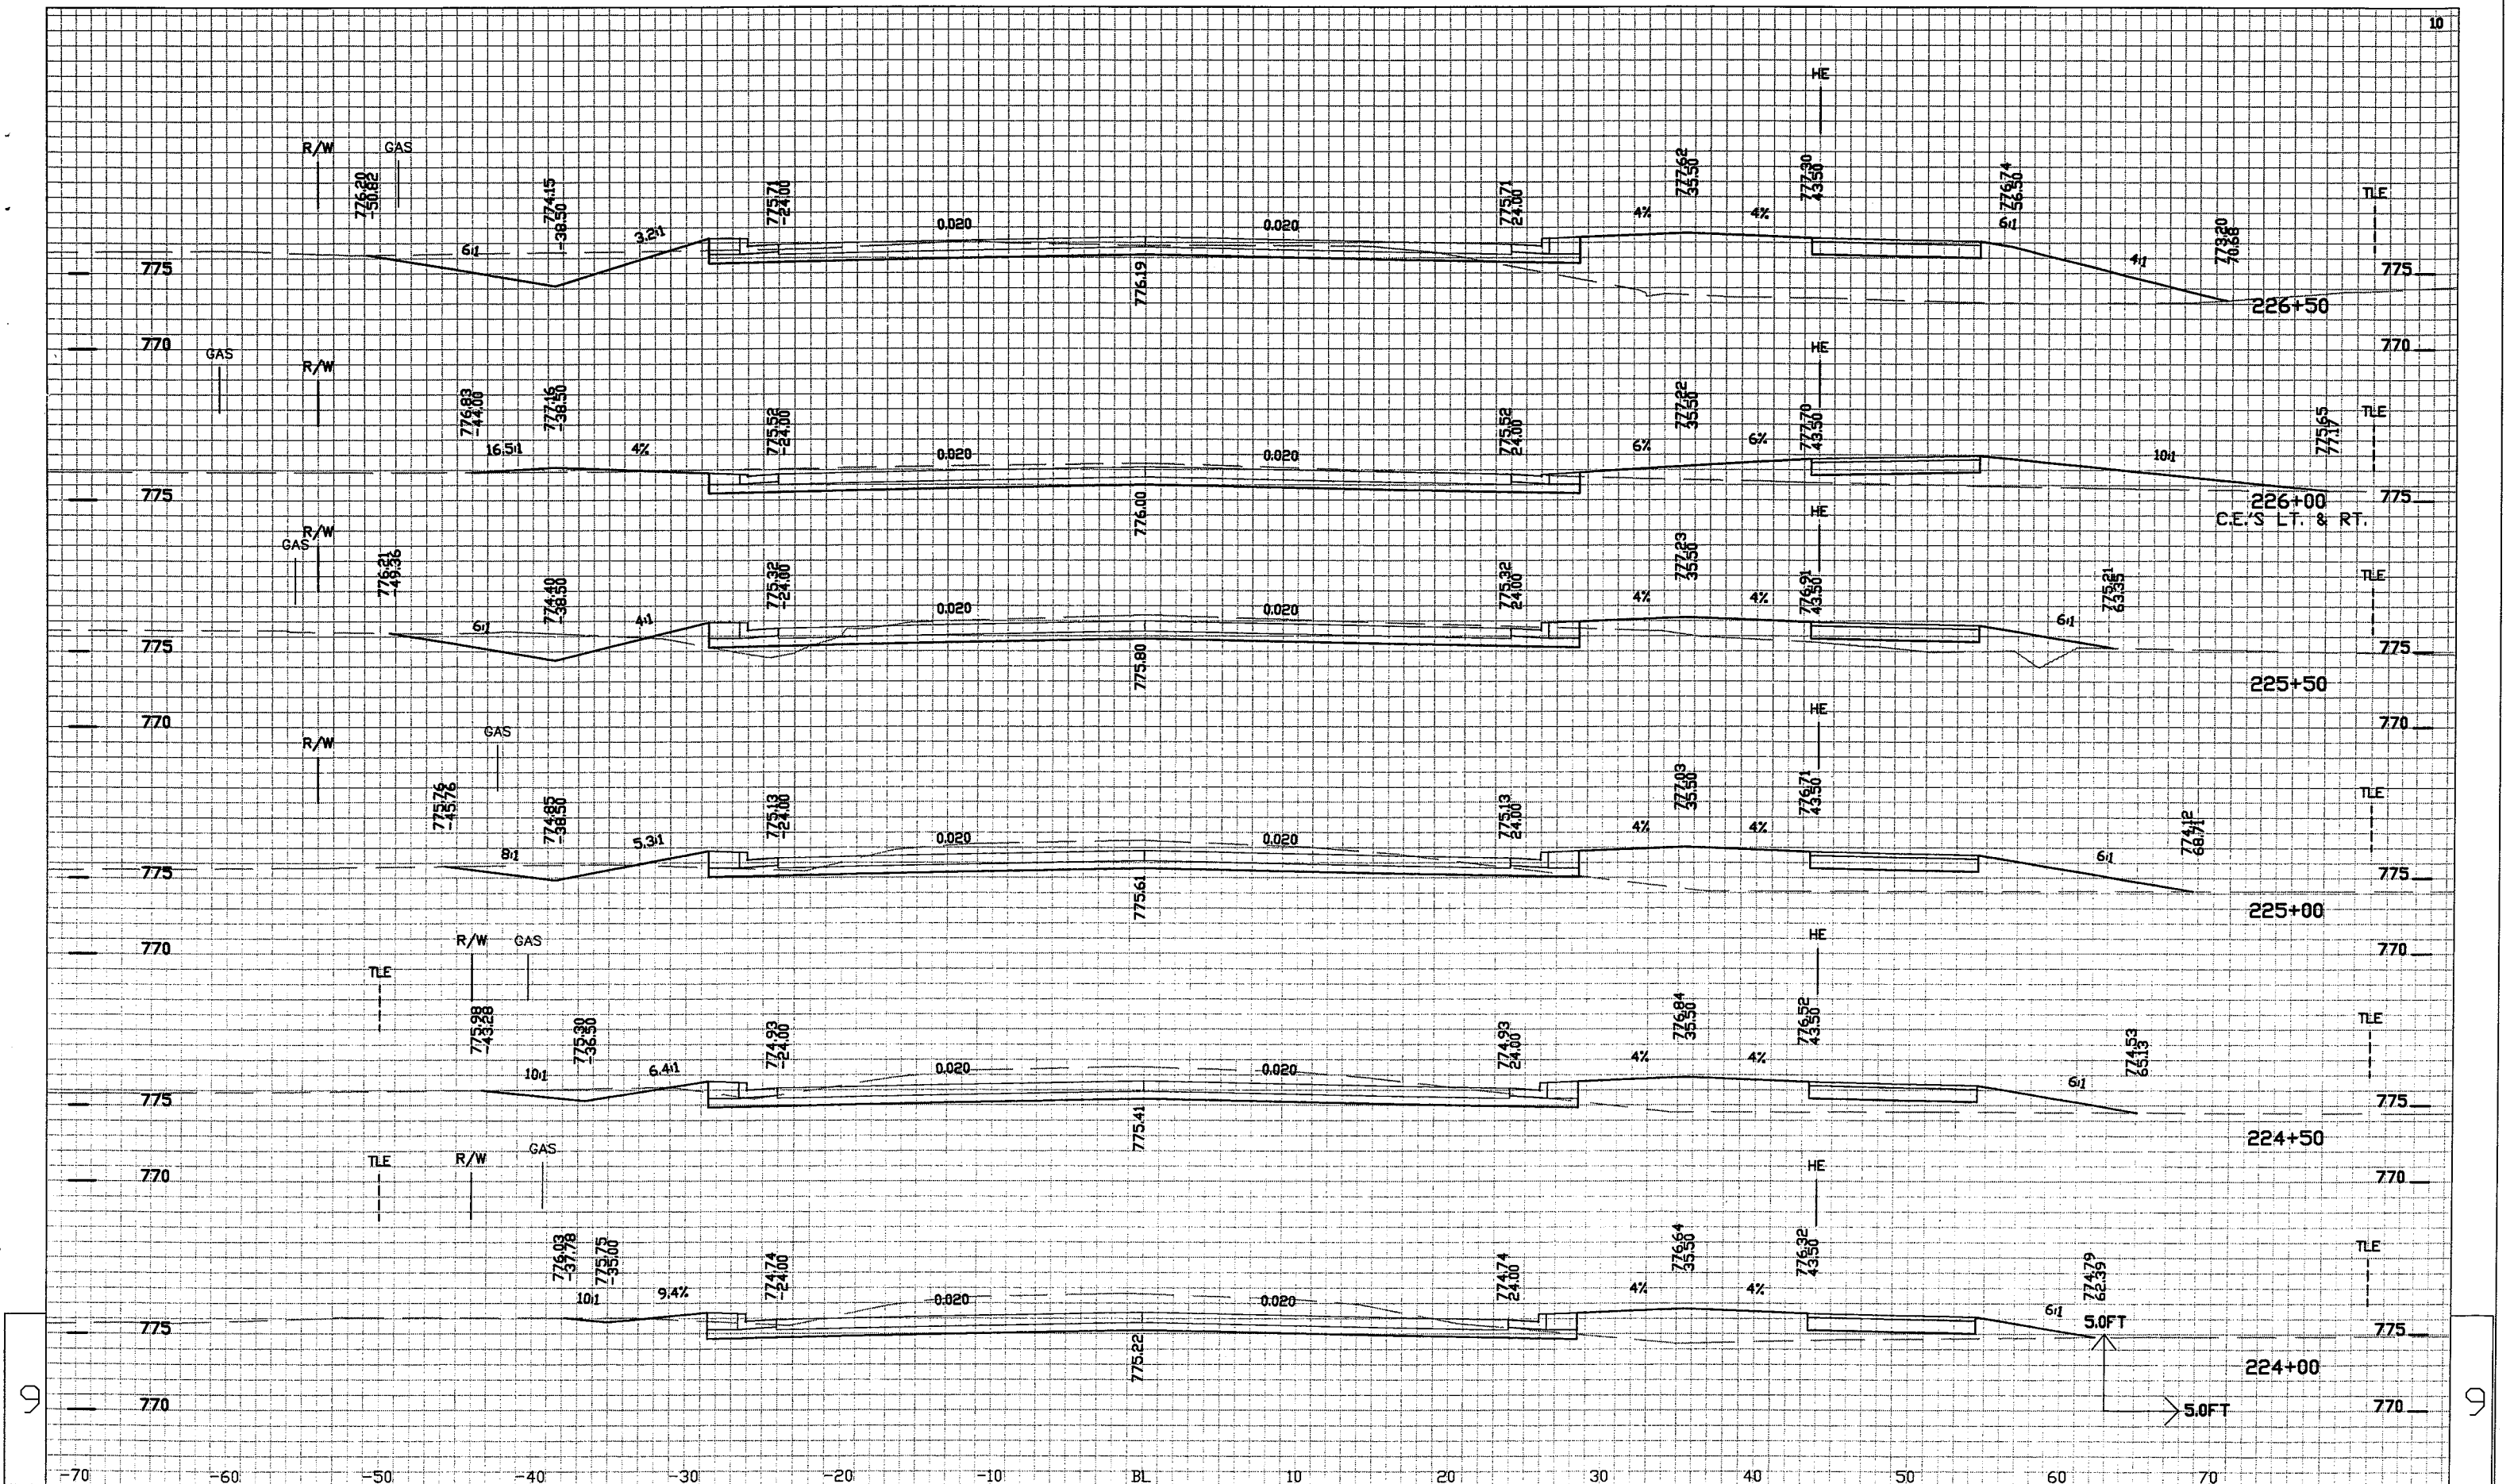

PROJECT NO: 4994-00-87

HWY: CTH Y

COUNTY: WINNEBAGO

CROSS SECTIONS

SHEET NO: 231

E


FILE NAME : \$\$\$designfile...\$\$

PLOT DATE : \$\$\$plottingdate...\$\$

PLOT BY : \$\$\$plotuser...\$\$

PLOT NAME :

PLOT SCALE : \$\$\$plotscale...\$\$

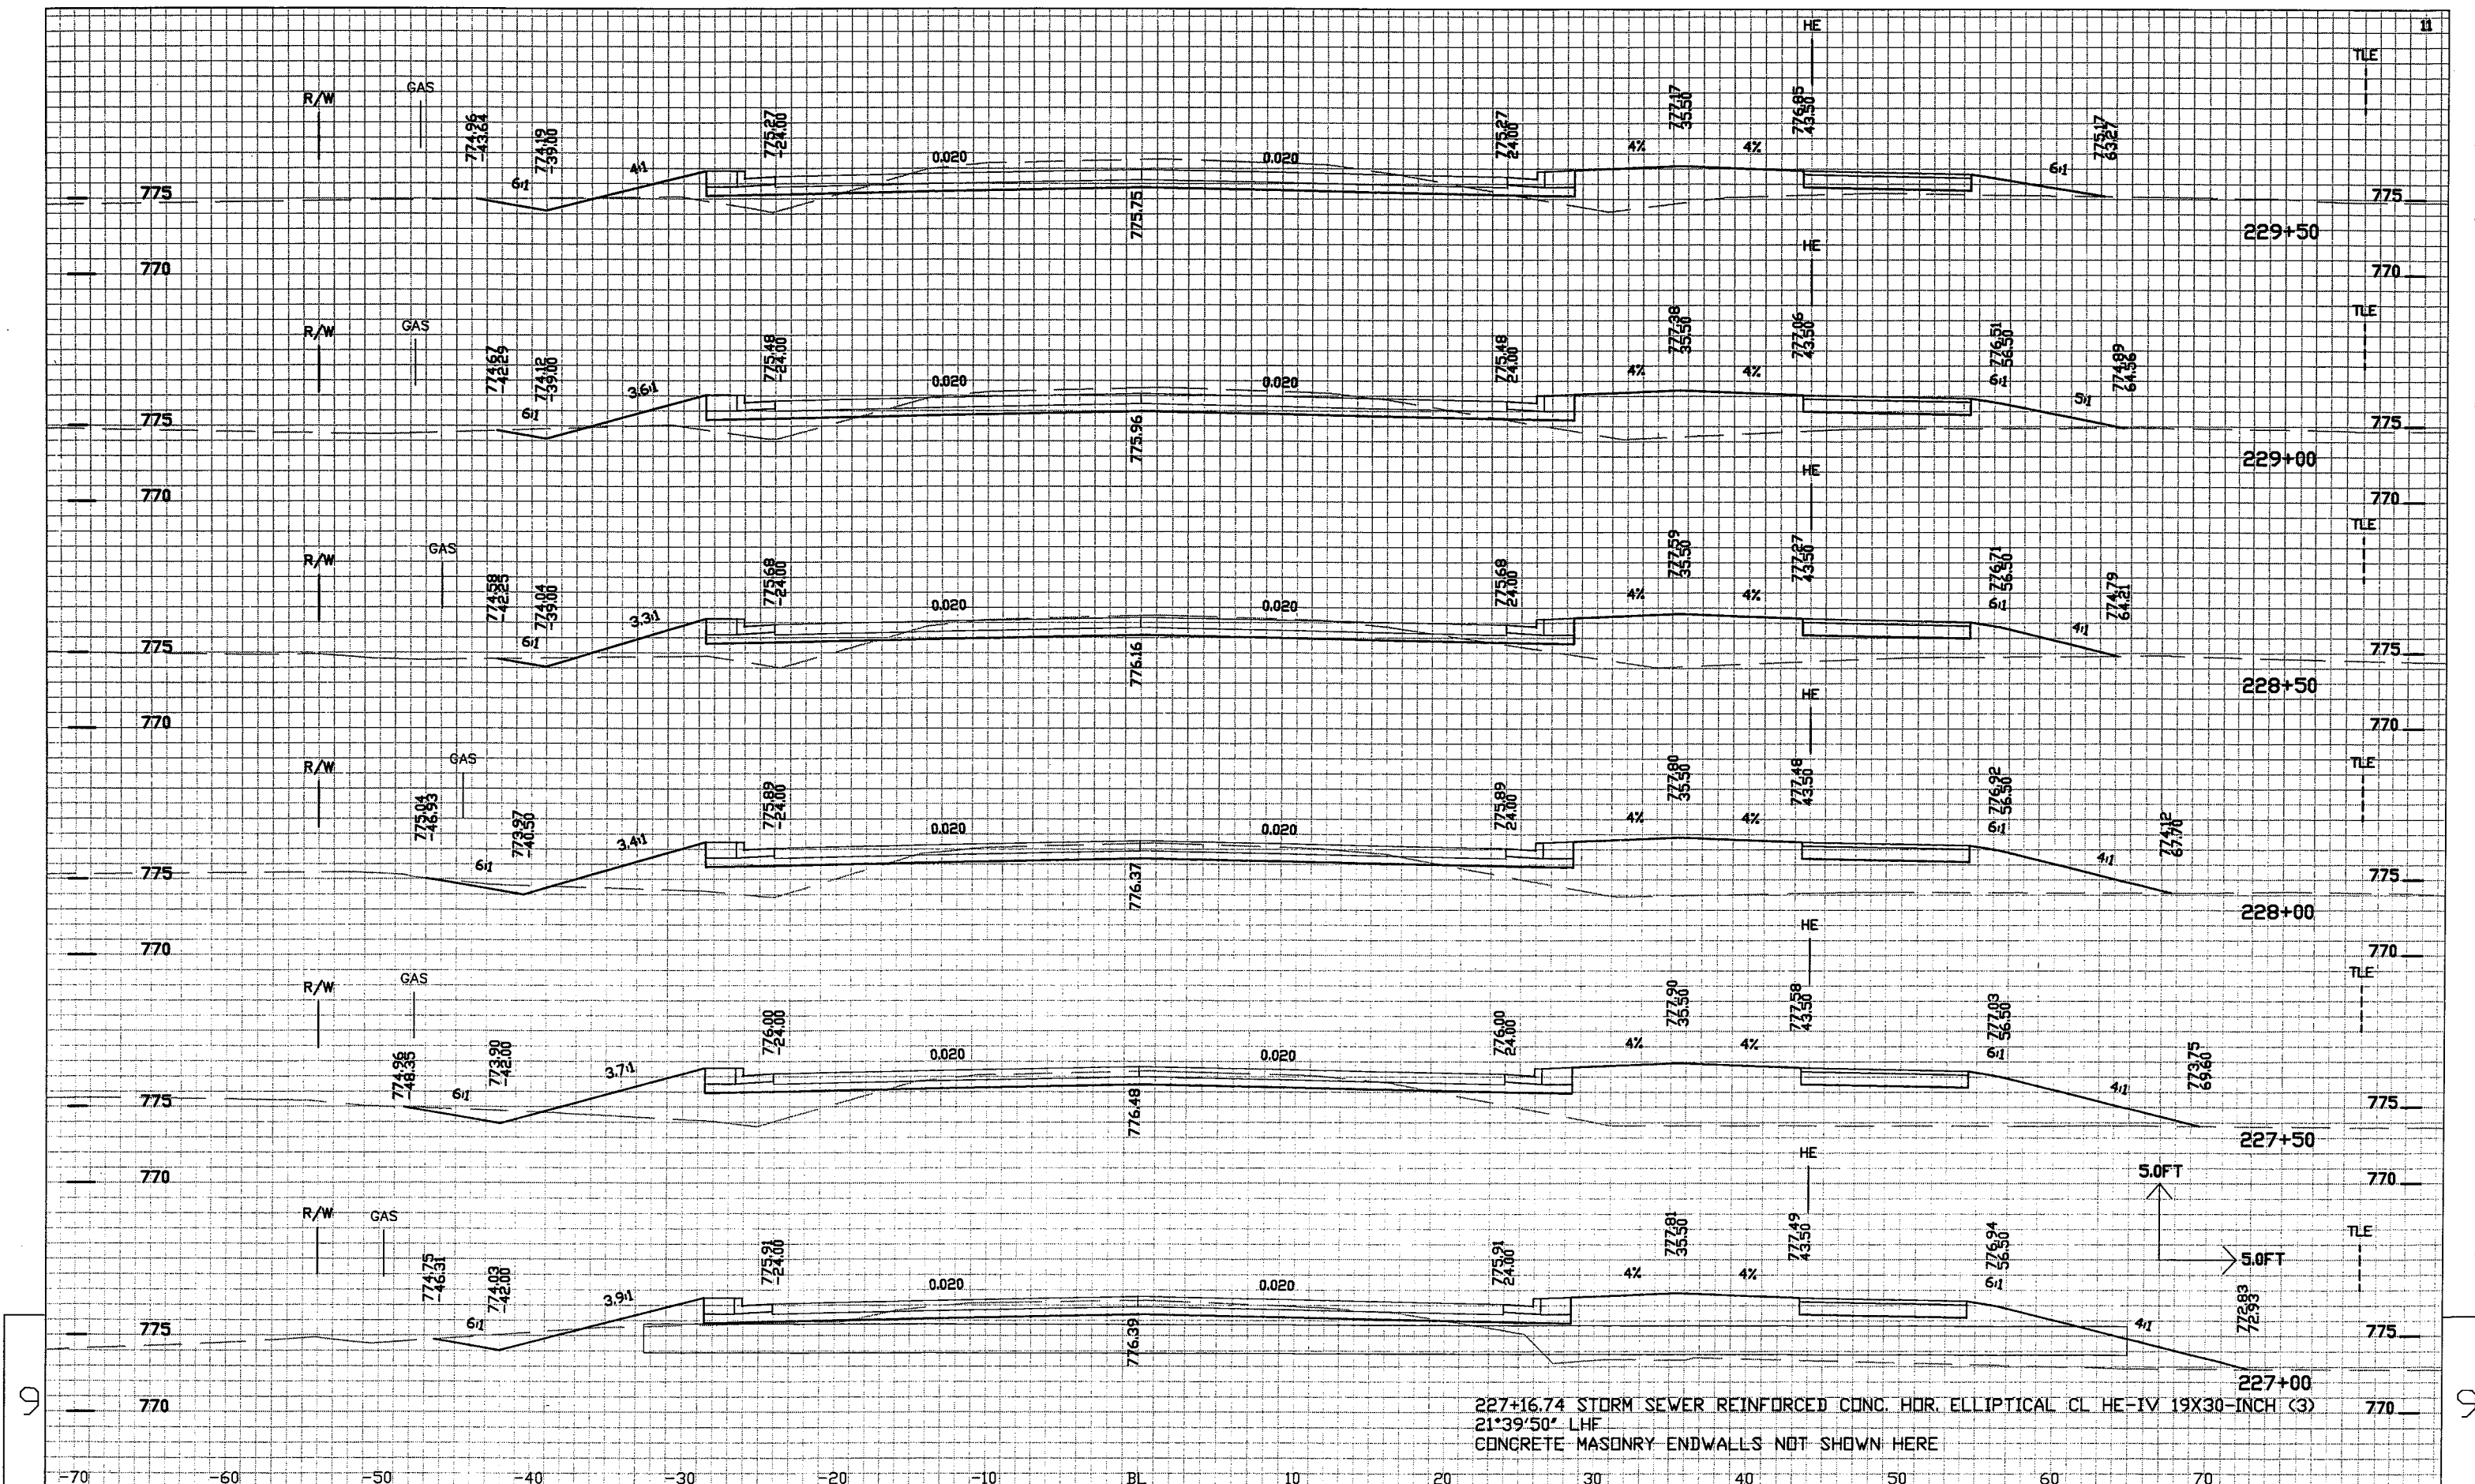

PROJECT NO: 4994-00-87

HWY: CTH Y

COUNTY: WINNEBAGO

CROSS SECTIONS

SHEET NO: 232

E


FILE NAME : \$\$\$...designfile...\$\$\$

PLOT DATE : \$\$\$...plottingdate...\$\$\$

PLOT BY : \$\$\$...plotuser...\$\$\$

PLOT NAME :

PLOT SCALE : \$\$\$...plotscale...\$\$\$

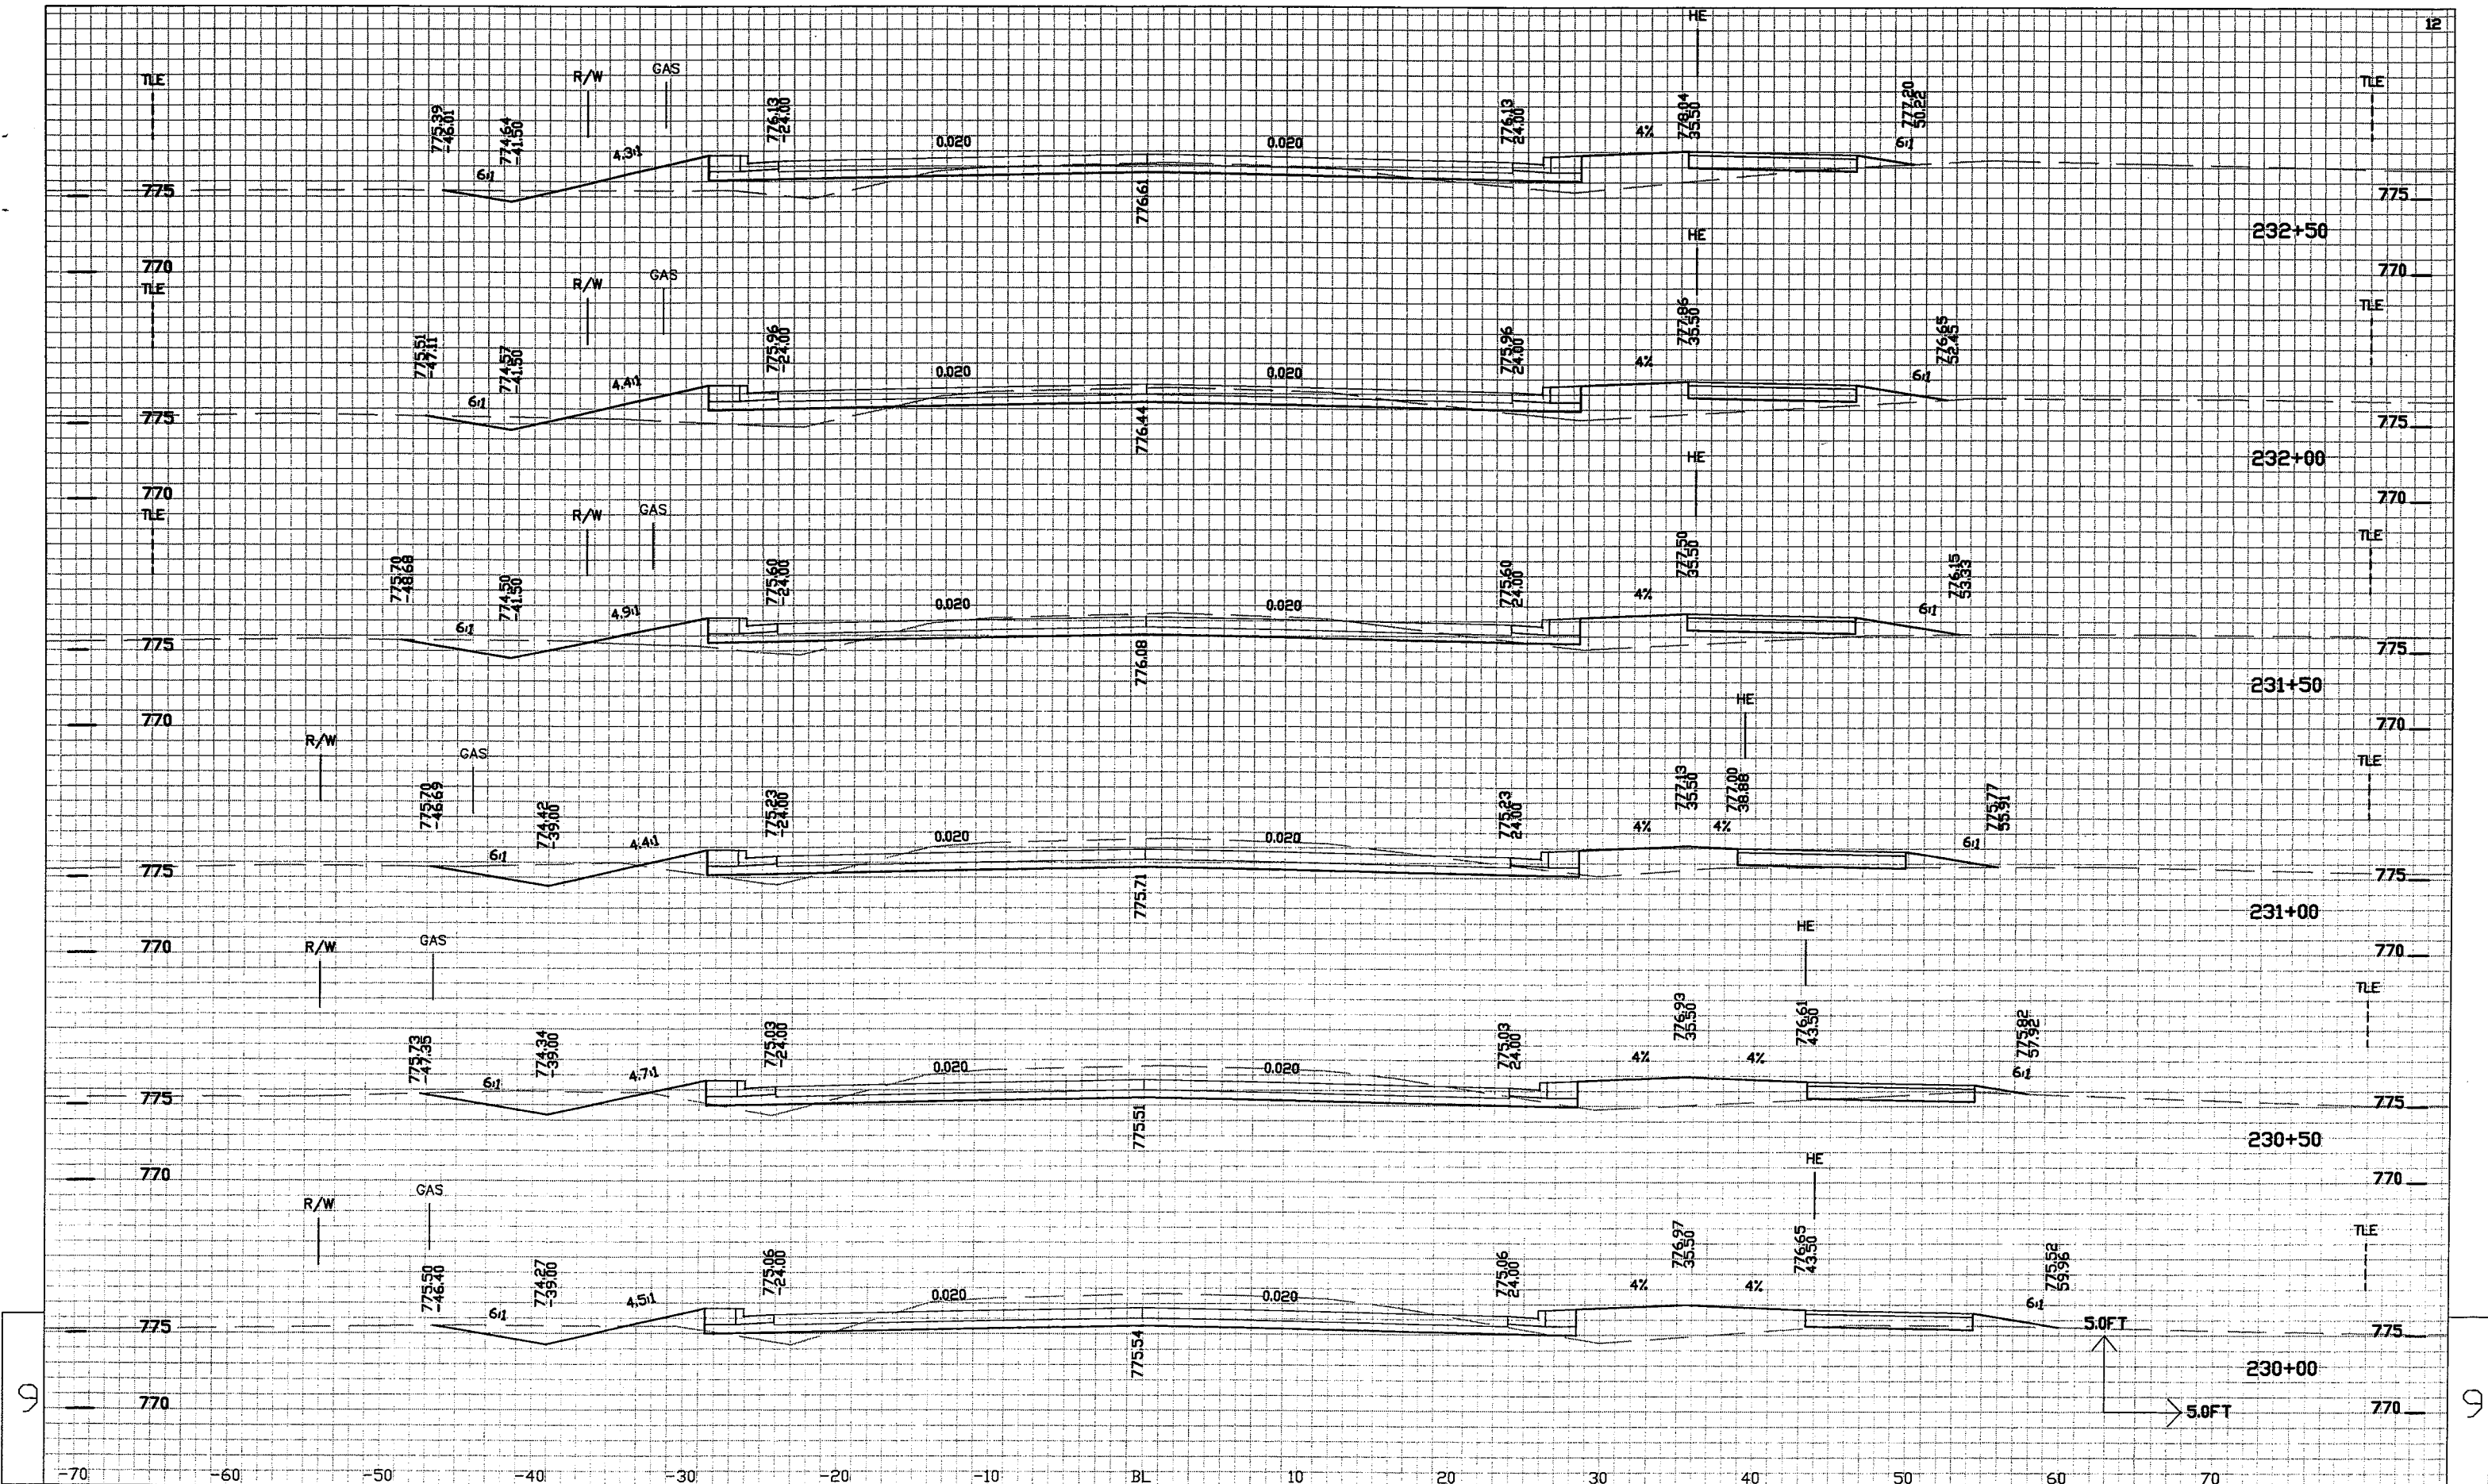

PROJECT NO: 4994-00-87

HWY: CTH Y

COUNTY: WINNEBAGO

CROSS SECTIONS

SHEET NO: 233

E


FILE NAME : \$\$...designfile...\$\$

PLOT DATE : \$\$..plottingdate..\$\$

PLOT BY : \$\$..plotuser..\$\$

PLOT NAME :

PLOT SCALE : \$\$...plotscale...\$\$

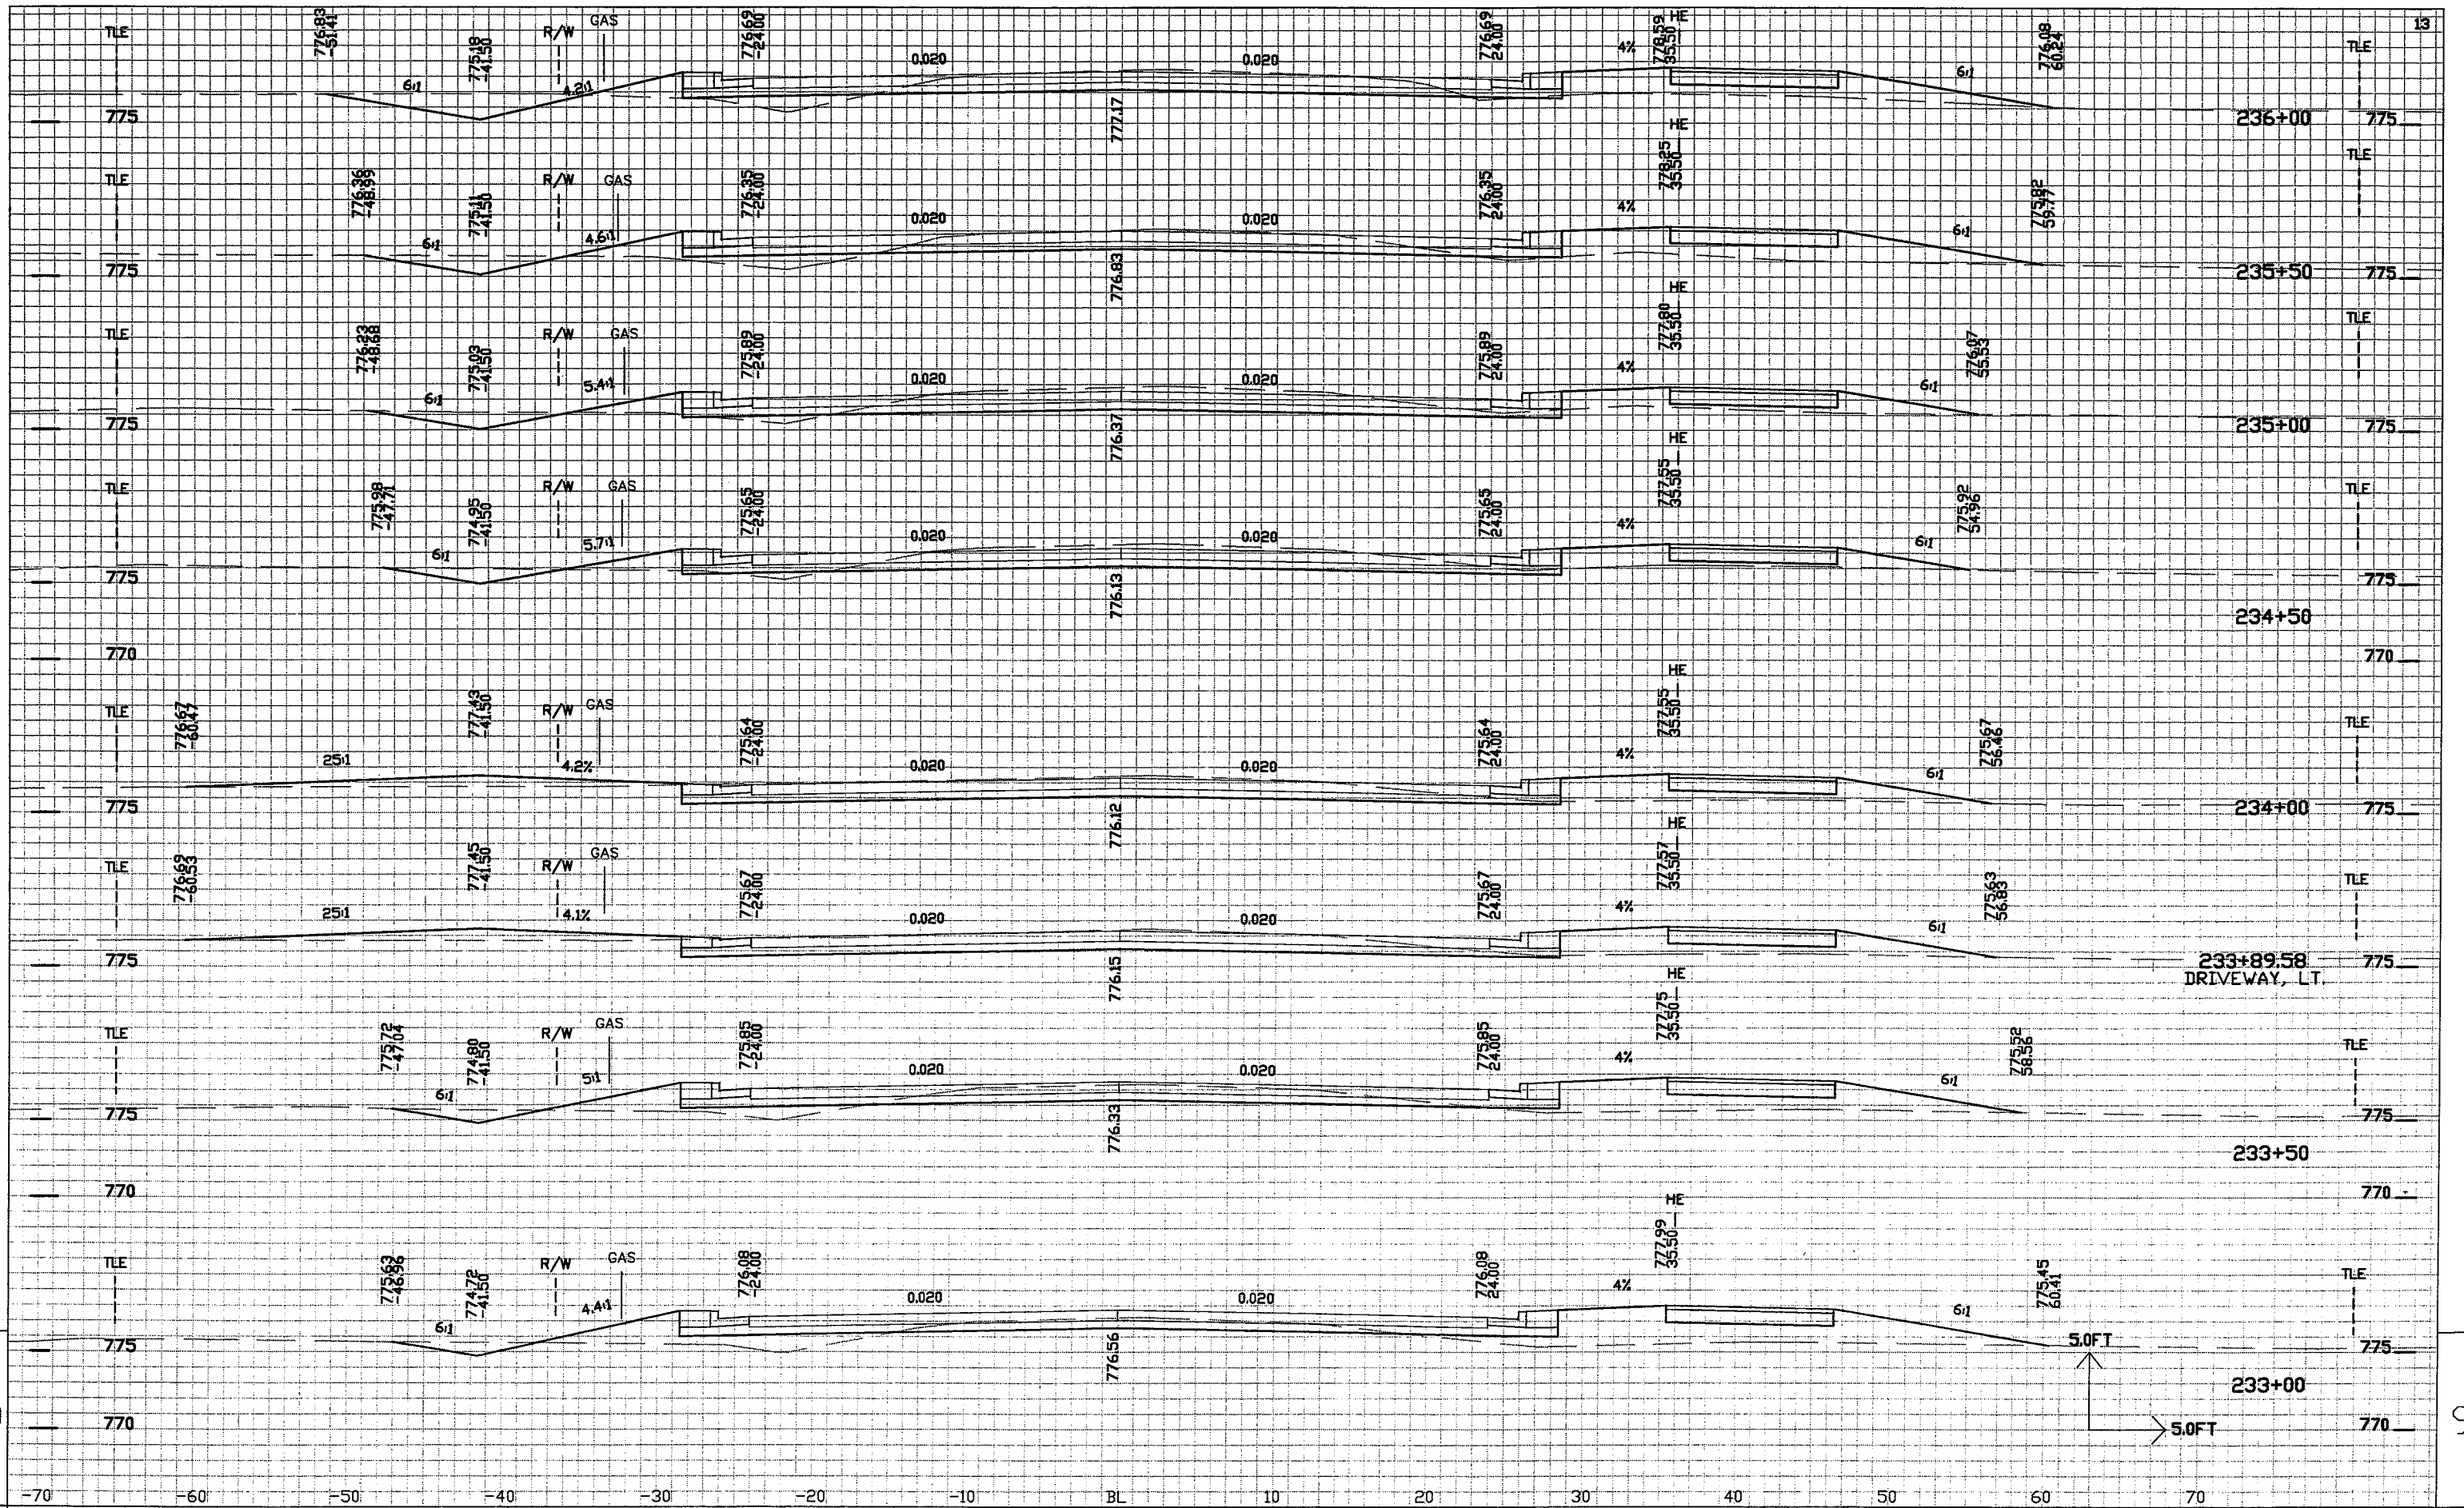

PROJECT NO: 4994-00-87

HWY: CTH Y

COUNTY: WINNEBAGO

CROSS SECTIONS

SHEET NO: 234

E


FILE NAME : \$\$...designfile...\$\$

PLOT DATE : \$\$...plottingdate...\$\$

PLOT BY : \$\$...plotuser...\$\$

PLOT NAME :

PLOT SCALE : \$\$...plotscale...\$\$

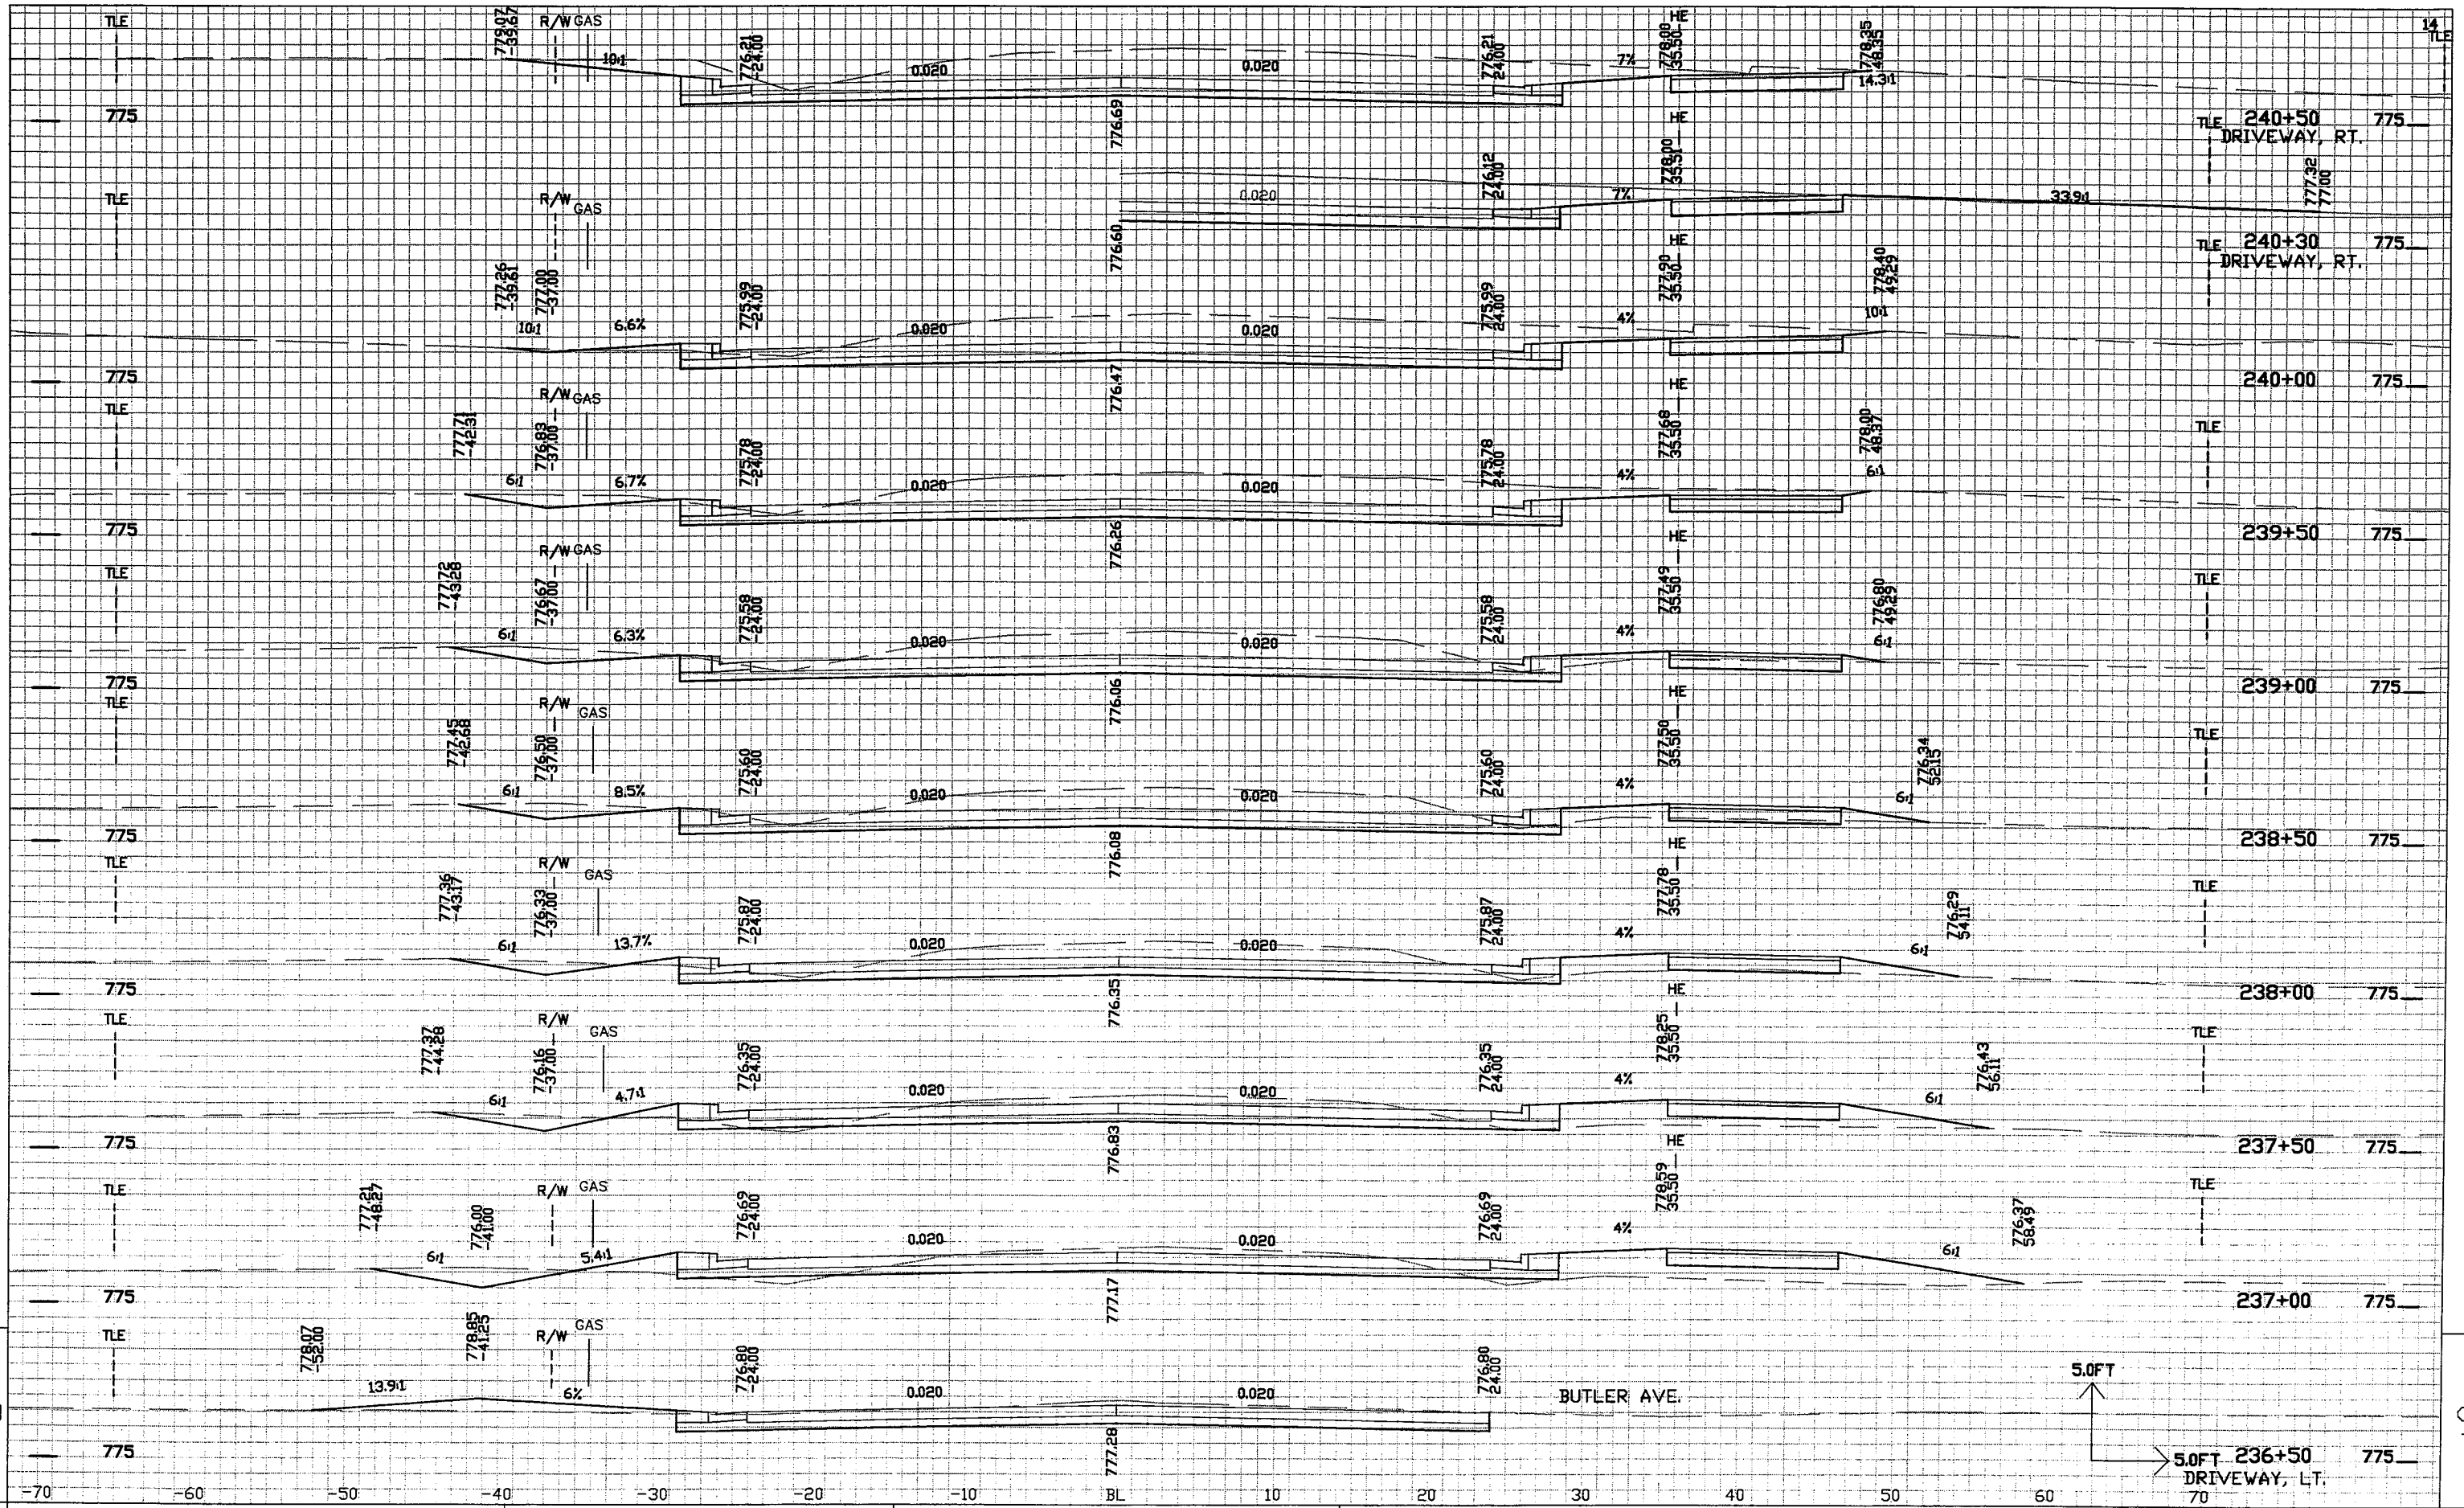

PROJECT NO: 4994-00-87

HWY: CTH Y

COUNTY: WINNEBAGO

CROSS SECTIONS

SHEET NO: 235

E


FILE NAME : \$\$\$...designfile...\$\$


PLOT DATE : \$\$\$...plottingdate...\$\$


PLOT BY : \$\$\$...plotuser...\$\$


PLOT NAME :


PLOT SCALE : \$\$\$...plotscale...\$\$

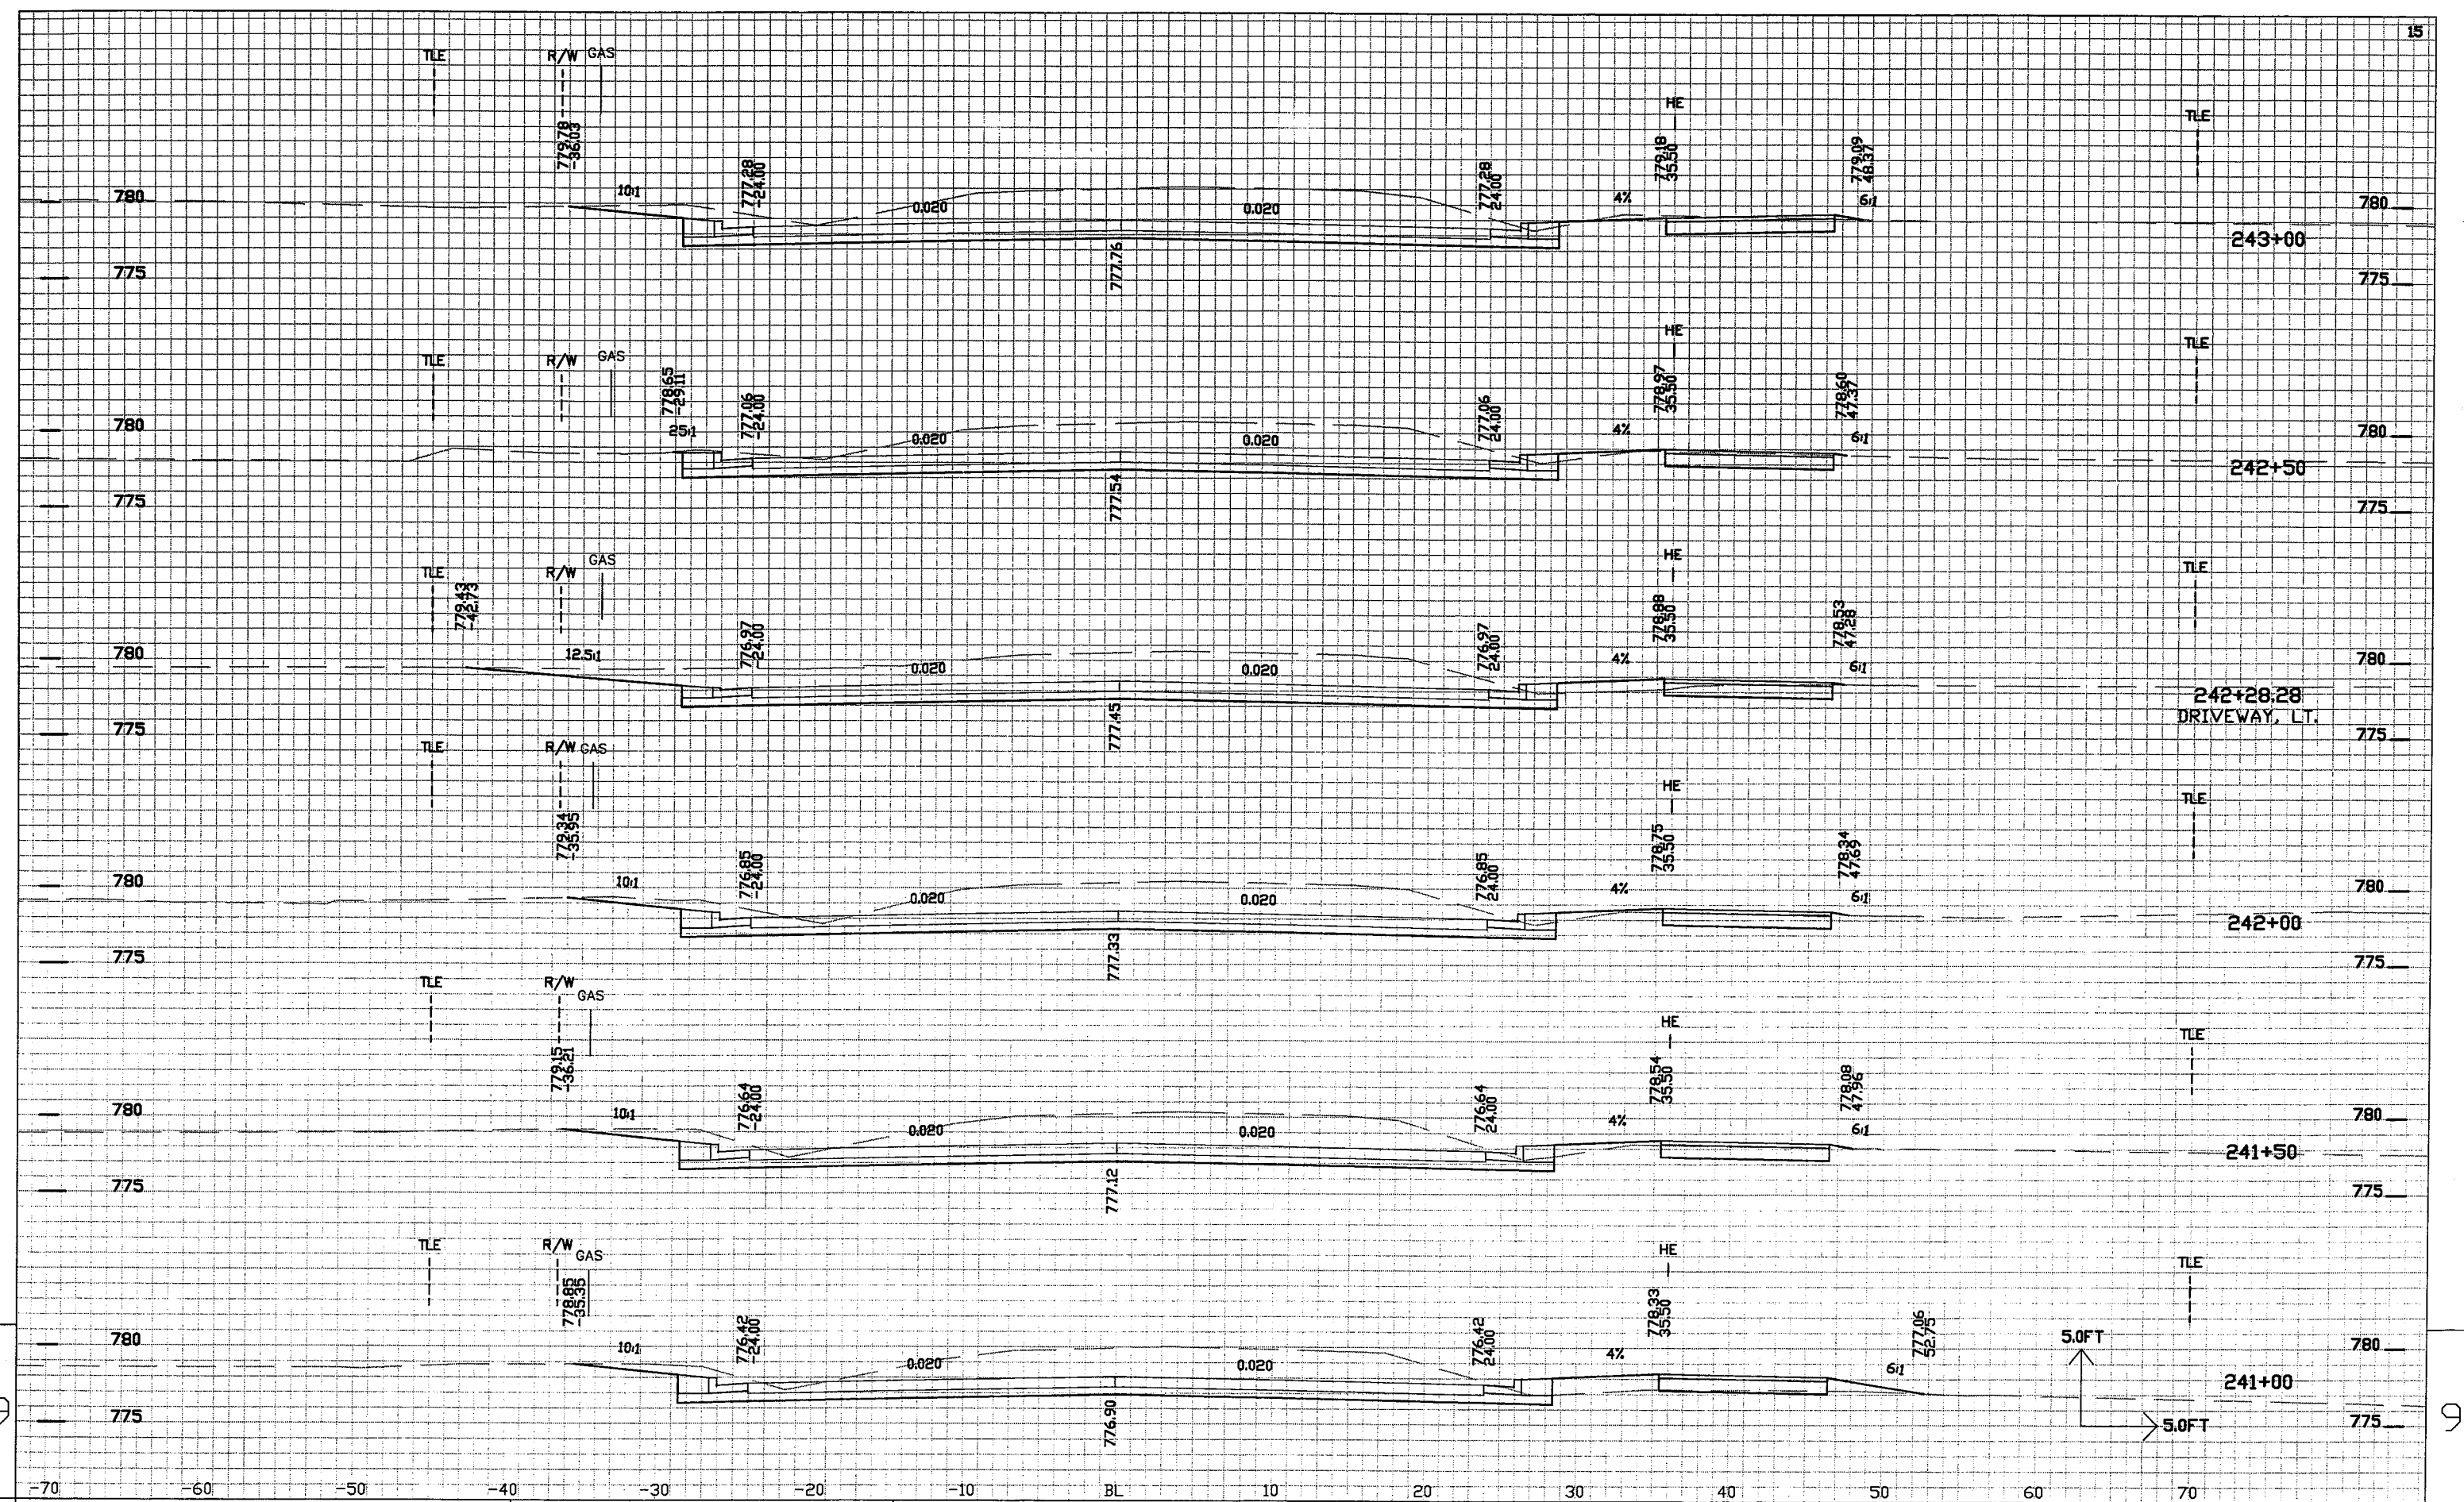

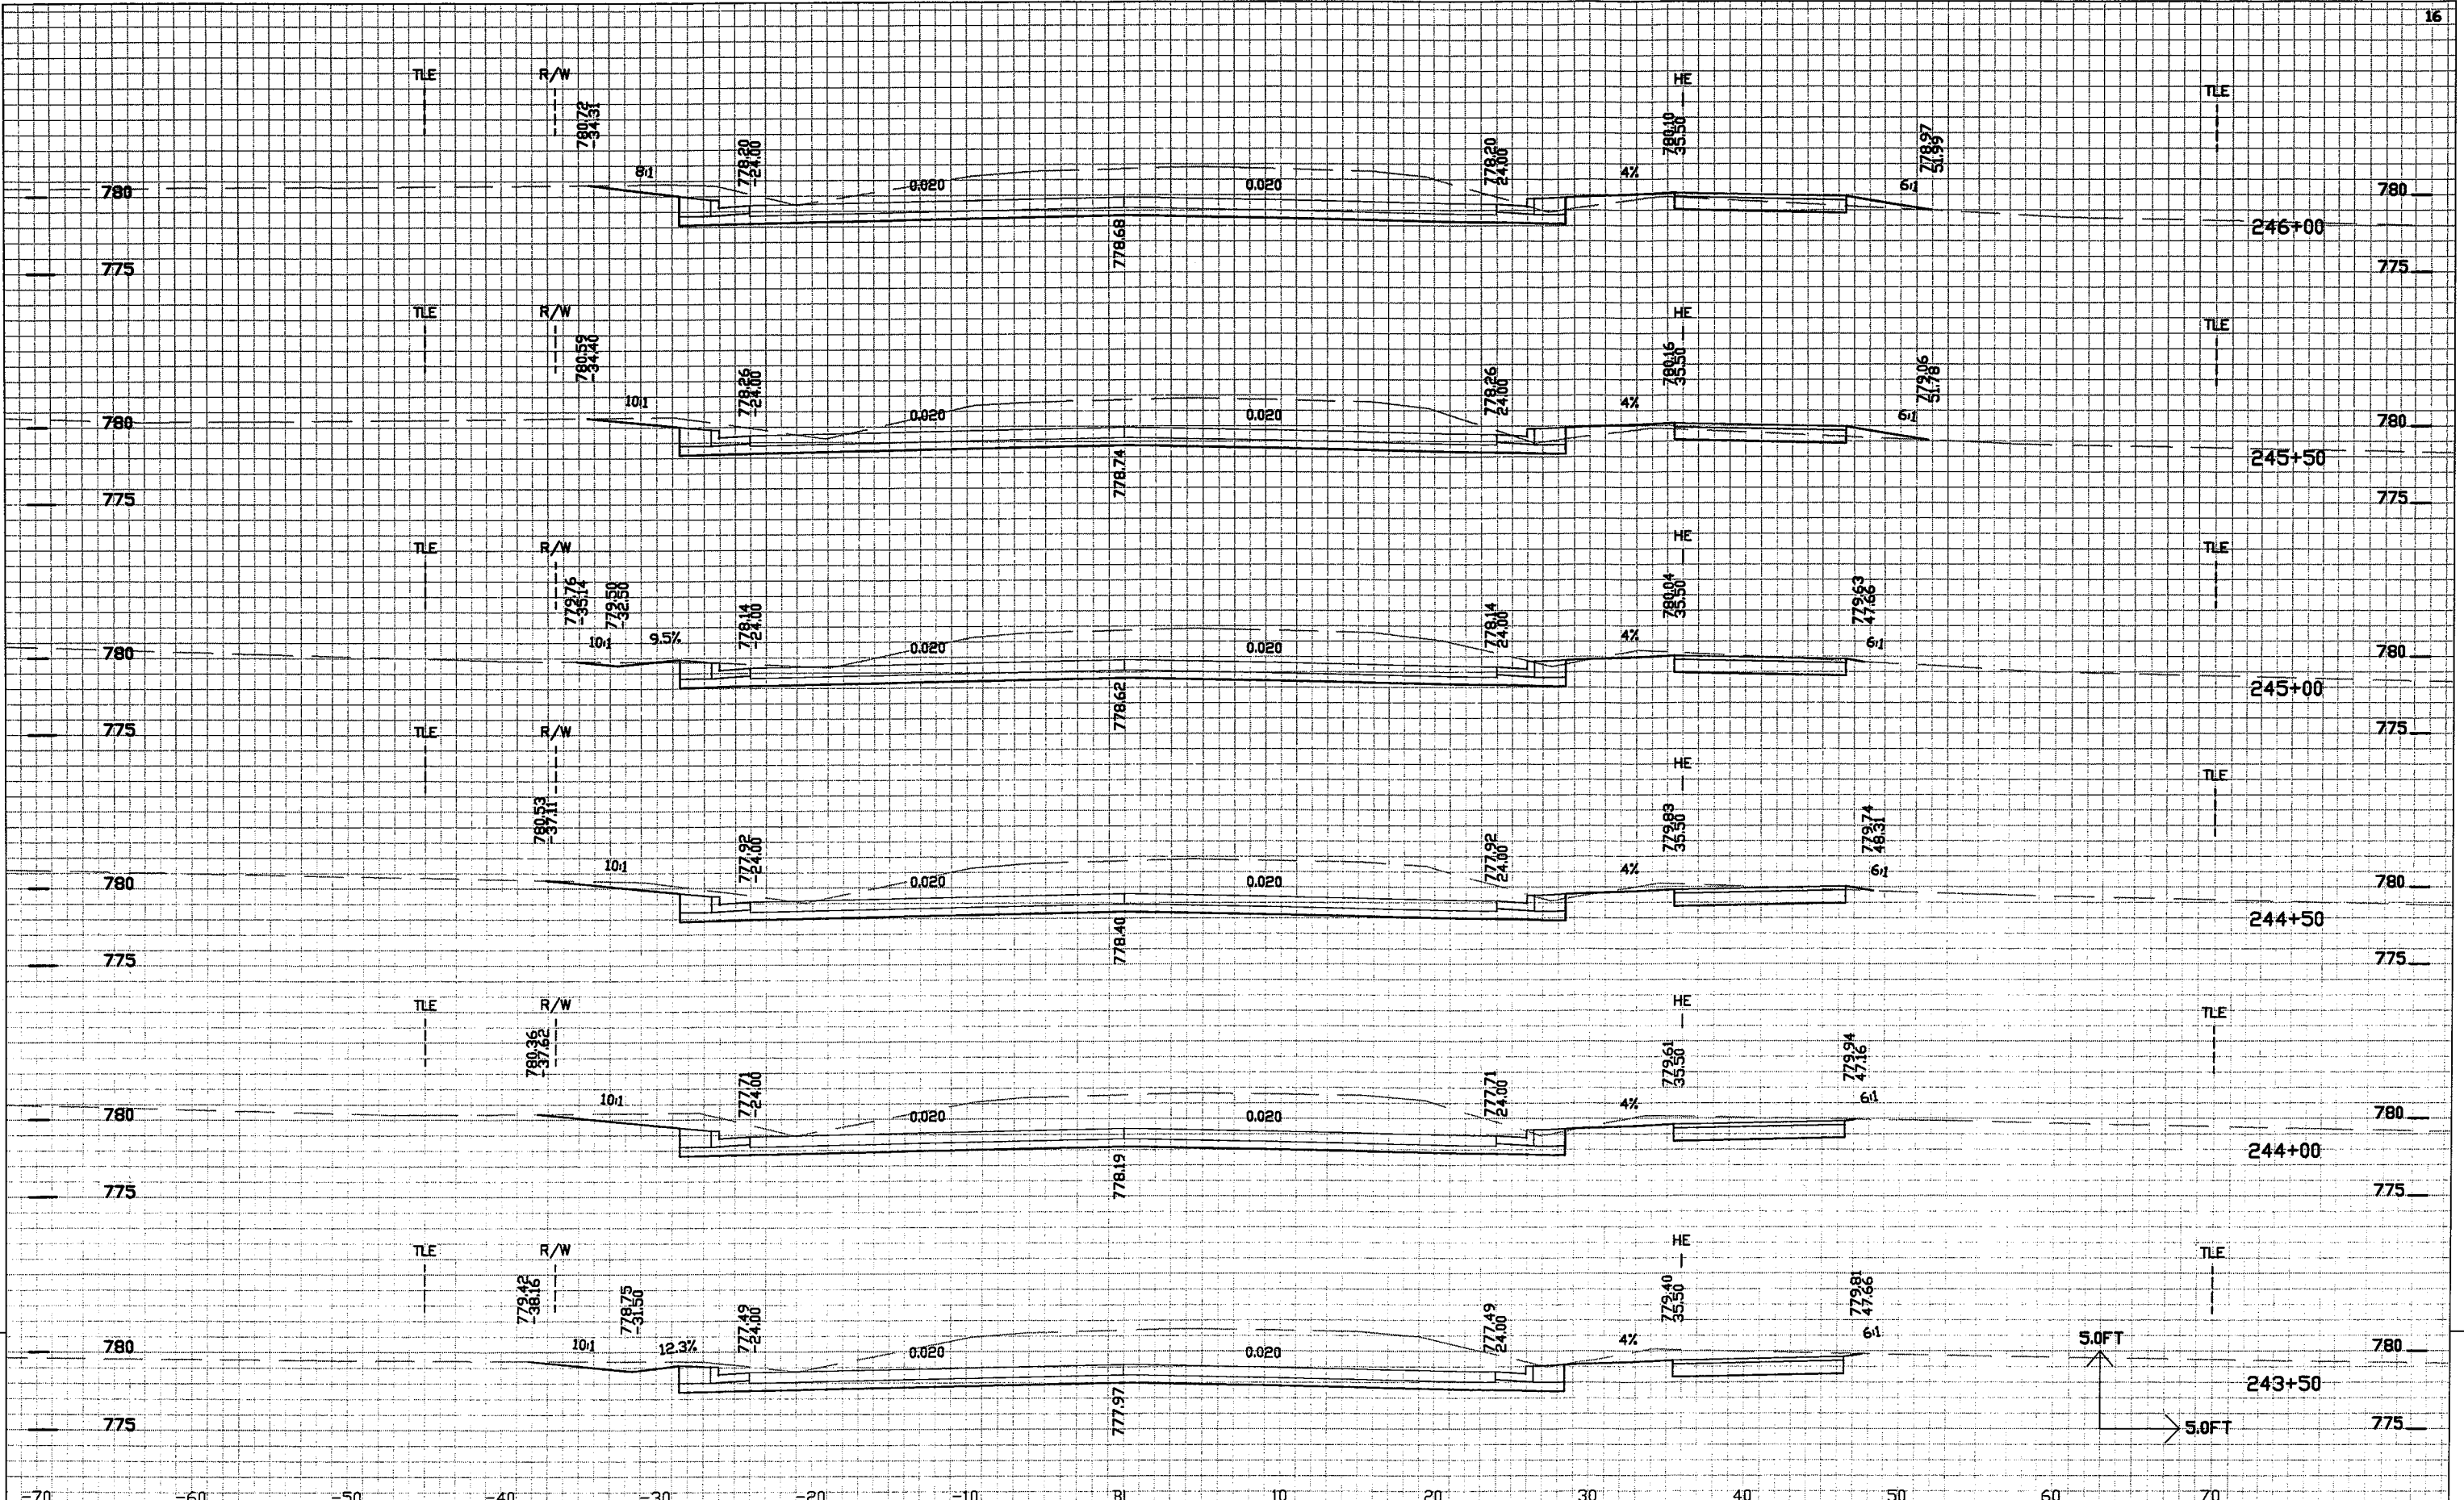

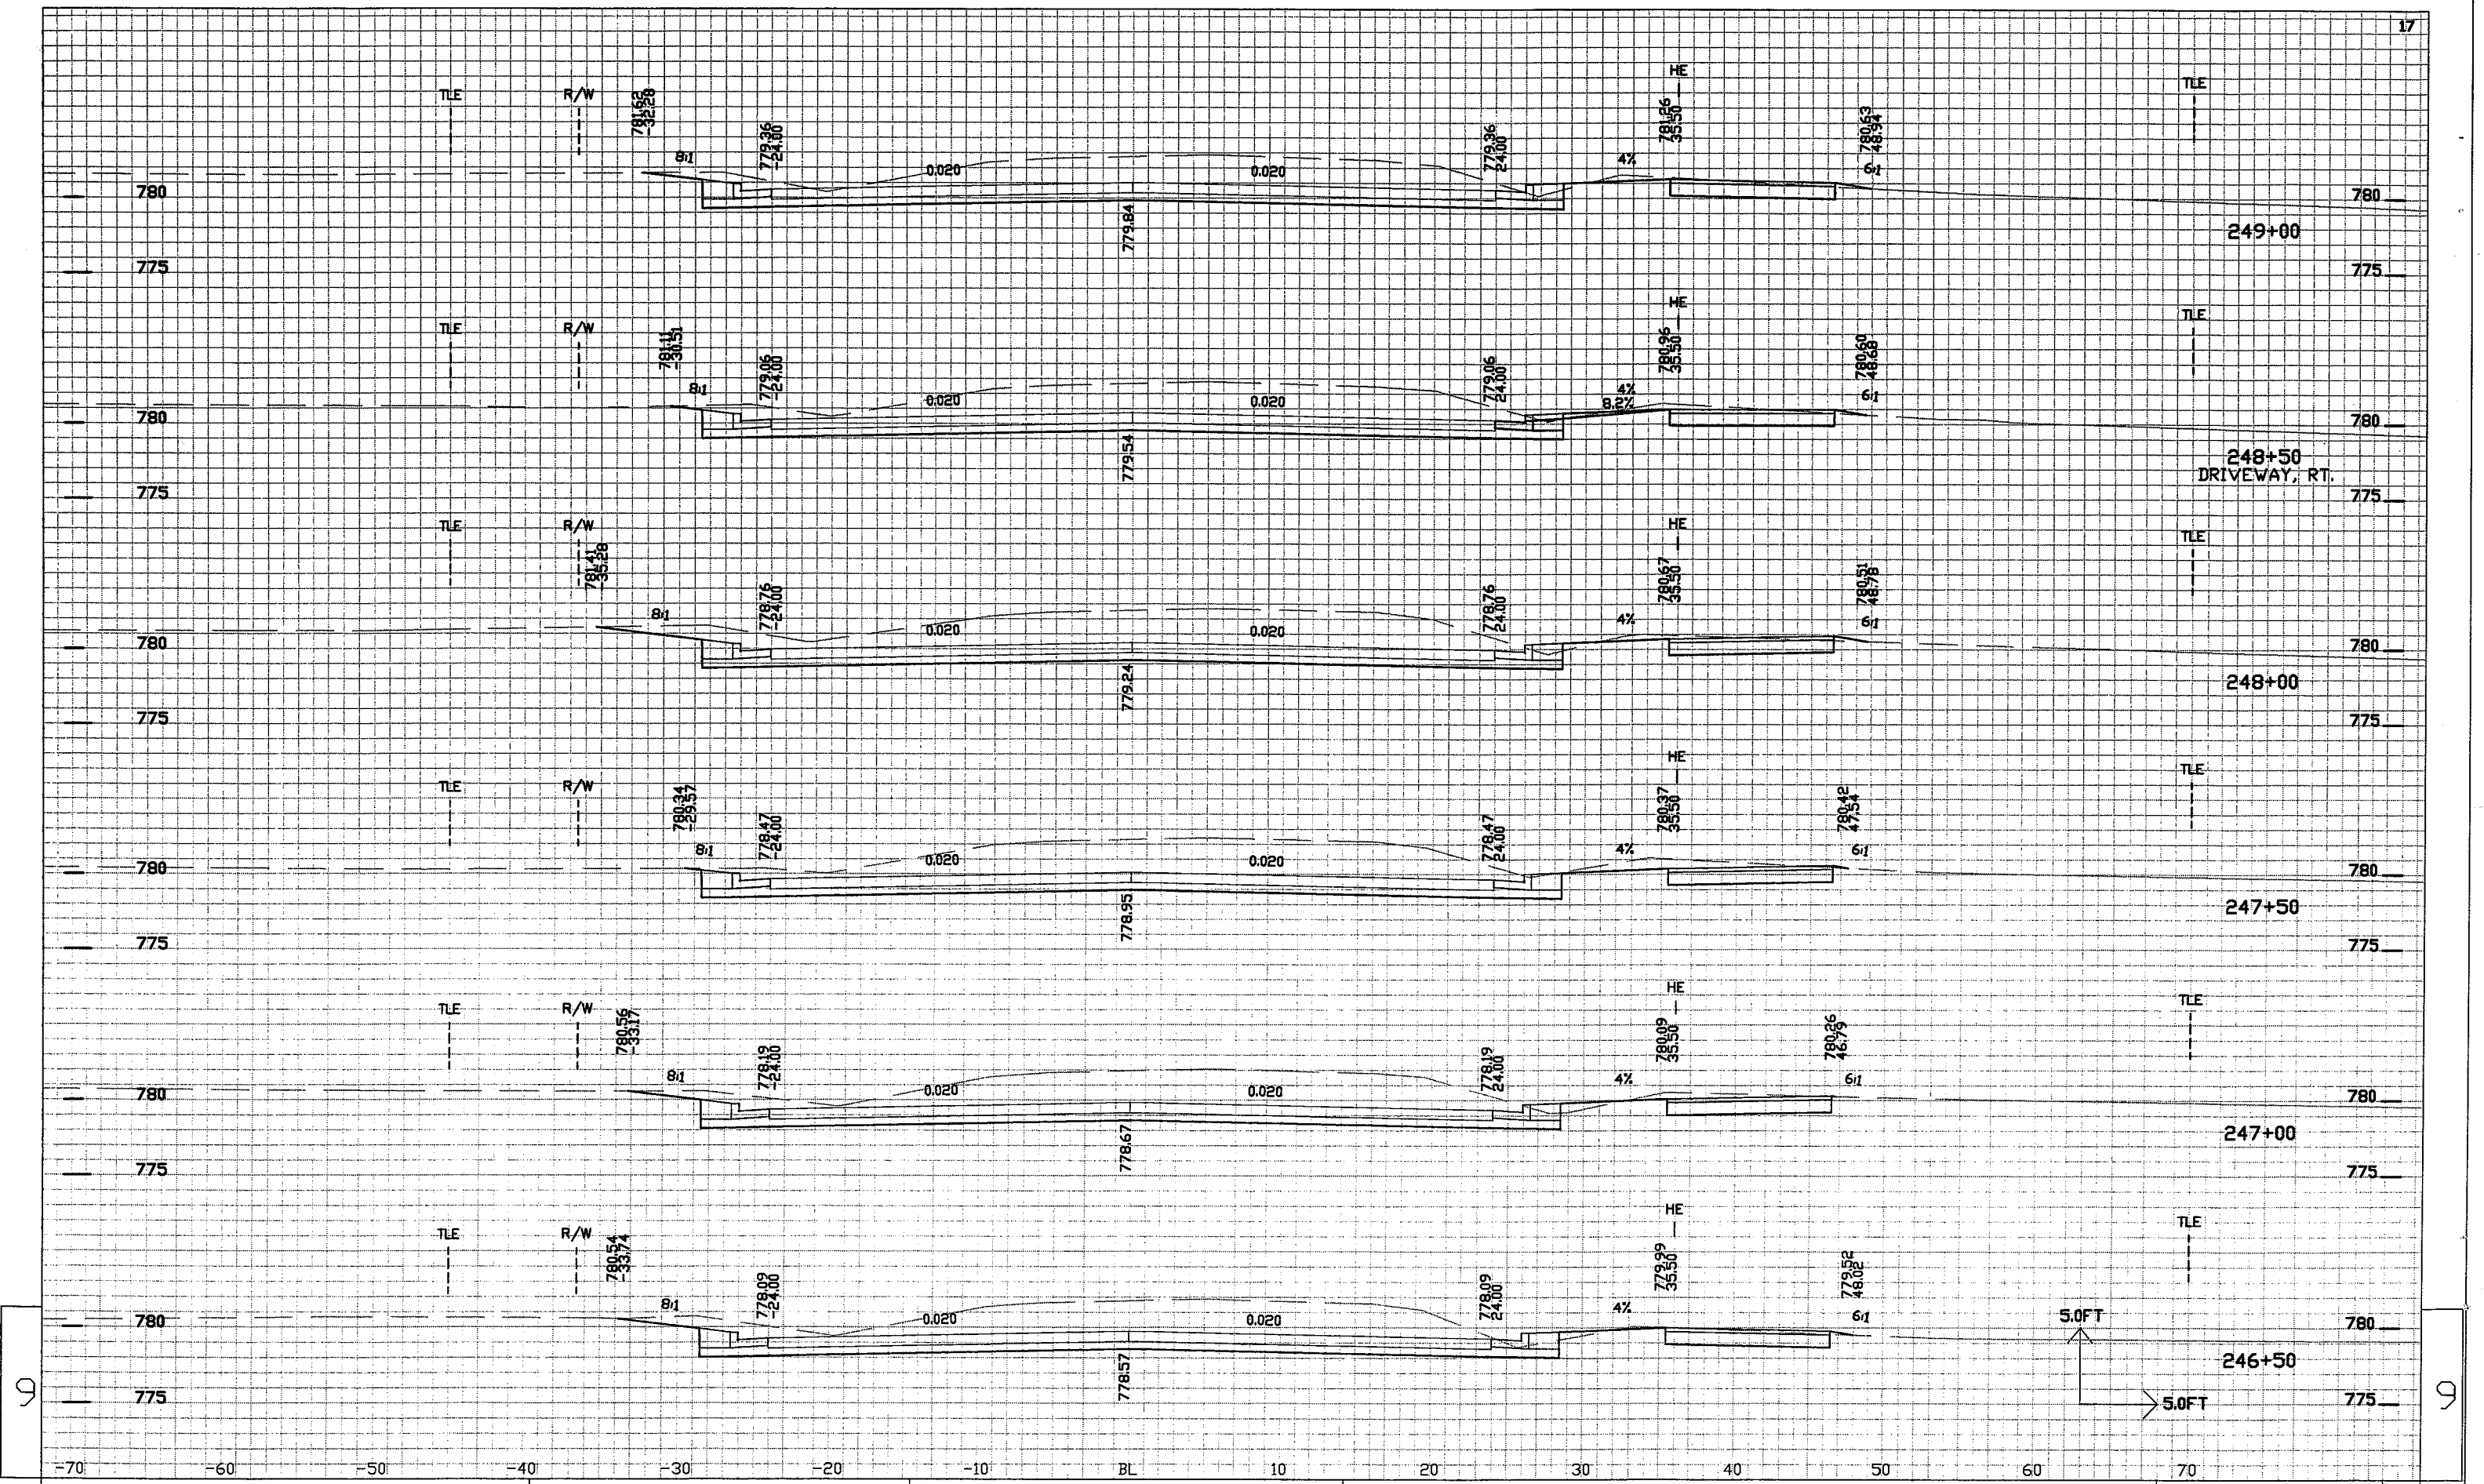

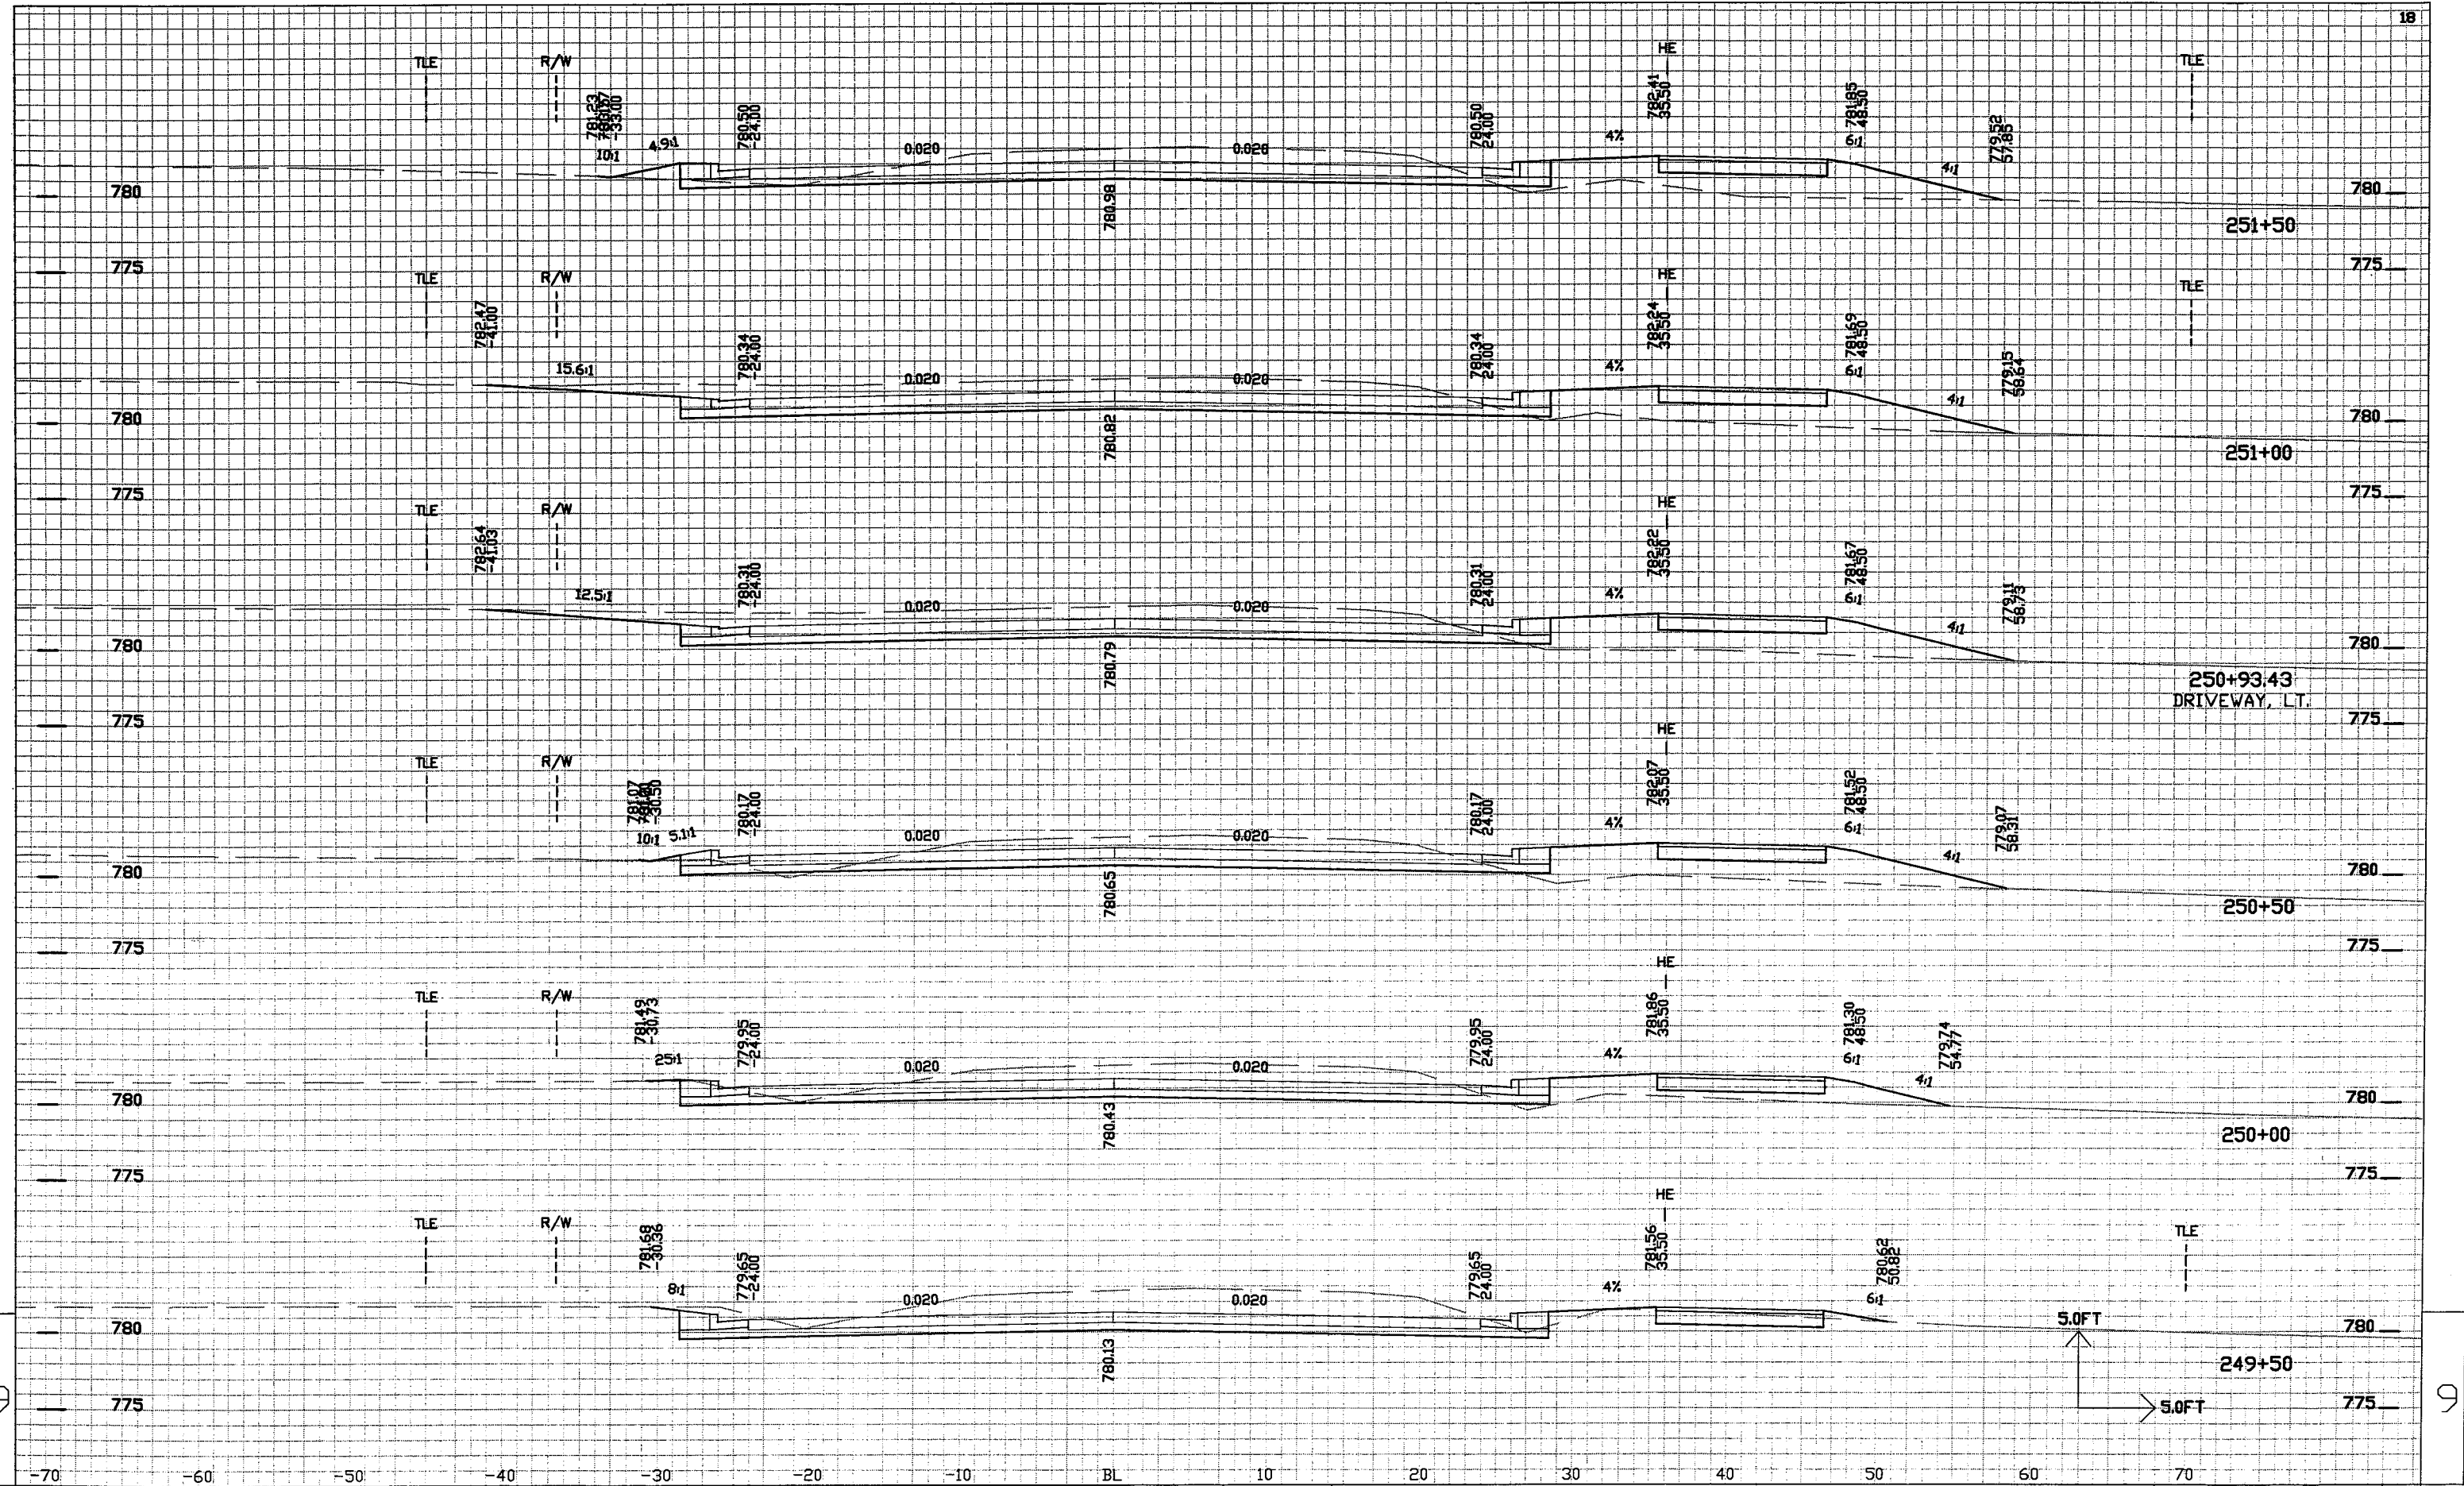

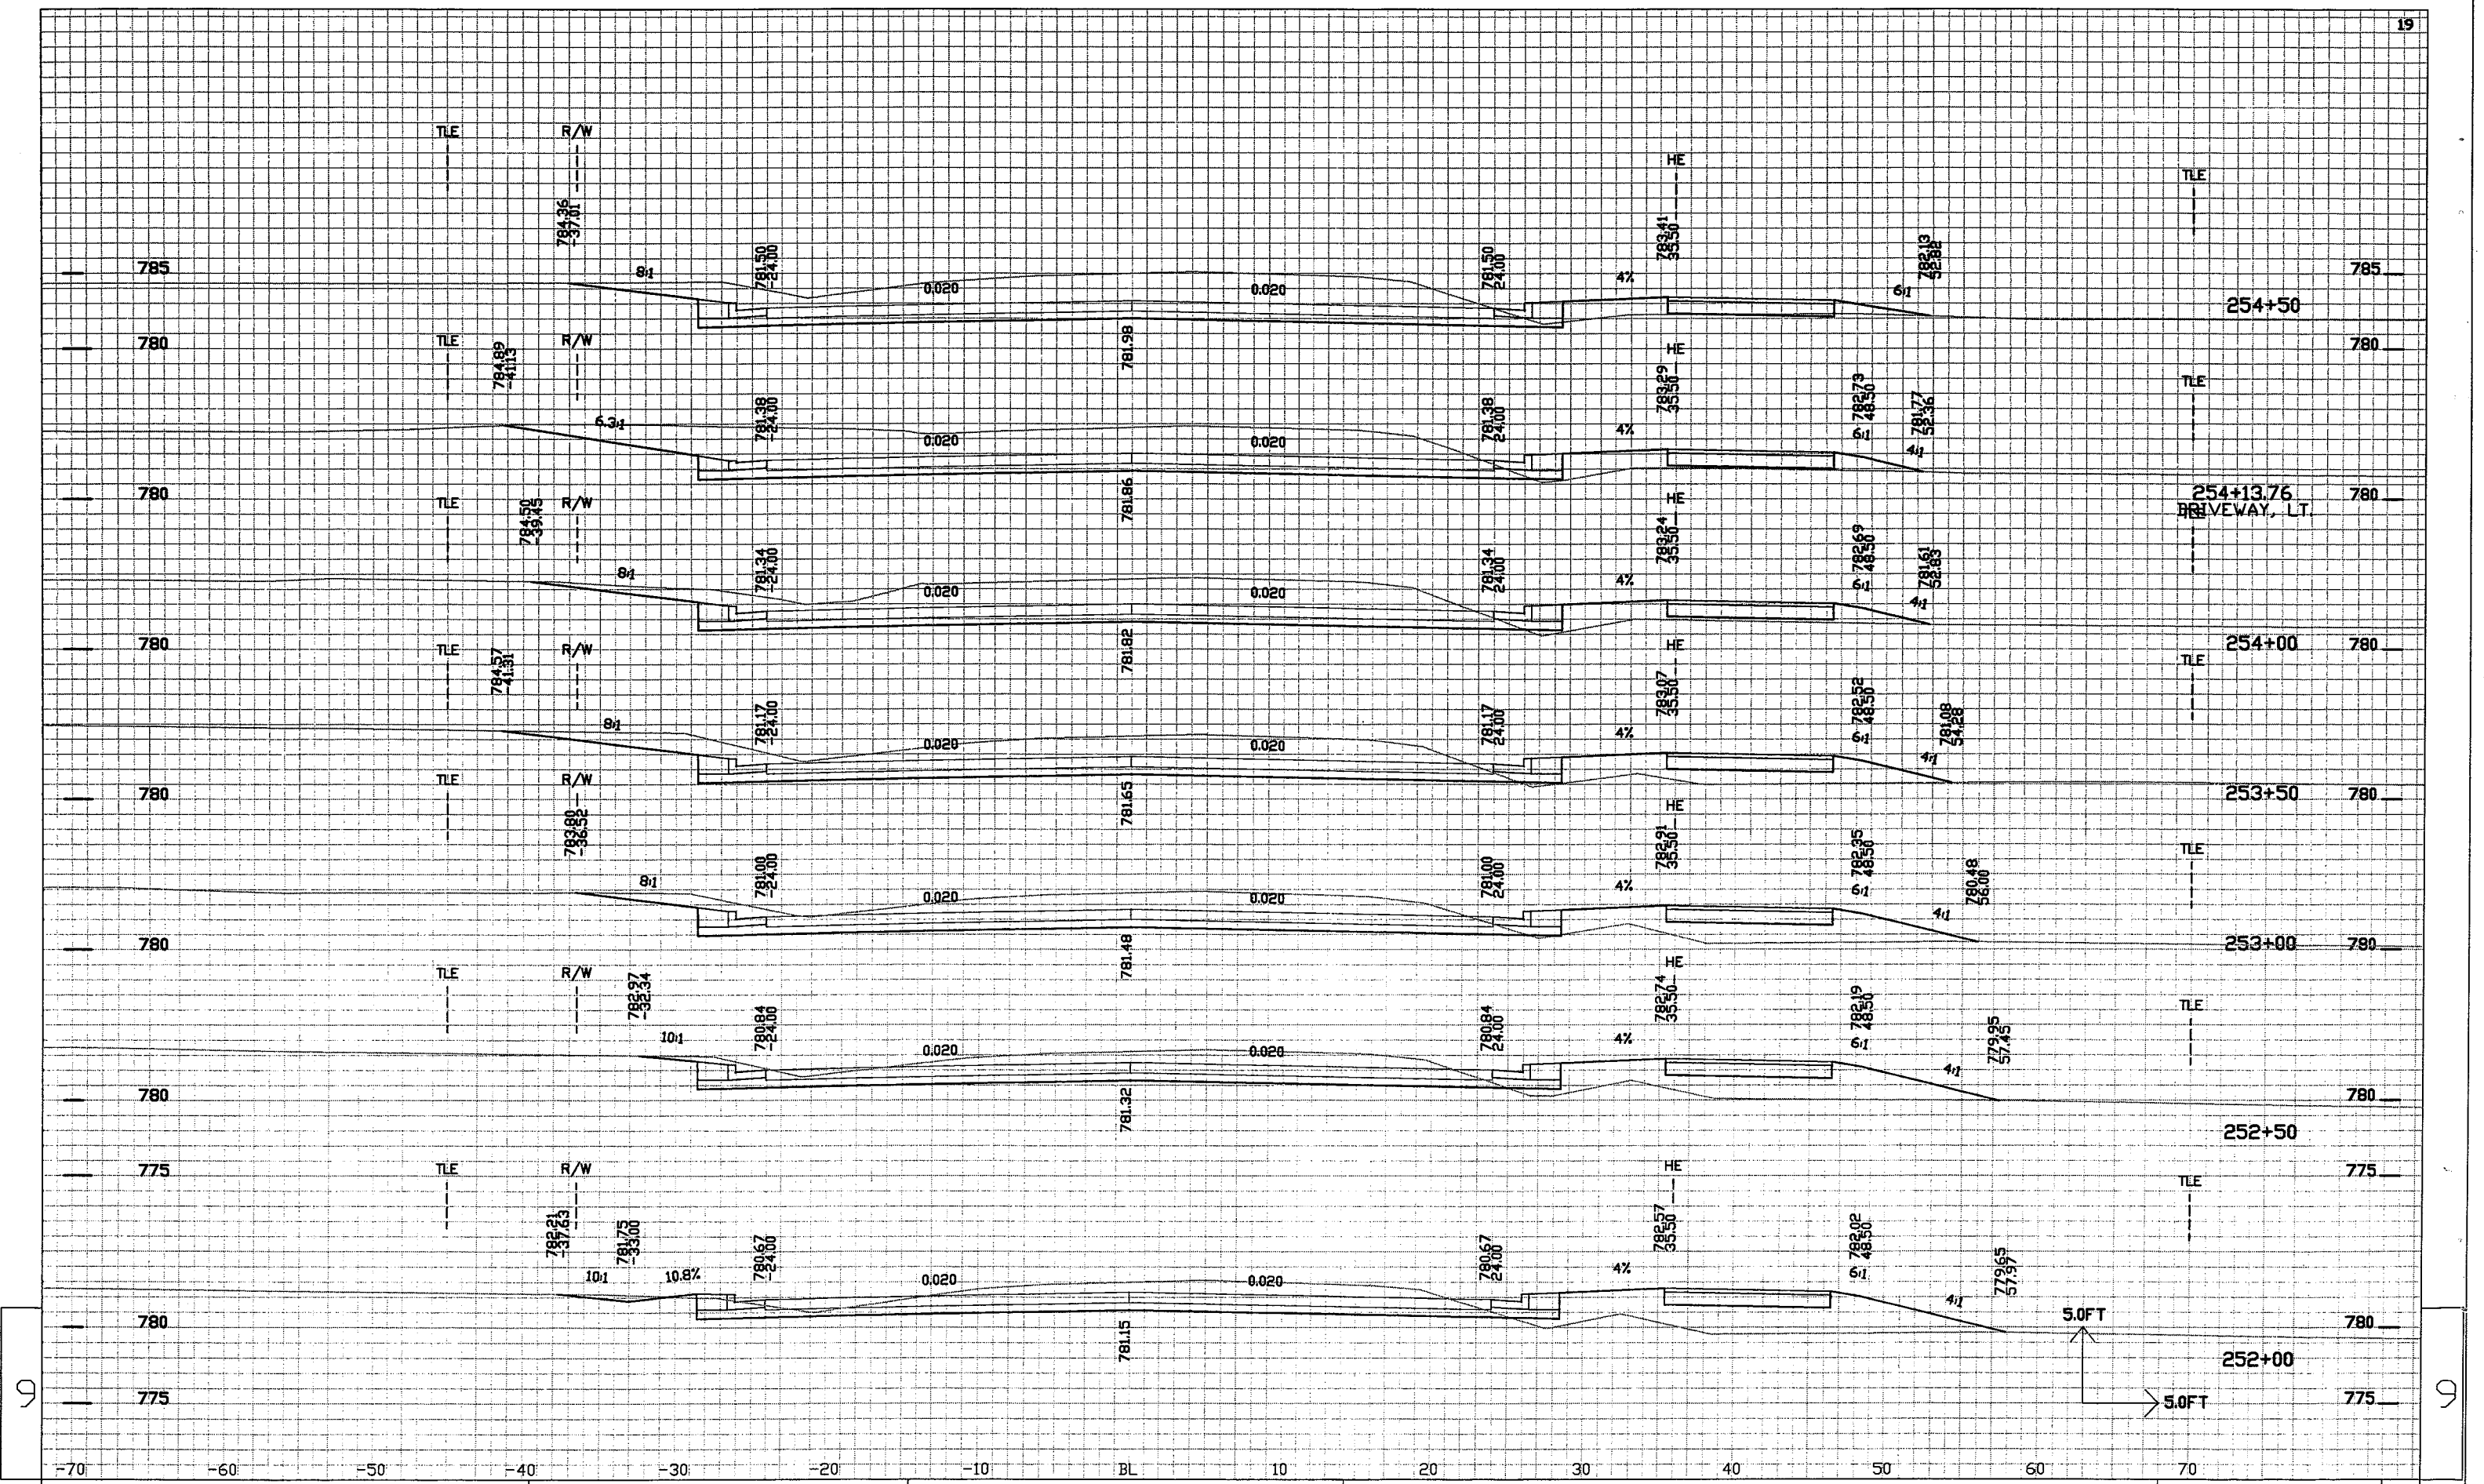

PROJECT NO: 4994-00-87

HWY: CTH Y

COUNTY: WINNEBAGO

CROSS SECTIONS

SHEET NO: 240

E


FILE NAME : \$\$...designfile...\$\$


PLOT DATE : \$\$...plottingdate...\$\$

PLOT BY : \$\$...plotuser...\$\$

PLOT NAME :

PLOT SCALE : \$\$...plotscale...\$\$

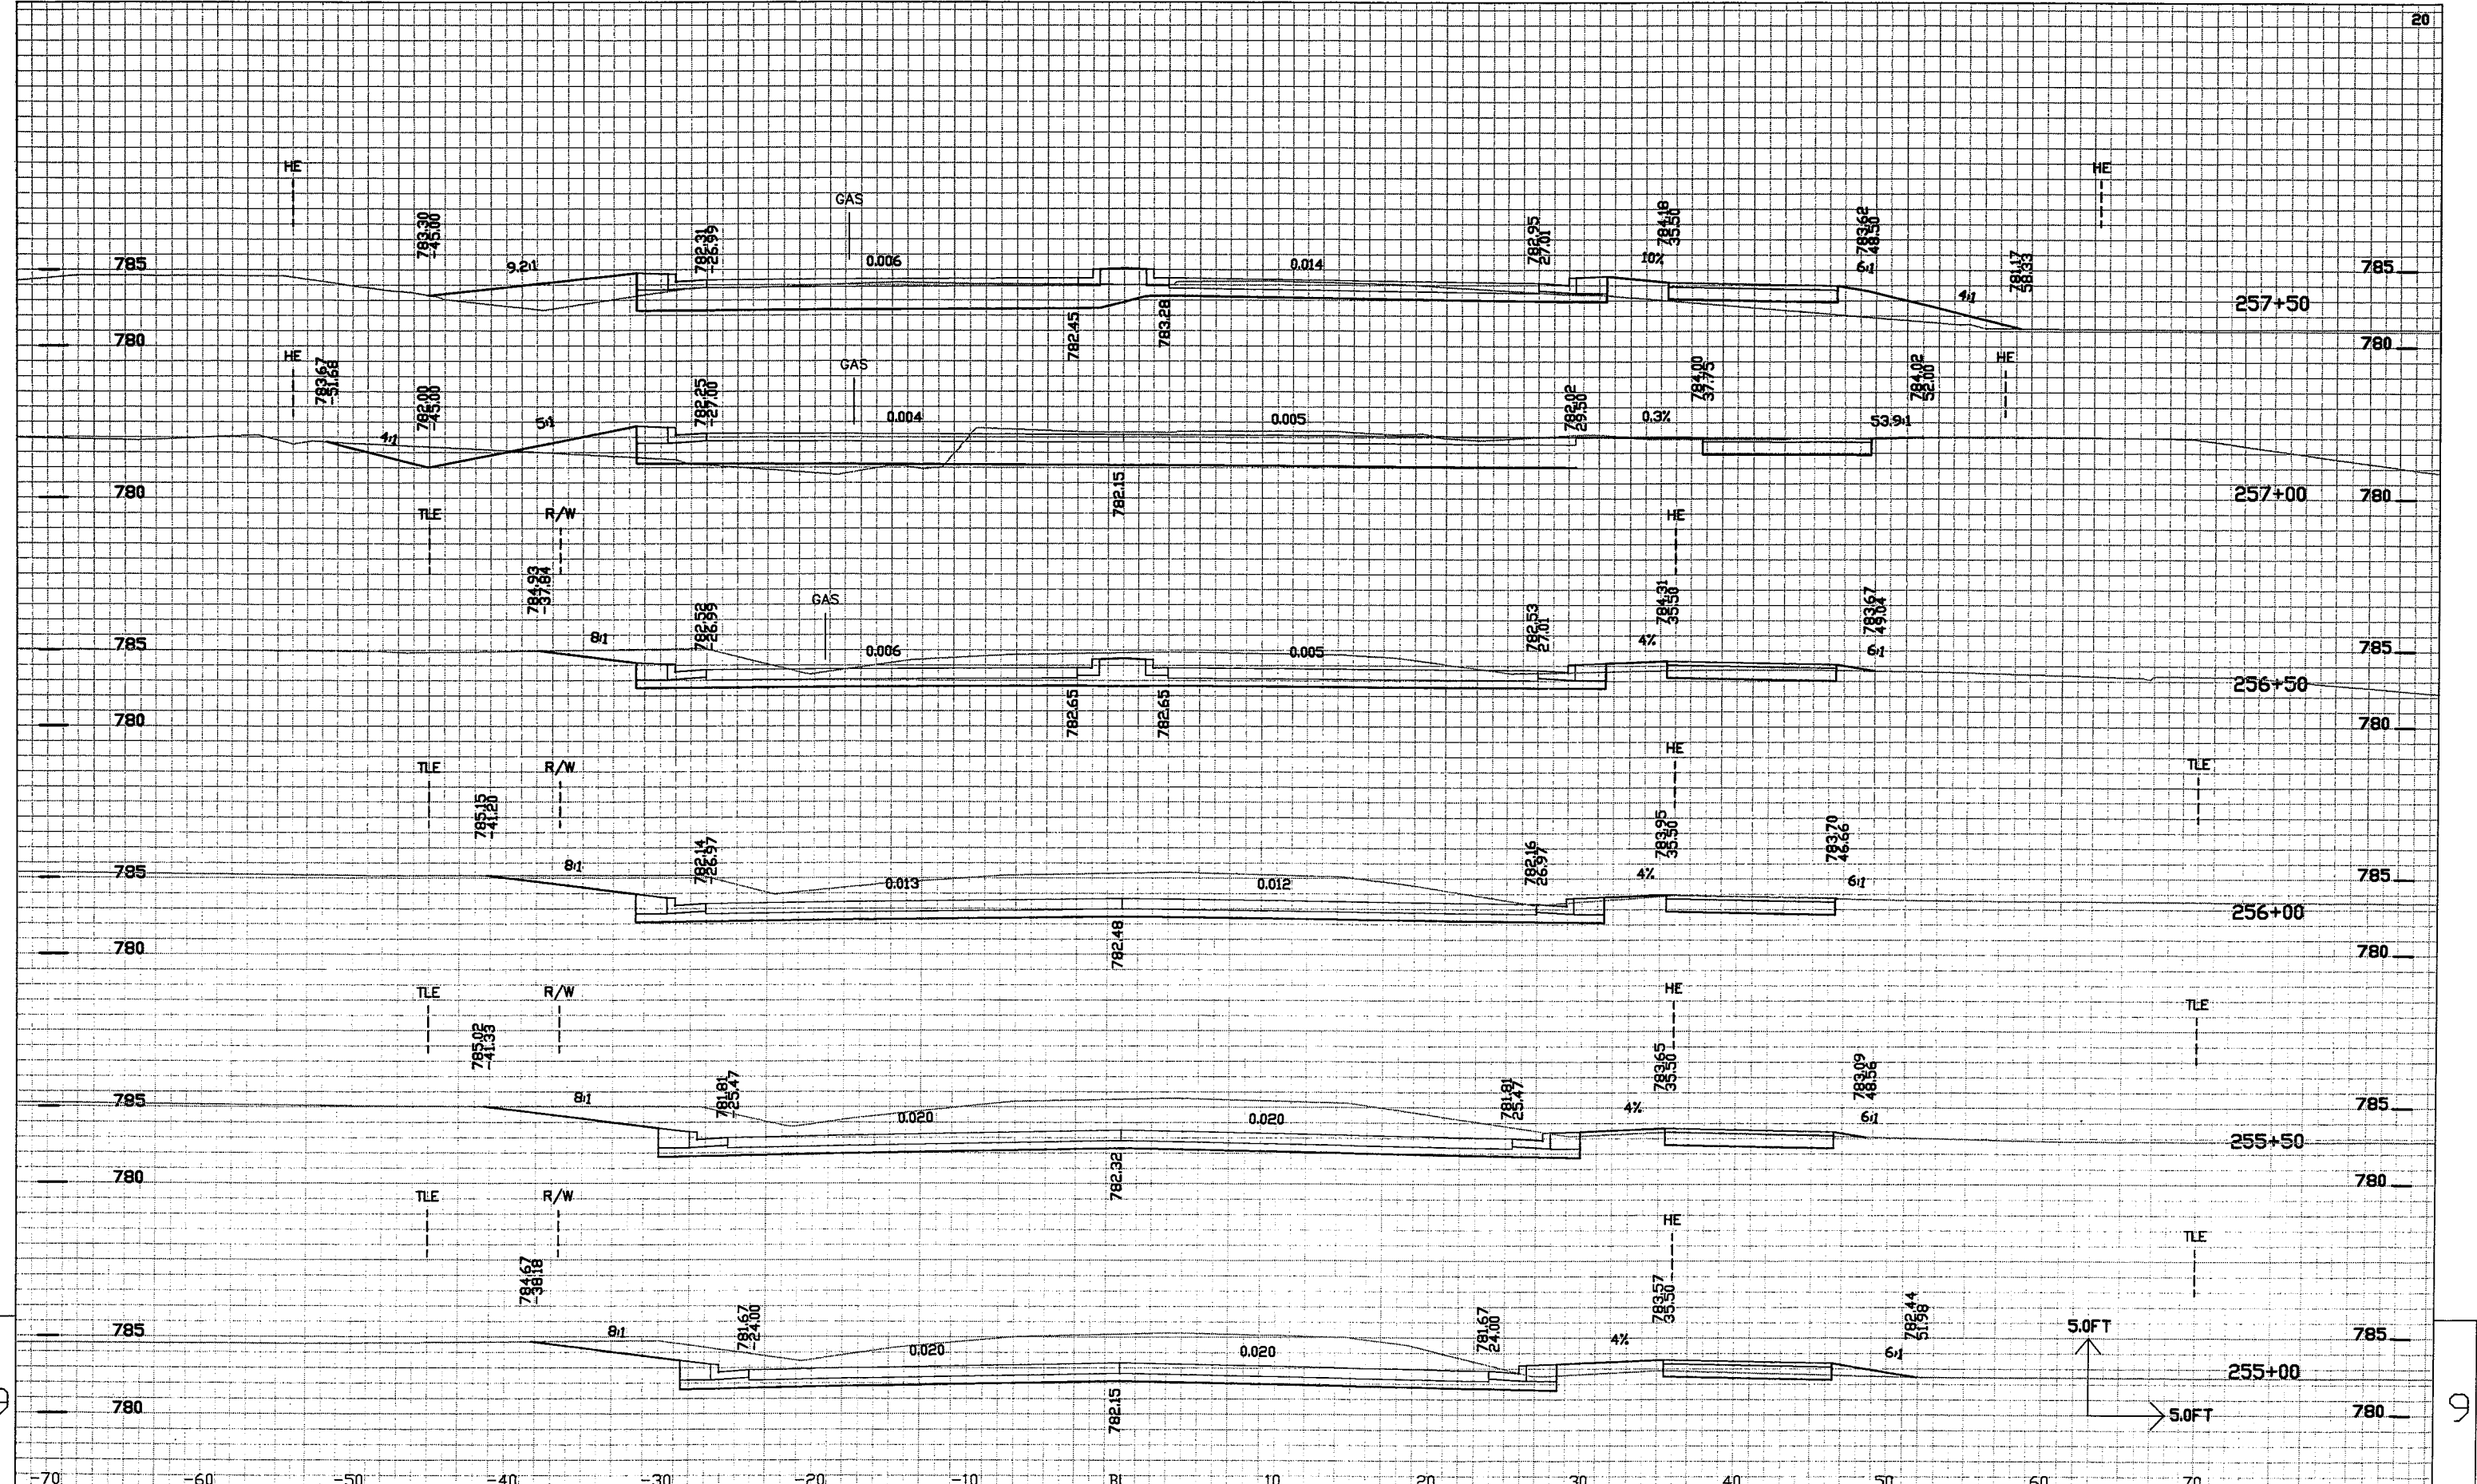


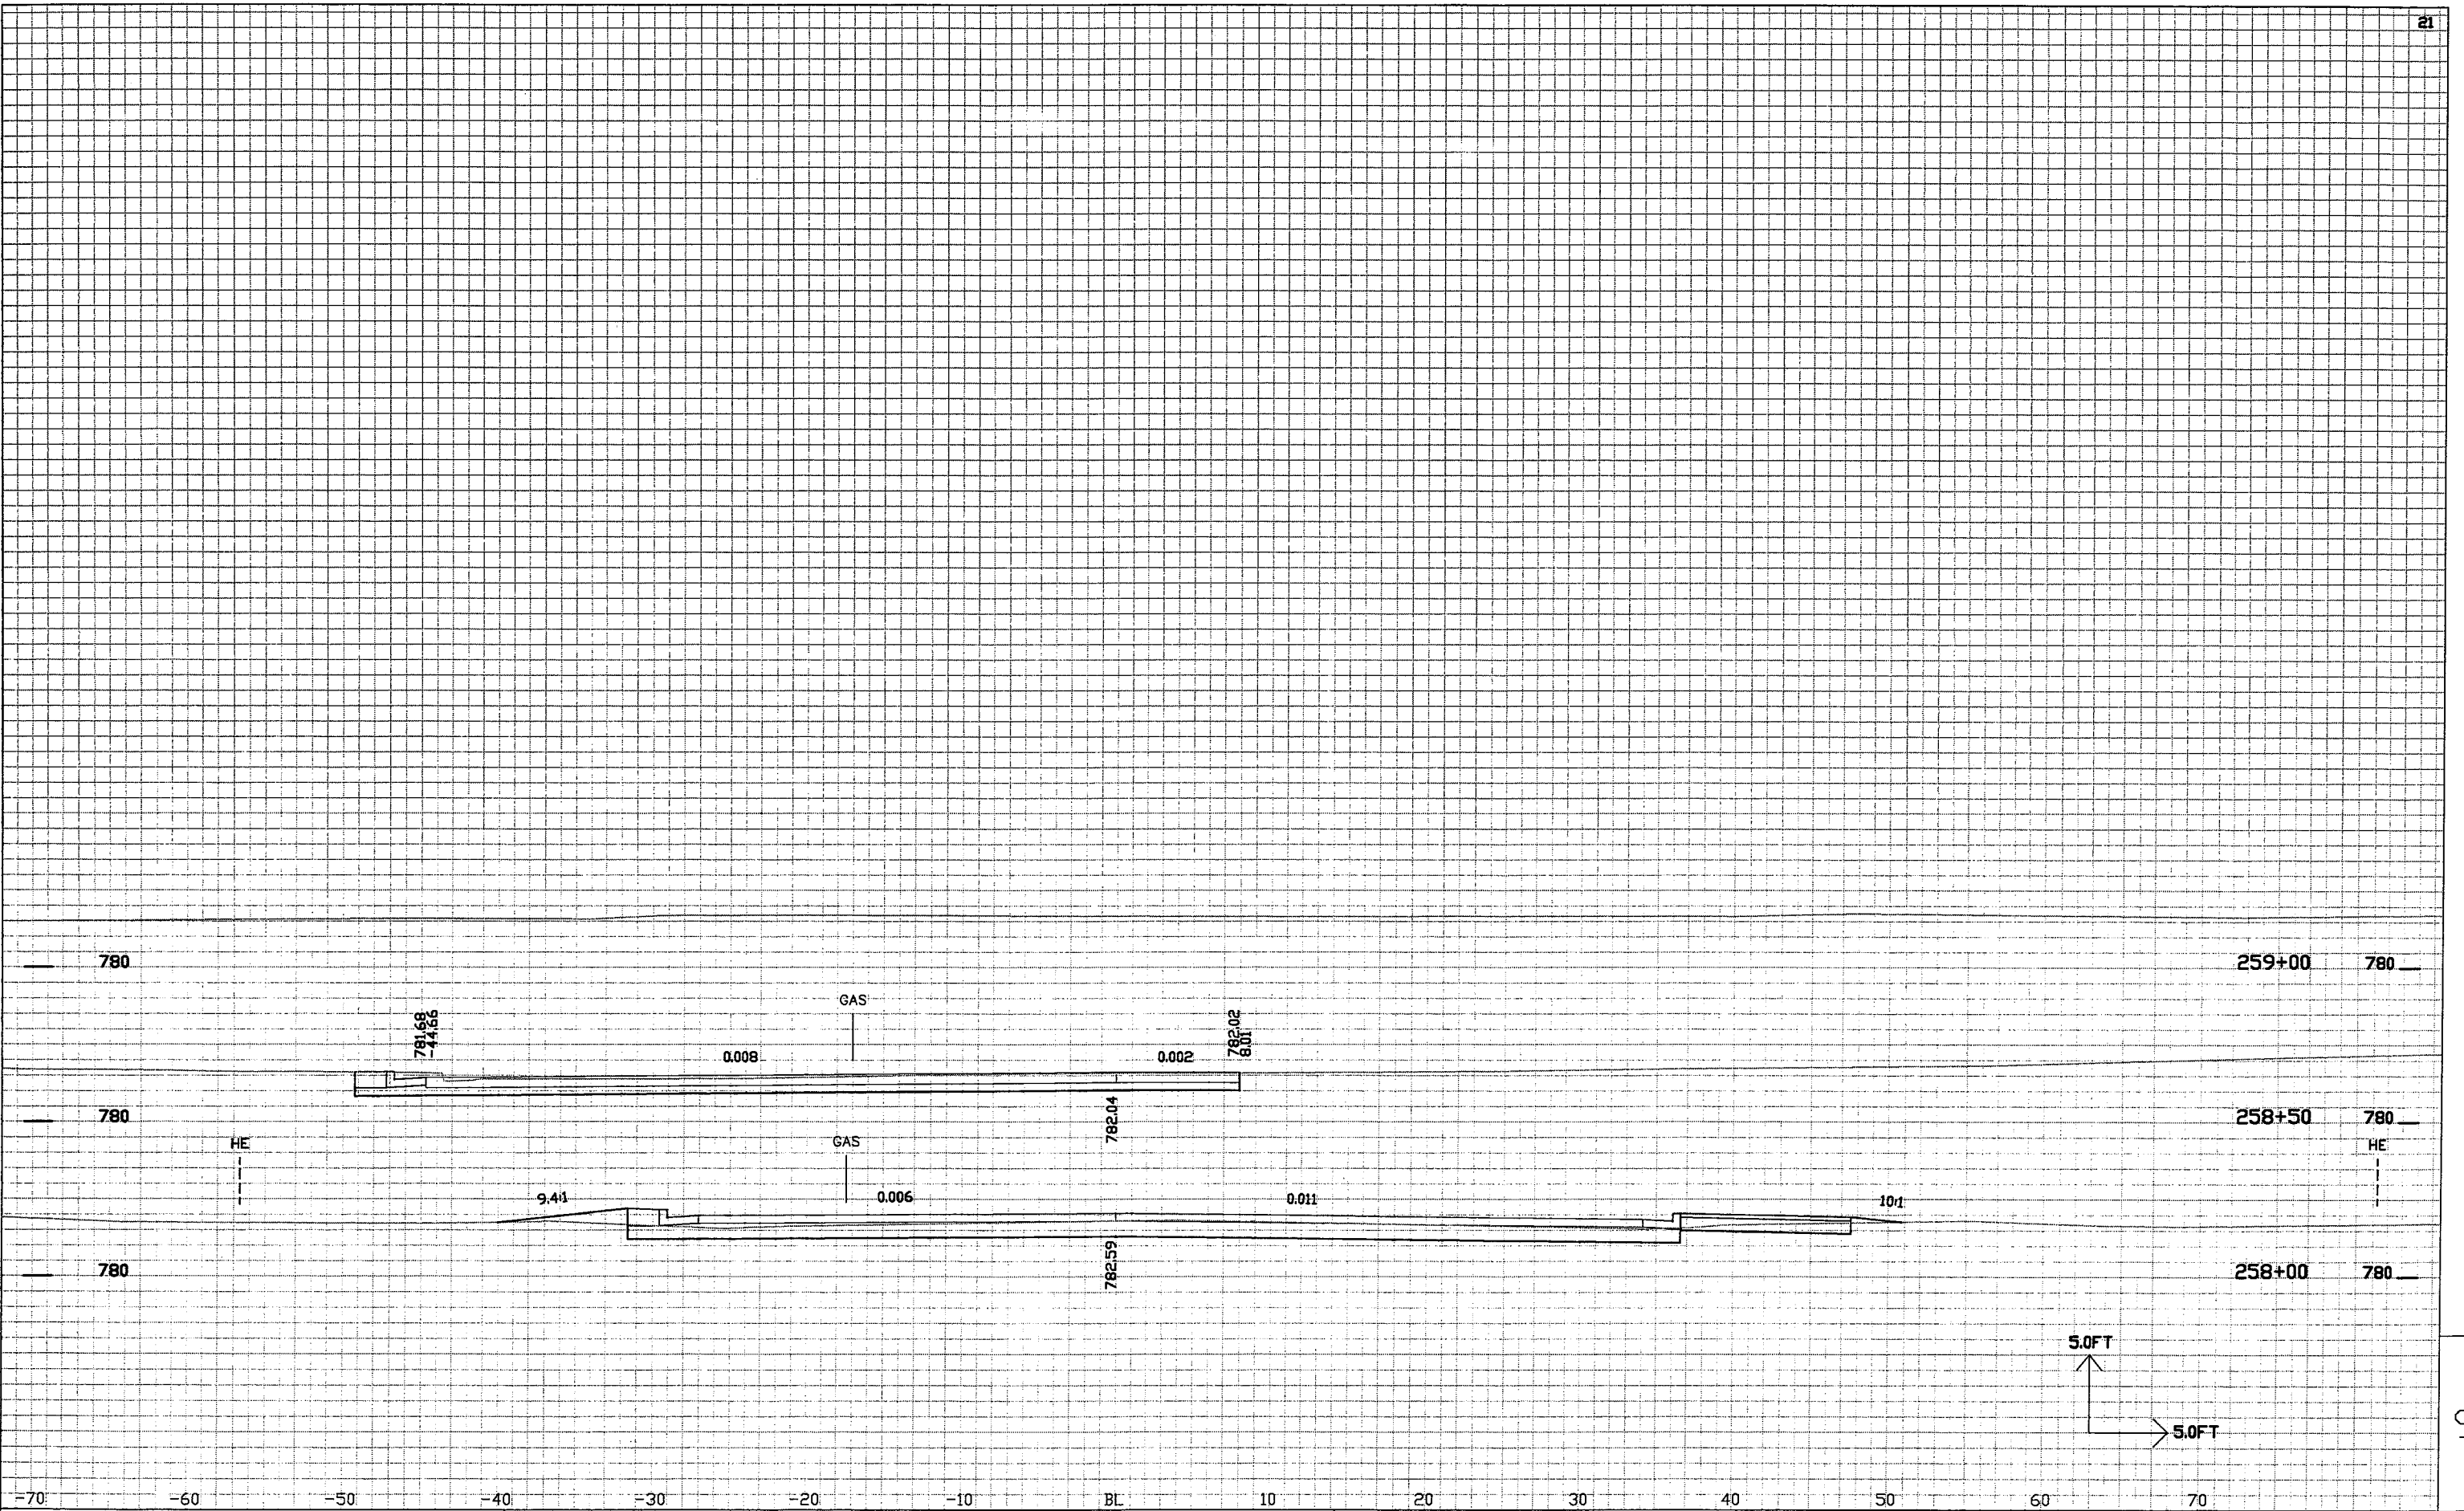

9


9

rgossen W:\DWG\W0202\970343\Cross Sections\CULVERTS.dwg 10/21/08 2:54 PM

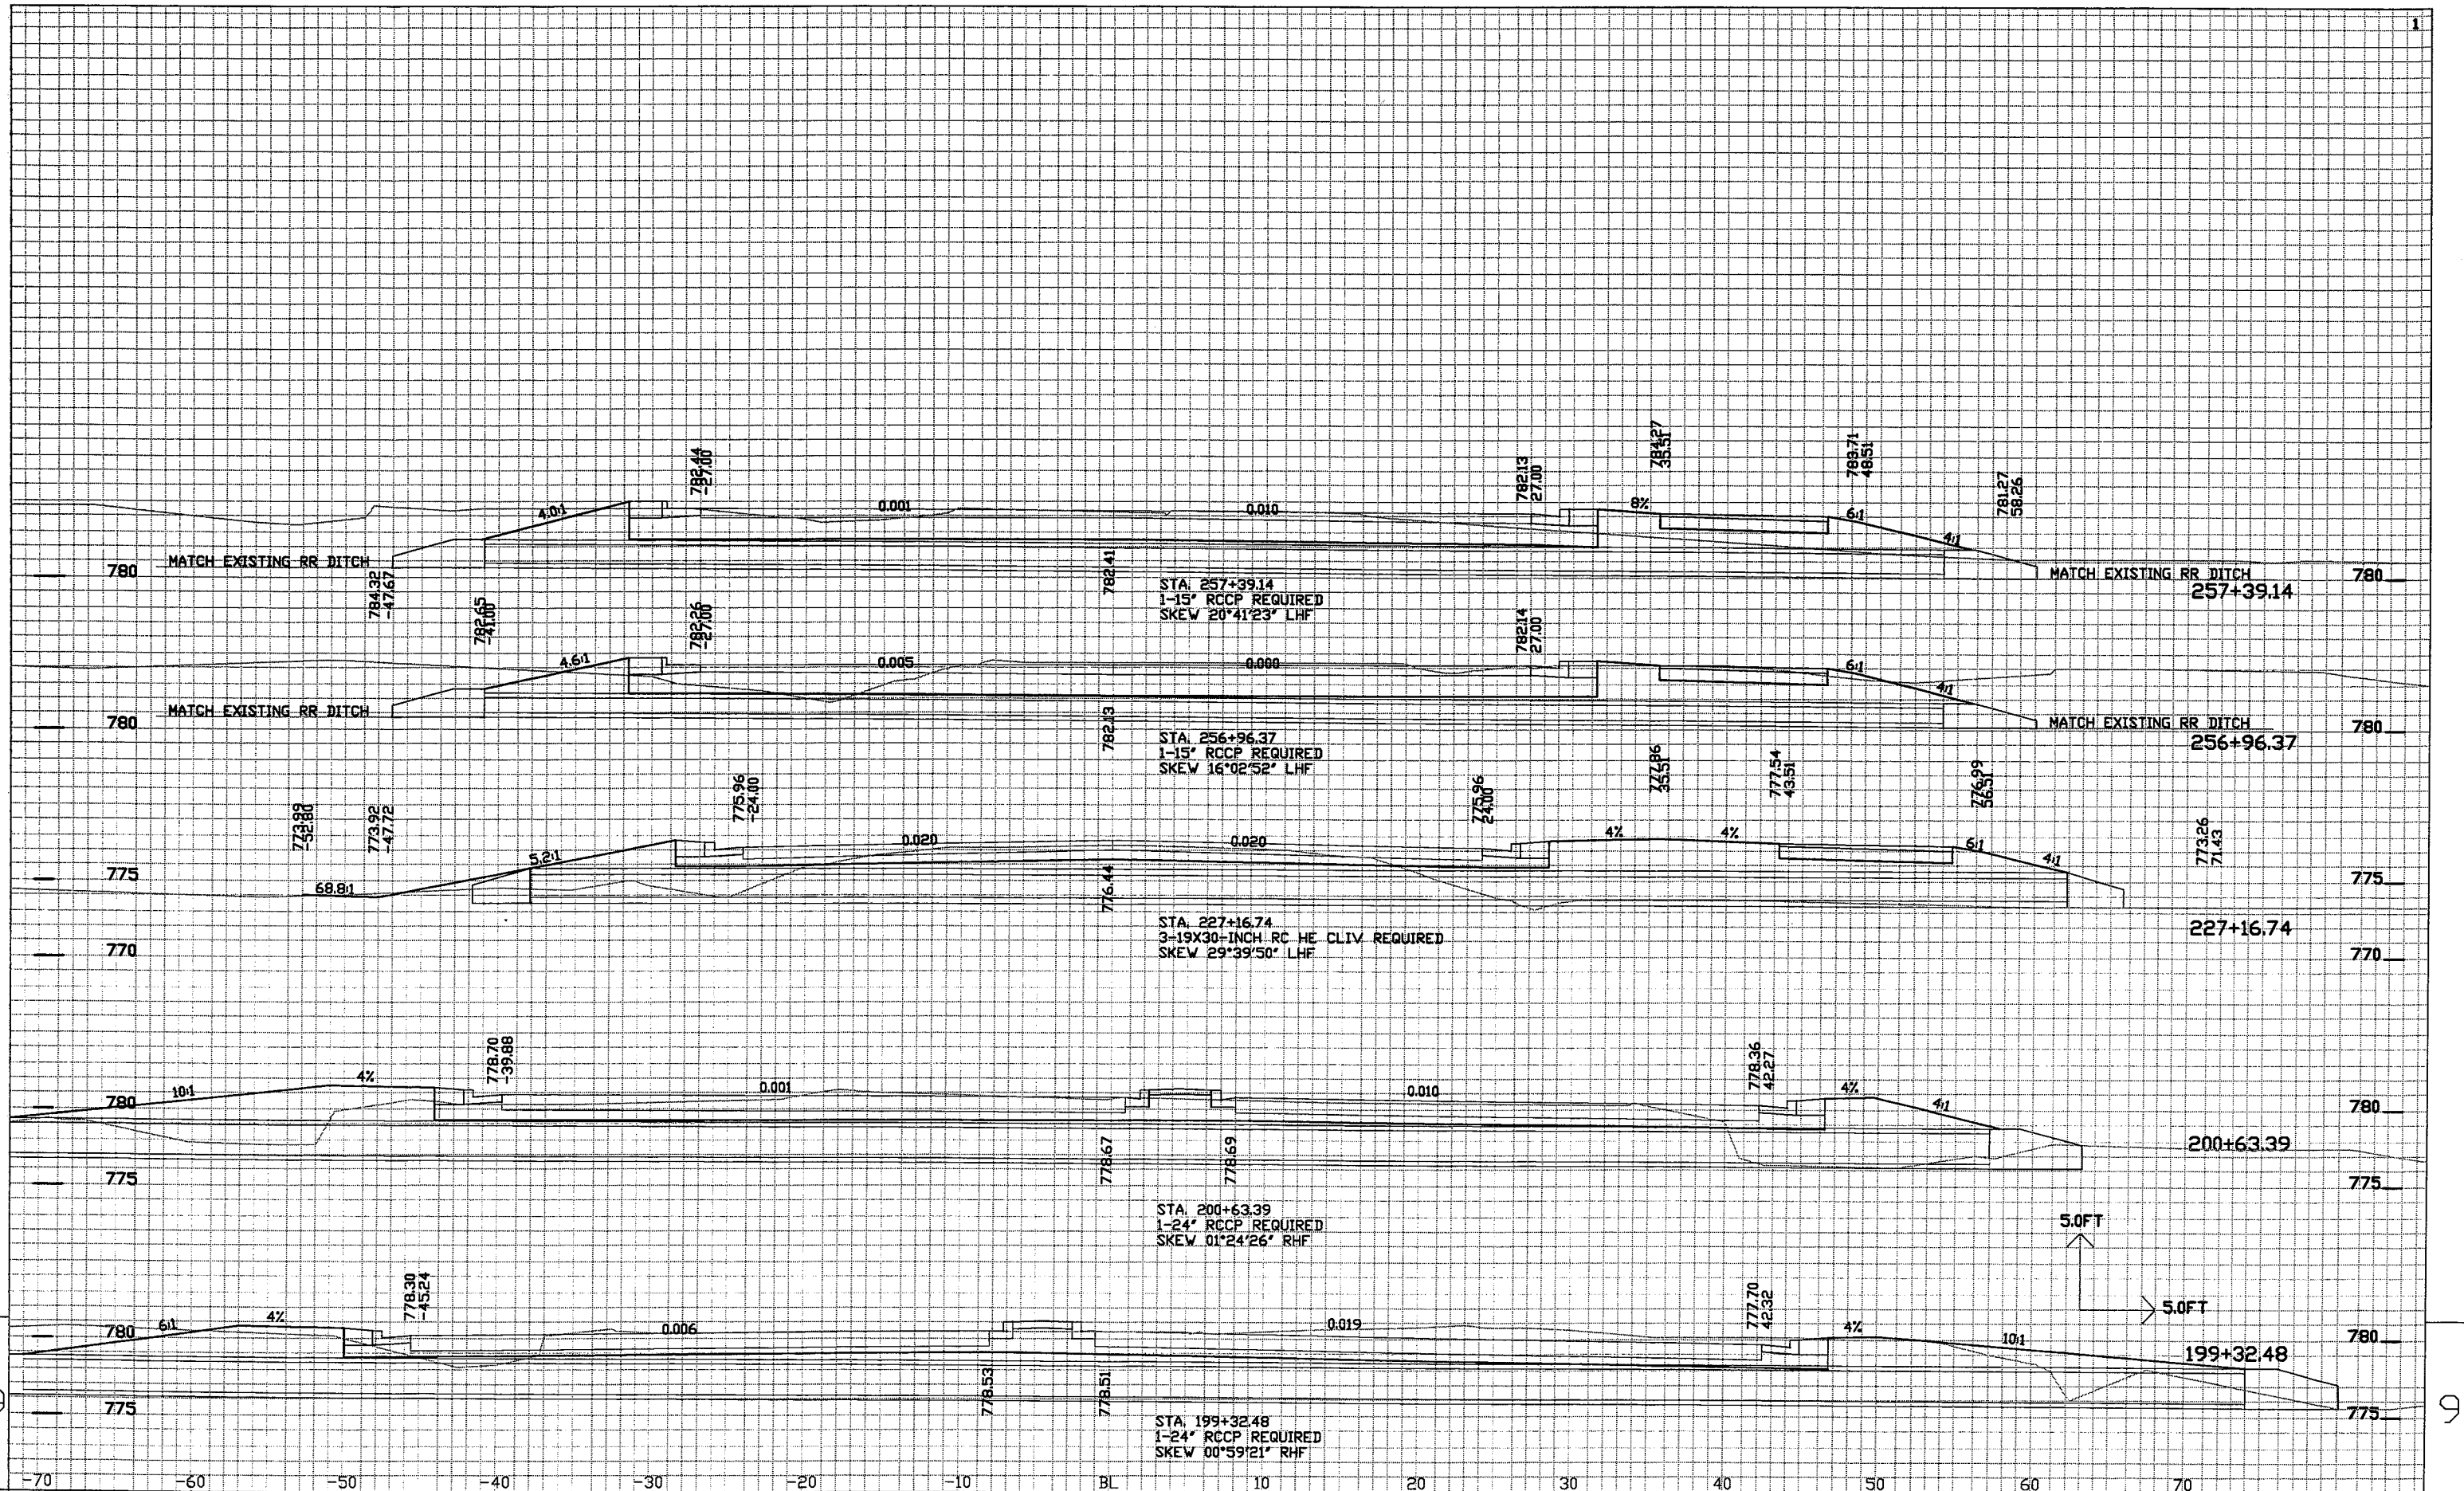

PROJECT NO: 4994-00-87	HWY: CTH Y	COUNTY: WINNEBAGO	CROSS SECTIONS FOR CULVERT PIPE CROSSINGS	SHEET NO: 243	E
------------------------	------------	-------------------	---	---------------	---

FILE NAME : \$\$\$designfile\$\$\$ PLOT DATE : \$\$\$plottingdate\$\$\$ PLOT BY : \$\$\$plotuser\$\$\$ PLOT NAME : PLOT SCALE : \$\$\$plotscale\$\$\$

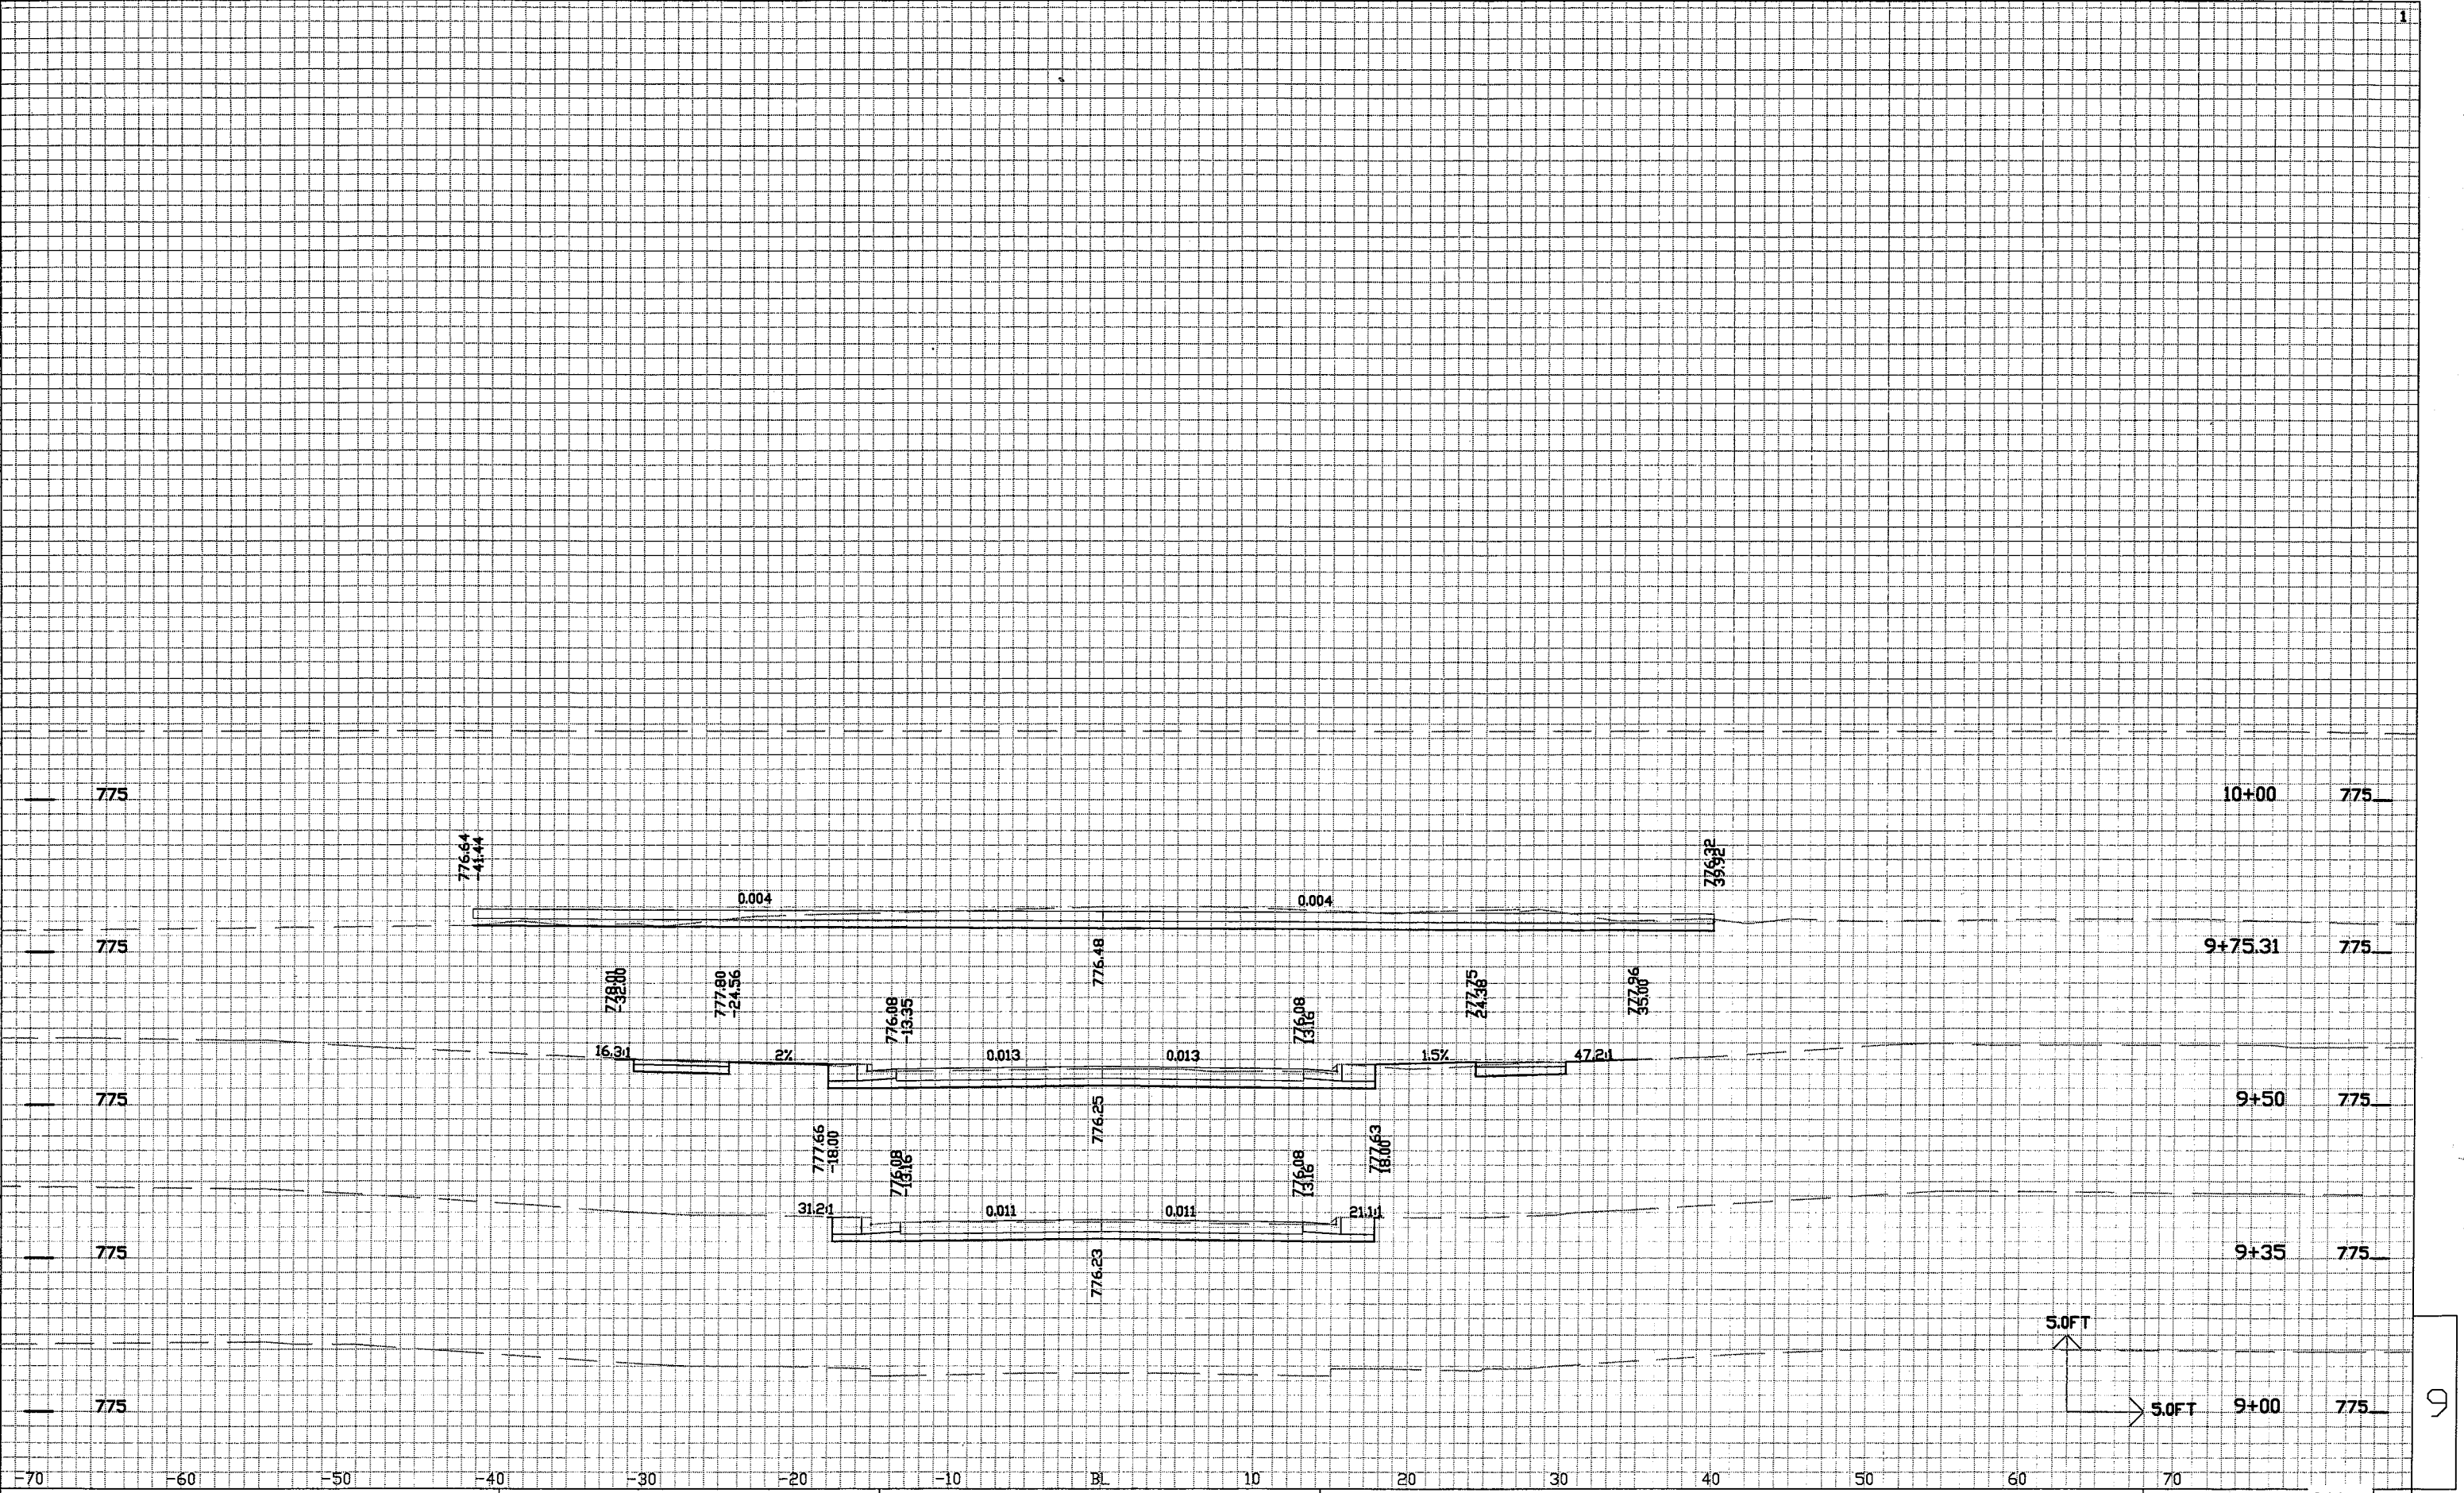

PROJECT NO: 4994-00-87

HWY: SODA CREEK RD

COUNTY: WINNEBAGO

CROSS SECTIONS

SHEET NO: 244

E


FILE NAME : \$\$...designfile...\$\$

PLOT DATE : \$\$...plottingdate...\$\$

PLOT BY : \$\$...plotuser...\$\$


PLOT NAME :

PLOT SCALE : \$\$...plotscale...\$\$

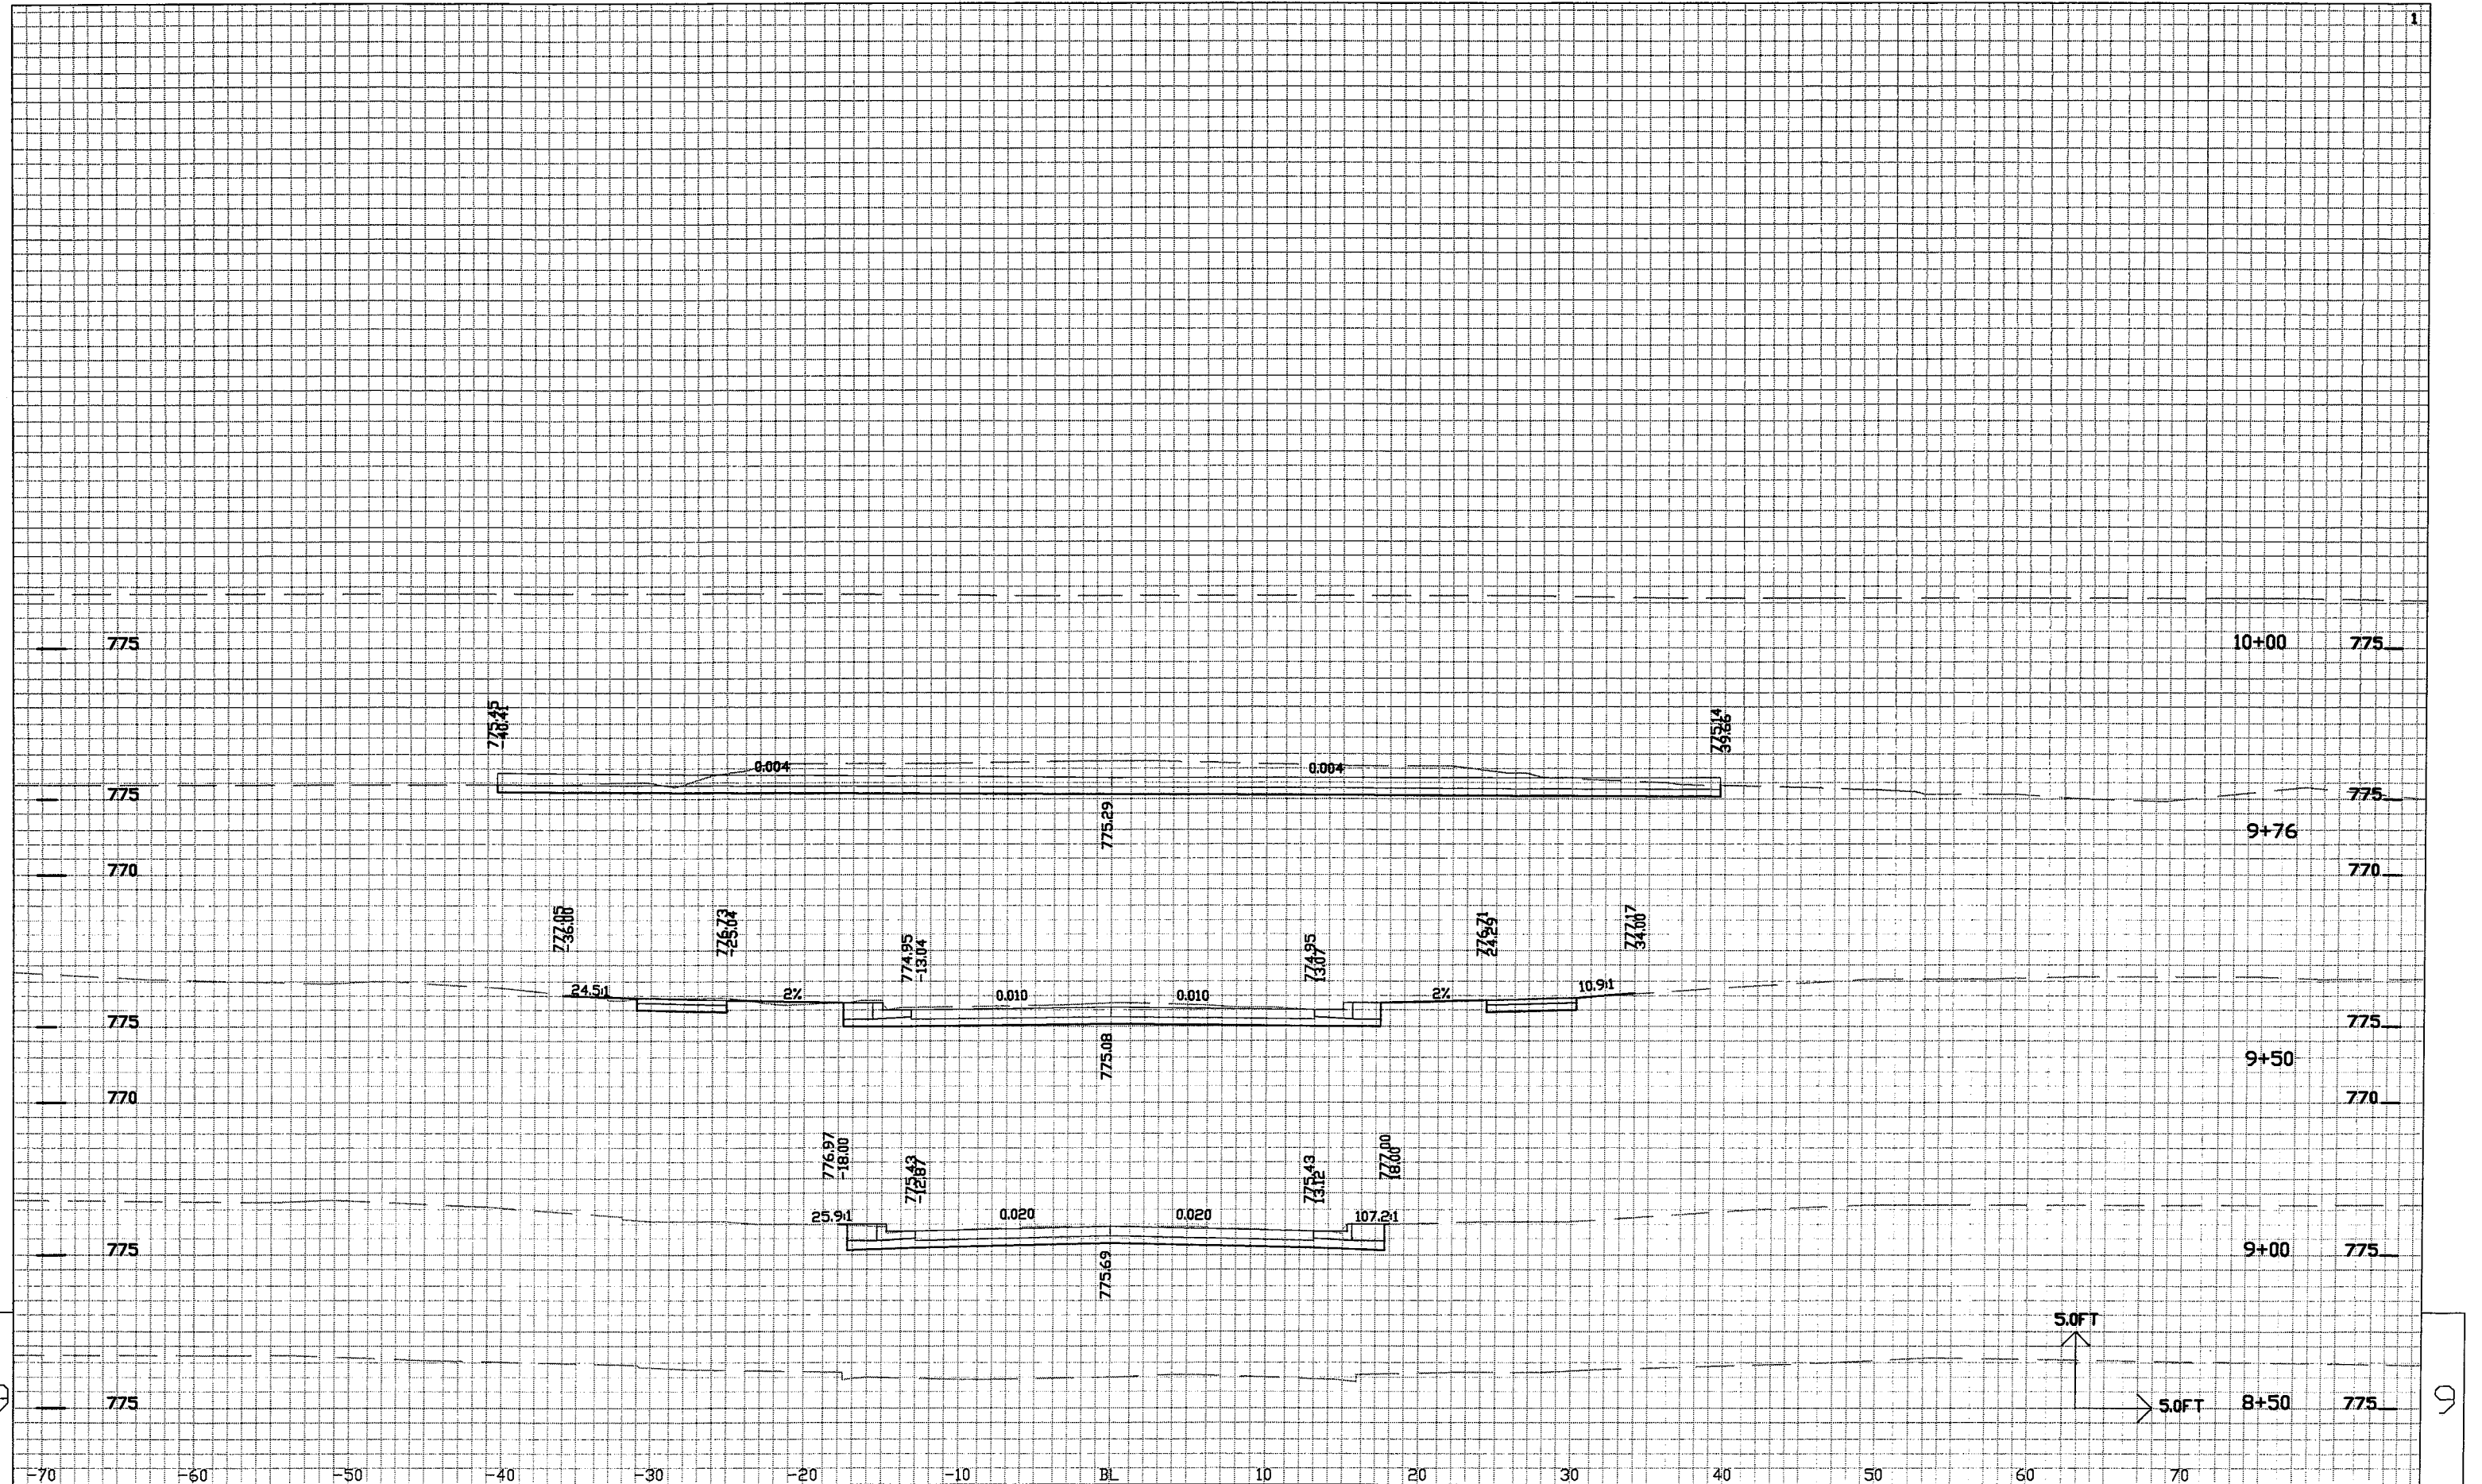

c:\chub. w. DWG\WD002\970343\Cross Sections\JACKTAR 3-20-06.dwg 04/17/08 7:59 AM

cschuh_w:\DWG\2002\920343\Cross Sections\BUTLER 3-20-08.dwg 04/17/08 8:00 AM

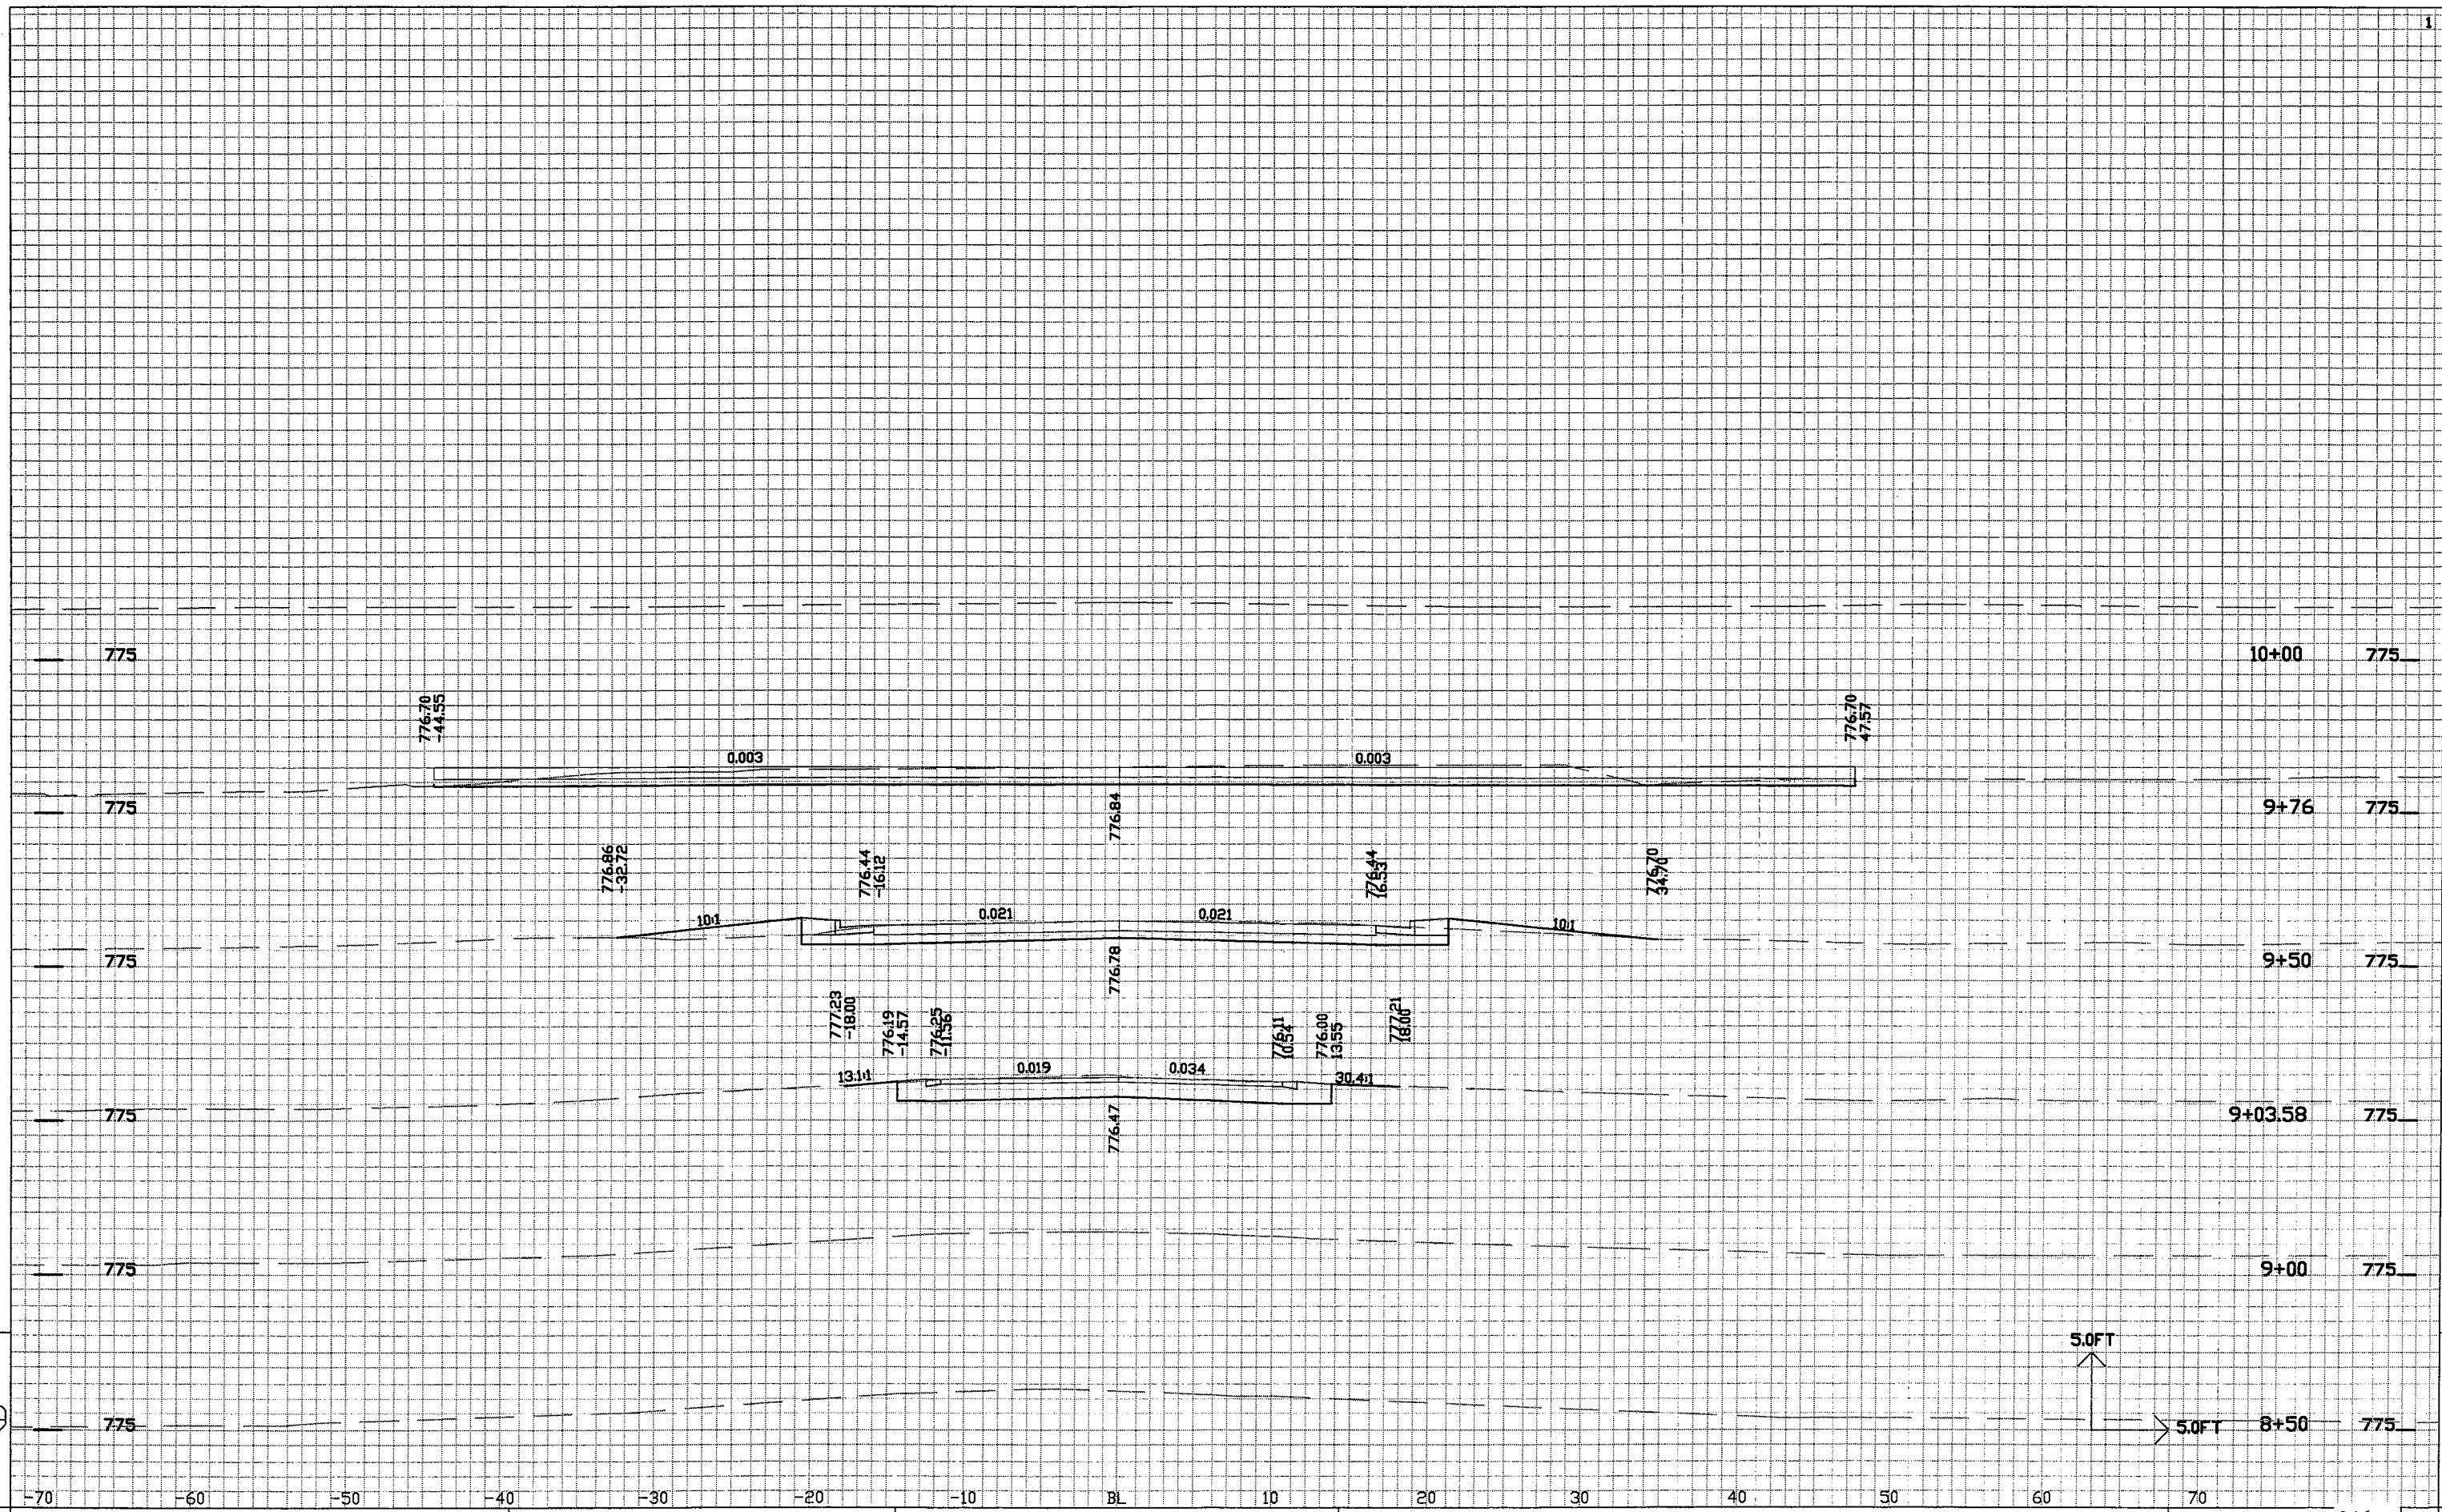

PROJECT NO: 4994-00-87

HWY: BUTLER AVE

COUNTY: WINNEBAGO

CROSS SECTIONS

SHEET NO: 246

E


FILE NAME : \$\$...designfile...\$\$

PLOT DATE : \$\$...plottingdate...\$\$

PLOT BY : \$\$...plotuser...\$\$


PLOT NAME :

PLOT SCALE : \$\$...plotscale...\$\$

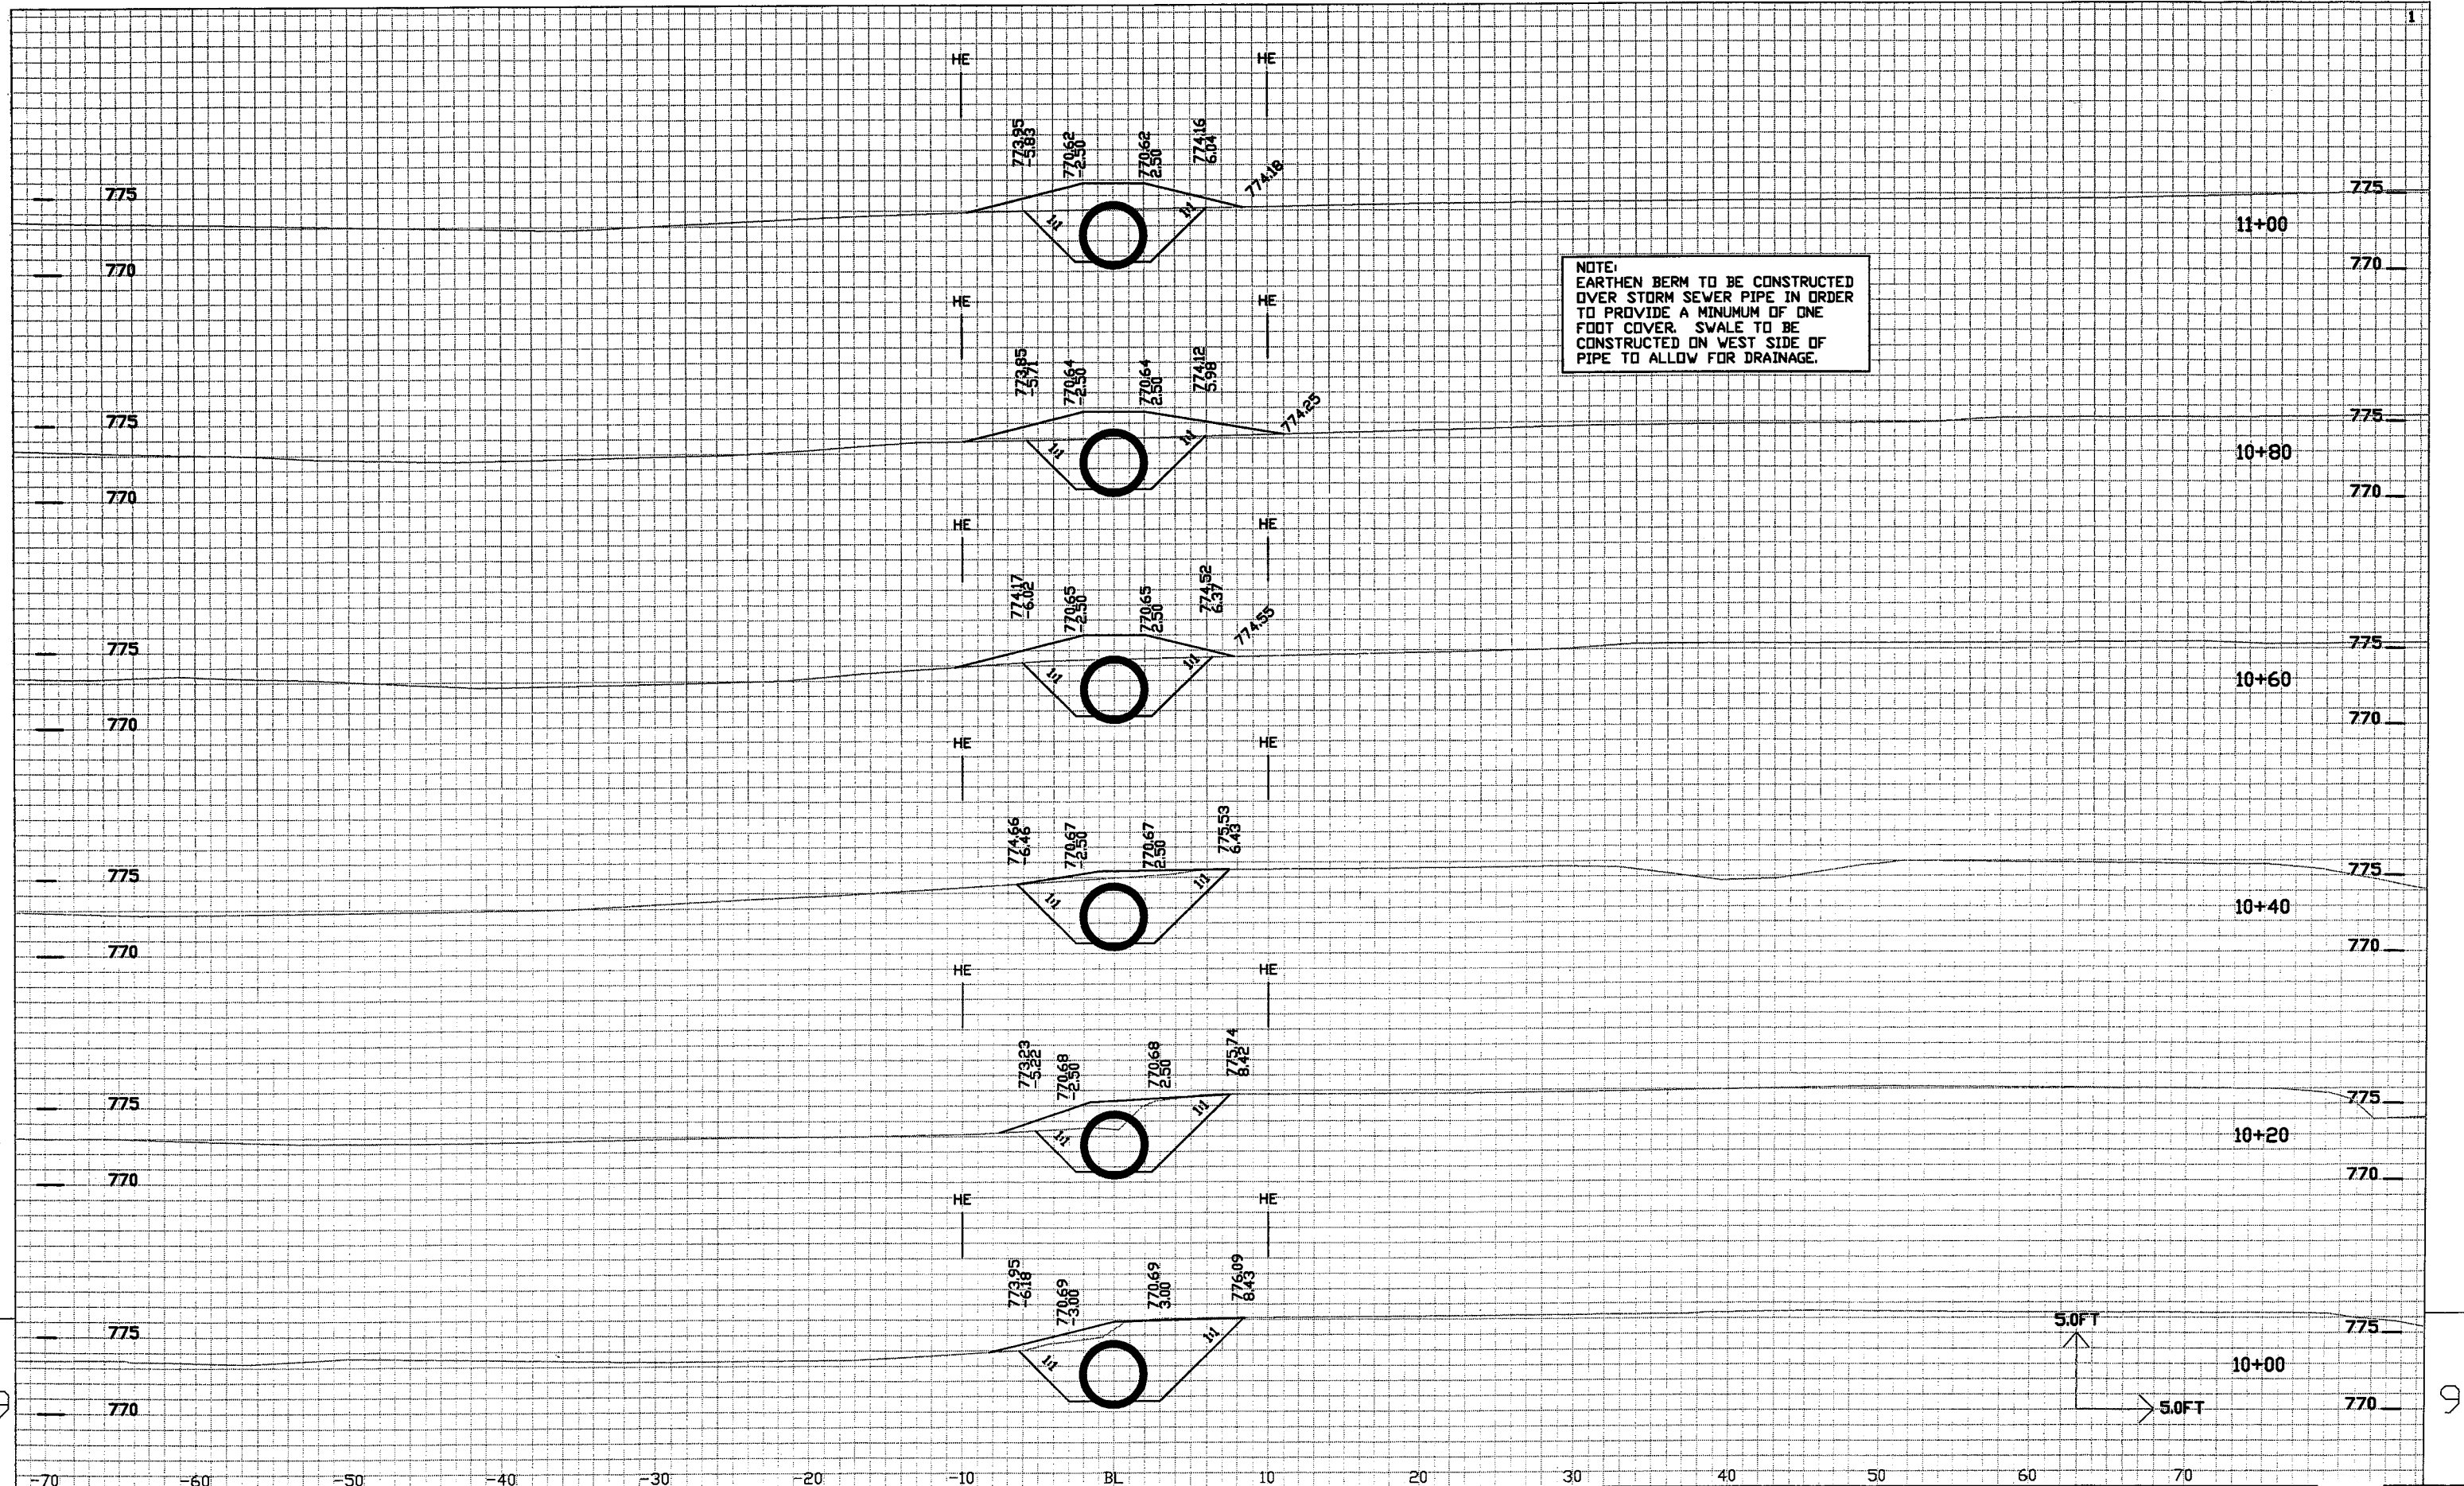

NOTE:
 EARTHEN BERM TO BE CONSTRUCTED
 OVER STORM SEWER PIPE IN ORDER
 TO PROVIDE A MINIMUM OF ONE
 FOOT COVER. SWALE TO BE
 CONSTRUCTED ON WEST SIDE OF
 PIPE TO ALLOW FOR DRAINAGE.

p:\mga\k:\dwg\w0002\970343\Cross Sections\DI_2-15-08.dwg 05/01/08 11:35 AM

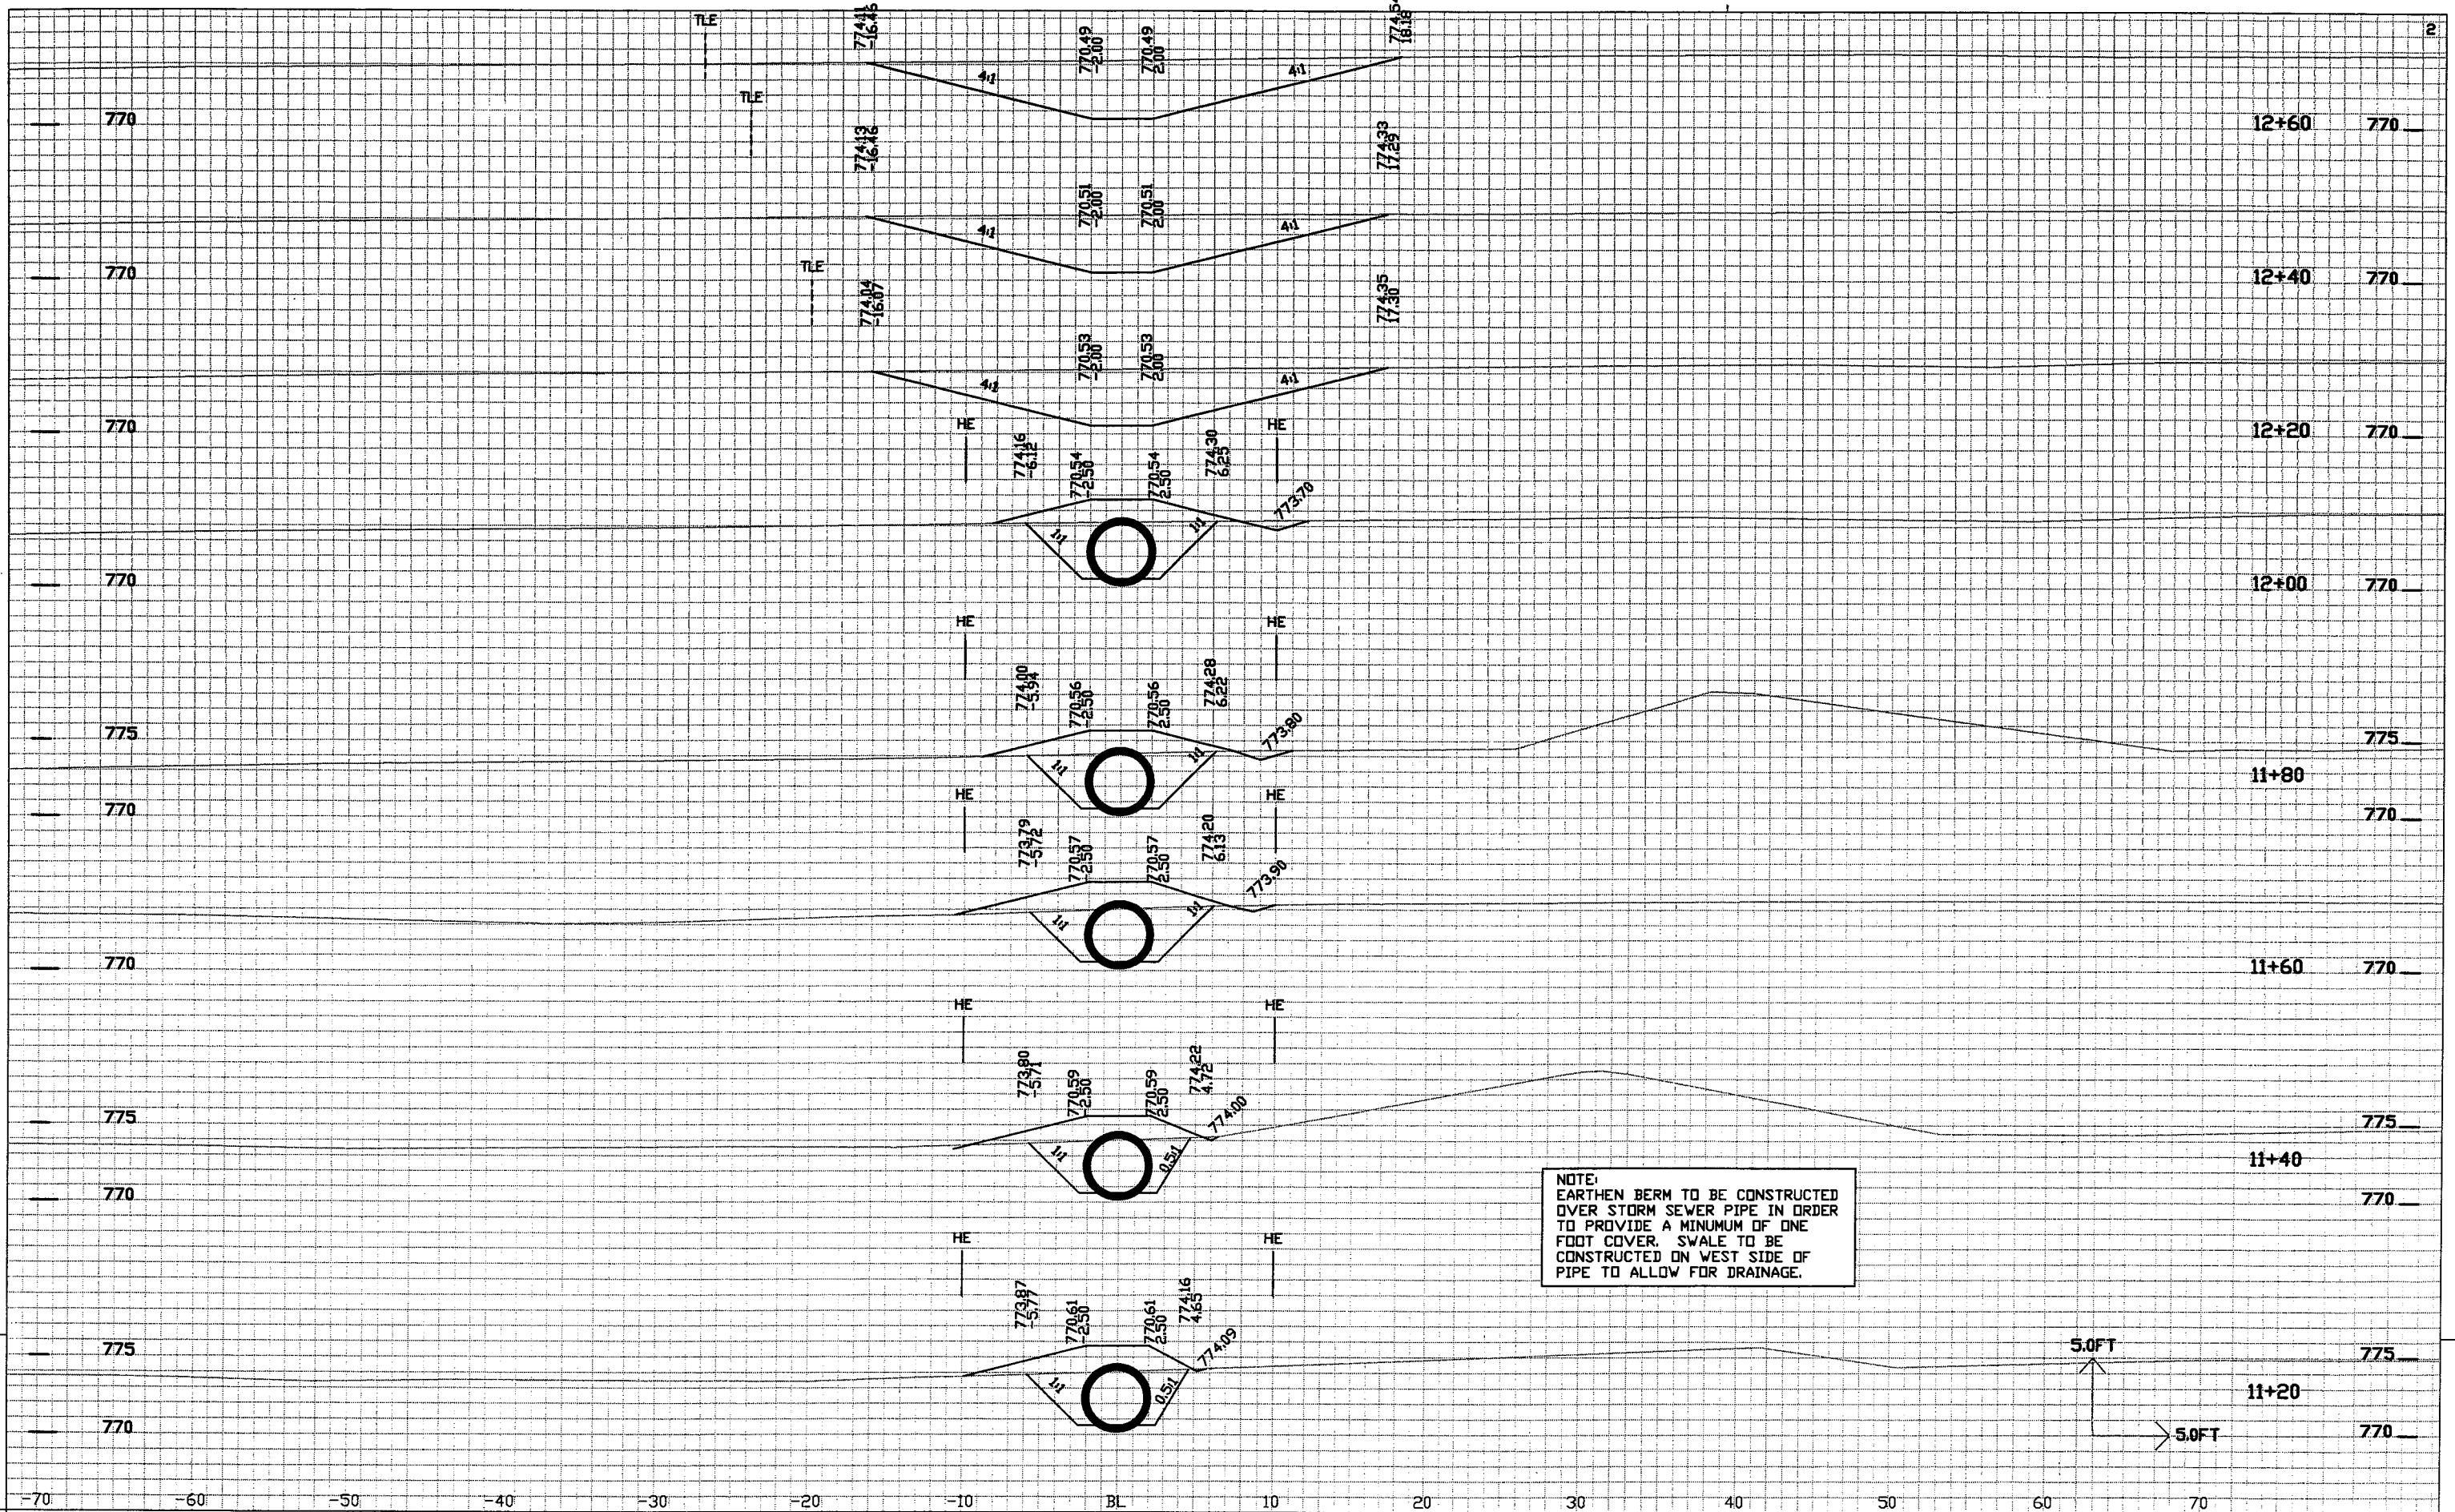



PROJECT NO: 4994-00-87

HWY: CTH Y

COUNTY: WINNEBAGO

CROSS SECTIONS - STORM SEWER OUTFALL BY WETLANDS

SHEET NO: 249

FILE NAME : \$\$...designfile...\$\$


PLOT DATE : \$\$...plottingdate...\$\$

PLOT BY : \$\$...plotuser...\$\$

PLOT NAME :

PLOT SCALE : \$\$...plotscale...\$\$

E

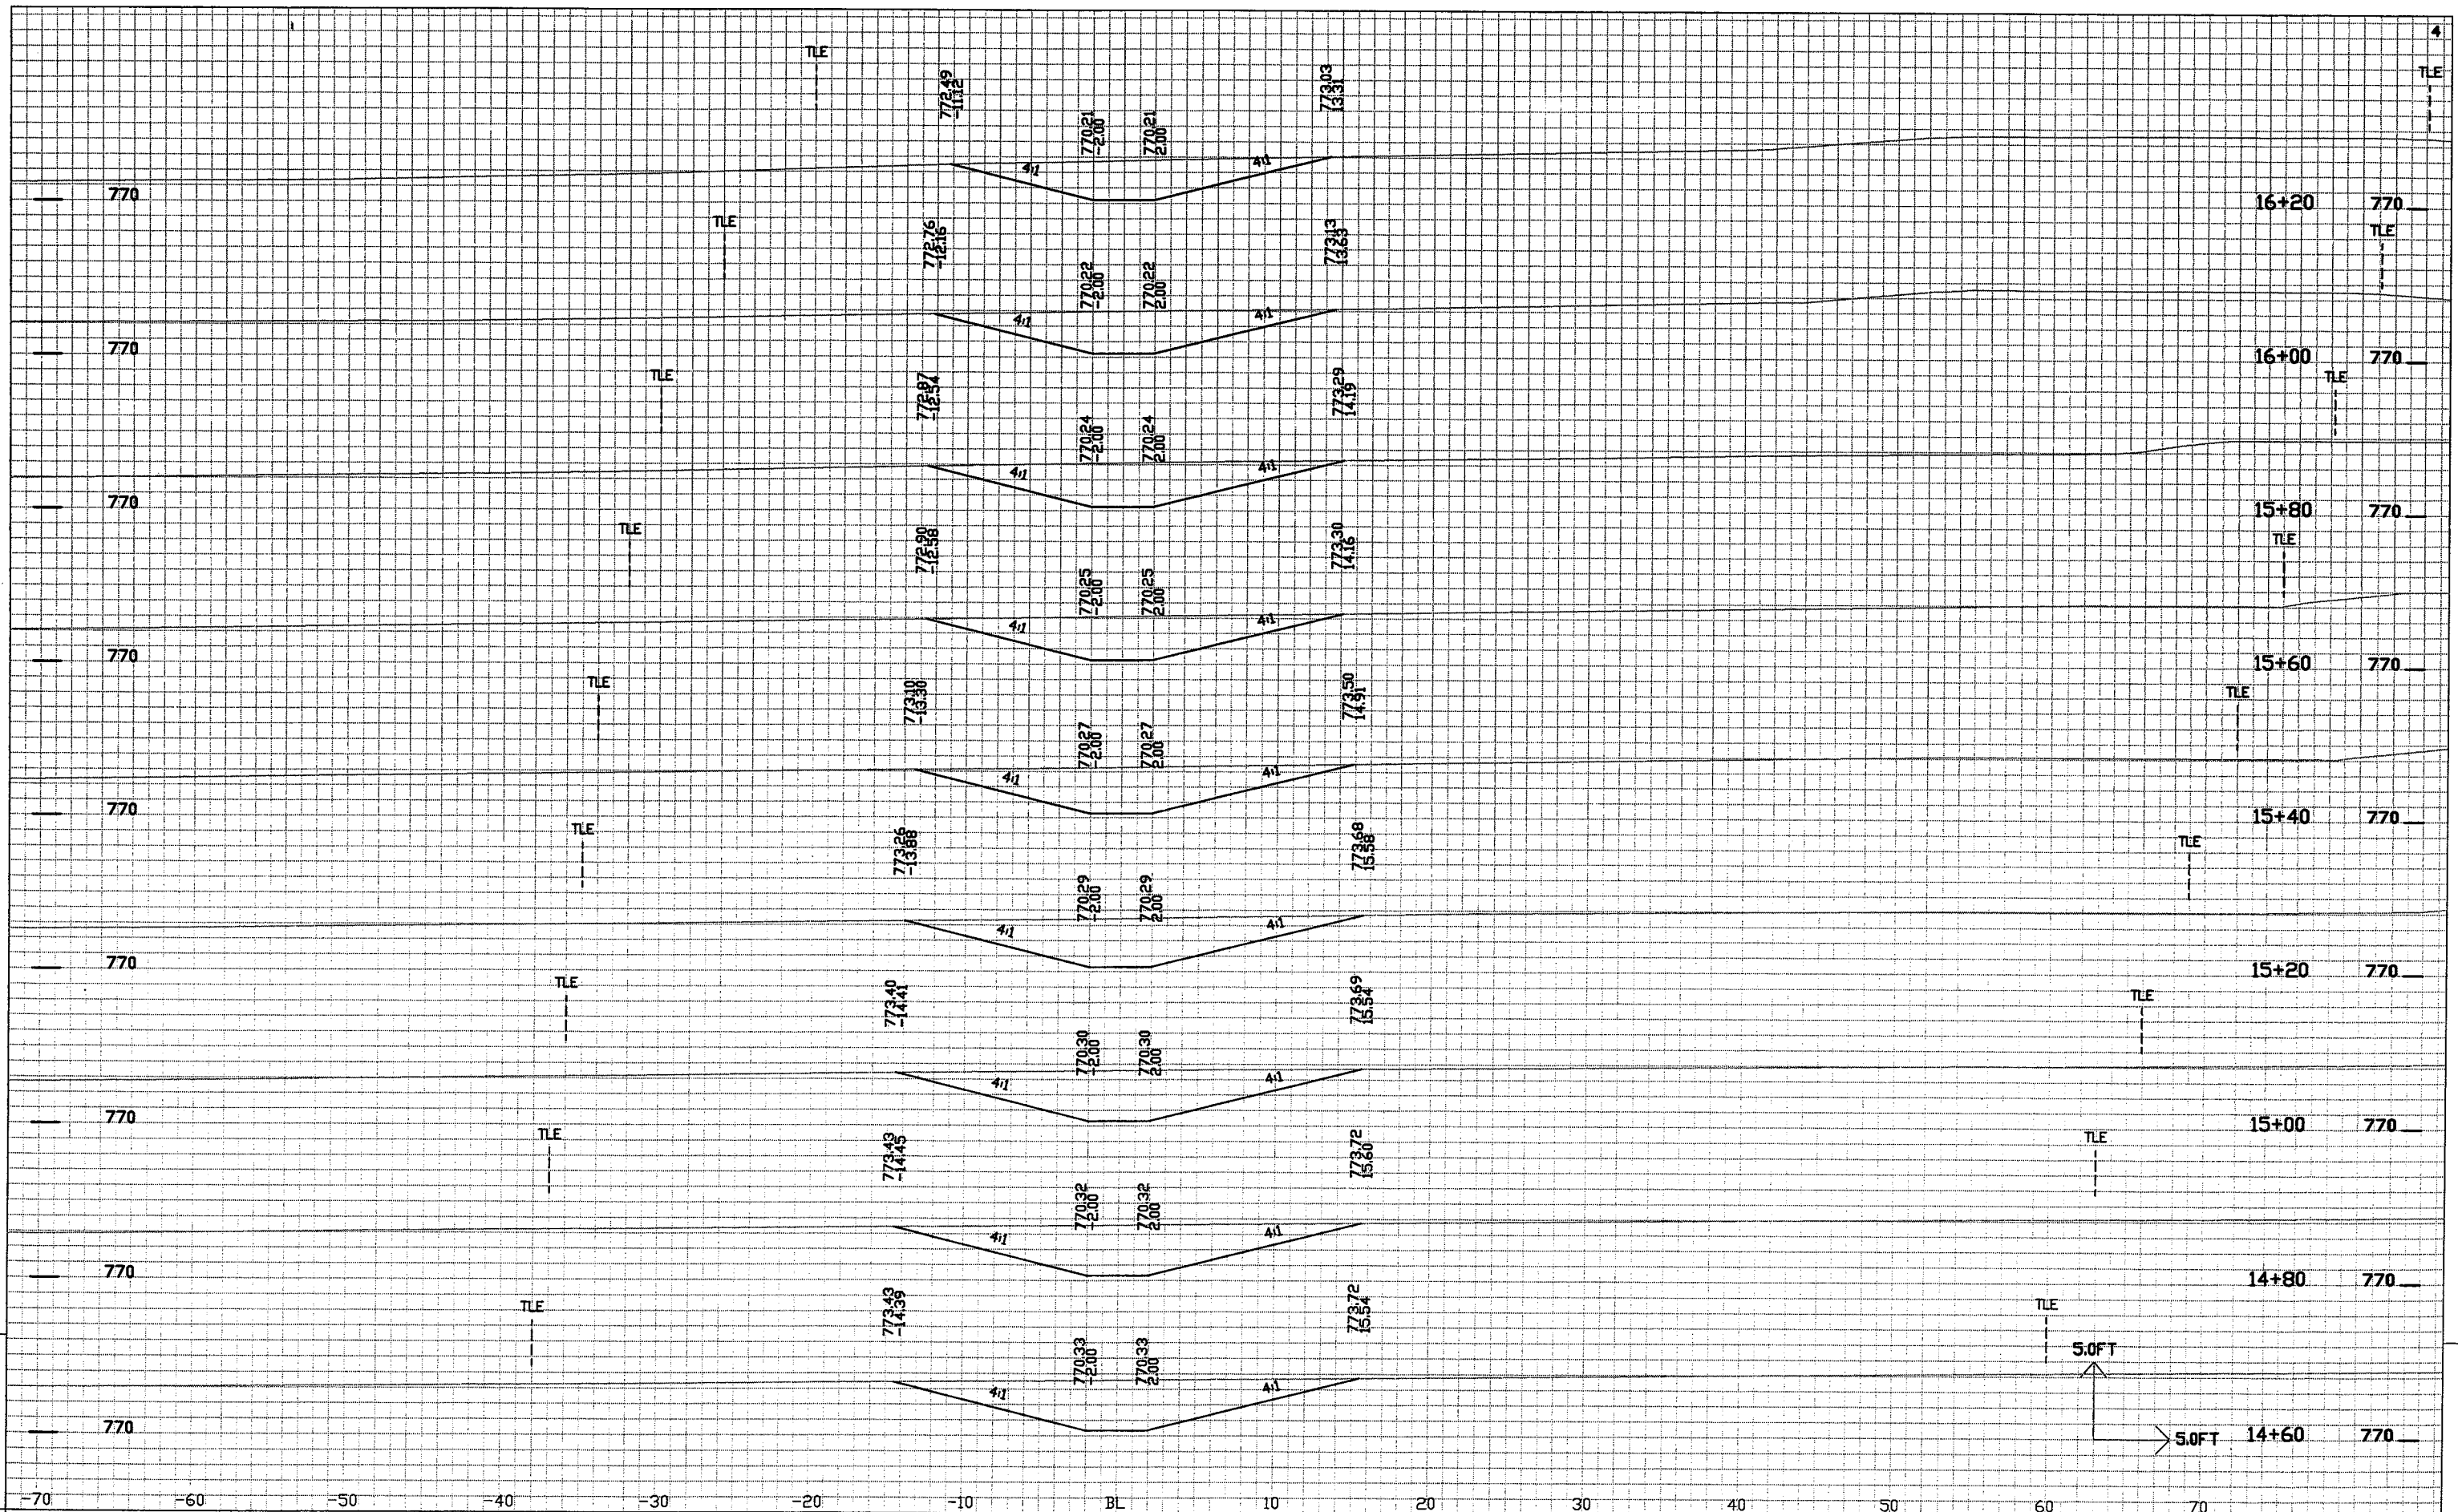

PROJECT NO: 4994-00-87

HWY: CTH Y

COUNTY: WINNEBAGO

CROSS SECTIONS - STORM SEWER OUTFALL BY WETLANDS

SHEET NO: 250

E


FILE NAME : \$\$...designfile...\$\$


PLOT DATE : \$\$...plottingdate...\$\$

PLOT BY : \$\$...plotuser...\$\$


PLOT NAME :

PLOT SCALE : \$\$...plotscale...\$\$

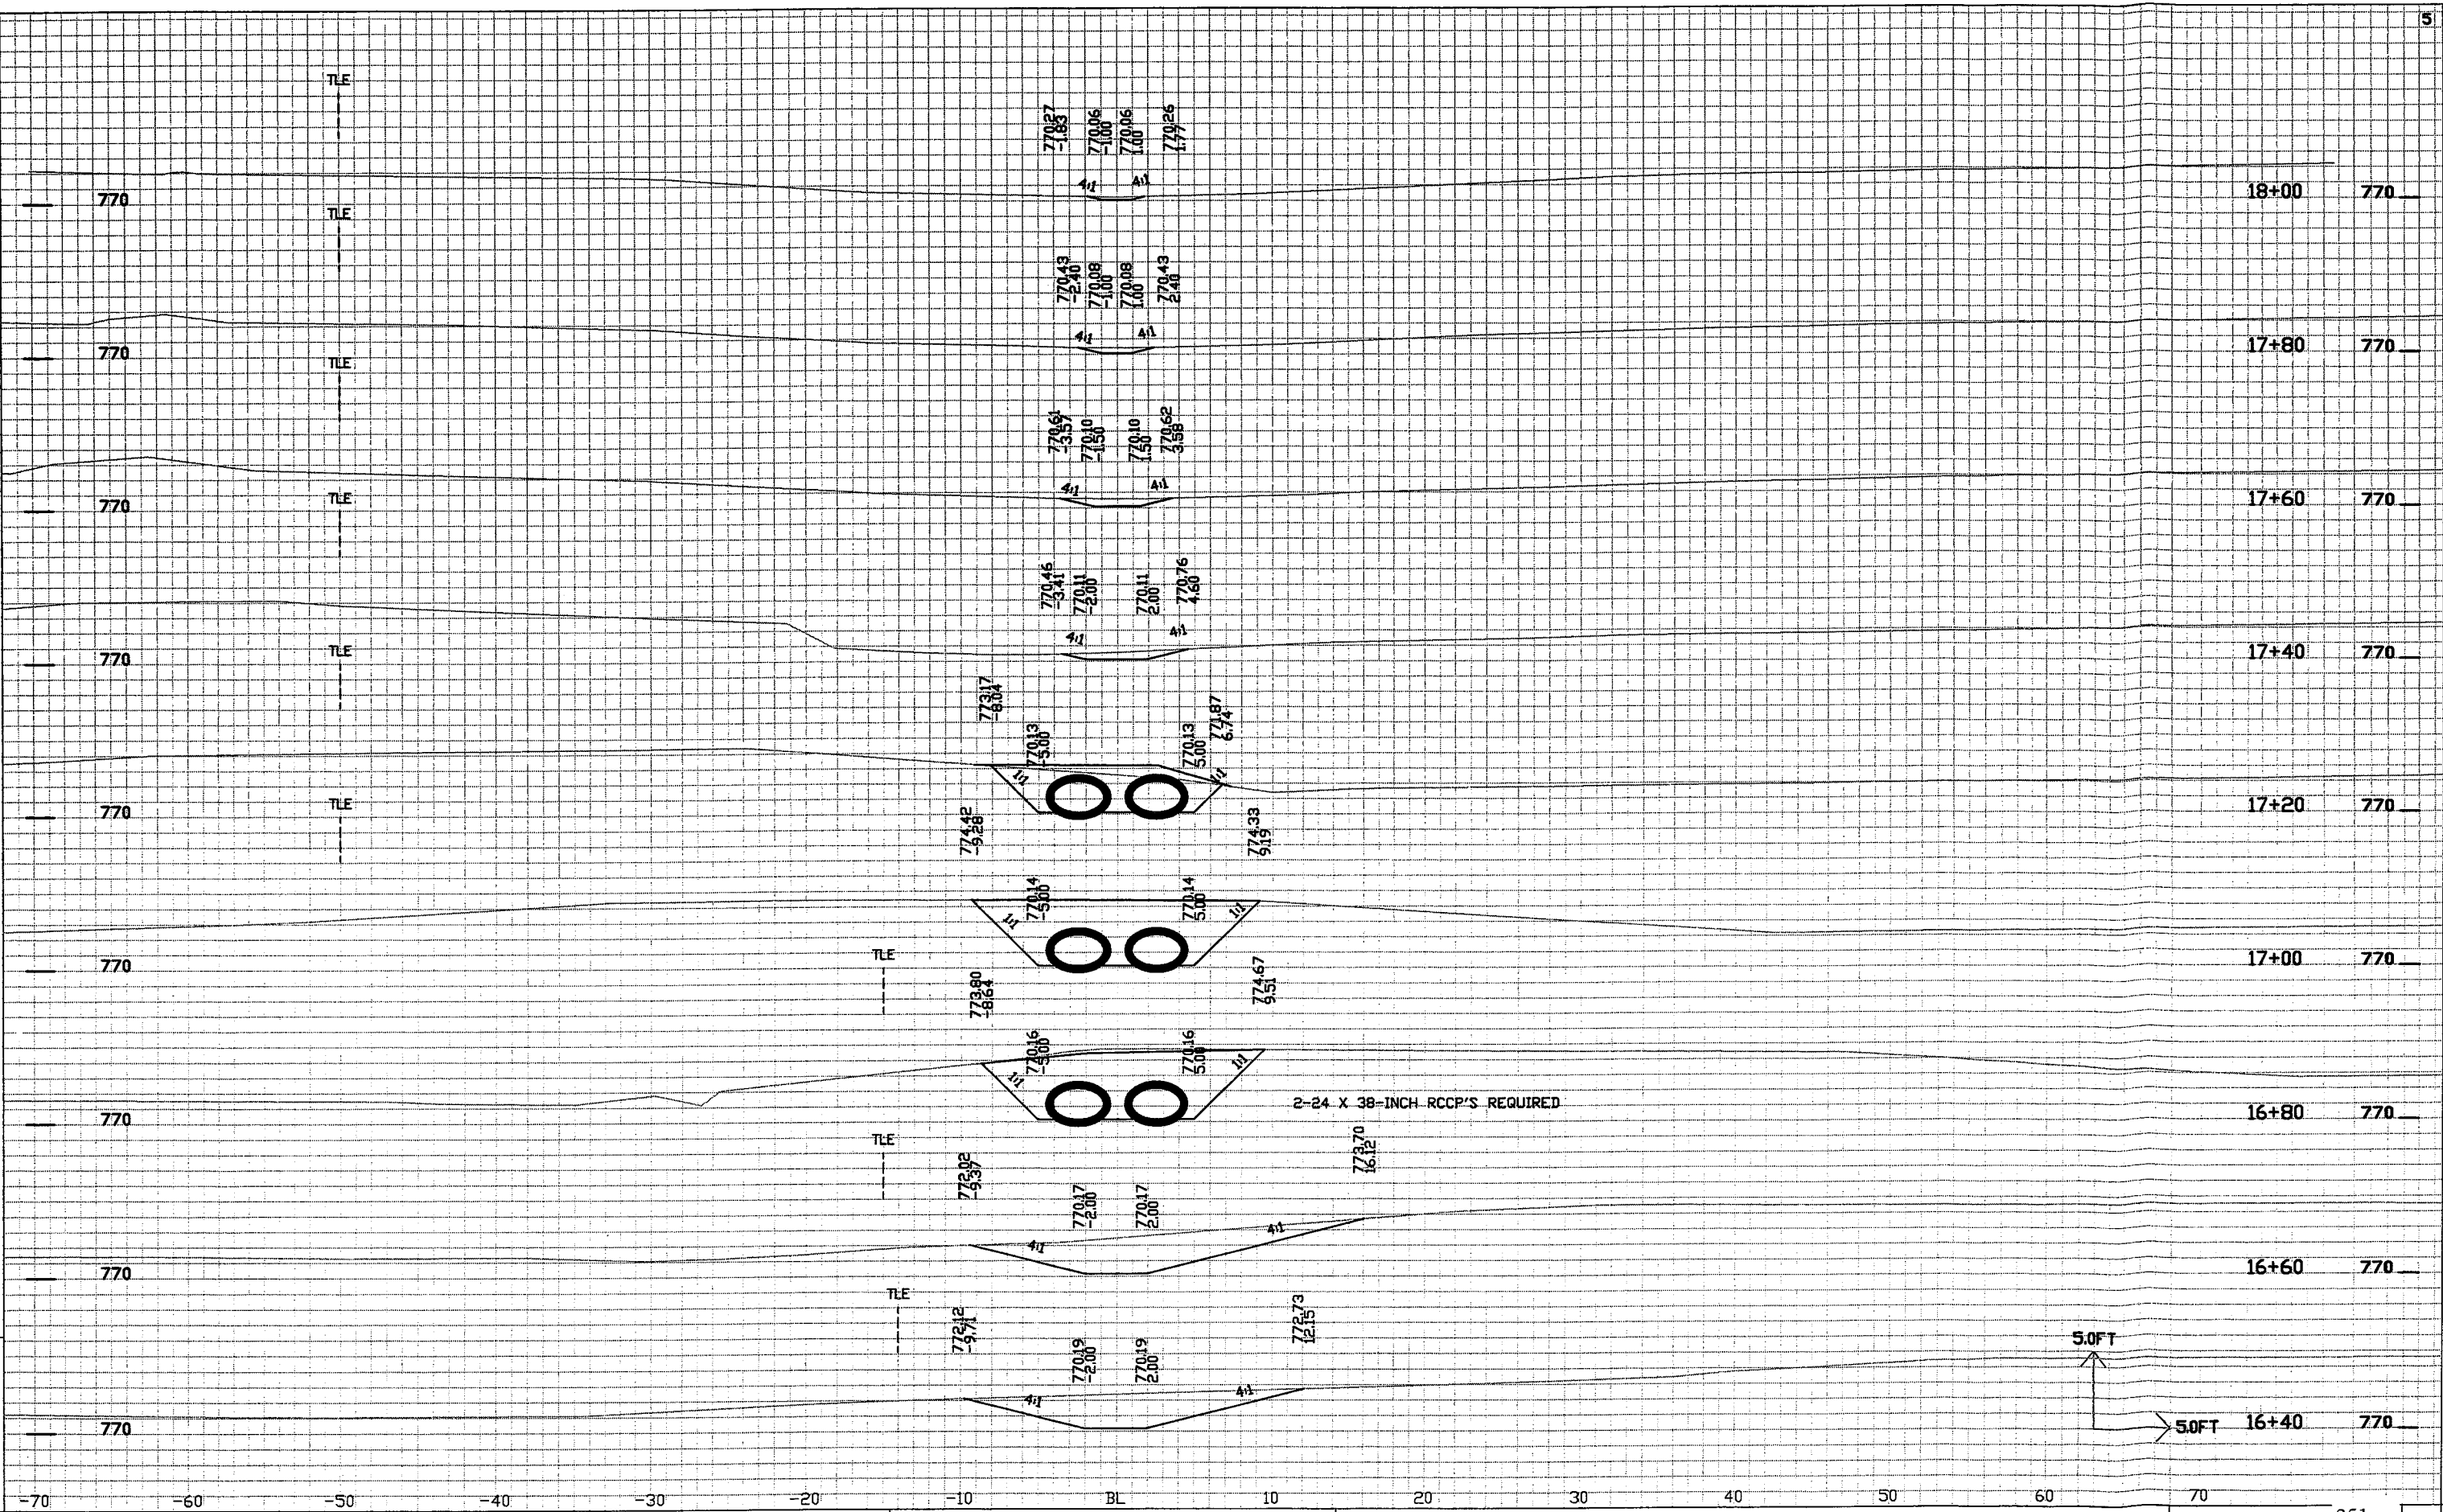

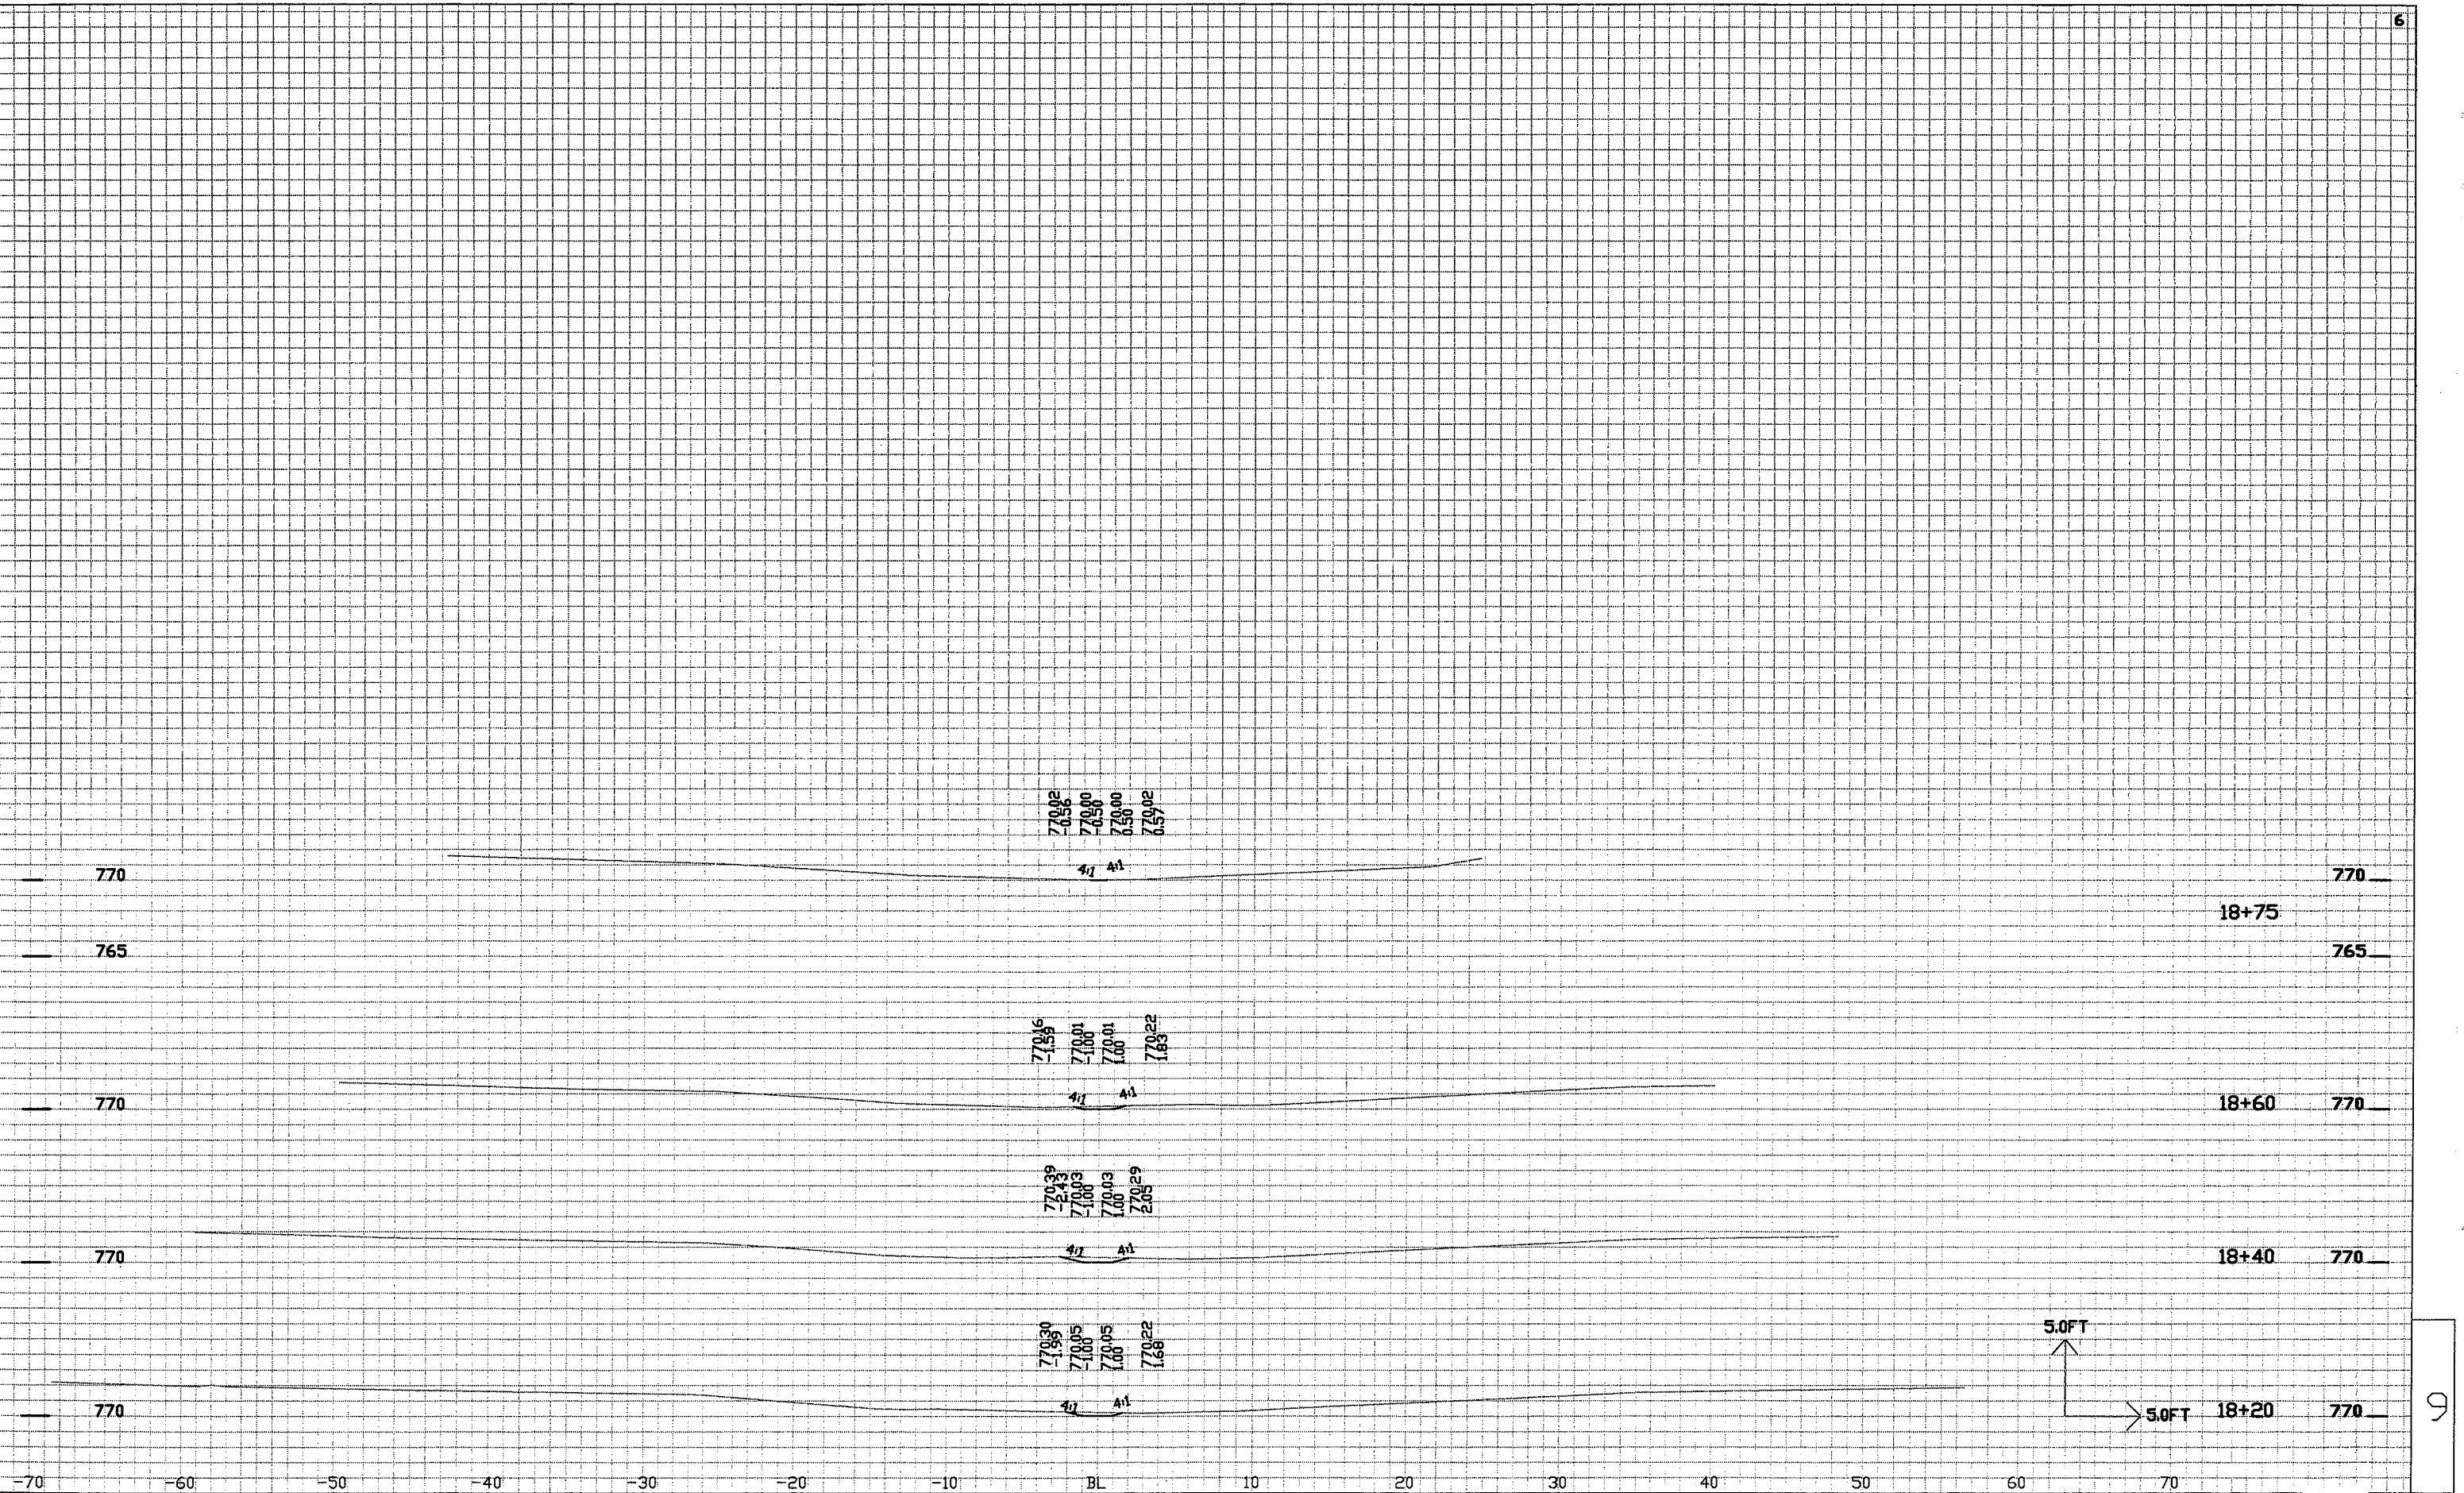

pmgskai_w:\DWG\W002\970343\Cross Sections\02_2-12-08.dwg 05/01/08 11:44 AM

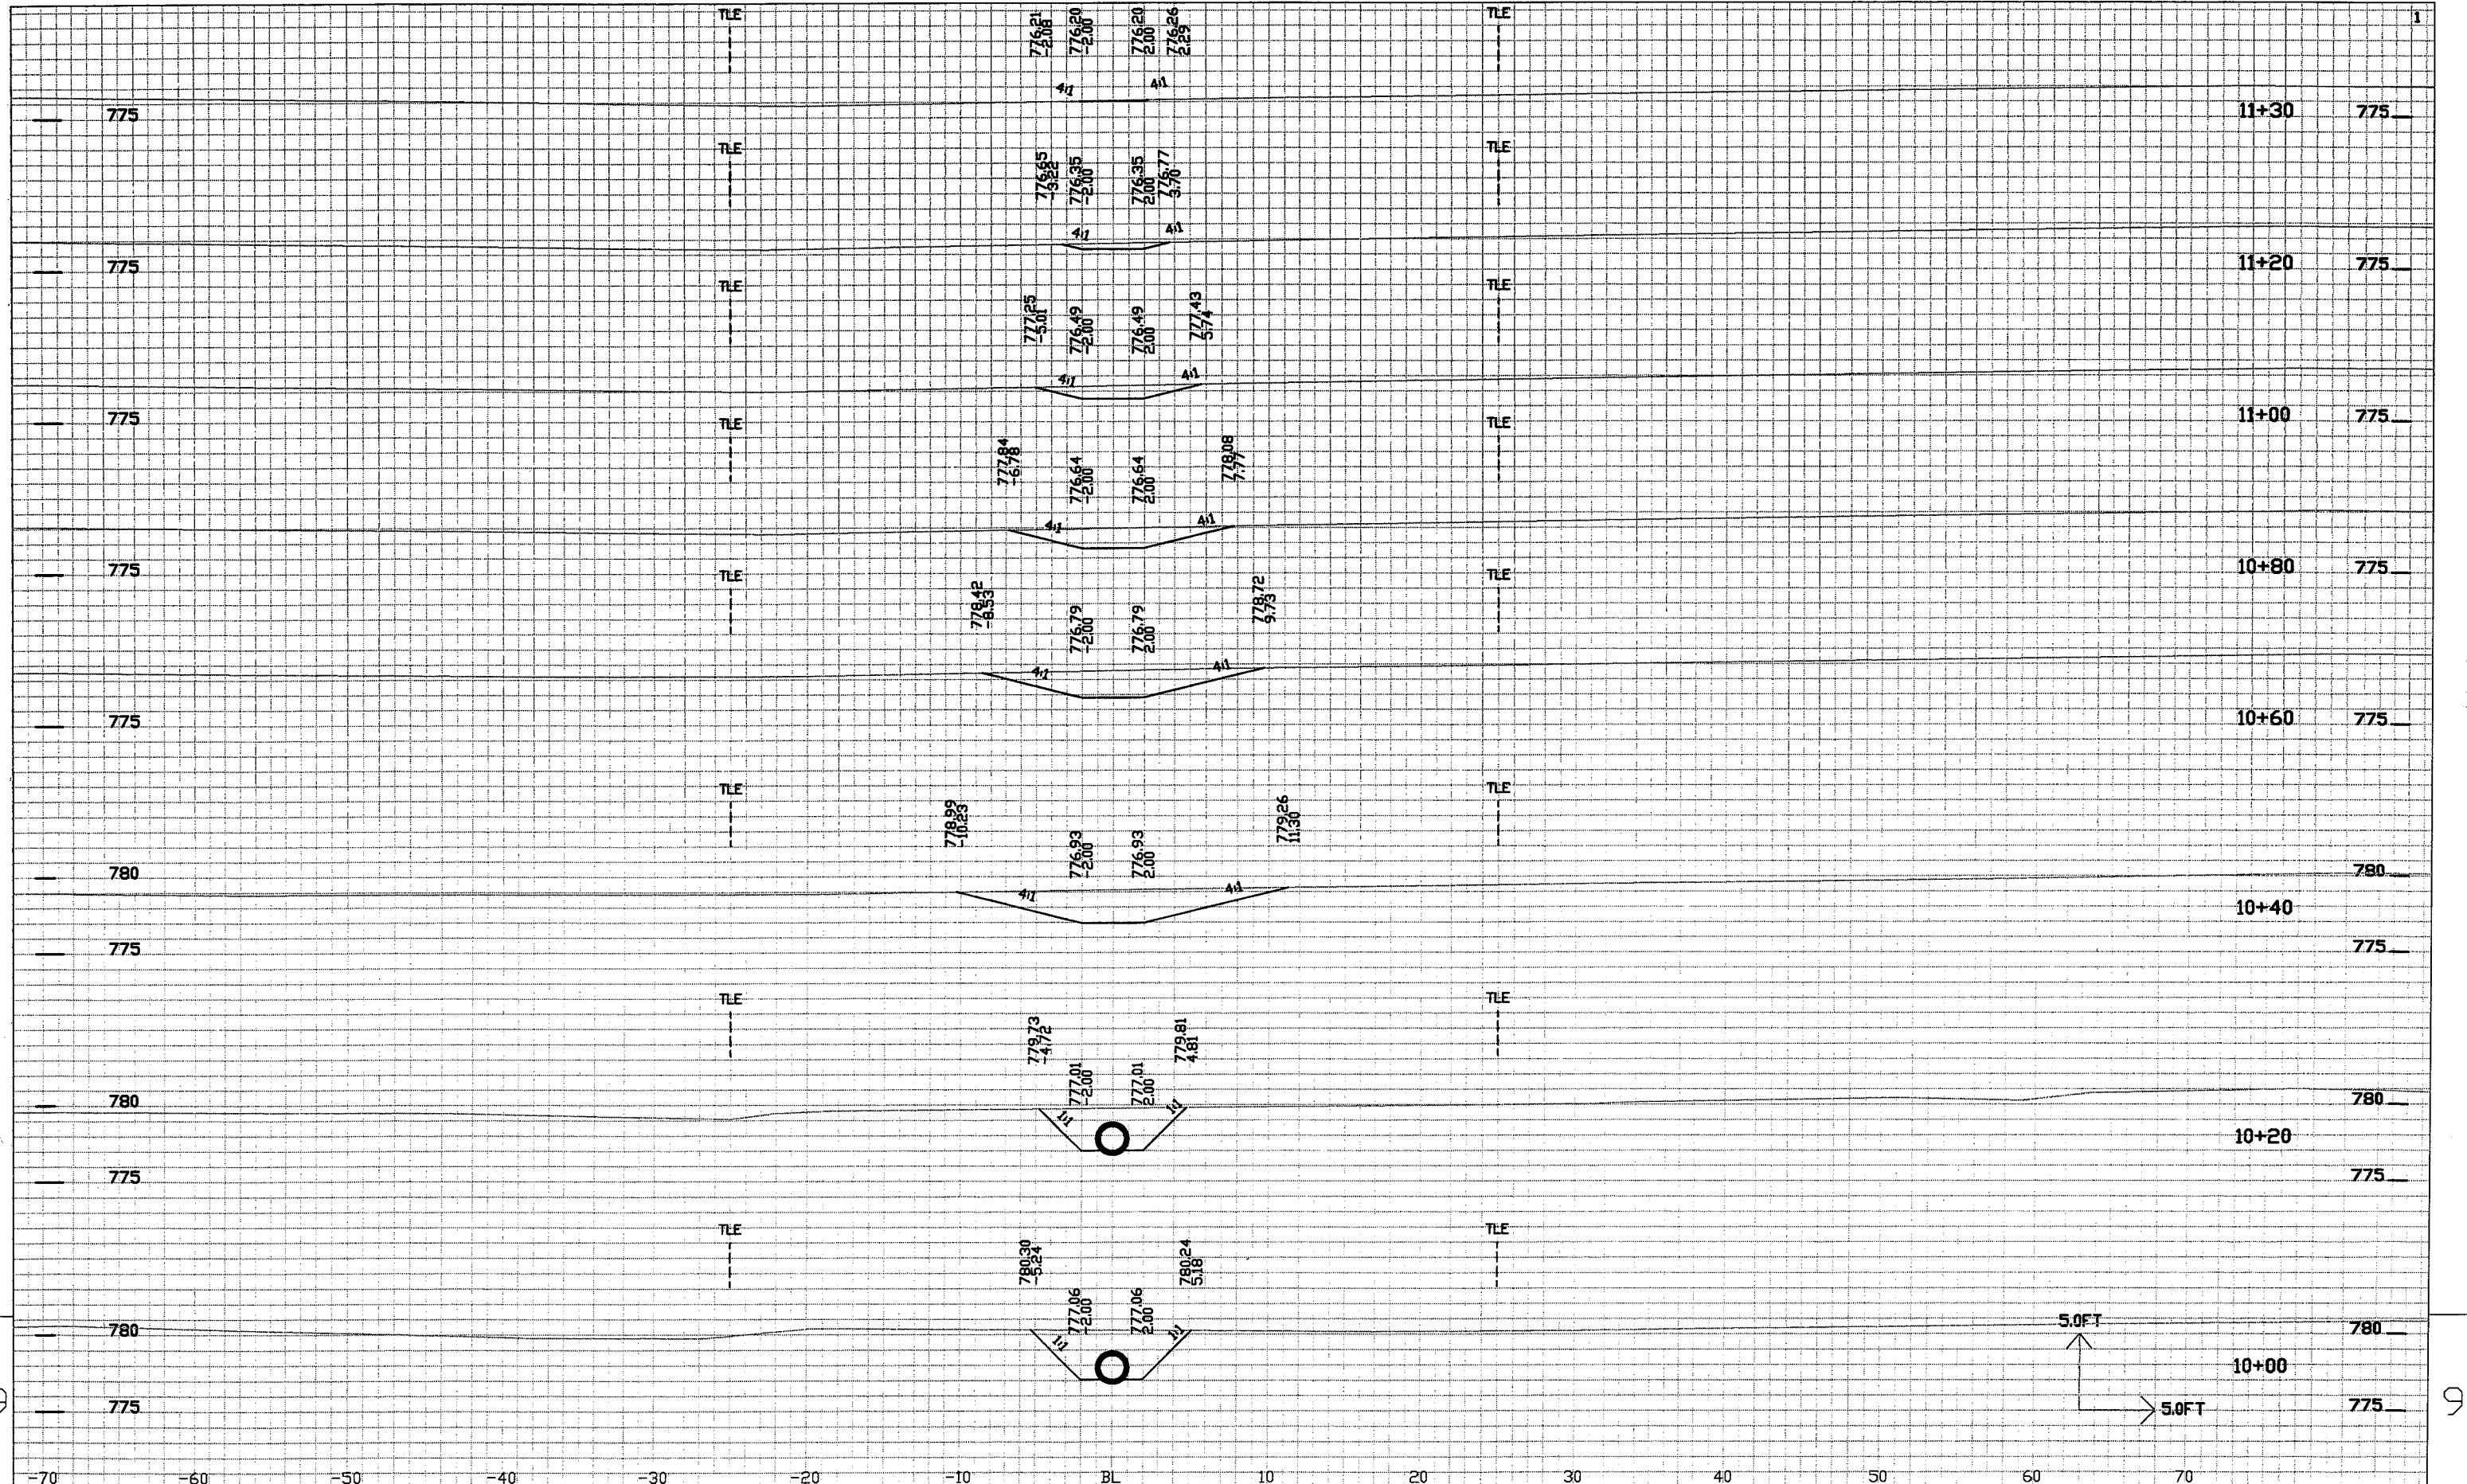

PROJECT NO: 4994-00-87

HWY: CTH Y

COUNTY: WINNEBAGO

CROSS SECTIONS - OUTFALL AT 250+30 RT

SHEET NO: 253

E

FILE NAME : \$\$...designfile...\$\$


PLOT DATE : \$\$...plottingdate...\$\$

PLOT BY : \$\$...plotuser...\$\$

PLOT NAME :

PLOT SCALE : \$\$...plotscale...\$\$




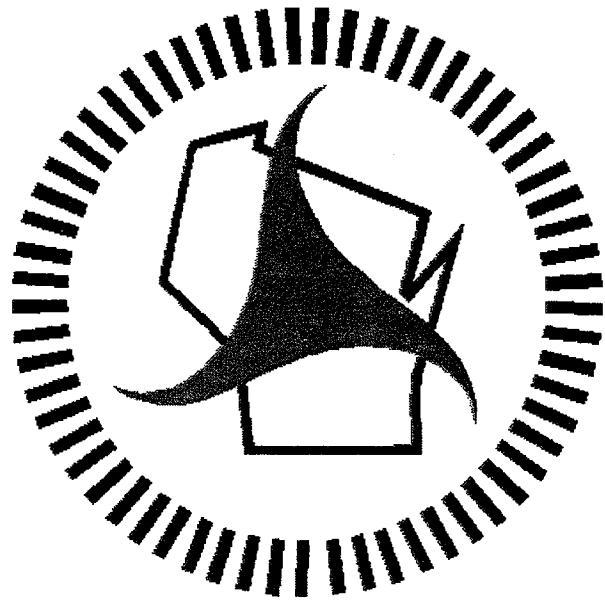

Wisconsin Department of Transportation

Dedicated people creating transportation solutions through innovation and exceptional service.

<http://www.dot.wisconsin.gov>

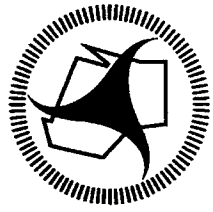

Wisconsin Department of Transportation

Division of Transportation Systems
Development
Bureau of Project Development
4802 Sheboygan Avenue, Rm 601
P O Box 7916
Madison, WI 53707-7916

February 4, 2009

Telephone: (608) 266-1631
Facsimile (FAX): (608) 266-8459

NOTICE TO ALL CONTRACTORS:

Proposal #24: 4994-00-87, STP 2008 486 6432-11-71
 CTH Y STH 76 and CTH Y Intersection
 STH 76 – CTH A STH 76 – CTH A
 CTH Y STH 76
 Winnebago County Winnebago County

Letting of February 10, 2009

This is Addendum No. 3, which provides for the following:

Special Provisions

The following special provision is revised:
Article 55, Plans

Schedule of Items

The following bid item quantity is revised:
Item 205.0100, Excavation Common; quantity increased from 36,436 CY to 36,936 CY.

Attached, dated February 4, 2009, is revised Schedule of Items Page 2.

The responsibility for notifying potential subcontractors and suppliers of these changes remains with the prime contractor.
Sincerely,

Jan G. Kinar, P.E.

Jan G. Kinar, P.E.
Contracts Development Engineer

ADDENDUM

4994-00-87 and 6432-11-71

Addendum No.	Article No.	Description	Date
3	55	Plans	2/04/2009

Addendum No. 3

Special Provisions

55. Plans.

On Plan Sheet 2, General Notes, add the following:

Plan quantities for base aggregate, excavation common, and asphaltic surface temporary are included for the construction and removal of the temporary widening required as shown in the traffic control details. Excavation common includes the removal of the widening and construction of temporary ditching not included on the plan cross sections. Quantities are based on constructing all fill sections for the temporary widening with base aggregate.

On Plan Sheet 80, Traffic Control Detail, delete the temporary ditching note and replace with the following:

Ditching required to accommodate the temporary widening. Refer to construction detail for additional information.

On Plan Sheet 96, Traffic Control Detail, delete the typical section note and replace with the following:

Temporarily modify the proposed typical section to provide a minimum lane width of 11-feet.

The following 8 ½ x 11-inch plan sheet is attached and made part of the plans for this proposal:

Revised Sheet 112, Miscellaneous Quantities.

BASE AGGREGATE AND BREAKER RUN		EARTHWORK SUMMARY		CONCRETE DRIVEWAY, 7-INCH		CONCRETE DRIVEWAY, 8-INCH		CONCRETE DRIVEWAY, 8-INCH		CONCRETE DRIVEWAY, 8-INCH		CONCRETE DRIVEWAY, 8-INCH		CONCRETE DRIVEWAY, 8-INCH	
STATION TO STATION	LOCATION	TON	TON	EXPANDED	COMMON	TON	TON	TON	TON	TON	TON	TON	TON	TON	TON
*195+01.74 - 199+53.51	CTH Y MAINLINE	3282	80	133	205.0100	202+00 RT	53	202+00 RT	2	202+00 RT	2	202+00 RT	2	202+00 RT	2
200+37.07 - 200+86.77	CTH Y MAINLINE	470	60	1976	205.0100	203+99 RT	61	203+99 RT	2	203+99 RT	2	203+99 RT	2	203+99 RT	2
9+35 - 9+76	CTH Y MAINLINE	1205	80	133	205.0100	204+00 RT	109	204+00 RT	2	204+00 RT	2	204+00 RT	2	204+00 RT	2
200+86.77 - 258+53.16	CTH Y MAINLINE	470	60	1976	205.0100	210+57 RT	54	210+57 RT	2	210+57 RT	2	210+57 RT	2	210+57 RT	2
9+00 - 9+76	CTH Y MAINLINE	108	80	133	205.0100	212+60 RT	15	212+60 RT	2	212+60 RT	2	212+60 RT	2	212+60 RT	2
195+01.84 - 258+53.16	CTH Y MAINLINE	1000	80	133	205.0100	214+60 RT	1	214+60 RT	2	214+60 RT	2	214+60 RT	2	214+60 RT	2
9+00 - 9+76	CTH Y MAINLINE	108	80	133	205.0100	216+60 RT	1	216+60 RT	2	216+60 RT	2	216+60 RT	2	216+60 RT	2
200+86.77 - 258+53.16	CTH Y MAINLINE	470	60	1976	205.0100	218+60 RT	1	218+60 RT	2	218+60 RT	2	218+60 RT	2	218+60 RT	2
9+00 - 9+76	CTH Y MAINLINE	108	80	133	205.0100	220+80 RT	1	220+80 RT	2	220+80 RT	2	220+80 RT	2	220+80 RT	2
195+01.84 - 258+53.16	CTH Y MAINLINE	1000	80	133	205.0100	222+10 RT	1	222+10 RT	2	222+10 RT	2	222+10 RT	2	222+10 RT	2
9+00 - 9+76	CTH Y MAINLINE	108	80	133	205.0100	224+10 RT	1	224+10 RT	2	224+10 RT	2	224+10 RT	2	224+10 RT	2
200+86.77 - 258+53.16	CTH Y MAINLINE	470	60	1976	205.0100	226+10 RT	1	226+10 RT	2	226+10 RT	2	226+10 RT	2	226+10 RT	2
9+00 - 9+76	CTH Y MAINLINE	108	80	133	205.0100	228+10 RT	1	228+10 RT	2	228+10 RT	2	228+10 RT	2	228+10 RT	2
195+01.84 - 258+53.16	CTH Y MAINLINE	1000	80	133	205.0100	230+10 RT	1	230+10 RT	2	230+10 RT	2	230+10 RT	2	230+10 RT	2
9+00 - 9+76	CTH Y MAINLINE	108	80	133	205.0100	232+10 RT	1	232+10 RT	2	232+10 RT	2	232+10 RT	2	232+10 RT	2
200+86.77 - 258+53.16	CTH Y MAINLINE	470	60	1976	205.0100	298+00 RT	1	298+00 RT	2	298+00 RT	2	298+00 RT	2	298+00 RT	2
9+00 - 9+76	CTH Y MAINLINE	108	80	133	205.0100	300+00 RT	1	300+00 RT	2	300+00 RT	2	300+00 RT	2	300+00 RT	2

Addendum #3
Revised Sheet 112
February 5, 2009

ALL ITEMS ON THIS SHEET ARE CATEGORY 0010 UNLESS OTHERWISE NOTED

CONTRACT: 20090210024
 PROJECT(S): 4994-00-87
 FEDERAL ID(S): STP 2008486
 SCHEDULE OF ITEMS N/A

LINE NO	ITEM DESCRIPTION	APPROX. QUANTITY AND UNITS	UNIT PRICE DOLLARS	BID AMOUNT DOLLARS
0110	204.0215 REMOVING CATCH BASINS	4.000 EACH		
0120	204.0220 REMOVING INLETS	2.000 EACH		
0130	204.0245 REMOVING STORM SEWER (SIZE) 01. 12-INCH	282.000 LF		
0140	204.0245 REMOVING STORM SEWER (SIZE) 02. 15-INCH	8.000 LF		
0150	204.0245 REMOVING STORM SEWER (SIZE) 03. 18-INCH	34.000 LF		
0160	204.9060.S REMOVING (ITEM DESCRIPTION) 01. PULL BOXES	7.000 EACH		
0170	205.0100 EXCAVATION COMMON	36,936.000 CY		
0180	213.0100 FINISHING ROADWAY (PROJECT) 01. 4994-00-87	1.000 EACH		
0190	213.0100 FINISHING ROADWAY (PROJECT) 02. 6432-11-71	1.000 EACH		
0200	305.0110 BASE AGGREGATE DENSE 3/4-INCH	80.000 TON		
0210	305.0120 BASE AGGREGATE DENSE 1 1/4-INCH	20,540.000 TON		



CR-Y

" QUIET ZONE CROSSING " R/R

CONSTRUCTION NOTES:

COORDINATION WITH THE CN RAILROAD, FLAGGERS AND PERMITTING ARE THE CONTRACTOR'S RESPONSIBILITY AND SHALL BE CONSIDERED INCIDENTAL TO THE CONTRACT.

WORK SHALL BE PERFORMED IN ACCORDANCE WITH WisDOT STANDARD SPECIFICATIONS. SEE ATTACHED WisDOT S.D.D.'S.

THE CONTRACTOR SHALL MAINTAIN A MINIMUM OF ONE LANE OF TRAFFIC IN EACH DIRECTION ON CTH Y DURING THE CONTRACT. THE CONTRACTOR SHALL PREPARE AND SUBMIT FOR APPROVAL A TRAFFIC CONTROL PLAN TO THE CITY OF OSHKOSH A MINIMUM OF 10 DAYS PRIOR TO BEGINNING WORK ON THE PROJECT. ALL TRAFFIC CONTROL SHALL BE IN ACCORDANCE WITH THE MUTCD, LATEST EDITION AND THE ATTACHED S.D.D.'S.

AN ESTIMATED QUANTITY OF BASE AGGREGATE DENSE 1 1/4-INCH HAS BEEN INCLUDED IN THE CONTRACT FOR FINE GRADING AREAS BELOW THE PROPOSED CONCRETE PAVEMENT, CURB & GUTTER, SIDEWALK AND SLOPED NOSE. BASE AGGREGATE DENSE 1 1/4-INCH SHALL ALSO BE USED FOR BACKFILLING THE CURB & GUTTER 18-INCH TYPE A. MAINTAIN EXISTING BASE AGGREGATE IN ALL AREAS.


CTH Y ESTIMATED QUANTITIES

Description	* WDOT Item No.	Quantity	Unit
Removing Pavement	204.0100	25	S.Y.
Base Aggregate Dense 1 1/4" Roadway	305.0120	20	TON
Drilled Tie Bars	416.0610	50	EACH
Concrete Curb and Gutter 18-Inch Type A	601.0405	64	L.F.
Concrete Sidewalk 4-Inch	602.0405	70	S.F.
Mobilization	619.1000	1	L.S.
Concrete Median Sloped Nose	620.0300	22	S.F.
Moving Signs, Type II	638.2102	1	EACH
Traffic Control	643.0100	1	L.S.
Pavement Marking Epoxy 4-Inch (Yellow Edgeline)	646.0106	70	L.F.
Pavement Marking Curb Epoxy (Yellow)	647.0456	10	L.F.
Pavement Marking Island Nose Epoxy (Yellow)	647.0606	1	EACH
Sawing Concrete	690.0250	80	L.F.
** Concrete Joint Sealing	SPV.0090.01	100	L.F.
** Concrete Safety Island	SPV.0165.01	14.00	SF

*Per City of Oshkosh
Completed
11/11*

* ALL ITEMS TO BE COMPLETED IN ACCORDANCE WITH WisDOT SPECIFICATIONS FOR THE REFERENCED BID ITEM.


** SEE ATTACHED DETAIL

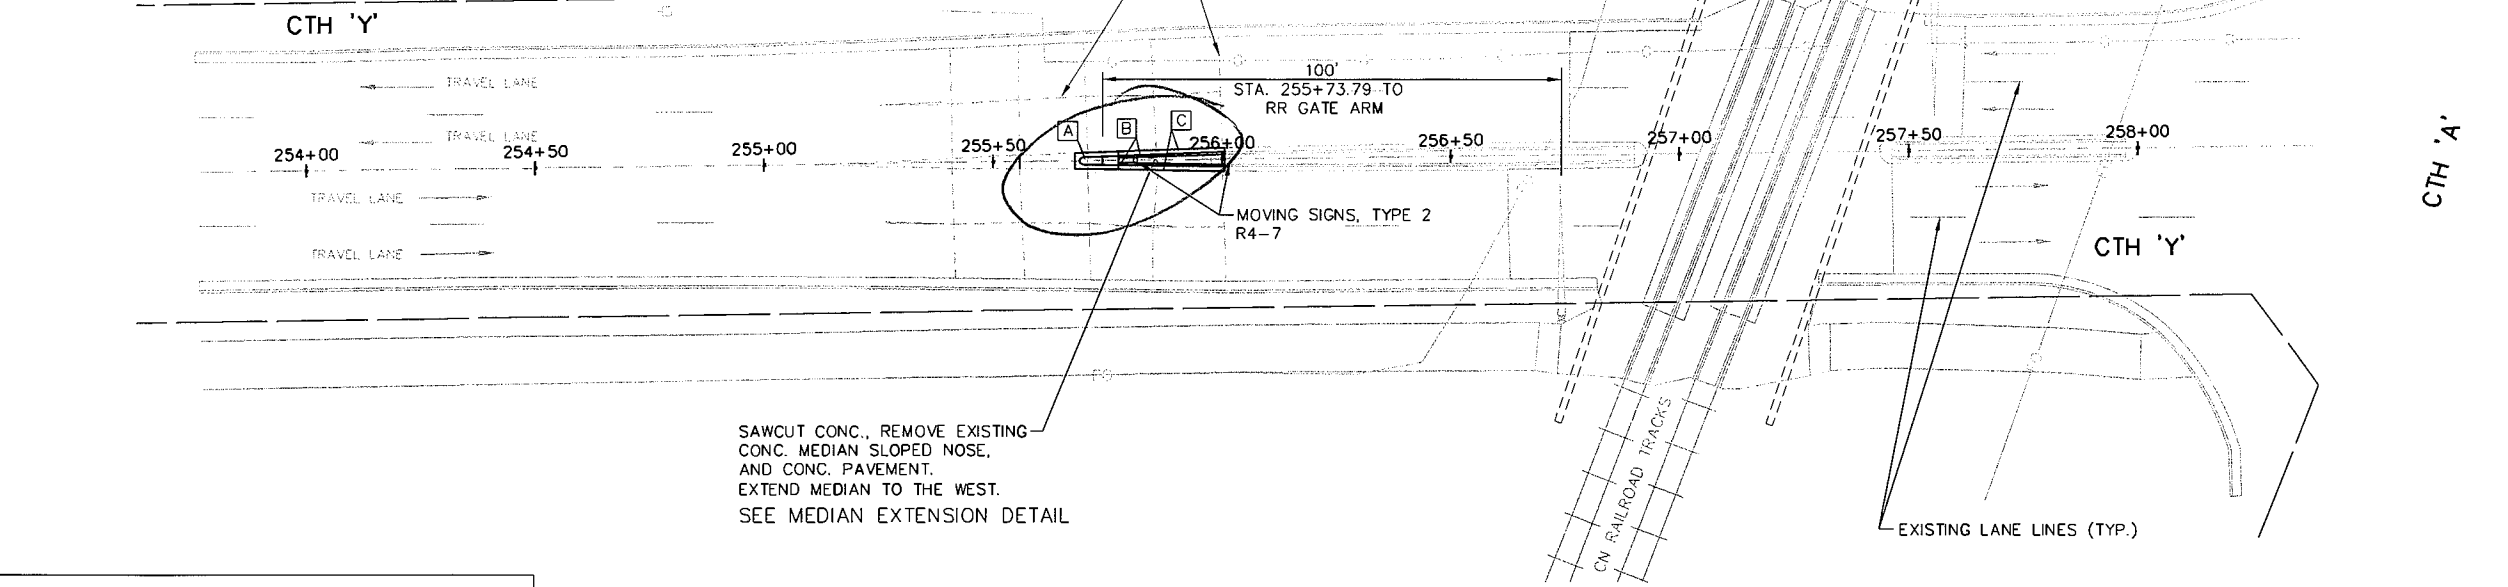

LEGEND

- SAWING CONCRETE
- [A] PAVEMENT MARKING, ISLAND NOSE, EPOXY, YELLOW
- [B] PAVEMENT MARKING, CURB, EPOXY, YELLOW
- [C] PAVEMENT MARKING, EDGELINE, EPOXY, 4-INCH YELLOW

NOTE:
THE UTILITIES SHOWN IN PLAN AND PROFILE ARE INDICATED IN ACCORDANCE WITH AVAILABLE RECORDS. THE CONTRACTOR SHALL BE RESPONSIBLE FOR OBTAINING EXACT LOCATIONS AND ELEVATIONS OF ALL UTILITIES FROM THE OWNERS OF THE RESPECTIVE UTILITIES. ALL UTILITIES SHALL BE NOTIFIED 72 HRS. PRIOR TO EXCAVATION.

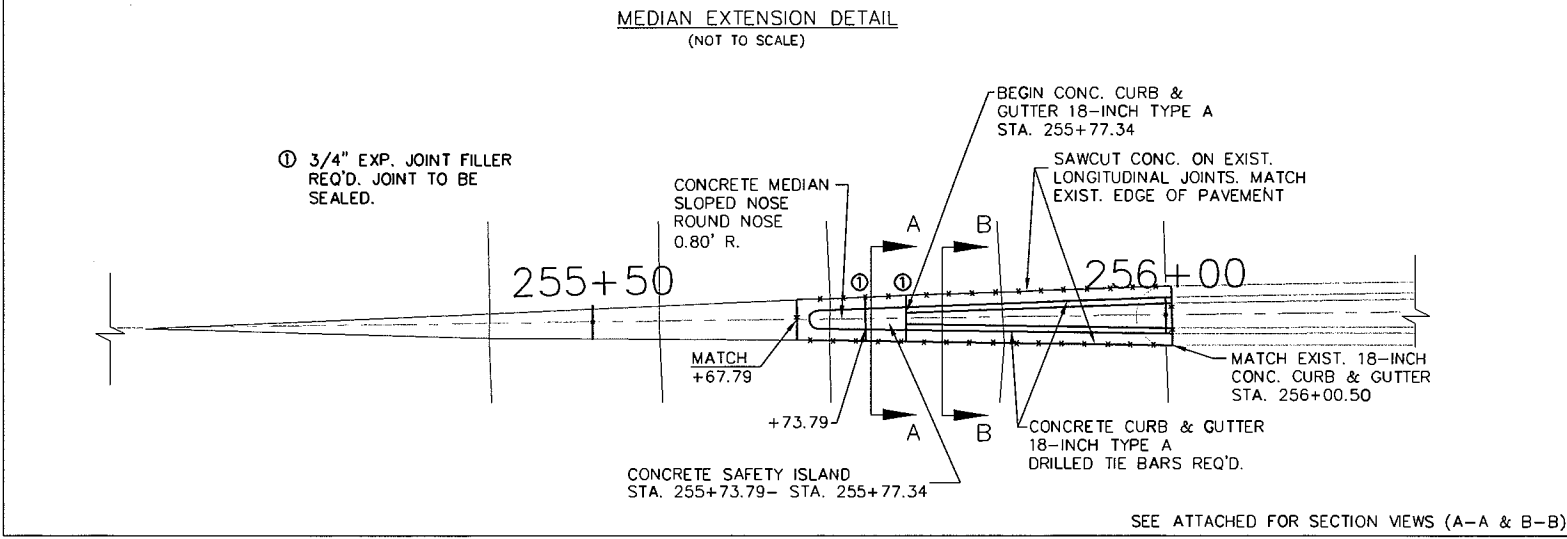

pmsgalski W:\PROJECTS\00005\910429\00\03-CTH Y.dwg 09/27/11 8:09 AM (X-QUIET ZONE CROSSINGS, --Align Coords and Rotation, gm_rrd, gm_por, gm_cos)



pmogalski W:\PROJECTS\00005\910429\00\03-CTH 'Y'.dwg 09/27/11 8:09 AM (X-QUIET ZONE CROSSINGS, --Align Coords and Rotation, gm_rrd, gm_par, gm_cos)

CONSTRUCTION NOTES:

COORDINATION WITH THE CN RAILROAD, FLAGGERS AND PERMITTING ARE THE CONTRACTOR'S RESPONSIBILITY AND SHALL BE CONSIDERED INCIDENTAL TO THE CONTRACT.

WORK SHALL BE PERFORMED IN ACCORDANCE WITH WisDOT STANDARD SPECIFICATIONS. SEE ATTACHED WisDOT S.D.D.'S.

THE CONTRACTOR SHALL MAINTAIN A MINIMUM OF ONE LANE OF TRAFFIC IN EACH DIRECTION ON CTH 'Y' DURING THE CONTRACT. THE CONTRACTOR SHALL PREPARE AND SUBMIT FOR APPROVAL A TRAFFIC CONTROL PLAN TO THE CITY OF OSHKOSH A MINIMUM OF 10 DAYS PRIOR TO BEGINNING WORK ON THE PROJECT. ALL TRAFFIC CONTROL SHALL BE IN ACCORDANCE WITH THE MUTCD, LATEST EDITION AND THE ATTACHED S.D.D.'S.


AN ESTIMATED QUANTITY OF BASE AGGREGATE DENSE 1 1/4-INCH HAS BEEN INCLUDED IN THE CONTRACT FOR FINE GRADING AREAS BELOW THE PROPOSED CONCRETE PAVEMENT, CURB & GUTTER, SIDEWALK AND SLOPED NOSE. BASE AGGREGATE DENSE 1 1/4-INCH SHALL ALSO BE USED FOR BACKFILLING THE CURB & GUTTER 18-INCH TYPE A. MAINTAIN EXISTING BASE AGGREGATE IN ALL AREAS.

CTH 'Y' ESTIMATED QUANTITIES



Description	* WDOT Item No.	Quantity	Unit
Removing Pavement	204.0100	25	S.Y.
Base Aggregate Dense 1 1/4" Roadway	305.0120	20	TON
Drilled Tie Bars	416.0610	50	EACH
Concrete Curb and Gutter 18-Inch Type A	601.0405	64	L.F.
Concrete Sidewalk 4-Inch	602.0405	70	S.F.
Mobilization	619.1000	1	L.S.
Concrete Median Sloped Nose	620.0300	22	S.F.
Moving Signs, Type II	638.2102	1	EACH
Traffic Control	643.0100	1	L.S.
Sawing Concrete	690.0250	80	L.F.
** Concrete Joint Sealing	SPV.0090.01	100	L.F.
** Concrete Safety Island	SPV.0165.01	14.00	SF

* ALL ITEMS TO BE COMPLETED IN ACCORDANCE WITH WisDOT SPECIFICATIONS FOR THE REFERENCED BID ITEM.
 ** SEE ATTACHED DETAIL

MEDIAN EXTENSION DETAIL
(NOT TO SCALE)

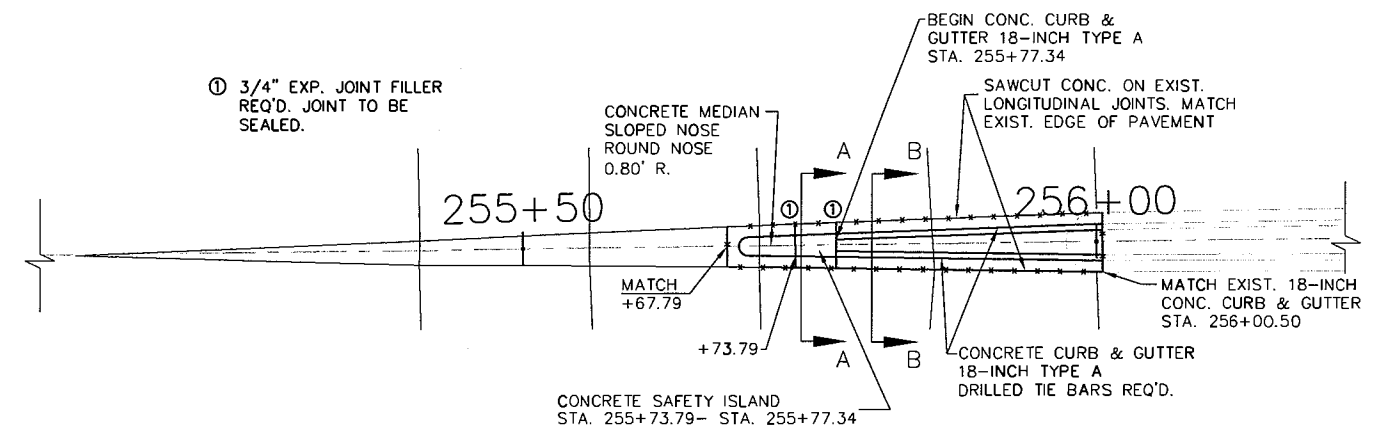

SEE ATTACHED FOR SECTION VIEWS (A-A & B-B)

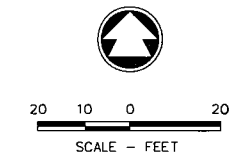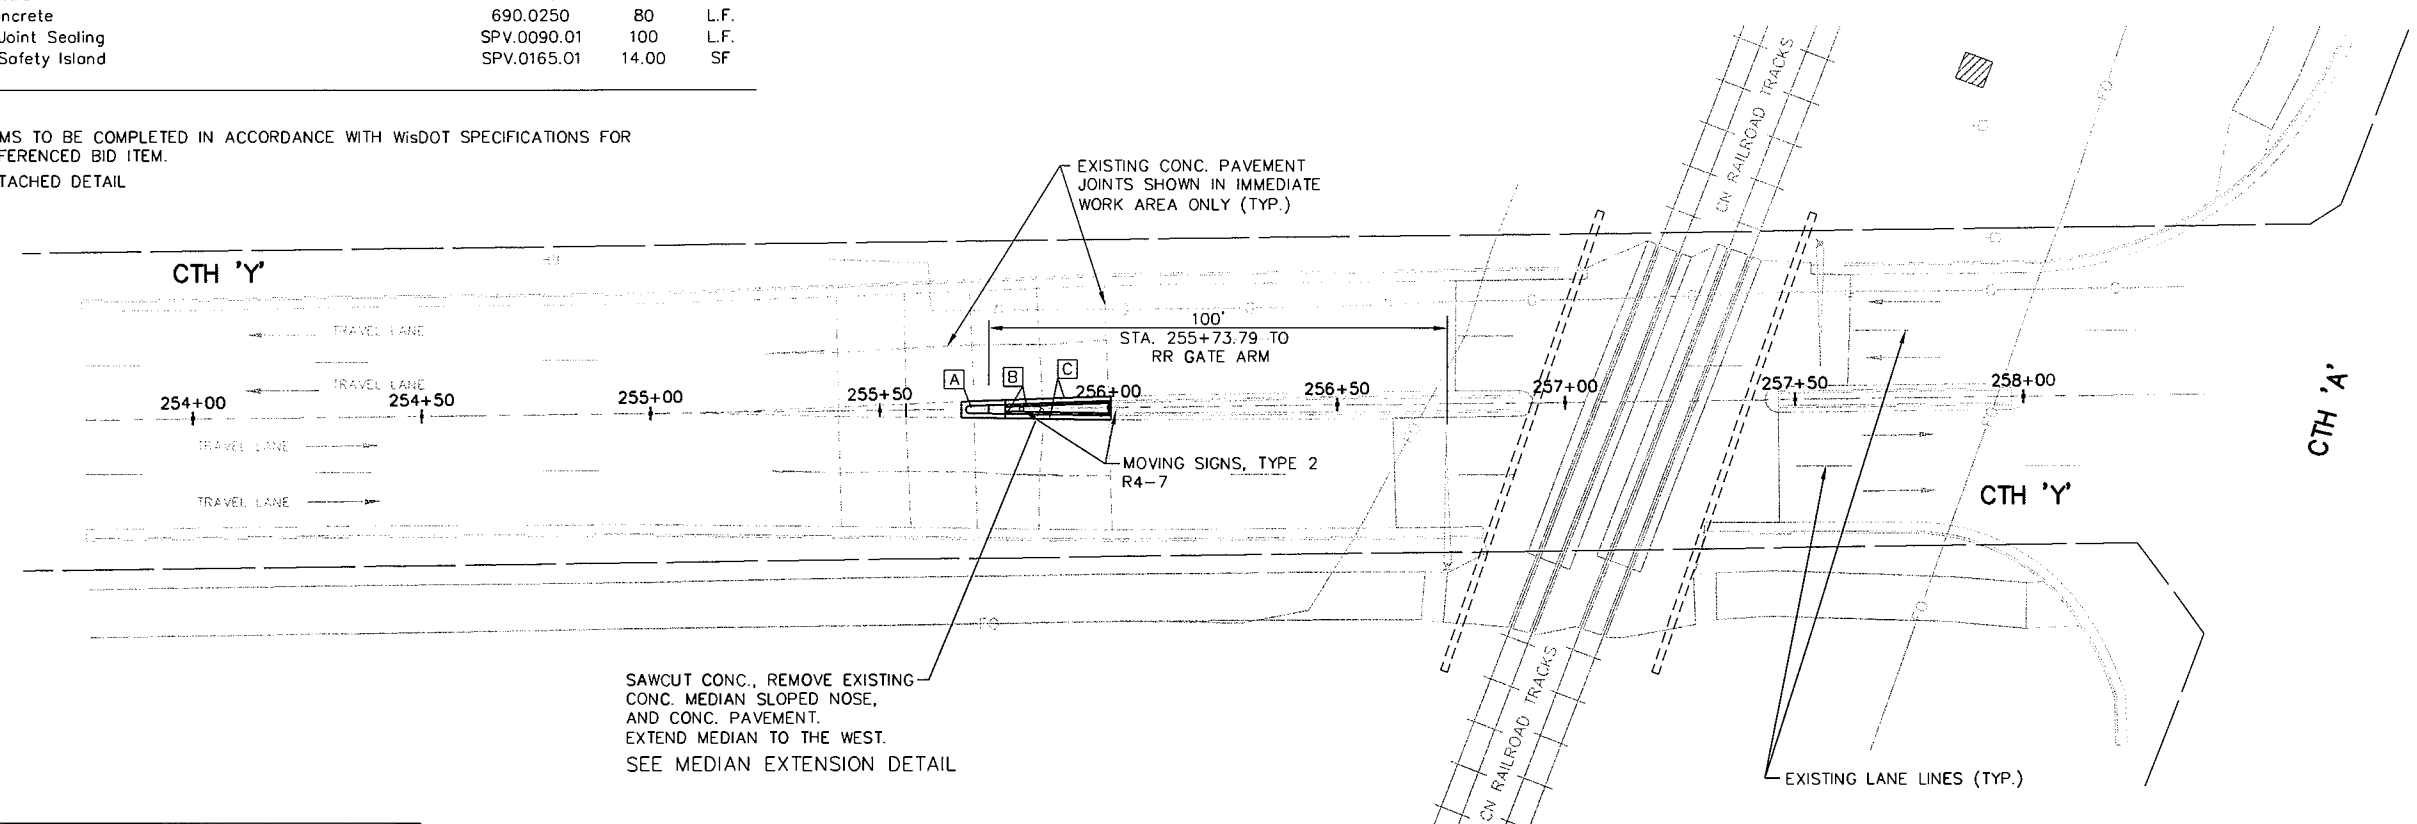


LEGEND

- SAWING CONCRETE
- A PAVEMENT MARKING, ISLAND NOSE, EPOXY, YELLOW
- B PAVEMENT MARKING, CURB, EPOXY, YELLOW
- C PAVEMENT MARKING, EDGELINE, EPOXY, 4-INCH YELLOW


NOTE:
 THE UTILITIES SHOWN IN PLAN AND PROFILE ARE INDICATED IN ACCORDANCE WITH AVAILABLE RECORDS. THE CONTRACTOR SHALL BE RESPONSIBLE FOR OBTAINING EXACT LOCATIONS AND ELEVATIONS OF ALL UTILITIES FROM THE OWNERS OF THE RESPECTIVE UTILITIES. ALL UTILITIES SHALL BE NOTIFIED 72 HRS. PRIOR TO EXCAVATION.

**PROPOSED SECTION A-A
CONCRETE SAFETY ISLAND**

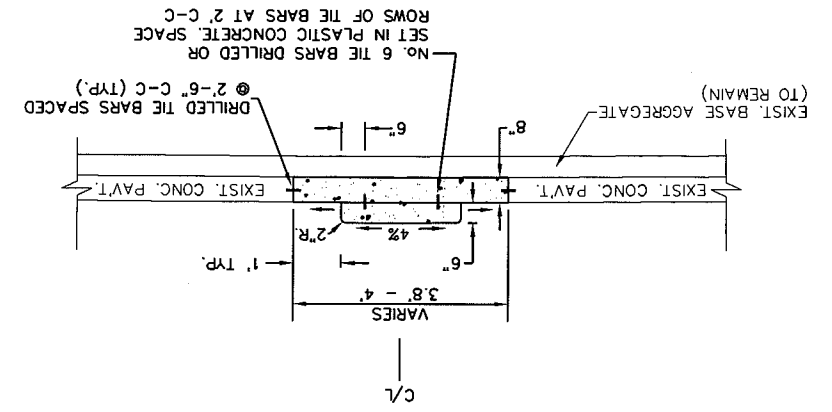


JOINT SEALING DETAIL FOR CONCRETE PAVEMENT

SEAL ALL CONSTRUCTION, LONGITUDINAL, AND TRANSVERSE CONCRETE PAVEMENT, CURB AND GUTTER, EXP. JOINTS AND SLOPED ISLAND NOSE JOINTS INCLUDING THE JOINT BETWEEN THE PAVEMENT AND CURB AND GUTTER.
FURNISH JOINT SEALANT MATERIAL CONFORMING TO THE REQUIREMENTS FOR THE SPECIFICATION FOR JOINT SEALANT, HOT-POURED, FOR CONCRETE AND ASPHALT PAVEMENT, ASTM DESIGNATION: D3405.

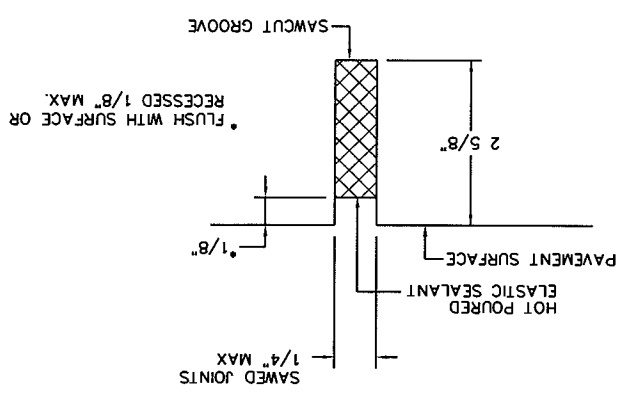


**PROPOSED SECTION B-B
C.I.H. 'Y' PROPOSED TYPICAL SECTION FOR MEDIAN EXTENSION**

* LIMITS OF RAISED MEDIAN AND CONC. SAFETY ISLAND ARE STA. 255+67.79 - STA. 256+00.50
STA. 255+67.79 - STA. 256+00.50

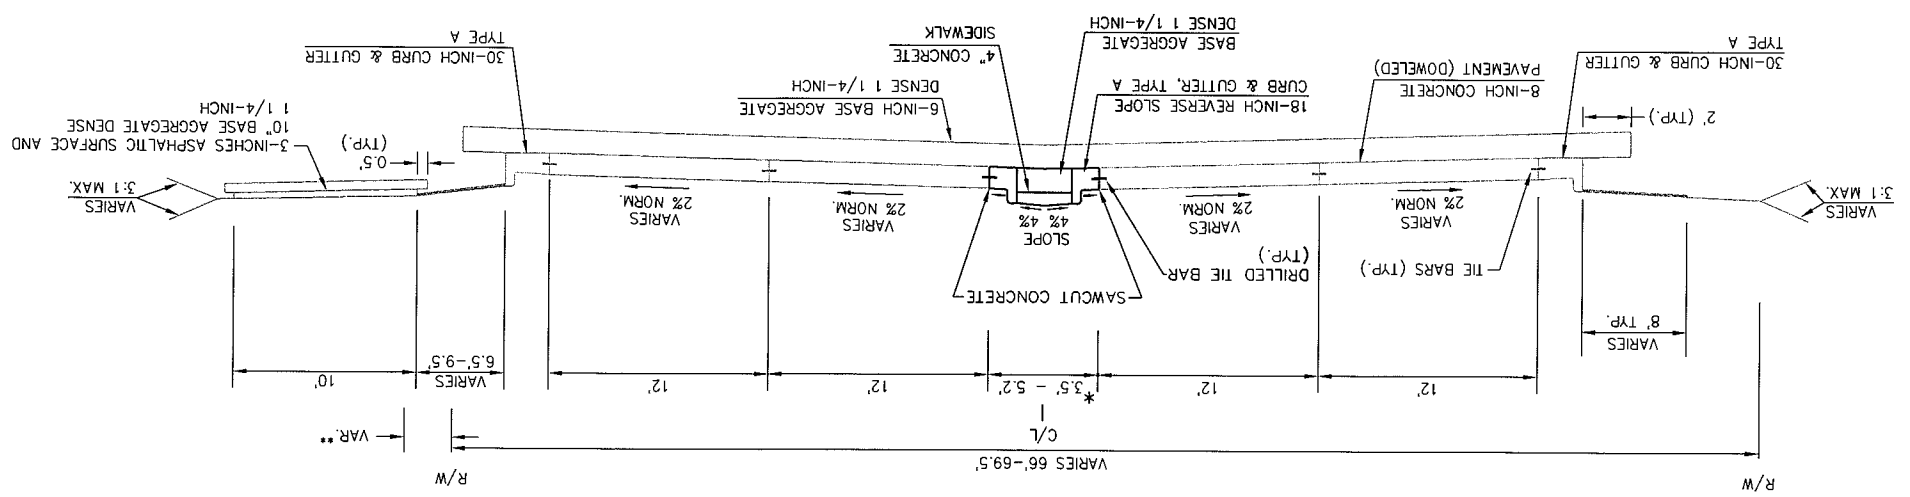


* LIMITS OF RAISED MEDIAN ARE STA. 256+00.50 TO STA. 256+93.56 AND STA. 257+41.48 TO STA. 257+97.00
STA. 255+01.14 - STA. 258+53.16

**EXISTING SECTION B-B
C.I.H. 'Y' TYPICAL EXISTING SECTION**

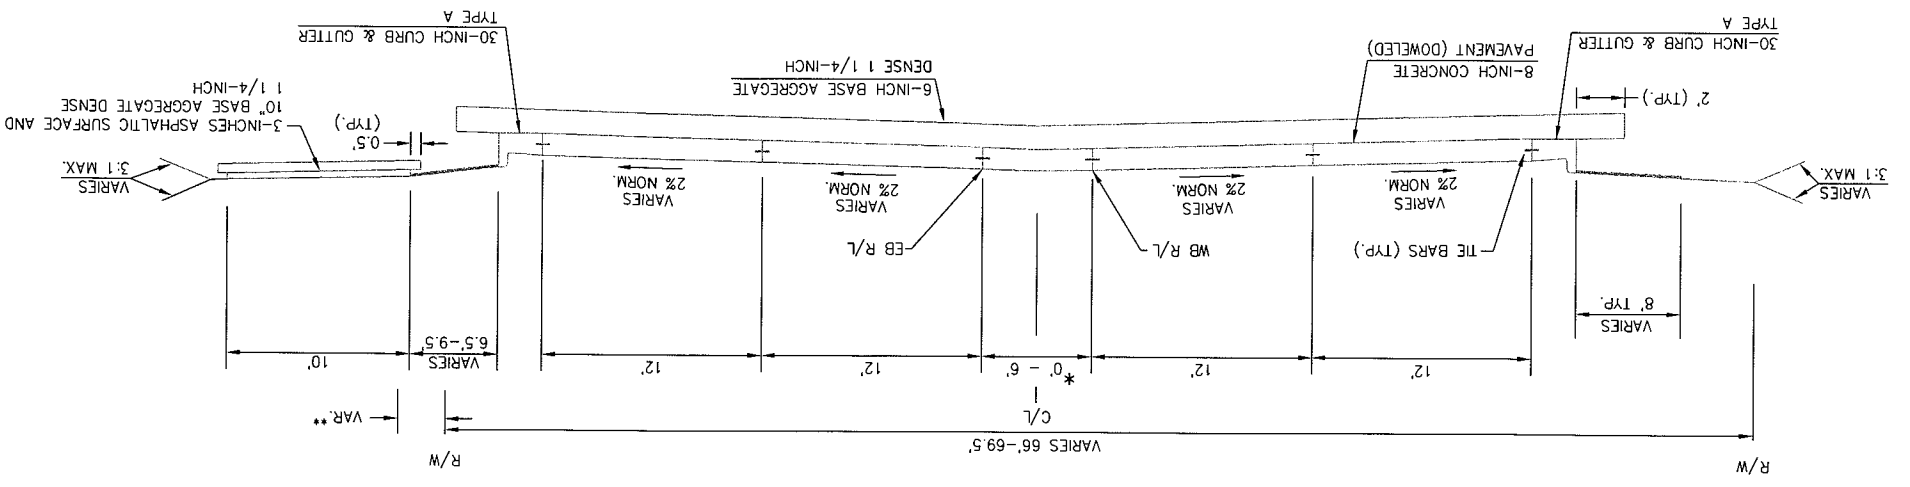





8D1: Concrete Curb, Concrete Curb & Gutter and Ties

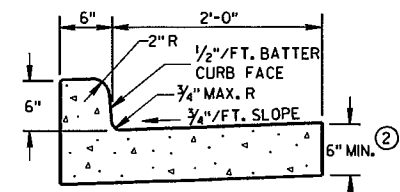


TYPES A & D ①

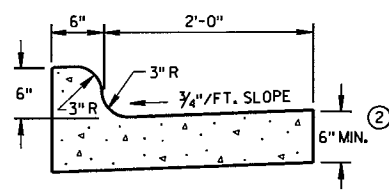


TYPES K & L ①

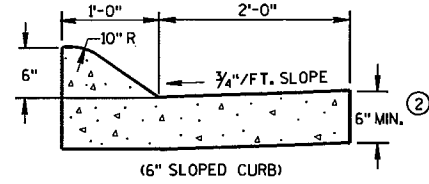


(6" SLOPED CURB)

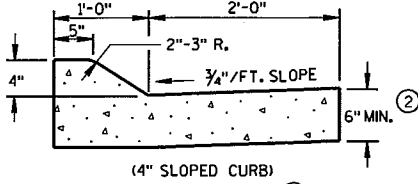


(4" SLOPED CURB)

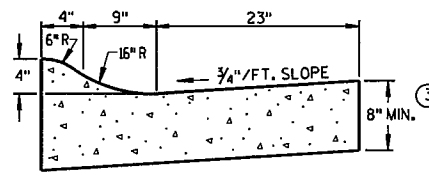


4" SLOPED CURB TYPES R & T ① ④

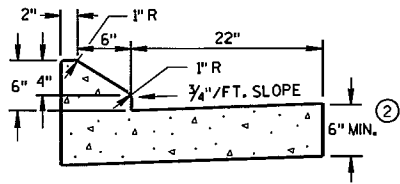

6" SLOPED CURB TYPES G & J ①

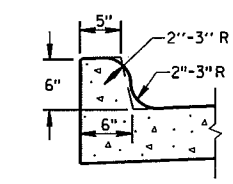


OPTIONAL CURB SHAPE FOR TYPES K & L ①

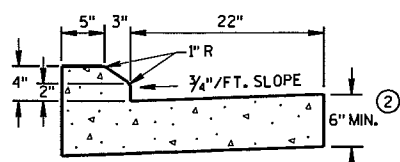


4" SLOPED CURB TYPES G & J ①


CONCRETE CURB & GUTTER 30"

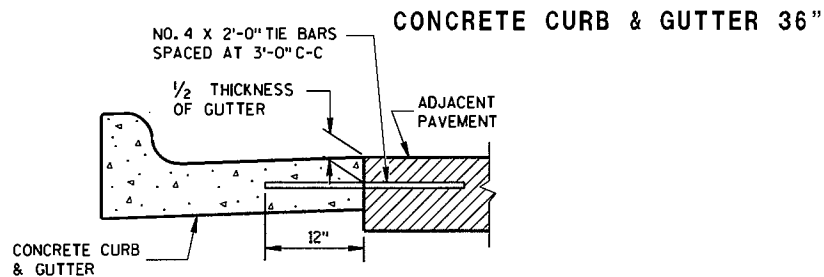

TYPICAL TIE BAR LOCATION ①

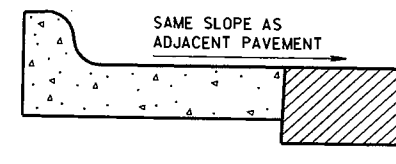


REVERSE SLOPE GUTTER ⑤
(TYPICAL FOR ALL CURB & GUTTER TYPES)

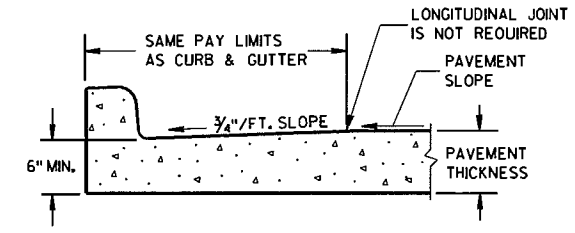

PARTIAL SECTION OF PAVEMENT WITH INTEGRAL CURB & GUTTER

6


6

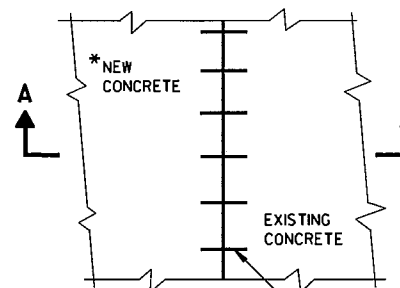

PLAN VIEW

*NEW CURB & GUTTER, SURFACE DRAINS, CONCRETE PAVEMENT OR OTHER NEW CONCRETE.


NO. 6 TIE BARS SPACED 2'-6" C-C, INSTALLED PERPENDICULAR TO THE LONGITUDINAL JOINT.

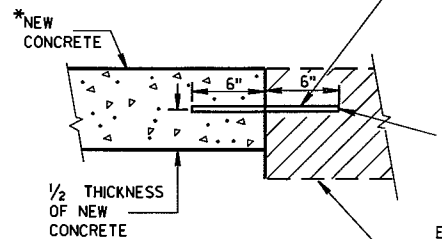


SECTION A-A
TIE BARS DRILLED INTO EXISTING PAVEMENT

MAXIMUM DRILL HOLE SIZE IS 1/8" GREATER THAN TIE BAR DIAMETER


EXISTING CONCRETE

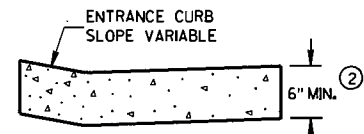


DRIVEWAY ENTRANCE CURB
(WHEN DIRECTED BY THE ENGINEER)

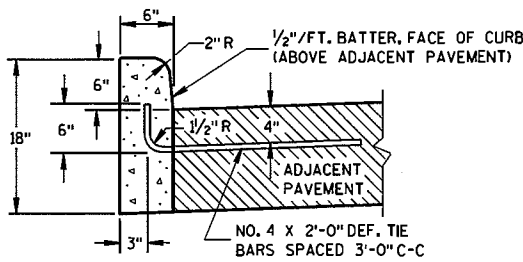

TYPES A & D ①

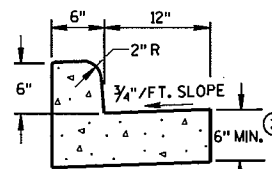

TYPES A & D
CONCRETE CURB & GUTTER 18"

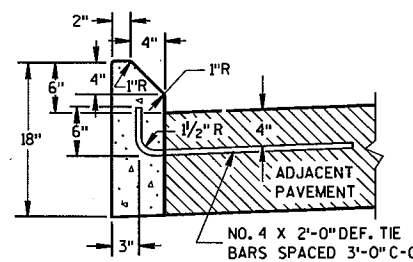

TYPES G & J ①

CONCRETE CURB

GENERAL NOTES

DETAILS OF CONSTRUCTION, MATERIALS AND WORKMANSHIP NOT SHOWN ON THIS DRAWING SHALL CONFORM TO THE PERTINENT REQUIREMENTS OF THE CONTRACT.

PAVEMENT TIES AND TIE BARS SHALL BE EPOXY COATED IN CONFORMANCE WITH SUBSECTION 505.2.6.2 OF THE STANDARD SPECIFICATIONS.

INTEGRAL CURB & GUTTER SHALL CONFORM TO THE DETAILS SHOWN FOR CONCRETE CURB & GUTTER INCLUDING THE TRANSVERSE GUTTER SLOPE. A LONGITUDINAL CONSTRUCTION JOINT IS NOT REQUIRED WITH INTEGRAL CURB AND GUTTER.

WHERE THE TRANSVERSE JOINTS IN THE PAVEMENT ARE REQUIRED TO BE SEALED, THE JOINTS IN THE INTEGRAL CURB AND GUTTER SHALL BE SEALED TO THE FACE OF CURB WITH THE SAME TYPE OF SEALANT. THE COST OF FURNISHING AND INSTALLING THIS SEALANT SHALL BE INCIDENTAL TO THE ITEM CONCRETE CURB AND GUTTER.

UNLESS OTHERWISE SHOWN ON THE TYPICAL CROSS SECTIONS, THE BASE AGGREGATE AND COMMON EXCAVATION LIMITS ARE 2'-0" BEHIND THE BACK OF CURBS.

- ① TIE BARS ARE REQUIRED FOR CURB AND GUTTER TYPES A, G, K AND R.
- ② THE BOTTOM OF CURB AND GUTTER MAY BE CONSTRUCTED EITHER LEVEL OR PARALLEL TO THE SLOPE OF THE SUBGRADE OR BASE AGGREGATE PROVIDED A 6" MINIMUM GUTTER THICKNESS IS MAINTAINED.
- ③ THE BOTTOM OF CURB AND GUTTER MAY BE CONSTRUCTED EITHER LEVEL OR PARALLEL TO THE SLOPE OF THE SUBGRADE OR BASE AGGREGATE PROVIDED A 8" MINIMUM GUTTER THICKNESS IS MAINTAINED.
- ④ THE FACE OF CURB IS 6" FROM THE BACK OF CURB.
- ⑤ WHEN REVERSE SLOPE GUTTER IS REQUIRED, THE LOCATION(S) WILL BE SHOWN ELSEWHERE IN THE PLAN.

S.D.D. 8 D 1-17

S.D.D. 8 D 1-17

CONCRETE CURB, CONCRETE CURB & GUTTER AND TIES

STATE OF WISCONSIN
DEPARTMENT OF TRANSPORTATION

APPROVED

9/4/08

DATE



FHWA

/S/ Jerry H. Zogg
ROADWAY STANDARDS DEVELOPMENT
ENGINEER




GENERAL NOTES




- 1 SEE PLAN FOR MEDIAN NOSE WIDTH AND RADIUS (FOR ROUND NOSE ALTERNATE).
- 2 WIDTH OF GUTTER TO MATCH EXISTING ADJACENT GUTTER OR AS SPECIFIED ELSEWHERE IN THE PLAN.
- 3 DEPTH EQUAL TO ADJACENT PAVEMENT. ADJACENT PAVEMENT STRUCTURE DETAILS ARE SHOWN ON THE PLAN. TYPICAL OPTIONS ARE:
- 4 (1) NEW OR EXISTING CONCRETE PAVEMENT.
(2) ASPHALTIC CONCRETE PAVEMENT OVER NEW OR EXISTING CONCRETE BASE COURSE.
(3) ASPHALTIC CONCRETE PAVEMENT OVER CRUSHED AGGREGATE BASE COURSE.
(4) THE BARS OR PAVEMENT TIES REQUIRED IN NEW CONCRETE PAVEMENT OR CONCRETE BASE COURSE. THE BARS SHALL BE NO. 4 X 2'-0" SPACED AT 2'-0" C-C.
- 5 PAVEMENT TIES REQUIRED IN EXISTING CONCRETE BASE COURSE. PAVEMENT TIES SHALL BE NO. 6 X 1'-0" SPACED AT 3'-0" C-C INSTALLED ON A HORIZONTAL SKEW OF 6:1 THE DIRECTION OF SKEW SHALL ALTERNATE AFTER EVERY ONE OR TWO BARS.
- 6 SURFACE TYPE AND DETAILS ARE SHOWN ELSEWHERE IN THE PLAN.

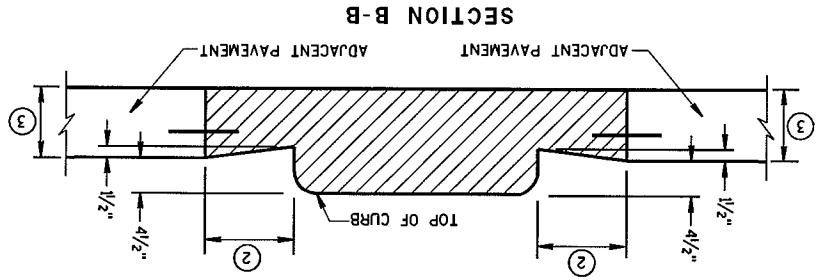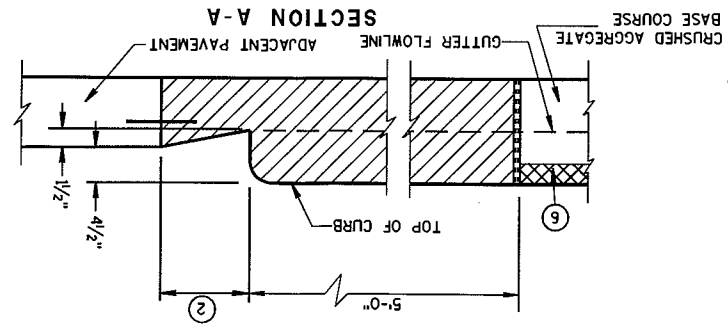


CONCRETE MEDIAN BLUNT NOSE DETAIL

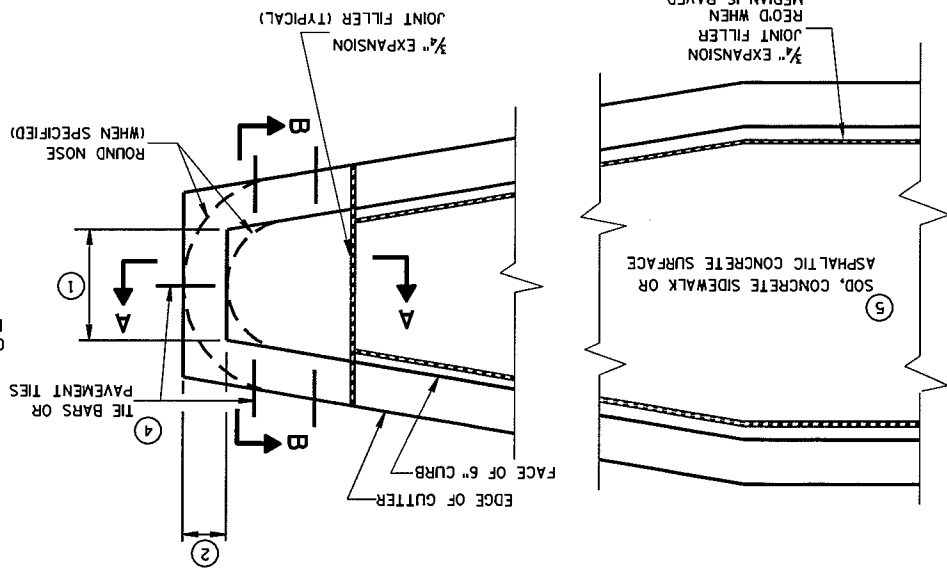

CONCRETE MEDIAN SLOPED NOSE TYPE 2

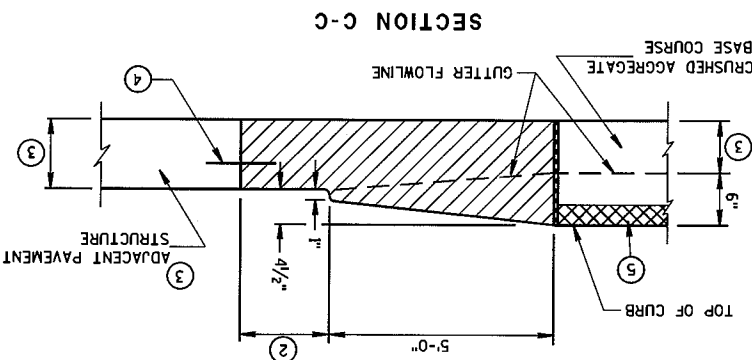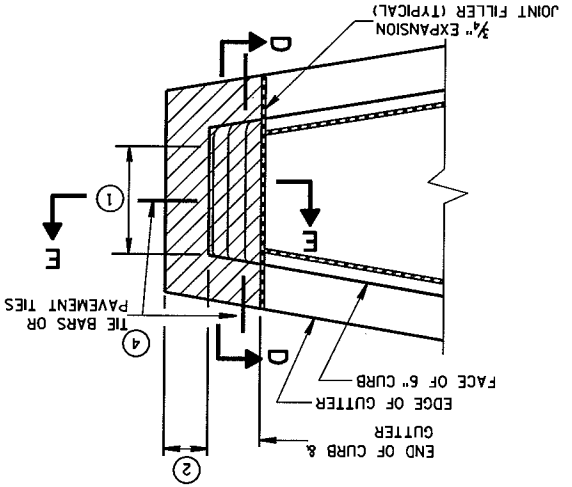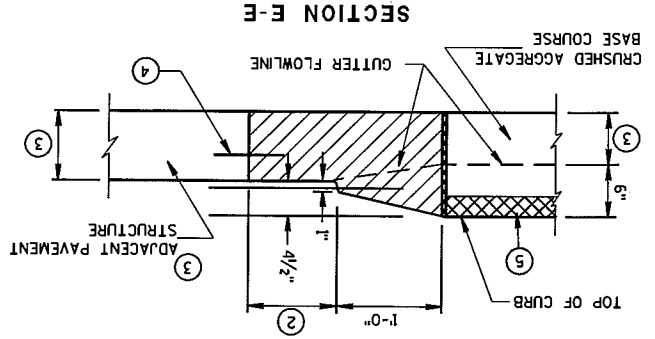

CONCRETE MEDIAN SLOPED NOSE TYPE 1

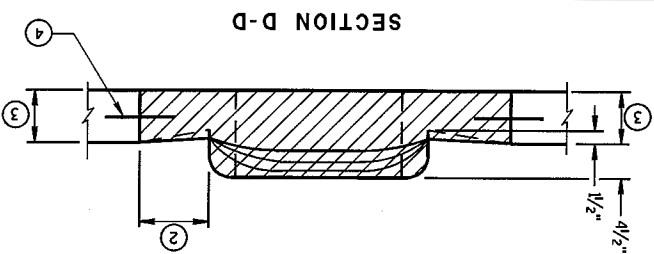


APPROVED	DATE	DATE	DATE
6/8/06	6/8/06	6/8/06	6/8/06
/S/ Jerry H. Zoog	/S/ Jerry H. Zoog	/S/ Jerry H. Zoog	/S/ Jerry H. Zoog
ROADWAY STANDARDS DEVELOPMENT	ROADWAY STANDARDS DEVELOPMENT	ROADWAY STANDARDS DEVELOPMENT	ROADWAY STANDARDS DEVELOPMENT
FHWA	FHWA	FHWA	FHWA


STATE OF WISCONSIN
DEPARTMENT OF TRANSPORTATION

CONCRETE MEDIAN NOSE

13C1: Concrete Pavement Longitudinal Joints and Ties

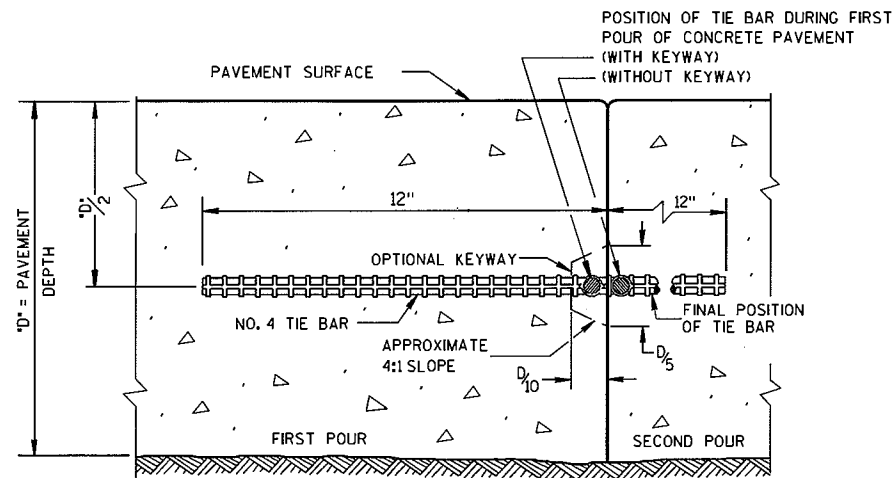


CONSTRUCTION JOINT

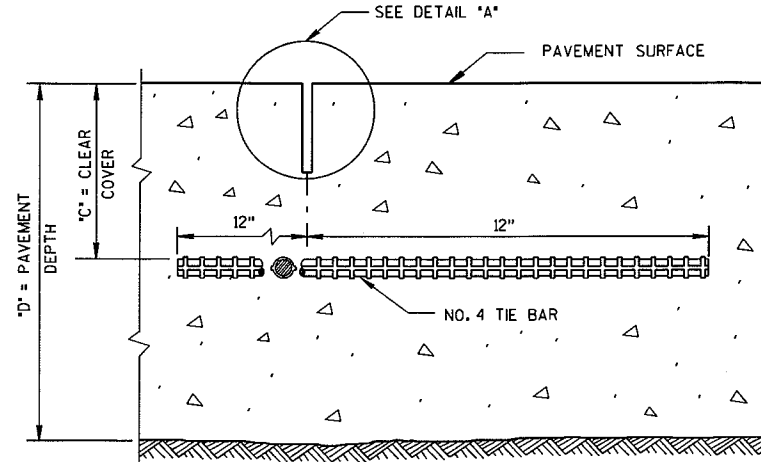

SAWED JOINT


GENERAL NOTES

- DO NOT SEAL OR FILL LONGITUDINAL JOINTS.
- CREATE A LONGITUDINAL JOINT FOR PAVEMENT WIDTHS GREATER THAN 15 FEET.
- CORRELATE LONGITUDINAL JOINTS WITH LANE LINES WHEN POSSIBLE.
- ① ANCHOR TIE BARS INTO DRILLED HOLES WITH AN EPOXY.

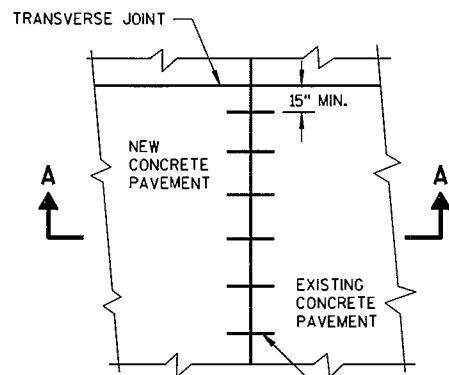


PLAN VIEW

NO. 6 TIE BARS SPACED 2'-6" C-C, INSTALLED PERPENDICULAR TO THE LONGITUDINAL JOINT. ①

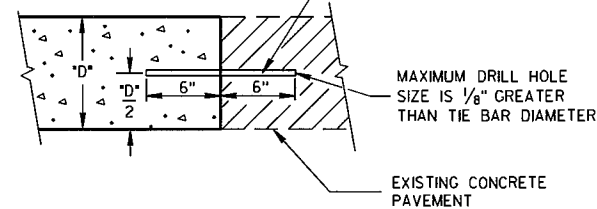


**SECTION A-A
LONGITUDINAL CONSTRUCTION JOINT
TIE BARS ANCHORED
INTO EXISTING PAVEMENT**

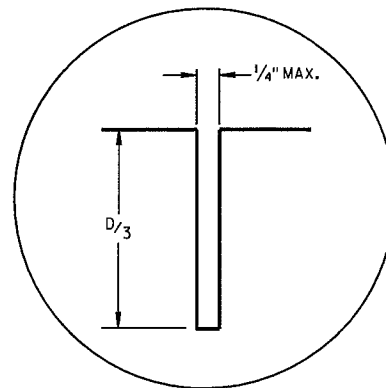



DETAIL "A"

PAVEMENT DEPTH "D"	CLEAR COVER "C"	MAXIMUM TIE BAR SPACING "S"	
		PAVEMENT WIDTH 24' OR 26'	≥ 30'
6, 6 1/2"	3" ± 1/2"	48"	42"
7, 7 1/2"	3 1/4" ± 1"	45"	36"
8, 8 1/2"	3 3/4" ± 1"	39"	30"
9, 9 1/2"	4 1/4" ± 1"	33"	27"
10, 10 1/2"	4 3/4" ± 1"	30"	24"
11, 11 1/2"	5 1/4" ± 1"	27"	21"
12"	5 3/4" ± 1"	24"	21"

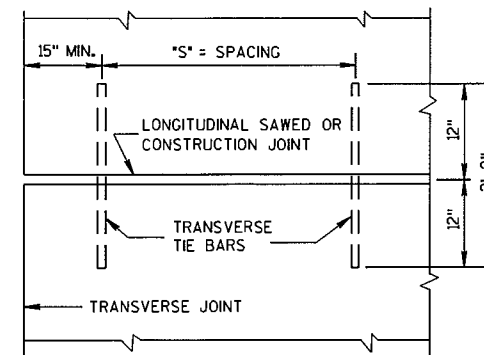


**PLAN VIEW
SHOWING LOCATION OF TIE BARS**

CONCRETE PAVEMENT LONGITUDINAL JOINTS AND TIES	
STATE OF WISCONSIN DEPARTMENT OF TRANSPORTATION	
APPROVED 10-5-2010 DATE	/S/ Deb Bischoff PAVEMENT POLICY & DESIGN ENGINEER
FHWA	

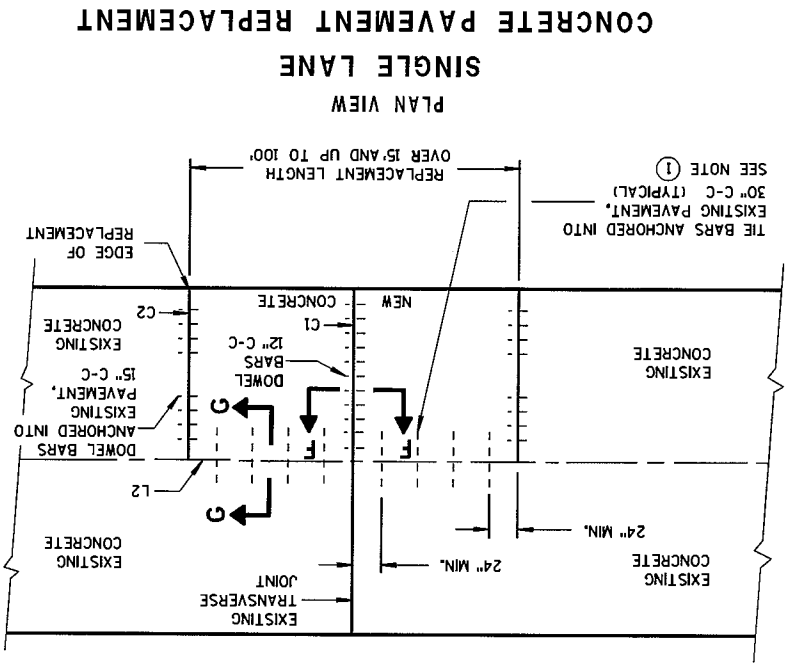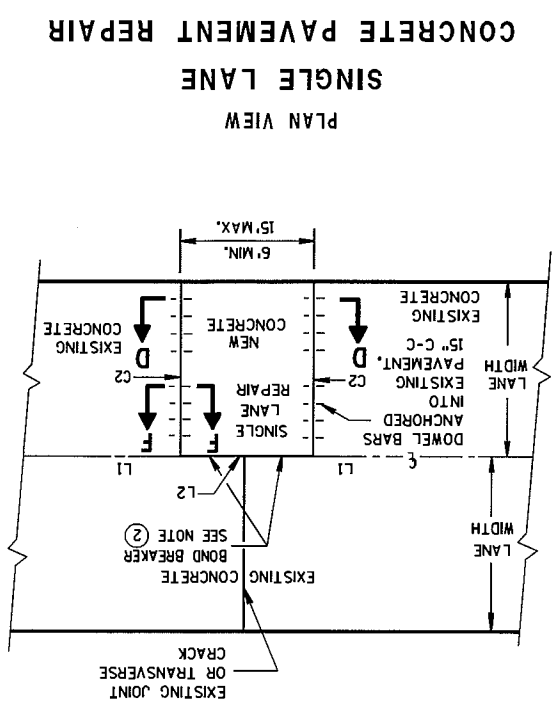


SECTION G-G
TIE BARS ANCHORED INTO EXISTING PAVEMENT

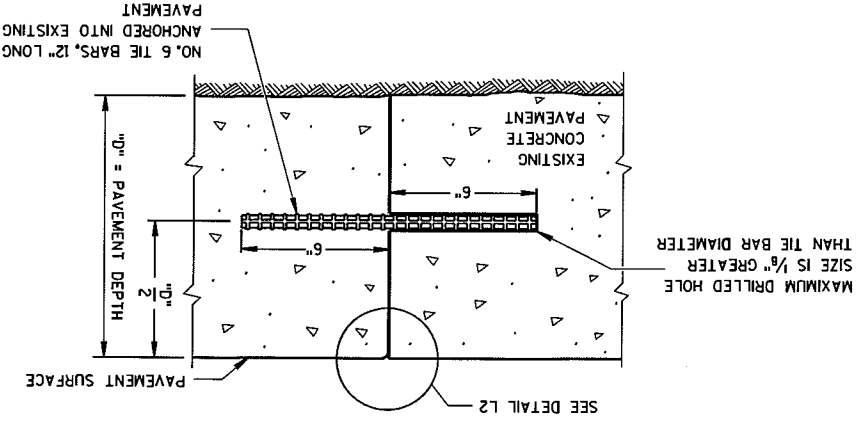


- ① WITH THE APPROVAL OF THE ENGINEER, FOR SINGLE LANE PAVEMENT REPLACEMENTS LESS THAN 30 FEET IN LENGTH, THE CONTRACTOR MAY INSTALL DRILLED TIE BARS ON 6:1 SKEW HORIZONTALLY, DIRECTION OF SKEW ALTERNATING WITH EACH SUCCESSIVE BAR, DRIVE SKEWED TIE BARS TO A DEPTH OF 6 INCHES AND TO SUCH A DIAMETER AS TO PROVIDE A TIGHT DRIVEN FIT.
- ② USE AN ENGINEER-APPROVED BOND BREAKER FOR SINGLE LANE REPAIRS UP TO 15 FEET IN LENGTH.

GENERAL NOTES


CONCRETE PAVEMENT REPAIR AND REPLACEMENT	STATE OF WISCONSIN DEPARTMENT OF TRANSPORTATION	APPROVED DATE 12-11-09 /S/ Deb Bischoff PAVEMENT POLICY & DESIGN ENGINEER F.H.M.A.
--	---	--

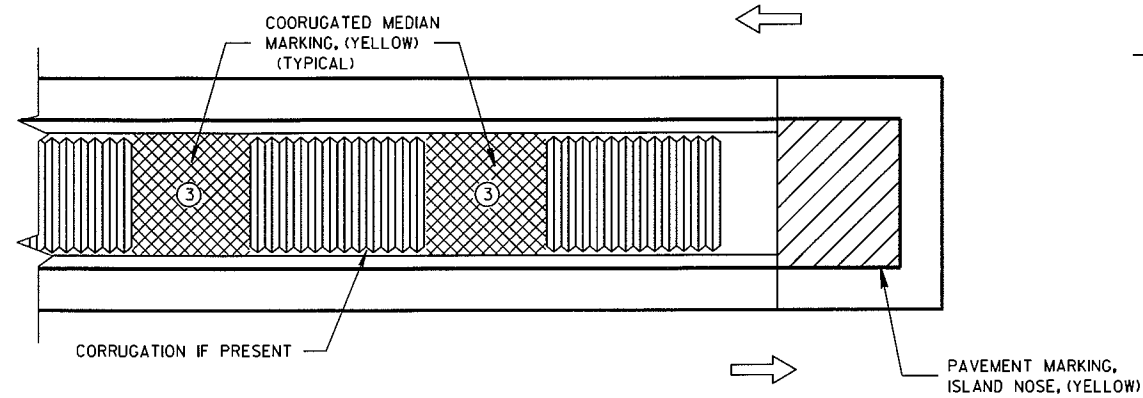

MEDIAN ISLAND WITH SQUARE BLUNT NOSE

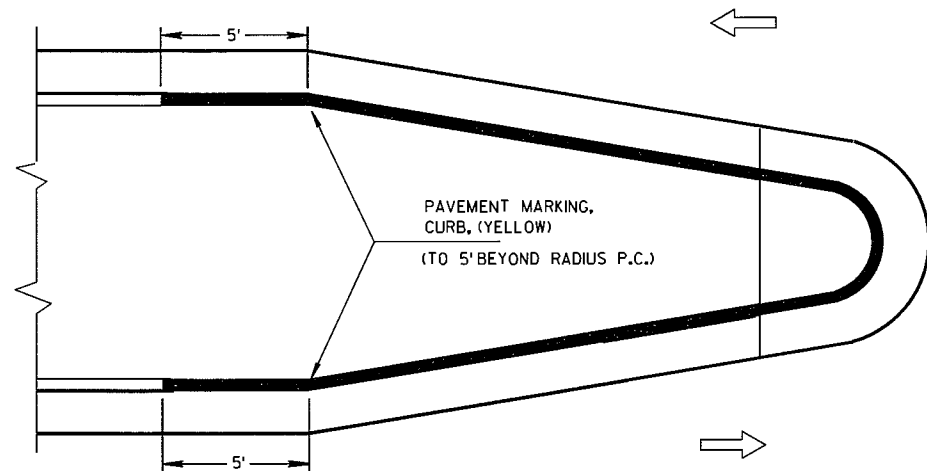


MEDIAN ISLAND WITH ROUND BLUNT NOSE

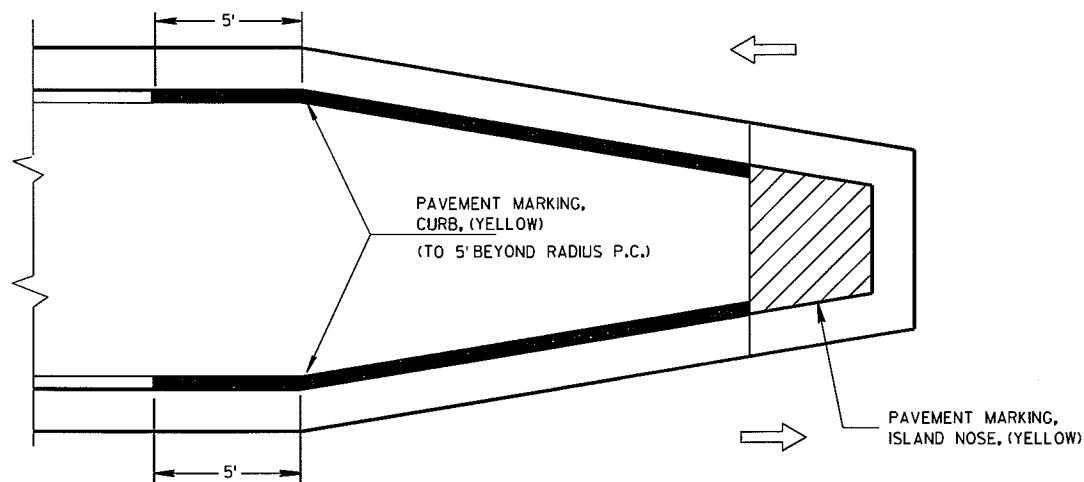

MEDIAN ISLAND WITH SLOPED NOSE


TYPICAL PLACEMENT OF PAVEMENT MARKING ON MEDIAN ISLANDS

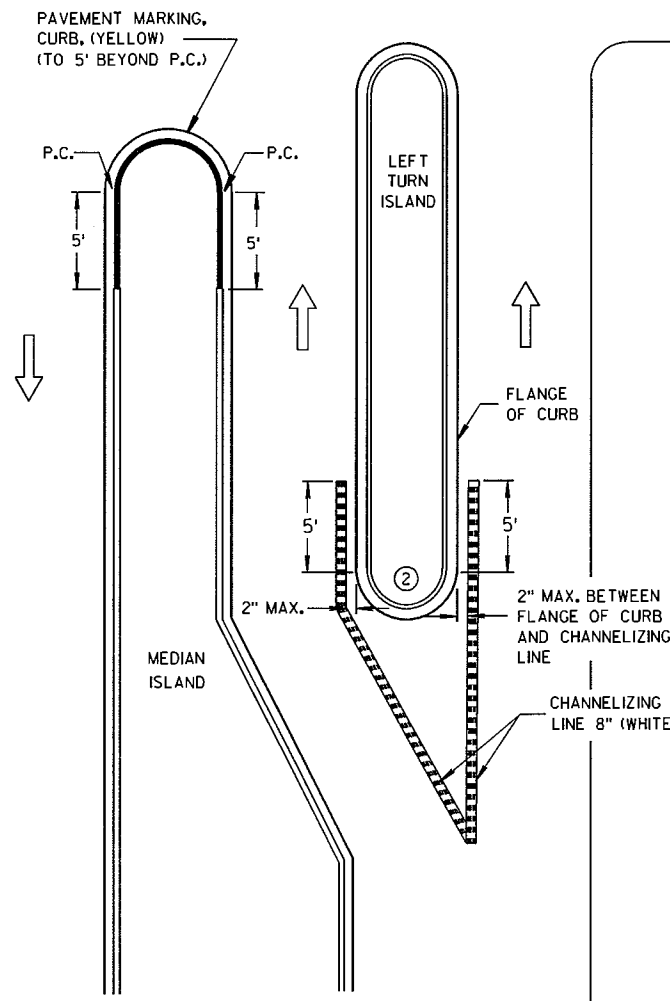

LEFT TURN & MEDIAN ISLAND

GENERAL NOTES


- ① STOP LINE IS REQUIRED ONLY WHEN SPECIFIED IN THE CONTRACT.
- ② DO NOT MARK CURB NOSES THAT SEPARATE LANES OF TRAFFIC TRAVELING IN THE SAME DIRECTION.
- ③ WHEN CONCRETE CORRUGATED MEDIAN IS CONSTRUCTED TO SEPARATE TRAFFIC OPERATING IN THE OPPOSING DIRECTION YELLOW PAVEMENT MARKING SHALL BE APPLIED TO THE FLAT PORTION OF THE CONCRETE CORRUGATED MEDIAN. THE ITEM OF PAVEMENT MARKING, CONCRETE CORRUGATED MEDIAN, WILL BE MEASURED IN PLACE AND ACCEPTED IN ACCORDANCE WITH THE CONTRACT AND PAID FOR AT THE CONTRACT UNIT PRICE PER SQUARE FOOT.

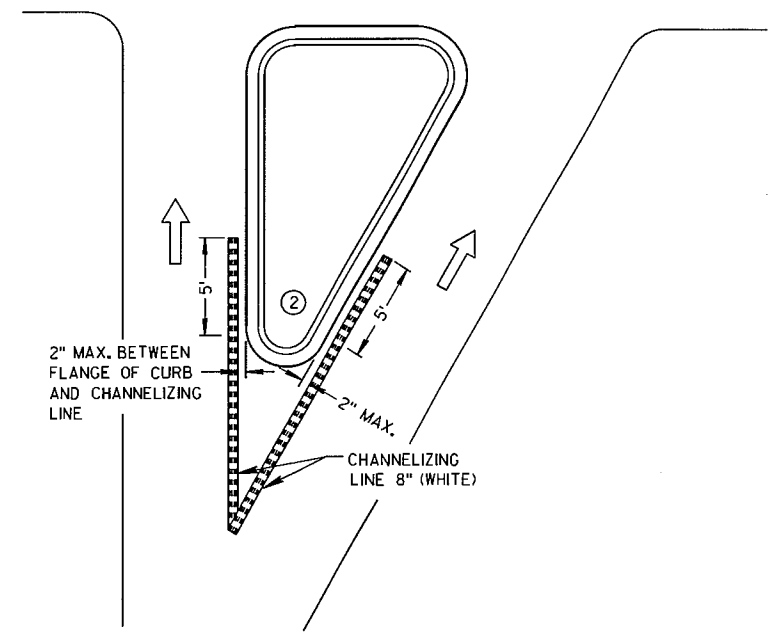

RIGHT TURN ISLAND

LEGEND

- ISLAND NOSE MARKING
- CURB MAKING
- CORRUGATED MEDIAN MARKING
- DIRECTION OF TRAVEL

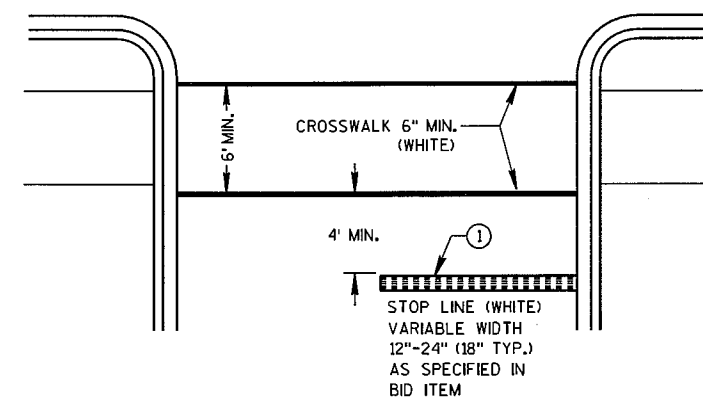



STOP LINE AND CROSSWALK

**PAVEMENT MARKING
(ISLANDS, STOP LINE &
CROSS WALK)**

STATE OF WISCONSIN
DEPARTMENT OF TRANSPORTATION

15D12: Traffic Control, Lane Closure, Speeds Greater than 40 M.P.H.

**TRAFFIC CONTROL,
LANE CLOSURE, SPEEDS
GREATER THAN 40 M.P.H.**
 STATE OF WISCONSIN
 DEPARTMENT OF TRANSPORTATION
 APPROVED
 DATE 8-7-95
 /S/ Chester J. Spang
 DIRECTOR, OFFICE OF TRAFFIC
 FHWA

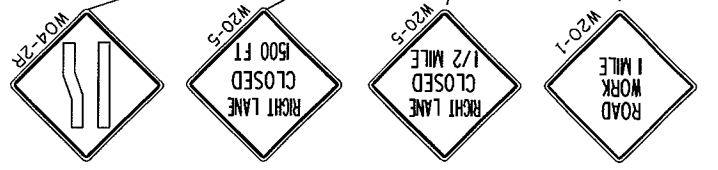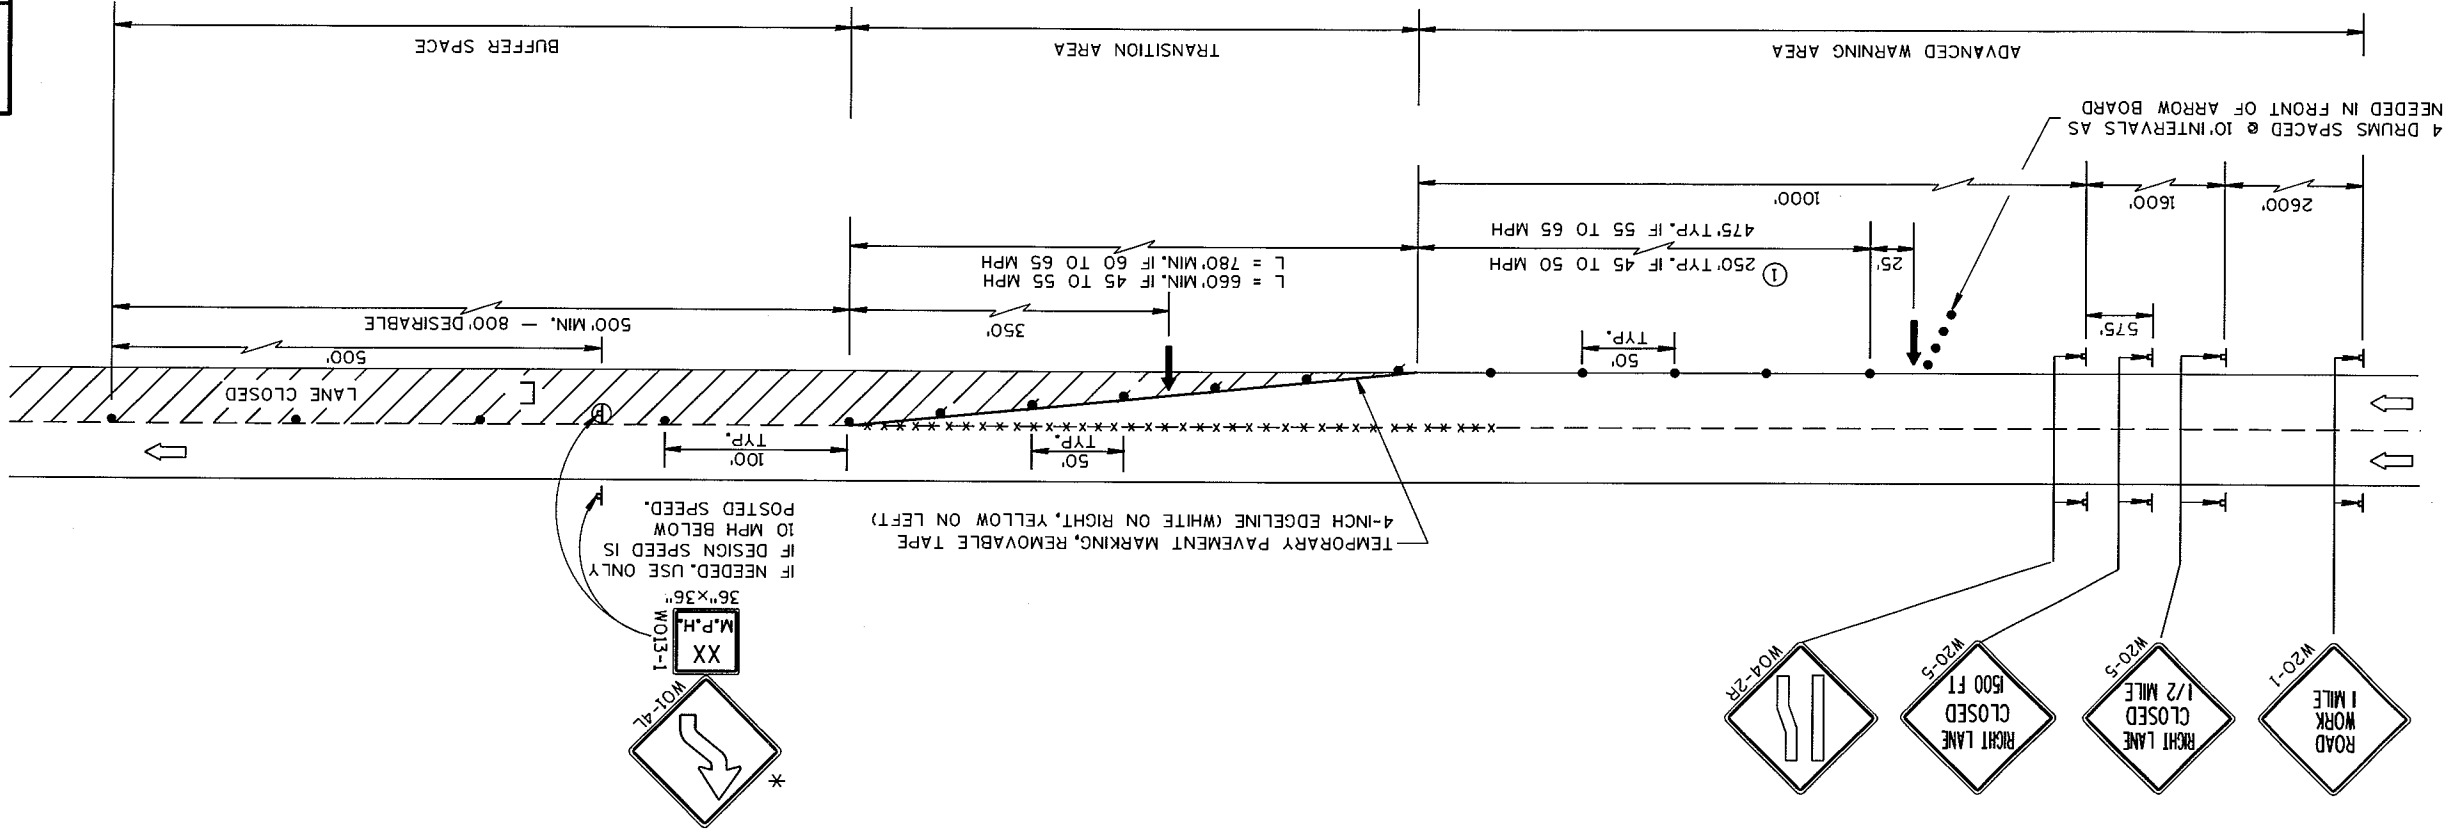


GENERAL NOTES :

- THE EXACT NUMBER, LOCATION, AND SPACING OF ALL SIGNS AND DEVICES SHALL BE ADJUSTED TO FIT FIELD CONDITIONS AS APPROVED BY THE ENGINEER.
- PROVIDE A MINIMUM OF 200 FEET, (500 FEET DESIRABLE) DISTANCE TO EXISTING SIGNS.
- THIS LANE CLOSURE IS TYPICAL FOR CLOSING RIGHT LANE - REVERSE FOR CLOSING LEFT LANE.
- ALL SIGNS ARE 48"x48" UNLESS OTHERWISE NOTED.
- "WO" IS THE SAME AS "W" EXCEPT THE BACKGROUND IS ORANGE.
- ANY SIGNS TEMPORARY OR EXISTING, WHICH CONFLICT WITH TRAFFIC CONTROL "IN USE" SHALL BE REMOVED OR COVERED AS NEEDED AND AS APPROVED BY THE ENGINEER. NO WARNING LIGHTS SHALL BE WORKING ON "COVERED" OR "DOWNED" SIGNS.
- CONSIDER GEOMETRICS WHEN LOCATING SIGNS AND ARROW BOARD SO THE DRIVER HAS A CLEAR VIEW OF THE ARROW BOARD AND LANE CLOSURE DRUMS FOR A MINIMUM 1500 FEET IN FRONT OF DRUMS.
- FOR A LANE CLOSURE THAT IS IN PLACE LESS THAN 7 CONTINUOUS DAYS AND NIGHTS, THE ADVANCED WARNING SIGNS MAY BE MOUNTED ON PORTABLE SUPPORTS.

GENERAL NOTES CONTINUED:

- REMOVE PAVEMENT MARKINGS IF LANE CLOSURE IS TO BE IN PLACE FOR LONGER THAN 7 CONTINUOUS DAYS AND NIGHTS.
- WARNING LIGHTS ARE NOT REQUIRED IF THE LANE CLOSURE IS A DAYTIME ONLY OPERATION.
- IF THE HORIZONTAL ALIGNMENT IS SUCH THAT A CURVE MAY REQUIRE ADDITIONAL DELINEATION, THE DEVICE SPACING MAY BE DECREASED TO 50 FEET.
- IF LANE CLOSURE IS MORE THAN 1 MILE, PLACE A TYPE III BARRICADE APPROXIMATELY EVERY 1/4 MILE ACROSS THE CLOSED LANE TO HELP ENFORCE THE DRUM LINE.
- ADJUSTMENTS IN BUFFER SPACE NEED TO BE INCORPORATED WHEN THE LANE CLOSURE OCCURS NEAR AN INTERCHANGE EXIT OR ENTRANCE RAMP. THE LANE CLOSURE MUST TAKE PLACE FAR ENOUGH IN ADVANCE OF AN EXIT OR ENTRANCE RAMP TO STILL ALLOW FOR ADEQUATE BUFFER SPACE. THE MINIMUM LENGTH OF THE BUFFER SPACE BEFORE AN EXIT RAMP SHOULD BE 1/2 THE LENGTH OF THE TRANSITION AREA. THE ENTRANCE RAMP SHOULD BE FOLLOWED BY THE ORIGINAL BUFFER SPACE LENGTH OF 800 FEET DESIRABLE PRIOR TO ANOTHER TRAFFIC CONTROL CHANGE SUCH AS A CROSSOVER MANUEVER.
- * THE LEFT REVERSE CURVE SIGN (W01-4L) IS ONLY REQUIRED WHEN THIS DETAIL IS USED IN COMBINATION WITH "SINGLE LANE CROSSOVER" DETAIL.


15D20: Traffic Control, Single Lane Closure, Non-Freeway/Expressway

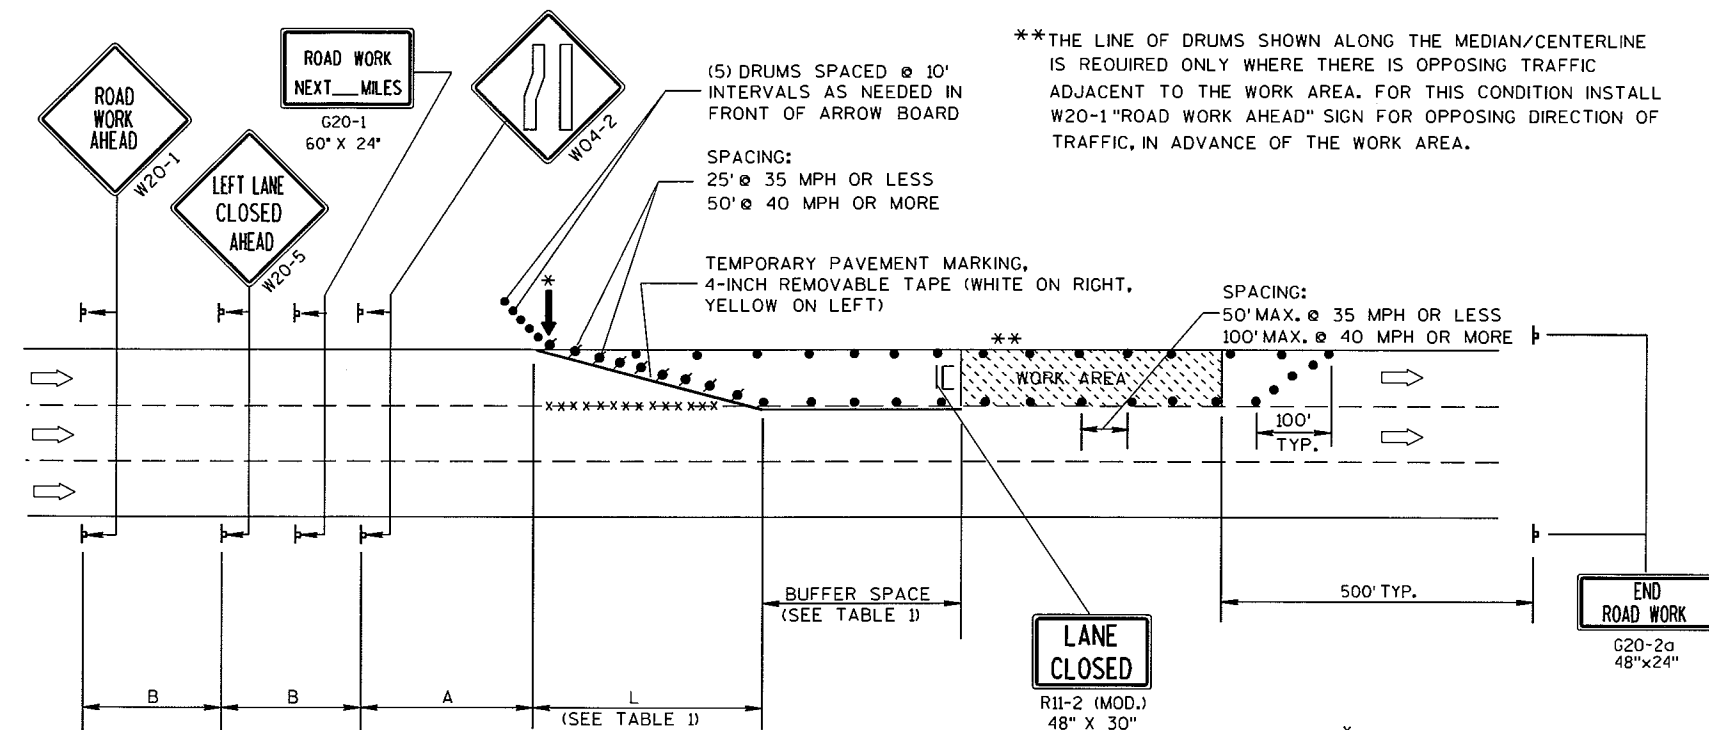

**THE LINE OF DRUMS SHOWN ALONG THE MEDIAN/CENTERLINE IS REQUIRED ONLY WHERE THERE IS OPPOSING TRAFFIC ADJACENT TO THE WORK AREA. FOR THIS CONDITION INSTALL W20-1 "ROAD WORK AHEAD" SIGN FOR OPPOSING DIRECTION OF TRAFFIC, IN ADVANCE OF THE WORK AREA.

(PLACE BARRICADE AND SIGN APPROX. EVERY 1000' ACROSS THE CLOSED LANE)

*IF ARROWBOARD IS NOT INCLUDED IN MISCELLANEOUS QUANTITIES, SUBSTITUTE A TYPE III BARRICADE WITH W01-6 SIGN IN THE LANE CLOSURE TAPER.

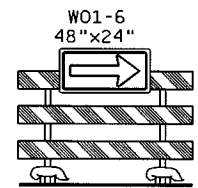

6

6

TABLE 1
TAPER AND BUFFER SPACE
FOR 12' LANE WIDTH

S	L	BUFFER SPACE
25	125'	55'
30	180'	85'
35	245'	120'
40	320'	170'
45	540'	220'
50	600'	280'
55	660'	335'

FOR LANE WIDTH OTHER THAN 12':
 $L = WS$ AT 45 MPH OR GREATER
 $L = \frac{WS^2}{60}$ AT 40 MPH OR LESS
 L = TAPER LENGTH IN FEET
 S = NON-CONSTRUCTION SPEED LIMIT (MPH)
 W = WIDTH OF LANE CLOSURE

LEGEND

- /● DRUM WITH/WITHOUT WARNING LIGHT, TYPE C (STEADY-BURN)
- ⊥ POST MOUNTED SIGN
- ↑ ARROW BOARD
- IC/C TYPE III BARRICADE (8' EQUIVALENT) AND WARNING LIGHTS, TYPE A (FLASHING) WITH/WITHOUT SIGN
- DIRECTION OF TRAFFIC FLOW
- xxxx REMOVING PAVEMENT MARKING (SEE GENERAL NOTES)

GENERAL NOTES

THIS LANE CLOSURE DETAIL IS TYPICAL FOR CLOSING THE LEFT LANE. FOR A RIGHT LANE CLOSURE, REVERSE THE TRAFFIC CONTROL.

THIS DETAIL MAY BE USED FOR ROADWAYS WITH EITHER TWO OR THREE LANES IN EACH DIRECTION.

THE EXACT NUMBER, LOCATION, AND SPACING OF ALL SIGNS AND DEVICES SHALL BE ADJUSTED TO FIT FIELD CONDITIONS AS APPROVED BY THE ENGINEER.

THE SPACING BETWEEN TRAFFIC CONTROL SIGNS SHOULD BE ADJUSTED TO NOT CONFLICT WITH AND SHOULD PROVIDE A DESIRABLE MINIMUM OF 200 FEET CLEARANCE TO EXISTING SIGNS THAT WILL REMAIN IN PLACE.

ALL SIGNS ARE 48" x 48" UNLESS OTHERWISE NOTED. IF NECESSARY DUE TO SPACE CONSTRAINTS IN URBAN AREAS, 36" x 36" SIGNS MAY BE USED IF APPROVED BY DISTRICT TRAFFIC UNIT.

"W0" SIGNS ARE THE SAME AS "W" SIGNS EXCEPT THE BACKGROUND IS ORANGE.

SIGNS THAT WILL BE IN PLACE LESS THAN 7 CONTINUOUS DAYS AND NIGHTS, OR THAT WILL BE PLACED IN A CLOSED LANE, MAY BE MOUNTED ON PORTABLE SUPPORTS.

ANY SIGNS TEMPORARY OR EXISTING, WHICH CONFLICT WITH TRAFFIC CONTROL "IN USE" SHALL BE REMOVED OR COVERED AS NEEDED AND AS APPROVED BY THE ENGINEER.

REMOVE PAVEMENT MARKINGS AND PLACE TEMPORARY PAVEMENT MARKING, REMOVABLE TAPE IF LANE CLOSURE IS TO BE IN PLACE FOR 7 OR MORE CONTINUOUS DAYS AND NIGHTS.

ON UNDIVIDED ROADWAYS, OMIT THE SIGNS SHOWN ON LEFT SIDE OF ROAD.

W20-1, G20-1 AND G20-2A SIGNS ARE NOT REQUIRED IF THE LANE CLOSURE IS WITHIN A LARGER WORK ZONE WHERE THESE SIGNS ARE ALREADY PRESENT.

OMIT G20-1 SIGNS IF LENGTH OF WORK AREA IS 2 MILES OR LESS.

CONSIDER GEOMETRICS WHEN LOCATING SIGNS AND ARROWBOARDS SO THE APPROACHING DRIVER HAS A CLEAR VIEW OF THE ARROWBOARDS AND LANE CLOSURE DRUMS.

PLACE THE ARROWBOARD AS CLOSE AS POSSIBLE TO THE BEGINNING OF THE LANE CLOSURE TAPER, PREFERABLY ON THE SHOULDER OR TERRACE.

CHANNELIZING DEVICES PLACED ADJACENT TO WORK AREA SHALL BE PULLED BACK FROM THE TRAVEL LANE WHEN WORK IS NOT IN PROGRESS.

BARRICADES IN A CLOSED LANE THAT MUST BE MOVED FOR A WORK OPERATION SHALL BE IMMEDIATELY RE-ESTABLISHED UPON COMPLETION OF THE OPERATION OR, FOR CONTINUING OPERATIONS, AT THE END OF EACH WORKING DAY.

WARNING LIGHTS ARE NOT REQUIRED IF THE LANE CLOSURE IS A DAYTIME ONLY OPERATION.

S.D.D. 15 D 20-1

S.D.D. 15 D 20-1

TRAFFIC CONTROL,
SINGLE LANE CLOSURE,
NON-FREEWAY/EXPRESSWAY

STATE OF WISCONSIN
DEPARTMENT OF TRANSPORTATION

APPROVED
5/23/00 /S/ Chester J. Spang
DATE CHIEF SIGNS AND MARKING ENGINEER
FHWA

