


SHEETS

120
WINN

- SHEET NO. 2 TYPICAL CROSS SECTIONS
- SHEET NO. 2 ESTIMATE OF QUANTITIES
- SHEET NO. 2 MISCELLANEOUS QUANTITIES
- SHEET NO. — RIGHT OF WAY PLAT
- SHEET NO. 3-7 PLAN AND PROFILE STA. 11+80.4 TO STA. 149+01.3
- SHEET NO. 8-14 STANDARD DETAILS
- SHEET NO. — DRAINAGE STRUCTURES
- SHEET NO. 15-29 CROSS SECTIONS

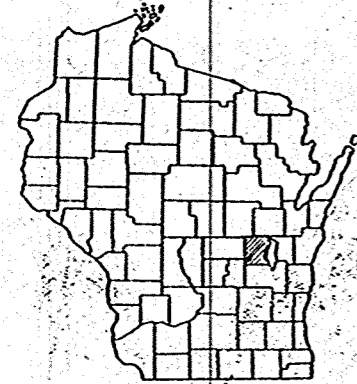


STATE OF WISCONSIN
STATE HIGHWAY COMMISSION OF WISCONSIN

PLAN AND PROFILE OF PROPOSED
S.T.H. 116 — EUREKA ROAD
C.T.H. "E"
WINNEBAGO COUNTY
PROJECT S0308 (4)

SCALES [PLAN 1 IN. = 100 FT.
[PROFILE HOR. 1 IN. = 100 FT. VERT. 1 IN. = 10 FT.
[CROSS SECTIONS HOR. 1 IN. = 5 FT. VERT. 1 IN. = 5 FT.

STA. 149+01.3 END PROJ. S0308(4)
2332' N & 879' E. OF S.W. COR. SEC. 28, T 18 N, R 14 E.

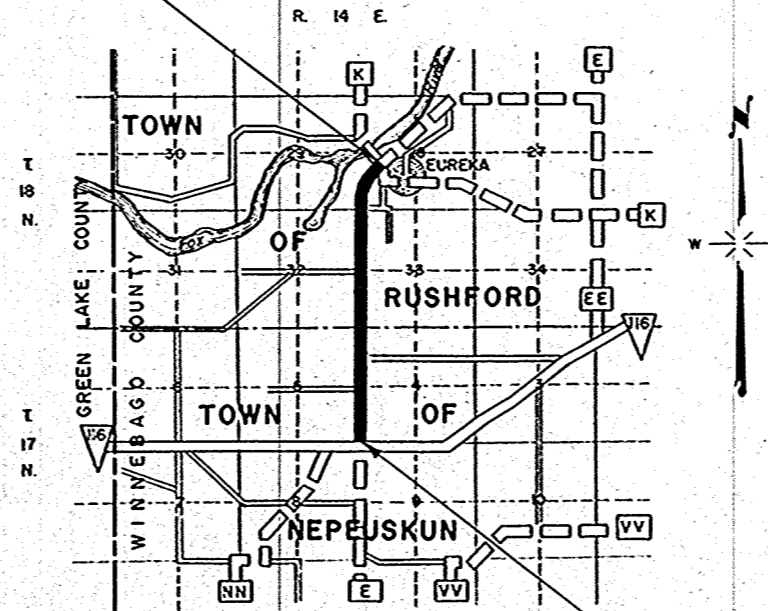

STA. 11+80.4 BEGIN PROJ. S0308 (4)
97' NORTH OF SE. COR. SEC. 5, T 17 N, R 14 E.

- STATE LINE
- COUNTY LINE
- TOWNSHIP OR RANGE LINE
- SECTION LINE
- NEW RIGHT OF WAY LINE
- PRESENT RIGHT OF WAY LINE
- WIRE FENCE (WOVEN)
- WIRE FENCE (BARBED)
- LOT LINE
- CORPORATE OR CITY LIMITS
- PROPERTY LINE
- TRAVELED WAY OR P.E.
- RAILROADS
- BASE OR SURVEY LINE

CONVENTIONAL SIGNS

- CULVERTS IN PLACE
- CULVERTS REQUIRED
- DROP INLET
- POWER POLE
- TELEPHONE OR TELEGRAPH POLE
- RIGHT OF WAY MARKERS
- REFERENCE STAKE FOR HUBS ONLY
- MARSH
- HEDGE
- TREES
- GROUND ELEVATION
- GRADE ELEVATION

LAYOUT

SCALE ONE MILE

TOTAL NET LENGTH OF CENTERLINE = 2.599 MI.

APPROVED FOR

Date _____ Title _____

COUNTY AND HIGHWAY	ROUTE AND SECTION	CLASS AND AGREEMENT		FEDERAL DIVISION OFFICE	SHEET NUMBER	TOTAL SHEETS
		STATE	FEDERAL			
70.6	308.0		11.4	WIS. 4	1	29

STATE HIGHWAY COMMISSION OF WISCONSIN MADISON, WIS.

SUPERVISOR R.W.N. NOTE BOOK 39, 40

DISTRICT ENGINEER L.J.L. U.D. CHECKER

DISTRICT CHECKER S.A.M. H.C.H. CONTRACT

CORRECT: DATE 1-14-58


RECOMMENDED FOR APPROVAL: DATE 1-20-58

APPROVED: DATE 1-23-58


DEPARTMENT OF COMMERCE BUREAU OF PUBLIC ROADS

APPROVED: DATE

DISTRICT ENGINEER

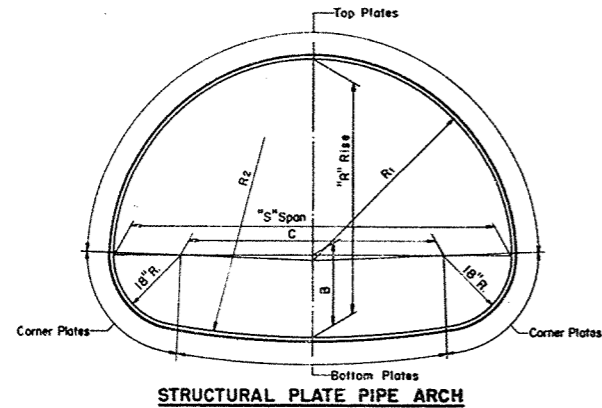

STRUCTURAL PLATE PIPE ARCH

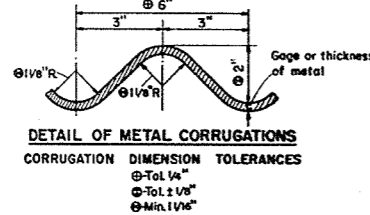

DETAIL OF METAL CORRUGATIONS
CORRUGATION DIMENSION TOLERANCES
⊕ Tol. 1/4"
⊕ Tol. 1/8"
⊕ Min. 1/16"

GENERAL NOTES

Details of construction not shown on this drawing shall conform to the pertinent requirements of the Standard Specifications, Sections 2412 and 3116 and the applicable Special Provisions.

TOLERANCES

Pipe Arch size dimensions are subject to manufacturing tolerances and the ratio of rise (R) to span (S) shall not exceed a tolerance of 5% plus or minus.

Metal corrugation dimension tolerances shall not exceed pertinent dimensions shown elsewhere on this drawing.

EMBANKMENT—Minimum for $\frac{1}{2}$ Culverts

For Flexible Type Pavement, the minimum depth of embankment or cover over top of Pipe Arch (finished construction) shall be $\frac{5}{10}$ or 1'-0" minimum.

For Rigid Type Pavement, the minimum depth of embankment over top of Pipe Arch shall be $\frac{5}{14}$ or a minimum of 6" cushion between pipe and pavement.

EMBANKMENT—Maximum for $\frac{1}{2}$ Culverts

The maximum depth of embankment shall be 15 feet (finished construction).

Adequate cover protection for Pipe Arches shall be provided at all times during construction operations to preclude any damage to structures.


Strutting of Pipe Arches will not be required during construction unless specifically called for on the plans or the applicable Special Provisions.

TABLE OF PROPERTIES
STRUCTURAL PLATE PIPE ARCH


SPAN Nominal Size	Dimensions taken from inside crests of corrugations								Table of Metal Gages—Minimum Acceptable																		
	Fabricators Size Min. Acceptable "S" Span — "R" Rise	R/S Ratio	Area Sq.Ft.	B In.	C In.	R ₁ In.	R ₂ In.	H-20 LOADING																			
								Depth of Embankment in Feet																			
1	2	3	4	5	6	7	8	9	10	11	12	13	14	15													
6 Feet	6'-1" x 4'-7"	.75	22	21.0	37.0	36.7	76.4	12	12	12	12	12	12	12	12	12	12	12	12	12	12	12	12	12	12	12	12
7 "	7'-0" x 5'-1"	.73	28	21.4	48.0	42.3	104.5	10	12	12	12	12	12	12	12	12	12	12	12	12	12	12	12	12	10	10	10
8 "	7'-11" x 5'-7"	.70	35	21.7	59.0	47.7	138.4	10	10	10	12	12	12	12	12	12	12	12	12	12	10	10	10	10	10	10	10
9 "	8'-10" x 6'-1"	.69	43	21.8	70.0	53.0	179.2	10	10	10	10	10	10	10	10	10	10	10	10	10	10	10	10	10	8	8	8
10 "	9'-9" x 6'-7"	.67	52	21.9	81.0	58.3	228.0	8	8	10	10	10	10	10	10	10	10	10	10	10	8	8	8	8	8	7	7
11 "	10'-11" x 7'-1"	.65	61	25.1	95.0	65.8	180.8	8	8	8	10	10	10	10	10	10	10	10	10	10	8	8	8	7	7	5	5
12 "	11'-10" x 7'-7"	.64	71	25.2	106.0	71.1	217.0	7	8	8	8	8	8	8	8	8	8	8	8	8	7	7	5	5	3	3	1
13 "	12'-10" x 8'-4"	.65	85	24.0	118.0	77.2	315.2	5	7	8	8	8	8	8	8	8	8	8	8	7	7	5	5	3	3	1	1
14 "	13'-11" x 8'-7"	.62	93	28.9	131.0	84.4	220.8	5	5	7	8	8	8	8	8	8	8	8	8	7	5	5	3	3	1	1	1
15 "	14'-10" x 9'-1"	.61	105	28.9	142.0	89.5	254.9	3	5	5	7	7	7	7	7	7	7	7	7	5	3	3	1	1	1	1	1
16 "	15'-10" x 9'-10"	.62	122	27.4	154.0	95.4	339.1	1	3	5	5	7	7	7	7	7	7	7	7	5	3	3	1	1	1	1	1
16.5 "	16'-7" x 10'-1"	.61	131	28.7	163.0	99.8	333.8	1	3	3	5	5	5	5	3	1	1	1	1	1	1	1	1	1	1	1	1

Note: For sizes of Structural Plate Pipe Arch between those shown in the table, the gage shall be interpolated (based on table data) where possible; otherwise the gage of the next larger size shown in the table shall be used.

STRUCTURAL PLATE PIPE ARCH

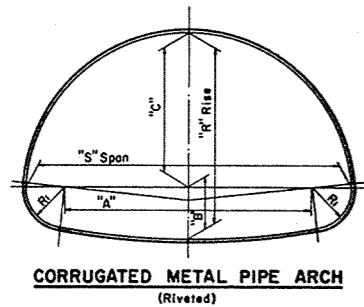

CORRUGATED METAL PIPE ARCH
(Riveted)

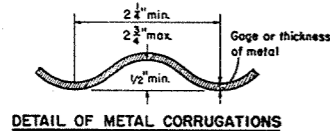

DETAIL OF METAL CORRUGATIONS

GENERAL NOTES

Details of construction not shown on this drawing shall conform to the pertinent requirements of the Standard Specifications, Sections 2411 and 3116 and the applicable Special Provisions.

TOLERANCES

Tolerance from the dimensions detailing size and shape will be permissible providing equivalent capacity and strength are attained.

EMBANKMENT—Minimum for $\frac{1}{2}$ Culverts

For Flexible Type Pavement, the minimum depth of embankment or cover over top of Pipe Arch (finished construction) shall be $\frac{5}{10}$ or 9" minimum.

For Rigid Type Pavement, the minimum depth of embankment over top of Pipe Arch shall be $\frac{5}{14}$ or a minimum of 3" cushion between pipe and pavement.

EMBANKMENT—Maximum for $\frac{1}{2}$ Culverts

The maximum depth of embankment shall be 10 feet (finished construction).

Adequate cover protection for Pipe Arches shall be provided at all times during construction operations to preclude any damage to structures.

TABLE OF DIMENSIONS
CORRUGATED METAL PIPE ARCH

CORRUGATED METAL PIPE ARCH										Round Pipe of Approx. Equal Periphery	
Gage (Min. Acceptable)	"S" Span (Inches)	"R" Rise (Inches)	"A" Inches	"B" Inches	"C" Inches	R ₁ Inches	R/S Ratio	Area Sq.Ft.	Area Sq.Ft.	Diag. Inches	
16	18	11	10	4 1/2	6 1/2	3 1/2	.61	1.1	1.23	15	
16	22	13	14	4 3/4	8 1/4	4	.59	1.6	1.77	18	
16	25	16	17	5 1/4	10 3/4	4	.64	2.2	2.41	21	
14	29	18	20	5 1/2	12 1/2	4 1/2	.62	2.8	3.14	24	
14	36	22	26	6 1/4	15 3/4	5	.61	4.4	4.91	30	
12	43	27	32	7	20	5 1/2	.63	6.4	7.07	36	
12	50	31	38	8	23	6	.62	8.7	9.62	42	
12	58	36	44	9 1/4	26 3/4	7	.62	11.4	12.57	48	
12	65	40	49	10 1/2	29 1/2	8	.62	14.3	15.90	54	
10	72	44	54	11 3/4	32 1/4	9	.61	17.6	19.64	60	

NOTE: All Dimensions measured from inside crest of corrugations.

CORRUGATED METAL PIPE ARCH

STRUCTURAL PLATE PIPE ARCH
CORRUGATED METAL PIPE ARCH

STATE HIGHWAY COMMISSION OF WISCONSIN

RECOMMENDED FOR APPROVAL:

5-27-57
DATE


APPROVED:

5/28/57
DATE

J. S. Pelt
ENGINEER OF DESIGN

E. G. Rostgen
STATE HIGHWAY ENGINEER

PLATE NO. 6-5.31

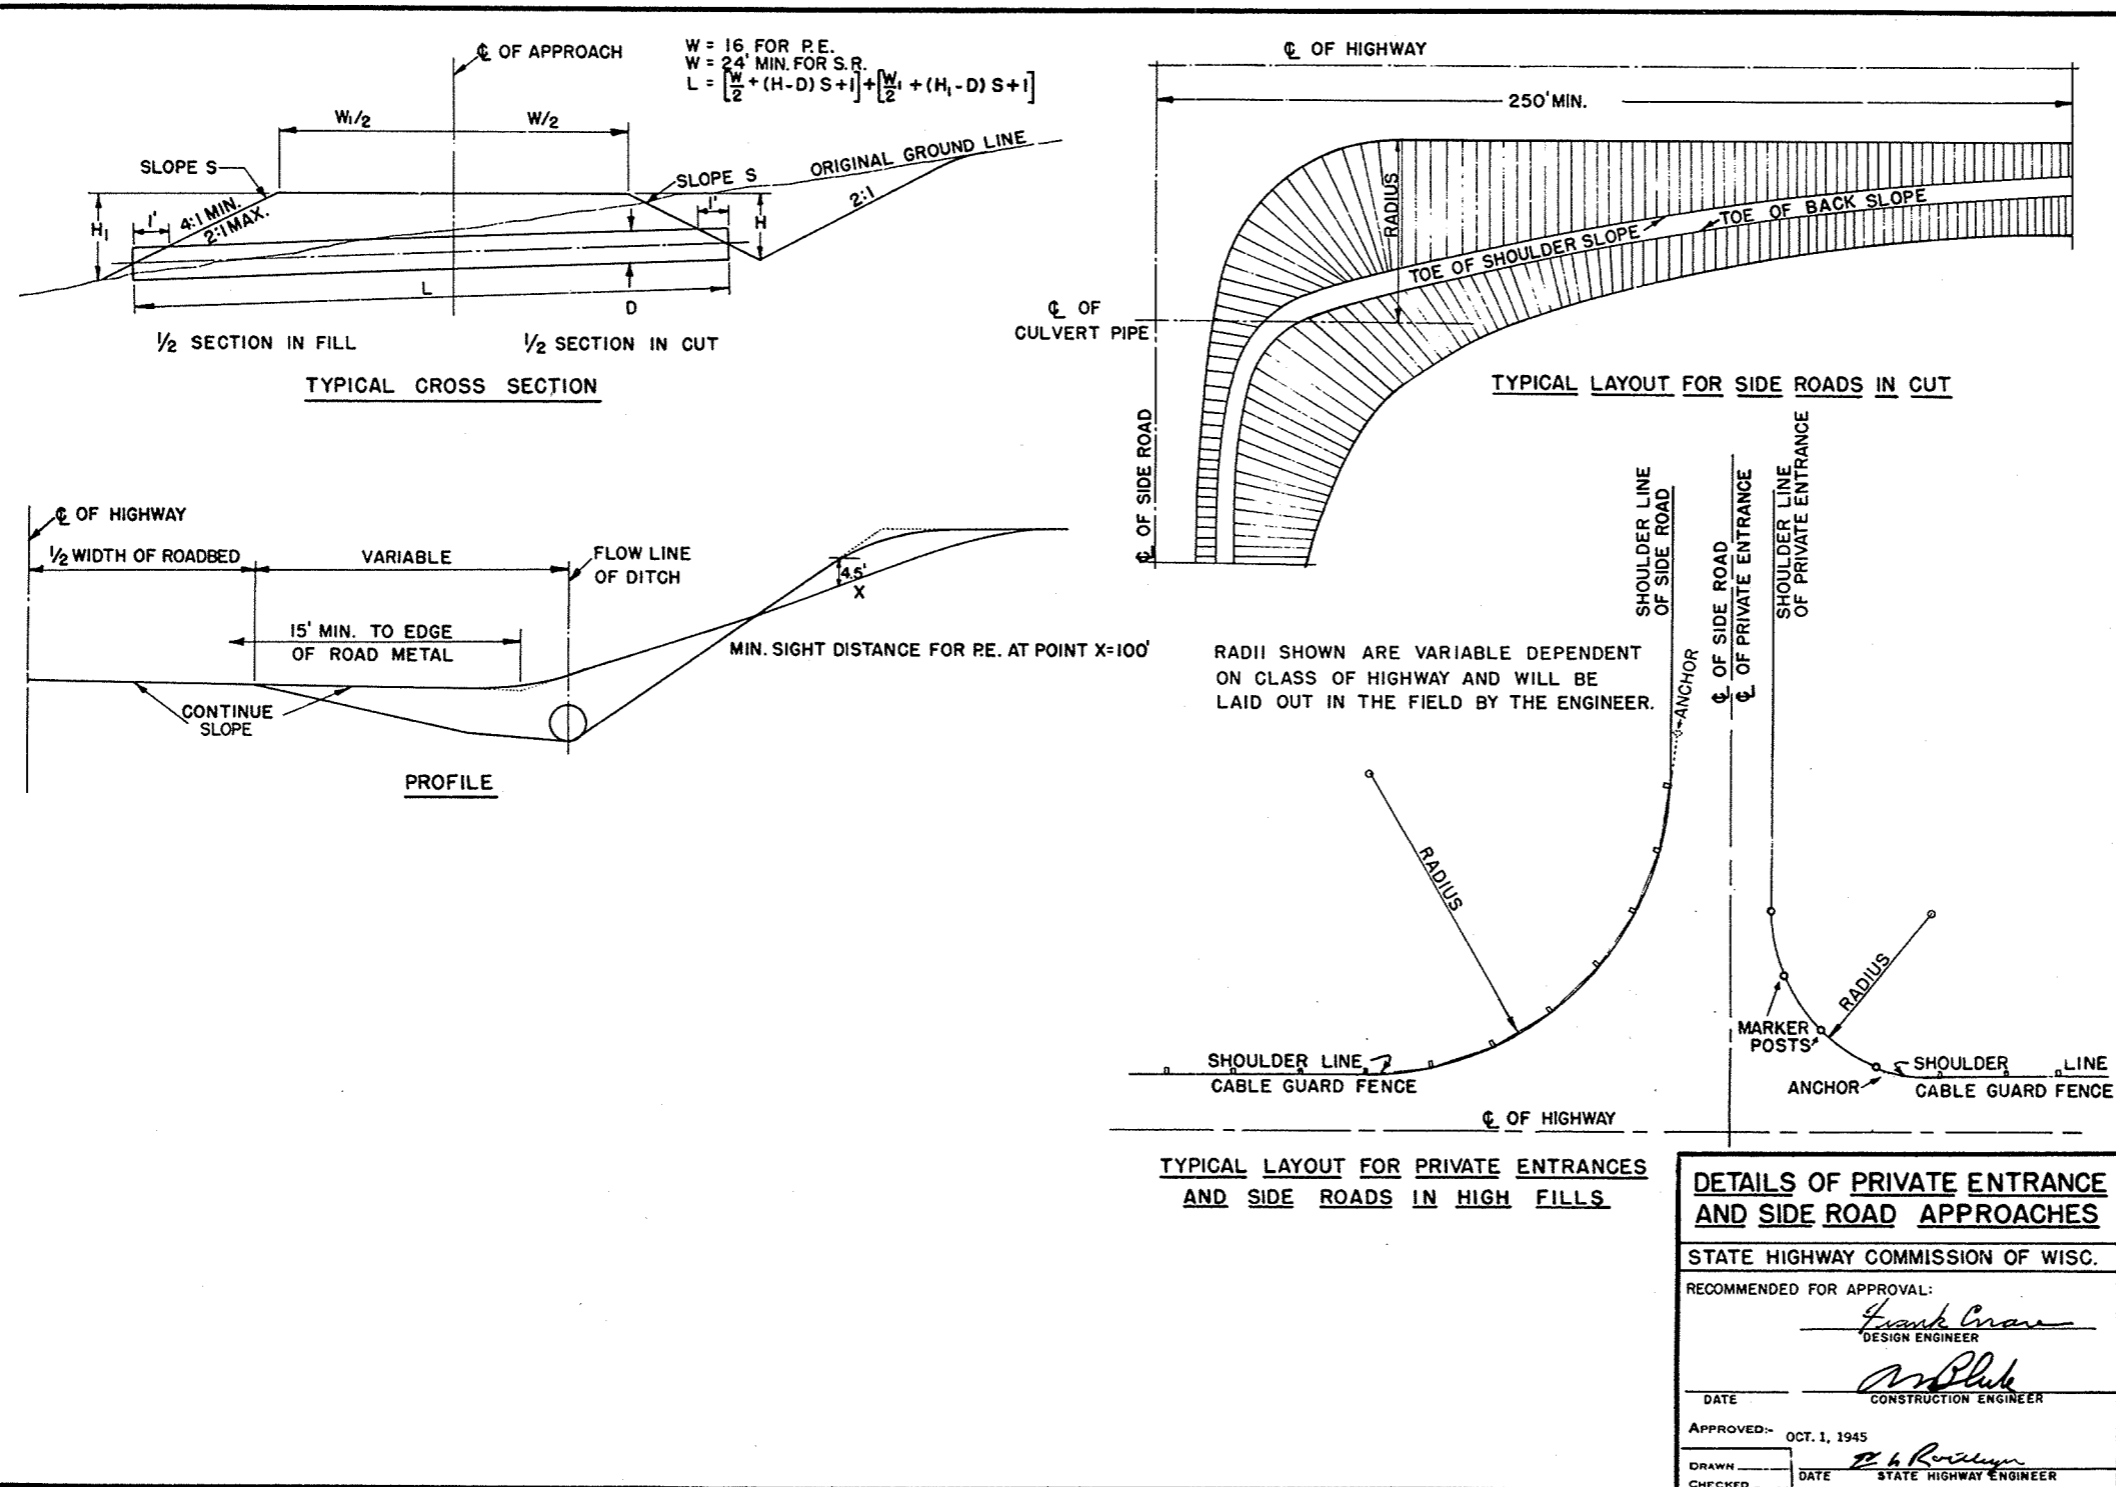

DETAILS OF PRIVATE ENTRANCE AND SIDE ROAD APPROACHES

STATE HIGHWAY COMMISSION OF WISC.

RECOMMENDED FOR APPROVAL:

Frank Crow
DESIGN ENGINEER


W. Bluh
CONSTRUCTION ENGINEER

DATE

APPROVED: OCT. 1, 1945

E. G. Riedinger
STATE HIGHWAY ENGINEER


DRAWN _____ DATE _____ CHECKED _____

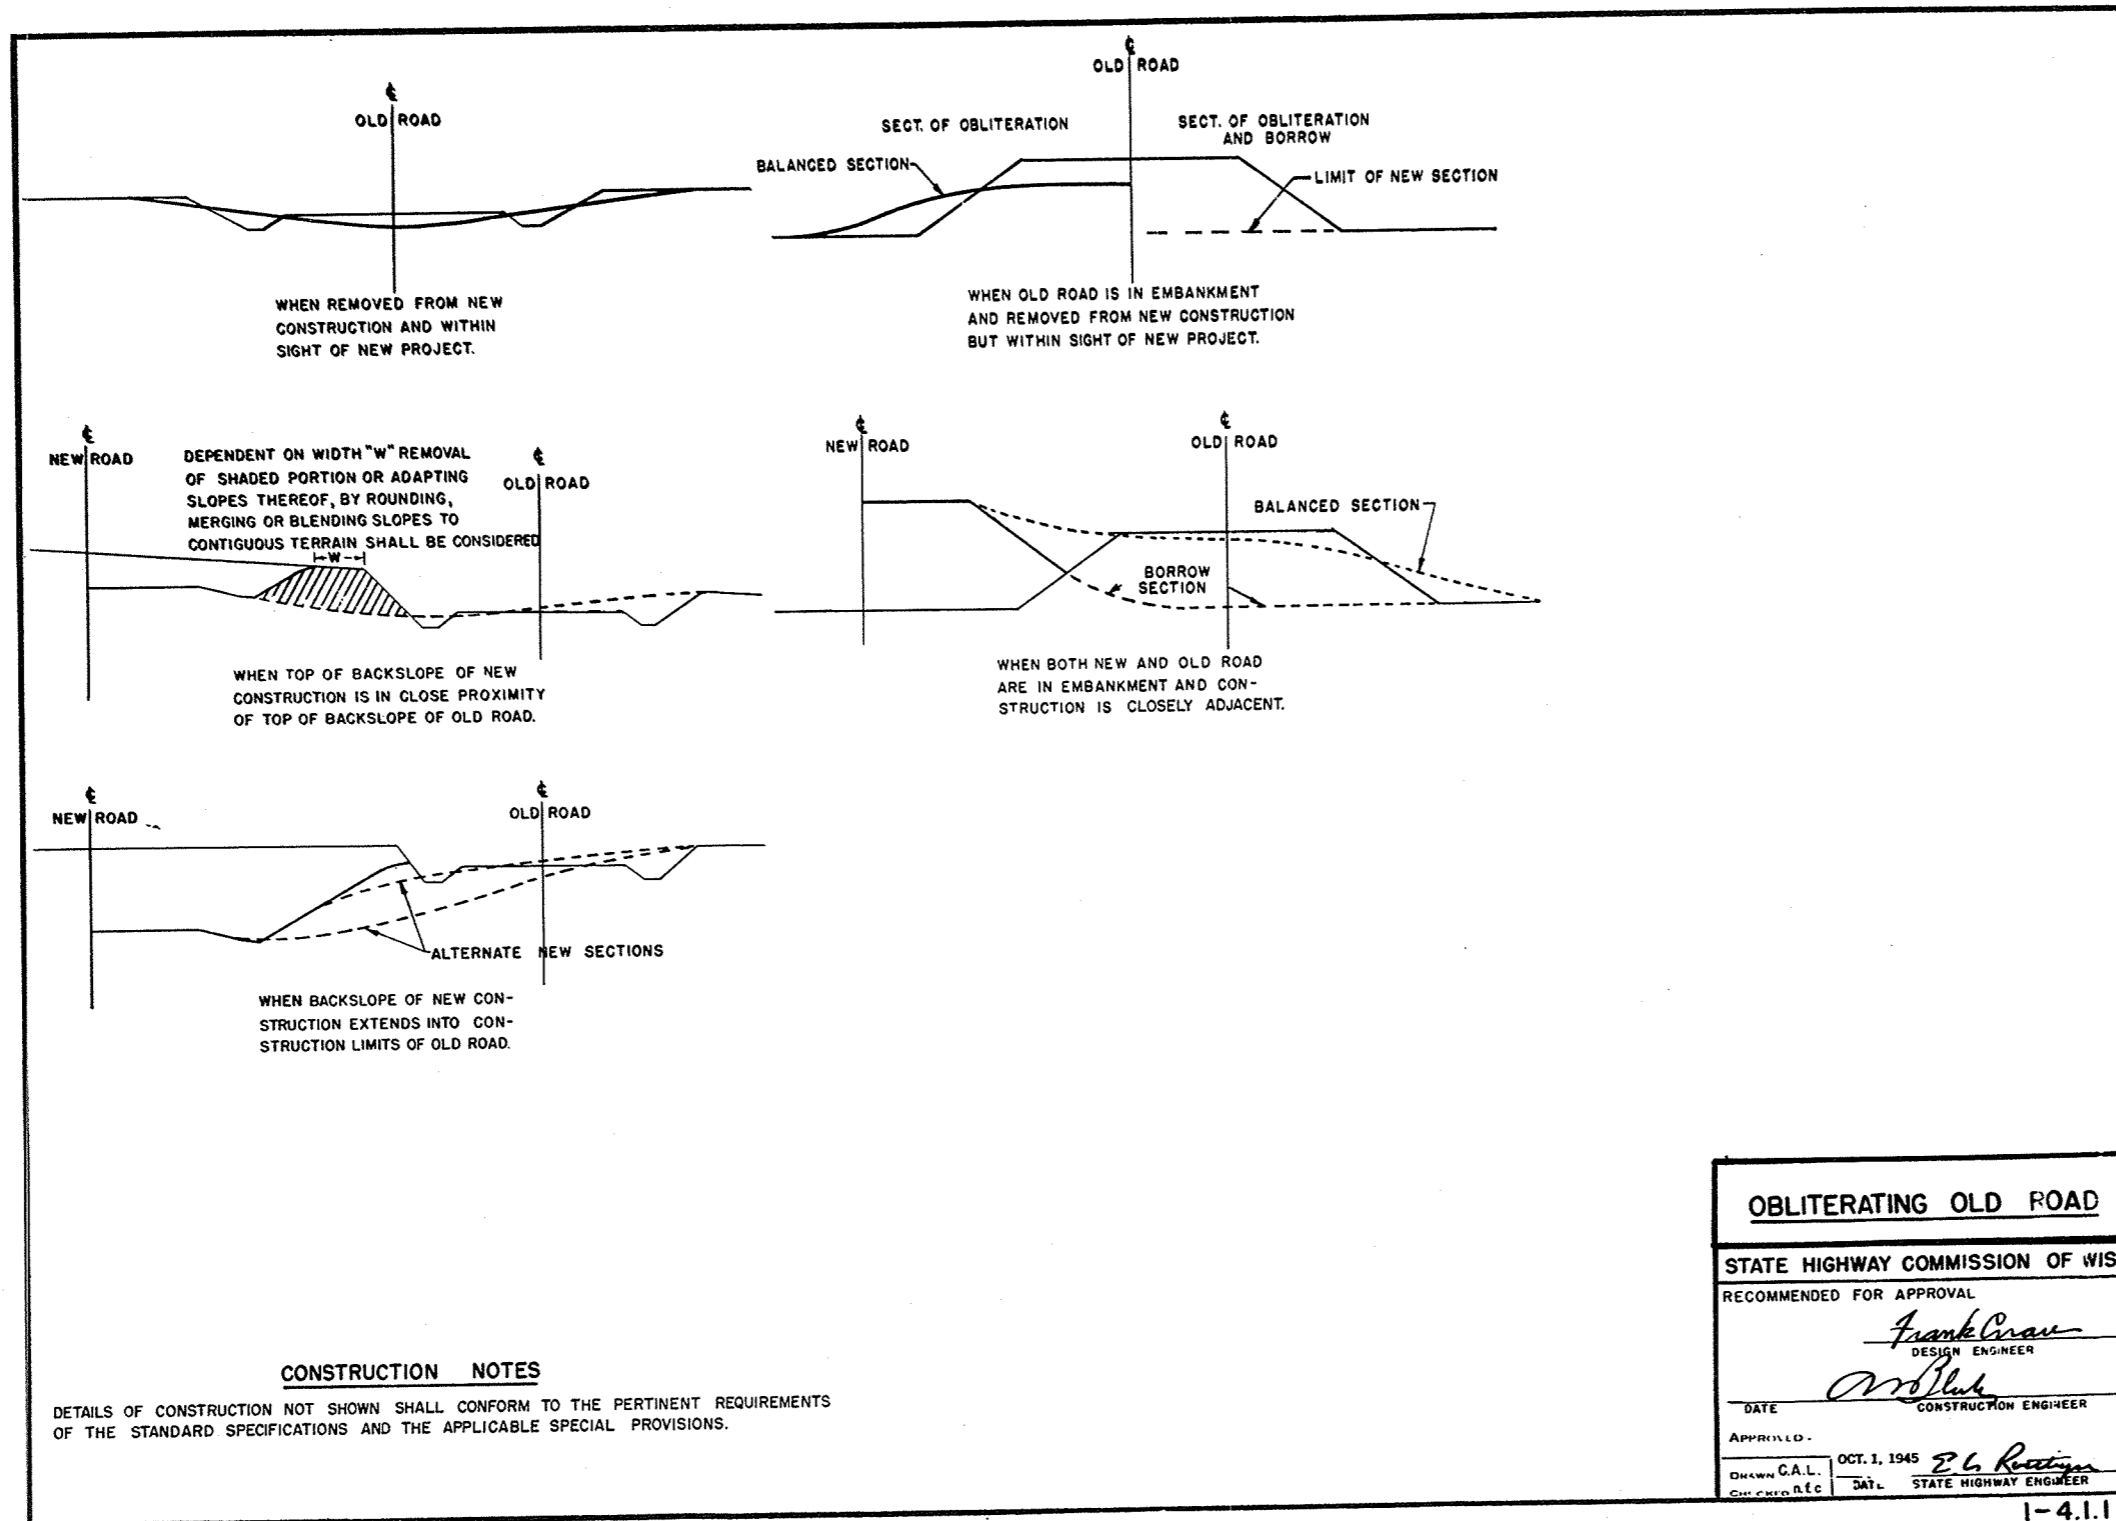


CONSTRUCTION NOTES

DETAILS OF CONSTRUCTION NOT SHOWN SHALL CONFORM TO THE PERTINENT REQUIREMENTS OF THE STANDARD SPECIFICATIONS AND THE APPLICABLE SPECIAL PROVISIONS.


OBLITERATING OLD ROAD	
STATE HIGHWAY COMMISSION OF WISC.	
RECOMMENDED FOR APPROVAL	
<i>Frank Crow</i> DESIGN ENGINEER	
<i>W. Bluh</i> CONSTRUCTION ENGINEER	
DATE	OCT. 1, 1945
APPROVED	<i>E. G. Reetz</i> STATE HIGHWAY ENGINEER
DRAWN C.A.L.	CHECKED R.E.C.

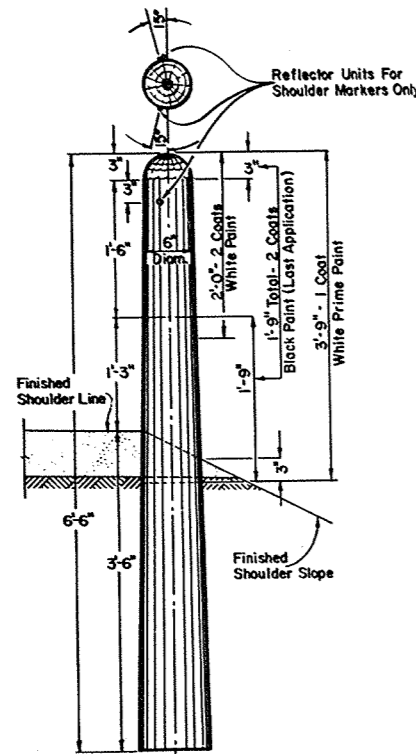


MARKER POST FOR ROAD SHOULDERS AND CULVERTS

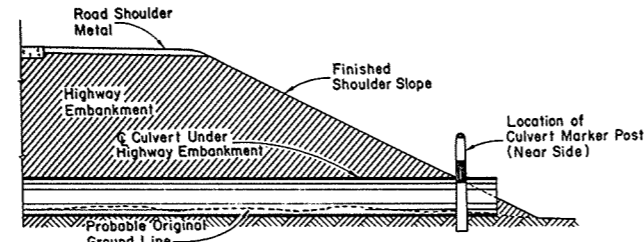


SECTION SHOWING RELATIVE LOCATION OF MARKER POST FOR CULVERTS

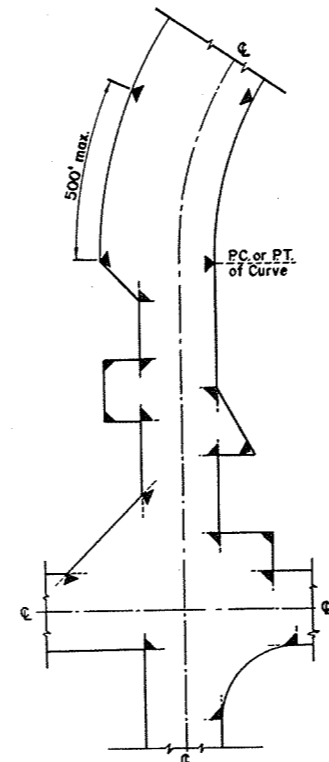

LOCATION DIAGRAM SHOWING TYPICAL LOCATIONS OF MARKER POSTS FOR RIGHT OF WAY

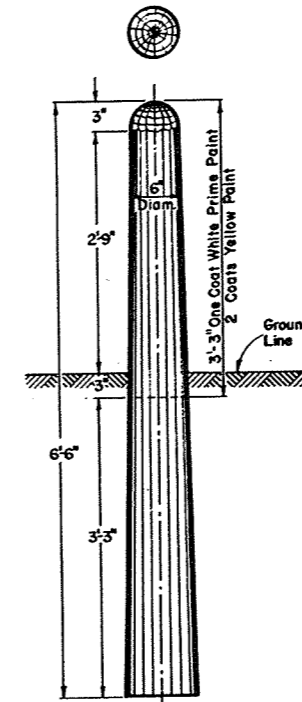

MARKER POST FOR RIGHT OF WAY

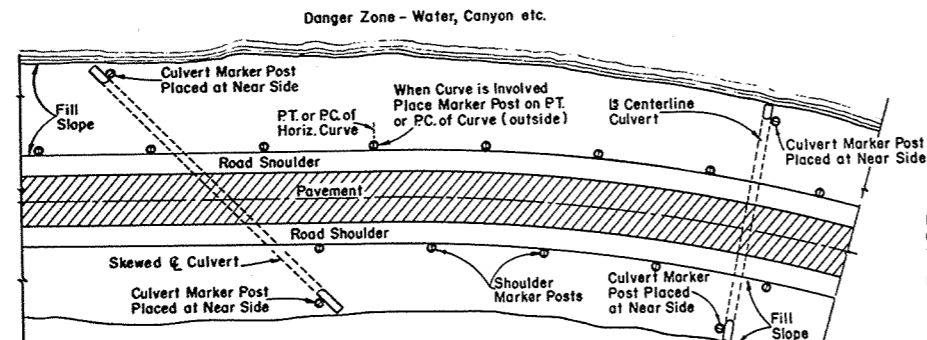

SPACING FOR SHOULDER MARKER POSTS
 50' C-C for 100' to 500' Danger Zones
 100' C-C for Over 500' Danger Zones
LOCATION DIAGRAM SHOWING RELATIVE LOCATIONS OF SHOULDER MARKER POSTS AND CULVERT MARKER POSTS

MARKER POSTS FOR ROAD SHOULDERS AND CULVERTS

MARKER POST FOR RIGHT OF WAY

GENERAL NOTES:
 Details of Construction not shown on this drawing shall conform to the pertinent requirements of the Standard Specifications Sections 2523, 4124 and 4125 and the applicable Special Provisions.
 All posts for Road Shoulder Markers, Culvert Markers and Right of Way Markers are identical except for Painting and Reflector Units. All Posts shall be round and untreated and shall be either Northern White Cedar, Southern Yellow Pine, Norway Pine, White Pine or Jack Pine.

MARKER POSTS FOR RIGHT OF WAY
 Right of Way Marker Posts shall be erected in advance of Grading Operations. Posts may be shaped and painted prior to erection. Any damaged areas occurring to paint surface during erection or other subsequent operations must be repainted prior to acceptance.
 Posts shall be placed at the outer limits of the Highway Right of Way, but entirely within the Right of Way and shall be so placed that the outer edge of the posts shall be tangent to the Right of Way line or lines extended. The exact location of all Right of Way Posts shall be staked in the field by the Engineer.
 Reflector Units for Right of Way Marker Posts will not be required.

REFLECTOR UNITS
 Reflector Units shall have plastic crystal lens 7/8" in diameter. Unit assembly shall be a minimum of 7/8" in length. Reflector Units shall be furnished with flared expanding metal clips for wood mounting. Units shall be mounted in tightest fit possible and securely stayed in posts. Reflector Units shall be installed in Road Shoulder Marker Posts only.

BID ITEMS
 No. 2523-5 Marker Posts.....Each
 No. 2523-6 Marker Posts for Right of Way.....Each

MARKER POSTS & MARKER POSTS FOR RIGHT OF WAY


STATE HIGHWAY COMMISSION OF WISCONSIN

RECOMMENDED FOR APPROVAL

5/16/57 DATE *J. P. Pitt* ENGINEER OF DESIGN

APPROVED: 5/16/57 DATE *E. L. Rottman* STATE HIGHWAY ENGINEER

PLATE NO. 7-1.3.3.

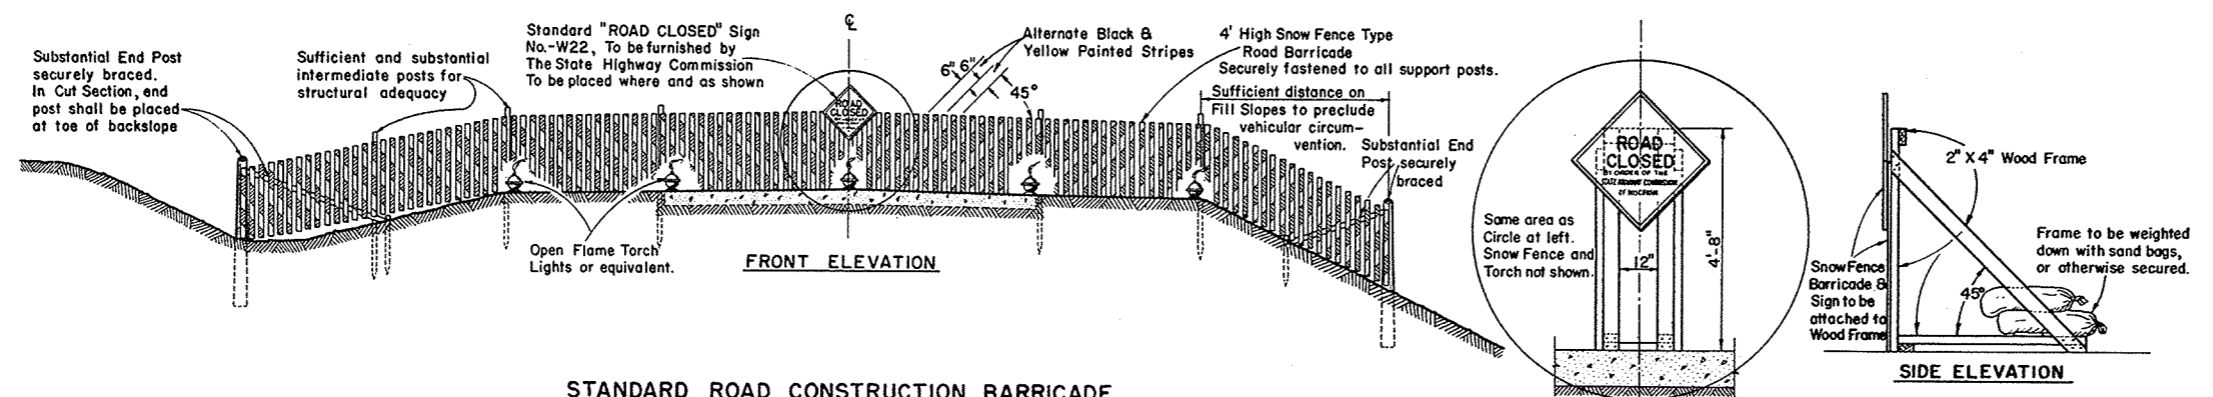

STANDARD ROAD CONSTRUCTION BARRICADE

SNOW FENCE TYPE-"A"

WOOD FRAME SUPPORT AT C FOR SNOWFENCE TYPE BARRICADE When Barricade is Erected on Rigid Type Surfacing

GENERAL NOTES

The Contractor shall construct, place and maintain barricades as shown on this drawing and as required by the Standard Specifications Section 1107 for the duration of the project. Barricades shall be painted and structurally maintained for maximum visibility at all times. Provision shall be made in the construction of barricades to provide for ingress and egress for local access as may be required.


ALTERNATE DESIGNS

Contractors may submit to the Engineer for approval, designs for Barricades other than shown on this drawing, and upon the Engineer's approval may be used as alternates.


MEASUREMENT & PAYMENT

All Barricades, unless otherwise provided for in the Plans and/or Special Provisions shall be furnished, placed, and maintained as noted above, and no additional compensation will be allowed but shall be construed to be included in the price bid for other items.

CONSTRUCTION BARRICADE	
<i>STATE HIGHWAY COMMISSION OF WISCONSIN</i>	
RECOMMENDED FOR APPROVAL:	
DATE <i>6/2/55</i>	<i>J. J. Pelt</i> ENGINEER OF DESIGN
APPROVED:	
DATE <i>6/2/55</i>	<i>E. C. Ruettinger</i> STATE HIGHWAY ENGINEER

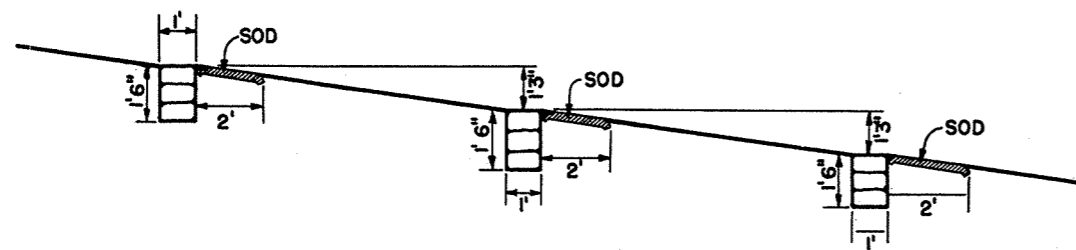


PROFILE OF DITCH GRADE

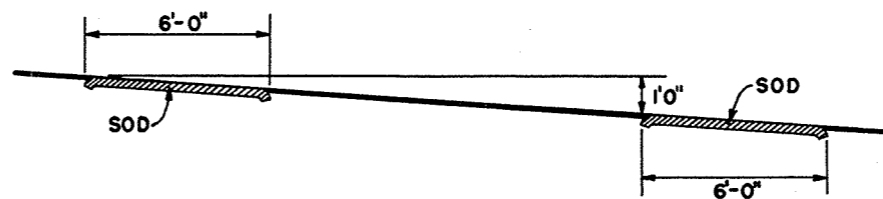


PROFILE OF DITCH GRADE

NOTE: NUMBER REQUIRED WILL BE DETERMINED BY VERTICAL SPACING.

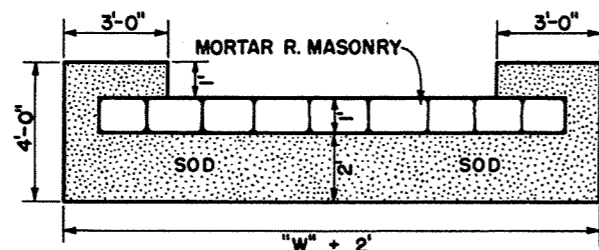


PLAN VIEW SHOWING SOD

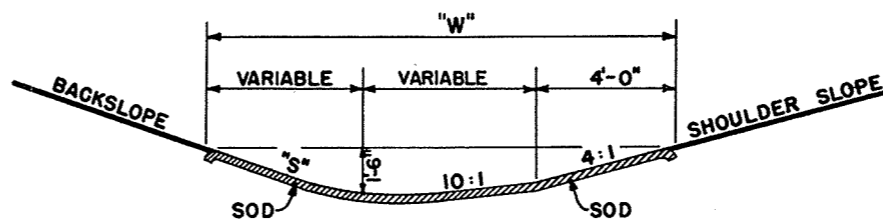

SECTION

SOD DITCH CHECKS

QUANTITIES		
"S"	"W"	EACH SQ. YD.
2:1	12'	8
3:1	13.5'	9
4:1	15'	10

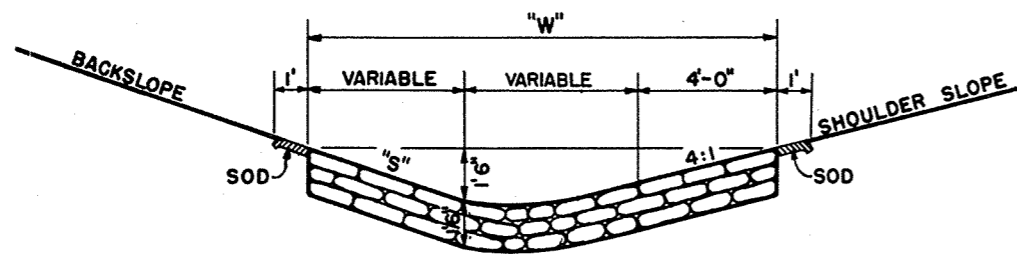




SECTION


MORTAR RUBBLE MASONRY

QUANTITIES			
"S"	"W"	SOD SQ. YD.	EACH CU. YD.
2:1	12'	4.0	0.67
3:1	13.5'	4.33	0.75
4:1	15'	4.67	0.83

CONSTRUCTION NOTES

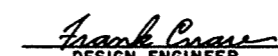DETAILS OF CONSTRUCTION NOT SHOWN SHALL CONFORM TO THE PERTINENT REQUIREMENTS OF THE STANDARD SPECIFICATIONS AND THE APPLICABLE SPECIAL PROVISIONS.

DITCH CHECKS	
MORTAR RUBBLE MASONRY & SOD	
STATE HIGHWAY COMMISSION OF WISC.	
RECOMMENDED FOR APPROVAL:	
 DESIGN ENGINEER	
 CONSTRUCTION ENGINEER	
DATE:	
APPROVED:	
 STATE HIGHWAY ENGINEER	
DRAWN DIV 9	CHECKED N.F.C.

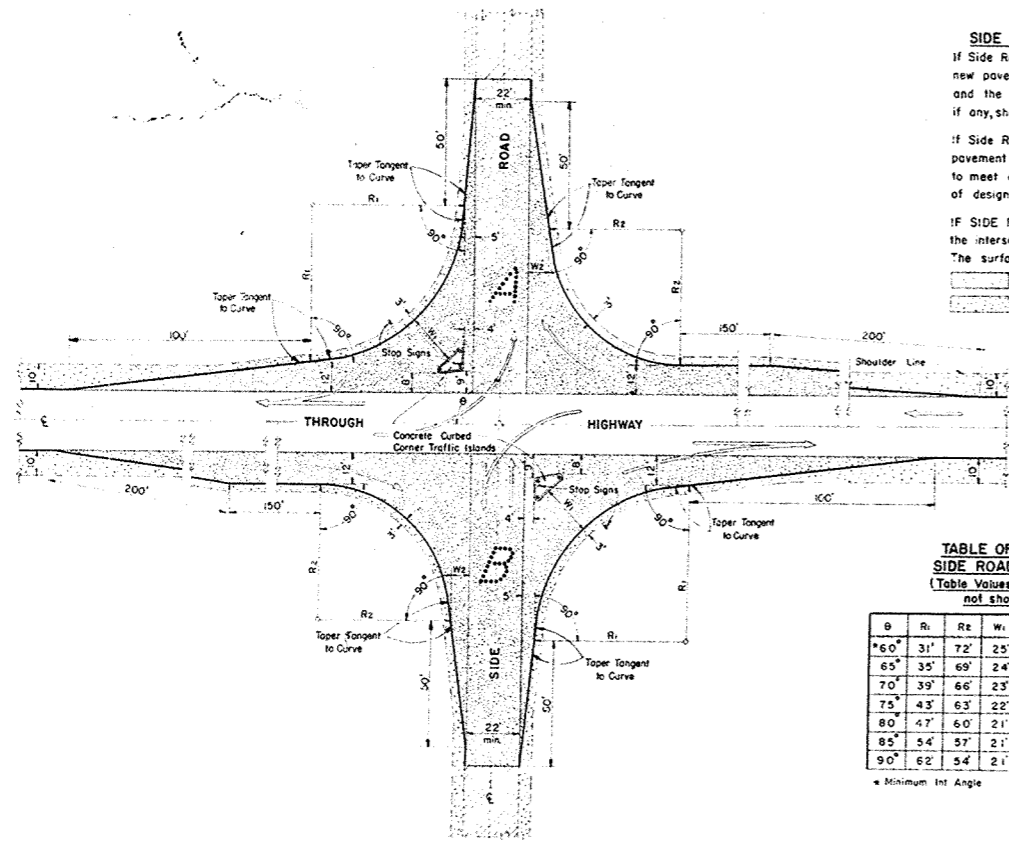

SIDE ROAD SURFACING NOTE
 If Side Road is not presently surfaced, new pavement shall be placed as shown, and the remainder to construction limits, if any, shall be gravel or crushed stone surfaced.
 If Side Road is presently paved, new pavement shall be placed only as necessary to meet existing pavement, and to limits of design as shown.



IF SIDE ROAD IS THE CONSTRUCTION PROJECT, the intersection geometrics remain as shown. The surfacing shall be same as for the project.

— Pavement
 — Gravel or Crushed Stone

TABLE OF VALUES FOR VARIABLE SIDE ROAD INTERSECTION ANGLES
 (Table Values for Angles between 60° & 120° not shown shall be interpolated)

θ	R ₁	R ₂	W ₁	W ₂	θ	R ₁	R ₂	W ₁	W ₂
*60°	31'	72'	25'	10'	95°	70'	52'	20'	8'
65°	35'	69'	24'	9'	100°	80'	50'	20'	8'
70°	39'	66'	23'	8'	105°	95'	48'	20'	8'
75°	43'	63'	22'	8'	110°	104'	46'	19'	8'
80°	47'	60'	21'	8'	115°	122'	44'	19'	8'
85°	54'	57'	21'	8'	*120°	143'	42'	19'	8'
90°	62'	54'	21'	8'					

* Minimum Int. Angle ** Maximum Int. Angle

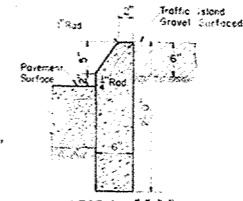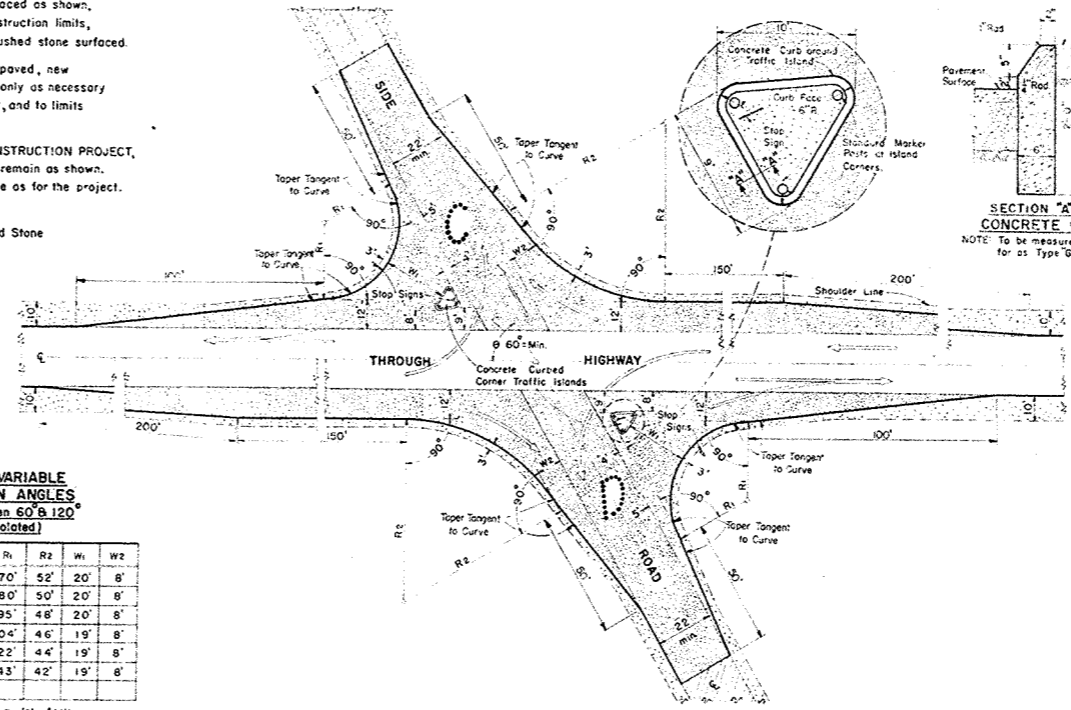

SECTION "A-A" CONCRETE CURB
 NOTE: To be measured and paid for as Type "G" or "J" Concrete Curb

MAJOR SIDE ROAD INTERSECTION DESIGN DETAILS
 To be used only when current ADT on Through Highway is 1500 or over, and on Side Road is Over 200

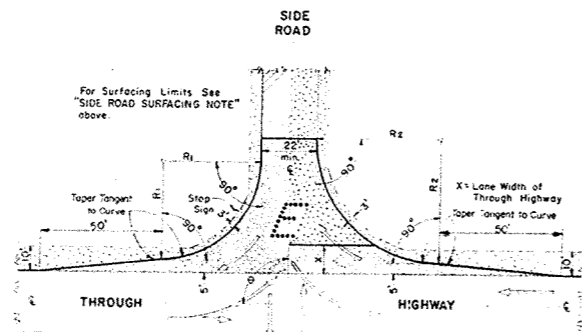


TABLE OF VALUES FOR VARIABLE SIDE ROAD INTERSECTION ANGLES
 (Table Values for Angles between 60° & 120° not shown shall be interpolated)

θ	R ₁	R ₂	θ	R ₁	R ₂
*50°	40'	50'	95°	40'	40'
55°	40'	50'	100°	50'	48'
70°	40'	50'	105°	55'	47'
75°	40'	50'	110°	60'	46'
80°	40'	50'	115°	65'	45'
85°	40'	50'	**120°	70'	44'
90°	40'	50'			

* Minimum Int. Angle ** Maximum Int. Angle

MINOR SIDE ROAD INTERSECTION DESIGN DETAILS
 To be used when current ADT on Through Highway is Less than 1500 or on Side Road is Less than 200

GENERAL NOTES
 Designs "A", "B", "C", "D", or "E" may be used interchangeably in combination or separately for any one complete intersection depending upon Traffic Volume, intersection angle and Surfacing of each approach roadway.

Details on this drawing are for Minimum Design Only, and not applicable to Special Conditions, as shown elsewhere on the plans.

DESIGN & LAYOUT DETAILS FOR SIDE ROAD AT GRADE INTERSECTIONS (RURAL IN CHARACTER)

STATE HIGHWAY COMMISSION OF WISCONSIN

RECOMMENDED FOR APPROVAL

DATE: 1/17/58
 APPROVED: J. J. [Signature]

DATE: 1/17/58
 APPROVED: E. L. [Signature]

ESTIMATE OF QUANTITIES

CONTRACT NO. 182






PROJECT	SHEET NO.	TOTAL SHEETS
S0308(4)	2	29

THIS PROJECT IS TO BE EXECUTED UNDER THE STANDARD SPECIFICATIONS FOR ROAD AND BRIDGE CONSTRUCTION OF THE STATE HIGHWAY COMMISSION OF WISCONSIN - EDITION OF 1957 SUBMITTED FOR APPROVAL MARCH 28, 1957; FEDERAL AID REQUIRED CONTRACT PROVISIONS APPROVED JAN. 31, 1955; AND SPECIAL PROVISIONS AS ATTACHED TO PROPOSALS.

CONTRACT NO.	STATION TO STATION	NET LENGTH OF CENTER LINE	CLEARING	GRUBBING	REMOVING PAV'T.	EXCAVATION		SAND GRAVEL FILL	FINISHING ROADWAY	OBLITERATING OLD ROAD	GRAVEL OR CRUSHED STONE BASE COURSE	CULVERT PIPE						GUARD FENCE		MARKER POSTS FOR R/W	BITUM. MAT'L FOR PRIME COAT	SINGLE AGG. BITUM. SURE	BITUM. MAT'L FOR SURFACE COURSE	MORTAR RUBBLE DITCH CHECKS	TOP SOIL	SALVAGED TOP SOIL	FERTILIZER	SEEDING						
						UNCLASSIFIED	CLASSIFIED					18"	24"	30"	18"X11"	22"X15"	36"X22"	2523-1	2523-2										2523-3	2523-4				
						CU	CY					LN. FT.	LN. FT.	LN. FT.	LN. FT.	LN. FT.	LN. FT.	LN. FT.	EACH										EACH	GAL.	TON	TON	CY.	2528-1
1	11+80.4 - 149+01.3	13,720.9	2,235	2,295	2,649	14,178				1	2.5		504	242	32	98	28	68			20				106								46	50,200
2	11+80.4 - 149+01.3	13,720.9									24,880																							
82	11+80.4 - 149+01.3	13,720.9	2,235	2,295	2,649	14,178				1	2.5	24,880	504	242	32	98	28	68			20				106								46	50,200

STA.	LOCATION	TYPE	SIZE	LENGTH
27+93	EX. LT. RT.	CMCP	18"	12'-12"
38+24	SDRD.	LT. C.P.	24"	30'
39	PE.	"	"	32'
60	"	"	30"	"
65	"	"	24"	"
65	RT.	"	"	"
82	"	LT.	"	"
97	"	RT. C.M.P.A.	18" X 11"	"
104	"	LT. C.P.	24"	"
110	"	RT. C.P.	"	"
122	SDRD.	CMCP	36" X 22"	36'
124	PE.	"	"	32'
142	"	"	18" X 11"	22'
143	"	"	"	"
143	"	LT.	"	"
137+32	EX. LT. RT.	CMCP	24"	4'-4"
144+50	"	"	"	6'-6"
144+75	SDRD.	RT. C.M.P.A.	22" X 13"	28'
15 EA.	PE'S	LT. RT. C.P.	18"	32'

LOCATION	NO.
CULV. PIPES	8
SHOULDER DELINEATION	12
TOTAL	20

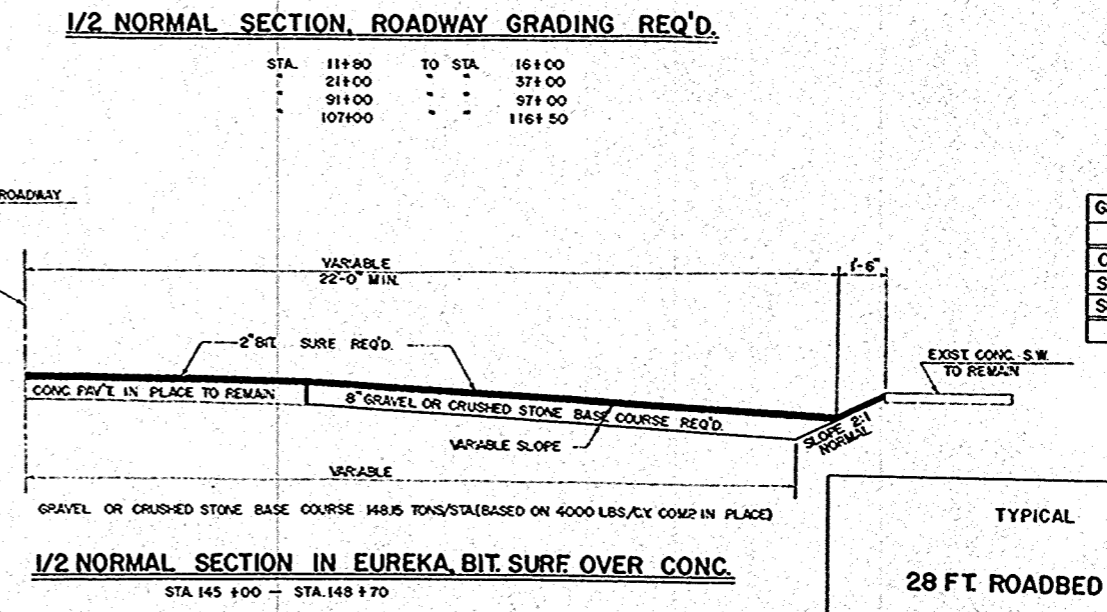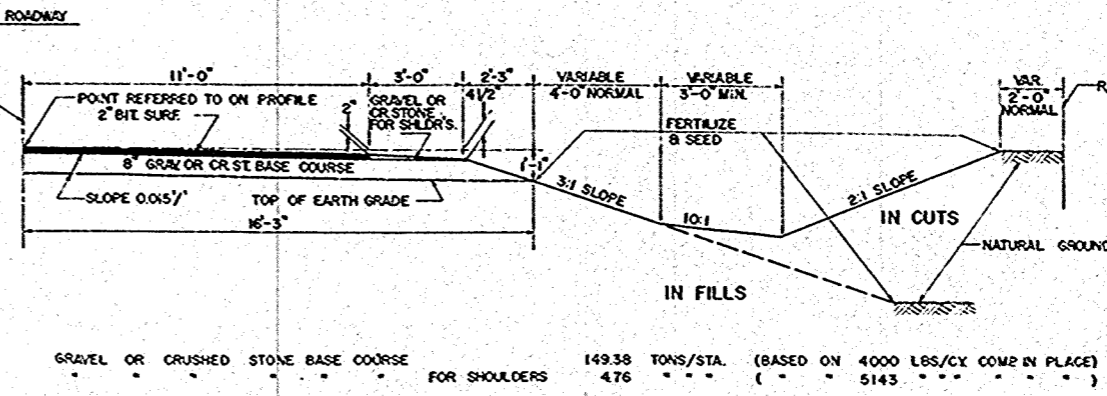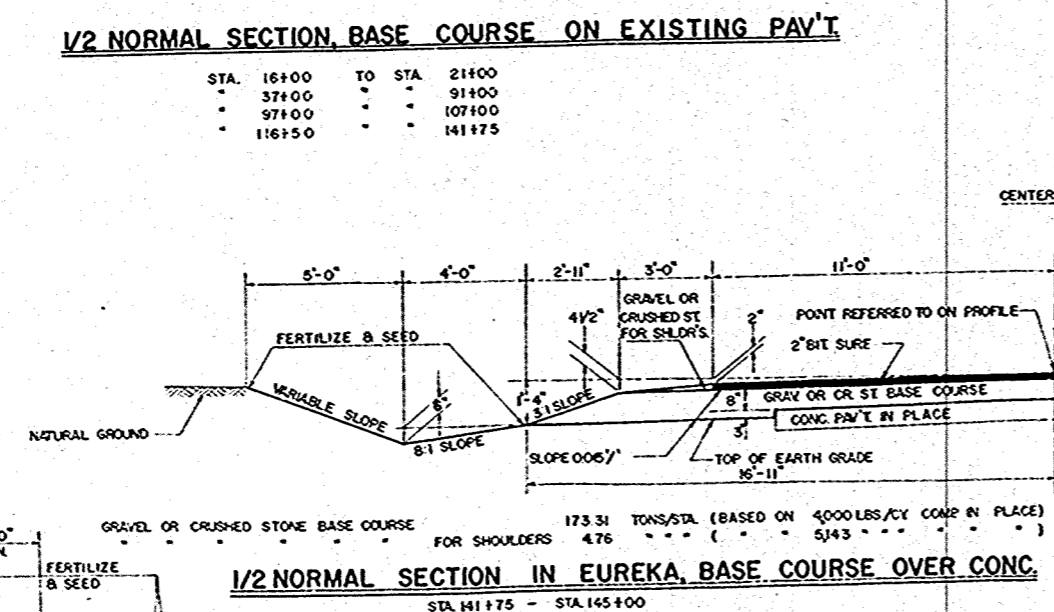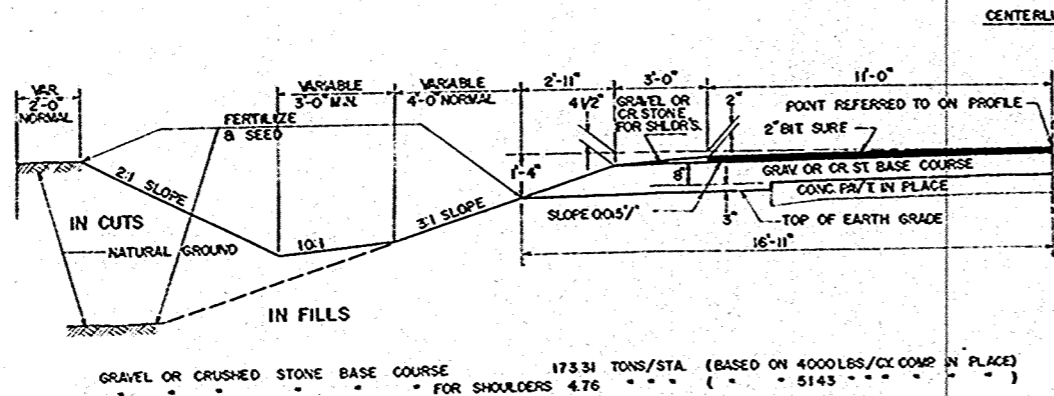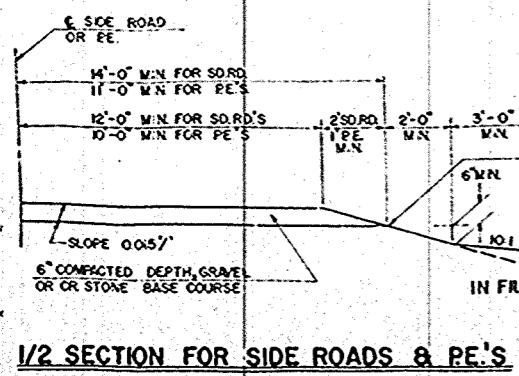

GENERAL NOTES

DETAILS OF CONSTRUCTION NOT SHOWN SHALL CONFORM TO THE PERTINENT REQUIREMENTS OF THE STANDARD SPECIFICATIONS AND THE APPLICABLE SPECIAL PROVISIONS.

ON ALL HORIZONTAL CURVES, THE NORMAL CROWN SHALL BE REMOVED AND THE EARTH GRADE, BASE COURSE AND PAVEMENT SURFACES SHALL RESULT IN A STRAIGHT LINE SLOPE ACROSS THE ENTIRE WIDTH OF ROADBED.

STANDARD DETAIL DRAWINGS

- CORR. METAL PIPE ARCH 6-5.3.1
- DETAILS OF PE. & SDRD APPR. 1-31.1
- OBLITERATING OLD RD. 1-41.1
- MARKER POSTS 7-13.3
- CONSTRUCTION BARRICADE 7-4.1.2
- MORTAR RUBBLE DITCH CHECKS 8-1.3.1
- DESIGN & LAYOUT OF SDRD INT. 9-1.1.3

LOCATION	TONS
CENTERLINE	22,610
SHOULDERS	630
SDRDS & PE'S	1,640
TOTAL	24,880

TYPICAL CROSS SECTIONS

FOR

28 FT ROADBED - 22' BIT SURE

BIT SURFACED URBAN WIDENING

AND

MISCELLANEOUS

CONSTRUCTION DETAILS AND QUANTITIES

SCALE VARIABLE

BENCH MARKS			
NO.	STATION	DESCRIPTION	ELEV.
1	9+61	SPIKE IN 24" OAK 40' LT.	175.90

CURVE NOTES
 P.I. = 13+06.5
 L = 89°-20'
 Δ = 90°-40'
 D = 19°-00'
 T = 306.5'
 L.C. = 477.2'



ST. 116-CTH "E" INTERSECTION
 INTERSECTION DESIGN "E" REQUIRED
 AS PER STD. DETAIL DRWG. 9-1.13

NET LENGTH OF CENTERLINE		
STATION	STATION	LIN. FT.
11+804	35+00	2319.6


STA 11+804 BEGIN
 PROJ. S0308(4)

GENERAL NOTES

DETAILS OF CONSTRUCTION NOT SHOWN SHALL CONFORM TO THE PERTINENT REQUIREMENTS OF THE STANDARD SPECIFICATIONS AND THE APPLICABLE SPECIAL PROVISIONS.
 CY OF FILL PERTAINS TO EMBANKMENT CONSTRUCTED FROM UNCLASSIFIED EXCAVATION AND IS COMPUTED WITH A SHRINKAGE ALLOWANCE VARYING FROM 35% - 45%.
 THE EXACT LOCATION OF PRIVATE ENTRANCE PIPES & MARKER POSTS SHALL BE DETERMINED BY THE ENGR. IN THE FIELD.

LEGEND

- DRAINAGE FLOW
- FACILITY TO BE REMOVED
- OLD ROAD OBLITERATION
- CUB. YARDS
- UNCLASSIFIED EXCAVATION
- PRIVATE ENTRANCE
- FIELD ENTRANCE
- CORRUGATED METAL PIPE ARCH
- CORRUGATED GALV. SHEET METAL CULV. PIPE

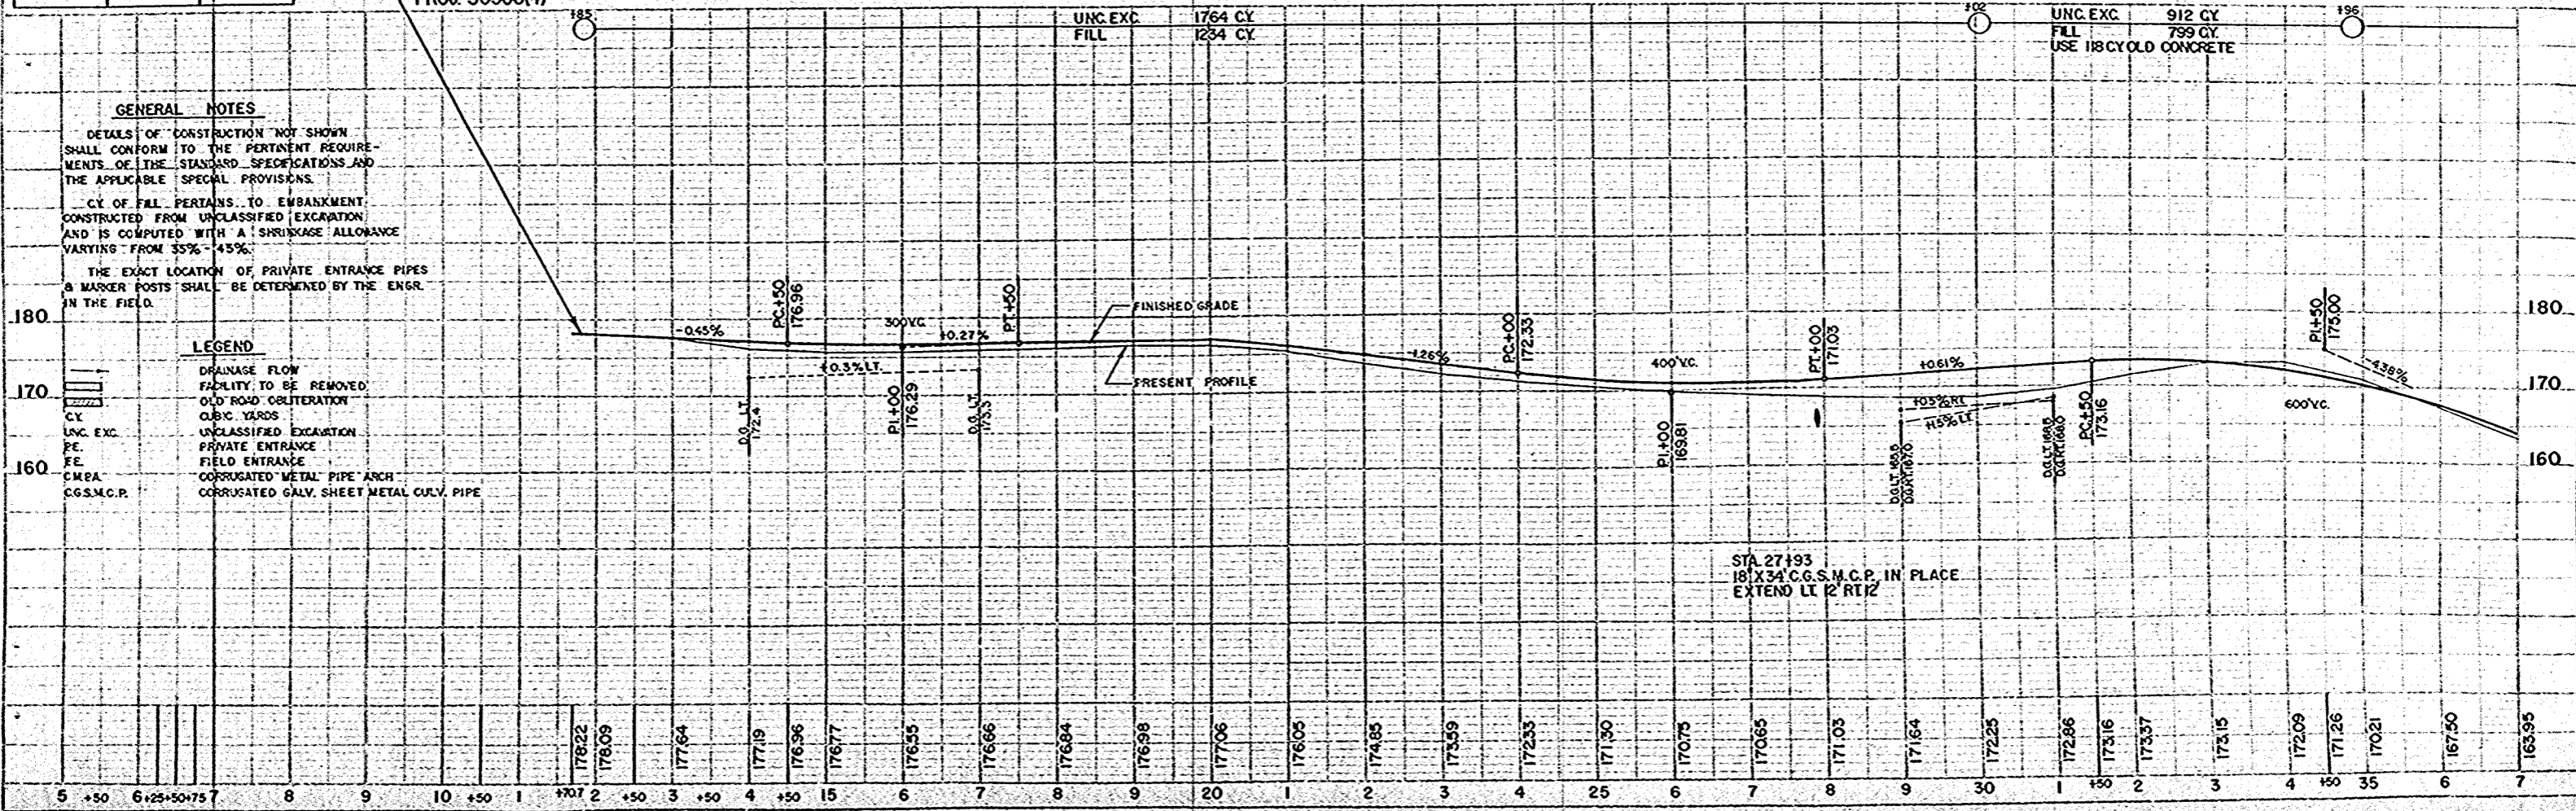


DRAWN BY: W.J.C.M.
 CHECKED BY: R.C.J.M.
 DATE: 11-57
 NO. 39

PROFILE
 NOTE BOOK: 8.8.11-11.57
 NO. 40


BENCH MARKS			
NÓ.	STATION	DESCRIPTION	ELEV.
2	38+40	SPIKE IN 16" ELM	126'LT. 158.19
3	45+00	SPIKE IN #	30'LT. 136.03
4	63+05	PT. MK. ON SE. WINGWALL BRIDGE	108.25

CURVE NOTES
 P.I. = STA. 41+72.2
 $\Delta = 178^\circ-38'-30''$
 $\Delta = 1^\circ-21'-30''$
 $D = 1^\circ-00'$
 $T = 67.92'$
 $LC = 135.8'$
 $SE = 002 \text{ FT/FT.}$

STA 38+24 S.D. RD. LT.
 REMOVE 24" X 30" CULV. P. PE.
 24" X 36" CULV. PIPE REQ'D.

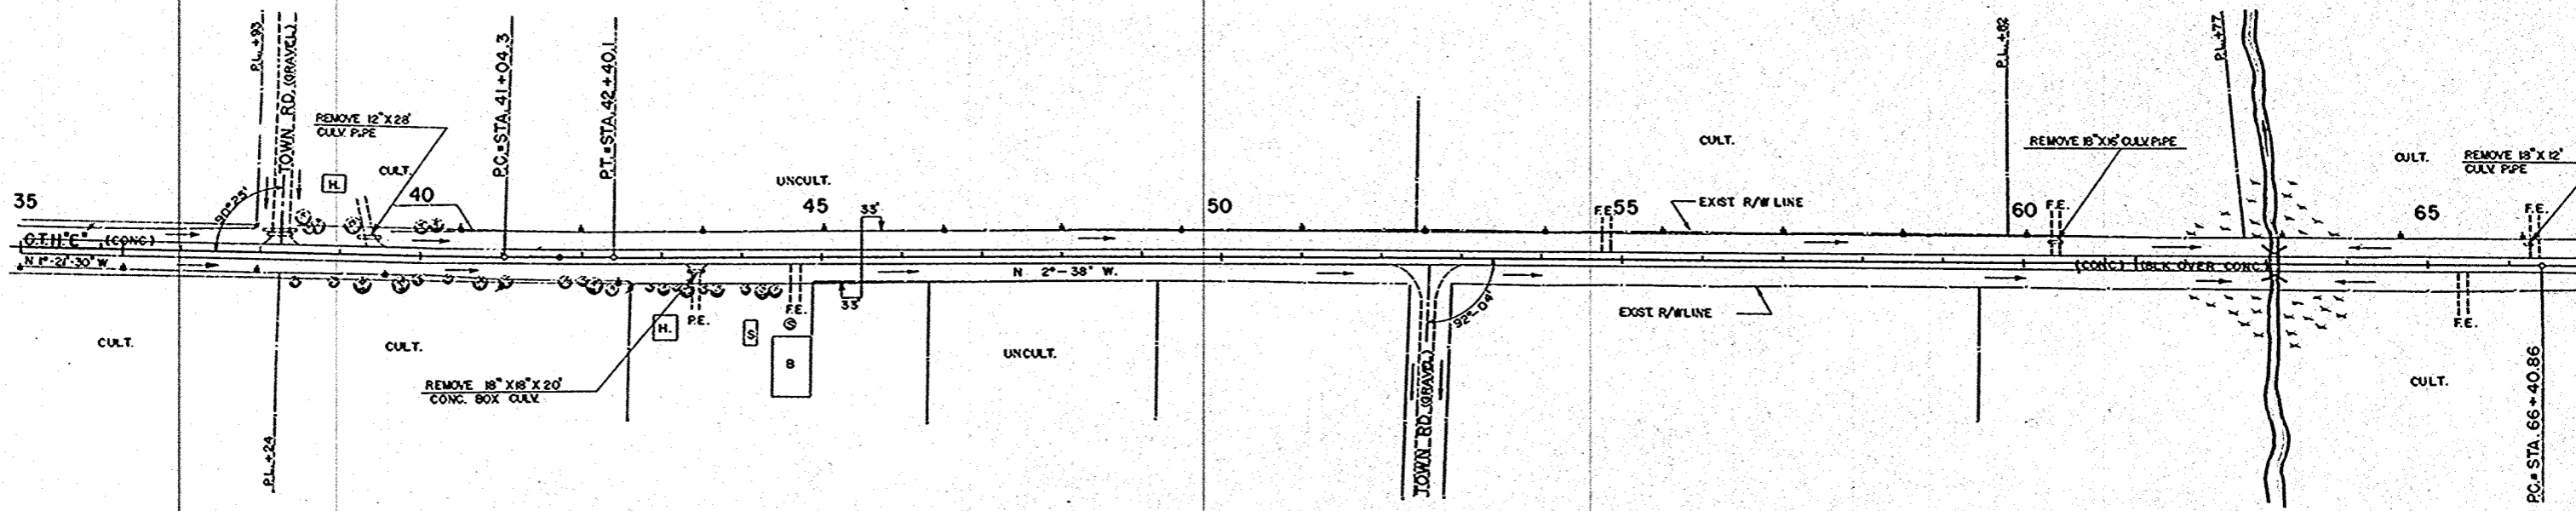


NET LENGTH OF CENTERLINE		
STATION TO STATION	LIN. FT.	
35+00	65+00	3000

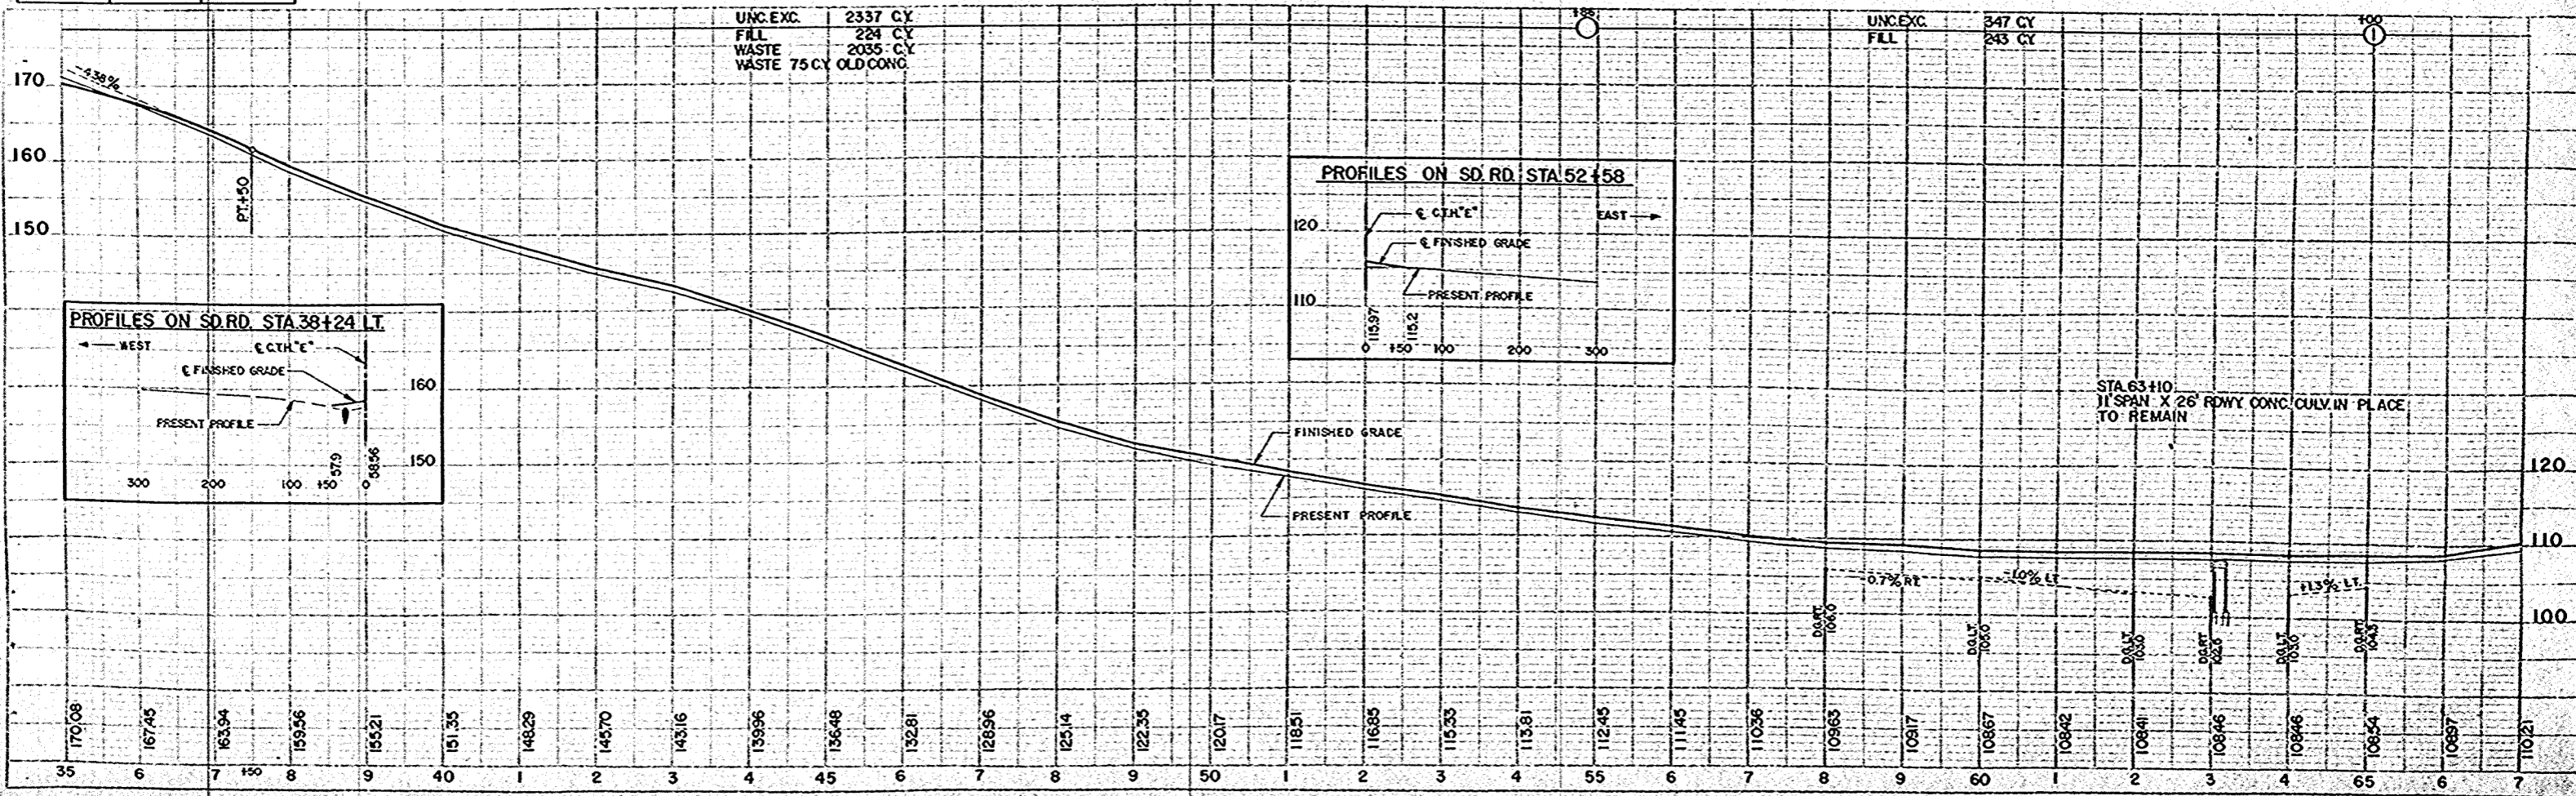



PLAN
 SCALE: 1" = 30'
 DATE: 08-27-54
 DRAWN BY: J.W. JENSEN
 CHECKED BY: R.L. JENSEN
 APPROVED BY: J.W. JENSEN
 PROJECT NO.: 40

BENCH MARKS			
NO.	STATION	DESCRIPTION	ELEV.
5	69+45	SPIKE IN 12" APPLE 30'LT.	114.16
6	80+10	24" MAPLE 27'RT.	144.80
7	86+88	14" ELM 84'RT.	164.80
8	94+92	20" MAPLE 36'RT.	193.41

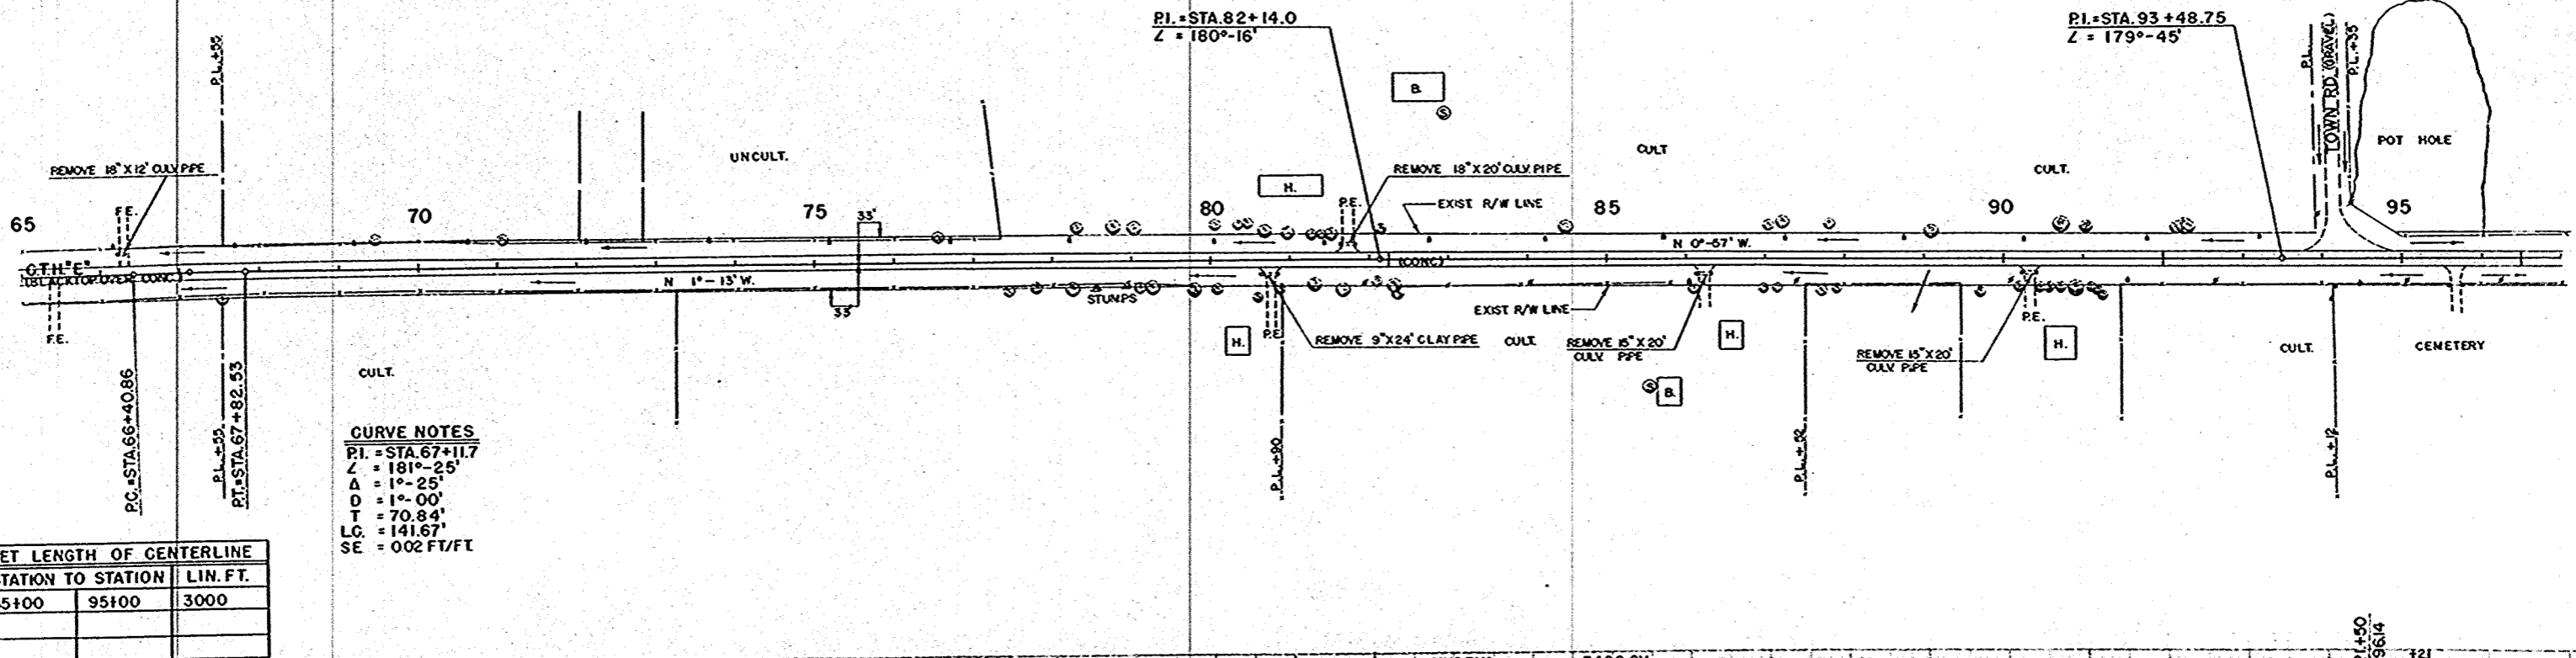

CURVE NOTES
 P.I. = STA. 67+11.7
 Z = 181°-25'
 A = 1°-25'
 D = 1°-00'
 T = 70.84'
 L.C. = 141.67'
 SE = 002 FT/FT


NET LENGTH OF CENTERLINE		
STATION TO STATION	LIN. FT.	
65+00	95+00	3000

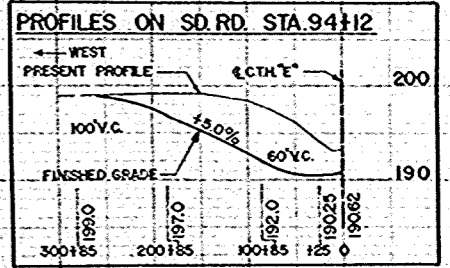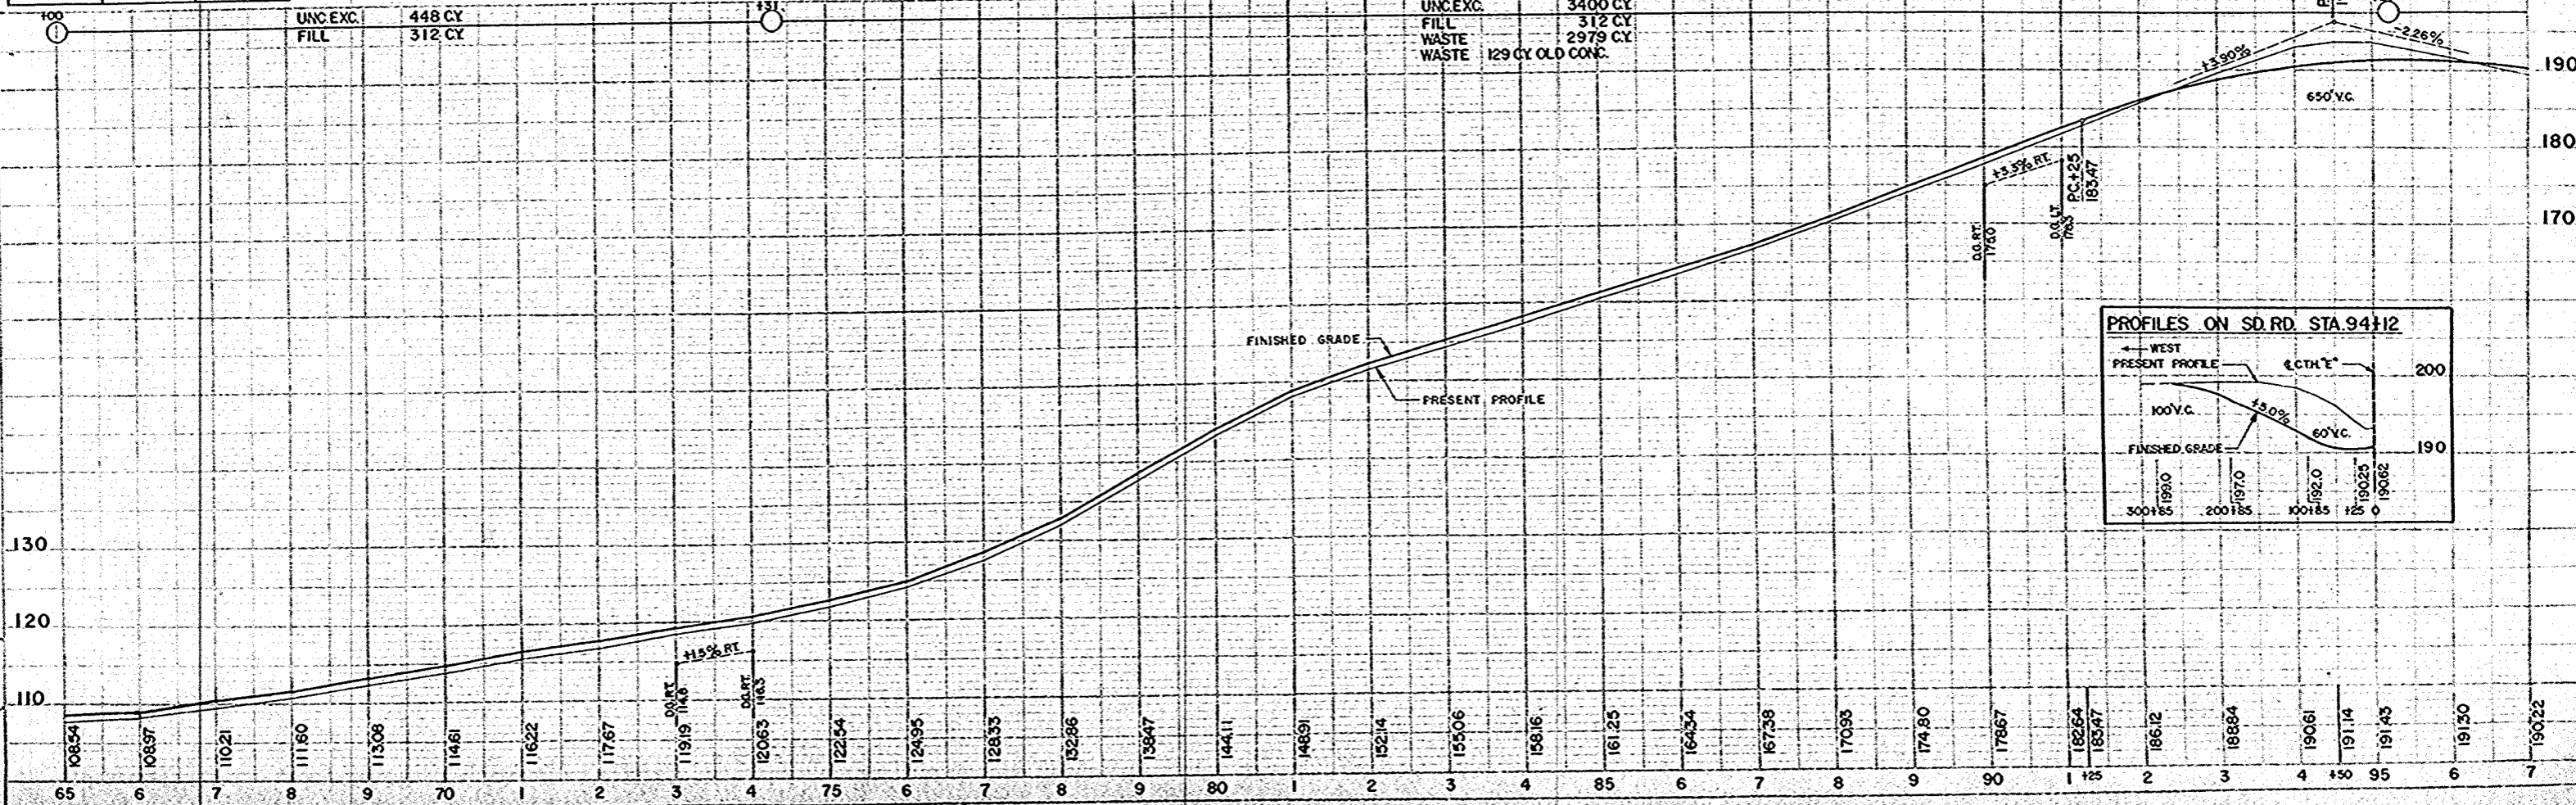

PLAN
 10-27
 10-27
 10-37



PROFILE
 10-27
 10-27
 10-37

BENCH MARKS			
NO.	STATION	DESCRIPTION	ELEV.
9		SPKE IN 24' ELM 35' RT	184.59
10	110+36	P.T. MK S.W. COR. CONC. PORCH 150' RT	160.82
11	116+73	SPIKE IN 16' HICKORY 33' RT	148.64

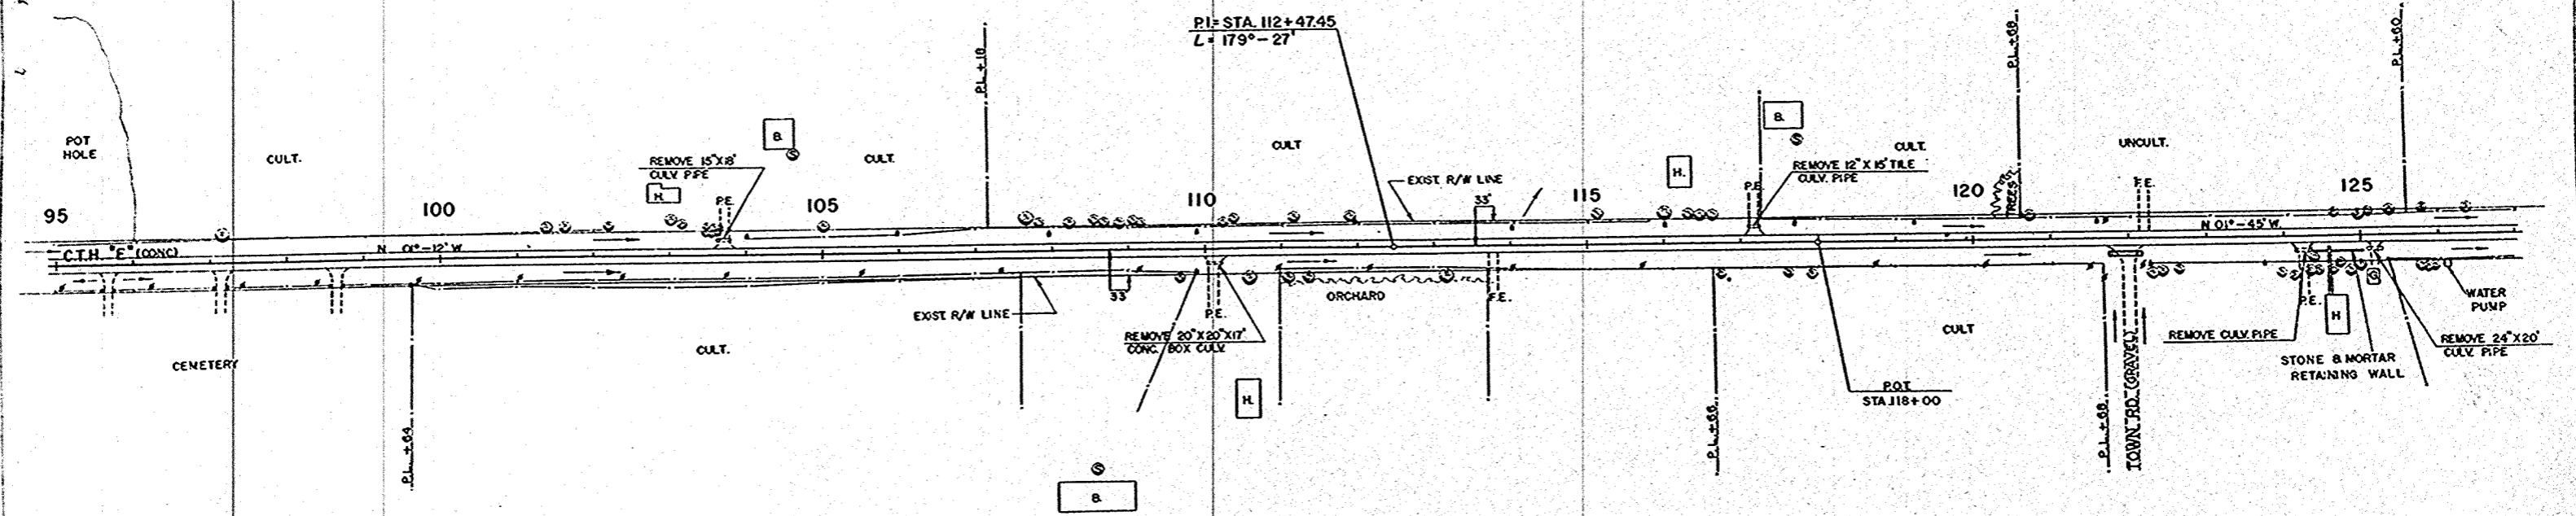

NET LENGTH OF CENTERLINE		
STATION TO STATION	L.W. FT.	
95+00	125+00	3000

STA 122+03 SD RD. RT.
 REMOVE 24" X 33" CULV. PIPE
 36" X 22" X 36" C.M.P.A. REQ'D.

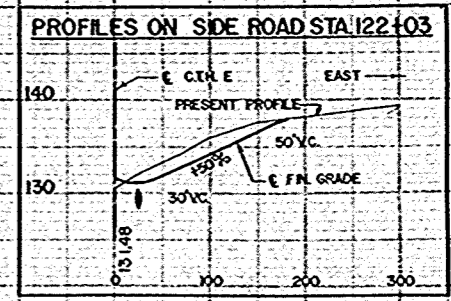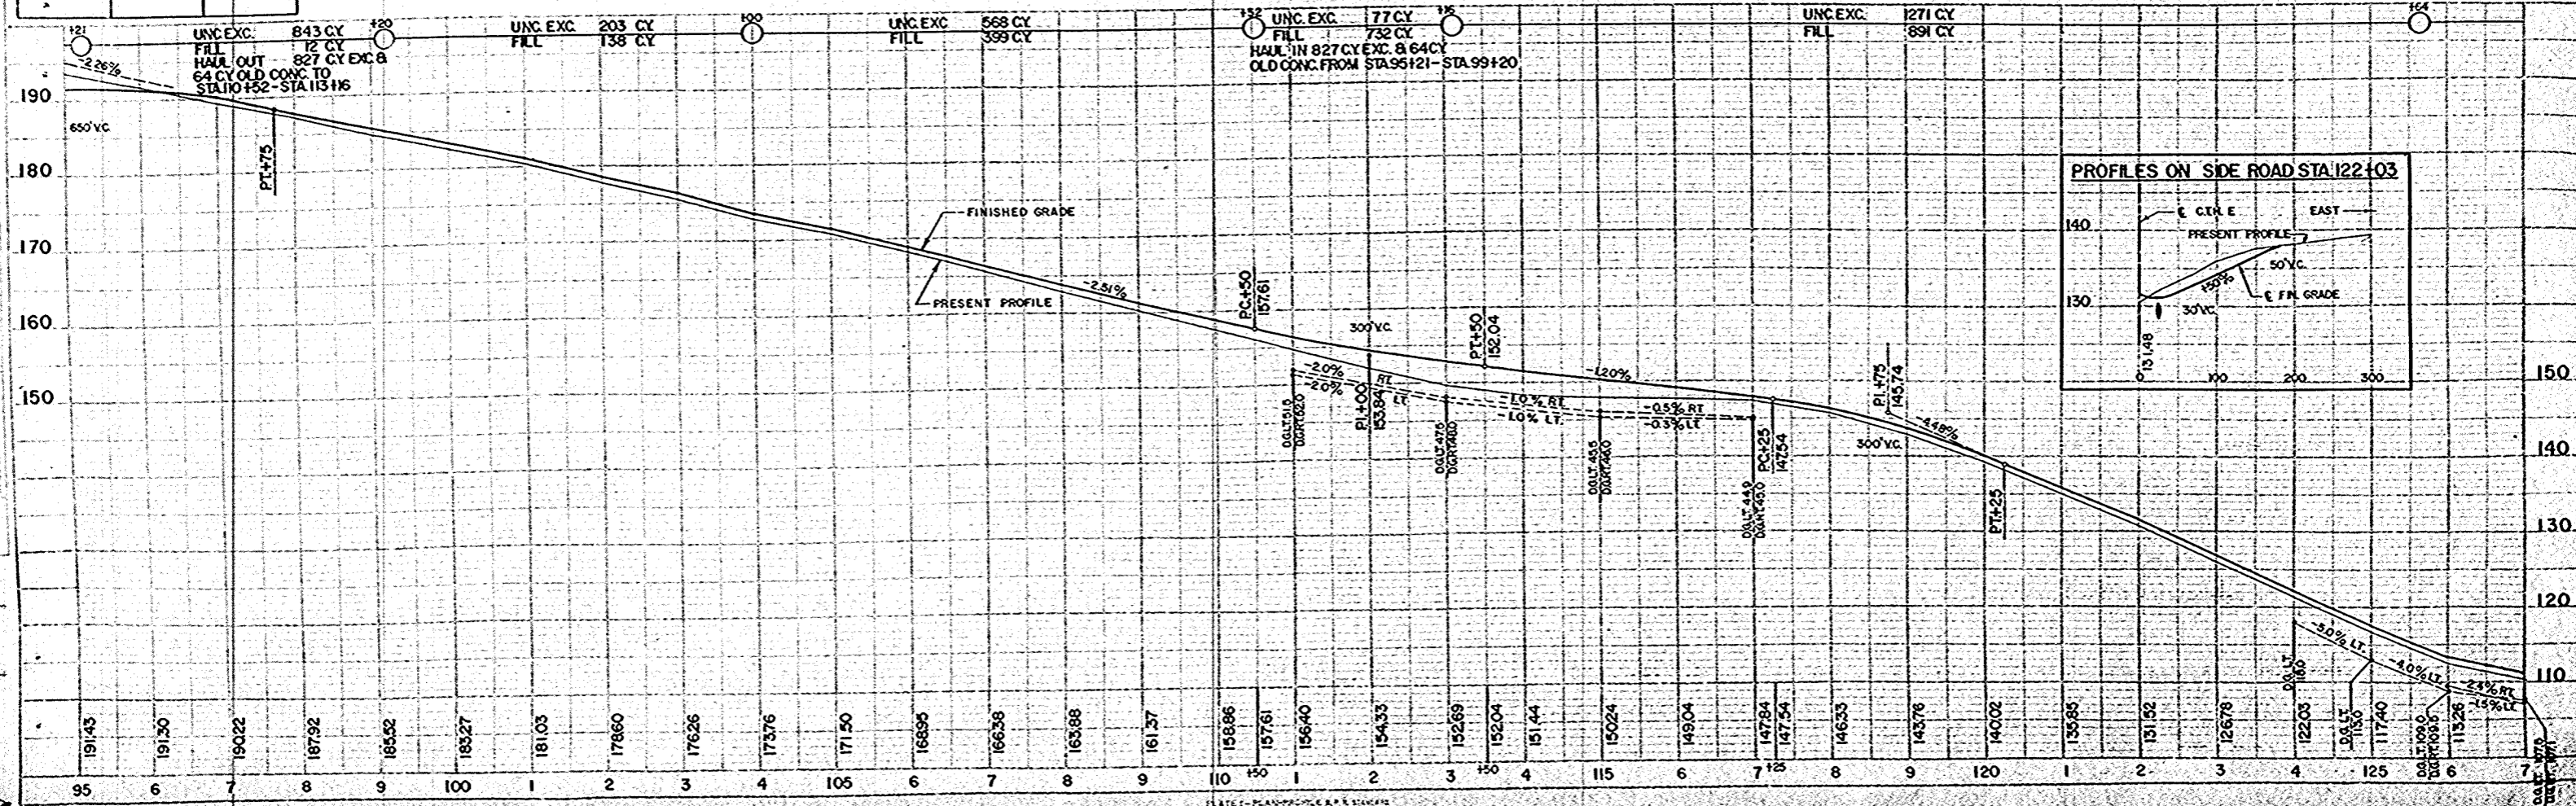


PLAN
 DATE: 10-10-57
 DRAWN BY: J.C.C.
 CHECKED BY: J.C.C.
 NO. 30

PROFILE
 DATE: 10-10-57
 DRAWN BY: J.C.C.
 CHECKED BY: J.C.C.
 NO. 40

DATE: PLAN, PROFILE & B.M. STATIONS
 BY: ENGINEER JOHN DA. COLE, 1957

BENCH MARKS			
NO.	STATION	DESCRIPTION	ELEV.
12	128+40	PT. MK. ON N.W. COR. OF END WALL OF BRIDGE 20' LT.	110.38
13	143+40	PT. MK. ON N.W. COR. OF CONC. STEP OF HOUSE 72' RT.	108.36
14	148+52	PT. MK. ON SQ. END GAS ISL. 30' LT.	118.35

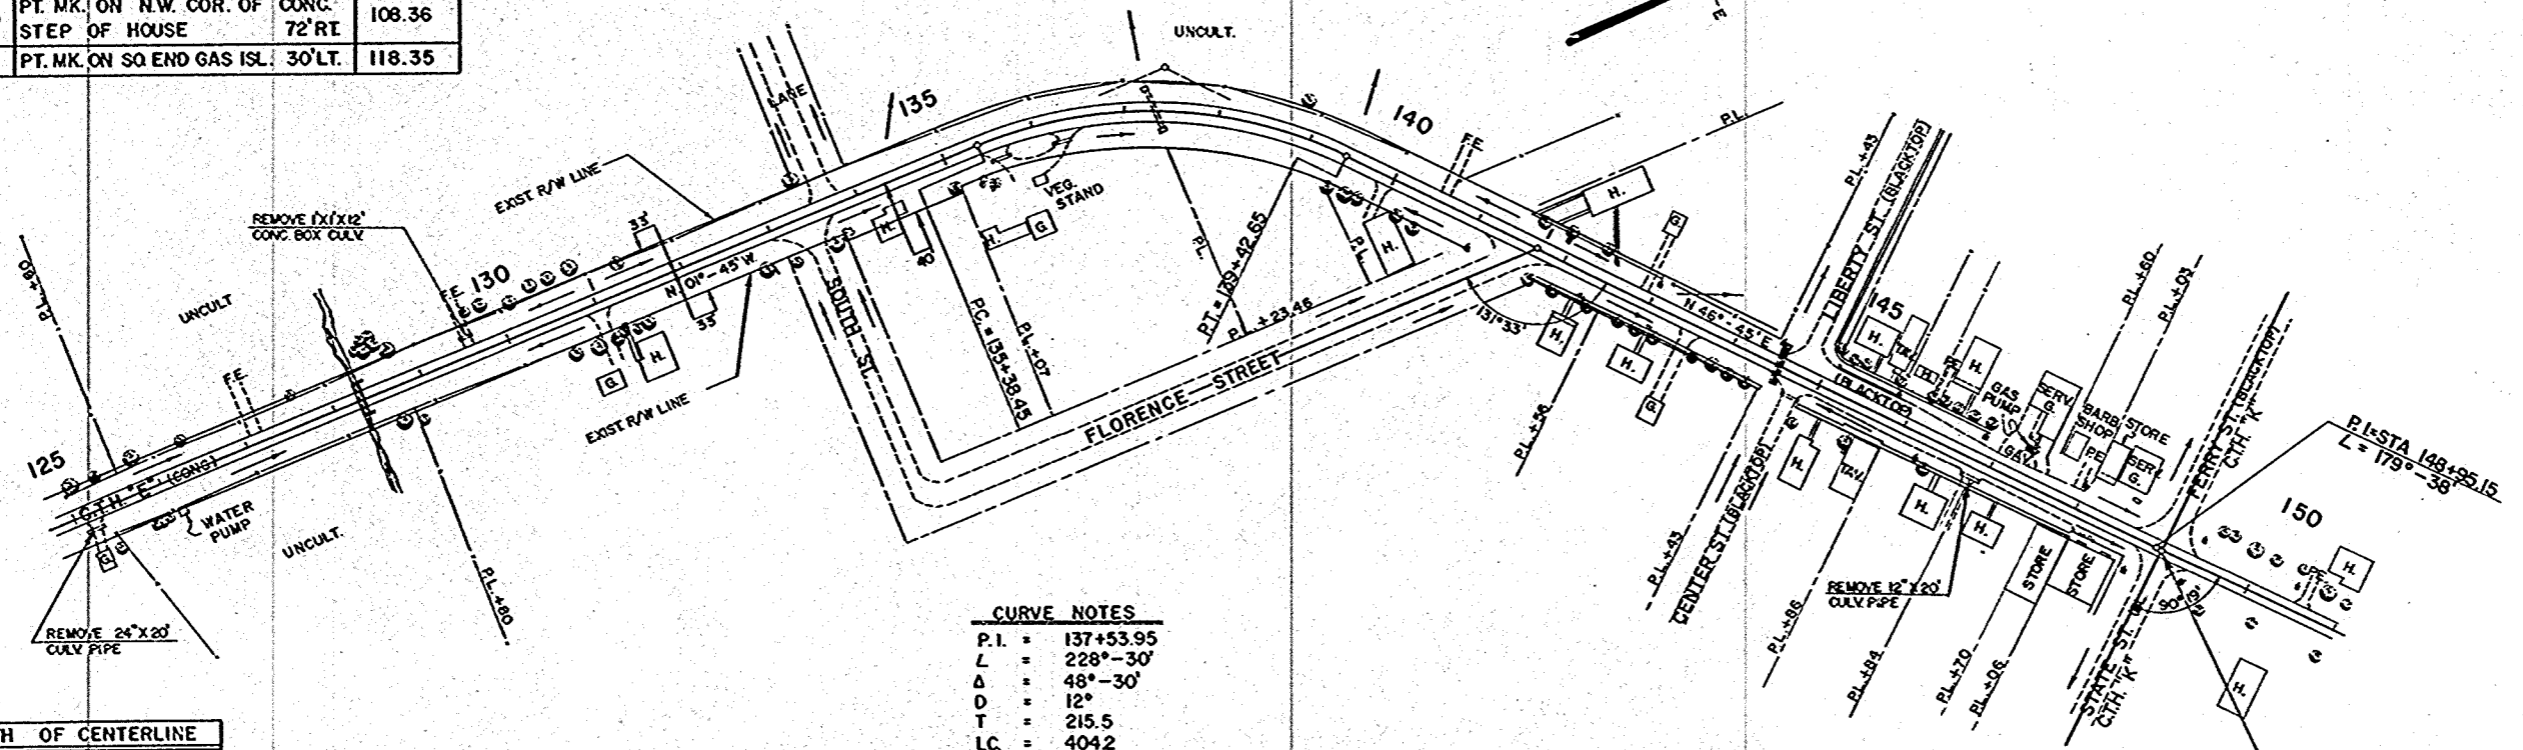

CURVE NOTES





P.I.	=	137+53.95
L	=	228°-30'
Δ	=	48°-30'
D	=	12°
T	=	215.5
LC	=	4042
SE	=	0.065 FT/FT

NET LENGTH OF CENTERLINE

STATION TO STATION	LIN. FT.	
125+00	149+01.3	2401.3

STA. 144+75 SIDE STREET RT
REMOVE 18" X 18" CULV. PIPE
22" X 13" X 28" CMPA. REQ'D.

STA. 149+01.3 END
PROJ. S0308(4)

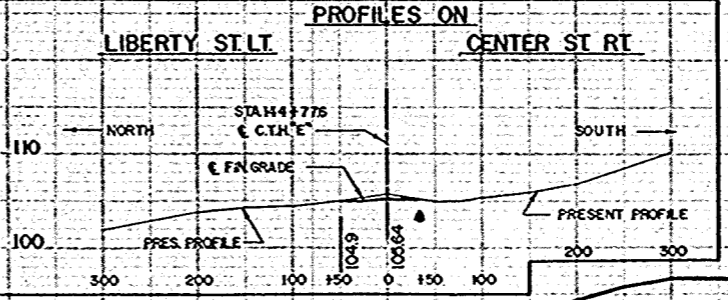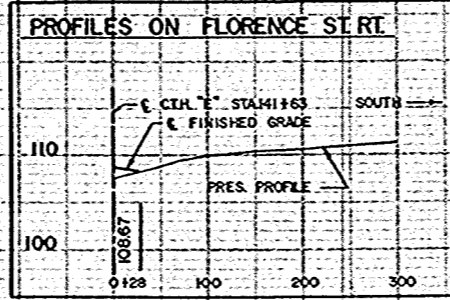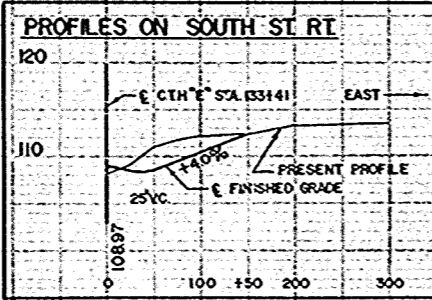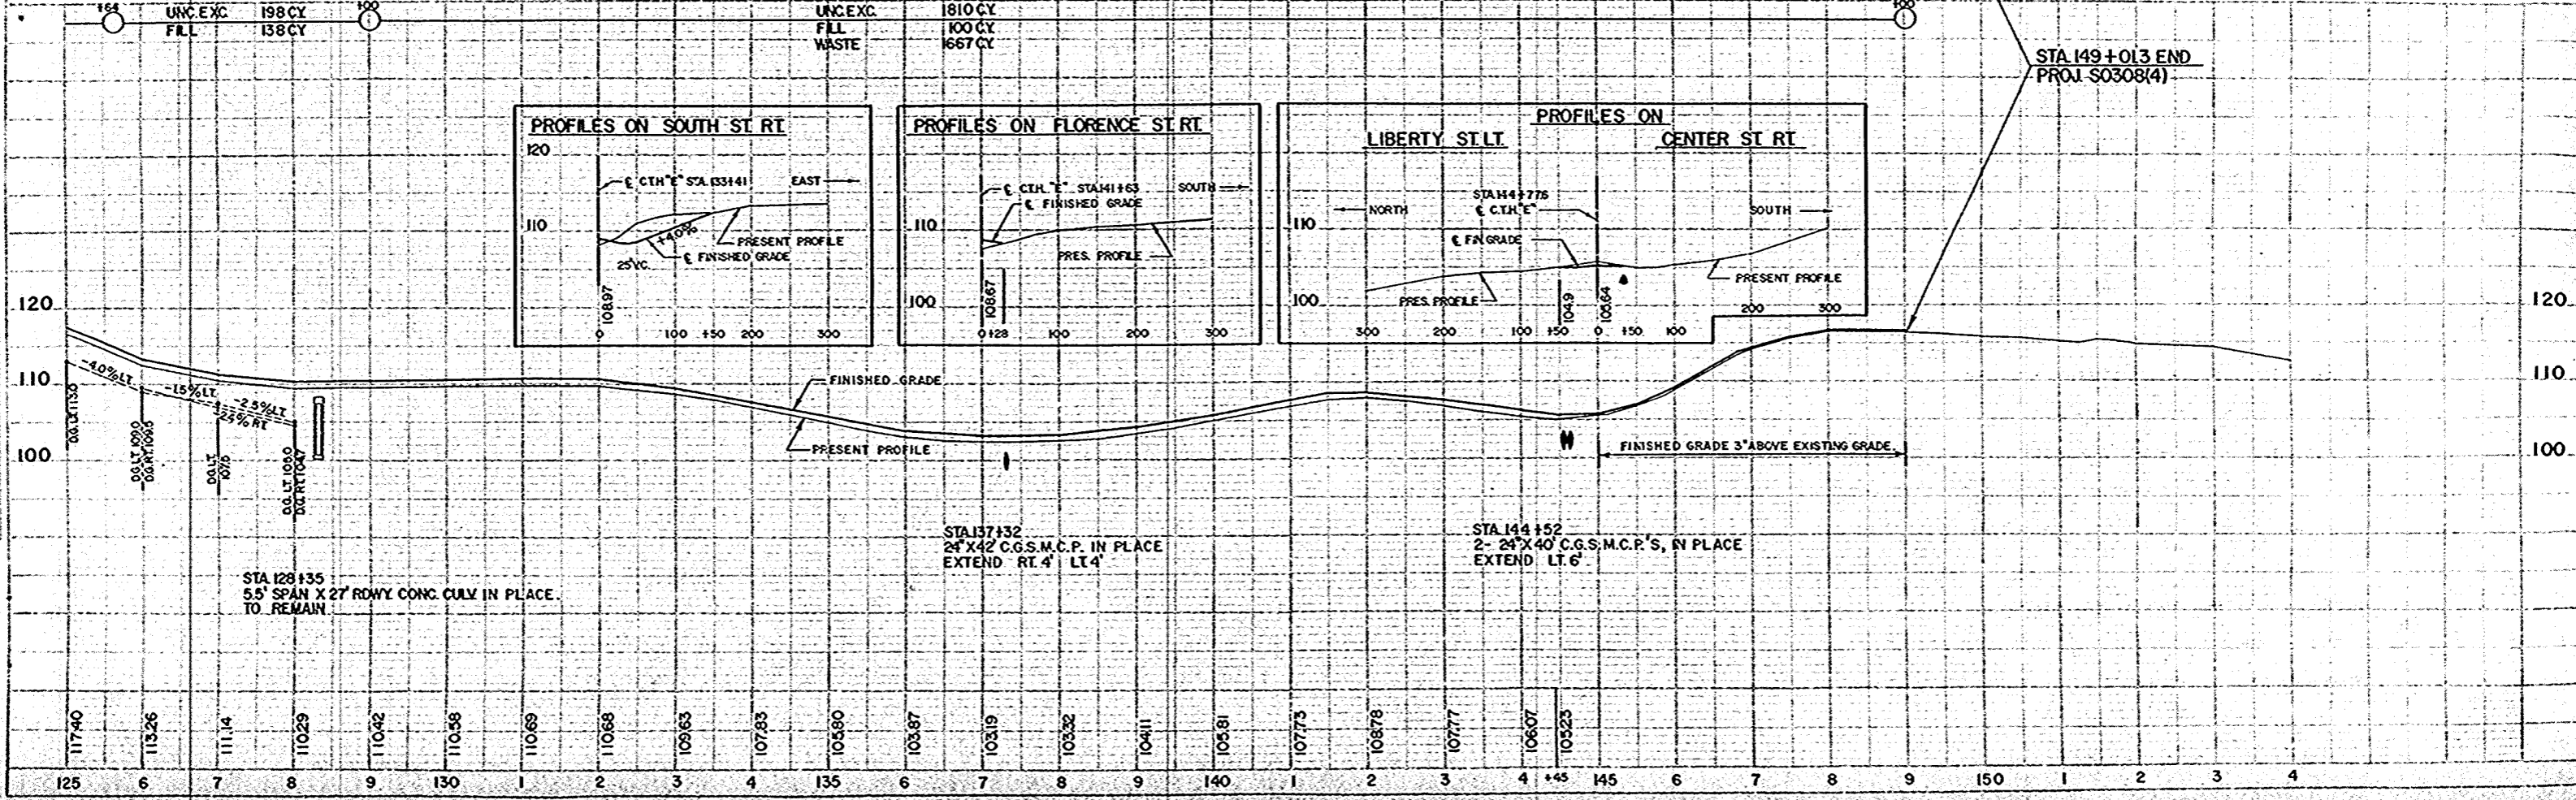

STA 128+35
5.5' SPAN X 27' ROWY CONC. CULV. IN PLACE
TO REMAIN

STA 137+32
24" X 42" C.G.S. M.C.P. IN PLACE
EXTEND RT. 4' LT. 4'

STA 144+52
2- 24" X 40" C.G.S. M.C.P.'S, IN PLACE
EXTEND LT. 6'

FINISHED GRADE 3" ABOVE EXISTING GRADE

PLAN
DATE: 10-27-57
BY: J.C.L.
CHECKED: J.C.L.
NO. 39


PROFILE
DATE: 10-27-57
BY: J.C.L.
CHECKED: J.C.L.
NO. 40

FINAL SURVEY PLOTTED
 NO. 40
 DATE

ORIGINAL SURVEY PLOTTED
 NO. 40
 DATE

R. W. B.
 E. C. K.
 W. E. G. JR.

10-07
 10-07
 11-07
 11-07

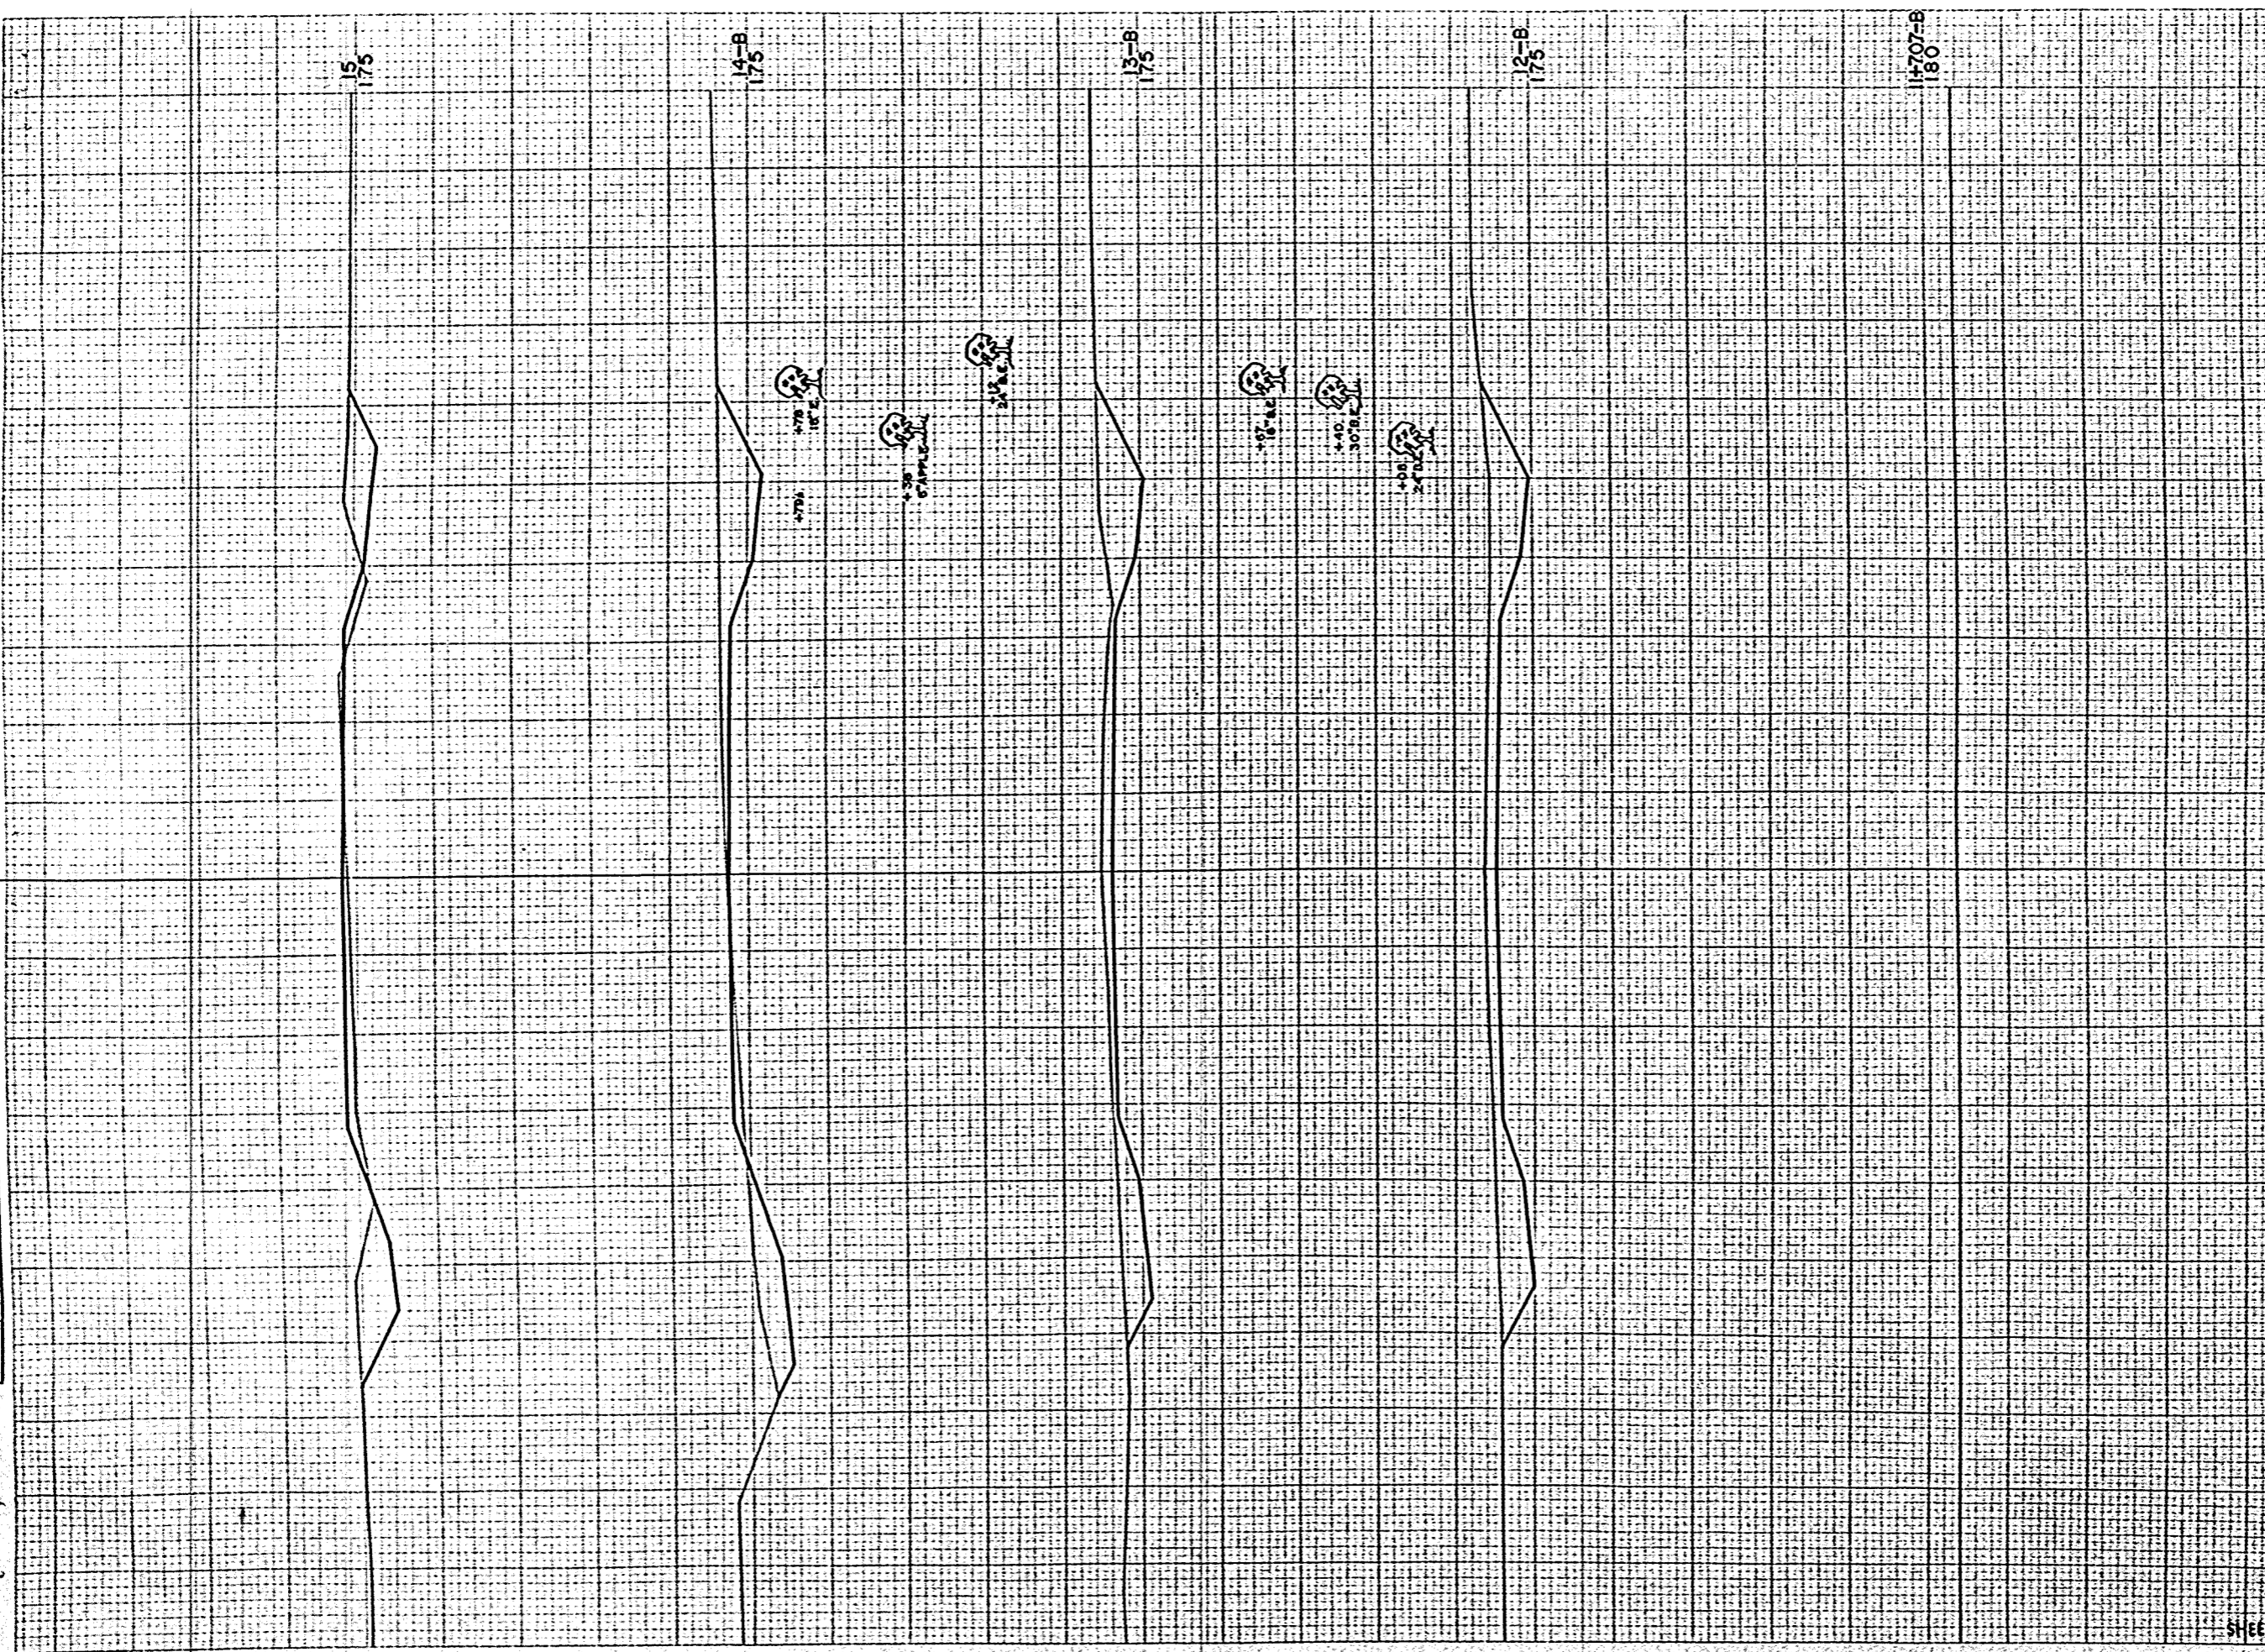


S.P.A. DISTRICT OFFICE	PROJECT	SHEET NUMBER	TOTAL SHEETS
WIS 4	S 0308(4)	15	29

STATION	DISTANCE	YARDAGE		
		UNC.	EXCAVATION	FILL
11	185			
12		9		
13		244		
14		217		9
15		167		33
SHEET TOTAL		647		42

ORIGINAL SURVEY PLOTTED
 DATE: 9-57
 PLOTTED BY: R.C.K.
 CHECKED BY: M.E.G.
 NO. 40

FINAL SURVEY PLOTTED
 DATE: 10-57
 PLOTTED BY: R.C.K.
 CHECKED BY: M.E.G.
 NO. 40

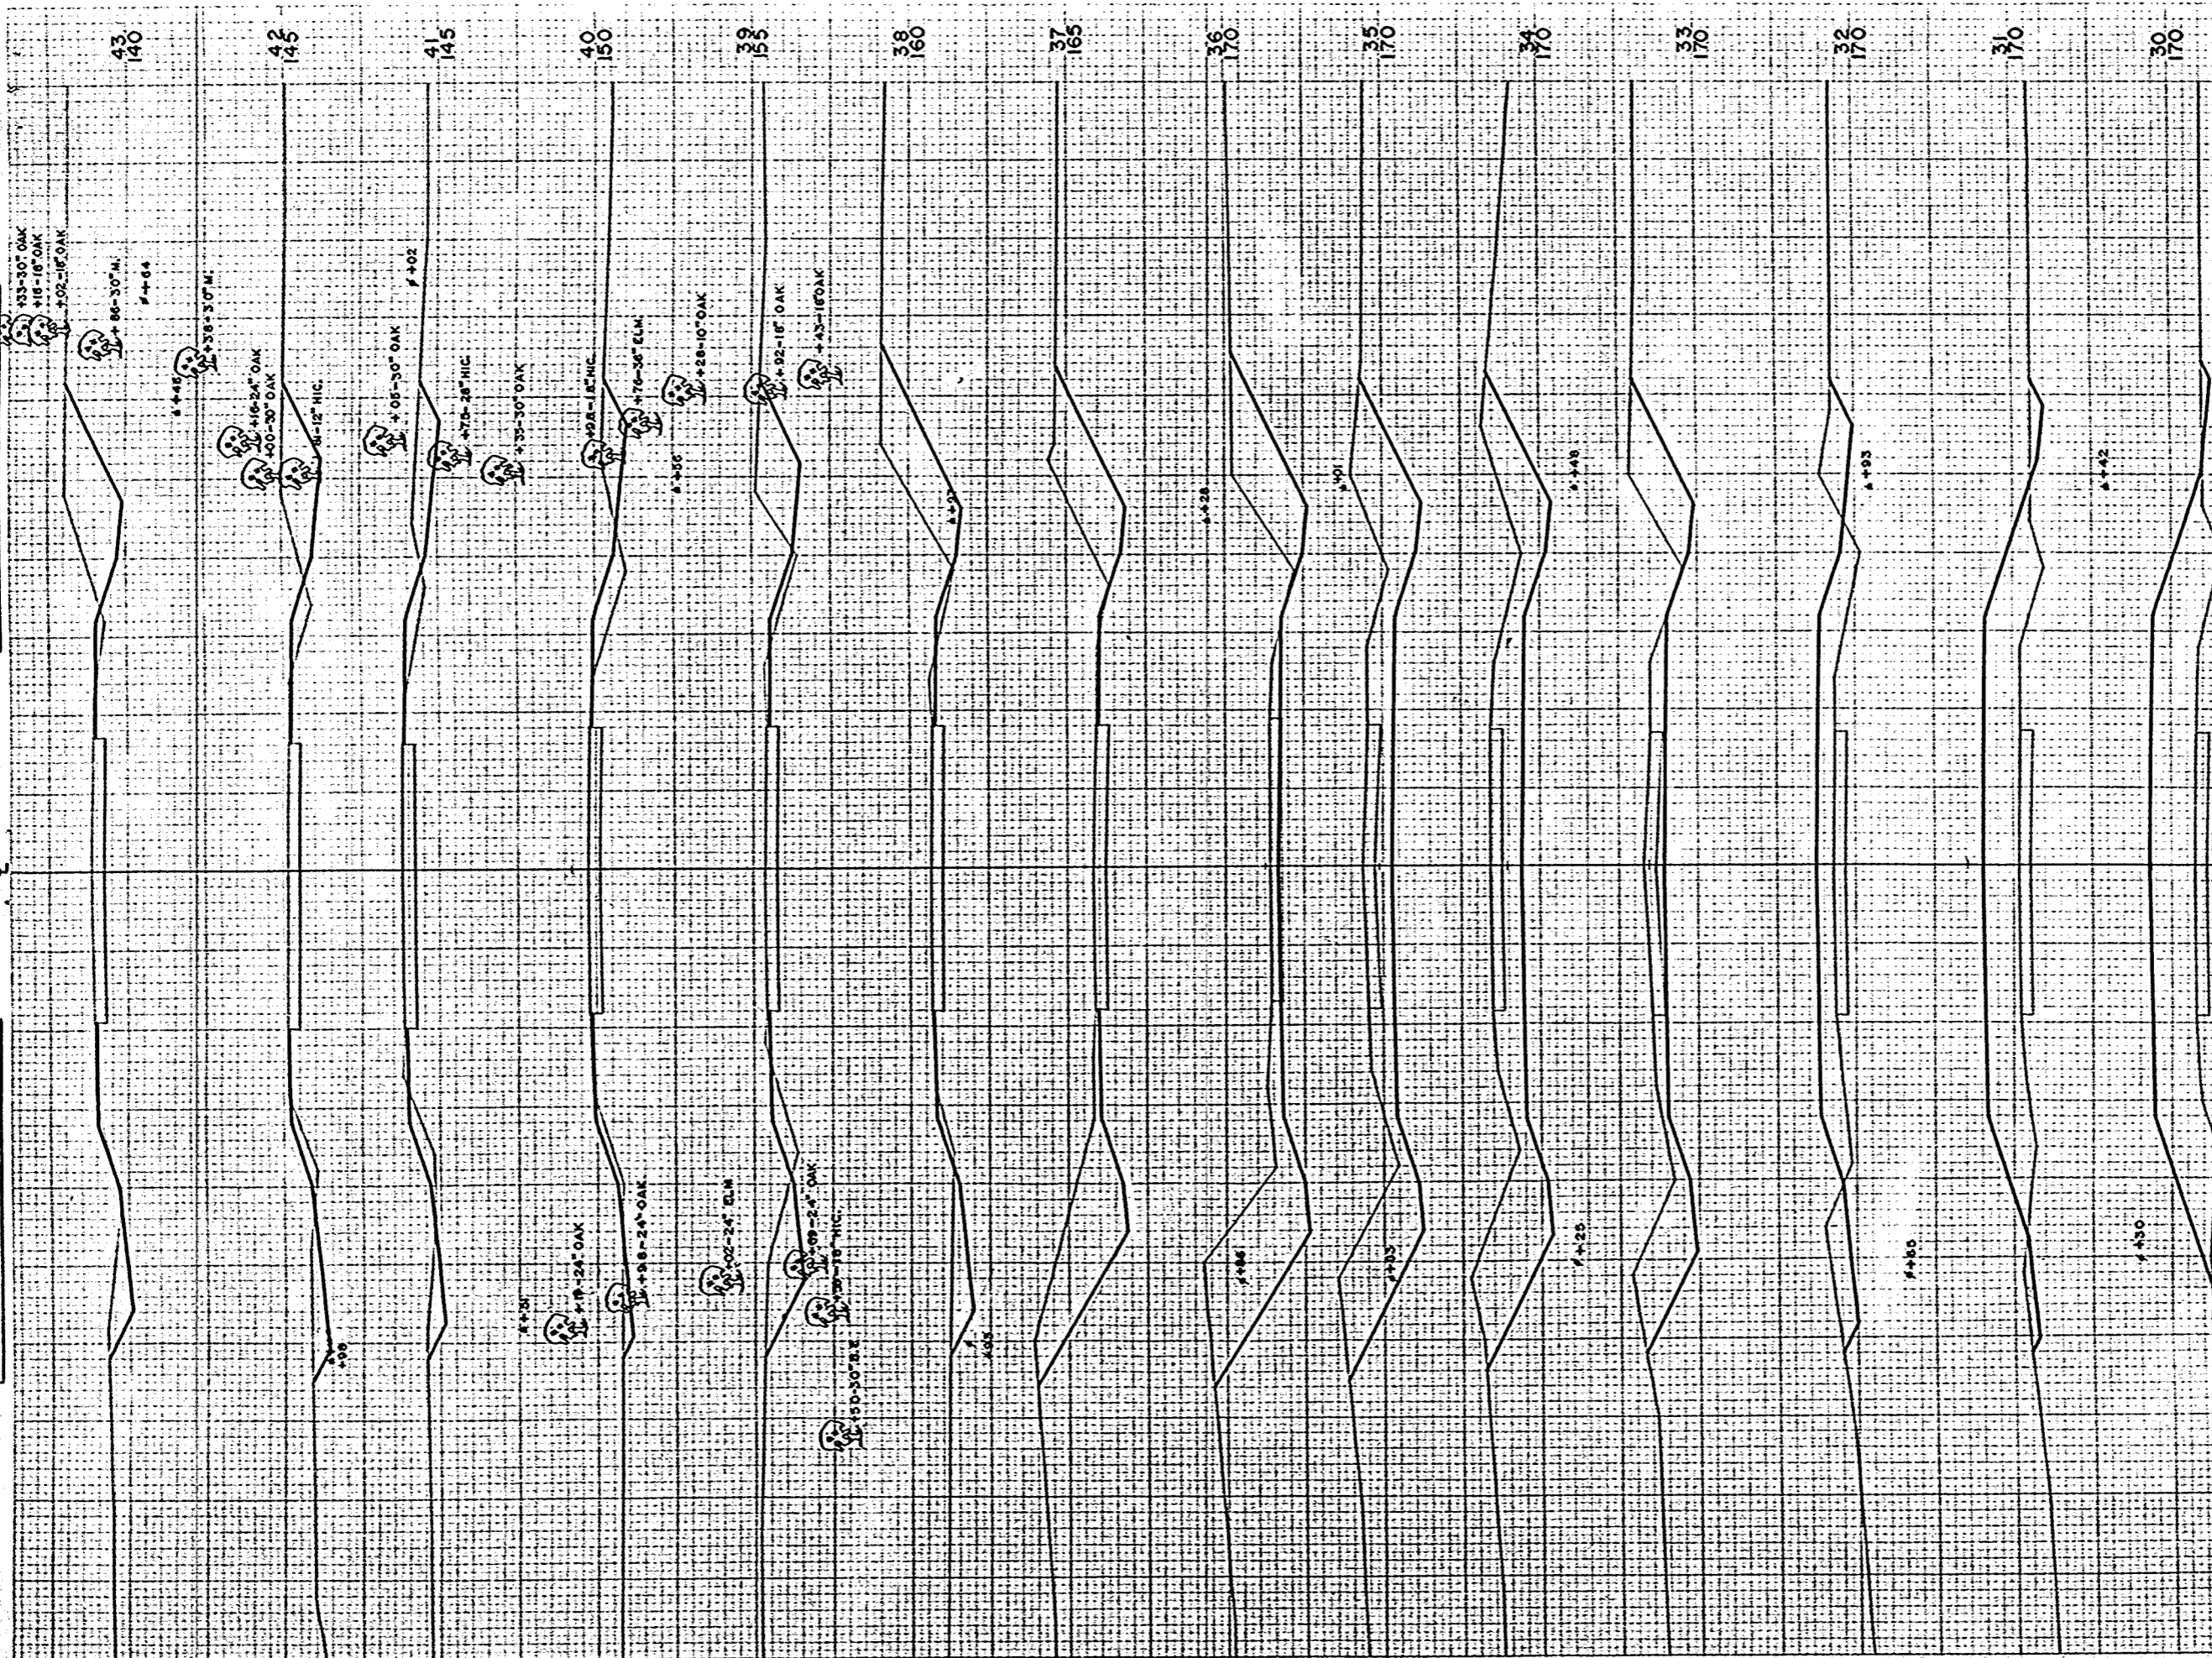


STATION	DISTANCE	YARDAGE	
		EXCAVATION	
		UNC.	FILL
29	19		435
30	20		435
31	52		281
32	137		91
33	307		0
34	413		0
35	374		0
36	322		0
37	226		6
38	139		18
39	89		31
40	59		35
41	85		28
42	122		15
43			
SHEET TOTAL		2364	1375

S.P.A. DISTRICT OFFICE PROJECT SHEET NUMBER TOTAL SHEETS
 WIS. 4 50308(4) 17 29

FINAL SURVEY
 DATE: 10-27-57
 BY: [Signature]
 NO. 40

ORIGINAL SURVEY
 DATE: 9-57
 BY: [Signature]
 NO. 40

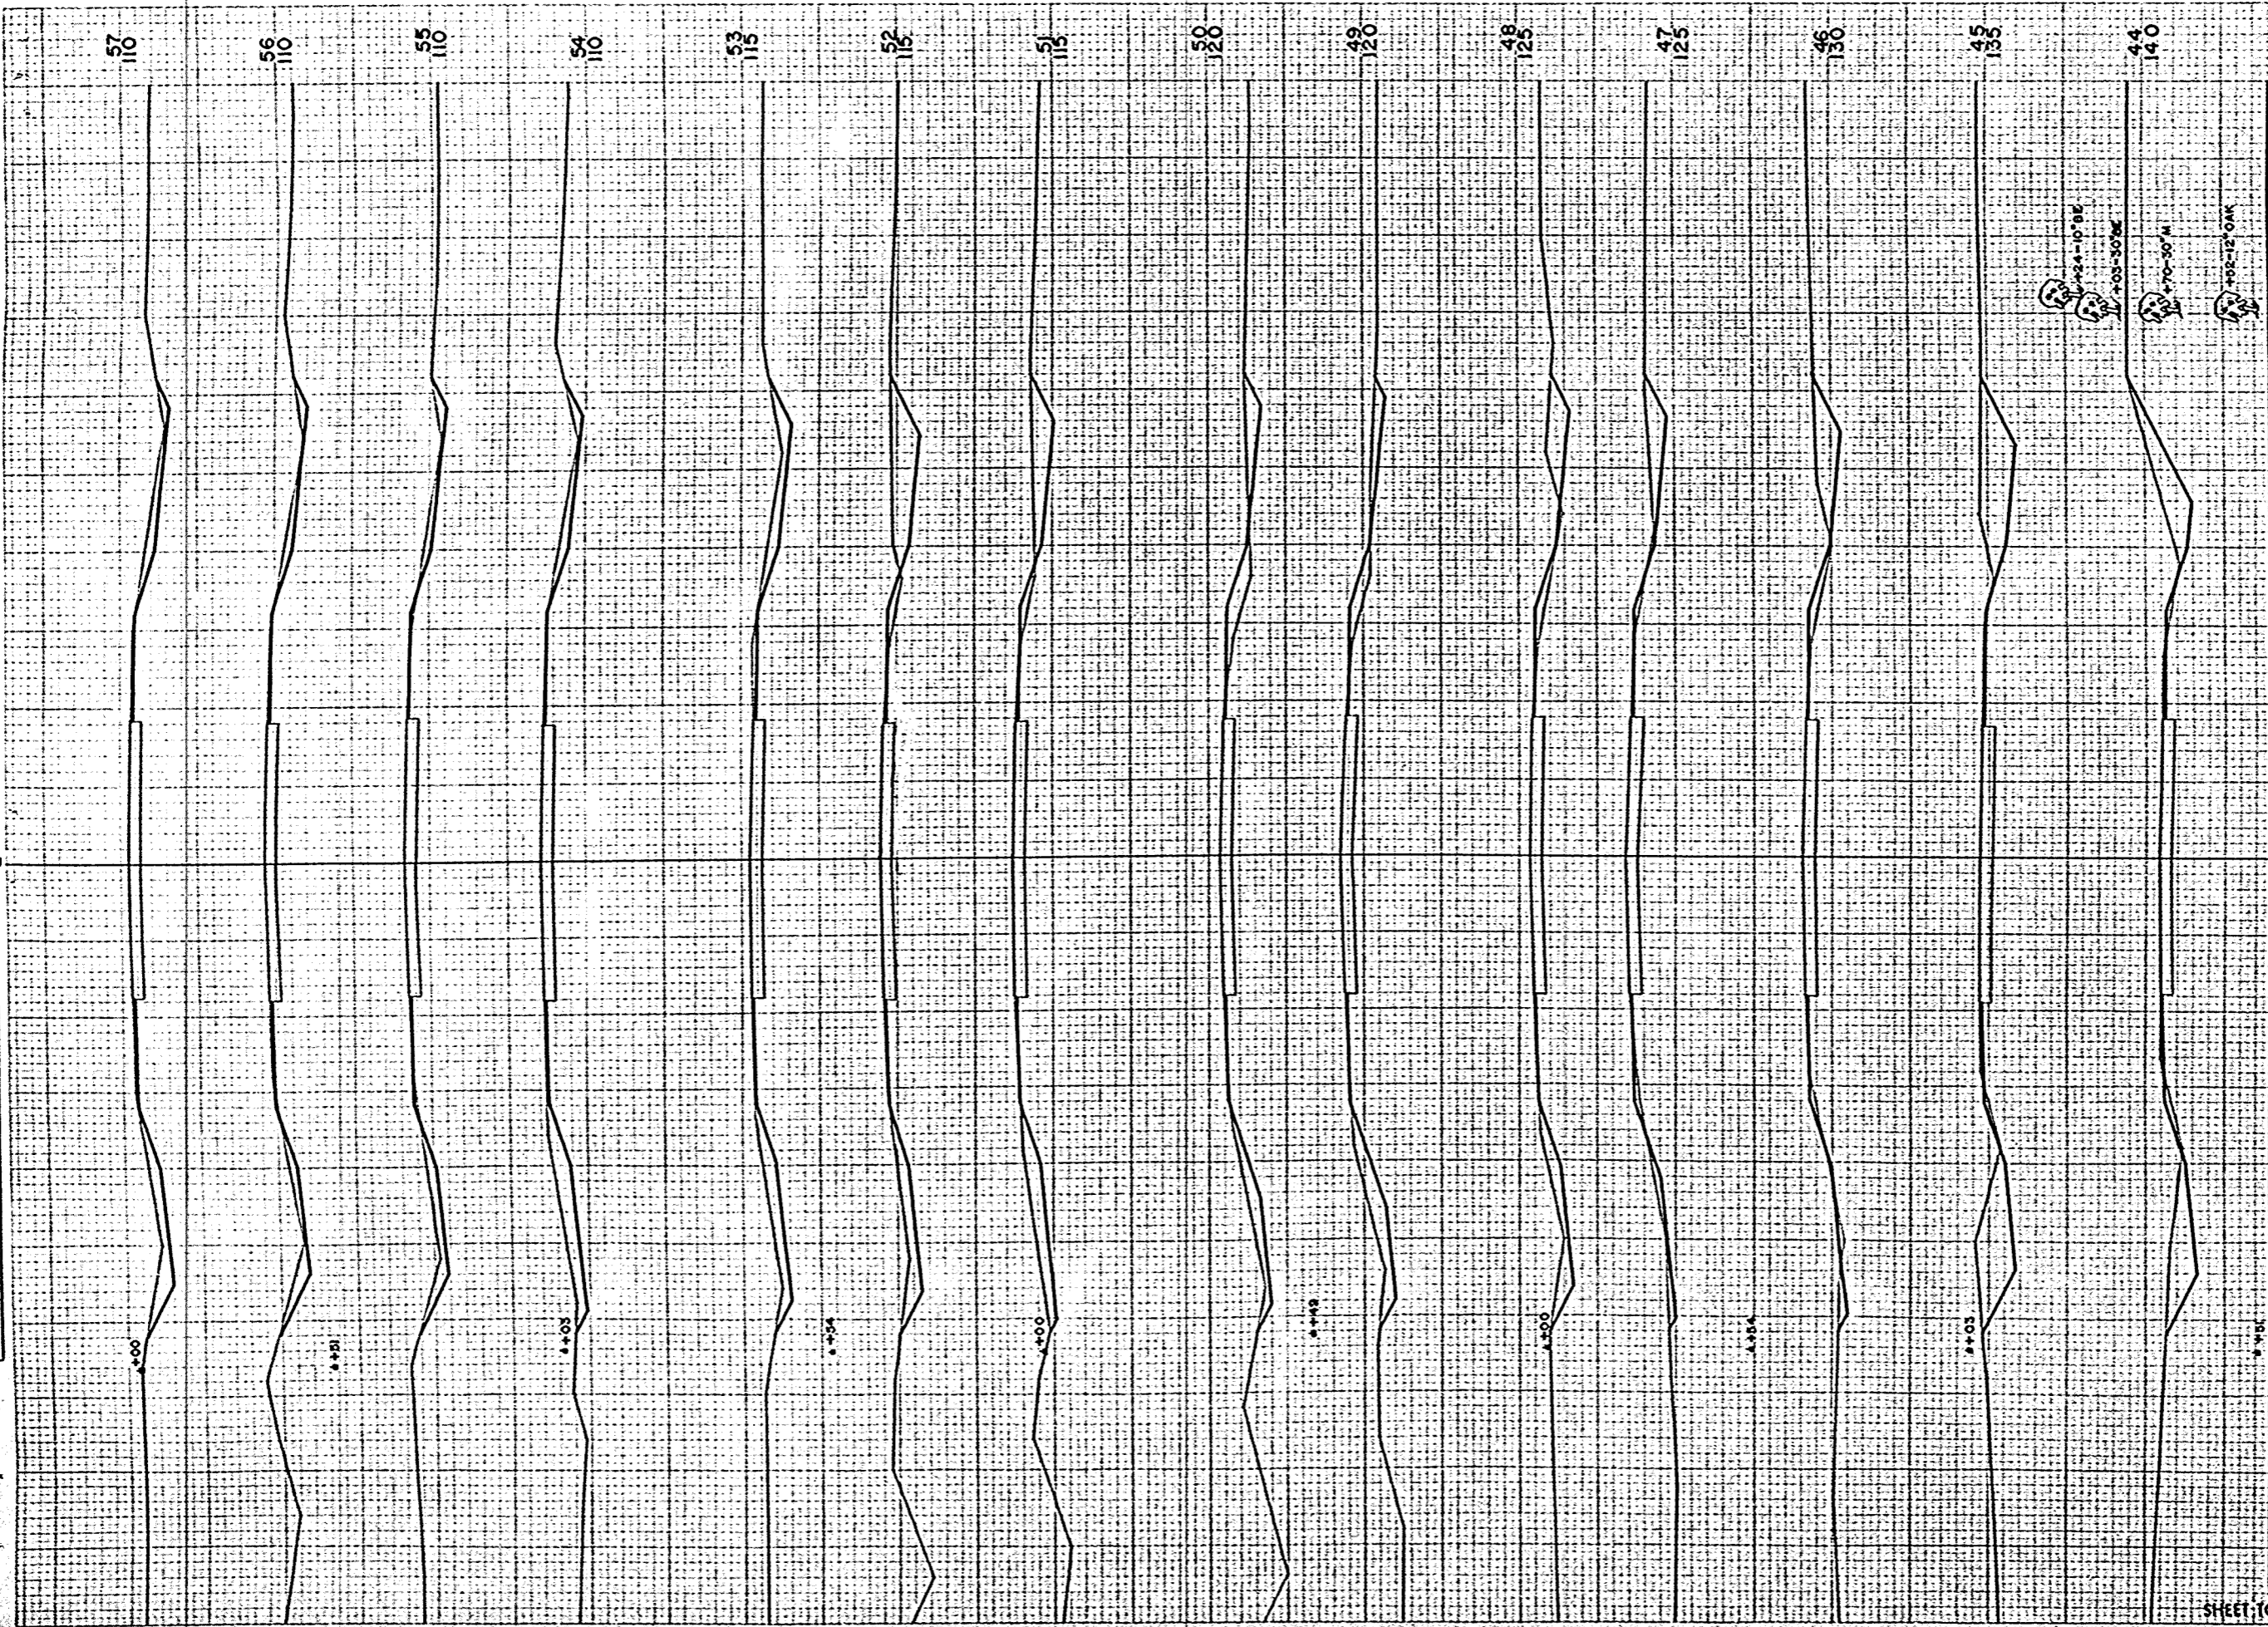


STATION	DISTANCE	YARDAGE	
		EXCAVATION	
		UNC.	FILL
43	119		6
44	119		4
45	95		9
46	44		11
47	56		9
48	59		11
49	50		15
50	63		13
51	83		7
52	85		4
53	78		0
54	81		2
55	50		2
56	57		0
57			
SHEET TOTAL:	109		93

B.P.A. DISTRICT OFFICE	PROJECT	SHEET NUMBER	TOTAL SHEETS
WIS. 4	S 0308 (4)	18	29

FINAL SURVEY
 DATE: 9-57
 BY: R.A.N.
 PROJECT: S.C.C.
 NO. 40

ORIGINAL SURVEY
 DATE: 9-57
 BY: R.A.N.
 PROJECT: S.C.C.
 NO. 40

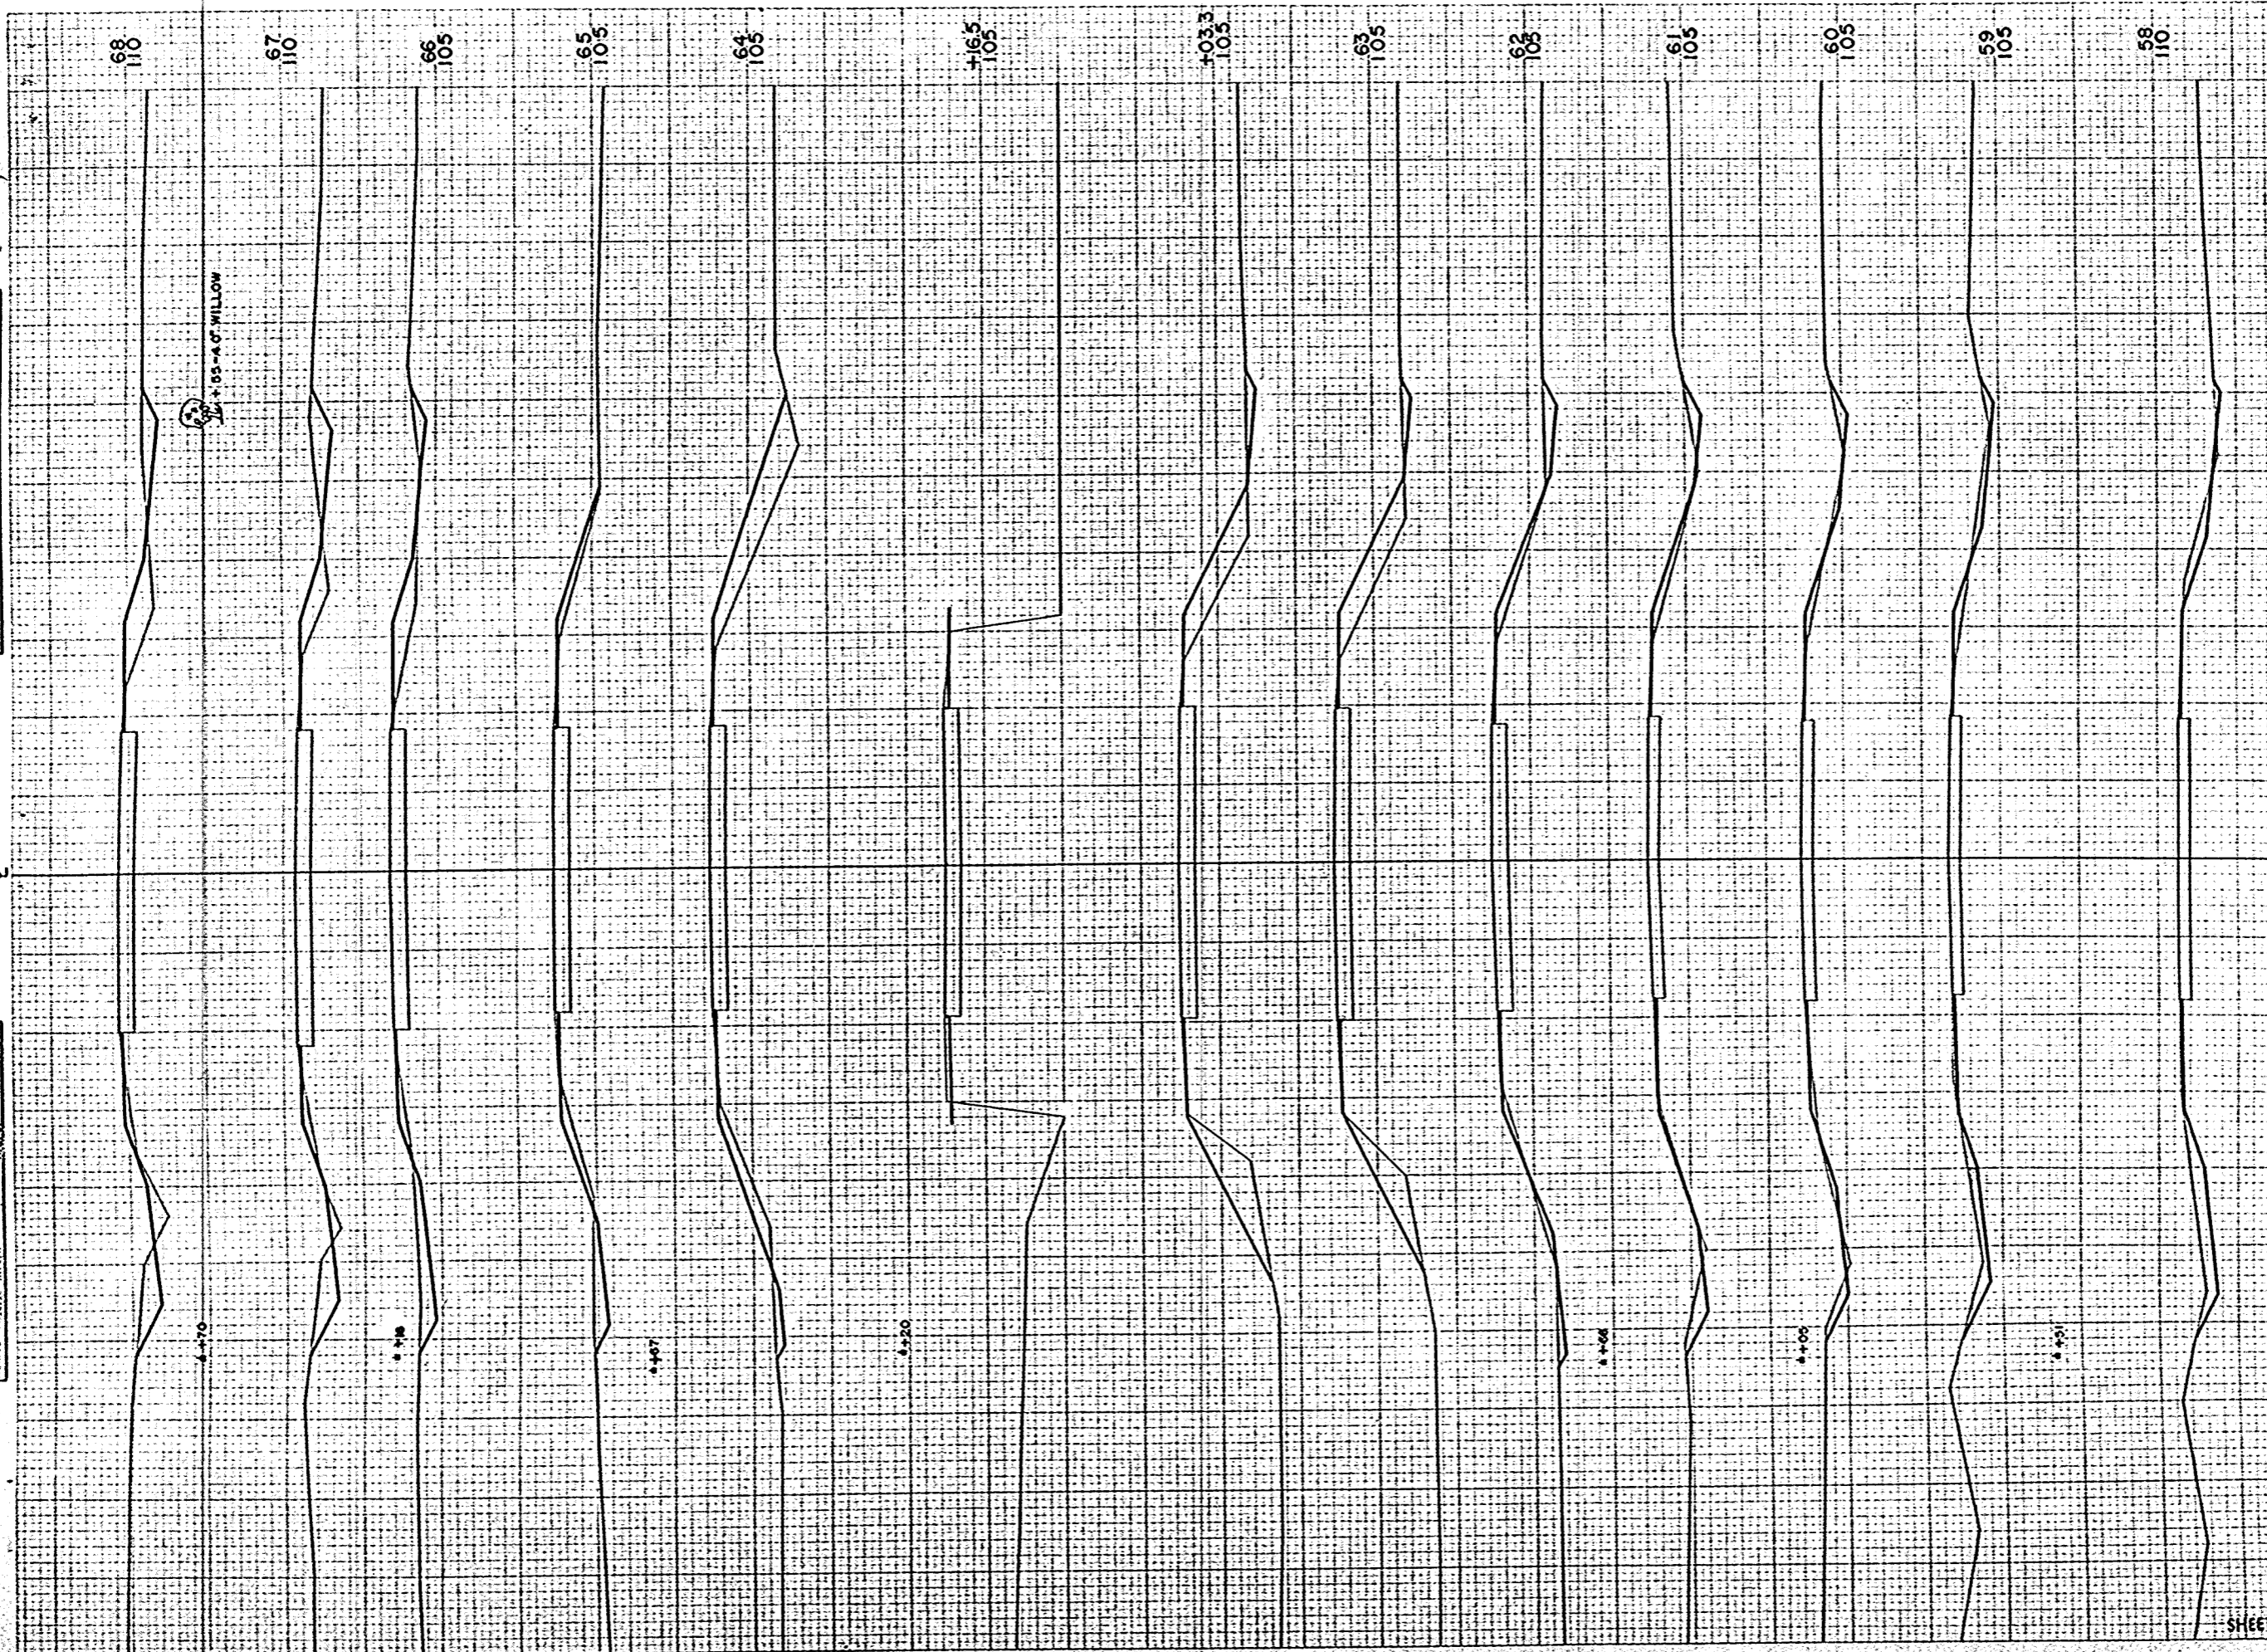


S.P.R. DISTRICT OFFICE	PROJECT	SHEET NUMBER	TOTAL SHEETS
WIS. 4	S0308(4)	19	29

STATION	DISTANCE	YARDAGE	
		EXCAVATION	FILL
57			
58	59		0
59	48		4
60	30		9
61	21		13
62	26		17
63	22		50
64	0		4
+033	0		0
+165	9		83
65	17		61
66	30		28
67	43		33
68	44		41
SHEET TOTAL		349	343

FINAL SURVEY
 DATE: 10-27-57
 DRAWN BY: J.A.M.
 CHECKED BY: C.C.C.
 NO. 40

ORIGINAL SURVEY
 DATE: 9-27-57
 DRAWN BY: J.A.M.
 CHECKED BY: C.C.C.
 NO. 40

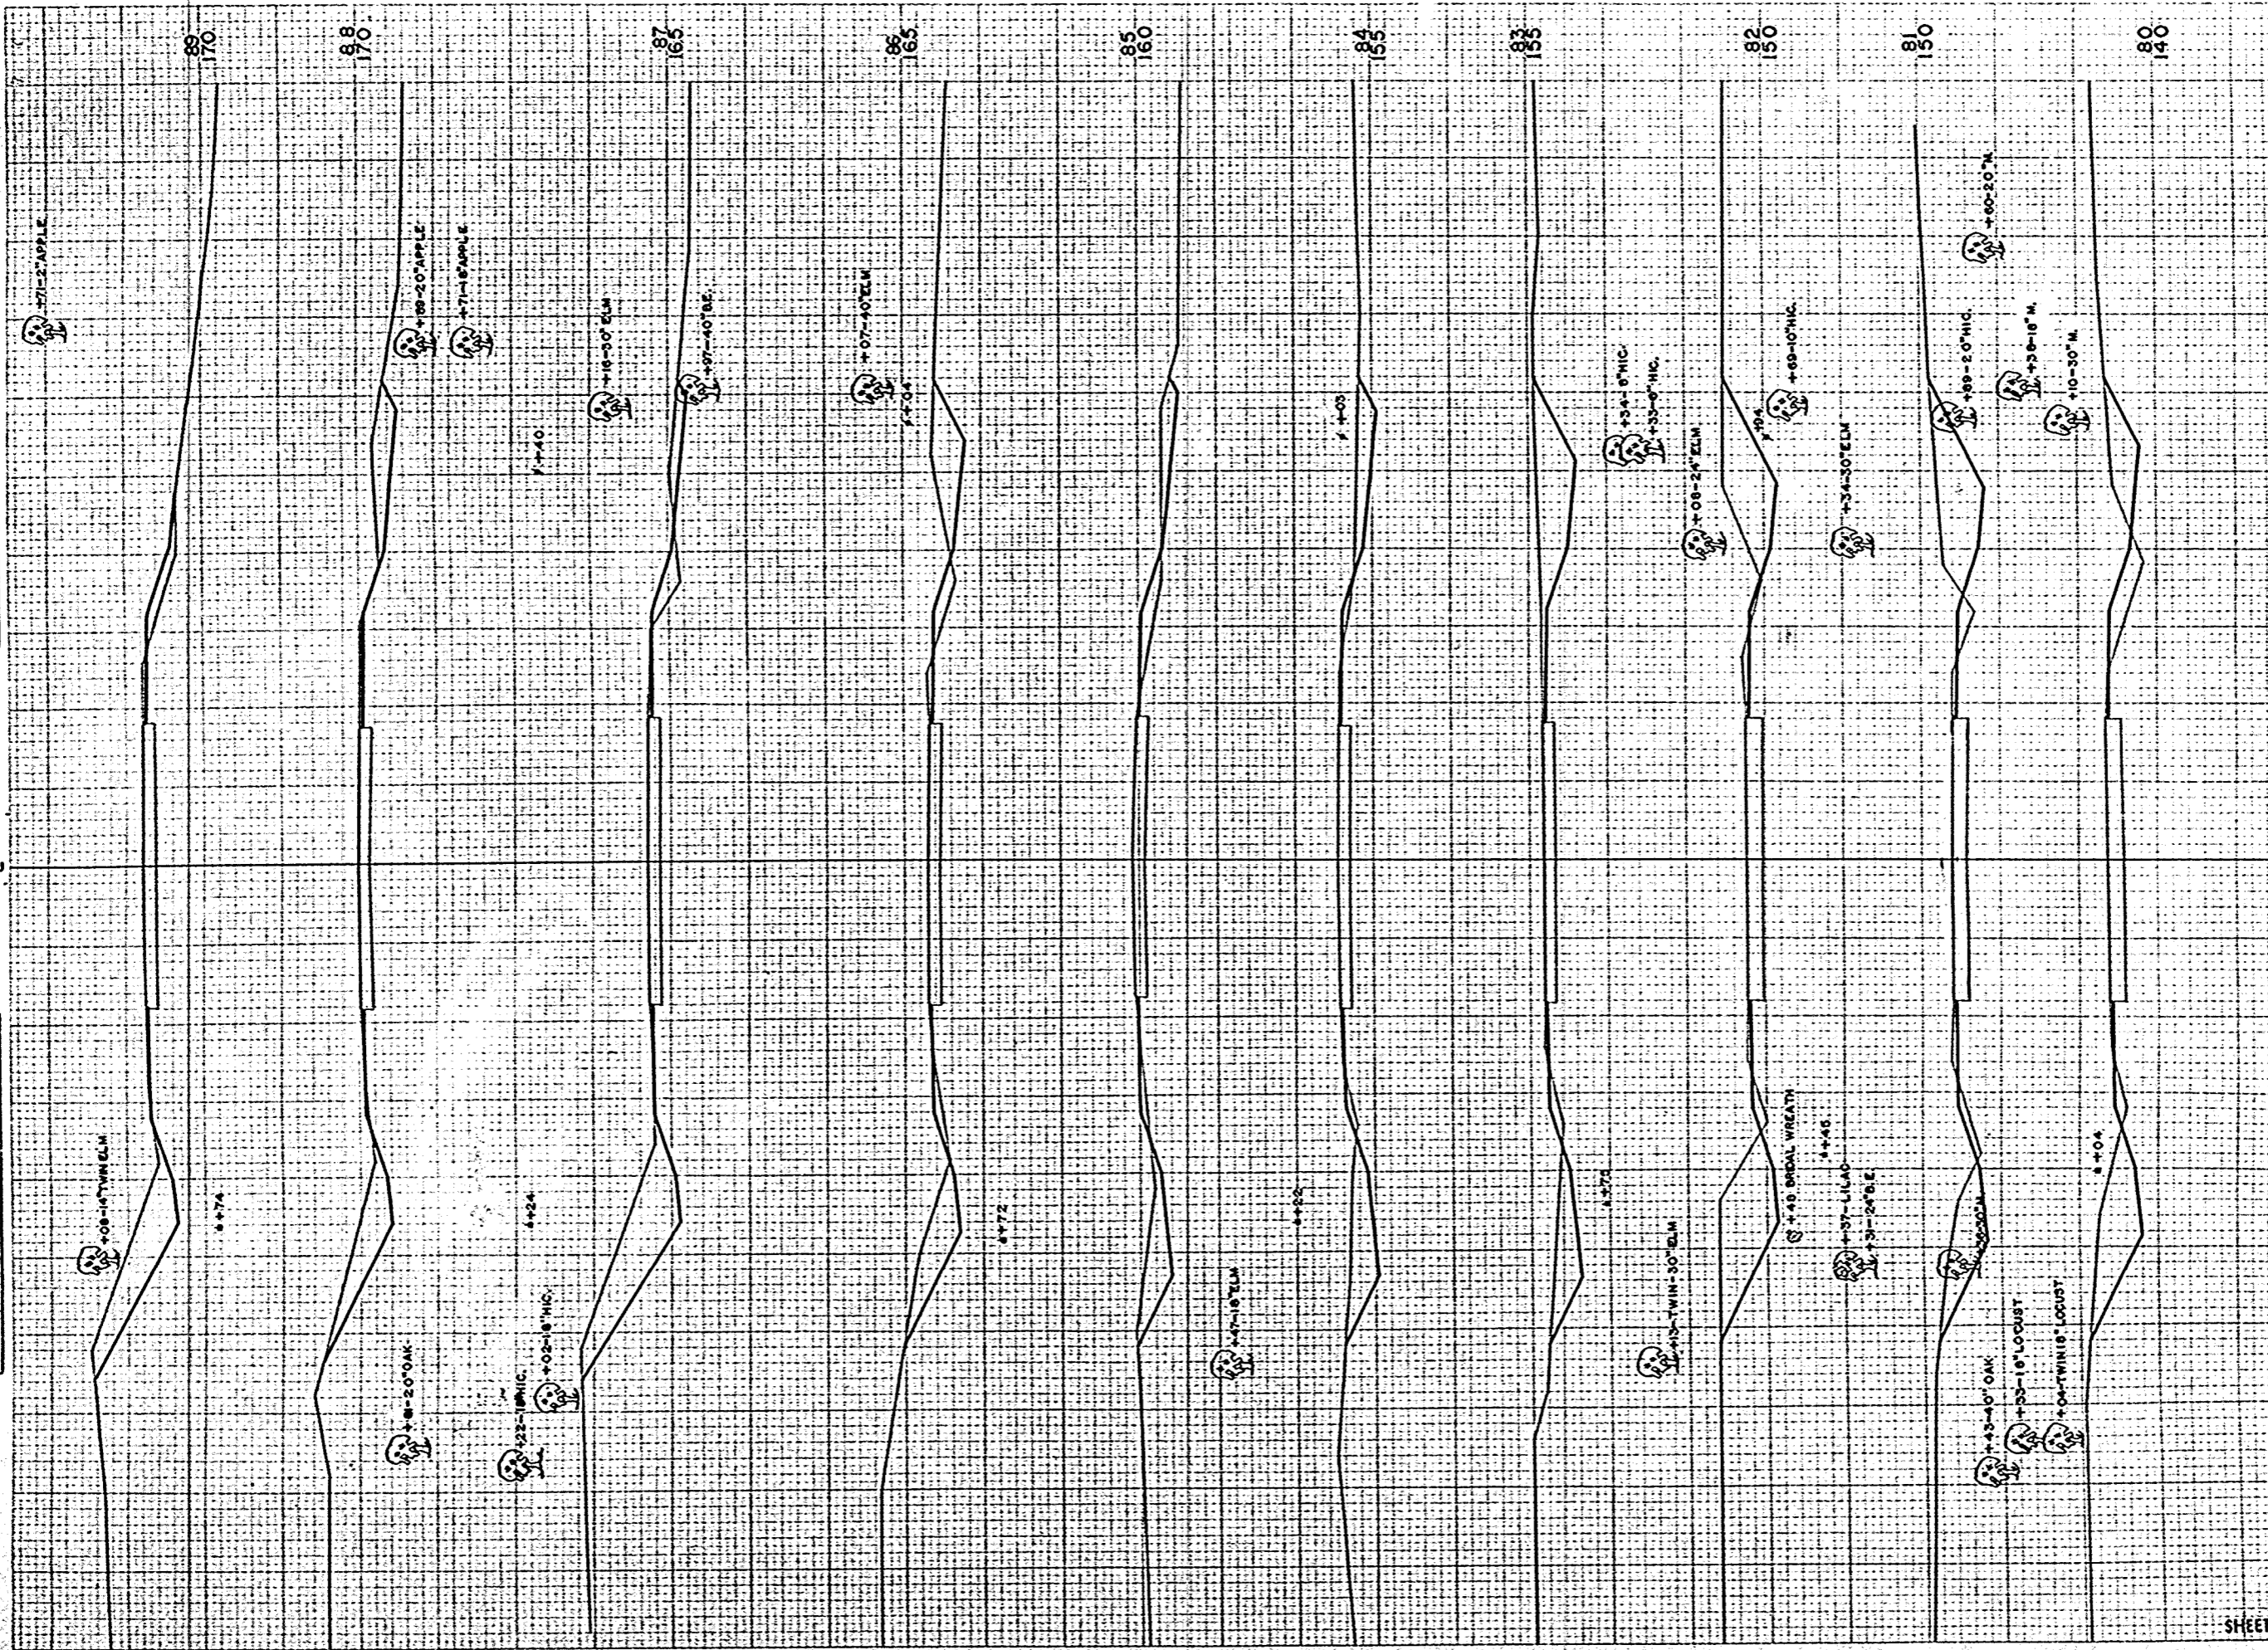

STATION	DISTANCE	YARDAGE	
		EXCAVATION	
		UNC.	FILL
79			
80	115		37
81	142		22
82	178		11
83	174		7
84	126		7
85	90		13
86	96		19
87	141		17
88	139		7
89	104		7
SHEET TOTAL		1305	147

R.P.A. DISTRICT OFFICE
 WIS. 4


PROJECT
 S0308(4)

SHEET NUMBER
 21

TOTAL SHEETS
 29

FINAL SURVEY PLANNED NOTE BOOK NO. 40

ORIGINAL SURVEY PLANNED NOTE BOOK NO. 40
 DATE: 9-87, 10-87, 11-87, 12-87
 P.L.M., P.C.K., P.C.K., P.C.K.

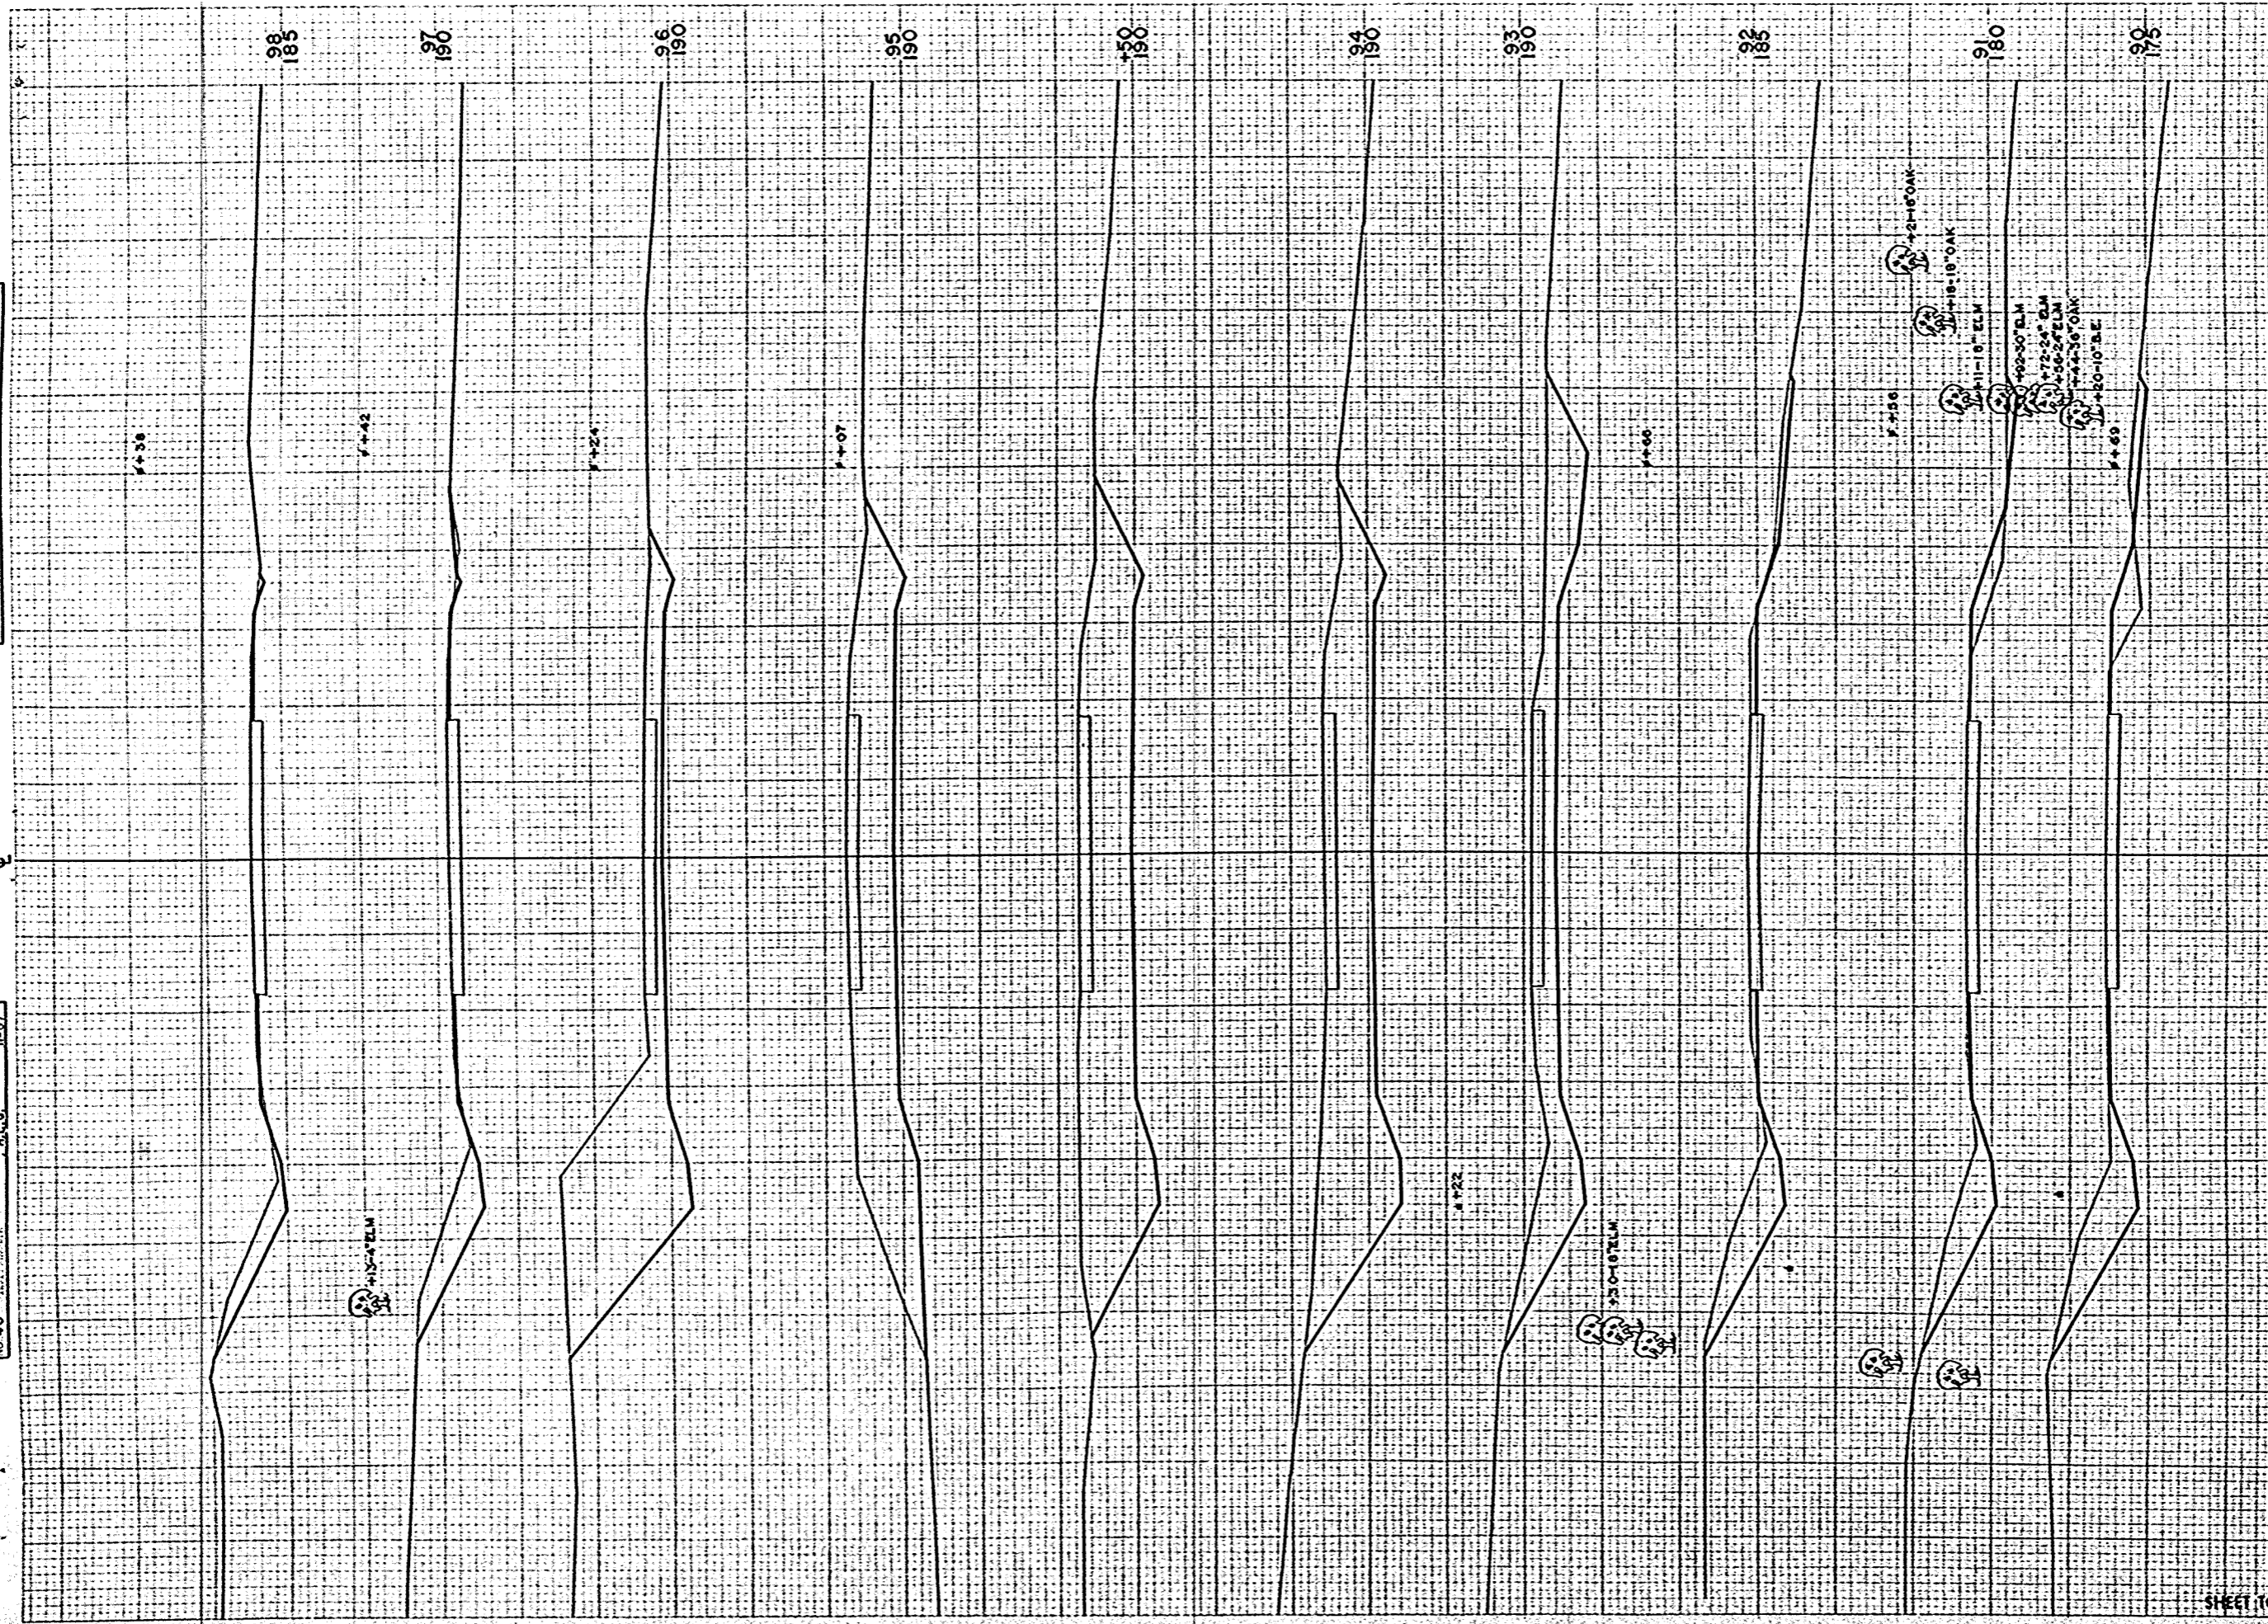


STATION	DISTANCE	YARDAGE	
		EXCAVATION	
		UNC.	FILL
89		118	24
90		119	29
91		109	11
92		219	0
93		444	0
94		294	0
150		278	0
95		507	0
96		300	2
97		68	2
98			
SHEET TOTAL		2456	68

B.P.A. DISTRICT OFFICE WIS. 4 PROJECT 50308(4) SHEET NUMBER 22 TOTAL SHEETS 29

FINAL SURVEY
 DATE: 10-27-57
 BY: R.C.K.
 CHECKED: R.C.K.
 NO. 40

ORIGINAL SURVEY
 DATE: 10-27-57
 BY: R.C.K.
 CHECKED: R.C.K.
 NO. 40

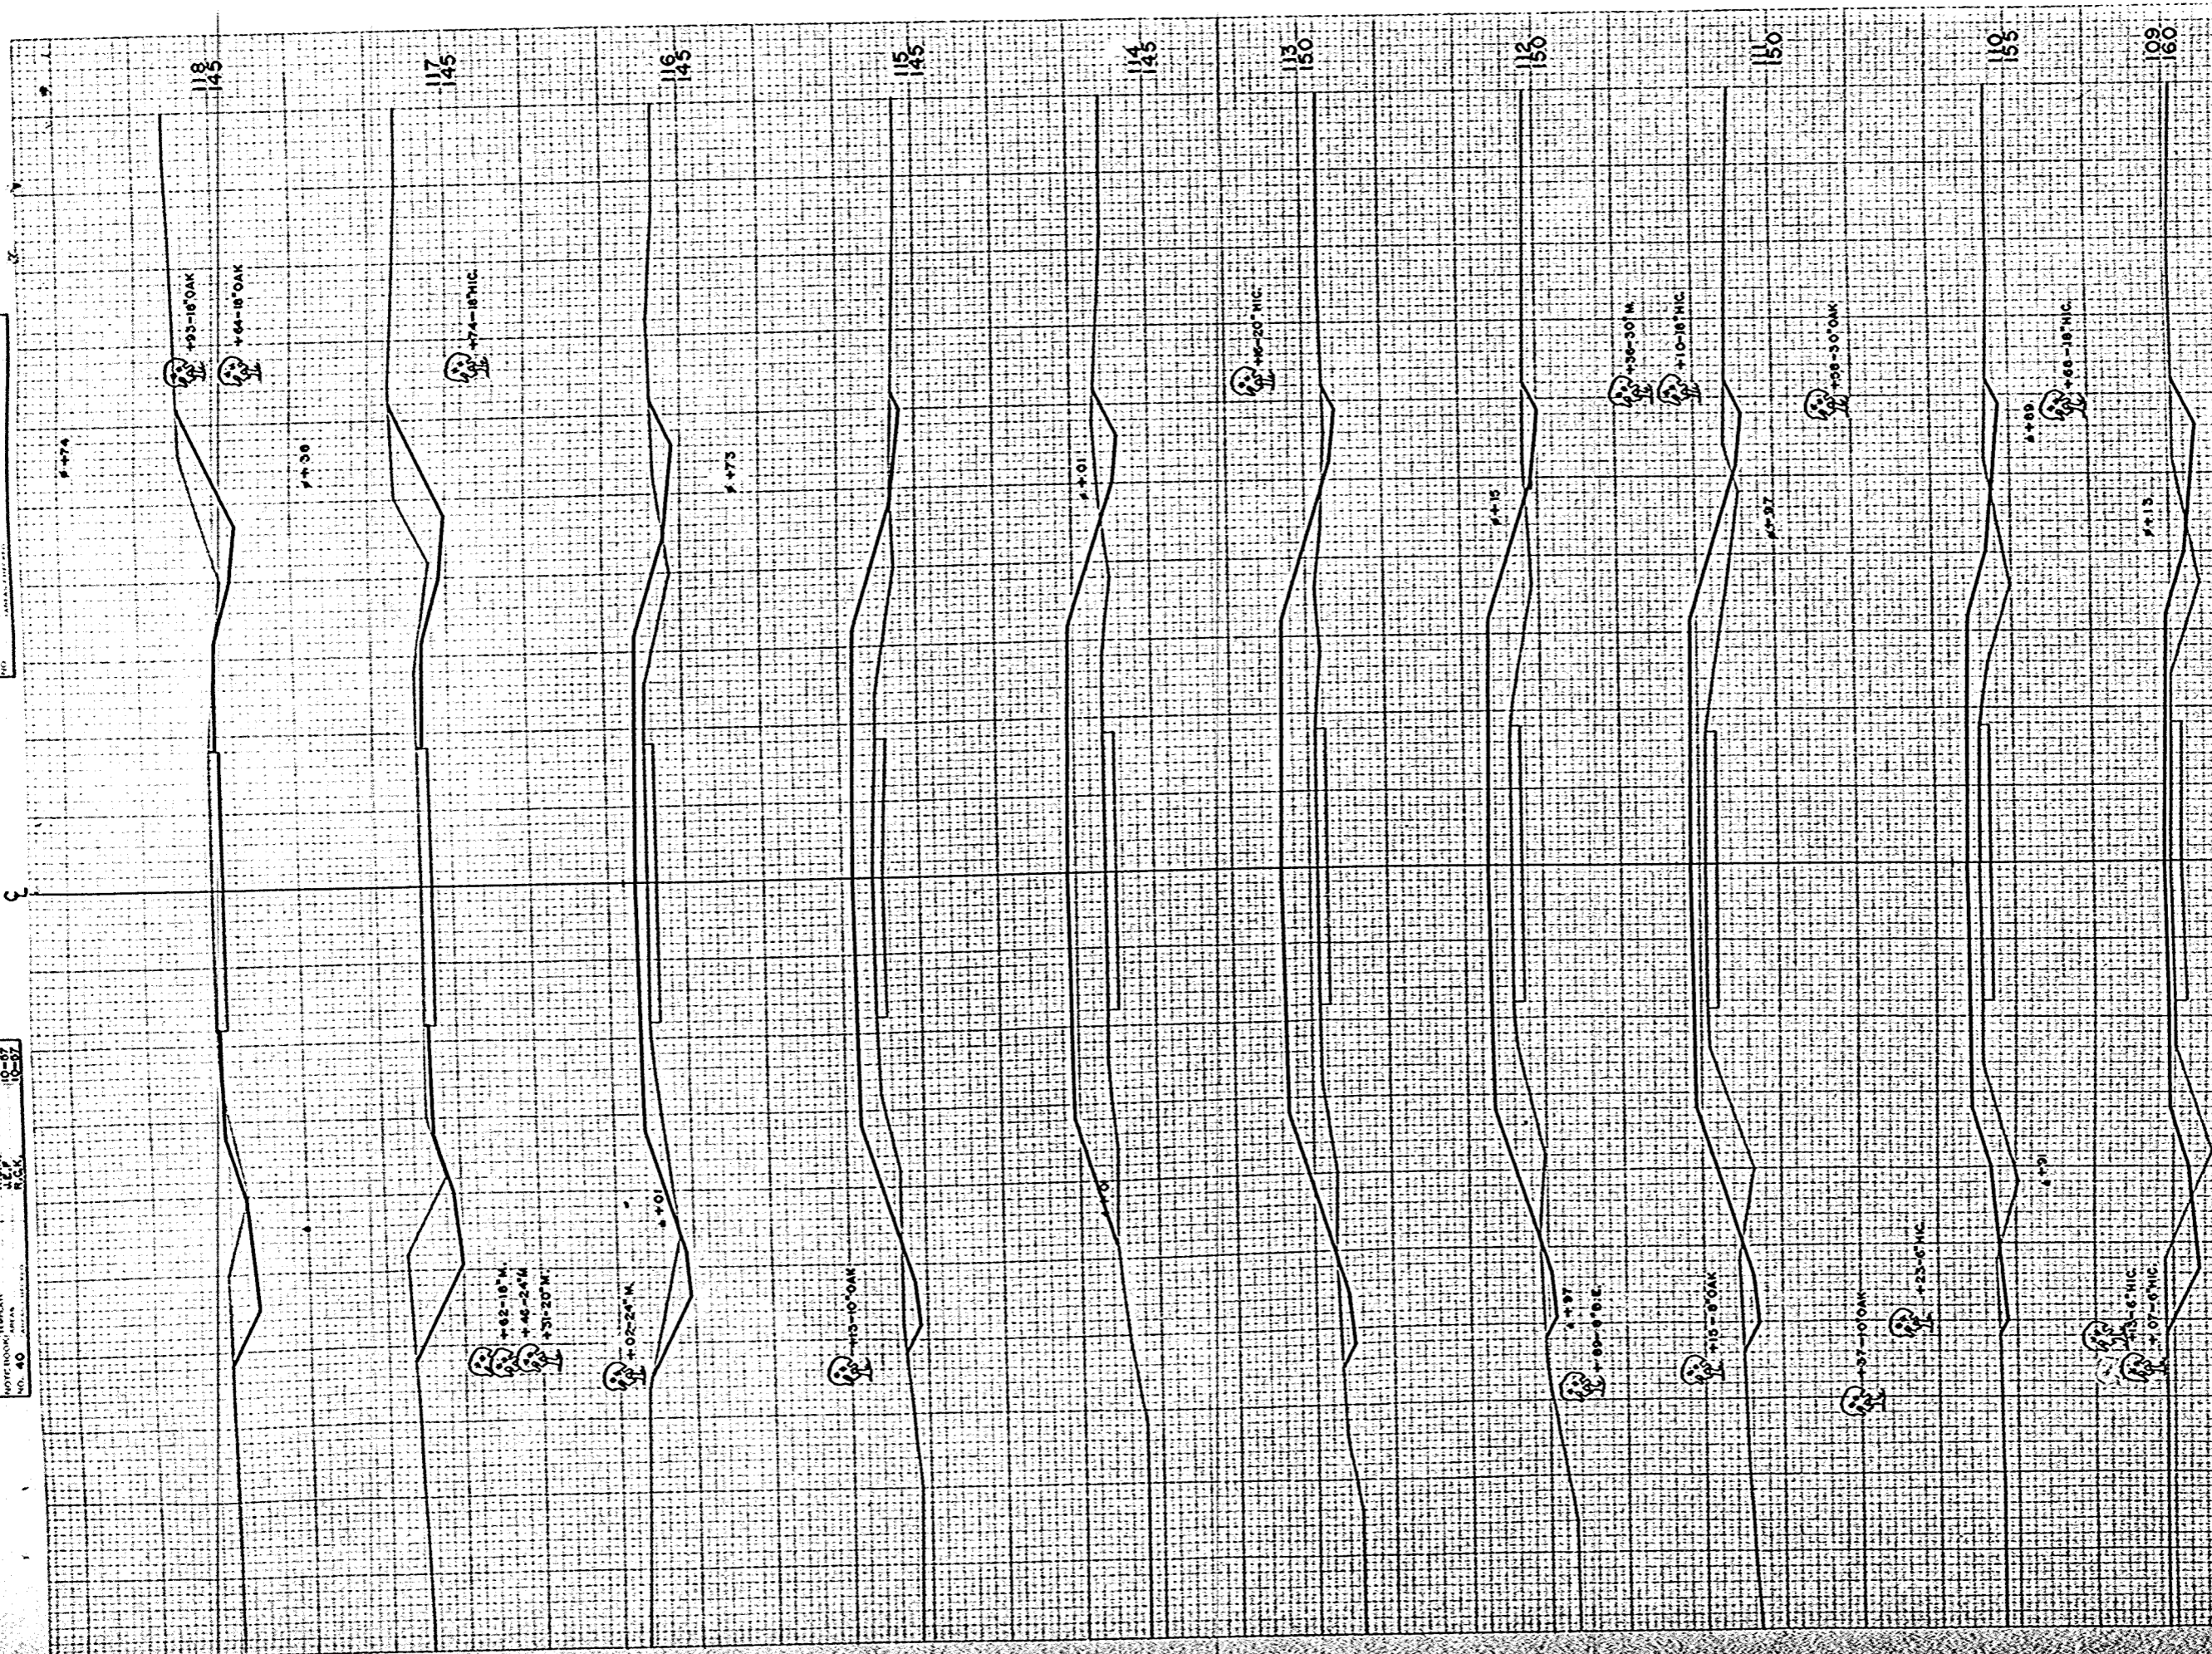


B.P.R. DISTRICT OFFICE	PROJECT	SHEET NUMBER	TOTAL SHEETS
WIS. 4	S0308(4)	24	29

STATION	DISTANCE	YARDAGE	
		EXCAVATION	FILL
108			
9	100		72
10	46		140
11	30		206
12	32		254
13	26		322
14	33		357
15	33		289
16	39		181
17	117		67
18	146		4
SHEET TOTAL		602	892

FINAL SURVEY PLATE
 DATE: 10-27-07
 BY: [Signature]
 CHECKED: [Signature]
 NO. 40

ORIGINAL SURVEY PLATE
 DATE: 10-27-07
 BY: [Signature]
 CHECKED: [Signature]
 NO. 40

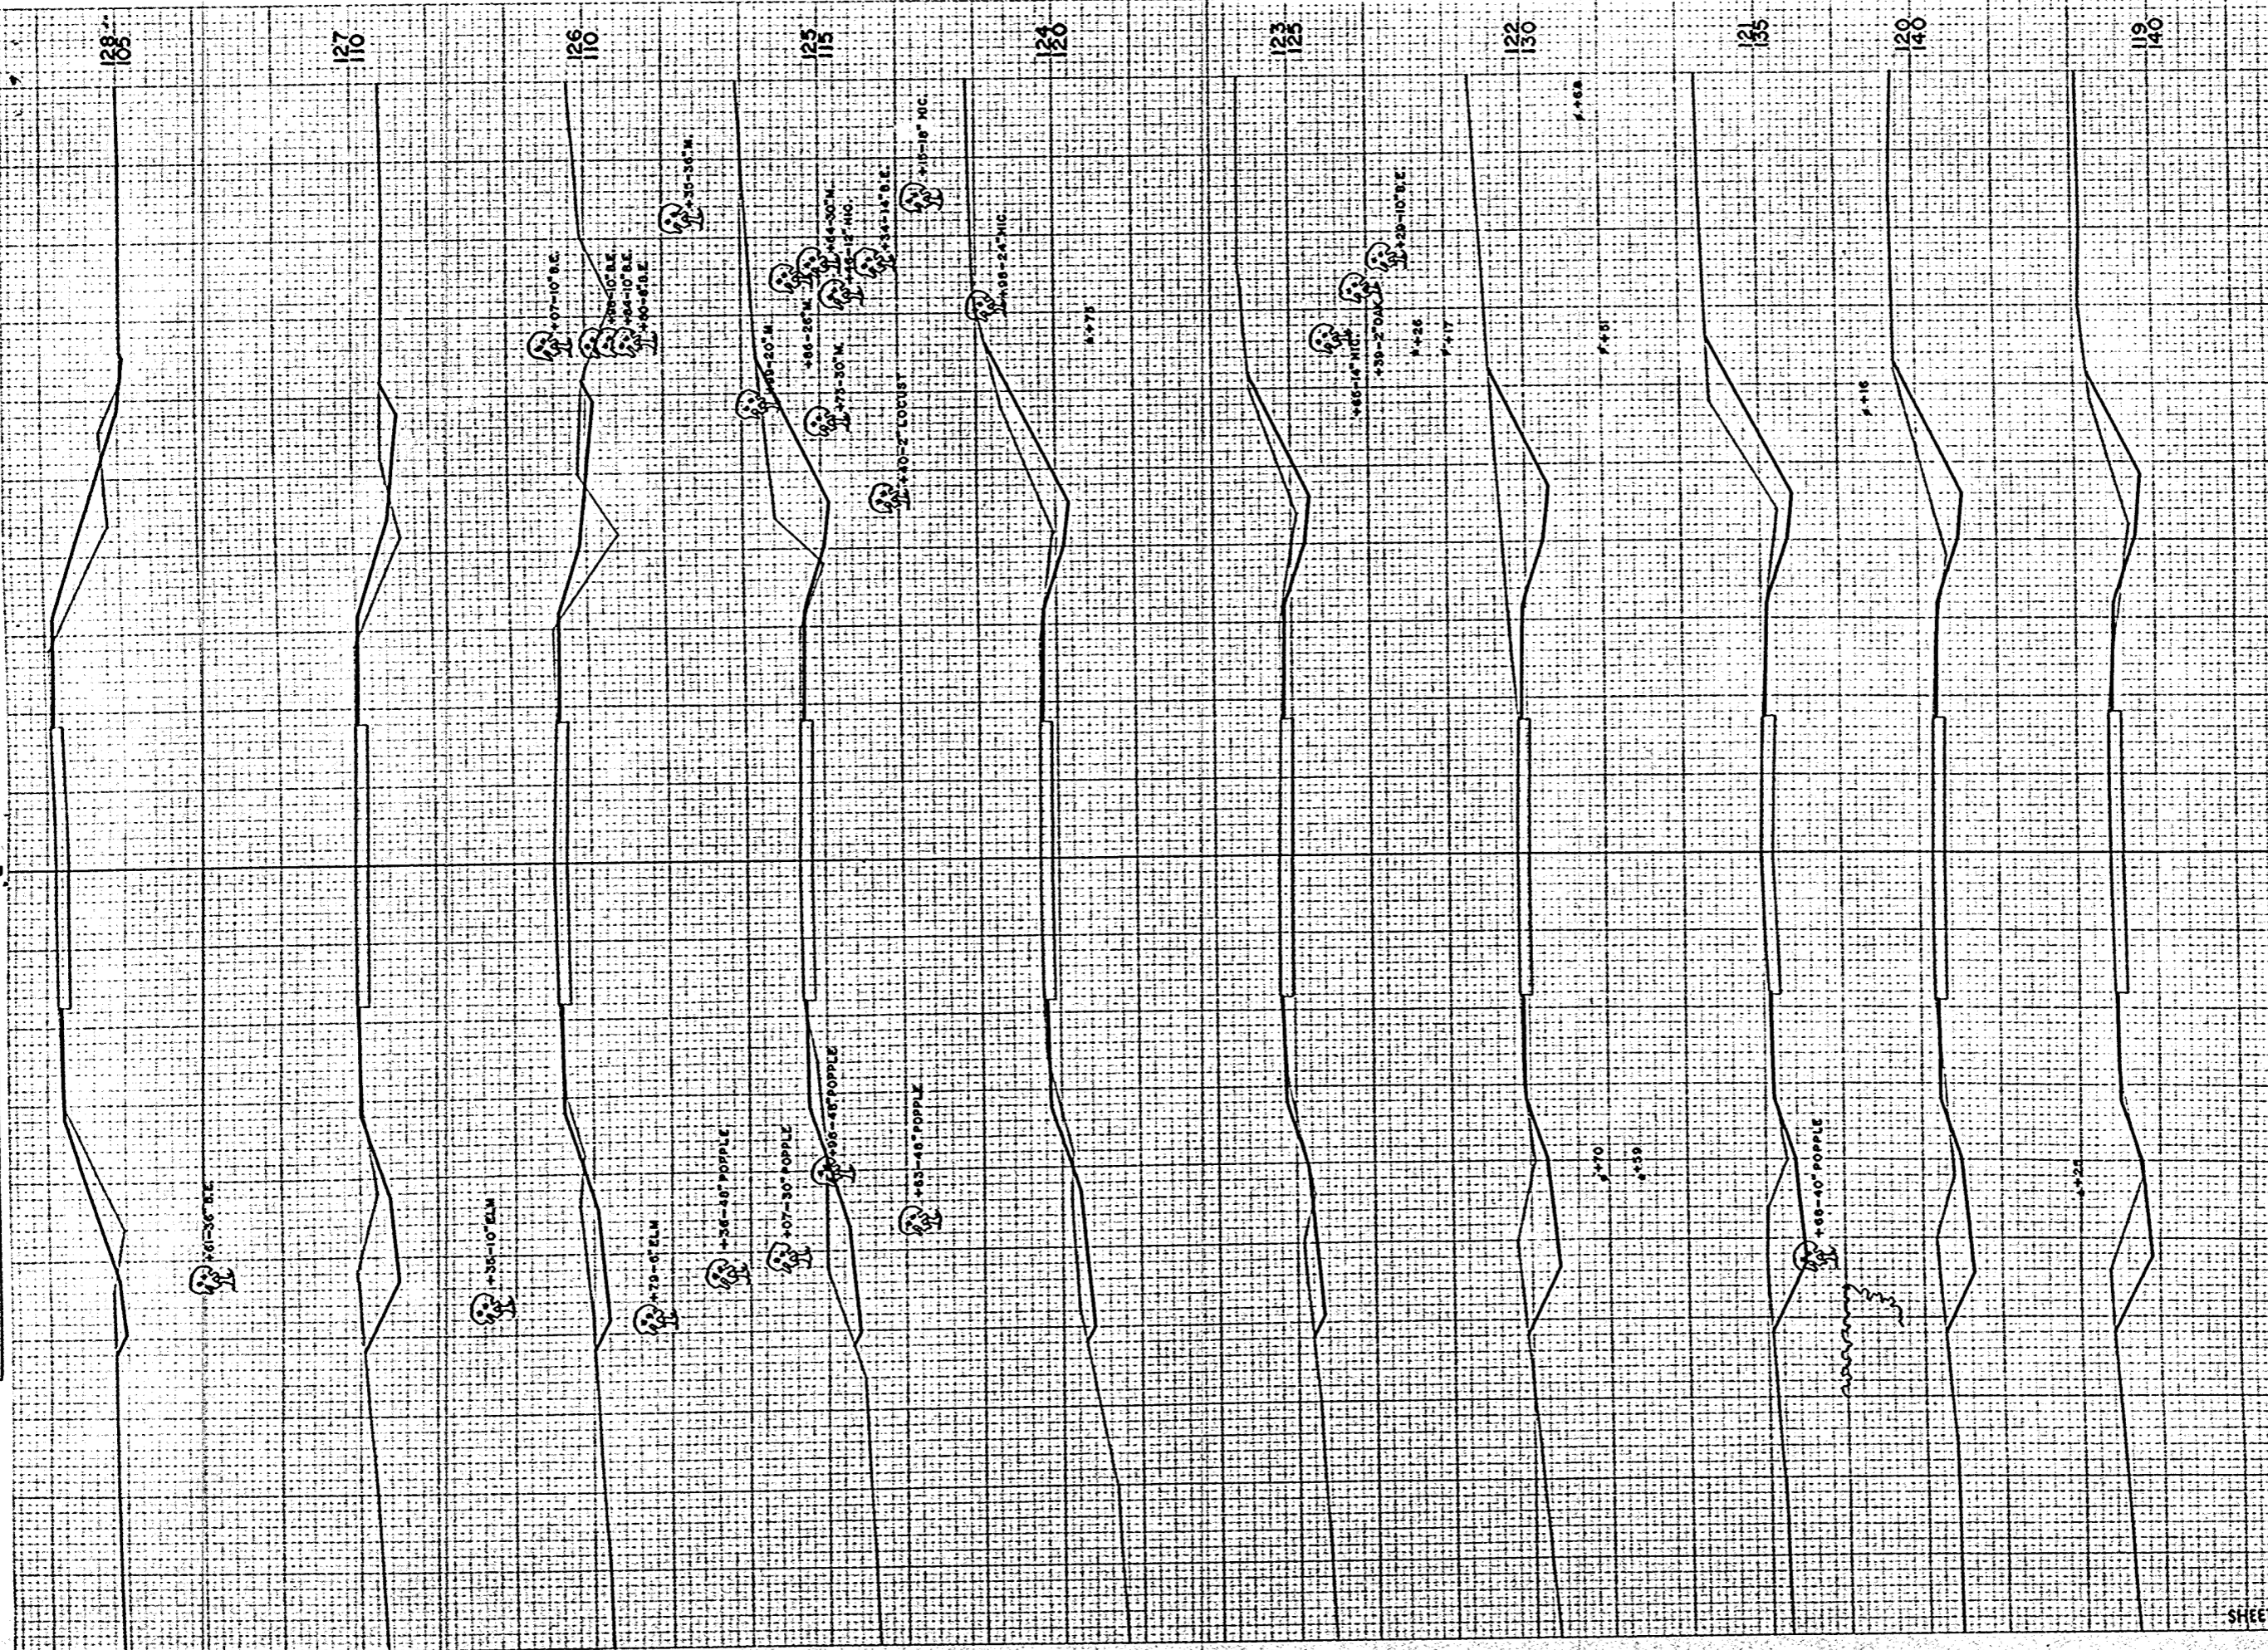


STATE DISTRICT OFFICE	PROJECT	SHEET NUMBER	TOTAL SHEETS
WIS. 4	50308(4)	25	29

STATION	DISTANCE	YARDAGE	
		EXCAVATION	FILL
118			
19	102		5
120	105		4
21	126		2
22	174		0
23	139		2
24	78		5
125	119		13
26	102		30
27	74		33
28	57		50
SHEET TOTAL		1076	144

FINAL SURVEY MAP
 PROJECT: [unclear]
 DATE: [unclear]


ORIGINAL SURVEY MAP
 PROJECT: [unclear]
 DATE: [unclear]

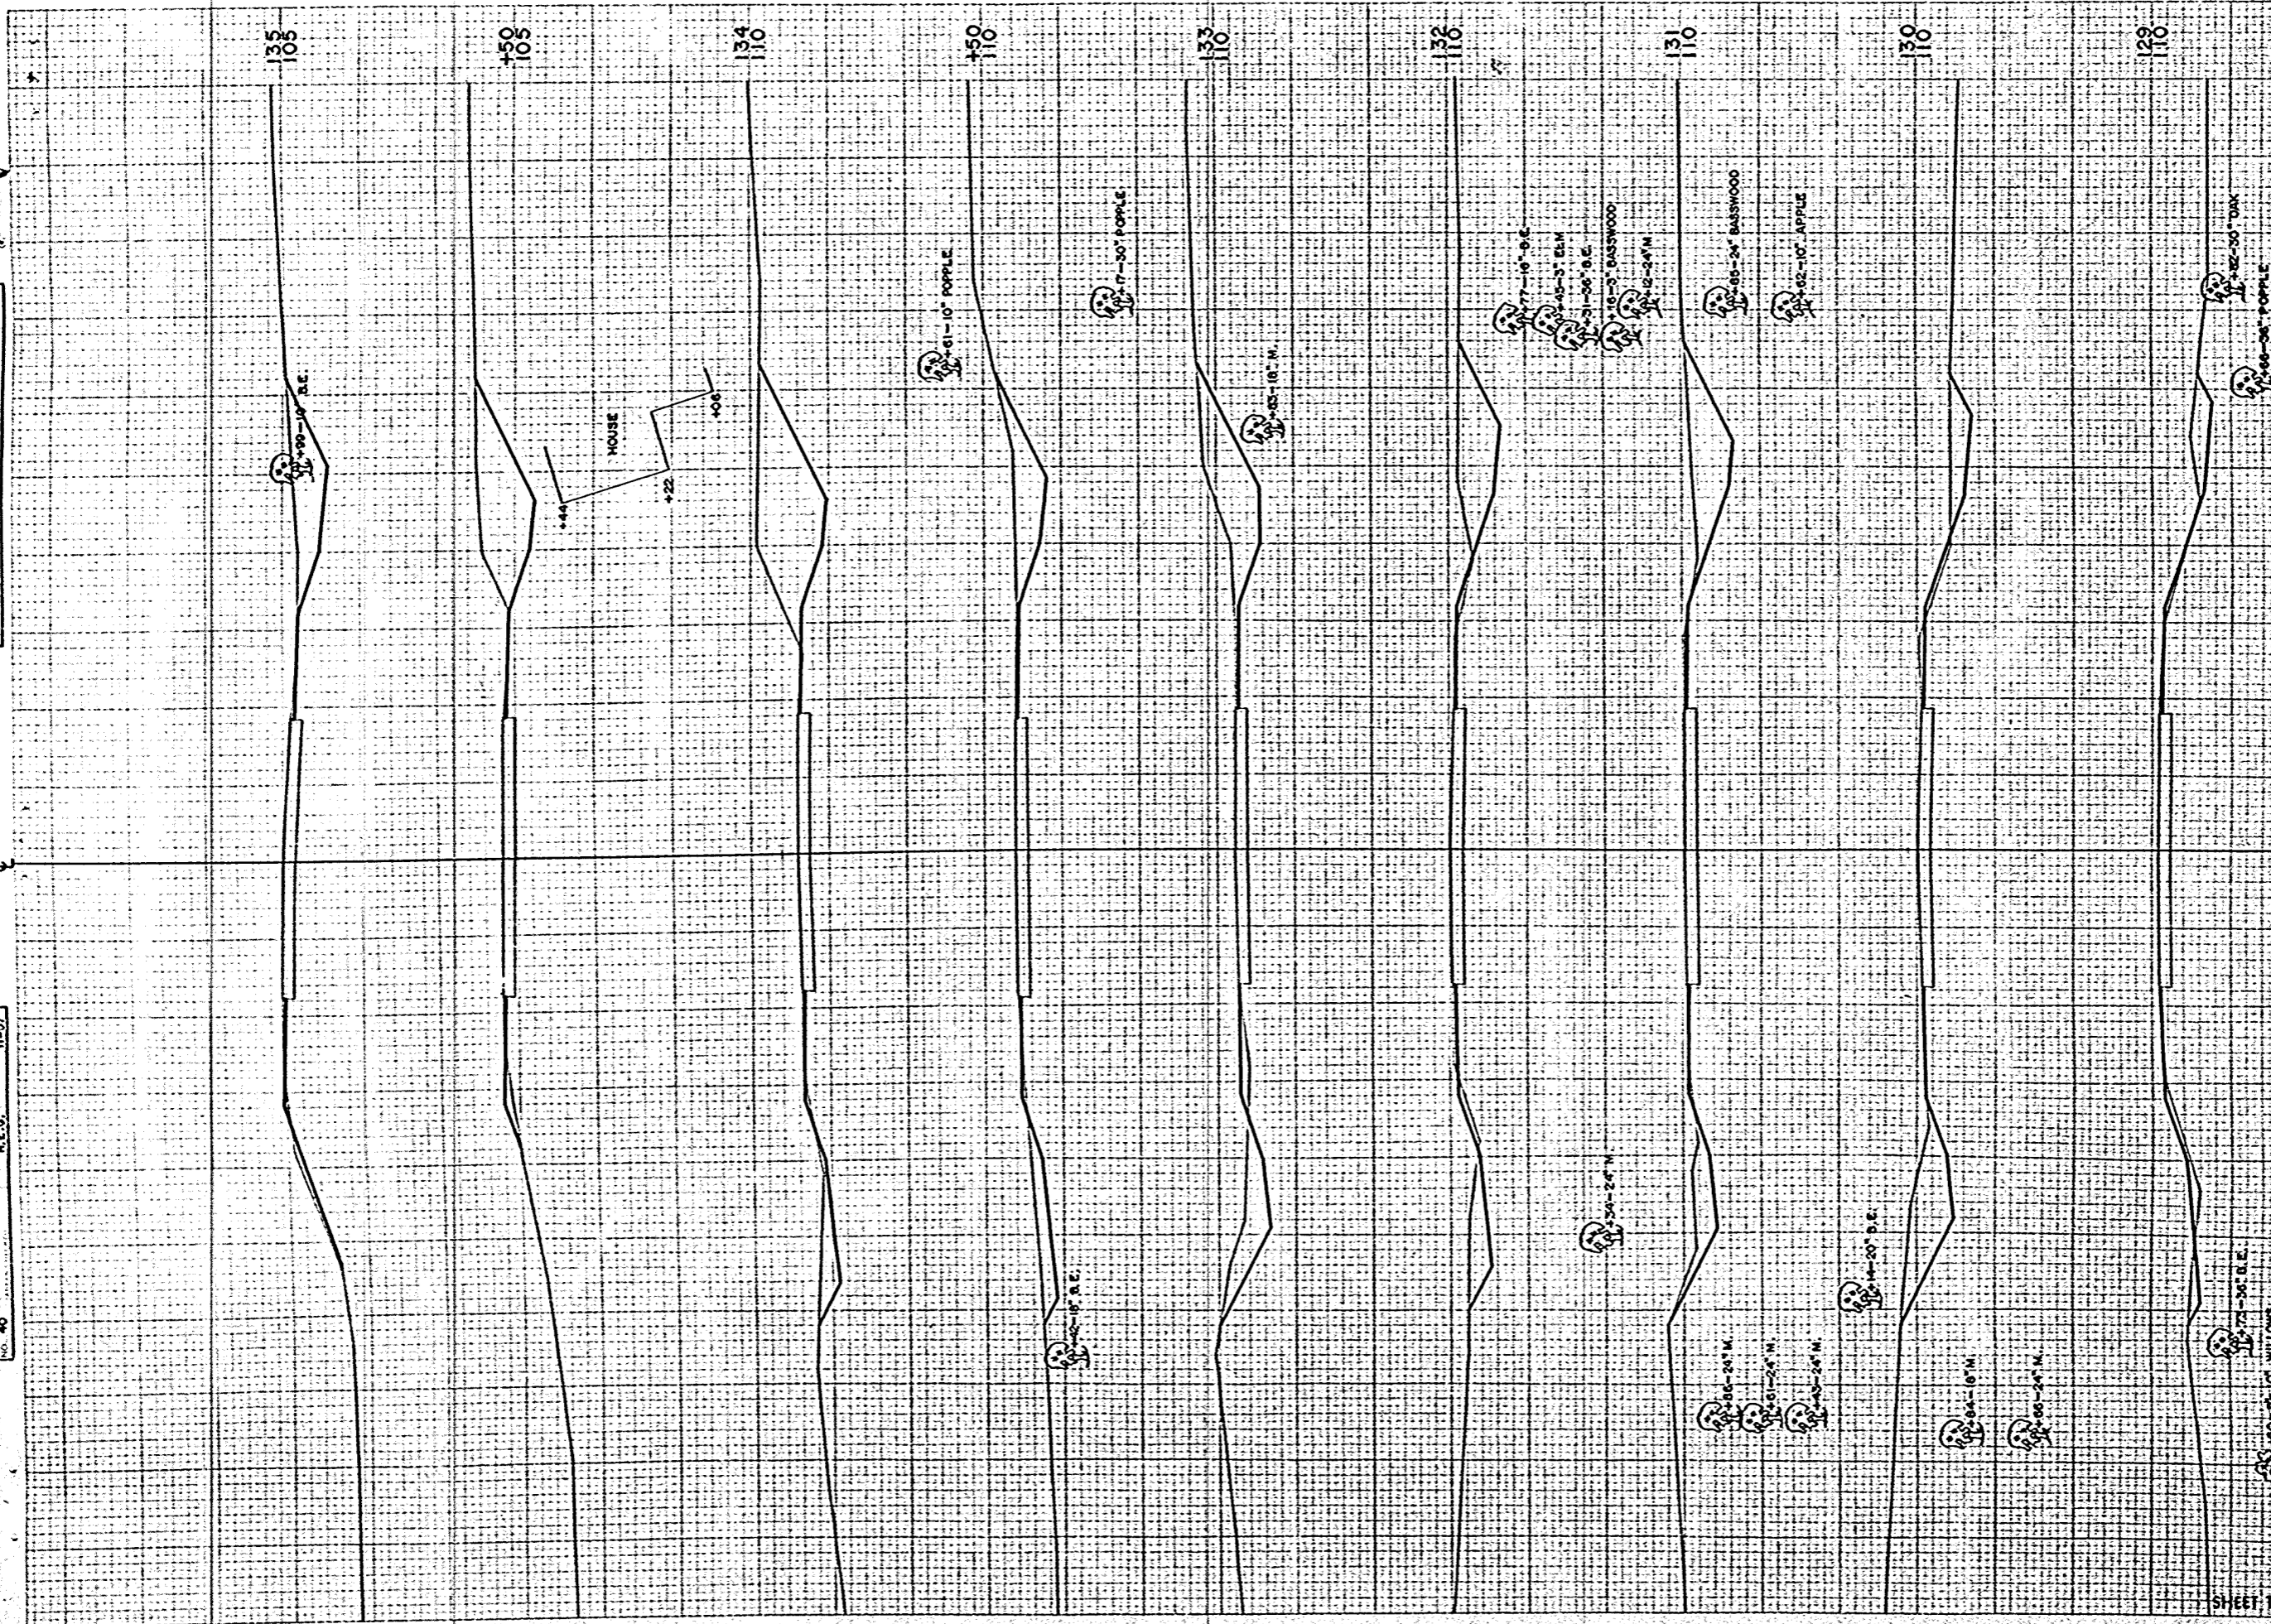

R.F. DISTRICT OFFICE		PROJECT	SHEET NUMBER	TOTAL SHEETS
WIS. 4		9 0308 (4)	26	29
STATION	DISTANCE	YARDAGE		
		EXCAVATION	FILL	
		UNC.		
126	30		44	
29	76		9	
130	120		2	
31	122		4	
32	146		9	
33	72		4	
150	80		2	
34	81		1	
150	50		2	
135				
SHEET TOTAL	777		77	

FINAL SURVEY
 DATE: 10-07-07
 BY: P.C.K.
 CHECKED: M.E.G.


ORIGINAL SURVEY
 DATE: 10-07-07
 BY: P.C.K.
 CHECKED: M.E.G.

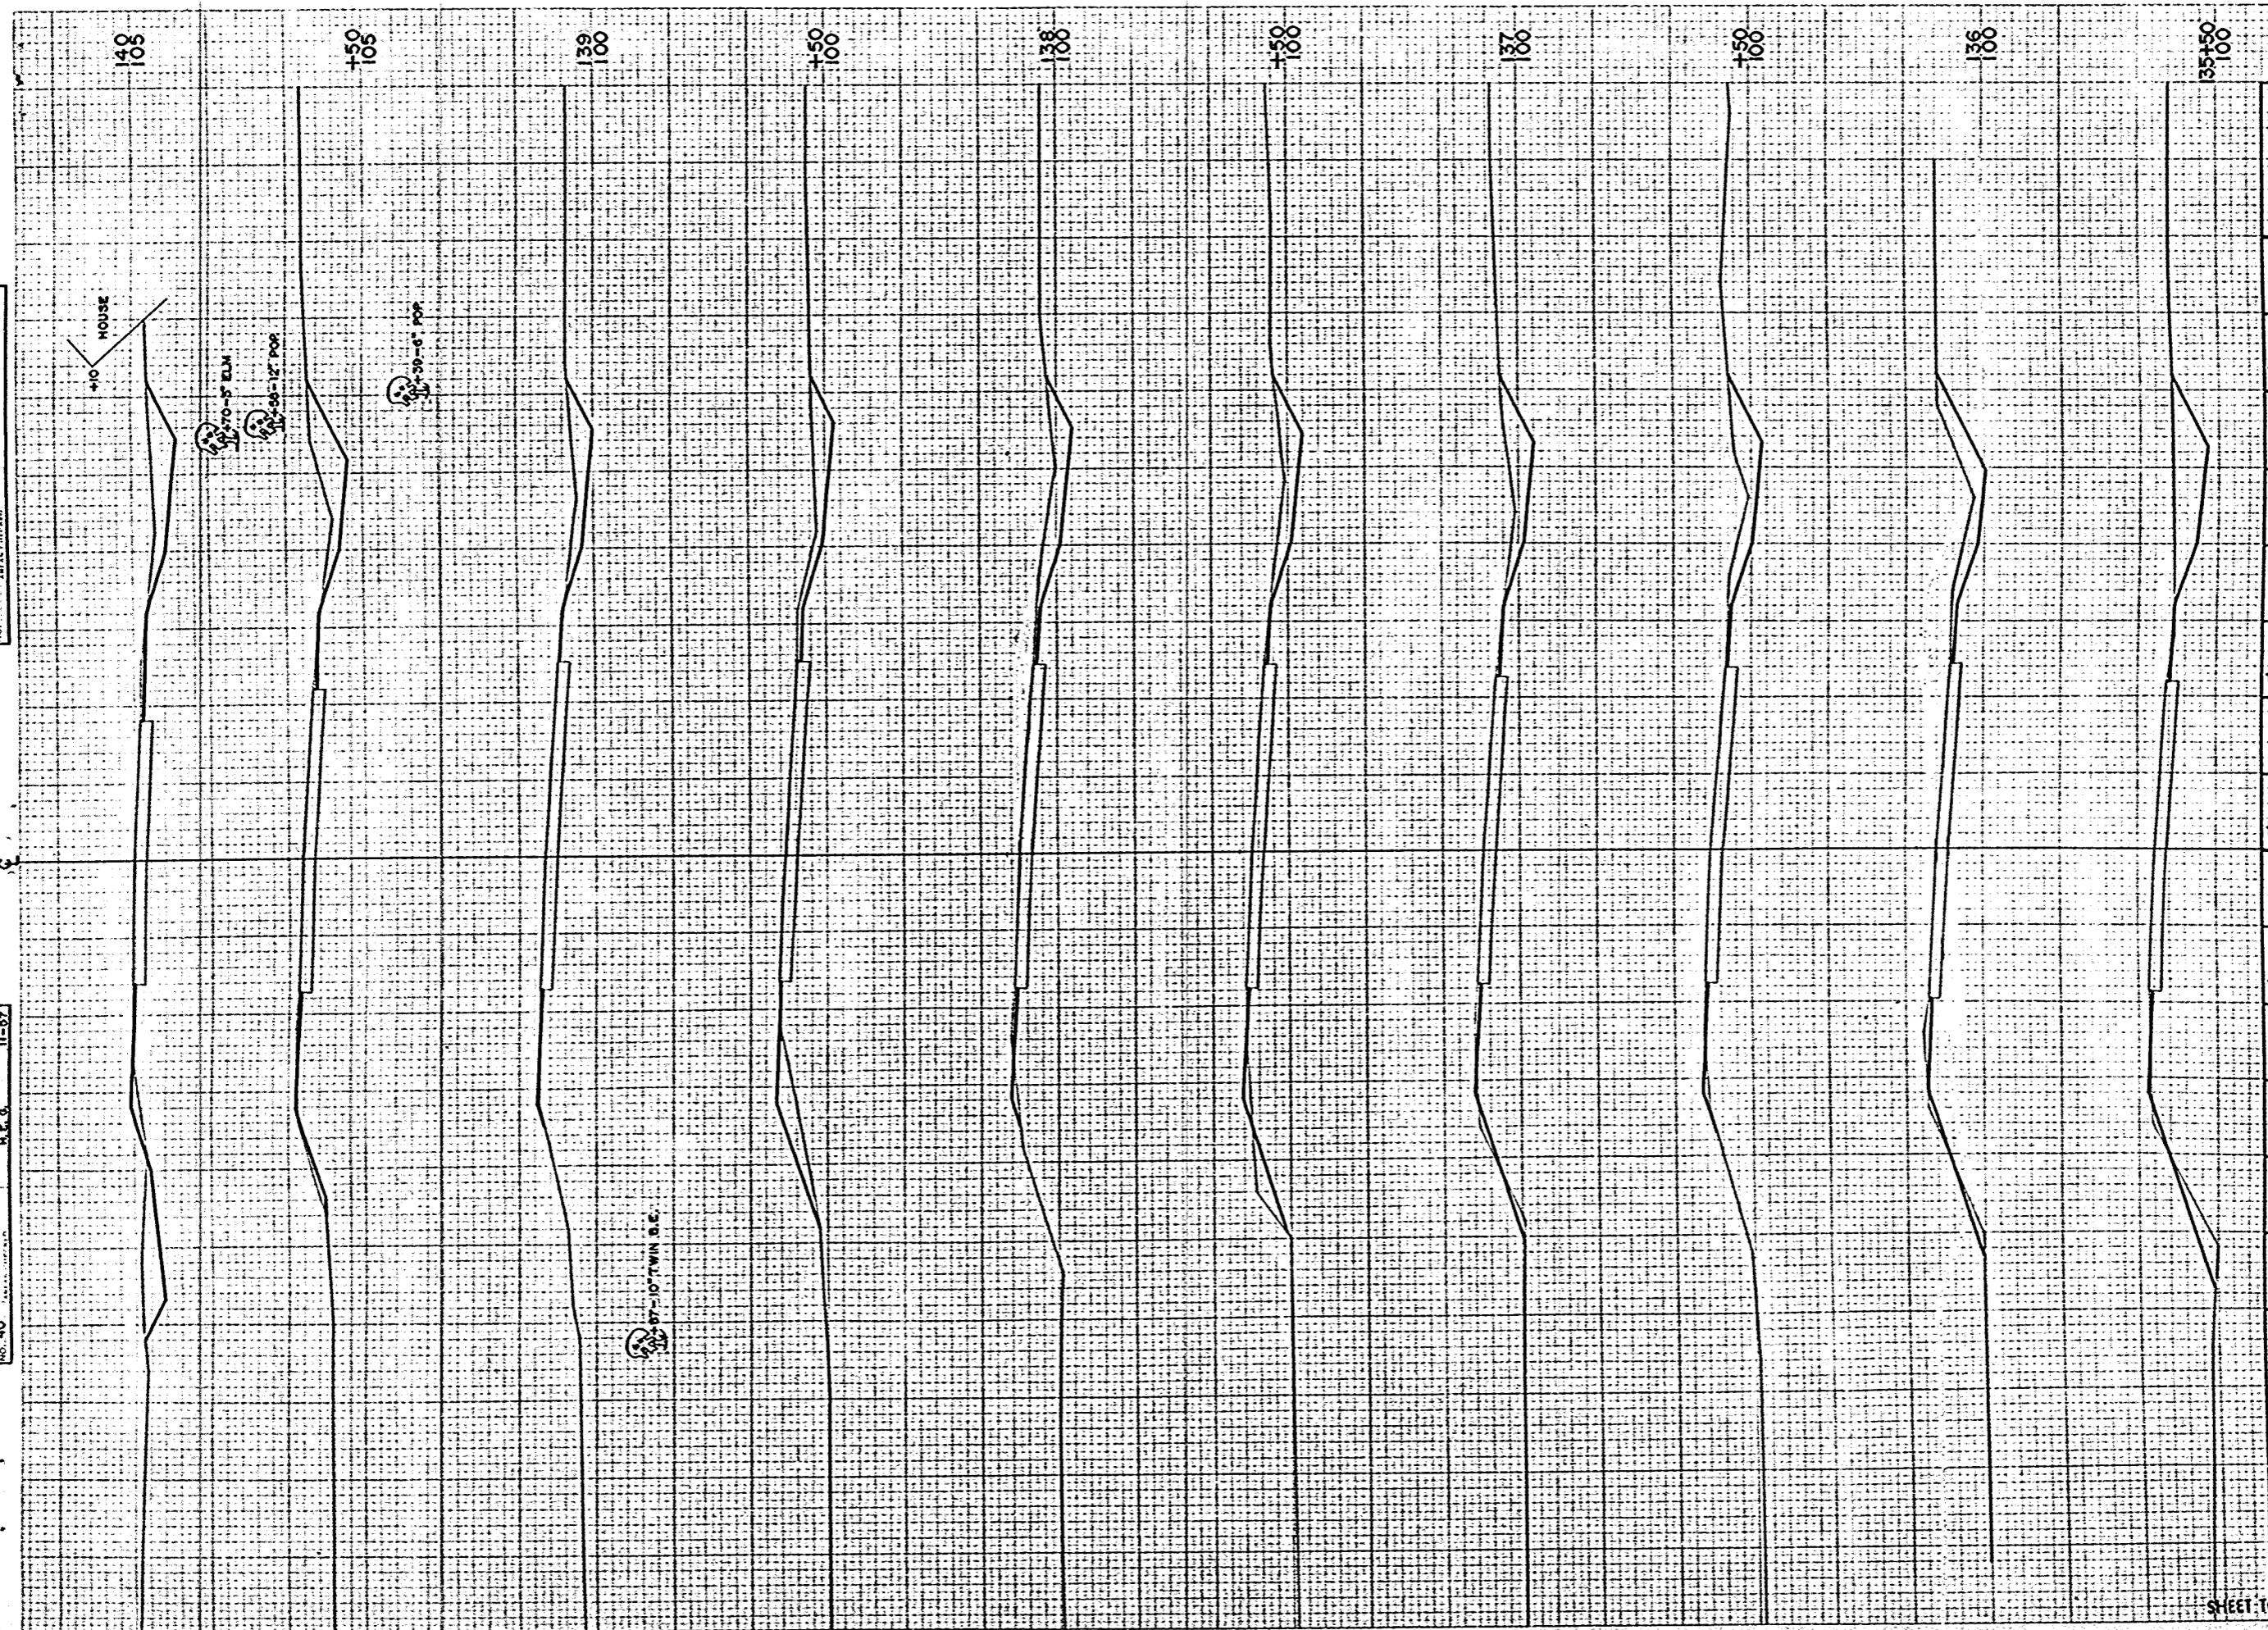

STATION	DISTANCE	YARDAGE		
		EXCAVATION		FILL
		UNC.		
135		43		5
+50		35		7
136		31		2
+50		32		2
37		32		4
+50		31		4
38		26		9
+50		22		7
39		28		0
+50		39		2
140				
SHEET TOTAL		319		42

FINAL SURVEY
 DATE: 10-27-07
 BY: J.C.K.
 CHECKED: J.C.K.
 NO. 40

ORIGINAL SURVEY
 DATE: 10-27-07
 BY: J.C.K.
 CHECKED: J.C.K.
 NO. 40

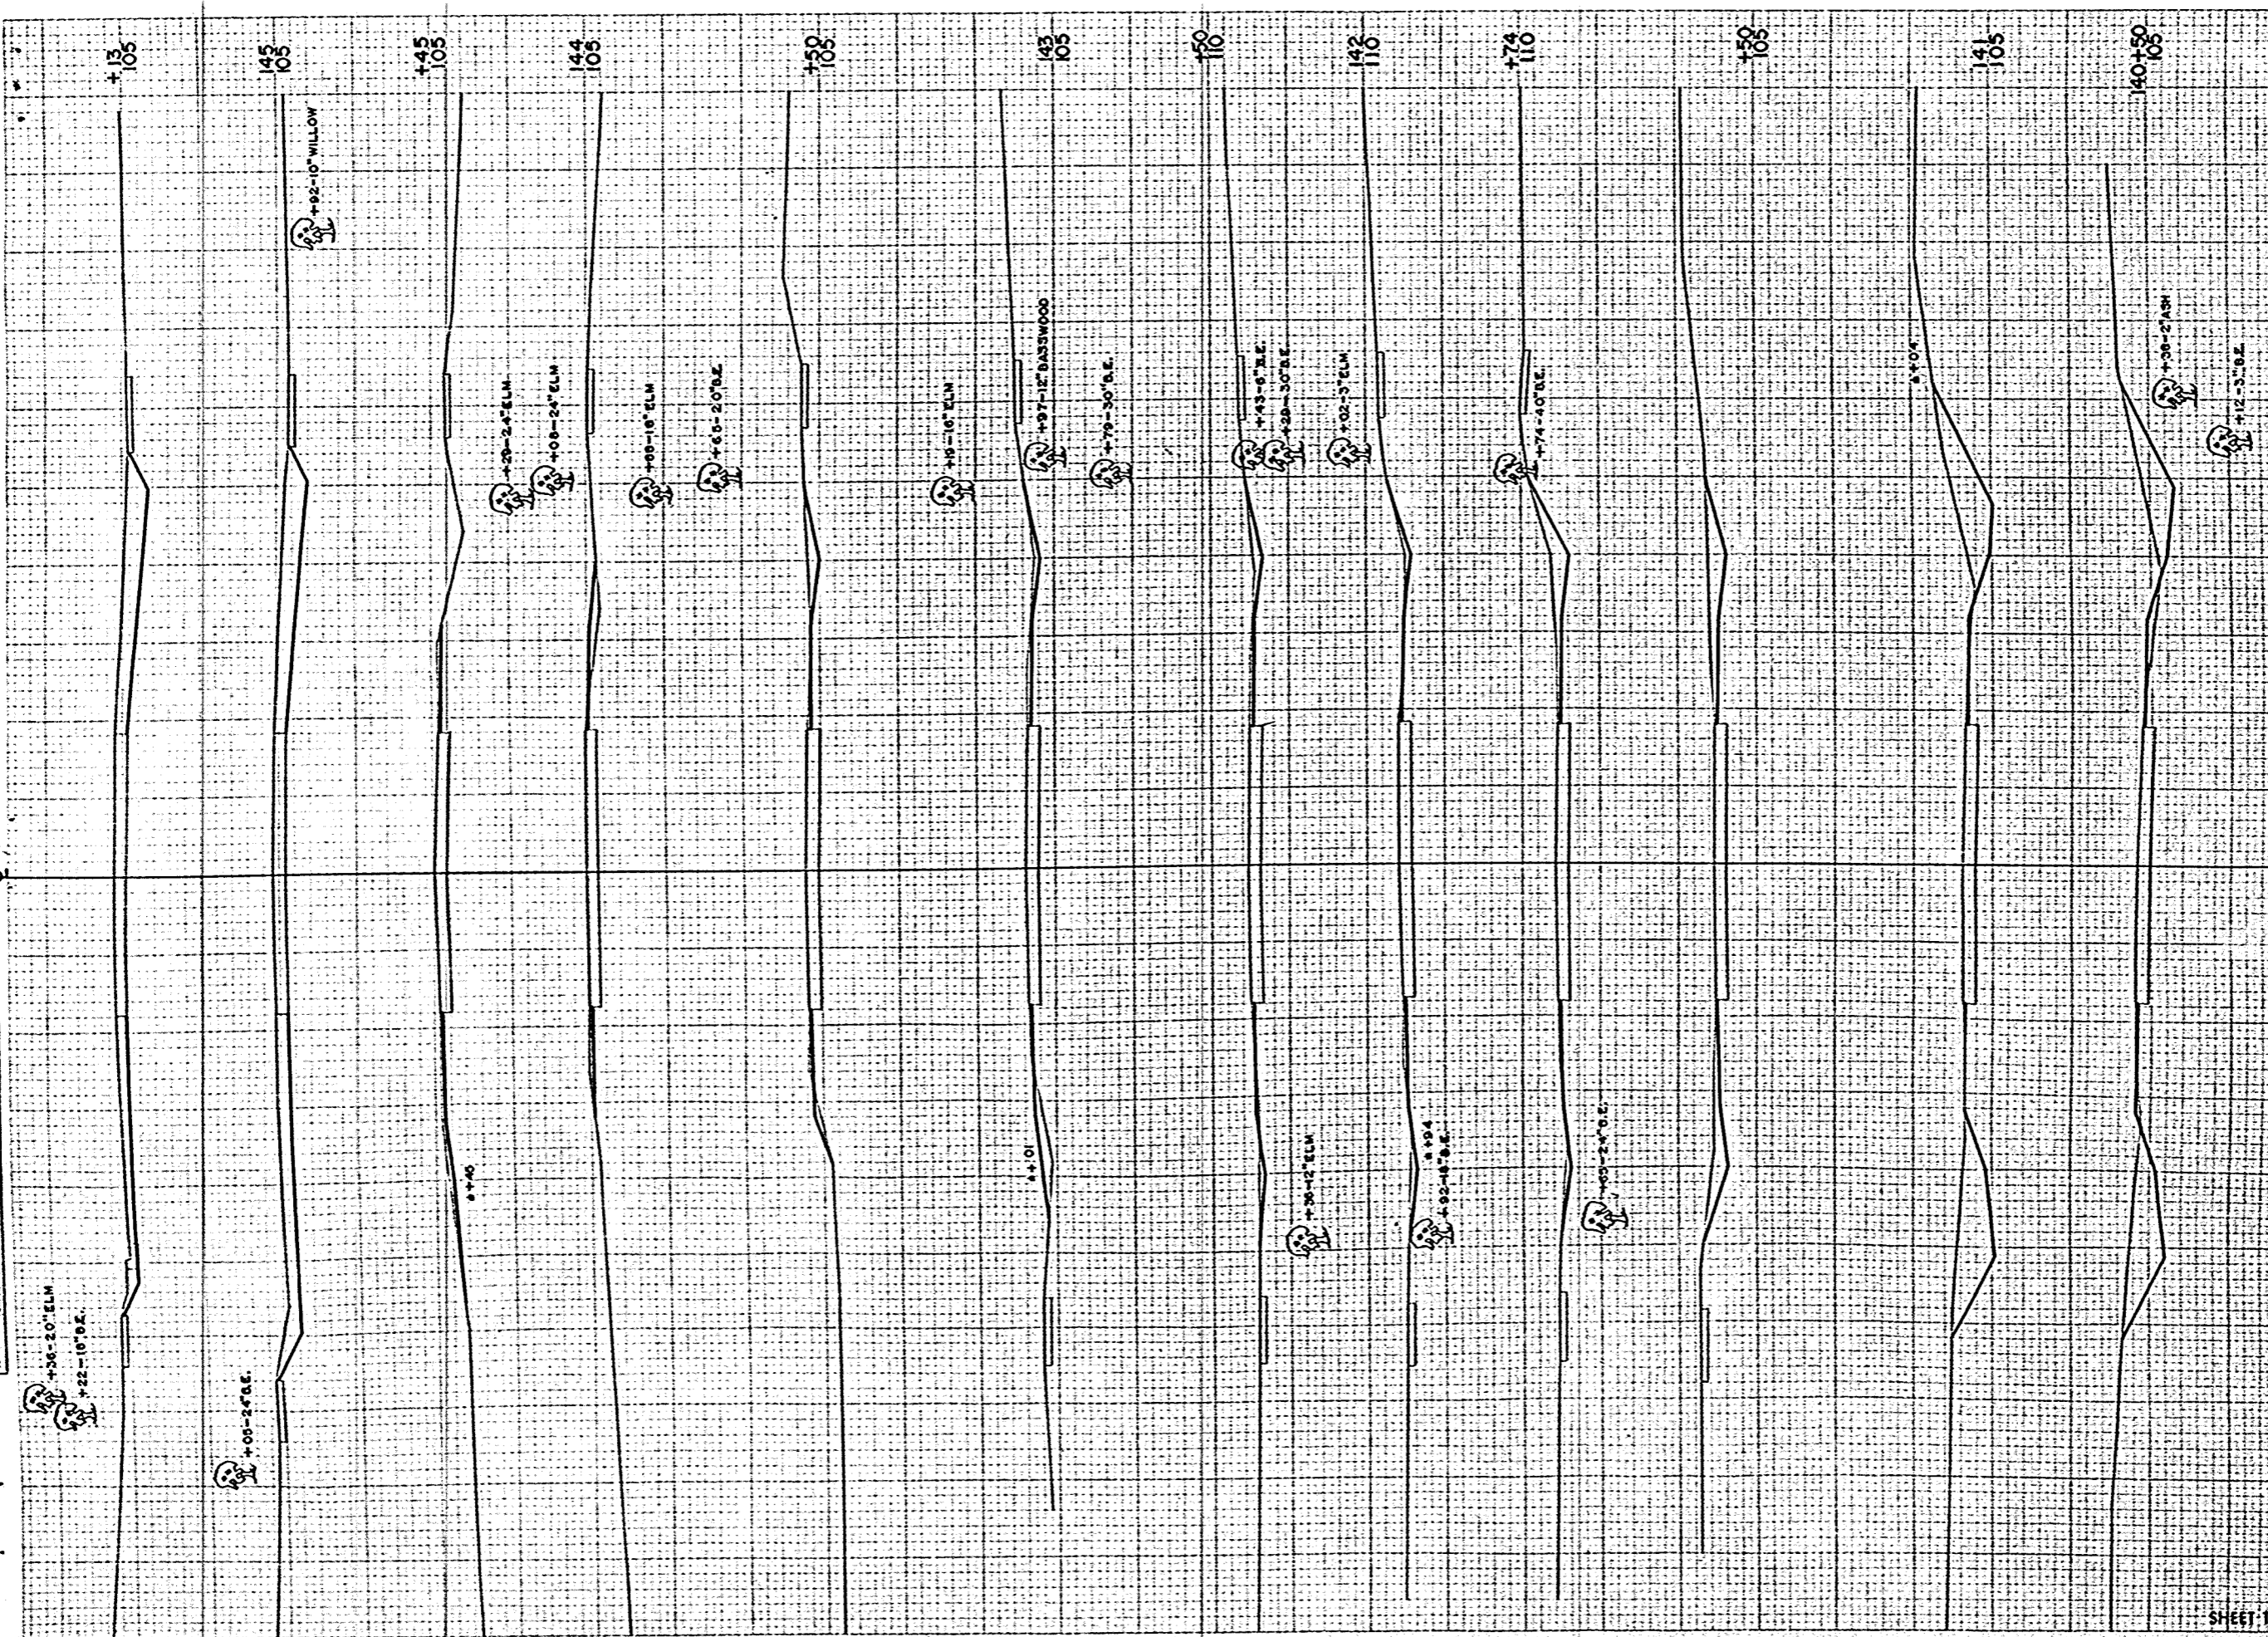


STATION	DISTANCE	YARDAGE	
		EXCAVATION	
		UNC	FILL
140		54	6
150		69	4
41		56	0
150		13	0
174		7	0
142		11	0
150		11	4
43		9	5
150		7	4
144		7	2
145		44	0
145		7	0
113			
SHEET TOTAL		305	25

S.P.A. DISTRICT OFFICE	PROJECT	SHEET NUMBER	TOTAL SHEETS
WIS. 4	50308 (4)	28	29

FINAL SURVEY
 DATE: 9-27, 10-27, 11-27, 11-27
 BY: J.R.K., R.C.K., H.E.G.
 PROJECT: WIS. 4
 SHEET: 29

ORIGINAL SURVEY
 DATE: 9-27, 10-27, 11-27, 11-27
 BY: J.R.K., R.C.K., H.E.G.
 PROJECT: WIS. 4
 SHEET: 29

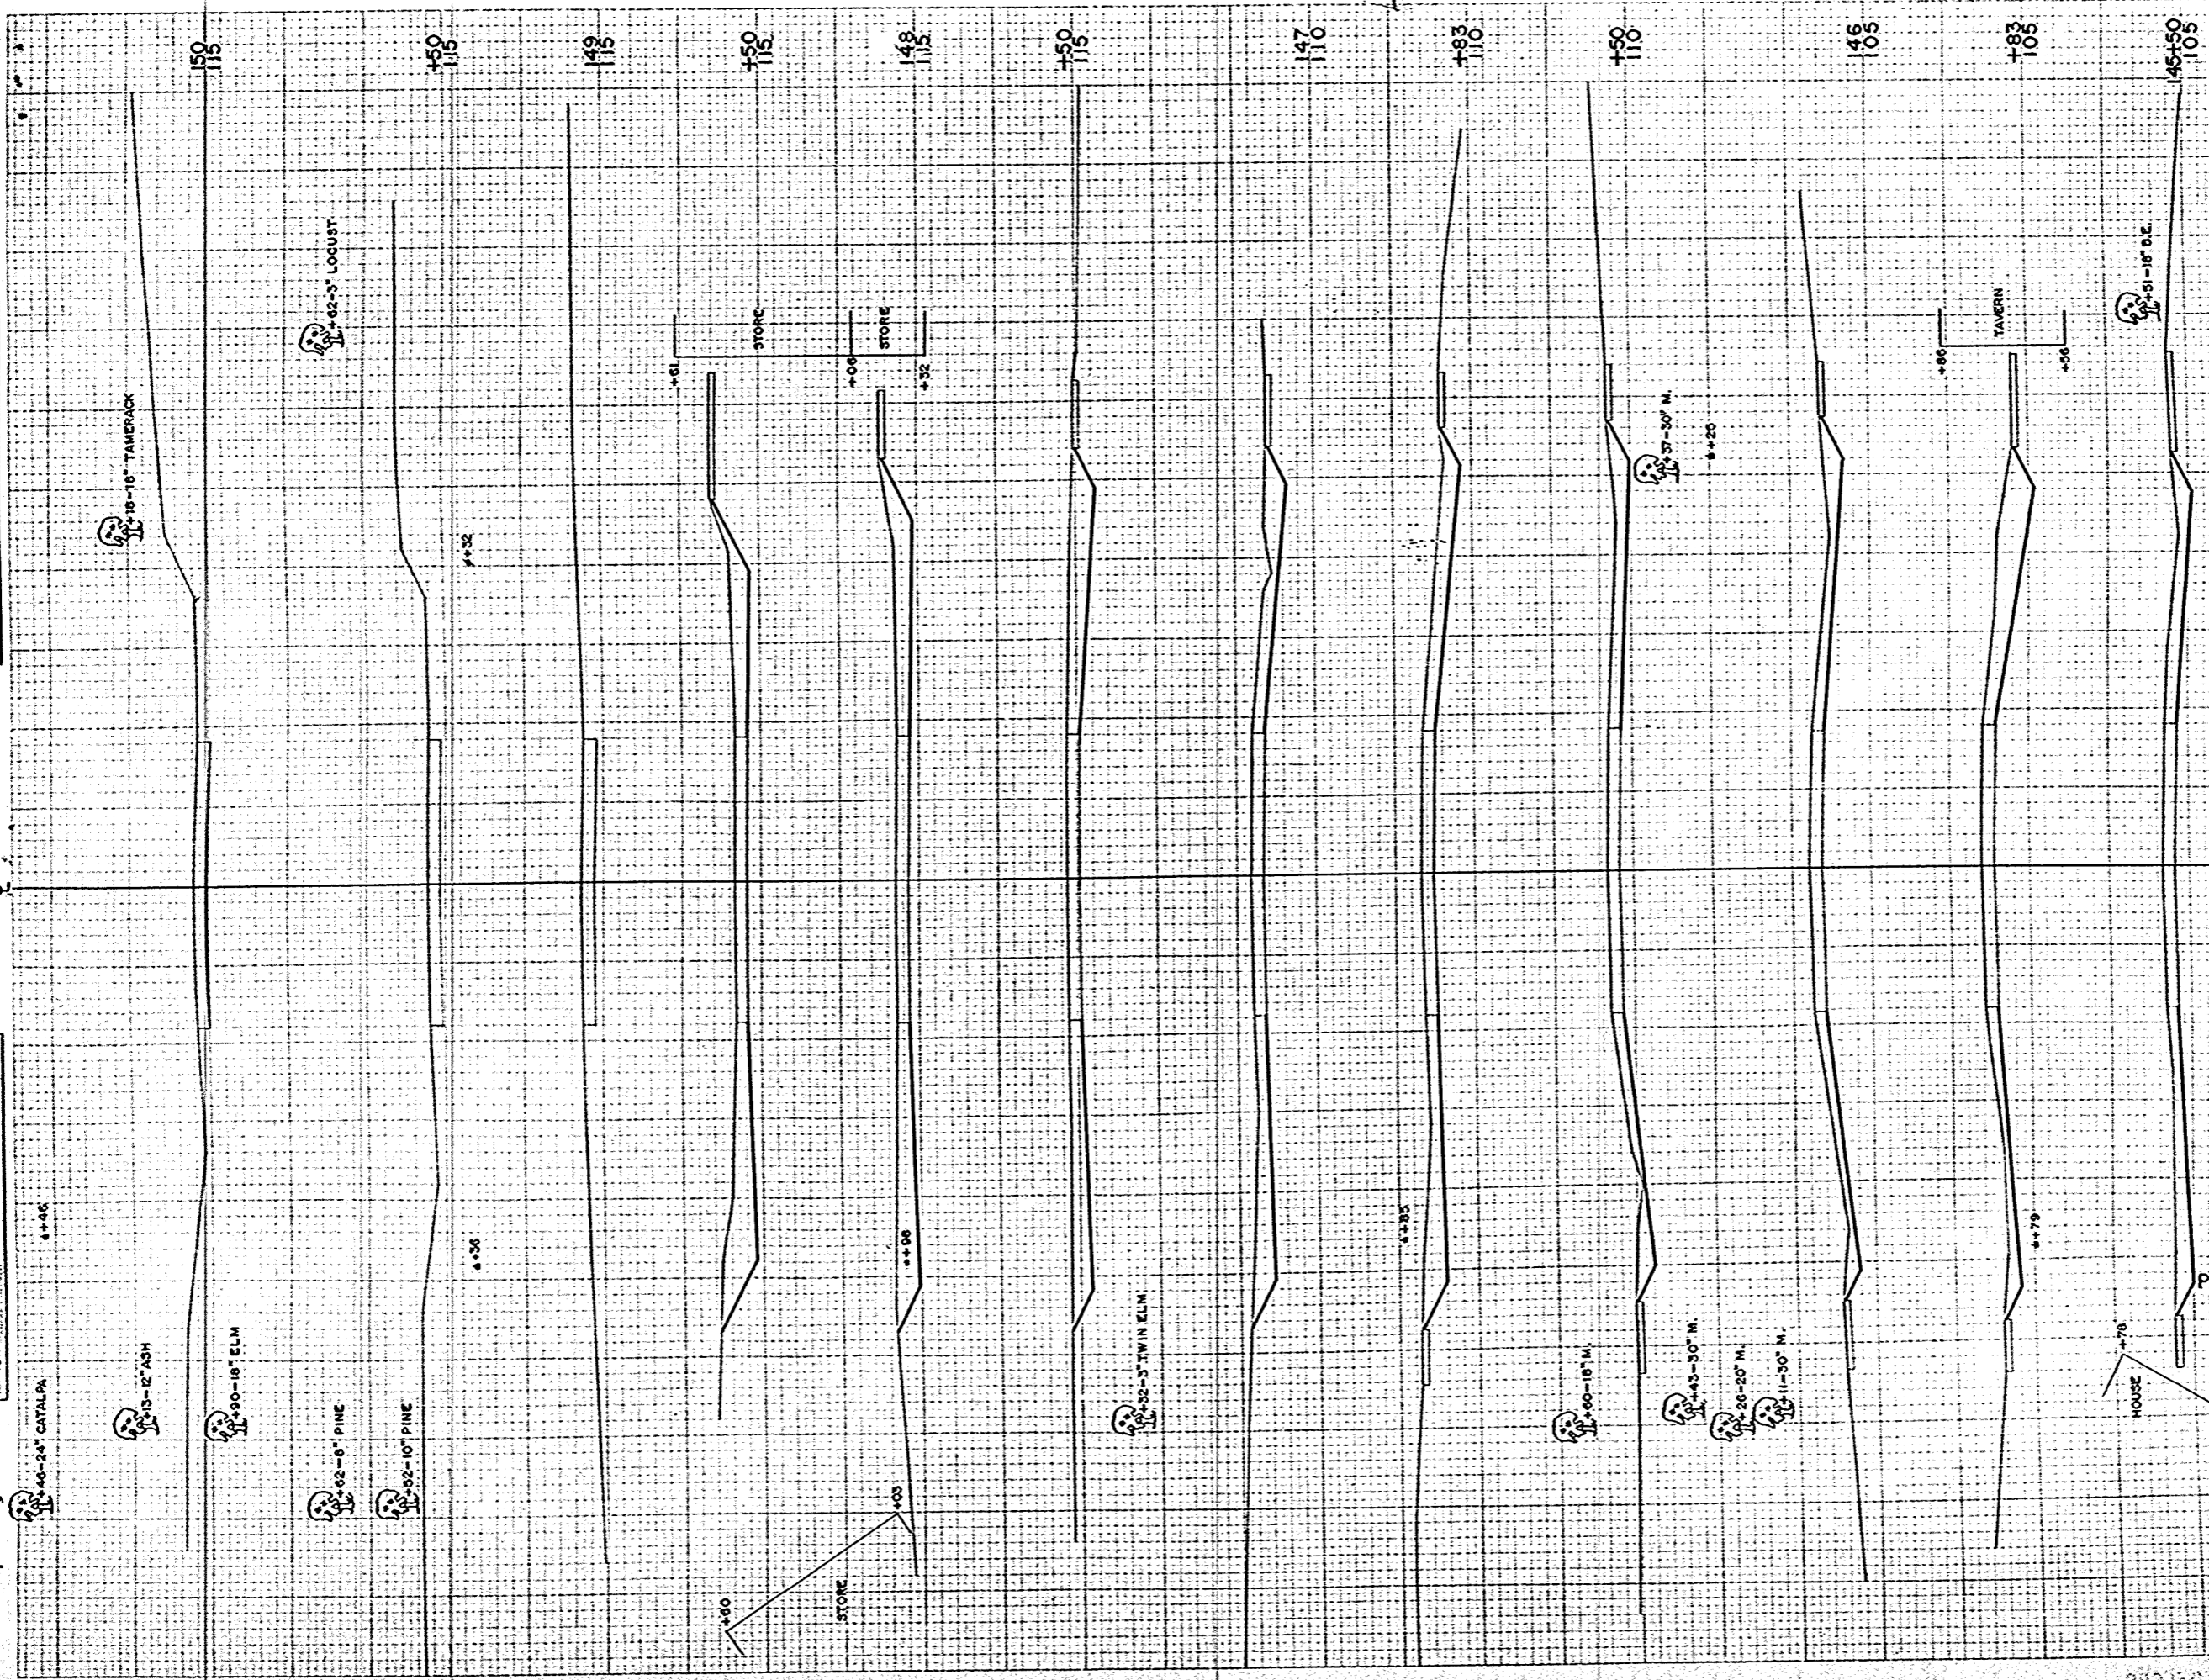

STATION	DISTANCE	YARDAGE	
		EXCAVATION	
		UNC.	FILL
145+13		39	0
145+50		39	0
148+83		18	0
146+46		46	0
145+50		37	0
148+83		22	0
147+47		69	0
145+50		69	0
148+48		67	0
145+50		33	0
149+49			
145+50			
145+50			
PROJ. TOTALS		4,178	5,534
SHEET TOTAL		439	0