

#563


#563

16

Index of Sheets

Sheet No. 1	Title
Sheet No. 2-2.6	Typical Cross Sections
Sheet No. 3	Estimate of Quantities
Sheet No. 3A-3B	Miscellaneous Quantities
Sheet No. -	Right of Way Plat
Sheet No. 5-5.9	Plan and Profile Sta. 116+50 to Sta. 157+64.39
Sheet No. 6-6.15	Standard Details
Sheet No. 7-7.9	Structure Plans
Sheet No. -	Computer Earthwork Data
Sheet No. 8-8.24	Cross Sections

TOTAL SHEETS = 72 + 2

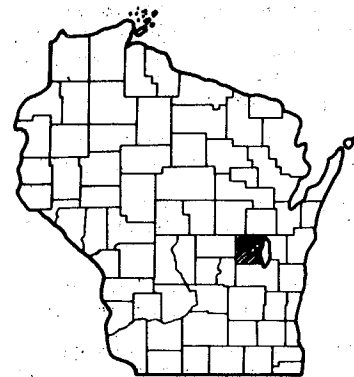

STATE OF WISCONSIN
 DEPARTMENT OF TRANSPORTATION
 DIVISION OF HIGHWAYS

PLAN AND PROFILE OF PROPOSED
 OREGON STREET, CITY OF OSHKOSH
 (WAUKAU AVENUE - 24 TH AVENUE)
 C. T. H. "1"
 WINNEBAGO COUNTY

STATE PROJECT NUMBER
 4994-0-17

Scales
 Plan 1 in. = 20 ft.
 Profile Hor. 1 in. = 20 ft. Vert. 1 in. = 2 ft.
 Cross Sections Hor. 1 in. = 5' Vert. 1 in. = 5'


AS BUILT PLAN
 #563

Design Designation

A.D.T. 1976	= 4,500
A.D.T. 1996	= 16,500
D.H.V. 1996	= 1,980
D. 1996	= 60-40
T. 1996	= 7%
V. 1996	= 35 M.P.H.

BEGIN PROJECT 4994-0-17
 STA. 116 + 50

* N 725,215 (± 200')
 * E 2,383,489 (± 200')
 77' S. OF THE S.E.
 CORNER OF SECTION 35,
 T 18 N - R 16 E.

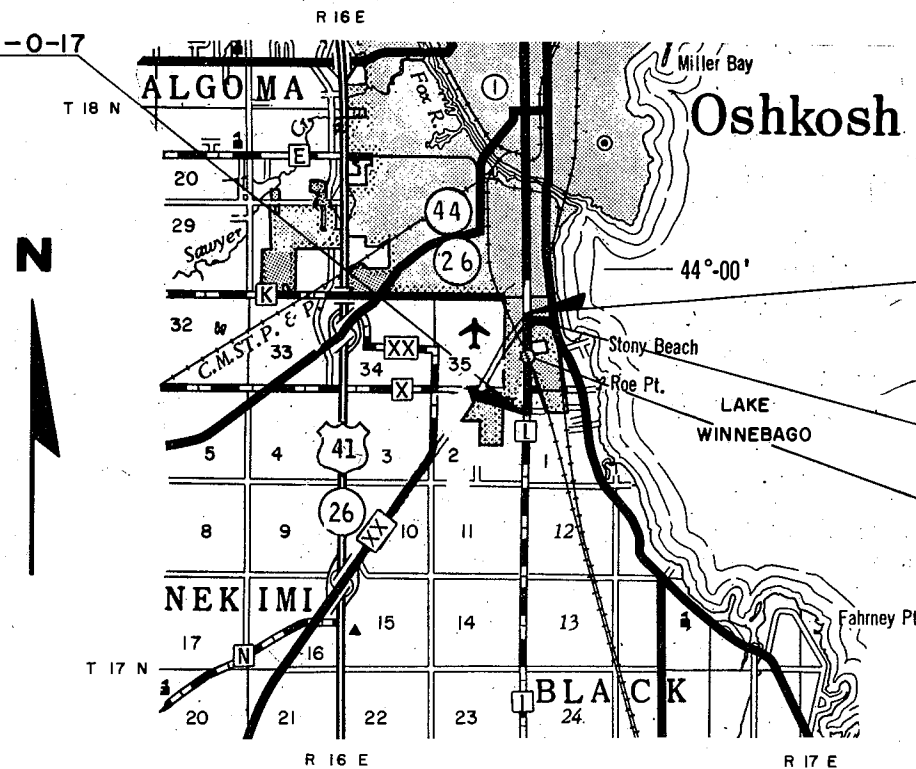

END PROJECT 4994-0-17
 STA. 157 + 64.39

* N. 729,369 (± 200')
 * E. 2,383,437 (± 200')
 1,374' N. OF THE W. QUARTER CORNER OF
 SECTION 36, T 18 N - R 16 E.
 = STA. 10+38.89 OF PROJ. UO10-2(7)

STA. 157+25.2 =
 STA. 10+00 BEGIN PROJ. UO10-2(7)

EXCEPTION TO NET C LENGTH
 STA. 135 + 96.81 TO STA. 136 + 27.17


Layout
 Scale 1/2" = 1 1/2 MILES

Total Net Length of Centerline = 0.774 Mi. URBAN

Conventional Signs

County Line	-----	Culverts in Place
Township or Range Line	-----	Culverts Required
Section Line	-----	Drop Inlet
New Right of Way Line	-----	Power Pole
Present Right of Way Line	-----	Telephone or Telegraph Pole
Wire Fence	Right of Way Markers
Corporate or City Limits	Reference Stake for Hubs Only
Property Line	Marsh
Traveled Way or P.E.	Hedge
Railroads	Trees
Base or Survey Line	Ground Elevation	Datum Line
Caution Symbol (combustible fluids under pressure)	Grade Elevation	Datum Line

APPROVED FOR
 WINNEBAGO COUNTY
 COUNTY HIGHWAY COMMISSIONER

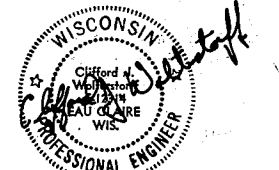

PLANS PREPARED BY
 OWEN AYRES & ASSOCIATES
 CONSULTING ENGINEERS
 EAU CLAIRE, WISCONSIN


STATE OF WISCONSIN
 DEPARTMENT OF TRANSPORTATION
 DIVISION OF HIGHWAYS

Surveyor OWEN AYRES & ASSOC. District Checker J.C.C.
 Designer OWEN AYRES & ASSOC. C.O. Checker R.A.H.

Correct:
 Date 11/3/75 C. R. Quinn District Engineer
 Recommended for Approval:
 Date 12/10/75 J. C. Hennrich Chief of Facilities Development
 Approved:
 Date 12/29/75 J. H. Juelzer State Highway Engineer


U.S. DEPARTMENT OF TRANSPORTATION
 FEDERAL HIGHWAY ADMINISTRATION
 REGION 5 WISCONSIN DIVISION

Approved:
 Date Division Engineer

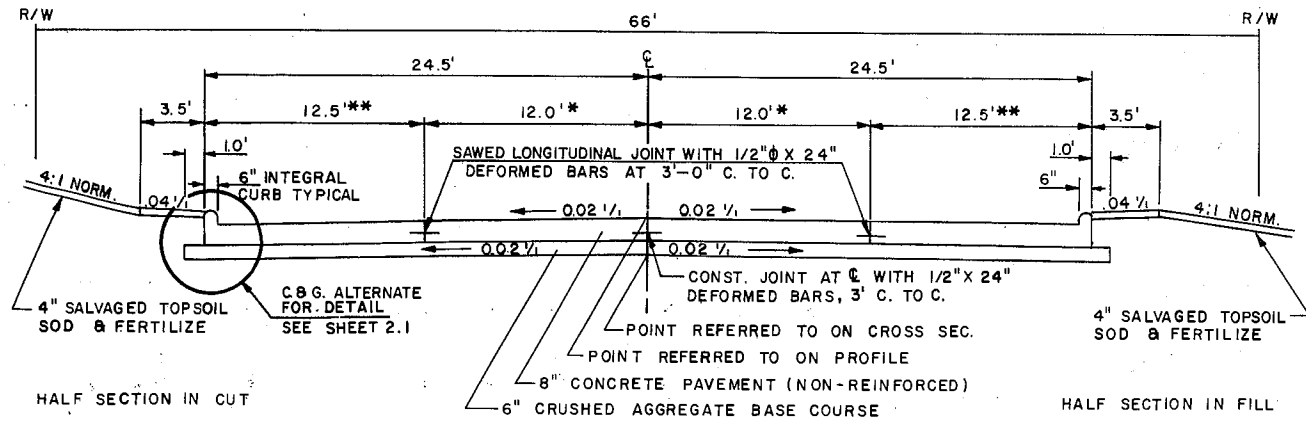


TYPICAL FINISHED SECTION
OREGON STREET STA. 116 + 50 - STA. 157 + 64
WAUPUN STREET
24 TH AVENUE


* 11.0' WHEN CURB AND GUTTER ALTERNATE IS USED.
 ** 13.5' WHEN CURB AND GUTTER ALTERNATE IS USED.

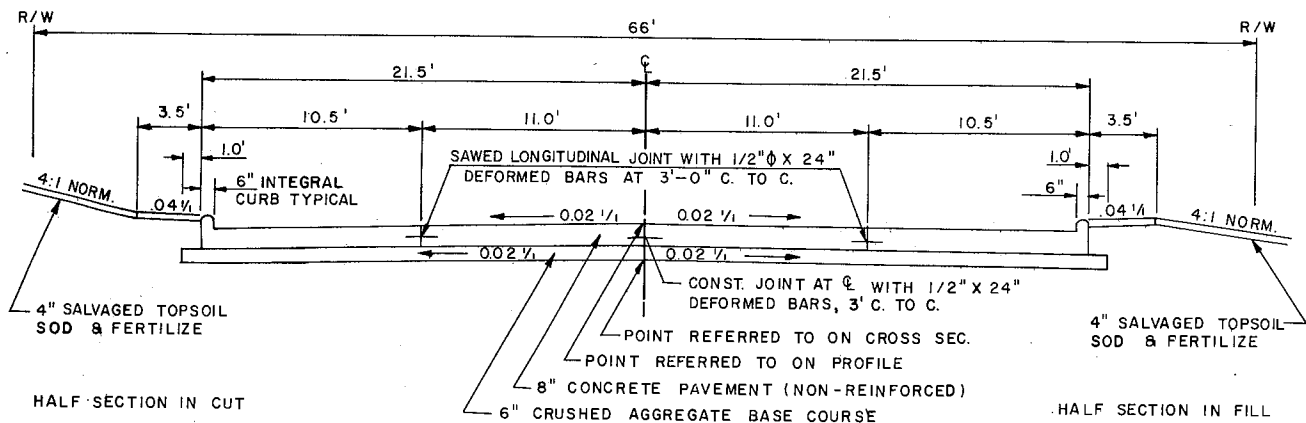

TYPICAL FINISHED SECTION
WAUKAU AVENUE
W 28 TH AVENUE

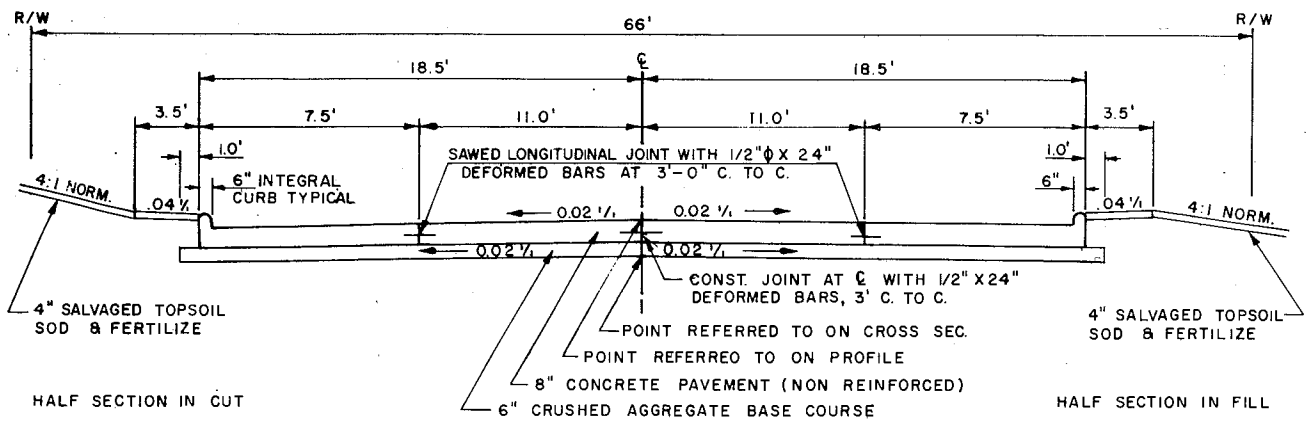

TYPICAL FINISHED SECTION
W 29 TH AVENUE
W 25 TH AVENUE

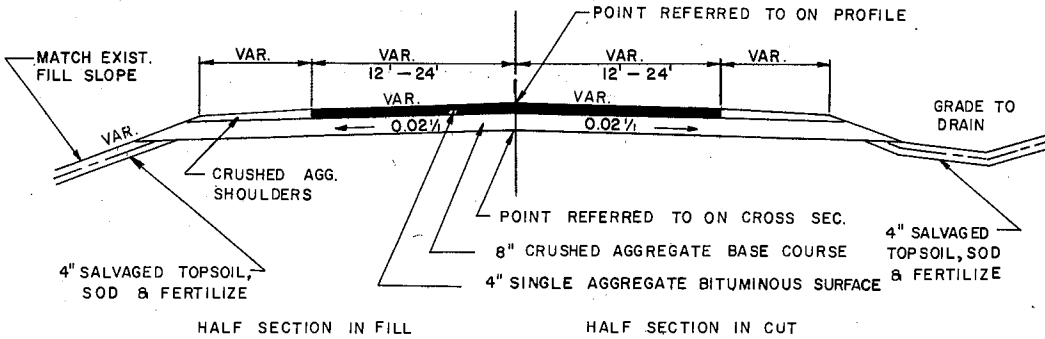

MATCHING SECTION
BETWEEN INPLACE ROADWAY & FINISHED SECTION

STA. 115 + 00 TO STA. 116 + 50	C.T.H "I"
STA. 1 + 35' TO STA. 2 + 40	WAUKAU
STA. 3 + 60 TO STA. 5 + 00	WAUKAU
STA. 5 + 00 TO STA. 5 + 50	W. 29 TH. AVE.
STA. 0 + 64 TO STA. 2 + 00	W. 28 TH. AVE.
STA. 0 + 45 TO STA. 1 + 50	W. 25 TH. AVE.
STA. 0 + 50 TO STA. 3 + 00	W. 24 TH. AVE.

STANDARD DETAIL DRAWINGS

- 8A5-2 CATCH BASIN, MANHOLE, AND INLET COVERS
- 8B6-2 MANHOLES, TYPE 1
- 8C1-3 INLETS, TYPE 1 & 2
- 8C5-1 INLETS, TYPE 8, 9, 10, 11
- 8D5-2 CURB RAMPS FOR HANDICAPPED PERSONS
- 9B2-1 METAL CONDUIT AND FIBER CONDUIT
- 9B3-2 TRAFFIC SIGNAL AND TRAFFIC COUNTER DETAILS
- 13B1-1 PAVEMENT DETAILS FOR RAILROAD APPROACH
- 8C2-3 INLETS, TYPE 3
- 8D1-2 CONCRETE CURB & GUTTER
- 13C1-2 LONGITUDINAL JOINTS CONCRETE PAVEMENT
- 13C4-3 TRANSVERSE JOINTS IN NON-REINFORCED CONCRETE PAVEMENT
- 15C1-4 CONSTRUCTION BARRICADES AND STANDARD SIGNS
- 16A1-2 LANDMARK REFERENCE MONUMENTS
- 8F1-6 APRON ENDWALLS FOR CULVERT PIPE
- 12A3-1 NAME PLATE (STRUCTURES)

UTILITIES

- WISCONSIN TELEPHONE COMPANY
 MR. RENZSHAWEL 414-922-2108
 70 EAST DIVISION STREET
 FOND DU LAC, WISCONSIN 54935
- DEPARTMENT OF PUBLIC WORKS
 MR. KOHRAD, CITY ENGINEER 414-424-0296
 215 CHURCH AVE.
 OSHKOSH, WISCONSIN 54901
- WISCONSIN PUBLIC SERVICE CORPORATION
 MR. R. C. BUTTKE 414-432-3311
 P.O. BOX 1200
 GREEN BAY, WISCONSIN 54315
- S&O LINE RAILROAD
 MR. J. P. GANNON 715-344-1910
 P.O. BOX 348
 STEVENS POINT, WISCONSIN 54481


STANDARD ABBREVIATIONS

C	CENTERLINE
CL	CLASS
CONST.	CONSTRUCTION
C.P.	CULVERT PIPE
Δ	DELTA OR CENTRAL ANGLE
DISCH.	DISCHARGE ELEVATION
F.E.	FIELD ENTRANCE
G	GAS
INL.	INLET
P.L.	PROPERTY LINE
P.E.	PRIVATE ENTRANCE
REQ'D	REQUIRED
P.P.	POWER POLE
S.S.D.	STOPPING SIGHT DISTANCE
STA.	STATION
T. TEL	TELEPHONE
V.C.	VERTICAL CURVE
I.P.	IRON PIPE
M.H.	MANHOLE
C.B.	CATCH BASIN
F.L.	FLOW LINE ELEVATION
COV.	COVER ELEVATION
S.	SANITARY
S.T.	STORM SEWER
W.	WATER
BIT.	BITUMINOUS
R.C.P.	REINFORCED CONCRETE PIPE
T.C.	TOP OF CASTING
Φ	DIAMETER
C. TO C.	CENTER TO CENTER
C. & G.	CURB & GUTTER
R/W	RIGHT OF WAY
CONC.	CONCRETE
SL.	SLOPE
DHN	DOUBLE HEADED NAIL
D/W	DRIVEWAY
C&G	CURB AND GUTTER


GENERAL NOTES

ALL RADII SHOWN ARE TO THE FACE OF CURB.
 PRIVATE UTILITY COMPANIES SHALL ADJUST OR MOVE ALL PRIVATELY OWNED FACILITIES TO FIT THE NEW CONSTRUCTION.
 CERTAIN UNDERGROUND UTILITY STRUCTURES HAVE BEEN LOCATED ON THESE PLANS. THESE LOCATIONS SHALL NOT BE TAKEN AS CONCLUSIVE. VERIFICATION AS TO THE LOCATION TO THE SATISFACTION OF THE CONTRACTOR OF ALL UNDERGROUND UTILITY STRUCTURES, WHETHER SHOWN ON THE PLANS OR NOT, SHALL BE ASSUMED AS A CONDITION OF THE CONTRACT.
 FINISHED GRADES AS SHOWN AT SIDE STREET INTERSECTION ARE APPROXIMATE AND MAY BE ADJUSTED BY ENGINEER.
 TRANSVERSE JOINTS SHALL BE SAWED AT 20' (± 2') SPACING FROM ADJACENT TRANSVERSE JOINTS, UNLESS SPECIFIED OTHERWISE BY THE ENGINEER.
 ALL SIDEWALK THROUGH DRIVEWAY LOCATIONS SHALL BE 6-INCHES IN THICKNESS AND SHALL BE PAID FOR AS CONCRETE DRIVEWAY.
 CITY OF OSHKOSH WILL ADJUST OR MOVE CITY OWNED FACILITIES TO FIT THE NEW CONSTRUCTION, EXCEPT AS LISTED AS PART OF THIS CONTRACT ON THE MISC. QUANTITIES SHEETS.
 ALL CURB RAMPS SHALL BE TYPE 3 UNLESS OTHERWISE NOTED. RAMP AND RAMP OPENING LOCATIONS ARE DESIGNATED BY THE SYMBOL (CR)


ALL CURVES ARE COMPUTED ON THE BASIS OF R = 5729.58 FOR A ONE (1) DEGREE CURVE.
 NO TREES OR SHRUBS ARE TO BE REMOVED UNLESS INDICATED FOR REMOVAL BY THE ENGINEER.
 THE COVERS FOR LANDMARK REFERENCE MONUMENTS WILL BE FURNISHED BY THE STATE OF WISCONSIN AND INSTALLED BY THE CONTRACTOR. THE COST OF INSTALLING THIS COVER SHALL BE INCLUDED IN THE BID PRICE FOR LANDMARK REFERENCE MONUMENTS.
 WHEN THE QUANTITY OF THE ITEMS OF BASE OR SURFACE COURSE IS MEASURED FOR PAYMENT BY THE TON THE DEPTH OR THICKNESS OF THE COURSE SHOWN ON THE PLANS IS APPROXIMATE AND THE ACTUAL THICKNESS WILL DEPEND ON THE DISTRIBUTION OF THE MATERIAL AS DIRECTED BY THE ENGINEER.
 SHRINKAGE OF EARTHWORK IS VARIABLE AND IS SHOWN IN THE YARDAGE SUMMARY.
 THE EXACT LOCATION OF PRIVATE ENTRANCES IS TO BE DETERMINED IN THE FIELD BY THE ENGINEER.
 SALVAGED TOPSOIL SHALL BE PLACED ON ALL CUT AND FILL SLOPES TO AN APPROXIMATE DEPTH OF 4 INCHES AT TIME OF PLACING.
 DRIVEWAYS SHALL BE REPLACED IN KIND.
 SOD AND FERTILIZE ALL DISTURBED AREAS

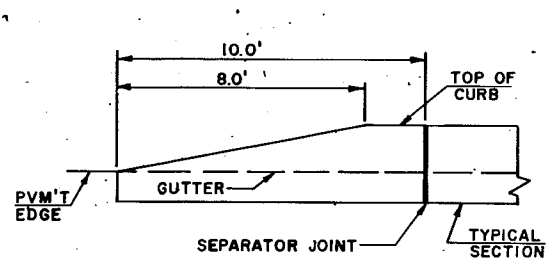


END SECTION INTEGRAL CURB
 NOTE: TO BE CONSTRUCTED AND BID AS 30" C. & G., TYPE "D"

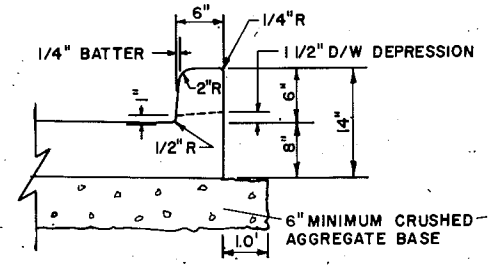


INTEGRAL CURB DETAIL

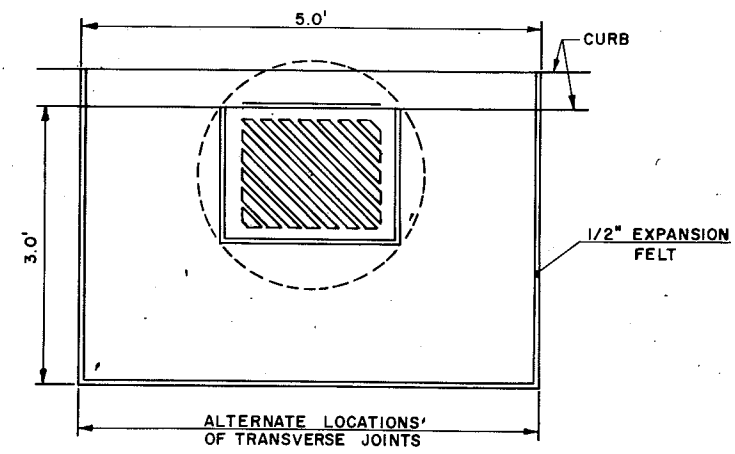

TYPICAL INLET BOXOUT

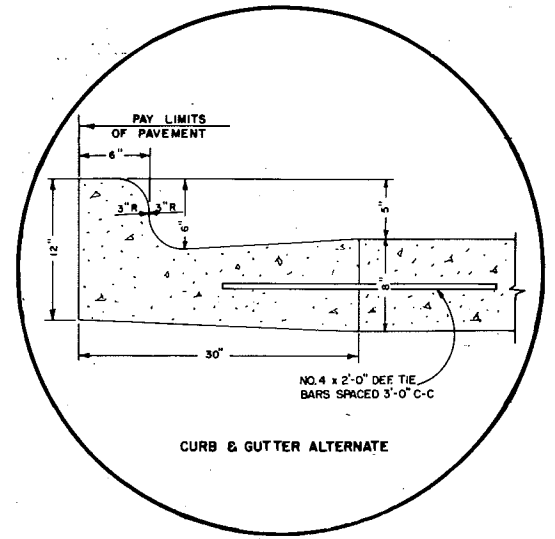


CURB & GUTTER ALTERNATE

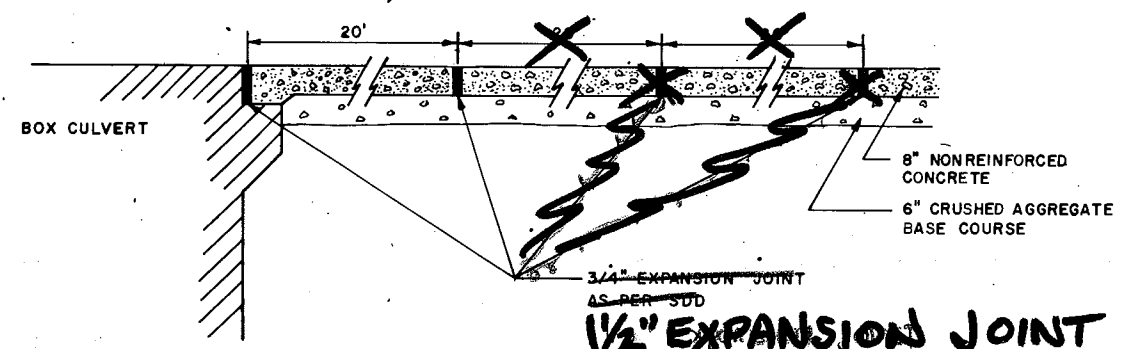


BOX CULVERT APPROACH DETAIL


1/2" EXPANSION JOINT AS PER SSD.

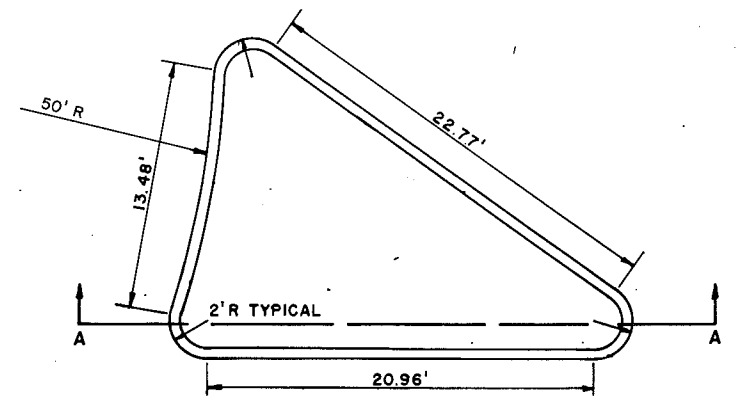


SECTION "A-A" IN ELEVATION

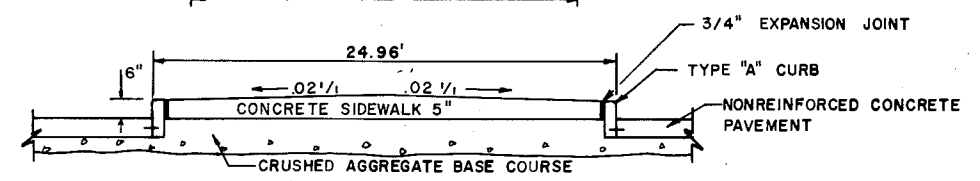

DETAIL FOR SAFETY ISLAND

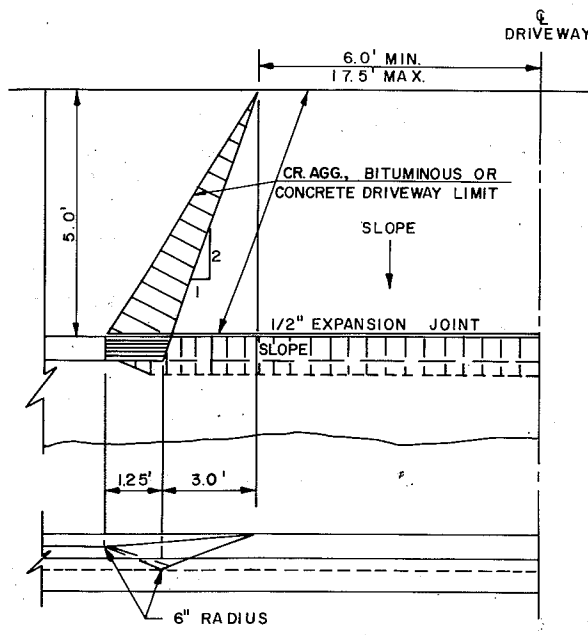


FRONT VIEW

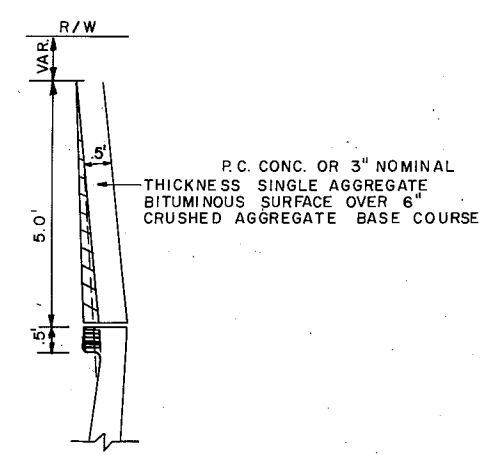


SIDE VIEW

DRIVEWAY DETAIL


INLET CASTING TO BE WELLED 1/2" BELOW FINISHED GRADE WITH SMOOTH TROWELED EDGES.

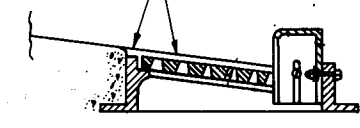

1/2" EXPANSION MATERIAL PREFORMED TO FIT CURB CONTOUR TO BE PLACED ON EACH SIDE.

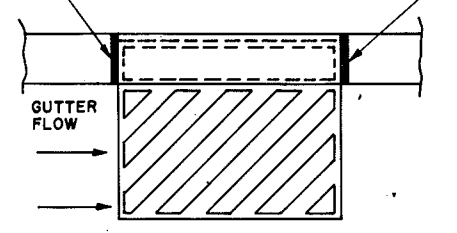

CONSTRUCTION DETAIL AT INLETS

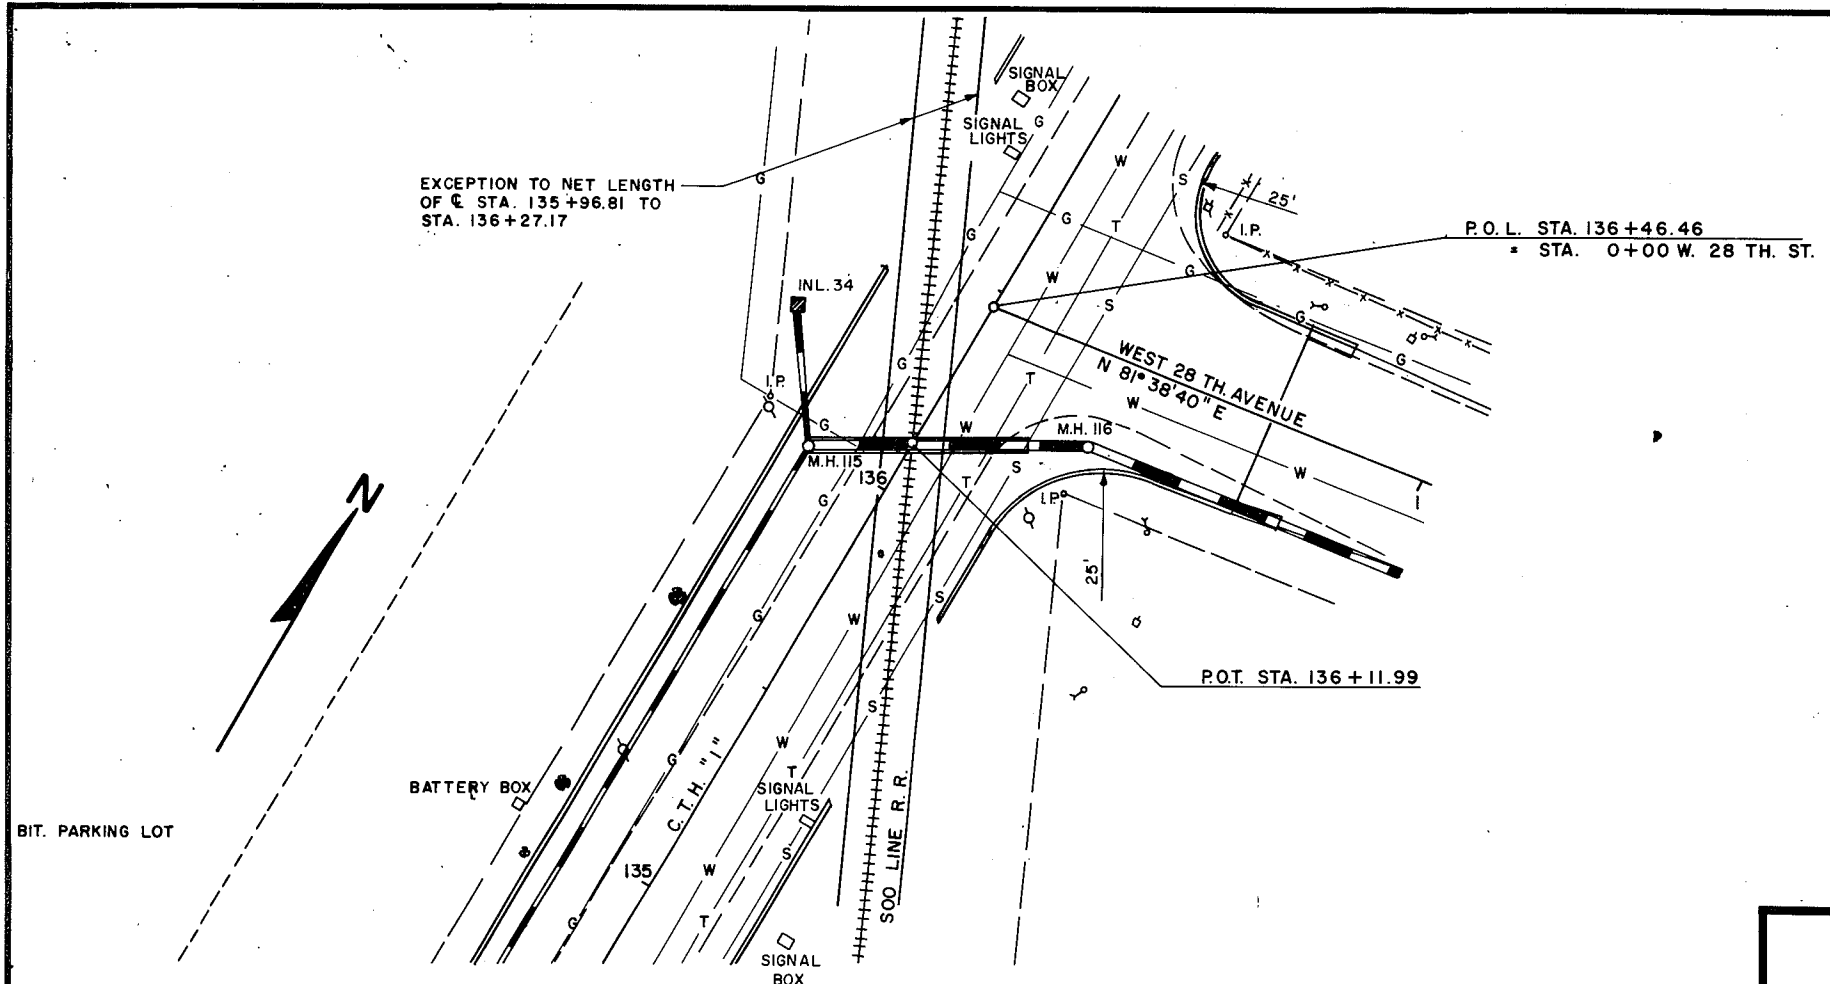

CASING PIPE NOTES



SPACE BETWEEN CARRIER AND CASING PIPES SHALL BE BLOWN FULL OF DRY SAND AND ENDS OF CASING PIPE SEALED

MIN. YIELD STRENGTH OF STEEL PIPE TO BE 35,000 P.S.I.



INSTALLATION SHALL BE BY BORING OR JACKING.

DATUM

ORIGIN OF BENCH MARKS TAKEN FROM U.S.G.S. B.M. NO. 36
D.S. 1930, ELEV. 749.546 ON R.R. BRIDGE 2ND TIER N.E. CORNER.

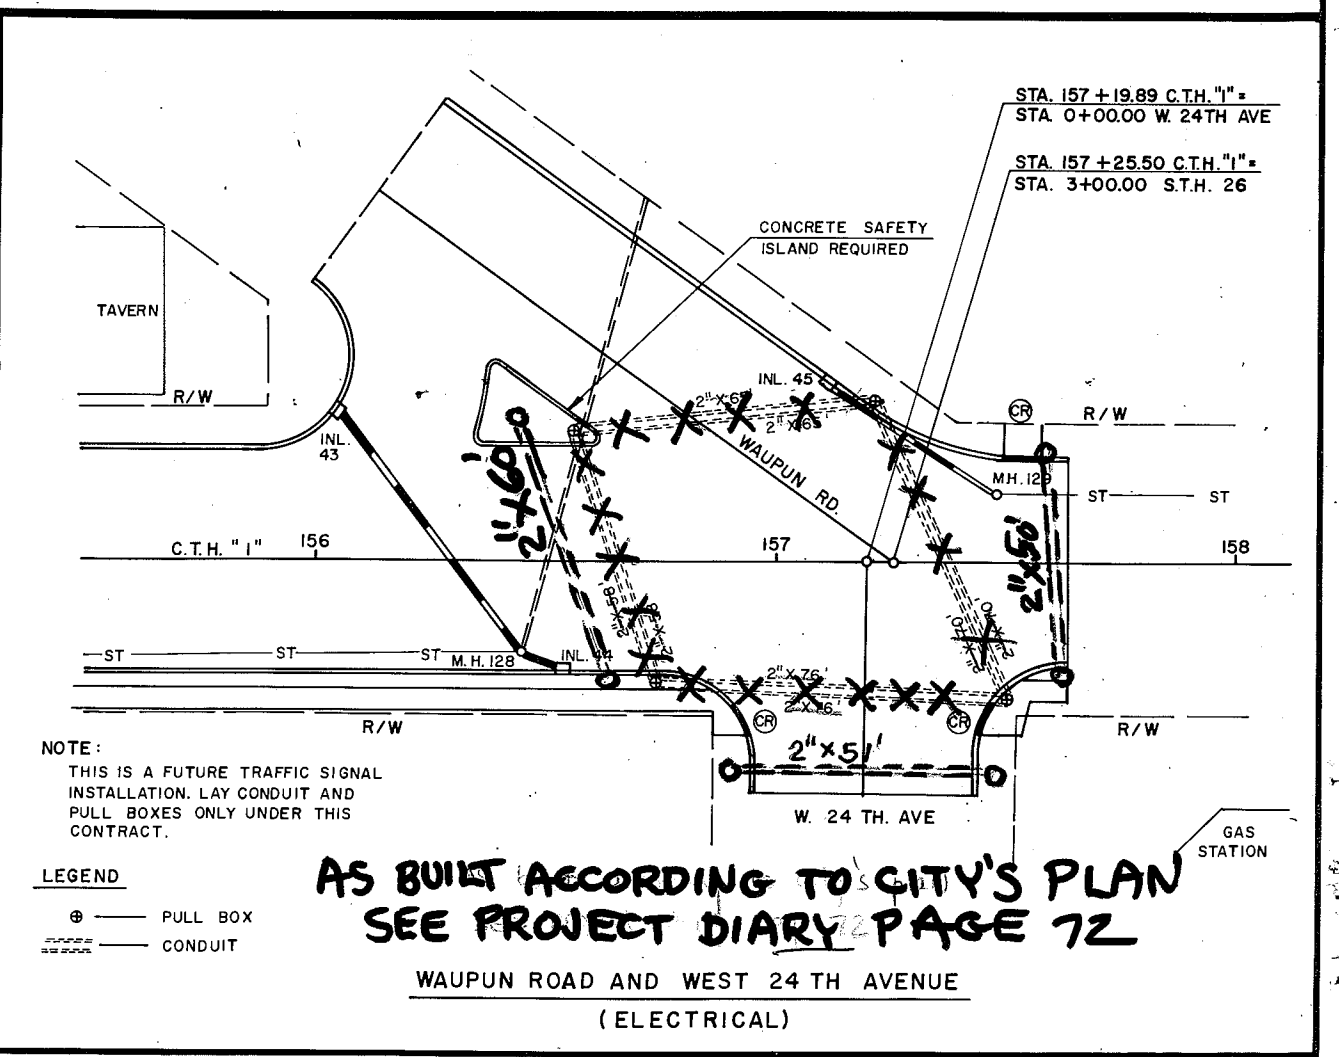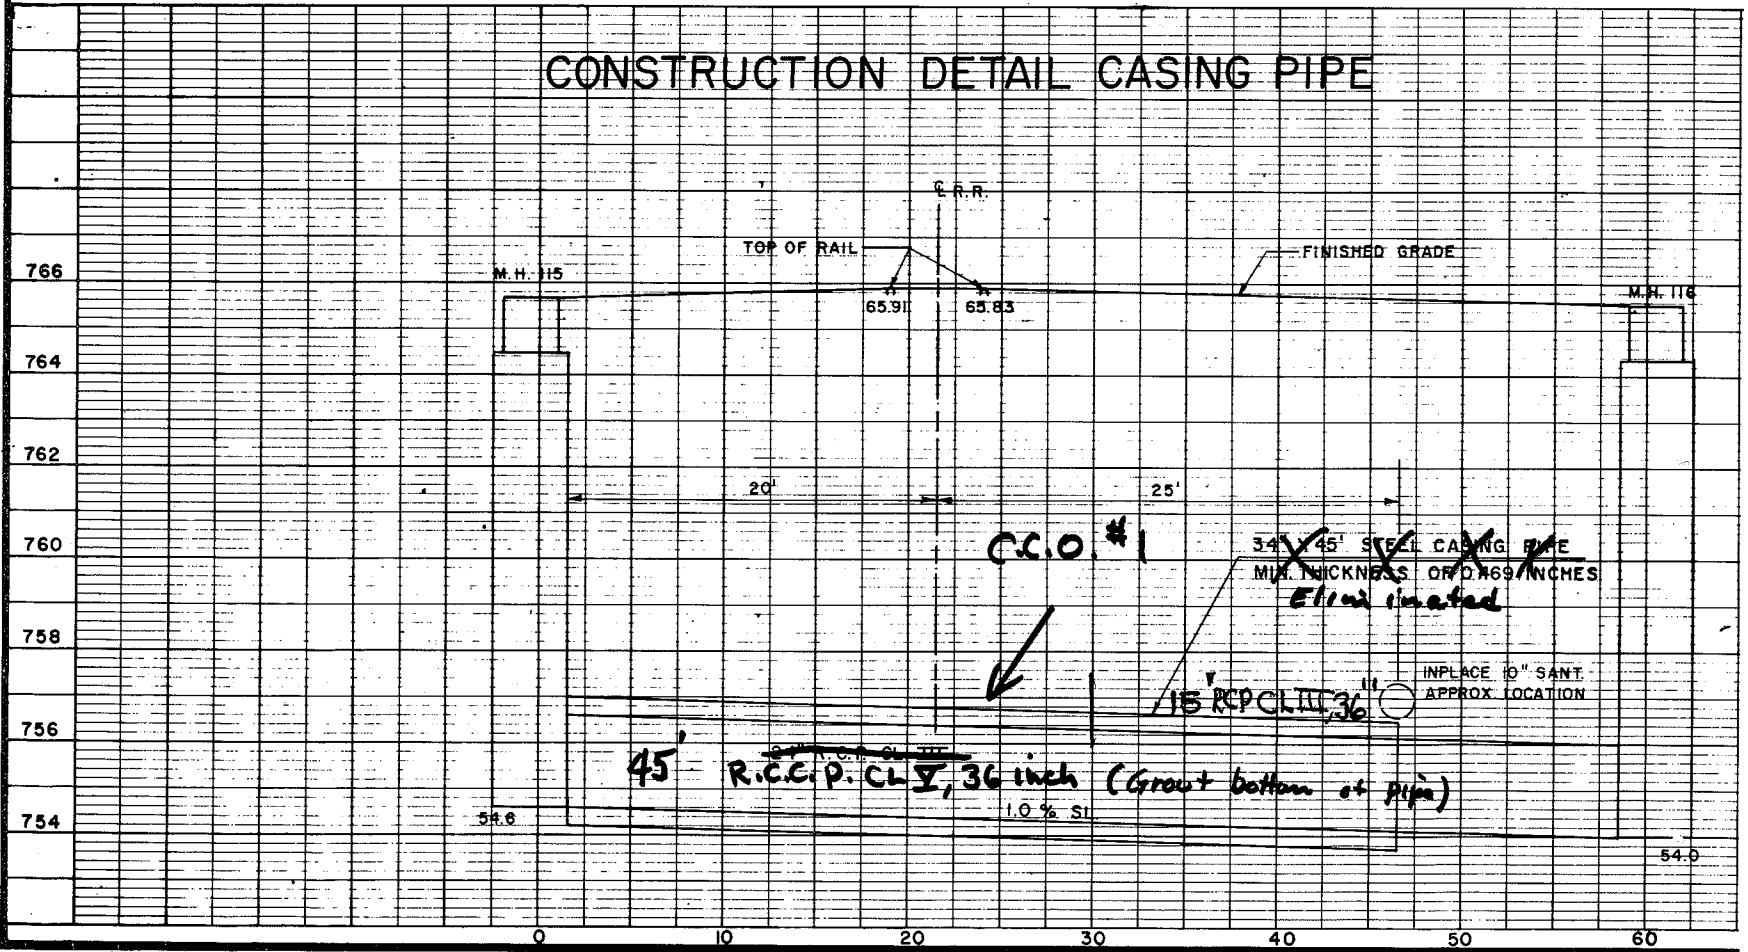


ADJUSTED TO GET WATER VALVE OUT OF CURB
 JRH 9/22/76

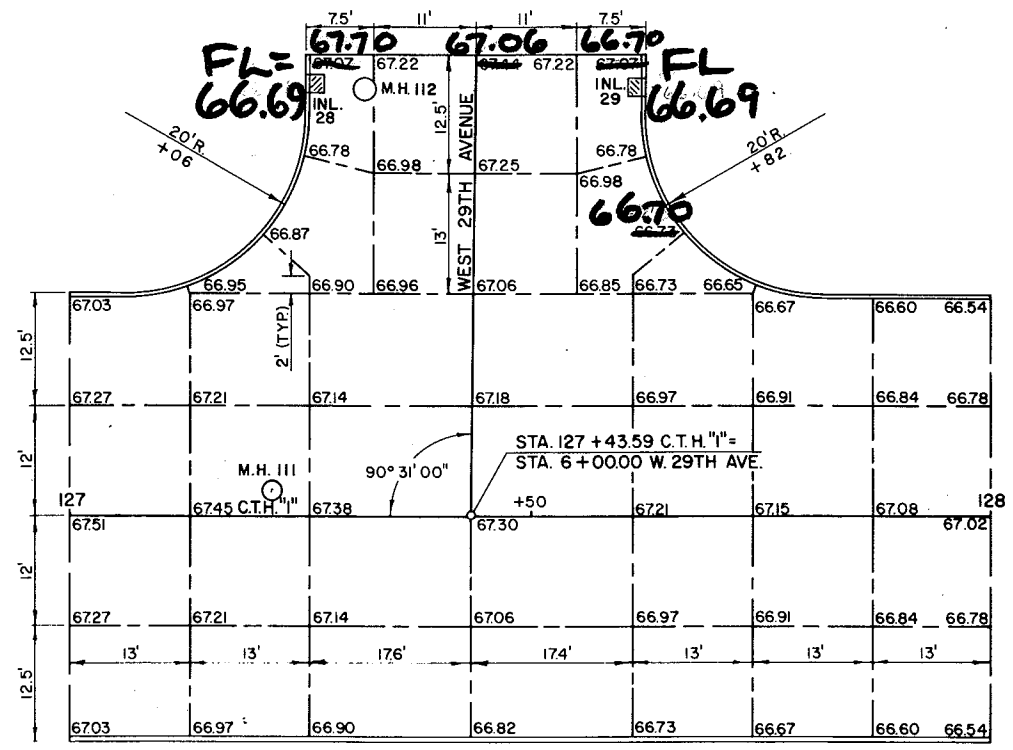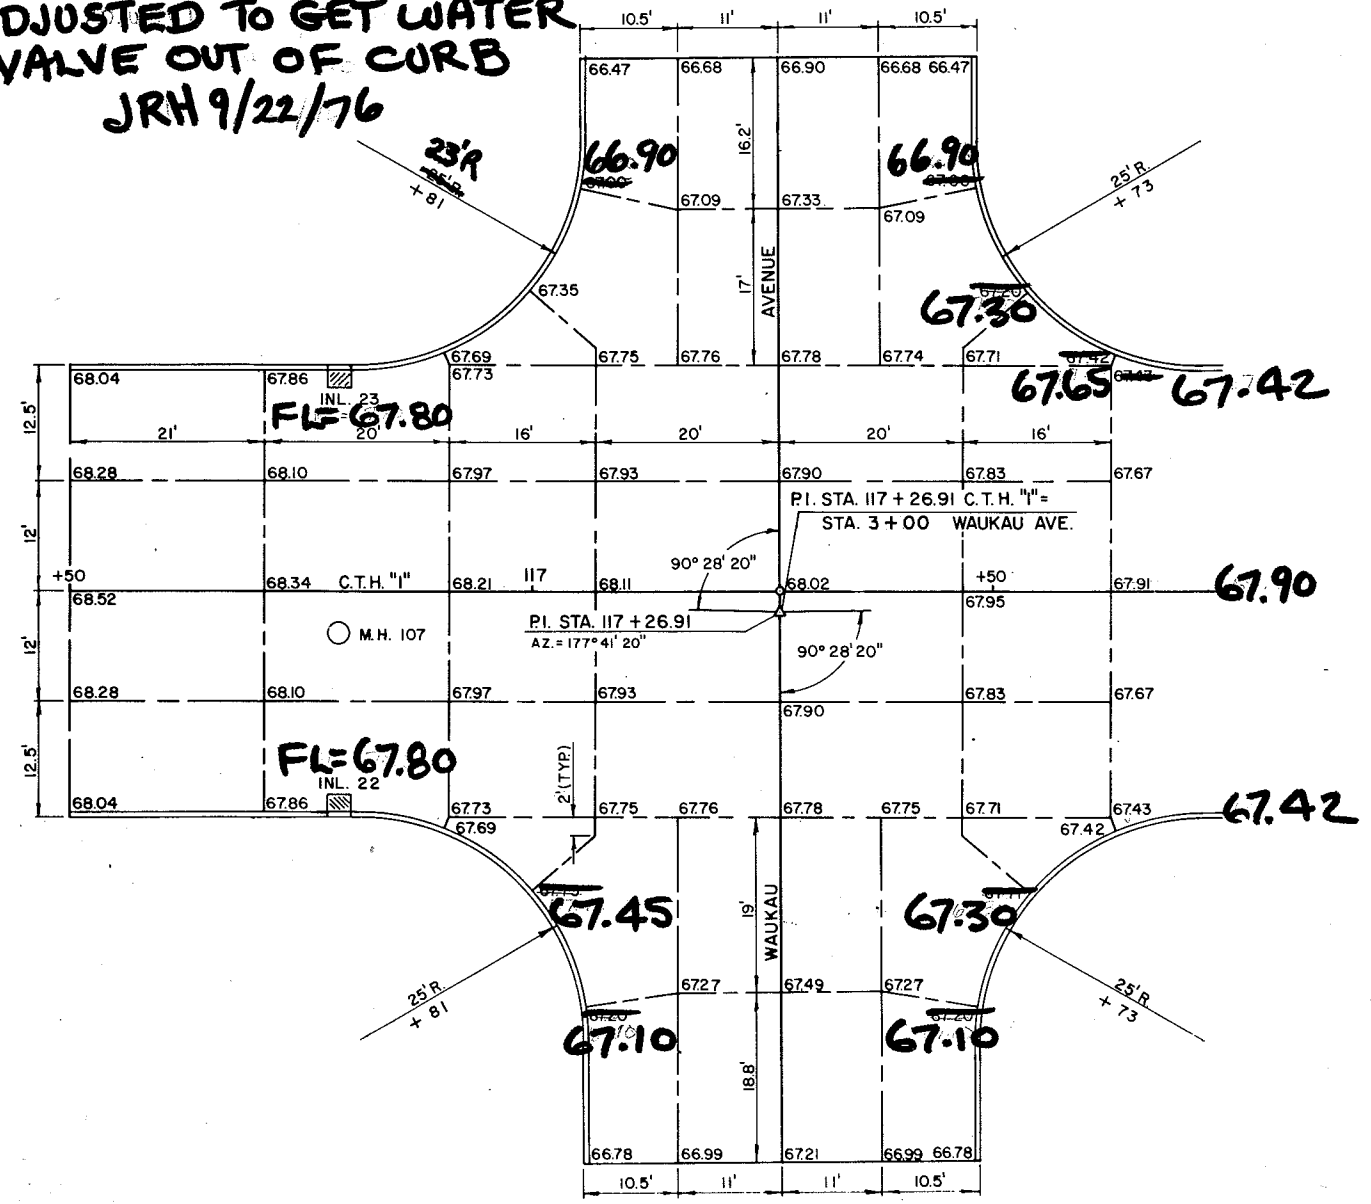


WEST 29 TH. AVENUE








WAUKAU AVENUE

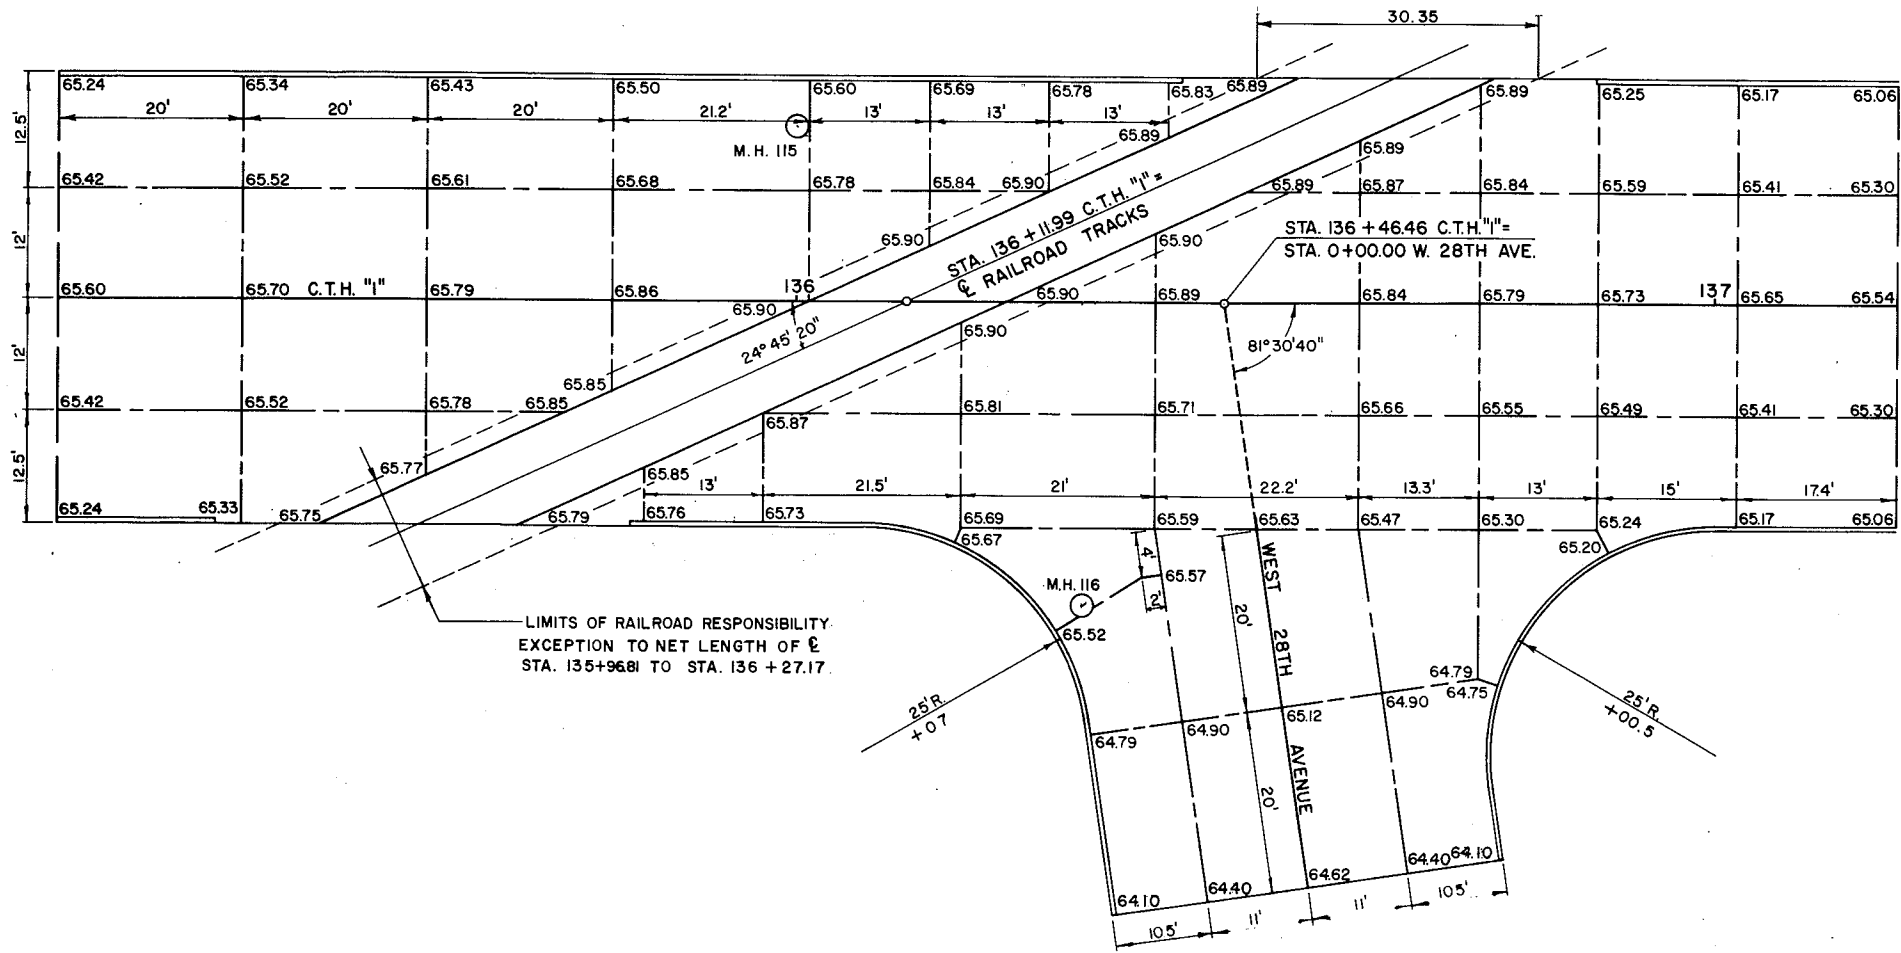

WEST 28 TH. AVENUE

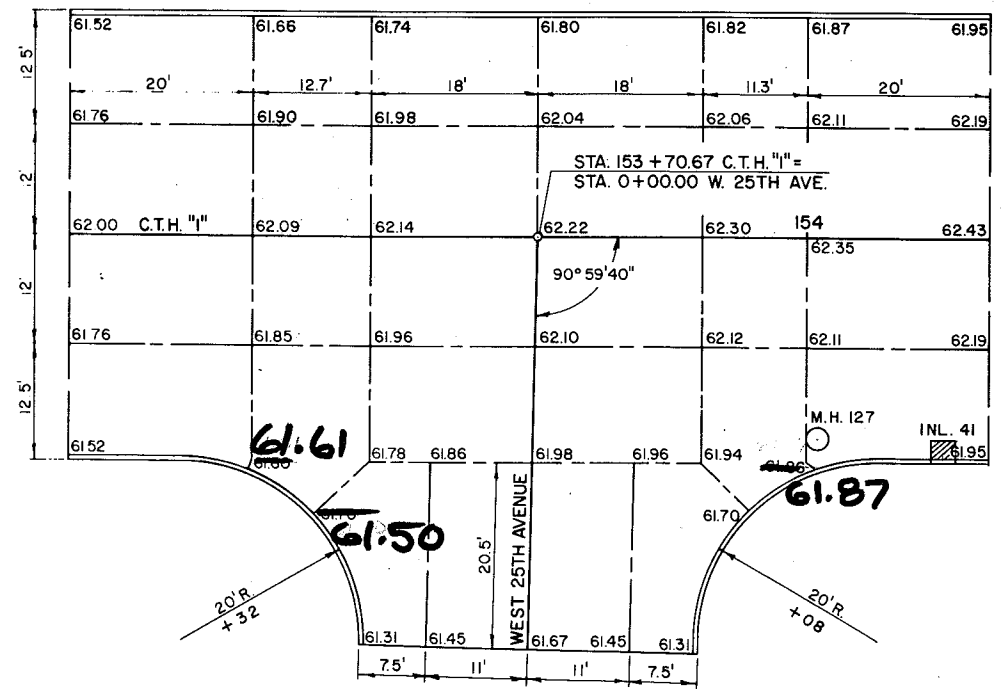

WEST 25 TH. AVENUE

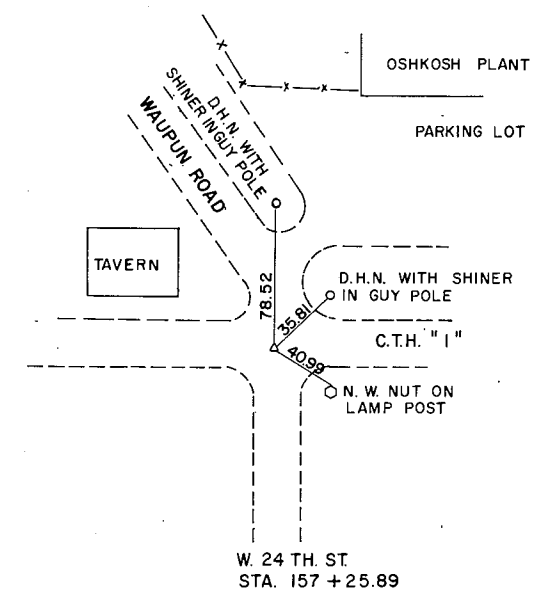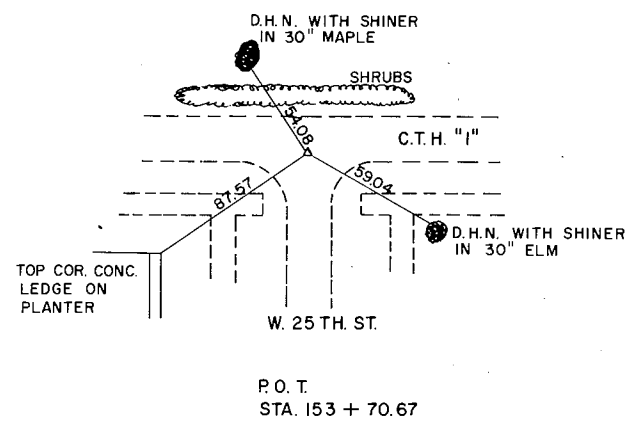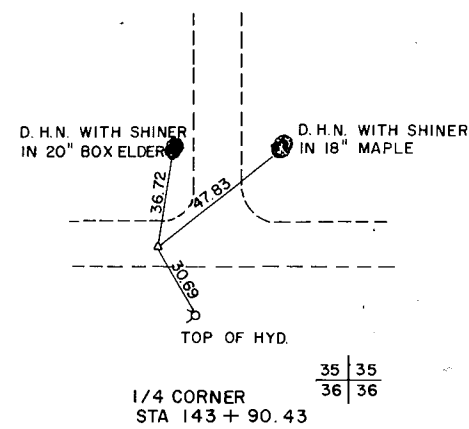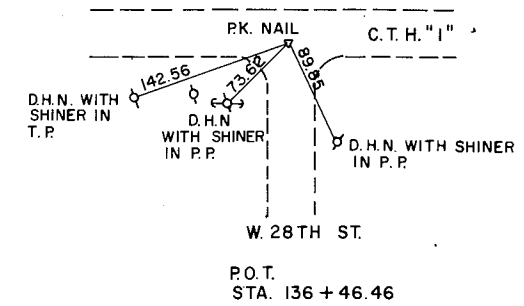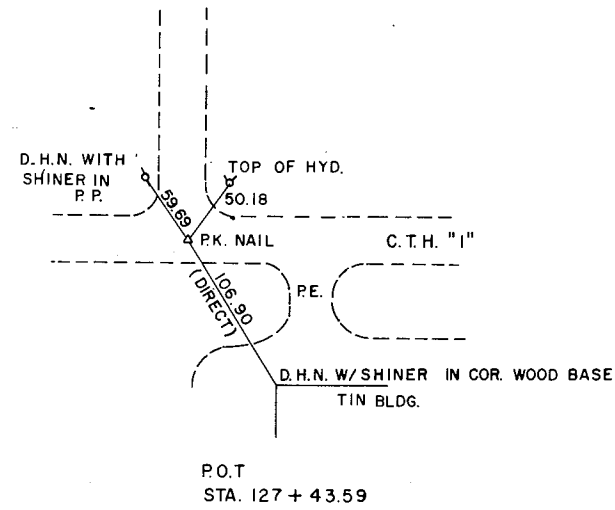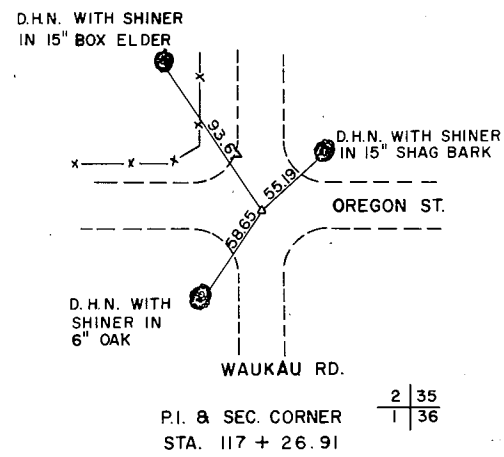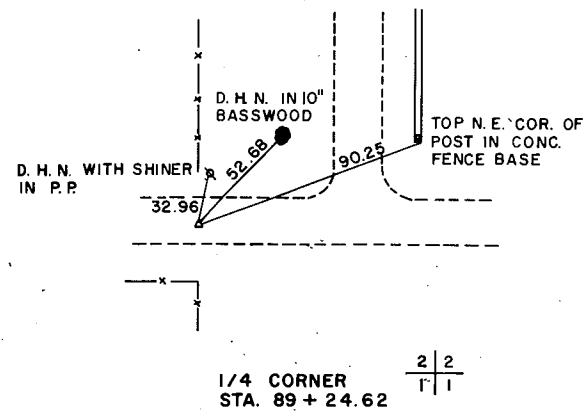

26

CLEARING & GRUBBING

STATION	LOCATION	IN. DIA.
120+07	24' LT.	30
120+15	22' LT.	30
122+33	28' LT.	20
123+64	24' LT.	30
127+67	30' RT.	18
127+67	25.5' LT.	15
127+90	26' LT.	18
128+16	26' LT.	14
128+65	24' LT.	20
129+76	22' LT.	24
130+12	26.5' LT.	20
131+26	22' LT.	12
131+31	25' LT.	24
131+83	24' LT.	24
134+36	27' LT.	20
134+53	27' LT.	24
134+93	27' LT.	18
135+08	26' LT.	24
135+57	27' LT.	36
143+29	32' LT.	48
149+09	30.5' LT.	20
148+70	30' LT±	TOTAL 29

Clearing completed by others
CLEARING BY OTHERS

CRUSHED AGGREGATE BASE COURSE

STATION TO STATION	(TONS)
115+00 - 118+13	757
WAUKAU AVENUE	857
118+33 - 135+97	3,329
W. 29TH AVENUE	188
W. 28TH AVENUE	188
136+27 - 157+64	3,985
W. 25TH AVENUE	400
W. 24TH AVENUE	160
WAUPUN RD	565
P.E.'S	396
UNDISTRIBUTED	275
TOTAL	11,100

OREGON ST LOCATION
 W. 24TH AVENUE
 Oregon St. STATION 136+40
 CULVERT PIPE *
 CL. III 18"
 LENGTH FT. 28
 APRONS REQ'D 1
 * THICKNESS: STEEL = .064
 ALUMINUM = .060

CONCRETE SIDEWALK

STA. TO STA.	LOCATION	REMOVAL S.Y.	5" SIDEWALK REQ'D S.F.
① 148+49-149+35	RT.	68	388
② 150+92-151+62	RT.	39	195
③ 152+50-153+54	RT.	63	549
④ 153+91-156+94	RT.	171	1540
⑤ 154+88-155+21	LT.	7	64
⑥ 157+43-157+58	LT.	7	74
⑦ 157+50-157+58	RT.	6	101
156+50	30' LT		229
TOTAL		361	3140

YARDAGE SUMMARY
 STA. 115+00 TO STA. 157+64.39

	QUANTITY C.Y.	QUANTITY C.Y.
UNCLASSIFIED EXCAVATION		11,788
FILL	1.843	
FILL EXPANDED BY 30%		2,396
WASTE		9,392

DRIVEWAYS

STATION	LOCATION	CONC. DRIVEWAY S.Y.	SINGLE AGG. BIT. SURFACE TON	CRUSHED AGG. BASE COURSE TON
115+89	LT.			5
116+00	RT.			5
118+64	LT.			10
119+86	LT.			12
120+56	RT.			5
121+05	LT.			13
121+30	RT.			5
121+57	RT.			4
122+53	RT.			12
125+66	LT.		2	3
128+41	RT.		10	20
130+98	RT.		12	22
130+98	LT.		21	41
133+62	RT.		18	34
133+65	LT.		6	12
138+31	LT.			15
139+70	LT.			18
140+29	RT.			9
140+31	LT.			8
143+69	RT.		4	7
144+05	LT.			9
145+22	LT.		7	13
145+43	RT.	33	3	17
146+12	LT.		5	10
146+50	LT.			3
147+11	RT.	33	3	17
147+24	LT.			3
149+50	LT.			4
150+00	LT.			4
151+12	RT.	22	4	18
151+12	LT.		5	9
151+45	RT.	37		12
151+63	LT.			5
152+73	LT.			4
155+02	LT.		24	8
TOTALS		149	100	396

LANDMARK REFERENCE MONUMENTS

STATION	LOCATION	CORNER SECTION QUARTER	NO. REQ'D.
117+26.91	P.I.		1
143+90.43	P.I.		1

REMOVING PAVEMENT

STATION TO STATION	S.Y.
155+68 - 157+64	1,100
0+40 - 1+00 WEST 24TH AVENUE	133
0+50 - 2+15 WAUPUN RD.	367
TOTAL	1,600

EXISTING UTILITIES

STATION	LOCATION	TYPE	EXT. ELEV.	FIN. ELEV.	EXISTING CONDITIONS
116+95	16.5' LT. GAS		66.77	67.86	1.0' OF ADJUSTMENT
117+03	44' LT. GAS		65.80	65.80	6 ADJUSTING RINGS
117+09.5	34.5' LT. SAN. #589		66.28	67.70	6 ADJUSTING RINGS
117+45	47.5' RT. SAN. #588		65.87	67.20	4 ADJUSTING RINGS
119+59.5	21' LT. SAN. #574		65.90	67.95	PRECAST CONE
					NO ADJUSTMENT
120+15	17.5' RT. TELE.		67.70 ±	67.97	3 ROWS BRICK
126+13	15.5' LT. GAS		67.93	67.46	PRECAST WITH 4 ADJUSTING RINGS
127+27	18' RT. TELE.		67.75	67.02	6" OF ADJUSTMENT
127+44.5	22' RT. SAN. #522		67.66	67.87	PRECAST WITH 2 ADJUSTING RINGS
131+23	22.5' RT. SAN. #521		65.68	64.98	PRECAST WITH 3 ADJUSTING RINGS
131+51	15.5' RT. TELE.		65.96	64.98	4 ROWS BRICK
134+71	22' RT. SAN. #520		63.98	64.92	NO ADJUSTMENT
137+97	21' RT. SAN. #519		62.59	64.46	1 ADJUSTING RING
138+22	13' RT. TELE.		64.37	64.37	
141+17	19' RT. SAN. #518		61.86	61.65	PRECAST WITH 1 ADJUSTING RING
144+15.5	19.5' RT. SAN. #515		62.26	62.26	2 ROWS BRICK
146+21	18' RT. SAN. #514		62.21	62.17	3 ROWS BRICK
146+31	11.5' RT. TELE.		62.33	62.27	4 ROWS BRICK
148+75.5	19' RT. SAN. #513		61.29	61.13	2 ADJUSTING RINGS
149+12.5	19.5' RT. SAN. #512		61.50	60.96	3 ROWS BRICK
150+52	21.5' RT. SAN. #595		61.88	60.58	2.5' OF ADJUSTMENT
150+77.5	3' RT. WATER		61.62	60.98	BRICK-POOR CONDITION
153+71	12' RT. TELE.		61.60	61.98	BURIED
153+71	21.5' RT. SAN. #294		61.69	61.78	PRECAST WITH NO ADJUSTMENT
157+36	17.5' RT. #180		61.53	61.53	BRICK-POOR CONDITION
157+38	6' RT. TELE.		61.61	61.54	2 ROWS BRICK
157+53	1' RT. #179		61.64	61.54	BRICK-POOR CONDITION
1+42*	13.5' RT. SAN. #570		65.67	65.67	2 ADJUSTING RINGS

* WAUKAU AVENUE STATIONING
CASTING NUMBER

STORM SEWER

INL./M.H. NUMBER	STA.	LI. OR RT.	TYPE	F.L. OR COV. ELEV.	EL. TOP BOX	INLET ELEV.	FROM	TO	PIPE	DEPTH	REMARKS
① INL. 20	115+50	RT.	10-MS	69.36	68.19	65.86	INL. 20	M.H. 106	28'x24"	7.0	
① INL. 21	115+50	LT.	10-MS	69.36	68.19	65.86	INL. 20	M.H. 106	28'x24"	7.0	
④ M.H. 106	115+50	3' RT.	1-J	69.36	68.19	65.86	INL. 20	M.H. 107	126'x36"	7.0	
④ M.H. 107	116+79	4.4' RT.	1-J	68.18	67.01	60.95	M.H. 106	M.H. 108	111'x36"	6.1	
④ M.H. 107A	116+79	23.5' RT.	1-A	67.56	66.73	62.72	INL. 21	M.H. 107	19'x12"	4.0	
④ INL. 22	116+79	23.5' LT.	1-A	67.56	66.73	62.80	INL. 21	M.H. 107	24'x12"	3.9	
④ M.H. 108	117+85	30.0' RT.	1-J	68.0	66.83	61.91	INL. 25-A	CREEK	24'x36"	6.4	
④ INL. 25	117+85	23.5' LT.	1-A	67.25	66.42	60.39	M.H. 107	M.H. 109	43'x12"	4.3	
④ INL. 25A	117+85	23.5' RT.	1-A	67.25	66.42	61.99	INL. 25	M.H. 109	8'x12"	4.4	
④ M.H. 109	118+70	3.8' RT.	1-J	68.01	66.84	60.58	M.H. 110	M.H. 109A	28'x24"	6.3	
④ M.H. 109A	118+61	30' RT.	1-J	66.00	65.25	59.40	M.H. 109	CREEK	20'x24"	5.9	
④ M.H. 110	123+20	3' RT.	1-J	66.81	65.64	62.02	M.H. 111	M.H. 109	450'x24"	3.6	
④ INL. 26	123+20	23.5' LT.	3-H	66.25	65.42	63.32	INL. 26	M.H. 110	24'x12"	2.1	
④ INL. 27	123+20	23.5' RT.	3-H	66.25	65.42	63.32	INL. 26	M.H. 110	19'x12"	2.1	
④ M.H. 111	127+22	3' RT.	1-J	67.34	66.17	62.83	M.H. 112	M.H. 110	402'x24"	3.3	
④ M.H. 112	5+54*	12' RT.	1-J	67.14	65.97	62.97	INL. 28	M.H. 111	50'x24"	3.0	
④ INL. 28	5+54*	18' RT.	1-A	66.69	65.86	63.17	INL. 28	M.H. 112	2'x12"	2.7	
④ INL. 29	5+54*	18' LT.	1-A	66.85	66.02	63.17	INL. 29	M.H. 112	26'x12"	2.8	
④ STUB	5+94*	12' RT.				63.20	(FUTURE)	M.H. 112	40'x24"		
④ M.H. 113	130+00	19' LT.	1-J	65.66	64.49	61.00	INL. 30	M.H. 114	290'x15"	3.5	
④ INL. 30	130+00	23.5' RT.	1-A	65.42	64.59	61.20	INL. 31	M.H. 113	40'x12"	3.0	
④ INL. 31	129+93	23.5' LT.	1-A	65.45	64.62	61.62	M.H. 113	M.H. 113	7'x12"	3.0	
④ M.H. 114	132+90	19' LT.	1-J	64.43	63.26	59.06	M.H. 113	M.H. 115	308'x18"	4.2	
④ INL. 32	132+90	23.5' RT.	3-H	64.19	63.36	59.56	INL. 32	M.H. 114	40'x12"	3.8	
④ INL. 33	132+87	23.5' LT.	3-H	64.19	63.36	59.56	INL. 32	M.H. 114	3'x12"	3.8	
④ M.H. 115	136+00	19' LT.	1-J	65.68	64.51	54.60	M.H. 114	M.H. 116	60'x24"	9.9	
④ INL. 34	136+25	37' LT.	1-C	65.5 ±	64.2 ±	61.2 ±	INL. 34	M.H. 115	30'x12"	3.0 ±	
④ M.H. 116	136+31	33' RT.	1-J	65.54	64.37	54.00	M.H. 115	M.H. 117	166'x24"	10.4	
④ M.H. 117	2+00**	20' RT.	1-C	MATCH GRADE	59.5 ±	53.49	M.H. 116	M.H. 118	246'x24"	60 ±	
④ INL. 35	2+00**	20' LT.	1-C	MATCH GRADE	59.5 ±	56.00	M.H. 116	M.H. 117	40'x12"	3.5 ±	
④ M.H. 118	4+50**	20' RT.	1-C	MATCH GRADE	58.0 ±	52.62	M.H. 117	M.H. 119	313'x24"	5.4 ±	
④ INL. 36	4+50**	20' LT.	1-C	MATCH GRADE	58.0 ±	54.40	M.H. 117	M.H. 118	40'x12"	3.6 ±	
④ M.H. 119	7+87**	17' RT.	EXISTING	EXISTING	51.35	51.35	M.H. 118	EXISTING			
④ INL. 37	7+87**	20' LT.	1-C	MATCH GRADE	54.5 ±	51.53	M.H. 118	M.H. 119	35'x12"	3.0 ±	
INL. 38-A	141+80	23.5' RT.	3-H	61.24	60.41	57.60	INL. 38	M.H. 121	232'x18"	2.8	
INL. 38	141+80	23.5' LT.	3-H	61.24	60.41	58.20	INL. 38-A	44'x12"	2.2		
④ M.H. 121	144+12	24' RT.	J	62.03	EXIST.	56.80	INL. 38-A	EXIST.			
④ M.H. 122	146+90	24.5' RT.	J	62.30	EXIST.	EXIST.					
CB	148+65	15' RT.	EXISTING	REMOVE AND PLUG LEAD							
④ M.H. 123	148+65.5	23.5' RT.	H	60.94	EXIST.	54.00	INL. 39	M.H. 123A	10'x24"		
④ M.H. 123A	148+73	31' RT.	1-J	MATCH GRADE	61.5 ±	53.52	M.H. 123	CREEK	6'x24"	8.0 ±	
INL. 39	148+65	23.5' LT.	1-A	60.94	60.10	54.44	M.H. 123	M.H. 123	44'x12"	5.7	
④ M.H. 124	149+25.5	25' RT.	EXISTING	61.35	EXISTING	54.7 ±	M.H. 125	M.H. 124-A	10'x24"		
CB	149+30	15.0' RT.	EXISTING	REMOVE AND PLUG LEAD							
④ M.H. 124A	149+17	31' RT.	1-J	MATCH GRADE	61.5 ±	53.76	M.H. 124	CREEK	10'x24"	7.7 ±	
④ M.H. 125	150+20	23.5' RT.	1-H	60.42	59.58	56.70	INL. 40	M.H. 124	EXISTING	3.3	
CB	150+02	14.0' RT.	EXISTING	REMOVE AND PLUG LEAD	57.40						
INL. 40	150+20	23.5' LT.	3-H	60.42	59.58	57.84	INL. 40	M.H. 125	44'x12"	4.7	
④ M.H. 126	152+13	21' RT.	EXISTING	61.11	60.25	58.0	M.H. 125	EXISTING			
④ INL. 40A	152+20	46' LT	1-C	61.0	60.25	58.0	M.H. 126	66'x12"			
④ INL. 40B	152+13	46.5' RT	1-C	60.0	57.25	57.8	M.H. 126	27'x12"			
④ M.H. 127	154+01	22' RT.	EXISTING	61.91	58.00	57.62	INL. 41	M.H. 126	EXISTING		
INL. 41	154+15	23.5' RT.	1-A	61.80	60.96	58.12	INL. 41	M.H. 127	10'x12"	2.8	
CB	154+01	29' LT	MS	60.0 ±				STORM SEWER			
④ M.H. 128	156+45	20' RT.	EXISTING	61.72	60.4 ±	57.88	INL. 43	M.H. 127	EXISTING		
INL. 43	156+05	32' LT.	1-A	61.03	60.19	58.07	INL. 44	M.H. 128	102'x12"	2.1	
INL. 44	156+64	23.5' RT.	1-A	61.40	60.56	57.93	M.H. 128	8'x12"	2.6		
④ M.H. 129	157+48	15' LT.	EXISTING	61.24	EXIST.	57.0 ±	INL. 45	EXISTING			
INL. 45	157+11	39' LT.	1-A	61.05	60.21	57.2 ±	M.H. 129	44'x12"	3.0 ±		

NOTES


- * WEST 29TH AVENUE STATIONING
- ** WEST 28TH AVENUE STATIONING
- ① APRON ENDWALL REQ'D.
- ② ADJUST WITH ECCENTRIC CONE INTO STREET
- ③ ADJUST WITH ECCENTRIC CONE BEHIND CURB
- ④ NON PARTICIPATING ITEM
- ⑤ RECONSTRUCT
- ⑥ ADJUST
- ⑦ TIE INTO EXISTING 24" STORM SEWER

THE COST OF INSTALLING THE STORM SEWER THROUGH THE STEEL CASING PIPE AT STA. 136+12 SHALL BE CONSIDERED AS INCIDENTAL TO THE UNIT COST OF R.C.P. CLASS III STORM SEWER, 24 INCH. MANHOLE NO. 106 SHALL BE CONSTRUCTED TO PERMIT FUTURE CONSTRUCTION OF 36" STORM SEWER TO THE SOUTH.

LEGEND


- S- INPLACE SANITARY
- W- INPLACE WATER
- T- INPLACE TELEPHONE
- G- INPLACE GAS LINE
- PROPOSED CURB
- PROPOSED STORM SEWER
- 10' TAPERED CURB & GUTTER
- FLOW LINE ELEVATION
- SINGLE AGG. BIT. SURFACE
- CRUSHED AGG. SURFACE
- SIDEWALK REMOVAL
- TYPE 3 CURB RAMP
- DRAINAGE


PROJECT DESIGNATION	SHEET NO.
4994-0-17	5

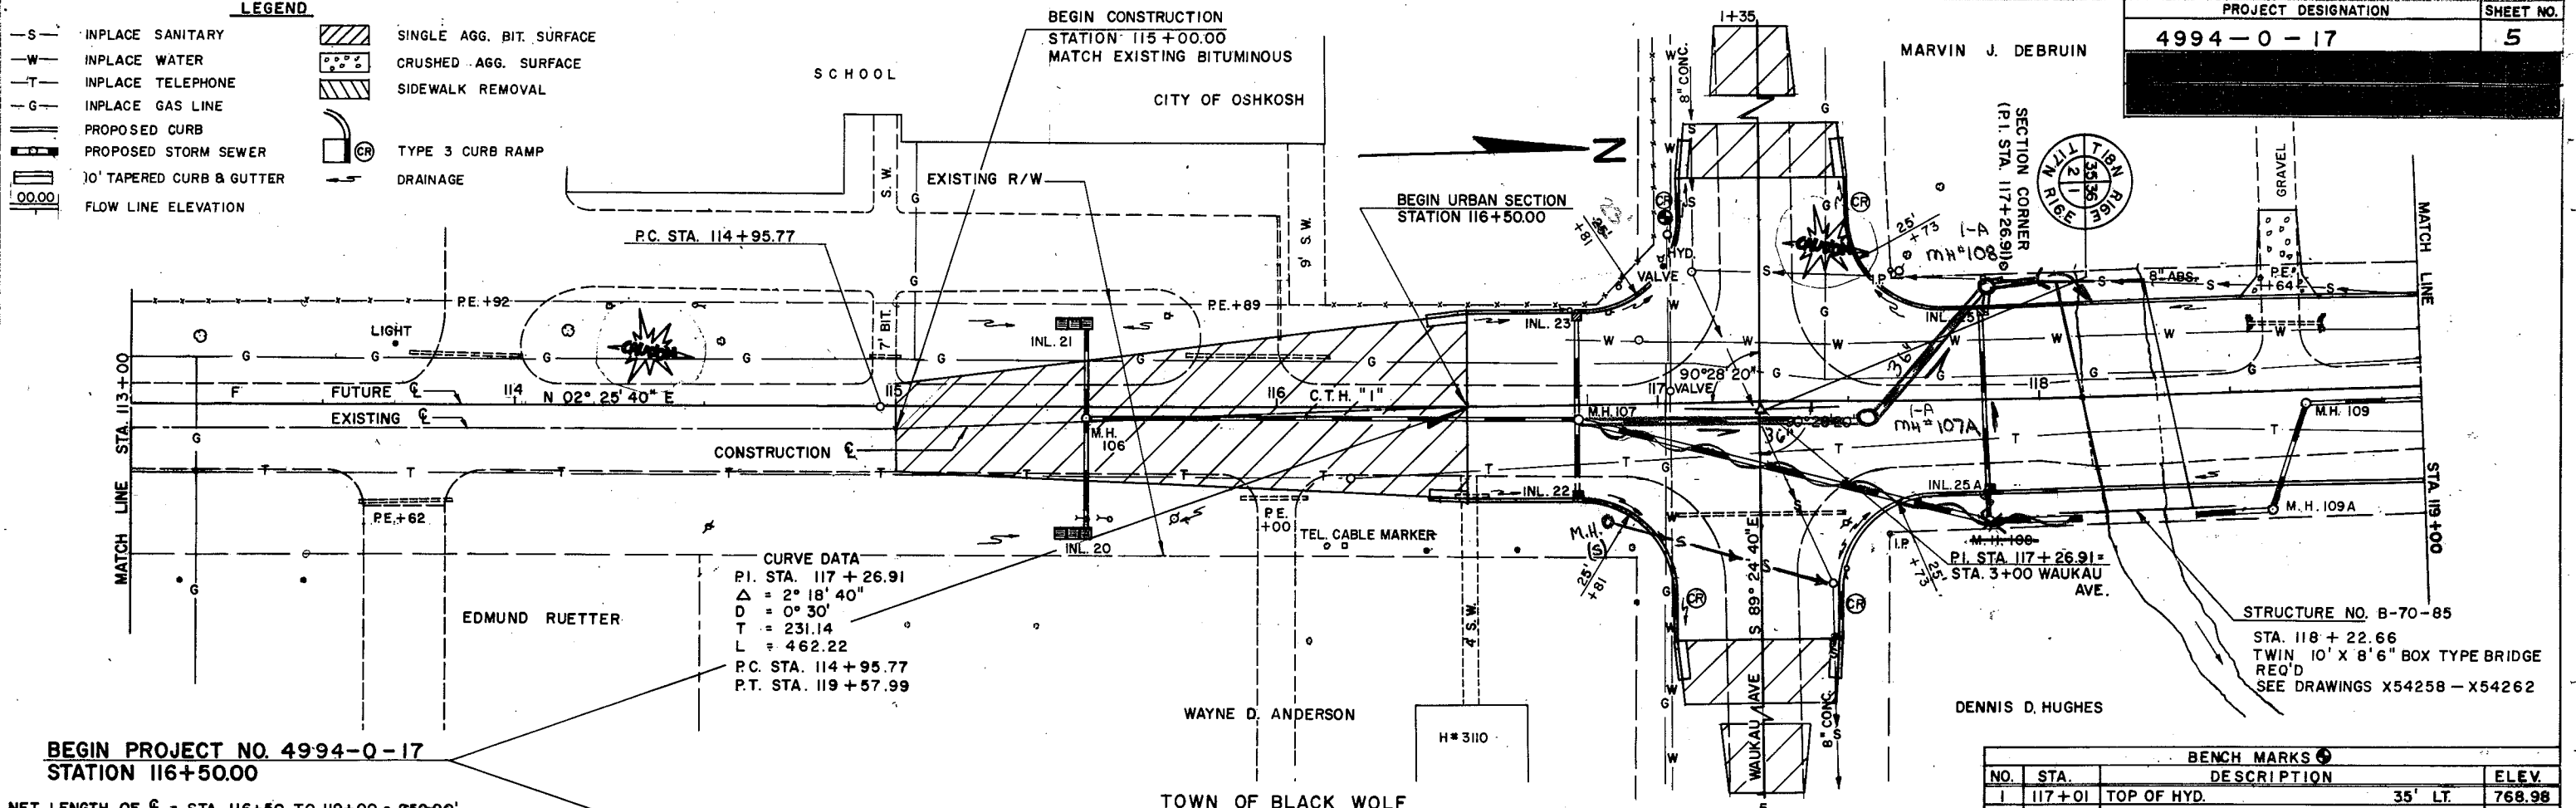

BEGIN PROJECT NO. 4994-0-17
STATION 116+50.00
 NET LENGTH OF \mathcal{C} = STA. 116+50 TO 119+00 = 250.00'


BENCH MARKS			
NO.	STA.	DESCRIPTION	ELEV.
1	117+01	TOP OF HYD.	768.98

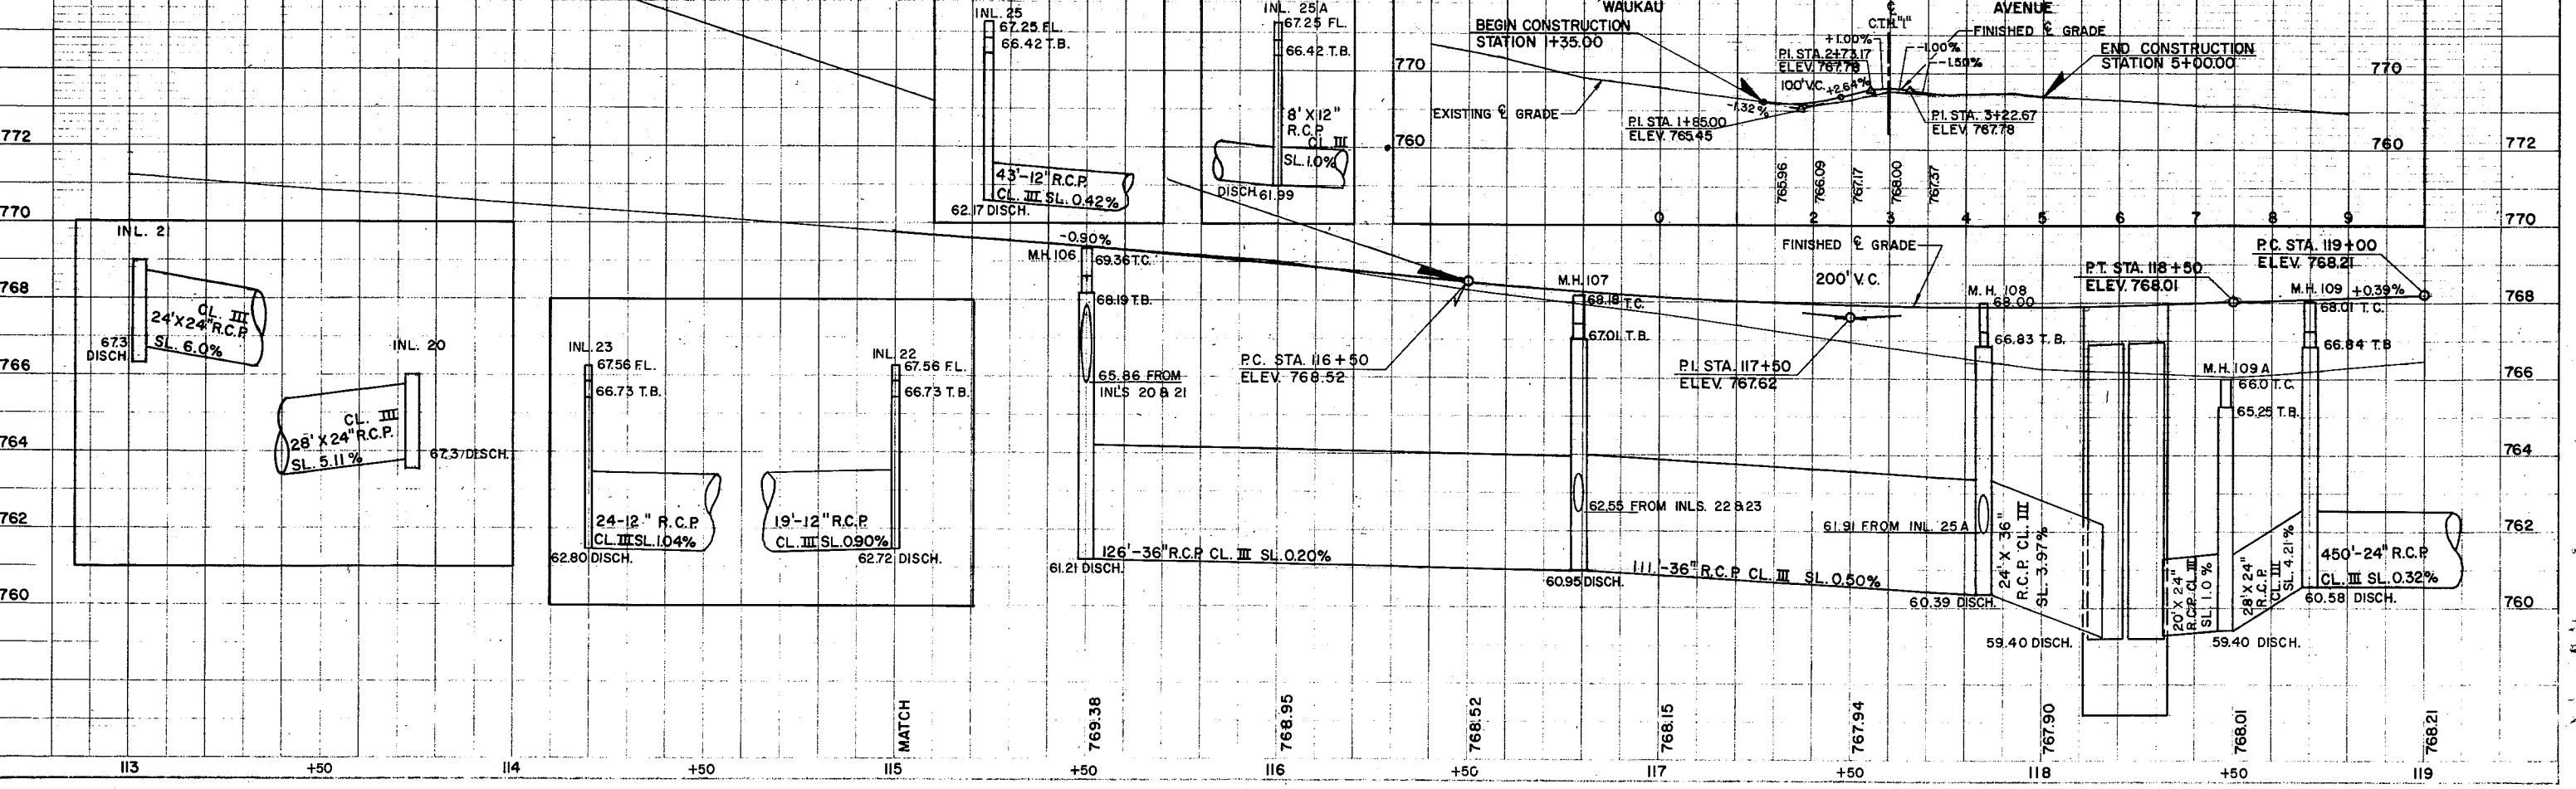

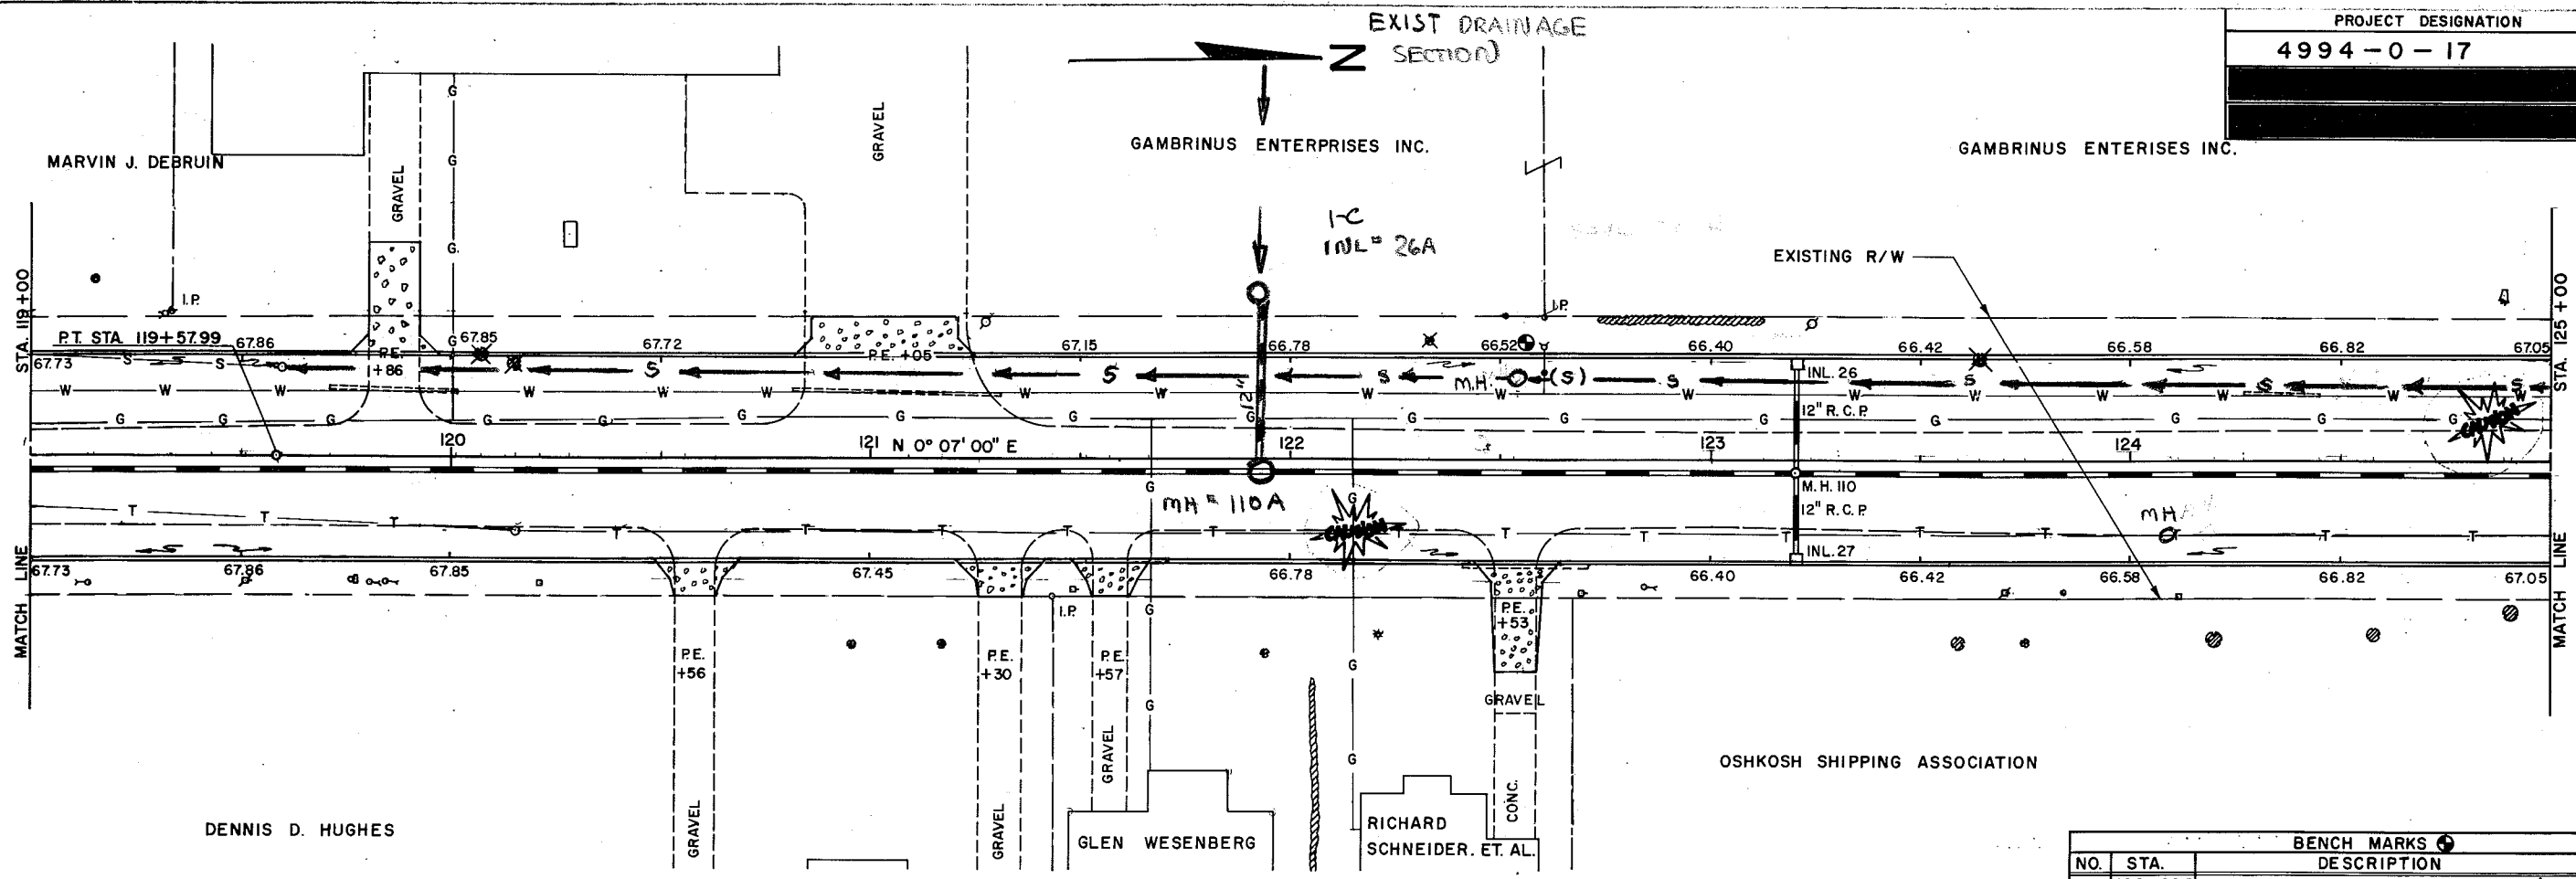


NET LENGTH OF ℓ = STA. 119+00 TO STA. 125+00 = 600.00'

BENCH MARKS			
NO.	STA.	DESCRIPTION	ELEV.
7	122+60.5	TOP OF HYD.	769.45

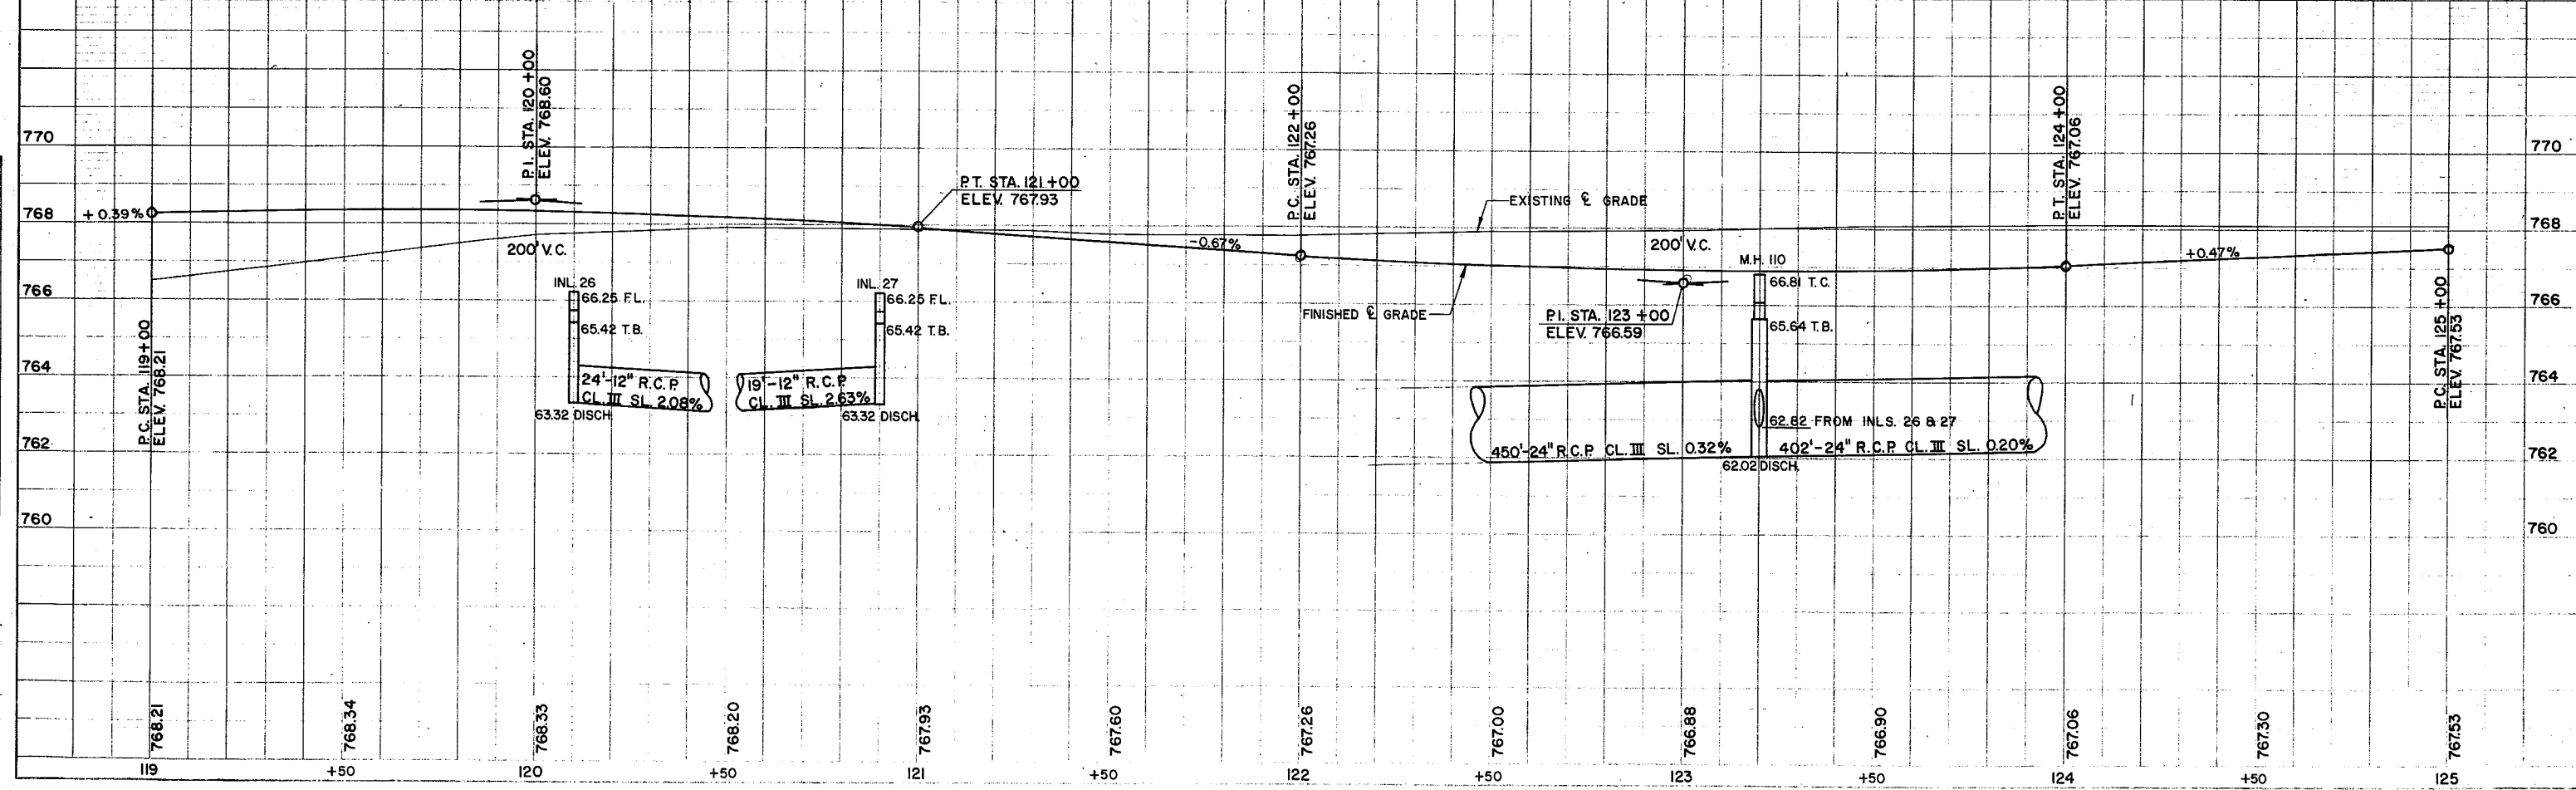

DATE: _____
BY: _____
CHECKED: _____
DATE: _____

DATE: _____
BY: _____
CHECKED: _____
DATE: _____

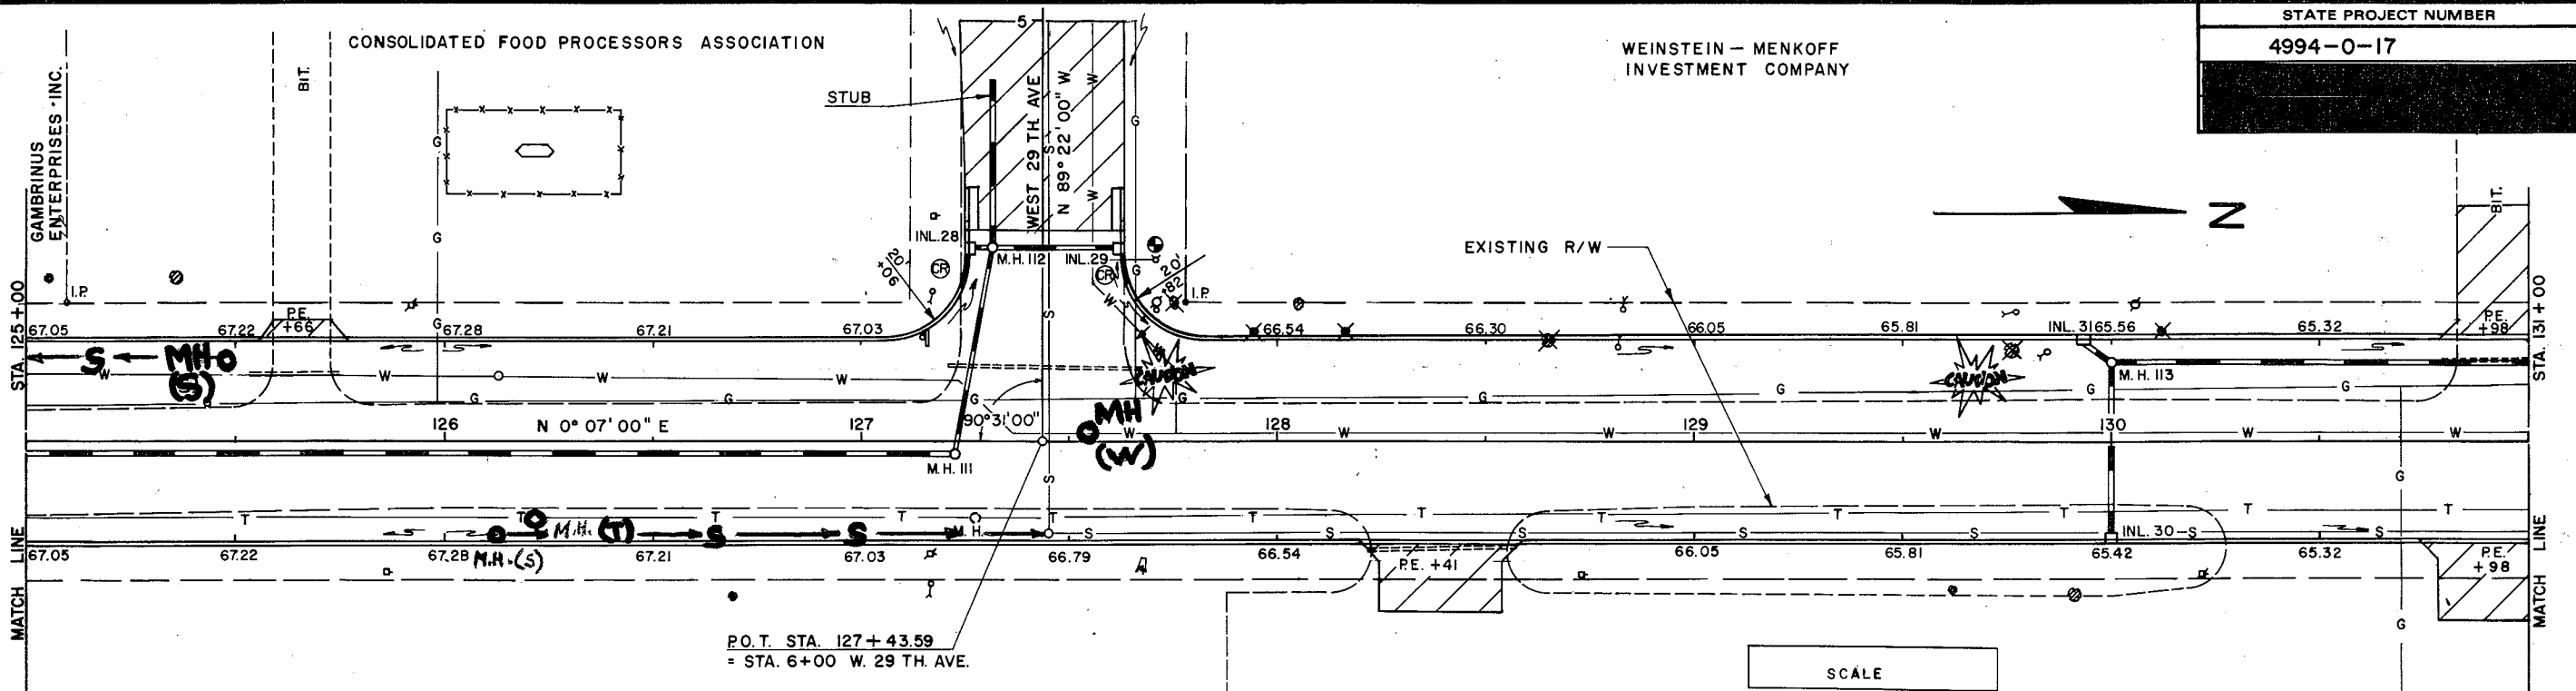


P.O.T. STA. 127+43.59
= STA. 6+00 W. 29 TH. AVE.

SCALE

BENCH MARKS			
NO.	STA.	DESCRIPTION	ELEV.
8	127+70.5	TOP OF HYD.	43' LT 770.16

NET LENGTH OF \mathcal{C} = STA. 125+00 TO STA. 131+00

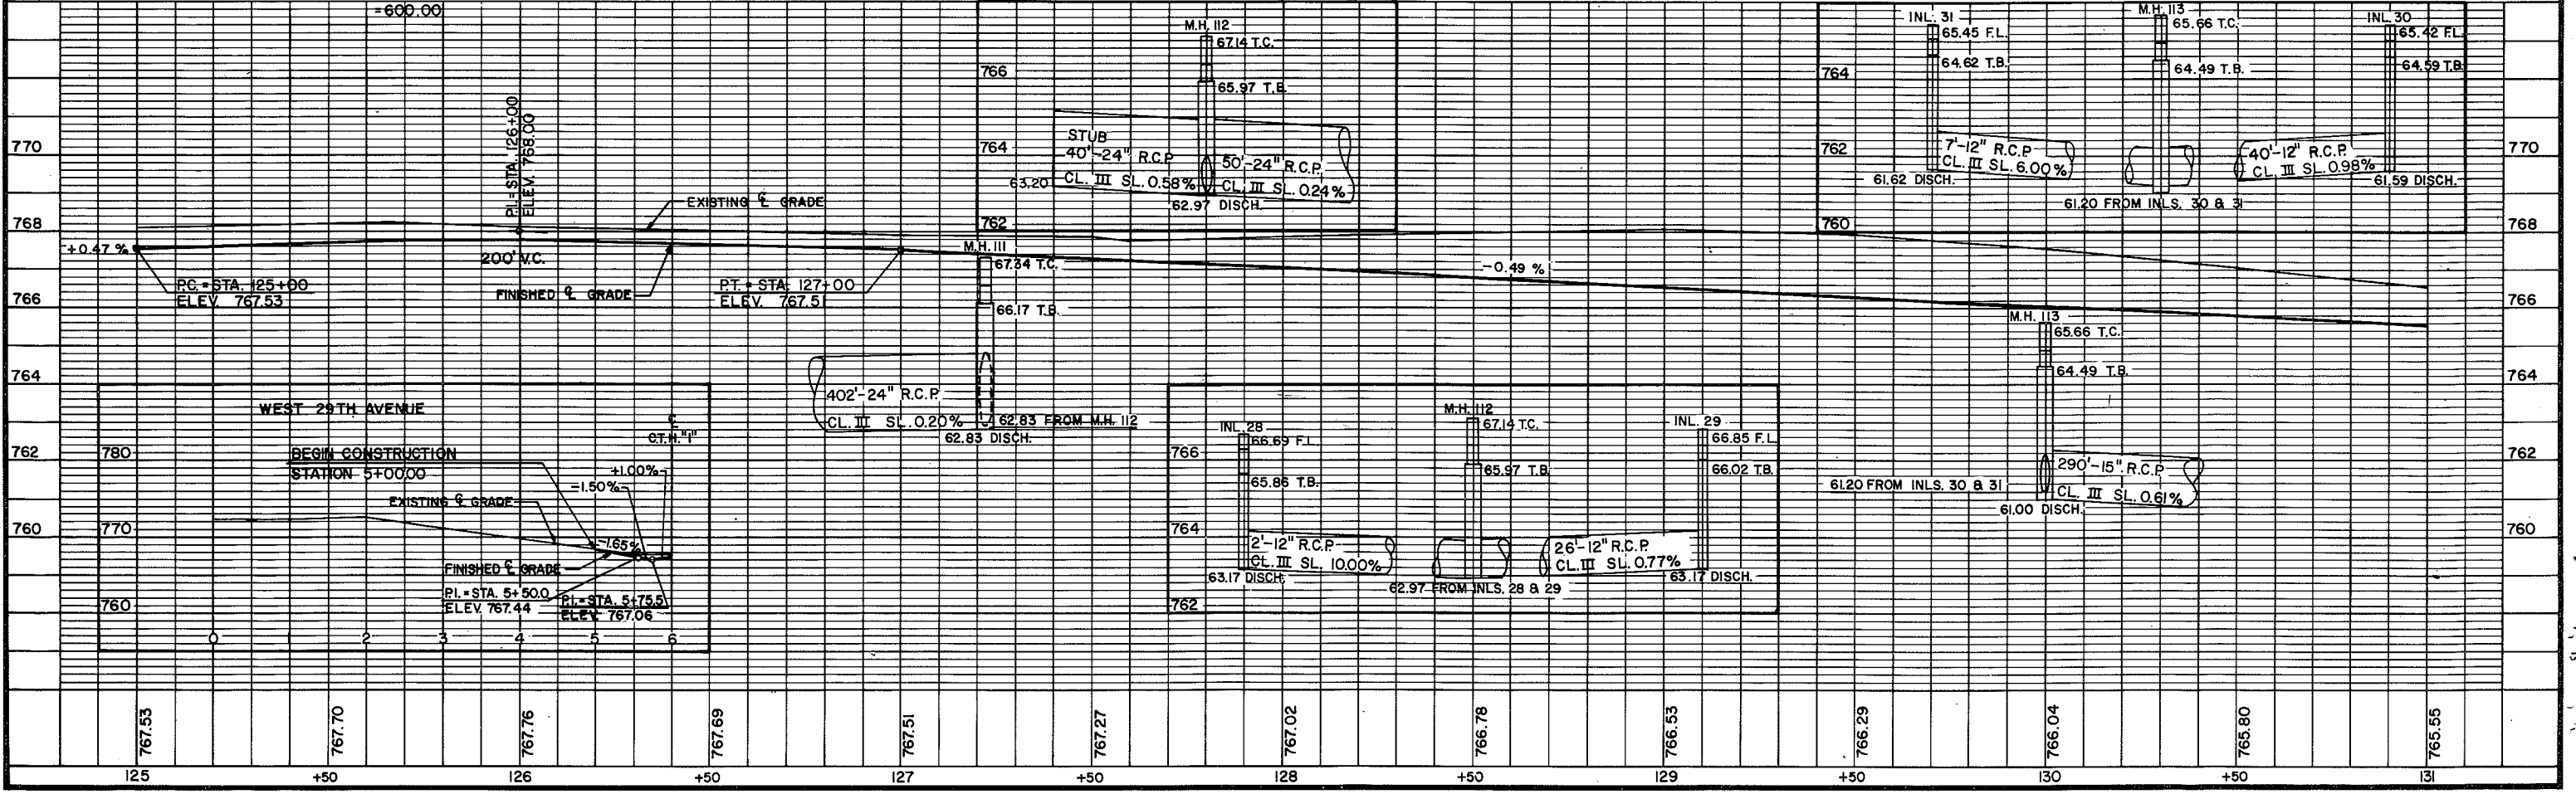

WEST 29TH AVENUE

BEGIN CONSTRUCTION STATION 5+00.00

PI. STA. 5+50.0
ELEV. 767.44

PI. STA. 5+75.5
ELEV. 767.06

767.53	767.70	767.76	767.69	767.51	767.27	767.02	766.78	766.53	766.29	766.04	765.80	765.55
125	+50	126	+50	127	+50	128	+50	129	+50	130	+50	131

WEINSTEIN - MENKOFF INVESTMENT

LEWIS A. THOMAS


1-18"x28" CMGP
1 ENDWALL

PROJECT DESIGNATION
4994-0-17

SHEET NO.
5.3


P.O.L. STA. 136+46.46 =
STA. 0+00 W. 28 TH. ST.

EXCEPTION TO NET LENGTH OF
C. STA. 135+96.81 TO
STA. 136+27.17

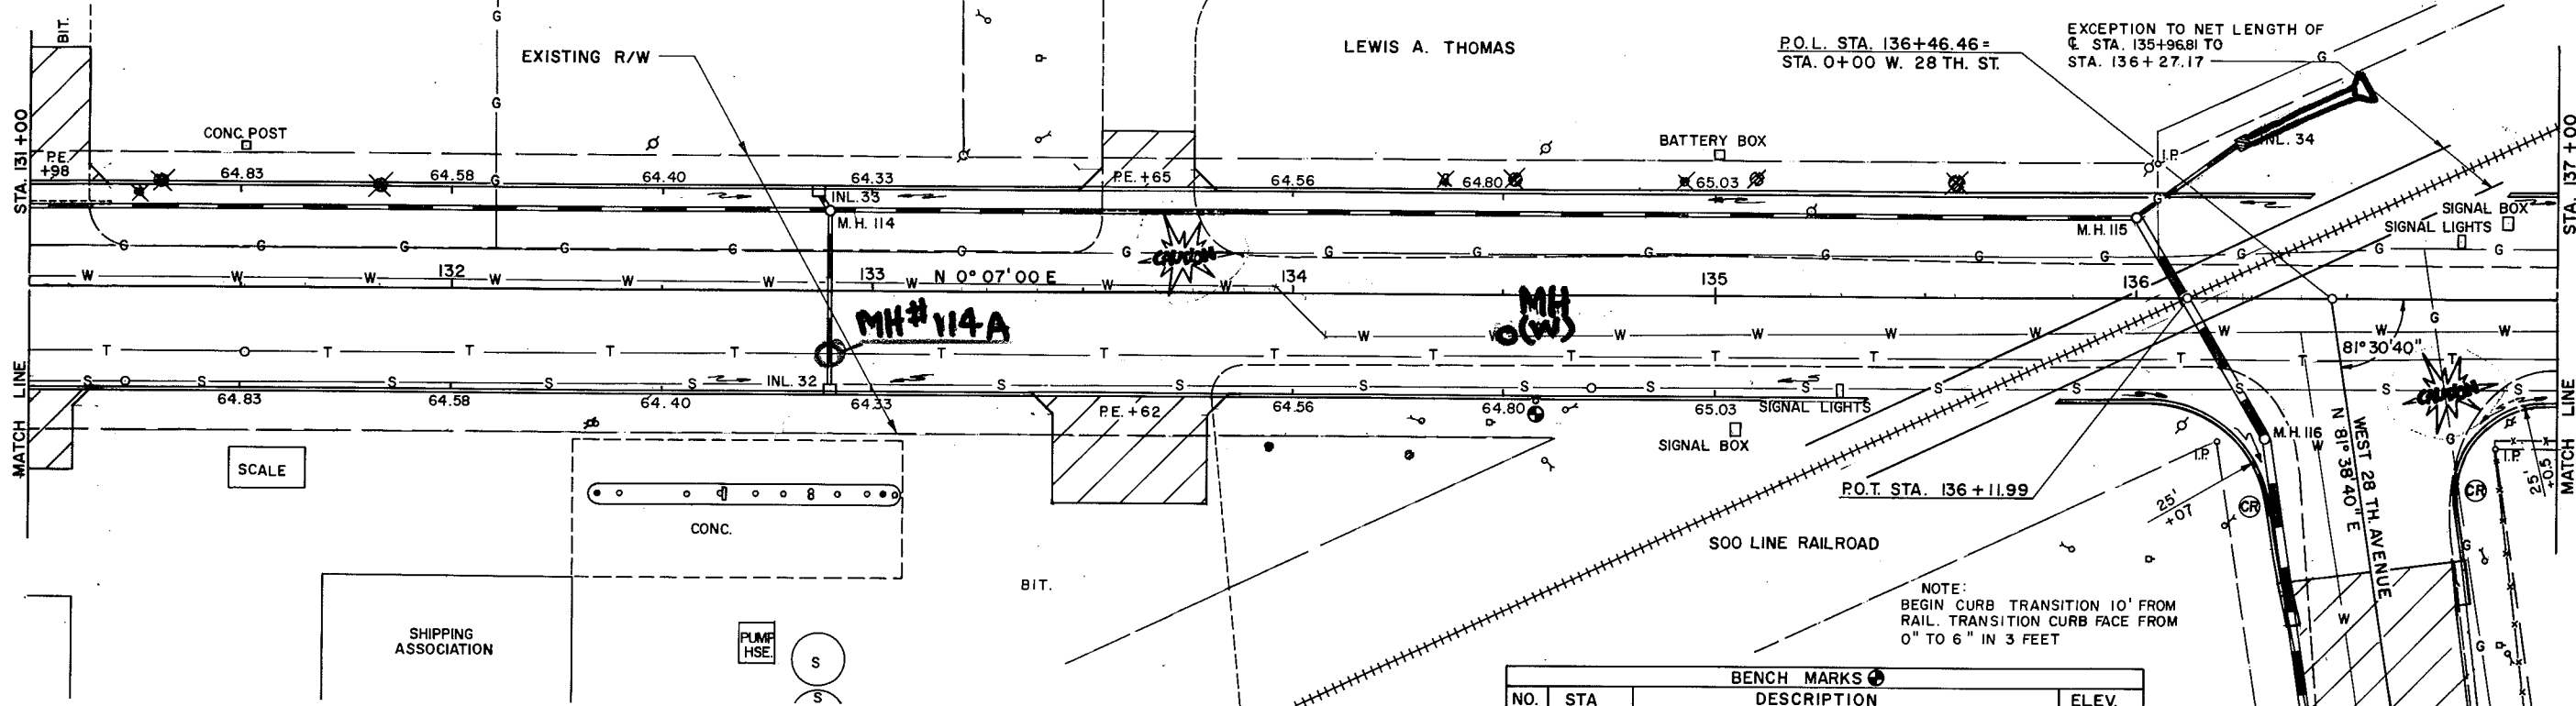

NET LENGTH OF C. = STA. 131+00 TO STA. 137+00 = 569.64'

BENCH MARKS			
NO.	STA.	DESCRIPTION	ELEV.
9	134+55	WORD "OPEN" ON HYD. 25' RT.	766.81

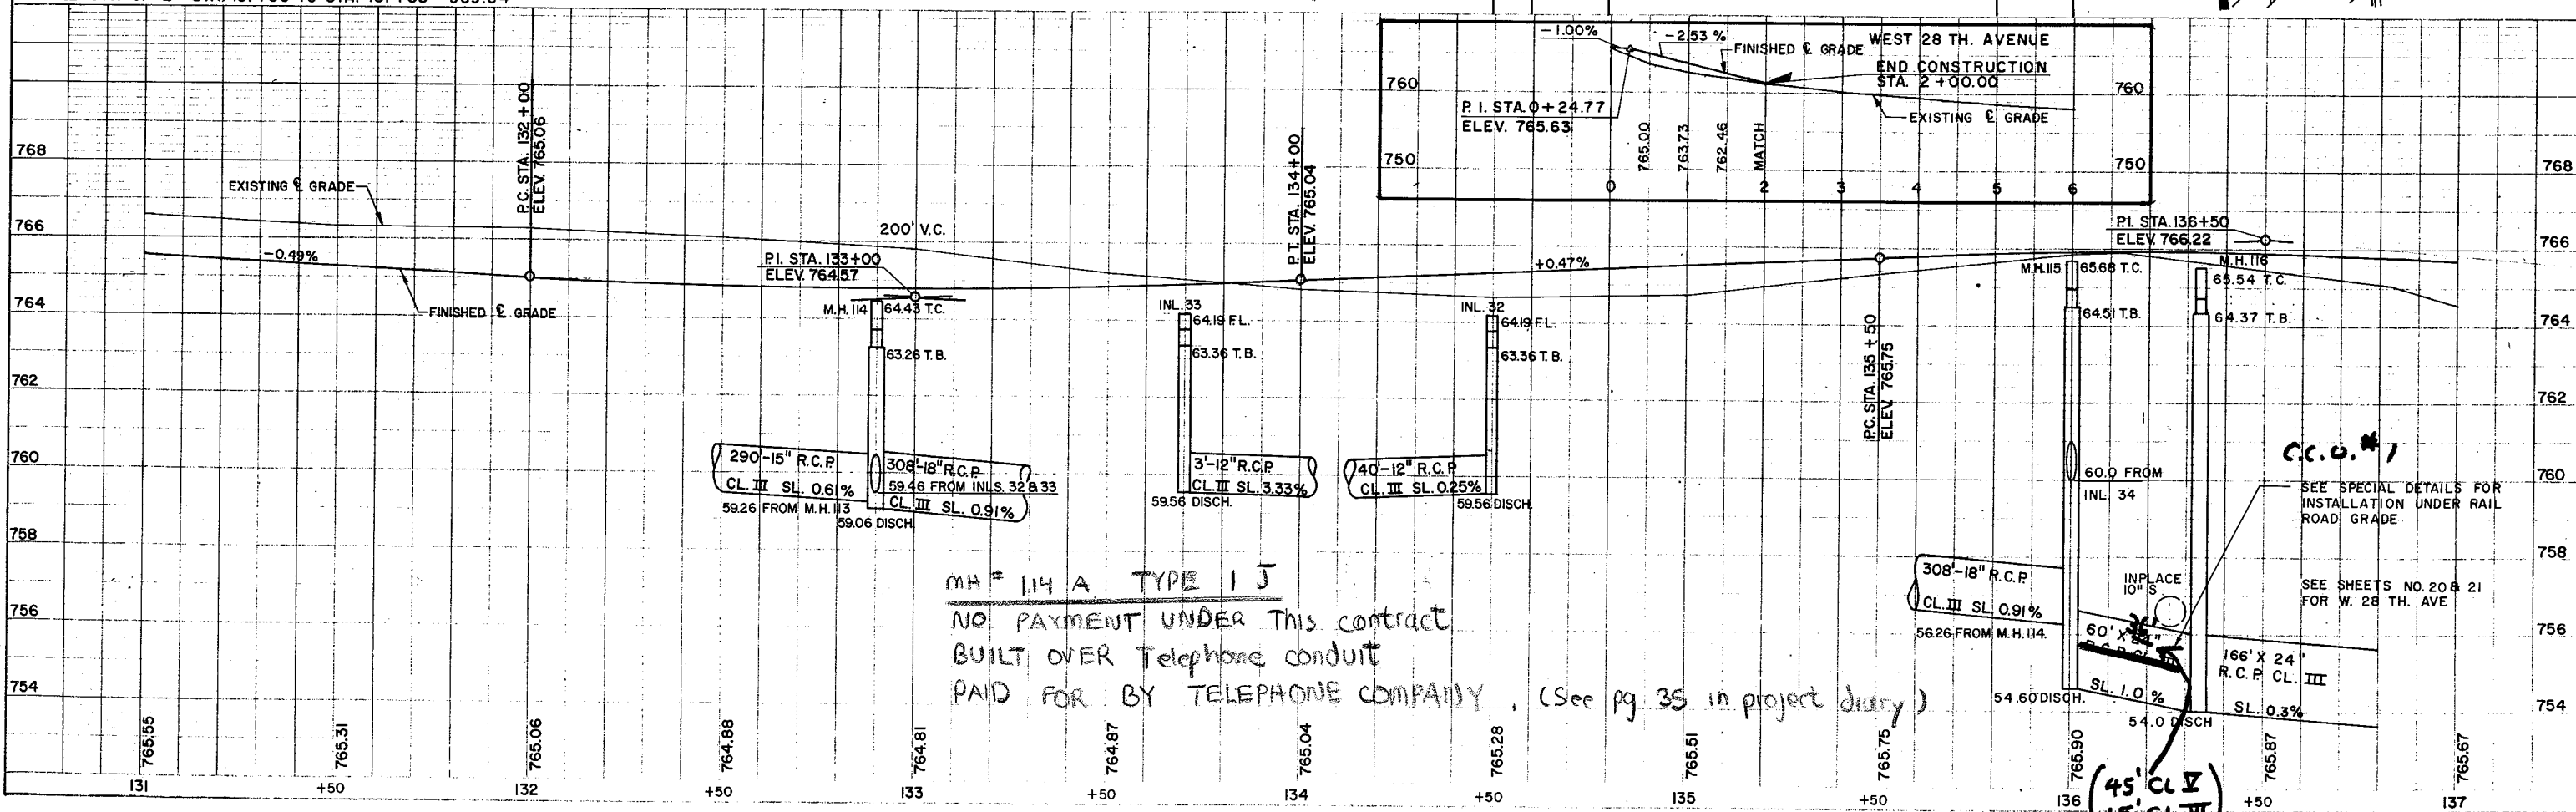

290'-15" R.C.P.
CL. III SL. 0.61%
59.26 FROM M.H. 113
59.06 DISCH.

308'-18" R.C.P.
CL. III SL. 0.91%
59.46 FROM INLS. 32 & 33
59.06 DISCH.

INL. 33
64.19 FL.
63.36 T.B.
59.56 DISCH.

40'-12" R.C.P.
CL. III SL. 0.25%
59.56 DISCH.

308'-18" R.C.P.
CL. III SL. 0.91%
56.26 FROM M.H. 114.

(45' CL V)
(15' CL III)


MH # 114 A TYPE I J
NO PAYMENT UNDER THIS CONTRACT
BUILT OVER TELEPHONE CONDUIT
PAID FOR BY TELEPHONE COMPANY. (See pg. 35 in project diary)

C.C.O. #1
SEE SPECIAL DETAILS FOR
INSTALLATION UNDER RAIL
ROAD GRADE
SEE SHEETS NO. 20 & 21
FOR W. 28 TH. AVE.


66' X 24"
R.C.P. CL. III
SL. 0.3%

PLAN
DATE
BY
CHECKED
NOTE BOOK
NO. OF WAY CHECKED

PROFILE
DATE
BY
CHECKED
NOTE BOOK
NO. OF WAY CHECKED

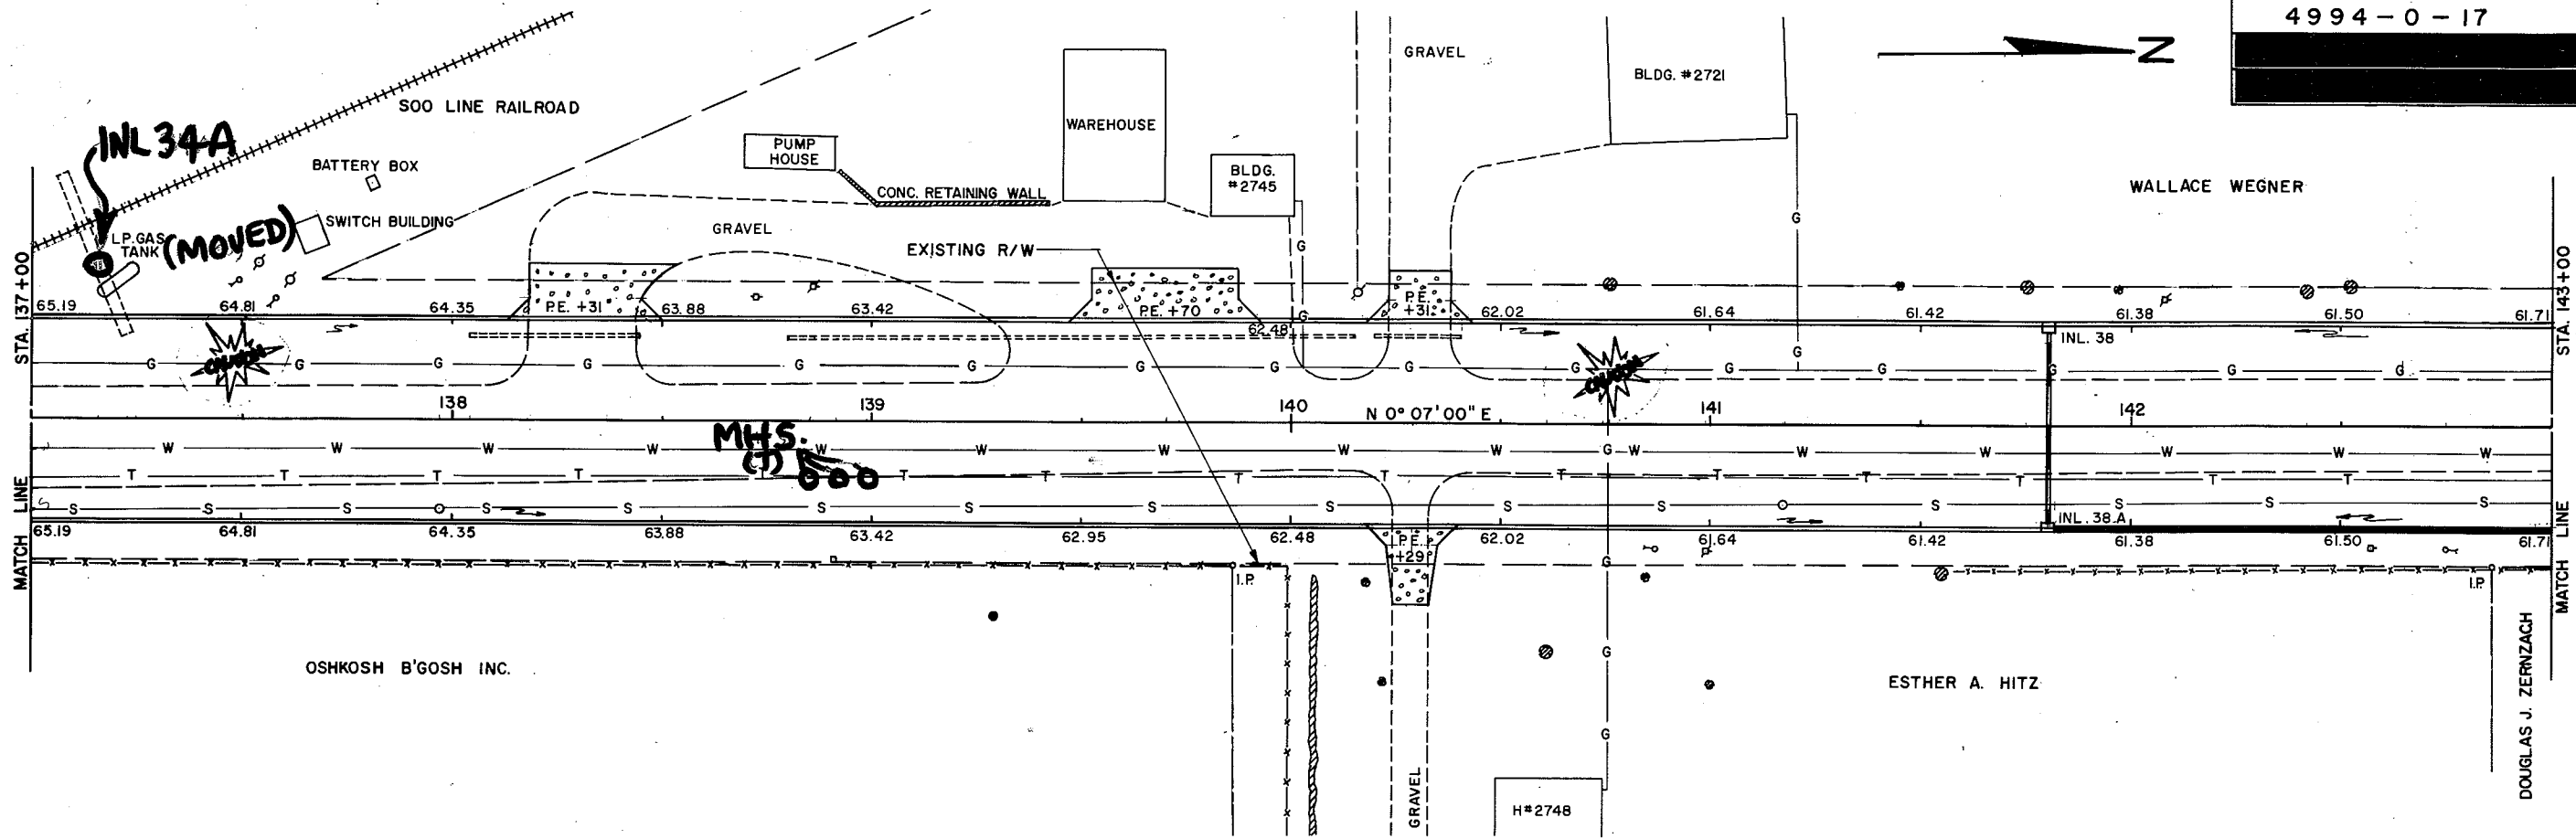


NET LENGTH OF ℓ = STA. 137+00 TO STA. 143+00 = 600.00'

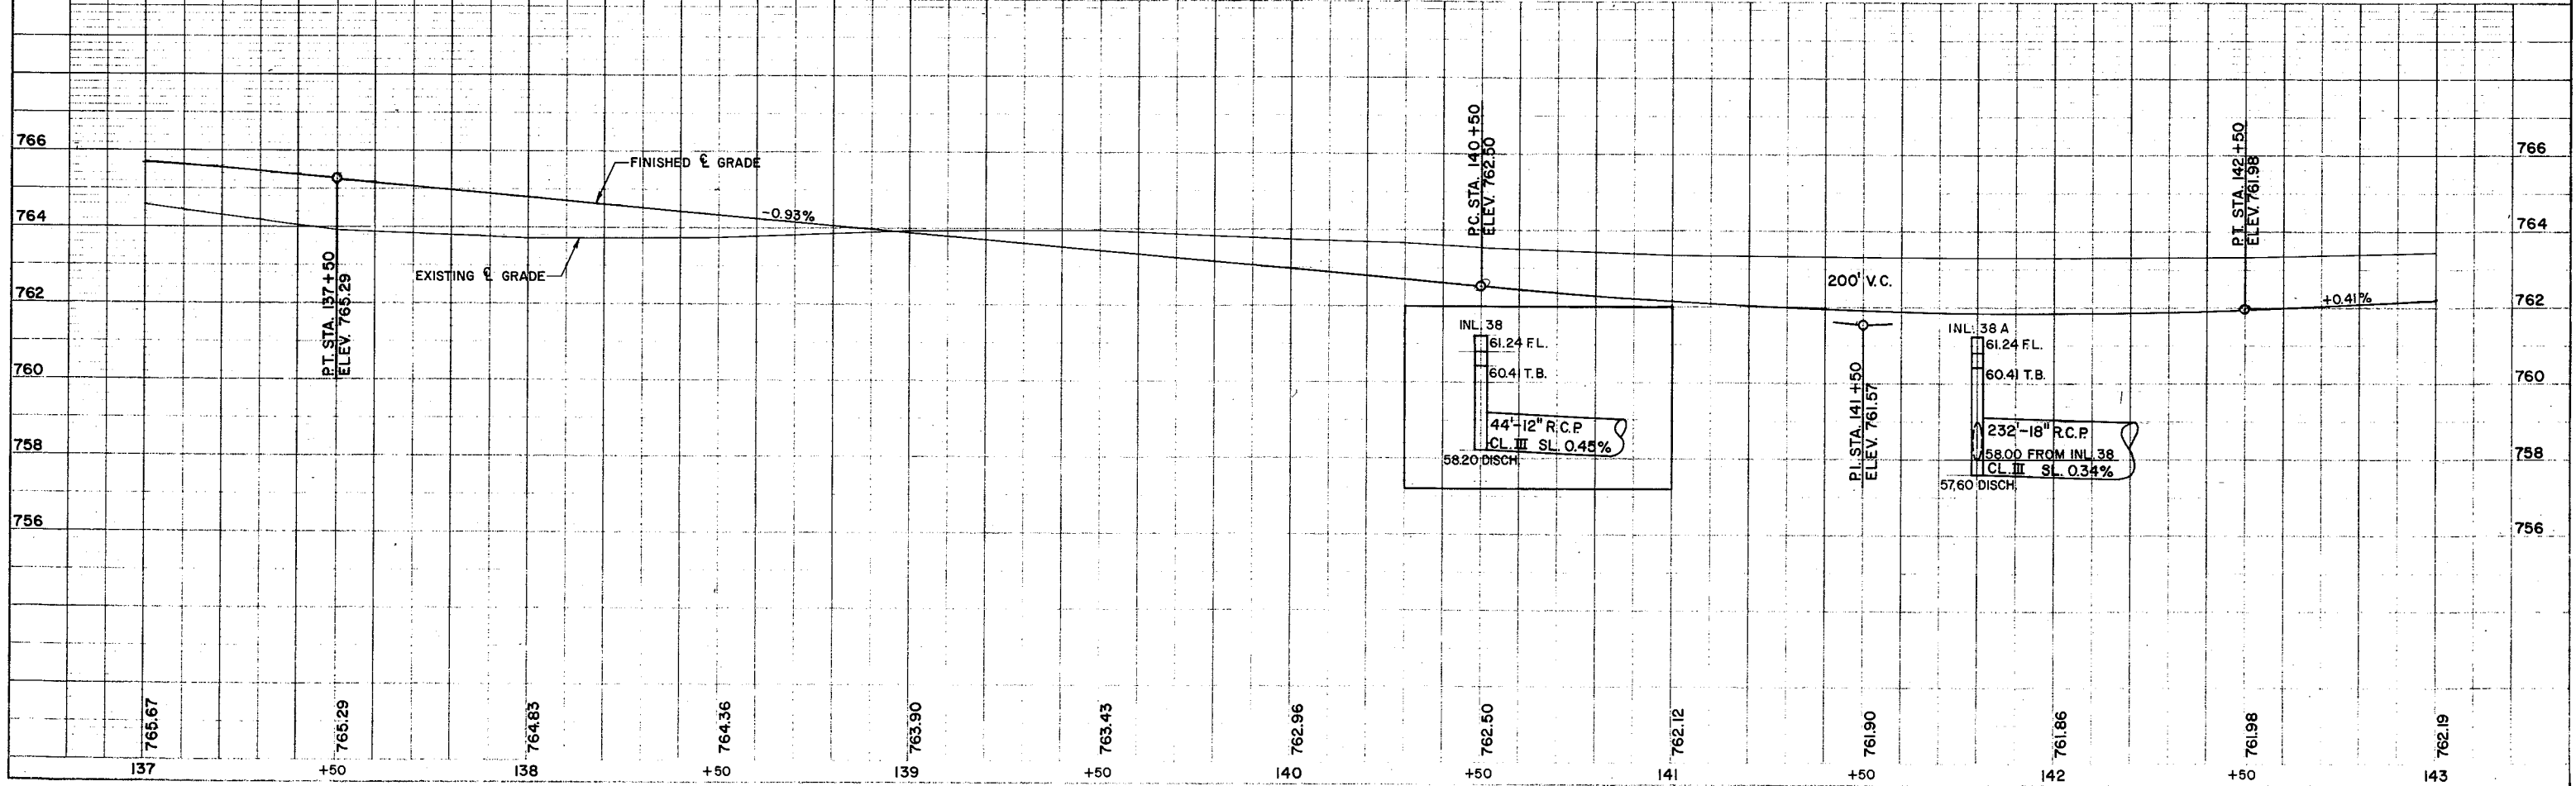

NOTE BOOK No. 101-111-112



CHECKED BY: [Signature] DATE: [Date]

NOTE: INLET # 41 STUBED INTO EXISTING STORM SEWER

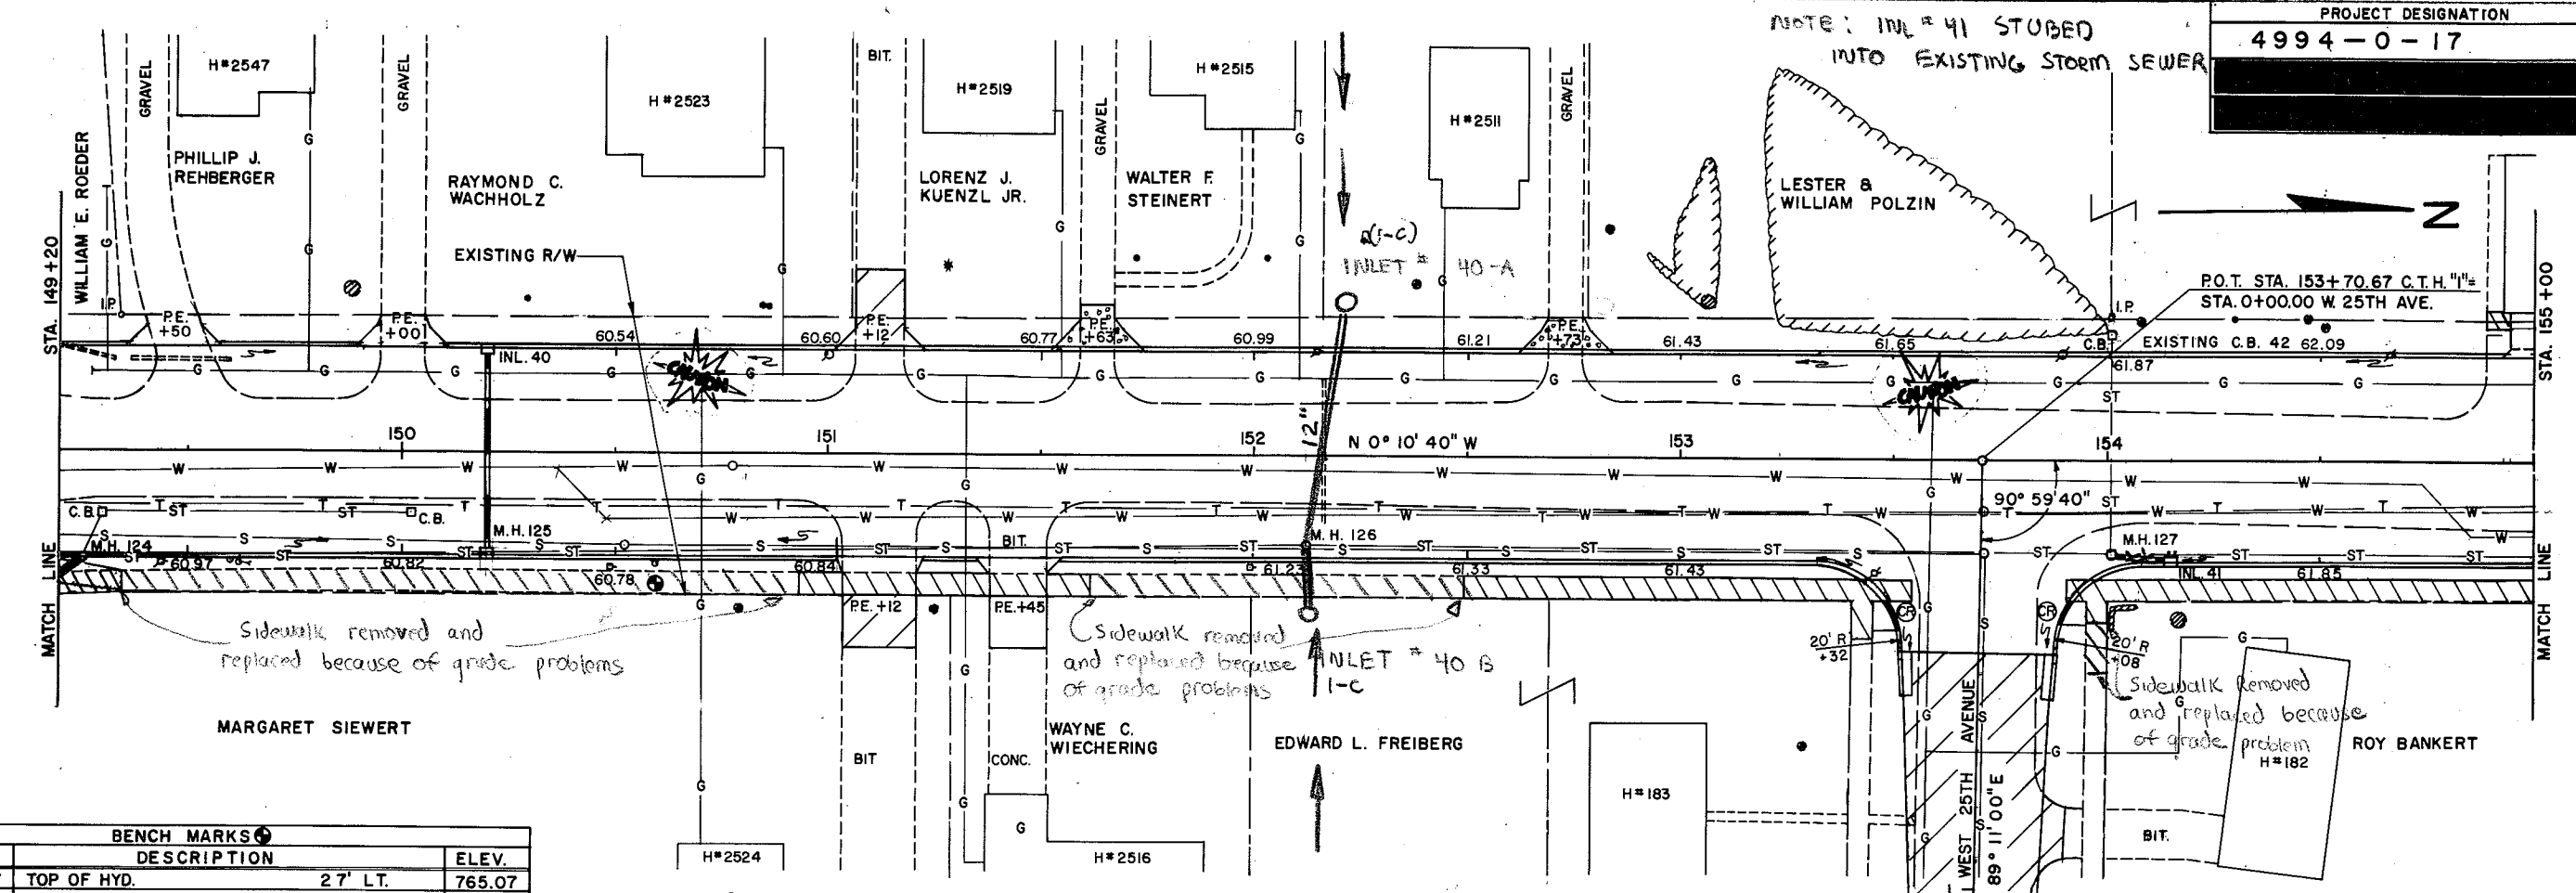

BENCH MARKS			
NO.	STA.	DESCRIPTION	ELEV.
11	150+57	TOP OF HYD. 27' LT.	765.07


NET LENGTH OF \bar{L} = STA. 149+20 TO STA. 155+00 = 580'

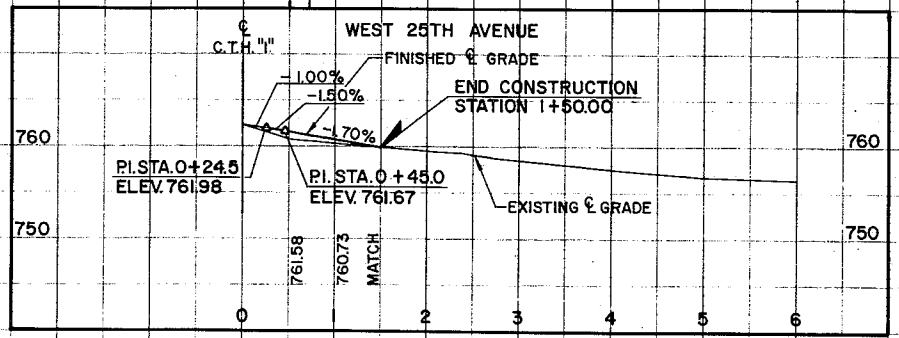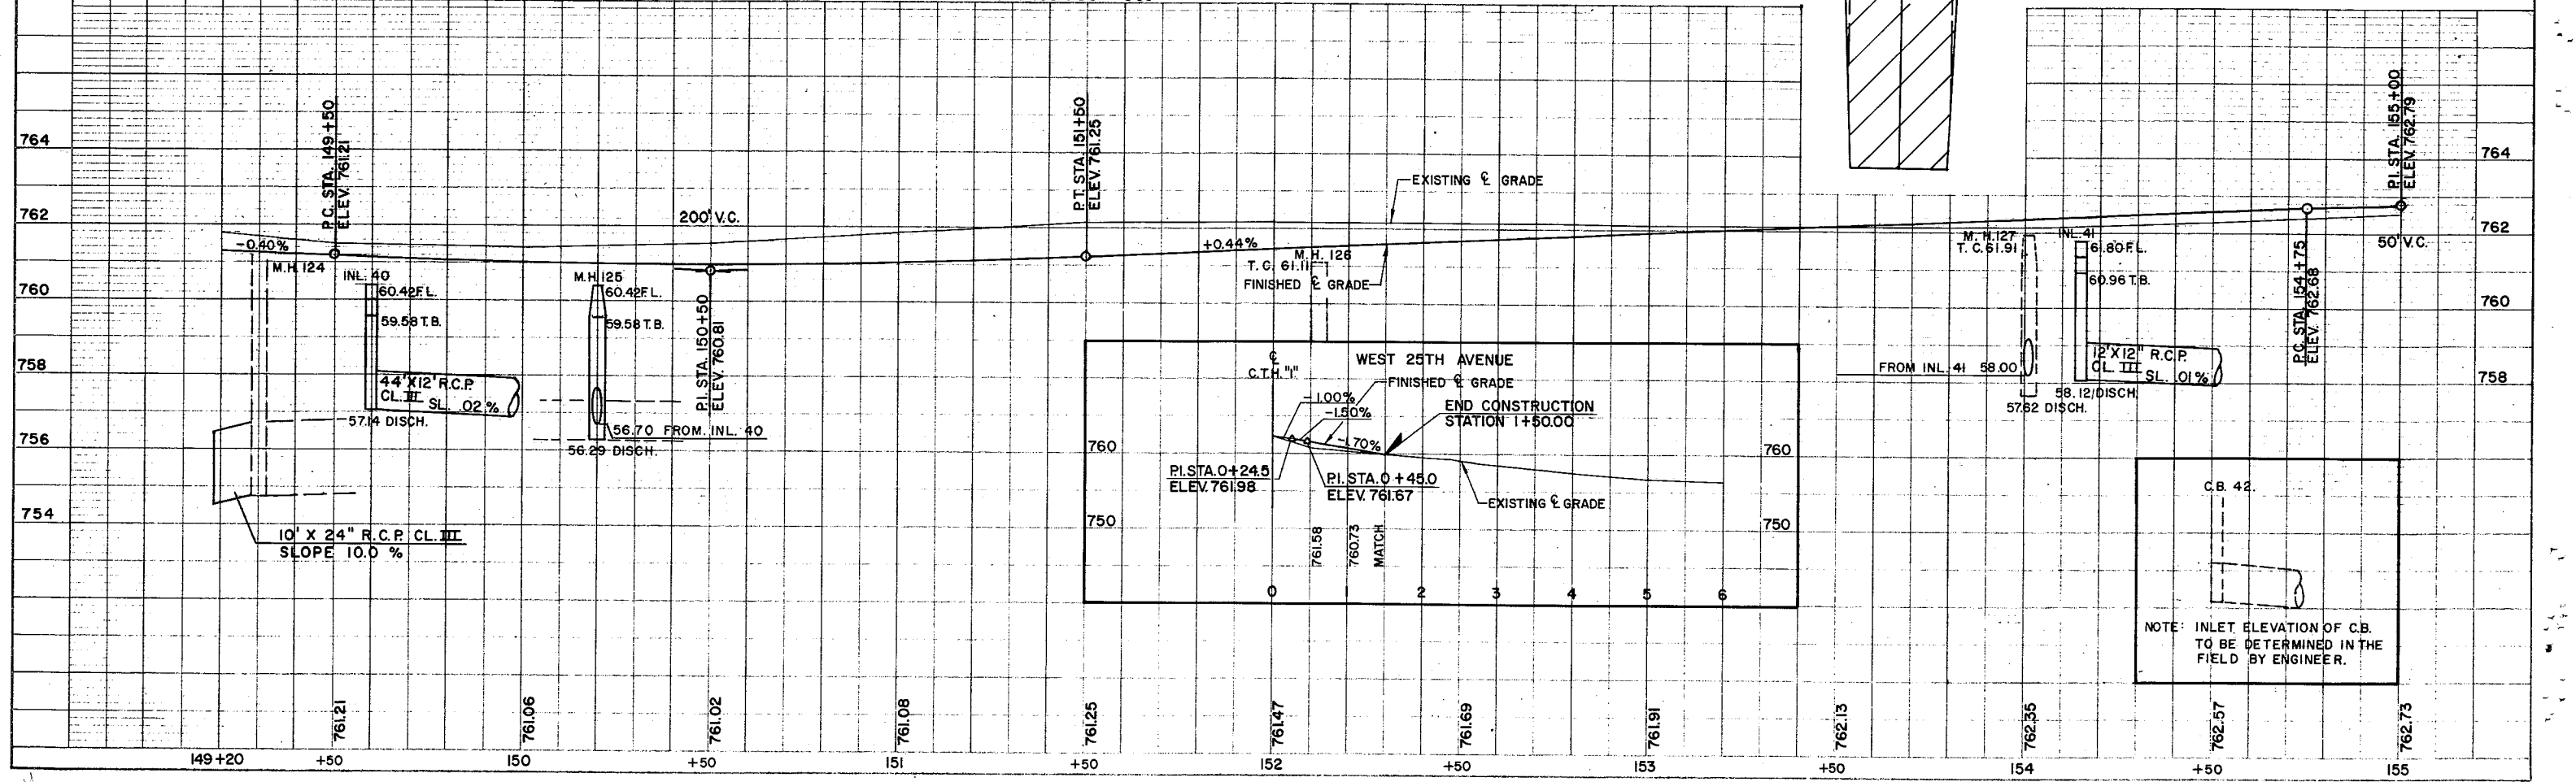



NOTE: INLET ELEVATION OF C.B. TO BE DETERMINED IN THE FIELD BY ENGINEER.


DATE: _____ BY: _____
 PLAN
 NOTE BOOK: _____
 No. _____

DATE: _____ BY: _____
 PROFILE
 NOTE BOOK: _____
 No. _____

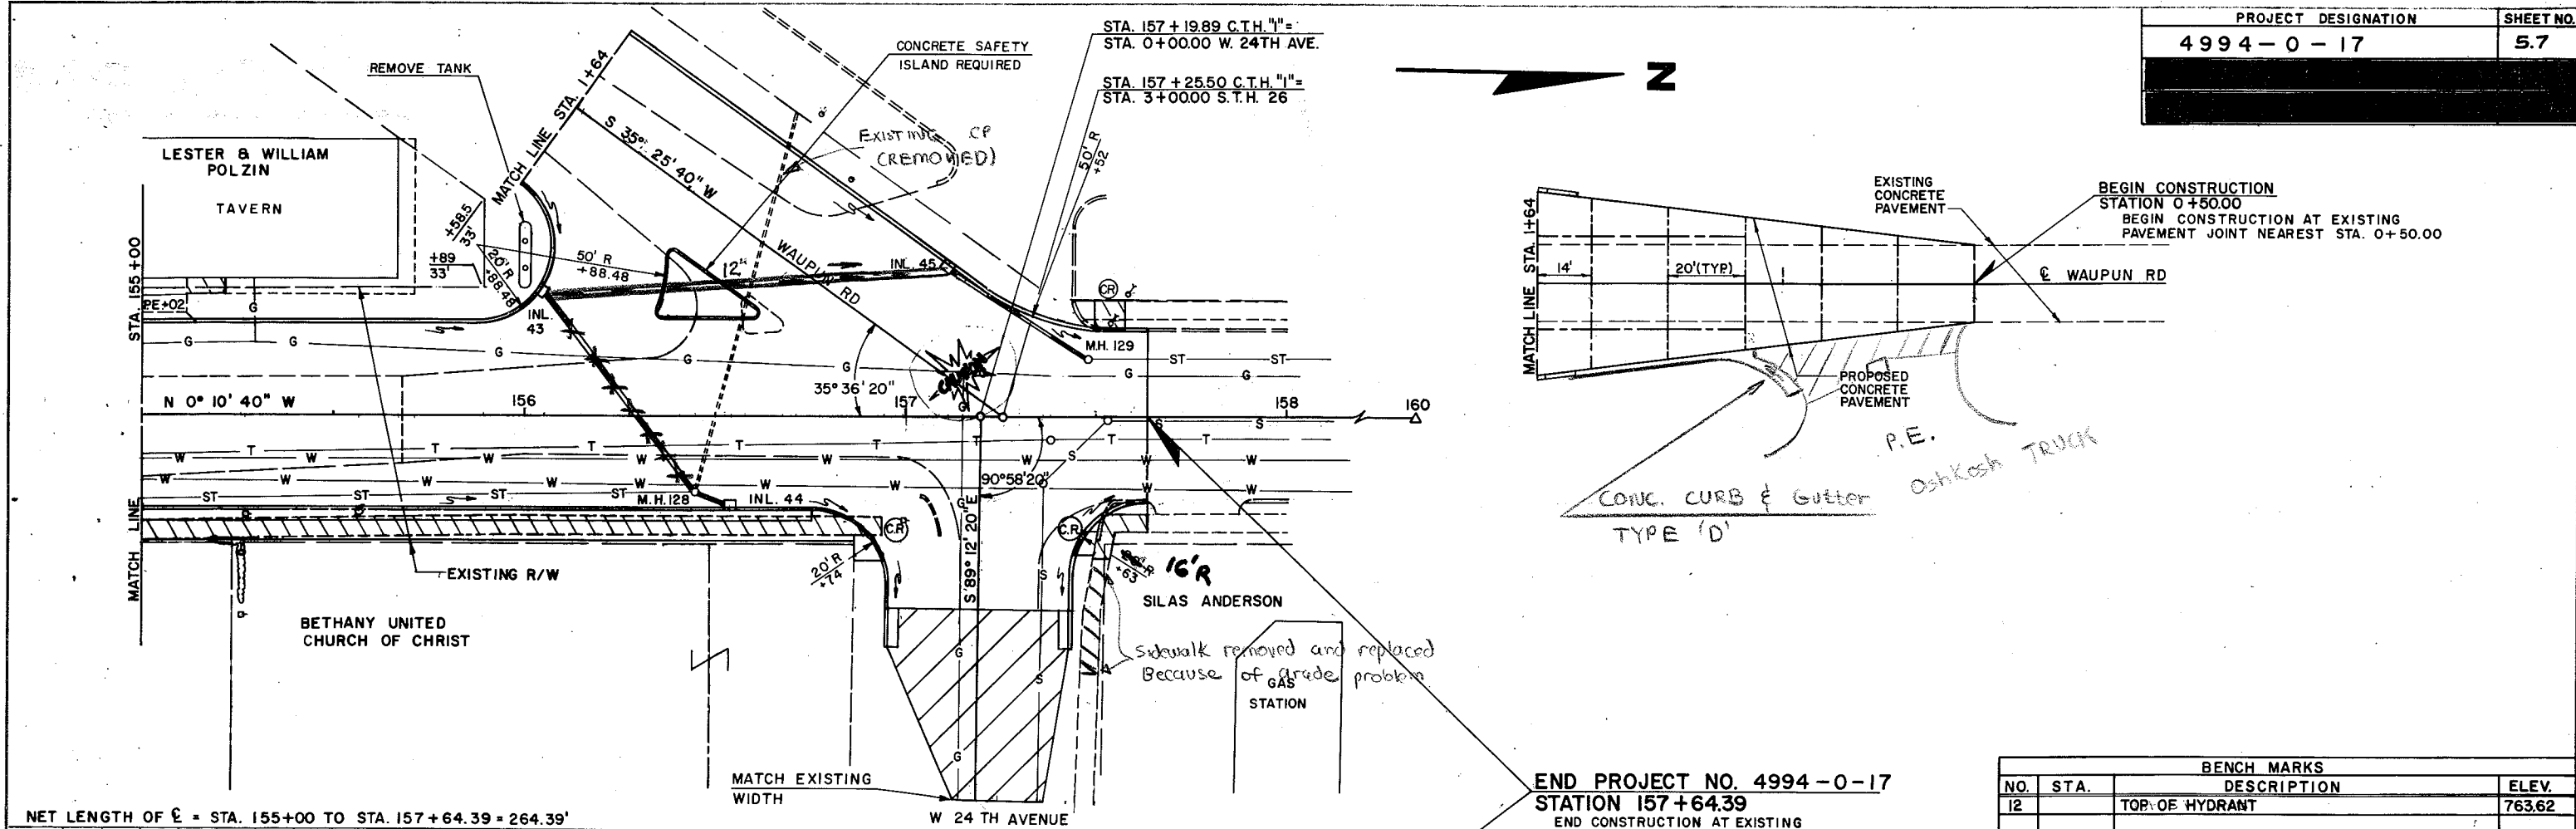


BENCH MARKS			
NO.	STA.	DESCRIPTION	ELEV.
12		TOP OF HYDRANT	763.62

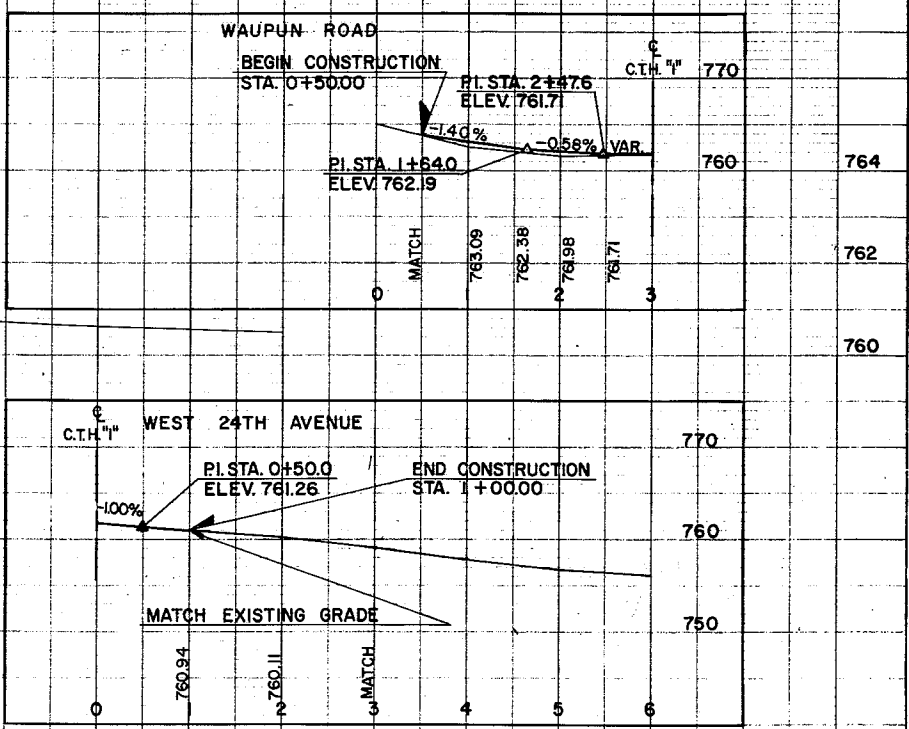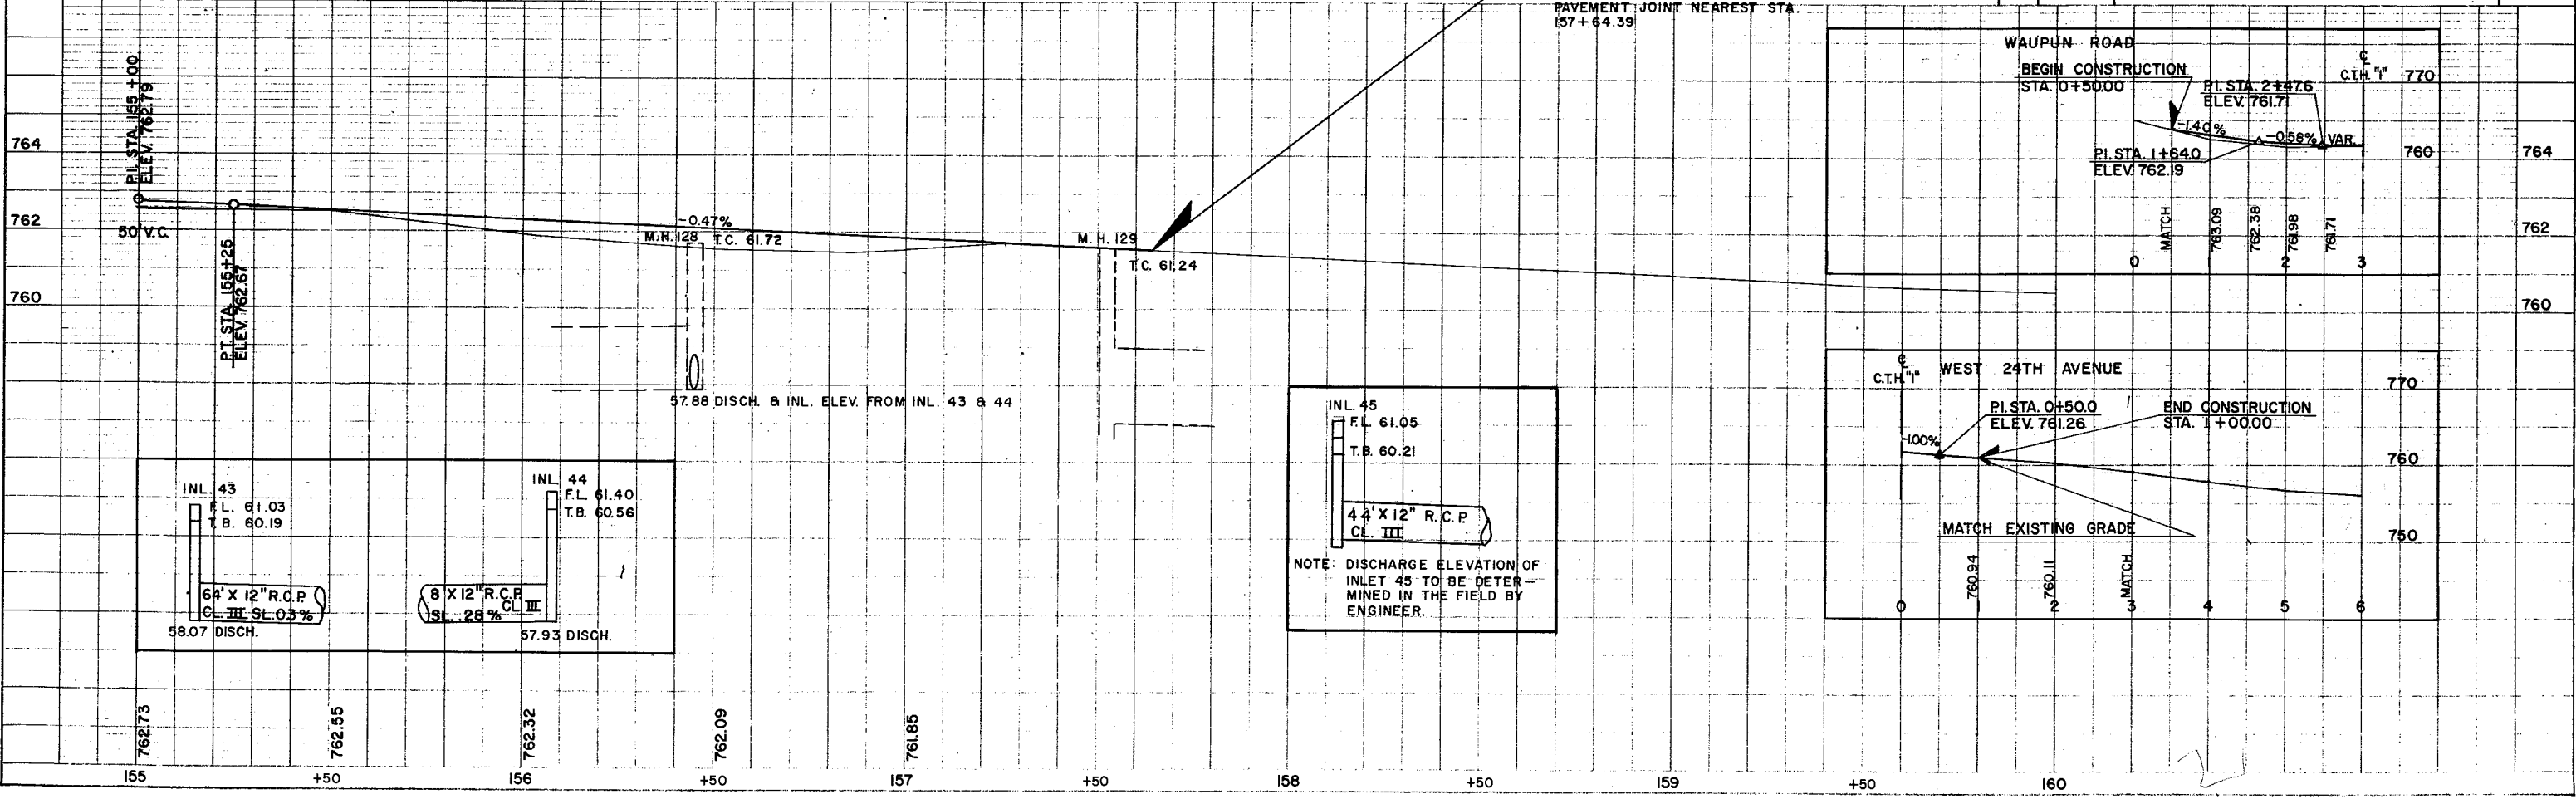

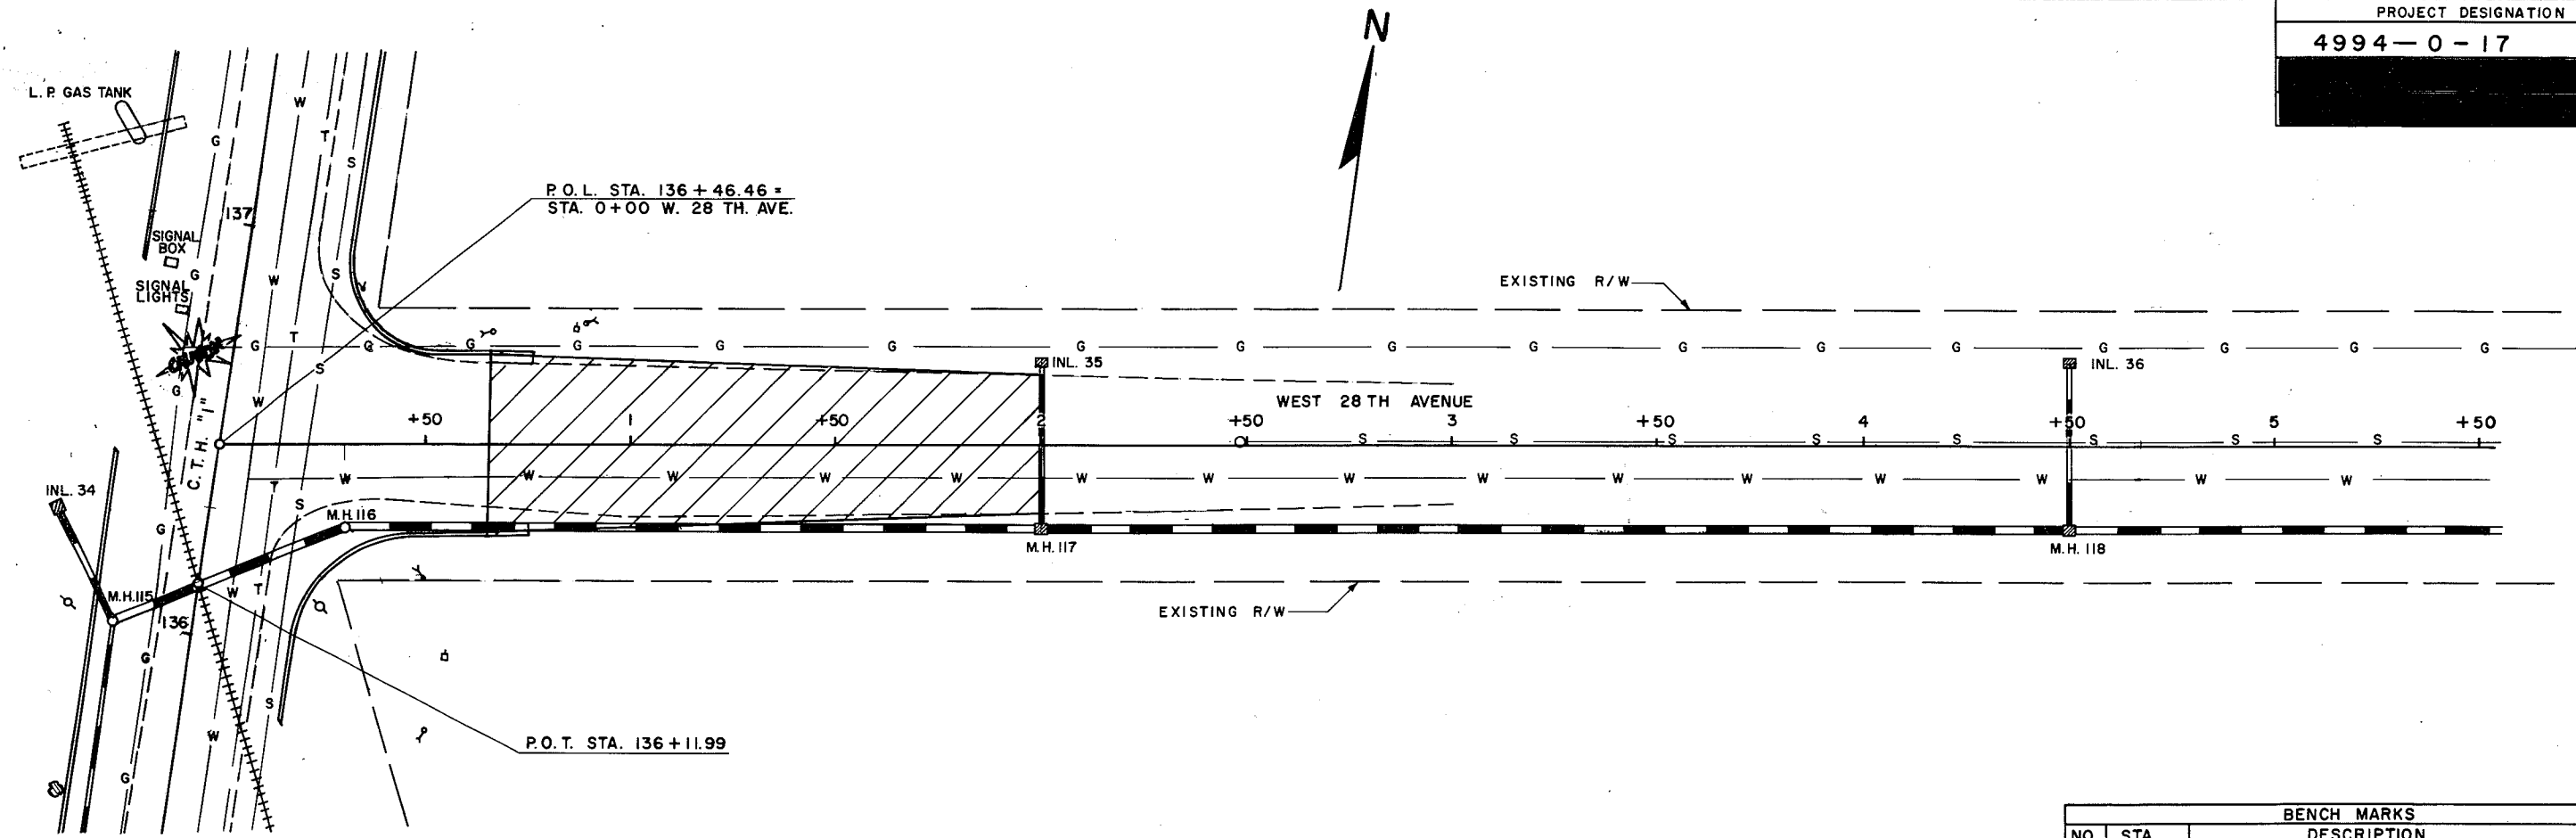


BENCH MARKS			
NO.	STA.	DESCRIPTION	ELEV.
9	134+55	WORD "OPEN" ON HYD. 25' RT.	766.81

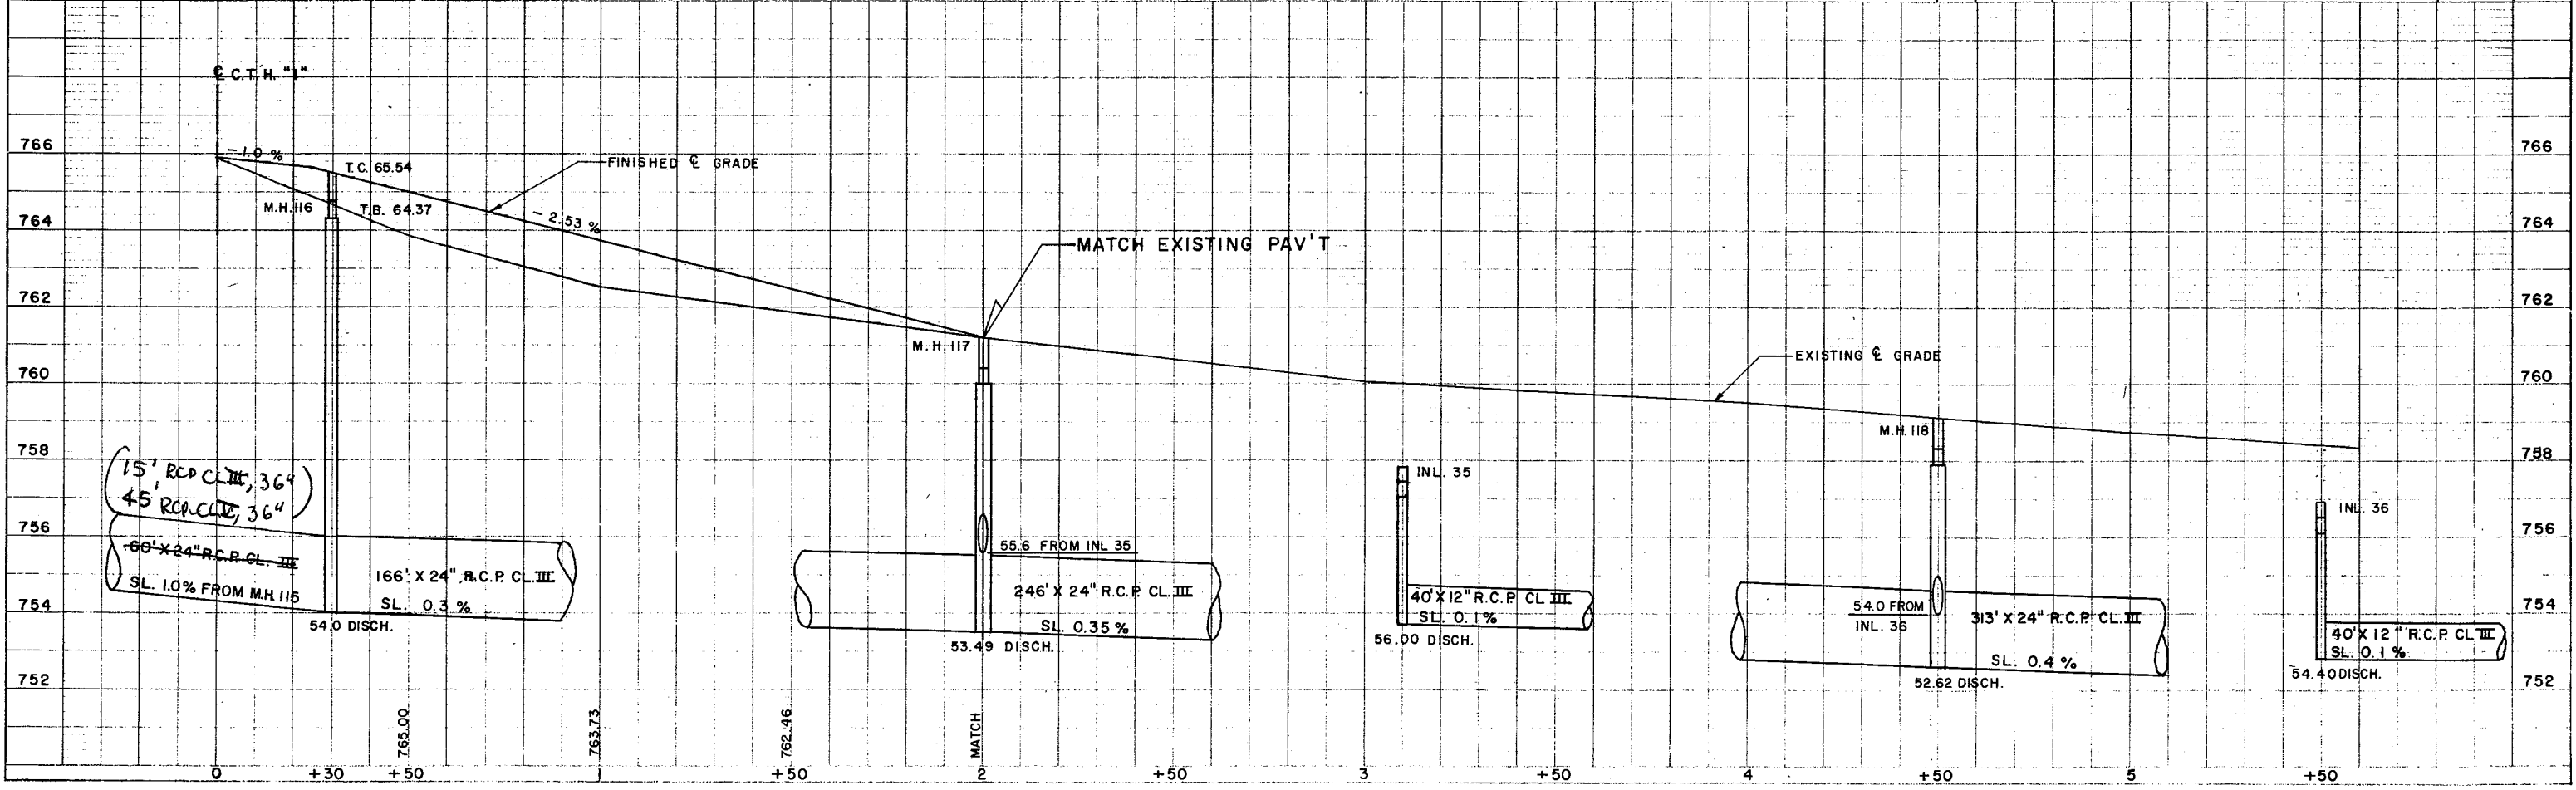


NOTE BOOK Alignment checked. List of utility checked.

NOTE BOOK Utility checked. Structure locations checked.

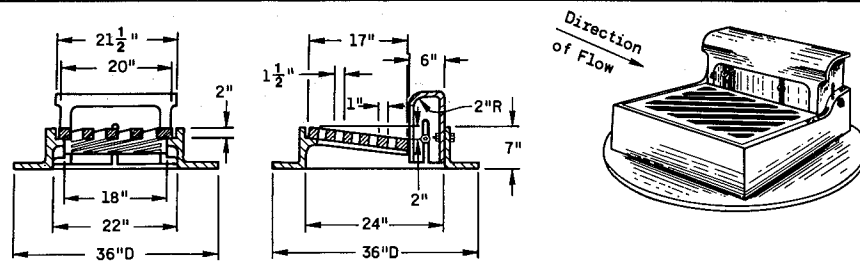


TYPE "A"

(Approximate Weight 405 lbs.)
 Frame Weight 250 lbs.
 Grate Weight 85 lbs.
 Box Weight 70 lbs.

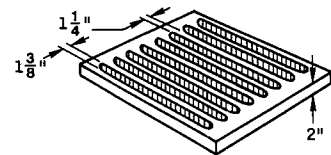


ALTERNATE TYPE GRATE *
 (Longitudinal Slots)
 Approximate Weight 100 lbs.

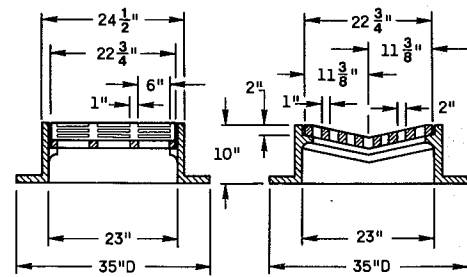


TYPE "B"


(Approximate Weight 395 lbs.)
 Frame Weight 285 lbs.
 Grate Weight 110 lbs.

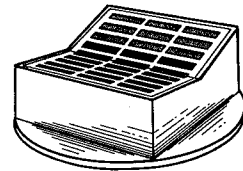

Round Frame

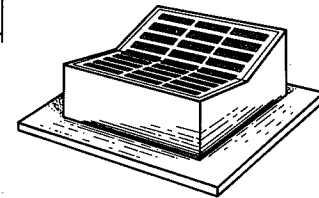


Alternate Frame
 (Square type)
 35" Square

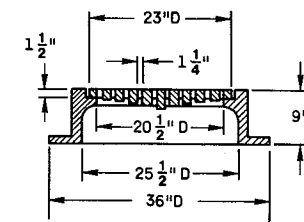


TYPE "C" - TYPE "J"

Frame Weight 250 lbs.
 Slotted Grate Weight 125 lbs.
 Solid Cover Weight 150 lbs.


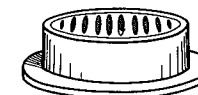


TYPE "C"
 Slotted Grate *

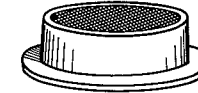


TYPE "J"
 Solid Cover

Diagonal Slots shall be oriented to the direction of flow as shown hereon. Hence RIGHT and LEFT Grates shall be furnished depending on direction of flow. (See Sketch Below)

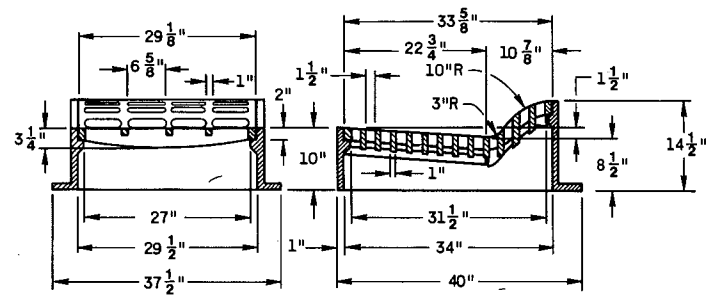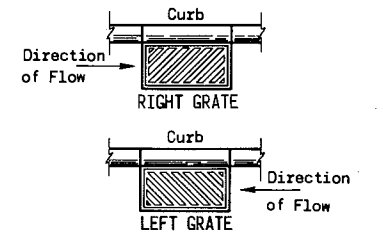


TYPE "F"

(Approximate Weight 850 lbs.)
 Frame 515 lbs.
 Back grate 160 lbs.
 Front grate 175 lbs.

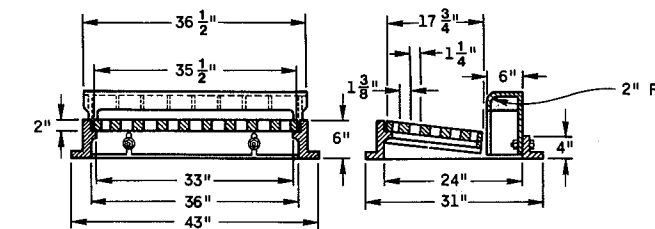


NOTE: Curb Box height adjustable 6" to 9"

* CAUTION: DO NOT USE GRATES WITH LONGITUDINAL SLOTS WHERE BICYCLE TRAFFIC IS PERMITTED.

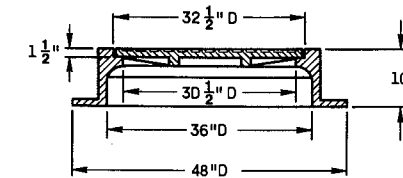

TYPE "K"

(Approximate Weight 785 lbs.)

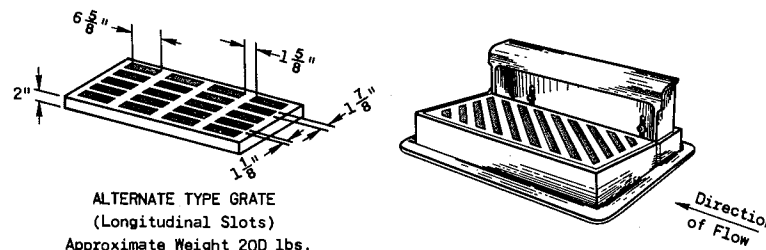


ALTERNATE TYPE GRATE
 (Longitudinal Slots)
 Approximate Weight 200 lbs.

Direction of Flow


TYPE "H"

(Approximate Weight 510 lbs.)
 Frame Weight 220 lbs.
 Grate Weight 175 lbs.
 Box Weight 115 lbs.

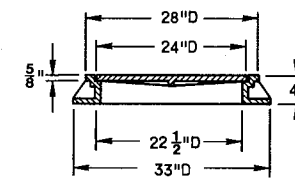


TYPE "L"

(Approximate Weight 220 lbs.)

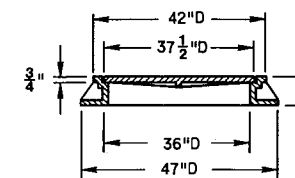


TYPE "M"

(Approximate Weight 535 lbs.)

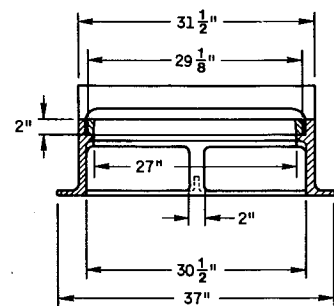


TYPE "WM"


(Approximate Weight 670 lbs.)
 Frame Weight 350 lbs.
 Grate Weight 185 lbs.
 Box Weight 135 lbs.

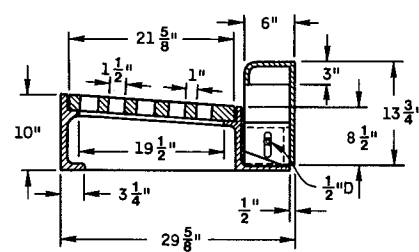

NOTE: Curb Box height adjustable 6" to 9"

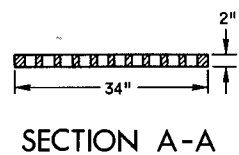

SECTION A-A

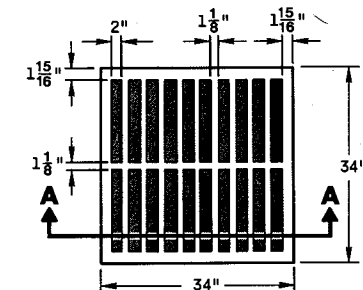

TYPE "MS" *

(Approximate Grate Weight 285 lbs.)

GENERAL NOTES

Details of construction, materials and workmanship not shown on this drawing shall conform to the pertinent requirements of the Standard Specifications and the applicable Special Provisions.

Detail drawings for proposed alternate designs for Catch Basin, Manhole and Inlet Covers shall be submitted to the Engineer for approval providing that such alternate designs make provision for equivalent capacity and strength.

All Catch Basin, Manhole and Inlet Covers which are placed in vehicular traffic areas shall be "Non-Rocking" type.

Adjustment of the cover to grade may be accomplished by the use of mortar and brick, or by Precast Concrete Grade Rings (AASHTO Designation M-199). Maximum adjustment shall be 8 inches.

Curb box height to be adjusted 4 to 9 inches, unless otherwise noted, after the form is in place.


The actual weight of covers may vary within 5 percent, plus or minus, of the approximate weight.

**CATCH BASIN
 MANHOLE AND
 INLET COVERS**


State of Wisconsin
 Department of Transportation
 Division of Highways

RECOMMENDED FOR APPROVAL:
 12-3-75
 DATE
 APPROVED
 12-9-75
 DATE


J. C. Hennrich
 CHIEF OF FACILITIES DEVELOPMENT
W. J. Siedler
 STATE HIGHWAY ENGINEER

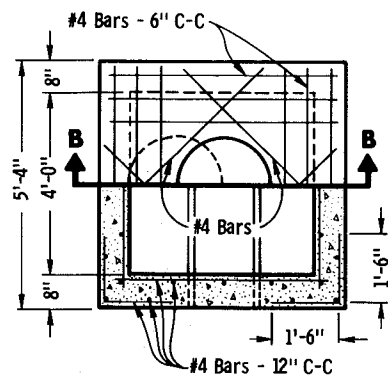


HALF SECTION A-A

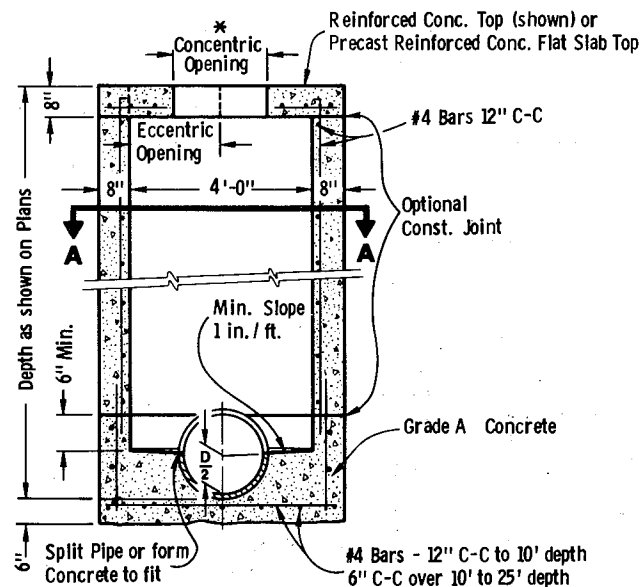

SECTION B-B
REINFORCED CONCRETE

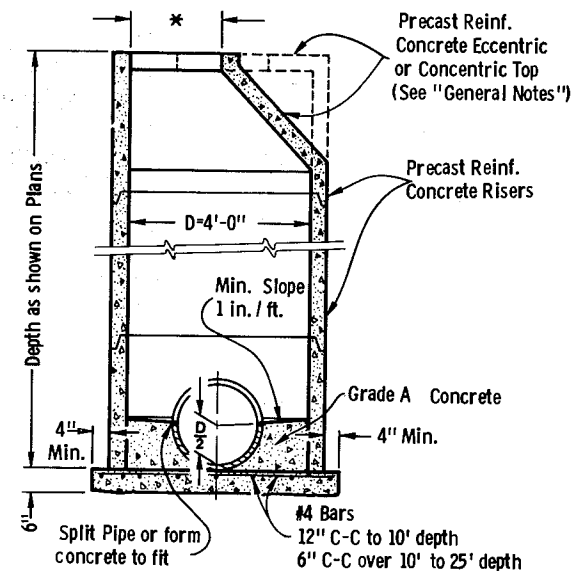

PRECAST REINFORCED CONCRETE

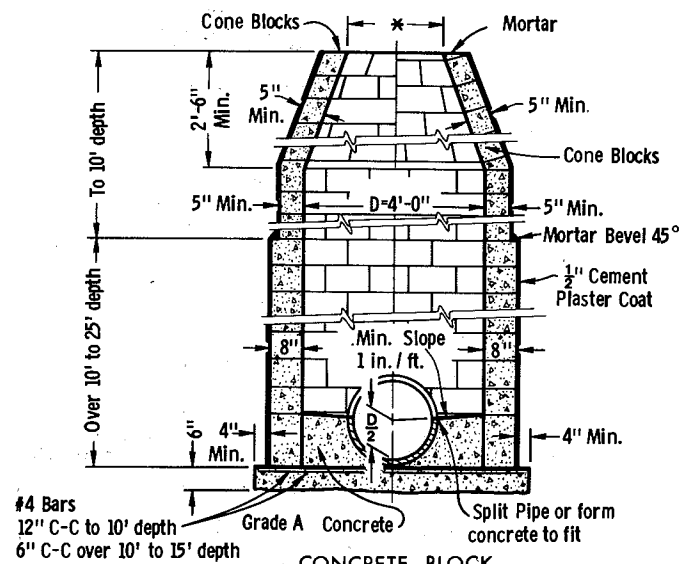

CONCRETE BLOCK

GENERAL NOTES

Details of construction, materials and workmanship not shown on this drawing shall conform to the pertinent requirements of the Standard Specifications and the applicable Special Provisions.

Detailed drawings for proposed alternate designs for underground drainage structures shall be submitted to the Engineer for approval providing that such alternate designs make provision for equivalent capacity and strength.

All drainage structures are designated on the plans as "Manholes 1 - C", "Catch Basins 1 - B", "Inlets 1 - H", etc. The first digit designates the masonry portion of the structure, and the following letter designates the type of cover to be used to comprise the complete unit.

Precast Reinforced Bases shall be placed on a bed of material at least 6 inches in depth, which meets the requirements for Granular Backfill. This bedding shall be compacted and provide uniform support for the entire area of the base.

Precast Reinforced Concrete Cone Tops (Eccentric or Concentric) may be used on concrete block structures. The Cone Tops shall be installed on a bed of mortar.

Eccentric Cone Tops may be used on all structures, and Concentric Cone Tops shall be used only on structures 5 feet or less in depth, unless otherwise directed by the Engineer.

Steps meeting the following requirements shall be installed in all structures over 5 feet in depth: 16 inch C-C maximum spacing; project a minimum clear distance of 4 inches from the wall at the point of embedment; minimum length of 10 inches; minimum wall embedment of 3 inches; and be capable of supporting a concentrated load of 300 lbs. Ferrous metal steps not painted or treated to resist corrosion shall have a minimum cross sectional dimension of 1 inch.

Solid Aluminum steps shall have a minimum cross sectional dimension of 0.75 inch. Aluminum surfaces to be embedded in concrete shall be given one coat of suitable quality paint, such as zinc chromate primer conforming to federal specification TT-P-645 or equivalent. Steps of approved Polypropylene plastic coated reinforcement bar will be acceptable.

All bar steel reinforcement shall be embedded 2 inches clear unless otherwise shown or noted.

Precast Reinforced Concrete Risers may be placed with tongue up or down.

* Use 2'-0" diameter opening with type "C", "L" and "J" covers, or 3'-0" diameter with type "K" and "M" covers.

S.D.D. 8B6-2

MANHOLES TYPE 1

MANHOLES TYPE 1

State of Wisconsin
Department of Transportation
Division of Highways

RECOMMENDED FOR APPROVAL:
DATE 12-3-75


J.C. Hennel
CHIEF OF FACILITIES DEVELOPMENT

APPROVED
DATE 12-9-75





W.P. Siddle
STATE HIGHWAY ENGINEER

S.D.D. 8B6-2

* Selection of Square or Circular Design will be based on the pipe sizes and the Inlet Cover being utilized.

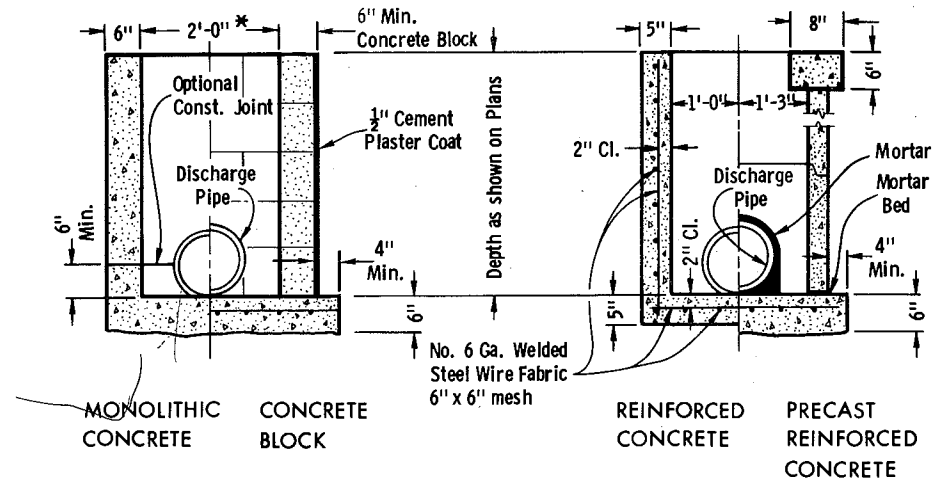

INLETS TYPE 1

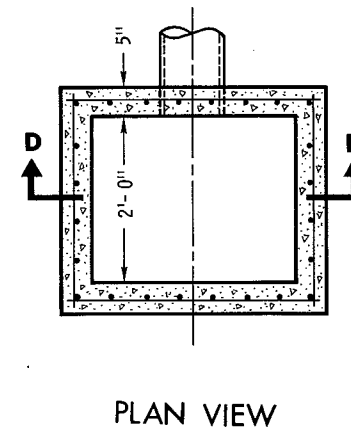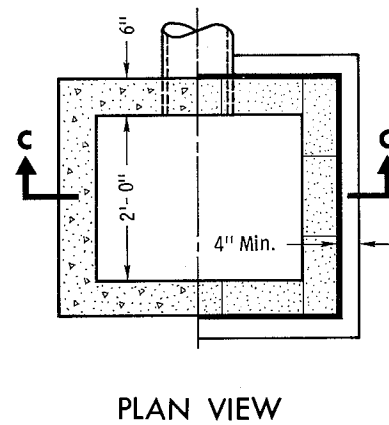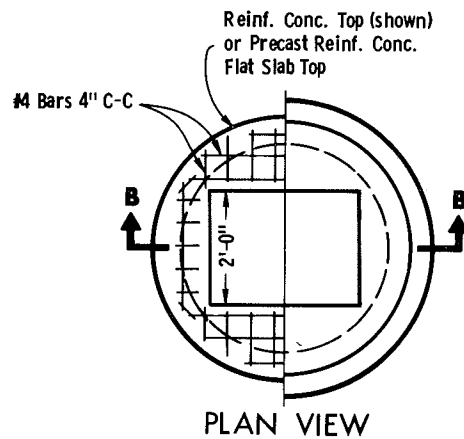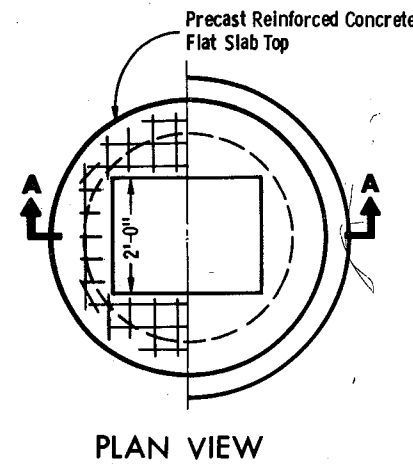

GENERAL NOTES

Details of construction, materials and workmanship not shown on this drawing shall conform to the pertinent requirements of the Standard Specifications and the applicable Special Provisions.

Detailed drawings for proposed alternate designs for underground drainage structures shall be submitted to the Engineer for approval providing that such alternate designs make provision for equivalent capacity and strength.

Square Precast Inlet units shall conform to the pertinent requirements of AASHTO Designation M 199.



All drainage structures are designated on the plans as "Manholes 1 - C", "Catch Basins 1 - B", "Inlets 1 - H", etc. The first digit designates the masonry portion of the structure, and the following letter designates the type of cover to be used to comprise the complete unit.

Precast Reinforced Bases shall be placed on a bed of material at least 6 inches in depth, which meets the requirements for Granular Backfill. This bedding shall be compacted and provide uniform support for the entire area of the base.

Precast Reinforced Concrete Flat Slab Tops may be used on the structures. The Tops shall be installed on a bed of mortar.

All bar steel reinforced reinforcement shall be embedded 2 inches clear unless otherwise shown or noted.

Precast Reinforced Concrete Risers may be placed with tongue up or down.

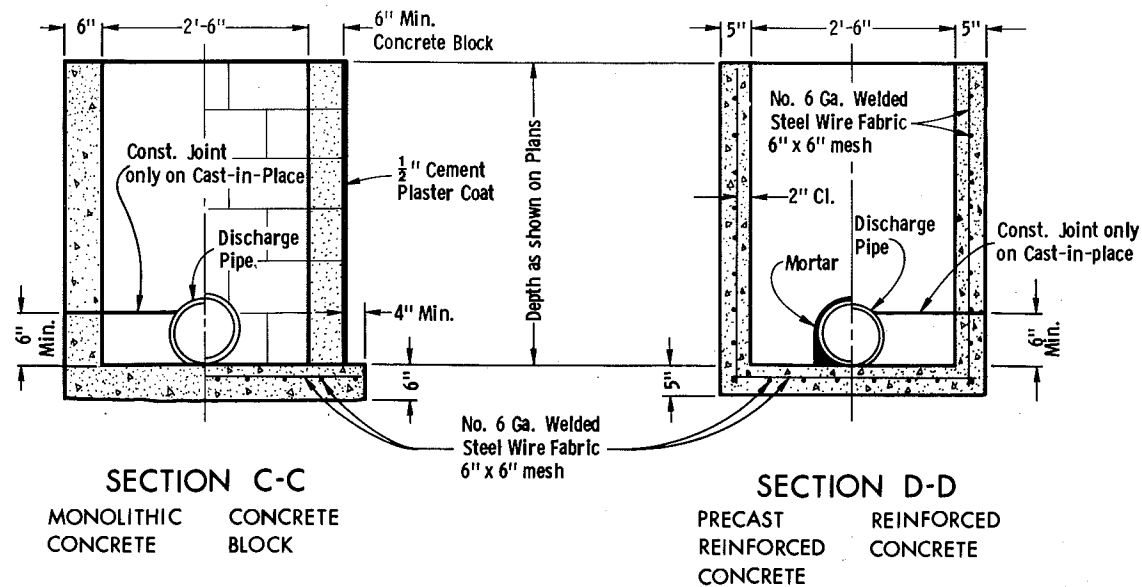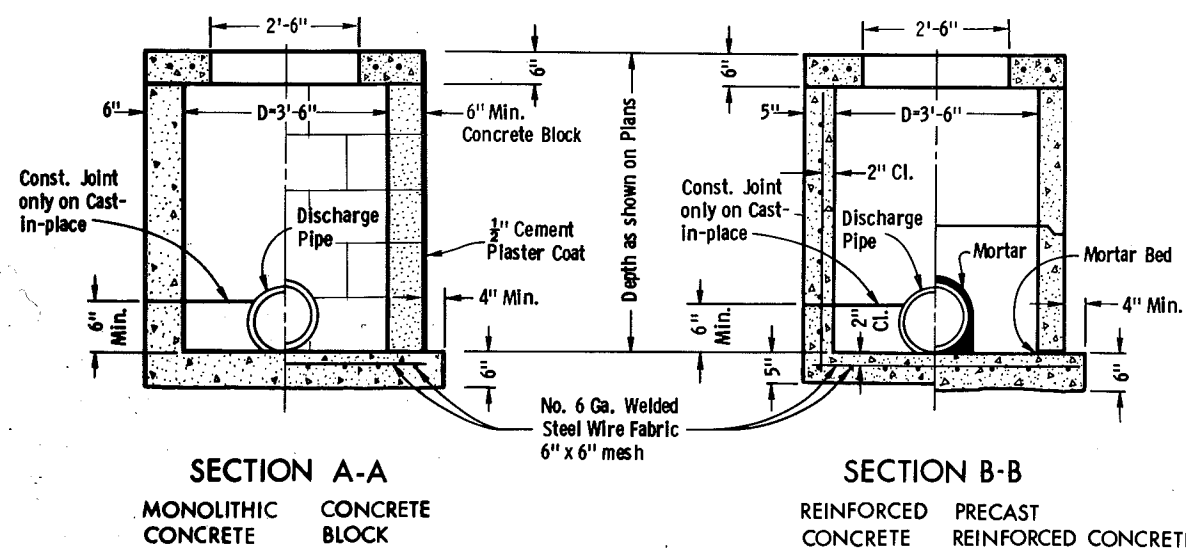


INLETS TYPE 2

INLETS TYPE 1 & 2


State of Wisconsin
Department of Transportation
Division of Highways

RECOMMENDED FOR APPROVAL:
DATE 10-16-75
APPROVED DATE 10-16-75

J.C. Hennrich
CHIEF OF FACILITIES DEVELOPMENT
W.J. Siddle
STATE HIGHWAY ENGINEER

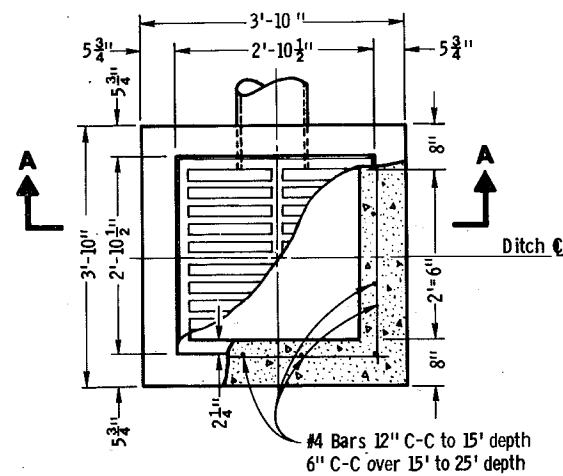

PLAN VIEW

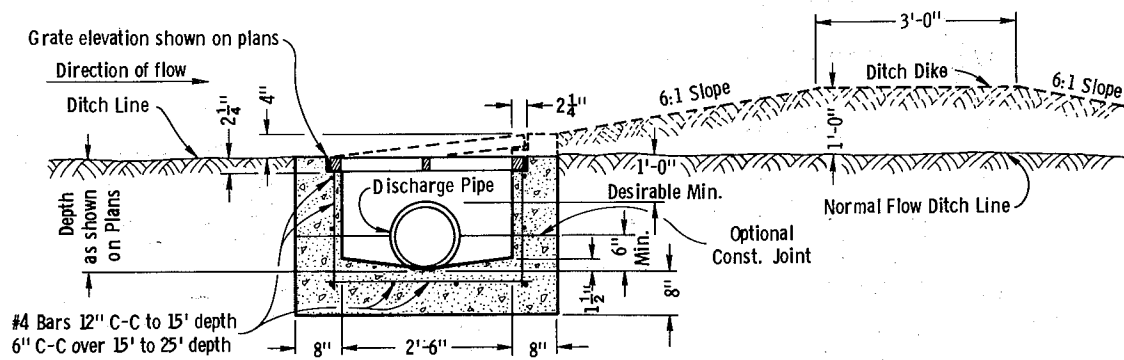

SECTION A-A

INLET TYPE 8
REINFORCED CONCRETE


GENERAL NOTES

Details of construction, materials and workmanship not shown on this drawing shall conform to the pertinent requirements of the Standard Specifications and the applicable Special Provisions. Detailed drawings for proposed alternate designs for Inlets which may include precast reinforced concrete inlets, shall be submitted to the Engineer for approval providing that such alternate designs make provision for equivalent capacity and strength.


Precast reinforced concrete inlet units, if used, shall conform to the requirements of the Catch Basins, Manholes and Inlets Section of the Standard Specification's.

All Inlets are designated on the Plans as "Inlets, 8-MS", etc. This designation is interpreted to mean that the number, or first digit designates the masonry portion of the structure and the following letter designates the type of cover or iron casting to be used therewith to comprise the complete unit.

All bar steel reinforcement shall be embedded 2 inches clear unless otherwise shown or noted.

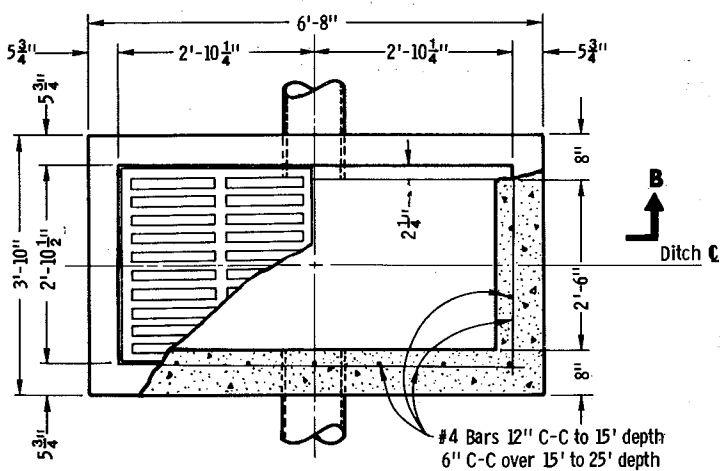


PLAN VIEW

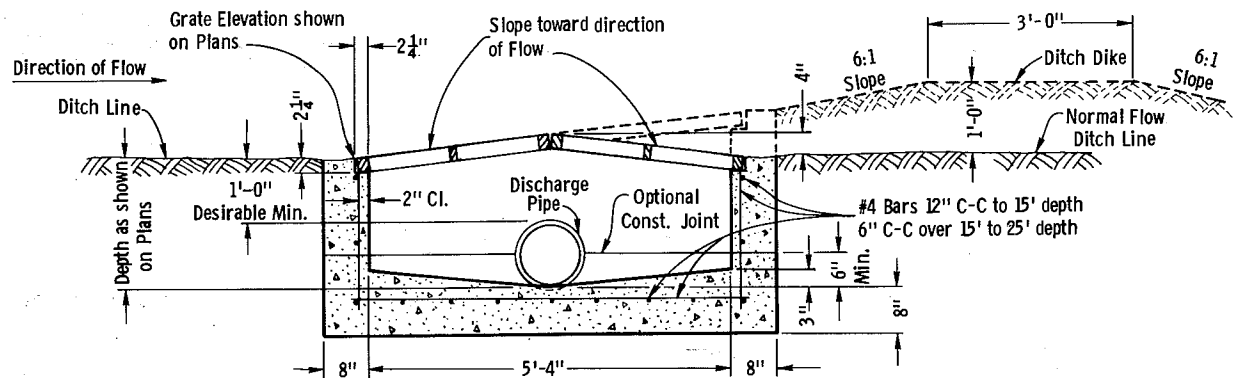


SECTION B-B


INLET TYPE 9
REINFORCED CONCRETE

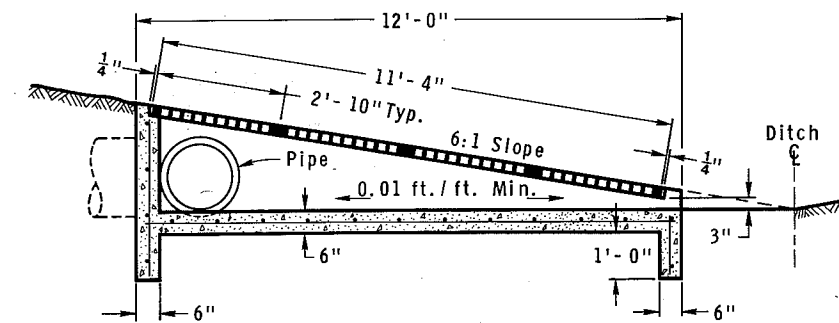

SECTION G-G

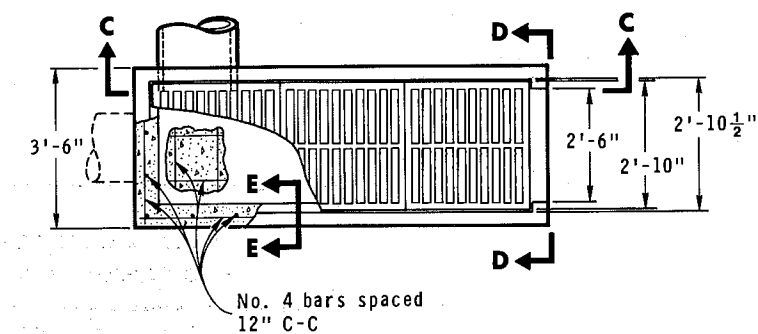


PLAN VIEW

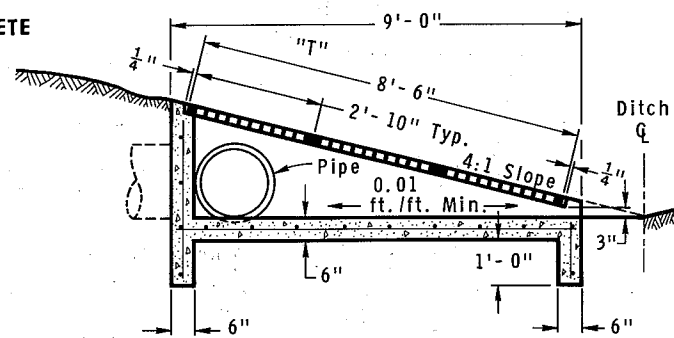


SECTION C-C

INLET TYPE 10
REINFORCED CONCRETE

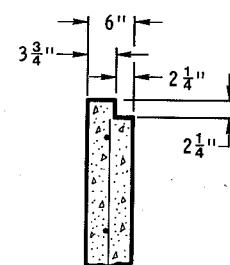


SECTION E-E

3 Grates @ 4:1
4 Grates @ 6:1

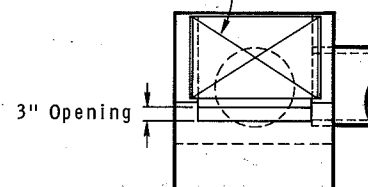

VIEW D-D

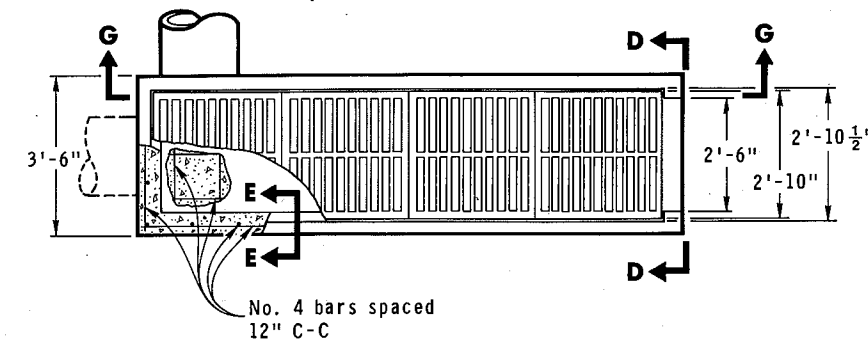

PLAN VIEW
INLET TYPE II
REINFORCED CONCRETE

INLETS TYPE 8, 9, 10 and 11

State of Wisconsin
Department of Transportation
Division of Highways


RECOMMENDED FOR APPROVAL:

4-30-74
DATE


APPROVED
5-02-74
DATE

J.C. Heinal
CHIEF OF FACILITIES DEVELOPMENT


H.S. Sudek
STATE HIGHWAY ENGINEER

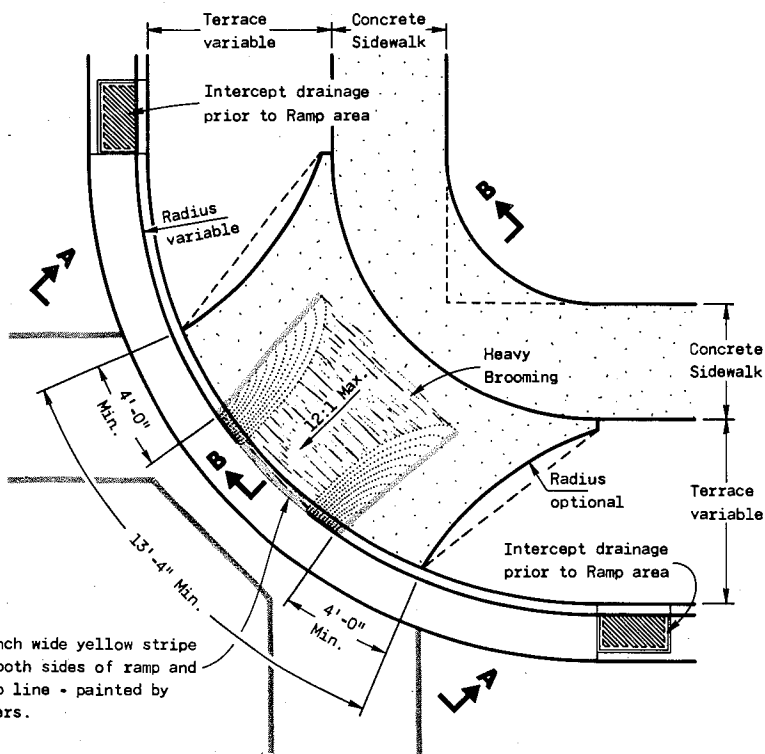


PLAN VIEW
TYPE 1 RAMP
(CENTER OF CORNER RADIUS)

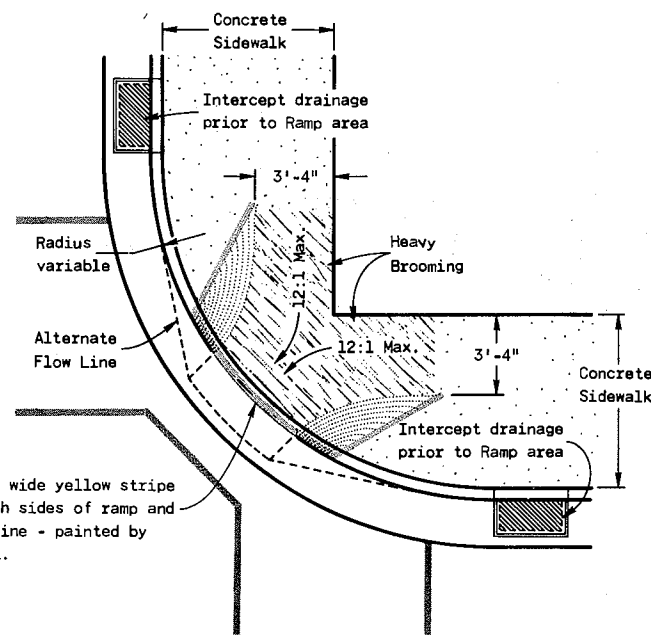


PLAN VIEW
TYPE 1-A RAMP
(NO TERRACE)

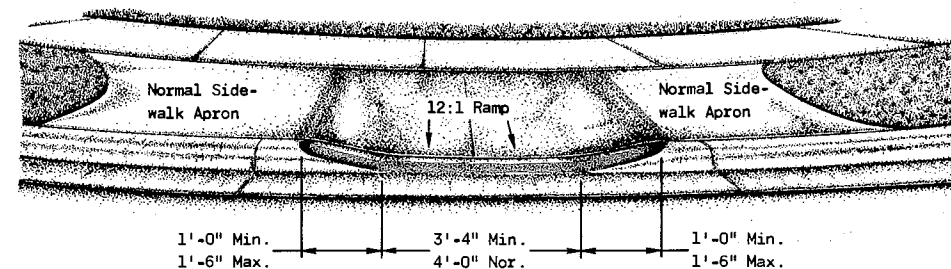

VIEW A-A

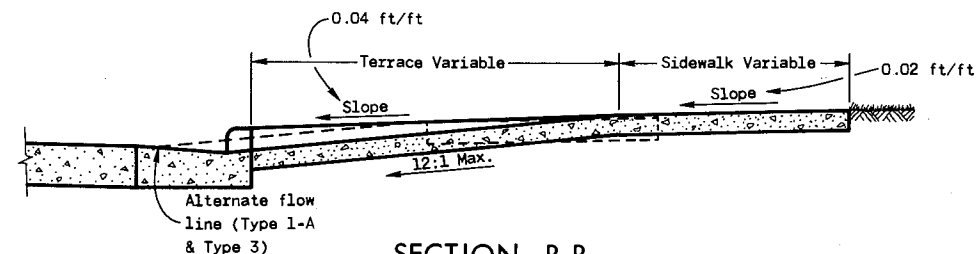


SECTION B-B

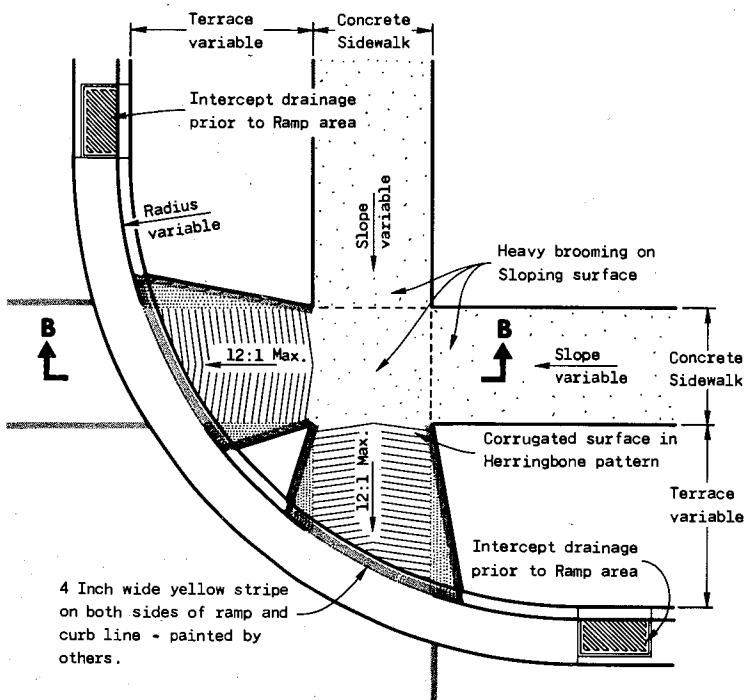


PLAN VIEW
TYPE 2 RAMP
(ON LINE WITH SIDEWALK)

4 Inch wide yellow stripe on both sides of ramp and curb line - painted by others.

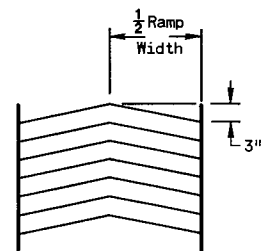

DETAIL OF
HERRINGBONE PATTERN

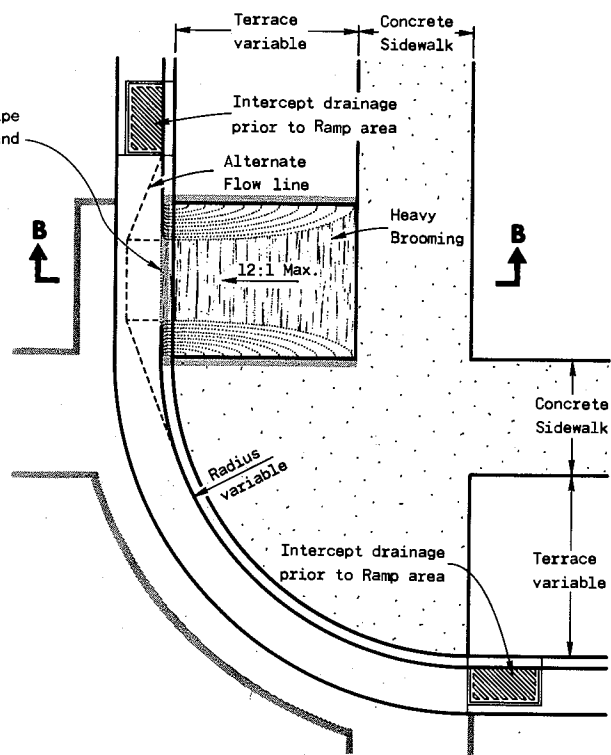

PLAN VIEW
TYPE 3 RAMP
(OUTSIDE OF CROSSWALK AREA)

GENERAL NOTES

Details of construction, materials and workmanship not shown on this drawing shall conform to the pertinent requirements of the Standard Specifications and the applicable Special Provisions.

Ramps shall be built at 12:1 or flatter. When necessary, the Sidewalk elevation may be lowered to meet the high point on the Ramp.

Type 1 or Type 1-A Ramps shall have a normal Sidewalk apron and Curb on both sides of Ramp. Entire Curb radius shall not be made into Ramp.

Curb Ramps shall be measured and paid for as Concrete Sidewalk and Concrete Curb and Gutter.

Section 66.616, Wisconsin Statutes requires Curb Ramping for handicapped persons. This law also states that "the Ramp shall be either bordered on both sides and the Curb line with a four inch wide yellow stripe, or the surface treatment on the Ramp shall have integral coloration".

The paint stripe alternate is shown to alert users of this drawing of the requirement for delineation of the Ramp. The paint stripes will be applied by state or municipal signing crews unless otherwise indicated by Special Provision.

**CURB RAMPS FOR
HANDICAPPED PERSONS**


State of Wisconsin
Department of Transportation
Division of Highways

RECOMMENDED FOR APPROVAL:
12-16-75
DATE


J. C. Henrich
CHIEF OF FACILITIES DEVELOPMENT

APPROVED
12-18-75
DATE


H. J. Sudler
STATE HIGHWAY ENGINEER

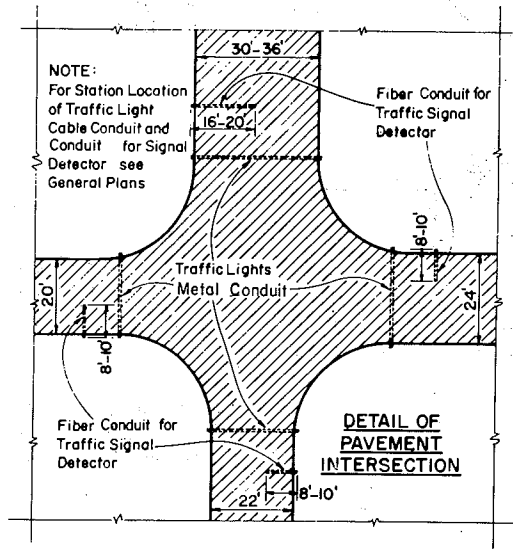


PLAN VIEW
SHOWING RELATIVE POSITION OF
TRAFFIC LIGHT CONDUITS AND
TRAFFIC SIGNAL DETECTOR CONDUITS
AT UNDIVIDED HIGHWAY INTERSECTIONS

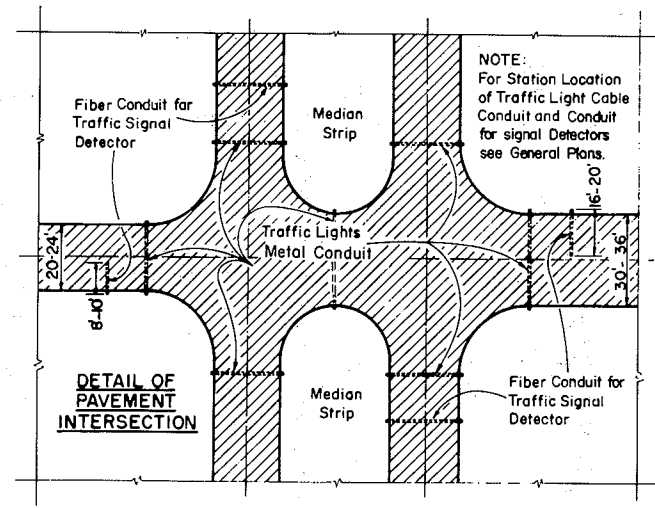

PLAN VIEW
SHOWING RELATIVE POSITION OF
TRAFFIC LIGHT CONDUITS AND
TRAFFIC SIGNAL DETECTOR CONDUITS
AT DIVIDED HIGHWAY INTERSECTIONS

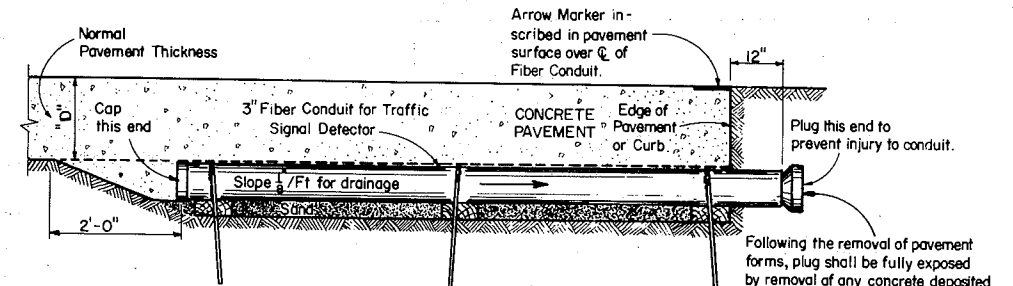


TRAFFIC SIGNAL DETECTOR FOR UNDIVIDED HIGHWAYS

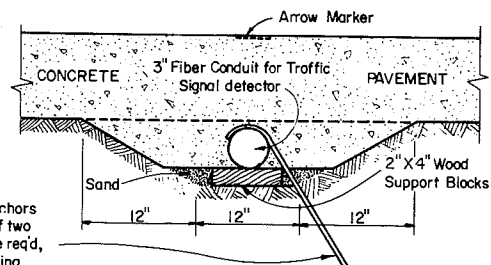


1/2" x 2'-6" Steel Anchors spaced at 3'-5" C.C. If two sections of conduit are req'd, place Anchor at coupling.

SIDE & END ELEVATIONS
SHOWING PLACEMENT DETAILS
FOR TRAFFIC SIGNAL DETECTOR CONDUIT

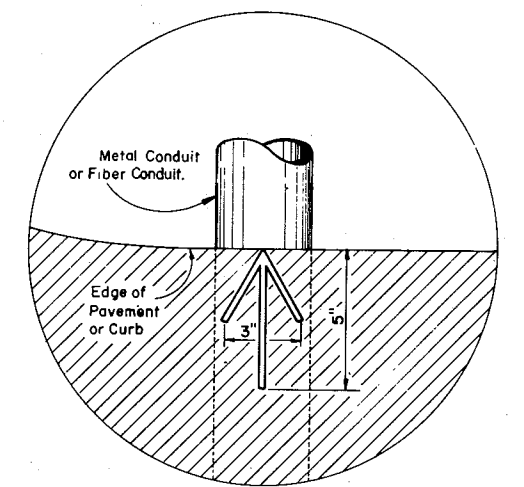


Arrow Marker to be inscribed in fresh concrete and/or bituminous surfacing 1/4" to 3/8" deep at each location where pipe conduit or fiber cond. are placed under rigid surfacing.

PLAN VIEW - ARROW MARKER

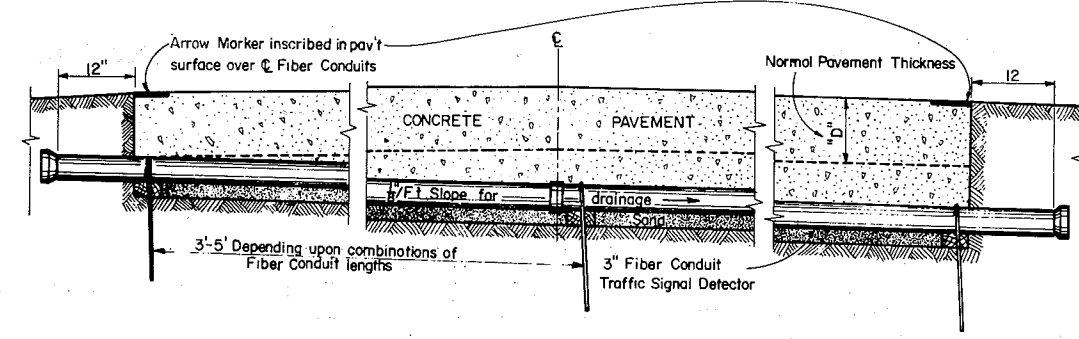

TRAFFIC SIGNAL DETECTOR FOR DIVIDED HIGHWAYS

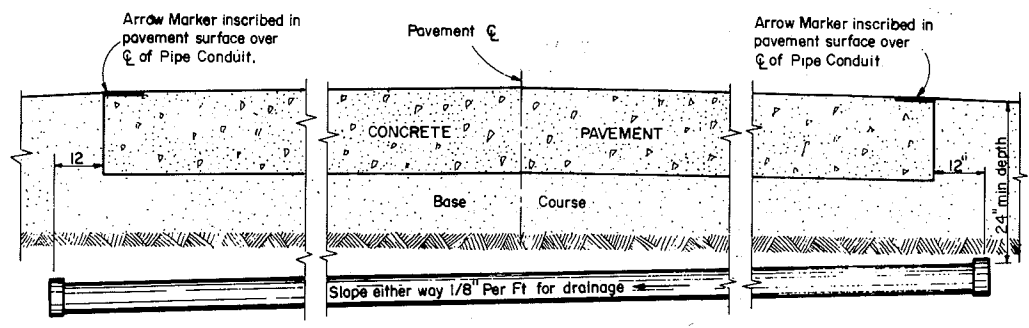

ELEVATION ON CENTERLINE
SHOWING PLACEMENT DETAILS
FOR TRAFFIC SIGNAL CONDUIT

GENERAL NOTES

Details of Construction not shown on this drawing shall conform to the pertinent requirements of the Standard Specifications, and the applicable Special Provisions.

MATERIALS

Metal Conduit shall be furnished and placed as shown hereon and in accord with the Standard Specifications.
Fiber Conduit shall be furnished and placed as shown hereon and in accord with the Standard Specifications.

MEASUREMENT & PAYMENT

The item of Fiber Conduit shall be measured and paid for by the linear foot complete in place and in accord with Standard Specifications

CONDUIT SIZE


Unless shown or required otherwise on the plans, Metal Conduit shall be 2" I.D.

METAL CONDUIT & FIBER CONDUIT

STATE HIGHWAY COMMISSION OF WISCONSIN

RECOMMENDED FOR APPROVAL:
DATE: 4-3-63
APPROVED: J. D. Pitt ENGINEER OF DESIGN
DATE: 4/5/63
APPROVED: E. C. Rostiger STATE HIGHWAY ENGINEER

S. D. D. 9B2-1

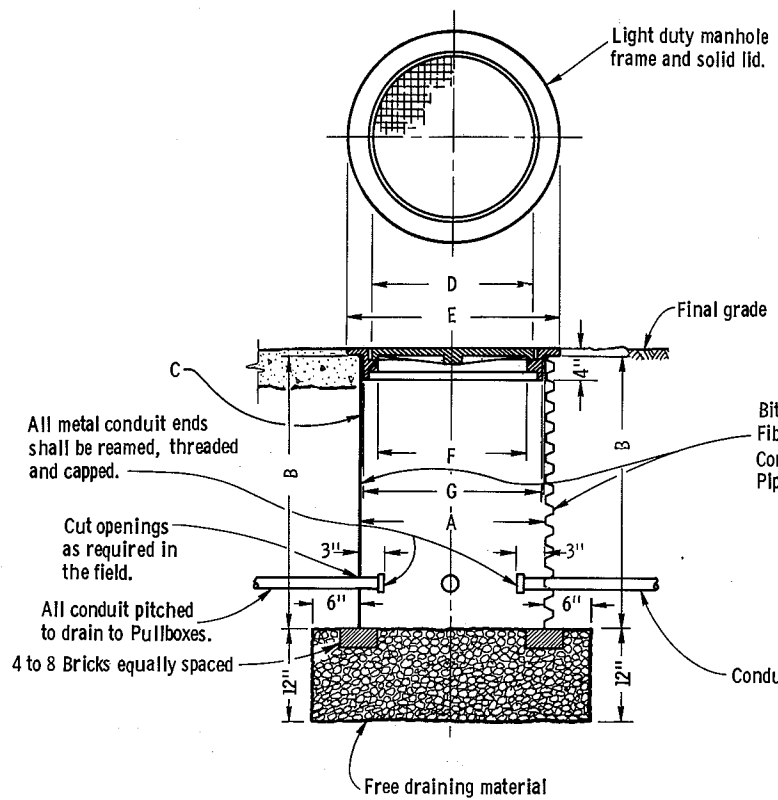


PIPE TYPE	BITUMINOUS FIBER					CORR. METAL
	A	B	C	D	E	
P Pipe Dia. (Inside)	12"	18"	24"	24"	24"	24"
Pipe Length	24"	24"	24"	36"	36"	36"
Wall Thickness	0.4"	0.4"	0.4"	0.4"	0.4"	.064"
Manhole Lid	10 1/4"	16 1/4"	22 1/4"	22 1/4"	22 1/4"	22 1/4"
Manhole Frame	14 1/2"	20 1/2"	26 1/2"	26 1/2"	26 1/2"	26 1/2"
Manhole Frame	8 1/2"	14 1/2"	20 1/2"	20 1/2"	20 1/2"	20 1/2"
Manhole Frame	11 1/2"	17 1/2"	23 1/2"	23 1/2"	23 1/2"	23 1/2"
Lid & Frame	--	55#	100#	160#	160#	160#

SHOWING INSTALLATION IN PAVED LOCATION


SHOWING INSTALLATION IN UNPAVED LOCATION

PULL BOX AND DETECTOR BOX DETAIL

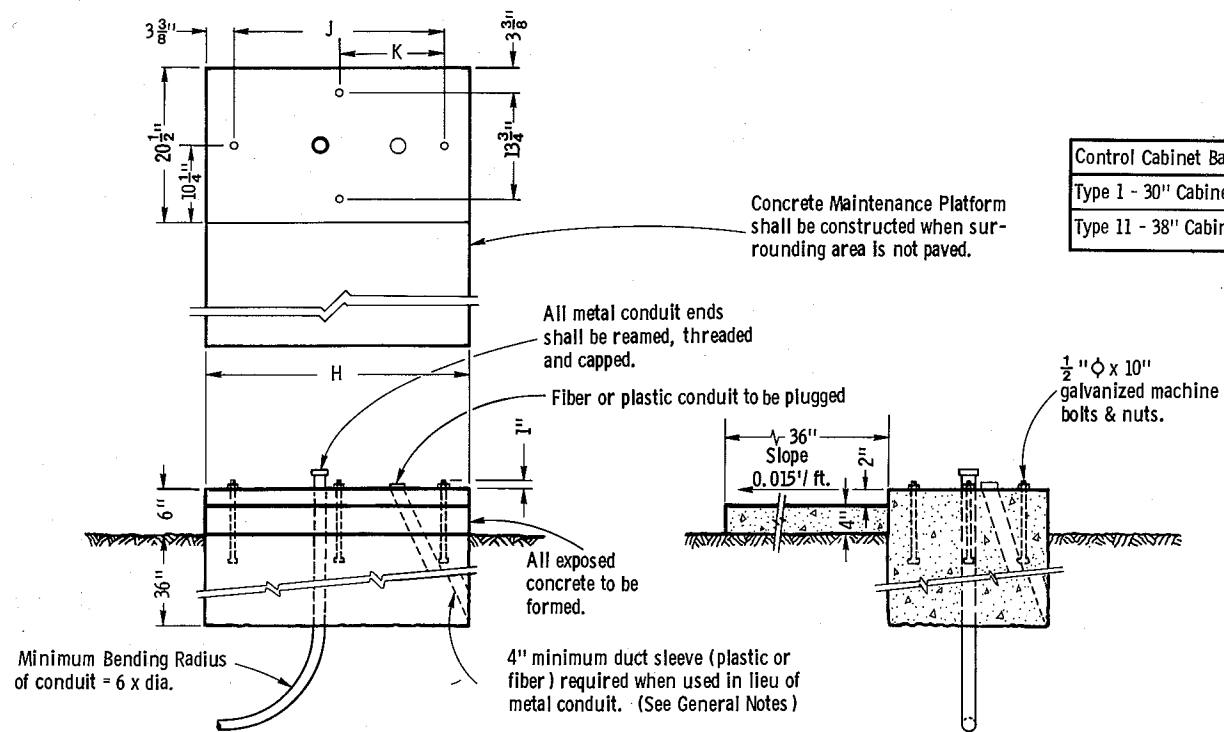

Control Cabinet Base	H	J	K
Type 1 - 30" Cabinet	34"	27 1/4"	13 3/8"
Type 11 - 38" Cabinet	42"	35 1/4"	17 3/8"

TRAFFIC SIGNAL AND TRAFFIC COUNTER CONTROL CABINET BASE
TYPE 1 and 2

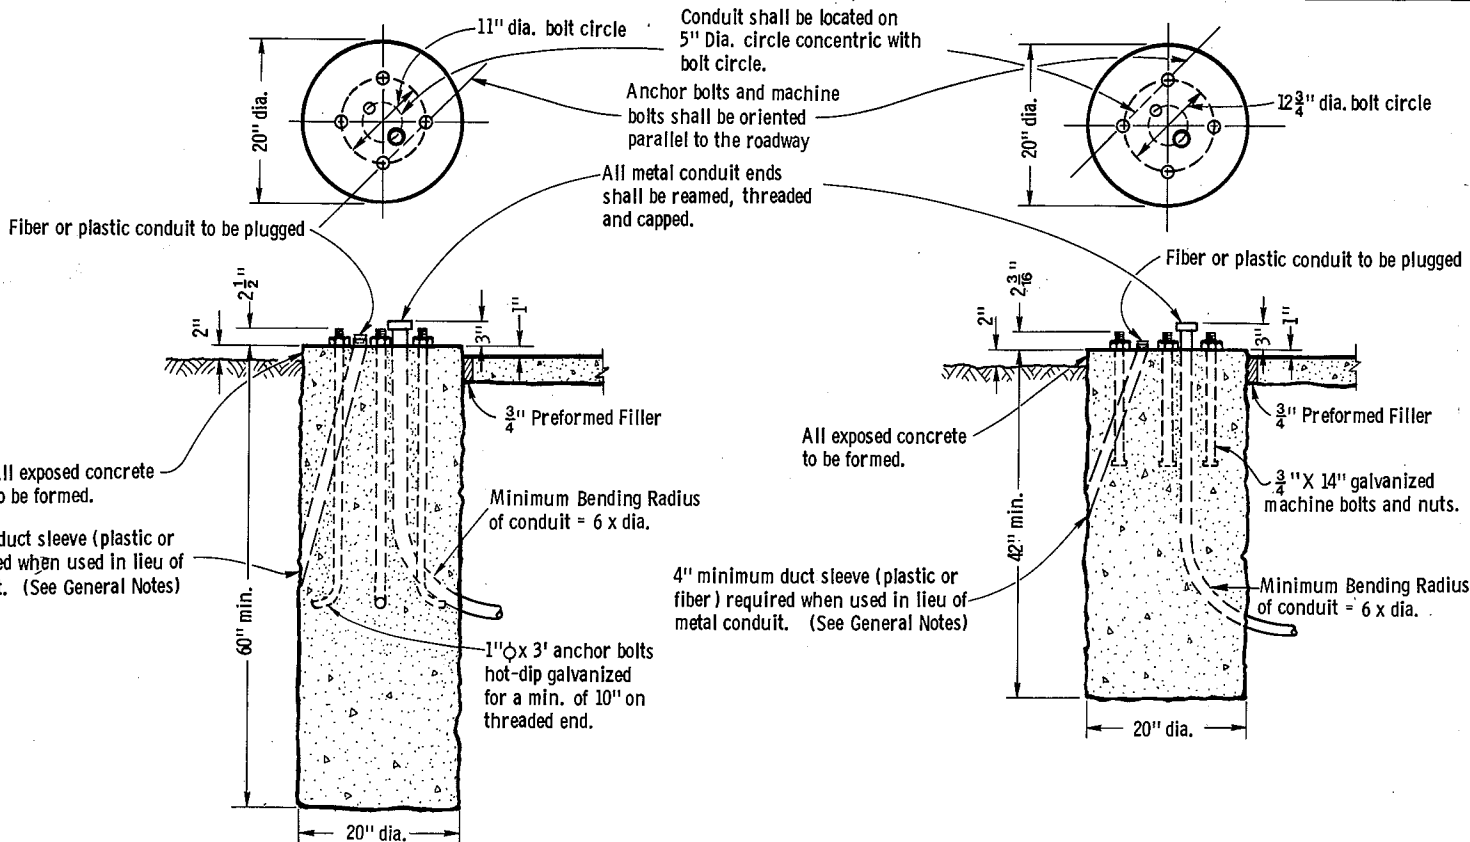


SHOWING INSTALLATION IN UNPAVED LOCATION

SHOWING INSTALLATION IN PAVED LOCATION

SHOWING INSTALLATION IN UNPAVED LOCATION

SHOWING INSTALLATION IN PAVED LOCATION

TRAFFIC SIGNAL BASE
TYPE 2

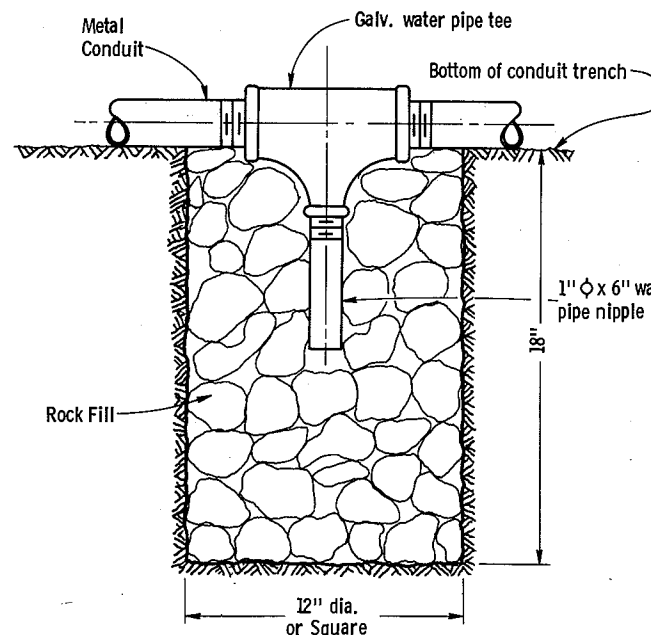

Note: Install as required at points in conduit for drainage.

DRAIN SUMP FOR METAL CONDUIT

TRAFFIC SIGNAL BASE
TYPE 1

GENERAL NOTES

Details of construction, materials and workmanship not shown on this drawing shall conform to the pertinent requirements of the Standard Specifications and the applicable Special Provisions.

Conduit may be metal, fiber or plastic. Locate as required. 12-inch min. bending radius applies to metal conduit only.

Concrete masonry shall be grade "AA".


Conduit installed as a continuous system between Pullboxes shall have a min. depth of 12 inches and shall always be below the pavement.

Detailed drawings for proposed alternate designs for "Traffic Signal and Traffic Counter Details" shall be submitted to the Engineer for approval.

TRAFFIC SIGNAL AND TRAFFIC COUNTER DETAILS

State of Wisconsin
Department of Transportation
Division of Highways

RECOMMENDED FOR APPROVAL:
4-13-72
DATE
S. C. Hennrich
CHIEF DESIGN ENGINEER
APPROVED:
4-13-72
DATE
S. E. Hicks
STATE HIGHWAY ENGINEER

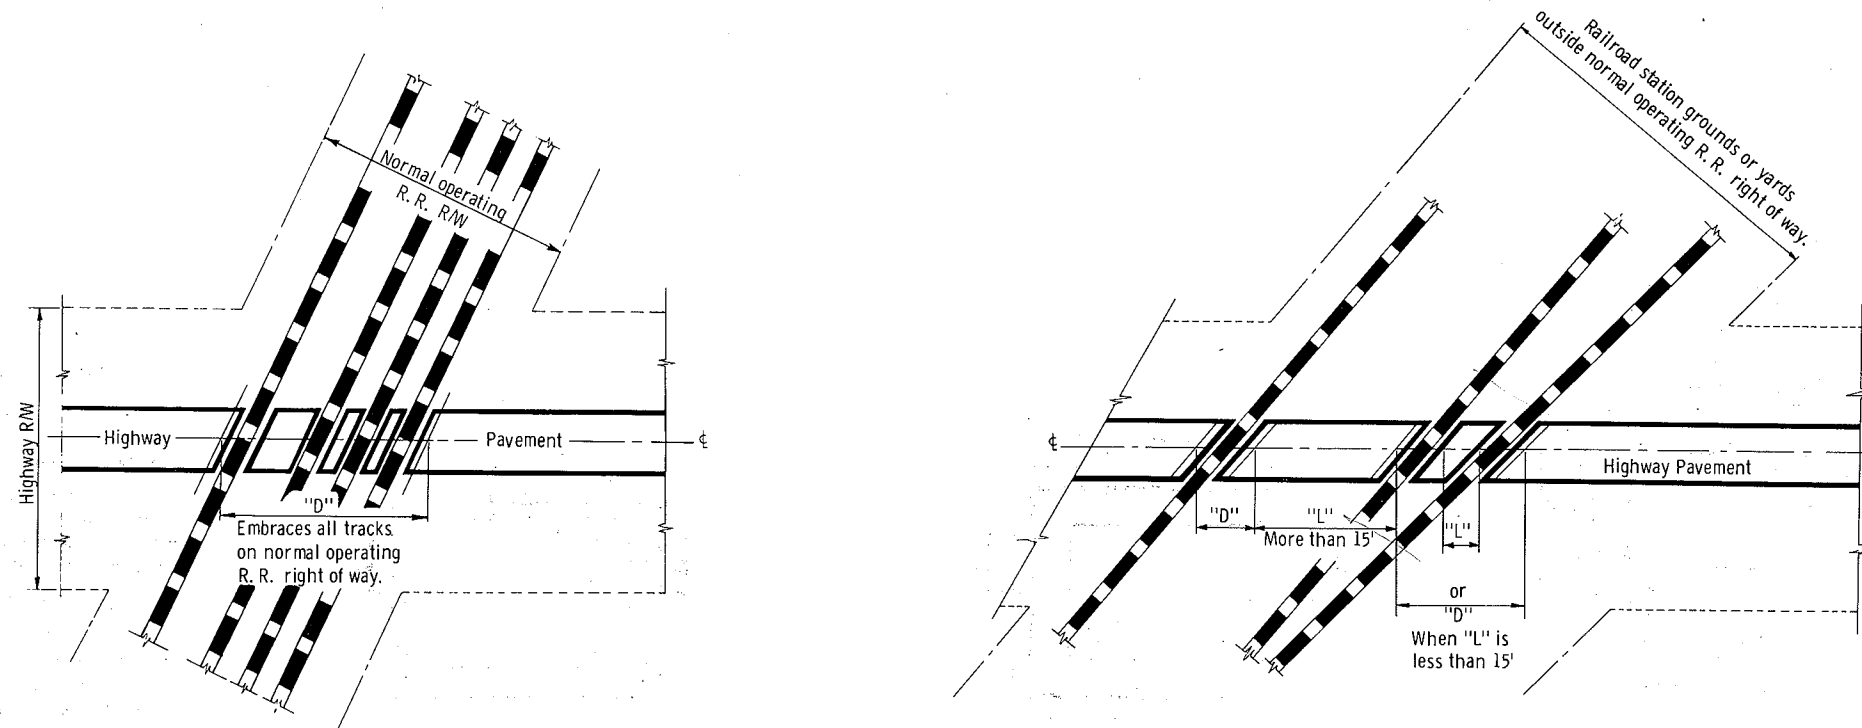


**TYPICAL TYPES OF RAILROAD GRADE CROSSINGS
SHOWING THE RAILROAD'S LIMIT OF RESPONSIBILITY
AND MEASUREMENT DETAILS**


GENERAL NOTES

Details of construction, materials, and workmanship not shown on this drawing shall conform to the pertinent requirements of the Standard Specifications and the applicable Special Provisions.

"D" = Exception to net length of ϵ . Paving or surfacing and shoulder material within limits designated by "D" to be at expense of railroad company. Trackage to industrial sites to be treated same as for trackage to R.R. station grounds or yards outside of normal operating R/W.

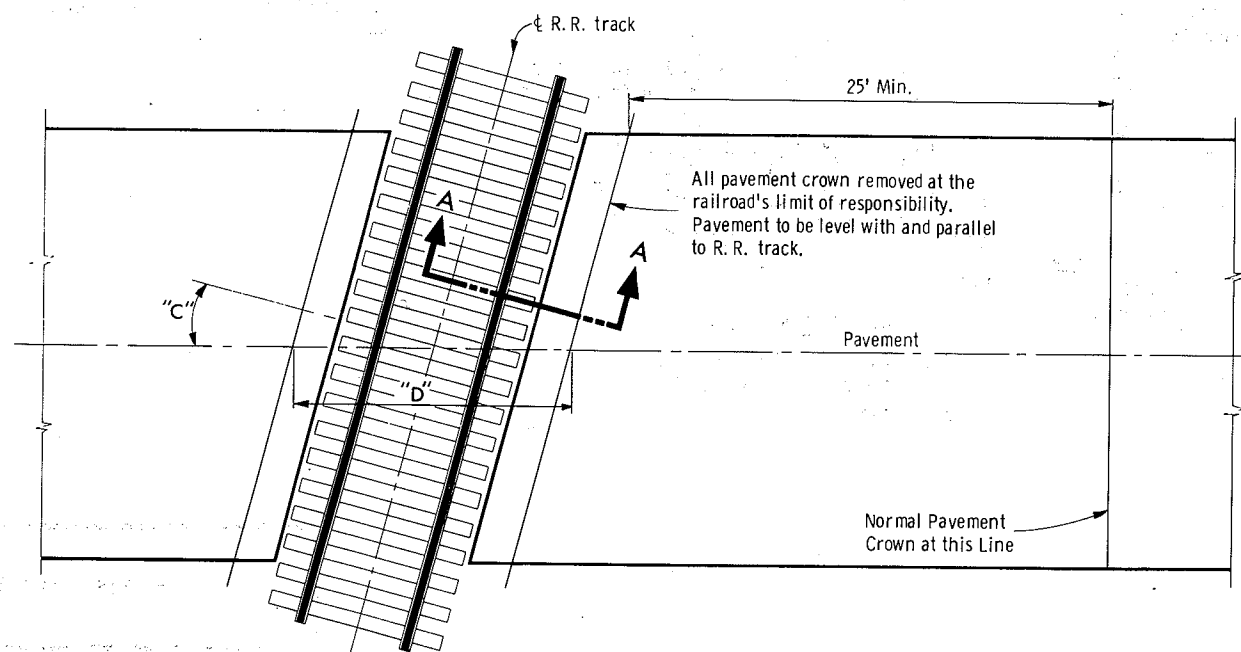

NOTE: $D = \frac{12.71}{\cos. "C"}$

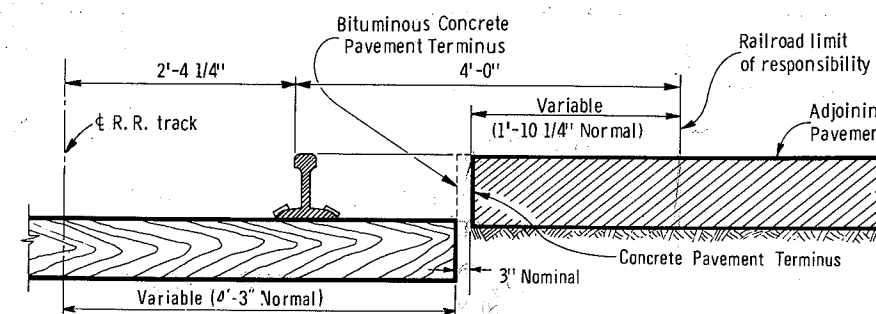







SECTION "A-A"

**RAILROAD APPROACH
CONSTRUCTION DETAILS**

**PAVEMENT DETAILS
FOR RAILROAD APPROACH**

State of Wisconsin
Department of Transportation
Division of Highways

RECOMMENDED FOR APPROVAL: DATE 3/13/69	<i>E. J. Byrkit</i> CHIEF DESIGN ENGINEER
APPROVED DATE 3/27/69	<i>H. J. Sumner</i> STATE HIGHWAY ENGINEER

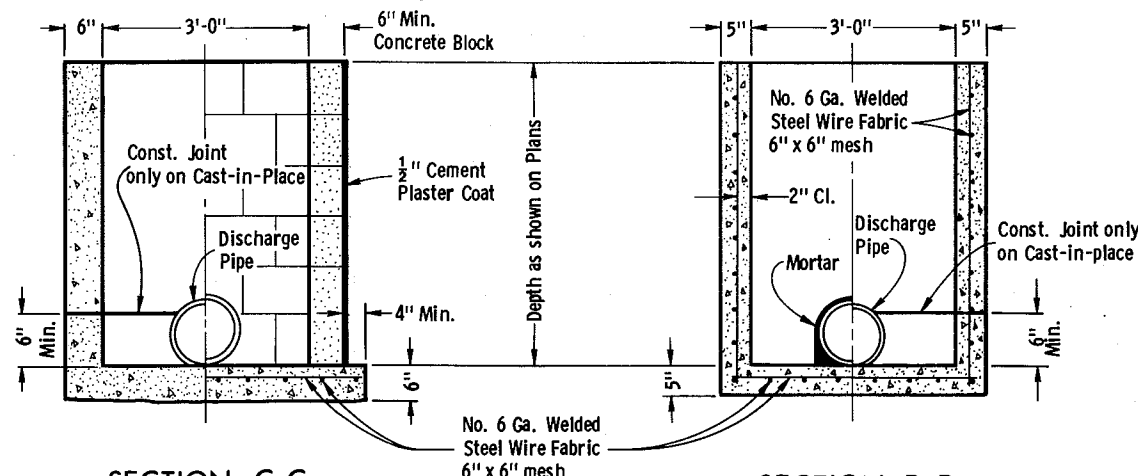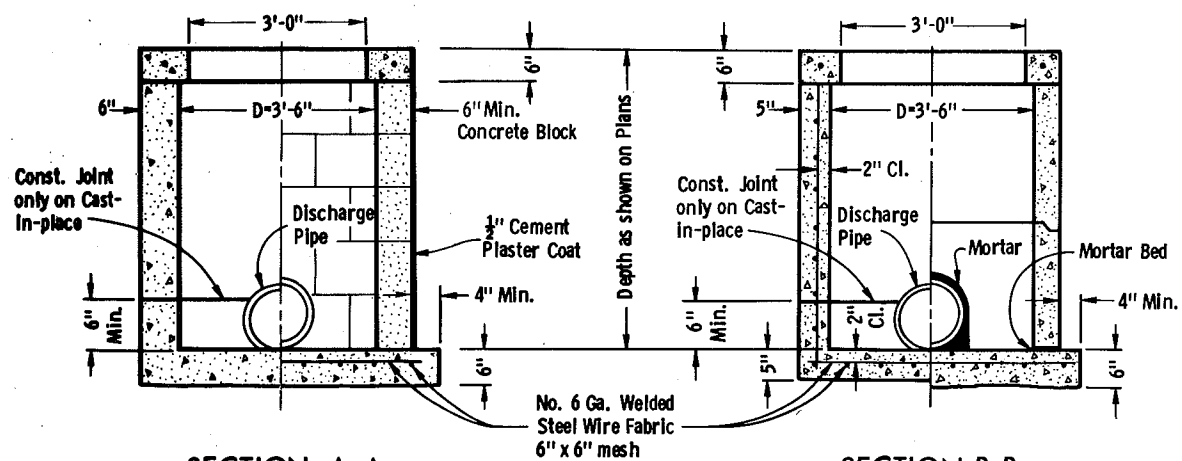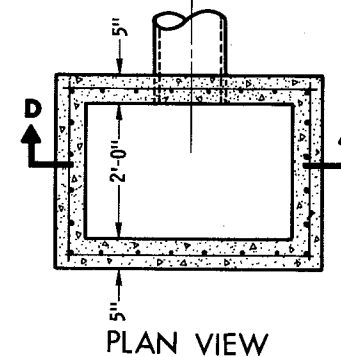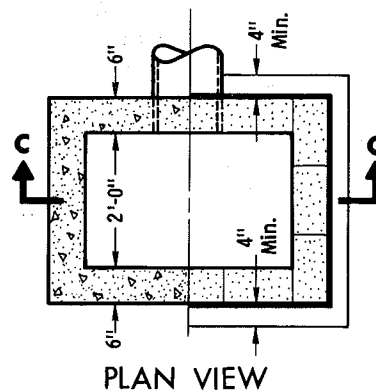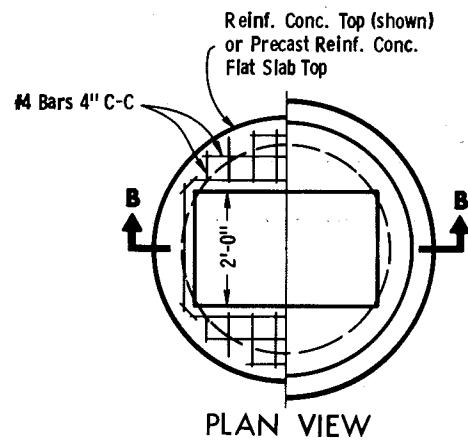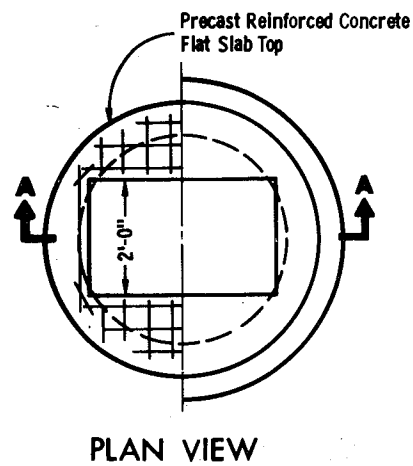

SECTION A-A
MONOLITHIC CONCRETE

SECTION B-B
REINFORCED CONCRETE PRECAST REINFORCED CONCRETE

SECTION C-C
MONOLITHIC CONCRETE

SECTION D-D
PRECAST REINFORCED CONCRETE

INLETS TYPE 3

GENERAL NOTES

Details of construction, materials and workmanship not shown on this drawing shall conform to the pertinent requirements of the Standard Specifications and the applicable Special Provisions.

Detailed drawings for proposed alternate designs for underground drainage structures shall be submitted to the Engineer for approval providing that such alternate designs make provision for equivalent capacity and strength.

Square Precast Inlet units shall conform to the pertinent requirements of AASHTO Designation M 199.

All drainage structures are designated on the plans as "Manholes 1 - C", "Catch Basins 1 - B", "Inlets 1 - H", etc. The first digit designates the masonry portion of the structure, and the following letter designates the type of cover to be used to comprise the complete unit.

Precast Reinforced Bases shall be placed on a bed of material at least 6 inches in depth, which meets the requirements for Granular Backfill. This bedding shall be compacted and provide uniform support for the entire area of the base.

Precast Reinforced Concrete Flat Slab Tops may be used on the structures. The Tops shall be installed on a bed of mortar.

All bar steel reinforcement shall be embedded 2 inches clear unless otherwise shown or noted.

Precast Reinforced Concrete Risers may be placed with tongue up or down.

INLETS TYPE 3

State of Wisconsin
Department of Transportation
Division of Highways

RECOMMENDED FOR APPROVAL:


10-16-75
DATE

J. E. Hennrich
CHIEF OF FACILITIES DEVELOPMENT

APPROVED


10-16-75
DATE

W. J. Sudler
STATE HIGHWAY ENGINEER

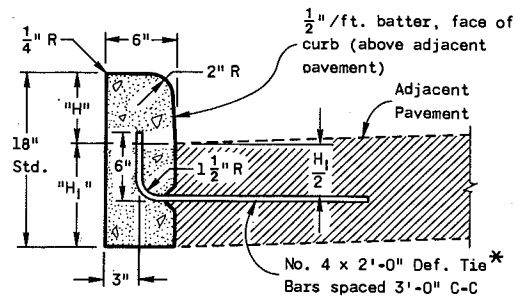


"H" = 9" Max. and 3 1/2" Min. and shall be 6" unless otherwise shown on the plans.
 "H₁" = Same as adjacent pavement thickness for rigid pavement and 12" for non-rigid pavement (Tie Bars omitted)

TYPE "A" (INCLUDING TIE BARS)
TYPE "D" (EXCLUDING TIE BARS)
CONCRETE CURB

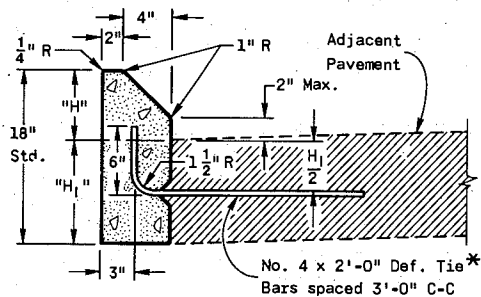


"H" = 6" Max. and 4" Min. and shall be 6" unless otherwise shown on the plans.
 "H₁" = Same as adjacent pavement thickness for rigid pavement and 12" for non-rigid pavement (Tie Bars omitted)


TYPE "G" (INCLUDING TIE BARS)
TYPE "J" (EXCLUDING TIE BARS)
CONCRETE CURB
 (MOUNTABLE)

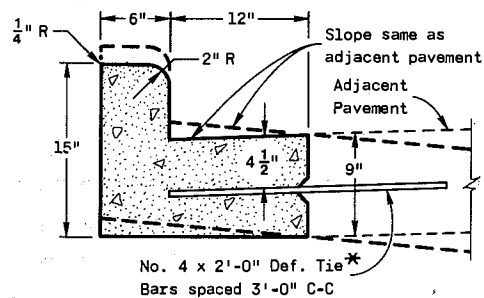

TYPE "A" (INCLUDING TIE BARS)
TYPE "D" (EXCLUDING TIE BARS)
CONCRETE CURB & GUTTER 18"
 Reverse slope Curb & Gutter shown thus ---

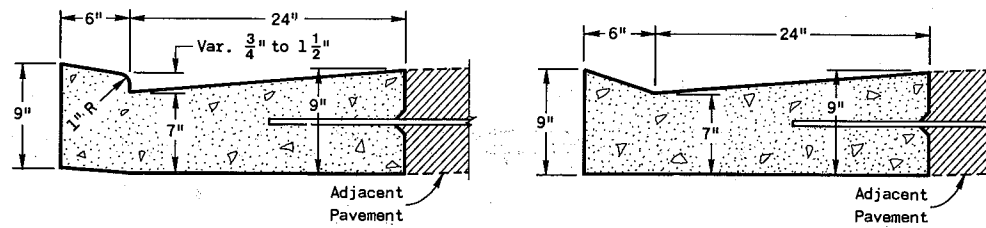


ALTERNATE ENTRANCES
CONCRETE CURB & GUTTER 30"

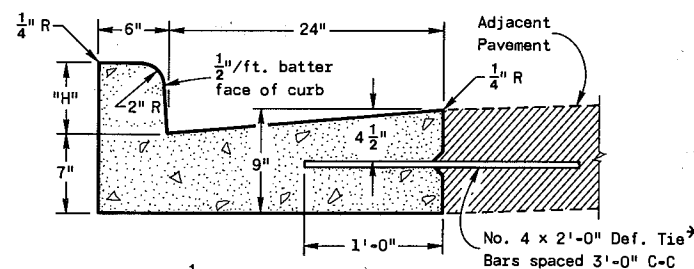


"H" = 9" Max. 3 1/2" Min. and shall be 6" unless otherwise shown on the plans.


TYPE "A" (INCLUDING TIE BARS)
TYPE "D" (EXCLUDING TIE BARS)
CONCRETE CURB & GUTTER 30"

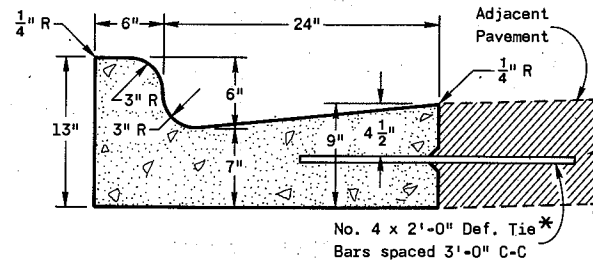

TYPE "K" (INCLUDING TIE BARS)
TYPE "L" (EXCLUDING TIE BARS)
CONCRETE CURB & GUTTER 30"

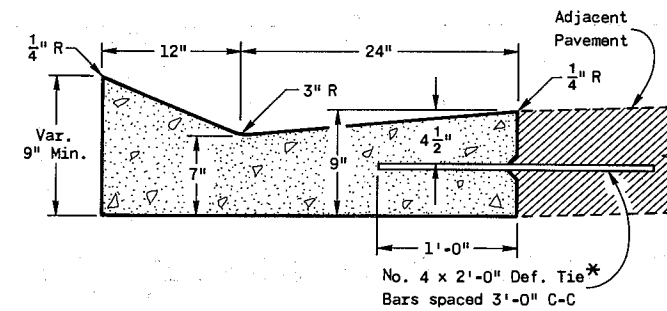

TYPE "A" (INCLUDING TIE BARS)
TYPE "D" (EXCLUDING TIE BARS)
CONCRETE GUTTER 36"

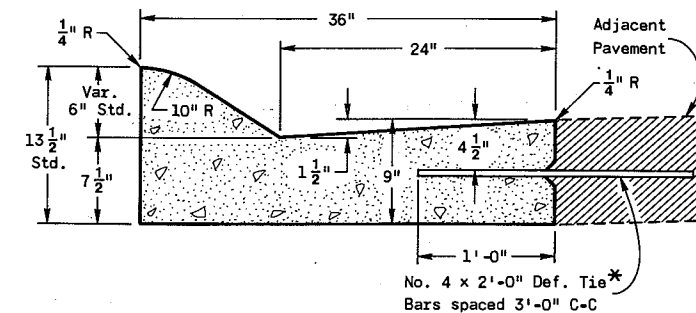

TYPE "A" (INCLUDING TIE BARS)
TYPE "D" (EXCLUDING TIE BARS)
CONCRETE CURB & GUTTER 36"
 (MOUNTABLE)

GENERAL NOTES

Details of construction, materials and workmanship not shown on this drawing shall conform to the pertinent requirements of the Standard Specifications and the applicable Special Provisions.

Detailed drawings for proposed alternate designs for Curb, Gutter and Combination Curb and Gutter shall be submitted to the Engineer for approval providing that such alternate designs make provision for equivalent capacity and strength.

Joints shall not be sealed in Concrete Curb, or Concrete Curb & Gutter.

* Where Curb and Gutter are poured adjacent to existing pavement, the Hook Bolt may be used as for "Longitudinal Joints - Concrete Pavement".


CONCRETE CURB, GUTTER, COMBINATION CURB & GUTTER

State of Wisconsin
 Department of Transportation
 Division of Highways


RECOMMENDED FOR APPROVAL:
 DATE 9-12-73
 APPROVED 9-19-73
 DATE

J.C. Henning
 CHIEF OF FACILITIES DEVELOPMENT

W.J. Siedler
 STATE HIGHWAY ENGINEER

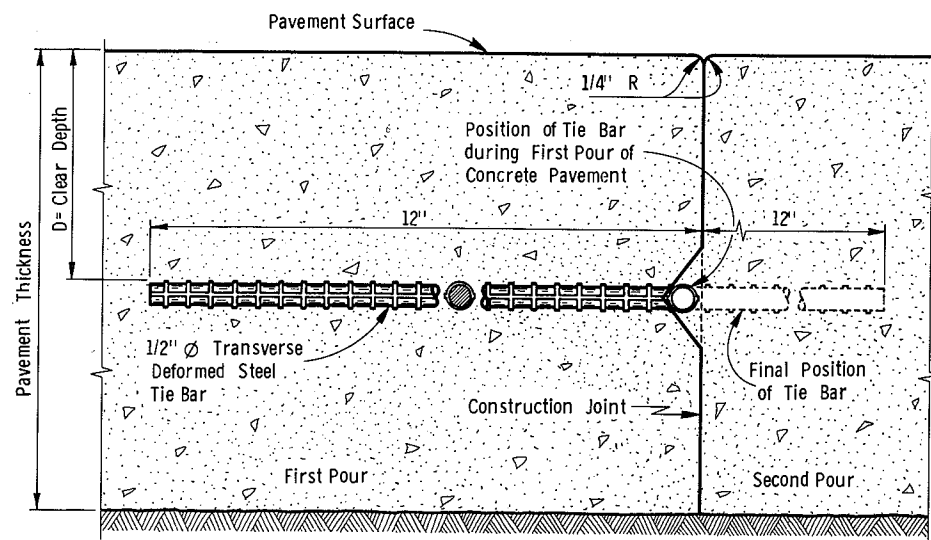


SECTION
CONSTRUCTION JOINT
(TIE BAR)

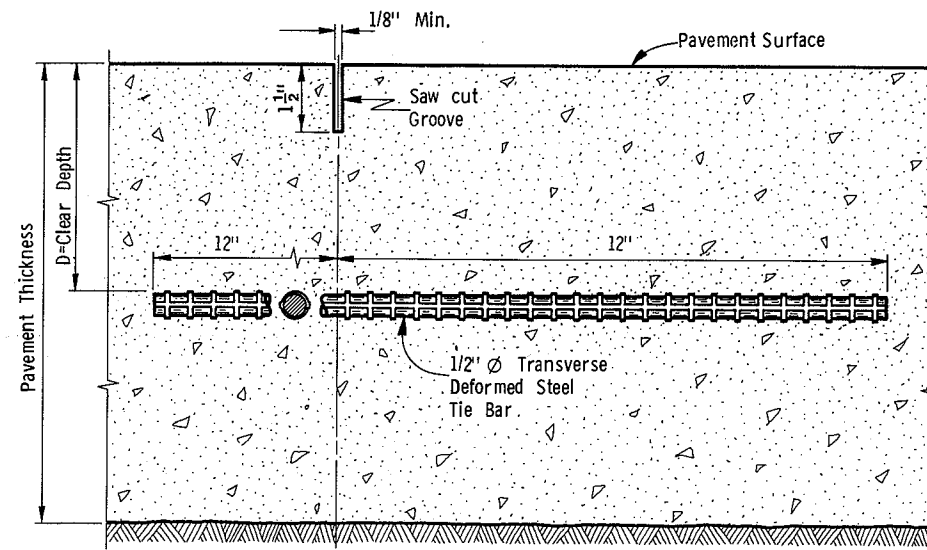


SECTION
SAWED JOINT
(TIE BAR)

Pavement Thickness	"D"	
	Tie Bar	Hook Bolt
8"	2 - 4 3/4"	4 - 4 3/4"
9"	2 - 5 1/2"	4 - 5 1/2"
10"	2 - 5 3/4"	4 - 5 3/4"

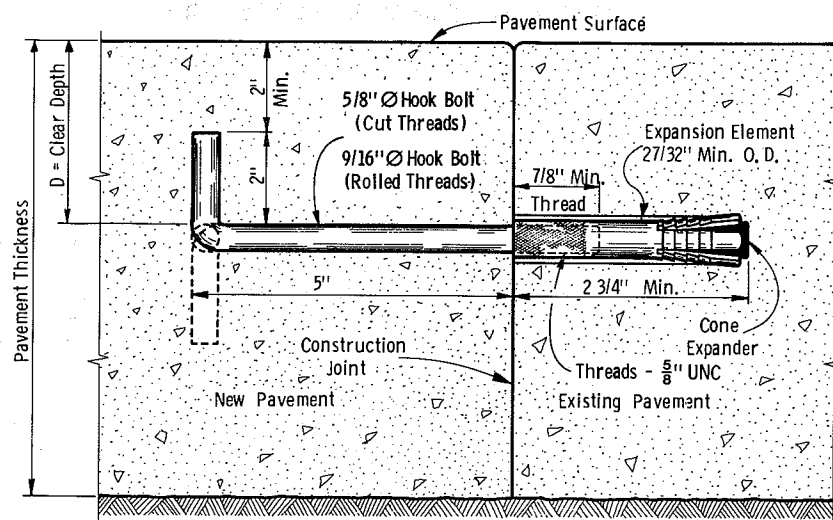

SECTION
CONSTRUCTION JOINT
(HOOK BOLT)

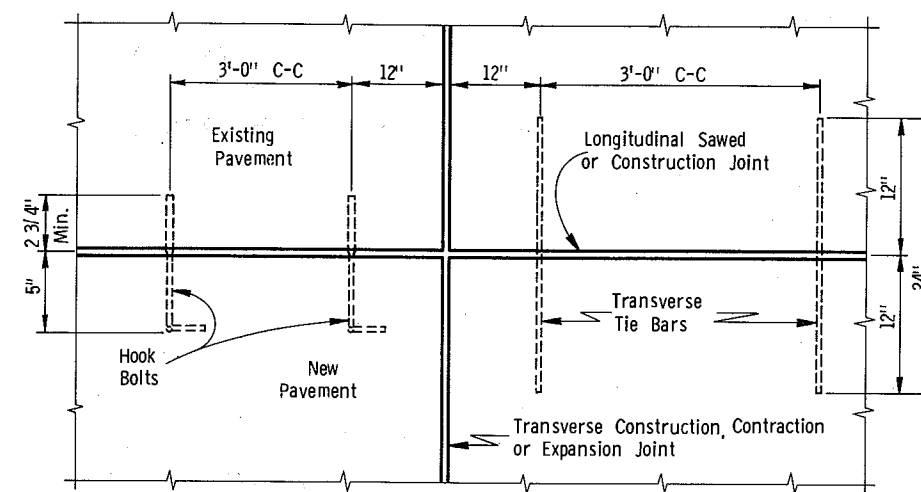

PLAN VIEW
Showing Location Details for
Hook Bolts and Tie Bars

GENERAL NOTES

Details of construction, materials and workmanship not shown on this drawing shall conform to the pertinent requirements of the Standard Specifications and the applicable Special Provisions.

Hook Bolts shall be used only when specified in the contract plans.

The Hook Bolts shall conform to ASTM specification A 307, except that the requirements of paragraph 1 (c) shall not apply.

The Expansion Anchor shall be an internally threaded anchor which consists of an externally slit Expansion Element and a single Cone Expander. The Expansion Element shall contain a minimum of three grips. The Expansion Element shall be threaded in such a manner as to prevent the machine bolt from coming in contact with the Cone Expander at any time.

The Expansion Anchor shall be set in existing pavement according to manufacturer's instructions. The holes shall be of the recommended diameter and depth and shall be drilled by methods recommended by the manufacturer of the particular anchor. The drilled holes shall be left rough, not reamed, and free from any drill dust.

Alternate designs of construction joint installations may be used upon written approval of the Engineer.


Longitudinal Joints shall not be sealed.

Tie Bars shall be placed at the required location by devices or methods approved by the Engineer.



LONGITUDINAL JOINTS
CONCRETE PAVEMENT

State of Wisconsin
Department of Transportation
Division of Highways


RECOMMENDED FOR APPROVAL:
DATE 5/23/72 *S. C. Hennrich*
CHIEF DESIGN ENGINEER
APPROVED
DATE 5/24/72 *S. E. Hicks*
STATE HIGHWAY ENGINEER

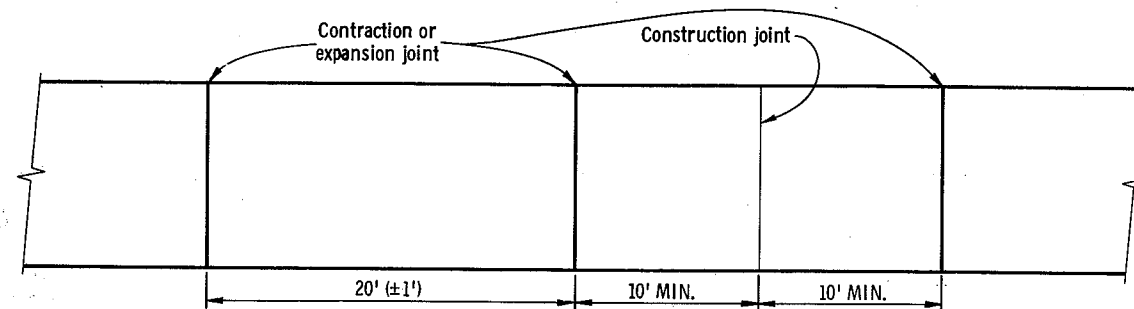


SCHMATIC SHOWING JOINT LOCATIONS

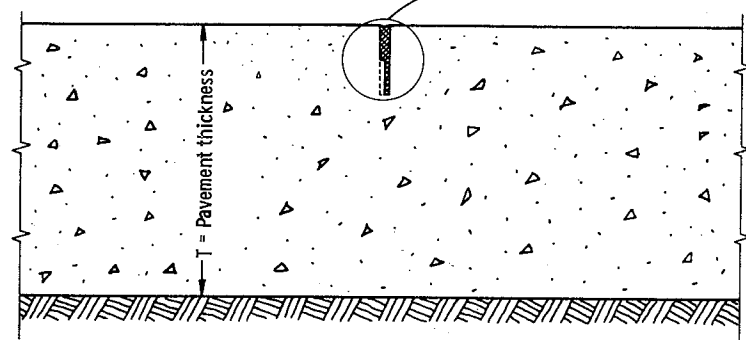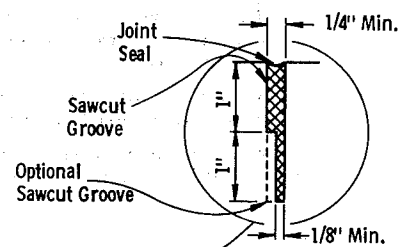


CONTRACTION JOINT

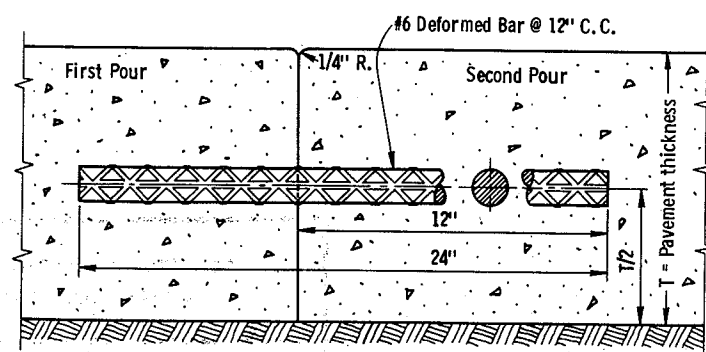

CONSTRUCTION JOINT

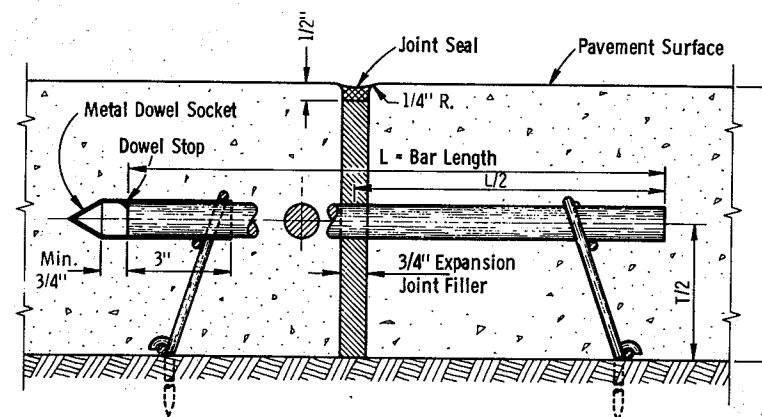

EXPANSION JOINT

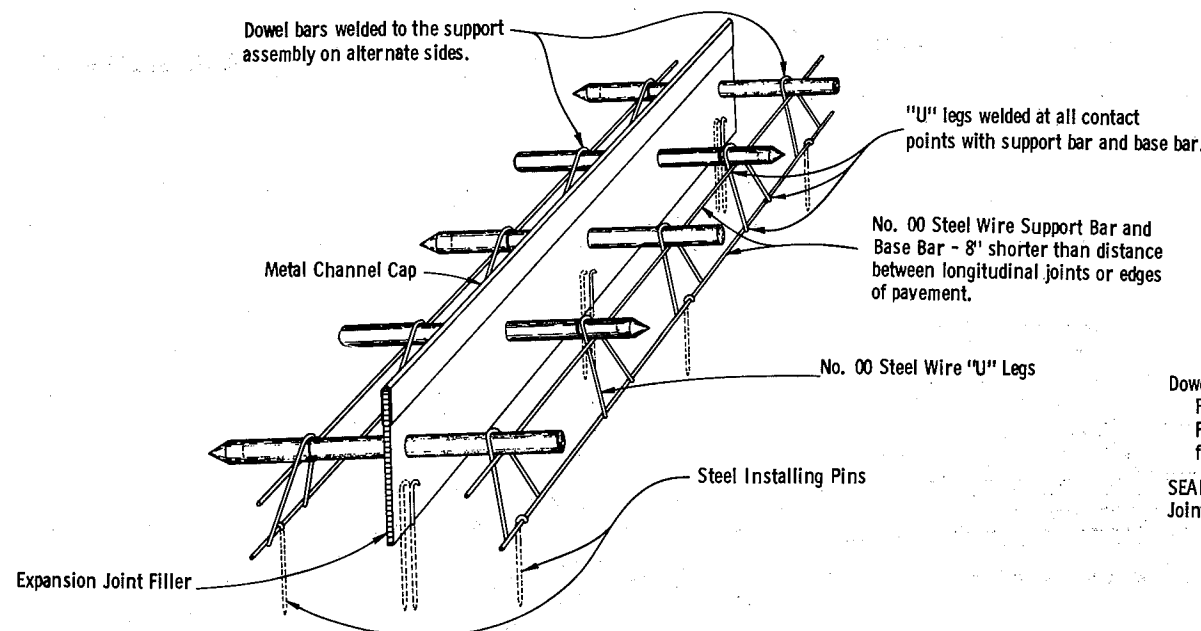

INSTALLING DEVICE FOR LOAD TRANSFER DOWELS AND EXPANSION JOINT ASSEMBLY

GENERAL NOTES

Details of construction not shown on this drawing shall conform to the pertinent requirements of the Standard Specifications and the applicable Special Provisions. Steel installing pins of sufficient number, length and rigidity shall be used to prevent movement of the joint assembly during construction operations.

ALTERNATE DESIGNS
Alternate designs for load transfer dowels at expansion joints and appurtenances other than shown here may be used upon written approval of the Engineer.

CONTRACTION JOINTS
Contraction joints shall be installed at 20' (± 1') spacing from adjacent contraction or expansion joints, except that lesser spacings shall be used:
1. At locations or spacing indicated on the plans.
2. As extensions of transverse joints or cracks in abutting pavement lanes.
3. At locations designated by the Engineer where there are manholes or other fixtures in the pavement.

CONSTRUCTION JOINTS
Construction joints shall be installed a minimum of 10' from the nearest joint. Deformed bars shall be spaced at 12\"/>

EXPANSION JOINTS
Expansion joints are required only at structure approaches and/or where shown on the plans. Locations may be shifted to avoid stationary fixtures in the pavement. Expansion joint filler shall be secured with sufficient number of steel pins to prevent horizontal movement during the placing of concrete.

DOWEL BARS
Dowel bars shall be spaced at 12\"/>

Dowel bars having one end sawed and one end sheared shall be oriented so that the sheared end is welded to the support assembly and the sawed end remains free. Metal dowel socket (CAP), 1 1/8\"/>

Dowel bars shall be installed in accordance with the plans and the section of the Standard Specifications entitled "TRANSVERSE JOINTS IN CONCRETE PAVEMENT" except as hereinafter provided.

Dowel bars shall be coated by one of the following processes:
1. Type I - Adhesive thermoplastic resin system coating in accordance with Federal Specification L - C530 B except the coating thickness shall be 17 mils nominal (± 3 mils) and the adhesive thickness shall be 4 mils nominal (+ 4 mils, - 1 mil).
2. Type II - Thermosetting epoxy system in accordance with Federal Specification L - C530 B except the total minimum thickness shall be 10 mils. The bars shall be coated with SAE # 140 oil or similar lubricant after installing in the support assembly.

The ends of the dowel bars need not be coated. Coating of the welds where the dowel bars are attached to the support assembly is not required. Selection of Type I or Type II coating is optional; however, one type shall be used throughout the project.

Dowel Bar Dimensions:
For 7\"/>

SEALING JOINTS
Joints shall be sealed as shown.

TRANSVERSE JOINTS IN NON-REINFORCED CONCRETE PAVEMENT

State of Wisconsin
Department of Transportation
Division of Highways


RECOMMENDED FOR APPROVAL:
DATE 6-12-73
I. O. Henrich
CHIEF OF FACILITIES DEVELOPMENT

APPROVED
DATE 6-19-73
STATE HIGHWAY ENGINEER


TABLE OF BARRICADE CHARACTERISTICS

BARRICADE TYPE	I	II	III
Height	3'(91.4 cm) Min.		5'(152.4 cm) Min.
* Rail Width	8"(20.3 cm) Min. to 12"(30.5 cm) Max.		
Rail Length	2'(61.0 cm) Min. to Variable Maximum		
** Stripe Width	6" (15.2 cm) at 45° Angle		
Stripe Colors	Reflectorized Orange & White		

* Nominal dimensions when barricade is constructed of lumber.
 ** May be 4"(10.2 cm) for rail lengths less than 3'(91.4 cm).

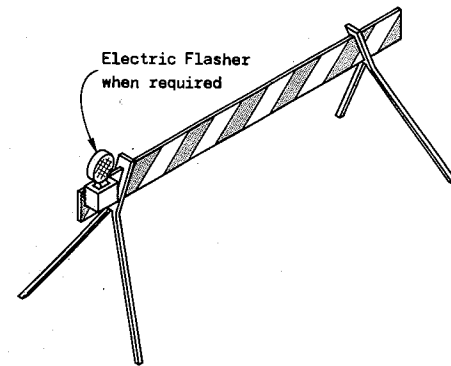


TYPICAL TYPE I BARRICADE

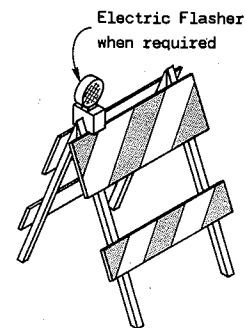

TYPICAL TYPE II BARRICADE




W20-3
 48"(121.9 cm) x 48"(121.9 cm)
 Black Lettering on Reflective
 Orange Background
 Letter Series "D"
 Letter height 7" (17.8 cm)

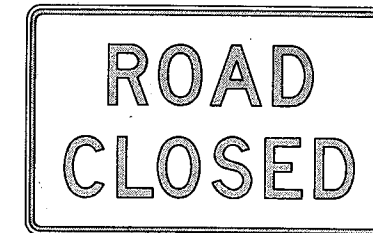

R11-2
 48"(121.9 cm) x 30"(76.2 cm)
 Black Lettering on Reflective
 White Background
 Letter Series "D"
 Letter height 8" (20.3 cm)

STANDARD SIGNS-TYPE II

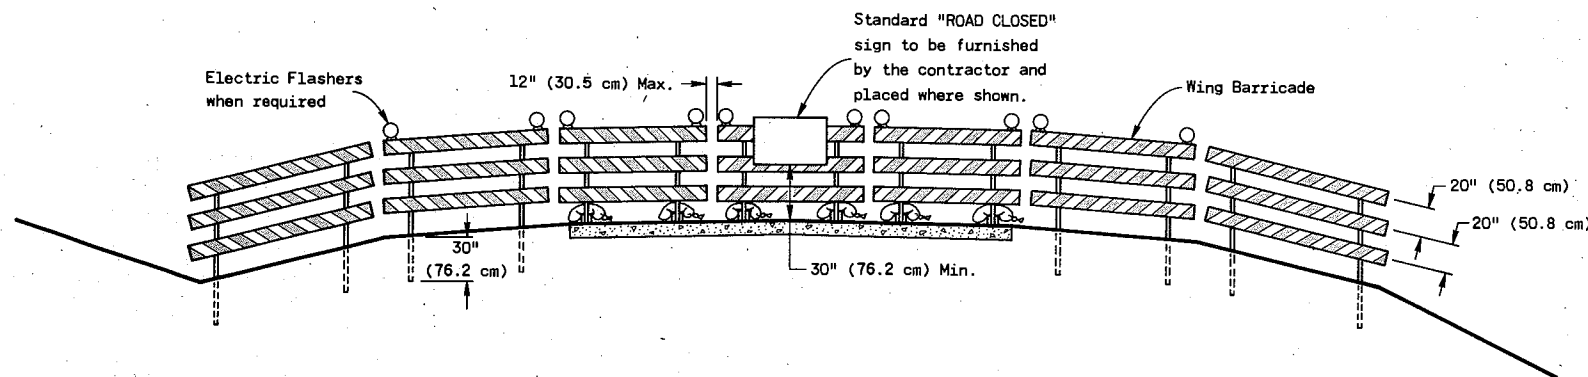

TYPICAL INSTALLATION SHOWING TYPE III BARRICADE

CONSTRUCTION BARRICADES

GENERAL NOTES

The contractor shall furnish, erect and maintain Barricades and Signs. Details regarding location, spacing, dimensions, fabrication, material, sign lettering, lighting devices and color of Barricades and Signs shall conform to this drawing, the Wisconsin Manual on Uniform Traffic Control Devices, the Standard Specifications, Special Provisions and/or plans.

Type III Barricades and Signs shall be erected at the termini of projects and at other road or street locations where it is necessary to control or eliminate public access to the construction area.

Type I and II Barricades shall be used on projects when traffic is to be maintained through the construction area.

The actual field location of barricade installations and advance signs shall be as directed by the Engineer.

CONSTRUCTION BARRICADES & STANDARD SIGNS

State of Wisconsin
 Department of Transportation
 Division of Highways

RECOMMENDED FOR APPROVAL:

DATE 6-6-75

DATE


APPROVED

DATE 6-6-75

DATE

J.C. Thomas
 CHIEF OF FACILITIES DEVELOPMENT


W.J. Fisher
 STATE HIGHWAY ENGINEER

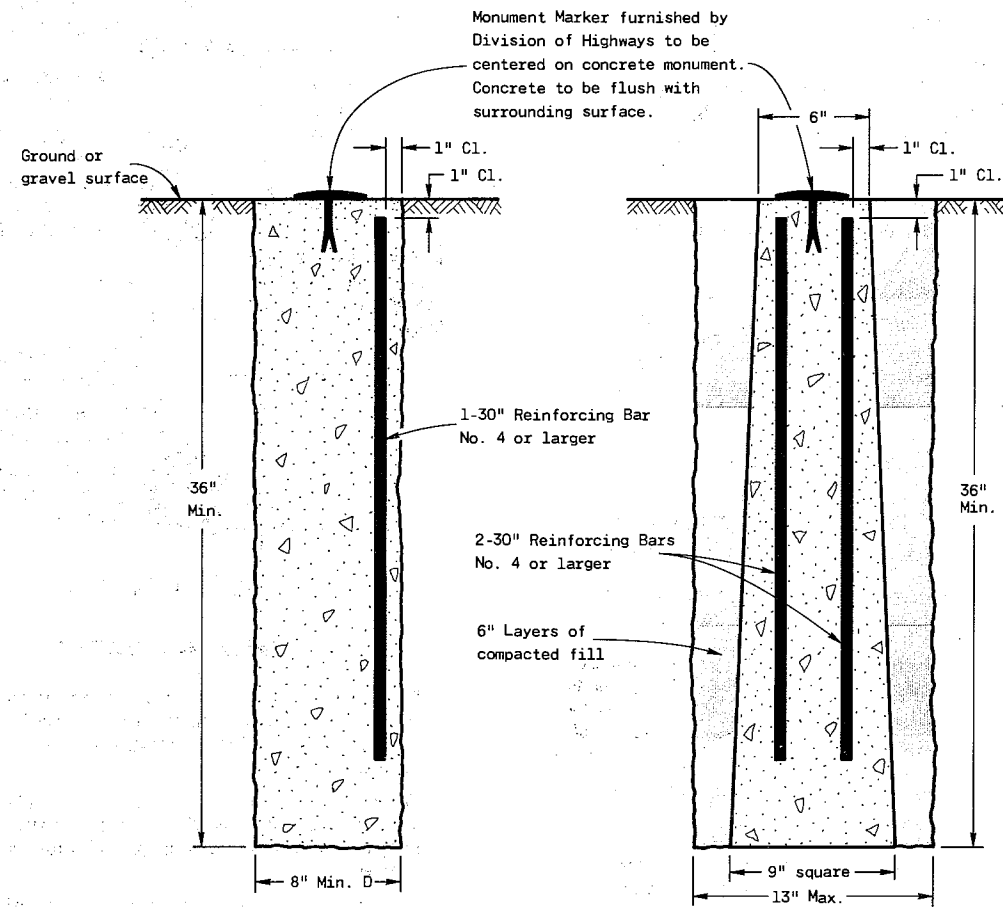

**CAST-IN-PLACE
CONCRETE MONUMENT**


**PRECAST
CONCRETE MONUMENT**

TYPE A

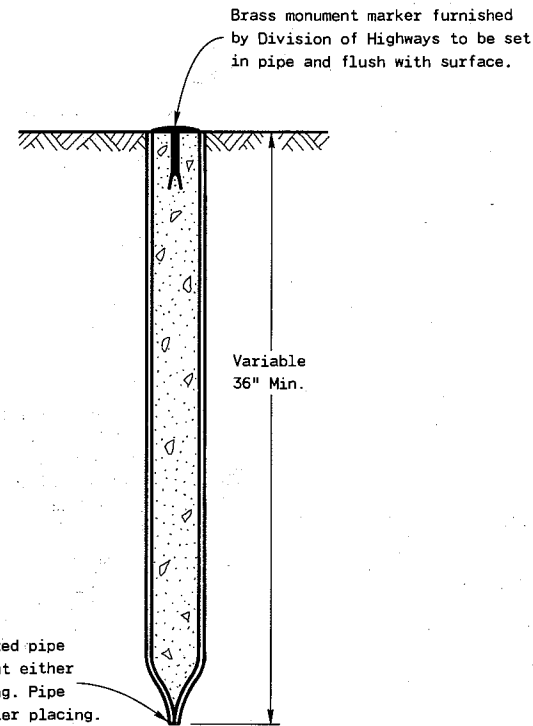

TYPE B

NOT TO BE USED IN PAVEMENT STRUCTURE

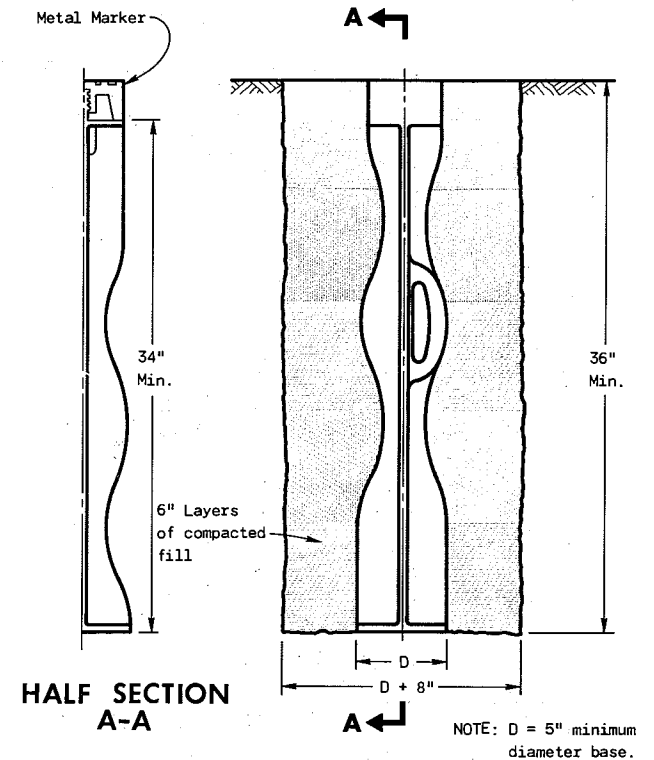


**HALF SECTION
A-A**

**METAL MONUMENT
(Includes Marker)**


TYPE C

NOTE: D = 5" minimum diameter base.

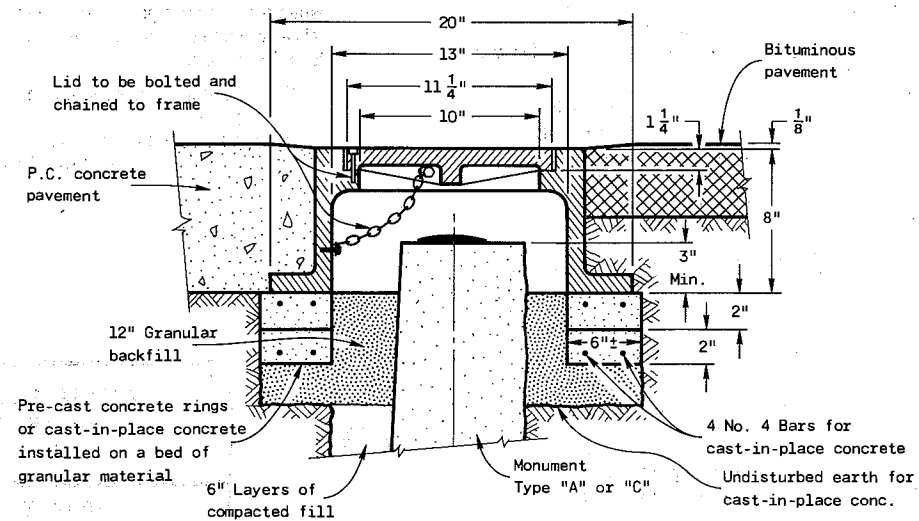

DETAIL OF MONUMENT COVER

INSTALLATION IN PAVEMENT OVER A MONUMENT

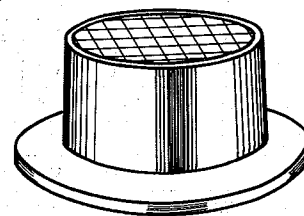

(Approximate weight - 95 lbs.)

GENERAL NOTES

Details of construction, materials and workmanship not shown on this drawing shall conform to the pertinent requirements of the Standard Specifications and the applicable Special Provisions.

Detailed drawings of proposed alternate designs for Metal Monuments or Monument Covers shall be submitted to the Engineer for approval.


The installed Metal Monument must be easily detected with a dip needle. Inert permanent magnets shall be attached near the top and bottom of those Monuments constructed of a metal alloy which is not attractive to a dip needle.

Type A and Type C Monuments are equal alternates unless otherwise specified on the plan or by special provision.

When Landmark Reference Monument and Cover is specified, contractor shall furnish and install Monument and Monument Cover in conformance with details on this drawing and pertinent requirements of Section 611 of the Standard Specifications.

The Monument Cover shall be a "Non-Rocking" type. Adjustment of the Cover to grade may be accomplished by the use of mortar and brick, or by either pre-cast or cast-in-place Reinforced Concrete Grade Rings.

Monuments shall be located and placed at the direction of the Engineer.

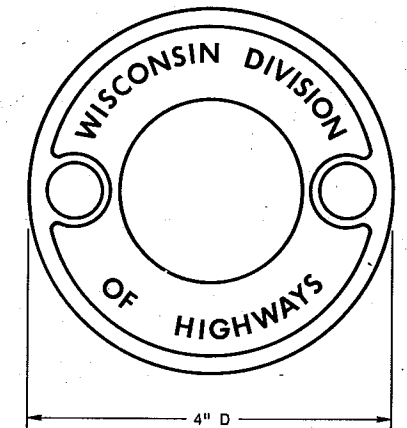

TOP LEGEND FOR MARKER

**LANDMARK REFERENCE
MONUMENTS**

State of Wisconsin
Department of Transportation
Division of Highways

RECOMMENDED FOR APPROVAL:

2-15-74

DATE










APPROVED

3-21-74


DATE

J.C. Thomas
CHIEF OF FACILITIES DEVELOPMENT


H.J. Sioder
STATE HIGHWAY ENGINEER

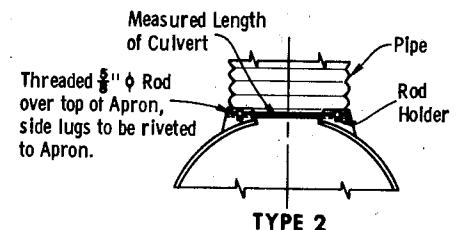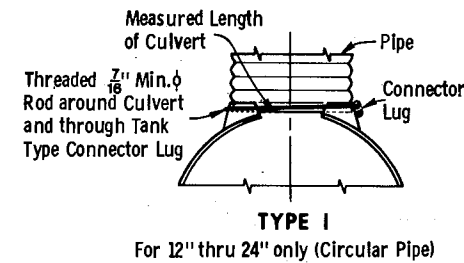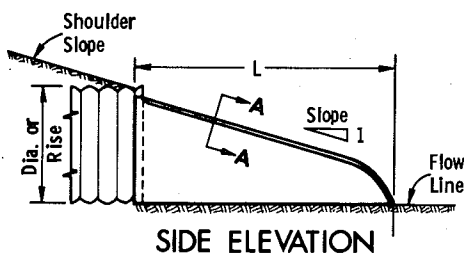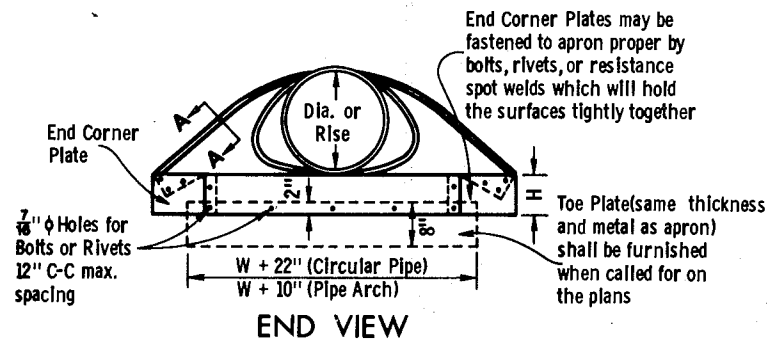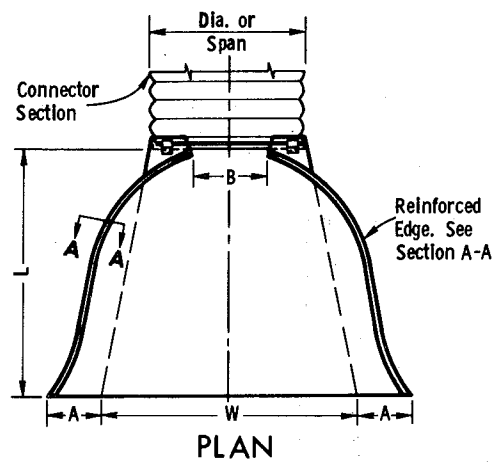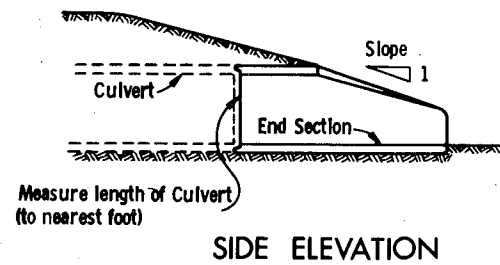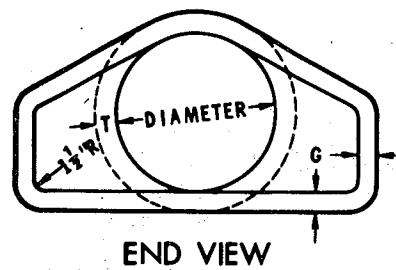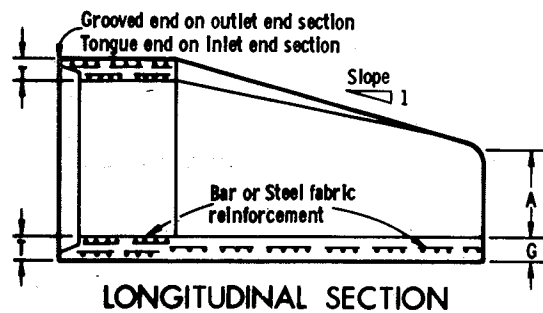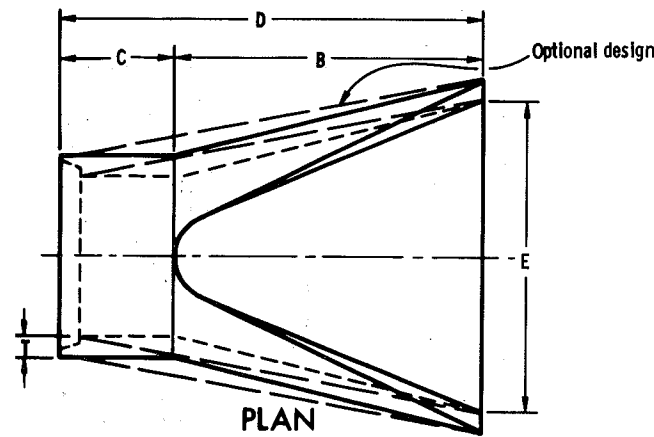

TYPE 2
For 30" and 36" only (Circular Pipe)
For 17" X 13" thru 57" X 38" only (Pipe Arch)

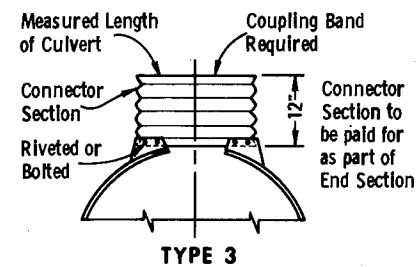

TYPE 3
For 42" thru 84" only (Circular Pipe)
For 64" X 43" & 71" X 47" (Pipe Arch)

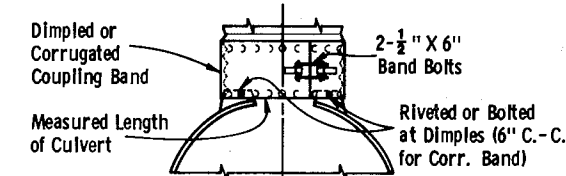

TYPE 5
Alternate for
All sizes Corrugated Circular Pipe and Pipe Arch

NOTE: Dimpled Band fits over Outside of Endwall, and Corr. Band fits Inside Endwall. Dimpled Band may be used with Hellically Corrugated Pipe

CONNECTION DETAILS

CIRCULAR PIPE


For Circumferentially Corrugated Pipe use Endwall Connection Details 1, 2, 3, or 5 as applicable.

For Hellically Corrugated Pipe use Endwall Connection Details 1, 2 or 5.

For Hellically Corrugated Pipes with two Circumferential Corrugations at each end use Endwall Connection Details 1, 2, or 3

PIPE ARCH

Use Endwall Connection Details 2, 3, or 5 as applicable.

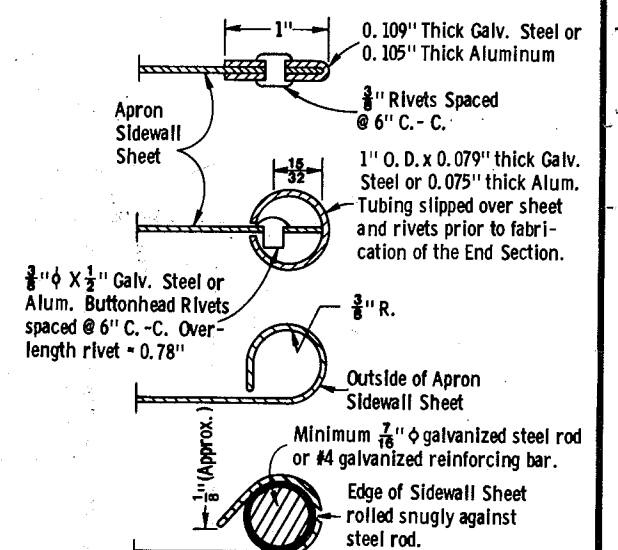

SECTION A-A

GENERAL NOTES

Details of construction, materials, and workmanship not shown on this drawing shall conform to the pertinent requirements of the Standard Specifications and the applicable Special Provisions.

Variations of the dimensions and designs shown hereon will be permitted providing equivalent capacity and structural integrity are attained, and prior approval of the Engineer is obtained.

Concrete culvert endwalls may not be used with galvanized steel or aluminum culvert pipe or vice versa.

Galvanized steel or aluminum endwalls shall normally be installed on culvert pipe of the same metal. The use of galvanized steel endwalls on aluminum pipes is permitted, provided the two metals at the joint interface are kept separated by a suitable insulating material approximately 1/8" thick or greater. Such material would be an asphalt impregnated fabric, a sheet plastic, a rubber gasket or other nondegradable material of substantial strength.

When two or more pipe arches with apron endwalls are to be laid adjacent to each other, they shall be separated by the following amount.

Pipes: Total width of apron endwall less the diameter of pipe plus 6 inches.

Pipe Arches: Total width of apron endwall less the span dimension of the pipe arch plus 6 inches.

DIA.	APPROX. WEIGHT/SECTION	T	A	B	C	D	E	G	APPROX. SLOPE
12"	530	2"	4"	24"	48 7/8"	72 7/8"	24"	2"	3 to 1
15"	740	2 1/2"	6"	27"	46"	73"	30"	2 1/4"	
18"	990	2 1/2"	9"	27"	46"	73"	36"	2 1/2"	
21"	1,280	2 3/4"	9"	36"	37 1/2"	73 1/2"	42"	2 3/4"	
24"	1,520	3"	9 1/2"	43 1/2"	30"	73 1/2"	48"	3"	
27"	1,930	3 1/4"	10 1/2"	49 1/2"	24"	73 1/2"	54"	3 1/4"	
30"	2,190	3 1/2"	12"	54"	19 3/4"	73 3/4"	60"	3 1/2"	
36"	4,100	4"	15"	63"	34 3/4"	97 3/4"	72"	4"	
42"	5,380	4 1/2"	21"	63"	35"	98"	78"	4 1/2"	
48"	6,550	5"	24"	72"	26"	98"	84"	5"	3 to 1
54"	8,040	5 1/2"	27"	65"	33 1/2" - 35"	98 1/2" - 100"	90"	5"	2 3/8 to 1
60"	8,730	6"	30"	60"	39"	99"	96"	5"	2 to 1
66"	10,630	6 1/2"	30"	72"	21" - 27"		102"	5 1/2"	
72"	12,520	7"	36"	78"	21"		108"	6"	
78"	14,430	7 1/2"	36"	78"	21"	99"	114"	6 1/2"	2 to 1
84"	18,160	8"	36"	90 1/2"	21"	111 1/2"	120"	6 1/2"	1 1/2 to 1

** Minimum
* Maximum

REINFORCED CONCRETE APRON ENDWALLS

D PIPE DIAM.	MIN. METAL THICKNESS	MIN. ALUM. THICKNESS	DIMENSIONS					APPROX. SLOPE
			A ± 1"	B MAX.	H ± 1"	L ± 1/2"	W ± 2"	
12"	0.064	0.060	6"	6"	6"	21"	24"	2 1/2 to 1
15"			7"	8"		26"	30"	
18"			8"	10"		31"	36"	
21"		0.060	9"	12"		36"	42"	
24"	0.064	0.075	10"	13"	6"	41"	48"	
30"	0.079	0.075	12"	16"	8"	51"	60"	
36"	0.079	0.105	14"	19"	9"	60"	72"	
42"	0.109		16"	22"	11"	69"	84"	2 1/2 to 1
48"			18"	27"	12"	78"	90"	2 1/4 to 1
54"		0.105	30"			84"	102"	2 to 1
60"		NA	33"			87"	114"	1 3/4 to 1
66"			36"			87"	120"	1 1/2 to 1
72"			39"			87"	126"	1 1/2 to 1
78"			42"			87"	132"	1 1/4 to 1
84"	0.109	NA	45"	12"	87"	138"	138"	1 1/8 to 1

NOTE: All splices to be lap riveted or bolted

PIPE - ARCH DIMENSIONS	MIN. METAL THICK.	DIMENSIONS					APPROX. SLOPE	
		A ± 1"	B MAX.	H ± 1"	L ± 1/2"	W ± 2"		
17"	13"	0.064	7"	9"	6"	19"	30"	2 1/2 to 1
21"	15"		7"	10"		23"	36"	
24"	18"		8"	12"		28"	42"	
28"	20"	0.064	9"	14"		32"	48"	
35"	24"	0.079	10"	16"	6"	39"	60"	
42"	29"	0.079	12"	18"	8"	46"	75"	
49"	33"	0.109	13"	21"	9"	53"	85"	
57"	38"		18"	26"	12"	63"	90"	2 1/2 to 1
64"	43"		18"	30"	12"	70"	102"	2 1/4 to 1
71"	47"		18"	33"	12"	77"	114"	2 1/4 to 1
77"	52"		18"	36"	12"	77"	126"	2 to 1
83"	57"	0.109	18"	39"	12"	77"	138"	2 to 1

NOTE: All splices to be lap riveted or bolted

METAL APRON ENDWALLS FOR PIPE ARCHES

METAL OR ALUMINUM APRON ENDWALLS FOR CIRCULAR PIPES

APRON ENDWALLS FOR CULVERT PIPE AND PIPE ARCH

State of Wisconsin
Department of Transportation
Division of Highways

RECOMMENDED FOR APPROVAL:
7-29-75

DATE


APPROVED

7-29-75


DATE

J. C. Hennel
CHIEF OF FACILITIES DEVELOPMENT


W. J. Siedler
STATE HIGHWAY ENGINEER

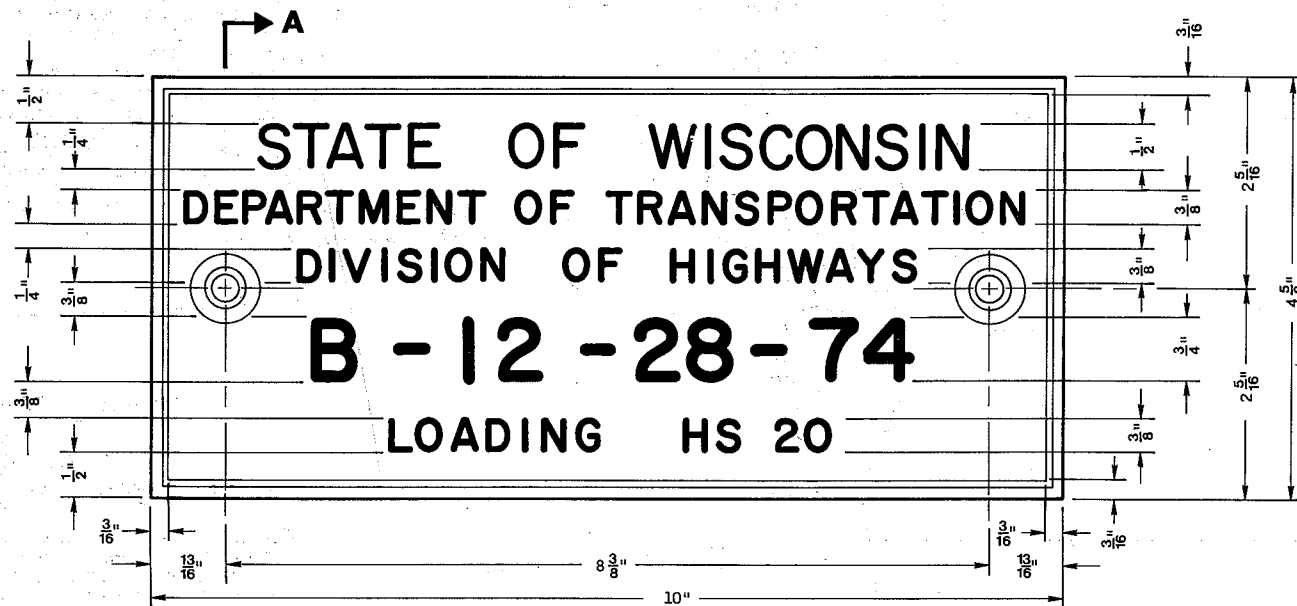

TYPICAL NAME PLATE
(BRIDGES, CULVERTS, AND RETAINING WALLS)

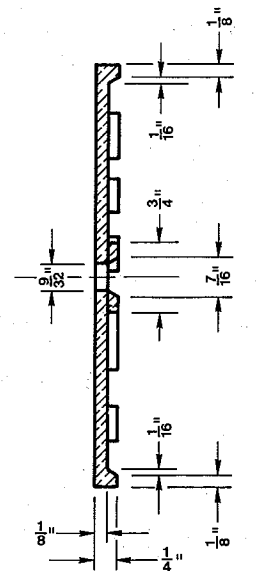

SECTION A-A

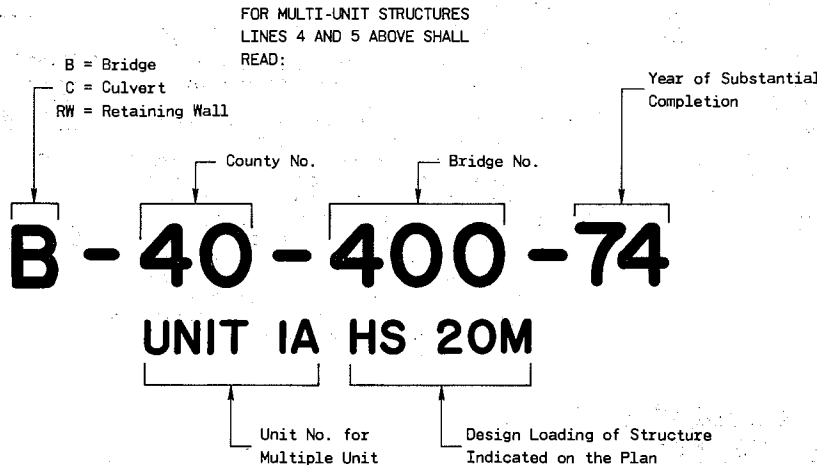



**NUMBERING AND LOADING DESIGNATION
MULTI-UNIT STRUCTURES**

GENERAL NOTES

Name Plates to be installed on Bridges, Culverts, and Retaining Walls shall conform to the requirements of Section 506.2.4 of the Standard Specifications.

The Bridge Number and Design Loading shown on this drawing are examples only. See Construction Plans for individual numbering and design loading.

NAME PLATE (STRUCTURES)	
State of Wisconsin Department of Transportation Division of Highways	
RECOMMENDED FOR APPROVAL: DATE 4-16-74	<i>J. C. Zeman</i> CHIEF OF FACILITIES DEVELOPMENT
APPROVED DATE 4-16-74	<i>W. J. Sieder</i> STATE HIGHWAY ENGINEER

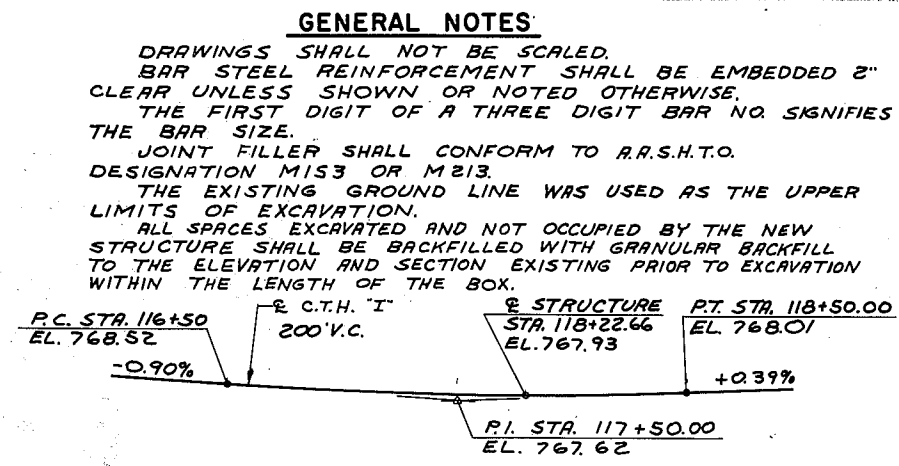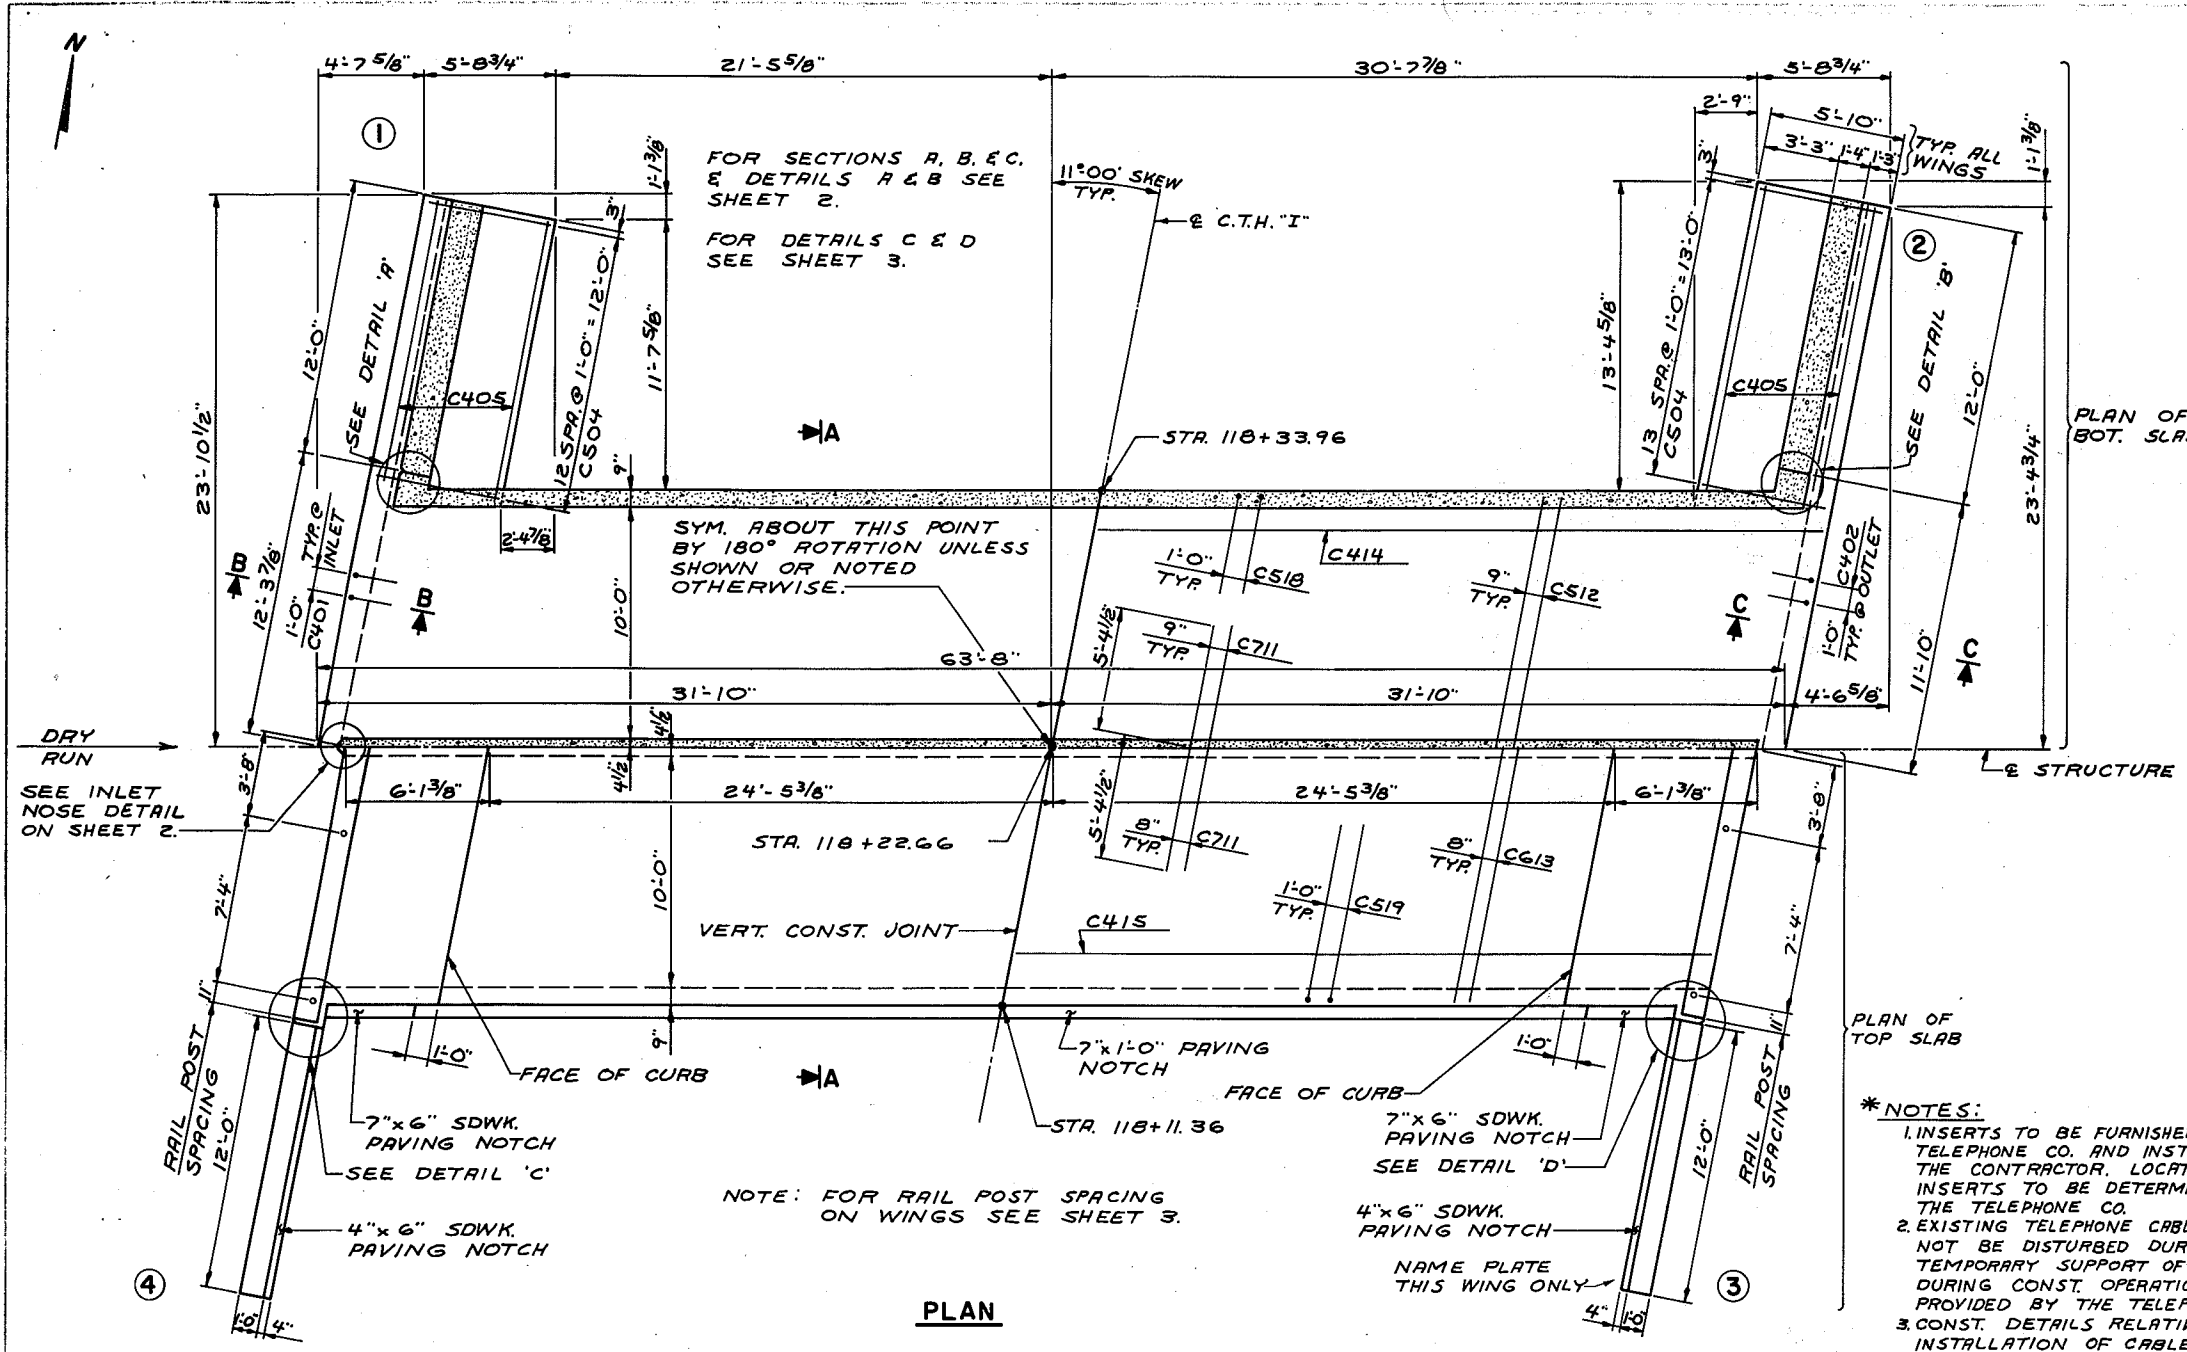

GENERAL NOTES

DRAWINGS SHALL NOT BE SCALED.
 BAR STEEL REINFORCEMENT SHALL BE EMBEDDED 2" CLEAR UNLESS SHOWN OR NOTED OTHERWISE.
 THE FIRST DIGIT OF A THREE DIGIT BAR NO. SIGNIFIES THE BAR SIZE.
 JOINT FILLER SHALL CONFORM TO A.R.S.H.T.O. DESIGNATION M153 OR M213.
 THE EXISTING GROUND LINE WAS USED AS THE UPPER LIMITS OF EXCAVATION.
 ALL SPACES EXCAVATED AND NOT OCCUPIED BY THE NEW STRUCTURE SHALL BE BACKFILLED WITH GRANULAR BACKFILL TO THE ELEVATION AND SECTION EXISTING PRIOR TO EXCAVATION WITHIN THE LENGTH OF THE BOX.

DESIGN DATA

LIVE LOAD: HS-20 (STRUCTURE IS DESIGNED FOR A FUTURE WEARING SURFACE OF 20"/SF.)

ALLOWABLE DESIGN STRESSES:

CONCRETE MASONRY	TOP SLAB $f_c = 4,000$ p.s.i.
HIGH STRENGTH BAR STEEL REINFORCEMENT (GRADE 60)	ALL OTHER $f_y = 3,500$ p.s.i.
	$f_y = 60,000$ p.s.i.

HYDRAULIC DATA:

DRAINAGE AREA = 31 Sq. Mi.
 WATERWAY AREA = 105 Sq. Ft.
 $V = 7.8$ f.p.s.
 $Q_{100} = 620$ c.f.s.
 HIGH WATER EL. 764.10

- *NOTES:**
- INSERTS TO BE FURNISHED BY THE TELEPHONE CO. AND INSTALLED BY THE CONTRACTOR. LOCATION OF INSERTS TO BE DETERMINED BY THE TELEPHONE CO.
 - EXISTING TELEPHONE CABLES SHALL NOT BE DISTURBED DURING CONST. TEMPORARY SUPPORT OF THESE CABLES DURING CONST. OPERATION WILL BE PROVIDED BY THE TELEPHONE CO.
 - CONST. DETAILS RELATIVE TO INSTALLATION OF CABLES ON THE NEW STRUCTURE SHALL BE THE RESPONSIBILITY OF THE TELEPHONE CO.
 - ALL MATERIAL AND LABOR FOR THE INSTALLATION OF THE TELEPHONE CABLES SHALL BE SUPPLIED BY THE TELEPHONE CO.

TOTAL ESTIMATED QUANTITIES

BID ITEMS		
REMOVING OLD BRIDGE		1 L.S.
EXCAVATION FOR STRUCTURES		1 L.S.
CONCRETE MASONRY		197 C.Y.
HIGH-STRENGTH BAR STEEL REINFORCEMENT		24270 LB.
STRUCTURAL CARBON STEEL		550 LB.
TUBULAR RAILING TYPE "H"		1 L.S.
NON-BID ITEMS		
FILLER		1/2" & 3/4" SIZE
POLYVINYL CHLORIDE WATERSTOP		38 L.F.



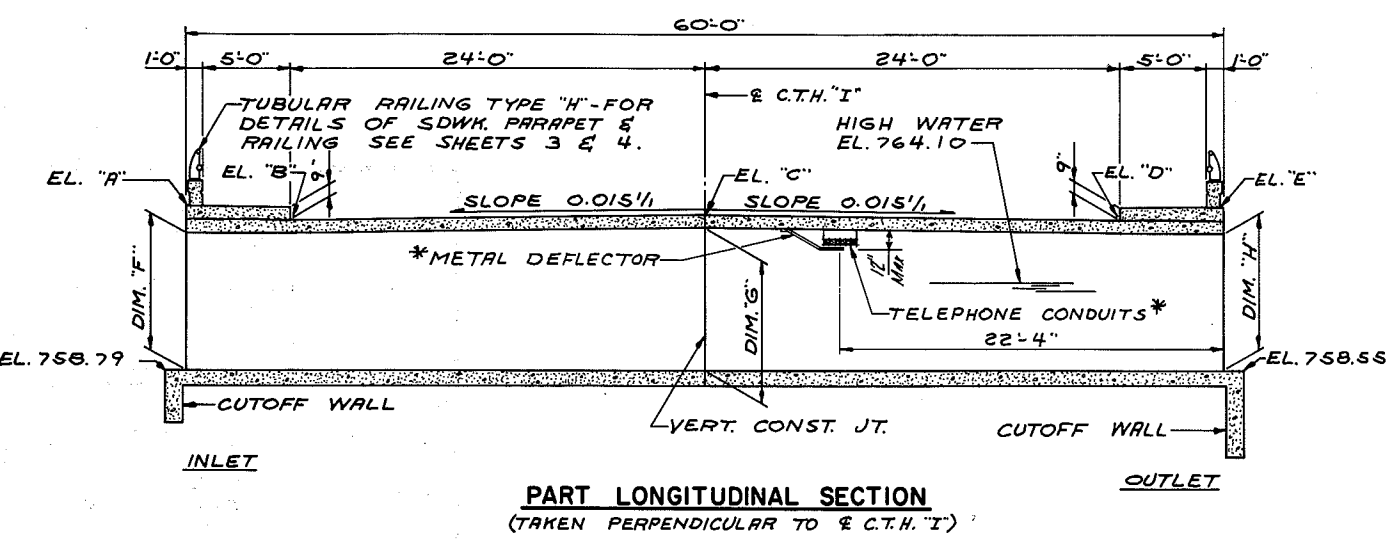


TABLE OF ELEVATIONS AND DIMENSIONS

	SOUTH WALL	CENTER WALL	NORTH WALL
EL. "A"	768.33	768.35	768.37
EL. "B"	767.54	767.56	767.58
EL. "C"	767.91	767.93	767.96
EL. "D"	767.55	767.58	767.61
EL. "E"	768.34	768.36	768.40
DIM. "F"	8'-0"	8'-0 1/4"	8'-0 1/2"
DIM. "G"	8'-5 7/8"	8'-6 1/8"	8'-6 1/2"
DIM. "H"	8'-3"	8'-3 1/4"	8'-3 3/4"

LIST OF DRAWINGS

- LAYOUT X 54258
- DETAILS X 54259
- VERTICAL FACE PARAPET "A" X 54260
- TUBULAR RAILING TYPE "H" X 54261
- SUBSURFACE EXPLORATION X 54262

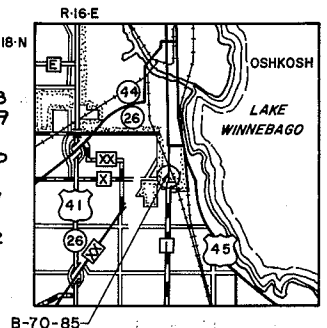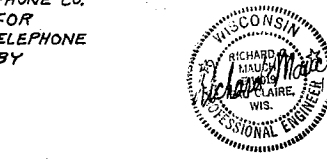

B-70-85

C.T.H. "I" OVER DRY RUN


WINNEBAGO OSHKOSH

A.A.S.H.T.O. '73 HS-20 1975




N.K.I.J. R.C.M. G.L.D. N.K.I.J.

W.A. Kline 12-11-75

PROJECT I.D. 4994-0-17	SHEET NUMBER 72	TOTAL SHEETS
FEDERAL PROJECT DESIGNATION		

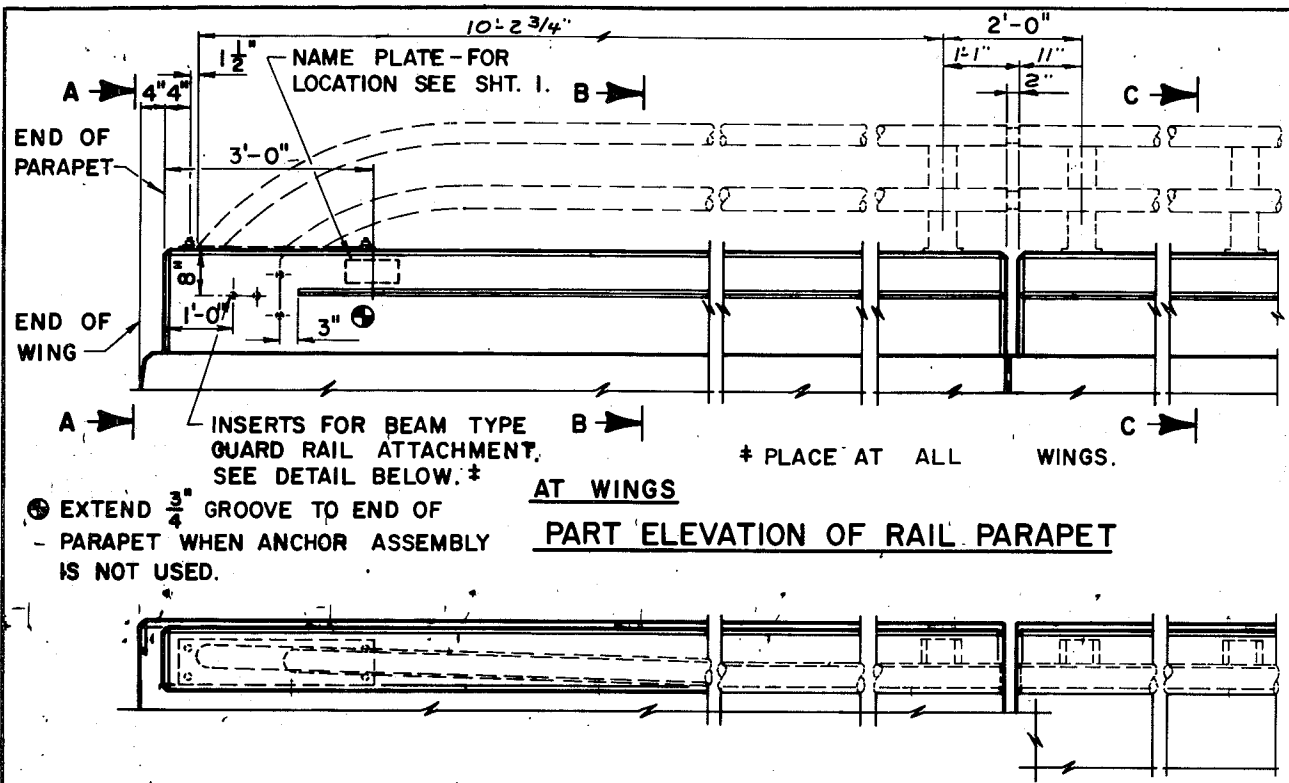

AT WINGS
PART PLAN OF RAIL PARAPET

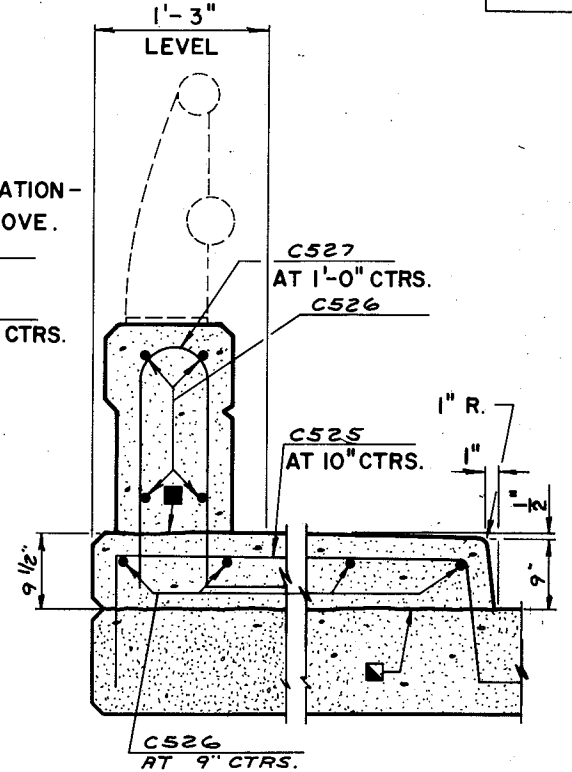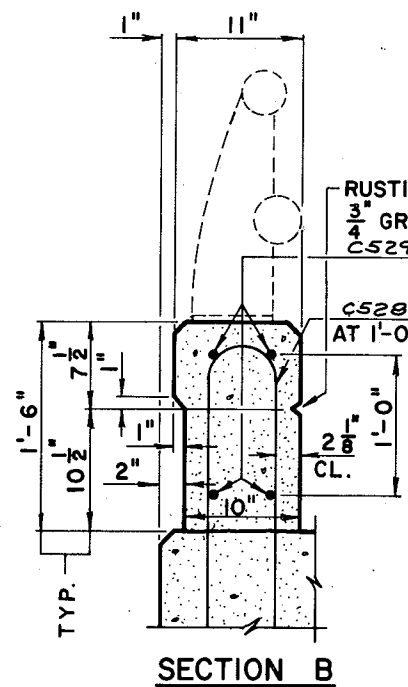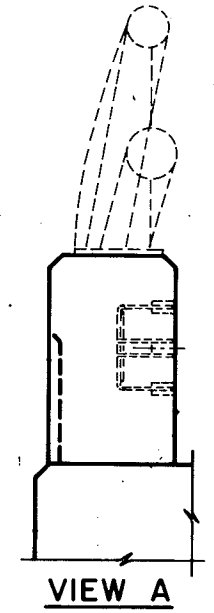

- CONST. JOINT - STRIKE OFF LEVEL & LEAVE ROUGH.
- OPTIONAL CONST. JOINT - STRIKE OFF LEVEL & LEAVE ROUGH.


AT SIDEWALK

SECTION C

NOTES



WHEN PARAPETS AND CURBS ARE POURED CONTINUOUSLY FROM END TO END, THEY SHALL BE SEPARATED AT THE DEFLECTION JOINTS BY A PIECE OF 1/8\"/>

WORK THIS SHEET WITH SHEET TITLED "DETAILS FOR TYPE 'H' TUBULAR ALUMINUM OR STEEL RAILING."

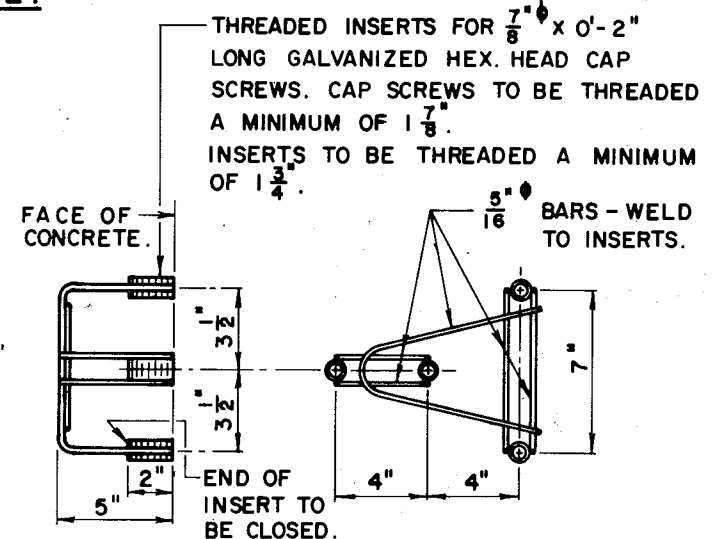






DETAIL OF ANCHOR ASSEMBLY FOR BEAM TYPE GUARD RAIL

ANCHOR ASSEMBLY SHALL BE PAID FOR AT THE UNIT PRICE BID FOR STRUCTURAL CARBON STEEL.

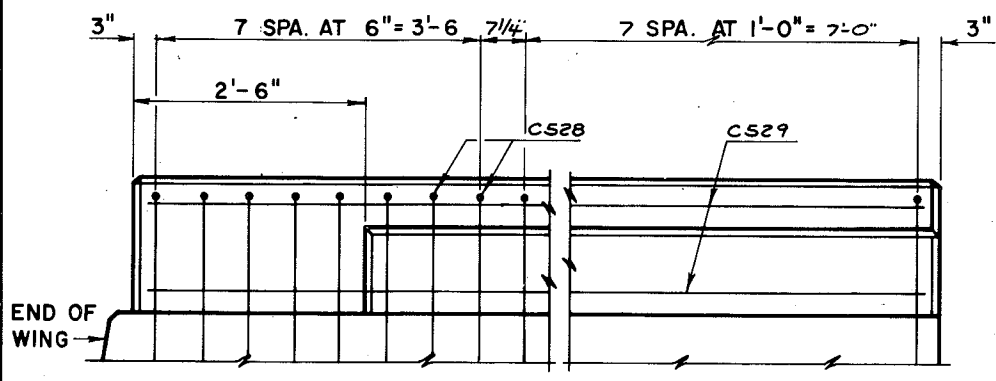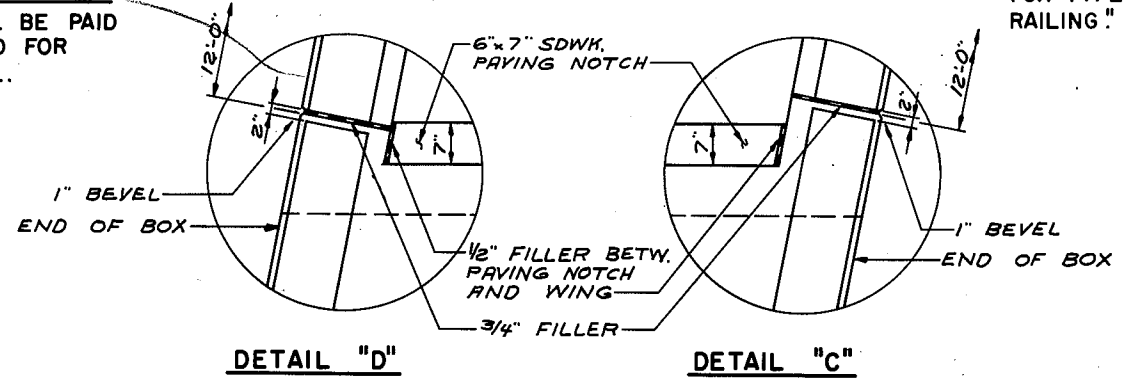

VIEW SHOWING OUTSIDE FACE OF PARAPET & REINF.

No.	Date	Revision	By
STATE OF WISCONSIN DEPARTMENT OF TRANSPORTATION DIVISION OF HIGHWAYS			
STRUCTURE B-70-85			
Const. Spec. 1975	Drawn By G.L.D.	Plans Checked N.K.I.J.	
VERTICAL FACE PARAPET "A"		SHEET 3 OF 5 X 54260	

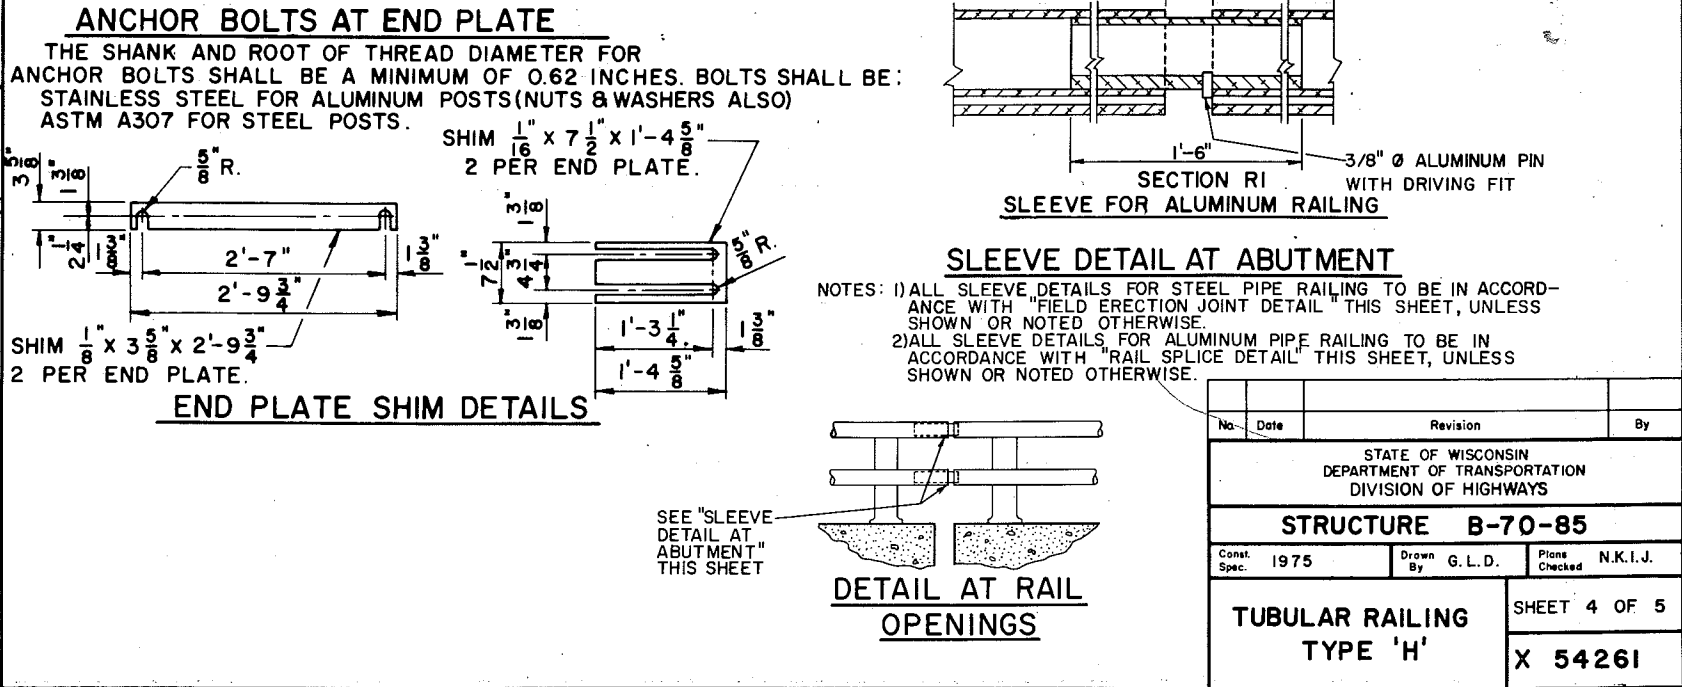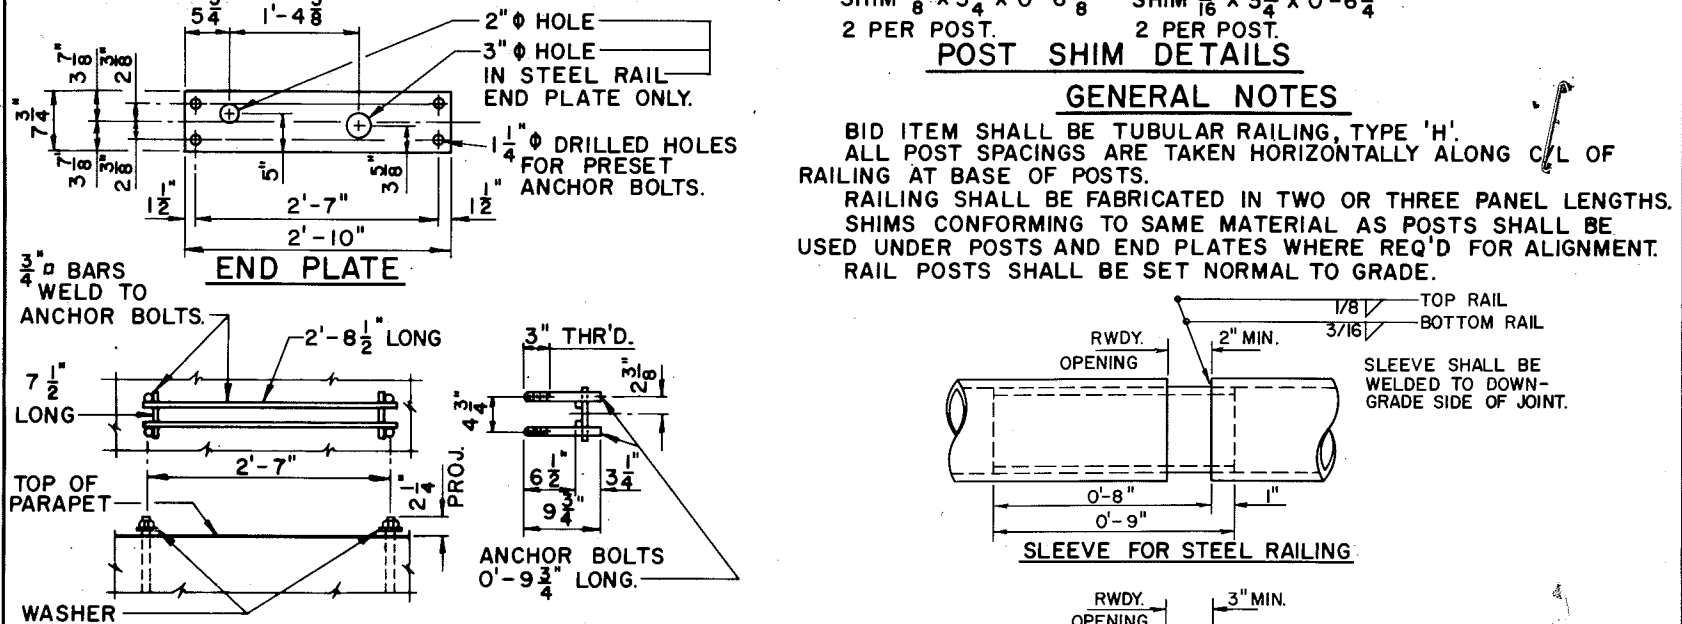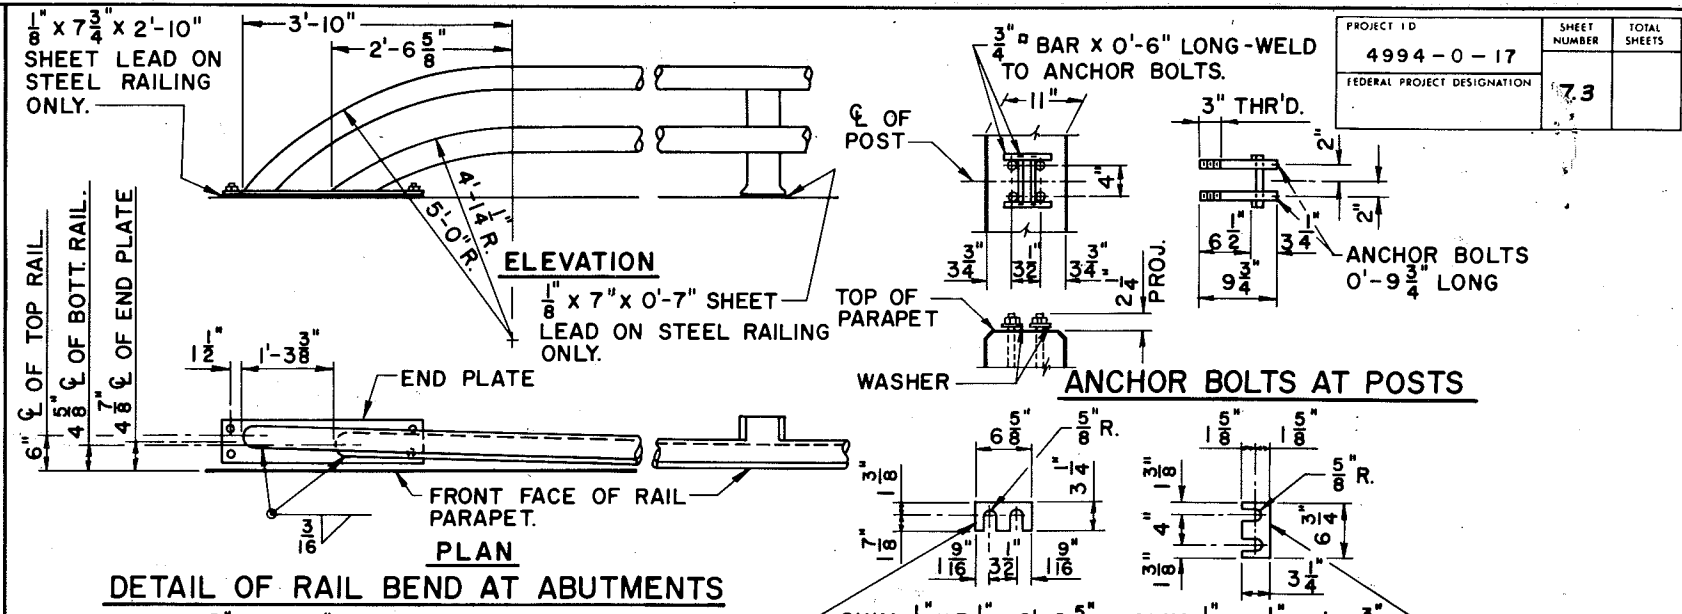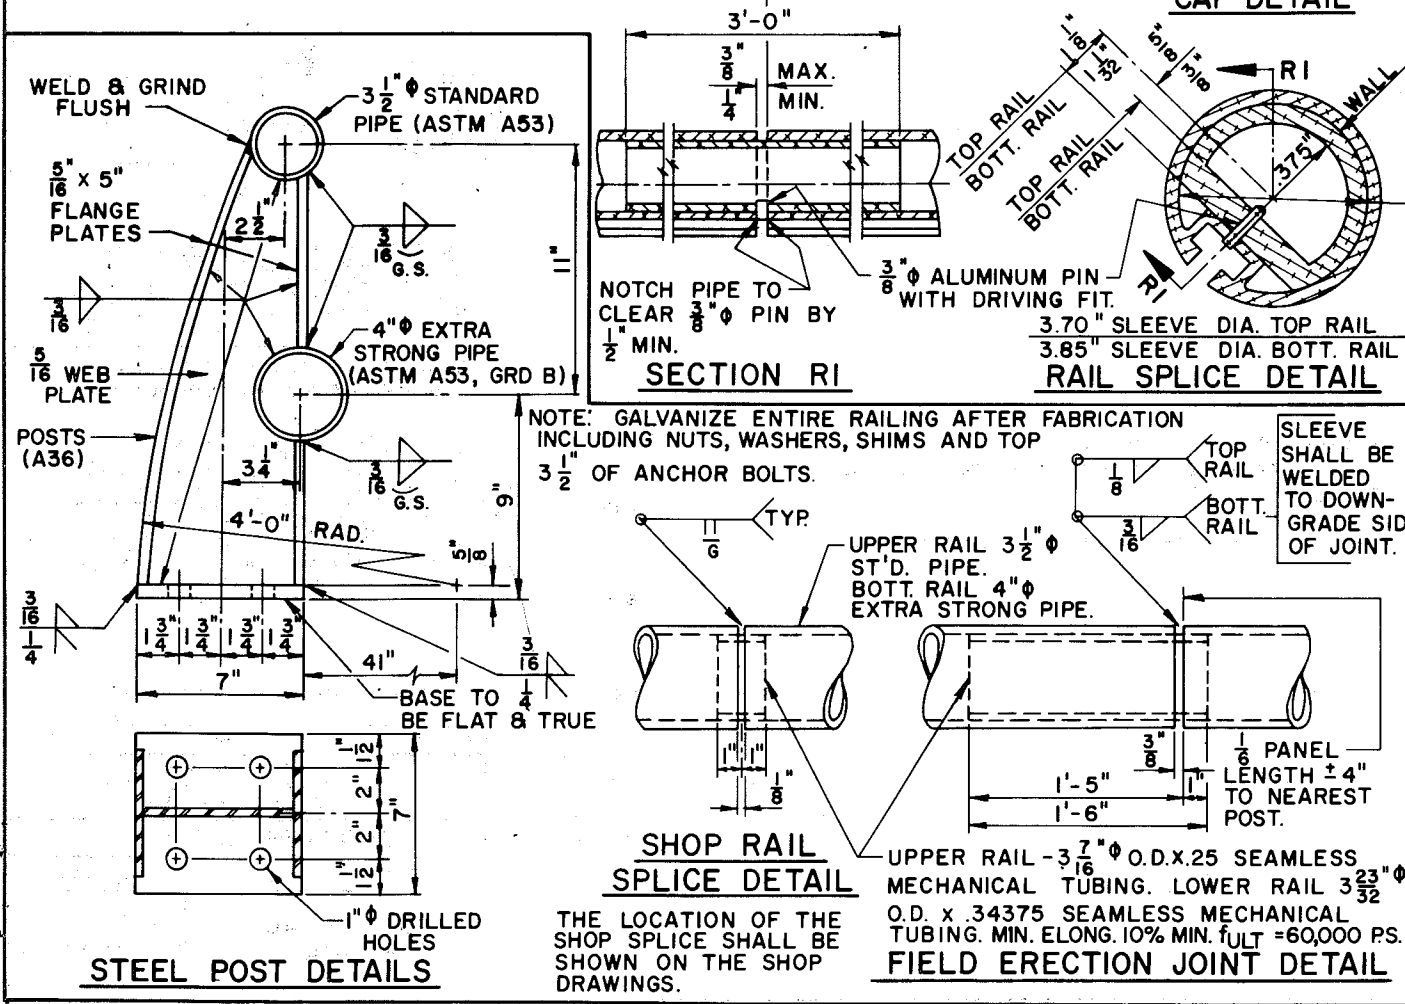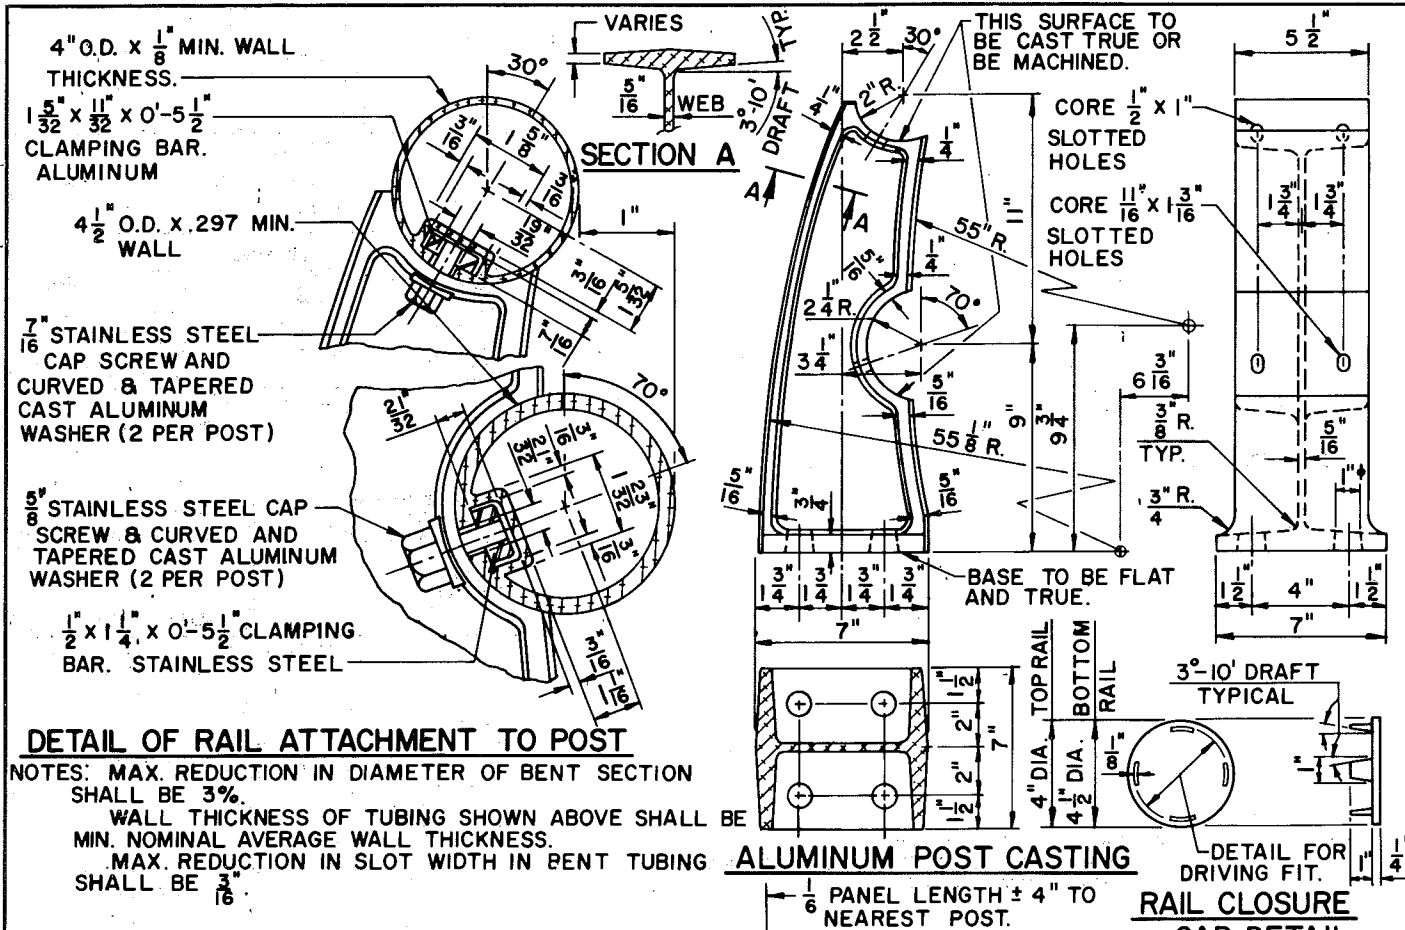

PROJECT ID	4994-0-17	SHEET NUMBER	73	TOTAL SHEETS	
FEDERAL PROJECT DESIGNATION					

No.	Date	Revision	By
STATE OF WISCONSIN DEPARTMENT OF TRANSPORTATION DIVISION OF HIGHWAYS			
STRUCTURE B-70-85			
Const. Spec.	1975	Drawn By	G.L.D.
		Plans Checked	N.K.I.J.
TUBULAR RAILING TYPE 'H'			SHEET 4 OF 5 X 54261



PROJECT I.D. 4994-0-17	SHEET NUMBER 7.4	TOTAL SHEETS
FEDERAL PROJECT DESIGNATION		

ABBREVIATIONS

F — FINE M — MEDIUM C — COARSE
 WS — WEATHERED SO — SOUND

MATERIAL SYMBOLS

TOPSOIL	SILT	SANDSTONE
SAND	PEAT	LIMESTONE
GRAVEL	CLAY	IGNEOUS ROCK

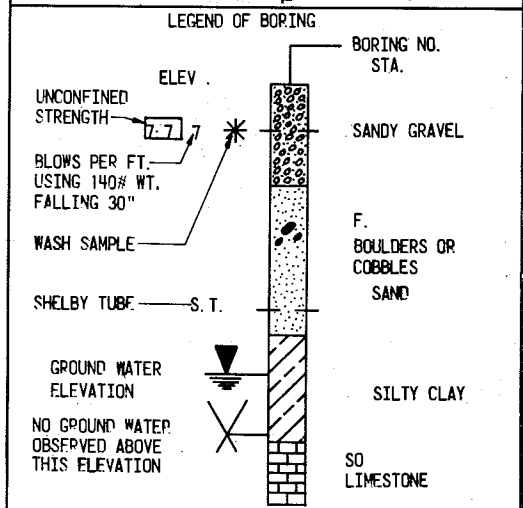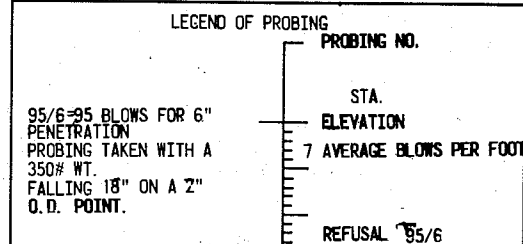


UNLESS OTHERWISE SPECIFIED, THE BLOWS PER FOOT AT THE LOCATIONS INDICATED ARE BASED ON DRIVING A 2" O. D. X 1 1/4" I. D. SPLIT SPOON SAMPLER WITH A 140# HAMMER HAVING A FREE FALL OF 30". THE BLOW COUNT IS TAKEN IN UNDISTURBED SOIL IMMEDIATELY BELOW A CASED OR OPEN HOLE ELIMINATING SIDE FRICTION ON THE DRIVE PIPE.

SUBSURFACE EXPLORATION FOR FOUNDATION DESIGN AND BIDDERS INFORMATION

TO OBTAIN RELATIVE DATA CONCERNING THE CHARACTER OF MATERIAL IN AND UPON WHICH THE FOUNDATION MIGHT BE BUILT, BORINGS AND/OR SOUNDINGS WERE MADE AT POINTS APPROXIMATELY AS INDICATED ON THIS DRAWING. THE DATA PRESENTED HEREIN REPRESENTS THE FINDINGS OF THE SUBSURFACE EXPLORATIONS MADE. HOWEVER, BECAUSE THE DEPTHS INVESTIGATED ARE LIMITED AND THE AREA OF THE BORINGS AND/OR SOUNDINGS IS VERY SMALL IN RELATION TO THE ENTIRE AREA, THE DIVISION OF HIGHWAYS DOES NOT WARRANT CONDITIONS BELOW THE DEPTHS INVESTIGATED OR THAT THE CLASSIFICATION OF MATERIAL ENCOUNTERED IN THESE INVESTIGATIONS IS NECESSARILY TYPICAL OF THE ENTIRE SITE.


No.	Date	Revision	By
STATE OF WISCONSIN DEPARTMENT OF TRANSPORTATION DIVISION OF HIGHWAYS			
STRUCTURE B-70-85			
Const. Spec. 1975	Drawn By G.L.D.	Plots Checked N.K.I.J.	
SUBSURFACE EXPLORATION		SHEET 5 OF 5 X 54262	

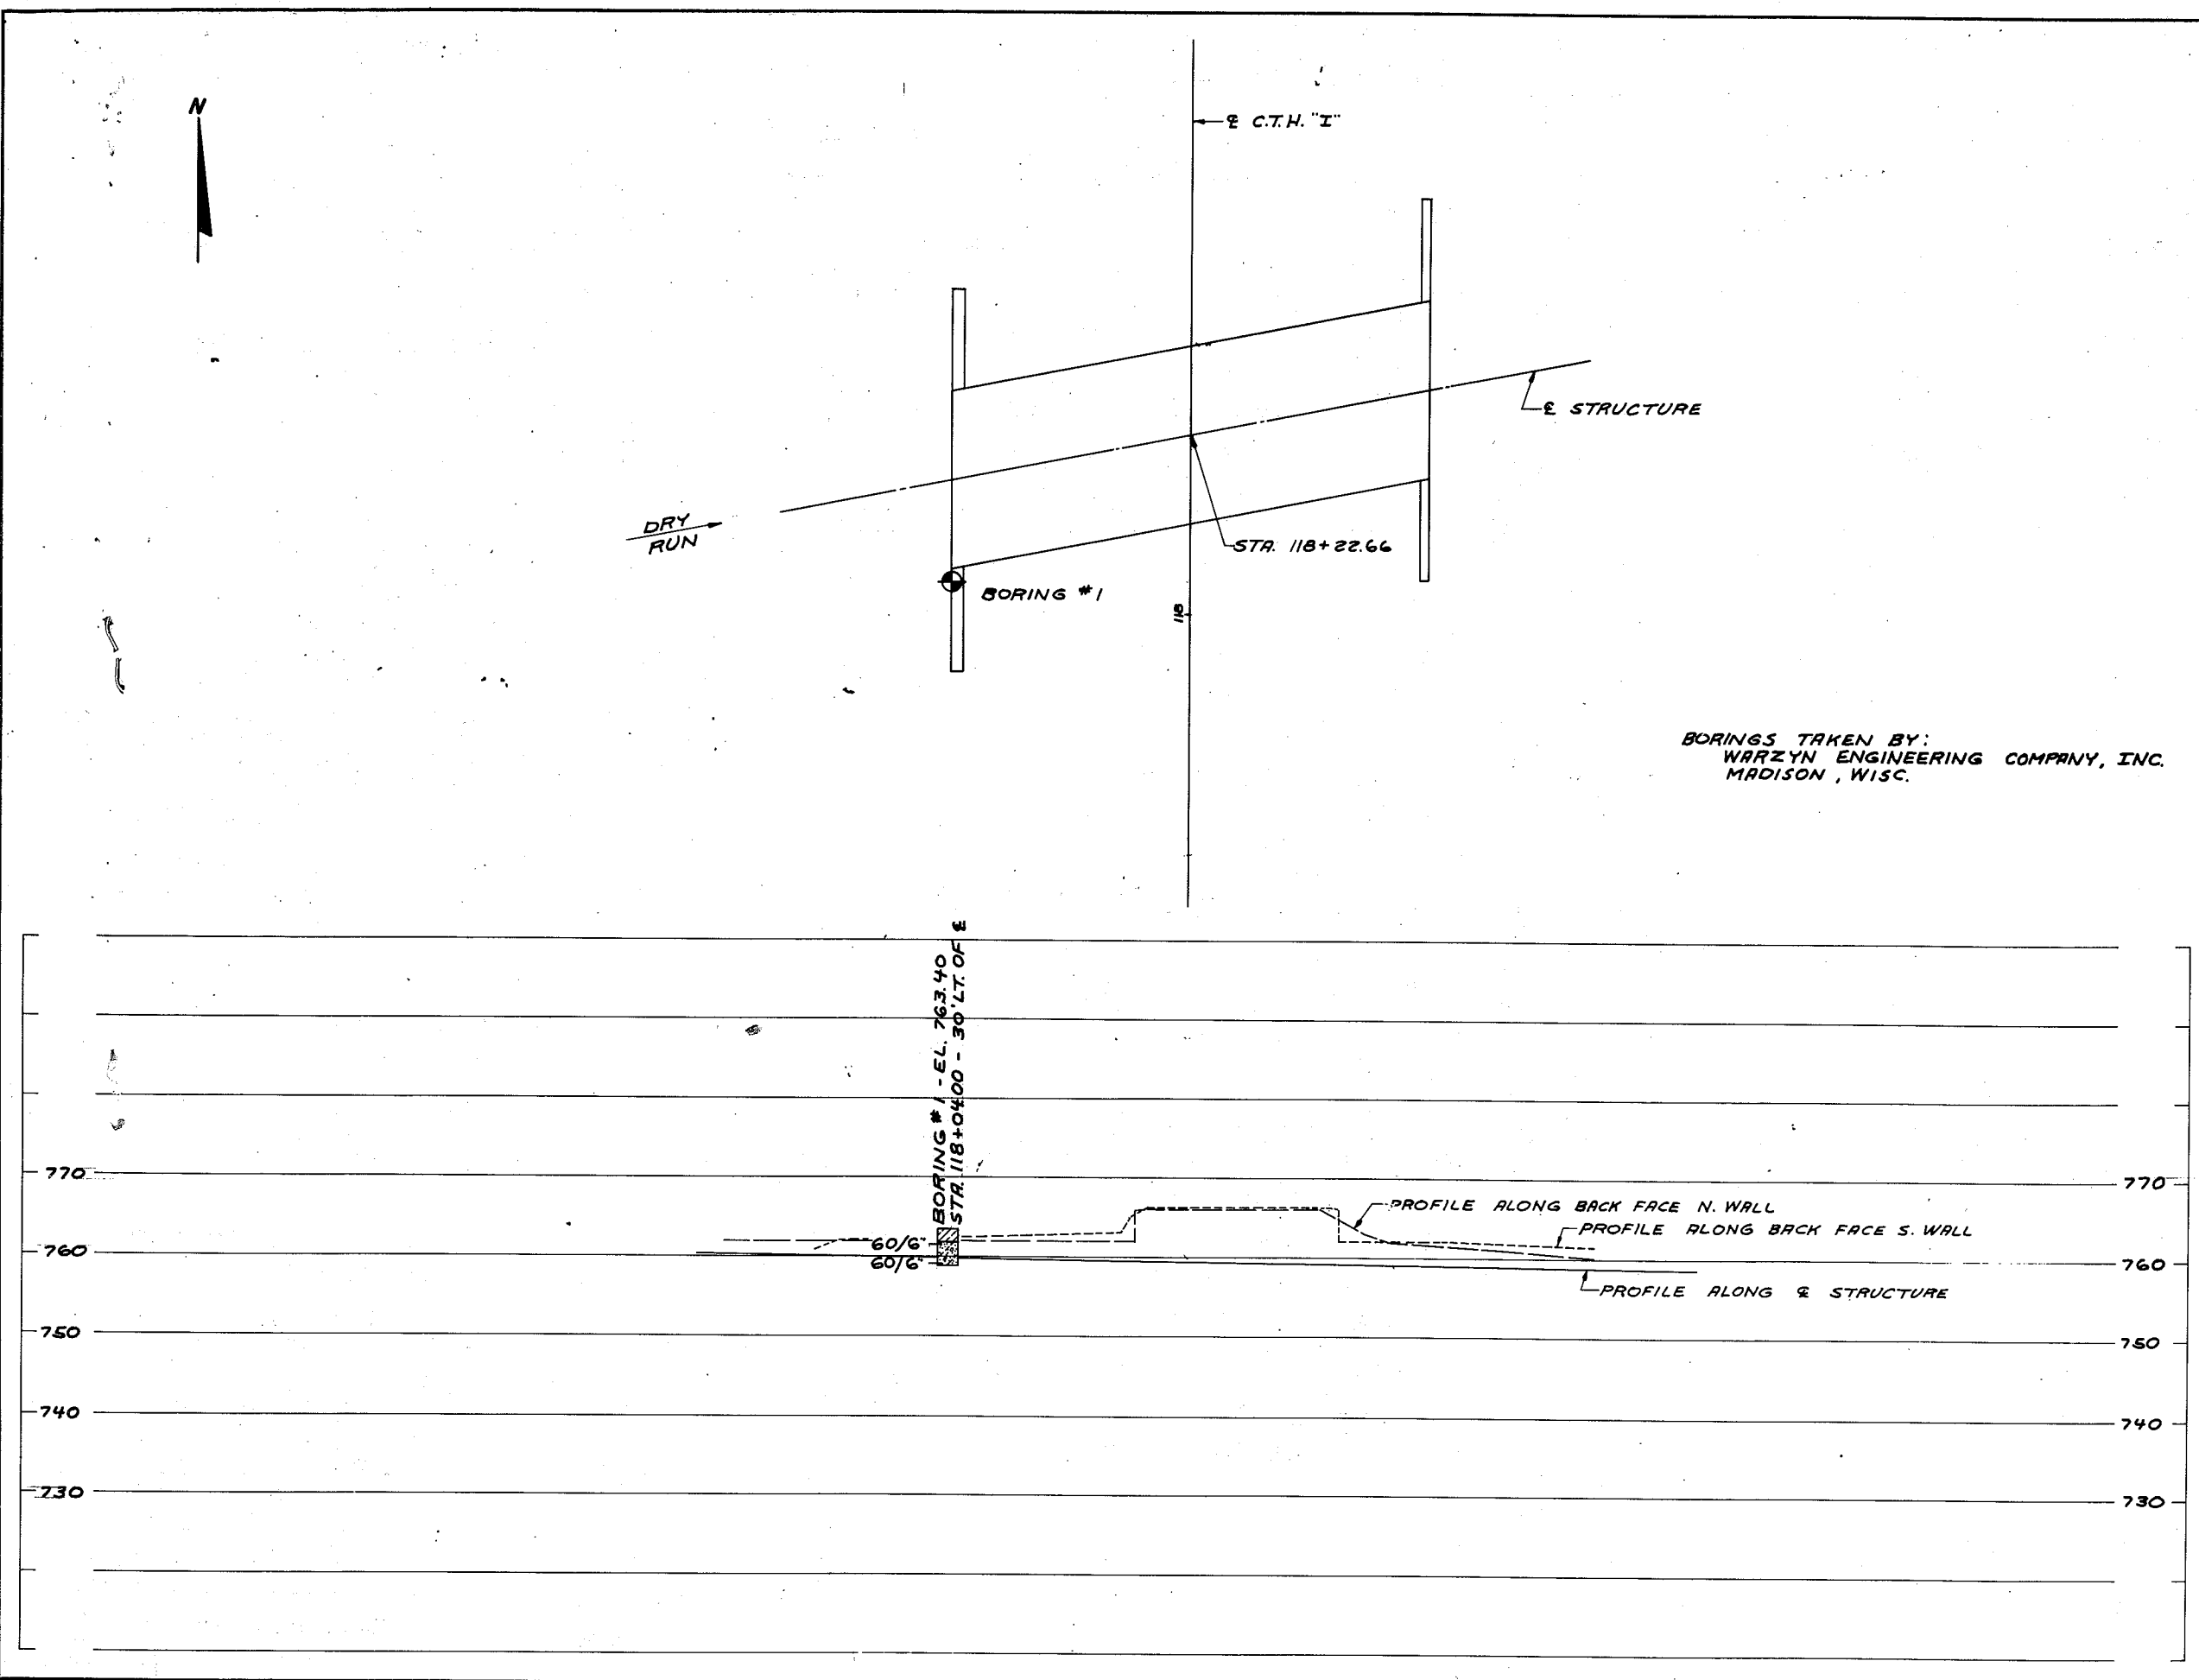

BORINGS TAKEN BY:
 WARZYN ENGINEERING COMPANY, INC.
 MADISON, WISC.

GENERAL NOTES

DRAWINGS SHALL NOT BE SCALED.
 BAR STEEL REINFORCEMENT SHALL BE EMBEDDED 2" CLEAR UNLESS SHOWN OR NOTED OTHERWISE.
 THE FIRST DIGIT OF A THREE DIGIT BAR NO. SIGNIFIES THE BAR SIZE.
 JOINT FILLER SHALL CONFORM TO A.A.S.H.T.O. DESIGNATION M153 OR M213.
 THE EXISTING GROUND LINE WAS USED AS THE UPPER LIMITS OF EXCAVATION.
 ALL SPACES EXCAVATED AND NOT OCCUPIED BY THE NEW STRUCTURE SHALL BE BACKFILLED WITH GRANULAR BACKFILL TO THE ELEVATION AND SECTION EXISTING PRIOR TO EXCAVATION WITHIN THE LENGTH OF THE BOX.

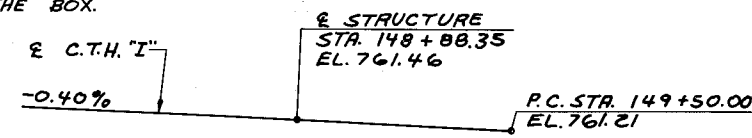


PROFILE GRADE LINE C.T.H. "I"

DESIGN DATA

LIVE LOAD: HS-20 (STRUCTURE IS DESIGNED FOR A FUTURE WEARING SURFACE OF 20"/SF.)
 ALLOWABLE DESIGN STRESSES:
 CONCRETE MASONRY TOP SLAB $f_c = 4,000$ p.s.i.
 HIGH STRENGTH BAR STEEL REINFORCEMENT (GRADE 60) ALL OTHER $f_c = 3,500$ p.s.i.
 $f_y = 60,000$ p.s.i.
 HYDRAULIC DATA:
 DRAINAGE AREA = 3.9 Sq. Mi.
 WATERWAY AREA = 120 Sq. Ft.
 $V = 9.4$ f.p.s.
 $Q_{100} = 750$ c.f.s.
 HIGH WATER EL. 758.40

TOTAL ESTIMATED QUANTITIES

BID ITEMS	
REMOVING OLD BRIDGE	1 L.S.
EXCAVATION FOR STRUCTURES	1 L.S.
CONCRETE MASONRY	197 C.Y.
HIGH-STRENGTH BAR STEEL REINFORCEMENT	24,270 L.B.
STRUCTURAL CARBON STEEL	550 L.B.
TUBULAR RAILING TYPE "H"	1' L.S.
NON-BID ITEMS	
FILLER	1/2 #3/4 SIZE
POLYVINYL CHLORIDE WATERSTOP	38 L.F.

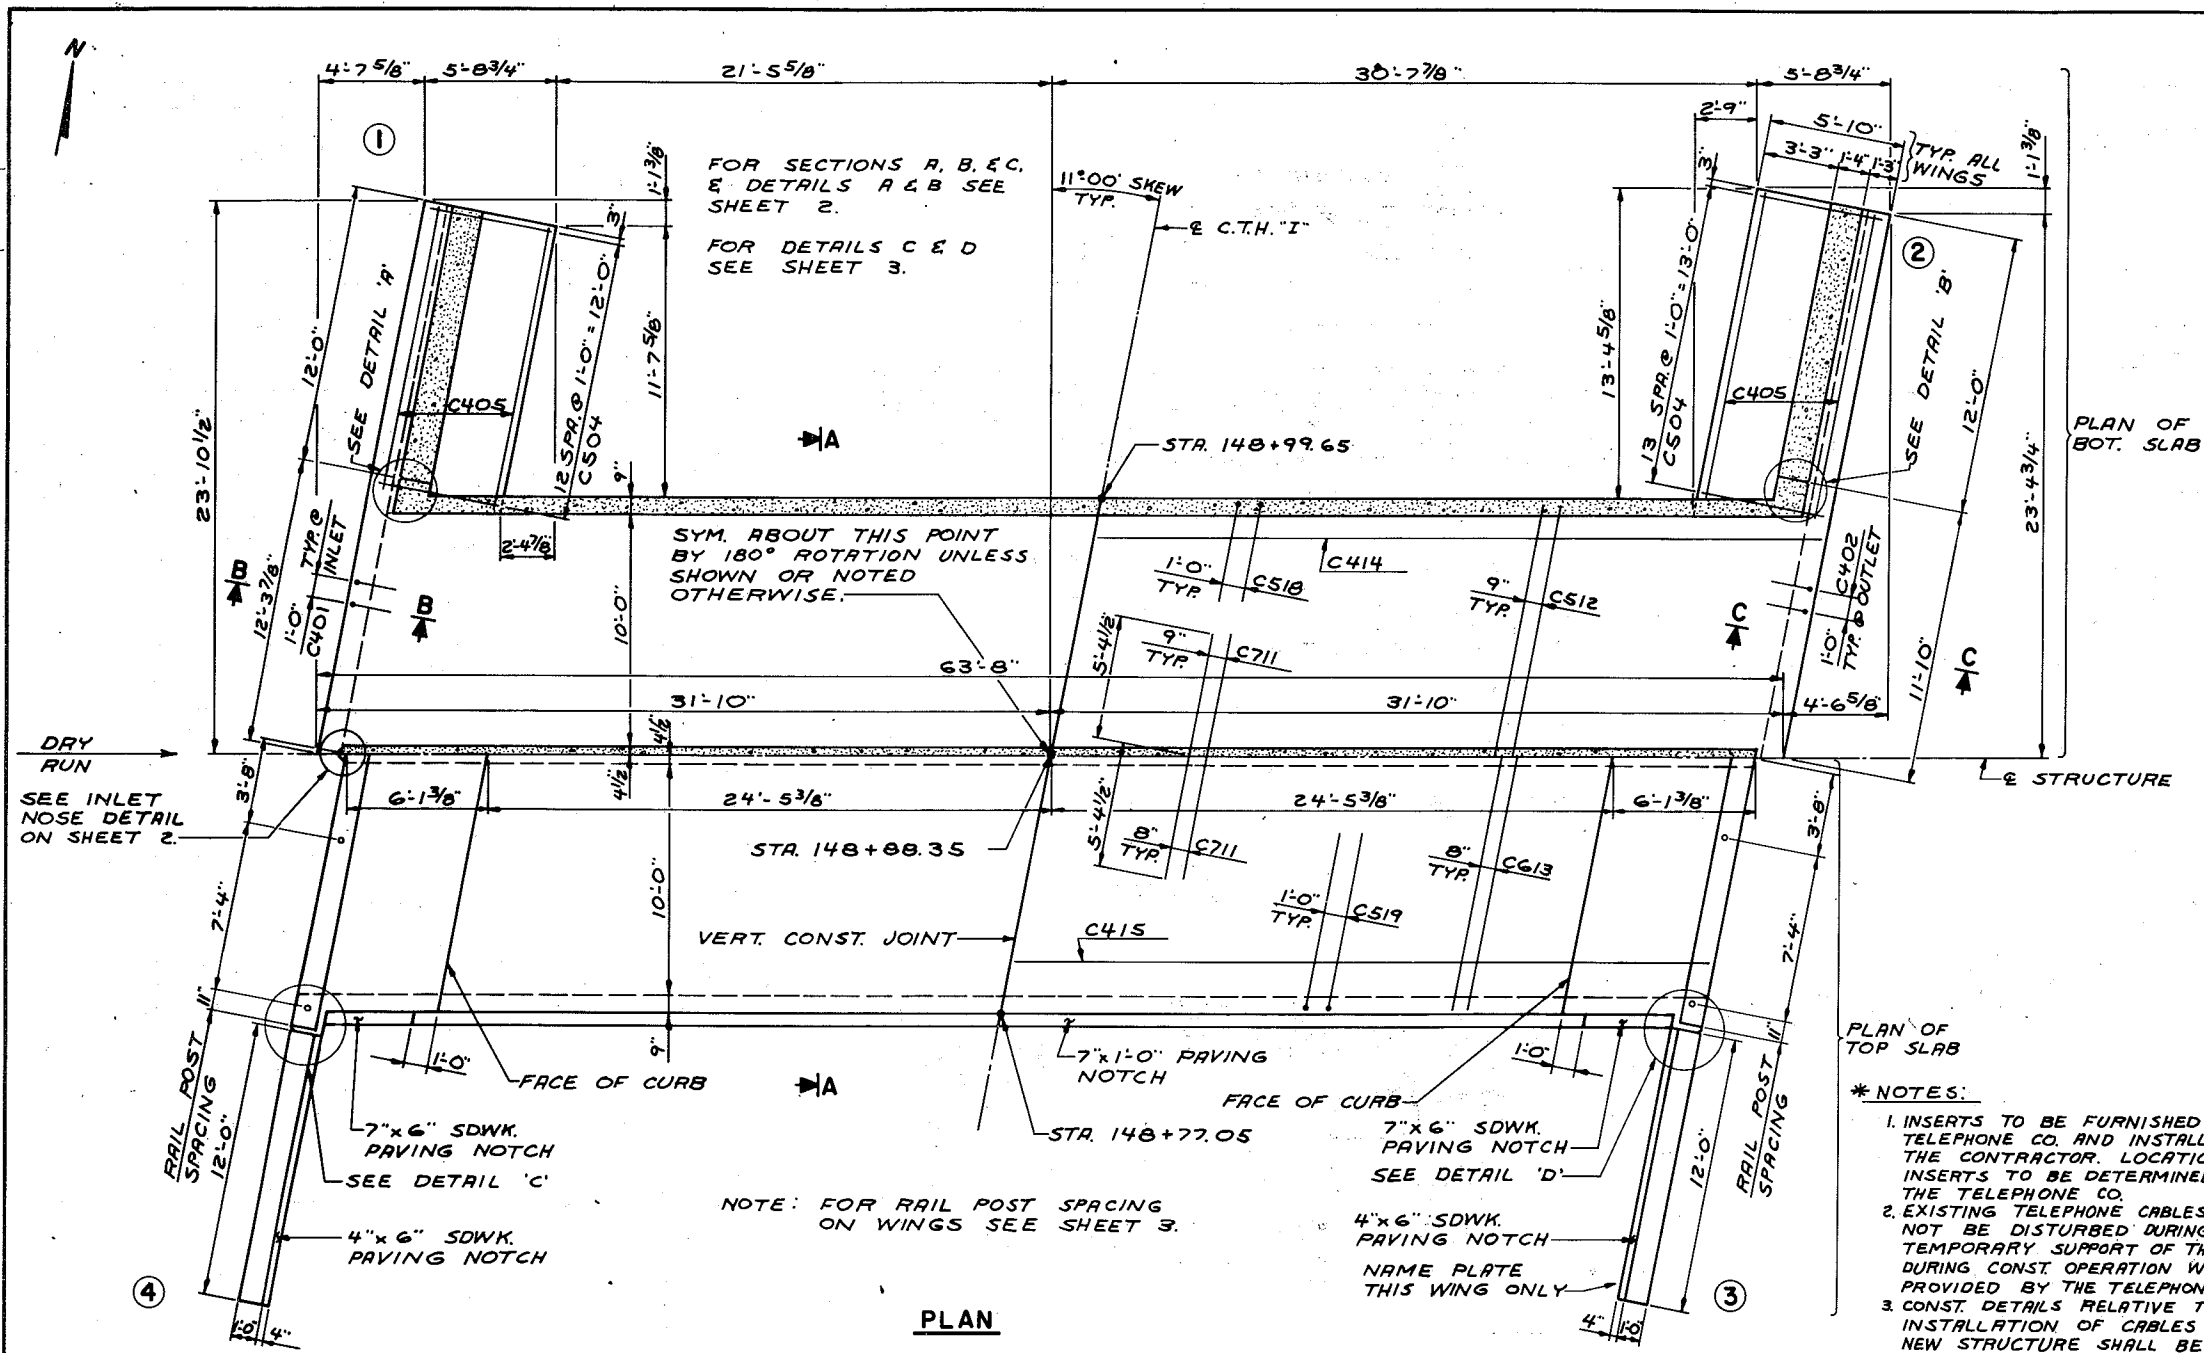


PLAN

TABLE OF ELEVATIONS AND DIMENSIONS


	SOUTH WALL	CENTER WALL	NORTH WALL
EL. "A"	761.95	761.91	761.86
EL. "B"	761.16	761.12	761.07
EL. "C"	761.50	761.46	761.41
EL. "D"	761.12	761.08	761.03
EL. "E"	761.91	761.86	761.82
DIM. "F"	8'-11 1/8"	8'-0 5/8"	8'-0"
DIM. "G"	8'-6 7/8"	8'-6 3/8"	8'-5 3/4"
DIM. "H"	8'-3 7/8"	8'-3 1/4"	8'-2 3/4"

LIST OF DRAWINGS

1. LAYOUT	X54263
2. DETAILS	X54264
3. VERTICAL FACE PARAPET "A"	X54265
4. TUBULAR RAILING TYPE "H"	X54266
5. SUBSURFACE EXPLORATION	X54267

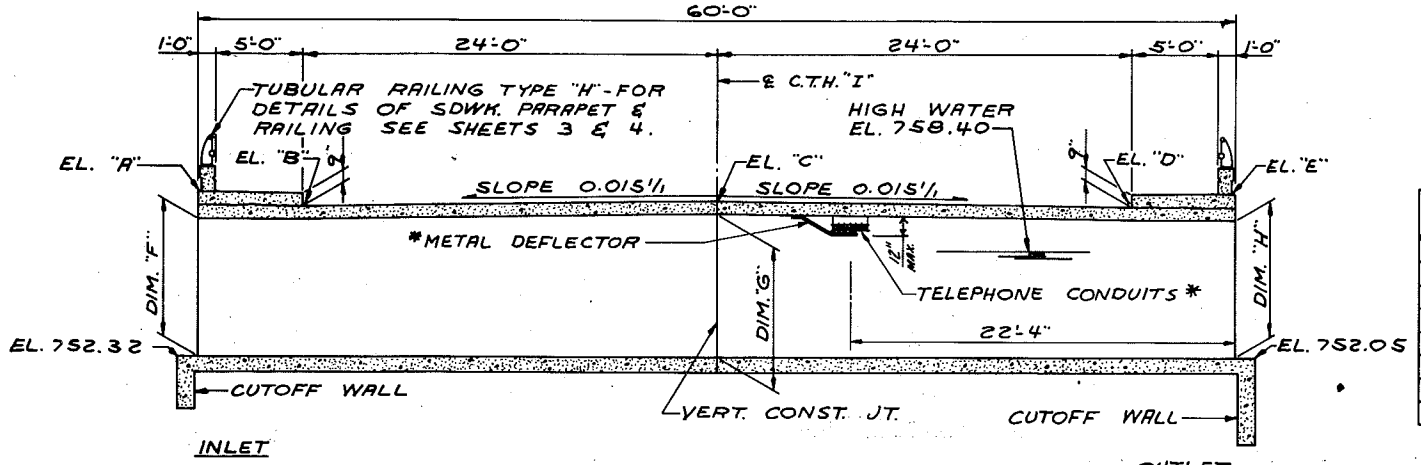

PART LONGITUDINAL SECTION
 (TAKEN PERPENDICULAR TO C.T.H. "I")

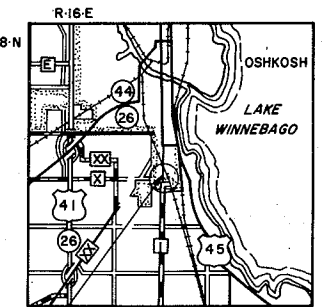

LAYOUT



NO.	DATE	REVISION	BY
PLANS PREPARED BY			
OWEN AYRES Associates			
STATE OF WISCONSIN DEPARTMENT OF TRANSPORTATION DIVISION OF HIGHWAYS			
STRUCTURE B-70-86			
C.T.H. "I" OVER DRY RUN			
County	WINNEBAGO	City	OSHKOSH
Design Spec.	A.A.S.H.T.O. '73	Load	HS-20
Design	N.K.I.J.	Checked	R.C.M.
Drawn	G.L.D.	Spec.	1975
Plane Checked	N.K.I.J.		
Approved	W.A. Kline	Date	12-11-75
Chief Bridge Engineer			
LAYOUT			SHEET 1 OF 5
			X 54263

PROJECT I.D.	SHEET NUMBER	TOTAL SHEETS
4994-0-17	76	
FEDERAL PROJECT DESIGNATION		

BILL OF BARS


BAR NO	NO. REQ'D	LENGTH	BENT	LOCATION
24,270#				
LOCATION				
C401	48	4-0	X	CUTOFF WALL - INLET
C402	48	6-0	X	" " " " OUTLET
C403	16	24-8		" " " " INLET & OUTLET
C504	54	5-3		WINGS - FOOTING
C405	8	12-4		" " " " DOWELS FF
C406	40	3-4		" " " " " B.F.
C607	48	6-4	X	" " " " -WALL -VERT. FF.
C408	40	9-4		" " " " " B.F.
C609	48	8-10		" " " " -HORIZ. FF & B.F.
C410	48	11-8		" " " " " " " "
C711	170	10-9		BOX - BOT. & TOP SLAB - TRANS.
C512	84	22-3		" " " " SLAB - TRANS.
C613	90	22-3		" " " " TOP " "
C414	50	31-6		" " " " BOT. " " -LONG.
C415	156	30-2		" " " " TOP " " & WALLS - LONG.
C416	124	3-1		" " " " DOWELS
C517	164	3-7		" " " " " " " "
C518	120	10-3	X	" " " " CORNERS BOT.
C519	120	13-8	X	" " " " TOP " " "
C420	120	8-1		" " " " EXT. WALLS - VERT.
C521	164	9-1	X	" " " " INT. " " "
C522	71	4-0		" " " " VERT. CONST. JOINT
C423	116	3-1	X	" " " " PAVING BLOCK
C424	8	28-10		" " " " " " " "
C525	52	8-7	X	" " " " SIDEWALK
C526	24	23-6		" " " " " " " "
C527	46	4-6	X	" " " " PARRAPET ON BOX
C528	64	5-0	X	" " " " " " " "
C529	16	11-8		" " " " " " " "
C430	28	4-4	X	" " " " WINGS - CORNERS

F.F. DENOTES FRONT FACE.
B.F. DENOTES BACK FACE
BENDING DIMENSIONS ARE OUT TO OUT OF BARS.

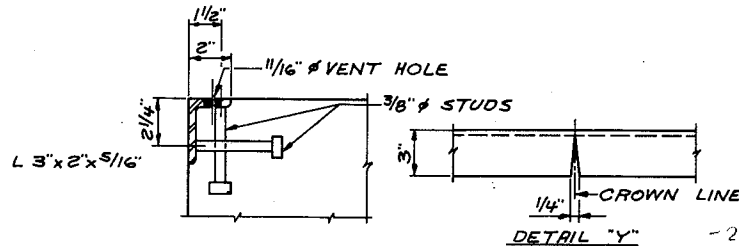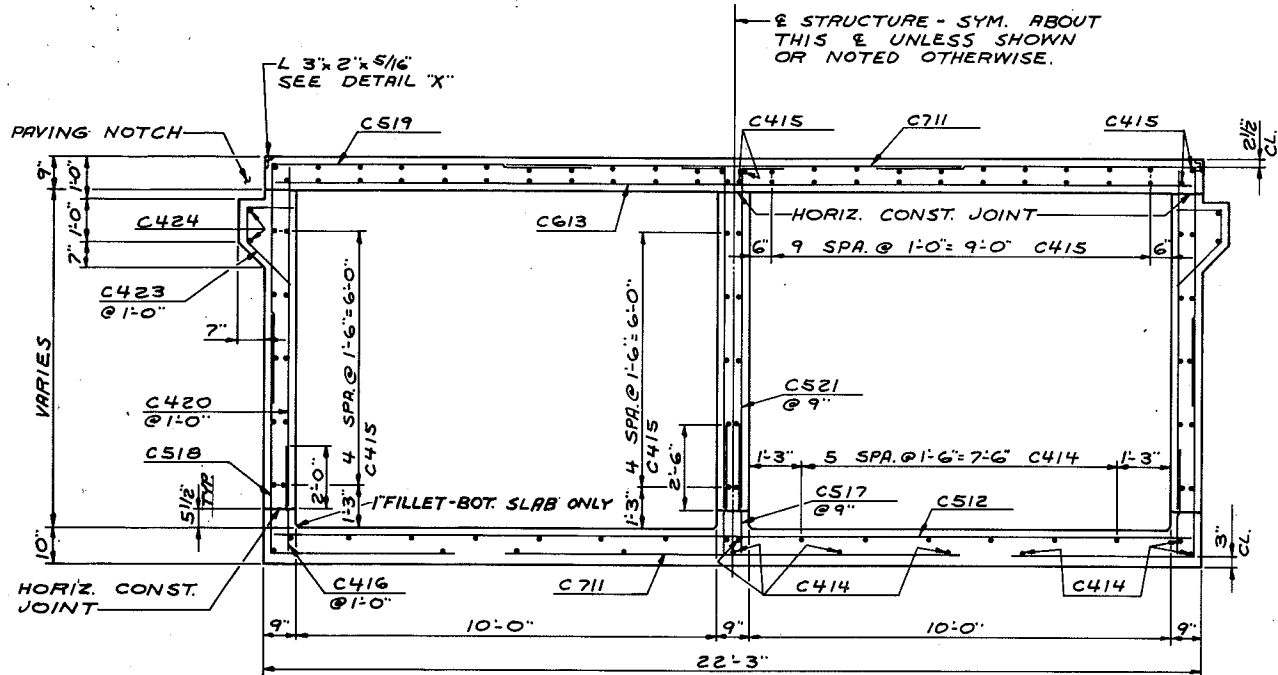


AT PAVING NOTCH, PROVIDE L 3"x2"x5/16"x49'-0" LG. PROVIDE 1/16" VENT HOLES IN 2" LEG AT 3'-0" CENTERS. ATTACH ANGLE TO CONCRETE WITH 3/8" STUDS x 4" LG. AT 6" ALTERNATE CENTERS. FIELD CUT 3" LEG OF ANGLE AS REQ'D. SEE DETAIL "Y". ANGLE AND STUDS TO BE PAID FOR AT THE UNIT PRICE BID FOR "STRUCTURAL CARBON STEEL".

DETAIL "X"

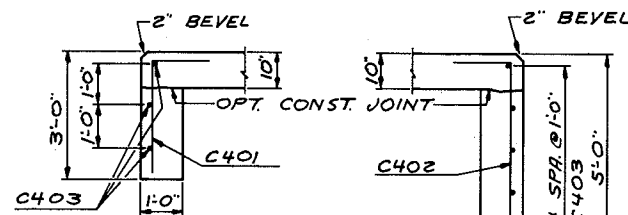


SECTION B (INLET)

SECTION C (OUTLET)

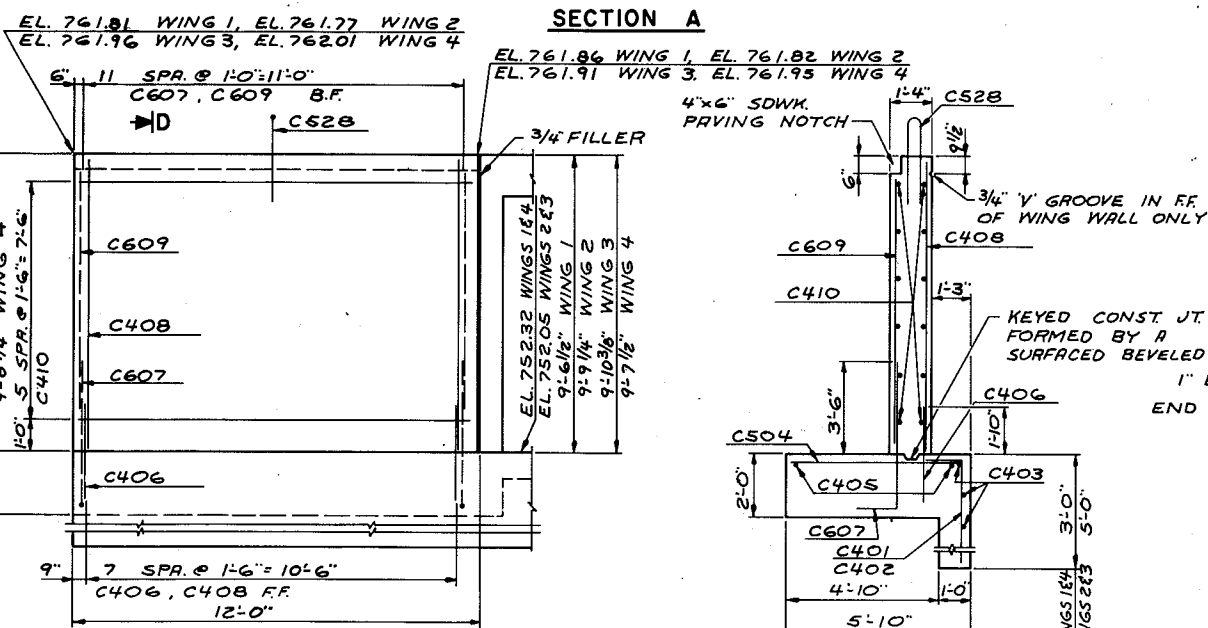


SECTION A

TYP. WING ELEVATION

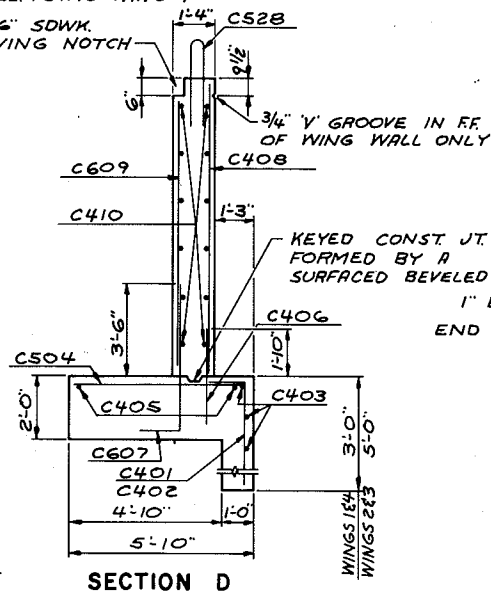


SECTION D

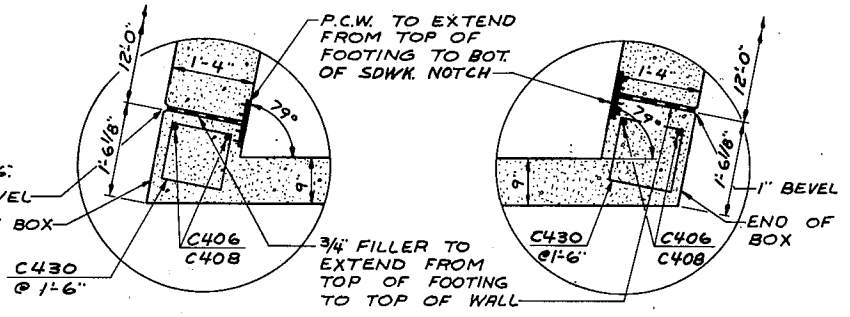


DETAIL "A"


DETAIL "B"

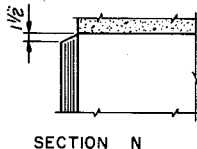


SECTION N

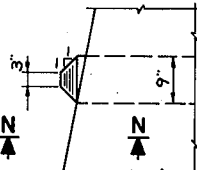


INLET NOSE DETAIL

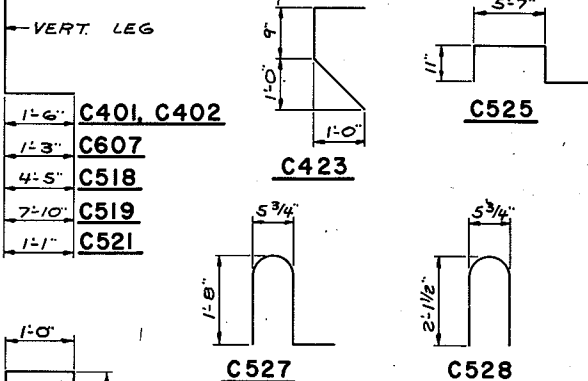

C430

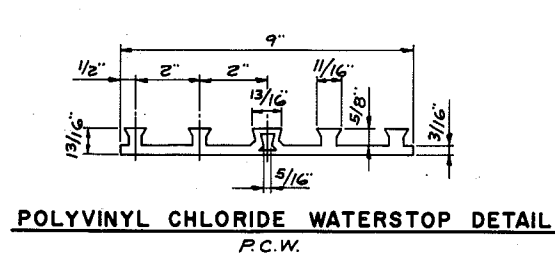

POLYVINYL CHLORIDE WATERSTOP DETAIL

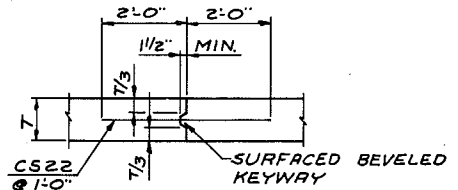

VERT. CONST. JOINT (ALL WALLS & SLABS)

NO.	DATE	REVISION	BY

PLANS PREPARED BY
OWEN AYRES Associates


STATE OF WISCONSIN
DEPARTMENT OF TRANSPORTATION
DIVISION OF HIGHWAYS

STRUCTURE B-70-86

Const. Spec. 1975 Drawn By G.L.D. Plans Checked N.K.I.J.


DETAILS SHEET 2 OF 5
X 54264

Revision

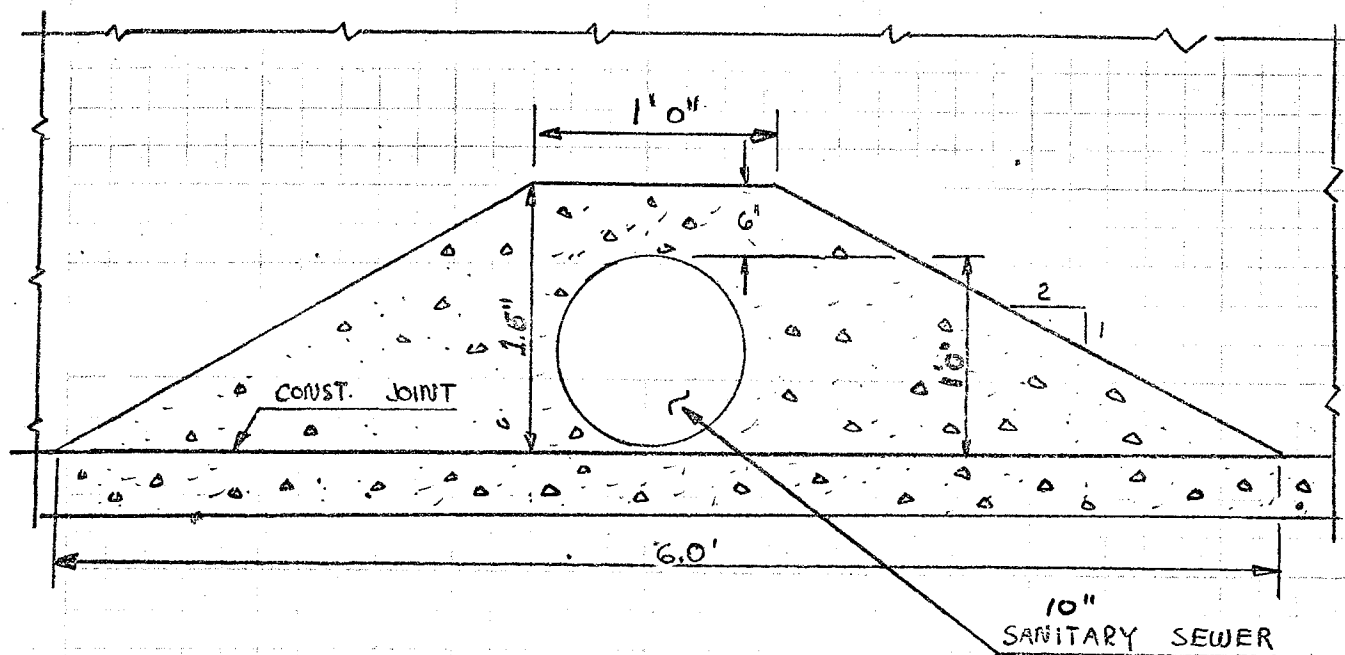

TYPICAL SECTION

SANITARY SEWER AT FLOOR OF B-70-86

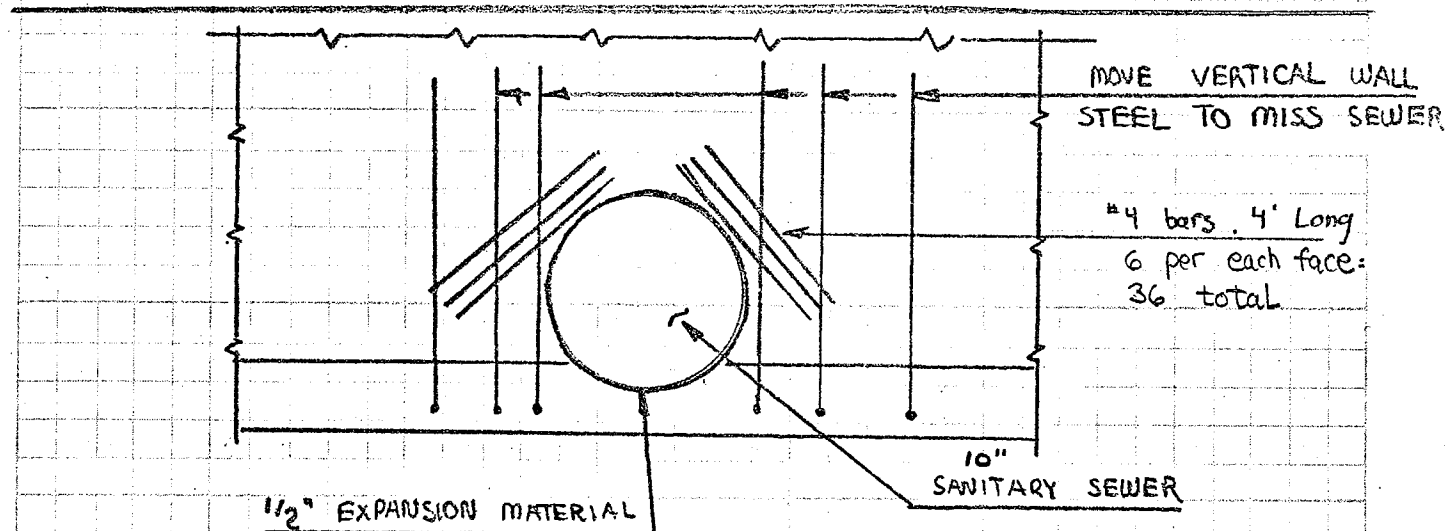



TYPICAL SECTION

SANITARY SEWER AT WALLS B-70-86

CONC. MASONRY: + 3.5 C.Y.

PROJECT/STRUCTURE NO. 4994-0-17	CTH. I	C.C.O. #4	COMPUTATIONS BY J.H.	DATE 9-10-76
TYPE OF ROAD B-70-86	WINN		CHECKED BY A.M.	DATE 9/76
TITLE/ITEM				SHEET

6

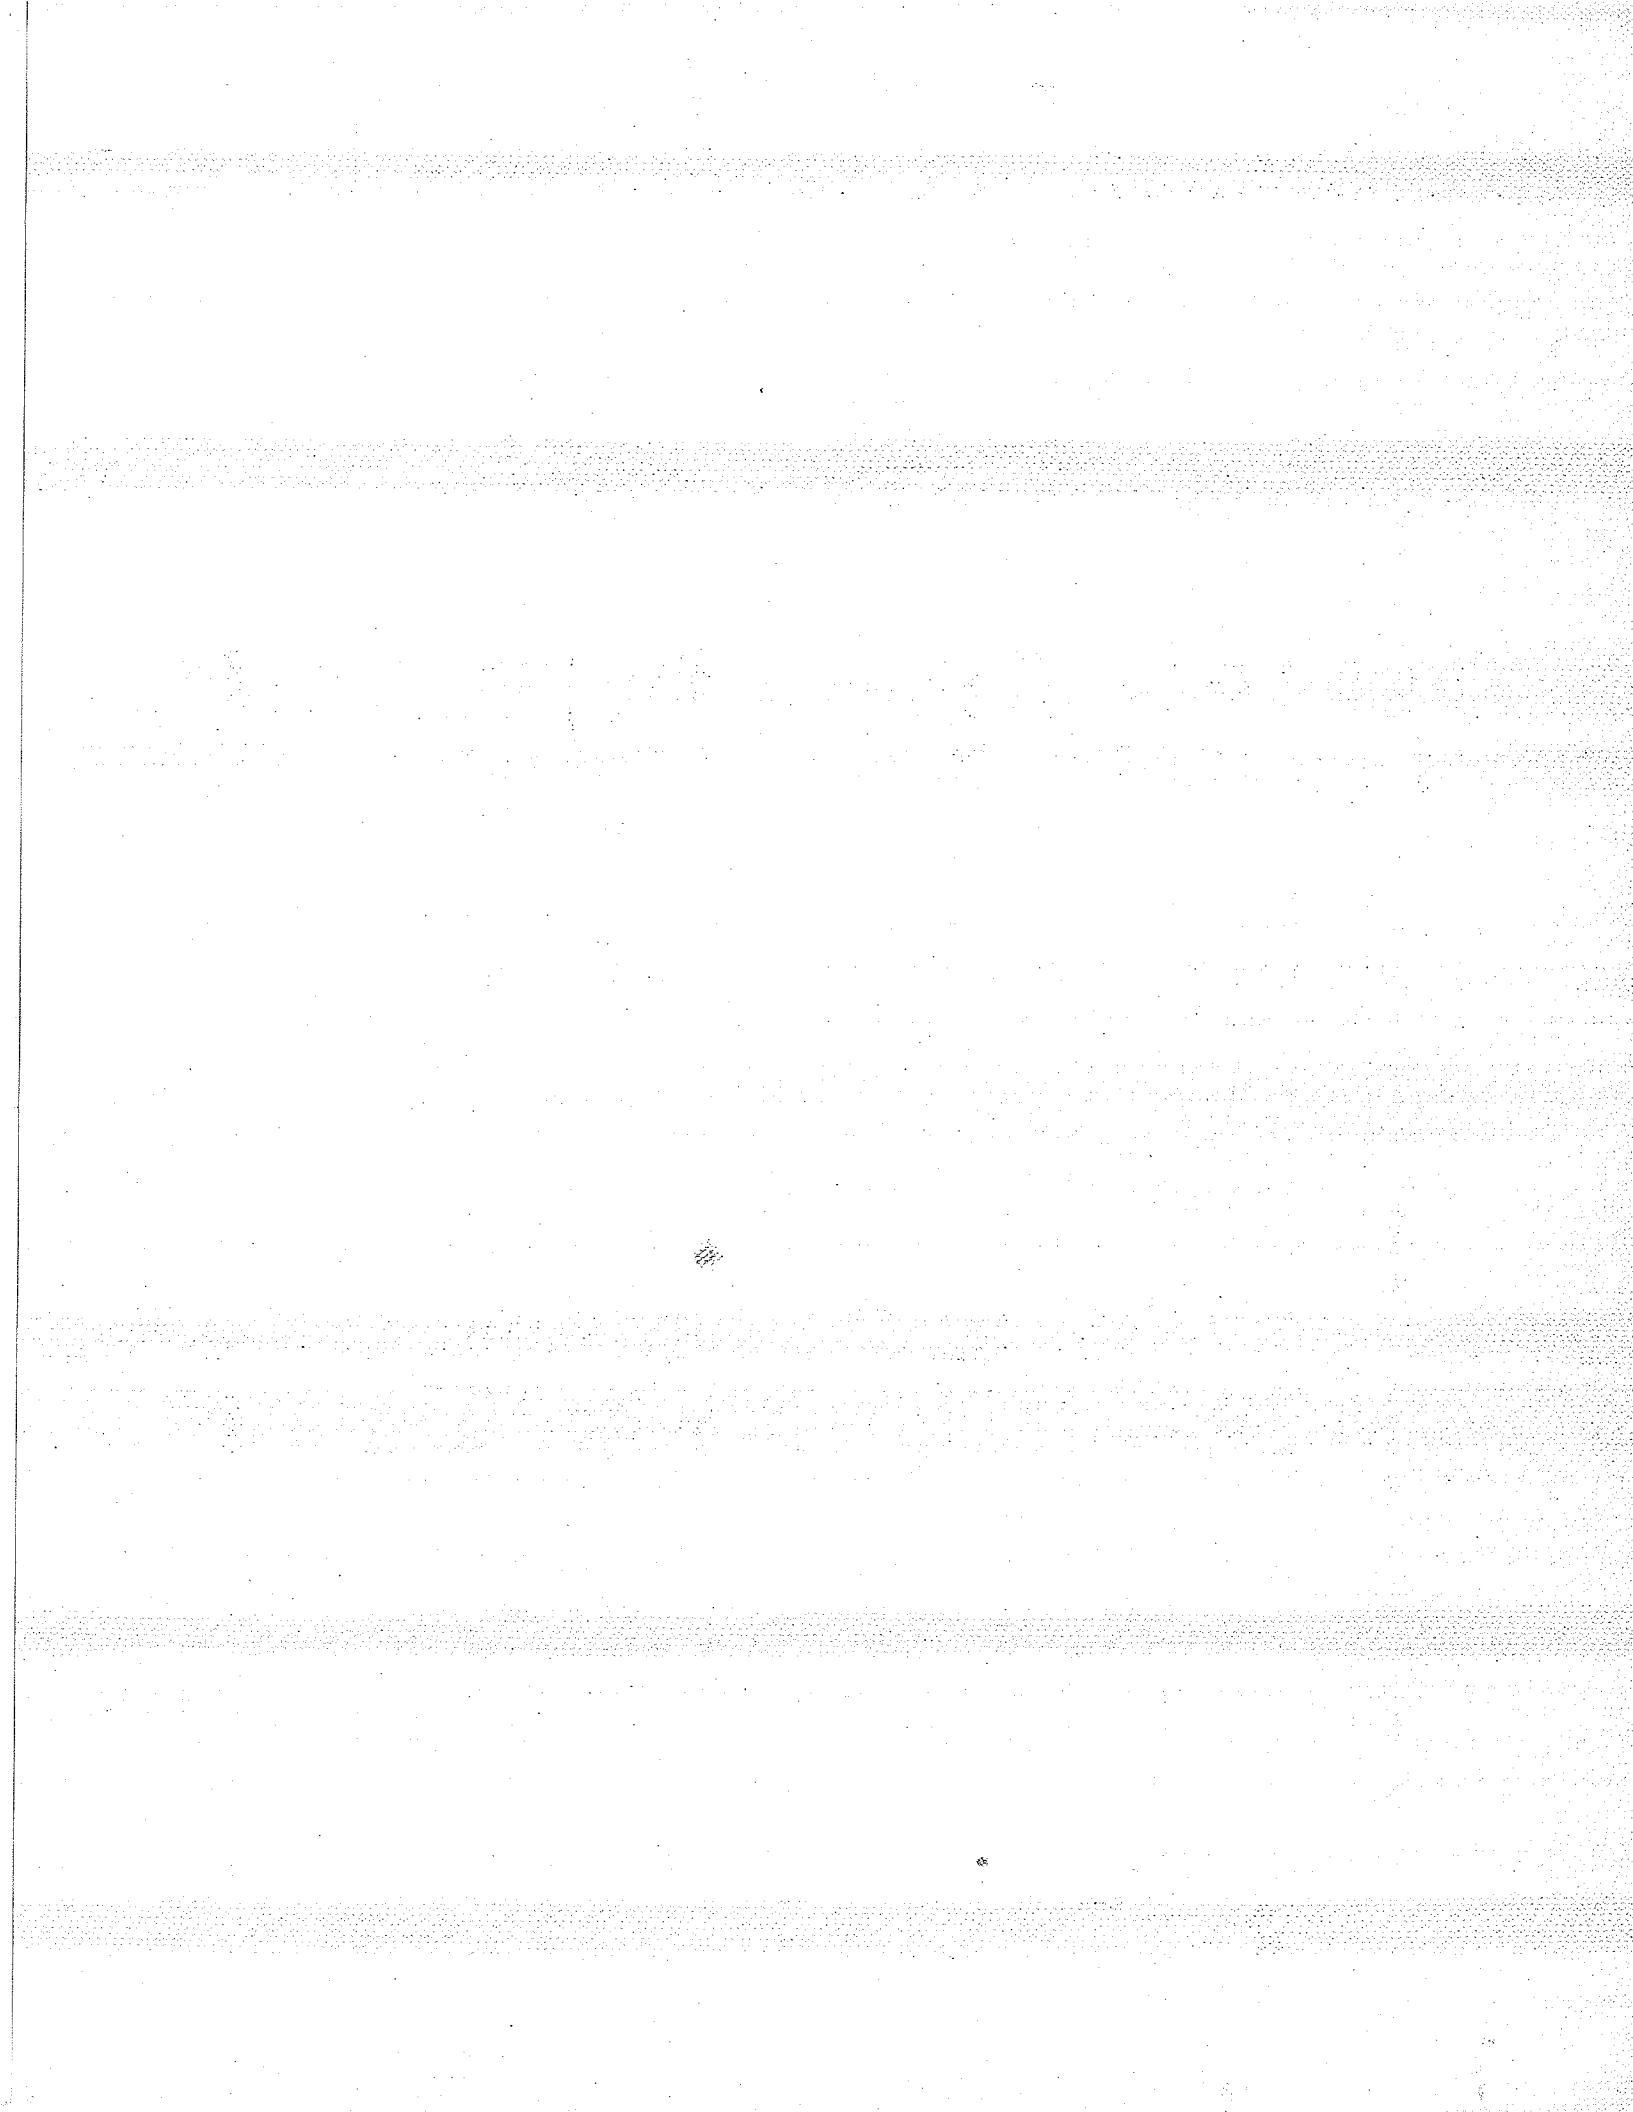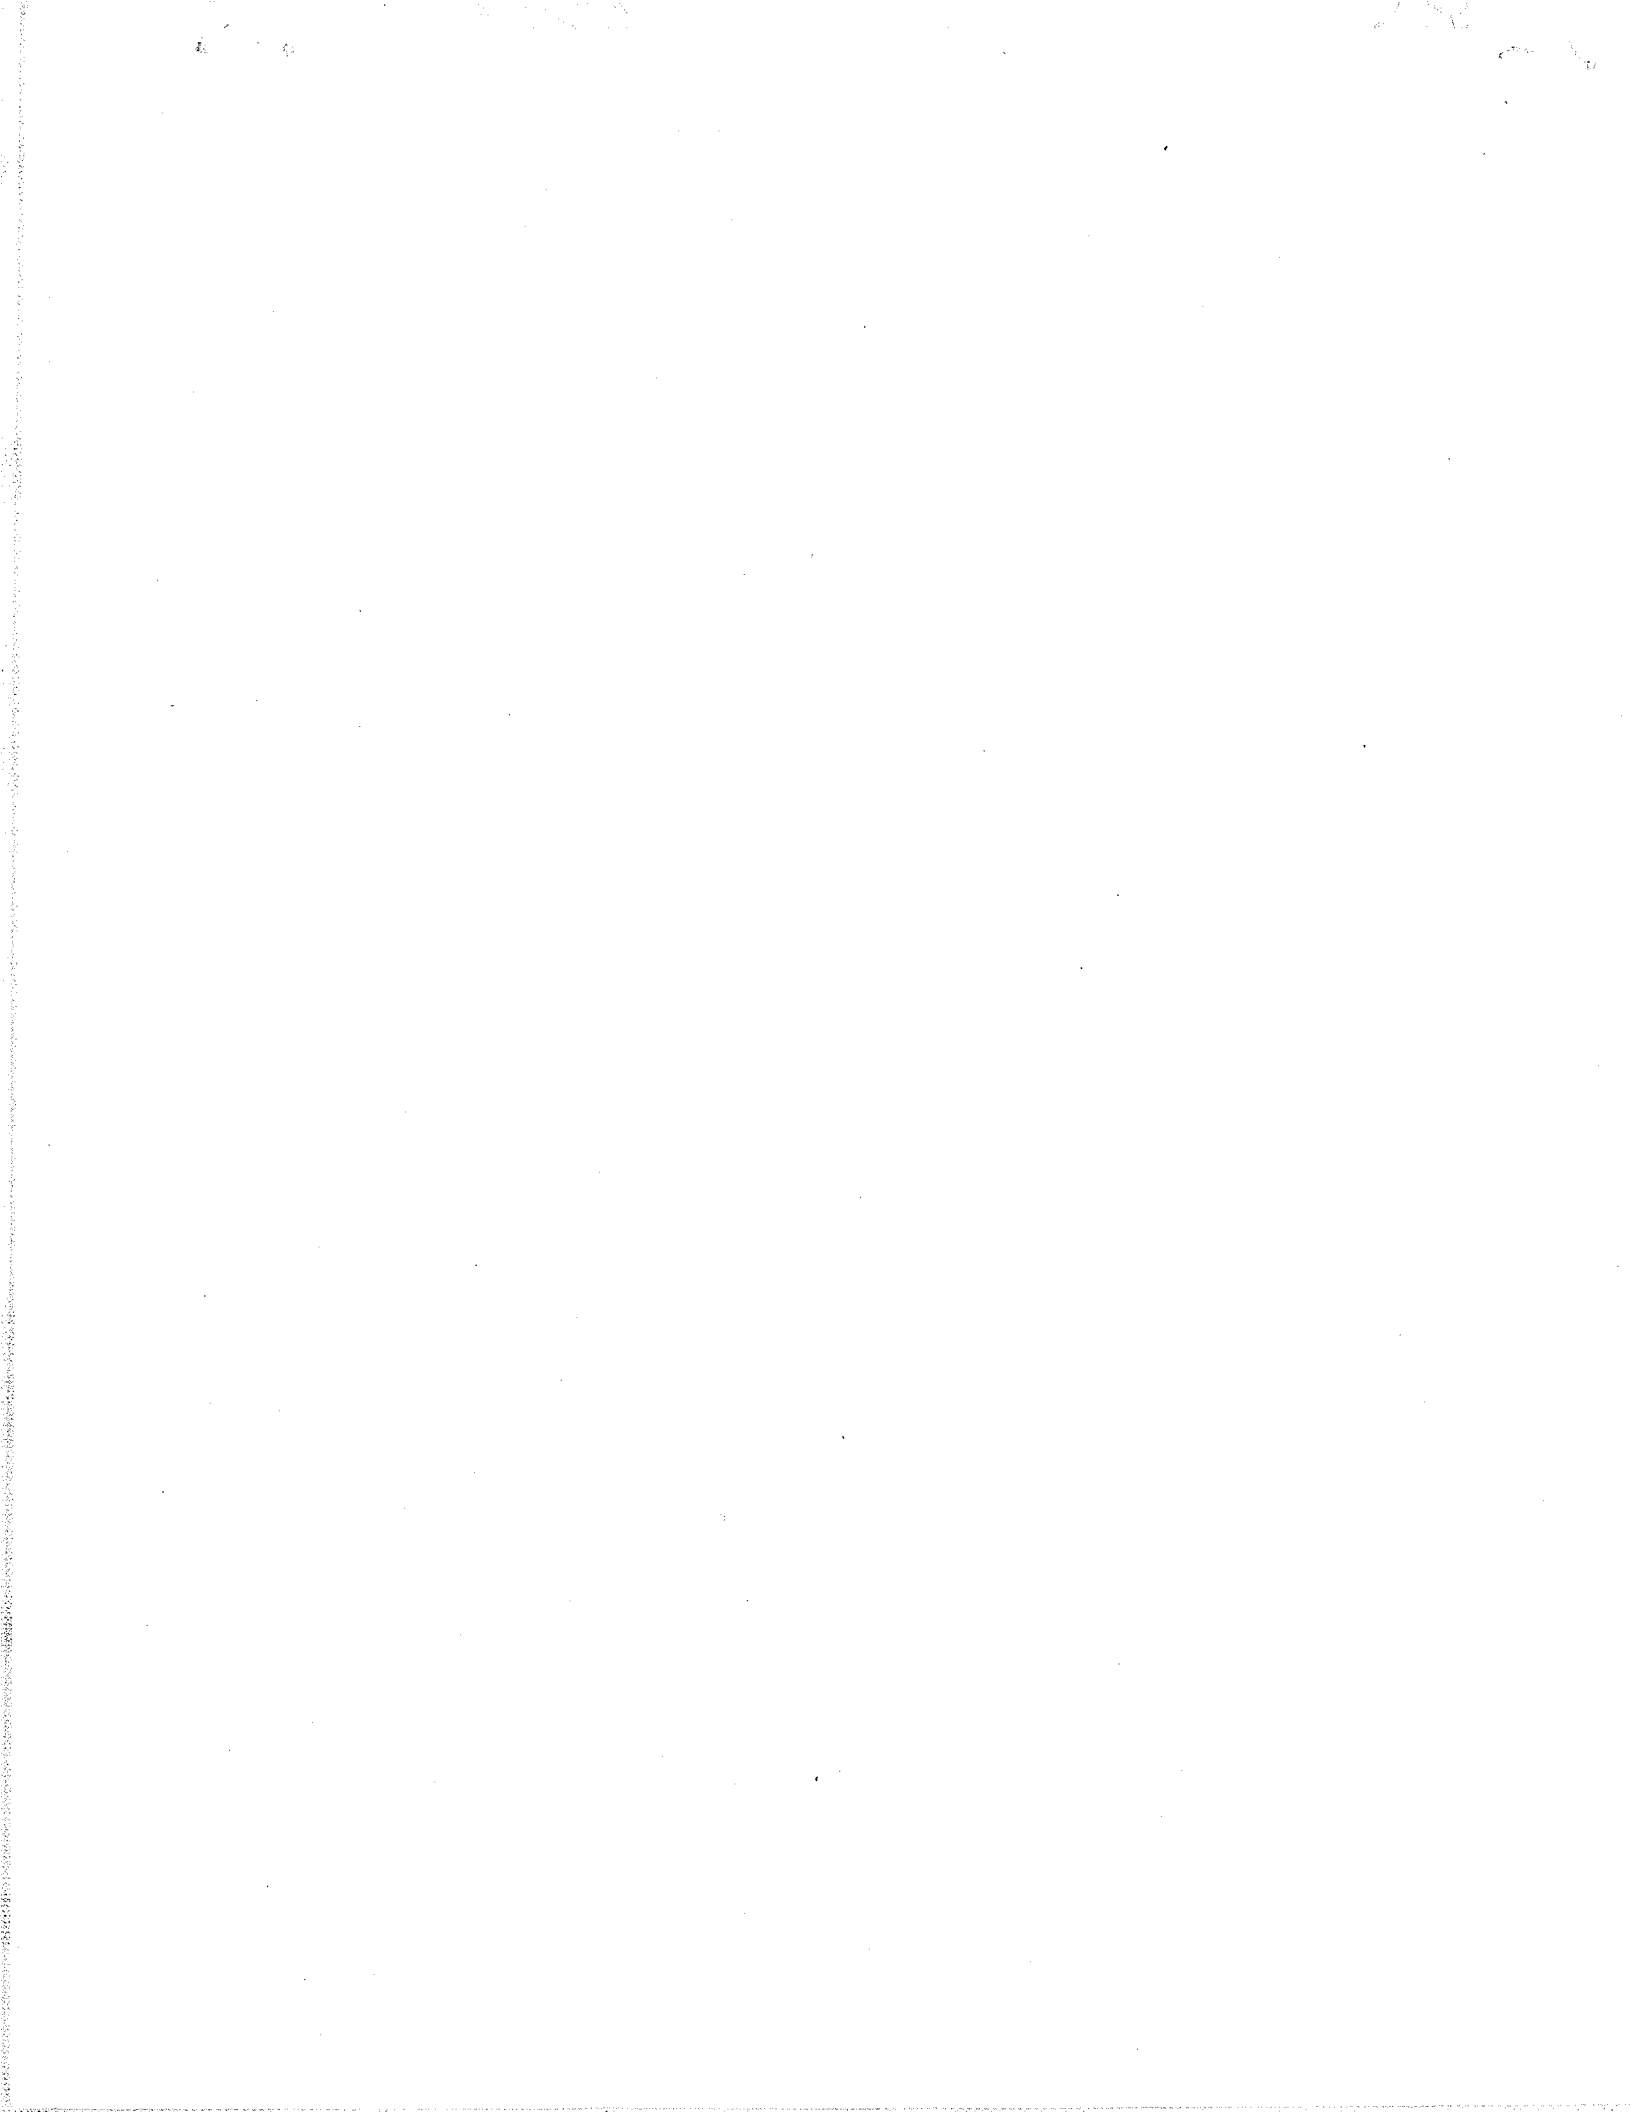


STRUCTURE B-70-85

Revisions to West Footings and cutoff wall

AS BUILT REVISIONS

PROJECT ID 4994-0-17	SHEET NUMBER 7.7	TOTAL SHEETS
FEDERAL PROJECT DESIGNATION		

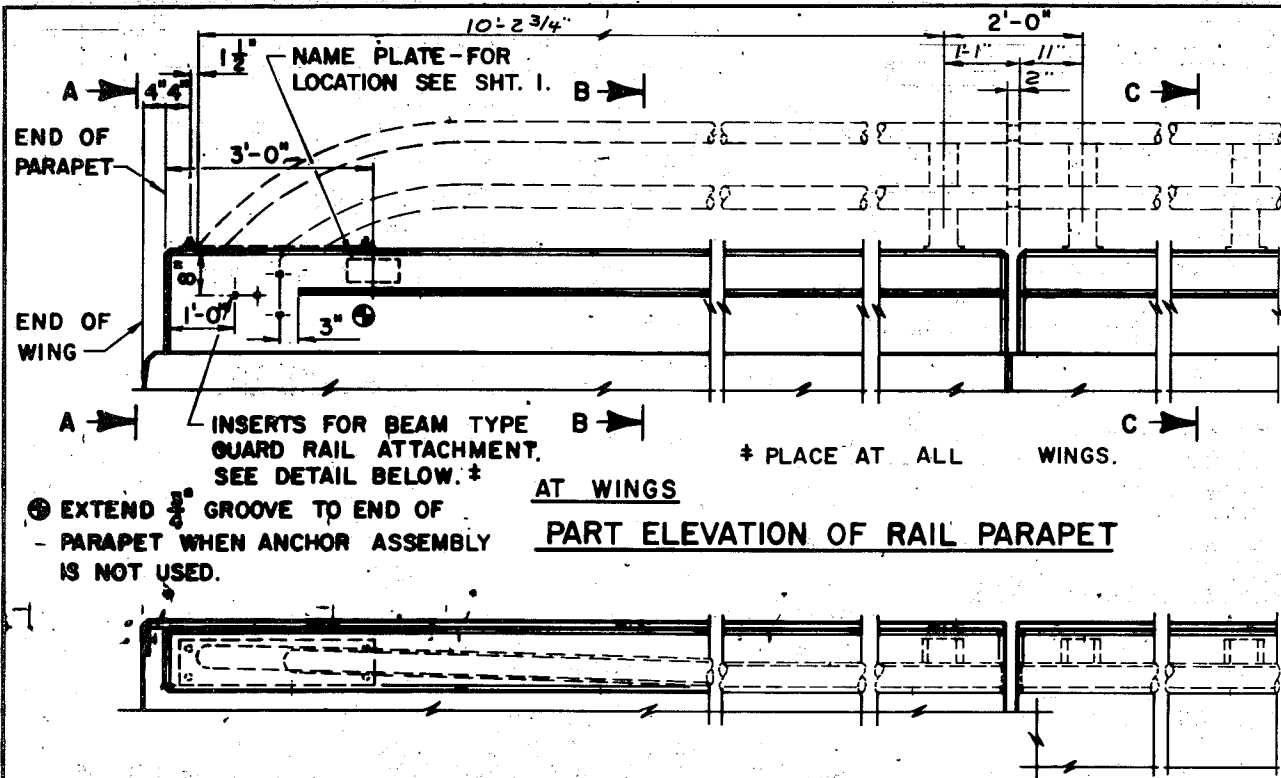

NAME PLATE - FOR LOCATION SEE SHT. 1.


END OF PARAPET

END OF WING

INSERTS FOR BEAM TYPE GUARD RAIL ATTACHMENT. SEE DETAIL BELOW. * PLACE AT ALL WINGS.


AT WINGS

EXTEND $\frac{3}{8}$ GROOVE TO END OF PARAPET WHEN ANCHOR ASSEMBLY IS NOT USED.

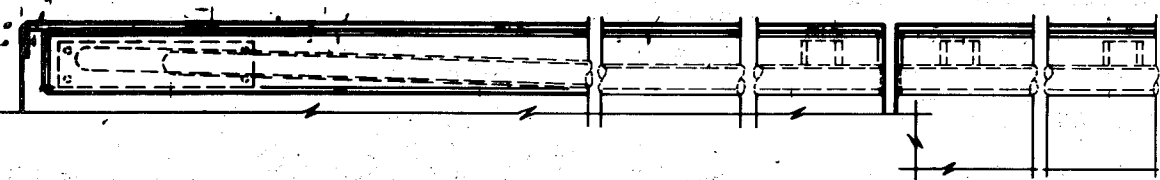


AT WINGS


PART PLAN OF RAIL PARAPET

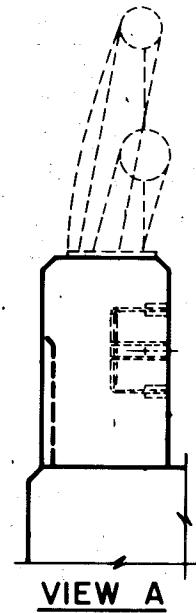

VIEW A

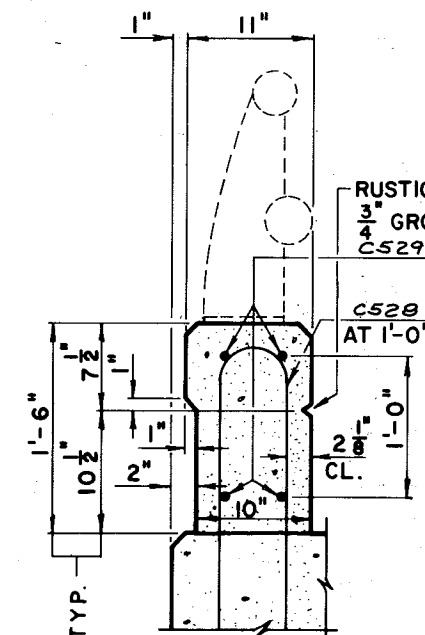


SECTION B

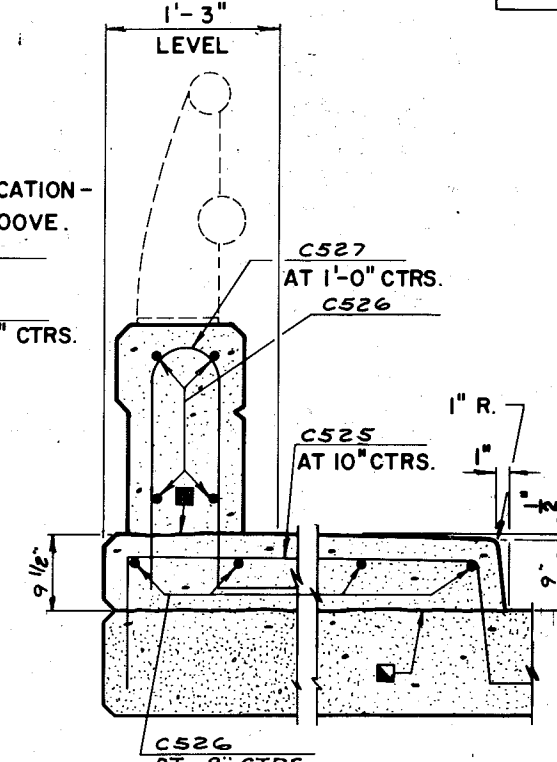

AT SIDEWALK


SECTION C

- CONST. JOINT - STRIKE OFF LEVEL & LEAVE ROUGH.
- OPTIONAL CONST. JOINT - STRIKE OFF LEVEL & LEAVE ROUGH.

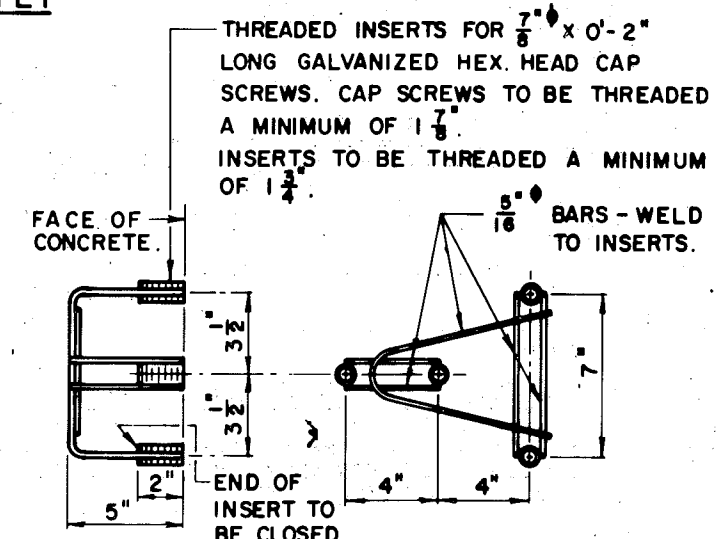

DETAIL OF ANCHOR ASSEMBLY FOR BEAM TYPE GUARD RAIL

ANCHOR ASSEMBLY SHALL BE PAID FOR AT THE UNIT PRICE BID FOR STRUCTURAL CARBON STEEL.

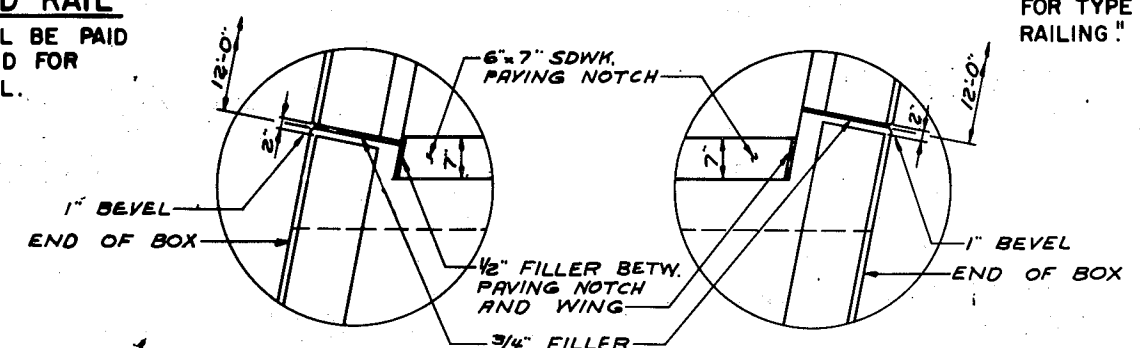


DETAIL "D"

DETAIL "C"

NOTES




WHEN PARAPETS AND CURBS ARE POURED CONTINUOUSLY FROM END TO END, THEY SHALL BE SEPARATED AT THE DEFLECTION JOINTS BY A PIECE OF $\frac{1}{8}$ ZINC OR ALUMINUM PLATE CUT AS SHOWN IN SECTION "D" BY SHADED AREA. IF CONSTRUCTION JOINTS IN PARAPETS AND CURBS ARE USED AT THE DEFLECTION JOINTS, ONE SIDE OF JOINT SHALL BE COATED WITH BITUMINOUS PAINT AND PLATE SEPARATORS MAY BE OMITTED.

WORK THIS SHEET WITH SHEET TITLED "DETAILS FOR TYPE 'H' TUBULAR ALUMINUM OR STEEL RAILING."

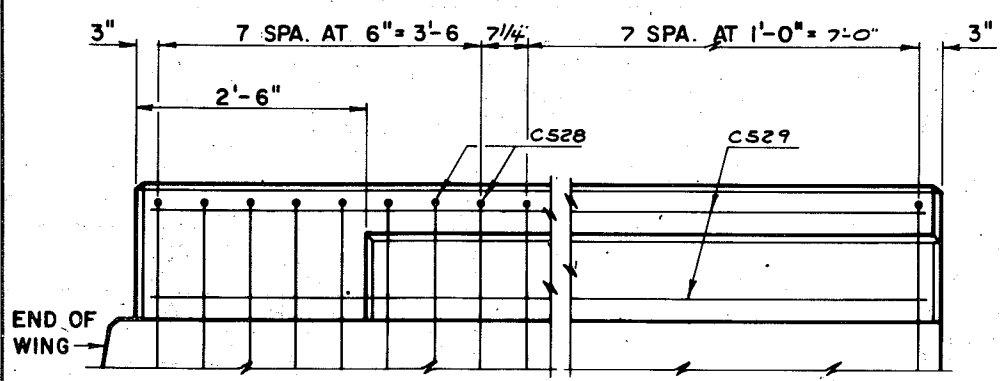

VIEW SHOWING OUTSIDE FACE OF PARAPET & REINF.

No.	Date	Revision	By
STATE OF WISCONSIN DEPARTMENT OF TRANSPORTATION DIVISION OF HIGHWAYS			
STRUCTURE B-70-86			
Const. Spec. 1975	Drawn By G.L.D.	Plans Checked N.K.I.J.	
VERTICAL FACE PARAPET "A"			SHEET 3 OF 5 X 54265

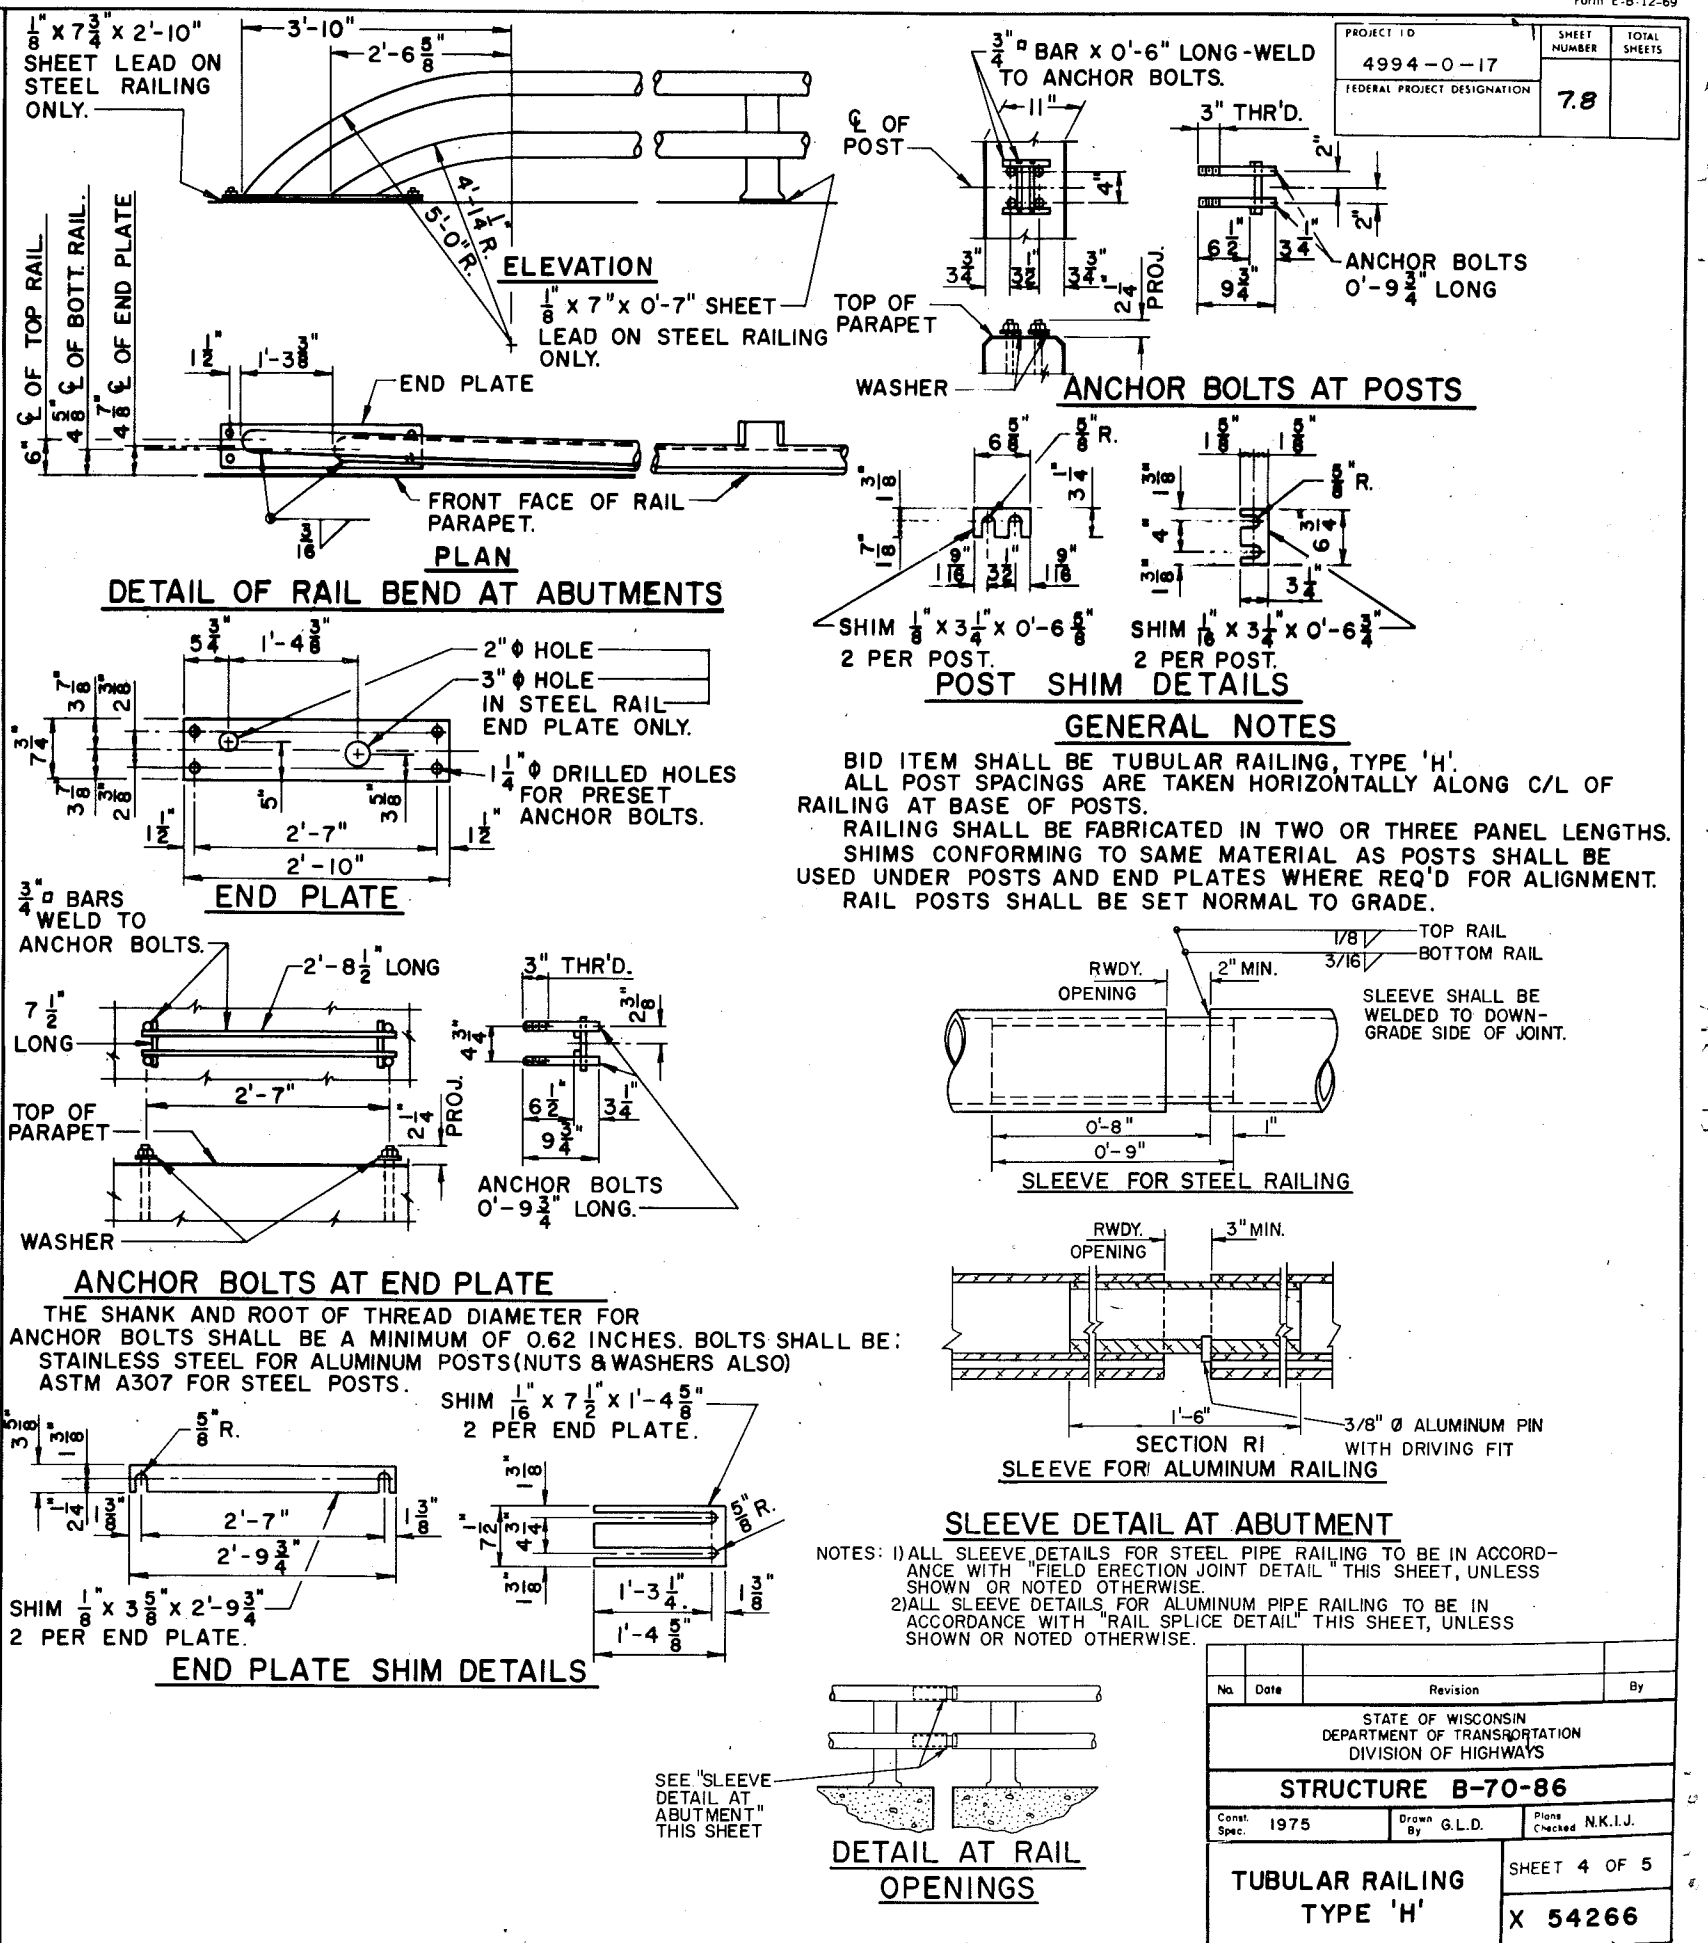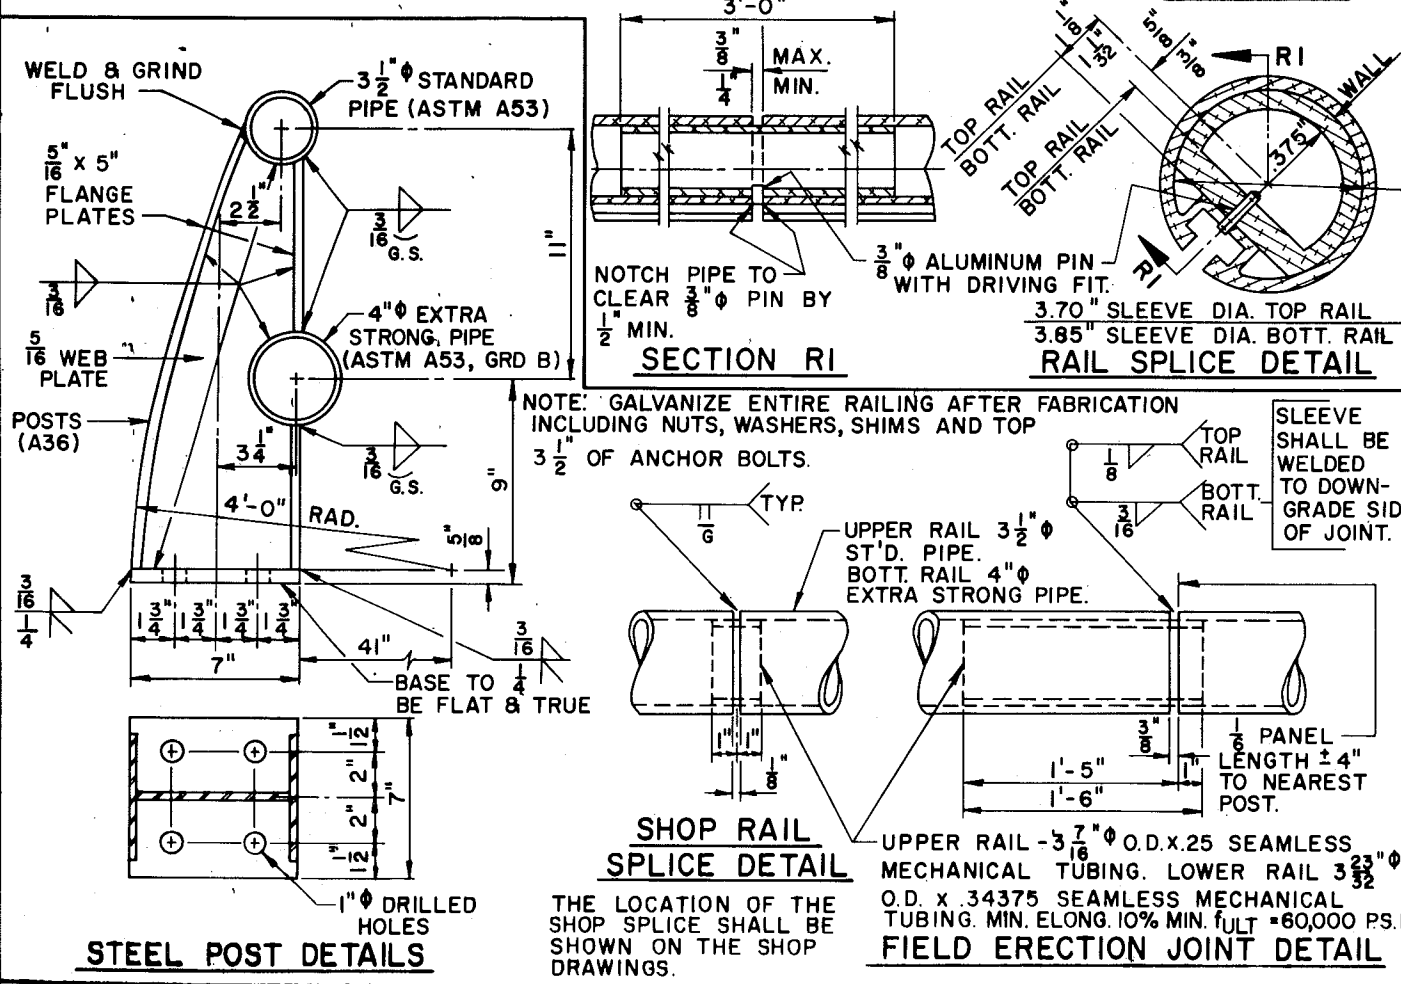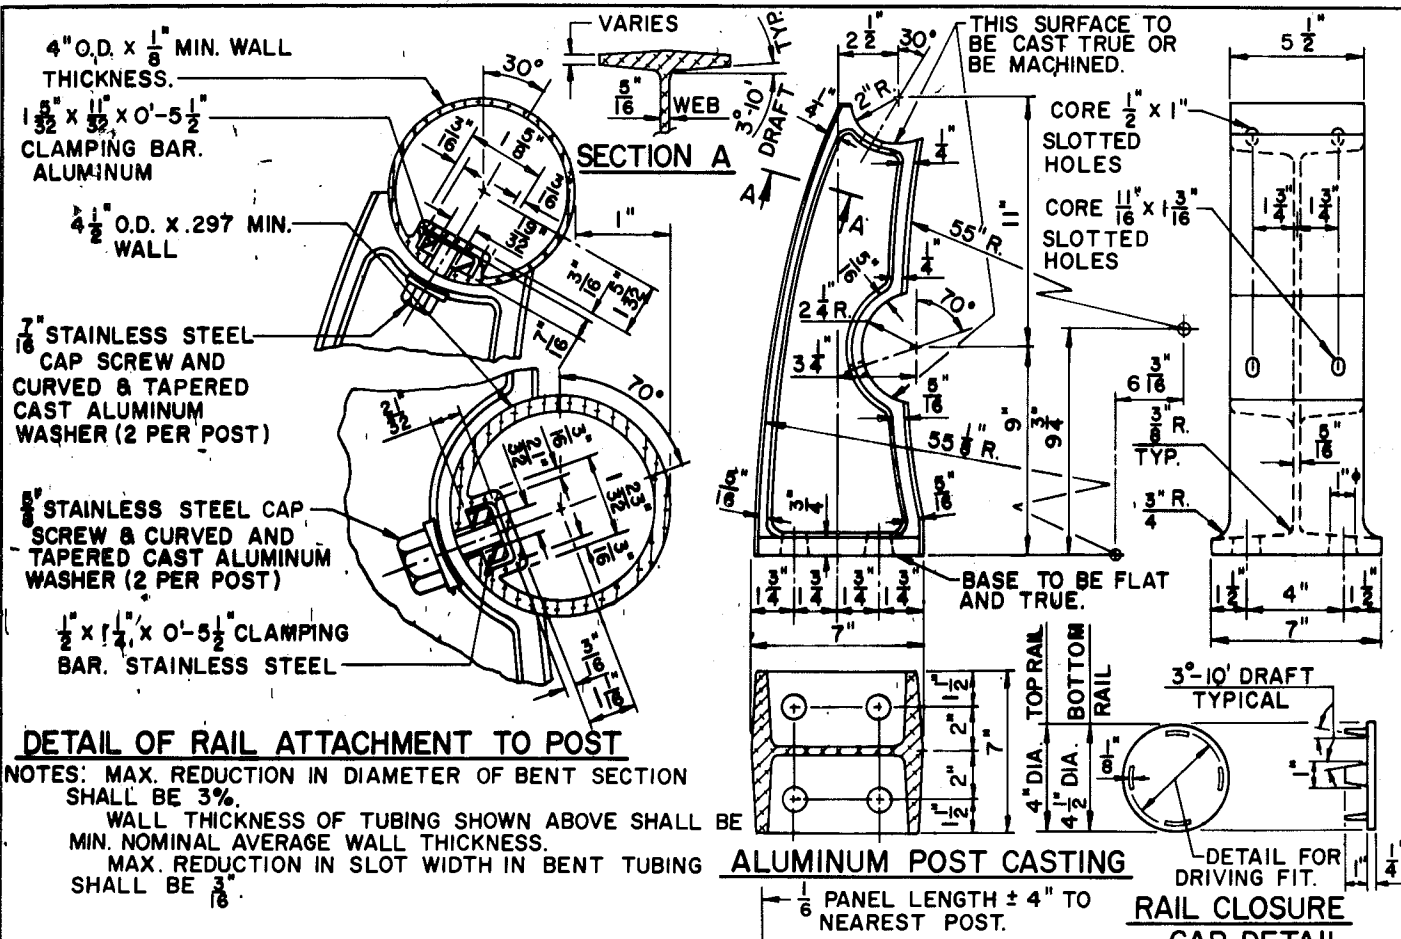

PROJECT ID 4994-0-17	SHEET NUMBER 7.8	TOTAL SHEETS
FEDERAL PROJECT DESIGNATION		

No.	Date	Revision	By
STATE OF WISCONSIN DEPARTMENT OF TRANSPORTATION DIVISION OF HIGHWAYS			
STRUCTURE B-70-86			
Const. Spec. 1975	Drawn By G.L.D.	Plans Checked N.K.I.J.	
TUBULAR RAILING TYPE 'H'			SHEET 4 OF 5 X 54266



PROJECT I.D. 4994-0-17	SHEET NUMBER	TOTAL SHEETS
FEDERAL PROJECT DESIGNATION	7.9	

ABBREVIATIONS

F — FINE	M — MEDIUM	C — COARSE
WS — WEATHERED	SO — SOUND	

MATERIAL SYMBOLS

TOPSOIL	SILT	SANDSTONE
SAND	PEAT	LIMESTONE
GRAVEL	CLAY	IGNEOUS ROCK

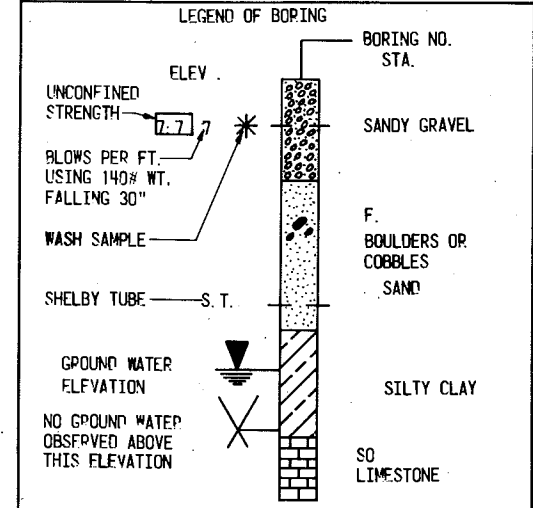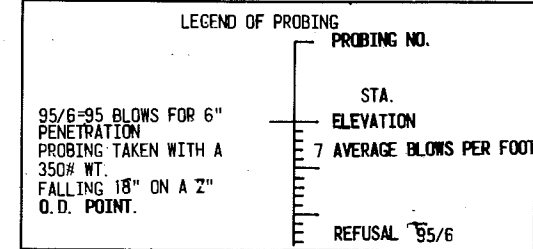


UNLESS OTHERWISE SPECIFIED, THE BLOWS PER FOOT AT THE LOCATIONS INDICATED ARE BASED ON DRIVING A 2" O.D. X 1.4" I.D. SPLIT SPOON SAMPLER WITH A 140# HAMMER HAVING A FREE FALL OF 30". THE BLOW COUNT IS TAKEN IN UNDISTURBED SOIL IMMEDIATELY BELOW A CASED OR OPEN HOLE ELIMINATING SIDE FRICTION ON THE DRIVE PIPE.

SUBSURFACE EXPLORATION FOR FOUNDATION DESIGN AND BIDDERS INFORMATION


TO OBTAIN RELATIVE DATA CONCERNING THE CHARACTER OF MATERIAL IN AND UPON WHICH THE FOUNDATION MIGHT BE BUILT, BORINGS AND/OR SOUNDINGS WERE MADE AT POINTS APPROXIMATELY AS INDICATED ON THIS DRAWING. THE DATA PRESENTED HEREIN REPRESENTS THE FINDINGS OF THE SUBSURFACE EXPLORATIONS MADE. HOWEVER, BECAUSE THE DEPTHS INVESTIGATED ARE LIMITED AND THE AREA OF THE BORINGS AND/OR SOUNDINGS IS VERY SMALL IN RELATION TO THE ENTIRE AREA, THE DIVISION OF HIGHWAYS DOES NOT WARRANT CONDITIONS BELOW THE DEPTHS INVESTIGATED OR THAT THE CLASSIFICATION OF MATERIAL ENCOUNTERED IN THESE INVESTIGATIONS IS NECESSARILY TYPICAL OF THE ENTIRE SITE.

No.	Date	Revision	By
STATE OF WISCONSIN DEPARTMENT OF TRANSPORTATION DIVISION OF HIGHWAYS			
STRUCTURE B-70-86			
Const. Spec. 1969	Drawn By G.L.D.	Plans Checked N.K.I.J.	
SUBSURFACE EXPLORATION			SHEET 5 OF 5 X 54267

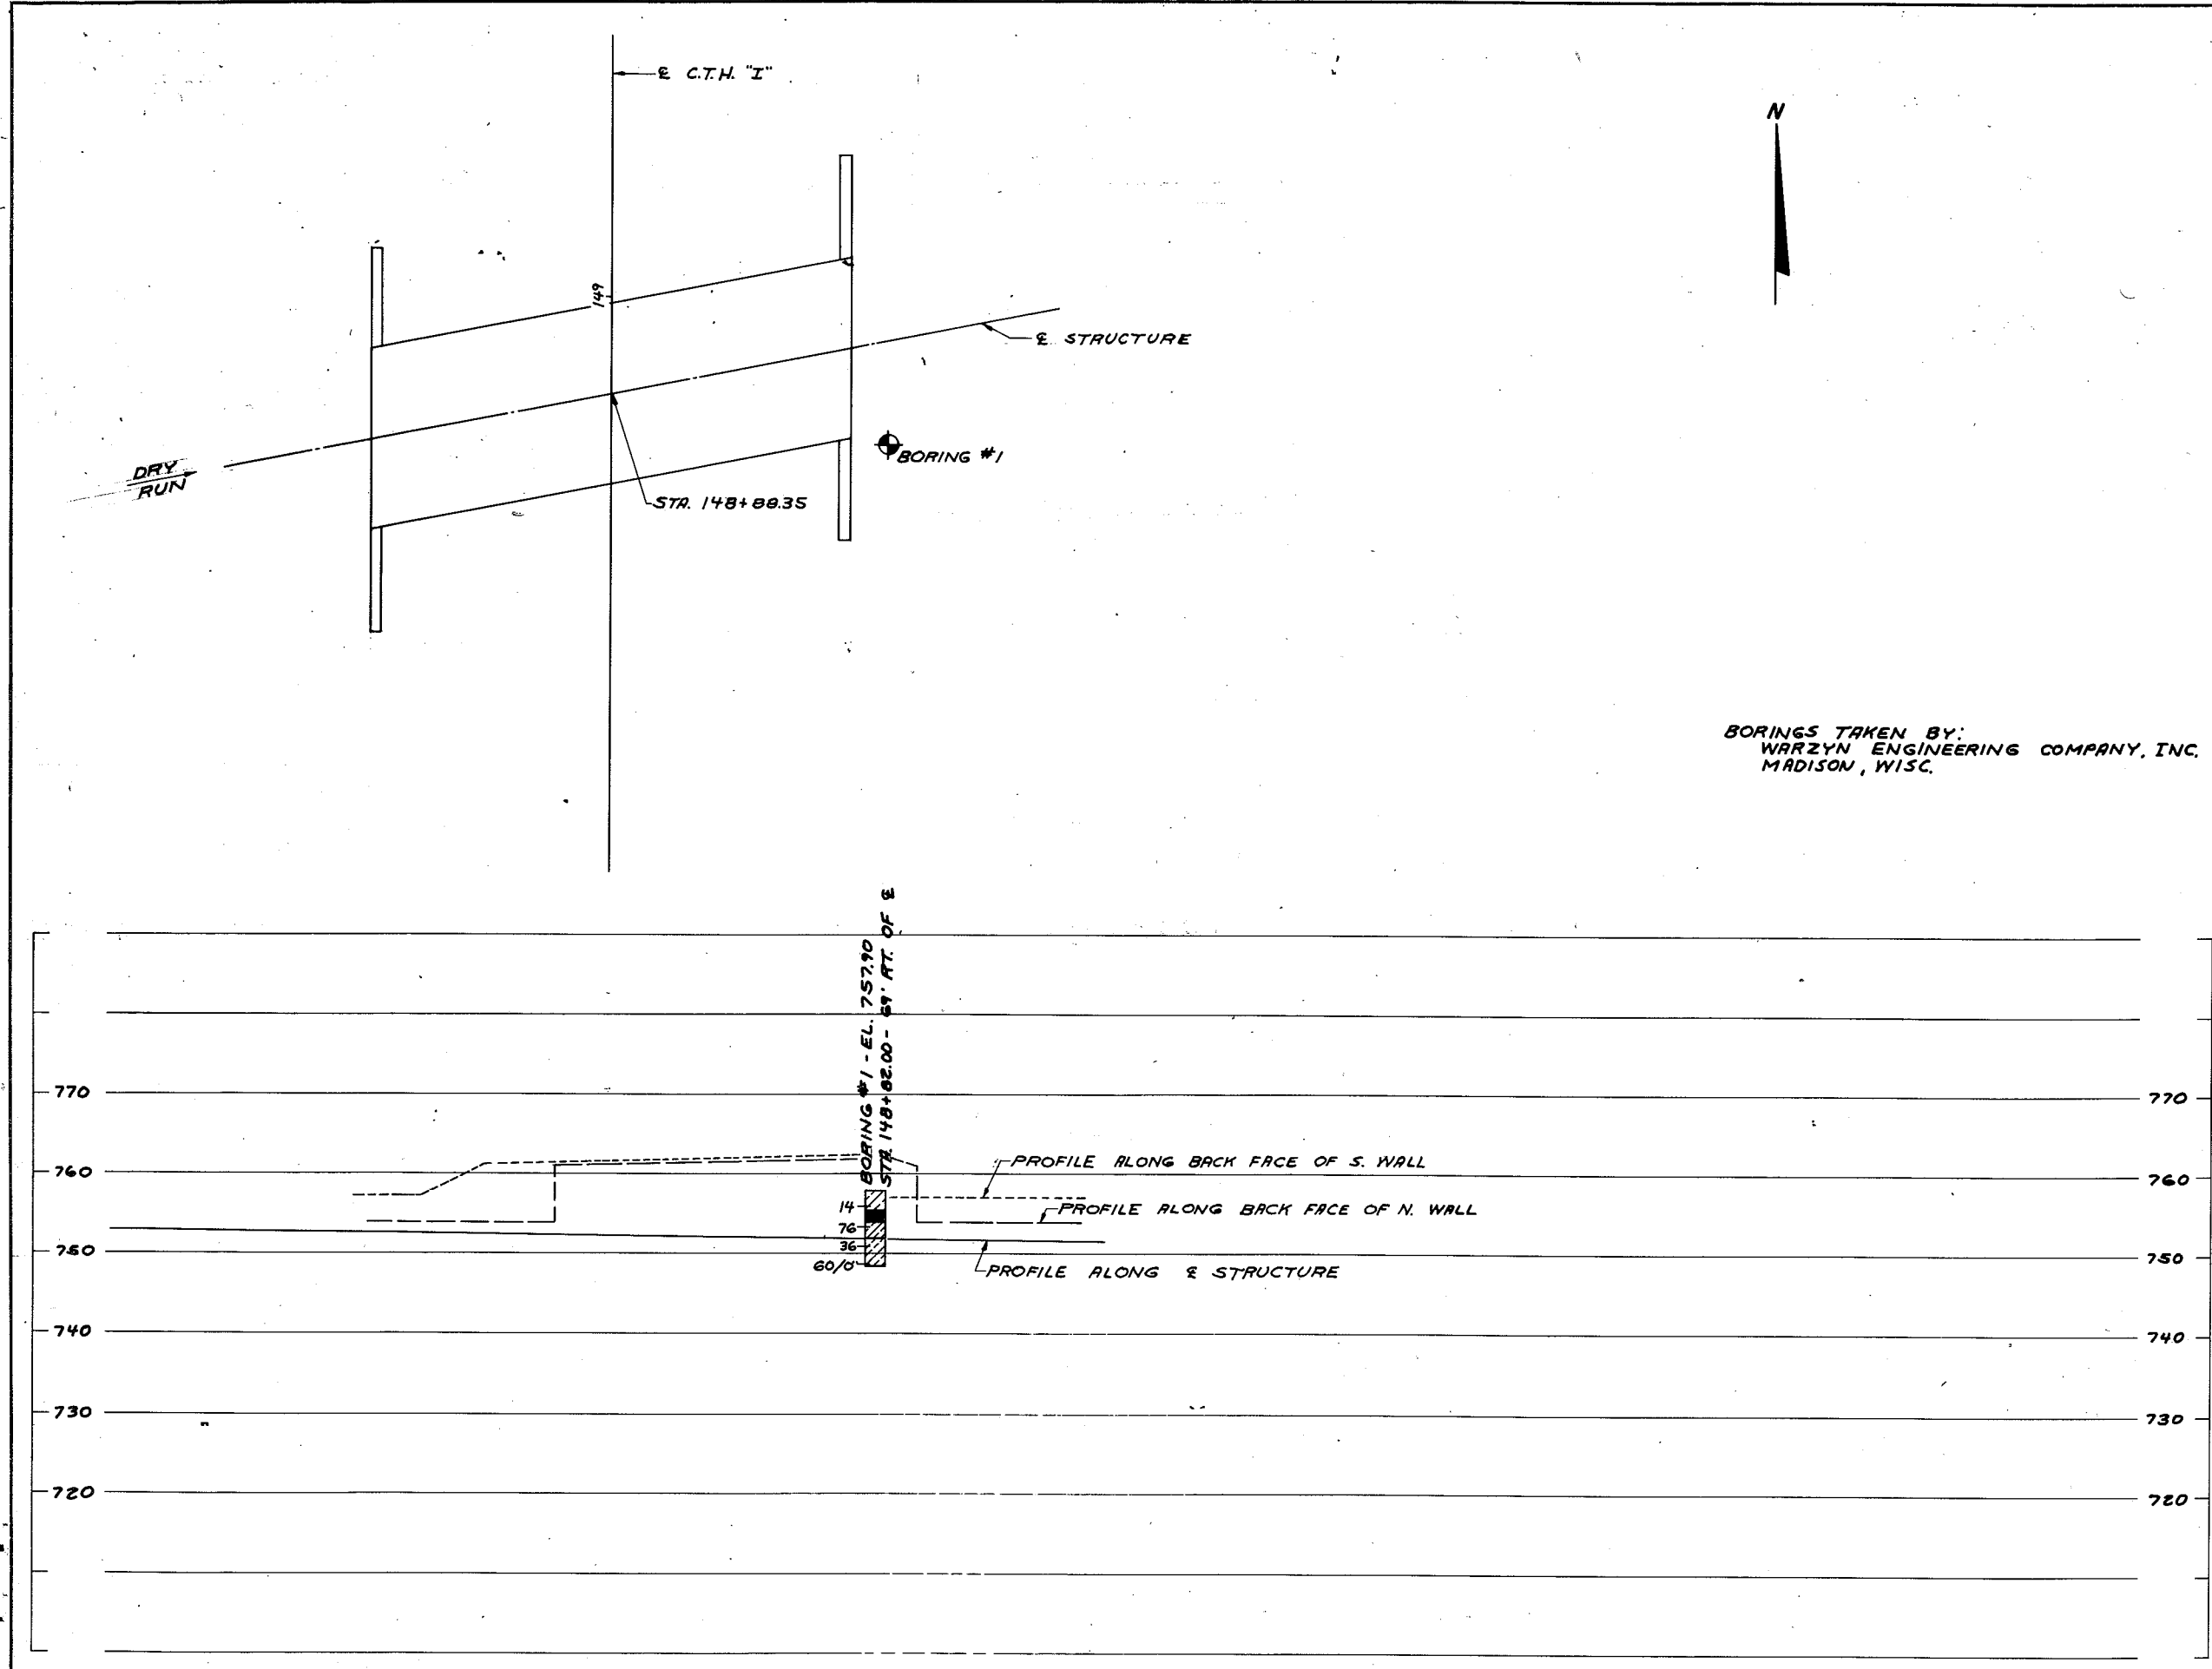

BORINGS TAKEN BY:
WARZYN ENGINEERING COMPANY, INC.
MADISON, WISC.

REGION	PROJECT	SHEET	TOTAL
DIVISION	NUMBER	NUMBER	SHEETS
6	4994-0-17	8	
WIS.			

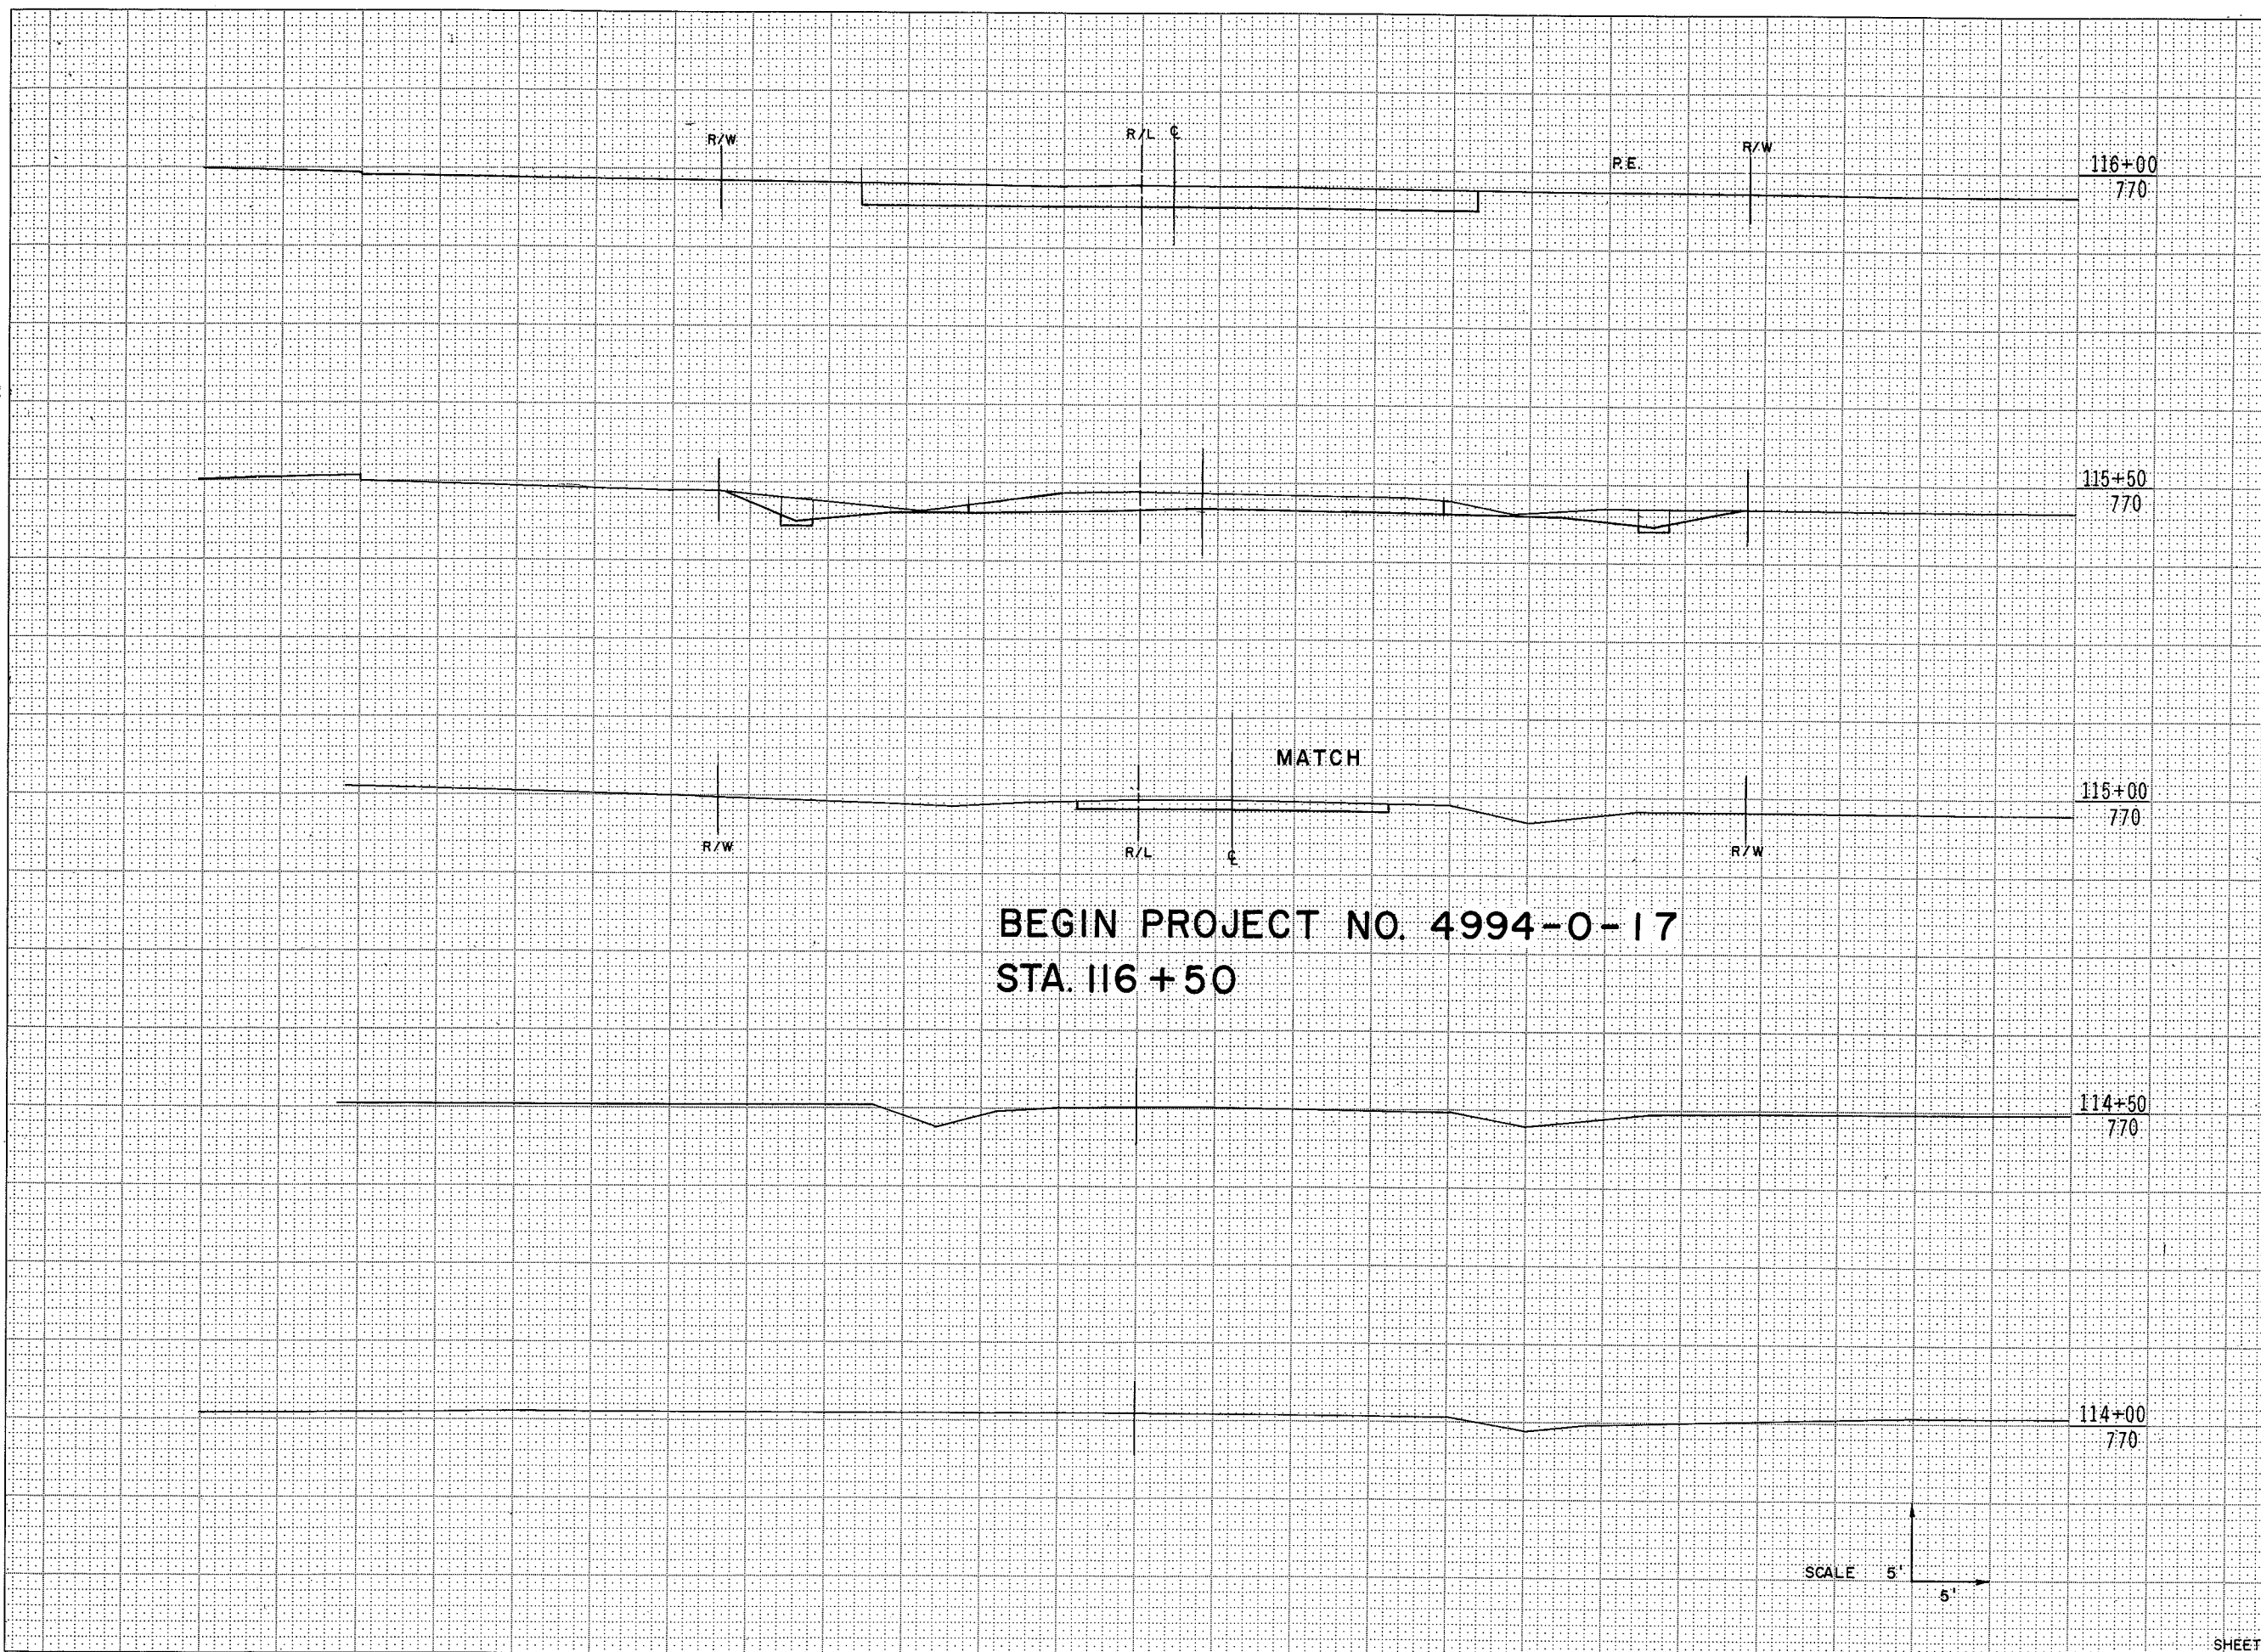

STATION	DISTANCE	YARDAGE	
		EXCAVATION	
		UNCL.	FILL
116+00	770		
115	50	56	0
+50	50	98	0
116			
115+50	770		
115+00	770		
114+50	770		
114+00	770		
SHEET TOTAL		154	0

BEGIN PROJECT NO. 4994-0-17
STA. 116 + 50

SCALE 5'


SURVEY
NOTE BOOK
NO.

SURVEY
NOTE BOOK
NO.

REGION DIVISION	PROJECT	SHEET NUMBER	TOTAL SHEETS
5 WIS.	4994-0-17	81	

DATE	BY
FINAL SURVEY NOTE BOOK NO.	SURVEY PLOTTED TEMPLATE AREAS CHECKED

DATE	BY
ORIGINAL SURVEY NOTE BOOK NO.	SURVEY PLOTTED AREAS CHECKED

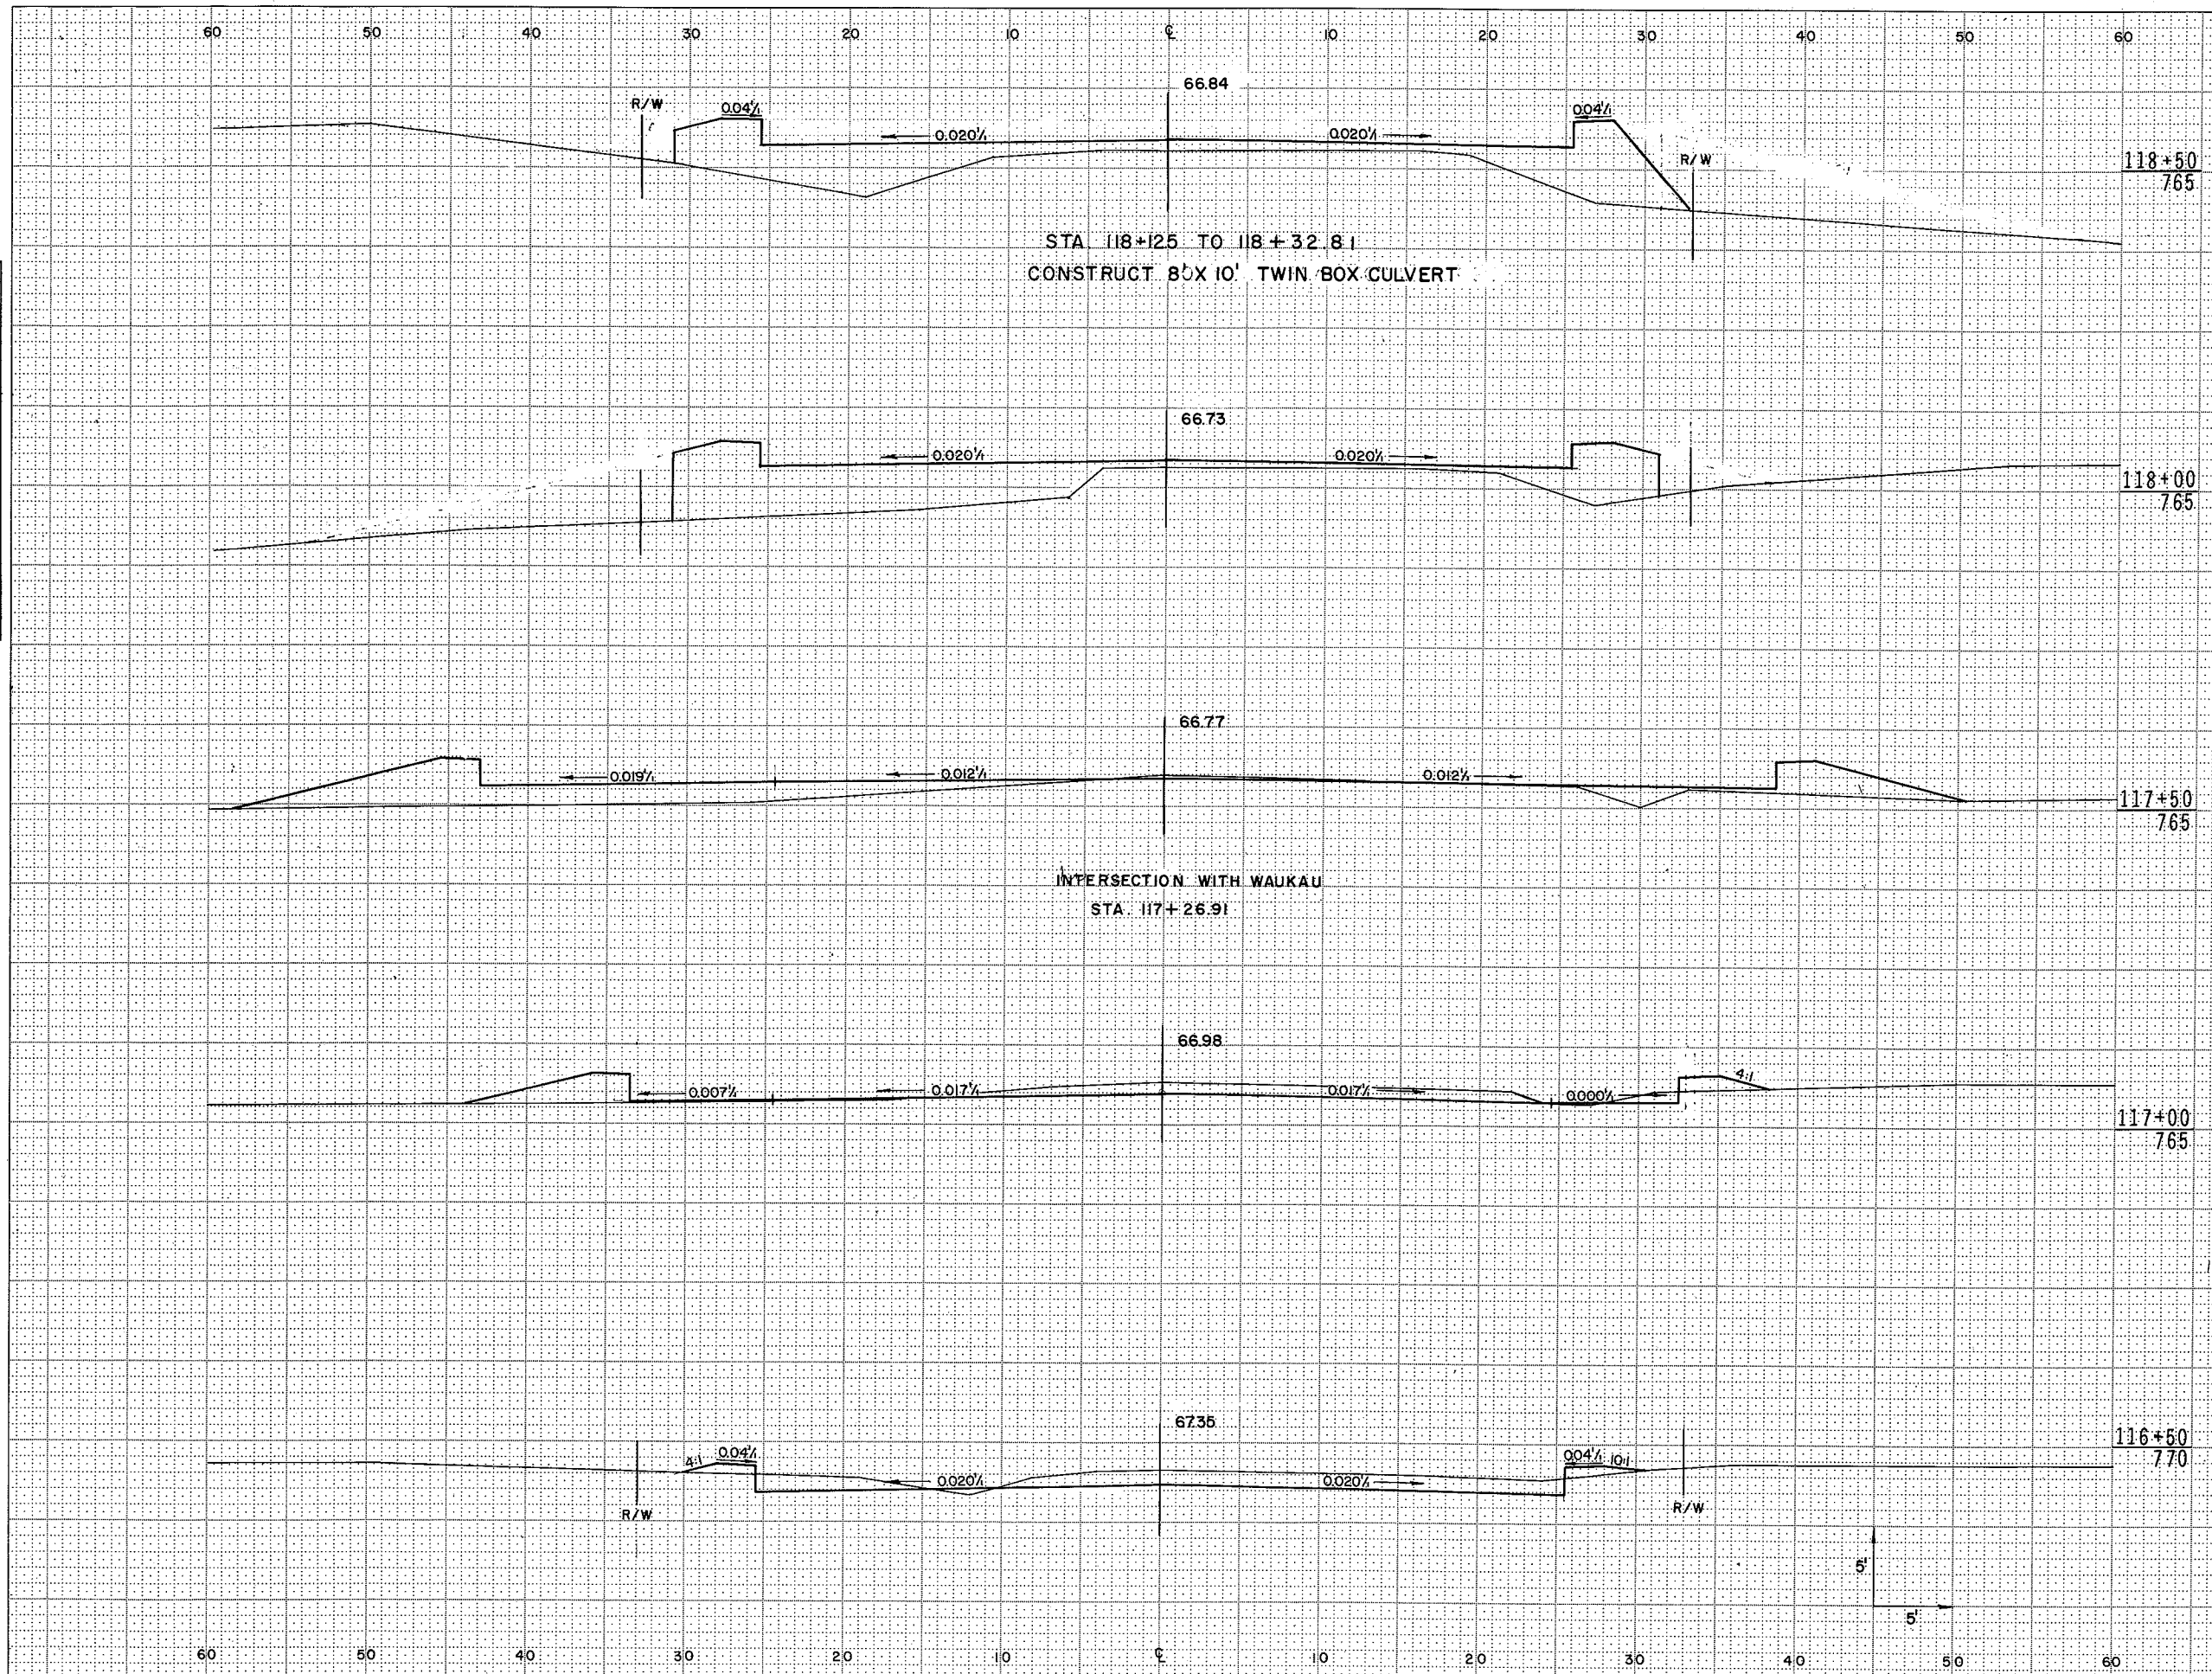

STATION	DISTANCE	YARDAGE	
		EXCAVATION UNCL.	FILL
118+50	765		
+50	50	88	2
117+50	765		
+50	50	67	19
118+50	765		
+50	50	24	95
118+50	765		
+50	50	0	176
118+50	765		
+11	11	0	44
117+50	765		
+34	16	0	66
117+50	765		
117+00	765		
116+50	770		
SHEET TOTAL		179	402

R/W PRIVATE ENTRANCE

66.76

R/W

121+00
765

5% 0.04%

0.020%

0.020%

0.04%

66.96

P E

+56
765

4%

67.03

4%

118

+50

50

0

174

119

50

2

90

+50

50

28

27

120

+50

50

61

13

121

50

91

9

0.04%

67.16

0.02%

120+00
765

5%

P E

67.17

+85
765

4%

67.17

4%

119+50
765

10% 0.04%

0.020%

0.020%

0.04%

67.04

119+00
765

PRIVATE ENTRANCE

66.89

3%

R/W


+64
765

PROJECT DESIGNATION		SHEET NUMBER	
4994-0-17		82	
STATION	DISTANCE	YARDAGE	
		EXCAVATION	FILL
		UNCL.	

SURVEYED
 SURVEY
 NOTE BOOK
 NO.

CHECKED
 PLOTTED
 TEMPLATE
 AREAS CHECKED

REGION DIVISION	PROJECT	SHEET NUMBER	TOTAL SHEETS
5 WIS.	4994-O-17	8.3	

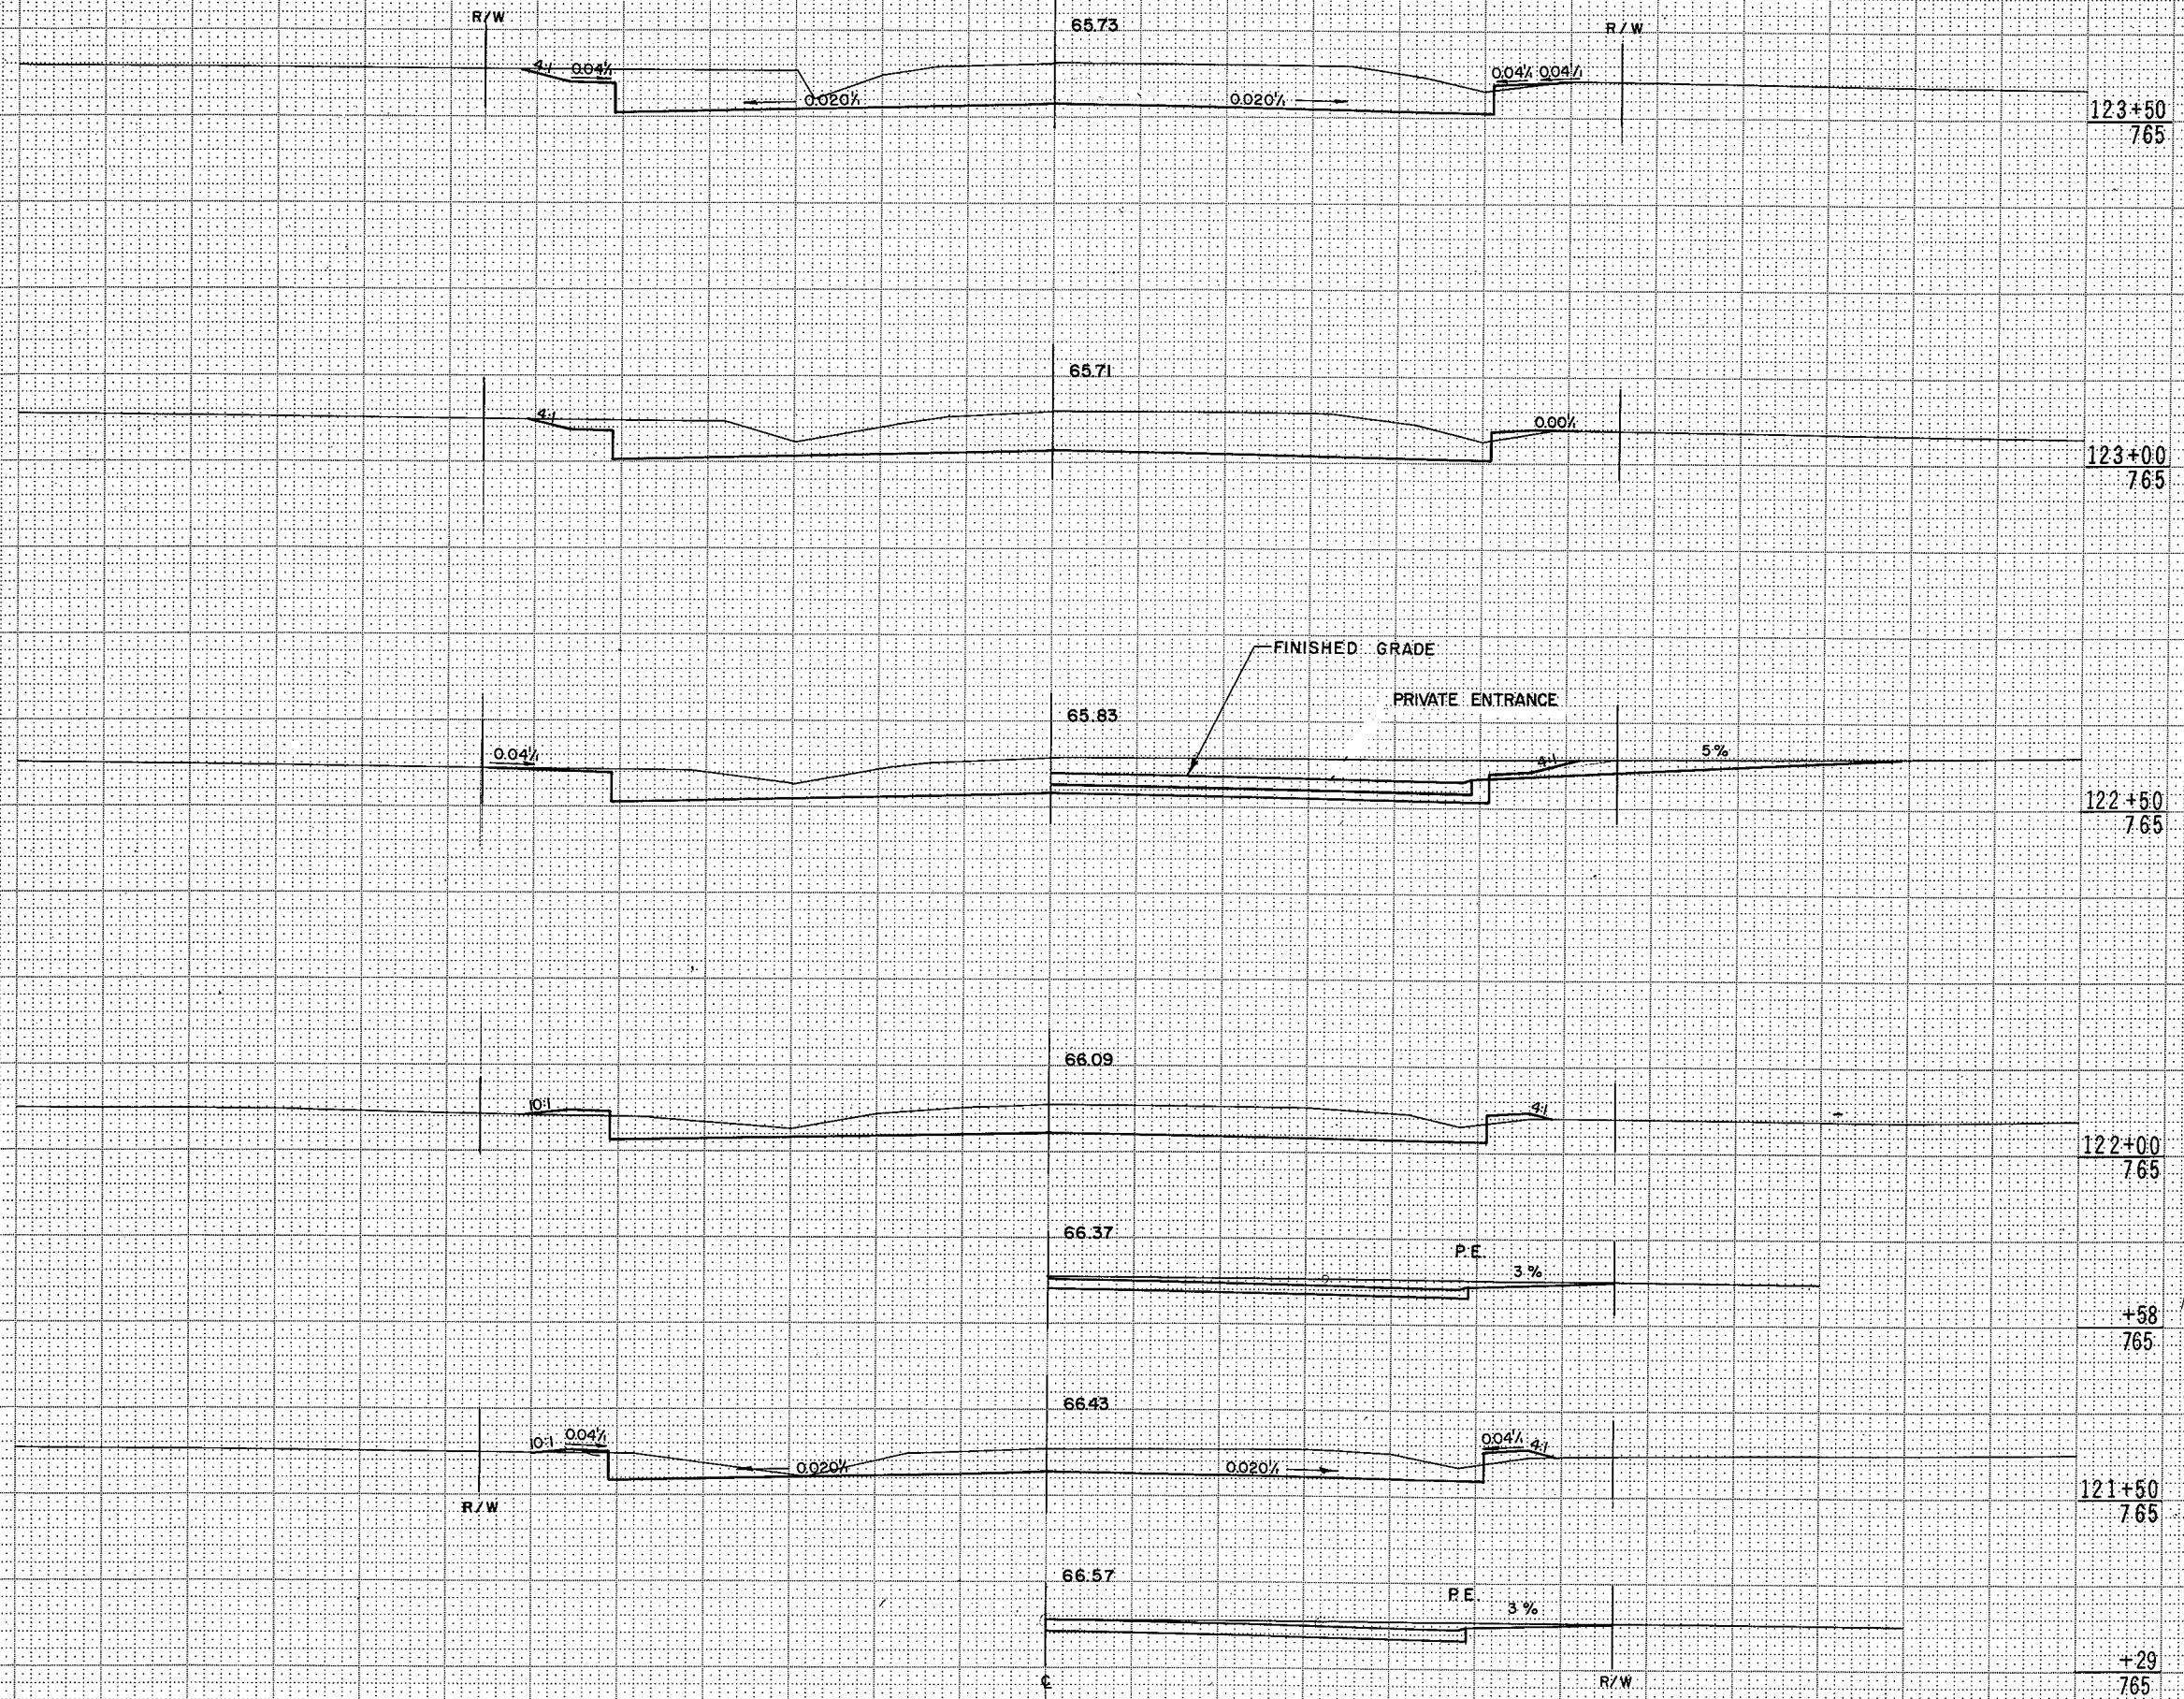


STATION	DISTANCE	YARDAGE	
		EXCAVATION UNCL	FILL
123+50	765		
+50	50	106	6
122+50	765		
+50	50	106	5
122+00	765		
+50	50	146	2
121+50	765		
+50	50	187	1
121+00	765		
+50	50	195	1
120+50	765		
+58	765		
121+50	765		
+29	765		
SHEET TOTAL		740	15

DATE	
BY	
FINAL SURVEY	
SURVEY PLOTTED	
NOTE BOOK REVISIONS	
NO.	
REVISED	
PLANNED	
REVISIONS	
NO.	

DATE	
BY	
ORIGINAL SURVEY	
SURVEY PLOTTED	
NOTE BOOK REVISIONS	
NO.	
REVISED	
PLANNED	
REVISIONS	
NO.	

REGION DIVISION	PROJECT	SHEET NUMBER	TOTAL SHEETS
5 WIS.	4994-0-17	84	

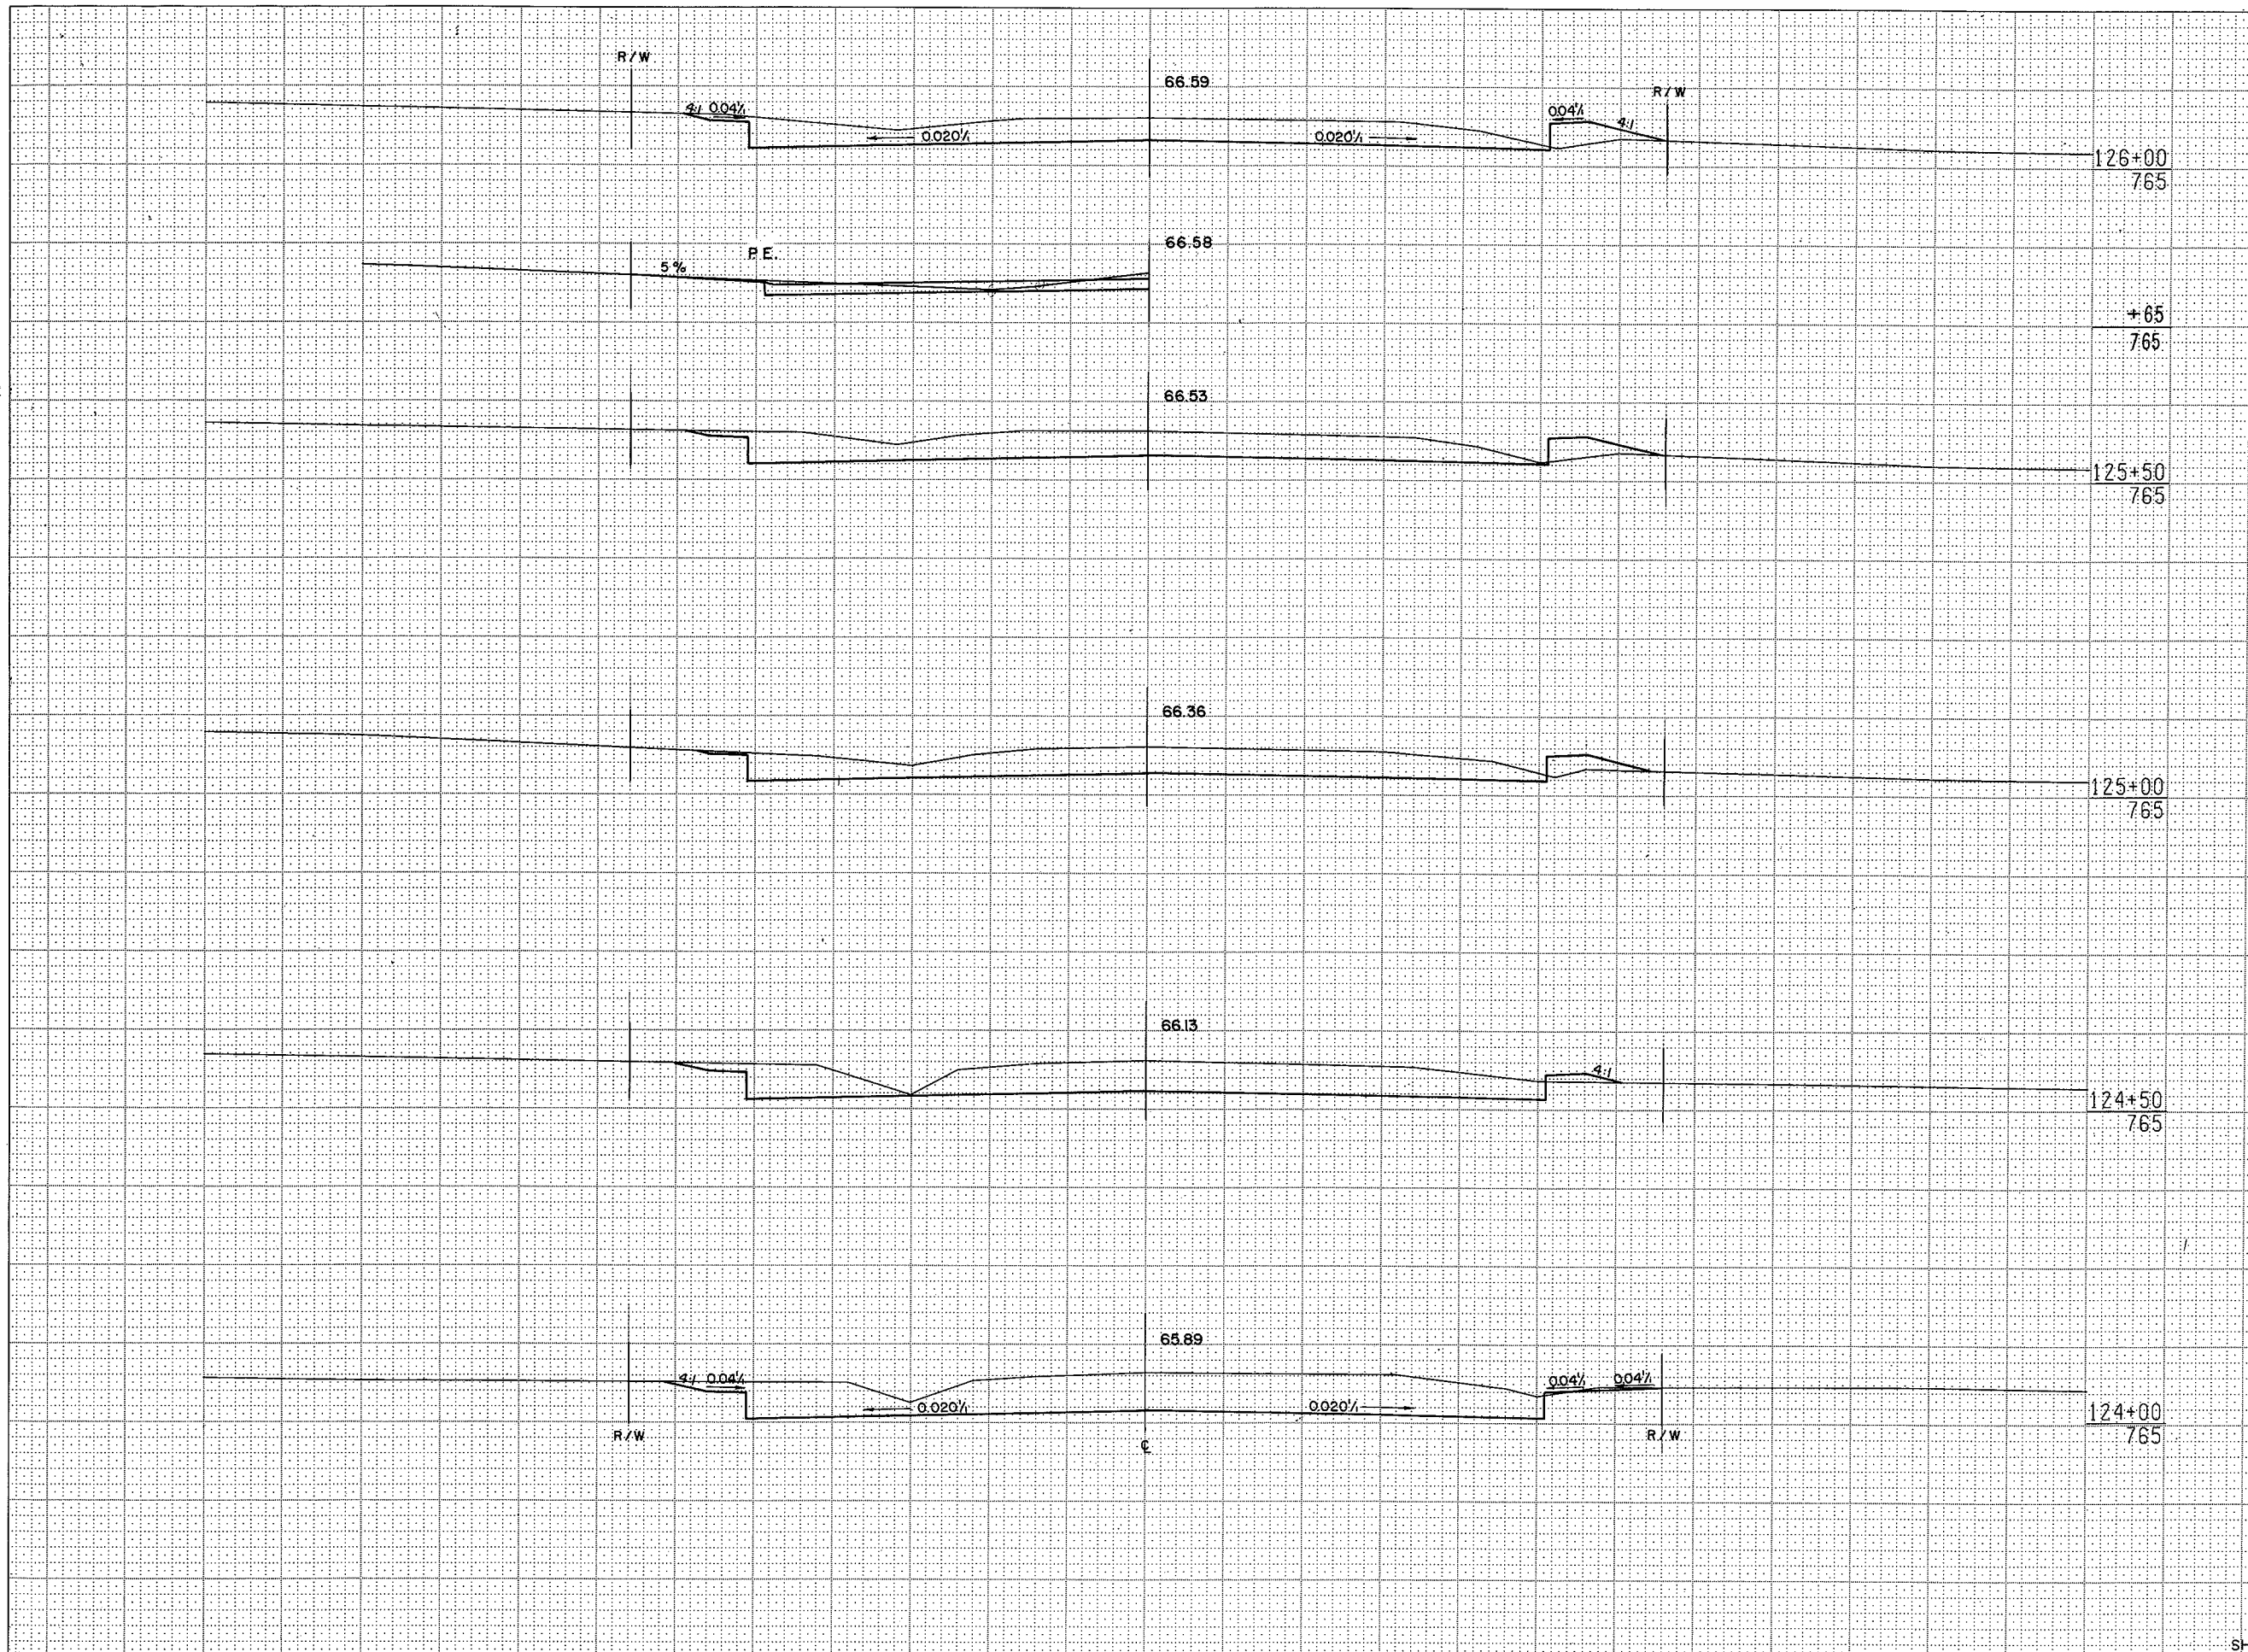


STATION	DISTANCE	YARDAGE	
		EXCAVATION	FILL
		UNCL.	
123+50	50	195	0
124+50	50	172	2
125+50	50	141	6
126+50	50	135	11
127+50	50	126	13
SHEET TOTAL		769	32

SURVEY PLOTTED
 NOTE BOOK NO. _____
 TEMPLATE AREA CHECKED
 NO. _____

SURVEY PLOTTED
 NOTE BOOK NO. _____
 TEMPLATE AREA CHECKED
 NO. _____

REGION DIVISION	PROJECT	SHEET NUMBER	TOTAL SHEETS
5 WIS.	4994-0-17	86	

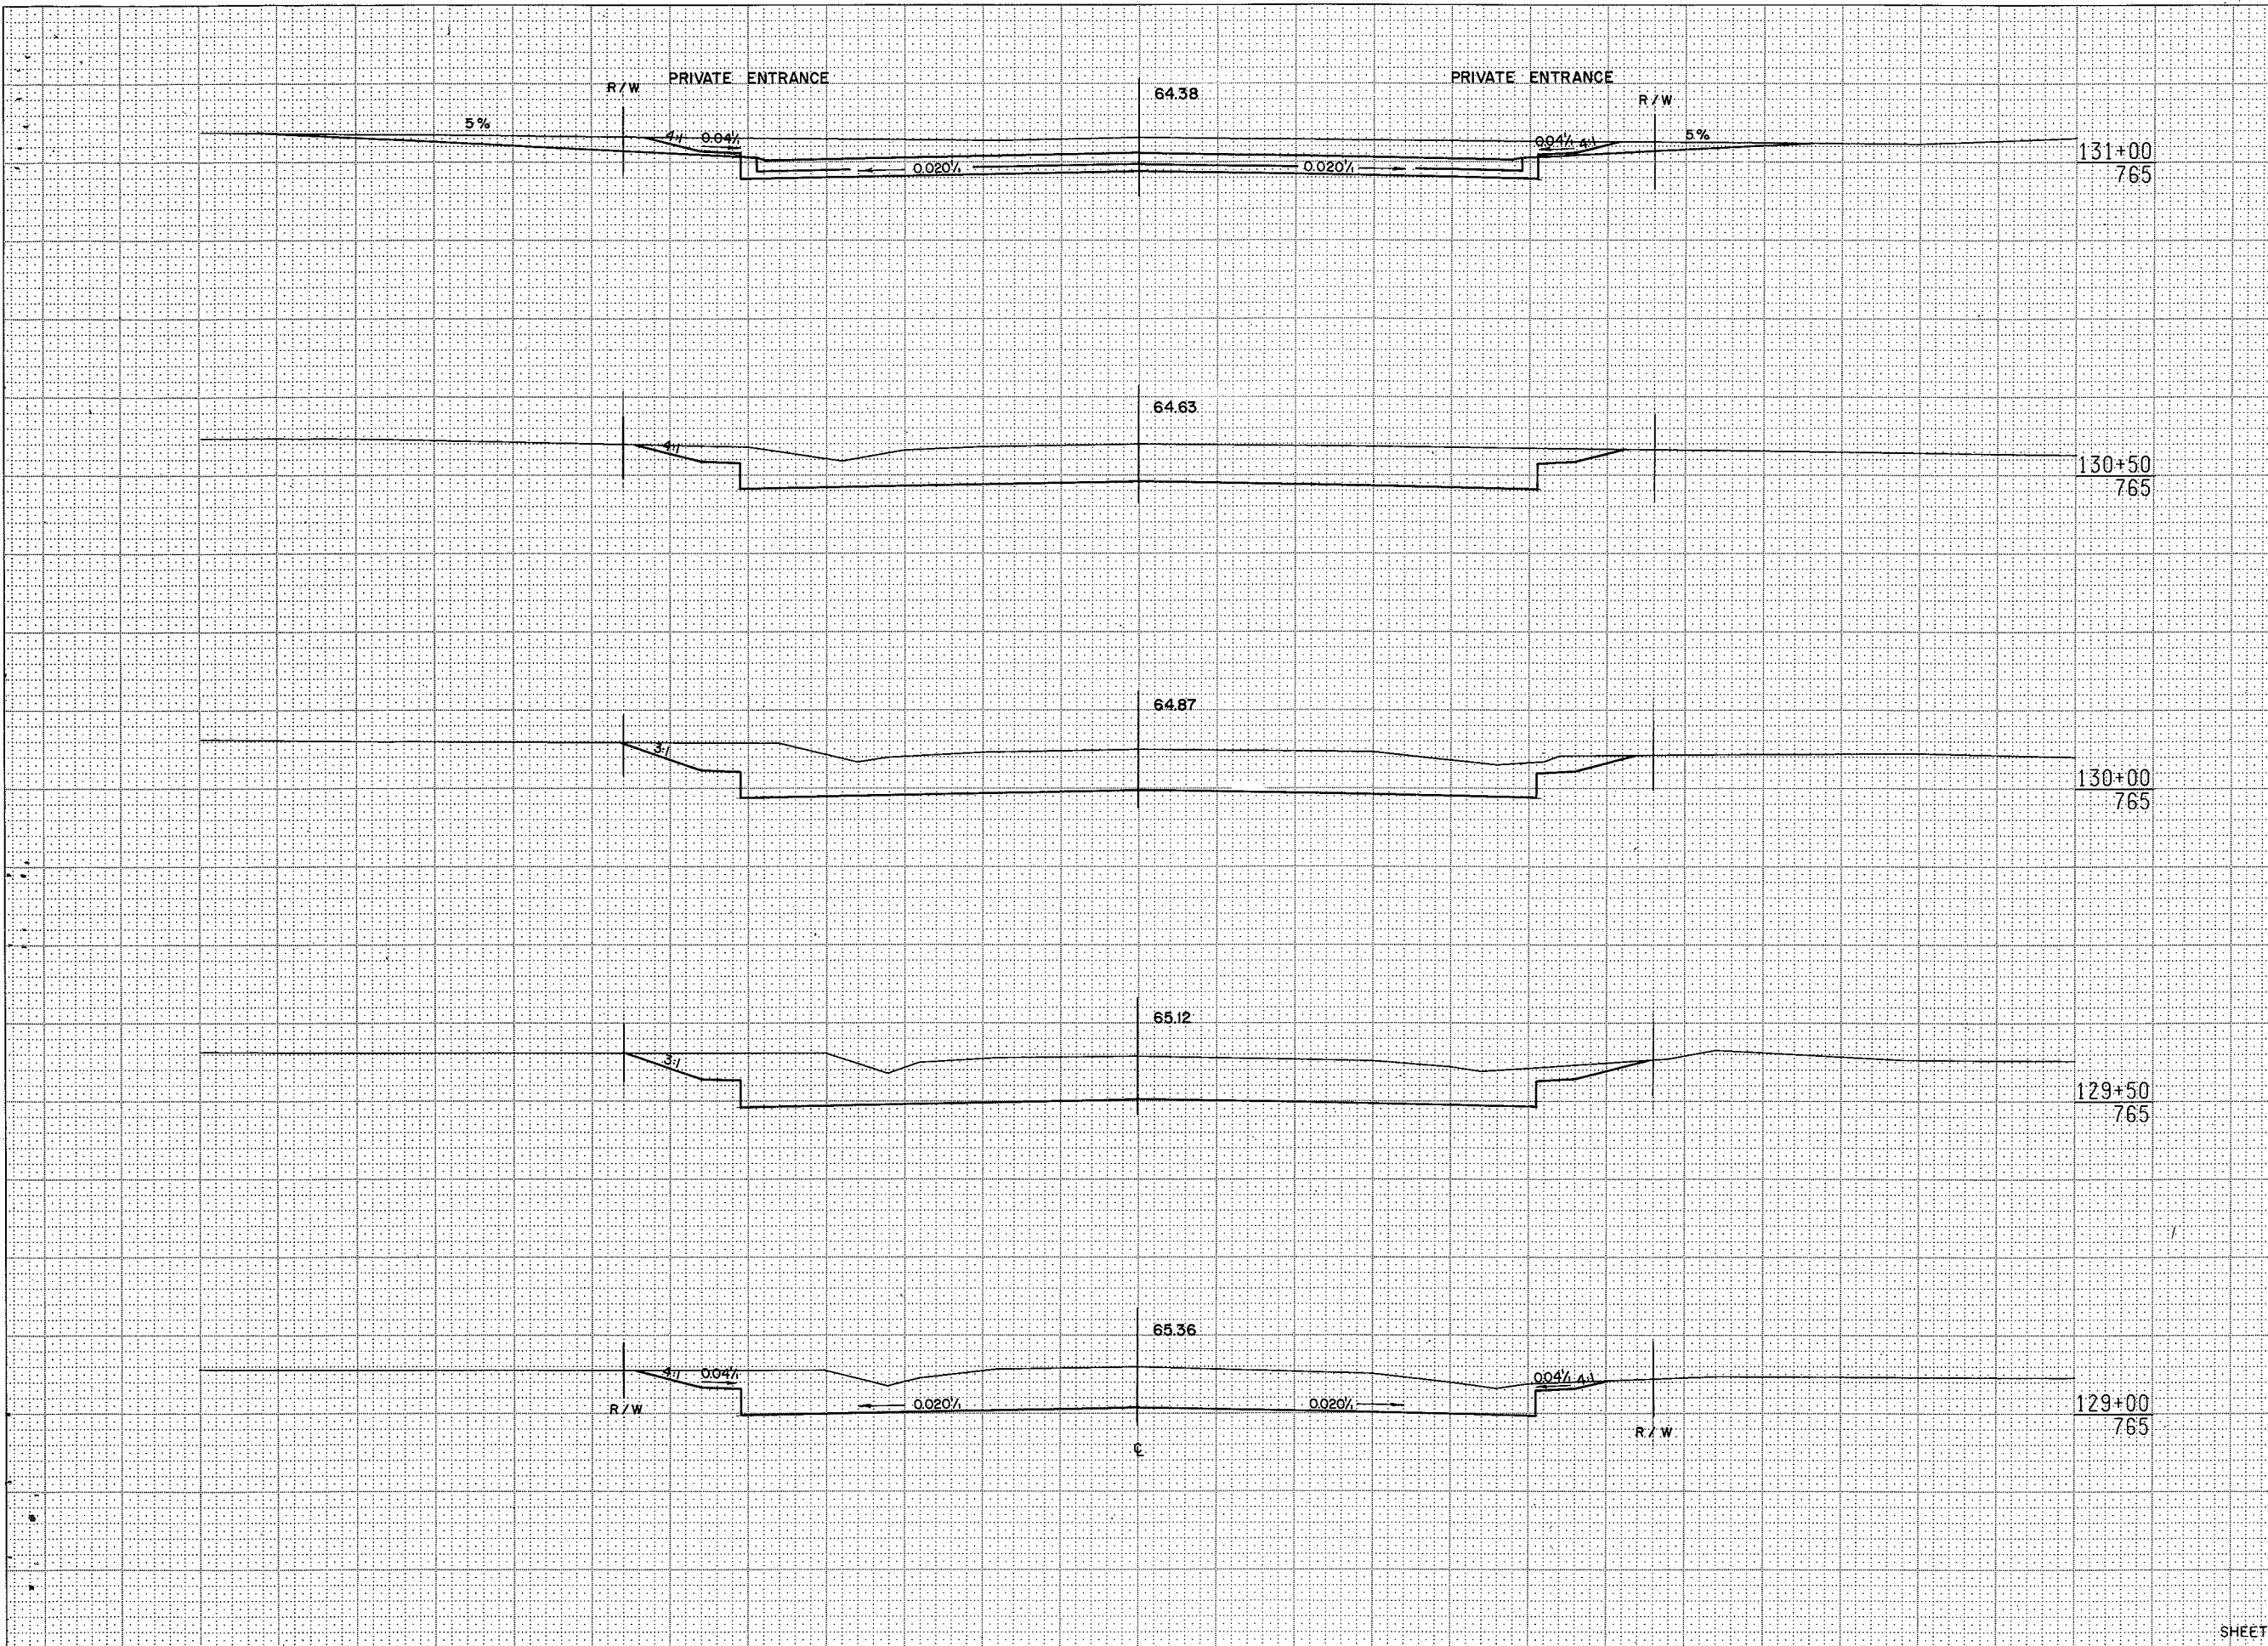

STATION	DISTANCE	YARDAGE	
		EXCAVATION	FILL
		UNCL.	
128+50	50	208	0
129+50	50	255	0
130+00	50	270	0
131+00	50	247	0
	50	219	0
SHEET TOTAL		1199	0


SURVEY PLOTTED
 NOTE BOOK
 NO.

SURVEY PLOTTED
 NOTE BOOK
 NO.

FINAL SURVEY
 SURVEYED
 PLOTTED
 TEMPLATE
 REVISIONS
 AREAS CHECKED
 DATE
 BY

ORIGINAL SURVEY
 SURVEYED
 PLOTTED
 TEMPLATE
 REVISIONS
 AREAS CHECKED
 DATE
 BY

REGION DIVISION	PROJECT	SHEET NUMBER	TOTAL SHEETS
5 WIS.	4994-0-17	8.5	

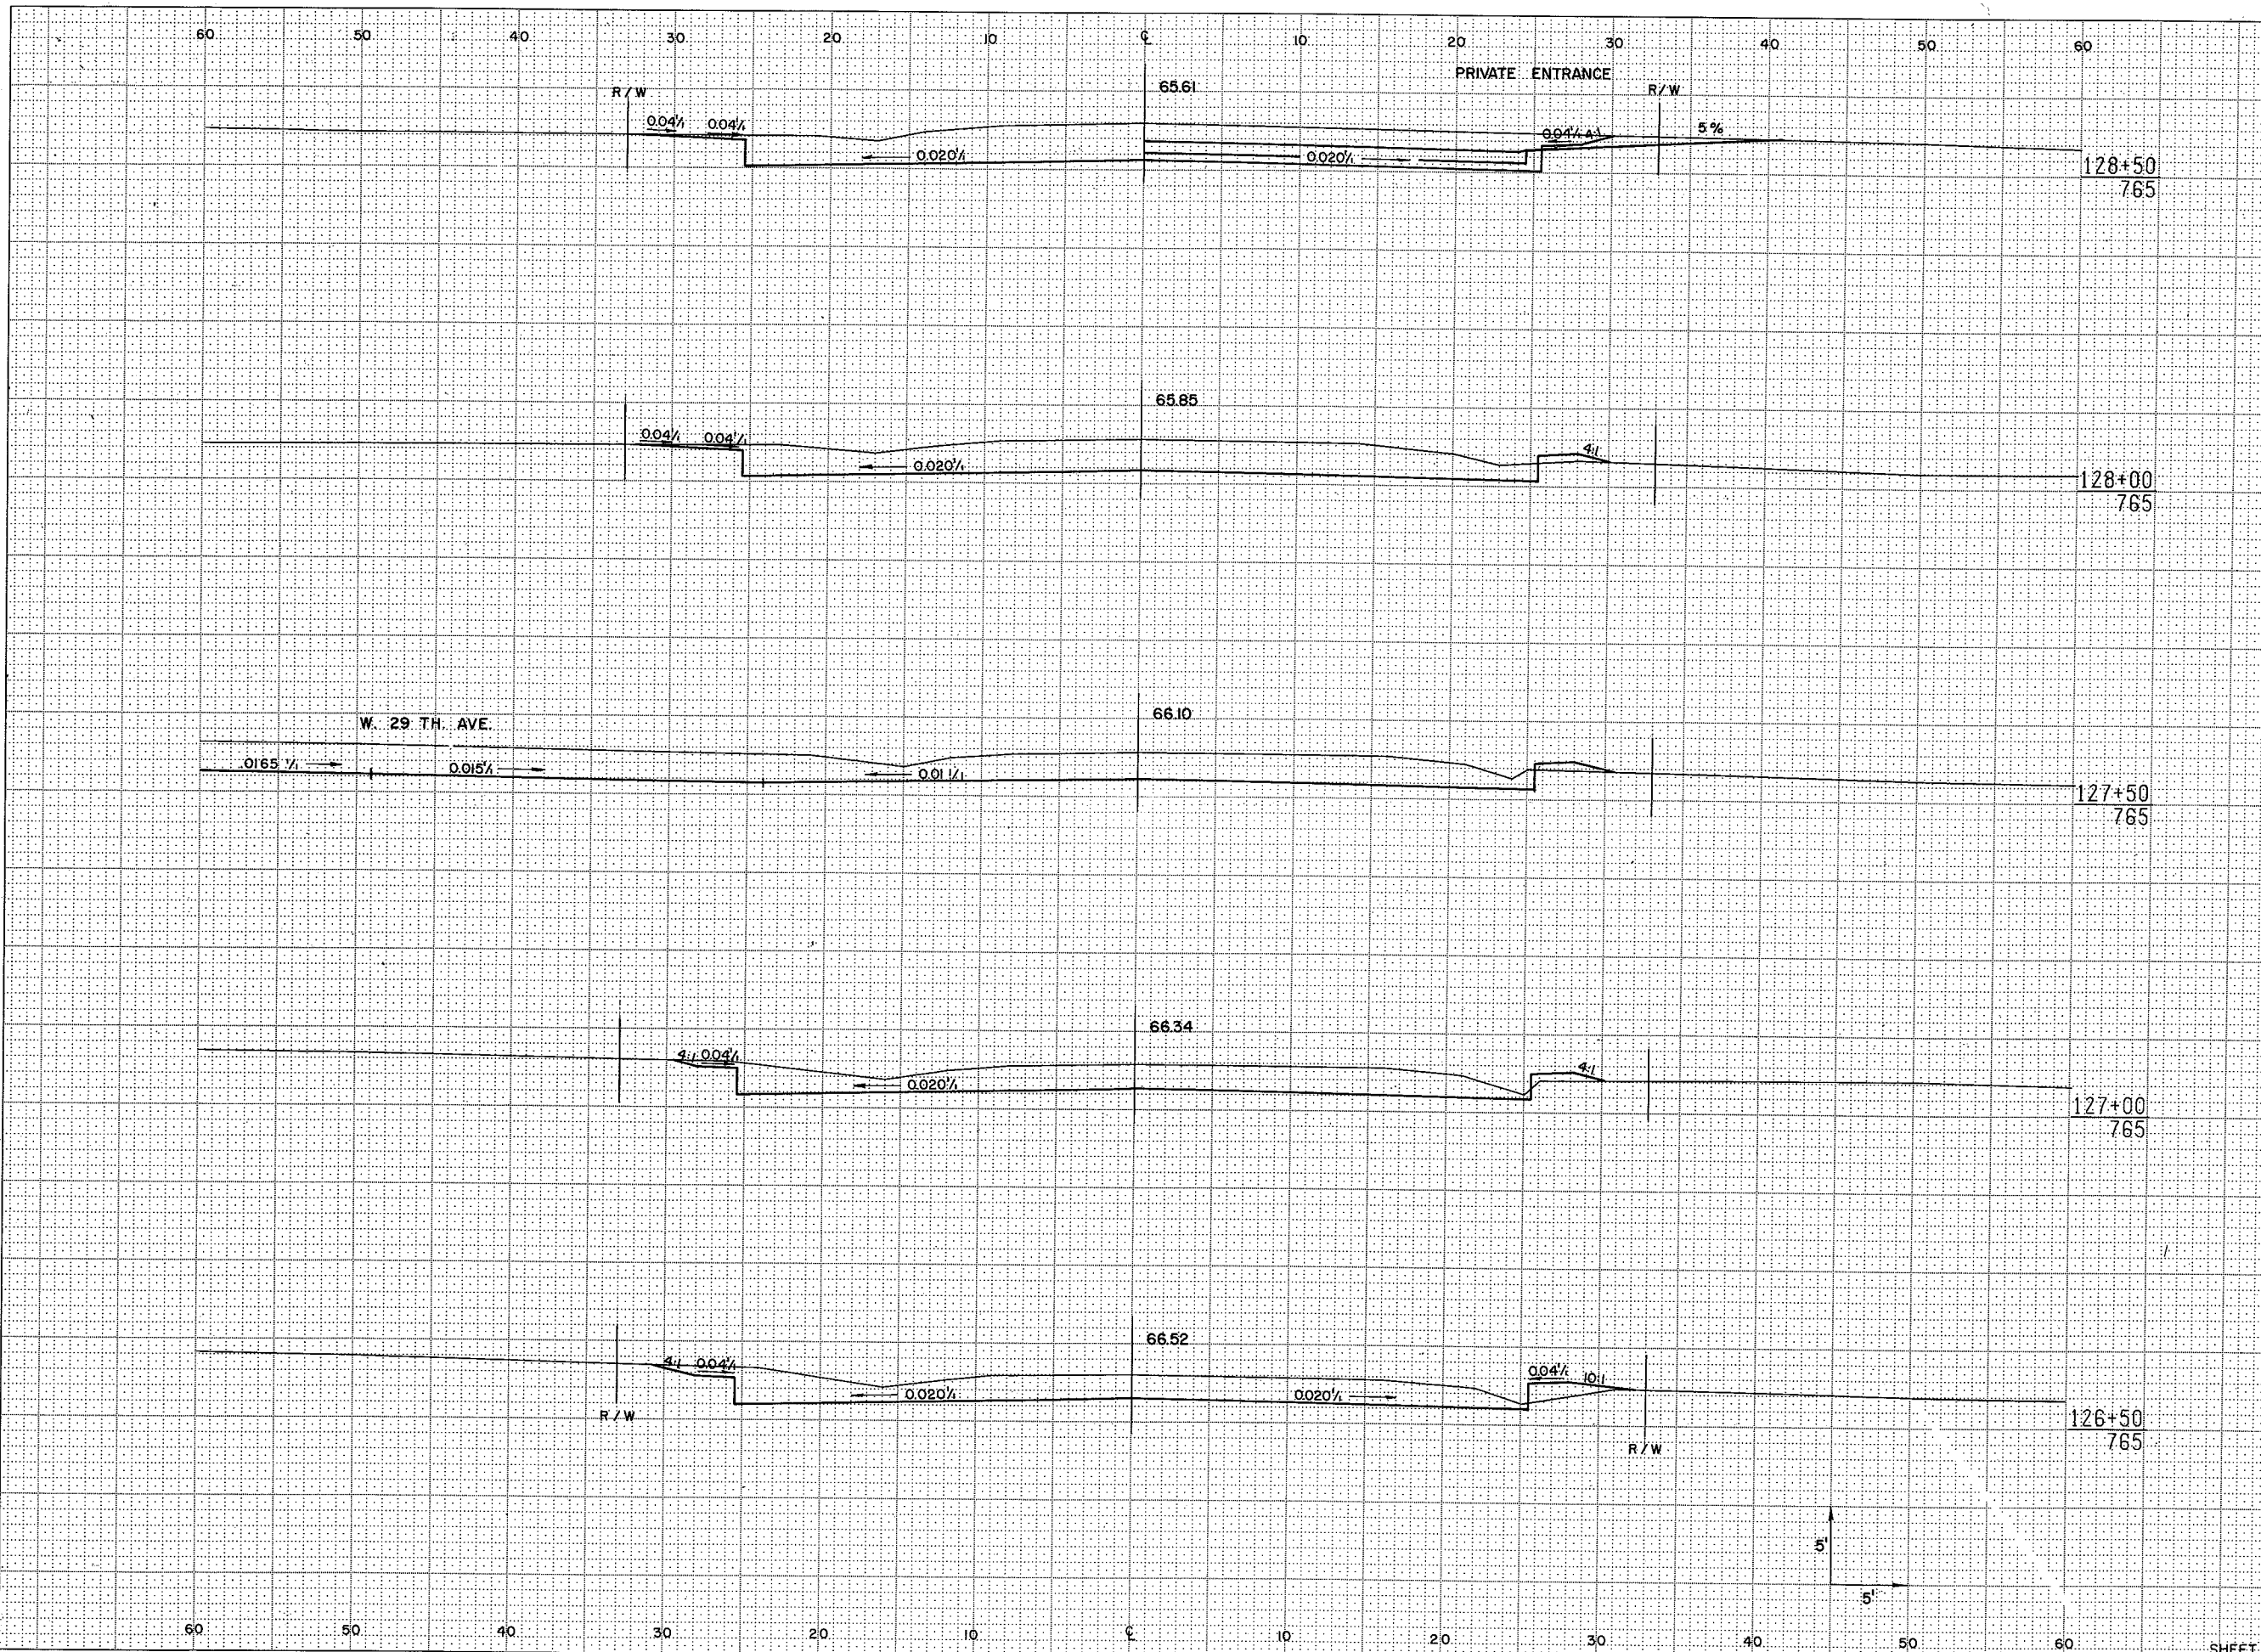


STATION	DISTANCE	YARDAGE	
		EXCAVATION	FILL
128+50			
	50	126	11
128+00			
	50	129	7
127+50			
	50	141	6
127+00			
	50	158	5
126+50			
	50	169	2
SHEET TOTAL		723	31

REGION	PROJECT	SHEET	TOTAL
DIVISION	NO.	NUMBER	SHEETS
5	4994-0-17	8.7	
WIS.			


DATE _____ BY _____
 SURVEYED _____
 SURVEY TEMPLATE _____
 NOTE BOOK _____
 AREA CHECKED _____

DATE _____ BY _____
 SURVEYED _____
 SURVEY TEMPLATE _____
 NOTE BOOK _____
 AREA CHECKED _____

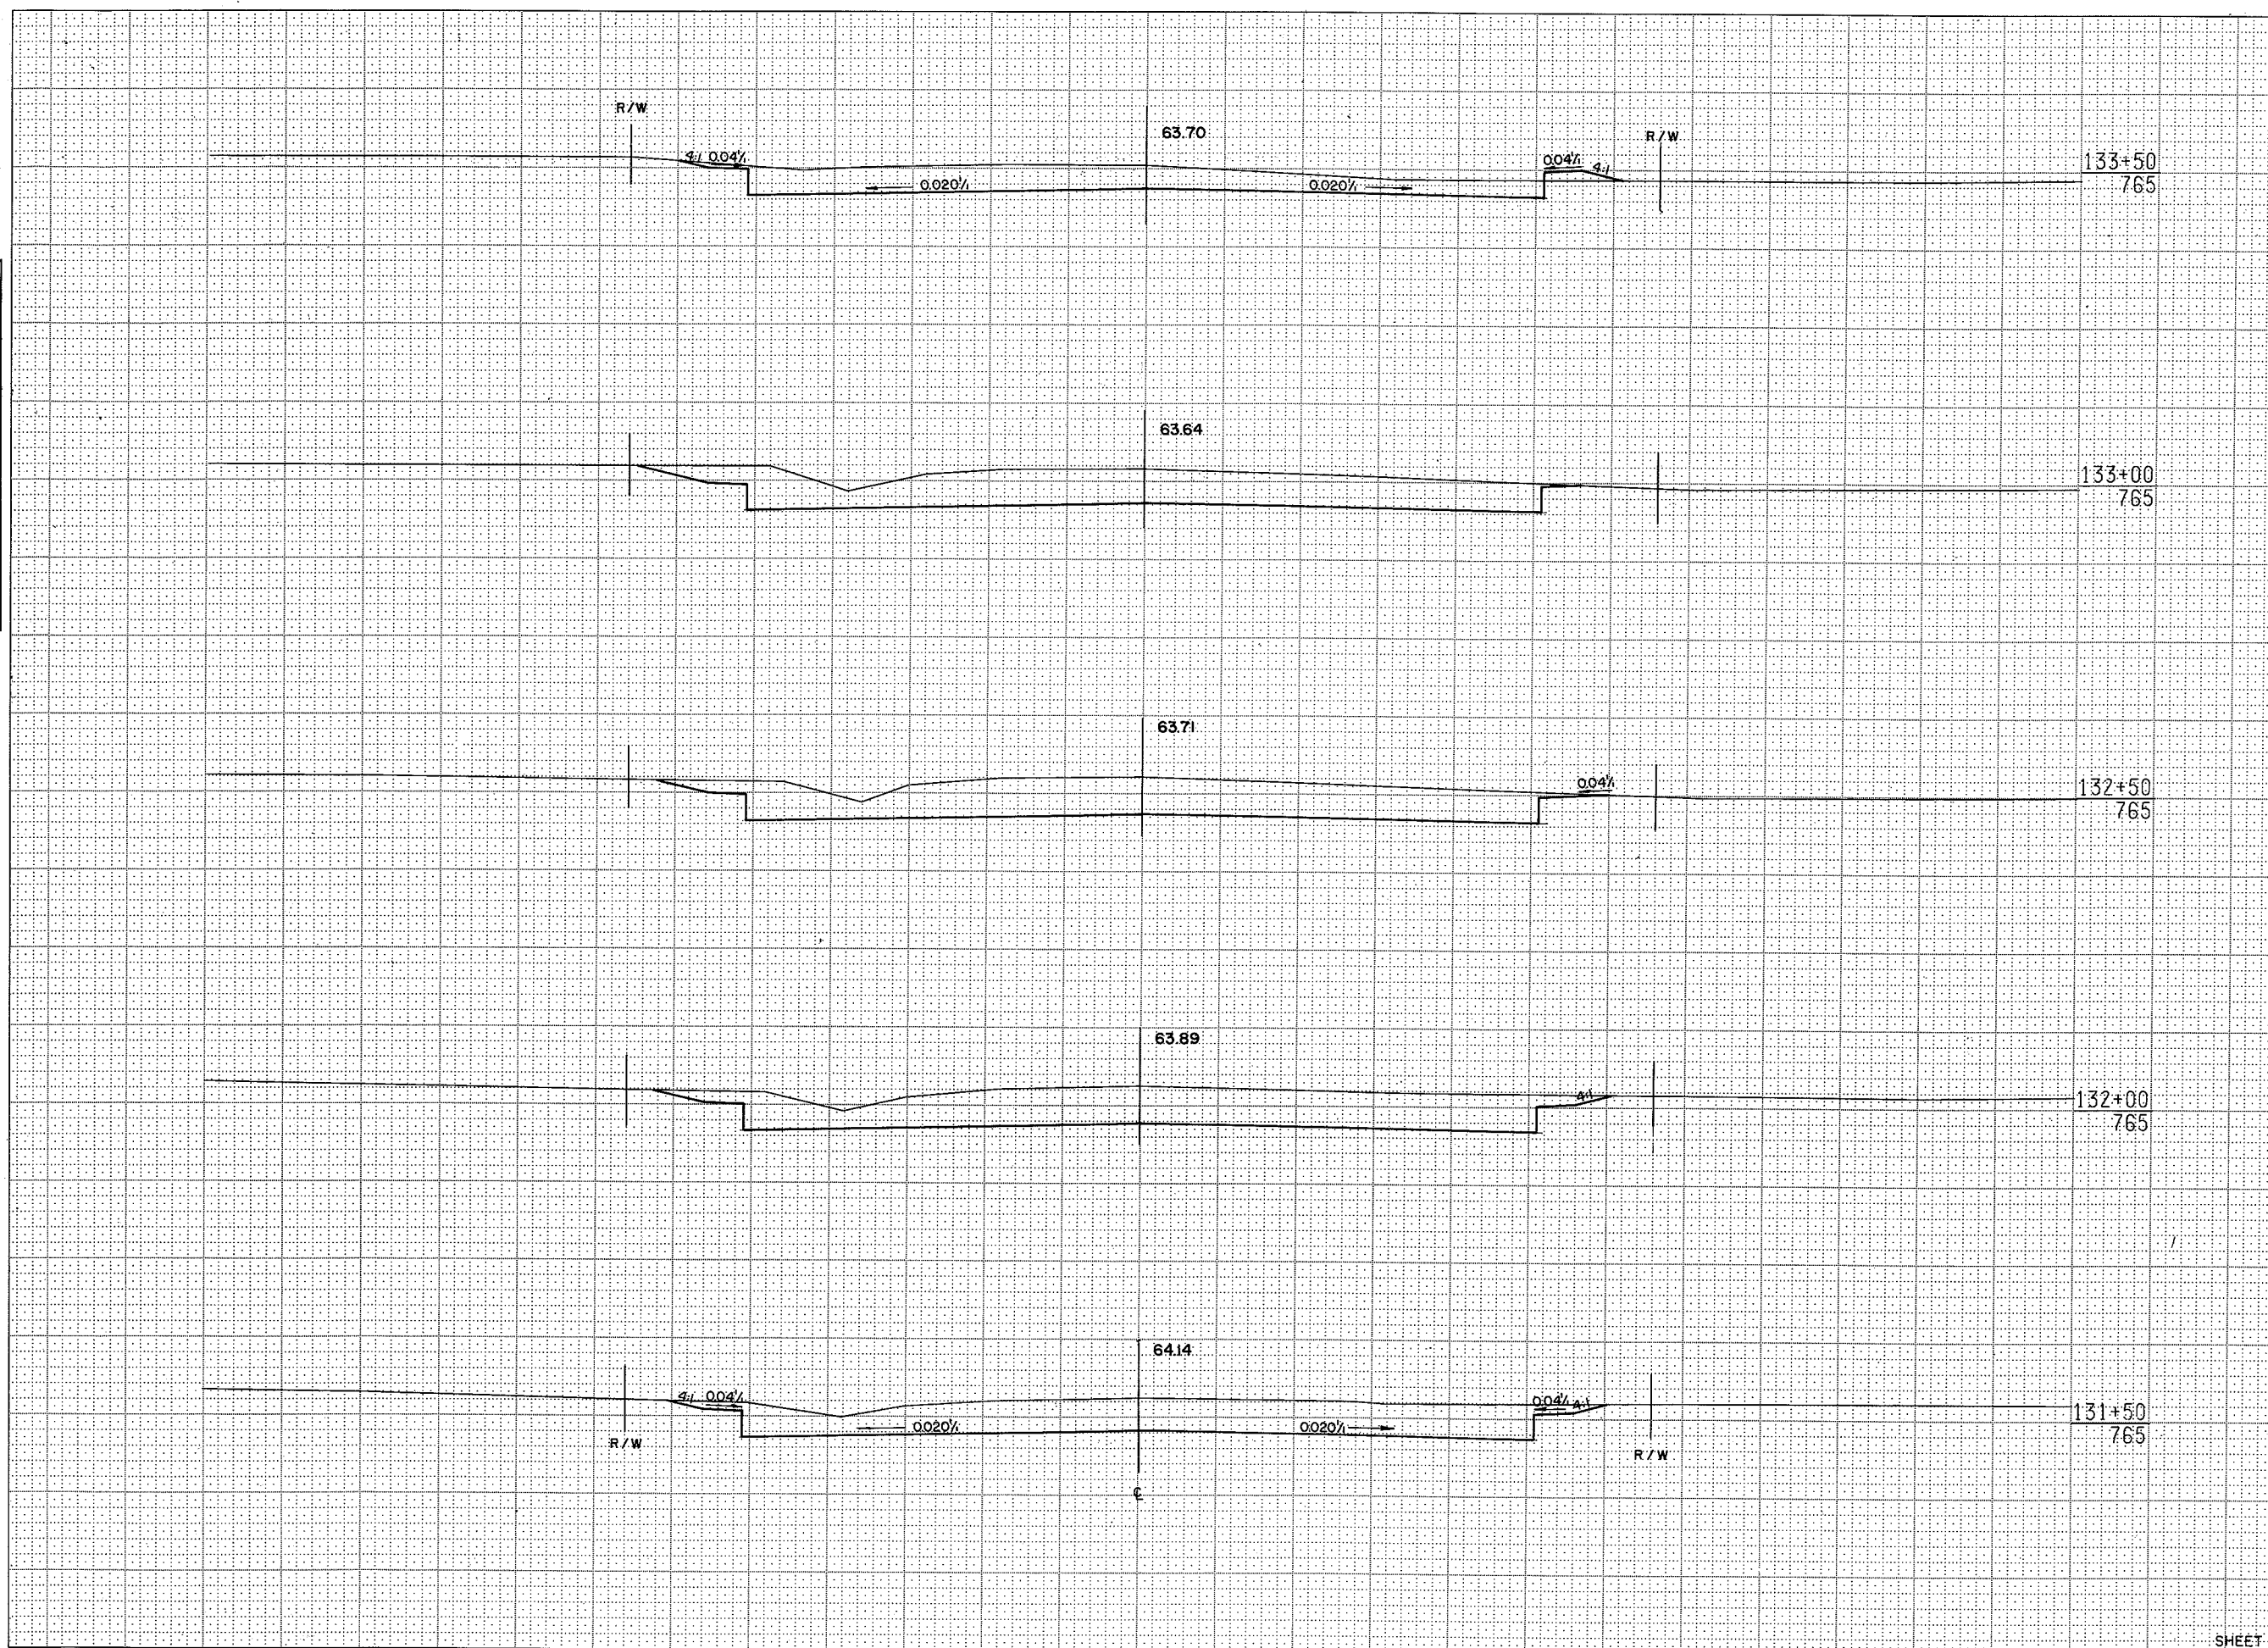

STATION	DISTANCE	YARDAGE	
		EXCAVATION	
		UNCL	FILL
131	50	192	0
	+50	192	0
132	-50	204	0
	+50	197	0
133	50	162	3
	+50		
SHEET TOTAL		947	3

REGION DIVISION	PROJECT	SHEET NUMBER	TOTAL SHEETS
5 WIS.	4994-0-17	88	

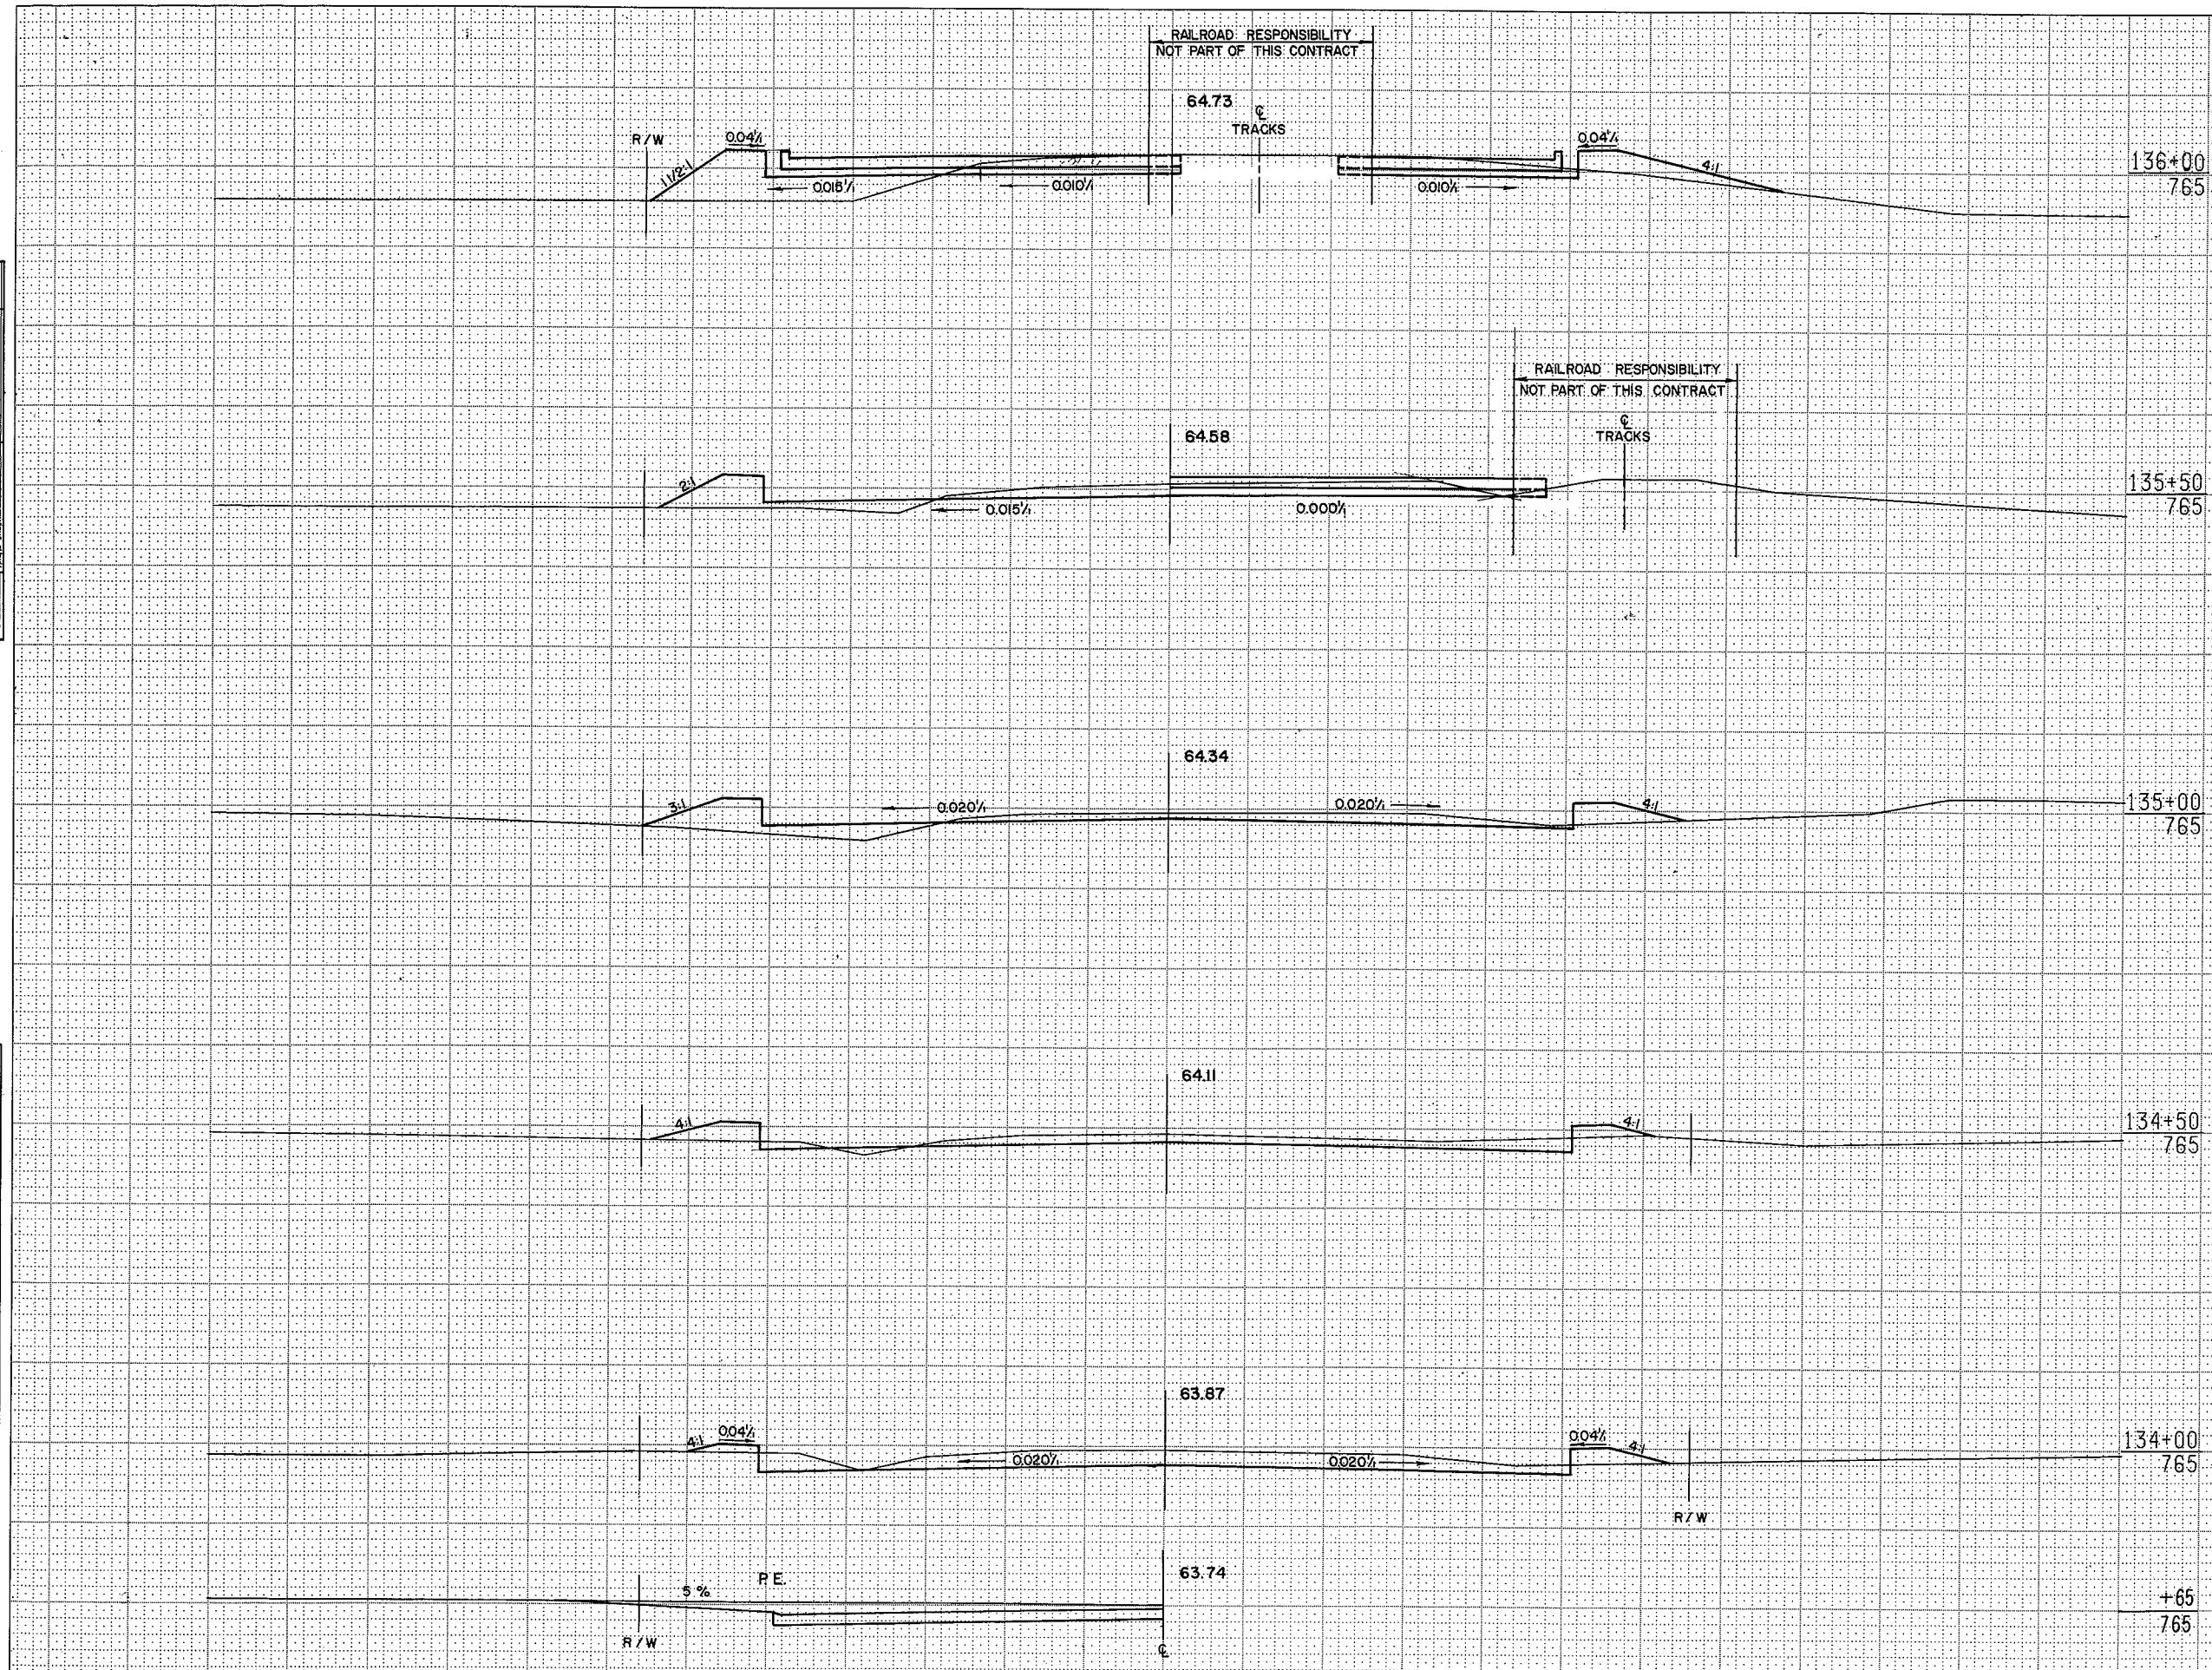

STATION	DISTANCE	YARDAGE	
		EXCAVATION	FILL
		UNCL.	
133			
+50	50	10	8
134			
+50	50	56	18
135			
+50	50	35	35
136			
+50	50	42	43
137			
+50	50	63	44

SHEET TOTAL 206 148


DATE: _____
DRAWN BY: _____
CHECKED BY: _____
NO. _____

DATE: _____
DRAWN BY: _____
CHECKED BY: _____
NO. _____

FINAL SURVEY
 SURVEY PLOTTED
 NOTE BOOK TEMPLATE
 NO. AREAS CHECKED

ORIGINAL SURVEY
 SURVEY PLOTTED
 NOTE BOOK TEMPLATE
 NO. AREAS CHECKED

REGION DIVISION	PROJECT	SHEET NUMBER	TOTAL SHEETS
5 WIS.	4994-0-17	89	

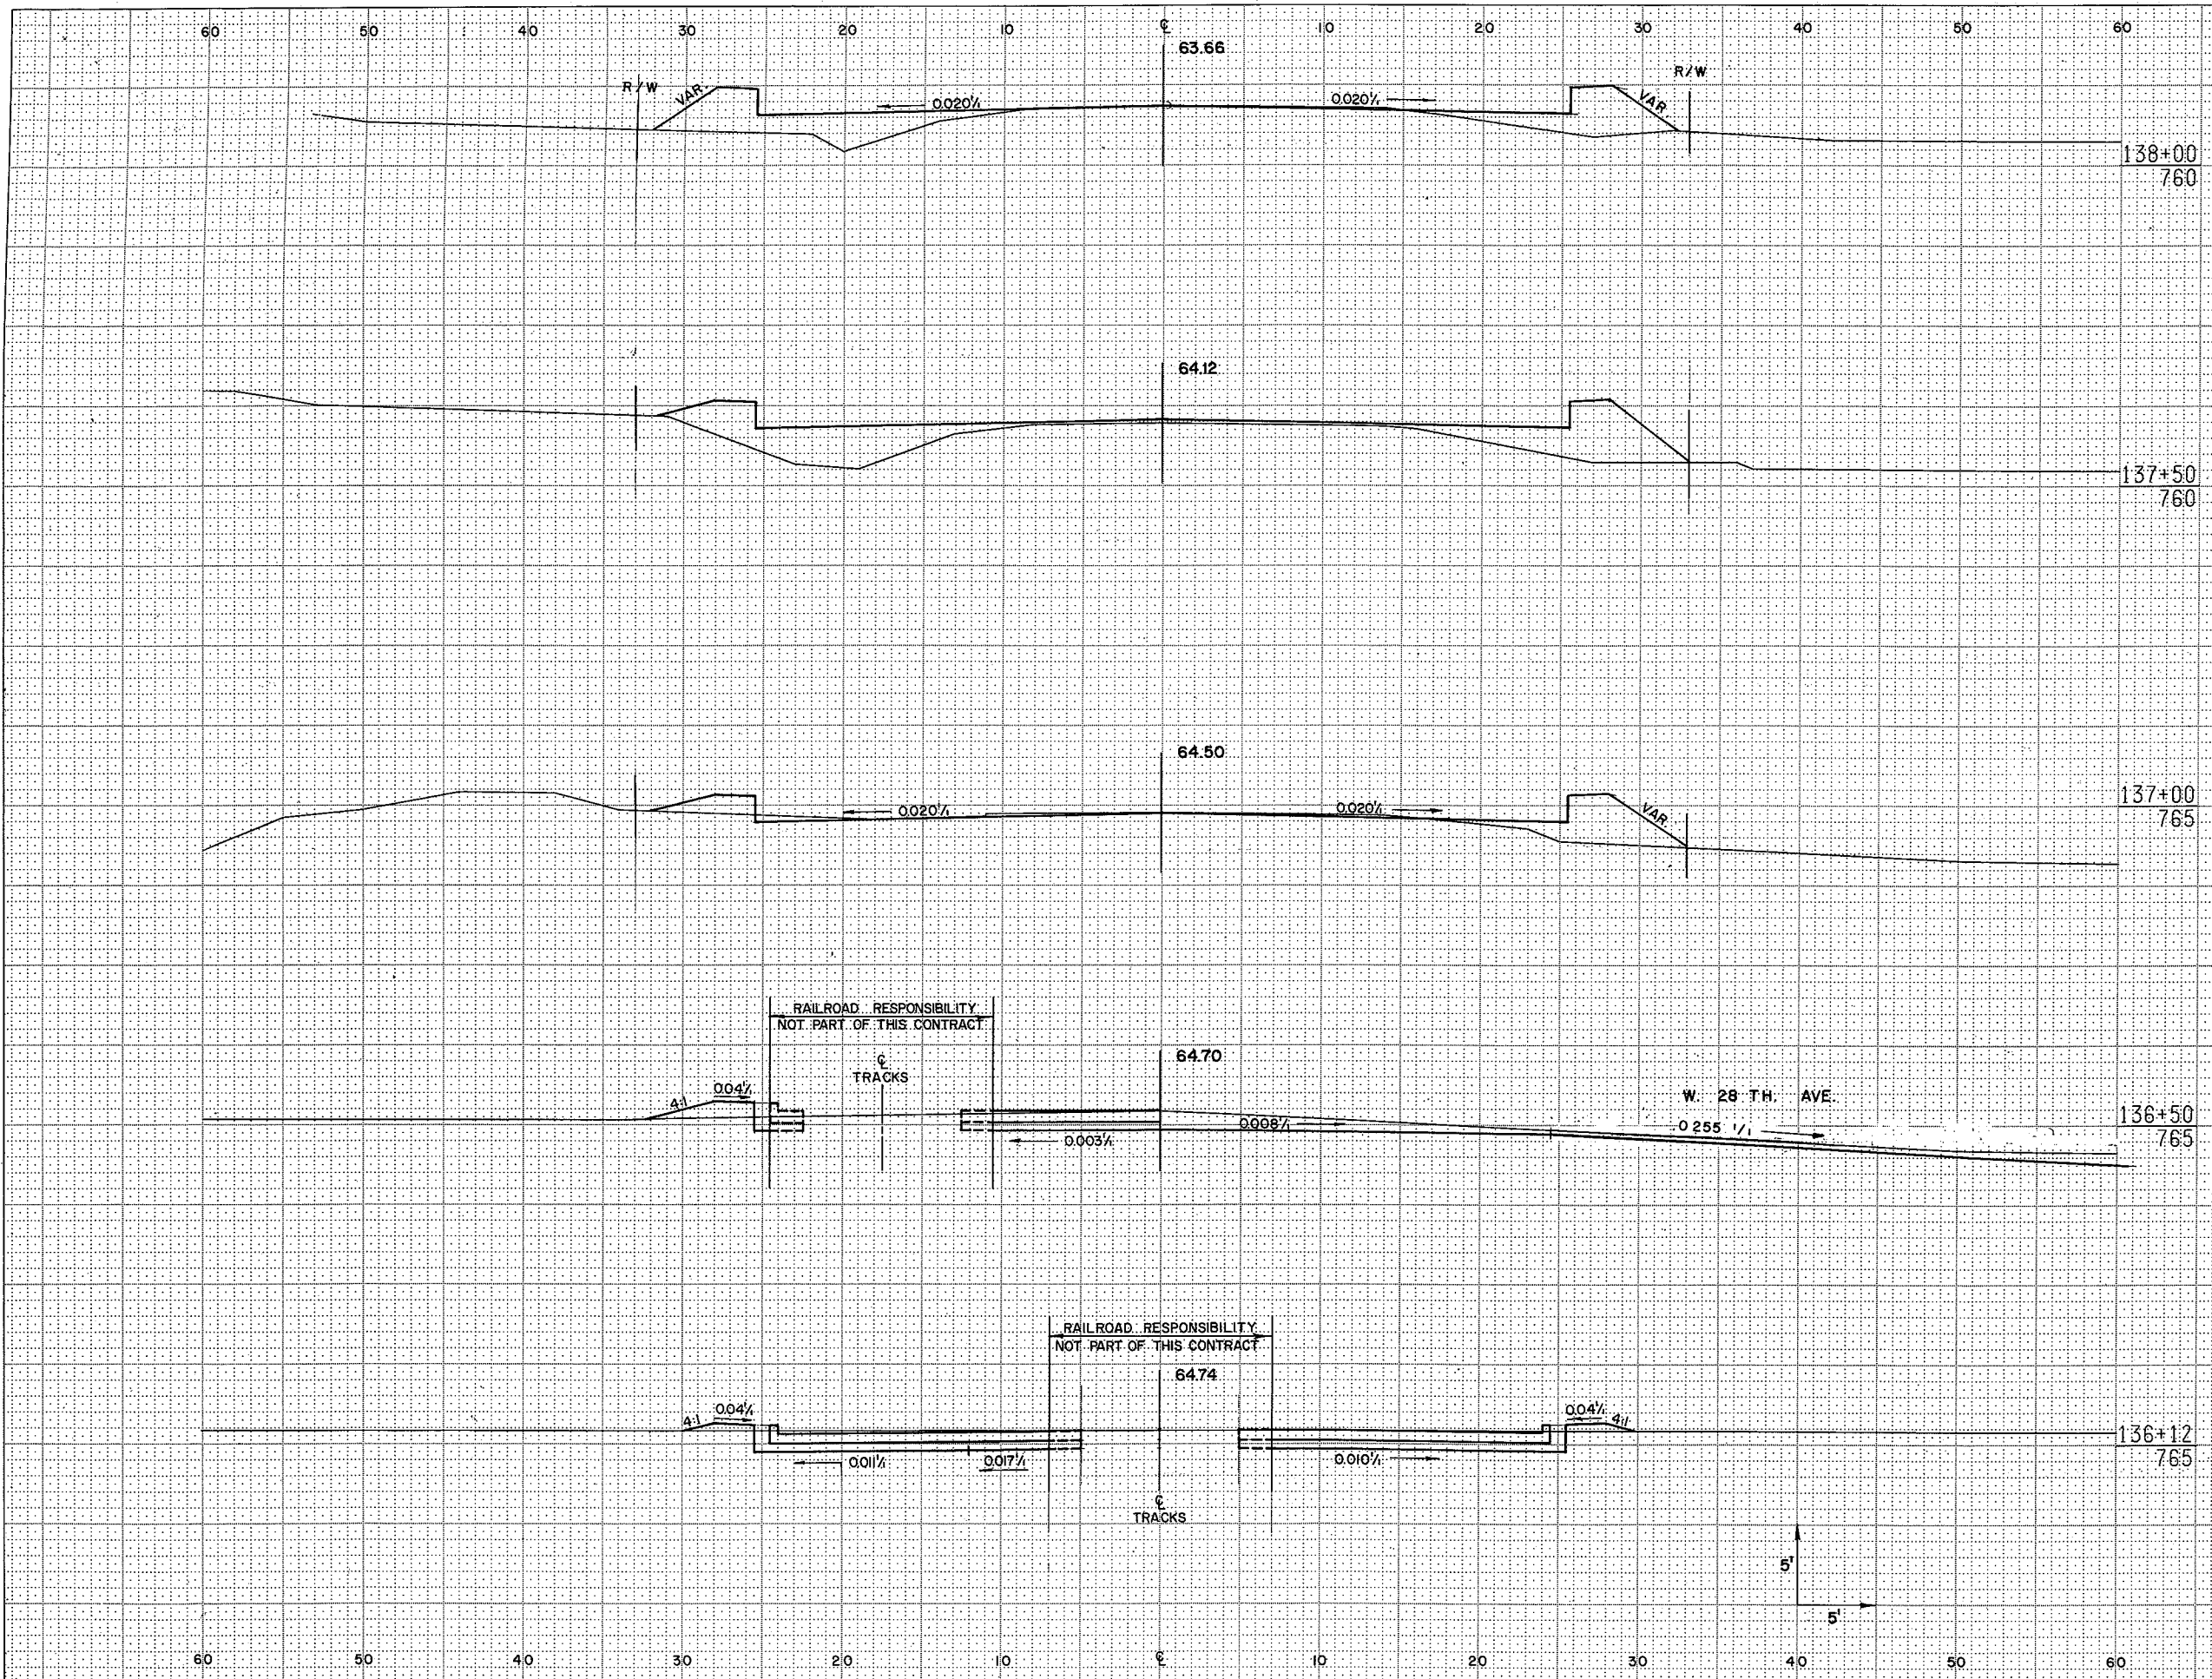


STATION	DISTANCE	YARDAGE	
		EXCAVATION	FILL
		UNCL	
138+00	760		
136	12	22	8
+12	88	99	65
137	50	1	111
+50	50	0	139
138			
137+00	765		
136+50	765		
136+12	765		
SHEET TOTAL		122	323

REGION DIVISION	PROJECT	SHEET NUMBER	TOTAL SHEETS
5 WIS.	4994-0-17	8/11	


DATE	BY
FINAL SURVEY	SURVEY
NOTE BOOK	TEMPLATE
NO.	AREA
	AREA CHECKED

DATE	BY
ORIGINAL SURVEY	SURVEY
NOTE BOOK	TEMPLATE
NO.	AREA
	AREA CHECKED

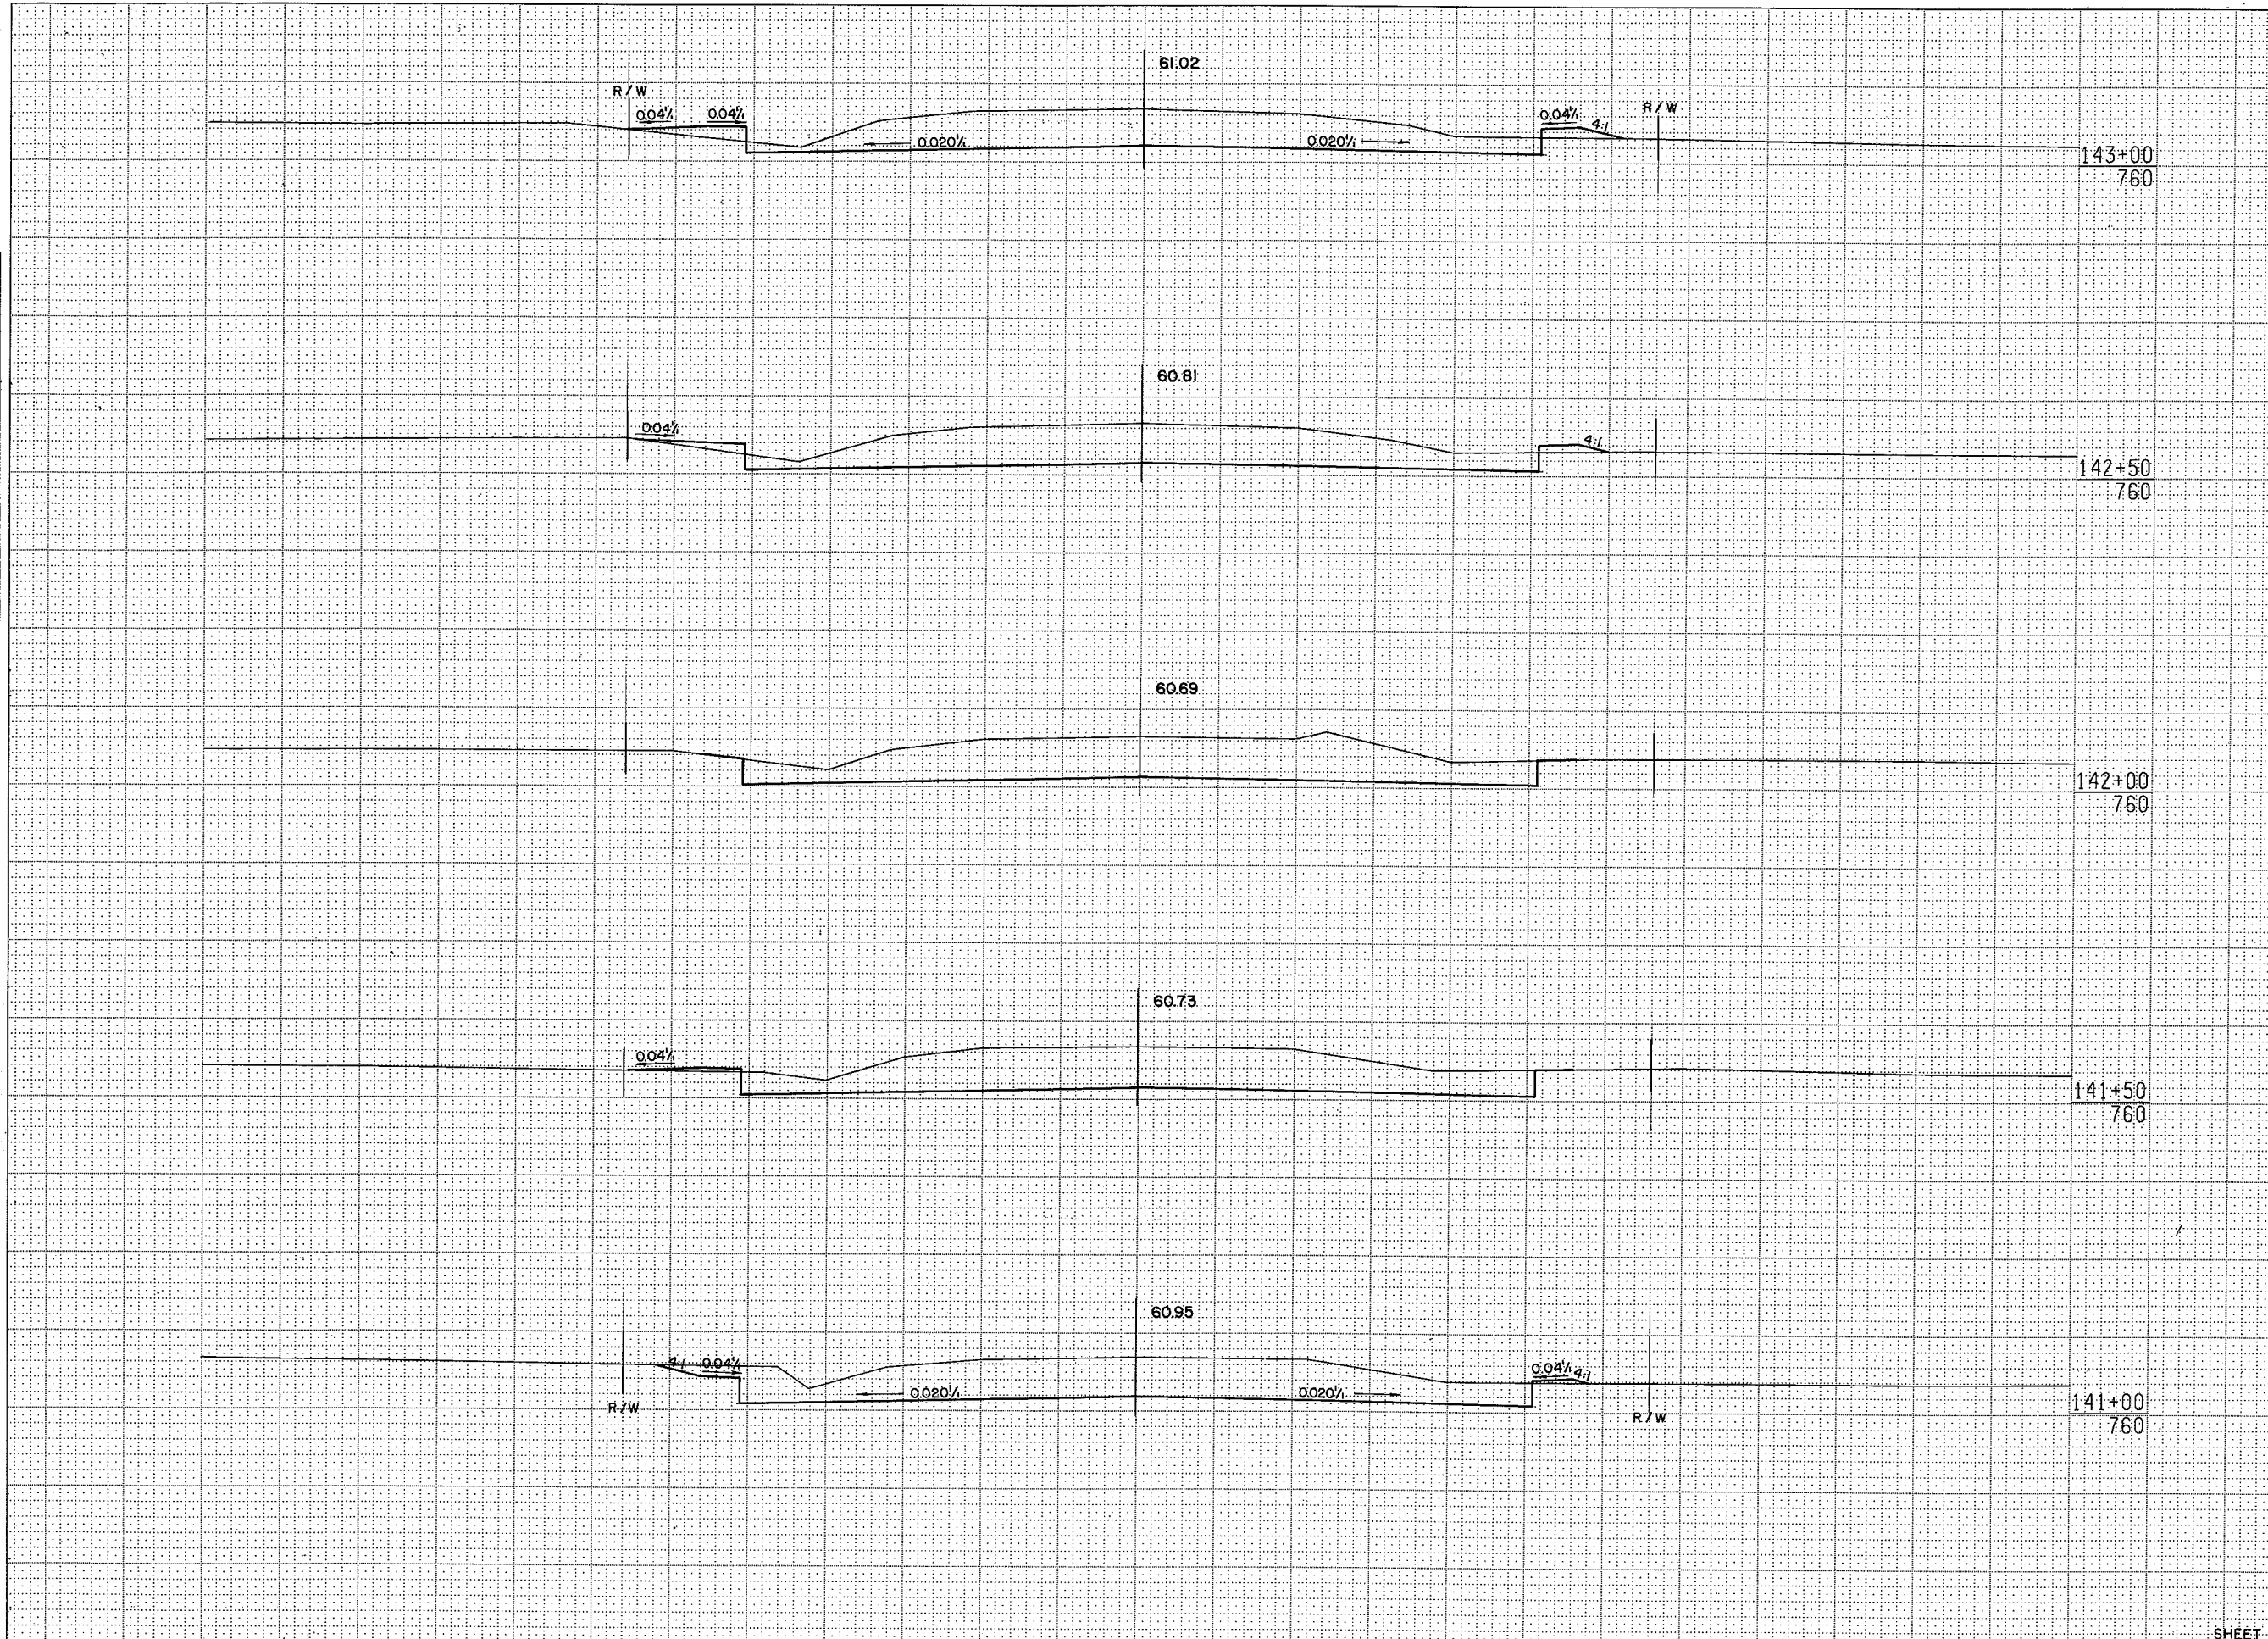

STATION	DISTANCE	YARDAGE	
		EXCAVATION	FILL
		UNCL.	
143+00			
+50	50	193	0
141			
+50	50	198	0
142			
+50	50	200	0
142			
+50	50	190	6
143			
+50	50	173	13
143			
SHEET TOTAL		954	19

REGION DIVISION	PROJECT	SHEET NUMBER	TOTAL SHEETS
5 WIS.	4994-0-17	8.12	

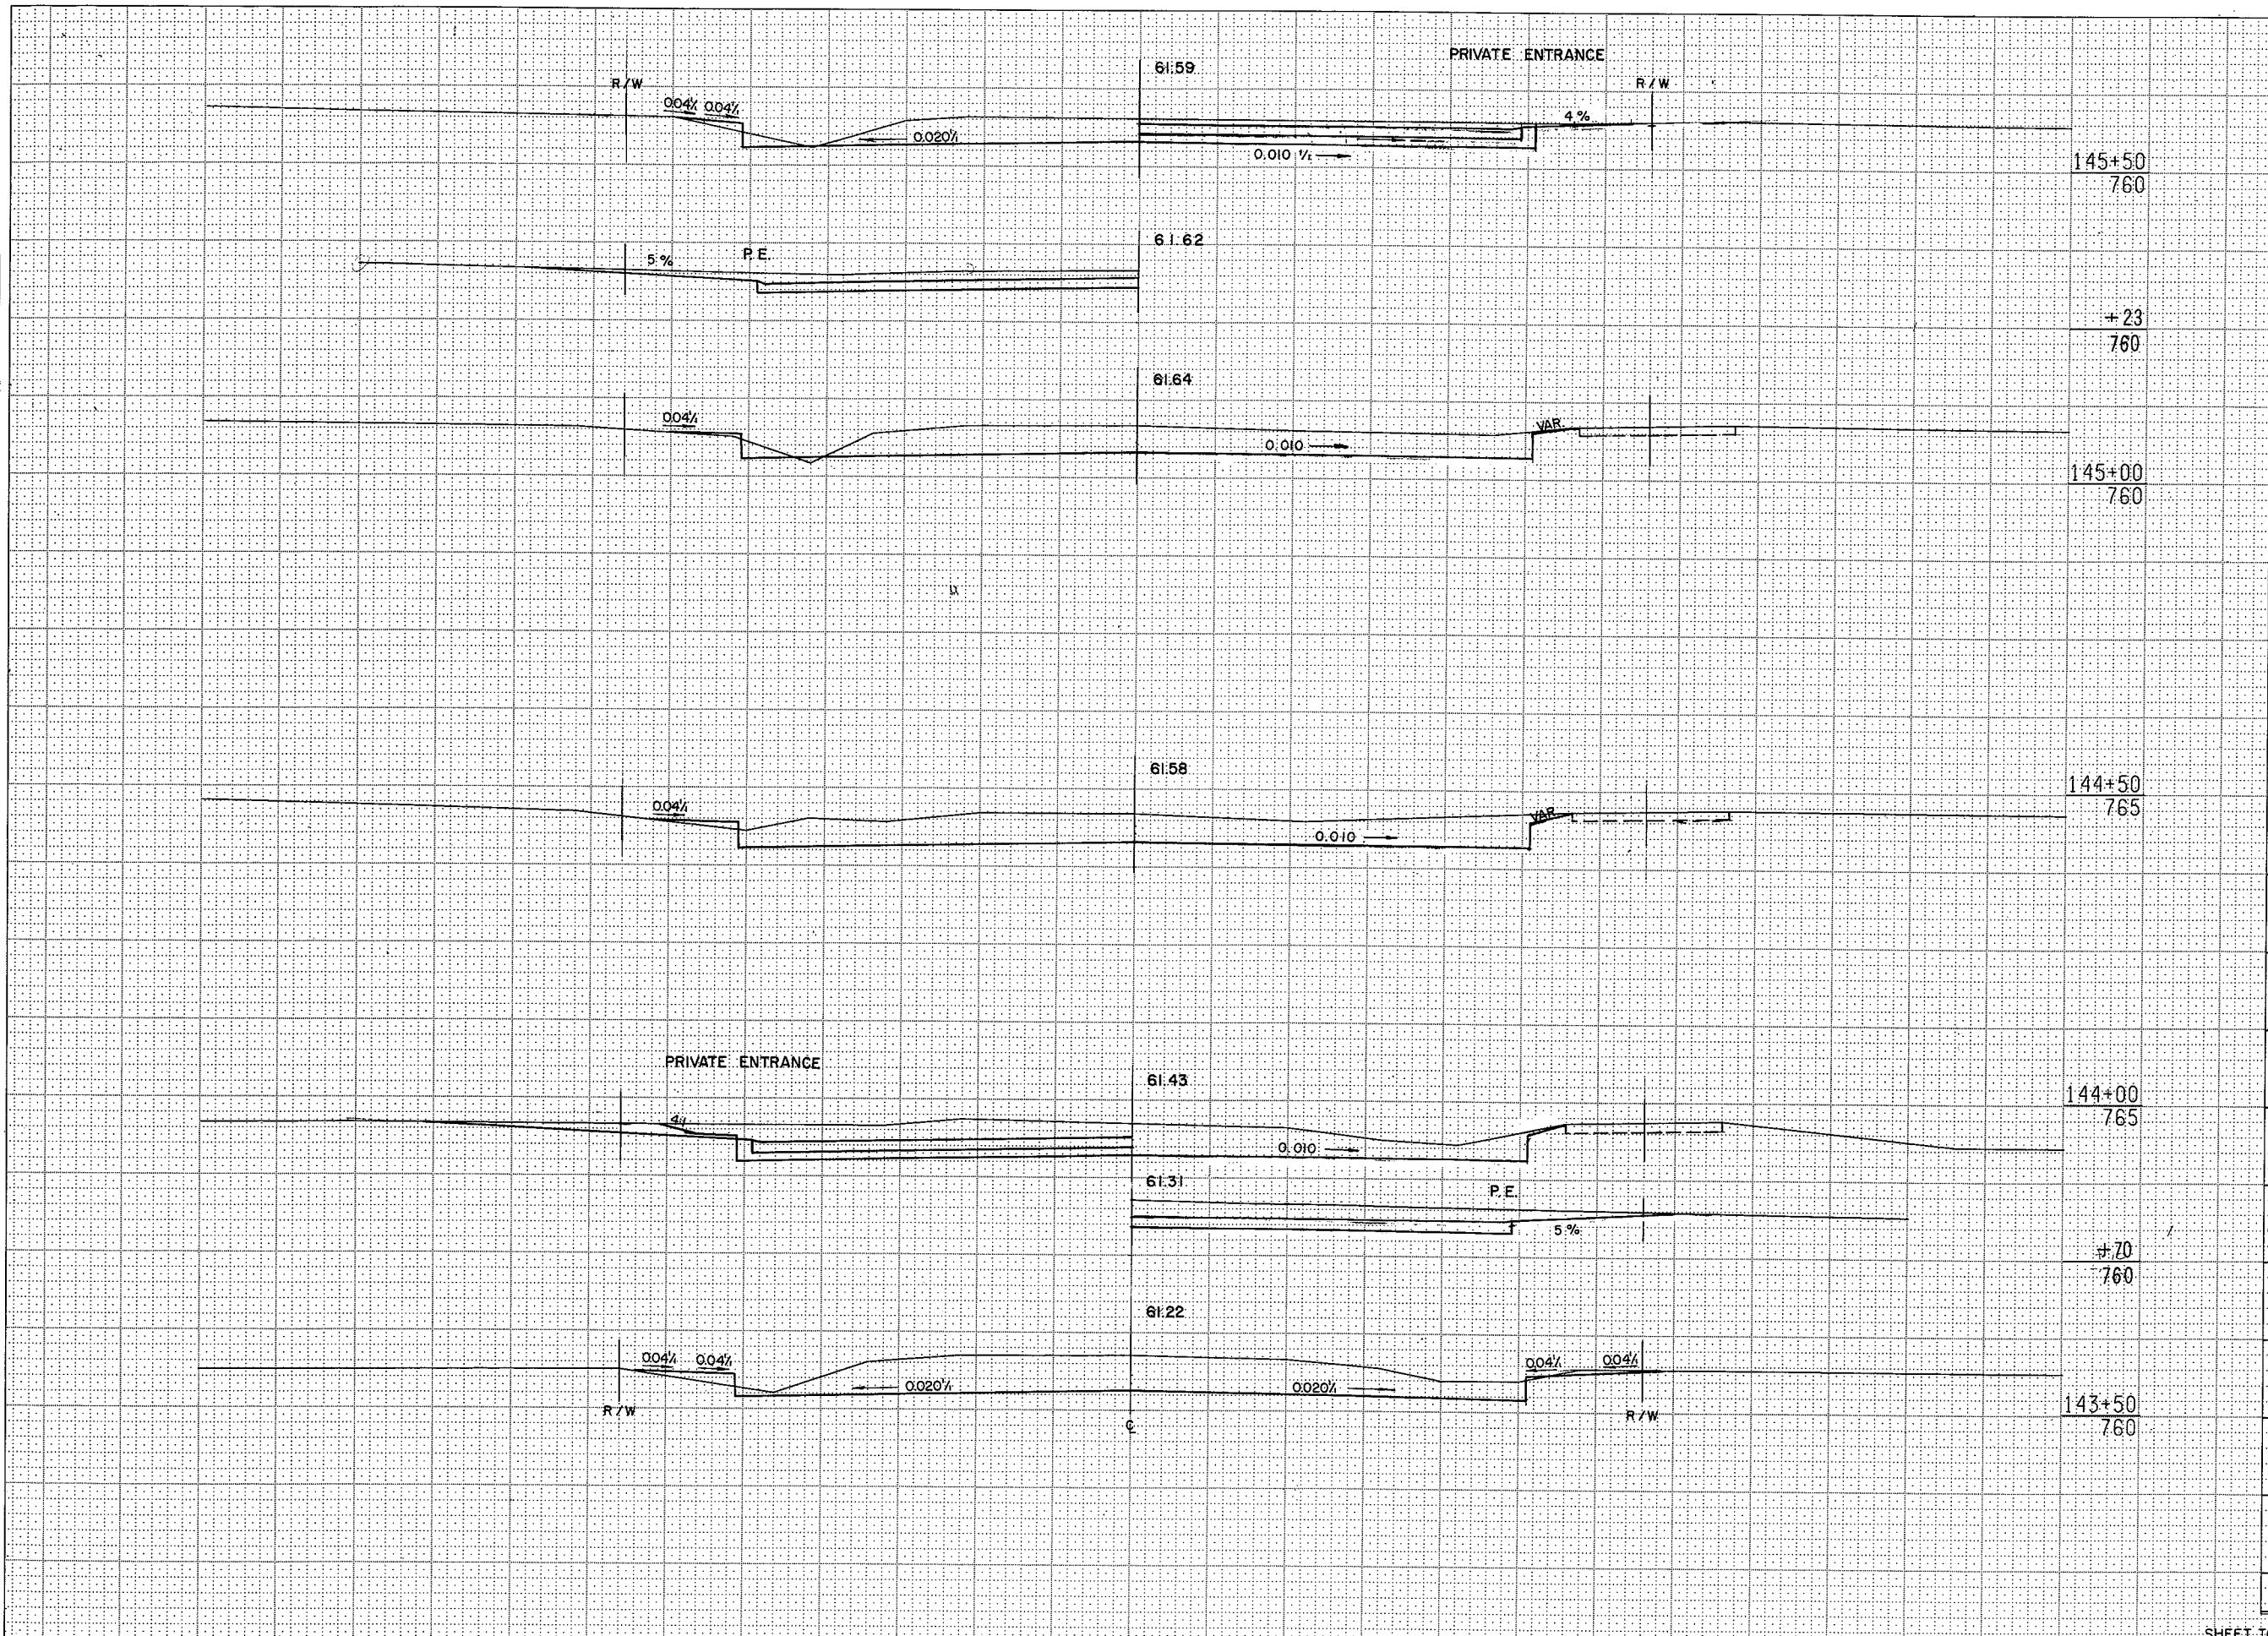


STATION	DISTANCE	YARDAGE	
		EXCAVATION	FILL
		UNCL	
145+50	760		
+23	760	178	10
+50	760	194	3
145+00	760	181	2
+50	760	156	3
145	760	141	3
+50			
144+50	765		
144+00	765		
+70	760		
143+50	760		
SHEET TOTAL		850	21

SURVEY PLOTTER
 NOTE BOOK TEMPLATE
 NO. _____
 SURVEY PLOTTER
 NOTE BOOK TEMPLATE
 NO. _____

DATE
BY
SURVEYED
DATE
NO. OF
NOTES
BOOK
NO.
AREAS
CHECKED


DATE
BY
ORIGINAL
SURVEY
DATE
NO. OF
NOTES
BOOK
NO.
AREAS
CHECKED

REGION DIVISION 5 WIS.	PROJECT 4994-0-17	SHEET NUMBER 813	TOTAL SHEETS
---------------------------------	----------------------	------------------------	-----------------

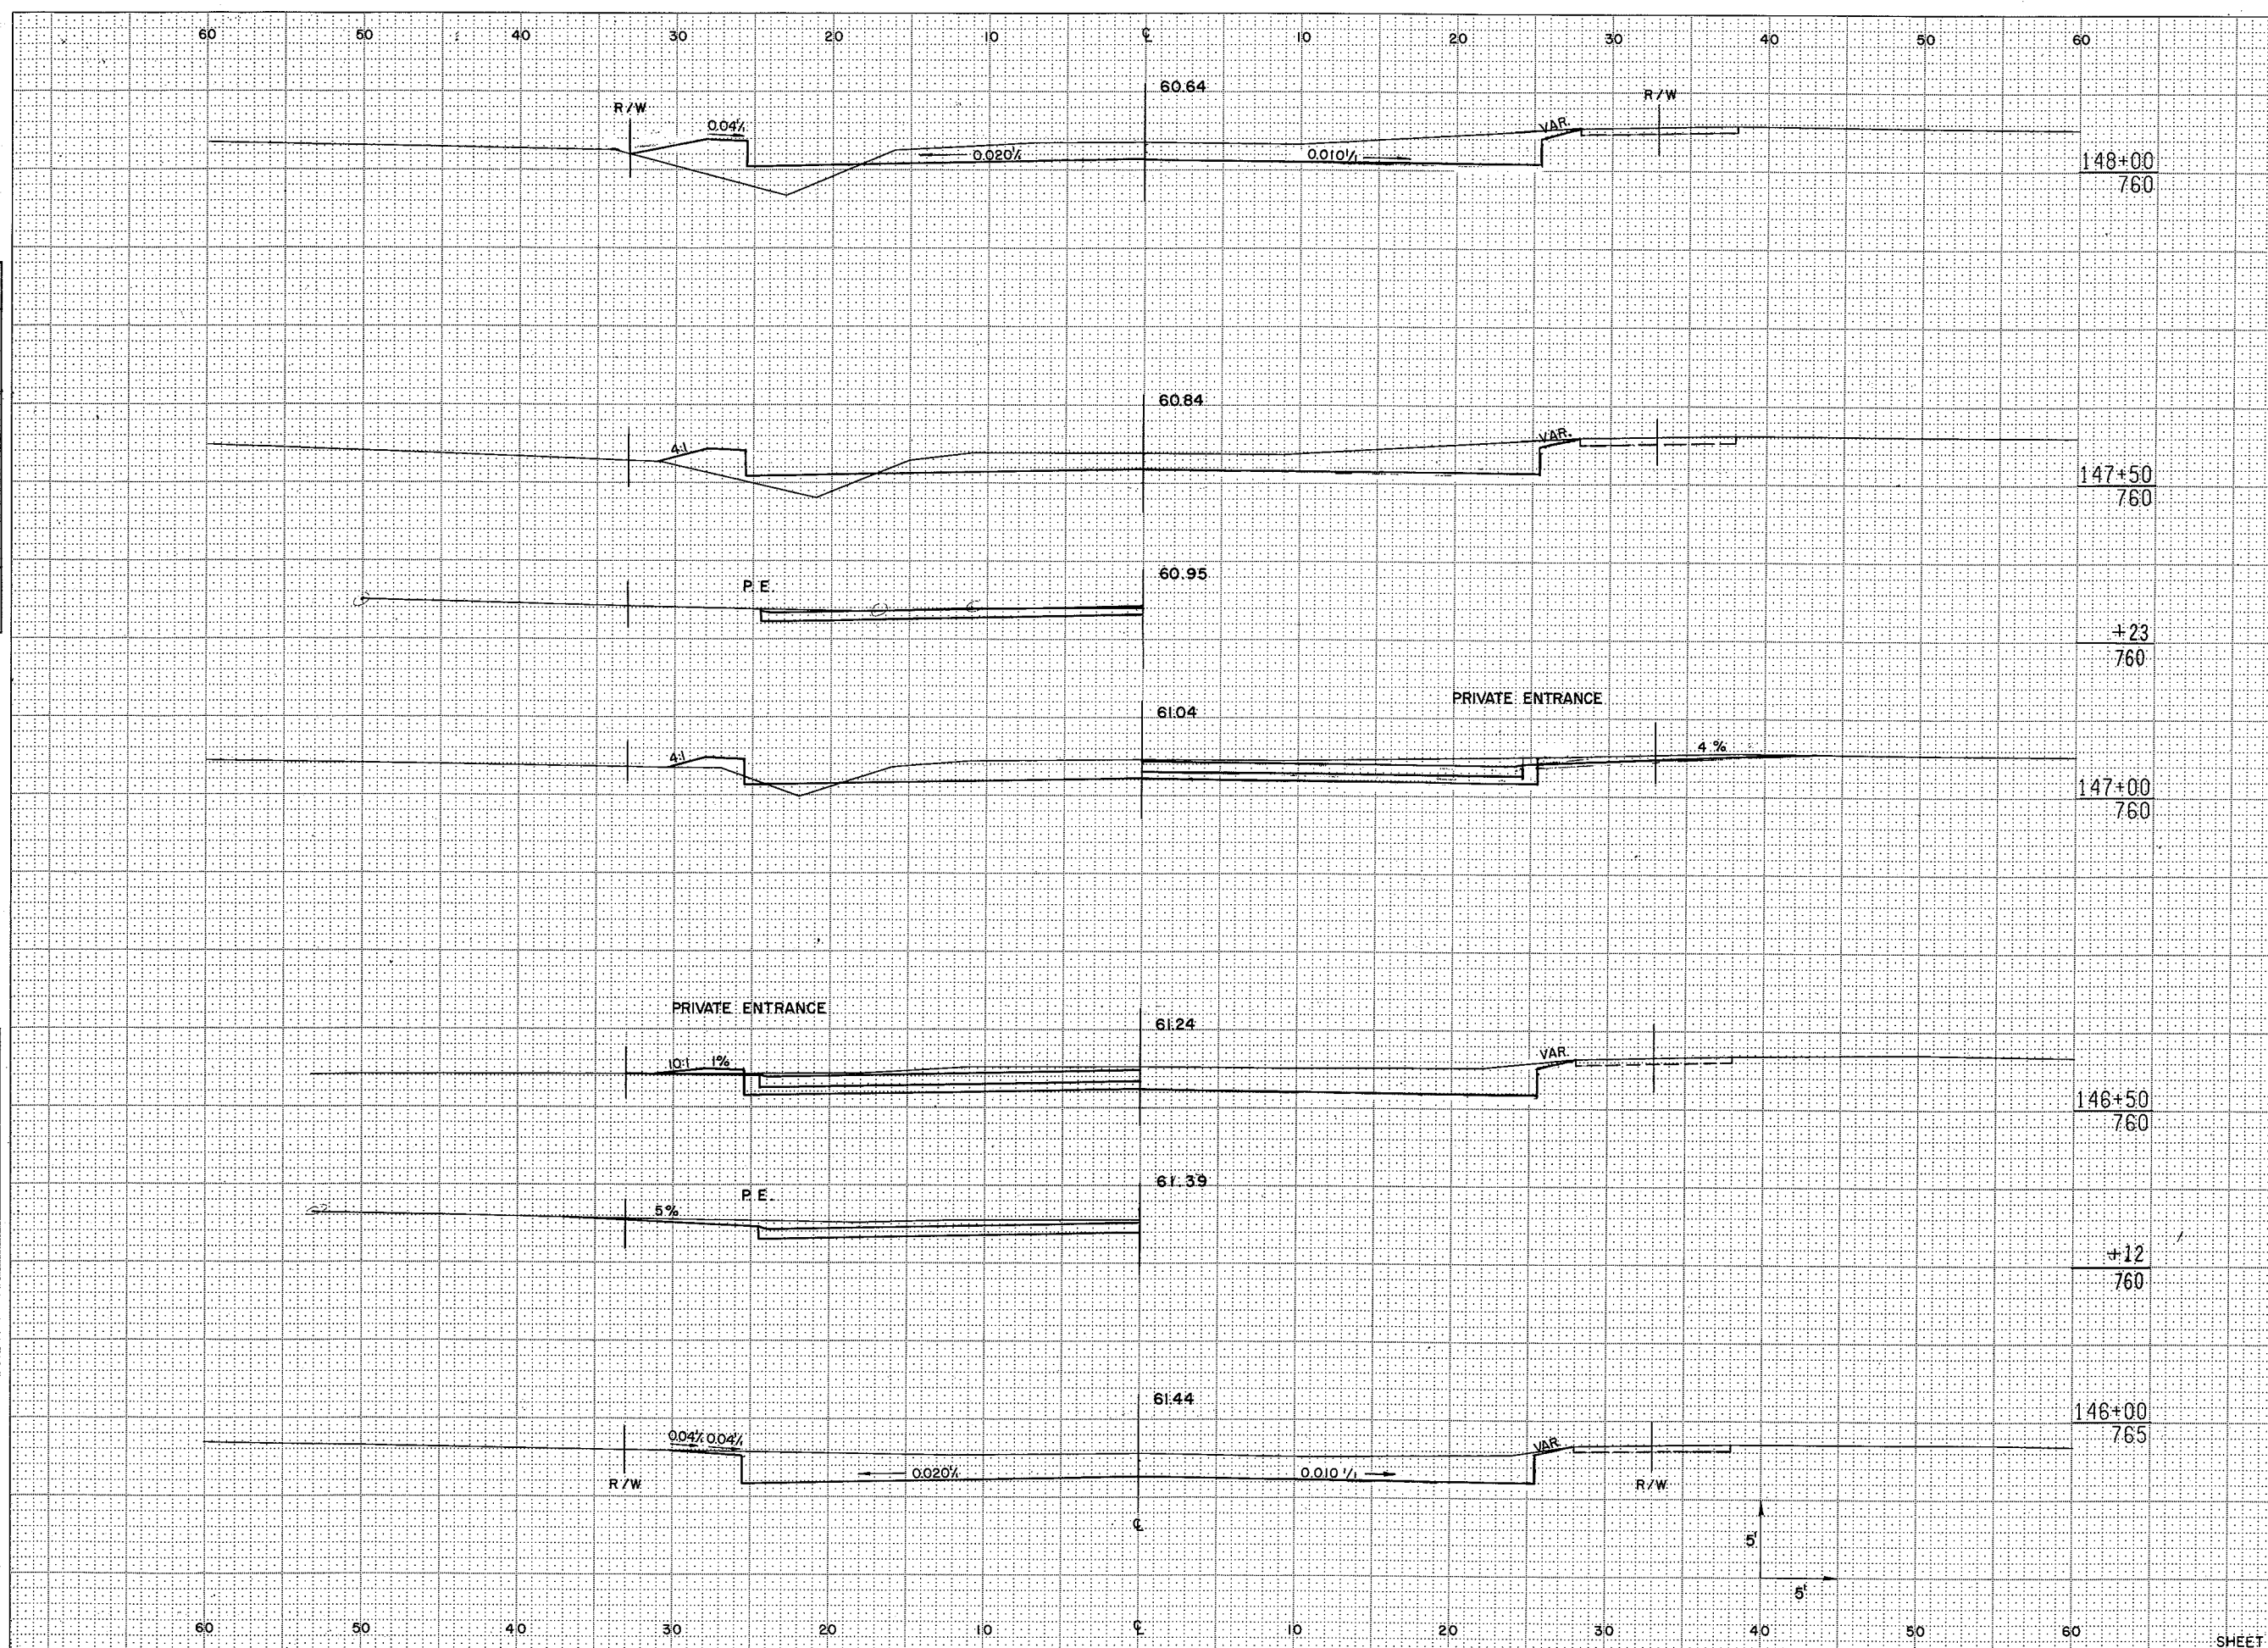

STATION	DISTANCE	YARDAGE	
		EXCAVATION UNCL	FILL
148+00	760		
+50	50	140	2
146+50	50	149	0
147+50	50	126	2
147	50	105	13
+50	50	108	26
148			
147+00	760		
146+50	760		
+12	760		
146+00	765		
SHEET TOTAL		628	43

REGION	PROJECT	SHEET	TOTAL
DIVISION	NUMBER	NUMBER	SHEETS
5	4994-0-17	814	
WIS.			

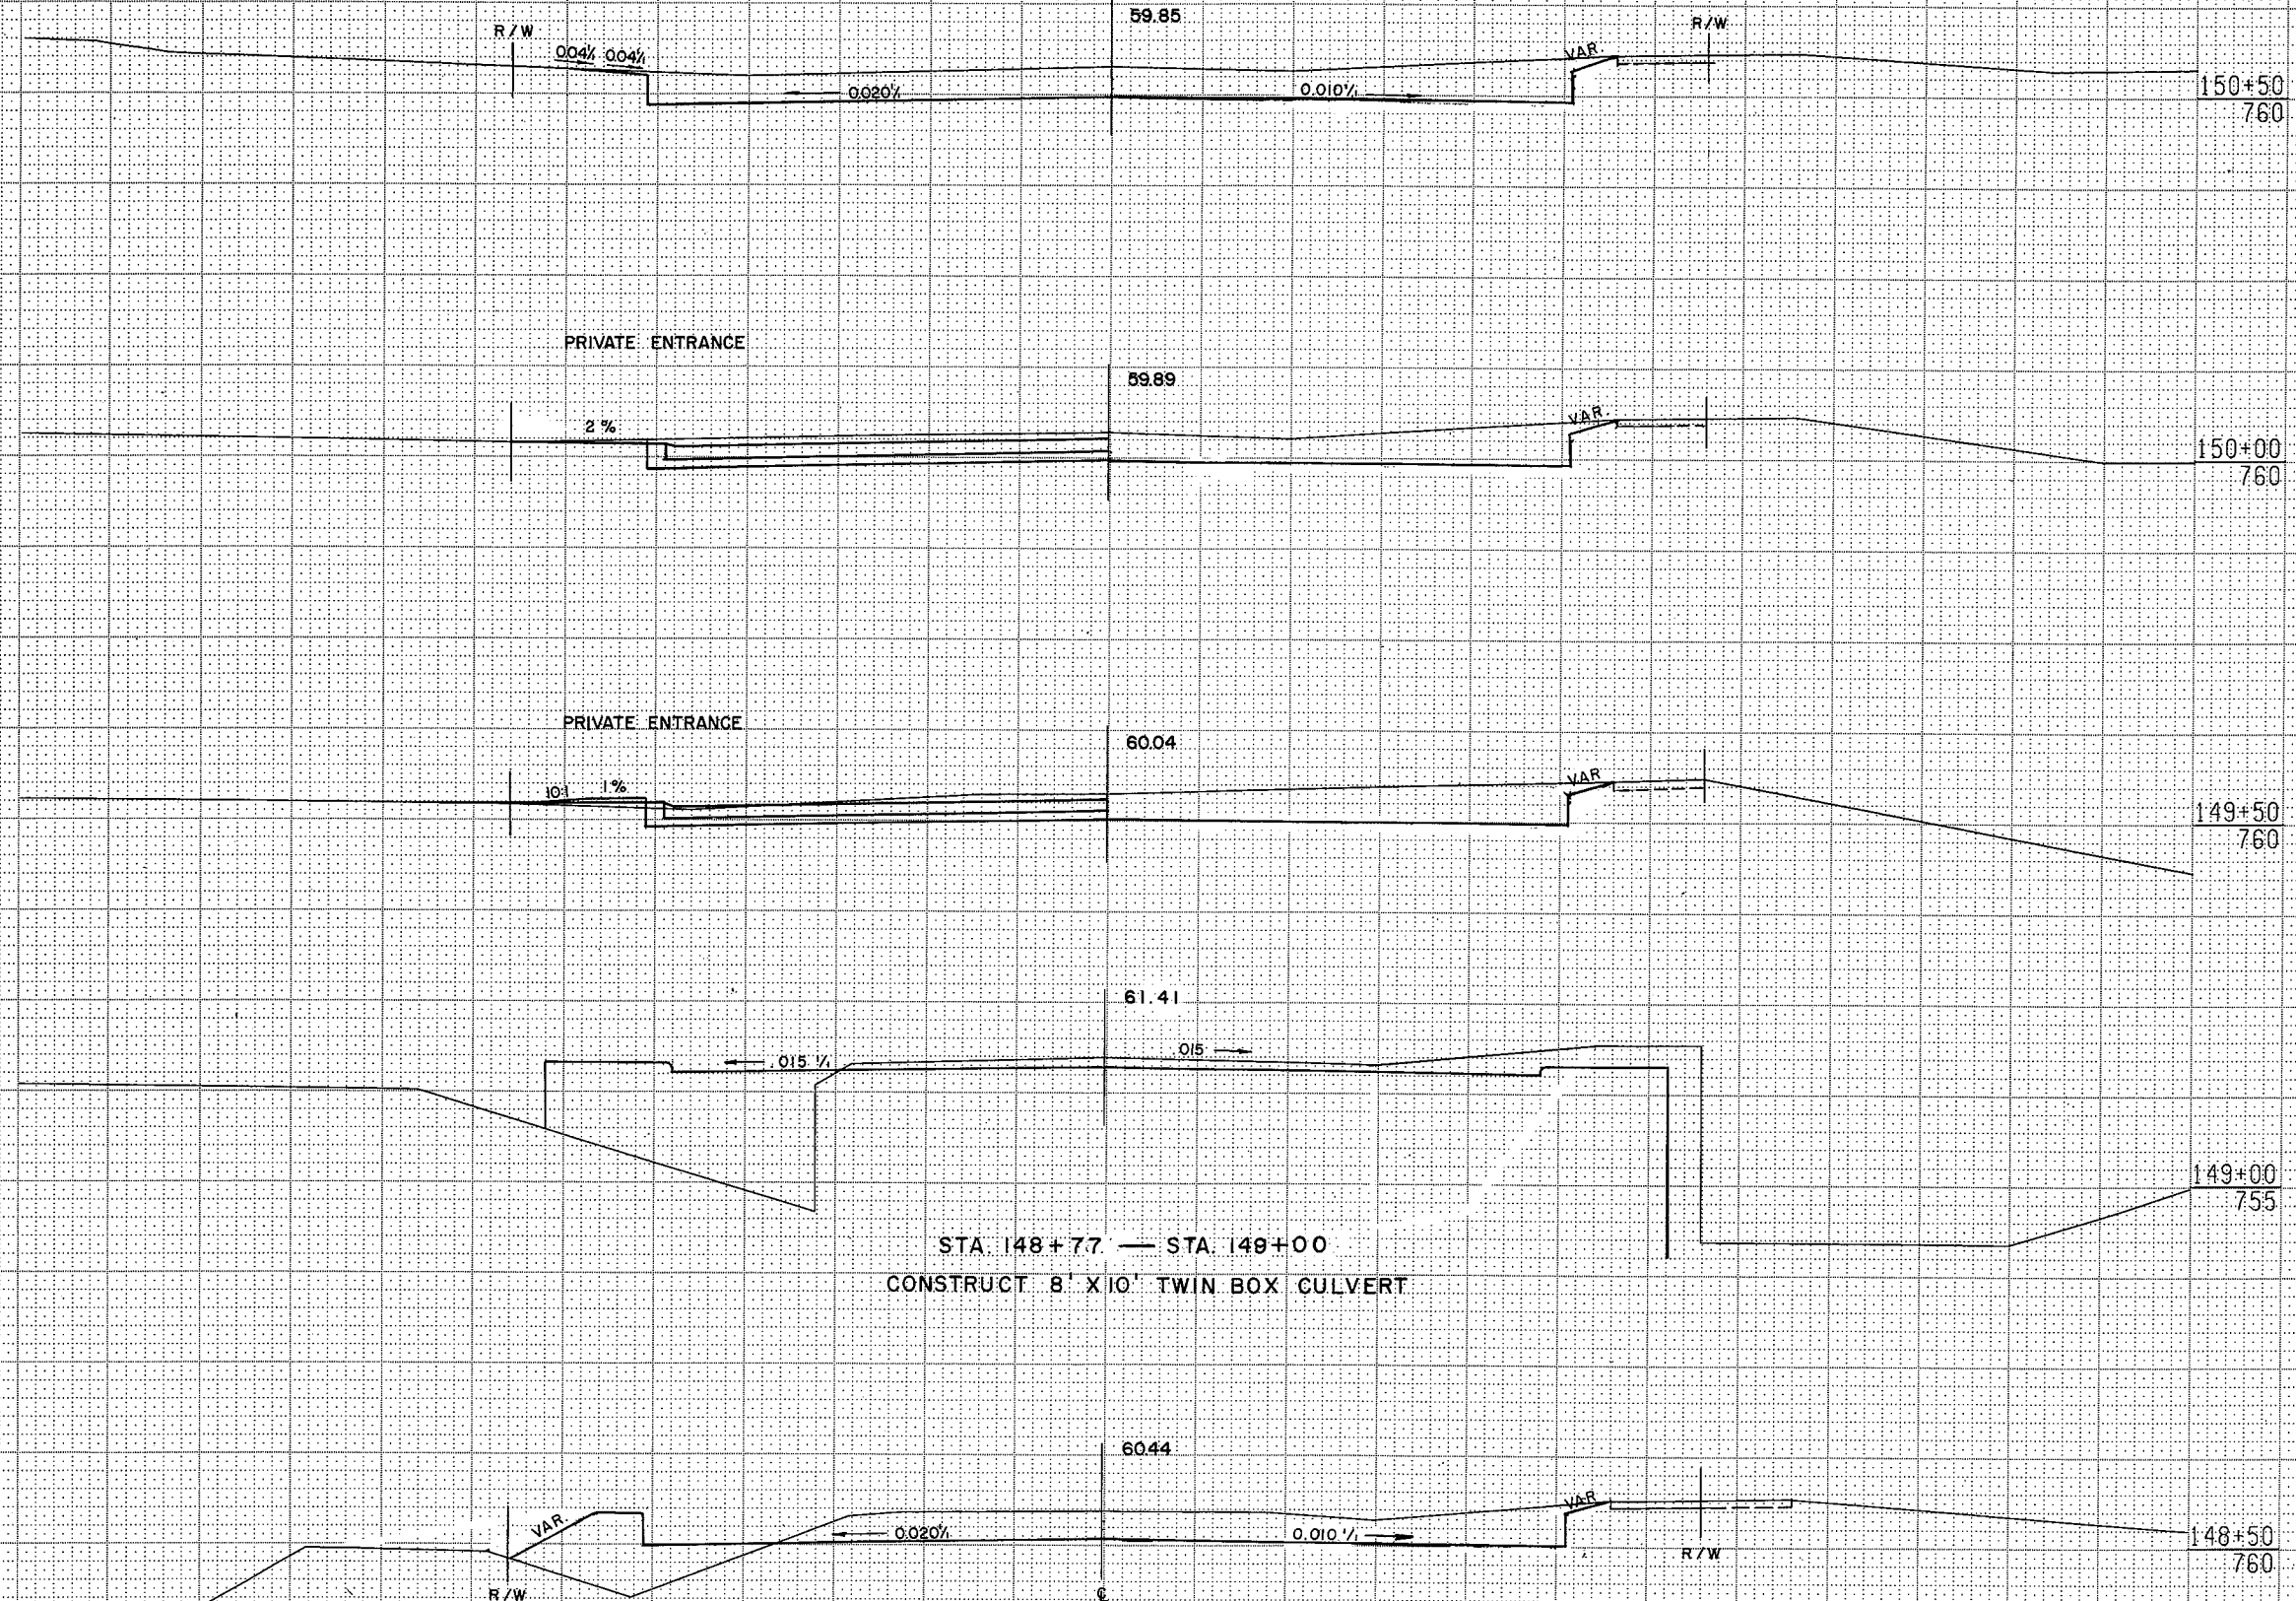


STATION	DISTANCE	YARDAGE	
		EXCAVATION	FILL
		UNCL.	
148+50	50	48	56
149+00	27	65	42
149+50	50	130	74
150+00	50	154	5
150+50		180	0
SHEET TOTAL		577	177

SURVEY PLOTTED
 NOTE BOOK NO.
 TEMPLATE NO.
 REVISIONS CHECKED

SURVEY PLOTTED
 NOTE BOOK NO.
 TEMPLATE NO.
 REVISIONS CHECKED

REGION DIVISION	PROJECT	SHEET NUMBER	TOTAL SHEETS
5 WIS.	4994-0-17	8.16	

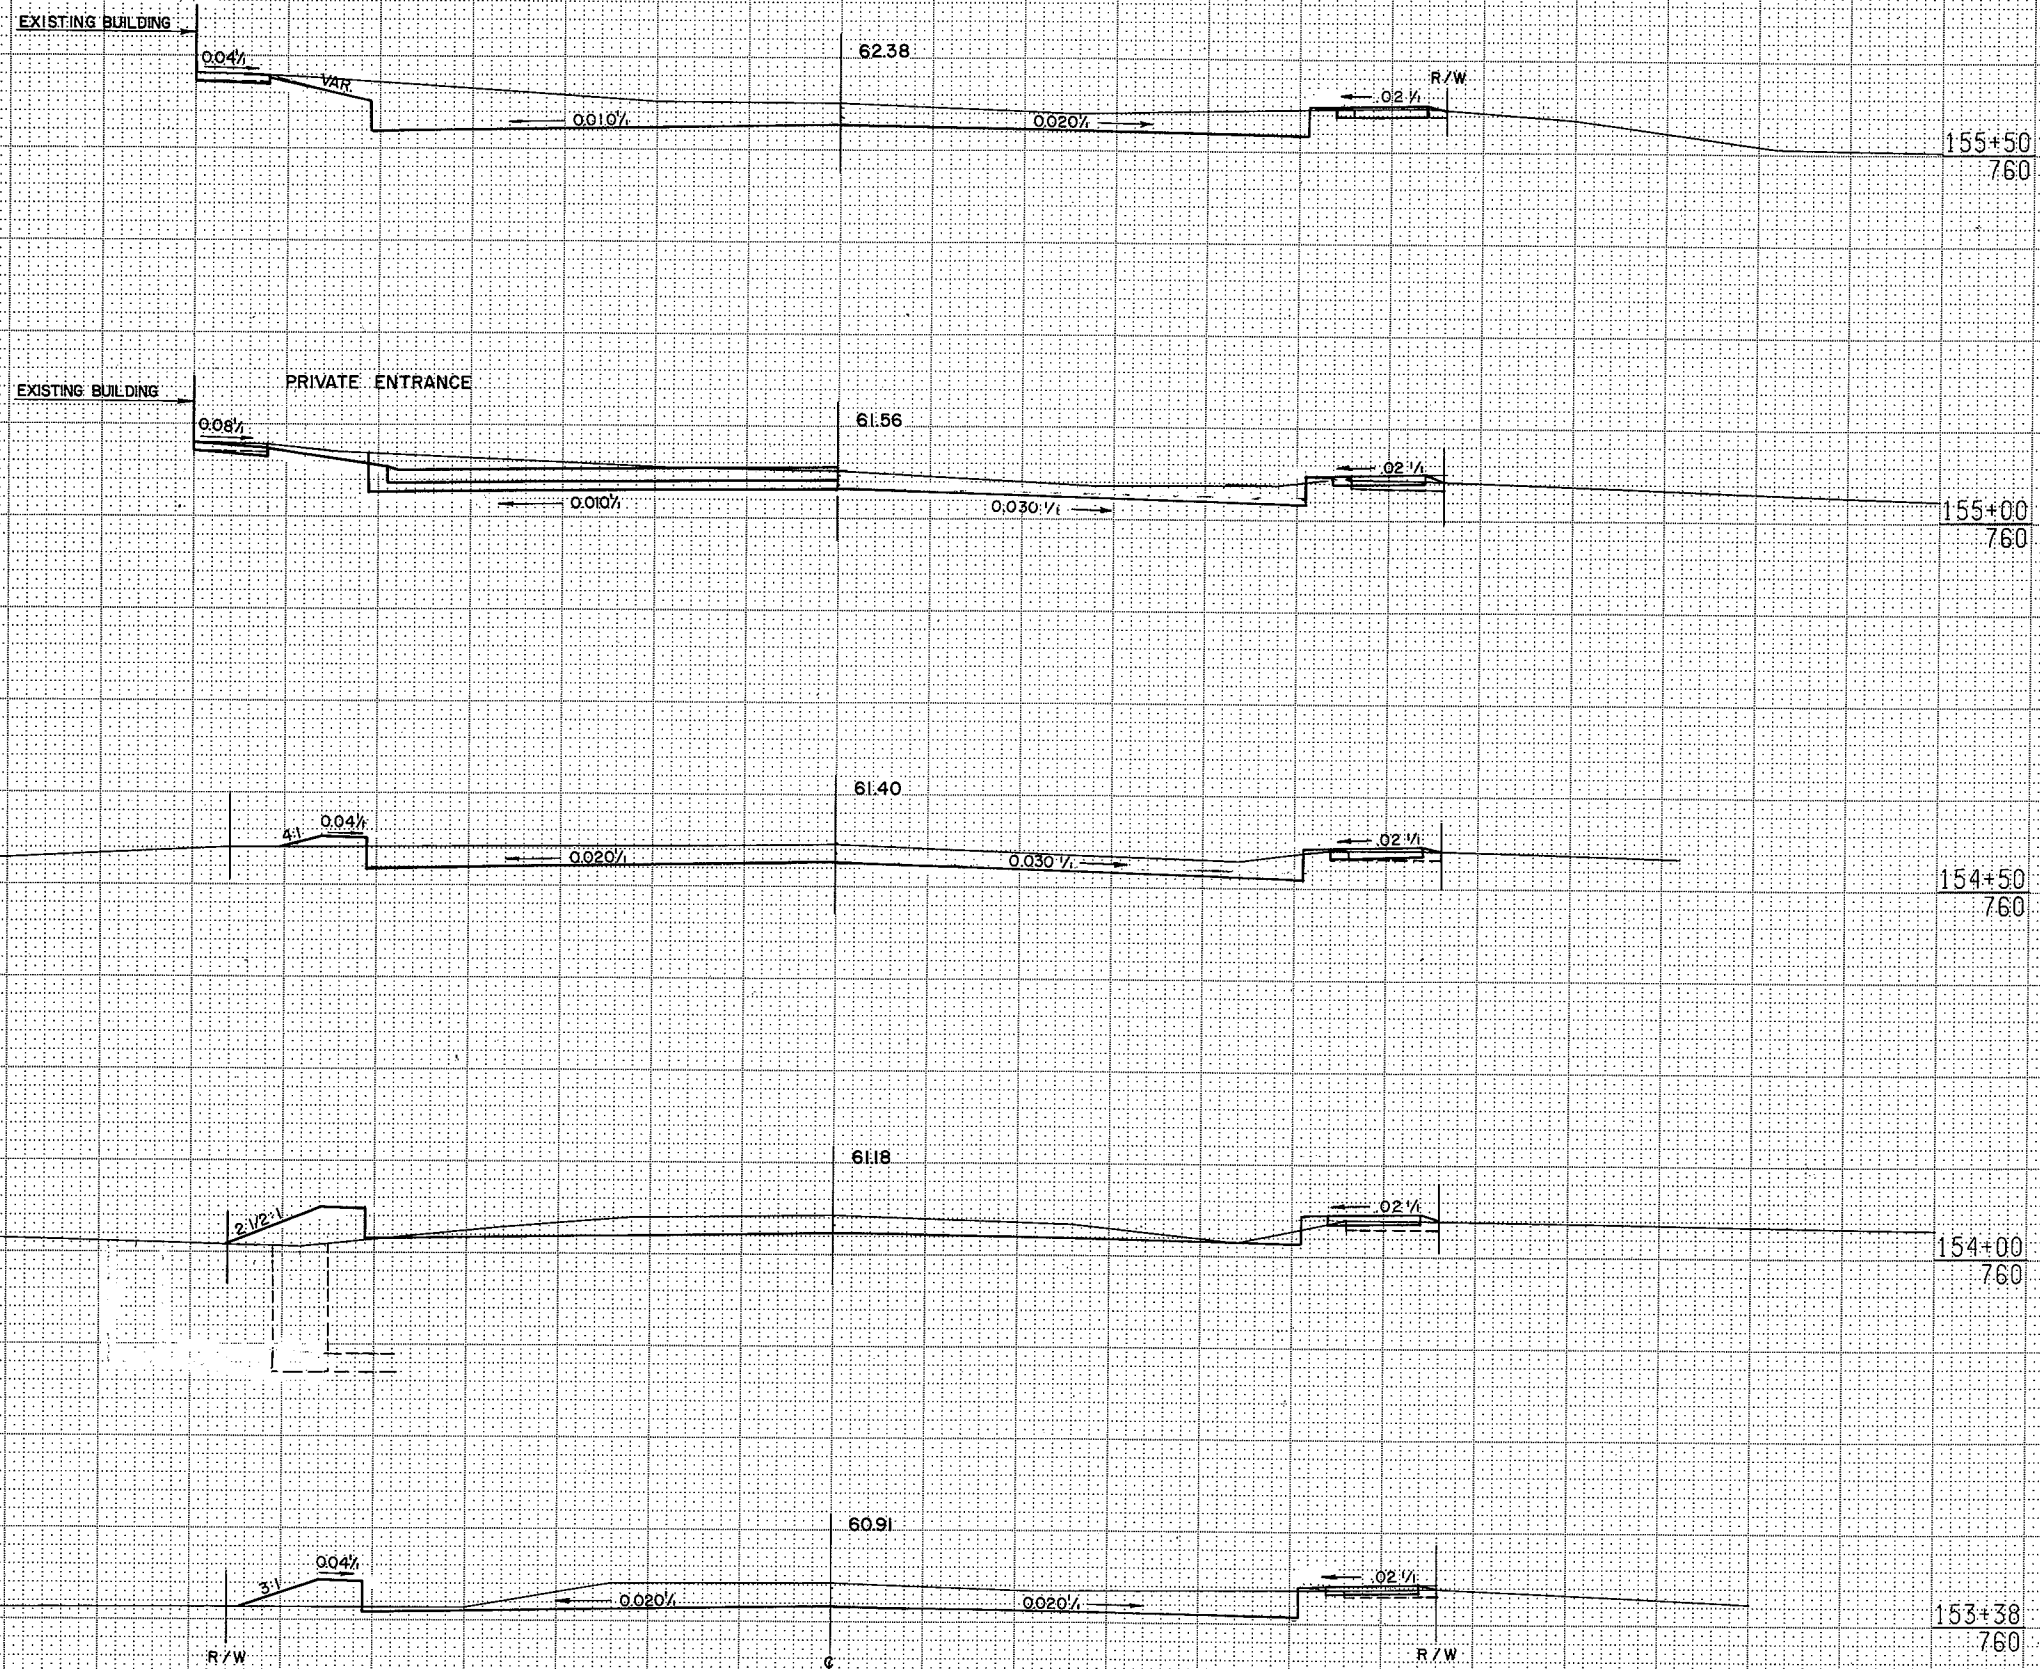

STATION	DISTANCE	YARDAGE	
		EXCAVATION	FILL
		UNCL.	
153+50	50	106	12
154+50	50	81	15
154+00	50	70	17
155+00	50	89	7
155+50	50	120	2
SHEET TOTAL		466	53


SURVEY PLOTTED: _____
NOTE BOOK: _____
MARK: _____
NO. _____

SURVEY PLOTTED: _____
NOTE BOOK: _____
MARK: _____
NO. _____

REGION DIVISION	PROJECT	SHEET NUMBER	TOTAL SHEETS
5 WIS.	4994-0-17	8.17	

DATE	
BY	
FINAL SURVEY	
NOTE BOOK	
NO.	


DATE	
BY	
ORIGINAL SURVEY	
NOTE BOOK	
NO.	

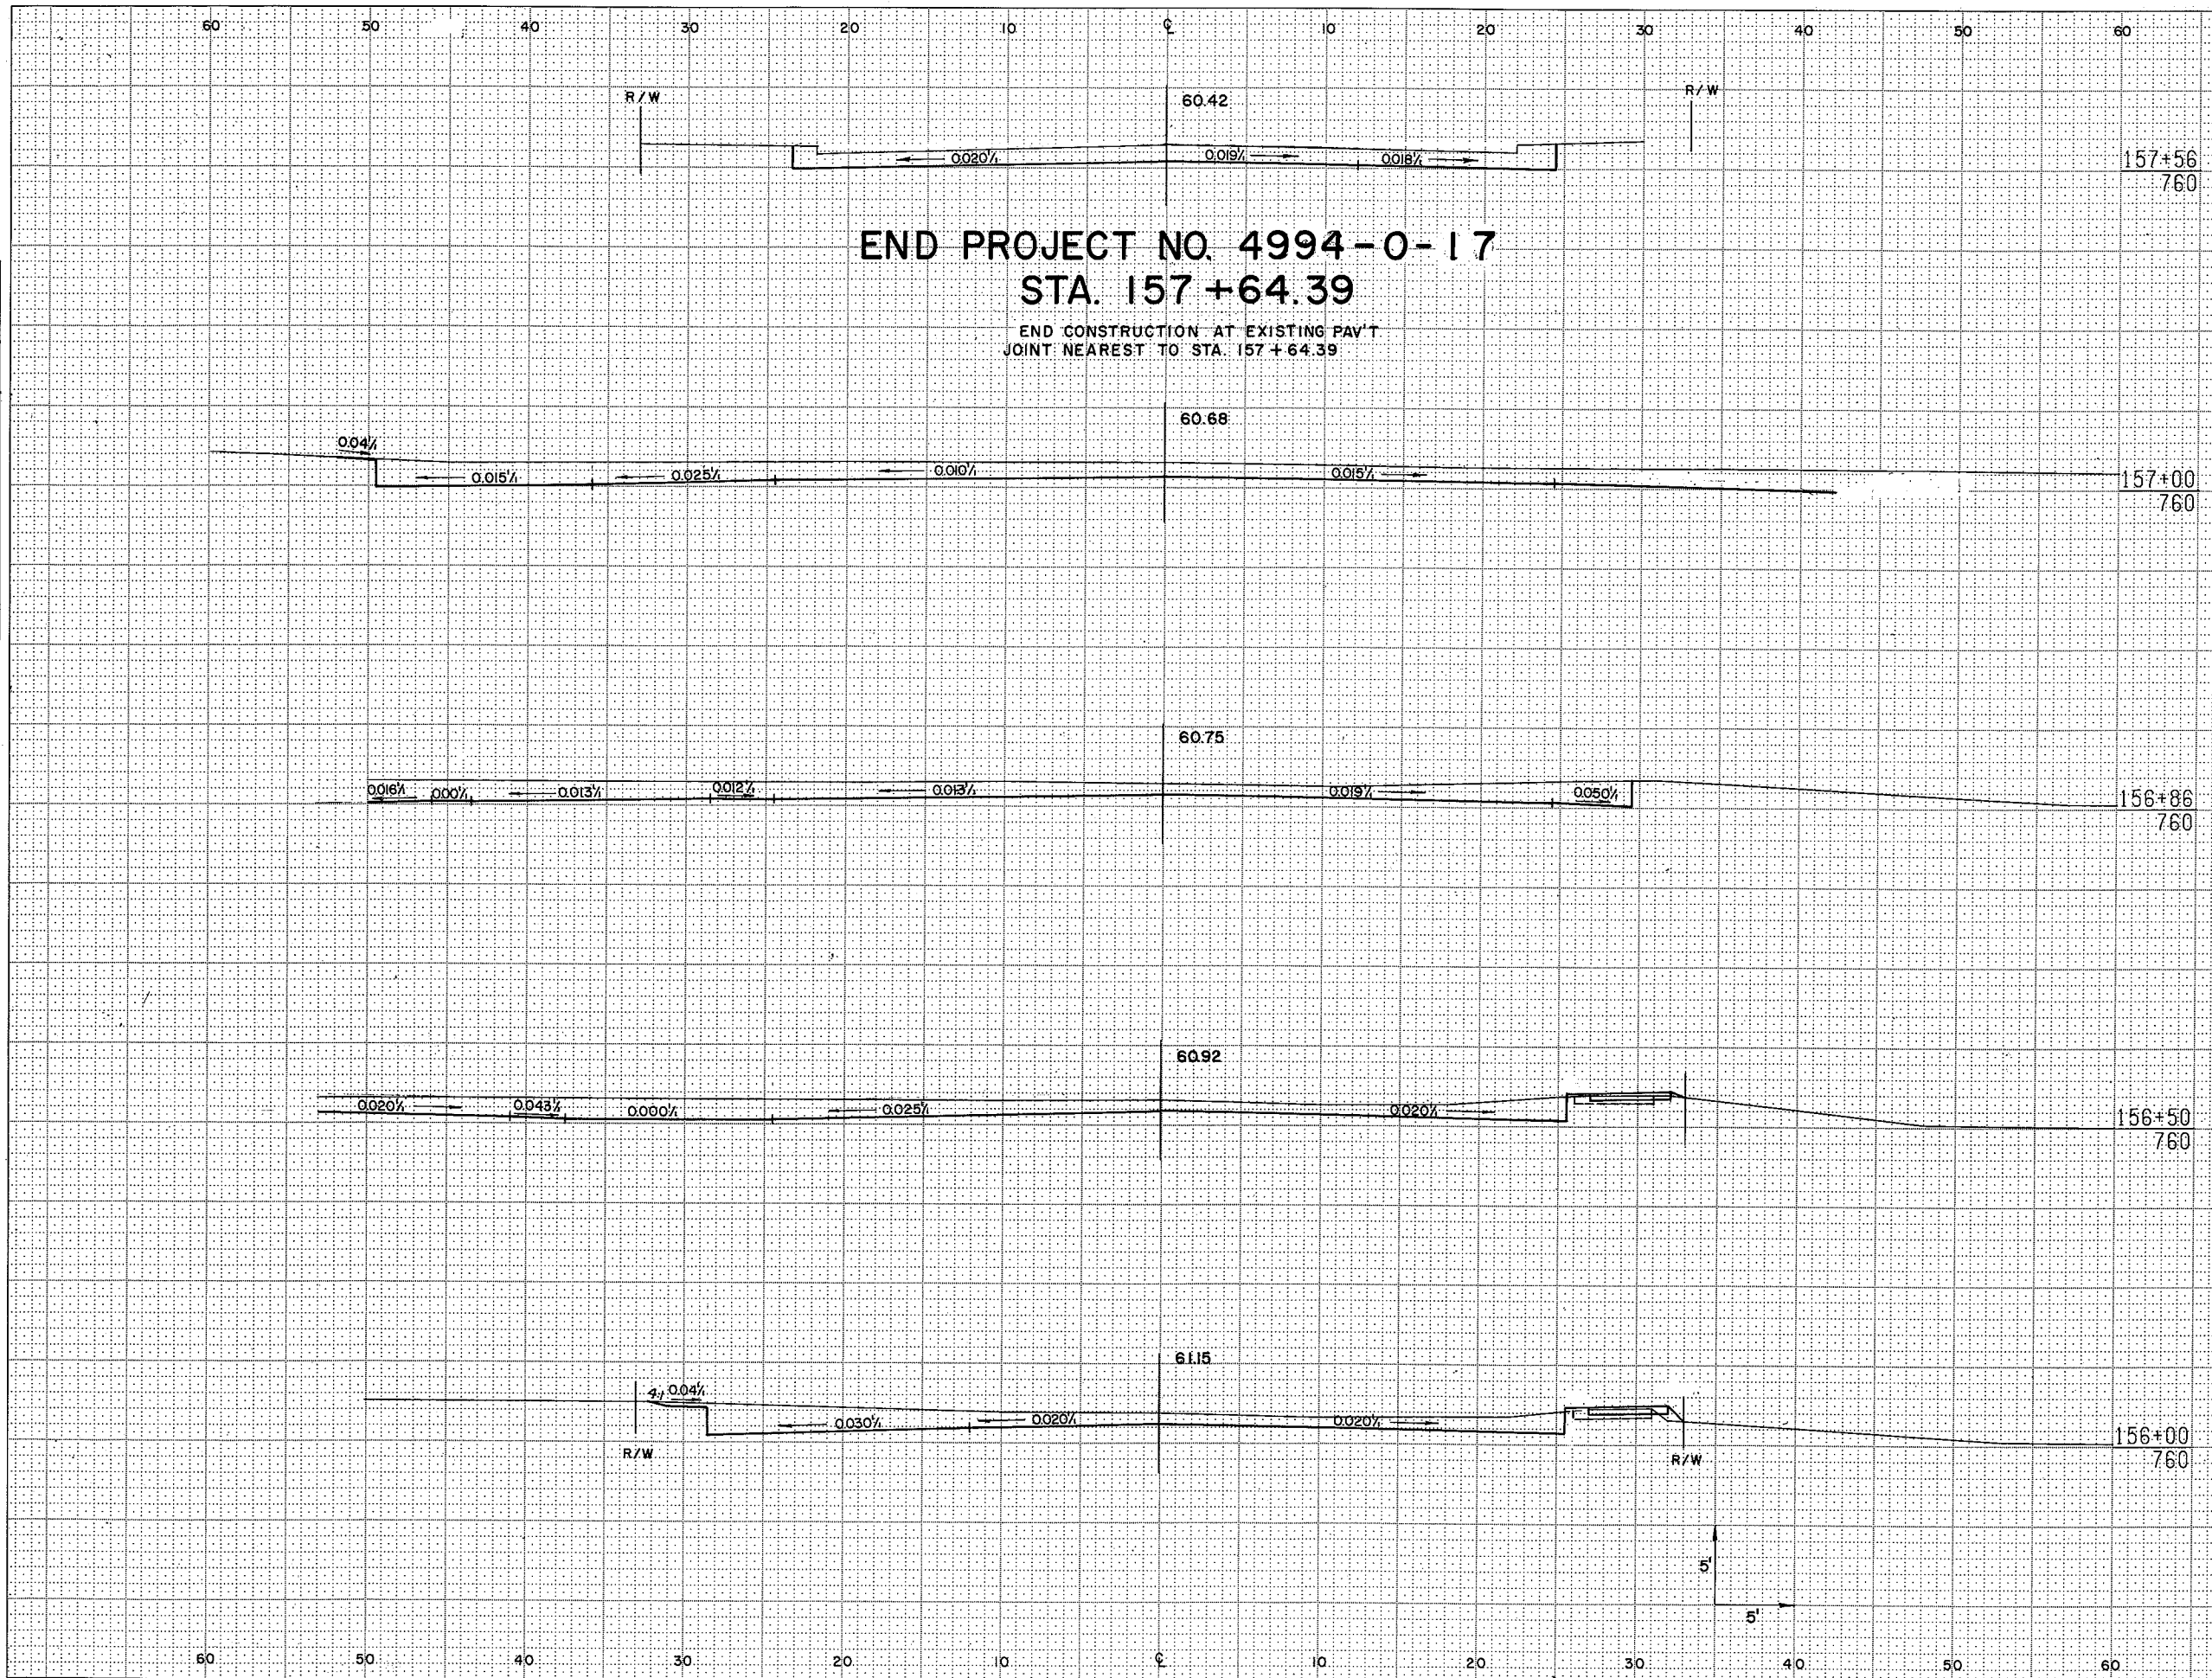

END PROJECT NO. 4994-0-17
STA. 157+64.39
 END CONSTRUCTION AT EXISTING PAV'T
 JOINT NEAREST TO STA. 157+64.39

STATION	DISTANCE	YARDAGE	
		EXCAVATION	FILL
		UNCL	
155+50	50	123	0
156+50	50	120	0
157+64	64	171	0
SHEET TOTAL		575	0

STATION	DISTANCE	YARDAGE	
		EXCAVATION	FILL
UNCL			

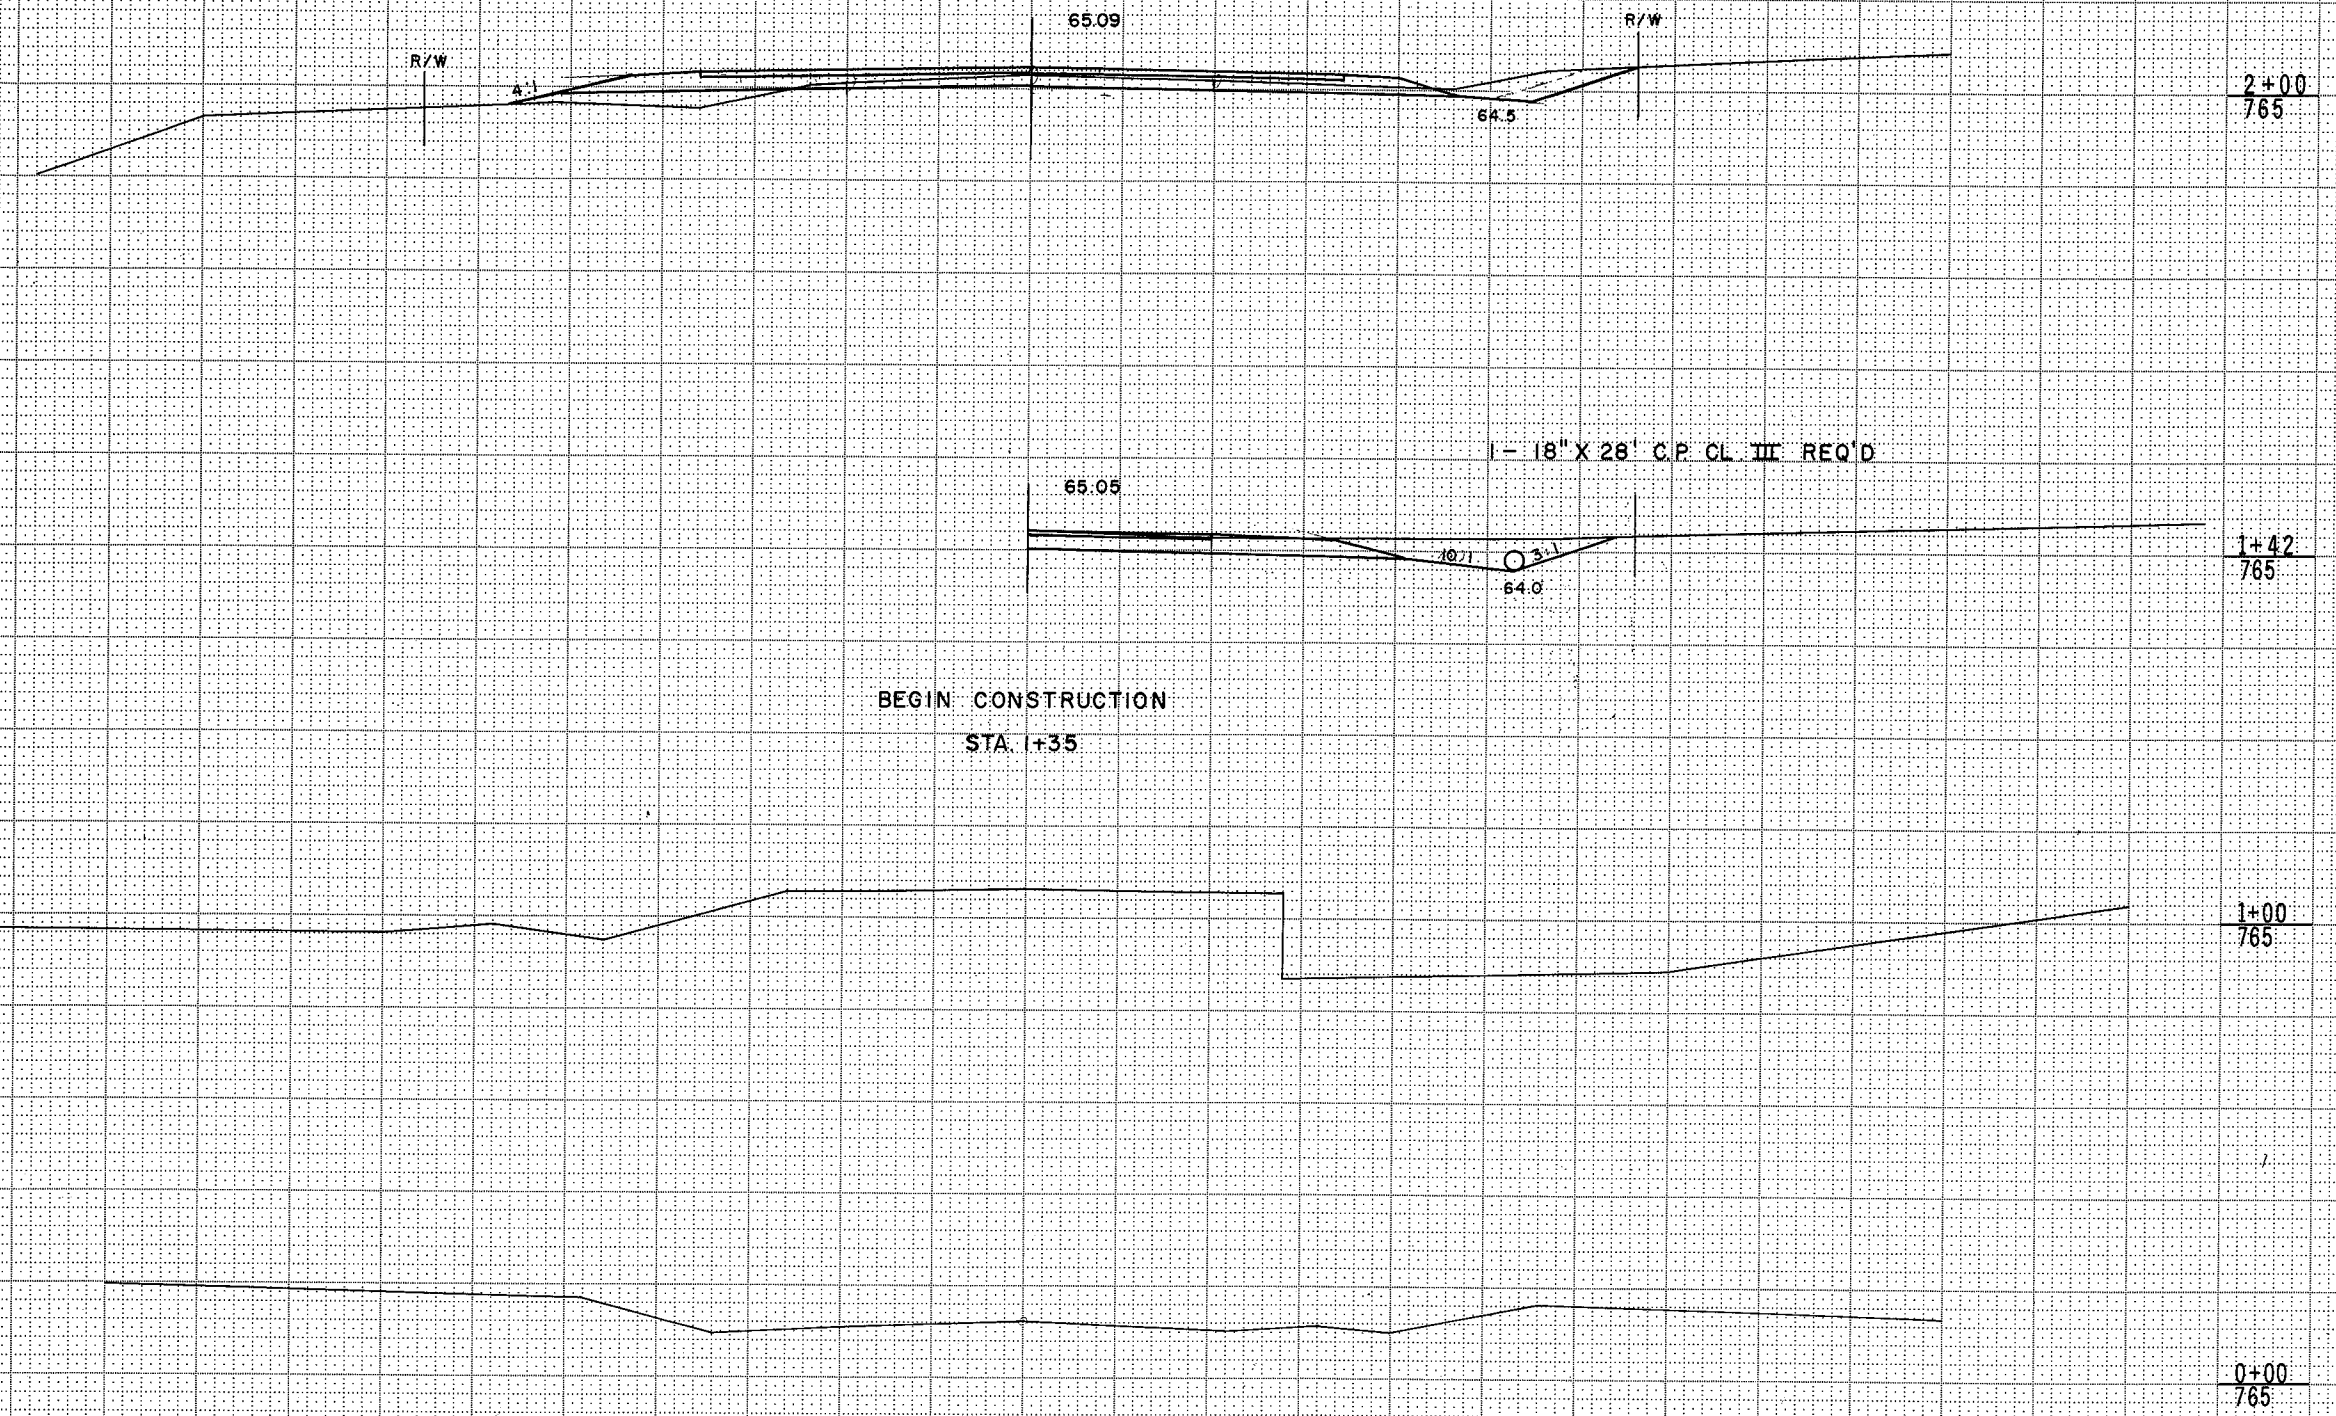

STATION	DISTANCE	YARDAGE	
UNCL		EXCAVATION	FILL
1+35	65	48	6
2+00	765		
1+42	765		
1+00	765		
0+00	765		
SHEET TOTAL		48	6


BEGIN CONSTRUCTION
STA. 1+35

1- 18" X 28' C.P. CL. III REQ'D

SURVEY PLOTTED
NOTE BOOK NO. _____
TEMPLATE AREA CHECKED

SURVEY PLOTTED
NOTE BOOK NO. _____
TEMPLATE AREA CHECKED

END CONSTRUCTION
STA. 5+00

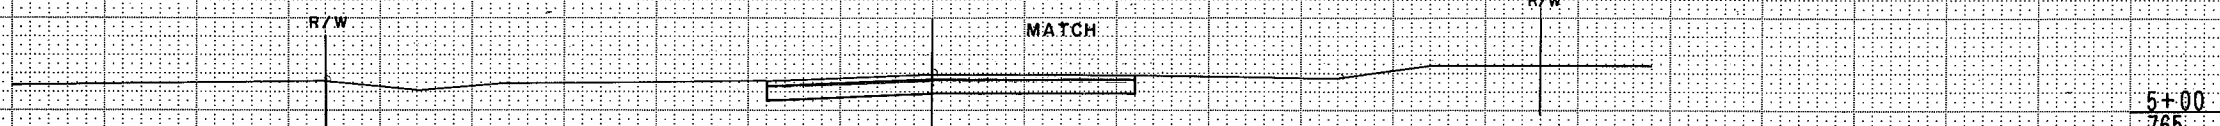


STATION	DISTANCE	YARDAGE	
		UNCL	FILL
5+00			
2+00	50	46	31
+50			

5+00
765

3+50	50	72	13
4+00	100	118	0
5+00			


4+61
765

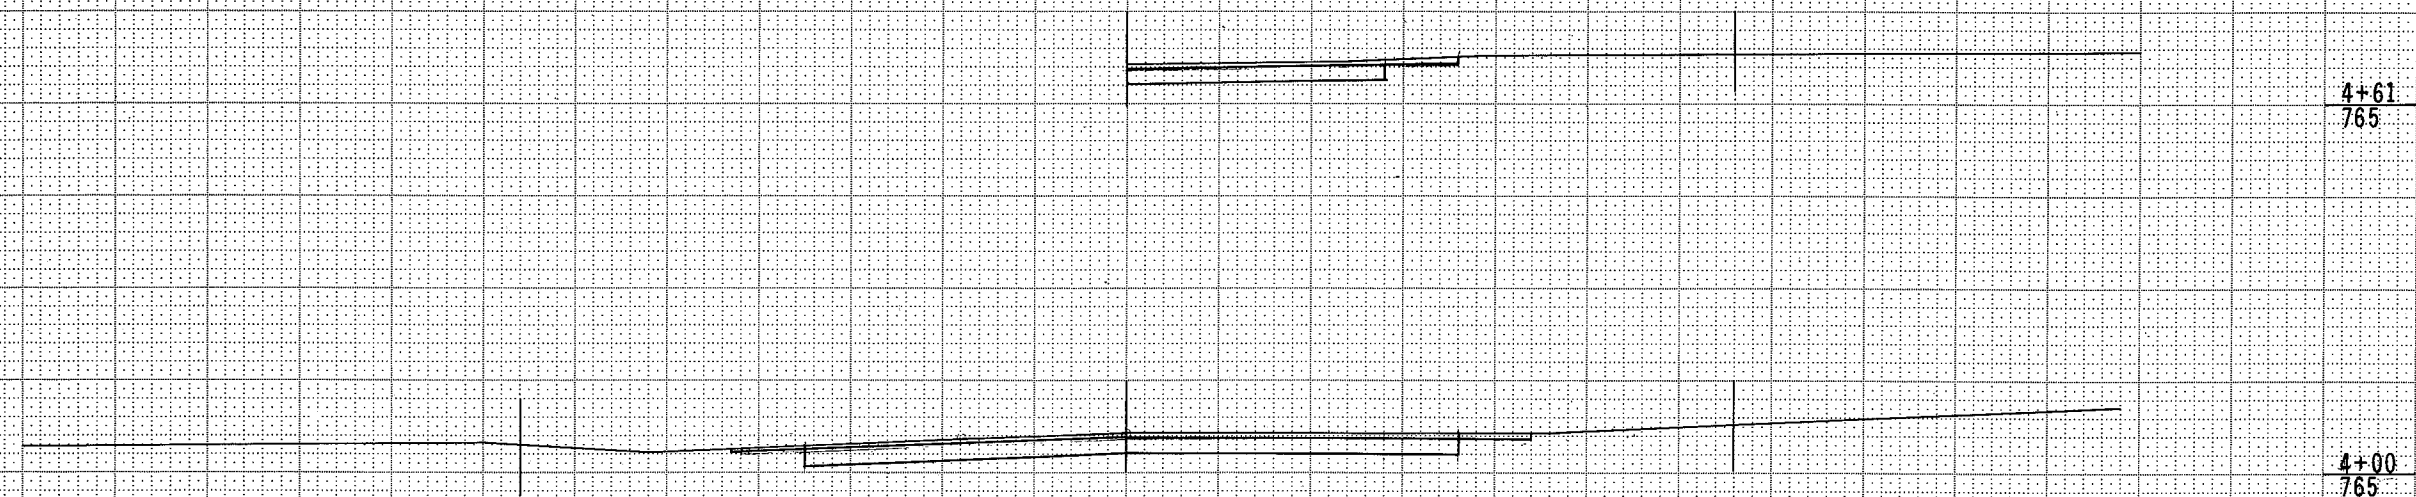

4+00
765

66.20

INTERSECTION WITH C.T.H. "1"
STA. 3+00

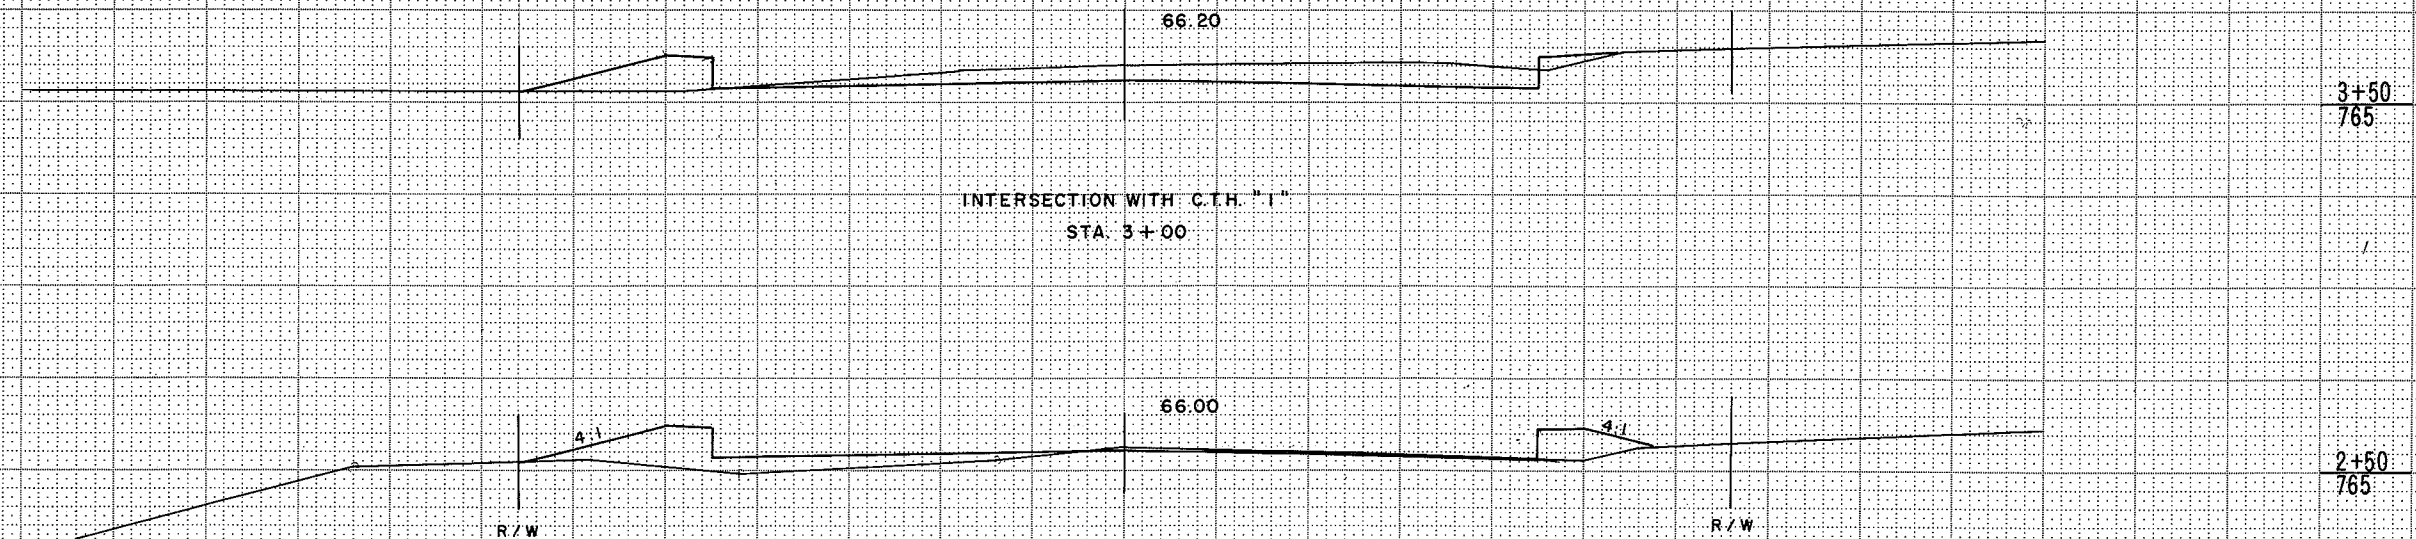

3+50
765


66.00

2+50
765

SHEET TOTAL		236	44
-------------	--	-----	----

FINAL SURVEY NOTE BOOK NO. _____
 SUBMITTED, PLOTTED, TEMPLATE AREAS CHECKED.
 BY _____ DATE _____

ORIGINAL SURVEY NOTE BOOK NO. _____
 SUBMITTED, PLOTTED, TEMPLATE AREAS CHECKED.
 BY _____ DATE _____

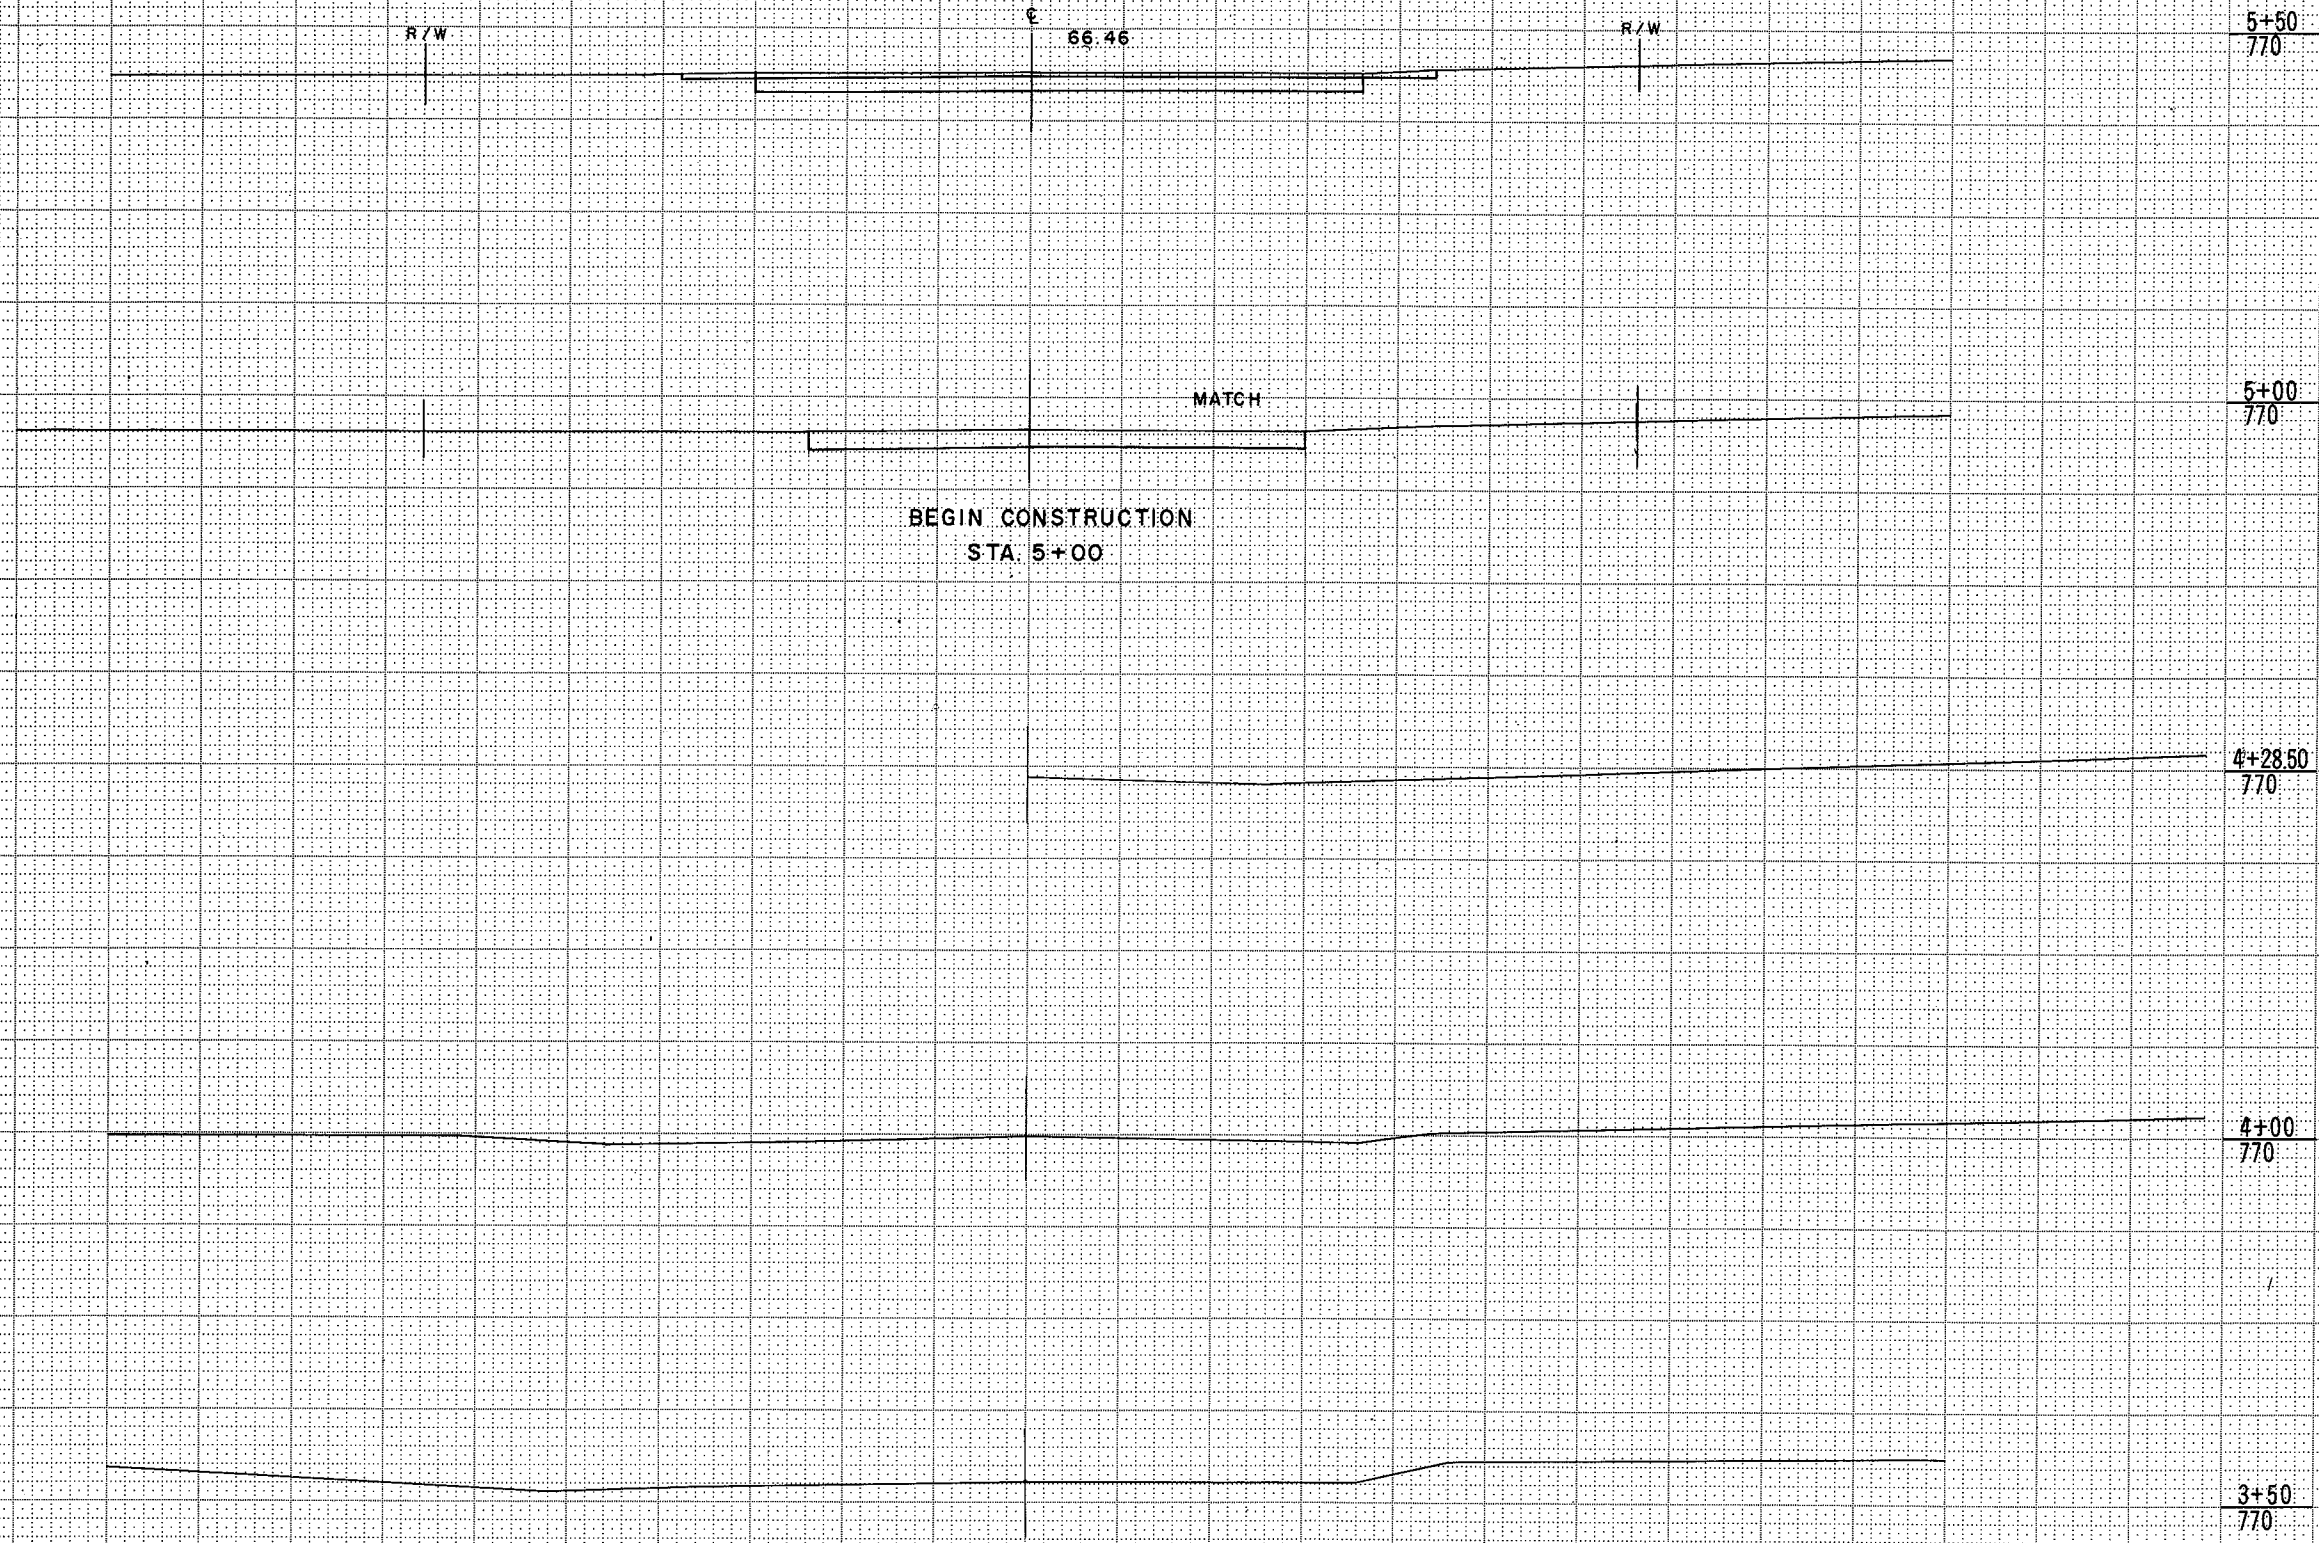

STATION	DISTANCE	YARDAGE	
		EXCAVATION	FILL
		UNCL	
5+50	50	115	0
+50			
5+00			
770			
4+2850			
770			
4+00			
770			
3+50			
770			
SHEET TOTAL		115	0

SURVEYED
NO.

PLOTTED
NO.

TEMPLATE
NO.

AREAS CHECKED

SURVEYED
NO.


PLOTTED
NO.

TEMPLATE
NO.

AREAS CHECKED


DATE _____
 BY _____
 SURVEYED _____
 PLOTTED _____
 FINAL SURVEY NOTE BOOK NO. _____
 AREAS CHECKED _____

DATE _____
 BY _____
 SURVEYED _____
 PLOTTED _____
 ORIGINAL SURVEY NOTE BOOK NO. _____
 AREAS CHECKED _____

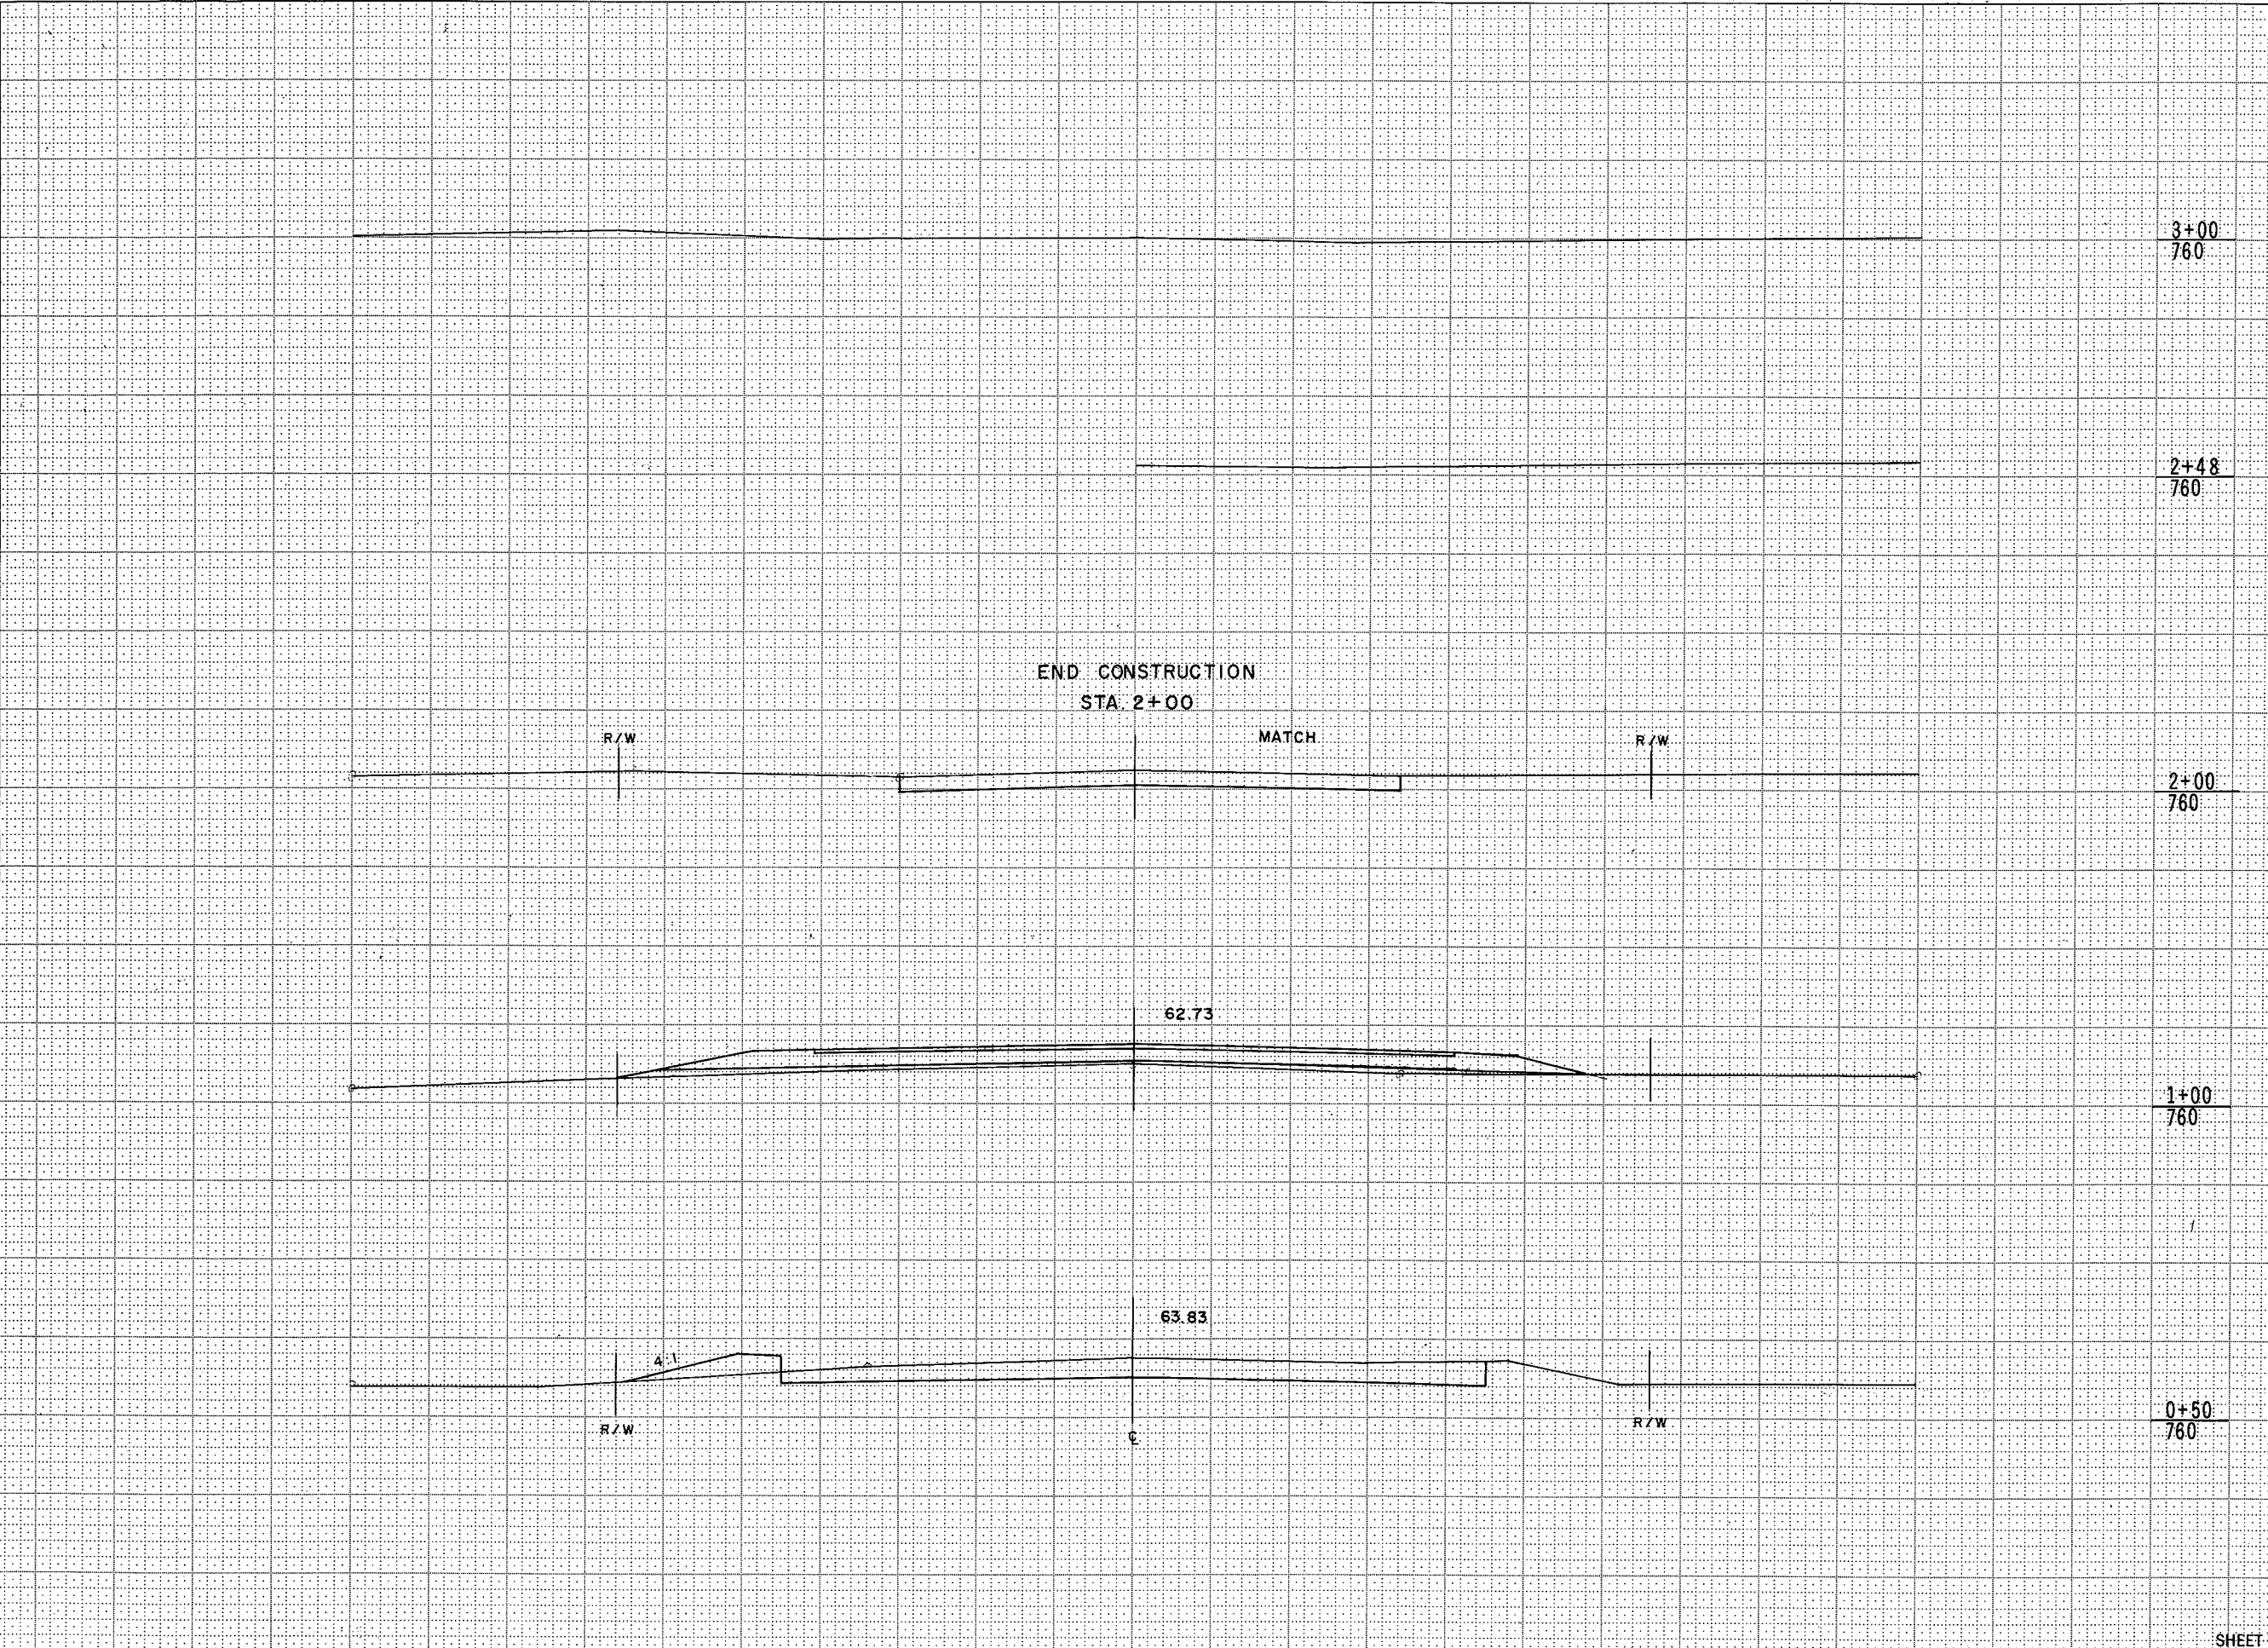

STATION	DISTANCE	YARDAGE	
		EXCAVATION	
		UNCL.	FILL
3+00	760		
0+50	50	47	49
1+00	100	53	33
2+00			
2+48	760		
2+00	760		
1+00	760		
0+50	760		
SHEET TOTAL		100	82

STATION	DISTANCE	YARDAGE	
		EXCAVATION	
		UNCL	FILL
2+35			
760			
0+50		73	0
1		74	0
+50			
2+00			
760			
1+17			
760			
1+00			
760			
0+86			
760			
0+50			
760			
SHEET TOTAL		147	0

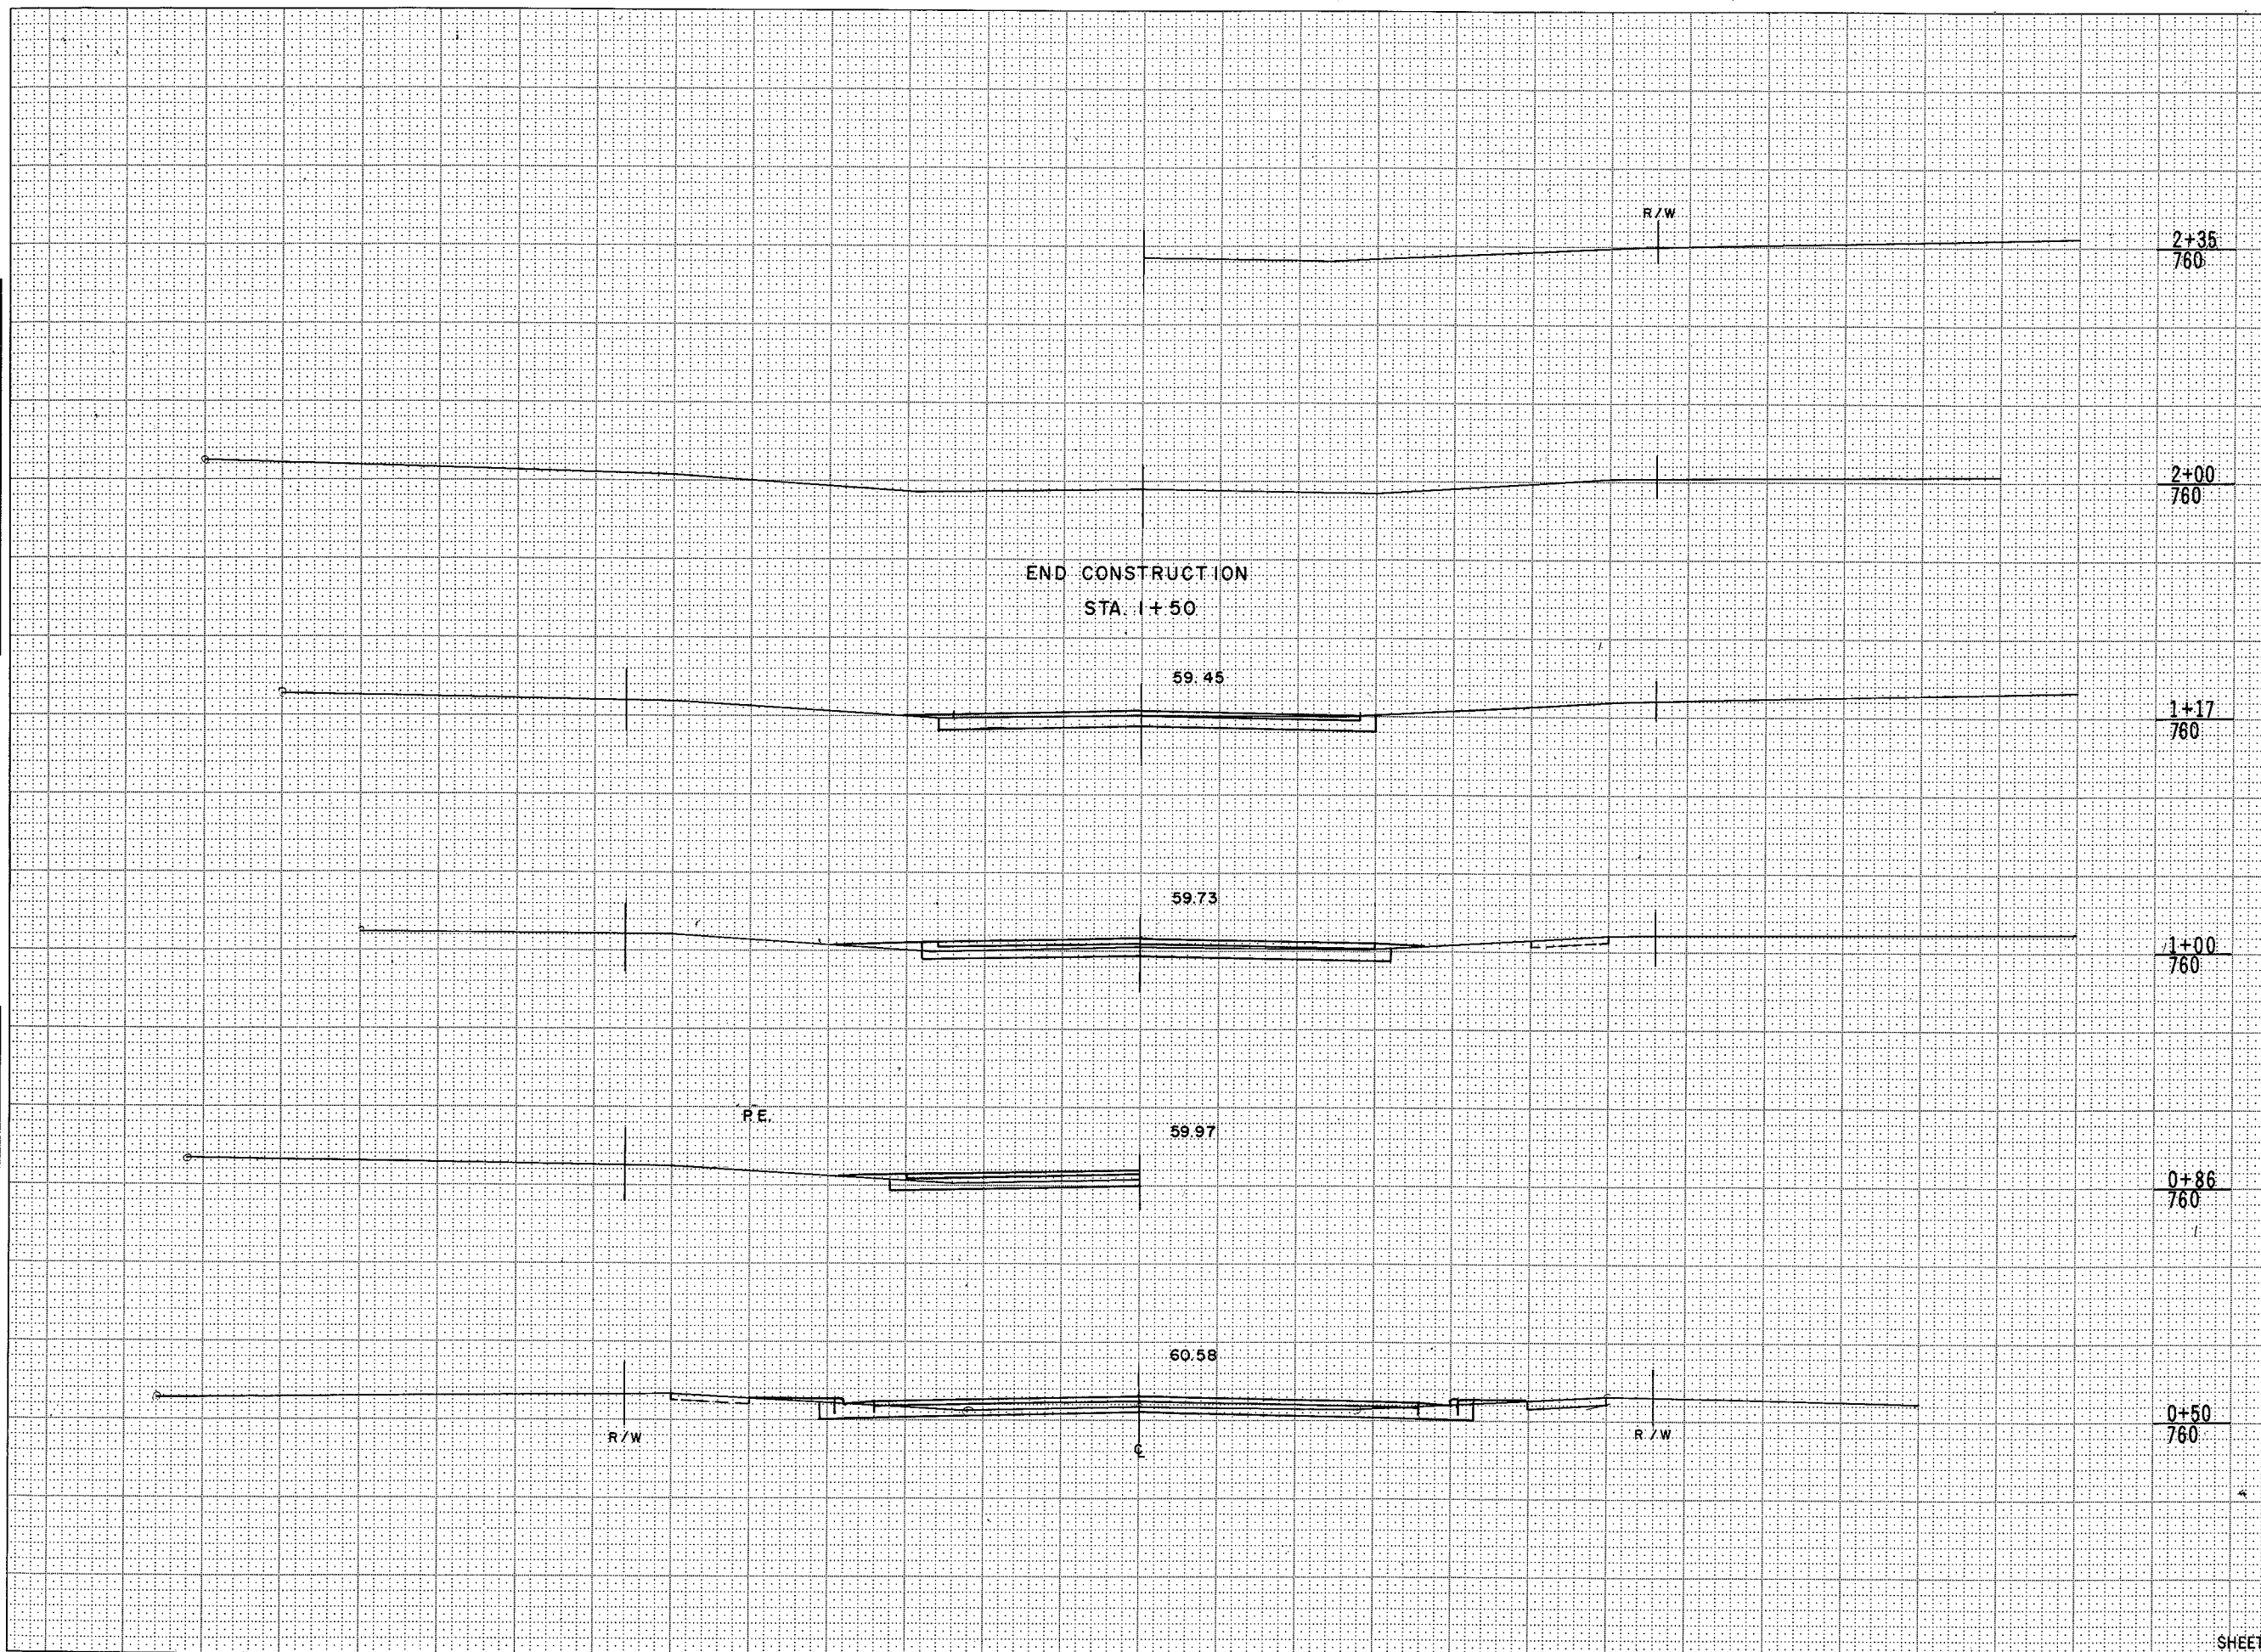

SURVEYED SURVEYED SURVEYED
 SURVEY SURVEY SURVEY
 NOTE BOOK NOTE BOOK NOTE BOOK
 TEMPLATE TEMPLATE TEMPLATE
 AREAS CHECKED AREAS CHECKED AREAS CHECKED
 NO. NO. NO.

SURVEYED SURVEYED SURVEYED
 SURVEY SURVEY SURVEY
 NOTE BOOK NOTE BOOK NOTE BOOK
 TEMPLATE TEMPLATE TEMPLATE
 AREAS CHECKED AREAS CHECKED AREAS CHECKED
 NO. NO. NO.

STATION	DISTANCE	YARDAGE	
		EXCAVATION	FILL
		UNCL.	
0+50	50	204	0
1+00	100		
SHEET TOTAL		204	0

FINAL SURVEY	SURVEYED	BY	DATE
NOTE BOOK	PLOTTED		
NO.	TEMPLATE		
	AREAS CHECKED		

ORIGINAL SURVEY	SURVEYED	BY	DATE
NOTE BOOK	PLOTTED		
NO.	TEMPLATE		
	AREAS CHECKED		

