

AS-BUILT PLAN

STATE OF WISCONSIN DEPARTMENT OF TRANSPORTATION

PLAN OF PROPOSED IMPROVEMENT

USH 45 - NORTH COUNTY LINE

(OLD STH 110)

CTH II

WINNEBAGO COUNTY

B-70-83 DECK OVERLAY

(OLD STH 110)

CTH II

WINNEBAGO COUNTY

STATE PROJECT	FEDERAL PROJECT	
	PROJECT	CONTRACT
6200-07-71		
6200-10-71		

STATE PROJECT NUMBER
6200-07-71

STATE PROJECT NUMBER
6200-10-71

ORDER OF SHEETS

- Section No. 1 Title
- Section No. 2 Typical Sections and Details
- Section No. 3 Estimate of Quantities
- Section No. 3 Miscellaneous Quantities
- Section No. 4 Right of Way Plat
- Section No. 5 Plan and Profile
- Section No. 6 Standard Detail Drawings
- Section No. 7 Sign Plates
- Section No. 8 Structure Plans
- Section No. 9 Computer Earthwork Data
- Section No. 9 Cross Sections

TOTAL SHEETS = 116



DESIGN DESIGNATION

DESIGN DESIGNATION	CTH II
A.A.D.T. 2005	2050
A.A.D.T. 2025	3050
D.H.V.	400
D.D.	62/38
T.	3.4%
DESIGN SPEED	60 MPH
ESALS	197,100 (TOTAL LIFE)


CONVENTIONAL SYMBOLS

PLAN

- CORPORATE LIMITS
- PROPERTY LINE
- LOT LINE
- LIMITED HIGHWAY EASEMENT
- EXISTING RIGHT OF WAY
- PROPOSED OR NEW R/W LINE
- SLOPE INTERCEPT
- REFERENCE LINE
- EXISTING CULVERT
- PROPOSED CULVERT (Box or Pipe)
- COMBUSTIBLE FLUIDS
- MARSH AREA
- WOODED OR SHRUB AREA

PROFILE

- GRADE LINE
- ORIGINAL GROUND
- MARSH OR ROCK PROFILE (To be noted as such)
- SPECIAL DITCH
- GRADE ELEVATION
- CULVERT (Profile View)
- UTILITIES
- ELECTRIC
- FIBER OPTIC
- GAS
- SANITARY SEWER
- STORM SEWER
- TELEPHONE
- WATER
- UTILITY PEDESTAL
- POWER POLE
- TELEPHONE POLE

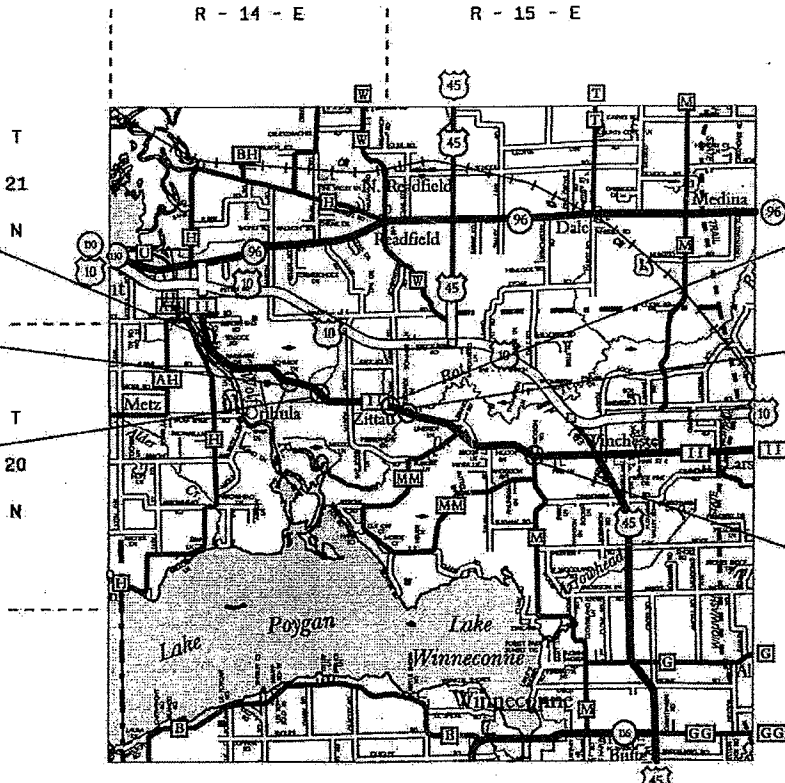

- 6200-07-71
CATTLE PASS REMOVAL
STA 28+50 TO 29+50
- 6200-07-71
STRUCTURE B-70-242
STA 144+23 TO 146+00
- 6200-07-71
STRUCTURE C-70-70
STA 183+73 TO 185+14

- 6200-07-71
STRUCTURE C-70-69
STA 276+13 TO 277+57
- 6200-10-71
STRUCTURE B-70-83
BRIDGE DECK OVERLAY
- 6200-07-71
INTERSECTION RECONSTRUCTION
STA 441+00 TO 461+00

LAYOUT
SCALE 0 2 MI.

TOTAL NET LENGTH OF CENTERLINE = 0.000 MI.

AS BUILT PLAN NO.

SUPERVISOR Jill Michaelson
RESIDENT ERIC JASTROMSKI
CONTRACTOR LUNPA CONSTRUCTION
COMPLETED SEPTEMBER 23, 2005

STATE OF WISCONSIN
DEPARTMENT OF TRANSPORTATION


PREPARED BY	
Surveyor	M D VANDEHEI
Designer	E A DANKE
Project Manager	W R BERTRAND
District Examiner	R W RAHLF
District Supervisor	R R APPERT
C.O. Examiner	

APPROVED FOR DISTRICT OFFICE
DATE: 11-30-04 William R. Bertrand
(Signature)

E


PROJECT ID: 6200-07-71 & 6200-10-71

COUNTY: WINNEBAGO

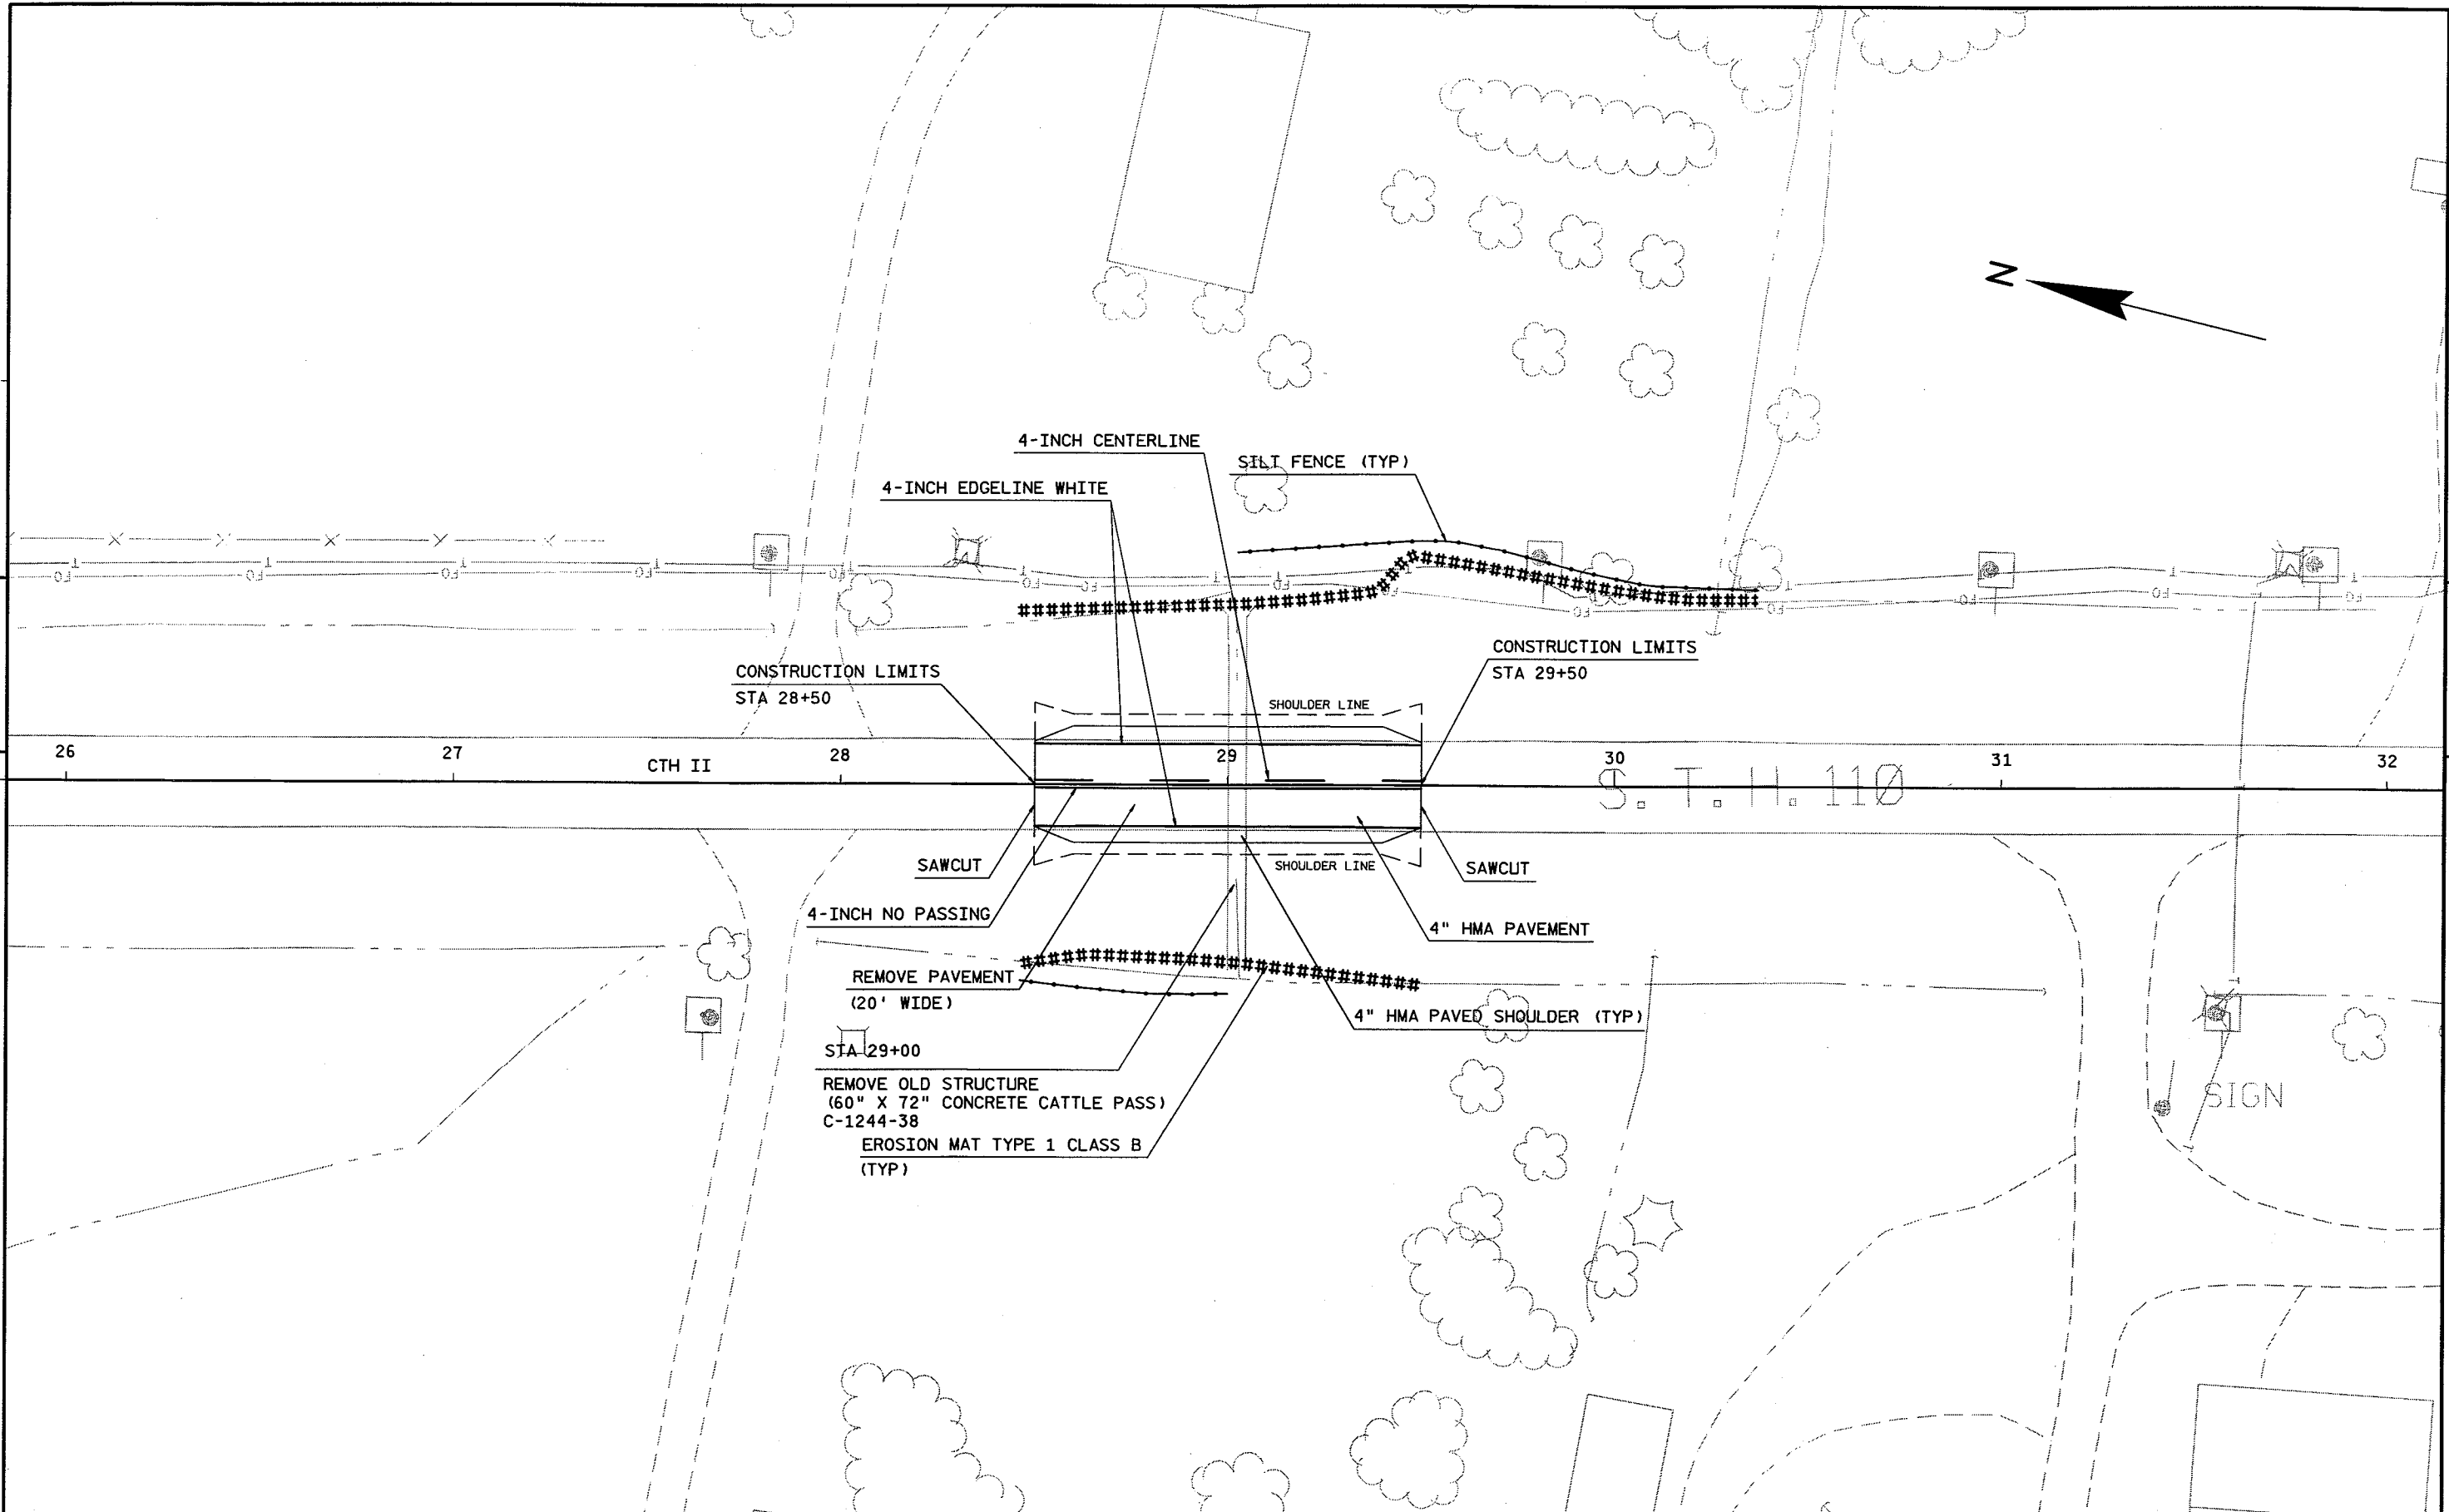


5


5

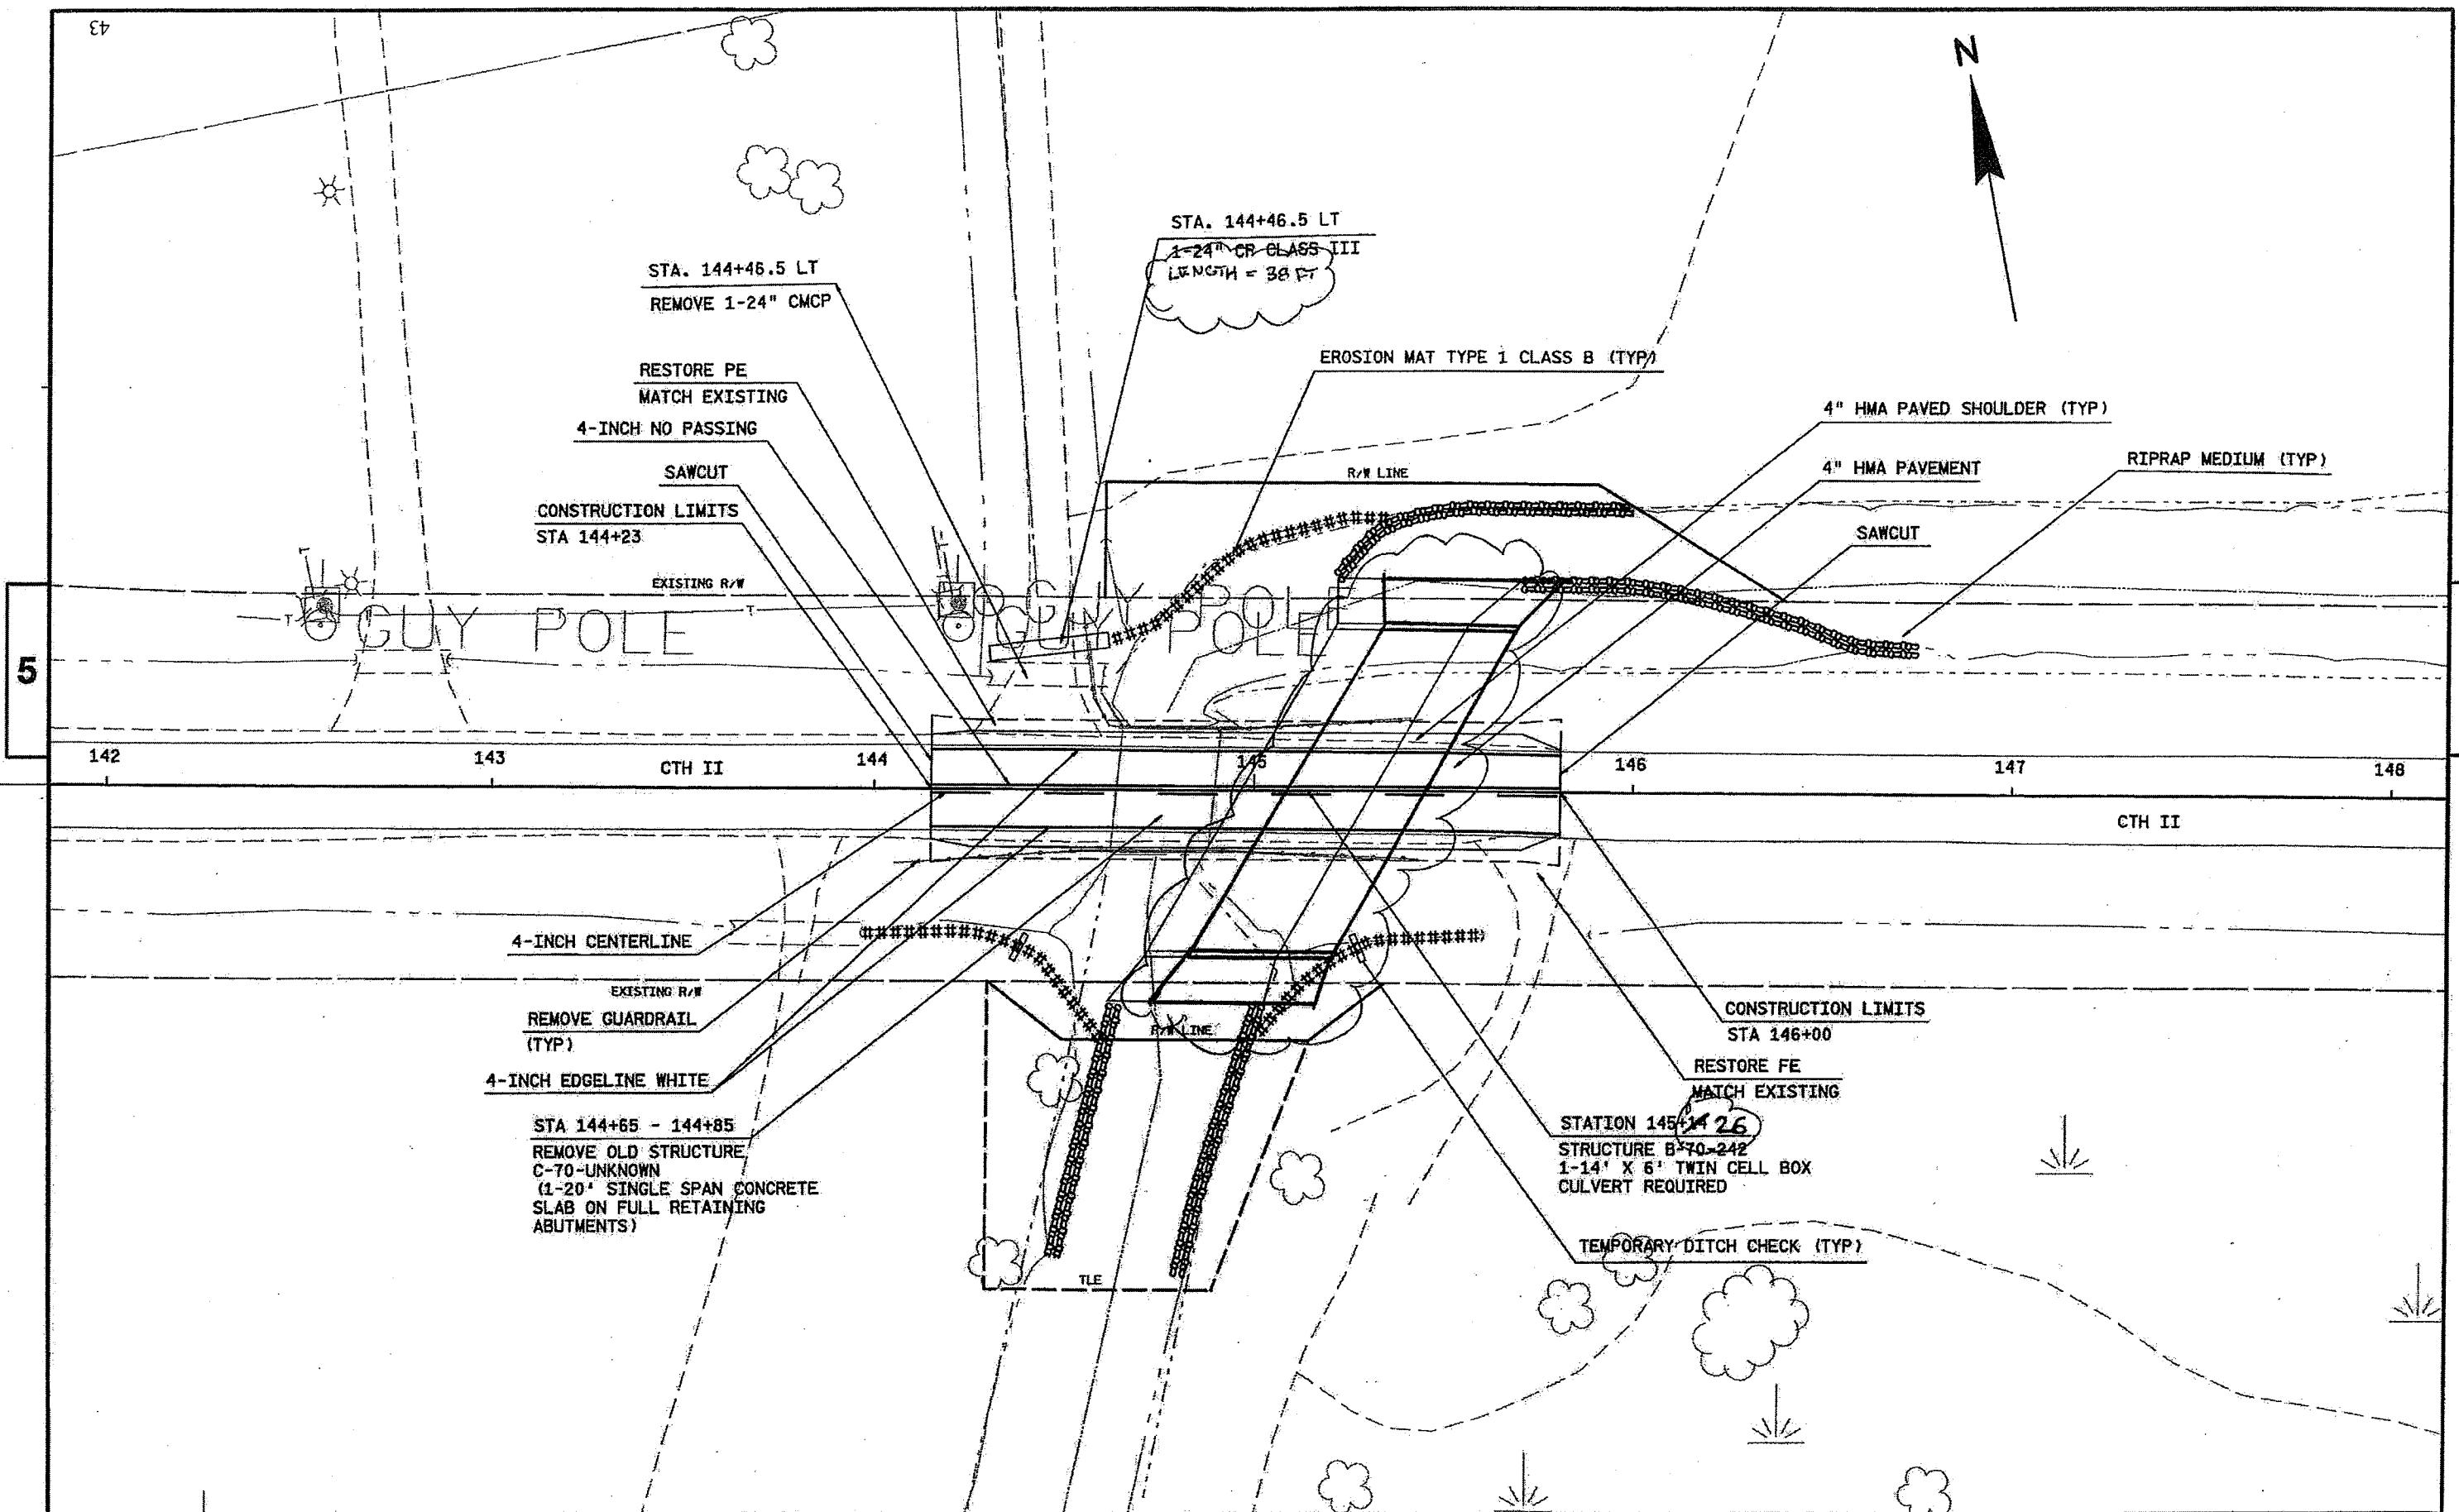

5

5

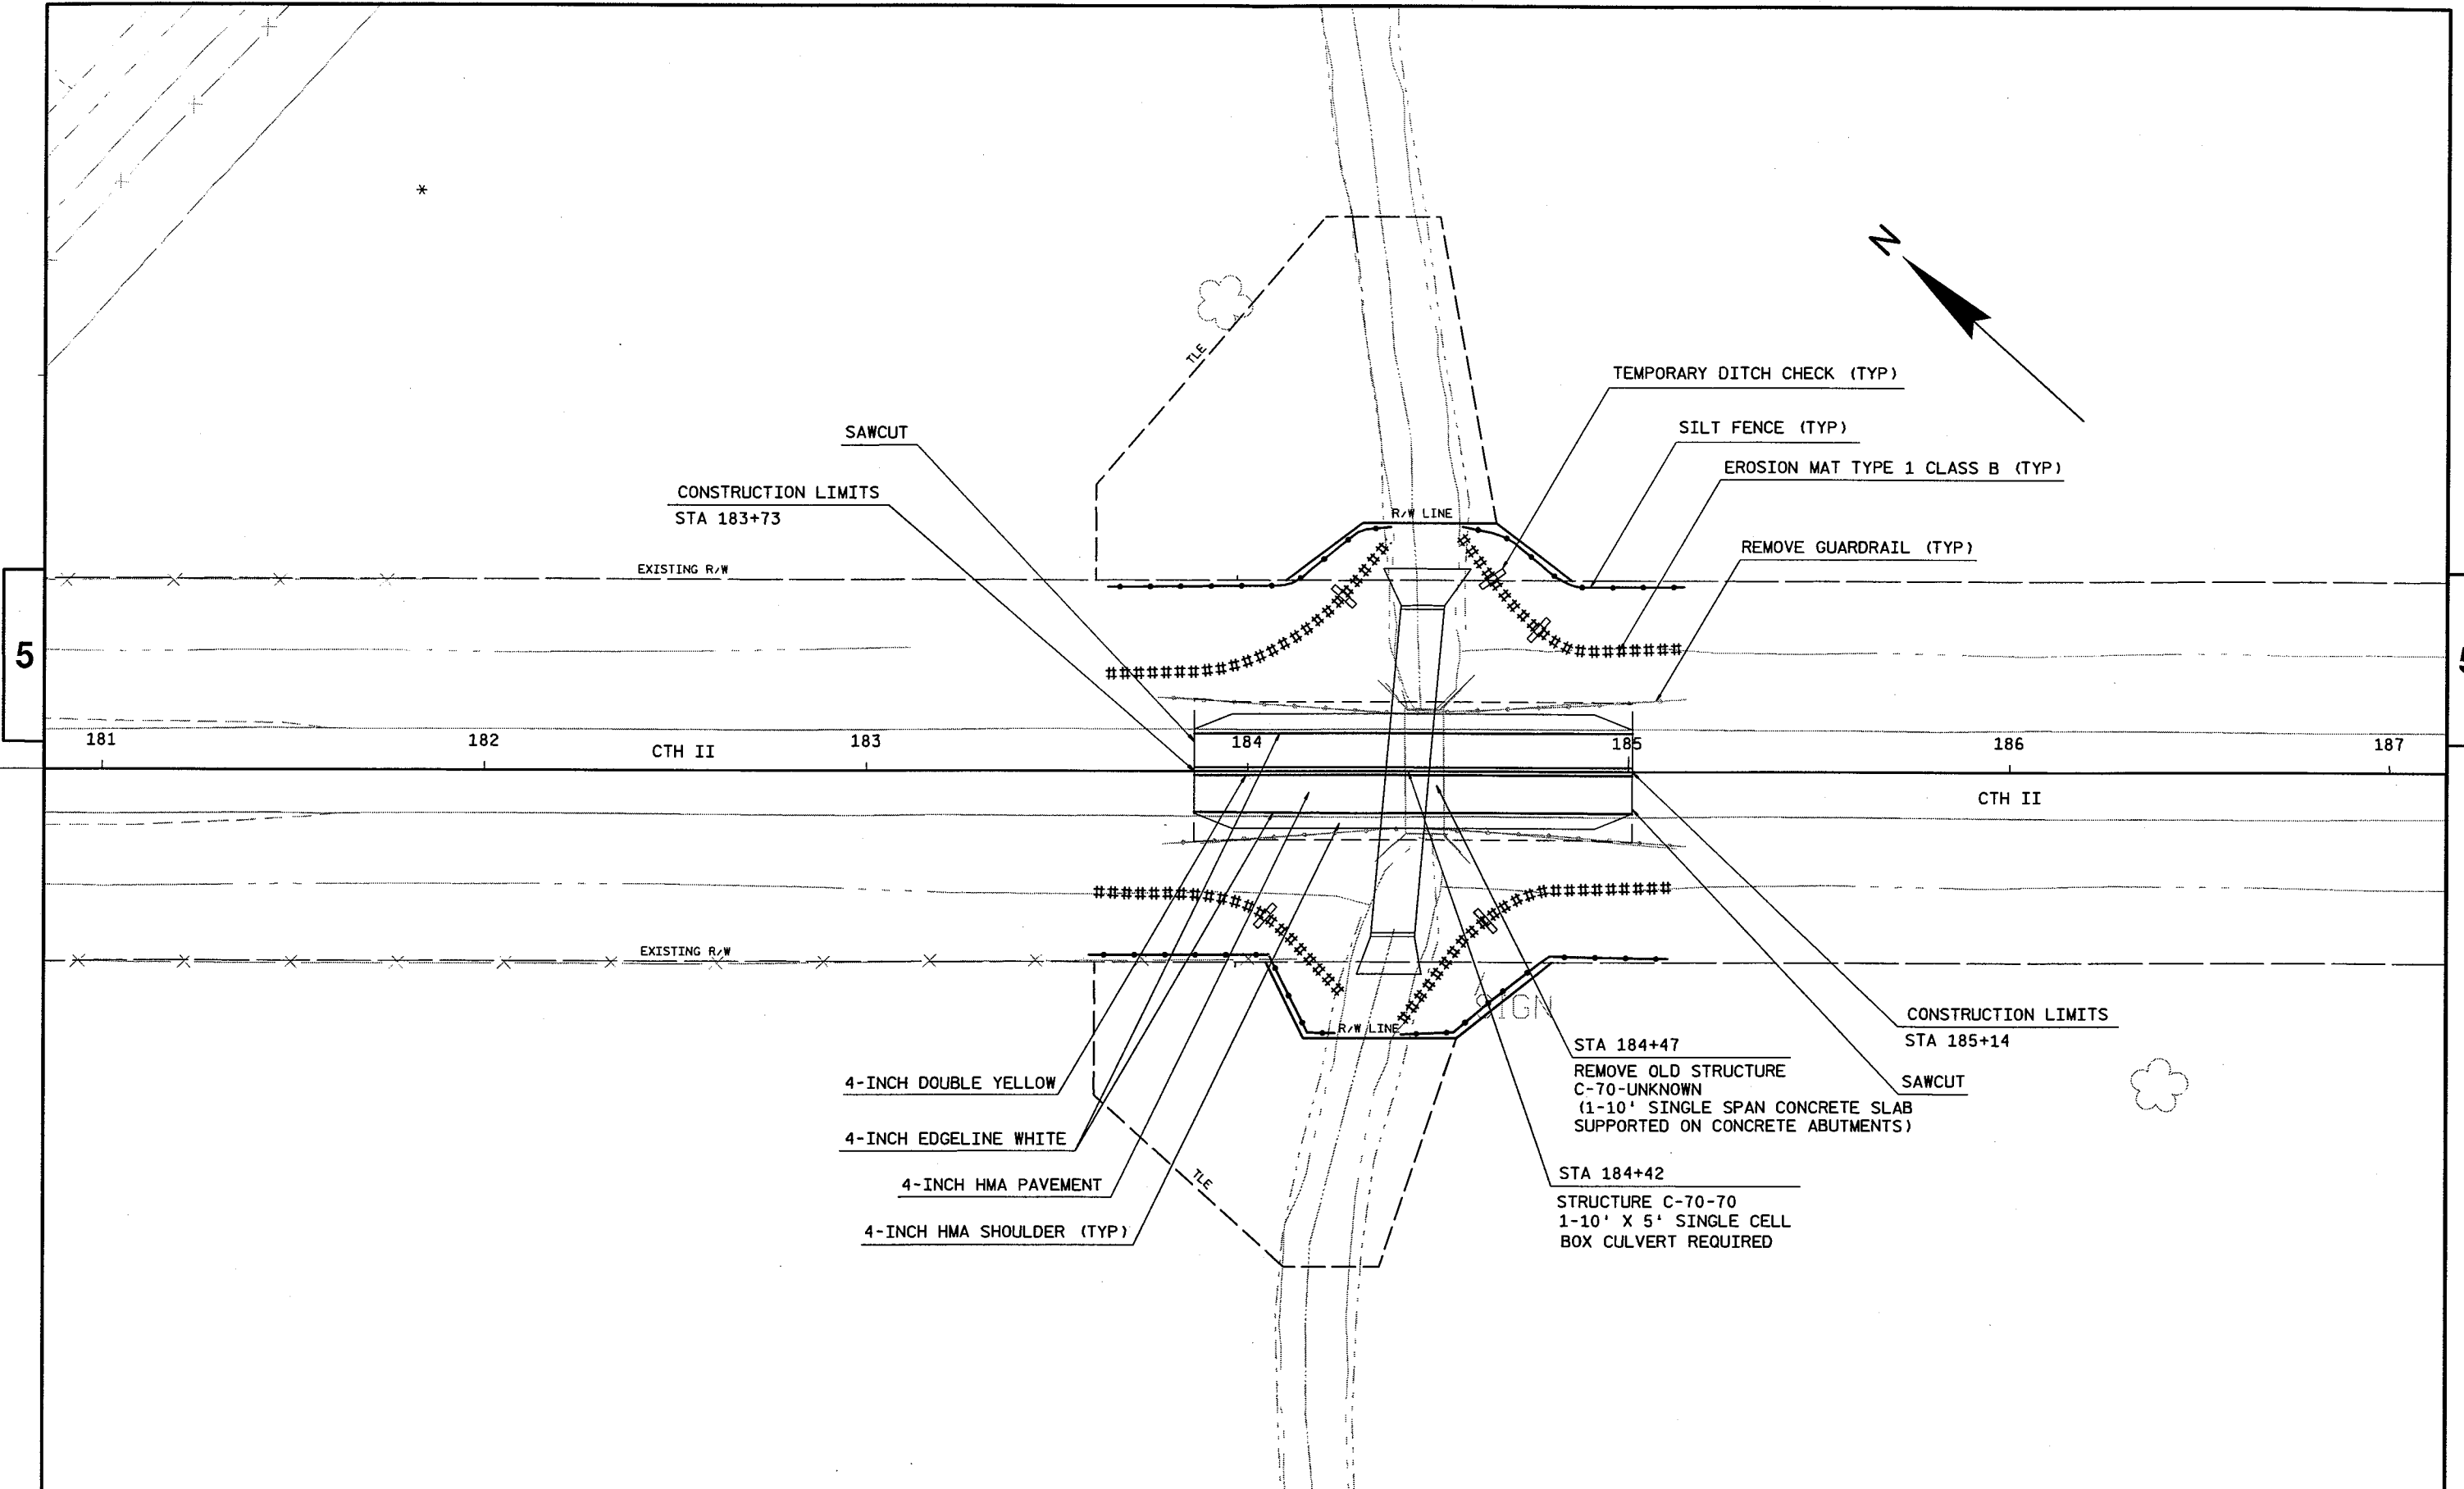

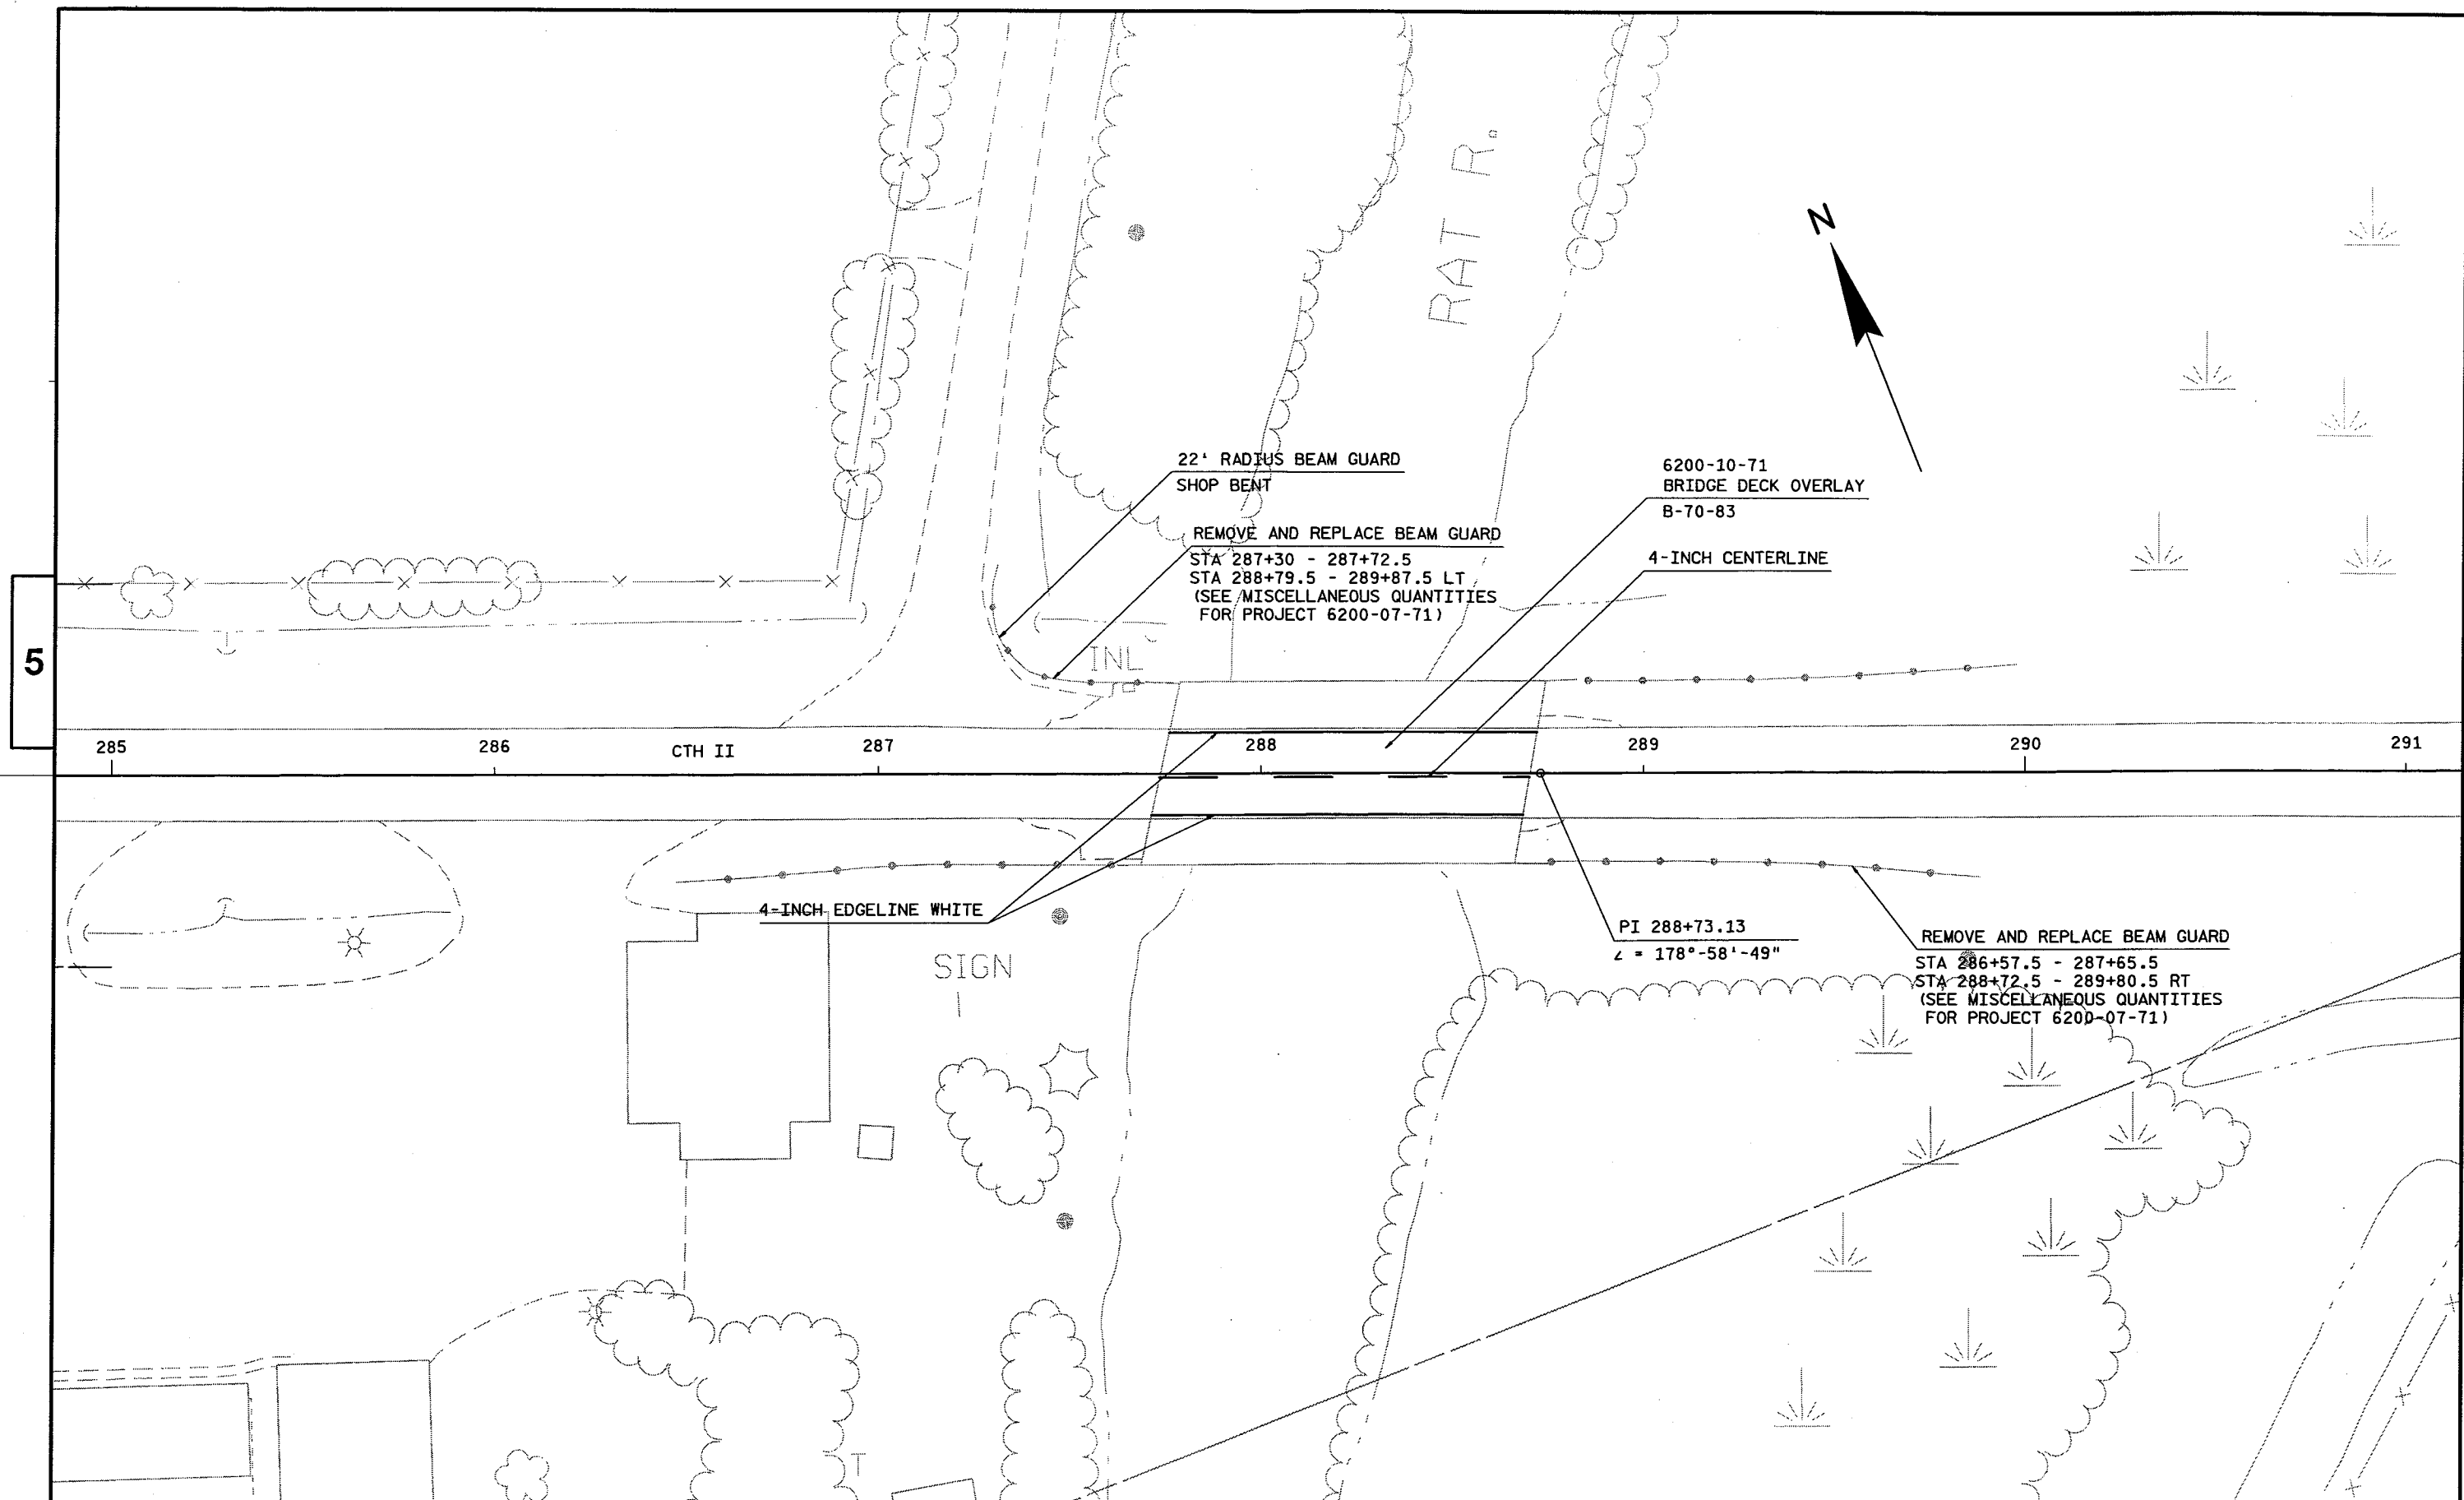

5

5

PROJECT NO: 6200-07-71/6200-10-71

HWY: CTH II

COUNTY: WINNEBAGO

PLAN - CTH II

SHEET 46

E

FILE NAME : \\gre31fp1\FCSERVER\D3_620007\050201.pn.dgn


PLOT DATE : 28-FEB-2005 07:08

PLOT BY : DOTC3S

PLOT NAME : 050201.pn5.l

PLOT SCALE : 40.000000:1.000000

WISDOT/CADD SHEET 44

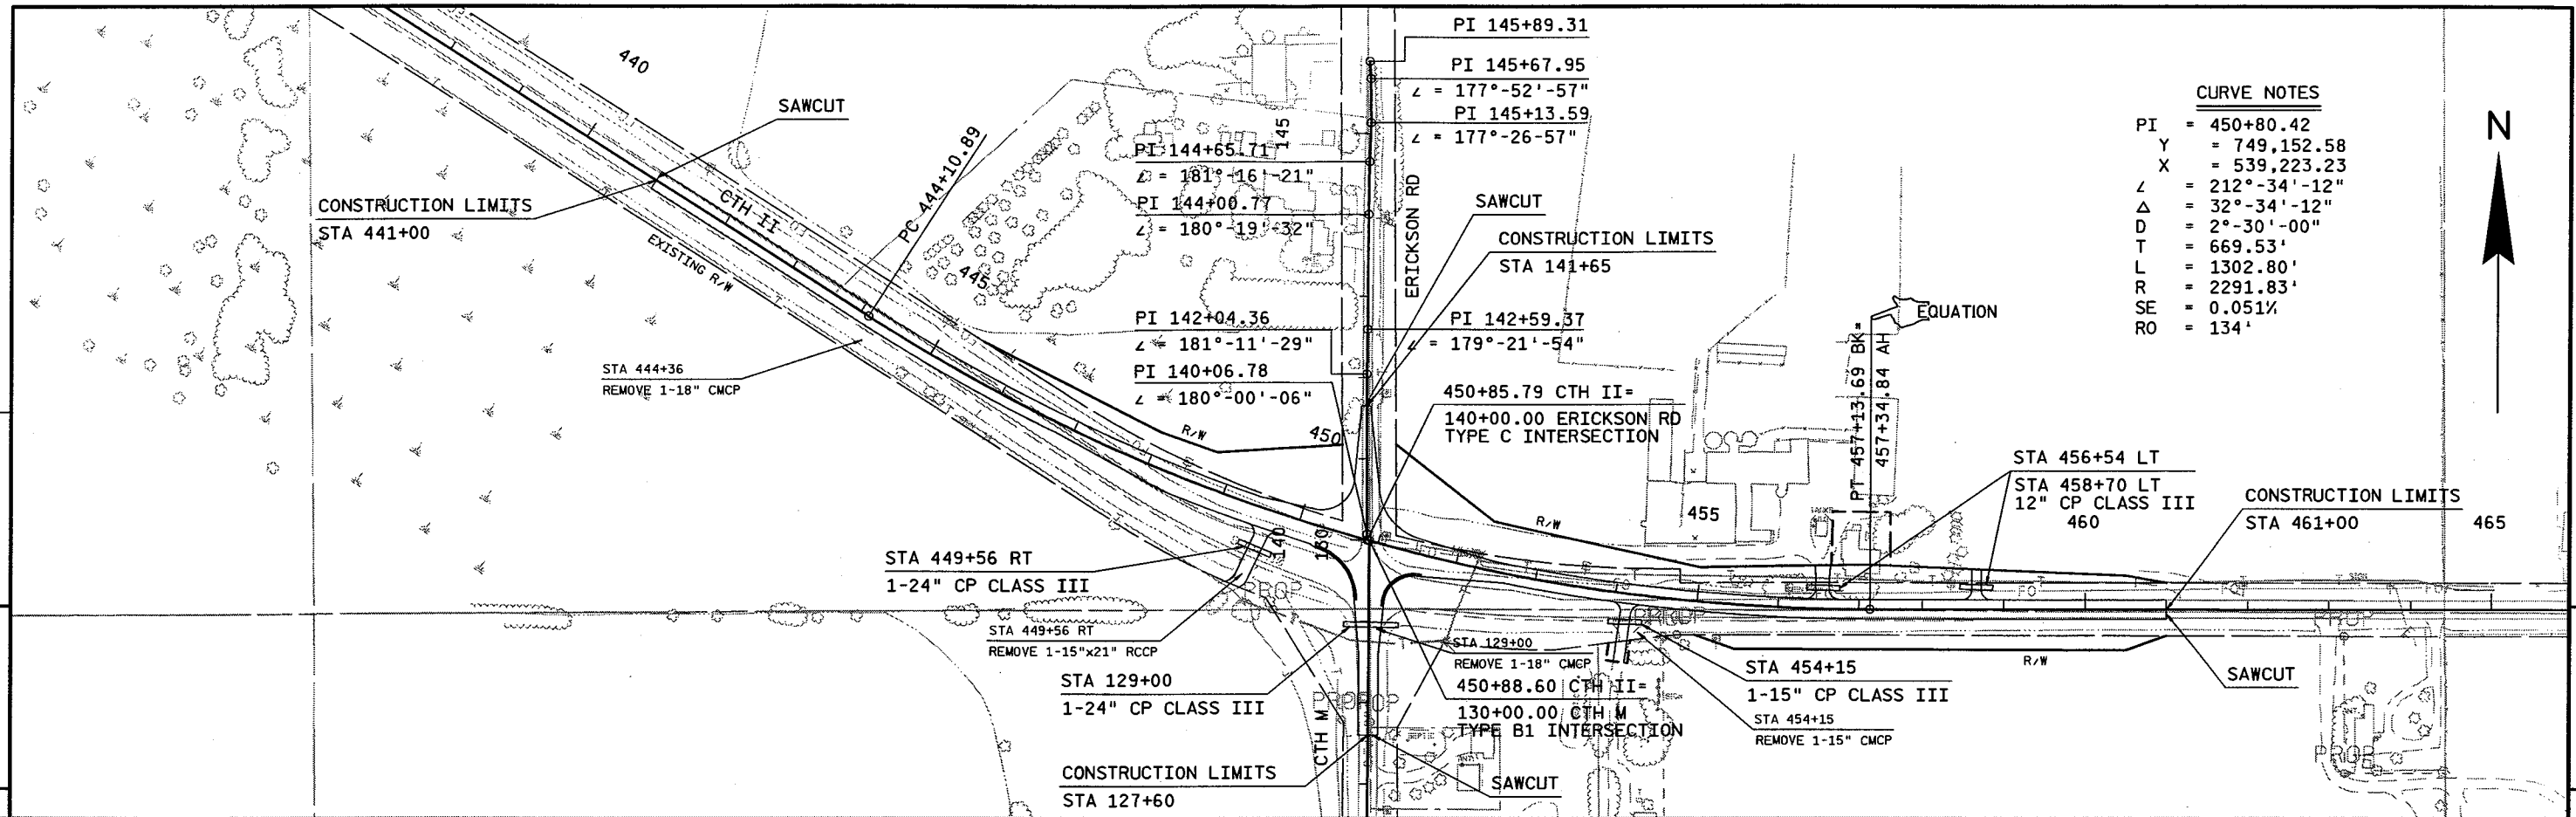


CURVE NOTES

PI	= 450+80.42
Y	= 749,152.58
X	= 539,223.23
∠	= 212°-34'-12"
Δ	= 32°-34'-12"
D	= 2°-30'-00"
T	= 669.53'
L	= 1302.80'
R	= 2291.83'
SE	= 0.051%
RO	= 134'







5

5

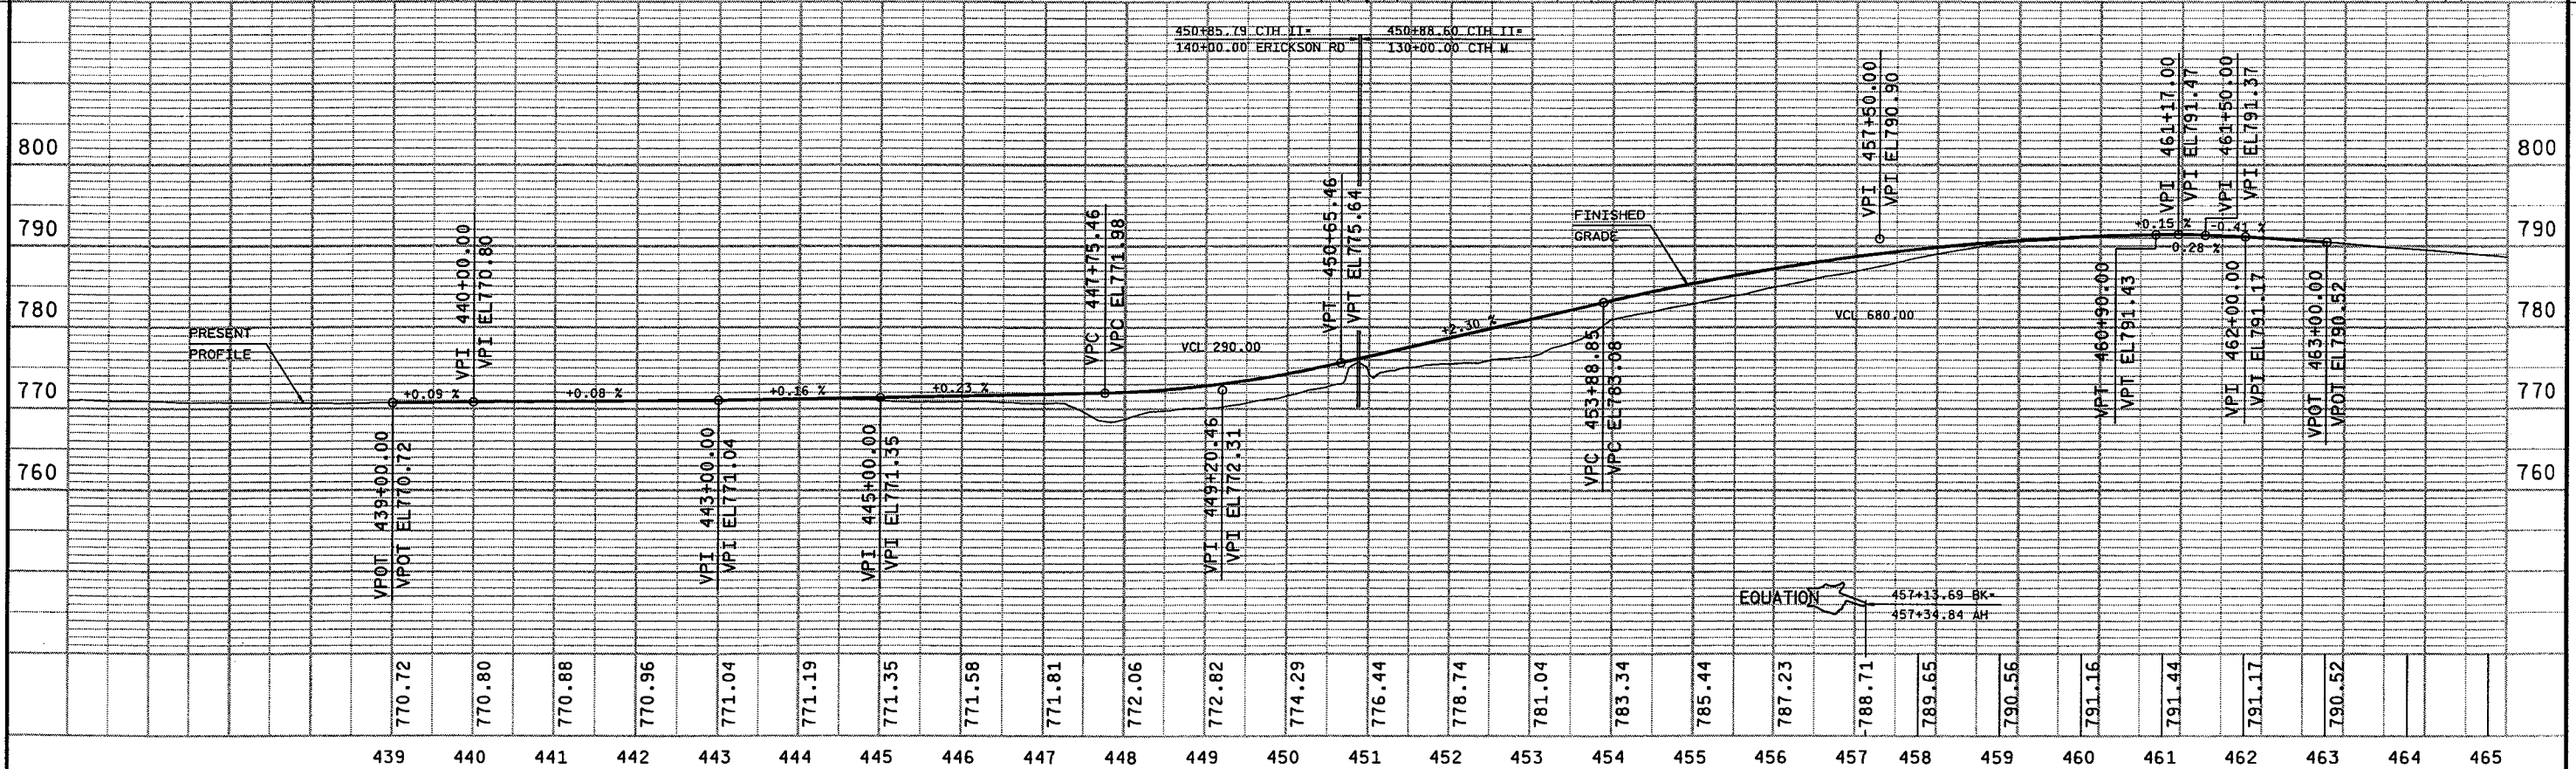

PROJECT NO: 6200-07-71	HWY: STH 110	COUNTY: WINNEBAGO	PLAN AND PROFILE	SHEET 47	E
------------------------	--------------	-------------------	------------------	----------	---

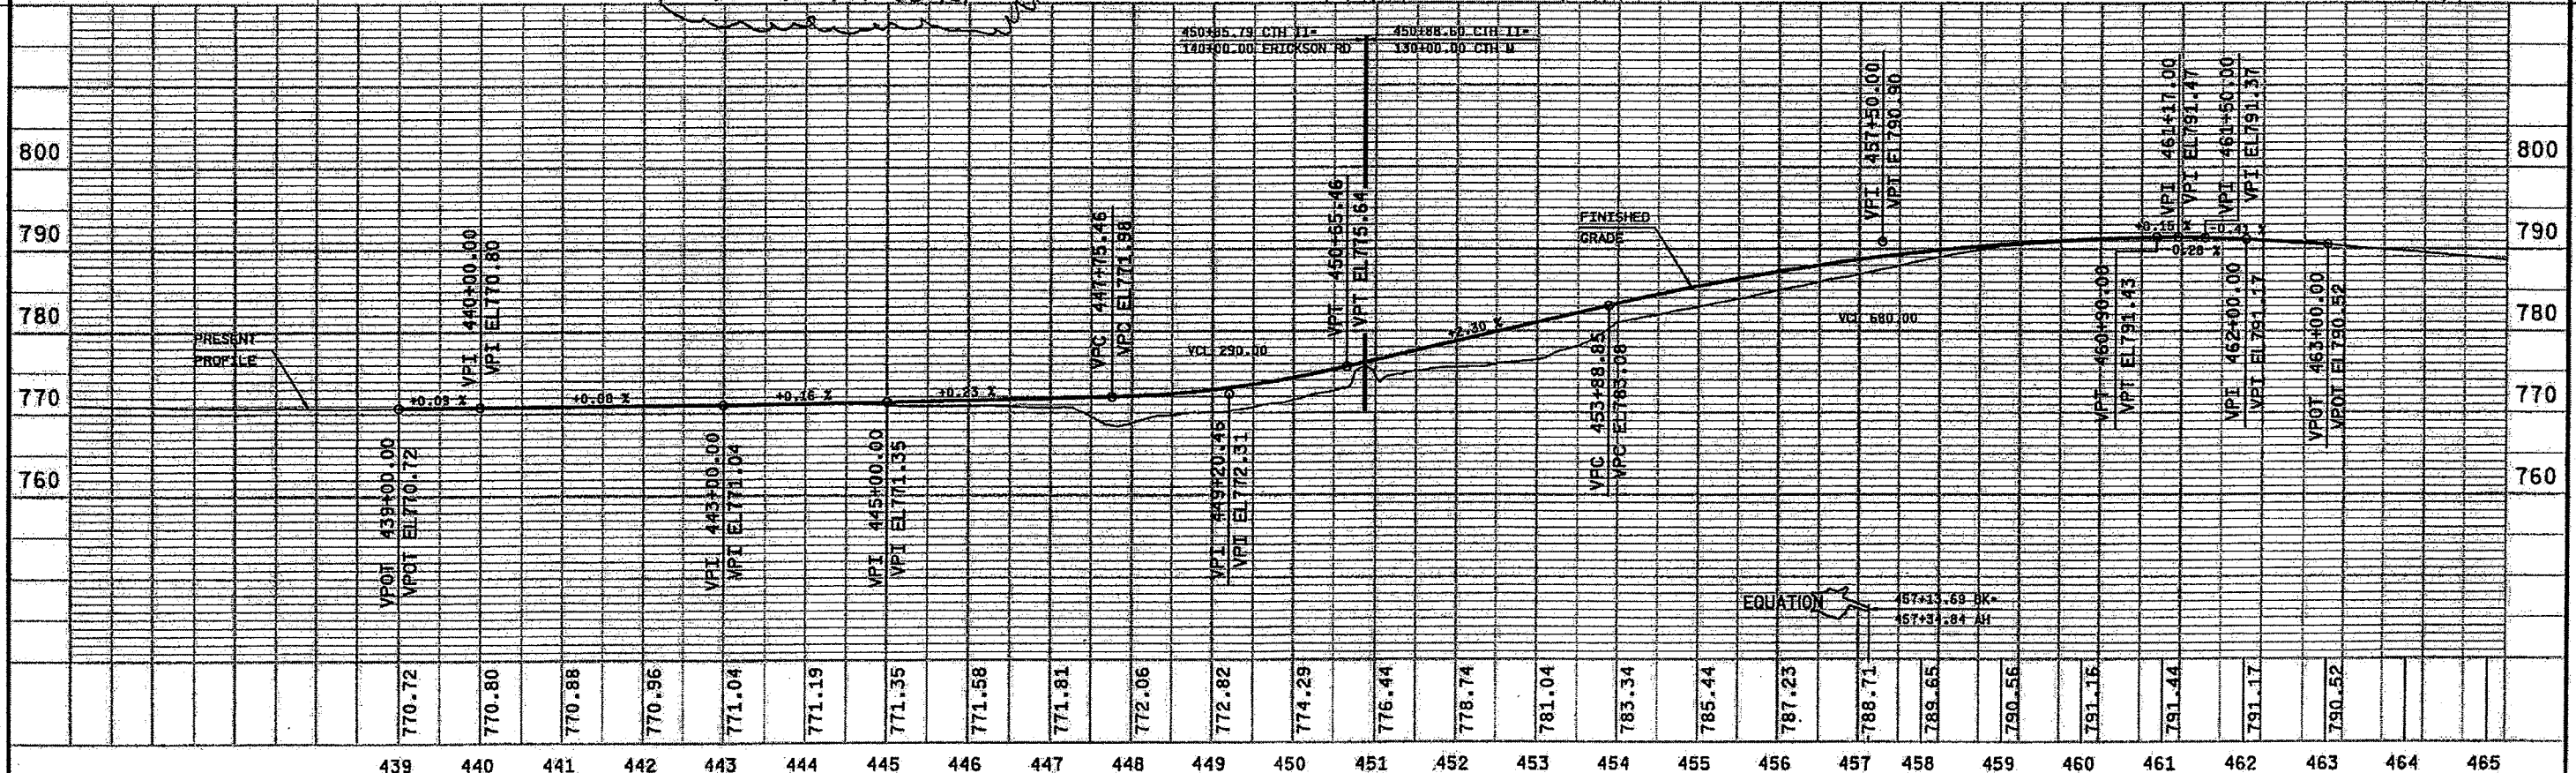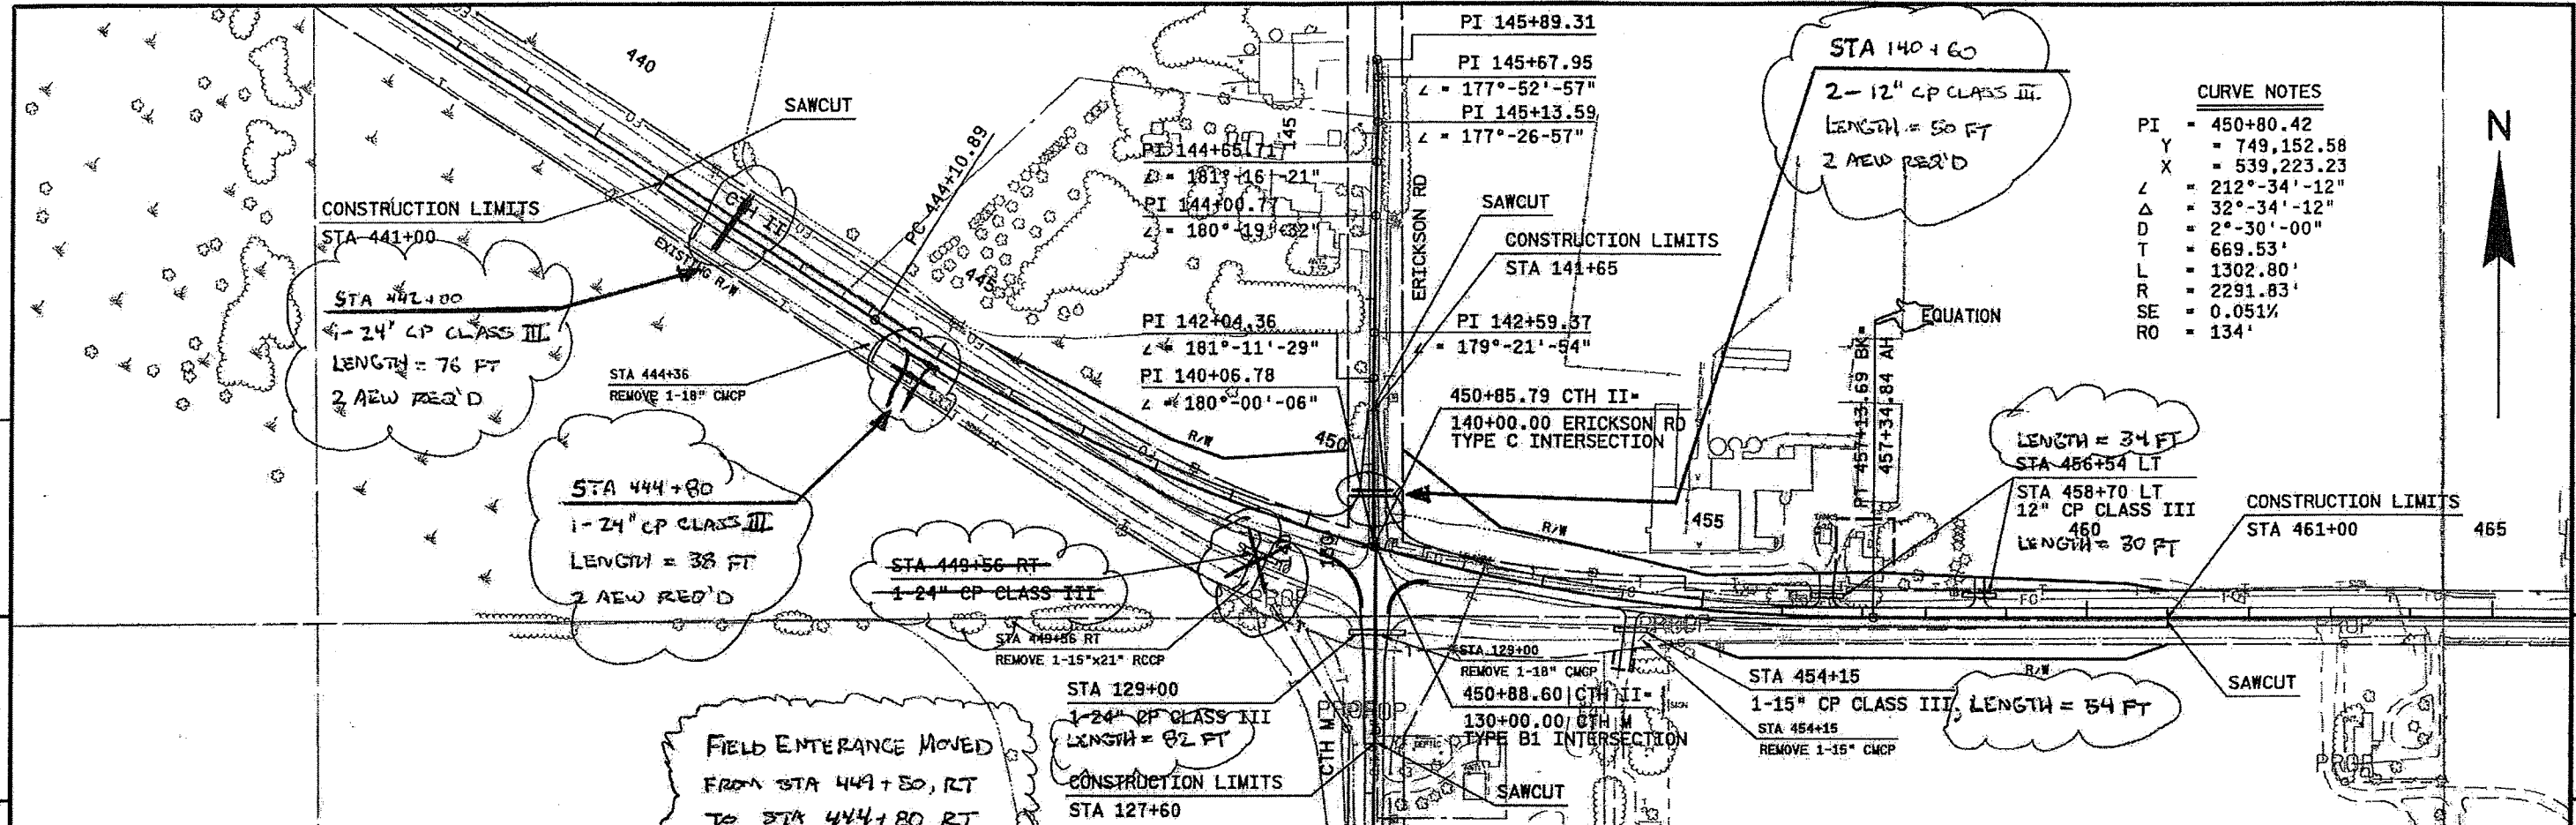

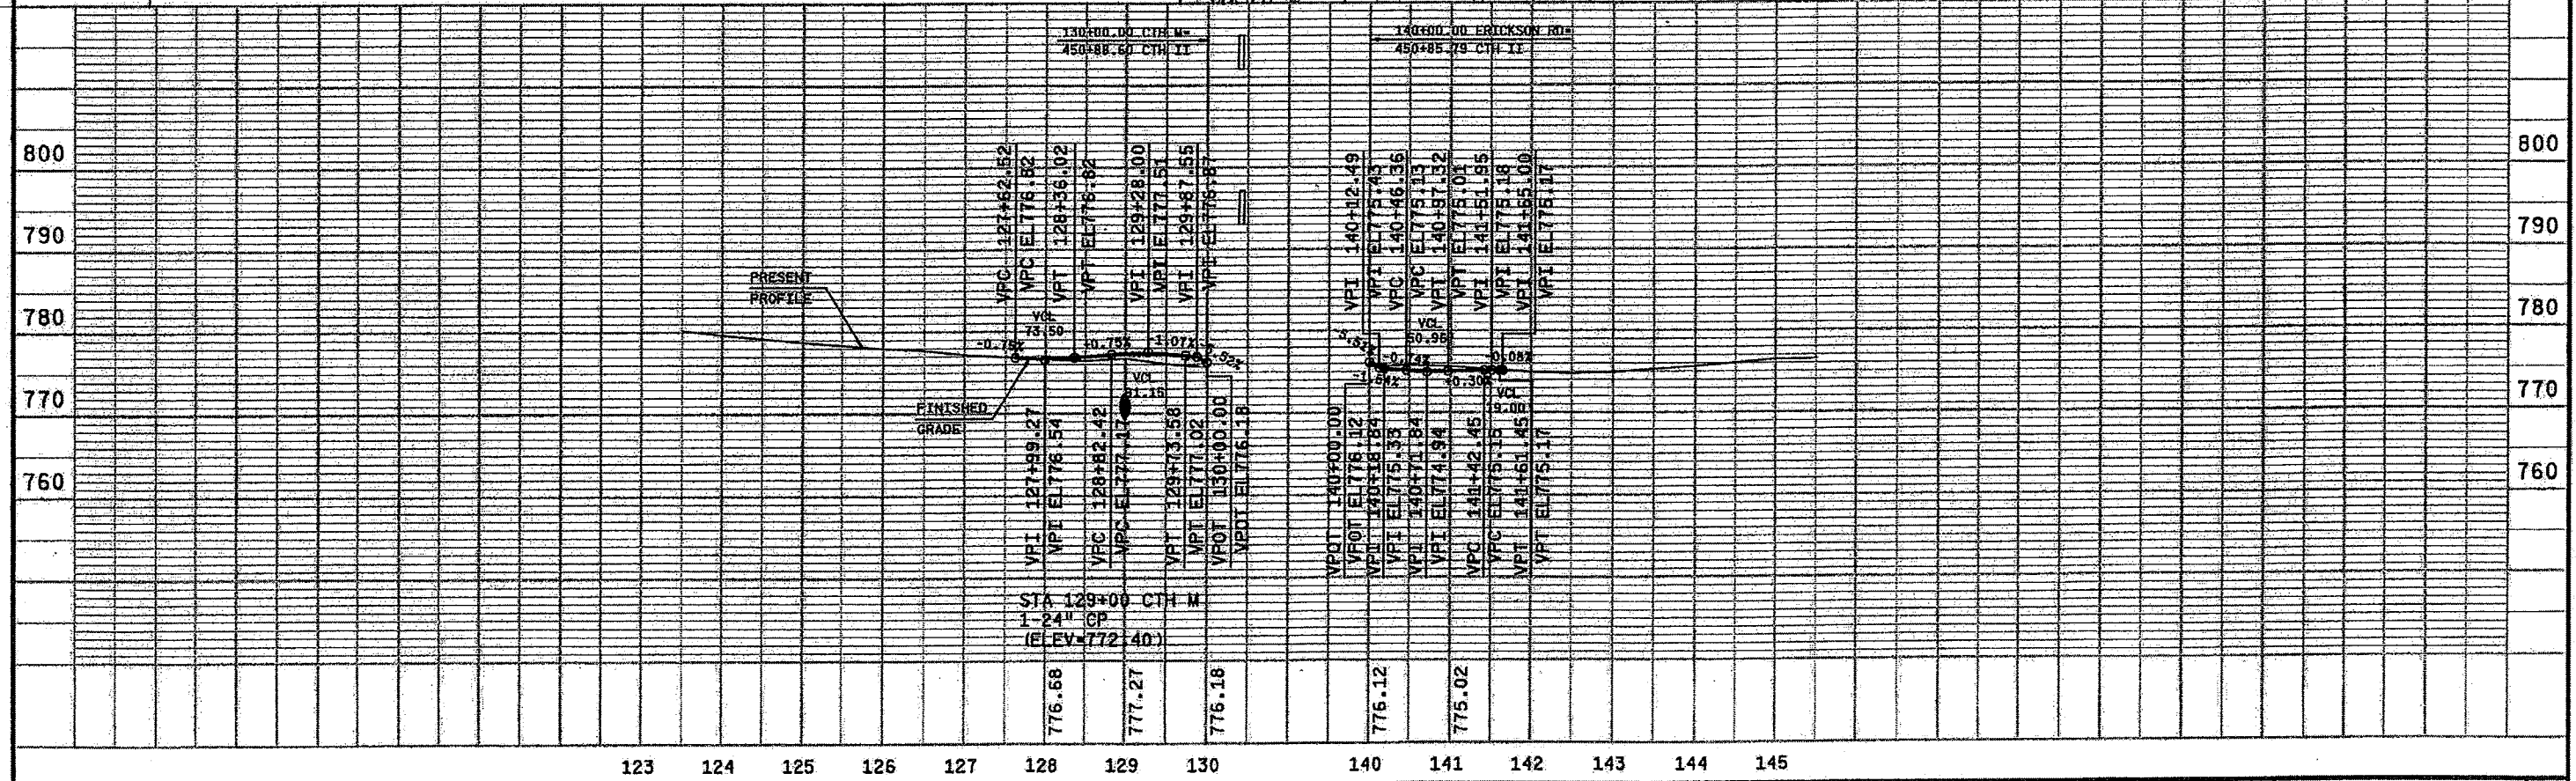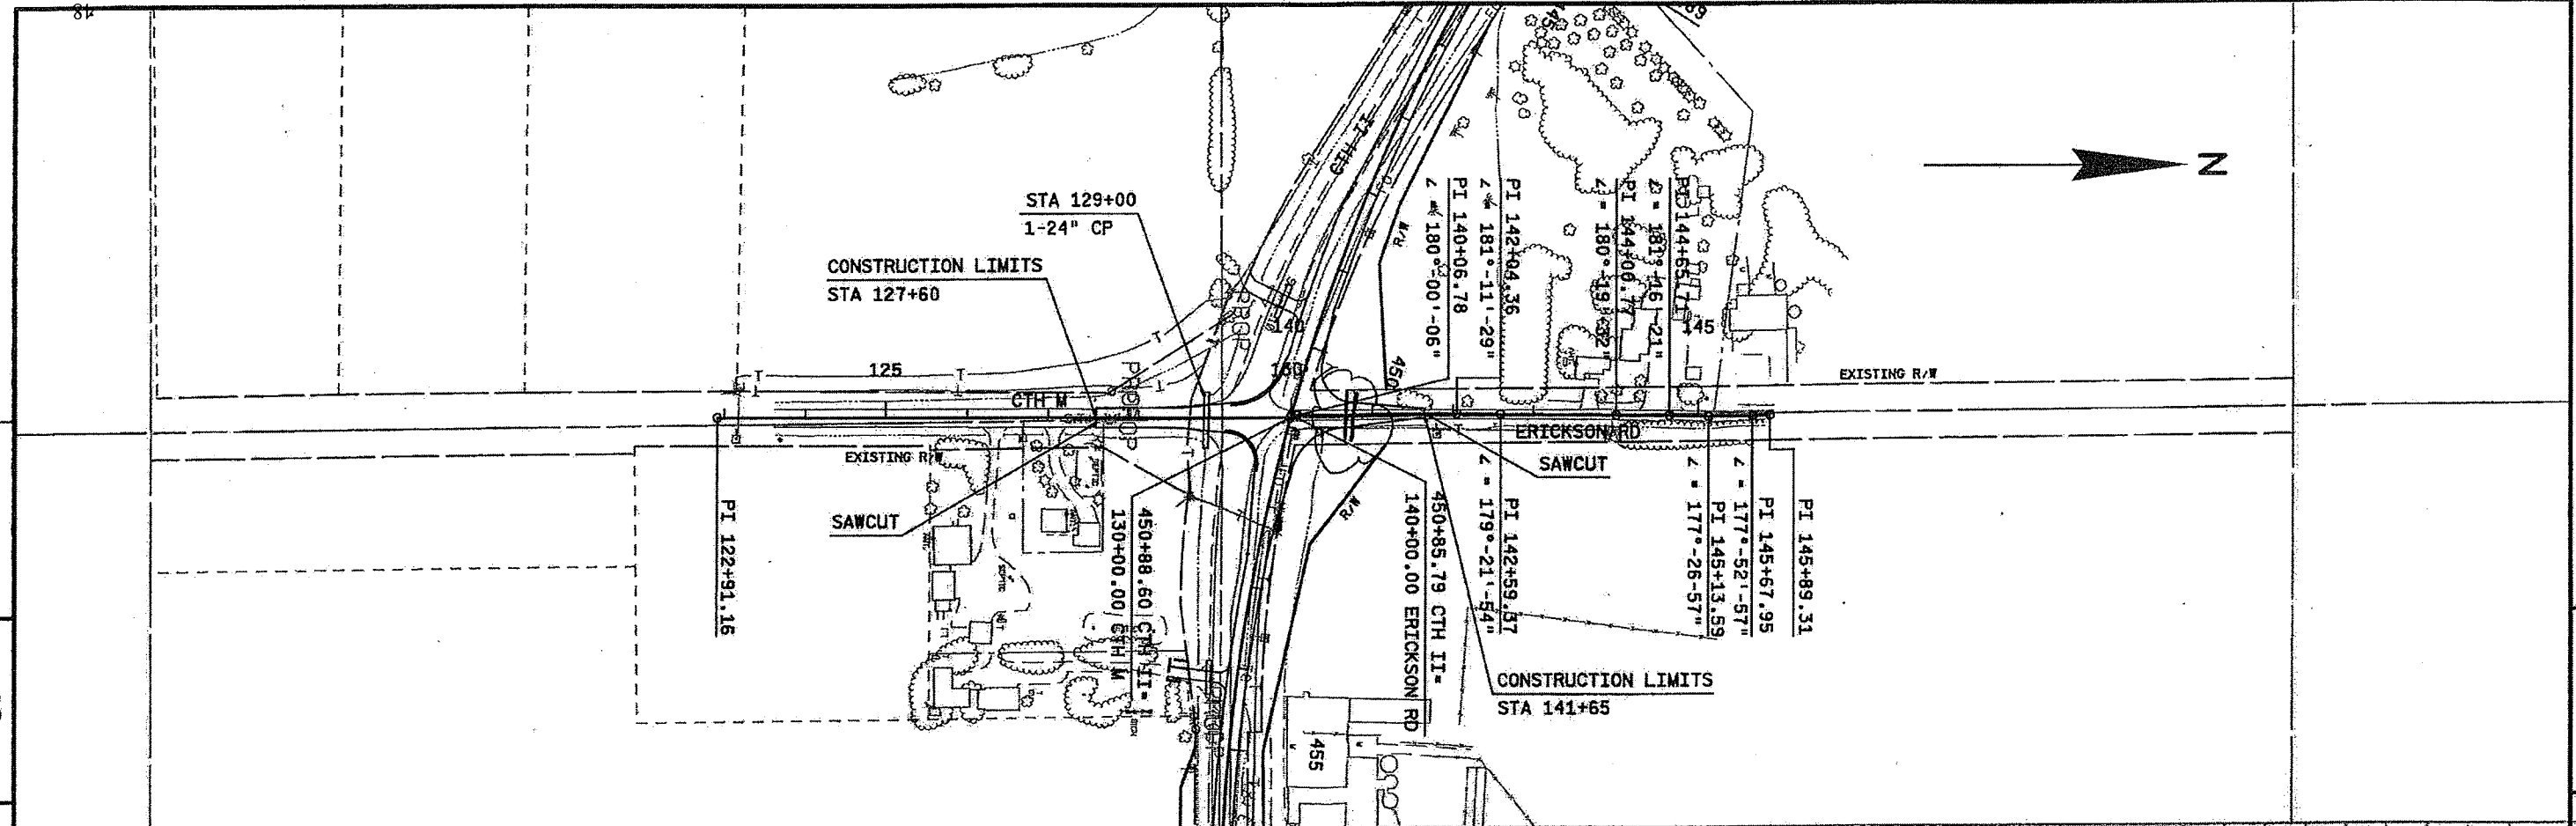


PROJECT ID: 6200-07-71
WITH: 6200-10-71

COUNTY: WINNEBAGO

ORDER OF SHEETS

- Section No. 1 Title
- Section No. 2 Typical Sections and Details
- Section No. 3 Estimate of Quantities
- Section No. 3 Miscellaneous Quantities
- Section No. 4 Right of Way Plat
- Section No. 5 Plan and Profile
- Section No. 6 Standard Detail Drawings
- Section No. 7 Sign Plates
- Section No. 8 Structure Plans
- Section No. 9 Computer Earthwork Data
- Section No. 9 Cross Sections

TOTAL SHEETS =

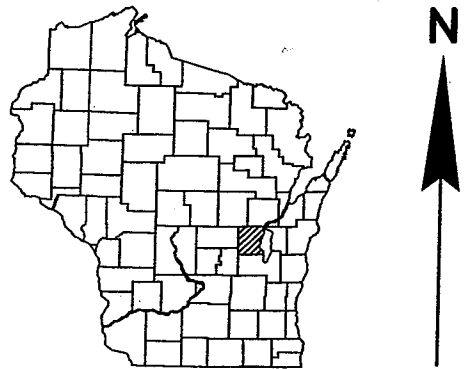

STATE OF WISCONSIN
DEPARTMENT OF TRANSPORTATION

PLAN OF PROPOSED IMPROVEMENT

USH 45 - NORTH COUNTY LINE

(OLD STH 110)

CTH II
WINNEBAGO COUNTY

B-70-83 DECK OVERLAY

(OLD STH 110)

CTH II
WINNEBAGO COUNTY


STATE PROJECT NUMBER
6200-10-71

STATE PROJECT NUMBER
6200-07-71

DESIGN DESIGNATION	CTH II
A.D.T. 2005	= 2050
A.D.T. 2025	= 3050
D.H.V.	= 400
D.D.	= 62/38
T.	= 3.4%
DESIGN SPEED	= 60 MPH
ESALS	= 197,100 (TOTAL LIFE)


CONVENTIONAL SYMBOLS

PLAN	PROFILE
CORPORATE LIMITS	GRADE LINE
PROPERTY LINE	ORIGINAL GROUND
LOT LINE	MARSH OR ROCK PROFILE (To be noted as such)
LIMITED HIGHWAY EASEMENT	SPECIAL DITCH
EXISTING RIGHT OF WAY	GRADE ELEVATION
PROPOSED OR NEW R/W LINE	CULVERT (Profile View)
SLOPE INTERCEPT	UTILITIES
REFERENCE LINE	ELECTRIC
EXISTING CULVERT	FIBER OPTIC
PROPOSED CULVERT (Box or Pipe)	GAS
COMBUSTIBLE FLUIDS	SANITARY SEWER
MARSH AREA	STORM SEWER
WOODED OR SHRUB AREA	TELEPHONE
	WATER
	UTILITY PEDESTAL
	POWER POLE
	TELEPHONE POLE

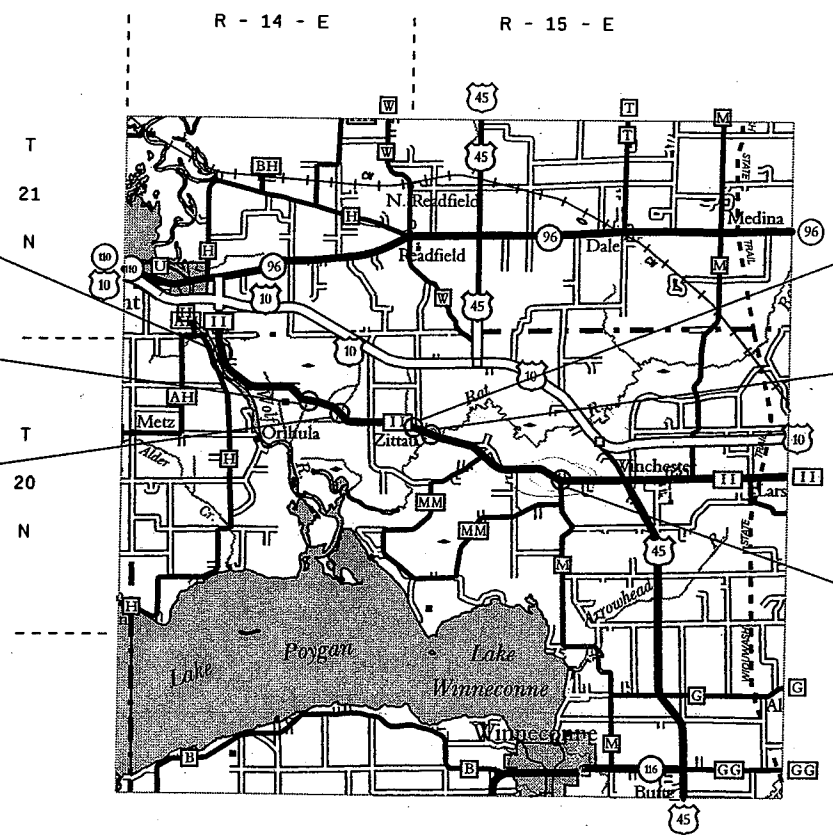

- 6200-07-71
CATTLE PASS REMOVAL
STA 28+50 TO 29+50
- 6200-07-71
STRUCTURE B-70-242
STA 144+15 TO 145+81
- 6200-07-71
STRUCTURE C-70-70
STA 183+86 TO 185+01

- 6200-07-71
STRUCTURE C-70-69
STA 276+13 TO 277+45 12
- 6200-10-71
STRUCTURE B-70-83
BRIDGE DECK OVERLAY
- 6200-07-71
INTERSECTION RECONSTRUCTION
STA 441+00 TO 461+00

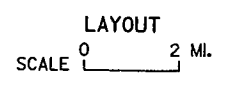

TOTAL NET LENGTH OF CENTERLINE = 0.0 MI.

COORDINATES ON THIS PLAN ARE REFERENCED TO THE WISCONSIN COUNTY COORDINATE SYSTEM (WCCS), WINNEBAGO COUNTY.
ALL ELEVATIONS ON THIS PROJECT ARE REFERENCED TO THE NATIONAL GEODETIC VERTICAL DATUM OF 1929 (N.G.V.D.).

STATE OF WISCONSIN DEPARTMENT OF TRANSPORTATION	
PREPARED BY	M D VANDEHEI
Surveyor	E A DANKE
Designer	W R BERTRAND
Project Manager	R W RAHLF
District Examiner	
District Supervisor	
C.O. Examiner	
APPROVED FOR DISTRICT OFFICE	
DATE:	(Signature)

UTILITIES

CENTURYTEL
DICK GRAMBSCH
2323 E CAPITOL DRIVE
APPLETON, WI 54911
920-986-2014

ORIHULA SANITARY DISTRICT
BRYAN HAHN
8761 RIVER TRAIL DRIVE
FREMONT, WI 54940
920-446-3999

TIME WARNER CABLE
LARRY PHILSTROM
1001 KENNEDY AVENUE
KIMBERLY, WI 54136-0145
920-831-9211

WISCONSIN ELECTRIC POWER COMPANY
CARL LEMMER
333 W EVERETT ST - A279
MILWAUKEE, WI 53203-2998
262-544-7248

WISCONSIN PUBLIC SERVICE
LORI BUTRY
700 NORTH ADAMS STREET
PO BOX 19001
GREEN BAY, WI 54307-9001
920-433-1703; FAX 920-433-1360



Toll Free (800) 242-8511
Milwaukee Area (414) 259-1181
Hearing Impaired TDD (800) 542-2289
www.DiggersHotline.com

STANDARD DETAIL DRAWINGS

8D1-13
8D4-3
8E8-3
8E9-5
8E10-2
8F1-11
8F4-5
9A1-12a

12A3-7
14B15-4a
14B15-4b
14B16-3a & b
14B18-4a
14B20-6a
14B20-6c
14B24-4a, b, & c
15A1-9
15A3-1
15C2-4a
15C2-4b
15C2-4c
15C3-1
15C8-9a
15C8-9b
15D29-1
16A1-6

Concrete Curb, Concrete Curb & Gutter and Pavement Ties
Concrete Surface Drain & Asphaltic Flume
Typical Installations for Erosion Bales/Temporary Ditch Checks
Silt Fence
Inlet Protection Type A, B, C, and D
Apron Endwalls for Culvert Pipe
Joint Ties for Concrete Pipe
At-Grade Side Road Intersection, Types "B1", "B2", "C", and "D" and Tee Intersection Bypass Lane
Name Plate (Structures)
Steel Plate Beam Guard, Class "A" Installation & Elements
Steel Plate Beam Guard, Class "A" Installation & Elements
Class "A" Steel Plate Beam Guard End Treatment with Anchorage, Type 2
Steel Plate Beam Guard, Class "A" (at Bridges, Obstacles, and Sideroads/Driveways)
Steel Thrie Beam Structure Approach
Steel Thrie Beam Structure Approach, Connection to Sloped End Parapets
Steel Plate Beam Guard Energy Absorbing Terminal
Marker Post for Right-of-Way
Marker Post, Flexible, for Culvert End
Barricades and Signs for Mainline Closures
Barricades and Signs for Mainline Closures
Detour Signing for Mainline Closures
Barricades and Signs for Sideroad Closures
Pavement Marking (Mainline)
Pavement Marking (Intersections)
Traffic Control, Vehicle Entrance/Exit or Haul Road
Landmark Reference Monuments and Covers

DNR AREA LIAISON

WISCONSIN DEPARTMENT OF NATURAL RESOURCES
BOBBY JO REISER 920-303-5442
JAMES P COUGHLIN CENTER
625 EAST COUNTY ROAD Y, SUITE 700
OSHKOSH, WISCONSIN 54901-9731

GENERAL NOTES

LIMITED EASEMENTS FOR P.E. AND DRAINAGE CONSTRUCTION HAVE BEEN OBTAINED AND THESE RIGHTS HAVE BEEN EXTENDED TO THE CONTRACTOR.

THE LOCATIONS OF EXISTING AND PROPOSED UTILITY FACILITIES AS SHOWN ON THE PLAN ARE APPROXIMATE. THERE MAY BE OTHER FACILITIES WITHIN THE PROJECT AREA THAT ARE NOT SHOWN.

NO TREES OR SHRUBS ARE TO BE REMOVED WITHOUT APPROVAL OF THE ENGINEER.

THE ELEVATIONS SHOWN ON THE ROADWAY CROSS SECTIONS ARE EARTH GRADE ELEVATIONS AT THE REFERENCE LINE OF THE ROADWAY.

INLET AND DISCHARGE ELEVATIONS FOR DRAINAGE STRUCTURES ARE APPROXIMATE AND SHALL BE DETERMINED BY THE ENGINEER IN THE FIELD.

WHEN THE QUANTITY OF ASPHALTIC CONCRETE PAVEMENT OR BASE AGGREGATE DENSE IS MEASURED FOR PAYMENT BY THE TON, THE DEPTH OR THICKNESS AS SHOWN ON THE PLAN IS APPROXIMATE AND THE ACTUAL THICKNESS WILL DEPEND UPON THE DISTRIBUTION OF THE MATERIAL AS DIRECTED BY THE ENGINEER IN THE FIELD.

TACK COAT HAS BEEN ESTIMATED AT AN APPLICATION RATE OF 0.025 GALLONS PER SQUARE YARD AND SHALL BE APPLIED BETWEEN LAYERS OF ASPHALTIC PAVEMENTS.

CURB AND GUTTER RADII ARE SHOWN TO THE FRONT FACE OF CURB.


THE ENGINEER IN THE FIELD SHALL DETERMINE THE EXACT LOCATIONS AND LIMITS OF PRIVATE AND COMMERCIAL ENTRANCES.

ALL DISTURBED AREAS WITHIN THE RIGHT-OF-WAY, EXCEPT THE AREAS BETWEEN THE SUBGRADE SHOULDER POINTS, SHALL BE FERTILIZED, SEED, AND MULCHED.


THE D.O.T. BRIDGE BENCHMARK MONUMENTS WILL BE FURNISHED BY THE STATE AND PLACED BY THE CONTRACTOR AS DIRECTED BY THE ENGINEER.

RUNOFF COEFFICIENT FOR THE PROJECT: EXISTING PAVEMENT 0.9, EXISTING SLOPES 0.3, NEW PAVEMENT 0.9, NEW SLOPES 0.3.


THE CONTRACTOR SHALL NOTIFY THE DISTRICT TRAFFIC UNIT, 920-492-3512 TWO WEEKS PRIOR TO PROJECT COMPLETION, TO ALLOW FOR THE PLACEMENT OF ANY PERMANENT SIGNING WHICH WAS REMOVED OR MOVED DURING CONSTRUCTION OPERATIONS.

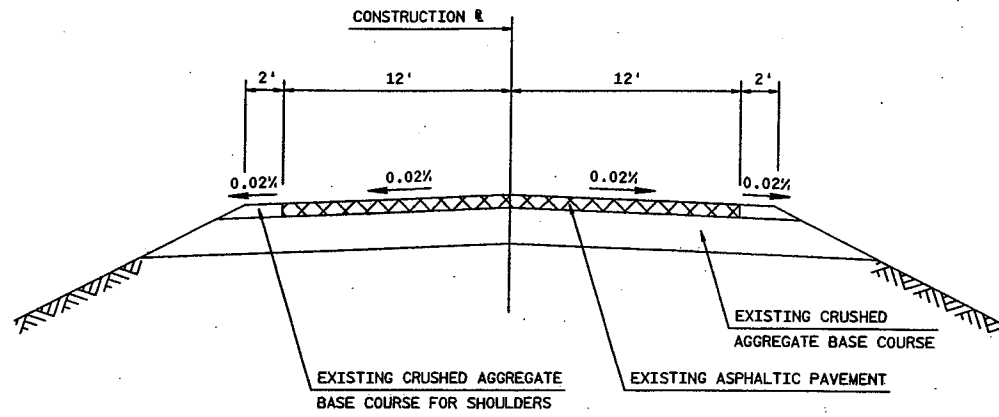


EXISTING TYPICAL CROSS SECTION FOR CTH M

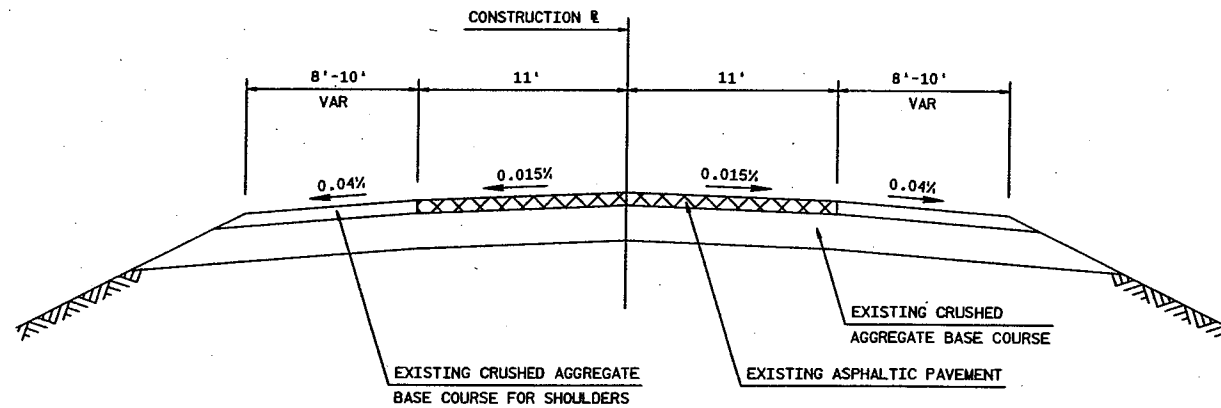

EXISTING TYPICAL CROSS SECTION FOR CTH II

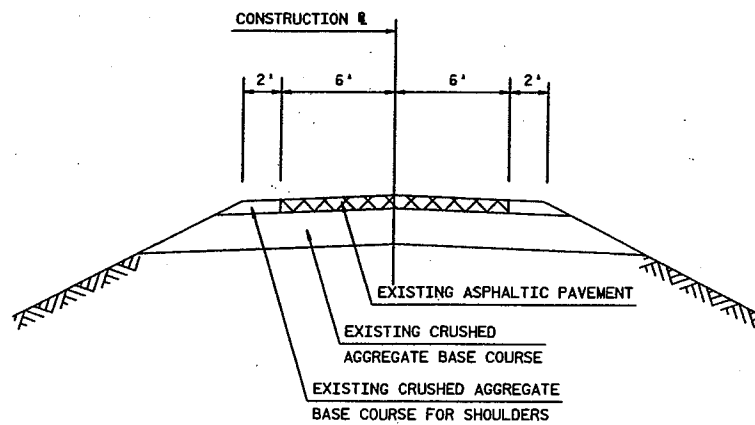


EXISTING TYPICAL CROSS SECTION FOR ERICKSON ROAD

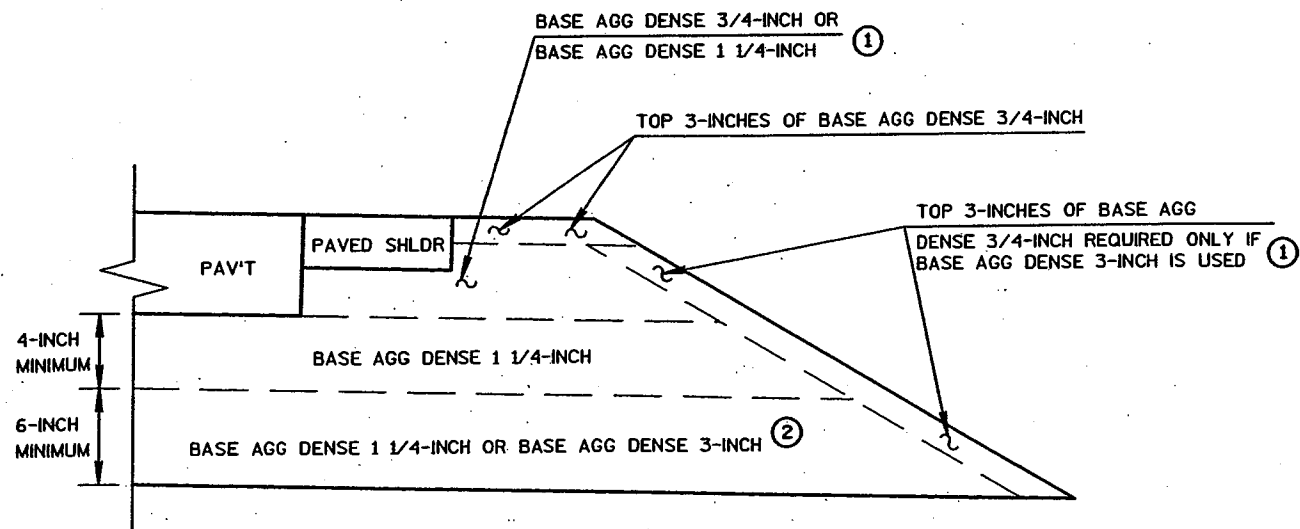





NOTES

- ① QUANTITY IS INCLUDED IN THE BID ITEM OF BASE AGG DENSE 3/4-INCH
- ② QUANTITY IS INCLUDED IN THE BID ITEM OF BASE AGG DENSE 1 1/4-INCH


CONTRACTOR OPTION TO USE BASE AGG DENSE 3-INCH

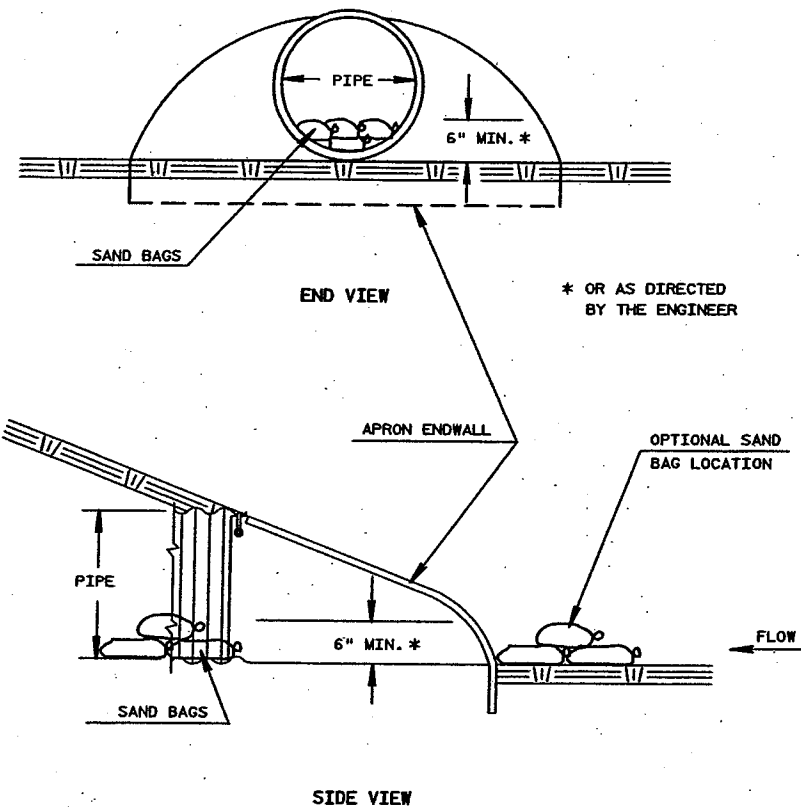


CULVERT PIPE DITCH CHECK (INSTALL ON INLET END ONLY)

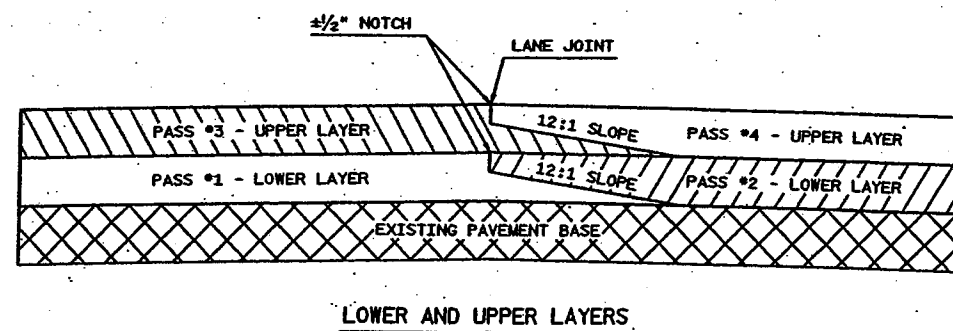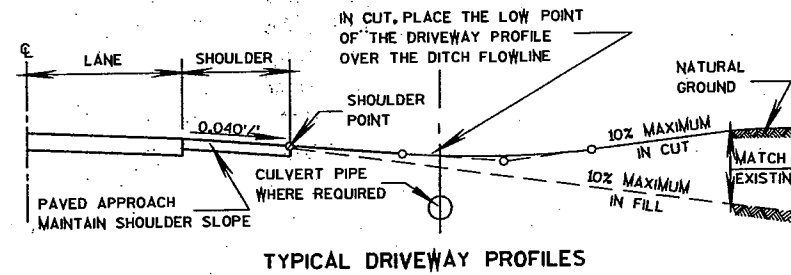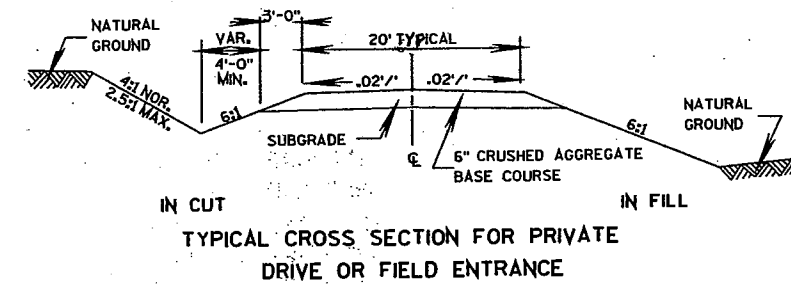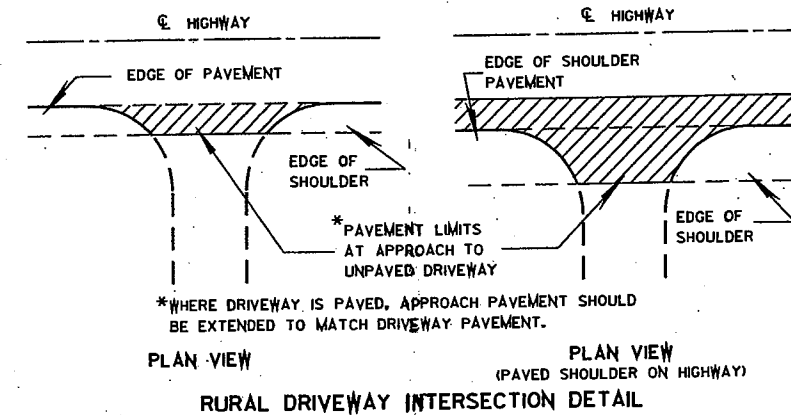


TYPICAL PAVEMENT CROSS SECTION OF TAPERED AND NOTCHED LONGITUDINAL JOINTS

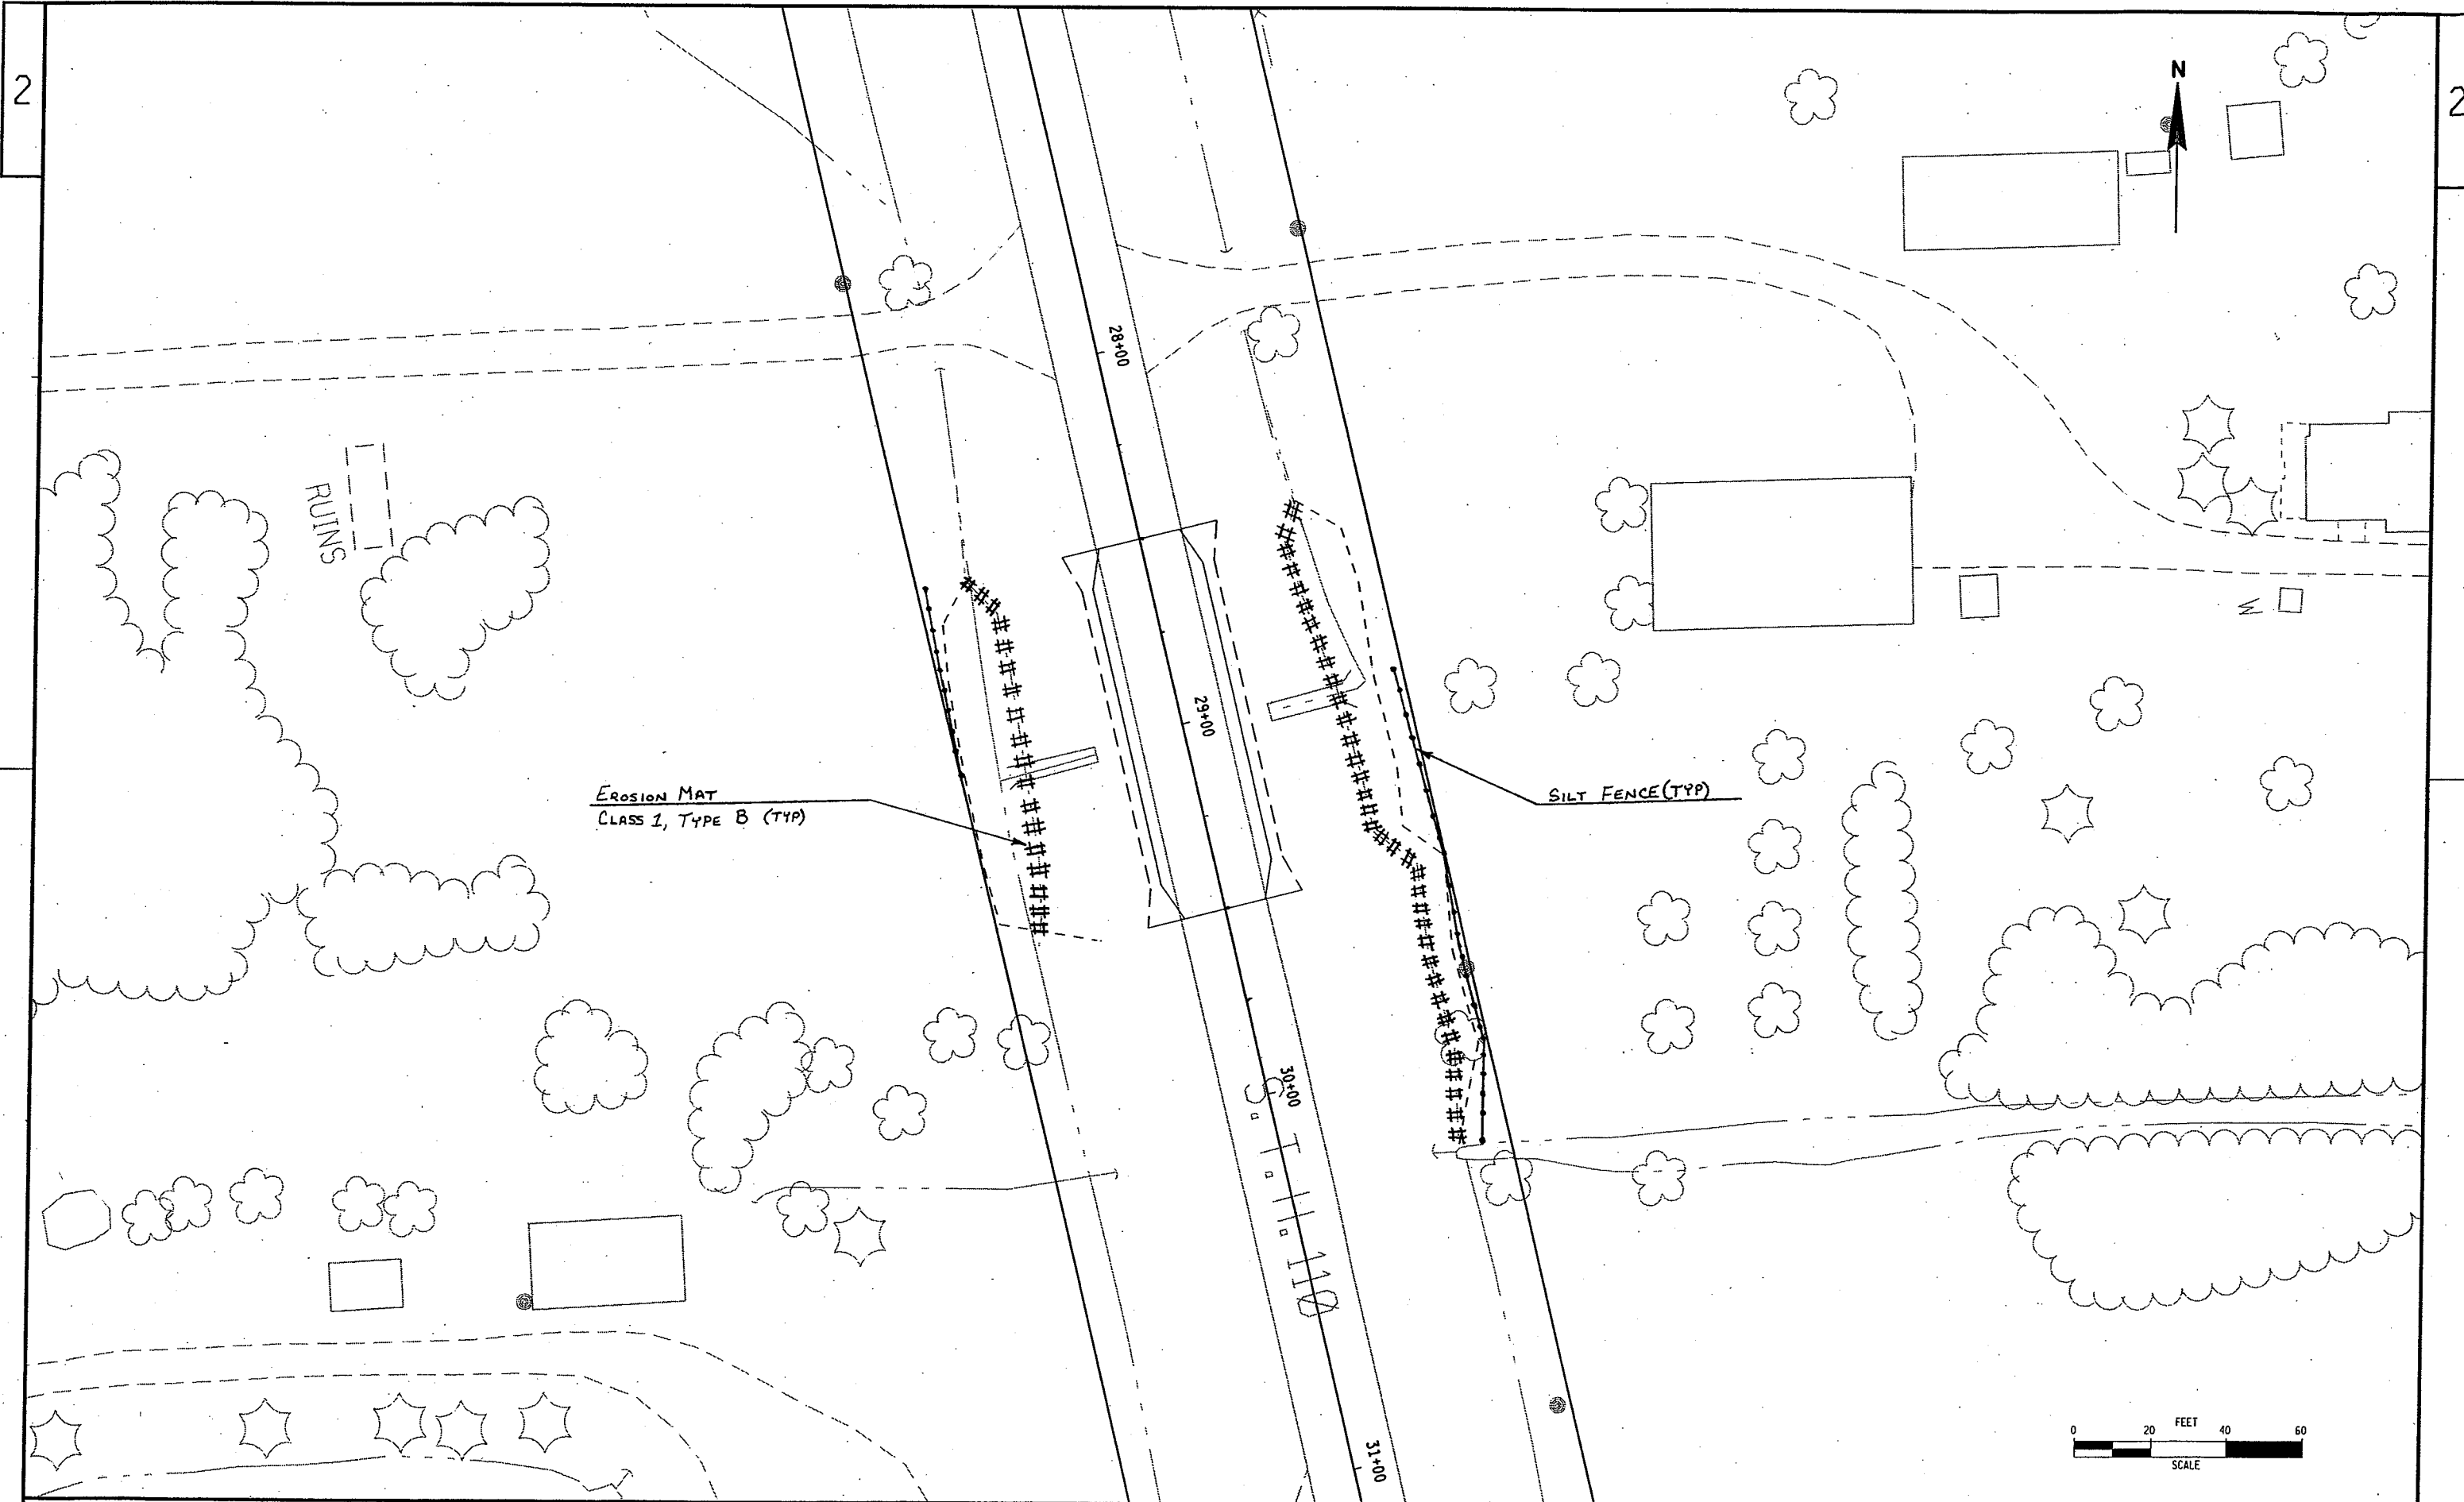


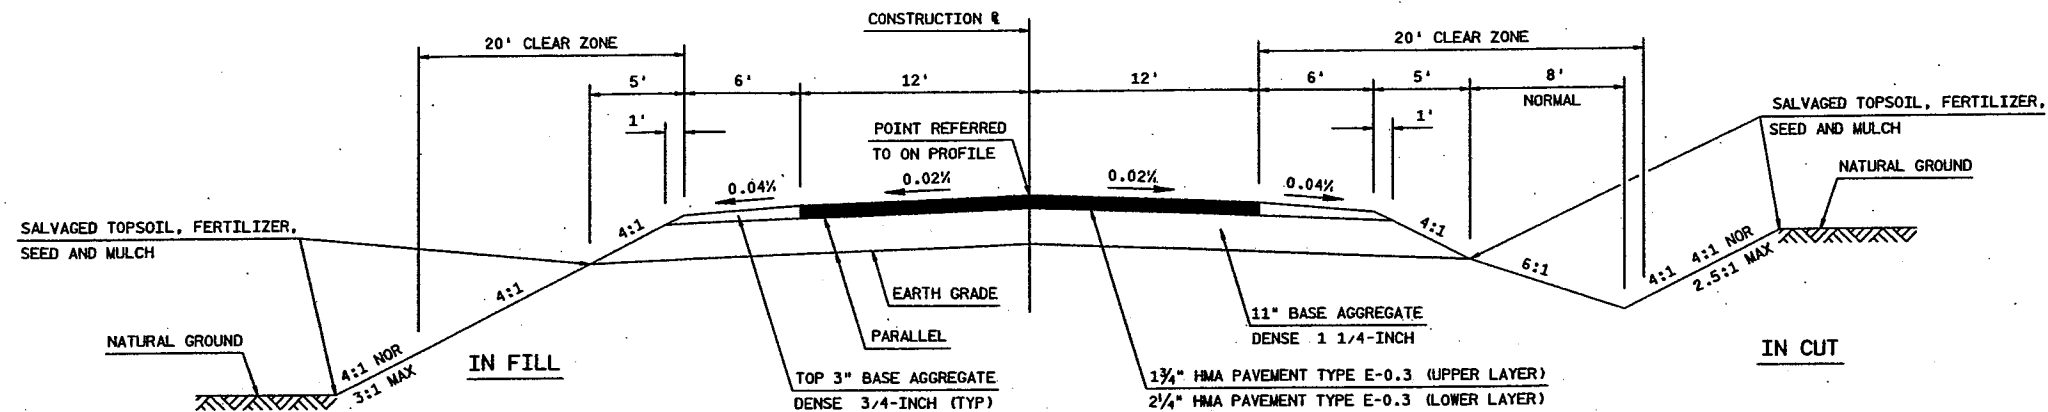



TYPICAL FINISHED CROSS SECTION FOR CTH M

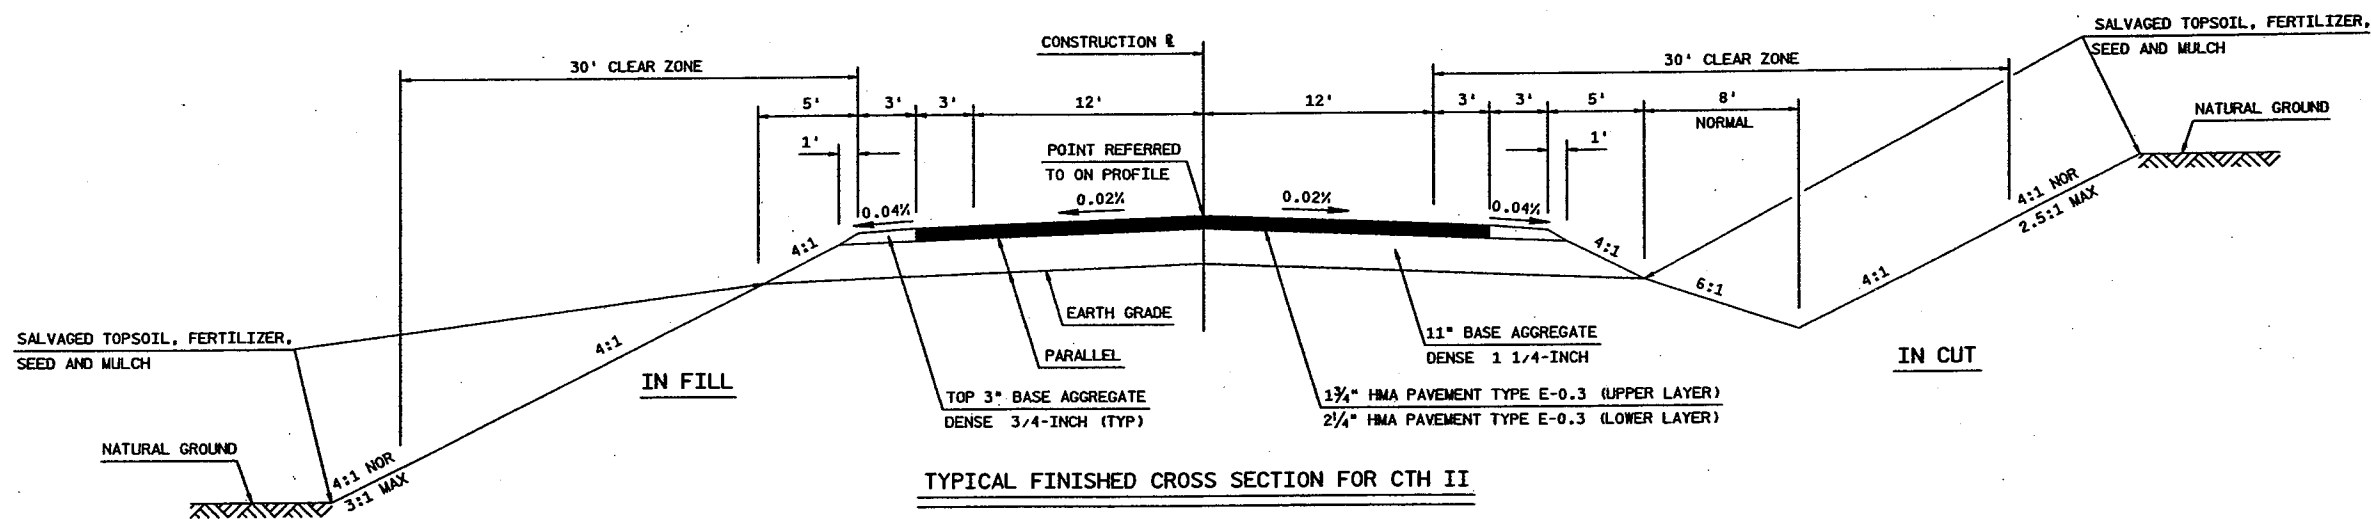

TYPICAL FINISHED CROSS SECTION FOR CTH II

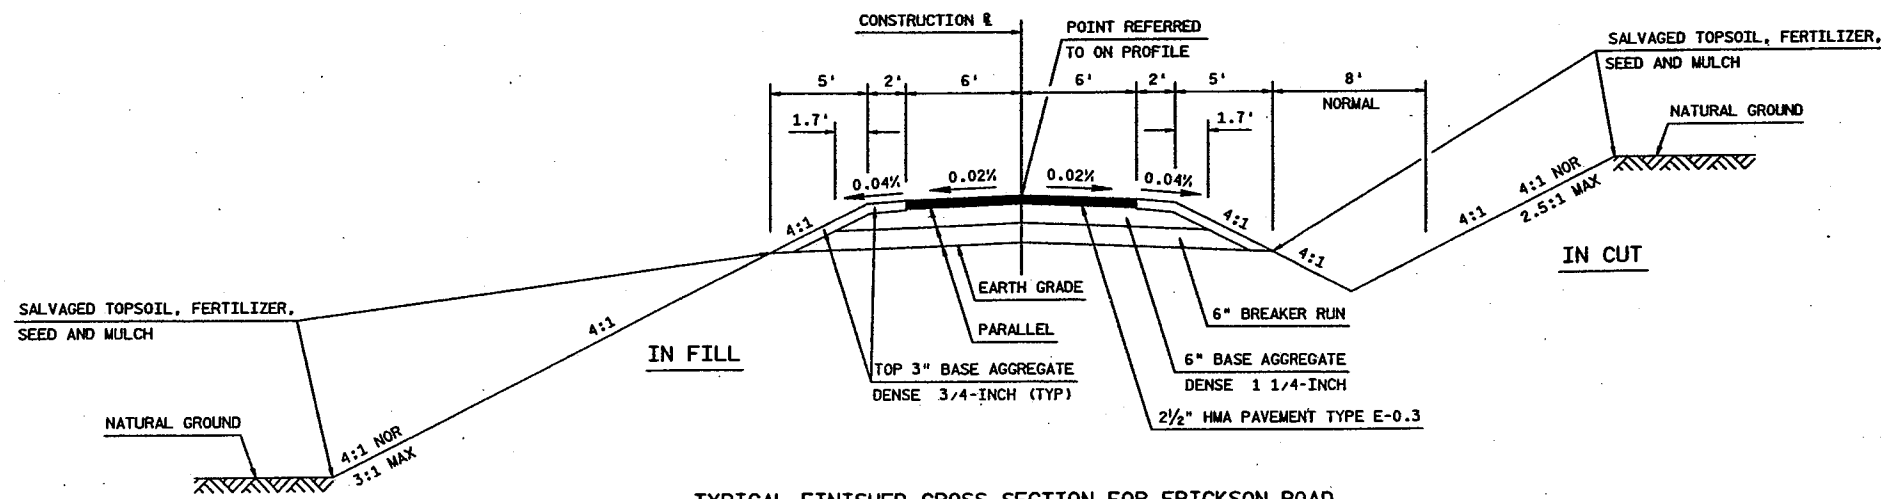

TYPICAL FINISHED CROSS SECTION FOR ERICKSON ROAD

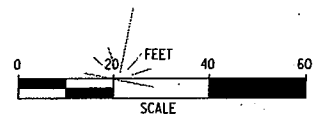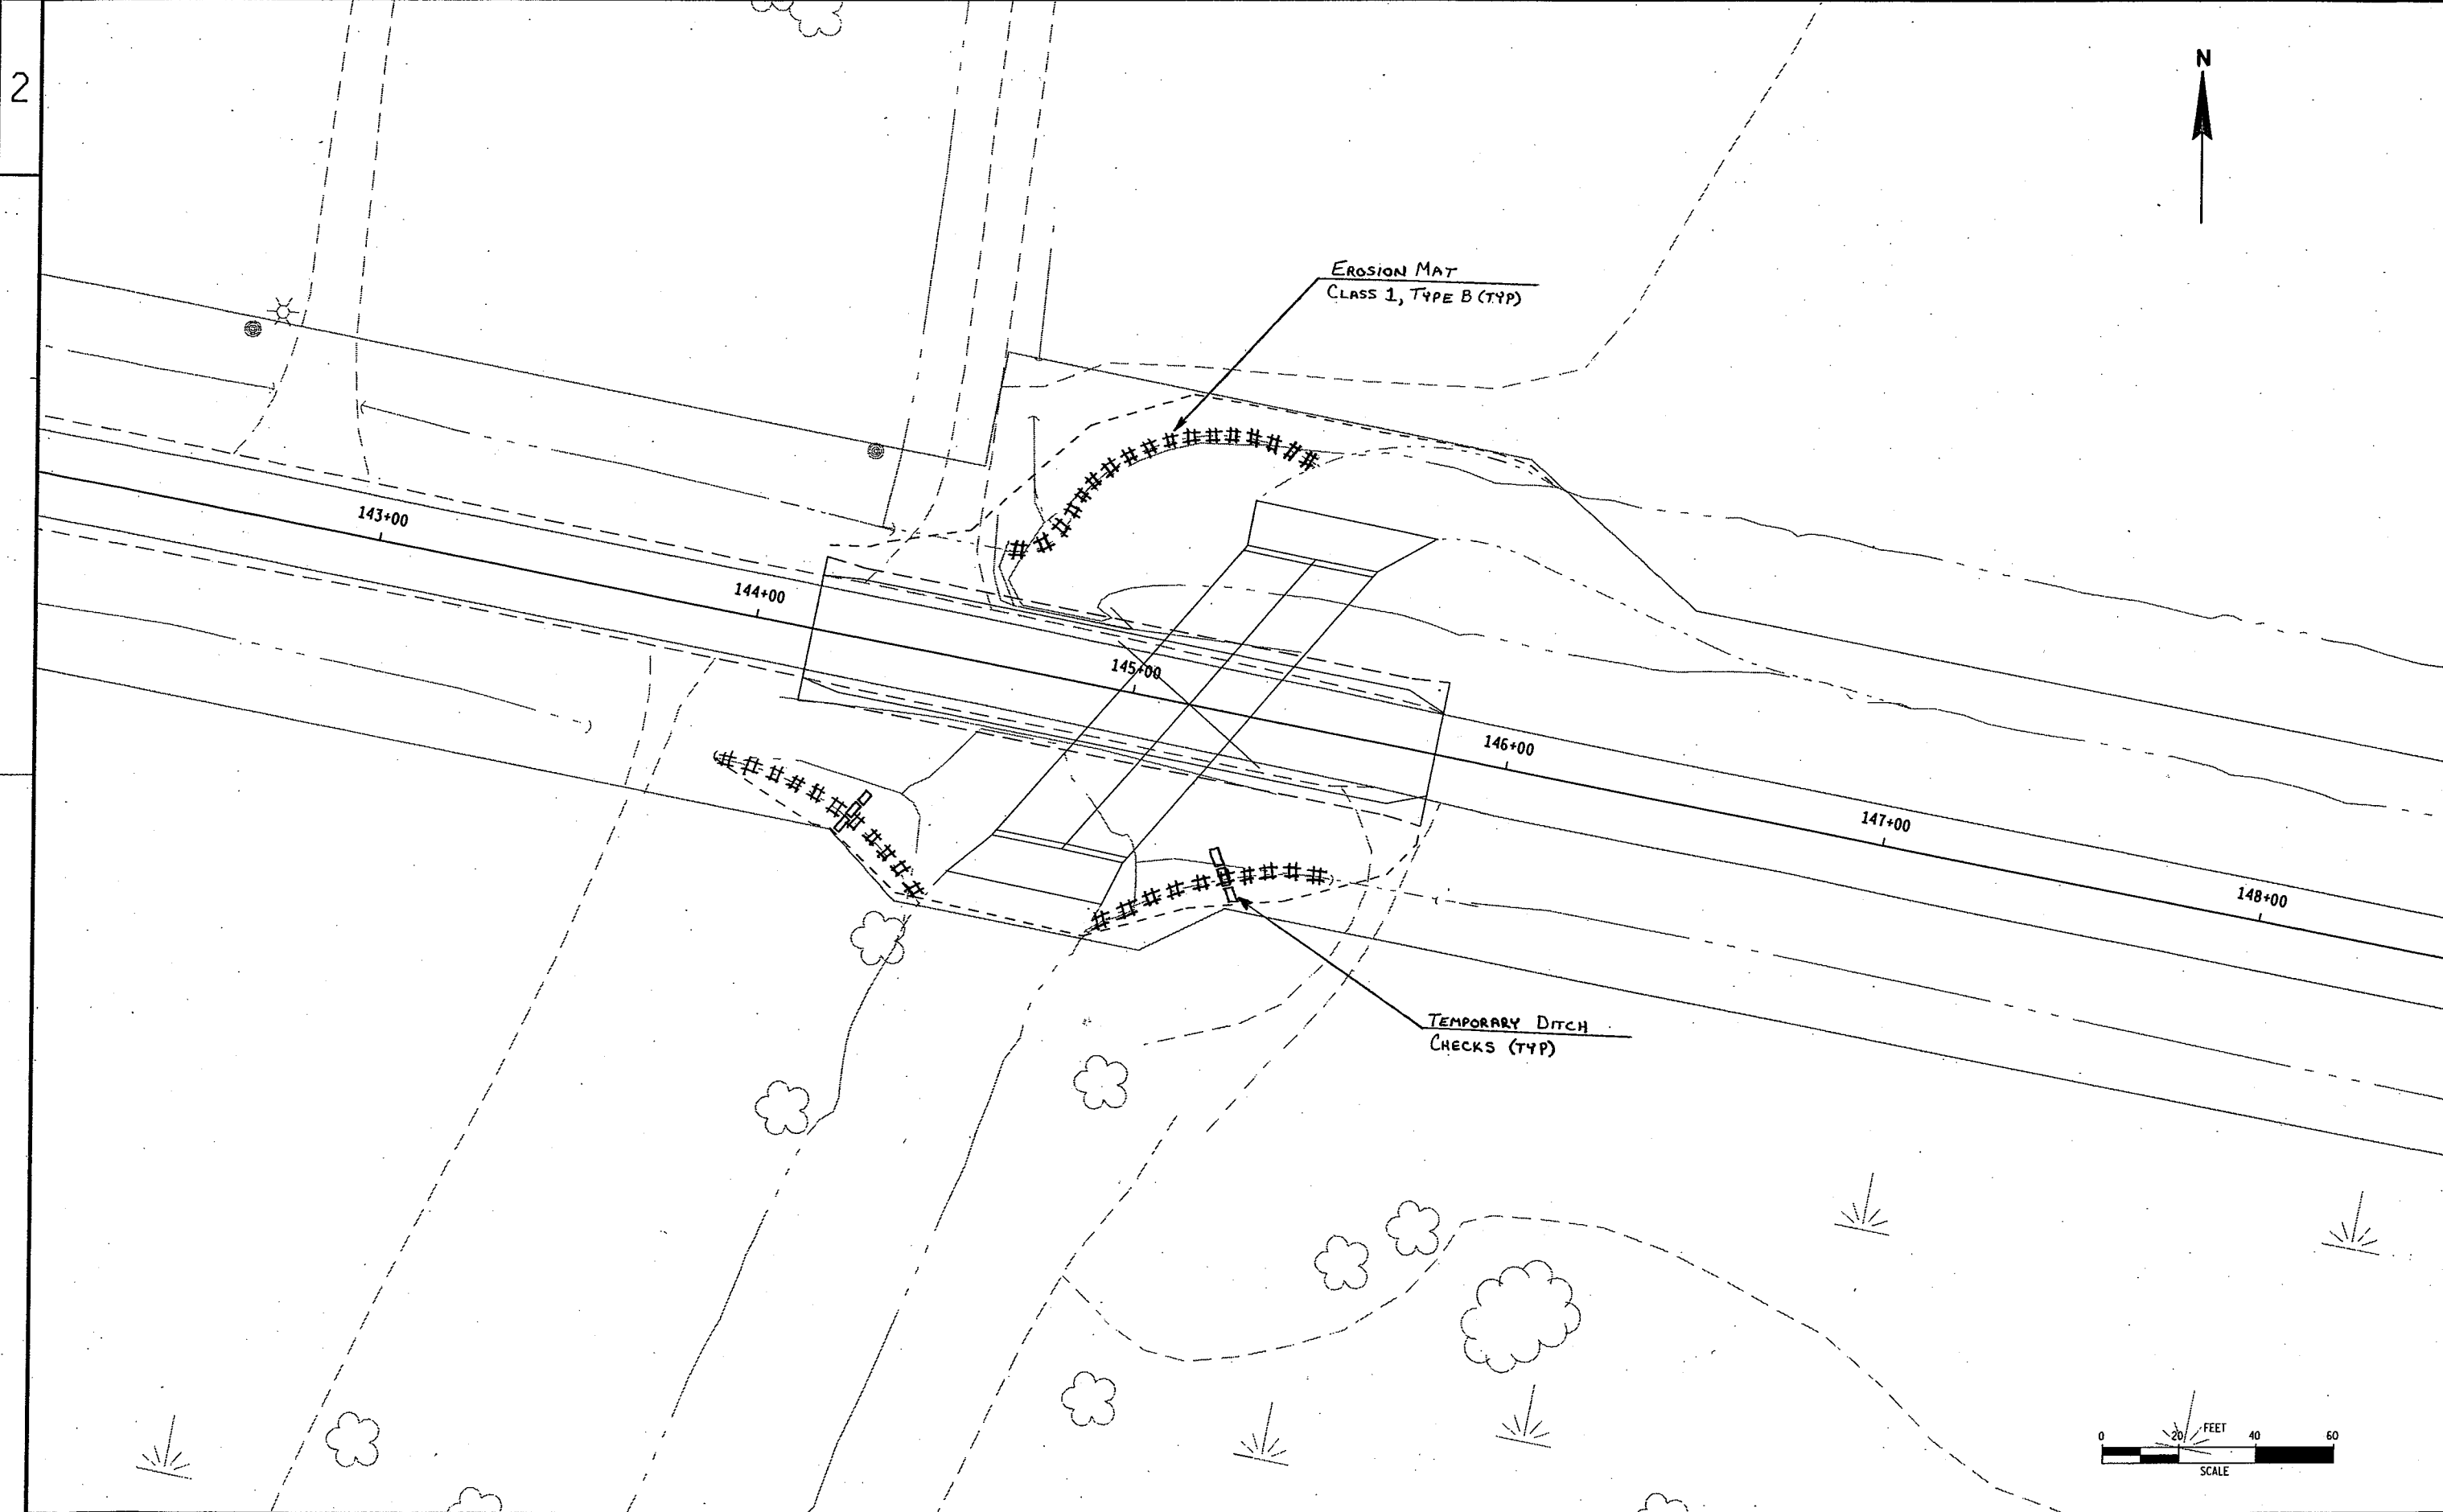






EROSION MAT
CLASS 1, TYPE B (TYP)

TEMPORARY DITCH
CHECKS (TYP)

SILT FENCE (TYP)

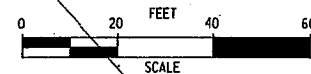

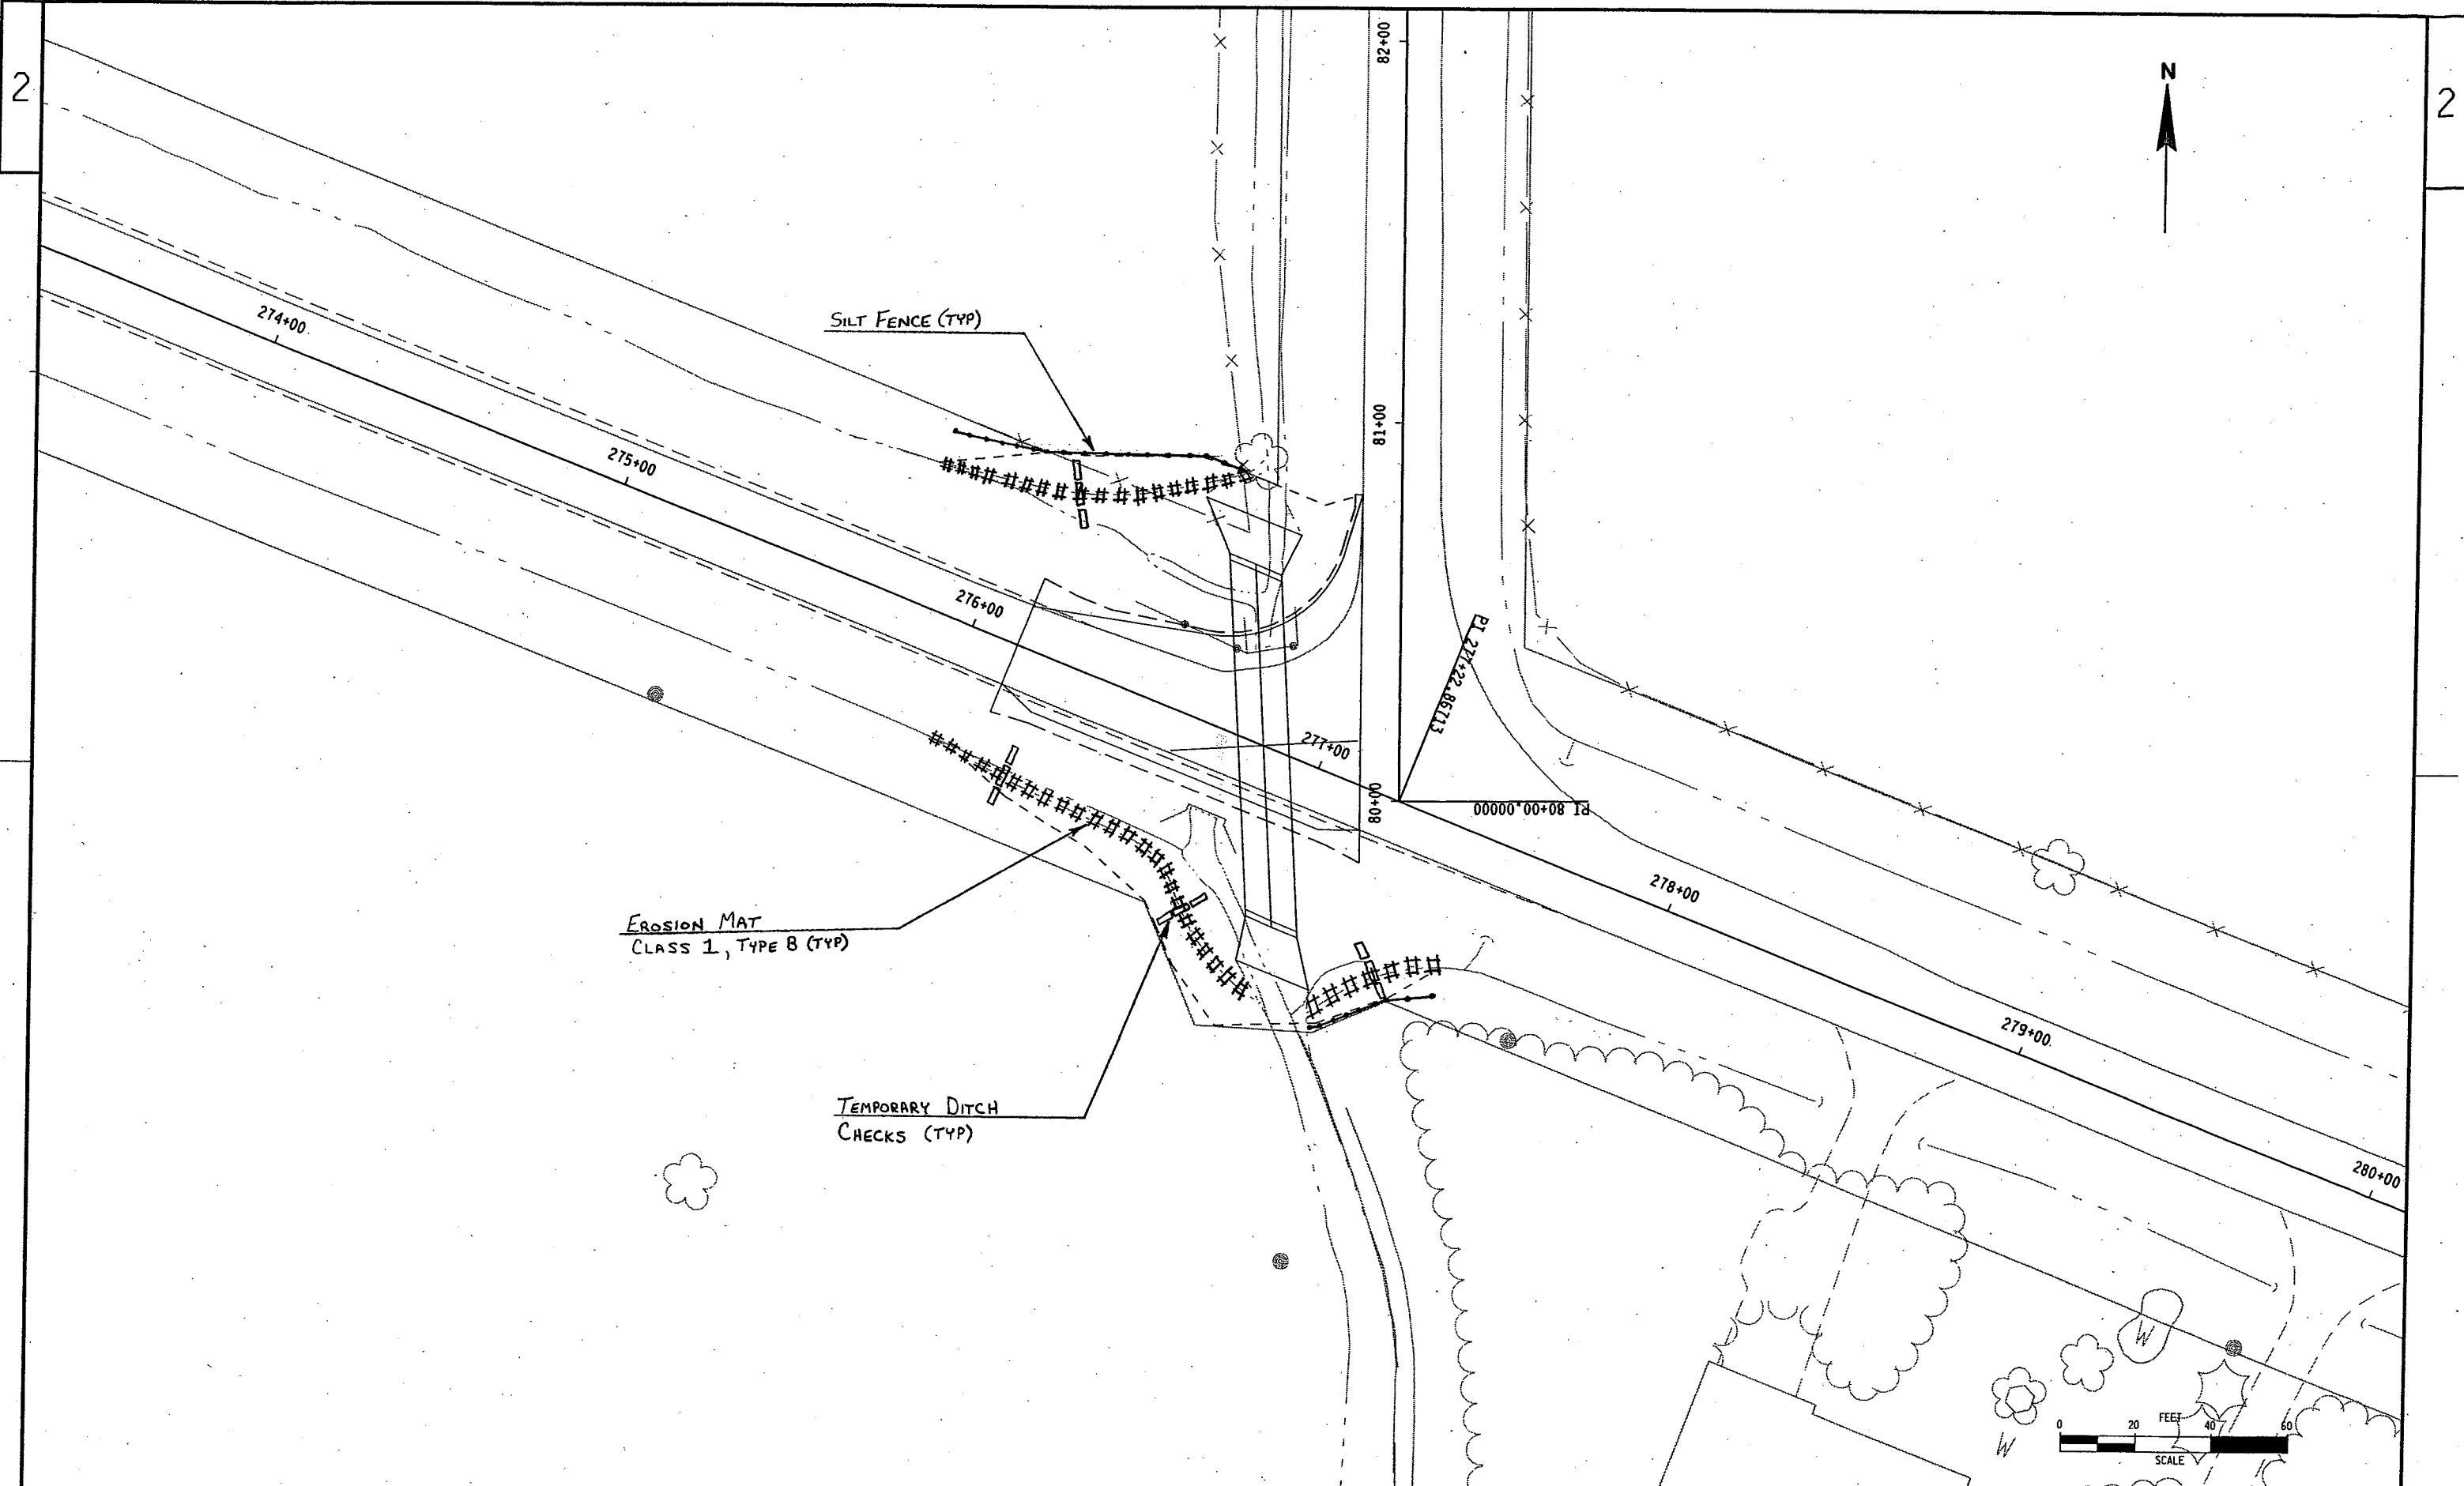

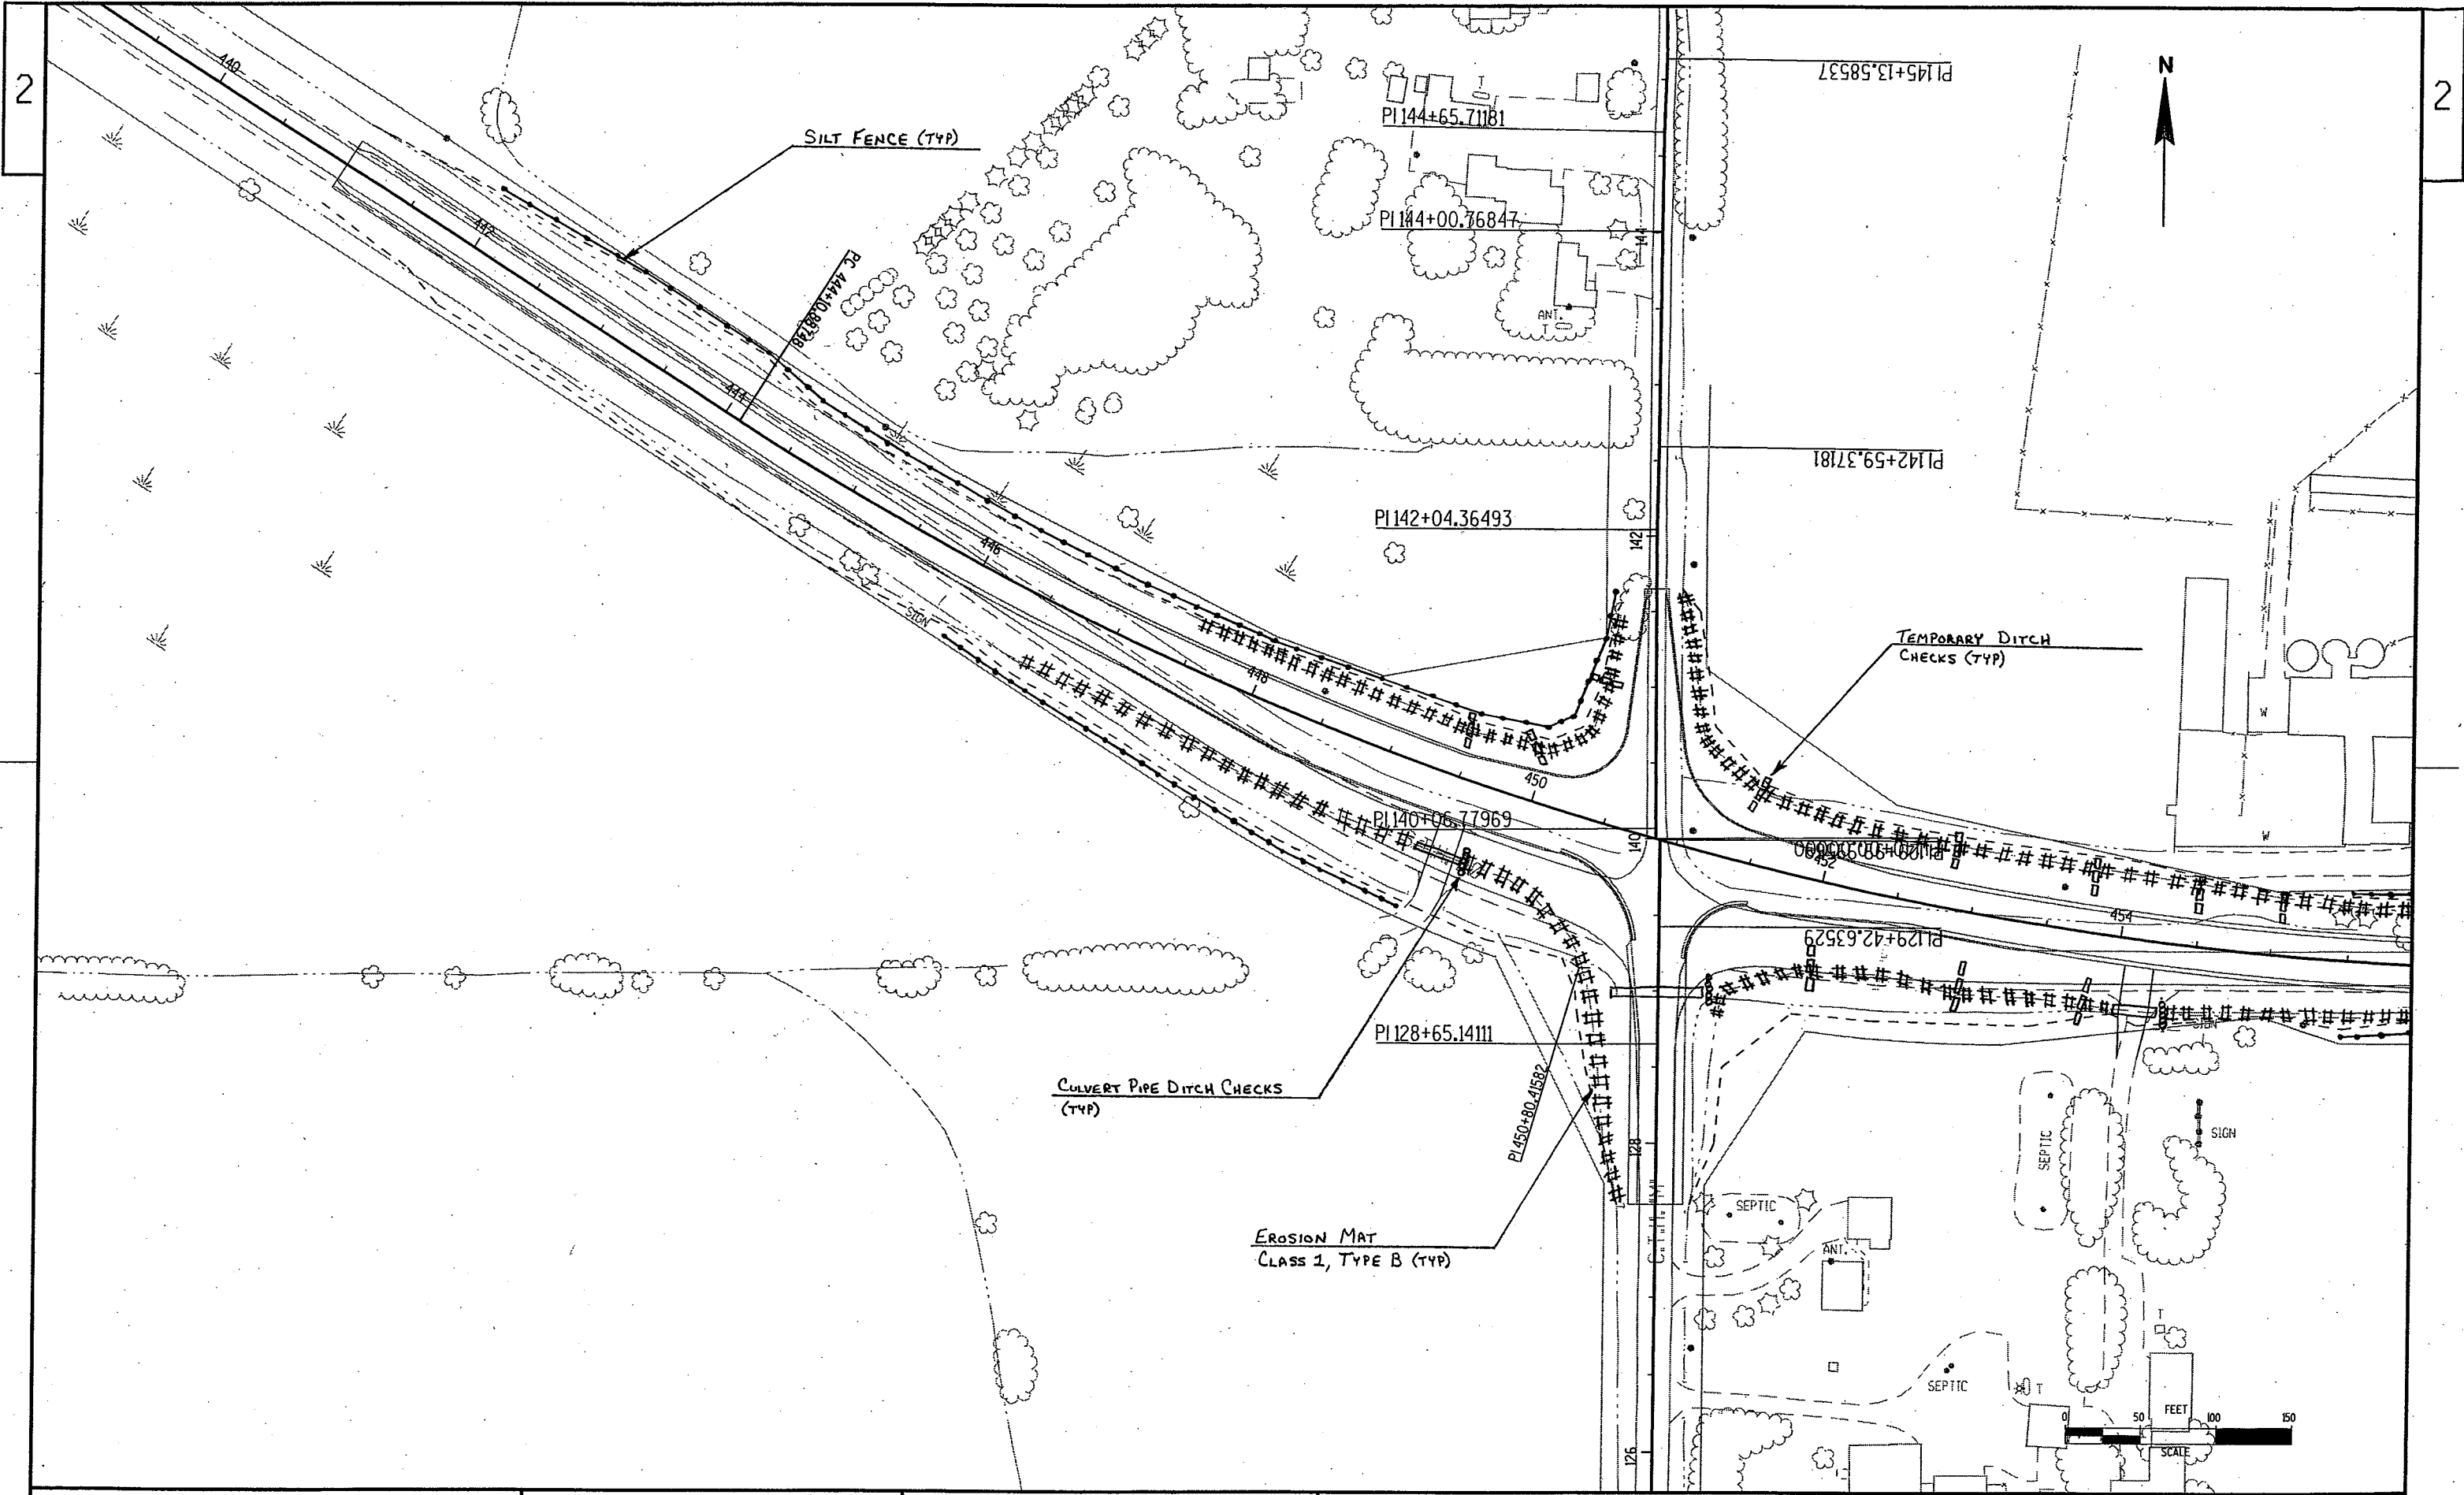

STATE PROJECT NO: 6200-07-71


HWY: CTH II





COUNTY: WINNEBAGO


EROSION CONTROL

SHEET NO:

E

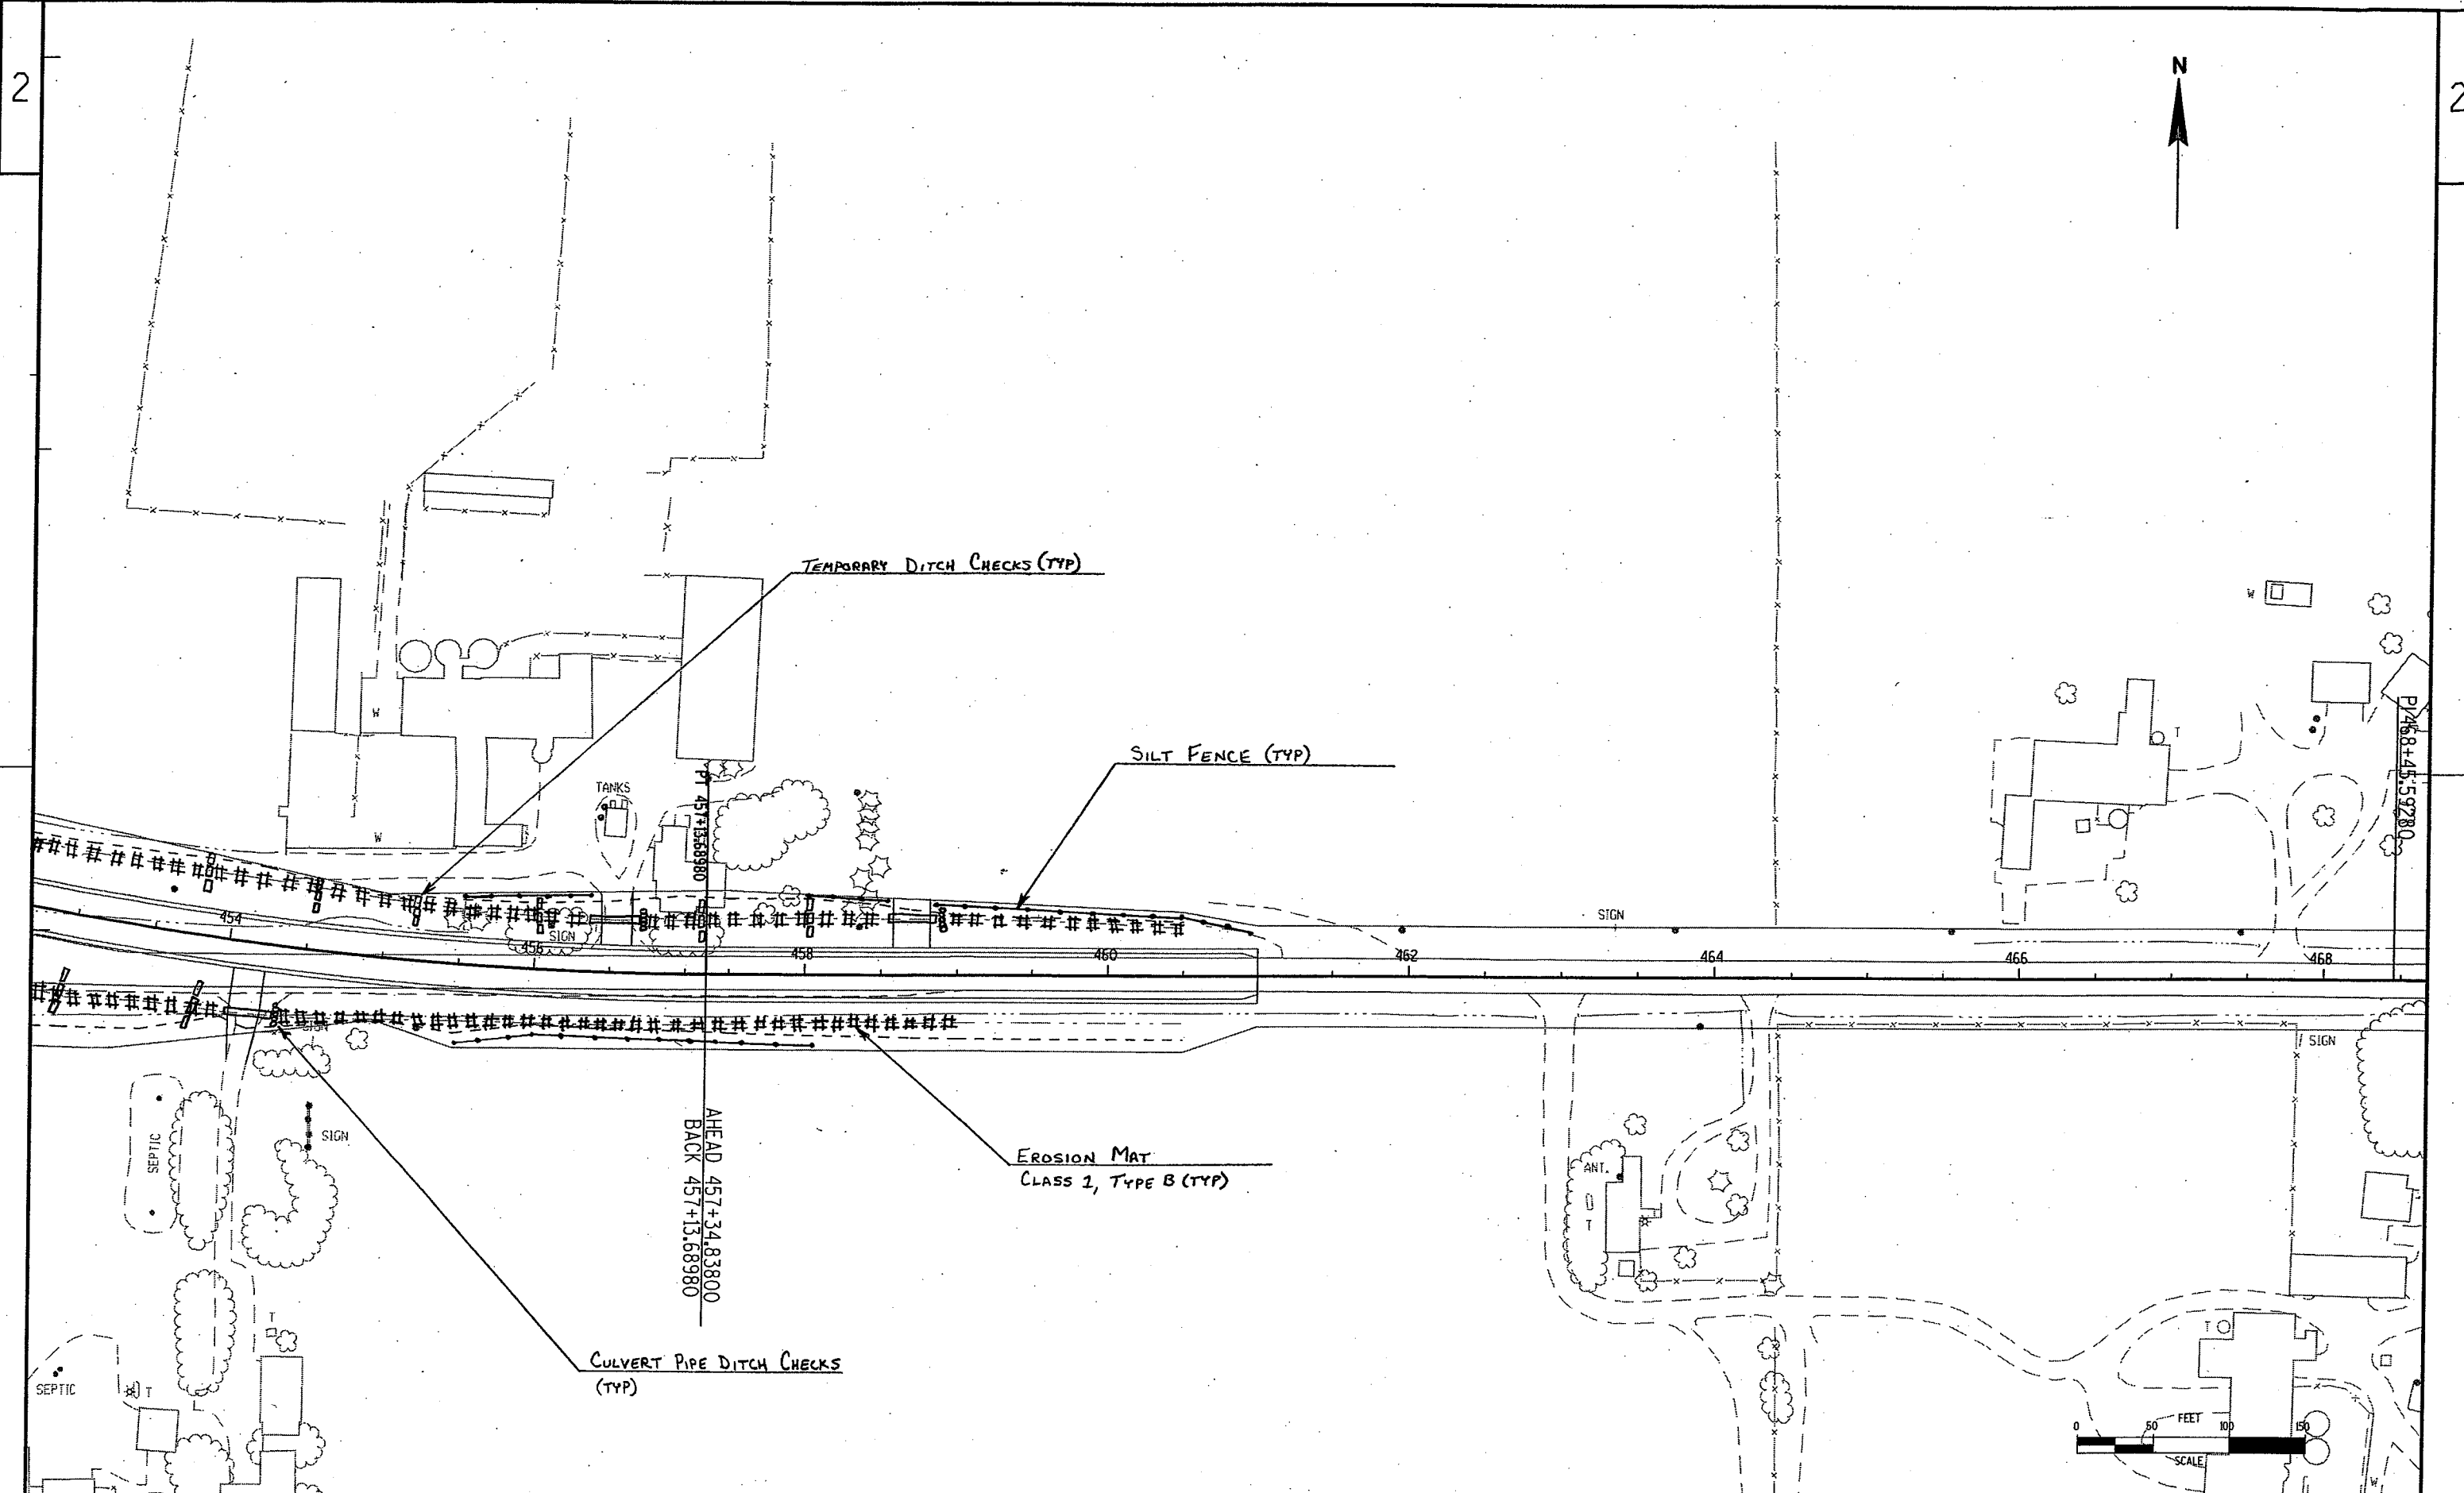

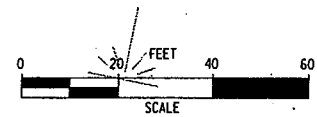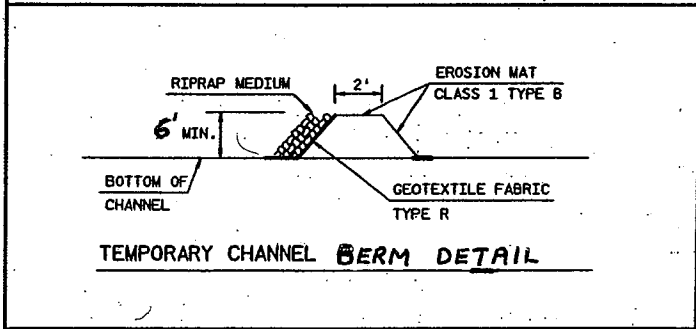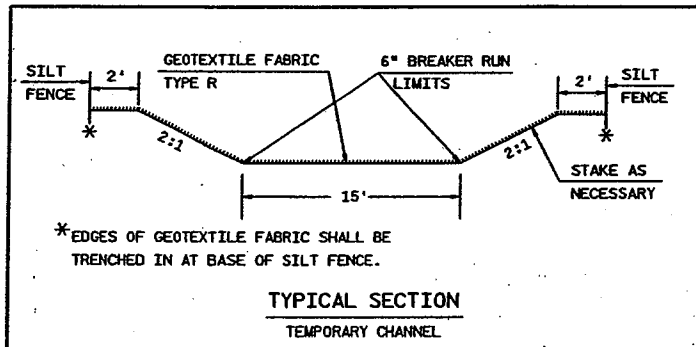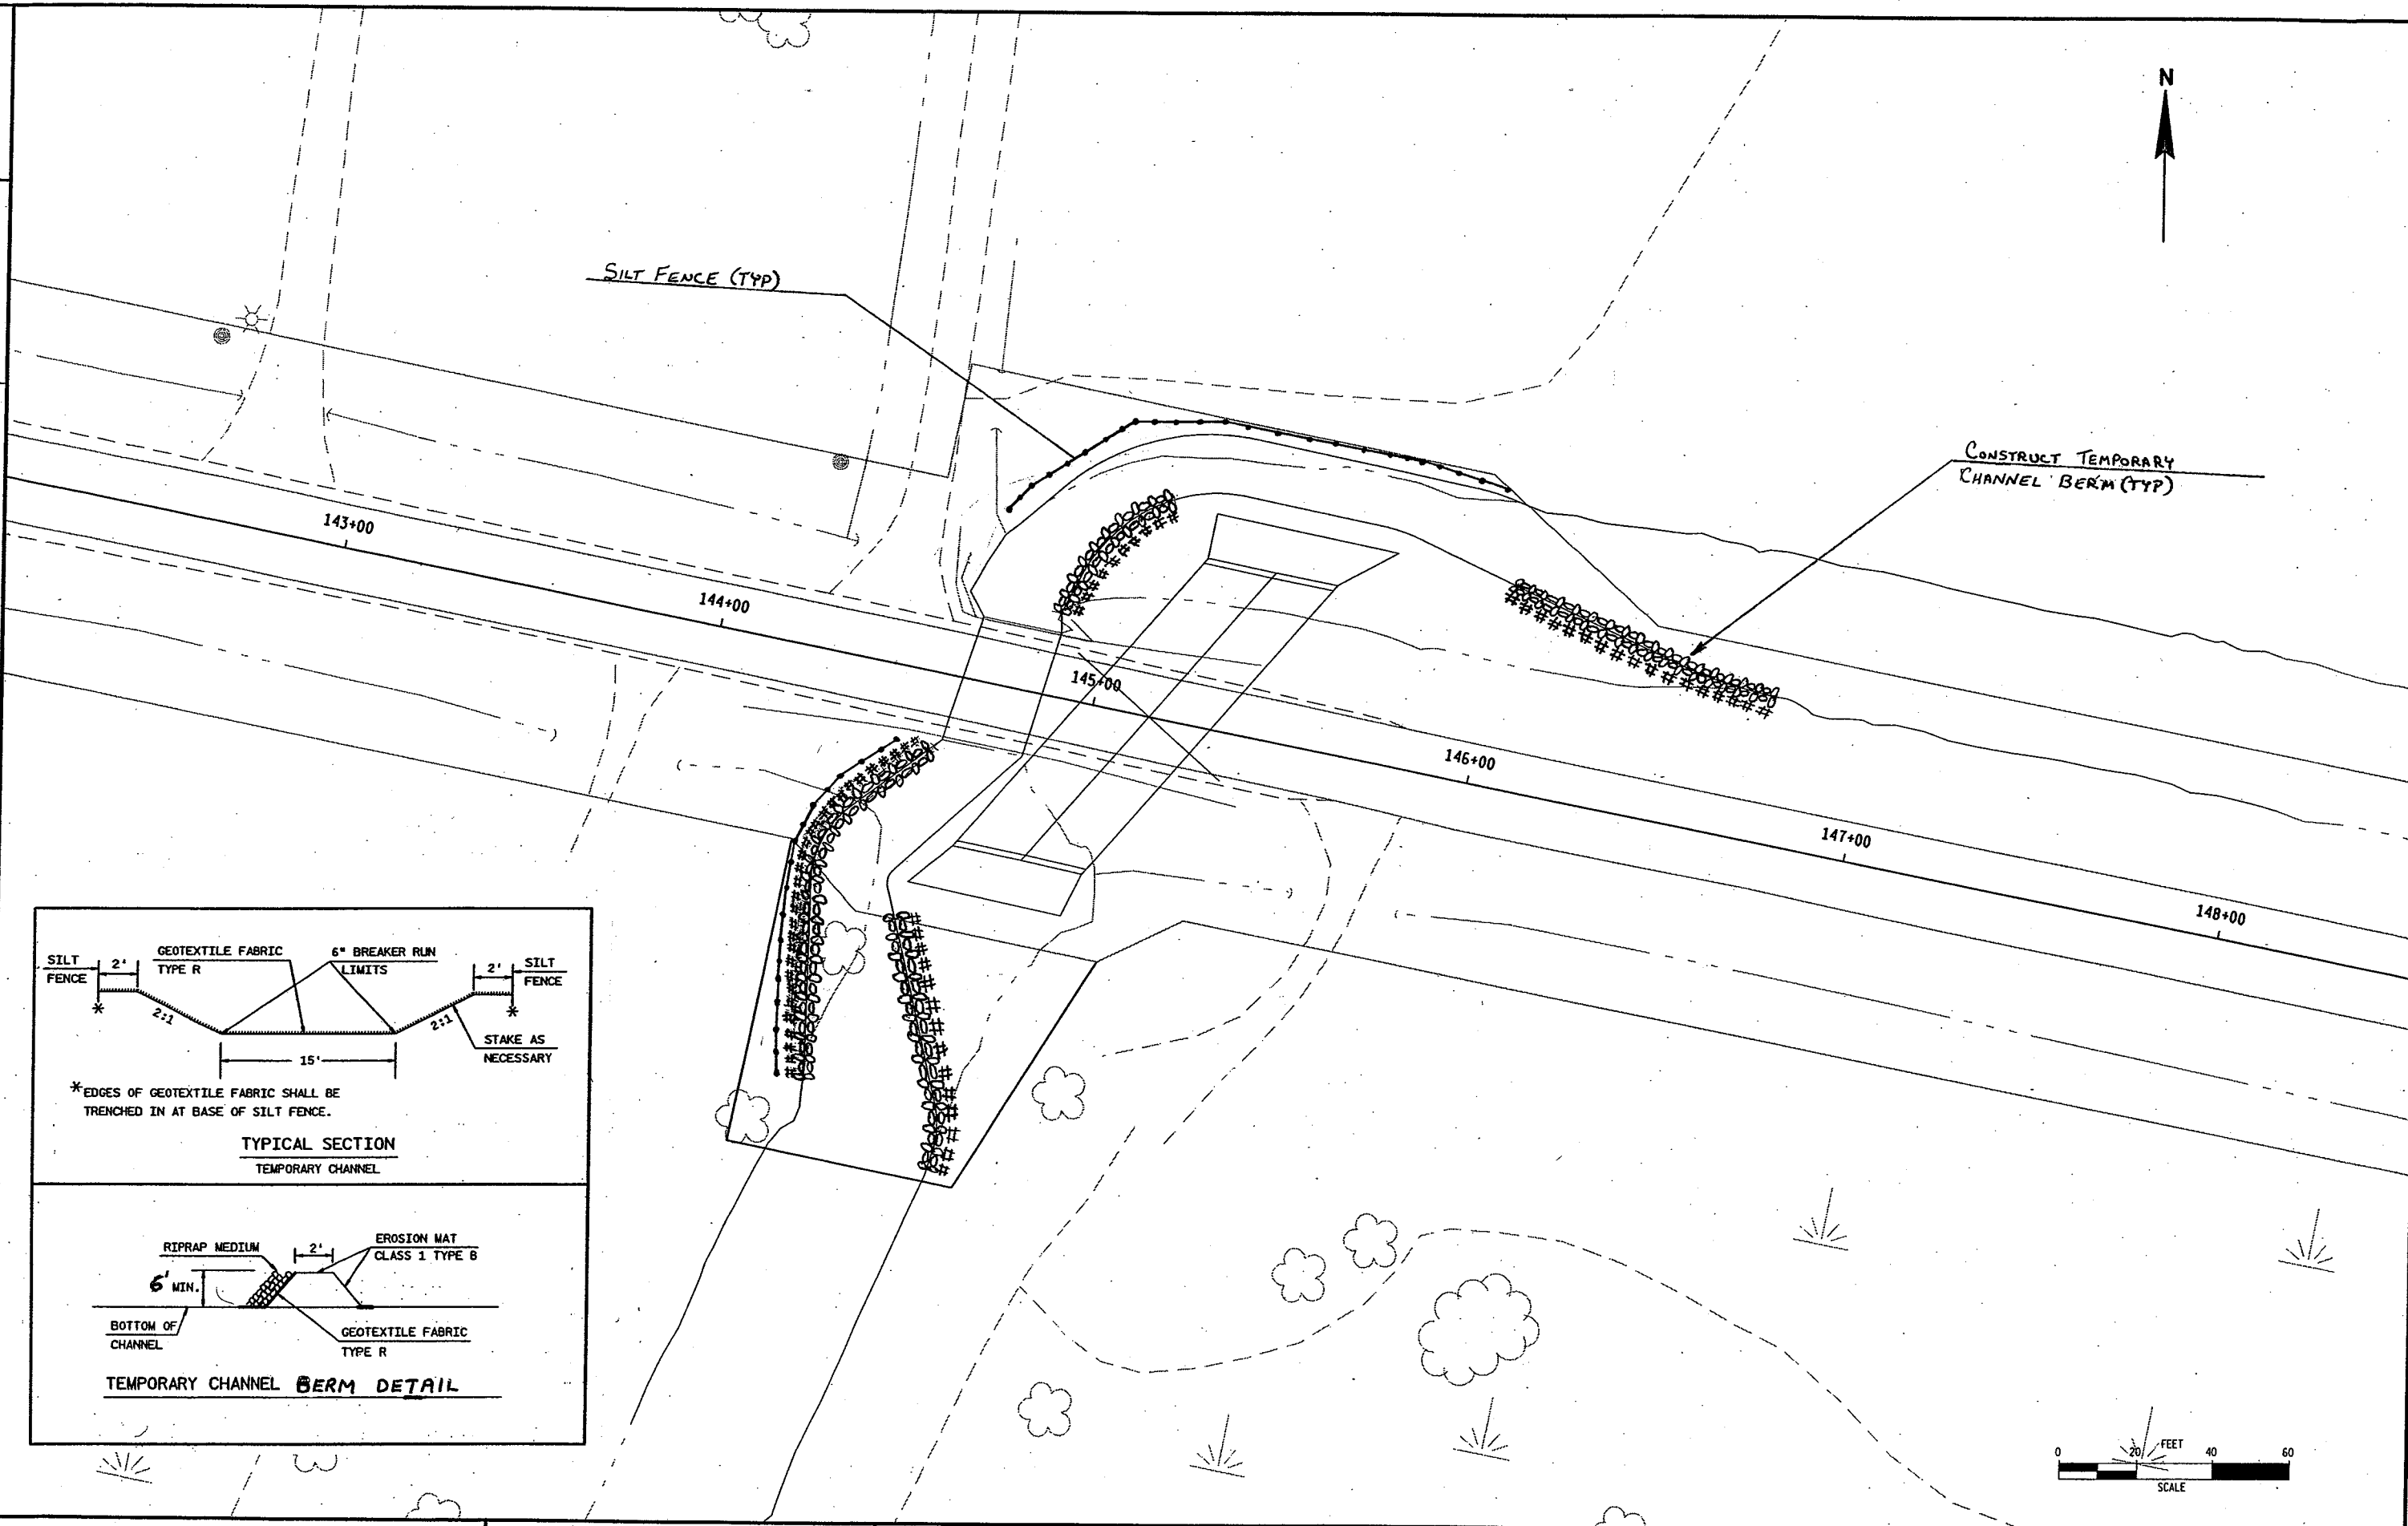

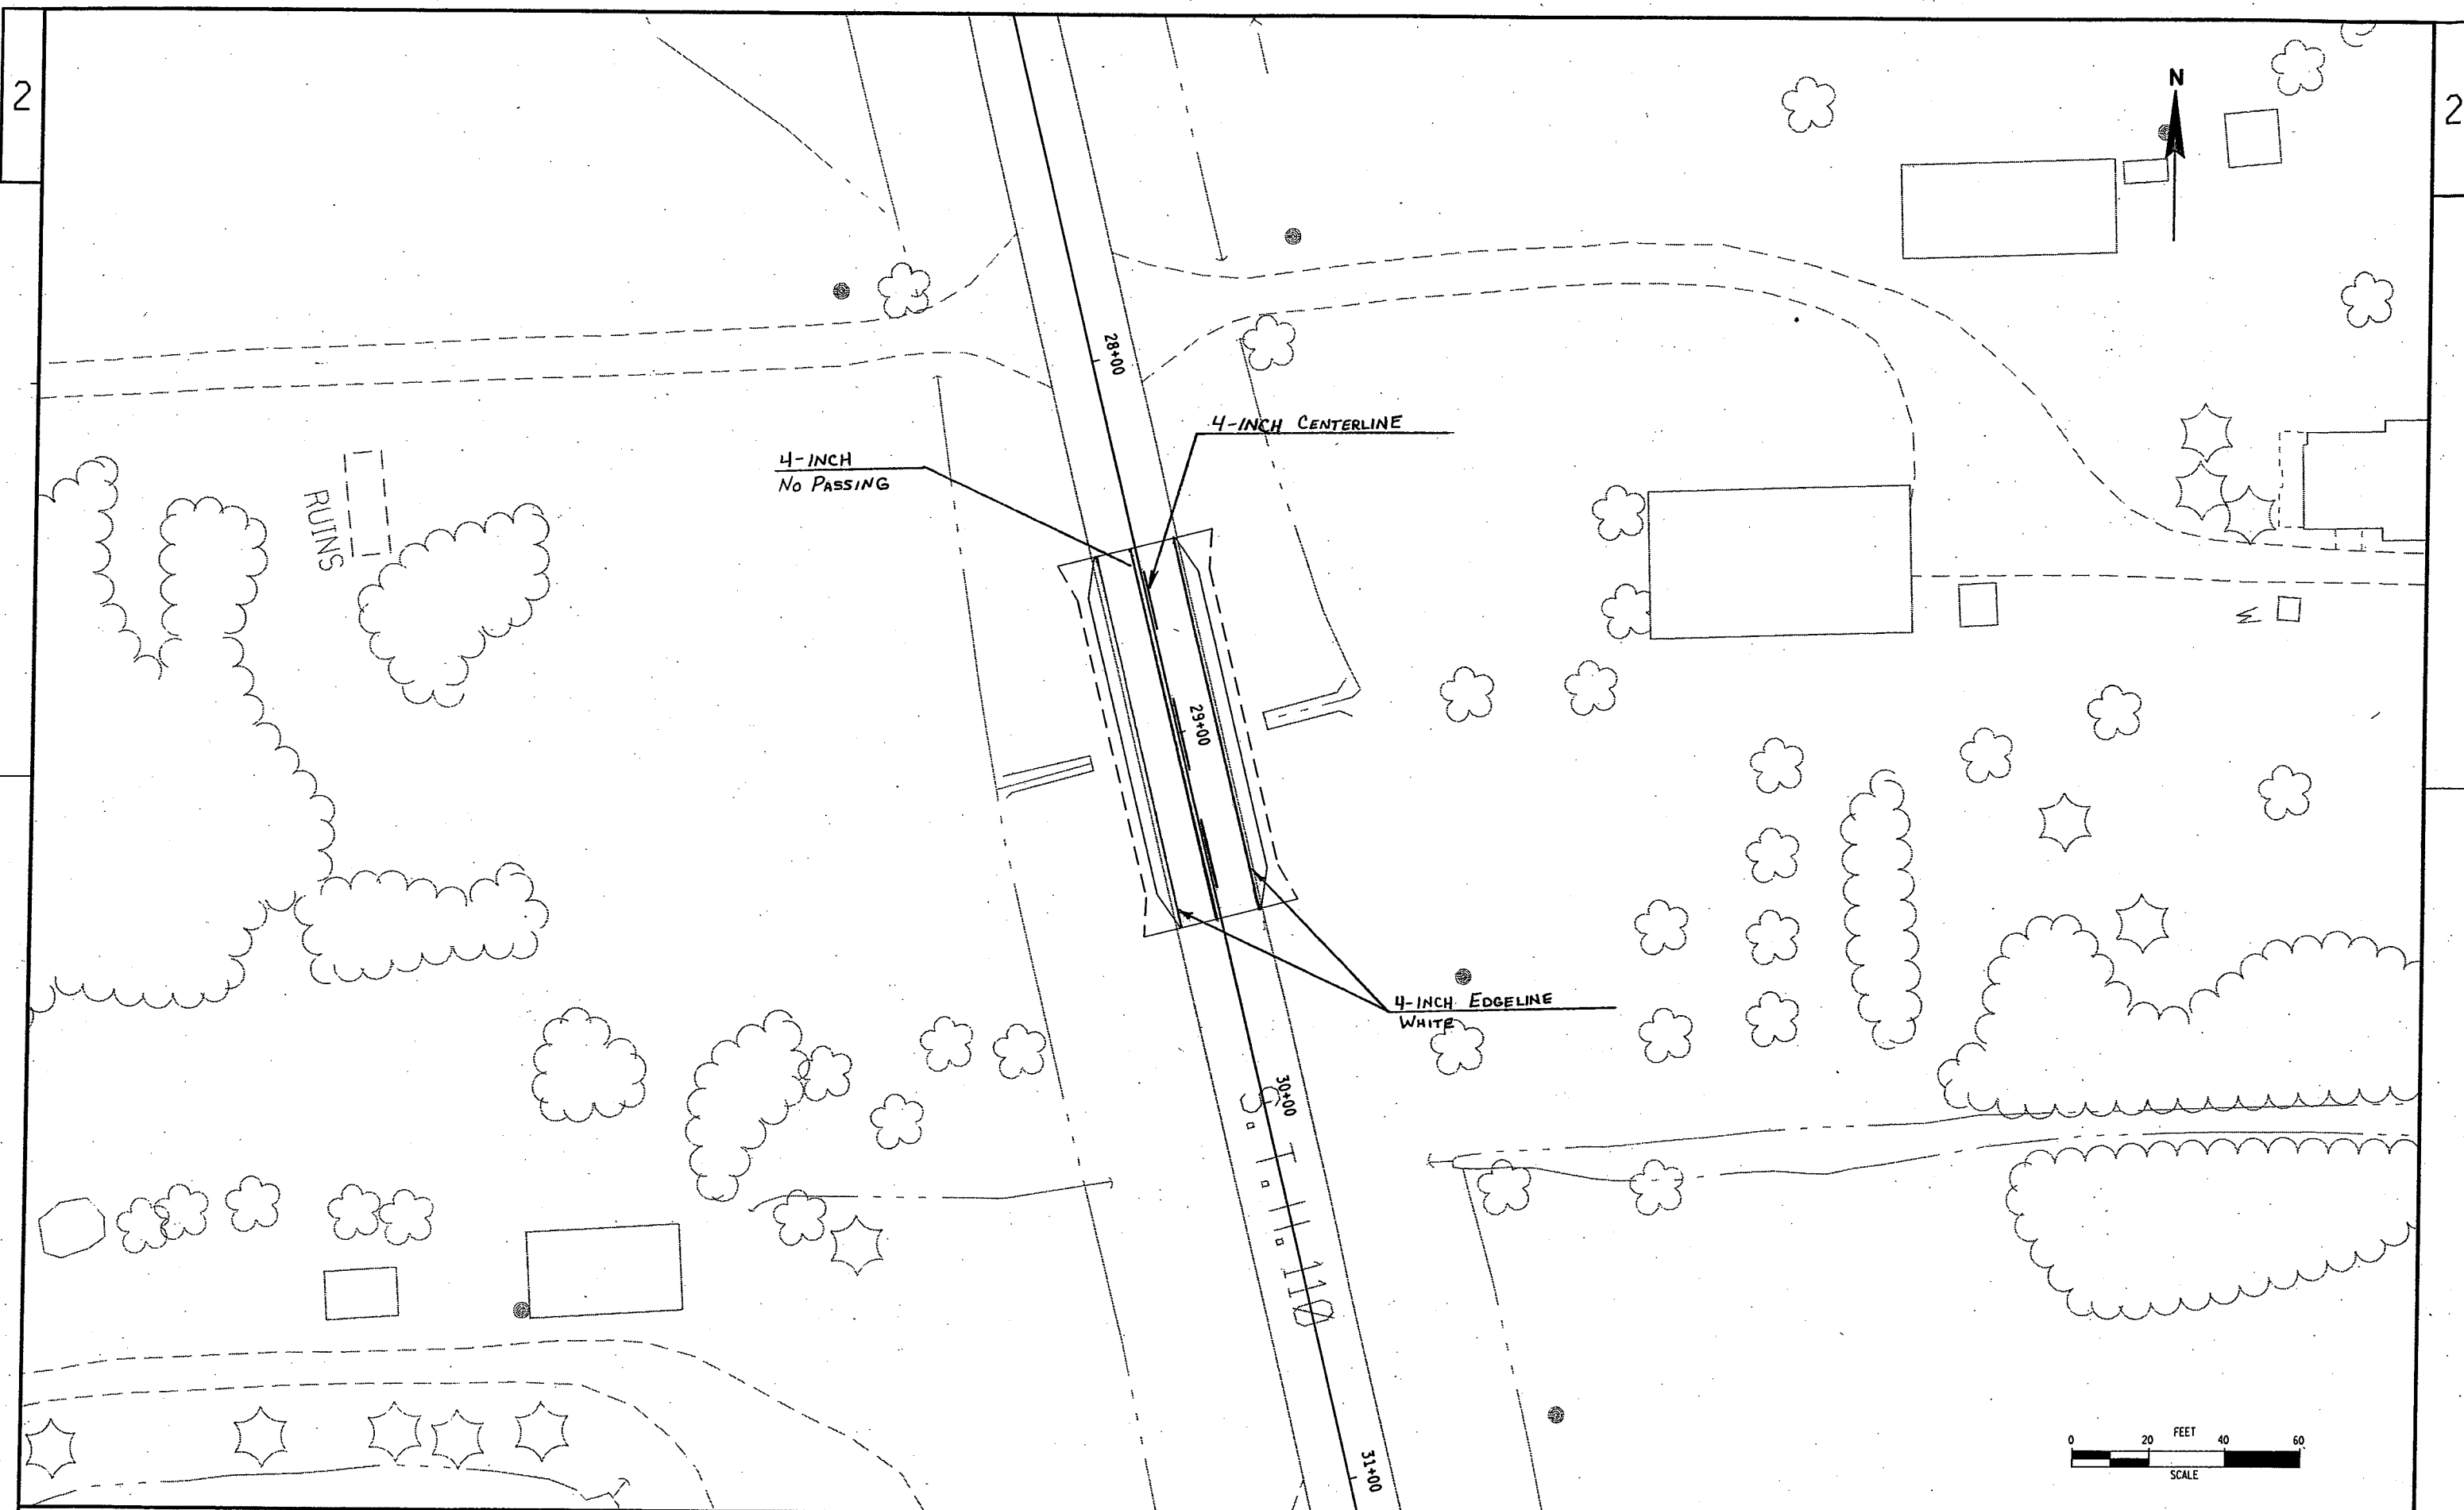

STATE PROJECT NO: 6200-07-71

HWY: CTH II

COUNTY: WINNEBAGO

EPOXY PAVEMENT MARKING

SHEET NO:

E



FILE NAME : C:\Users\PA03\STH10\DGN FILES\PMCattlePass.DGN



PLOT DATE : 29-APR-2004 14:28


PLOT BY : DOTEAD

PLOT NAME :

PLOT SCALE : 1.993976:1.000000

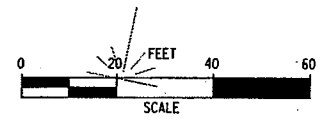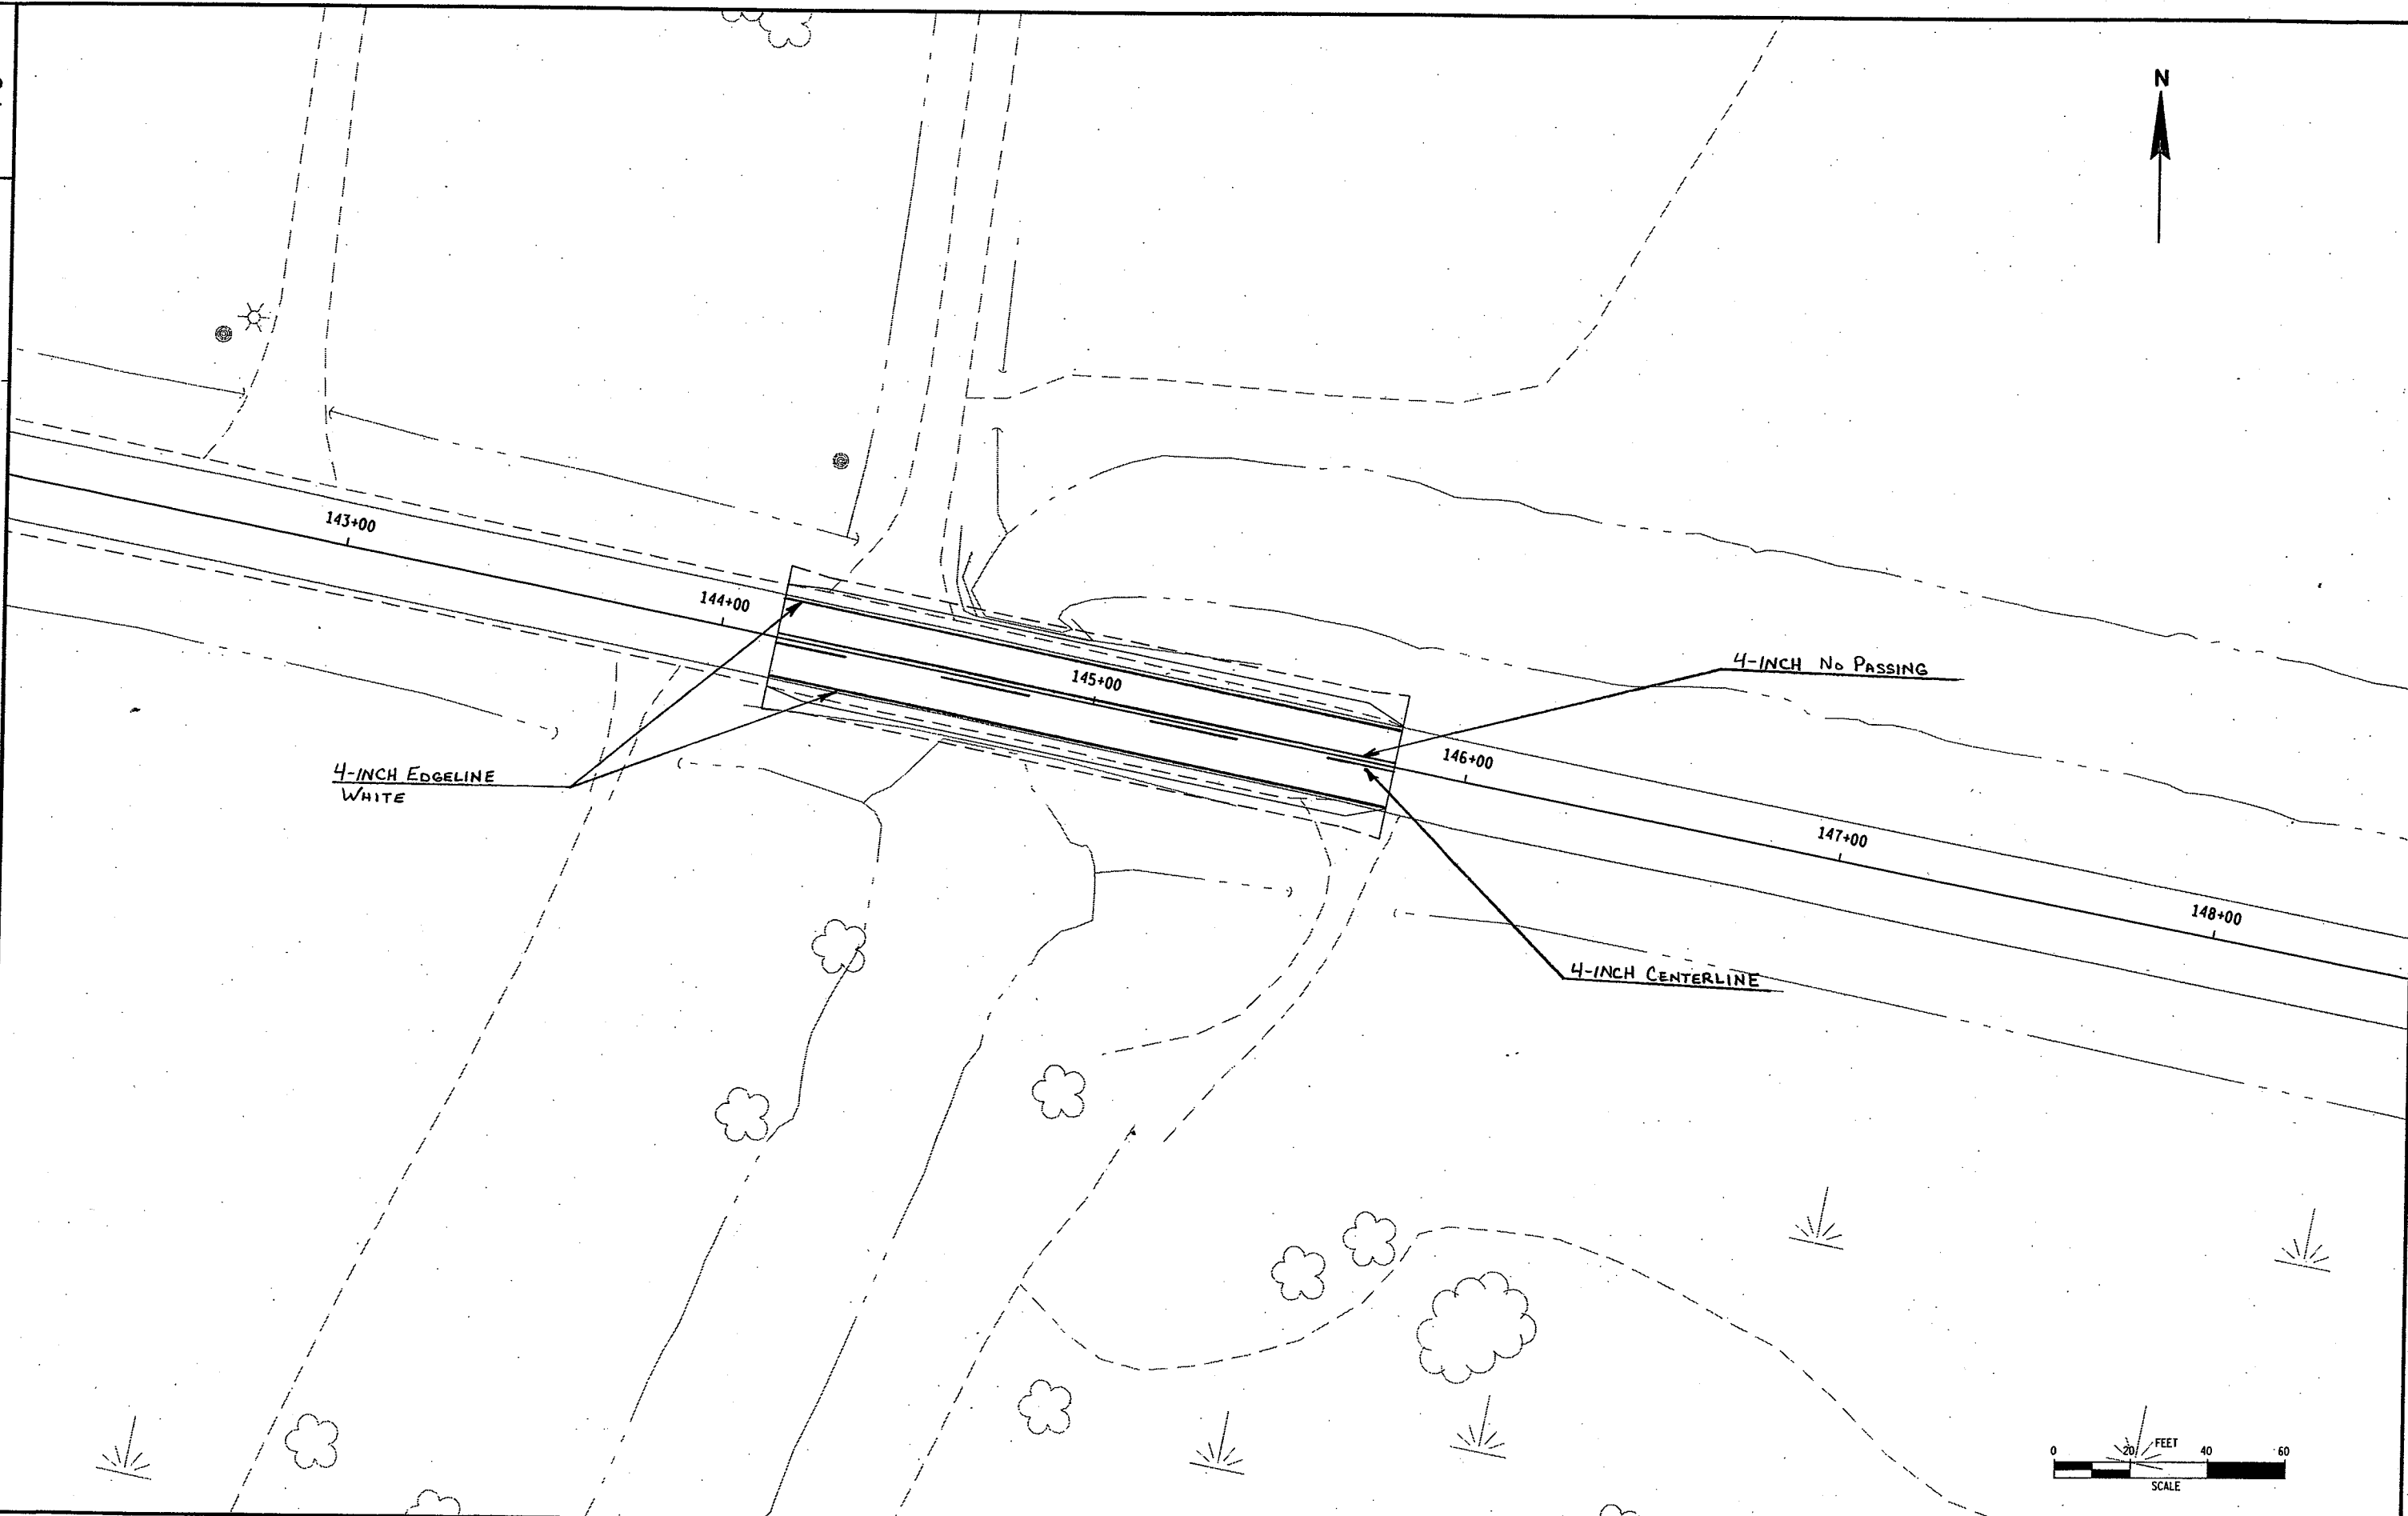


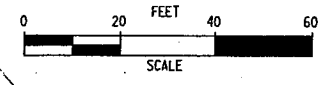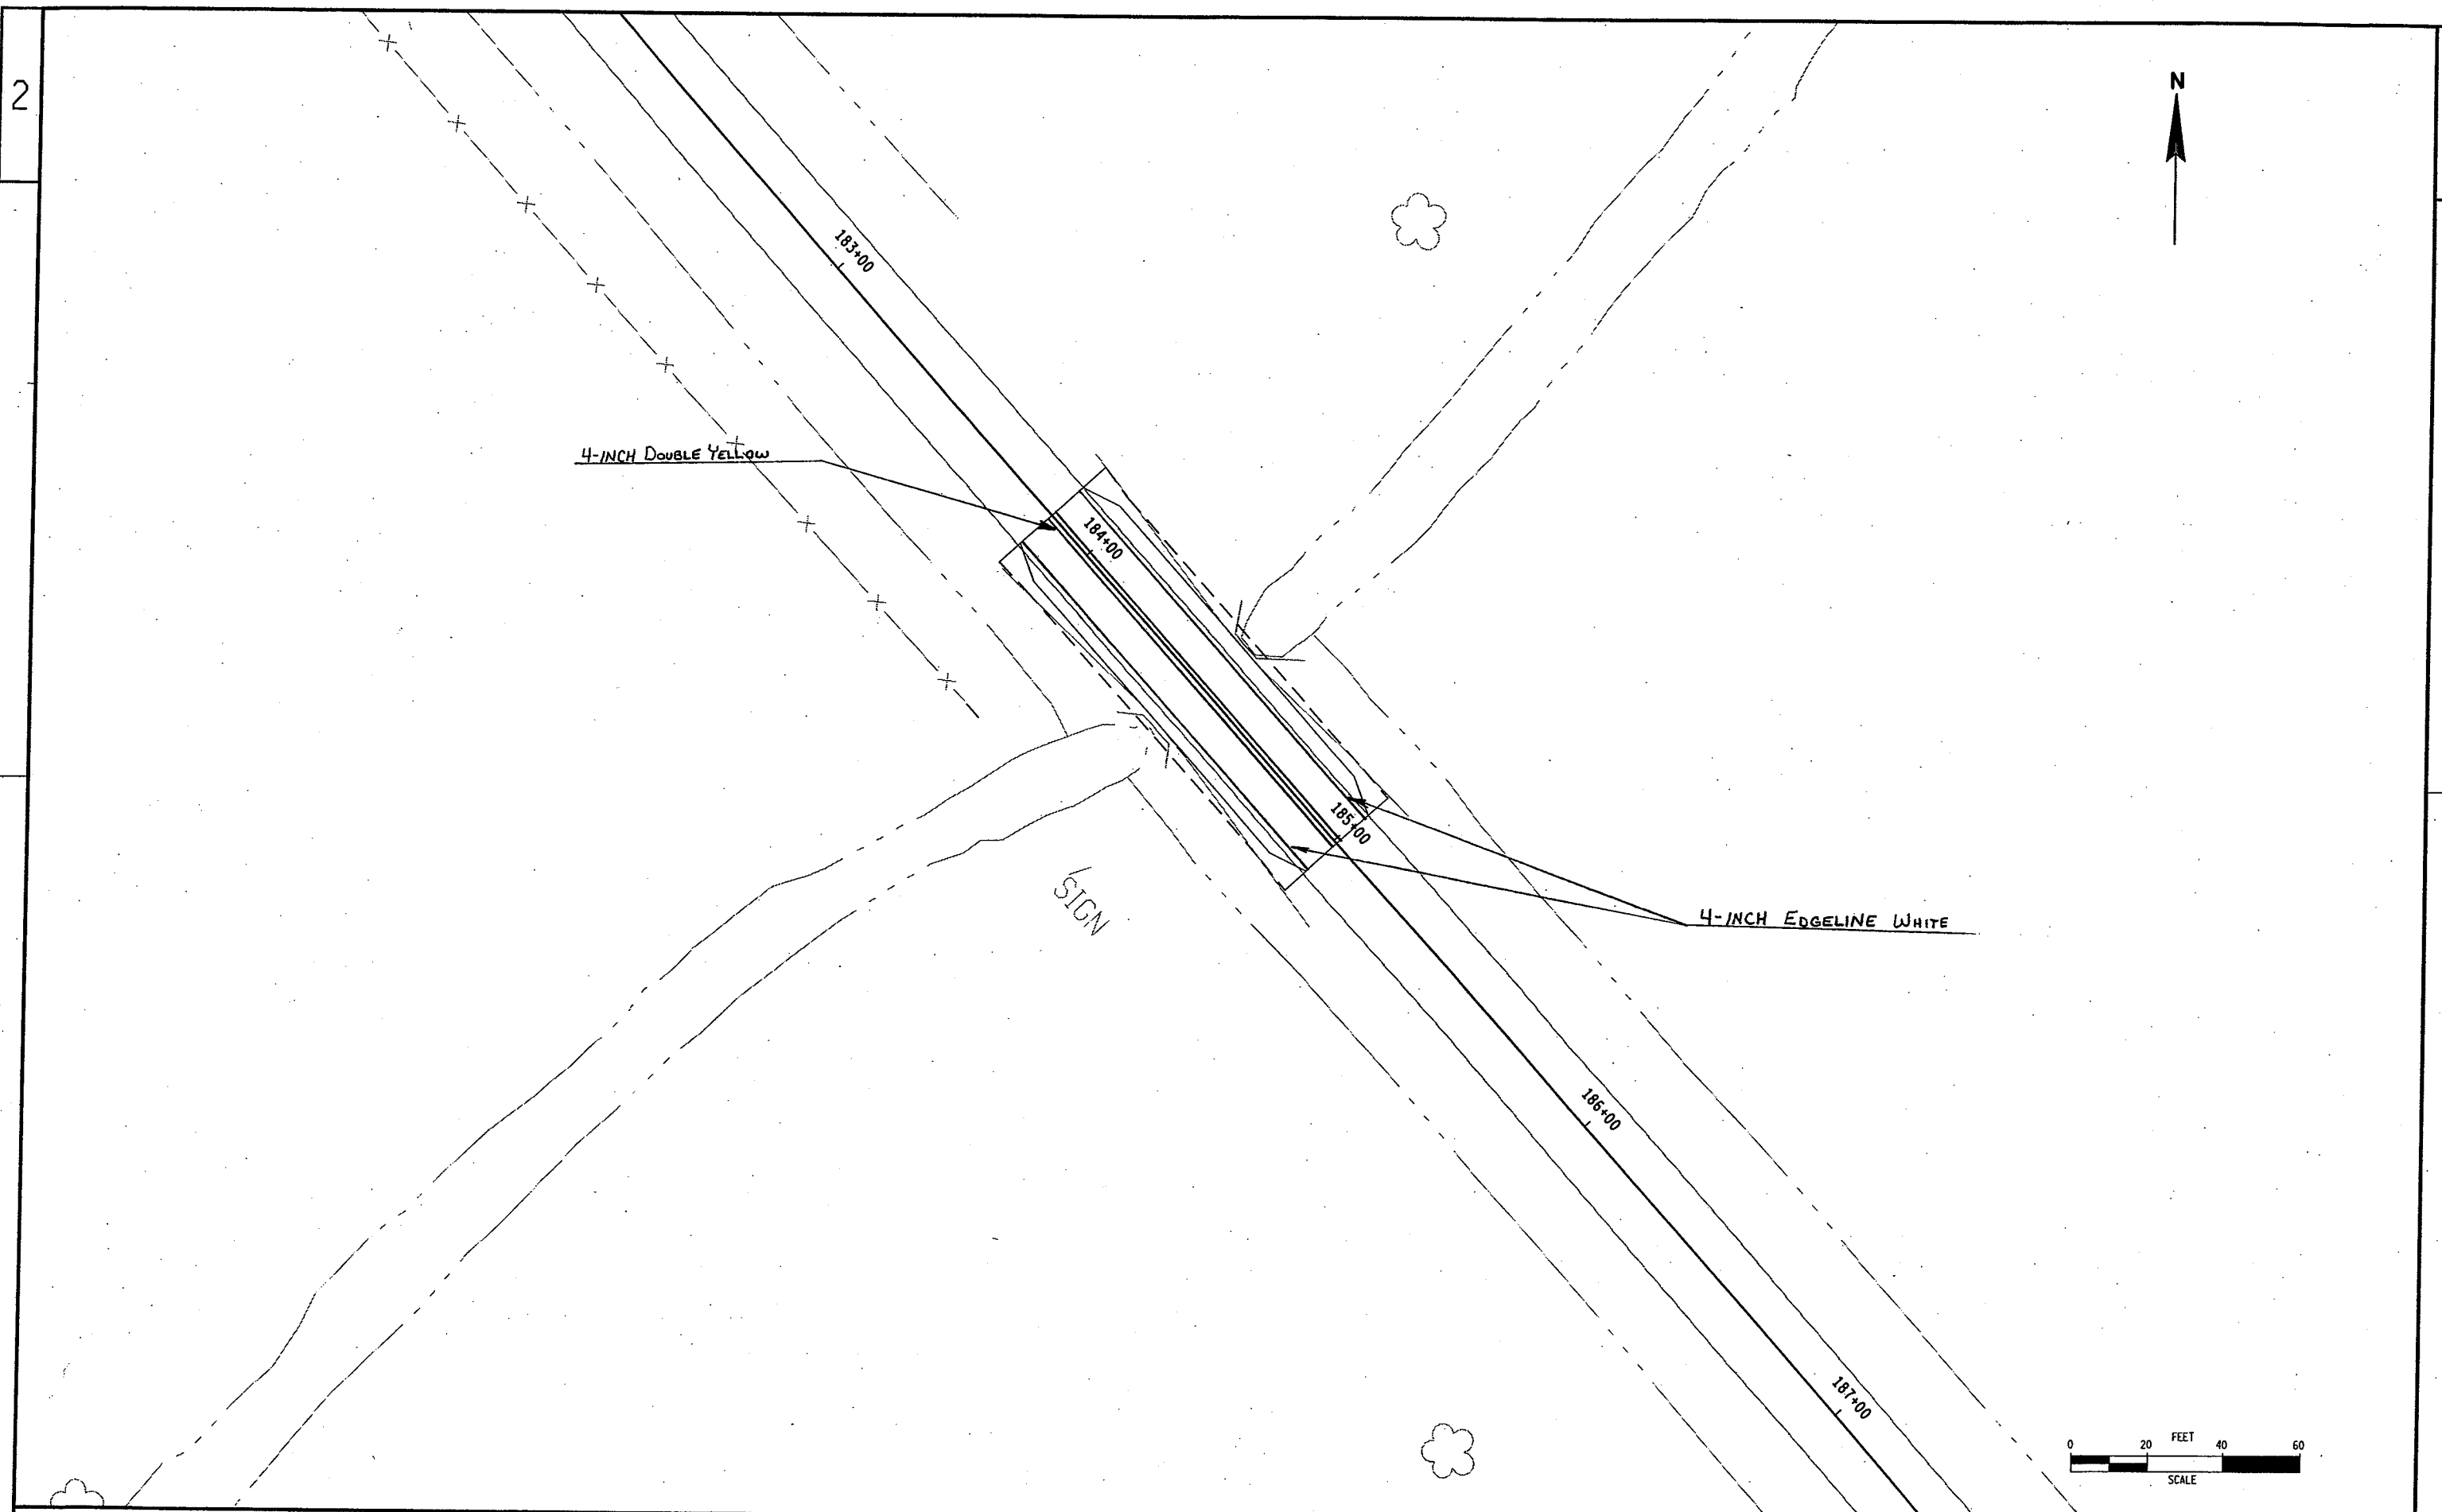


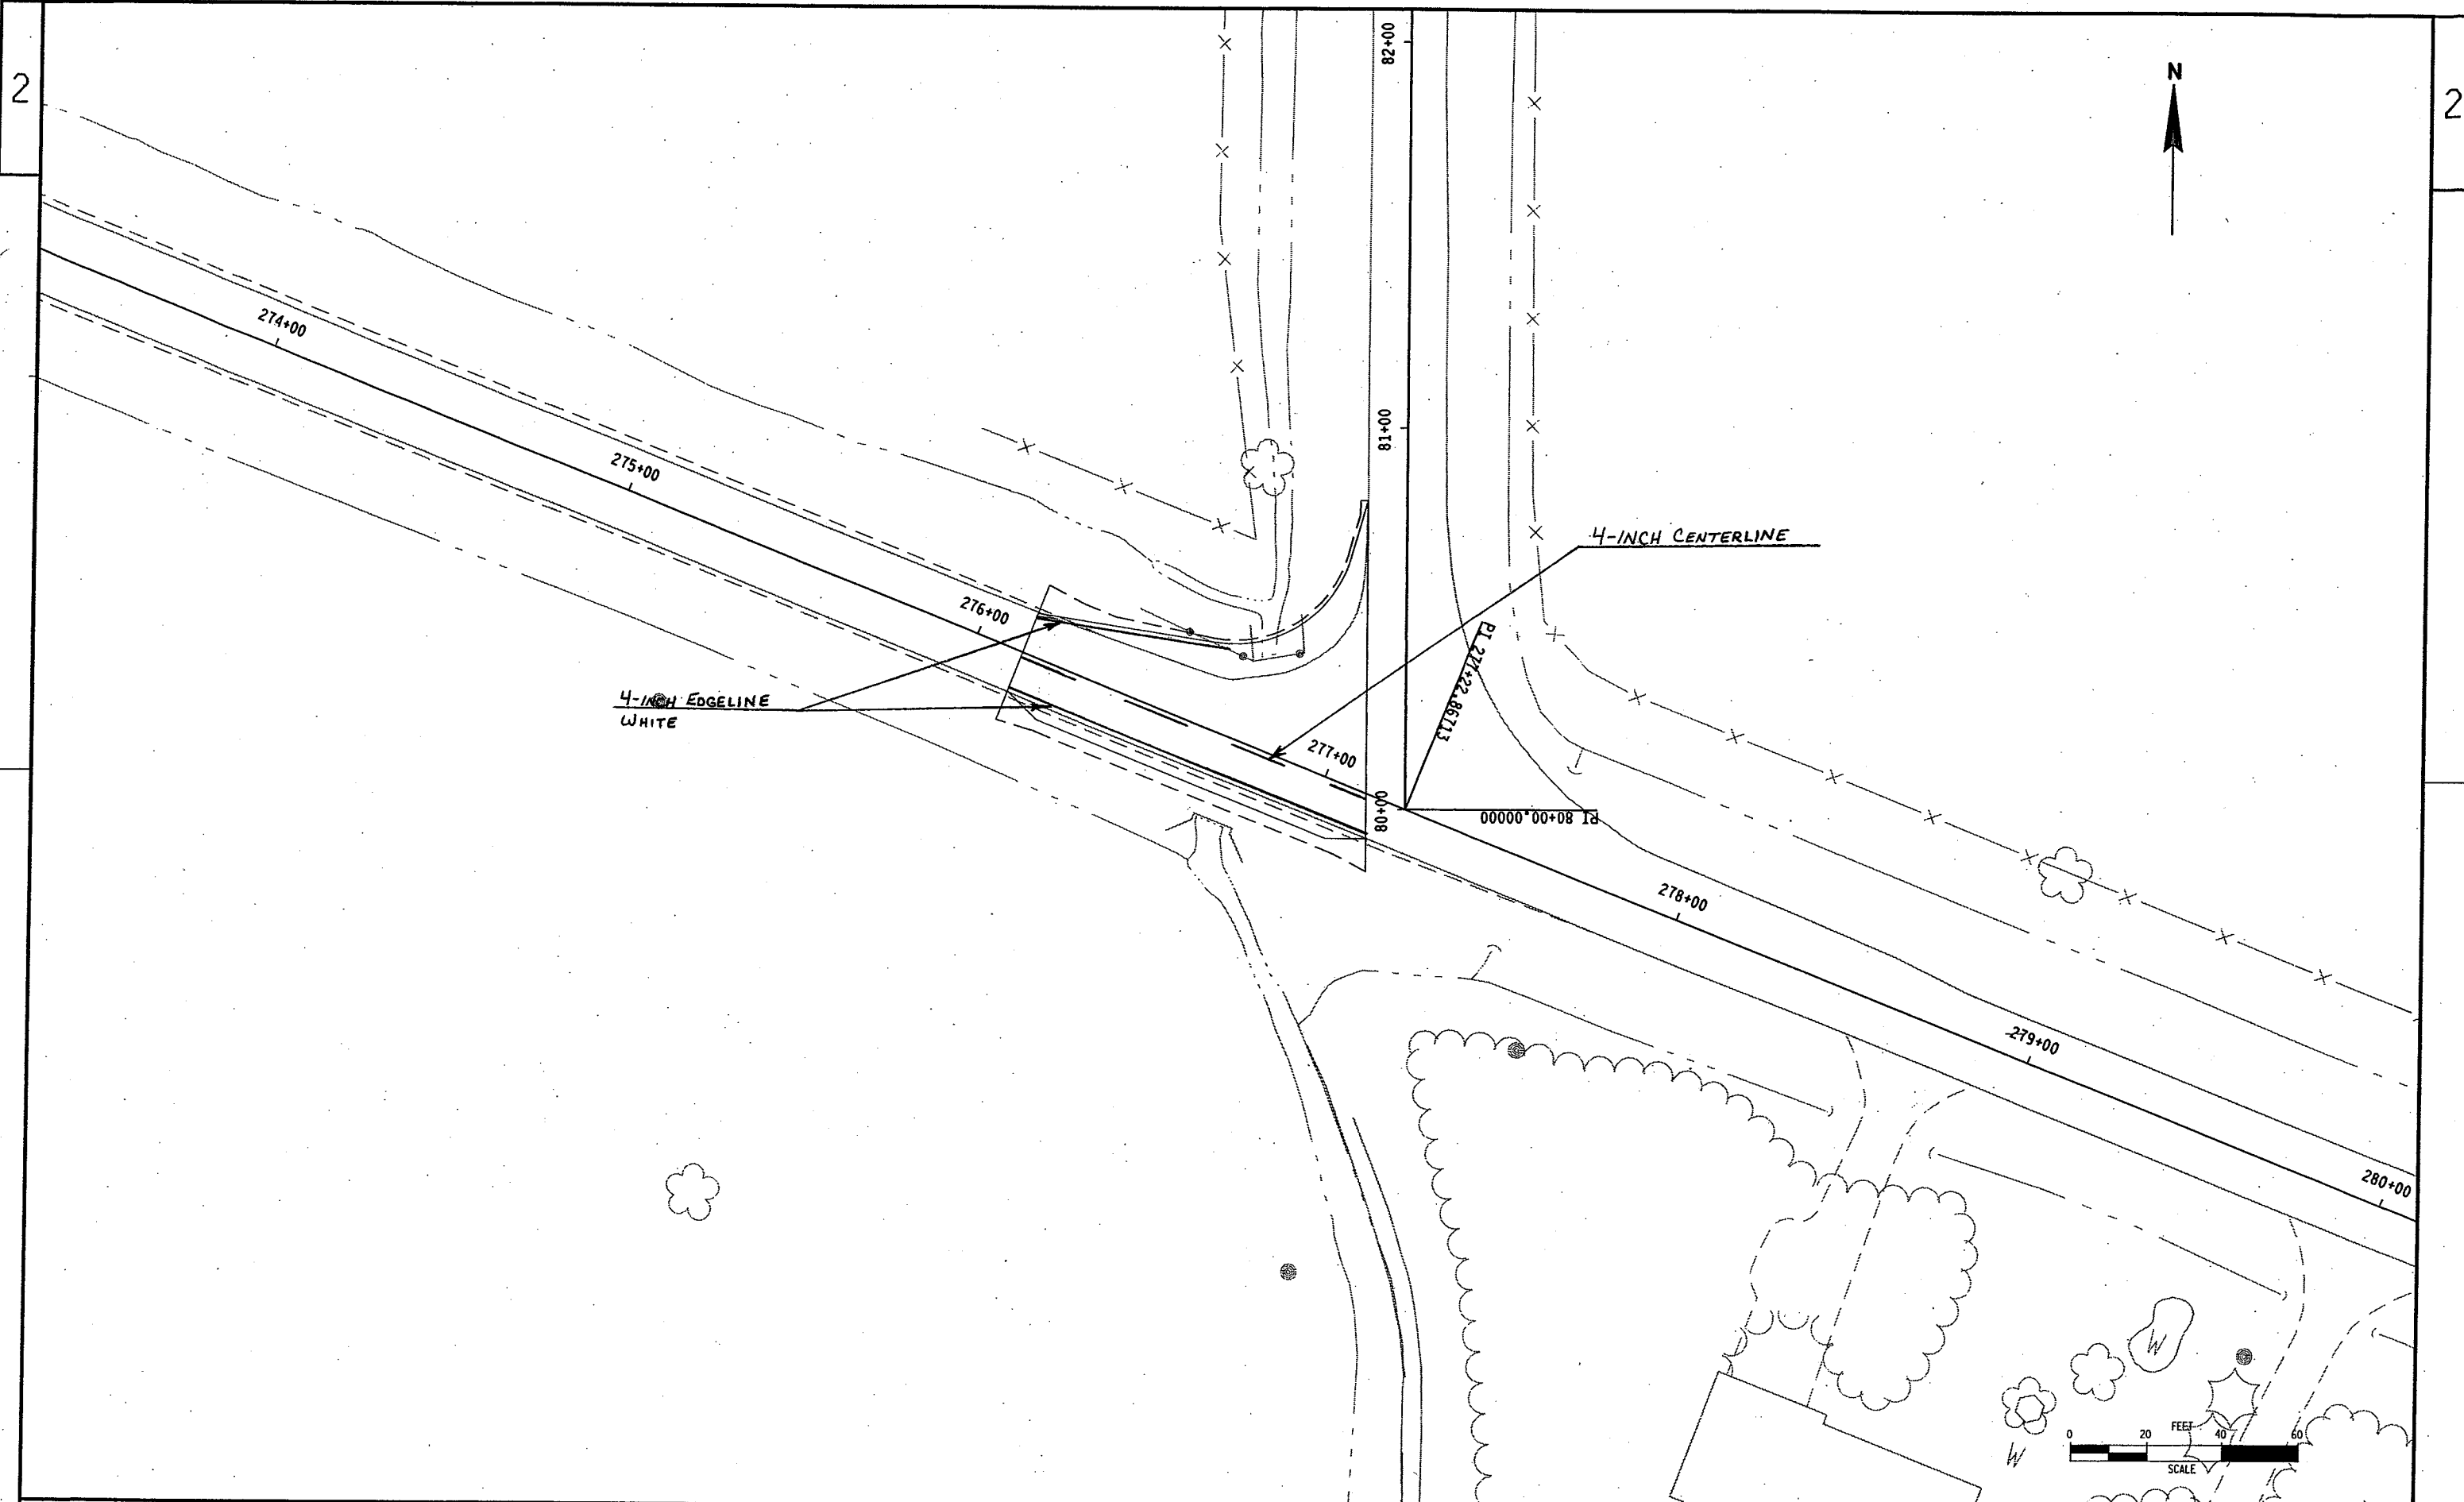

STATE PROJECT NO: 6200-07-71	HWY: CTH II	COUNTY: WINNEBAGO	EPOXY PAVEMENT MARKING	SHEET NO: E
------------------------------	-------------	-------------------	------------------------	-------------

FILE NAME : C:\Users\PD3\STH110\GDN FILES\PMIBC.DGN PLOT DATE : 23-APR-2004 14:28 PLOT BY : DOTEAD PLOT NAME : PLOT SCALE : 1.993976:1.000000

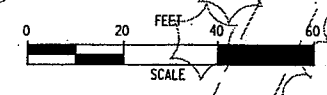

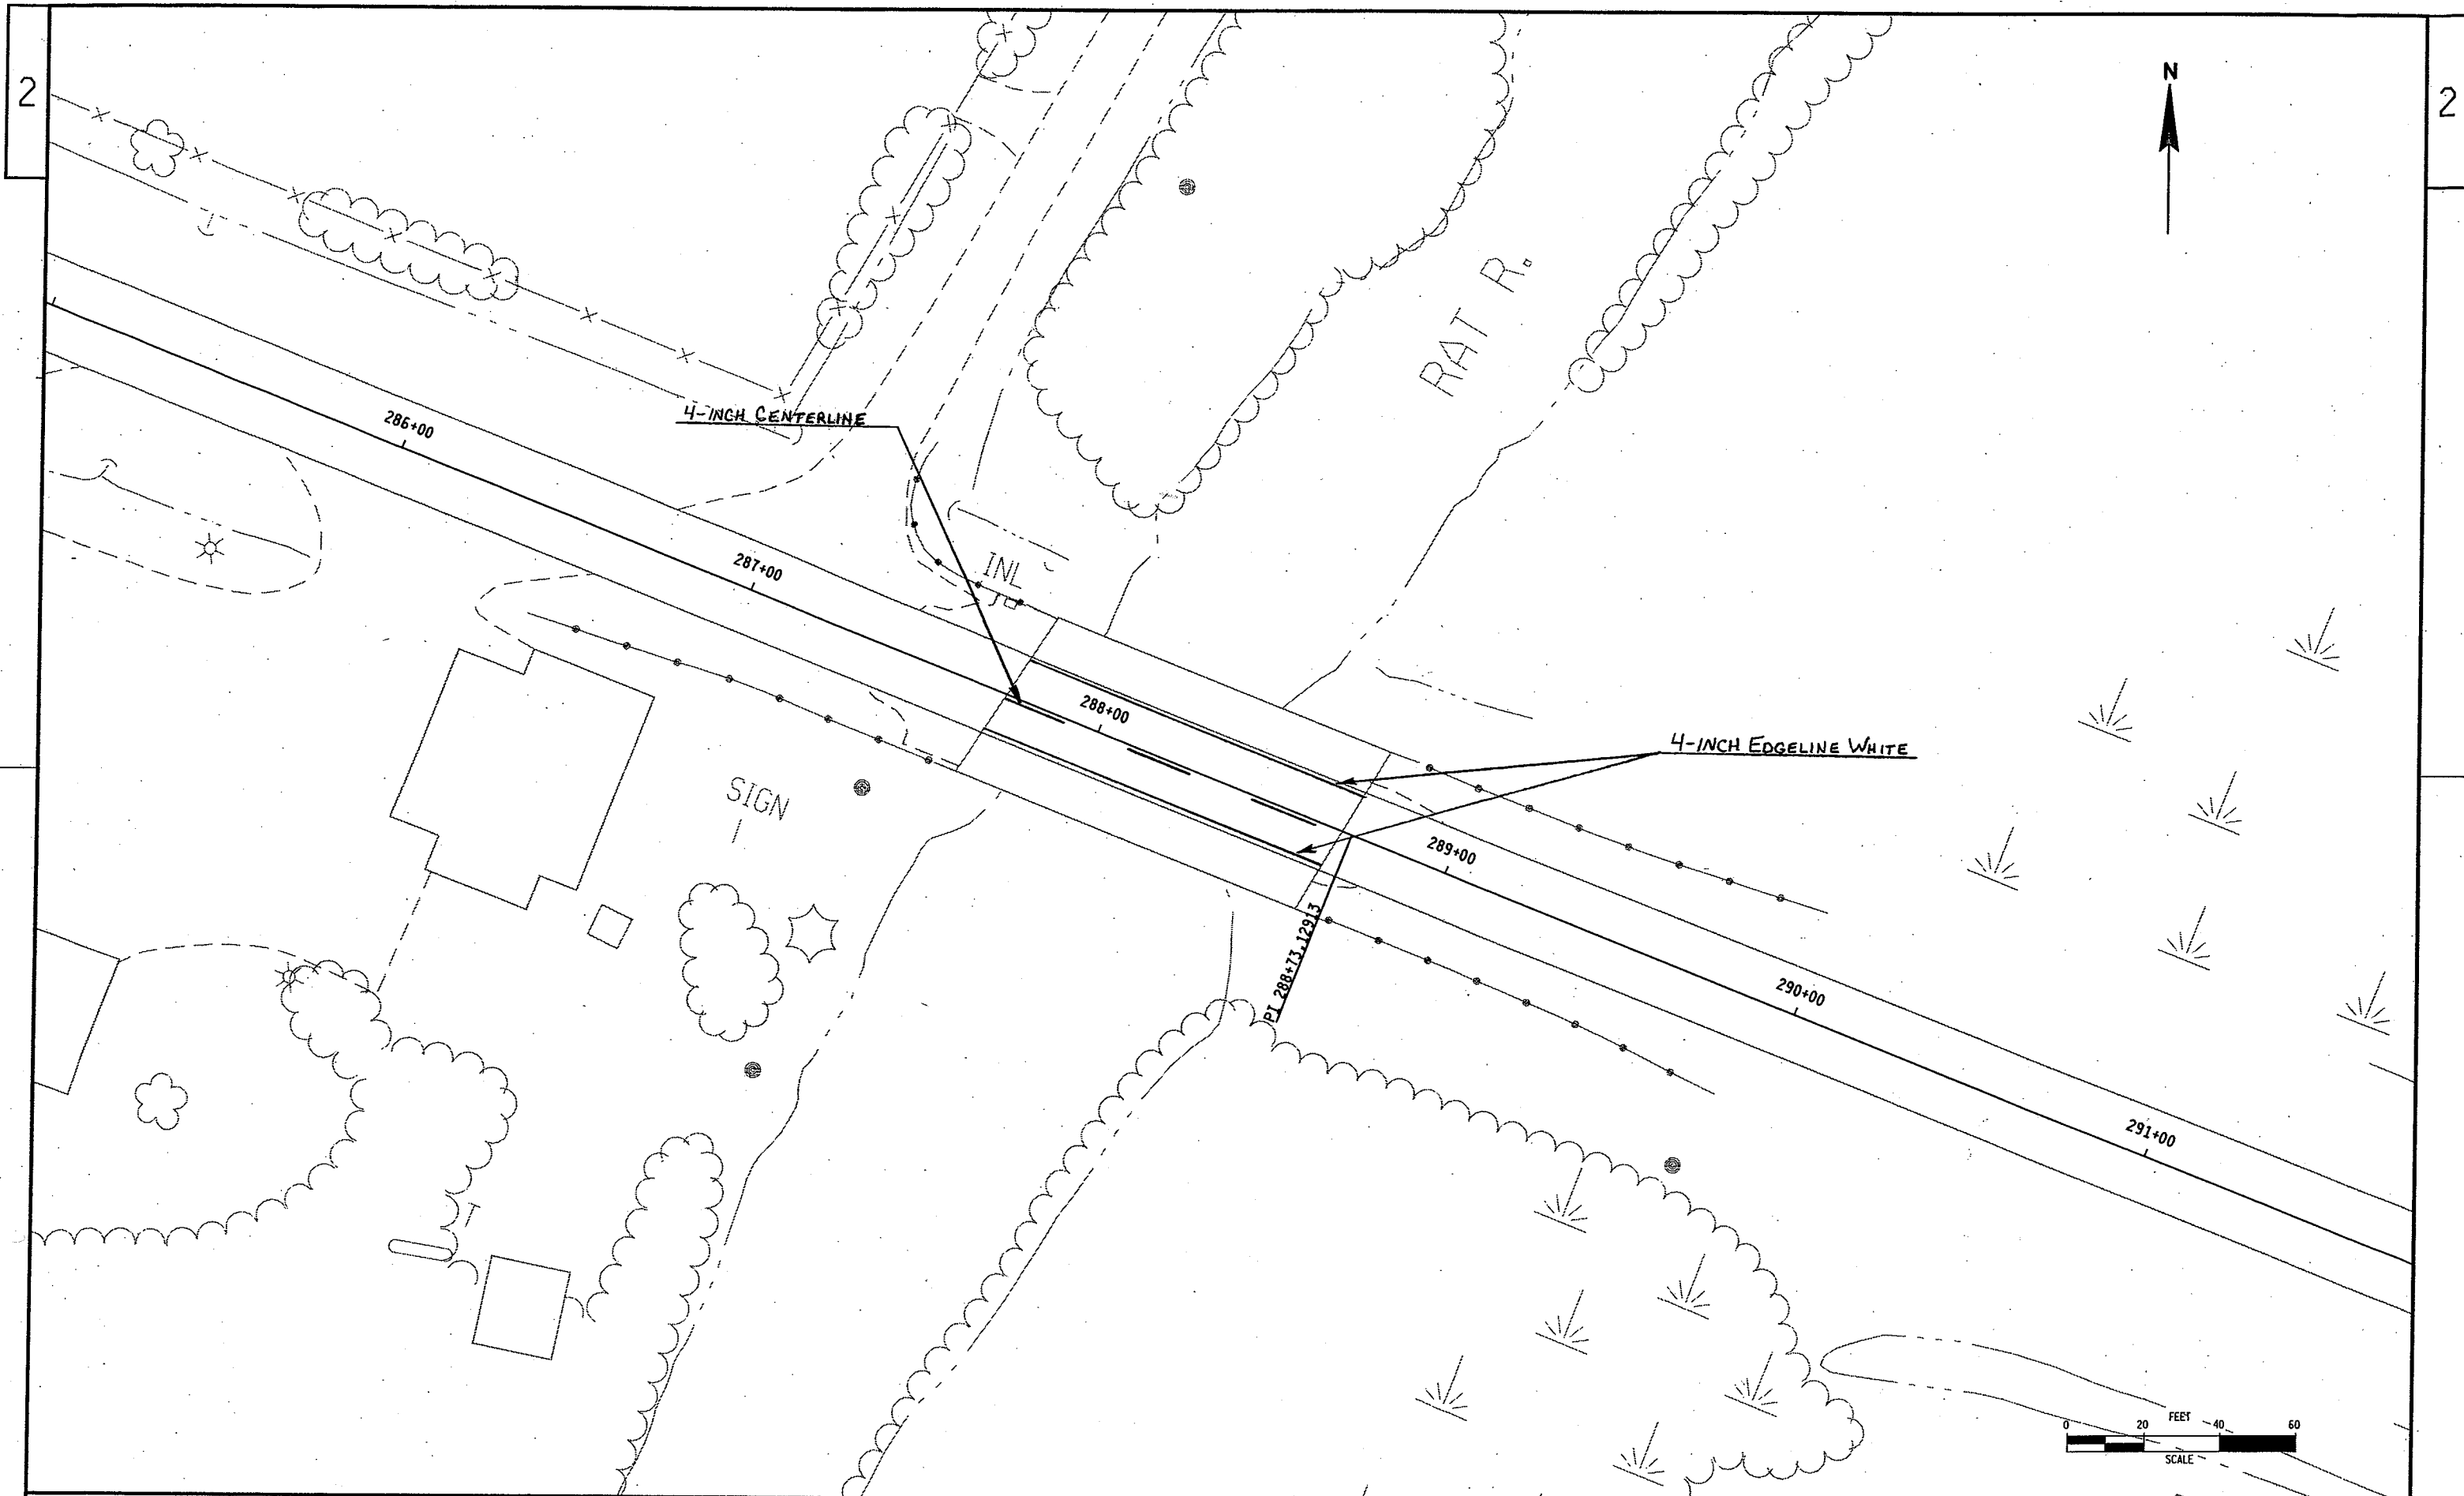

STATE PROJECT NO: 6200-07-71

HWY: CTH II

COUNTY: WINNEBAGO

EPOXY PAVEMENT MARKING

SHEET NO:

E


FILE NAME : C:\Users\VP\03\STH10\DGN FILES\PMR\RiverBridge.DGN

PLOT DATE : 29-APR-2004 14:29

PLOT BY : DOTEAD

PLOT NAME :

PLOT SCALE : 1.993976:1.000000

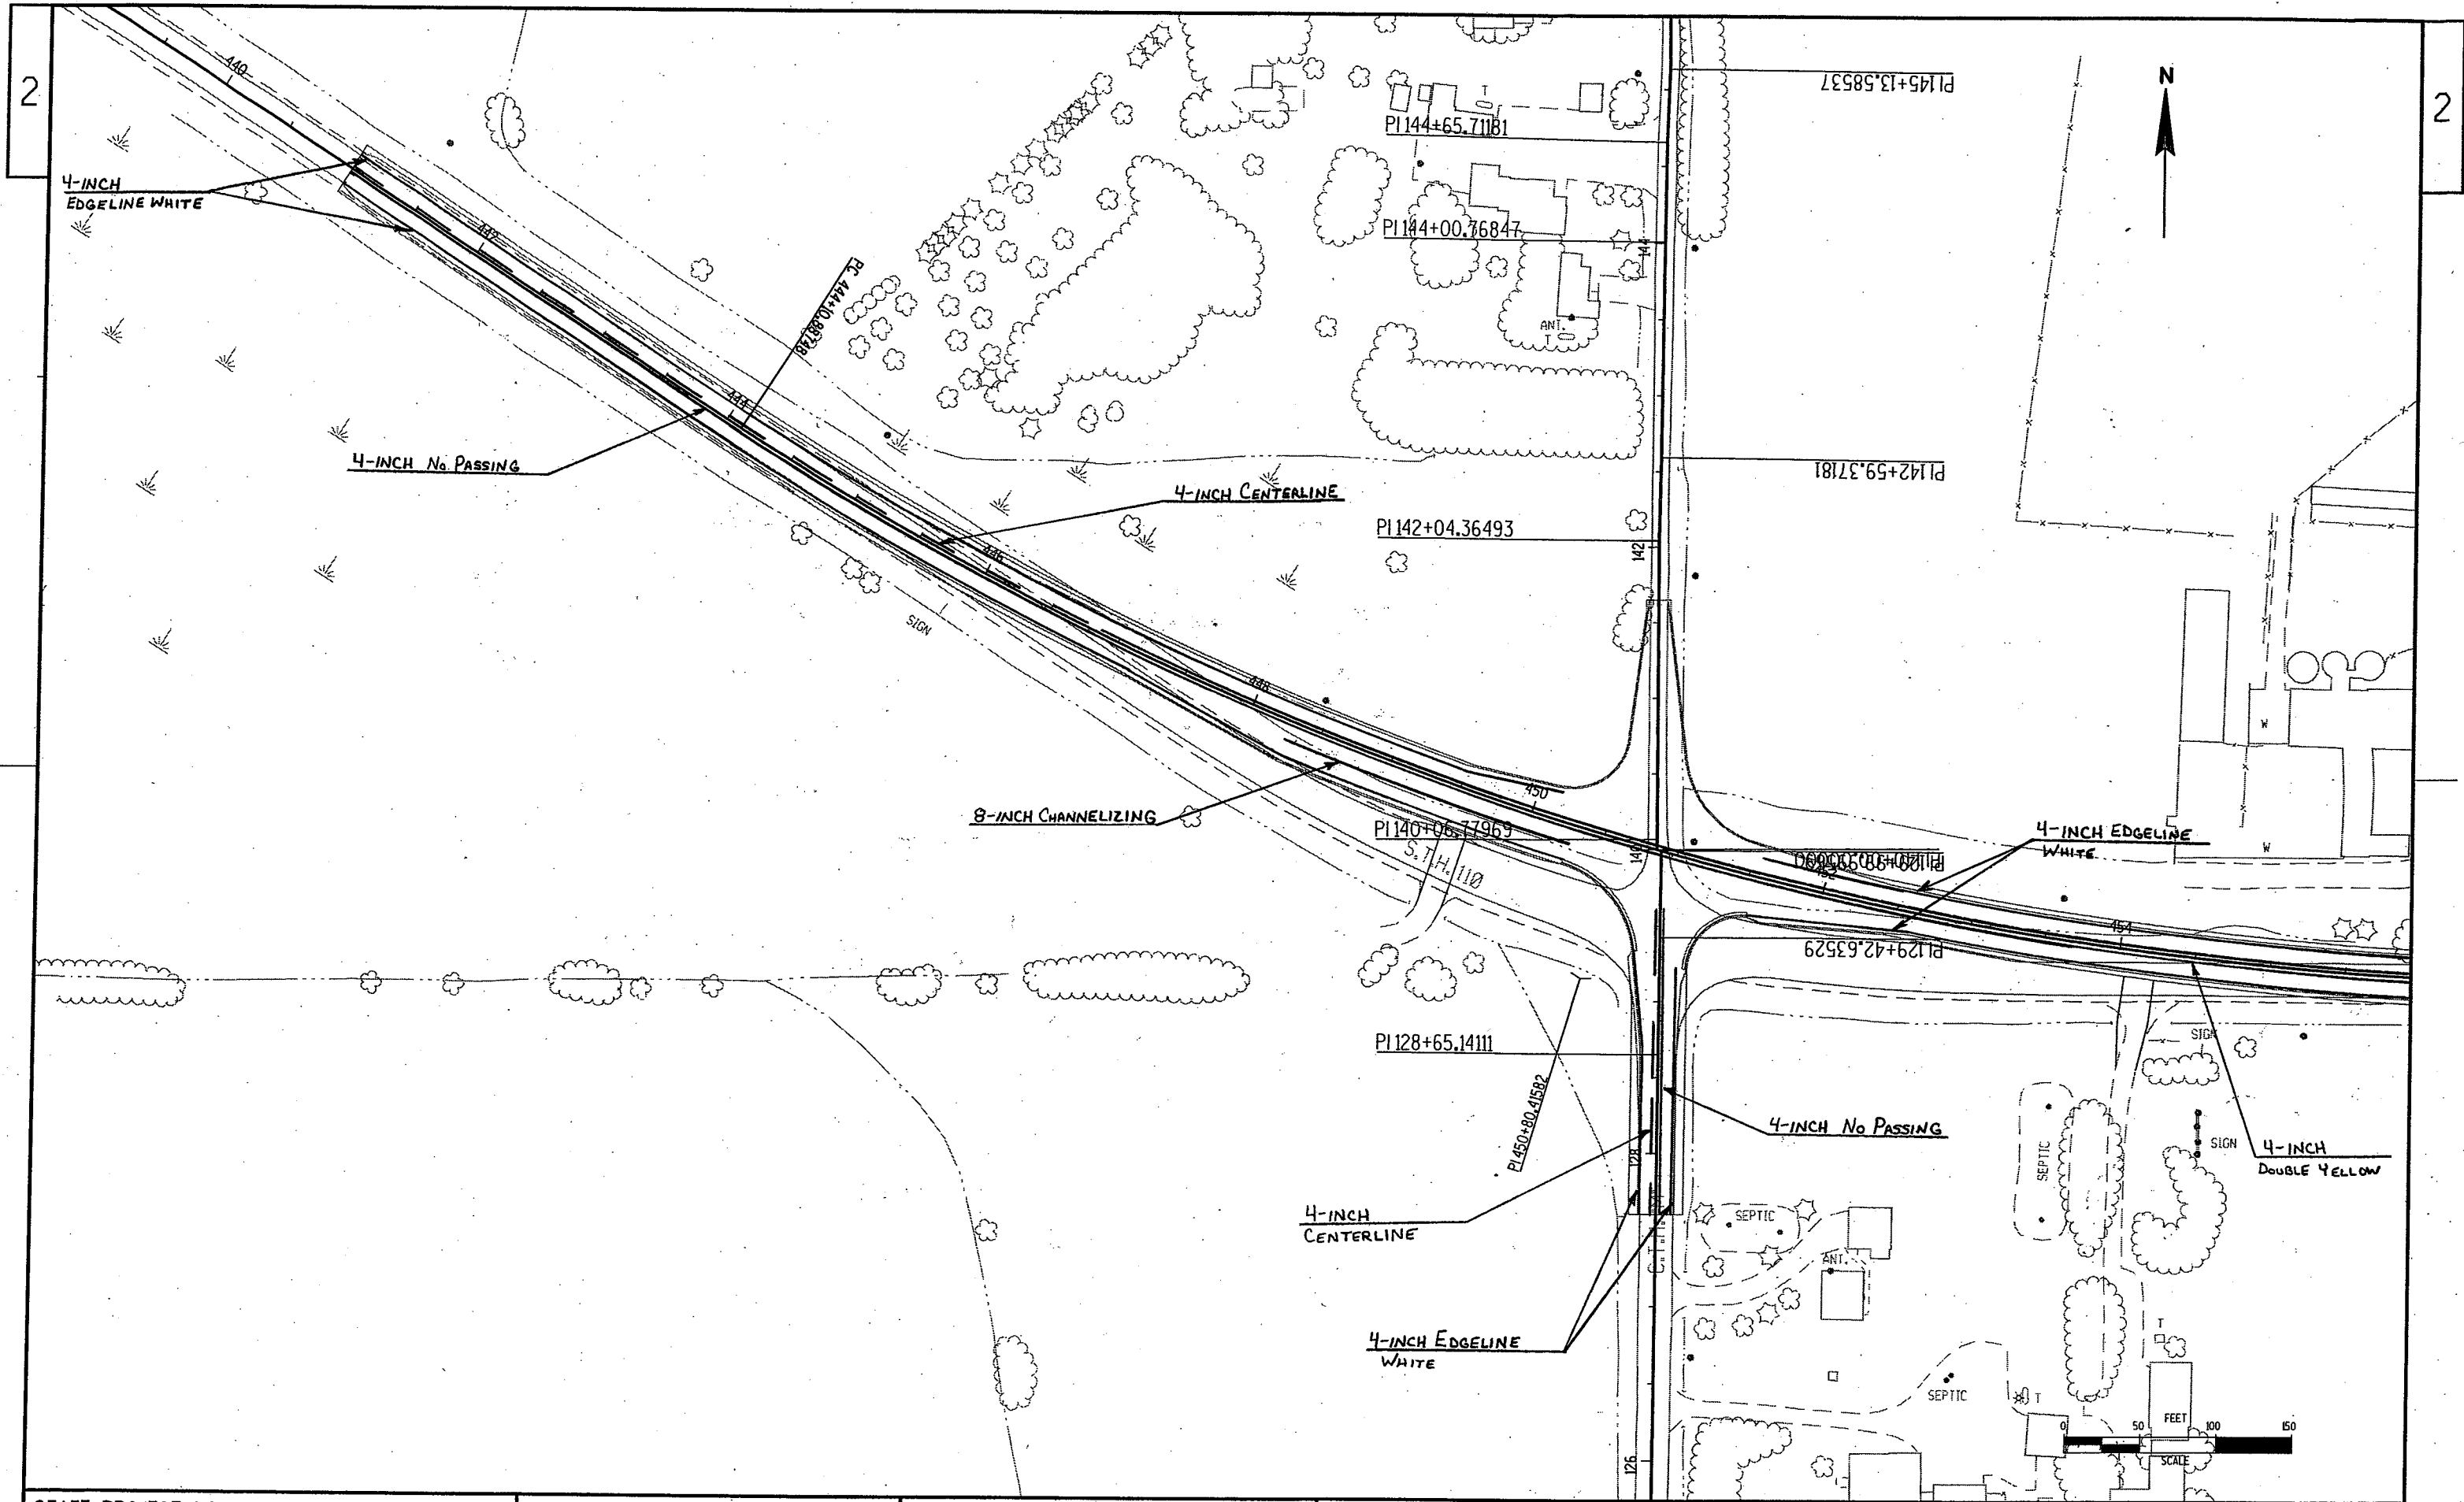

STATE PROJECT NO: 6200-07-71

HWY: CTH II

COUNTY: WINNEBAGO

EPOXY PAVEMENT MARKING

SHEET NO:

E


FILE NAME : C:\Users\PD3\STH110\DN FILES\PMHcurve.DGN

PLOT DATE : 29-APR-2004 14:34

PLOT BY : DOTEAD

PLOT NAME :

PLOT SCALE : 1.993976:1.000000

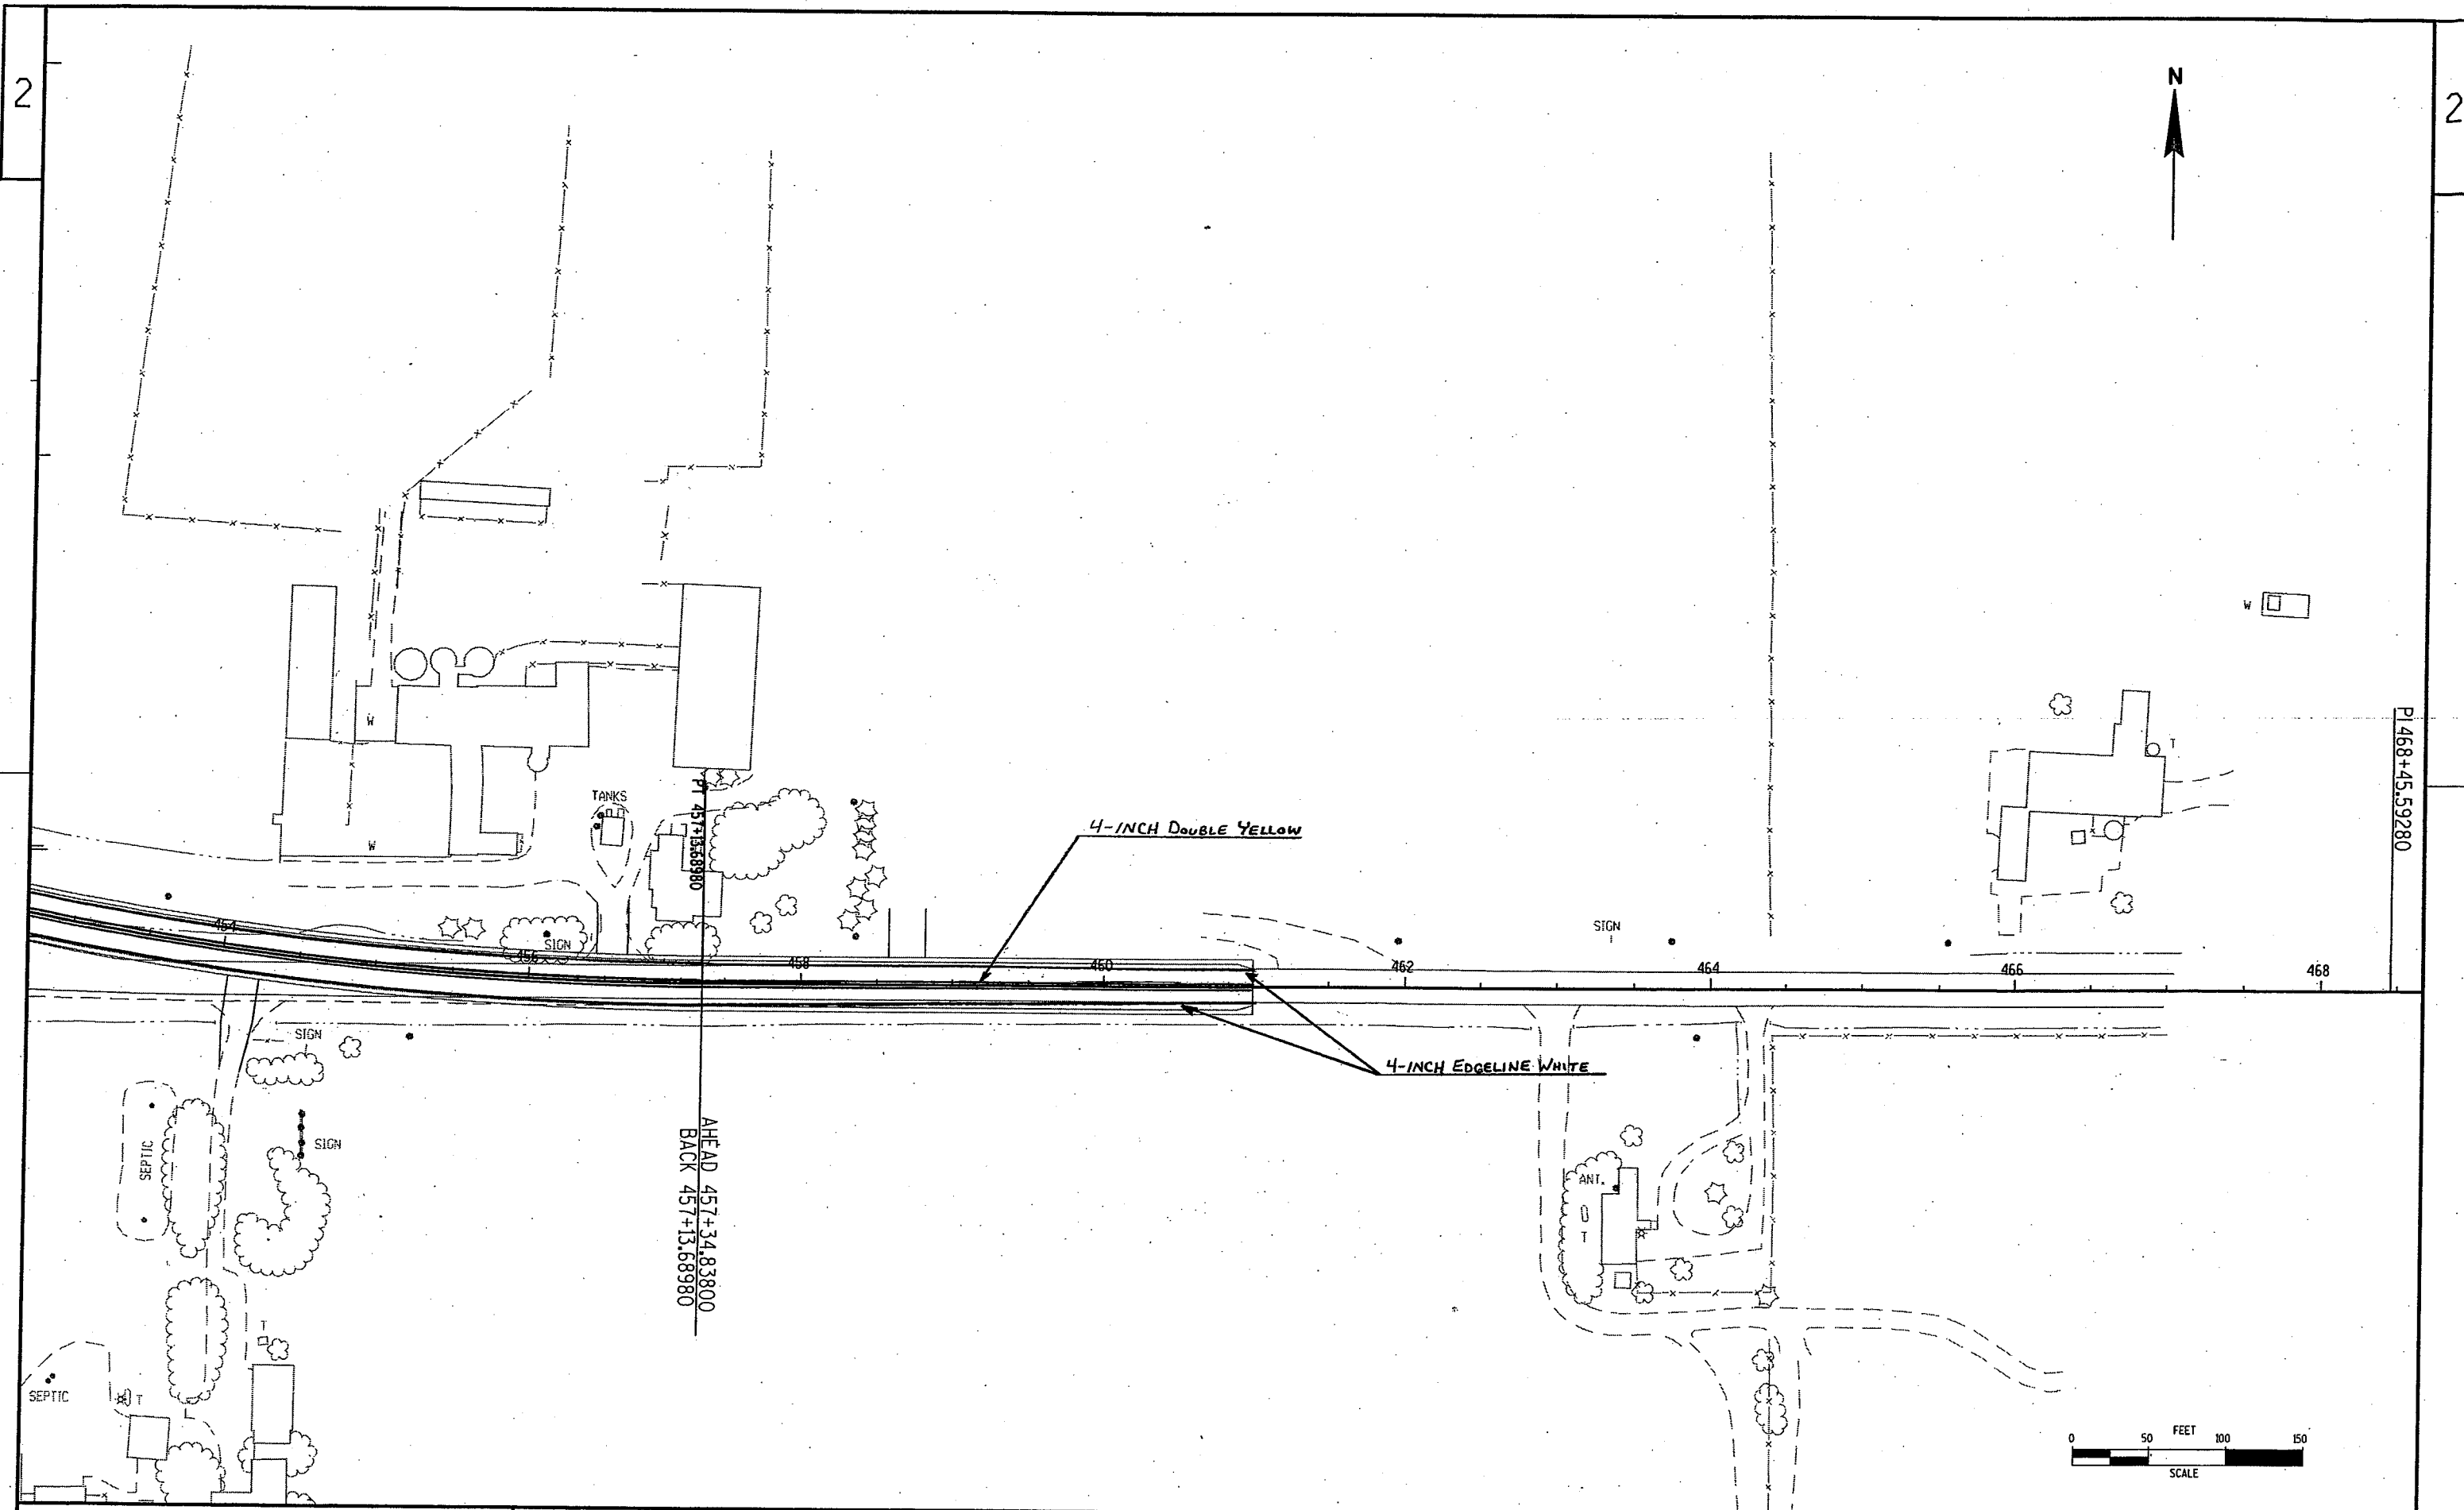



2

2

P1468+45.59280


PI 457+34.83800
AHEAD 457+34.83800
BACK 457+13.68980


LEVELS ON - 1, 2, 3, 62, 63

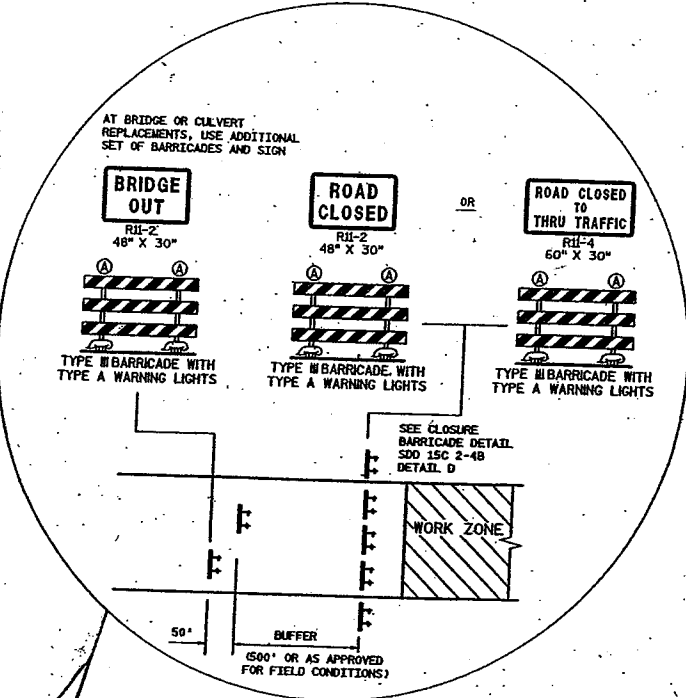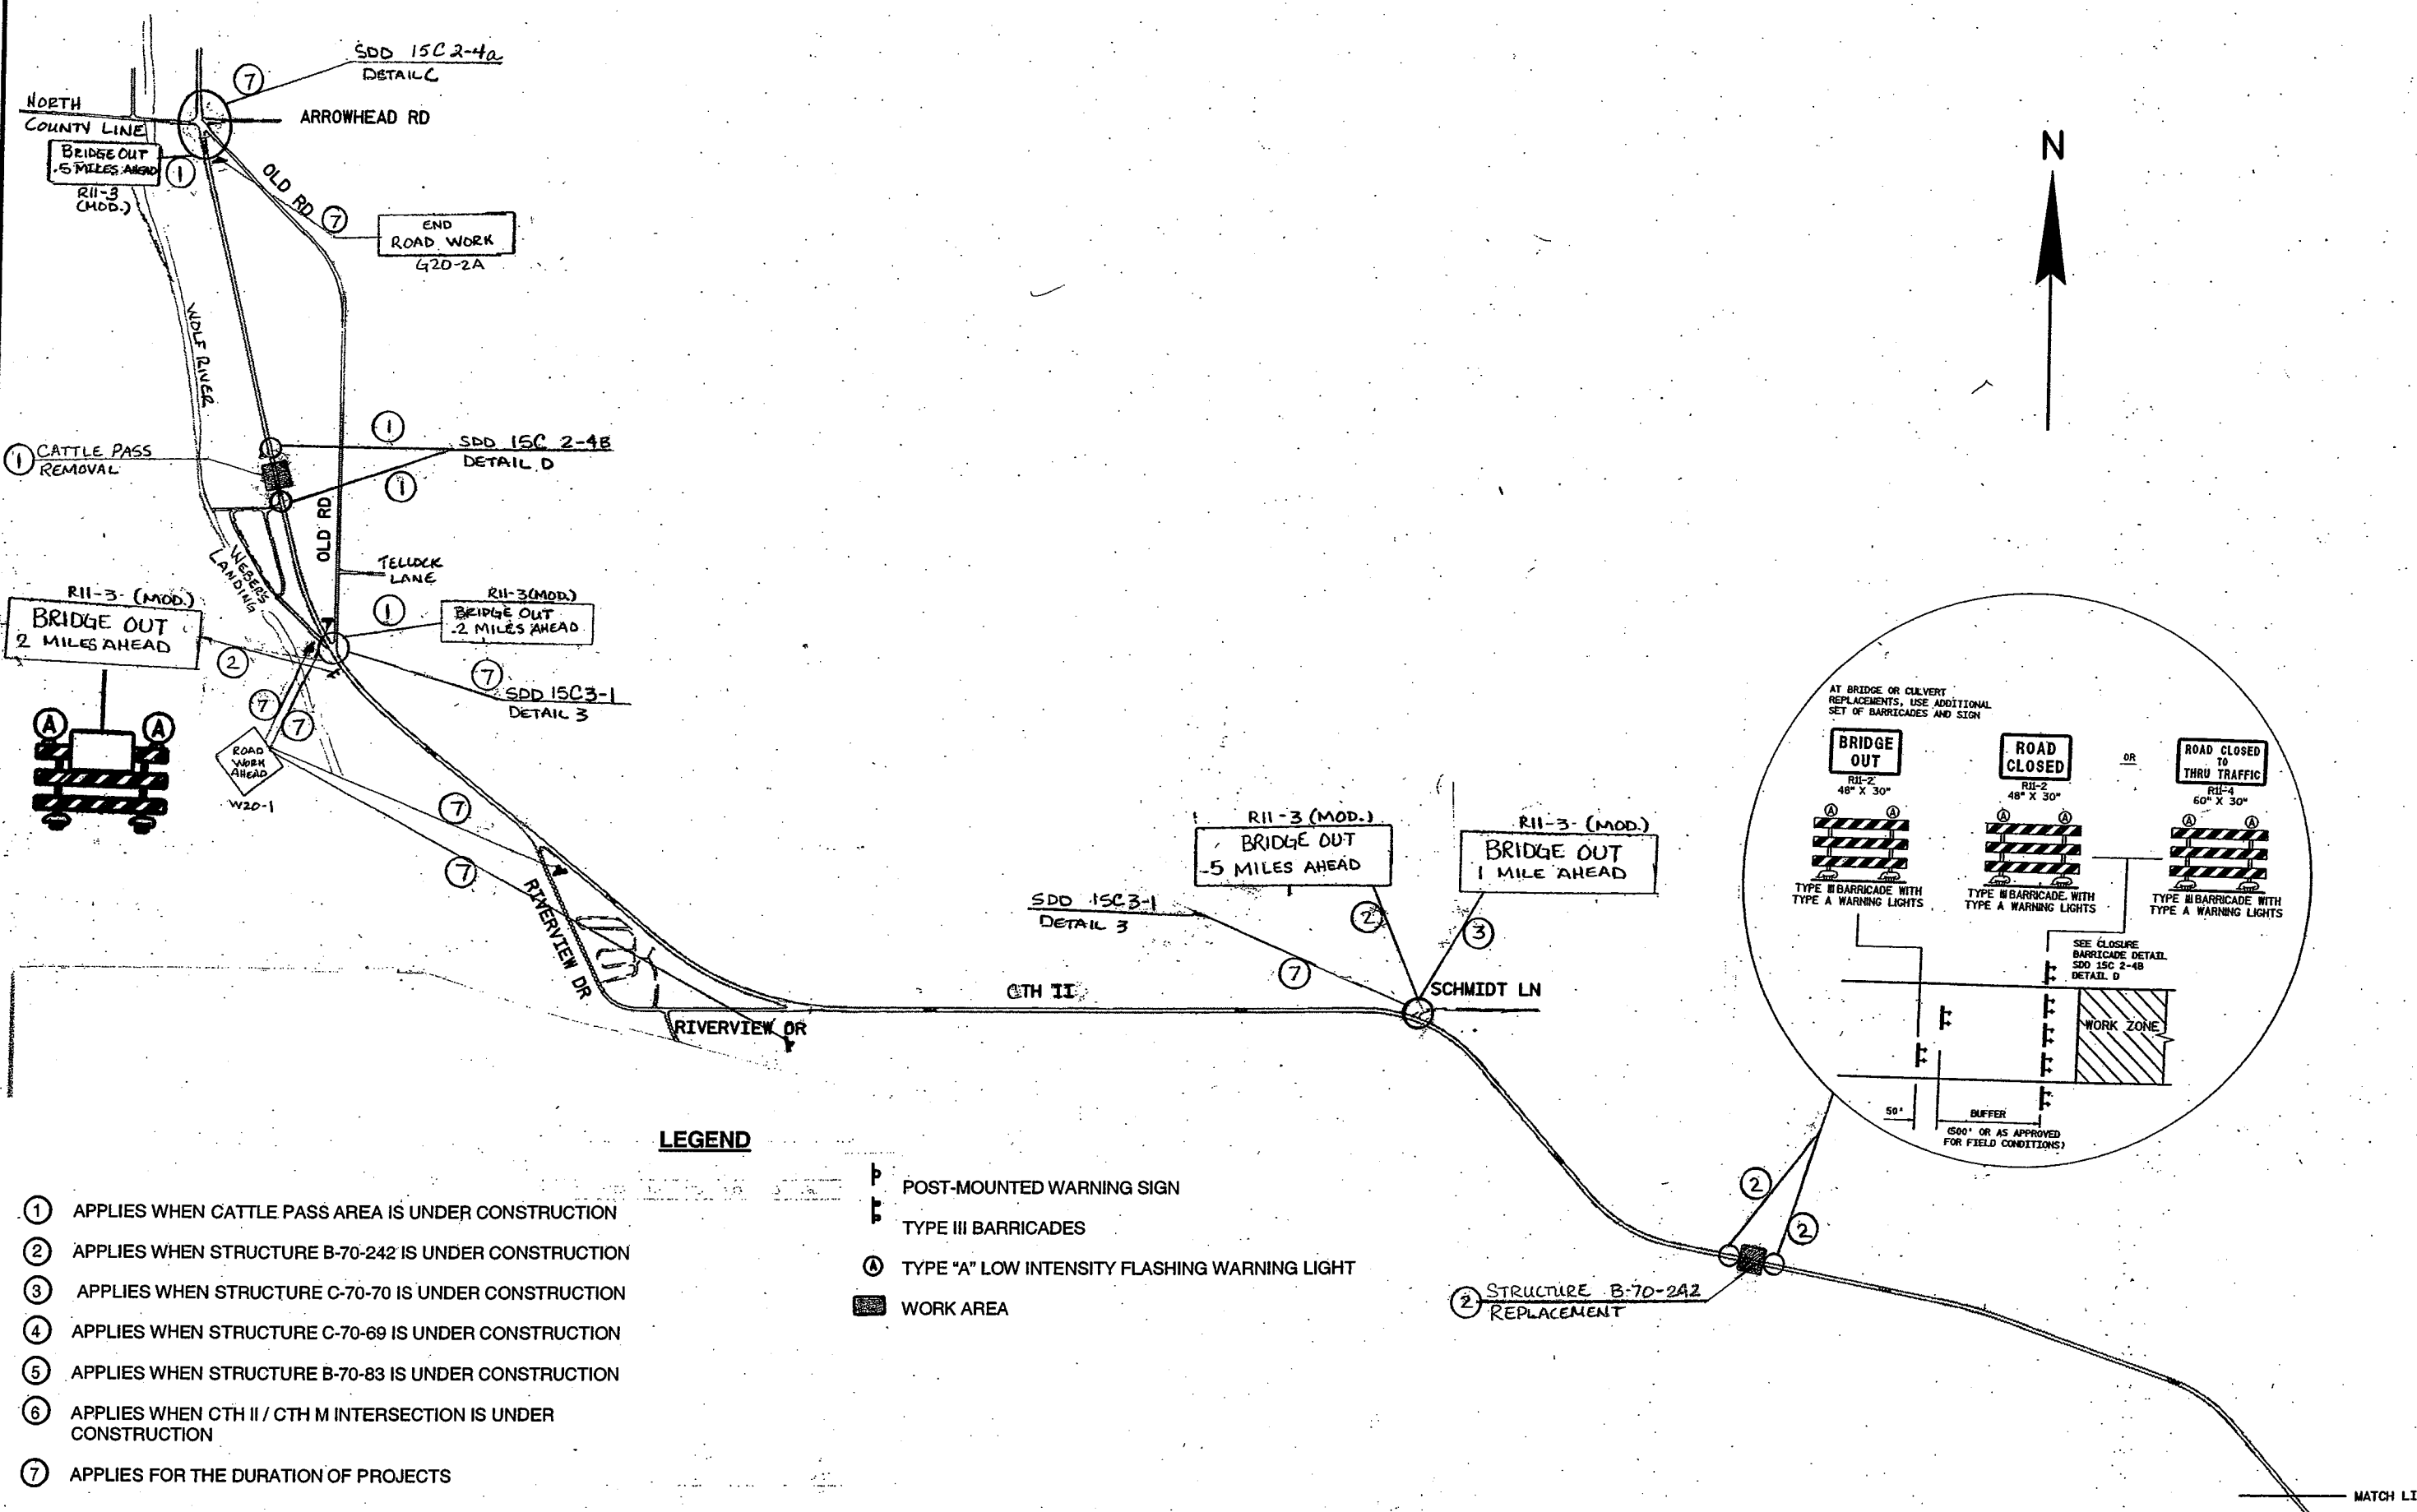


LEGEND

- ① APPLIES WHEN CATTLE PASS AREA IS UNDER CONSTRUCTION
- ② APPLIES WHEN STRUCTURE B-70-242 IS UNDER CONSTRUCTION
- ③ APPLIES WHEN STRUCTURE C-70-70 IS UNDER CONSTRUCTION
- ④ APPLIES WHEN STRUCTURE C-70-69 IS UNDER CONSTRUCTION
- ⑤ APPLIES WHEN STRUCTURE B-70-83 IS UNDER CONSTRUCTION
- ⑥ APPLIES WHEN CTH II / CTH M INTERSECTION IS UNDER CONSTRUCTION
- ⑦ APPLIES FOR THE DURATION OF PROJECTS
- P POST-MOUNTED WARNING SIGN
- III TYPE III BARRICADES
- A TYPE "A" LOW INTENSITY FLASHING WARNING LIGHT
- WORK AREA

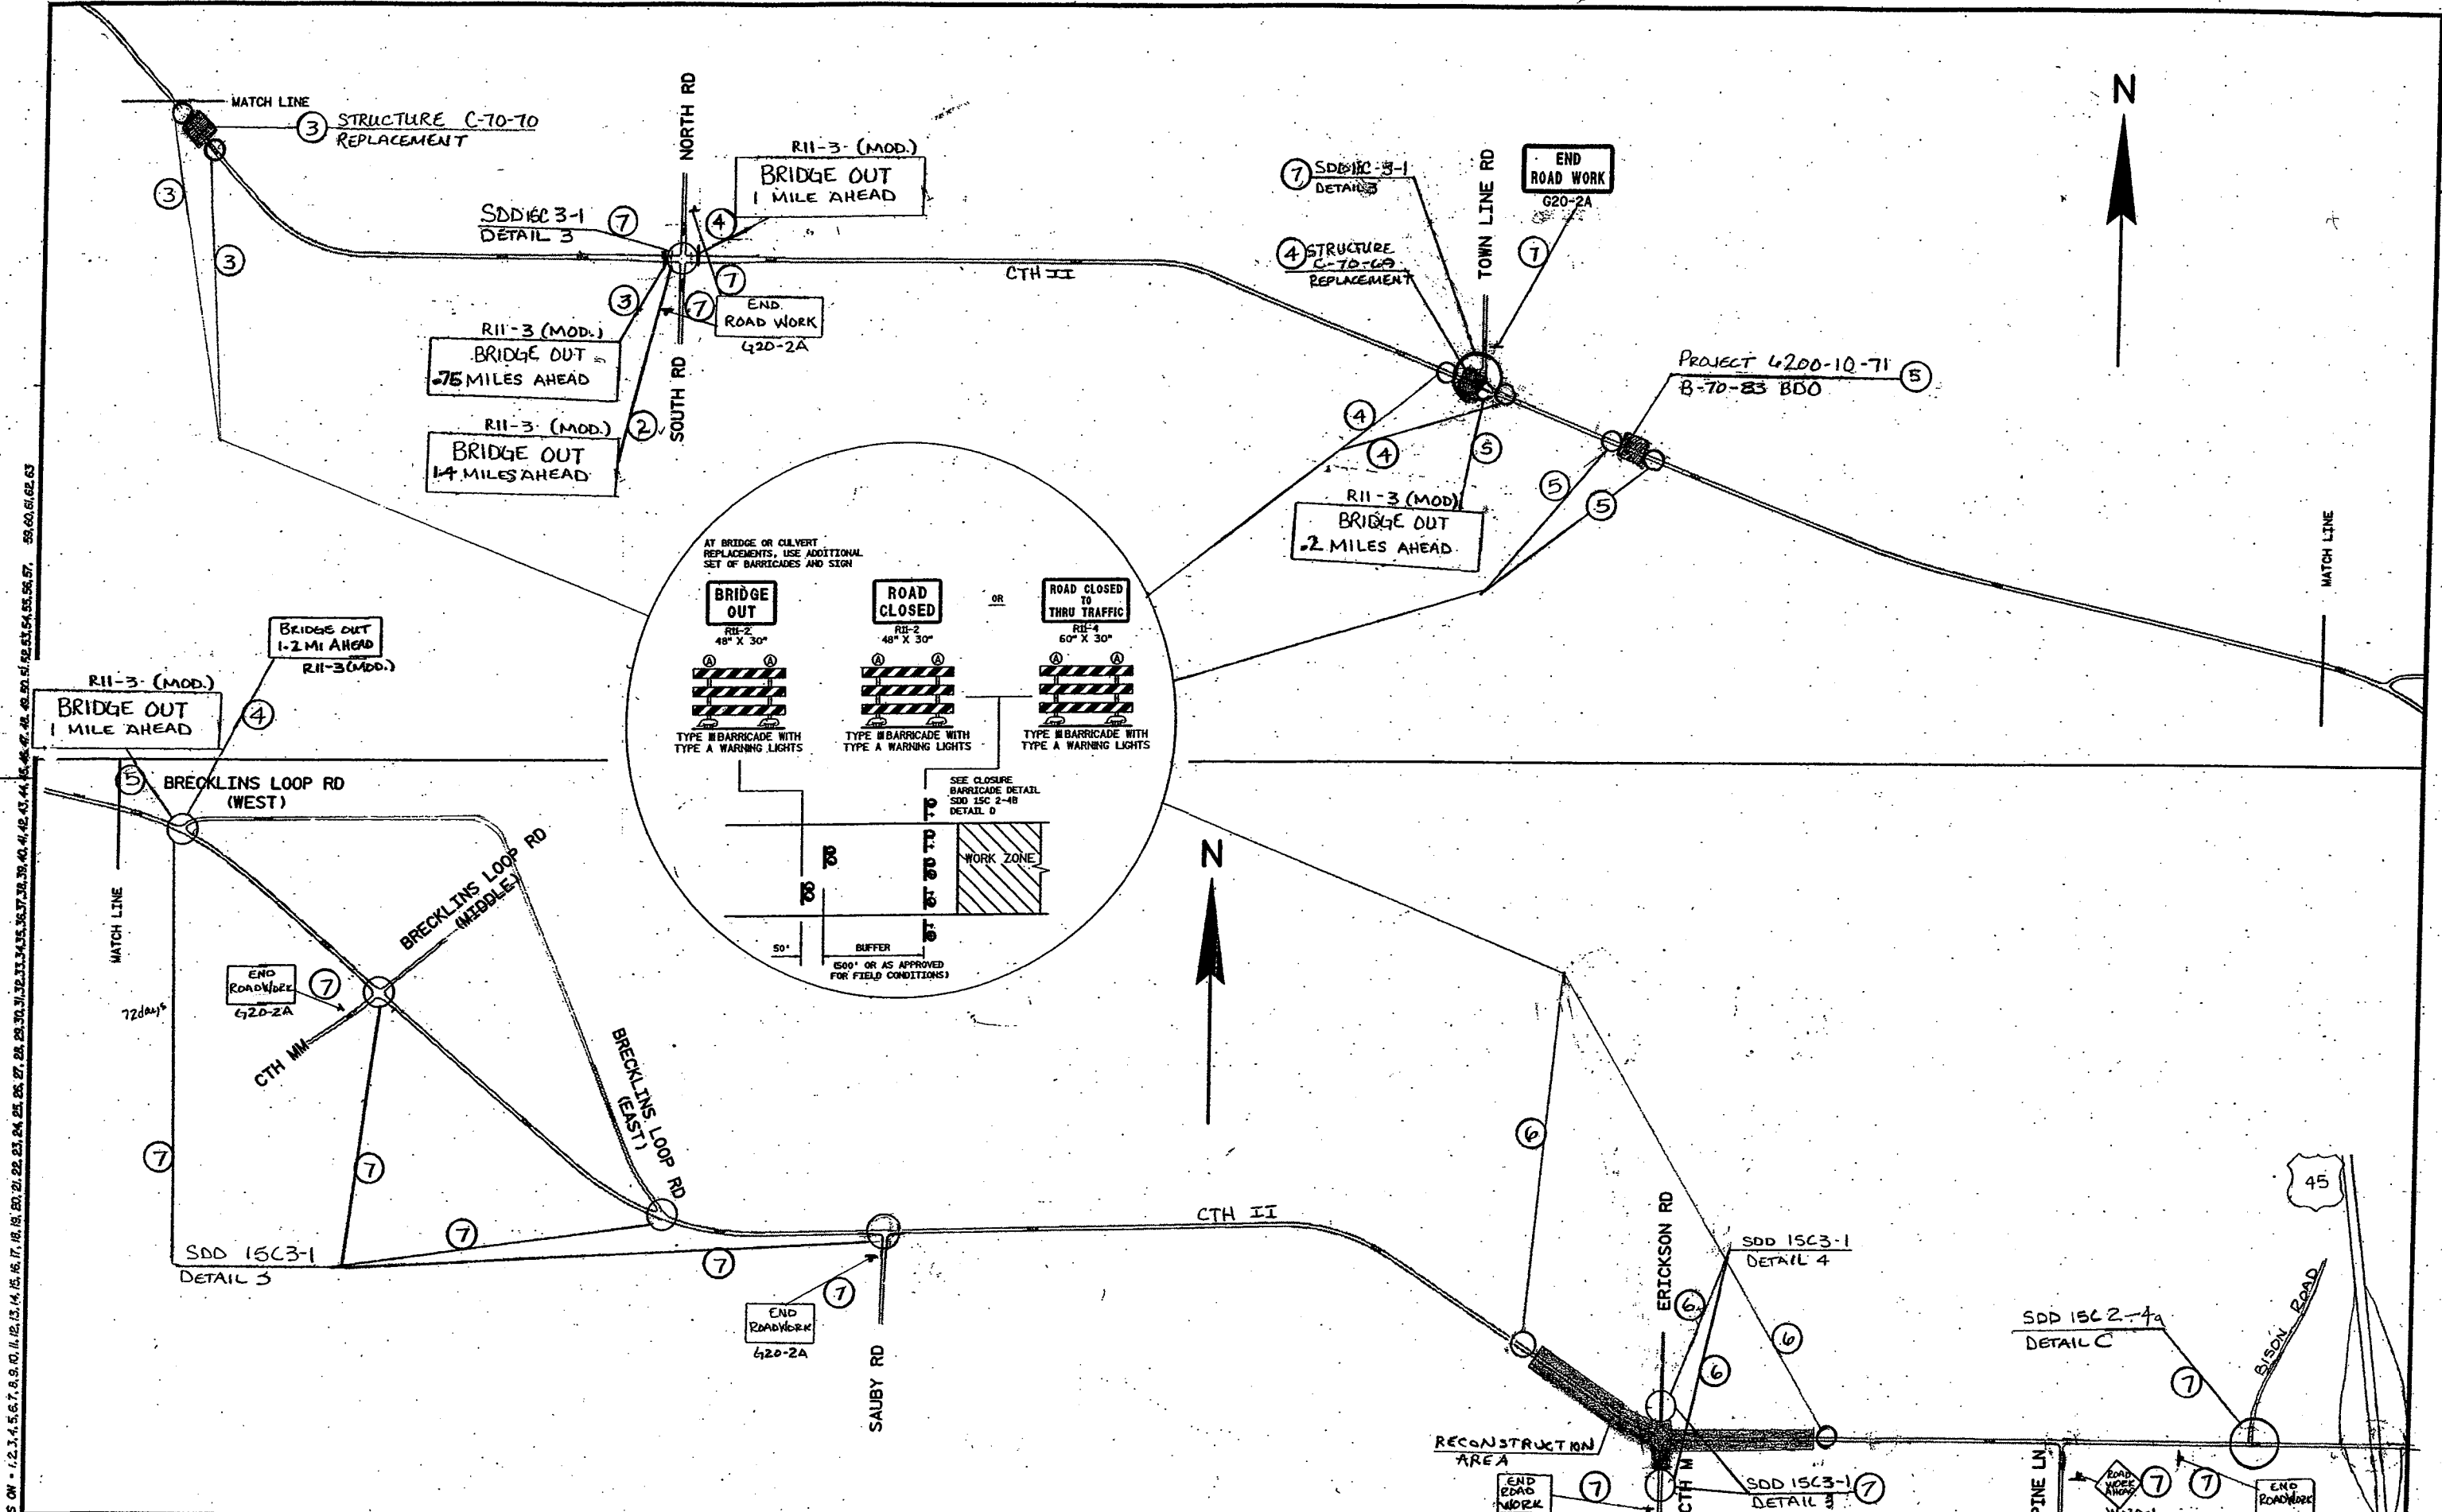

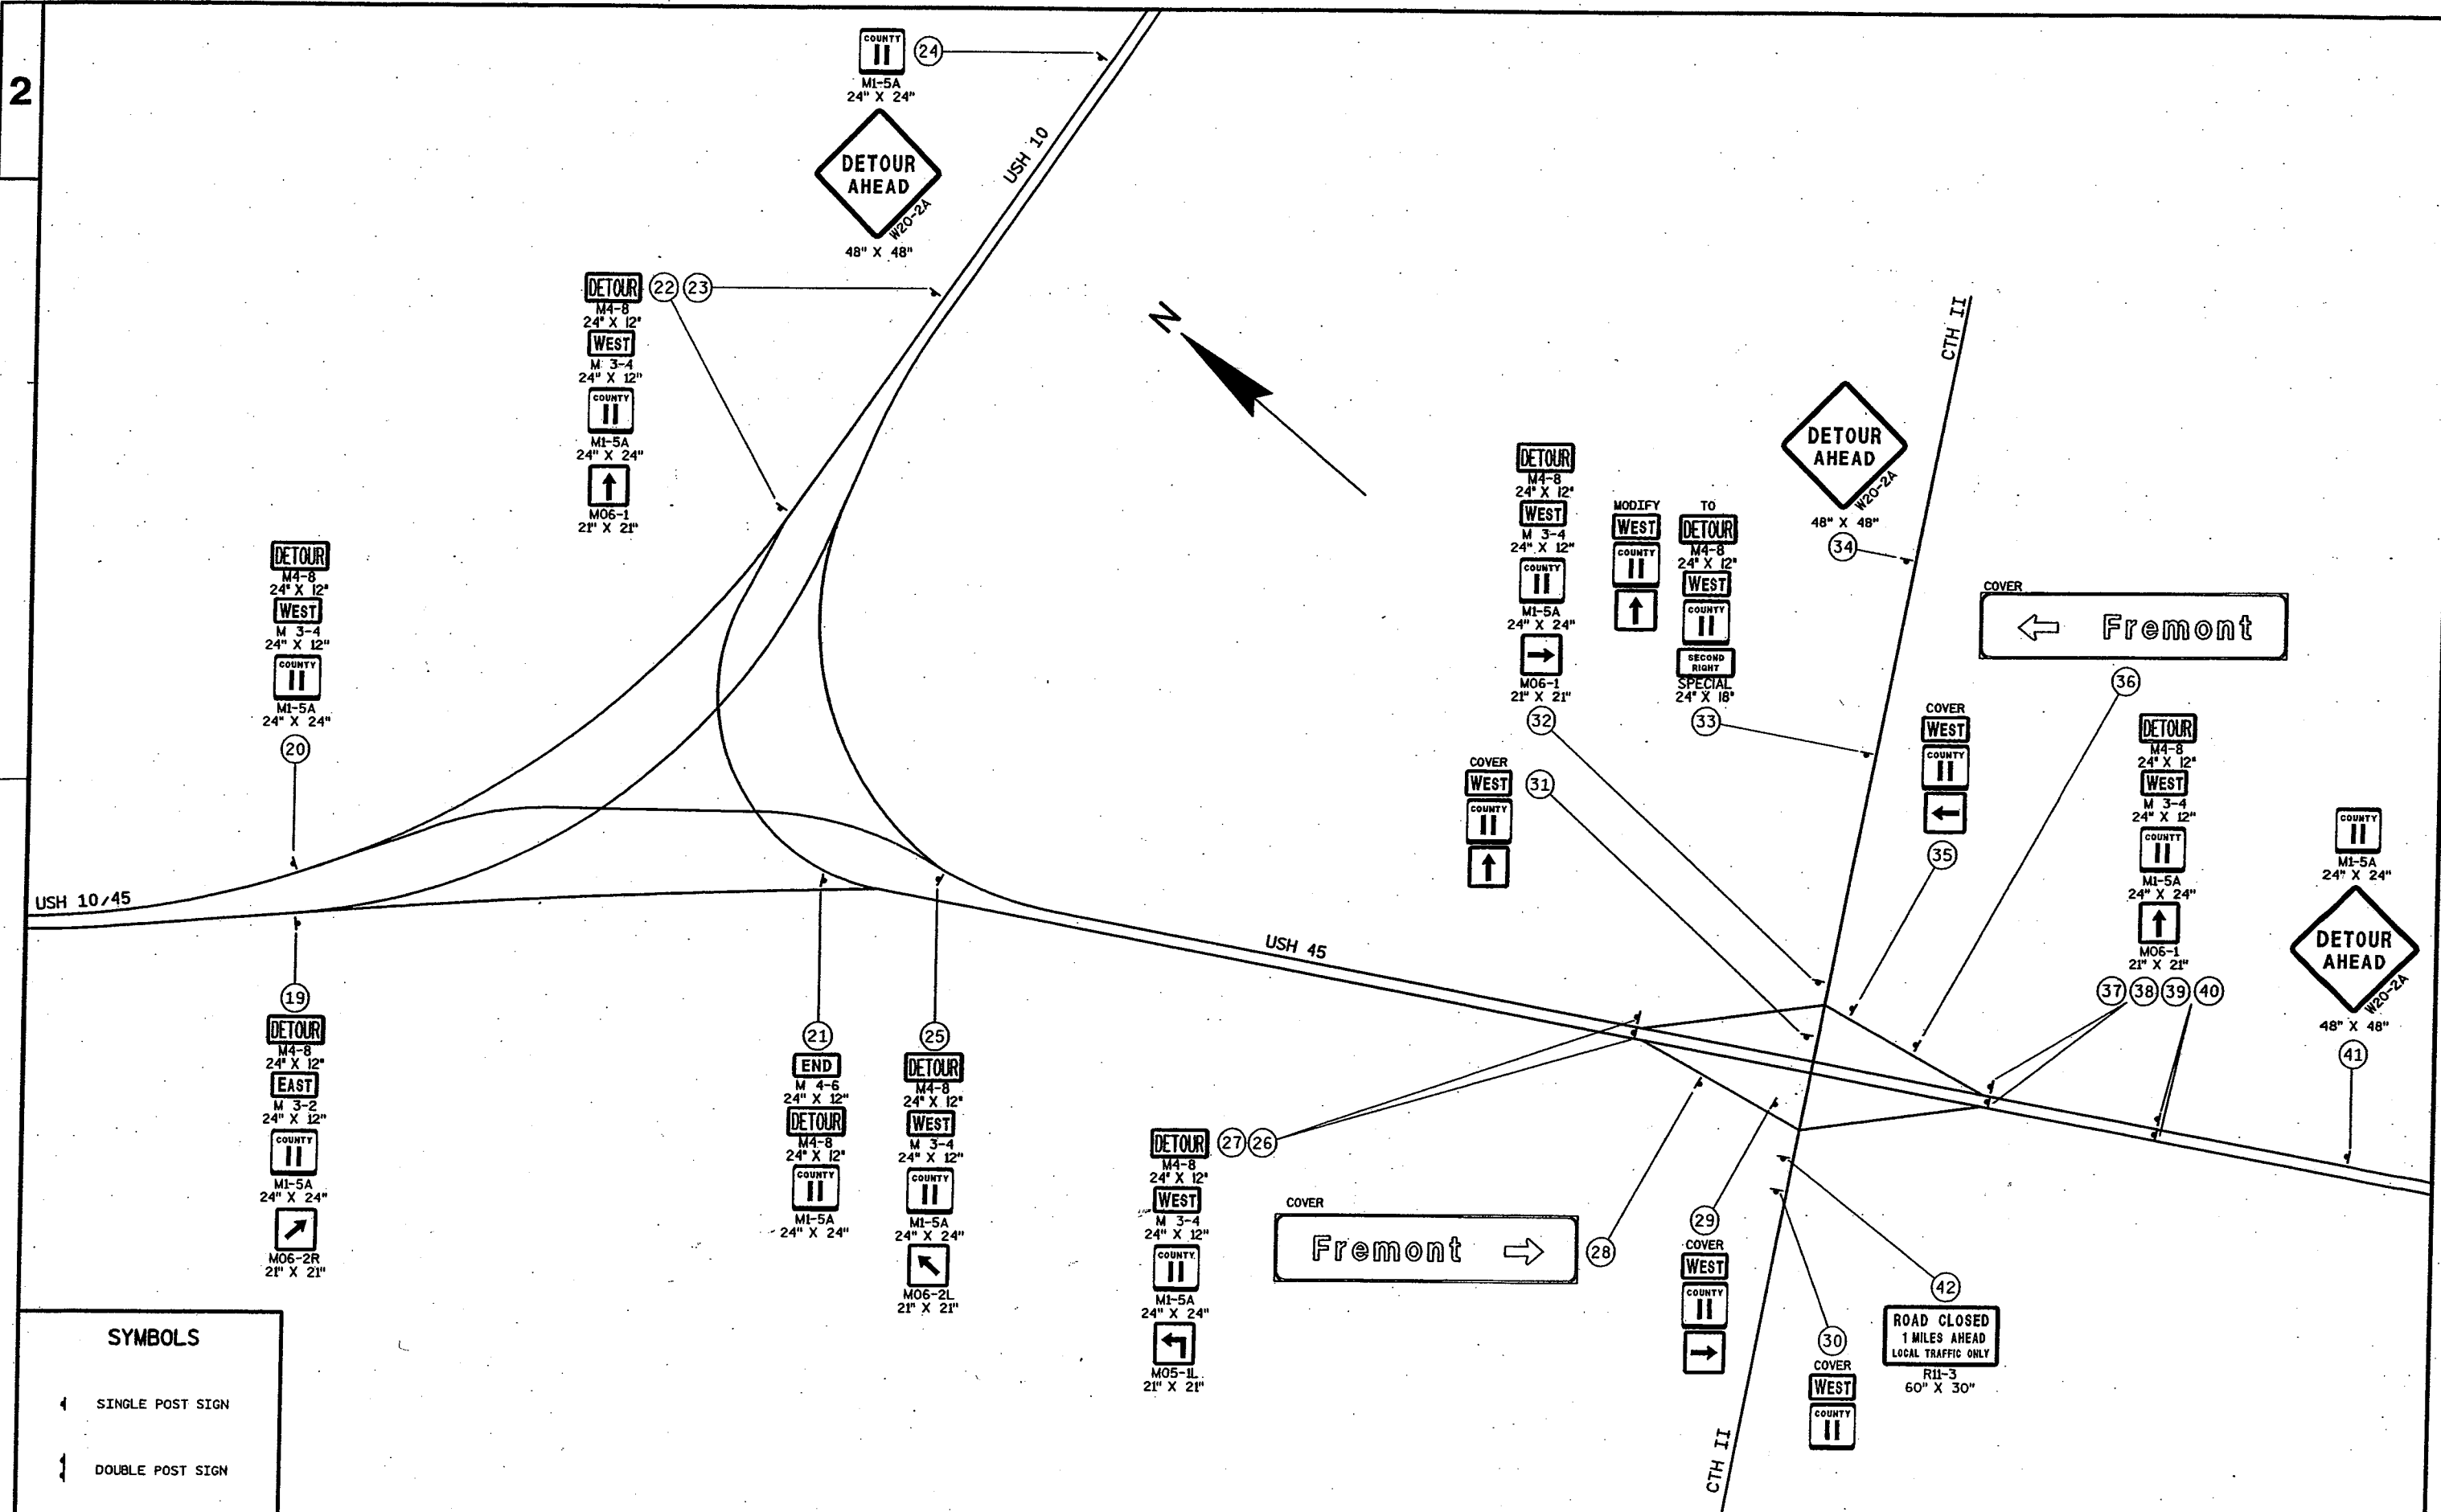

SYMBOLS	
↑	SINGLE POST SIGN
↑↑	DOUBLE POST SIGN

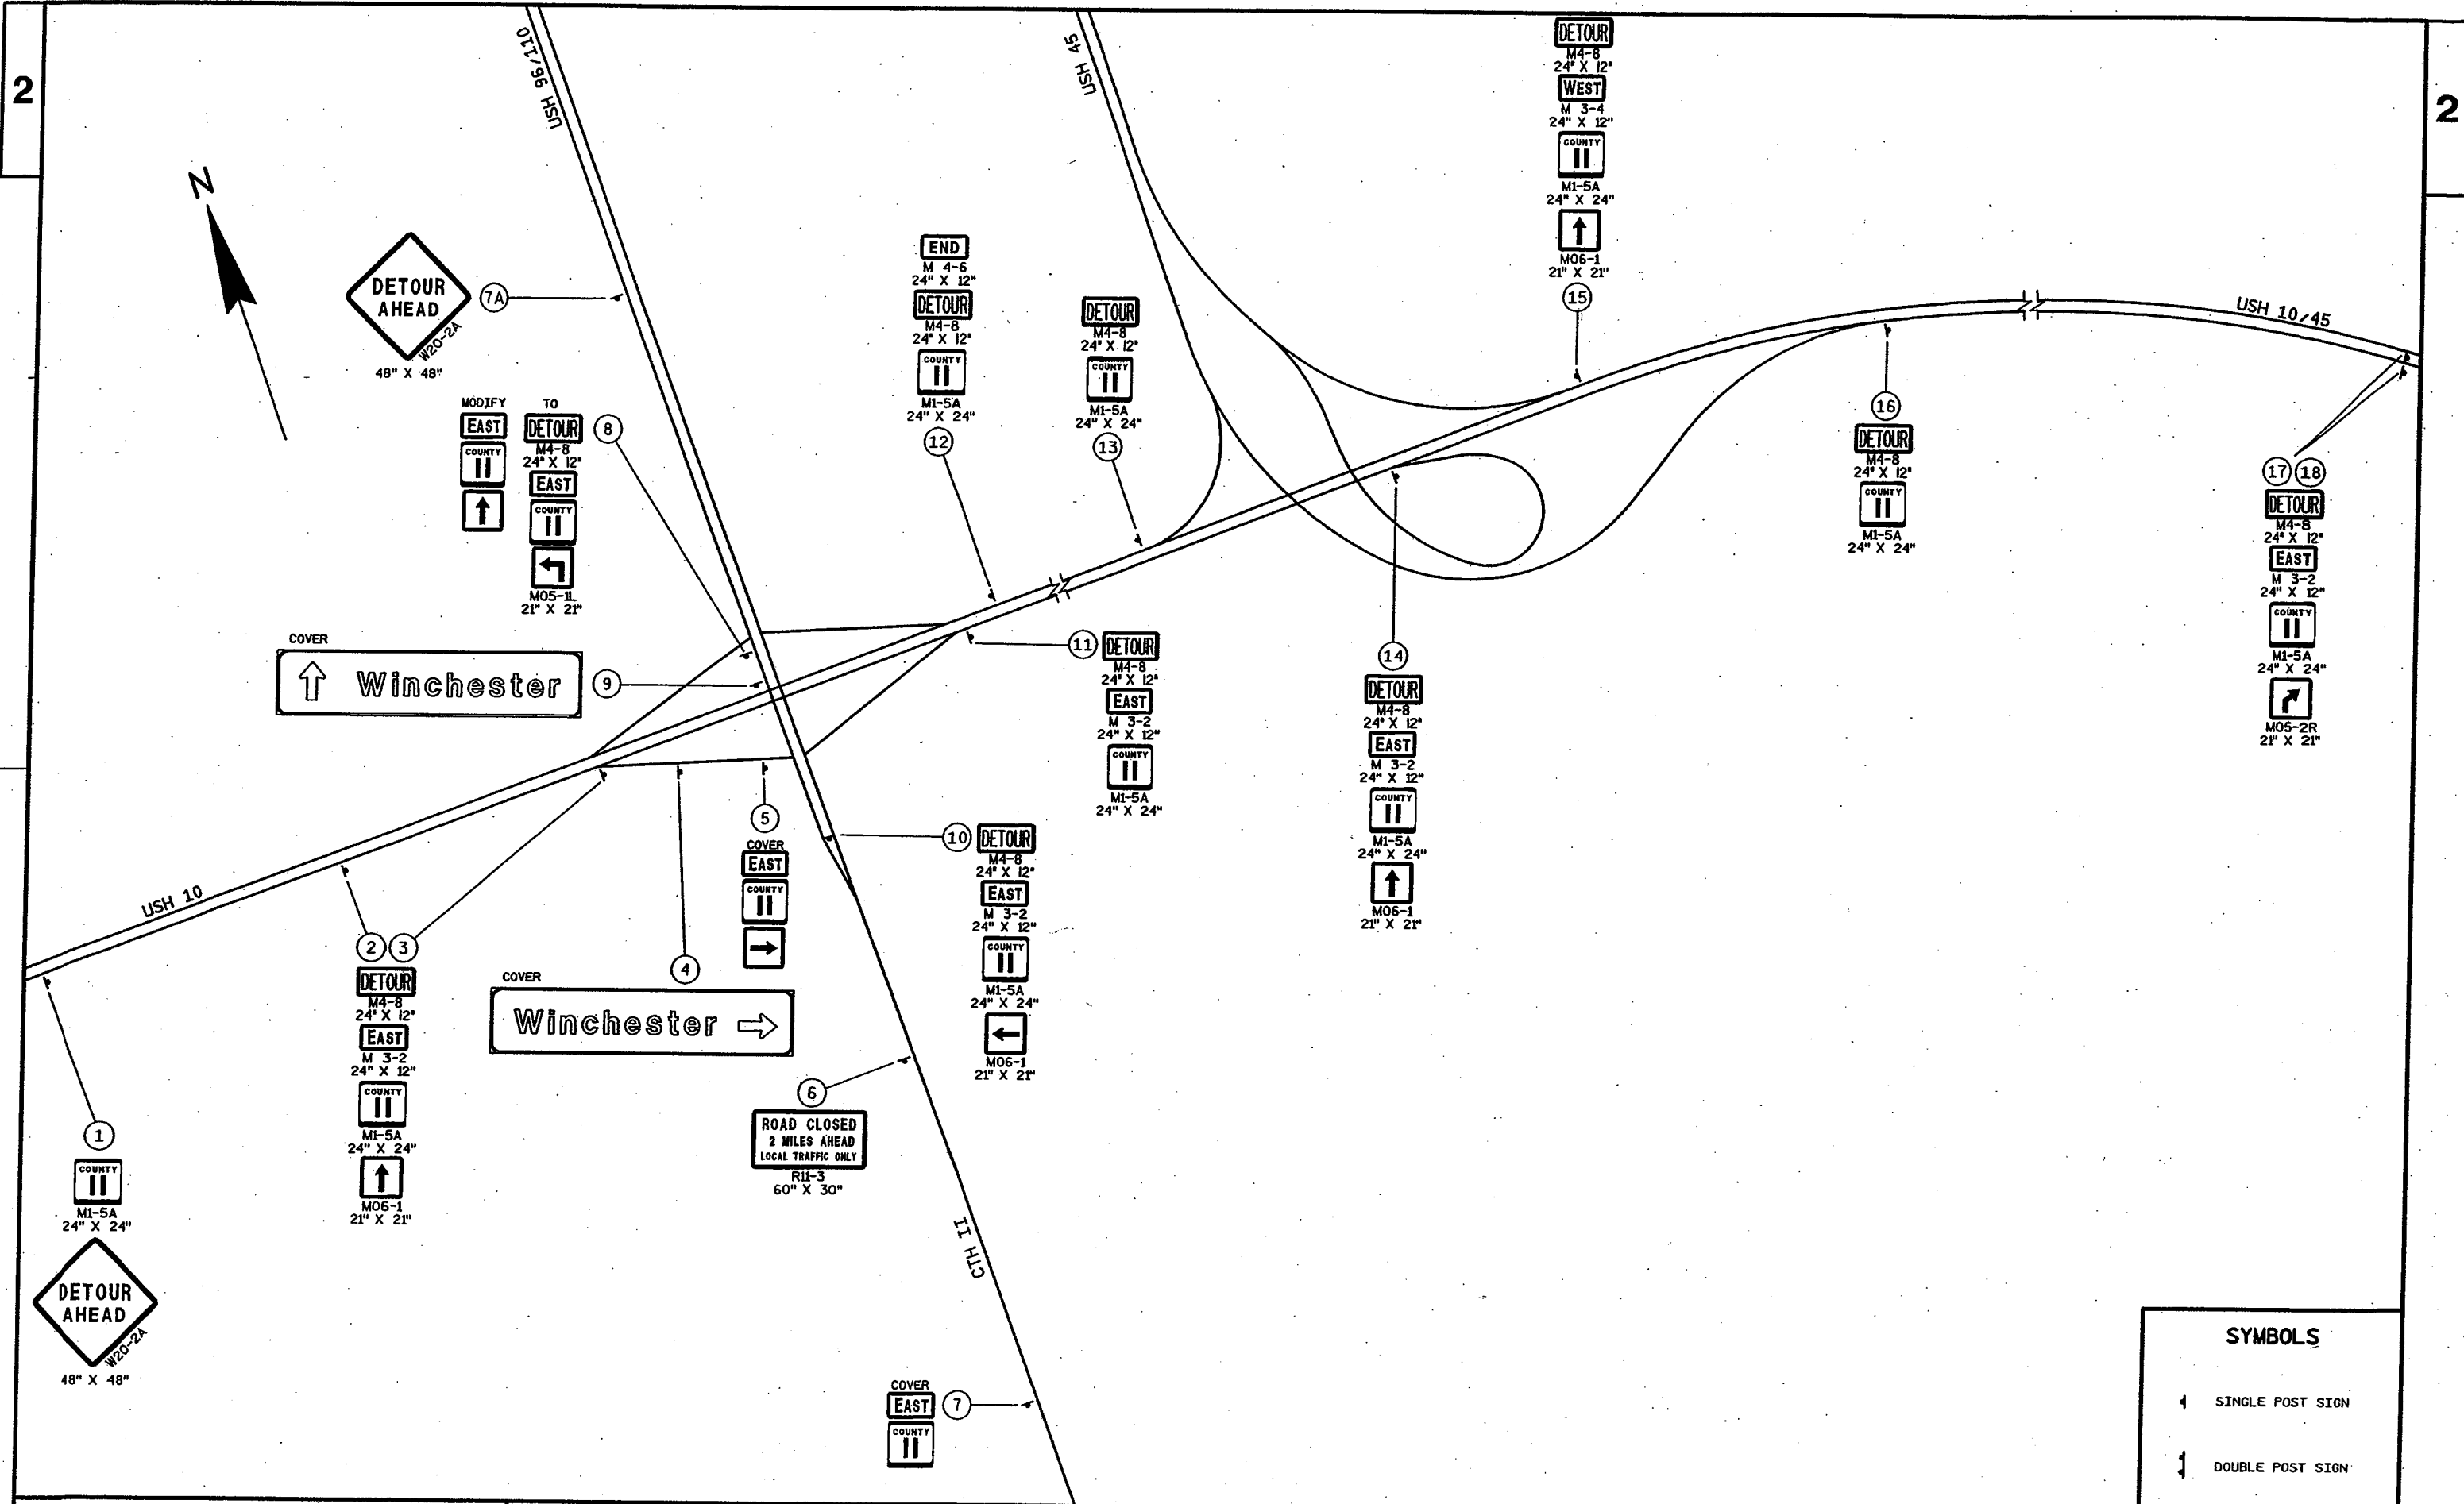

PROJECT NO: 6200-07-71

HWY: CTH II

COUNTY: WINNEBAGO

DETOUR DETAIL

SHEET

E

FILE NAME : \\gre31fp1\FCSEVER\03_620007\027001.dwg

PLOT DATE : 03-MAR-2004 13:13

PLOT BY : DOTTFK

PLOT NAME : 027001.dwg

PLOT SCALE : 200.000000:1.000000

WISDOT/CADDs SHEET 42

CLEARING AND GRUBBING

STATION TO STATION	LOCATION	201.0105 201.0205	
		CLEARING STA	GRUBBING STA
144+00 - 145+00 RT	CTH II	1	1
455+00 - 458+00 LT	CTH II	3	3
141+00 - 142+00 LT	ERICKSON ROAD	1	1
TOTAL		5	5

REMOVING SMALL PIPE CULVERTS

STATION	LOCATION	203.0100		REMARKS
		EACH		
129+00	CTH M	1	15" X	CSCP CROSSDRAIN
444+40	CTH II	1	18" X	CSCP CROSSDRAIN
449+65 RT	FE, CTH II	1	15" X	RCCP
454+18 RT	PE, CTH II	1	15" X	CSCP
TOTAL		4		

REMOVING OLD STRUCTURE (STATION)

STATION	LOCATION	203.0200		REMARKS
		LS		
29+00	CTH II	1	60" X 90'	CONCRETE CATTLE PASS
TOTAL		1		

REMOVING PAVEMENT

STATION TO STATION	LOCATION	204.0100		REMARKS
		SY		
28+50 - 29+50	CTH II	222	6"	CONCRETE PAVEMENT
453+43 - 461+00	CTH II	1,682	6"	CONCRETE PAVEMENT
TOTAL		1,904		

REMOVING GUARDRAIL

STATION TO STATION	LOCATION	204.0165	
		LF	
144+62 - 145+41 LT	B-70-242, CTH II	101	
144+10 - 145+44 RT	B-70-242, CTH II	134	
183+81 - 185+08 LT	C-70-70, CTH II	127	
183+88 - 185+12 RT	C-70-70, CTH II	124	
276+28 - 276+82 LT	C-70-69, CTH II	57	
276+28 - 276+82 RT	C-70-69, CTH II	82	
287+30 - 289+97 LT	B-70-83, CTH II	197	
286+48 - 289+89 RT	B-70-83, CTH II	245	
TOTAL		1,067	

REMOVING FENCE

STATION TO STATION	LOCATION	204.0170	
		LF	
80+71 - 81+46	TOWNLINER ROAD	75	
183+60 - 184+13	CTH II	53	
275+80 - 276+59	CTH II	79	
TOTAL		207	

EARTHWORK SUMMARY

BALANCE POINT	STATION TO STATION	LOCATION	205.0100		***	***	208.0100
			EXCAVATION COMMON CY	UNEXPANDED FILL CY	*EXPANDED FILL CY	**BORROW CY	
1	28+50 - 30+25	CATTLE PASS, CTH II	475	46			
	FILL REQUIRED TO BACKFILL REMOVAL VOLUME			300			
	BALANCE 1 SUBTOTAL		475	346	533	43	
2	144+00 - 147+00	B-70-242, CTH II	330	644	992	494	
-	DIVERSION CHANNEL	B-70-242, CTH II	78	133	205	95	
3	183+50 - 185+25	C-70-70, CTH II	303	242	372	52	
4	275+75 - 277+50	C-70-69, CTH II	307	237	365	44	
5.1	441+00 - 461+00	CTH II	4,444	4,015			
5.2	127+60 - 129+21.73	CTH M	472	40			
5.3	140+73.8 - 141+65	ERICKSON RD	180	6			
	BALANCE 5 SUBTOTAL		5,096	4,061	6,255	866	
	TOTAL		6,589	5,663	8,722	1,594	

*FILL EXPANSION FACTOR = 1.54
 **BORROW FACTOR = 1.15
 ***NON-BID ITEMS; FOR INFORMATION ONLY

AGGREGATE SUMMARY

STATION TO STATION	LOCATION	305.0110		305.0120		305.0199	311.0110	624.0100
		BASE AGGREGATE DENSE		BASE AGGREGATE DENSE		QMP BASE	BREAKER	WATER
		3/4-INCH		1 1/4-INCH		AGGREGATE	RUN	MGAL
		SHOULDER	DRIVEWAY	SHOULDER	MAINLINE			
		TON	TON	TON	TON	TON	TON	
28+50 - 29+50	CATTLE PASS, CTH II	14		130	163	307		4
144+15 - 145+81	B-70-242, CTH II	23		217	272	512		7
DIVERSION CHANNEL	B-70-242, CTH II						50	-
183+86 - 185+01	C-70-70, CTH II	17		150	187	354		5
276+13 - 277+12	C-70-69, CTH II	15		137	227	379		5
441+00 - 461+00	CTH II	268		2,870	4,138	7,276		102
127+60 - 129+21	CTH M	45		259	293	597		8
140+77 - 141+65	ERICKSON RD	28		19	76	123	93	2
449+65 RT	PE, CTH II		48			48		1
454+15 RT	FE, CTH II		44			44		1
456+54 LT	PE, CTH II		23			23		0.5
458+70 LT	FE, CTH II		28			28		0.5
SUBTOTAL		410	143	3,782	5,356			
TOTAL		553		9,138		9,691	143	137

HMA SUMMARY

STATION TO STATION	LOCATION	455.0105		460.1100	
		ASPHALTIC		CONCRETE	
		455.0605	TACK	TYPE E-0.3	QMP
		PG58-28	COAT	MIXTURE	HMA
		TON	GAL	TON	TON
28+50 - 29+50	CATTLE PASS, CTH II	4.2	8	75	75
144+15 - 145+82	B-70-242, CTH II	6.8	14	123	123
183+86 - 185+01	C-70-70, CTH II	4.8	9	87	87
276+13 - 277+12	C-70-69, CTH II	5.5	11	99	99
441+00 - 450+20	CTH II	43.6	86	793	793
INTERSECTION AREA	CTH II & CTH M	16.1	32	292	292
451+55 - 461+00	CTH II	41.6	82	755	755
140+77 - 141+65	ERICKSON ROAD	1.9	-	34	34
127+60 - 129+21	CTH M	6.1	12	110	110
TOTAL		130.6	254	2,368	2,368

ASPHALTIC FLUMES

465.0315			
STATION	LOCATION	SY	REMARKS
450+30 RT	CTH II	18	WEST END C & G
129+25 RT	CTH M	21	SOUTH END C & G
TOTAL		39	

PILING STEEL SHEET TEMPORARY

512.1000		
STATION	LOCATION	SF
145+00 RT	DIVERSION CHANNEL, B-70-242	850
145+00 LT	DIVERSION CHANNEL, B-70-242	550
TOTAL		1,400

3

3

CULVERT PIPE SUMMARY

520.0112 520.0115 520.0124 520.1012 520.1015 520.1024

STATION	LOCATION	CULVERT PIPE DIAMETER			APRON ENDWALLS FOR CULVERT PIPE			RCCP CLASS	THICKNESS (INCHES)		JOINT TIES EACH	INLET ELEVATION	DISCHARGE ELEVATION
		12-INCH LF	15-INCH LF	24-INCH LF	12-INCH EACH	15-INCH EACH	24-INCH EACH		STEEL	ALUMINUM			
129+00	CTH M			60			2	III	0.064	0.075	4	773.13	771.75
PRIVATE ENTRANCE AND FIELD ENTRANCE													
449+65 RT	FE, CTH II			54			2	III	0.064	0.075	4	770.31	769.77
454+15 RT	PE, CTH II		58			2		III	0.064	0.060	4	780.28	778.57
456+54 LT	PE, CTH II	38			2			III	0.064	0.060	4	784.07	783.45
458+70 LT	FE, CTH II	40			2			III	0.064	0.060	4	786.66	786.16
TOTAL 0010		78	58	114	4	2	4						

*NON-BID ITEM (FOR INFORMATION ONLY)

CONCRETE CURB AND GUTTER
6-INCH MOUNTABLE 36-INCH TYPE D

601.0558

LOCATION	LF
SW RADIUS, CTH M & CTH II INTERSECTION	80
SE RADIUS, CTH M & CTH II INTERSECTION	60
TOTAL	140

STEEL PLATE BEAM GUARD

STATION TO STATION	LOCATION	614.0115	614.0200	614.0305	614.0370	REMARKS
		ANCHORAGES TYPE 2 EACH	STEEL THRIE BEAM STR. APPROACH LF	*STEEL PLATE BEAM GUARD CLASS A LF	ENERGY ABSORBING TERMINAL EACH	
286+57.35 - 287+65.5 RT	B-70-83, CTH II		20.65	37.5	1	
288+72.5 - 289+80.65 RT	B-70-83, CTH II		20.65	37.5	1	
287+30 - 287+72.5 LT	B-70-83, CTH II	1	20.65	37.5		*SHOP BENT TO 22' RADIUS
288+79.5 - 289+87.65 LT	B-70-83, CTH II		20.65	37.5	1	
TOTAL		1	82.6	150	3	

GRADING SHAPING AND FINISHING FOR BEAM GUARD TERMINAL AND ANCHORAGES

STATION-LOCATION (ANCHORAGE POST #1)	*COMMON EXCAVATION	*FILL	*BORROW EXCAVATION	*SALVAGED TOPSOIL	*FERTILIZER TYPE B	*SEEDING #10	*MULCHING	205.9005.S
	CY	CY	CY	SY	CWT	LB	SY	EACH
STA. 286+57.5, 25' RT	0.6	1.3	1.1	60.5	0.04	0.8	60.5	1
STA. 289+80.5, 25' RT	0.0	55.5	63.9	318.0	0.20	4.3	318.0	1
STA. 289+87.5, 25' LT	0.0	49.1	56.5	350.3	0.22	4.7	350.3	1
STA. 287+32.2, 47.7' LT	0.0	1.1	1.2	8.3	0.01	0.1	8.3	1
TOTAL	0.6	107.0	122.7	737.1	0.47	9.9	737.1	4

* ITEMS & QUANTITIES LISTED FOR BID INFORMATION ONLY

3

MARKER POSTS RIGHT-OF-WAY

614.0605

LOCATION	STATION	OFFSET	EACH	REMARKS
CTH II	445+50	45.86' LT	1	PRW1
	448+00	42' LT	1	PRW2
	448+75	45' LT	1	PRW3
	450+21.36	103.62' LT	1	PRW4
	450+87.82	122.73' LT	1	PRW5
	452+35.00	60' LT	1	PRW6
	455+00	42' LT	1	PRW7
	457+34.84	55' LT	1	PRW8
	460+50	42' LT	1	PRW9
	461+00	33' LT	1	PRW10
	455+00	41.57' RT	1	PRW11
	455+50	55' RT	1	PRW12
	457+34.84	49.36' RT	1	PRW18
	460+50	50' RT	1	PRW13
461+00	32.12' RT	1	PRW14	
B-70-242, CTH II	144+60	50' LT	1	PRW19
	144+60	80' LT	1	PRW20
	145+90	80' LT	1	PRW21
	146+40	50' LT	1	PRW22
	144+30	50' RT	1	PRW23
	144+50	65' RT	1	PRW24
	145+15	65' RT	1	PRW25
	145+35	50' RT	1	PRW26
C-70-70, CTH II	184+05	50' RT	1	PRW27
	184+15	70' RT	1	PRW28
	184+55	70' RT	1	PRW29
	184+80	50' RT	1	PRW30
	184+10	50' LT	1	PRW32
	184+30	65' LT	1	PRW33
	184+65	65' LT	1	PRW34
C-70-69, CTH II	184+85	50' LT	1	PRW35
	276+00	50' LT	1	PRW36
	276+40	65' LT	1	PRW37
	276+61.09	65' LT	1	PRW38
	276+70	50' RT	1	PRW40
	276+95	75' RT	1	PRW41
	277+25	65' RT	1	PRW42
277+40	50' RT	1	PRW43	
TOTAL			38	

MARKER POSTS CULVERT END FLEXIBLE

614.0620.S

STATION	LOCATION	EACH
129+00 RT	CTH M	1
129+00 LT	CTH M	1
TOTAL		2

MONUMENT SUMMARY

621.0100

SPV.0060

LANDMARK SPECIAL
REFERENCE SECTION CORNER
MONUMENTS MONUMENTS

LOCATION	EACH	EACH
SE CORNER SECTION 15 T20N R15E	4	1
TOTAL		4
		1

LANDSCAPING SUMMARY

625.0500

627.0200

629.0210

630.0110

630.0130

630.0200

SALVAGED TOPSOIL SY FERTILIZER TYPE B CWT SEEDING MIXTURE #10 LB SEEDING MIXTURE #30 LB SEEDING TEMPORARY LB

STATION TO	STATION	LOCATION	SY	SY	CWT	LB	LB	LB
28+50 - 30+25	LT	CATTLE PASS, CTH II	638	482	0.4	4.7	5.2	17.2
28+50 - 29+50	RT	CATTLE PASS, CTH II	425	336	0.3	3.5	2.9	11.5
144+15 - 147+00	LT	B-70-242, CTH II	920	853	0.6	7.3	6.9	24.8
144+00 - 145+75	RT	B-70-242, CTH II	577	474	0.4	4.0	5.0	15.6
183+75 - 185+25	LT	C-70-70, CTH II	455	339	0.3	2.9	4.3	12.3
183+50 - 185+25	RT	C-70-70, CTH II	509	368	0.3	3.2	4.9	13.7
275+75 - 276+80	LT	C-70-69, CTH II	305	238	0.2	1.7	3.3	8.2
276+00 - 277+50	RT	C-70-69, CTH II	418	293	0.3	2.4	4.3	11.3
NW QUAD		CTH II & ERICKSON RD	1,734	1,439	1.1	2.9	27.4	46.8
NE QUAD		CTH II & ERICKSON RD	2,546	1,625	1.6	10.8	31.4	68.7
SW QUAD		CTH II & CTH M	4,172	3,658	2.6	30.7	34.1	112.6
SE QUAD		CTH II & CTH M	3,326	2,648	2.1	20.3	32.9	89.8
SUBTOTAL			16,025	12,753	10.2	94.4	162.6	432.5
UNDISTRIBUTED				3,188	2.6	23.6	40.7	108.1
TOTAL			16,025	15,941	12.8	118.0	203.3	540.6

PROJECT NO: 6200-07-71

HWY: CTH II

COUNTY: WINNEBAGO

MISCELLANEOUS QUANTITIES

SHEET:

E

3

3

EROSION CONTROL SUMMARY

STATION TO STATION	LOCATION	628.2010 628.3010						
		606.0200 628.1505 628.1510 628.1520			EROSION MAT		645.0130	
		RIPRAP	SILT FENCE		DELIVERED	INSTALLED	GEOTEXTILE	
		MEDIUM	DELIVERED	INSTALLED	MAINT.	CLASS I	CLASS I	FABRIC
		CY	LF	LF	LF	TYPE B	TYPE B	TYPE R
						SY	SY	SY
28+50 - 30+25 LT	CATTLE PASS REMOVAL		125	125	125	156	156	
28+50 - 29+50 RT	CATTLE PASS REMOVAL		50	50	50	89	89	
144+15 - 147+00 LT	B-70-242, CTH II					67	67	
144+00 - 145+75 RT	B-70-242, CTH II					103	103	
DIVERSION CHANNEL	B-70-242, CTH II	90	230	230	230	65	65	349
183+75 - 185+25 LT	C-70-70, CTH II		131	131	131	116	116	
183+50 - 185+25 RT	C-70-70, CTH II		158	158	158	141	141	
275+75 - 276+80 LT	C-70-69, CTH II		75	75	75	67	67	
276+00 - 277+50 RT	C-70-69, CTH II		25	25	25	125	125	
NW QUAD	CTH II & ERICKSON RD		895	895	895	295	295	
NE QUAD	CTH II & ERICKSON RD		366	366	366	921	921	
SW QUAD	CTH II & CTH M		345	345	345	514	514	
SE QUAD	CTH II & CTH M		250	250	250	678	678	
	SUBTOTAL	90	2,650	2,650	2,650	3,337	3,337	349
	UNDISTRIBUTED	-	663	663	663	834	834	87
	TOTAL	90	3,313	3,313	3,313	4,171	4,171	436

CULVERT PIPE DITCH CHECKS

628.7550		
STATION	LOCATION	EACH
129+00 RT	CROSSDRAIN, CTH M	1
449+65 RT	FE, CTH II	1
454+15 RT	PE, CTH II	1
456+54 LT	PE, CTH II	1
458+70 LT	FE, CTH II	1
	TOTAL	5

TEMPORARY DITCH CHECKS

628.7505 628.7510			
TEMPORARY DITCH CHECKS			
STATION	LOCATION	DELIVERED	INSTALLED
		LF	LF
144+35 RT	B-70-242	12.5	12.5
145+35 RT	B-70-242	15.0	15.0
184+00 RT	C-70-70	10.0	10.0
184+25 LT	C-70-70	12.5	12.5
184+65 LT	C-70-70	12.5	12.5
184+75 RT	C-70-70	12.5	12.5
184+90 LT	C-70-70	12.5	12.5
276+15 LT	C-70-69	10.0	10.0
276+25 RT	C-70-69	10.0	10.0
276+80 RT	C-70-69	12.5	12.5
277+35 RT	C-70-69	12.5	12.5
141+00 LT	ERICKSON RD	15.0	15.0
449+00 LT	CTH II	12.5	12.5
450+00 LT	CTH II	15.0	15.0
451+50 LT	CTH II	15.0	15.0
452+10 RT	CTH II	15.0	15.0
452+70 LT	CTH II	12.5	12.5
453+00 RT	CTH II	12.5	12.5
453+65 LT	CTH II	12.5	12.5
453+80 RT	CTH II	12.5	12.5
454+45 LT	CTH II	12.5	12.5
454+50 RT	CTH II	10.0	10.0
455+15 LT	CTH II	12.5	12.5
456+00 LT	CTH II	12.5	12.5
457+00 LT	CTH II	12.5	12.5
458+00 LT	CTH II	12.5	12.5
	SUBTOTAL	327.5	327.5
	UNDISTRIBUTED	81.5	81.5
	TOTAL	409	409

TRAFFIC CONTROL SUMMARY

AREA	LOCATION	643.0300 643.0420 643.0705 643.0900								
		APPROXIMATE	DRUMS		BARRICADES		WARNING LIGHTS		SIGNS	
		SERVICE PERIOD	NUMBER		NUMBER	TYPE III	NUMBER	TYPE A	NUMBER	
		DAYS	IN SERVICE	DAYS	IN SERVICE	DAYS	IN SERVICE	DAYS	IN SERVICE	DAYS
1	CATTLE PASS REMOVAL, CTH II	5			10	50	12	60	6	30
2	STRUCTURE B-70-242, CTH II	31			15	465	22	682	7	217
3	STRUCTURE C-70-70, CTH II	15			14	210	20	300	6	90
4	STRUCTURE C-70-69, CTH II	19	10	190	14	266	20	380	8	152
5	STRUCTURE B-70-83, CTH II	11			14	154	20	220	6	66
6	CTH II & CTH M INTERSECTION	21			18	378	28	588	8	168
7	PROJECT AREA	72			34	2,448	68	4,896	49	3,528
	TOTAL			190		3,971		7,126		4,251

PROJECT NO: 6200-07-71

HWY: CTH II

COUNTY: WINNEBAGO

MISCELLANEOUS QUANTITIES

SHEET:

E

3

TRAFFIC CONTROL DETOUR SIGNS AND COVERING SIGNS

APPROX. 643.3000 643.0905.s

SIGN NO.	LOCATION	SIGN CODE	SIZE W X H	NUMBER IN SERVICE	SERVICE PERIOD DAYS	DETOUR SIGNS DAYS	COVERING SIGNS EACH	REMARKS
1	WEST OF STRUCTURE OVER STREET	M 1-5A	24"x24"	1	72	72		
	"	W 20-2A	48"x48"	1	72	72		MOUNT WITH 1
2	WEST OF STRUCTURE OVER RIVER	M 4-8	24"x12"	1	72	72		
	"	M 3-2	24"x12"	1	72	72		MOUNT WITH 2
	"	M 1-5A	24"x24"	1	72	72		"
	"	MO 6-1	21"x21"	1	72	72		"
3	AT EXIT TAPER	M 4-8	24"x12"	1	72	72		
	"	M 3-2	24"x12"	1	72	72		MOUNT WITH 3
	"	M 1-5A	24"x24"	1	72	72		"
	"	MO 6-1	21"x21"	1	72	72		"
4	EXISTING D1 SIGN						1	
5	EXISTING J3 SIGN						1	
6	IN FRONT OF J4 SIGN	R 11-3	60"x30	1	72	72		"2 MILES AHEAD"
7	EXISTING J4 SIGN						1	
7A	300' NORTH OF J1 SIGN	W 20-2A	48"x48"	1	72	72		
8	EXISTING J2 SIGN	M 4-8	24"x12"	1	72	72		
	"	MO 2-1L	21"x21"	1	72	72		MOUNT WITH 8
9	EXISTING D1 SIGN						1	
10	BEHIND "NO LEFT TURN" SIGN	M 4-8	24"x12"	1	72	72		
	"	M 3-2	24"x12"	1	72	72		MOUNT WITH 10
	"	M 1-5A	24"x24"	1	72	72		"
	"	MO 6-1	21"x21"	1	72	72		"
11	AT ENTRANCE TAPER	M 4-8	24"x12"	1	72	72		
	"	M 3-2	24"x12"	1	72	72		MOUNT WITH 11
	"	M 1-5A	24"x24"	1	72	72		"
12	750' EAST OF EXIT TAPER	M 4-6	24"x12"	1	72	72		
	"	M 4-8	24"x12"	1	72	72		MOUNT WITH 12
	"	M 1-5A	24"x24"	1	72	72		"
13	AT ENTRANCE TAPER	M 4-8	24"x12"	1	72	72		
	"	M 1-5A	24"x24"	1	72	72		MOUNT WITH 13
14	AT EXIT TAPER	M 4-8	24"x12"	1	72	72		
	"	M 3-4	24"x12"	1	72	72		MOUNT WITH 14
	"	M 1-5A	24"x24"	1	72	72		"
	"	MO 6-1	21"x21"	1	72	72		"
15	AT EXIT TAPER	M 4-8	24"x12"	1	72	72		
	"	M 3-2	24"x12"	1	72	72		MOUNT WITH 15
	"	M 1-5A	24"x24"	1	72	72		"
	"	MO 6-1	21"x21"	1	72	72		"
SUBTOTAL 1-15					2,448		4	

CONTINUED

TRAFFIC CONTROL DETOUR SIGNS AND COVERING SIGNS

CONTINUED

APPROX. 643.3000 643.0905.S

SIGN NO.	LOCATION	SIGN CODE	SIZE W X H	NUMBER IN SERVICE	SERVICE PERIOD DAYS	DETOUR SIGNS DAYS	COVERING SIGNS EACH	REMARKS
16	AT ENTRANCE TAPER	M 4-8	24"x12"	1	72	72		
	"	M 1-5A	24"x24"	1	72	72		MOUNT WITH 16
17	1000' WEST OF SIGN BRIDGE	M 4-8	24"x12"	1	72	72		
	"	M 3-2	24"x12"	1	72	72		MOUNT WITH 17
	"	M 1-5A	24"x24"	1	72	72		"
	"	MO 5-2R	21"x21"	1	72	72		"
18	ACROSS FROM 17, IN MEDIAN	M 4-8	24"x12"	1	72	72		
	"	M 3-2	24"x12"	1	72	72		MOUNT WITH 18
	"	M 1-5A	24"x24"	1	72	72		"
	"	MO 5-2R	21"x21"	1	72	72		"
19	AT SIGN BRIDGE	M 4-8	24"x12"	1	72	72		
	"	M 3-2	24"x12"	1	72	72		MOUNT WITH 19
	"	M 1-5A	24"x24"	1	72	72		"
	"	MO 6-2R	21"x21"	1	72	72		"
20	AT ENTRANCE TAPER	M 4-8	24"x12"	1	72	72		
	"	M 3-4	24"x12"	1	72	72		MOUNT WITH 20
	"	M 1-5A	24"x24"	1	72	72		"
21	IN GORE WHERE ROADWAYS MEET	M 4-6	24"x12"	1	72	72		
	"	M 4-8	24"x12"	1	72	72		MOUNT WITH 21
	"	M 1-5A	24"x24"	1	72	72		"
22	AT SIGN BRIDGE	M 4-8	24"x12"	1	72	72		
	"	M 3-4	24"x12"	1	72	72		MOUNT WITH 22
	"	M 1-5A	24"x24"	1	72	72		"
	"	MO 6-1	21"x21"	1	72	72		"
23	750' EAST OF SIGN BRIDGE	M 4-8	24"x12"	1	72	72		
	"	M 3-4	24"x12"	1	72	72		MOUNT WITH 23
	"	M 1-5A	24"x24"	1	72	72		"
	"	MO 6-1	21"x21"	1	72	72		"
24	AT MEDIAN X-OVER	M 1-5A	24"x24"	1	72	72		
	"	W 20-2A	48"x48"	1	72	72		MOUNT WITH 24
25	AT SIGN BRIDGE IN MEDIAN	M 4-8	24"x12"	1	72	72		
	"	M 3-4	24"x12"	1	72	72		MOUNT WITH 25
	"	M 1-5A	24"x24"	1	72	72		"
	"	MO 6-2L	21"x21"	1	72	72		"
26	1000' SOUTH OF SIGN BRIDGE	M 4-8	24"x12"	1	72	72		
	"	M 3-4	24"x12"	1	72	72		MOUNT WITH 26
	"	M 1-5A	24"x24"	1	72	72		"
	"	MO 5-2R	21"x21"	1	72	72		"
SUBTOTAL 16-26					2,736	0		

CONTINUED

TRAFFIC CONTROL DETOUR SIGNS AND COVERING SIGNS

CONTINUED

APPROX. **643.3000 643.0905.s**

SIGN NO.	LOCATION	SIGN CODE	SIZE W X H	NUMBER IN SERVICE	SERVICE PERIOD DAYS	DETOUR SIGNS DAYS	COVERING SIGNS EACH	REMARKS	
27	ACROSS FROM 26, IN MEDIAN	M 4-8	24"x12"	1	72	72			
	"	M 3-4	24"x12"	1	72	72		MOUNT WITH 27	
	"	M 1-5A	24"x24"	1	72	72		"	
	"	MO 5-2R	21"x21"	1	72	72		"	
28	EXISTING D1 SIGN						1		
29	EXISTING J3 SIGN						1		
30	EXISTING J4 SIGN						1		
31	EXISTING J2 SIGN						1		
32	RIGHT OF J3 SIGN	M 4-8	24"x12"	1	72	72			
	"	M 3-4	24"x12"	1	72	72		MOUNT WITH 32	
	"	M 1-5A	24"x24"	1	72	72		"	
	"	MO 6-1	21"x21"	1	72	72		"	
33	EXISTING J2 SGN	M 4-8	24"x12"	1	72	72			
	"	SPECIAL	24"x18"	1	72	72		"SECOND RIGHT", MOUNT WITH 33	
34	200' WEST OF J4 SIGN	W 20-2A	48"x48"	1	72	72			
35	EXISTING J3 SIGN						1		
36	EXISTING D1 SIGN						1		
37	AT EXIT TAPER	M 4-8	24"x1	1	72	72			
	"	M 3-4	24"x1	1	72	72		MOUNT WITH 37	
	"	M 5-1A	24"x24"	1	72	72		"	
	"	MO 6-1	21"x21"	1	72	72		"	
38	ACROSS FROM 37, IN MEDIAN	M 4-8	24"x1	1	72	72			
	"	M 3-4	24"x1	1	72	72		MOUNT WITH 38	
	"	M 5-1A	24"x24"	1	72	72		"	
	"	MO 6-1	21"x21"	1	72	72		"	
39	AT END OF BARRIER LINE	M 4-8	24"x1	1	72	72			
	"	M 3-4	24"x1	1	72	72		MOUNT WITH 39	
	"	M 5-1A	24"x24"	1	72	72		"	
	"	MO 6-1	21"x21"	1	72	72		"	
40	ACROSS FROM 39, IN MEDIAN	M 4-8	24"x1	1	72	72			
	"	M 3-4	24"x1	1	72	72		MOUNT WITH 40	
	"	M 5-1A	24"x24"	1	72	72		"	
	"	MO 6-1	21"x21"	1	72	72		"	
41	AT START OF GORE FOR DIVIDED HWY	M 1-5A	24"x24"	1	72	72			
	"	W 20-2A	48"x48"	1	72	72		MOUNT WITH 41	
42	EAST OF J4 SIGN	R 11-3	60"x30	1	72	72		"3 MILES AHEAD"	
	SUBTOTAL 27-42					2,160	6		
	SUBTOTAL 16-26					2,736	0		
	SUBTOTAL 1-15					2,448	4		
	TOTAL					7,344	10		

EPOXY PAVEMENT MARKING

646.0106
4-INCH

646.0226
8-INCH

STATION TO STATION	LOCATION	EDGELINE	CENTERLINE	NO PASSING	DOUBLE	CHANNELIZING
		WHITE	YELLOW	YELLOW	YELLOW	8-INCH
		LF	LF	LF	LF	LF
28+50 - 29+50	CATTLE PASS, CTH II	200	25	100		
144+15 - 145+81	B-70-242, CTH II	332	42	166		
183+86 - 185+01	C-70-70, CTH II	230			230	
276+13 - 277+12	C-70-69, CTH II	149	25			
287+73 - 288+69	B-70-83, CTH II	192	25			
127+60 - 129+34	CTH M	336	50	200		
441+00 - 450+29	CTH II	1,842				
446+78 - 461+00	CTH II				2,844	
441+00 - 446+78	CTH II		145	578		
451+48 - 461+00	CTH II	1,898				
448+28 - 450+28	CTH II					200
SUBTOTAL		5,179	312	1,044	3,074	
TOTAL			9,609			200

CONSTRUCTION STAKING SUMMARY

CATEGORY	STATION TO STATION	LOCATION	650.4500	650.5000	650.6500			650.9900
			CONST. STAKING SUBGRADE	CONST. STAKING BASE	CONSTRUCTION STAKING STRUCTURE LAYOUT (STRUCTURE)			CONST. STAKING INITIAL LAYOUT
			LF	LF	*B-70-242	**C-70-70	***C-70-69	LF
0010	28+50 - 29+50	CATTLE PASS, CTH II	100	100				100
0010	144+15 - 145+81	B-70-242, CTH II	166	166	1			166
0010	183+86 - 185+01	C-70-70, CTH II	115	115		1		115
0010	276+13 - 277+12	C-70-69, CTH II	99	99			1	99
0010	441+00 - 461+00	CTH II	2,000	2,000				2,000
0010	127+60 - 130+00	CTH M	240	240				240
0010	140+00 - 141+65	ERICKSON RD	165	165				165
TOTAL			2,885	2,885	1	1	1	2,885

*CATEGORY 0020; **CATEGORY 0030; ***CATEGORY 0040

SAWCUT SUMMARY

STATION	LOCATION	690.0100	690.0200
		SAWING EXISTING PAVEMENT LF	SAWING CONCRETE PAVEMENT FULL DEPTH LF
28+50	CATTLE PASS, CTH II	2	20
29+50	CATTLE PASS, CTH II	2	20
144+15	B-70-242, CTH II	22	
145+81	B-70-242, CTH II	22	
183+86	C-70-70, CTH II	22	
185+01	C-70-70, CTH II	22	
276+13	C-70-69CTH II	22	
277+12	C-70-69, CTH II	81	
441+00	CTH II	22	
461+00	CTH II	2	20
127+60	CTH M	24	
141+65	ERICKSON ROAD	12	
TOTAL		255	60

R/W PROJECT NUMBER 6200-07-21	SHEET NUMBER 4.1	TOTAL SHEETS 11
FEDERAL PROJECT NUMBER		
PLAT OF RIGHT OF WAY REQUIRED FOR STH 150 - NCL		
STH 110		WINNEBAGO CO.

CONVENTIONAL ABBREVIATIONS AND SYMBOLS

ACCESS POINT	AP	SET R/W MONUMENT	O
ACCESS RIGHTS	AR	(1-1/4" OUTSIDE DIA. IRON PIPE)	
ACRES	AC		
AND OTHERS	ET AL		
CENTERLINE	CL	EXISTING R/W POINT	△
CENTRAL ANGLE OR DELTA	Δ	PROPOSED R/W BOUNDARY POINT	PRW0001
CHORD BEARING	CH BRG		
CHORD DISTANCE	CH DIS		
DEED	DD	CORPORATE LIMITS	////
DOCUMENT	DOC	EXISTING R/W SECTION LINE	---
EAST BOUND	EB	QUARTER LINE	---
ENVELOPE DESCRIPTION	ENV1	SIXTEENTH LINE	---
ESTATE	EST	OLD CENTERLINE	---
GAS VALVE	GV	PROPOSED OR NEW R/W LINE	---
LAND CONTRACT	LC	EASEMENT LINE	---
LENGTH OF CURVE	L		
MONUMENT	MON	PARCEL NUMBER	01
NORTH BOUND	NB	UTILITY PARCEL NUMBER	100
OUTLOT	OL		
PAGE	PG	PROPERTY LINE	PL
PERMANENT LIMITED EASEMENT	PERM	LOT, TIE AND OTHER MINOR DASHED LINES	---
PRIVATE DRIVEWAY	PD	NO ACCESS (By Previous Acquisition or Covenant)	◆◆◆◆
PROPERTY LINE	PL	NO ACCESS (By Acquisition)	
QUIT CLAIM DEED	QCD	NO ACCESS (By Statutory Authority)	●●●●●
RADIUS	R	LIMITED EASEMENT (Temporary or Permanent)	---
REFERENCE LINE	RL	BURIED FIBER OPTICS CABLE	FO---
REMAINING	REM	BURIED TELEPHONE CABLE	T---
RIGHT OF WAY	R/W	BURIED GAS LINE	G---
SPECIAL CROSSING	SC	BUILDING TO BE RAZED	■
SECTION	SEC	FEE ACQUISITION	VARIOUS CROSS HATCHING
SECTION LINE	S		
FOUND IRON PIPE	IP		
STATION	STA		
TANGENT	TN		
TEMPORARY INTEREST	TI		
TEMPORARY LIMITED EASEMENT	TLE		
TIE POINT	TP		
VOLUME	VOL		
ADJOINING LANDS WITH SAME OWNER PARALLEL TO LINE			

COMPENSABLE	NON-COMPENSABLE
POWER POLE	□
TELEPHONE POLE	○
SIGN	⊞
TELEPHONE PEDESTAL	⊞

BEGIN RELOCATION ORDER



PROJECT 6200-07-21
STATION 142+00.00

1639.92 FEET, S 24°-41'-57" E OF THE NORTH 1/4 CORNER OF SECTION 10, TOWNSHIP 20 NORTH, RANGE 14 EAST.
Y 548372.486
X 720789.907

END RELOCATION ORDER

PROJECT 6200-07-21
STATION 463+00.00

1181.50 FEET, S 89°-57'-19" E OF THE SOUTHWEST CORNER OF SECTION 15, TOWNSHIP 20 NORTH, RANGE 15 EAST.
Y 539222.725
X 750387.270

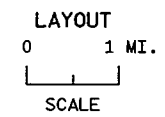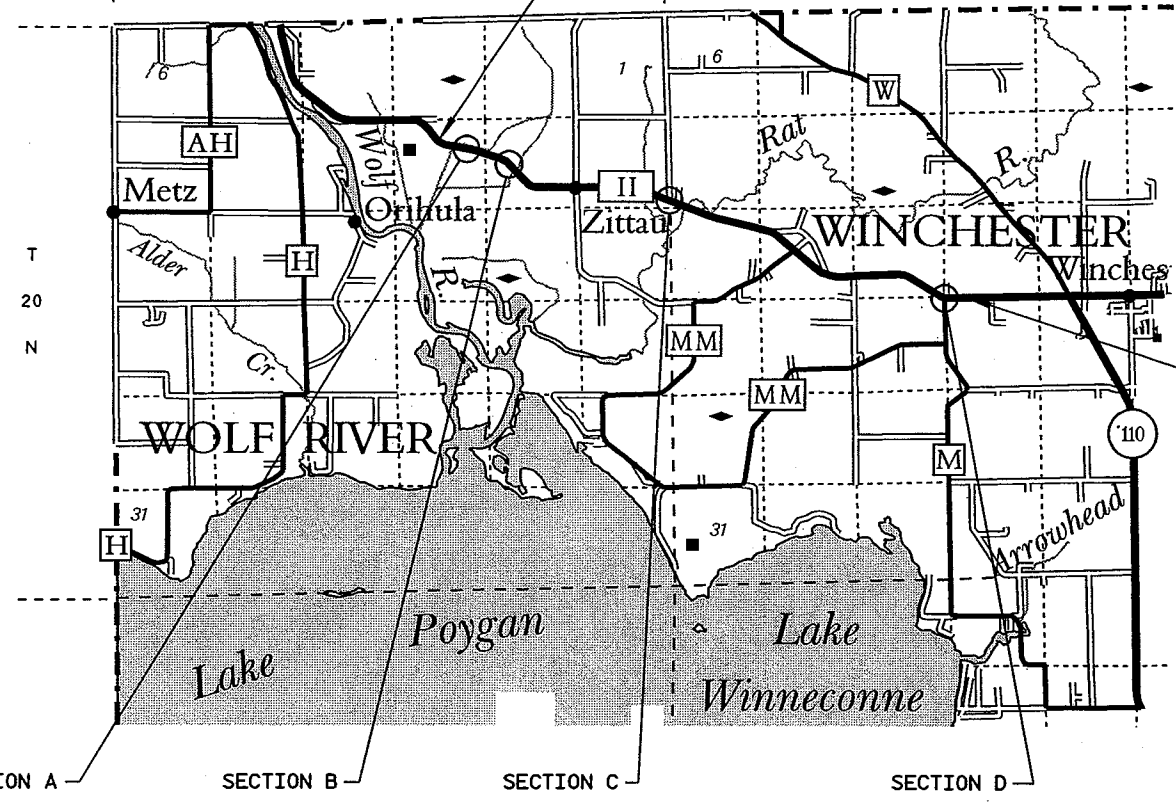

TOTAL NET LENGTH OF CENTERLINE = 6.08 MI.

NOTE (S):

COORDINATES AND BEARINGS ON THIS PLAT ARE ORIENTED TO THE WINNEBAGO COUNTY COORDINATE SYSTEM. ALL PLAT DISTANCES ARE GROUND LENGTHS.

RIGHT OF WAY BOUNDARIES ARE DEFINED WITH COURSES OF THE PERIMETER OF THE HIGHWAY LANDS AND ARE REFERENCED TO THE US PUBLIC LAND SURVEY OR OTHER SURVEYS OF PUBLIC RECORD.

RIGHT OF WAY MONUMENTS ARE TYPE 2 AND ARE PLACED PRIOR TO OR AT THE TIME OF LAND TITLE TRANSFER.

PROPERTY LINES SHOWN ON THIS PLAT ARE DRAWN FROM DATA DERIVED FROM MAPS AND DOCUMENTS OF PUBLIC RECORD AND/OR EXISTING OCCUPATIONAL LINES. THIS PLAT MAY NOT BE A TRUE REPRESENTATION OF EXISTING PROPERTY LINES AND SHOULD NOT BE USED AS A SUBSTITUTE FOR AN ACCURATE FIELD SURVEY.


ALL ACCESS AS SHOWN SHALL BE SUBJECT TO s.86.07 WISCONSIN STATUTE. PERMITS ISSUED UNDER THIS STATUTE ARE REVOCABLE.

DRAFT

REVISION DATE	STATE OF WISCONSIN DEPARTMENT OF TRANSPORTATION
	APPROVED:
	DATE: _____ DISTRICT DIRECTOR

LEVELS ON = 1, 2, 3, 62, 63.

INDEX OF PARCELS

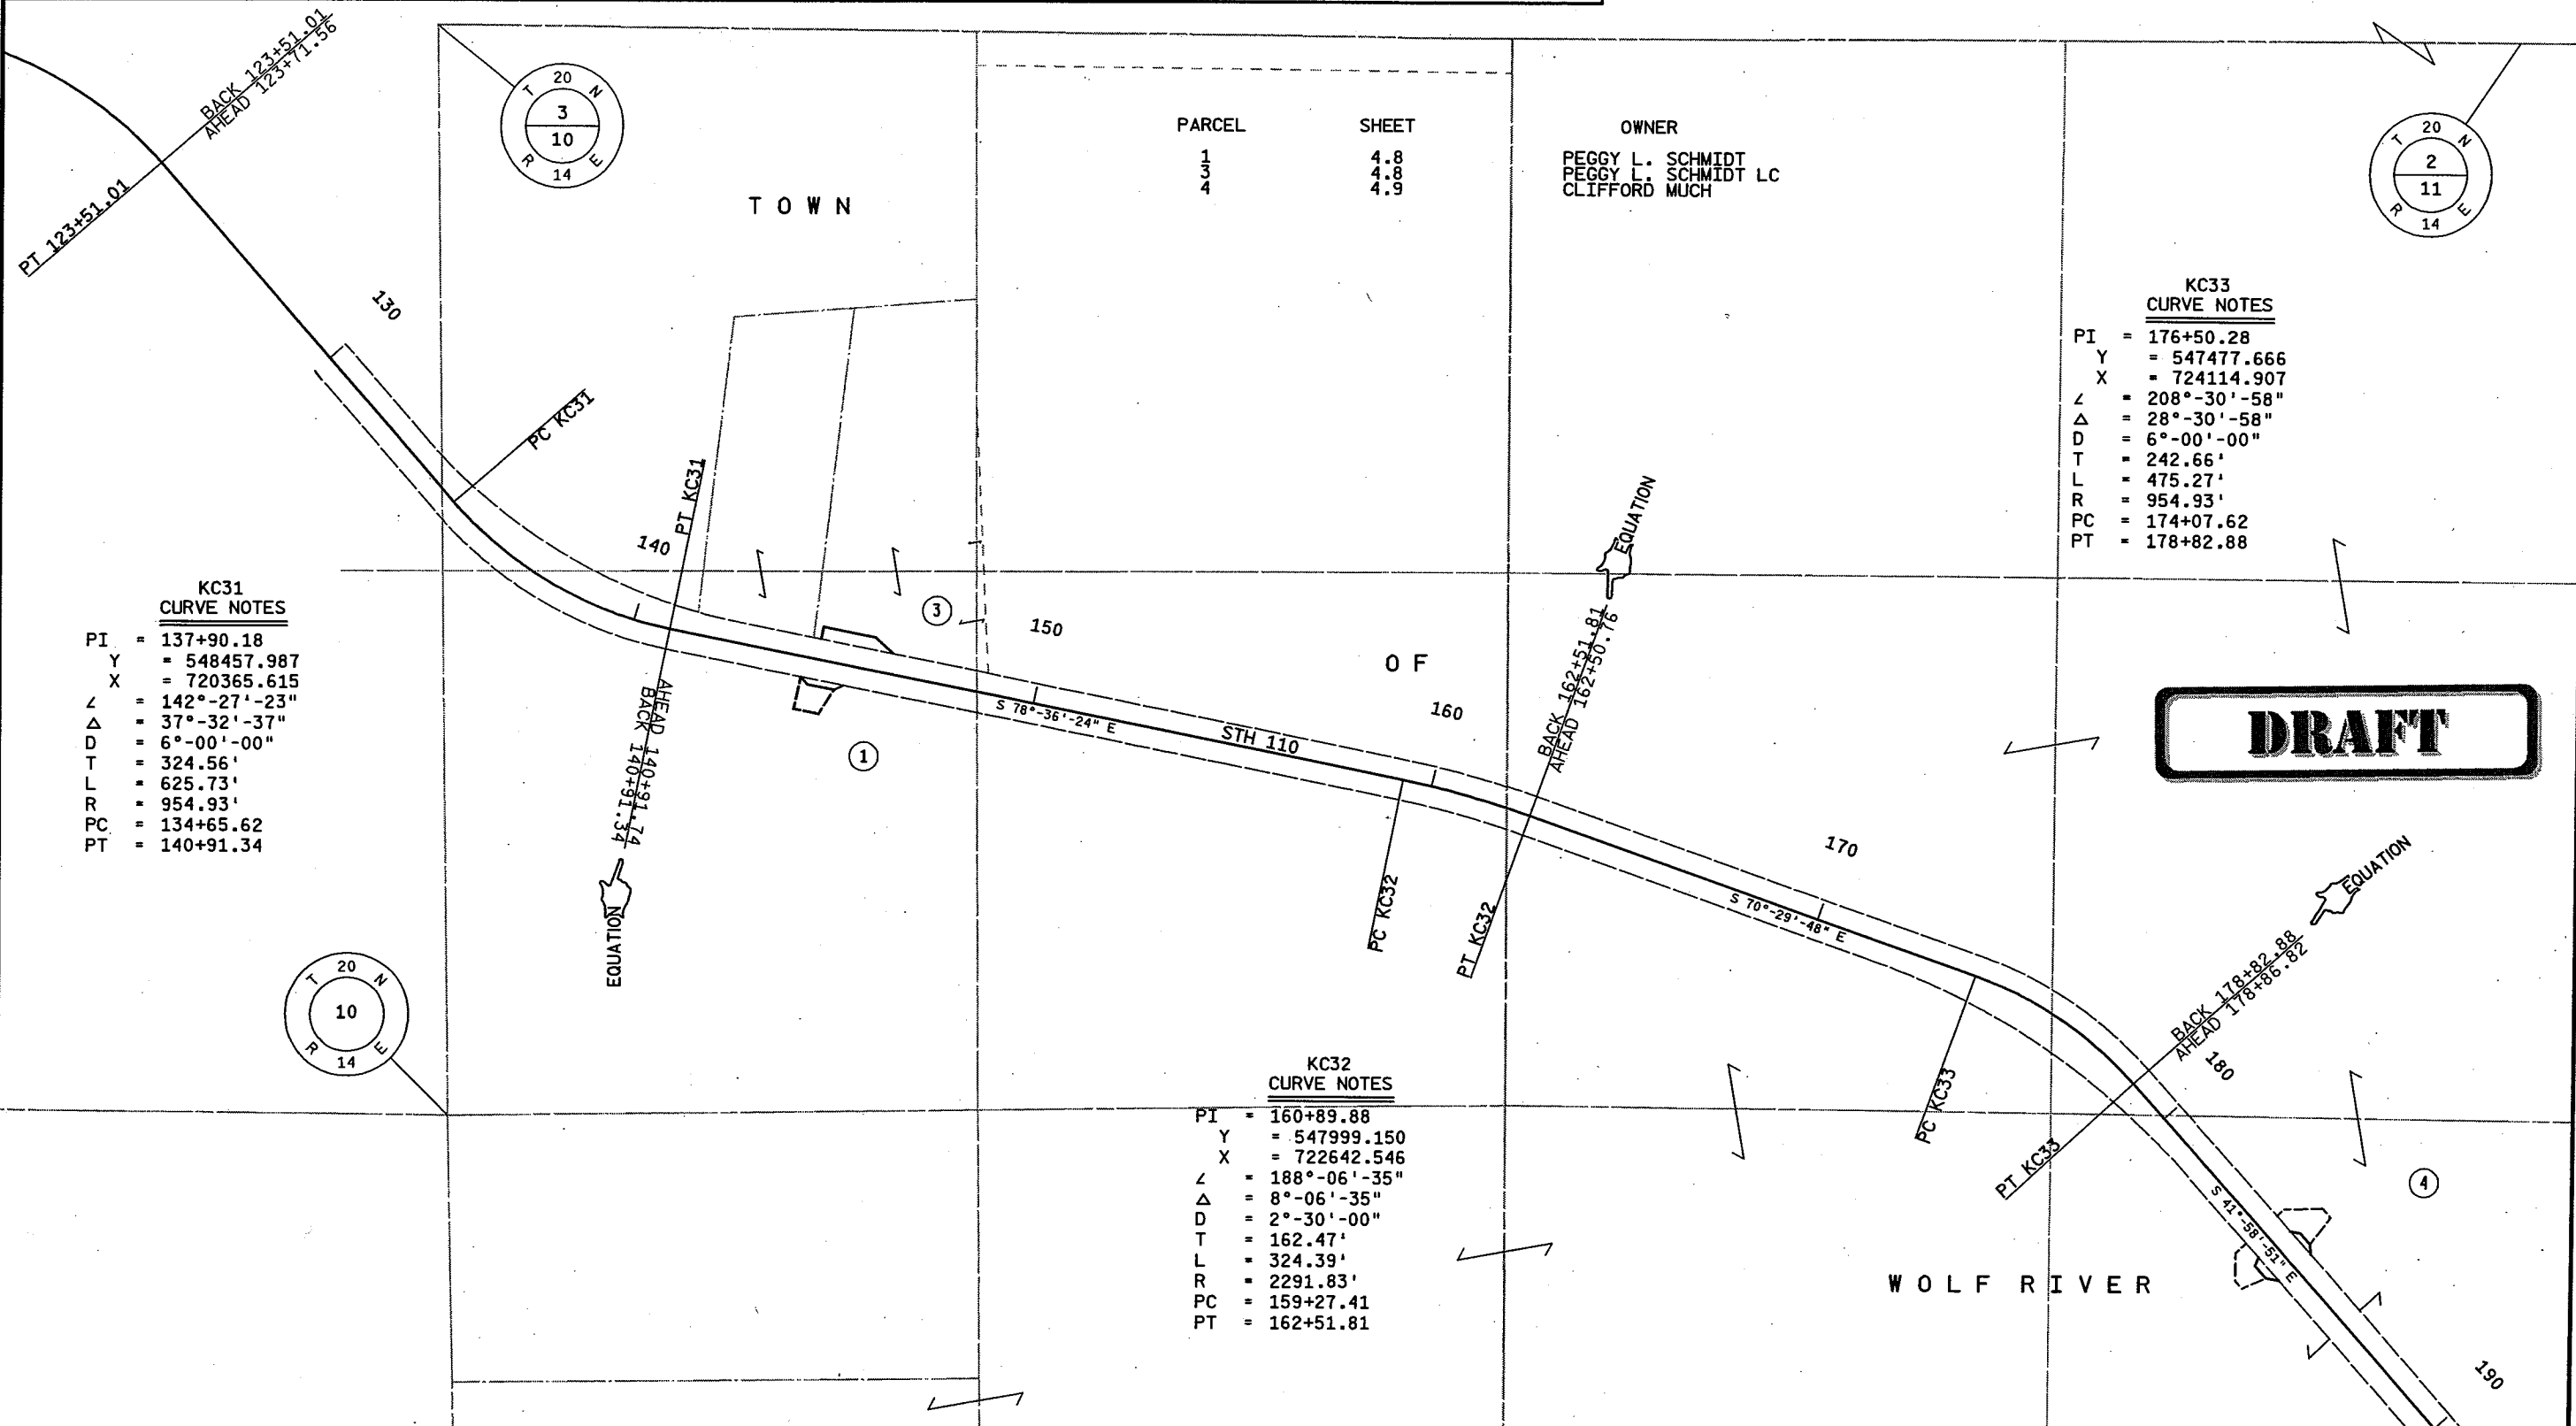

PARCEL	SHEET	OWNER
1	4.8	PEGGY L. SCHMIDT
3	4.8	PEGGY L. SCHMIDT LC
4	4.9	CLIFFORD MUCH

**KC33
CURVE NOTES**

PI = 176+50.28
 Y = 547477.666
 X = 724114.907
 Z = 208°-30'-58"
 Δ = 28°-30'-58"
 D = 6°-00'-00"
 T = 242.66'
 L = 475.27'
 R = 954.93'
 PC = 174+07.62
 PT = 178+82.88

DRAFT

**KC31
CURVE NOTES**

PI = 137+90.18
 Y = 548457.987
 X = 720365.615
 Z = 142°-27'-23"
 Δ = 37°-32'-37"
 D = 6°-00'-00"
 T = 324.56'
 L = 625.73'
 R = 954.93'
 PC = 134+65.62
 PT = 140+91.34


**KC32
CURVE NOTES**

PI = 160+89.88
 Y = 547999.150
 X = 722642.546
 Z = 188°-06'-35"
 Δ = 8°-06'-35"
 D = 2°-30'-00"
 T = 162.47'
 L = 324.39'
 R = 2291.83'
 PC = 159+27.41
 PT = 162+51.81

LEVELS ON - 1, 2, 3, 62, 63

REVISION DATE	DATE 7-22-03	NOT TO SCALE	HWY: STH 110	STATE R/W PROJECT NUMBER 6200-07-21	PLAT SHEET NO: 4.2
			COUNTY: WINNEBAGO	CONSTRUCTION PROJECT NUMBER	PS&E SHEET NO: 4.

INDEX OF PARCELS

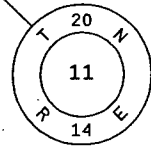


T O W N

**KC34
CURVE NOTES**
 PI = 197+75.95
 Y = 545892.956
 X = 725540.821
 Δ = 132°-36'-25"
 Δ = 47°-23'-35"
 D = 6°-00'-00"
 T = 419.11'
 L = 789.88'
 R = 954.93'
 PC = 193+56.83
 PT = 201+46.72

LEVELS ON - 1, 2, 3, 62, 63

PT KC34
 EQUATION
 27.99+101.20
 AHEAD 201+57.20
 BACK 201+46.72

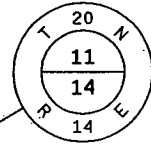

STH 110

O F

PI STA 227+49.71
 Δ = 179°-37'-22"
 Y 545860.144
 X 728542.268

WOLF RIVER

DRAFT

4

REVISION DATE	DATE 7-22-03	NOT TO SCALE	HWY: STH 110	STATE R/W PROJECT NUMBER 6200-07-21	PLAT SHEET NO: 4.3
			COUNTY: WINNEBAGO	CONSTRUCTION PROJECT NUMBER	PS&E SHEET NO: 4.

INDEX OF PARCELS

TOWN

TOWN

PARCEL
5

SHEET
4.10

OWNER
ROY LUEDTKE & BARBARA V. LUEDTKE

LEVELS ON = 1, 2, 3, 62, 63

4

250

260

270

(5)

280

290

OF

**KC35
CURVE NOTES**
 PI = 255+69.75
 Y = 545847.882
 X = 731362.276
 Δ = 201°-29'-19"
 Δ = 21°-29'-19"
 D = 6°-00'-00"
 T = 181.20'
 L = 358.14'
 R = 954.93'
 PC = 253+88.55
 PT = 257+46.69

PI STA 227+22.87
 Δ = 180°-01'-27"
 Y 545048.639
 X 733366.854

PI STA 288+73.13
 Δ = 179°58'-50"
 Y 544622.182
 X 734435.141

**KC40
CURVE NOTES**
 PI = 307+33.95
 Y = 543932.880
 X = 736163.580
 Δ = 171°-38'-48"
 Δ = 8°-21'-12"
 D = 1°-00'-00"
 T = 418.41'
 L = 835.33'
 R = 5729.58'
 PC = 303+15.54
 PT = 311+50.87

WOLF RIVER
 WINCHESTER
 TOWNLINE RD
 OF
 TOWN OF

STH 110

WOLF RIVER

WINCHESTER

DRAFT

REVISION DATE	DATE 7-22-03	NOT TO SCALE	HWY: STH 110	STATE R/W PROJECT NUMBER 6200-07-21	PLAT SHEET NO: 4.4
			COUNTY: WINNEBAGO	CONSTRUCTION PROJECT NUMBER	PS&E SHEET NO: 4.

INDEX OF PARCELS

TOWN

310
PT KC40

320

330

STH 110

340

PC KC37

O F

PT KC37

BACK 345+04.37
AHEAD 345+05.38

EQUATION

350

S 49°-10'-45" E

360

DRAFT

WINCHESTER

370

**KC40
CURVE NOTES**
 PI = 307+33.95
 Y = 543932.880
 X = 736163.580
 Δ = 171°-38'-48"
 Δ = 8°-21'-12"
 D = 1°-00'-00"
 T = 418.41'
 L = 835.33'
 R = 5729.58'
 PC = 303+15.54
 PT = 311+50.87


**KC37
CURVE NOTES**
 PI = 340+56.11
 Y = 543163.152
 X = 739397.352
 Δ = 207°-25'-55"
 Δ = 27°-25'-55"
 D = 3°-00'-00"
 T = 466.14'
 L = 914.40'
 R = 1909.86'
 PC = 335+89.98
 PT = 345+04.37

LEVELS ON = 1, 2, 3, 58, 60, 61, 62, 63

4

REVISION DATE	DATE 7-22-03	NOT TO SCALE	HWY: STH 110	STATE R/W PROJECT NUMBER 6200-07-21	PLAT SHEET NO: 4.5
			COUNTY: WINNEBAGO	CONSTRUCTION PROJECT NUMBER	PS&E SHEET NO: 4.
FILE NAME : \\gre31fb1\FCSERVER\03_620007\040105_r.w.dgn			PLOT DATE : 03-NOV-2003 10:27		PLOT BY : DITJYM
PLOT NAME : 040104 rw.l			ORG DATE : 04-08-03		Originator : Dis+3JMM
PLOT SCALE : 401.212121:1.000000			WISDOT/CADD SHEET 65C		

INDEX OF PARCELS

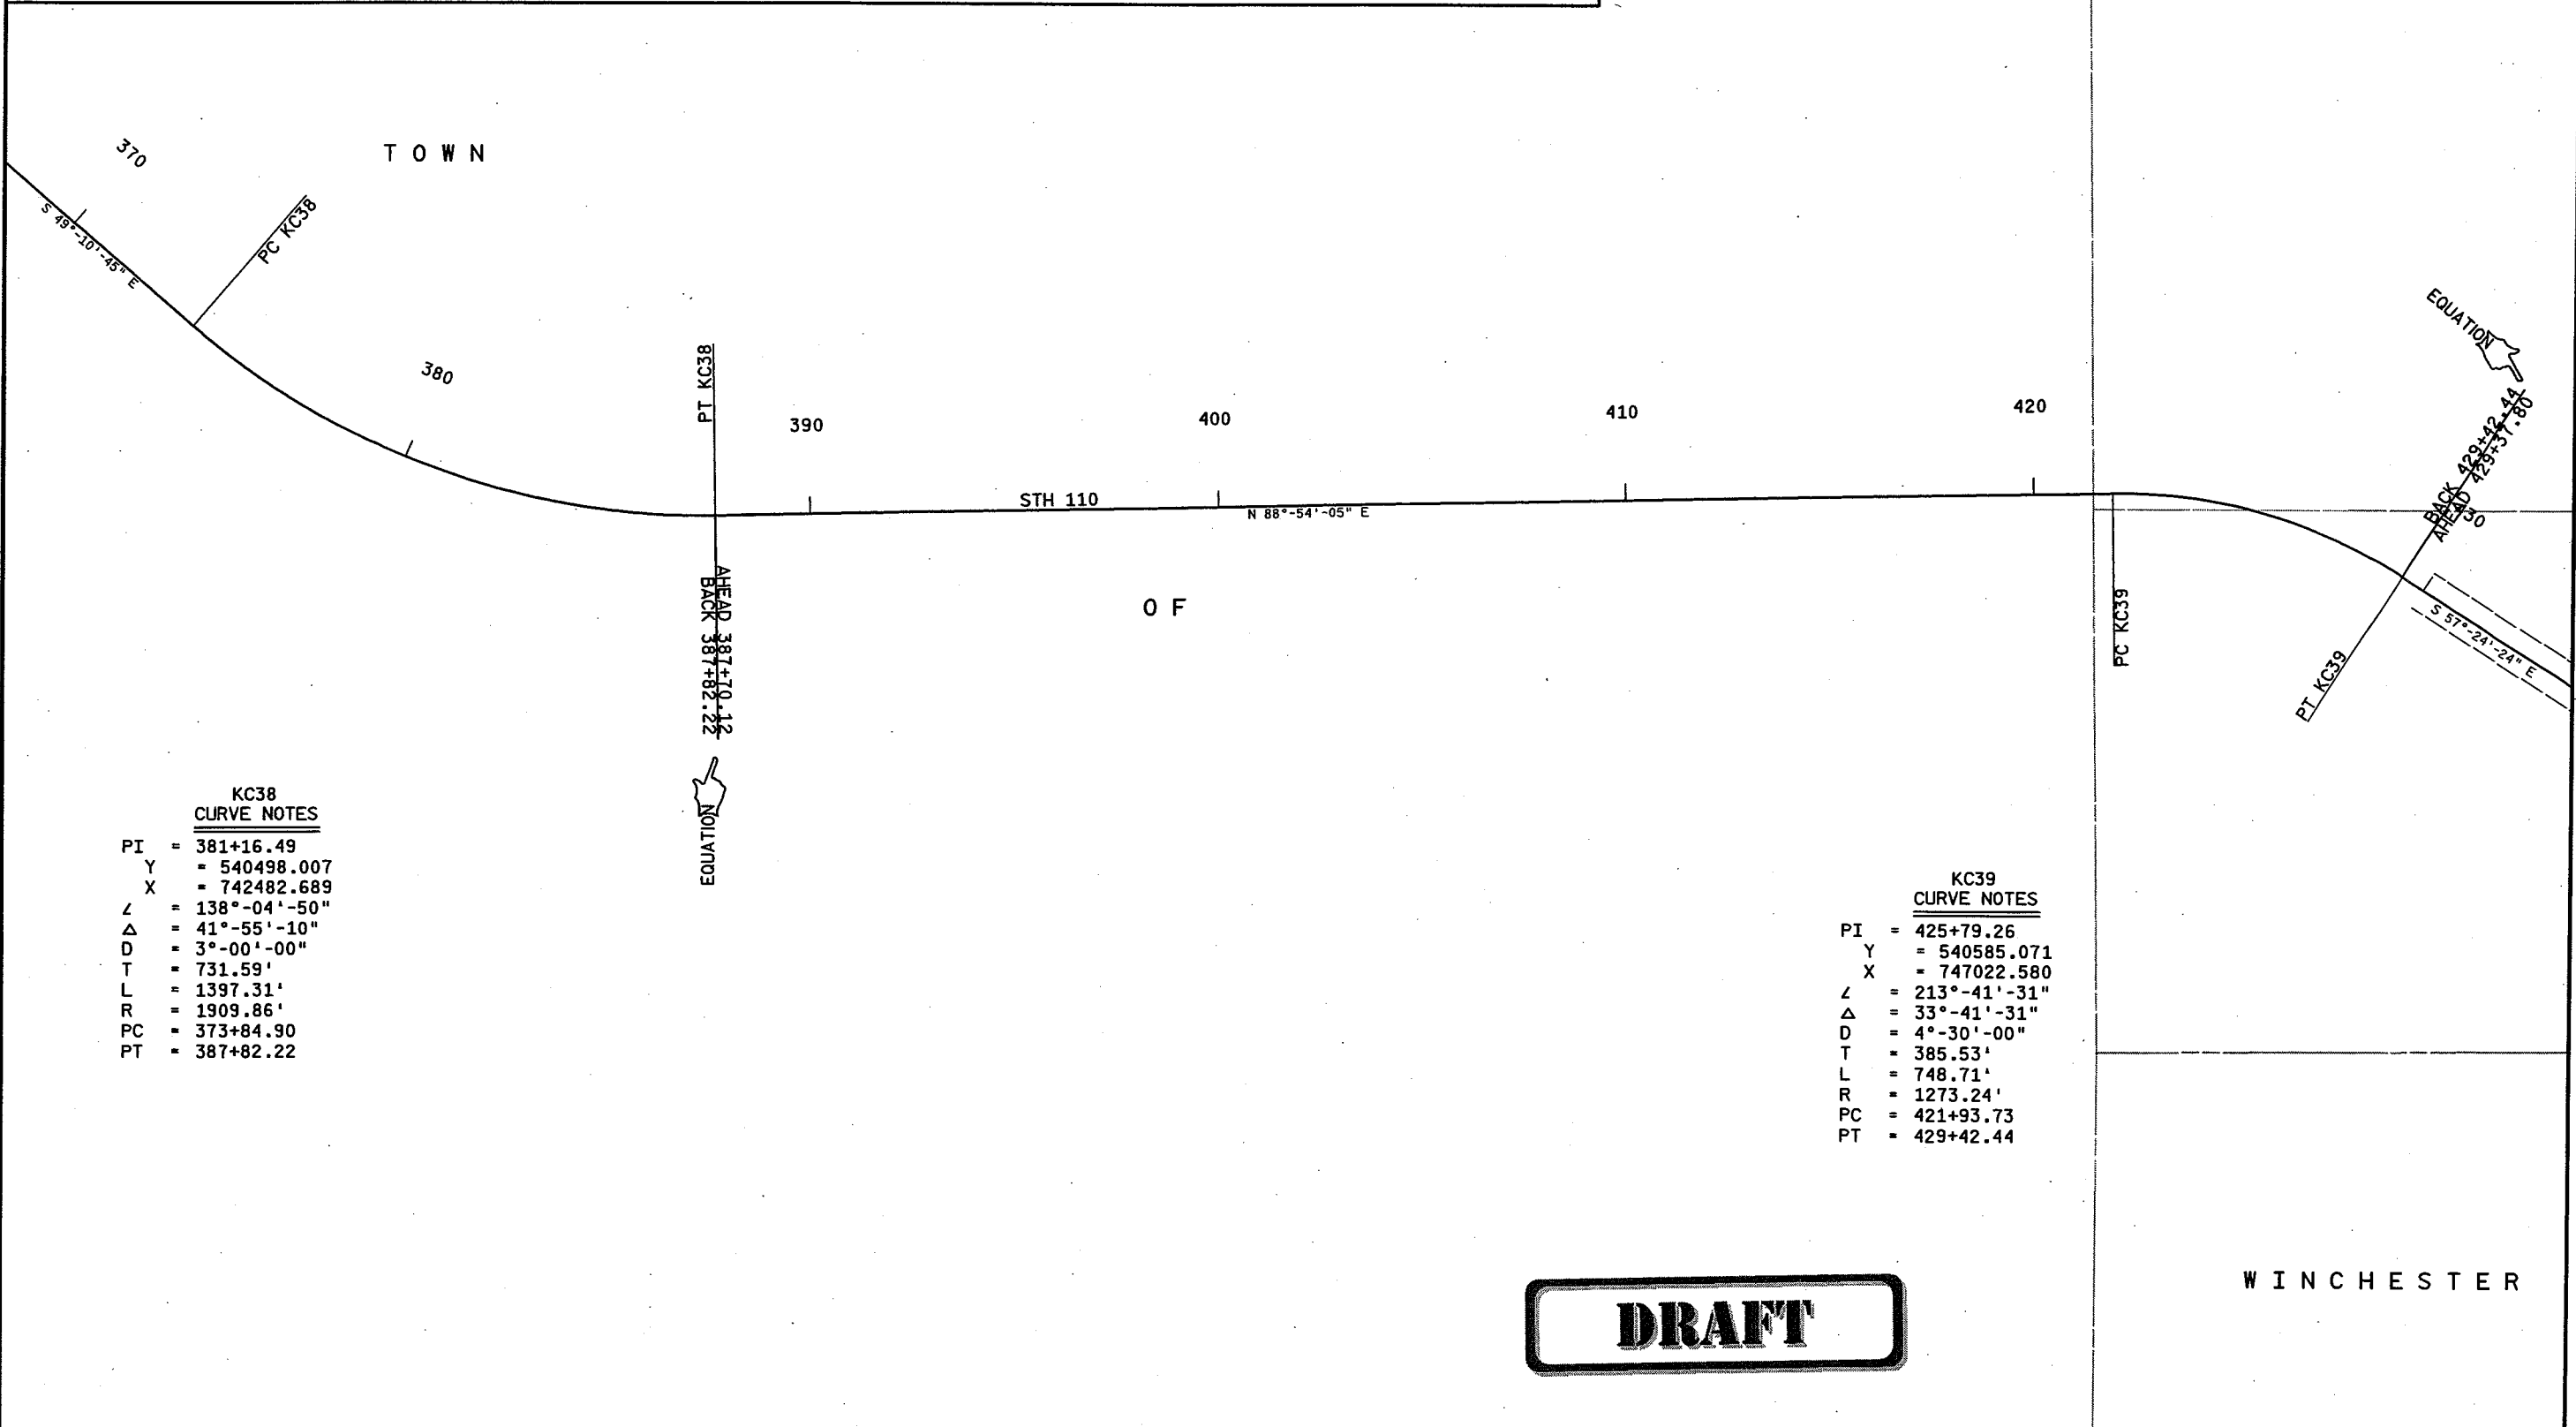

KC38 CURVE NOTES

PI = 381+16.49
 Y = 540498.007
 X = 742482.689
 Z = 138°-04'-50"
 Δ = 41°-55'-10"
 D = 3°-00'-00"
 T = 731.59'
 L = 1397.31'
 R = 1909.86'
 PC = 373+84.90
 PT = 387+82.22

KC39 CURVE NOTES

PI = 425+79.26
 Y = 540585.071
 X = 747022.580
 Z = 213°-41'-31"
 Δ = 33°-41'-31"
 D = 4°-30'-00"
 T = 385.53'
 L = 748.71'
 R = 1273.24'
 PC = 421+93.73
 PT = 429+42.44

DRAFT

LEVELS ON = 1, 2, 3, 62, 63

REVISION DATE	DATE 7-22-03	NOT TO SCALE	HWY: STH 110	STATE R/W PROJECT NUMBER 6200-07-21	PLAT SHEET NO: 4.6
			COUNTY: WINNEBAGO	CONSTRUCTION PROJECT NUMBER	PS&E SHEET NO: 4.

INDEX OF PARCELS

TOWN

PARCEL	SHEET
6	4.11
7	4.11
11	4.11

OWNER
 MICHAEL SCHLIMM
 DOUGLAS D. FINK & MARIE C. NEUBER
 BRADEN O. & CHRISTINE C. BENNETT


KC50 CURVE NOTES

PI = 450+80.42
 Y = 539223.227
 X = 749152.580
 Z = 147°-25'-48"
 Δ = 32°-34'-12"
 D = 2°-30'-00"
 T = 669.53'
 L = 1302.80'
 R = 2291.83'
 PC = 444+10.89
 PT = 457+13.69

KC39 CURVE NOTES

PI = 425+79.26
 Y = 540585.071
 X = 747022.580
 Z = 213°-41'-31"
 Δ = 33°-41'-31"
 D = 4°-30'-00"
 T = 385.53'
 L = 748.71'
 R = 1273.24'
 PC = 421+93.73
 PT = 429+42.44

LEVELS ON = 1, 2, 3, 62, 63

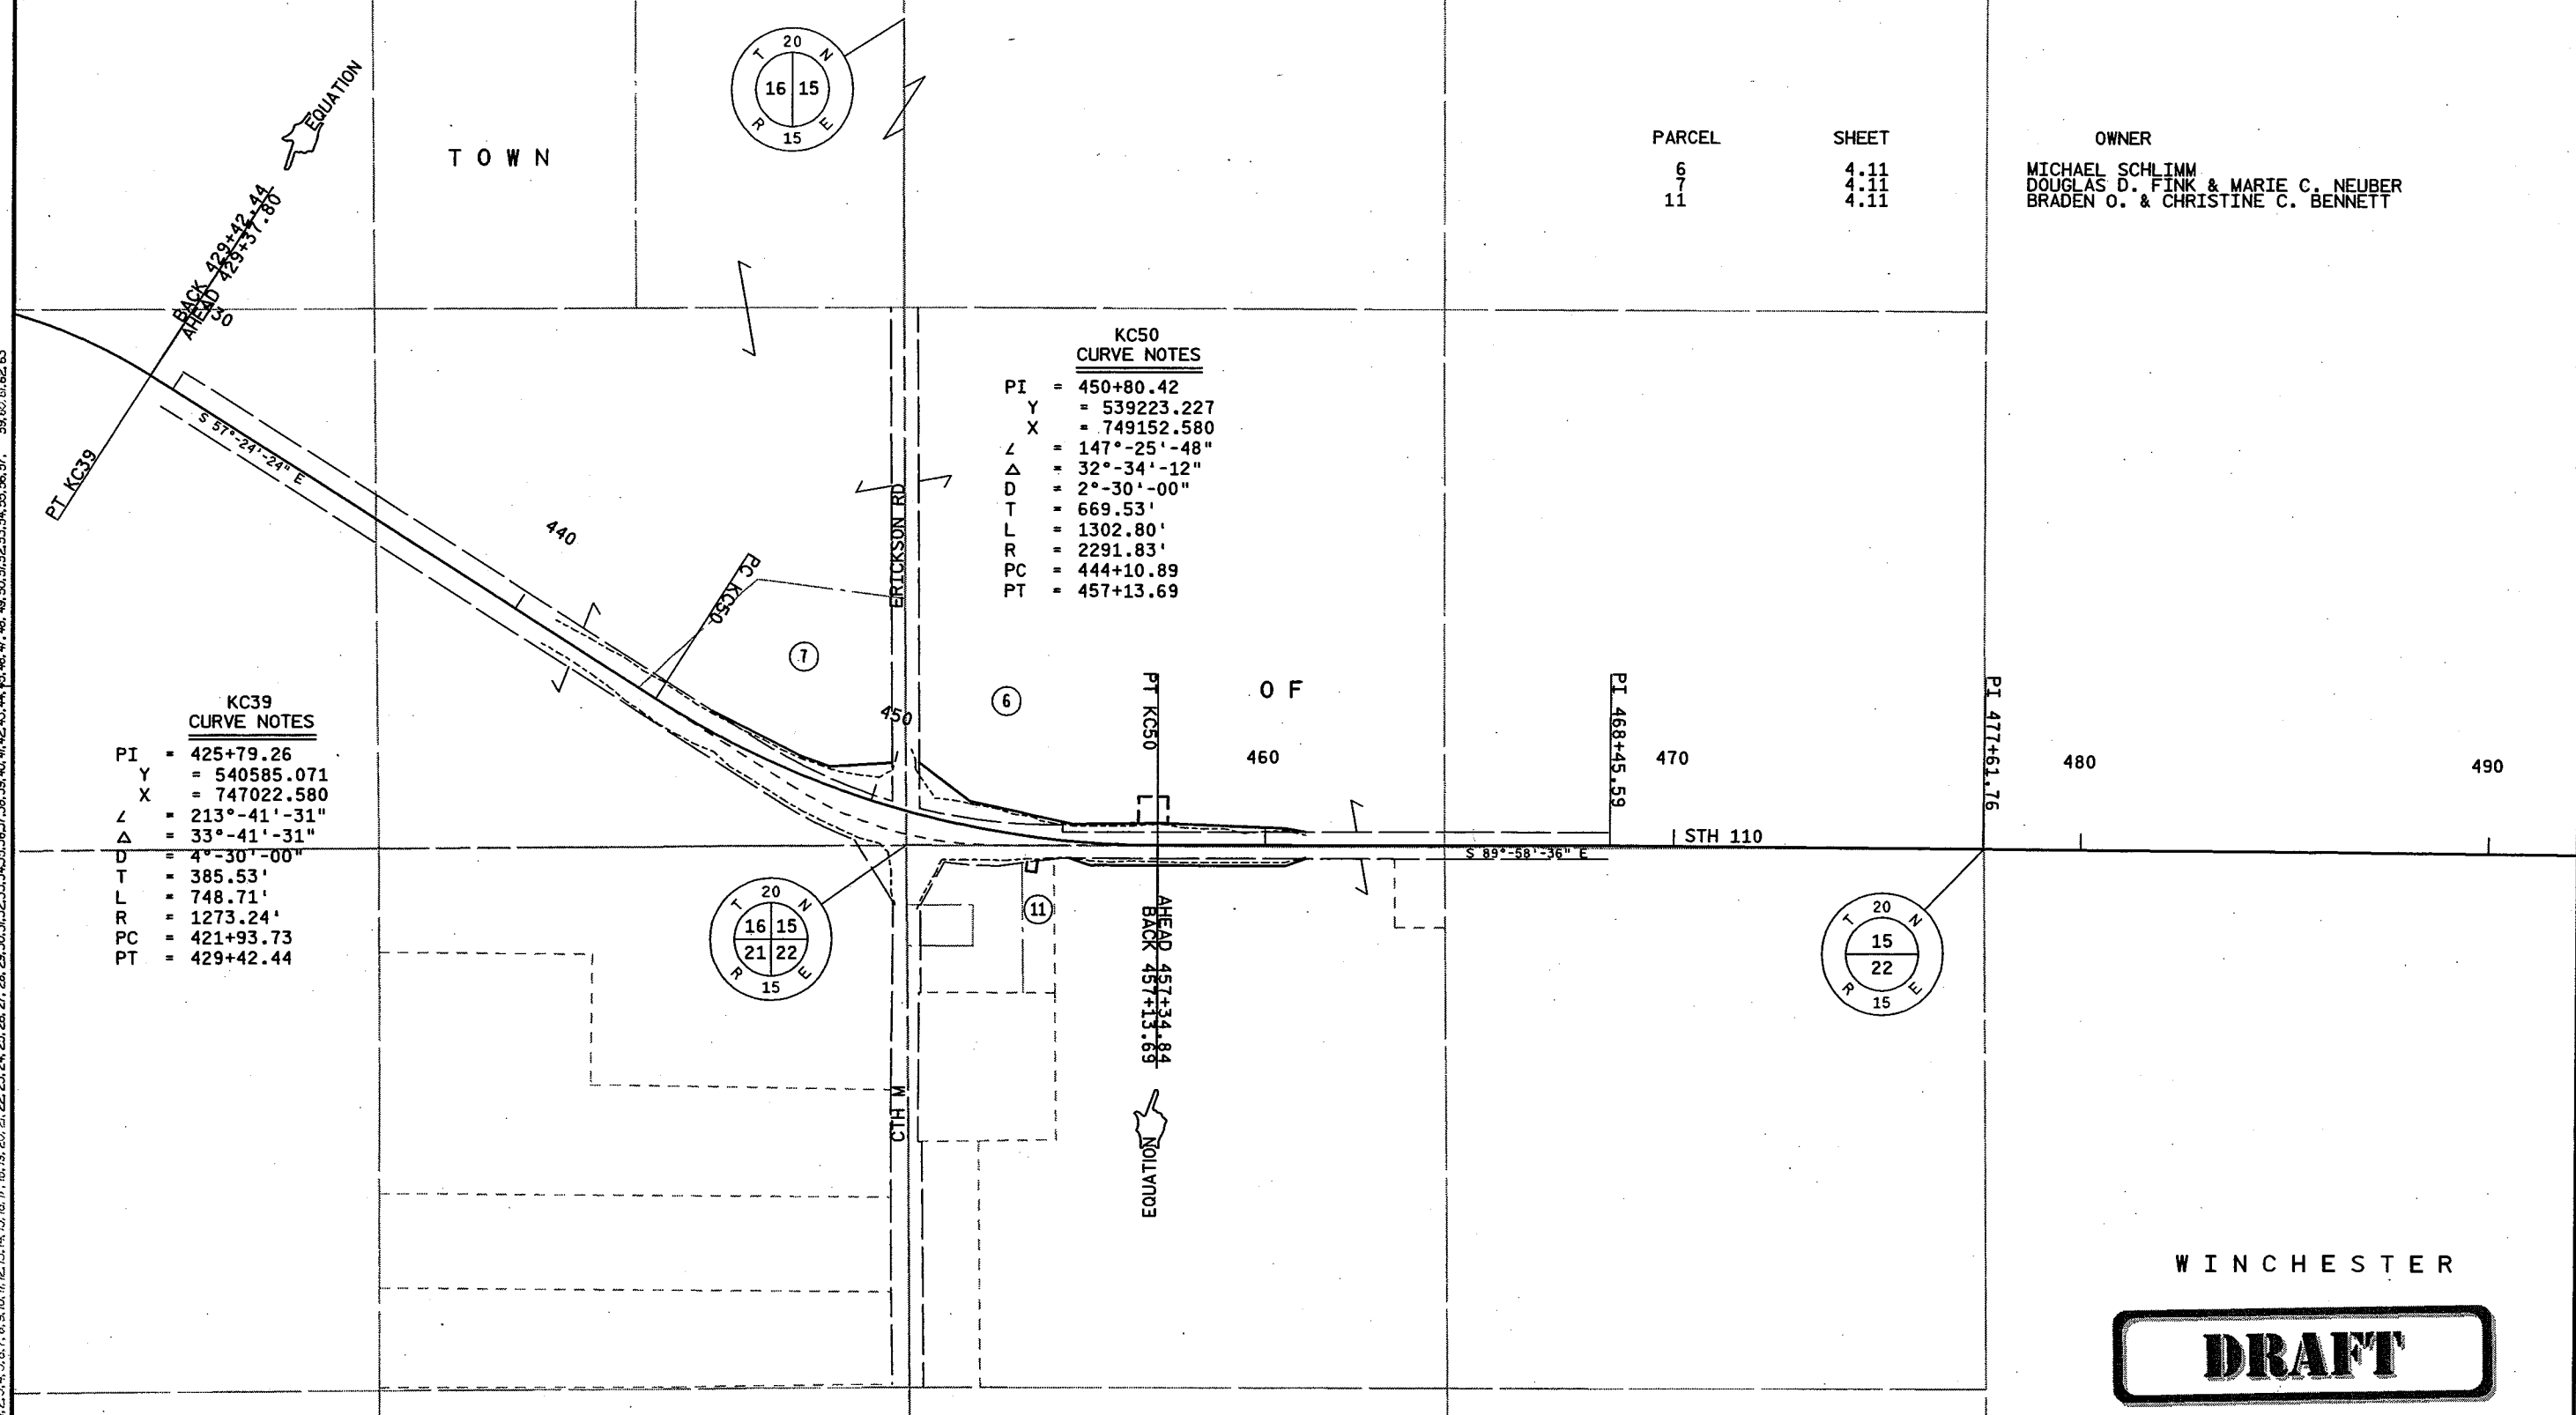


4

REVISION DATE	DATE 7-22-03	NOT TO SCALE	HWY: STH 110	STATE R/W PROJECT NUMBER 6200-07-21	PLAT SHEET NO: 4.7
			COUNTY: WINNEBAGO	CONSTRUCTION PROJECT NUMBER	PS&E SHEET NO: 4.

GN

4

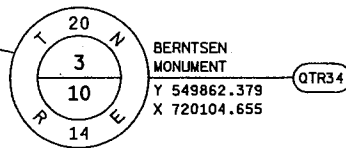

BERNTSEN
MONUMENT
Y 549862.379
X 720104.655
QTR34

**KC31
CURVE NOTES**
 PI = 137+90.18
 Y = 548457.987
 X = 720365.615
 Z = 142°-27'-23"
 Δ = 37°-32'-37"
 D = 6°-00'-00"
 T = 324.56'
 L = 625.73'
 R = 954.93'
 PC = 134+65.62
 PT = 140+91.34

TOWN

NW-NE

NE-NE

CONSTRUCTION R

STH 110

140

PI KC31

S 78°-36'-24" E 353.26'

GUY POLE
 N 11°-23'-36" E 30.00'
 N 28°-05'-34" E 52.20'

101
VOL 788 D19

S 47°-38'-34" E 58.31'

PROP
PROP

N 28°-05'-34" E 52.20'
 N 41°-44'-12" W 25.00'

S 64°-31'-25" W 25.00'

S 78°-36'-24" E E

SCHEDULE OF LANDS & INTERESTS REQUIRED

PARCEL NUMBER	SHEET NUMBER	OWNER	INTEREST REQUIRED	TOTAL ACRES	R/W ACRES REQUIRED			TOTAL ACRES REM.	T.L.E. ACRES
					NEW	EXISTING	TOTAL		
1	4.8	PEGGY L. SCHMIDT	FEE & TLE	36.00	0.03	-	0.03	35.97	0.11
3	4.8	PEGGY L. SCHMIDT LC	FEE	7.55	0.11	-	0.11	7.44	
101	4.8 & 4.10	WEPCO (41)	RELEASE OF RIGHTS						

BEGIN RELOCATION ORDER

PROJECT 6200-07-21
STATION 142+00.00

Y 548372.486
X 720789.907

SW-NE

TLE FOR SLOPING


1

SE-NE

WOLF RIVER

DRAFT

NOTE (S):
 AREAS SHOWN IN THE TOTAL ACRES COLUMN OF THE SCHEDULE OF LANDS & INTEREST TABLE MAY BE APPROXIMATE AND ARE DERIVED FROM TAX ROLLS OR OTHER AVAILABLE SOURCES AND MAY NOT INCLUDE LANDS OF THE OWNER WHICH ARE NOT CONTIGUOUS TO THE AREA TO BE ACQUIRED.
 EXISTING R/W WAS ACQUIRED FROM PROJECT (S):
 T 037-1 (3)

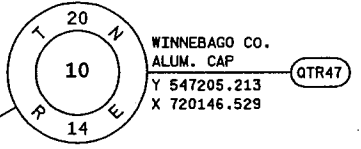


WINNEBAGO CO.
ALUM. CAP
Y 547205.213
X 720146.529
QTR47

LEVELS ON - 1, 2, 3, 62, 63

REVISION DATE	DATE 7-22-03	SCALE, FEET 0 50 100	HWY: STH 110	STATE R/W PROJECT NUMBER 6200-07-21	PLAT SHEET NO: 4.8
	GRID FACTOR N/A		COUNTY: WINNEBAGO	CONSTRUCTION PROJECT NUMBER 6200-07-	PS&E SHEET NO: 4. E

LEVELS ON : 1, 2, 3, 62, 63

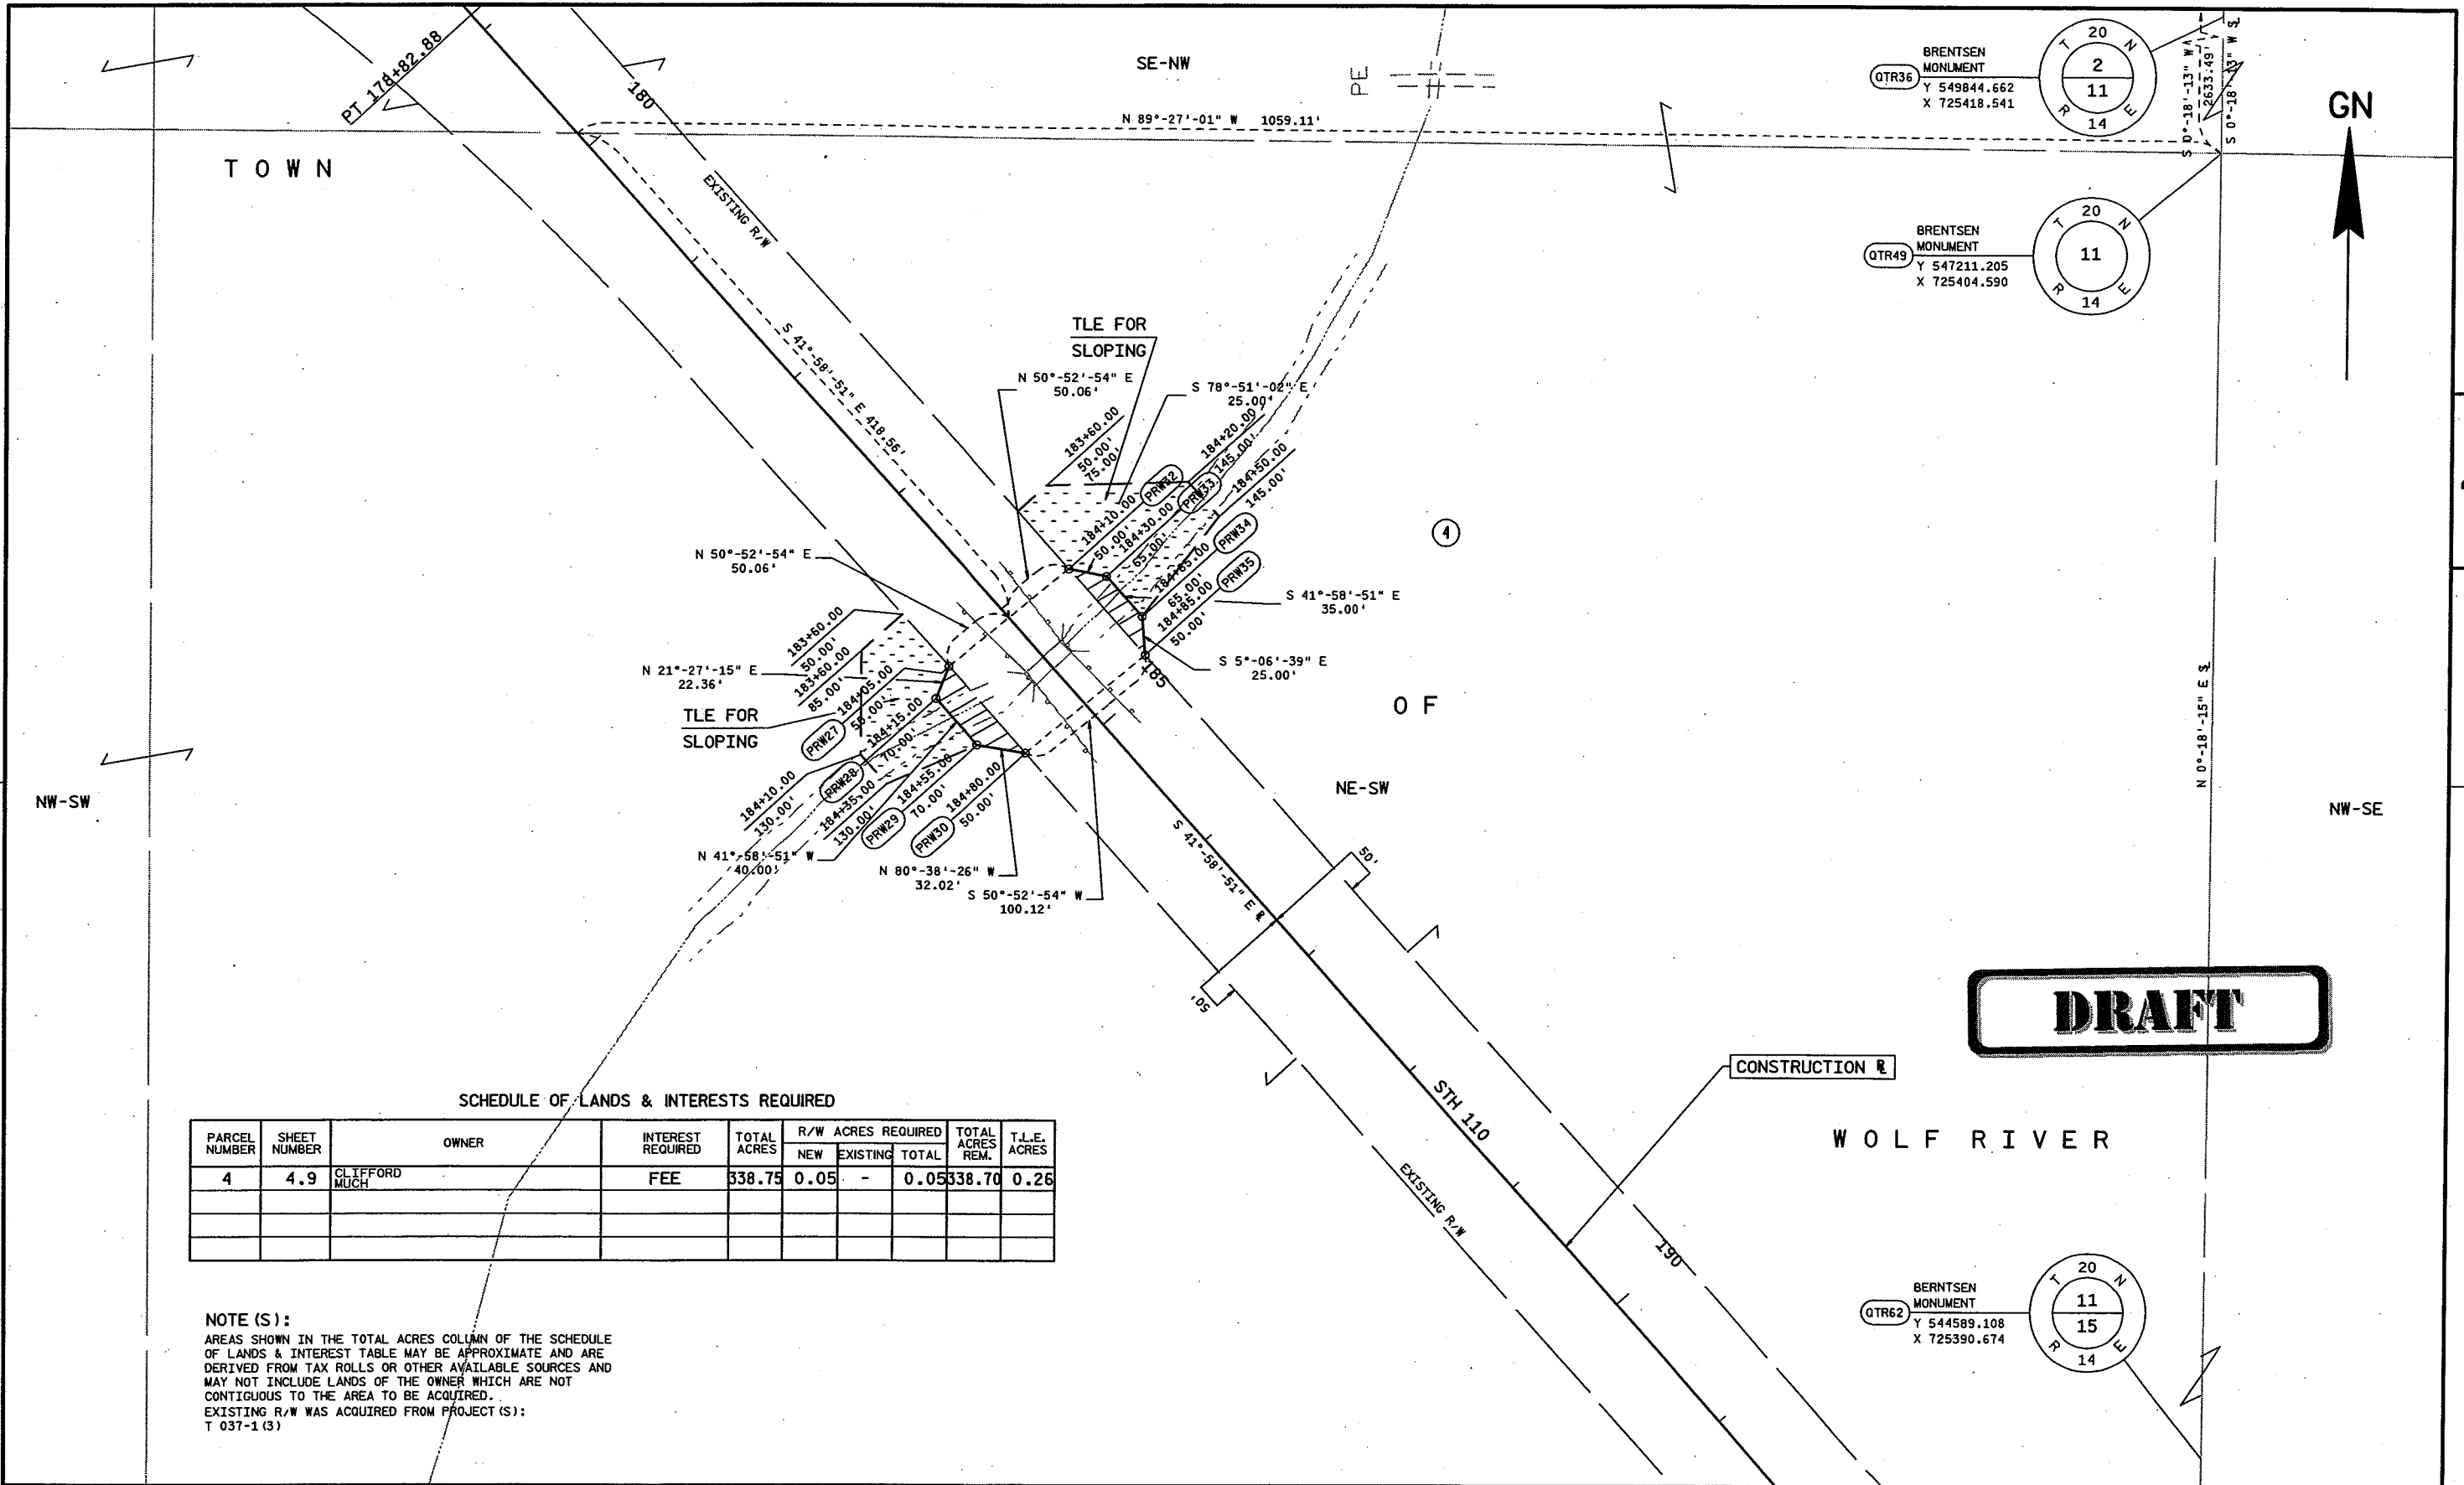

DRAFT


SCHEDULE OF LANDS & INTERESTS REQUIRED

PARCEL NUMBER	SHEET NUMBER	OWNER	INTEREST REQUIRED	TOTAL ACRES	R/W ACRES REQUIRED			TOTAL ACRES REM.	T.L.E. ACRES
					NEW	EXISTING	TOTAL		
4	4.9	CLIFFORD MUCH	FEE	338.75	0.05	-	0.05	338.70	0.26

NOTE (S):
 AREAS SHOWN IN THE TOTAL ACRES COLUMN OF THE SCHEDULE OF LANDS & INTEREST TABLE MAY BE APPROXIMATE AND ARE DERIVED FROM TAX ROLLS OR OTHER AVAILABLE SOURCES AND MAY NOT INCLUDE LANDS OF THE OWNER WHICH ARE NOT CONTIGUOUS TO THE AREA TO BE ACQUIRED.
 EXISTING R/W WAS ACQUIRED FROM PROJECT (S):
 T 037-1 (3)

REVISION DATE	DATE 7-22-03	SCALE, FEET 0 50 100	HWY: STH 110	STATE R/W PROJECT NUMBER 6200-07-21	PLAT SHEET NO: 4.9
	GRID FACTOR N/A		COUNTY: WINNEBAGO	CONSTRUCTION PROJECT NUMBER 6200-07-	PS&E SHEET NO: 4. E

LEVELS ON = 1, 2, 3, 58, 60, 61, 62, 63

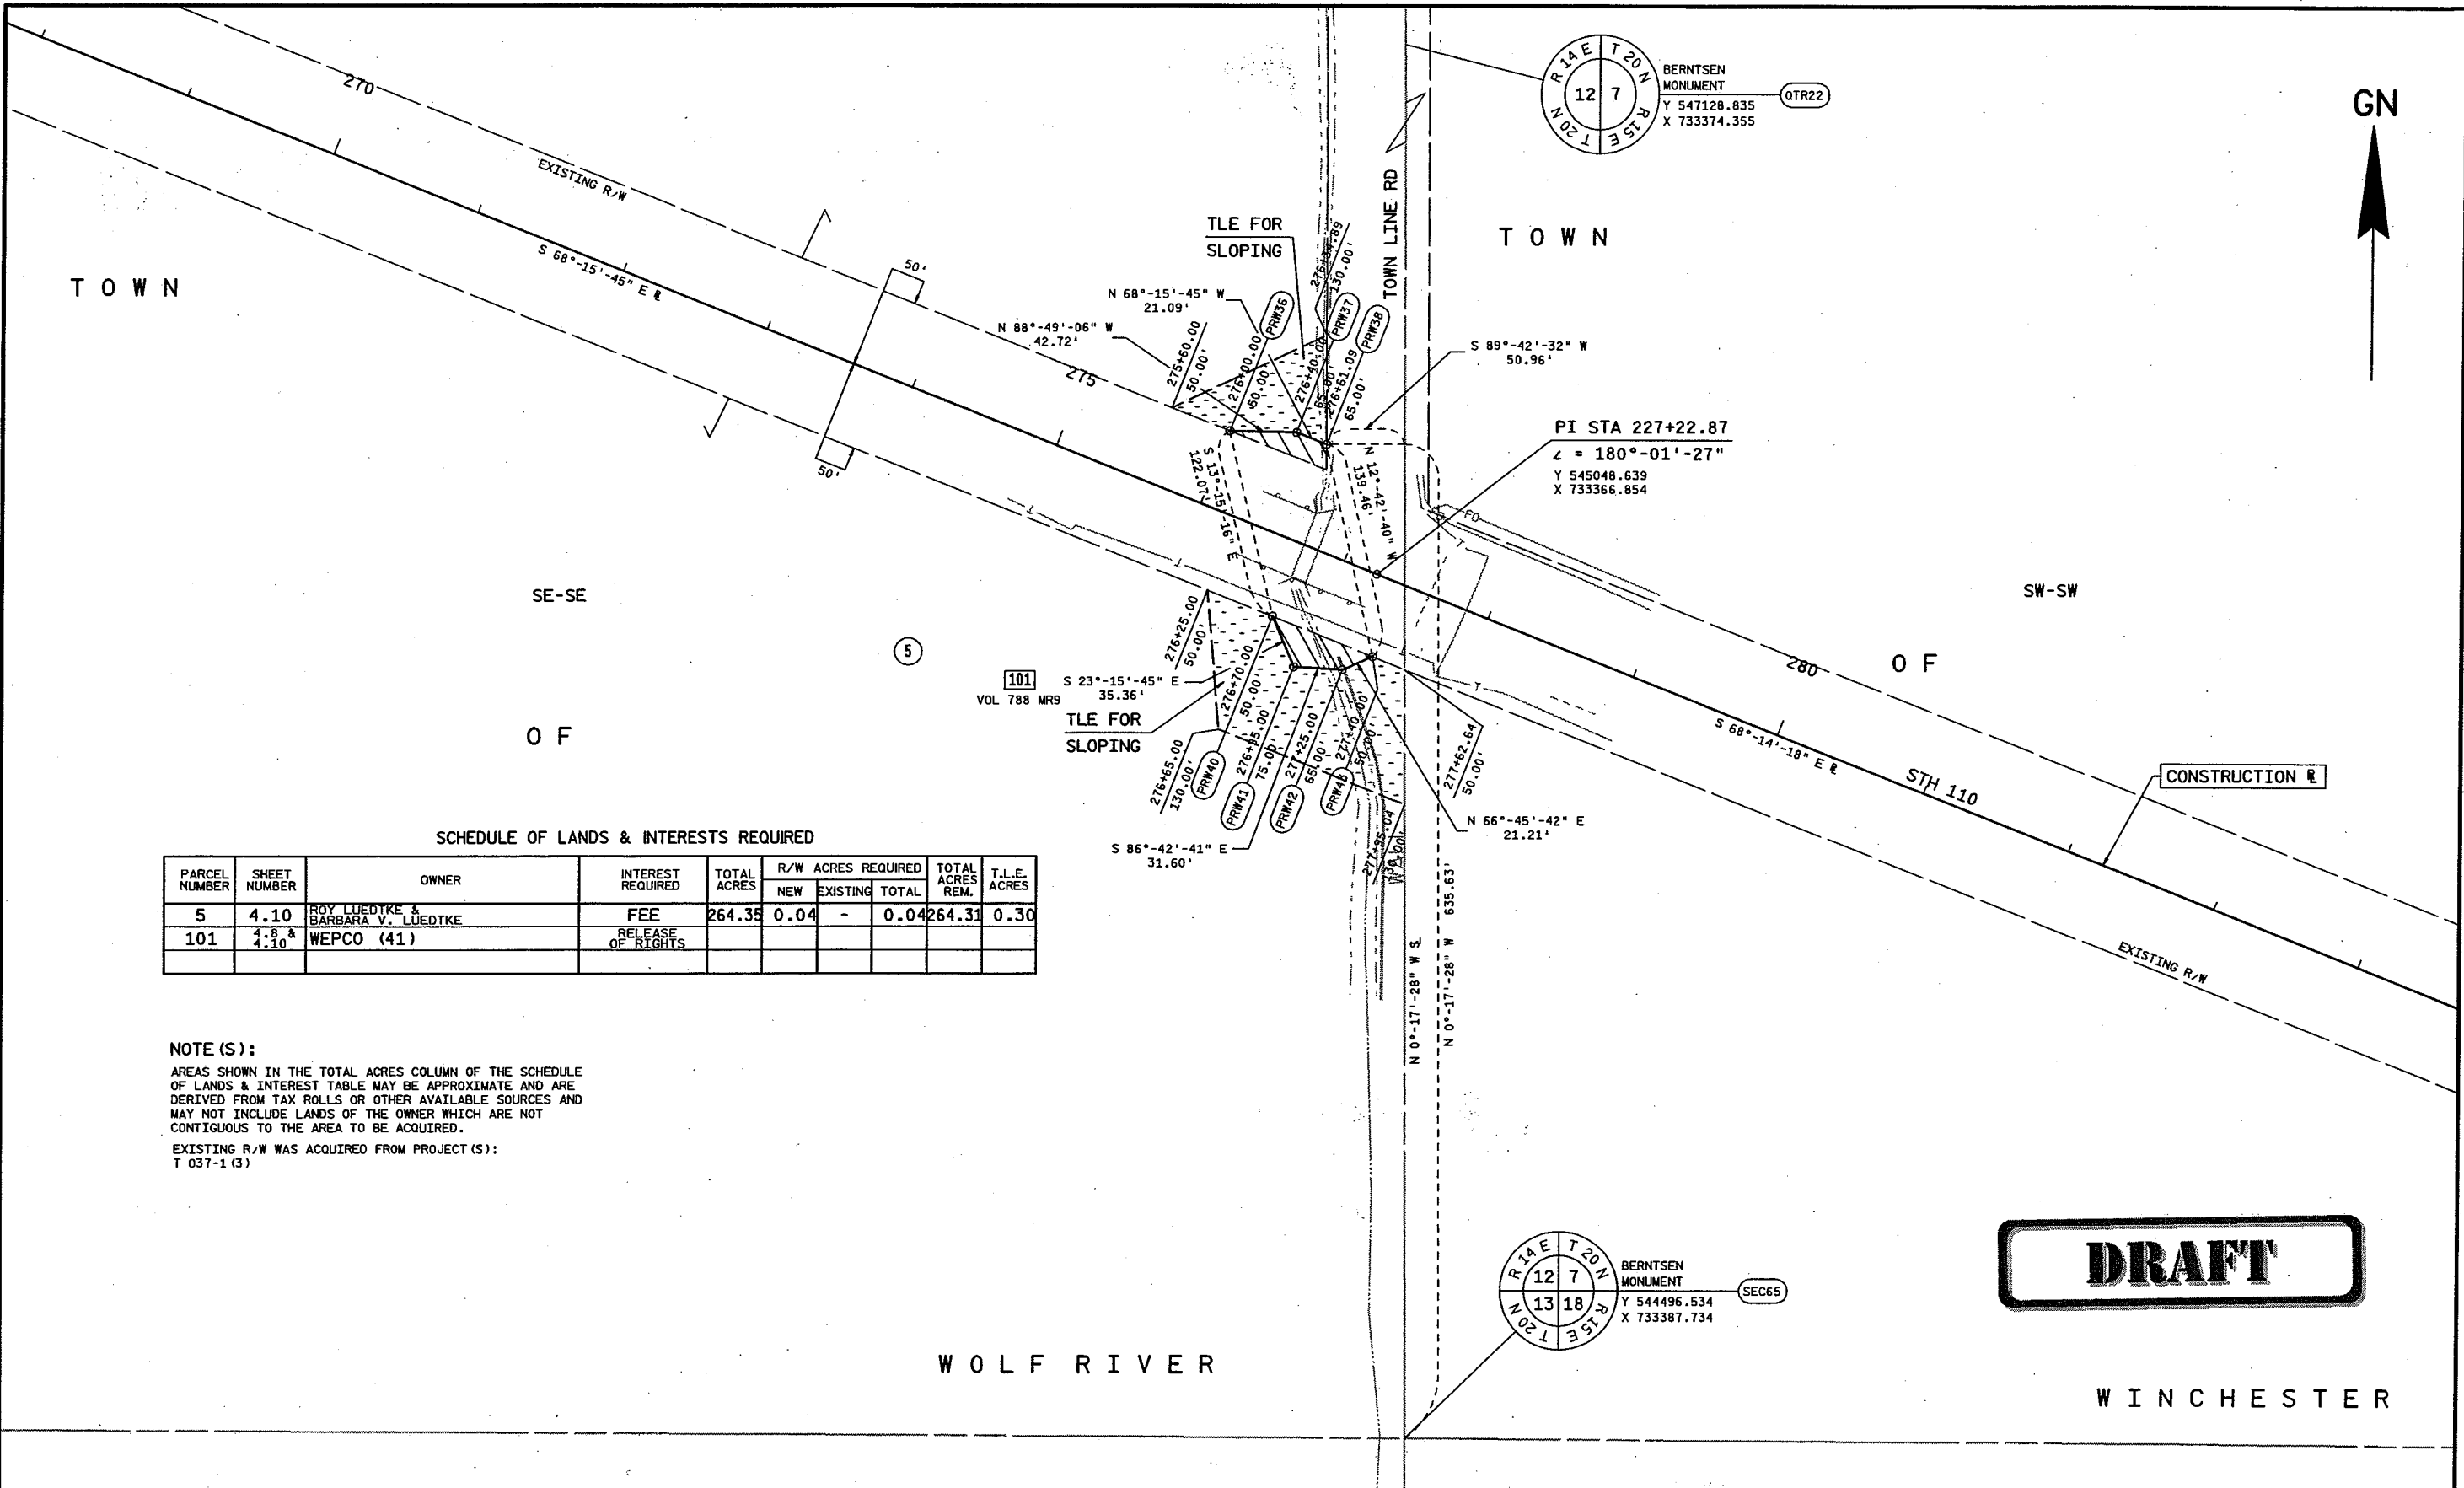

SCHEDULE OF LANDS & INTERESTS REQUIRED

PARCEL NUMBER	SHEET NUMBER	OWNER	INTEREST REQUIRED	TOTAL ACRES	R/W ACRES REQUIRED			TOTAL ACRES REM.	T.L.E. ACRES
					NEW	EXISTING	TOTAL		
5	4.10	ROY LIEDTKE & BARBARA V. LIEDTKE	FEE	264.35	0.04	-	0.04	264.31	0.30
101	4.8 & 4.10	WPCO (41)	RELEASE OF RIGHTS						

NOTE (S):
 AREAS SHOWN IN THE TOTAL ACRES COLUMN OF THE SCHEDULE OF LANDS & INTEREST TABLE MAY BE APPROXIMATE AND ARE DERIVED FROM TAX ROLLS OR OTHER AVAILABLE SOURCES AND MAY NOT INCLUDE LANDS OF THE OWNER WHICH ARE NOT CONTIGUOUS TO THE AREA TO BE ACQUIRED.
 EXISTING R/W WAS ACQUIRED FROM PROJECT (S):
 T 037-1 (3)

DRAFT

REVISION DATE	DATE 7-22-03	SCALE, FEET 0 50 100	HWY: STH 110	STATE R/W PROJECT NUMBER 6200-07-21	PLAT SHEET NO: 4.10
	GRID FACTOR N/A		COUNTY: WINNEBAGO	CONSTRUCTION PROJECT NUMBER 6200-07-	PS&E SHEET NO: 4. E

DRAFT

Parcel 7

DISTANCE FEET	BEARING	GROUND COORDINATES
SEC85		N 539223.647 E 749205.766
DB3	N 0°27'06" W	N 539250.335 E 749205.556
DB23	N 0°27'06" W	N 539426.120 E 749204.170
PRW4	S 89°40'19" W	N 539425.931 E 749171.170
PRW3	S 86°40'46" W	N 539417.055 E 749018.194
PRW2	N 70°24'24" W	N 539441.748 E 748948.824
PRW1	N 63°06'27" W	N 539552.618 E 748730.214
DB25	S 26°53'33" W	N 539507.804 E 748707.486
DB1	S 57°24'24" E	N 539373.498 E 748917.547
PC CURVE DB1		N 539373.498 E 748917.547
L.C.	= 313.24'	
L.C.B.	= S 66°50'48" E	
R.	= 954.93'	
ARC	= 314.66'	

KC50 CURVE NOTES

PI = 450+80.42
 Y = 539223.227
 X = 749152.580
 Δ = 147°-25'-48"
 Δ = 32°-34'-12"
 D = 2°-30'-00"
 T = 669.53'
 L = 1302.80'
 R = 2291.83'
 PC = 444+10.89
 PT = 457+13.69

Parcel 6

DISTANCE FEET	BEARING	GROUND COORDINATES
SEC85		N 539223.647 E 749205.766
DB23	N 89°40'19" E	N 539426.120 E 749204.170
PRW5	S 52°14'21" E	N 539426.308 E 749237.170
PRW6	S 77°21'09" E	N 539331.649 E 749359.377
PRW7	N 89°08'26" E	N 539274.812 E 749612.659
PRW8	S 87°36'53" E	N 539277.955 E 749822.131
PRW9	S 79°46'22" E	N 539264.827 E 750137.287
PRW10	S 0°01'24" W	N 539255.806 E 750187.284
PRW14	S 70°21'01" W	N 539190.882 E 750187.257
PRW13	S 70°21'01" W	N 539172.827 E 750137.250
PRW18	N 89°51'36" W	N 539173.597 E 749822.088
PRW12	N 89°51'36" W	N 539174.006 E 749654.613
PRW11	N 70°31'37" W	N 539191.604 E 749604.844
DB26	N 0°12'20" E	N 539222.215 E 749604.954
SEC85	N 89°47'40" W	N 539223.647 E 749205.766

SCHEDULE OF LANDS & INTERESTS REQUIRED

PARCEL NUMBER	SHEET NUMBER	OWNER	INTEREST REQUIRED	TOTAL ACRES	R/W ACRES REQUIRED			TOTAL ACRES REM.	T.L.E. ACRES
					NEW	EXISTING	TOTAL		
6	4.11	MICHAEL SCHLIMM	FEE & TLE	284.44	0.81	1.14	1.95	282.49	0.11
7	4.11	DOUGLAS D. FINK & MARIE C. NEUBER	FEE	7.44	0.33	0.82	1.15	6.29	
11	4.11	BRADEN O. CHRISTINE C. BENNETT	TLE	0.66					0.02
100	4.11	CENTURYTEL (40)	RELEASE OF RIGHTS						

NOTE (S):
 AREAS SHOWN IN THE TOTAL ACRES COLUMN OF THE SCHEDULE OF LANDS & INTEREST TABLE MAY BE APPROXIMATE AND ARE DERIVED FROM TAX ROLLS OR OTHER AVAILABLE SOURCES AND MAY NOT INCLUDE LANDS OF THE OWNER WHICH ARE NOT CONTIGUOUS TO THE AREA TO BE ACQUIRED.
 EXISTING R/W WAS ACQUIRED FROM PROJECT (S):
 T 037-1 (3) & 3957

REVISION DATE	DATE 7-22-03	SCALE, FEET	HWY: STH 110	STATE R/W PROJECT NUMBER 6200-07-21	PLAT SHEET NO: 4.11
	GRID FACTOR N/A		COUNTY: WINNEBAGO	CONSTRUCTION PROJECT NUMBER 6200-07-	PS&E SHEET NO: 4.

LEVELS ON = 1, 2, 3, 62, 63

REVISION DATE: 9/31/89

PLOT NAME: S8D403

PLOT SCALE: 48

FILE NAME: S8D402

ORIGINATOR: MEL ZEMICKA


LEVELS ON: 1, 5

APPROVED _____
DATE _____
STATE MAINT. ENGINEER FOR HWYS

APPROVED _____
DATE _____
STATE CONST. ENGINEER FOR HWYS

S.D.D. 8 D 4-3

ASPHALTIC FLUME

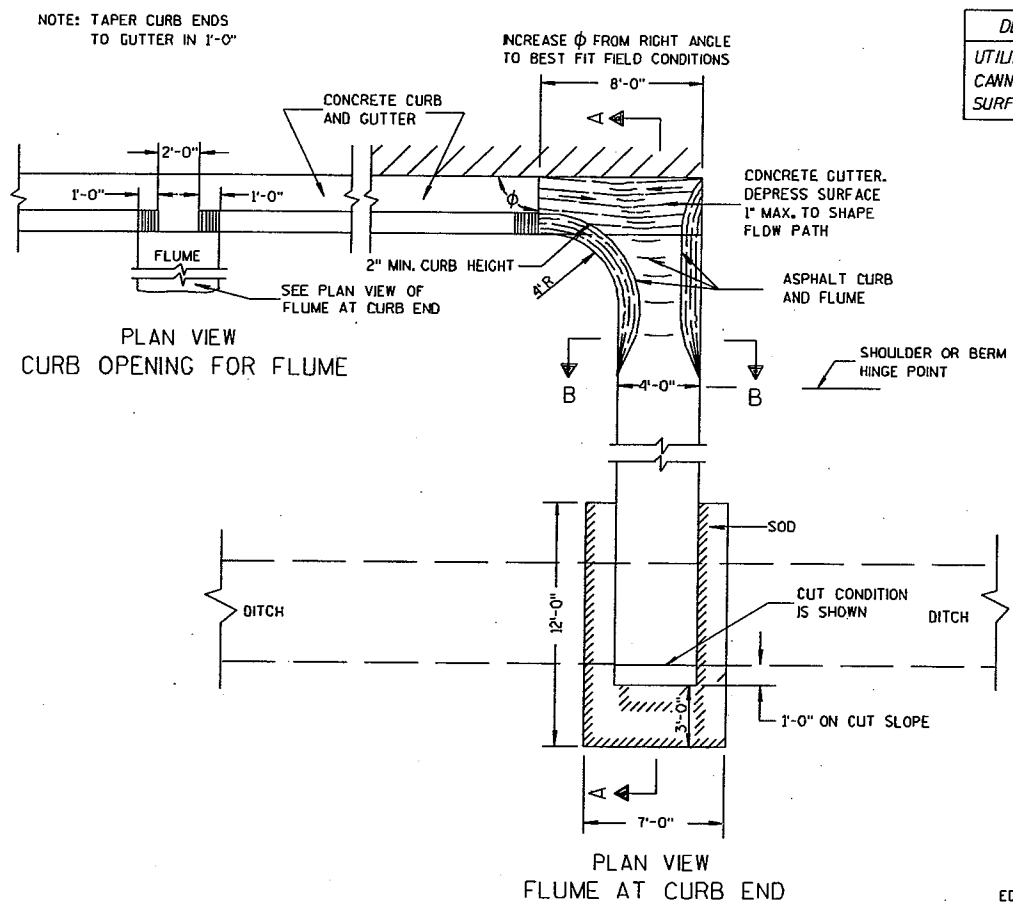



DESIGN NOTES: (WILL NOT APPEAR IN CONTRACT PLANS)

UTILIZE INLETS WHERE STORM WATER VOLUME AND VELOCITY CANNOT BE ACCOMMODATED EFFECTIVELY WITH A FLUME OR SURFACE DRAIN.


GENERAL NOTES

- DETAILS OF CONSTRUCTION, MATERIALS AND WORKMANSHIP NOT SHOWN ON THIS DRAWING SHALL CONFORM TO PERTINENT REQUIREMENTS OF THE STANDARD SPECIFICATIONS AND APPLICABLE SPECIAL PROVISIONS.
- WELDED STEEL WIRE FABRIC SHALL BE IN ACCORDANCE WITH AASHTO SPECIFICATION M55.
- JOINTS SHALL BE 1/8" TO 1/4" INCH WIDE BY 1/2" INCHES DEEP AND SPACED AT UNIFORM INTERVALS OF APPROXIMATELY 4 FEET.
 - GEOTEXTILE FABRIC TYPE "R" SHALL UNDERLAY THE FULL LENGTH AND WIDTH OF THE CONCRETE SURFACE DRAIN AND RIPRAP.
 - CONCRETE SURFACE DRAIN WITHOUT CURB AND GUTTER MAY BE USED ON BACKSLOPES WHEN SPECIFIED


③ CONCRETE SURFACE DRAIN

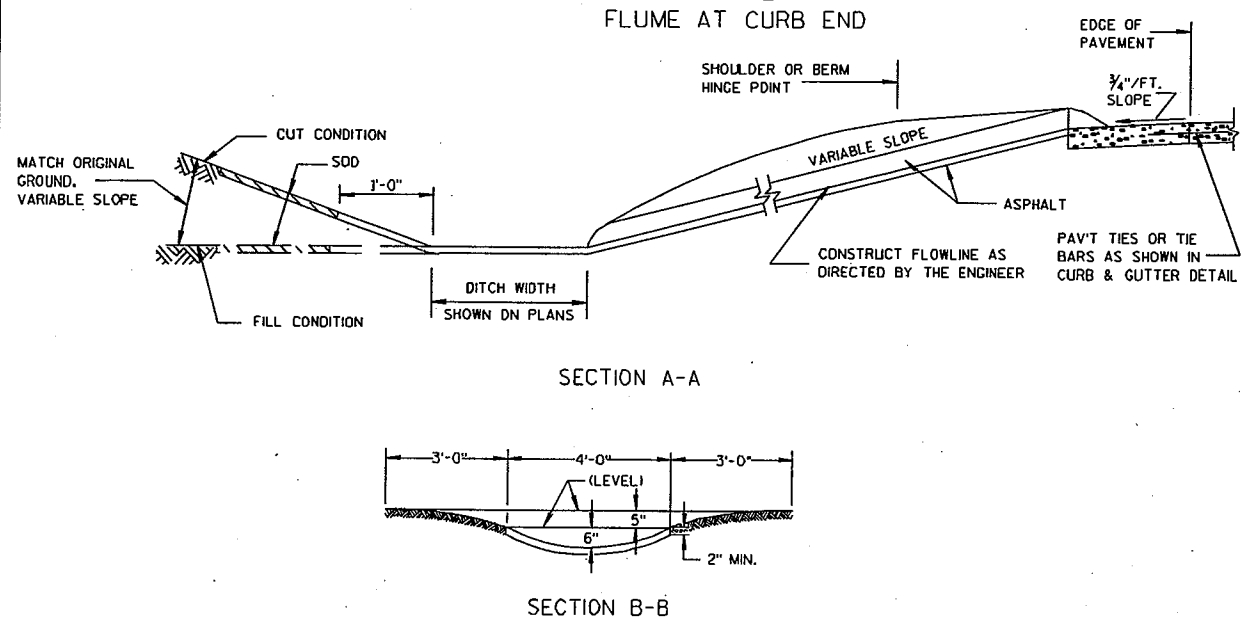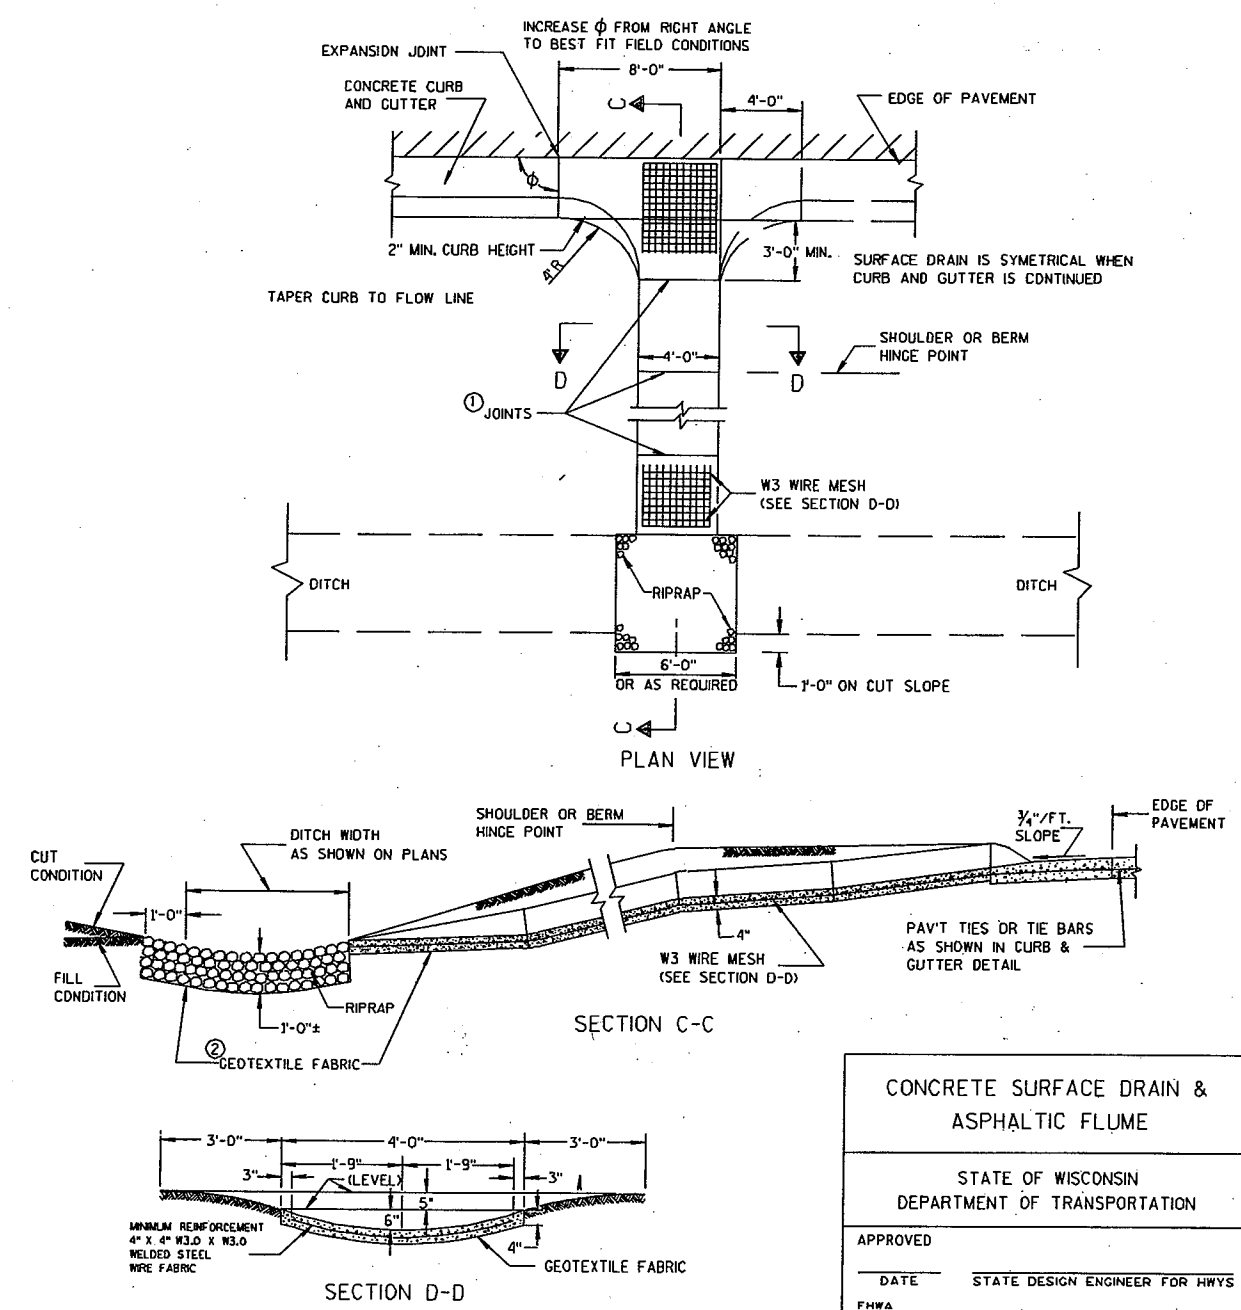


WOOD STAKES (2 PER BALE)
NOMINAL 2" X 2" X 30" MIN.
LENGTH OR EQUIVALENT

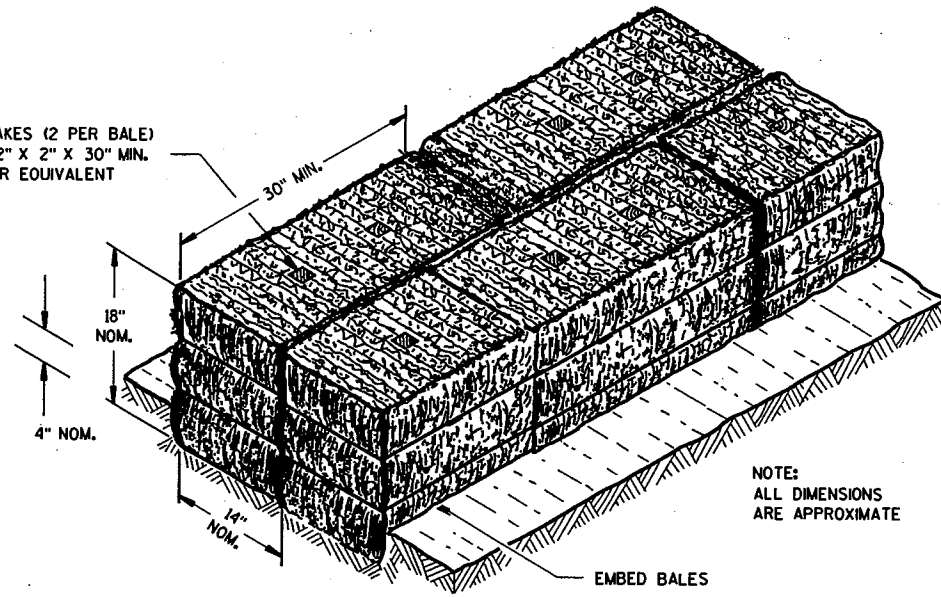

SECTION A-A

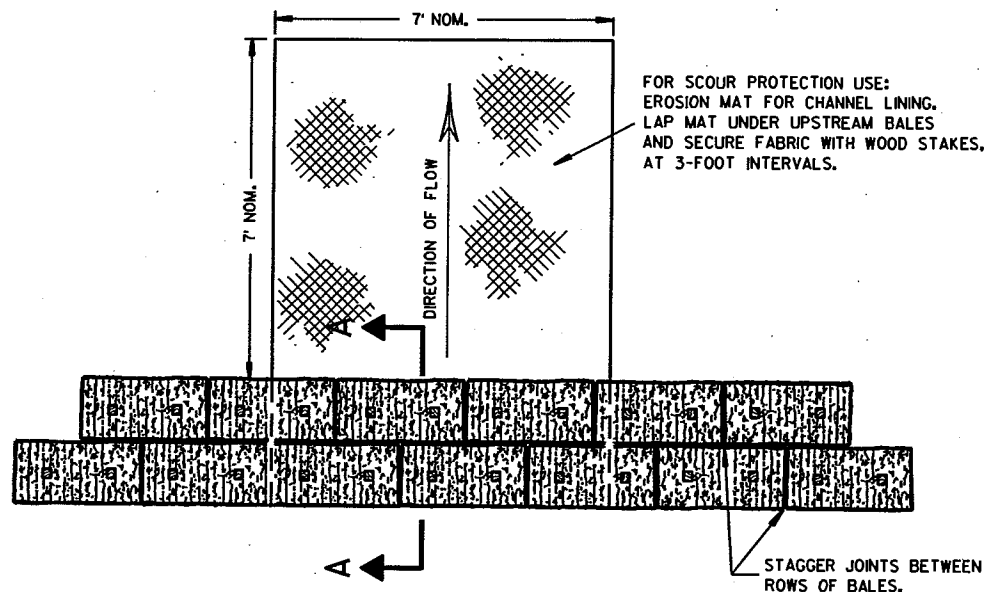

PLAN VIEW

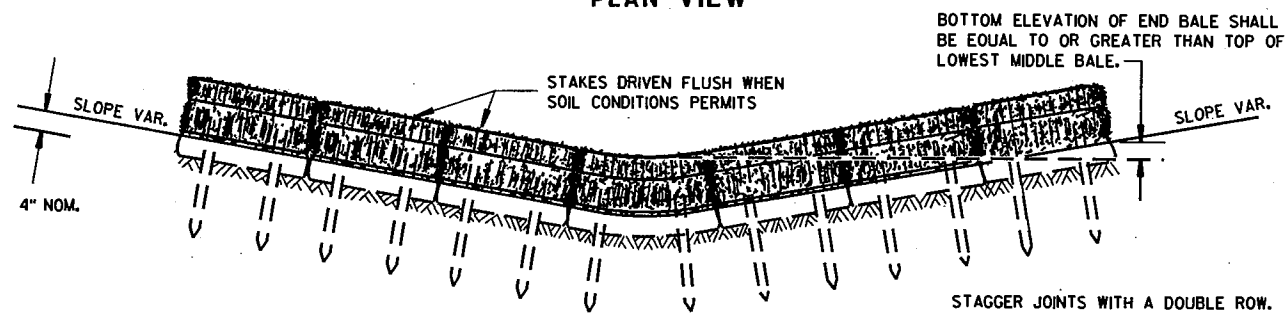


FRONT ELEVATION

TEMPORARY DITCH CHECK USING EROSION BALES ①

GENERAL NOTES

DETAILS OF CONSTRUCTION, MATERIALS AND WORKMANSHIP NOT SHOWN ON THIS DRAWING SHALL CONFORM TO THE PERTINENT REQUIREMENTS OF THE STANDARD SPECIFICATIONS AND THE APPLICABLE SPECIAL PROVISIONS.


- ① TEMPORARY DITCH CHECKS EITHER EROSION BALES OR MANUFACTURED SHALL BE PAID FOR UNDER THE BID ITEM OF TEMPORARY DITCH CHECK. THE DEPARTMENT WILL NOT PAY FOR TEMPORARY DITCH CHECKS CONSTRUCTED OF A SINGLE ROW OF EROSION BALES.

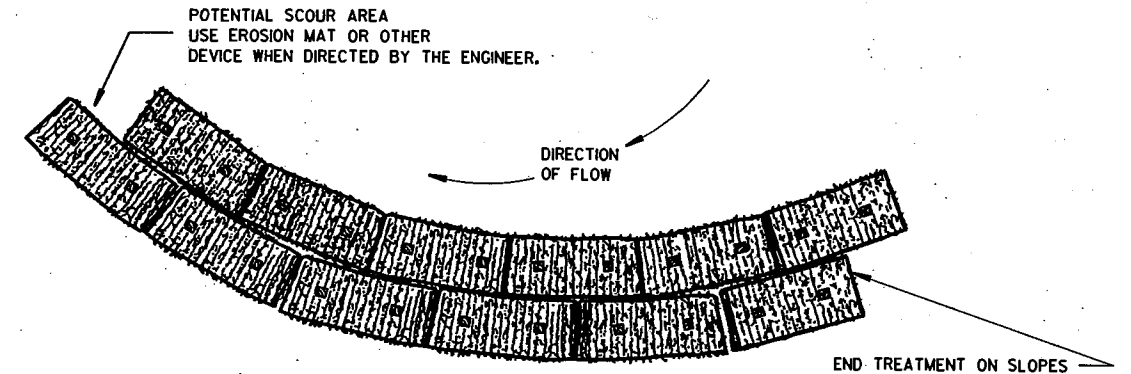


PLAN VIEW

WHEN ALTERING THE DIRECTION OF FLOW

END TREATMENT ON SLOPES TO BE SIMILAR TO CHANNEL FLOW DETAIL.

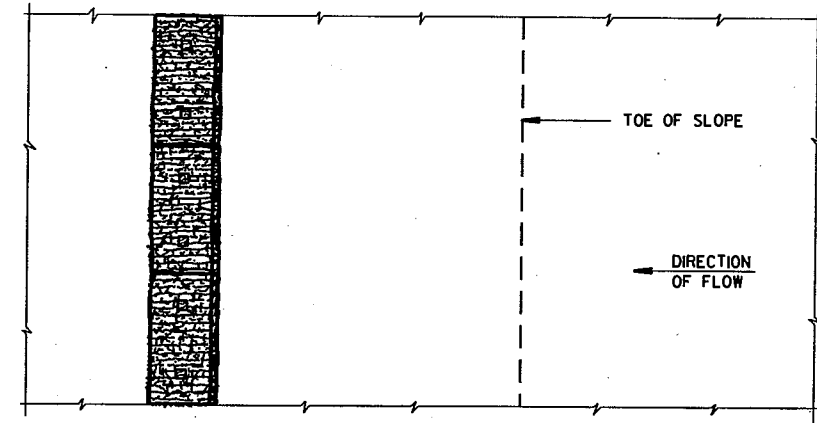

PLAN VIEW

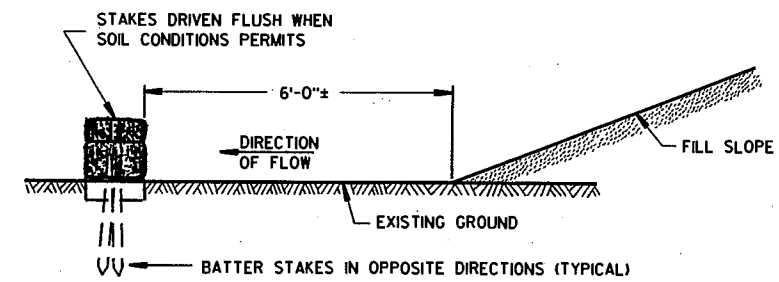

FRONT ELEVATION

WHEN EXISTING GROUND SLOPES AWAY FROM FILL SLOPE

EROSION BALES FOR SHEET FLOW


TYPICAL INSTALLATIONS OF EROSION BALES / TEMPORARY DITCH CHECKS

STATE OF WISCONSIN
DEPARTMENT OF TRANSPORTATION

APPROVED

DATE _____
CHIEF ROADWAY DEVELOPMENT ENGINEER

FHWA

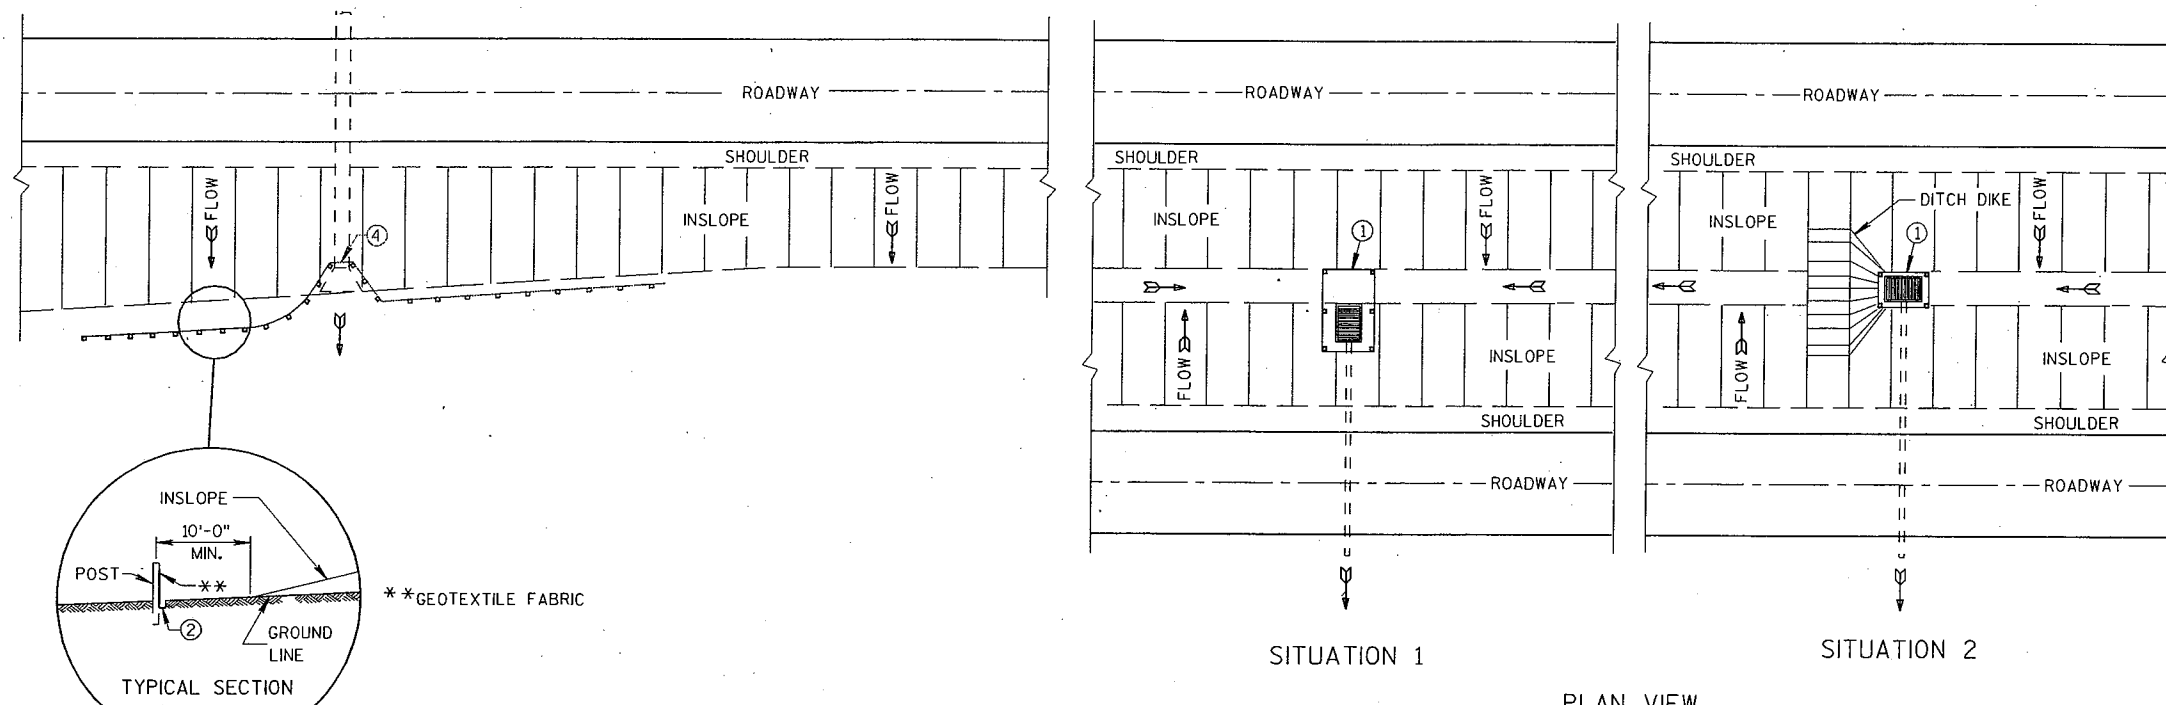


GENERAL NOTES



DETAILS OF CONSTRUCTION NOT SHOWN ON THIS DRAWING SHALL CONFORM TO THE PERTINENT REQUIREMENTS OF THE STANDARD SPECIFICATIONS AND APPLICABLE SPECIAL PROVISIONS.

- ① HORIZONTAL BRACE REQUIRED WITH 2" X 4" WOODEN FRAME OR EQUIVALENT AT TOP OF POSTS.
- ② TRENCH SHALL BE A MINIMUM OF 4" WIDE & 6" DEEP TO BURY AND ANCHOR THE GEOTEXTILE FABRIC. FOLD MATERIAL TO FIT TRENCH AND BACKFILL & COMPACT TRENCH WITH EXCAVATED SOIL.
- ③ WOOD POSTS SHALL BE A MINIMUM SIZE OF 1 1/8" X 1 1/8" OF OAK OR HICKORY.
- ④ SILT FENCE TO EXTEND ACROSS THE TOP OF THE PIPE.


SITUATION 1
SITUATION 2
PLAN VIEW
SILT FENCE AT MEDIAN SURFACE DRAINS

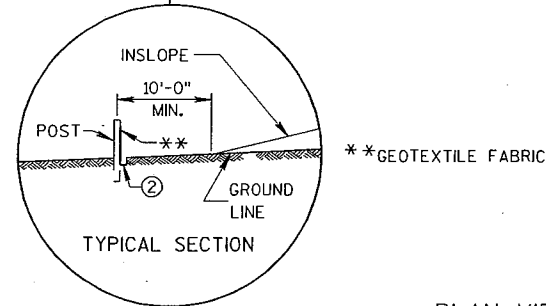

TYPICAL SECTION
PLAN VIEW
TYPICAL APPLICATION OF SILT FENCE

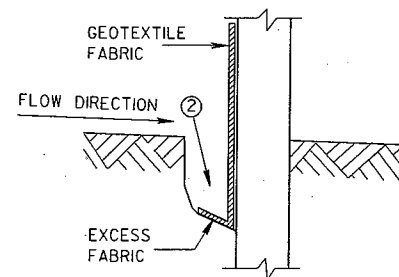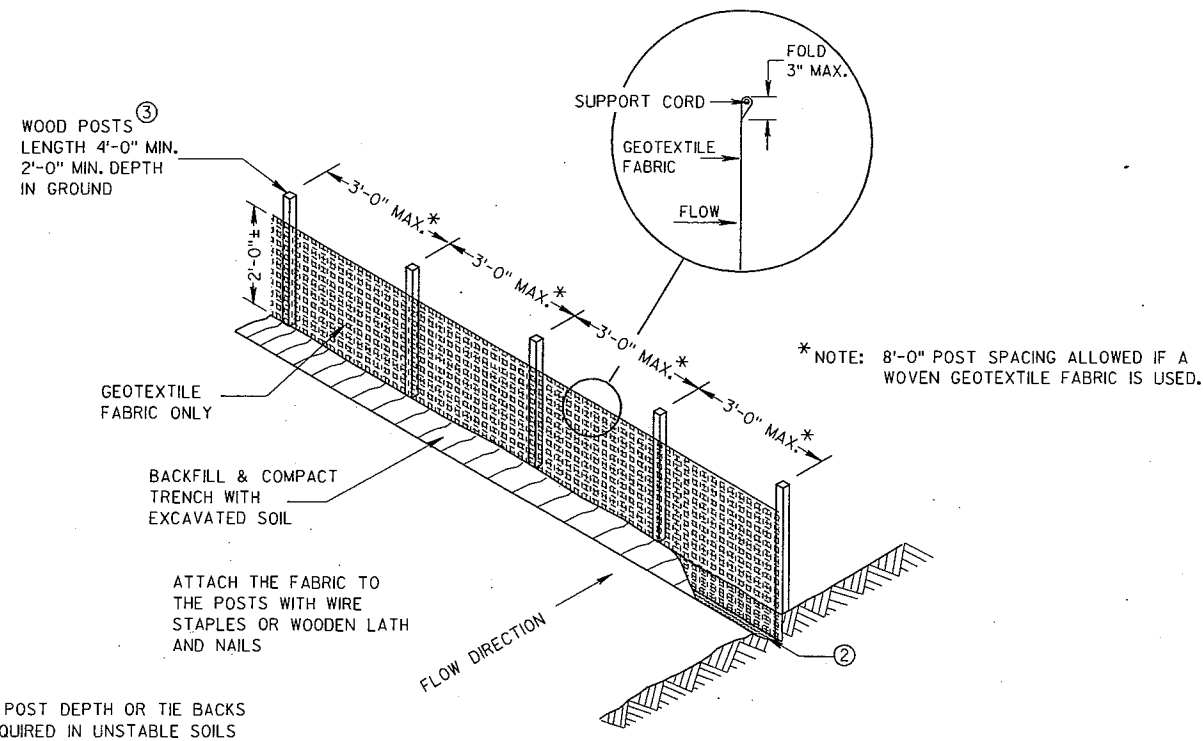

TRENCH DETAIL

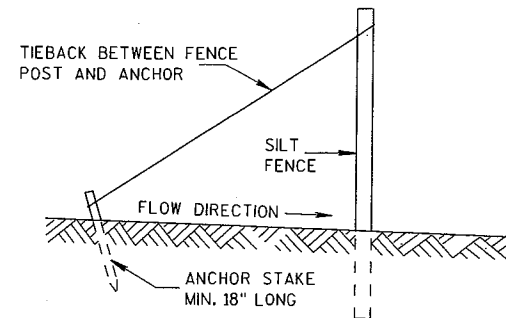


SILT FENCE TIE BACK
(WHEN REQUIRED BY THE ENGINEER)

NOTE: ADDITIONAL POST DEPTH OR TIE BACKS MAY BE REQUIRED IN UNSTABLE SOILS



SILT FENCE

SILT FENCE	
STATE OF WISCONSIN DEPARTMENT OF TRANSPORTATION	
APPROVED	
DATE _____	CHIEF ROADWAY DEVELOPMENT ENGINEER
FHWA	

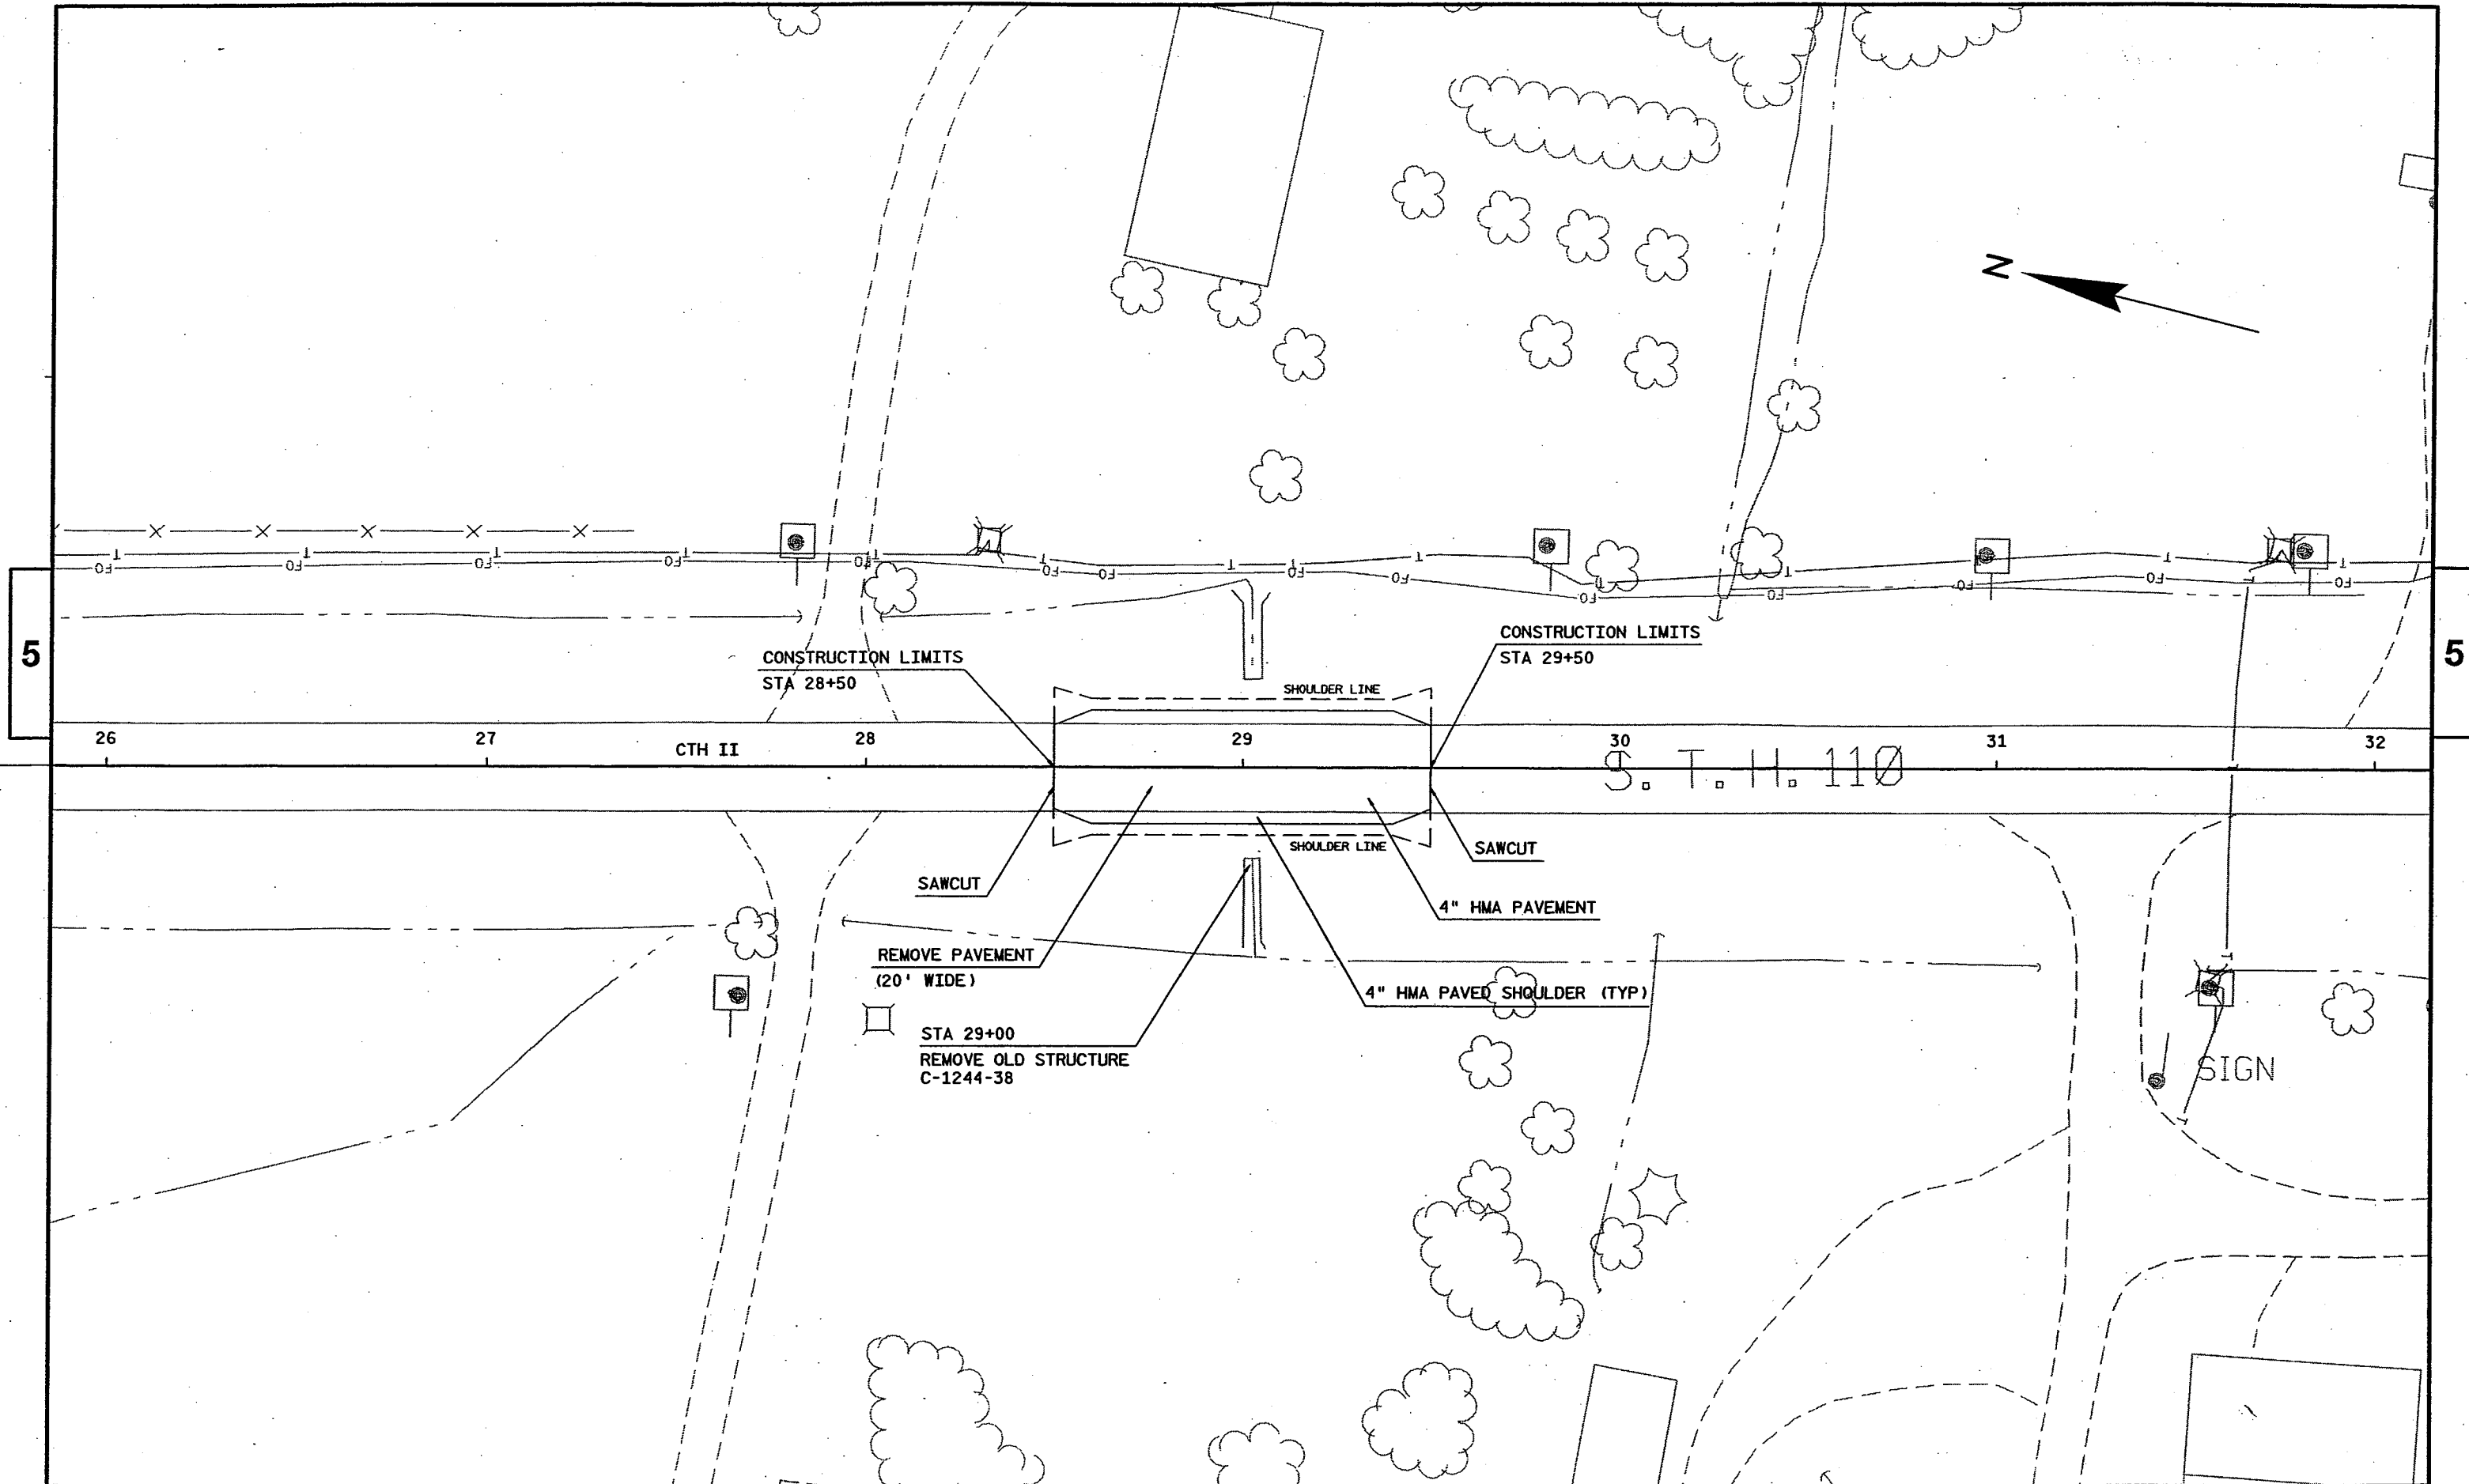




5

5

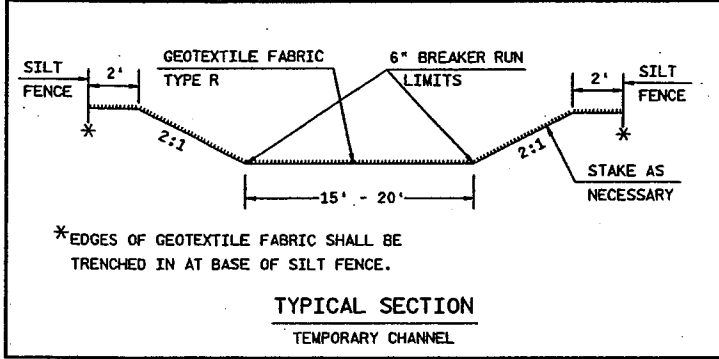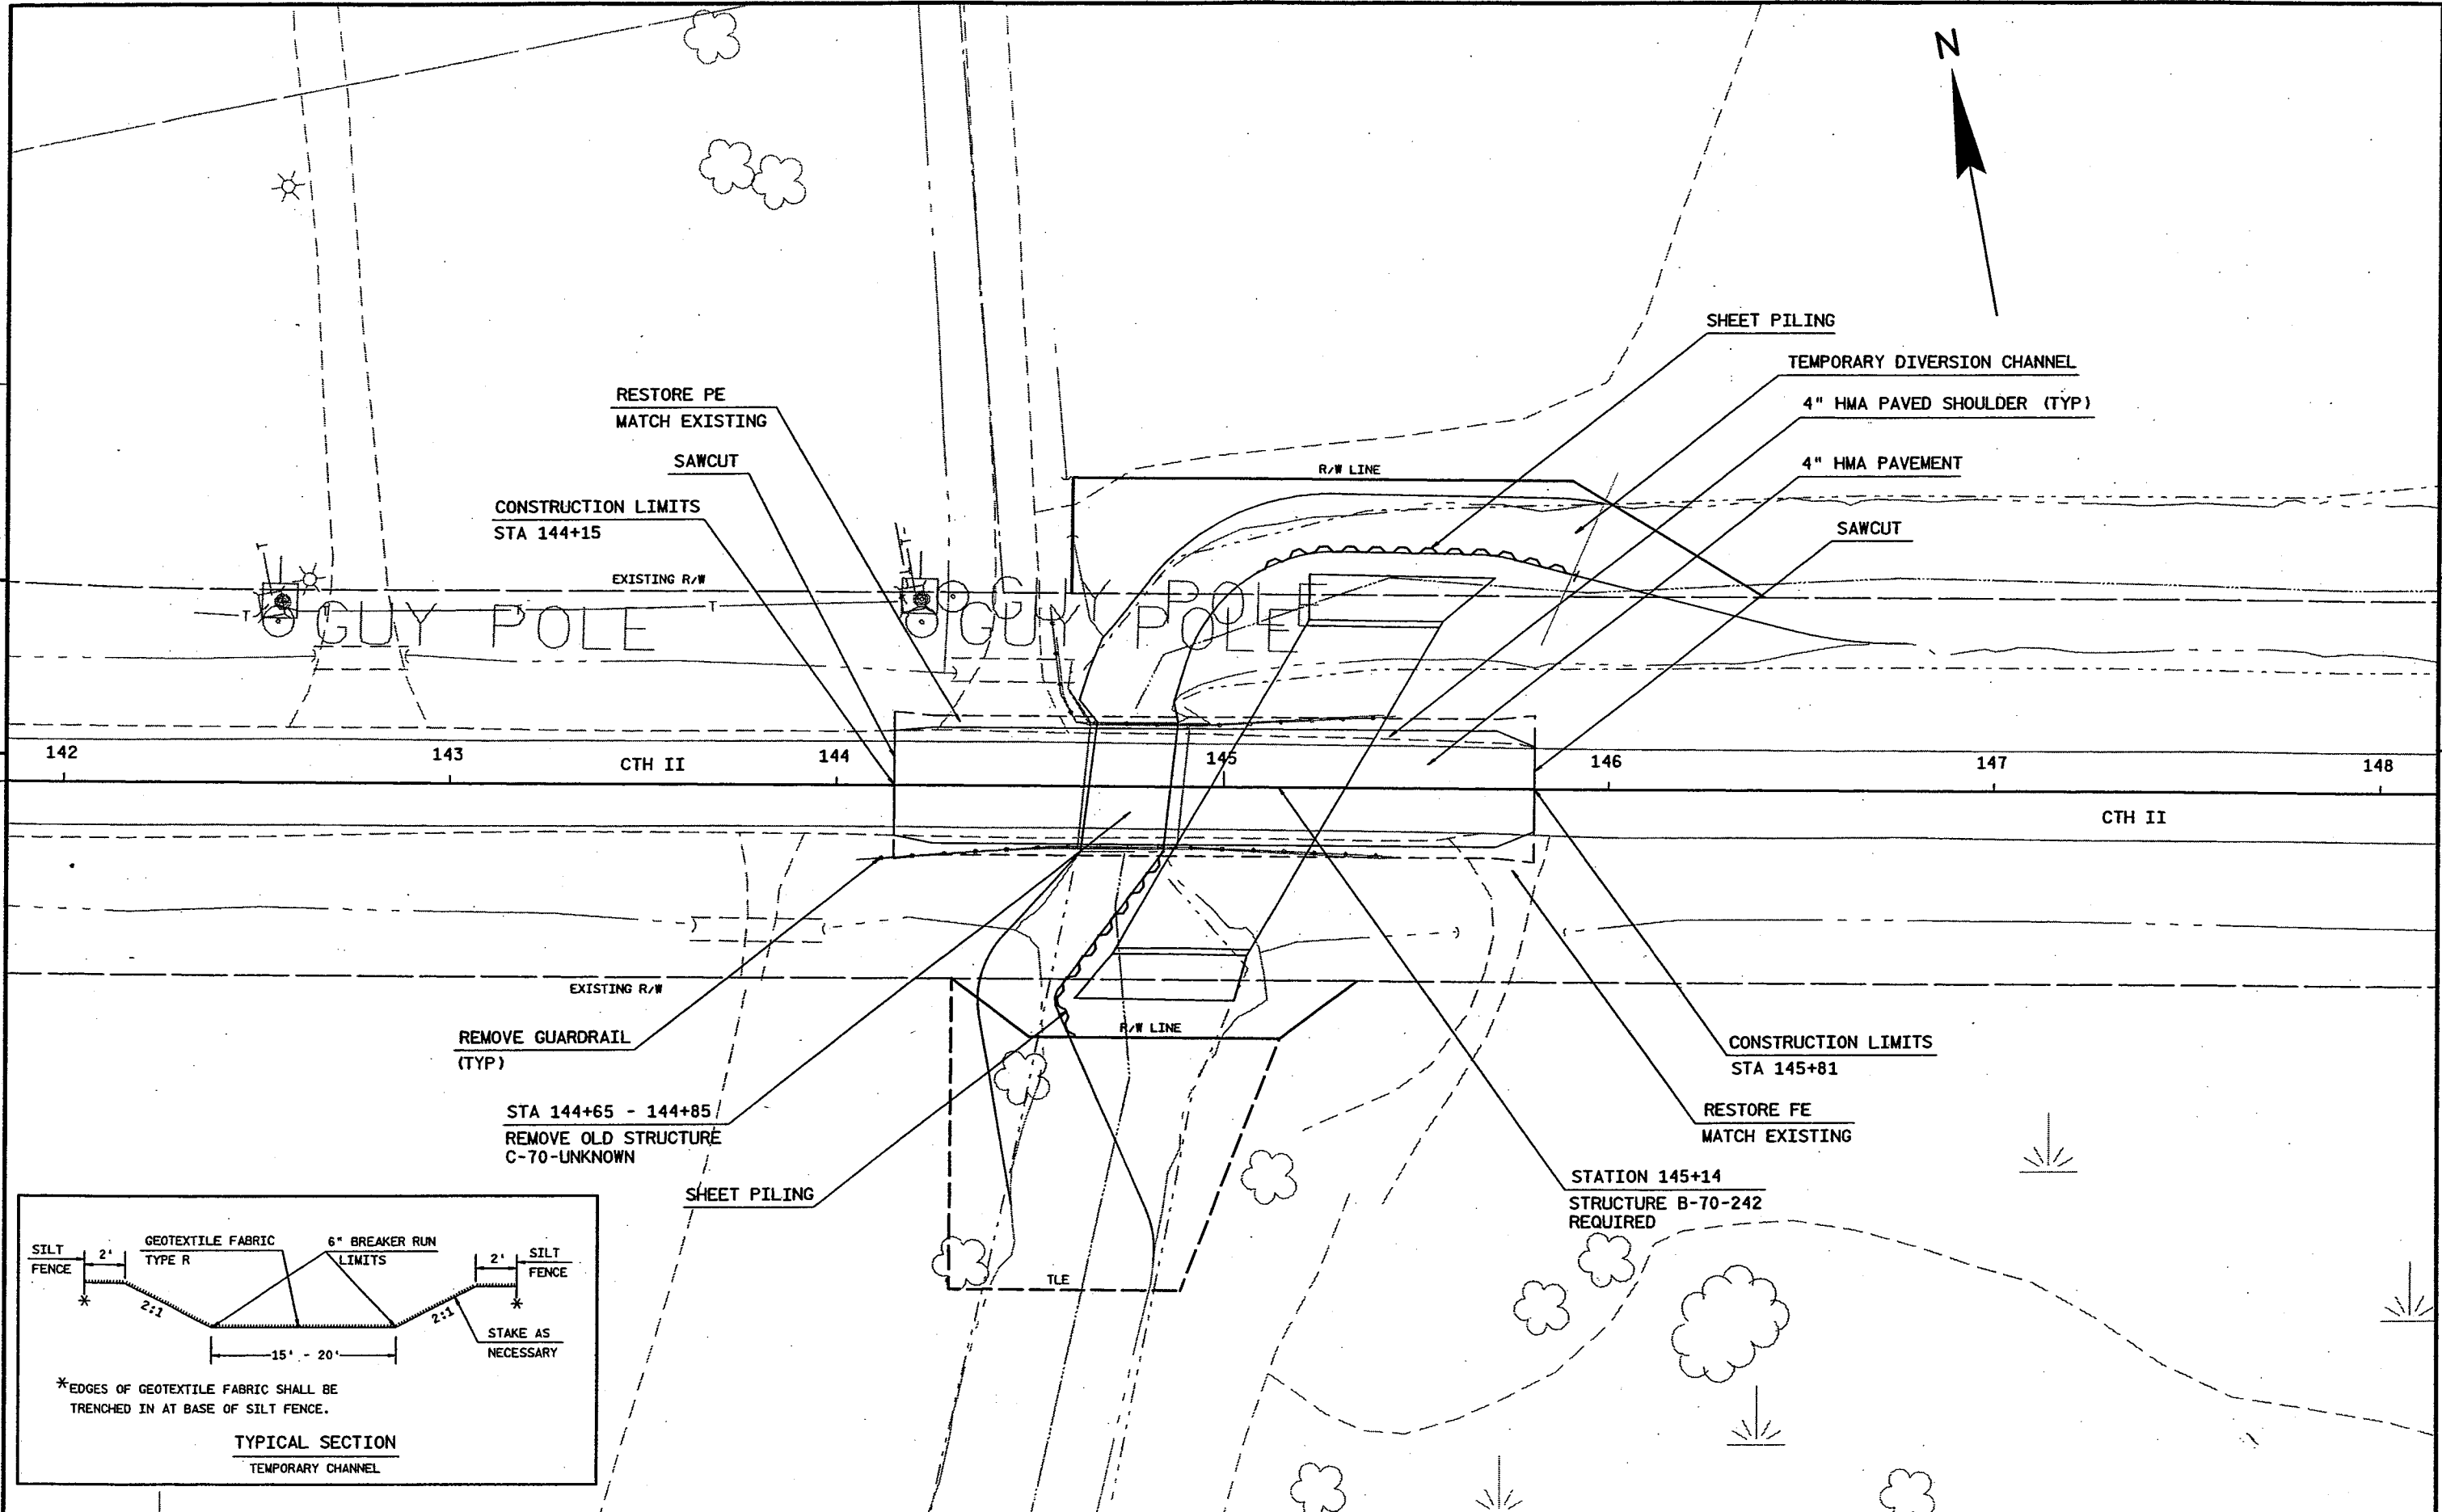

* TEMPORARY DIVERSION CHANNEL MAY BE REQUIRED DEPENDING ON AMOUNT OF FLOW IN CHANNEL AT TIME OF CONSTRUCTION.

* POTENTIAL TEMPORARY DIVERSION CHANNEL

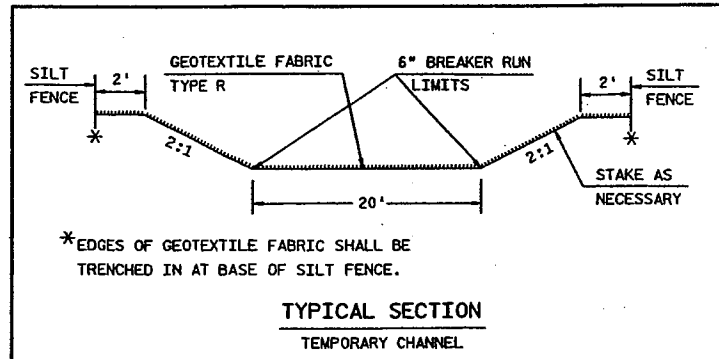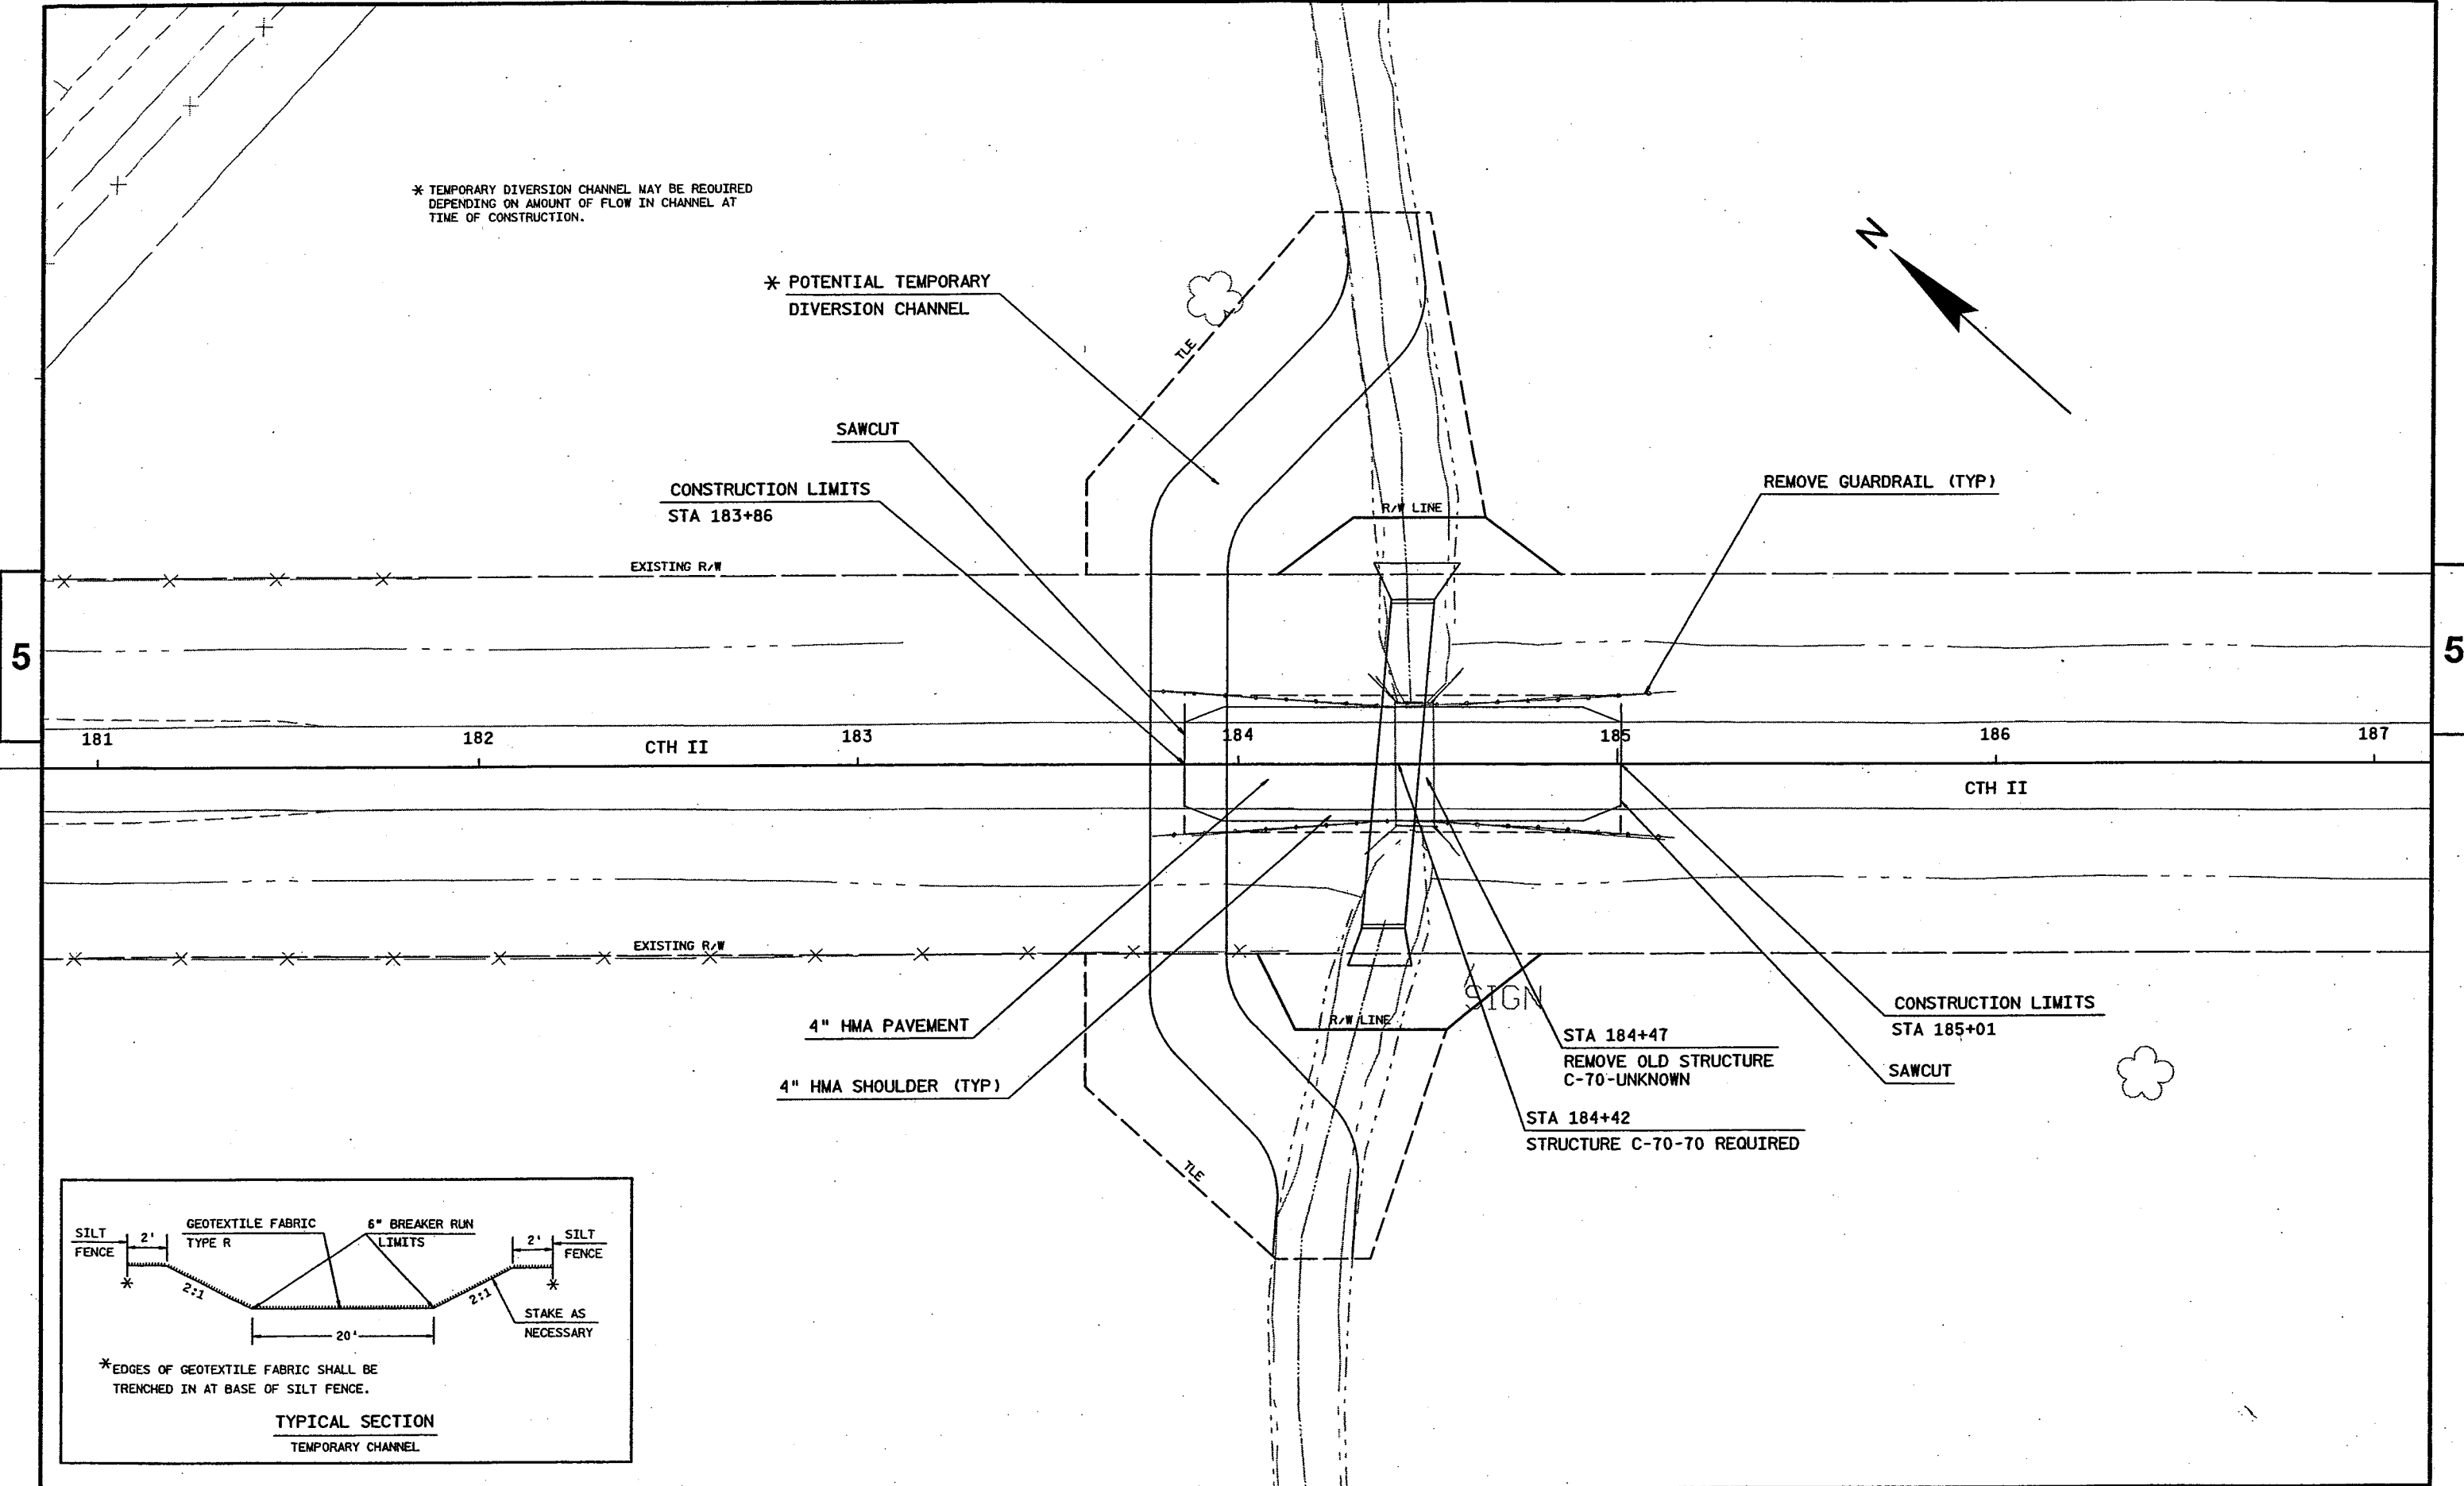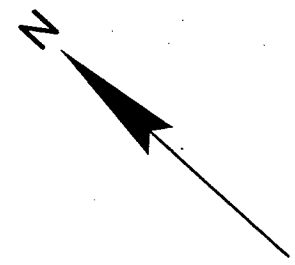

* TEMPORARY DIVERSION CHANNEL MAY BE REQUIRED DEPENDING ON AMOUNT OF FLOW IN CHANNEL AT TIME OF CONSTRUCTION.


* POTENTIAL TEMPORARY DIVERSION CHANNEL

REMOVE GUARDRAIL (TYP)

CONSTRUCTION LIMITS
STA 276+13

SAWCUT

STA 276+84
STRUCTURE C-70-69 REQUIRED

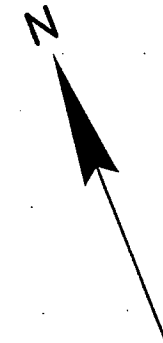

5

5

274 275 276 277 278 279 280

CTH II

277+22.87 CTH II
80+00.00 TOWN LINE RD

EXISTING R/W


SAWCUT


4" HMA PAVEMENT



4" HMA PAVED SHOULDER (TYP)

CONSTRUCTION LIMITS
STA 277+12



STA 276+76
REMOVE OLD STRUCTURE
C-70-24

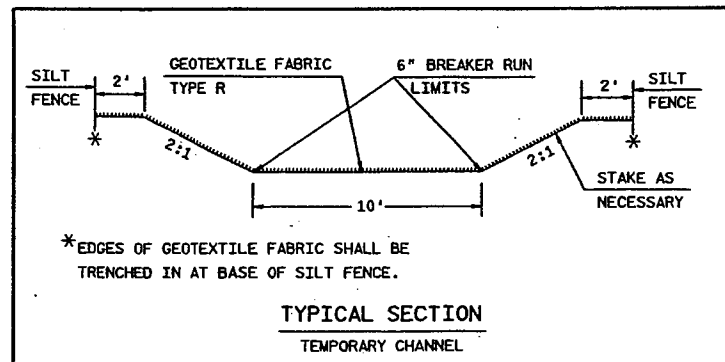


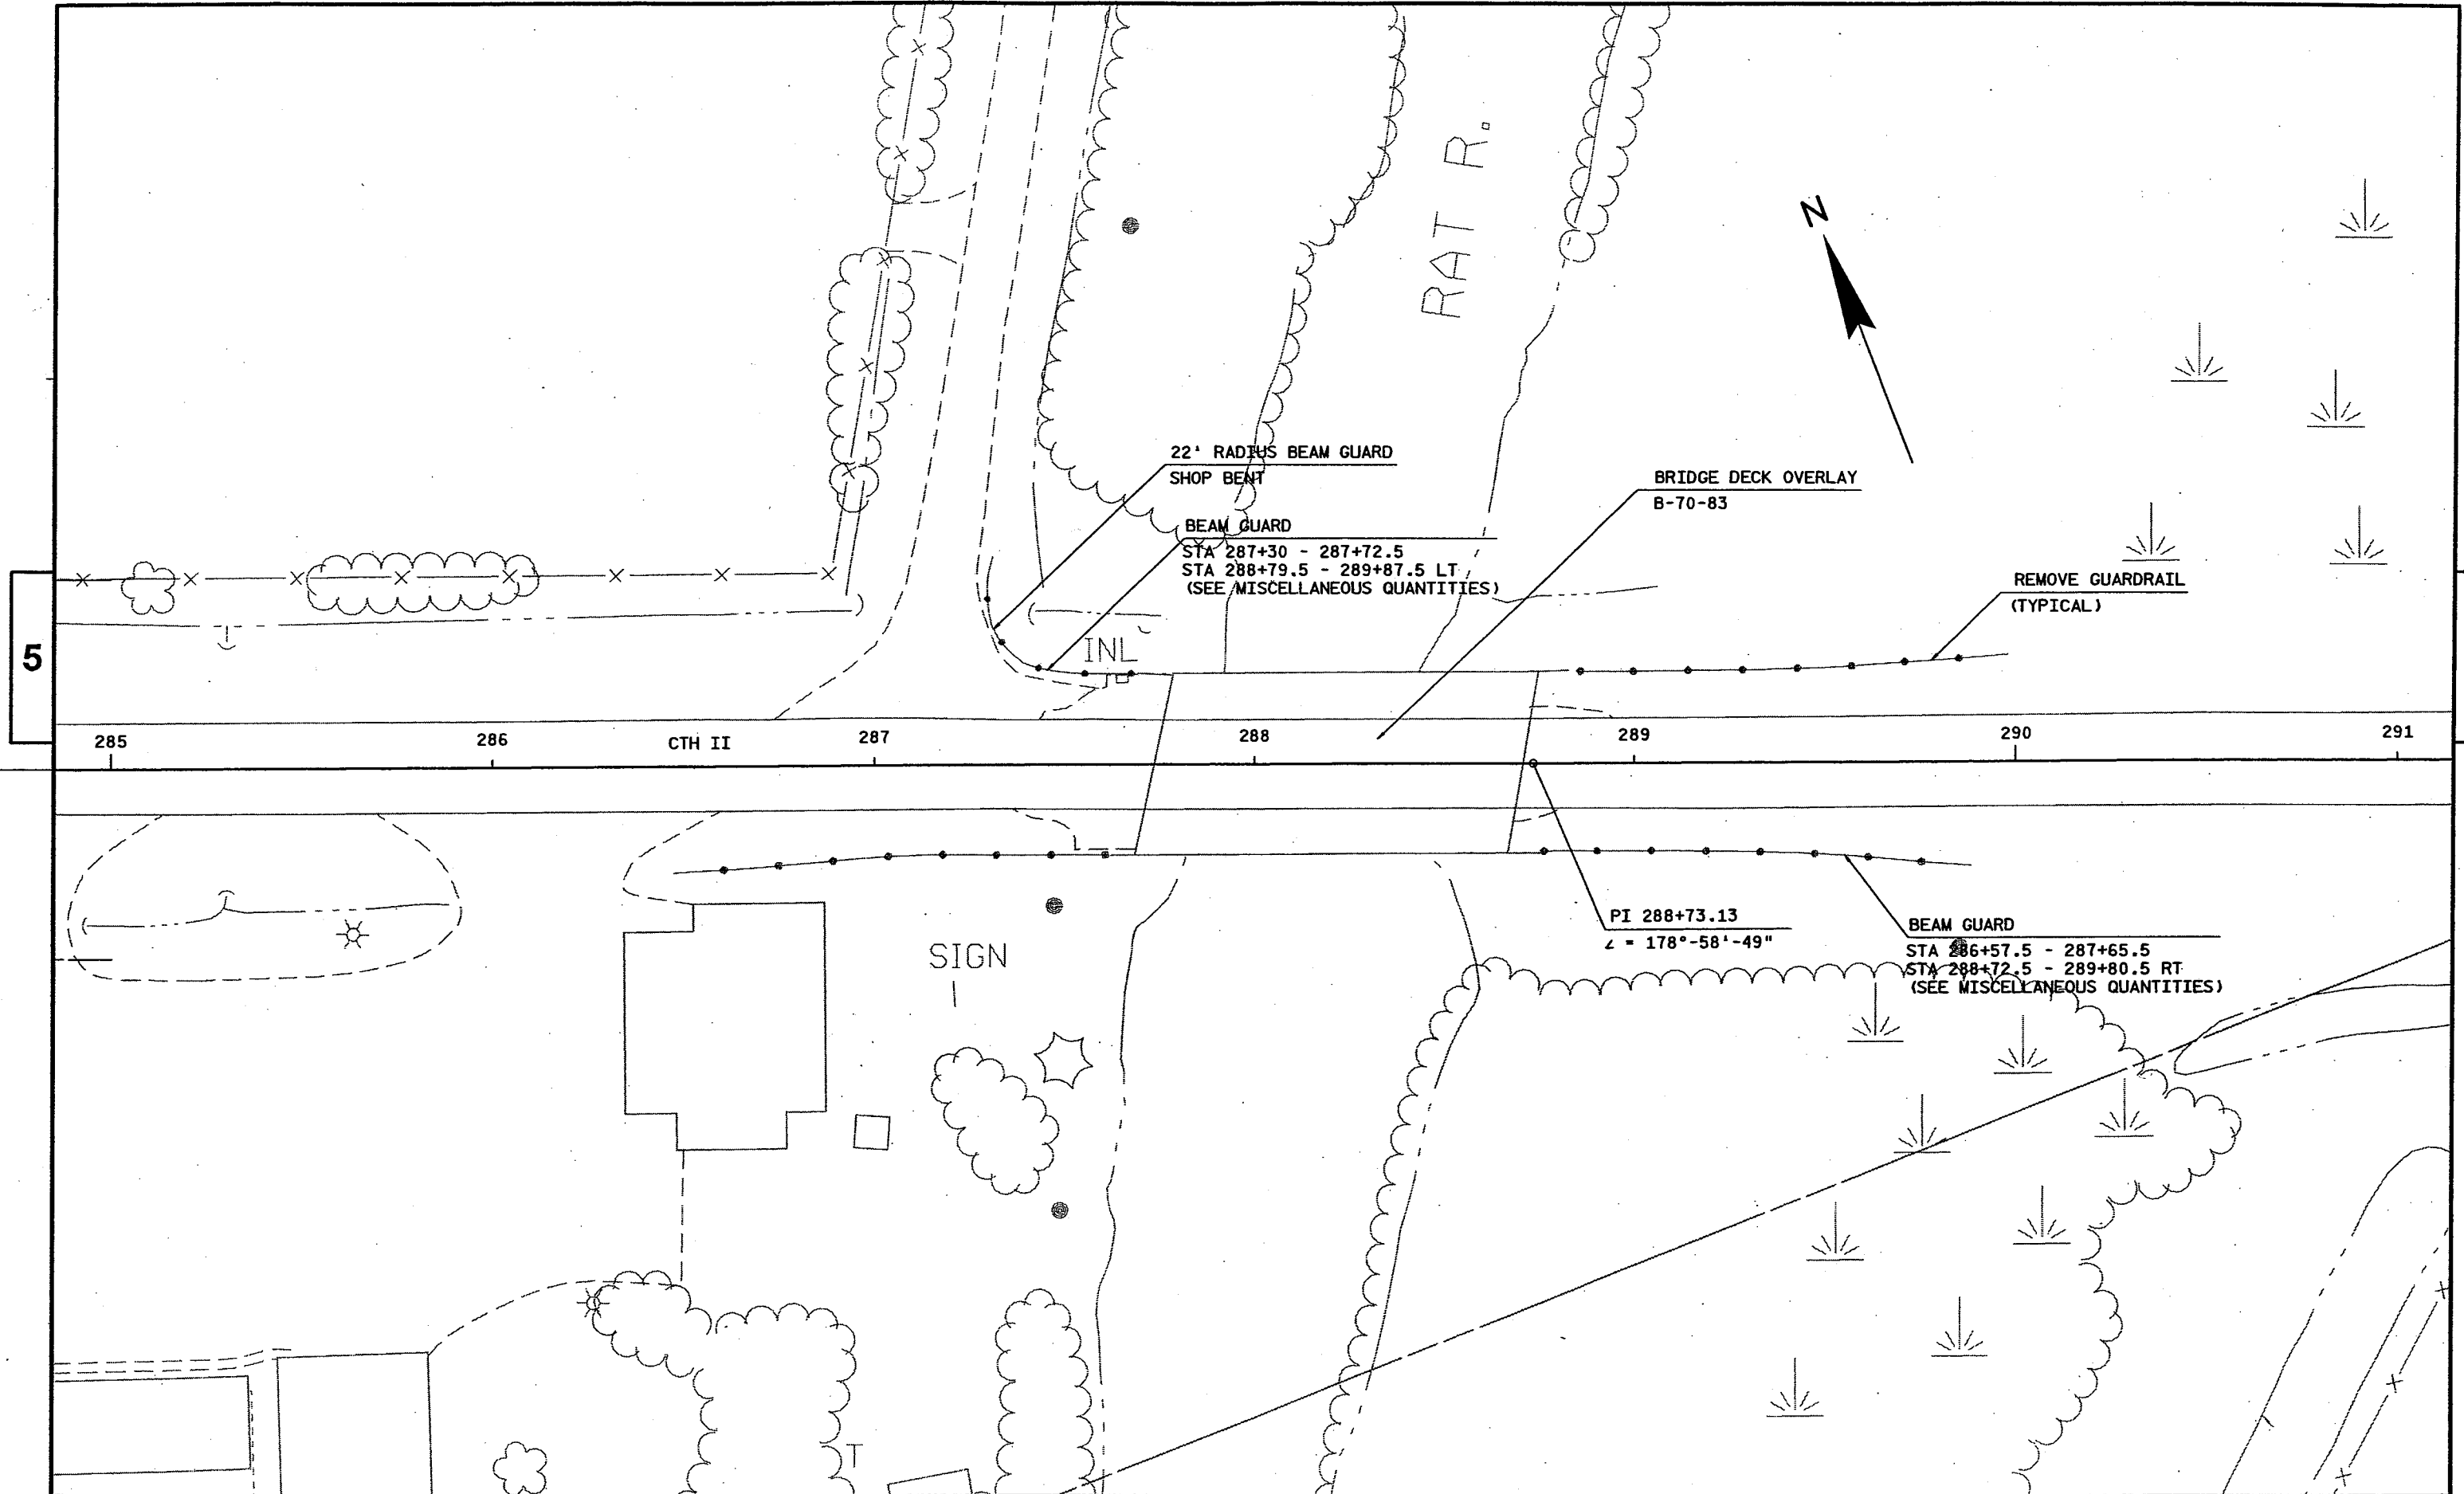

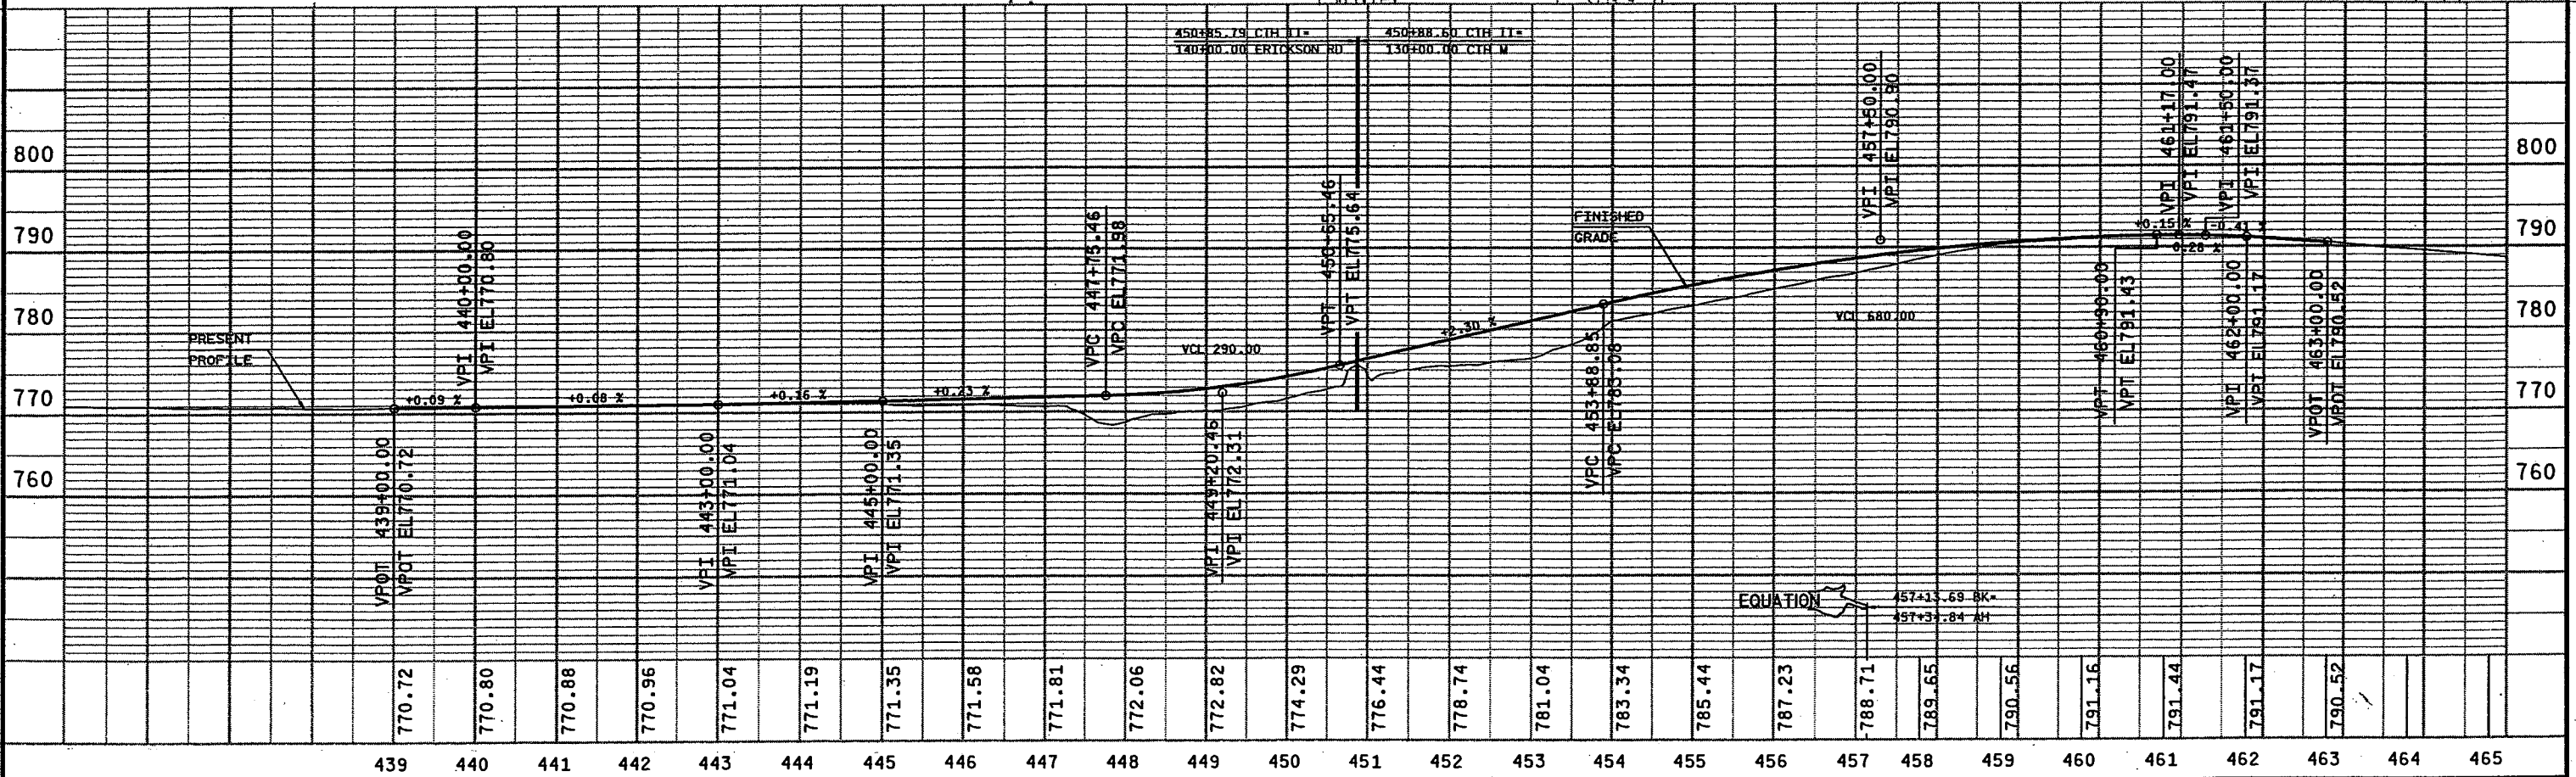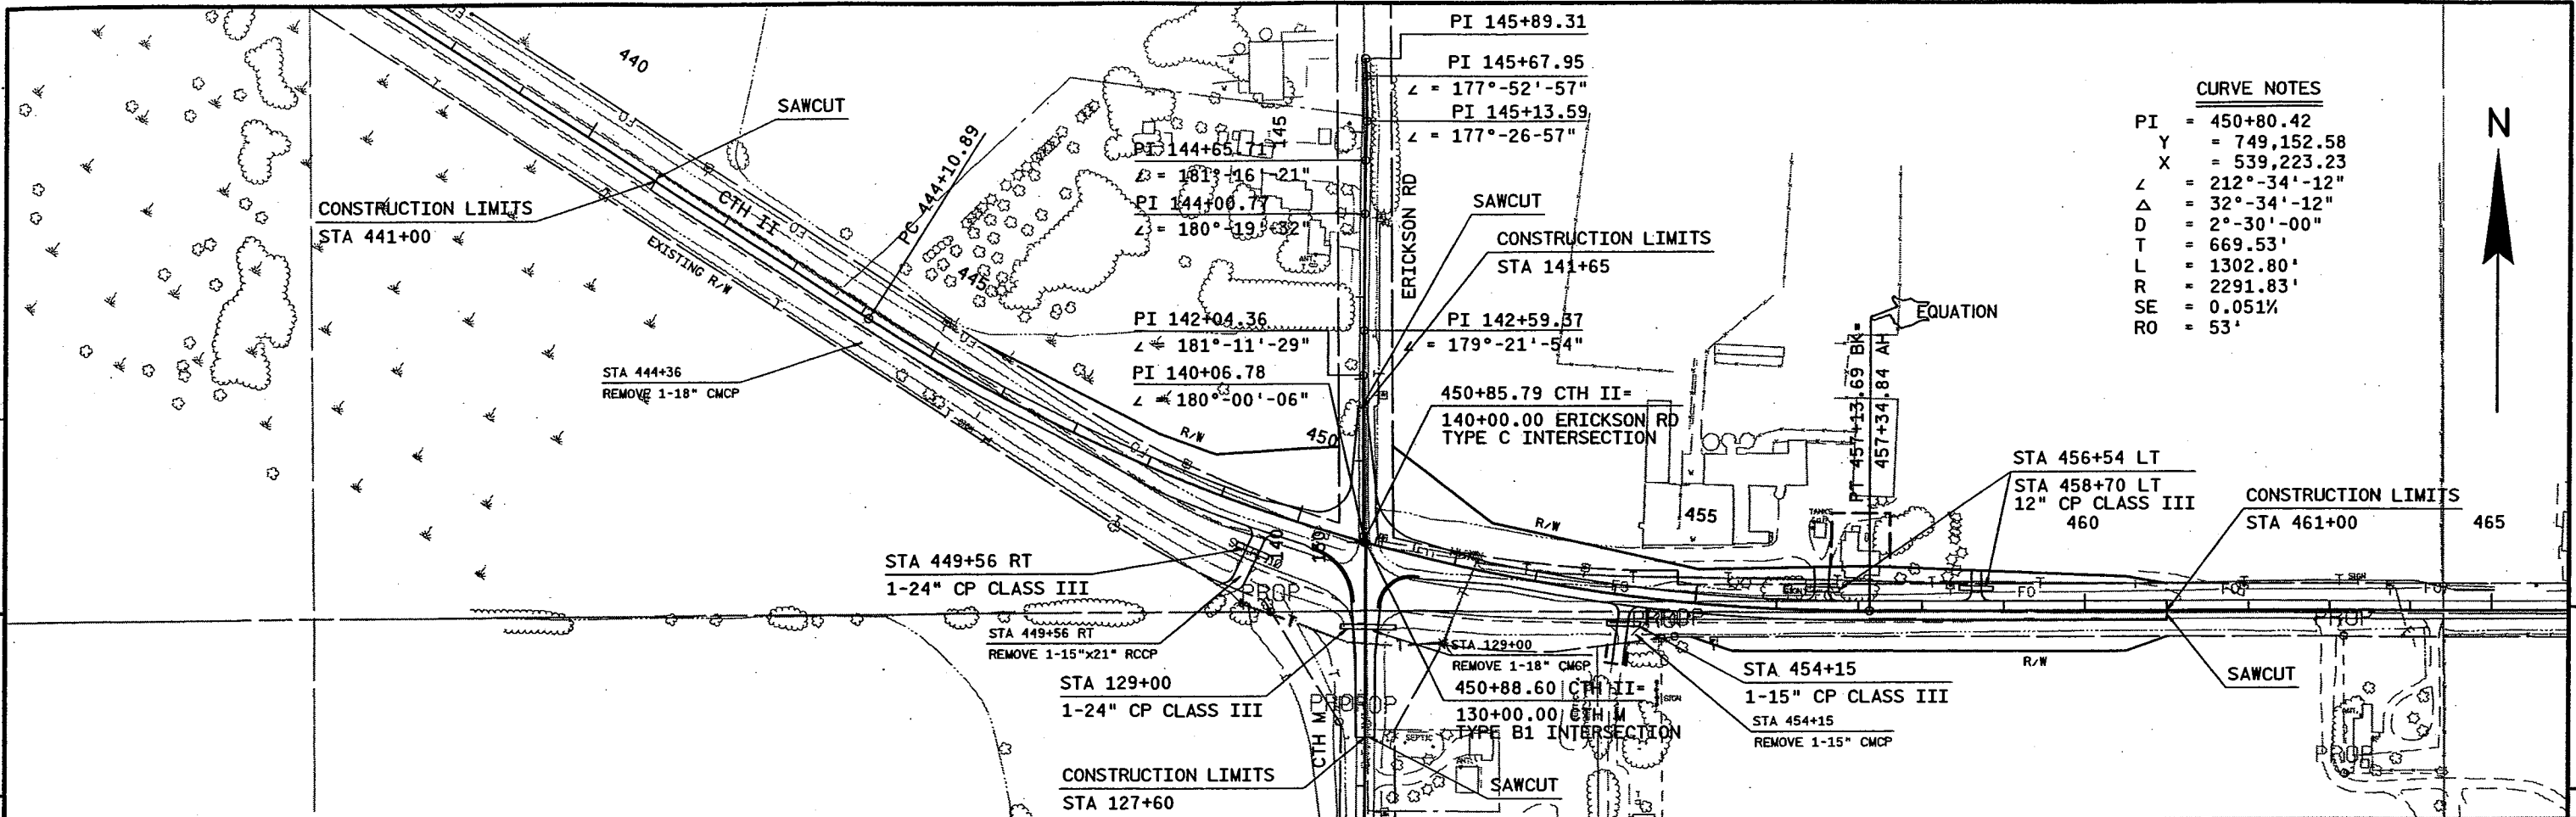

PROJECT NO: 6200-07-71 HWY: STH 110 COUNTY: WINNEBAGO PLAN AND PROFILE SHEET **E**

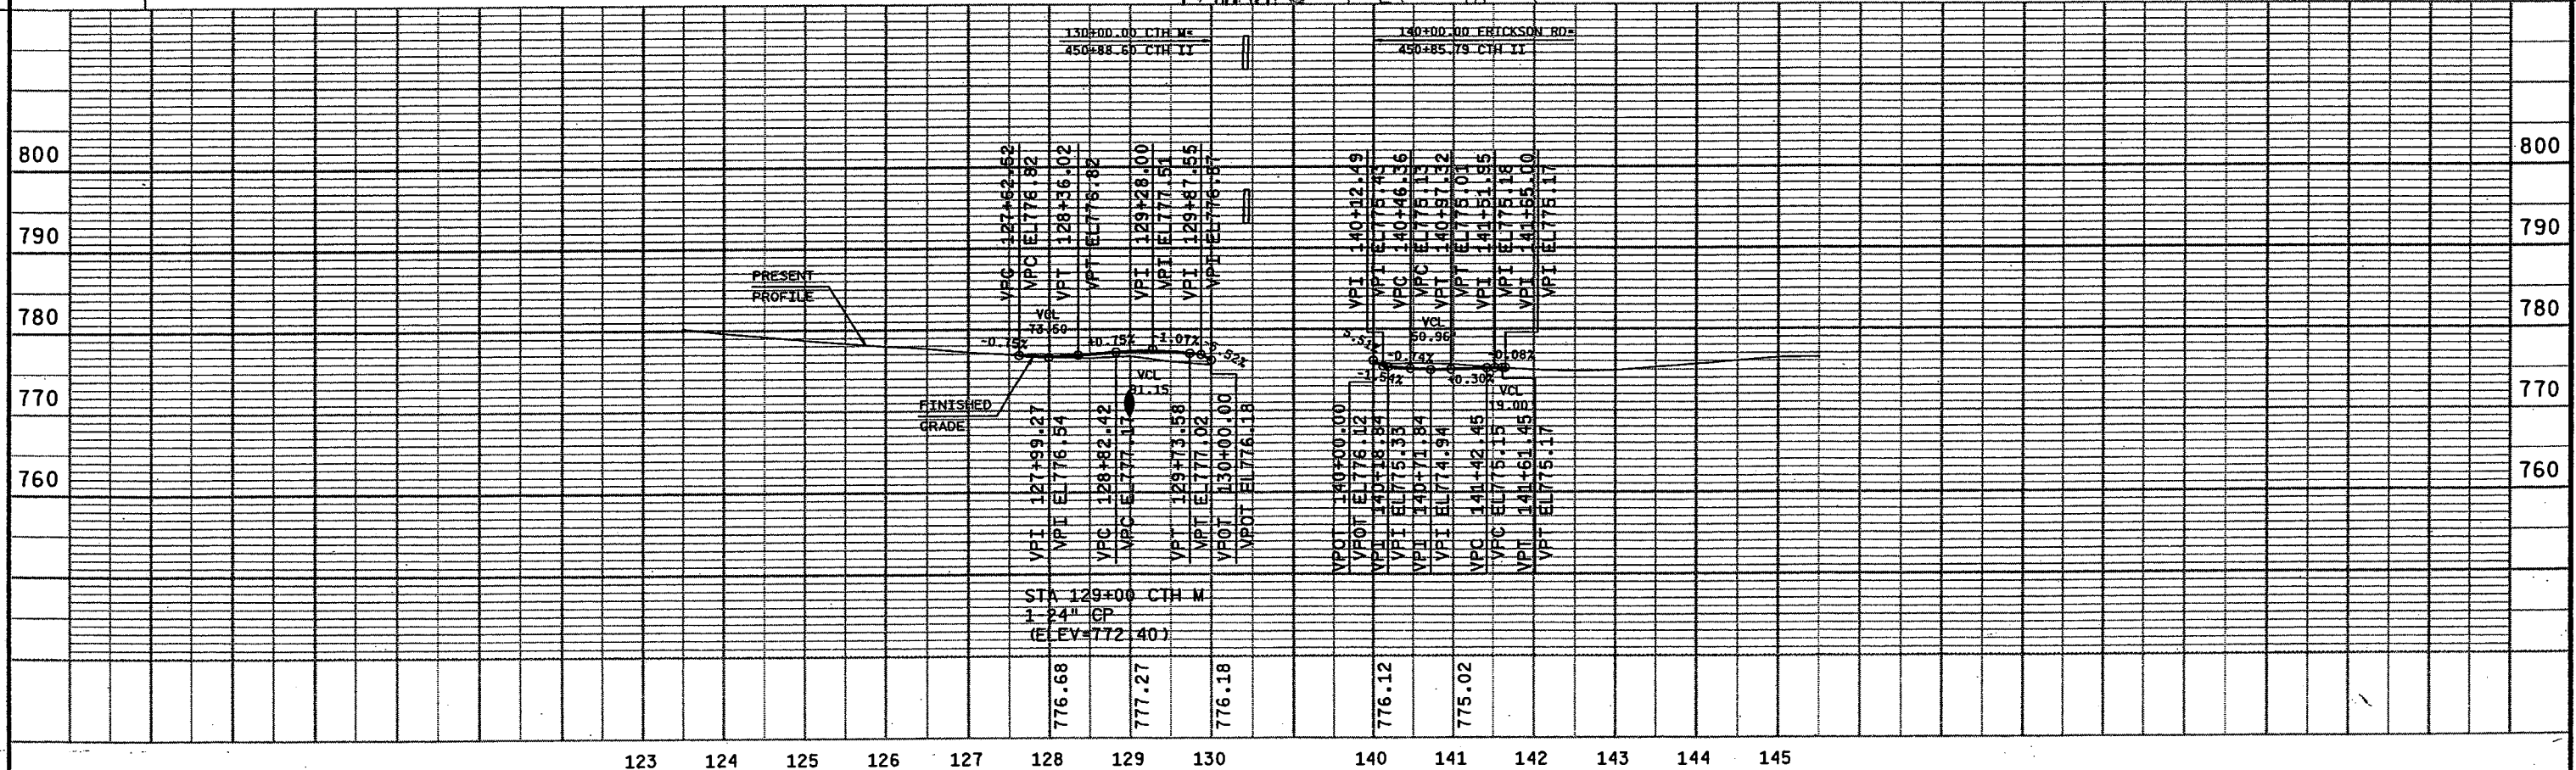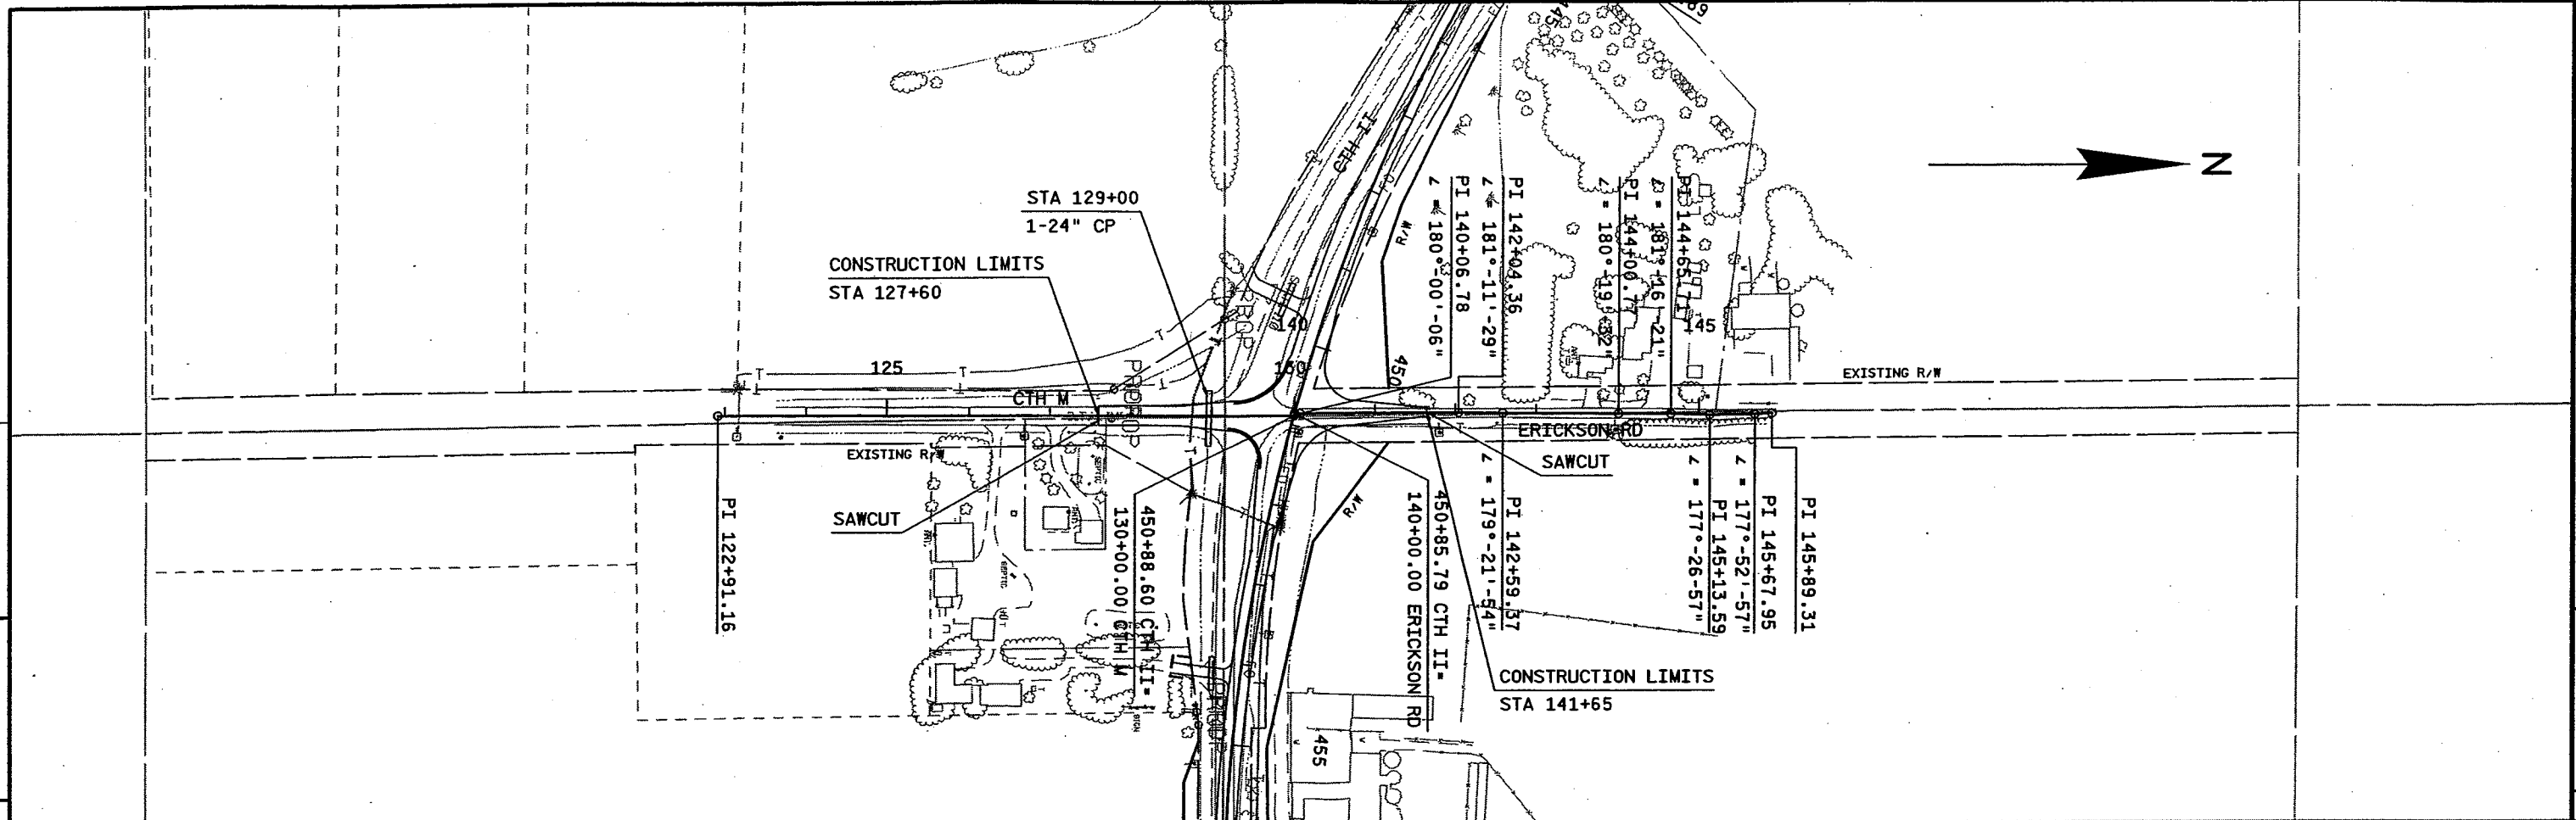


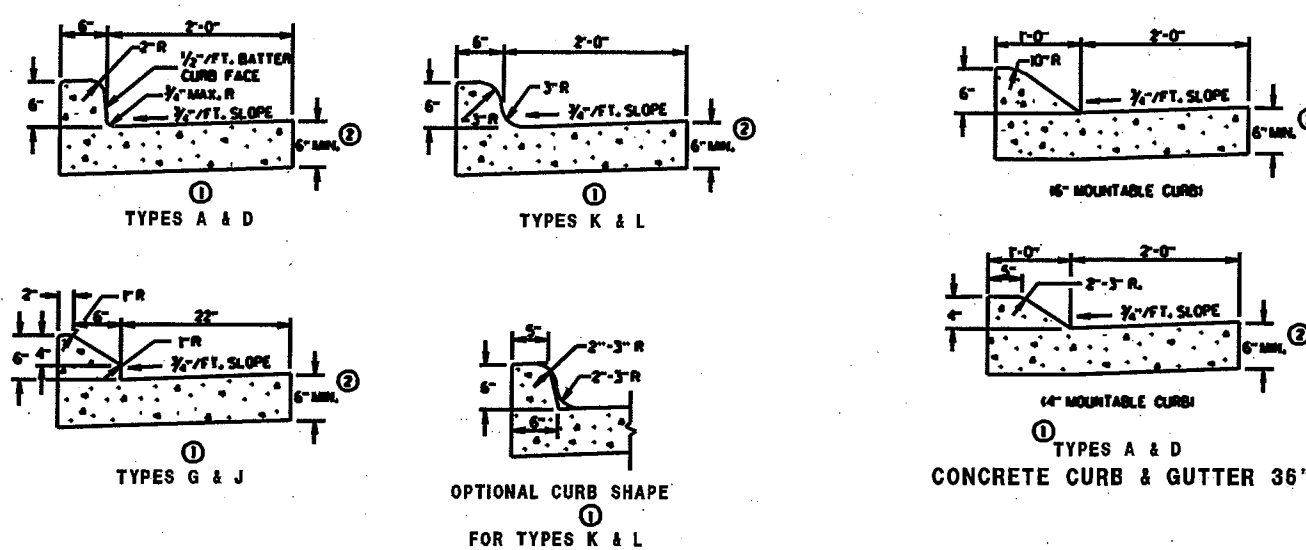


① TYPES A & D

① TYPES K & L


① 16" MOUNTABLE CURB

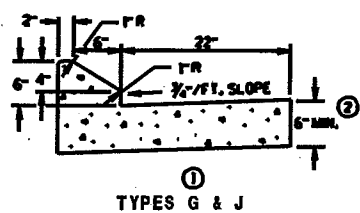

① TYPES G & J

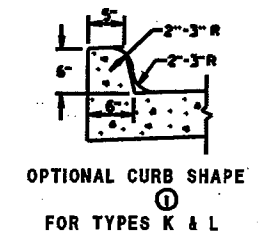


① OPTIONAL CURB SHAPE FOR TYPES K & L

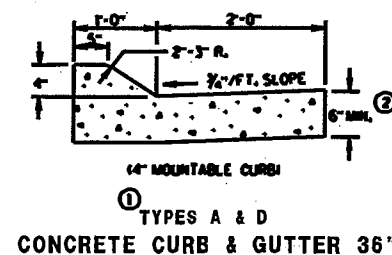


① 14" MOUNTABLE CURB
① TYPES A & D
CONCRETE CURB & GUTTER 36"


CONCRETE CURB & GUTTER 30"

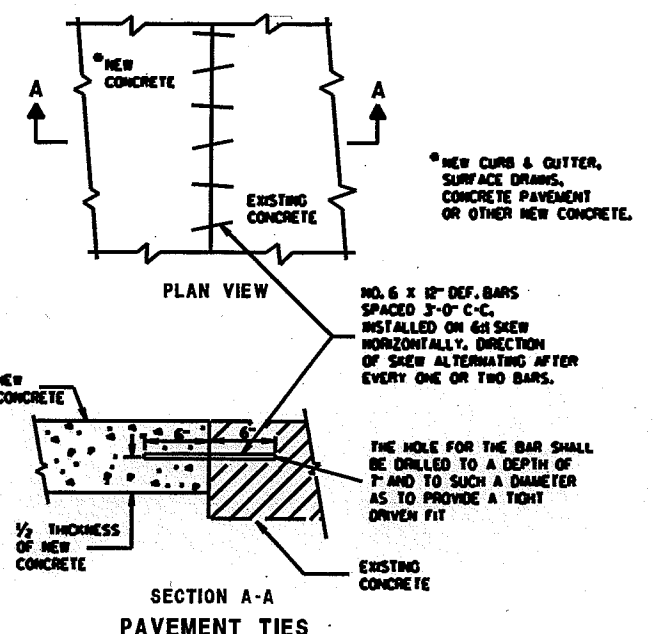


SECTION A-A
PAVEMENT TIES

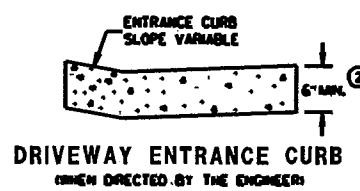


ENTRANCE CURB
SLOPE VARIABLE
②
DRIVEWAY ENTRANCE CURB
(WHEN DIRECTED BY THE ENGINEER)

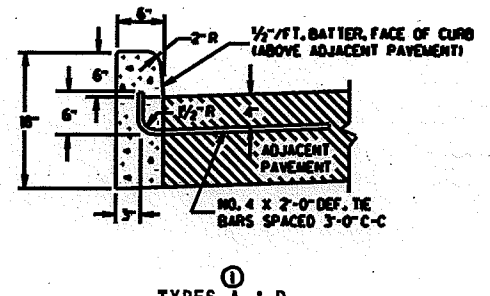

① TYPES A & D
CONCRETE CURB

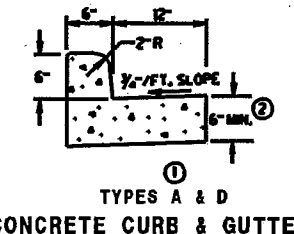


① TYPES G & J
CONCRETE CURB & GUTTER 18"

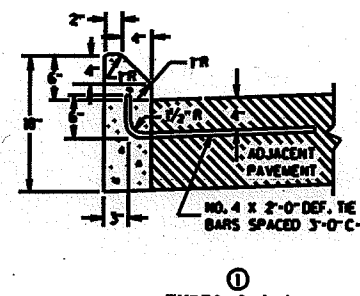


① TYPES G & J

GENERAL NOTES


- DETAILS OF CONSTRUCTION, MATERIALS AND WORKMANSHIP NOT SHOWN ON THIS DRAWING SHALL CONFORM TO THE PERTINENT REQUIREMENTS OF THE CONTRACT.
- PAVEMENT TIES AND TIE BARS SHALL BE EPOXY COATED IN CONFORMANCE WITH SUBSECTION 505.2.6.2 OF THE STANDARD SPECIFICATIONS.
- INTEGRAL CURB & GUTTER SHALL CONFORM TO THE DETAILS SHOWN FOR CONCRETE CURB & GUTTER INCLUDING THE TRANSVERSE GUTTER SLOPE. A LONGITUDINAL CONSTRUCTION JOINT IS NOT REQUIRED WITH INTEGRAL CURB AND GUTTER.
- WHERE THE TRANSVERSE JOINTS IN THE PAVEMENT ARE REQUIRED TO BE SEALED, THE JOINTS IN THE INTEGRAL CURB AND GUTTER SHALL BE SEALED TO THE FACE OF CURB WITH THE SAME TYPE OF SEALANT. THE COST OF FURNISHING AND INSTALLING THIS SEALANT SHALL BE INCIDENTAL TO THE ITEM CONCRETE CURB AND GUTTER.
- UNLESS OTHERWISE SHOWN ON THE TYPICAL CROSS SECTIONS, THE BASE COURSE AND UNCLASSIFIED EXCAVATION LIMITS ARE 2'-0" BEHIND THE BACK OF CURBS.
- ① TIE BARS ARE REQUIRED FOR CURB AND GUTTER TYPES A, G AND K.
 - ② THE BOTTOM OF CURB AND GUTTER MAY BE CONSTRUCTED EITHER LEVEL OR PARALLEL TO THE SLOPE OF THE SUBGRADE OR BASE COURSE PROVIDED A 6" MINIMUM GUTTER THICKNESS IS MAINTAINED.
 - ③ WHEN REVERSE SLOPE GUTTER IS REQUIRED, THE LOCATION(S) WILL BE SHOWN ELSEWHERE IN THE PLAN.

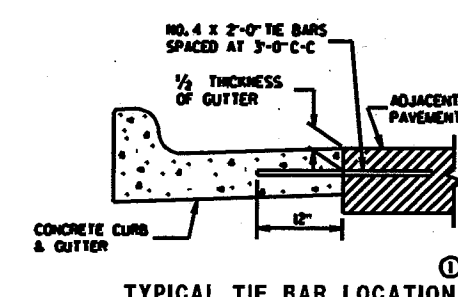

① TYPICAL TIE BAR LOCATION

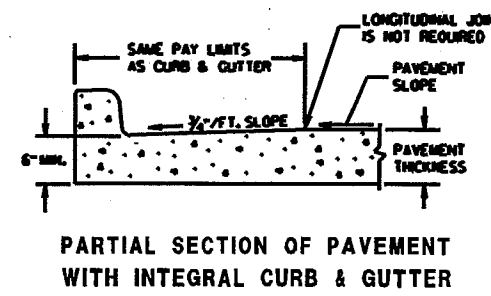

PARTIAL SECTION OF PAVEMENT WITH INTEGRAL CURB & GUTTER


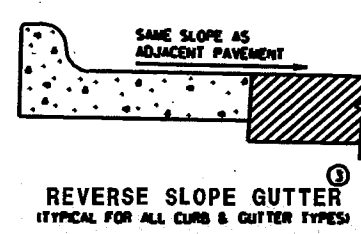


③ REVERSE SLOPE GUTTER
(TYPICAL FOR ALL CURB & GUTTER TYPES)

CONCRETE CURB, CONCRETE CURB & GUTTER AND PAVEMENT TIES	
STATE OF WISCONSIN DEPARTMENT OF TRANSPORTATION	
APPROVED	
DATE	CHIEF ROADWAY DEVELOPMENT ENGINEER
FWA:	

S.D.D. 8 D 1-13

S.D.D. 8 D 1-13

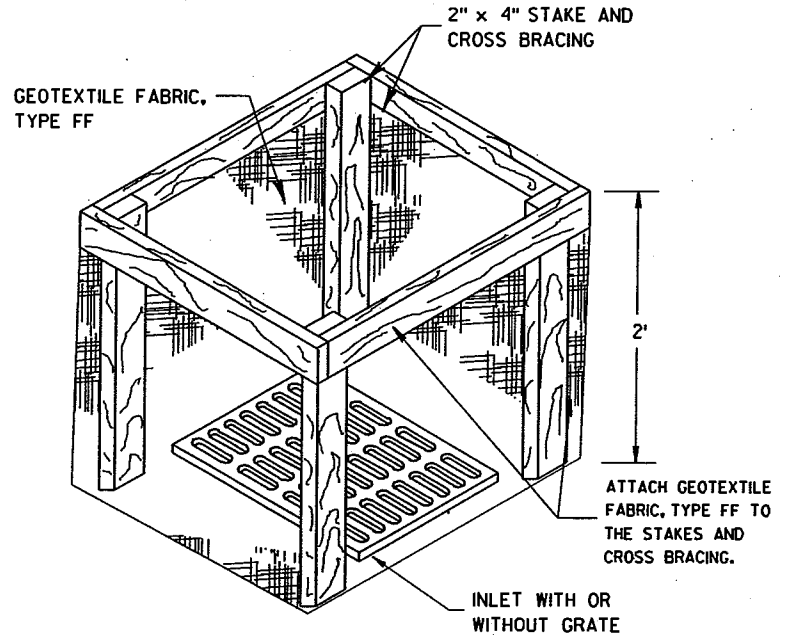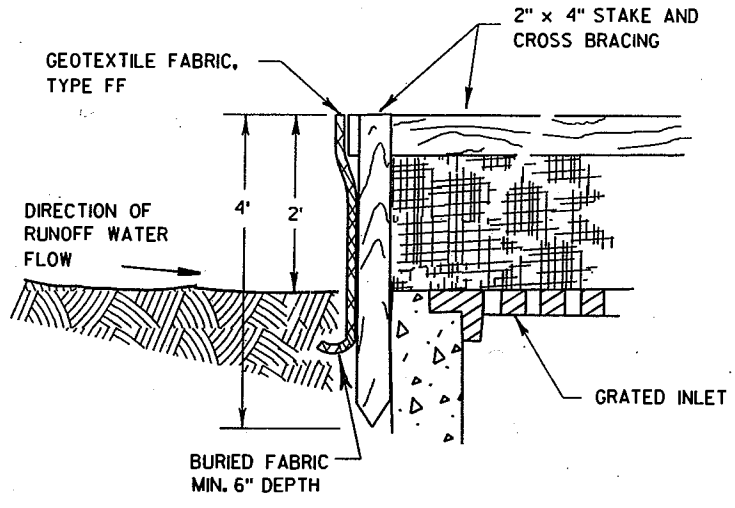

INLET PROTECTION, TYPE A


GENERAL NOTES

INLET PROTECTION DEVICES SHALL BE MAINTAINED OR REPLACED AT THE DIRECTION OF THE ENGINEER.

MANUFACTURED ALTERNATIVES APPROVED AND LISTED ON THE DEPARTMENT'S EROSION CONTROL PRODUCT ACCEPTABILITY LIST MAY BE SUBSTITUTED.


WHEN REMOVING OR MAINTAINING INLET PROTECTION, CARE SHALL BE TAKEN SO THAT THE SEDIMENT TRAPPED ON THE GEOTEXTILE FABRIC DOES NOT FALL INTO THE INLET. ANY MATERIAL FALLING INTO THE INLET SHALL BE REMOVED IMMEDIATELY.

- ① FINISHED SIZE, INCLUDING FLAP POCKETS WHERE REQUIRED, SHALL EXTEND A MINIMUM OF 10" AROUND THE PERIMETER TO FACILITATE MAINTENANCE OR REMOVAL.
- ② FOR INLET PROTECTION, TYPE C (WITH CURB BOX), AN ADDITIONAL 18" OF FABRIC IS WRAPPED AROUND THE WOOD AND SECURED WITH STAPLES. THE WOOD SHALL NOT BLOCK THE ENTIRE HEIGHT OF THE CURB BOX OPENING.
- ③ FLAP POCKETS SHALL BE LARGE ENOUGH TO ACCEPT WOOD 2X4.

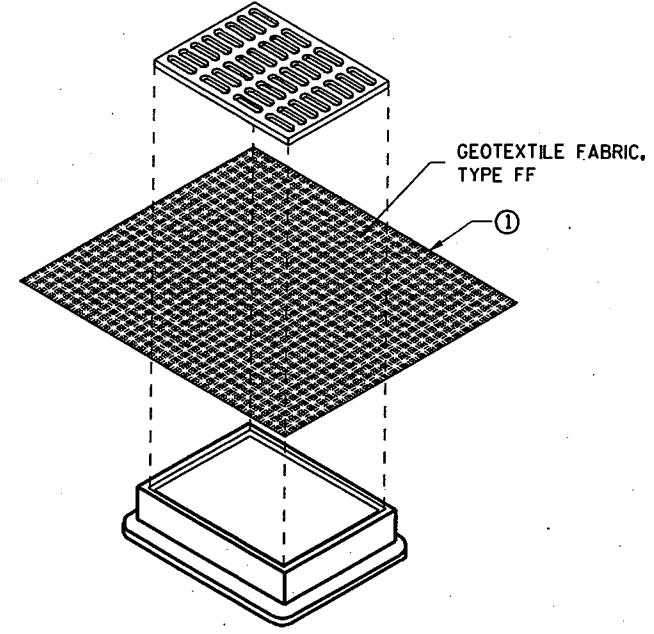

INLET PROTECTION, TYPE B (WITHOUT CURB BOX)

(CAN BE INSTALLED IN ANY INLET WITHOUT A CURB BOX)

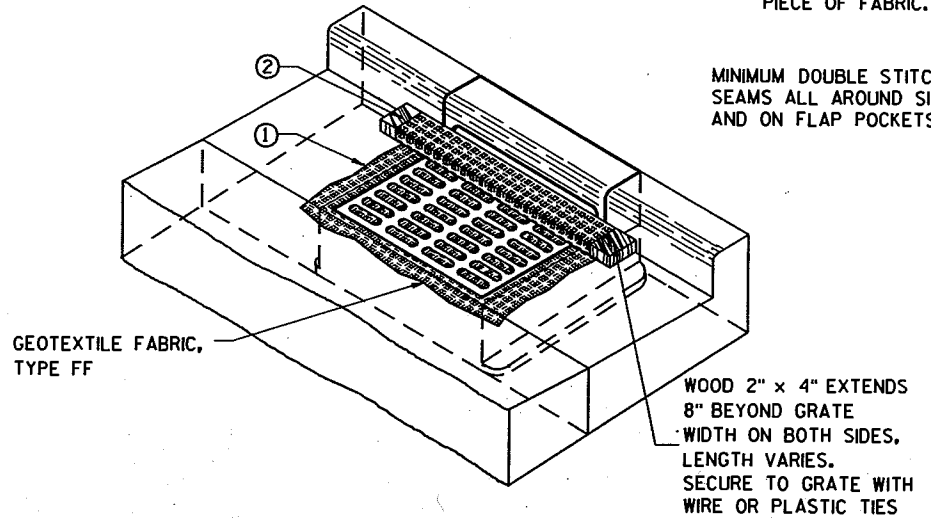

INLET PROTECTION, TYPE C (WITH CURB BOX)

INSTALLATION NOTES


TYPE B & C

TRIM EXCESS FABRIC IN THE FLOW LINE TO WITHIN 3" OF THE GRATE. THE CONTRACTOR SHALL DEMONSTRATE A METHOD OF MAINTENANCE, USING A SEWN FLAP, HAND HOLDS OR OTHER METHOD TO PREVENT ACCUMULATED SEDIMENT FROM ENTERING THE INLET.

TYPE D

DO NOT INSTALL INLET PROTECTION TYPE D IN INLETS SHALLOWER THAN 30", MEASURED FROM THE BOTTOM OF THE INLET TO THE TOP OF THE GRATE. TRIM EXCESS FABRIC IN THE FLOW LINE TO WITHIN 3" OF THE GRATE.

THE INSTALLED BAG SHALL HAVE A MINIMUM SIDE CLEARANCE, BETWEEN THE INLET WALLS AND THE BAG, MEASURED AT THE BOTTOM OF THE OVERFLOW HOLES, OF 3". WHERE NECESSARY THE CONTRACTOR SHALL CINCH THE BAG, USING PLASTIC ZIP TIES, TO ACHIEVE THE 3" CLEARANCE. THE TIES SHALL BE PLACED AT A MAXIMUM OF 4" FROM THE BOTTOM OF THE BAG.

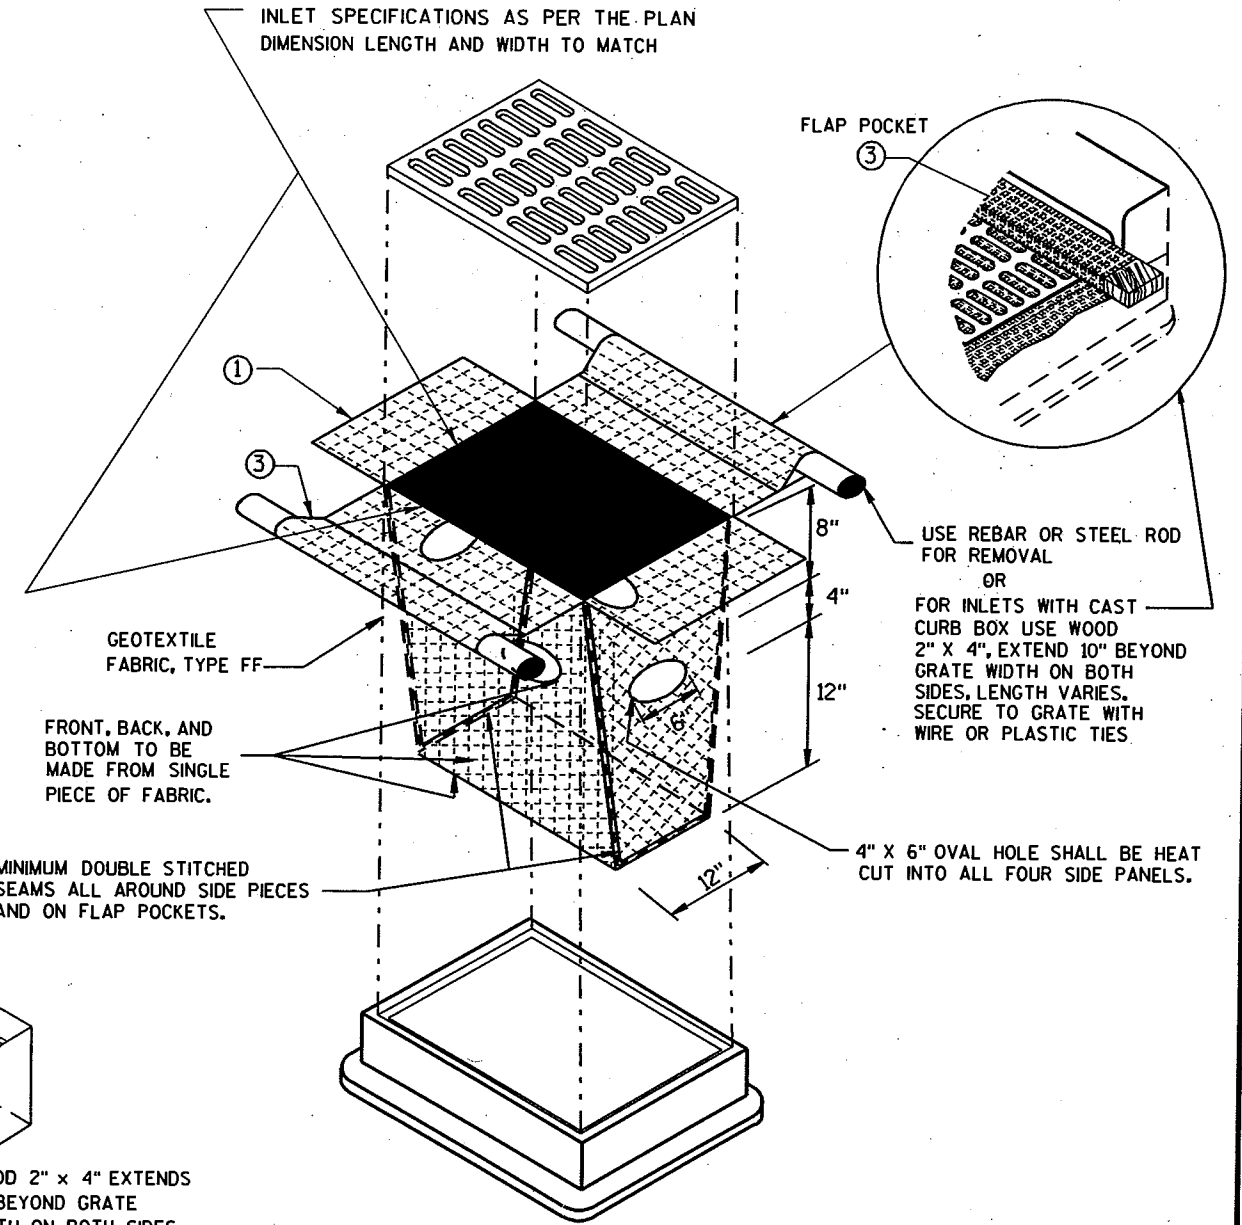

INLET PROTECTION, TYPE D

(CAN BE INSTALLED IN ANY INLET TYPE WITH OR WITHOUT A CURB BOX AS PER NOTE ②)

INLET PROTECTION TYPE A, B, C, AND D	
STATE OF WISCONSIN DEPARTMENT OF TRANSPORTATION	
APPROVED	
DATE	CHIEF ROADWAY DEVELOPMENT ENGINEER
FHWA	

REVISION DATE: 9-7-94

PLOT NAME: SBF11A

PLOT SCALE: 1/4"

FILE NAME: SDBRIDG

ORIGINATOR: MEL ZEMLICKA 6-2782
LEVELS ON: 1, 5








S.D.D. 8 F 1-11

METAL APRON ENDWALLS											
PIPE DIA. (IN.)	MIN. THICK. (Inches)		DIMENSIONS (Inches)							APPROX. SLOPE	BODY
	STEEL	ALUM.	A (±1")	B (MAX.)	H (±1")	L (±1 1/2")	L1 (1)	L2 (1)	W (±2")		
12	.064	.060	6	6	6	21	12	17 1/2	24	2 1/2 to 1	1 Pc.
15	.064	.060	7	8	6	26	14	21 3/4	30	2 1/2 to 1	1 Pc.
18	.064	.060	8	10	6	31	15	28 1/4	36	2 1/2 to 1	1 Pc.
21	.064	.060	9	12	6	36	18	29 3/4	42	2 1/2 to 1	1 Pc.
24	.064	.075	10	13	6	41	18	37 1/4	48	2 1/2 to 1	1 Pc.
30	.079	.075	12	16	8	51	18	52 1/4	60	2 1/2 to 1	1 Pc.
36	.079	.105	14	19	9	60	24	59 1/4	72	2 1/2 to 1	2 Pc.
42	.109	.105	16	22	11	69	24	75 3/4	84	2 1/2 to 1	3 Pc.
48	.109	.105	18	27	12	78	24	81	90	2 1/2 to 1	3 Pc.
54	.109	.105	18	30	12	84	30	85 1/2	102	2 1/2 to 1	3 Pc.
60	.109x	.105x	18	33	12	87	—	—	114	2 to 1	3 Pc.
66	.109x	.105x	18	36	12	87	—	—	120	2 to 1	3 Pc.
72	.109x	.105x	18	39	12	87	—	—	126	2 to 1	3 Pc.
78	.109x	.105x	18	42	12	87	—	—	132	1 1/2 to 1	3 Pc.
84	.109x	.105x	18	45	12	87	—	—	138	1 1/2 to 1	3 Pc.
90	.109x	.105x	18	37	12	87	—	—	144	1 1/2 to 1	3 Pc.
96	.109x	.105x	18	35	12	87	—	—	150	1 1/2 to 1	3 Pc.





* EXCEPT CENTER PANEL SEE GENERAL NOTES

REINFORCED CONCRETE APRON ENDWALLS									
PIPE DIA. (IN.)	DIMENSIONS (Inches)							APPROX. SLOPE	
	T	A	B	C	D	E	G		
12	2	4	24	48 1/2	72 1/2	24	2	3 to 1	
15	2 1/4	6	27	46	73	30	2 1/4	3 to 1	
18	2 1/2	9	27	46	73	36	2 1/2	3 to 1	
21	2 3/4	9	36	37 1/2	73 1/2	42	2 3/4	3 to 1	
24	3	9 1/2	43 1/2	30	73 1/2	48	3	3 to 1	
27	3 1/4	10 1/2	49 1/2	24	73 1/2	54	3 1/4	3 to 1	
30	3 1/2	12	54	19 1/2	73 1/2	60	3 1/2	3 to 1	
36	4	15	63	34 1/4	97 1/4	72	4	3 to 1	
42	4 1/2	21	63	35	98	78	4 1/2	3 to 1	
48	5	24	72	26	98	84	5	3 to 1	
54	5 1/2	27	65	33 1/4-35	98 1/4-100	90	5 1/2	2 1/2 to 1	
60	6	30-35	60	39	99	96	5	2 to 1	
66	6 1/2	24-30	72-78	21-27	99	102	5 1/2	2 to 1	
72	7	24-36	78	21	99	108	6	2 to 1	
78	7 1/2	24-36	78	21	99	114	6 1/2	2 to 1	
84	8	36	90 1/2	21	111 1/2	120	6 1/2	1 1/2 to 1	
90	8 1/2	41	87 1/2	24	111 1/2	132	6 1/2	1 1/2 to 1	

* MINIMUM
** MAXIMUM

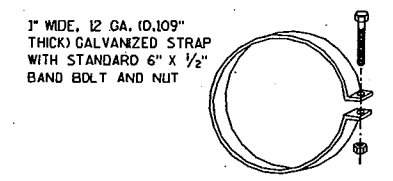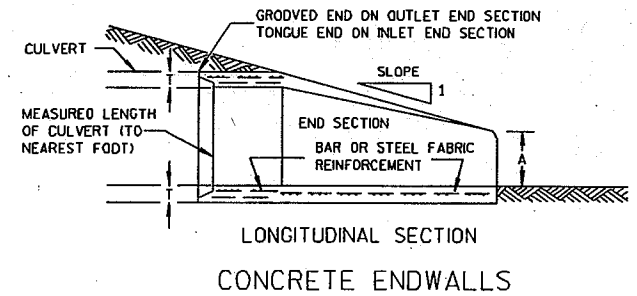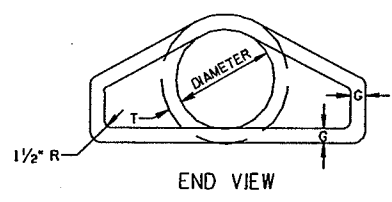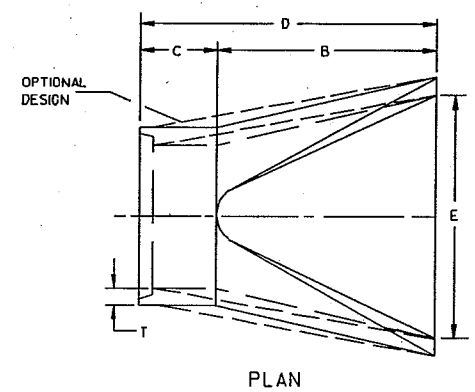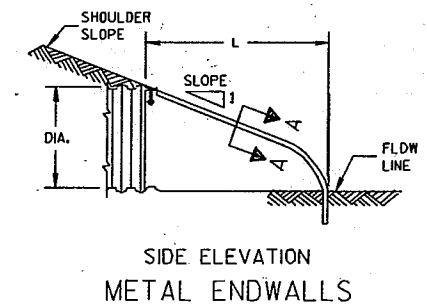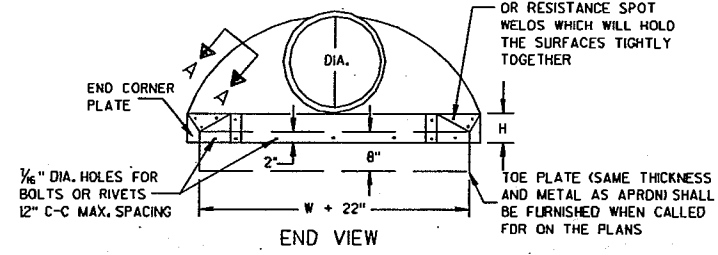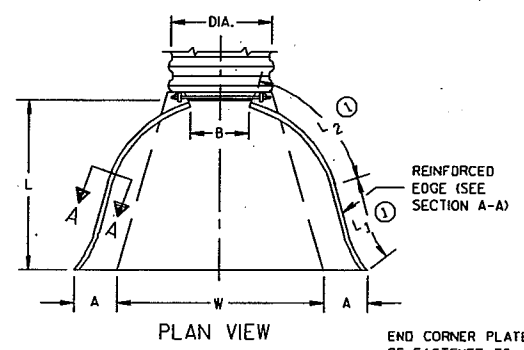

ALTERNATE FOR TYPE 1 CONNECTION
END SECTION CONNECTOR STRAP

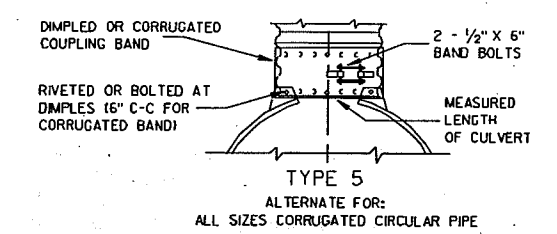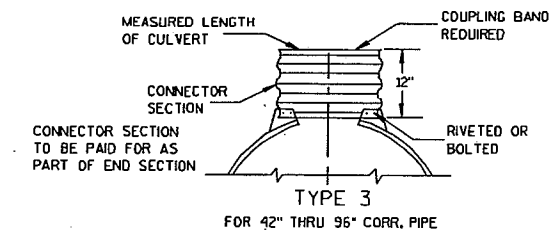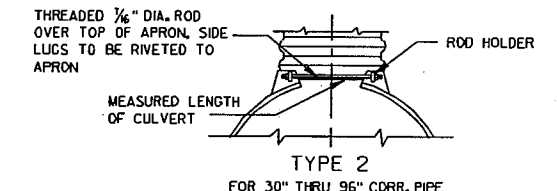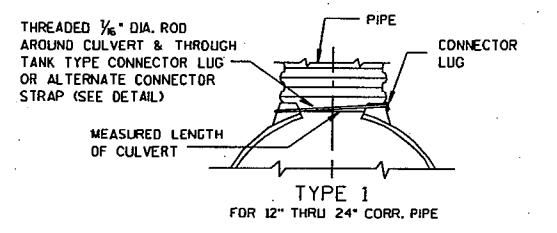


NOTE: DIMPLED BAND FITS OVER OUTSIDE OF ENDWALL AND CORRUGATED BAND FITS INSIDE ENDWALL. DIMPLED BAND MAY BE USED WITH HELICALLY CORRUGATED PIPE.

FOR CIRCUMFERENTIALLY CORRUGATED PIPE USE ENDWALL CONNECTION DETAILS 1, 2, 3 OR 5 AS APPLICABLE.

FOR HELICALLY CORRUGATED PIPE USE ENDWALL CONNECTION DETAILS 1, 2 OR 5.

FOR HELICALLY CORRUGATED PIPES WITH TWO CIRCUMFERENTIAL CORRUGATIONS AT EACH END USE ENDWALL CONNECTION DETAILS 1, 2 OR 3.

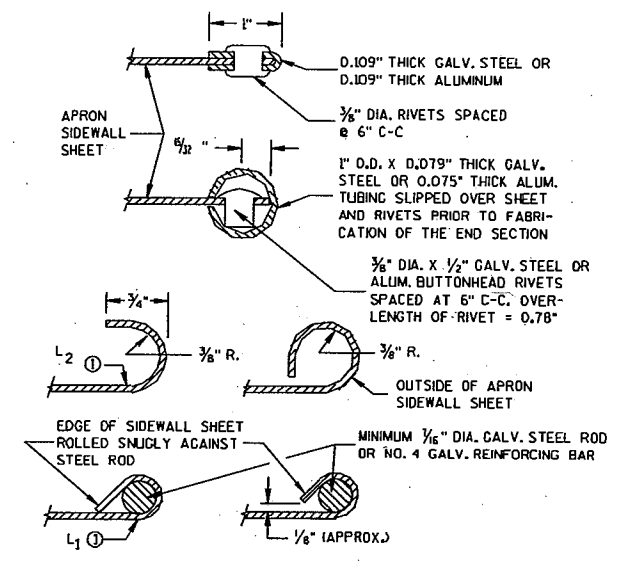

SECTION A-A

GENERAL NOTES

DETAILS OF CONSTRUCTION, MATERIALS AND WORKMANSHIP NOT SHOWN ON THIS DRAWING SHALL CONFORM TO THE PERTINENT REQUIREMENTS OF THE STANDARD SPECIFICATIONS AND THE APPLICABLE SPECIAL PROVISIONS.

CONCRETE CULVERT ENDWALLS MAY NOT BE USED WITH GALVANIZED STEEL OR ALUMINUM CULVERT PIPE OR VICE VERSA. GALVANIZED STEEL OR ALUMINUM ENDWALLS SHALL NORMALLY BE INSTALLED ON CULVERT PIPE OF THE SAME METAL.

ALL THREE PIECE STEEL APRON ENDWALLS FOR 60" DIAMETER PIPE AND LARGER SHALL HAVE 0.109" SIDES AND 0.138" CENTER PANELS. ALL THREE PIECE ALUMINUM APRON ENDWALLS FOR 60" DIAMETER PIPE AND LARGER SHALL HAVE 0.105" SIDES AND 0.134" CENTER PANELS. THE WIDTH OF CENTER PANELS SHALL BE GREATER THAN 20 PERCENT OF THE PIPE PERIMETER.

LAP SEAMS SHALL BE TIGHTLY JOINED BY GALVANIZED RIVETS OR BOLTS FOR STEEL UNITS AND ALUMINUM RIVETS AND BOLTS FOR ALUMINUM UNITS. FOR THE 60" THROUGH 96" DIAMETER APRON ENDWALL SIZES, THE REINFORCED EDGES AND CENTER PANEL SEAMS SHALL BE FURTHER REINFORCED WITH GALVANIZED STEEL OR ALUMINUM STIFFENER ANGLES. THE ANGLES SHALL BE ATTACHED BY GALVANIZED NUTS AND BOLTS FOR STEEL UNITS AND ALUMINUM NUTS AND BOLTS FOR ALUMINUM UNITS.

WHERE TWO OR MORE PIPES WITH APRON ENDWALLS ARE LAID ADJACENT TO EACH OTHER, THEY SHALL BE SEPARATED BY A DISTANCE SUFFICIENT TO PROVIDE A MINIMUM CLEARANCE OF 6 INCHES BETWEEN APRON ENDWALLS.

① FOR PIPE SIZES UP TO 60" DIAMETER, A 180° ROLLED EDGE MAY BE USED INSTEAD OF STEEL ROD REINFORCEMENT. SEE SECTION A-A.

APRON ENDWALLS FOR CULVERT PIPE	
STATE OF WISCONSIN DEPARTMENT OF TRANSPORTATION	
APPROVED	
DATE	CHIEF ROADWAY DEVELOPMENT ENGINEER
FHWA	


S.D.D. 8 F 1-11

REVISION DATE: 8/12/92
 PLOT NAME:
 PLOT SCALE: 0:10
 FILE NAME:
 ORIGINAL: DENNIS HOAGLAND DESIGN SECTION
 LEVELS: 01 - 1, 2, 3, 62, 63


APPROVED _____
 DATE _____ STATE MAT. ENGINEER FOR HWYS

APPROVED _____
 DATE _____ STATE CONST. ENGINEER FOR HWYS

S.D.D. 8 F 4-5

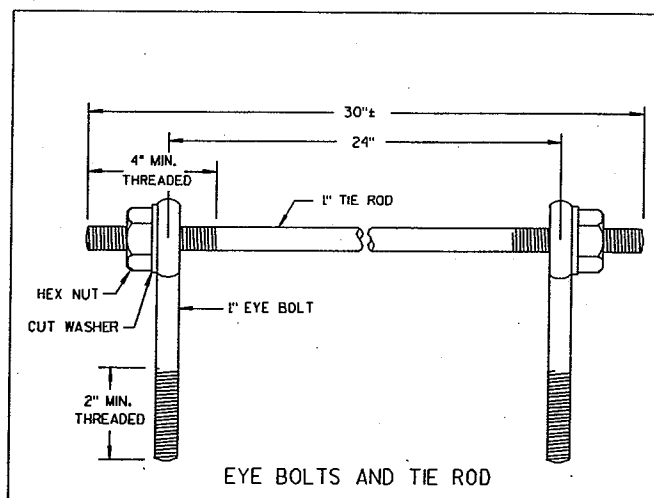

EYE BOLTS AND TIE ROD

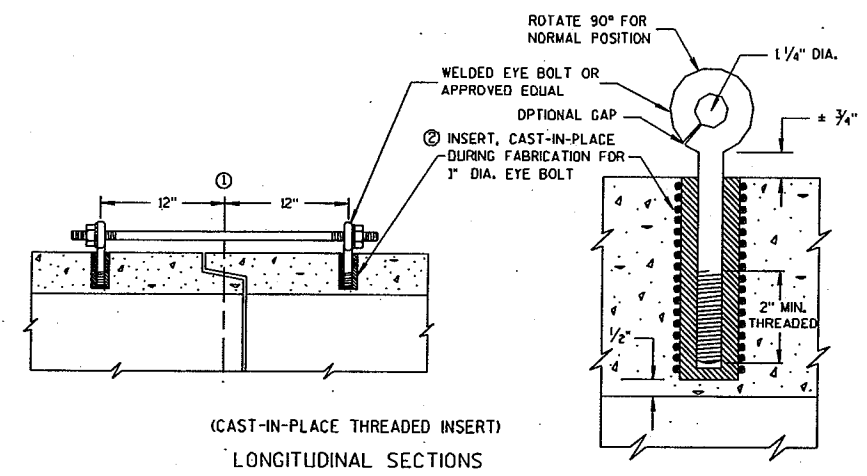

(CAST-IN-PLACE THREADED INSERT)
 LONGITUDINAL SECTIONS


GENERAL NOTES

CONCRETE CULVERT PIPE SHALL BE TIED TOGETHER IN THE MANNER ILLUSTRATED BY THIS DETAIL AT LOCATIONS DESIGNATED ON THE PLAN. THE CONTRACTOR MAY USE EITHER ALTERNATE 1, 2 OR 3 FOR DRAINAGE STRUCTURES. ONLY ALTERNATE 1 AND 3 MAY BE USED FOR CATTLE PASSES, UNLESS OTHERWISE STATED IN THE CONTRACT. THE MATERIALS, FABRICATION AND WORK NECESSARY TO TIE CULVERT PIPE AS INDICATED ON THE PLANS AND BY THIS DETAIL WILL BE CONSIDERED INCIDENTAL TO CULVERT PIPE, REINFORCED CONCRETE CULVERT PIPE, OR REINFORCED CONCRETE PIPE CATTLE PASS.

DETAILED DRAWINGS FOR PROPOSED ALTERNATE DESIGNS FOR JOINT TIES SHALL BE SUBMITTED TO THE ENGINEER FOR APPROVAL.

- ① ϵ OF TONGUE AND GROOVE OR BELL AND SPIGOT JOINTS.
- ② THE INSIDE OF THE THREADED INSERTS SHALL BE CLEAN TO ALLOW THE INSERTION OF THREADED EYE BOLTS.
- ③ HOLES SHALL BE CAST-IN-PLACE OR DRILLED 12" FROM ϵ OF TONGUE AND GROOVE.
- ④ BOLT PROJECTION INSIDE OF PIPE SHALL NOT EXCEED 2".
- ⑤ ROD DIAMETER + 1 INCH.
- ⑥ LENGTH ADEQUATE TO EXTEND TO WITHIN 1/2 INCH OF THE INNER SURFACE OF THE PIPE.

EYE BOLT AND TIE ROD ASSEMBLY (ALTERNATE NO. 1)

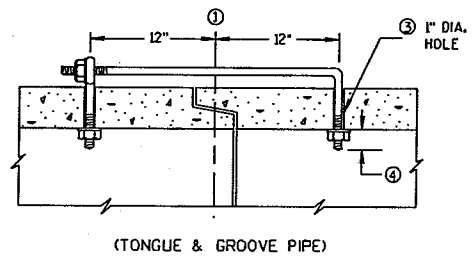

(TONGUE & GROOVE PIPE)


EYE BOLT DIMENSION TABLE

PIPE SIZE	L = LENGTH	
	TONGUE & GROOVE PIPE	MODIFIED BELL PIPE
18" TO 24"	4 1/2"	6 1/4"
30"	5"	7"
36"	5 1/2"	7"
42"	6"	
48"	6 1/2"	
60"	7 1/2"	
66"	8"	


ADJUSTABLE TIE ROD TABLE

PIPE DIAMETER	TIE ROD DIAMETER	D	L ₁	N
12-60	3/8"	3/8"	5	1/2
66-84	3/4"	3/4"	5	1/2
90-108	1"	1"	7	1 1/4


DIMENSIONS SHOWN ARE IN INCHES

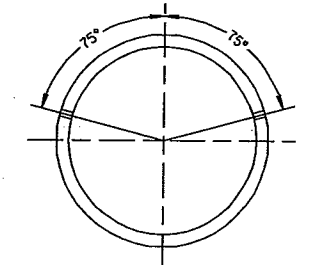


PLACEMENT OF (2) CAST-IN-PLACE INSERTS OR HOLES DURING FABRICATION FOR PIPE SECTIONS REQUIRING TIE RODS
 TRANSVERSE SECTION

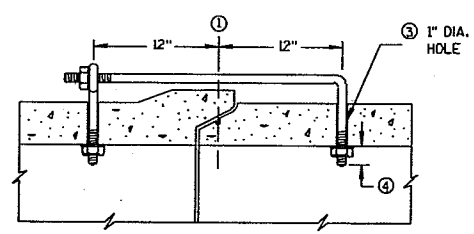

(MODIFIED BELL PIPE)
 LONGITUDINAL SECTION

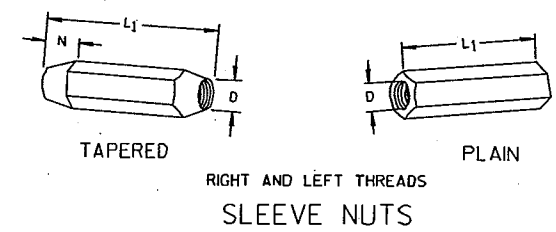


TAPERED PLAIN
 RIGHT AND LEFT THREADS
 SLEEVE NUTS

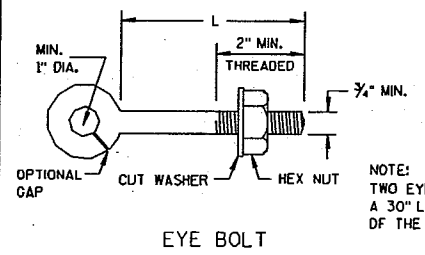


EYE BOLT

NOTE: TWO EYE BOLTS MAY BE USED WITH A 30" LONG THREADED ROD IN LIEU OF THE 90° BENT TIE ROD.

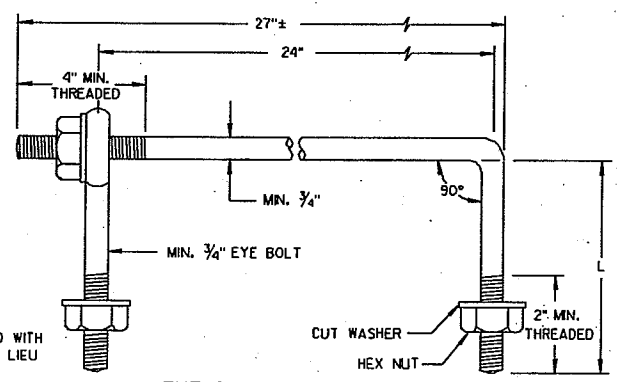

EYE BOLT AND TIE ROD

(JOINT TIES FOR 18" TO 66" DIA. CONCRETE PIPE)
 EYE BOLT AND TIE ROD ASSEMBLY (ALTERNATE NO. 2)

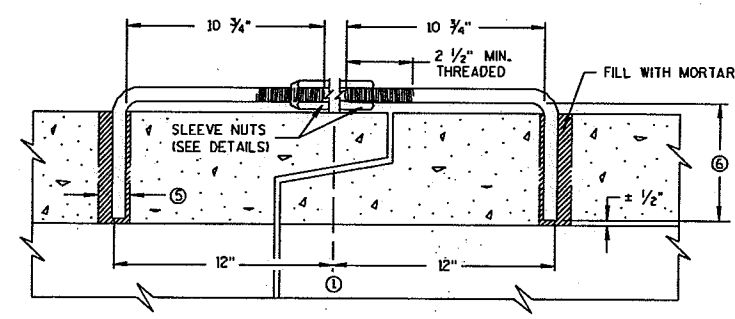

LONGITUDINAL SECTION
 (JOINT TIES FOR 12" TO 108" DIA. CONCRETE PIPE)
 ADJUSTABLE TIE ROD (ALTERNATE NO. 3)

DESIGN NOTE:
 THE NUMBER OF PIPE TIES REQUIRED SHOULD BE INCLUDED ON THE MISCELLANEOUS QUANTITIES SHEET WITH THE CULVERT PIPE LISTING.

NOTE:
 DESIGN NOTE WILL NOT APPEAR ON THE CONTRACT PLAN.

JOINT TIES FOR CONCRETE PIPE


STATE OF WISCONSIN
 DEPARTMENT OF TRANSPORTATION

APPROVED _____
 DATE _____ STATE DESIGN ENGINEER FOR HWYS
 FHWA


S.D.D. 8 F 4-5

AT-GRADE SIDE ROAD INTERSECTION, TYPES "B1", "B2", "C", AND "D" AND TEE INTERSECTION BYPASS LANE
 STATE OF WISCONSIN DEPARTMENT OF TRANSPORTATION


TEE INTERSECTION BYPASS LANE DETAIL

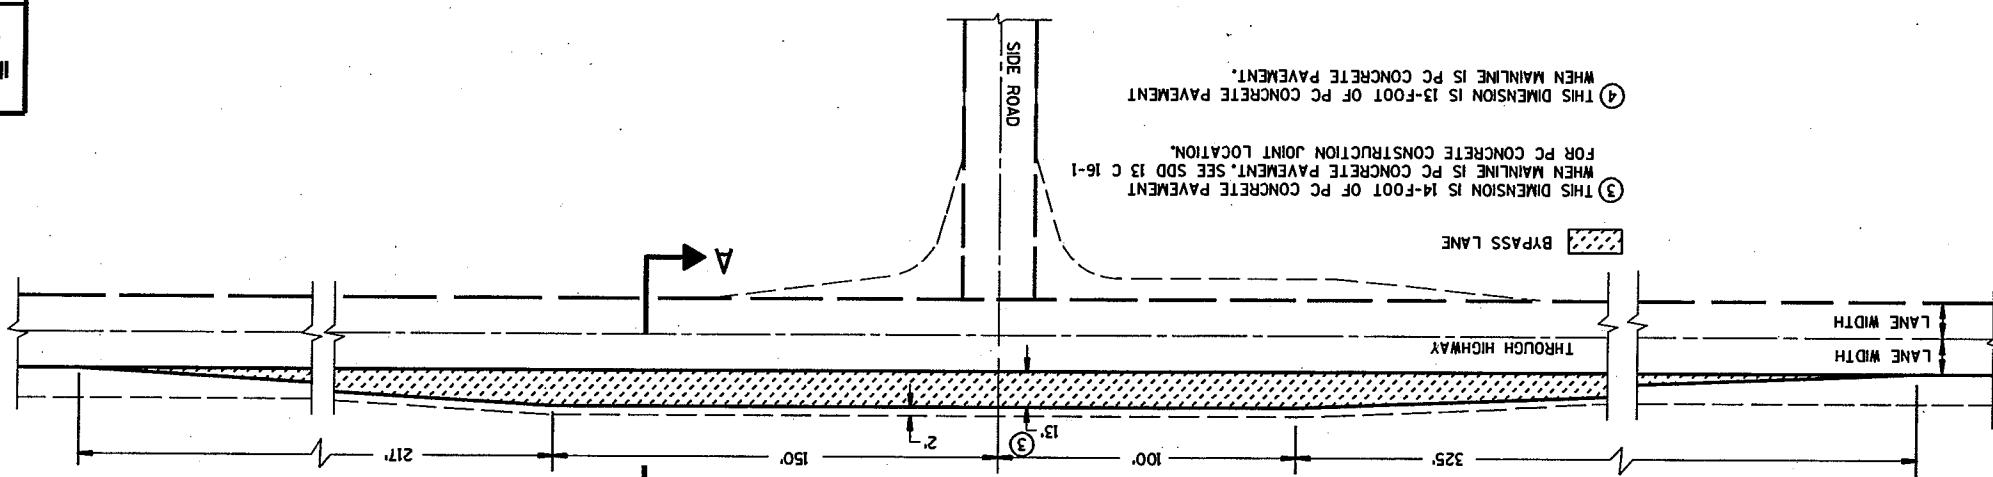

③ THIS DIMENSION IS 14-FOOT OF PC CONCRETE PAVEMENT WHEN MAINLINE IS PC CONCRETE PAVEMENT. SEE SDD 13 C 16-1 FOR PC CONCRETE CONSTRUCTION JOINT LOCATION.
 ④ THIS DIMENSION IS 13-FOOT OF PC CONCRETE PAVEMENT WHEN MAINLINE IS 13-FOOT OF PC CONCRETE PAVEMENT.

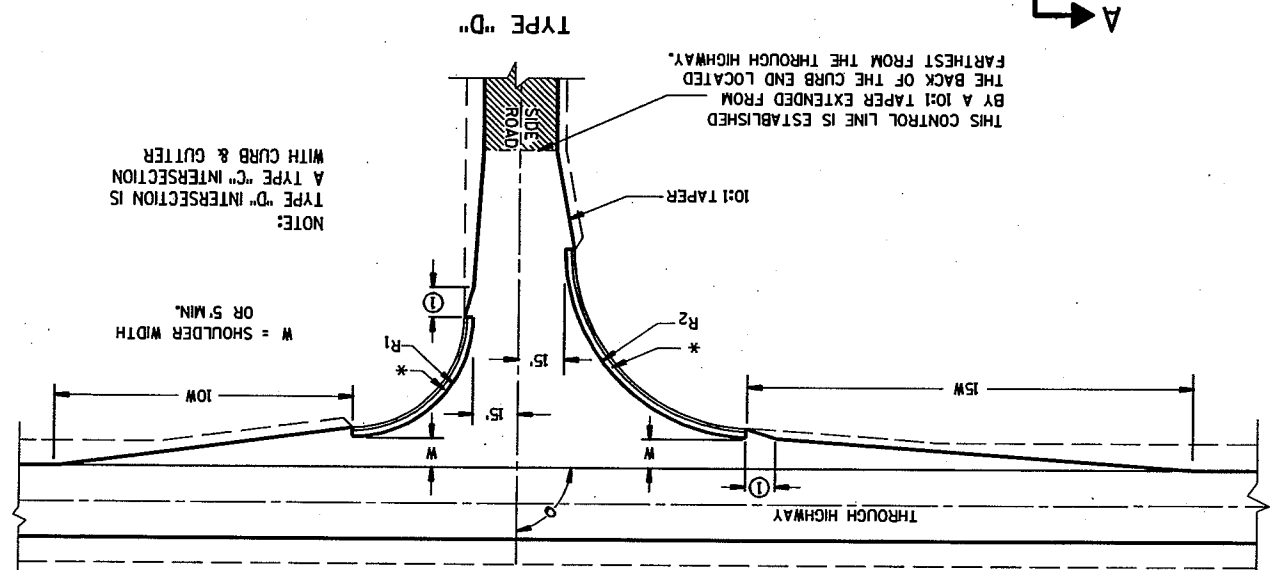


NOTE:
 TYPE "D" INTERSECTION IS WITH CURB & GUTTER
 TYPE "C" INTERSECTION IS WITH CURB & GUTTER

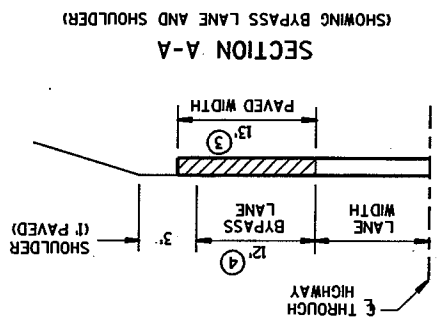

DESIGNS MAY BE USED INTERCHANGEABLY IN COMBINATION OR SEPARATELY FOR ANY ONE COMPLETE INTERSECTION DEPENDING UPON INTERSECTION OR ANGLE AND SURFACING OF EACH APPROACH ROADWAY.
 SIDE ROAD SURFACING NOTE
 WHEN THE SIDE ROAD IS NOT PRESENTLY PAVED, PAVEMENT SHALL BE PLACED TO THE LIMITS SHOWN UNLESS OTHERWISE PROVIDED IN THE CONTRACT, WHERE THE CONSTRUCTION LIMITS ARE BEYOND THE PAVING LIMITS, CRUSHED AGGREGATE SURFACING SHALL BE PLACED BETWEEN THE PAVING LIMITS AND CONSTRUCTION LIMITS.
 WHEN THE SIDE ROAD IS PRESENTLY PAVED, NEW PAVEMENT SHALL BE PLACED TO THE LIMITS OF DESIGN AS SHOWN AND BEYOND, IF NECESSARY, TO MEET EXISTING PAVEMENT.
 WHEN THE SIDE ROAD IS THE CONSTRUCTION PROJECT, THE INTERSECTION SURFACING SHALL BE THE SAME AS FOR THE PROJECT.


GENERAL NOTES

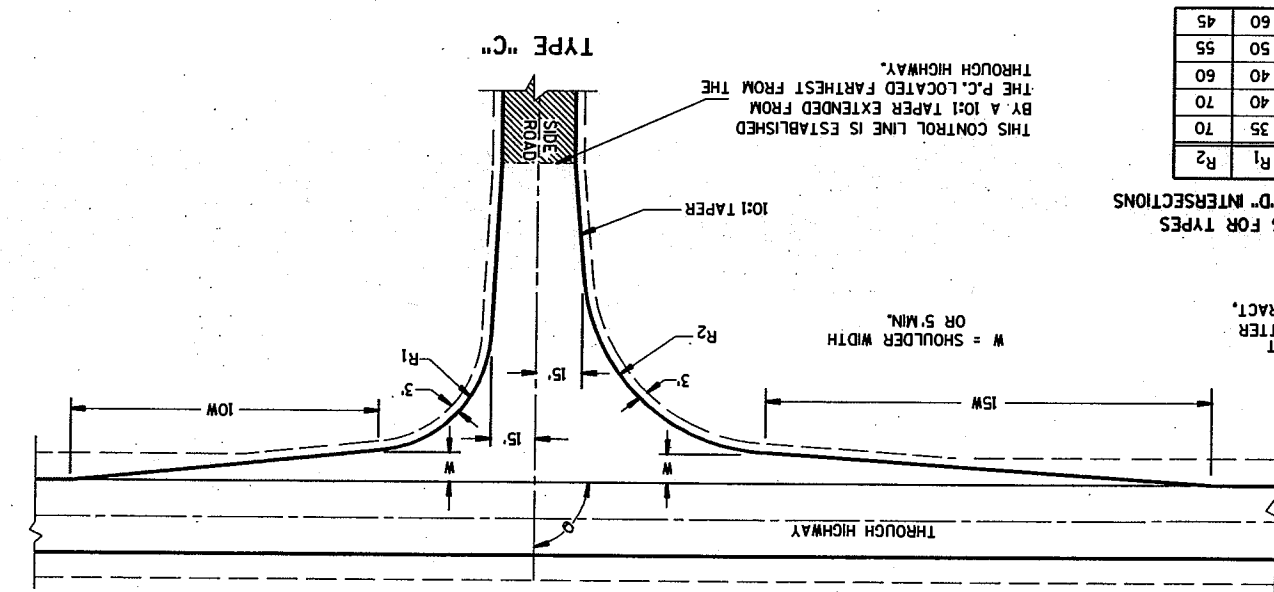


RADI DIMENSIONS FOR TYPES "B1", "B2", "C" AND "D" INTERSECTIONS

0	R ₁	60
65-70	35	70
71-80	40	70
81-90	40	60
91-100	50	55
101-110	60	45

* CONCRETE CURB & GUTTER 36" TAPER CURB HEIGHT 0" TO 6" IN 10'-0" LENGTH AT ENDS OF CURB & GUTTER SECTIONS, WHEN SPECIFIED ELSEWHERE IN THE CONTRACT, PROVIDE CURB OPENING AND FLUME.
 ① 10' TYPICAL
 ② 12' (TYPE B1) RESURFACING PROJECTS WHERE A 10' WIDTH MAY BE USED WHEN SPECIFIED IN THE CONTRACT OR DIRECTED BY THE ENGINEER.

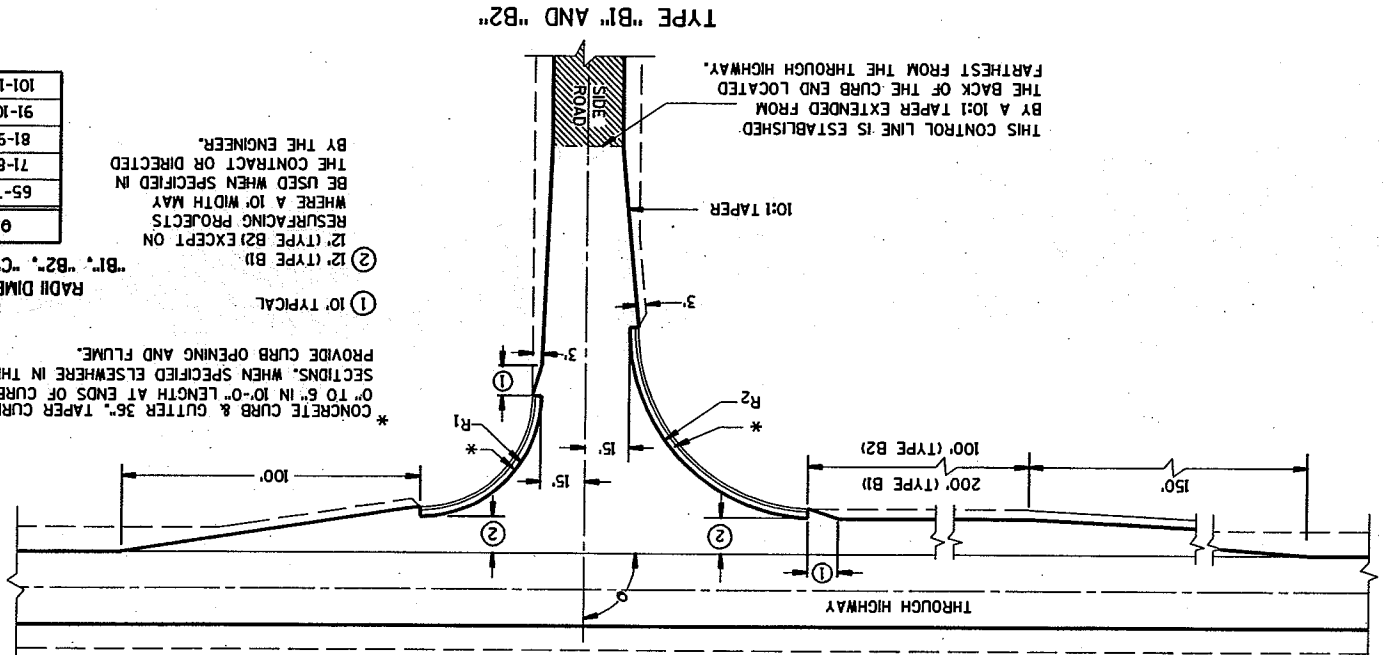

THIS CONTROL LINE IS ESTABLISHED BY A 10:1 TAPER EXTENDED FROM THE BACK OF THE CURB END LOCATED FARTHEST FROM THE THROUGH HIGHWAY.

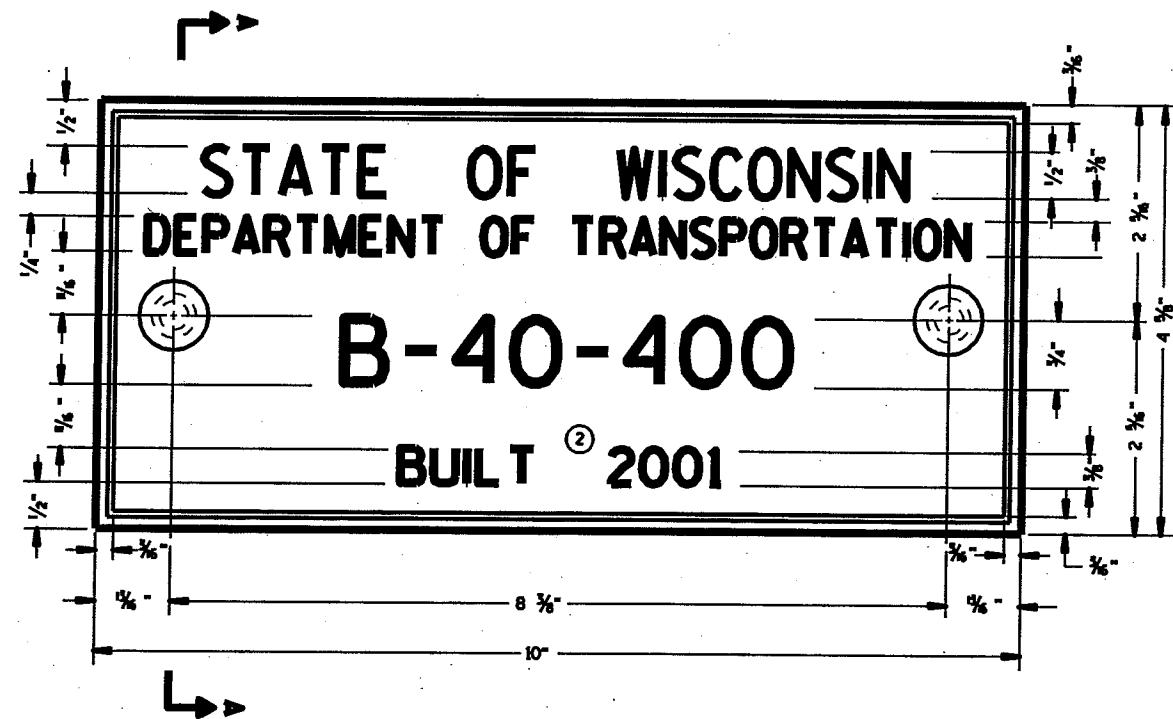


TYPICAL NAME PLATE
(BRIDGES, CULVERTS, AND RETAINING WALLS)

GENERAL NOTES


NAME PLATES TO BE INSTALLED ON BRIDGES, CULVERTS, AND RETAINING WALLS SHALL CONFORM TO THE REQUIREMENTS OF SECTION 506.2.4 OF THE STANDARD SPECIFICATIONS.

THE BRIDGE NUMBER AND YEAR BUILT SHOWN ON THIS DRAWING ARE EXAMPLES ONLY. SEE CONSTRUCTION PLANS FOR INDIVIDUAL NUMBERING AND YEAR BUILT.

- ① EPOXY RESIN SHALL BE FROM AN APPROVED MANUFACTURER AND USED IN ACCORDANCE WITH MANUFACTURER'S RECOMMENDATIONS.
- ② REHABILITATION OF AN EXISTING STRUCTURE SHOULD USE THE DATE OF ORIGINAL STRUCTURE CONSTRUCTION.

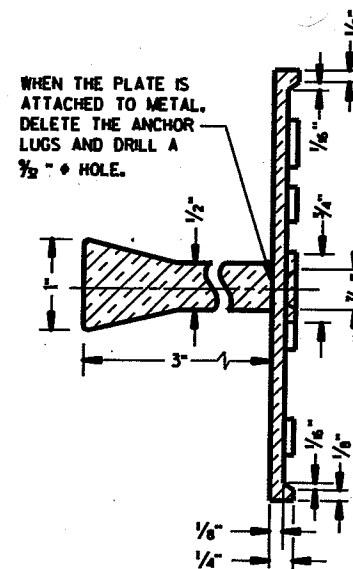

SECTION A-A

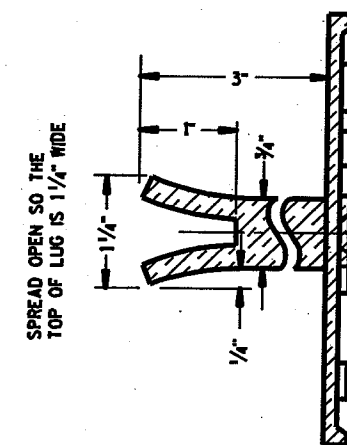


ALTERNATE LUG

FOR MULTI-UNIT STRUCTURES
LINE 3 ABOVE SHALL READ


B = BRIDGE
C = CULVERT
R = RETAINING WALL

UNIT NO. FOR MULTIPLE
UNIT BRIDGE

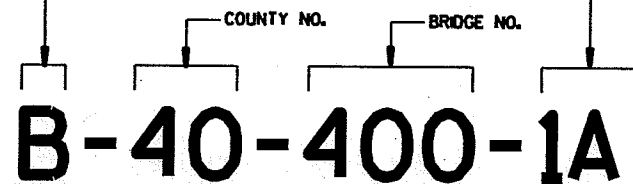

**NUMBERING DESIGNATION
MULTI-UNIT STRUCTURES**

- ① ADHERE ANCHOR LUG TO PRECAST RETAINING WALL WITH EPOXY RESIN.

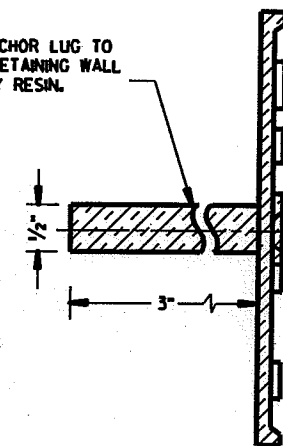


ALTERNATE LUG
(FOR ATTACHMENT TO PRECAST STRUCTURES)

NAME PLATE (STRUCTURES)	
STATE OF WISCONSIN DEPARTMENT OF TRANSPORTATION	
APPROVED	
DATE	_____ CHIEF STRUCTURAL DEVELOPMENT ENGINEER
FHWA	


GENERAL NOTES

DETAILS OF CONSTRUCTION, MATERIALS AND WORKMANSHIP NOT SHOWN ON THIS DRAWING SHALL CONFORM TO THE PERTINENT REQUIREMENTS OF THE STANDARD SPECIFICATIONS, AND THE APPLICABLE SPECIAL PROVISIONS.


- ① W6 X 9 OR W6 X 8.5 STEEL POSTS AND NOTCHED PLASTIC BLOCKOUTS ARE ACCEPTABLE ALTERNATIVES FOR 6" X 8" WOOD POSTS WITH WOOD OR PLASTIC BLOCKOUTS. USE APPROVED NOTCHED PLASTIC BLOCKOUTS WITH STEEL POSTS. DO NOT MIX STEEL POSTS AND WOOD POSTS IN A SINGLE INSTALLATION.
 - ② USE STRUCTURAL STEEL POSTS CONFORMING TO AASHTO M183. GALVANIZE ACCORDING TO AASHTO M 111 EITHER SET THE POSTS IN DRILLED HOLES OR DRIVE TO GRADE. REMOVE MUSHROOMING CAUSED BY DRIVING AND REPAIR DAMAGED SPECTER COATING ON GALVANIZED POSTS.
 - ③ INSTALL STEEL POSTS WITH HOLES ON APPROACHING TRAFFIC SIDE.
 - ④ USE EITHER WOOD OR APPROVED PLASTIC BLOCKOUTS ON WOOD POSTS.
 - ⑤ WHEN SPECIFIED IN THE PLANS, THE 2-FOOT MINIMUM TO HINGE POINT MAY BE REDUCED OR ELIMINATED IF EXISTING CONDITIONS DO NOT PERMIT THE DESIRABLE EARTHWORK.
INCREASE POST LENGTH TO PROVIDE A MINIMUM EMBEDMENT OF 3'-6" IF THE SHOULDER HINGE POINT IS LOCATED IN FRONT OF THE POST.
 - ⑥ IF ROCK IS ENCOUNTERED DURING EXCAVATION, THE ENGINEER MAY APPROVE USING A 12 INCH DIAMETER POST HOLE EXTENDING 20 INCHES DEEP INTO THE ROCK. PLACE GRANULAR MATERIAL IN THE BOTTOM OF THE HOLE APPROXIMATELY 2 1/2 INCHES DEEP, CUT THE POSTS TO LENGTH AND PLACE IN THE HOLE. BACKFILL WITH MATERIAL EXCAVATED FROM THE HOLE AND COMPACT ADEQUATELY.
- INSTALL BEAM GUARD SECTIONS AND ALL NECESSARY HARDWARE ACCORDING TO THE APPLICABLE PLAN AND CURRENT STANDARD AND SUPPLEMENTAL SPECIFICATIONS.
- ALL DIMENSIONS ARE SUBJECT TO MANUFACTURER'S TOLERANCES EXCEPT WHERE ALLOWABLE TOLERANCES ARE SHOWN.

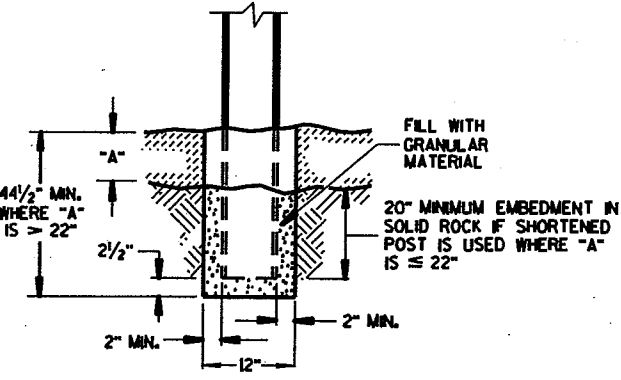


END VIEW SETTING STEEL OR WOOD POST IN ROCK ⑥

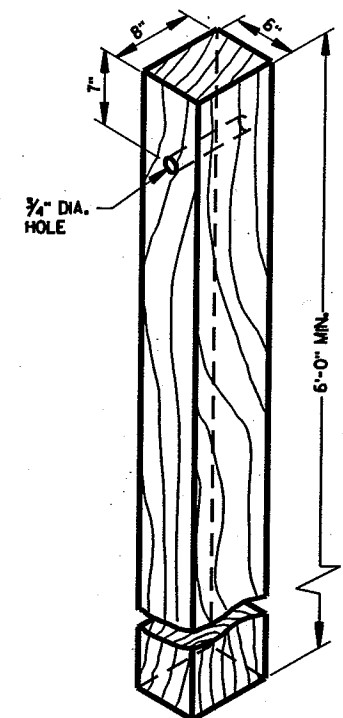


WOOD POST (6" X 8") NOMINAL

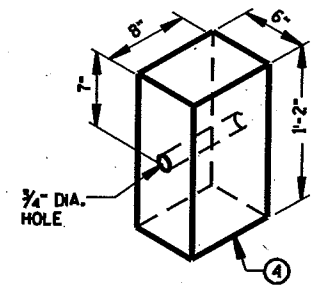


WOOD OR PLASTIC BLOCKOUT FOR WOOD POSTS

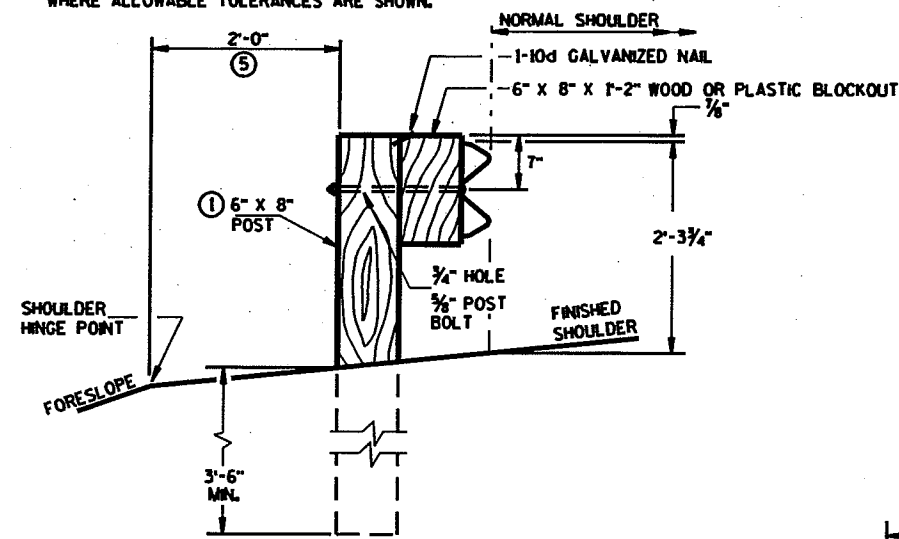


END VIEW LOCATED ALONG A ROADWAY SHOULDER

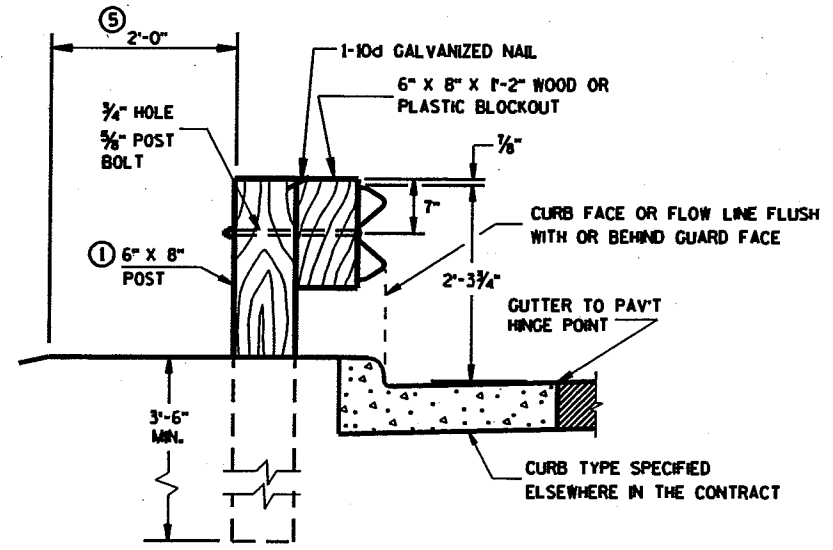


END VIEW LOCATED ALONG A CURBED ROADWAY

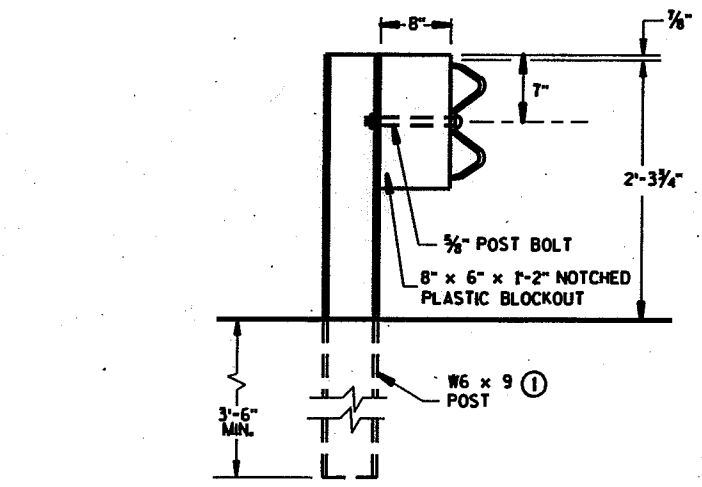


END VIEW STEEL POST & NOTCHED PLASTIC BLOCKOUT ALTERNATIVE

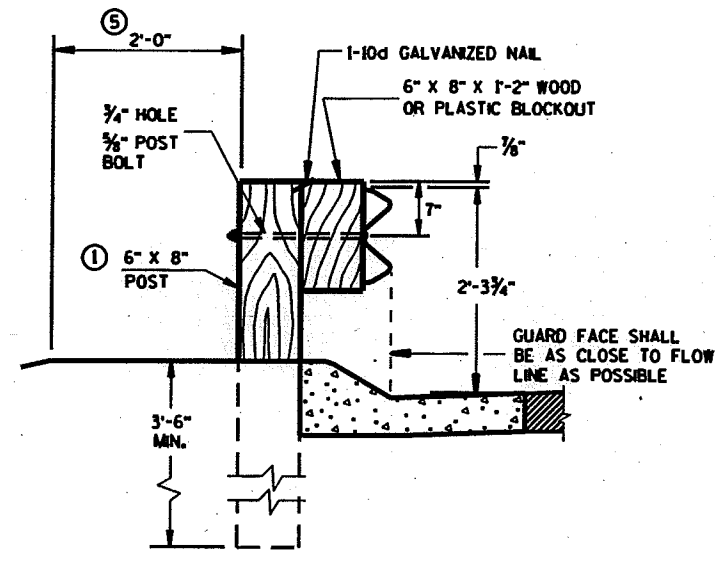


END VIEW LOCATED ALONG A MOUNTABLE CURBED ROADWAY

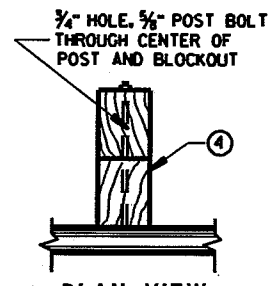

PLAN VIEW WOOD POST, BLOCKOUT & BEAM

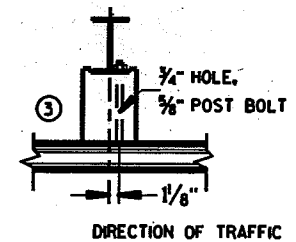


PLAN VIEW STEEL POST, NOTCHED PLASTIC BLOCKOUT & BEAM

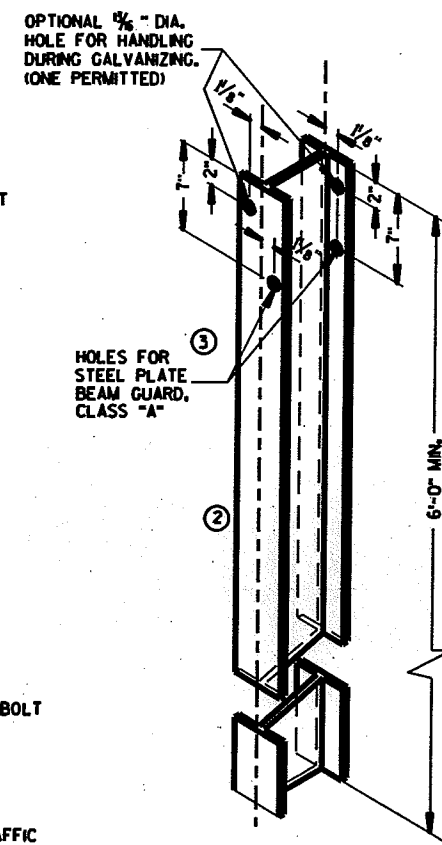

STEEL POST & HOLE PUNCHING DETAIL (W6 X 9) ①

ALL HOLES 1/4" DIAMETER EXCEPT AS NOTED

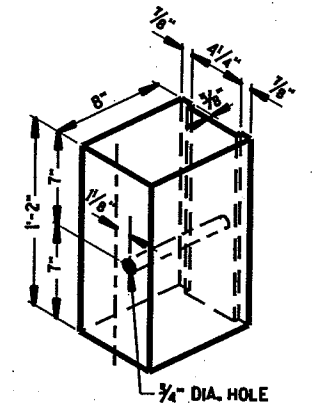


NOTCHED PLASTIC BLOCKOUT FOR STEEL POSTS

STEEL PLATE BEAM GUARD, CLASS "A" INSTALLATION & ELEMENTS
STATE OF WISCONSIN DEPARTMENT OF TRANSPORTATION


S.D.D. 14 B 15-40

S.D.D. 14 B 15-40

TYPICAL INSTALLATION OF STEEL PLATE BEAM GUARD

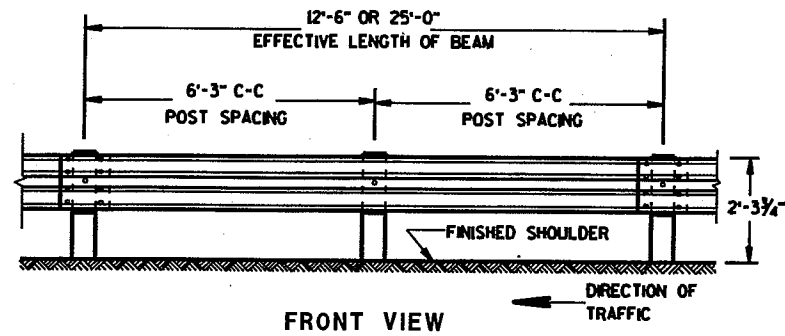


FRONT VIEW

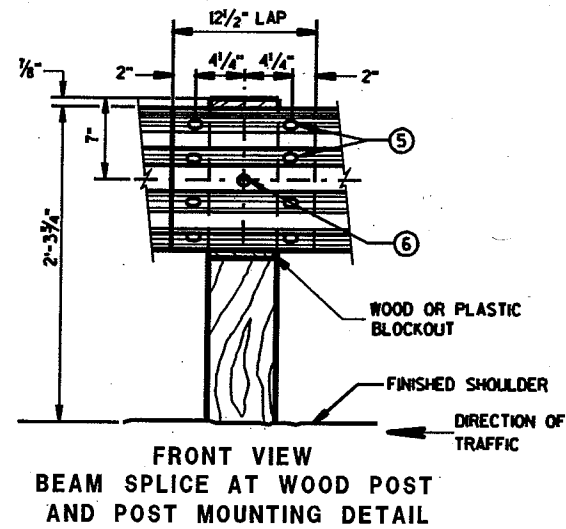


FRONT VIEW
BEAM SPLICE AT WOOD POST
AND POST MOUNTING DETAIL

GENERAL NOTES

- ① PROVIDE TYPE "H" SILVER REFLECTIVE SHEETING ON ALL REFLECTORS EXCEPT THOSE LOCATED ALONG THE LEFT EDGE OF ONE-WAY ROADWAYS, WHICH SHALL BE PROVIDED WITH TYPE "H" YELLOW REFLECTIVE SHEETING.
- ② DO NOT INSTALL REFLECTORS ON THE FIRST 50 FEET OF THE APPROACH END OF THE ENERGY ABSORBING TERMINAL.
- ③ REVERSE EVERY OTHER REFLECTOR FOR 2-WAY VISIBILITY. THE CONTRACTOR MAY FURNISH TWO-SIDED REFLECTORS IN LIEU OF ONE-SIDED REFLECTORS.
- ④ PROVIDE AN ANGLE OF BEND OF $90^\circ \pm 1^\circ$ FOR TWO-SIDED REFLECTORS.
- ⑤ 8 - $\frac{3}{8}$ " ϕ X $\frac{1}{4}$ " BUTTON HEAD BOLTS WITH OVAL SHOULDERS & RECESS NUTS.
- ⑥ $\frac{3}{8}$ " ϕ X 1'-6" BUTTON HEAD BOLT AND AND RECESS NUT WITH ROUND WASHER UNDER NUT.

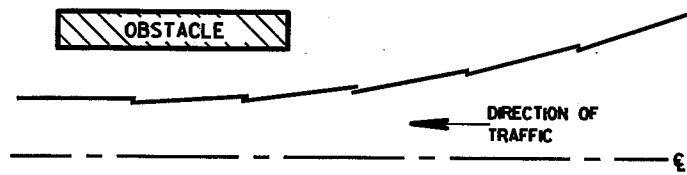

PLAN VIEW
BEAM LAPPING DETAIL

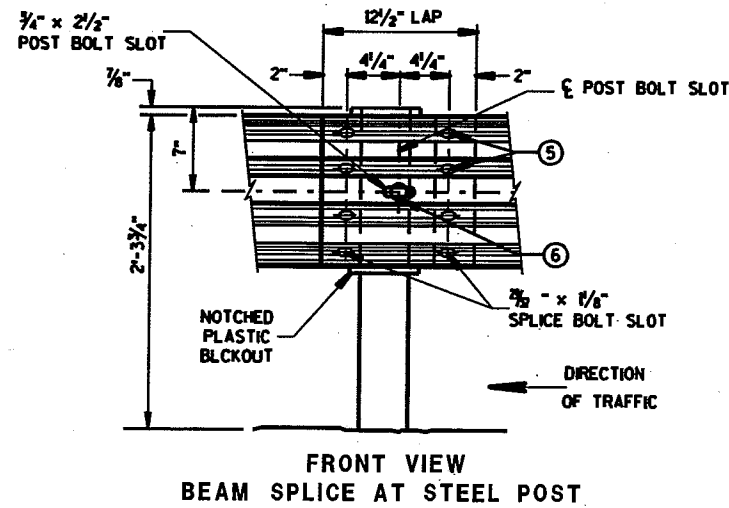


FRONT VIEW
BEAM SPLICE AT STEEL POST



TYPICAL SPLICING DETAILS OF STEEL PLATE BEAM GUARD

REFLECTOR SPACING ②


	BEAM GUARD LENGTH	REFLECTOR SPACING	NO. SURFACES REFLECTORIZED	MIN. NO. REFLECTORS
ONE WAY TRAFFIC	< 200'	50' C-C	1	3
ONE WAY TRAFFIC	> 200'	100' C-C	1	3
TWO WAY TRAFFIC	< 200'	25' C-C	1 ③	6
TWO WAY TRAFFIC	> 200'	50' C-C	1	6
TWO WAY TRAFFIC	< 200'	50' C-C	2 ④	3
TWO WAY TRAFFIC	> 200'	100' C-C	2	3

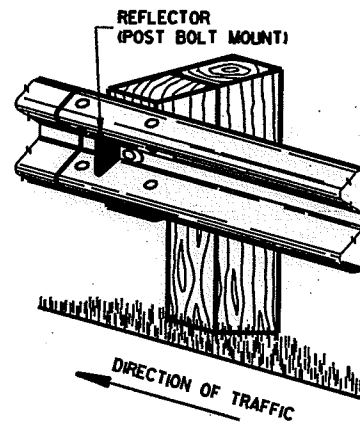

ONE SIDED REFLECTOR DETAIL AND TYPICAL INSTALLATION ①

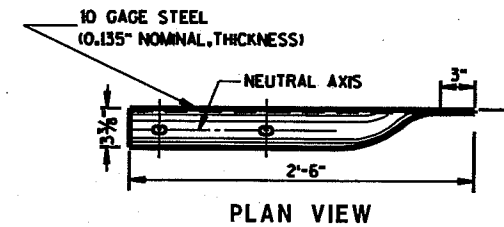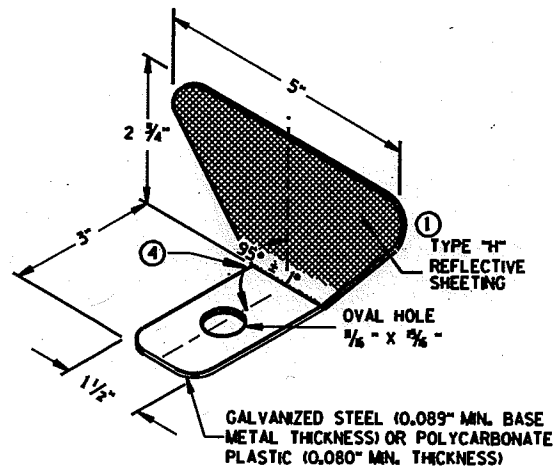


PLAN VIEW

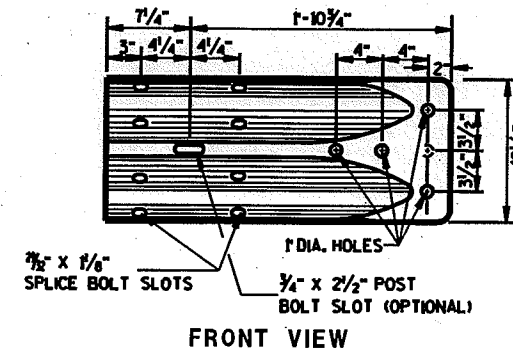

FRONT VIEW

W BEAM TERMINAL CONNECTOR
(USE ONLY ON THE TRAFFIC EXIT END OF ONE WAY BRIDGES)

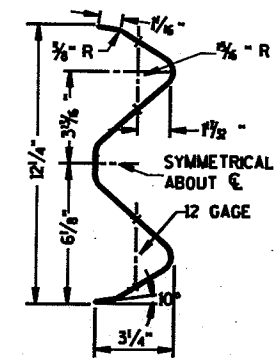


SECTION THRU W BEAM


STEEL PLATE BEAM GUARD, CLASS "A", INSTALLATION & ELEMENTS

STATE OF WISCONSIN
DEPARTMENT OF TRANSPORTATION

APPROVED
DATE _____
CHEF ROADWAY DEVELOPMENT ENGINEER

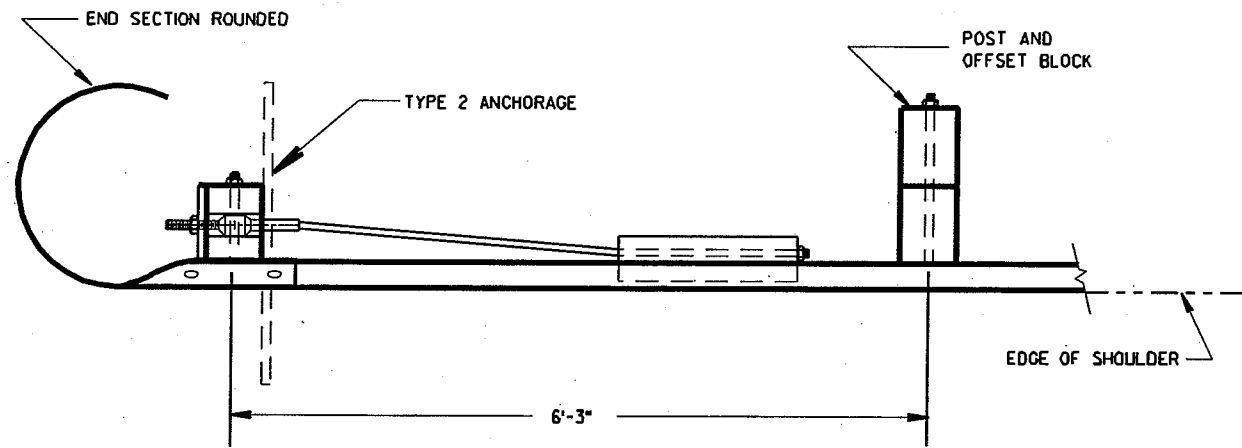


PLAN VIEW

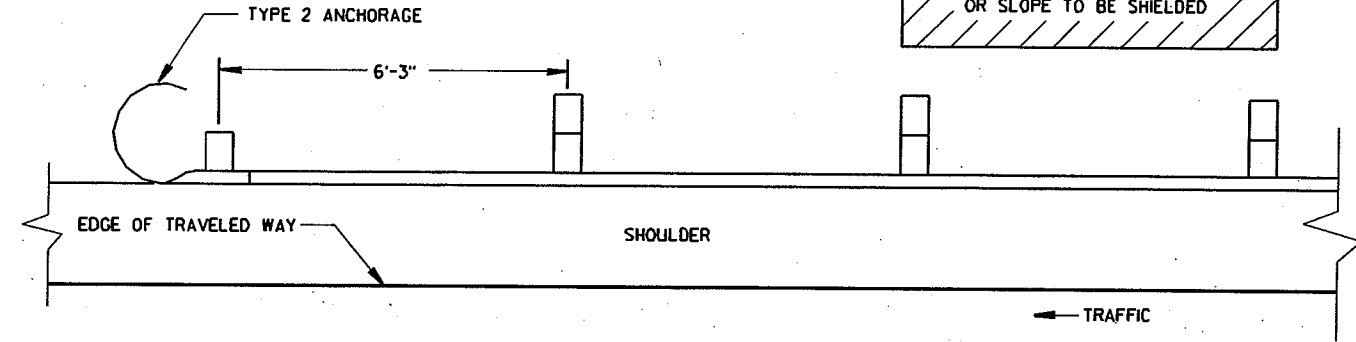


PLAN VIEW

BEAM GUARD WITH TYPE 2 ANCHORAGE
EXIT END - ONE WAY TRAFFIC

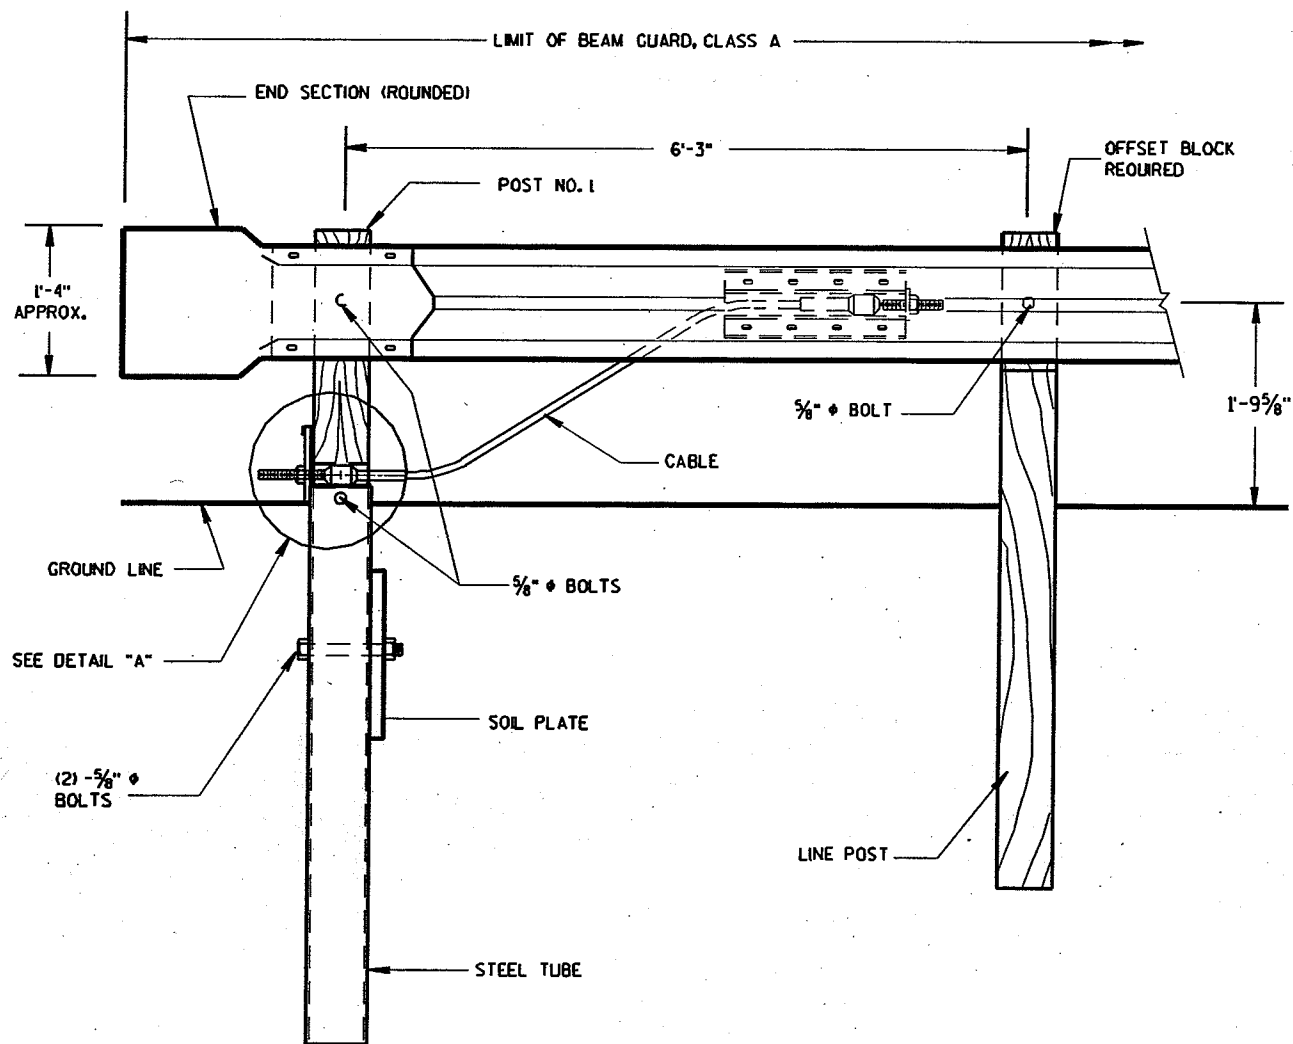


FRONT VIEW

END TREATMENT WITH TYPE 2 ANCHORAGE
(USE ON ONE-WAY ROADWAYS ONLY - DEPARTING END)

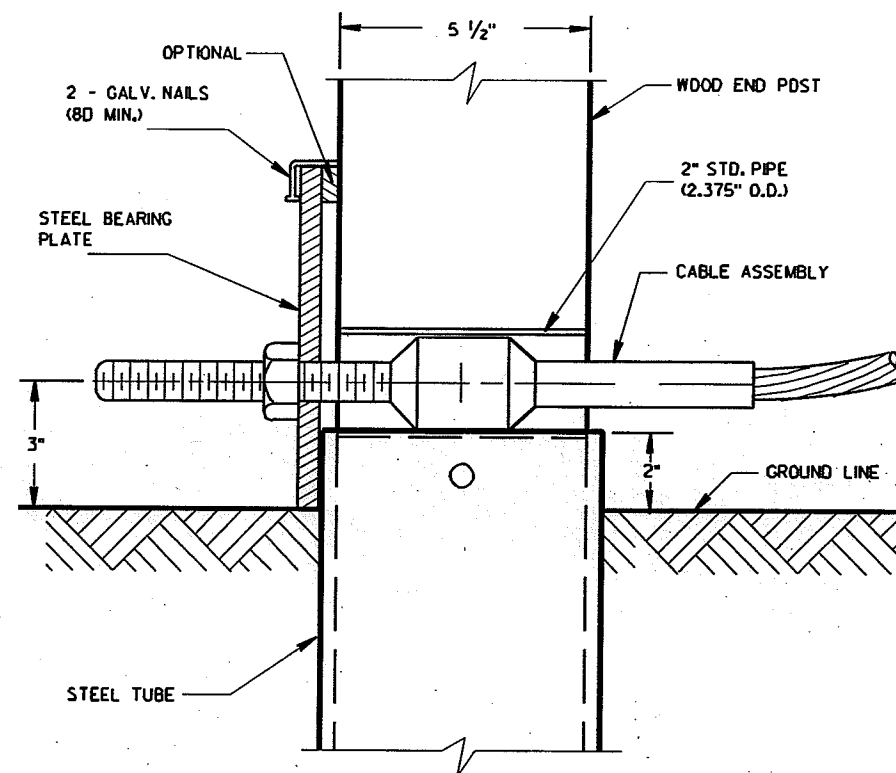

DETAIL "A"


POST NO. 1

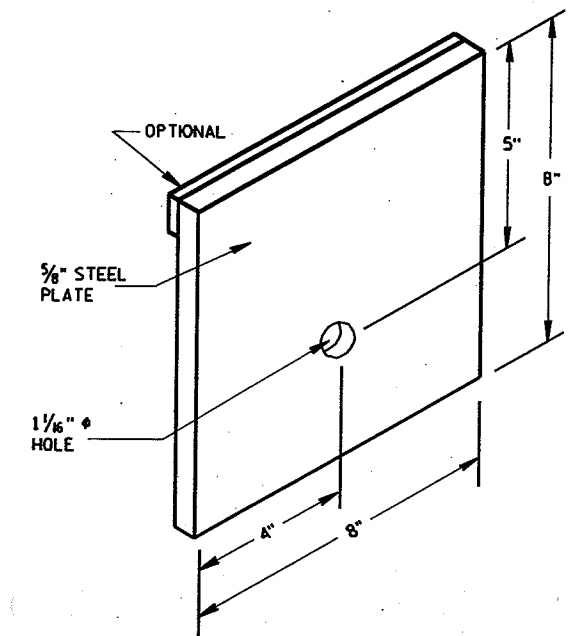

STEEL BEARING PLATE


CLASS "A" STEEL PLATE BEAM GUARD
END TREATMENT WITH ANCHORAGE,
TYPE 2

STATE OF WISCONSIN
DEPARTMENT OF TRANSPORTATION

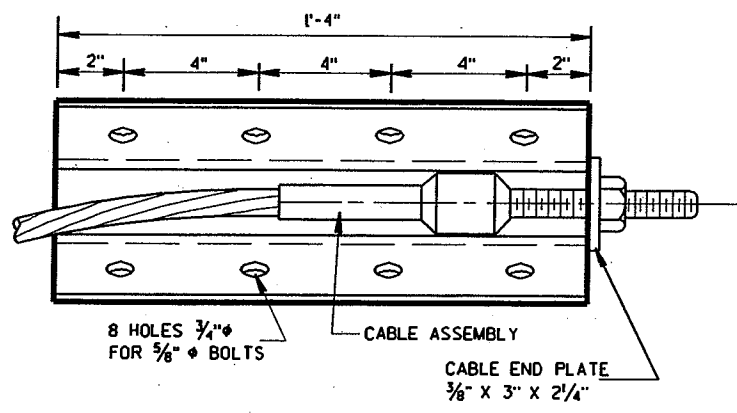


FRONT VIEW


ANCHOR PLATE DETAIL

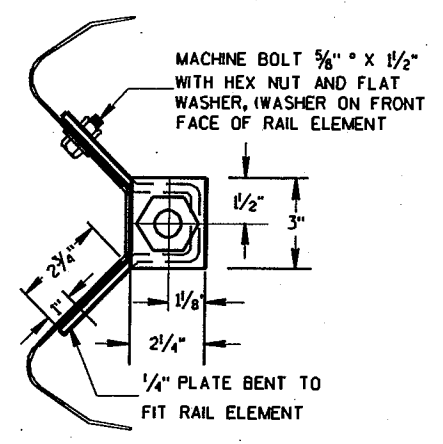

END VIEW

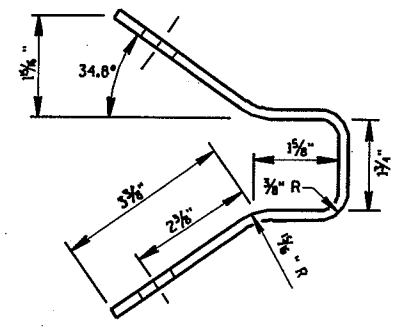

END VIEW OF BRACKET

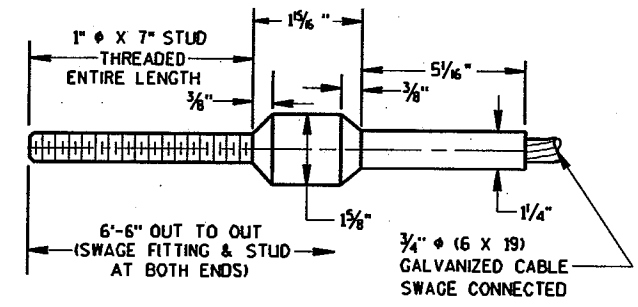

CABLE ASSEMBLY

CABLE, SWAGE FITTING, STUD AND NUT SHALL DEVELOP A MINIMUM BREAKING STRENGTH OF 40,000 LB (TIGHTEN UNTIL TAUT)


GENERAL NOTES

DETAILS OF CONSTRUCTION, MATERIALS AND WORKMANSHIP NOT SHOWN ON THIS DRAWING SHALL CONFORM TO THE PERTINENT REQUIREMENTS OF THE STANDARD SPECIFICATIONS AND THE APPLICABLE SPECIAL PROVISIONS.


STRUCTURAL TUBING SHALL CONFORM TO THE REQUIREMENTS OF ASTM A-500 GRADE B OR ASTM A-501.

POST NO. 1 SHALL BE WOOD BREAKAWAY POST INSERTED AND BOLTED INTO STEEL TUBE.


TYPE 2 ANCHORAGE SHALL CONSIST OF A STEEL TUBE, SOIL PLATE WOOD BREAKAWAY POST, BEARING PLATE, ANCHOR PLATE, CABLE ASSEMBLY AND ALL ASSOCIATED HARDWARE, ALL STEEL PARTS SHALL BE GALVANIZED.

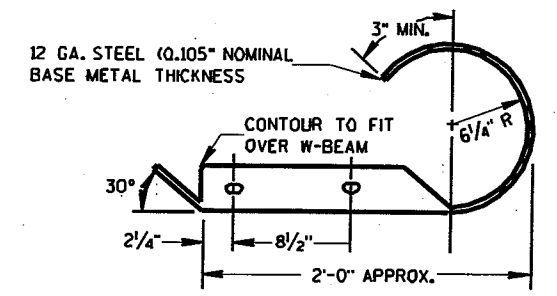

PLAN VIEW

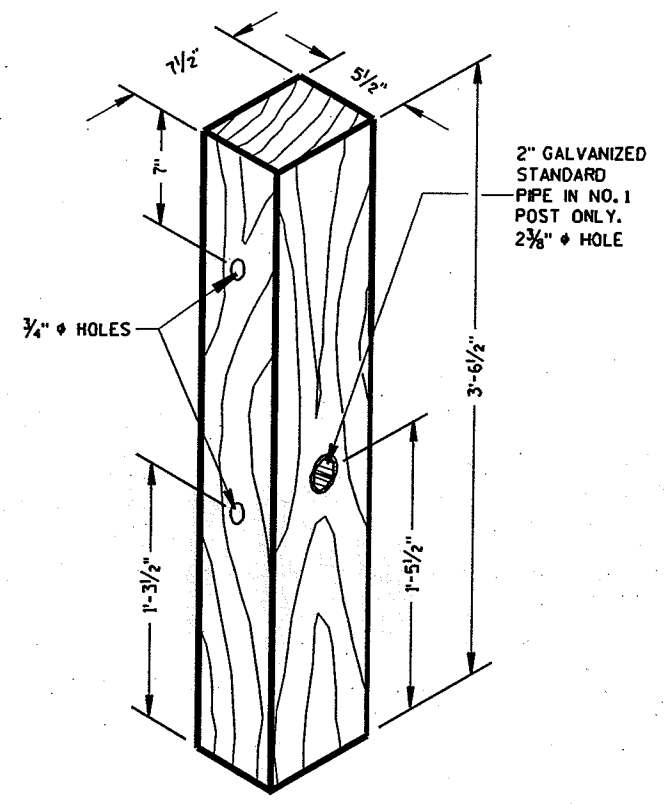


WOOD BREAKAWAY POST

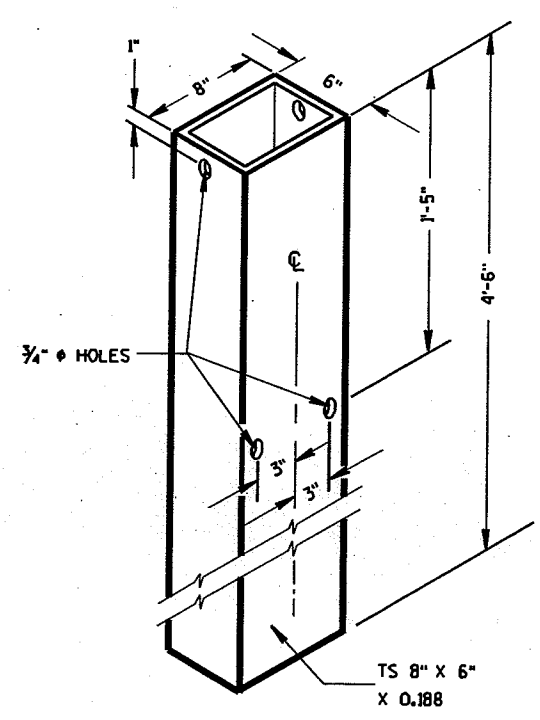


STEEL TUBE

STEEL TUBE SHALL CONFORM TO REQUIREMENTS OF ASTM A500

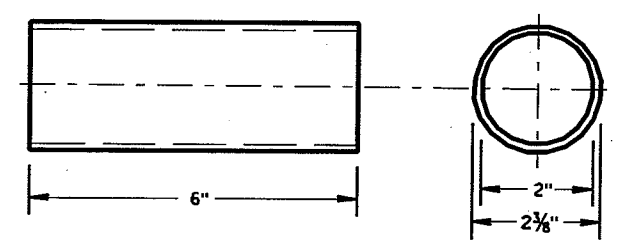


BREAKAWAY TERMINAL POST SLEEVE

GALVANIZED STANDARD STRENGTH STEEL PIPE, ASTM 53 GRADE "B"

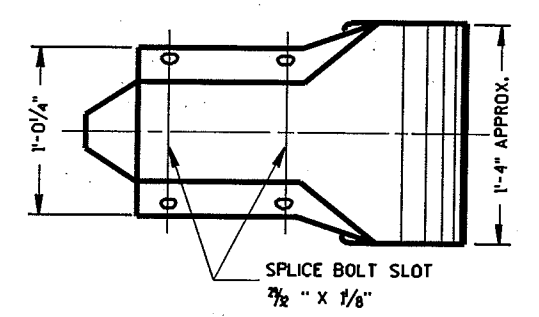


FRONT VIEW W BEAM END SECTION ROUNDED

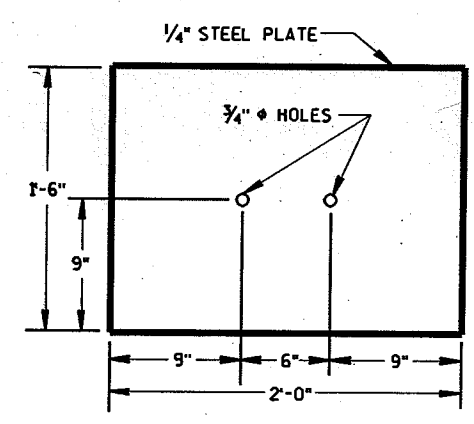


SOIL PLATE

CLASS "A" STEEL PLATE BEAM GUARD END TREATMENT WITH ANCHORAGE, TYPE 2	
STATE OF WISCONSIN DEPARTMENT OF TRANSPORTATION	
APPROVED	
DATE	CHIEF ROADWAY DEVELOPMENT ENGINEER
FHWA	

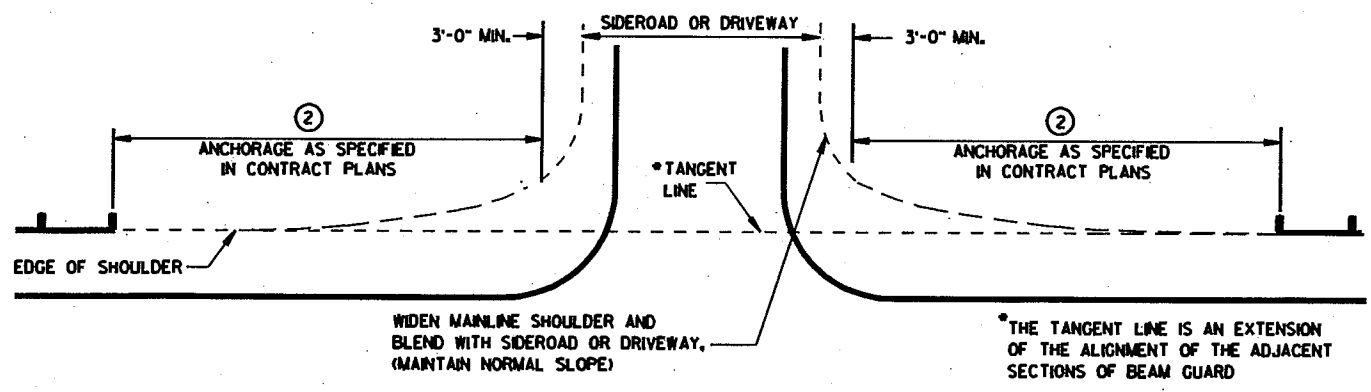

BEAM GUARD AT SIDEROADS OR DRIVEWAYS

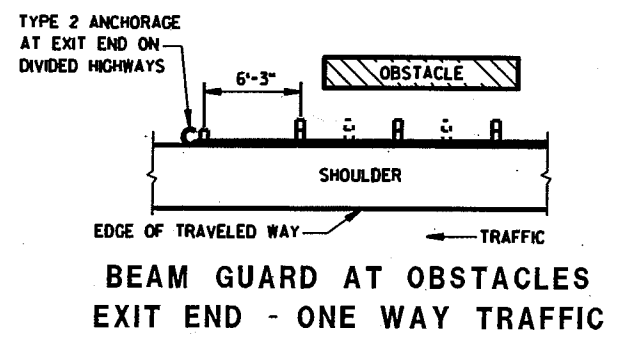

**BEAM GUARD AT OBSTACLES
EXIT END - ONE WAY TRAFFIC**

GENERAL NOTES

DETAILS OF CONSTRUCTION, MATERIALS AND WORKMANSHIP NOT SHOWN ON THIS DRAWING SHALL CONFORM TO THE PERTINENT REQUIREMENTS OF THE STANDARD SPECIFICATIONS AND THE APPLICABLE SPECIAL PROVISIONS.


W6 X 9 OR W6 X 8.5 STEEL POSTS WITH NOTCHED PLASTIC BLOCKOUTS ARE ACCEPTABLE ALTERNATIVES FOR 6" X 8" WOOD POSTS WITH WOOD OR PLASTIC BLOCKOUTS. USE APPROVED NOTCHED PLASTIC BLOCKOUTS WITH STEEL POSTS.

THE LOCATIONS AND LENGTHS OF BEAM GUARD ARE SHOWN ELSEWHERE IN THE PLAN.


- ① USE STEEL THRIE BEAM STRUCTURAL APPROACH (STBSA).
- ② USE AN APPROVED END TREATMENT FOR THE TRAFFIC APPROACH SIDE OF BRIDGE/OBSTACLES. USE TYPE 2 ANCHORAGE ONLY AT THE DOWNSTREAM ENDS OF BEAM GUARD LOCATED ALONG ROADWAYS WITH ONE WAY TRAFFIC.

③ DESIGN DEFLECTION OF W-BEAM BARRIER SYSTEM


LATERAL DISTANCE TO FIXED OBJECT	POST SPACING
3'-6" TO 4'-6"	3'- 1/2"
4'-6" AND OVER	6'- 3"

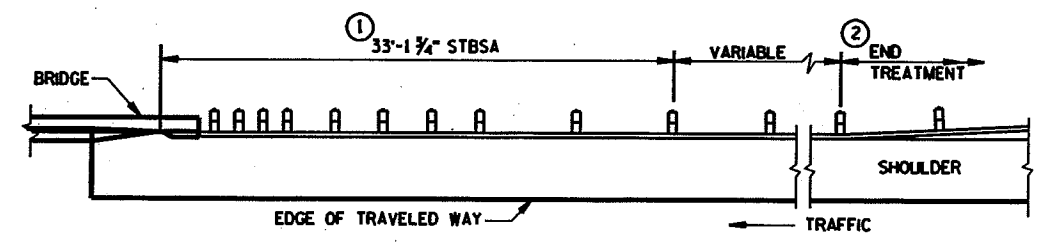

BEAM GUARD AT FULL WIDTH BRIDGES

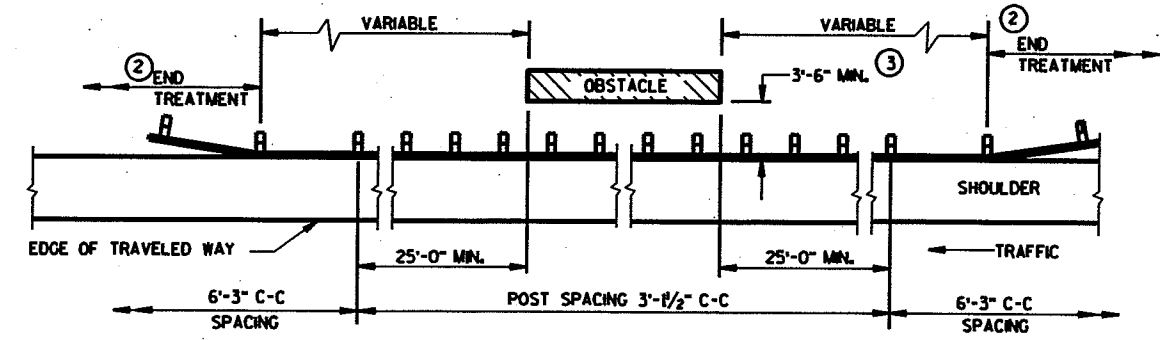

BEAM GUARD AT OBSTACLES - TWO WAY TRAFFIC
(RAIL TO OBSTACLE CLEARANCE 3'-6" TO 4'-6")

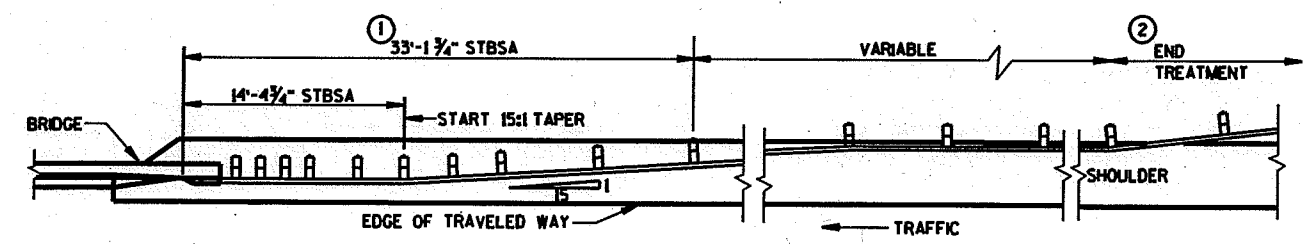



BEAM GUARD AT NARROW BRIDGES
(FLARED TO SHOULDER EDGE, THEN PARALLEL TO ROADWAY)

**STEEL PLATE BEAM GUARD,
CLASS "A"
(AT BRIDGES, OBSTACLES
AND SIDEROADS/DRIVEWAYS)**





STATE OF WISCONSIN
DEPARTMENT OF TRANSPORTATION

APPROVED _____
DATE _____ CHIEF ROADWAY DEVELOPMENT ENGINEER
FHWA

S.D.D. 14 B 18-40

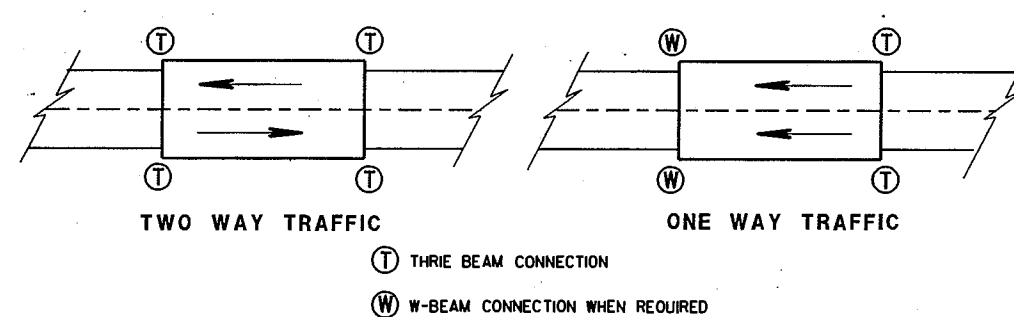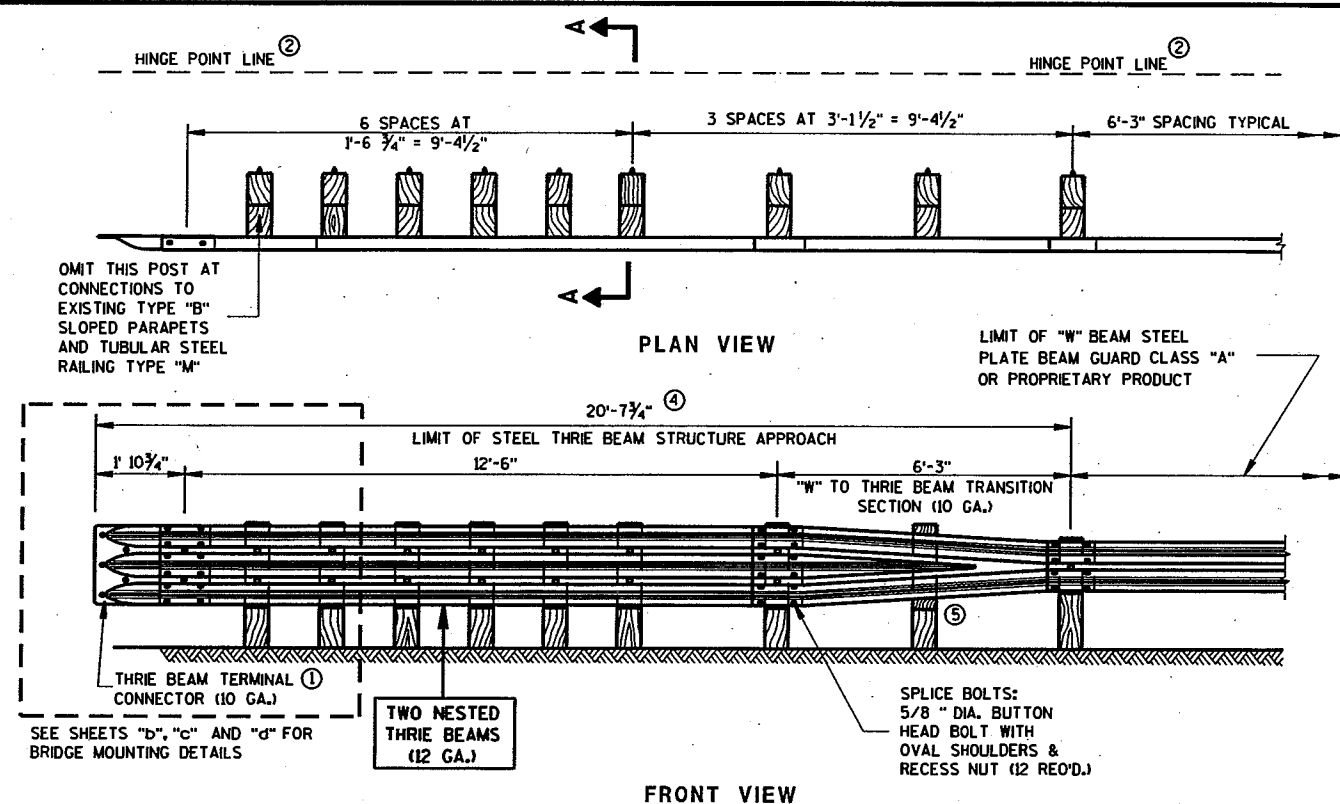

TYPICAL LOCATIONS OF THRIE BEAM AND W-BEAM CONNECTIONS TO BRIDGE

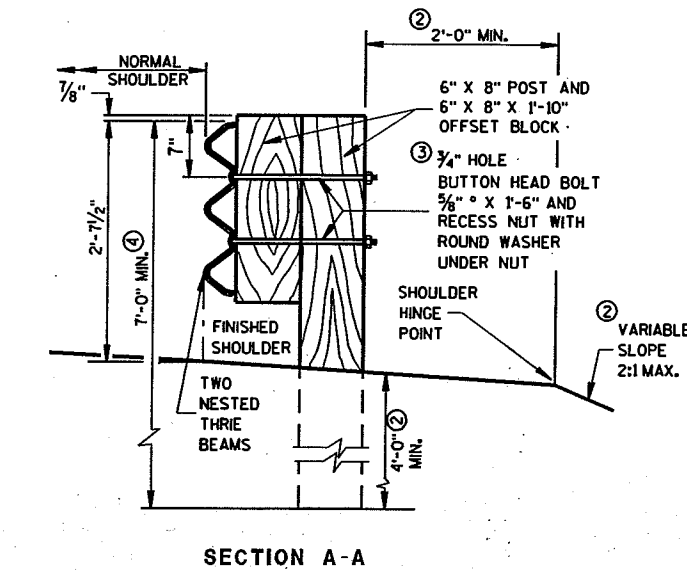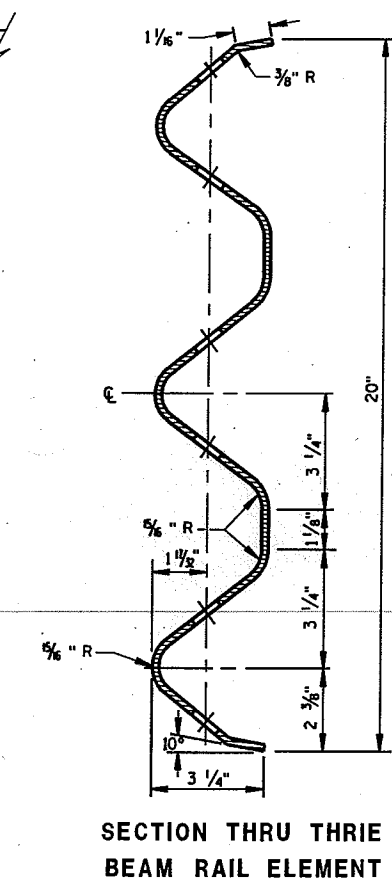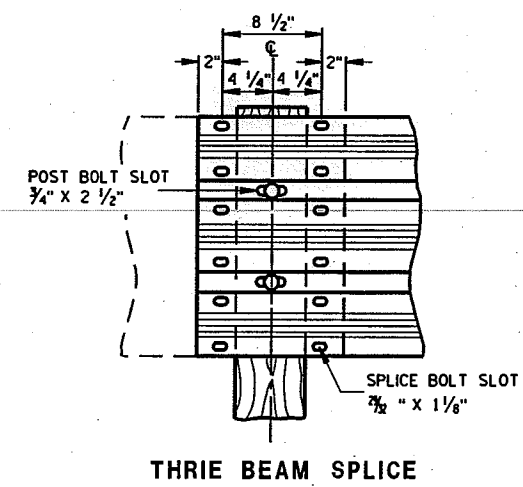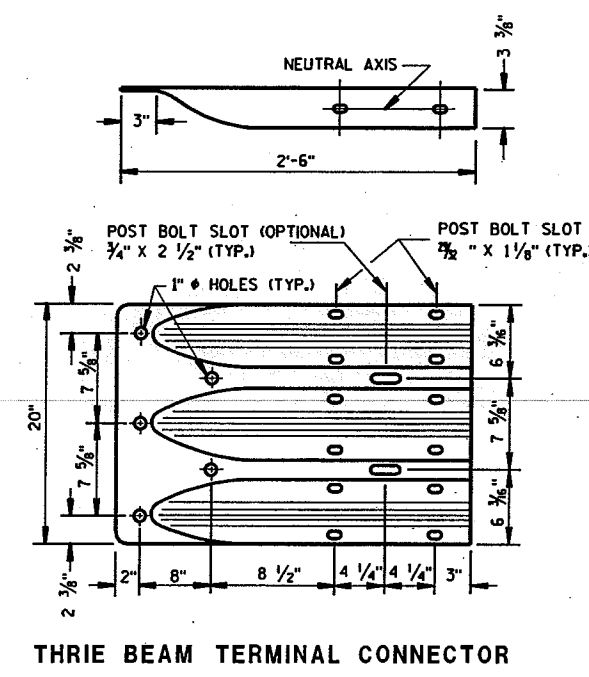


GENERAL NOTES

- DETAILS OF CONSTRUCTION, MATERIALS AND WORKMANSHIP NOT SHOWN ON THIS DRAWING SHALL CONFORM TO THE PERTINENT REQUIREMENTS OF THE STANDARD SPECIFICATIONS AND THE APPLICABLE SPECIAL PROVISIONS.
- FURNISH AND CONSTRUCT THRIE BEAM STRUCTURAL APPROACH ACCORDING TO THE REQUIREMENTS OF SECTION 614 OF THE STANDARD SPECIFICATIONS. THRIE BEAM SECTIONS SHALL CONFORM TO THE REQUIREMENTS OF AASHTO DESIGNATION M180, CLASS "A", TYPE 2.
- BOLT THE THRIE BEAM TO ALL POSTS AND BLOCKOUTS. DRILL OR PUNCH BOLT HOLES IN THE BEAM IF THE POST SPACING IS LESS THAN 6'-3".
- DO NOT USE STEEL POSTS AND NOTCHED PLASTIC BLOCKOUTS IN THE STEEL THRIE BEAM STRUCTURAL APPROACH AND THE TRANSITION SECTION OF STEEL PLATE BEAM GUARD, CLASS "A" INSTALLATIONS.
- IF ROCK IS ENCOUNTERED DURING EXCAVATION, THE ENGINEER MAY APPROVE USING A 12 INCH DIAMETER POST HOLE EXTENDING 20 INCHES DEEP INTO THE ROCK. PLACE GRANULAR MATERIAL IN THE BOTTOM OF THE HOLE APPROXIMATELY 2 1/2 INCHES DEEP. CUT THE POSTS TO LENGTH AND PLACE IN THE HOLE. BACKFILL WITH MATERIAL EXCAVATED FROM THE HOLE AND COMPACT ADEQUATELY. (SEE SDD-14 B 15-40).
- BRIDGE RAILING TYPE "W" DOES NOT REQUIRE A TERMINAL CONNECTOR.
 - MINIMUM EMBEDMENT SHALL BE 4'-0". WHERE EXISTING CONDITIONS DO NOT PERMIT THE APPROPRIATE EARTHWORK SHOWN ON THE PLAN TYPICAL SECTIONS OR DETAILS, THE ENGINEER MAY ALLOW THE REDUCTION OR ELIMINATION OF THE 2 FOOT DISTANCE TO THE HINGE POINT. OTHERWISE BUILD AS THE PLAN SHOWS OR AS THE ENGINEER DIRECTS. IF THE 2 FOOT DISTANCE TO THE HINGE POINT IS REDUCED OR ELIMINATED, INCREASE THE POST EMBEDMENT DEPTH TO 4'-6" OR MORE.
 - BOLTS SHALL CONFORM TO THE REQUIREMENTS OF ASTM F-1554, GRADE 55. NUTS SHALL CONFORM TO THE REQUIREMENTS OF ASTM A-563 DH.
 - ALL WOOD POSTS MUST BE 6" X 8" AND AT LEAST 7'-0" LONG.
 - DO NOT ATTACH POST IN "W" TO THRIE BEAM TRANSITION SECTION.

STEEL THRIE BEAM STRUCTURE APPROACH

STATE OF WISCONSIN DEPARTMENT OF TRANSPORTATION

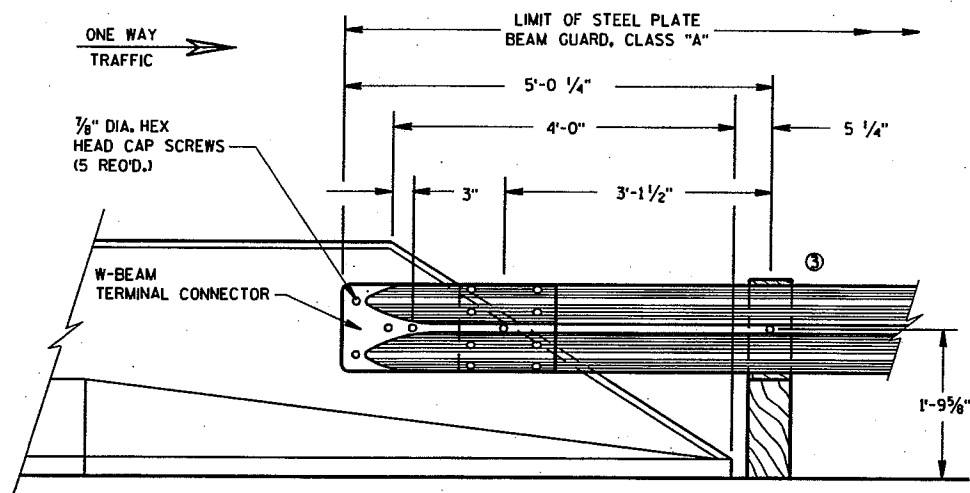

FRONT VIEW
W BEAM CONNECTION TO
PARAPETS WITH SLOPED ENDS
 (USE ONLY AT TRAFFIC EXIT END OF ONE WAY BRIDGE)

GENERAL NOTES

THESE ARE TYPICAL CONNECTION DETAILS. ADJUST THE POSITION OF CONNECTIONS TO EXISTING BRIDGES TO FIT THE ACTUAL BRIDGE AND SITE DIMENSIONS.


BOLTS, PLATES, NUTS AND WASHERS SHALL CONFORM TO THE REQUIREMENTS OF ASTM SPECIFICATION A 325, AND BE GALVANIZED IN ACCORDANCE WITH ASTM A 153.

① INCLUDE THE PAYMENT FOR DRILLING BOLT HOLES THROUGH THE PARAPET, AND THE BACKUP PLATE AND ALL BOLTS, NUTS AND WASHERS IN THE ITEM "STEEL THRIE BEAM STRUCTURAL APPROACH".


② EACH BOLT AT THE BACK FACE OF THE PARAPET REQUIRES A HARDENED ROUND STEEL WASHER WITH A 2 1/4" O.D. X 5/16" THICK.

③ W6 X 9 OR W6 X 8.5 STEEL POSTS AND NOTCHED PLASTIC BLOCKOUTS ARE ACCEPTABLE ALTERNATIVES FOR 6" X 8" WOOD POST WITH WOOD OR PLASTIC BLOCKOUTS. USE APPROVED NOTCHED PLASTIC BLOCKOUTS WITH STEEL POSTS.

DO NOT USE STEEL POSTS AND NOTCHED PLASTIC BLOCKOUTS IN THE STEEL THRIE BEAM STRUCTURAL APPROACH AND THE TRANSITION SECTION OF STEEL PLATE BEAM GUARD, CLASS "A" INSTALLATIONS.

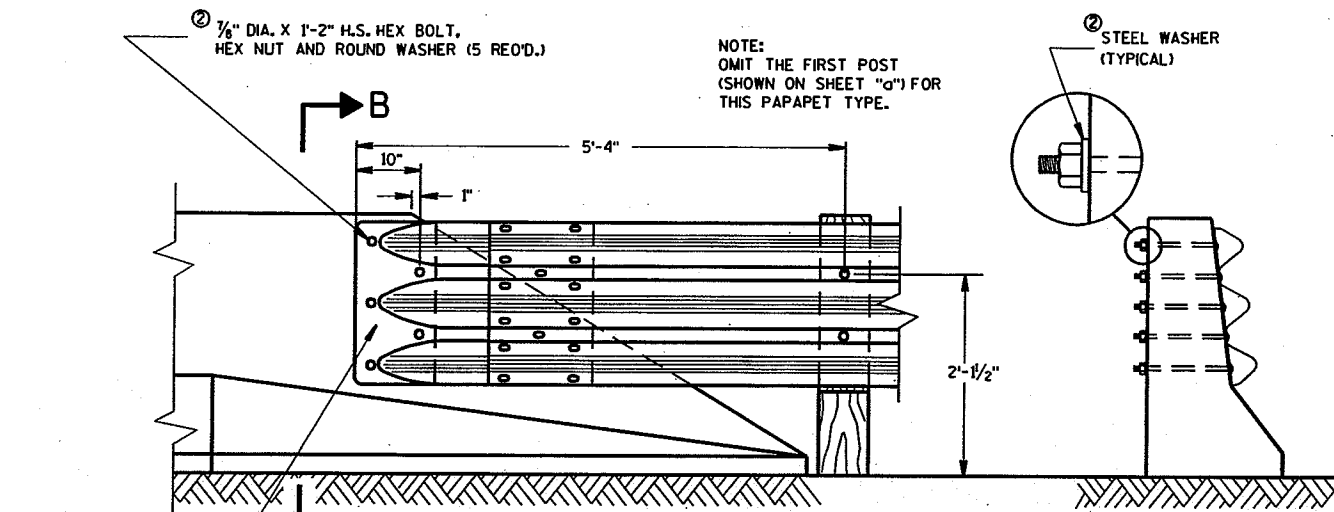

FRONT VIEW
THRIE BEAM CONNECTION TO BRIDGE
PARAPETS WITH SLOPED ENDS

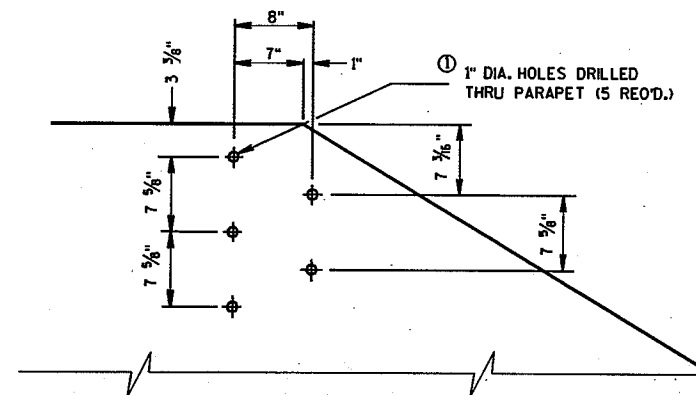

DRILL HOLE LOCATION AND PATTERN
FOR THRIE BEAM CONNECTION

STEEL THRIE BEAM STRUCTURE
APPROACH, CONNECTION TO
SLOPED END PARAPETS

STATE OF WISCONSIN
 DEPARTMENT OF TRANSPORTATION

APPROVED



DATE _____ CHIEF ROADSIDE DEVELOPMENT ENGINEER
 FHWA

BILL OF MATERIALS


NOTE NO.	QTY.	DESCRIPTION
①	4	WOOD BREAKAWAY TERMINAL POST: 5 1/2" X 1 1/2" X 3'-9"
②	4	STEEL TUBE: TS 8" X 6" X 0.188", 4'-6" LONG
③	4	SOIL PLATE: 2'-0" X 1'-6" X 1/4"
④	4	WOOD BREAKAWAY CRT POST: 6" X 8" X 6'-0"
⑤	6	WOOD OFFSET BLOCKS: 6" X 8" X 1'-2"
⑥	1	PIPE SLEEVE: 2" X 5 1/2" STANDARD PIPE
⑦	1	BEARING PLATE
⑧	1	BCT CABLE ASSEMBLY
⑨	1	CABLE ANCHOR BOX
⑩	1	STRUT & YOKE
⑪	1	STEEL PLATE BEAM, END PANEL 12 GA. 13'-6 1/2" LONG FOR SKT-350, ET-2000 AND ET-2000 PLUS
⑫	3	STEEL PLATE BEAM: 12 GA. 13'-6 1/2"
⑬	1	ET-2000/ET-2000 PLUS GUARDRAIL EXTRUDER OR SKT-350 IMPACT HEAD: AS FURNISHED BY MANUFACTURER
⑭	1	REFLECTIVE SHEETING: 18" X 18"

GENERAL NOTES


- Ⓐ USE 3:1 OR FLATTER SLOPE FOR INSTALLATION ON EXISTING HIGHWAYS.
 - Ⓑ DO NOT ATTACH GUARDRAIL TO POST BLOCKS AT POSTS NO. 3, 5 & 7.
 - Ⓒ AFTER FINAL ASSEMBLY, RECHECK CABLE TO BE SURE IT IS TAUT AND HAS NOT RELAXED.
- STEEL POSTS SHALL NOT BE ALLOWED FOR USE WITH ENERGY ABSORBING TERMINALS.
DO NOT INSTALL REFLECTORS ON THE FIRST 50 FEET OF THE APPROACH END OF THE ENERGY ABSORBING TERMINAL.
* DO NOT ATTACH BLOCKOUTS TO POSTS 1 AND 2.

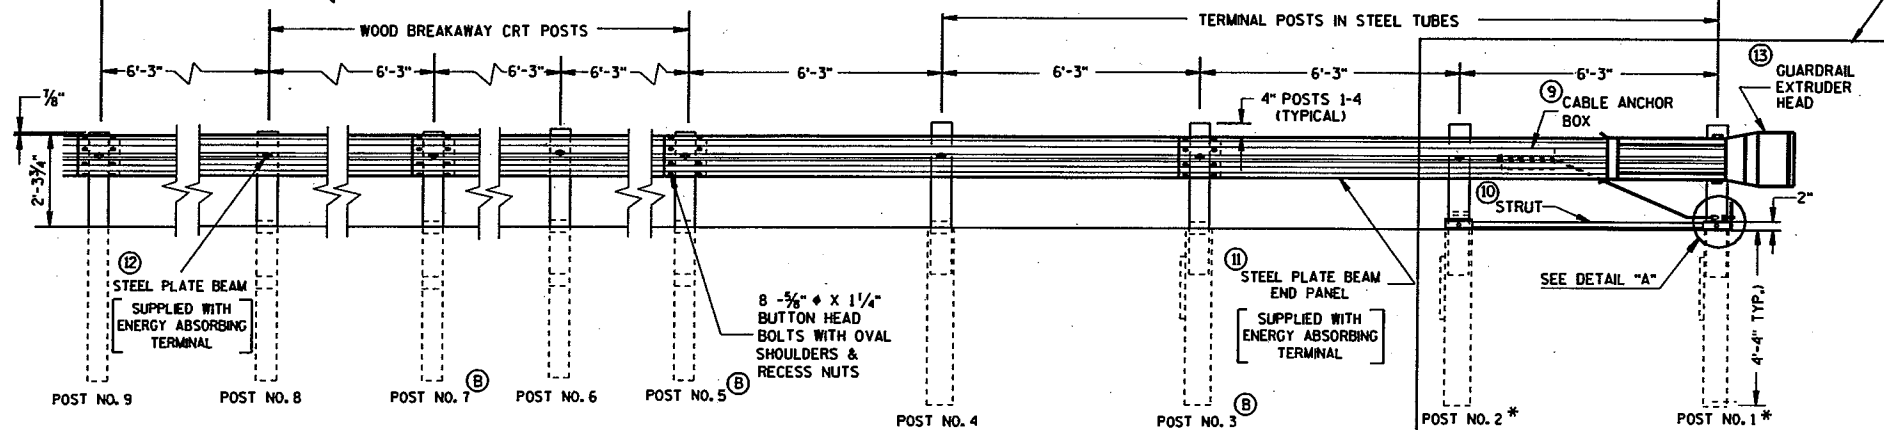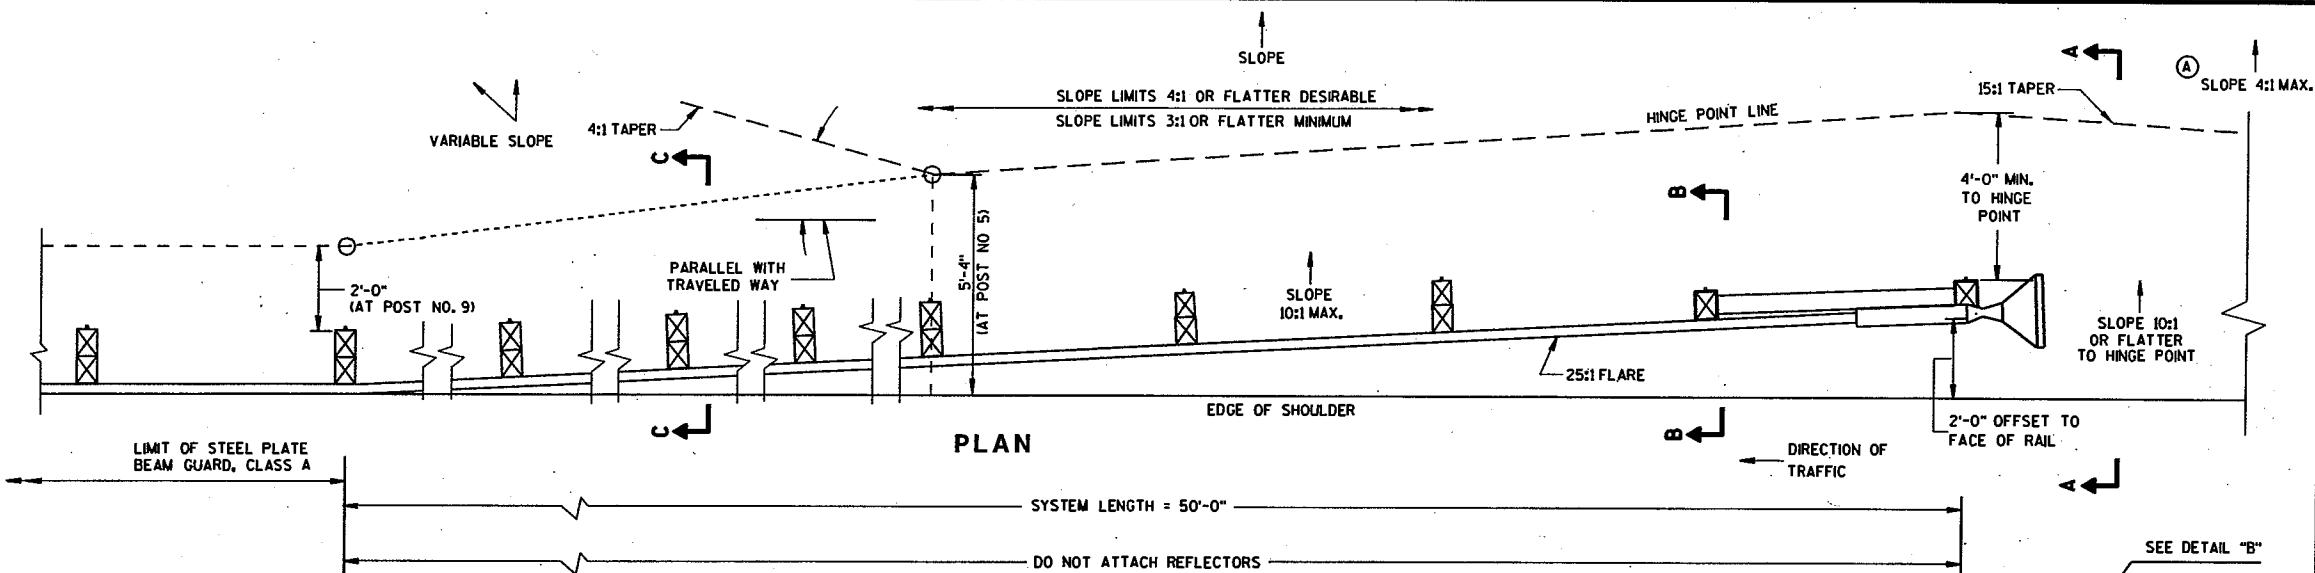


ELEVATION

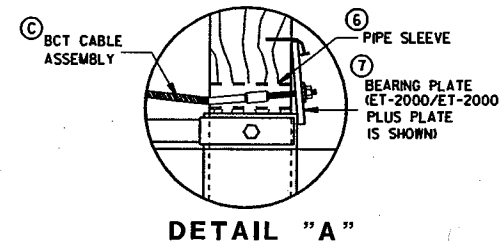

DETAIL "A"

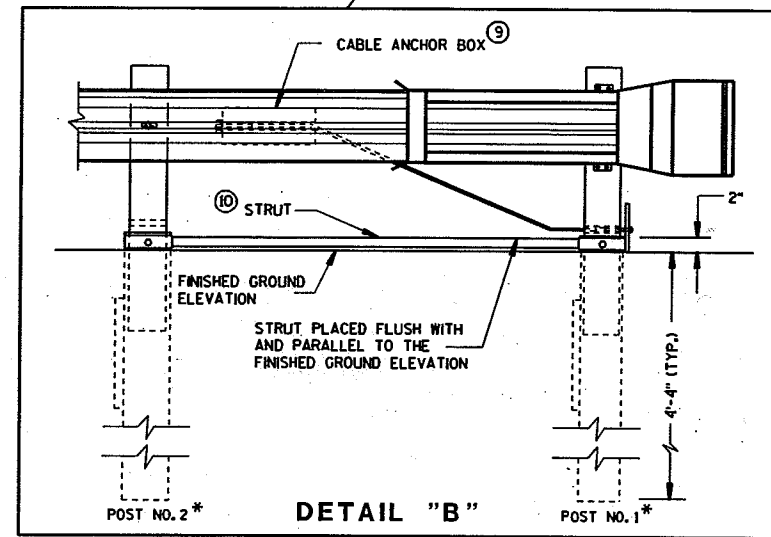


DETAIL "B"

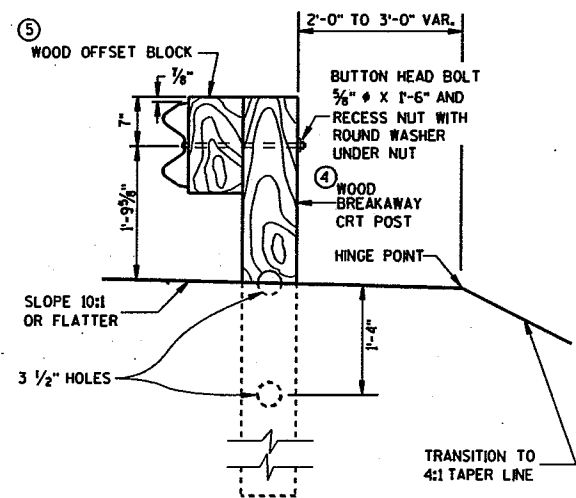


SECTION C-C

TYPICAL AT POST NOS. 4, 6, 8

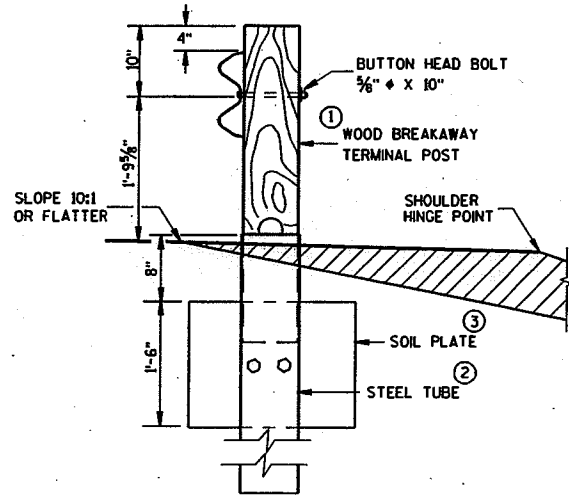

SECTION B-B

TYPICAL AT POST NO. 2*

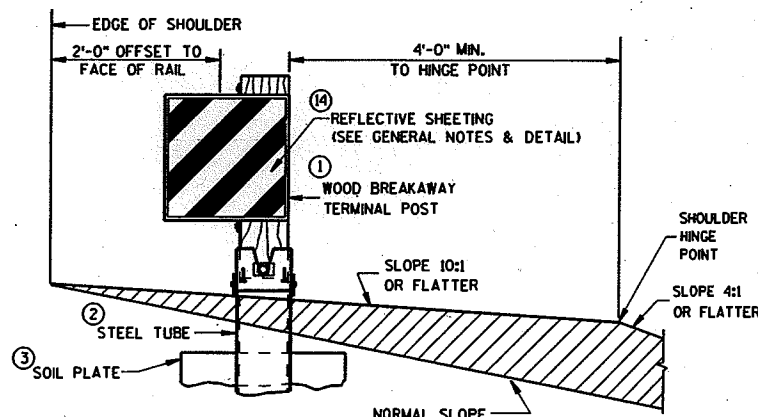


SECTION A-A


TYPICAL AT POST NO. 1*

STEEL PLATE BEAM GUARD ENERGY ABSORBING TERMINAL


STATE OF WISCONSIN
DEPARTMENT OF TRANSPORTATION

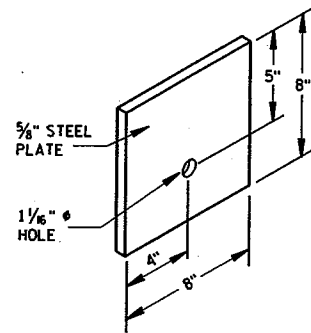

STEEL BEARING PLATE (SKT-350)

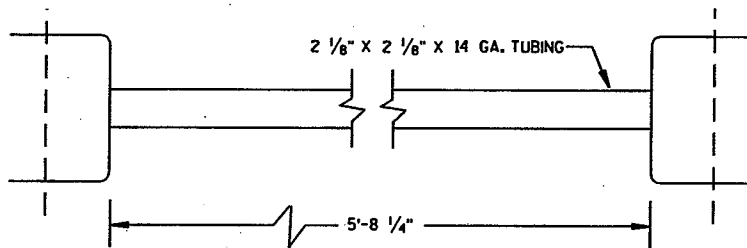


STRUT DETAIL (SKT-350)

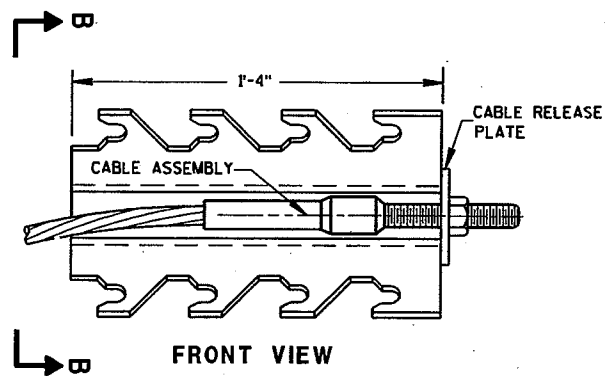


FRONT VIEW

CABLE ANCHOR BOX (SKT-350)

(SKT-350)

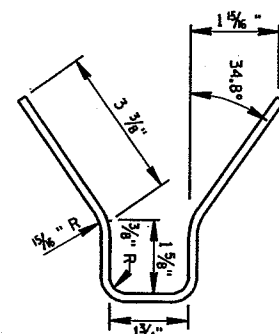


SECTION B-B

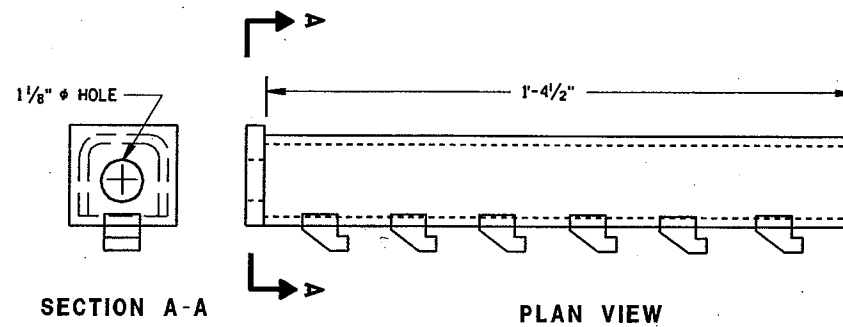


SECTION A-A

PLAN VIEW


CABLE ANCHOR BOX (ET-2000/ET-2000 PLUS)

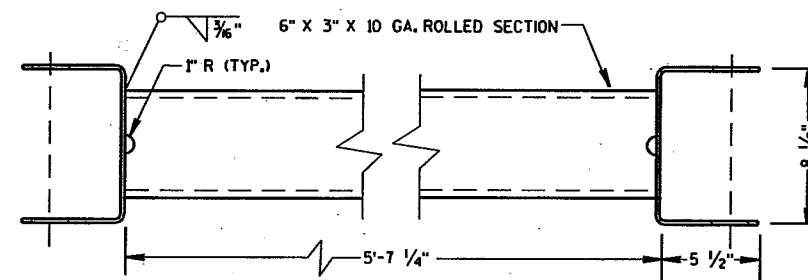

STRUT DETAIL (ET-2000/ET-2000 PLUS)

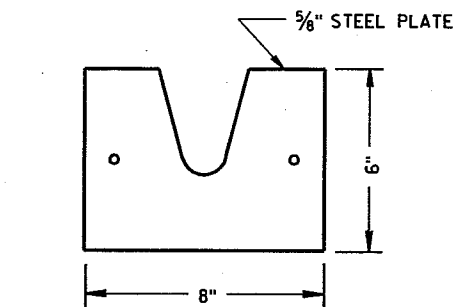


STEEL BEARING PLATE (ET-2000/ET-2000 PLUS)

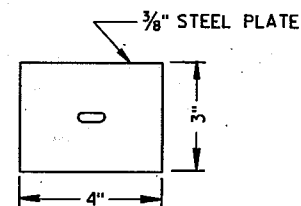


BEARING PLATE WASHER (ET-2000/ET-2000 PLUS)

(ET-2000/ET-2000 PLUS)

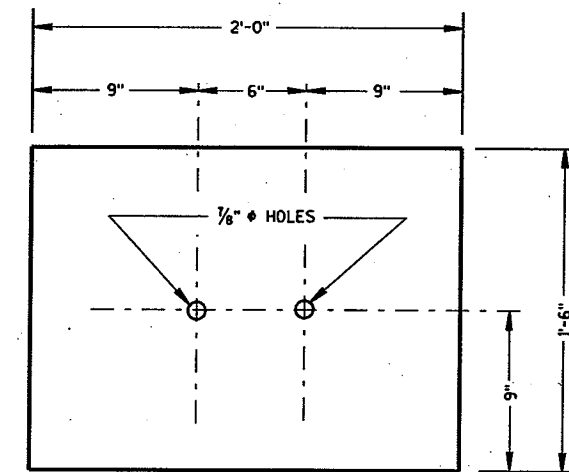


1/4" STEEL PLATE

SOIL PLATE (SKT-350, ET-2000/ET-2000 PLUS)

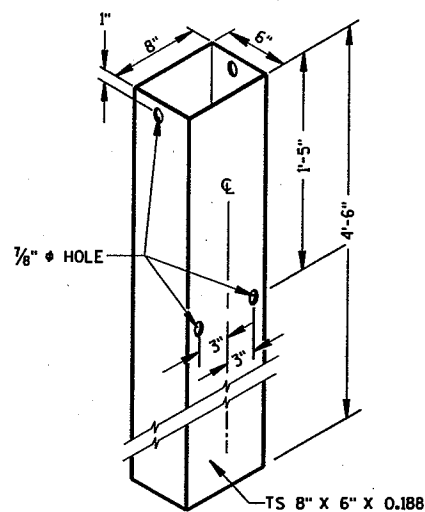


STEEL TUBE


(POSTS NO. 1-4)
THE STEEL TUBE SHALL CONFORM TO REQUIREMENTS OF ASTM A500

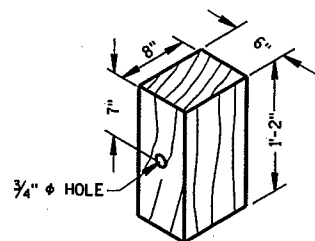

WOOD OFFSET BLOCK
REQ'D. AT ALL POSTS EXCEPT POST NO'S 1 & 2

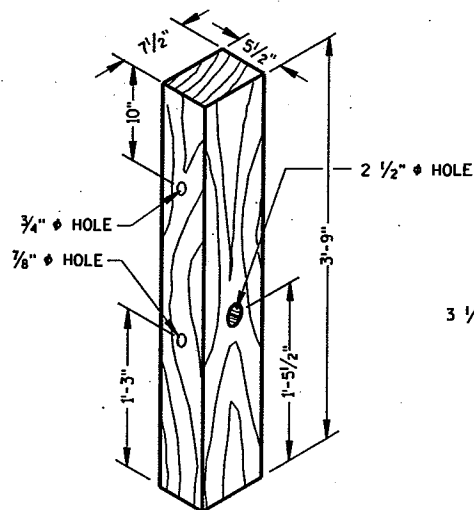


TERMINAL POST
(POSTS NO. 1-4)

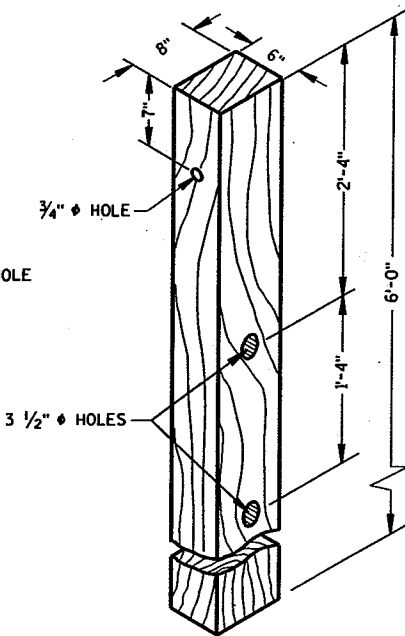


CRT POST
(POSTS NO'S 5-8)

WOOD BREAKAWAY POSTS

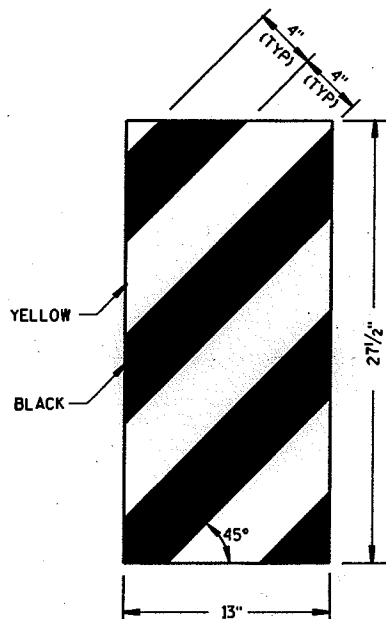

ET-2000 PLUS ONLY

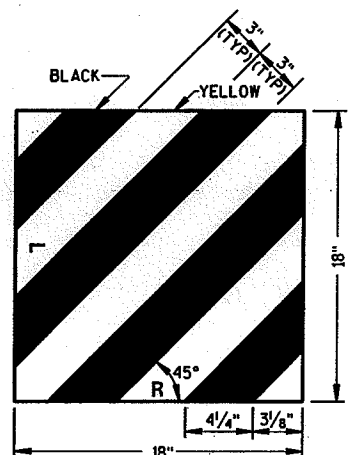

ET-2000 AND SKT-350

REFLECTIVE SHEETING DETAILS

GENERAL NOTES

DETAILS OF CONSTRUCTION, MATERIALS AND WORKMANSHIP NOT SHOWN ON THIS DRAWING SHALL CONFORM TO THE PERTINENT REQUIREMENTS OF THE STANDARD SPECIFICATIONS, APPLICABLE SPECIAL PROVISIONS AND MANUFACTURERS INSTRUCTIONS.

STEEL PLATE BEAM GUARD ENERGY ABSORBING TERMINAL SHALL BE EITHER THE EXTRUDER TERMINAL (ET-2000), OR THE SEQUENTIAL KINKING TERMINAL (SKT-350). THE CONTRACTOR SHALL NOT INTERMIX PROPRIETARY PRODUCT MATERIALS.

STEEL PLATE BEAM GUARD, ENERGY ABSORBING TERMINAL SHALL BE PAID FOR AT THE CONTRACT UNIT PRICE EACH, WHICH SHALL INCLUDE HARDWARE. STEEL PLATE BEAM GUARD, POSTS, REFLECTIVE SHEETING AND INSTALLATION AS SHOWN.


REFLECTIVE SHEETING - SHALL CONFORM TO ASTM SPECIFICATION D4956-94, REFLECTIVE SHEETING TYPE III, BACKING CLASS 4, PERFORMANCE REQUIREMENT TYPE III. THE MESSAGE AND LINES SHALL BE APPLIED TO THE SIGNS BY THE SILK SCREEN STENCIL PROCESS USING A BLACK OR DARK STENCIL PASTE AS A TYPE APPROVED BY THE MANUFACTURER OF THE FACE MATERIAL TO WHICH IT IS TO BE APPLIED. MESSAGE UNITS CUT FROM NONREFLECTIVE SHEETING AND APPLIED TO THE SIGN FACE ARE NOT ACCEPTABLE. AFTER THE APPROACH END OF THE STEEL PLATE BEAM GUARD INSTALLATION IS COMPLETE, CLEAN THE AREA WHERE THE REFLECTIVE SHEETING WILL BE APPLIED IN ACCORDANCE WITH THE MANUFACTURERS RECOMMENDATION. ONCE CLEAN, APPLY REFLECTIVE SHEETING DIRECTLY TO THE STEEL PLATE BEAM GUARD AS SHOWN. THE CONTRACTOR SHALL TURN OVER THE MANUFACTURERS WARRANTY FOR THE REFLECTIVE SHEETING TO THE DEPARTMENT FOR POTENTIAL DEALING WITH THE MANUFACTURER. PAYMENT OF REFLECTIVE SHEETING IS INCIDENTAL TO STEEL PLATE BEAM GUARD, ENERGY ABSORBING TERMINAL.

WHEN ROCK IS ENCOUNTERED DURING EXCAVATION, A 12 INCH DIA. POST HOLE EXTENDING 20 INCHES DEEP INTO THE ROCK MAY BE USED IF APPROVED BY THE ENGINEER. GRANULAR MATERIAL SHALL BE PLACED IN THE BOTTOM OF THE HOLE APPROXIMATELY 2 1/2 INCHES DEEP TO PROVIDE DRAINAGE. THE SOIL TUBES SHALL BE FIELD CUT TO LENGTH, PLACED IN THE HOLE AND BACKFILLED WITH ADEQUATELY COMPACTED MATERIAL EXCAVATED FROM THE HOLE.


S.D.D. 14 B 24-4C

S.D.D. 14 B 24-4C


STEEL PLATE BEAM GUARD ENERGY ABSORBING TERMINAL	
STATE OF WISCONSIN DEPARTMENT OF TRANSPORTATION	
APPROVED	
DATE	CHIEF ROADWAY DEVELOPMENT ENGINEER
FHWA	

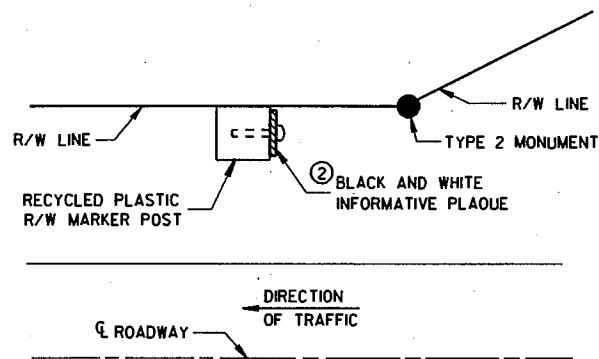

PLAN VIEW
TYPICAL LOCATION ②

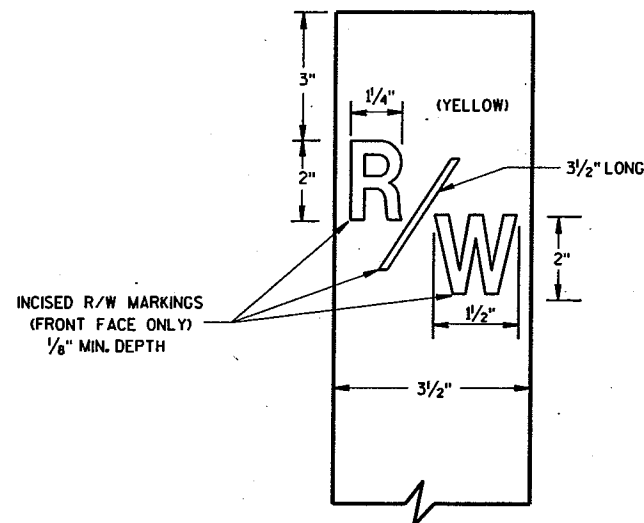


RECYCLED PLASTIC
RIGHT-OF-WAY MARKER POST
FRONT FACE

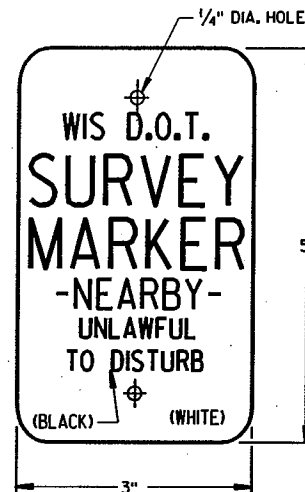


INFORMATIVE PLAQUE ③

MARKING & SIGNING DETAILS

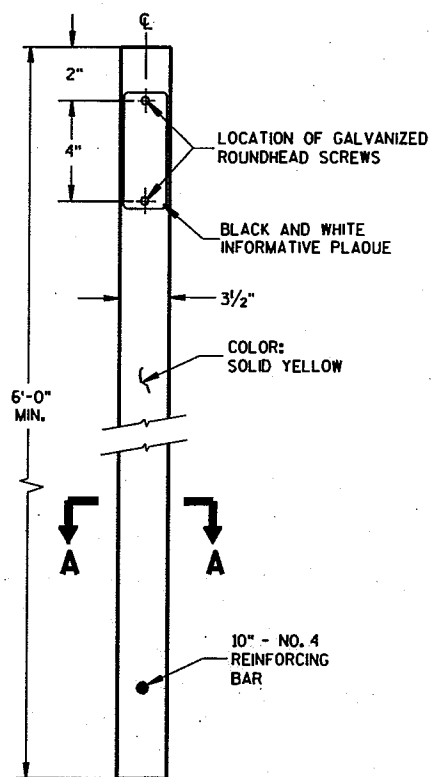

SIDE VIEW
STANDARD RECYCLED
PLASTIC MARKER POST

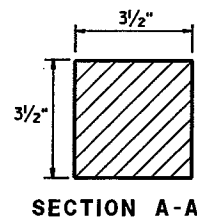


SECTION A-A


GENERAL NOTES

DETAILS OF CONSTRUCTION, MATERIALS, AND WORKMANSHIP NOT SHOWN ON THIS DRAWING SHALL CONFORM TO THE PERTINENT REQUIREMENTS OF THE STANDARD SPECIFICATIONS AND THE APPLICABLE SPECIAL PROVISIONS.

- ① POSTS SHALL BE ANCHORED AND SET INTO EXCAVATED HOLES AS ILLUSTRATED OR MAY BE DRIVEN AND ANCHORED INTO THE GROUND BY ALTERNATE DEVICES APPROVED BY THE ENGINEER.
- ② A MARKER POST FOR RIGHT-OF-WAY SHALL BE PLACED ADJACENT TO EACH TYPE 2 MONUMENT TO SERVE AS A GUARD POST, AND AT OTHER LOCATIONS AS SHOWN ON THE PLANS OR AS DIRECTED BY THE ENGINEER.
- ③ INFORMATIVE PLAQUES WILL BE FURNISHED BY THE DEPARTMENT OF TRANSPORTATION AND BE PLACED ON THE SIDE OF THE POST FACING THE TYPE 2 MONUMENT.
- ④ IN AREAS OF SOLID ROCK, DRILL A 1/2" MIN. BORE HOLE INTO THE ROCK TO A DEPTH OF 12". CUT THE POST SO THAT A LENGTH OF 3'-6" PROTRUDES ABOVE THE GROUND. DRILL A 5/8" PILOT HOLE 1 FOOT INTO THE BOTTOM OF THE POST. DRIVE A 2 FOOT PIECE OF NO. 6 REINFORCING BAR INTO THE POST. BLOW OUT THE BORE HOLE IN THE ROCK USING COMPRESSED AIR. FILL THE BORE HOLE WITH EPOXY, CONCRETE CEMENT OR EQUIVALENT. PLACE THE POST WITH THE EXTENDED REINFORCING BAR INTO THE BORE HOLE WITH ADHESIVE. DEPENDING ON THE STABILITY OF THE ROCK, DEPTH OF THE BORE HOLE AND REINFORCING BAR MAY BE INCREASED AT THE DIRECTION OF THE ENGINEER.

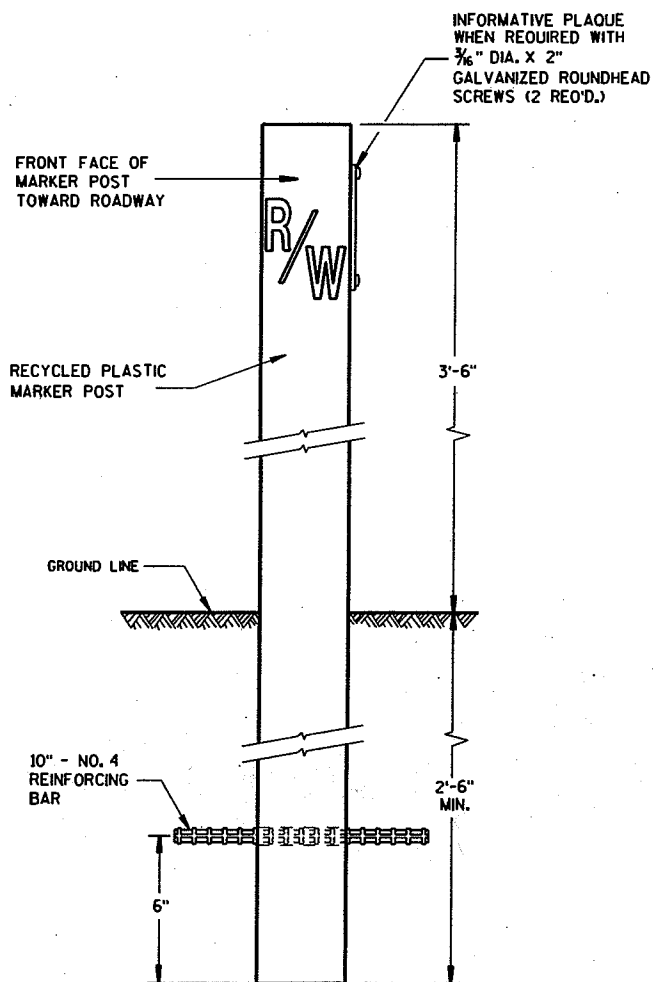

FRONT VIEW
TYPICAL INSTALLATION ①

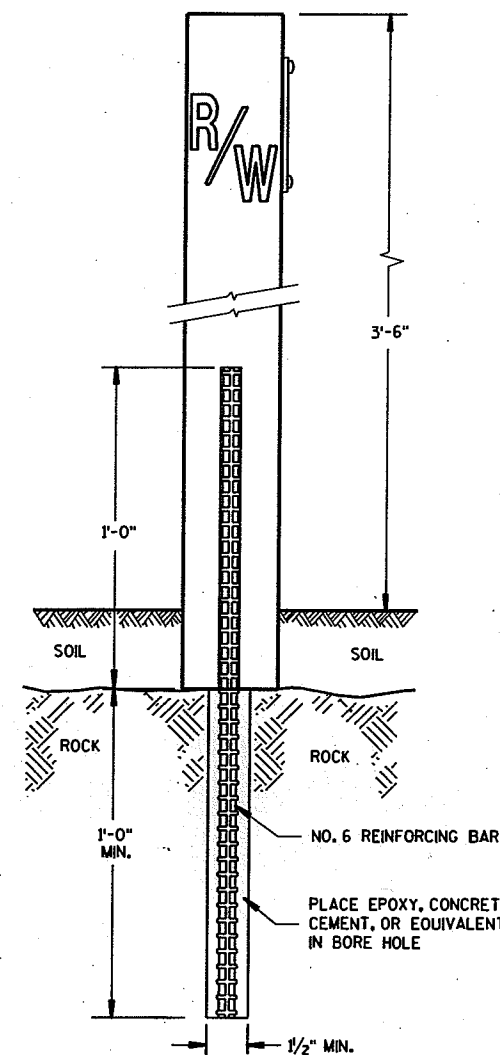

FRONT VIEW
ROCK INSTALLATION ④

MARKER POST FOR RIGHT-OF-WAY	
STATE OF WISCONSIN DEPARTMENT OF TRANSPORTATION	
APPROVED	
DATE	_____ CHIEF SURVEYING AND MAPPING ENGINEER
FHWA	

REVISION DATE: 9-3-88

PLAT NAME:


PLAT SCALE: 20:1

FILE NAME:


ORIGINATOR: DENNIS HOAGLAND

LEVELS: 01 - 1, 2, 3, 62, 63


S.D.O. 15 A 3-1

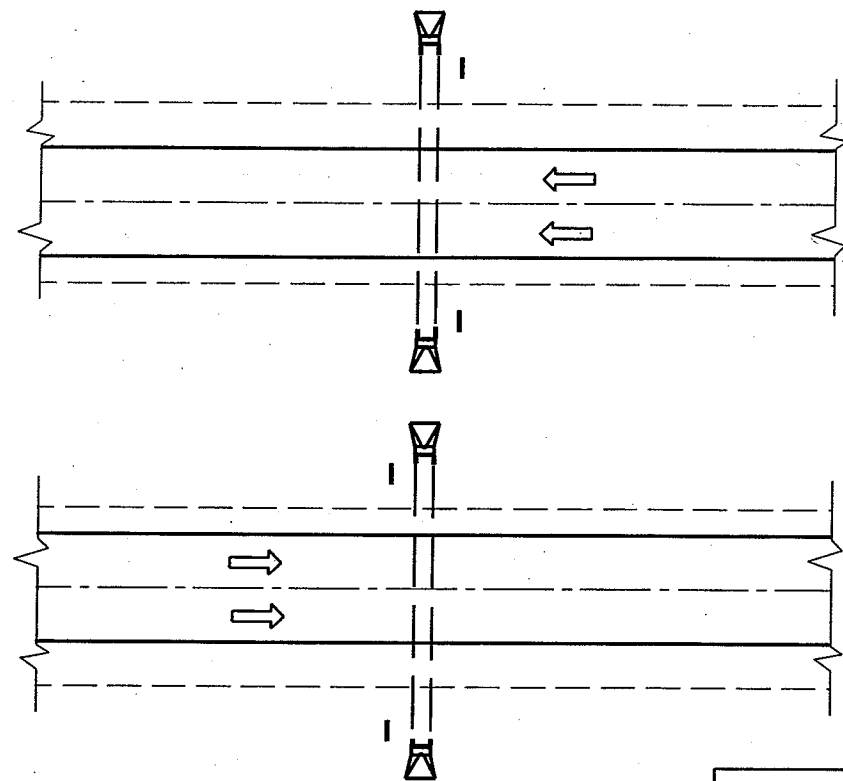


PLAN VIEW DIVIDED HIGHWAY

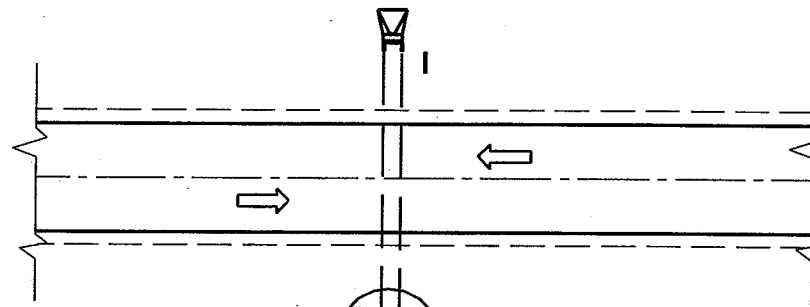

PLAN VIEW UNDIVIDED HIGHWAY

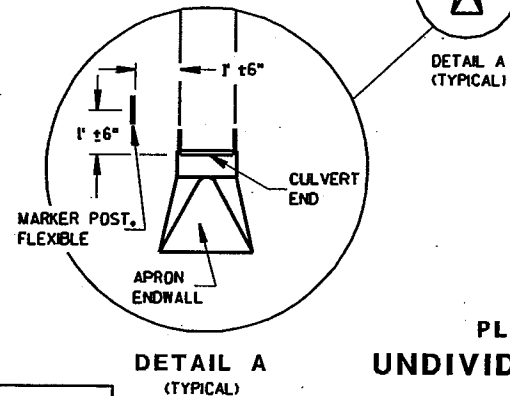


DETAIL A (TYPICAL)

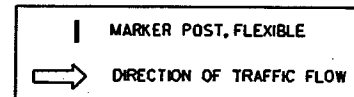


FLEXIBLE MARKER POST LOCATION

GENERAL NOTES





DETAILS OF CONSTRUCTION, MATERIALS AND WORKMANSHIP NOT SHOWN ON THIS DRAWING SHALL CONFORM TO THE PERTINENT REQUIREMENTS OF THE STANDARD SPECIFICATIONS AND THE APPLICABLE SPECIAL PROVISIONS.

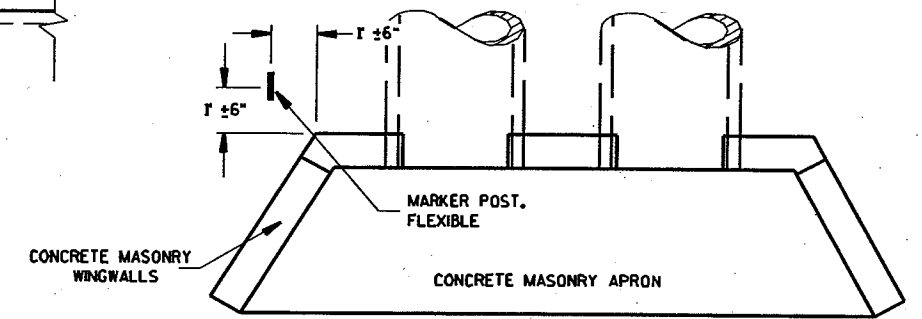


PLAN VIEW CONCRETE MASONRY ENDWALLS FOR CULVERT PIPE AND PIPE ARCH

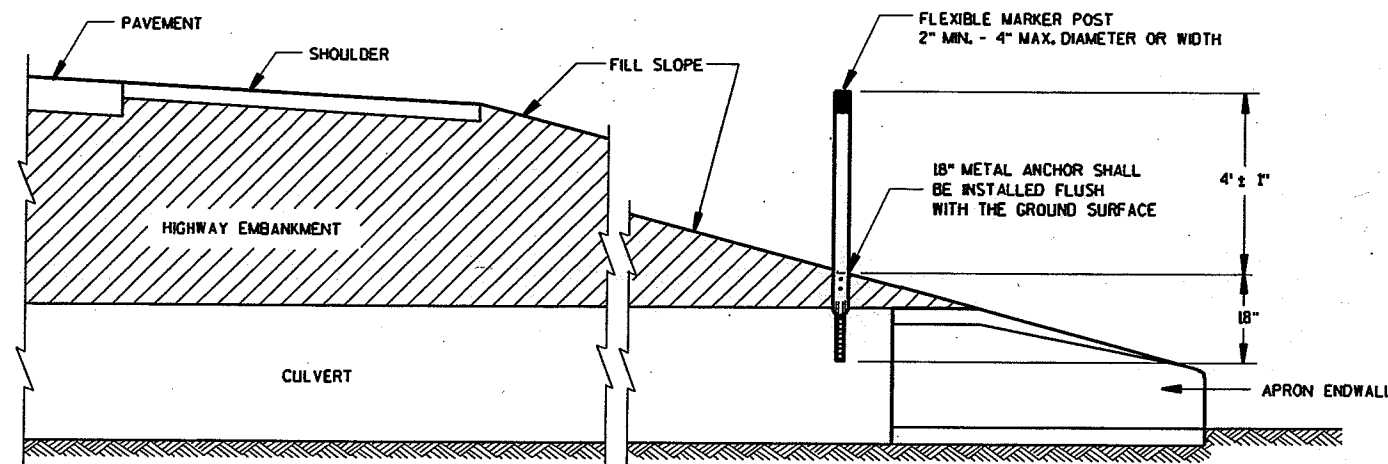

CROSS SECTION FLEXIBLE MARKER POST

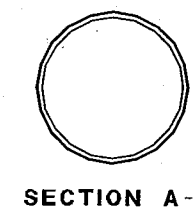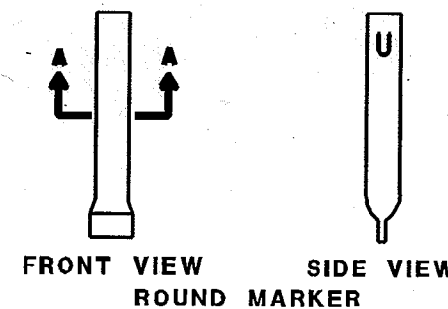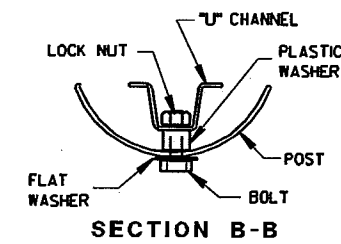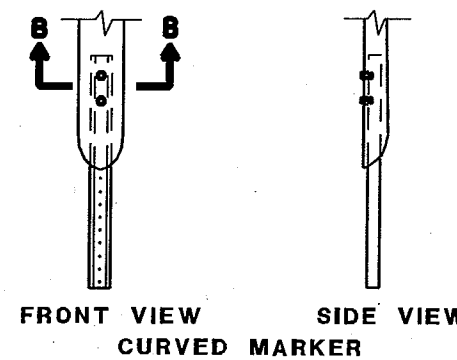


FLEXIBLE MARKER POST ANCHORS

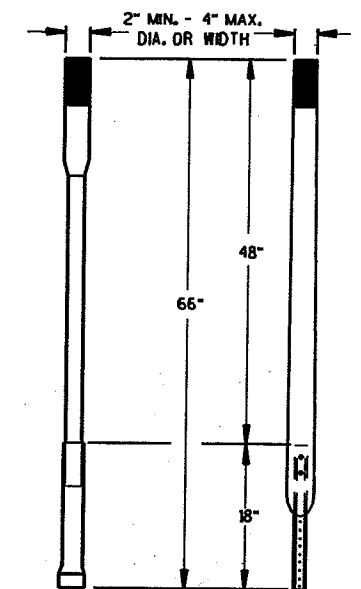


ALTERNATE 1 ALTERNATE 2 FLEXIBLE MARKER POST

MARKER POST, FLEXIBLE, FOR CULVERT END	
STATE OF WISCONSIN DEPARTMENT OF TRANSPORTATION	
APPROVED	
DATE _____	_____ CHIEF ROADWAY DEVELOPMENT ENGINEER
FHWA	

S.D.O. 15 A 3-1

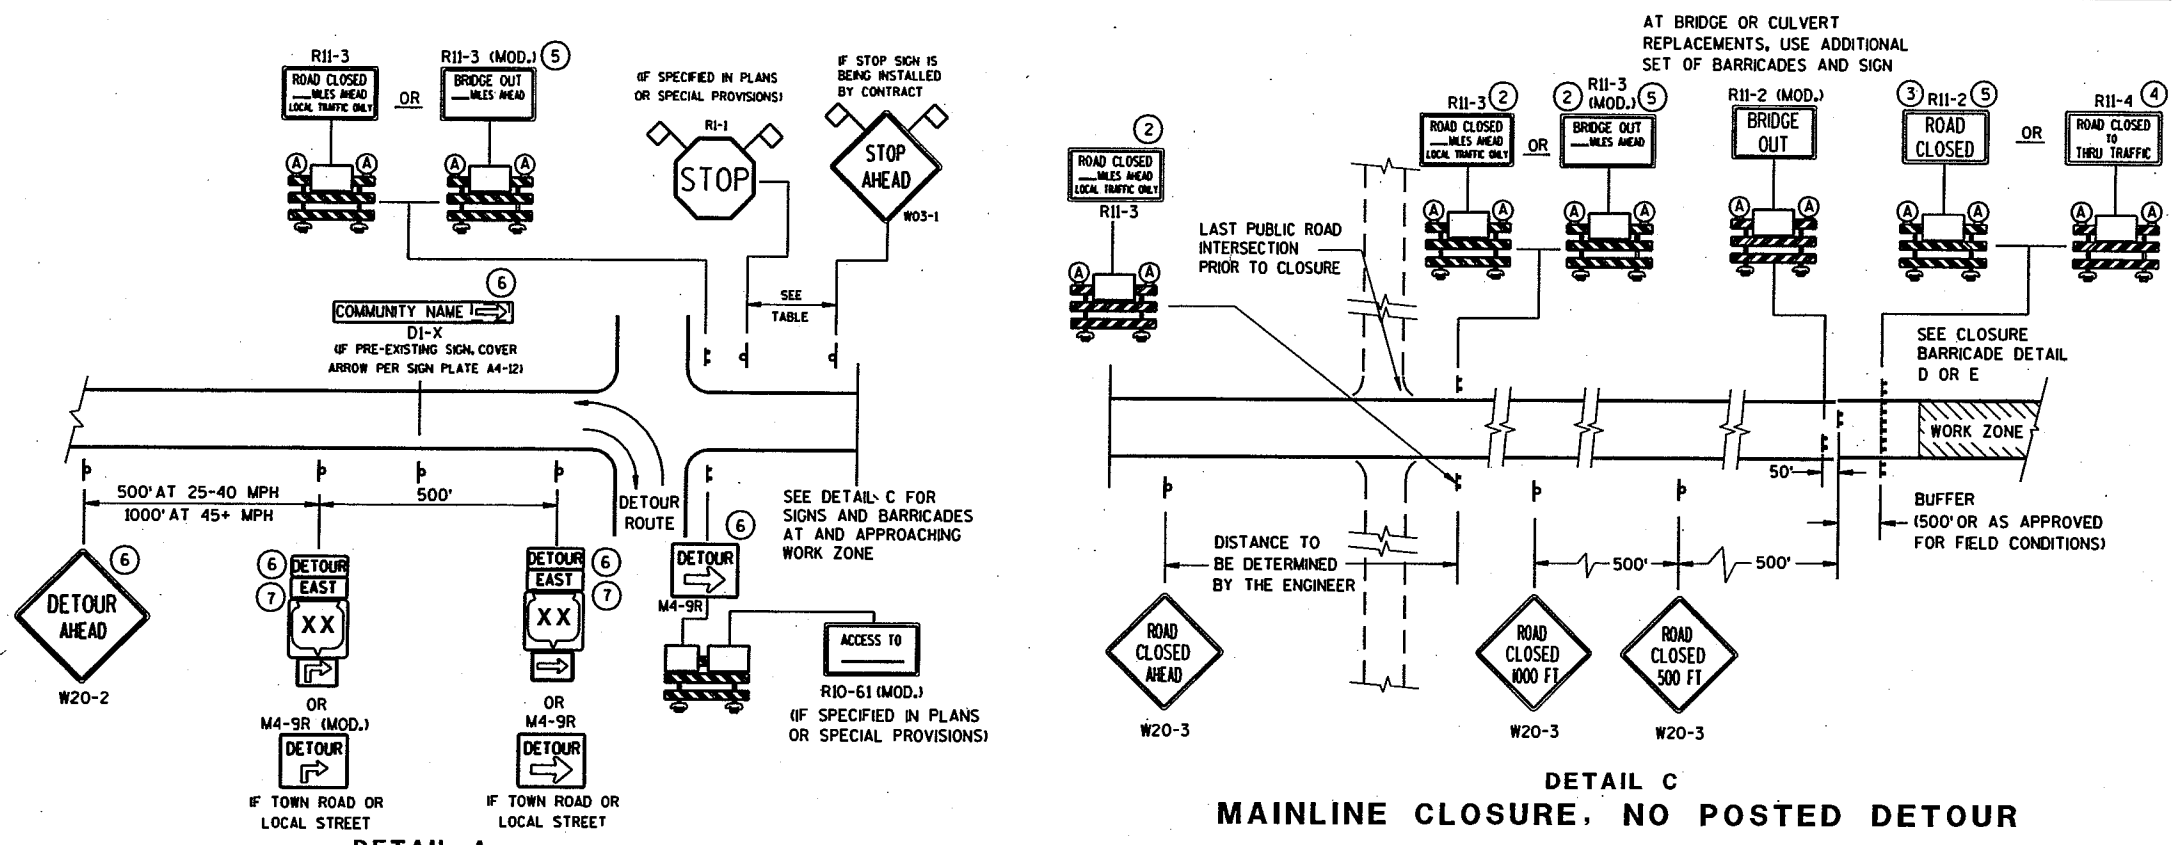


DETAIL A
MAINLINE CLOSURE WITH POSTED DETOUR
 WORK ZONE GREATER THAN 1/2 MILE FROM DETOUR ROUTE (1000 FEET IF URBAN)

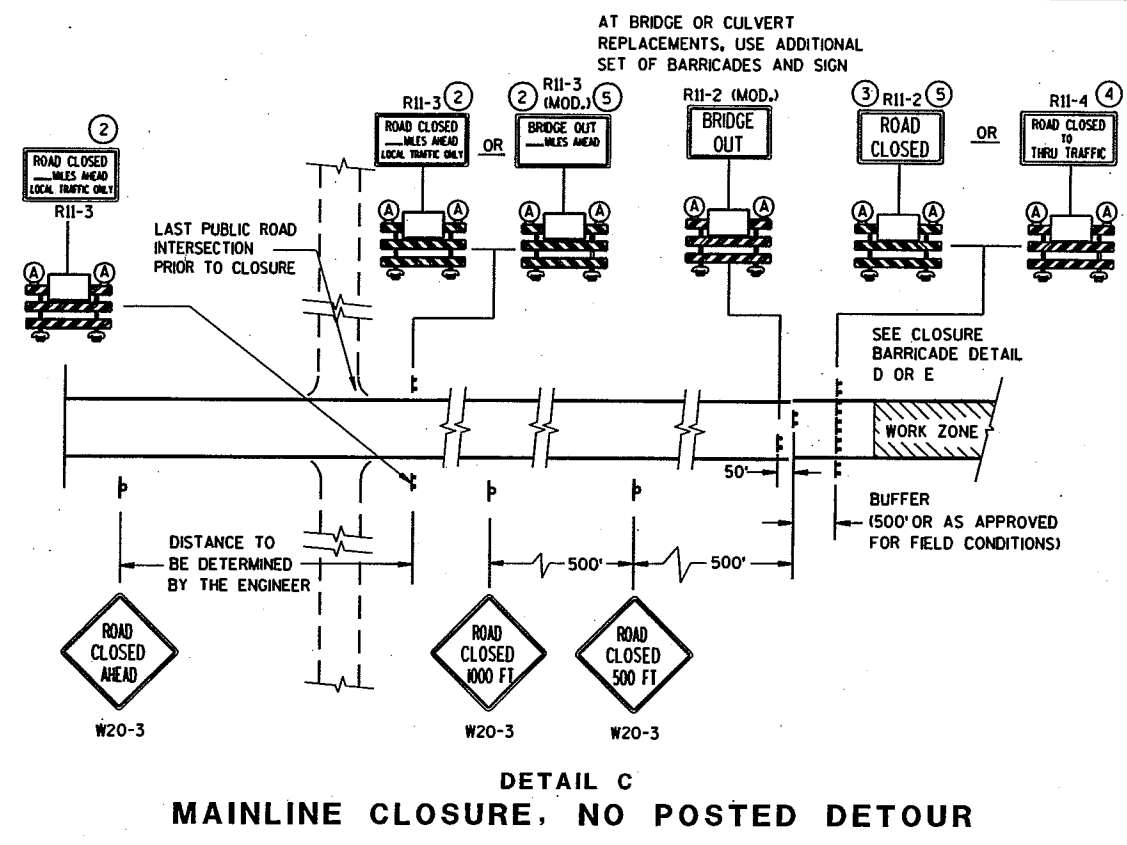

DETAIL C
MAINLINE CLOSURE, NO POSTED DETOUR

SPEED LIMIT (MPH)	"STOP AHEAD" ADVANCE WARNING DISTANCE (FT)
25	200
30	200
35	350
40	350
45	500
50	550
55	750


SEE SDD 15C2-4b FOR GENERAL NOTES AND FOOTNOTES ① THROUGH ⑦

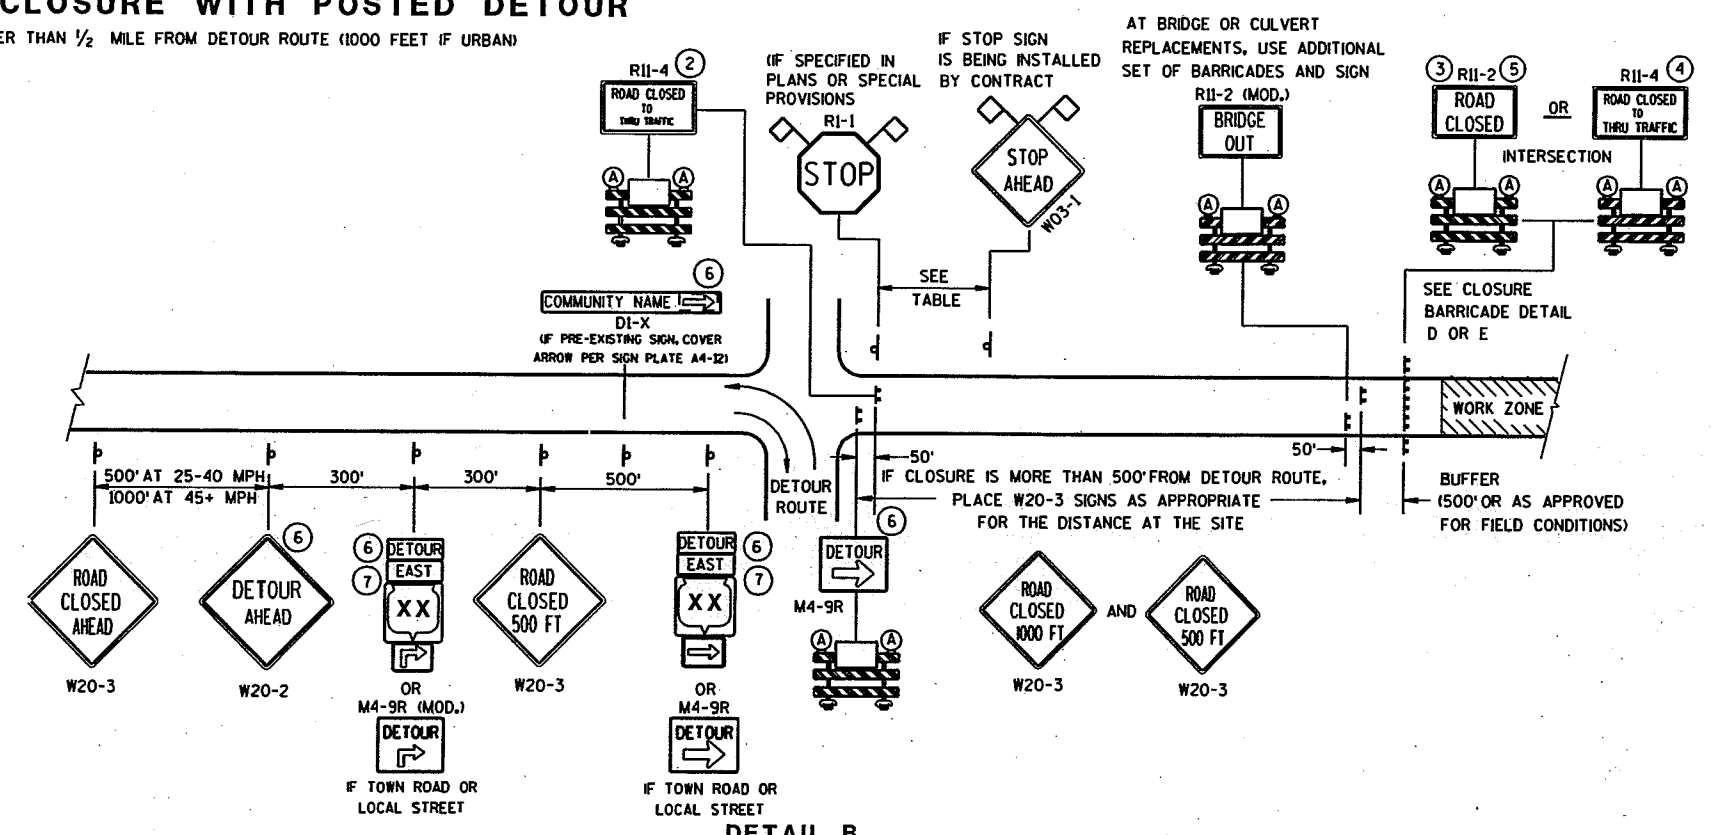


DETAIL B
MAINLINE CLOSURE WITH POSTED DETOUR
 WORK ZONE LESS THAN 1/2 MILE FROM DETOUR ROUTE (1000 FEET IF URBAN)

- LEGEND**
- ⌋ POST MOUNTED SIGN
 - ⌋ TYPE III BARRICADES
 - Ⓐ TYPE "A" LOW INTENSITY FLASHING WARNING LIGHT (FOR NIGHT USE)
 - ▨ WORK ZONE
 - DETOUR EAST M4-8
 - M3-X
 - MJ-4 OR COUNTY MI-5A OR MI-6
 - MI-4 OR MI-6
 - MO5-1 OR MO6-1
 - ◇ FLAGS, 16" X 16" MIN., (ORANGE)

BARRICADES AND SIGNS FOR MAINLINE CLOSURES
 STATE OF WISCONSIN
 DEPARTMENT OF TRANSPORTATION

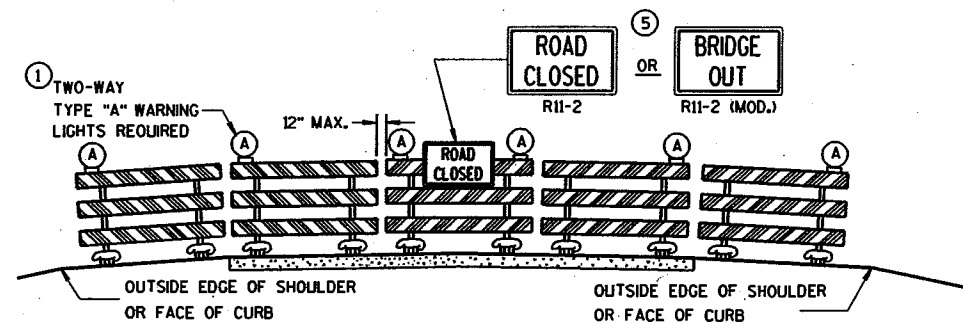

DETAIL D
ROAD CLOSURE BARRICADE DETAIL
 APPROACH VIEW

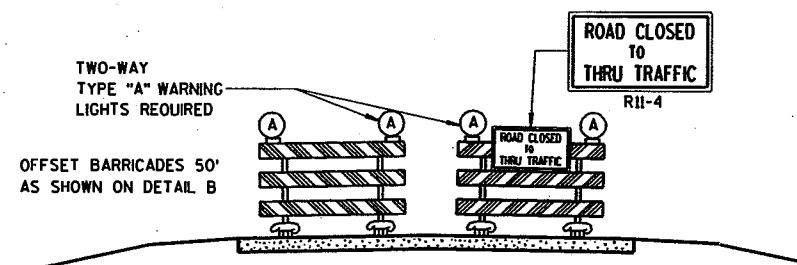

DETAIL E
LANE CLOSURE BARRICADE DETAIL
 APPROACH VIEW

SEE SDD 15C2-4a FOR LEGEND

GENERAL NOTES

THE EXACT NUMBER, LOCATION, AND SPACING OF ALL SIGNS AND BARRICADES SHALL BE ADJUSTED TO FIT FIELD CONDITIONS AS APPROVED BY THE ENGINEER.

ANY SIGNS TEMPORARY OR EXISTING, WHICH CONFLICT WITH TRAFFIC CONTROL "IN USE" SHALL BE REMOVED OR COVERED AS NEEDED AND AS APPROVED BY THE ENGINEER.

THE SPACING BETWEEN TRAFFIC CONTROL SIGNS SHOULD BE ADJUSTED TO NOT CONFLICT WITH AND SHOULD PROVIDE A DESIRABLE MINIMUM OF 200 FEET CLEARANCE TO EXISTING SIGNS THAT WILL REMAIN IN PLACE.

BARRICADES THAT MUST BE MOVED FOR A WORK OPERATION SHALL BE IMMEDIATELY RE-ESTABLISHED UPON COMPLETION OF THE OPERATION OR, FOR CONTINUING OPERATIONS, AT THE END OF EACH WORKING DAY.

SIGNS THAT WILL BE IN PLACE LESS THAN 7 CONTINUOUS DAYS AND NIGHTS MAY BE MOUNTED ON PORTABLE SUPPORTS.

ALL TYPE III BARRICADES SHALL HAVE RAILS REFLECTORIZED ON BOTH FACES. STRIPES SHALL BE PROPERLY SLOPED DOWN TOWARD THE TRAFFIC SIDE OR AS SHOWN IN THE ROAD CLOSURE BARRICADE DETAIL D FOR FULL ROAD CLOSURES.

TYPE "A" LOW-INTENSITY FLASHING WARNING LIGHTS SHALL BE VISIBLE ON BOTH SIDES OF THE BARRICADE.

THE R11-2, R11-3, M4-9, R11-4 AND R10-61 SIGNS PLACED ON BARRICADES SHALL COVER NO MORE THAN THE TOP RAIL. THE SIGNS SHALL NOT COVER ANY PORTION OF THE MIDDLE OR BOTTOM RAILS.

THE REFLECTIVE SHEETING USED ON R11-2, R11-3, R11-4, R10-61 AND R1-1 SIGNS SHALL COMPLY WITH SUBSECTION 637.2.2.2 OF THE STANDARD SPECIFICATIONS.

"WO AND "MO" SIGNS ARE THE SAME AS "W" AND "M" SIGNS EXCEPT THE BACKGROUND IS ORANGE.

ALL SIGNS SHALL BE 48" X 48" UNLESS OTHERWISE NOTED BELOW:

- R11-2 SHALL BE 48" X 30".
- R11-3, R11-4 AND R10-61 SHALL BE 60" X 30".
- M4-9 SHALL BE 30" X 24".
- M3-X AND M4-8 SHALL BE 24" X 12". (30" X 15" IF NEEDED TO MATCH EXISTING SIGNS.)
- M1-4, M1-5A, AND M1-6 SHALL BE 24" X 24". (36" X 36" IF NEEDED TO MATCH EXISTING SIGNS.)
- M05-1 AND M06-1 SHALL BE 21" X 21". (30" X 30" IF NEEDED TO MATCH EXISTING SIGNS.)
- D1-X SHALL BE AS SHOWN ON SPECIFIC PROJECT SIGNING DETAIL SHEETS.
- R1-1 SHALL BE 36" X 36".

- ① TWO WARNING LIGHTS SHALL BE PROVIDED ON THE CENTER BARRICADE AND A MINIMUM OF ONE WARNING LIGHT SHALL BE PROVIDED ON EACH OF THE OTHER BARRICADES WITHIN THE ROADWAY LIMITS. SPACING OF THE WARNING LIGHTS SHALL BE UNIFORM TO THE EDGE OF ROADWAY AS SHOWN (APPROX. 8-FOOT LIGHT SPACING).
- ② THESE SIGNS AND BARRICADES ARE NOT REQUIRED IF ROAD CLOSURE BEGINS AT INTERSECTION.
- ③ FOR ROAD CLOSURE WITHOUT LOCAL ACCESS TO PROJECT, SEE ROAD CLOSURE BARRICADE DETAIL D.
- ④ FOR ROAD CLOSURE WITH LOCAL ACCESS TO PROJECT, SEE LANE CLOSURE BARRICADE DETAIL E.
- ⑤ FOR BRIDGE OR CULVERT REPLACEMENTS, SUBSTITUTE "BRIDGE OUT" INSTEAD OF "ROAD CLOSED" ON R11-2 AND R11-3 SIGNS.
- ⑥ INSTALL DETOUR AND COMMUNITY GUIDE SIGNS AND ARROWS ONLY IF SPECIFIED IN THE CONTRACT. IF THERE ARE EXISTING ROUTE MARKER ASSEMBLIES THAT WILL REMAIN IN PLACE, ADJUST THE LOCATION OF THE DETOUR ROUTE SIGNS TO CORRESPOND WITH THE EXISTING ASSEMBLIES. MODIFY EXISTING SIGNS WHERE POSSIBLE. SEE SPECIFIC PROJECT DETOUR SIGNING DETAIL SHEETS. IF DETOUR SIGNS ARE BEING INSTALLED BY OTHERS, PLACE THE CONTRACTED TRAFFIC CONTROL SIGNS TO ALLOW FOR PLACEMENT OF ALL WARNING, DETOUR AND GUIDE SIGNS AS SHOWN.
- ⑦ "EAST" CARDINAL DIRECTION MARKERS AND RIGHT TURN ARROWS ARE SHOWN. USE OTHER CARDINAL DIRECTIONS AND ARROWS AS APPROPRIATE.

BARRICADES AND SIGNS FOR MAINLINE CLOSURES	
STATE OF WISCONSIN DEPARTMENT OF TRANSPORTATION	
APPROVED	
DATE _____	CHIEF SIGNS AND MARKING ENGINEER _____
FHWA	

THIS DRAWING PROVIDES GENERAL GUIDANCE ON TYPICAL DETOUR SIGN LAYOUT AND SPACING. SEE PROJECT DETOUR SIGNING SHEETS FOR SPECIFIC DETAILS FOR EACH PROJECT.

GENERAL NOTES

THE EXACT NUMBER, LOCATION AND SPACING OF ALL SIGNS SHALL BE ADJUSTED TO FIT FIELD CONDITIONS AS APPROVED BY THE ENGINEER.

IF THERE ARE EXISTING ROUTE MARKER ASSEMBLIES THAT WILL REMAIN IN PLACE, ADJUST THE LOCATION OF THE DETOUR ROUTE SIGNS TO CORRESPOND WITH THE EXISTING ASSEMBLIES. SEE SPECIFIC PROJECT DETOUR SIGNING DETAIL SHEETS. MODIFY EXISTING SIGNS WHERE POSSIBLE.

THE SPACING BETWEEN TRAFFIC CONTROL AND DETOUR SIGNS SHOULD BE ADJUSTED TO NOT CONFLICT WITH AND TO PROVIDE A DESIRABLE MINIMUM OF 200 FEET CLEARANCE TO EXISTING SIGNS THAT WILL REMAIN IN PLACE.

ANY SIGNS TEMPORARY OR EXISTING, WHICH CONFLICT WITH TRAFFIC CONTROL "IN USE", SHALL BE REMOVED OR COVERED AS NEEDED AND AS APPROVED BY THE ENGINEER.

SIGNS THAT WILL BE IN PLACE LESS THAN 7 CONTINUOUS DAYS AND NIGHTS MAY BE MOUNTED ON PORTABLE SUPPORTS.


"MO" SIGNS ARE THE SAME AS "M" SIGNS EXCEPT THE BACKGROUND IS ORANGE.

SIGN SIZES SHALL BE AS FOLLOWS:

- M3-X AND M4-8 SHALL BE 24" X 12". (30" X 15" IF NEEDED TO MATCH EXISTING SIGNS.)
- M1-4, M1-5A, AND M1-6 SHALL BE 24" X 24". (36" X 36" IF NEEDED TO MATCH EXISTING SIGNS.)
- M05-1 AND M06-1 SHALL BE 21" X 21". (30" X 30" IF NEEDED TO MATCH EXISTING SIGNS.)
- M4-9 SHALL BE 30" X 24".
- M4-8a SHALL BE 24" X 18".
- G20-51 SHALL BE 60" X 24".
- W20-2 SHALL BE 48" X 48".
- DI-X SHALL BE AS SHOWN ON SPECIFIC PROJECT SIGNING DETAIL SHEETS.

* OPTIONAL SIGNS. SEE SPECIFIC PROJECT DETOUR SIGNING DETAIL SHEETS.





** FOR A TOWN ROAD OR LOCAL STREET DETOURED ONTO A STATE TRUNK HIGHWAY, PLACE A ROAD NAME PLAQUE ABOVE THE M4-9 SIGN AS SPECIFIED IN THE CONTRACT.

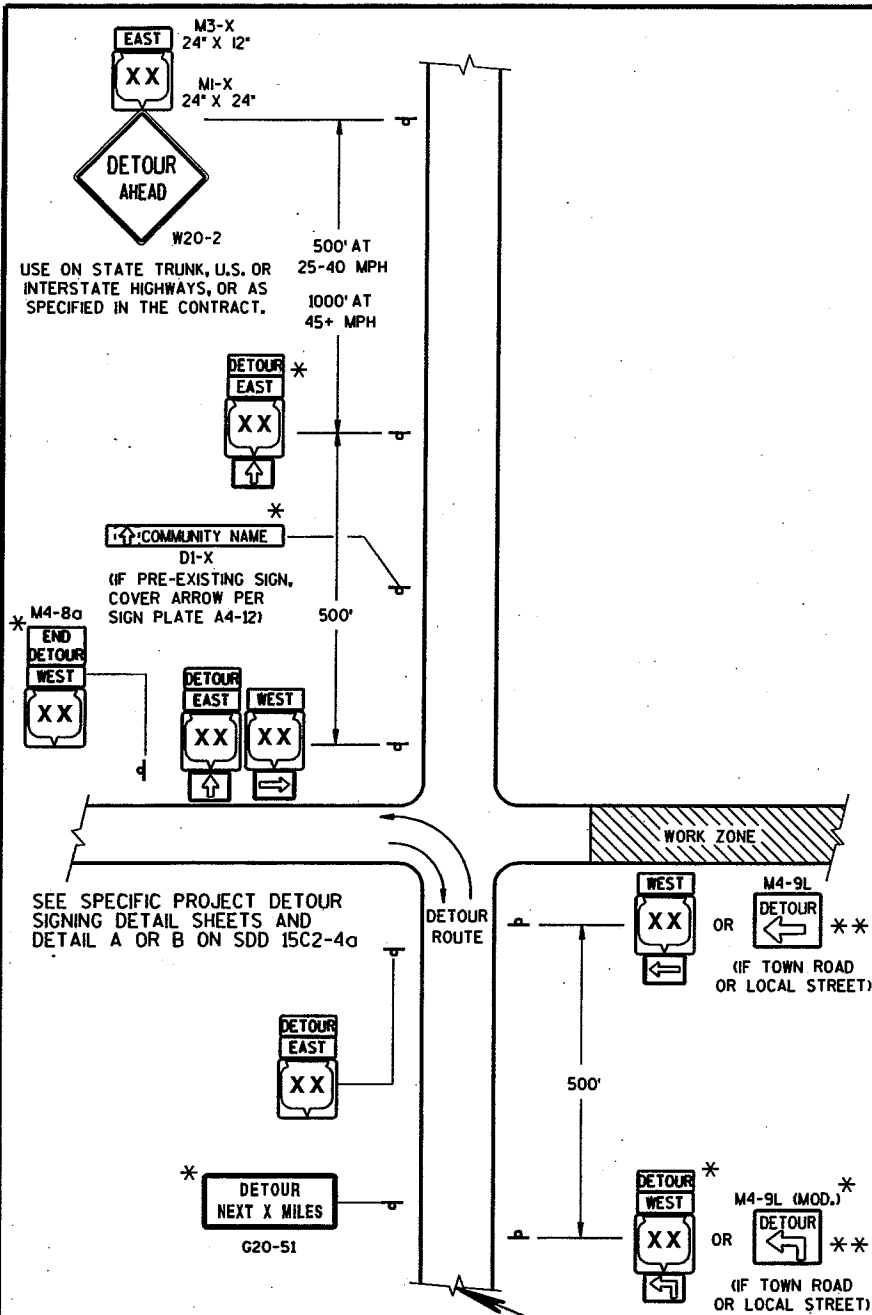

MATCH POINT

DETAIL F
DETOUR SIGNING

USE ON STATE TRUNK, U.S. OR INTERSTATE HIGHWAYS, OR AS SPECIFIED IN THE CONTRACT.

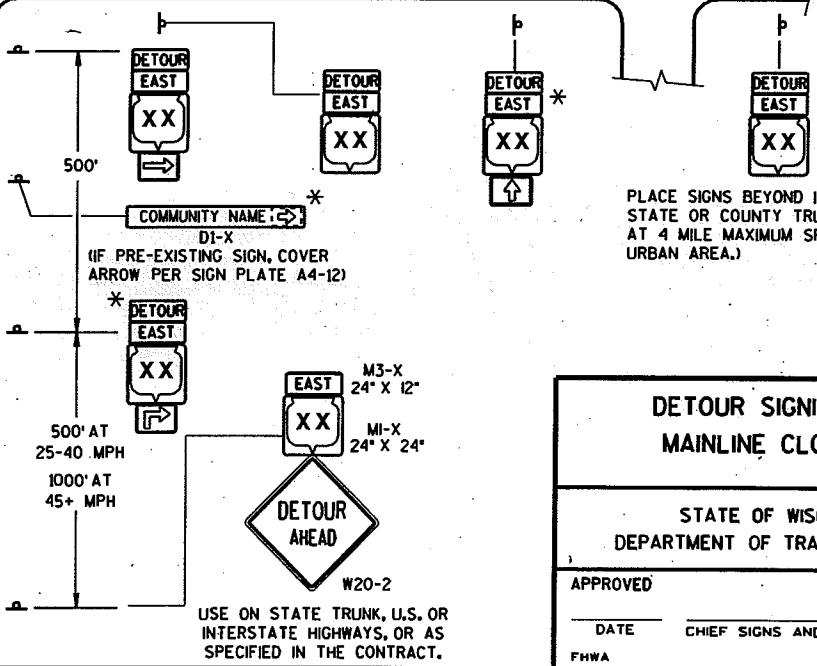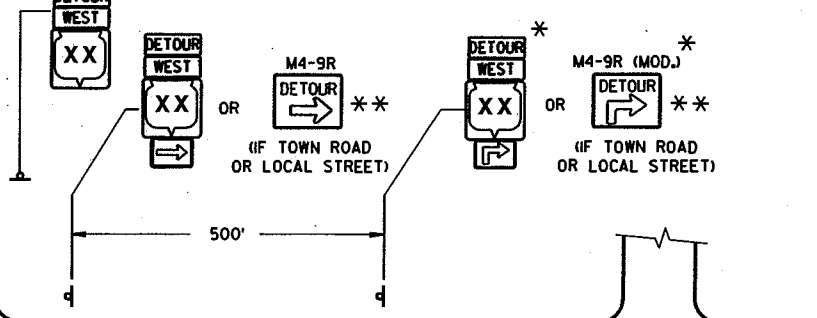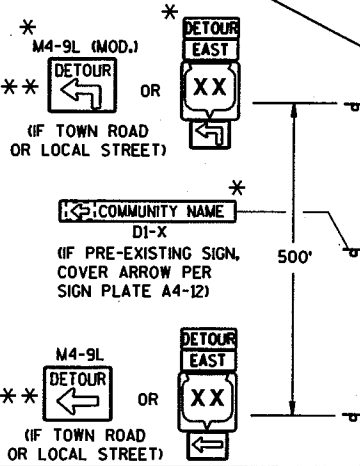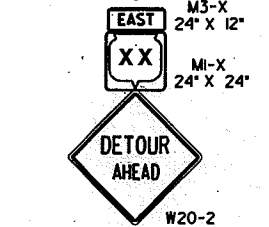

PLACE SIGNS BEYOND INTERSECTIONS WITH STATE OR COUNTY TRUNK HIGHWAYS OR AT 4 MILE MAXIMUM SPACING (4 BLOCKS IF URBAN AREA.)

DETOUR SIGNING FOR MAINLINE CLOSURES	
STATE OF WISCONSIN DEPARTMENT OF TRANSPORTATION	
APPROVED	DATE
CHIEF SIGNS AND MARKING ENGINEER	
FHWA	


LEGEND

- POST MOUNTED SIGN
- WORK ZONE
- M4-8
M3-X
- M1-4 OR MI-5A OR MI-6
- M05-1 OR M06-1 OR M06-1


S.D.D. 15 C 2-4C

6


S.D.D. 15 C 2-4C

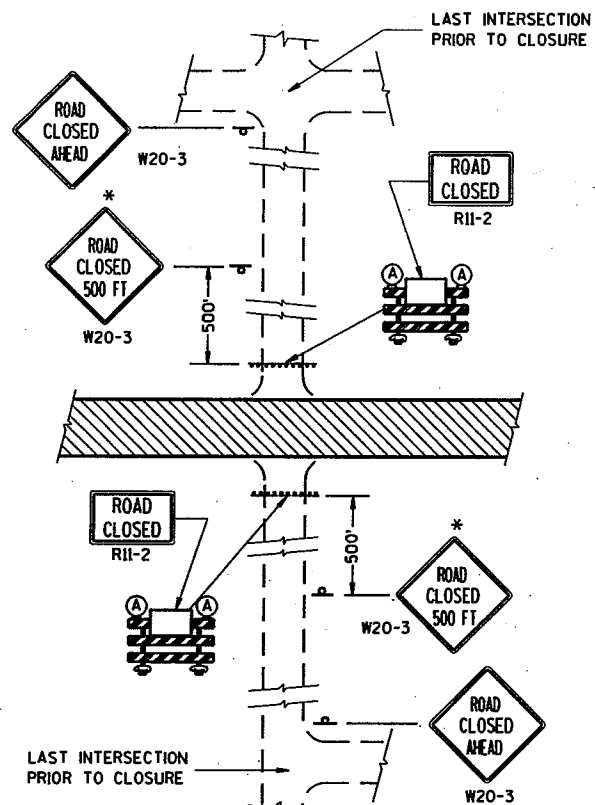


DETAIL 1
(NO ACCESS TO PROJECT)

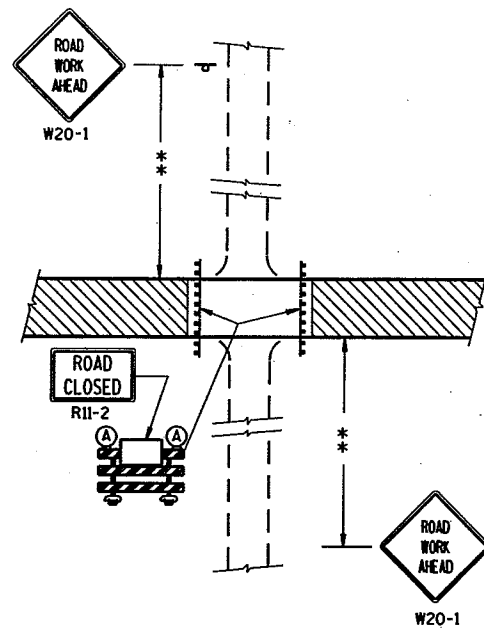

DETAIL 2
(PUBLIC CROSS-TRAFFIC MAINTAINED.
NO ACCESS TO PROJECT).

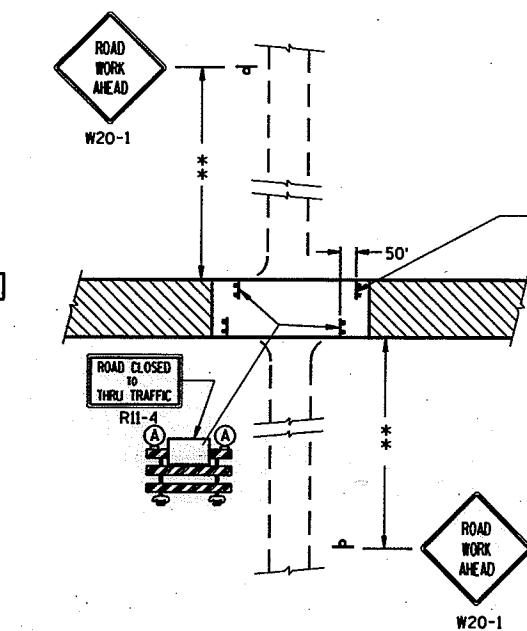

DETAIL 3
(PUBLIC CROSS-TRAFFIC MAINTAINED. CONTRACTOR,
LOCAL BUSINESS AND RESIDENT ACCESS).

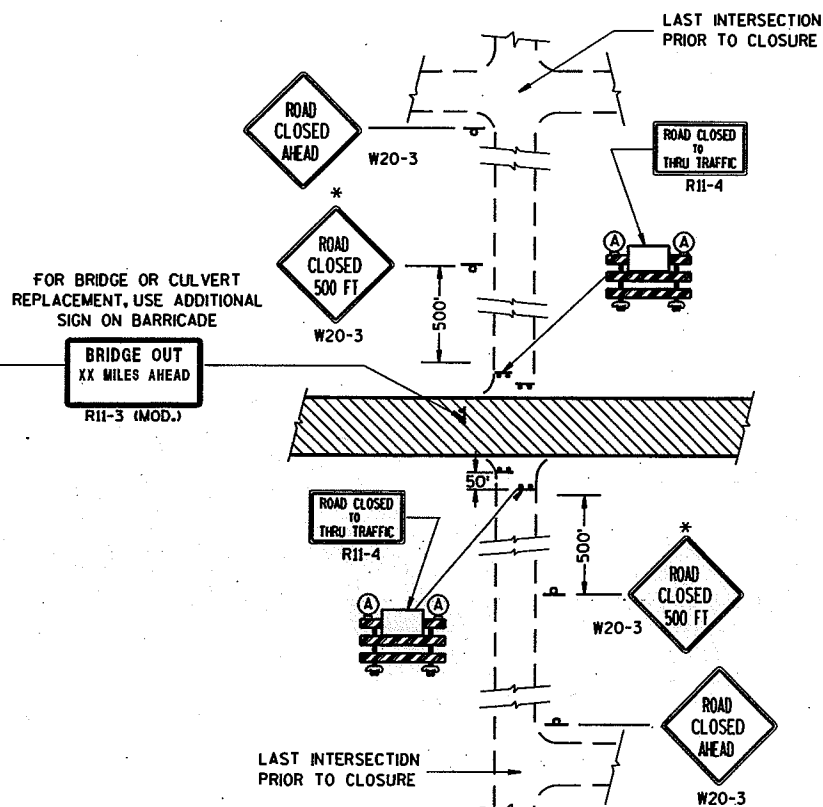

DETAIL 4
(CONTRACTOR, LOCAL BUSINESS AND
RESIDENT ACCESS TO PROJECT)

GENERAL NOTES

THE EXACT NUMBER, LOCATION, AND SPACING OF ALL SIGNS AND BARRICADES SHALL BE ADJUSTED TO FIT FIELD CONDITIONS AS APPROVED BY THE ENGINEER.

ANY SIGNS TEMPORARY OR EXISTING, WHICH CONFLICT WITH TRAFFIC CONTROL "IN USE" SHALL BE REMOVED OR COVERED AS NEEDED AND AS APPROVED BY THE ENGINEER.

THE SPACING BETWEEN TRAFFIC CONTROL SIGNS SHOULD BE ADJUSTED TO NOT CONFLICT WITH AND SHOULD PROVIDE A DESIRABLE MINIMUM OF 200 FEET CLEARANCE TO EXISTING SIGNS THAT WILL REMAIN IN PLACE.

IF A "STOP" SIGN MUST BE REMOVED FOR A WORK OPERATION, A TEMPORARY "STOP" SIGN SHALL BE PLACED PRIOR TO THE SIGN REMOVAL, OR A FLAGGER SHALL BE PROVIDED UNTIL THE SIGN IS RE-ESTABLISHED.

BARRICADES THAT MUST BE MOVED FOR A WORK OPERATION SHALL BE IMMEDIATELY RE-ESTABLISHED UPON COMPLETION OF THE OPERATION OR, FOR CONTINUING OPERATIONS, AT THE END OF EACH WORKING DAY.

SIGNS THAT WILL BE IN PLACE LESS THAN 7 CONTINUOUS DAYS AND NIGHTS MAY BE MOUNTED ON PORTABLE SUPPORTS.

ALL TYPE III BARRICADES SHALL HAVE RAILS REFLECTORIZED ON BOTH FACES. STRIPES SHALL BE PROPERLY SLOPED DOWN TOWARD THE TRAFFIC SIDE OR AS SHOWN IN THE ROAD CLOSURE BARRICADE DETAIL D FOR FULL ROAD CLOSURES.

TYPE "A" LOW-INTENSITY FLASHING WARNING LIGHTS SHALL BE VISIBLE ON BOTH SIDES OF THE BARRICADE.

THE R11-2, R11-3 AND R11-4 SIGNS PLACED ON BARRICADES SHALL COVER NO MORE THAN THE TOP RAIL. THE SIGNS SHALL NOT COVER ANY PORTION OF THE MIDDLE OR BOTTOM RAILS.

THE REFLECTIVE SHEETING USED ON R11-2, R11-3 AND R11-4 SIGNS SHALL COMPLY WITH SUBSECTION 637.2.2.2 OF THE STANDARD SPECIFICATIONS.

ALL SIGNS SHALL BE 48" X 48" UNLESS OTHERWISE NOTED BELOW:

R11-2 SHALL BE 48" X 30".

R11-4 AND R11-3 SHALL BE 60" X 30".


*OMIT THE "ROAD CLOSED 500 FT." SIGN IF THE LAST INTERSECTION IS 500 FT. OR LESS FROM THE WORK ZONE.

**500' MAX. OR AT LAST INTERSECTION WHICHEVER IS CLOSER.


LEGEND

- ⊥ POST MOUNTED WARNING SIGN
- ▬ TYPE III BARRICADES
- Ⓐ TYPE "A" LOW INTENSITY FLASHING WARNING LIGHT (FOR NIGHT USE)
- ▨ WORK AREA

BARRICADES AND SIGNS FOR SIDEROAD CLOSURES	
STATE OF WISCONSIN DEPARTMENT OF TRANSPORTATION	
APPROVED _____	
DATE _____	CHIEF SIGNS AND MARKING ENGINEER
FHWA	

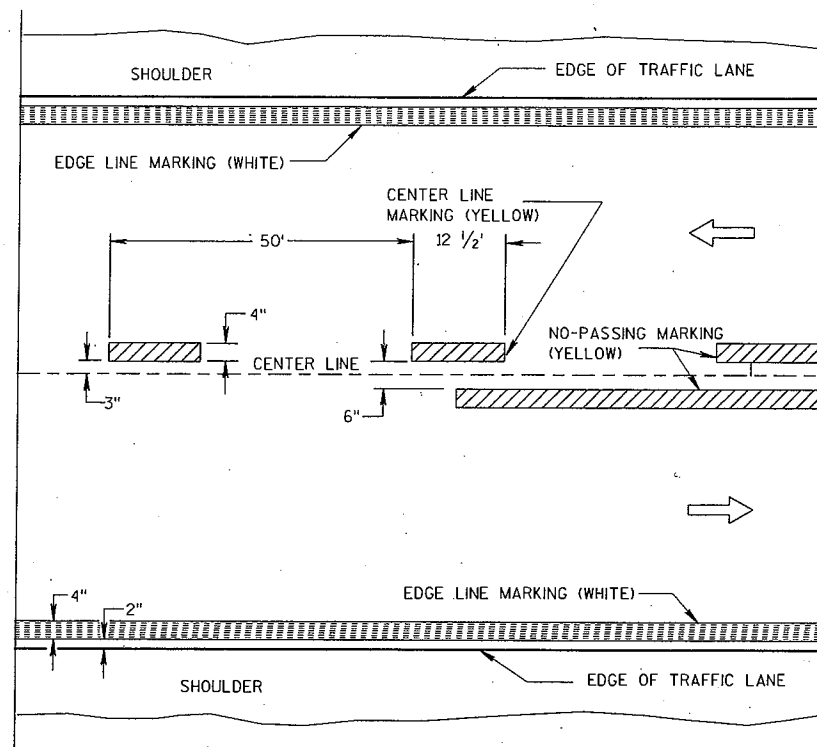


TWO WAY TRAFFIC

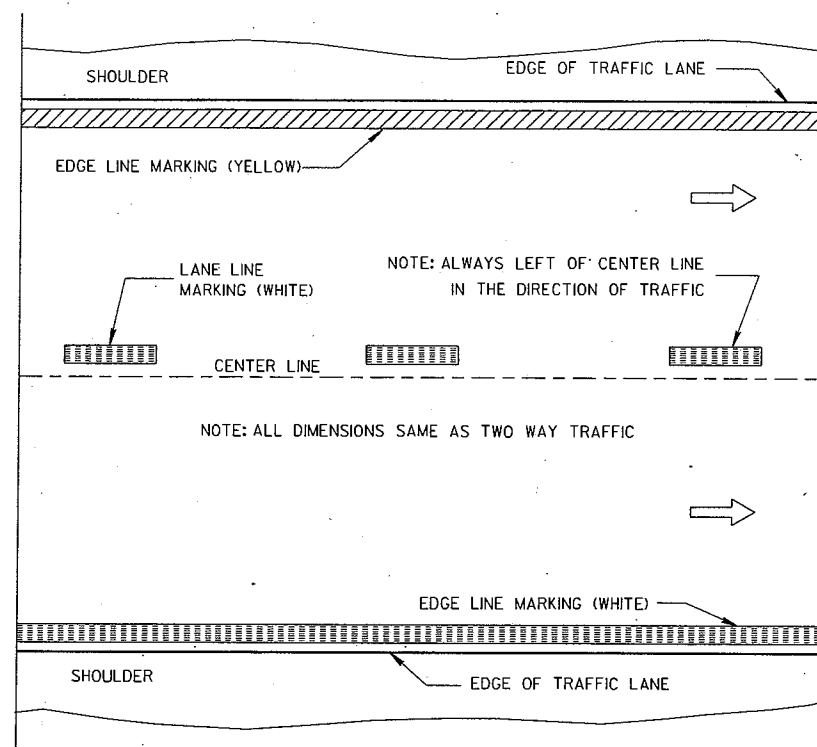


ONE WAY TRAFFIC

PERMANENT PAVEMENT MARKING

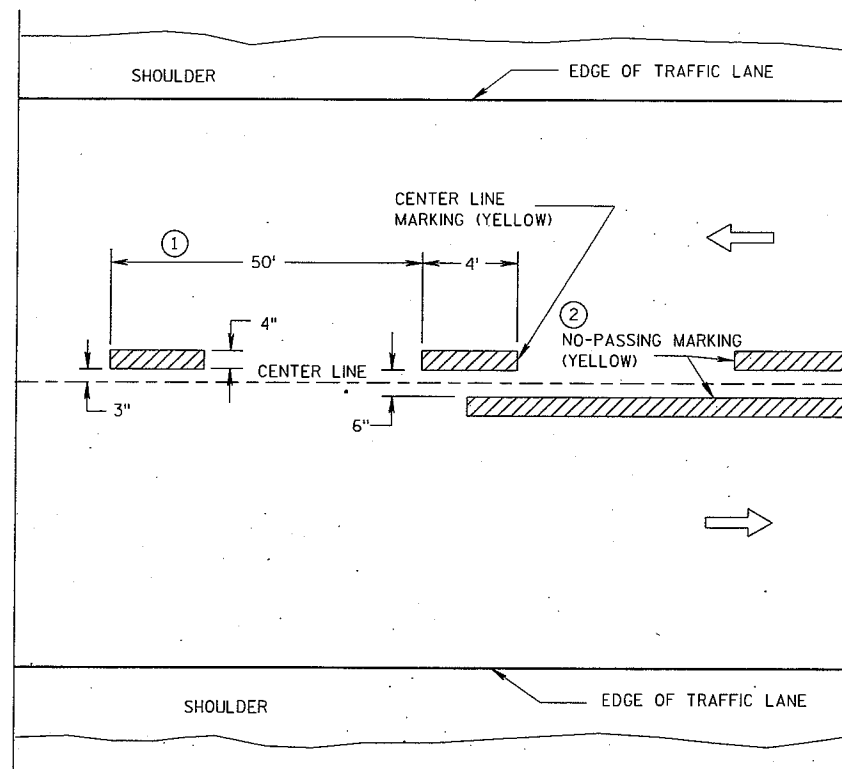

TWO WAY TRAFFIC

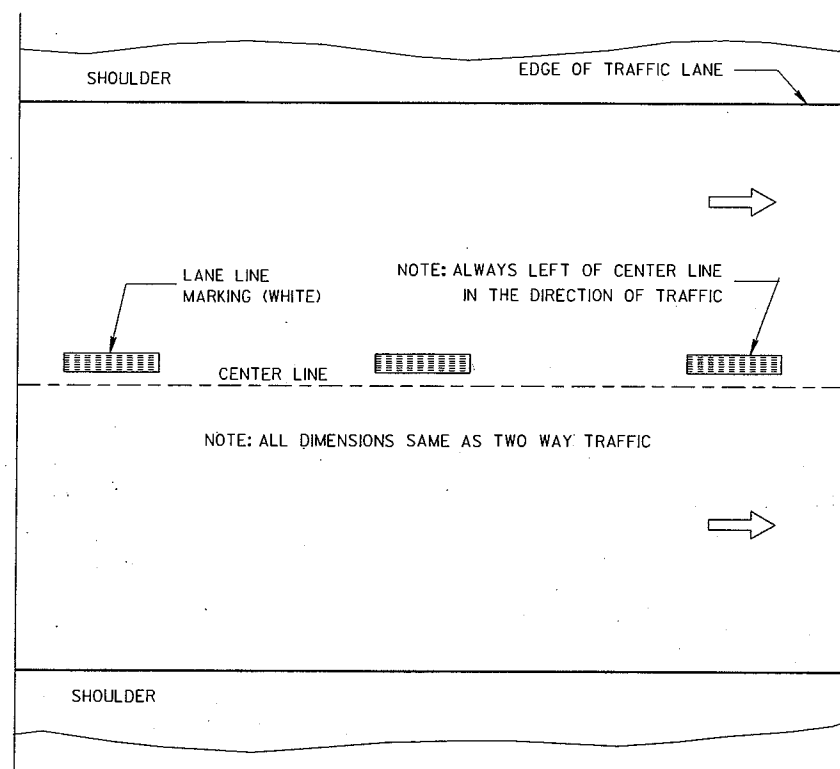

ONE WAY TRAFFIC

TEMPORARY (INTERMEDIATE) PAVEMENT MARKING
(SHOWS CYCLE FOR TEMPORARY CENTER LINE OR TEMPORARY LANE LINE MARKING)

GENERAL NOTES

DETAILS OF CONSTRUCTION NOT SHOWN ON THIS DRAWING SHALL CONFORM TO STANDARD SPECIFICATIONS AND SPECIAL PROVISIONS.

- ① HALF CYCLE LENGTHS (25'±) WITH 2' MINIMUM STRIPE LENGTHS SHALL BE PROVIDED ON ROADWAYS (INCLUDING TEMPORARY TRAVELED WAYS) WITH REVERSE CURVATURE, CURVATURE OF OVER 5 DEGREES OR WHEN DIRECTED BY THE ENGINEER TO MARK UNUSUAL ALIGNMENT OF THE TRAVELED WAY.
- ② NO PASSING ZONE TEMPORARY PAVEMENT MARKING IS REQUIRED TO BE PLACED, WHERE APPROPRIATE, ALONG WITH CENTERLINE TEMPORARY PAVEMENT MARKING WHEN A SAME DAY PERMANENT PAVEMENT MARKING ITEM IS INCLUDED IN THE CONTRACT.

NOTE

ARROW SYMBOL (⇨) SHOWS DIRECTION OF TRAVEL

S.D.D. 15 C 8-9a


PAVEMENT MARKING (MAINLINE)	
STATE OF WISCONSIN DEPARTMENT OF TRANSPORTATION	
APPROVED	
DATE	CHIEF SIGNS AND MARKING ENGINEER
FHWA	

NOTES


EDGE LINES SHALL BE OMITTED THROUGH INTERSECTIONS. EDGE LINES SHALL BE CONTINUED THROUGH DRIVEWAYS.

- ① WHEN DISTANCE "A" IS LESS THAN 250 FEET, OMIT LANE LINE.
- ② WHEN DISTANCE "B" IS LESS THAN 100 FEET, OMIT CHANNELIZING LANE LINE.
- ③ ALTERNATIVE MARKING SHALL BE PROVIDED WHEN SPECIFIED IN THE CONTRACT. TYPICAL SITUATIONS WHERE THIS MARKING MAY BE REQUIRED ARE WHERE THE INTERSECTION IS ON A SHARP HORIZONTAL CURVE OR CREST VERTICAL CURVE IN AN UNLIGHTED AREA SUCH THAT THE EDGE LINE MAY BE MISLEADING TO THE MOTORIST OR DISAPPEAR FROM SIGHT.
- ④ LOCATE THE EDGE LINE ALONG THE TAPER WHERE "W" IS 10' OR MORE.
- ⑤ THE EDGE LINE IN THE TAPER AREAS OF THE BYPASS LANE AND THE BYPASS LANE SHALL BE LOCATED 1-FOOT FROM EDGE OF PAVEMENT TO THE OUTSIDE EDGE OF EDGE LINE.
- ⑥ BARRIER LINE ENDS AT SIDE ROAD PAVEMENT/SURFACE EDGE EXTENSION.


ARROW SYMBOL (→) SHOWS DIRECTION OF TRAVEL

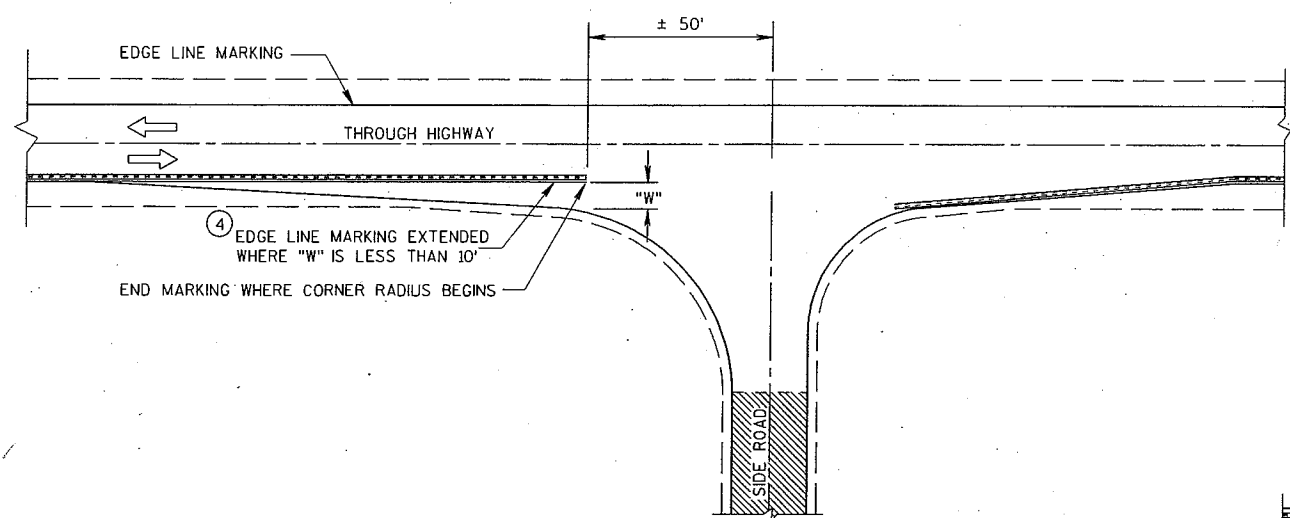


MINOR INTERSECTION WITHOUT CURBS

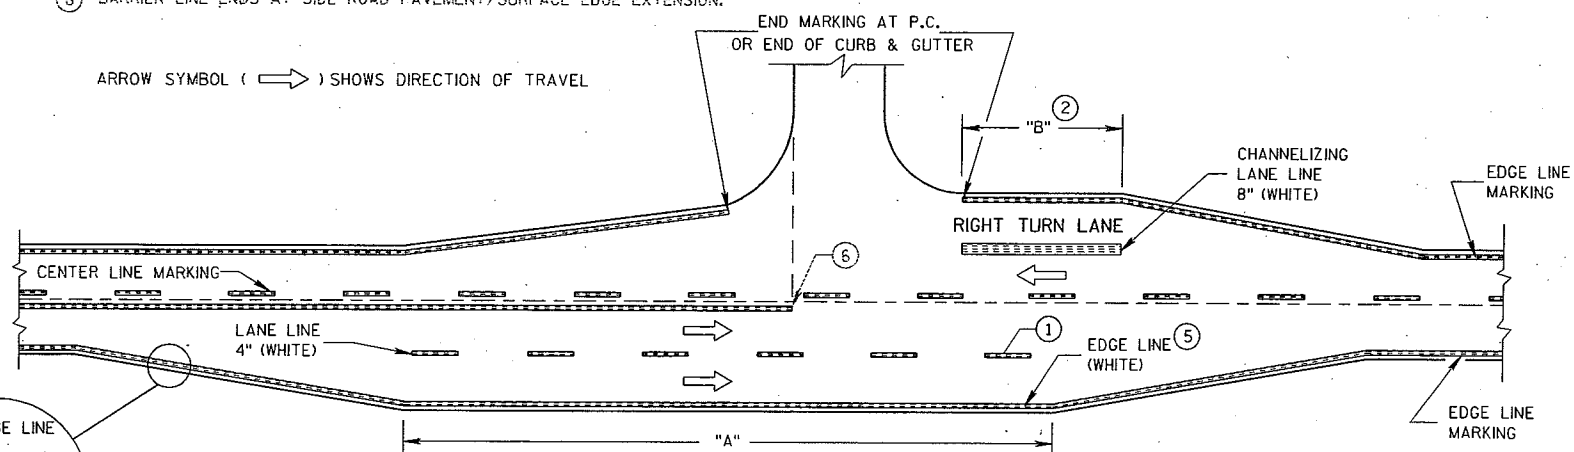

MAJOR INTERSECTIONS
(INTERSECTION WITH FULL RIGHT TURN LANE OR BYPASS LANES)

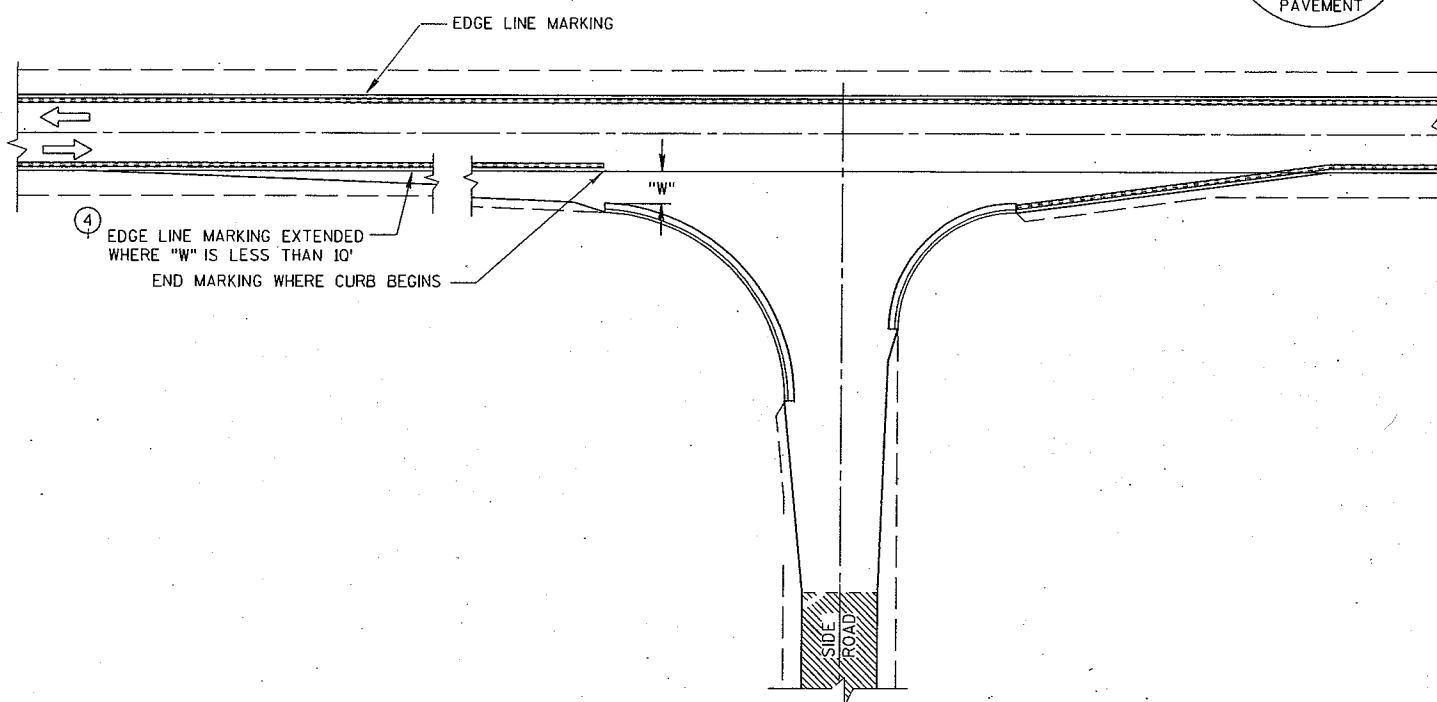


MINOR INTERSECTION WITH CURBS
(TYPICAL MARKING)

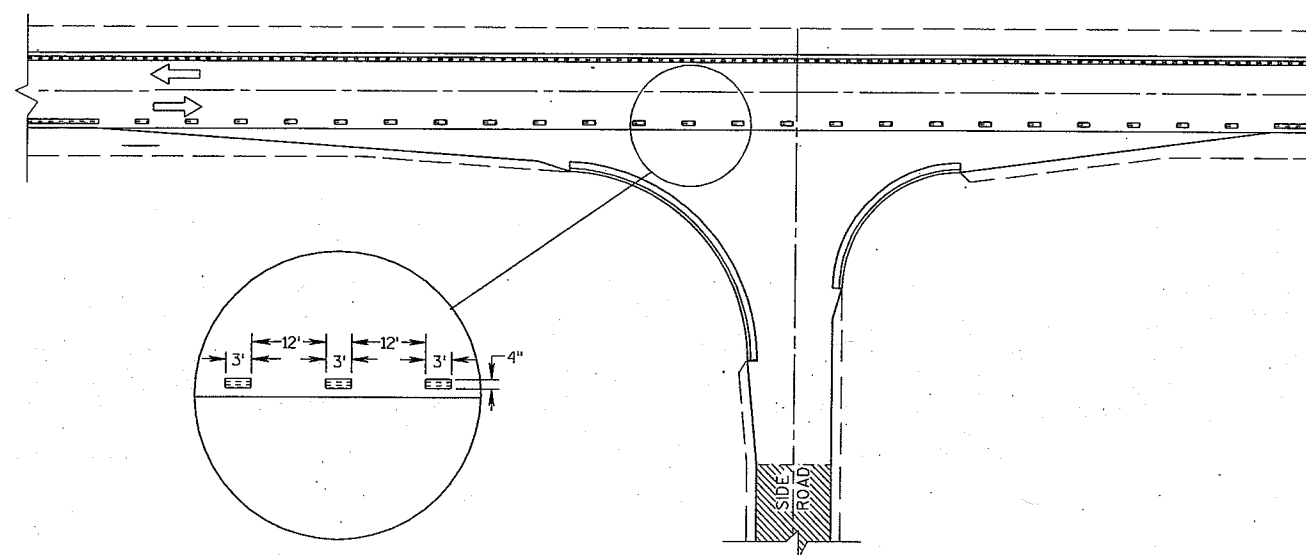


MINOR INTERSECTION WITH CURBS
③ (FOR SPECIAL CONDITIONS AS SPECIFIED)

PAVEMENT MARKING
(INTERSECTIONS)



STATE OF WISCONSIN
DEPARTMENT OF TRANSPORTATION

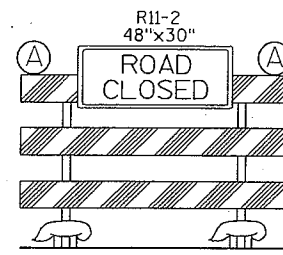

VEHICLE ENTRANCE/EXIT OR HAUL ROAD

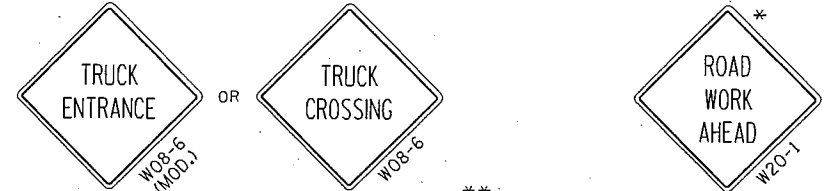

500' MIN. 500' MIN.

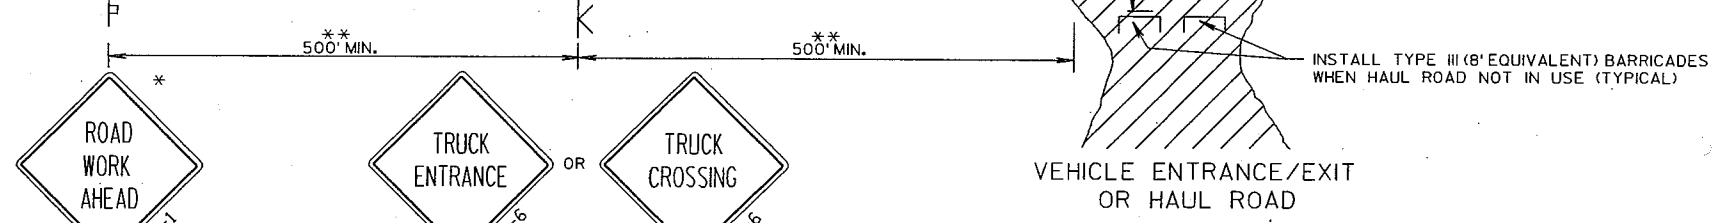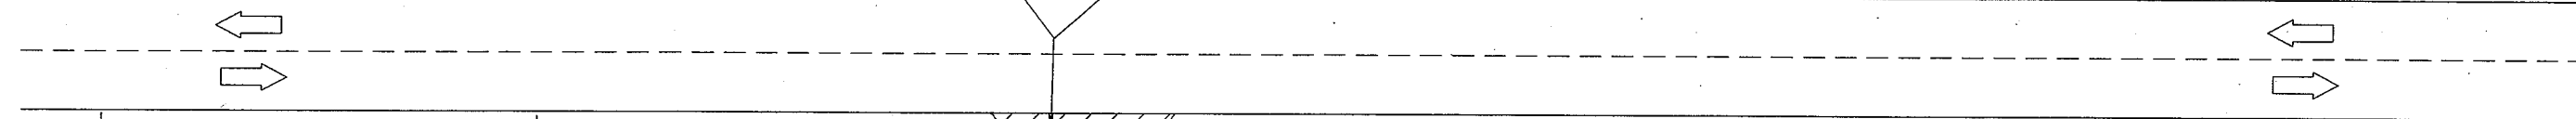

THE ABOVE DETAIL TO BE USED WHEN CONSTRUCTION VEHICLE TRAFFIC YIELDS TO THE FREE FLOW OF MAINLINE OR RAMP TRAFFIC

LEGEND

- SIGN ON PORTABLE SUPPORT
- POST MOUNTED SIGN
- TYPE III BARRICADE (8 FOOT EQUIVALENT) WITH/WITHOUT SIGN
- FLAGGER, EQUIPPED WITH STOP/SLOW PADDLE FASTENED ON SUPPORT STAFF
- WARNING LIGHT, TYPE A, (LOW-INTENSITY FLASHING)
- DIRECTION OF TRAFFIC FLOW

GENERAL NOTES :

THE EXACT NUMBER, LOCATION, AND SPACING OF ALL SIGNS AND DEVICES (AND THE LOCATION OF ALL FLAGGERS) SHALL BE ADJUSTED TO FIT FIELD CONDITIONS AS APPROVED BY THE ENGINEER.

WHEN ACTIVITY REFLECTED BY THE SIGN IS NOT CURRENTLY TAKING PLACE, THE HIGHWAY SHALL BE RESTORED TO NORMAL CONDITION AND THE SIGNS SHALL BE REMOVED, COVERED OR TURNED AWAY FROM TRAFFIC.

WHEN A SIDE ROAD OR RAMP INTERSECTS WITHIN THE ADVANCE SIGNING AREA, ADDITIONAL TRAFFIC CONTROLS SHALL BE PROVIDED AS SPECIFIED IN THE PLANS AND/OR THE SPECIAL PROVISIONS OR AS APPROVED BY THE ENGINEER.

* THESE SIGNS ARE TO BE USED ONLY WHEN VEHICLE ENTRANCE/EXIT CONDITIONS ARE SEPARATED BY MORE THAN 2 MILES FROM PREVIOUS WORK AREA OR SIGNING OR AS ORDERED BY THE ENGINEER.

** 500' SHOWN IS FOR ROADWAYS WITH A NON-CONSTRUCTION REGULATORY SPEED LIMIT OF 45 MPH OR MORE, FOR 35-40 MPH, USE 350', FOR 25-30 MPH, USE 200'.

ALL SIGNS ARE 48"x48" UNLESS OTHERWISE NOTED.


"WO" IS THE SAME AS "W" EXCEPT THE BACKGROUND IS ORANGE.

SIGN LAYOUTS SHALL BE IN ACCORDANCE WITH THE FHWA'S MANUAL OF STANDARD HIGHWAY SIGNS OR THE WISCONSIN STANDARD SIGN PLATES.


THE FIRST ADVANCE WARNING SIGN AND THE W20-7b SIGN SHOULD TYPICALLY BE LOCATED IN ADVANCE OF THE ANTICIPATED TRAFFIC BACKUP OR QUEUE.

FLAGGERS SHALL BE IN SIGHT OF EACH OTHER OR IN DIRECT COMMUNICATION AT ALL TIMES. THEY SHALL BE EQUIPPED WITH STOP/SLOW PADDLES FASTENED ON SUPPORT STAFFS.



WARNING SIGNS THAT WILL BE IN PLACE LESS THAN 7 CONTINUOUS DAYS AND NIGHTS MAY BE MOUNTED ON PORTABLE SUPPORTS.

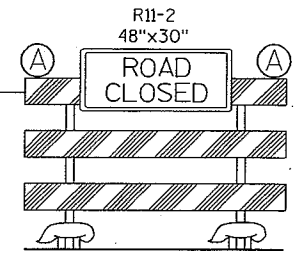

VEHICLE ENTRANCE/EXIT OR HAUL ROAD

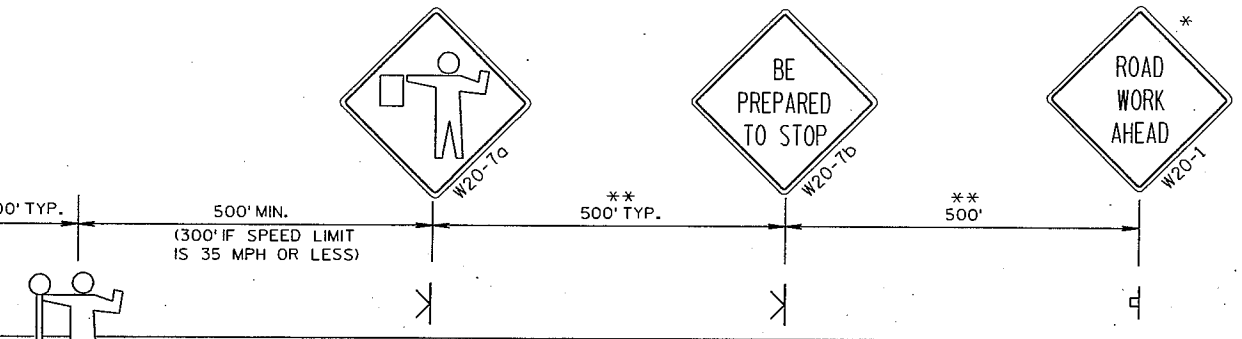


INSTALL TYPE III (8' EQUIVALENT) BARRICADES WHEN HAUL ROAD NOT IN USE (TYPICAL)

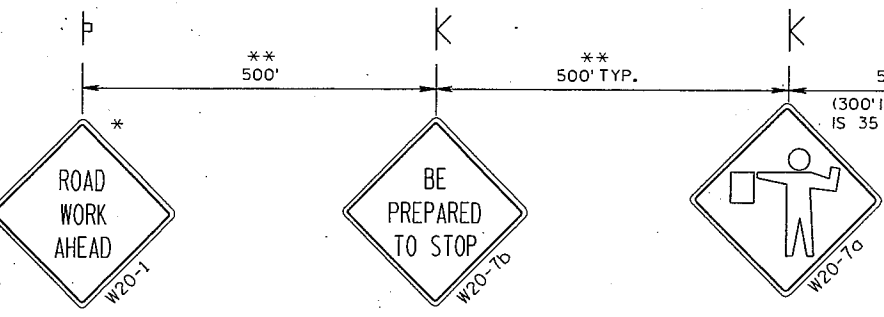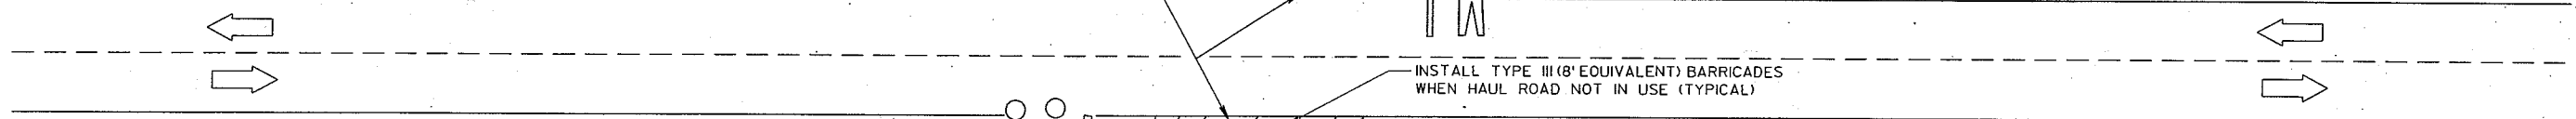


THIS DETAIL TO BE USED WHEN CONSTRUCTION WORK INCLUDING TRUCKING ACTIVITY REQUIRES MAINLINE TRAFFIC TO BE TEMPORARILY STOPPED IN ONE OR BOTH DIRECTIONS..DELAY TO HIGHWAY TRAFFIC SHALL BE MINIMIZED.

TRAFFIC CONTROL, VEHICLE ENTRANCE/EXIT OR HAUL ROAD	
STATE OF WISCONSIN DEPARTMENT OF TRANSPORTATION	
APPROVED	
DATE	CHIEF SIGNS AND MARKING ENGINEER
FHWA	

S.D.D. 15 D 29-1

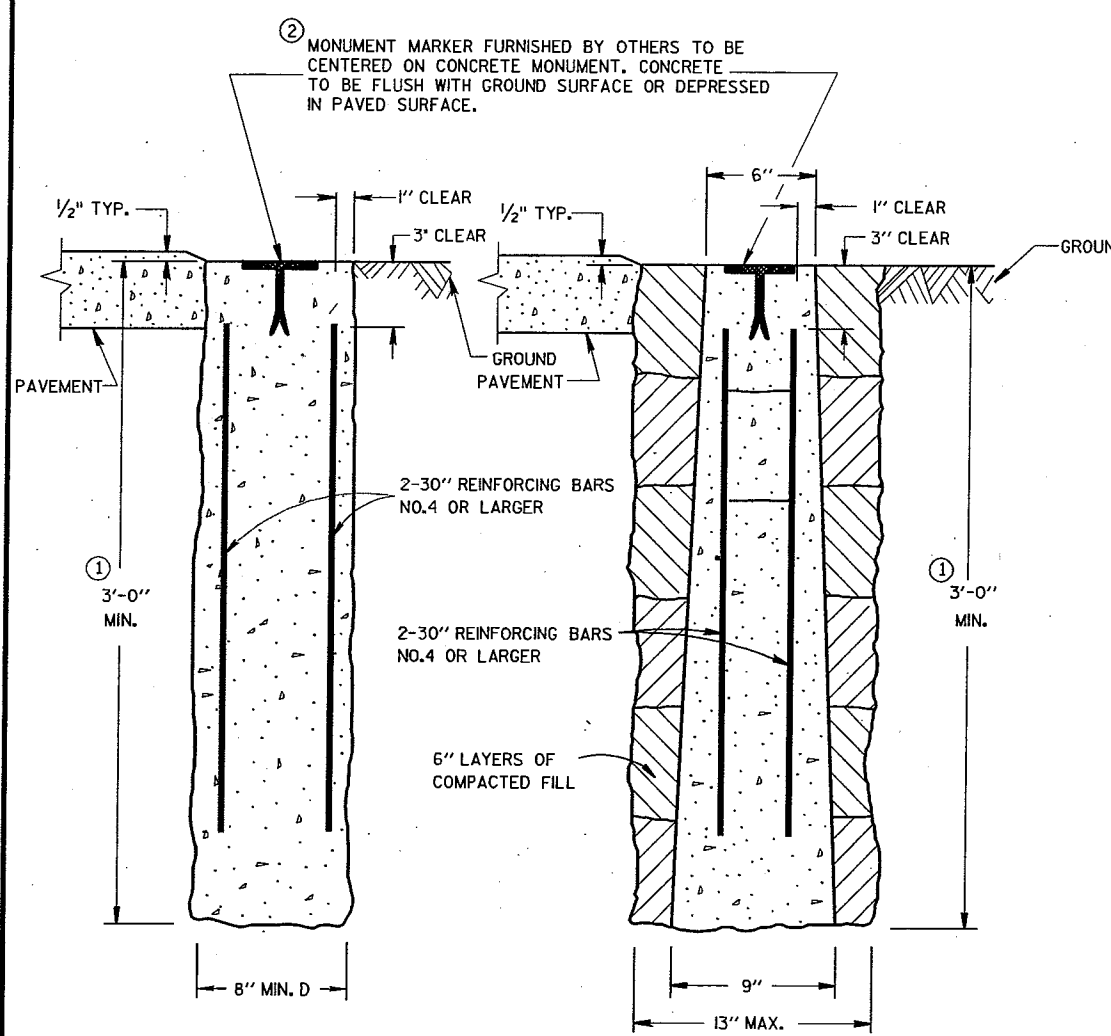

CAST-IN-PLACE
PRECAST
CONCRETE MONUMENTS
TYPE A

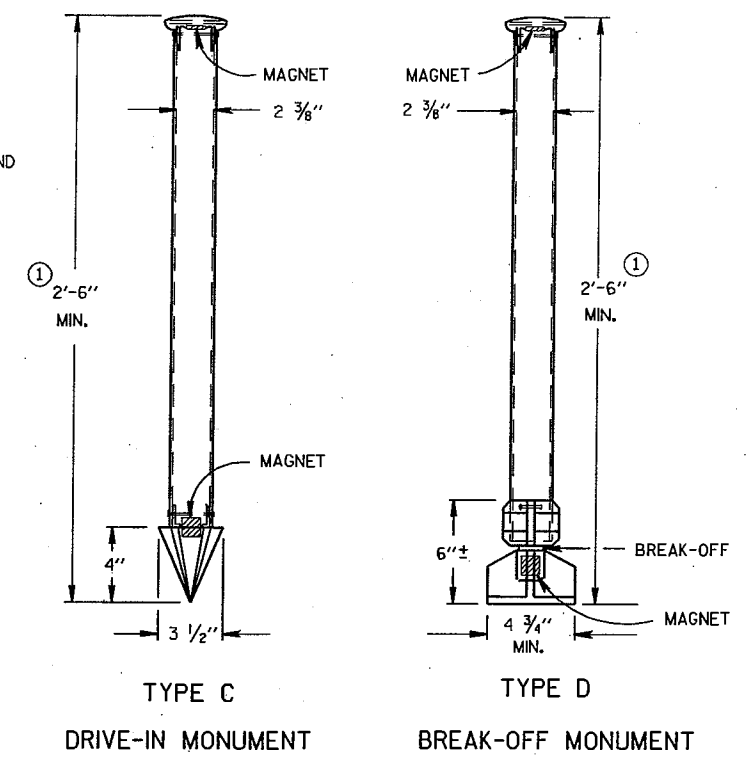

TYPE C
TYPE D
DRIVE-IN MONUMENT
BREAK-OFF MONUMENT
ALUMINUM MONUMENTS
(INCLUDES MARKER)

GENERAL NOTES

DETAILS OF CONSTRUCTION, MATERIALS AND WORKMANSHIP NOT SHOWN ON THIS DRAWING SHALL CONFORM TO THE PERTINENT REQUIREMENTS OF THE STANDARD SPECIFICATIONS AND THE APPLICABLE SPECIAL PROVISIONS.

DETAILED DRAWINGS OF PROPOSED ALTERNATE DESIGNS FOR METAL MONUMENTS OR MONUMENT COVERS SHALL BE SUBMITTED TO THE ENGINEER FOR APPROVAL.

INSTALLED METAL MONUMENTS MUST BE EASILY DETECTED WITH A DIP NEEDLE. INSERT PERMANENT MAGNETS SHALL BE ATTACHED NEAR THE TOP AND BOTTOM OF THOSE MONUMENTS CONSTRUCTED OF A METAL ALLOY WHICH IS NOT ATTRACTIVE TO A DIP NEEDLE.

THE CAST IRON MONUMENT COVER SHALL BE A "NON-ROCKING" TYPE. ADJUSTMENT OF THE COVER TO GRADE MAY BE ACCOMPLISHED BY THE USE OF MORTAR AND BRICK, OR BY EITHER PRECAST OR CAST-IN-PLACE REINFORCED CONCRETE GRADE RINGS.

MONUMENTS SHALL BE LOCATED AND PLACED AT THE DIRECTION OF THE ENGINEER.


ALUMINUM MONUMENTS AND MONUMENT COVERS SHALL BE MADE FROM AN ALUMINUM AND MAGNESIUM ALLOY AS DETERMINED BY THE MANUFACTURER.

THE MONUMENT COVERS DETAILED ON THIS DRAWING ARE NOT EQUAL ALTERNATES. MONUMENT COVERS SHALL BE CAST IRON UNLESS ALUMINUM IS SPECIFIED ELSEWHERE IN THE CONTRACT.


MONUMENT SHALL BE CAST-IN-PLACE CONCRETE UNLESS PRECAST CONCRETE OR ALUMINUM MONUMENTS ARE SPECIFIED IN THE CONTRACT OR PERMITTED BY THE ENGINEER.

① MINIMUM LENGTH SHALL BE 4'-0" FOR MONUMENTS INSTALLED IN PAVED AREAS.


② AN OFFICIAL COUNTY MONUMENT MARKER SUPPLIED BY A COUNTY MAY BE REQUIRED FOR SOME SECTION CORNERS AND WITNESS MONUMENTS INSTEAD OF THIS WIS DOT MARKER.

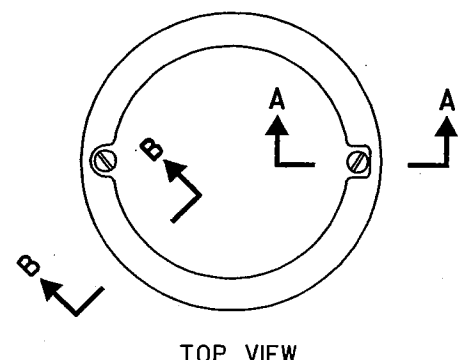


TOP VIEW

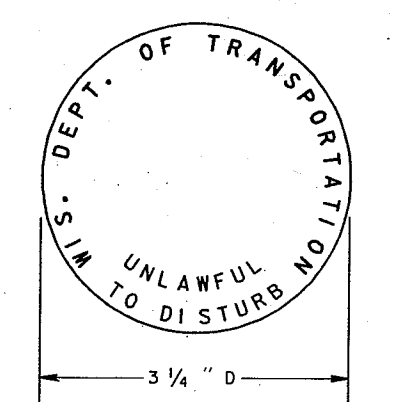

② WIS DOT MONUMENT MARKER LOGO
FOR TYPES "A", "C" & "D"

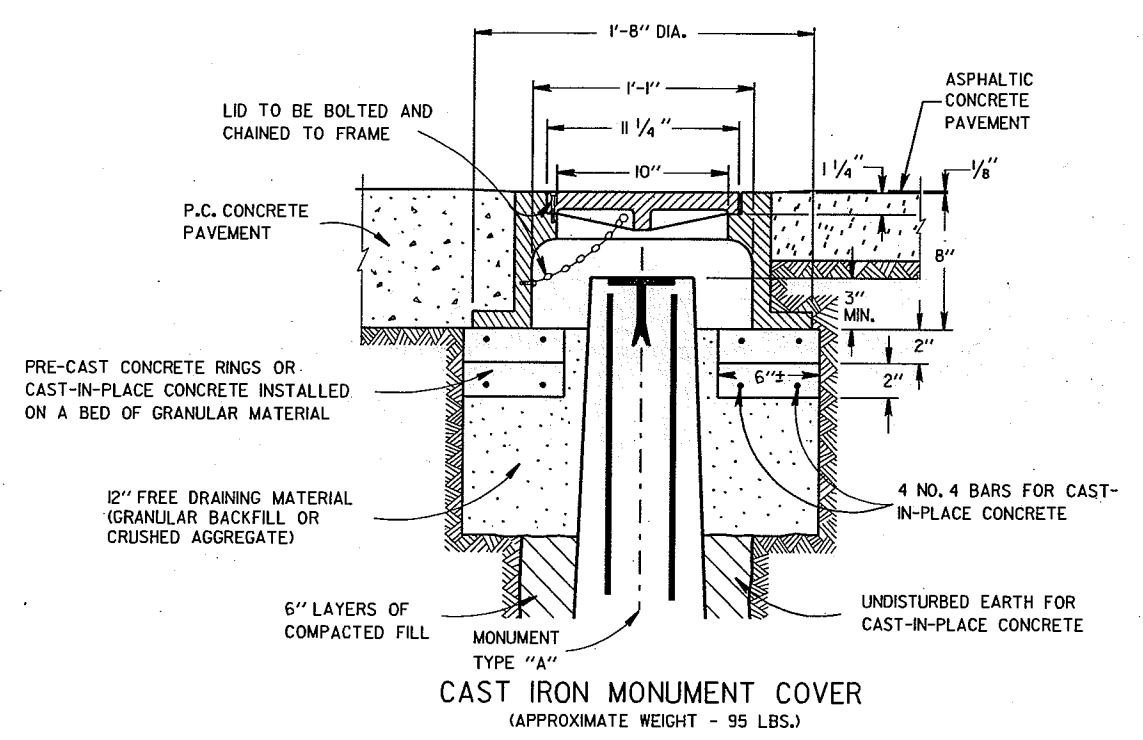

CAST IRON MONUMENT COVER
(APPROXIMATE WEIGHT - 95 LBS.)

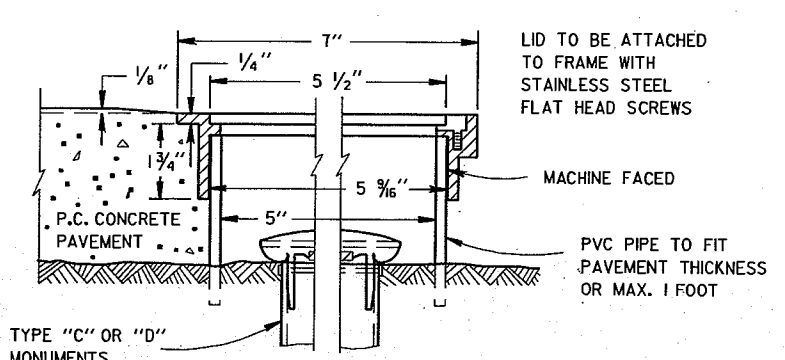


SECTION B-B SECTION A-A
ALUMINUM MONUMENT COVER
(APPROXIMATE WEIGHT 2 LBS)
(FOR CONCRETE PAVEMENT ONLY)

LANDMARK REFERENCE MONUMENTS AND COVERS	
STATE OF WISCONSIN DEPARTMENT OF TRANSPORTATION	
APPROVED	
DATE	CHIEF ROADWAY DEVELOPMENT ENGINEER
FHWA	

S.D.D. 16 A 1-6


LEVELS ON - 1, 2, 3, 62, 63

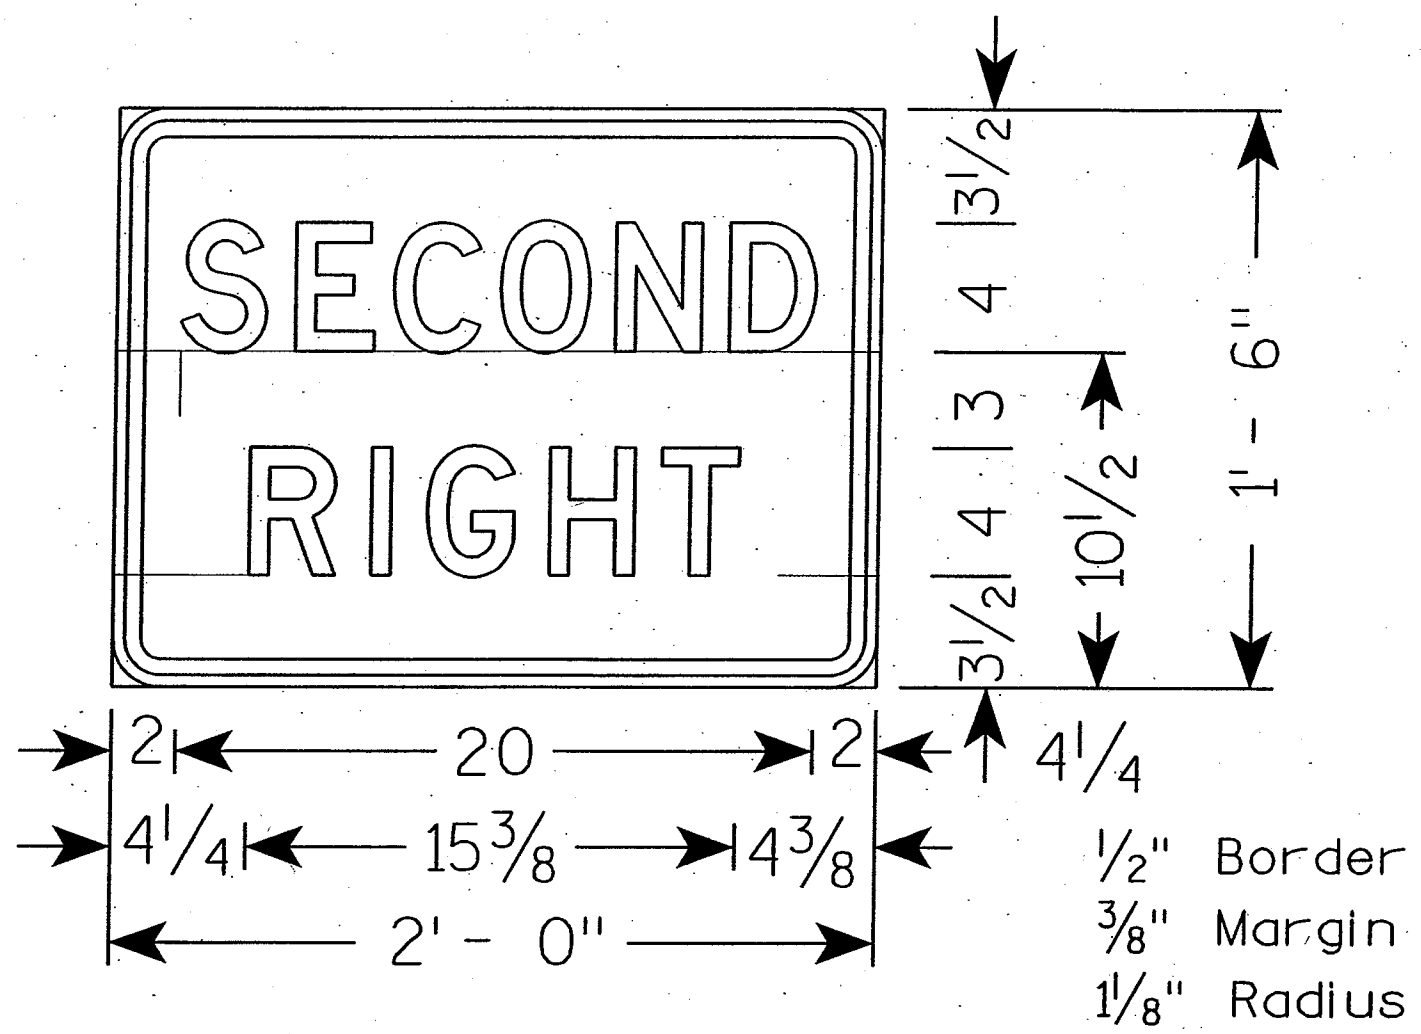

NOTES

1. Sign Is Type II - Type H Reflective - reference WIS DOT Standard Specification for HIGHWAY and STRUCTURE CONSTRUCTION latest edition.
2. Color:
 Background - White
 Message - Black
3. Message Series - D


- ▲ SEE CORNER DETAILS
- NAME PLATE LOCATION (SEE SHT 4)
- ** 1'-6" (TYP.)
- * BUILD APRON AND END OF BOX LEVEL
- ▲ VERT. CONST. JOINT (TYP.)
- INDICATES WING NUMBER

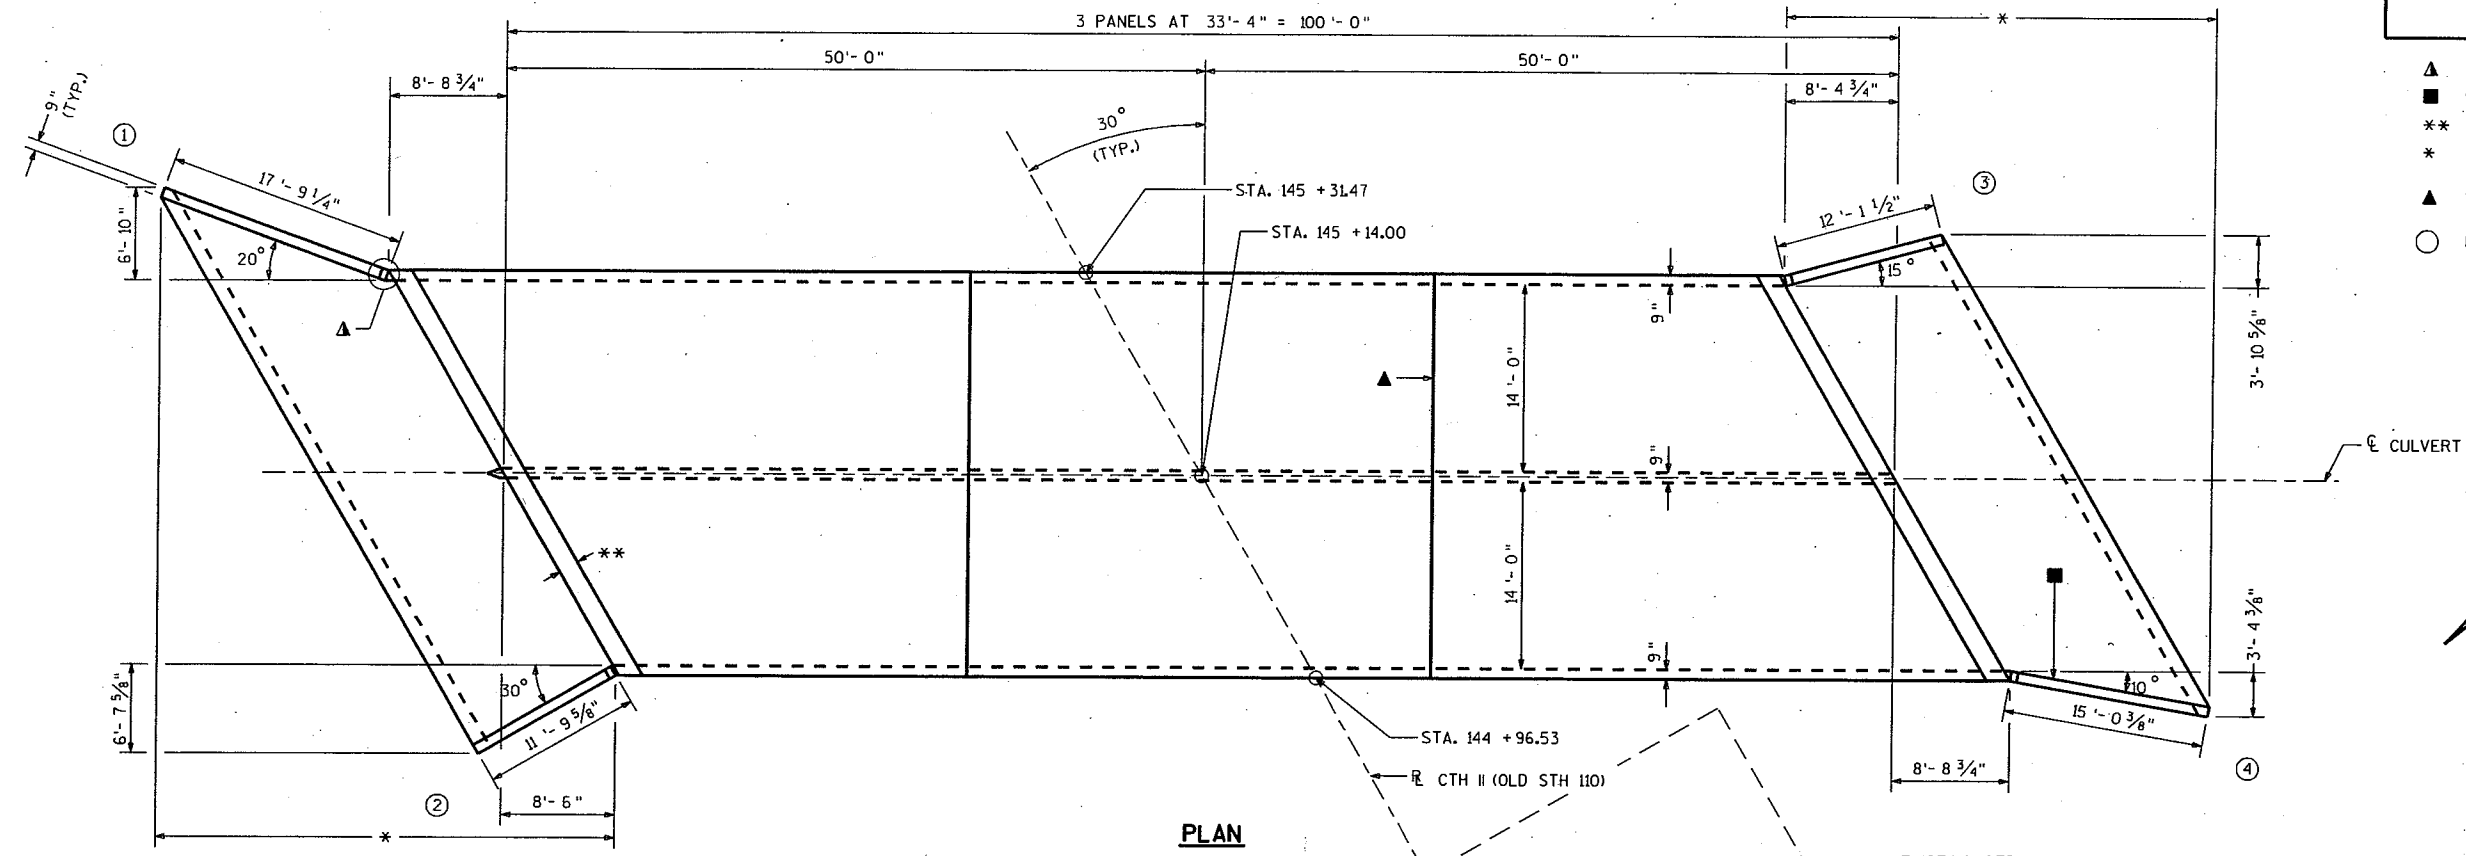

PLAN

IN LIEU OF CONSTRUCTION JOINTS IN THE BOTTOM SLAB, THE CONTRACTOR MAY PROVIDE 2" DEEP SAW CUTS WITHIN 12 HOURS AFTER POURING

EXISTING STRUCTURE (C-70-UNKNOWN) A SINGLE SPAN CONCRETE SLAB ON FULL RETAINING ABUTMENTS LOCATED AT STA. 144+65 TO STA. 144+85 TO BE REMOVED.

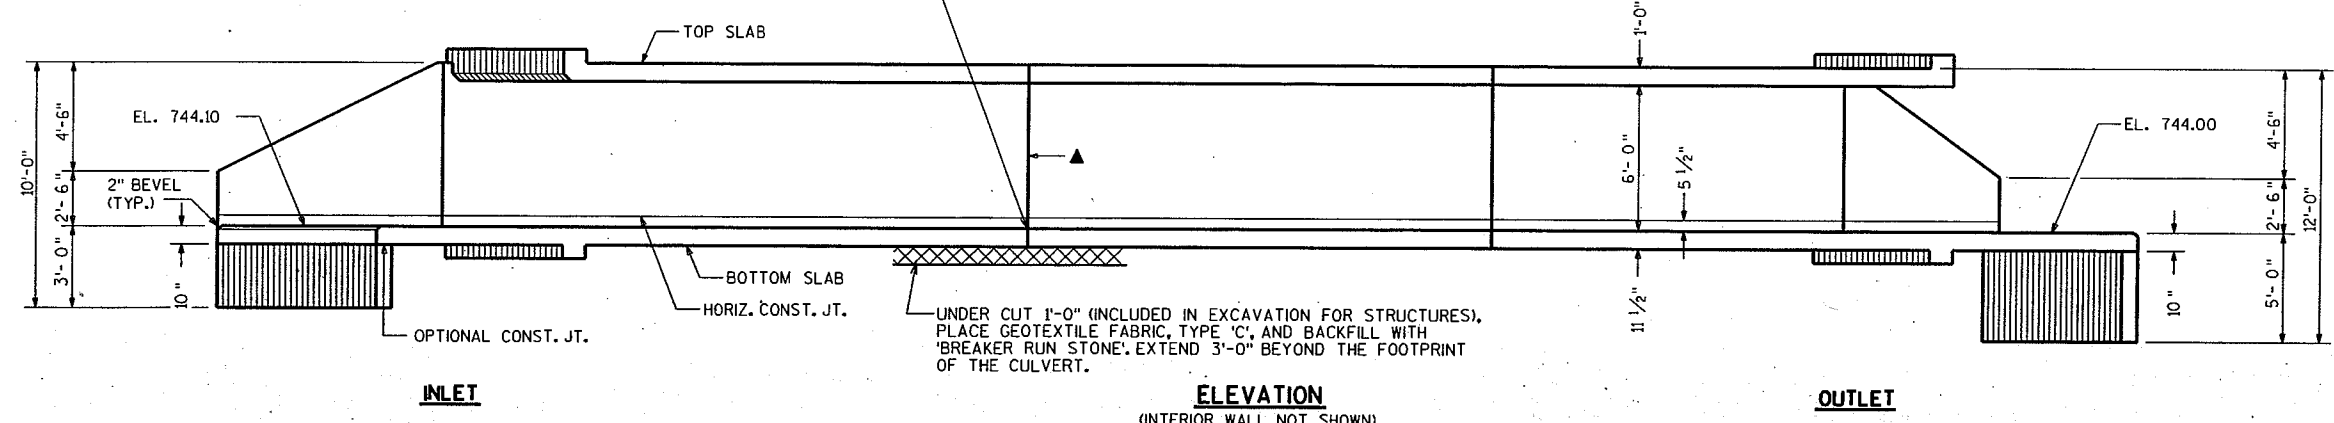

ELEVATION
(INTERIOR WALL NOT SHOWN)

LIST OF DRAWINGS

1. LAYOUT
2. BOX DETAILS
3. APRON DETAILS
4. DETAILS
5. SUBSURFACE EXPLORATION

DESIGN DATA

LIVELOAD: HS20
 EARTHLOAD: DESIGNED FOR 3.0 FT. OF FILL.
 STRENGTH DESIGN METHOD:
 CONCRETE MASONRY, GRADE A-FA $f'_c = 3500$ P.S.I.
 HIGH STRENGTH BAR STEEL REINFORCEMENT $f_y = 60000$ P.S.I.
 INVERTS ARE SET 6" BELOW STREAM BED.

TRAFFIC VOLUME

CTH II (OLD STH 110)
 A.D.T. = 2340 (2024)
 R.D.S. = 55 M.P.H.

HYDRAULIC DATA

100 YEAR FREQUENCY
 $Q_{100} = 1320$ C.F.S.
 VEL. = 9.0 F.P.S.
 HW. = EL. 751.4
 DRAINAGE AREA = 7.5 SQ. MI.
 OVERTOPPING RDWY. = 75L3

TOTAL ESTIMATED QUANTITIES

BID ITEMS	QUANTITY	UNIT
REMOVING OLD STRUCTURE, STA. 144+75.00	1	L.S.
EXCAVATION FOR STRUCTURES, CULVERTS, B-70-242	1	L.S.
CONCRETE MASONRY, CULVERTS	322	C.Y.
BAR STEEL REINFORCEMENT HS BRIDGES	36,040	LBS.
BACKFILL STRUCTURE	800	C.Y.
RUBBERIZED MEMBRANE WATERPROOFING	30	S.Y.
BREAKER RUN STONE	140	C.Y.
GEOTEXTILE FABRIC, TYPE 'C'	420	S.Y.

NON-BID ITEMS

FILLER	3/4" SIZE
--------	-----------

GENERAL NOTES

DRAWINGS SHALL NOT BE SCALED.
 BAR STEEL REINFORCEMENT SHALL BE EMBEDDED 2 INCHES CLEAR UNLESS SHOWN OR NOTED OTHERWISE.
 THE UPPER LIMITS OF EXCAVATION FOR STRUCTURES SHALL BE THE EXISTING GROUNDLINE. ALL SPACES EXCAVATED AND NOT OCCUPIED BY THE NEW STRUCTURE SHALL BE BACKFILLED WITH STRUCTURE BACKFILL TO THE ELEVATION AND SECTION EXISTING PRIOR TO EXCAVATION WITHIN THE LENGTH OF THE CULVERT.
 THE CONCRETE IN THE CUTOFF WALLS MAY BE PLACED UNDERWATER IF THE EXCAVATION CANNOT BE DEWATERED.
 THE CONTRACTOR MAY FURNISH A PRECAST CONCRETE BOX CULVERT IN LIEU OF THE CAST-IN-PLACE BOX CULVERT WITH APPROVAL OF THE STRUCTURES DESIGN SECTION. THE PRECAST CULVERT SHALL CONFORM TO PRECAST DETAILS ON CHAPTER 36 STANDARDS OF THE CURRENT WISC. DOT BRIDGE MANUAL. PAYMENT FOR THE PRECAST CULVERT SHALL BE BASED ON THE PRICES BID FOR THE ITEMS LISTED IN THE "TOTAL ESTIMATED QUANTITIES".
 PLACE A 18" (MIN.) WIDE SHEET OF 'RUBBERIZED MEMBRANE WATERPROOFING' ON TOP SLAB OVER ALL CONSTRUCTION JOINTS AND EXTEND DOWN TO BOTTOM OF OUTSIDE WALLS.

BRIDGE CONTACT PERSON: DAVE GENSON (608)-266-8491

NO.	DATE	REVISION	BY

Plans Prepared By **WISDOT**
BUREAU OF STRUCTURES

APPROVED _____
 CHIEF STRUCTURAL DESIGN ENGINEER DATE _____

STRUCTURE B-70-242

CTH II (OLD STH 110) OVER DRAINAGE WAY

COUNTY WINNEBAGO	TOWN/CITY/VILLAGE WOLF RIVER
------------------	------------------------------

DESIGN SPEC. AASHTO STD. SPEC. 2002	LOAD HS-20	CONST. SPEC. 2003
-------------------------------------	------------	-------------------

DESIGNED BY COMP. _____	DESIGN CK'D. _____	DRAWN BY _____	PLANS CK'D. _____
-------------------------	--------------------	----------------	-------------------

LAYOUT

SHEET 1 OF 5

FILE= 702-PLA.DGN
 SCALE = 4

BILL OF BARS

THE FIRST OR FIRST AND SECOND DIGIT OF THE MARK SIGNIFIES THE BAR SIZE. THE DIMENSION IN THE BENT COLUMN IS THE OUT TO OUT HORIZONTAL LEG OF A "L" SHAPED BAR. LONGER BARS OF THE SAME SIZE MAY BE SUBSTITUTED FOR SHORTER BARS. PAYMENT BASED ON BAR LENGTHS AS DETAILED.


MARK	NUMBER REQ'D.	LENGTH	BENT	BAR SERIES	LOCATION
B501	600	7-4	2-11	NO	CORNERS
B702	75	12-6	NO	NO	BOTTOM SLAB TRANS.
B703	72	5-10	NO	NO	BOTTOM SLAB TRANS.
B604	48	29-6	NO	NO	BOTTOM SLAB TRANS.
B605	94	10-1	NO	NO	BOTTOM SLAB TRANS.
B406	102	2-0	NO	NO	WALLS-DOWELS VERT.
B507	204	2-0	NO	NO	WALLS-DOWELS VERT.
B408	62	32-10	NO	NO	TOP&BOTTOM SLAB & WALL
B409	102	6-2	NO	NO	WALLS VERT.
B510	204	7-2	1-0	NO	WALLS VERT.
B611	58	29-6	NO	NO	TOP SLAB TRANS.
B612	114	10-1	NO	NO	TOP SLAB TRANS.
B813	60	12-6	NO	NO	TOP SLAB TRANS.
B814	57	5-10	NO	NO	TOP SLAB TRANS.
B815	28	32-10	NO	NO	TOP SLAB LONGIT.
B416	36	21-9	NO	NO	TOP&BOTTOM SLAB & WALL
B417	28	32-11	NO	NO	TOP&BOTTOM SLAB & WALL
B418	18	24-5	NO	NO	TOP&BOTTOM SLAB & WALL
B419	4	39-8	NO	NO	TOP&BOTTOM SLAB LONGIT.
B420	4	36-3	NO	NO	TOP&BOTTOM SLAB LONGIT.
B421	4	34-4	NO	NO	TOP&BOTTOM SLAB LONGIT.
B422	4	31-0	NO	NO	TOP&BOTTOM SLAB LONGIT.
B423	4	29-1	NO	NO	TOP&BOTTOM SLAB LONGIT.
B424	4	25-8	NO	NO	TOP&BOTTOM SLAB LONGIT.
B425	36	23-5	NO	NO	BOTTOM SLAB LONGIT.
B426	18	6-6	NO	YES	BOTTOM SLAB LONGIT.
B427	18	15-0	NO	YES	BOTTOM SLAB LONGIT.
B528	28	6-9	NO	YES	TOP SLAB LONGIT.
B529	28	15-3	NO	YES	TOP SLAB LONGIT.
B530	56	23-5	NO	NO	TOP SLAB LONGIT.
B631	38	16-6	NO	YES	BOTTOM SLAB TRANS.
B632	44	16-7	NO	YES	TOP SLAB TRANS.
B333	184	5-1	YES	NO	HEADER STIRRUPS VERT.
B1034	16	34-5	NO	NO	HEADERS HORIZ.
B535	156	4-0	NO	NO	VERT.CONST.JOINT

LENGTH SHOWN FOR BAR SERIES IN "BILL OF BARS" IS AVERAGE LENGTH.

BAR SERIES TABLE


MARK	LENGTH	NO.OF BARS/SERIES	NO.OF EACH SERIES
B426	3-0 TO 9-11	9	2
B427	11-6 TO 18-5	9	2
B528	3-0 TO 10-6	14	2
B529	11-6 TO 19-0	14	2
B631	3-6 TO 29-6	19	2
B632	3-9 TO 29-6	22	2

BUNDLE AND TAG EACH SERIES SEPARATELY

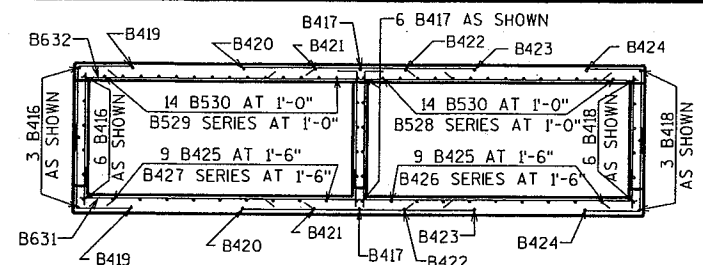


TYPICAL SECTION THRU BOX-EXTERIOR PANEL

BAR LABELS AND DIMENSIONS NOT SHOWN ARE IDENTICAL TO THOSE IN INTERIOR PANEL

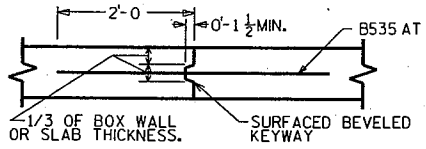


VERTICAL CONSTRUCTION JOINT

2" DEEP SAW CUT WITHIN 12 HOURS AFTER POURING MAY BE USED IN LIEU OF CONST. JT. IN BOTTOM SLAB.

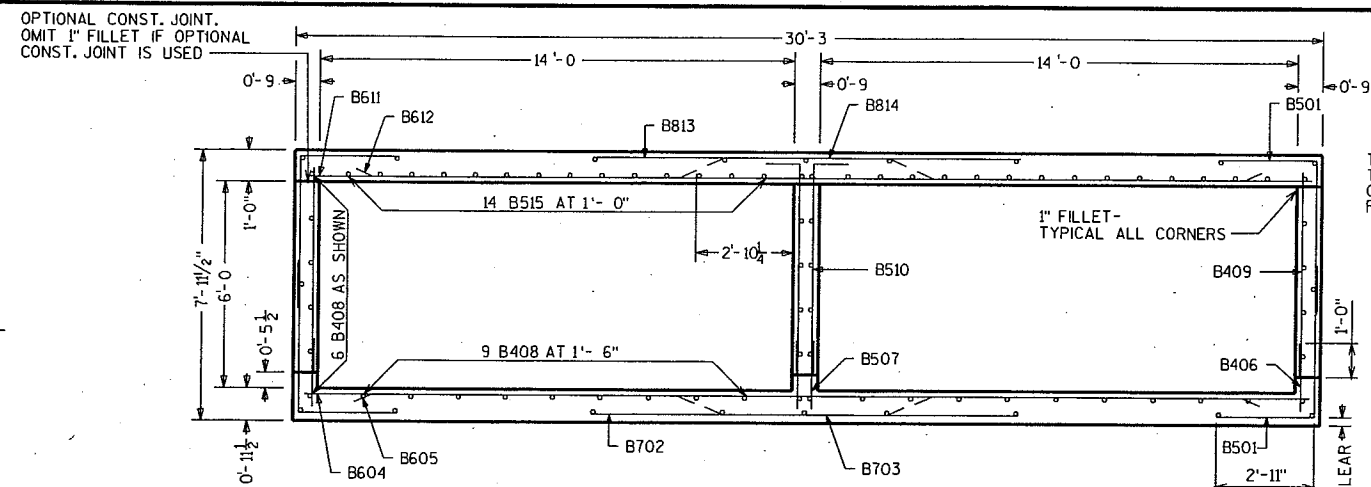

TYPICAL SECTION THRU BOX-INTERIOR PANEL


ALL LONGITUDINAL BARS NOT IDENTIFIED ARE B406 AS SHOWN.

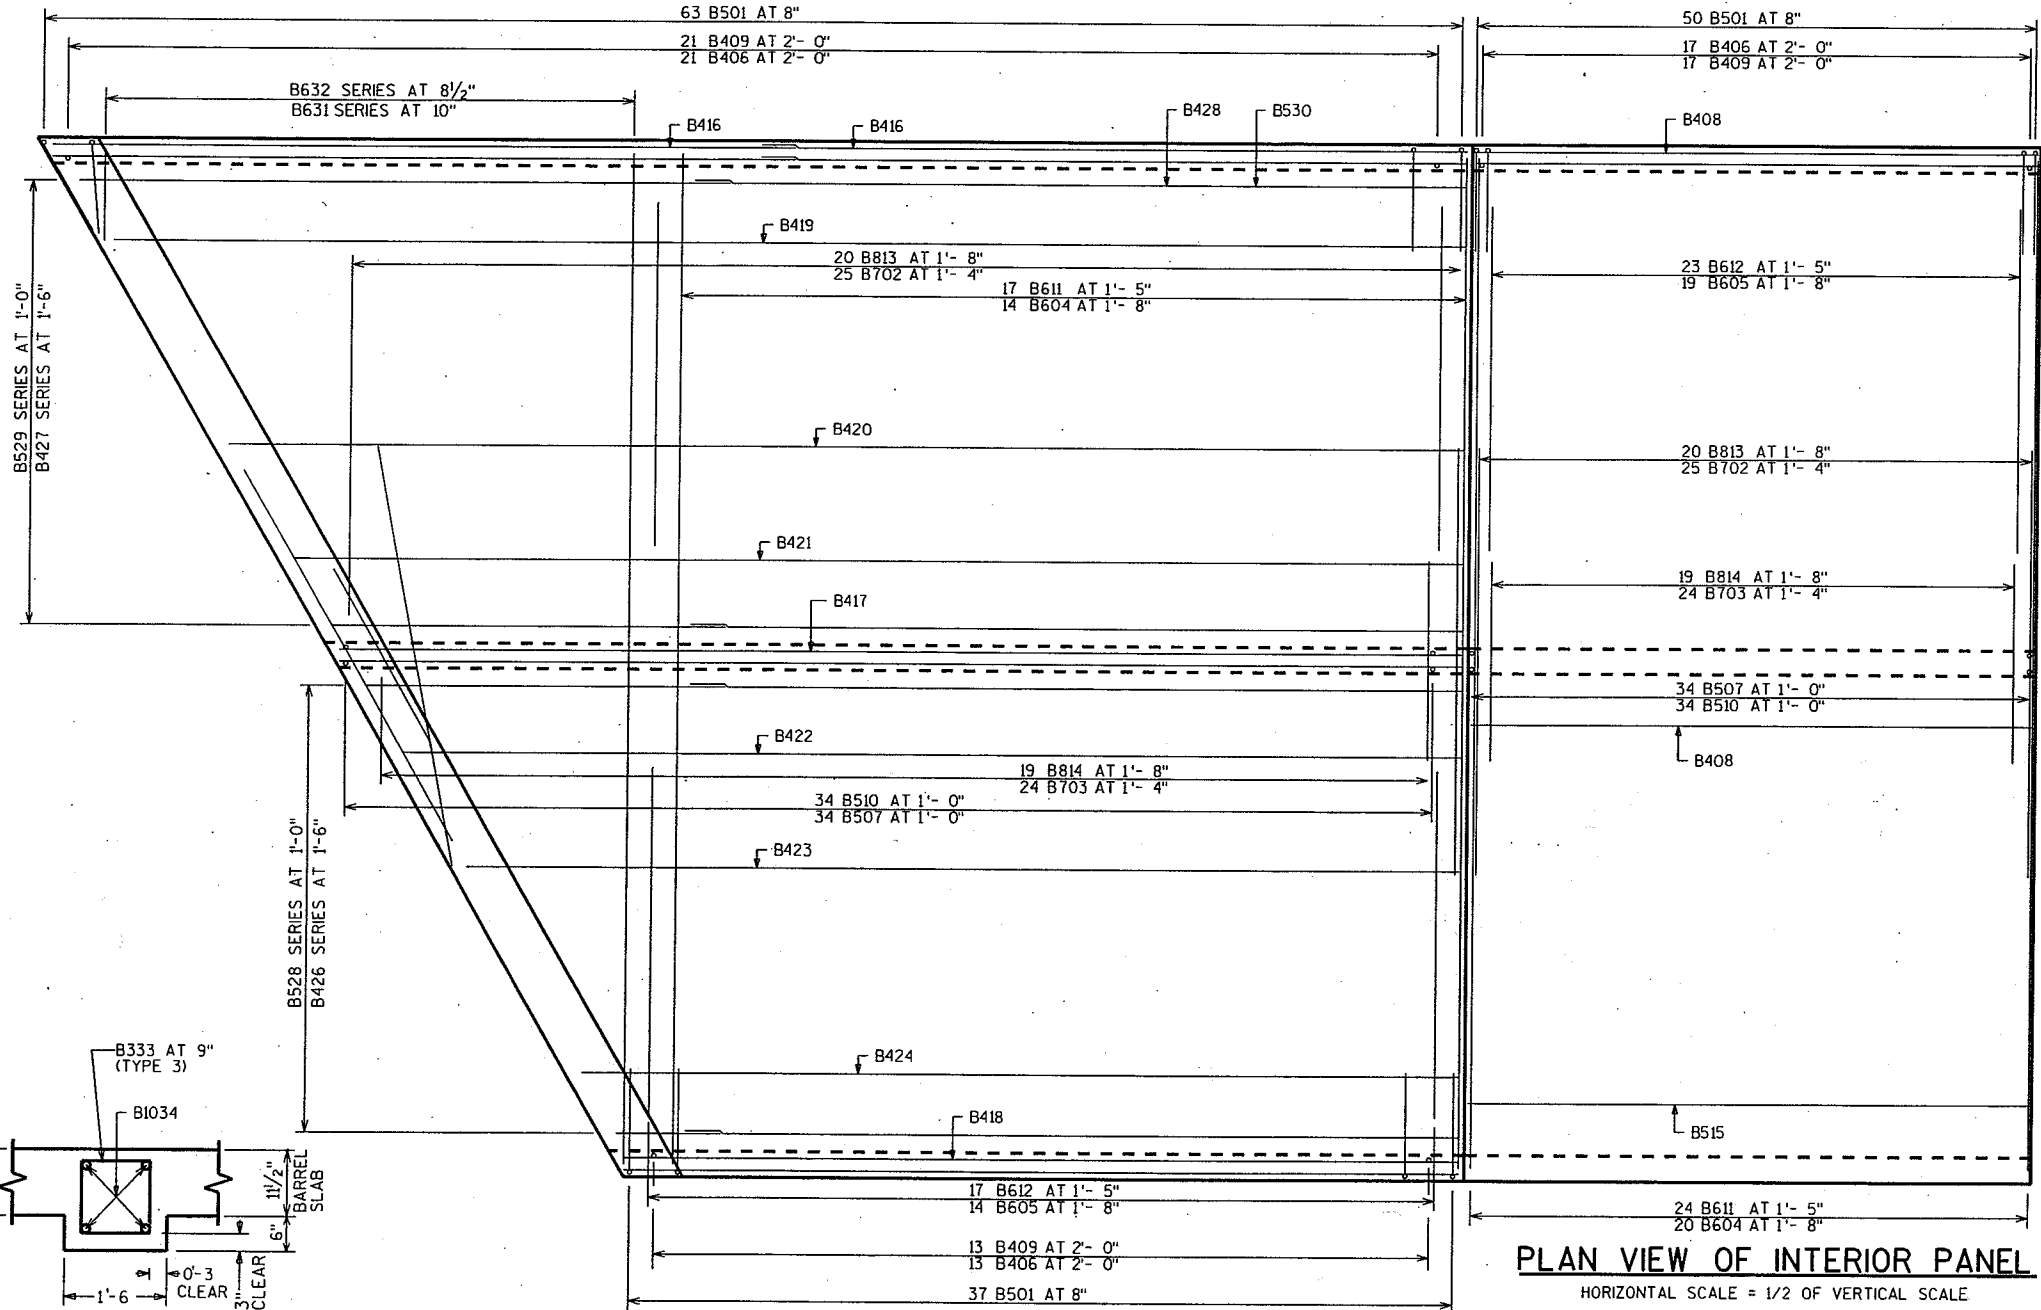



PLAN VIEW OF INTERIOR PANEL

HORIZONTAL SCALE = 1/2 OF VERTICAL SCALE

PLAN VIEW OF EXTERIOR PANEL


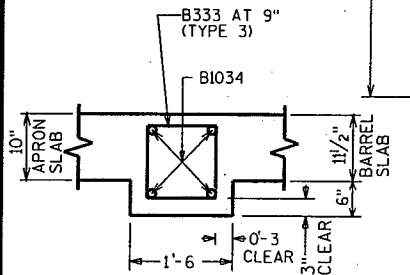


SECTION THRU BOTTOM HEADER

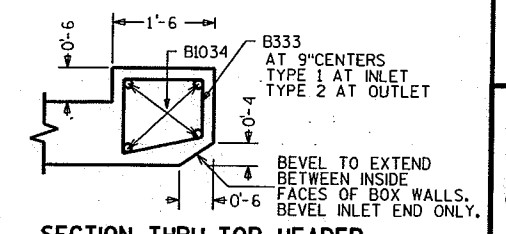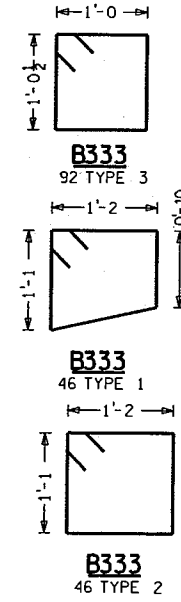


SECTION THRU TOP HEADER

NO.	DATE	REVISION	BY
STATE OF WISCONSIN DEPARTMENT OF TRANSPORTATION STRUCTURES DESIGN SECTION			
STRUCTURE B-70-242			
CONST. SPEC.	2003	DRAWN BY	RES
		PLANS CK'D.	DRG
BOX DETAILS			SHEET 2

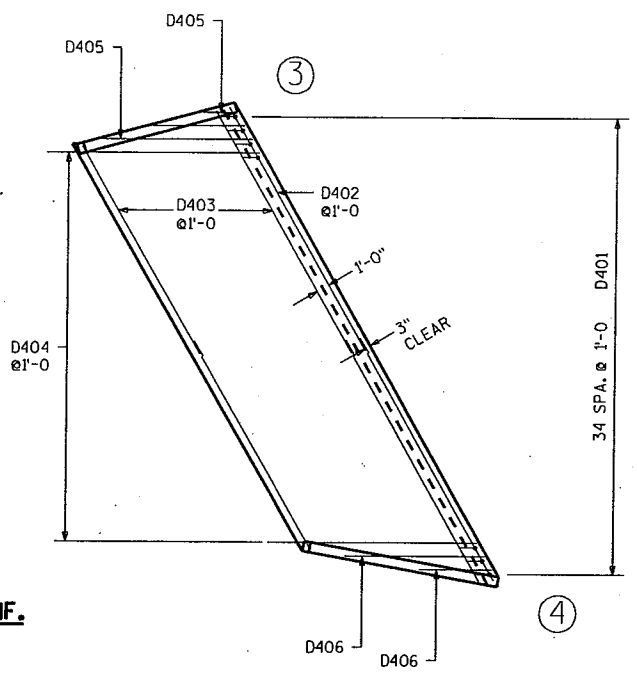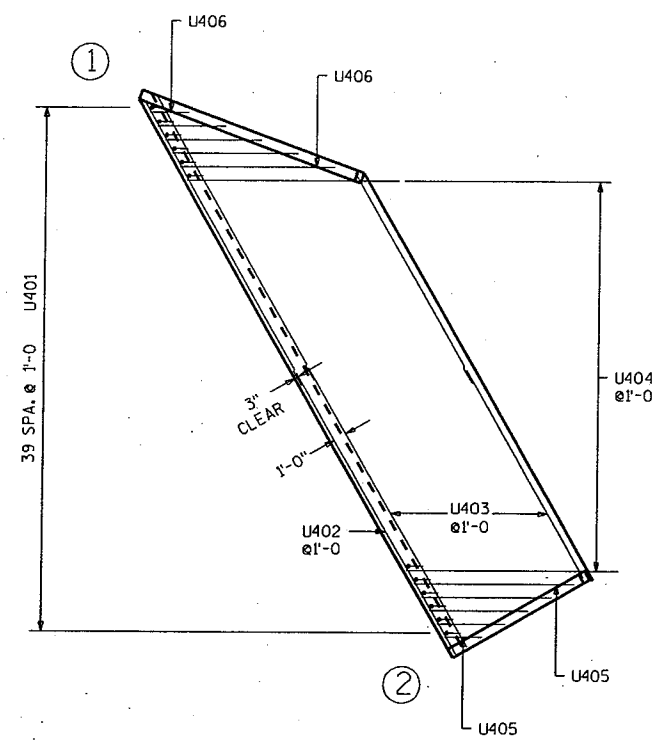


APRON REINF.


▲ 18" RUBBERIZED MEMBRANE WATER-PROOFING, PLACE ALONG HORIZ. CONST. JT. FOR ENTIRE WING LENGTH (TYP.).

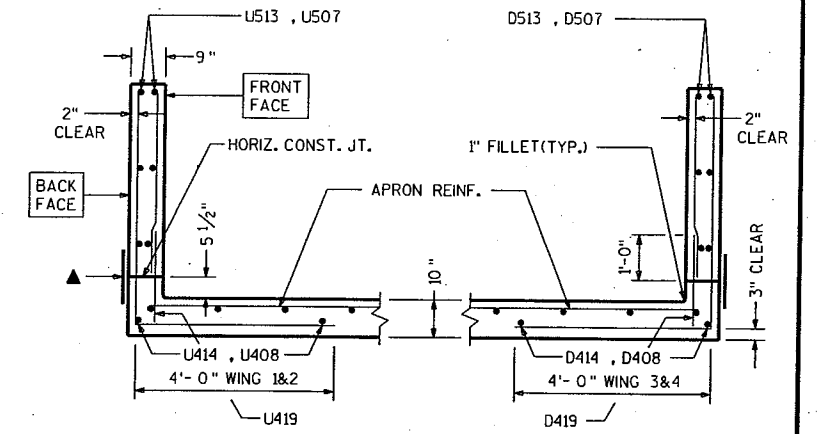


SECTION THRU WINGS AT RIGHT ANGLES TO WING WALLS

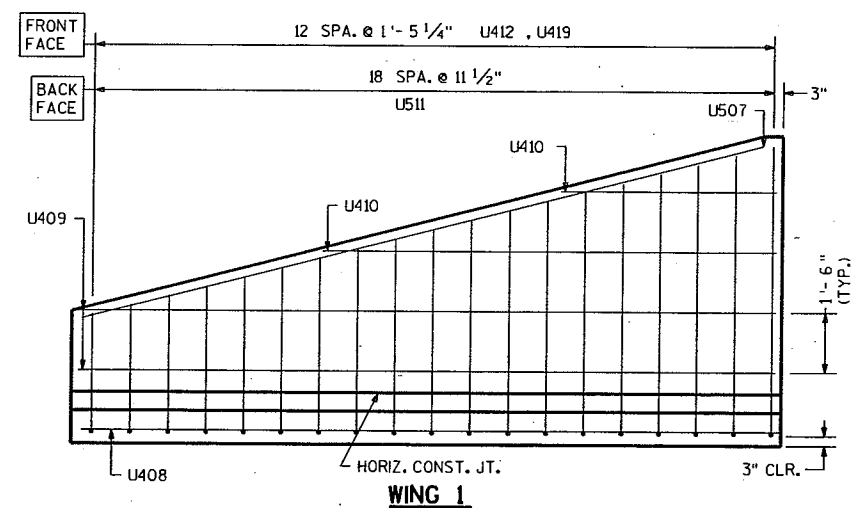


WING 1

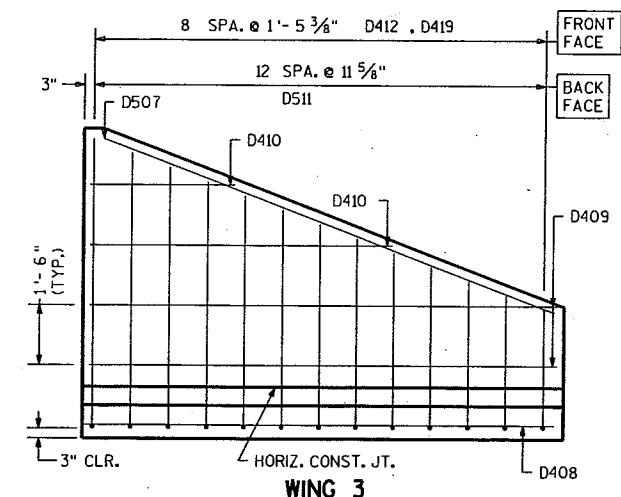


WING 3

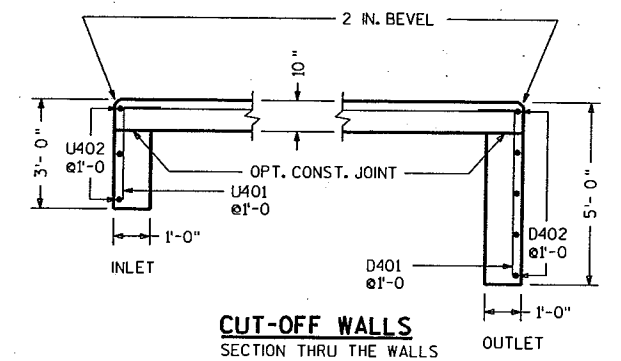


CUT-OFF WALLS SECTION THRU THE WALLS

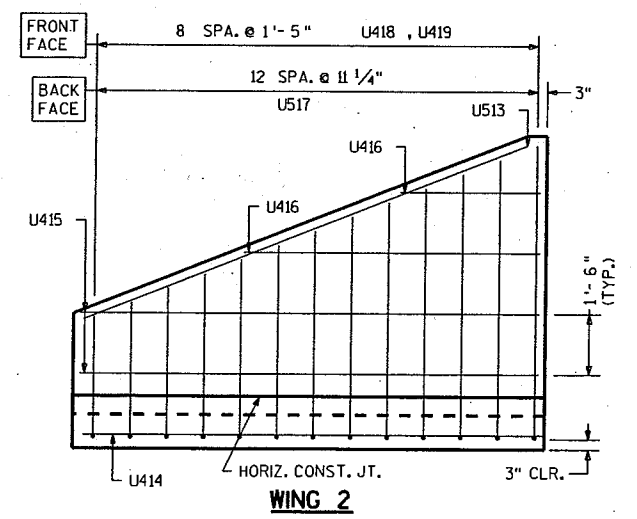

WING 2

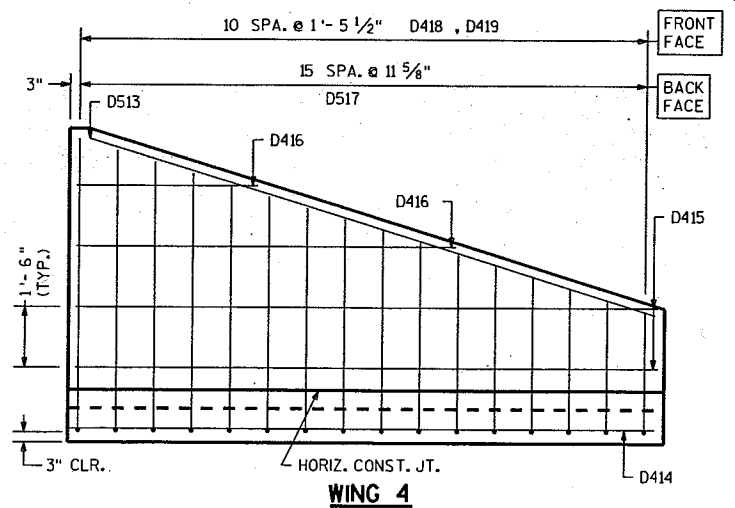

WING 4

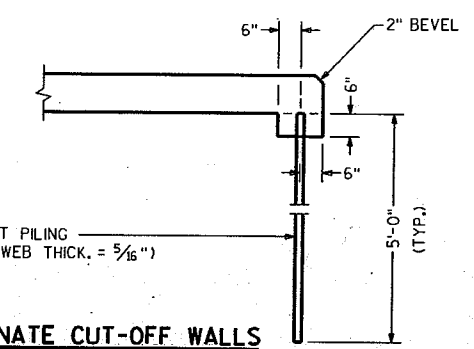

ALTERNATE CUT-OFF WALLS
THE ABOVE ALT. MAY BE USED IN LIEU OF THE CAST-IN-PLACE CONC. CUT-OFF WALLS. PAYMENT WILL BE BASED ON THE CONC. CUT-OFF WALLS.

NO.	DATE	REVISION	BY
STATE OF WISCONSIN DEPARTMENT OF TRANSPORTATION STRUCTURES DESIGN SECTION			
STRUCTURE B-70-242			
CONST. SPEC.	2003	DRAWN BY	RIES
		PLANS CK'D.	DRG
APRON DETAILS		SHEET 3	

BILL OF BARS


THE FIRST DIGIT OF THE BAR MARK SIGNIFIES THE BAR SIZE.
THE DIMENSION IN THE BENT COLUMN IS THE OUT TO OUT HORIZONTAL LEG OF AN L - SHAPED BAR.

BAR MARK	NO. REQ'D.	LENGTH	BENT	BAR SERIES	LOCATION
U401	40	3 - 6	1 - 0		INLET APRON AND CUTOFF WALL
U402	6	24 - 1			INLET APRON AND CUTOFF WALL
U403	22	21 - 0		*	" APRON
U404	30	15 - 10			" APRON
U405	5	7 - 4		*	" APRON
U406	5	7 - 3		*	" APRON
U507	2	17 - 10			WING 1 - HORIZONTAL - BOTH FACES
U408	2	18 - 0			WING " - HORIZONTAL - APRON BOTT. SLAB
U409	4	17 - 5			WING " - HORIZONTAL - BOTH FACES
U410	4	8 - 5		*	WING " - HORIZONTAL - BOTH FACES
U511	19	9 - 0	4 - 0	*	WING " - VERTICAL - BACK FACE
U412	13	4 - 0		*	WING " - VERTICAL - FRONT FACE
U513	2	12 - 2			WING 2 - HORIZONTAL - BOTH FACES
U414	2	12 - 1			WING " - HORIZONTAL - APRON BOTT. SLAB
U415	4	11 - 6			WING " - HORIZONTAL - BOTH FACES
U416	4	5 - 5		*	WING " - HORIZONTAL - BOTH FACES
U517	13	9 - 0	4 - 0	*	WING " - VERTICAL - BACK FACE
U418	9	4 - 0		*	WING " - VERTICAL - FRONT FACE
U419	22	2 - 0			WINGS 1 AND 2 - DOWELS - FRONT FACE
D401	35	5 - 6	1 - 0		OUTLET APRON AND CUTOFF WALL
D402	10	20 - 8			OUTLET APRON AND CUTOFF WALL
D403	22	19 - 3		*	" APRON
D404	30	15 - 10			" APRON
D405	3	6 - 10		*	" APRON
D406	2	8 - 1		*	" APRON
D507	2	12 - 5			WING 3 - HORIZONTAL - BOTH FACES
D408	2	12 - 4			WING " - HORIZONTAL - APRON BOTT. SLAB
D409	4	11 - 9			WING " - HORIZONTAL - BOTH FACES
D410	4	5 - 7		*	WING " - HORIZONTAL - BOTH FACES
D511	13	9 - 0	4 - 0	*	WING " - VERTICAL - BACK FACE
D412	9	4 - 0		*	WING " - VERTICAL - FRONT FACE
D513	2	15 - 2			WING 4 - HORIZONTAL - BOTH FACES
D414	2	15 - 3			WING " - HORIZONTAL - APRON BOTT. SLAB
D415	4	14 - 8			WING " - HORIZONTAL - BOTH FACES
D416	4	7 - 1		*	WING " - HORIZONTAL - BOTH FACES
D517	16	9 - 0	4 - 0	*	WING " - VERTICAL - BACK FACE
D418	11	4 - 0		*	WING " - VERTICAL - FRONT FACE
D419	20	2 - 0			WINGS 3 AND 4 - DOWELS - FRONT FACE


* LENGTH SHOWN FOR BAR IS AN AVERAGE LENGTH AND SHOULD ONLY BE USED FOR BAR WEIGHT CALCULATIONS. SEE BAR SERIES TABLE FOR ACTUAL LENGTHS.

BAR SERIES TABLE --- BUNDLE AND TAG EACH SERIES SEPARATELY


BAR MARK	NO. REQ'D.	LENGTHS FOR EACH SERIES
U403	2 SERIES OF 11	17 - 11 TO 24 - 1
U405	1 SERIES OF 5	2 - 9 TO 12 - 0
U406	1 SERIES OF 5	2 - 11 TO 11 - 8
U410	2 SERIES OF 2	5 - 5 TO 11 - 4
U511	1 SERIES OF 19	6 - 9 TO 11 - 3
U412	1 SERIES OF 13	1 - 9 TO 6 - 3
U416	2 SERIES OF 2	3 - 6 TO 7 - 5
U517	1 SERIES OF 13	6 - 9 TO 11 - 3
U418	1 SERIES OF 9	1 - 9 TO 6 - 3
D403	2 SERIES OF 11	17 - 10 TO 20 - 8
D405	1 SERIES OF 3	2 - 6 TO 11 - 2
D406	1 SERIES OF 2	5 - 7 TO 10 - 8
D410	2 SERIES OF 2	3 - 7 TO 7 - 7
D511	1 SERIES OF 13	6 - 9 TO 11 - 3
D412	1 SERIES OF 9	1 - 9 TO 6 - 3
D416	2 SERIES OF 2	4 - 7 TO 9 - 6
D517	1 SERIES OF 16	6 - 9 TO 11 - 3
D418	1 SERIES OF 11	1 - 9 TO 6 - 3

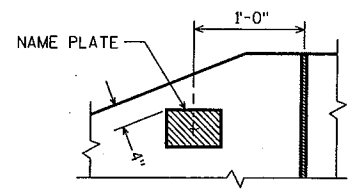

NAME PLATE LOCATION
WING 4

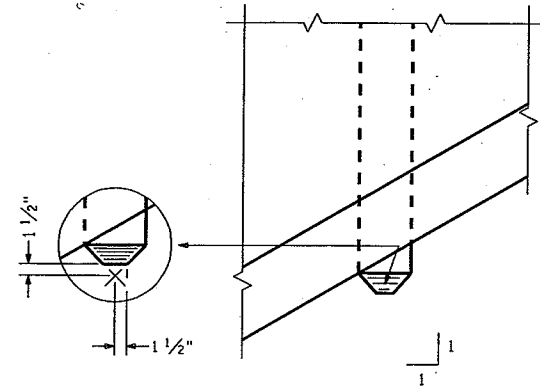


PLAN

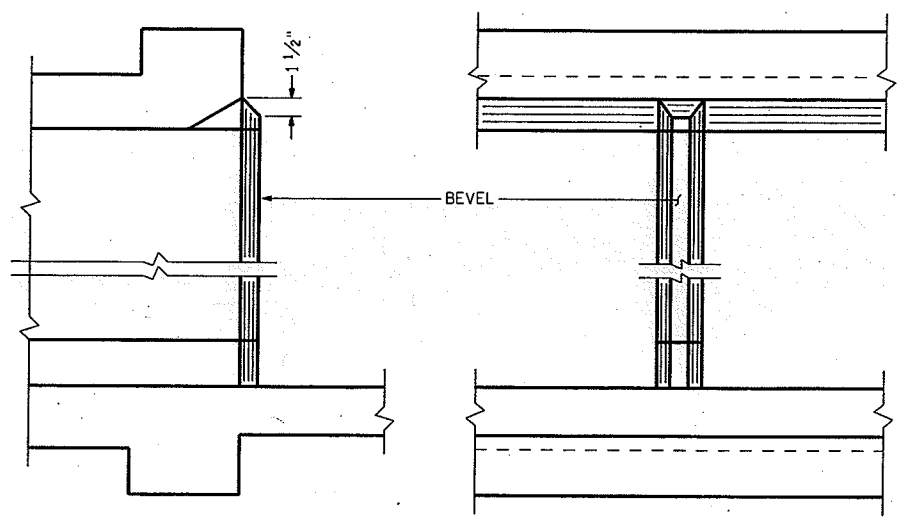


SECTION

ELEVATION


INLET NOSE DETAILS

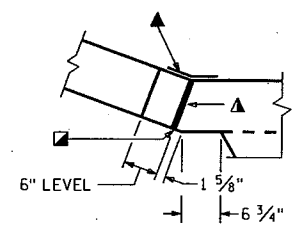


CORNER 1

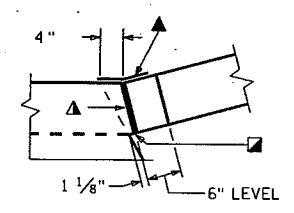

CORNER 3

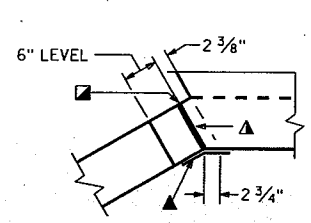

CORNER 2

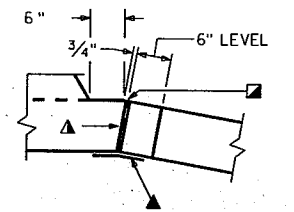

CORNER 4

CORNER DETAILS


▲ 3/4" FILLER TYPICAL. EXTEND FILLER FROM HORIZ. CONST. JT. TO TOP OF WING.

1" BEVEL TYPICAL

▲ 18" RUBBERIZED MEMBRANE WATER-PROOFING. EXTEND FROM HORIZ. CONST. JT. TO TOP OF WALL.

NO.	DATE	REVISION	BY
STATE OF WISCONSIN DEPARTMENT OF TRANSPORTATION STRUCTURES DESIGN SECTION			
STRUCTURE B-70-242			
CONST. SPEC.	2003	DRAWN BY	RIES PLANS CK'D. DRG
DETAILS			SHEET 4

CTH II (OLD STH 110) OVER UNNAMED CREEK
NORTH CO LN- WINCHESTER, WINNEBAGO COUNTY

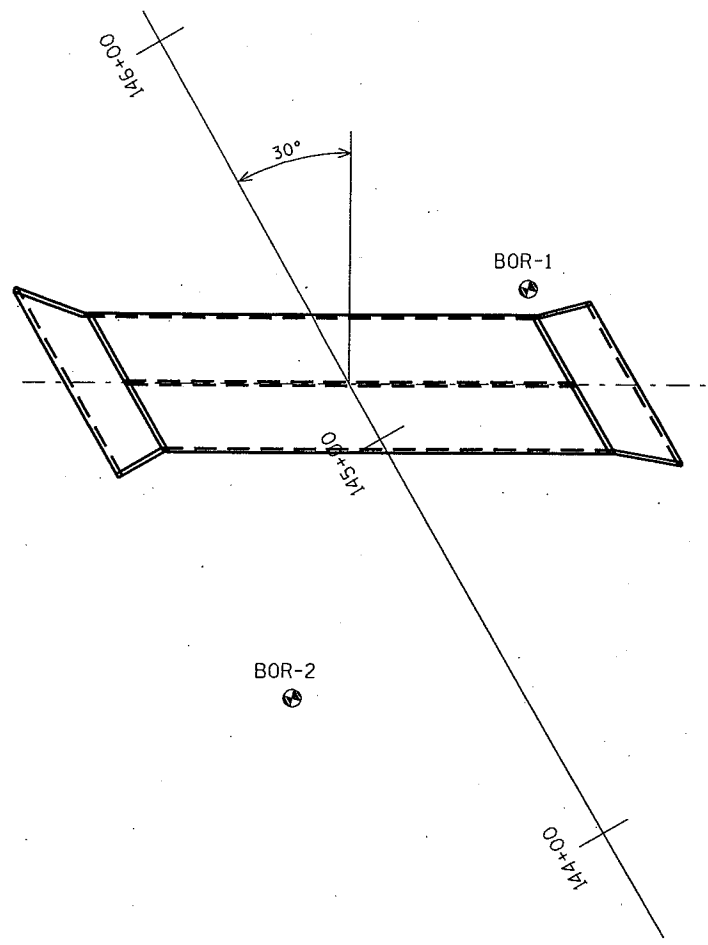

STATE PROJECT NUMBER
6200-07-71

ABBREVIATIONS
F— FINE M— MEDIUM C— COARSE
WS— WEATHERED SO— SOUND

MATERIAL SYMBOLS

TOPSOIL	SILT	SANDSTONE
SAND	PEAT	LIMESTONE
GRAVEL	CLAY	IGNEOUS ROCK

LEGEND OF PROBING

PROBING NO.
STA.
ELEVATION
7 AVERAGE BLOWS PER FOOT
REFUSAL 95/6

95/6=95 BLOWS FOR 6" PENETRATION PROBING TAKEN WITH A 350# WT. FALLING 18" ON A 2" O.D. POINT.


LEGEND OF BORING

ELEV. BORING NO. STA.

UNCONFINED STRENGTH → 7.7
BLOWS PER FT. USING 140# WT. FALLING 30"
WASH SAMPLE
SHELBY TUBE — S.T.
GROUND WATER ELEVATION
NO GROUND WATER OBSERVED ABOVE THIS ELEVATION

SANDY GRAVEL
F. BOULDERS OR COBBLES
SAND
SILTY CLAY
SO
LIMESTONE

UNLESS OTHERWISE SPECIFIED, THE BLOWS PER FOOT AT THE LOCATIONS INDICATED ARE BASED ON DRIVING A 2" O.D. X 1.4" I.D. SPLIT SPOON SAMPLER WITH A 140# HAMMER HAVING A FREE SPOON OF 30". THE BLOW COUNT IS TAKEN IN UNDISTURBED SOIL IMMEDIATELY BELOW A CASED OR OPEN HOLE ELIMINATING SIDE FRICTION ON THE DRIVE PIPE.

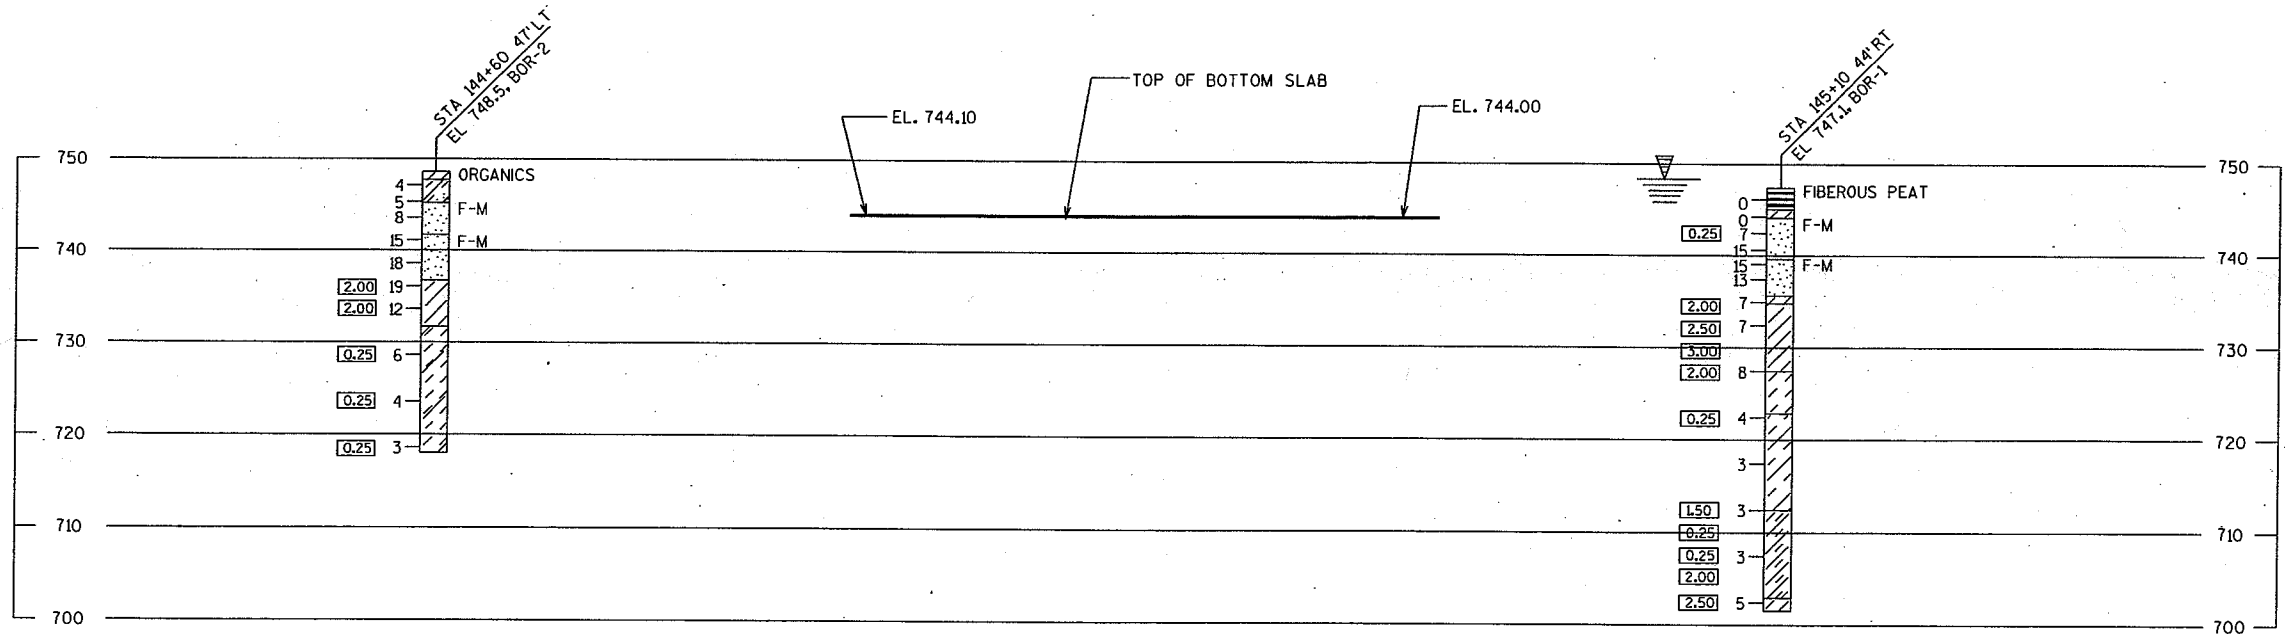

SUBSURFACE EXPLORATION FOR FOUNDATION DESIGN AND BIDDERS INFORMATION

TO OBTAIN RELATIVE DATA CONCERNING THE CHARACTER OF MATERIAL IN AND UPON WHICH THE FOUNDATION MIGHT BE BUILT, BORINGS AND/OR SOUNDINGS WERE MADE AT POINTS APPROXIMATELY AS INDICATED ON THIS DRAWING. THE DATA PRESENTED HEREIN REPRESENTS THE FINDINGS OF THE SUBSURFACE EXPLORATIONS MADE. HOWEVER, BECAUSE THE DEPTHS INVESTIGATED ARE LIMITED AND THE AREA OF THE BORINGS AND/OR SOUNDINGS IS VERY SMALL IN RELATION TO THE ENTIRE AREA, THE WISCONSIN DEPARTMENT OF TRANSPORTATION DOES NOT WARRANT CONDITIONS BELOW THE DEPTHS INVESTIGATED OR THAT THE CLASSIFICATION OF MATERIAL ENCOUNTERED IN THESE INVESTIGATIONS IS NECESSARILY TYPICAL OF THE ENTIRE SITE.

NO.	DATE	REVISION	BY
STATE OF WISCONSIN DEPARTMENT OF TRANSPORTATION STRUCTURES DESIGN SECTION			
STRUCTURE B-70-242			
CONST. SPEC.	2003	DRAWN BY	SJJ
		PLANS CKD.	DRG
SUBSURFACE EXPLORATION		SHEET 5	



FILE= 702 'BOR.DGN SCALE = 1/4"

- ▲ SEE CORNER DETAILS
- NAME PLATE LOCATION (SEE SHT 4)
- ** 1'-0" (TYP.)
- * BUILD APRON AND END OF BOX LEVEL
- ▲ VERT. CONST. JOINT


○ INDICATES WING NUMBER

○ CULVERT

HEAVY RIPRAP AND GEOTEXTILE FABRIC, TYPE 'HR'

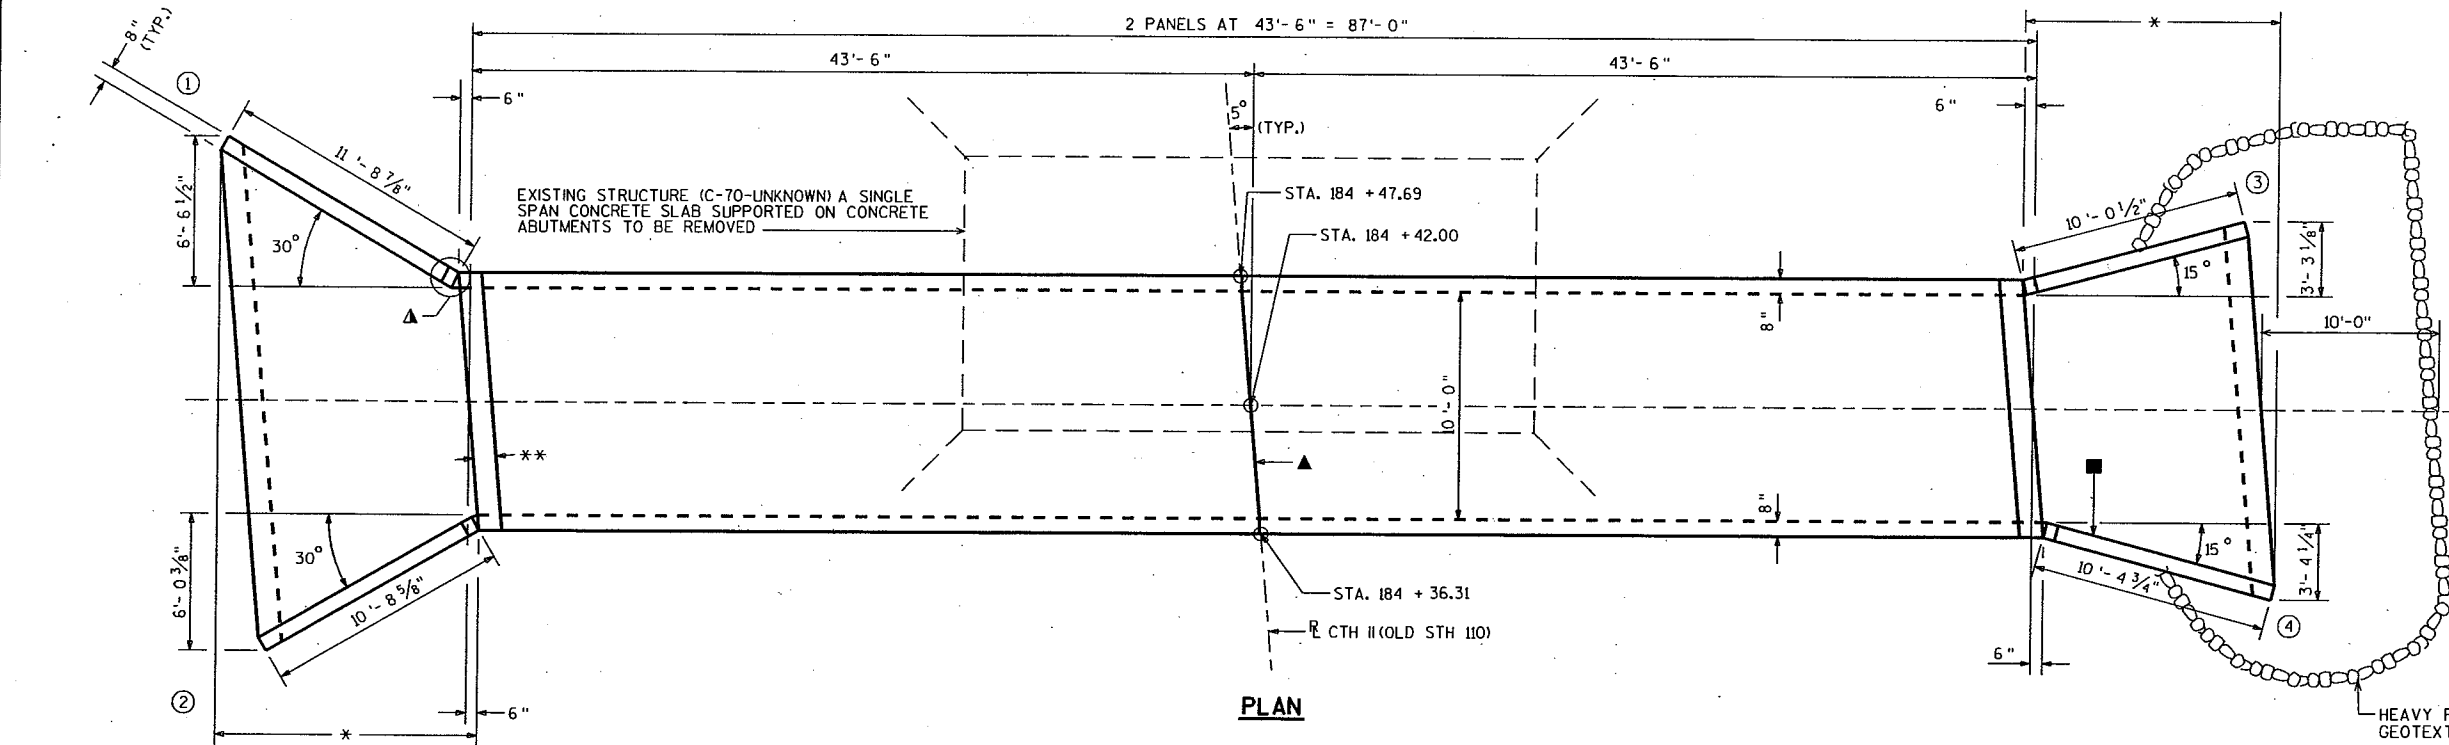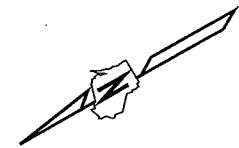

PLAN

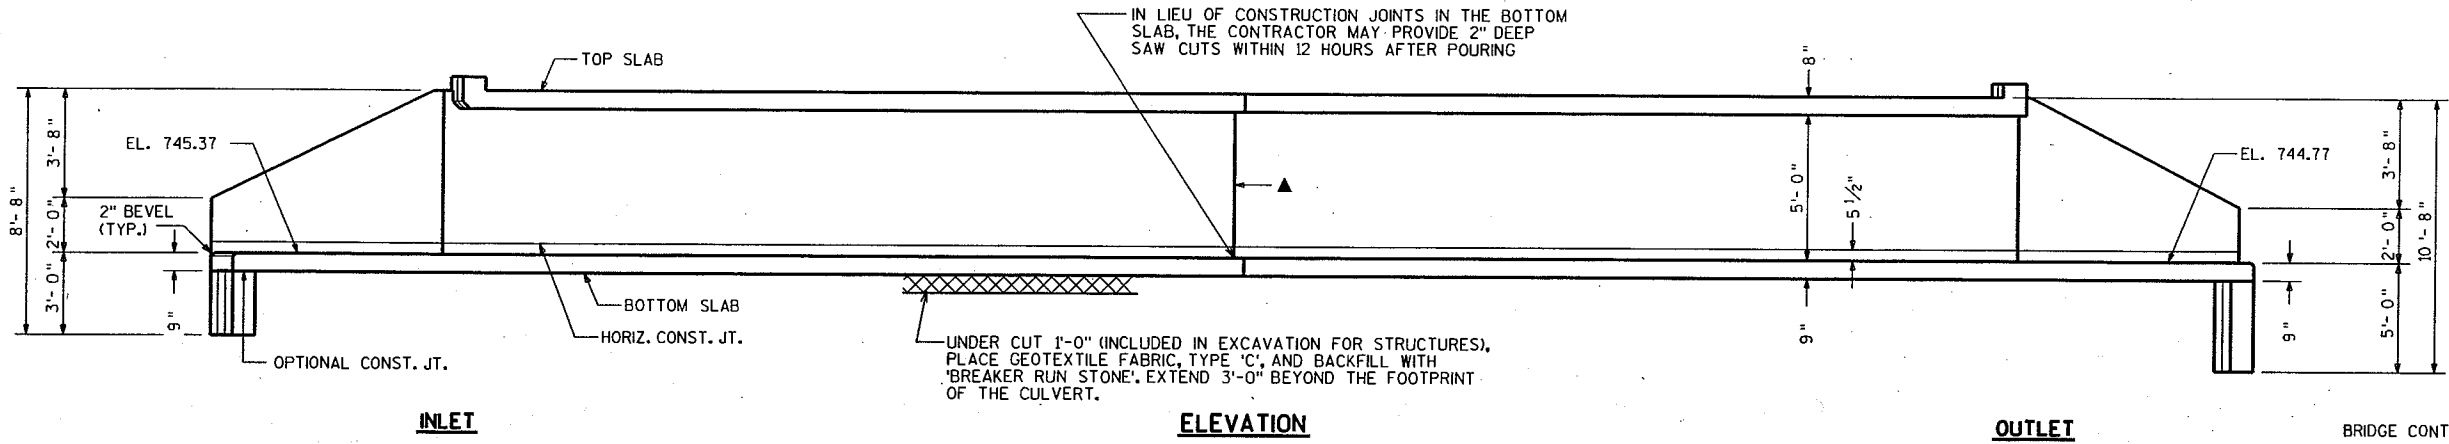

ELEVATION

LIST OF DRAWINGS

1. LAYOUT
2. BOX DETAILS
3. APRON DETAILS
4. DETAILS
5. SUBSURFACE EXPLORATION

DESIGN DATA

LIVELOAD: HS20
 EARTHLOAD: DESIGNED FOR 5.0 FT. OF FILL.
 STRENGTH DESIGN METHOD:
 CONCRETE MASONRY, GRADE A-FA $f'_c = 3500$ P.S.I.
 HIGH STRENGTH BAR STEEL REINFORCEMENT $f_y = 60000$ P.S.I.
 INVERTS SET 6" BELOW STREAM BED.

HYDRAULIC DATA

100 YEAR FREQUENCY
 $Q_{100} = 260$ C.F.S.
 VEL. = 11.0 F.P.S.
 HW. = EL. 750.1
 DRAINAGE AREA = 0.4 SQ. MI.
 OVERTOPPING RDWY. = N.A.

TRAFFIC VOLUME

CTH II (OLD STH 110)
 A.D.T. = 2340 (2024)
 R.D.S. = 55 M.P.H.

TOTAL ESTIMATED QUANTITIES

BID ITEMS		
REMOVING OLD STRUCTURE, STA. 184 + 42.00	1	L.S.
EXCAVATION FOR STRUCTURES, CULVERTS, C-70-70	1	L.S.
CONCRETE MASONRY, CULVERTS	92	C.Y.
BAR STEEL REINFORCEMENT HS BRIDGES	12,100	LBS.
GEOTEXTILE FABRIC, TYPE C	225	S.Y.
GEOTEXTILE FABRIC, TYPE HR	50	S.Y.
RIPPRAP HEAVY	25	C.Y.
BACKFILL STRUCTURE	1,050	C.Y.
RUBBERIZED MEMBRANE WATERPROOFING	16	S.Y.
BREAKER RUN STONE	75	C.Y.

NON-BID ITEMS

FILLER $3/4"$ SIZE

GENERAL NOTES

DRAWINGS SHALL NOT BE SCALED.
 BAR STEEL REINFORCEMENT SHALL BE EMBEDDED 2 INCHES CLEAR UNLESS SHOWN OR NOTED OTHERWISE.
 THE UPPER LIMITS OF EXCAVATION FOR STRUCTURES SHALL BE THE EXISTING GROUNDLINE. ALL SPACES EXCAVATED AND NOT OCCUPIED BY THE NEW STRUCTURE SHALL BE BACKFILLED WITH STRUCTURE BACKFILL TO THE ELEVATION AND SECTION EXISTING PRIOR TO EXCAVATION WITHIN THE LENGTH OF THE CULVERT.
 THE CONCRETE IN THE CUTOFF WALLS MAY BE PLACED UNDERWATER IF THE EXCAVATION CANNOT BE DEWATERED.
 THE CONTRACTOR MAY FURNISH A PRECAST CONCRETE BOX CULVERT IN LIEU OF THE CAST-IN-PLACE BOX CULVERT WITH APPROVAL OF THE STRUCTURES DESIGN SECTION. THE PRECAST CULVERT SHALL CONFORM TO PRECAST DETAILS ON CHAPTER 36 STANDARDS OF THE CURRENT WISCONSIN DOT BRIDGE MANUAL. PAYMENT FOR THE PRECAST CULVERT SHALL BE BASED ON THE PRICES BID FOR THE ITEMS LISTED IN THE "TOTAL ESTIMATED QUANTITIES".
 PLACE A 18" (MIN.) WIDE SHEET OF 'RUBBERIZED MEMBRANE WATERPROOFING' ON TOP SLAB OVER ALL CONSTRUCTION JOINTS AND EXTEND DOWN TO BOTTOM OF OUTSIDE WALLS.

BRIDGE CONTACT PERSON: DAVE GENSON (608)-266-8491

NO.	DATE	REVISION	BY

Plans Prepared By **WISDOT**
BUREAU OF STRUCTURES

STRUCTURE C-70-70

CTH II (OLD STH 110) OVER TRIBUTARY TO WOLF RIVER

COUNTY	WINNEBAGO	TOWN/CITY/VILLAGE	WOLF RIVER
DESIGN SPEC.	AASHTO STD. SPEC. 2002	LOAD	HS-20
DESIGNED BY	COMP. CK'D. FWG	DRAWN BY	RIES
PLANS CK'D.	DRG	DATE	SEPT. '02

APPROVED: _____
 CHIEF STRUCTURAL DESIGN ENGINEER


LAYOUT

SHEET 1 OF 5
 DATE: SEPT. '02

BILL OF BARS


THE FIRST OR FIRST AND SECOND DIGIT OF THE MARK SIGNIFIES THE BAR SIZE. THE DIMENSION IN THE BENT COLUMN IS THE OUT TO OUT HORIZONTAL LEG OF A "L" SHAPED BAR. LONGER BARS OF THE SAME SIZE MAY BE SUBSTITUTED FOR SHORTER BARS. PAYMENT BASED ON BAR LENGTHS AS DETAILED.

MARK	NUMBER REQ'D.	LENGTH	BENT	BAR SERIES	LOCATION
B601	424	7-2	3-2	NO	CORNERS
B402	116	2-0	NO	NO	WALLS-DOWELS VERT.
B403	80	22-0	NO	NO	TOP&BOTTOM SLAB & WALL
B404	24	22-0	NO	NO	BOTTOM SLAB LONGIT.
B505	82	10-8	NO	NO	BOTTOM SLAB TRANS.
B506	80	7-2	NO	NO	BOTTOM SLAB TRANS.
B407	116	5-0	NO	NO	WALLS VERT.
B508	82	10-8	NO	NO	TOP SLAB TRANS.
B509	80	7-2	NO	NO	TOP SLAB TRANS.
B510	20	43-0	NO	NO	TOP SLAB LONGIT.
B411	4	11-0	NO	NO	HEADERS HORIZ.
B312	30	2-9	YES	NO	HEADER STIRRUPS VERT.
B513	32	4-0	NO	NO	VERT.CONST.JOINT

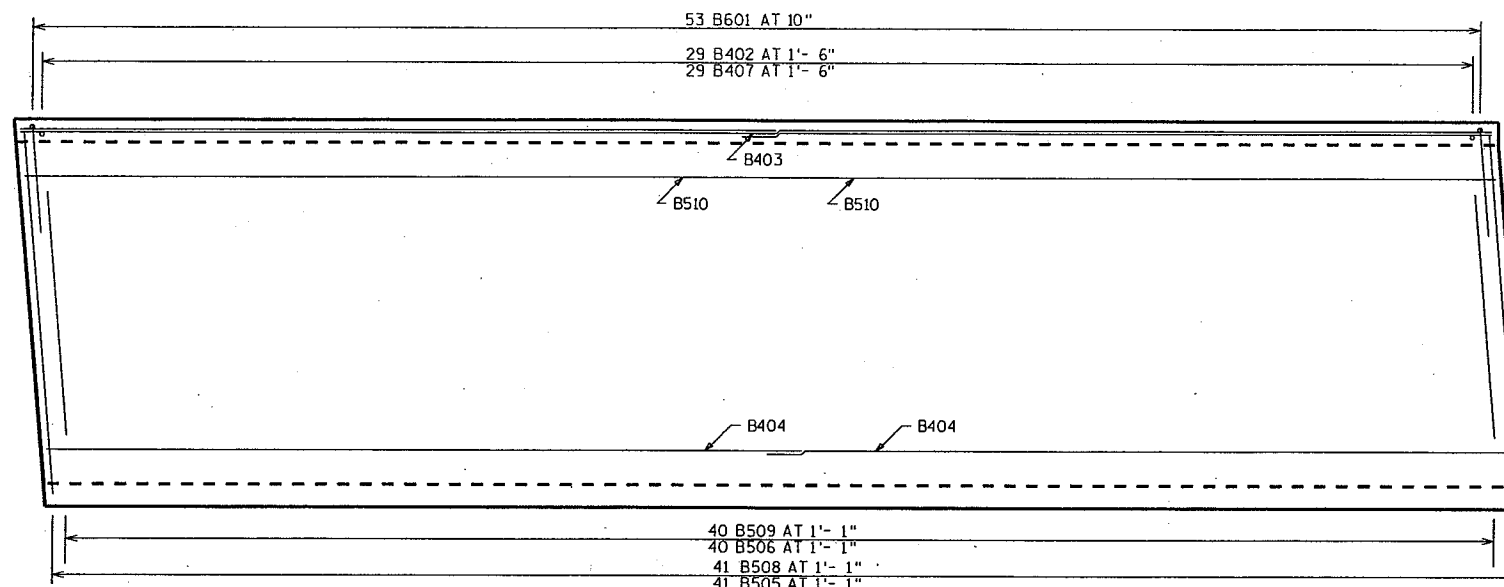


PLAN VIEW OF EXTERIOR PANEL

USE IDENTICAL STEEL IN OTHER PANELS.
APRON AND HEADER ARE NOT SHOWN.

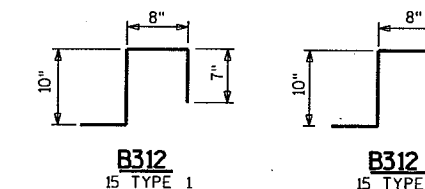


B312
15 TYPE 1


B312
15 TYPE 2

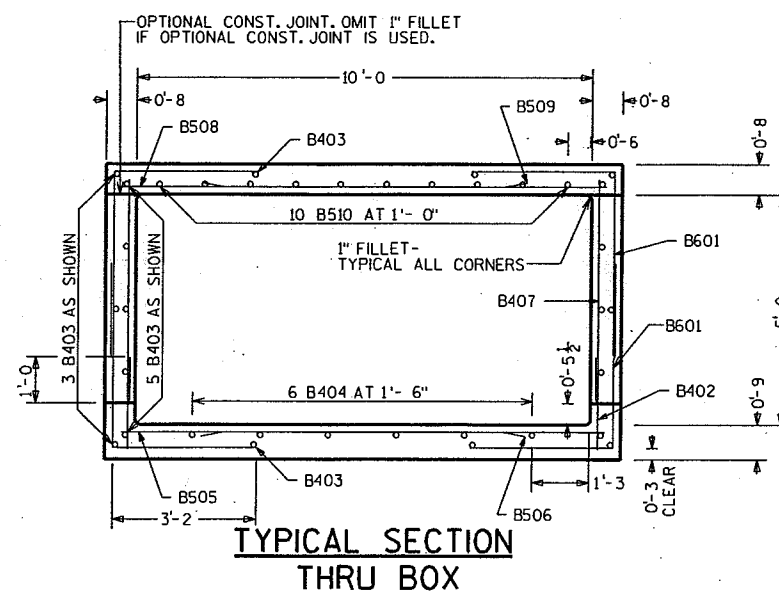

TYPICAL SECTION THRU BOX


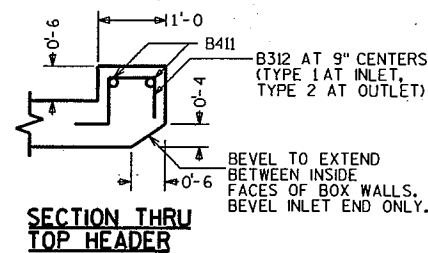


SECTION THRU TOP HEADER

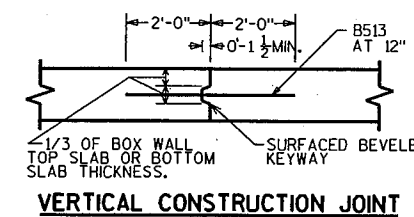


VERTICAL CONSTRUCTION JOINT

NO.	DATE	REVISION	BY
STATE OF WISCONSIN DEPARTMENT OF TRANSPORTATION STRUCTURES DESIGN SECTION			
STRUCTURE C-70-70			
CONST. SPEC.	2003	DRAWN BY	RIES PLANS CKD. DRG
BOX DETAILS			SHEET 2

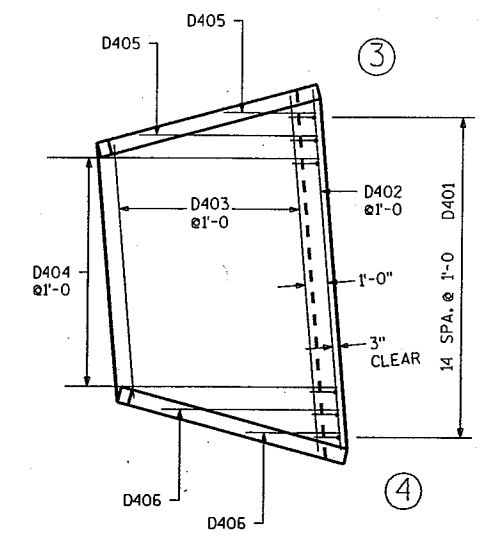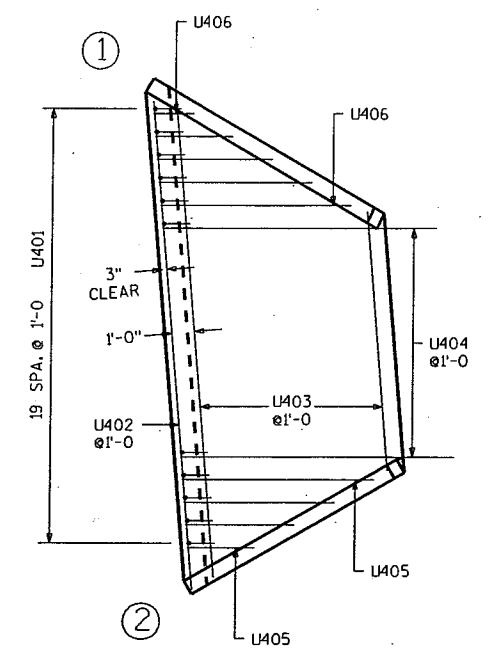


APRON REINF.


▲ 18" RUBBERIZED MEMBRANE WATER-PROOFING. PLACE ALONG HORIZ. CONST. JT. FOR ENTIRE WING LENGTH (TYP.).

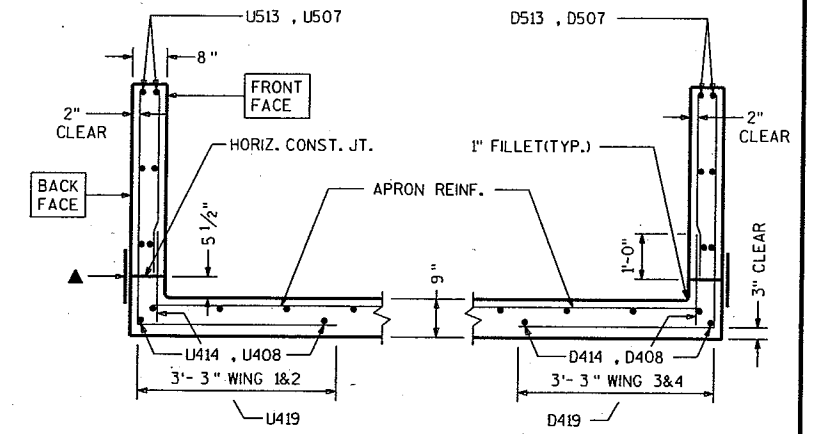


SECTION THRU WINGS
AT RIGHT ANGLES TO WING WALLS

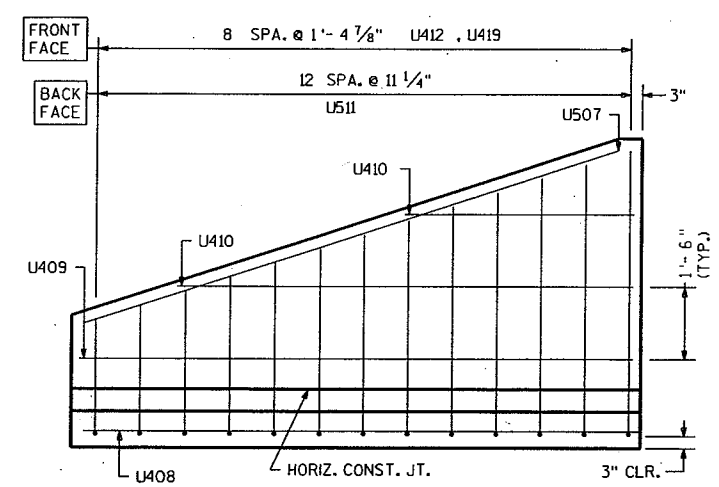


WING 1

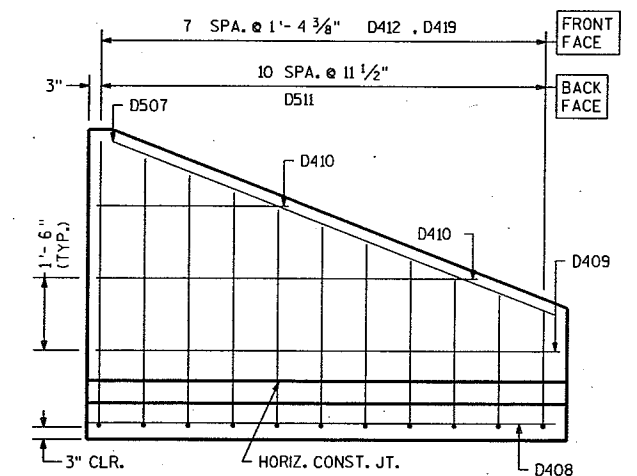


WING 3

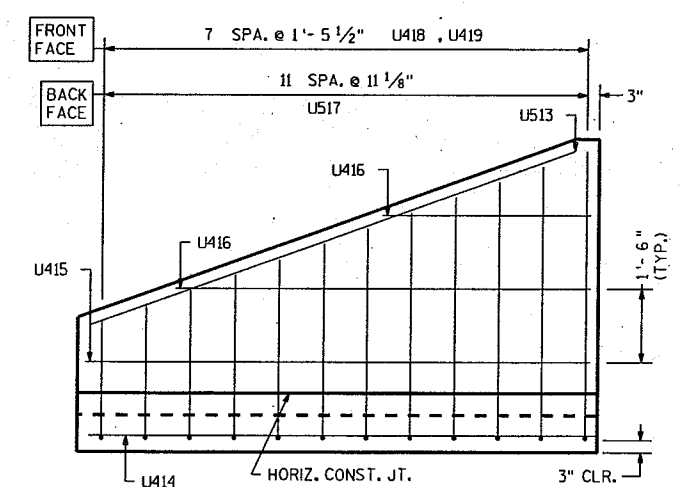


WING 2

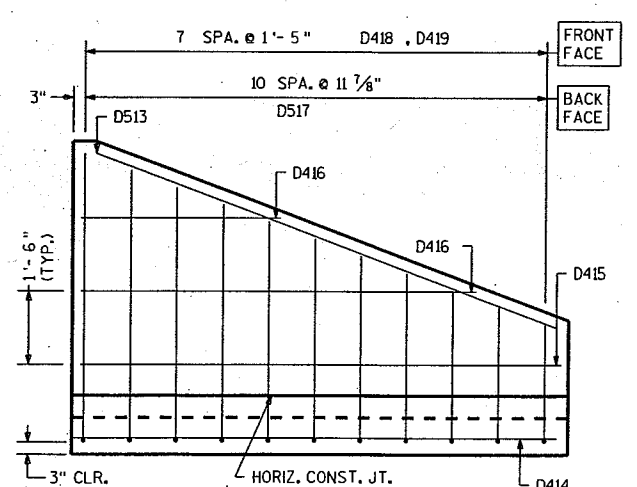

WING 4

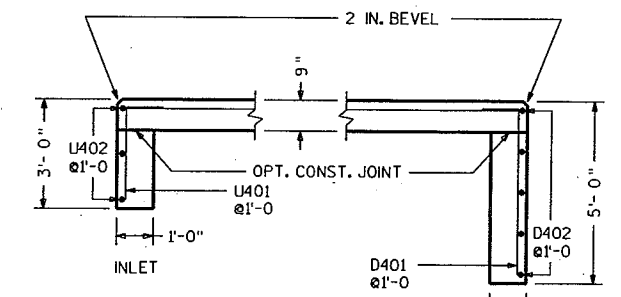

CUT-OFF WALLS
SECTION THRU THE WALLS

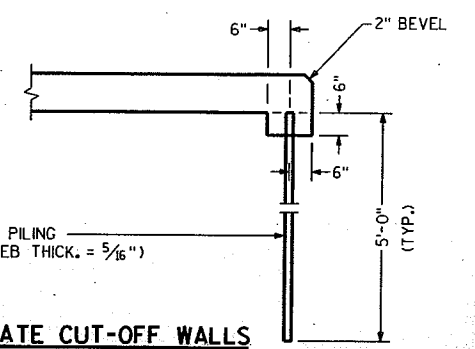


ALTERNATE CUT-OFF WALLS
THE ABOVE ALT. MAY BE USED IN LIEU OF THE CAST-IN-PLACE CONC. CUT-OFF WALLS. PAYMENT WILL BE BASED ON THE CONC. CUT-OFF WALLS.

NO.	DATE	REVISION	BY
STATE OF WISCONSIN DEPARTMENT OF TRANSPORTATION STRUCTURES DESIGN SECTION			
STRUCTURE C-70-70			
CONSTR. SPEC.	2003	DRAWN BY	RIES
		PLANS CKD.	DRG
APRON DETAILS		SHEET 3	

BILL OF BARS

THE FIRST DIGIT OF THE BAR MARK SIGNIFIES THE BAR SIZE.
THE DIMENSION IN THE BENT COLUMN IS THE OUT TO OUT HORIZONTAL LEG OF AN L - SHAPED BAR.

BAR MARK	NO. REQ'D.	LENGTH	BENT	BAR SERIES	LOCATION
U401	20	3 - 6	1 - 0		INLET APRON AND CUTOFF WALL
U402	3	21 - 3			INLET APRON AND CUTOFF WALL
U403	9	16 - 4		*	" APRON
U404	11	12 - 0			" APRON
U405	4	5 - 8		*	" APRON
U406	5	5 - 1		*	" APRON
U507	2	11 - 10			WING 1 -HORIZONTAL - BOTH FACES
U408	2	12 - 0			WING " -HORIZONTAL -APRON BOTT. SLAB
U409	2	11 - 5			WING " -HORIZONTAL - BOTH FACES
U410	4	7 - 1		*	WING " -HORIZONTAL - BOTH FACES
U511	13	7 - 3	3 - 3	*	WING " -VERTICAL - BACK FACE
U412	9	3 - 1		*	WING " -VERTICAL - FRONT FACE
U513	2	10 - 10			WING 2 -HORIZONTAL - BOTH FACES
U414	2	11 - 0			WING " -HORIZONTAL -APRON BOTT. SLAB
U415	2	10 - 5			WING " -HORIZONTAL - BOTH FACES
U416	4	6 - 5		*	WING " -HORIZONTAL - BOTH FACES
U517	12	7 - 3	3 - 3	*	WING " -VERTICAL - BACK FACE
U418	8	3 - 1		*	WING " -VERTICAL - FRONT FACE
U419	17	2 - 0			WINGS 1 AND 2 - DOWELS - FRONT FACE
D401	15	5 - 6	1 - 0		OUTLET APRON AND CUTOFF WALL
D402	5	15 - 7			OUTLET APRON AND CUTOFF WALL
D403	9	13 - 5		*	" APRON
D404	11	12 - 0			" APRON
D405	2	6 - 0		*	" APRON
D406	2	6 - 0		*	" APRON
D507	2	10 - 3			WING 3 -HORIZONTAL - BOTH FACES
D408	2	10 - 3			WING " -HORIZONTAL -APRON BOTT. SLAB
D409	2	9 - 8			WING " -HORIZONTAL - BOTH FACES
D410	4	6 - 0		*	WING " -HORIZONTAL - BOTH FACES
D511	11	7 - 3	3 - 3	*	WING " -VERTICAL - BACK FACE
D412	8	3 - 1		*	WING " -VERTICAL - FRONT FACE
D513	2	10 - 7			WING 4 -HORIZONTAL - BOTH FACES
D414	2	10 - 8			WING " -HORIZONTAL -APRON BOTT. SLAB
D415	2	10 - 1			WING " -HORIZONTAL - BOTH FACES
D416	4	6 - 3		*	WING " -HORIZONTAL - BOTH FACES
D517	11	7 - 3	3 - 3	*	WING " -VERTICAL - BACK FACE
D418	8	3 - 1		*	WING " -VERTICAL - FRONT FACE
D419	16	2 - 0			WINGS 3 AND 4 - DOWELS - FRONT FACE

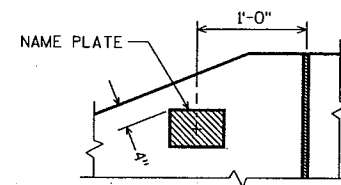


NAME PLATE LOCATION
WING 4

* LENGTH SHOWN FOR BAR IS AN AVERAGE LENGTH AND SHOULD ONLY BE USED FOR BAR WEIGHT CALCULATIONS. SEE BAR SERIES TABLE FOR ACTUAL LENGTHS.

BAR SERIES TABLE

... BUNDLE AND TAG EACH SERIES SEPARATELY



BAR MARK	NO. REQ'D.	LENGTHS FOR EACH SERIES
U403	1 SERIES OF 9	11 - 5 TO 21 - 3
U405	1 SERIES OF 4	2 - 11 TO 8 - 5
U406	1 SERIES OF 5	1 - 9 TO 8 - 4
U410	2 SERIES OF 2	4 - 9 TO 9 - 5
U511	1 SERIES OF 13	5 - 5 TO 9 - 1
U412	1 SERIES OF 9	1 - 3 TO 4 - 11
U416	2 SERIES OF 2	4 - 4 TO 8 - 7
U517	1 SERIES OF 12	5 - 5 TO 9 - 1
U418	1 SERIES OF 8	1 - 3 TO 4 - 11
D403	1 SERIES OF 9	11 - 2 TO 15 - 7
D405	1 SERIES OF 2	4 - 1 TO 7 - 11
D406	1 SERIES OF 2	4 - 2 TO 7 - 10
D410	2 SERIES OF 2	4 - 0 TO 8 - 0
D511	1 SERIES OF 11	5 - 5 TO 9 - 1
D412	1 SERIES OF 8	1 - 3 TO 4 - 11
D416	2 SERIES OF 2	4 - 2 TO 8 - 3
D517	1 SERIES OF 11	5 - 5 TO 9 - 1
D418	1 SERIES OF 8	1 - 3 TO 4 - 11

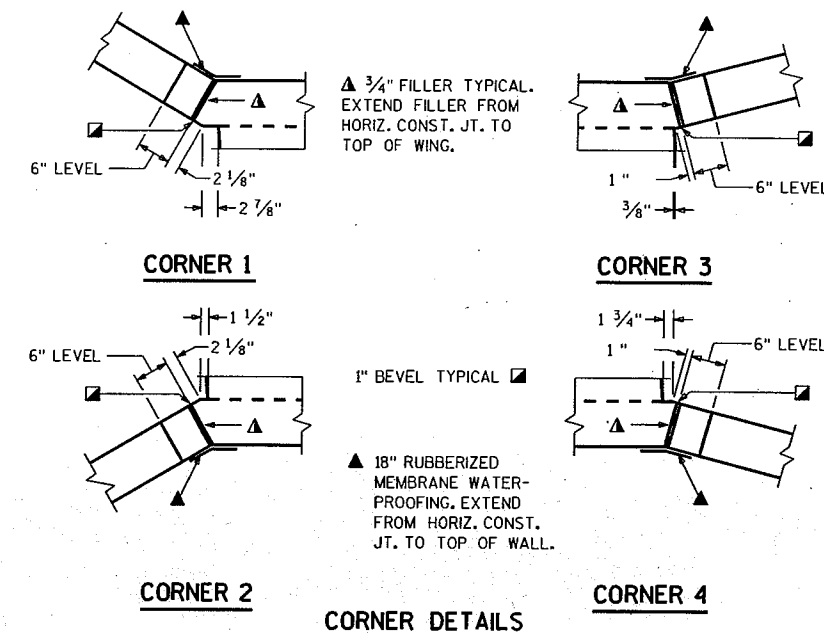

CORNER DETAILS

NO.	DATE	REVISION	BY
STATE OF WISCONSIN DEPARTMENT OF TRANSPORTATION STRUCTURES DESIGN SECTION			
STRUCTURE C-70-70			
CONST. SPEC.	2003	DRAWN BY	RIES
		PLANS CKD.	DRG
DETAILS		SHEET 4	

CTH II (OLD STH 110) OVER UNNAMED STREAM
 NORTH CO LN- WINCHESTER, WINNEBAGO COUNTY

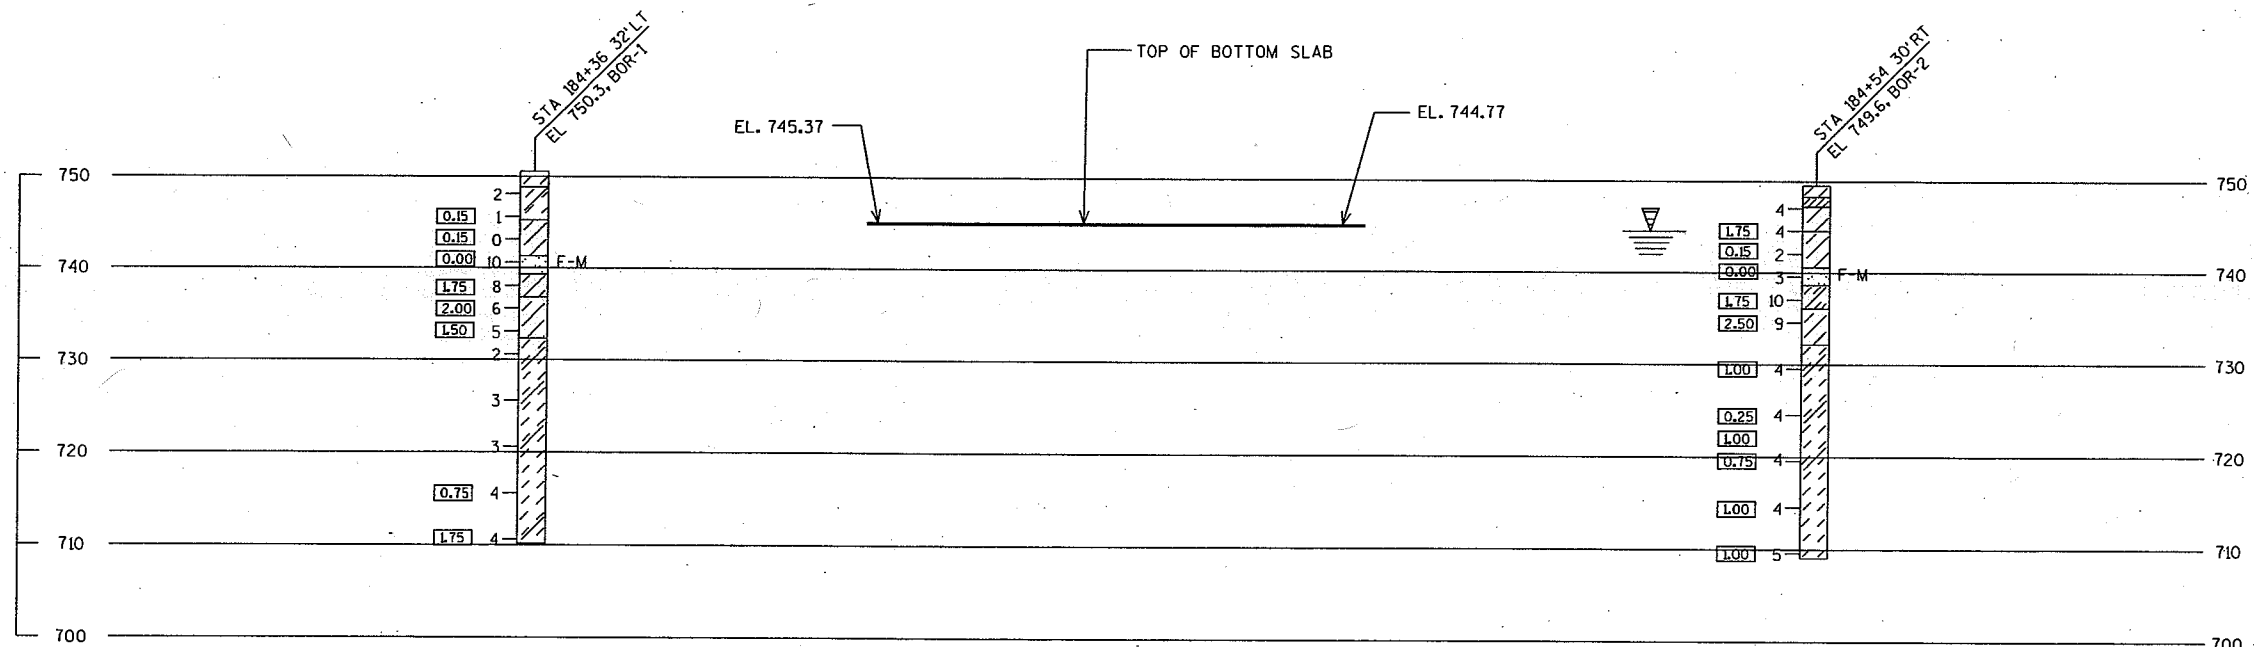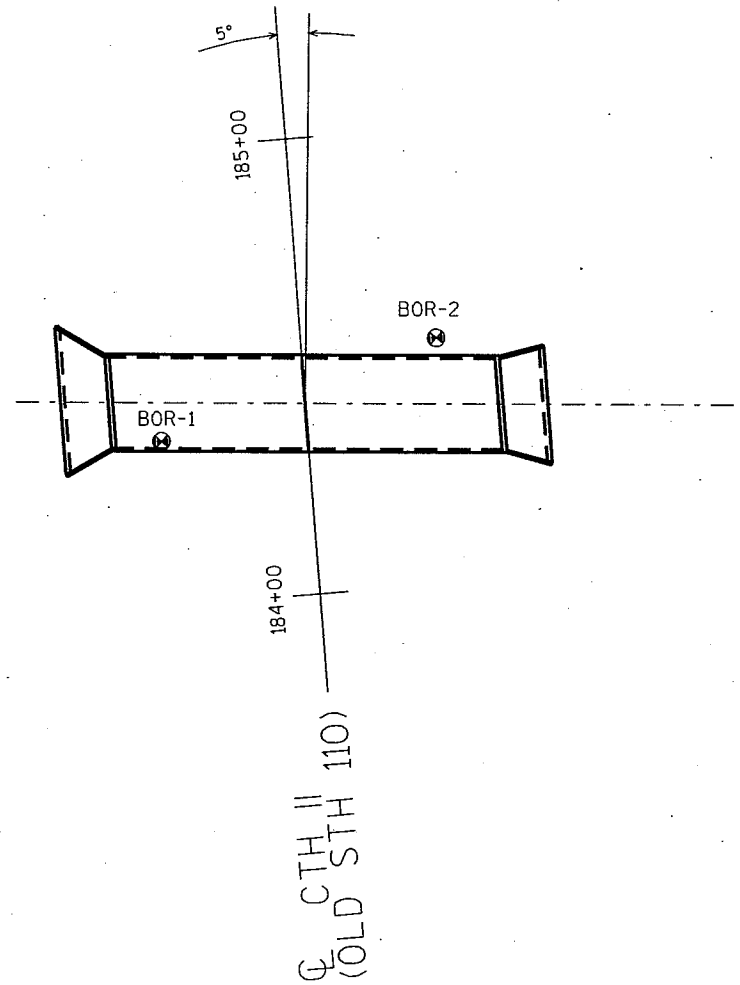


STATE PROJECT NUMBER

6200-07-71


ABBREVIATIONS

F— FINE M— MEDIUM C— COARSE
 WS— WEATHERED SO— SOUND


MATERIAL SYMBOLS

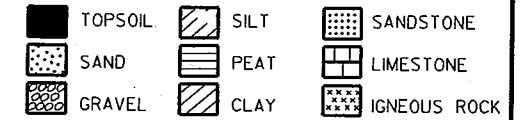

LEGEND OF PROBING

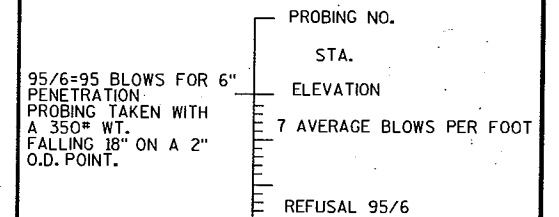

LEGEND OF BORING

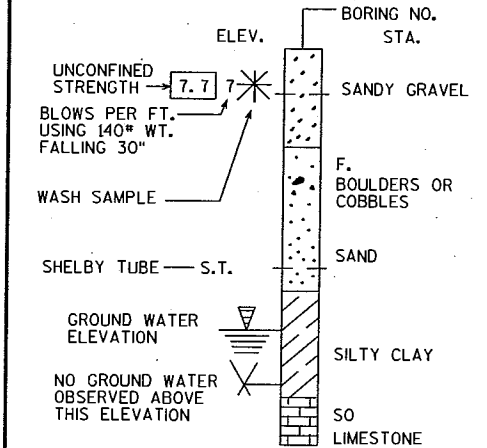

UNLESS OTHERWISE SPECIFIED, THE BLOWS PER FOOT AT THE LOCATIONS INDICATED ARE BASED ON DRIVING A 2\"/>

SUBSURFACE EXPLORATION FOR FOUNDATION DESIGN AND BIDDERS INFORMATION


TO OBTAIN RELATIVE DATA CONCERNING THE CHARACTER OF MATERIAL IN AND UPON WHICH THE FOUNDATION MIGHT BE BUILT, BORINGS AND/OR SOUNDINGS WERE MADE AT POINTS APPROXIMATELY AS INDICATED ON THIS DRAWING. THE DATA PRESENTED HEREIN REPRESENTS THE FINDINGS OF THE SUBSURFACE EXPLORATIONS MADE. HOWEVER, BECAUSE THE DEPTHS INVESTIGATED ARE LIMITED AND THE AREA OF THE BORINGS AND/OR SOUNDINGS IS VERY SMALL IN RELATION TO THE ENTIRE AREA, THE WISCONSIN DEPARTMENT OF TRANSPORTATION DOES NOT WARRANT CONDITIONS BELOW THE DEPTHS INVESTIGATED OR THAT THE CLASSIFICATION OF MATERIAL ENCOUNTERED IN THESE INVESTIGATIONS IS NECESSARILY TYPICAL OF THE ENTIRE SITE.

8

NO.	DATE	REVISION	BY
STATE OF WISCONSIN DEPARTMENT OF TRANSPORTATION STRUCTURES DESIGN SECTION			
STRUCTURE C-70-70			
CONST. SPEC.	2003	DRAWN BY SJJ/RIES	PLANS DRG
SUBSURFACE EXPLORATION		SHEET 5	

FILE= 707 30R.DGN
 SCALE = 1/4"


- ▲ SEE CORNER DETAILS
- NAME PLATE LOCATION (SEE SHIT 4)
- ** 1'-6" (TYP.)
- * BUILD APRON AND END OF BOX LEVEL
- ▲ VERT. CONST. JOINT (TYP.)
- INDICATES WING NUMBER

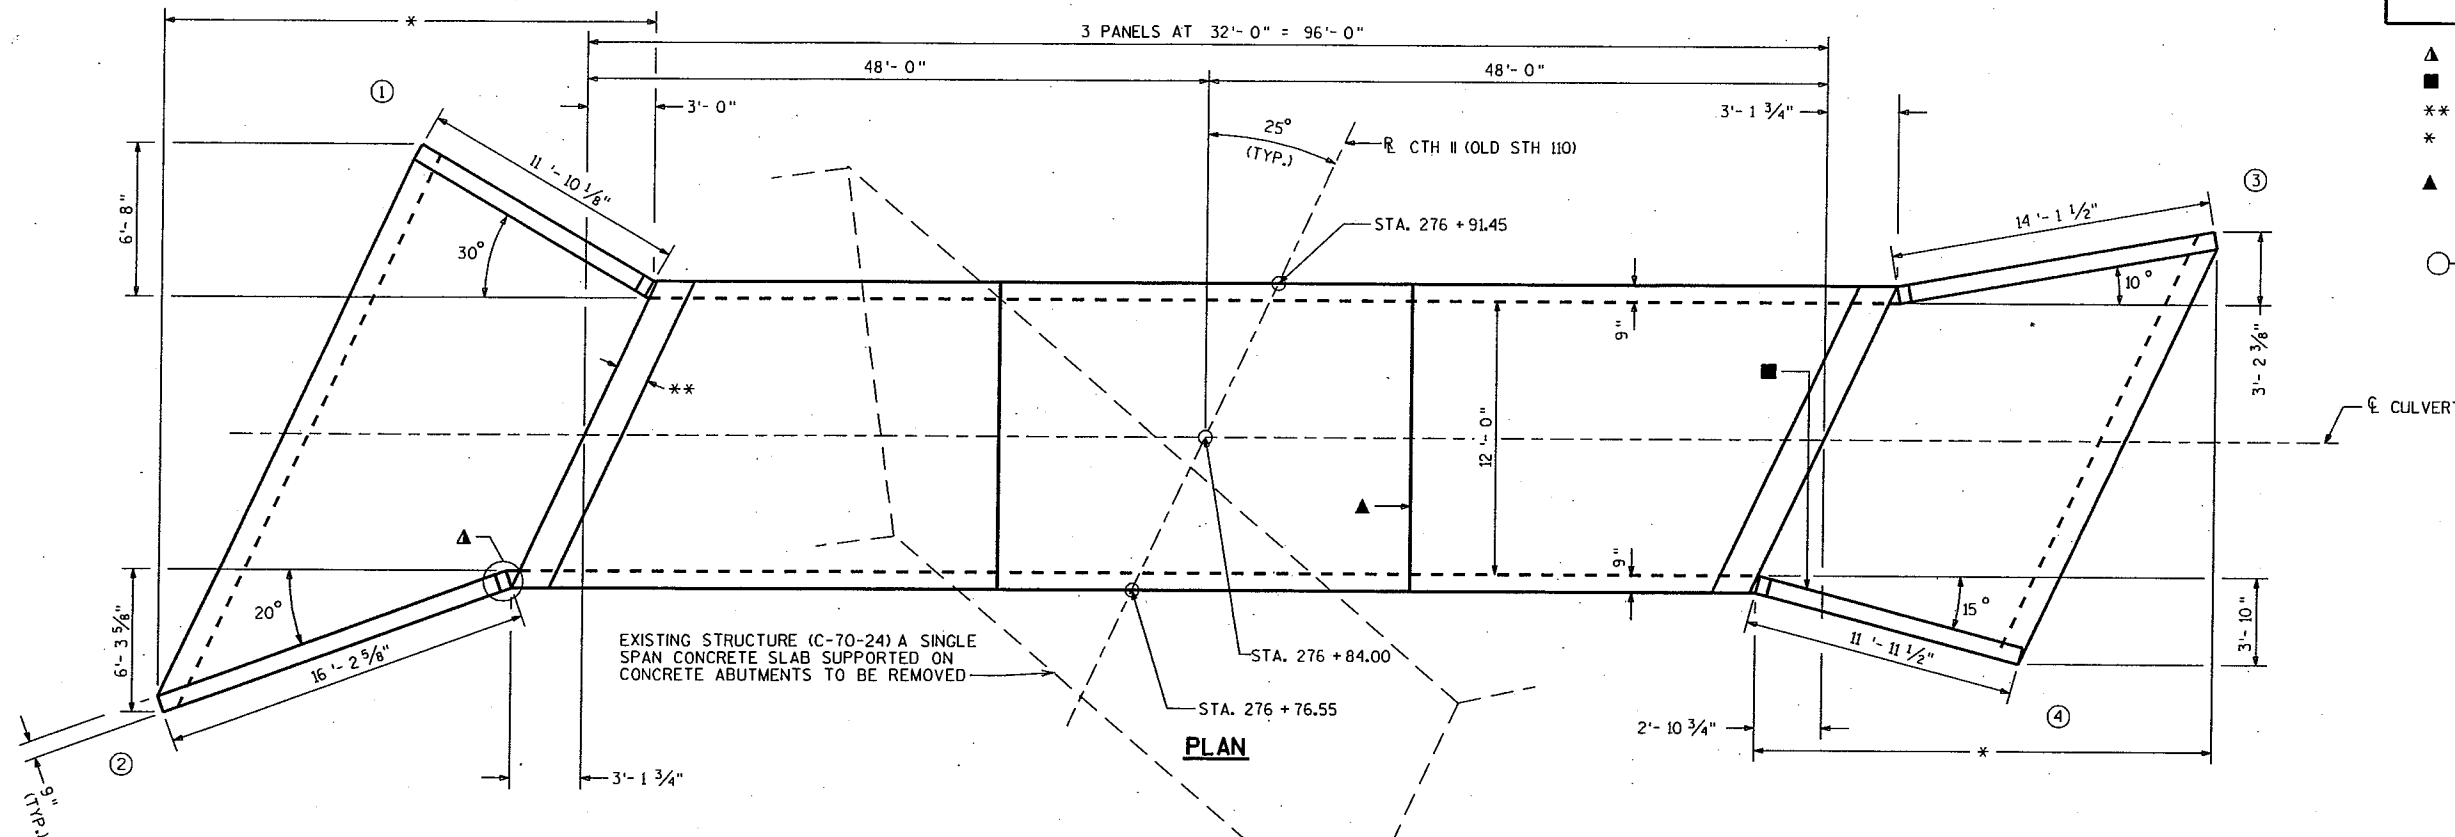

EXISTING STRUCTURE (C-70-24) A SINGLE SPAN CONCRETE SLAB SUPPORTED ON CONCRETE ABUTMENTS TO BE REMOVED

PLAN

IN LIEU OF CONSTRUCTION JOINTS IN THE BOTTOM SLAB, THE CONTRACTOR MAY PROVIDE 2" DEEP SAW CUTS WITHIN 12 HOURS AFTER POURING

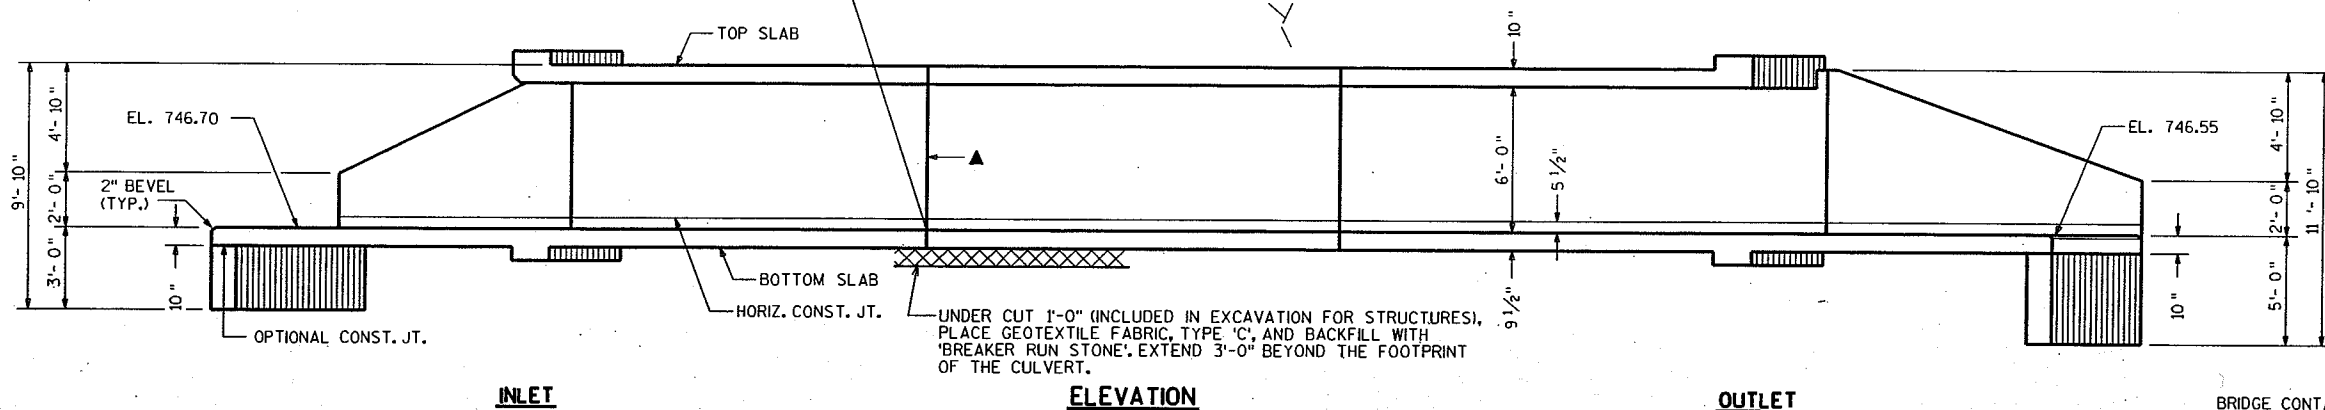

INLET

ELEVATION

OUTLET

LIST OF DRAWINGS

1. LAYOUT
2. BOX DETAILS
3. APRON DETAILS
4. DETAILS
5. SUBSURFACE EXPLORATION

DESIGN DATA

LIVELOAD: HS20
 EARTHLOAD: DESIGNED FOR 2.0 FT. OF FILL.
 STRENGTH DESIGN METHOD:
 CONCRETE MASONRY, GRADE A-FA $f'_c = 3500$ P.S.I.
 HIGH STRENGTH BAR STEEL REINFORCEMENT $f_y = 60000$ P.S.I.
 INVERTS SET 6" BELOW STREAM BED.

TRAFFIC VOLUME

CTH II (OLD STH 110)
 A.D.T. = 3000 (2024)
 R.D.S. = 55 M.P.H.

HYDRAULIC DATA

100 YEAR FREQUENCY
 $Q_{100} = 525$ C.F.S.
 VEL. = 8.5 F.P.S.
 HW. = EL. 753.7
 DRAINAGE AREA = 1.8 SQ. MI.
 OVERTOPPING RDWY. = N.A.

TOTAL ESTIMATED QUANTITIES

BID ITEMS		NON-BID ITEMS	
REMOVING OLD STRUCTURE, STA. 276 + 84.00	1 L.S.	FILLER	3/4" SIZE
EXCAVATION FOR STRUCTURES, CULVERTS, C-70-69	1 L.S.		
CONCRETE MASONRY, CULVERTS	140 C.Y.		
BAR STEEL REINFORCEMENT HS BRIDGES	19,220 LBS.		
GEOTEXTILE FABRIC, TYPE C	280 S.Y.		
BACKFILL STRUCTURE	1,000 C.Y.		
RUBBERIZED MEMBRANE WATERPROOFING	24 S.Y.		
BREAKER RUN STONE	95 C.Y.		

GENERAL NOTES

DRAWINGS SHALL NOT BE SCALED.
 BAR STEEL REINFORCEMENT SHALL BE EMBEDDED 2 INCHES CLEAR UNLESS SHOWN OR NOTED OTHERWISE.
 THE UPPER LIMITS OF EXCAVATION FOR STRUCTURES SHALL BE THE EXISTING GROUNDLINE. ALL SPACES EXCAVATED AND NOT OCCUPIED BY THE NEW STRUCTURE SHALL BE BACKFILLED WITH STRUCTURE BACKFILL TO THE ELEVATION AND SECTION EXISTING PRIOR TO EXCAVATION WITHIN THE LENGTH OF THE CULVERT.
 THE CONCRETE IN THE CUTOFF WALLS MAY BE PLACED UNDERWATER IF THE EXCAVATION CANNOT BE DEWATERED.
 THE CONTRACTOR MAY FURNISH A PRECAST CONCRETE BOX CULVERT IN LIEU OF THE CAST-IN-PLACE BOX CULVERT WITH APPROVAL OF THE STRUCTURES DESIGN SECTION. THE PRECAST CULVERT SHALL CONFORM TO PRECAST DETAILS ON CHAPTER 36 STANDARDS OF THE CURRENT WISC. DOT BRIDGE MANUAL. PAYMENT FOR THE PRECAST CULVERT SHALL BE BASED ON THE PRICES BID FOR THE ITEMS LISTED IN THE "TOTAL ESTIMATED QUANTITIES".
 PLACE A 18" (MIN.) WIDE SHEET OF 'RUBBERIZED MEMBRANE WATERPROOFING' ON TOP SLAB OVER ALL CONSTRUCTION JOINTS AND EXTEND DOWN TO BOTTOM OF OUTSIDE WALLS.

BRIDGE CONTACT PERSON: DAVE GENSON (608)-266-8491

NO.	DATE	REVISION	BY

Plans Prepared By **WISDOT**
 BUREAU OF STRUCTURES

STRUCTURE C-70-69

CTH II (OLD STH 110) OVER TRIB. TO RAT RIVER

COUNTY	WINNEBAGO	TOWN/CITY/VILLAGE	WOLF RIVER
DESIGN SPEC.	AASHTO STD. SPEC. 2002	LOAD	HS-20
DESIGNED BY	COMP.	DRAWN BY	PLANS CK'D.
		FWG	DRG

APPROVED _____ DATE _____
 CHIEF STRUCTURAL DESIGN ENGINEER


LAYOUT

SHEET 1 OF 5
 DATE: SEPT. '02

BILL OF BARS


THE FIRST OR FIRST AND SECOND DIGIT OF THE MARK SIGNIFIES THE BAR SIZE. THE DIMENSION IN THE BENT COLUMN IS THE OUT TO OUT HORIZONTAL LEG OF A "L" SHAPED BAR. LONGER BARS OF THE SAME SIZE MAY BE SUBSTITUTED FOR SHORTER BARS. PAYMENT BASED ON BAR LENGTHS AS DETAILED.

MARK	NUMBER REQ'D.	LENGTH	BENT	BAR SERIES	LOCATION
B701	384	8-9	3-10	NO	CORNERS
B402	132	2-0	NO	NO	WALLS-DOWELS VERT.
B403	22	31-6	NO	NO	TOP&BOTTOM SLAB & WALL
B404	8	31-6	NO	NO	BOTTOM SLAB LONGIT.
B505	84	12-9	NO	NO	BOTTOM SLAB TRANS.
B506	81	10-0	NO	NO	BOTTOM SLAB TRANS.
B407	132	6-0	NO	NO	WALLS VERT.
B608	90	12-9	NO	NO	TOP SLAB TRANS.
B609	87	10-0	NO	NO	TOP SLAB TRANS.
B510	12	31-6	NO	NO	TOP SLAB LONGIT.
B411	18	28-8	NO	NO	TOP&BOTTOM SLAB & WALL
B412	4	30-4	NO	NO	TOP&BOTTOM SLAB LONGIT.
B413	4	33-0	NO	NO	TOP&BOTTOM SLAB LONGIT.
B414	18	34-8	NO	NO	TOP&BOTTOM SLAB & WALL
B415	8	63-3	NO	YES	BOTTOM SLAB LONGIT.
B516	9	14-1	NO	YES	BOTTOM SLAB TRANS.
B517	12	62-7	NO	YES	TOP SLAB LONGIT.
B618	11	14-9	NO	YES	TOP SLAB TRANS.
B319	80	4-11	YES	NO	HEADER STIRRUPS VERT.
B920	16	14-5	NO	NO	HEADERS HORIZ.
B521	84	4-0	NO	NO	TOP SLAB VERT.CONST.JOINT

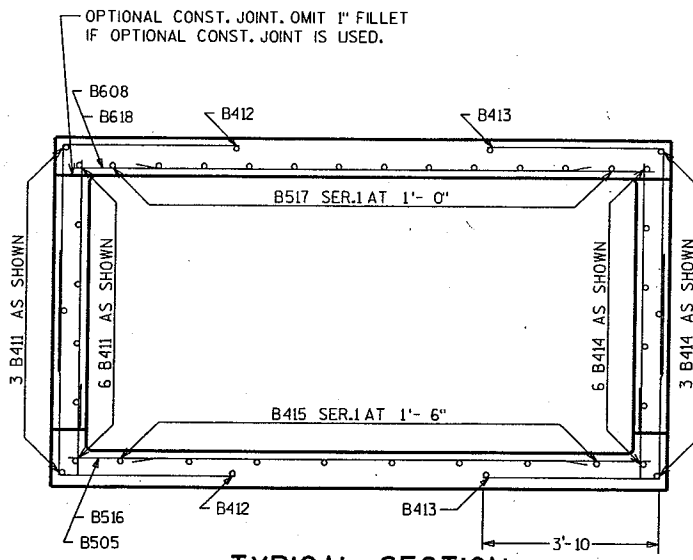


TYPICAL SECTION THRU BOX-EXTERIOR PANEL


BAR LABELS AND DIMENSIONS NOT SHOWN ARE IDENTICAL TO THOSE SHOWN IN THE INTERIOR PANEL SECTION.

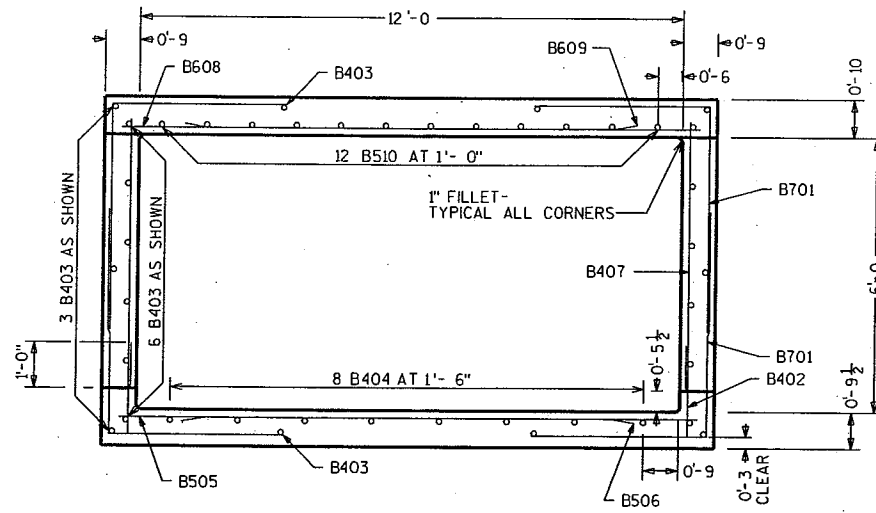


TYPICAL SECTION THRU BOX-INTERIOR PANEL

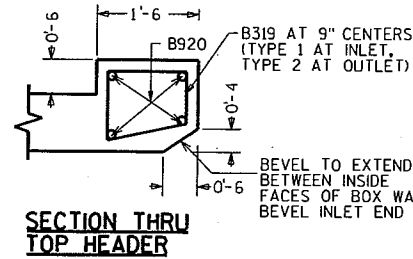

SECTION THRU TOP HEADER

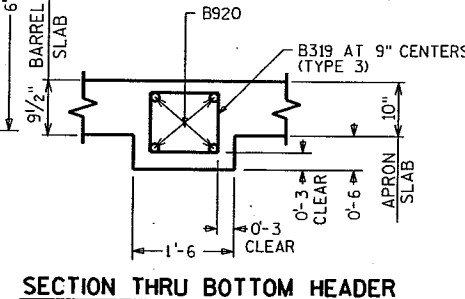


SECTION THRU BOTTOM HEADER

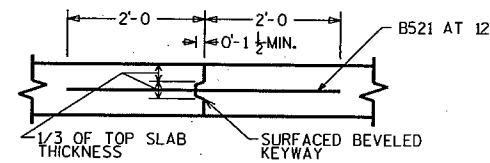


VERTICAL CONSTRUCTION JOINT

BAR ON EACH SIDE OF THIS LINE CONSTITUTE ONE SERIES. BUNDLE EACH SERIES SEPARATELY AND TAG WITH BAR MARK AND SERIES NUMBER.

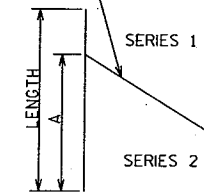

MARK	A	B	NO. OF BARS/SERIES	NO. OF EACH SERIES
B415	34-1	29-2	8	1
B516	11-8	2-5	9	1
B517	33-10	28-8	12	1
B618	12-9	2-0	11	1

BAR SERIES TABLE

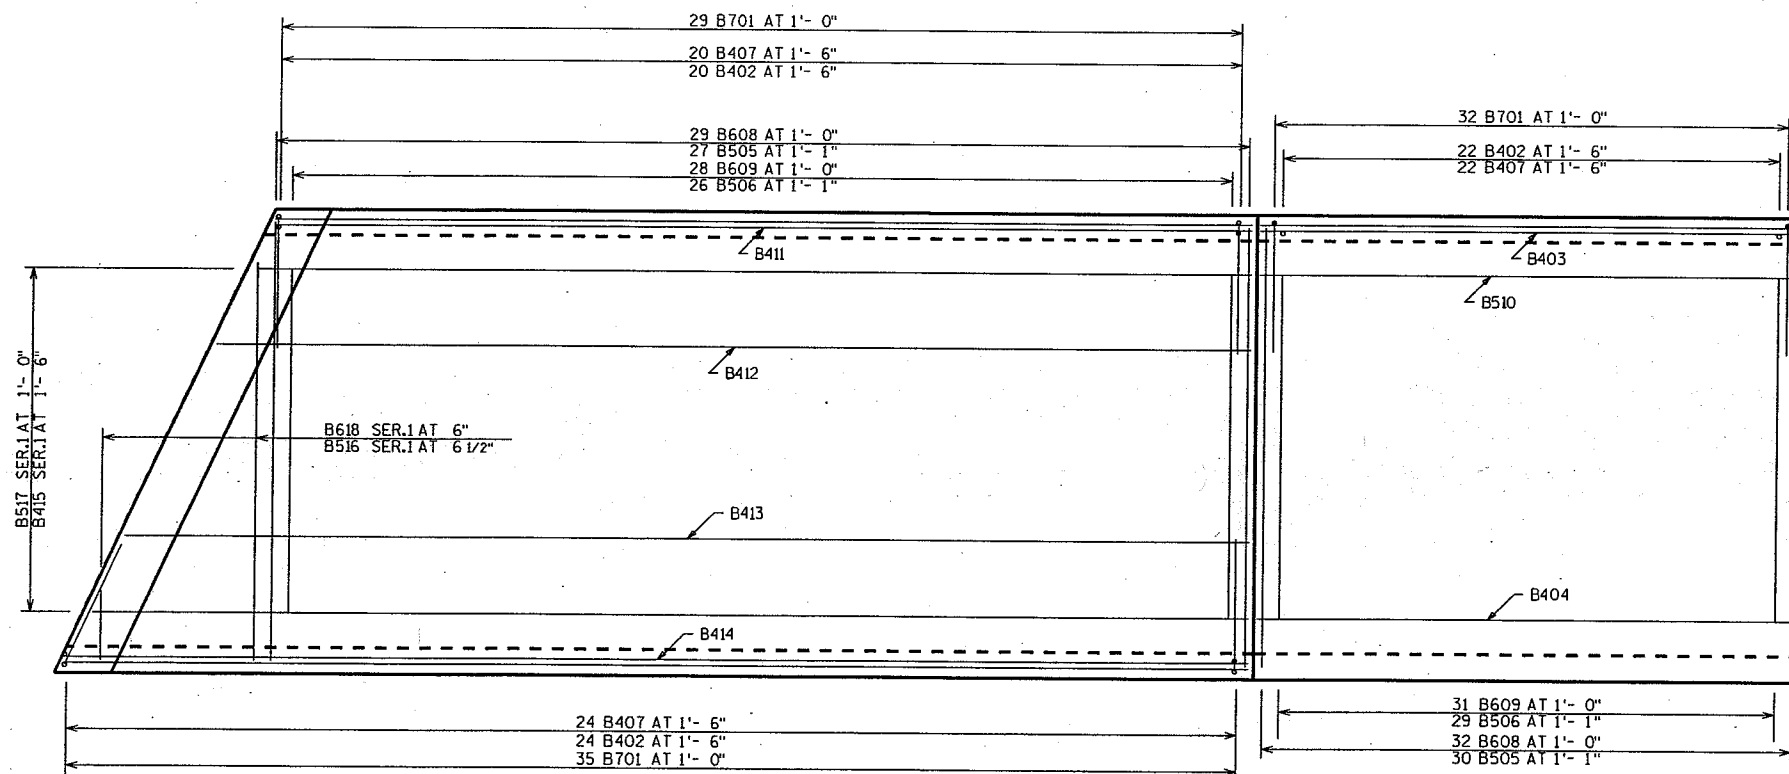


PLAN VIEW OF EXTERIOR PANEL


SERIES 2 MAY BE PLACED WHERE SERIES 1 IS SHOWN

PLAN VIEW OF INTERIOR PANEL


HORIZONTAL SCALE = 1/2 OF VERTICAL SCALE

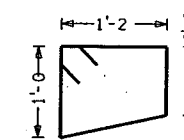

B319
20 TYPE 1

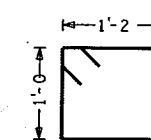


B319
20 TYPE 2





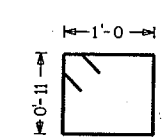


B319
40 TYPE 3


NO.	DATE	REVISION	BY
STATE OF WISCONSIN DEPARTMENT OF TRANSPORTATION STRUCTURES DESIGN SECTION			
STRUCTURE C-70-69			
CONST. SPEC.	2003	DRAWN BY	RIES
PLANS CK'D.	DRG		
BOX DETAILS			SHEET 2

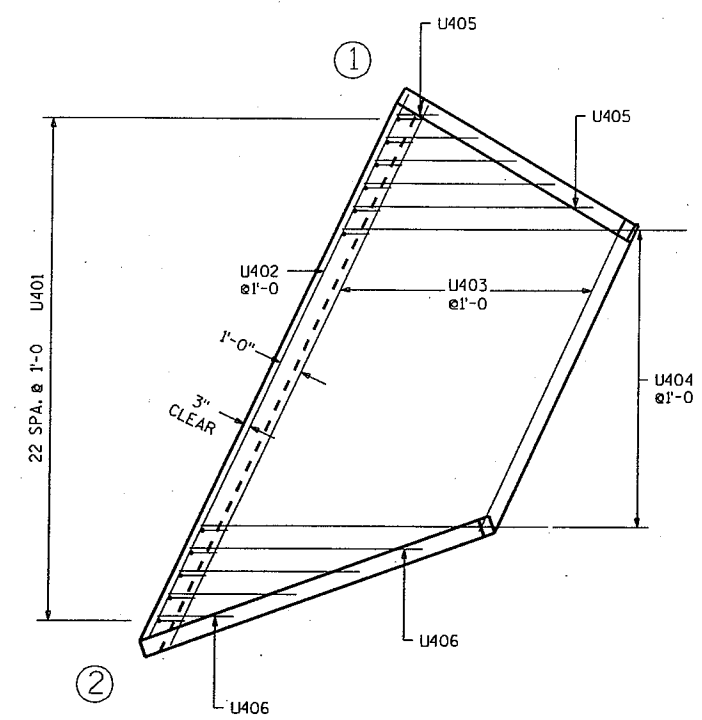



APRON REINF.

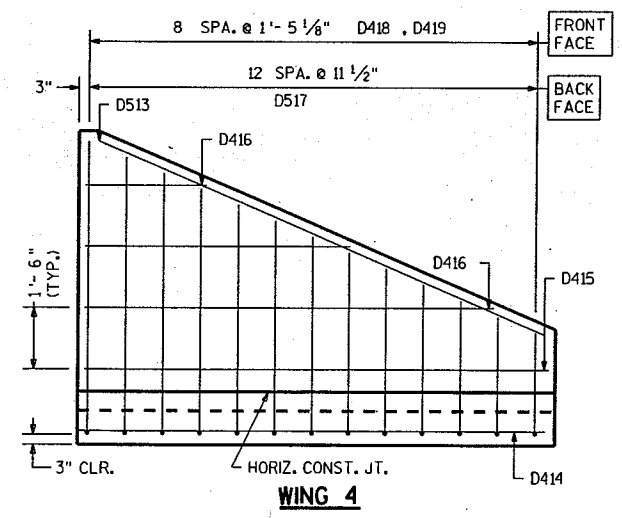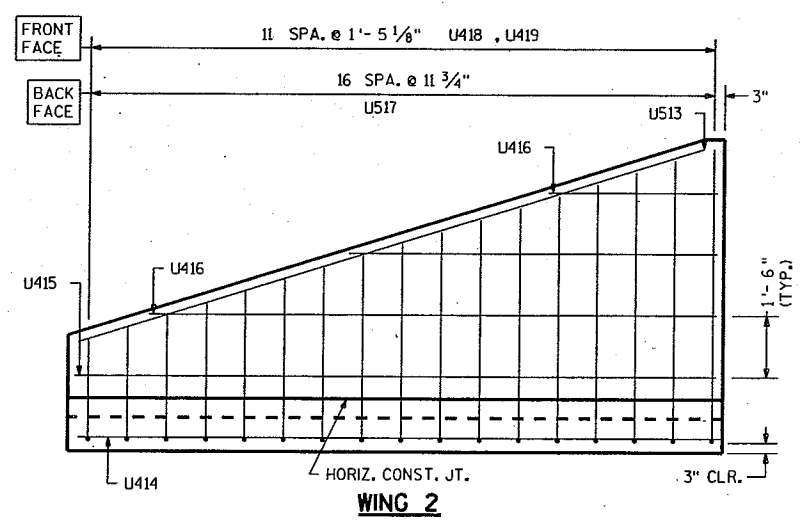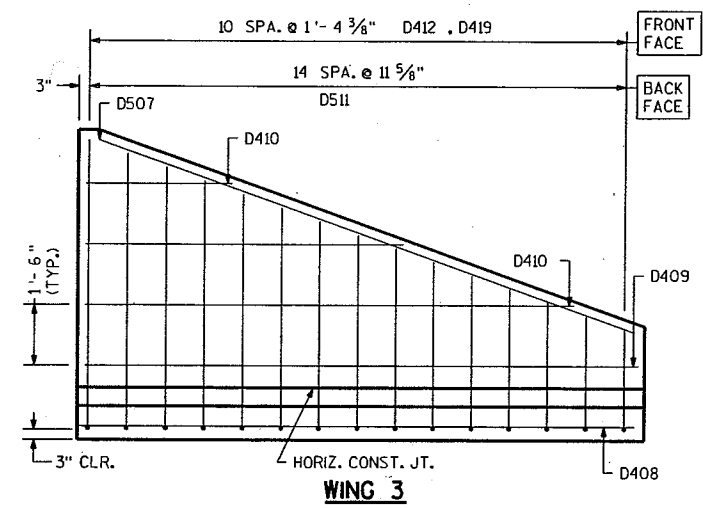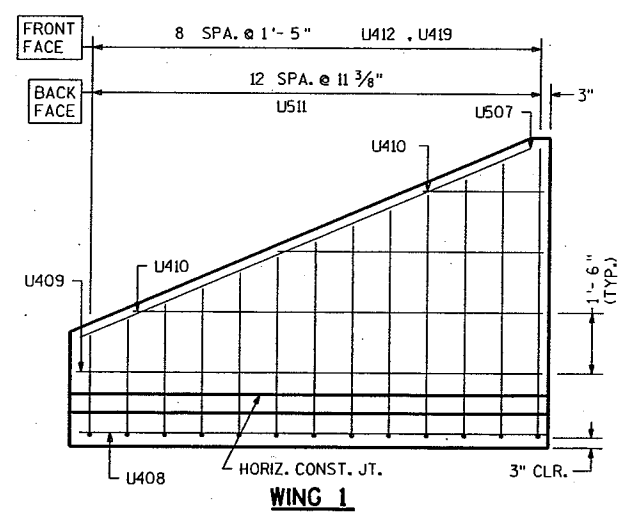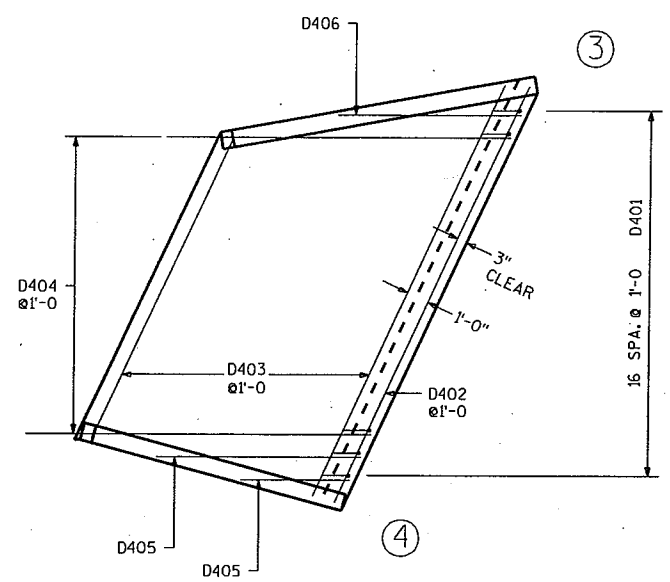

▲ 18" RUBBERIZED MEMBRANE WATER-PROOFING. PLACE ALONG HORIZ. CONST. JT. FOR ENTIRE WING LENGTH (TYP.).

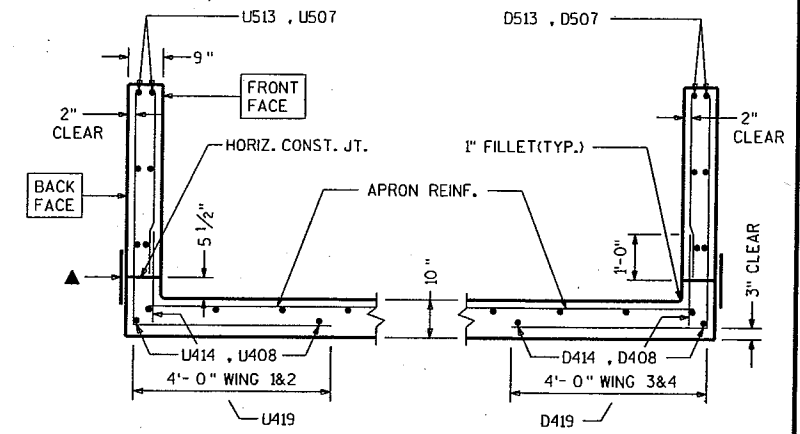

SECTION THRU WINGS AT RIGHT ANGLES TO WING WALLS

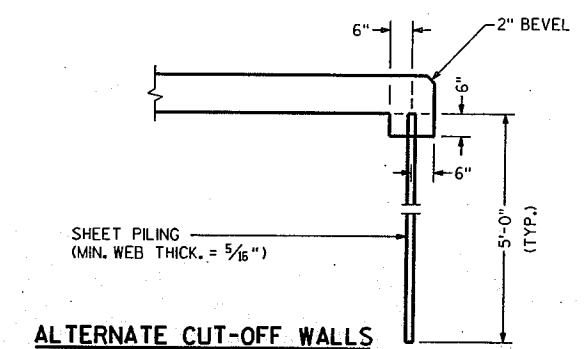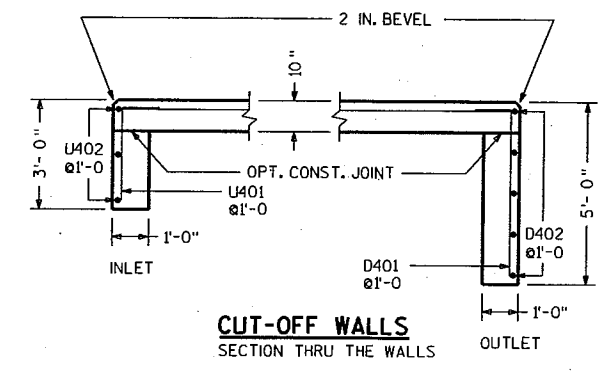


THE ABOVE ALT. MAY BE USED IN LIEU OF THE CAST-IN-PLACE CONC. CUT-OFF WALLS. PAYMENT WILL BE BASED ON THE CONC. CUT-OFF WALLS.

NO.	DATE	REVISION	BY
STATE OF WISCONSIN DEPARTMENT OF TRANSPORTATION STRUCTURES DESIGN SECTION			
STRUCTURE C-70-69			
CONST. SPEC.	2003	DRAWN BY	RIES
		PLANS CKD.	DRG
APRON DETAILS		SHEET 3	

BILL OF BARS

THE FIRST DIGIT OF THE BAR MARK SIGNIFIES THE BAR SIZE.
THE DIMENSION IN THE BENT COLUMN IS THE OUT TO OUT HORIZONTAL LEG OF AN L - SHAPED BAR.

BAR MARK	NO. REQ'D.	LENGTH	BENT	BAR SERIES	LOCATION
U401	23	3 - 6	1 - 0		INLET APRON AND CUTOFF WALL
U402	3	26 - 1			INLET APRON AND CUTOFF WALL
U403	11	20 - 5		*	" APRON
U404	14	15 - 3			" APRON
U405	5	6 - 3		*	" APRON
U406	4	6 - 9		*	" APRON
U507	2	12 - 4			WING 1 -HORIZONTAL - BOTH FACES
U408	2	12 - 1			WING "-HORIZONTAL -APRON BOTT. SLAB
U409	2	11 - 6			WING "-HORIZONTAL - BOTH FACES
U410	6	6 - 7		*	WING "-HORIZONTAL - BOTH FACES
U511	13	8 - 8	4 - 0	*	WING "-VERTICAL - BACK FACE
U412	9	3 - 8		*	WING "-VERTICAL - FRONT FACE
U513	2	16 - 5			WING 2 -HORIZONTAL - BOTH FACES
U414	2	16 - 6			WING "-HORIZONTAL -APRON BOTT. SLAB
U415	2	15 - 11			WING "-HORIZONTAL - BOTH FACES
U416	6	9 - 2		*	WING "-HORIZONTAL - BOTH FACES
U517	17	8 - 8	4 - 0	*	WING "-VERTICAL - BACK FACE
U418	12	3 - 8		*	WING "-VERTICAL - FRONT FACE
U419	21	2 - 0			WINGS 1 AND 2 - DOWELS - FRONT FACE
D401	17	5 - 6	1 - 0		OUTLET APRON AND CUTOFF WALL
D402	5	19 - 11			OUTLET APRON AND CUTOFF WALL
D403	11	17 - 3		*	" APRON
D404	14	15 - 3			" APRON
D405	2	6 - 11		*	" APRON
D406	1	8 - 1			" APRON
D507	2	14 - 5			WING 3 -HORIZONTAL - BOTH FACES
D408	2	14 - 4			WING "-HORIZONTAL -APRON BOTT. SLAB
D409	2	13 - 9			WING "-HORIZONTAL - BOTH FACES
D410	6	7 - 11		*	WING "-HORIZONTAL - BOTH FACES
D511	15	8 - 8	4 - 0	*	WING "-VERTICAL - BACK FACE
D412	11	3 - 8		*	WING "-VERTICAL - FRONT FACE
D513	2	12 - 5			WING 4 -HORIZONTAL - BOTH FACES
D414	2	12 - 2			WING "-HORIZONTAL -APRON BOTT. SLAB
D415	2	11 - 7			WING "-HORIZONTAL - BOTH FACES
D416	6	6 - 7		*	WING "-HORIZONTAL - BOTH FACES
D517	13	8 - 8	4 - 0	*	WING "-VERTICAL - BACK FACE
D418	9	3 - 8		*	WING "-VERTICAL - FRONT FACE
D419	20	2 - 0			WINGS 3 AND 4 - DOWELS - FRONT FACE

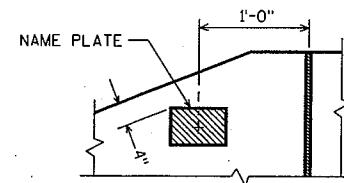


NAME PLATE LOCATION
WING 4

* LENGTH SHOWN FOR BAR IS AN AVERAGE LENGTH AND SHOULD ONLY BE USED FOR BAR WEIGHT CALCULATIONS. SEE BAR SERIES TABLE FOR ACTUAL LENGTHS.

BAR SERIES TABLE --- BUNDLE AND TAG EACH SERIES SEPARATELY

BAR MARK	NO. REQ'D.	LENGTHS FOR EACH SERIES
U403	1 SERIES OF 11	14 - 9 TO 26 - 1
U405	1 SERIES OF 5	1 - 10 TO 10 - 7
U406	1 SERIES OF 4	3 - 4 TO 10 - 2
U410	2 SERIES OF 3	3 - 0 TO 10 - 2
U511	1 SERIES OF 13	6 - 3 TO 11 - 1
U412	1 SERIES OF 9	1 - 3 TO 6 - 1
U416	2 SERIES OF 3	4 - 3 TO 14 - 1
U517	1 SERIES OF 17	6 - 3 TO 11 - 1
U418	1 SERIES OF 12	1 - 3 TO 6 - 1
D403	1 SERIES OF 11	14 - 7 TO 19 - 11
D405	1 SERIES OF 2	4 - 10 TO 9 - 1
D410	2 SERIES OF 3	3 - 7 TO 12 - 2
D511	1 SERIES OF 15	6 - 3 TO 11 - 1
D412	1 SERIES OF 11	1 - 3 TO 6 - 1
D416	2 SERIES OF 3	3 - 0 TO 10 - 3
D517	1 SERIES OF 13	6 - 3 TO 11 - 1
D418	1 SERIES OF 9	1 - 3 TO 6 - 1


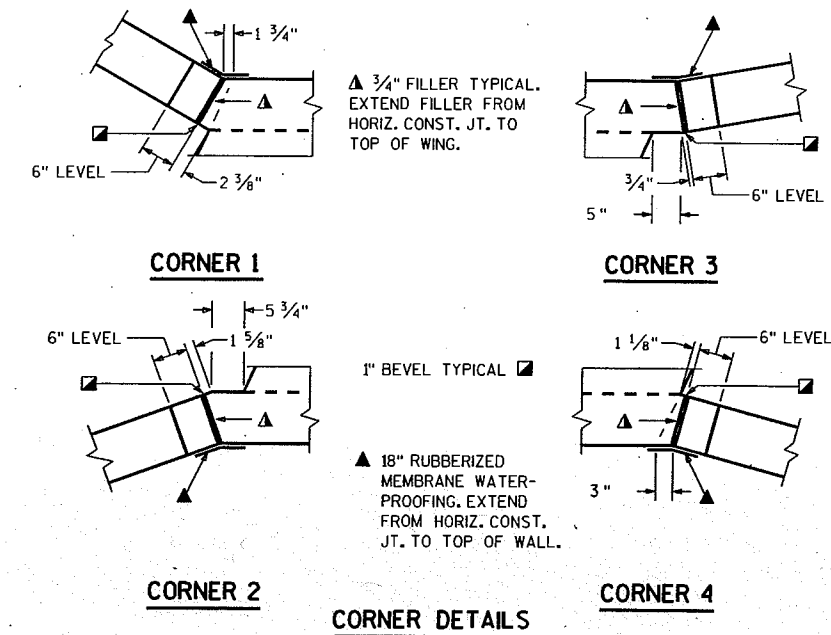


CORNER DETAILS

NO.	DATE	REVISION	BY
STATE OF WISCONSIN DEPARTMENT OF TRANSPORTATION STRUCTURES DESIGN SECTION			
STRUCTURE C-70-69			
CONST. SPEC.	2003	DRAWN BY	PLANS Ckd. DRG
		RIES	
DETAILS		SHEET 4	

FILE= 706 -AR.DGN
SCALE = 4

STH 110 OVER UNNAMED STREAM
NORTH CO LN- WINCHESTER, WINNEBAGO COUNTY

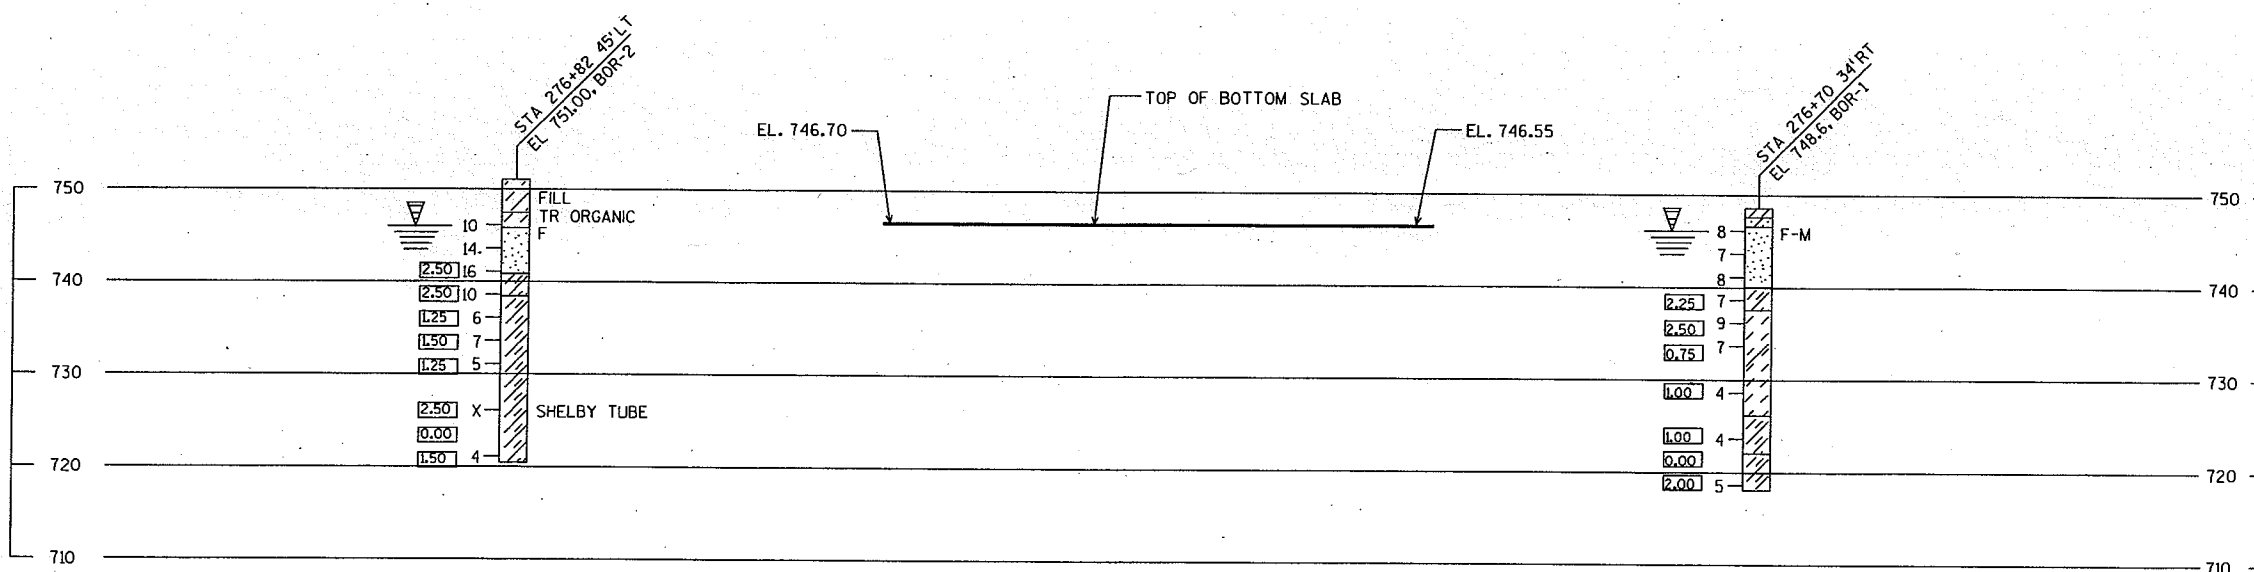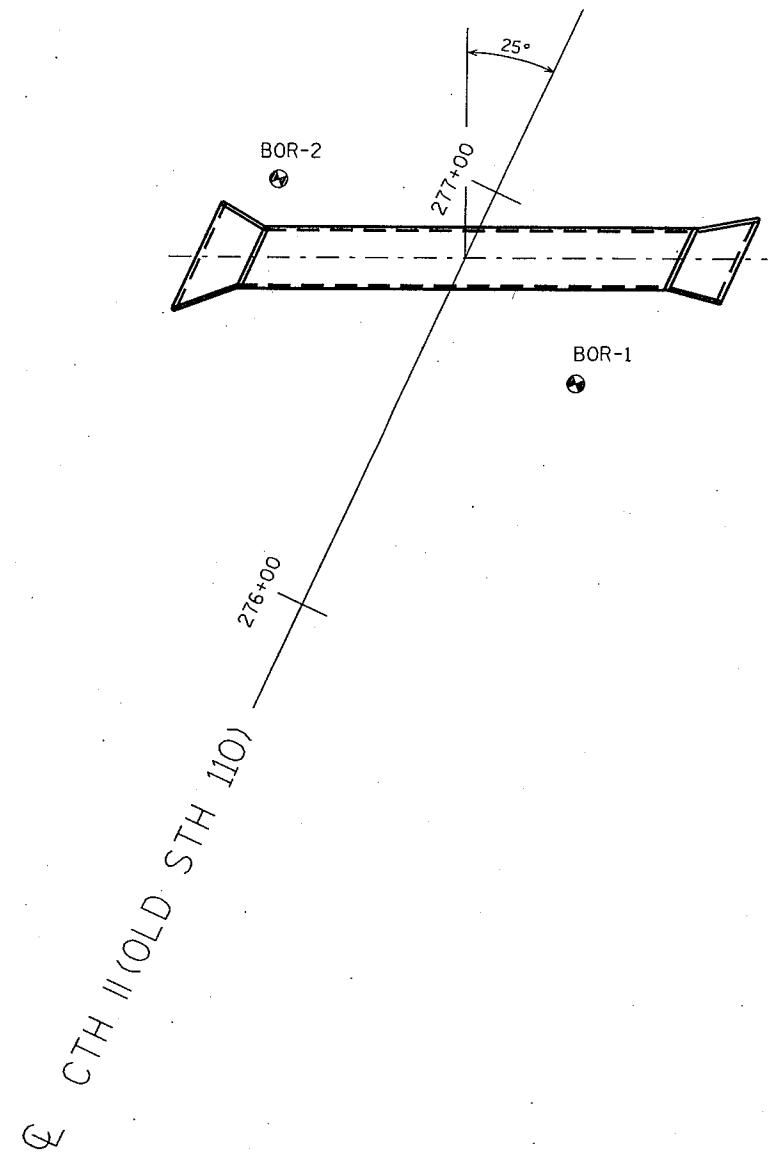

STATE PROJECT NUMBER
6200-07-71

ABBREVIATIONS
F— FINE M— MEDIUM C— COARSE
WS— WEATHERED SO— SOUND

MATERIAL SYMBOLS

TOPSOIL	SILT	SANDSTONE
SAND	PEAT	LIMESTONE
GRAVEL	CLAY	IGNEOUS ROCK

LEGEND OF PROBING

PROBING NO.
STA.
ELEVATION
7 AVERAGE BLOWS PER FOOT
REFUSAL 95/6

95/6=95 BLOWS FOR 6" PENETRATION PROBING TAKEN WITH A 350# WT. FALLING 18" ON A 2" O.D. POINT.

LEGEND OF BORING

ELEV. BORING NO. STA.

UNCONFINED STRENGTH → 7.7
BLOWS PER FT. USING 140# WT. FALLING 30"
WASH SAMPLE
SHELBY TUBE → S.T.
GROUND WATER ELEVATION
NO GROUND WATER OBSERVED ABOVE THIS ELEVATION

SANDY GRAVEL
F. BOULDERS OR COBBLES
SAND
SILTY CLAY
SO
LIMESTONE

UNLESS OTHERWISE SPECIFIED, THE BLOWS PER FOOT AT THE LOCATIONS INDICATED ARE BASED ON DRIVING A 2" O.D. X 1.4" I.D. SPLIT SPOON SAMPLER WITH A 140# HAMMER HAVING A FREE FALL OF 30". THE BLOW COUNT IS TAKEN IN UNDISTURBED SOIL IMMEDIATELY BELOW A CASED OR OPEN HOLE ELIMINATING SIDE FRICTION ON THE DRIVE PIPE.

SUBSURFACE EXPLORATION FOR FOUNDATION DESIGN AND BIDDERS INFORMATION

TO OBTAIN RELATIVE DATA CONCERNING THE CHARACTER OF MATERIAL IN AND UPON WHICH THE FOUNDATION MIGHT BE BUILT, BORINGS AND/OR SOUNDINGS WERE MADE AT POINTS APPROXIMATELY AS INDICATED ON THIS DRAWING. THE DATA PRESENTED HEREIN REPRESENTS THE FINDINGS OF THE SUBSURFACE EXPLORATIONS MADE. HOWEVER, BECAUSE THE DEPTHS INVESTIGATED ARE LIMITED AND THE AREA OF THE BORINGS AND/OR SOUNDINGS IS VERY SMALL IN RELATION TO THE ENTIRE AREA, THE WISCONSIN DEPARTMENT OF TRANSPORTATION DOES NOT WARRANT CONDITIONS BELOW THE DEPTHS INVESTIGATED OR THAT THE CLASSIFICATION OF MATERIAL ENCOUNTERED IN THESE INVESTIGATIONS IS NECESSARILY TYPICAL OF THE ENTIRE SITE.

NO.	DATE	REVISION	BY

STATE OF WISCONSIN
DEPARTMENT OF TRANSPORTATION
STRUCTURES DESIGN SECTION

STRUCTURE C-70-69

CONST. SPEC.	2003	DRAWN BY	SJJ/RIES	PLANS CKD.	DRG
--------------	------	----------	----------	------------	-----

SUBSURFACE EXPLORATION SHEET 5

8
FILE= 706 10R.DGN
SCALE = 1/4"

GENERAL NOTES

DRAWINGS SHALL NOT BE SCALED.
DIMENSIONS SHOWN ARE BASED ON THE EXISTING ORIGINAL STRUCTURE PLANS.


* A MIN. OF 1" OF CONCRETE SHALL BE REMOVED FROM THE ENTIRE BRIDGE DECK UNDER THE BID ITEM "CLEANING DECKS".

ANY EXCAVATION REQUIRED TO COMPLETE THE OVERLAY OR PAVING BLOCK AT THE ABUTMENTS IS TO BE CONSIDERED INCIDENTAL TO THE BID ITEM "CONCRETE MASONRY, OVERLAY, DECKS".

TOP SURFACE OF NEW OVERLAY TO BE 1/2" MIN. ABOVE CLEANED DECK AFTER CLEANING.

CONTACT THE BUREAU OF STRUCTURES DESIGN SECTION BEFORE PLACEMENT OF OVERLAY IF THE AVERAGE THICKNESS OF THE NEW OVERLAY WILL EXCEED 1/2" MORE THAN THE AVERAGE THICKNESS SHOWN ON THIS PLAN.

THE AVERAGE OVERLAY THICKNESS EQUALS 2 1/2".

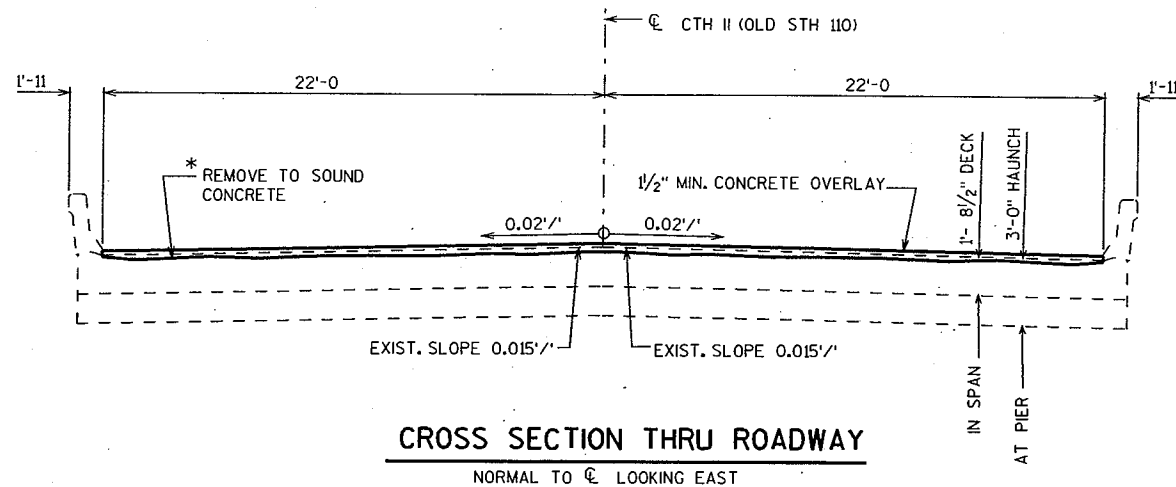

CROSS SECTION THRU ROADWAY
NORMAL TO CL LOOKING EAST

DESIGN DATA

LIVE LOAD:

INVENTORY RATING; HS-21
OPERATIONAL RATING; HS-35
MAXIMUM STANDARD PERMIT VEHICLE LOAD = 250 KIPS.


ULTIMATE DESIGN STRESSES:

CONCRETE MASONRY, OVERLAY, DECKS — f'c = 4,000 P.S.I.


TOTAL ESTIMATED QUANTITIES

CONCRETE MASONRY, OVERLAY, DECKS	40	C.Y.
PROTECTIVE SURFACE TREATMENT	470	S.Y.
PREPARATION, DECKS, TYPE 1	72	S.Y.
PREPARATION, DECKS, TYPE 2	48	S.Y.
CLEANING, DECKS	470	S.Y.

BRIDGE OFFICE CONTACTS :
DAVE GENSON (608)266-8491

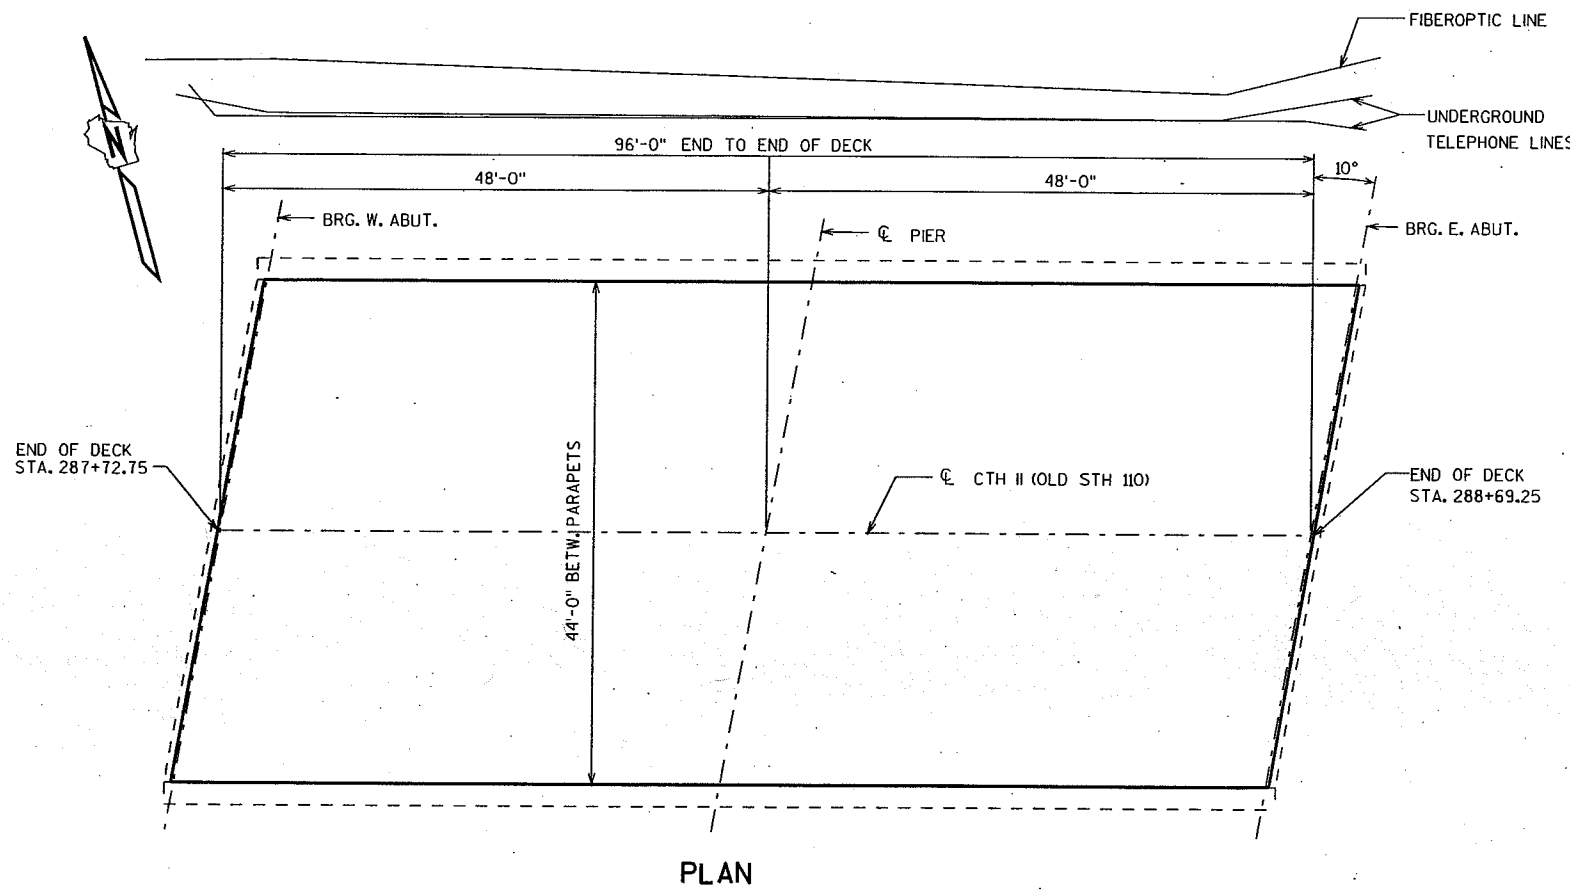

PLAN

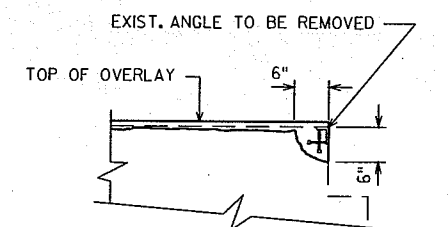

SECTION AT END OF SLAB

NO.	DATE	REVISION	BY
Plans Prepared By WISDOT BUREAU OF STRUCTURES			
APPROVED		CHIEF STRUCTURAL DESIGN ENGINEER	DATE
STRUCTURE B-70-83			
CTH II (OLD STH 110) OVER RAT RIVER			
COUNTY	WINNEBAGO	TOWN/VILLAGE	WINCHESTER
DESIGN SPEC.	AASHTO STD. SPEC. 2002	LOAD	CONST. SPEC. 2003
DESIGNED BY	GENSON	DRAWN BY	JHG
DESIGN CK'D.		PLANS CK'D.	DRG
OVERLAY DETAILS		SHEET 1 OF 1	

8

FILE# B30VEF Y.DGN
SCALE = 8

CATTLE PASS REMOVAL, CTH II		
BALANCE POINT 1		
STATION	EXCAVATION	
	COMMON CY	FILL CY
28+50.00		
	109.38	7.73
28+75.00	103.14	17.43
29+00.00	107.05	16.56
29+25.00	123.66	4.01
29+50.00	14.76	0.00
29+75.00	12.66	0.23
30+00.00	4.81	0.23
30+25.00		
SUBTOTAL	475.46	46.19

STRUCTURE B-70-242, CTH II		
BALANCE POINT 2		
STATION	EXCAVATION	
	COMMON CY	FILL CY
144+00.00		
	1.58	2.24
144+15.00	18.51	5.67
144+25.00	49.20	48.96
144+50.00	44.39	139.79
144+75.00	39.27	169.30
145+00.00	62.36	82.58
145+25.00	62.63	29.54
145+50.00	42.18	46.37
145+75.00	10.34	13.25
145+81.00	0.02	38.25
146+00.00	0.00	37.70
146+25.00	0.00	20.94
146+50.00	0.00	8.10
146+75.00	0.00	1.41
147+00.00		
SUBTOTAL	330.48	644.10

STRUCTURE C-70-70, CTH II		
BALANCE POINT 3		
STATION	EXCAVATION	
	COMMON CY	FILL CY
183+50.00		
	0.06	1.36
183+75.00	0.86	1.35
183+86.00	27.42	6.70
184+00.00	58.59	31.62
184+25.00	59.46	105.13
184+50.00	76.84	88.82
184+75.00	73.24	6.29
185+00.00	2.17	0.02
185+01.00	4.21	0.22
185+25.00		
SUBTOTAL	302.85	241.51

STRUCTURE C-70-69		
BALANCE POINT 4		
STATION	EXCAVATION	
	COMMON CY	FILL CY
275+75.00		
	4.47	2.22
276+00.00	7.78	4.83
276+13.00	33.09	8.83
276+25.00	70.44	38.29
276+50.00	65.02	103.32
276+75.00	26.36	34.29
276+83.06	59.15	20.52
277+00.00	29.78	10.82
277+19.42	2.03	5.08
277+25.00	8.99	9.23
277+50.00		
SUBTOTAL	307.11	237.43

**CTH II - HORIZONTAL CURVE
BALANCE POINT 5.1**

STATION	EXCAVATION		STATION	EXCAVATION	
	COMMON CY	FILL CY		COMMON CY	FILL CY
441+00.00			451+00.00		
	89.81	16.53		9.47	7.43
441+50.00			451+03.91		
	35.98	11.09		94.46	138.82
441+70.00			451+50.00		
	55.29	19.13		86.67	195.48
442+00.00			452+00.00		
	97.75	34.25		215.59	192.93
442+50.00			452+50.00		
	109.66	35.78		194.54	189.95
443+00.00			453+00.00		
	105.59	44.56		150.61	186.75
443+50.00			453+50.00		
	98.19	56.27		101.11	177.09
444+00.00			454+00.00		
	97.06	61.99		23.93	76.94
444+50.00			454+14.99		
	86.37	63.75		37.49	193.78
445+00.00			454+50.00		
	61.66	69.56		14.22	217.99
445+50.00			455+00.00		
	31.18	72.00		15.61	205.34
446+00.00			455+50.00		
	21.54	69.11		42.26	170.20
446+50.00			456+00.00		
	47.38	72.58		63.68	146.15
447+00.00			456+50.00		
	86.07	81.44		5.61	10.96
447+50.00			456+53.99		
	116.19	93.36		95.69	102.73
448+00.00			457+00.00		
	152.69	114.79		81.58	42.91
448+50.00			457+50.00		
	197.59	133.79		120.10	37.17
449+00.00			458+00.00		
	204.66	163.37		110.57	7.17
449+50.00			458+50.00		
	22.59	22.82		50.74	6.00
449+55.99			458+70.00		
	192.81	150.40		72.77	8.70
450+00.00			459+00.00		
	94.50	51.70		115.49	2.10
450+17.34			459+50.00		
	157.06	113.46		131.83	1.92
450+50.00			460+00.00		
	152.65	145.22		159.69	0.00
451+00.00			460+50.00		
				136.15	0.04
			461+00.00		
			SUBTOTAL	4444.14	4015.50

**CTH M
BALANCE POINT 5.2**

STATION	EXCAVATION	
	COMMON CY	FILL CY
127+60.00		
	82.27	1.86
128+00.00		
	121.24	3.43
128+50.00		
	85.60	15.79
128+85.38		
	42.82	11.03
129+00.00		
	140.30	8.19
129+21.73		
SUBTOTAL	472.22	40.30

**ERICKSON ROAD
BALANCE POINT 5.3**

STATION	EXCAVATION	
	COMMON CY	FILL CY
140+73.80		
	74.47	0.67
141+00.00		
	89.87	4.34
141+50.00		
	15.51	1.16
141+65.00		
SUBTOTAL	179.85	6.17

9

9

PROJECT NO: 6200-07-71

HWY: CTH II


COUNTY: WINNEBAGO

EARTHWORK

SHEET:

E

LEVELS ON . 1 2 3 4 5 6 7 8 9 10 11 12 13 14 15 16 17 18 19 20 21 22 23 24 25 26 27 28 29 30 31 32 33 34 35 36 37 38 39 40 41 42 43 44 45 46 47 48 49 50 51 52 53 54 55 56 57 58 59 60 61 62 63

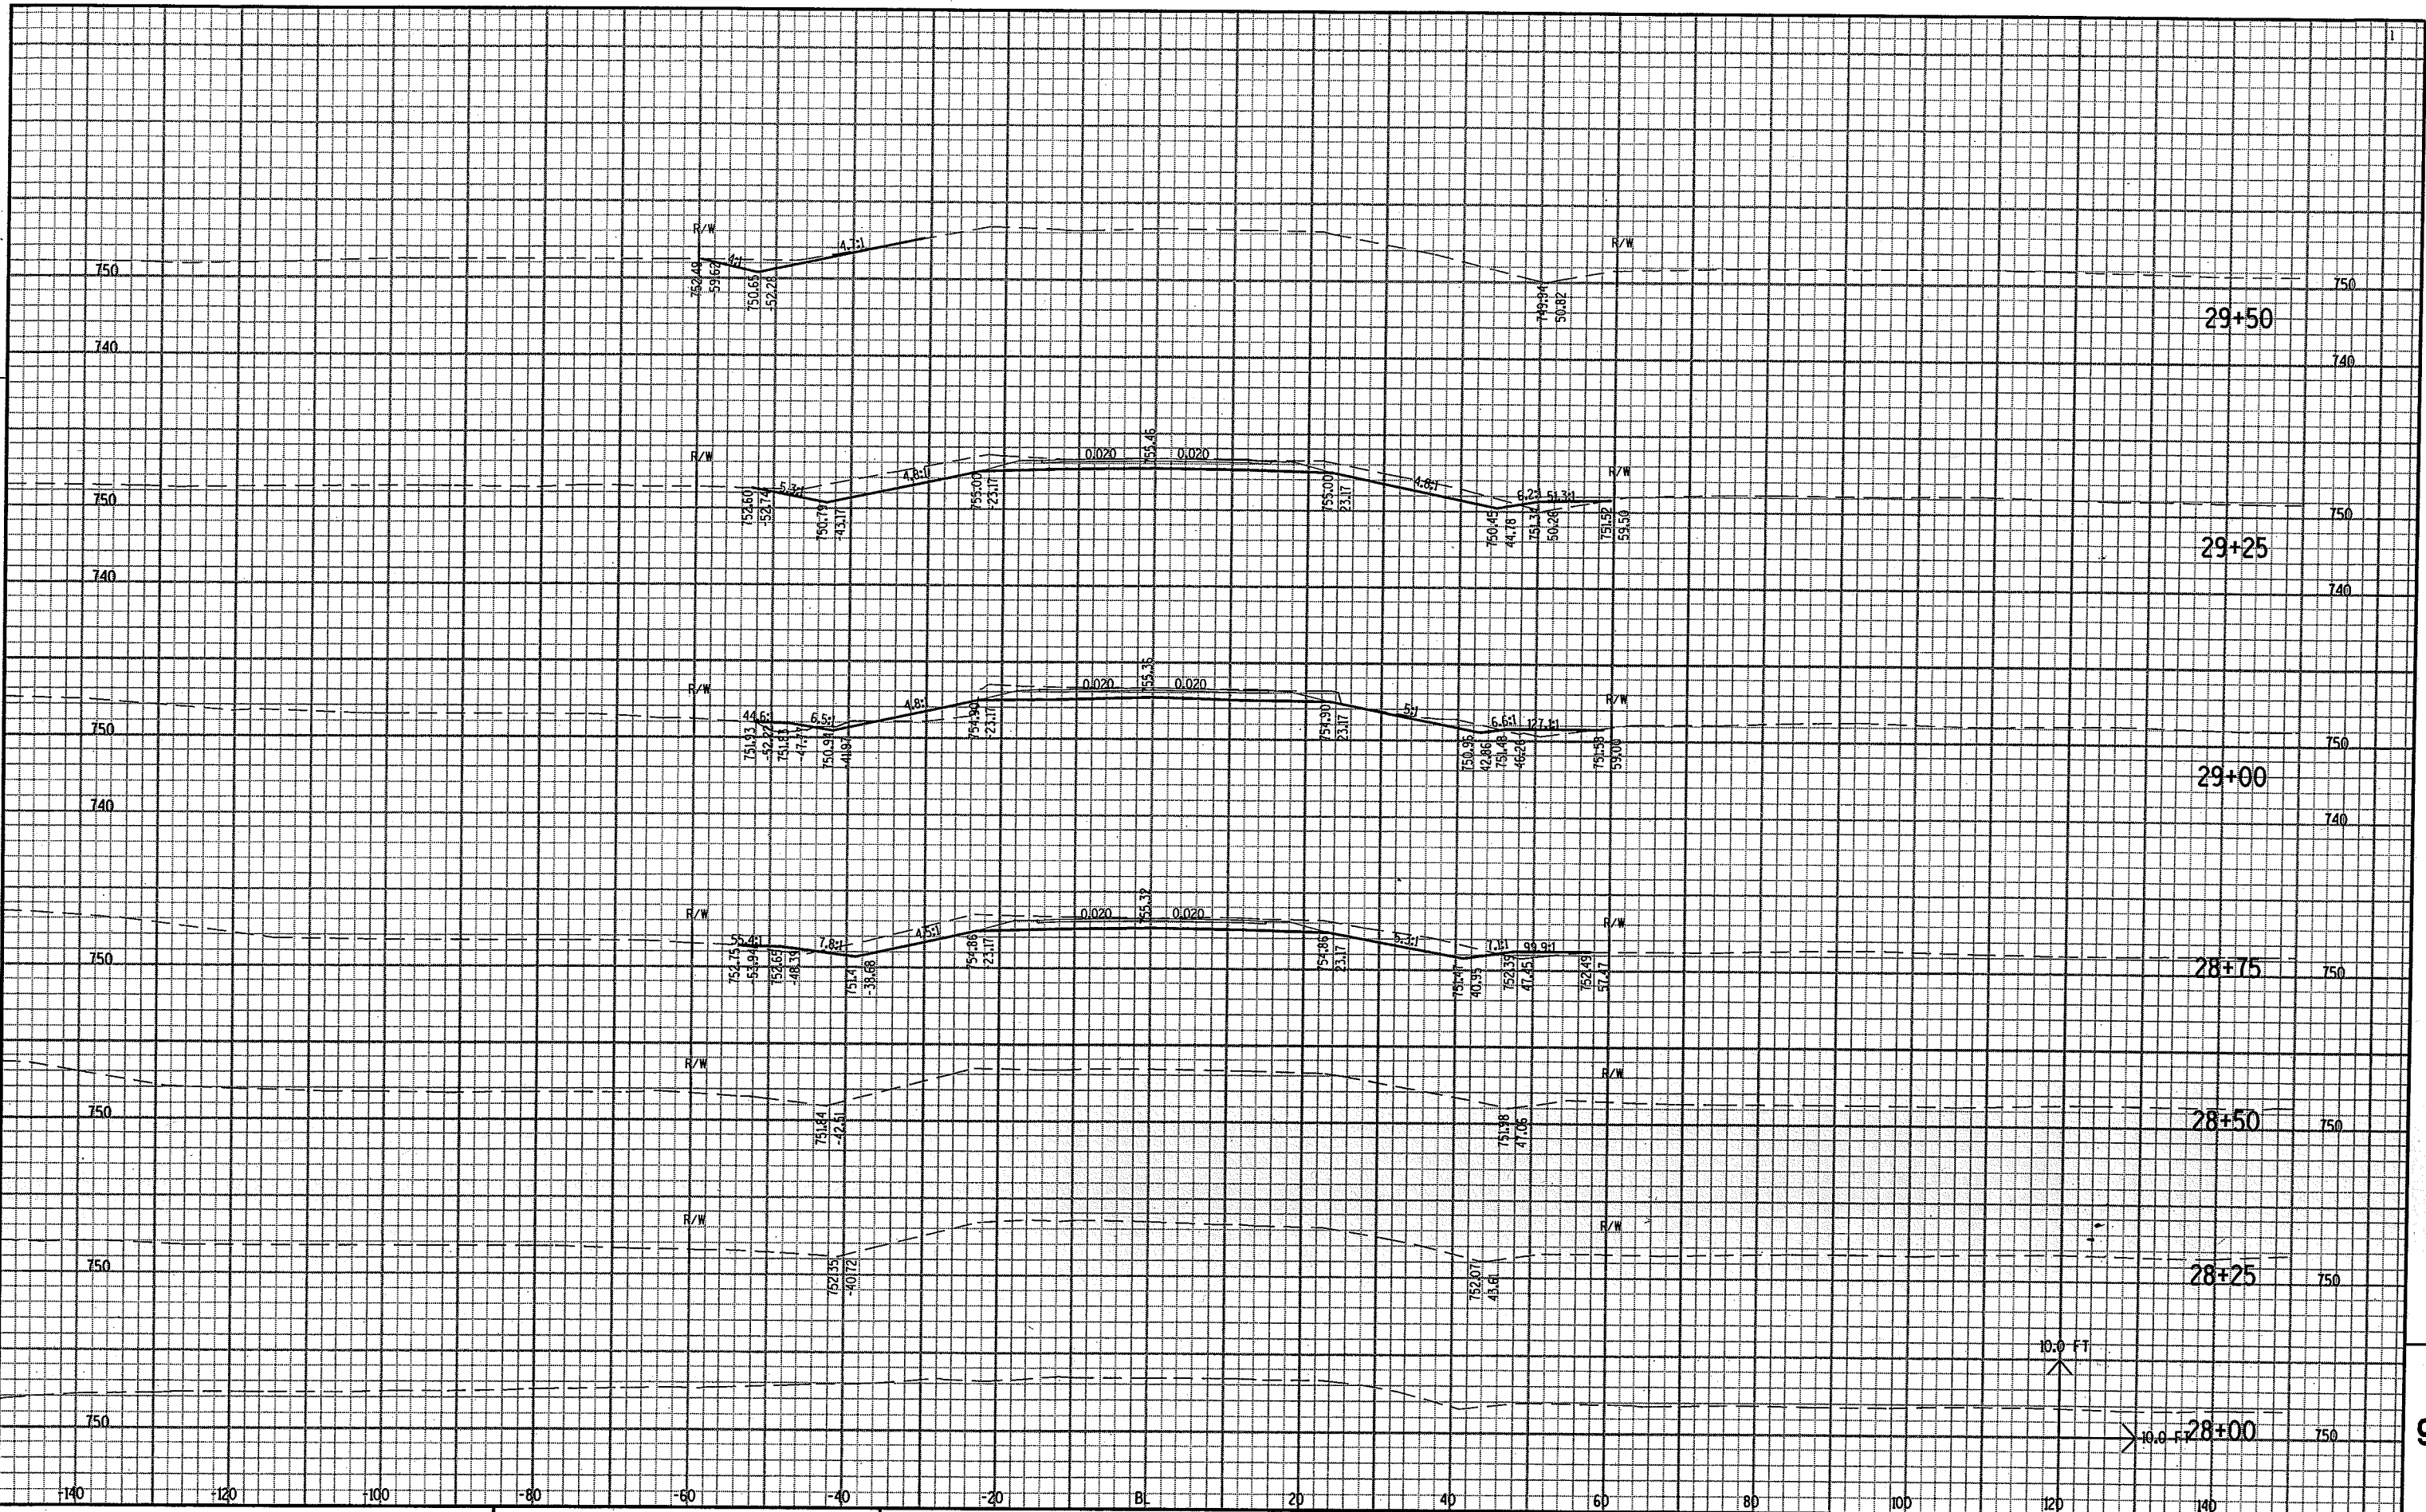

PROJECT NO: 6200-07-71

HWY: CTH II

COUNTY: WINNEBAGO

CROSS SECTIONS -- CTH II AT CATTLE PASS

SHEET NO:

9

FILE NAME : C:\Users\PD3\STH110\DCN FILES\catt1\epassd1\chesbx.s.DGN


PLOT DATE : 19-MAR-2004 08:43

PLOT BY : DOTEAD

PLOT NAME :

PLOT SCALE : 1.994518:1.000000


LEVELS ON: 1, 2, 3, 62, 63

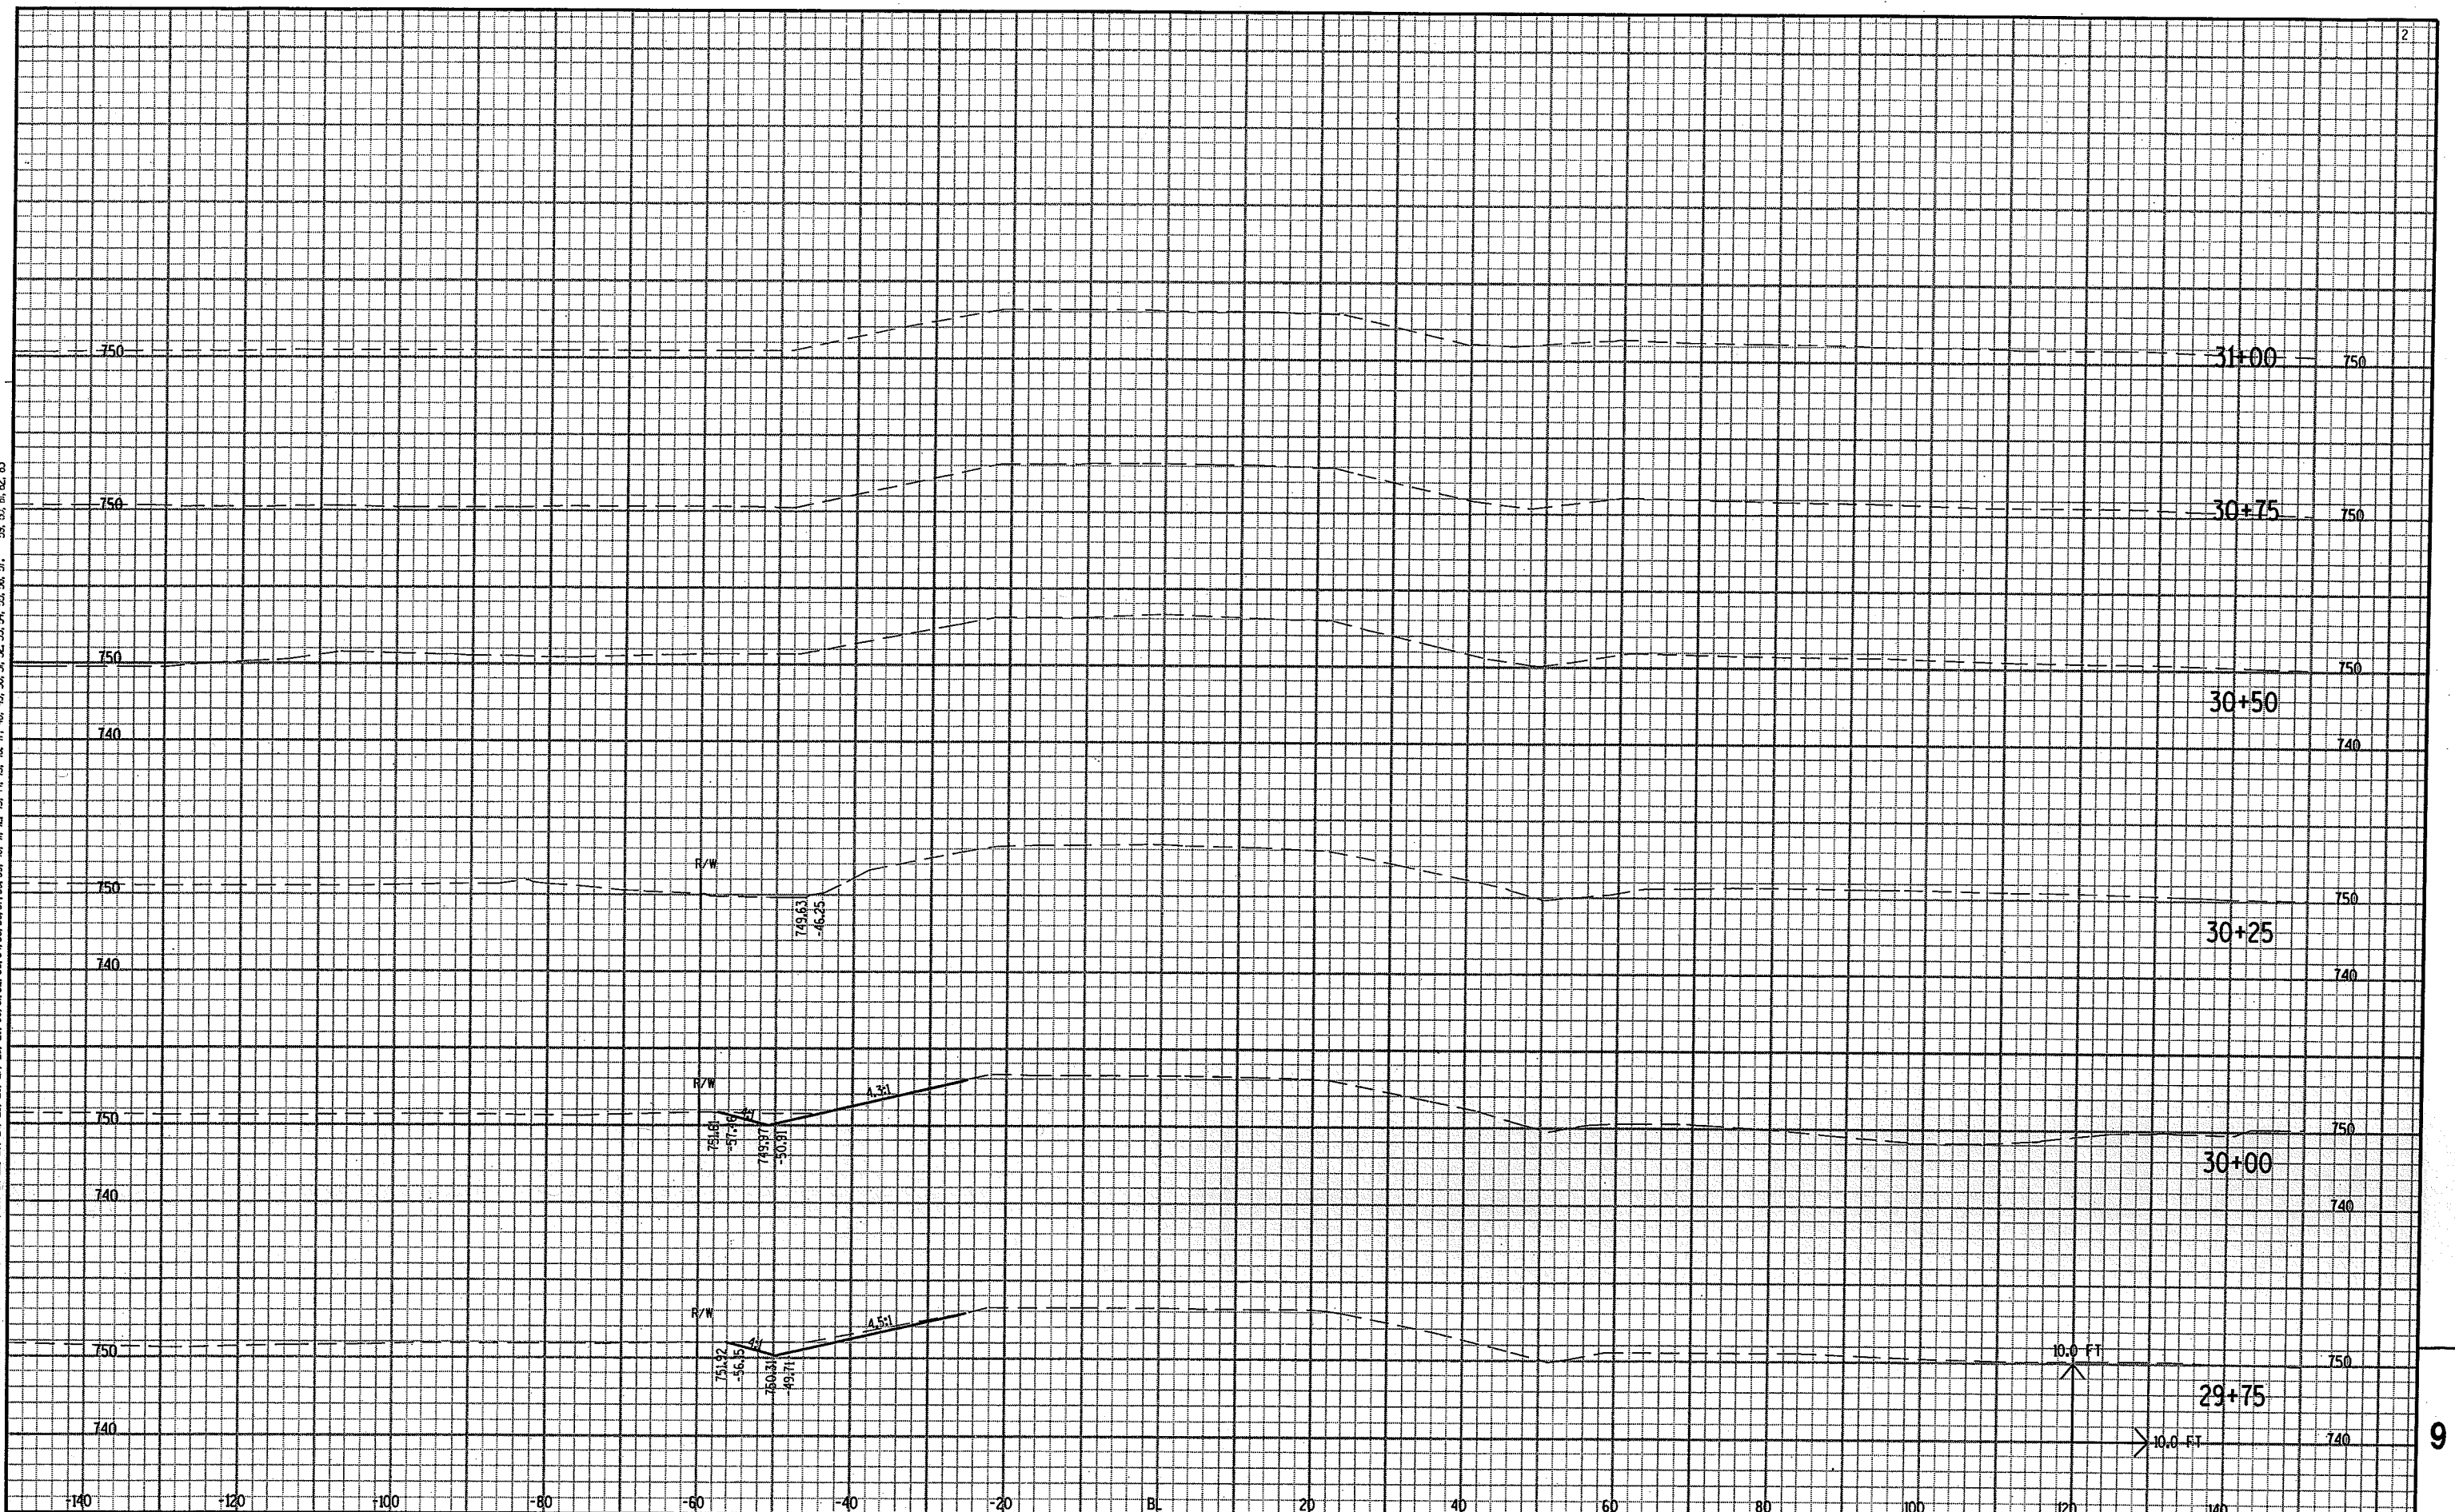

PROJECT NO: 6200-07-71	HWY: CTH II	COUNTY: WINNEBAGO	CROSS SECTIONS -- CTH II AT CATTLE PASS	SHEET NO:	E
------------------------	-------------	-------------------	---	-----------	---

FILE NAME : C:\Users\PD3\STH110\DCN FILES\cott1\epassd1\chesbx.s.DGN PLOT DATE : 19-MAR-2004 08:43 PLOT BY : DOTEAD PLOT NAME : PLOT SCALE : 1.994518:1.000000

LEVELS ON: 1, 2, 3, 62, 63

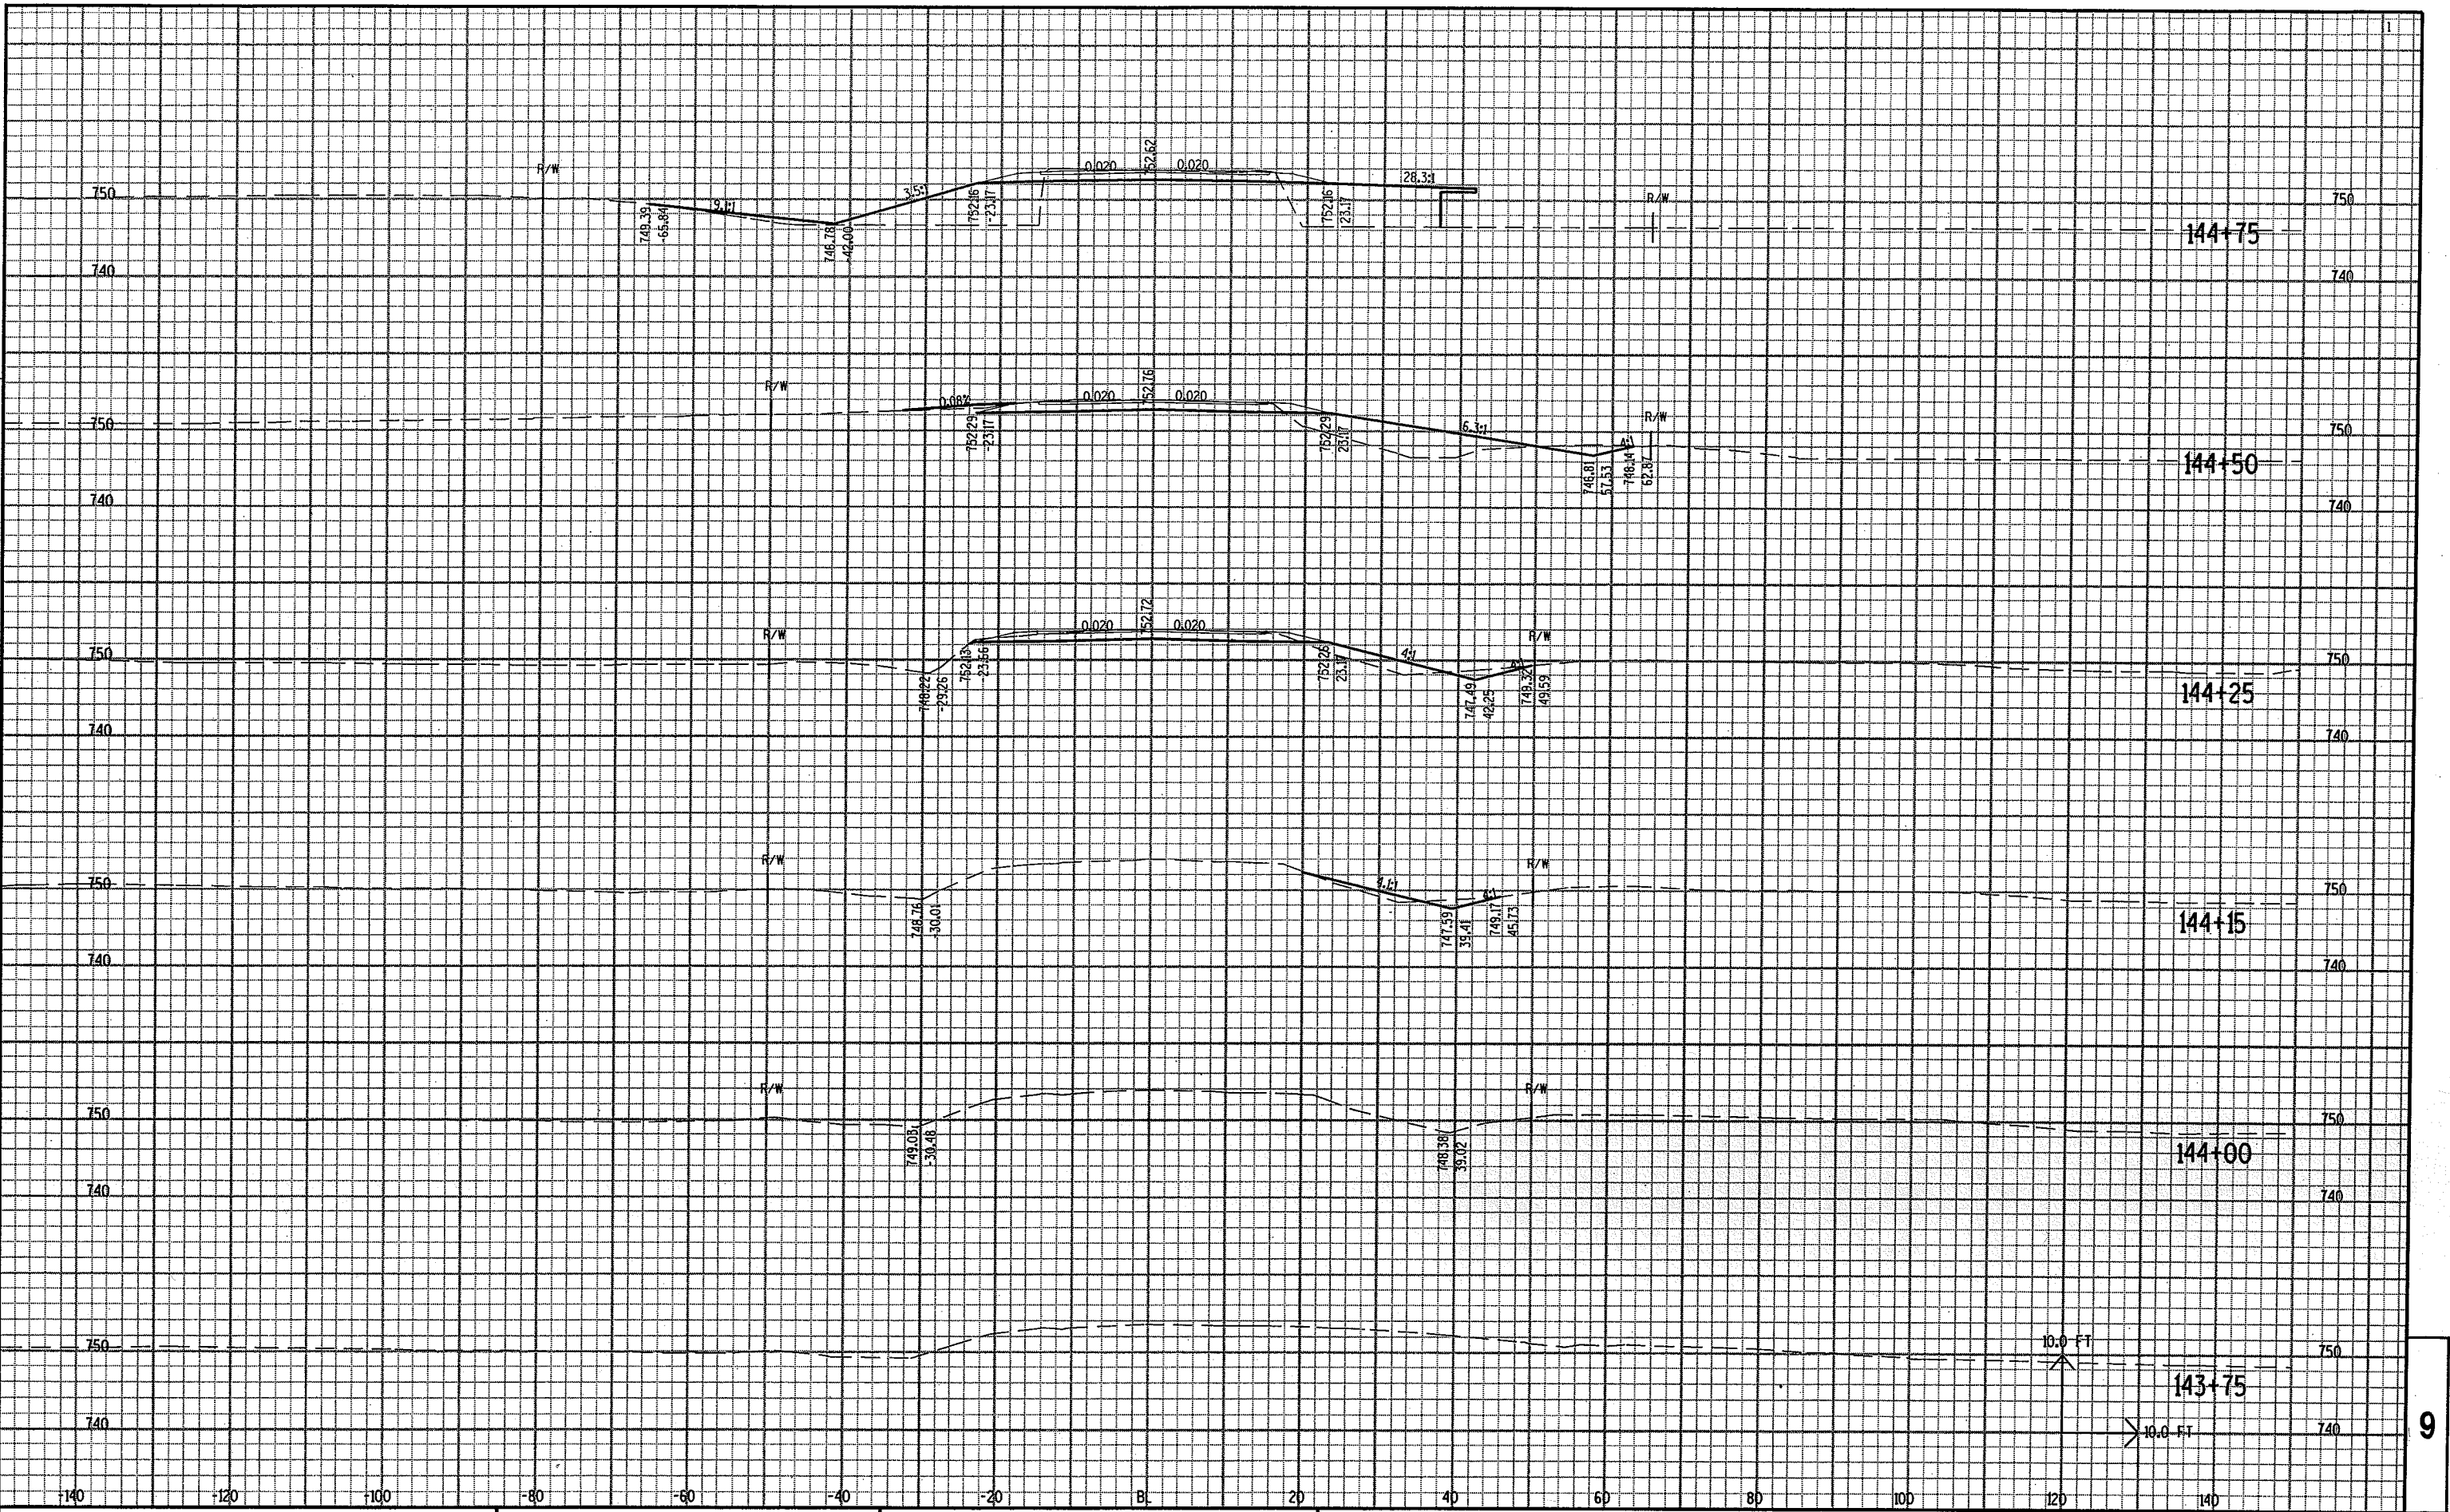

PROJECT NO: 6200-07-71

HWY: CTH II


COUNTY: WINNEBAGO

CROSS SECTIONS -- CTH II AT B-70-242


SHEET NO:

E

LEVELS ON: 1, 2, 3, 62, 63

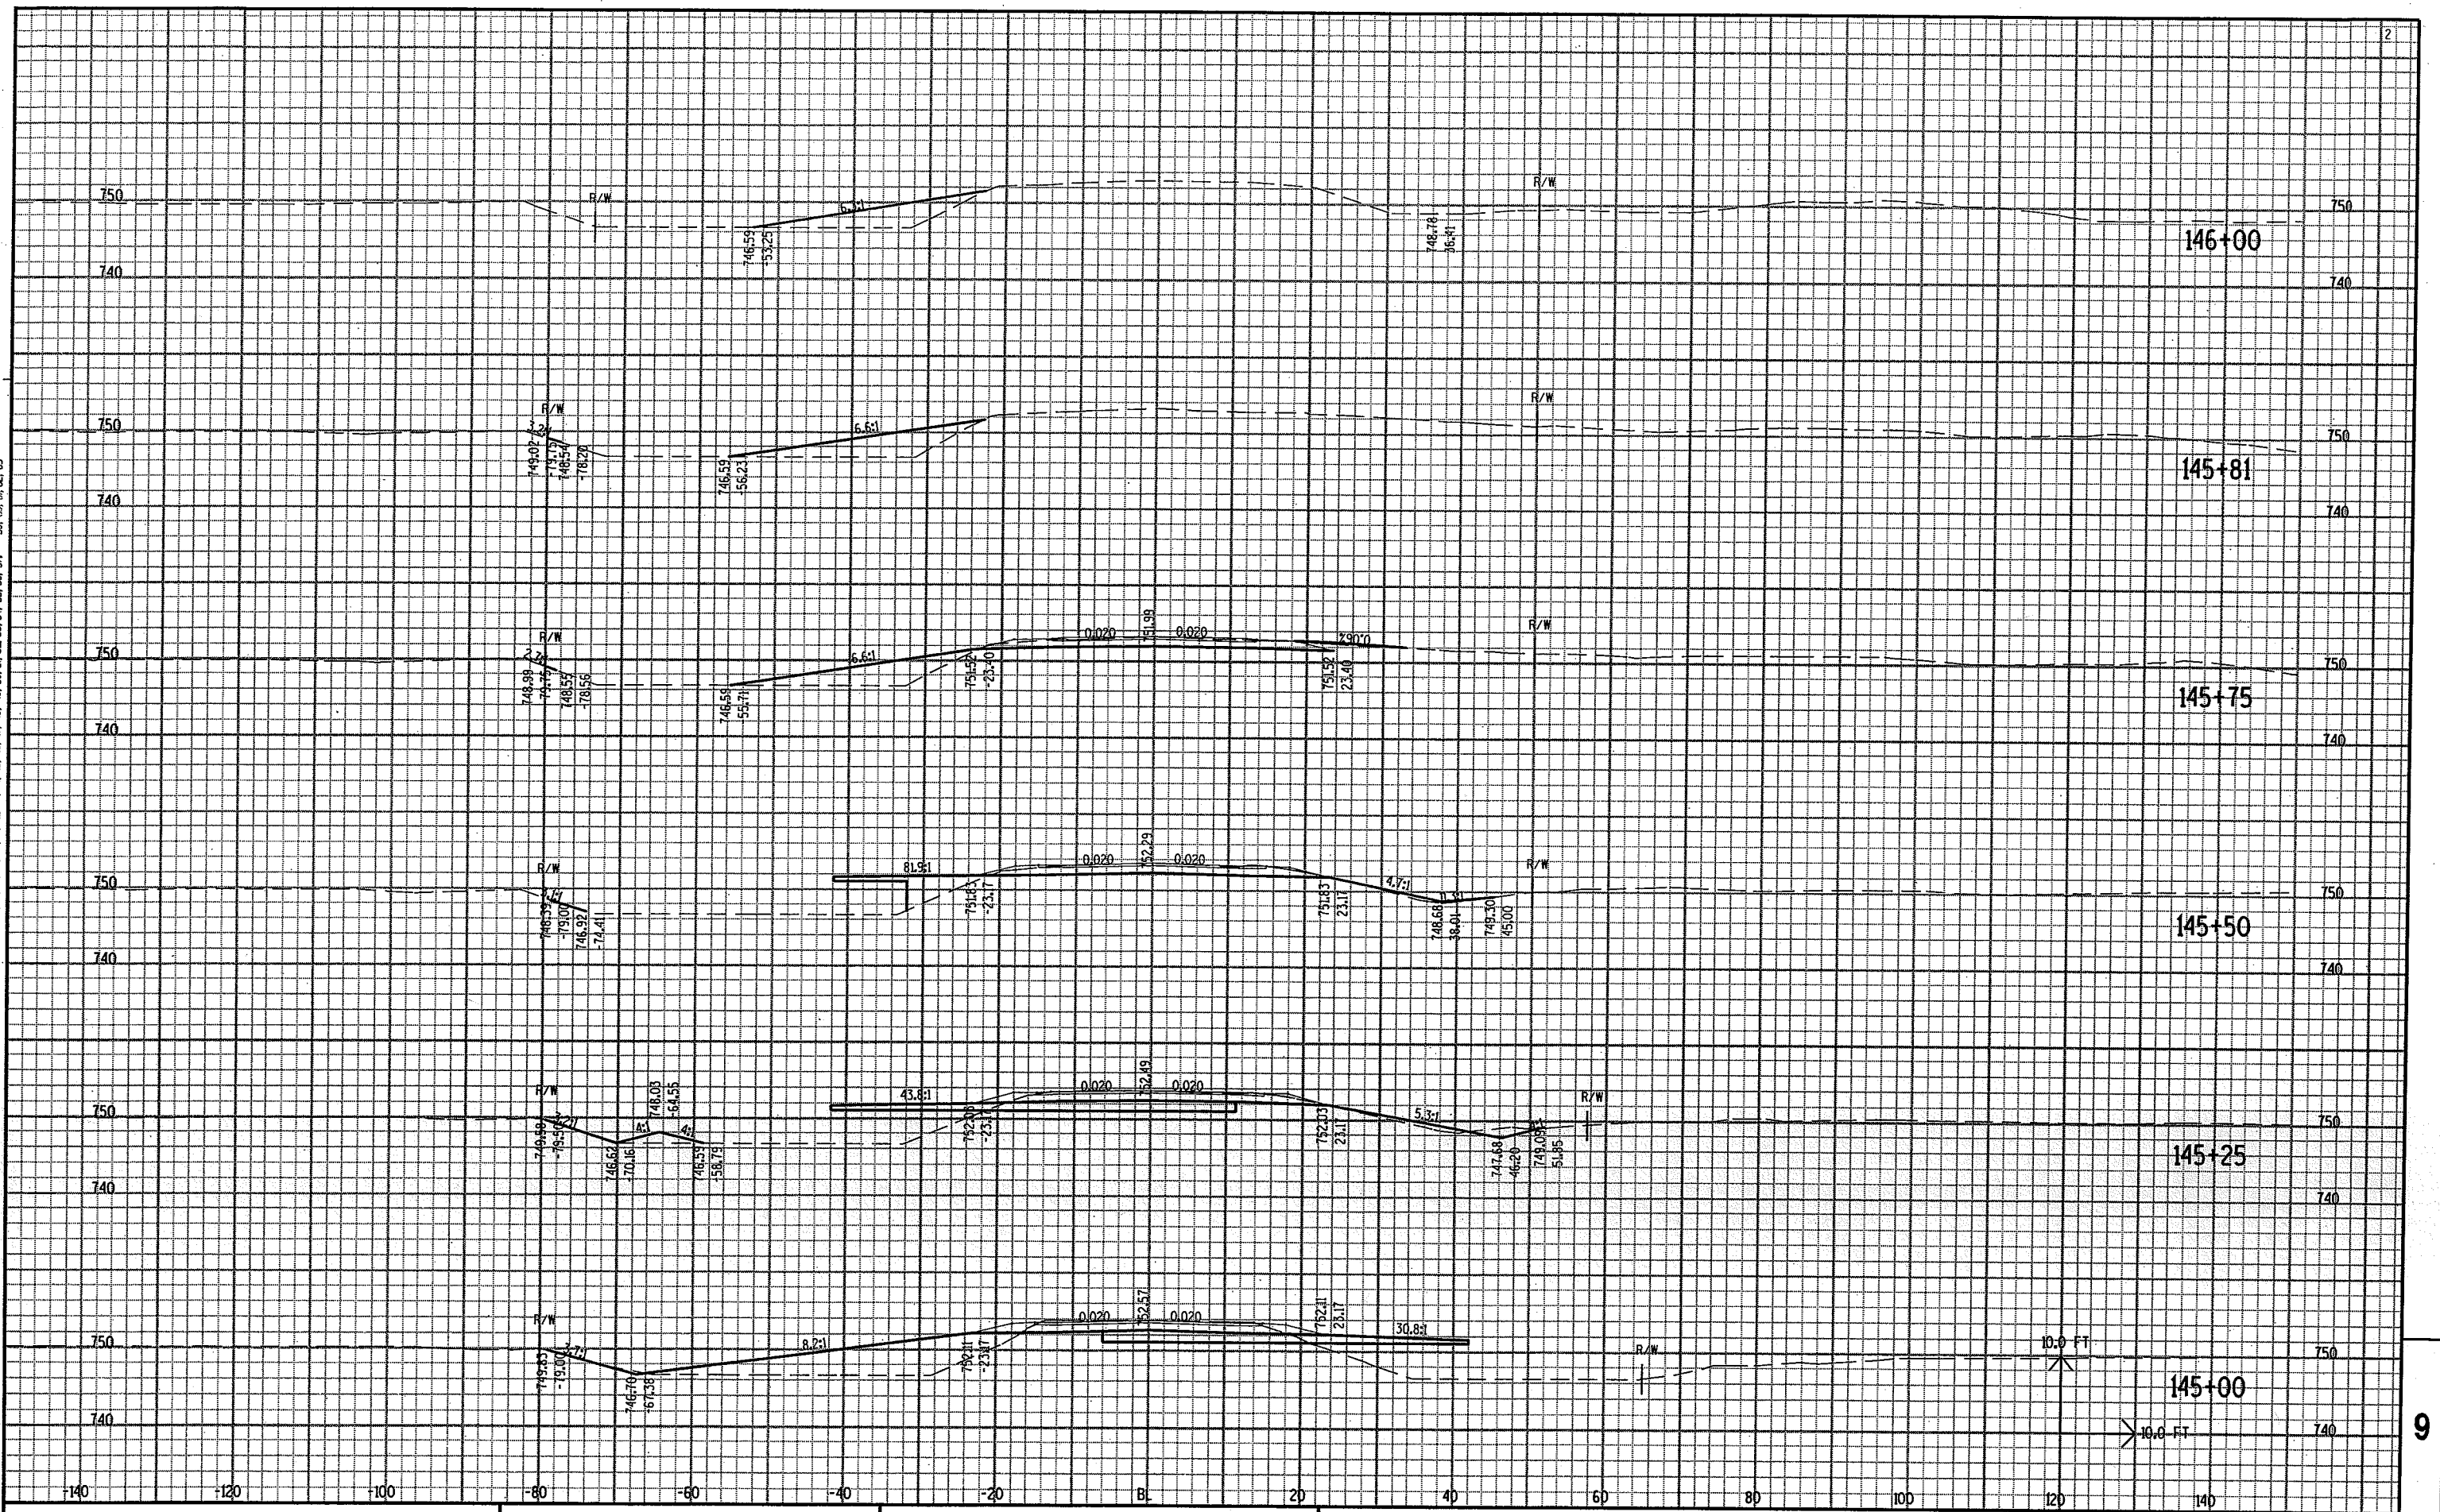

LEVELS ON: 1 2 3 4 5 6 7 8 9 10 11 12 13 14 15 16 17 18 19 20 21 22 23 24 25 26 27 28 29 30 31 32 33 34 35 36 37 38 39 40 41 42 43 44 45 46 47 48 49 50 51 52 53 54 55 56 57 58 59 60 61 62 63

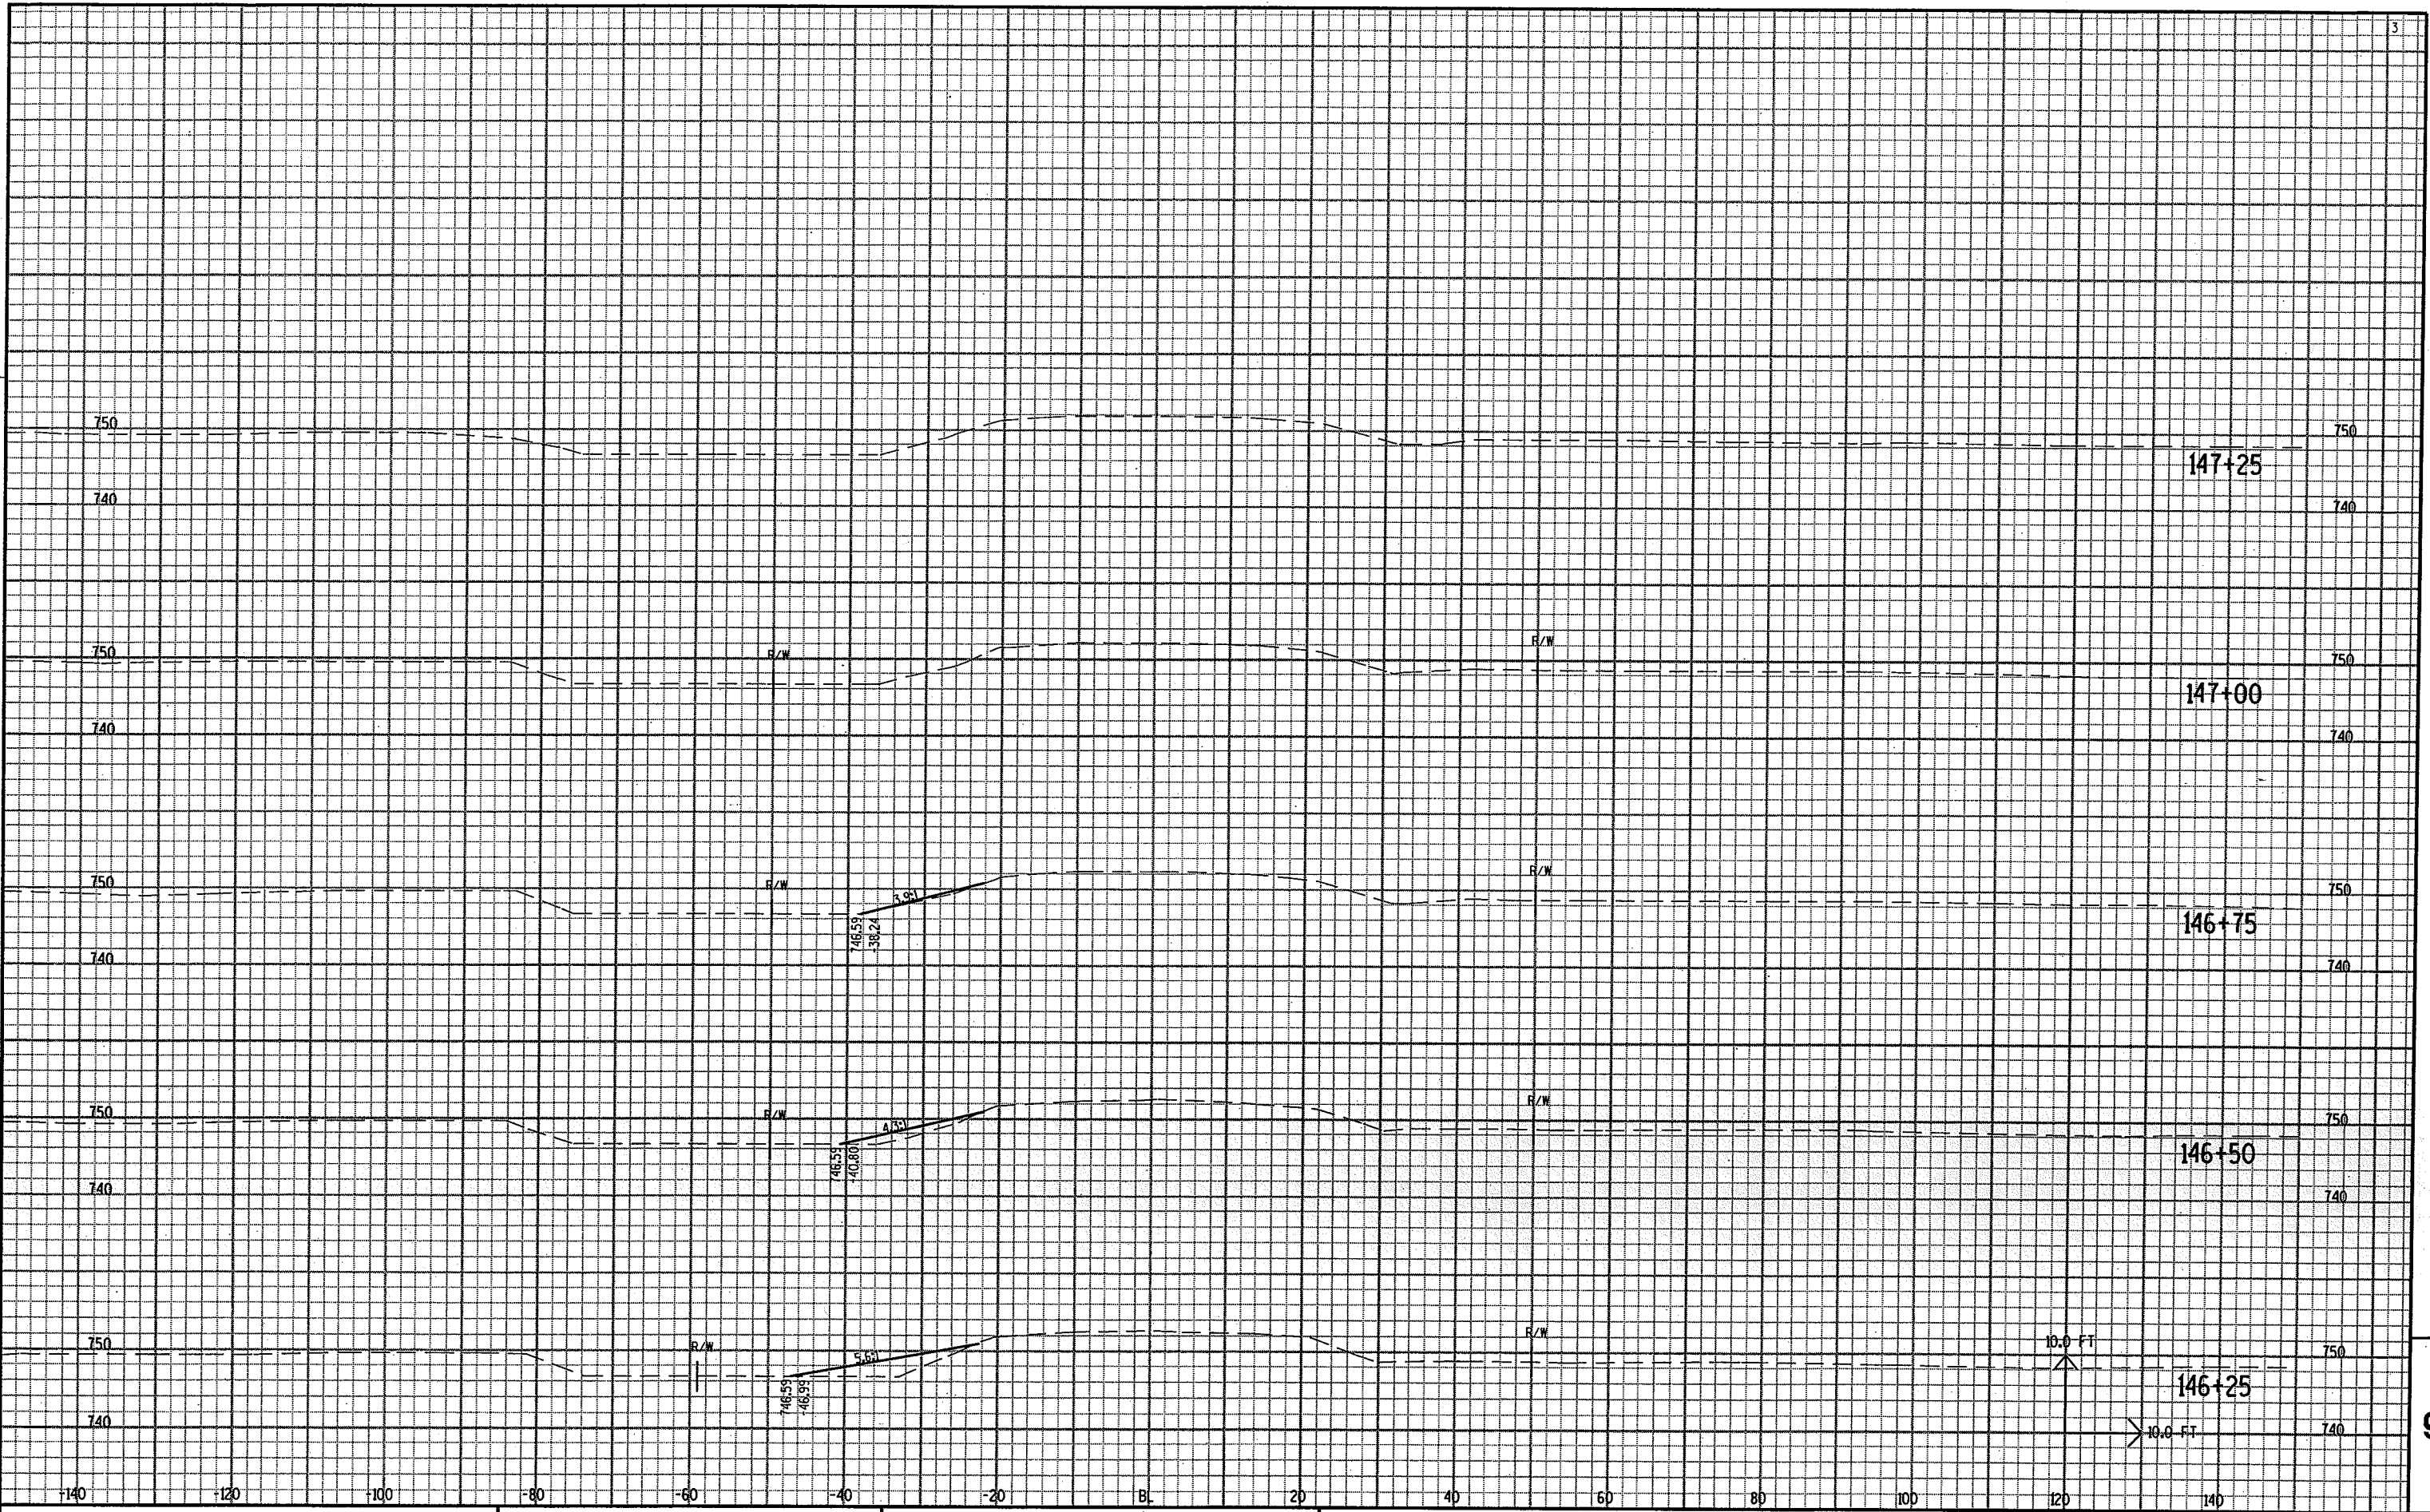

PROJECT NO: 6200-07-71

HWY: CTH II


COUNTY: WINNEBAGO

CROSS SECTIONS -- CTH II AT B-70-242


SHEET NO:

E


LEVELS ON: 1 2 3 4 5 6 7 8 9 10 11 12 13 14 15 16 17 18 19 20 21 22 23 24 25 26 27 28 29 30 31 32 33 34 35 36 37 38 39 40 41 42 43 44 45 46 47 48 49 50 51 52 53 54 55 56 57 58 59 60 61 62 63

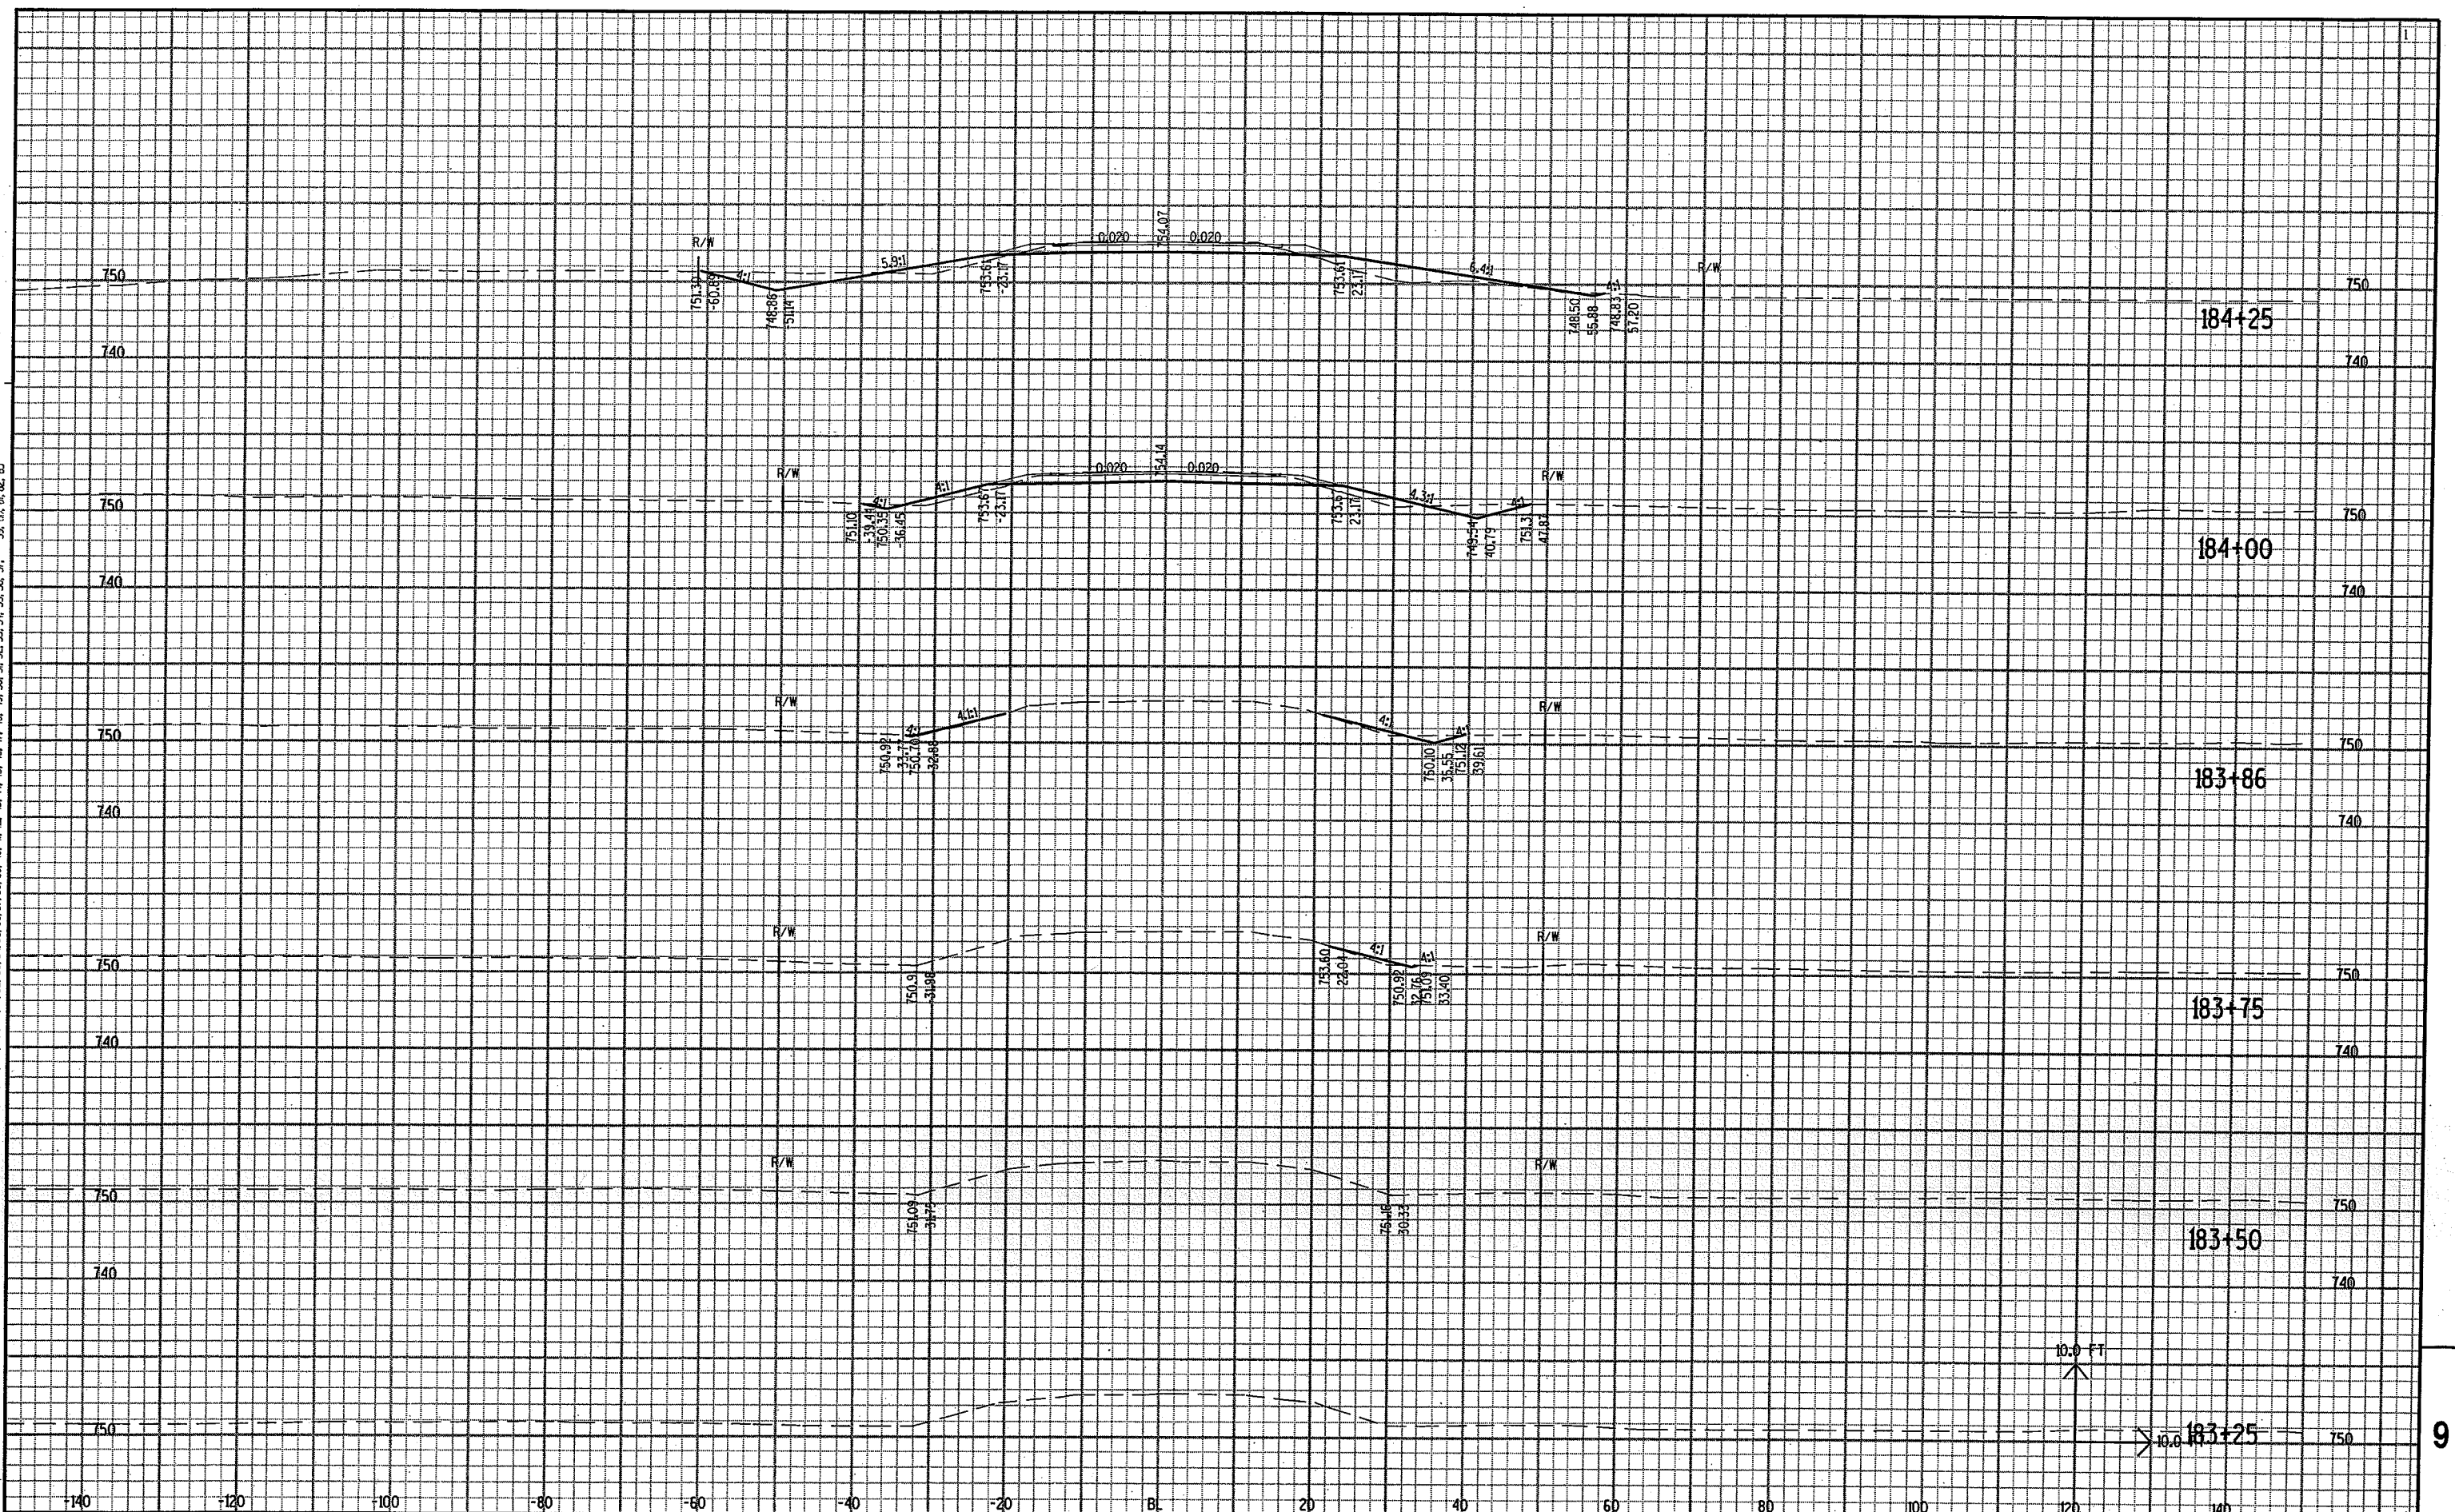

LEVELS ON + 1, 2, 3, 62, 63

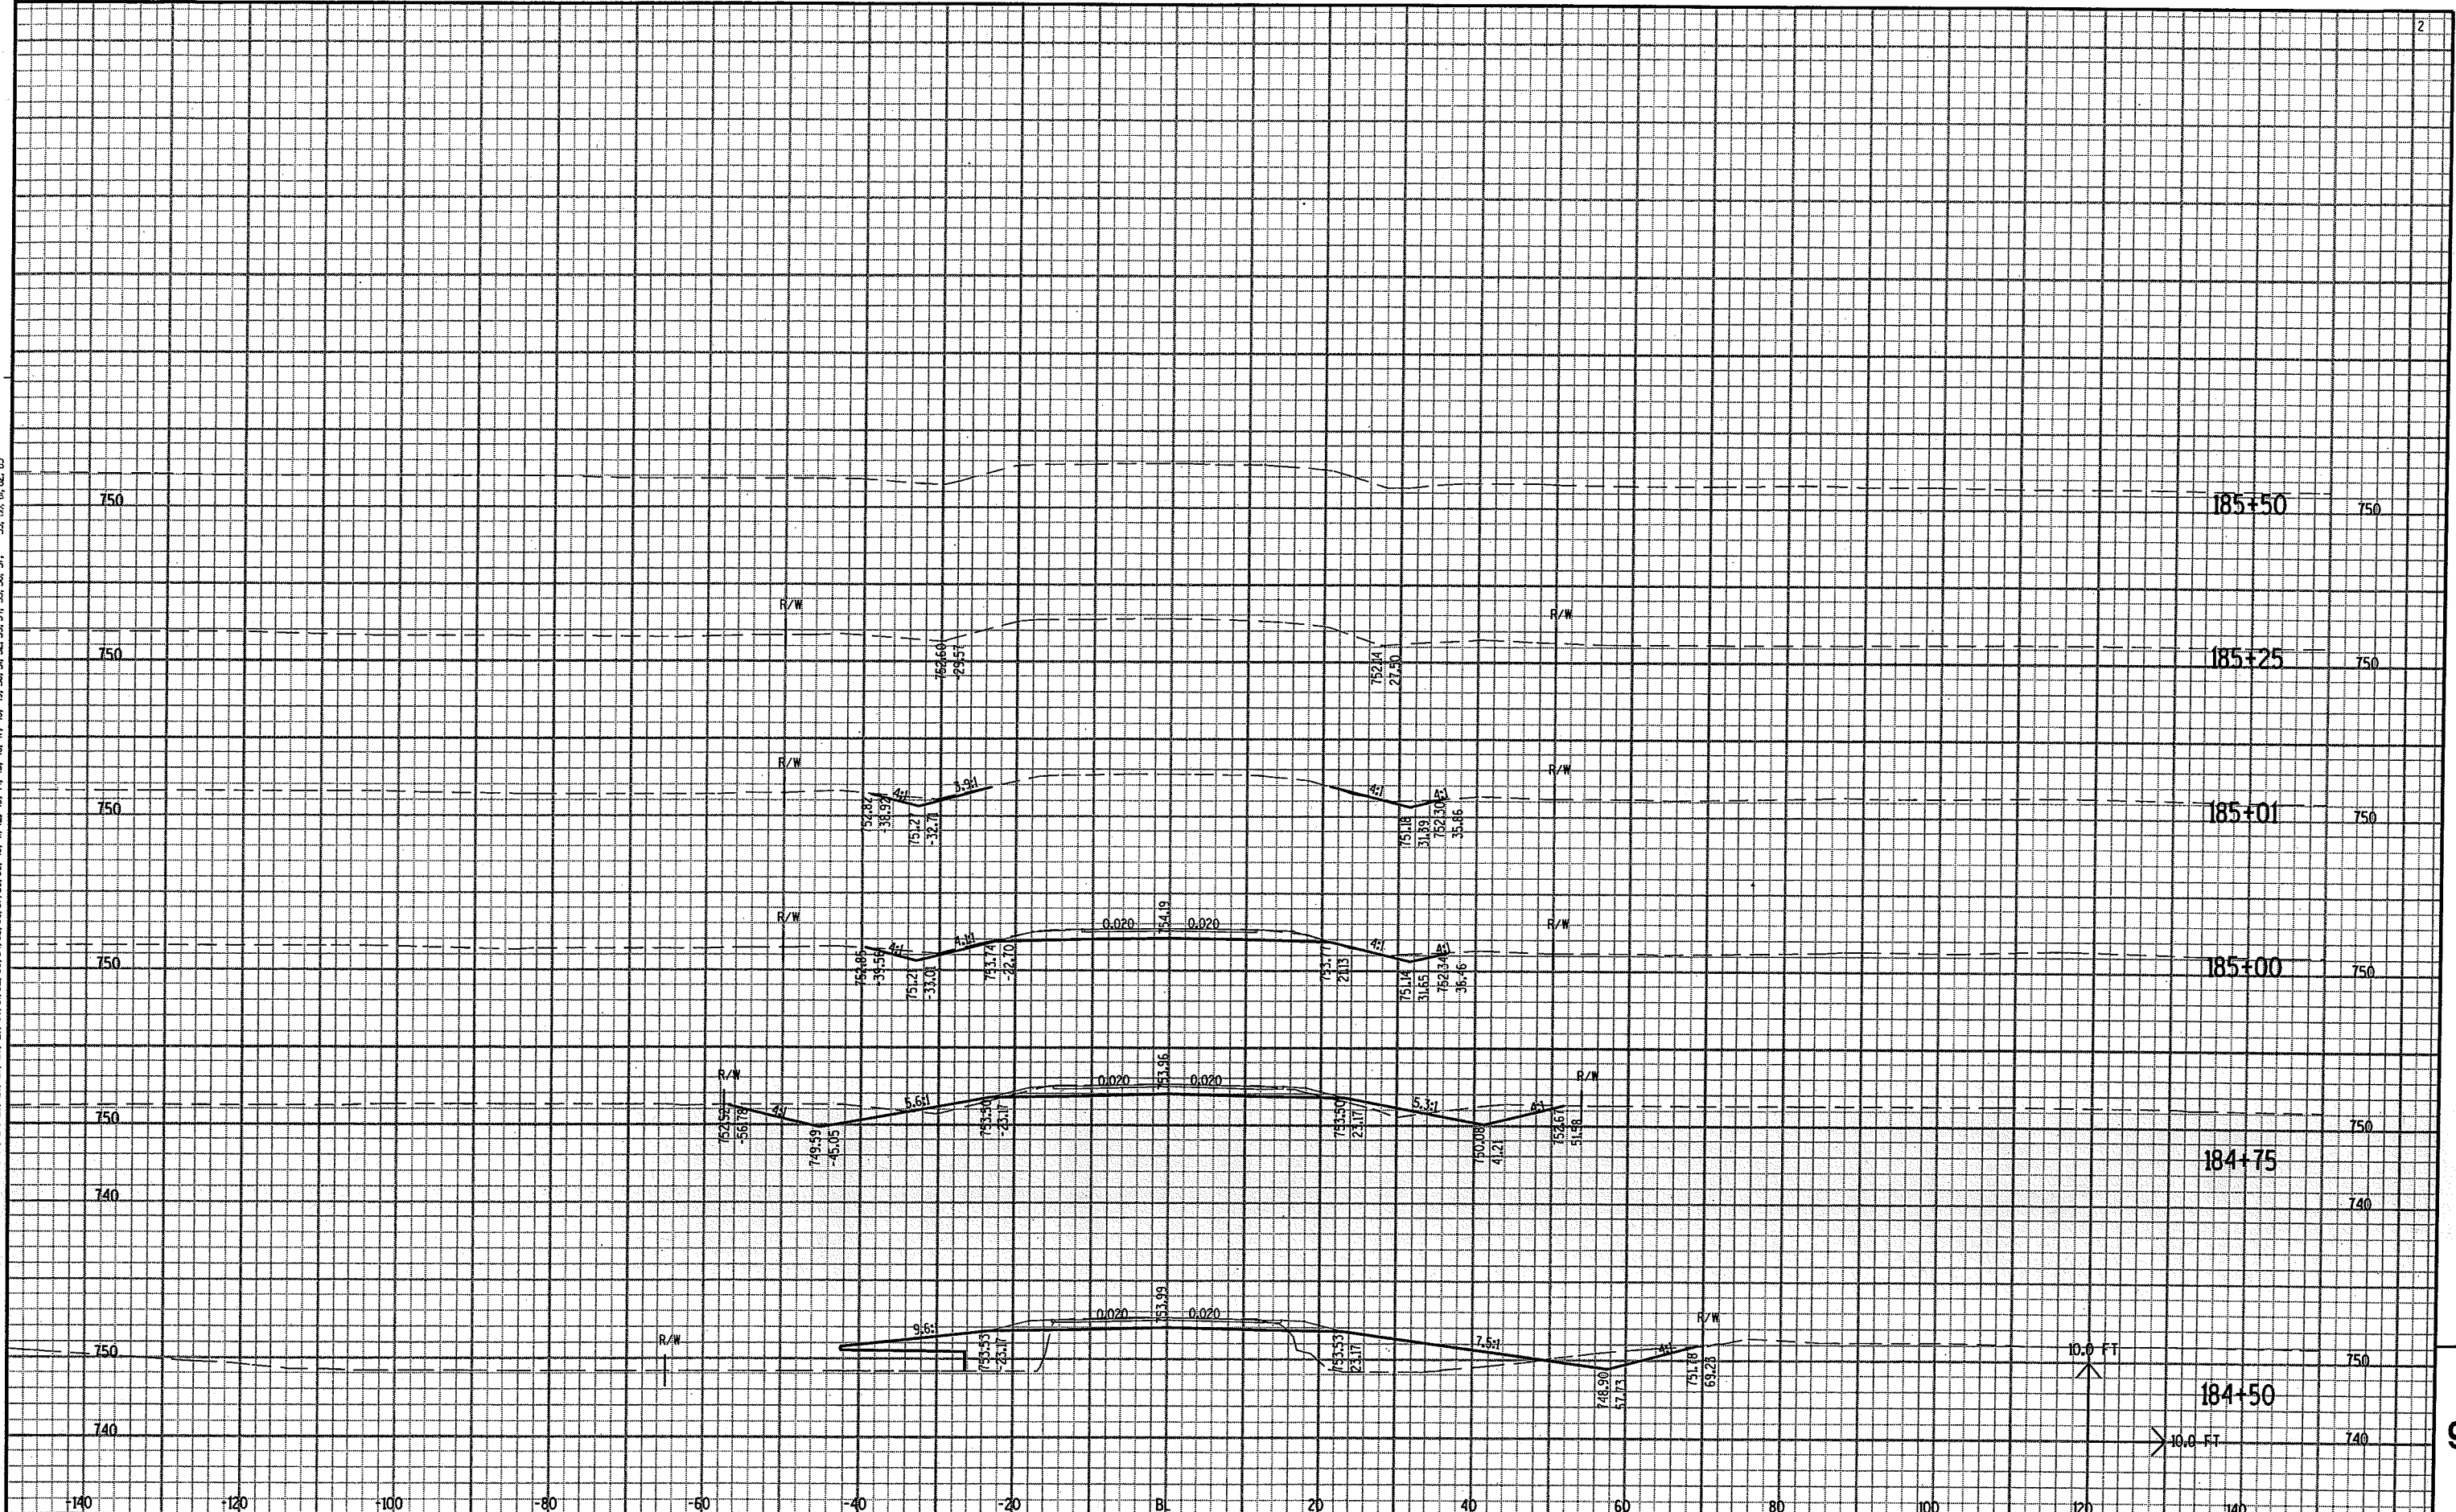

LEVELS ON: 1, 2, 3, 62, 63

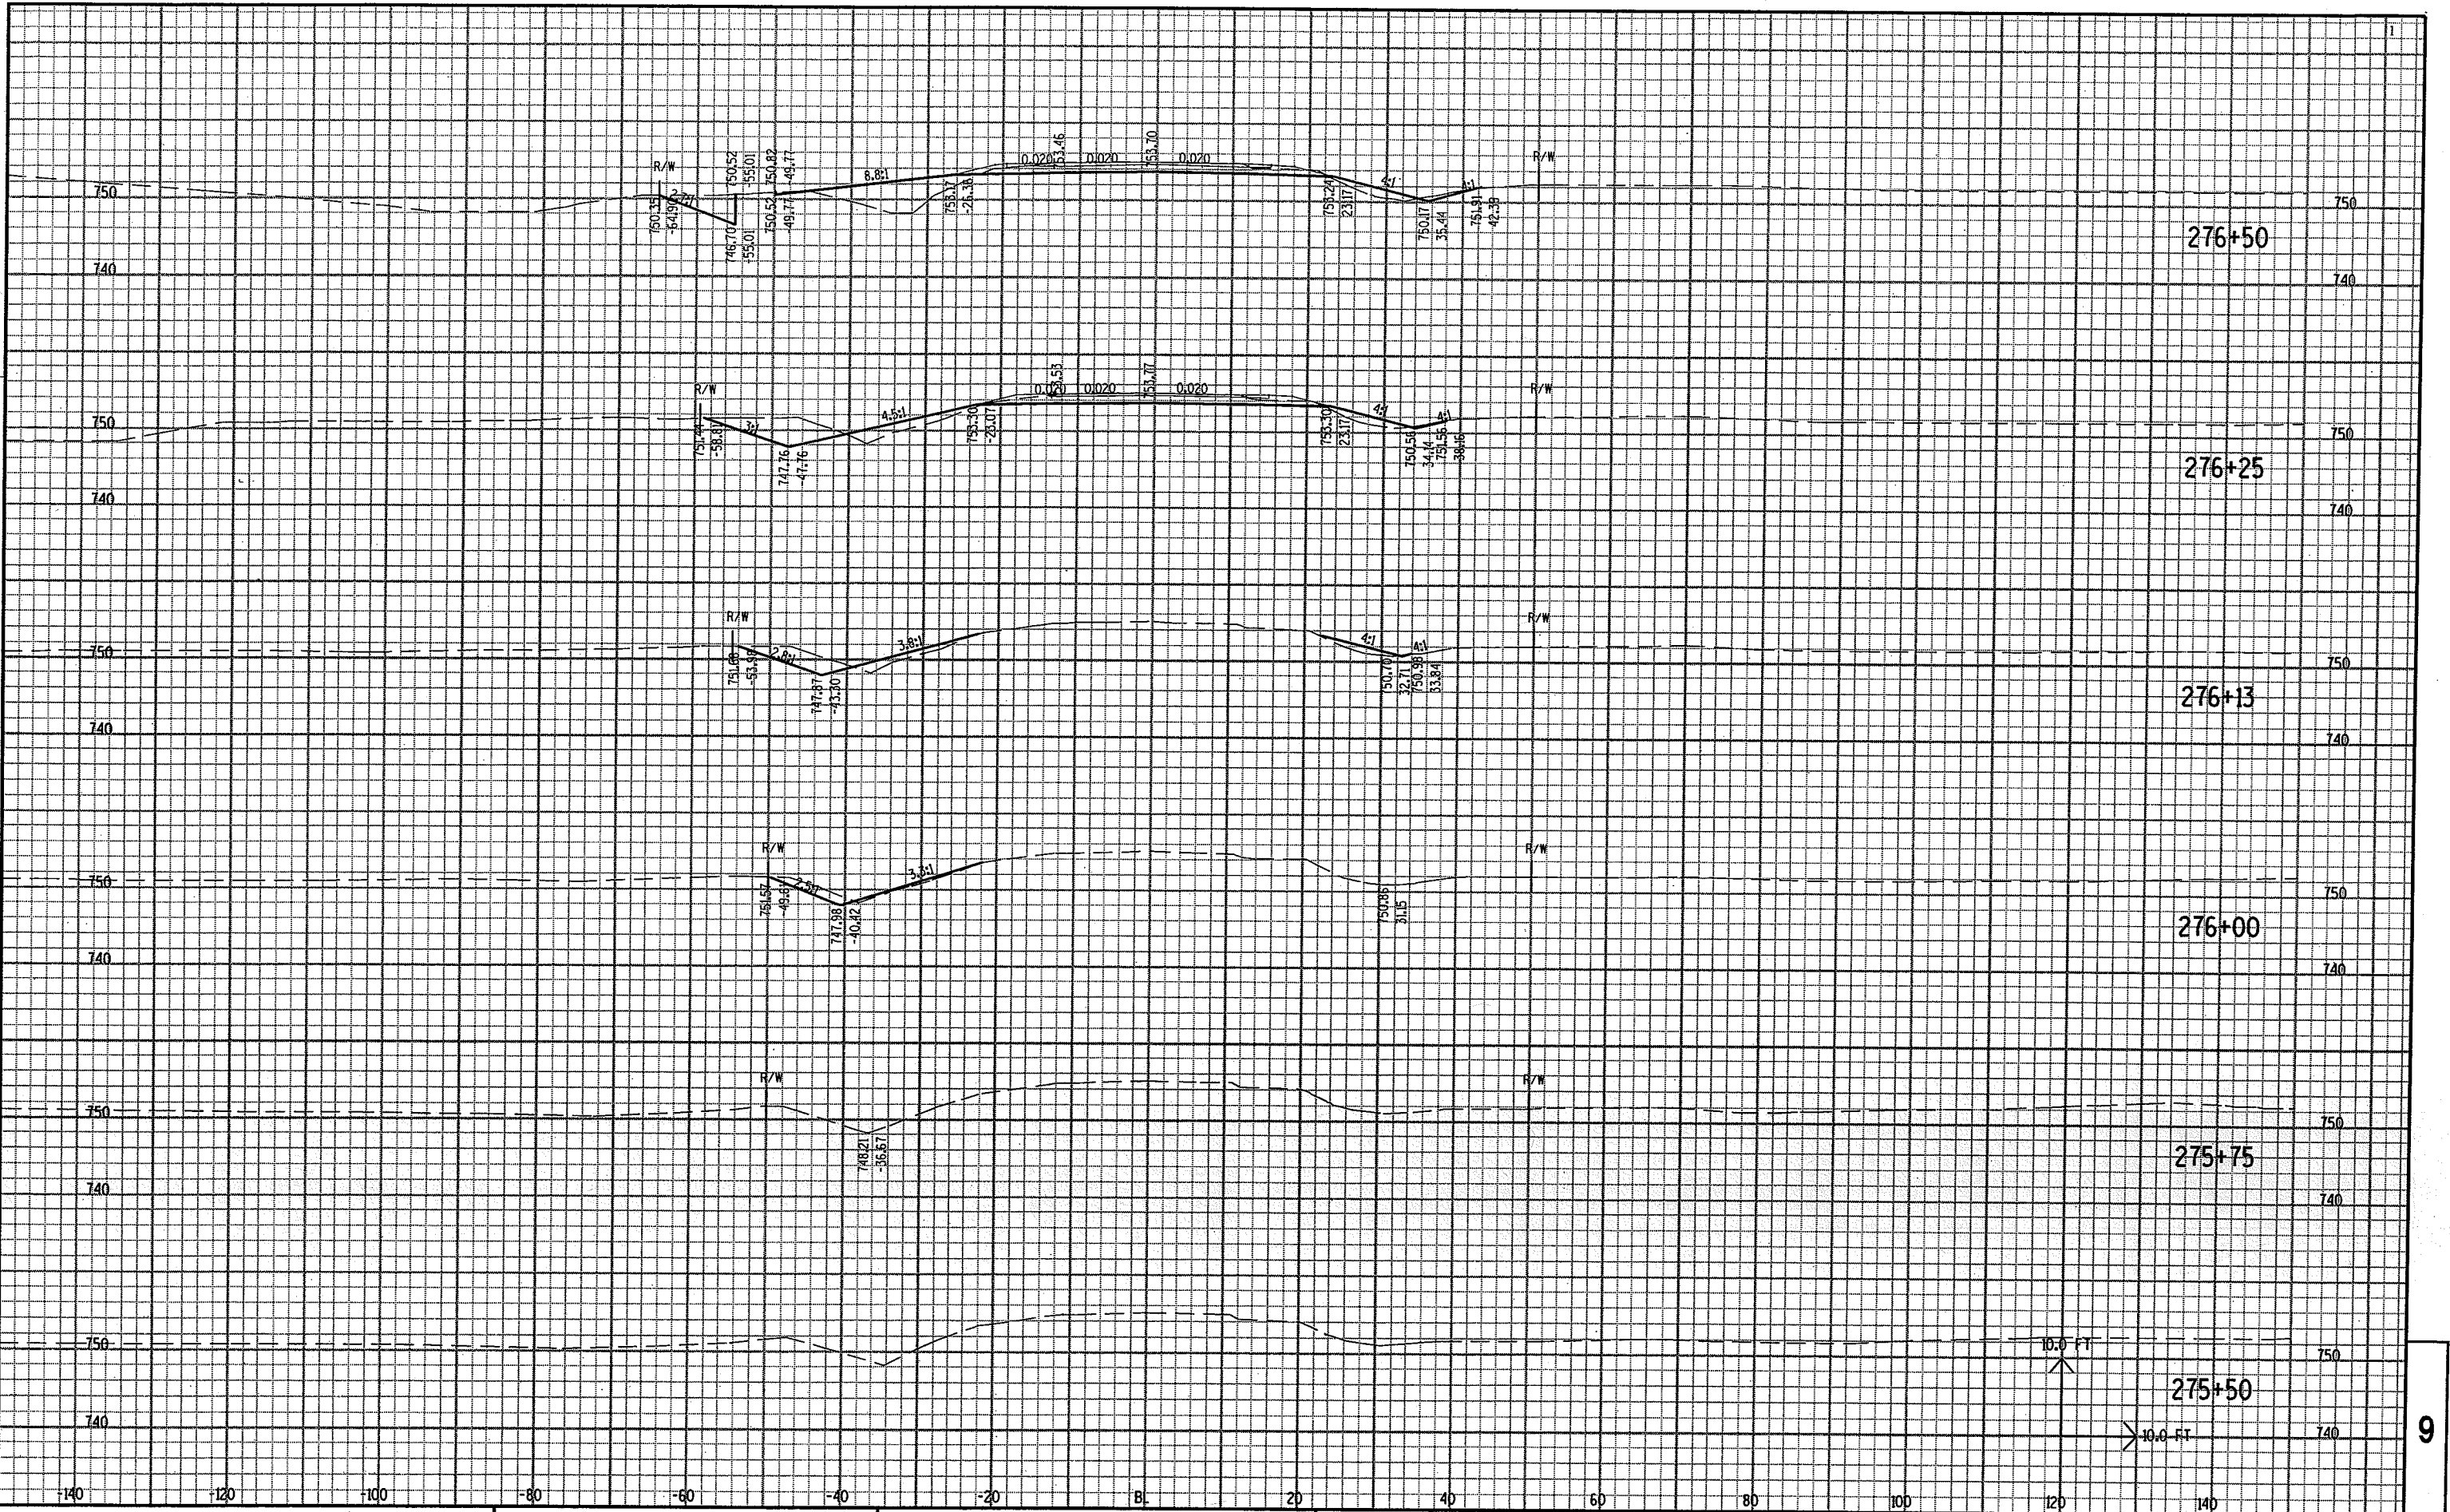

PROJECT NO: 6200-07-71

HWY: CTH II


COUNTY: WINNEBAGO

CROSS SECTIONS -- CTH II AT C-70-69

SHEET NO:

9 E

LEVELS ON: 1, 2, 3, 62, 63

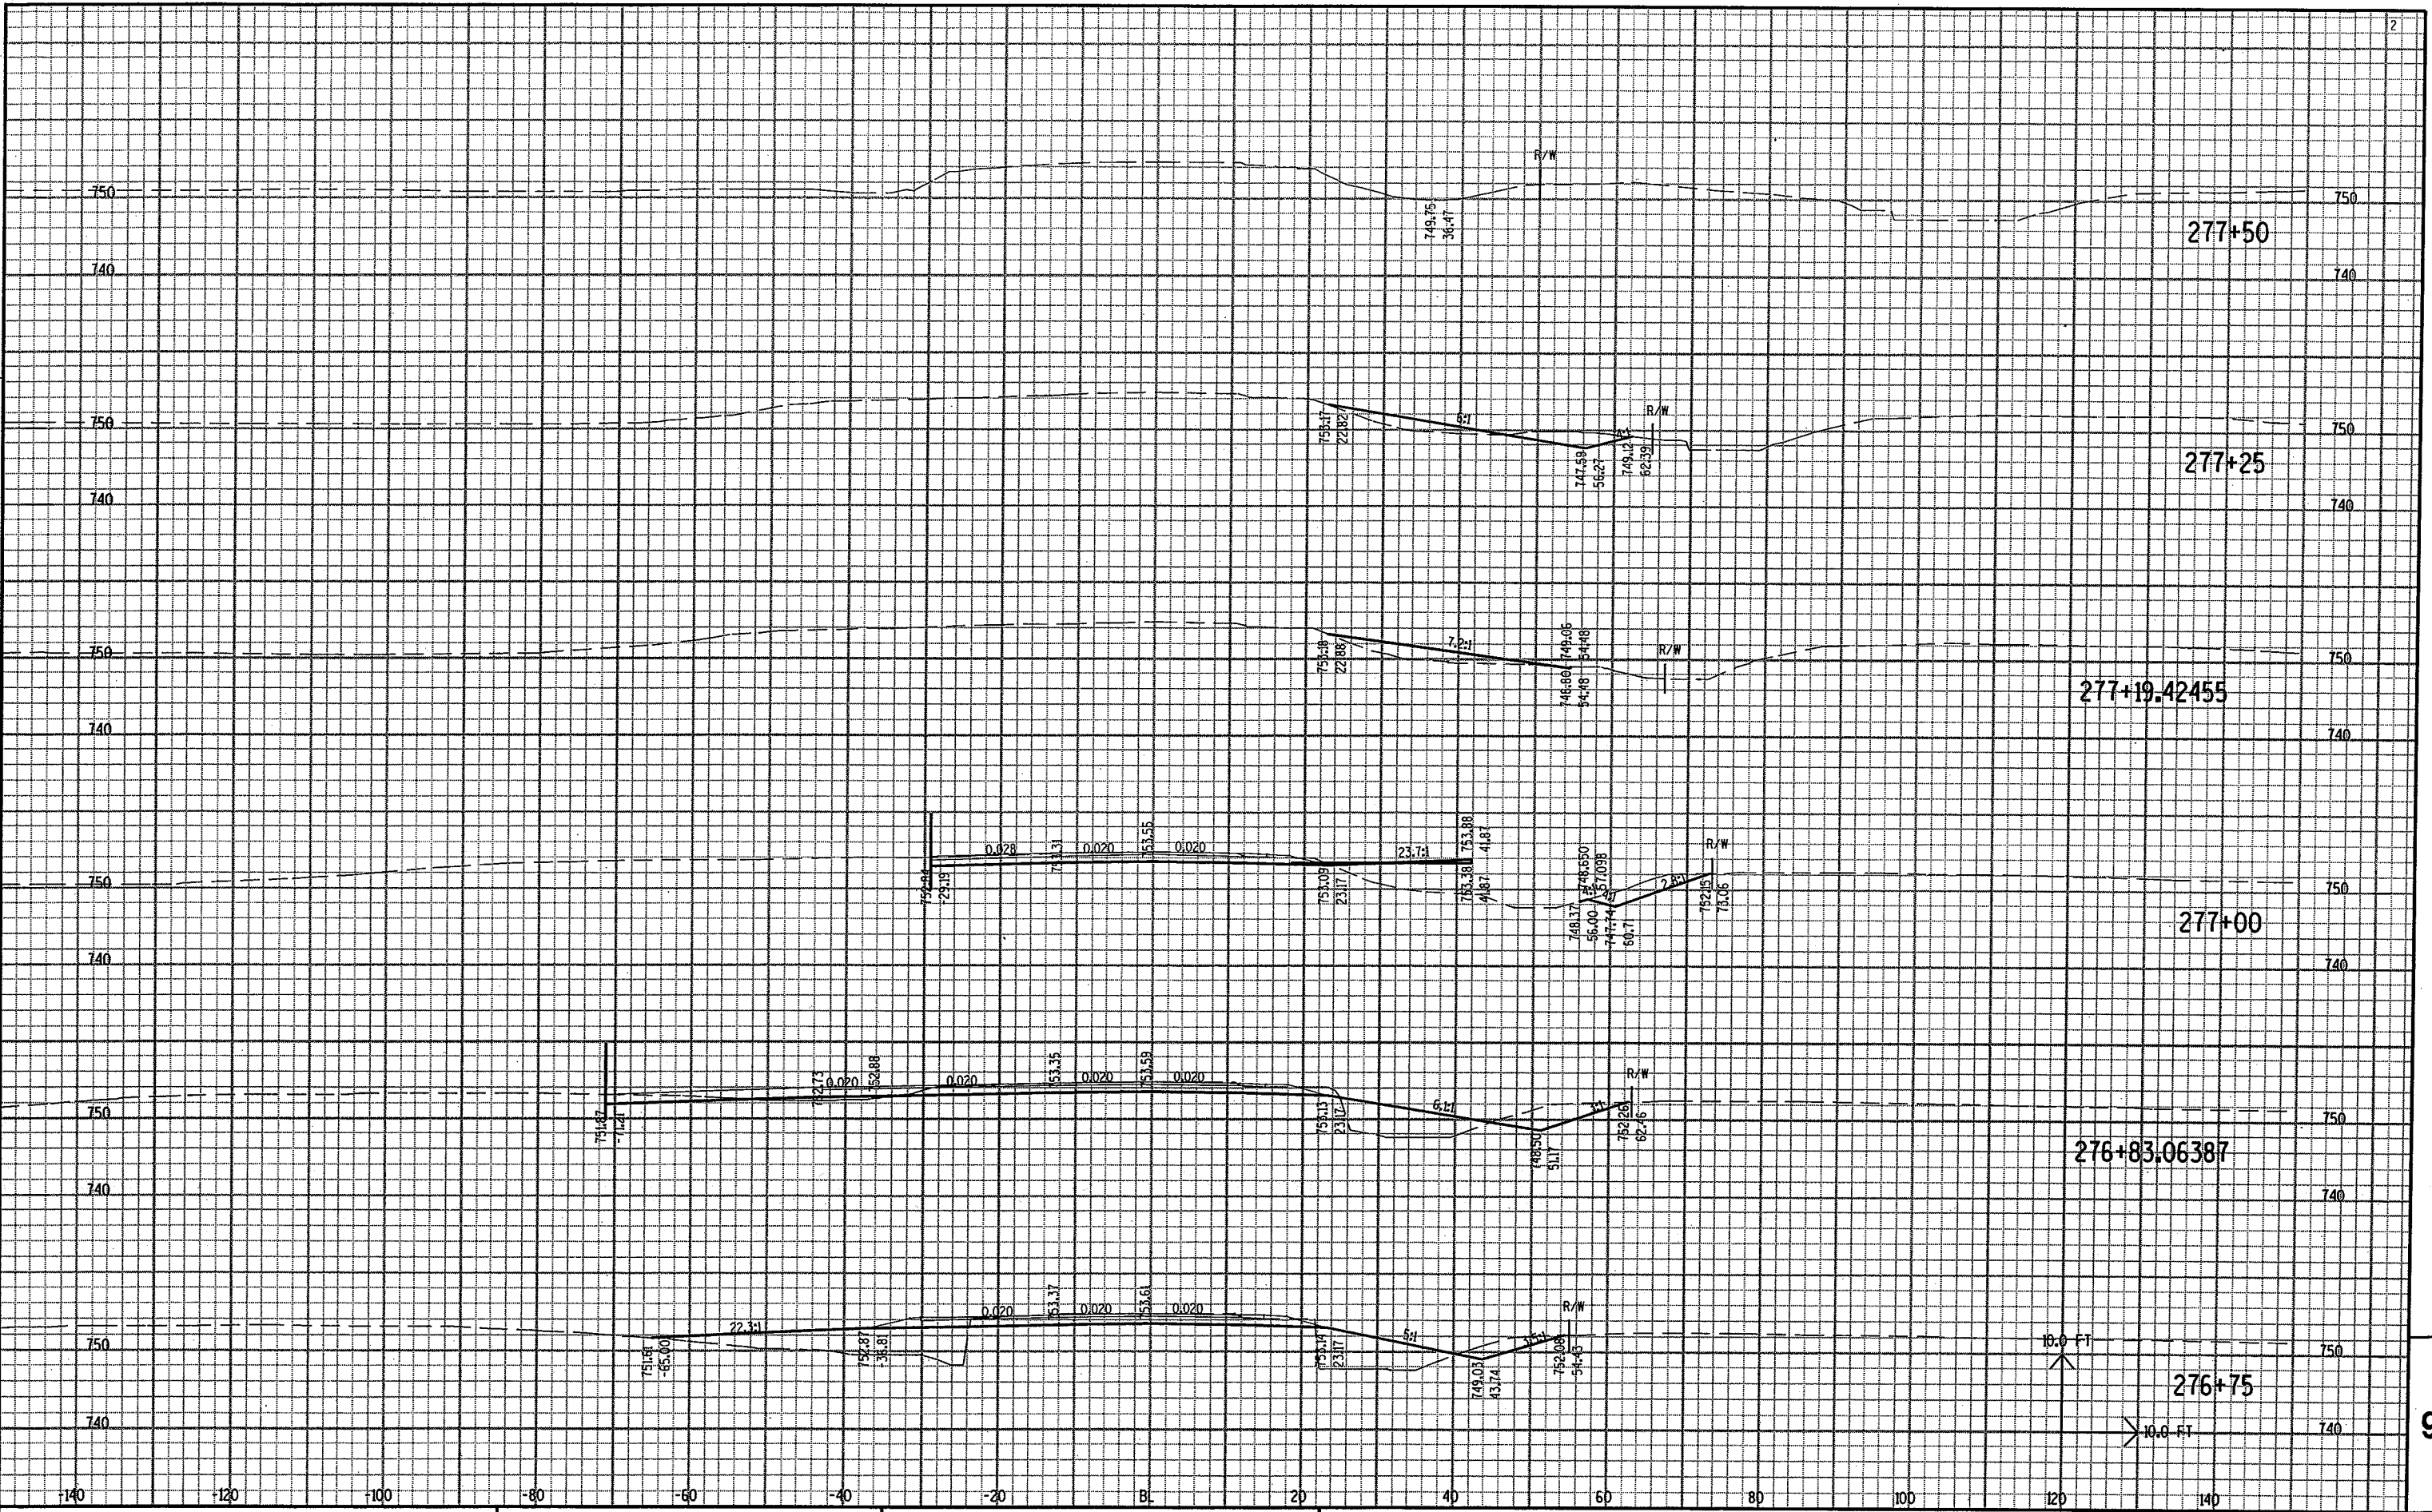

PROJECT NO: 6200-07-71

HWY: CTH II

COUNTY: WINNEBAGO

CROSS SECTIONS -- CTH II AT C-70-69

SHEET NO:

E

LEVELS ON - 1, 2, 3, 62, 63



PROJECT NO: 6200-07-71

HWY: CTH II

COUNTY: WINNEBAGO

CROSS SECTIONS -- CTH II AT INTERSECTION

SHEET NO:

E

FILE NAME : C:\Users\PJ\Documents\STH110\Drawings\newcurve\toxs.DGN


PLOT DATE : 21-APR-2004 09:02

PLOT BY : DOTEAD

PLOT NAME :

PLOT SCALE : 1.993675:1.000000

LEVELS ON * 1, 2, 3, 62, 63

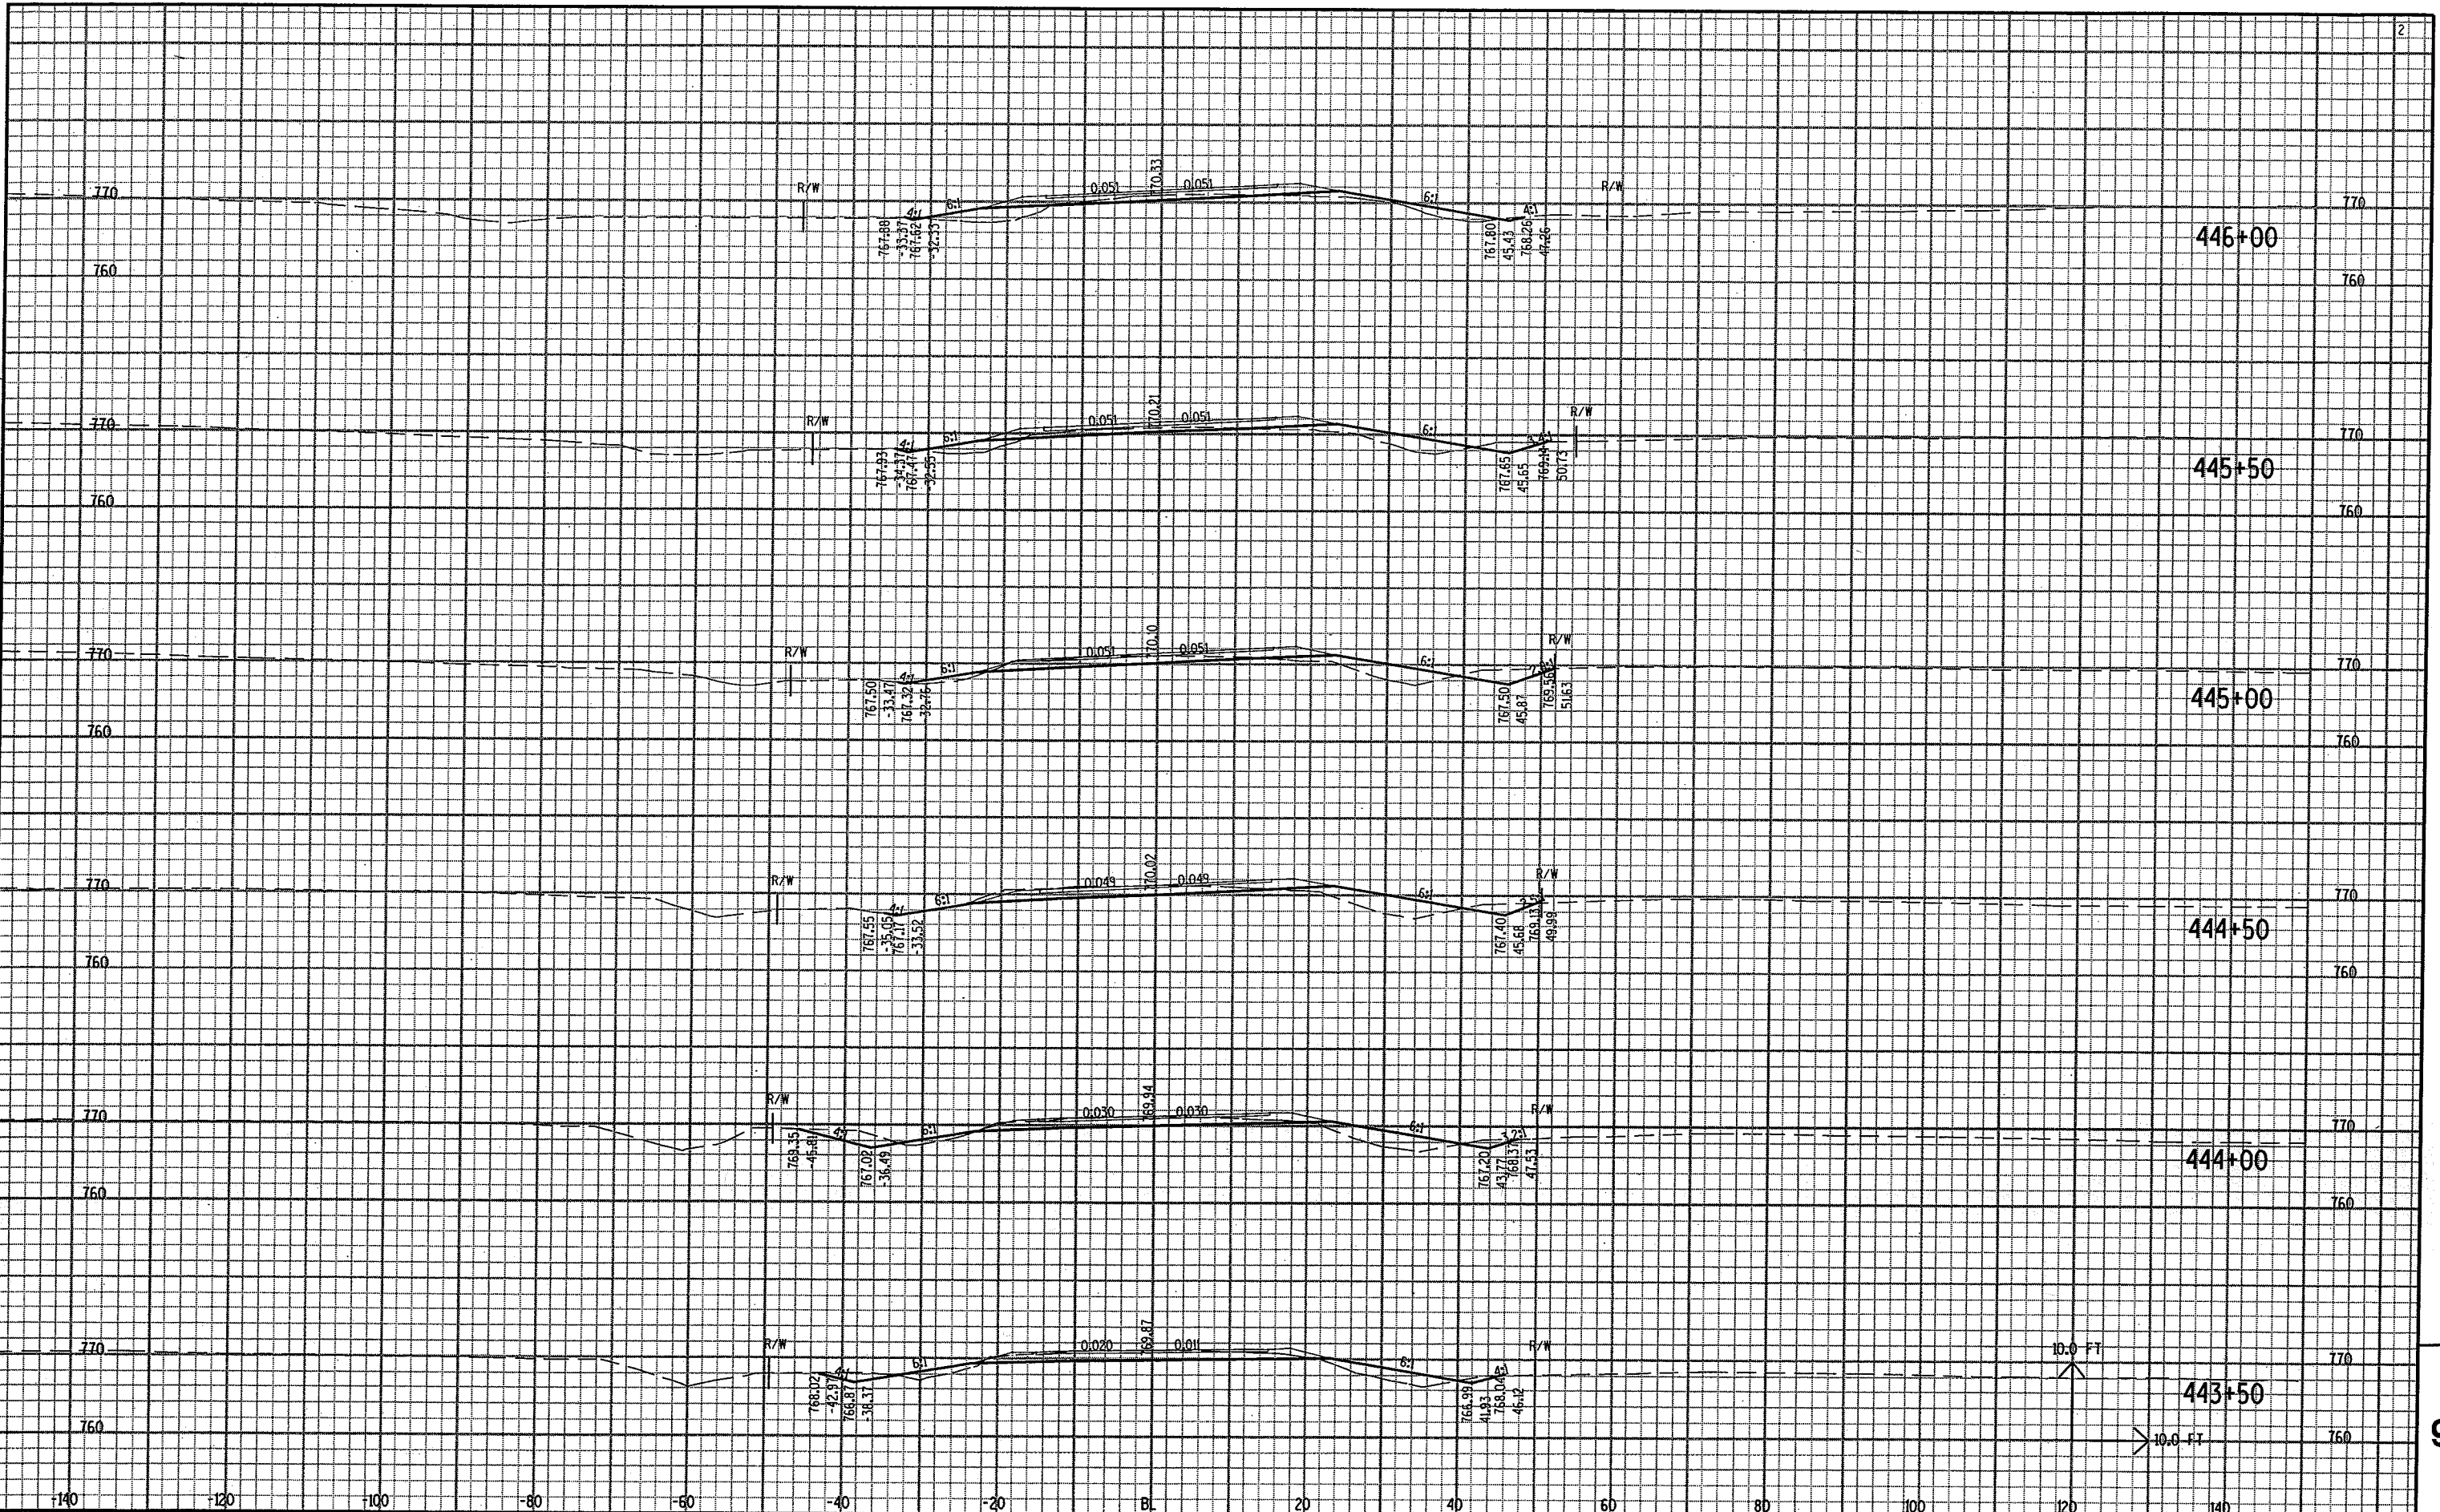

PROJECT NO: 6200-07-11

HWY: CTH II

COUNTY: WINNEBAGO

CROSS SECTIONS -- CTH II AT INTERSECTION

SHEET NO:

E

FILE NAME : C:\Users\VPD3\STH110\DN FILES\newhourve70xs.dgn


PLOT DATE : 21-APR-2004 09:02

PLOT BY : DOT/EAJ

PLOT NAME :

PLOT SCALE : 1.993675:1.000000

LEVELS ON: 1, 2, 3, 62, 63

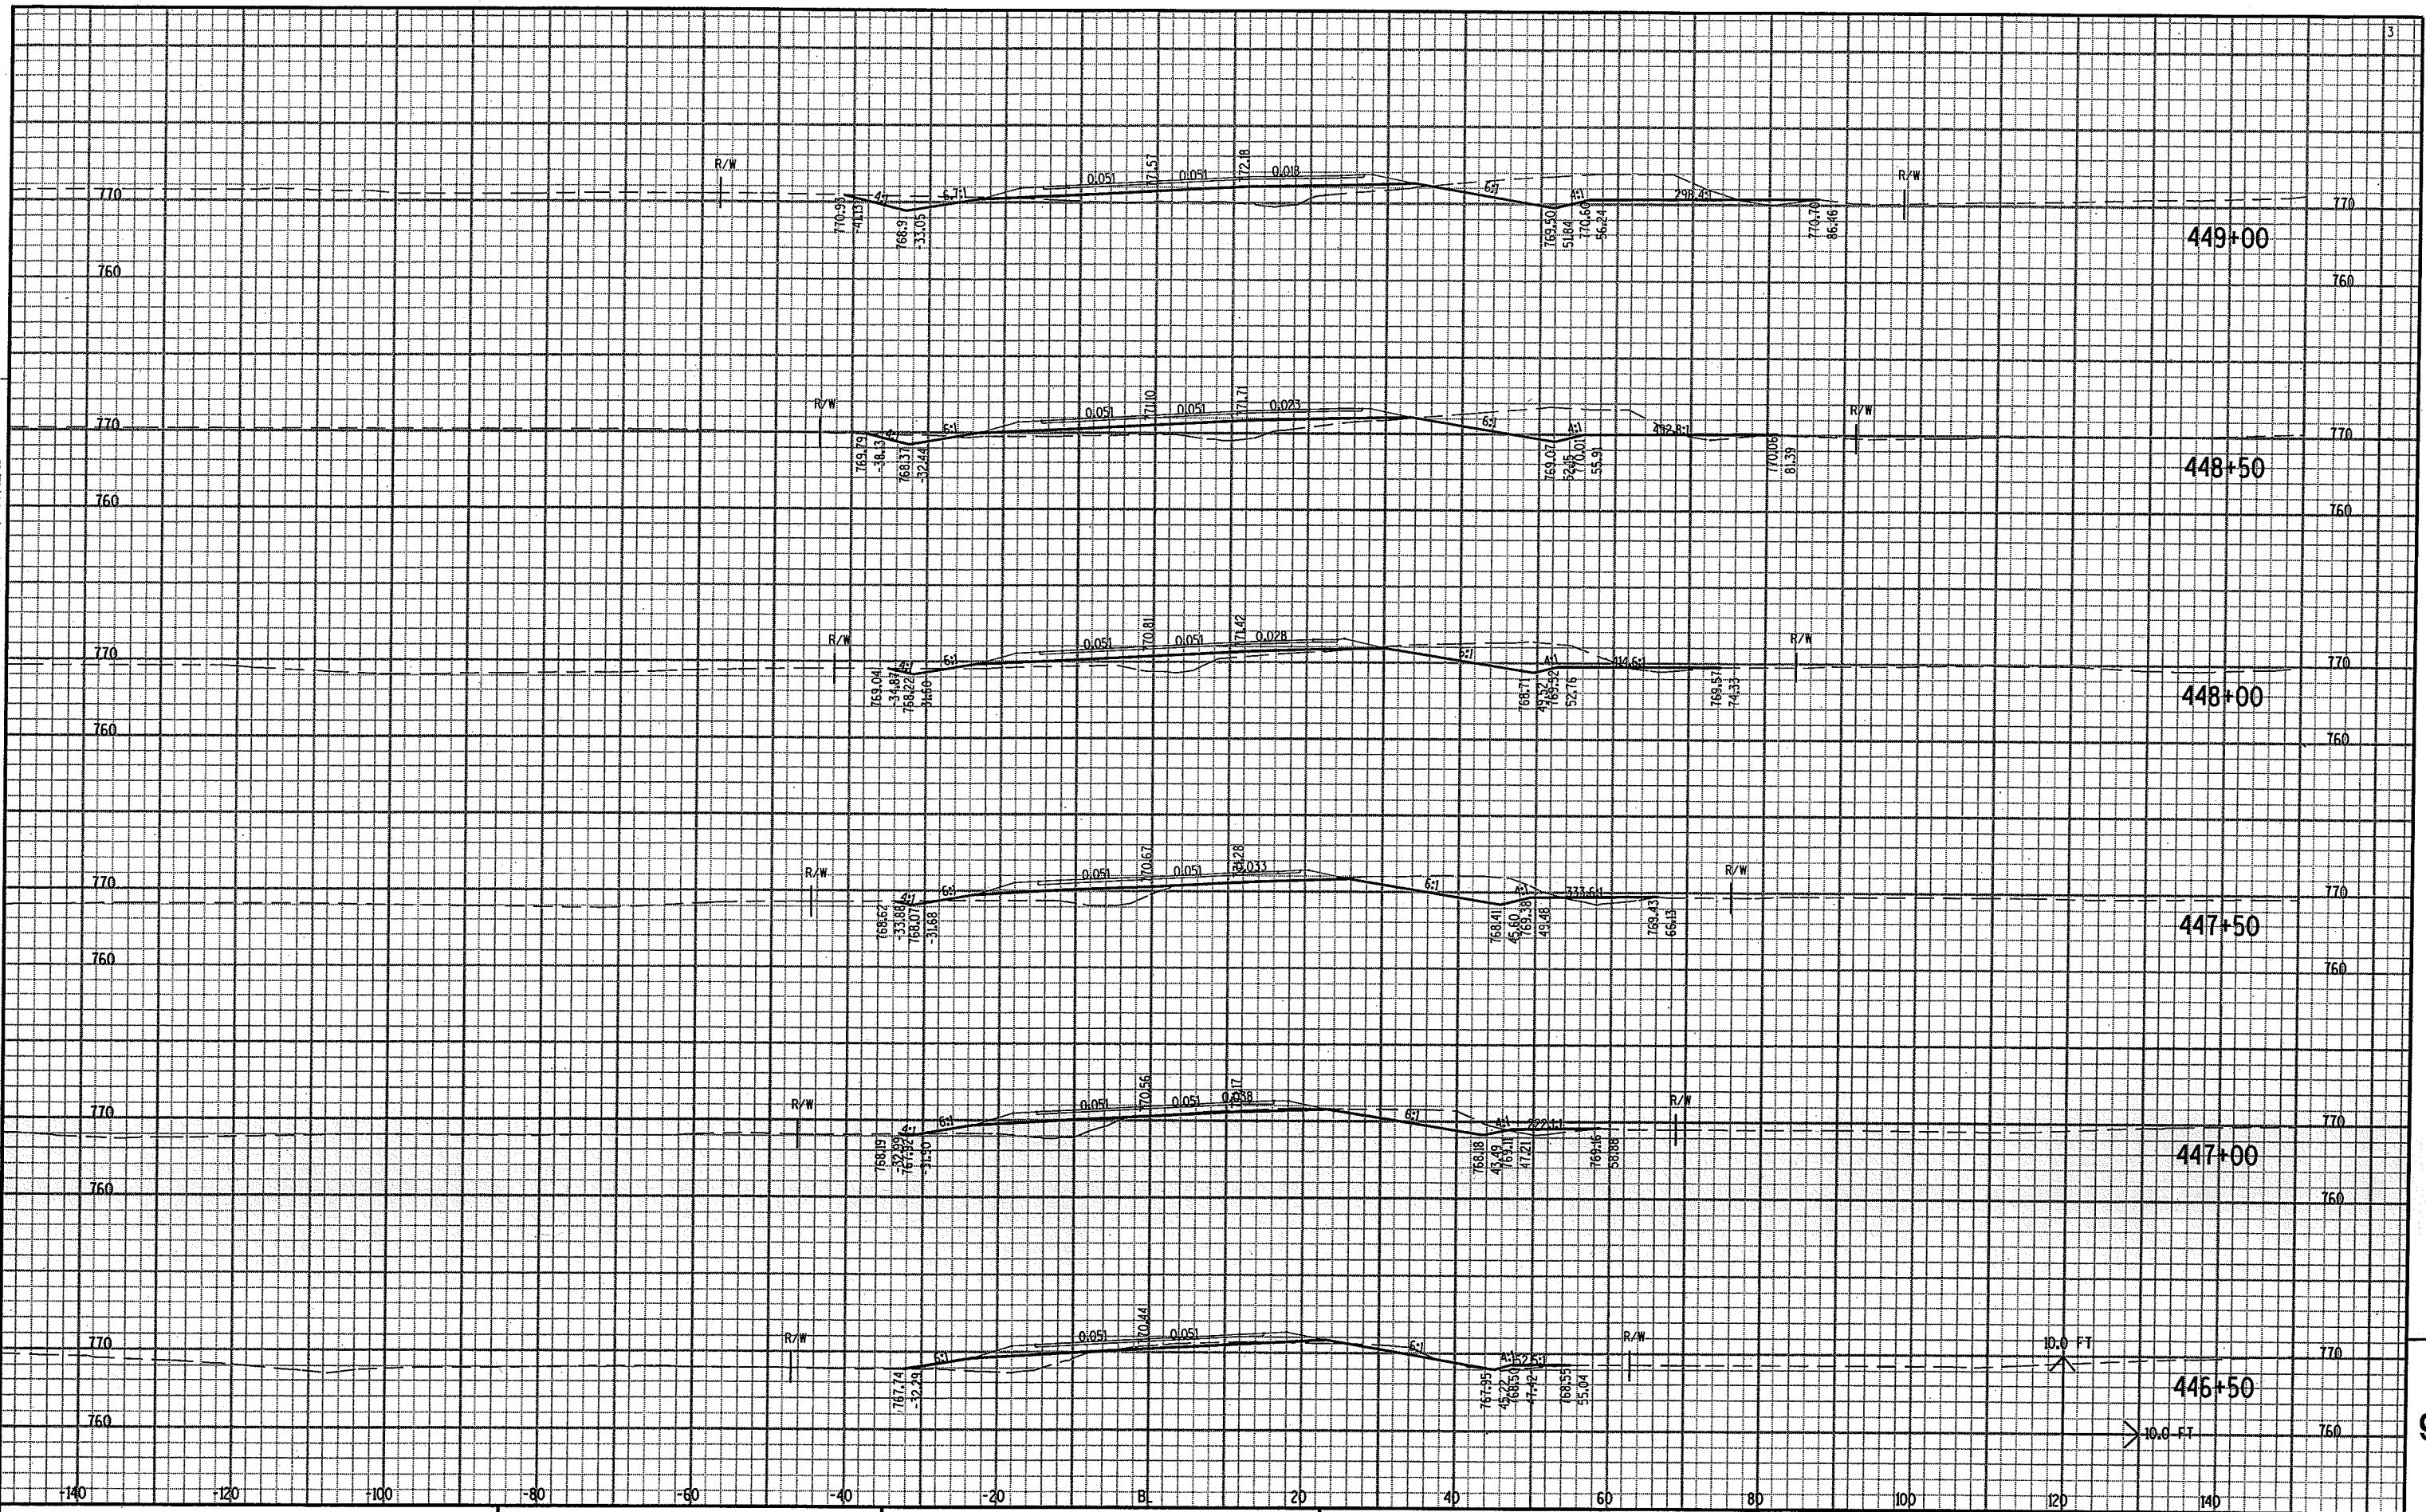

PROJECT NO: 6200-07-71

HWY: CTH II


COUNTY: WINNEBAGO

CROSS SECTIONS -- CTH II AT INTERSECTION

SHEET NO:

E


LEVELS ON: 1, 2, 3, 62, 63

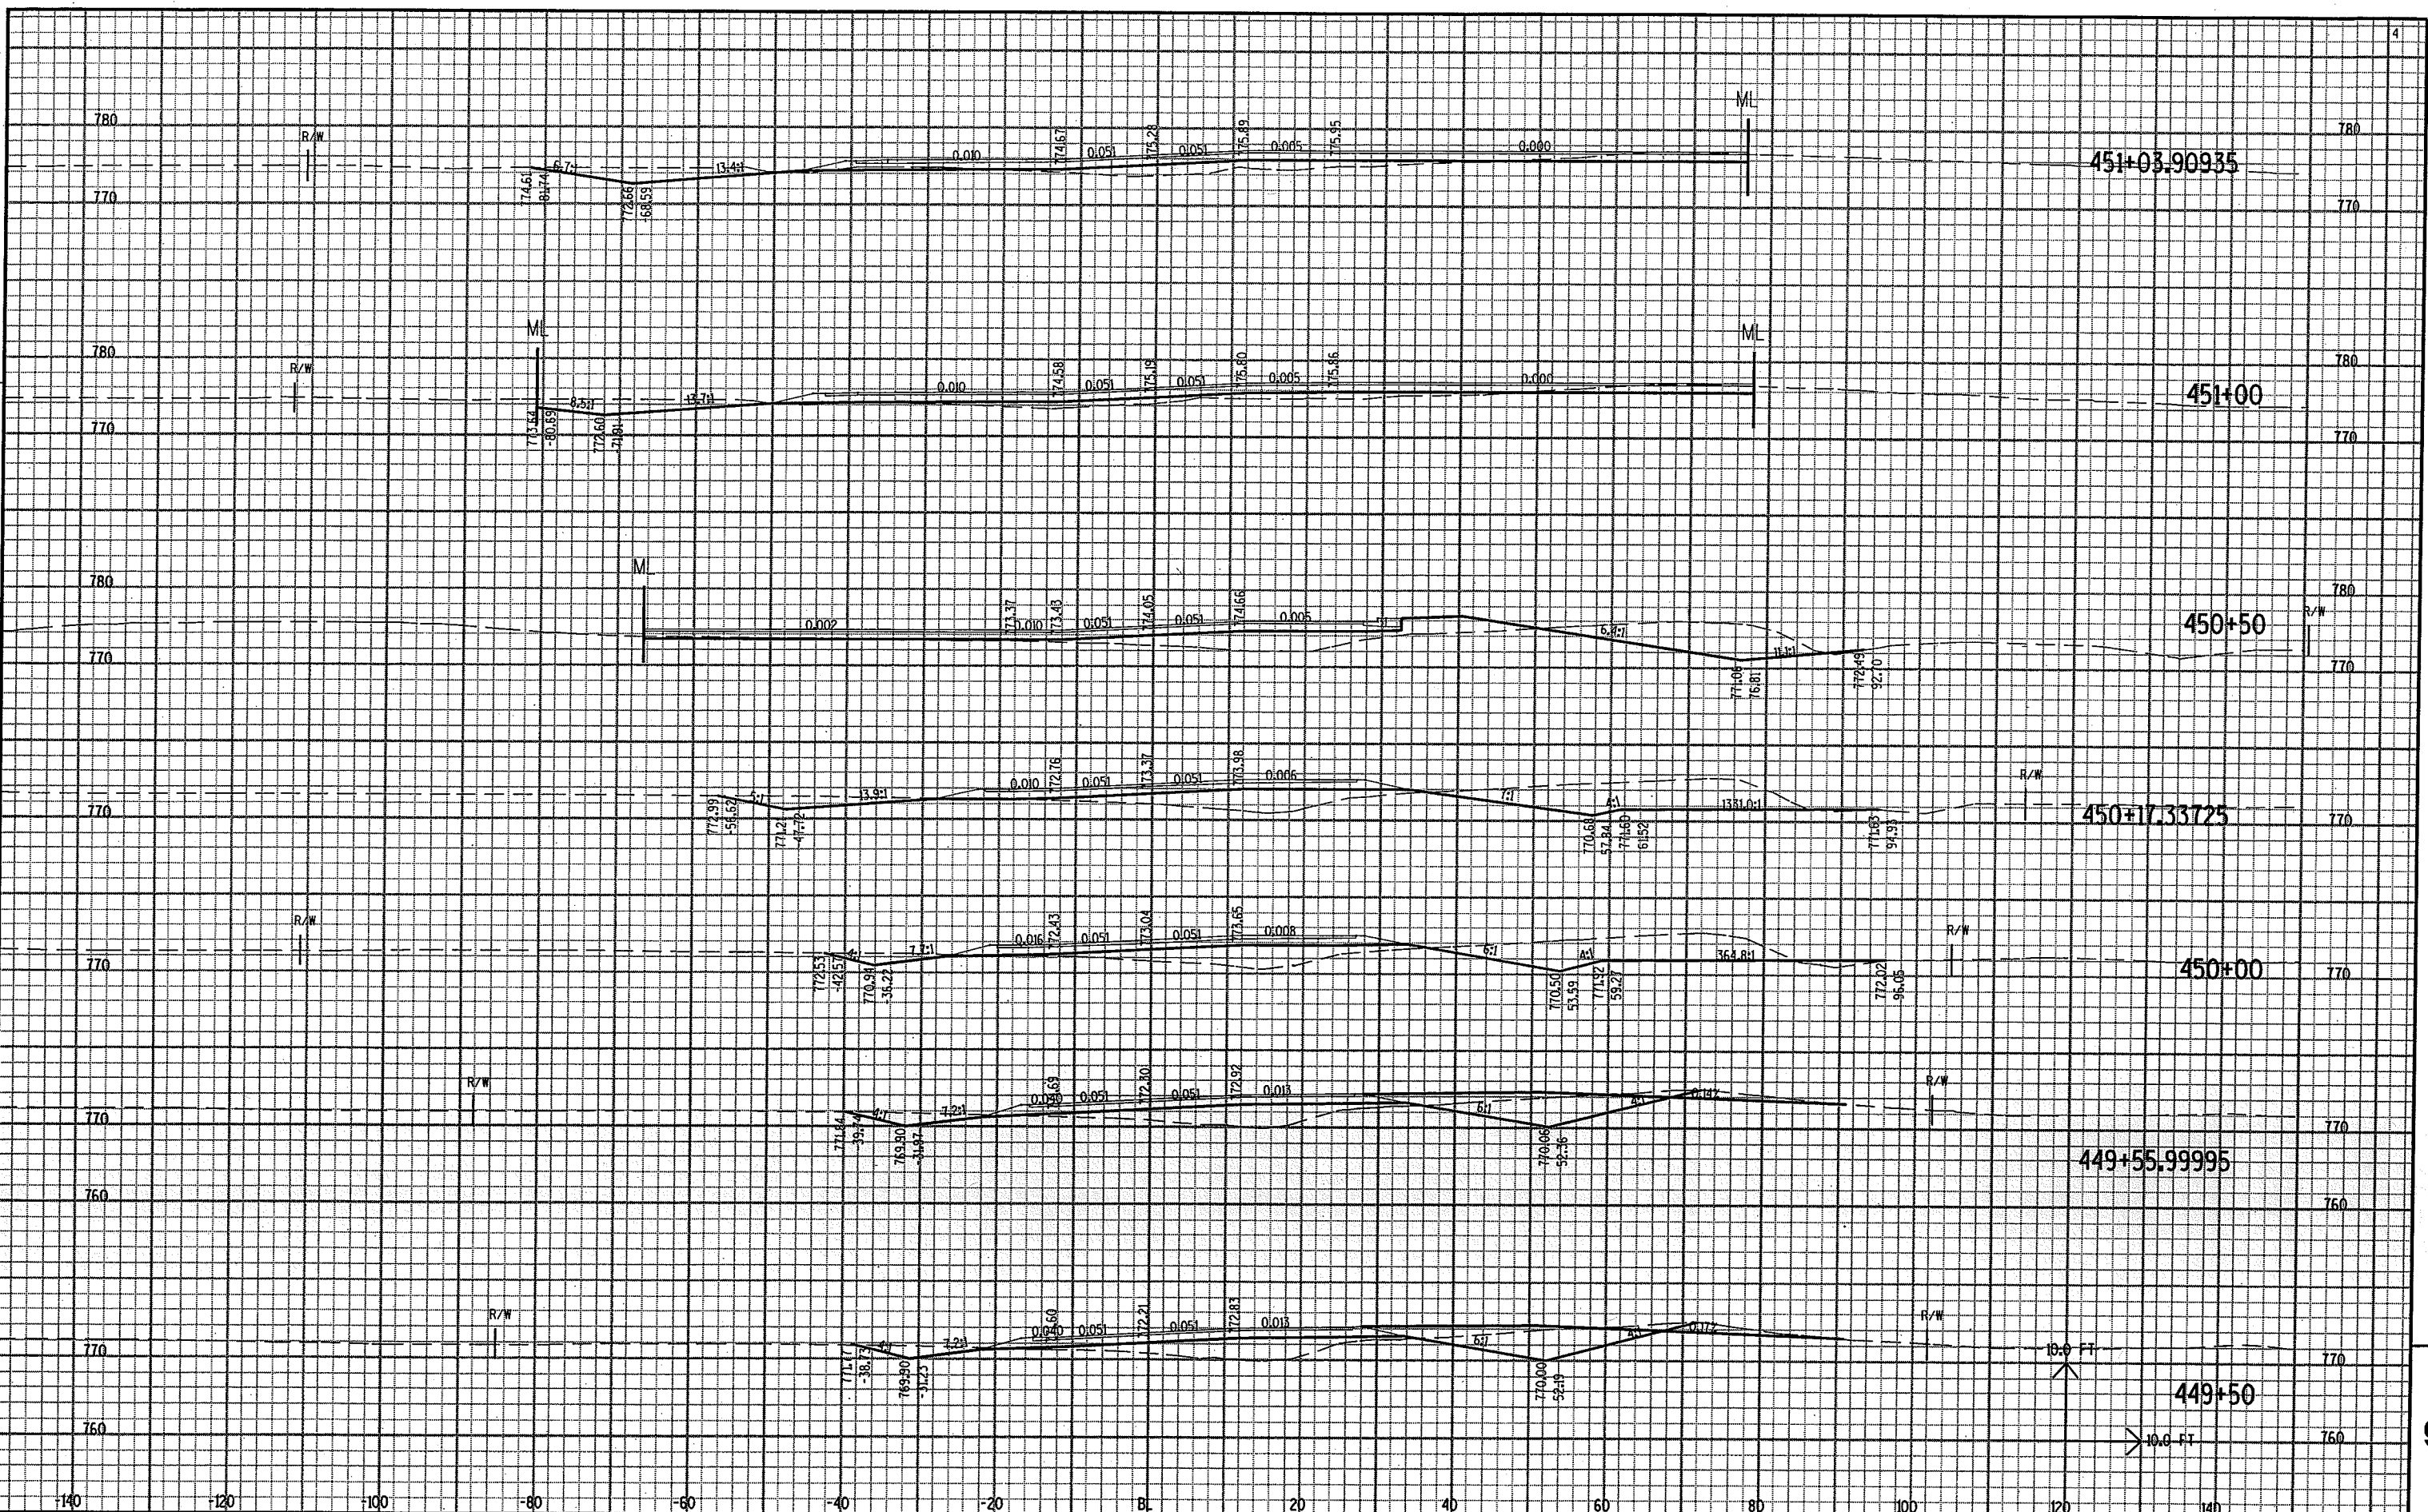

PROJECT NO: 6200-07-71	HWY: CTH II	COUNTY: WINNEBAGO	CROSS SECTIONS -- CTH II AT INTERSECTION	SHEET NO:	E
------------------------	-------------	-------------------	--	-----------	---

FILE NAME : C:\Users\VP\03\STH110\XGN FILES\newcurvefoxs.DGN PLOT DATE : 21-APR-2004 09:02 PLOT BY : DOTEAD PLOT NAME : PLOT SCALE : 1.993675:1.00000

LEVELS ON: 1, 2, 3, 62, 63

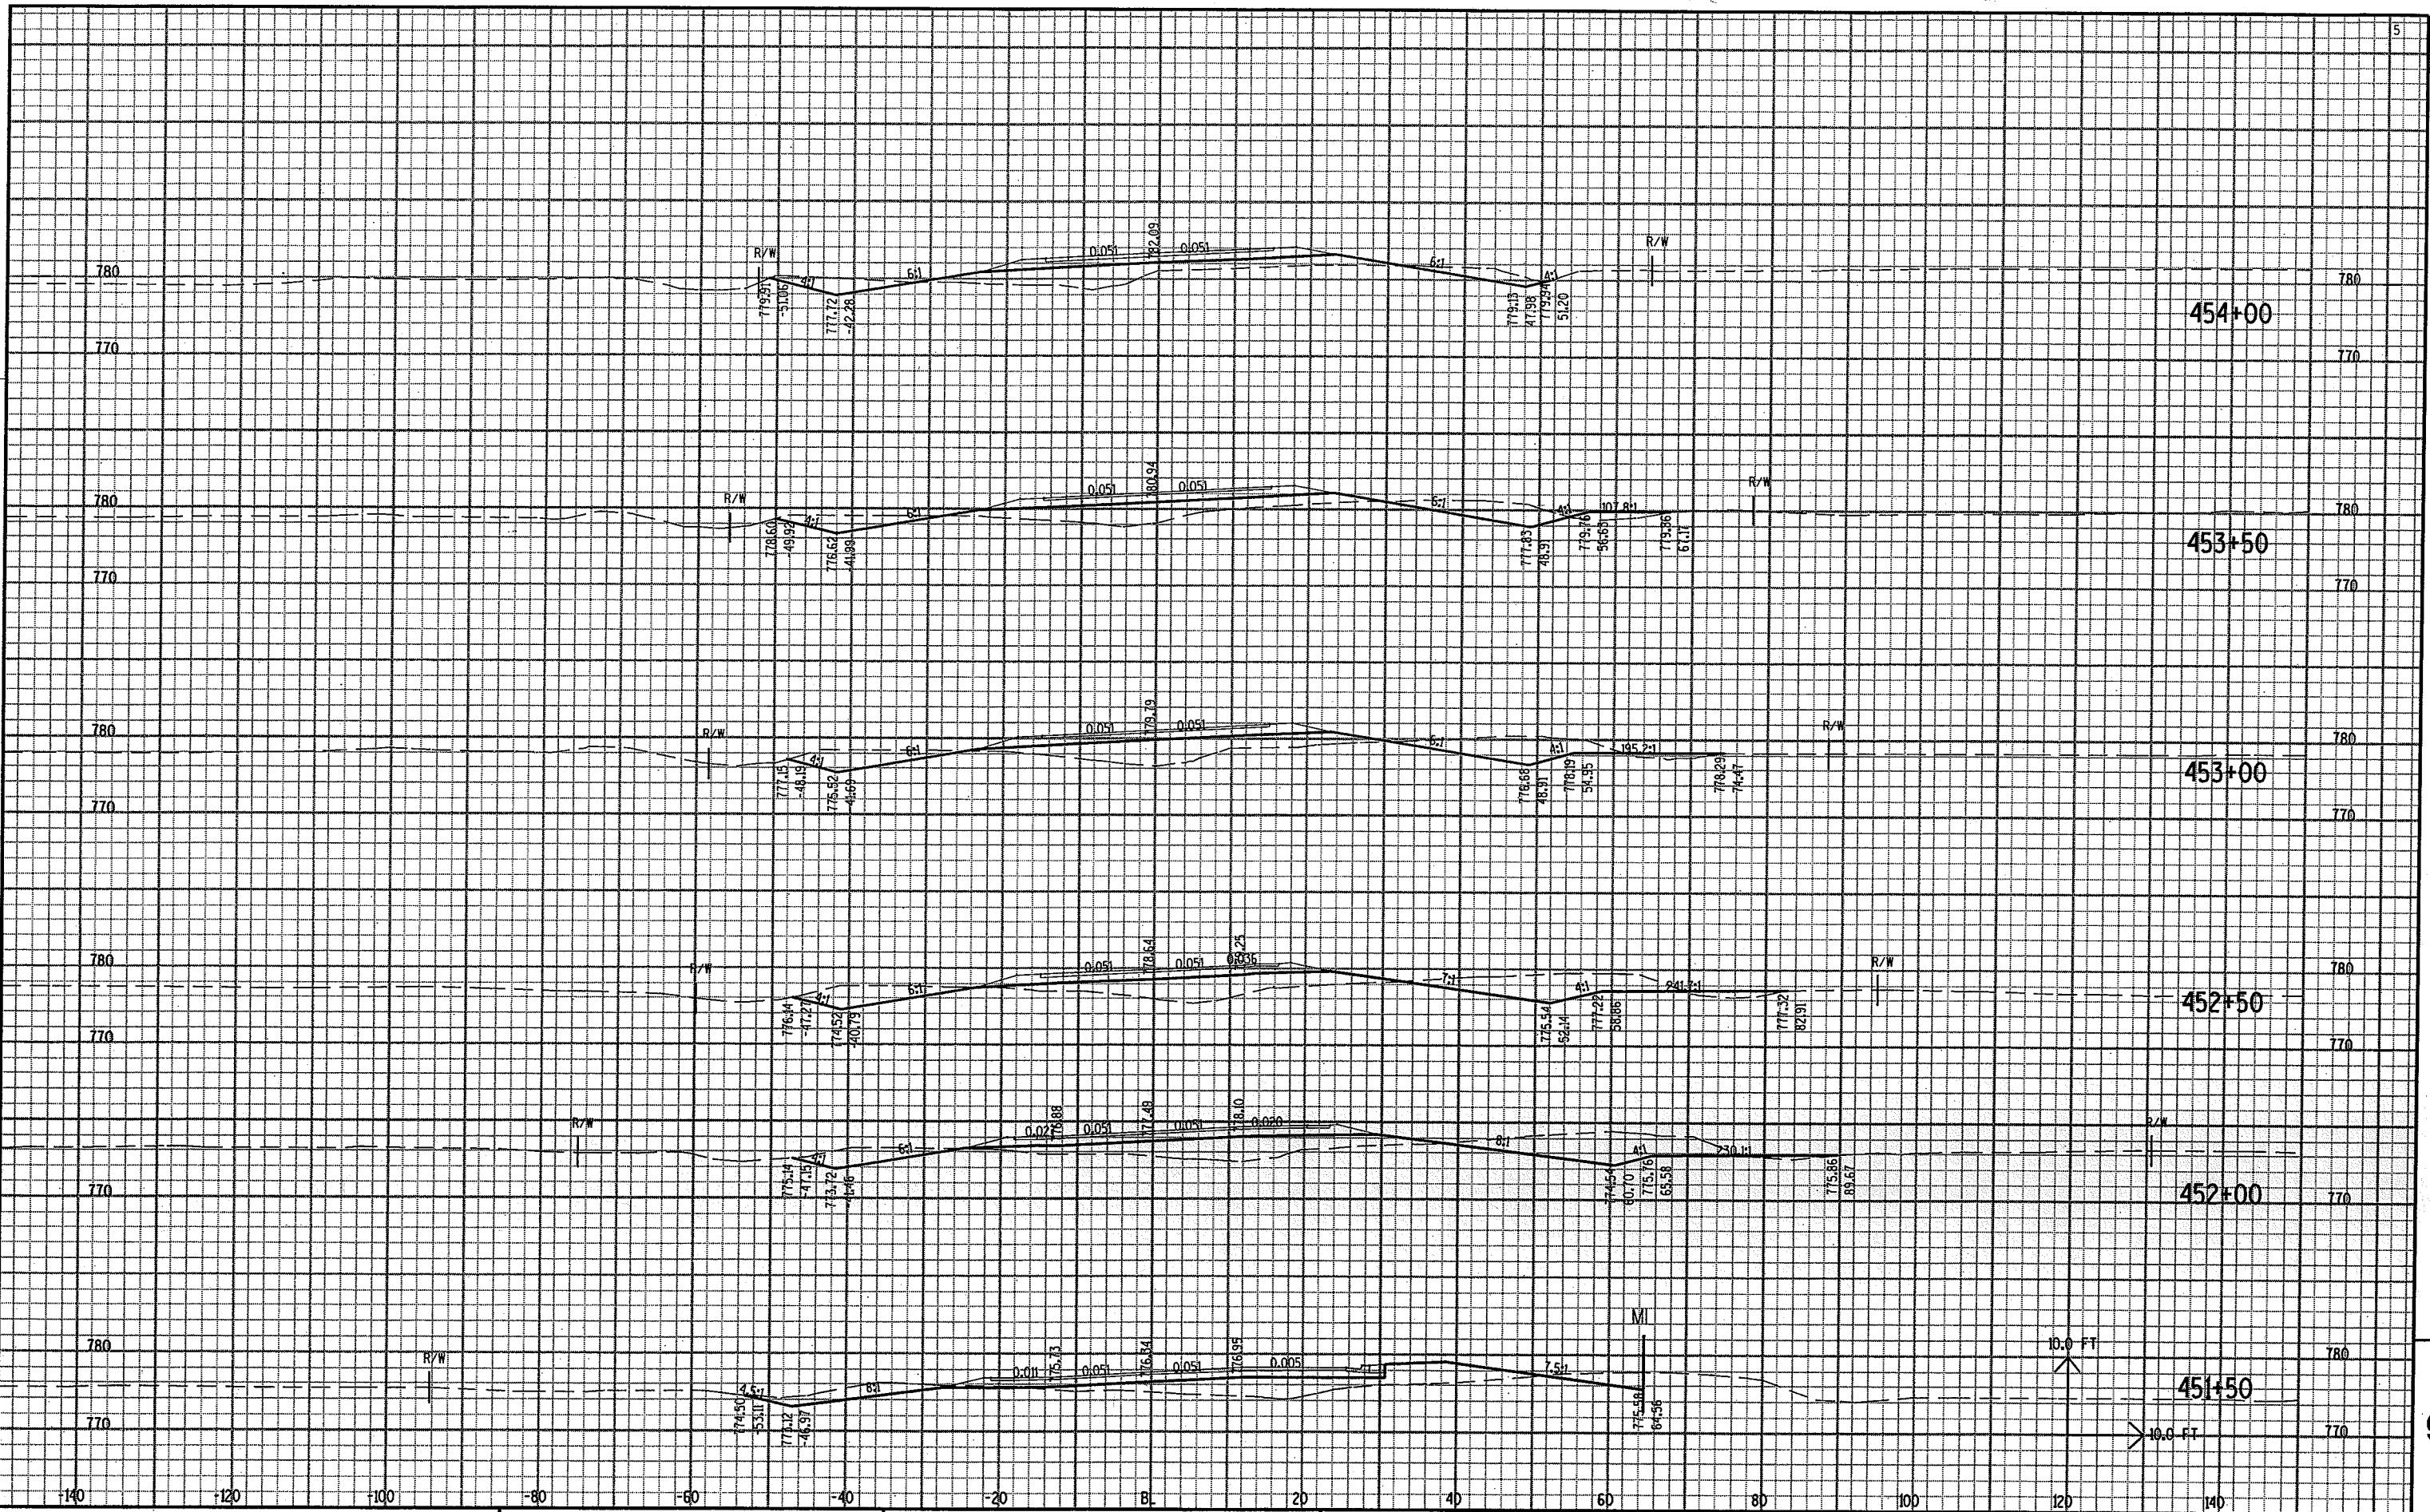

PROJECT NO: 6200-07-71

HWY: CTH II

COUNTY: WINNEBAGO

CROSS SECTIONS -- CTH II AT INTERSECTION

SHEET NO:

E

FILE NAME : C:\Users\VP\03\STH110\DCN FILES\newhourveToxs.DGN

PLOT DATE : 21-APR-2004 09:02


PLOT BY : DOTEAD

PLOT NAME :

PLOT SCALE : 1.993675:1.000000

9

LEVELS ON - 1, 2, 3, 62, 63

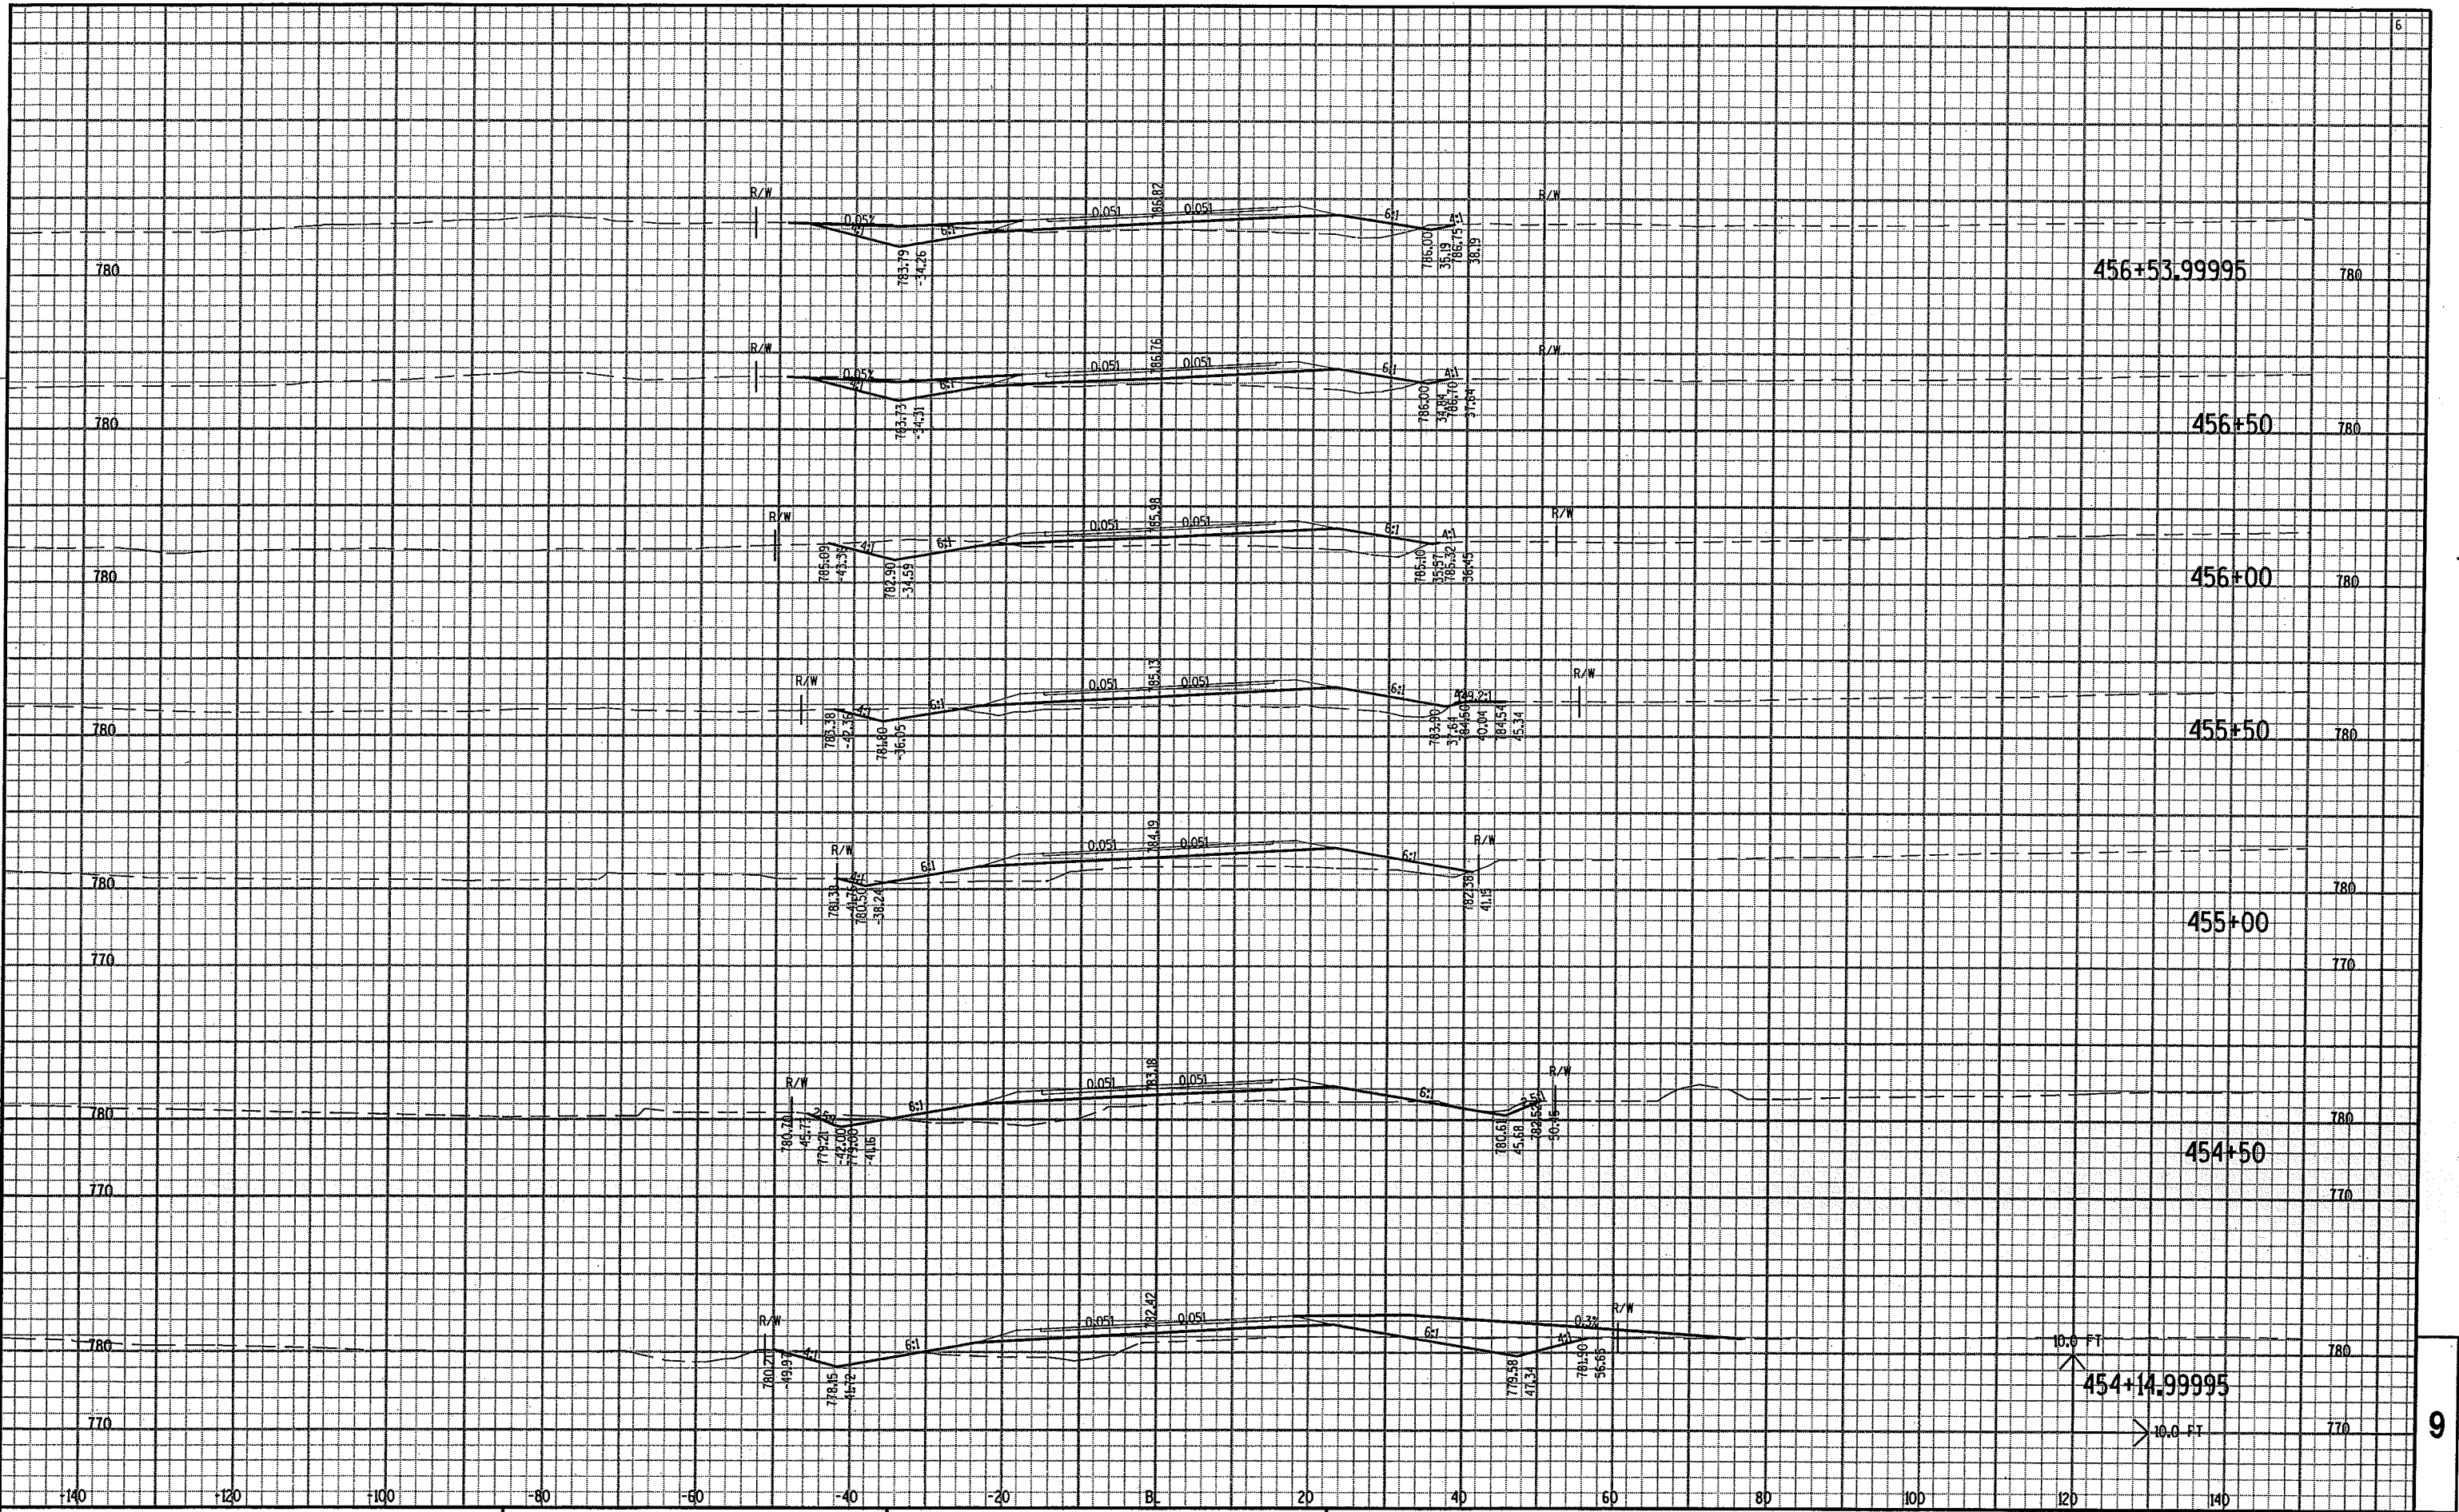

PROJECT NO: 6200-07-71

HWY: CTH II

COUNTY: WINNEBAGO

CROSS SECTIONS -- CTH II AT INTERSECTION

SHEET NO:

E

FILE NAME : C:\Users\PKD3\STH110\DGN FILES\new\curveToxs.DGN

PLOT DATE : 21-APR-2004 09:03

PLOT BY : DOTEAD

PLOT NAME :

PLOT SCALE : 1.993675:1.00000

9

LEVELS ON - 1, 2, 3, 62, 63



PROJECT NO: 6200-07-71	HWY: CTH II	COUNTY: WINNEBAGO	CROSS SECTIONS -- CTH II AT INTERSECTION	SHEET NO:	E
------------------------	-------------	-------------------	--	-----------	---

FILE NAME : C:\Users\VPD3\STH110\DN FILES\newhourve70xs.DGN PLOT DATE : 21-APR-2004 09:03 PLOT BY : DOTEAD PLOT NAME : PLOT SCALE : 1.993675:1.000000

LEVELS ON * 1, 2, 3, 62, 63



PROJECT NO: 6200-07-71

HWY: CTH II

COUNTY: WINNEBAGO

CROSS SECTIONS -- CTH II AT INTERSECTION

SHEET NO:

9

FILE NAME : C:\Users\PD3\STH110\DN FILES\newcurve70xs.DGN

PLOT DATE : 21-APR-2004 09:03

PLOT BY : DOTEAD

PLOT NAME :

PLOT SCALE : 1.993675:1.000000

LEVELS ON 1, 2, 3, 62, 63



PROJECT NO: 6200-07-71

HWY: CTH II

COUNTY: WINNEBAGO

CROSS SECTIONS -- CTH M

SHEET NO:

9 E

FILE NAME : C:\Users\VP03\STH110\DGN FILES\newcthm6xs.DGN


PLOT DATE : 21-APR-2004 09:01

PLOT BY : DOTEAD

PLOT NAME :

PLOT SCALE : 1.993675:1.000000

LEVELS ON : 1.2 3.4 5.6 7.8 9.0 10.0 11.0 63.0

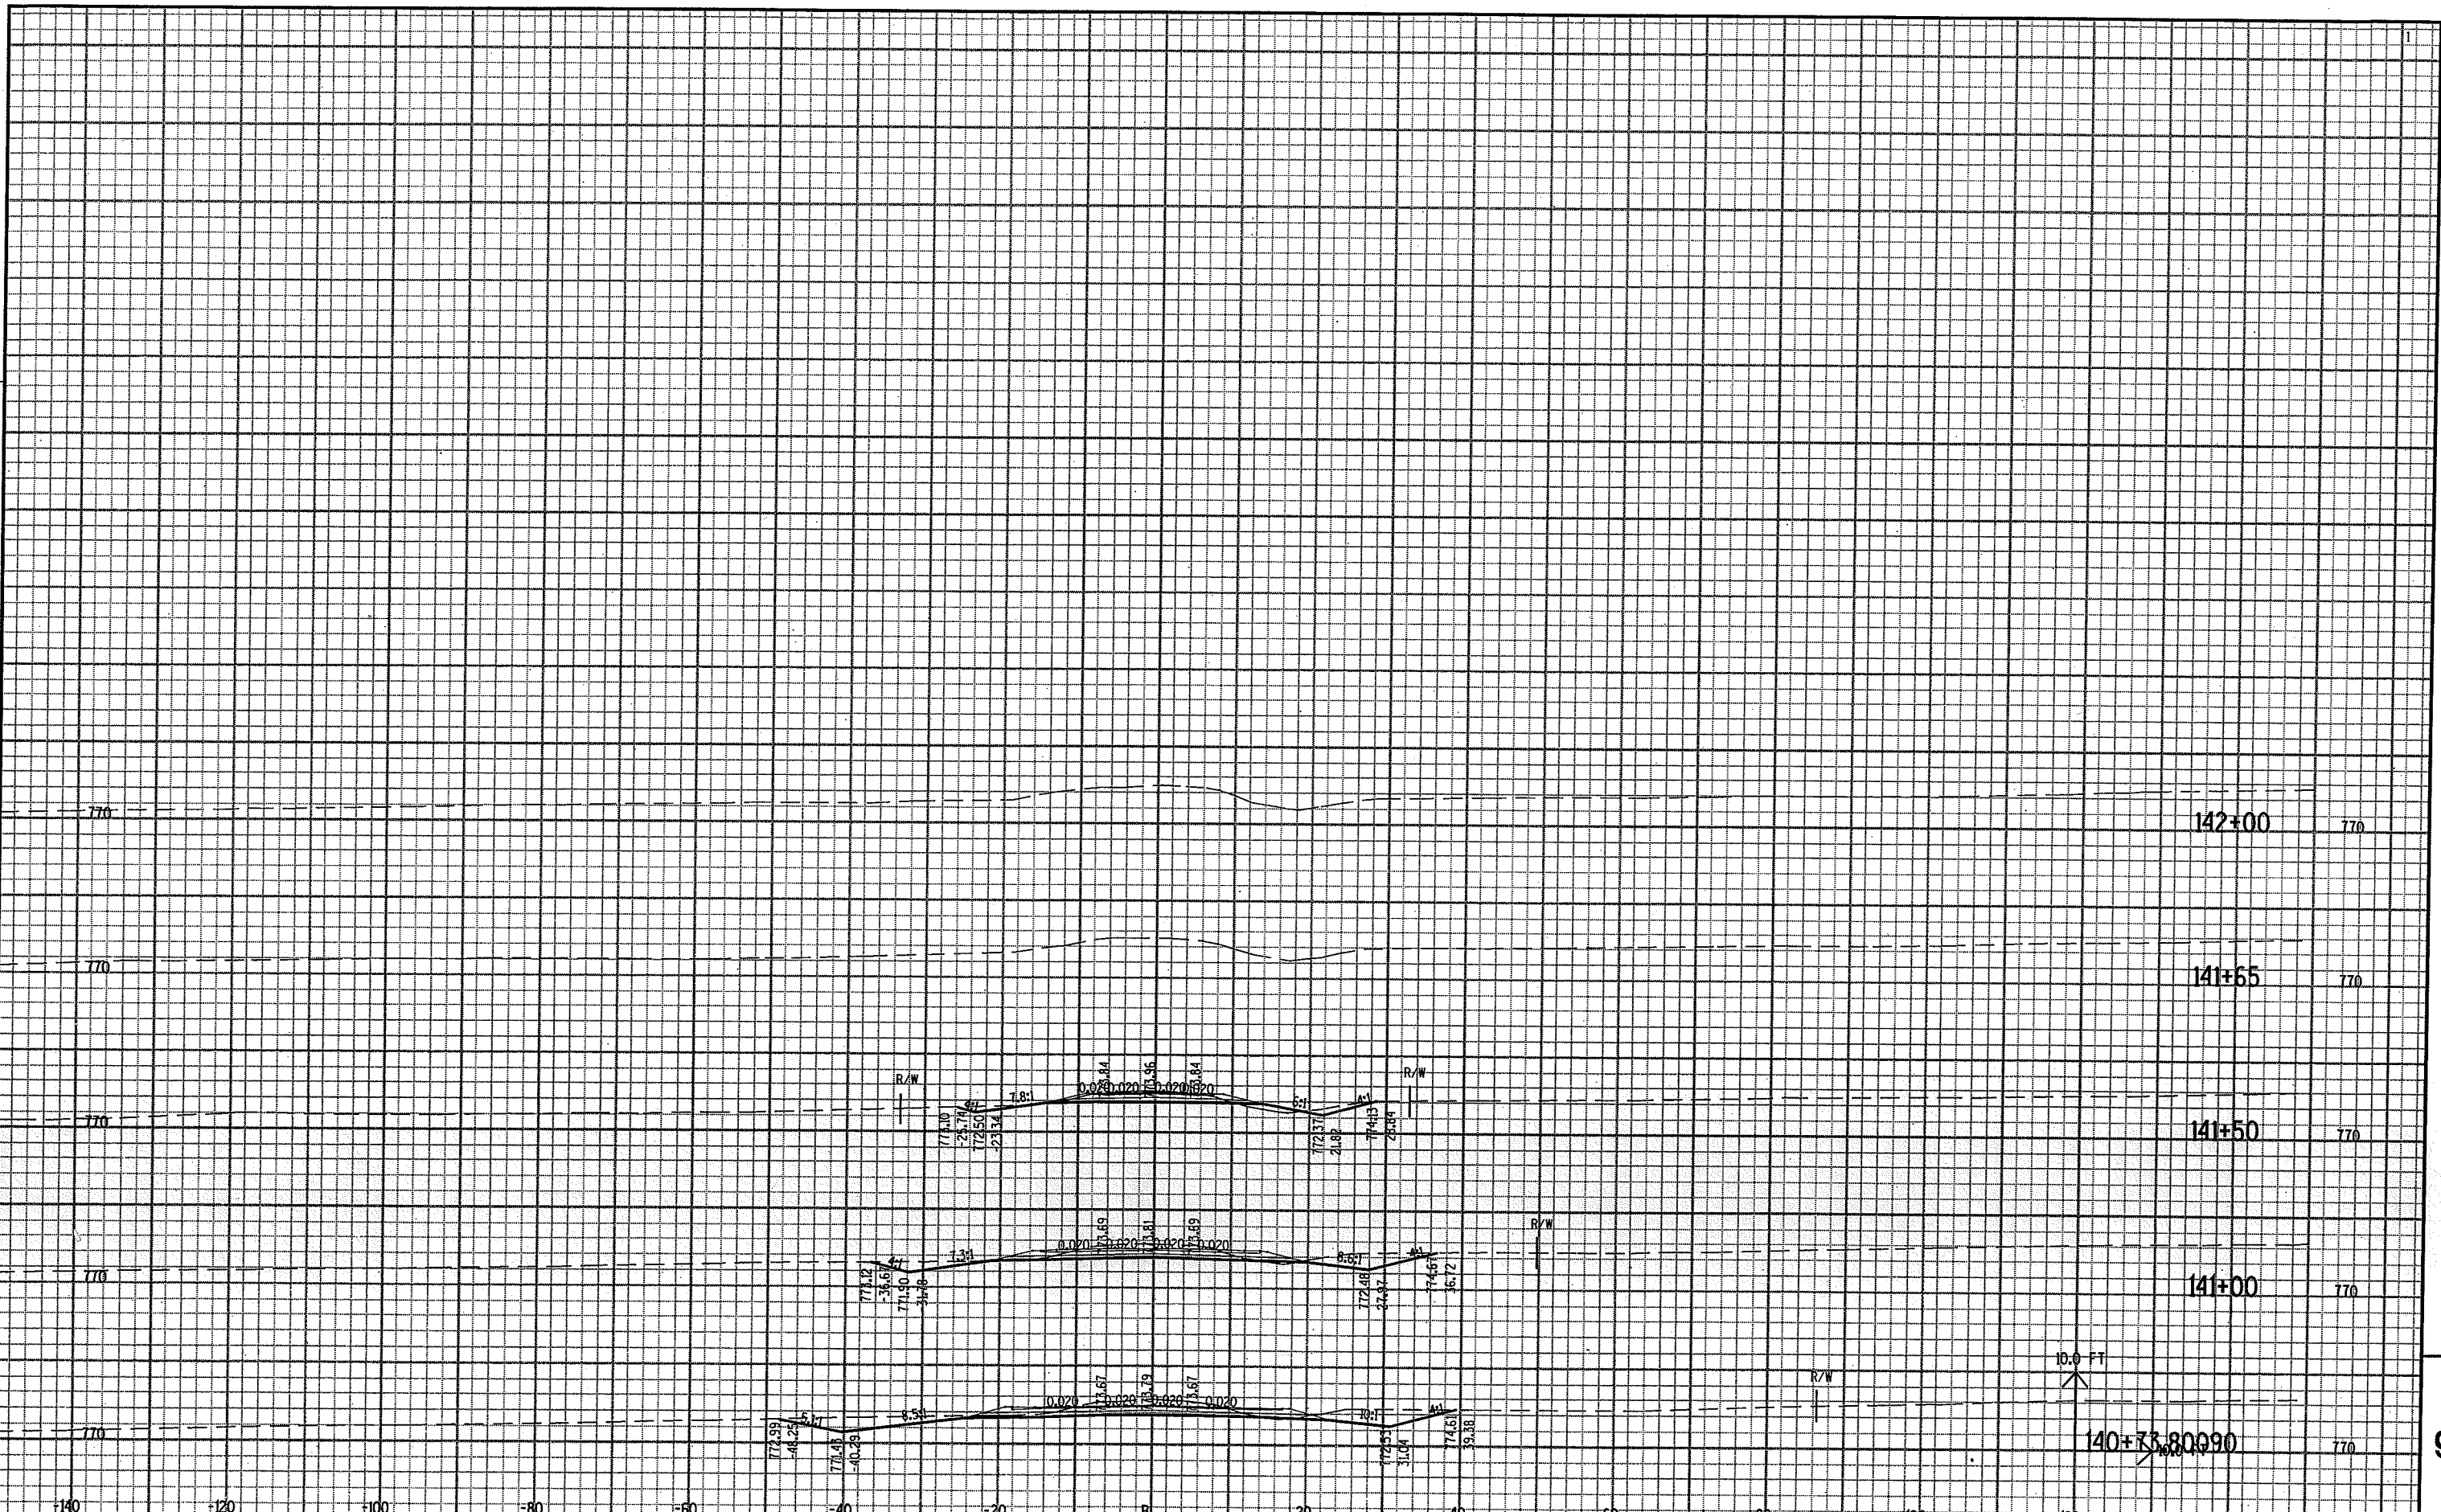

PROJECT NO: 6200-07-71

HWY: CTH II

COUNTY: WINNEBAGO

CROSS SECTIONS -- ERICKSON ROAD

SHEET NO:

E

FILE NAME : C:\Users\VP\03\STH110\DXG FILES\newer\k4\ks.DGN

PLOT DATE : 21-APR-2004 09:02

PLOT BY : DOTEAD

PLOT NAME :

PLOT SCALE : 1.993675:1.000000

9