

INDEX OF SHEETS

Sheet No. 1	Title
Sheet No.	Typical Sections and Details
Sheet No.	Miscellaneous Quantities
Sheet No.	Plan and Profile
Sheet No.	Computer Earthwork Data
Sheet No.	Cross Sections

TOTAL SHEETS =


WINNEBAGO COUNTY

PLAN OF PROPOSED IMPROVEMENT


CTH M

LIMITS

SOUTH COUNTY LINE TO STH 44

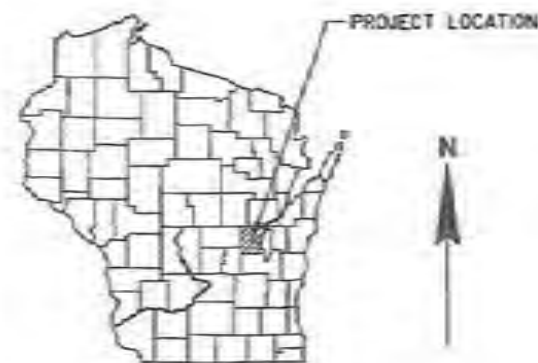

SEH PROJECT NUMBER
A WINNW0302.00

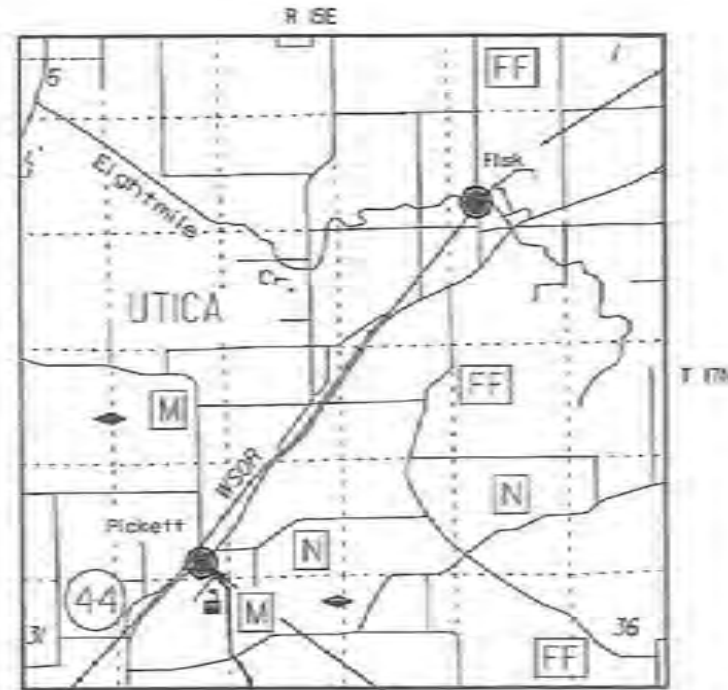

DESIGN DESIGNATION

A.D.T. 2007	=	958
A.D.T. 2027	=	1333
D.A.V.	=	60/40
D.	=	0.50
T.	=	7.62
DESIGN SPEED	=	56/40
ESALS	=	197,100


CONVENTIONAL SYMBOLS

COUNTY LINE		COMBUSTIBLE FLUIDS	
CORPORATE LIMITS		UNDERGROUND UTILITIES	
PROPERTY LINE		GAS	
LOT LINE		ELECTRIC	
LIMITED EASEMENT		TELEPHONE OR TELEGRAPH	
EARTHWORK BALANCE POINT		TV/CABLE	
EXISTING RIGHT OF WAY		SERVICE PEDESTAL	
PROPOSED OR NEW R/W LINE		POWER POLE	
SURVEY LINE		TELEPHONE POLE	
SLOPE INTERCEPT		RAILROAD	
ORIGINAL GROUND		SANITARY SEWER	
MARSH OR ROCK PROFILE (to be noted as such)		STORM SEWER	
MARSH AREA		WATER	
WOODED OR SHRUB AREA		EXISTING CULVERT	
		PROPOSED CULVERT (Box or Pipe)	
		CULVERT (Profile View)	

BEGIN PROJECT
STA 103+75.00

Y = 428397.292
X = 744672.131

END PROJECT
STA 172+82.84

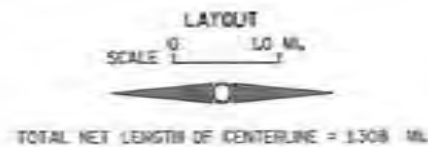

Coordinates on this plan are referenced to the Wisconsin County Coordinate System (WCCS), Winnebago County.

ACCEPTED FOR
COUNTY of WINNEBAGO
DATE: 11/31/13 *[Signature]*

ORIGINAL PLANS PREPARED BY:
SEH
MURRAY GLEN
36246-000
GREEN BAY, WI
PROFESSIONAL ENGINEER & SURVEYOR

STANDARD ABBREVIATIONS

ABUT	ABUTMENT	HYD	HYDRANT
AC	ACRE	ID	INSIDE DIAMETER
AGG	AGGREGATE	INV	INVERT
AECPRC	APRON ENDWALL FOR CULVERT PIPE REINFORCED CONCRETE	IP	IRON PIPE ON PIN
ASPH	ASPHALTIC	LHF	LEFT-HAND FORWARD
AVG	AVERAGE	L	LENGTH OF CURVE
ADT	AVERAGE DAILY TRAFFIC	LF	LINEAR FOOT
BF	BACK FACE	LC	LONG CHORD OF CURVE
BM	BENCH MARK	LS	LUMP SUM
BR	BRIDGE	MH	MANHOLE
CE	COMMERCIAL ENTRANCE	MOR	MID POINT OF RADIUS
CL OR C/L OR €	CENTER LINE	NC	NORMAL CROWN
Δ	CENTRAL ANGLE OR DELTA	NO	NUMBER
CONC	CONCRETE	OBLIT	OBLITERATE
CPRC	CULVERT PIPE REINFORCED CONCRETE	PAVT	PAVEMENT
CPRCHE	CULVERT PIPE REINFORCED CONCRETE HORIZONTAL ELLIPTICAL	PE	PRIVATE ENTRANCE
CR	CREEK	PVRC	POINT OF VERTICAL REVERSE CURVE
CY	CUBIC YARD	QOR	QUARTER POINT OF RADIUS
C & G	CURB AND GUTTER	R	RADIUS
D	DEGREE OF CURVE	REQ'D	REQUIRED
DHV	DESIGN HOUR VOLUME	RES	RESIDENCE OR RESIDENTIAL
DISCH	DISCHARGE	RHF	RIGHT-HAND FORWARD
DG	DITCH GRADE	R/W	RIGHT-OF-WAY
DWY	DRIVEWAY	R	RIVER
X	EAST GRID COORDINATE	RDWY	ROADWAY
EAT	STEEL PLATE BEAM GUARD ENERGY ABSORBING TERMINAL	R/L OR R	REFERENCE LINE
EOR	END POINT OF RADIUS	SALV	SALVAGED
EL	ELEVATION	SAN	SANITARY SEWER
ENT	ENTRANCE	SF	SQUARE FEET
ESALS	EQUIVALENT SINGLE AXLE LOADS	SY	SQUARE YARD
EXC	EXCAVATION	SDD	STANDARD DETAIL DRAWINGS
EBS	EXCAVATION BELOW SUBGRADE	STA	STATION
EXIST	EXISTING	SS	STORM SEWER
FC	FACE OF CURB	SSPRC	STORM SEWER PIPE REINFORCED CONCRETE
FF	FACE TO FACE	SE	SUPERELEVATION RATE
FERT	FERTILIZE	TC	TOP OF CURB
FE	FIELD ENTRANCE	T OR TN	TOWN
FL	FLOW LINE	T	TRUCKS (PERCENT OF)
FO	FIBER OPTIC	TYP	TYPICAL
CWT	HUNDREDWEIGHT	VAR	VARIABLE
		VC	VERTICAL CURVE
		Y	NORTH GRID COORDINATE
		YD	YARD

UTILITY CONTACTS

CENTURYLINK
 201 STARK ST
 RANDOLPH, WI 53956
 TELEPHONE: 920.236.2224
 EMAIL: TIM.KROEZE@CENTURYLINK.COM
 ATTENTION: TIM KROEZE

WISCONSIN PUBLIC SERVICE-GAS
 300 N MAIN ST
 OSHKOSH, WI 54901
 TELEPHONE: 920.236.5908
 ATTENTION: PAUL SPANGLER

WISCONSIN PUBLIC SERVICE-ELECTRIC
 300 N MAIN ST
 OSHKOSH, WI 54901
 TELEPHONE: 920.236.5912
 ATTENTION: BYRON WALLESER

DNR CONTACT
 625 EAST CTH Y, SUITE 700
 OSHKOSH, WI 54901-9731
 TELEPHONE: 920.303.5442
 ATTENTION: BOBBI JO FISCHER

DESIGN CONTACT
 SEH INC
 425 WEST WATER STREET, SUITE 300
 APPLETON, WI 54911-6058
 TELEPHONE: 920.380.2800
 ATTENTION: RICH GLEN, P.E.

TO OBTAIN LOCATION OF PARTICIPANT'S UNDERGROUND FACILITIES BEFORE YOU DIG IN WISCONSIN




FOR FIELD LOCATES
 CALL: 1.800.242.8511
 www.DiggersHotline.com


WIS. STATUTE 182.0175 (1974)
 REQUIRES MIN. OF 3 WORK DAYS
 NOTICE BEFORE YOU EXCAVATE.

GENERAL NOTES


- ELEVATIONS SHOWN ON THE PLAN ARE REFERENCED TO THE NGVD 29 DATUM.
- THE LOCATION OF EXISTING AND PROPOSED UTILITY INSTALLATIONS AS SHOWN ON THE PLANS ARE APPROXIMATE. THERE MAY BE OTHER UTILITY INSTALLATIONS WITHIN THE PROJECT AREA THAT ARE NOT SHOWN.
- NO TREES OR SHRUBS ARE TO BE REMOVED WITHOUT THE APPROVAL OF THE ENGINEER.
- CURVE DATA IS BASED ON THE ARC DEFINITION.
- THE EXACT LOCATION OF THE EROSION CONTROL DEVICES SHALL BE DETERMINED IN THE FIELD.
- DISTURBED AREAS WITHIN THE RIGHT-OF-WAY, EXCEPT THE AREAS WITHIN THE FINISHED SHOULDER POINTS, ARE TO BE 4-INCH SALVAGED TOPSOIL, FERTILIZED, SEEDED, AND MULCHED.
- BEARINGS SHOWN ON THE PLANS ARE GROUND BEARINGS TO THE NEAREST SECOND.
- THE LOCATION OF ALL DRIVEWAYS WILL BE DETERMINED IN THE FIELD.
- ALL CURB AND GUTTER RADII, PAVEMENT DIMENSIONS AND STATIONS ARE SHOWN TO THE EDGE OF PAVEMENT UNLESS NOTED OTHERWISE.
- A VERTICAL SAWCUT SHALL BE MADE THROUGH EXISTING DRIVEWAYS AND PAVEMENTS AT REMOVAL LIMITS.
- TACK COAT HAS BEEN ESTIMATED AT AN APPLICATION RATE OF 0.025 GAL/S.Y. AND SHALL BE PLACED BETWEEN LAYERS OF ASPHALTIC PAVEMENT.
- FILL AS SHOWN ON THE PLANS PERTAINS TO EMBANKMENTS CONSTRUCTED FROM UNCLASSIFIED EXCAVATION. THE ALLOWANCE USED FOR EXPANDING THE FILLS TO COMPUTE THE VOLUME OF MATERIAL REQUIRED IS 25 PERCENT. ALL FILL VOLUMES SHOWN ARE ACTUAL VOLUMES.
- ALL DRAIN TILE OUTLETS SHALL BE MAINTAINED.
- ALL NEW DRIVEWAY CULVERTS WHICH FALL WITHIN THE CLEAR ZONE AS SHOWN ON THE TYPICAL SECTION SHALL BE INSTALLED WITH SLOPED END SECTION ENDWALLS
- WINNEBAGO COUNTY HIGHWAY DEPARTMENT FORCES WILL PERFORM THE CLEARING FOR THE PROJECT. TREES WILL BE REMOVED DOWN TO A STUMP. REMOVAL OR GRUBBING OF STUMPS SHALL BE INCIDENTAL TO EXCAVATION COMMON.

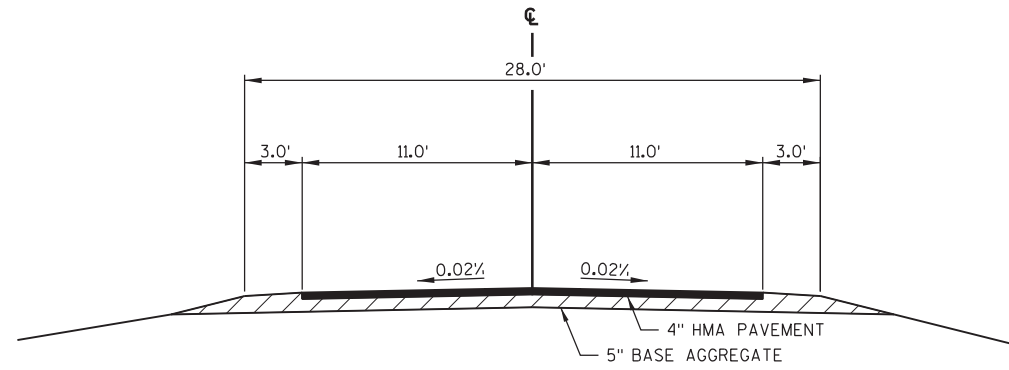

EXISTING SECTION
CTH M

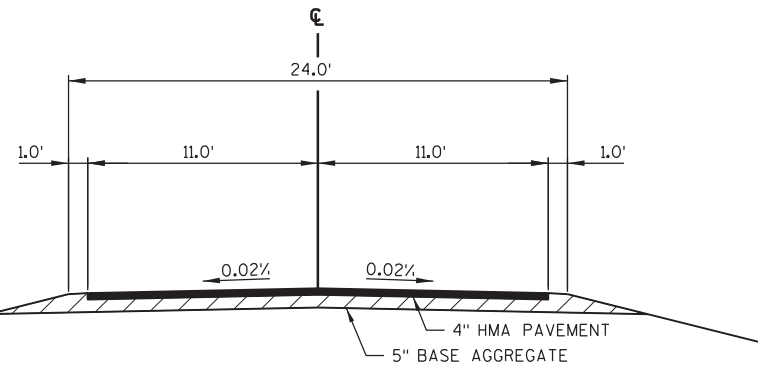


EXISTING SECTION
MAHLKE ROAD
WEELAUNEE DRIVE

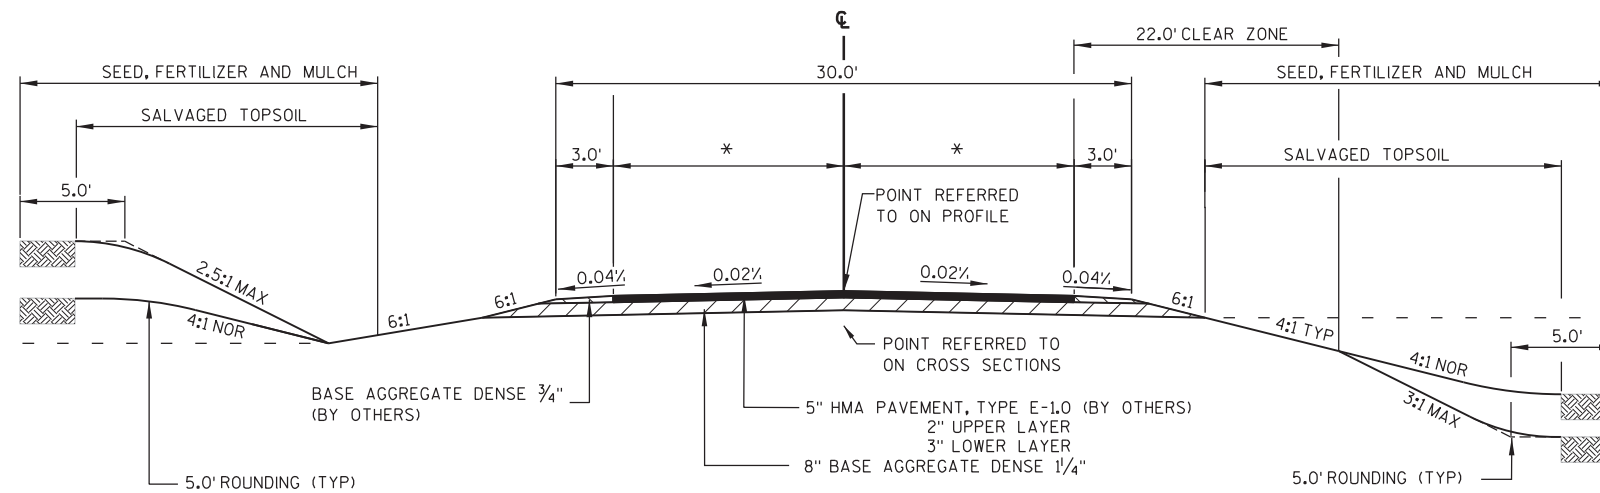


TYPICAL FINISHED SECTION
MAHLKE ROAD
WEELAUNEE DRIVE

* = 11' ON WEELAUNEE DRIVE
12' ON MAHLKE ROAD

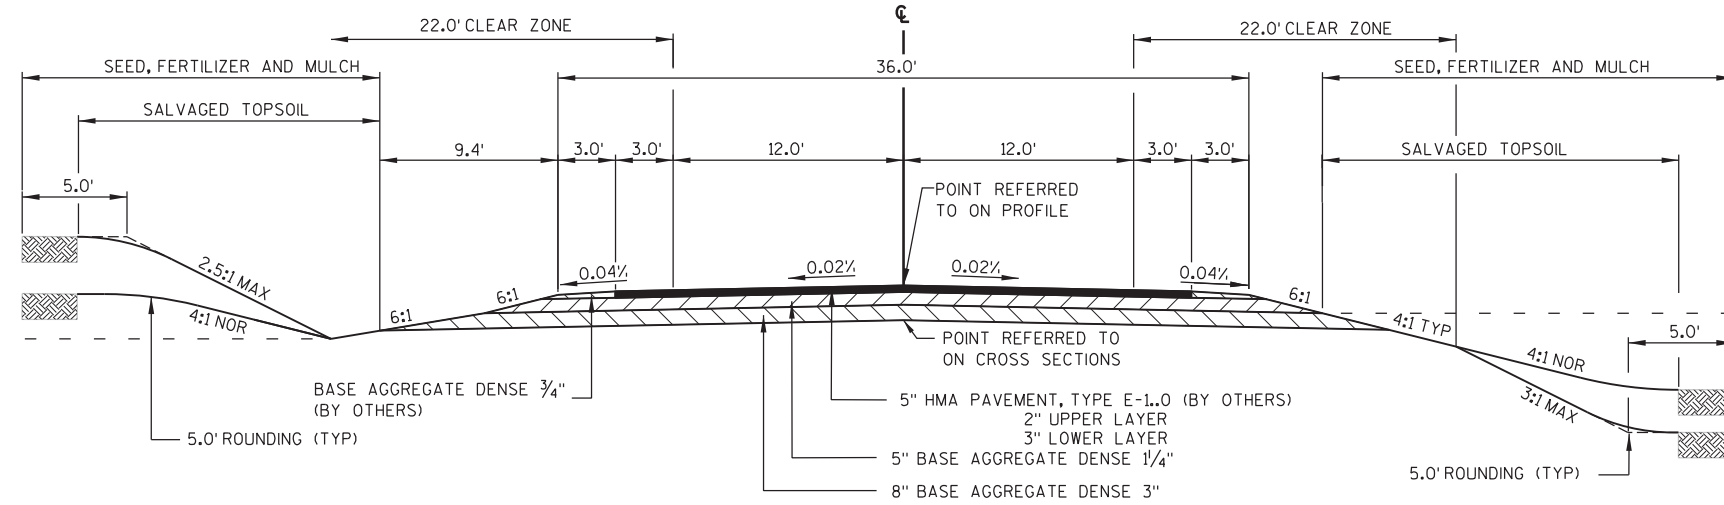


TYPICAL FINISHED SECTION

STA 103+75.00 TO STA 145+00.00
STA 149+00.00 TO STA 156+50.00
STA 158+00.00 TO STA 161+00.00

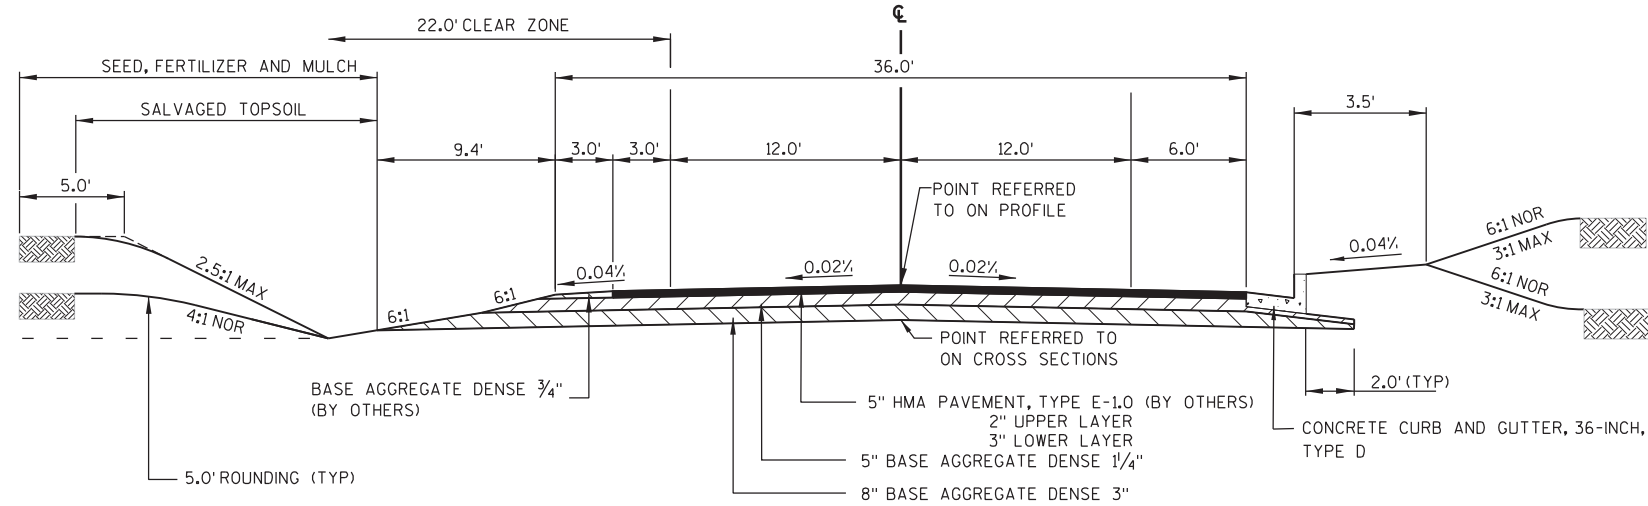


TYPICAL FINISHED SECTION

STA 145+00.00 TO STA 149+00.00
STA 156+50.00 TO STA 158+00.00

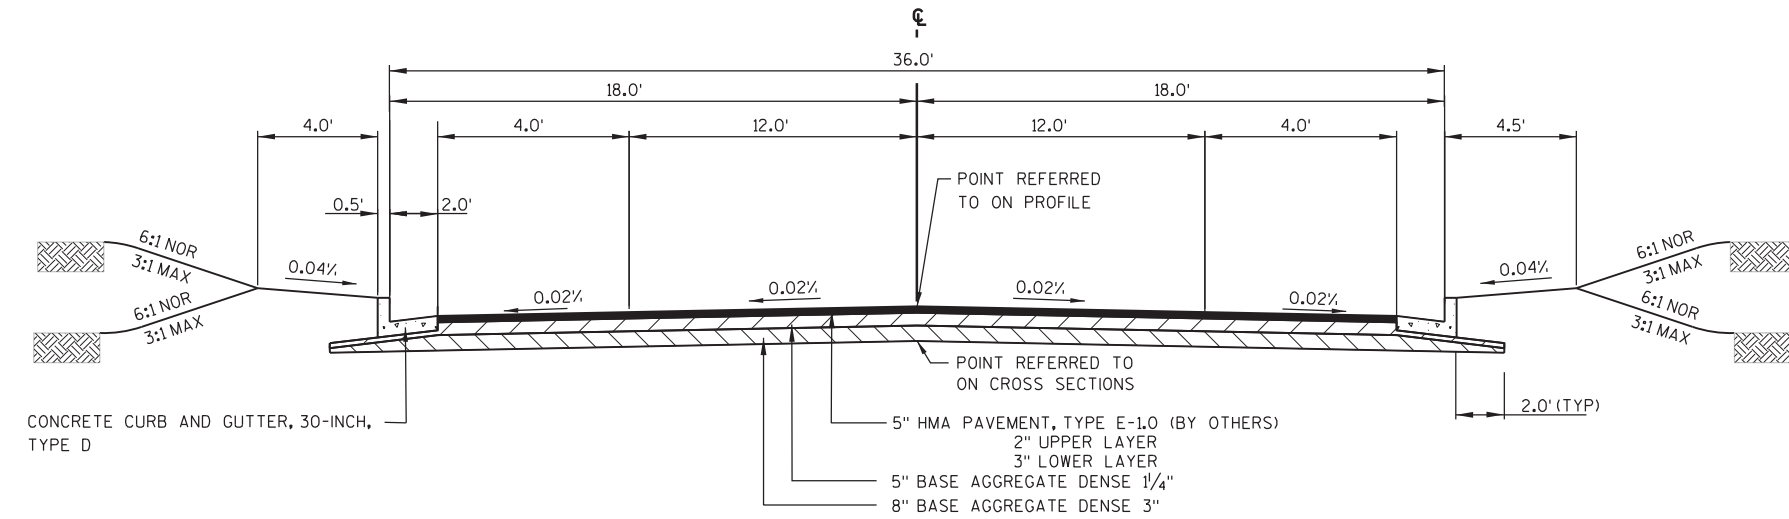

TYPICAL FINISHED SECTION

STA 161+00.00 TO STA 172+82.84

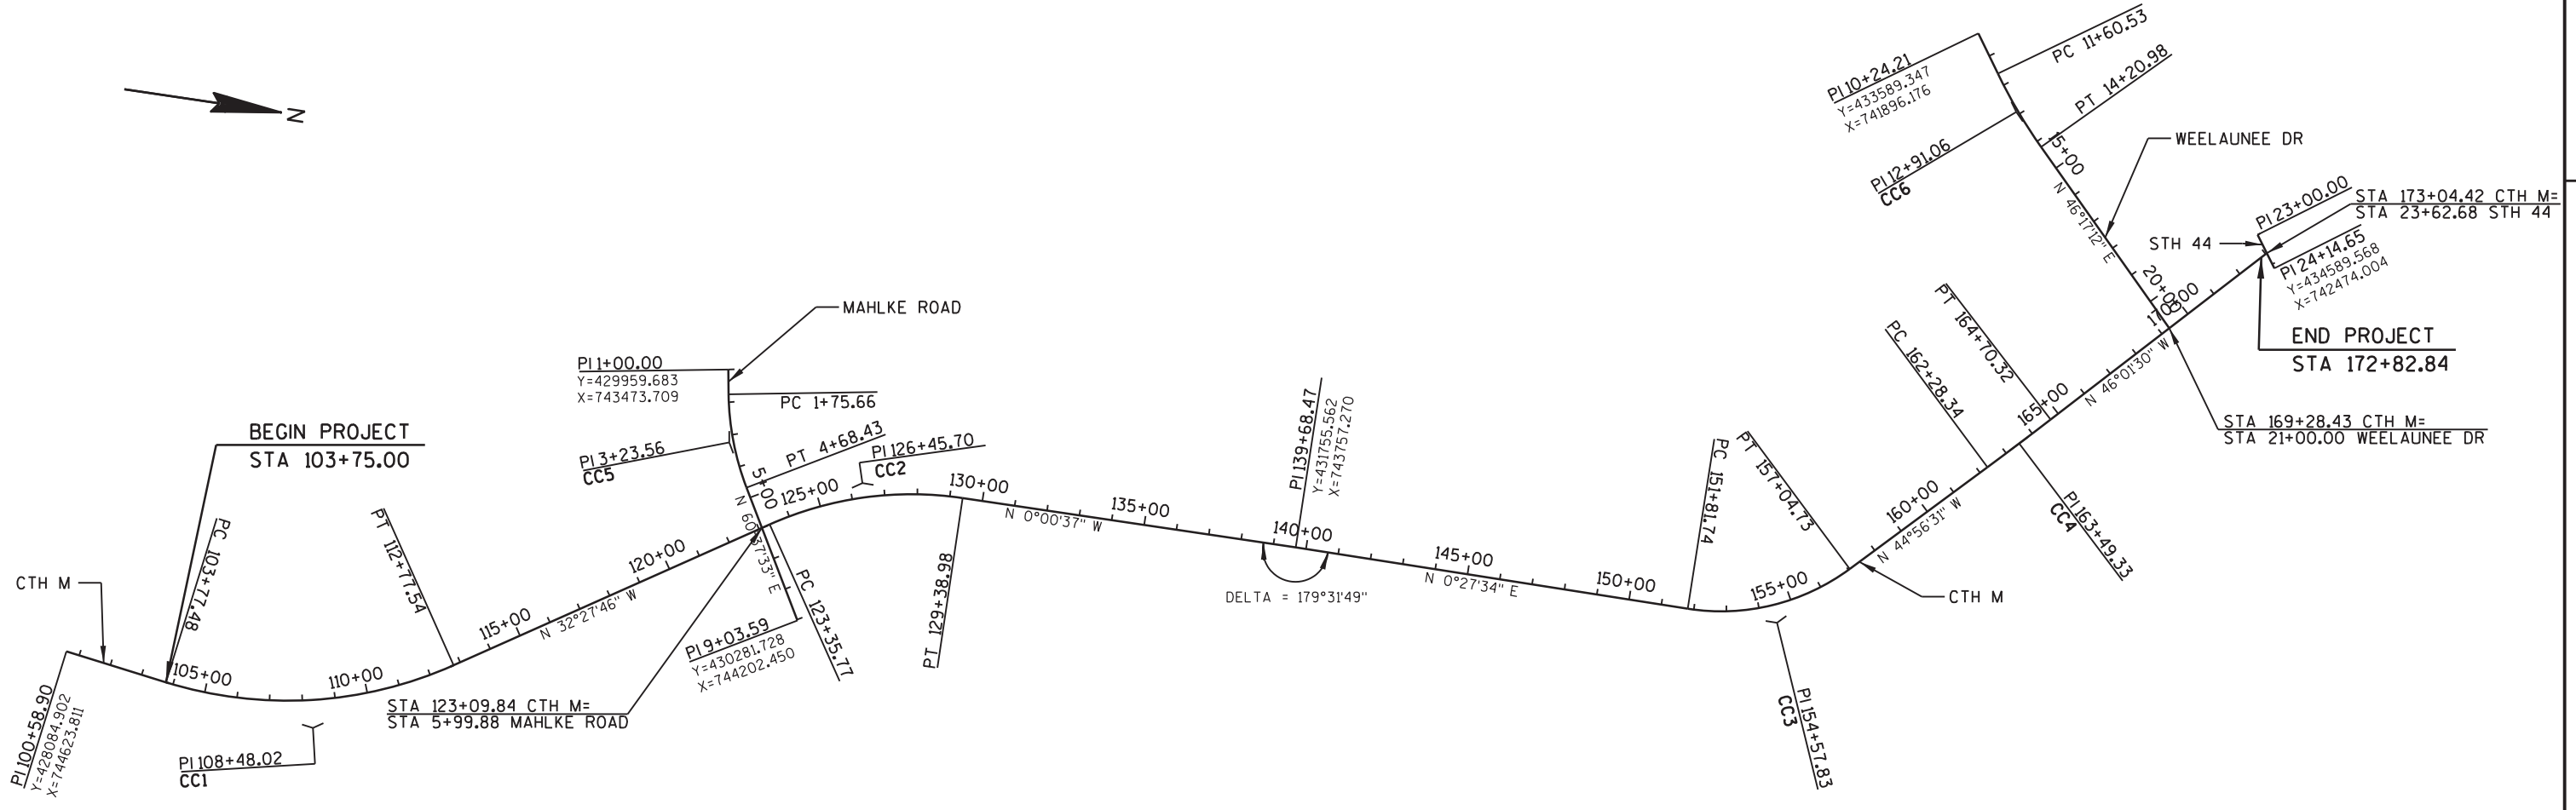

CURVE DATA CC1

DELTA = -41°15'19" (LT)

D = 4°35'01"

T = 470.53

L = 900.05

E = 85.63

R = 1250.00

DB = N 8°47'34" E

DA = N 32°27'46" W

PC STA 103+77.48

PC Y = 428399.7474

PC X = 744672.5107

PI STA 108+48.02

PI Y = 428864.7517

PI X = 744744.4362

PT STA 112+77.54

PT Y = 429261.7603

PT X = 744491.8766

SE = 5.8

CURVE DATA CC2

DELTA = 32°27'09" (RT)

D = 5°22'48"

T = 309.94

L = 603.22

E = 44.18

R = 1065.00

DB = N 32°27'46" W

DA = N 0°00'37" W

PC STA 123+35.77

PC Y = 430154.6294

PC X = 743923.8721

PI STA 126+45.70

PI Y = 430416.1376

PI X = 743757.5120

PT STA 129+38.98

PT Y = 430726.0767

PT X = 743757.4559

SE = 6.0

CURVE DATA CC3

DELTA = -45°24'05" (LT)

D = 8°40'52"

T = 276.09

L = 522.99

E = 55.42

R = 660.00

DB = N 0°27'34" E

DA = N 44°56'31" W

PC STA 151+81.74

PC Y = 432968.7971

PC X = 743766.9998

PI STA 154+57.83

PI Y = 433244.8816

PI X = 743769.2139

PT STA 157+04.73

PT Y = 433440.3070

PT X = 743031.7715

SE = 3.8

CURVE DATA CC4

DELTA = -1°04'59" (LT)

D = 0°26'51"

T = 120.99

L = 241.97

E = 5.7

R = 12800.00

DB = N 44°56'31" W

DA = N 46°01'30" W

PC STA 162+28.34

PC Y = 433810.9352

PC X = 743204.3073

PI STA 163+49.33

PI Y = 433896.5748

PI X = 743118.8412

PT STA 164+70.32

PT Y = 433980.5836

PT X = 743031.7715

SE = NC

CURVE DATA CC5

DELTA = -20°05'47" (LT)

D = 6°51'51"

T = 147.90

L = 292.77

E = 13.00

R = 834.70

DB = N 80°43'19" E

DA = N 60°37'33" E

PC STA 11+75.66

PC Y = 429971.8805

PC X = 743548.3749

PI STA 12+91.06

PI Y = 429995.7262

PI X = 743694.3443

PT STA 14+68.43

PT Y = 430068.2750

PT X = 743823.2333

CURVE DATA CC6

DELTA = -9°32'24" (LT)

D = 3°39'46"

T = 130.53

L = 260.45

E = 5.44

R = 1564.23

DB = N 55°49'36" E

DA = N 46°17'12" E

PC STA 11+60.53

PC Y = 433665.9202

PC X = 742008.9629

PI STA 12+91.06







PI Y = 433739.2368




PI X = 742116.9529

PT STA 14+20.98


PT Y = 433829.4371

PT X = 742211.2984

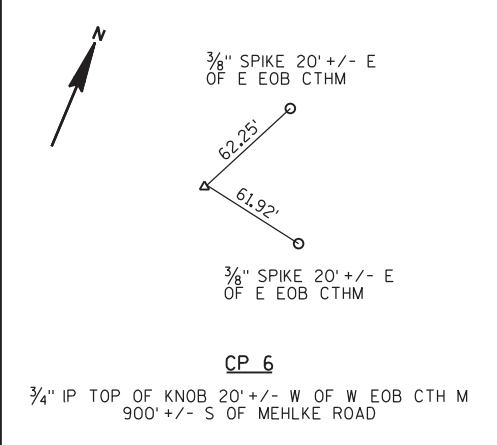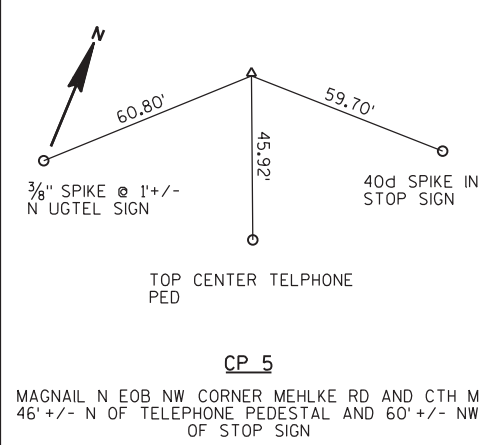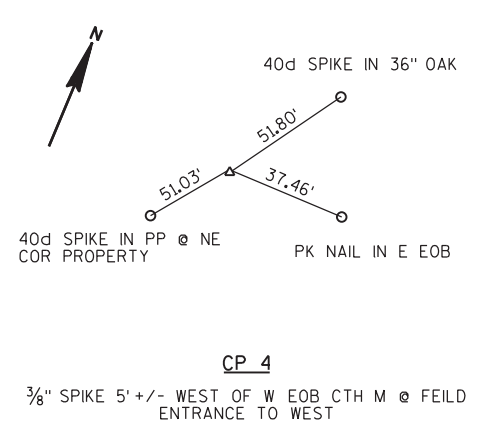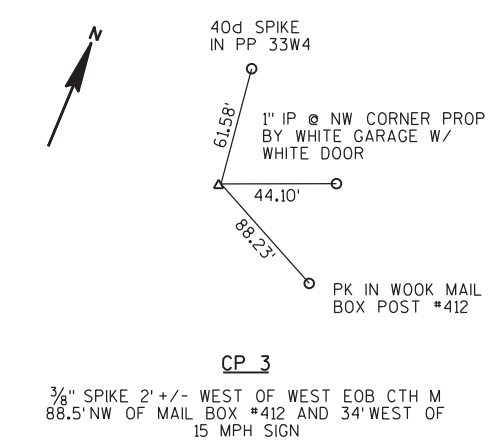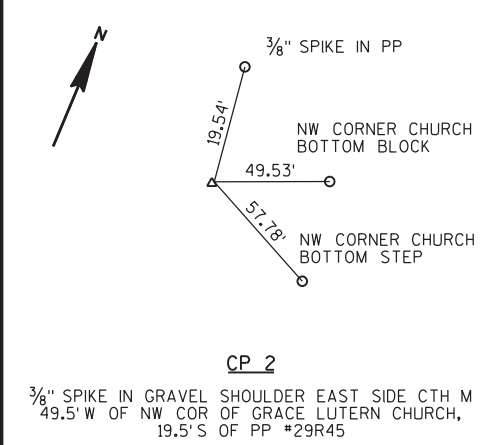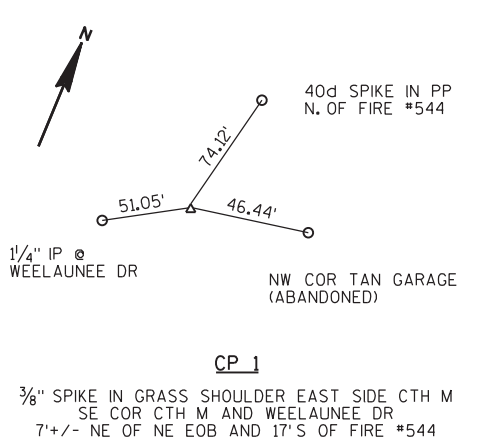


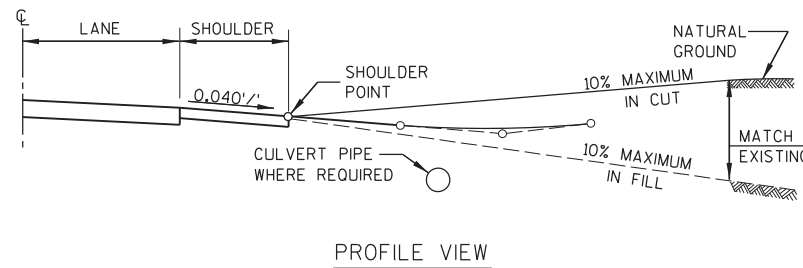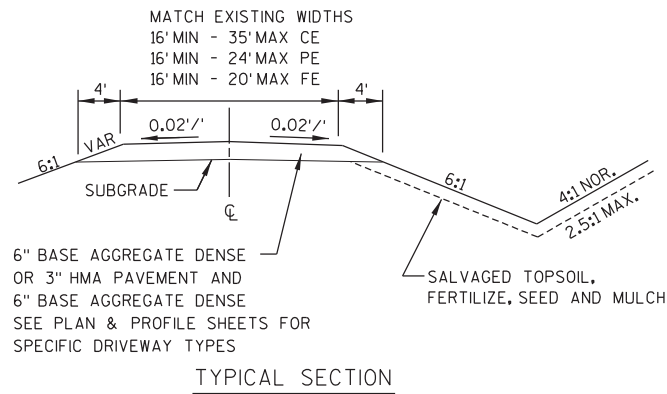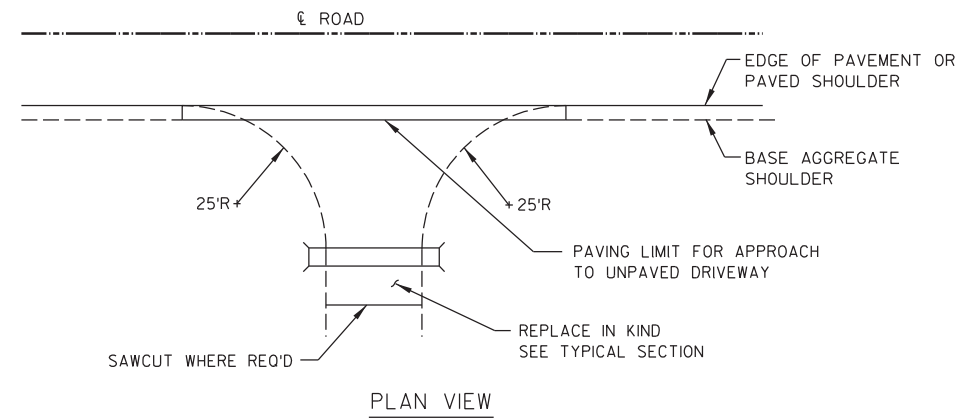

RURAL DRIVEWAY DETAIL

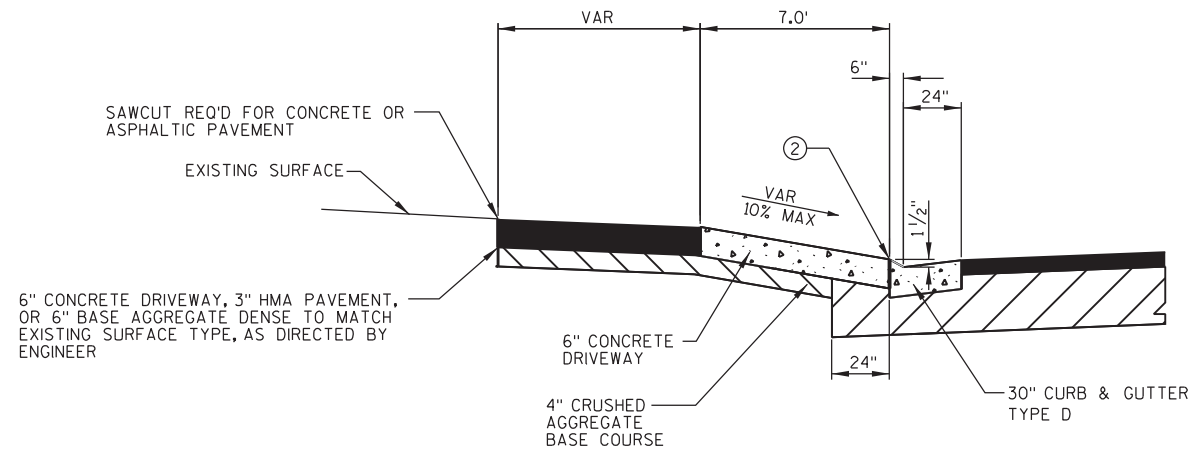


SECTION A-A

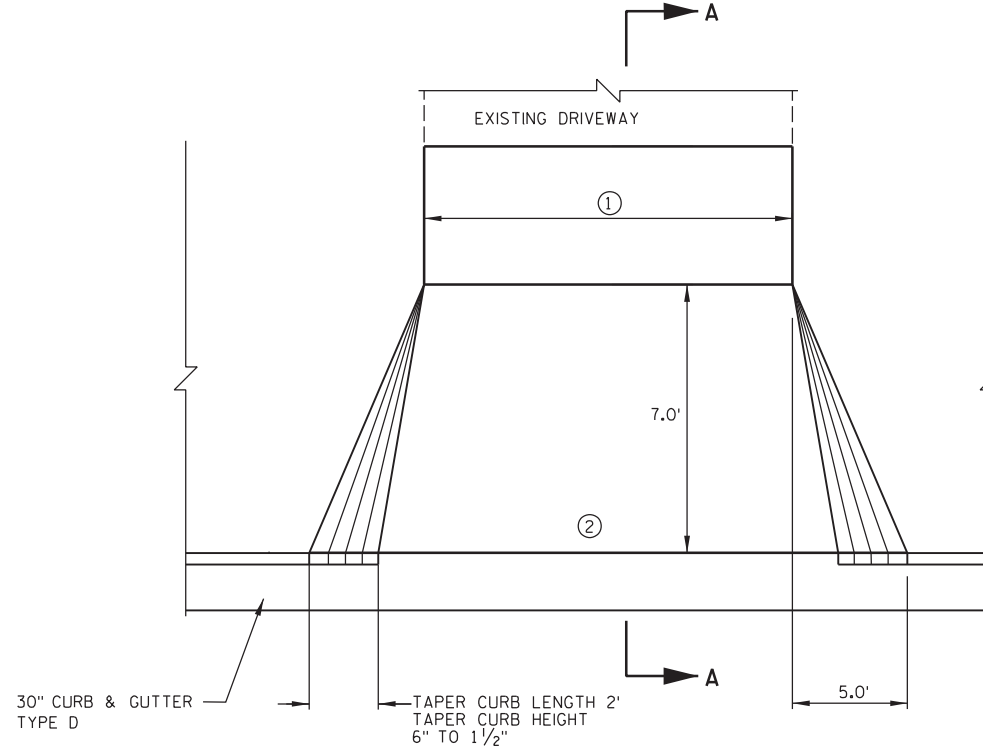




URBAN ENTRANCE

NOTES:

- ① MATCH EXISTING DRIVEWAY WIDTHS (35' MAX WIDTH)
- ② 1/2" PREFORMED EXPANSION FILLER BETWEEN CURB AND NEW DRIVEWAY AND BETWEEN NEW DRIVEWAY AND EXISTING CONCRETE DRIVEWAY.

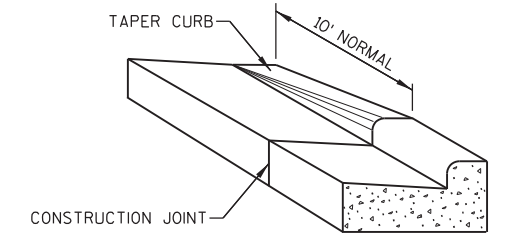


DETAIL OF CURB & GUTTER TERMINI

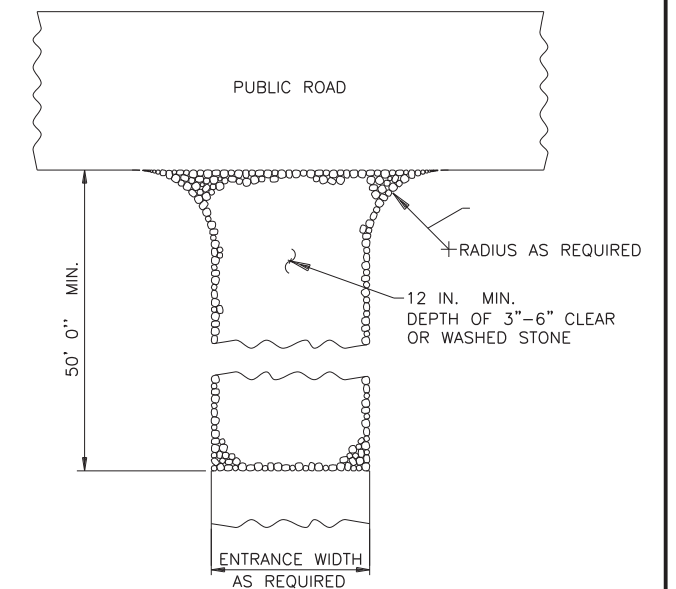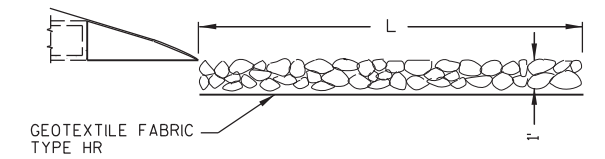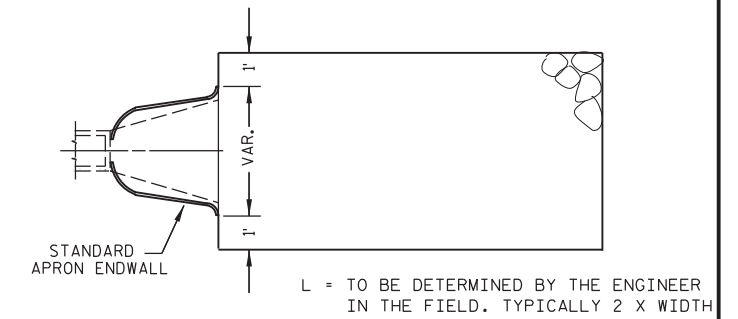

NOTES:
STONES AT ENTRANCE CLEAN WORKSITE MUD OFF OF TRUCKS TIRES BEFORE DRIVING ON MAIN ROAD. THIS WILL PREVENT AUTO DAMAGE. KEEP CONSTRUCTION SEDIMENT OUT OF DRAINAGE SYSTEMS AND WETLANDS.

TRACKING PAD DETAIL

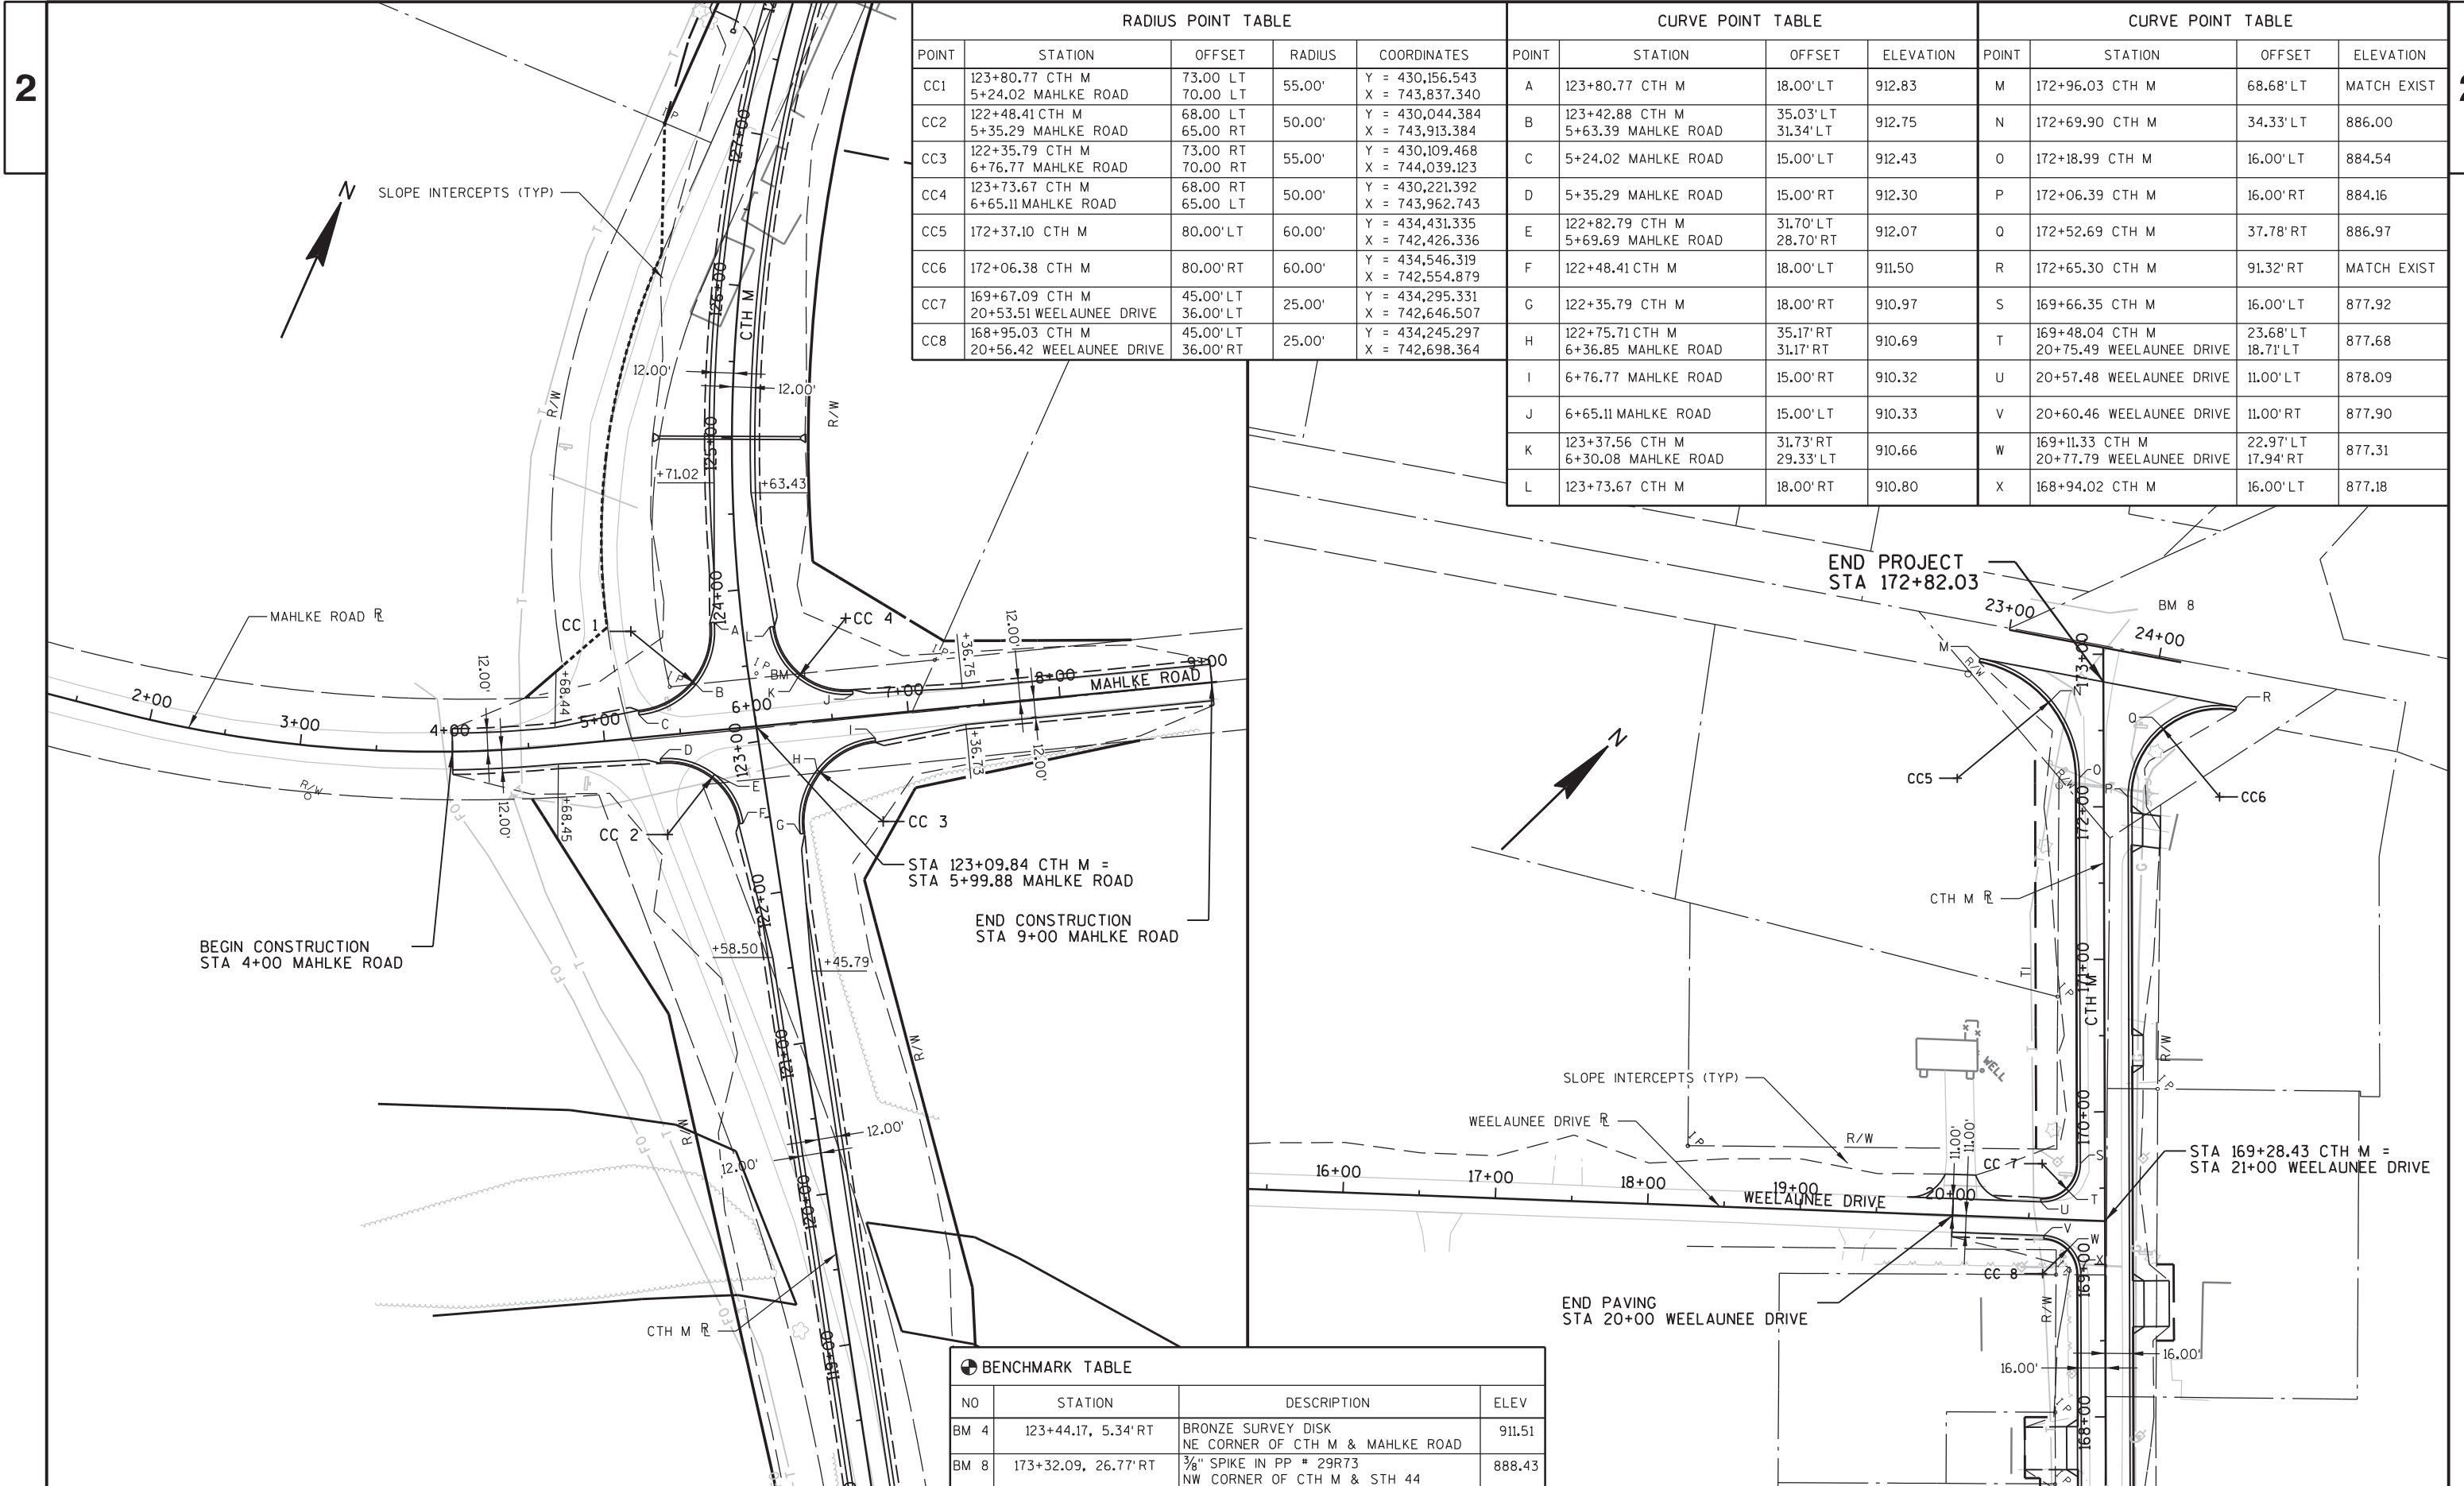


RADIUS POINT TABLE				
POINT	STATION	OFFSET	RADIUS	COORDINATES
CC1	123+80.77 CTH M 5+24.02 MAHLKE ROAD	73.00 LT 70.00 LT	55.00'	Y = 430,156.543 X = 743,837.340
CC2	122+48.41 CTH M 5+35.29 MAHLKE ROAD	68.00 LT 65.00 RT	50.00'	Y = 430,044.384 X = 743,913.384
CC3	122+35.79 CTH M 6+76.77 MAHLKE ROAD	73.00 RT 70.00 RT	55.00'	Y = 430,109.468 X = 744,039.123
CC4	123+73.67 CTH M 6+65.11 MAHLKE ROAD	68.00 RT 65.00 LT	50.00'	Y = 430,221.392 X = 743,962.743
CC5	172+37.10 CTH M	80.00' LT	60.00'	Y = 434,431.335 X = 742,426.336
CC6	172+06.38 CTH M	80.00' RT	60.00'	Y = 434,546.319 X = 742,554.879
CC7	169+67.09 CTH M 20+53.51 WEELAUNEE DRIVE	45.00' LT 36.00' LT	25.00'	Y = 434,295.331 X = 742,646.507
CC8	168+95.03 CTH M 20+56.42 WEELAUNEE DRIVE	45.00' LT 36.00' RT	25.00'	Y = 434,245.297 X = 742,698.364

CURVE POINT TABLE			
POINT	STATION	OFFSET	ELEVATION
A	123+80.77 CTH M	18.00' LT	912.83
B	123+42.88 CTH M 5+63.39 MAHLKE ROAD	35.03' LT 31.34' LT	912.75
C	5+24.02 MAHLKE ROAD	15.00' LT	912.43
D	5+35.29 MAHLKE ROAD	15.00' RT	912.30
E	122+82.79 CTH M 5+69.69 MAHLKE ROAD	31.70' LT 28.70' RT	912.07
F	122+48.41 CTH M	18.00' LT	911.50
G	122+35.79 CTH M	18.00' RT	910.97
H	122+75.71 CTH M 6+36.85 MAHLKE ROAD	35.17' RT 31.17' RT	910.69
I	6+76.77 MAHLKE ROAD	15.00' RT	910.32
J	6+65.11 MAHLKE ROAD	15.00' LT	910.33
K	123+37.56 CTH M 6+30.08 MAHLKE ROAD	31.73' RT 29.33' LT	910.66
L	123+73.67 CTH M	18.00' RT	910.80

CURVE POINT TABLE			
POINT	STATION	OFFSET	ELEVATION
M	172+96.03 CTH M	68.68' LT	MATCH EXIST
N	172+69.90 CTH M	34.33' LT	886.00
O	172+18.99 CTH M	16.00' LT	884.54
P	172+06.39 CTH M	16.00' RT	884.16
Q	172+52.69 CTH M	37.78' RT	886.97
R	172+65.30 CTH M	91.32' RT	MATCH EXIST
S	169+66.35 CTH M	16.00' LT	877.92
T	169+48.04 CTH M 20+75.49 WEELAUNEE DRIVE	23.68' LT 18.71' LT	877.68
U	20+57.48 WEELAUNEE DRIVE	11.00' LT	878.09
V	20+60.46 WEELAUNEE DRIVE	11.00' RT	877.90
W	169+11.33 CTH M 20+77.79 WEELAUNEE DRIVE	22.97' LT 17.94' RT	877.31
X	168+94.02 CTH M	16.00' LT	877.18

BENCHMARK TABLE			
NO	STATION	DESCRIPTION	ELEV
BM 4	123+44.17, 5.34' RT	BRONZE SURVEY DISK NE CORNER OF CTH M & MAHLKE ROAD	911.51
BM 8	173+32.09, 26.77' RT	3/8" SPIKE IN PP # 29R73 NW CORNER OF CTH M & STH 44	888.43

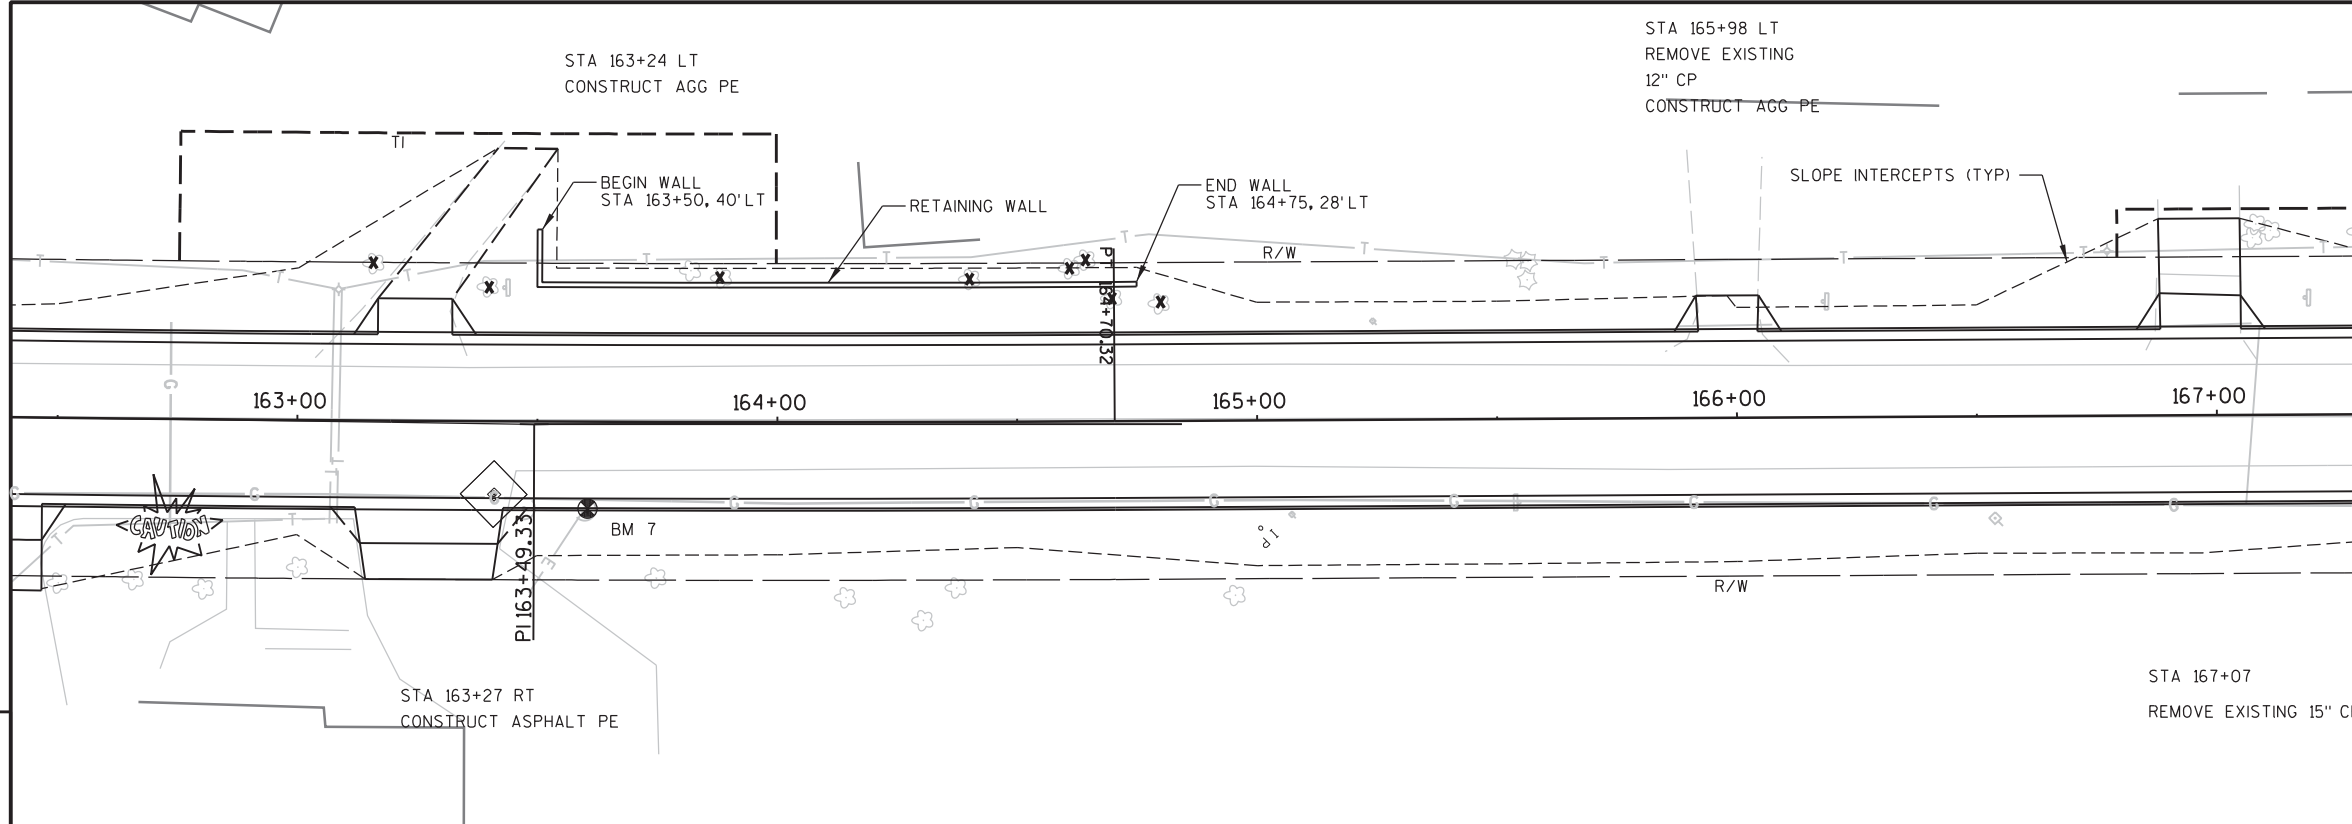

NOTES

THE CONTRACTOR SHALL PROVIDE COMPLETE DESIGN PLANS, DETAILS, SPECIFICATIONS AND SHOP DRAWINGS FOR THE RETAINING WALLS IN ACCORDANCE WITH THE SPECIAL PROVISIONS. THE RETAINING WALL MANUFACTURER SHALL PROVIDE TECHNICAL ASSISTANCE TO THE CONTRACTOR DURING CONSTRUCTION. THE COST OF FURNISHING THESE ITEMS SHALL BE INCLUDED IN THE BID ITEM "MODULAR BLOCK GRAVITY WALL"

PLANS, ELEVATIONS AND DETAILS SHOWN ON THESE DRAWINGS ARE INTENDED TO INDICATE WALL LOCATIONS, LENGTHS, HEIGHTS AND DETAILS COMMON TO THE WALL SYSTEM SELECTED. THE CONTRACTOR SHALL VERIFY THAT THE WALL SYSTEM SELECTED WILL CONFORM TO THE REQUIRED ALIGNMENTS AND DETAILS.



THE RETAINING WALL SHALL BE DESIGNED USING THE ELEVATIONS GIVEN ON THIS SHEET.

DESIGN FOR THE RETAINING WALL TO PROVIDE FOR FINISHED GRADE SLOPED BEHIND THE WALL IS SHOWN.

SEE SPECIAL PROVISIONS FOR AESTHETIC TREATMENT TO WALL.

BENCHMARK TABLE

NO	STATION	DESCRIPTION	ELEV
BM 7	163+61.13, 17.96' RT	3/8" SPIKE IN PP # 29R45 EAST SIDE OF EXISTING CTH M	885.38

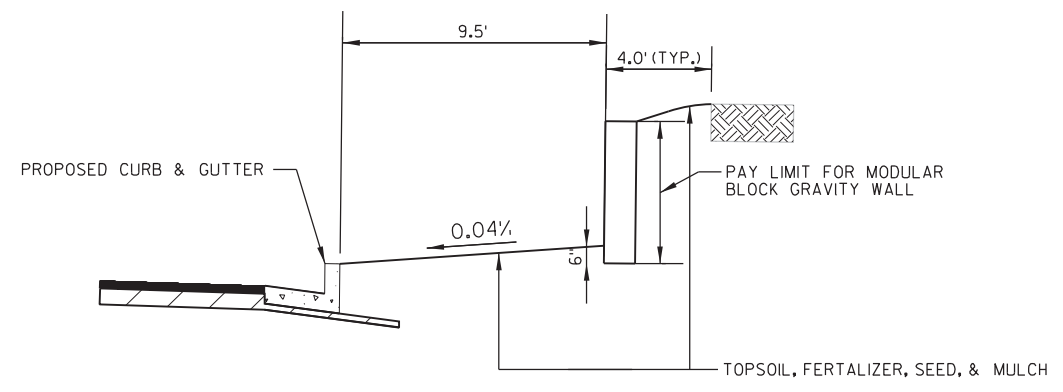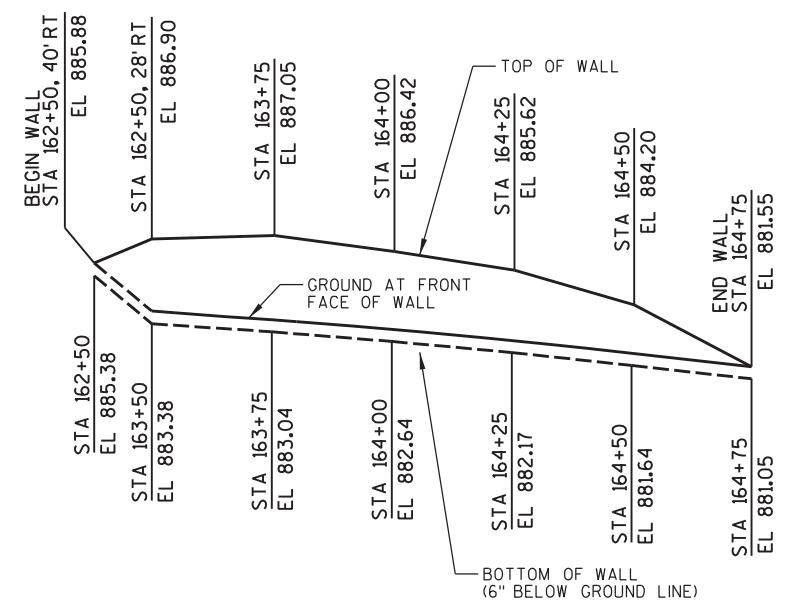



TYPICAL CROSS SECTION AT RETAINING WALL

LEGEND

- SILT FENCE
- ▲ DITCH CHECKS
- ⊗ INLET PROTECTION
- FILTER BAGS
- ← DRAINAGE ARROW
- ▨ RIPRAP WITH GEOTEXTILE FABRIC, TYPE "HR"

2

2

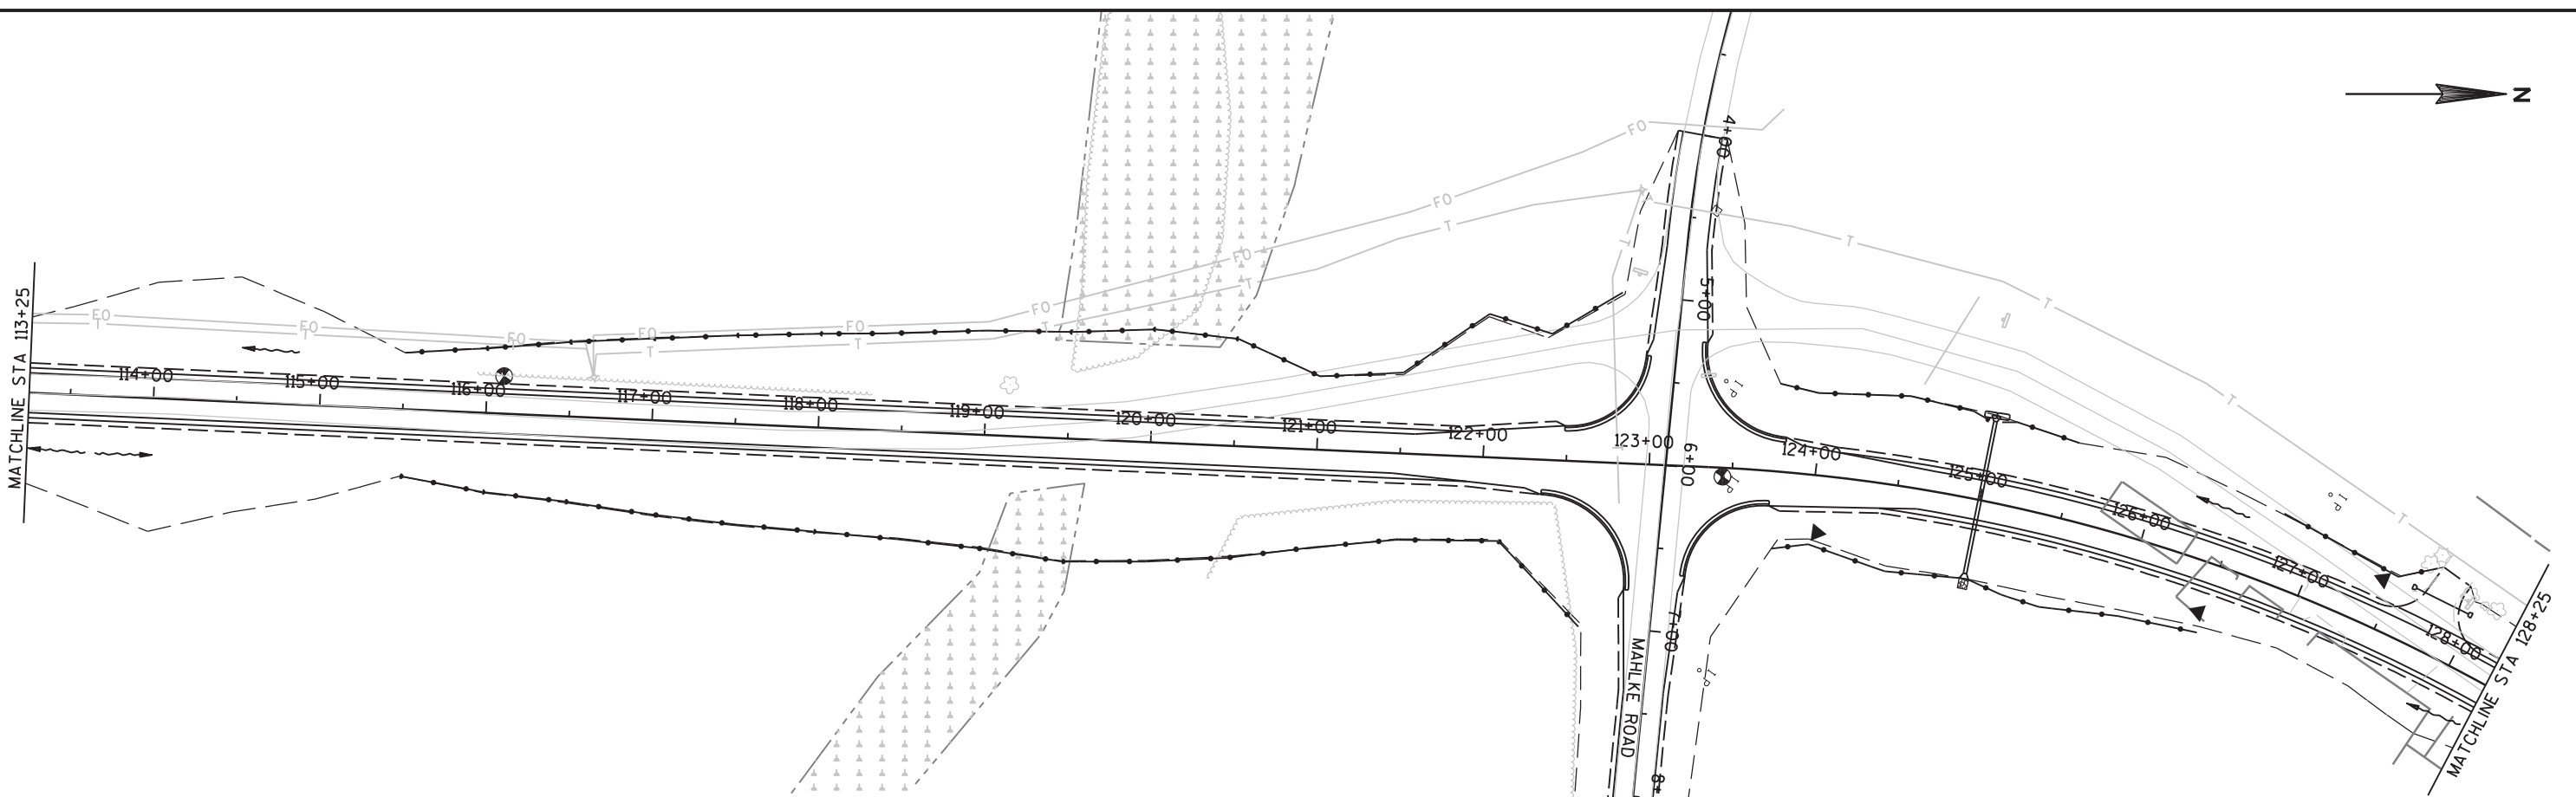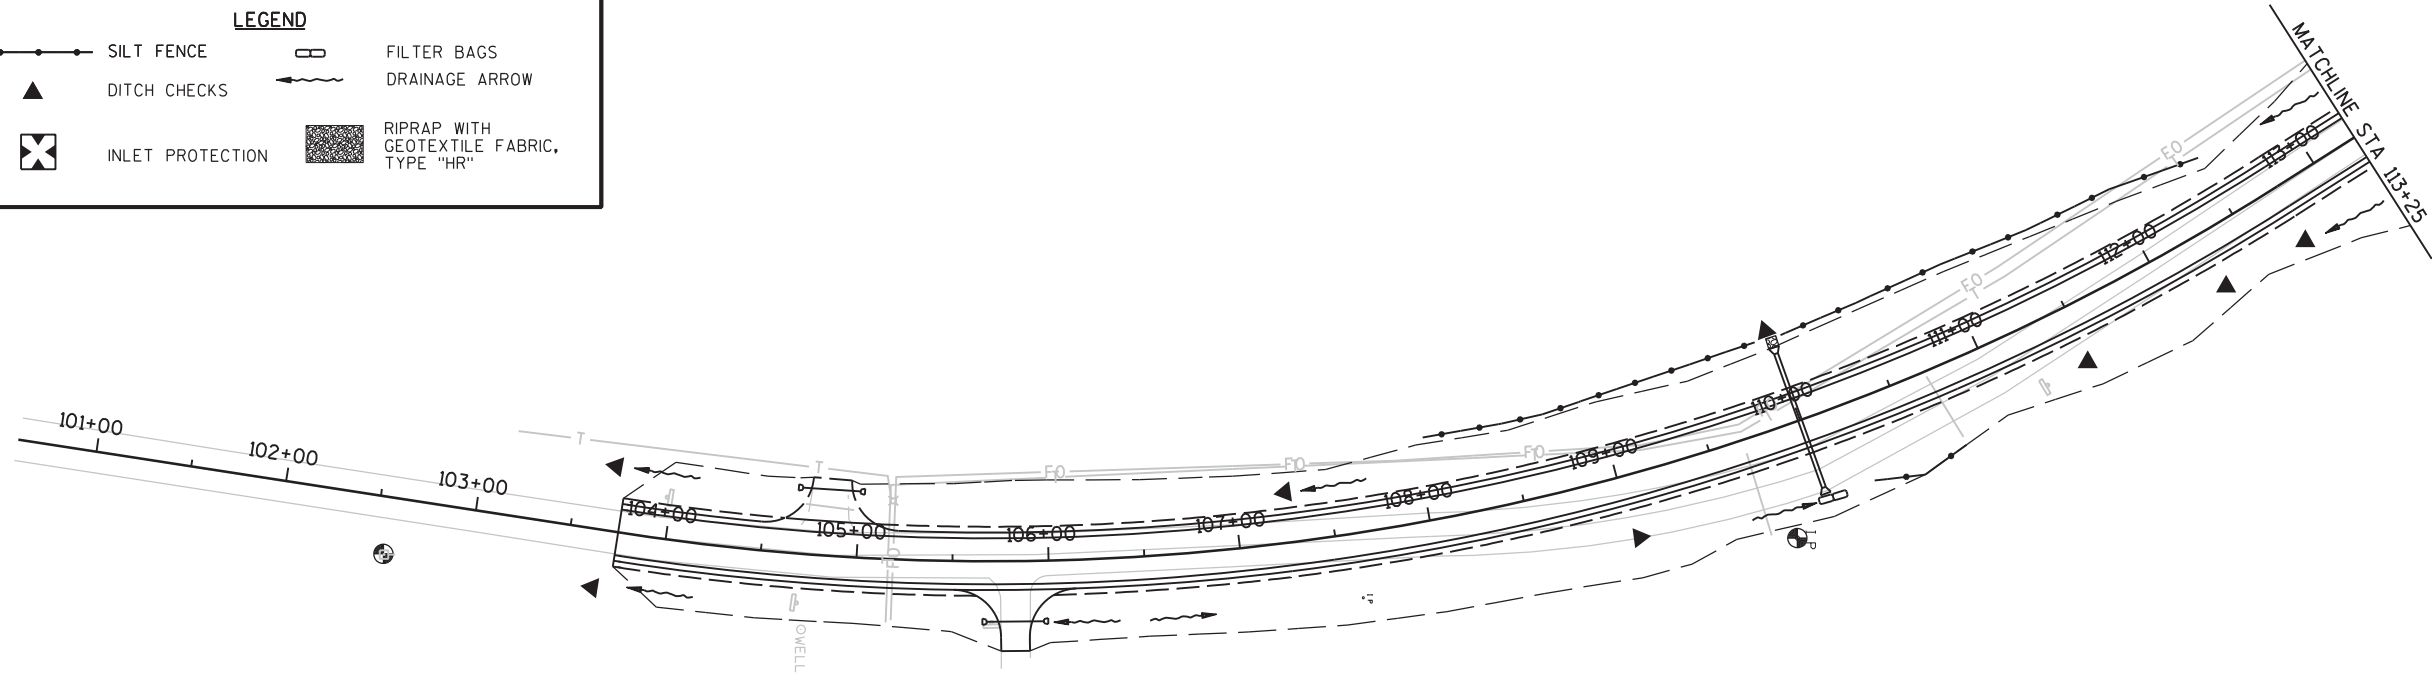

PROJECT NO:

HWY: CTH M

COUNTY: WINNEBAGO

EROSION CONTROL PLAN

SCALE, FEET

SHEET

9

E



2

LEGEND

- SILT FENCE
- ▲ DITCH CHECKS
- ⊗ INLET PROTECTION
- FILTER BAGS
- ← DRAINAGE ARROW
- RIPRAP WITH GEOTEXTILE FABRIC, TYPE "HR"



2

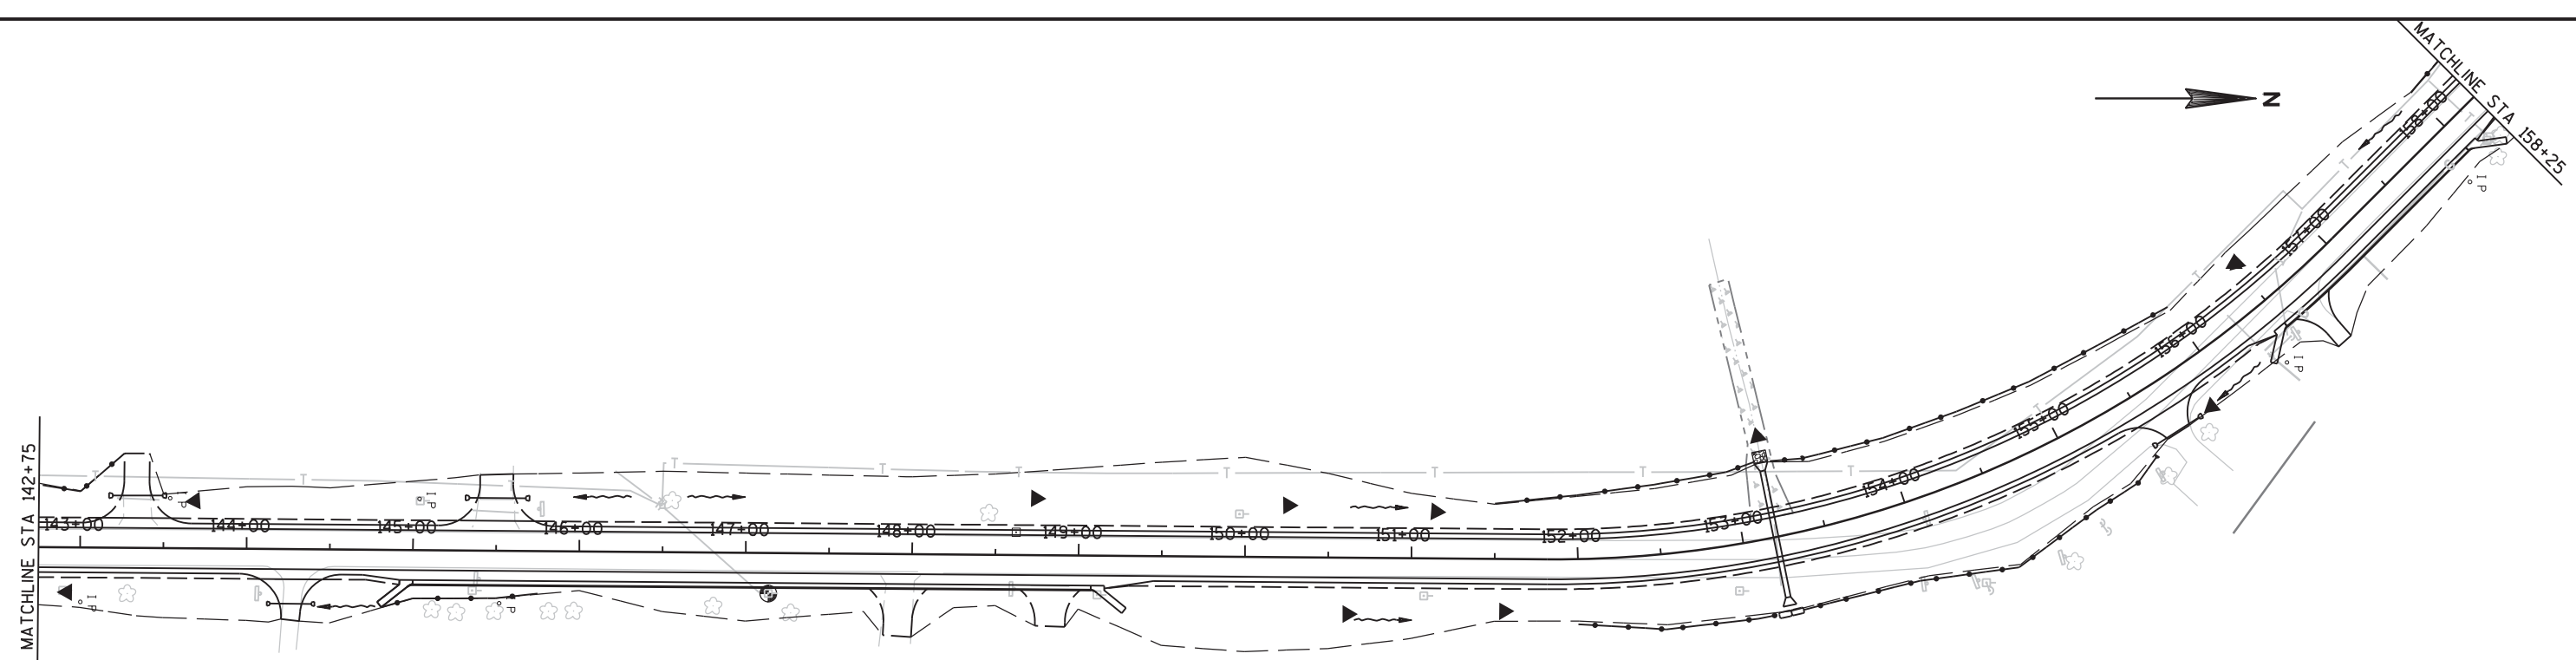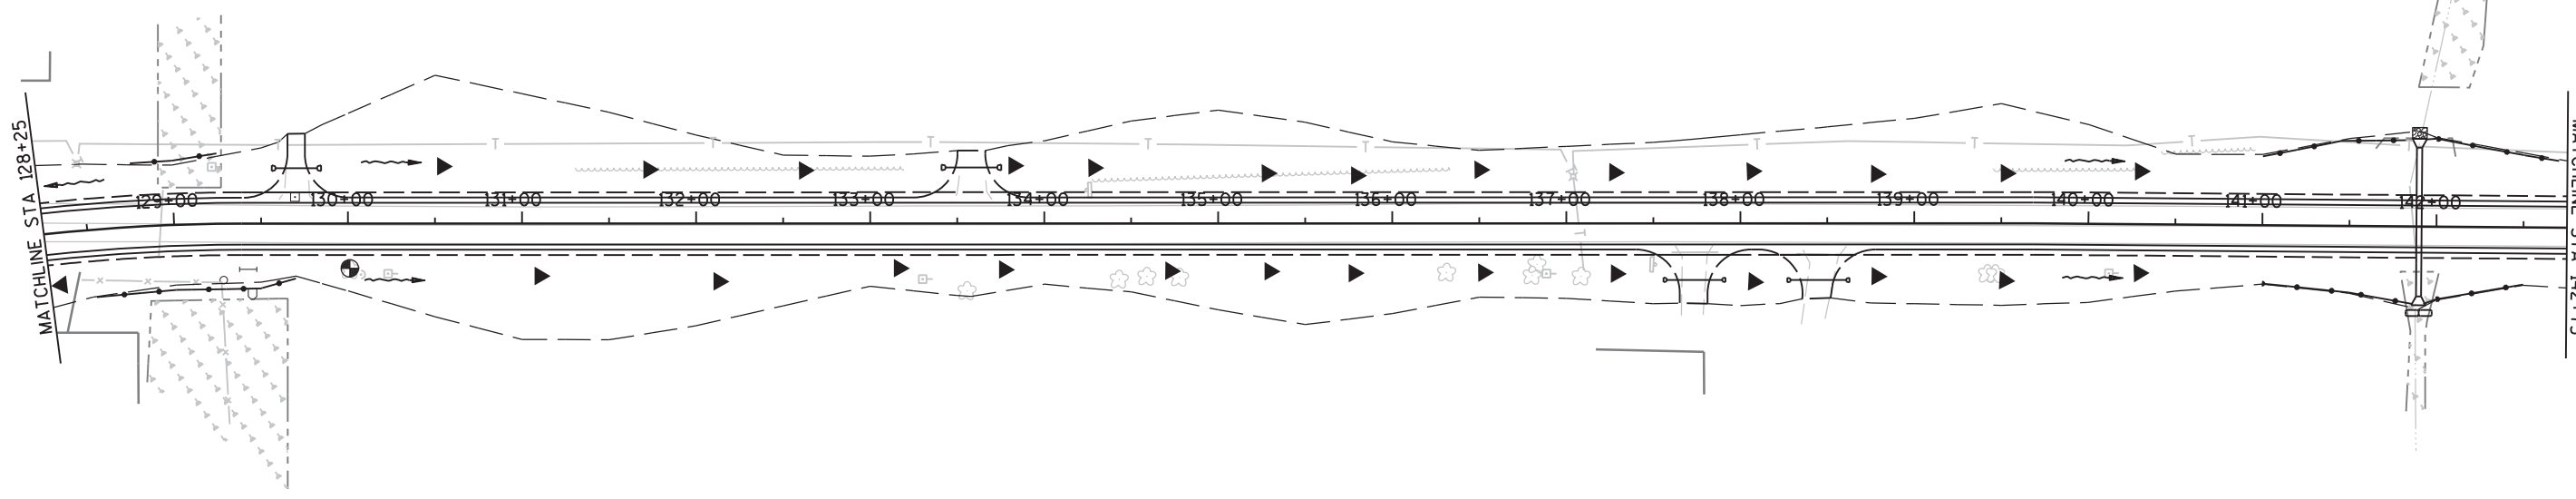

PROJECT NO:

HWY: CTH M

COUNTY: WINNEBAGO

EROSION CONTROL PLAN

SCALE, FEET







SHEET 10


E


2

2

LEGEND

	SILT FENCE		FILTER BAGS
	DITCH CHECKS		DRAINAGE ARROW
	INLET PROTECTION		RIPRAP WITH GEOTEXTILE FABRIC, TYPE "HR"

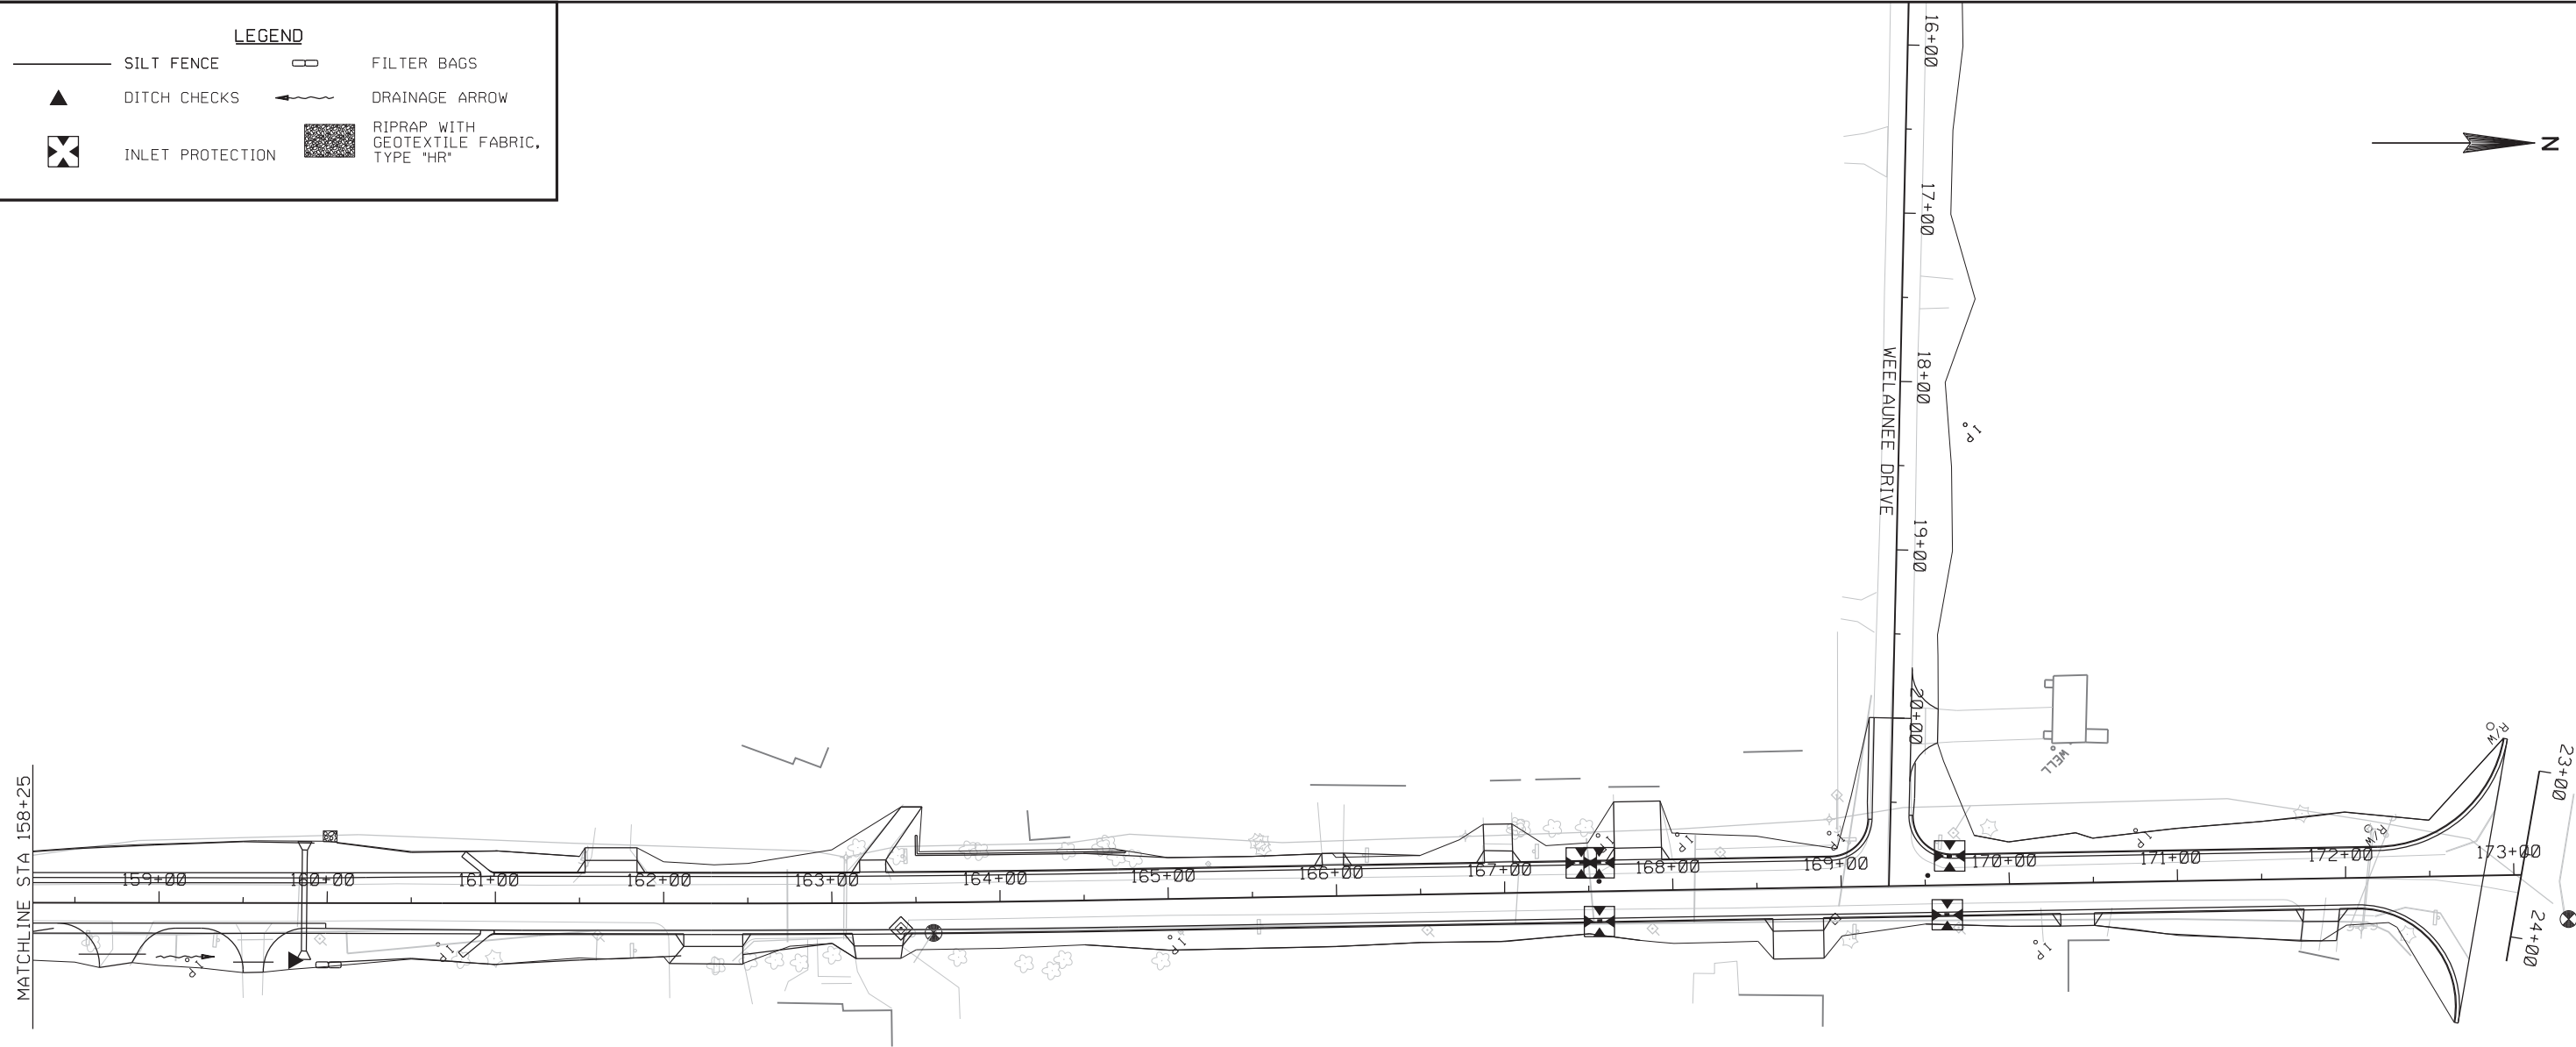

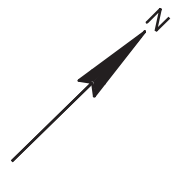


NOTE: MANHOLE STATION/OFFSET IS MEASURED TO THE CENTER OF STRUCTURE AND INLET STATION/OFFSET IS MEASURED TO THE FACE OF CURB
 NOTE: ALL INLETS INCLUDE A 6-INCH SUMP

STRUCTURE NO.	STATION	LOCATION	PAY LENGTH C-C FT	TO	INLET OR MANHOLE	TYPE	FLOW LINE/RIM ELE	TOP OF STRUCTURE ELE	STRUCTURE DEPTH FT	DISCHARGE PIPE				
										INLET ELE	OUTLET ELE	SIZE IN	INSTALL LENGTH FT	SLOPE %
1	167+57.0	6.00'LT	195.00	2	MH	6-FT	876.46	875.21	3.13	872.08	871.50	24	195.00	0.30%
1A	167+00.0	30.00'RT	58.00	1	AEW		875.54			875.54	872.53	12	58.00	5.19%
1B	167+57.0	18.00'RT	24.00	1	INL	2X3	876.13	875.30	3.24	872.51	872.53	12	24.00	0.33%
1C	167+47.0	18.00'LT	12.00	1D	INL	2X3	876.16	875.53	3.06	872.97	872.87	12	10.00	1.00%
1D	167+57.0	18.00'LT	10.00	1	INL	2X3	876.13	875.30	2.93	872.87	872.53	18	12.00	2.83%
2	169+52.4	6.00'LT	742.00	3	MH	4-FT	877.97	876.72	5.22	871.50	870.16	30	742.00	0.18%
2A	169+68.6	18.00'RT	26.00	2	INL	2X3	877.80	877.00	3.70	873.80	873.50	18	26.00	1.15%
2B	169+68.6	18.00'LT	17.00	2	INL	2X3	877.80	877.00	3.00	874.50	873.50	12	17.00	5.88%
3	13+50	24.60'LT			AEW		870.16							

MANHOLES 4-FT	MANHOLES 6-FT	INLETS 2X3-FT	MANHOLE COVERS TYPE J	INLET COVERS TYPE H	INLET COVERS TYPE H-S	SSPRC C-C CLASS III				AEW CLASS III	
						12-INCH	18-INCH	24-INCH	30-INCH	12-INCH	30-INCH
1	1	5	2	2	3	109	38	195	742	1	1

SEE PROFILE VIEW FOR ELEVATION AND PIPE LENGTH FIELD REVISIONS

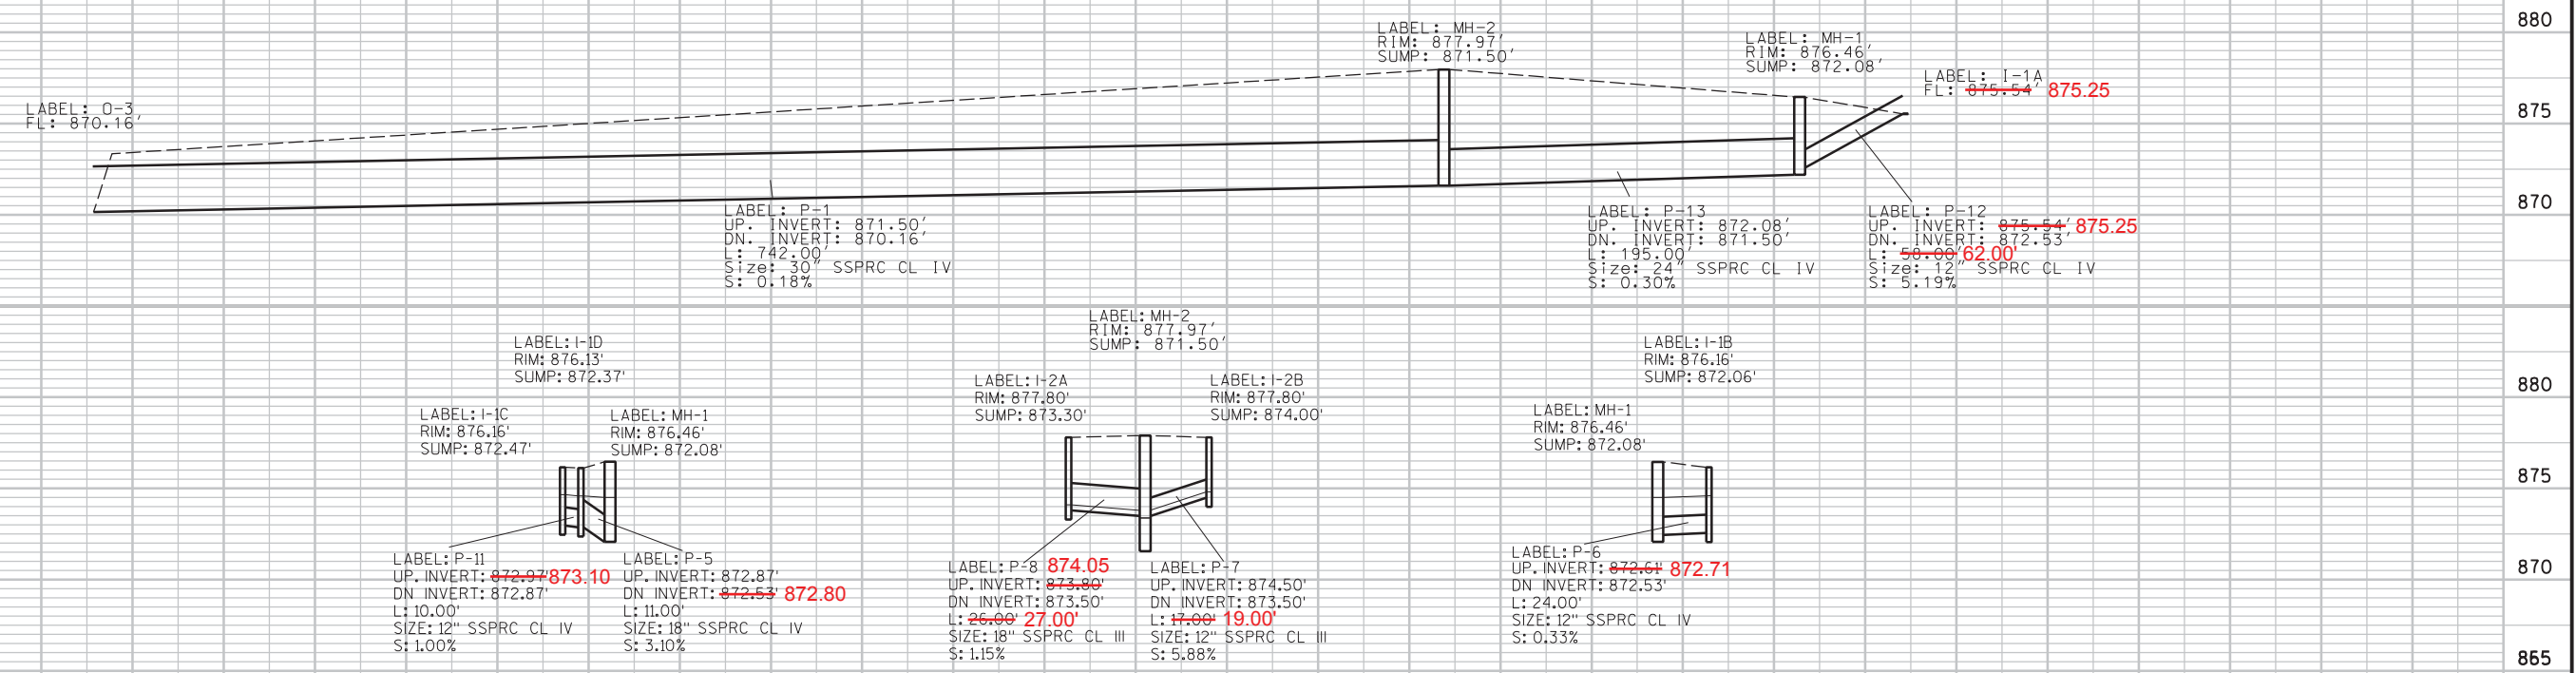

REMOVING SMALL PIPE CULVERTS

STATION	LOCATION	203.0100 EACH
104+85	CTH M, LT	1
105+83	CTH M, RT	1
109+69	CTH M	1
110+73	CTH M	1
124+73	CTH M	1
128+92	CTH M	1
137+73	CTH M, RT	1
138+45	CTH M, RT	1
141+90	CTH M	1
143+34	CTH M, LT	1
144+27	CTH M, RT	1
145+50	CTH M, LT	1
148+84	CTH M, RT	1
153+20	CTH M	1
158+74	CTH M, RT	1
158+83	CTH M	1
159+56	CTH M, RT	1
165+98	CTH M, LT	1
166+97	CTH M, LT	1
167+07	CTH M	1
TOTAL		20

REMOVING CURB AND GUTTER

STATION - STATION	LOCATION	204.0150 L.F.
172+17 - 172+83	CTH M, RIGHT	73
172+60 - 172+83	CTH M, LEFT	61
TOTAL		134

REMOVING CONCRETE SIDEWALK

STATION - STATION	LOCATION	204.0155 S.Y.
166+97	CTH M, LEFT	22
TOTAL		22

REMOVING FENCE

STATION-STATION	LOCATION	204.0170 L.F.
128+44 - 129+27	CTH M, RT	85
TOTAL		85

BASE AGGREGATE DENSE

STATION - STATION	LOCATION	305.0120 1 1/4-INCH TONS	305.0130 3-INCH TONS	311.0110 BREAKER RUN TONS
103+75 - 121+00	CTH M	2200	4125	---
121+00 - 125+00	CTH M	525	985	---
125+00 - 145+00	CTH M	2550	4780	---
145+00 - 149+00	CTH M	510	930	---
149+00 - 156+50	CTH M	805	1510	---
156+50 - 158+00	CTH M	195	350	---
158+00 - 161+00	CTH M	380	715	---
161+00 - 172+00	CTH M	1370	2565	---
172+00 - 172+82.84	CTH M	155	290	---
4+00 - 9+00	MAHLKE ROAD	1280	---	---
20+00 - 21+00	WEELAUNEE DR.	225	---	---
DRIVEWAYS		605	---	---
UNDISTRIBUTED		---	---	100
TOTALS		10800	16250	100

EXCAVATION COMMON

LOCATION	205.0100 EXCAVATION COMMON C.Y.	FILL C.Y.	*EXPAND. FILL C.Y.	+BORROW -WASTE C.Y.
CTH M	24,386	27,730	36,049	11,663
MAHLKE ROAD	941	0	0	-941
WEELAUNEE ROAD	324	64	83	-241
TOTALS	25,651	27,794	36,132	10,481

*NOTE: EXPANSION FACTOR = 1.3

PROJECT NO:

HWY: CTH M

COUNTY: WINNEBAGO

MISCELLANEOUS QUANTITIES

SHEET NO:

13

E

CONCRETE DRIVEWAY, 6-INCH

STATION	LOCATION	416.0160 S.Y.
161+69	CTH M, LT	30
162+30	CTH M, RT	33
163+24	CTH M, LT	17
163+27	CTH M, RT	29
165+98	CTH M, LT	14
166+97	CTH M, LT	46
167+80	CTH M, LT	28
168+74	CTH M, RT	29
170+40	CTH M, RT	21
171+85	CTH M, RT	27
TOTAL		274

CONCRETE CURB & GUTTER

STATION - STATION	LOCATION	601.0411	601.0557	REMARKS
		30-INCH TYPE D L.F.	36-INCH TYPE D L.F.	
122+35 - 123+10	CTH M, RT	---	90	MAHLKE ROAD
122+48 - 123+10	CTH M, LT	---	76	MAHLKE ROAD
123+10 - 123+74	CTH M, RT	---	78	MAHLKE ROAD
123+10 - 123+80	CTH M, LT	---	60	MAHLKE ROAD
145+00 - 149+00	CTH M, RT	---	400	
156+50 - 158+00	CTH M, RT	---	150	
161+00 - 172+83	CTH M, LT	1227	---	
161+00 - 172+83	CTH M, RT	1184	---	
TOTAL		2411	854	

CROSS DRAINS & PRIVATE ENTRANCE PIPES

STATION	LOCATION	CULVERT CORRUGATED STEEL			APRON ENDWALLS FOR CULVERT PIPE	633.5200 MARKERS CULVERT
		521.0115 15-INCH L.F.	521.0124 24-INCH L.F.	521.0136 36-INCH L.F.	521.1015 15-INCH EACH	END EACH
104+85	CTH M, LT	25	---	---	2	---
105+83	CTH M, RT	25	---	---	2	---
109+50	CTH M	---	90	---	---	2
125+00	CTH M	---	100	---	---	2
127+80	CTH M, LT	27	---	---	2	---
129+70	CTH M, LT	27	---	---	2	---
133+58	CTH M, LT	27	---	---	2	---
137+73	CTH M, RT	33	---	---	2	---
138+45	CTH M, RT	29	---	---	2	---
141+90	CTH M	---	---	100	---	2
143+34	CTH M, LT	23	---	---	2	---
144+27	CTH M, RT	18	---	---	2	---
145+50	CTH M, LT	35	---	---	2	---
153+20	CTH M	---	---	88	---	2
155+63	CTH M, RT	22	---	---	2	---
158+74	CTH M, RT	34	---	---	2	---
159+56	CTH M, RT	17	---	---	2	---
159+85	CTH M	---	---	72	---	2
TOTALS		342	190	260	26	10

WALL MODULAR BLOCK GRAVITY

STATION - STATION	LOCATION	532.0200.S S.Y.
162+50 - 164+75	CTH M, LEFT	420
TOTAL		420

RIPRAP AND GEOTEXTILE FABRIC

STATION	LOCATION	606.0200 RIPRAP MEDIUM C.Y.	645.0120 GEOTEXTILE FABRIC TYPE HR S.Y.
		109+50	CTH M
125+00	CTH M	2	4
141+90	CTH M	2	6
153+20	CTH M	2	6
160+00	CTH M	2	6
TOTALS		10	26

PROJECT NO:

HWY: CTH M

COUNTY: WINNEBAGO

MISCELLANEOUS QUANTITIES

SHEET NO:

14 E

3

3

EROSION CONTROL

STATION - STATION	LOCATION	628.1504	628.152	628.7504	628.757	INLET PROTECTION		
		SILT FENCE LF	SILT FENCE MAINTENANCE LF	TEMPORARY DITCH CHEKS LF	ROCK BAGS EACH	628.7005 TYPE A EACH	628.7010 TYPE B EACH	628.7015 TYPE C EACH
103+75 - 113+25	CTH M	450	450	80	5	---	---	---
113+25 - 128+25	CTH M	1393	1393	20	5	---	---	---
128+25 - 149+75	CTH M	425	425	270	5	---	---	---
149+75 - 158+25	CTH M	875	875	80	5	---	---	---
158+25 - 173+00	CTH M	1500	1500	10	5	5	5	5
	TOTALS	4643	4643	460	25	5	5	5

SAWING ASPHALT

STATION	LOCATION	690.0150 L.F.	REMARKS
103+75	CTH M	23	
172+82.84	CTH M	110	
4+00	MAHLKE ROAD	24	
9+00	MAHLKE ROAD	23	
20+00	WEELAUNEE DRIVE	23	
105+83	CTH M, RT	15	PE
144+27	CTH M, RT	11	PE
155+63	CTH M, RT	16	PE
156+70	CTH M, RT	10	PE
158+74	CTH M, RT	18	PE
162+30	CTH M, RT	27	PE
163+27	CTH M, RT	45	PE
166+97	CTH M, LT	17	PE
171+85	CTH M, RT	21	PE
20+00	WEELAUNEE DRIVE, LT	18	PE
	TOTAL	401	

TOPSOIL, SALVAGED TOPSOIL, MULCHING, FERTILIZER, AND SEEDING

STATION - STATION	LOCATION	625.0500	627.0200	629.0210	630.0130	630.0140	630.0200
		SALVAGED TOPSOIL S.Y.	MULCHING S.Y.	FERTILIZER TYPE B CWT	SEEDING MIXTURE NO. 30 LB	SEEDING MIXTURE NO. 40 LB	SEEDING TEMPORARY LB
103+75 - 123+00	CTH M	11250	11250	7	187	16	304
123+00 - 161+00	CTH M	20600	20600	13	329	42	556
161+00 - 172+83	CTH M	13085	13085	9	182	54	353
4+00 - 9+00	MAHLKE ROAD	1890	1890	1	34	---	51
20+00 - 21+00	WEELAUNEE DRIVE	1920	1920	1	---	35	52
	TOTALS	48745	48745	31	732	147	1316

PAVEMENT MARKING EPOXY

STATION - STATION	LOCATION	646.0106	646.0106	647.0556
		4-INCH EDGELINE WHITE L.F.	4-INCH YELLOW L.F.	STOPLINE 12-INCH WHITE L.F.
103+75 - 172+83	CTH M	6760	9450	35
4+00 - 9+00	MAHLKE ROAD	---	880	40
20+00 - 21+00	WEELAUNEE DR	---	160	20
	TOTALS	6760	10490	95

PROJECT NO:

HWY: CTH M

COUNTY: WINNEBAGO

MISCELLANEOUS QUANTITIES

SHEET NO:

15

E

CONVENTIONAL SIGNS AND ABBREVIATIONS



- AP ACCESS POINT
- AC ACRES
- AG AGRICULTURAL
- ALUM. ALUMINIUM
- ANT ANTENNA
- B BARN
- BLDG BUILDING
- CL CENTERLINE
- CONC CONCRETE
- COR CORNER
- CSM CERTIFIED SURVEY MAP
- CTH COUNTY TRUNK HIGHWAY
- DOC DOCUMENT
- EASE EASEMENT
- ETAL AND OTHERS
- FDN FOUNDATION
- FE FIELD ENTRANCE
- FRL FRACTIONAL
- G GARAGE
- GP GAS PUMPS
- GRAV GRAVEL
- GV GAS
- HSE HOUSE
- IP IRON PIPE OR PIN
- L LENGTH OF CURVE
- LC LONG CHORD OR LAND CONTRACT
- LCB LONG CHORD BEARING
- LT LEFT
- MH MANHOLE
- MON MONUMENT
- OL OUTLOT
- P PAGE
- PC POINT OF CURVATURE
- PE PRIVATE ENTRANCE
- PI POINT OF INTERSECTION
- PK PARKER-KALON FASTENER
- PL PROPERTY LINE
- PLE PERMANENT LIMITED EASEMENT
- PT POINT OF TANGENCY
- R RADIUS OR RANGE
- RDE RESTRICTED DEVELOPMENT EASEMENT
- REM REMAINING
- RL REFERENCE LINE
- RT RIGHT
- R/W RIGHT OF WAY
- S SHED
- SEC SECTION
- SEPV SEPTIC VENT
- STH STATE TRUNK HIGHWAY
- STA STATION
- T TANGENT LENGTH OF CURVE OR TOWN
- TAV TAVERN
- TLE TEMPORARY LIMITED EASEMENT
- USH UNITED STATES HIGHWAY
- V VOLUME
- W WALL
- X EAST COORDINATE (GRID)
- Y NORTH COORDINATE (GRID)
- N NORTH COORDINATE (GROUND) OR NORTH
- E EAST COORDINATE (GROUND), EAST OR EXTERNAL
- Δ CENTRAL ANGLE OR DELTA

----- STATE LINE	⊙ SECTION CORNER	(Size) _W WATER	⊕ RAILROAD
----- COUNTY LINE	⊙ RIGHT OF WAY POINT (NOT MONUMENTED)	(Size) _G GAS	⊕ BRIDGE
----- TOWN OR RANGE LINE	⊙ RIGHT OF WAY POINT (MONUMENTED)	— T — TELEPHONE OR TELEGRAPH	(Label) BUILDING
----- SECTION LINE	⊙ (Type) RECOVERED IRON PIN/PIPE	— E — ELECTRIC	(Label) FOUNDATION OR RUINS
----- QUARTER LINE	⊙ TRIANGULATION POINT OR HORIZONTAL CONTROL STATION	— Tv — CABLE TELEVISION	— X — X — FENCE
----- SIXTEENTH LINE	⊙ INLET	— F0 — FIBER OPTIC	(Label) MARSH AREA
----- PROPOSED OR NEW R/W LINE	⊙ HYDRANT	(Size) _{SAN} SANITARY SEWER	⊕ LAKE OR POND
----- EXISTING R/W LINE	⊙ TELEPHONE POLE	(Size) _{SS} STORM SEWER	⊕ WOODED OR SHRUB AREA
----- LOT LINE	⊙ POWER POLE	⊕ NOTATION FOR COMBUSTIBLE FLUIDS	⊕ SERVICE PEDESTAL
PL ± 58.1 PROPERTY LINE	⊙ POWER POLE	(Label) SILO, MANHOLE OR WELL, ETC.	⊕ TREE
◆◆◆◆ NO ACCESS (By Previous Acquisition)	⊙ TELEPHONE POLE		⊕ BUILDING TO BE REMOVED
NO ACCESS (By Acquisition)	⊙ POWER POLE		
●●●● NO ACCESS (By Statutory Authority)	⊙ POWER POLE		
//// CORPORATE LIMITS			
▨ FEE ACQUISITION (Cross-hatching varies by parcel)			
▨ PLE ACQUISITION (Pattern varies by parcel)			
▨ TLE ACQUISITION (Pattern varies by parcel)			

R/W PROJECT NUMBER AWINN0302.00	SHEET NUMBER 4.1	TOTAL SHEETS 5
PLAT OF RIGHT-OF-WAY REQUIRED FOR SOUTH COUNTY LINE TO STH 44		
CTH M		WINNEBAGO CO.
CONSTRUCTION PROJECT NUMBER AWINN0302.00		

END RELOCATION ORDER
STA. 173+04.42
 Y= 434,559.737
 X= 742,431.516
 783.97 FEET NORTH AND 1349.21 FEET WEST OF THE SE CORNER OF SECTION 29, T17N, R15E.

BEGIN RELOCATION ORDER
STA. 103+77.48
 Y= 428,399.747
 X= 744,672.511
 101.61 FEET SOUTH AND 922.85 FEET EAST OF THE SW CORNER OF SECTION 33, T17N, R15E.

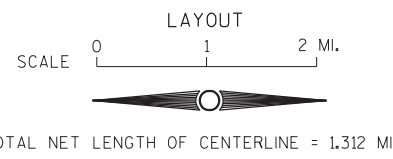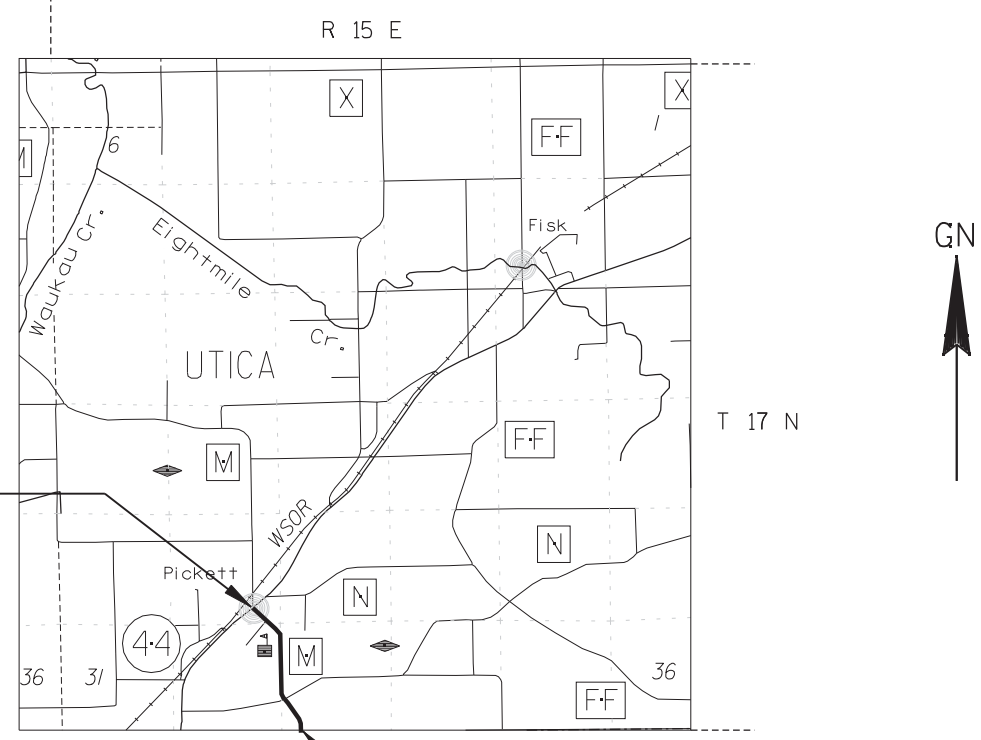

NOTES:
 COORDINATES AND BEARINGS ON THIS PLAT ARE ORIENTED TO THE WISCONSIN COUNTY COORDINATE SYSTEM, WINNEBAGO COUNTY (ENGLISH) NAD 83, 1997 ADJUSTMENT. ALL DISTANCES ARE GROUND LENGTH.
 RIGHT OF WAY MONUMENTS ARE TYPE-2 (3/4" X 24" REINFORCEMENT BAR WEIGHING 1.502 lb/FT) AND ARE PLACED PRIOR TO THE COMPLETION OF THE PROJECT
 RIGHT OF WAY BOUNDARIES ARE DEFINED WITH COURSES OF THE PERIMETER OF THE HIGHWAY LANDS REFERENCED TO THE U.S. PUBLIC LAND SURVEY OR OTHER SURVEYS OF PUBLIC RECORD.

ORIGINAL PLANS PREPARED BY

DATE: 12/15/2006
 (Signature)

REVISION DATE	WINNEBAGO COUNTY
	APPROVED FOR WINNEBAGO COUNTY
DATE: _____	(Signature)


SCHEDULE OF LANDS & INTERESTS REQUIRED

AREAS SHOWN IN THE TOTAL ACRES COLUMN MAY BE APPROXIMATE AND ARE DERIVED FROM TAX ROLLS OR OTHER AVAILABLE SOURCES AND MAY NOT INCLUDE LANDS OF THE OWNER WHICH ARE NOT CONTIGUOUS TO THE AREA TO BE ACQUIRED.

PARCEL NUMBER	SHEET NUMBER	OWNER (S)	INTEREST REQUIRED	TOTAL ACRES	R/W ACRES REQUIRED			TOTAL ACRES REM.	TLE ACRES
					NEW	EXISTING	TOTAL		
1	4.3	NANCY L. MUCKS, DAVID C. MILLER, BRUCE M. MILLER & JEFFREY J. MILLER	FEE	78.81	1.48	2.03	3.51	75.30	-
2	4.3,4.4	THOMAS R. HUETTL & CLAUDIA HUETTL	FEE,TLE	136.30	1.48	2.01	3.49	132.81	0.02
3	4.3	NICHOLAS J. RIPPLE III & THERESA A. CROSSMAN-RIPPLE	FEE,TLE	5.00	0.92	0.86	1.78	3.22	0.30
4	4.3	BRUCE M. MILLER	FEE	1.19	0.11	0.19	0.30	0.89	-
5	4.3	D. JERRY HALE & LEIGH O. HALE	FEE	56.58	0.58	0.62	1.20	55.38	-
6	4.4	MARGARET MACKIE	FEE	2.00	0.20	0.23	0.43	1.57	-
7	4.4,4.5	MICHEAL J. HINZ & KAREN L. HINZ	FEE,TLE	36.94	0.70	1.35	2.05	34.89	0.03
8	4.4	NELSON HINZ & SHIRLEY HINZ	FEE	115.05	0.51	0.87	1.38	113.67	-
9	4.4	DENNIS J. CLARK & DAWN M. CLARK	FEE	2.21	0.10	0.15	0.25	1.96	-
10	4.4	TOBIN J. STORZER & LAURA T. STORZER	FEE	2.80	0.12	0.19	0.31	2.49	-
12	4.4	MARY K. FLANAGAN & SCOTT L. KEARNEY	FEE,TLE	2.06	0.04	0.22	0.26	1.80	0.02
13	4.4	HERMAN F. BERNDT & DIANE D. BERNDT	FEE,TLE	0.55	0.02	0.12	0.14	0.41	0.01
14	4.4,4.5	GRACE EVANGELICAL LUTHERAN CHURCH	TLE	3.54	-	-	-	3.54	0.05
16	4.5	GARY JOLIN & JUDY JOLIN	TLE	1.00	-	-	-	1.00	0.04
18	4.5	JOHN D. TOPPER	TLE	0.36	-	-	-	0.36	0.02
19	4.5	THOMAS J. EBERHART & JOYCE J. EBERHART	TLE	0.11	-	-	-	0.11	0.02
21	4.5	CENTURYTEL OF CENTRAL WISCONSIN, LLC	TLE	0.71	-	-	-	0.71	0.03
22	4.5	ROBERT M. HUNTER & PATRICIA C. HUNTER	TLE	4.00	-	-	-	4.00	0.05
24	4.5	SHELLY WINK	TLE	0.89	-	-	-	0.89	0.01
40	4.3,4.4	CENTURYTEL OF CENTRAL WISCONSIN, LLC	RELEASE OF RIGHTS						

PROPOSED R/W POINT NO. AND COORDINATE VALUE					
POINT	Y	X	POINT	Y	X
700	428499.4660	744633.7183	727	429288.5979	744534.0636
701	428863.6364	744605.7777	728	429123.4624	744623.0733
702	429234.9228	744449.6895	729	428886.3710	744703.1591
703	429340.5560	744341.0083	730	428499.2516	744733.9718
704	429485.9034	744290.0266	731	431755.8244	743690.2697
705	429937.0806	743961.5253	732	431887.5314	743703.3264
706	430030.1580	743822.7063	733	432687.5057	743709.7421
707	430088.4138	743791.5882	734	432787.5426	743705.5442
708	430152.9245	743821.9048	735	432969.1981	743717.0014
709	430391.2466	743755.7912	736	433167.5239	743685.5392
710	430470.3132	743723.0473	737	433300.8528	743628.0307
711	430726.0706	743723.8763	738	433412.0515	743545.8716
712	430837.0792	743672.4359	739	433621.0519	743337.2946
713	430987.0825	743690.4087	740	433697.0626	743271.8946
714	431125.8701	743690.3836	741	433708.6500	743354.2880
715	431125.5049	743803.6724	742	433678.9758	743395.3361
716	430912.1073	743827.4223	743	433469.9754	743603.9131
717	430726.0858	743807.4559	744	433424.0520	743639.6514
718	430246.6303	743927.9329	745	433352.8880	743711.0068
719	430233.6004	744027.2452	746	433256.8296	743776.3081
720	430284.0037	744139.6737	747	433132.0557	743801.4983
721	430226.4883	744172.0478	748	432786.5802	743825.5403
722	430139.2933	744049.5609	749	432586.6637	743814.7387
723	430069.6002	744043.1499	750	431886.6894	743808.3230
724	429853.6740	744216.0687	751	431755.3815	743803.2698
725	429539.5785	744374.4006	752	431437.1029	743803.3274
726	429434.4875	744488.6629	753	431337.1055	743817.3454

RECOVERED MONUMENT TABLE					
POINT	STATION	OFFSET	Y	X	DESCRIPTION
2973	107+59.64	33.91'RT	428785.56	744706.26	1" IRON PIPE HIT
2938	109+79.02	57.49'RT	429011.74	744675.09	BRASS CAP MON
101	123+35.45	122.26'RT	430219.99	744027.20	1" IRON PIPE
100	123+43.64	52.18'LT	430135.61	743875.44	1" IRON PIPE
2654	123+44.27	5.36'RT	430164.67	743923.88	BRASS CAP
102	126+95.55	63.80'LT	430470.29	743723.06	1" IRON PIPE
103	129+28.28	32.28'RT	430715.71	743789.79	1" IRON PIPE
105	143+00.34	32.71'RT	432087.16	743792.64	3/4" REBAR
104	143+53.88	30.09'LT	432141.20	743730.27	1" IRON PIPE HIT
2043	145+03.75	30.86'LT	432291.08	743730.70	1" IRON PIPE HIT
2010	145+52.05	31.49'RT	432338.87	743793.44	1" IRON PIPE HIT
110	156+36.57	37.33'RT	433413.17	743648.76	1" IRON PIPE
111	157+87.25	34.53'RT	433523.11	743540.33	1" IRON PIPE
112	159+16.83	33.87'RT	433614.36	743448.33	1" IRON PIPE
113	160+65.87	24.56'RT	433713.28	743336.47	1" IRON PIPE
1366	165+00.58	22.57'RT	434017.84	743025.67	1 1/4" IRON PIPE
114	167+56.02	33.24'LT	434155.04	742803.09	1" IRON PIPE
1384	168+03.11	32.96'LT	434187.94	742769.39	1" IRON PIPE
1385	168+93.40	32.19'LT	434251.19	742704.95	1" IRON PIPE
116	170+14.93	34.78'LT	434383.76	742664.00	1" IRON PIPE
115	170+75.64	30.58'LT	434378.89	742574.92	1" IRON PIPE

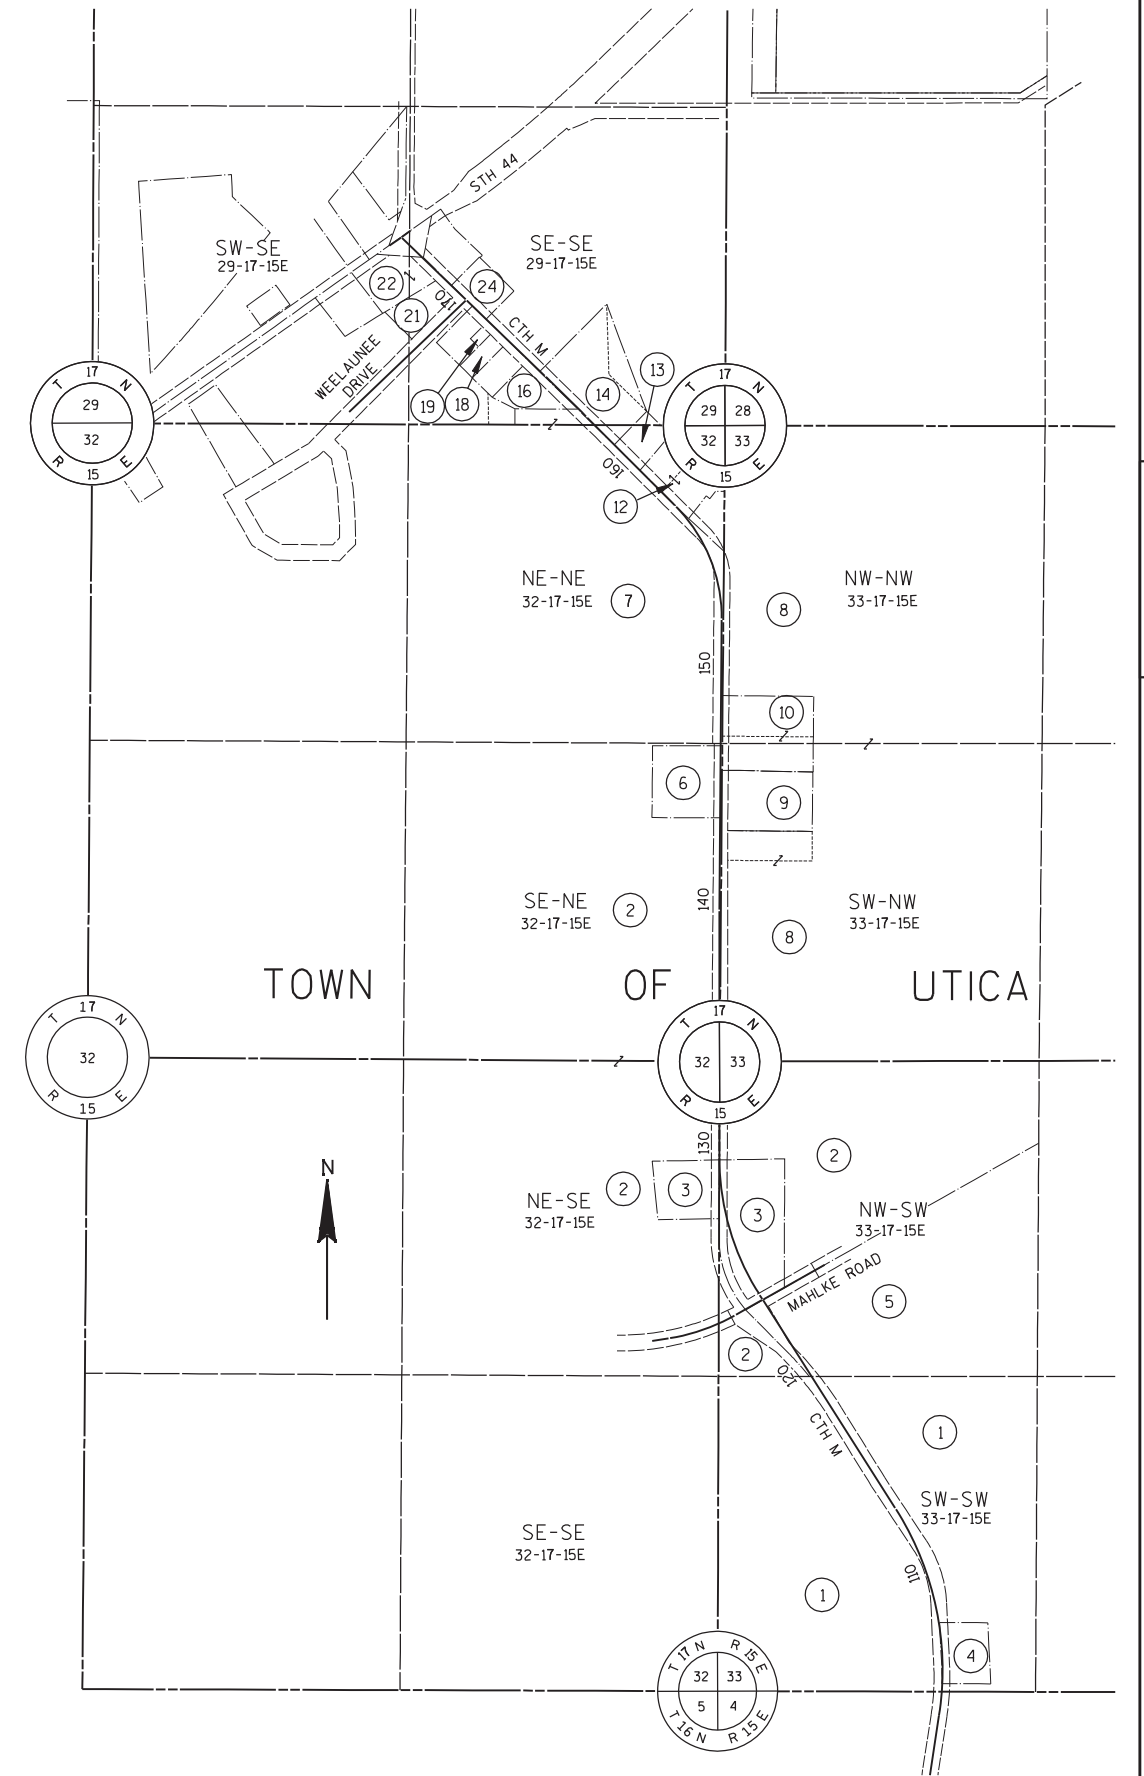


REVISION DATE	DATE	SCALE, FEET 0 N/A	HWY: CTH M	STATE R/W PROJECT NUMBER AWINNWO302.00	PLAT SHEET NO: 42
			COUNTY: WINNEBAGO	CONSTRUCTION PROJECT NUMBER AWINNWO302.00	PS&E SHEET 17

BASIS OF EXISTING R/W
 EXISTING R/W FOR C.T.H. M & MAHLKE ROAD ESTABLISHED FROM
 CENTER LINE OF EXISTING PAVEMENT, PRIVATE SURVEYS, CSM 3982
 AND FROM PREVIOUS COUNTY AID PROJECT NO. 3570.

R/W COURSE TABLE		
COURSE	BEARING	DISTANCE
706-707	N28°06'34"W	66.05'
707-708	N25°10'16"E	71.28'
709-710	N22°29'45"W	85.58'
710-711	N00°11'09"E	255.76'
711-712	N24°51'45"W	122.35'
602-709	S00°11'09"W	734.17'

R/W COURSE TABLE		
COURSE	BEARING	DISTANCE
714-602	S89°36'55"E	67.79'
602-715	N89°53'12"E	45.50'
718-719	S82°31'31"E	100.16'
719-720	N65°51'09"E	123.21'
720-721	S29°22'27"E	66.00'

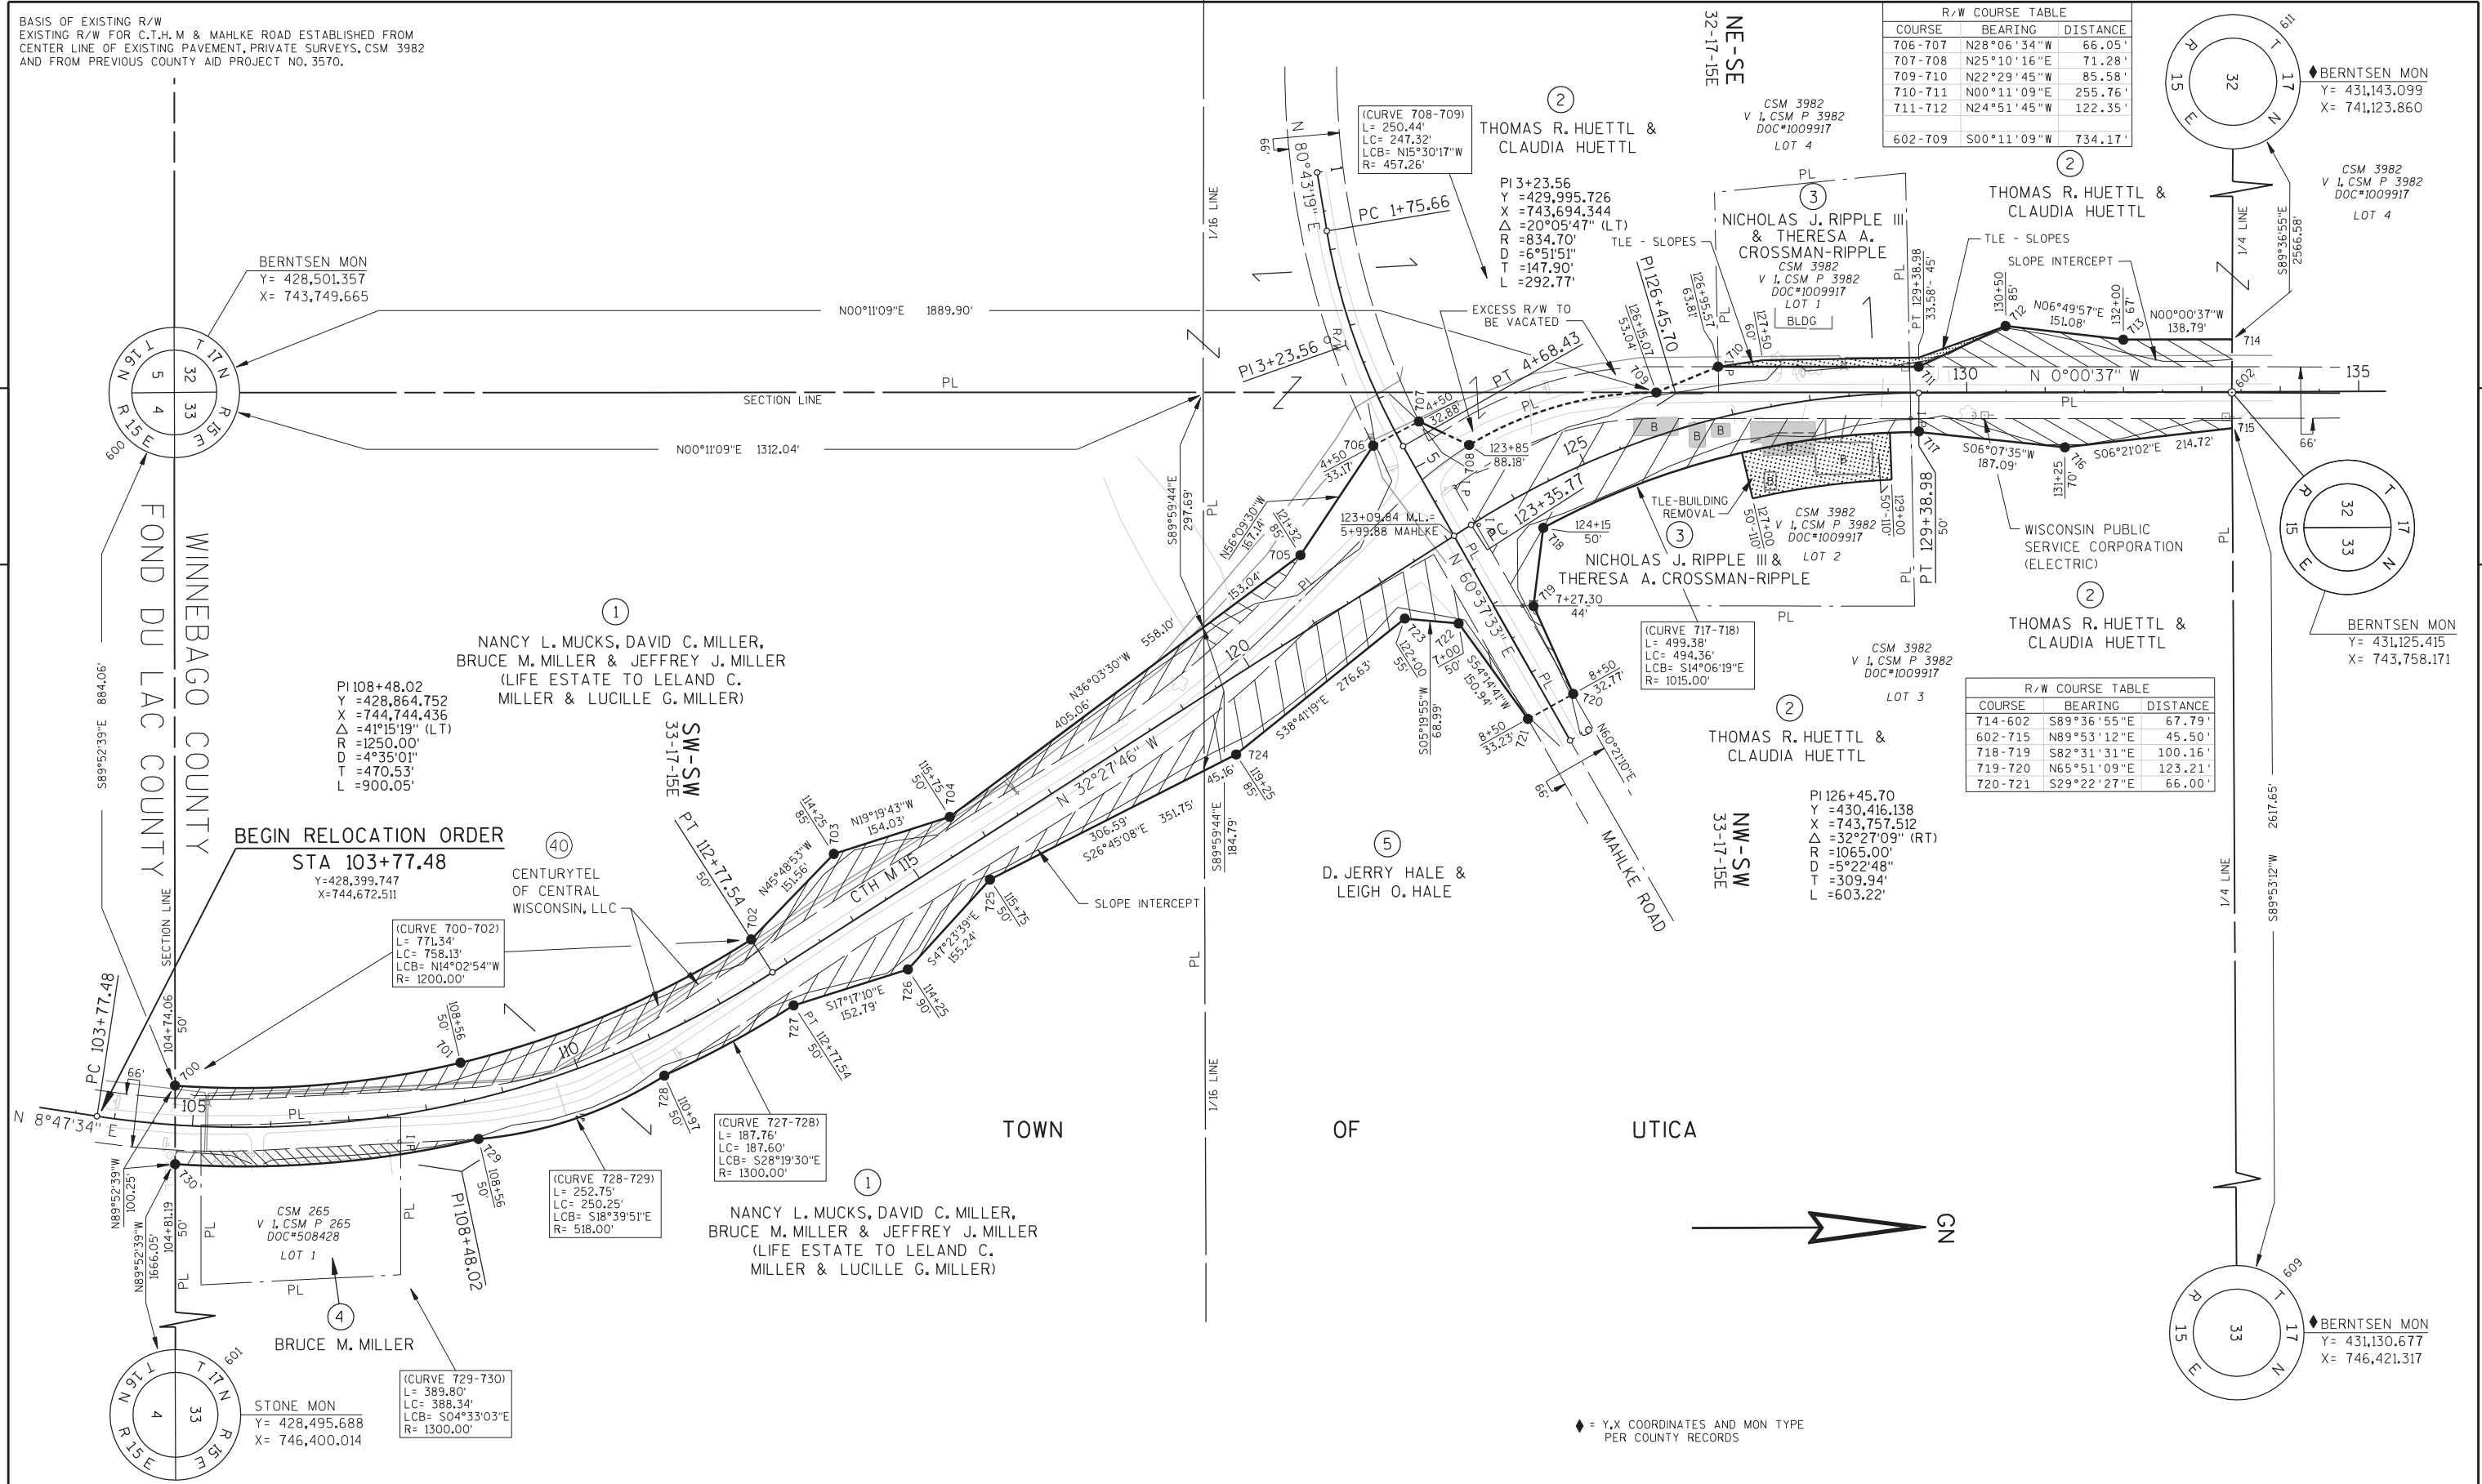

4

4



◆ = Y,X COORDINATES AND MON TYPE PER COUNTY RECORDS


REVISION DATE	DATE	SCALE, FEET 0 100 200	HWY: CTH M	STATE R/W PROJECT NUMBER AWINNWO302.00	PLAT SHEET NO: 4.3
	GRID FACTOR N/A		COUNTY: WINNEBAGO	CONSTRUCTION PROJECT NUMBER AWINNWO302.00	PS&E SHEET 18

BASIS OF EXISTING R/W FOR C.T.H.M ESTABLISHED FROM CENTER LINE OF EXISTING PAVEMENT, PRIVATE SURVEYS, CSM's 2760, 214, & 3527.

TOWN OF UTICA



NO MONUMENT -
COMPUTED FROM TIES
Y= 433,785.727
X= 741,143.943

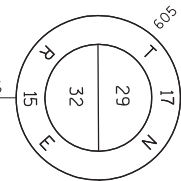





R/W COURSE TABLE (PARCEL 7)		
COURSE	BEARING	DISTANCE
740-193	N72°06'08"E	74.63'
193-745	S45°04'37"E	519.87'
R/W COURSE		
195-194	S89°47'01"E	94.90'
194-193	S45°43'14"E	82.57'

R/W COURSE TABLE (PARCELS 12 & 13)		
COURSE	BEARING	DISTANCE
745-737	S57°54'28"W	97.94'
193-741	S45°04'37"E	16.07'
741-742	S54°08'11"E	50.65'
742-743	S44°56'31"E	295.27'
743-744	S37°53'26"E	58.19'
744-745	S45°04'37"E	100.78'

PI 126+45.70
Y = 430,416.138
X = 743,757.512
Δ = 32°27'09" (RT)
R = 1065.00'
D = 5°22'48"
T = 309.94'
L = 603.22'

R/W COURSE TABLE		
COURSE	BEARING	DISTANCE
602-714	N89°36'55"W	67.79'
715-602	S89°53'12"W	45.50'


BERNTSEN MON
Y= 431,125.415
X= 743,758.171

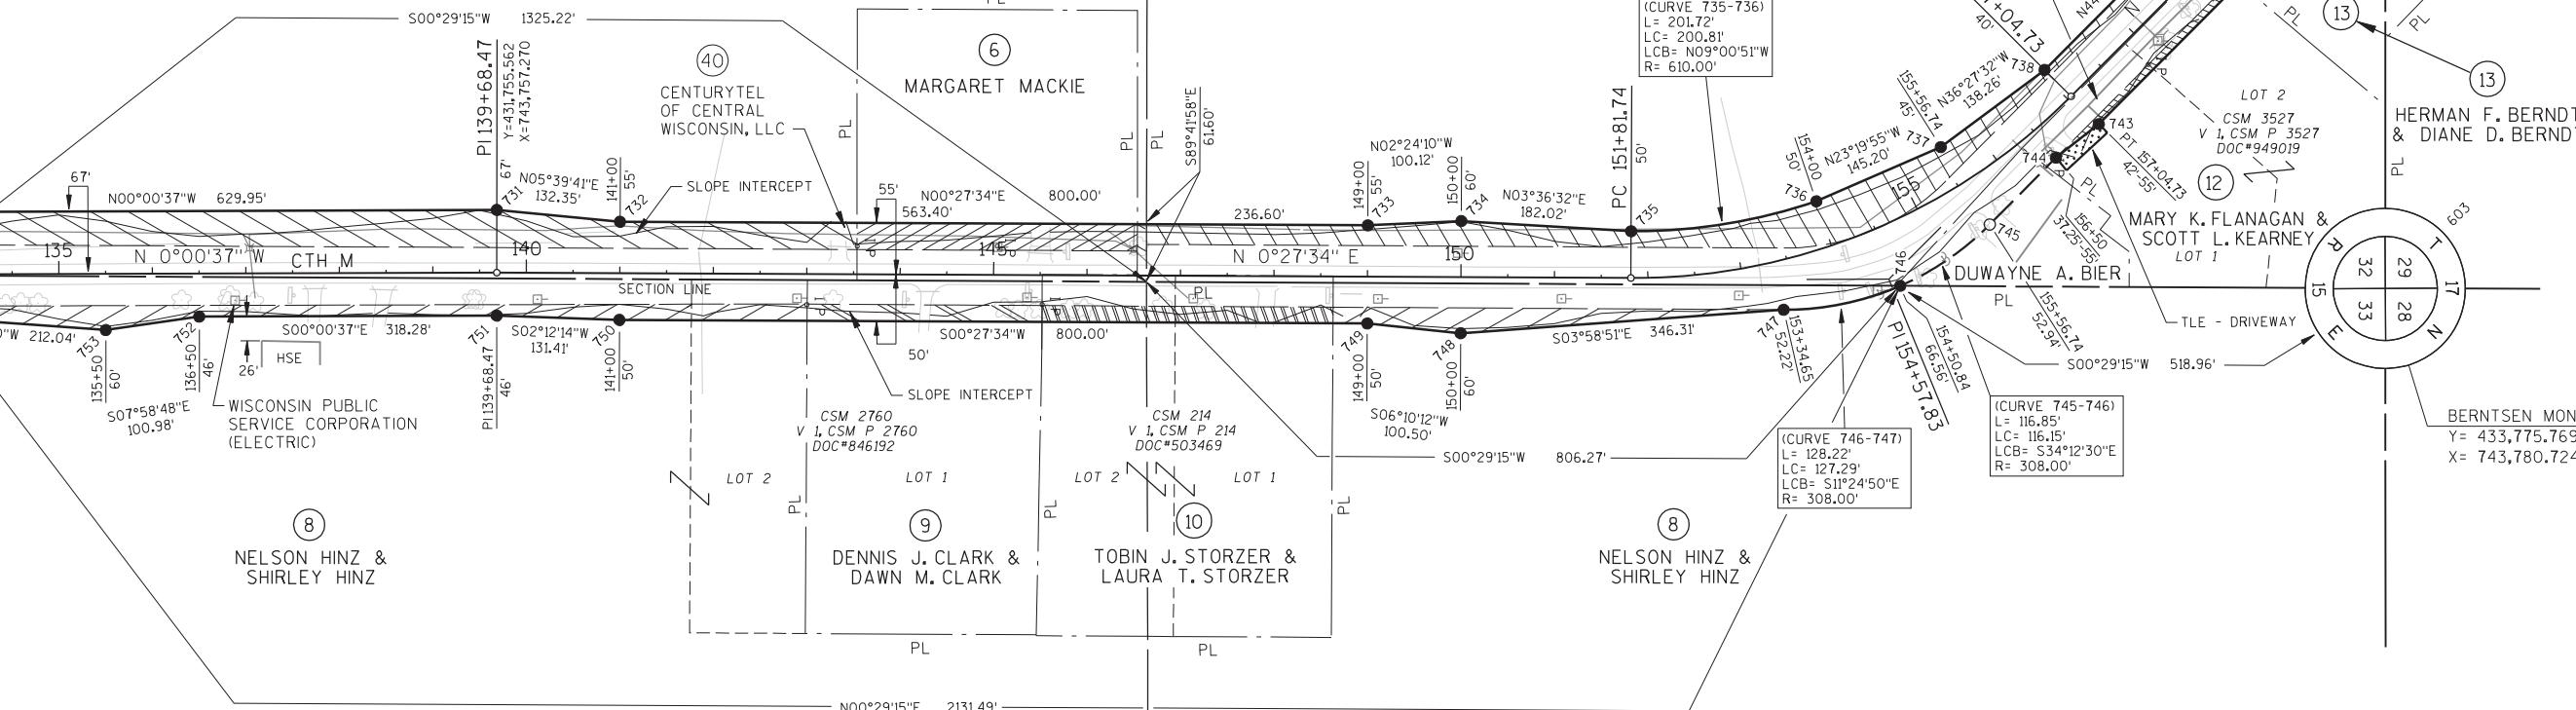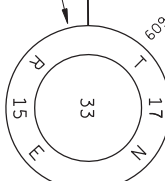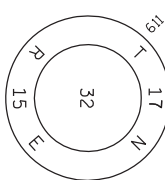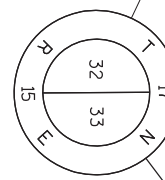

REVISION DATE	DATE	SCALE, FEET	HWY: CTH M	STATE R/W PROJECT NUMBER AWINNWO302.00	PLAT SHEET NO: 4.4
	GRID FACTOR N/A	0 100 200	COUNTY: WINNEBAGO	CONSTRUCTION PROJECT NUMBER AWINNWO302.00	PS&E SHEET 19

BASIS OF EXISTING R/W FOR C.T.H. M ESTABLISHED FROM CENTER LINE OF EXISTING PAVEMENT, PRIVATE SURVEYS, CSM'S 694, 2309, 1264 & 1829
 BASIS OF EXISTING R/W FOR S.T.H. 44 R/W ESTABLISHED FROM PREVIOUS WISDOT PROJECT NO. F 073-1(2).

NO MONUMENT -
 COMPUTED FROM TIES
 Y= 433,785.727
 X= 741,143.943


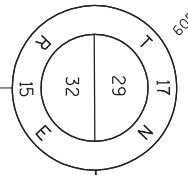


PI 163+49.33
 Y = 433,896.575
 X = 743,118.841
 $\Delta = 1^{\circ}04'59''$ (L.T.)
 R = 12,800.00'
 D = 0^{\circ}26'51''
 T = 120.99'
 L = 241.97'

NE-NE
 32-17-15E

TOWN OF UTICA


BERNTSEN MON
 Y= 433,775.769
 X= 743,780.724

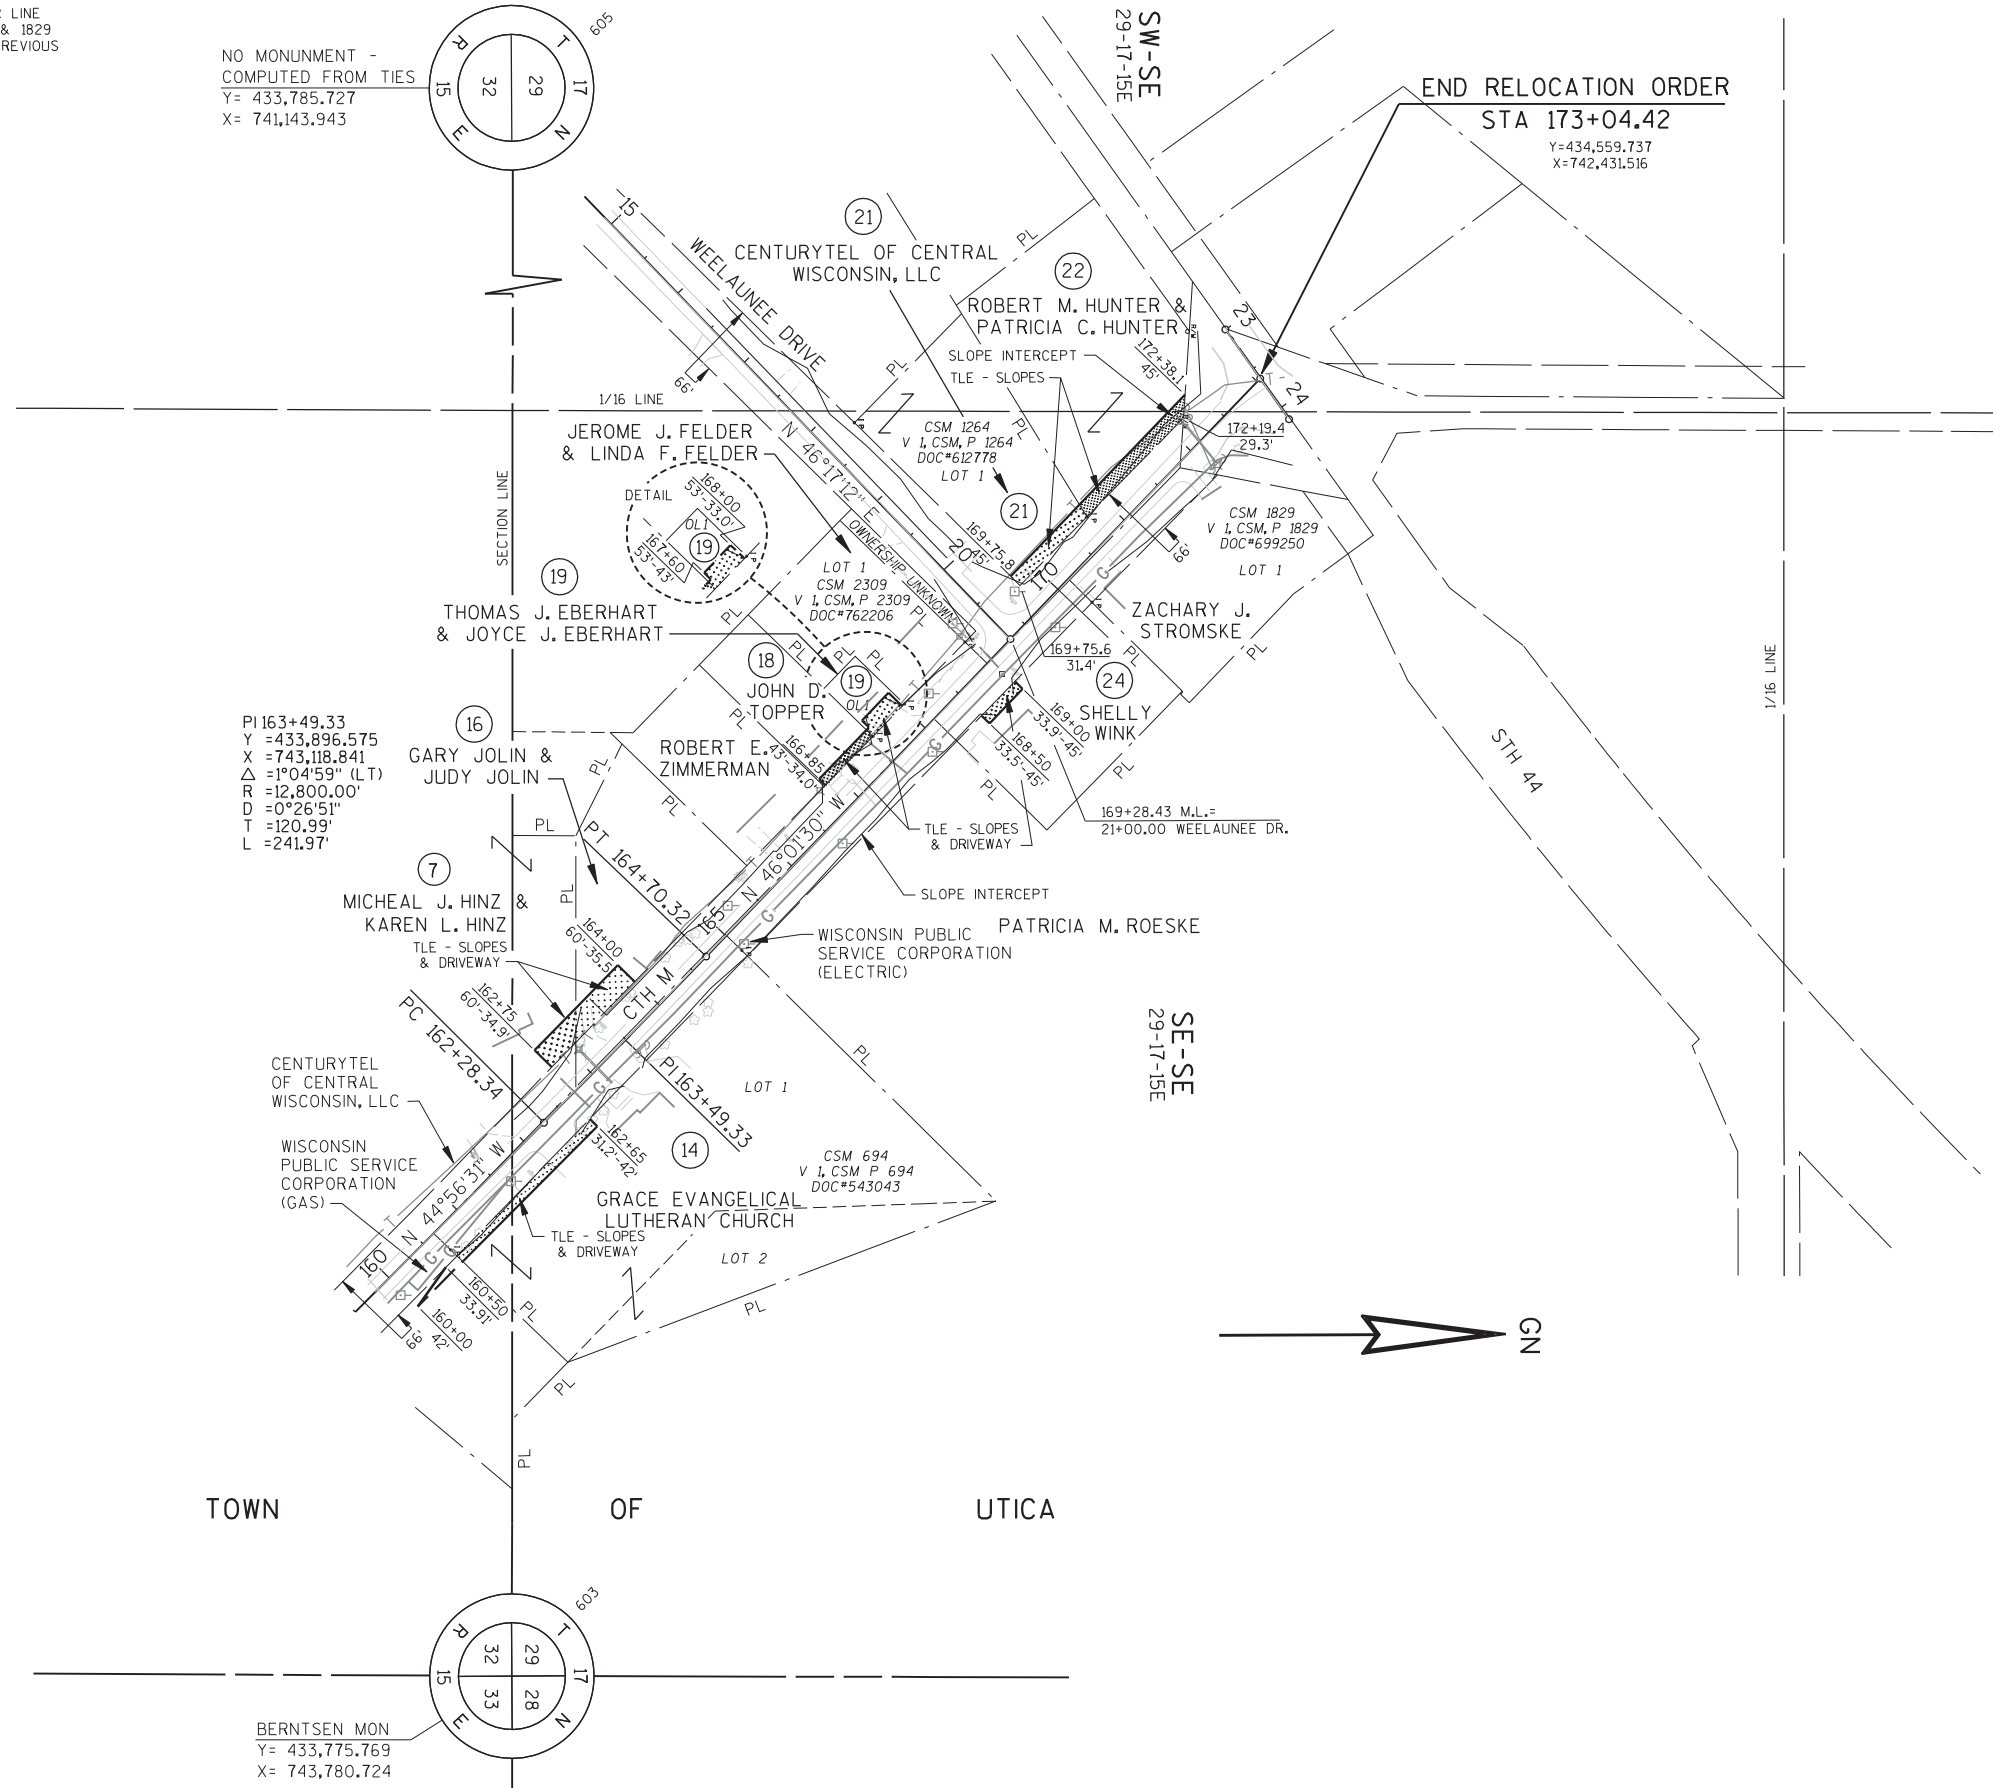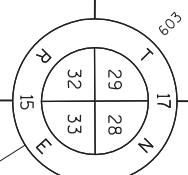

END RELOCATION ORDER
 STA 173+04.42
 Y=434,559.737
 X=742,431.516




REVISION DATE	DATE	SCALE, FEET 0 100 200	HWY: CTH M	STATE R/W PROJECT NUMBER AWINNWO302.00	PLAT SHEET NO: 4.5
	GRID FACTOR N/A		COUNTY: WINNEBAGO	CONSTRUCTION PROJECT NUMBER AWINNWO302.00	PS&E SHEET 20

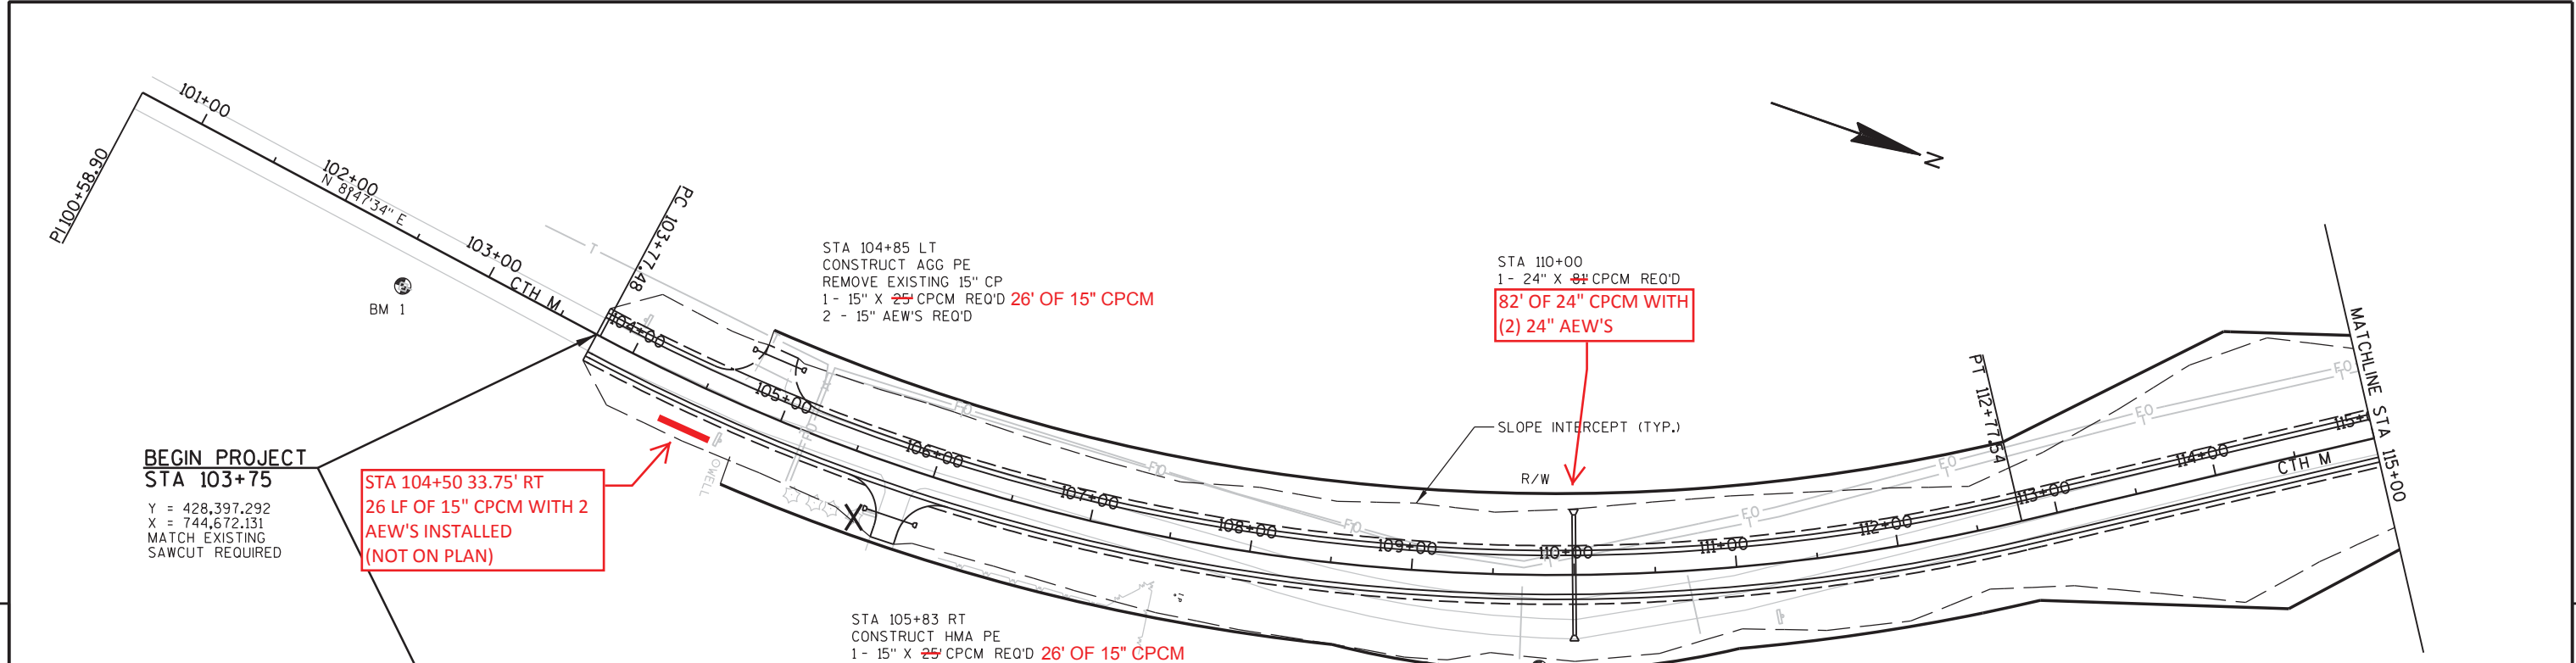

BENCHMARK TABLE			
NO	STATION	DESCRIPTION	ELEV
BM 1	102+55.82, 29.74'RT	3/8" SPIKE IN PP # 16-15-4, EAST SIDE OF EXISTING CTH M	899.19
BM 2	109+78.99, 57.52'RT	BRONZE SURVEY DISK, EAST SIDE OF EXISTING CTH M	903.48



X = REMOVE TREE

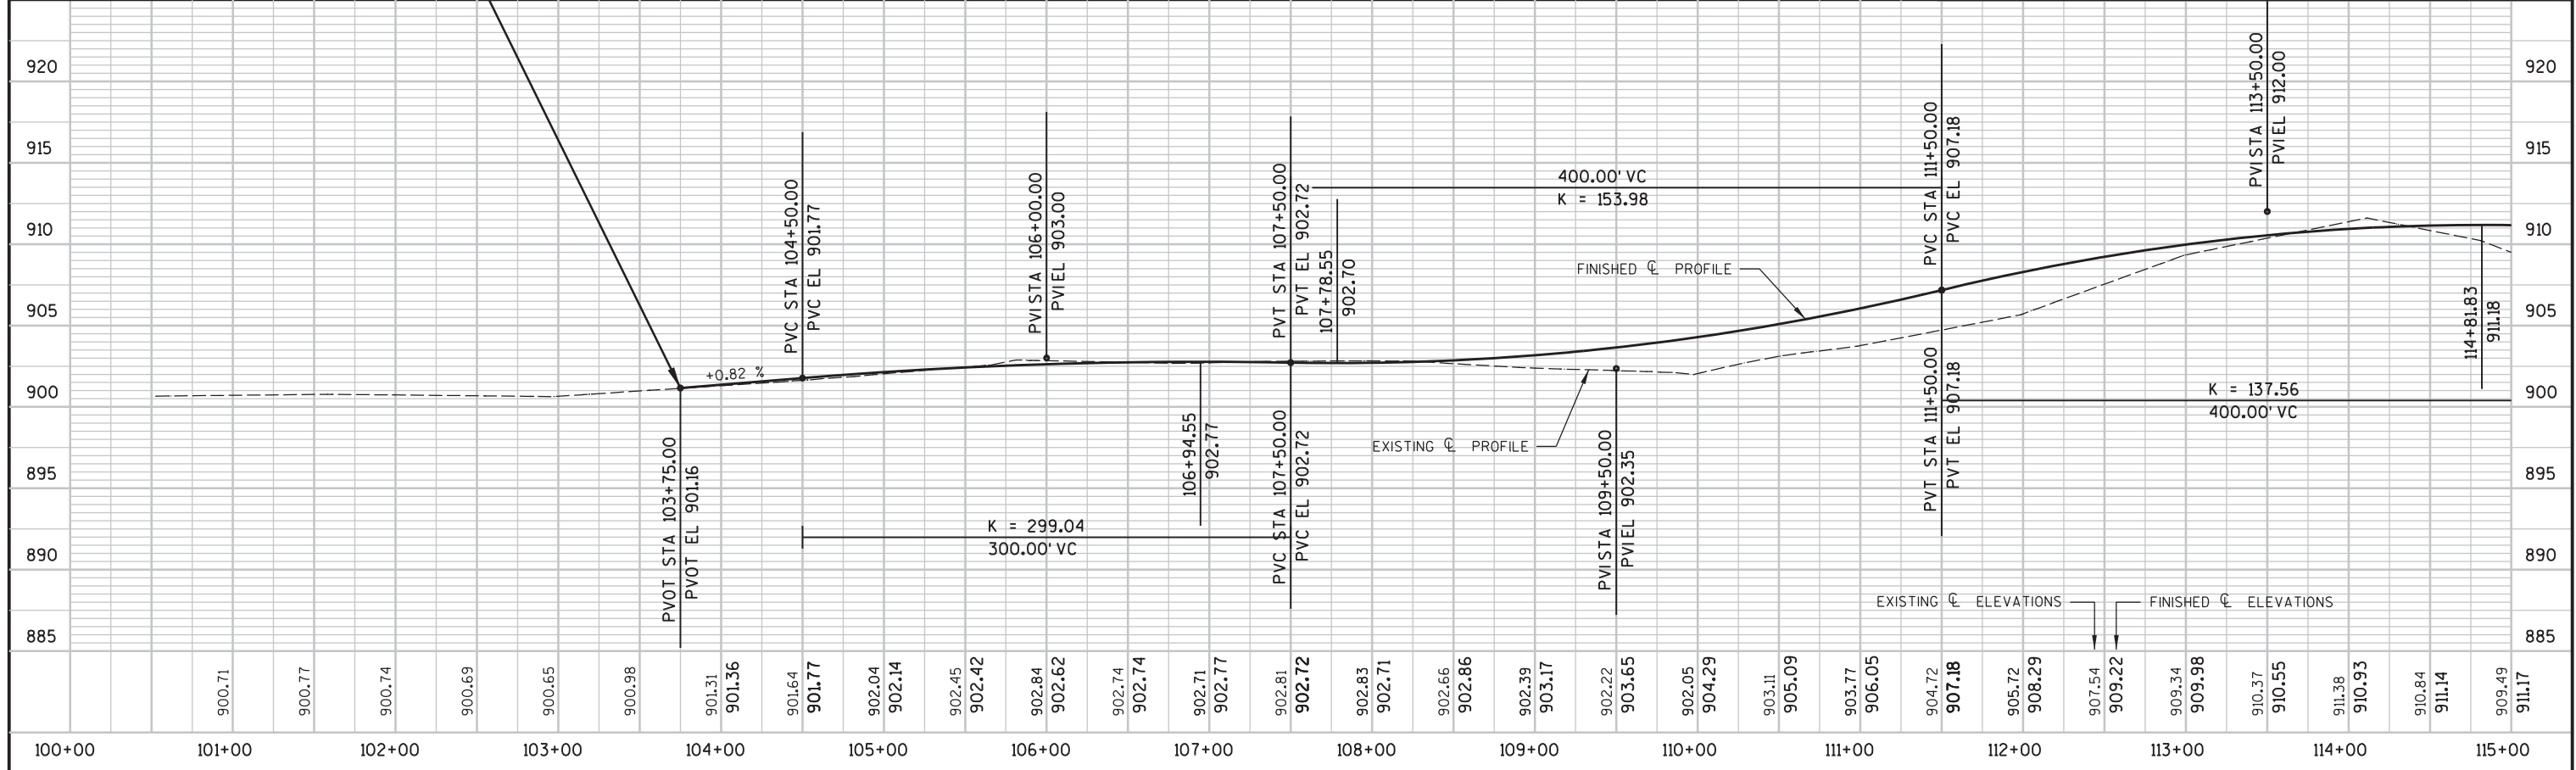

PROJECT NO: HWY: CTH M COUNTY: WINNEBAGO PLAN AND PROFILE - CTH M SCALE, FEET SHEET 21 E

BENCHMARK TABLE			
NO	STATION	DESCRIPTION	ELEV
BM 3	116+09.98, 22.58' LT	SPIKE IN RED OAK TREE WEST SIDE OF EXISTING CTH M	906.05
BM 4	123+44.17, 5.34' RT	BRONZE SURVEY DISK NE CORNER OF CTH M & MAHLKE ROAD	911.51



X = REMOVE TREE

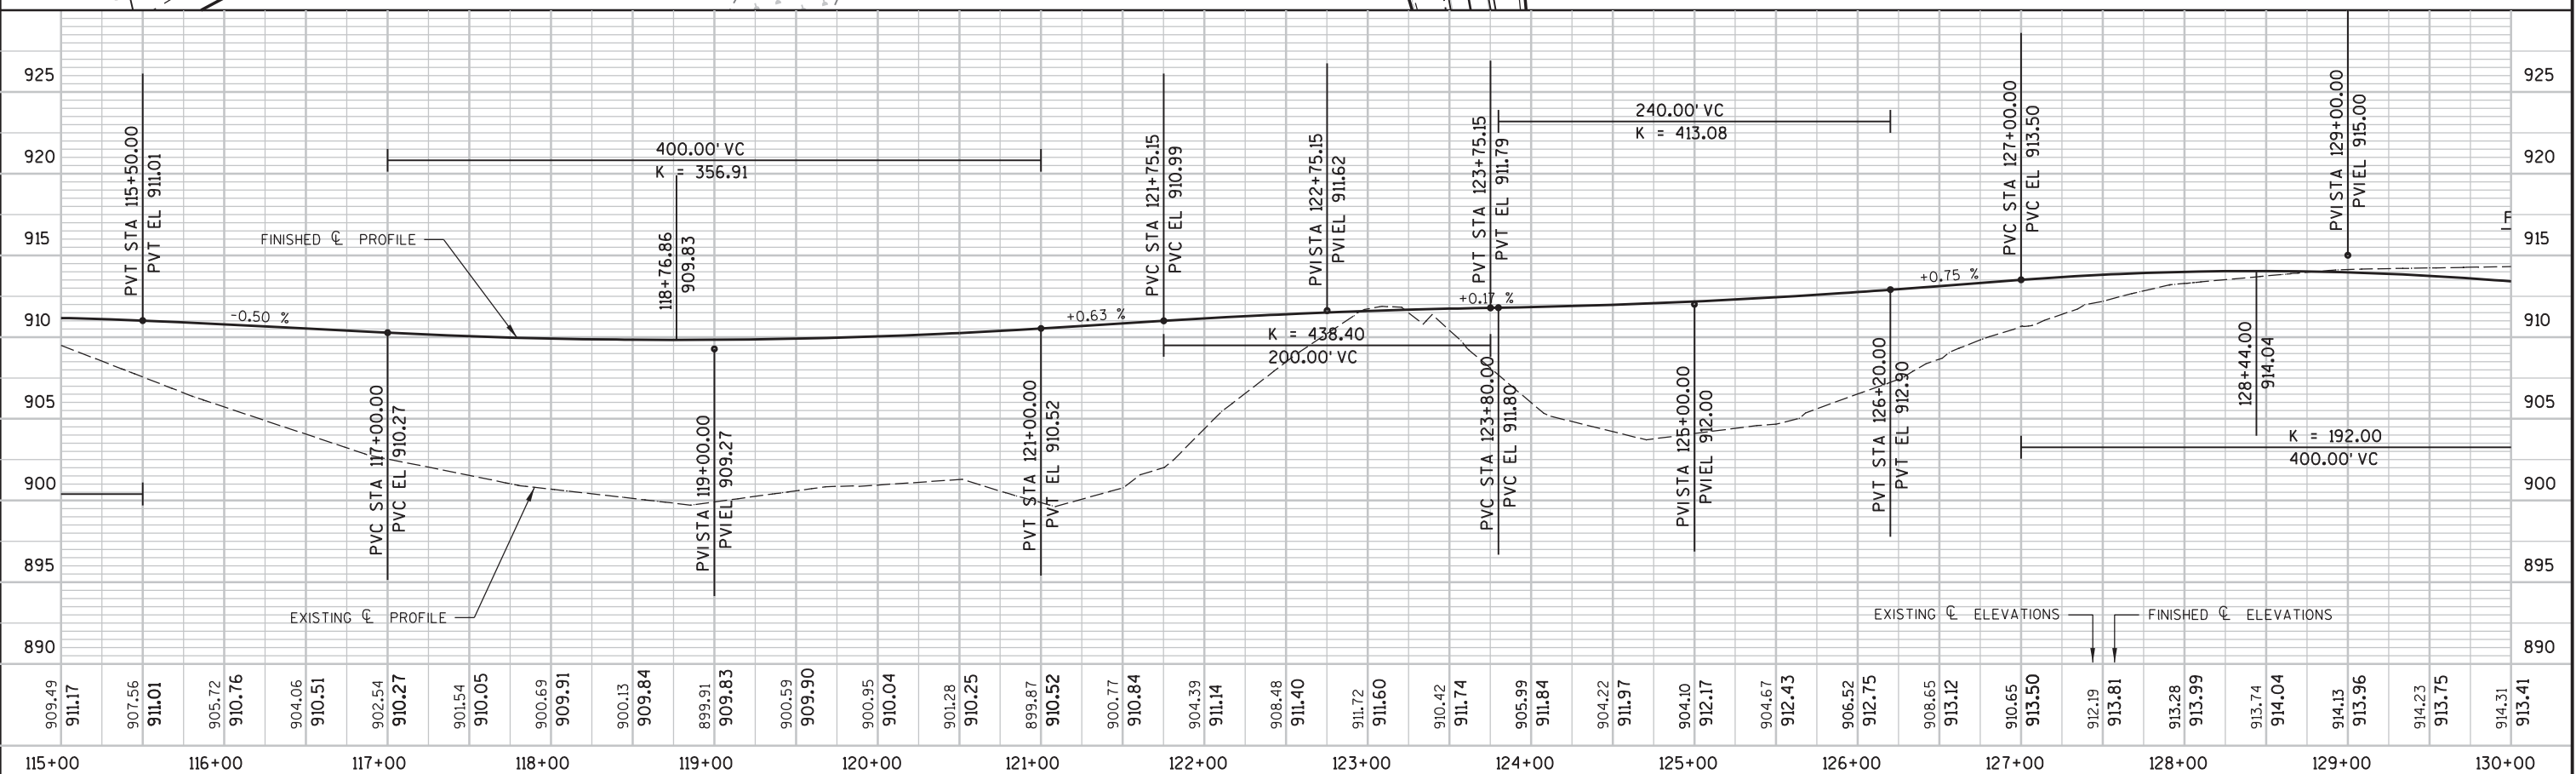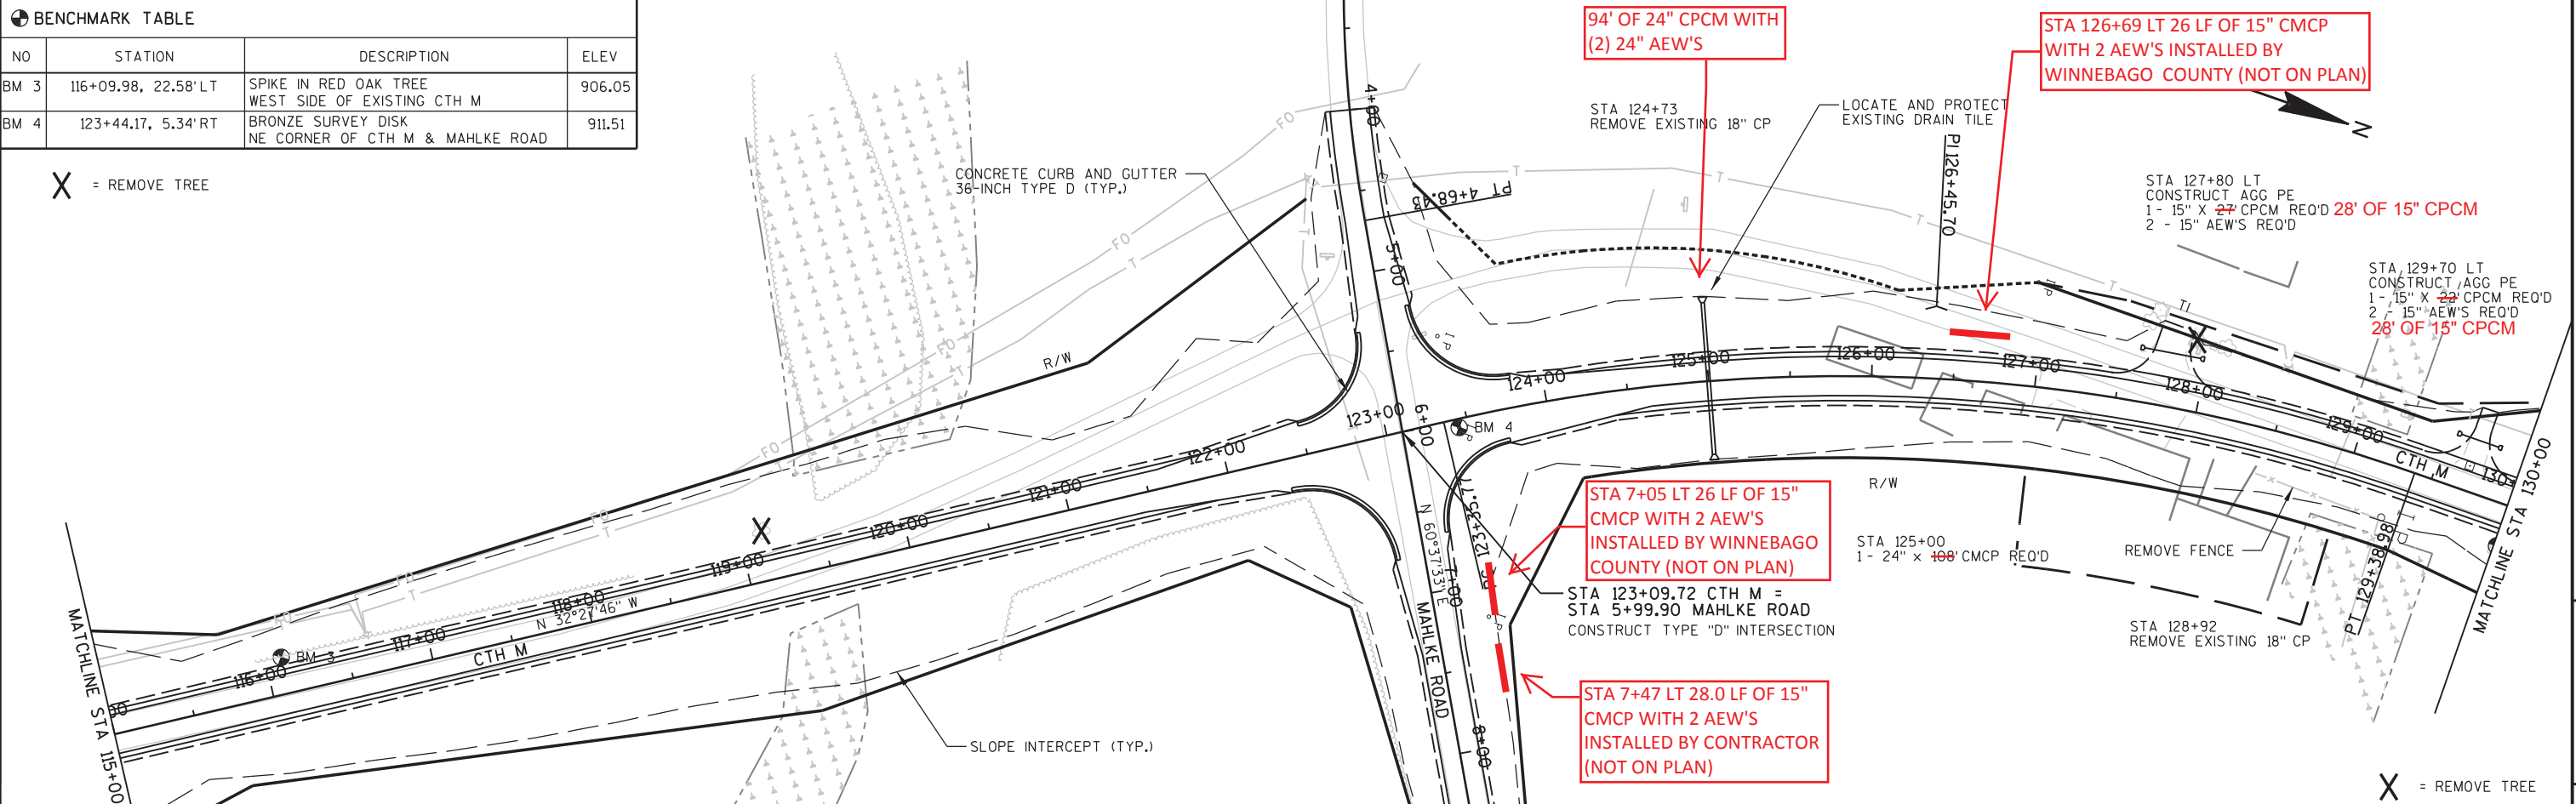


PROJECT NO:	HWY: CTH M	COUNTY: WINNEBAGO	PLAN AND PROFILE - CTH M	SCALE, FEET	SHEET 22
-------------	------------	-------------------	--------------------------	-------------	----------

BENCHMARK TABLE			
NO	STATION	DESCRIPTION	ELEV
BM 5	130+01.80, 25.86' RT	SPIKE IN RED OAK TREE EAST SIDE OF EXISTING CTH M	914.63

X = REMOVE TREE

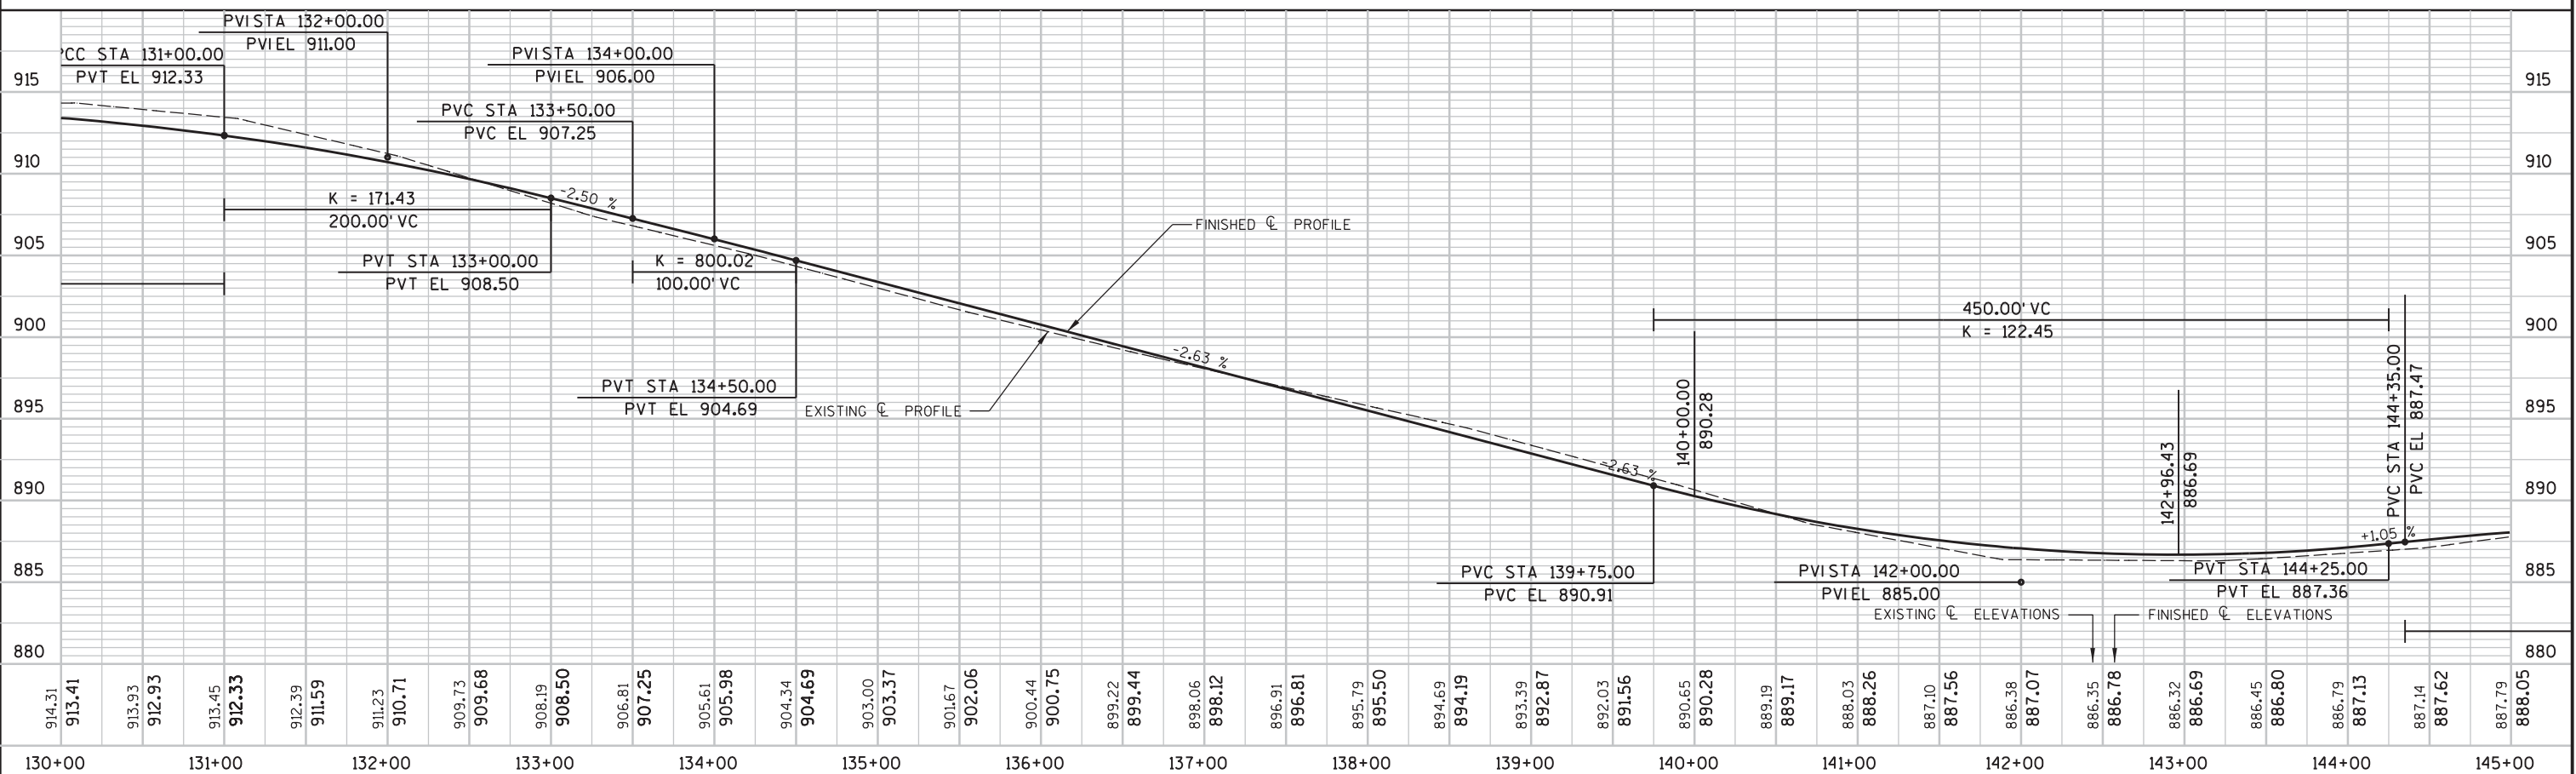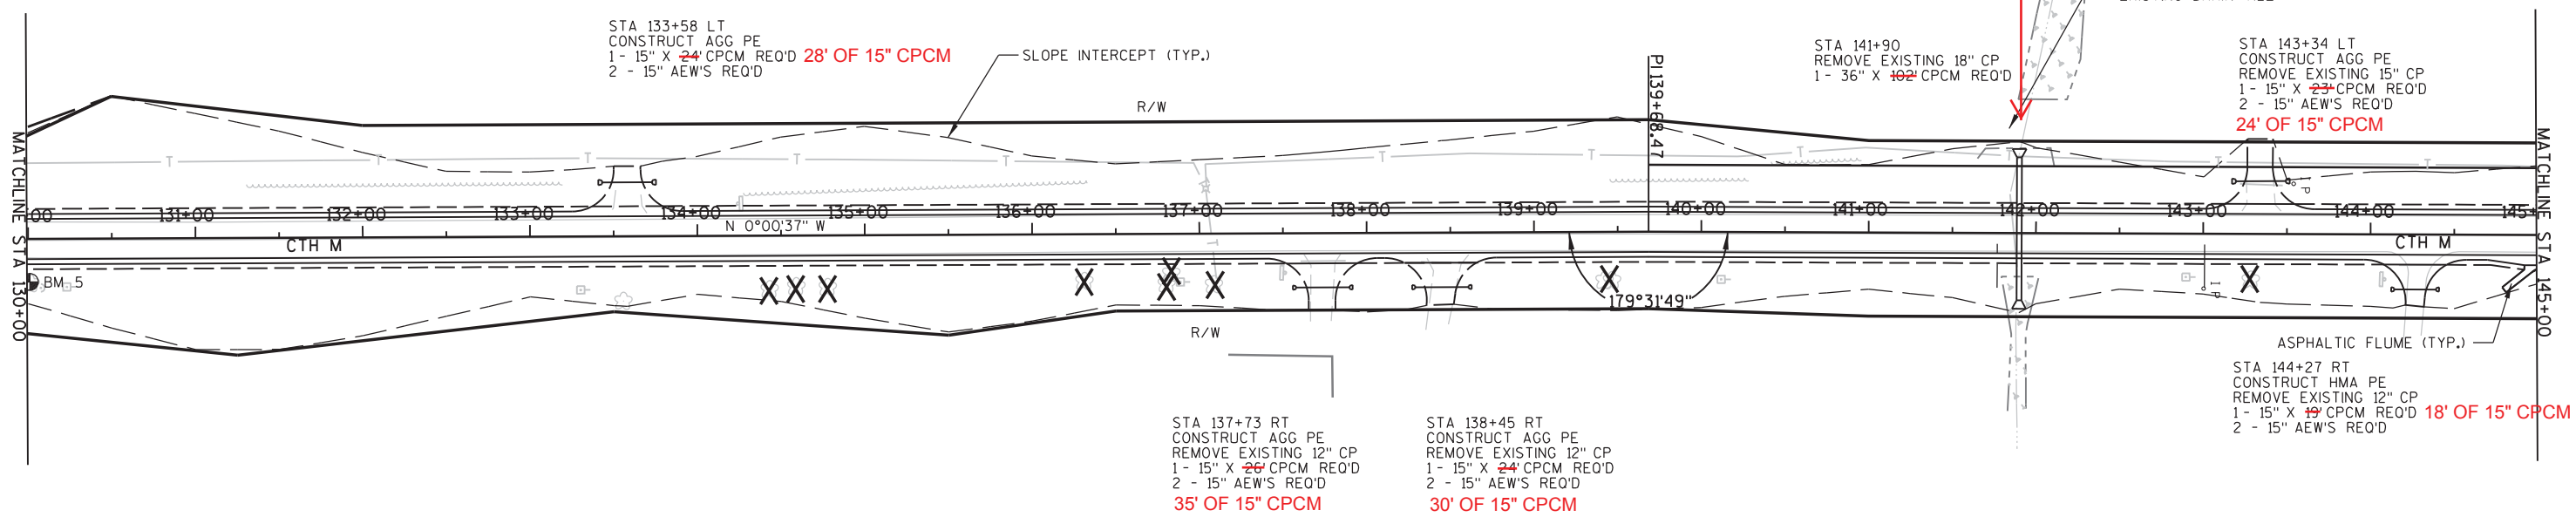


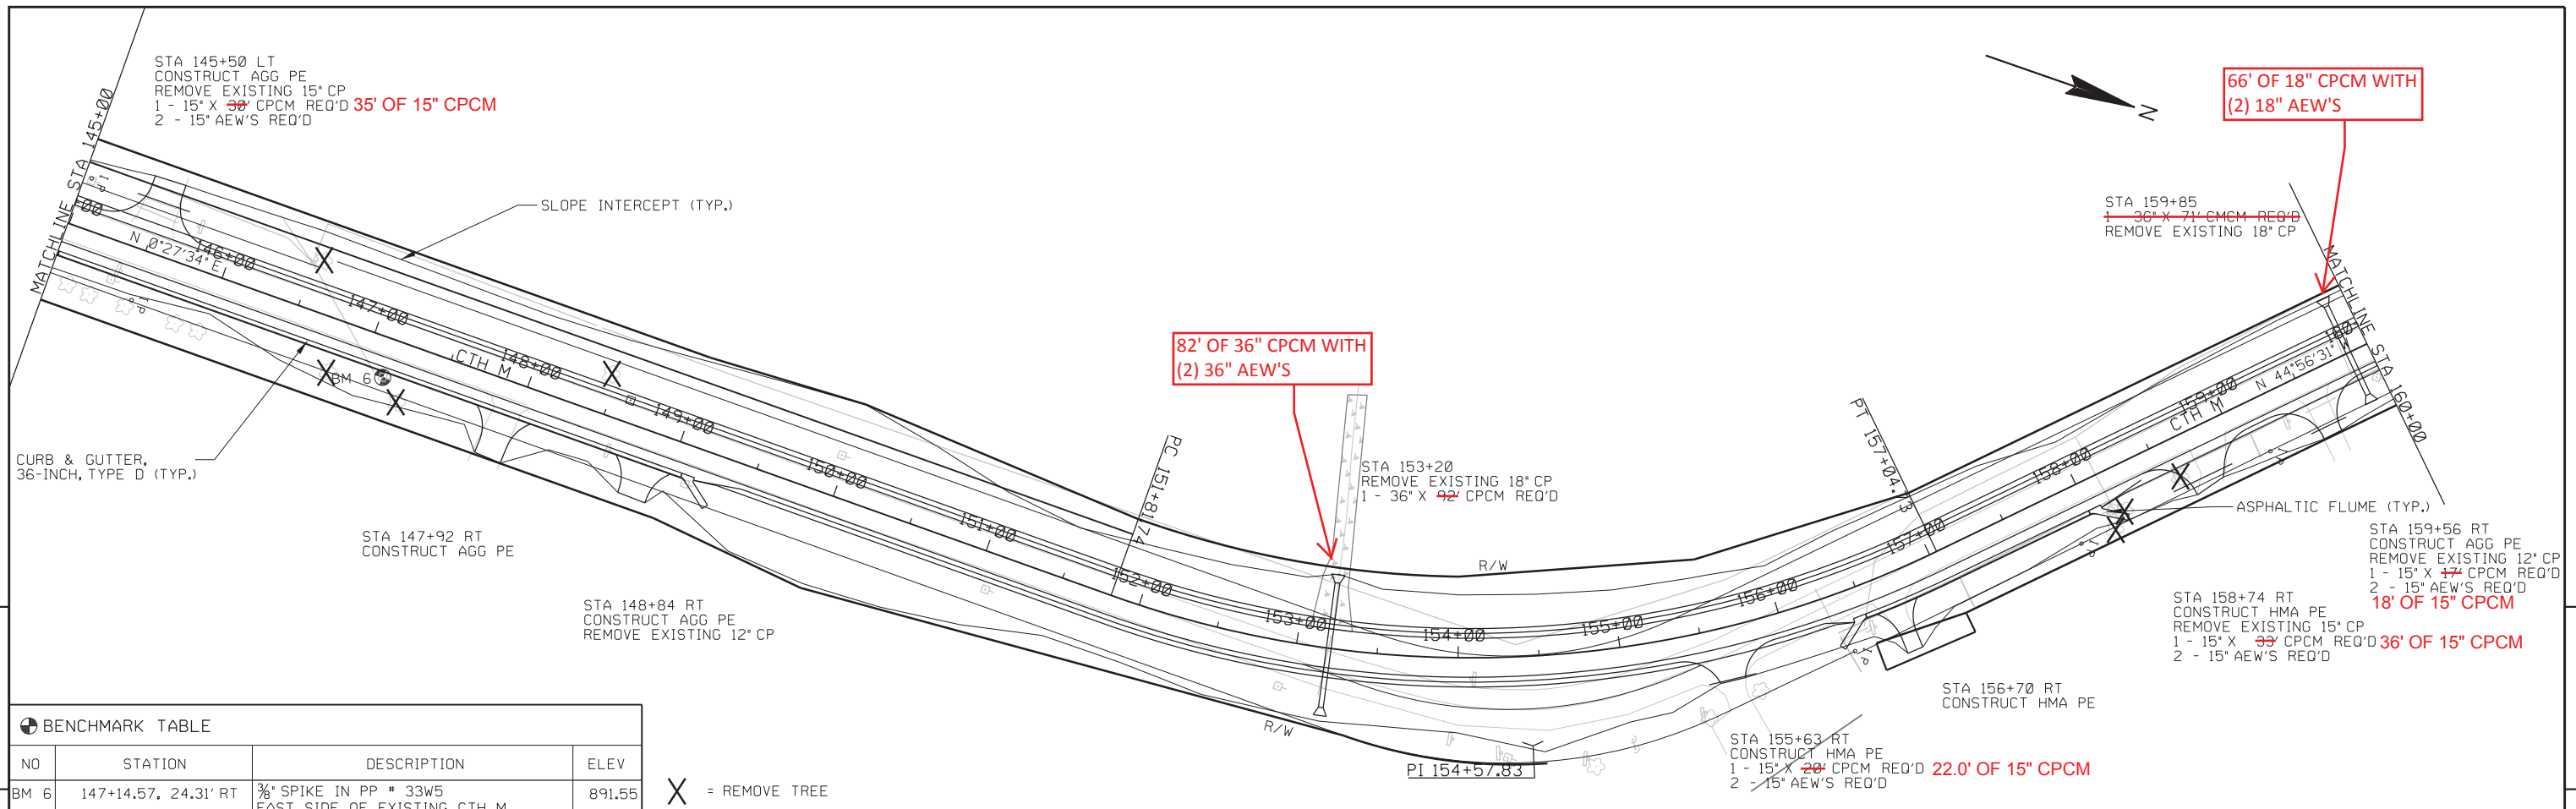


BENCHMARK TABLE

NO	STATION	DESCRIPTION	ELEV
BM 6	147+14.57, 24.31' RT	3/8" SPIKE IN PP # 33W5 EAST SIDE OF EXISTING CTH M	891.55

X = REMOVE TREE

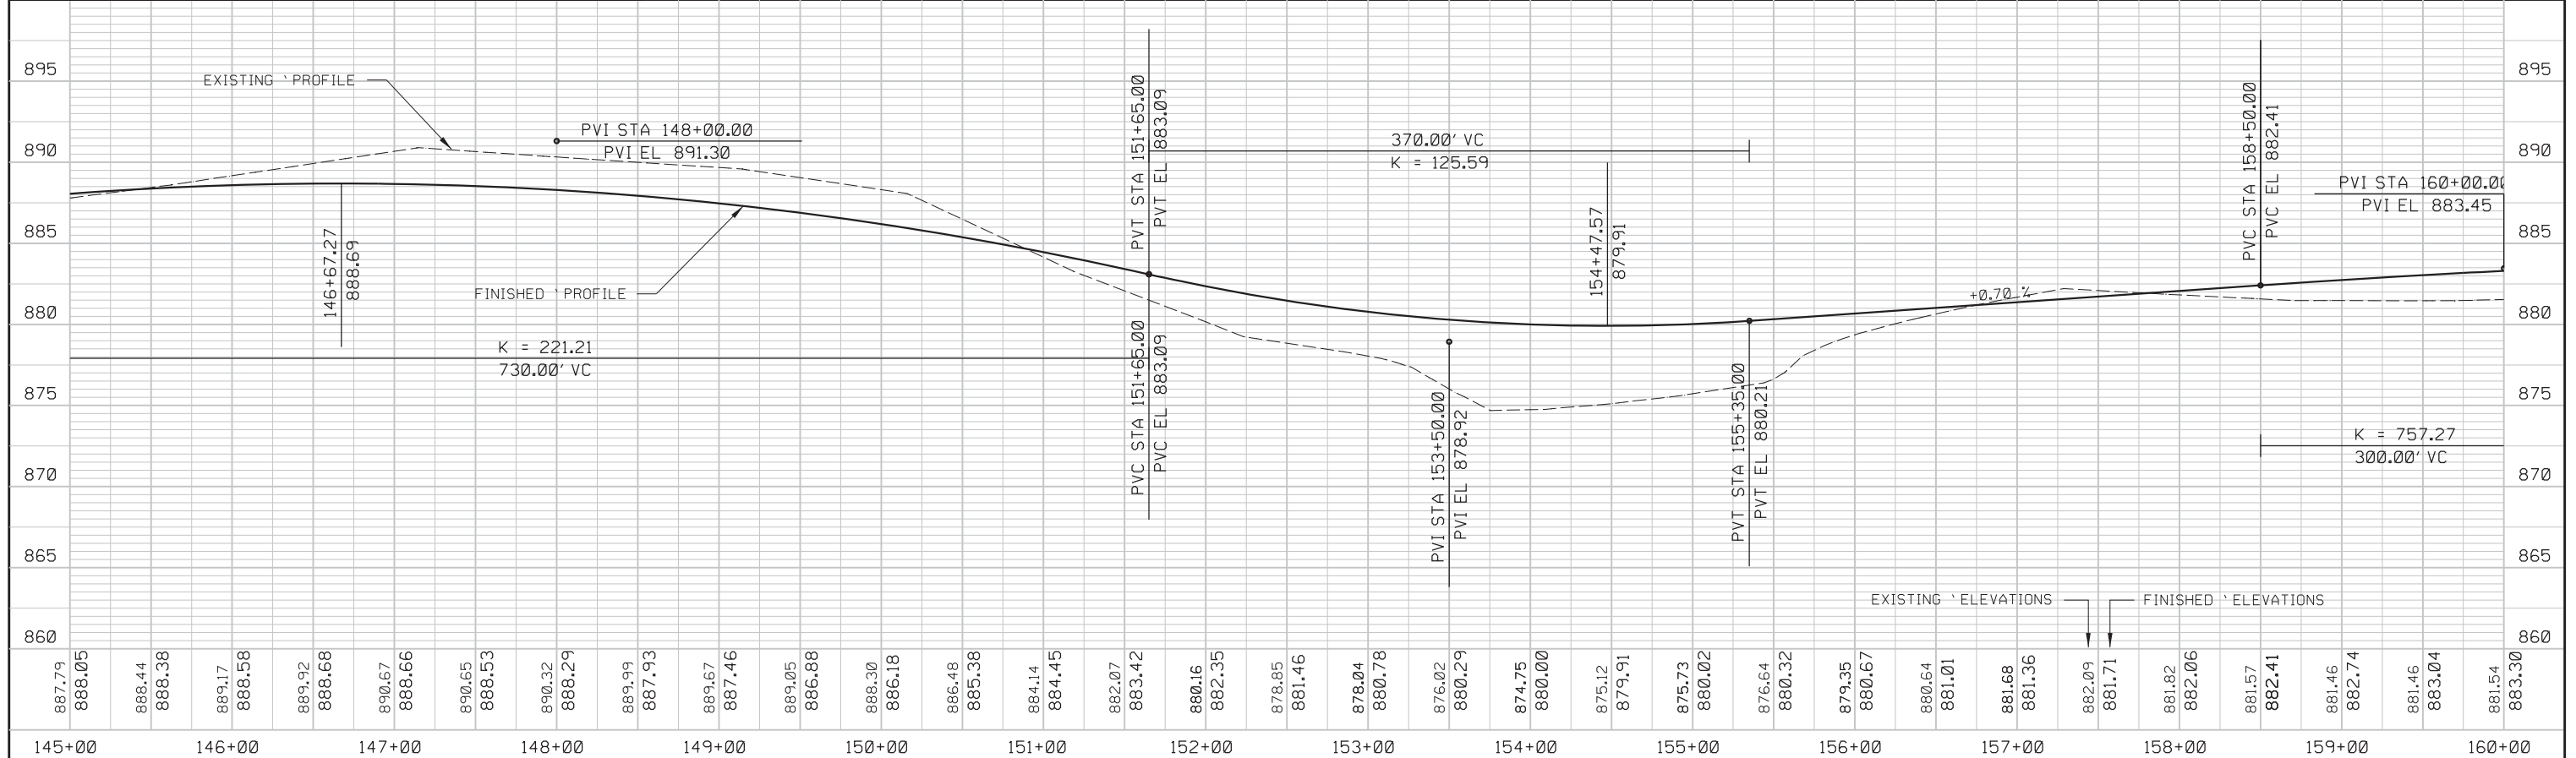


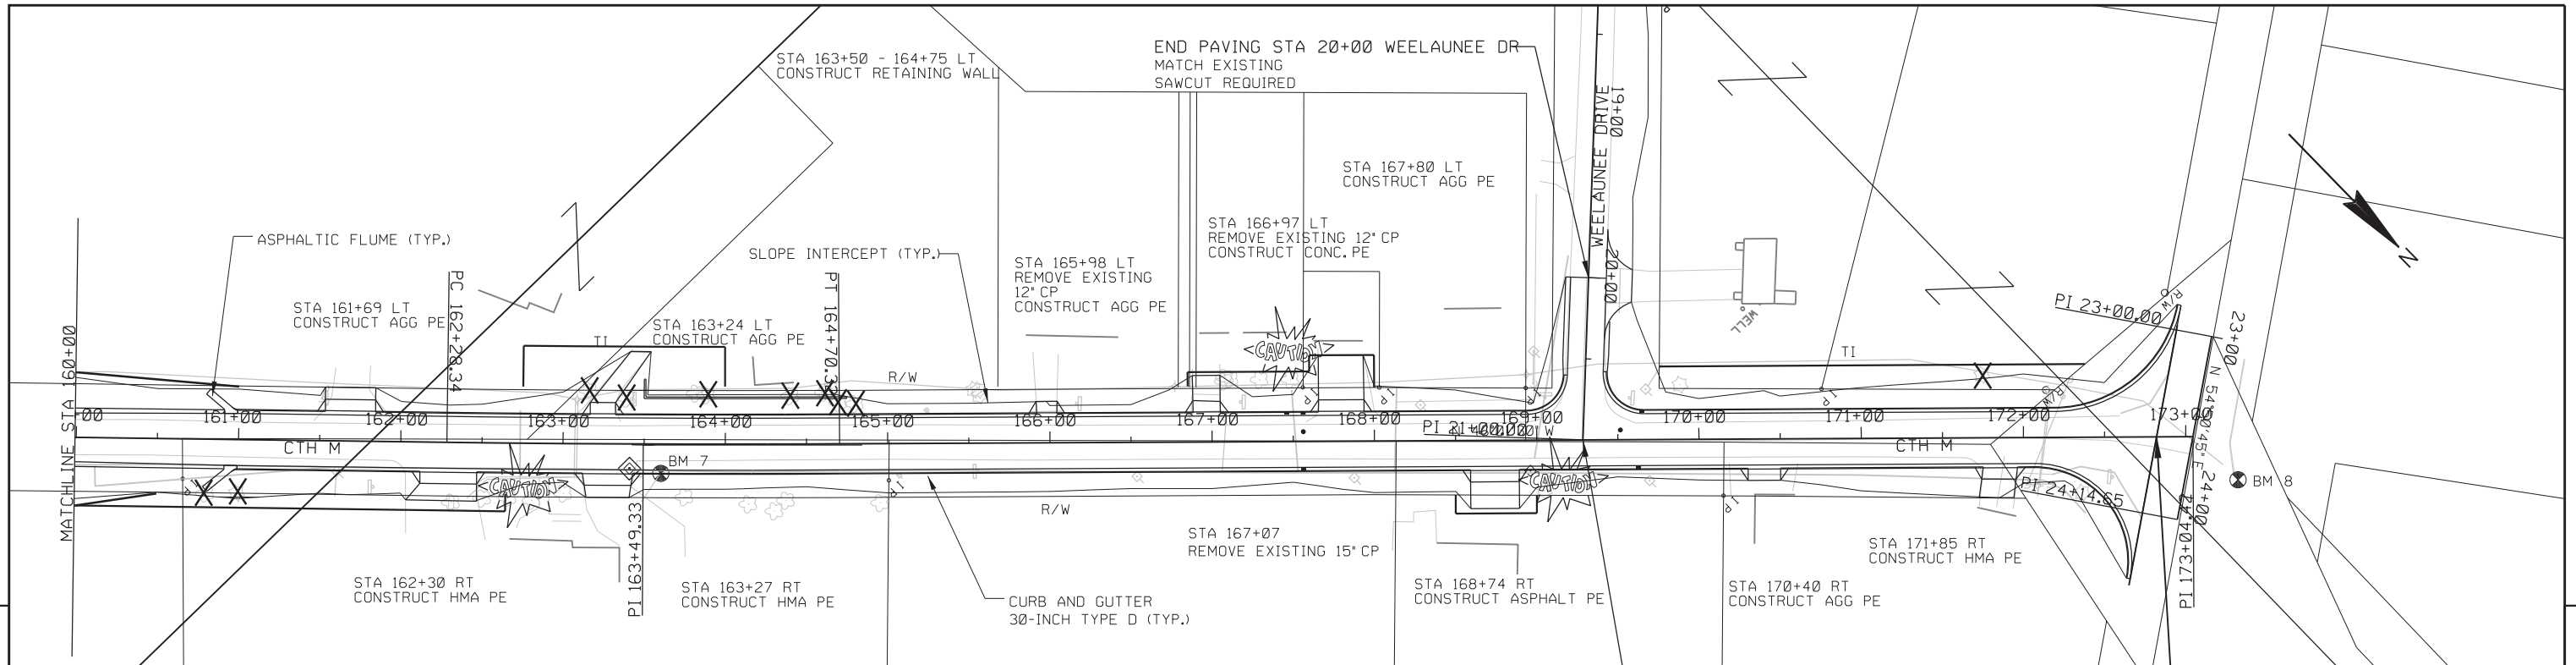

BENCHMARK TABLE

NO	STATION	DESCRIPTION	ELEV
BM 7	163+61.13, 17.96' RT	3/8" SPIKE IN PP # 29R45 EAST SIDE OF EXISTING CTH M	885.38
BM 8	173+32.87, 26.75' RT	3/8" SPIKE IN PP # 29R73 NW CORNER OF CTH M & STH 44	888.43

X = REMOVE TREE

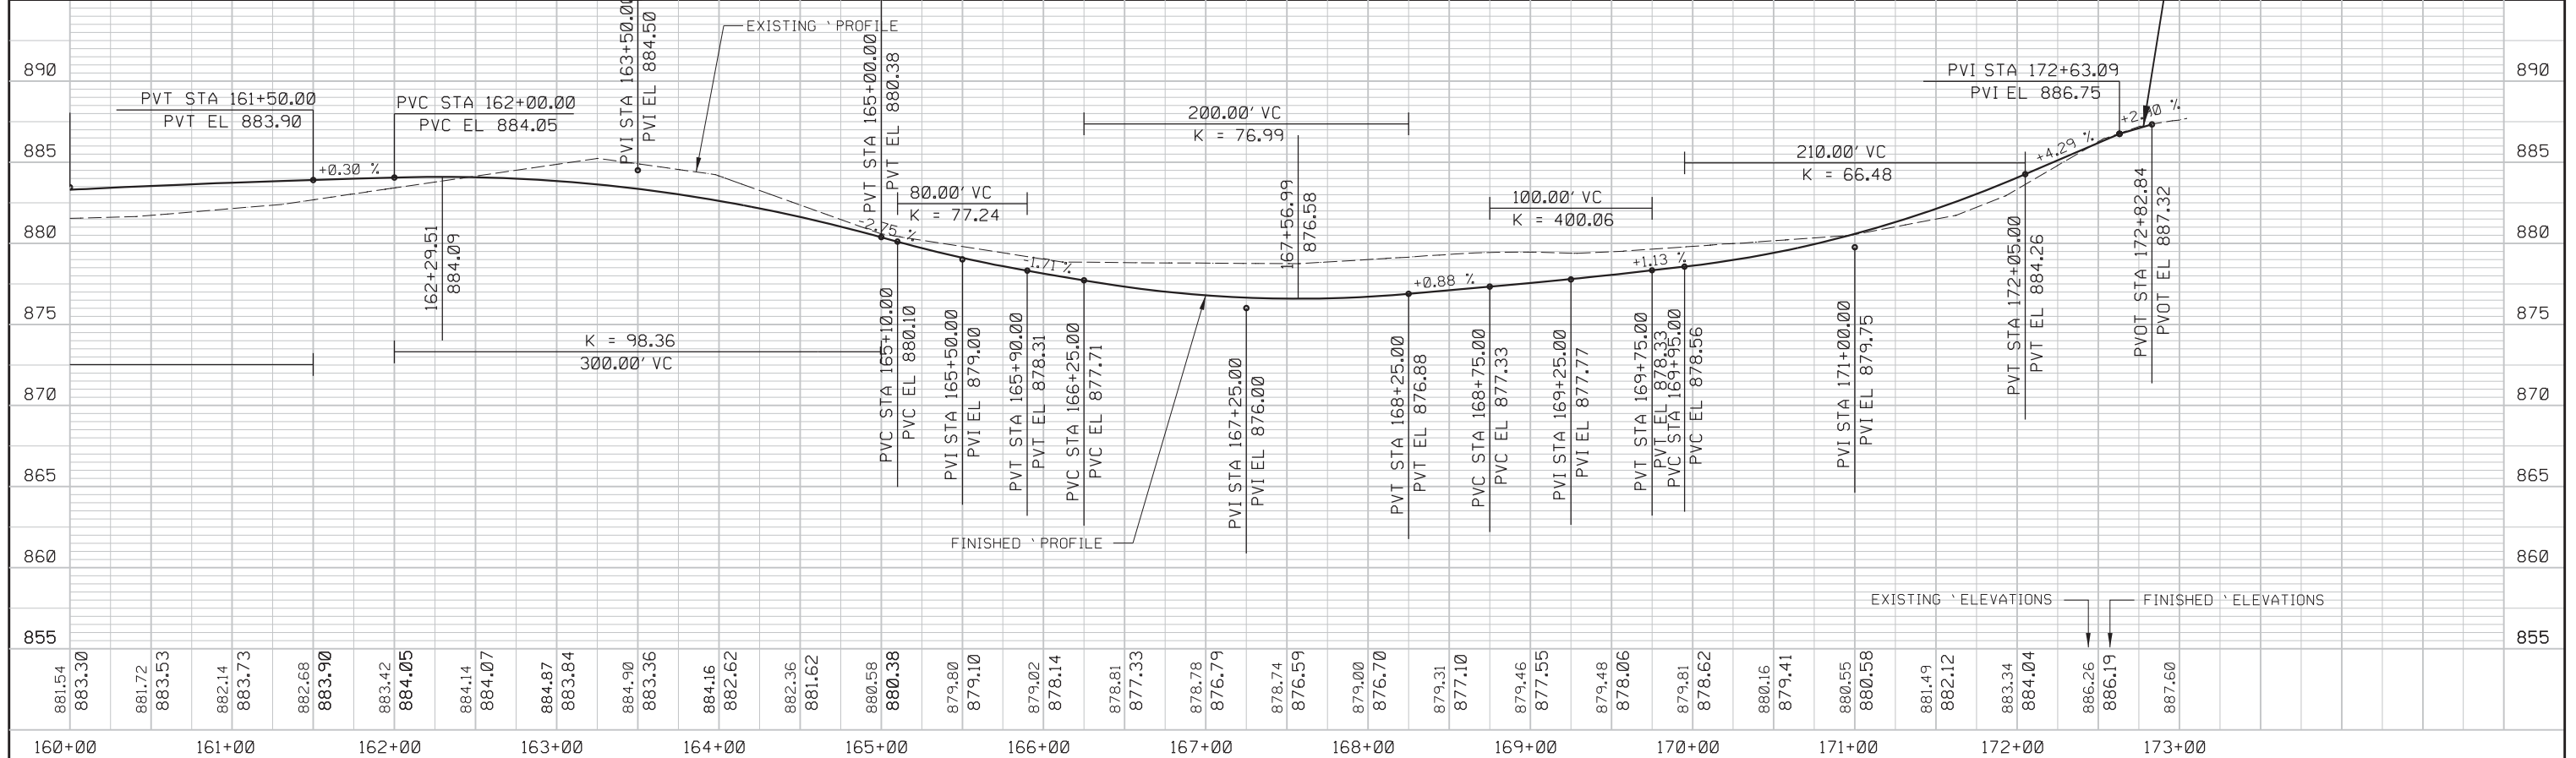


STATION	EXISTING ELEVATIONS	FINISHED ELEVATIONS
160+00	881.54	
160+00	883.30	
161+00	881.72	
161+00	883.53	
161+00	882.14	
161+00	883.73	
162+00	882.68	
162+00	883.90	
162+00	883.42	
162+00	884.05	
162+00	884.14	
162+00	884.07	
163+00	884.87	
163+00	883.84	
163+00	884.90	
163+00	883.36	
164+00	884.16	
164+00	882.62	
164+00	882.36	
164+00	881.62	
165+00	880.58	
165+00	880.38	
165+00	879.80	
165+00	879.10	
165+00	879.02	
165+00	878.14	
166+00	878.81	
166+00	877.33	
166+00	878.78	
166+00	876.79	
166+00	878.74	
166+00	876.59	
167+00	879.00	
167+00	876.70	
167+00	879.31	
167+00	877.10	
167+00	879.46	
167+00	877.55	
168+00	879.48	
168+00	878.06	
168+00	879.81	
168+00	878.62	
169+00	880.16	
169+00	879.41	
169+00	880.55	
169+00	880.58	
170+00	881.49	
170+00	882.12	
170+00	883.34	
170+00	884.04	
171+00	886.26	
171+00	886.19	
171+00	887.60	


PROJECT NO: HWY:CTH M COUNTY:WINNEBAGO PLAN AND PROFILE - CTH M SCALE, FEET SHEET 25

5



5

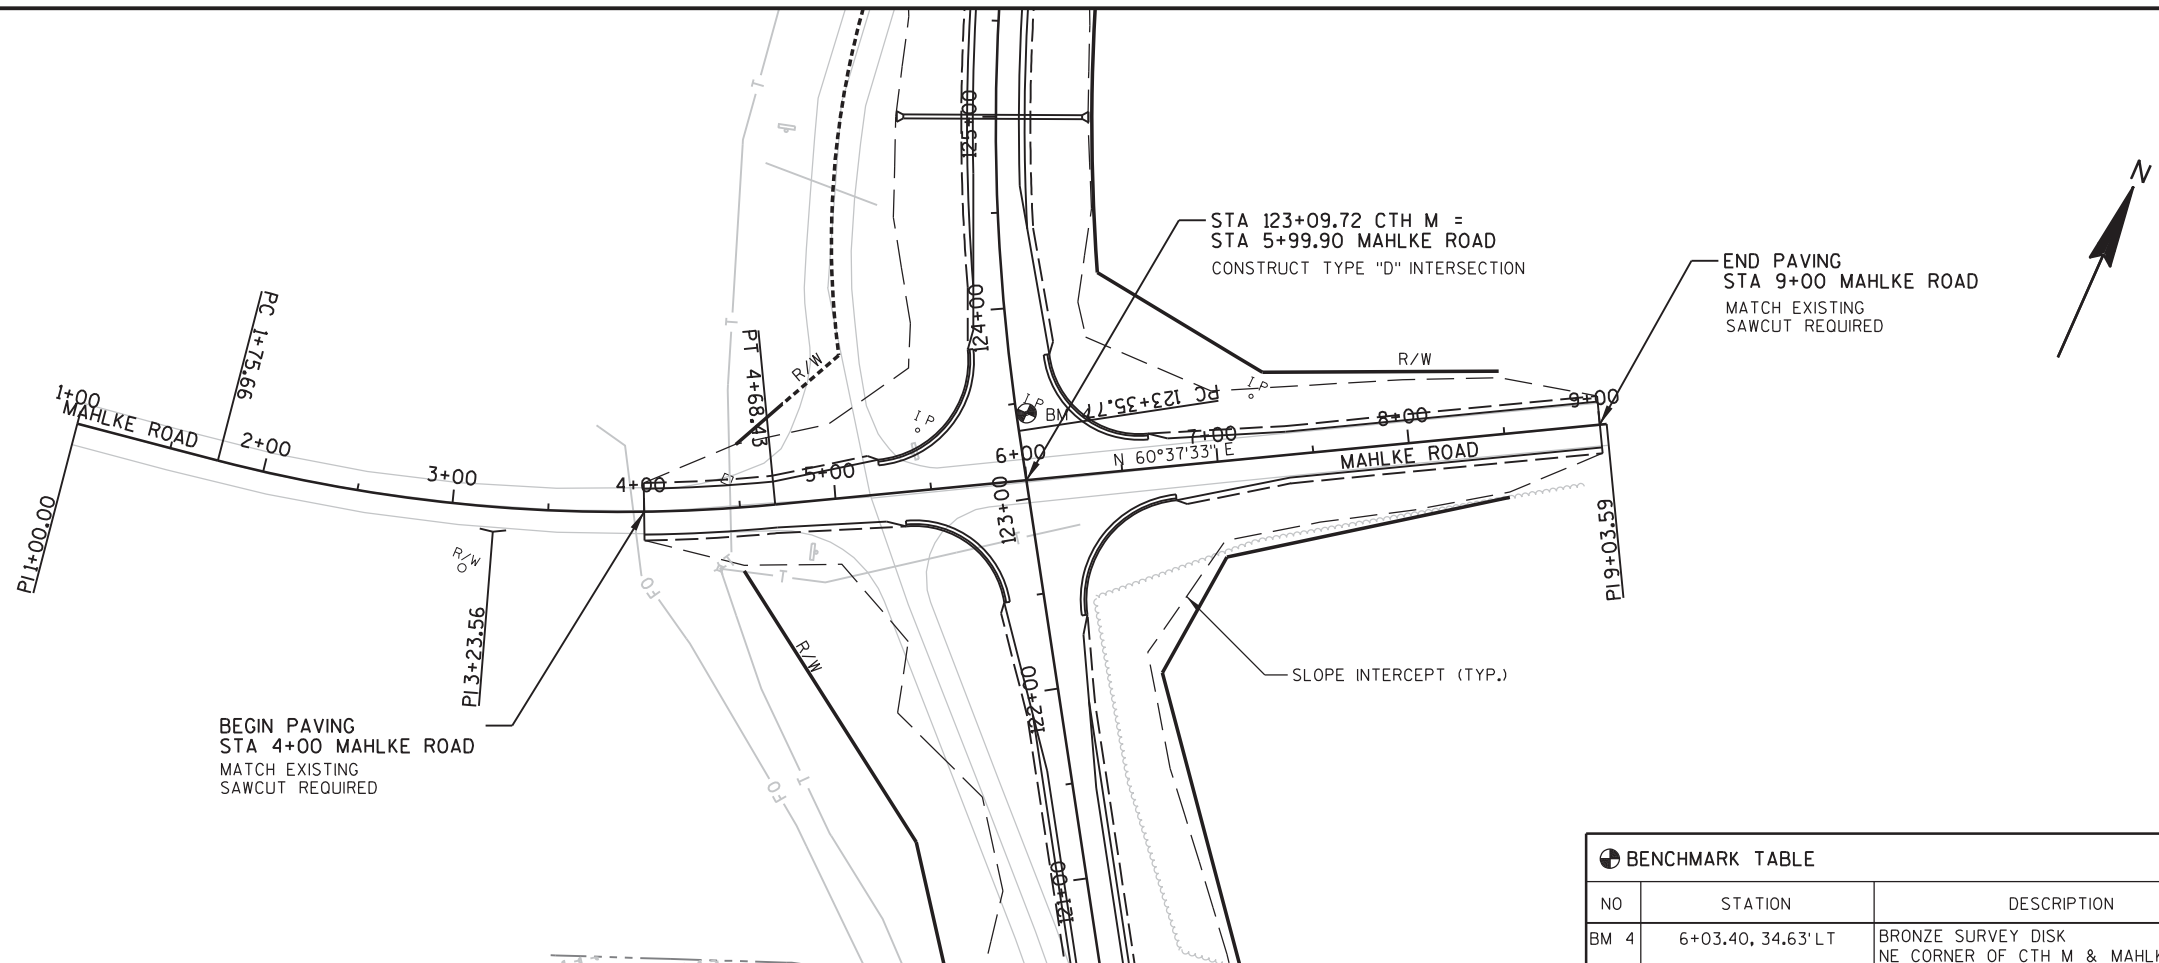






BENCHMARK TABLE			
NO	STATION	DESCRIPTION	ELEV
BM 4	6+03.40, 34.63' LT	BRONZE SURVEY DISK NE CORNER OF CTH M & MAHLKE ROAD	911.51

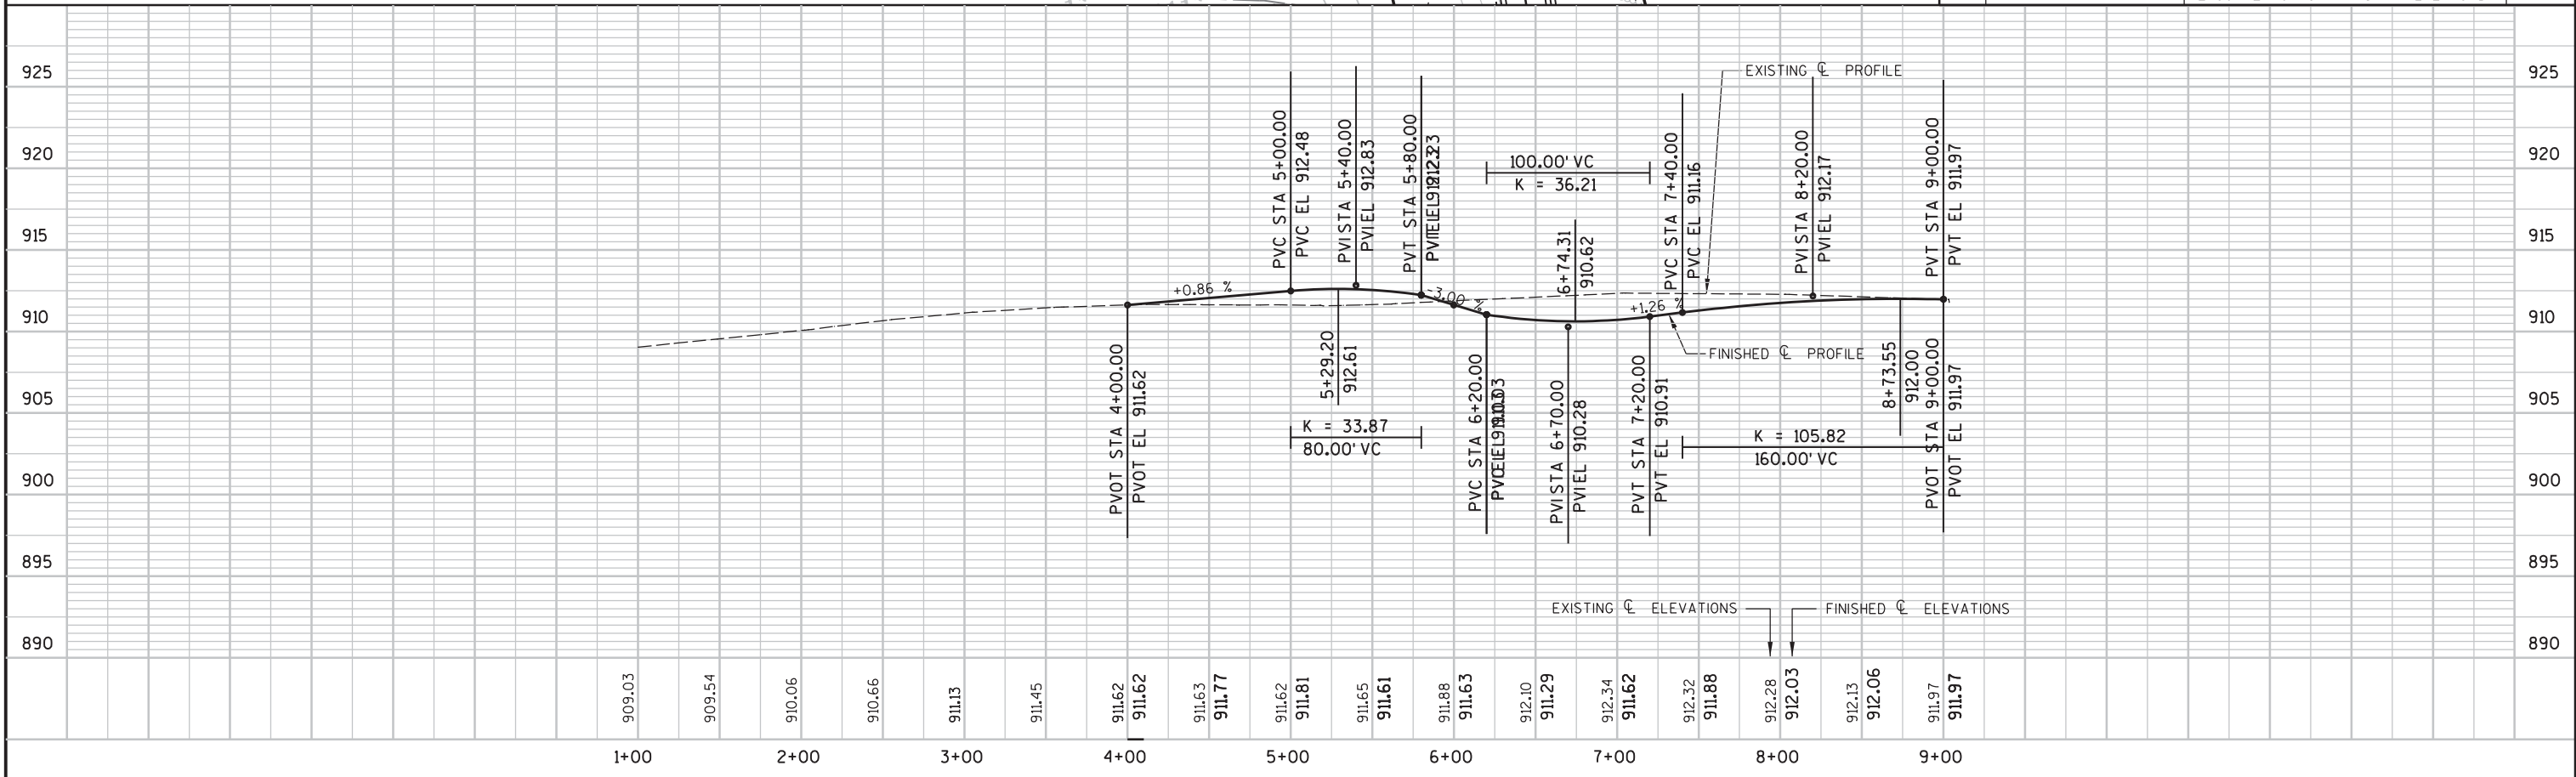


PROJECT NO:	HWY: CTH M	COUNTY: WINNEBAGO	PLAN AND PROFILE - MAHLKE RD	SCALE, FEET	SHEET 26	E
-------------	------------	-------------------	------------------------------	-------------	----------	---

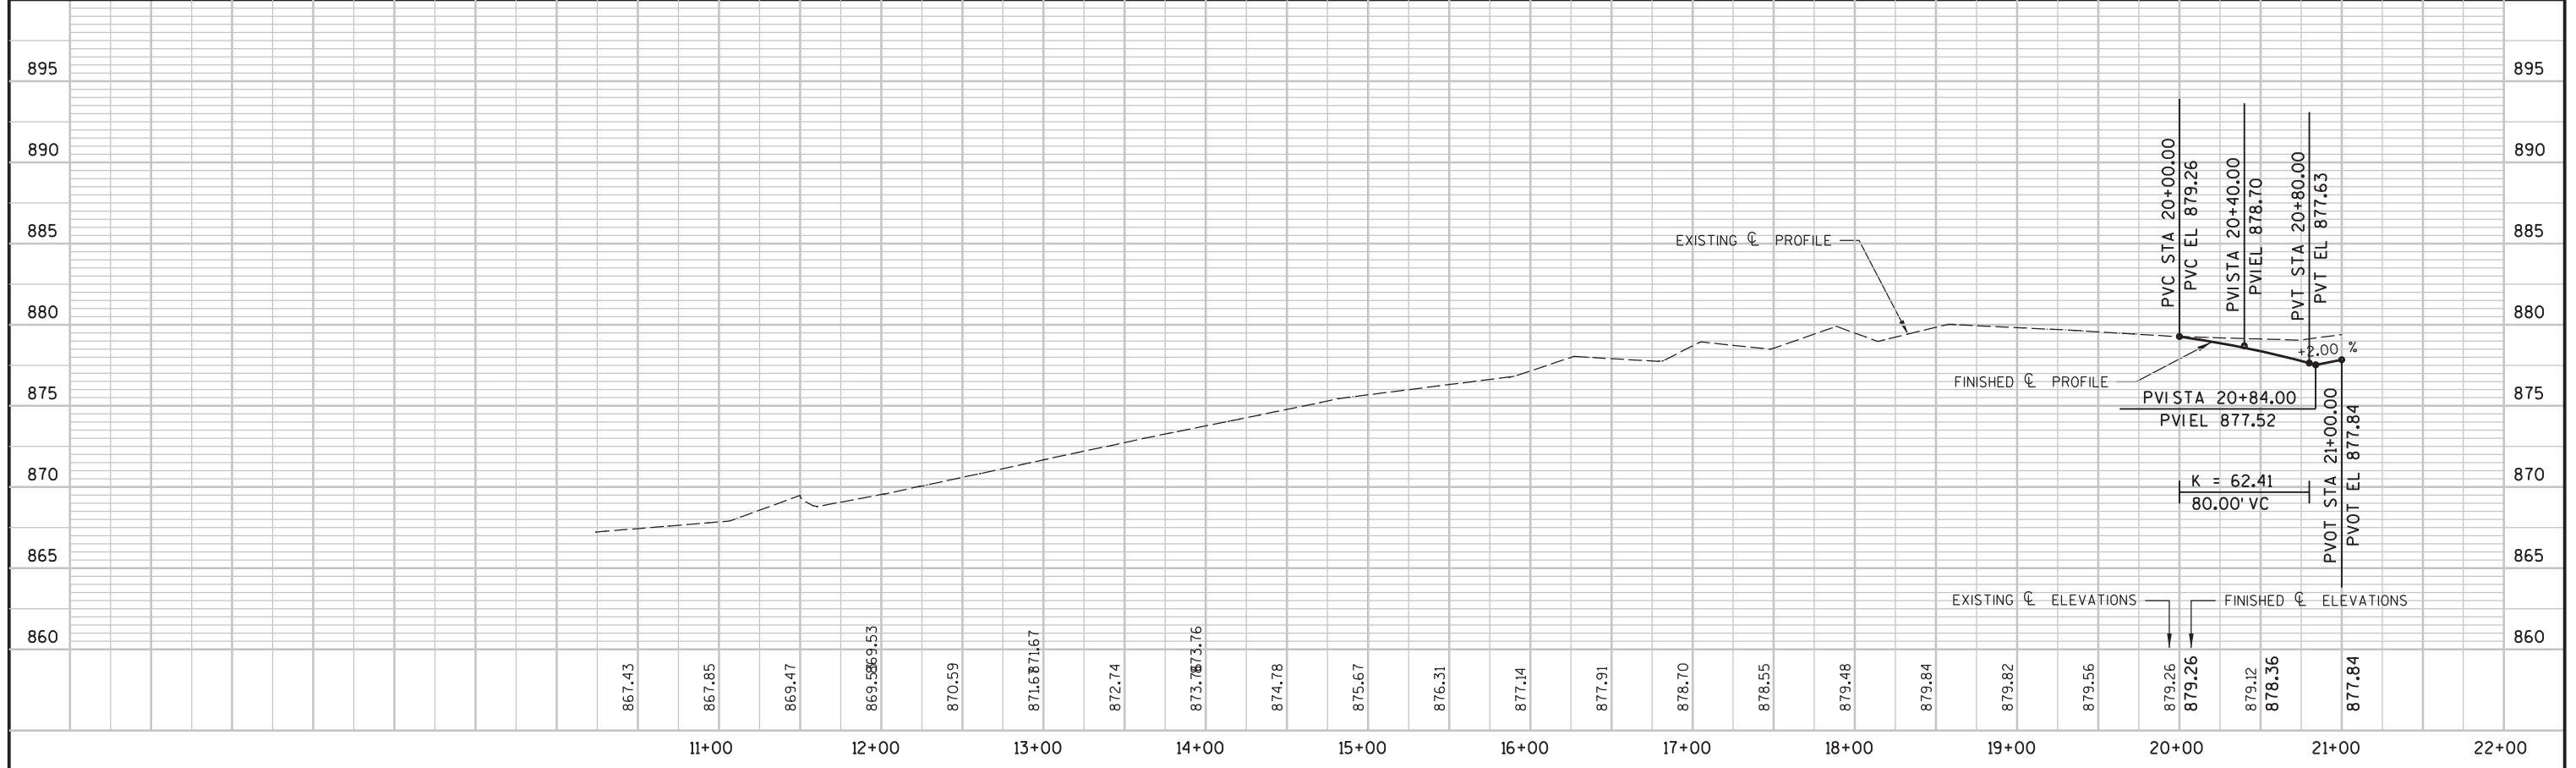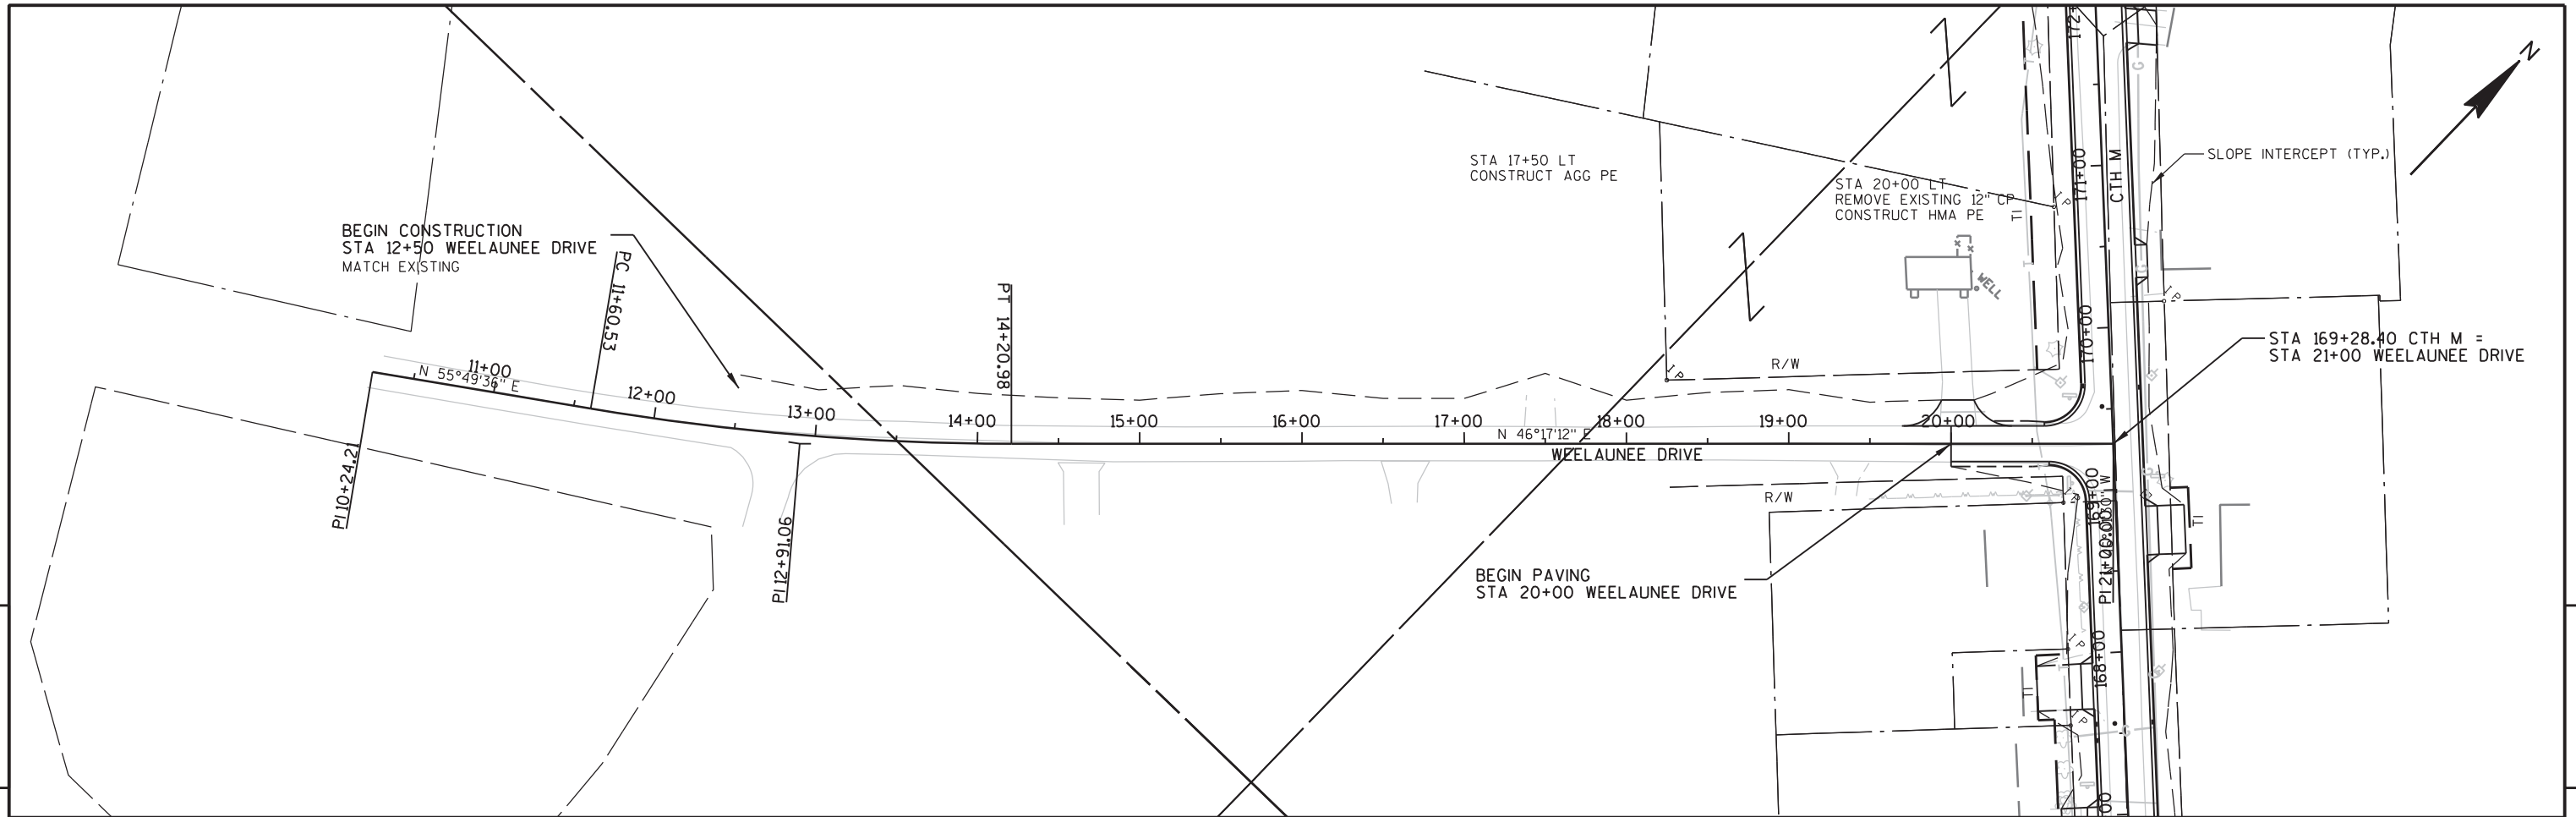


PROJECT NO:	HWY: CTH M	COUNTY: WINNEBAGO	PLAN AND PROFILE-WEELAUNEE DR	SCALE, FEET	SHEET 27	E
-------------	------------	-------------------	-------------------------------	-------------	----------	---

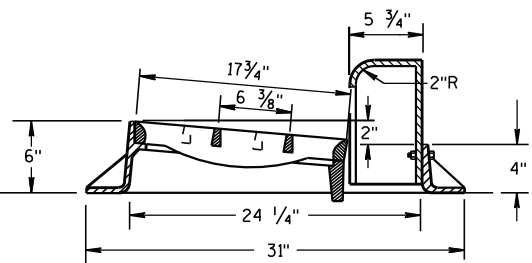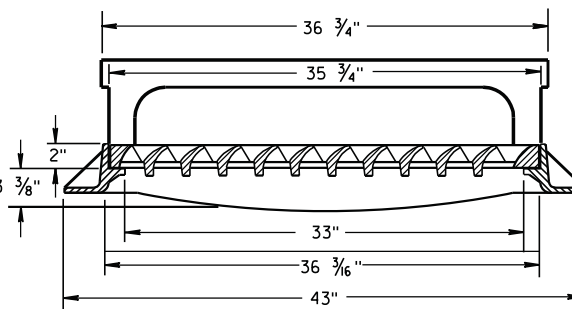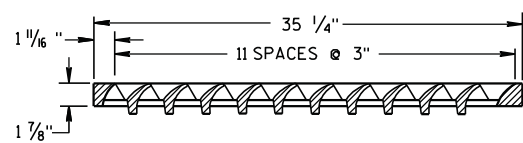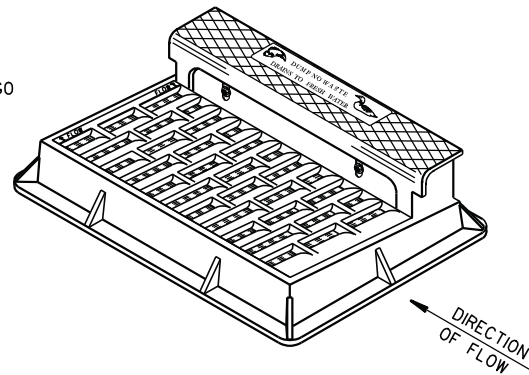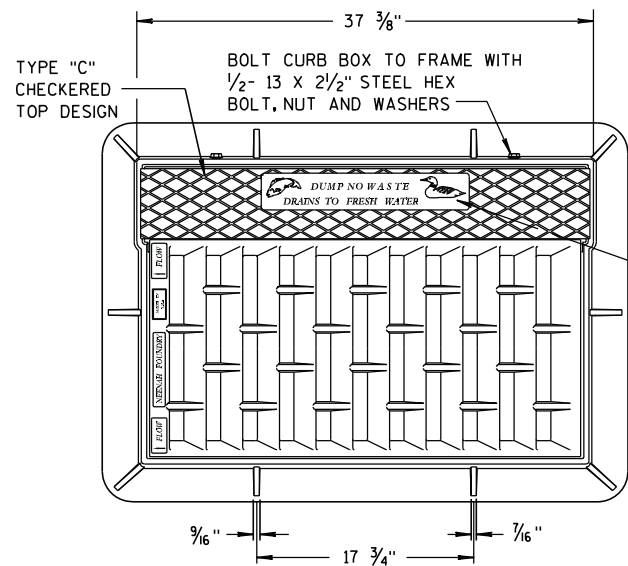




TYPE "H"
(APPROXIMATE WEIGHT 441 LBS.)
FRAME..... 181 LBS.
GRATE..... 146 LBS.
CURB BOX..... 114 LBS.

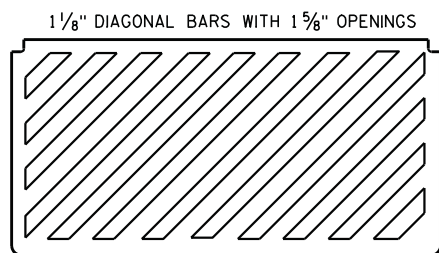

**SPECIAL GRATE FOR
TYPE "H" COVER**
(MEASURES 35 1/4" X 17 3/4" X 2")
(APPROXIMATE WEIGHT 159 LBS.)
GRATE..... 159 LBS.
(NOTED AS TYPE H-S ON DRAINAGE TABLE)

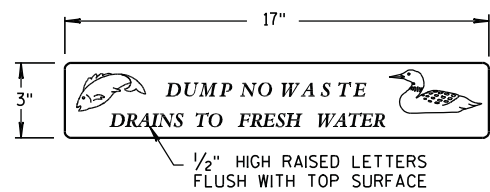


LOGO DETAIL

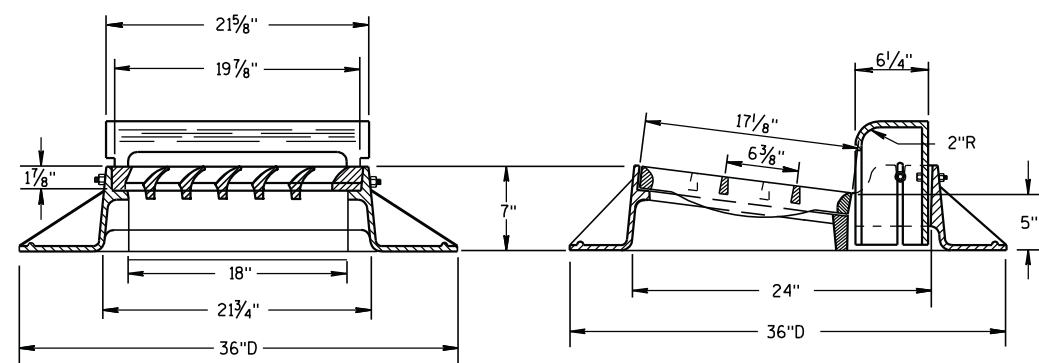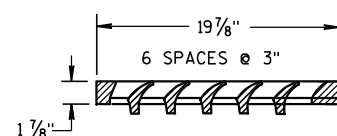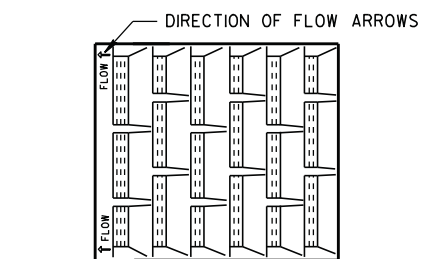


TYPE "A"

(APPROXIMATE WEIGHT 340 LBS.)
FRAME..... 185 LBS.
GRATE..... 71 LBS.
CURB BOX..... 84 LBS.

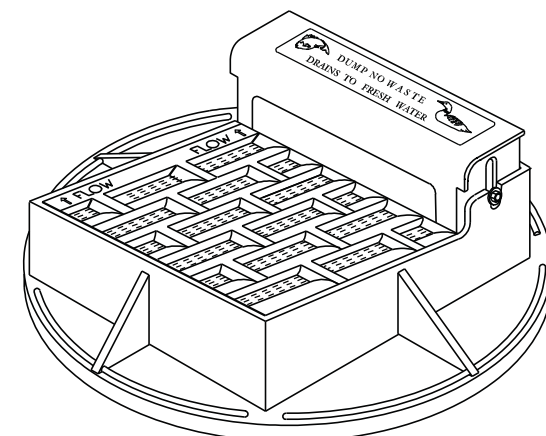


NOTE: CURB BOX ADJUSTABLE 4" TO 9"

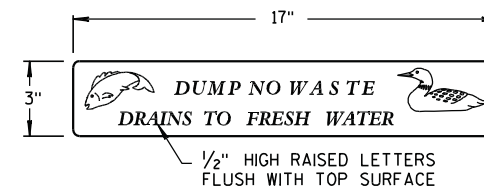

LOGO DETAIL

NOTE:
GRATE IS REVERSIBLE.

1" DIAGONAL BARS
WITH 1 1/2" OPENINGS

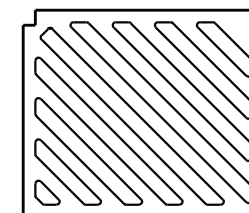

**SPECIAL GRATE FOR
TYPE "A" COVER**
(MEASURES 19 3/4" X 17" X 1 7/8")
GRATE..... 84 LBS.
(NOTED AS TYPE A-S ON DRAINAGE TABLE)

GENERAL NOTES

DETAILS OF CONSTRUCTION, MATERIALS AND WORKMANSHIP NOT SHOWN ON THIS DRAWING SHALL CONFORM TO THE PERTINENT REQUIREMENTS OF THE STANDARD SPECIFICATIONS AND THE APPLICABLE SPECIAL PROVISIONS.

DETAIL DRAWINGS FOR PROPOSED ALTERNATE DESIGNS FOR CATCH BASIN, MANHOLE AND INLET COVERS SHALL BE SUBMITTED TO THE ENGINEER FOR APPROVAL PROVIDING THAT SUCH ALTERNATE DESIGNS MAKE PROVISION FOR EQUIVALENT CAPACITY AND STRENGTH.



ROUND FRAMES AND COVERS SHALL HAVE CONTINUOUSLY MACHINED BEARING SURFACES TO PREVENT ROCKING AND RATTLING.

THE ACTUAL WEIGHT OF COVERS MAY VARY WITHIN 5 PERCENT, PLUS OR MINUS, OF THE APPROXIMATE WEIGHT.



**INLET COVERS
TYPE A, H, A-S, & H-S**

STATE OF WISCONSIN
DEPARTMENT OF TRANSPORTATION



APPROVED
6/5/2012 /S/ Jerry H. Zogg
DATE ROADWAY STANDARDS DEVELOPMENT
ENGINEER
FHWA

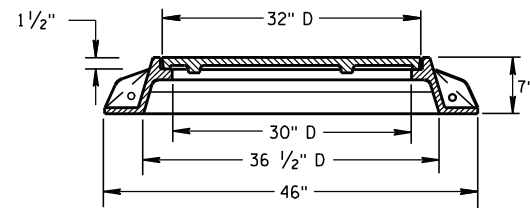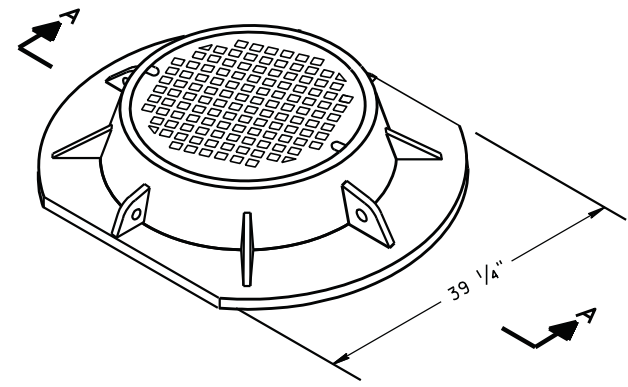

**SECTION A-A
TYPE "K"**
(APPROXIMATE WEIGHT 439 LBS.)
FRAME.....216 LBS.
LID.....223 LBS.

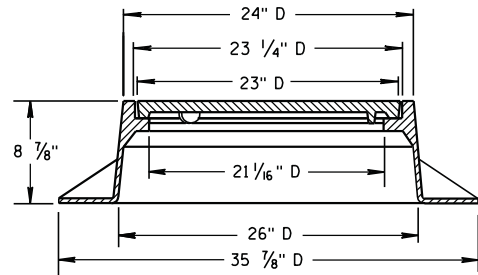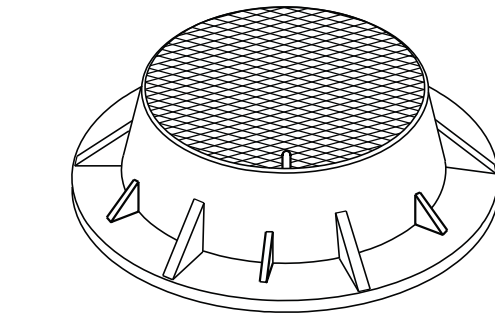

TYPE "J"
(APPROXIMATE WEIGHT 267 LBS.)
FRAME.....152 LBS.
LID.....115 LBS.

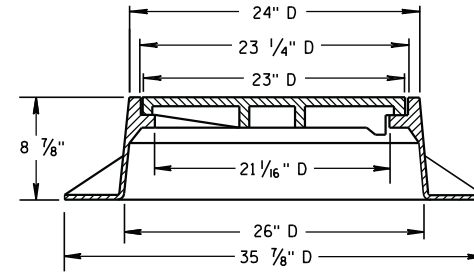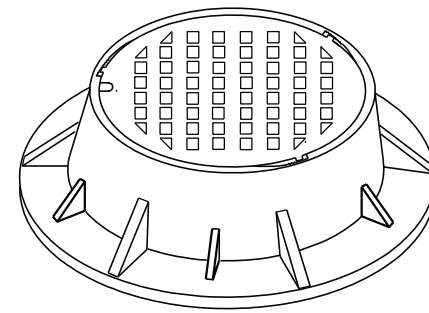

TYPE "J" SPECIAL
TYPE "B" NON-ROCKING SELF-SEAL LID
(APPROXIMATE WEIGHT 267 LBS.)
FRAME.....158 LBS.
LID.....109 LBS.
(NOTED AS TYPE J-S ON THE DRAINAGE TABLE)


GENERAL NOTES

DETAILS OF CONSTRUCTION, MATERIALS AND WORKMANSHIP NOT SHOWN ON THIS DRAWING SHALL CONFORM TO THE PERTINENT REQUIREMENTS OF THE STANDARD SPECIFICATIONS AND THE APPLICABLE SPECIAL PROVISIONS.


DETAIL DRAWINGS FOR PROPOSED ALTERNATE DESIGNS FOR MANHOLE COVERS SHALL BE SUBMITTED TO THE ENGINEER FOR APPROVAL PROVIDING THAT SUCH ALTERNATE DESIGNS MAKE PROVISION FOR EQUIVALENT CAPACITY AND STRENGTH.

ROUND FRAMES AND COVERS SHALL HAVE CONTINUOUSLY MACHINED BEARING SURFACES TO PREVENT ROCKING AND RATTLING.



THE ACTUAL WEIGHT OF COVERS MAY VARY WITHIN 5 PERCENT, PLUS OR MINUS, OF THE APPROXIMATE WEIGHT.

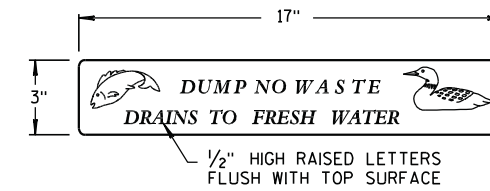



LOGO DETAIL

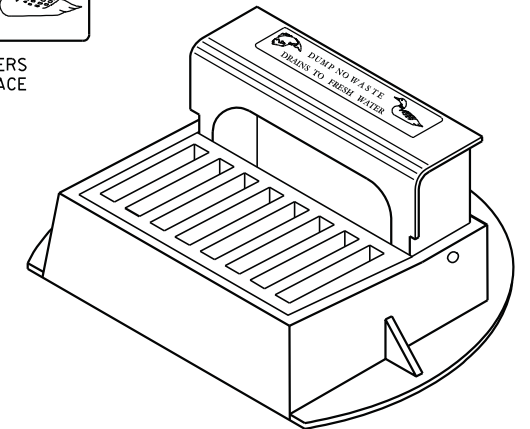



6

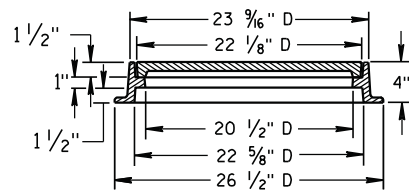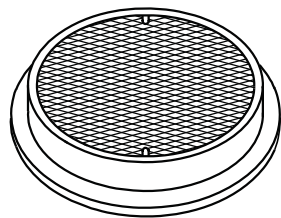



TYPE "L"
(APPROXIMATE WEIGHT 158 LBS.)
FRAME.....81 LBS.
LID.....77 LBS.

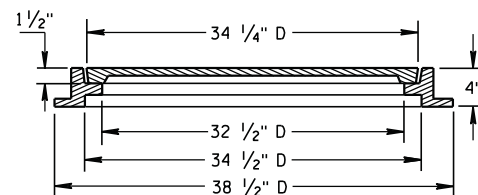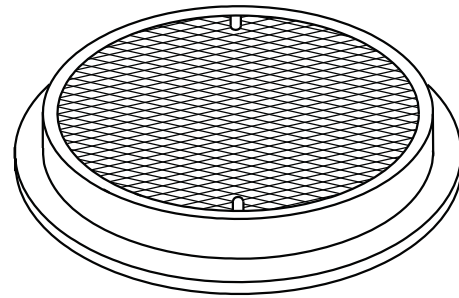

TYPE "M"
(APPROXIMATE WEIGHT 377 LBS.)
FRAME.....125 LBS.
LID.....252 LBS.

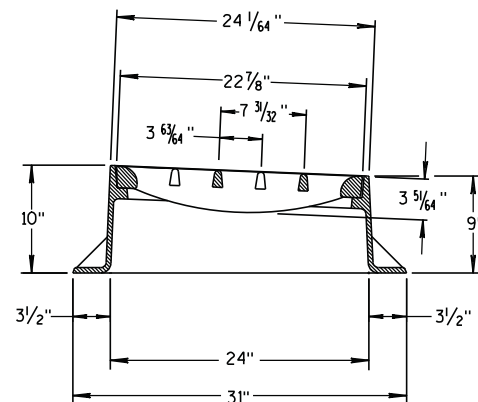
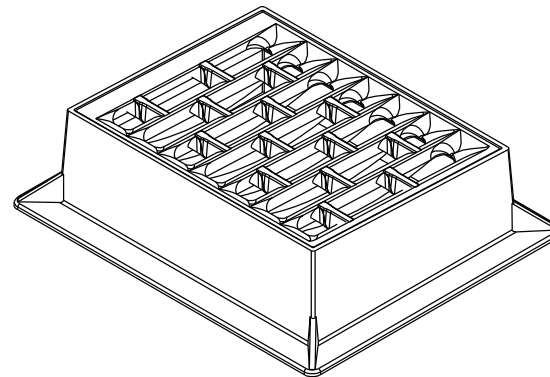


INLET COVER TYPE "BW"

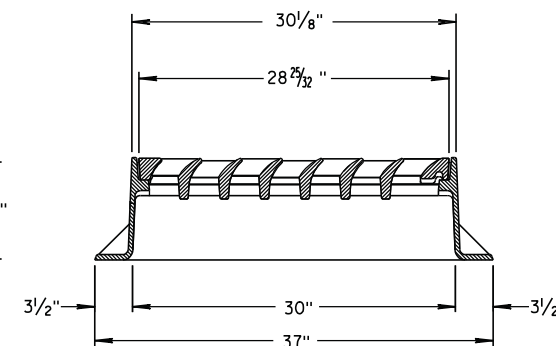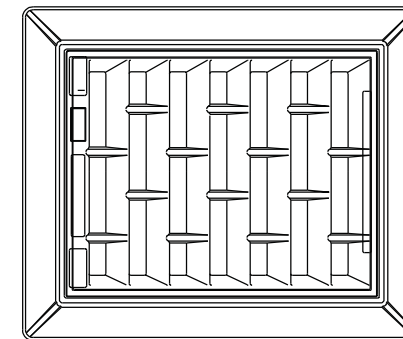

INLET COVER TYPE "Z"

(APPROXIMATE WEIGHT 344 LBS.)
FRAME.....206 LBS.
GRATE.....46 LBS.
CURB BOX.....92 LBS.

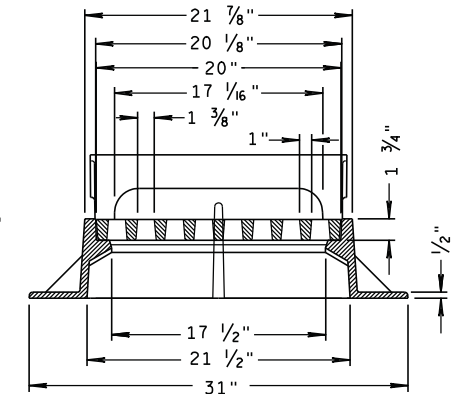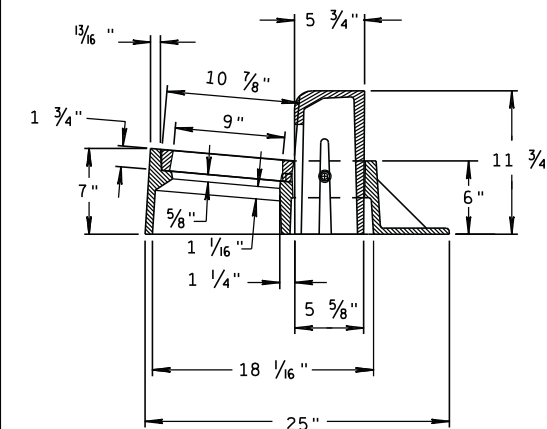


**INLET COVERS, TYPE BW, Z
MANHOLE COVERS, TYPE
K, J, J-S, L & M**


STATE OF WISCONSIN
DEPARTMENT OF TRANSPORTATION

APPROVED
6/5/2012 /S/ Jerry H. Zogg
DATE ROADWAY STANDARDS DEVELOPMENT
ENGINEER
FHWA

6

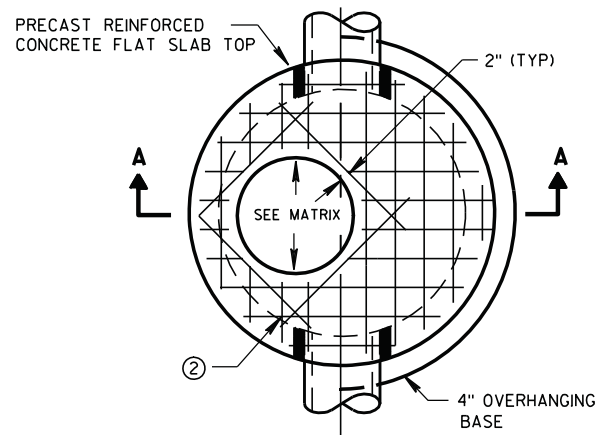


PLAN VIEW CIRCULAR OPENING

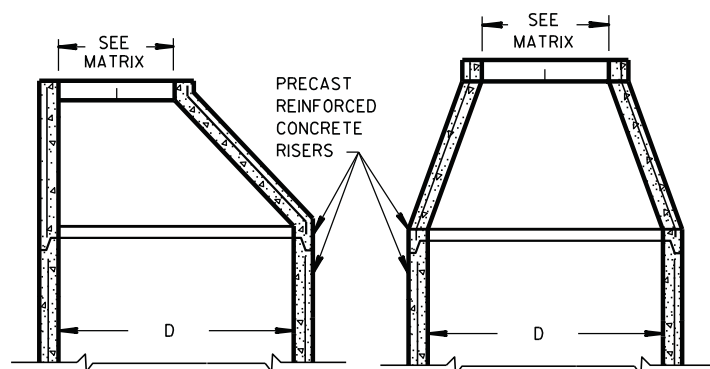


OPTIONAL PRECAST REINFORCED CONCRETE ECCENTRIC TOP


OPTIONAL PRECAST REINFORCED CONCRETE CONCENTRIC TOP

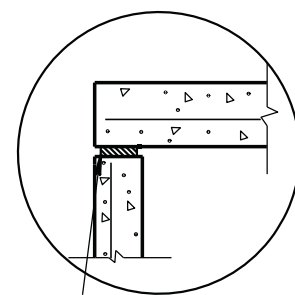

TOP WITH PLAIN END JOINT

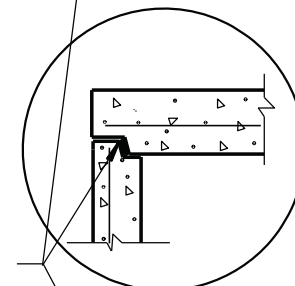


TOP WITH TONGUE AND GROOVE JOINT

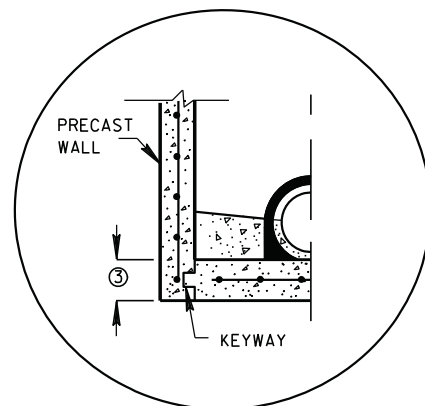


PRECAST REINFORCED CONCRETE WITH INTEGRAL BASE OPTION

JOINTS TO BE SEALED WITH A BUTYL RUBBER SEAL PER SEALANT MANUFACTURERS RECOMMENDATIONS CONFORMING TO ASTM C990 (TYP)

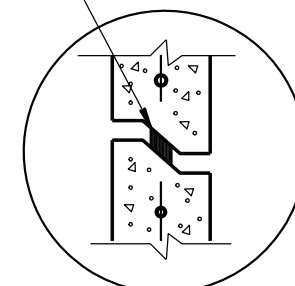


RISER WITH TONGUE AND GROOVE JOINT

DETAIL "B"

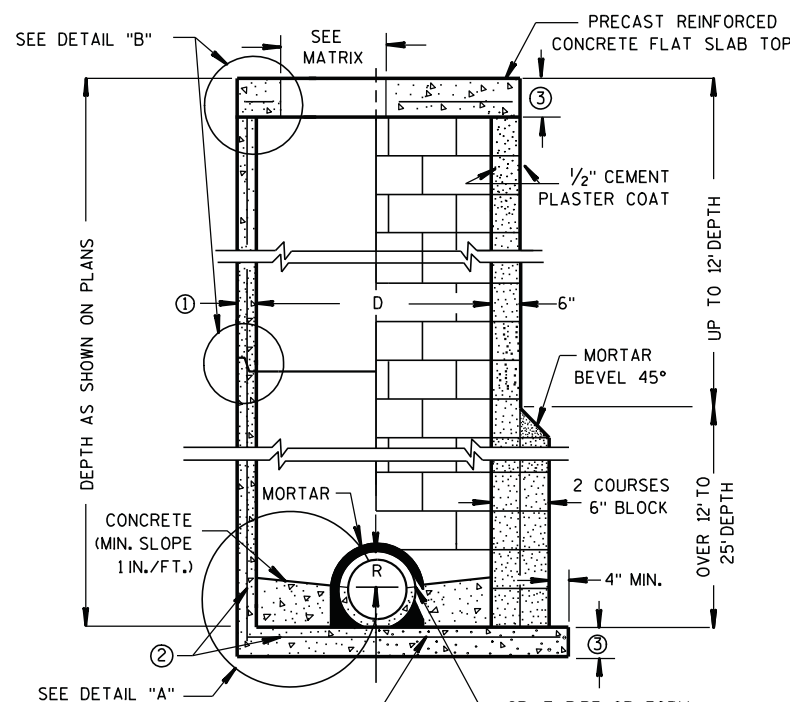


CONTRACTOR TO PROVIDE DRAWING(S) STAMPED BY A PROFESSIONAL ENGINEER FOR STEEL REINFORCING DESIGN FOR CAST-IN-PLACE STRUCTURES

PRECAST REINFORCED CONCRETE BLOCK WITH CONCRETE WITH MONOLITHIC BASE CAST-IN-PLACE OR PRECAST REINFORCED CONCRETE BASE ②

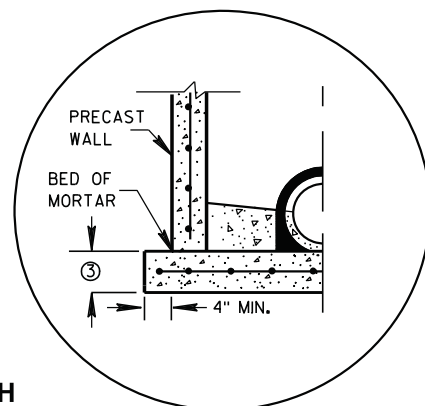

SEPERATE PRECAST REINFORCED CONCRETE BASE OPTION

DETAIL "A"

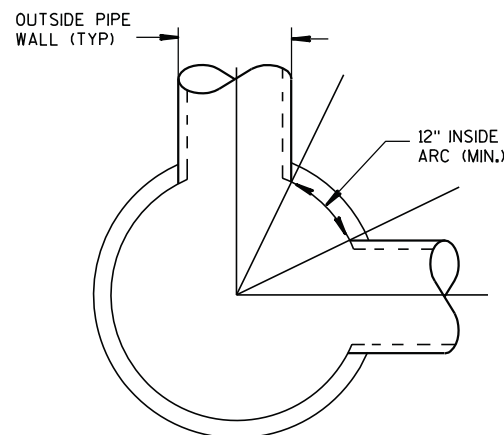

DETAIL "C"

GENERAL NOTES

DETAILS OF CONSTRUCTION, MATERIALS AND WORKMANSHIP NOT SHOWN ON THIS DRAWING SHALL CONFORM TO THE PERTINENT REQUIREMENTS OF THE STANDARD SPECIFICATIONS AND THE APPLICABLE SPECIAL PROVISIONS. UNLESS OTHERWISE AUTHORIZED IN WRITING BY THE ENGINEER, THE CONTRACTOR SHALL NOT ORDER AND DELIVER PRECAST MANHOLE UNITS REQUIRED FOR THE PROJECT UNTIL A LIST OF SIZES IS FURNISHED BY THE ENGINEER.

DETAILED DRAWINGS FOR PROPOSED ALTERNATE DESIGNS FOR UNDERGROUND DRAINAGE STRUCTURES SHALL BE SUBMITTED TO THE ENGINEER FOR APPROVAL PROVIDING THAT SUCH ALTERNATE DESIGNS MAKE PROVISION FOR EQUIVALENT CAPACITY AND STRENGTH.

ALL DRAINAGE STRUCTURES ARE DESIGNATED ON THE PLANS AS "MANHOLES 3X3-L", "CATCH BASINS 4-B", "INLETS 2X3-H", ETC. THE FIRST NUMBERS DESIGNATE THE SIZE OF THE STRUCTURE, AND THE FOLLOWING LETTER DESIGNATES THE TYPE OF COVER TO BE USED TO COMPRISE THE COMPLETE UNIT.

BASES SHALL BE PLACED ON A BED OF MATERIAL AT LEAST 6 INCHES IN DEPTH, WHICH MEETS THE REQUIREMENTS OF GRANULAR BACKFILL. THIS BEDDING SHALL BE COMPACTED AND PROVIDE UNIFORM SUPPORT FOR THE ENTIRE AREA OF THE BASE.

PRECAST REINFORCED CONE TOPS (ECCENTRIC OR CONCENTRIC) OR PRECAST REINFORCED FLAT SLAB TOPS MAY BE USED ON CONCRETE BLOCK STRUCTURES. THE CONE TOPS SHALL BE INSTALLED ON A BED OF MORTAR.

ECCENTRIC CONE TOPS MAY BE USED ON ALL STRUCTURES, AND CONCENTRIC CONE TOPS SHALL BE USED ONLY ON STRUCTURES 5 FEET OR LESS IN DEPTH, UNLESS OTHERWISE DIRECTED BY THE ENGINEER.

STEPS MEETING AASHTO M199 AND THE FOLLOWING REQUIREMENTS SHALL BE INSTALLED IN ALL STRUCTURES OVER 5 FEET IN DEPTH: 16 INCH C-C MAXIMUM SPACING; PROJECT A MINIMUM CLEAR DISTANCE OF 4 INCHES FROM THE WALL AT THE POINT OF EMBEDMENT; MINIMUM LENGTH OF 10 INCHES; MINIMUM WALL EMBEDMENT OF 3 INCHES. FERROUS METAL STEPS NOT PAINTED OR TREATED TO RESIST CORROSION SHALL HAVE A MINIMUM CROSS SECTIONAL DIMENSION OF 1 INCH.

STEPS OF APPROVED POLYPROPYLENE PLASTIC COATED REINFORCEMENT BAR ARE ACCEPTABLE. REINFORCING BAR MUST BE A MINIMUM OF 1/2" AND MEET THE REQUIREMENTS OF ASTM A615.

CERTIFICATION SHALL BE PROVIDED THAT INSTALLED STEPS WHEN TESTED IN ACCORDANCE WITH SECTION 10 OF AASHTO T280 CAN WITHSTAND A VERTICAL LOAD OF 800 LBS. AND A HORIZONTAL LOAD OF 400 LBS.

ALL BAR STEEL REINFORCEMENT SHALL BE EMBEDDED 2 INCHES CLEAR UNLESS OTHERWISE SHOWN OR NOTED. CONCRETE BLOCK WILL NOT BE PERMITTED FOR STRUCTURES GREATER THAN 4 FEET IN DIAMETER.

PRECAST REINFORCED RISERS SHALL HAVE A TONGUE AND GROOVE JOINT WITH TONGUE UP OR DOWN.

ALL PRECAST MANHOLE UNITS SHALL CONFORM TO THE PERTINENT REQUIREMENTS OF AASHTO DESIGNATION M 199.

4" OVERHANGING BASES ARE REQUIRED FOR ALL CONCRETE BLOCK INSTALLATIONS. 4" OVERHANG IS REQUIRED WHEN SEPERATE PRECAST BASE IS PROVIDED. OVERHANG IS NOT REQUIRED ON PRECAST STRUCTURES WITH AN INTEGRAL OR MONOLITHIC BASE.

FOR ADDITIONAL CONFIGURATIONS, MAINTAIN A MINIMUM OF 12 INCHES AS MEASURED FROM THE INSIDE OF THE STRUCTURE WALL BETWEEN THE OUTSIDE PIPE WALLS OF ADJACENT PIPES. SEE DETAIL "C".

① MINIMUM WALL THICKNESS SHALL BE 4 INCHES FOR 3-FT, 5 INCHES FOR 4-FT, 6 INCHES FOR 5-FT, 7 INCHES FOR 6-FT, 8 INCHES FOR 7-FT AND 9 INCHES FOR 8-FT DIAMETER PRECAST MANHOLES.

② FOR PRECAST MANHOLES PROVIDE REINFORCING STEEL IN ACCORDANCE TO AASHTO M199.

③ PRECAST FLAT SLAB TOPS AND BASES WITH A DIAMETER OF 48" AND LESS SHALL HAVE A MINIMUM THICKNESS OF 6". PRECAST FLAT SLAB TOPS AND BASES WITH A DIAMETER LARGER THAN 48" SHALL HAVE A MINIMUM THICKNESS OF 8".

MANHOLE COVER OPENING MATRIX

MANHOLE COVER TYPE	C	ALL J'S	K	L	M
OPENING SIZE (FT)					
2 DIA.	X	X		X	
3 DIA.			X		X

PIPE MATRIX

MANHOLE SIZE	MAXIMUM INSIDE PIPE DIAMETER FOR TWO PIPES	
	180° SEPARATION (IN)	90° SEPARATION (IN)
3-FT	15	12
4-FT	24	18
5-FT	36	24
6-FT	42	36
7-FT	48	36
8-FT	60	42

MANHOLES 3-FT, 4-FT, 5-FT, 6-FT, 7-FT AND 8-FT DIAMETER


STATE OF WISCONSIN DEPARTMENT OF TRANSPORTATION

APPROVED
6/5/2012 /S/ Jerry H. Zogg
DATE ROADWAY STANDARDS DEVELOPMENT ENGINEER 30
FHWA


MANHOLES 3-FT, 4-FT, 5-FT, 6-FT, 7-FT AND 8-FT DIAMETER




8C7: Inlets 2x2-FT, 2x2.5-FT, 2x3-FT, & 2.5x3-FT

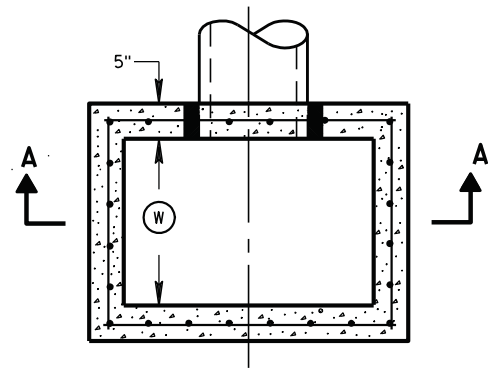


PLAN VIEW

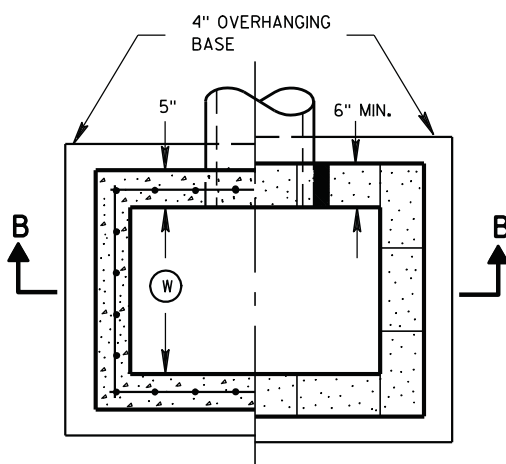


PLAN VIEW

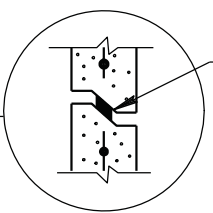


RISER JOINTS TO BE SEALED WITH A BUTYL RUBBER SEAL PER SEALANT MANUFACTURERS RECOMMENDATIONS CONFORMING TO ASTM C 990 (TYP)

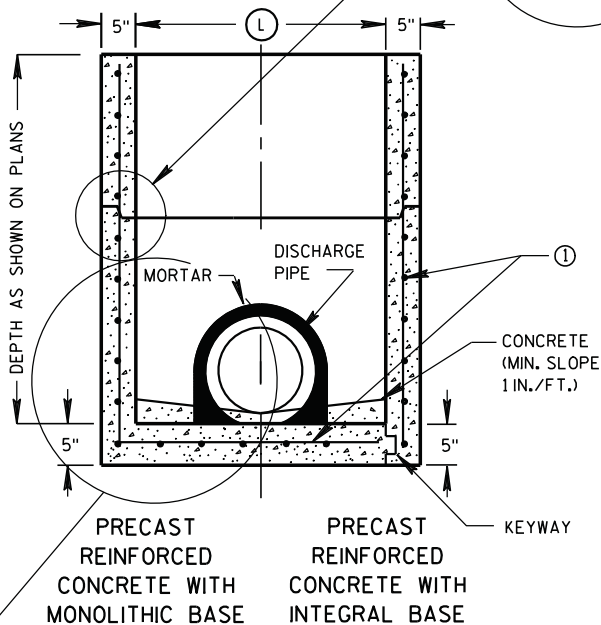

SECTION A-A

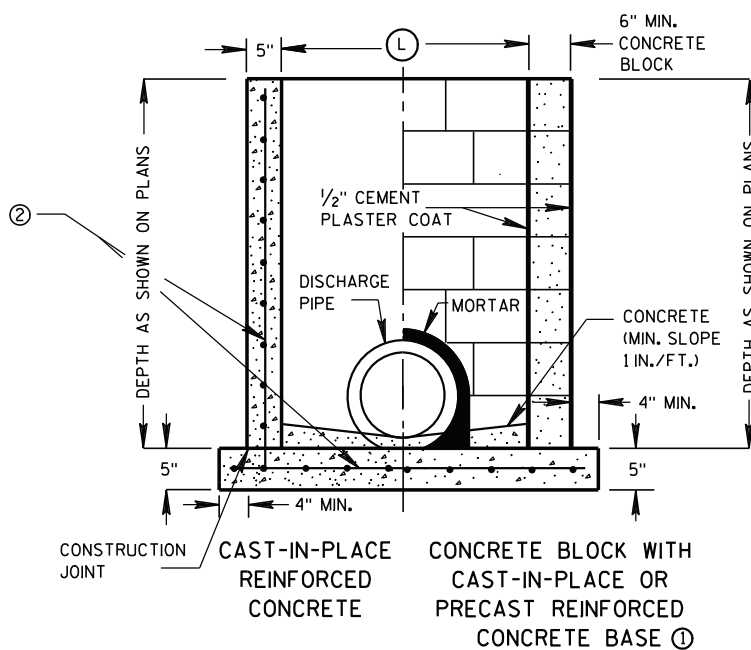

SECTION B-B

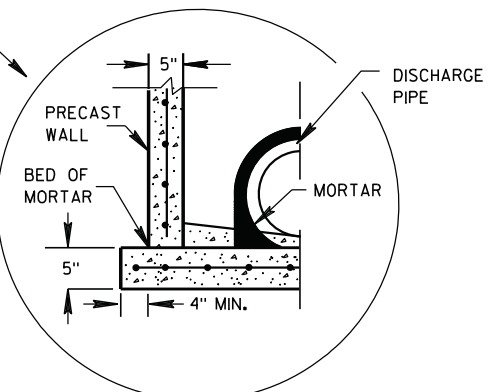

SEPERATE PRECAST REINFORCED CONCRETE BASE OPTION

GENERAL NOTES

DETAILS OF CONSTRUCTION, MATERIALS AND WORKMANSHIP NOT SHOWN ON THIS DRAWING SHALL CONFORM TO THE PERTINENT REQUIREMENTS OF THE STANDARD SPECIFICATIONS AND THE APPLICABLE SPECIAL PROVISIONS.

UNLESS OTHERWISE AUTHORIZED IN WRITING BY THE ENGINEER, THE CONTRACTOR SHALL NOT ORDER AND DELIVER PRECAST INLET UNITS REQUIRED FOR THE PROJECT UNTIL A LIST OF SIZES IS FURNISHED BY THE ENGINEER.

DETAILED DRAWINGS FOR PROPOSED ALTERNATE DESIGNS FOR UNDERGROUND DRAINAGE STRUCTURES SHALL BE SUBMITTED TO THE ENGINEER FOR APPROVAL PROVIDING THAT SUCH ALTERNATE DESIGNS MAKE PROVISION FOR EQUIVALENT CAPACITY AND STRENGTH.

ALL PRECAST INLET UNITS SHALL CONFORM TO THE PERTINENT REQUIREMENTS OF ASTM C 913.

ALL DRAINAGE STRUCTURES ARE DESIGNATED ON THE PLANS AS "MANHOLES 3X3-L", "CATCH BASINS 4-B", "INLETS 2X3-H", ETC. THE FIRST NUMBERS DESIGNATES THE SIZE OF THE STRUCTURE, AND THE FOLLOWING LETTER DESIGNATES THE TYPE OF COVER TO BE USED TO COMPRISE THE COMPLETE UNIT.

BASES SHALL BE PLACED ON A BED OF MATERIAL AT LEAST 6 INCHES IN DEPTH, WHICH MEETS THE REQUIREMENTS OF GRANULAR BACKFILL. THIS BEDDING SHALL BE COMPACTED AND PROVIDE UNIFORM SUPPORT FOR THE ENTIRE AREA OF THE BASE.

ALL BAR STEEL REINFORCEMENT SHALL BE EMBEDDED 2 INCHES CLEAR UNLESS OTHERWISE SHOWN OR NOTED.

PRECAST REINFORCED RISERS SHALL HAVE A TONGUE AND GROOVE JOINT WITH TONGUE UP OR DOWN.

4" OVERHANGING BASES ARE REQUIRED FOR CAST-IN-PLACE REINFORCED CONCRETE AND CONCRETE BLOCK INSTALLATIONS. 4" OVERHANG IS REQUIRED WHEN SEPERATE PRECAST BASE IS PROVIDED. OVERHANG IS NOT REQUIRED ON PRECAST STRUCTURES WITH AN INTEGRAL OR MONOLITHIC BASE.

MAXIMUM INSIDE PIPE DIAMETER DETERMINED BY 3 INCH CLEARANCE ON EACH SIDE OF THE OUTSIDE WALL OF THE PIPE. SEE DETAIL "A". ASSUMES PIPE ENTERS PERPENDICULAR TO THE STRUCTURE.


- ① FOR PRECAST INLETS PROVIDE REINFORCING STEEL IN ACCORDANCE TO ASTM C 913.
- ② CONTRACTOR TO PROVIDE DRAWING(S) STAMPED BY A PROFESSIONAL ENGINEER FOR STEEL REINFORCING DESIGN FOR CAST-IN-PLACE STRUCTURES.

INLET COVER MATRIX

INLET SIZE	INLET COVER TYPE		ALL A'S	ALL B'S	BW	F	ALL H'S	S	T	V	WM
	WIDTH (W) (FT)	LENGTH (L) (FT)									
2X2-FT	2	2	X	X				X		X	
2X2.5-FT	2	2.5			X			X	X	X	X
2X3-FT	2	3					X				
2.5X3-FT	2.5	3				X					

PIPE MATRIX

INLET SIZE	MAXIMUM INSIDE PIPE DIAMETER	
	WIDTH (IN)	LENGTH (IN)
2X2-FT	12	12
2X2.5-FT	12	18
2X3-FT	12	24
2.5X3-FT	18	24

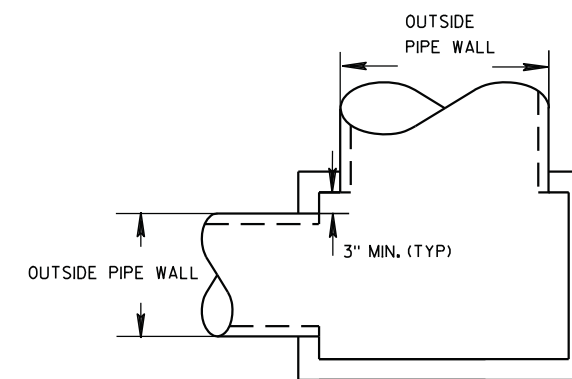


DETAIL "A"

INLETS 2X2-FT, 2X2.5-FT, 2X3-FT AND 2.5X3-FT


STATE OF WISCONSIN
DEPARTMENT OF TRANSPORTATION

APPROVED
DATE 6/5/2012
DATE /S/ Jerry H. Zogg
ROADWAY STANDARDS DEVELOPMENT
ENGINEER
FHWA


INLETS 2X2-FT, 2X2.5-FT, 2X3-FT AND 2.5X3-FT

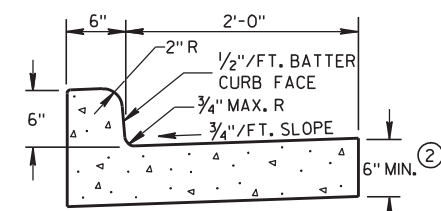


TYPES A & D ①

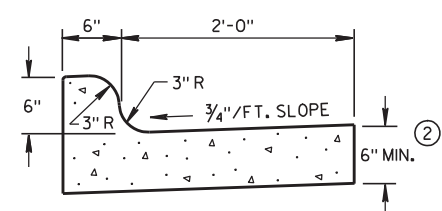


TYPES K & L ①

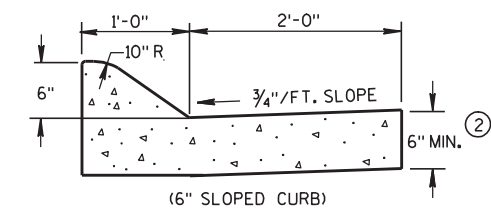


(6" SLOPED CURB) ②

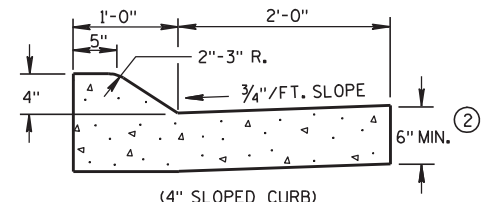


(4" SLOPED CURB) ②

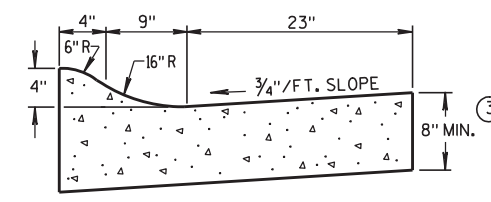


4" SLOPED CURB TYPES R & T ① ④

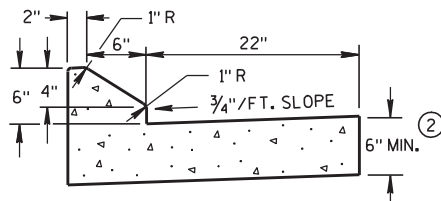

6" SLOPED CURB TYPES G & J ①

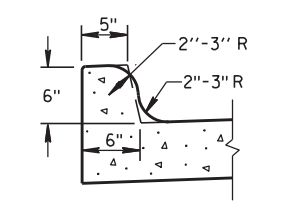


OPTIONAL CURB SHAPE FOR TYPES K & L ①

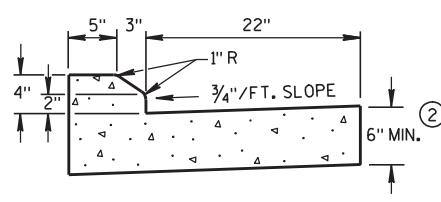


4" SLOPED CURB TYPES G & J ①


CONCRETE CURB & GUTTER 30"

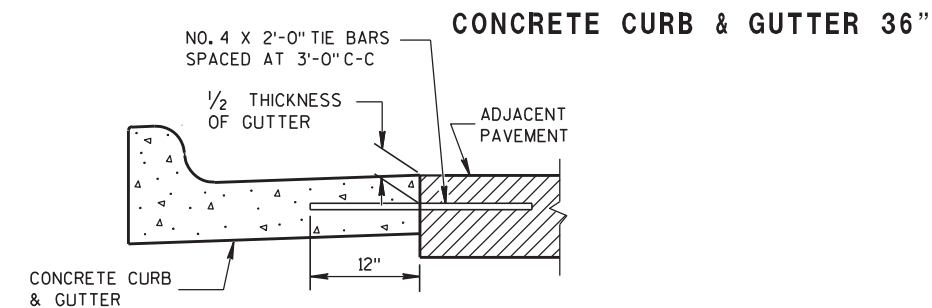


TYPICAL TIE BAR LOCATION ①

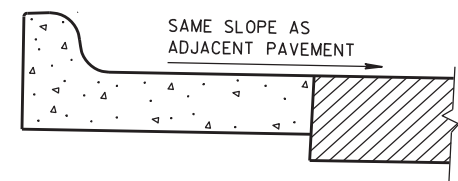

REVERSE SLOPE GUTTER ⑤ (TYPICAL FOR ALL CURB & GUTTER TYPES)

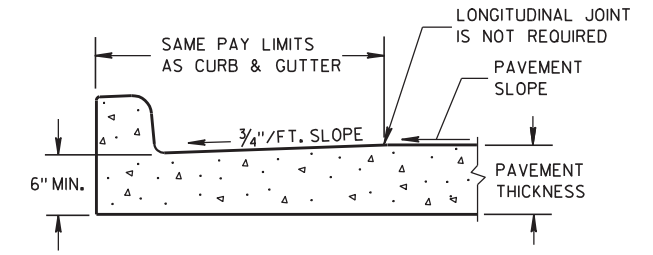


PARTIAL SECTION OF PAVEMENT WITH INTEGRAL CURB & GUTTER

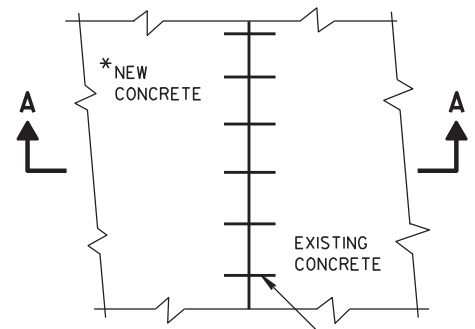


PLAN VIEW

* NEW CURB & GUTTER, SURFACE DRAINS, CONCRETE PAVEMENT OR OTHER NEW CONCRETE.


NO. 6 TIE BARS SPACED 2'-6" C-C, INSTALLED PERPENDICULAR TO THE LONGITUDINAL JOINT.

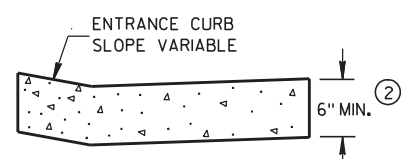


DRIVEWAY ENTRANCE CURB (WHEN DIRECTED BY THE ENGINEER) ②

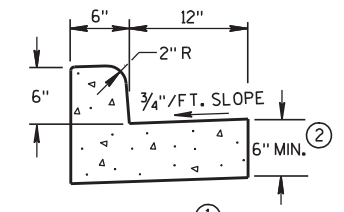


TYPES A & D CONCRETE CURB & GUTTER 18" ②

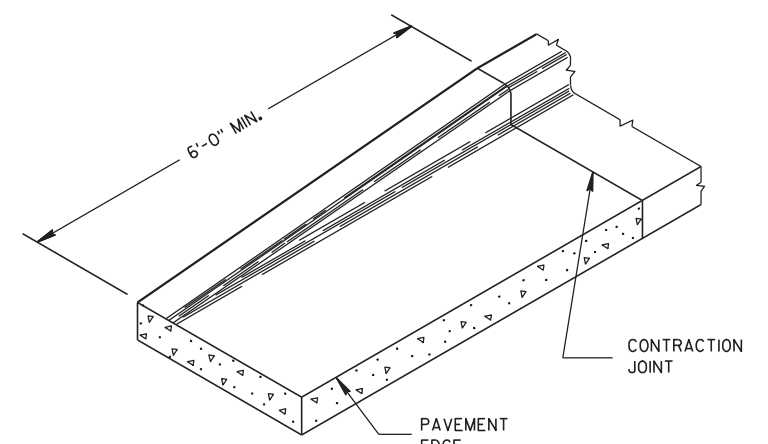

END SECTION CURB & GUTTER

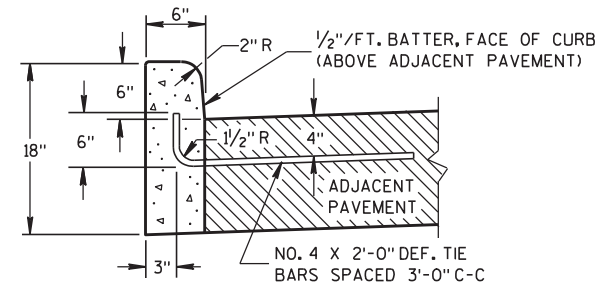

TYPES A & D CONCRETE CURB ①

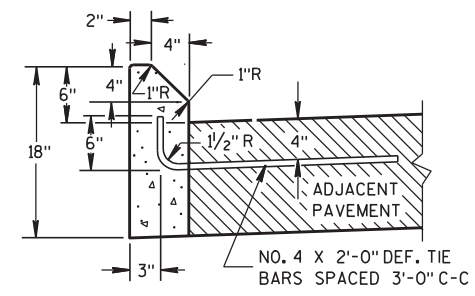

TYPES G & J CONCRETE CURB ①

GENERAL NOTES

- DETAILS OF CONSTRUCTION, MATERIALS AND WORKMANSHIP NOT SHOWN ON THIS DRAWING SHALL CONFORM TO THE PERTINENT REQUIREMENTS OF THE CONTRACT.
- PAVEMENT TIES AND TIE BARS SHALL BE EPOXY COATED IN CONFORMANCE WITH SUBSECTION 505.2.6.2 OF THE STANDARD SPECIFICATIONS.
- INTEGRAL CURB & GUTTER SHALL CONFORM TO THE DETAILS SHOWN FOR CONCRETE CURB & GUTTER INCLUDING THE TRANSVERSE GUTTER SLOPE. A LONGITUDINAL CONSTRUCTION JOINT IS NOT REQUIRED WITH INTEGRAL CURB AND GUTTER.
- WHERE THE TRANSVERSE JOINTS IN THE PAVEMENT ARE REQUIRED TO BE SEALED, THE JOINTS IN THE INTEGRAL CURB AND GUTTER SHALL BE SEALED TO THE FACE OF CURB WITH THE SAME TYPE OF SEALANT. THE COST OF FURNISHING AND INSTALLING THIS SEALANT SHALL BE INCIDENTAL TO THE ITEM CONCRETE CURB AND GUTTER.
- UNLESS OTHERWISE SHOWN ON THE TYPICAL CROSS SECTIONS, THE BASE AGGREGATE AND COMMON EXCAVATION LIMITS ARE 2'-0" BEHIND THE BACK OF CURBS.
- TIE BARS ARE REQUIRED FOR CURB AND GUTTER TYPES A, G, K AND R.
 - THE BOTTOM OF CURB AND GUTTER MAY BE CONSTRUCTED EITHER LEVEL OR PARALLEL TO THE SLOPE OF THE SUBGRADE OR BASE AGGREGATE PROVIDED A 6" MINIMUM GUTTER THICKNESS IS MAINTAINED.
 - THE BOTTOM OF CURB AND GUTTER MAY BE CONSTRUCTED EITHER LEVEL OR PARALLEL TO THE SLOPE OF THE SUBGRADE OR BASE AGGREGATE PROVIDED A 8" MINIMUM GUTTER THICKNESS IS MAINTAINED.
 - THE FACE OF CURB IS 6" FROM THE BACK OF CURB.
 - WHEN REVERSE SLOPE GUTTER IS REQUIRED, THE LOCATION(S) WILL BE SHOWN ELSEWHERE IN THE PLAN.

6

6


CONCRETE CURB, CONCRETE CURB & GUTTER AND TIES

STATE OF WISCONSIN
DEPARTMENT OF TRANSPORTATION

APPROVED
9/4/08 /S/ Jerry H. Zogg
DATE ROADWAY STANDARDS DEVELOPMENT ENGINEER

FHWA


WOOD STAKES (2 PER BALE)
NOMINAL 2" X 2" X 30" MIN.
LENGTH OR EQUIVALENT

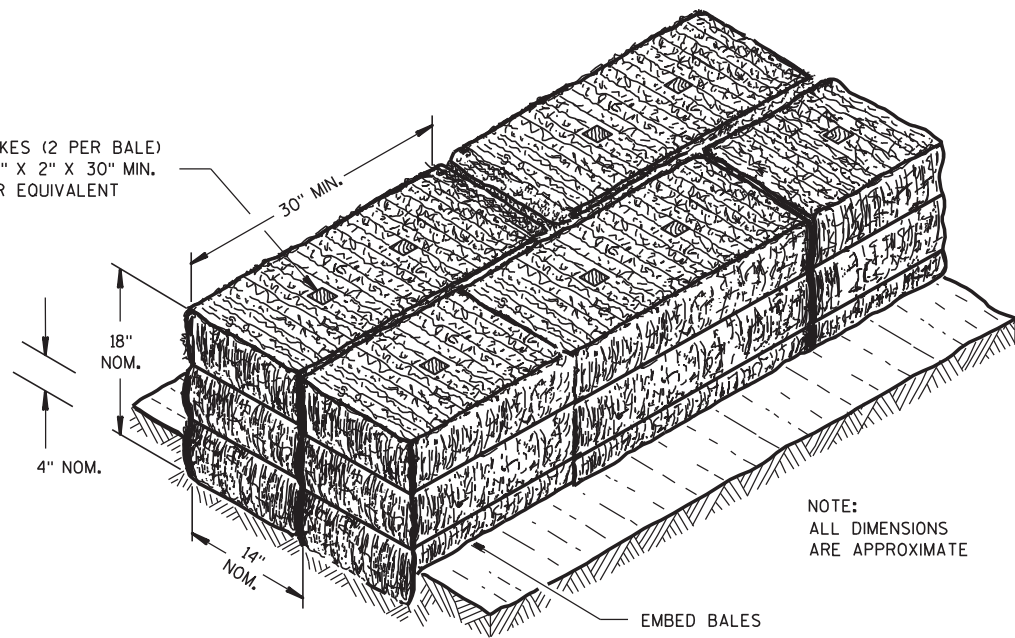

NOTE:
ALL DIMENSIONS
ARE APPROXIMATE

EMBED BALES

SECTION A-A

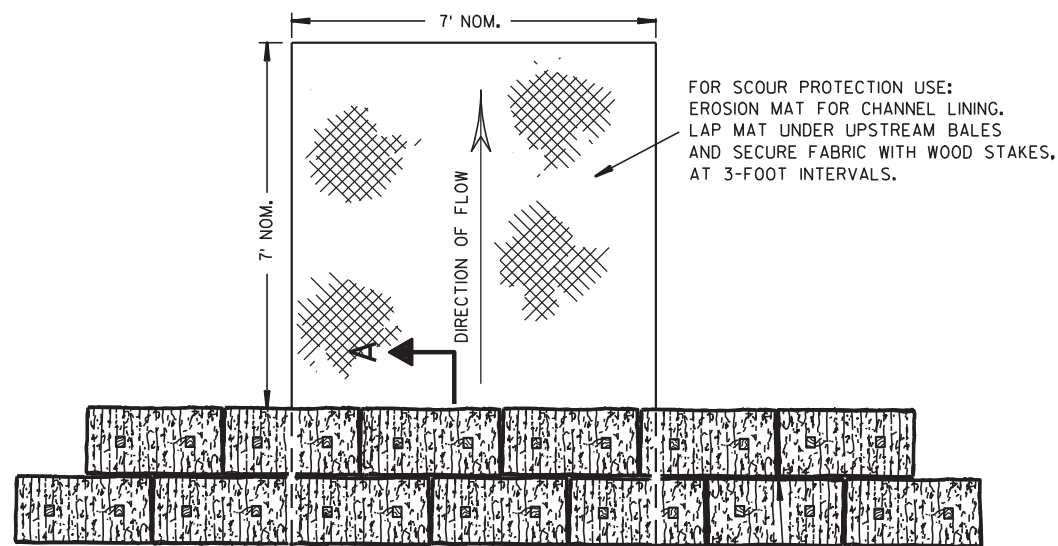


FOR SCOUR PROTECTION USE:
EROSION MAT FOR CHANNEL LINING.
LAP MAT UNDER UPSTREAM BALES
AND SECURE FABRIC WITH WOOD STAKES,
AT 3-FOOT INTERVALS.

PLAN VIEW

STAGGER JOINTS BETWEEN ADJACENT
ROWS OF BALES.

BOTTOM ELEVATION OF END BALE SHALL
BE EQUAL TO OR GREATER THAN TOP OF
LOWEST MIDDLE BALE.

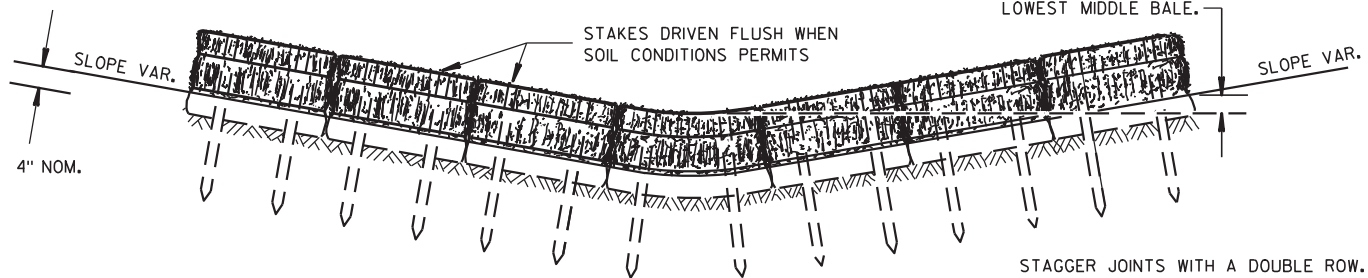


FRONT ELEVATION

TEMPORARY DITCH CHECK USING EROSION BALES ①

GENERAL NOTES


DETAILS OF CONSTRUCTION, MATERIALS AND WORKMANSHIP NOT SHOWN ON THIS DRAWING SHALL CONFORM TO THE PERTINENT REQUIREMENTS OF THE STANDARD SPECIFICATIONS AND THE APPLICABLE SPECIAL PROVISIONS.

- ① TEMPORARY DITCH CHECKS EITHER EROSION BALES OR MANUFACTURED SHALL BE PAID FOR UNDER THE BID ITEM OF TEMPORARY DITCH CHECK. THE DEPARTMENT WILL NOT PAY FOR TEMPORARY DITCH CHECKS CONSTRUCTED OF A SINGLE ROW OF EROSION BALES.

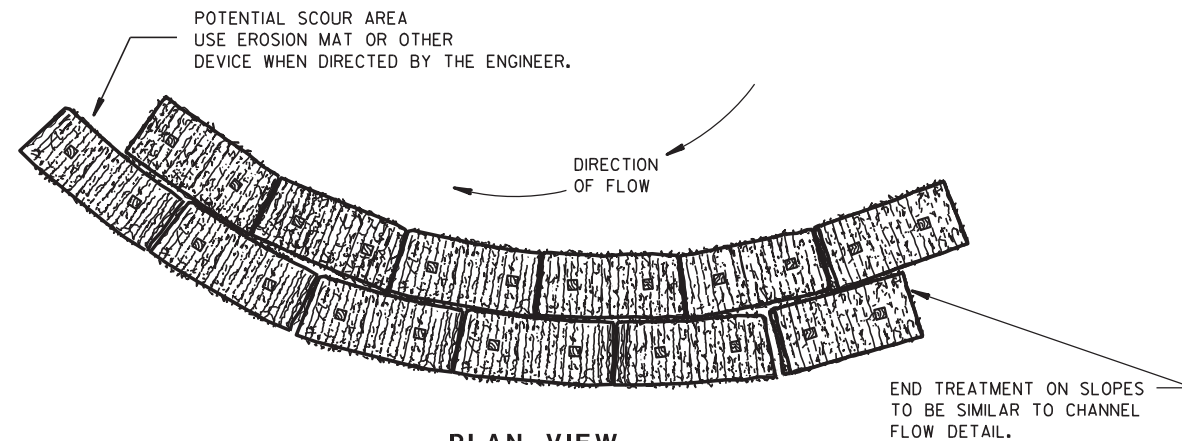


PLAN VIEW

WHEN ALTERING THE DIRECTION OF FLOW

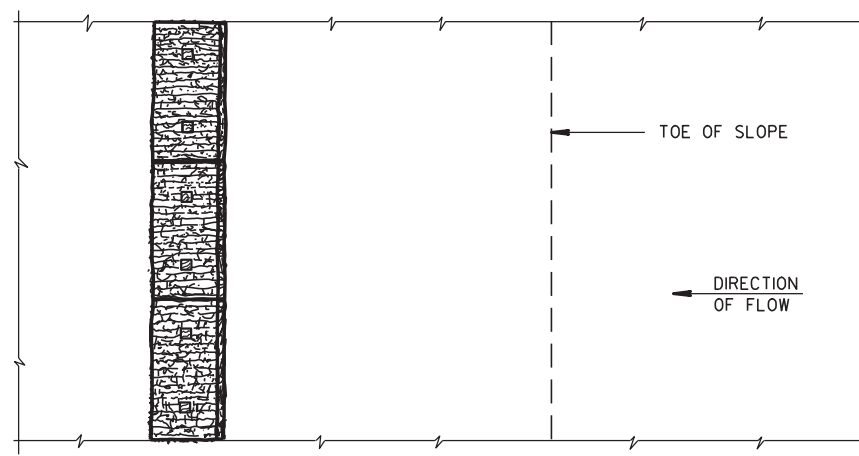

PLAN VIEW

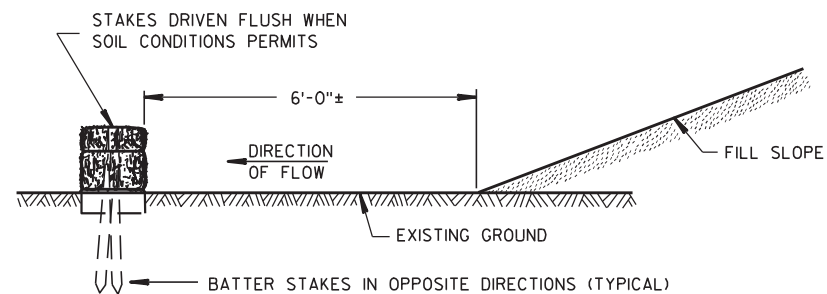

FRONT ELEVATION


WHEN EXISTING GROUND SLOPES AWAY FROM FILL SLOPE

EROSION BALES FOR SHEET FLOW


TYPICAL INSTALLATIONS OF
EROSION BALES / TEMPORARY
DITCH CHECKS

STATE OF WISCONSIN
DEPARTMENT OF TRANSPORTATION

APPROVED
6/04/02 DATE /S/ Beth Canestra
CHIEF ROADWAY DEVELOPMENT ENGINEER
FHWA

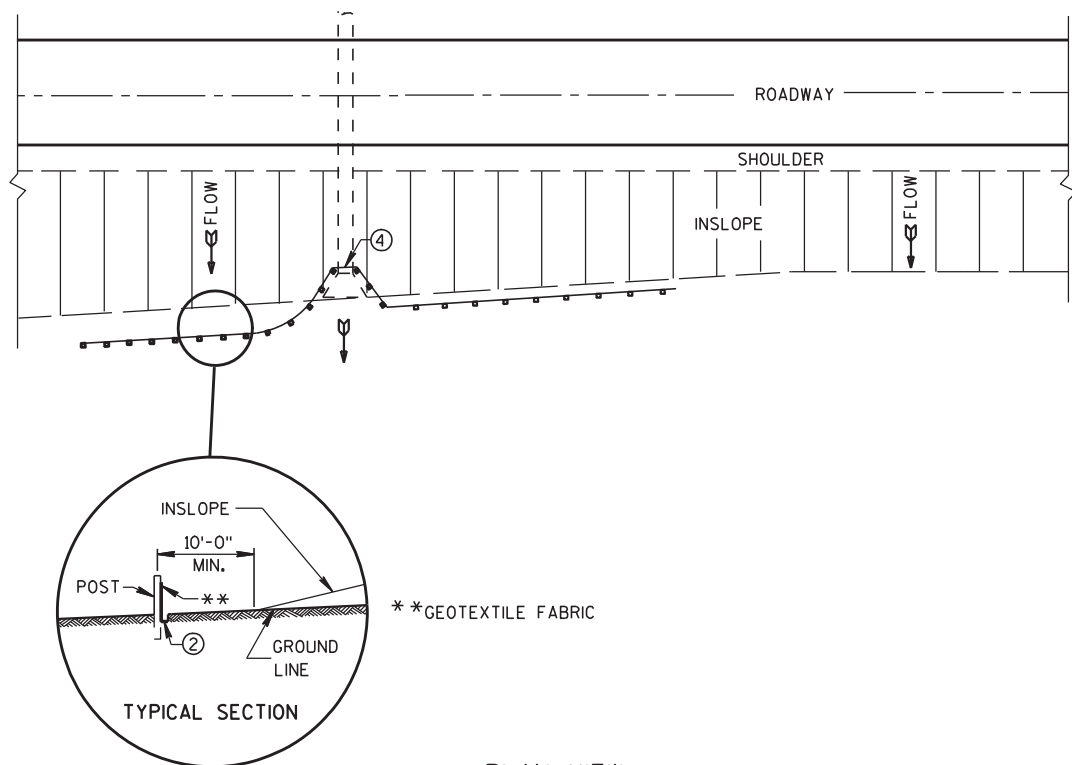

PLAN VIEW
TYPICAL APPLICATION OF SILT FENCE

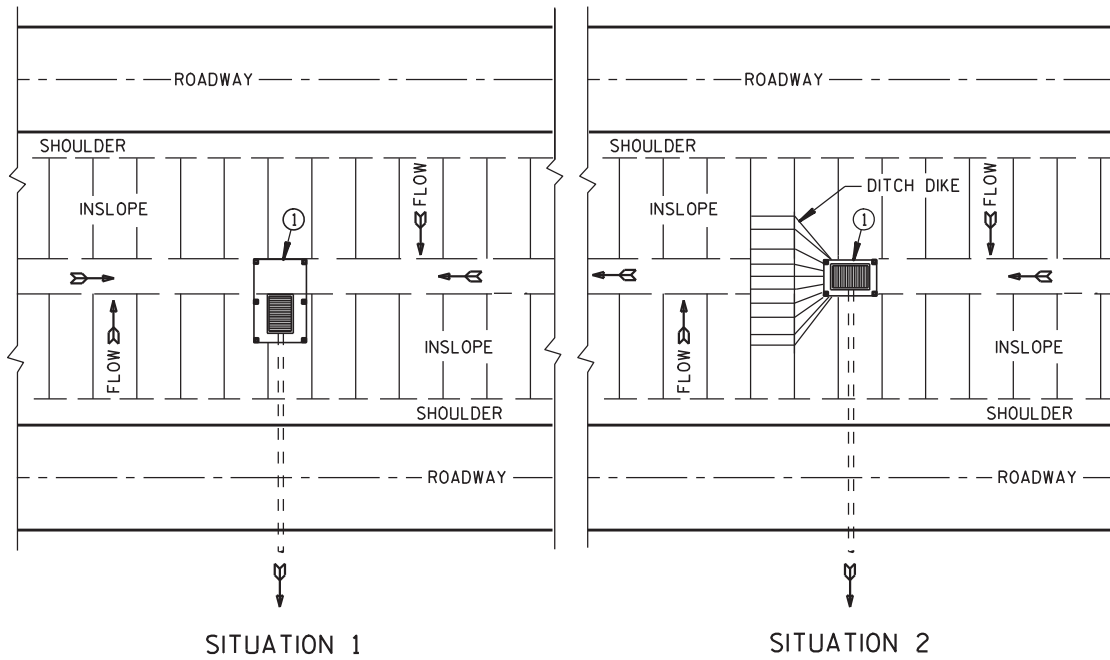


SITUATION 1 SITUATION 2
PLAN VIEW
SILT FENCE AT MEDIAN SURFACE DRAINS

GENERAL NOTES


DETAILS OF CONSTRUCTION NOT SHOWN ON THIS DRAWING SHALL CONFORM TO THE PERTINENT REQUIREMENTS OF THE STANDARD SPECIFICATIONS AND APPLICABLE SPECIAL PROVISIONS.

- ① HORIZONTAL BRACE REQUIRED WITH 2" X 4" WOODEN FRAME OR EQUIVALENT AT TOP OF POSTS.
- ② FOR MANUAL INSTALLATIONS THE TRENCH SHALL BE A MINIMUM OF 4" WIDE & 6" DEEP TO BURY AND ANCHOR THE GEOTEXTILE FABRIC. FOLD MATERIAL TO FIT TRENCH AND BACKFILL & COMPACT TRENCH WITH EXCAVATED SOIL.
- ③ WOOD POSTS SHALL BE A MINIMUM SIZE OF 1 1/8" X 1 1/8" OF OAK OR HICKORY.
- ④ SILT FENCE TO EXTEND ACROSS THE TOP OF THE PIPE.
- ⑤ CONSTRUCT SILT FENCE FROM A CONTINUOUS ROLL IF POSSIBLE BY CUTTING LENGTHS TO AVOID JOINTS. IF A JOINT IS NECESSARY USE ONE OF THE FOLLOWING TWO METHODS; A) OVERLAP THE END POSTS AND TWIST, OR ROTATE, AT LEAST 180 DEGREES, B) HOOK THE END OF EACH SILT FENCE LENGTH.

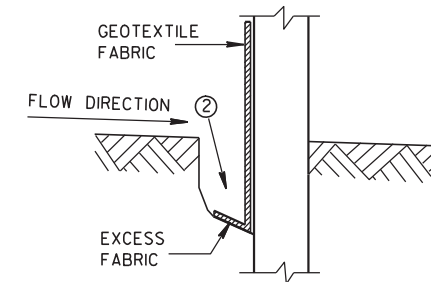


TRENCH DETAIL


NOTE: ADDITIONAL POST DEPTH OR TIE BACKS MAY BE REQUIRED IN UNSTABLE SOILS

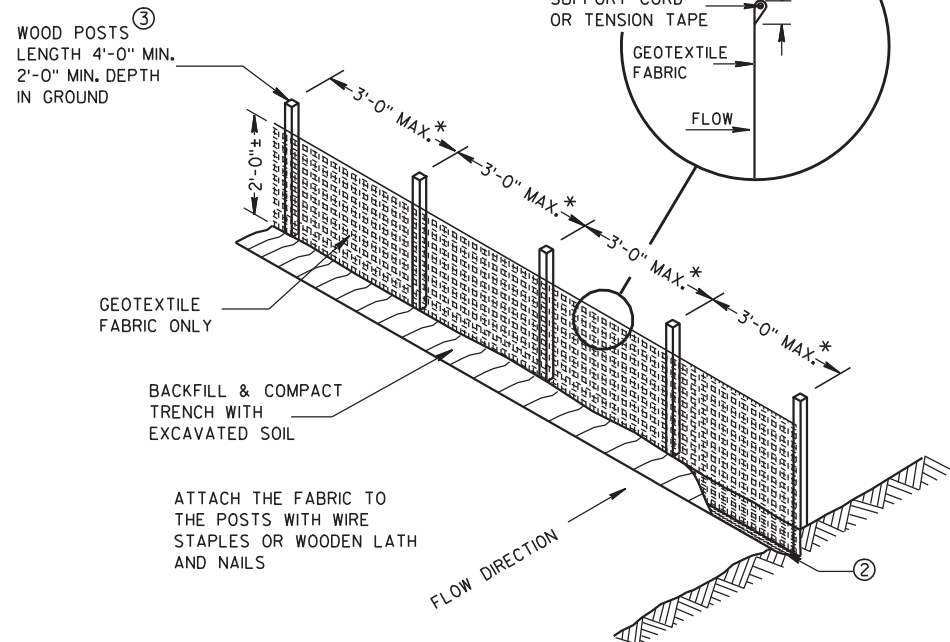

SILT FENCE


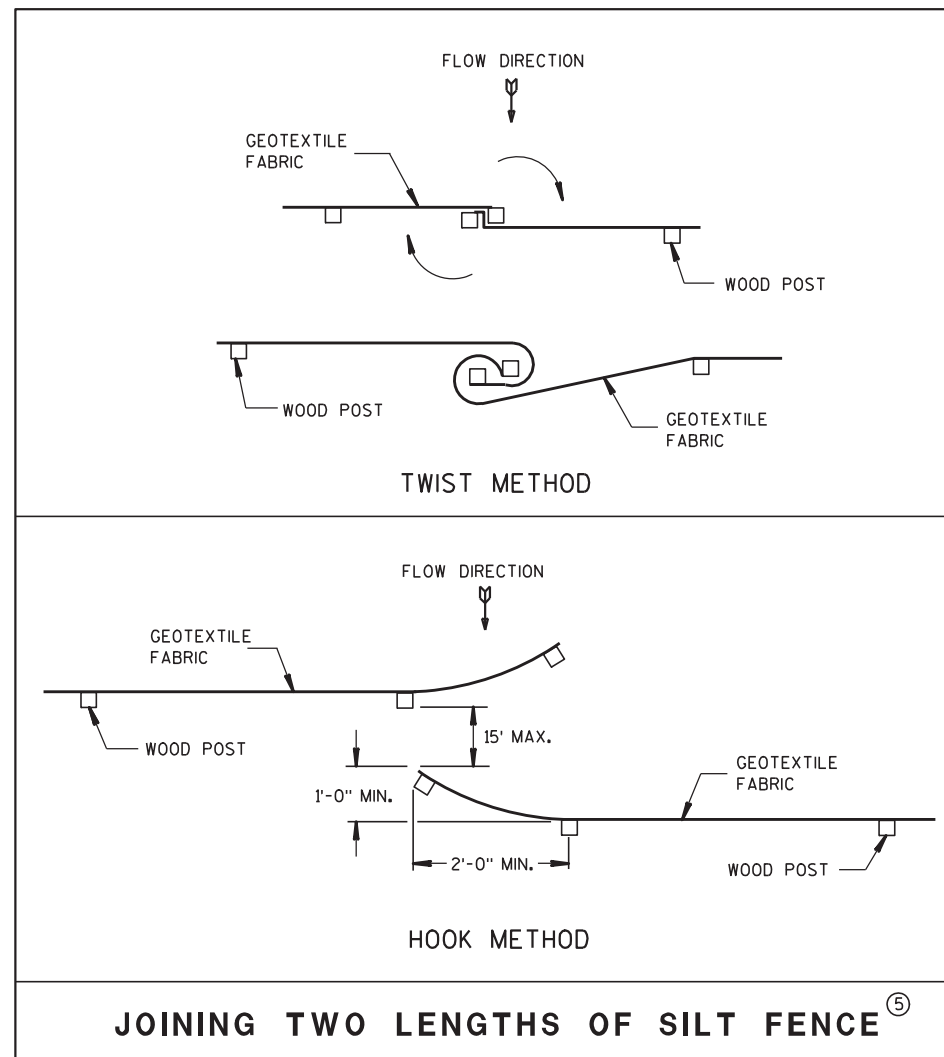


JOINING TWO LENGTHS OF SILT FENCE ⑤

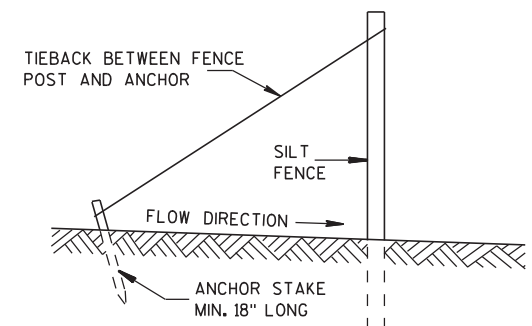

SILT FENCE TIE BACK
(WHEN REQUIRED BY THE ENGINEER)

SILT FENCE	
STATE OF WISCONSIN DEPARTMENT OF TRANSPORTATION	
APPROVED 4-29-05 DATE	/S/ Beth Canestra CHIEF ROADWAY DEVELOPMENT ENGINEER
FHWA	

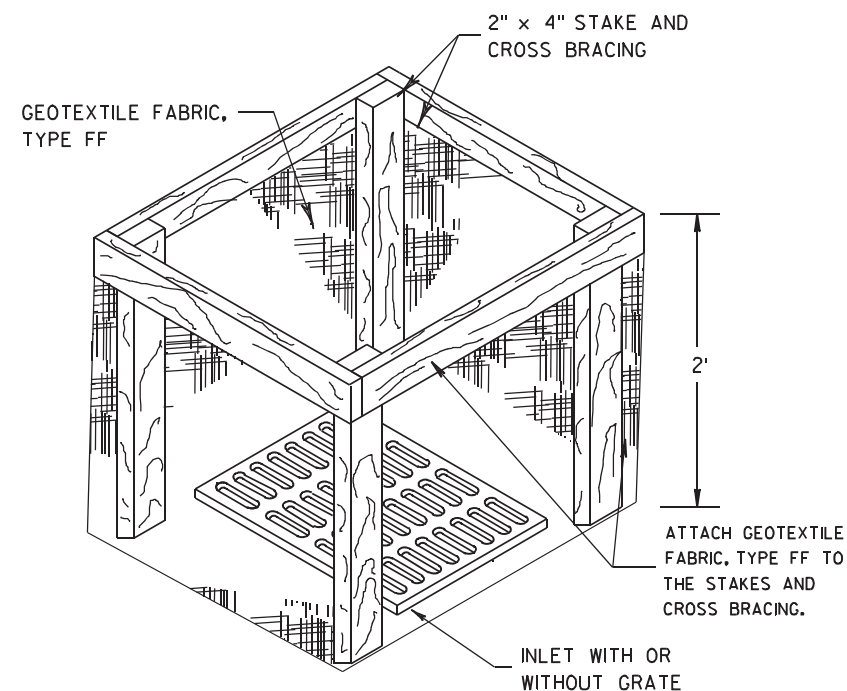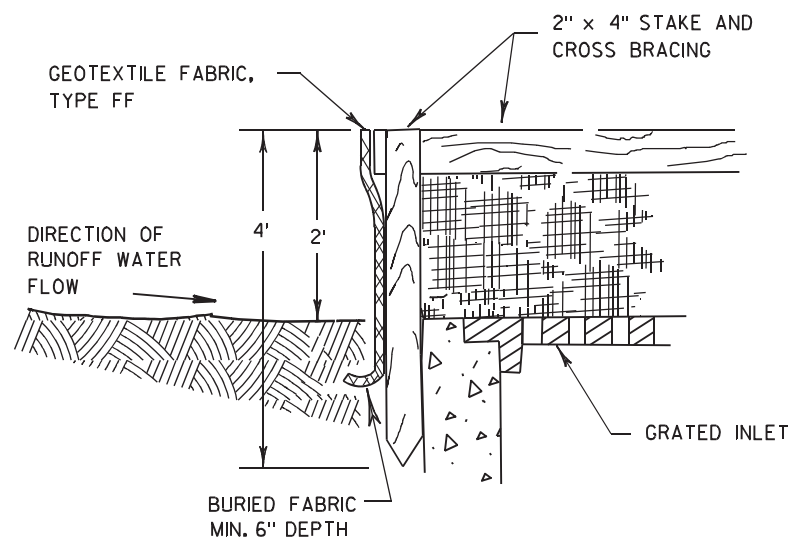

INLET PROTECTION, TYPE A


GENERAL NOTES

INLET PROTECTION DEVICES SHALL BE MAINTAINED OR REPLACED AT THE DIRECTION OF THE ENGINEER.

MANUFACTURED ALTERNATIVES APPROVED AND LISTED ON THE DEPARTMENT'S EROSION CONTROL PRODUCT ACCEPTABILITY LIST MAY BE SUBSTITUTED.


WHEN REMOVING OR MAINTAINING INLET PROTECTION, CARE SHALL BE TAKEN SO THAT THE SEDIMENT TRAPPED ON THE GEOTEXTILE FABRIC DOES NOT FALL INTO THE INLET. ANY MATERIAL FALLING INTO THE INLET SHALL BE REMOVED IMMEDIATELY.

- ① FINISHED SIZE, INCLUDING FLAP POCKETS WHERE REQUIRED, SHALL EXTEND A MINIMUM OF 10" AROUND THE PERIMETER TO FACILITATE MAINTENANCE OR REMOVAL.
- ② FOR INLET PROTECTION, TYPE C (WITH CURB BOX), AN ADDITIONAL 18" OF FABRIC IS WRAPPED AROUND THE WOOD AND SECURED WITH STAPLES. THE WOOD SHALL NOT BLOCK THE ENTIRE HEIGHT OF THE CURB BOX OPENING.
- ③ FLAP POCKETS SHALL BE LARGE ENOUGH TO ACCEPT WOOD 2X4.

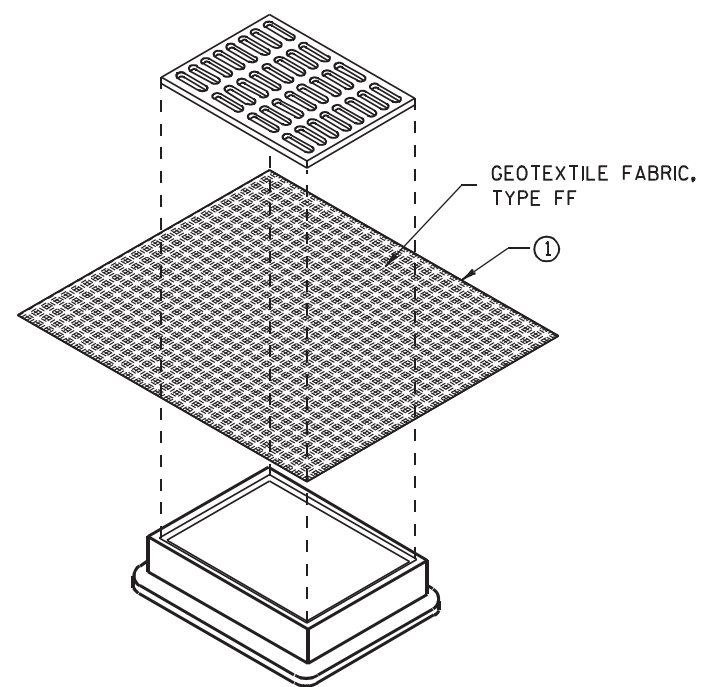

INLET PROTECTION, TYPE B (WITHOUT CURB BOX)

(CAN BE INSTALLED IN ANY INLET WITHOUT A CURB BOX)

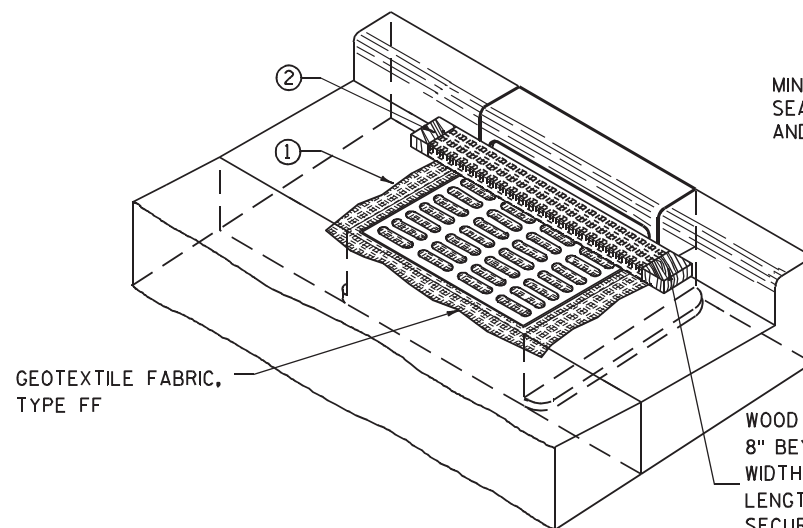

INLET PROTECTION, TYPE C (WITH CURB BOX)

INSTALLATION NOTES

TYPE B & C

TRIM EXCESS FABRIC IN THE FLOW LINE TO WITHIN 3" OF THE GRATE.


THE CONTRACTOR SHALL DEMONSTRATE A METHOD OF MAINTENANCE, USING A SEWN FLAP, HAND HOLDS OR OTHER METHOD TO PREVENT ACCUMULATED SEDIMENT FROM ENTERING THE INLET.

TYPE D

DO NOT INSTALL INLET PROTECTION TYPE D IN INLETS SHALLOWER THAN 30", MEASURED FROM THE BOTTOM OF THE INLET TO THE TOP OF THE GRATE.

TRIM EXCESS FABRIC IN THE FLOW LINE TO WITHIN 3" OF THE GRATE.

THE INSTALLED BAG SHALL HAVE A MINIMUM SIDE CLEARANCE, BETWEEN THE INLET WALLS AND THE BAG, MEASURED AT THE BOTTOM OF THE OVERFLOW HOLES, OF 3". WHERE NECESSARY THE CONTRACTOR SHALL CINCH THE BAG, USING PLASTIC ZIP TIES, TO ACHIEVE THE 3" CLEARANCE. THE TIES SHALL BE PLACED AT A MAXIMUM OF 4" FROM THE BOTTOM OF THE BAG.

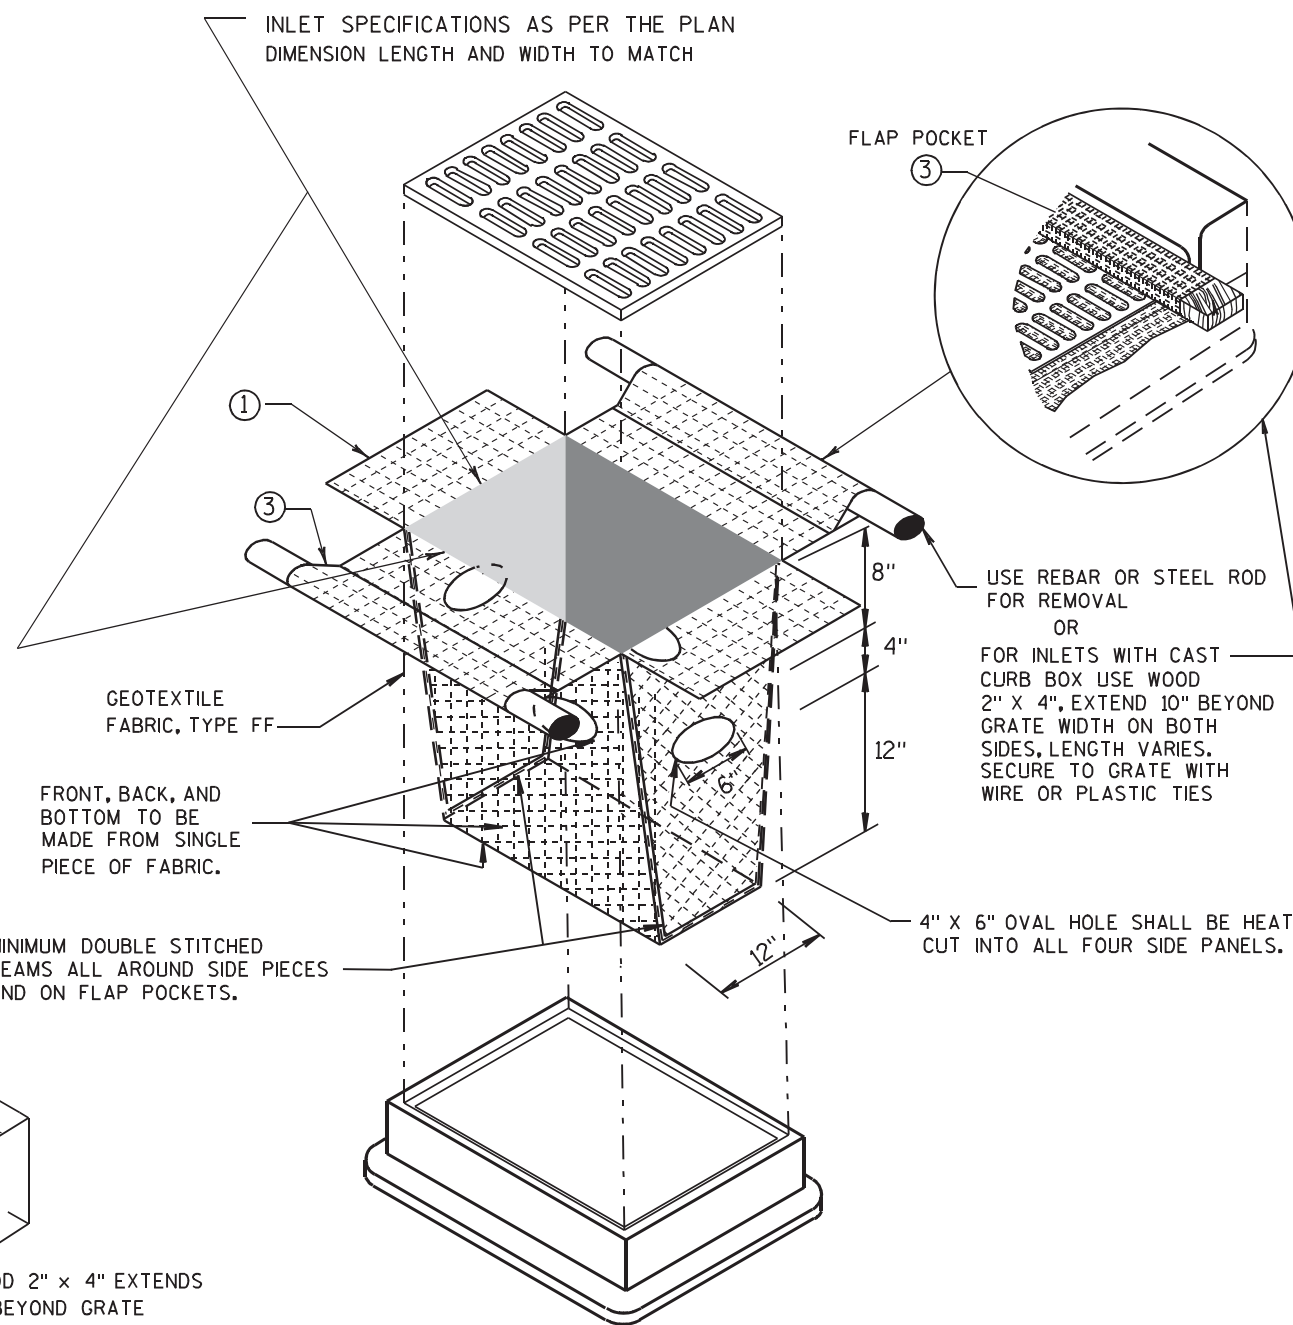

INLET PROTECTION, TYPE D

(CAN BE INSTALLED IN ANY INLET TYPE WITH OR WITHOUT A CURB BOX AS PER NOTE ②)

INLET PROTECTION TYPE A, B, C, AND D

STATE OF WISCONSIN DEPARTMENT OF TRANSPORTATION

APPROVED

10/16/02 /S/ Beth Connegra

DATE 35

FHWA CHIEF ROADWAY DEVELOPMENT ENGINEER

GENERAL NOTES

DETAILS OF CONSTRUCTION, MATERIALS AND WORKMANSHIP NOT SHOWN ON THIS DRAWING SHALL CONFORM TO THE PERTINENT REQUIREMENTS OF THE STANDARD SPECIFICATIONS AND THE APPLICABLE SPECIAL PROVISIONS.

TRACKING PAD SHALL BE INSPECTED DAILY. DEFICIENT AREAS SHALL BE REPAIRED OR REPLACED IMMEDIATELY.




TRACKING PAD TO BE REMOVED AFTER CONSTRUCTION IS COMPLETED.

TRACKING PAD SHALL BE THE FULL WIDTH OF THE EGRESS POINT.

SURFACE WATER MUST BE PREVENTED FROM PASSING THROUGH THE TRACKING PAD. FLOWS SHALL BE DIVERTED AWAY, AROUND OR CONVEYED UNDER THE TRACKING PAD.

CULVERT PIPE OR OTHER BMP USED TO DIVERT WATER AWAY, AROUND OR UNDER THE TRACKING PAD SHALL BE DESIGNED TO CONVEY THE 2 YEAR - 24 HOUR EVENT.

THE COST OF ADDITIONAL BMP TO DIVERT WATER ARE INCIDENTAL TO THE TRACKING PAD BID ITEM.

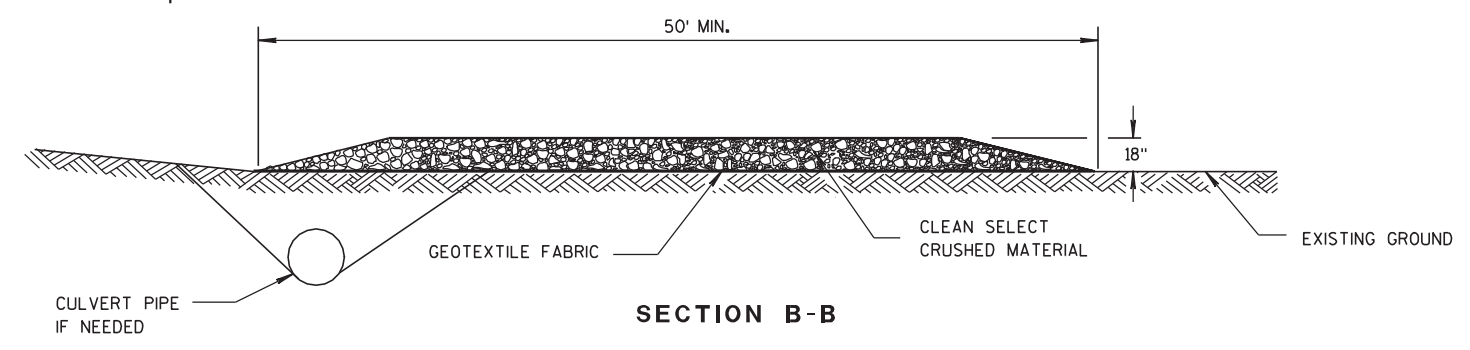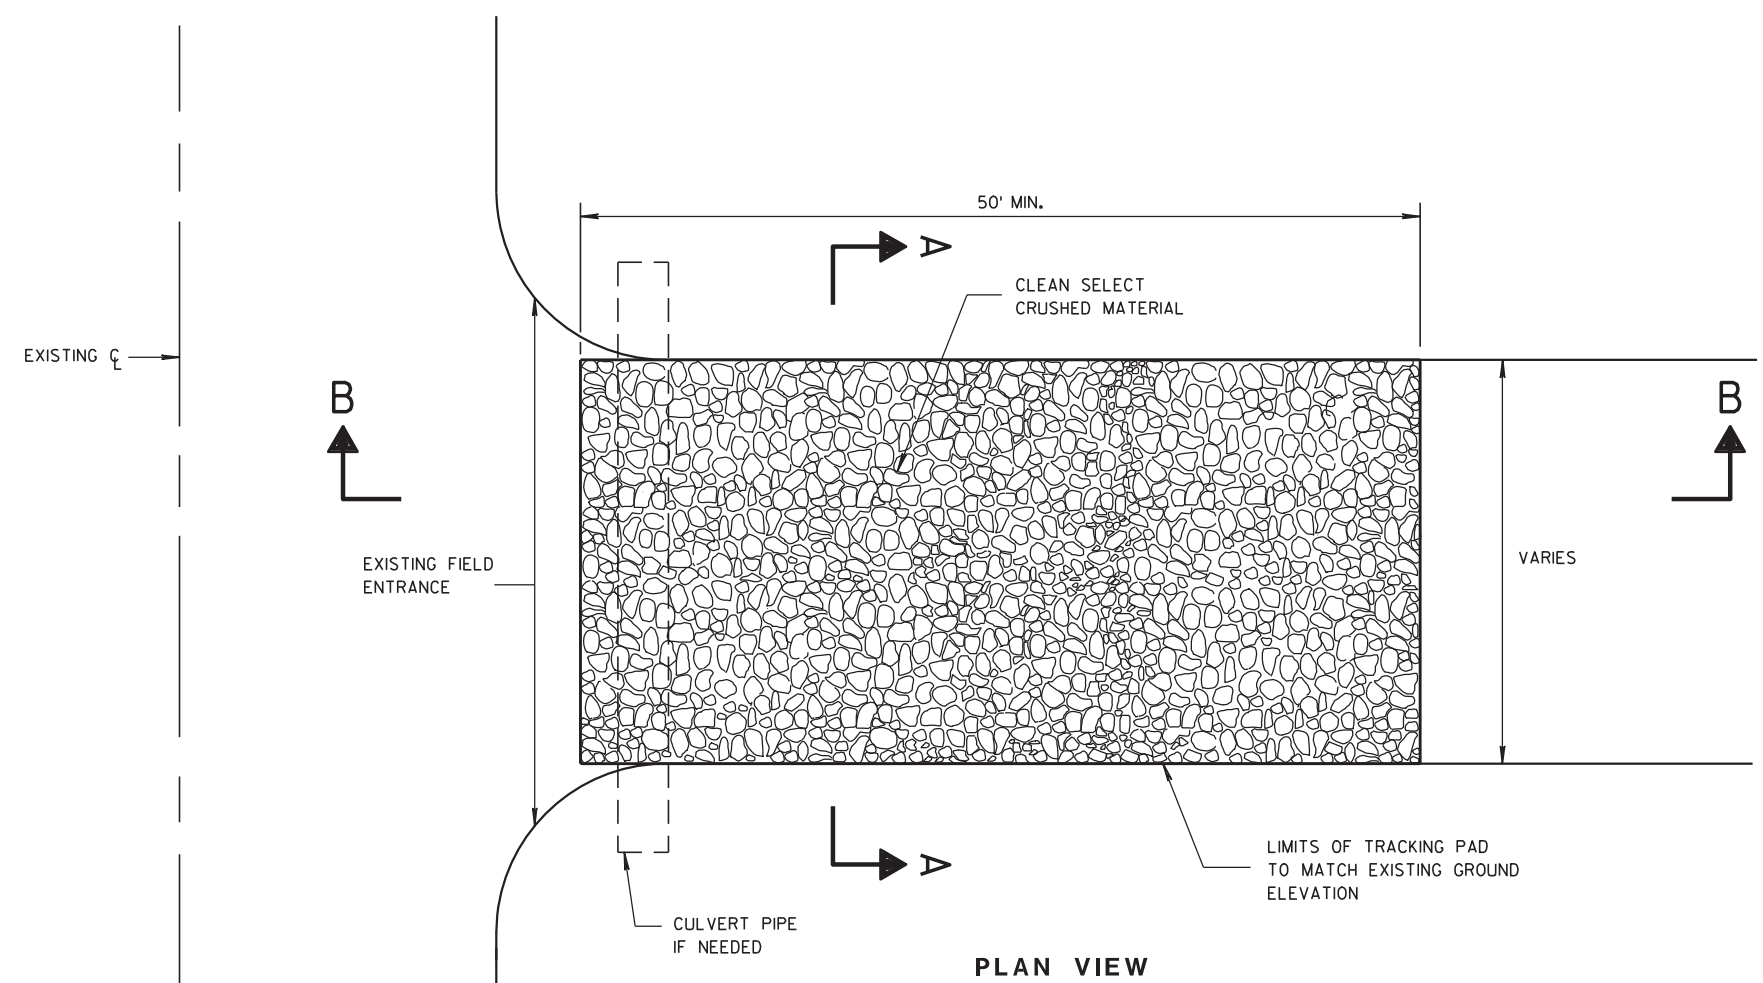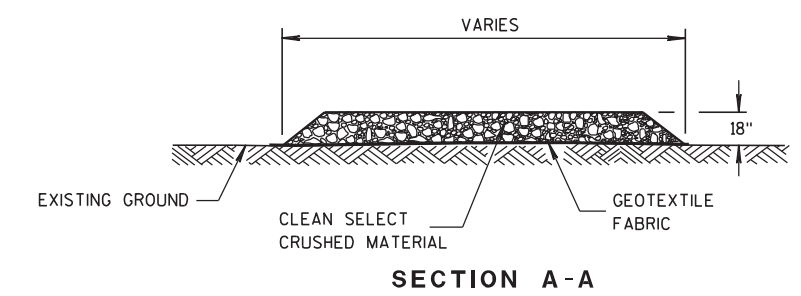

TRACKING PAD

TRACKING PAD	
STATE OF WISCONSIN DEPARTMENT OF TRANSPORTATION	
APPROVED DATE 3/24/2011	/s/ Jerry H. Zogg ROADWAY STANDARDS DEVELOPMENT ENGINEER
FHWA	

6

6

S.D.D. 8 E 14-1


S.D.D. 8 E 14-1

METAL APRON ENDWALLS											
PIPE DIA. (IN.)	MIN. THICK. (Inches)		DIMENSIONS (Inches)							APPROX. SLOPE	BODY
	STEEL	ALUM.	A (±1")	B (MAX.)	H (±1")	L (±1 1/2")	L1	L2	W (±2")		
12	.064	.060	6	6	6	21	12	17 1/2	24	2 1/2 to 1	1 Pc.
15	.064	.060	7	8	6	26	14	21 3/4	30	2 1/2 to 1	1 Pc.
18	.064	.060	8	10	6	31	15	28 1/4	36	2 1/2 to 1	1 Pc.
21	.064	.060	9	12	6	36	18	29 5/8	42	2 1/2 to 1	1 Pc.
24	.064	.075	10	13	6	41	18	37 1/4	48	2 1/2 to 1	1 Pc.
30	.079	.075	12	16	8	51	18	52 1/4	60	2 1/2 to 1	1 Pc.
36	.079	.105	14	19	9	60	24	59 3/4	72	2 1/2 to 1	2 Pc.
42	.109	.105	16	22	11	69	24	75 5/8	84	2 1/2 to 1	2 Pc.
48	.109	.105	18	27	12	78	24	81	90	2 1/4 to 1	3 Pc.
54	.109	.105	18	30	12	84	30	85 1/2	102	2 1/4 to 1	3 Pc.
60	.109x	.105x	18	33	12	87	—	114	120	2 to 1	3 Pc.
66	.109x	.105x	18	36	12	87	—	120	120	2 to 1	3 Pc.
72	.109x	.105x	18	39	12	87	—	126	120	2 to 1	3 Pc.
78	.109x	.105x	18	42	12	87	—	132	112 to 1	3 Pc.	
84	.109x	.105x	18	45	12	87	—	138	112 to 1	3 Pc.	
90	.109x	.105x	18	37	12	87	—	144	112 to 1	3 Pc.	
96	.109x	.105x	18	35	12	87	—	150	112 to 1	3 Pc.	


* EXCEPT CENTER PANEL SEE GENERAL NOTES

REINFORCED CONCRETE APRON ENDWALLS									
PIPE DIA. (IN.)	DIMENSIONS (Inches)							APPROX. SLOPE	
	T	A	B	C	D	E	G		
12	2	4	24	48 1/8	72 1/8	24	2	3 to 1	
15	2 1/4	6	27	46	73	30	2 1/4	3 to 1	
18	2 1/2	9	27	46	73	36	2 1/2	3 to 1	
21	2 3/4	9	36	37 1/2	73 1/2	42	2 3/4	3 to 1	
24	3	9 1/2	43 1/2	30	73 1/2	48	3	3 to 1	
27	3 1/4	10 1/2	49 1/2	24	73 1/2	54	3 1/4	3 to 1	
30	3 1/2	12	54	19 3/4	73 1/2	60	3 1/2	3 to 1	
36	4	15	63	34 3/4	97 3/4	72	4	3 to 1	
42	4 1/2	21	63	35	98	78	4 1/2	3 to 1	
48	5	24	72	26	98	84	5	3 to 1	
54	5 1/2	27	65	33 1/4-35	98 1/4-100	90	5 1/2	2 1/2 to 1	
60	6	30-35	60	39	99	96	5	2 to 1	
66	6 1/2	30-35	72-78	21-27	99	102	5 1/2	2 to 1	
72	7	30-35	78	21	99	108	6	2 to 1	
78	7 1/2	30-35	78	21	99	114	6 1/2	2 to 1	
84	8	36	90 1/2	21	111 1/2	120	6 1/2	1 1/2 to 1	
90	8 1/2	41	87 1/2	24	111 1/2	132	6 1/2	1 1/2 to 1	


* MINIMUM
** MAXIMUM

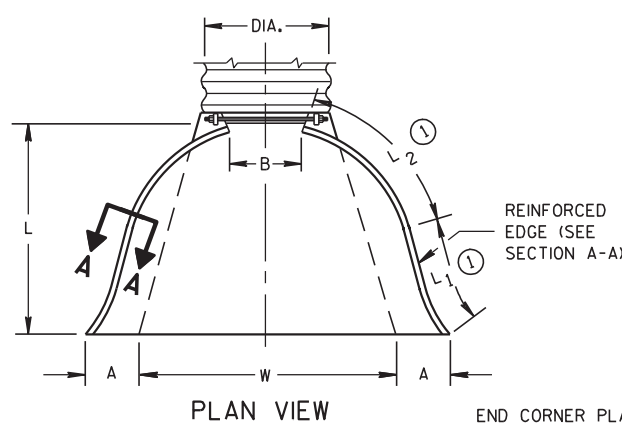


END CORNER PLATES MAY BE FASTENED TO APRON PROPER BY BOLTS, RIVETS, OR RESISTANCE SPOT WELDS WHICH WILL HOLD THE SURFACES TIGHTLY TOGETHER

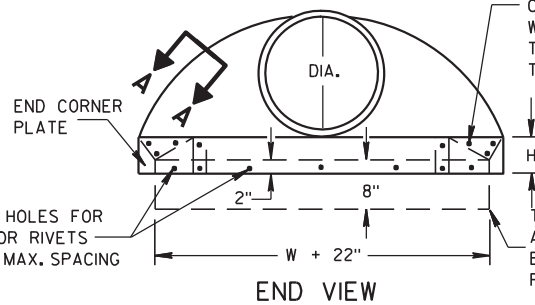


SIDE ELEVATION METAL ENDWALLS

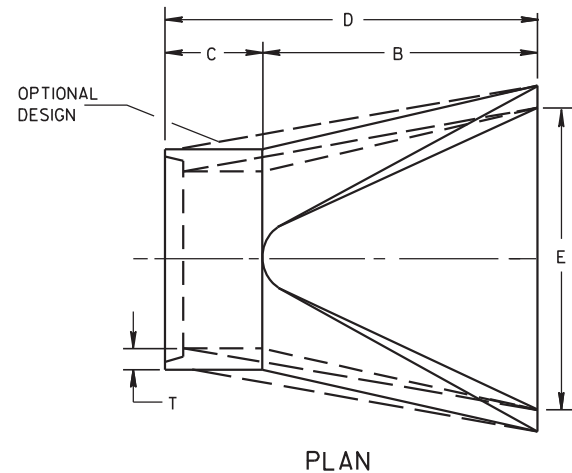

PLAN

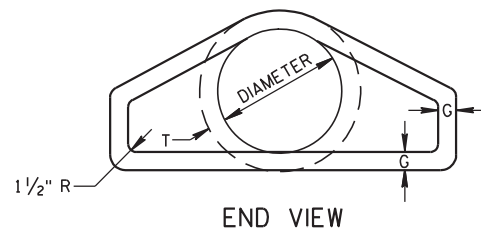


END VIEW

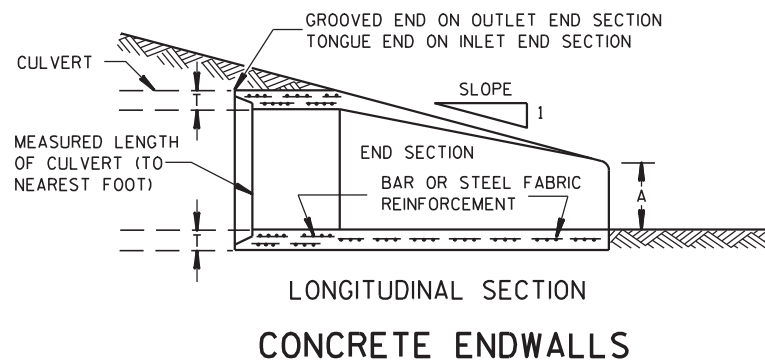


LONGITUDINAL SECTION CONCRETE ENDWALLS


1" WIDE, 12 GA. (0.109" THICK) GALVANIZED STRAP WITH STANDARD 6" X 1/2" BAND BOLT AND NUT

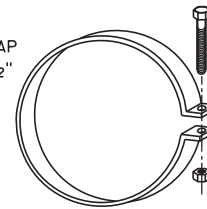


ALTERNATE FOR TYPE 1 CONNECTION END SECTION CONNECTOR STRAP

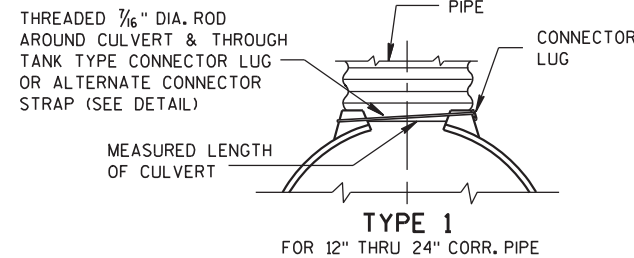


TYPE 1 FOR 12" THRU 24" CORR. PIPE

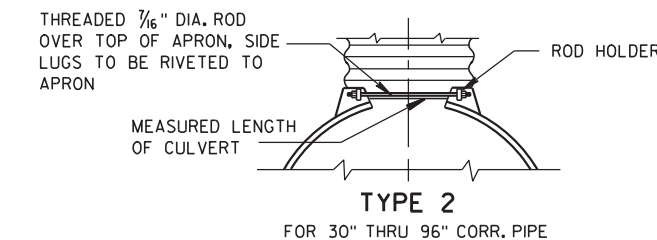

TYPE 2 FOR 30" THRU 96" CORR. PIPE

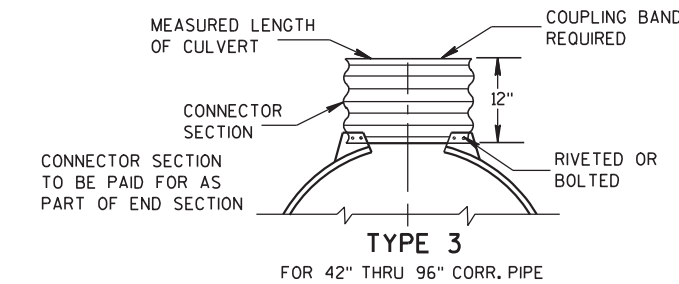

TYPE 3 FOR 42" THRU 96" CORR. PIPE

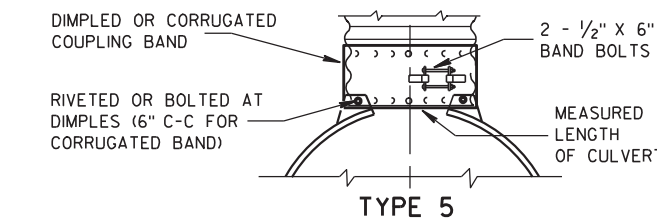

ALTERNATE FOR: ALL SIZES CORRUGATED CIRCULAR PIPE


NOTE: DIMPLED BAND FITS OVER OUTSIDE OF ENDWALL, AND CORRUGATED BAND FITS INSIDE ENDWALL. DIMPLED BAND MAY BE USED WITH HELICALLY CORRUGATED PIPE.

FOR CIRCUMFERENTIALLY CORRUGATED PIPE USE ENDWALL CONNECTION DETAILS 1, 2, 3 OR 5 AS APPLICABLE.

FOR HELICALLY CORRUGATED PIPE USE ENDWALL CONNECTION DETAILS 1, 2 OR 5.

FOR HELICALLY CORRUGATED PIPES WITH TWO CIRCUMFERENTIAL CORRUGATIONS AT EACH END USE ENDWALL CONNECTION DETAILS 1, 2 OR 3.

CONNECTION DETAILS

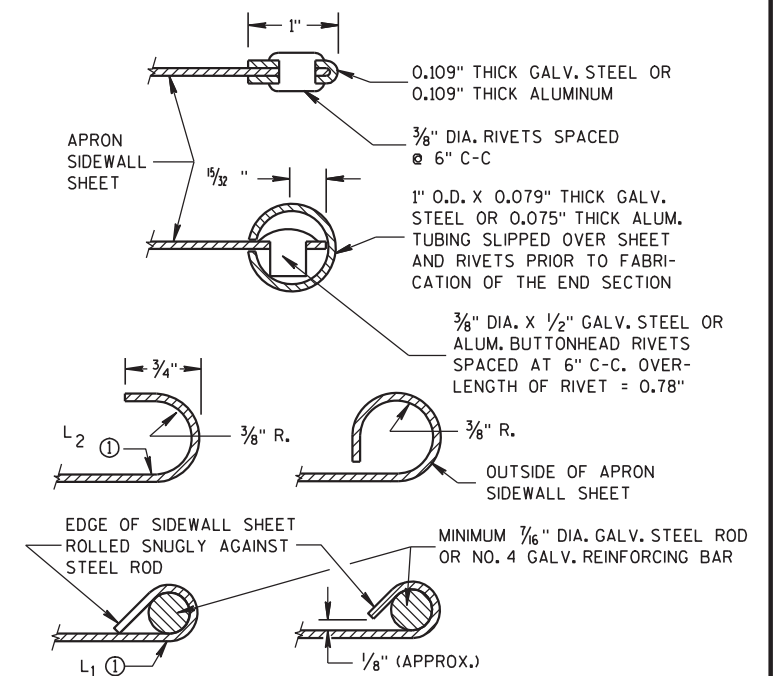

SECTION A-A

GENERAL NOTES

DETAILS OF CONSTRUCTION, MATERIALS AND WORKMANSHIP NOT SHOWN ON THIS DRAWING SHALL CONFORM TO THE PERTINENT REQUIREMENTS OF THE STANDARD SPECIFICATIONS AND THE APPLICABLE SPECIAL PROVISIONS.

CONCRETE CULVERT ENDWALLS MAY NOT BE USED WITH GALVANIZED STEEL OR ALUMINUM CULVERT PIPE OR VICE VERSA. GALVANIZED STEEL OR ALUMINUM ENDWALLS SHALL NORMALLY BE INSTALLED ON CULVERT PIPE OF THE SAME METAL.

ALL THREE PIECE STEEL APRON ENDWALLS FOR 60" DIAMETER PIPE AND LARGER SHALL HAVE 0.109" SIDES AND 0.138" CENTER PANELS. ALL THREE PIECE ALUMINUM APRON ENDWALLS FOR 60" DIAMETER PIPE AND LARGER SHALL HAVE 0.105" SIDES AND 0.134" CENTER PANELS. THE WIDTH OF CENTER PANELS SHALL BE GREATER THAN 20 PERCENT OF THE PIPE PERIMETER.

LAP SEAMS SHALL BE TIGHTLY JOINED BY GALVANIZED RIVETS OR BOLTS FOR STEEL UNITS AND ALUMINUM RIVETS AND BOLTS FOR ALUMINUM UNITS. FOR THE 60" THROUGH 96" DIAMETER APRON ENDWALL SIZES, THE REINFORCED EDGES AND CENTER PANEL SEAMS SHALL BE FURTHER REINFORCED WITH GALVANIZED STEEL OR ALUMINUM STIFFENER ANGLES. THE ANGLES SHALL BE ATTACHED BY GALVANIZED NUTS AND BOLTS FOR STEEL UNITS AND ALUMINUM NUTS AND BOLTS FOR ALUMINUM UNITS.

WHERE TWO OR MORE PIPES WITH APRON ENDWALLS ARE LAID ADJACENT TO EACH OTHER, THEY SHALL BE SEPARATED BY A DISTANCE SUFFICIENT TO PROVIDE A MINIMUM CLEARANCE OF 6 INCHES BETWEEN APRON ENDWALLS.



① FOR PIPE SIZES UP TO 60" DIAMETER, A 180° ROLLED EDGE MAY BE USED INSTEAD OF STEEL ROD REINFORCEMENT. SEE SECTION A-A.

APRON ENDWALLS FOR CULVERT PIPE

STATE OF WISCONSIN DEPARTMENT OF TRANSPORTATION

APPROVED 11/30/94 DATE /S/ Rory L. Rhinesmith CHIEF ROADWAY DEVELOPMENT ENGINEER

FHWA

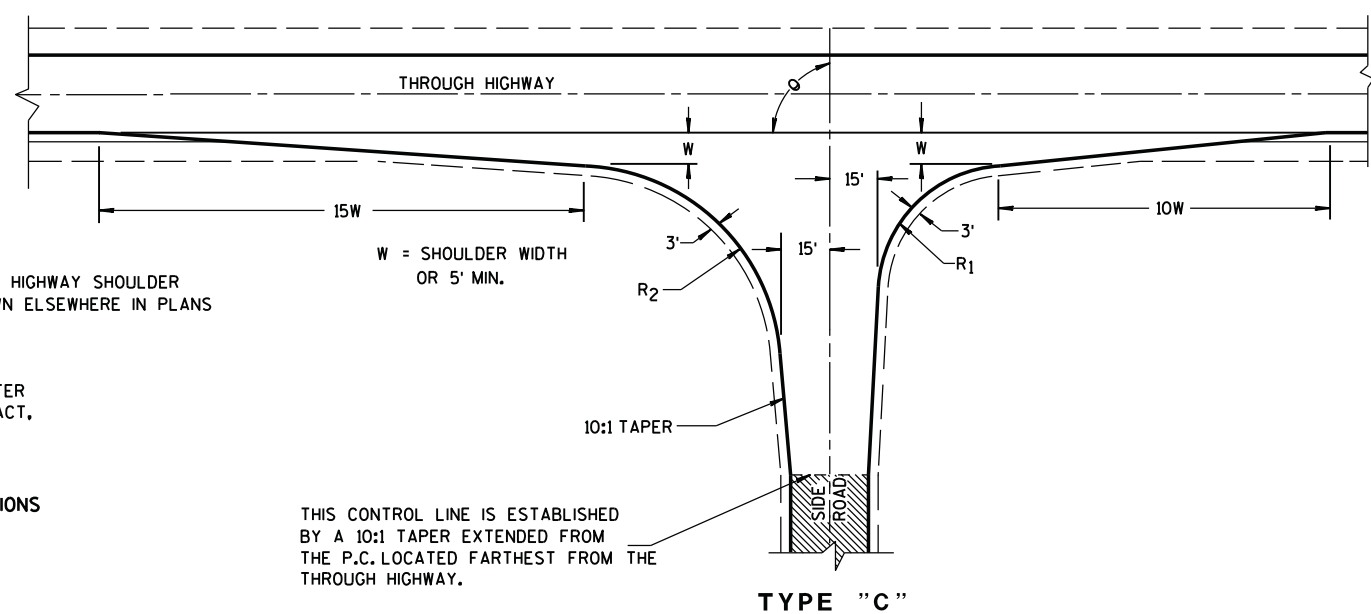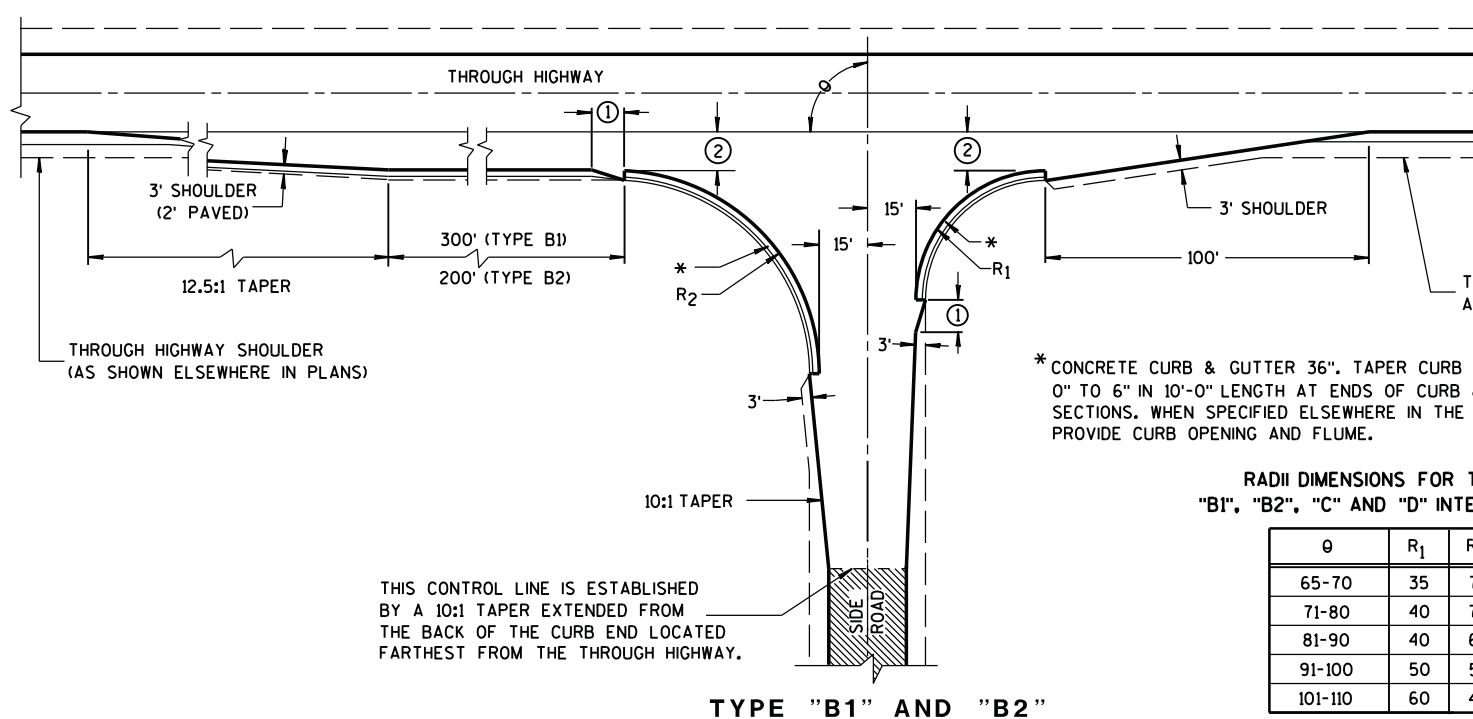

GENERAL NOTES

DESIGNS MAY BE USED INTERCHANGEABLY IN COMBINATION OR SEPARATELY FOR ANY ONE COMPLETE INTERSECTION DEPENDING UPON INTERSECTION ANGLE AND SURFACING OF EACH APPROACH ROADWAY.

SIDE ROAD SURFACING NOTE

WHEN THE SIDE ROAD IS NOT PRESENTLY PAVED, PAVEMENT SHALL BE PLACED TO THE LIMITS SHOWN UNLESS OTHERWISE PROVIDED IN THE CONTRACT. WHERE THE CONSTRUCTION LIMITS ARE BEYOND THE PAVING LIMITS, CRUSHED AGGREGATE SURFACING SHALL BE PLACED BETWEEN THE PAVING LIMITS AND CONSTRUCTION LIMITS.




WHEN THE SIDE ROAD IS PRESENTLY PAVED, NEW PAVEMENT SHALL BE PLACED TO THE LIMITS OF DESIGN AS SHOWN AND BEYOND, IF NECESSARY, TO MEET EXISTING PAVEMENT.

WHEN THE SIDE ROAD IS THE CONSTRUCTION PROJECT, THE INTERSECTION SURFACING SHALL BE THE SAME AS FOR THE PROJECT.

EXISTING PAVED SURFACE

BYPASS LANE

- ① 10-FT TYPICAL.
- ② 12-FT** PLUS ADDITIONAL WIDTH FOR BIKE LANE IF SHOWN ELSEWHERE IN THE PLAN.
- **10-FT MAY BE USED ON TYPE B2 ON RESURFACING PROJECTS IF SPECIFIED IN THE CONTRACT.
- ③ BYPASS LANE PAVED SURFACE WIDTH OUTSIDE OF TRAVEL LANE
-ASPHALT = 12-FT PLUS PAVED SHOULDER WIDTH.
-PC CONCRETE = 13-FT PLUS PAVED SHOULDER WIDTH.
- ④ BYPASS LANE PAVED SHOULDER WIDTH = THE GREATER OF 1-FT OR THE PAVED SHOULDER WIDTH OF THE THROUGH HIGHWAY.

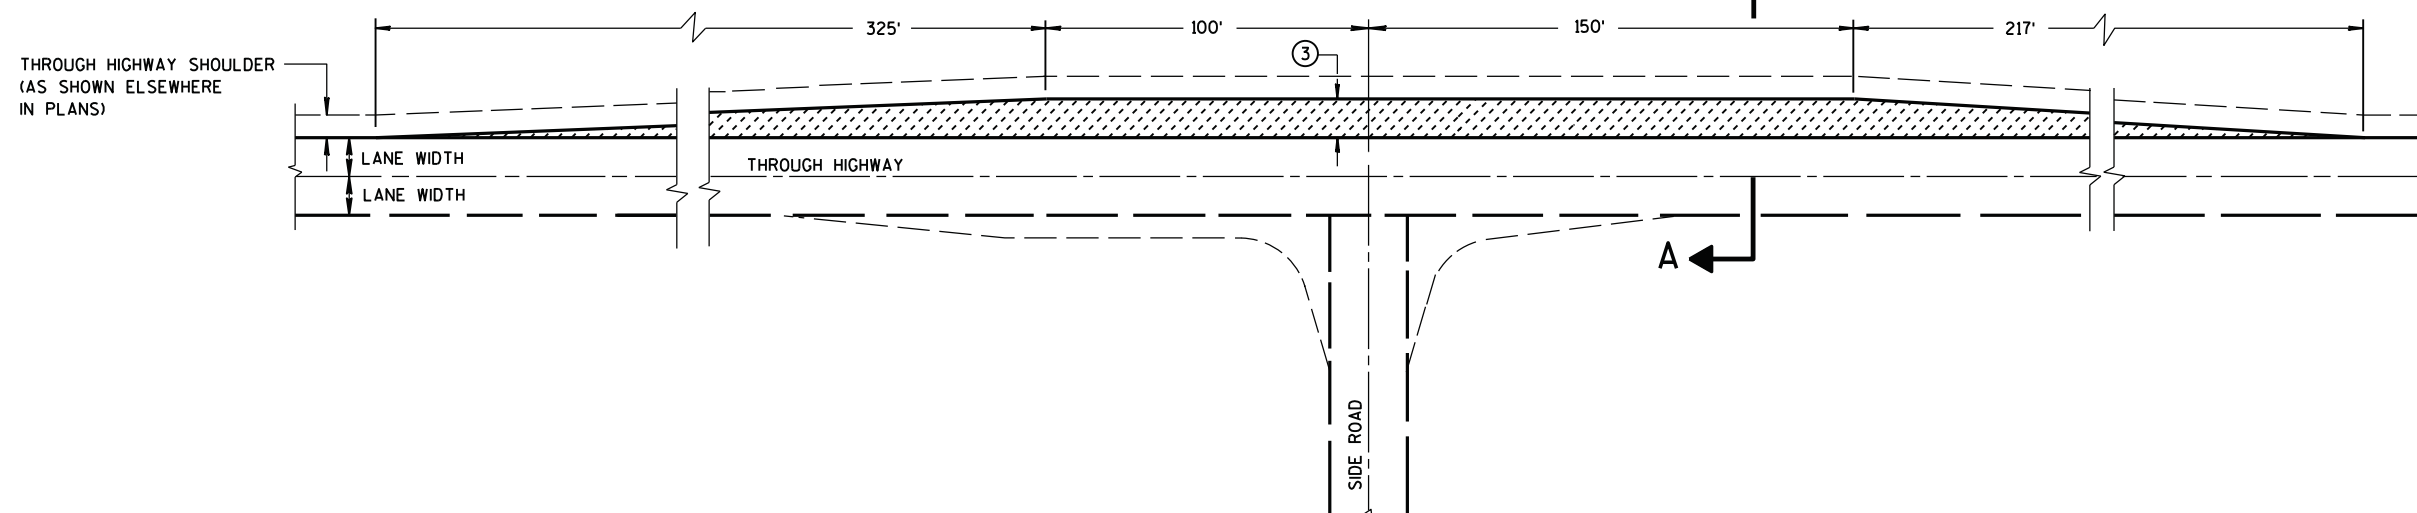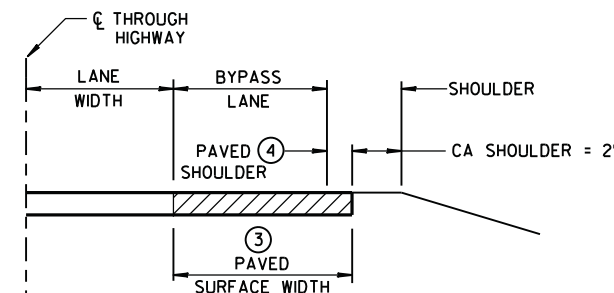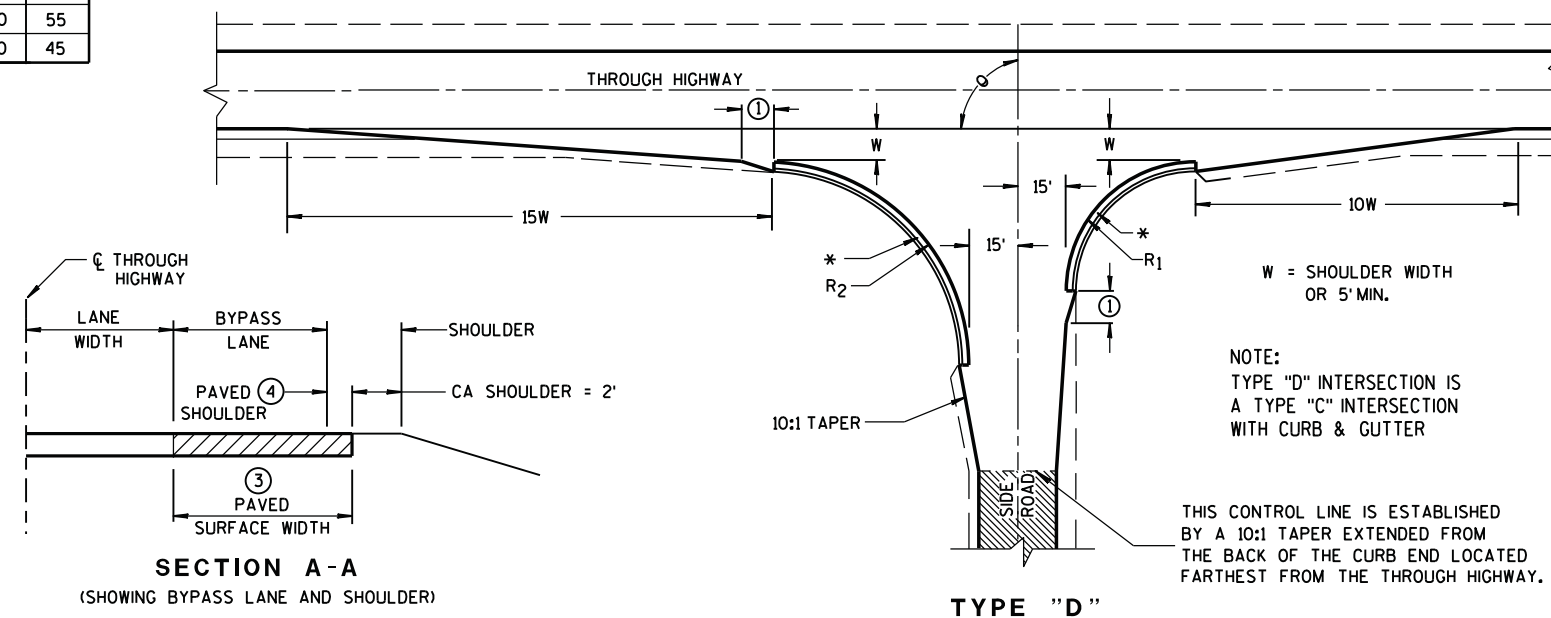

AT-GRADE SIDE ROAD INTERSECTION, TYPES "B1", "B2", "C" AND "D" AND TEE INTERSECTION BYPASS LANE


STATE OF WISCONSIN DEPARTMENT OF TRANSPORTATION

6


6

S.D.D. 9 A 1-13a

S.D.D. 9 A 1-13a

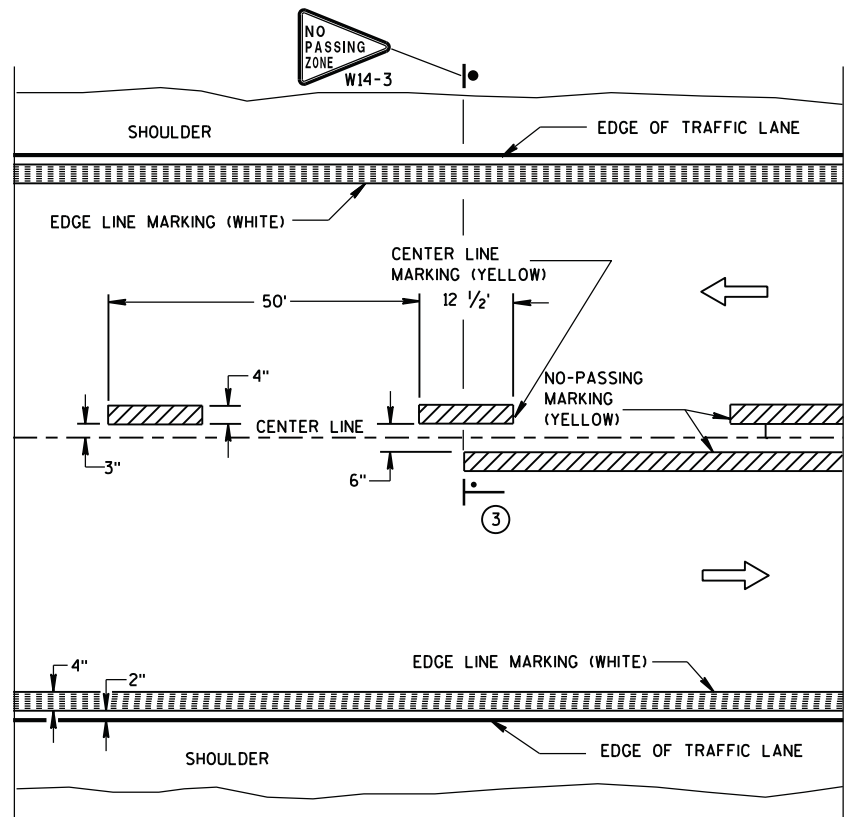

TWO WAY TRAFFIC

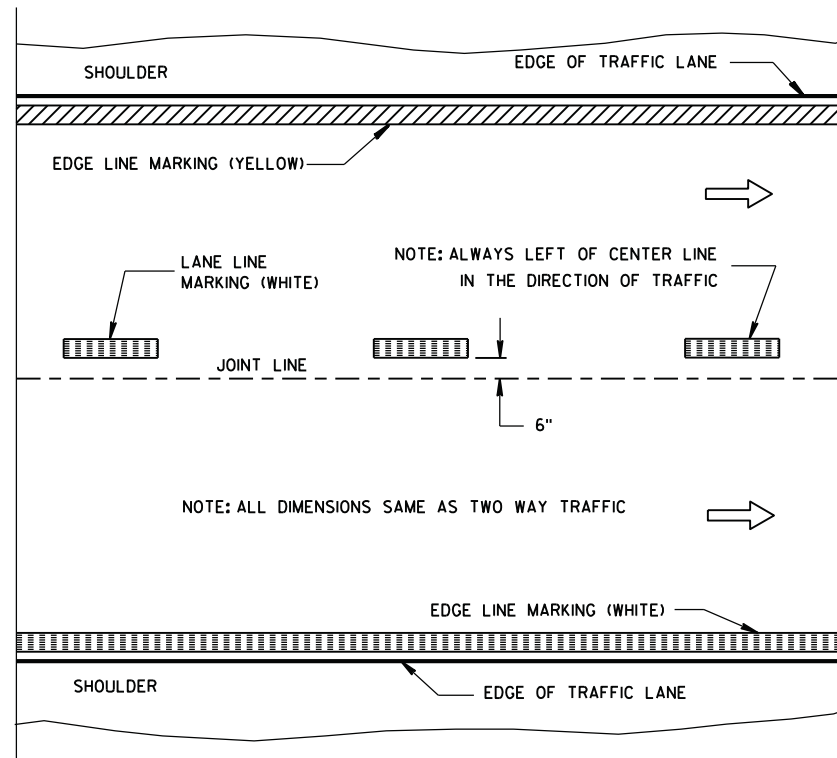

ONE WAY TRAFFIC

PERMANENT PAVEMENT MARKING


GENERAL NOTES

DETAILS OF CONSTRUCTION NOT SHOWN ON THIS DRAWING SHALL CONFORM TO STANDARD SPECIFICATIONS AND SPECIAL PROVISIONS.

- ① HALF CYCLE LENGTHS (25'±) WITH 2' MINIMUM STRIPE LENGTHS SHALL BE PROVIDED ON ROADWAYS (INCLUDING TEMPORARY TRAVELED WAYS) WITH REVERSE CURVATURE, CURVATURE OF OVER 5 DEGREES OR WHEN DIRECTED BY THE ENGINEER TO MARK UNUSUAL ALIGNMENT OF THE TRAVELED WAY.
- ② NO PASSING ZONE TEMPORARY PAVEMENT MARKING IS REQUIRED TO BE PLACED, WHERE APPROPRIATE, ALONG WITH CENTERLINE TEMPORARY PAVEMENT MARKING WHEN A SAME DAY PERMANENT PAVEMENT MARKING ITEM IS INCLUDED IN THE CONTRACT.
- ③ NO PASSING ZONE MARKINGS ARE PLACED ACCORDING TO "T" MARKINGS. IF EXISTING NO PASSING ZONE W14-3 SIGNS ARE BEYOND 50 FEET IN EITHER DIRECTION, THE SIGNS SHALL BE MOVED TO THE "T" MARKINGS.
- ④ CONCRETE ONLY.

NOTE


ARROW SYMBOL (→) SHOWS DIRECTION OF TRAVEL

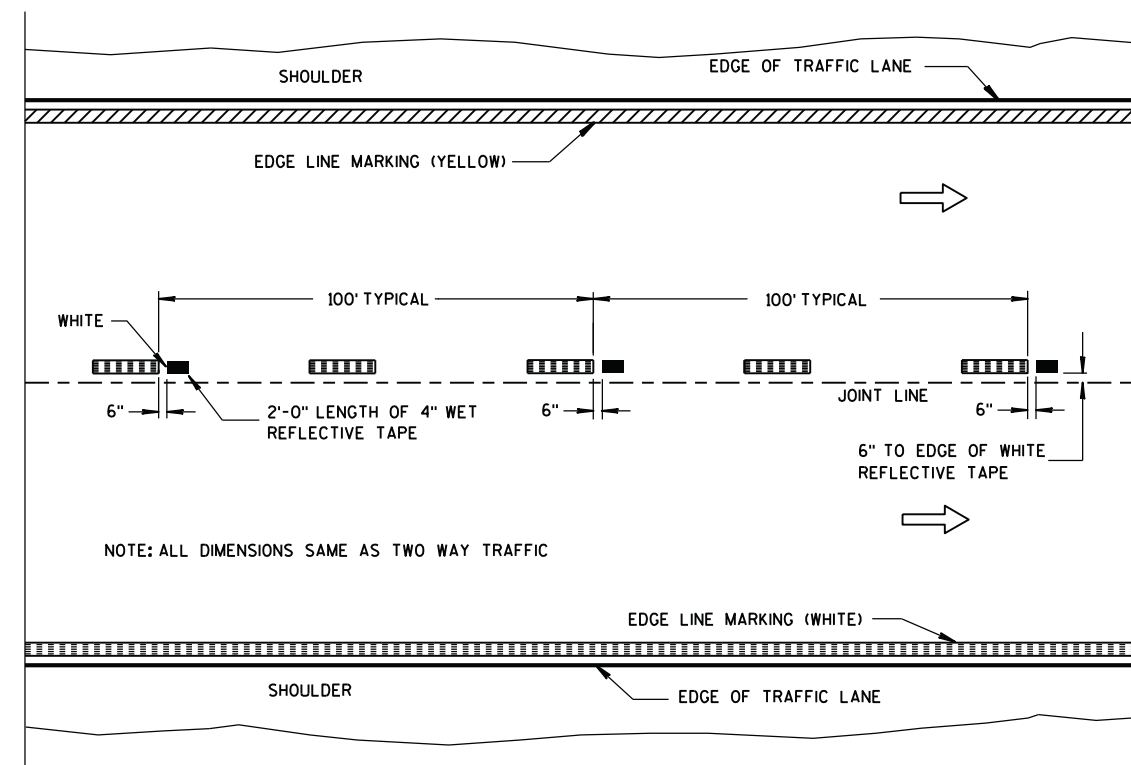


WET REFLECTIVE TAPE SUPPLEMENT TO SPRAYED OR NON WET REFLECTIVE TAPE LANE LINE

6

6

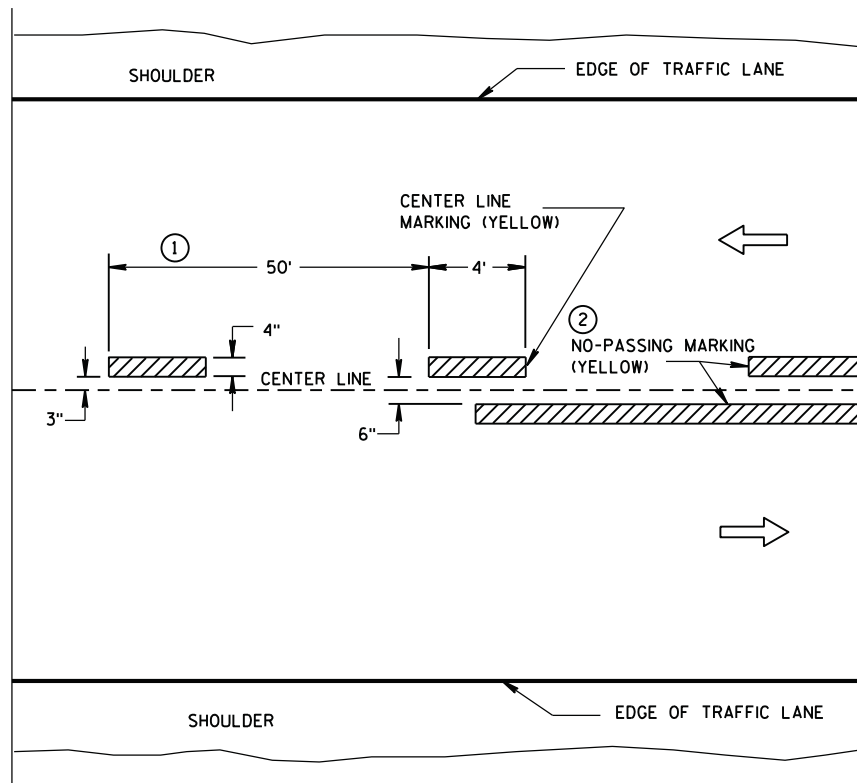

TWO WAY TRAFFIC

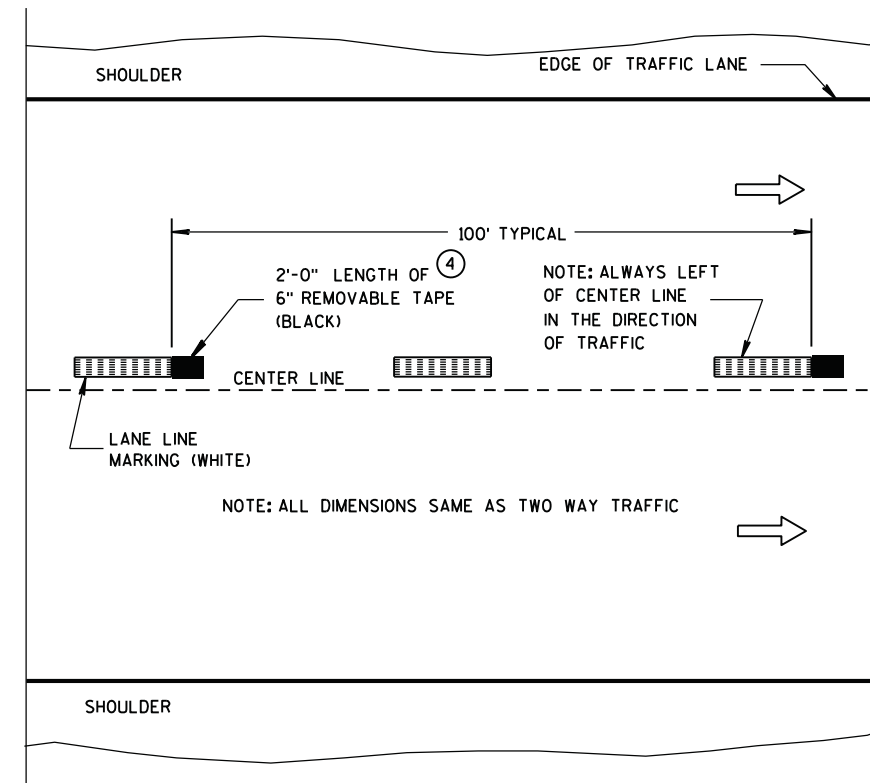

ONE WAY TRAFFIC

TEMPORARY (INTERMEDIATE) PAVEMENT MARKING (SHOWS CYCLE FOR TEMPORARY CENTER LINE OR TEMPORARY LANE LINE MARKING)

LEGEND

- "T" MARKING
- POST MOUNTED SIGN


PAVEMENT MARKING (MAINLINE)

STATE OF WISCONSIN DEPARTMENT OF TRANSPORTATION

APPROVED
 10-1-2012 /S/ Travis Feltes
 DATE STATE TRAFFIC ENGINEER DESIGN
 FHWA


S.D.D. 15 C 8-15a


S.D.D. 15 C 8-15a

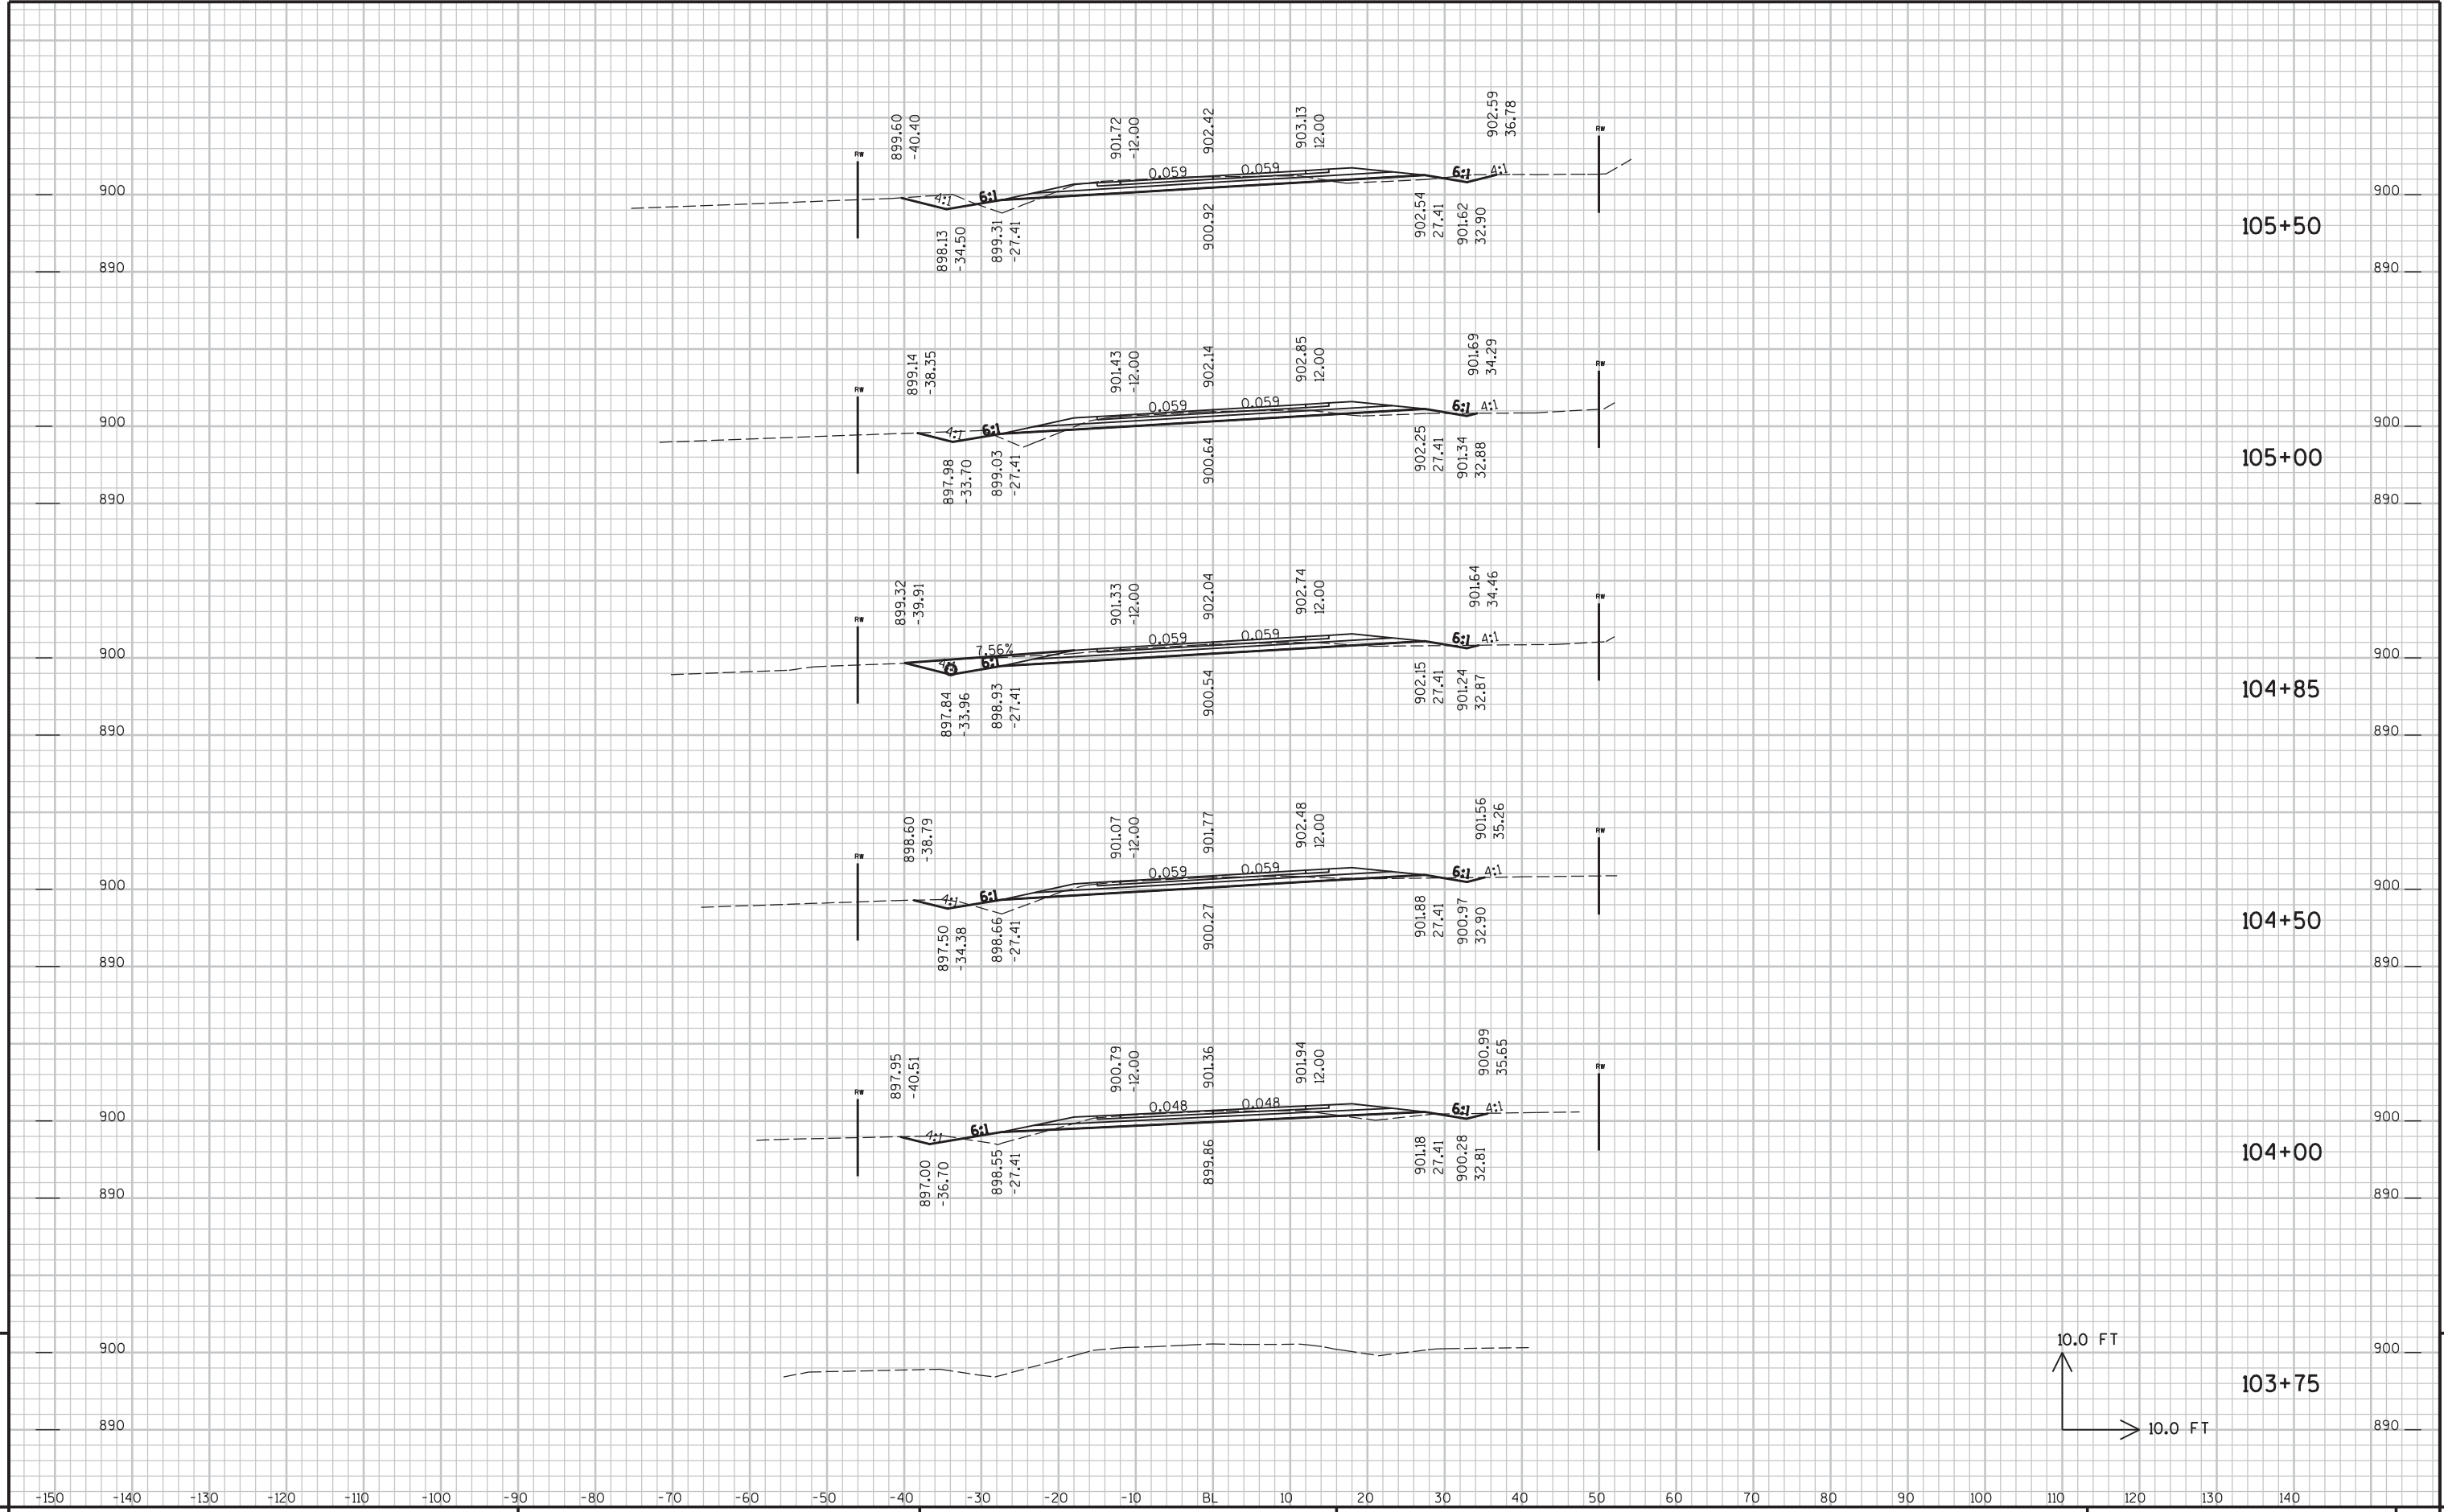

9


9

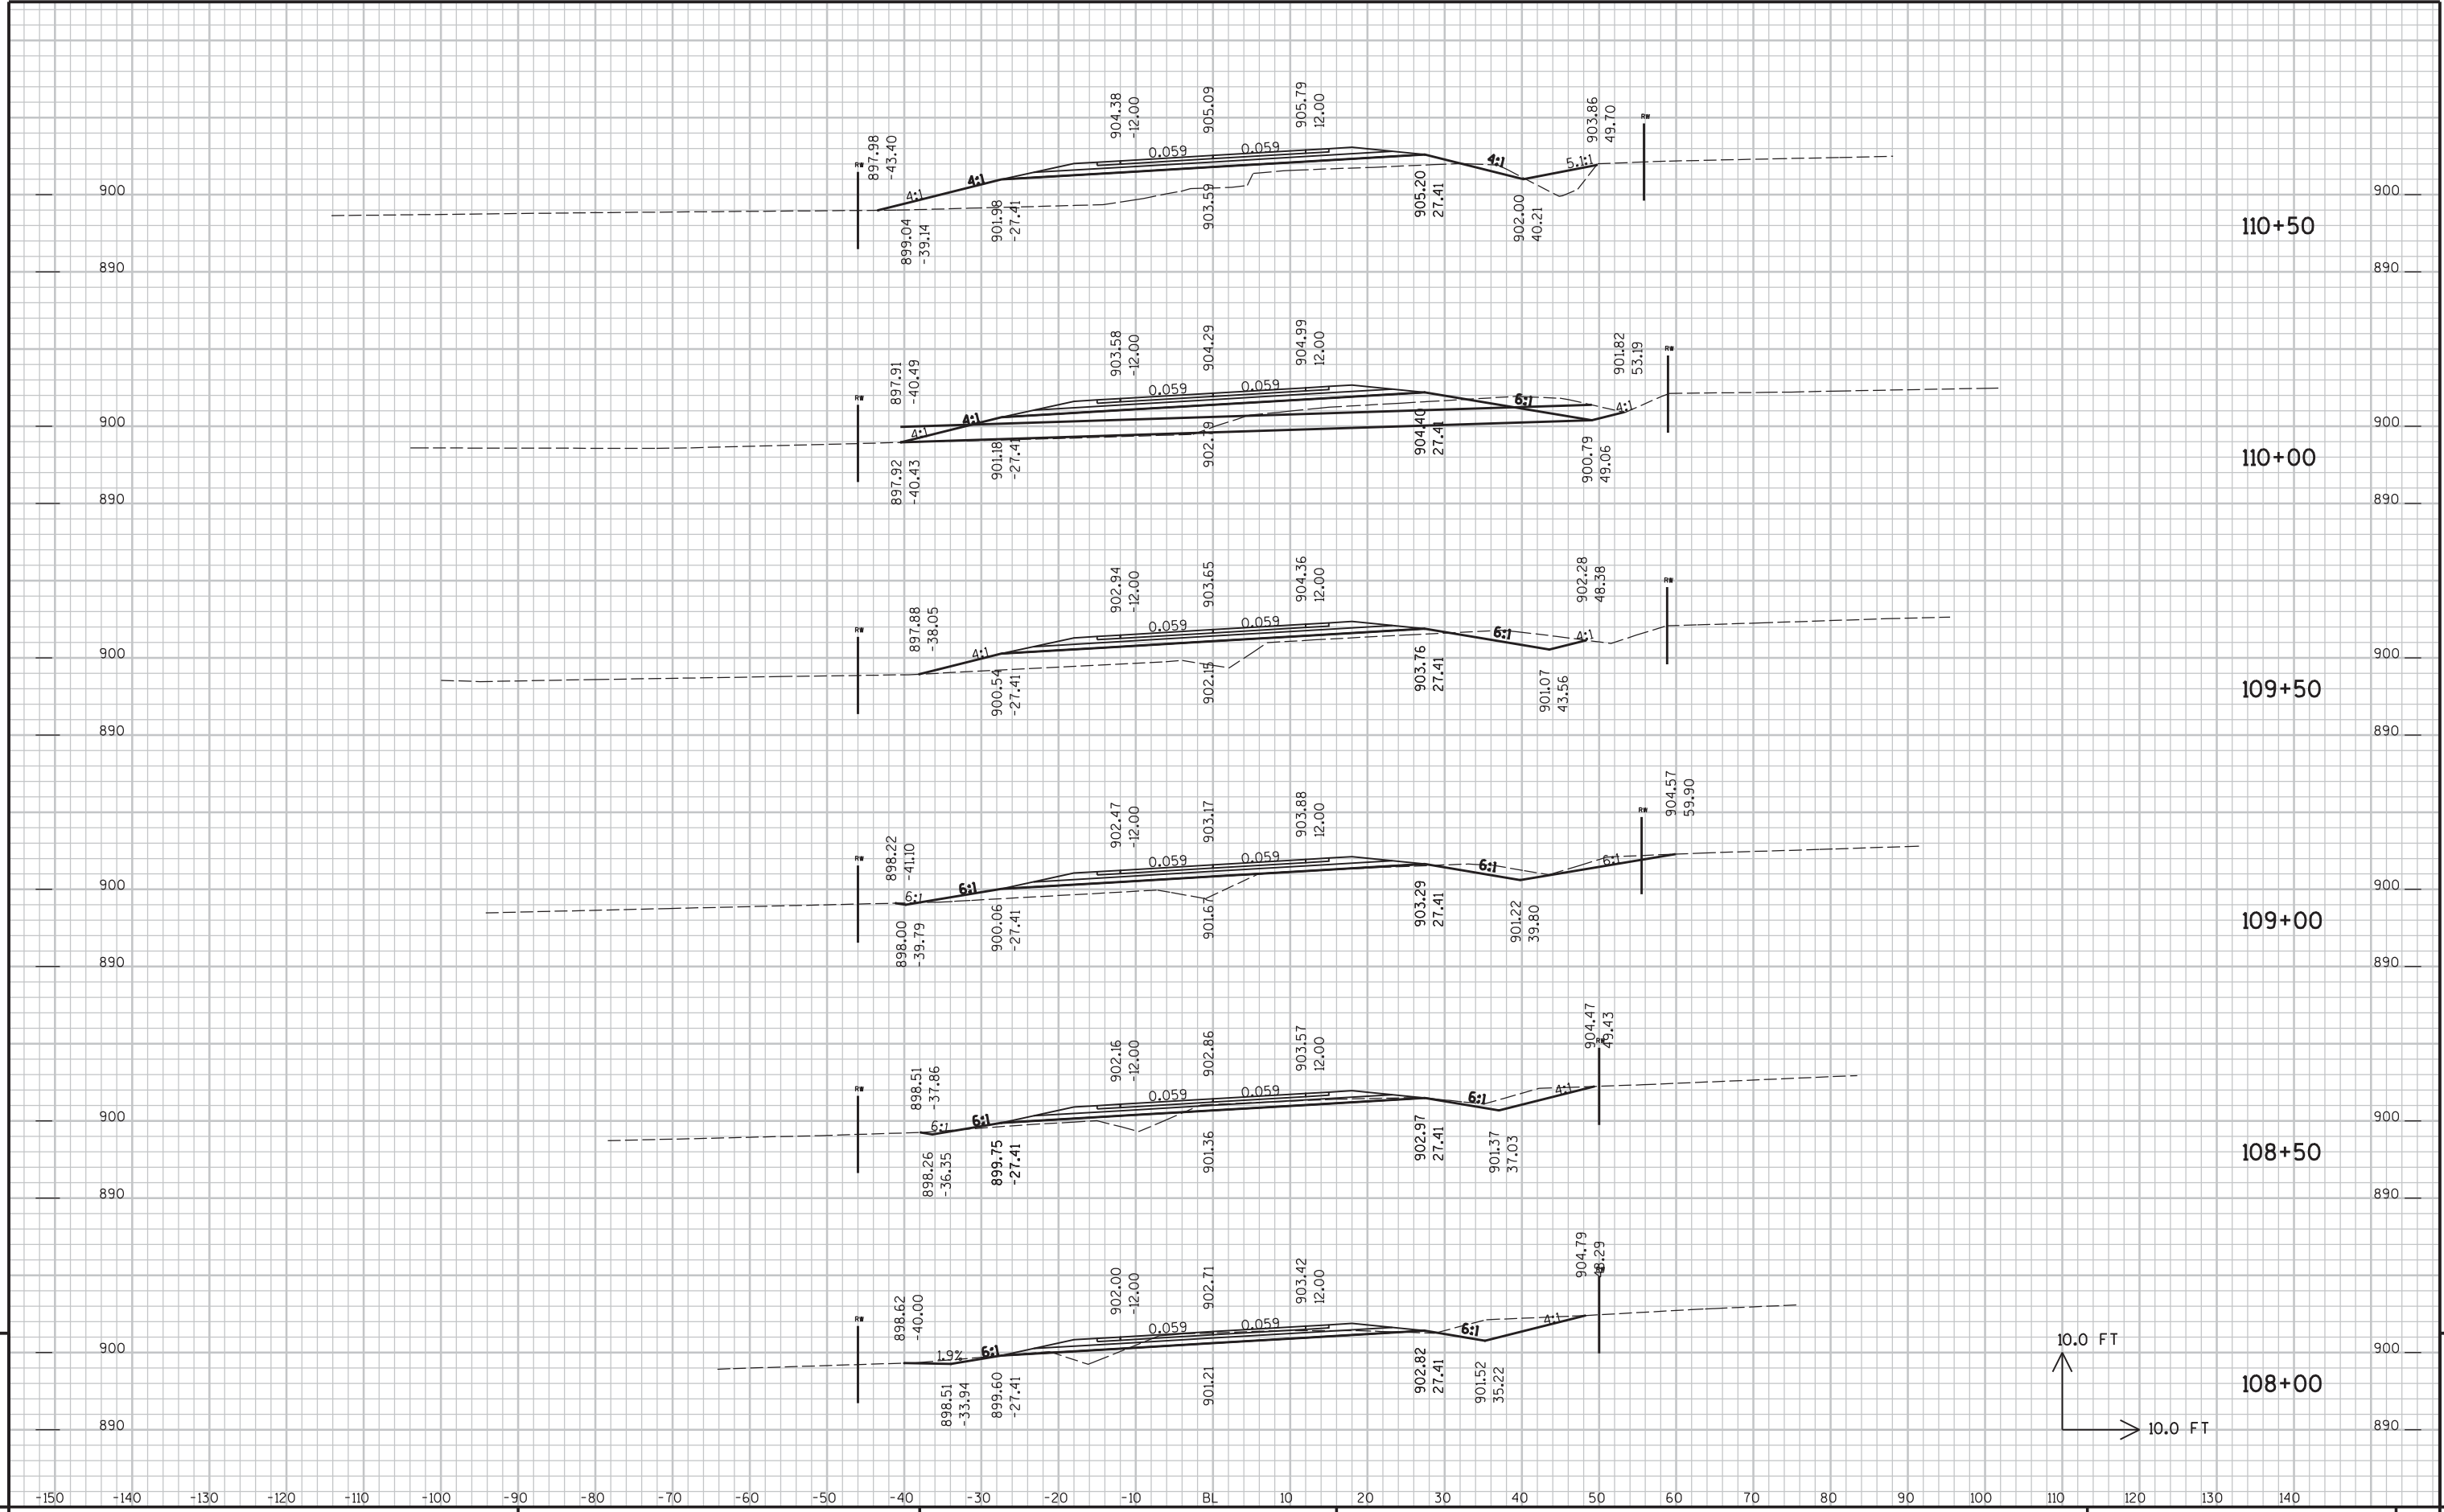

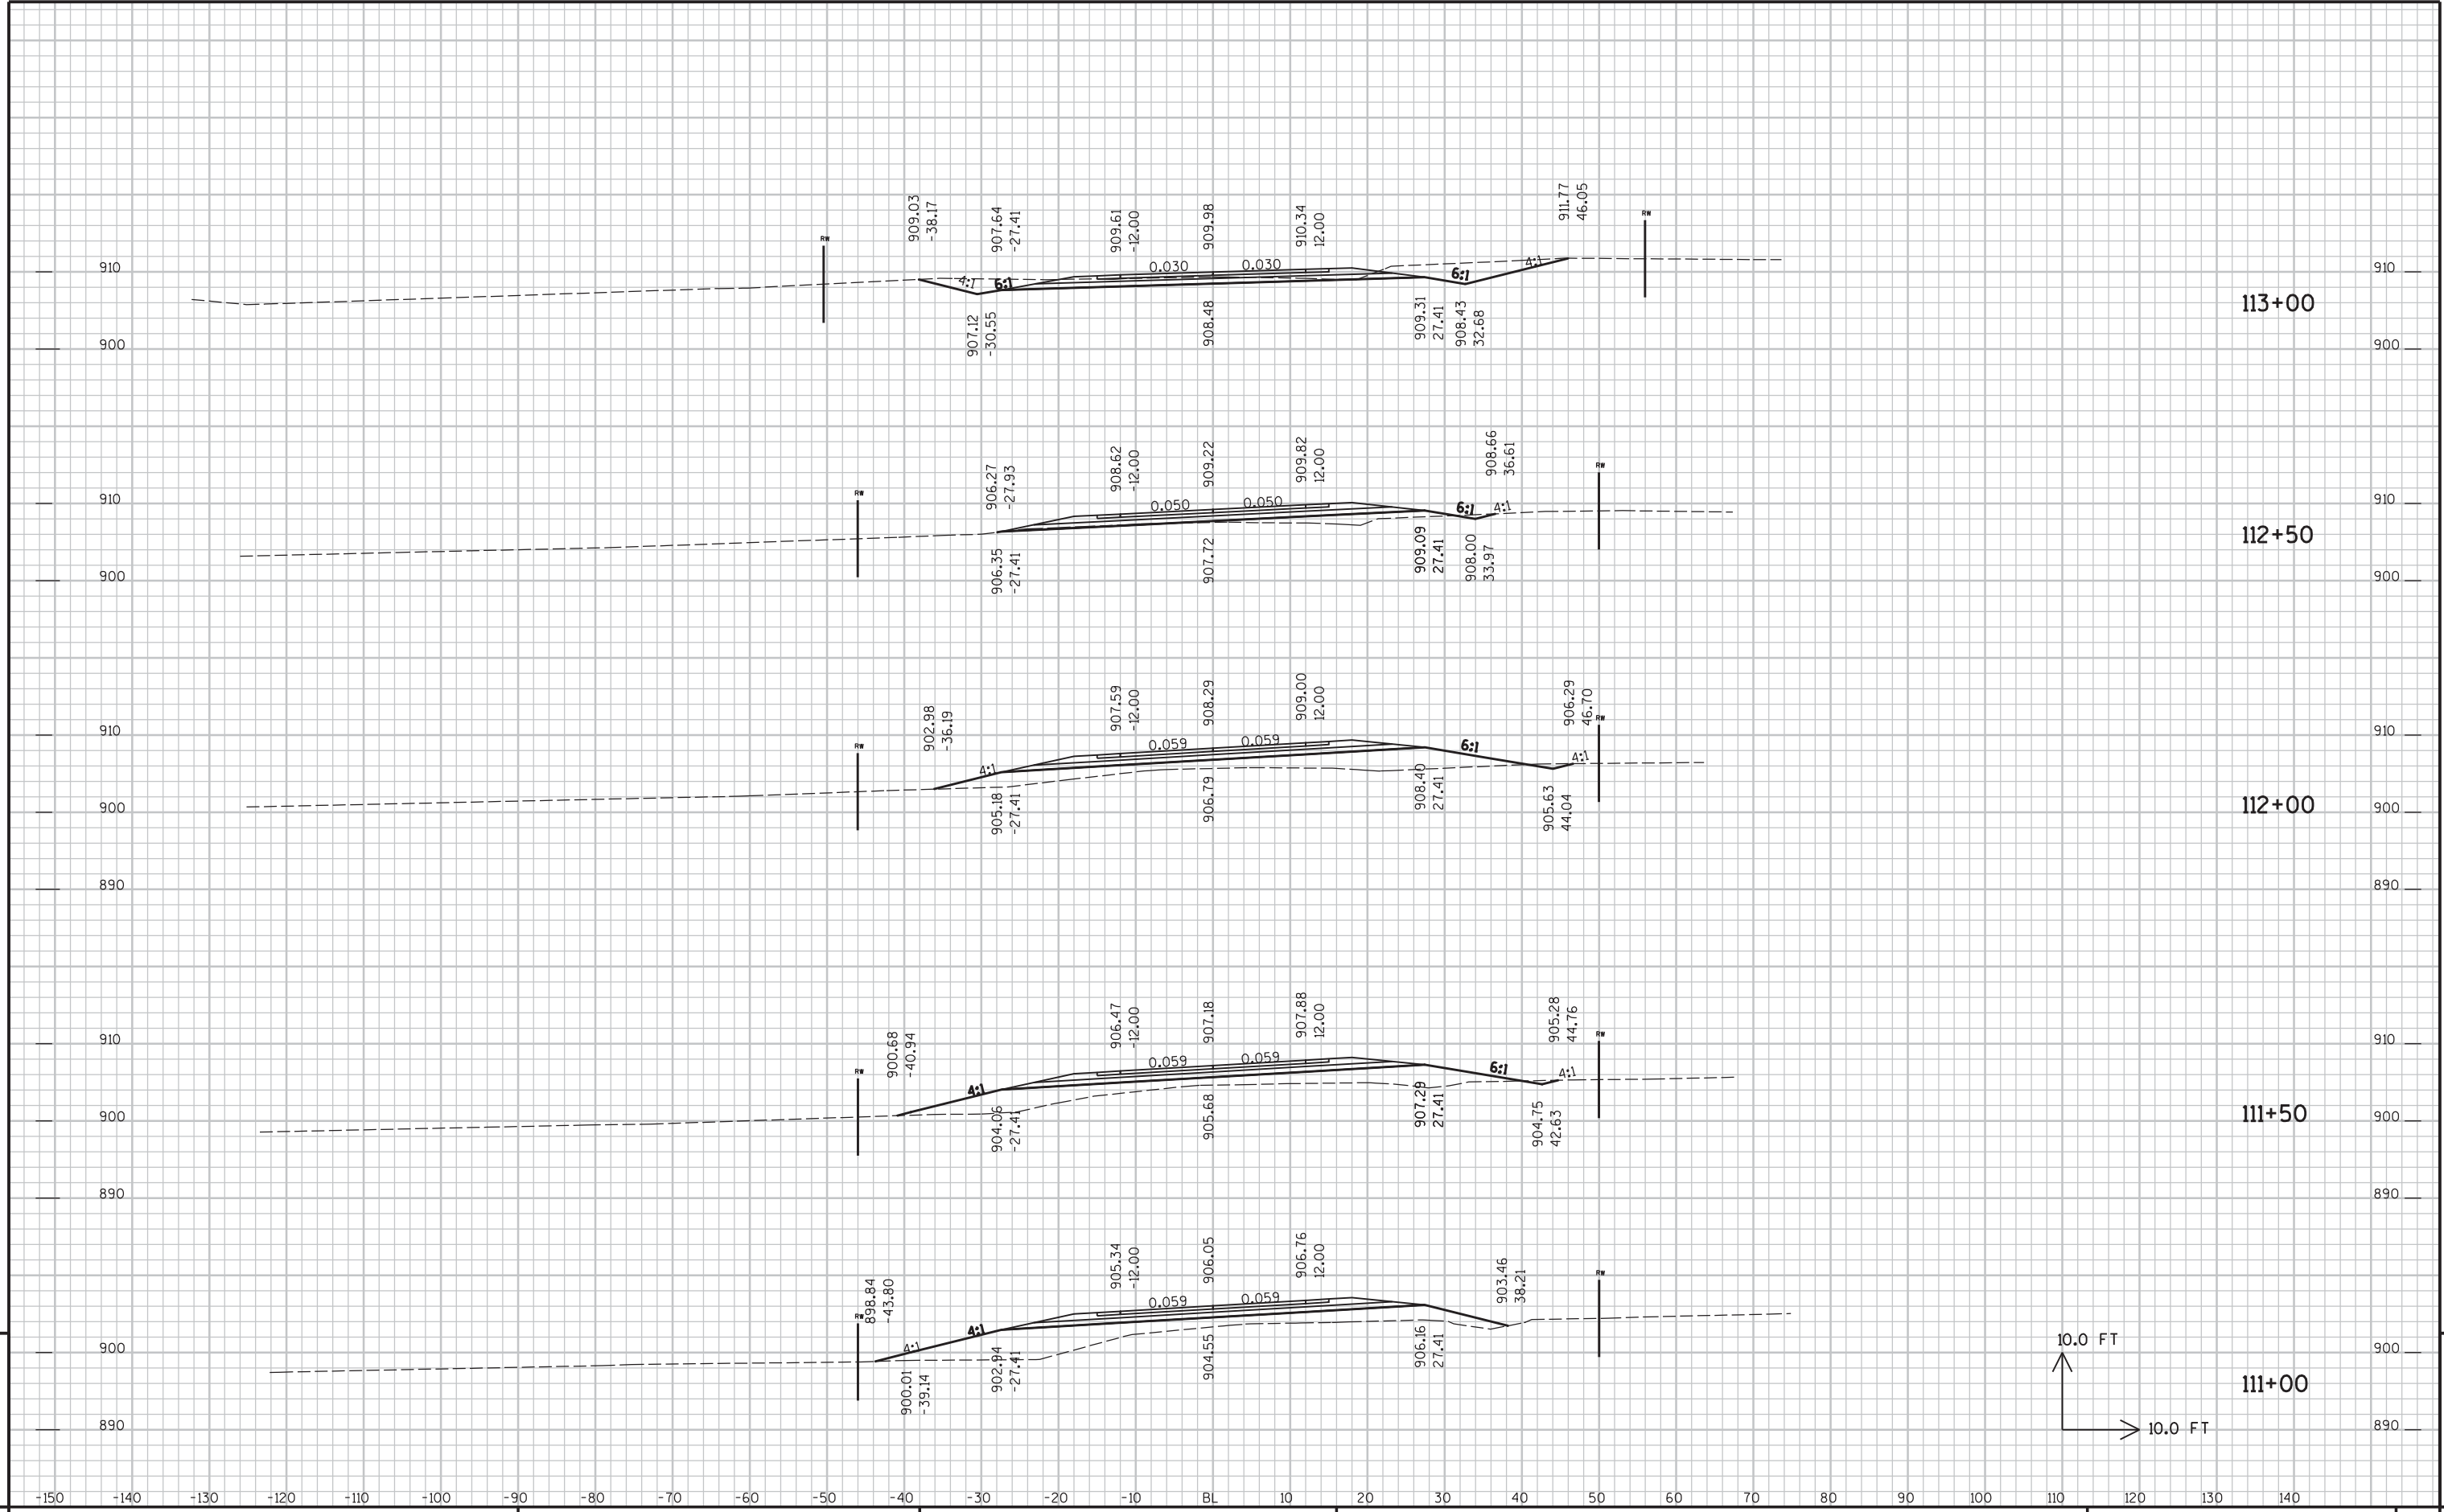

9

9

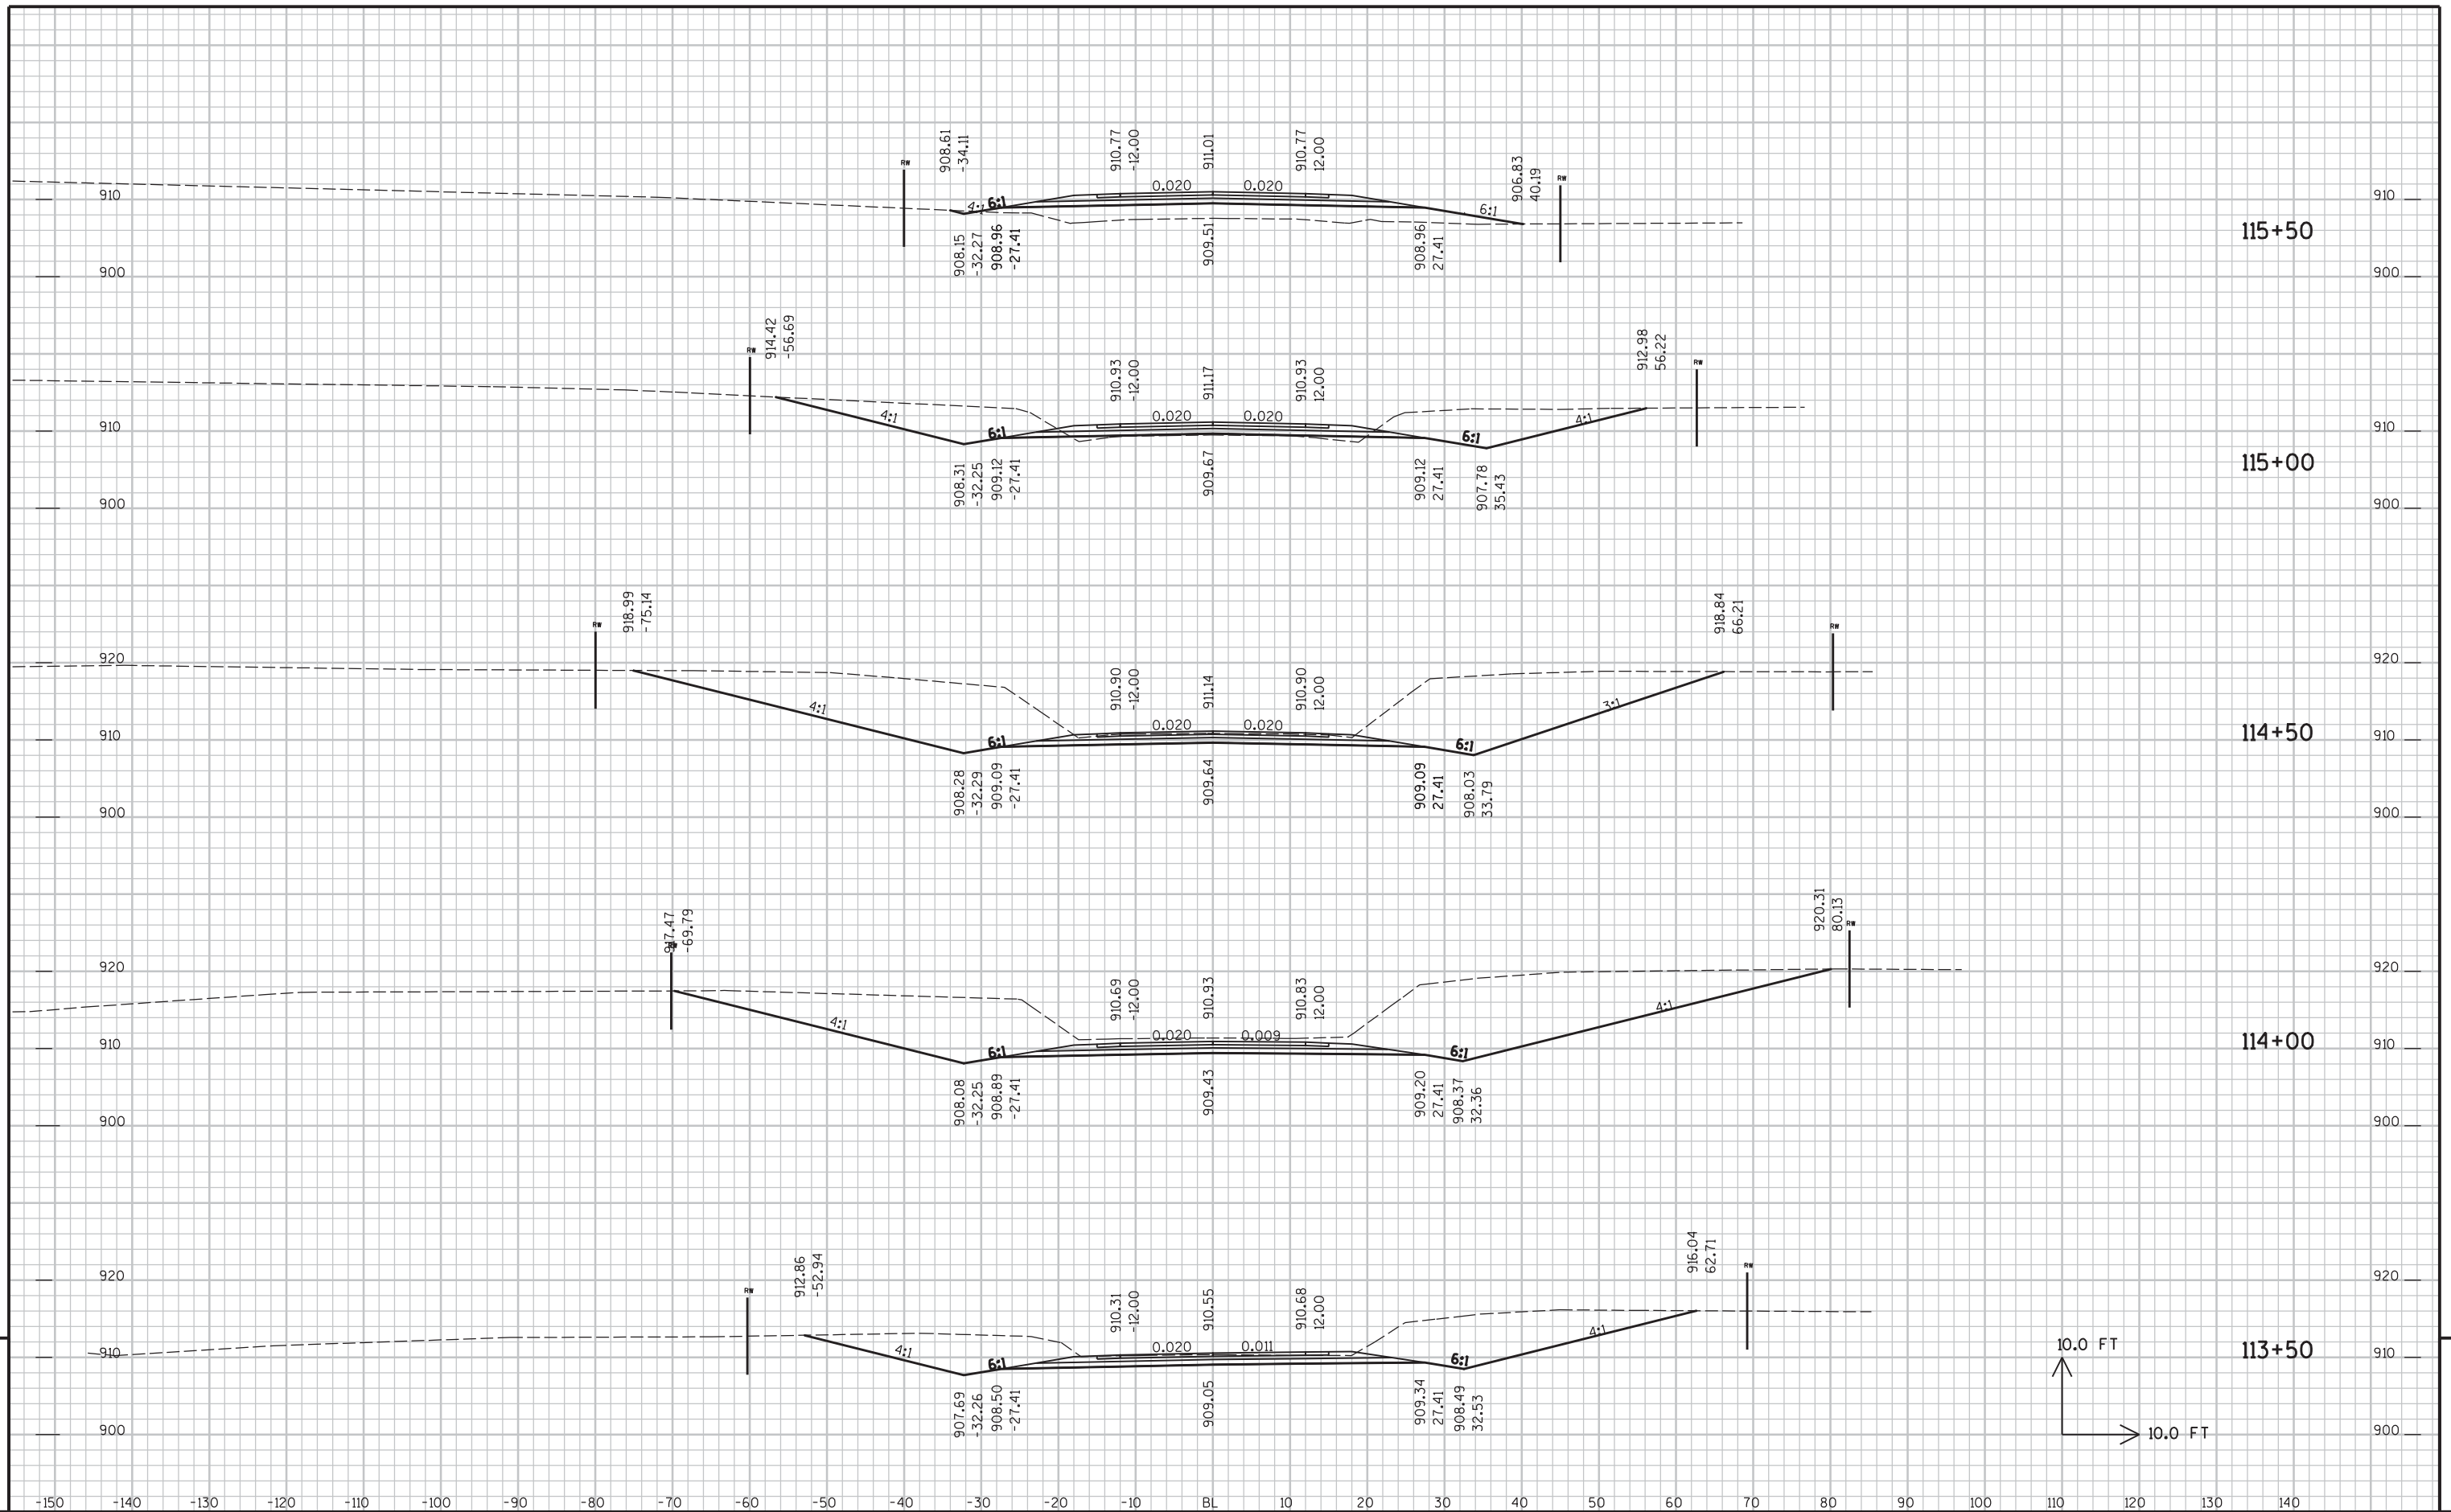



9

9

PROJECT NO : HWY : CTH M COUNTY : WINNEBAGO CROSS SECTIONS - CTH M SHEET NO: 44 E



FILE NAME : P:\UZ\N\WINN\030200_CTH.M\CAD\XSCT\M 2013.DGN PLOT TIME : 12:56:08 PM PLOT DATE : 1/18/2013 PLOT BY : SEH PLOT NAME : PLOT SCALE : N/A

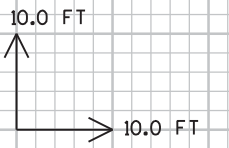


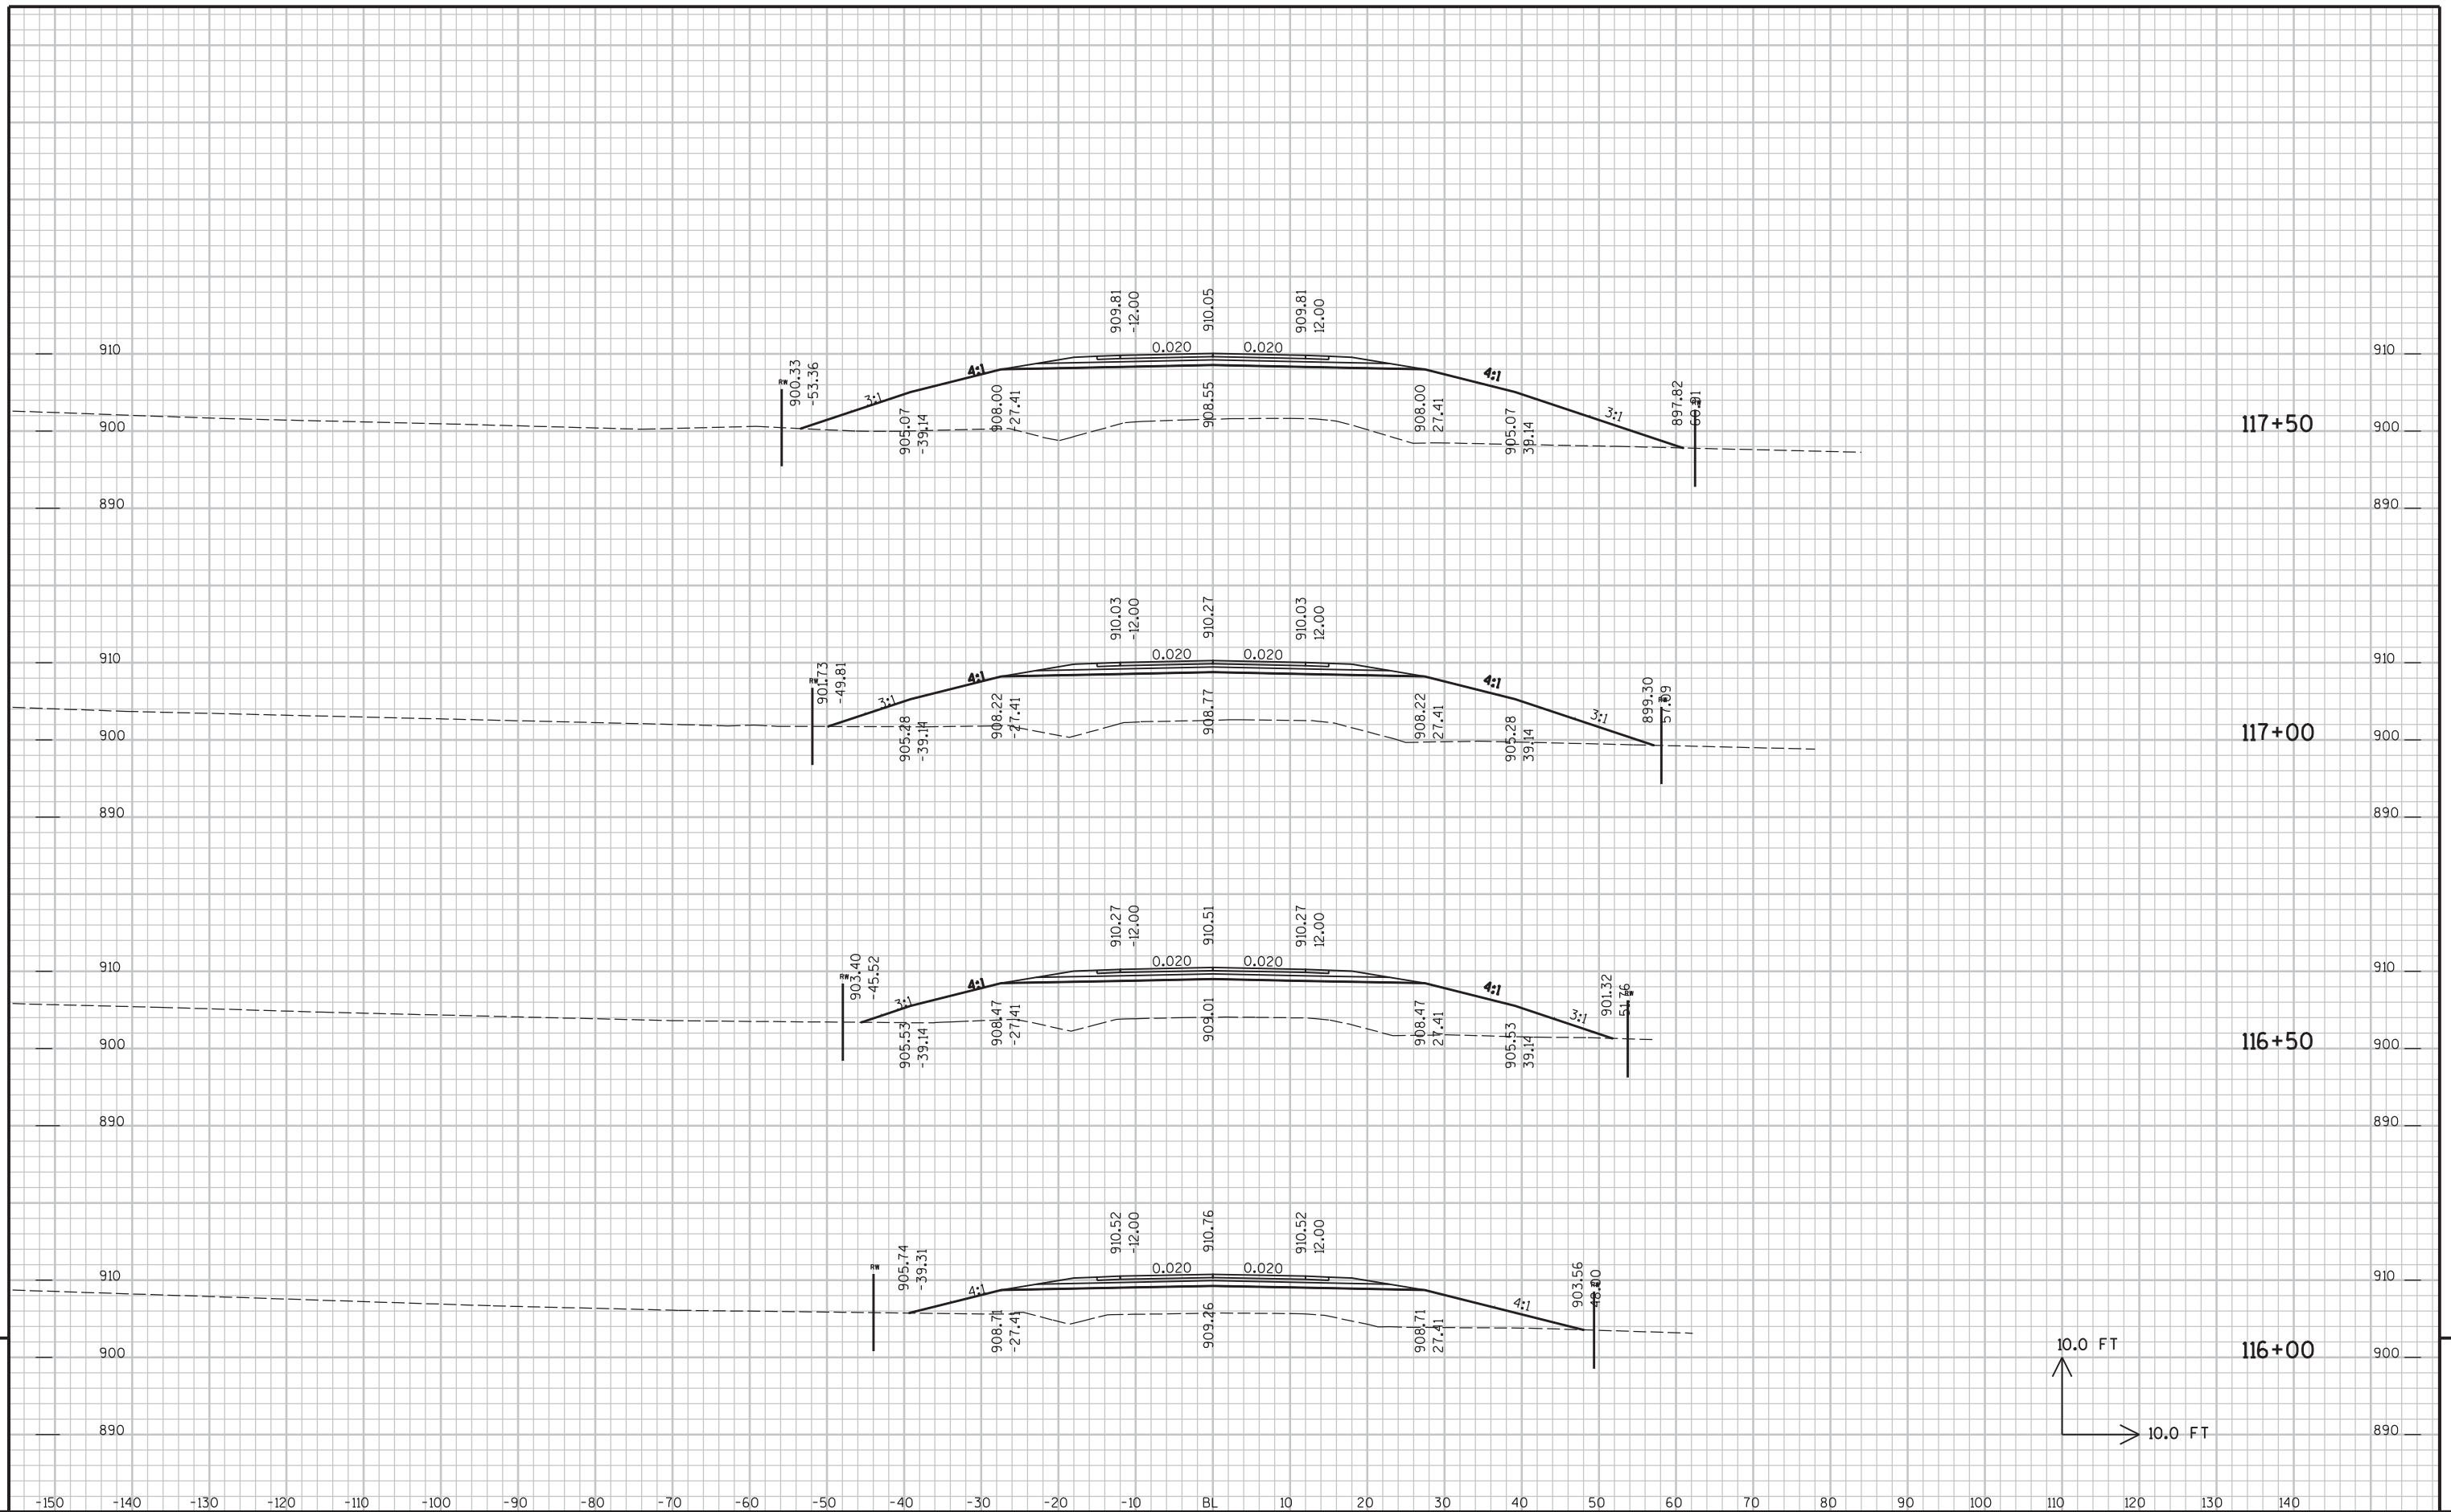

9

9

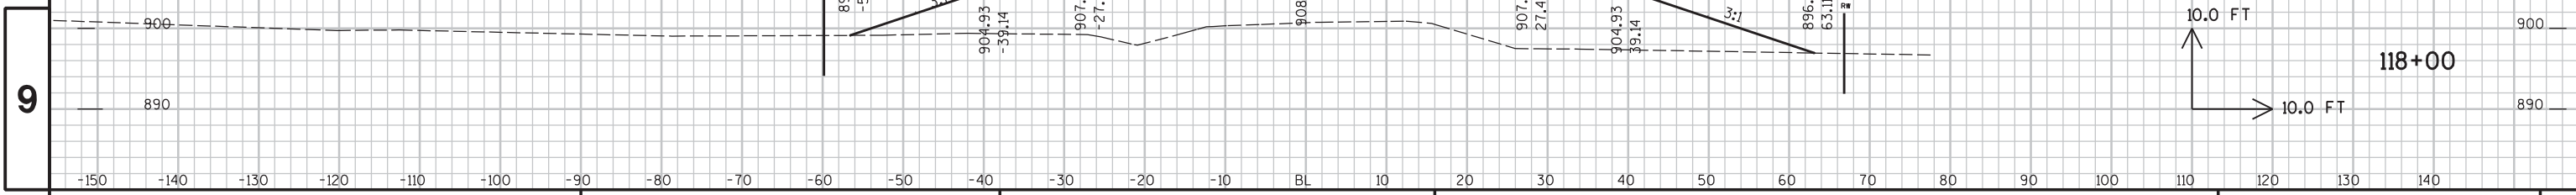
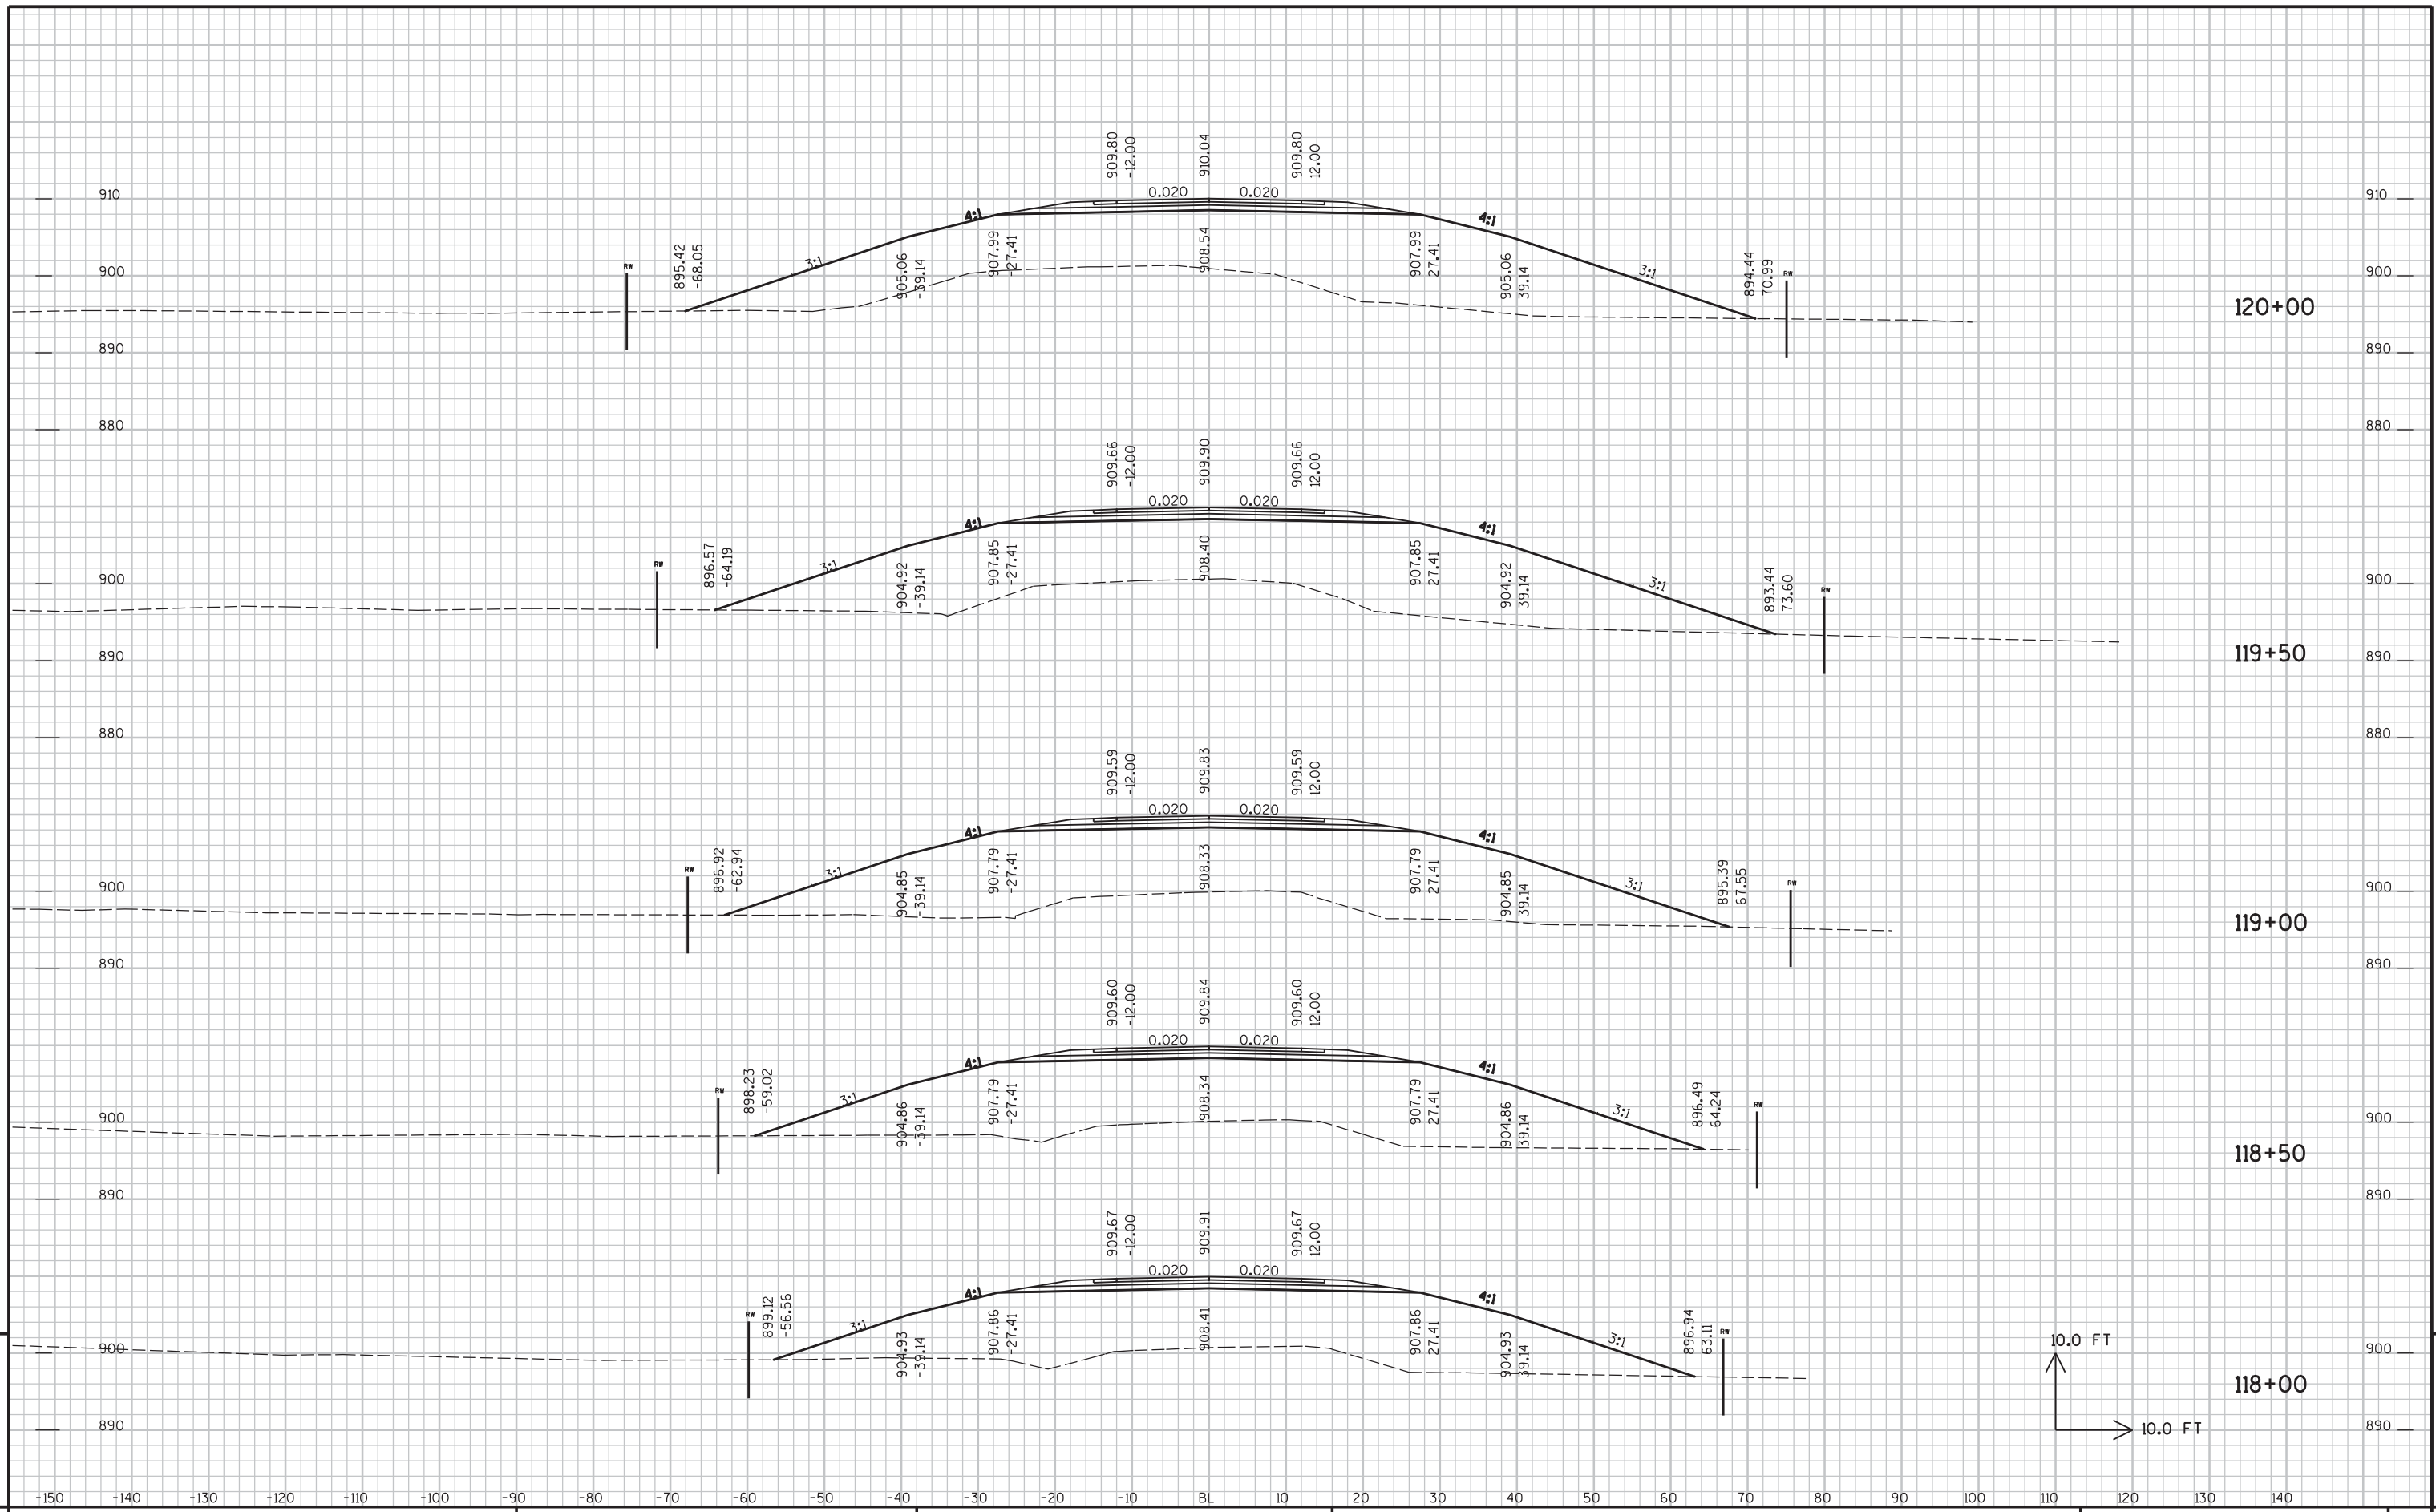


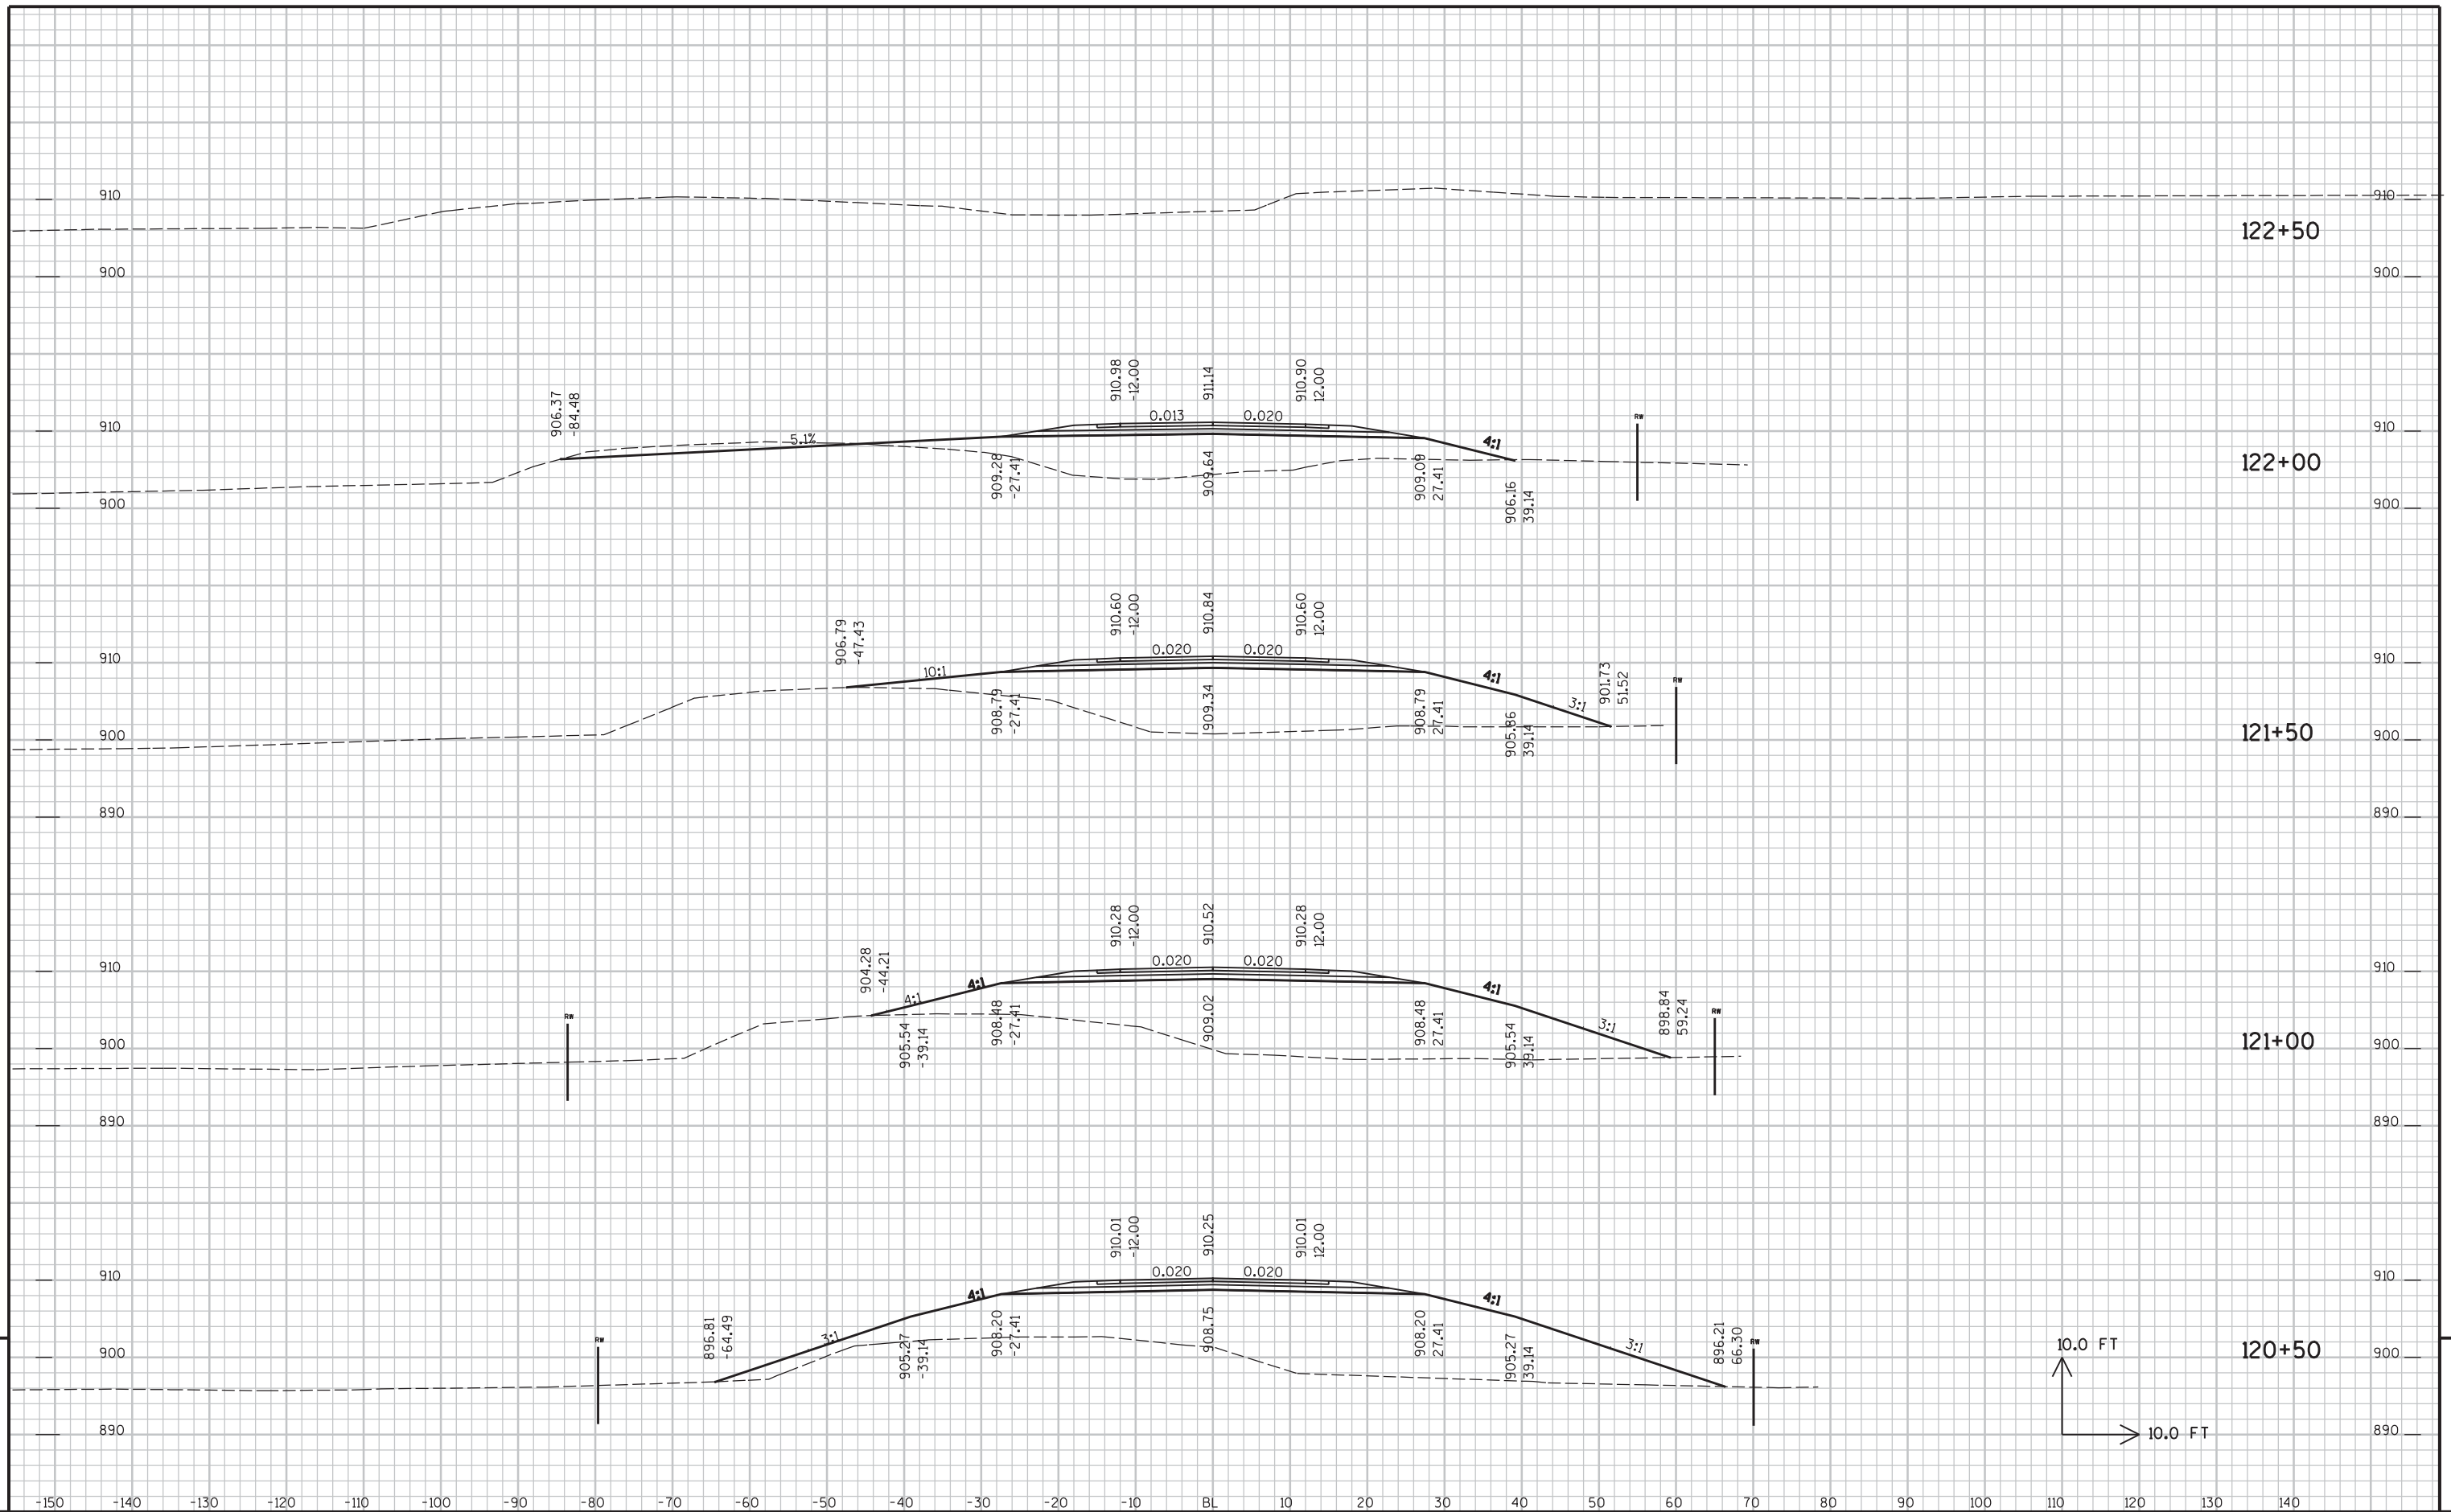


PROJECT NO : HWY : CTH M COUNTY : WINNEBAGO CROSS SECTIONS - CTH M SHEET NO: 47

FILE NAME : P:\UZ\WINN\030200_CTH.M\CAD\XSC\THM 2013.DGN PLOT TIME : 12:56:09 PM PLOT DATE : 1/18/2013 PLOT BY : SEH PLOT NAME : PLOT SCALE : N/A




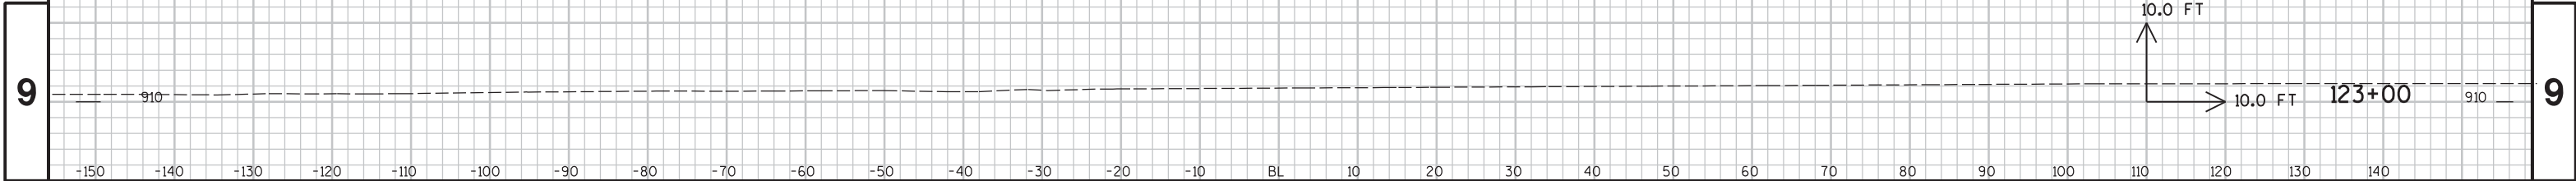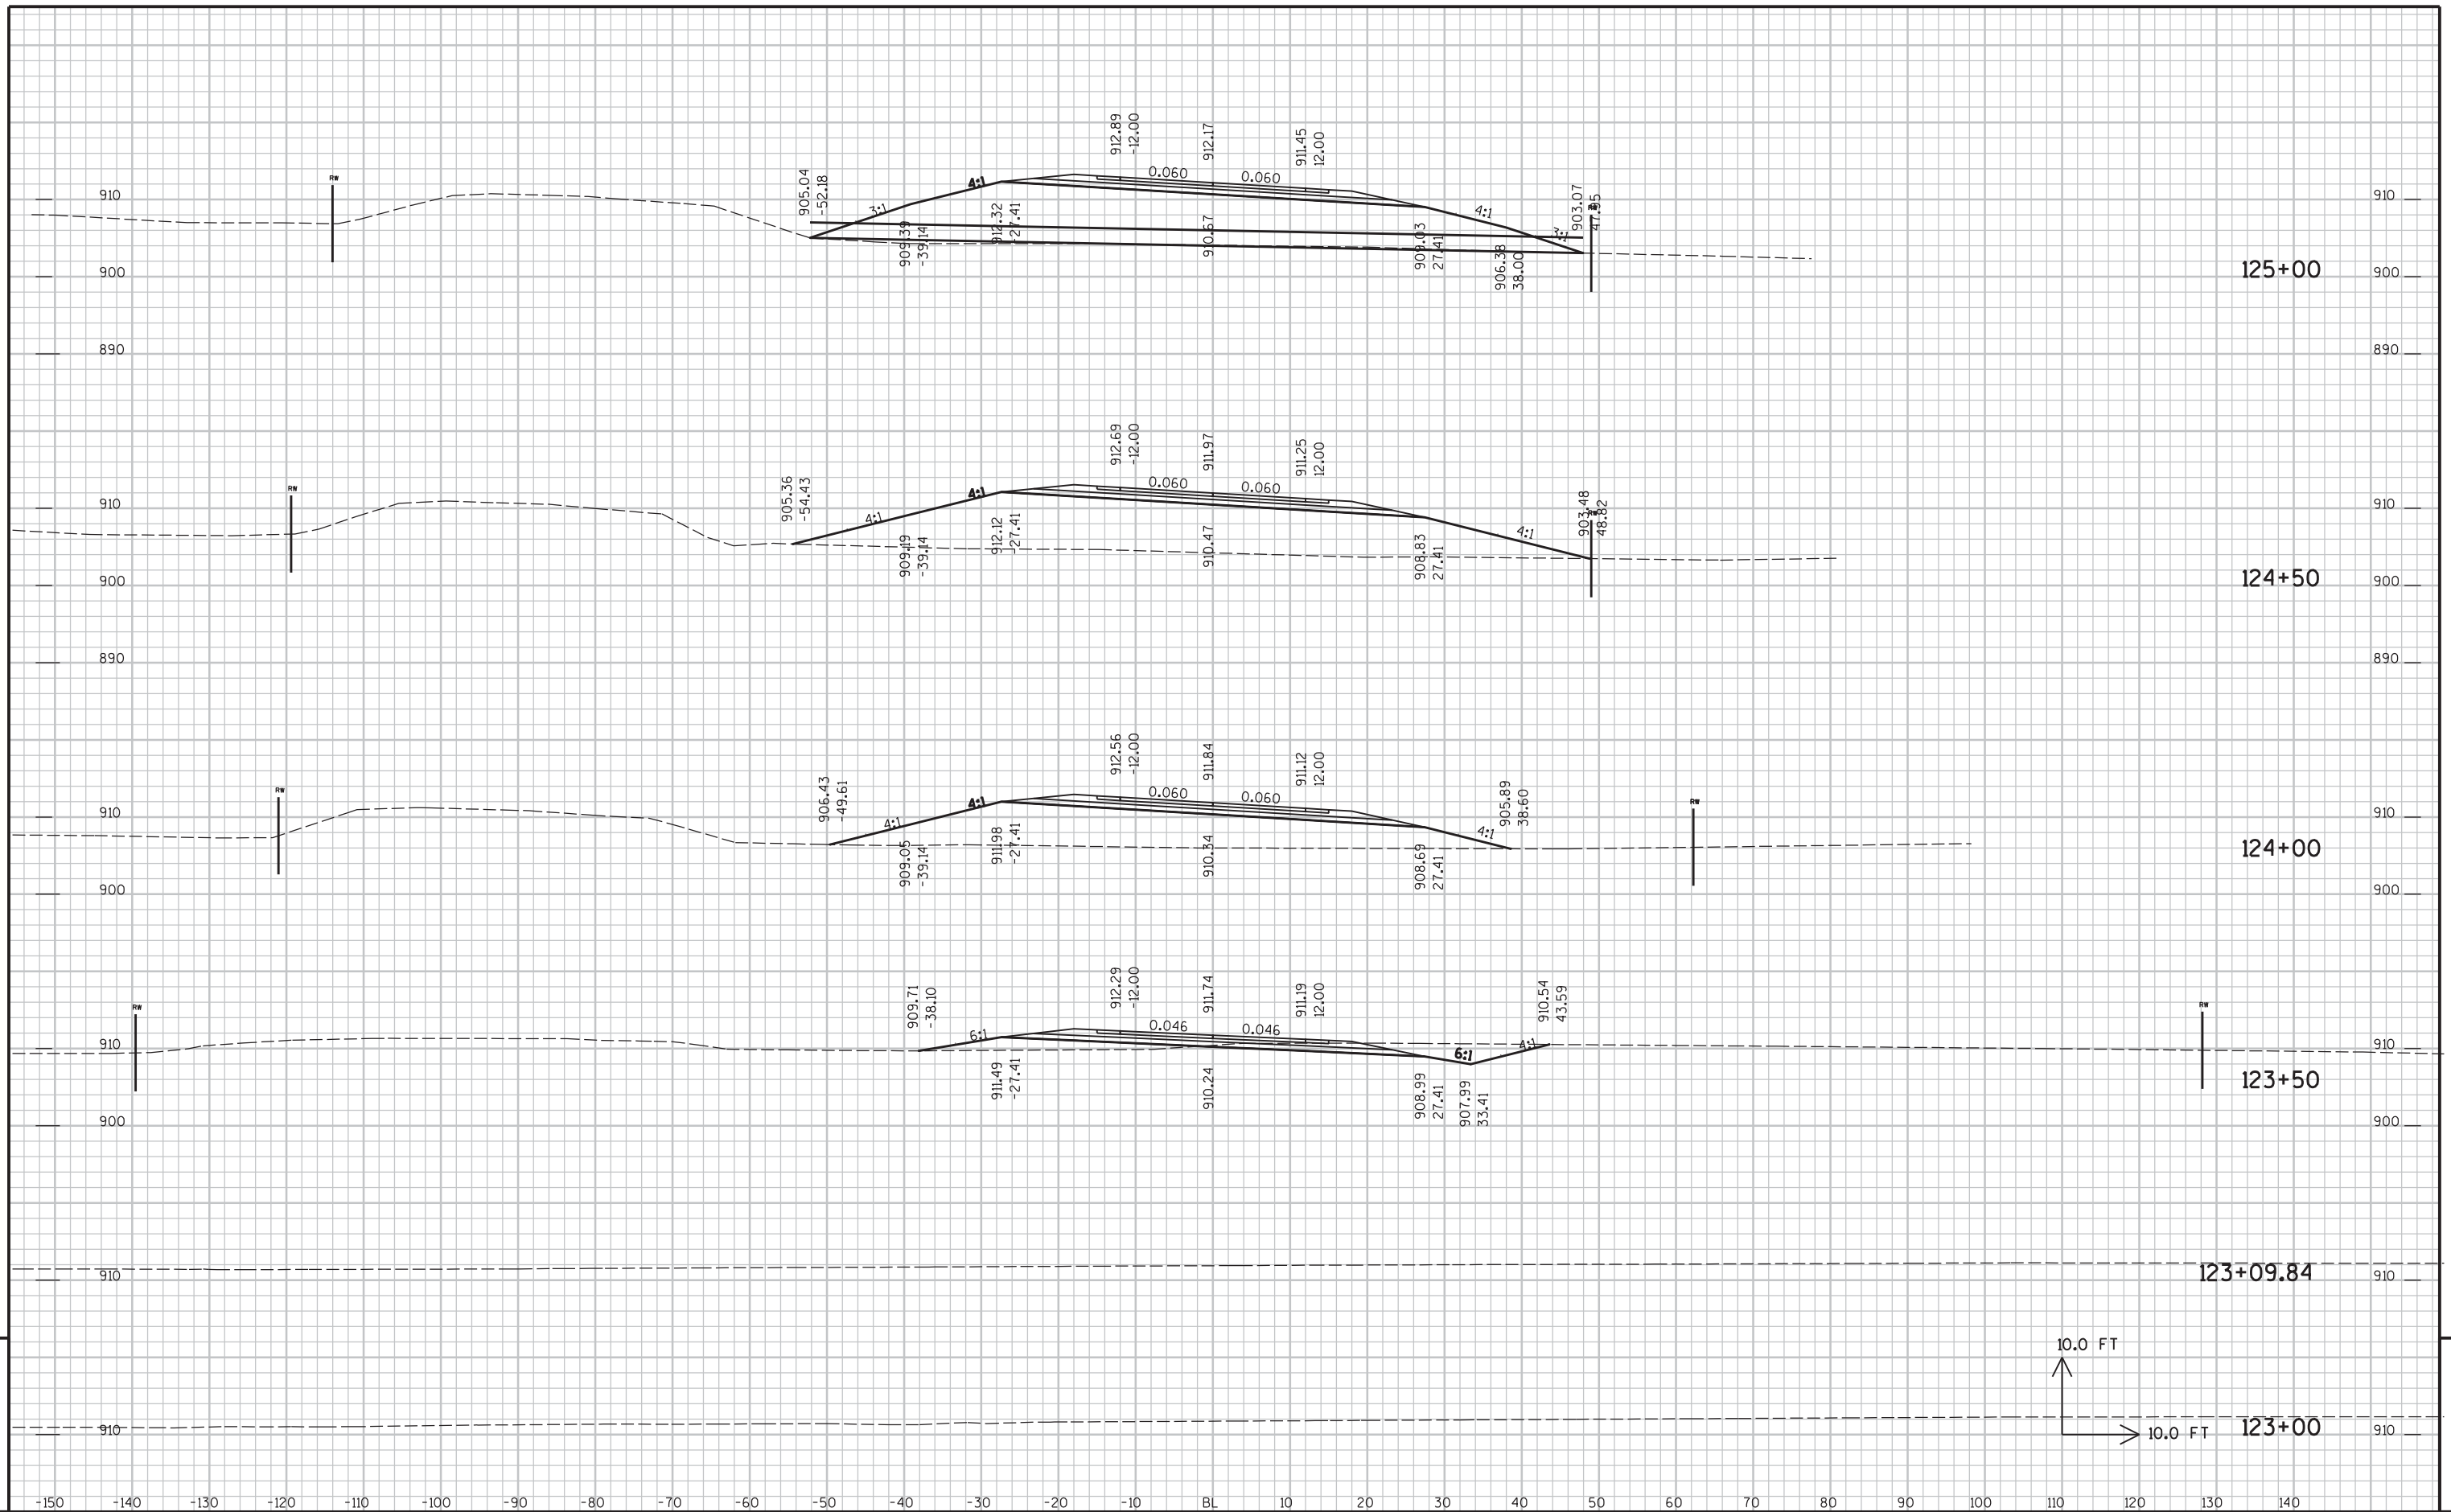


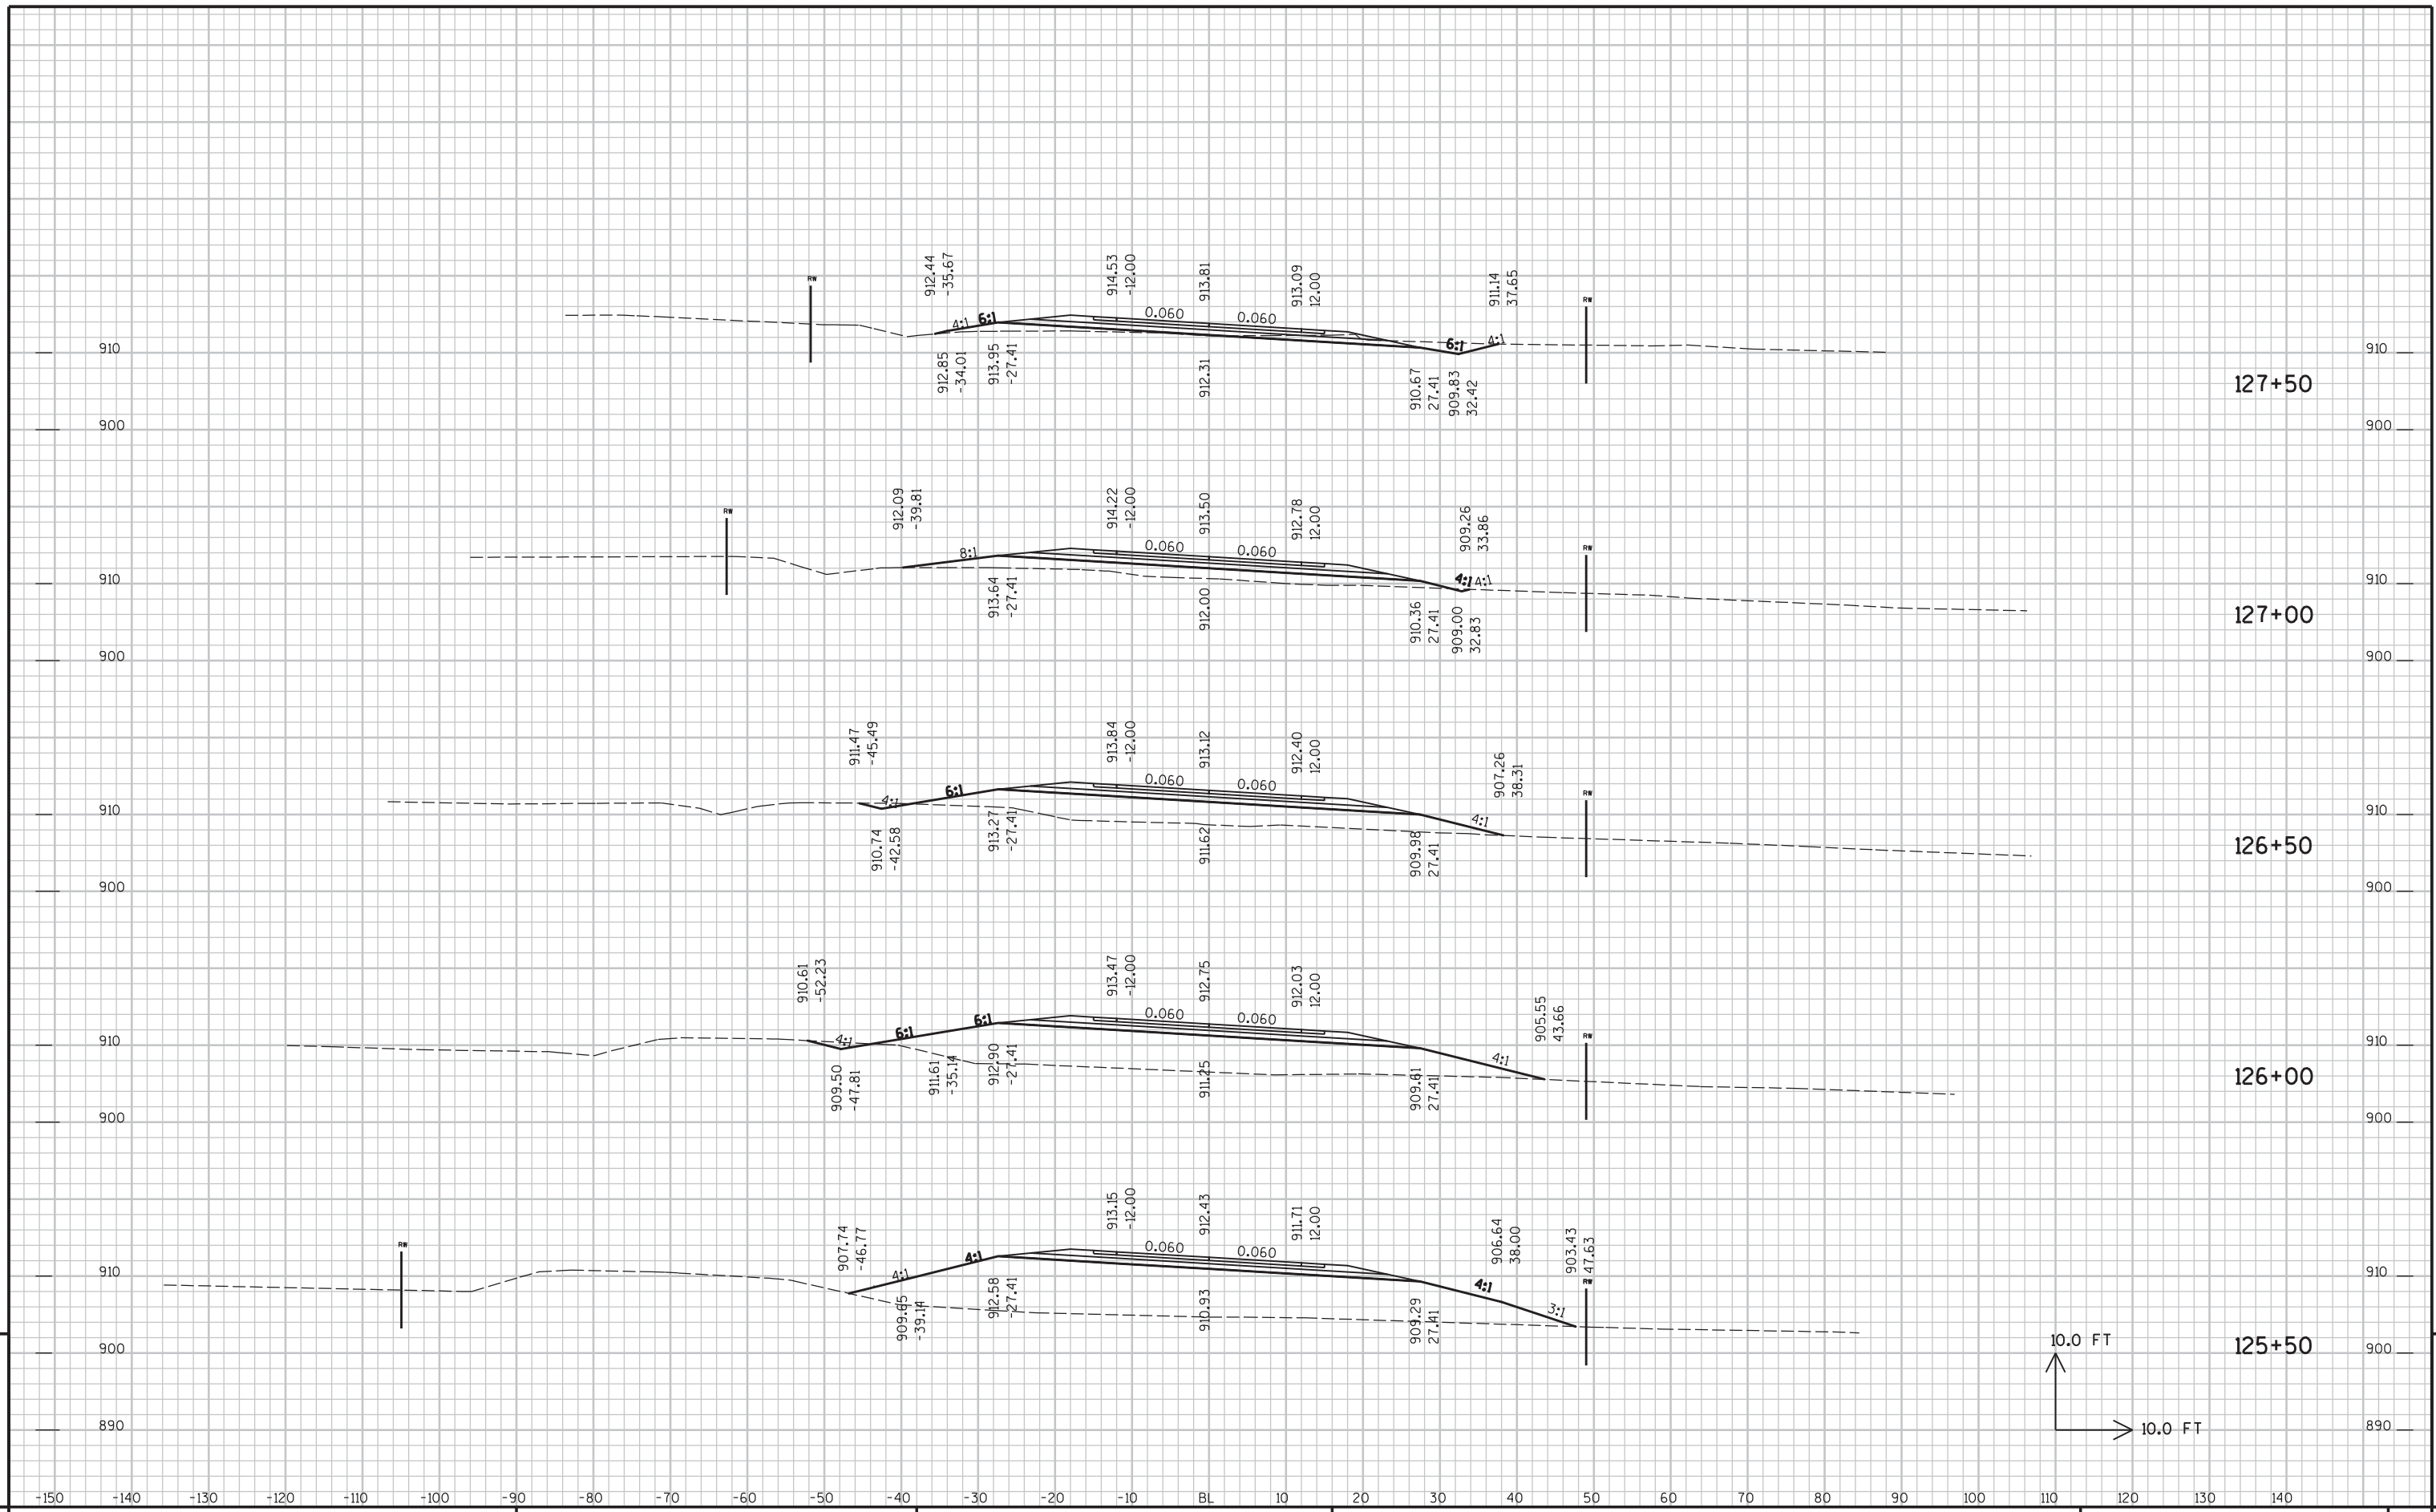

9


9

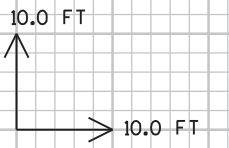


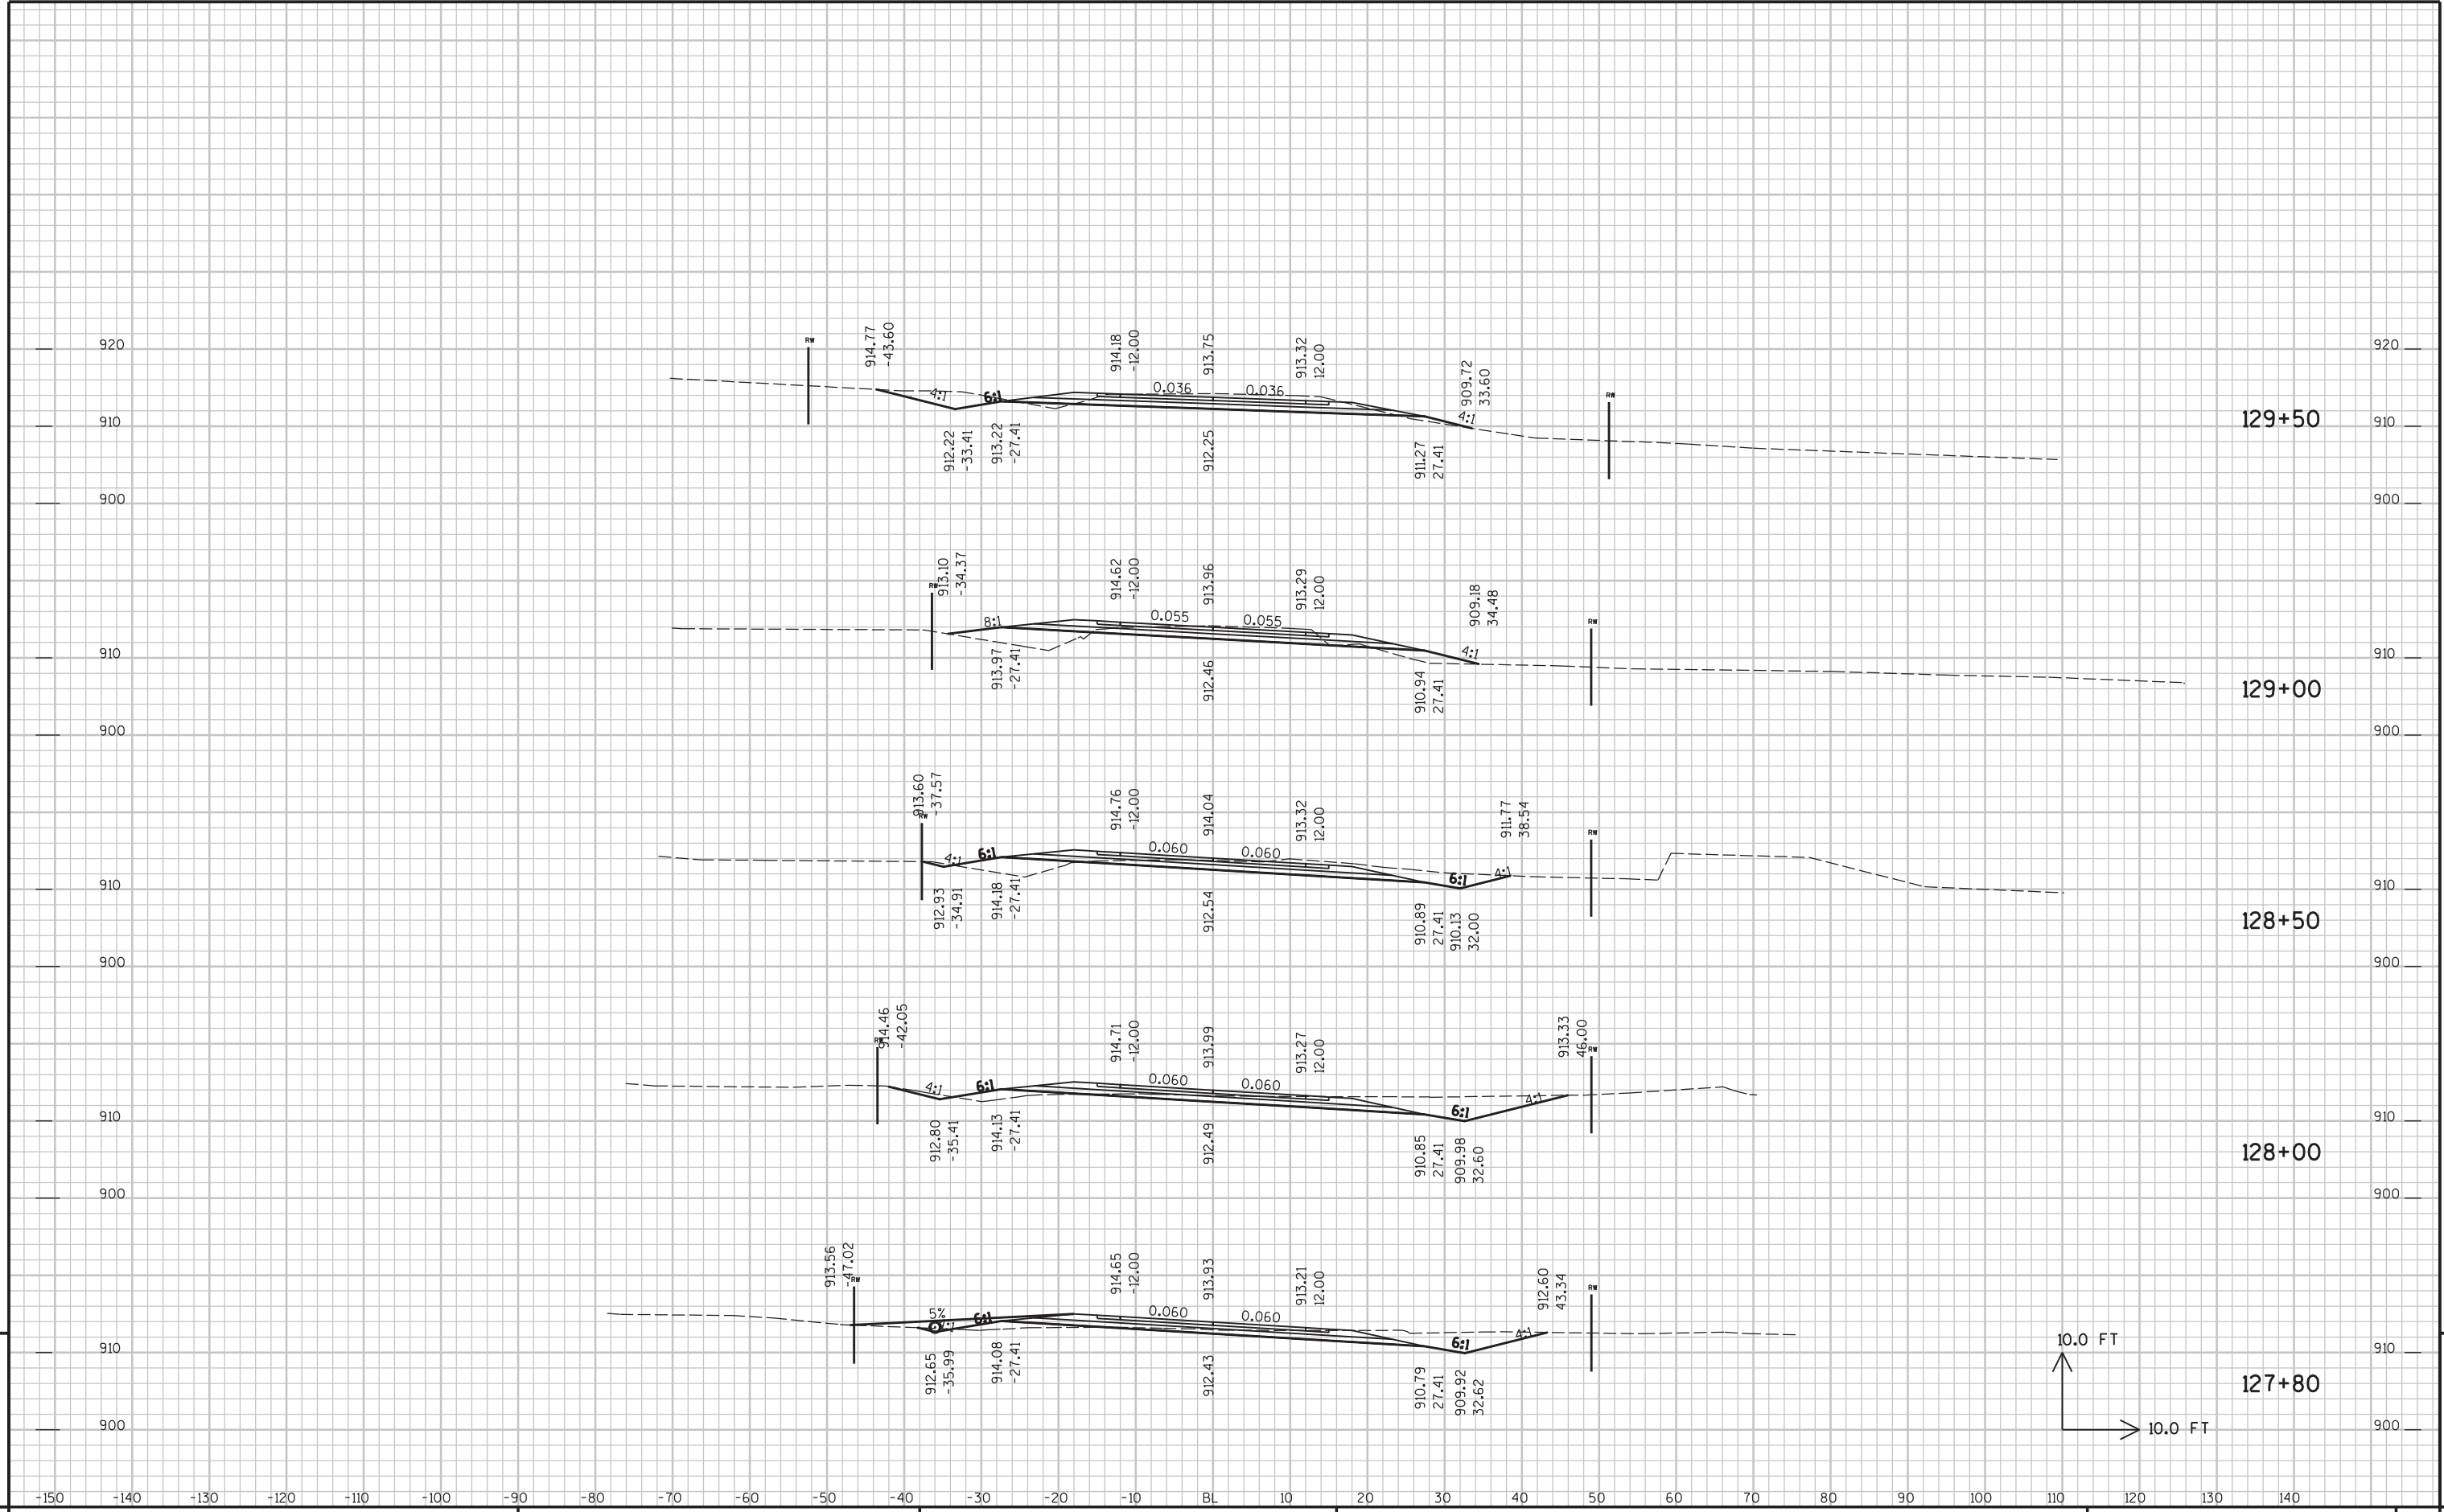


9

9

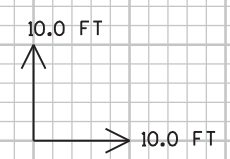


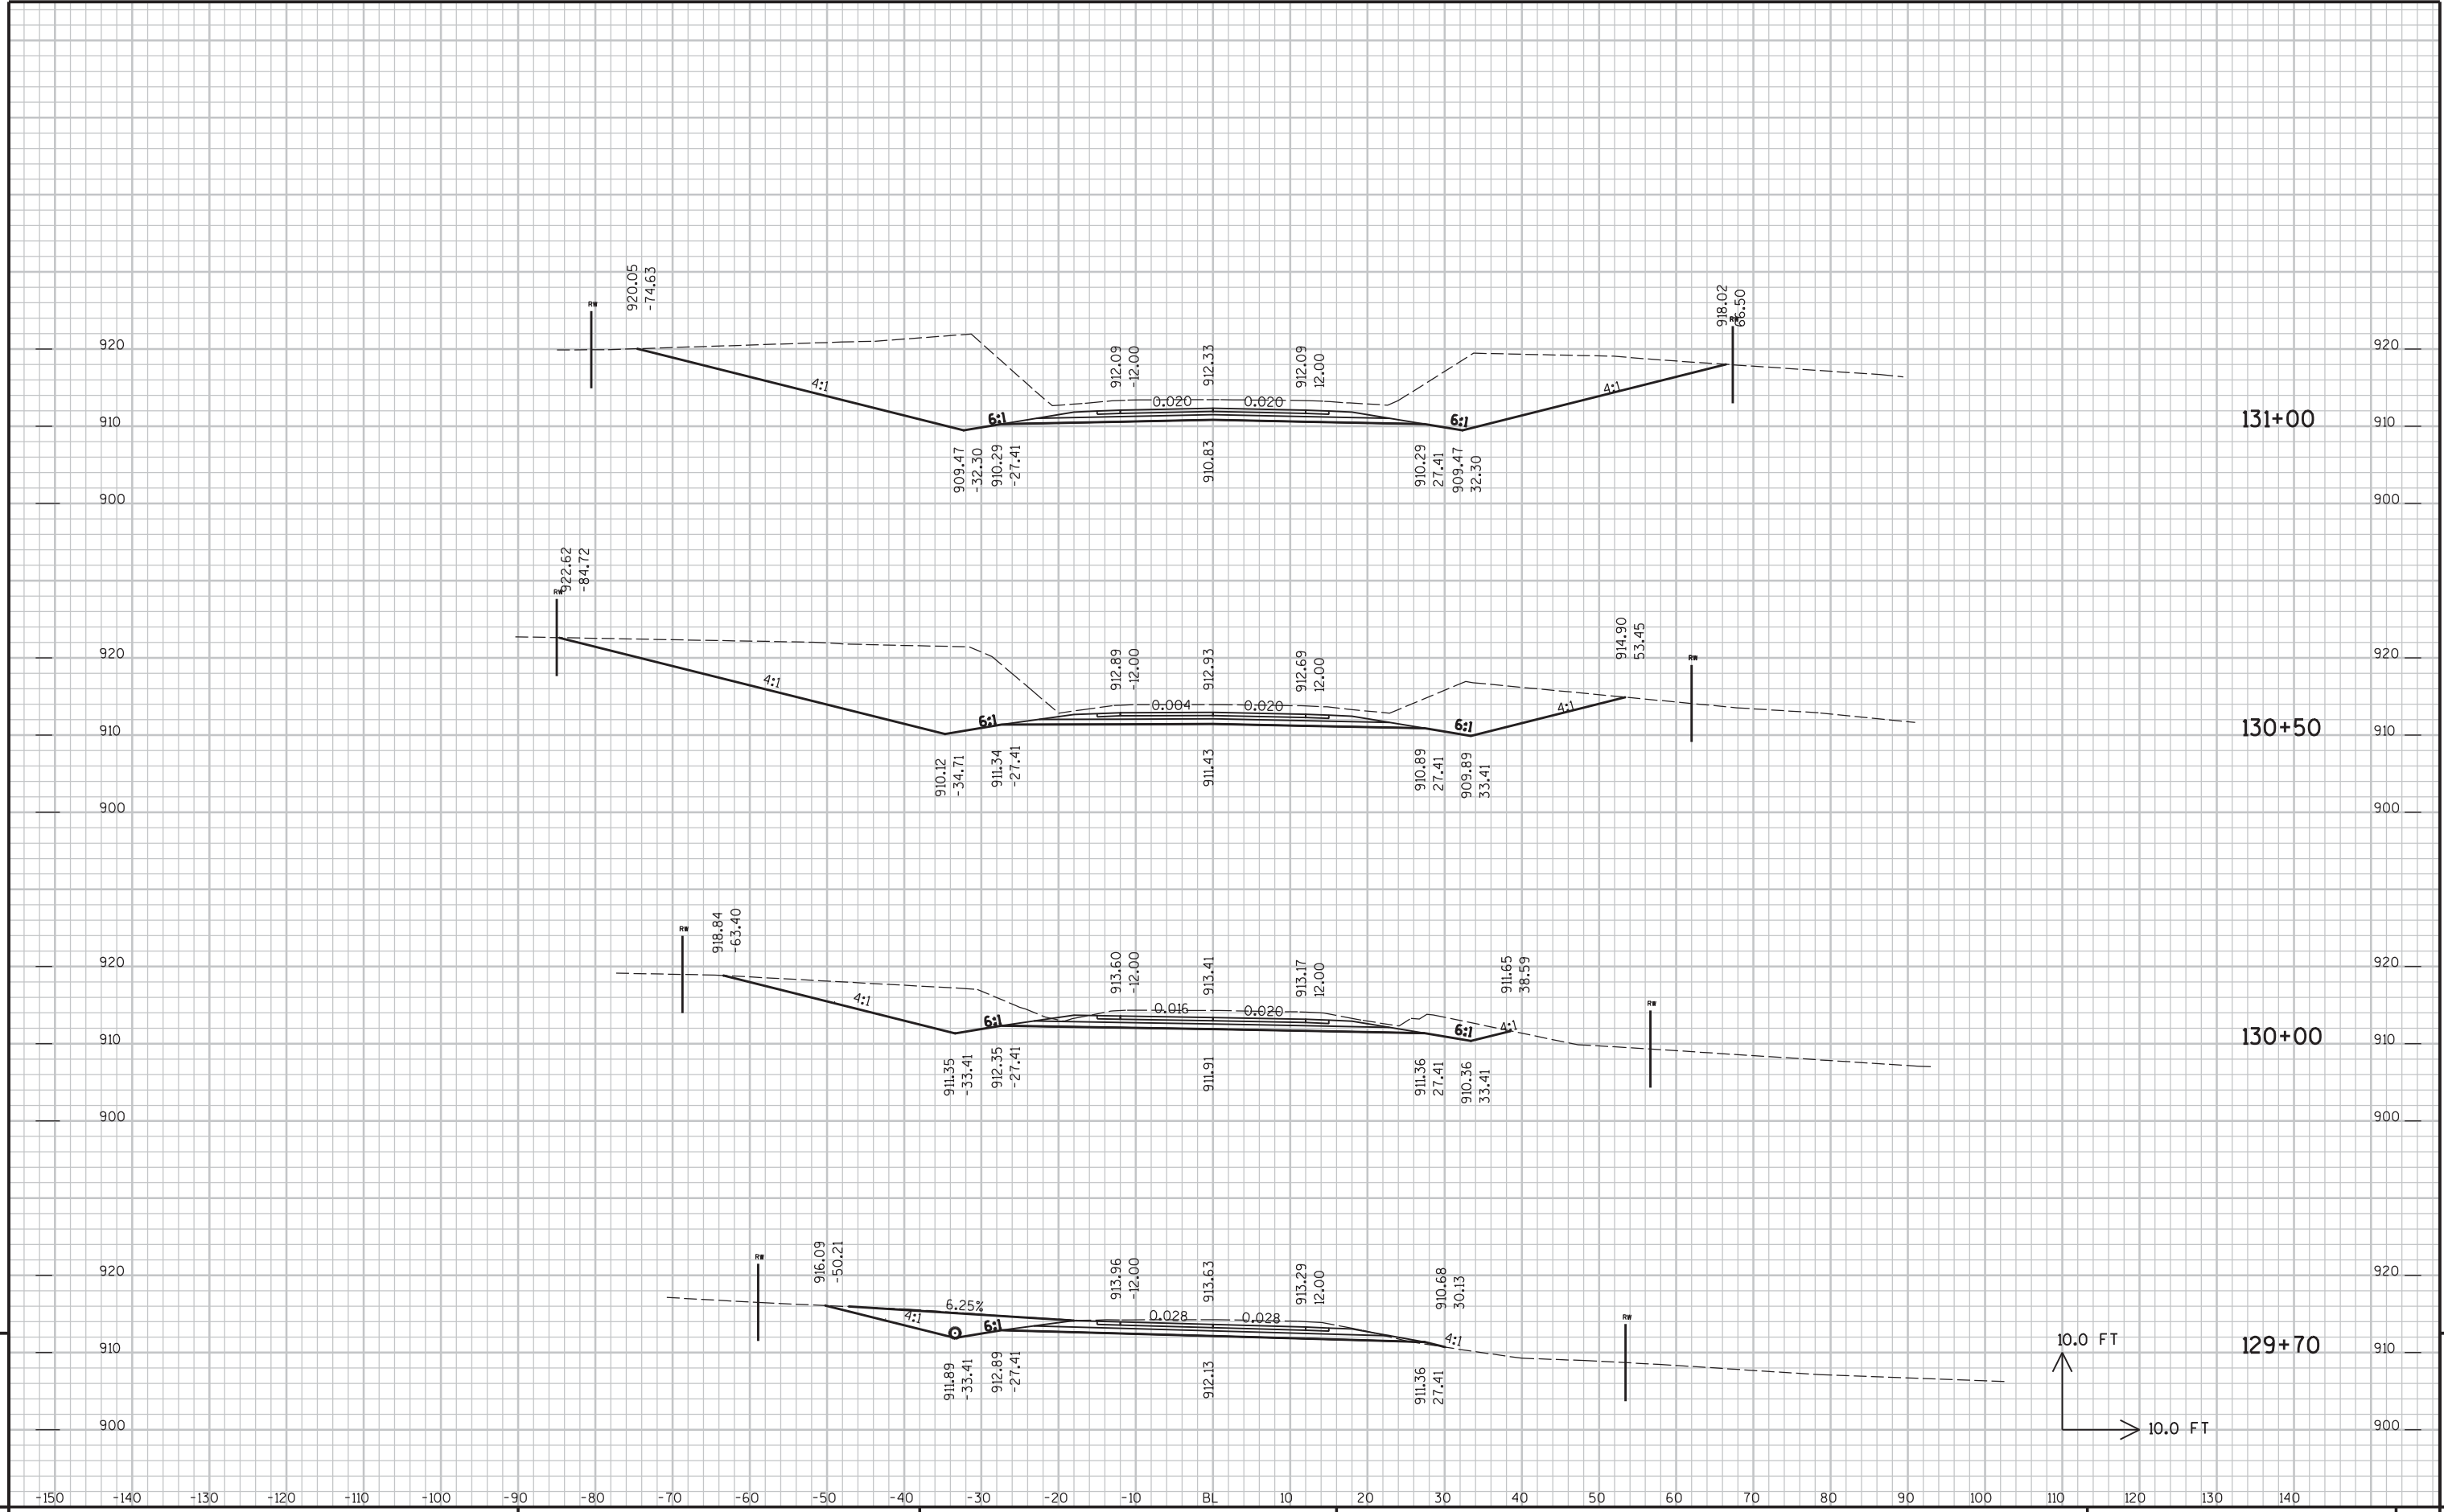

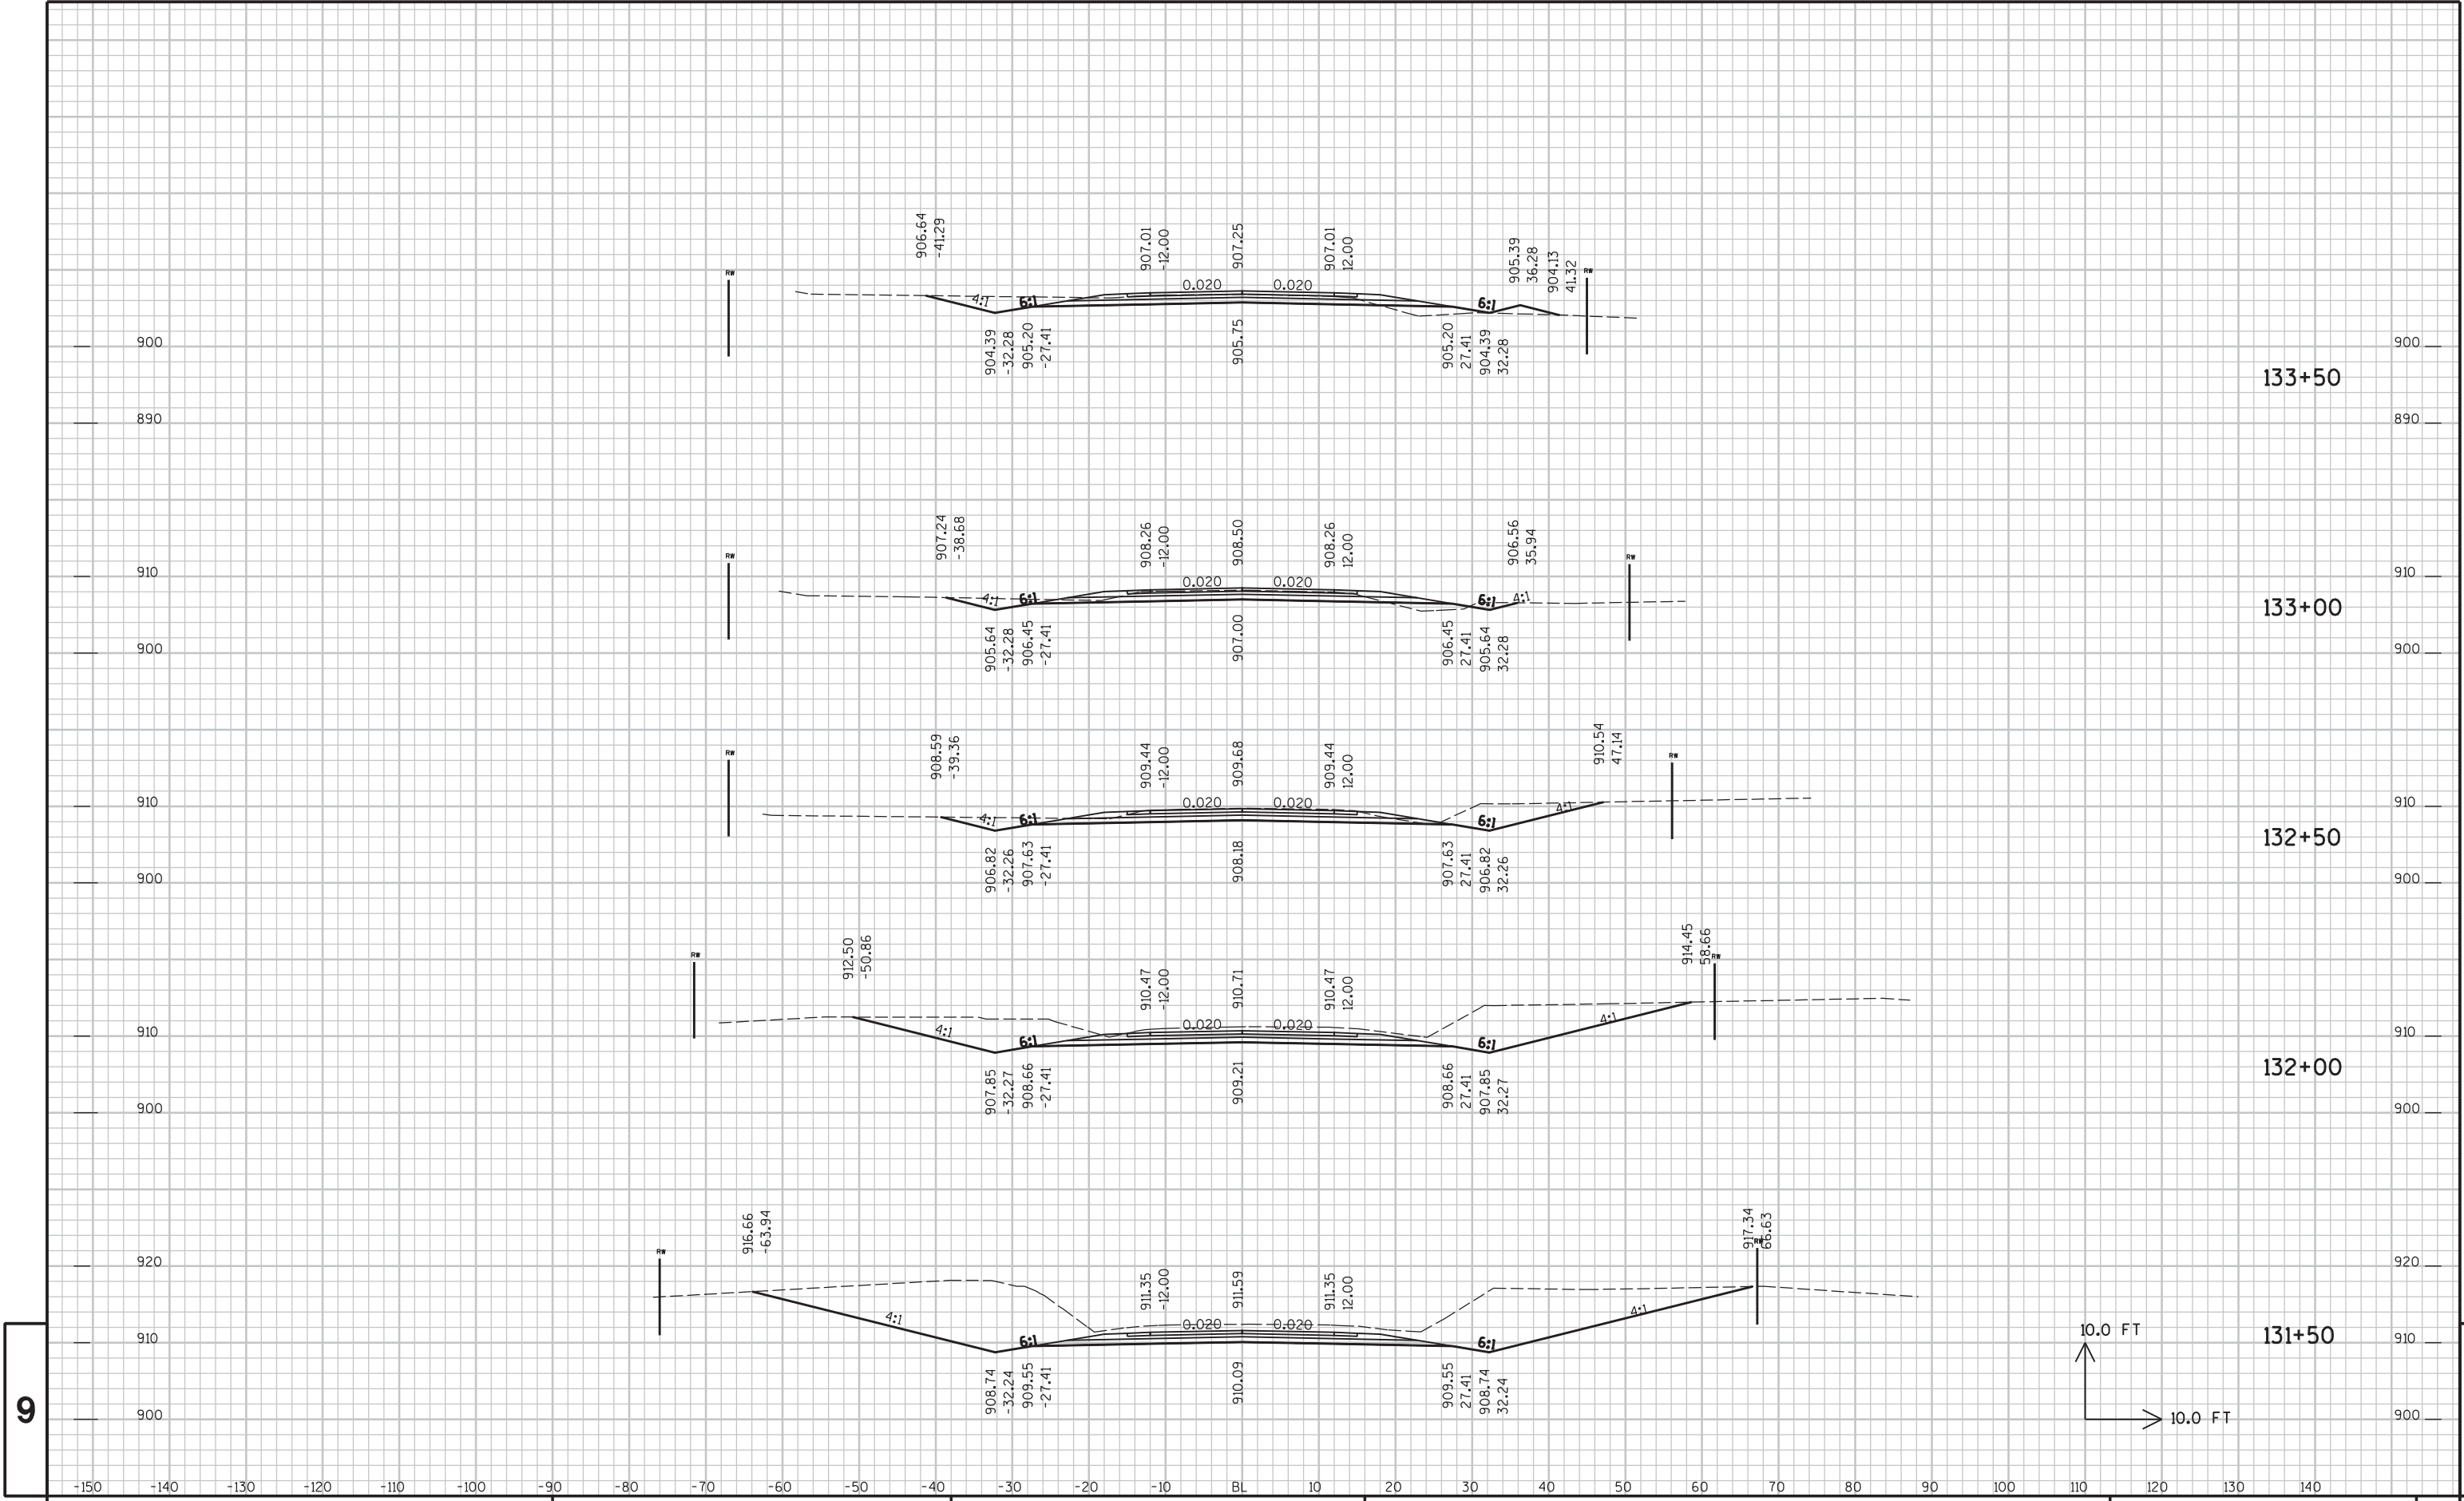


9


9

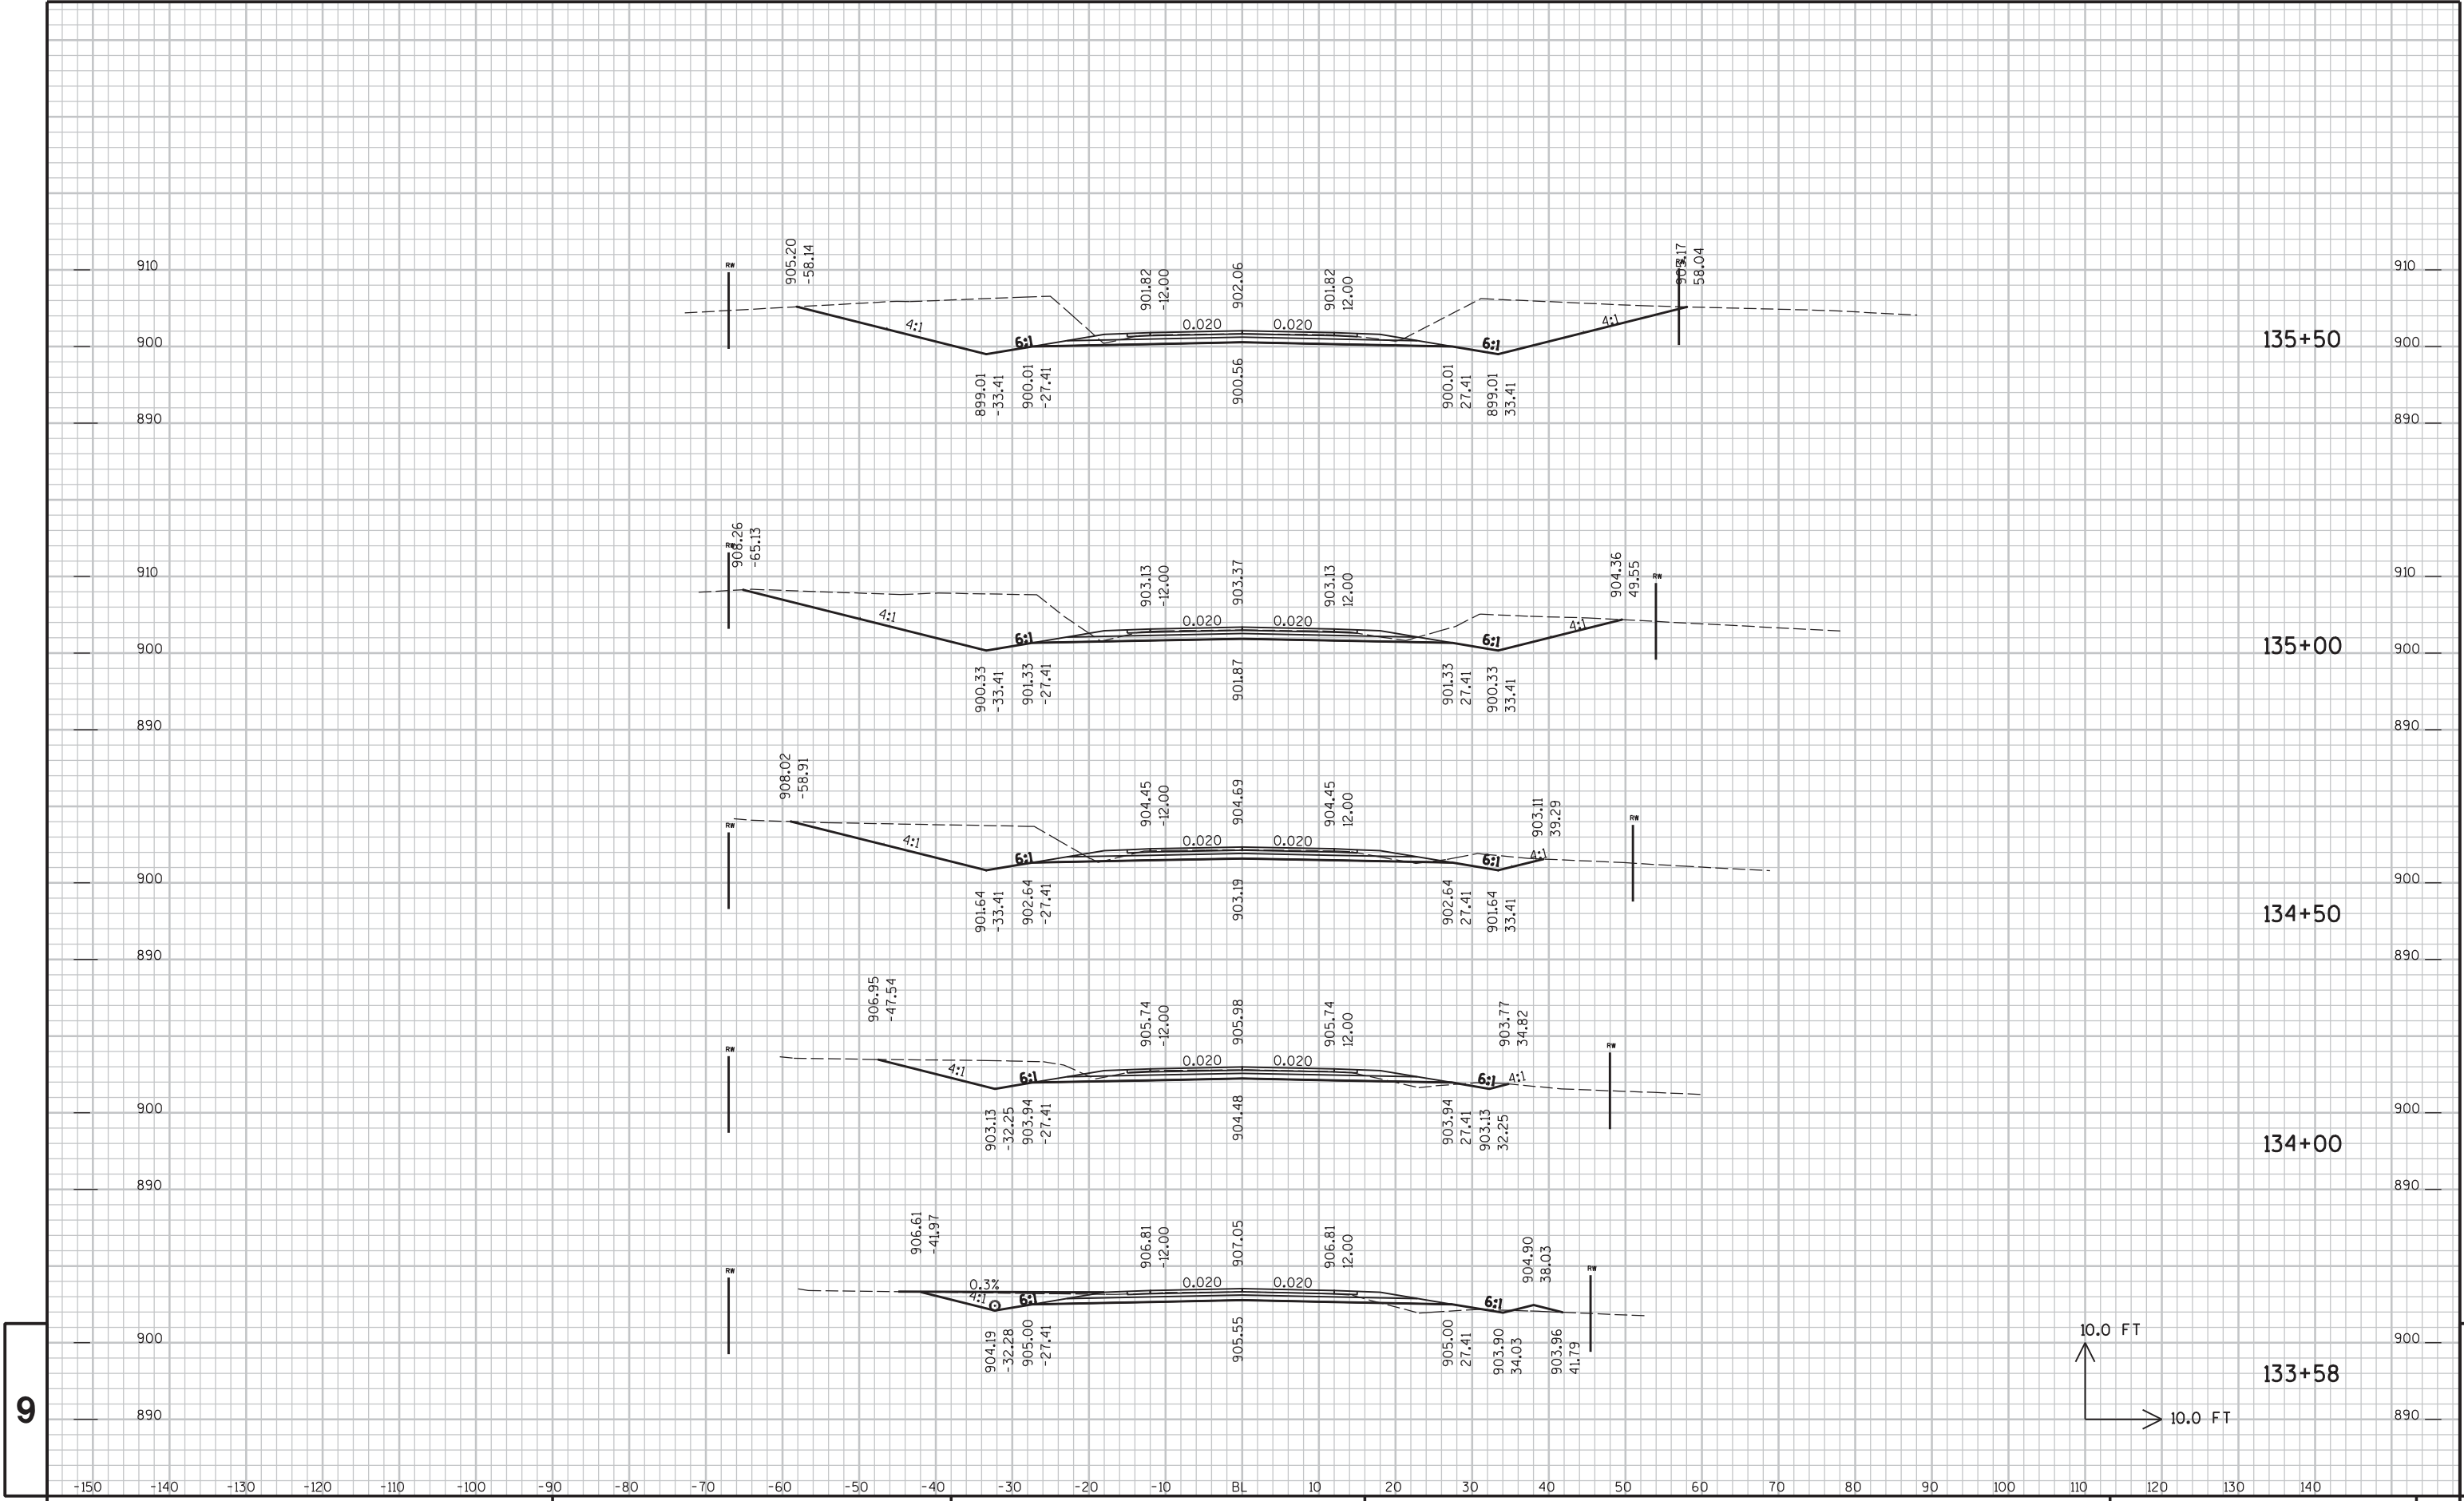


9

9

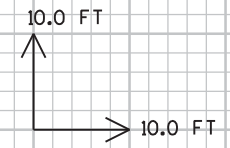


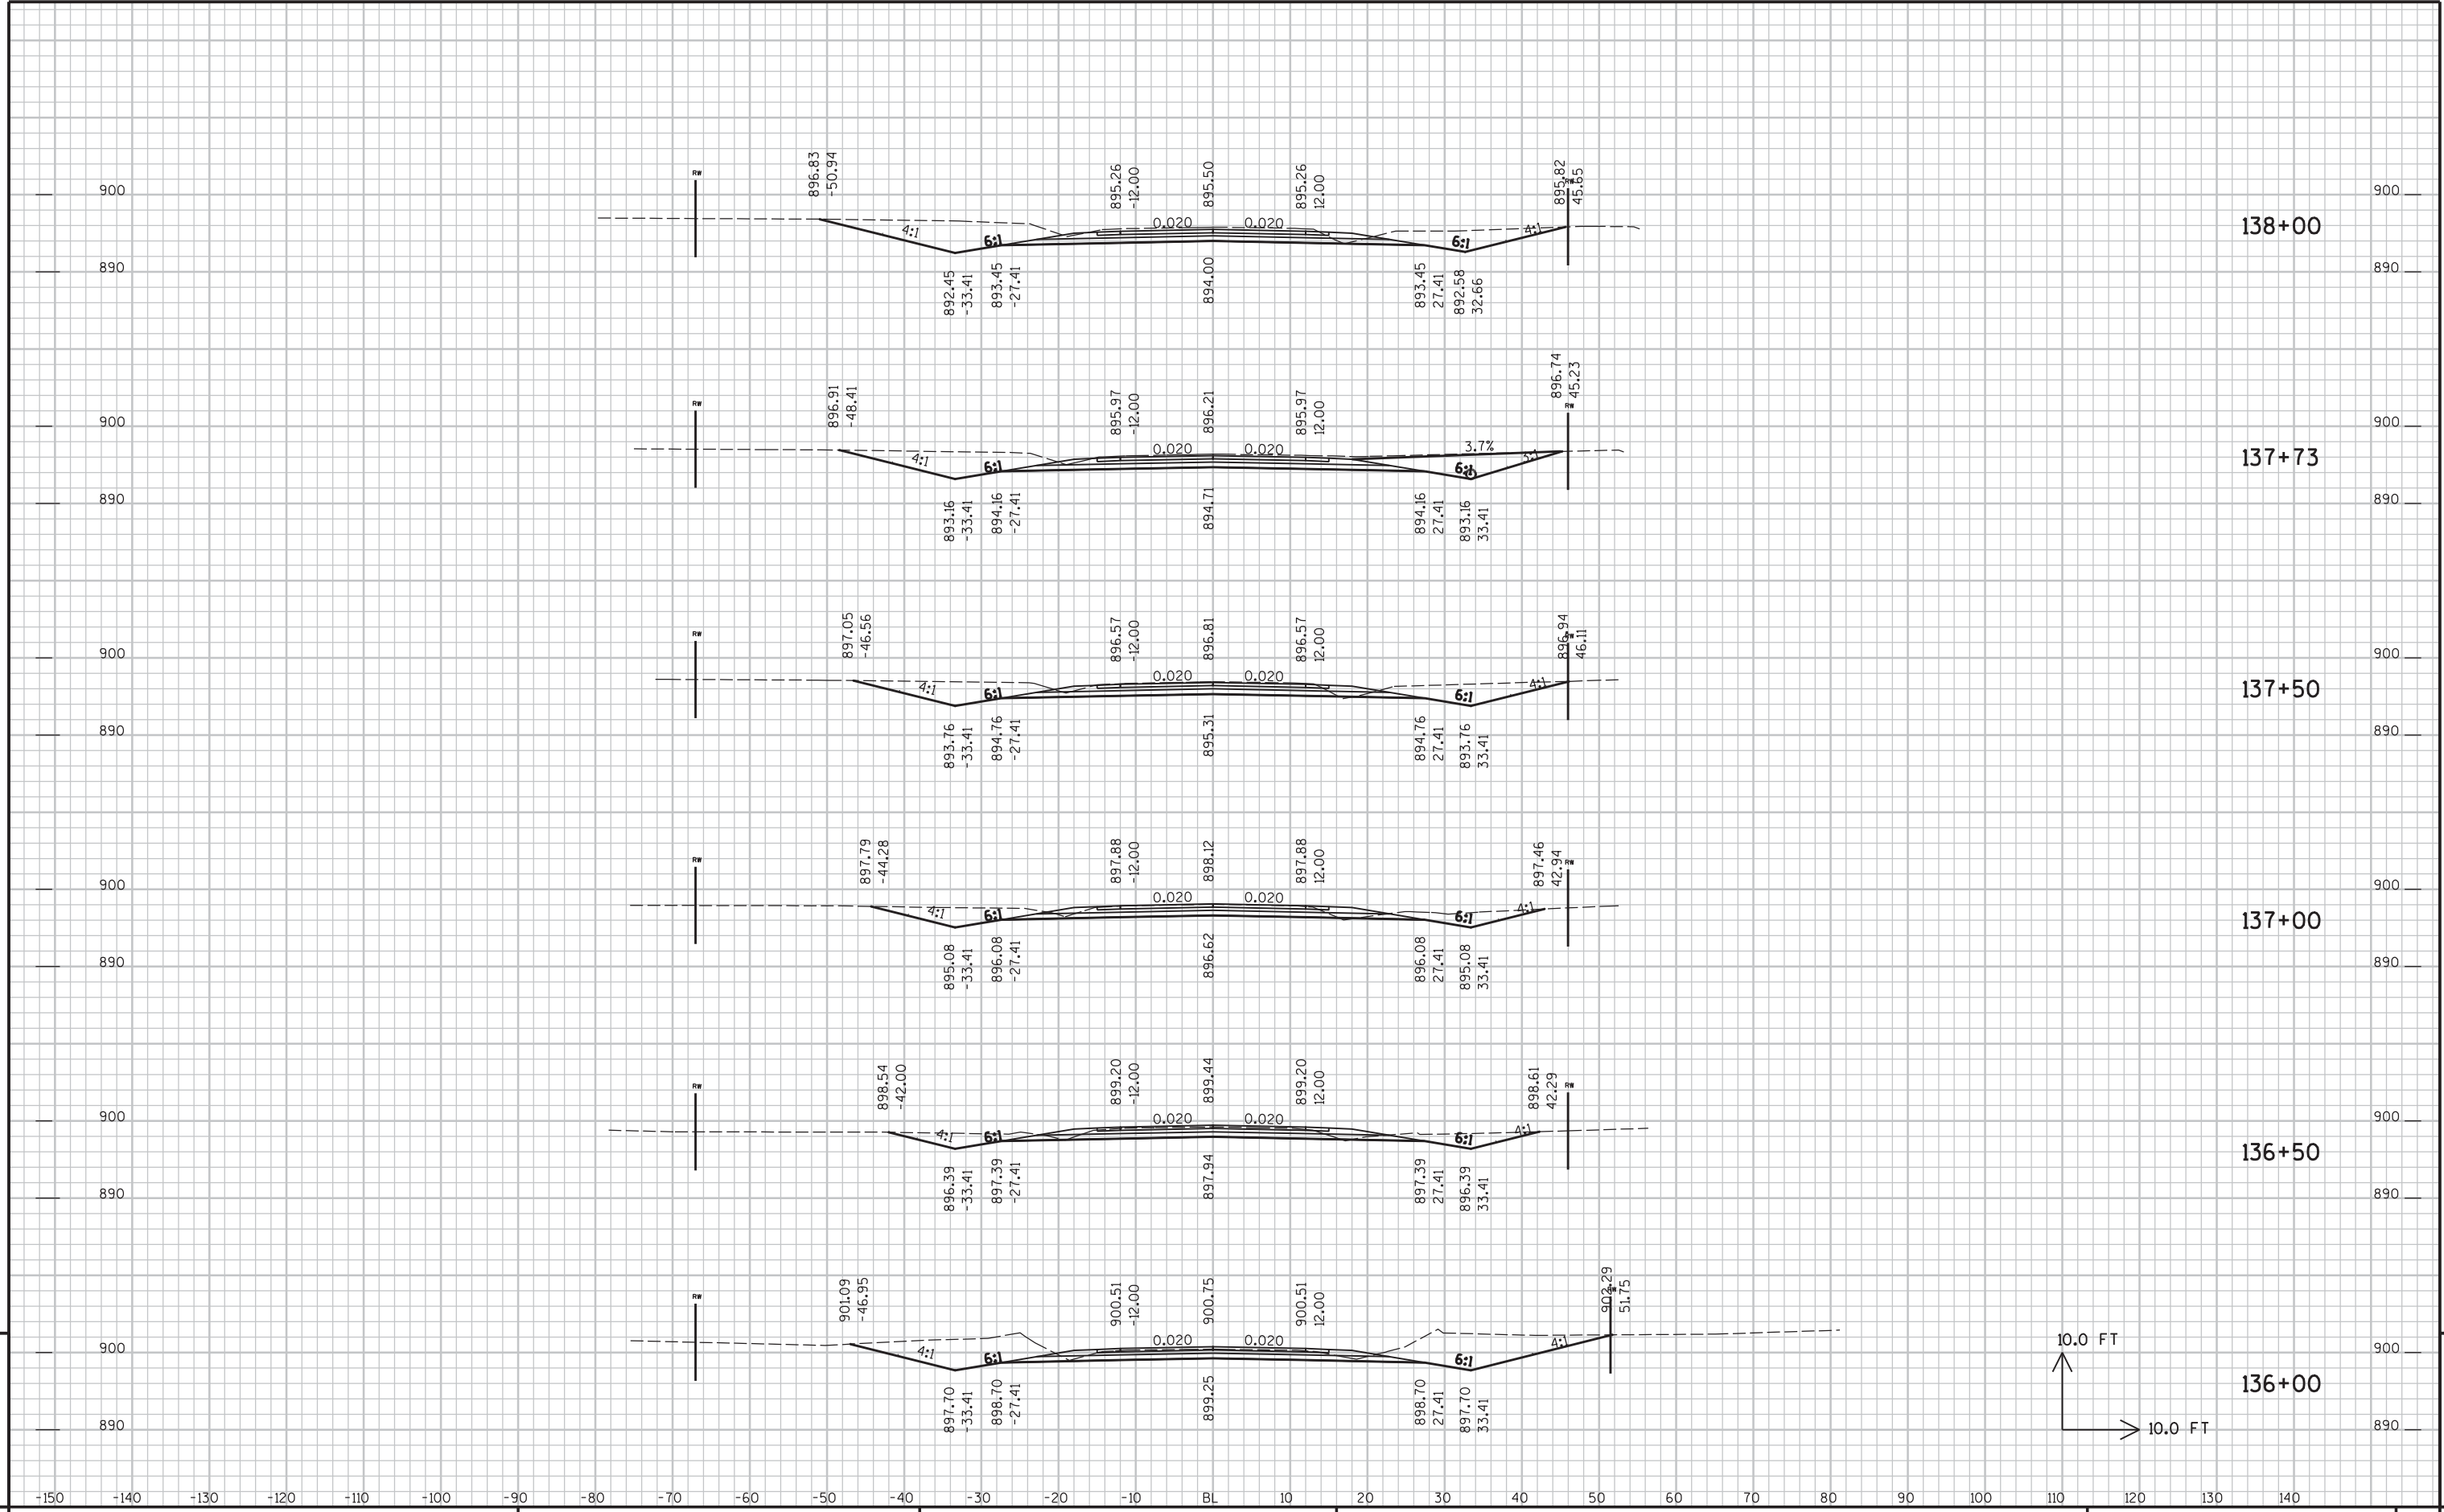

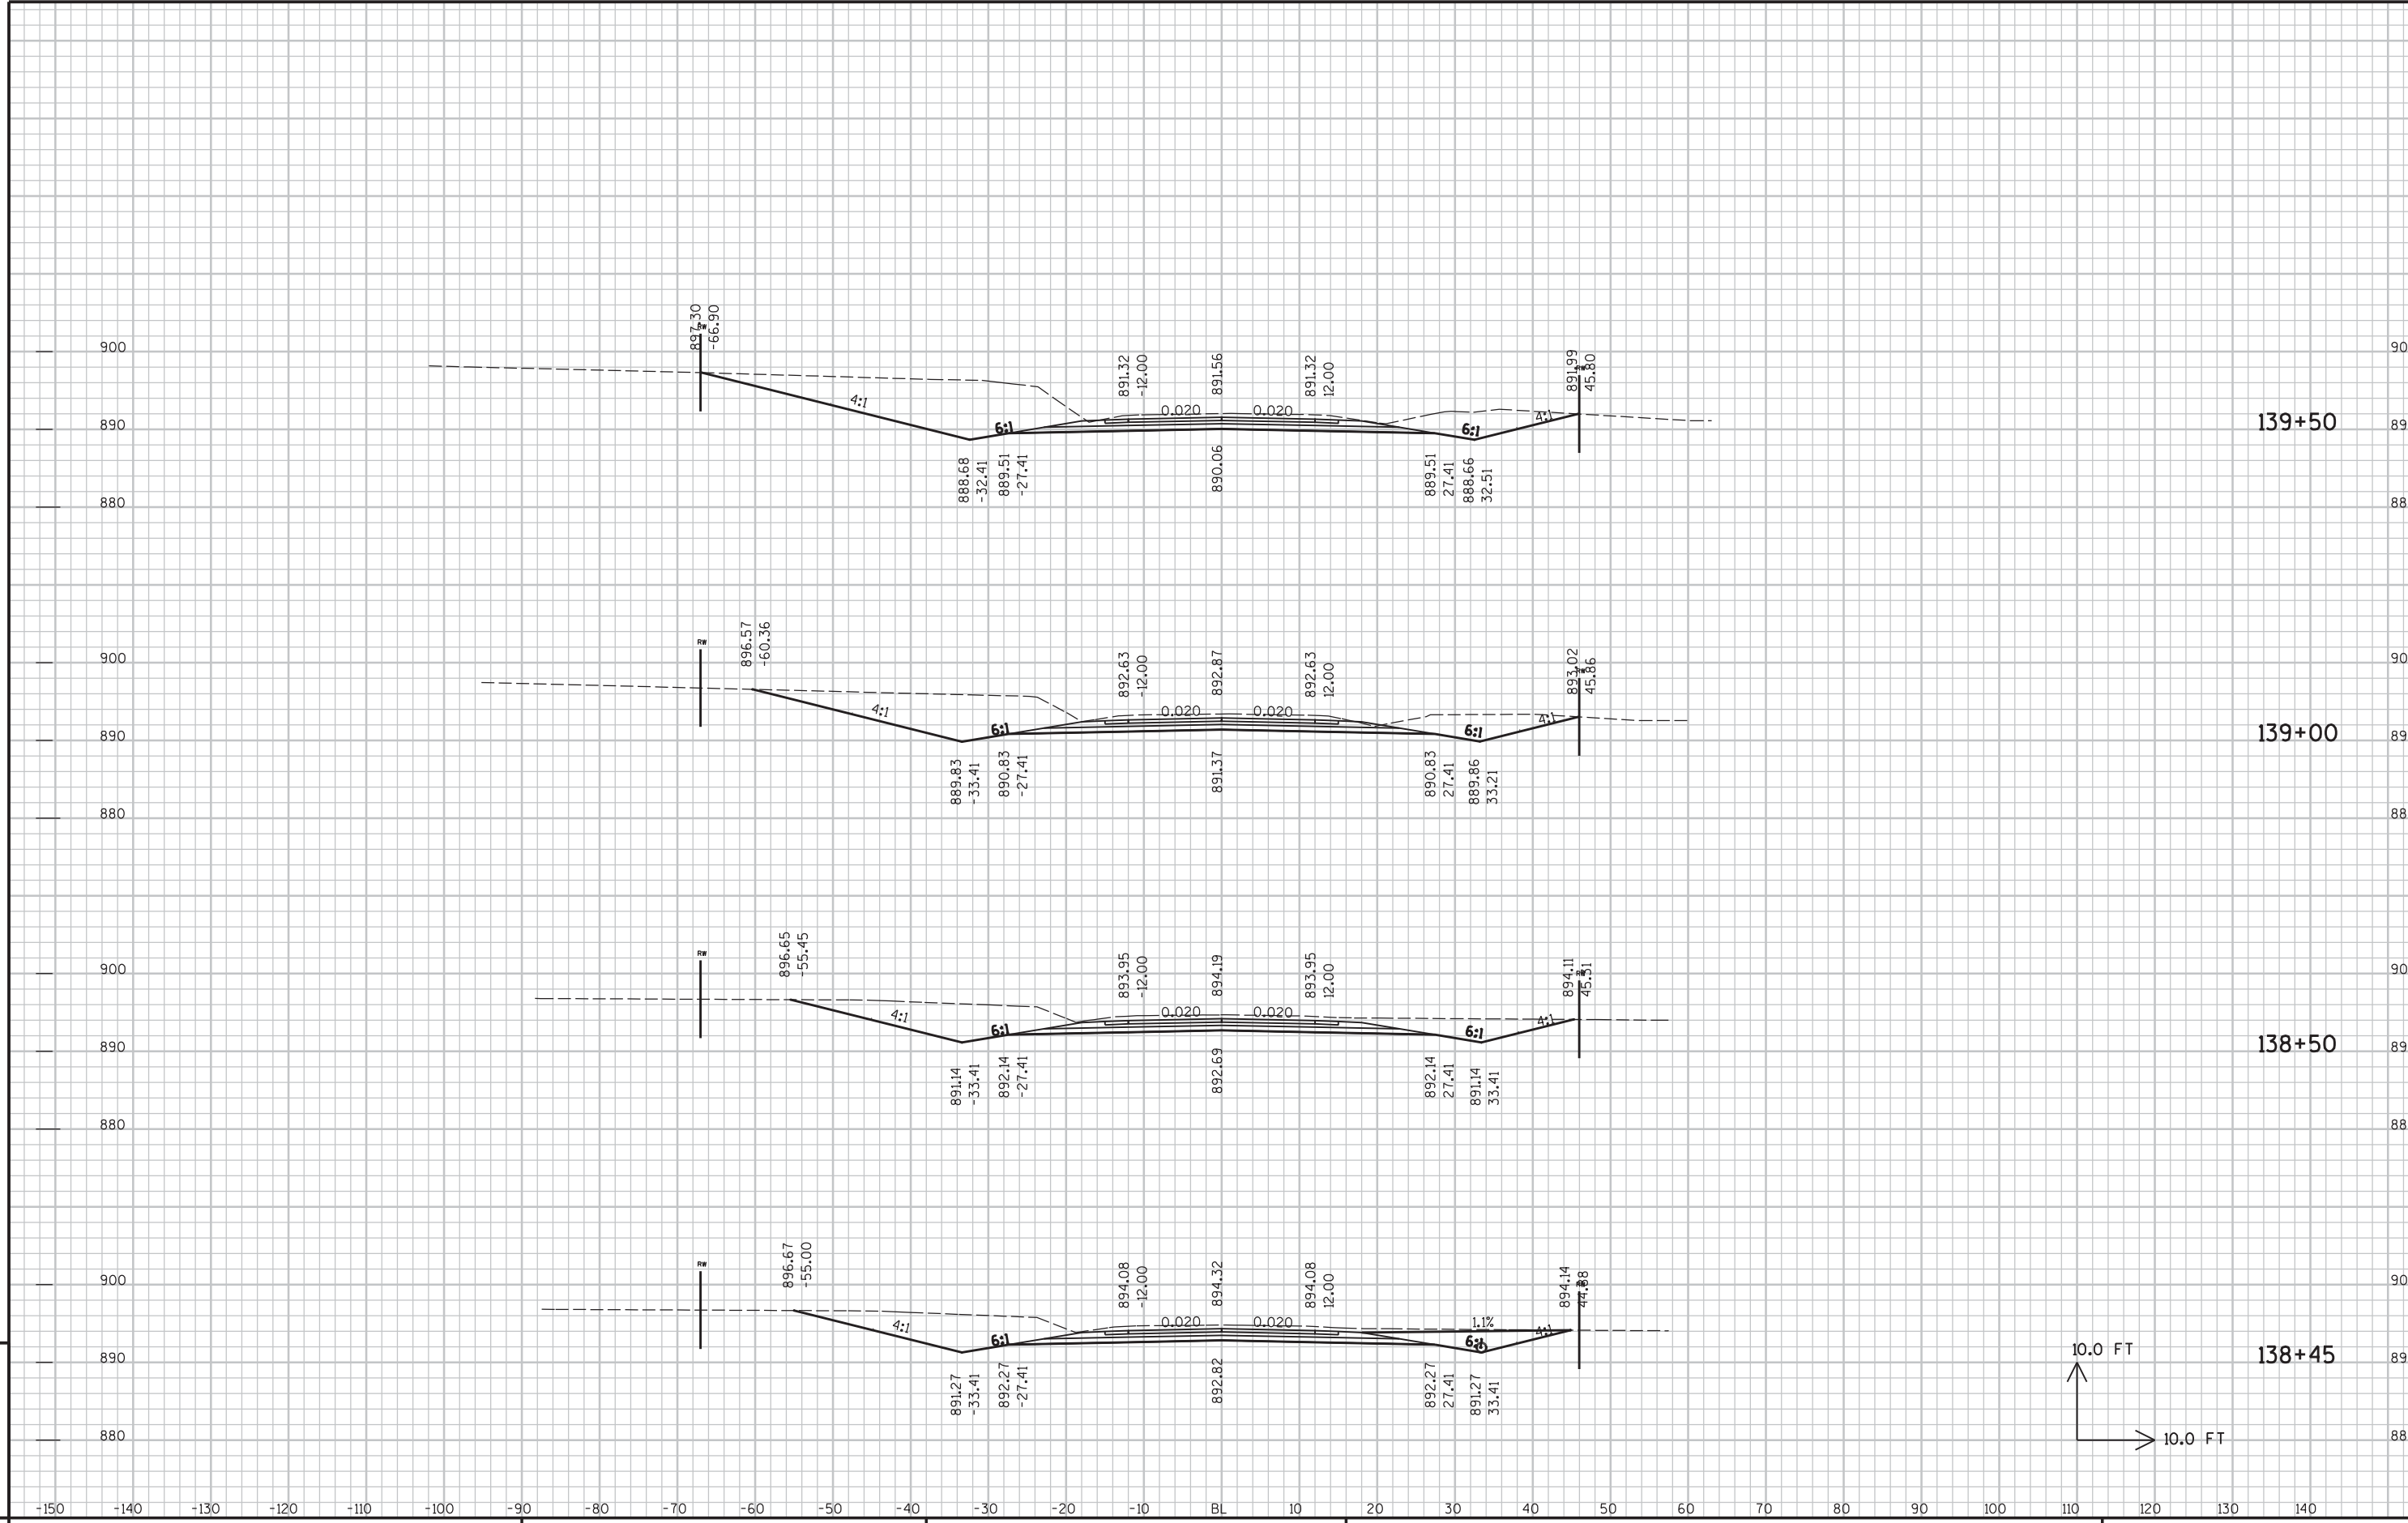


9

9

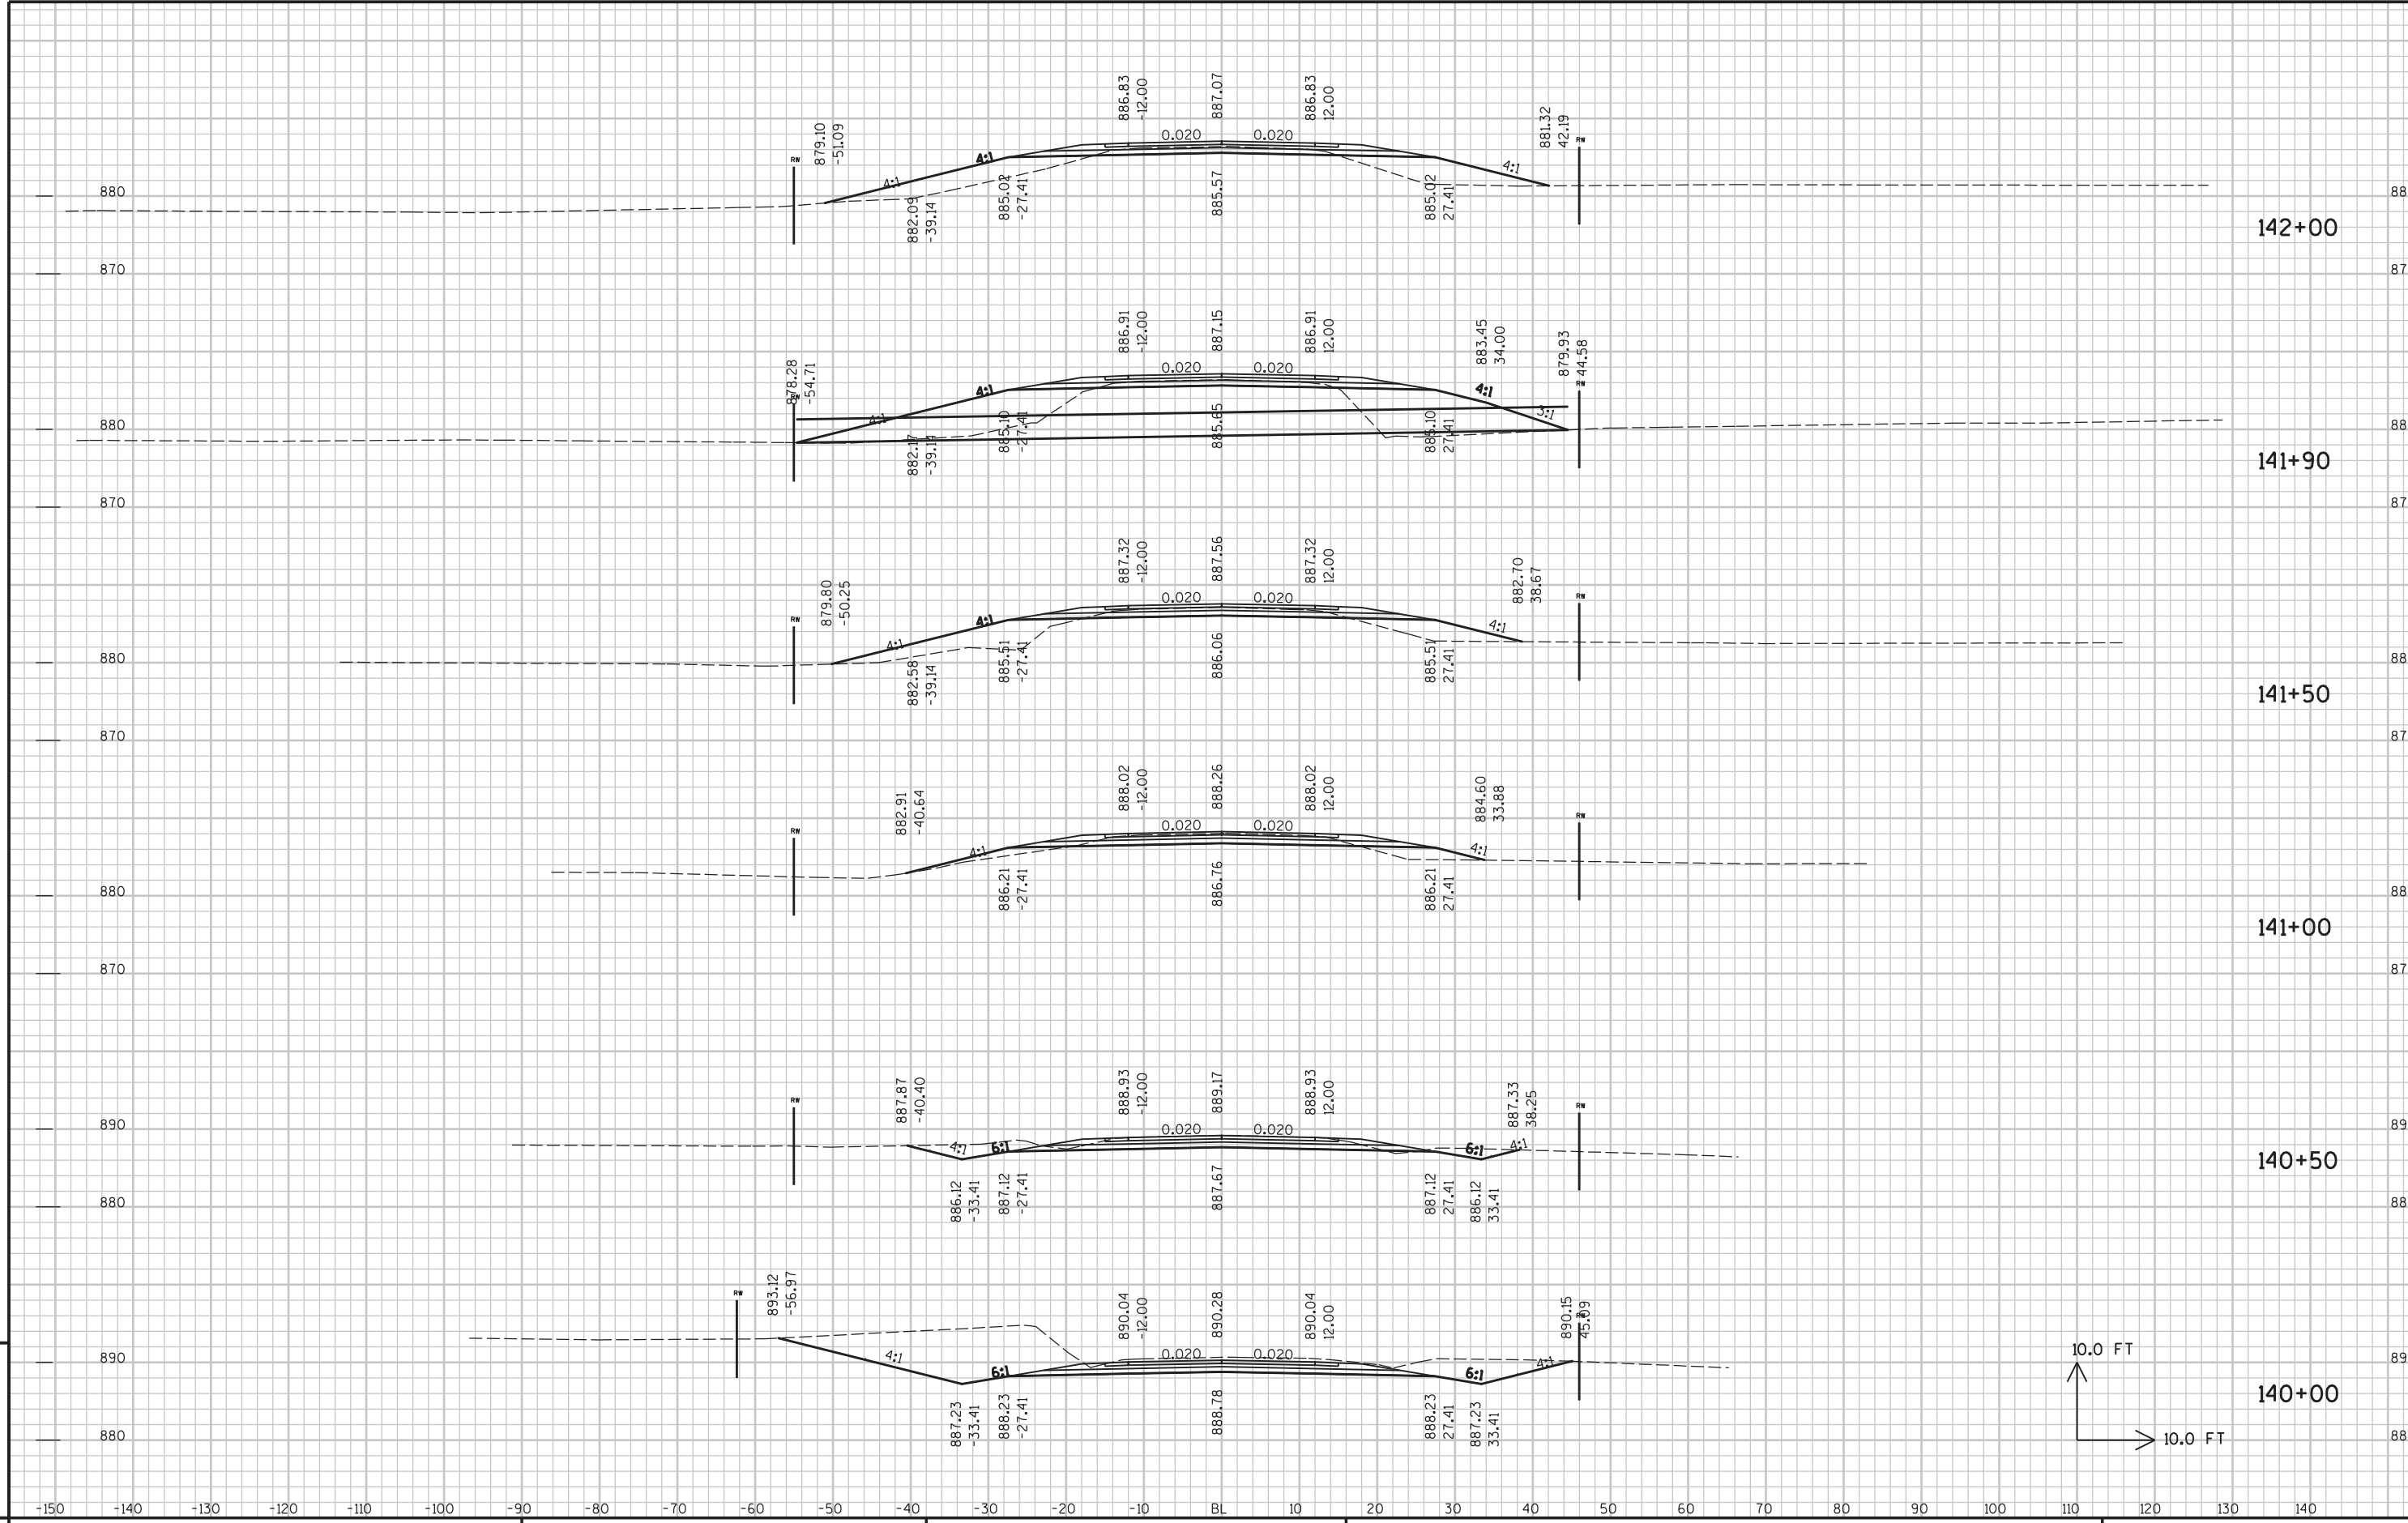


9

9

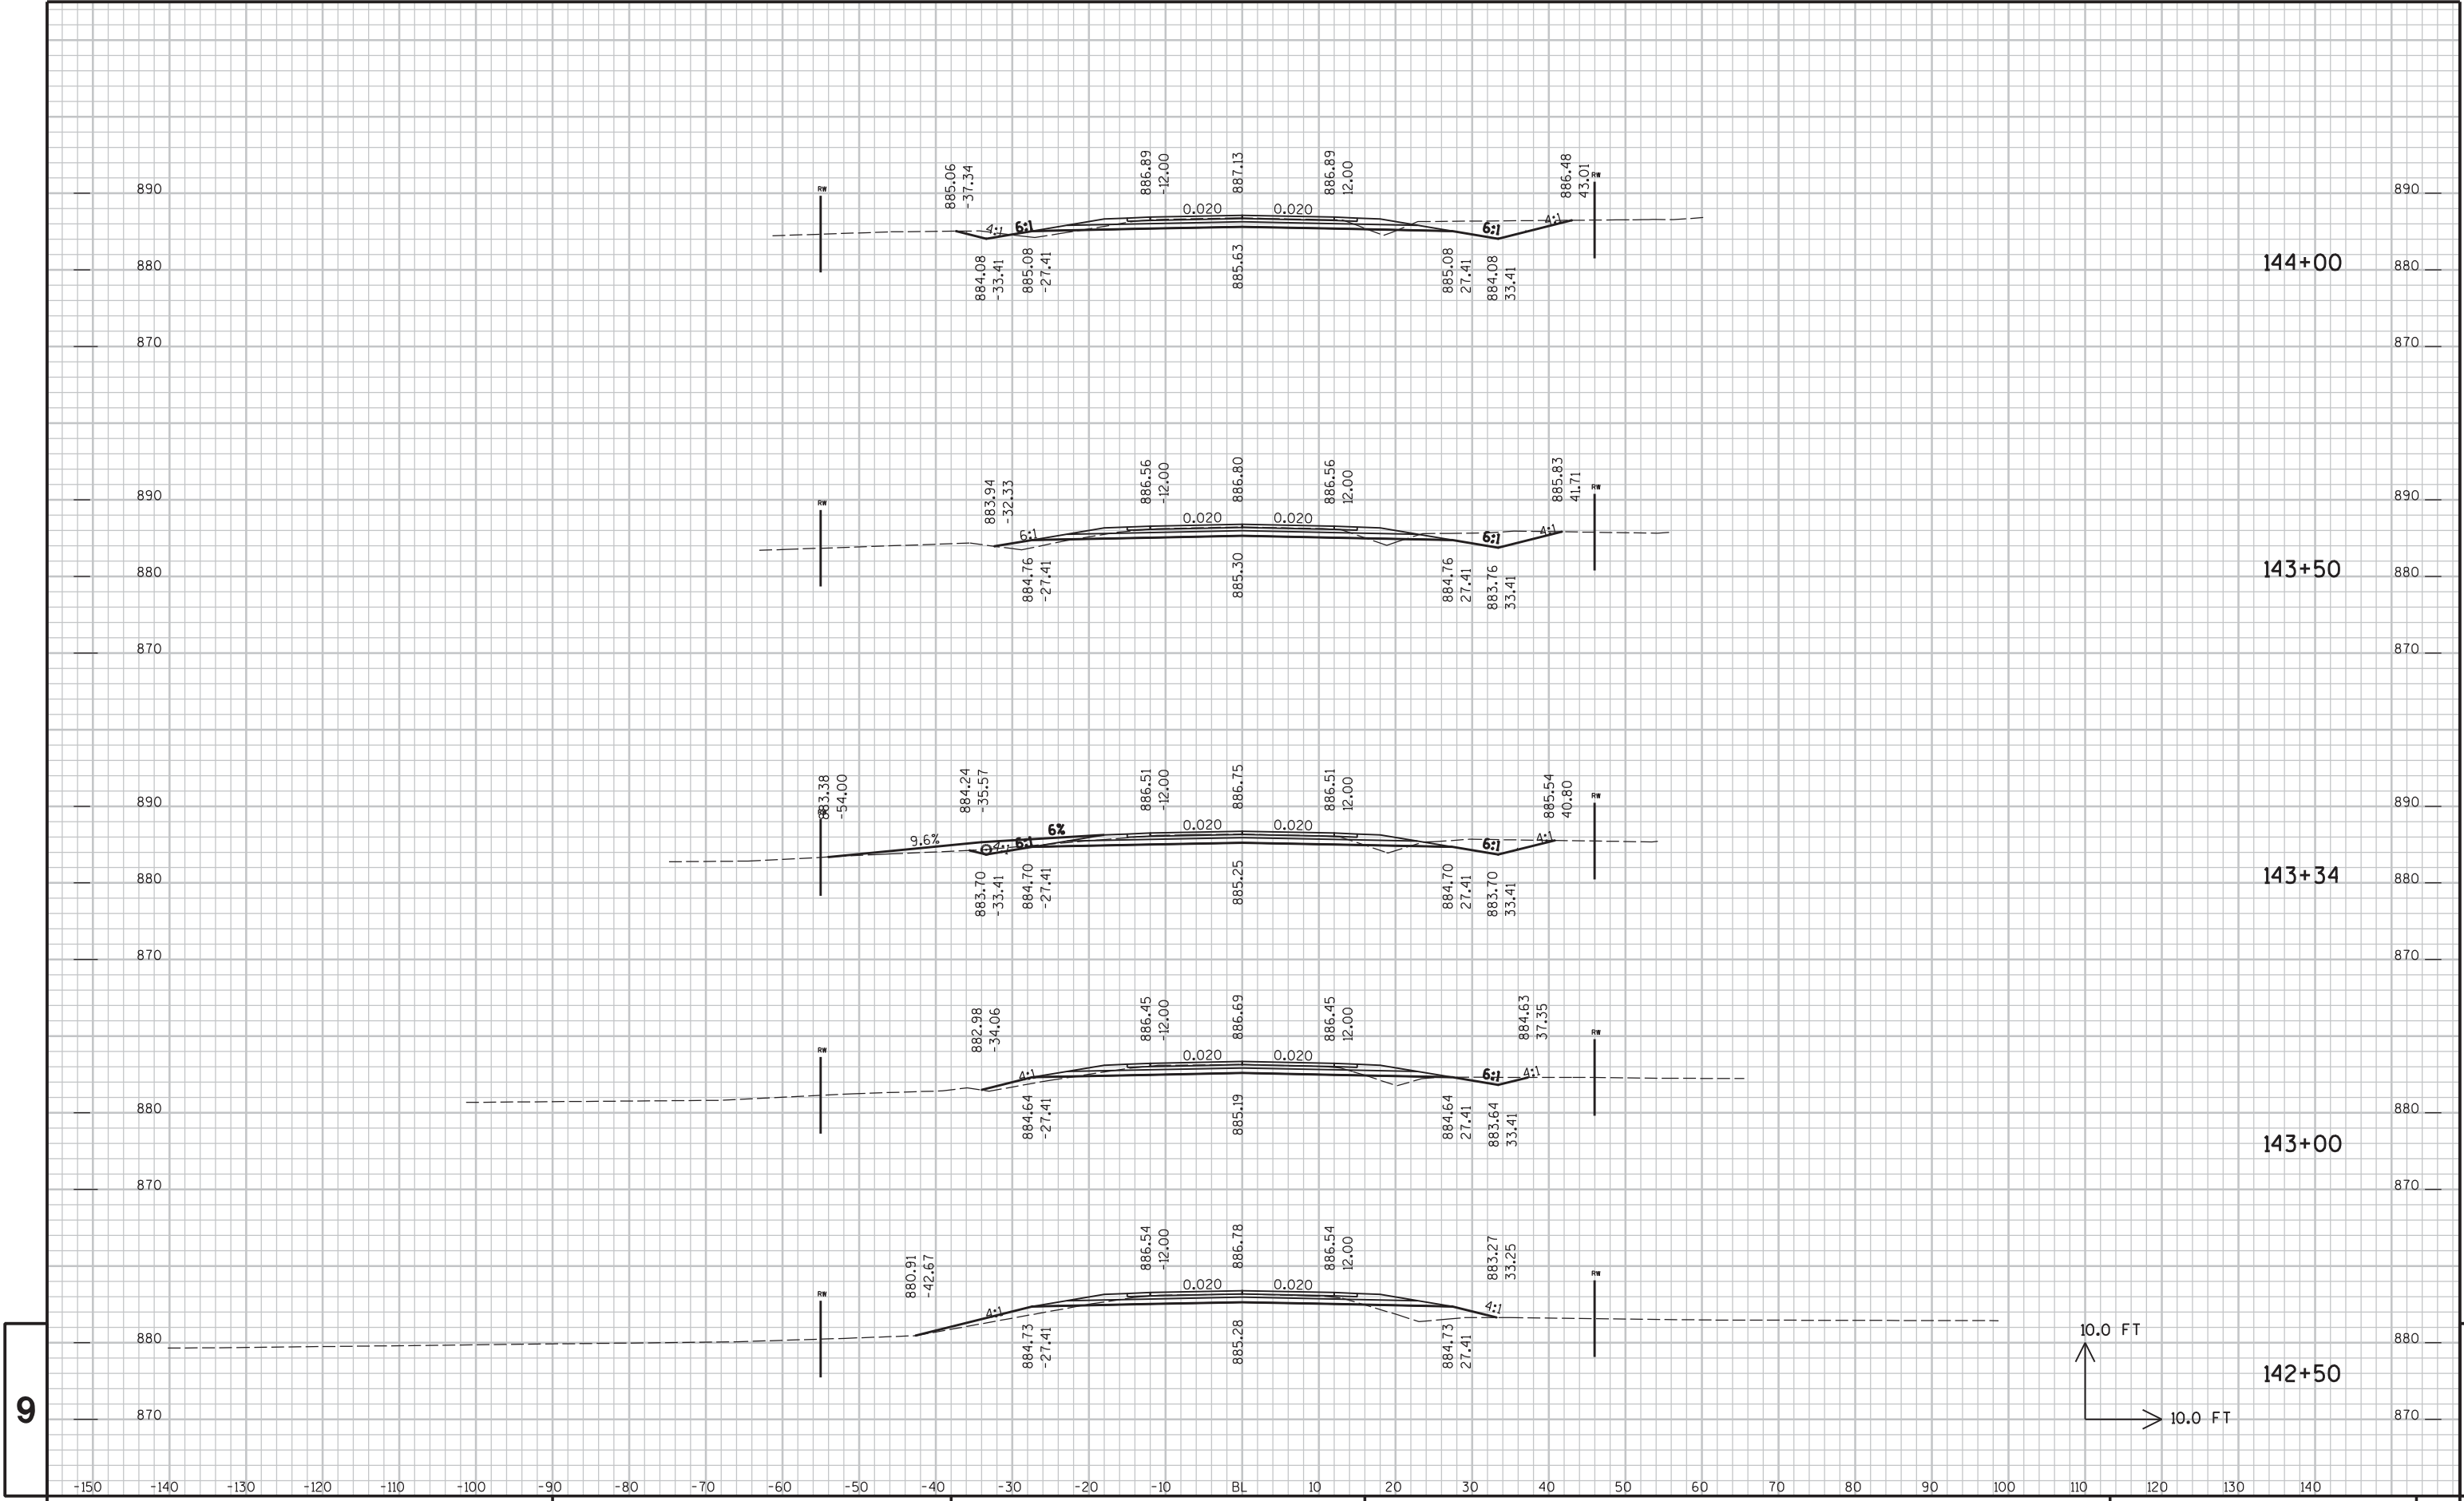


9


9

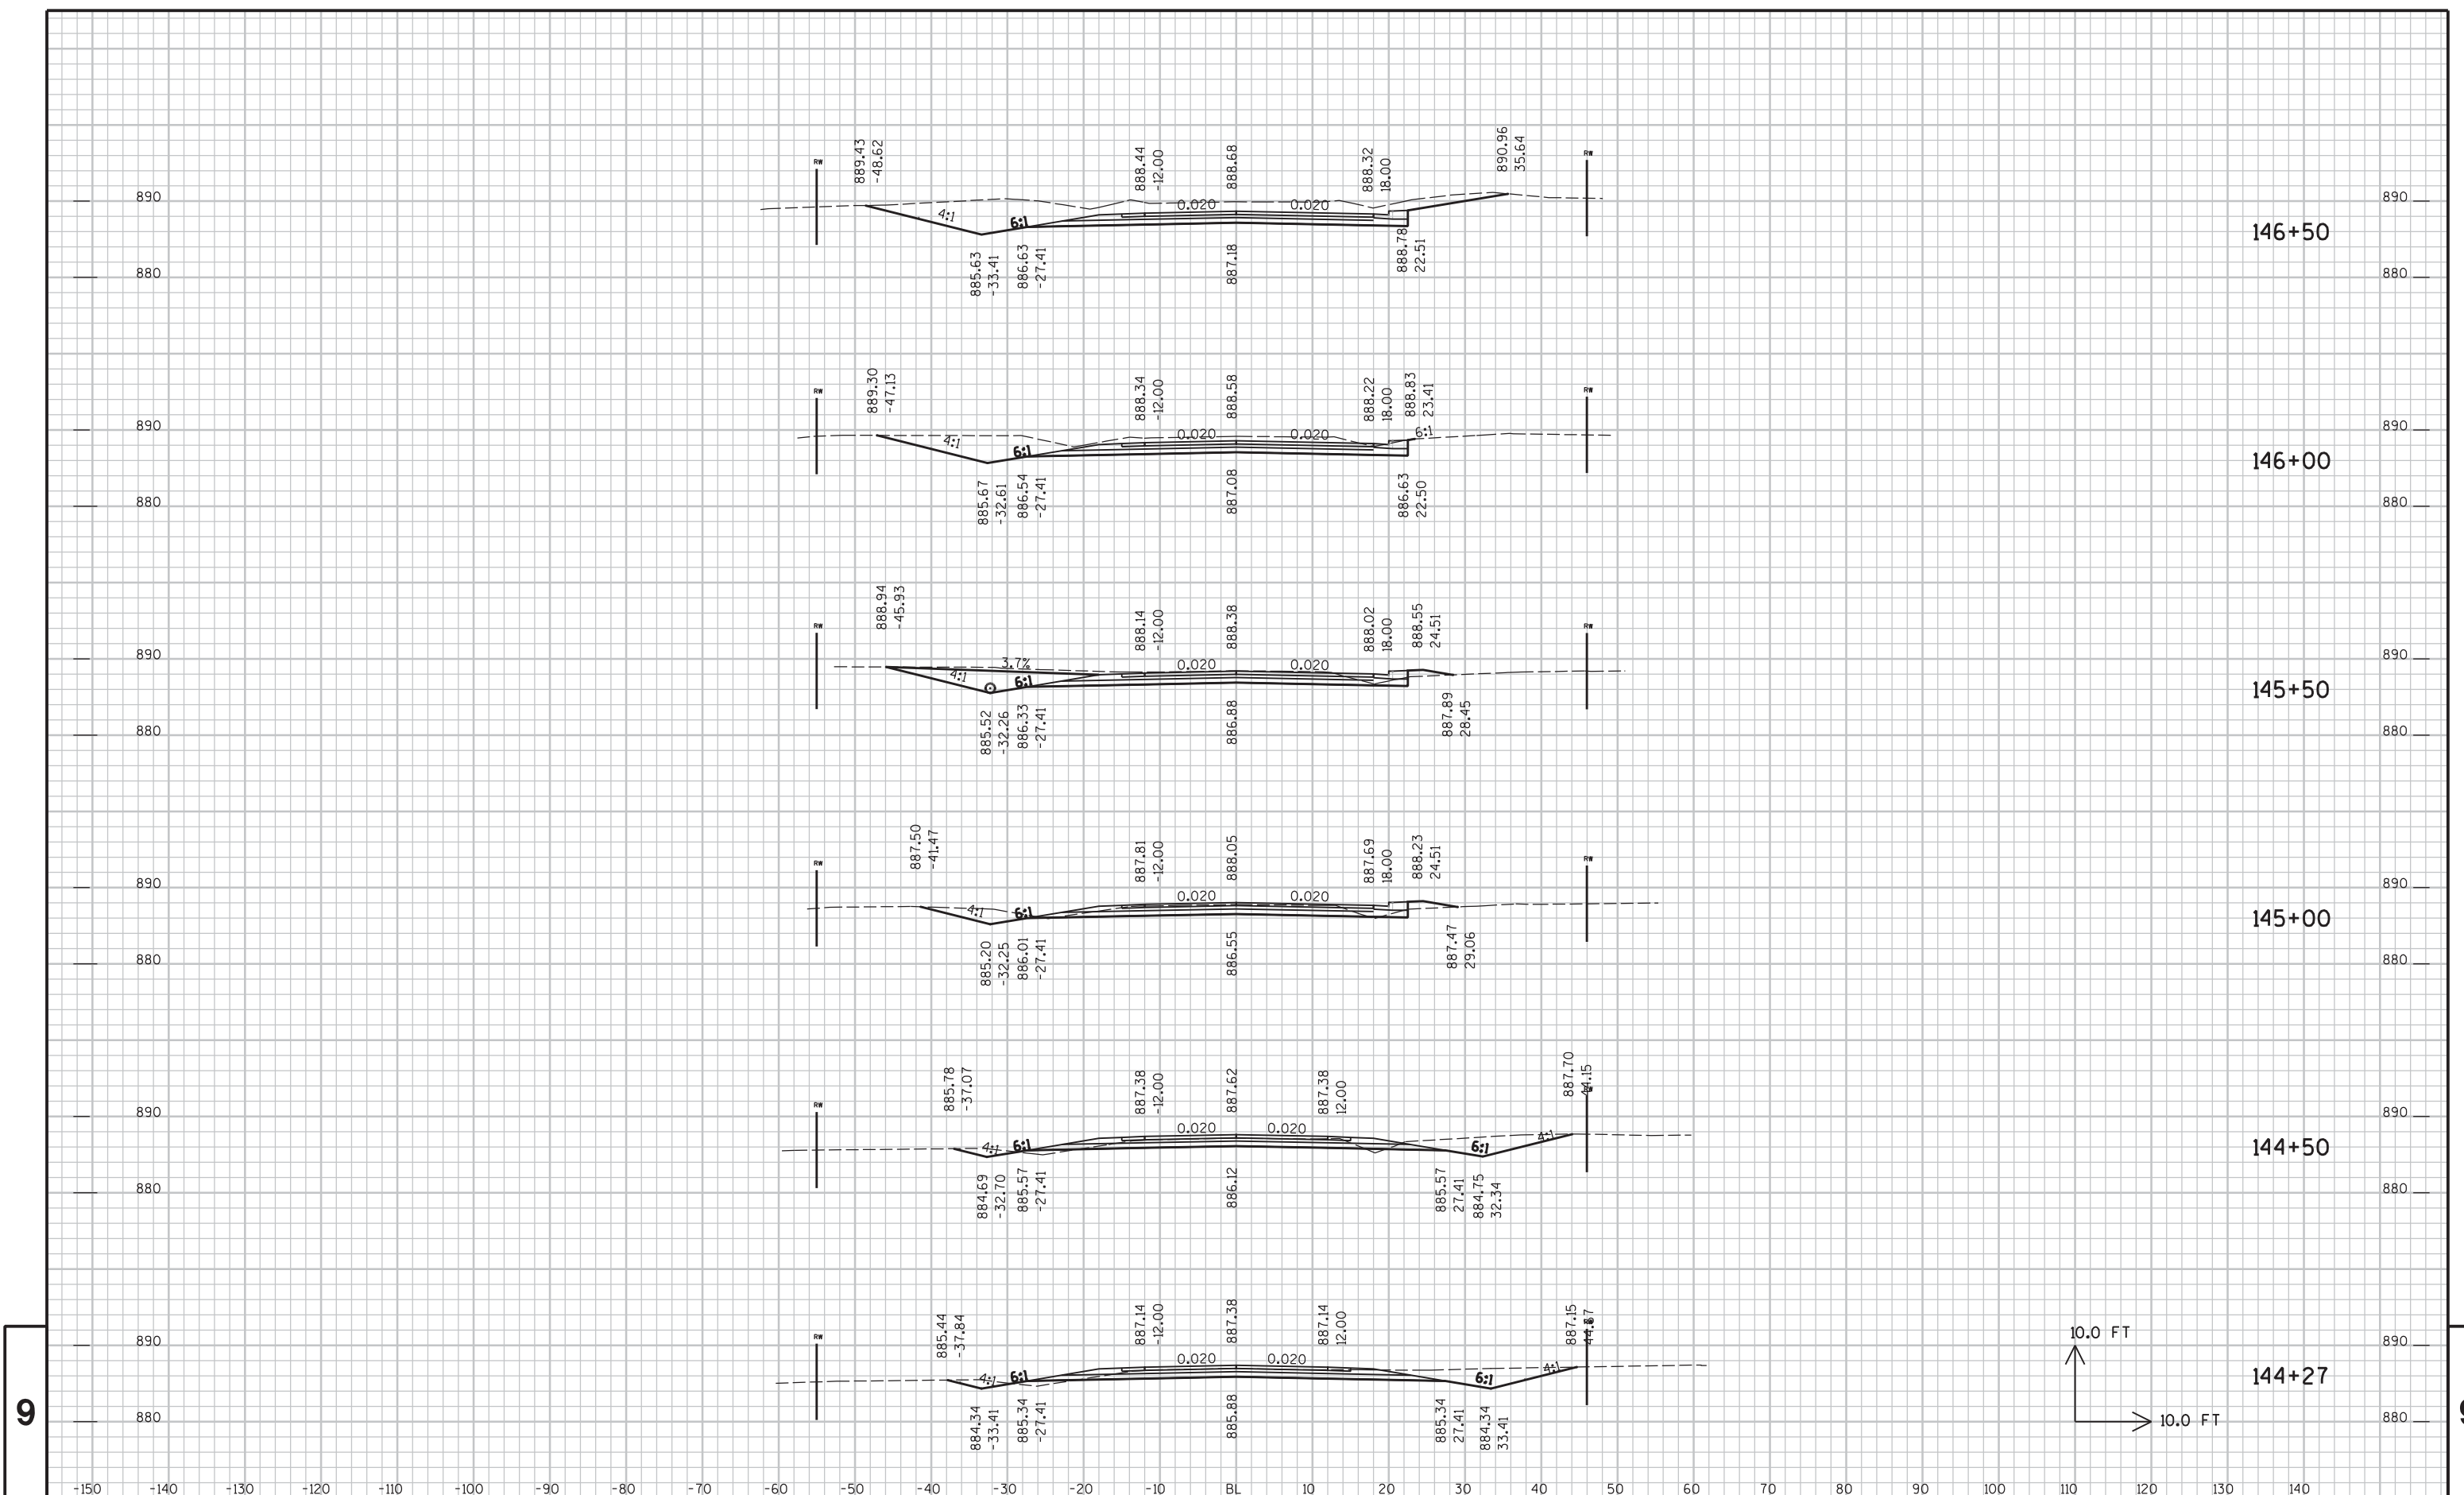

9


9

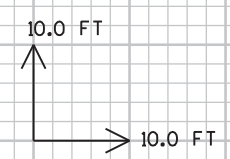


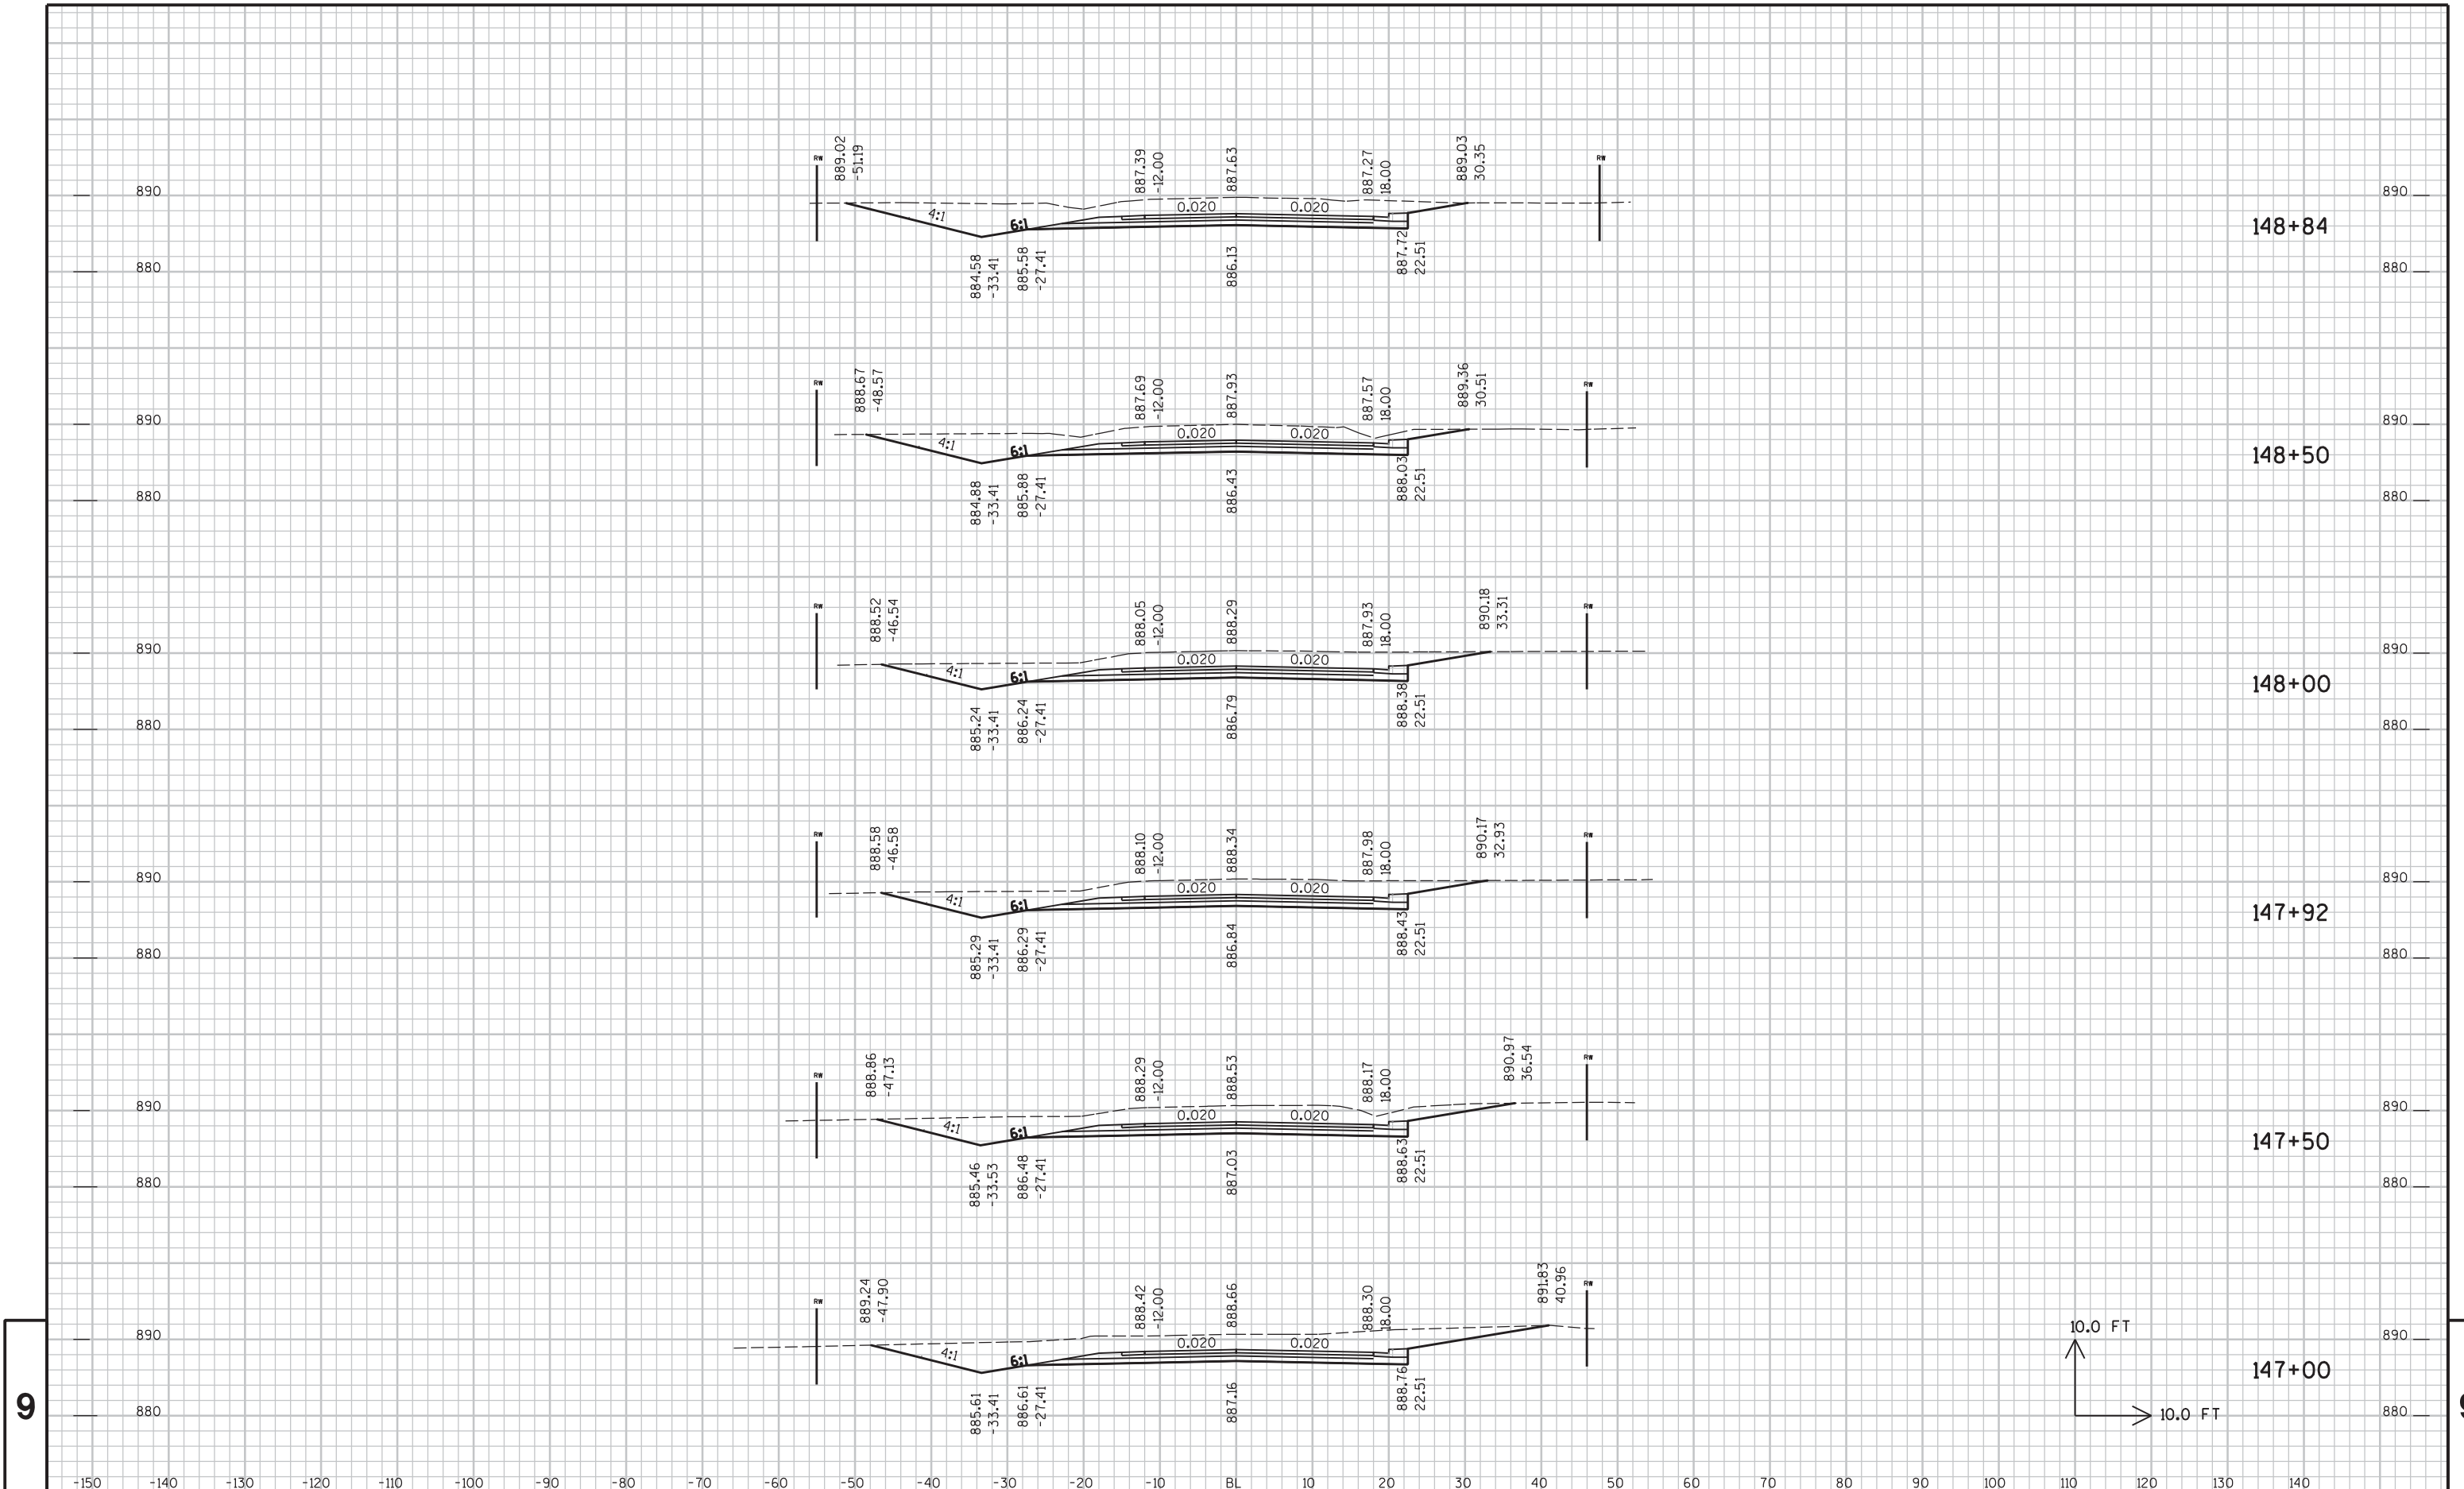

9


9

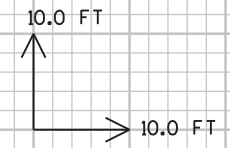


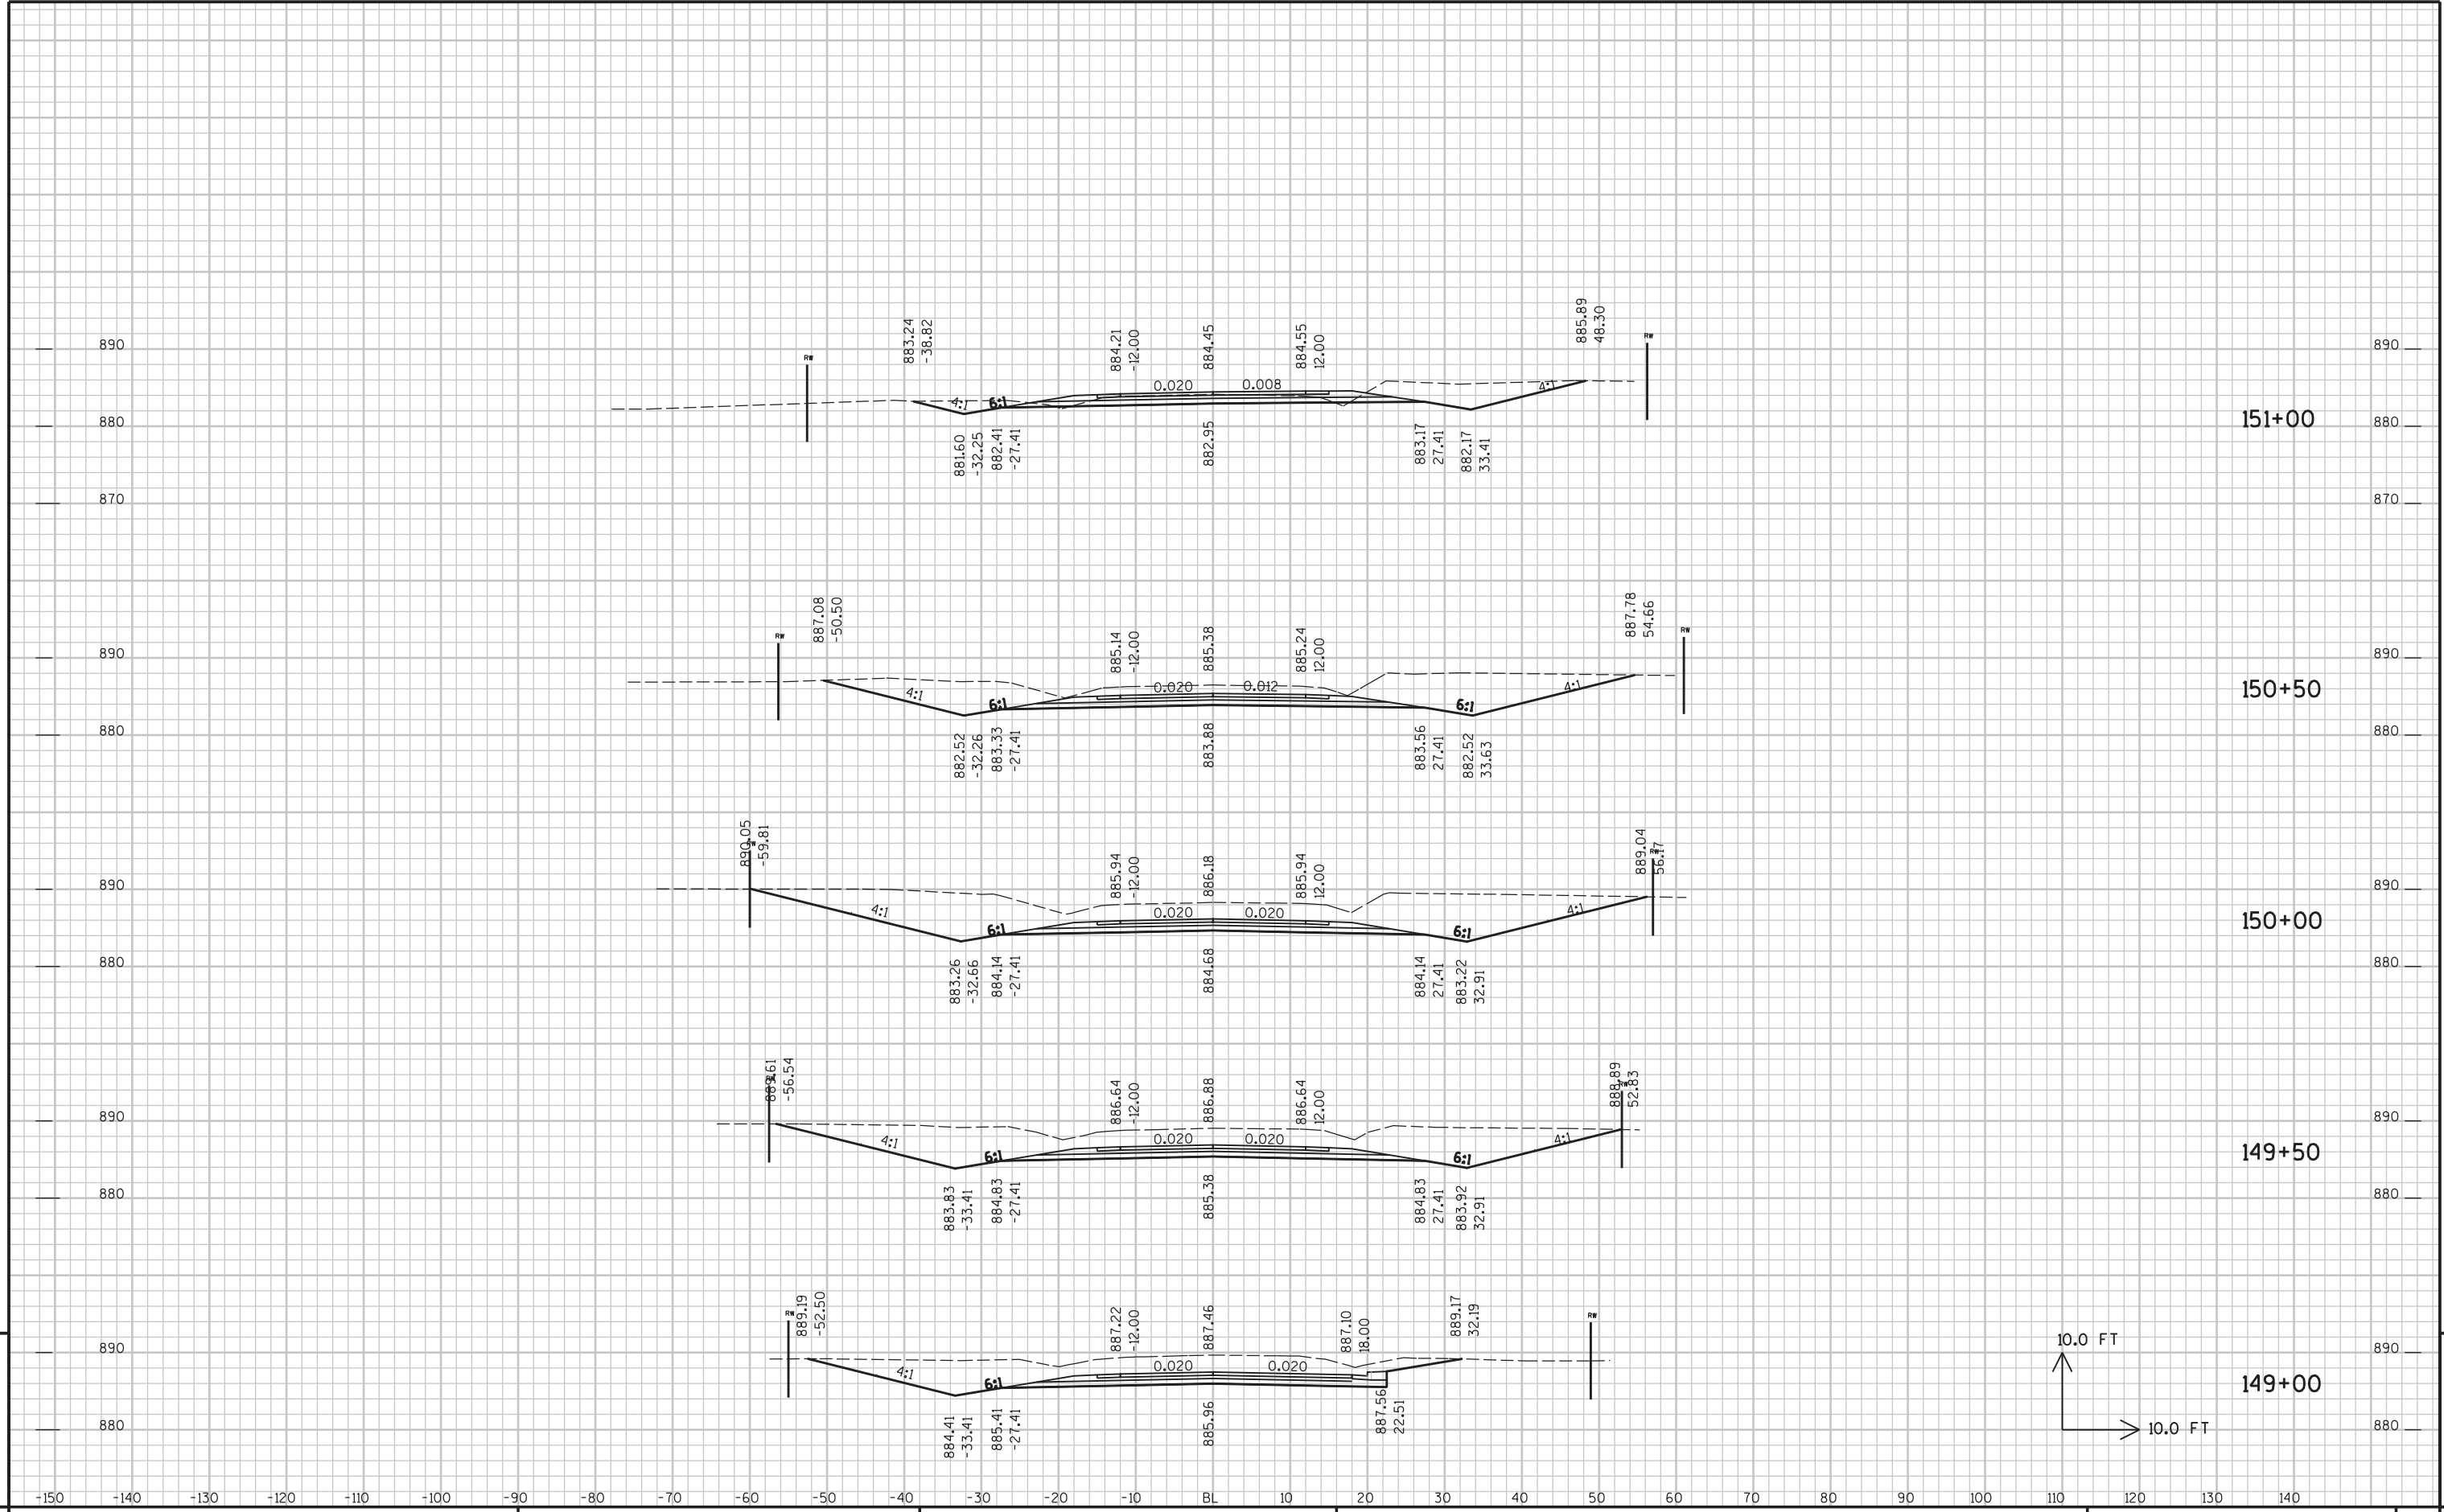

9


9

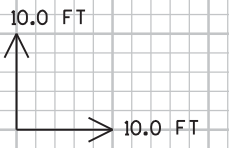

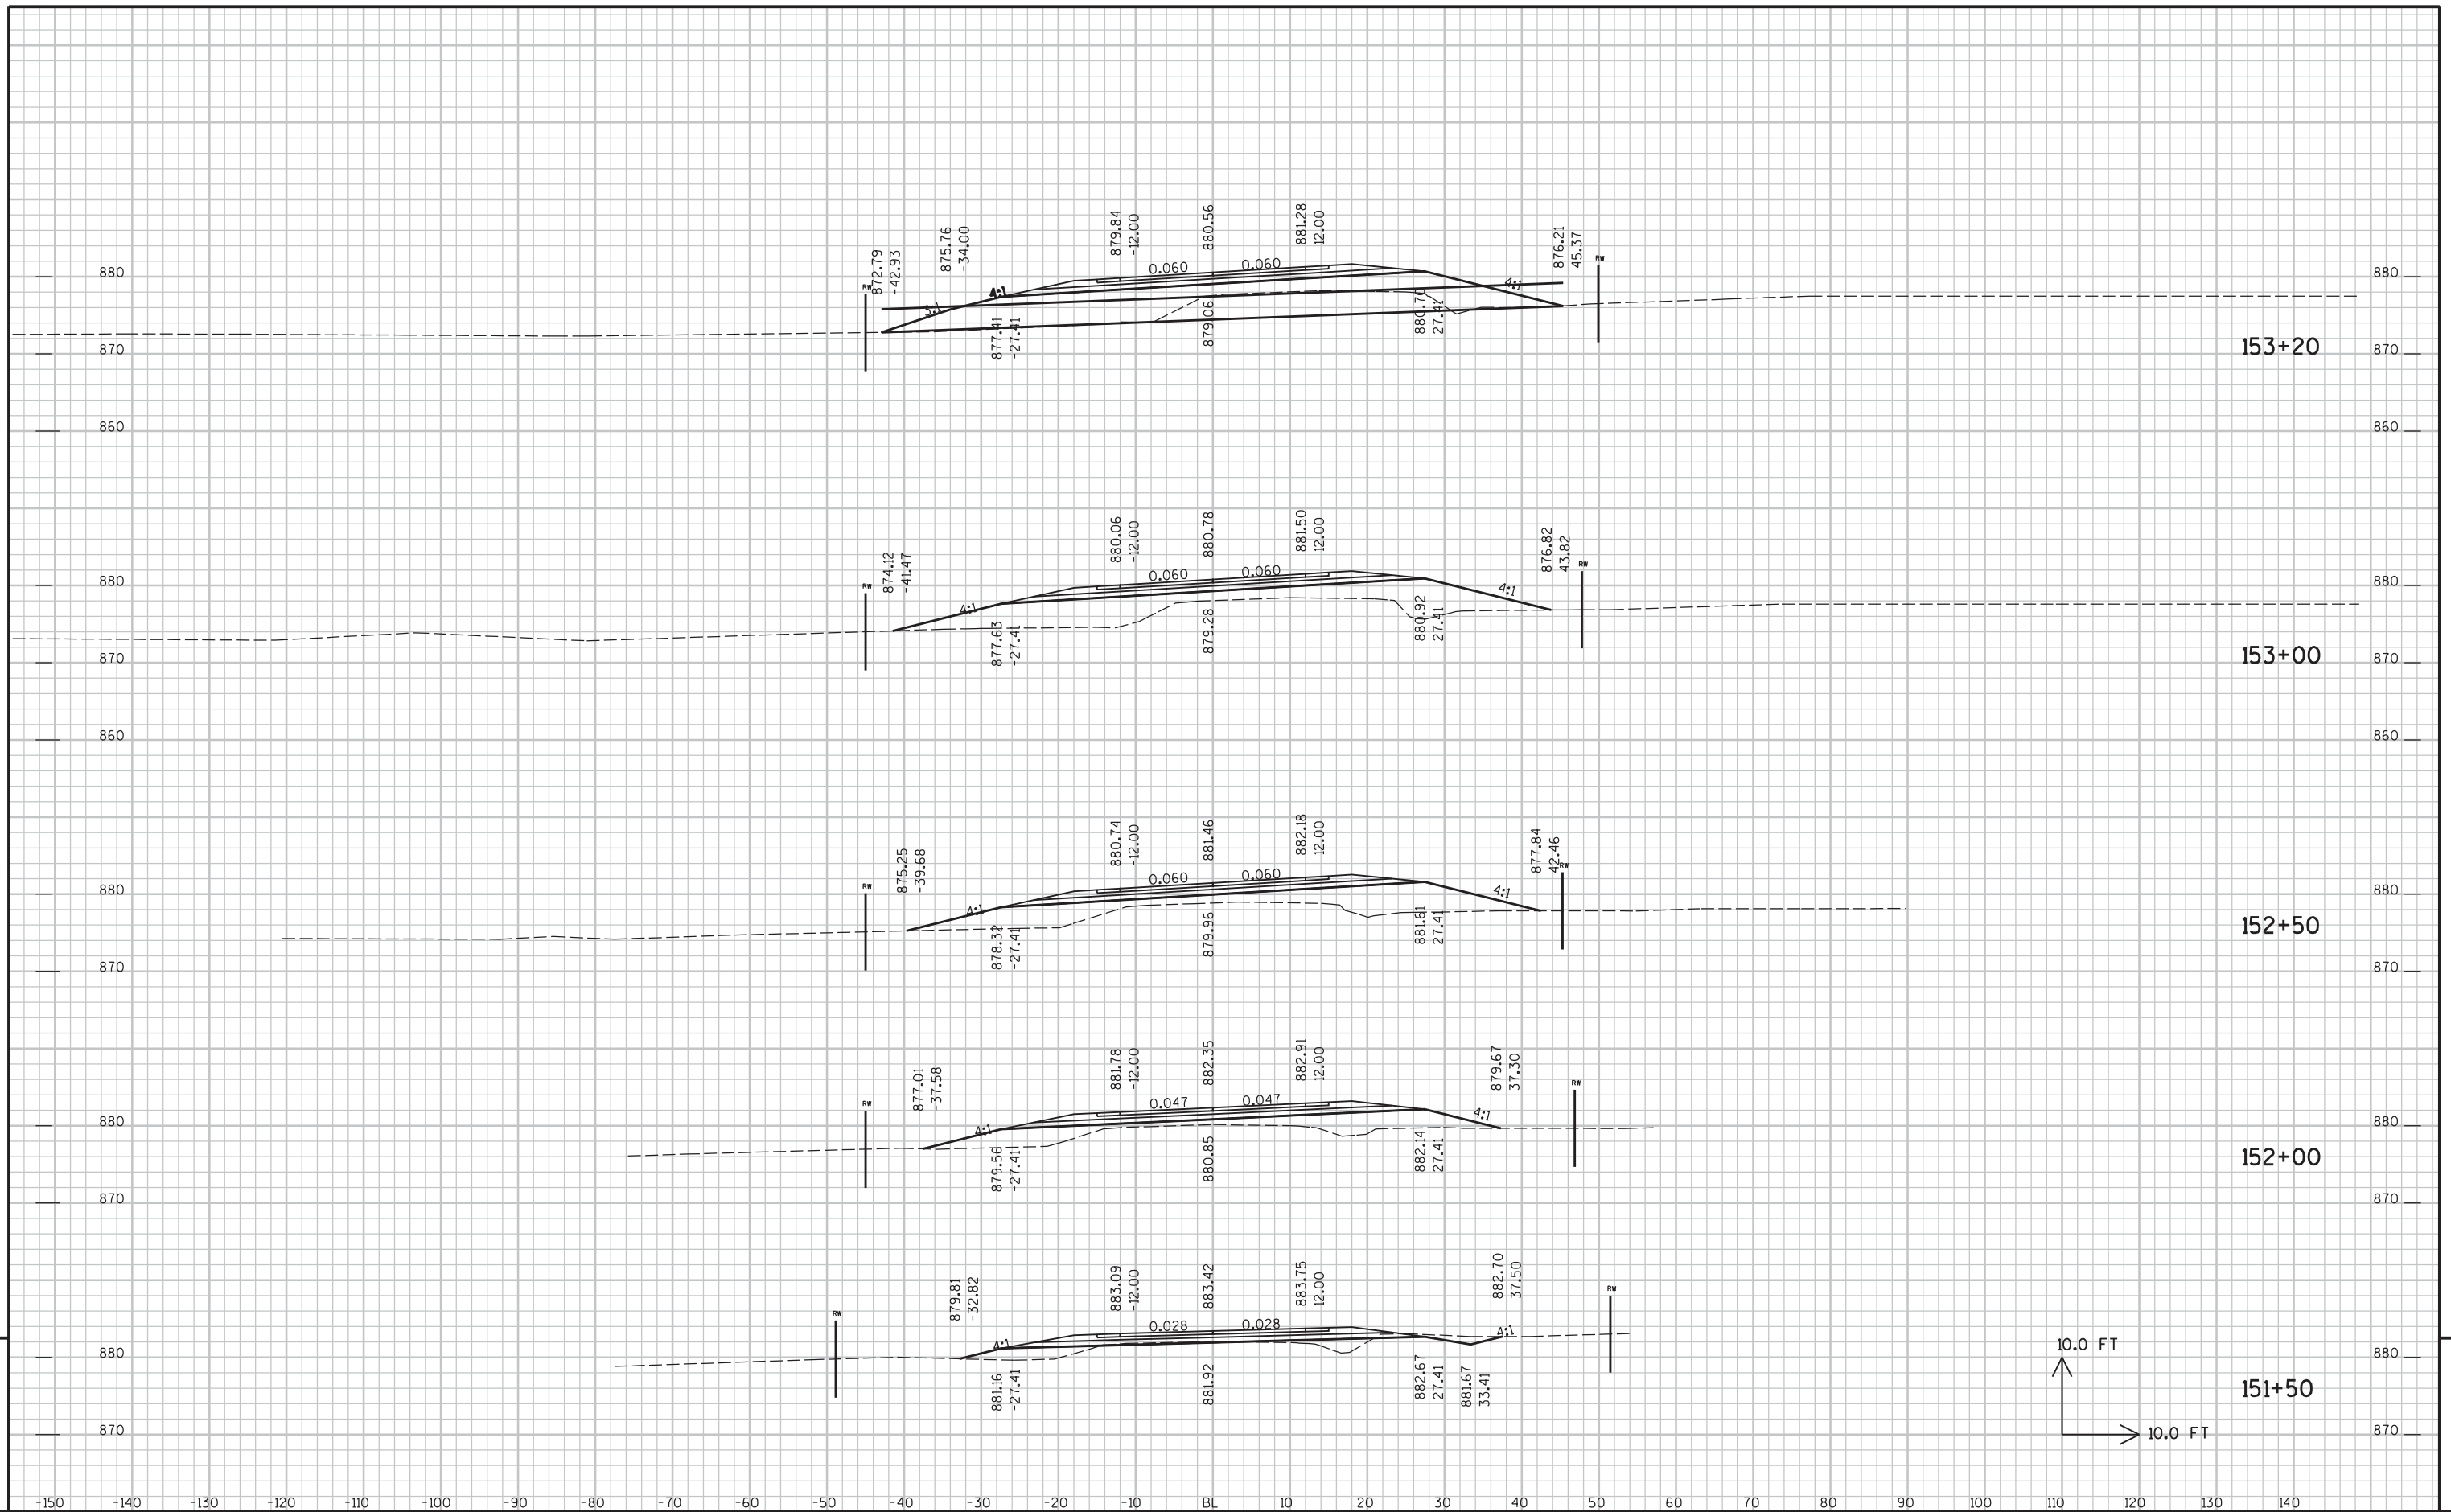


9

9

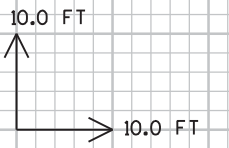


PROJECT NO :	HWY : CTH M	COUNTY : WINNEBAGO	CROSS SECTIONS - CTH M	SHEET NO: 61	E
--------------	-------------	--------------------	------------------------	--------------	---

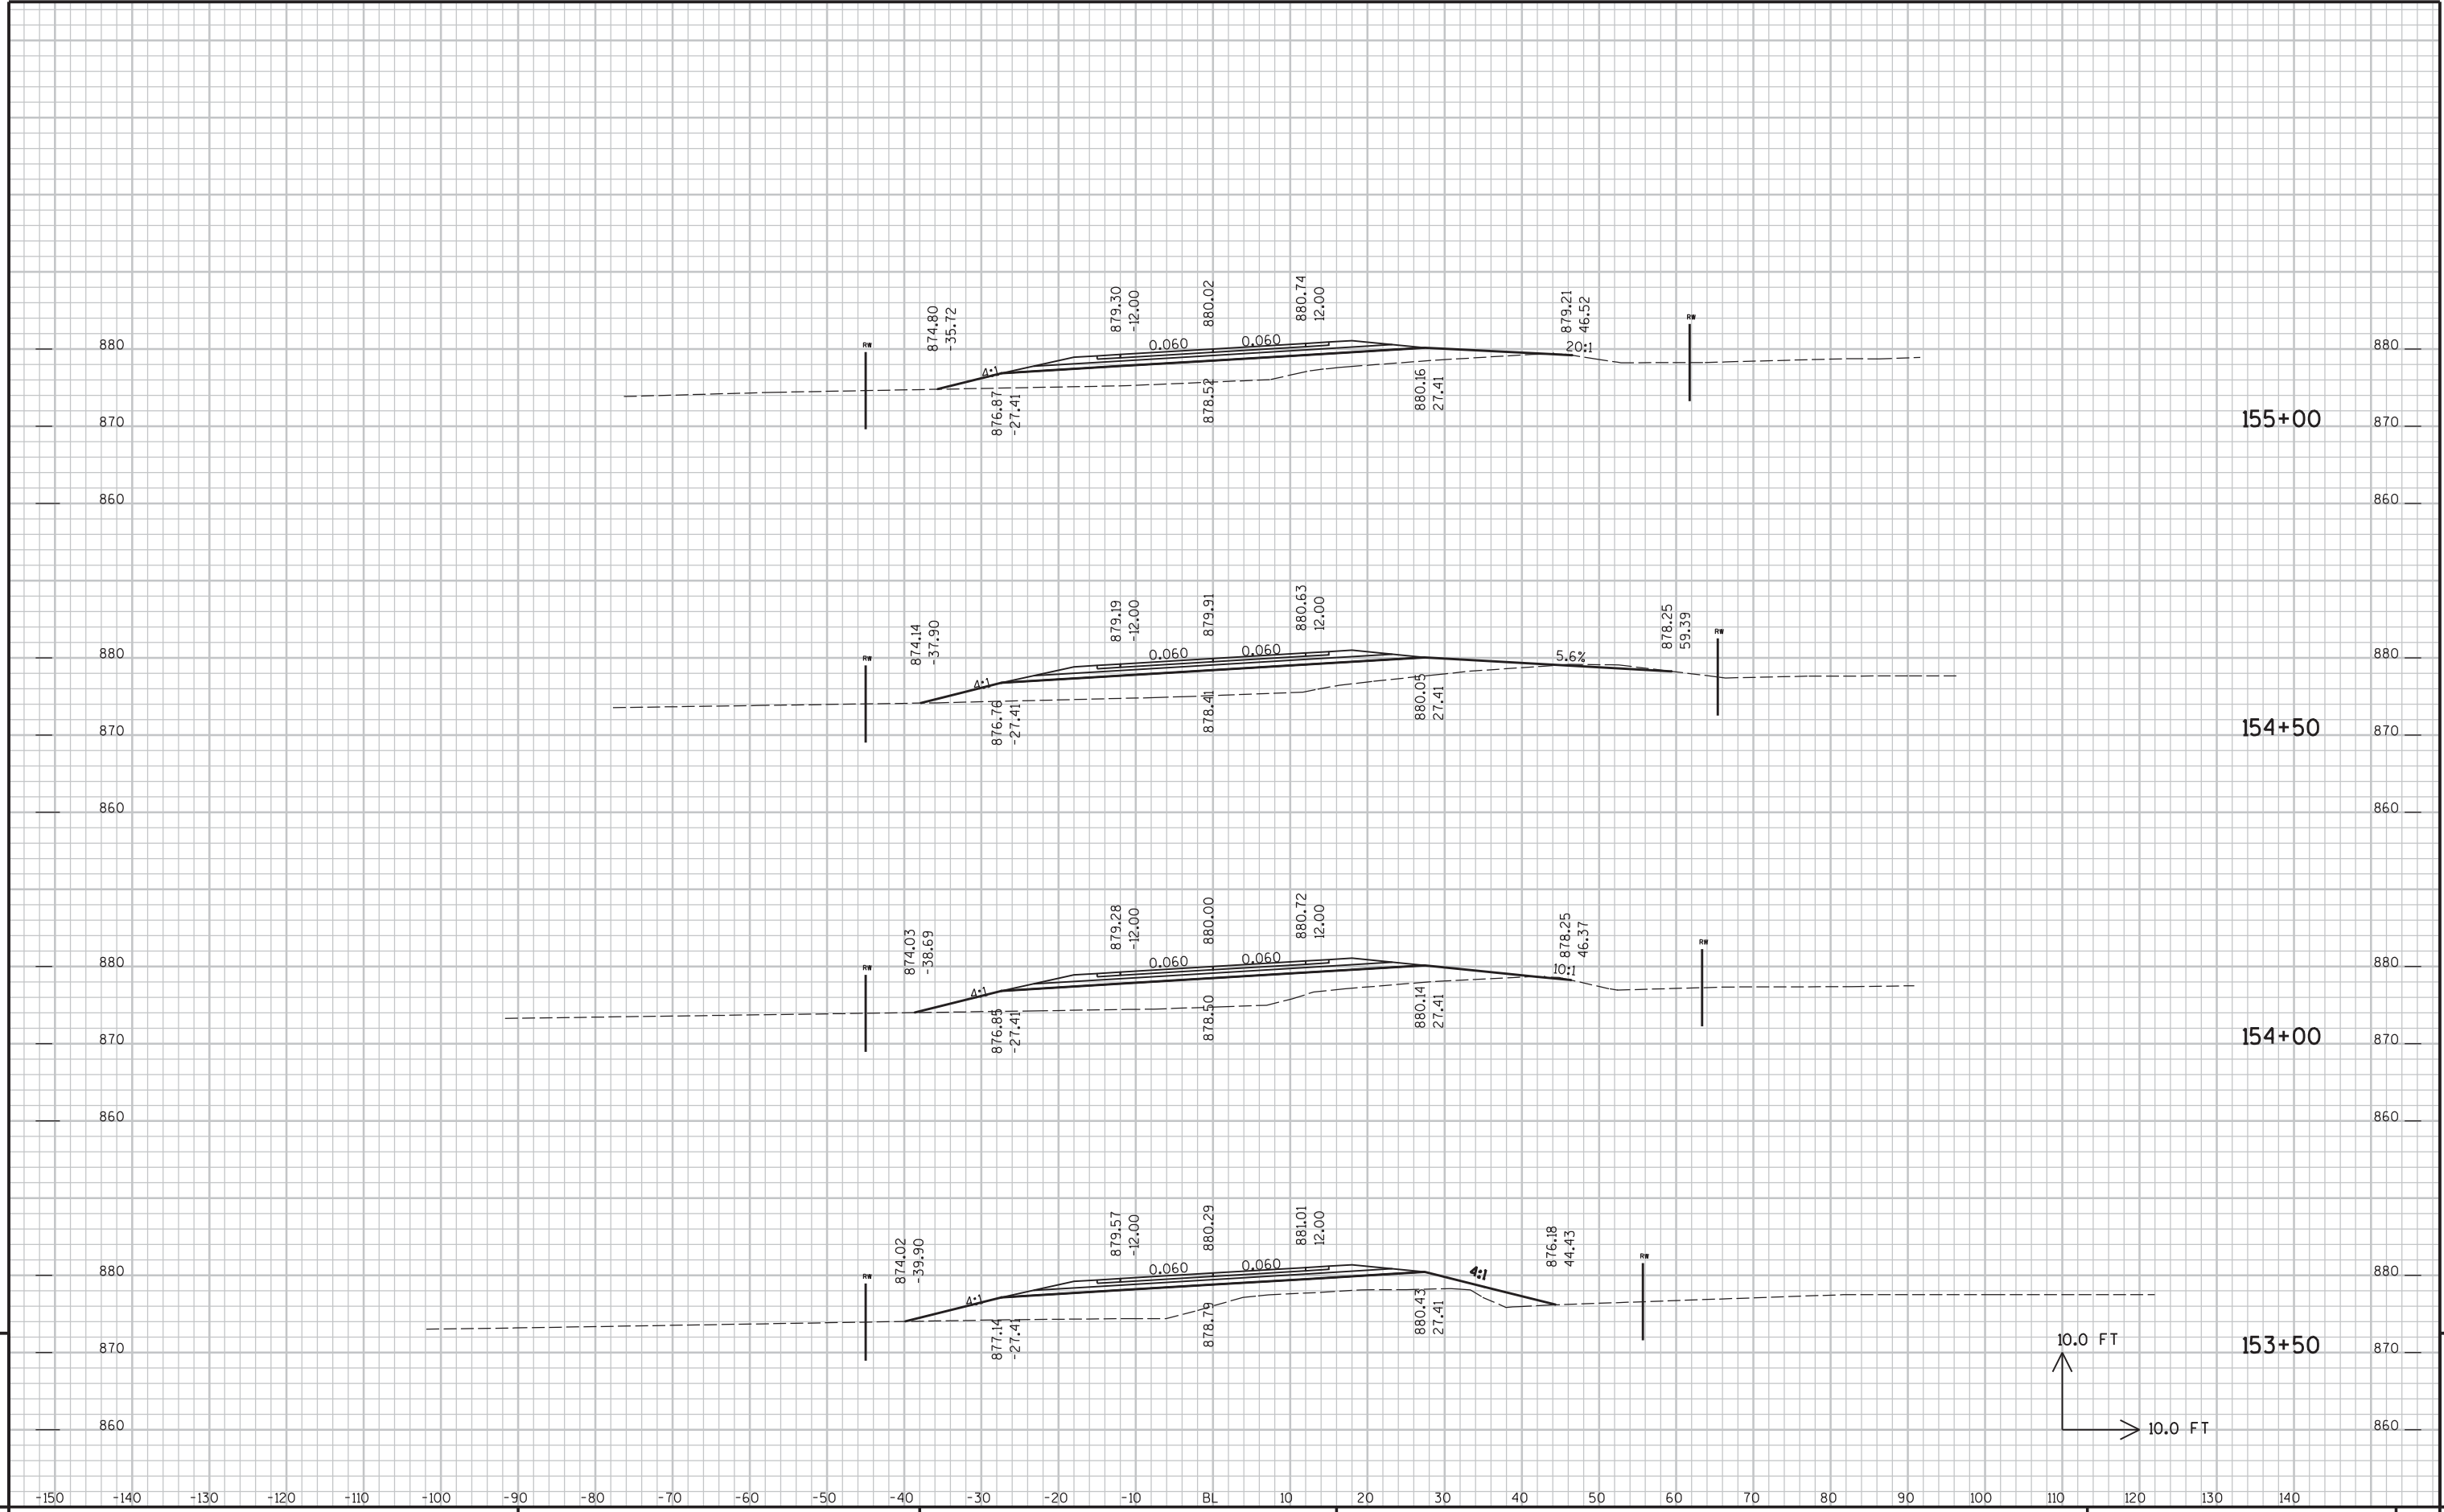



9

9

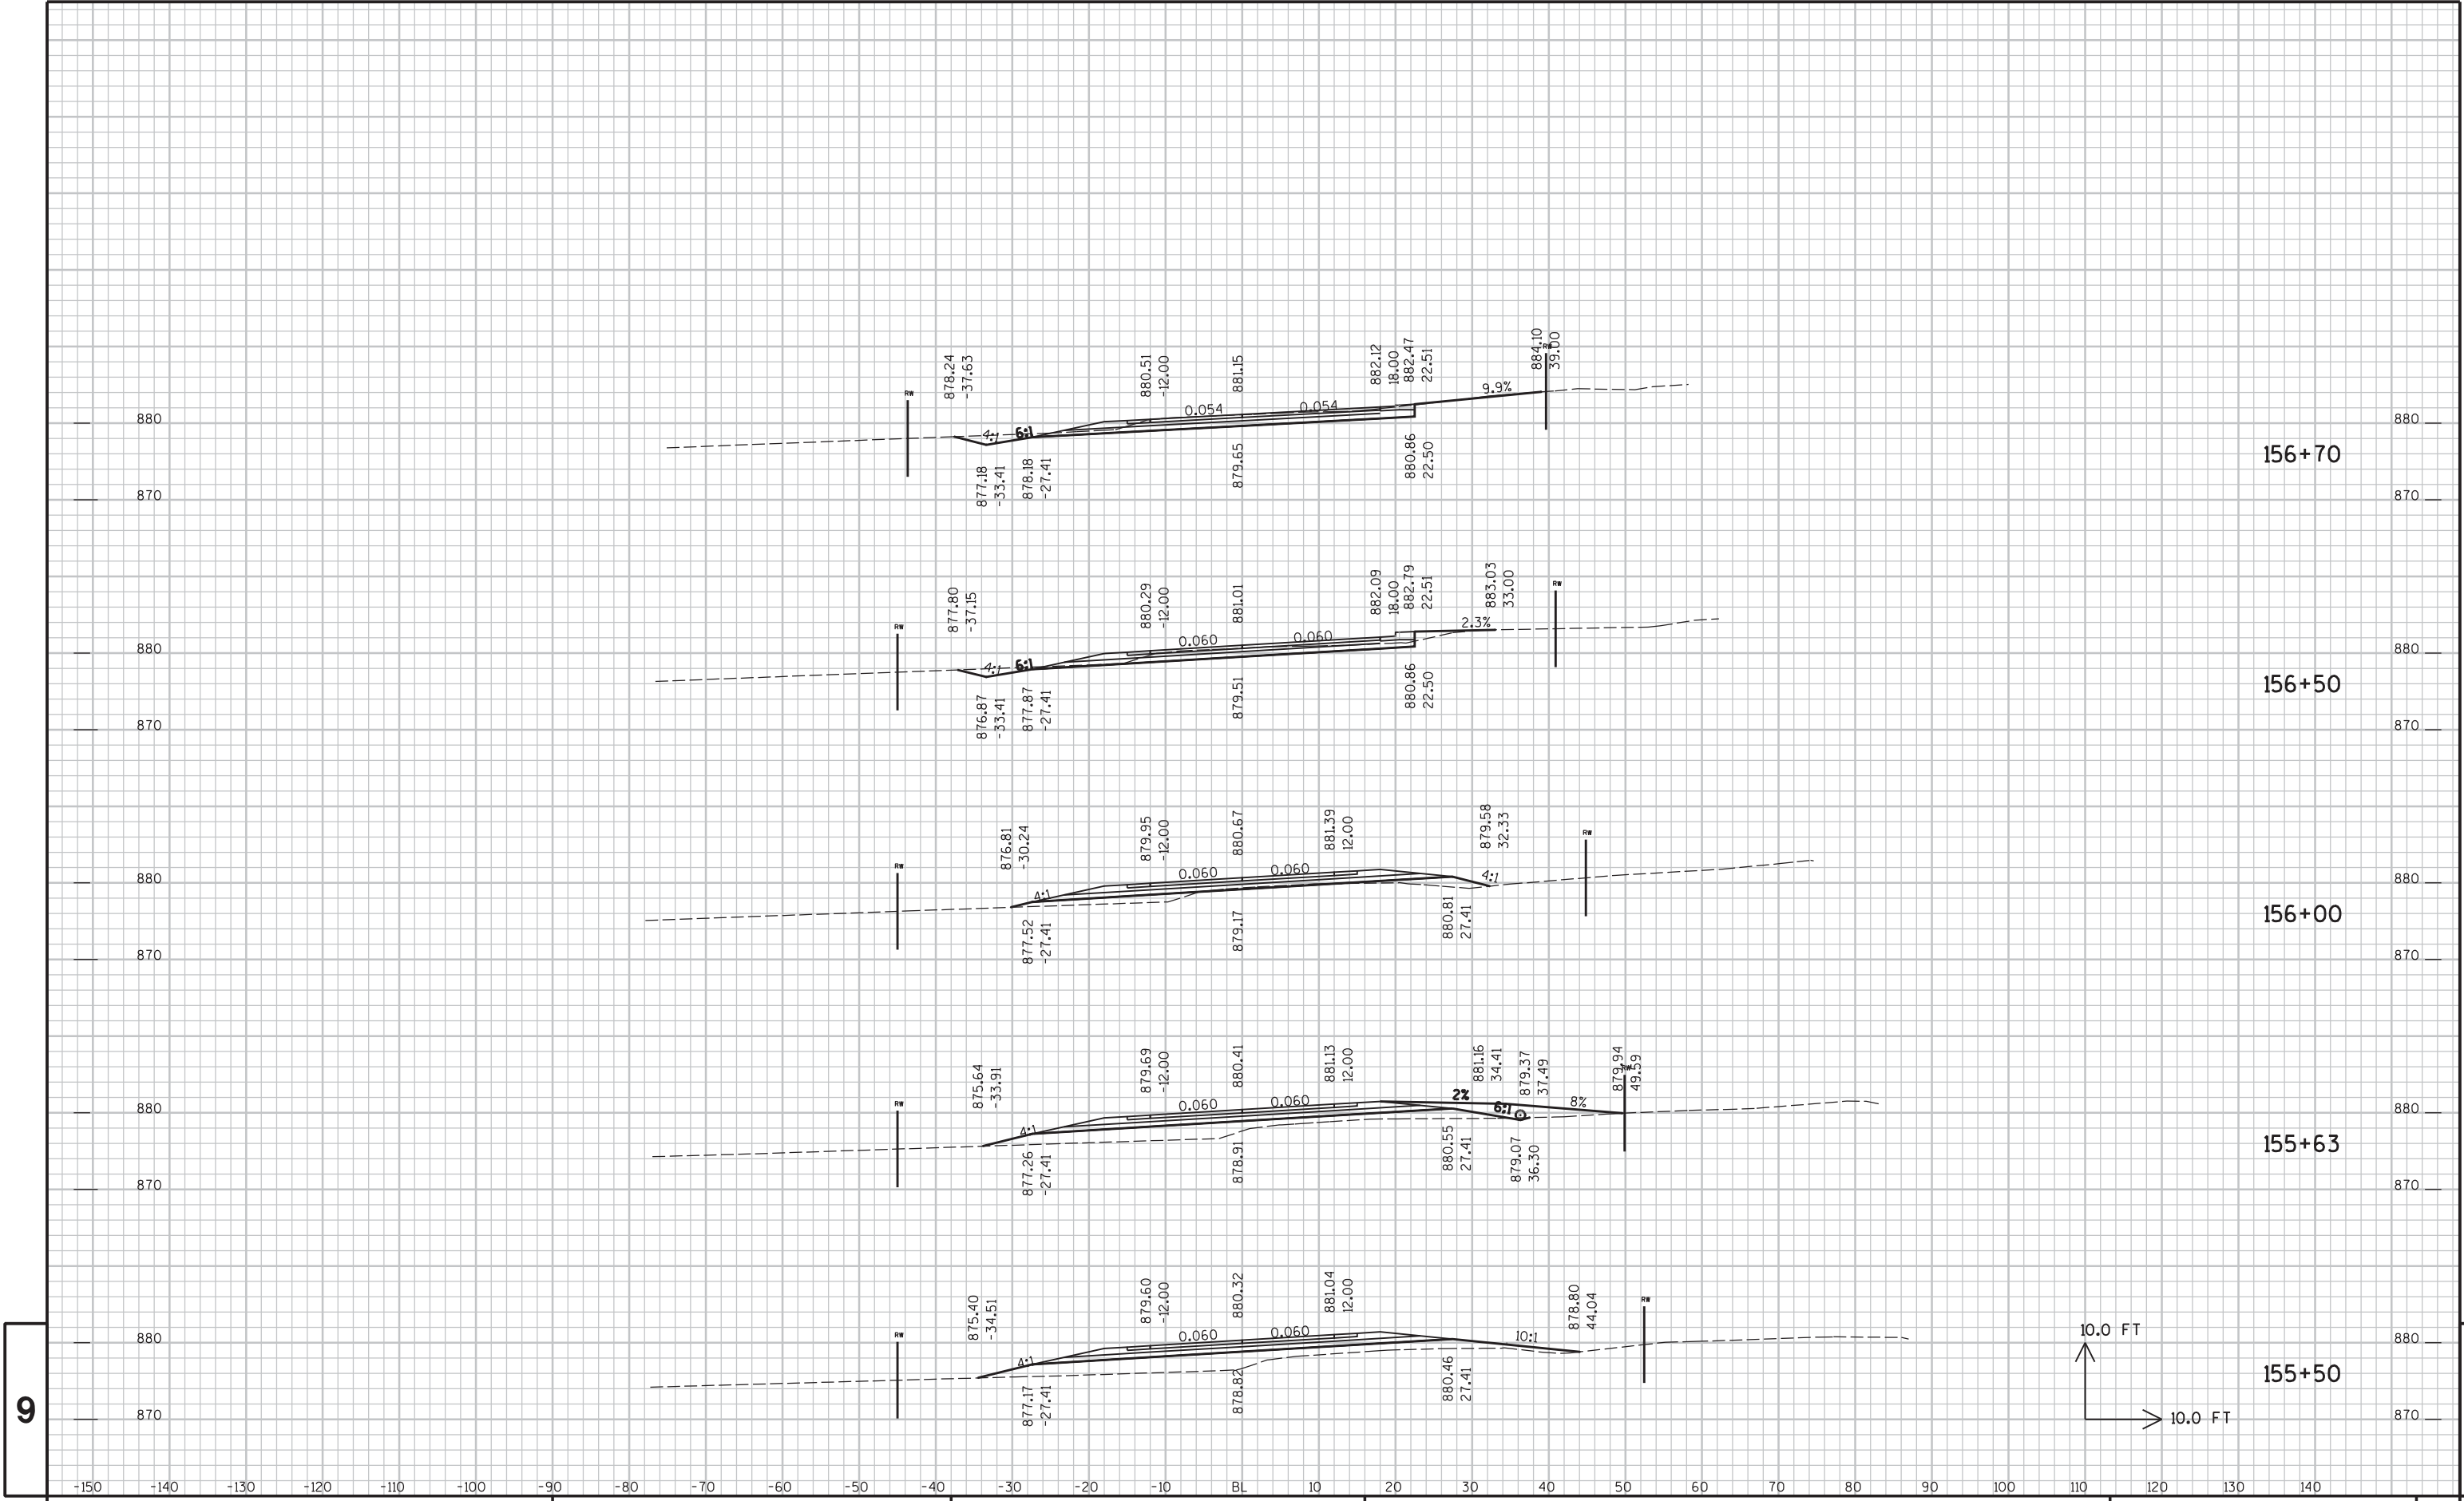



9	155+50	155+63	156+00	156+50	156+70	9																							
-150	-140	-130	-120	-110	-100	-90	-80	-70	-60	-50	-40	-30	-20	-10	BL	10	20	30	40	50	60	70	80	90	100	110	120	130	140
PROJECT NO :		HWY : CTH M				COUNTY : WINNEBAGO				CROSS SECTIONS - CTH M				SHEET NO: 63				E											
FILE NAME :		P:\UZ\W\WINNC\030200_CTH.M\CAD\XSCT\M 2013.DGN				PLOT TIME : 12:56:12 PM				PLOT DATE : 1/18/2013				PLOT BY : SEH				PLOT NAME :				PLOT SCALE : N/A							

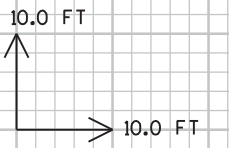


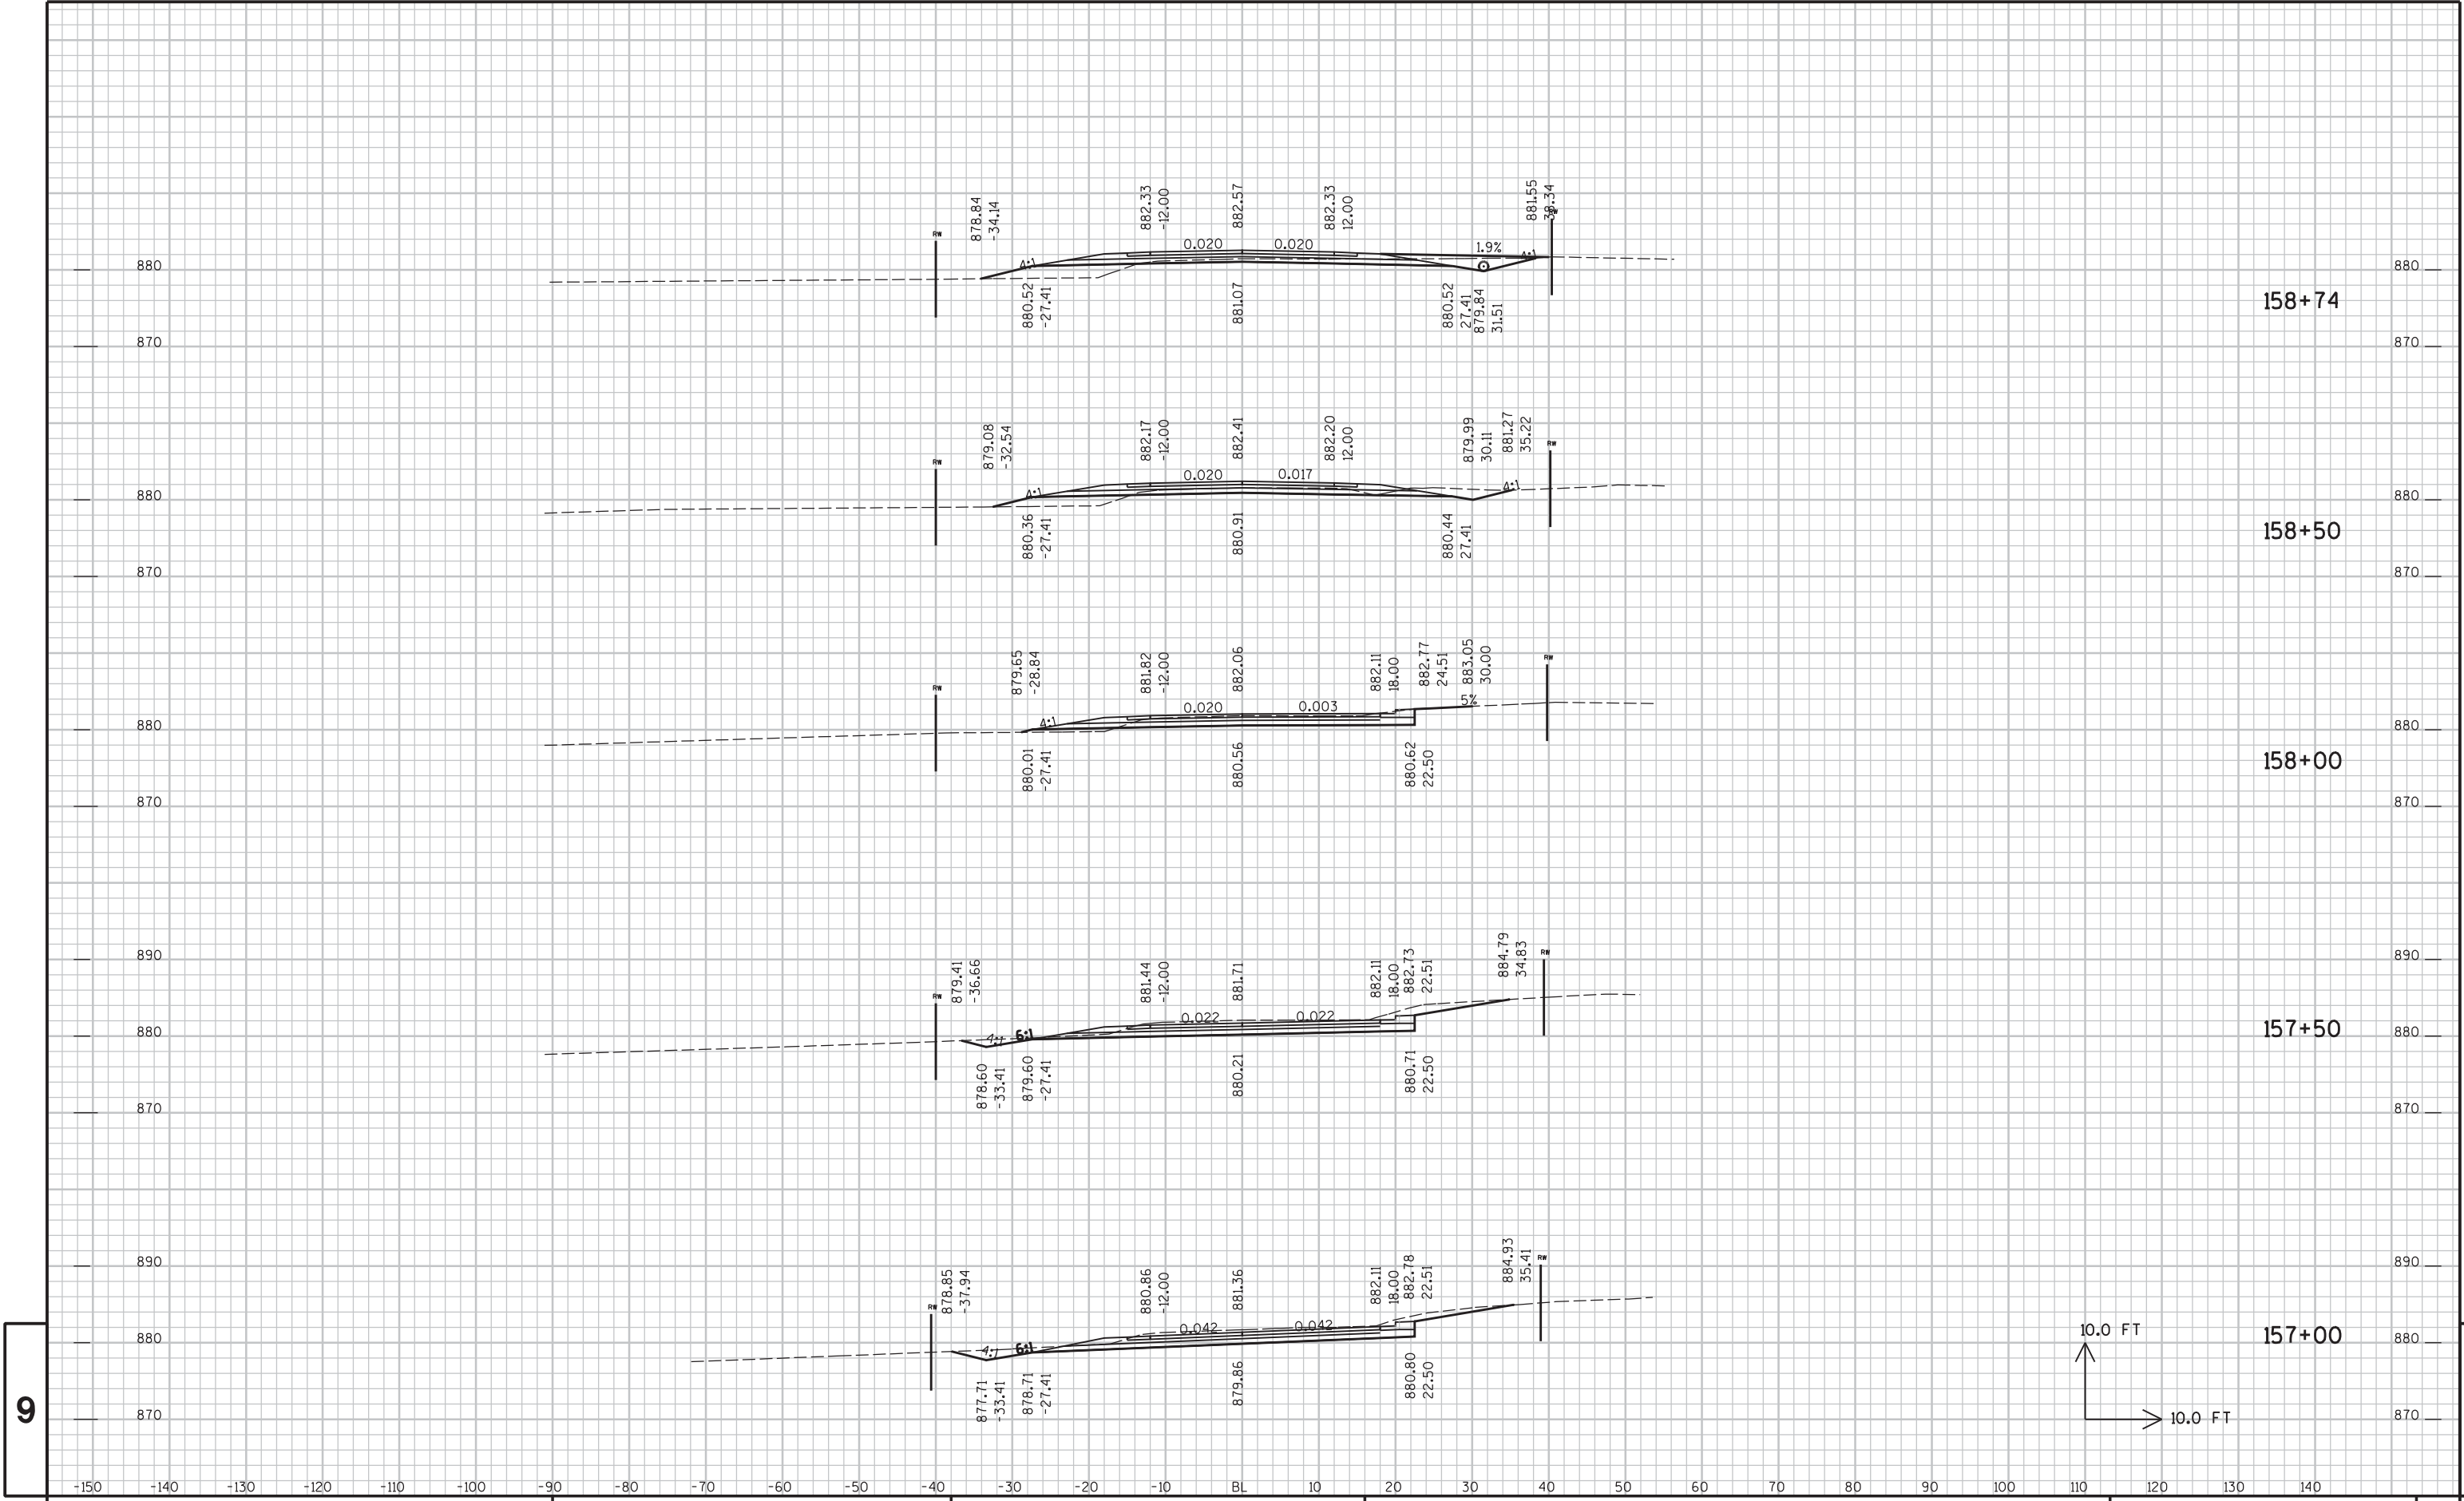

PROJECT NO : HWY : CTH M COUNTY : WINNEBAGO CROSS SECTIONS - CTH M SHEET NO: 64 E


FILE NAME : P:\UZ\W\WINNC\030200_CTH_M\CAD\XSCTHM 2013.DGN PLOT TIME : 12:56:12 PM PLOT DATE : 1/18/2013 PLOT BY : SEH PLOT NAME : PLOT SCALE : N/A

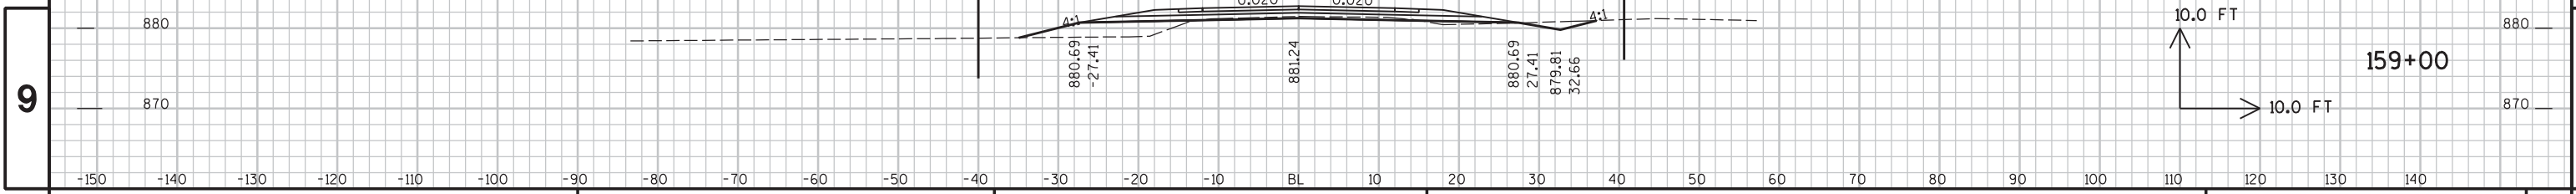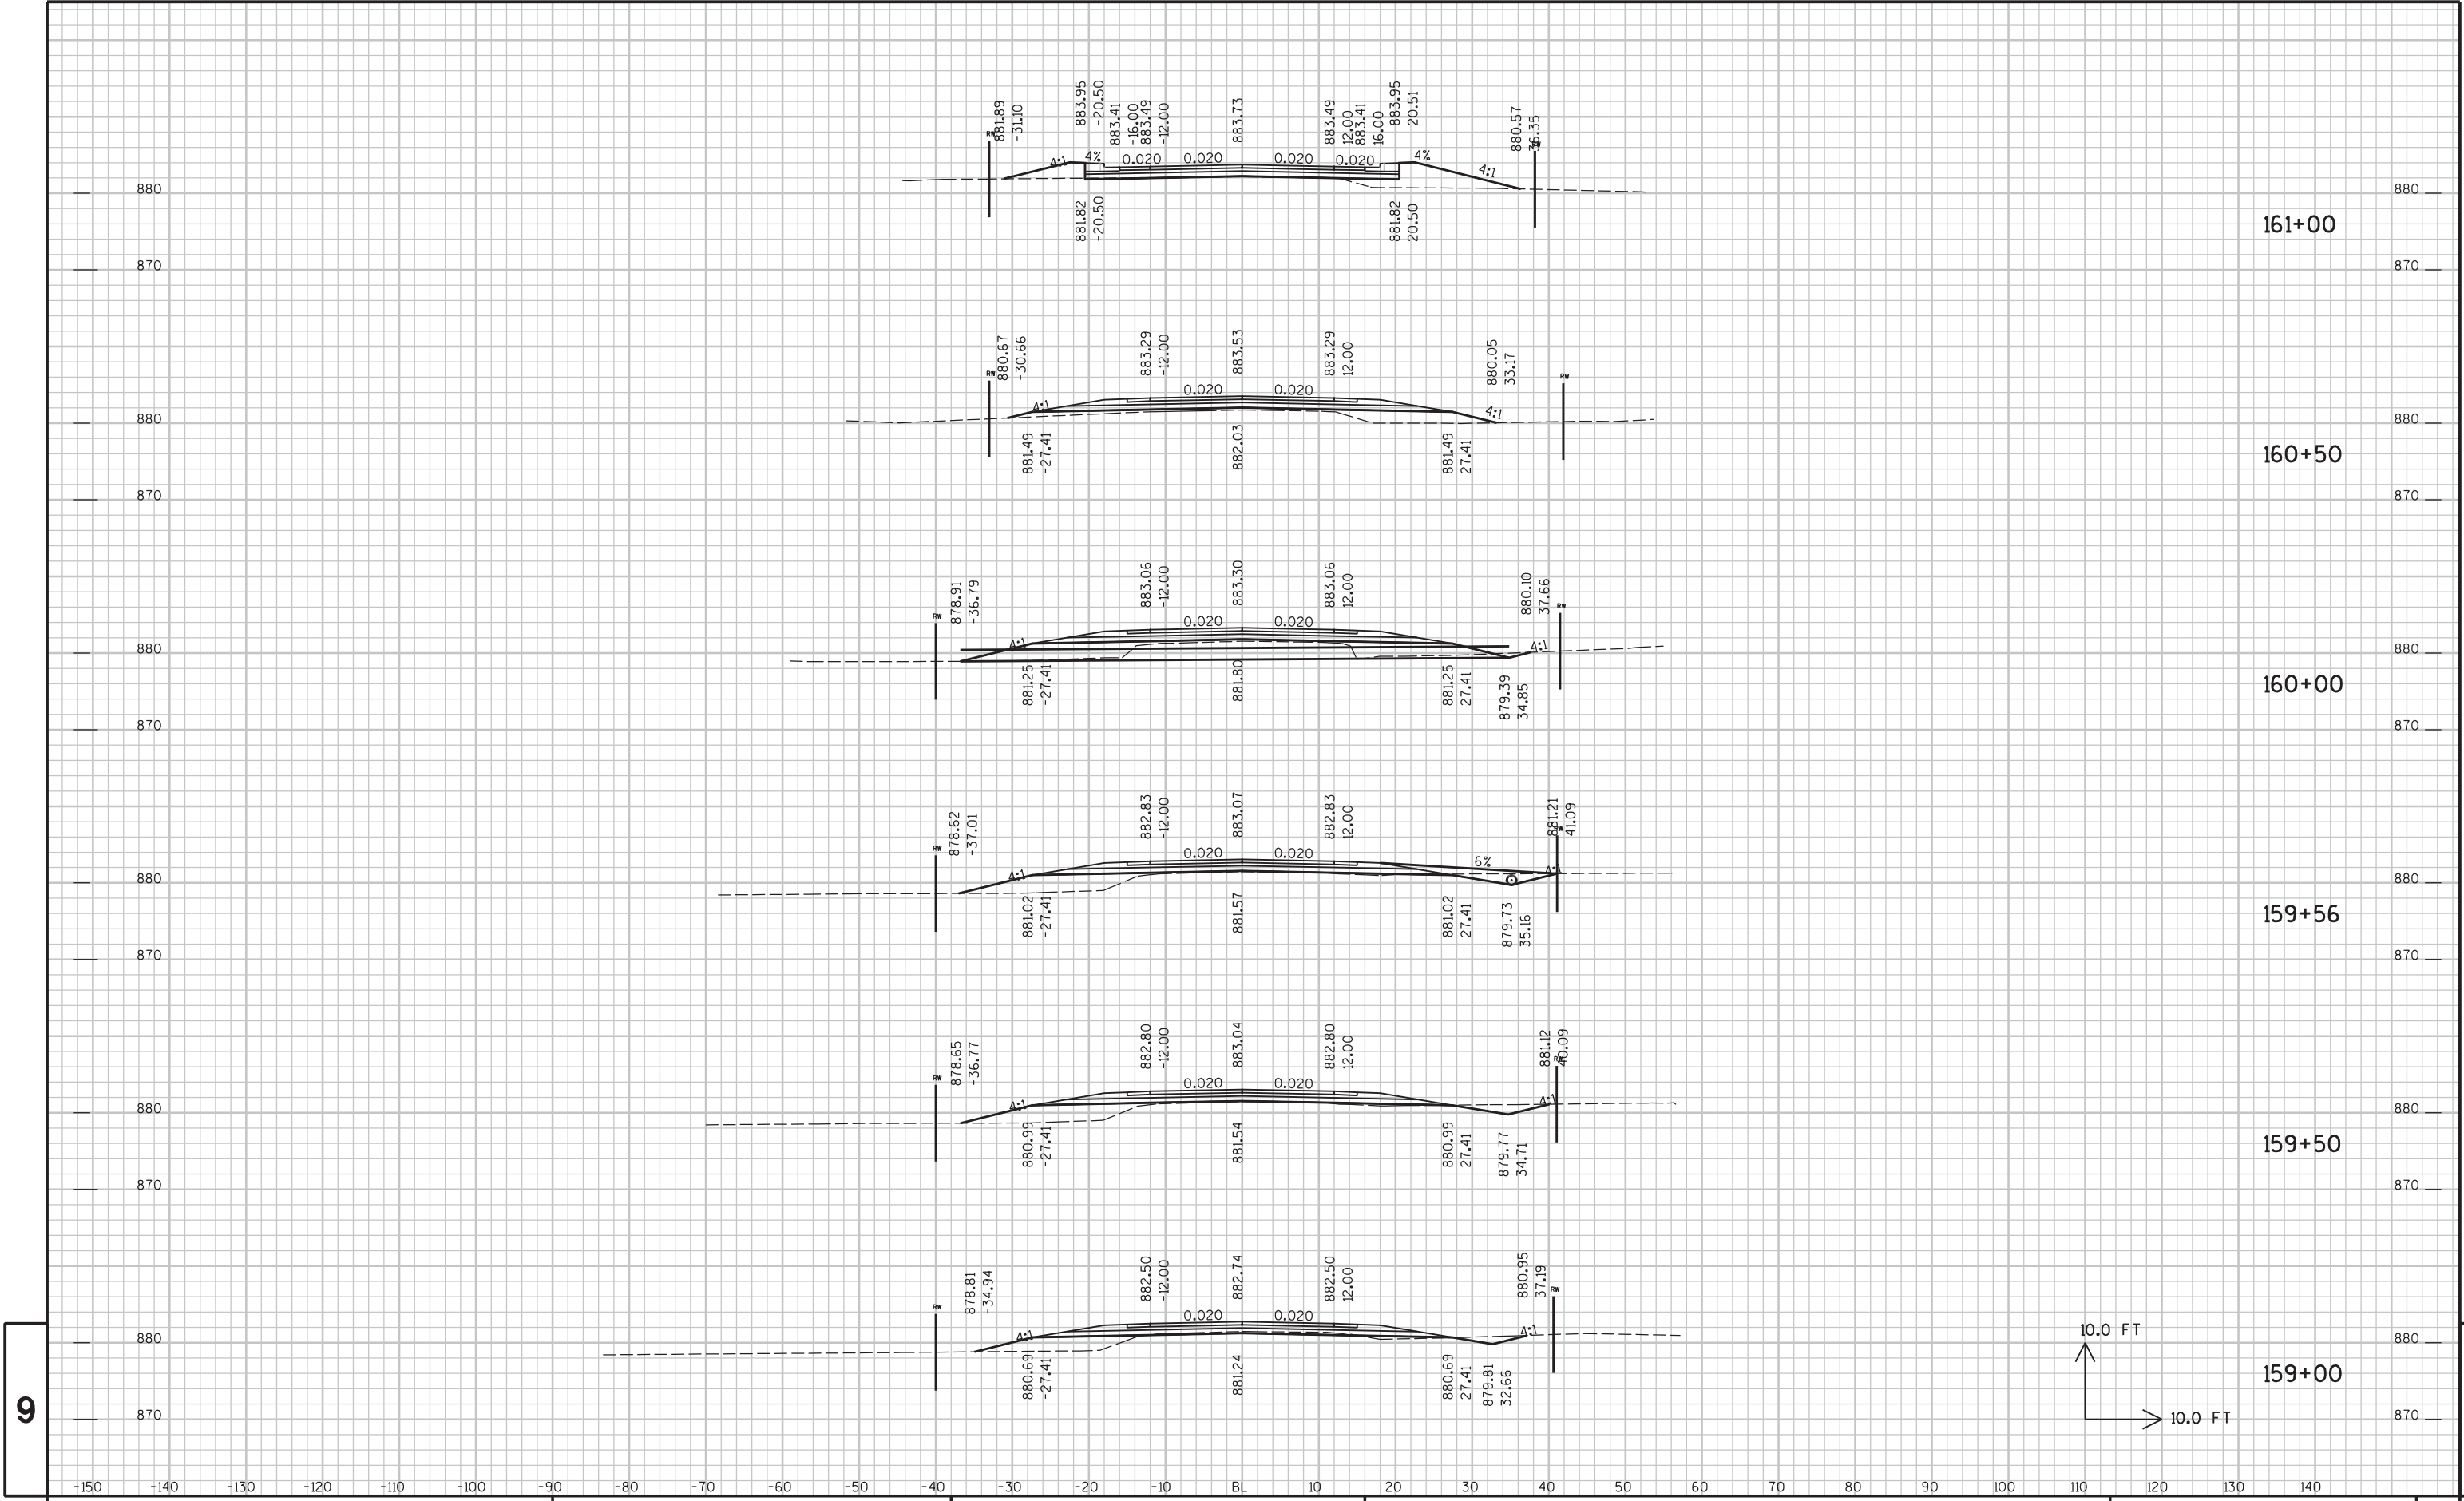

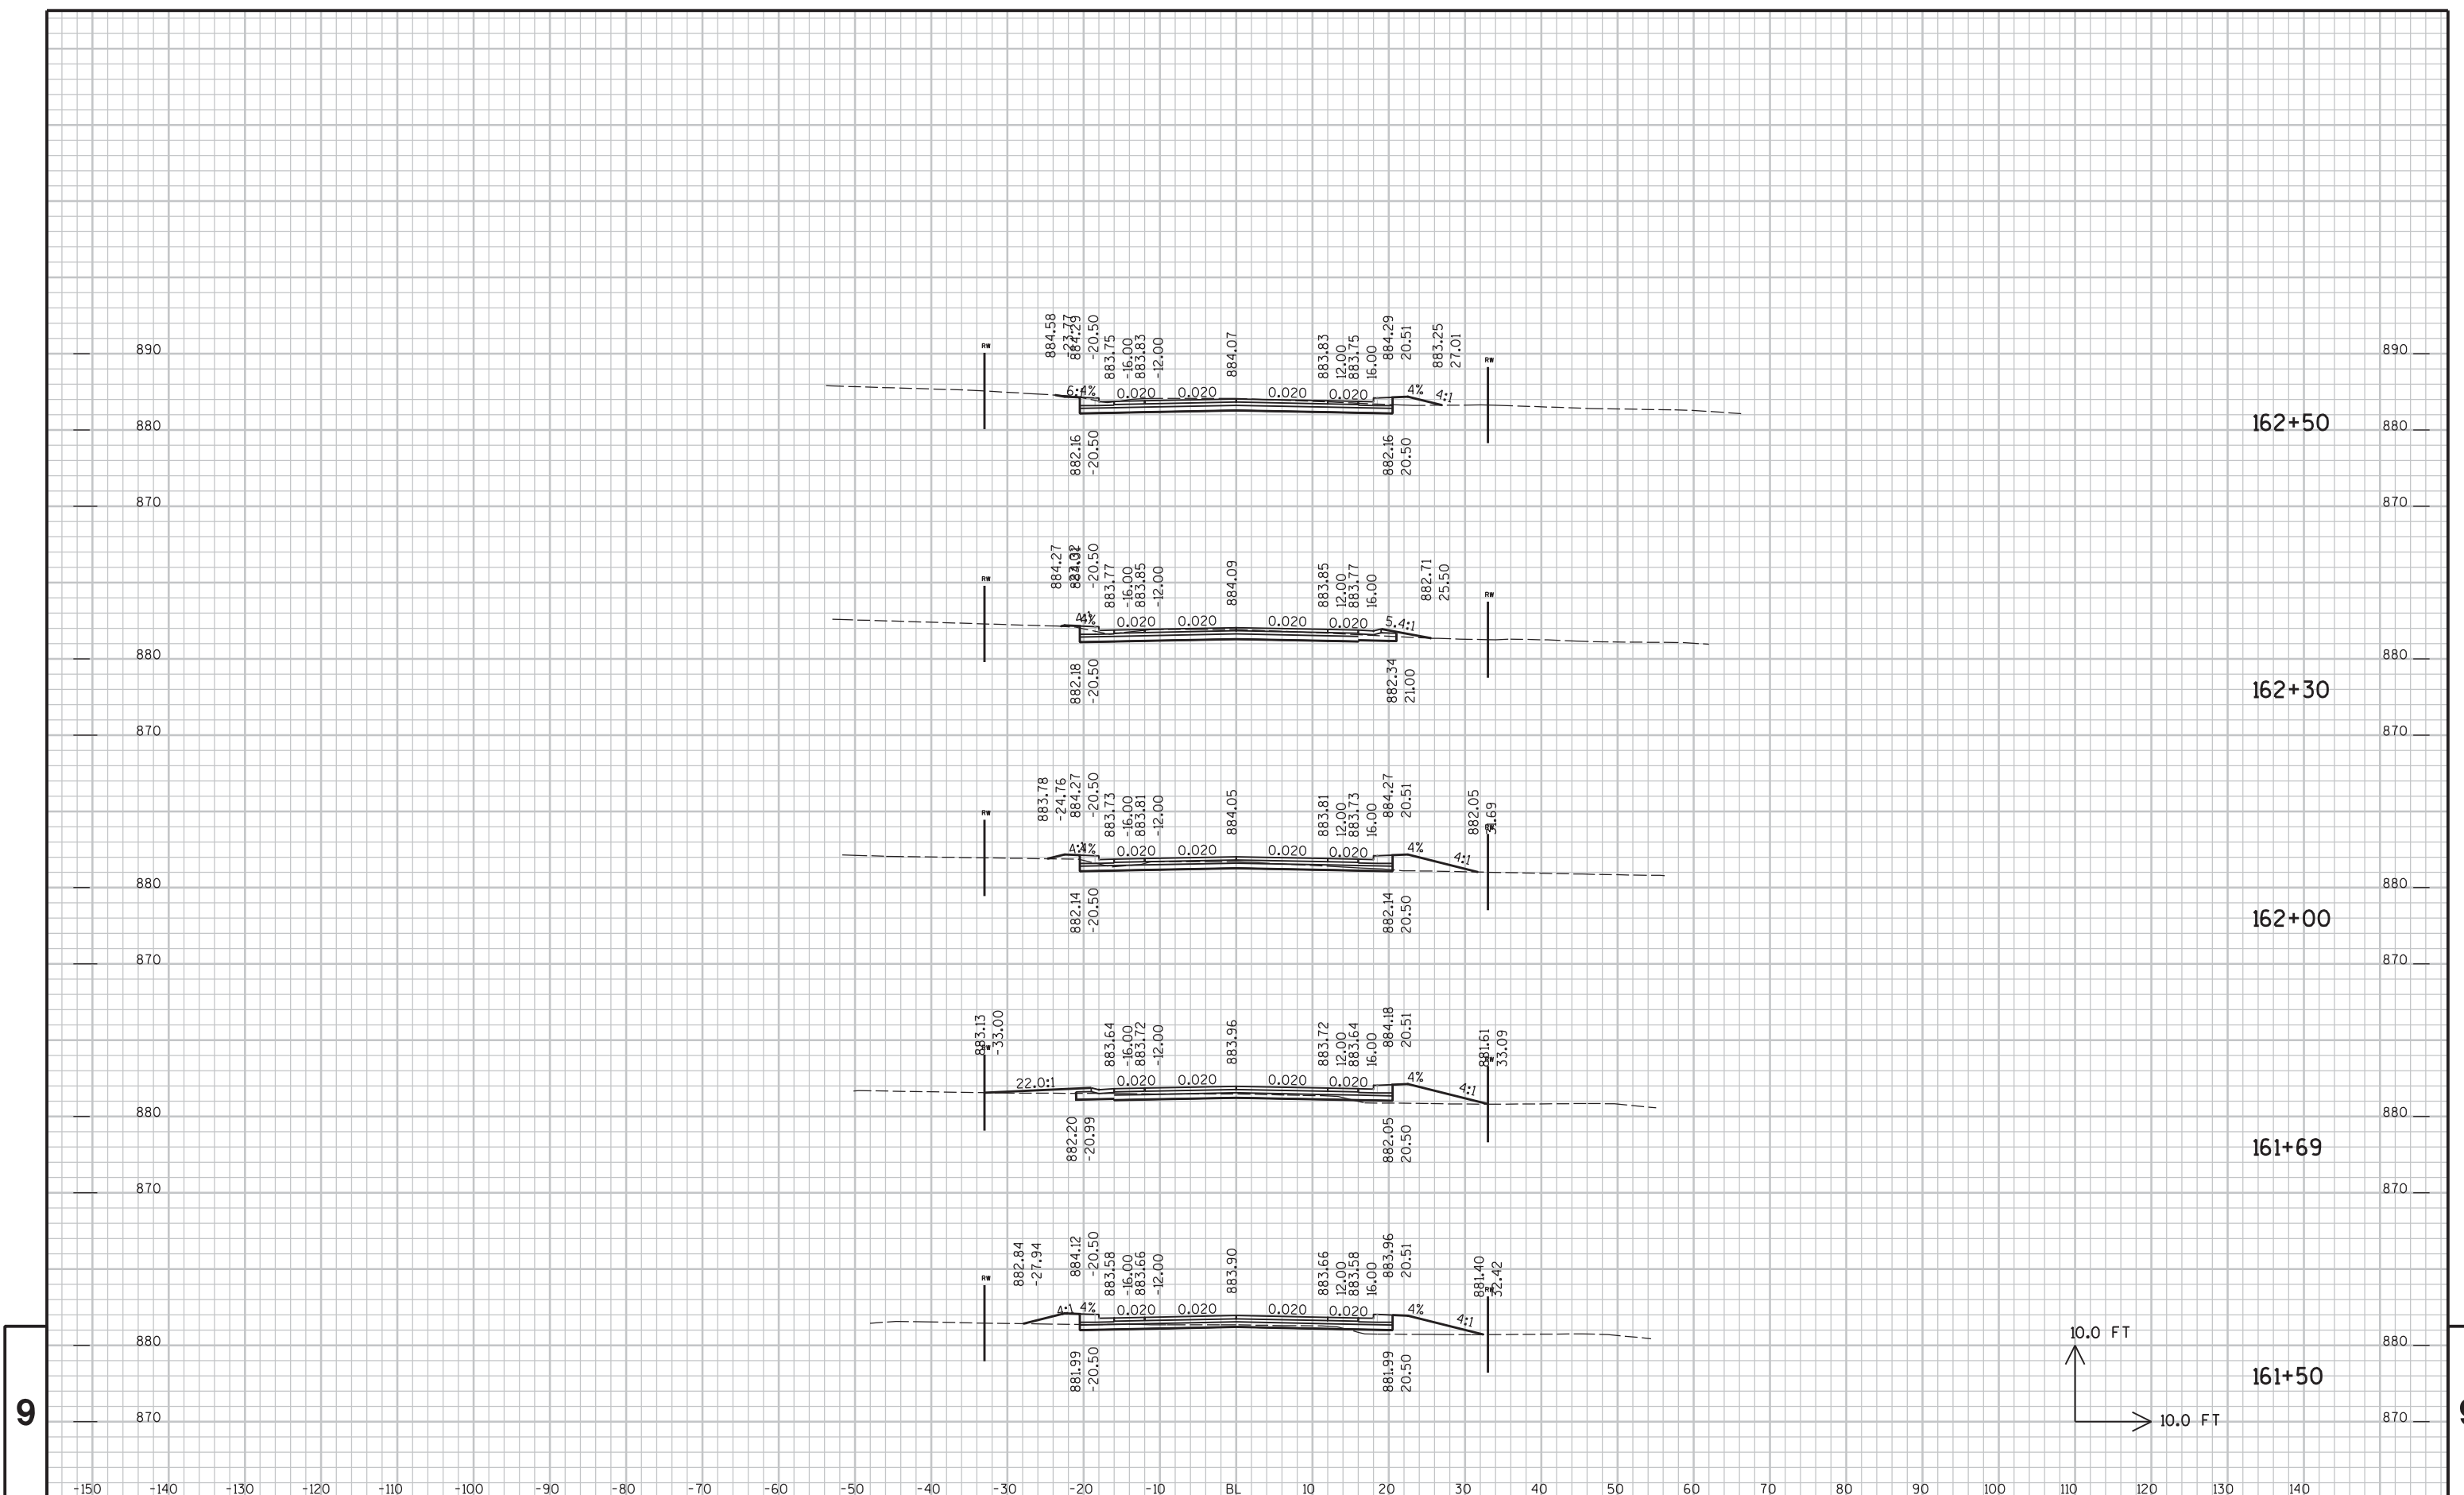

9

9

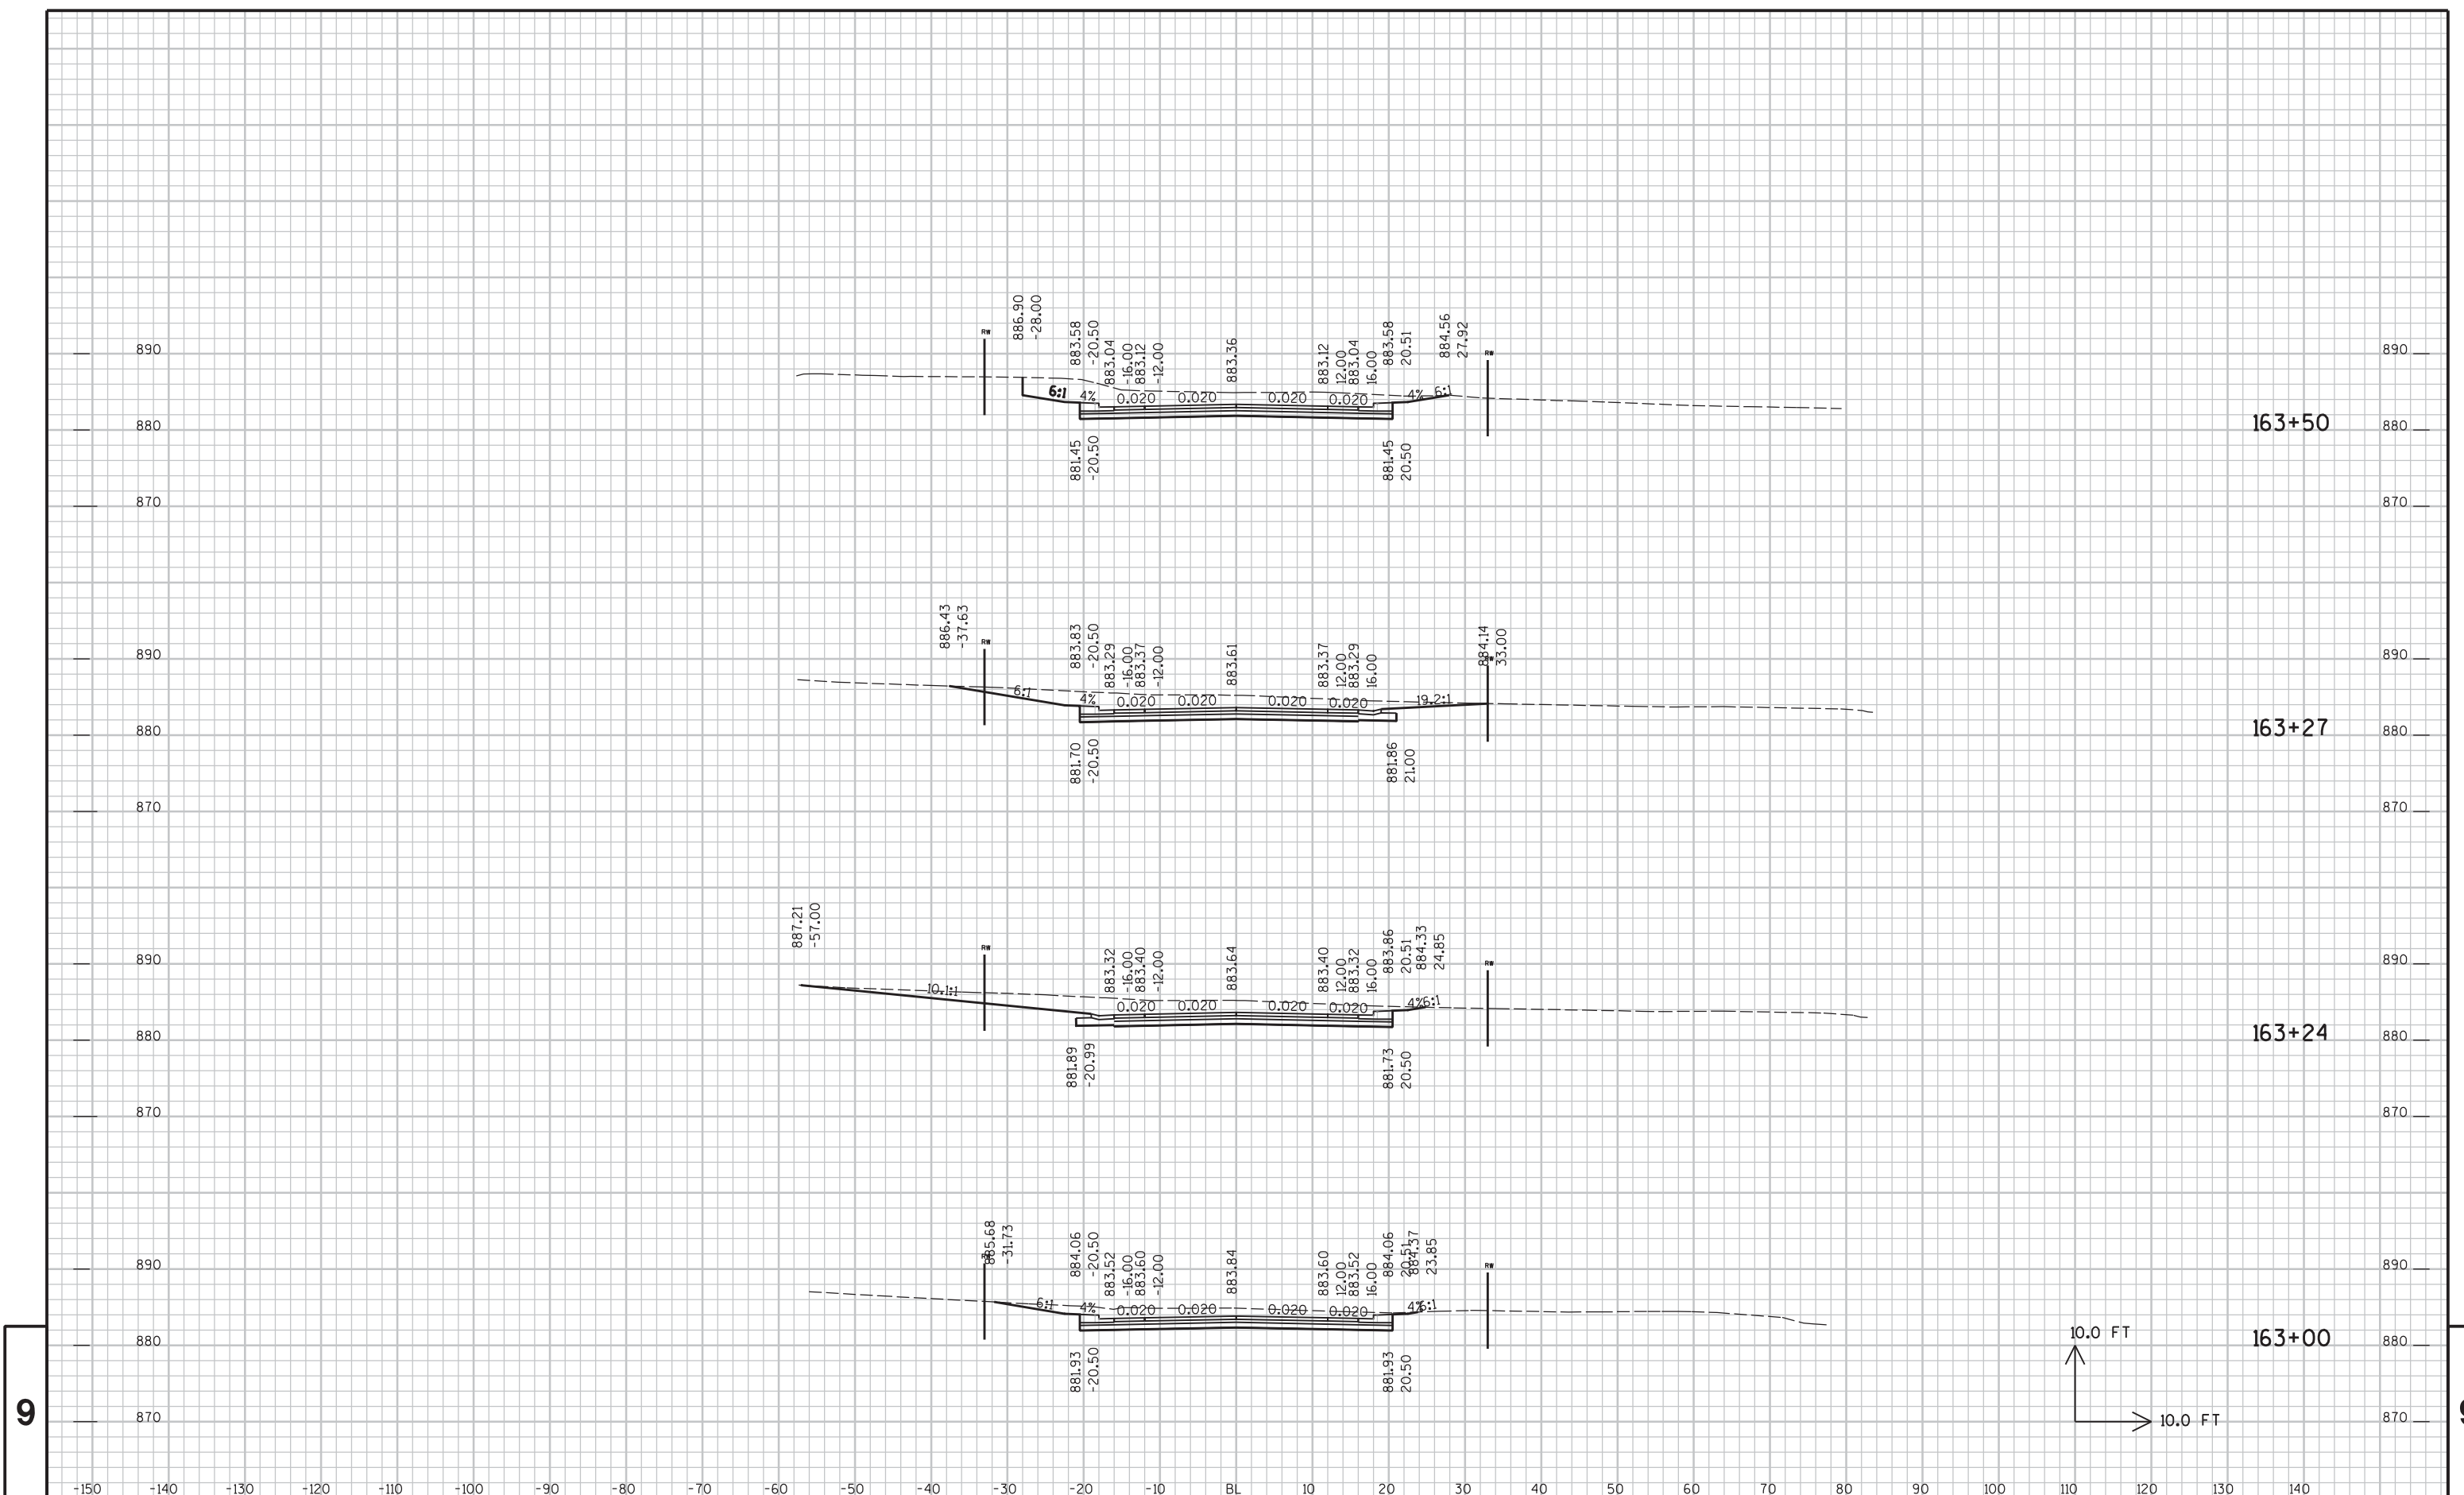



9

10.0 FT

10.0 FT


9

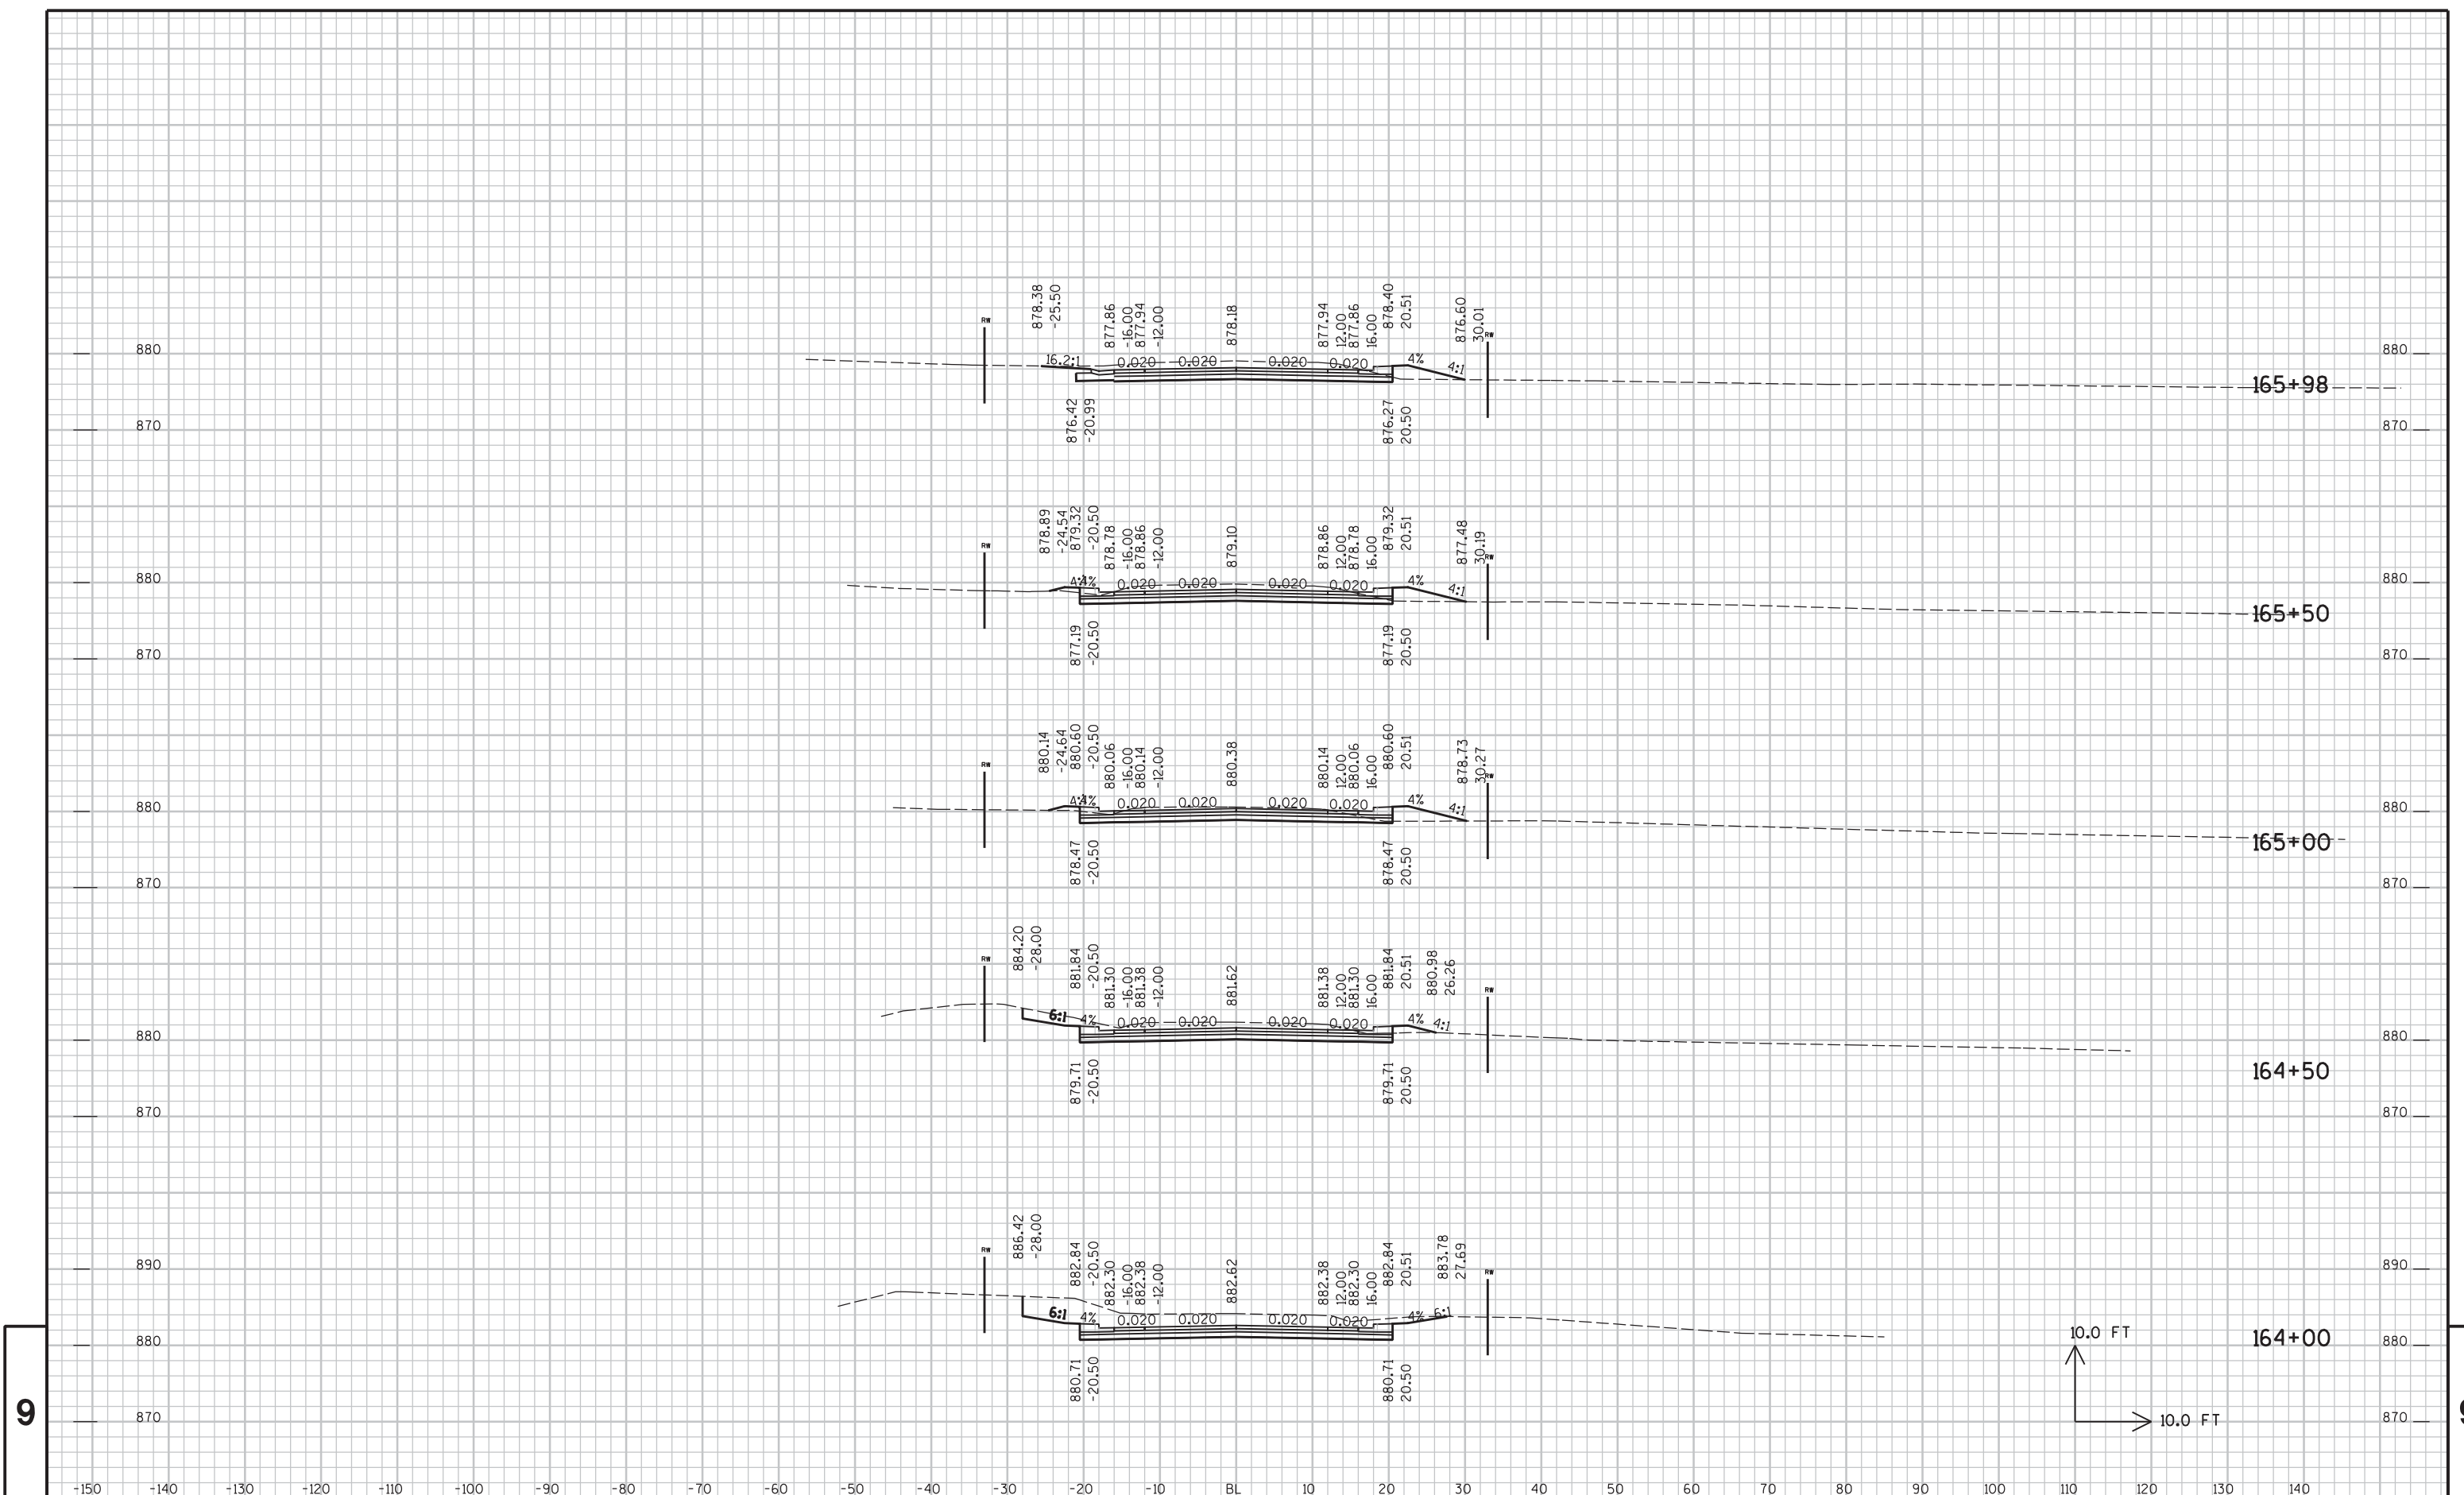

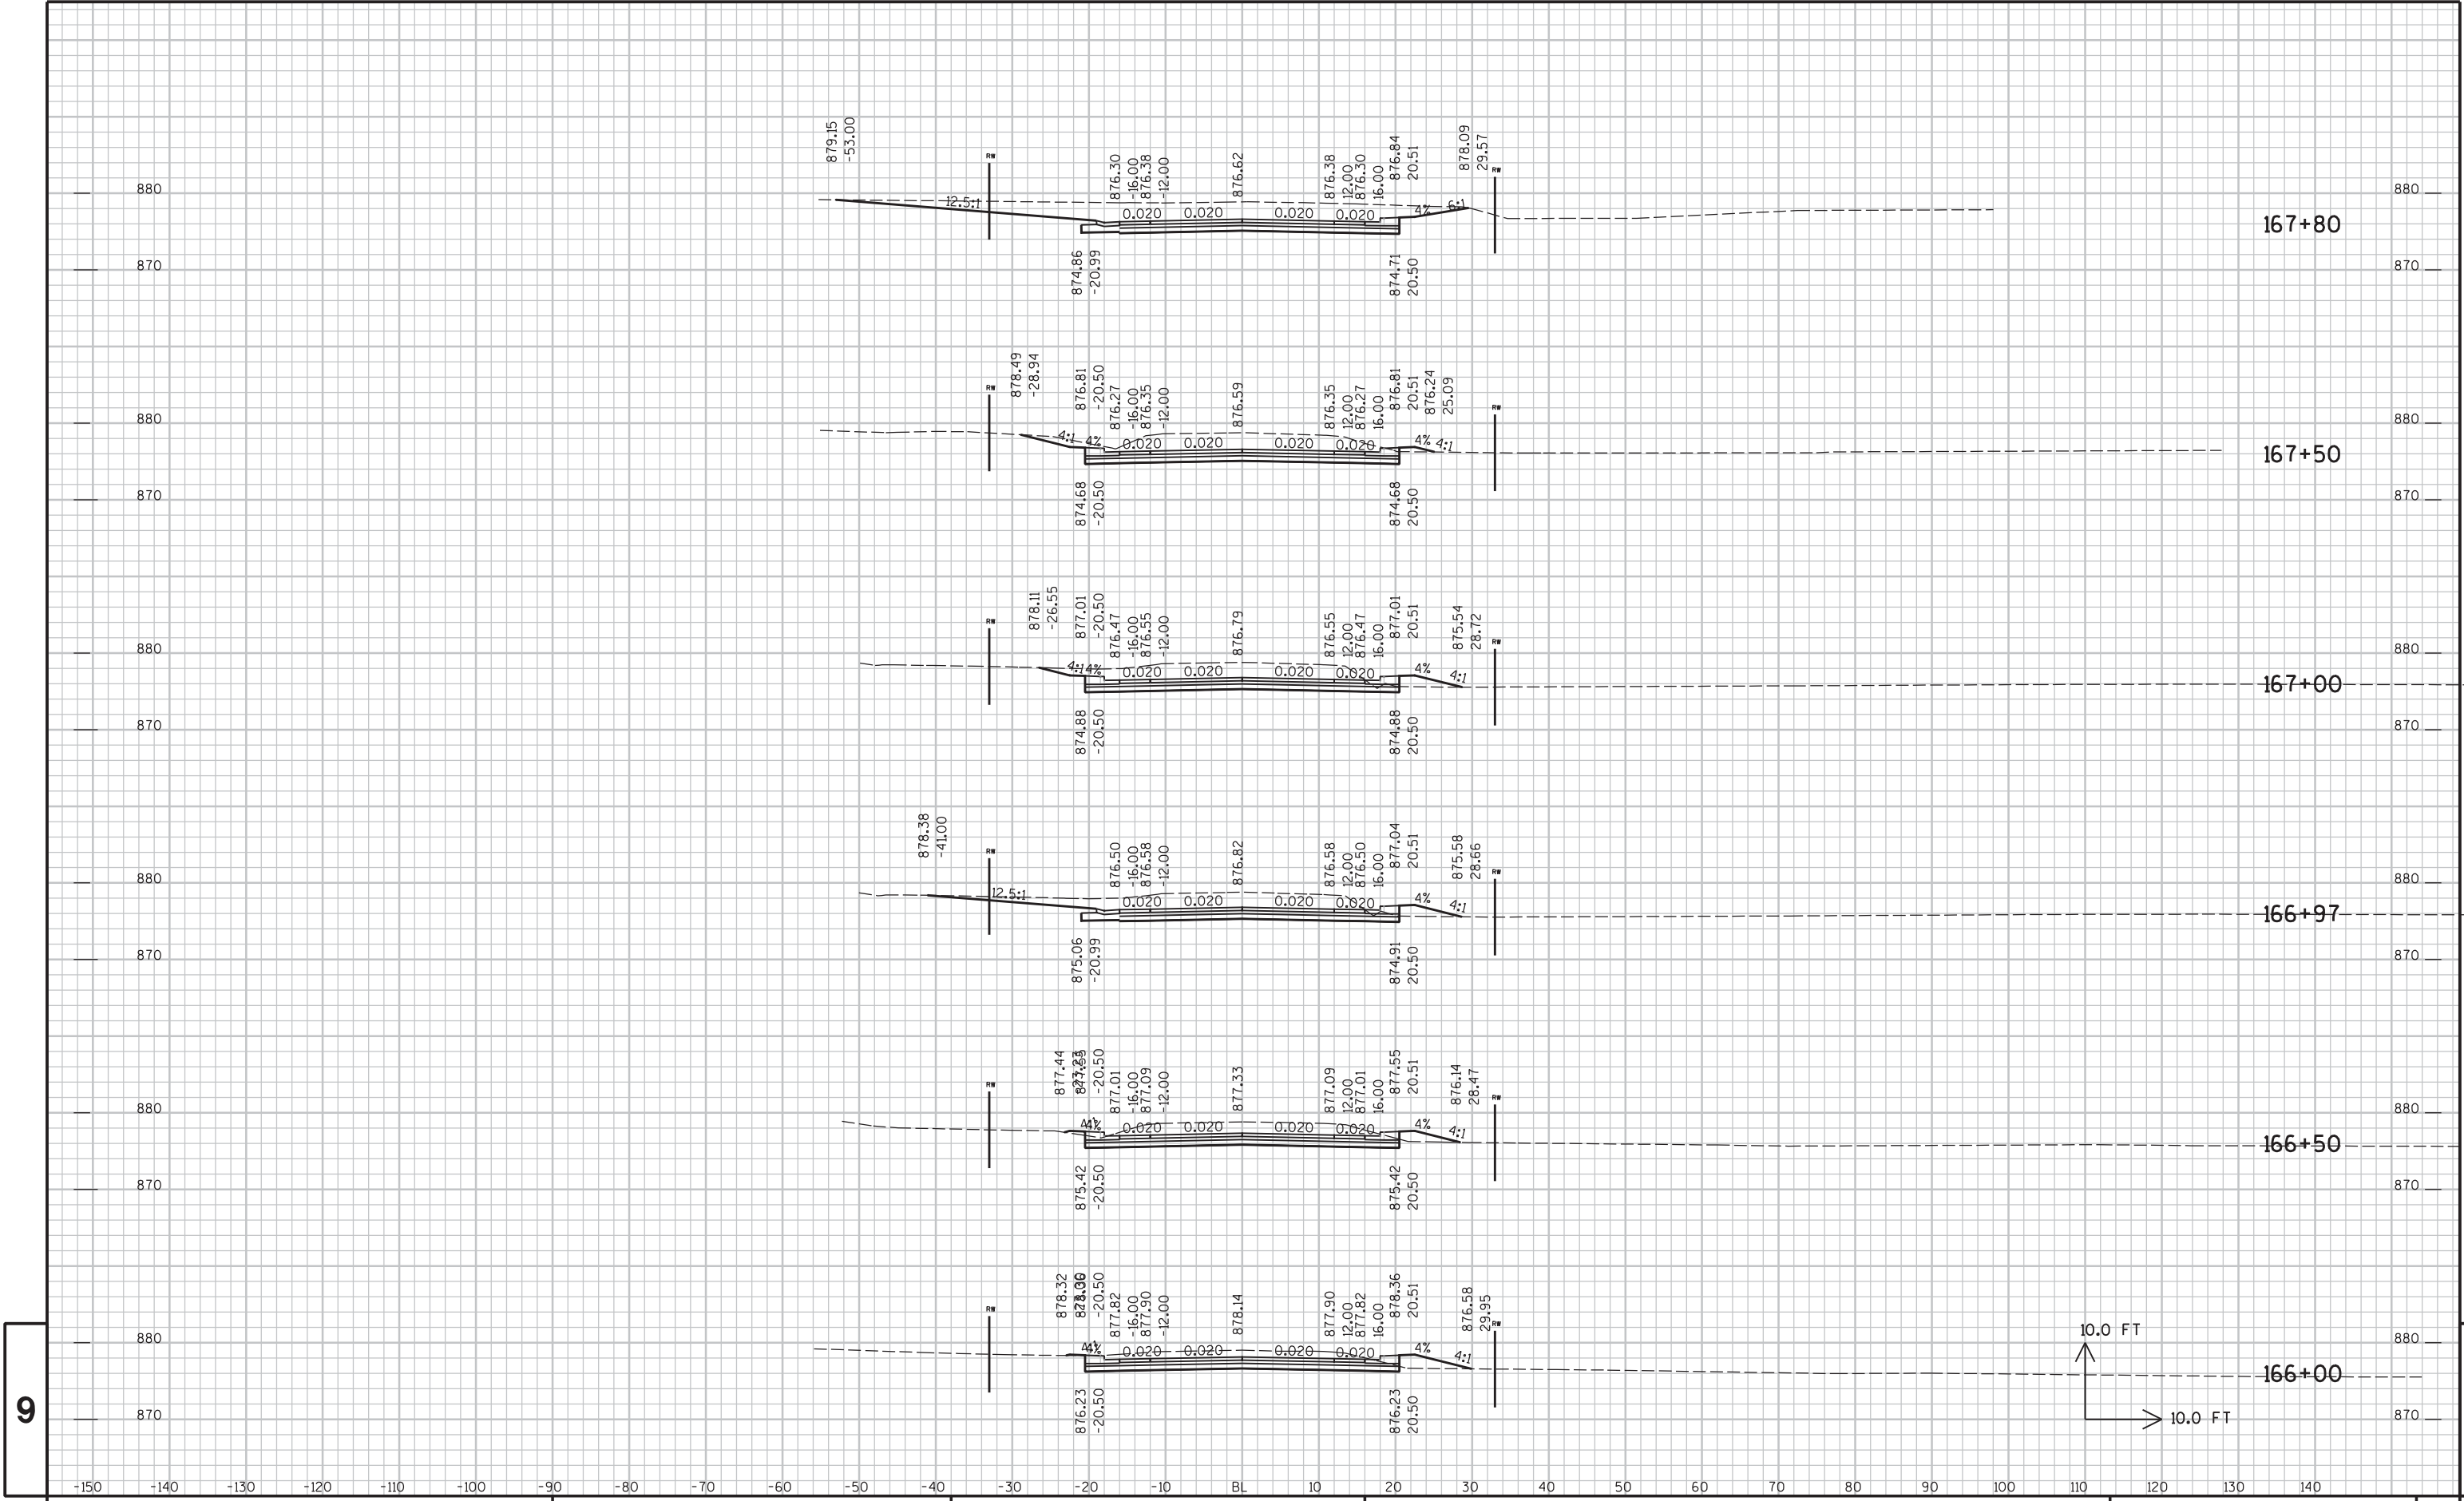

9

9

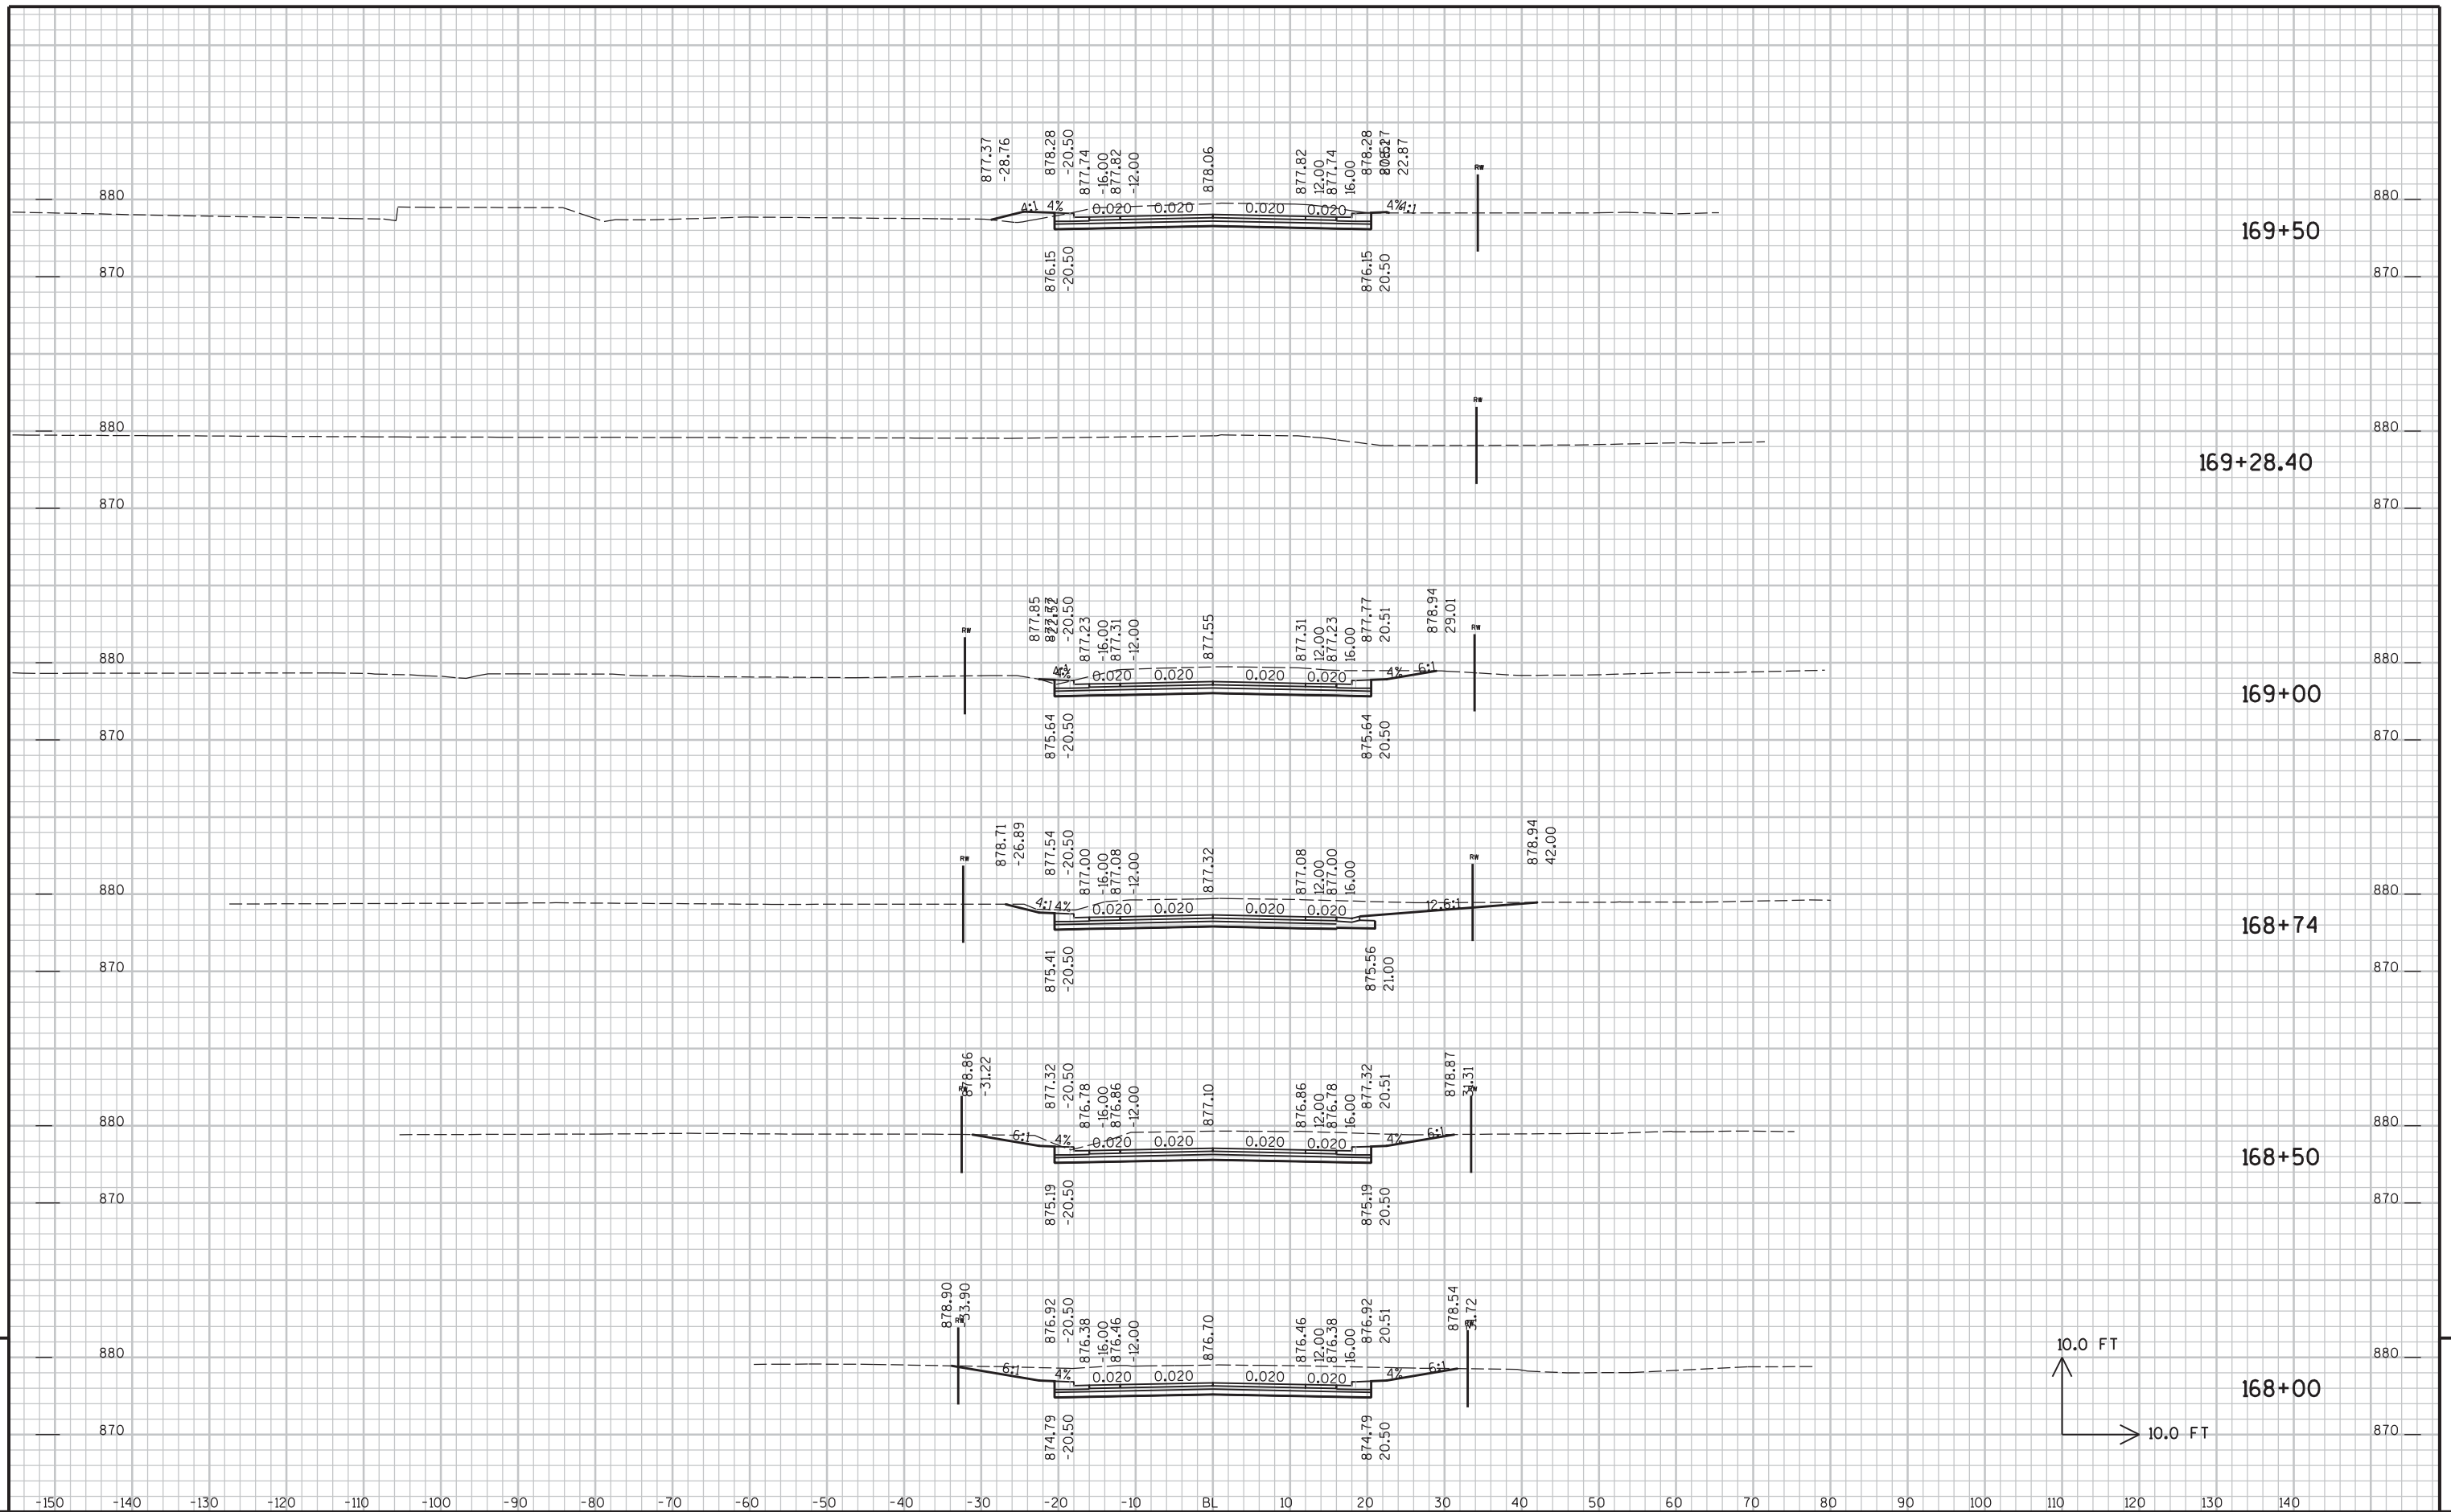


9

9

PROJECT NO : HWY : CTH M COUNTY : WINNEBAGO CROSS SECTIONS - CTH M SHEET NO: 70 E

FILE NAME : P:\UZ\X\WINN\030200_CTH_M\CAD\XSC\THM 2013.DGN PLOT TIME : 12:56:13 PM PLOT DATE : 1/18/2013 PLOT BY : SEH PLOT NAME : PLOT SCALE : N/A

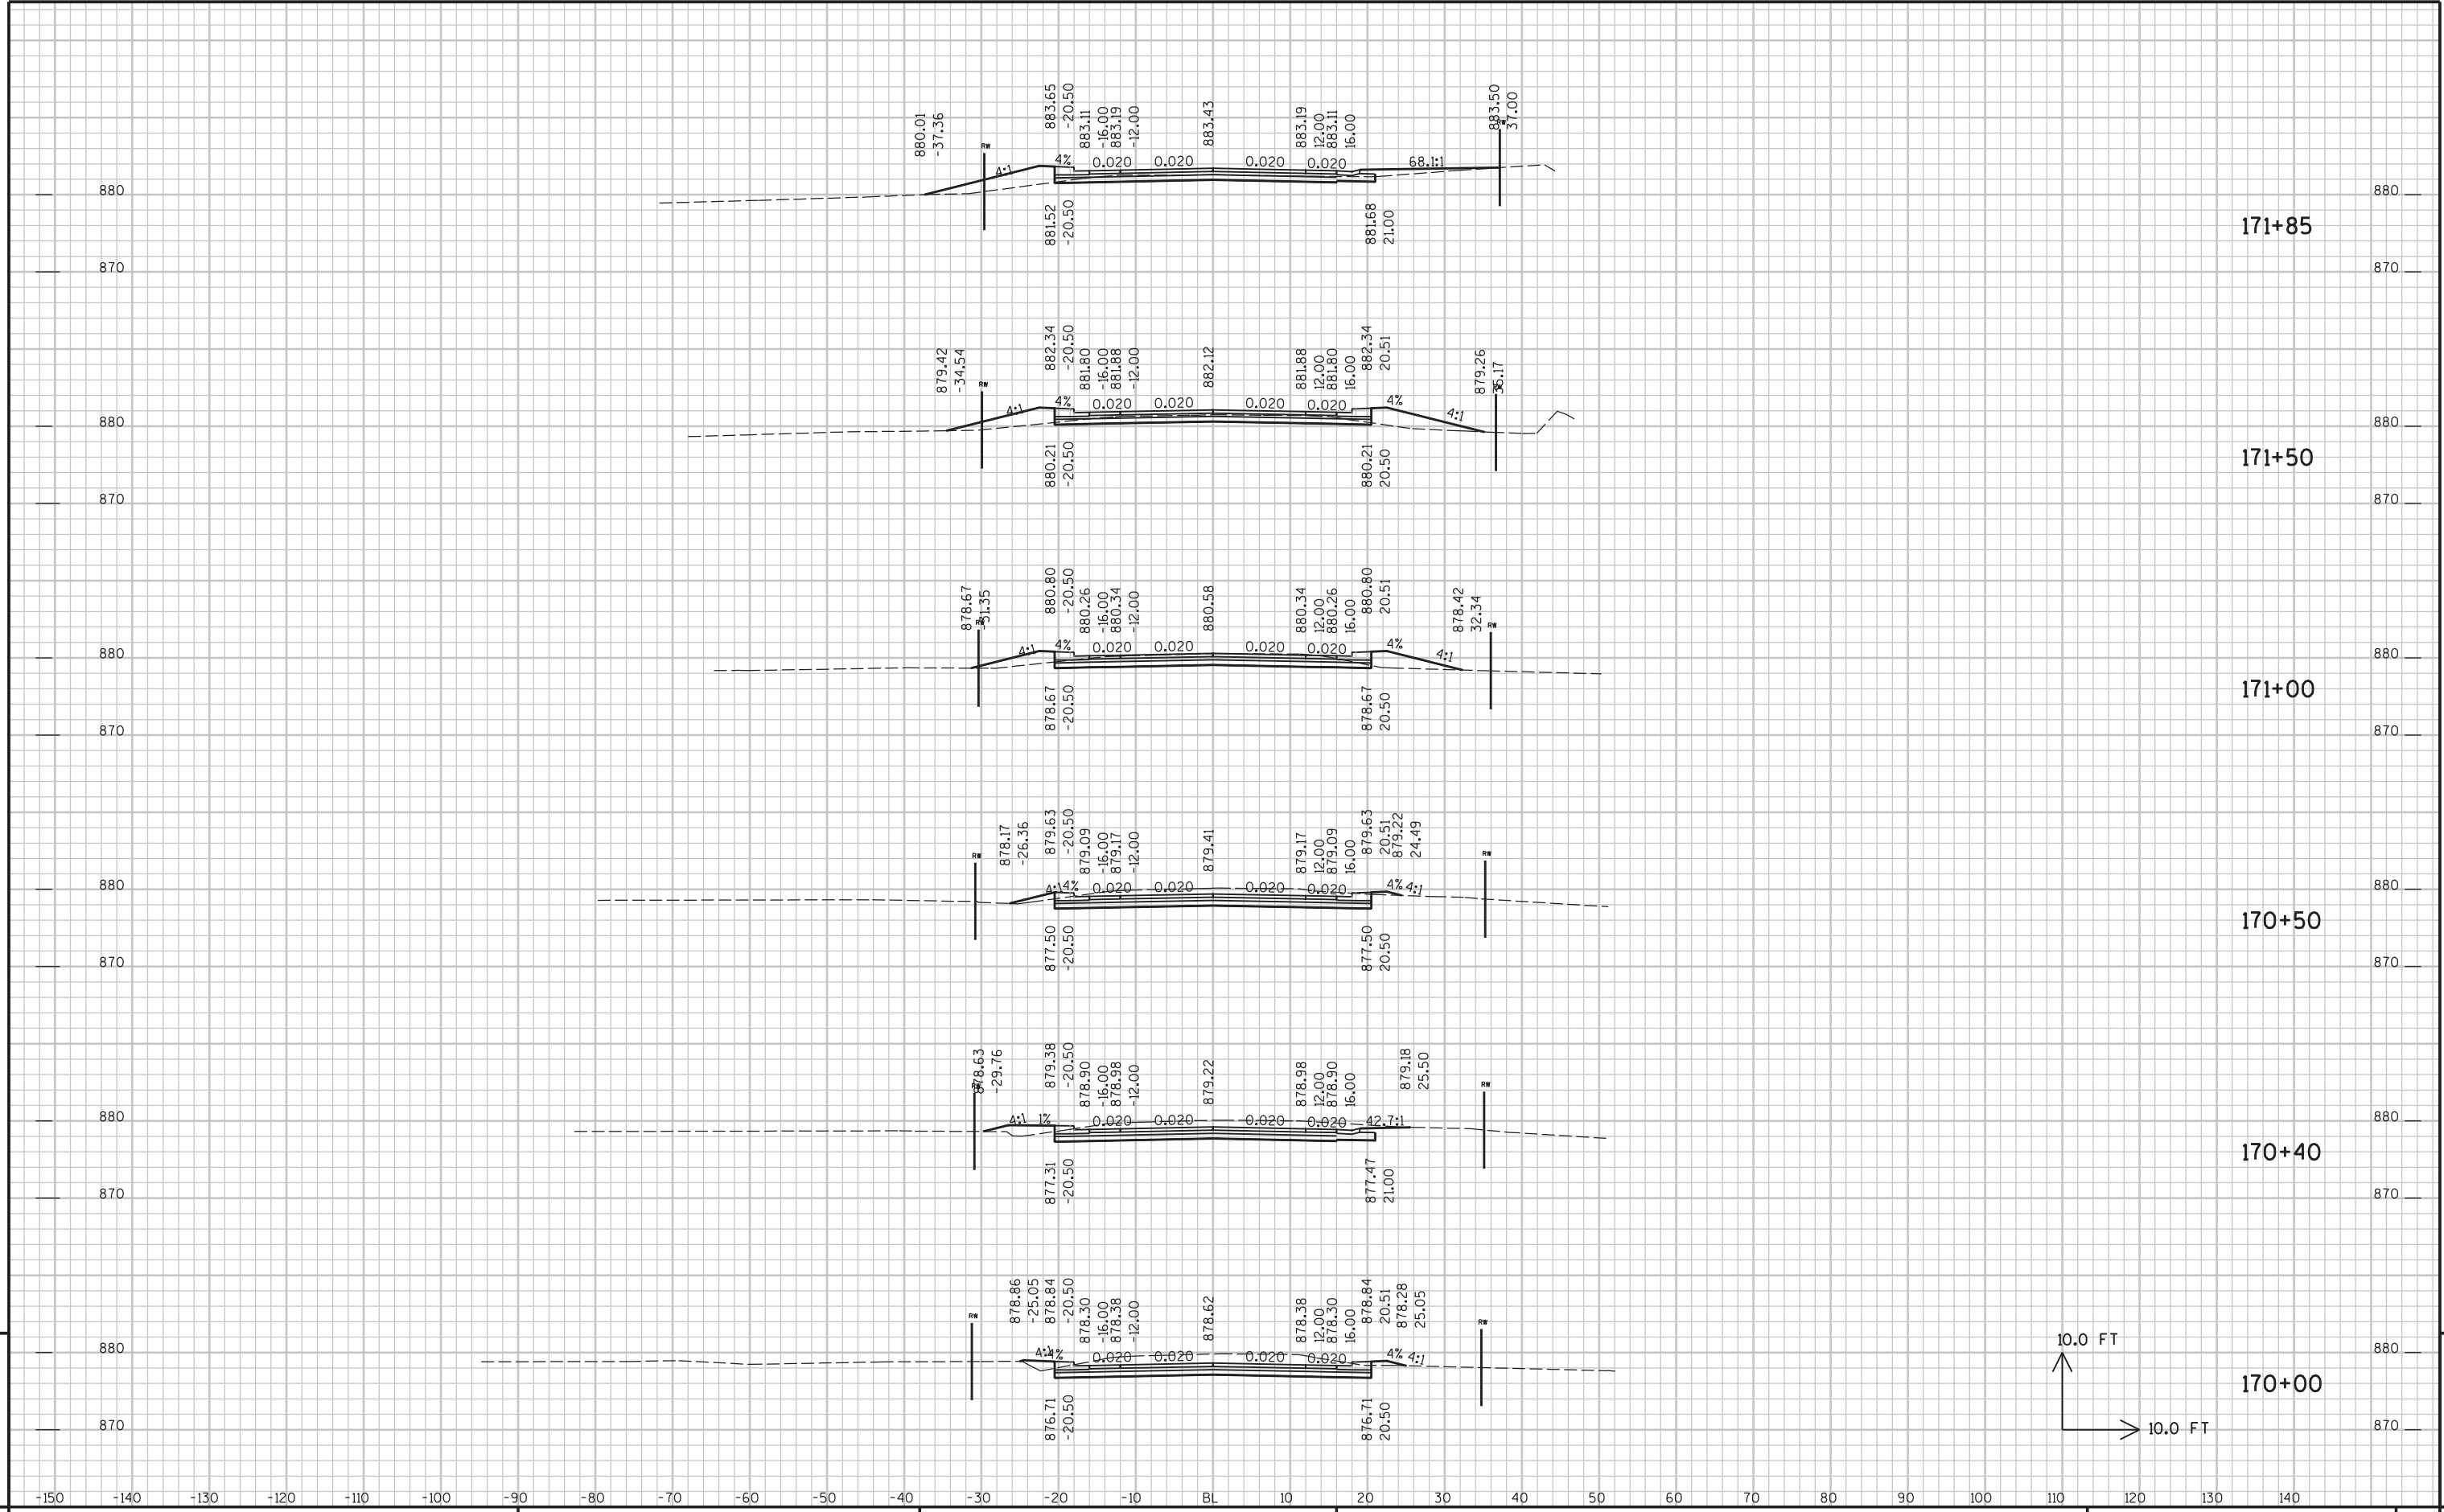


9

9

PROJECT NO :	HWY : CTH M	COUNTY : WINNEBAGO	CROSS SECTIONS - CTH M	SHEET NO: 71	E
--------------	-------------	--------------------	------------------------	--------------	---

FILE NAME : P:\UZ\X\WINN\030200_CTH.M\CAD\XSC\THM 2013.DGN PLOT TIME : 12:56:13 PM PLOT DATE : 1/18/2013 PLOT BY : SEH PLOT NAME : PLOT SCALE : N/A

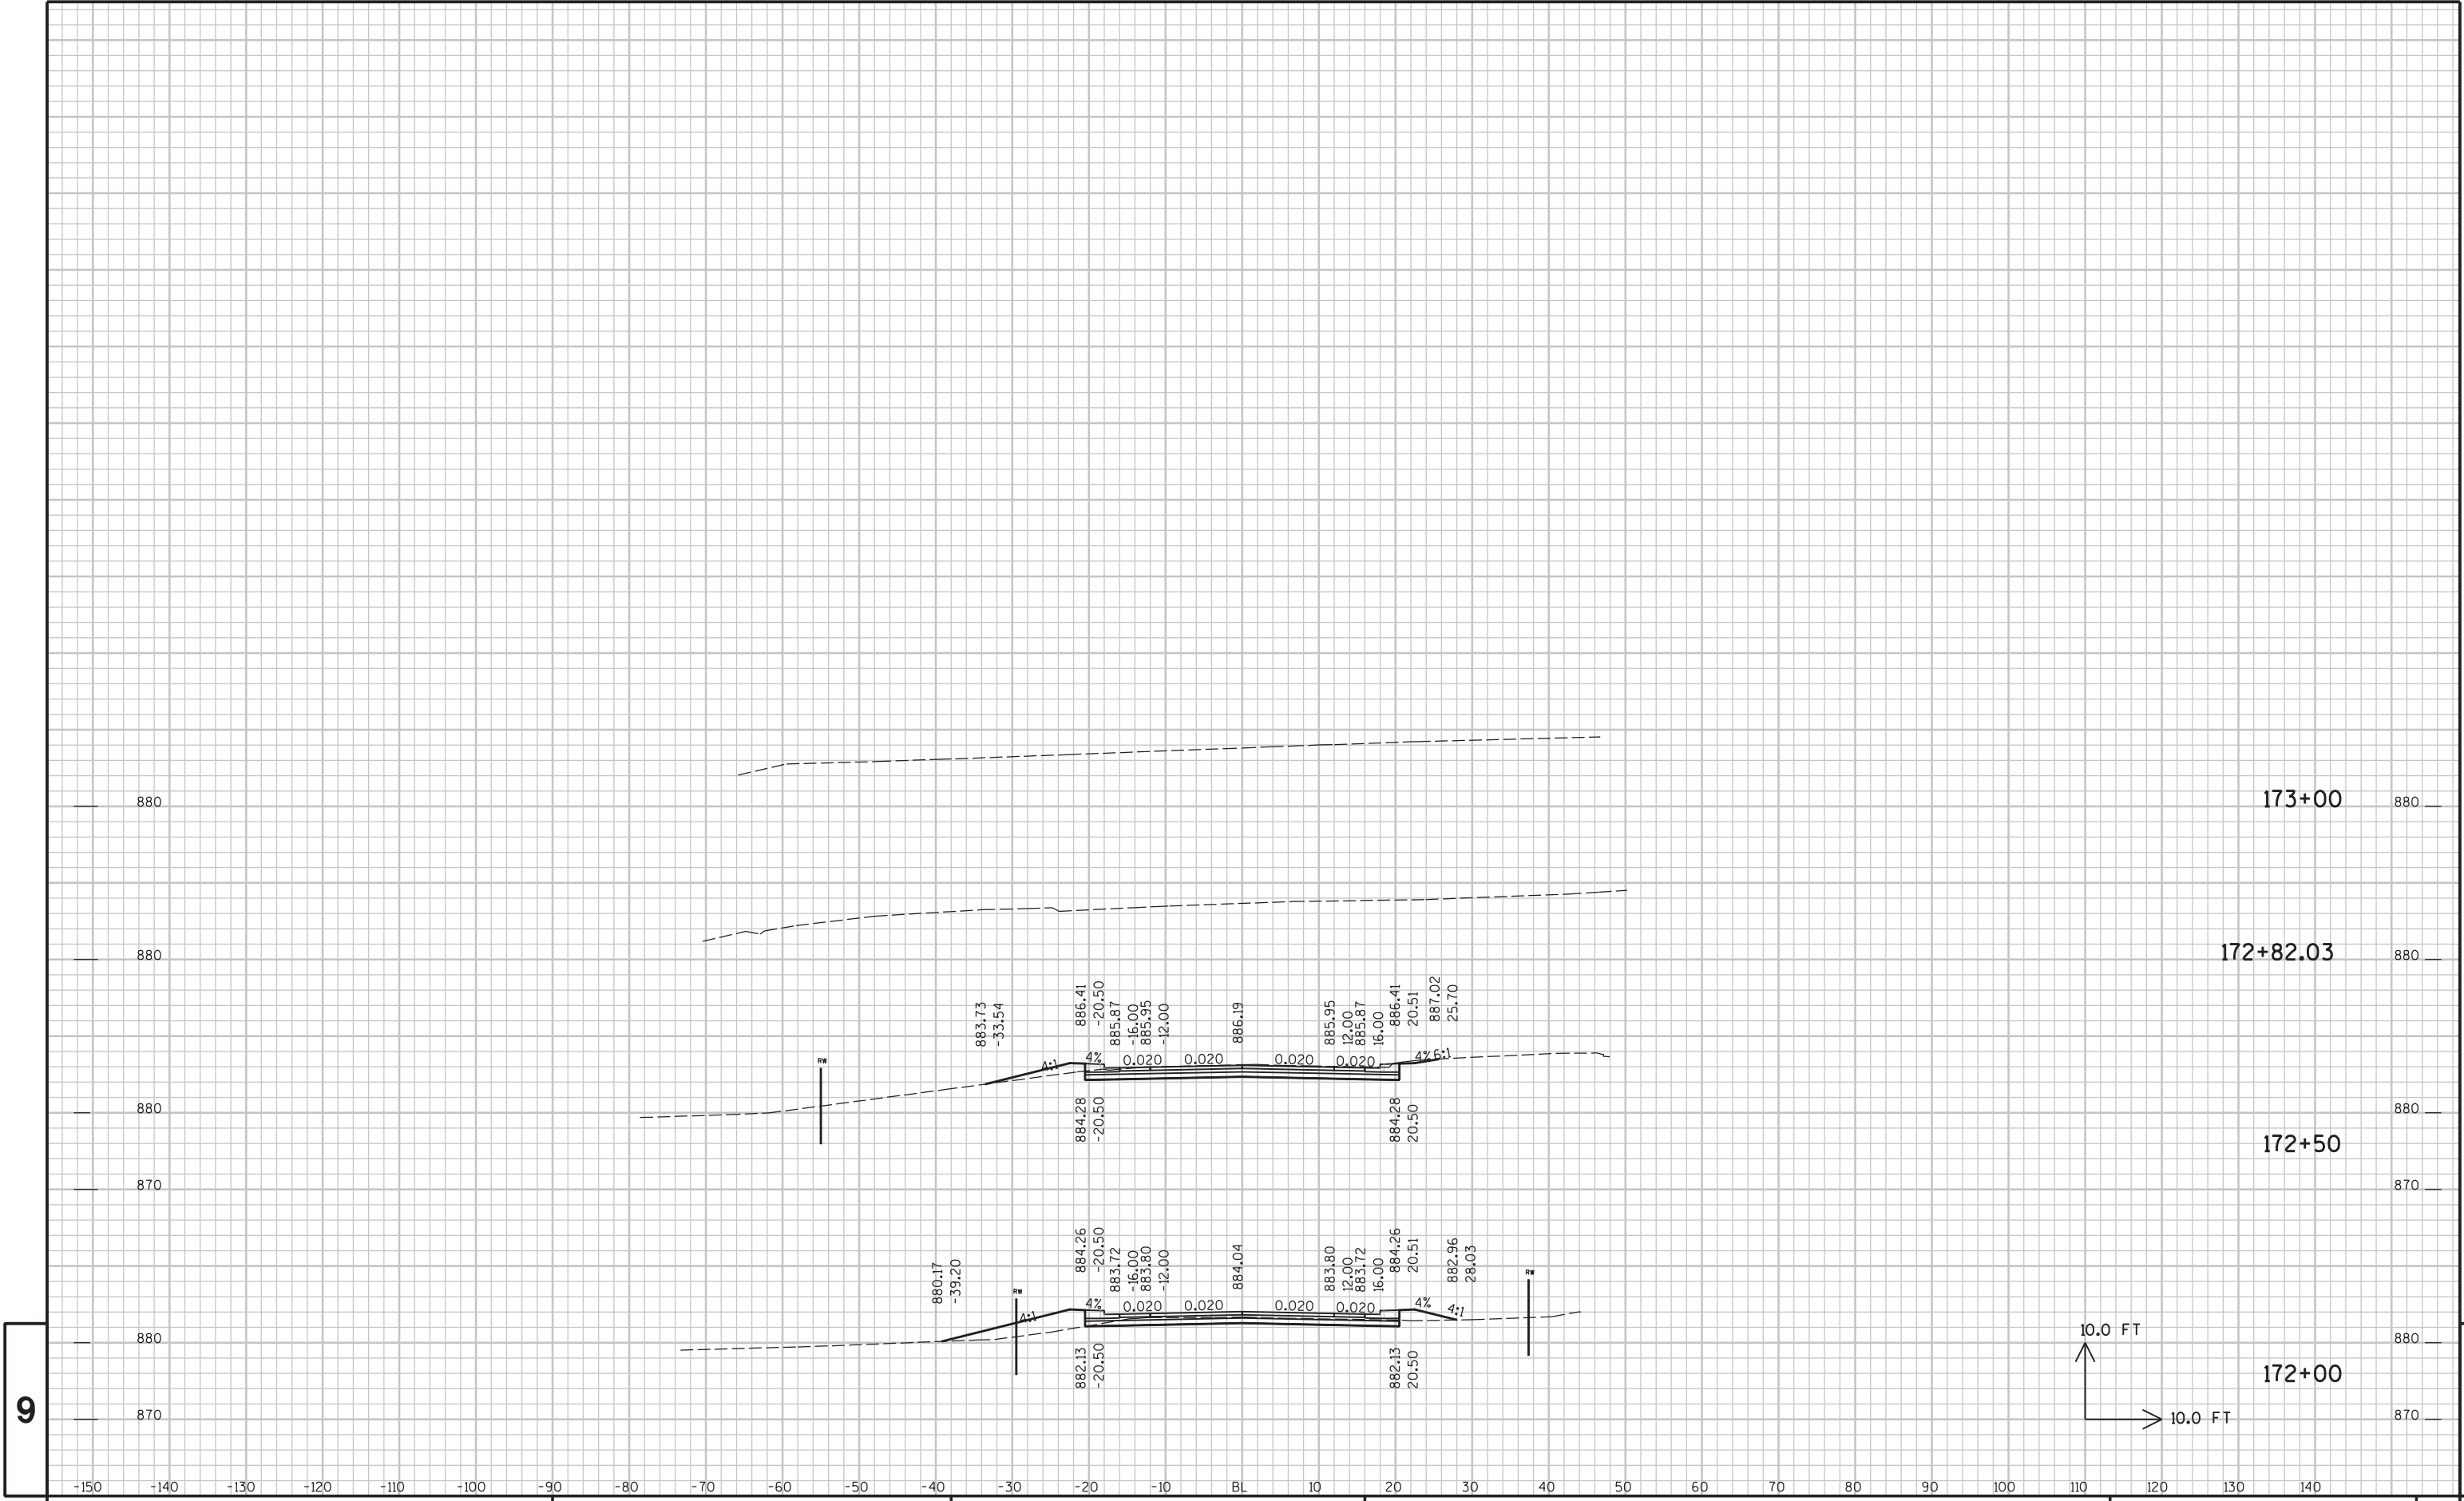


9



9

PROJECT NO :	HWY : CTH M	COUNTY : WINNEBAGO	CROSS SECTIONS - CTH M	SHEET NO: 72	E
--------------	-------------	--------------------	------------------------	--------------	---

FILE NAME : P:\UZ\W\WINNC\030200_CTH_M\CAD\XSC\THM 2013.DGN PLOT TIME : 12:56:13 PM PLOT DATE : 1/18/2013 PLOT BY : SEH PLOT NAME : PLOT SCALE : N/A

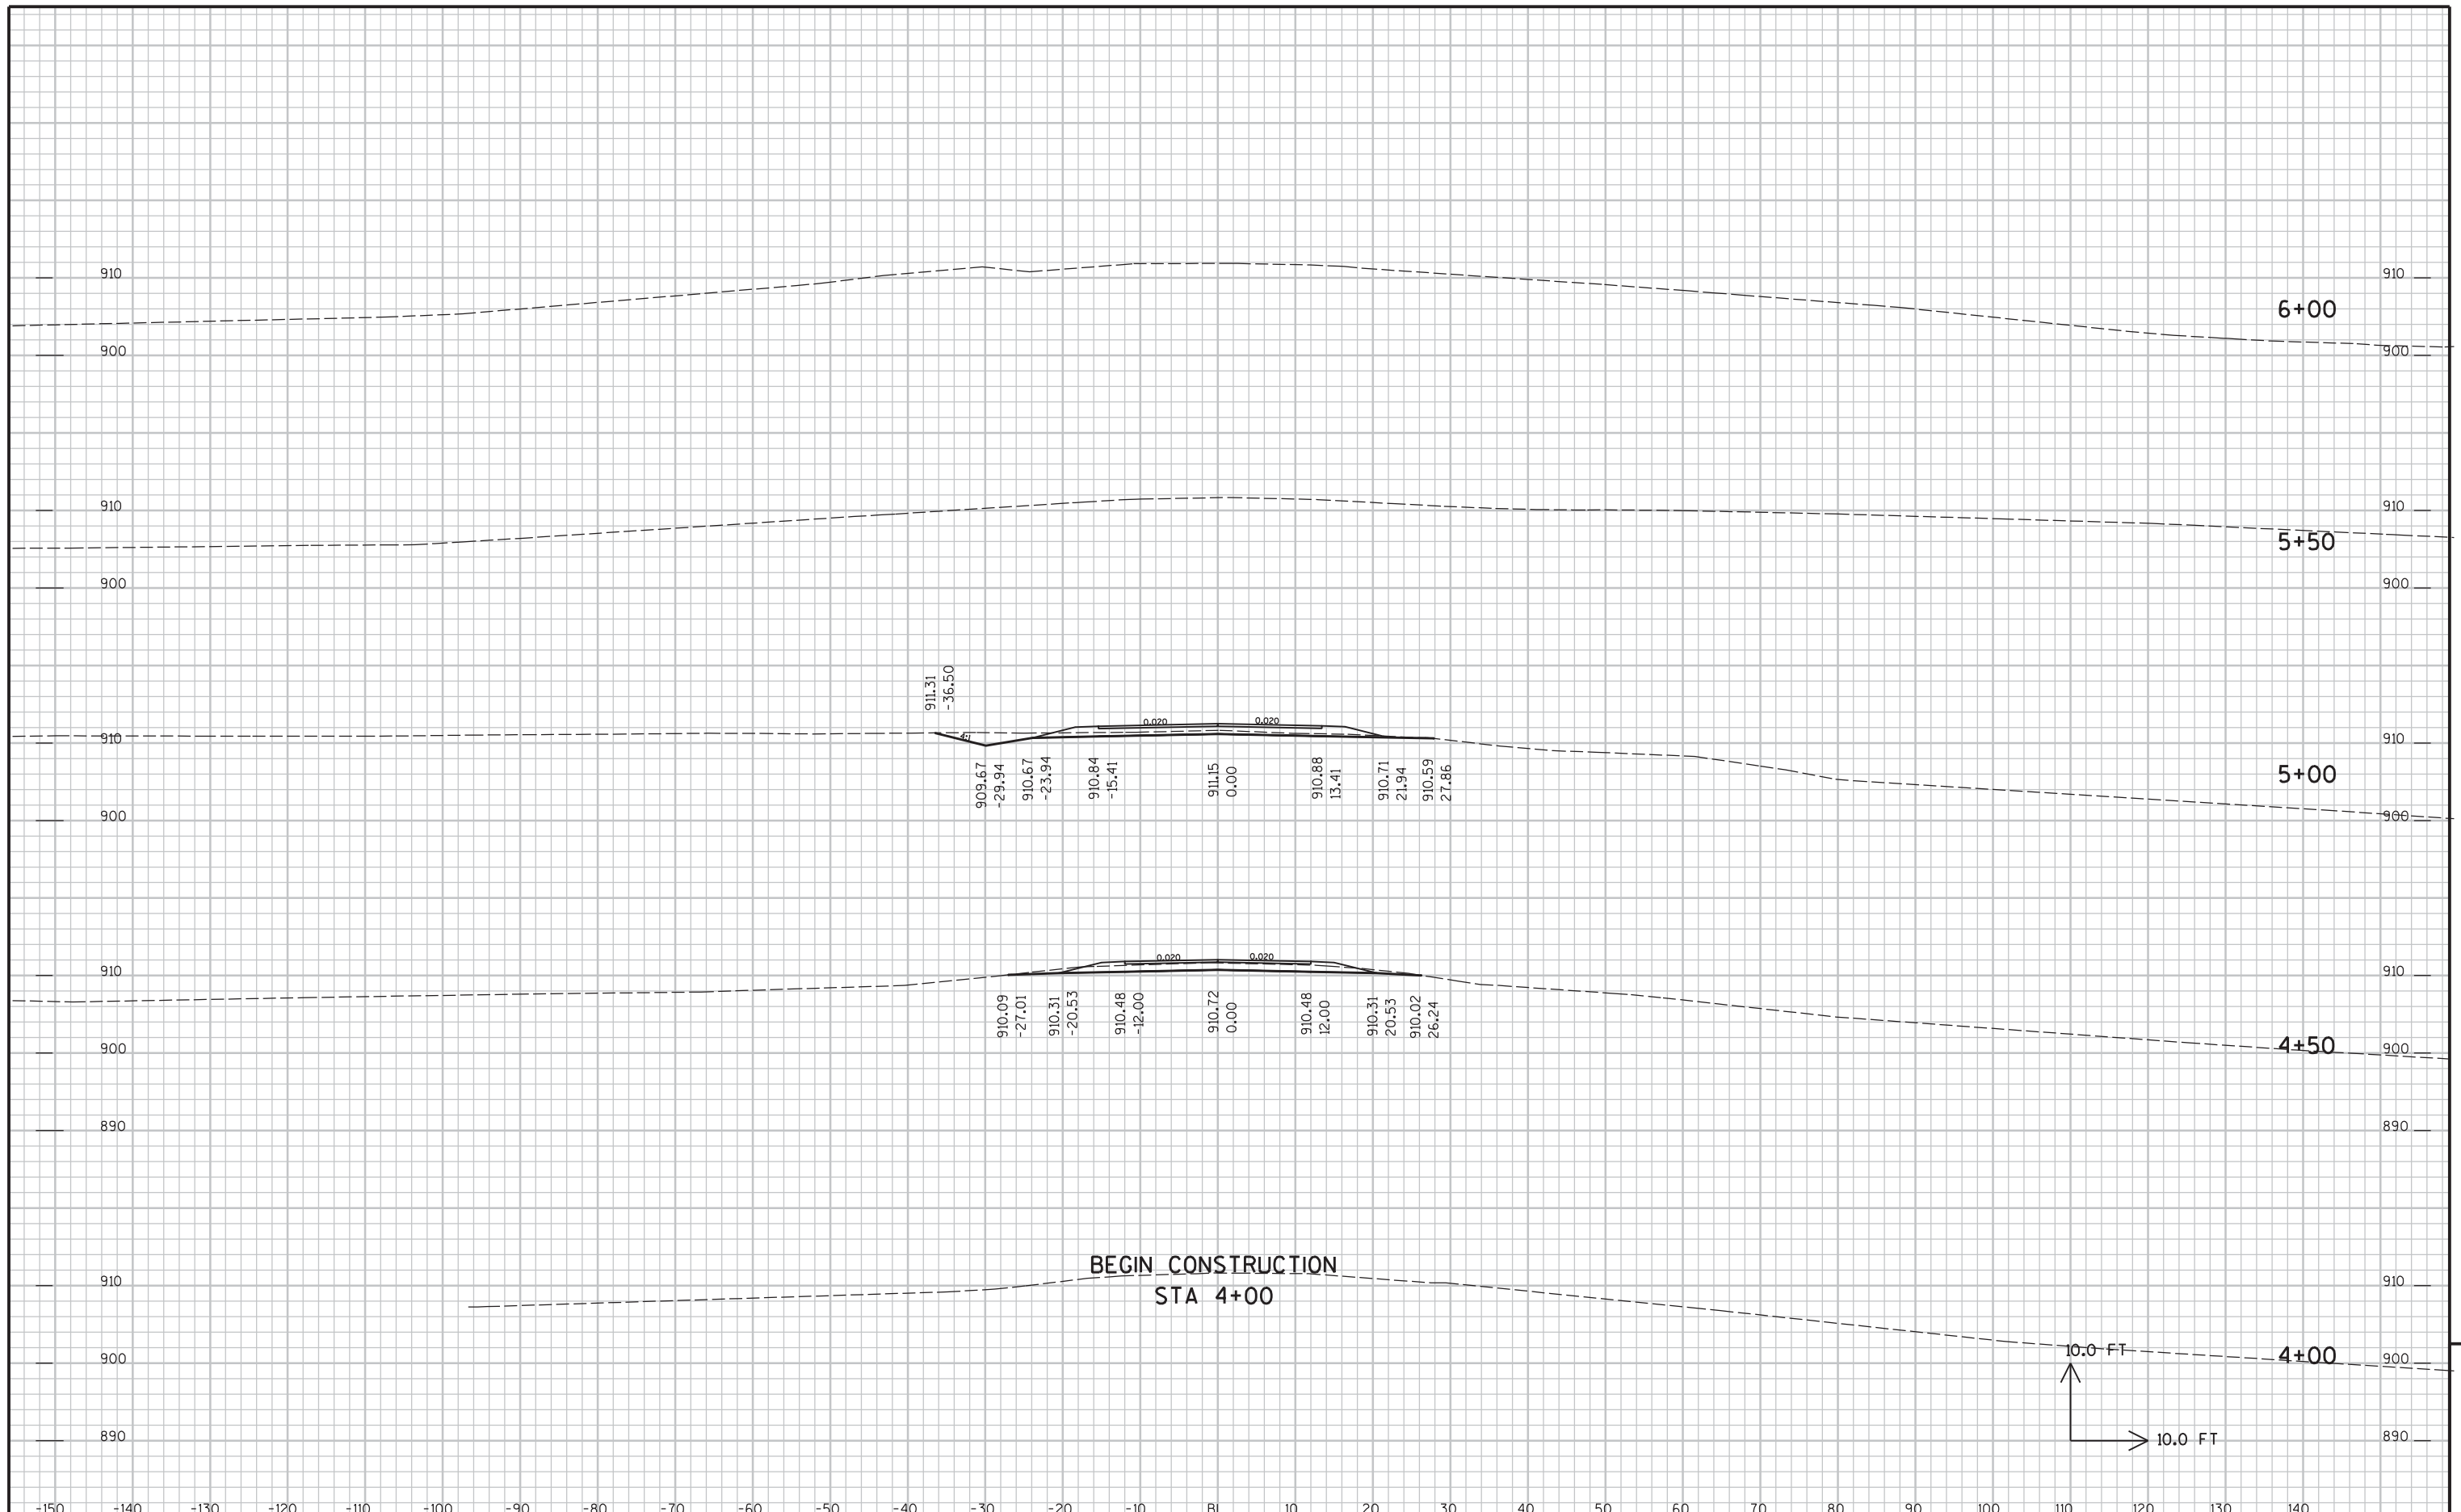


END CONSTRUCTION
STA 9+00

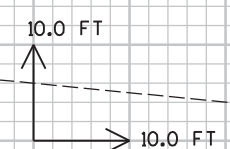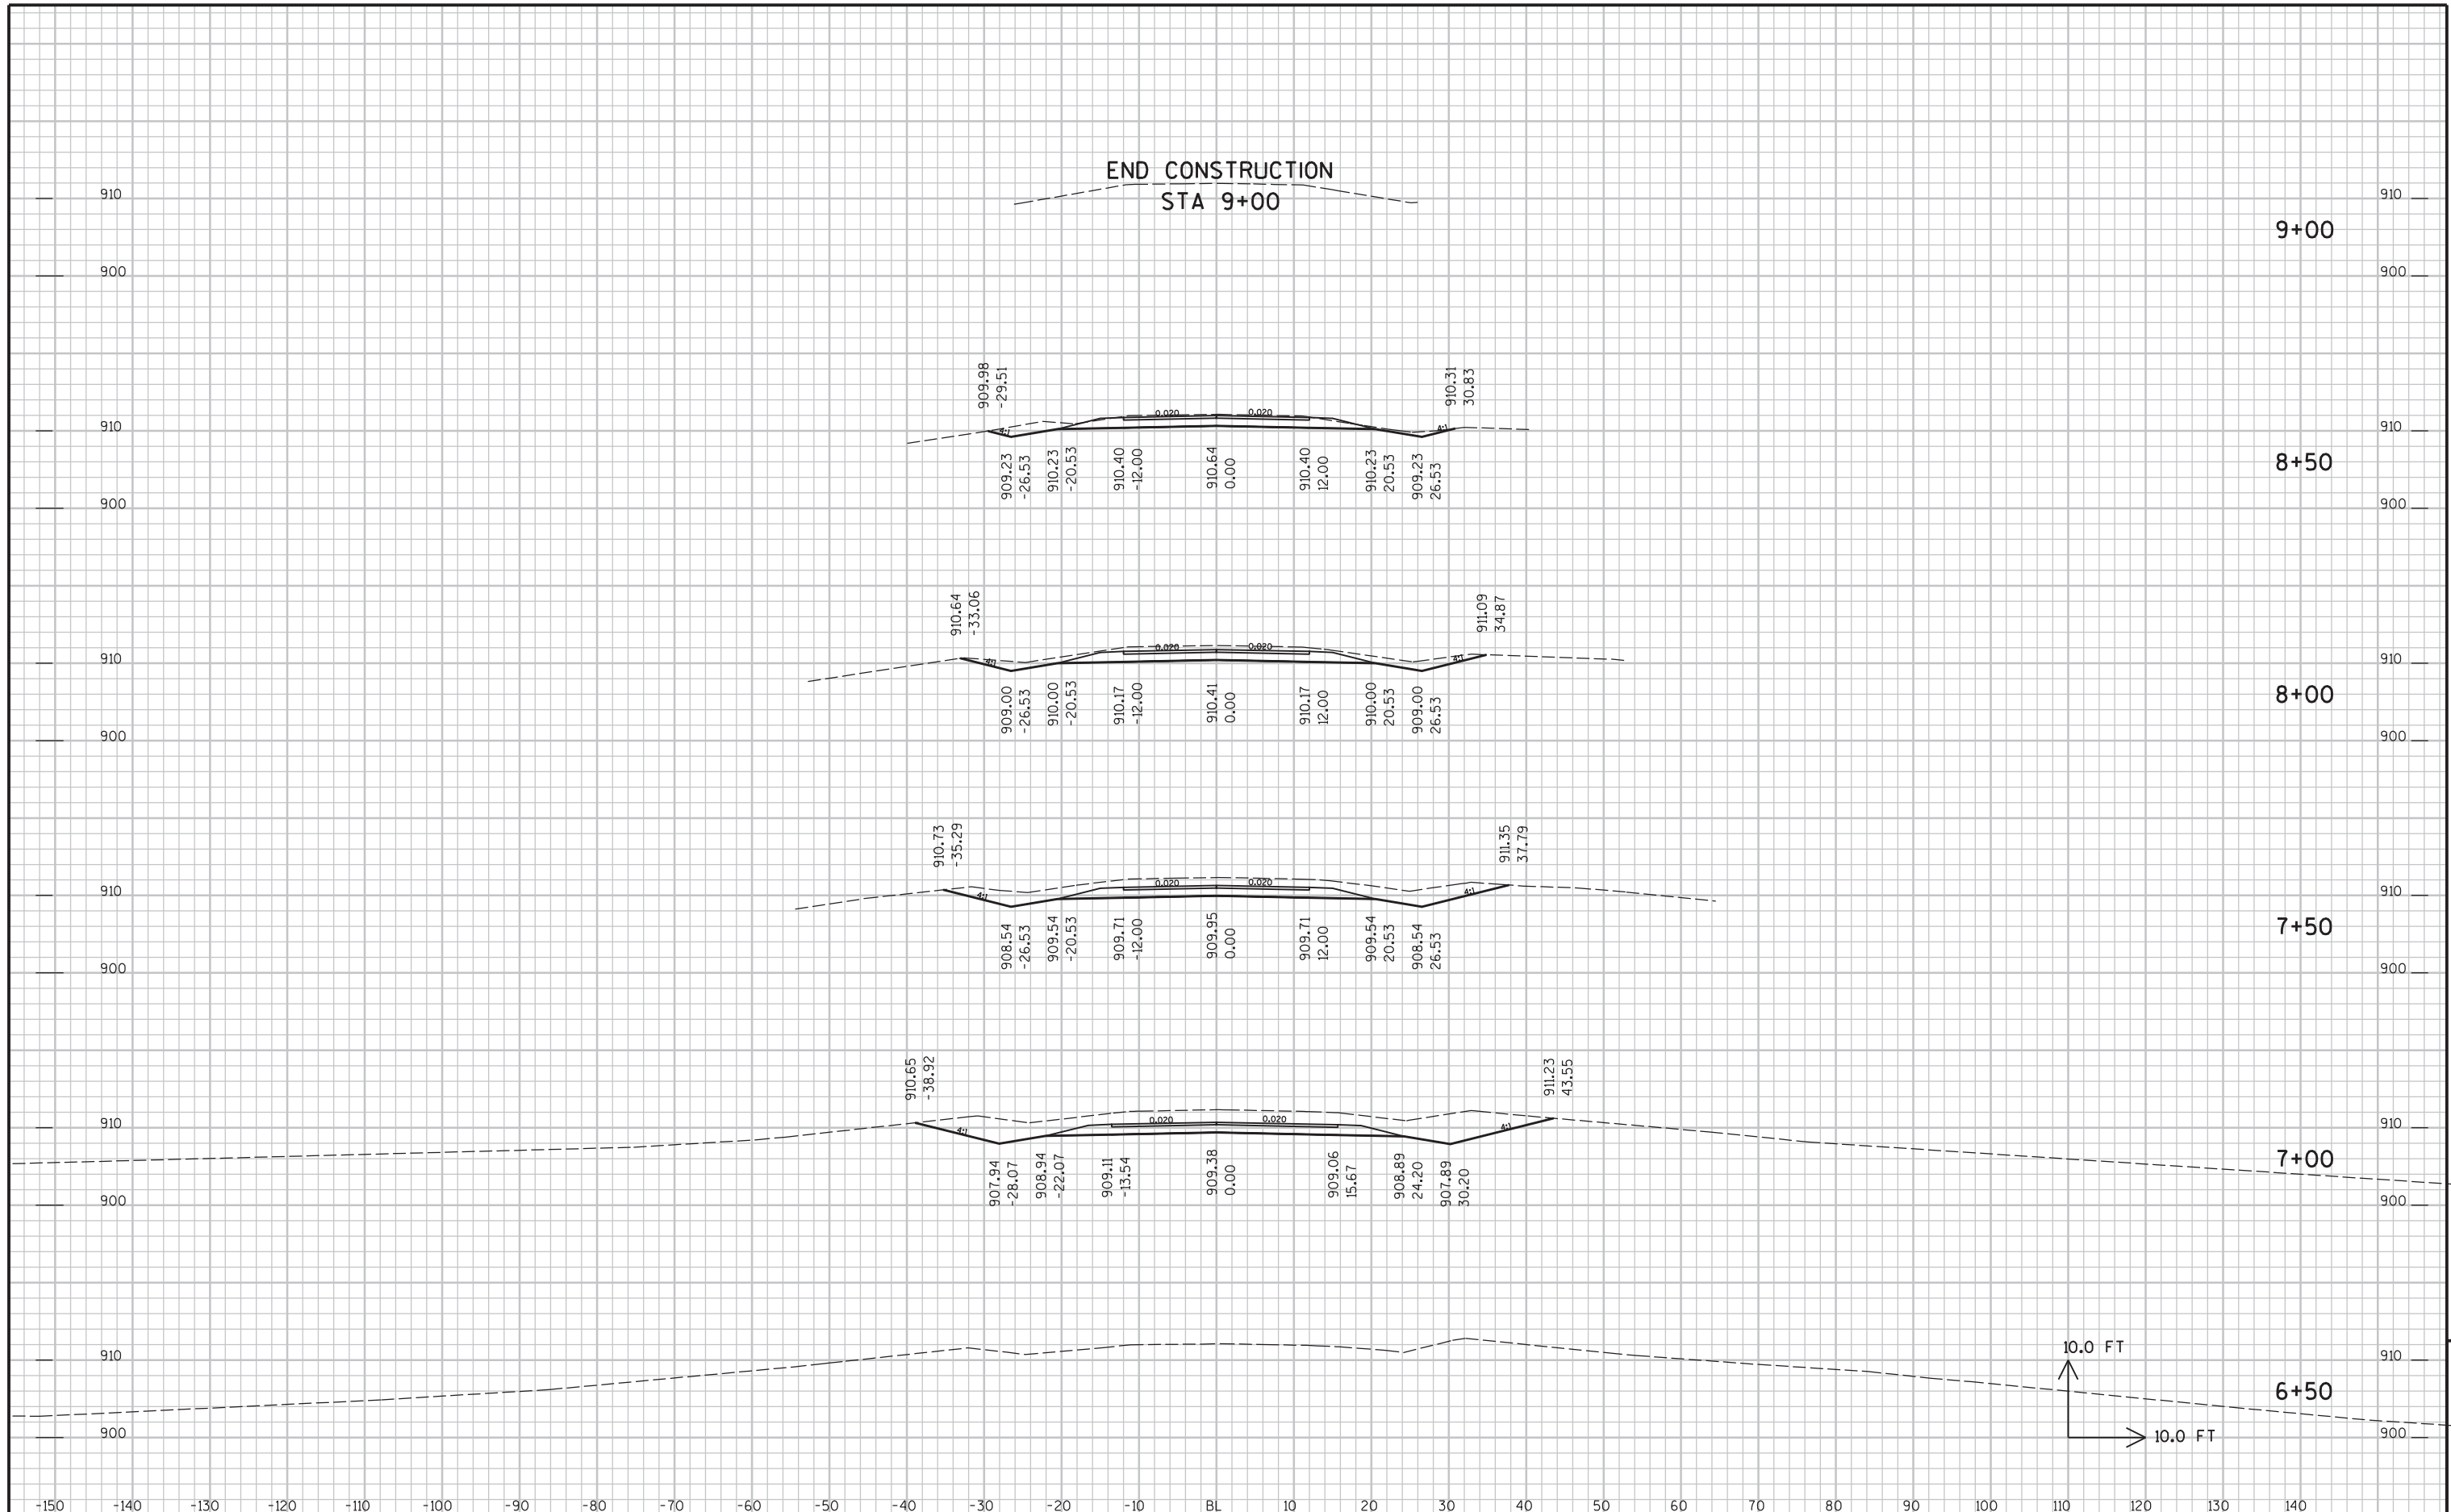



STATE PROJECT NO : HWY : CTH M COUNTY : WINNEBAGO CROSS SECTIONS - MAHLKE ROAD SHEET NO: 74 E

FILE NAME : P:\UZ\WINN\030200_CTH_M\CAD\XSmahl.DGN PLOT DATE: 1/18/2013 PLOT TIME: 12:56:14 PM ORG DATE : PLOT NAME : Originator : Dist PLOT SCALE : N/A


9

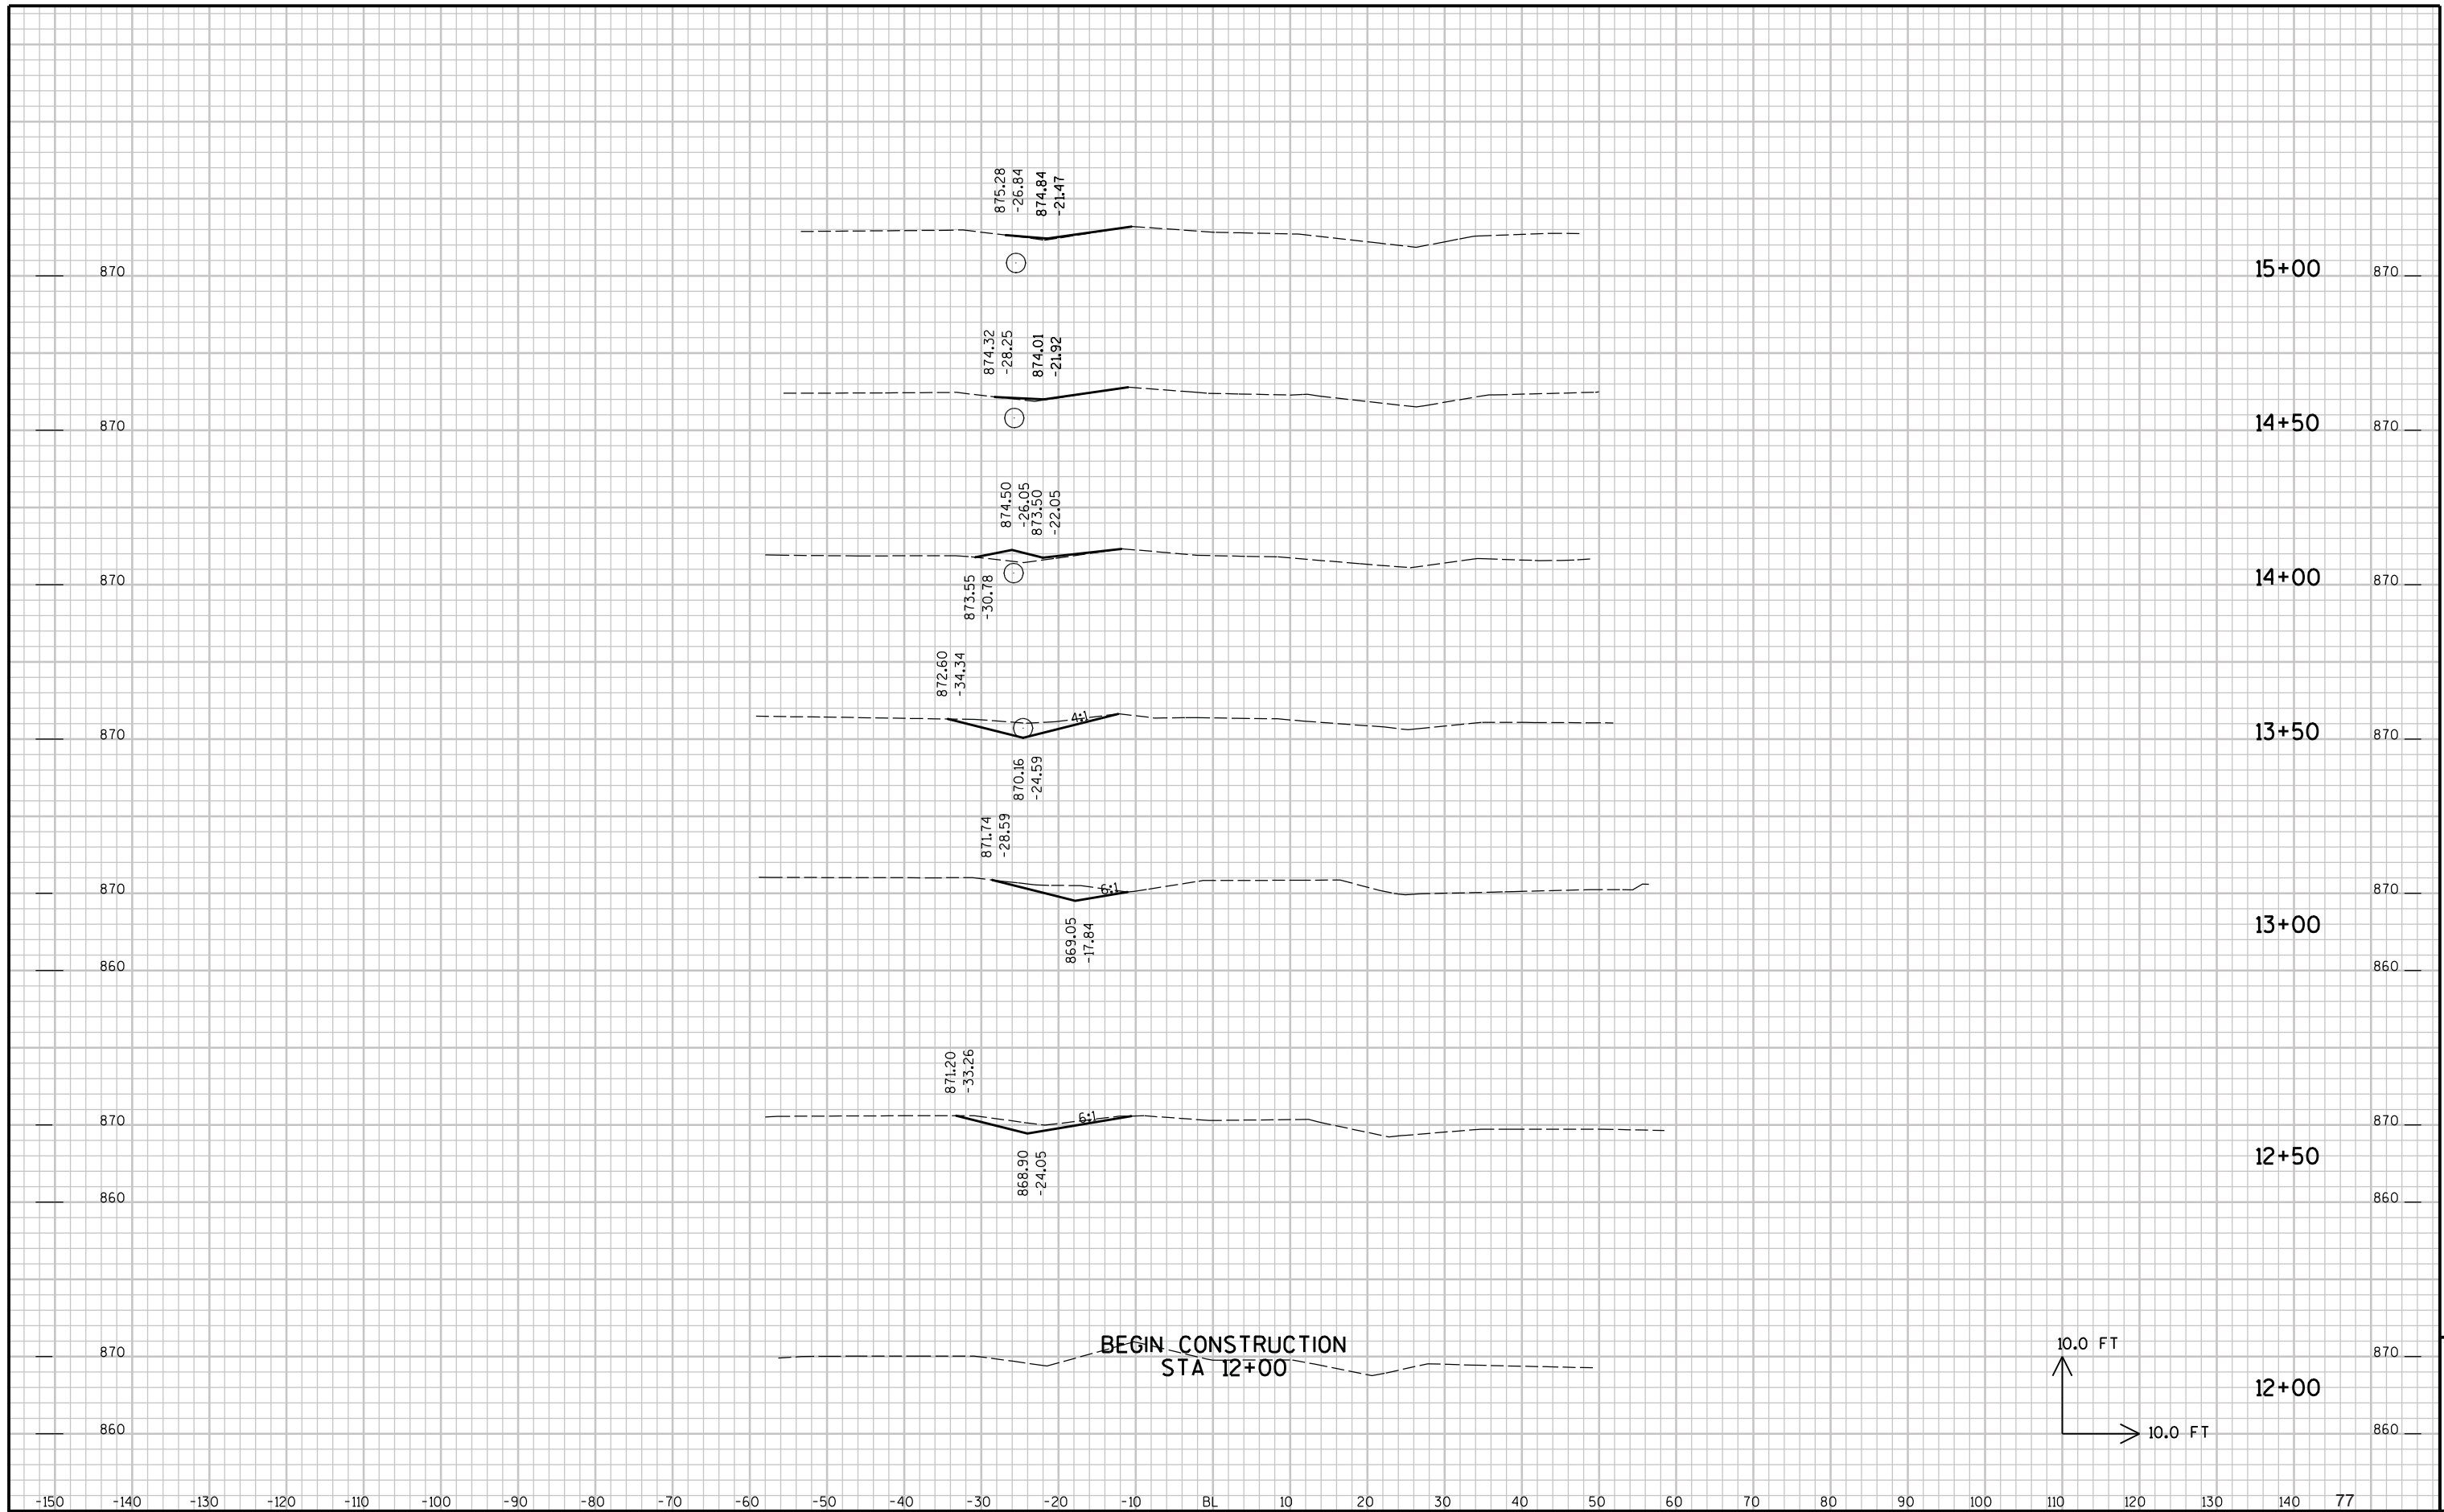

STATE PROJECT NO : HWY : CTH M COUNTY : WINNEBAGO CROSS SECTIONS - WEELAUNEE ROAD SHEET NO: 75 E

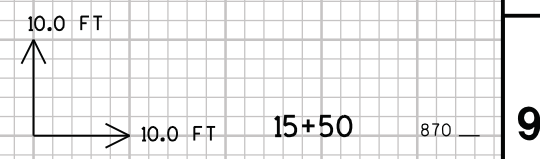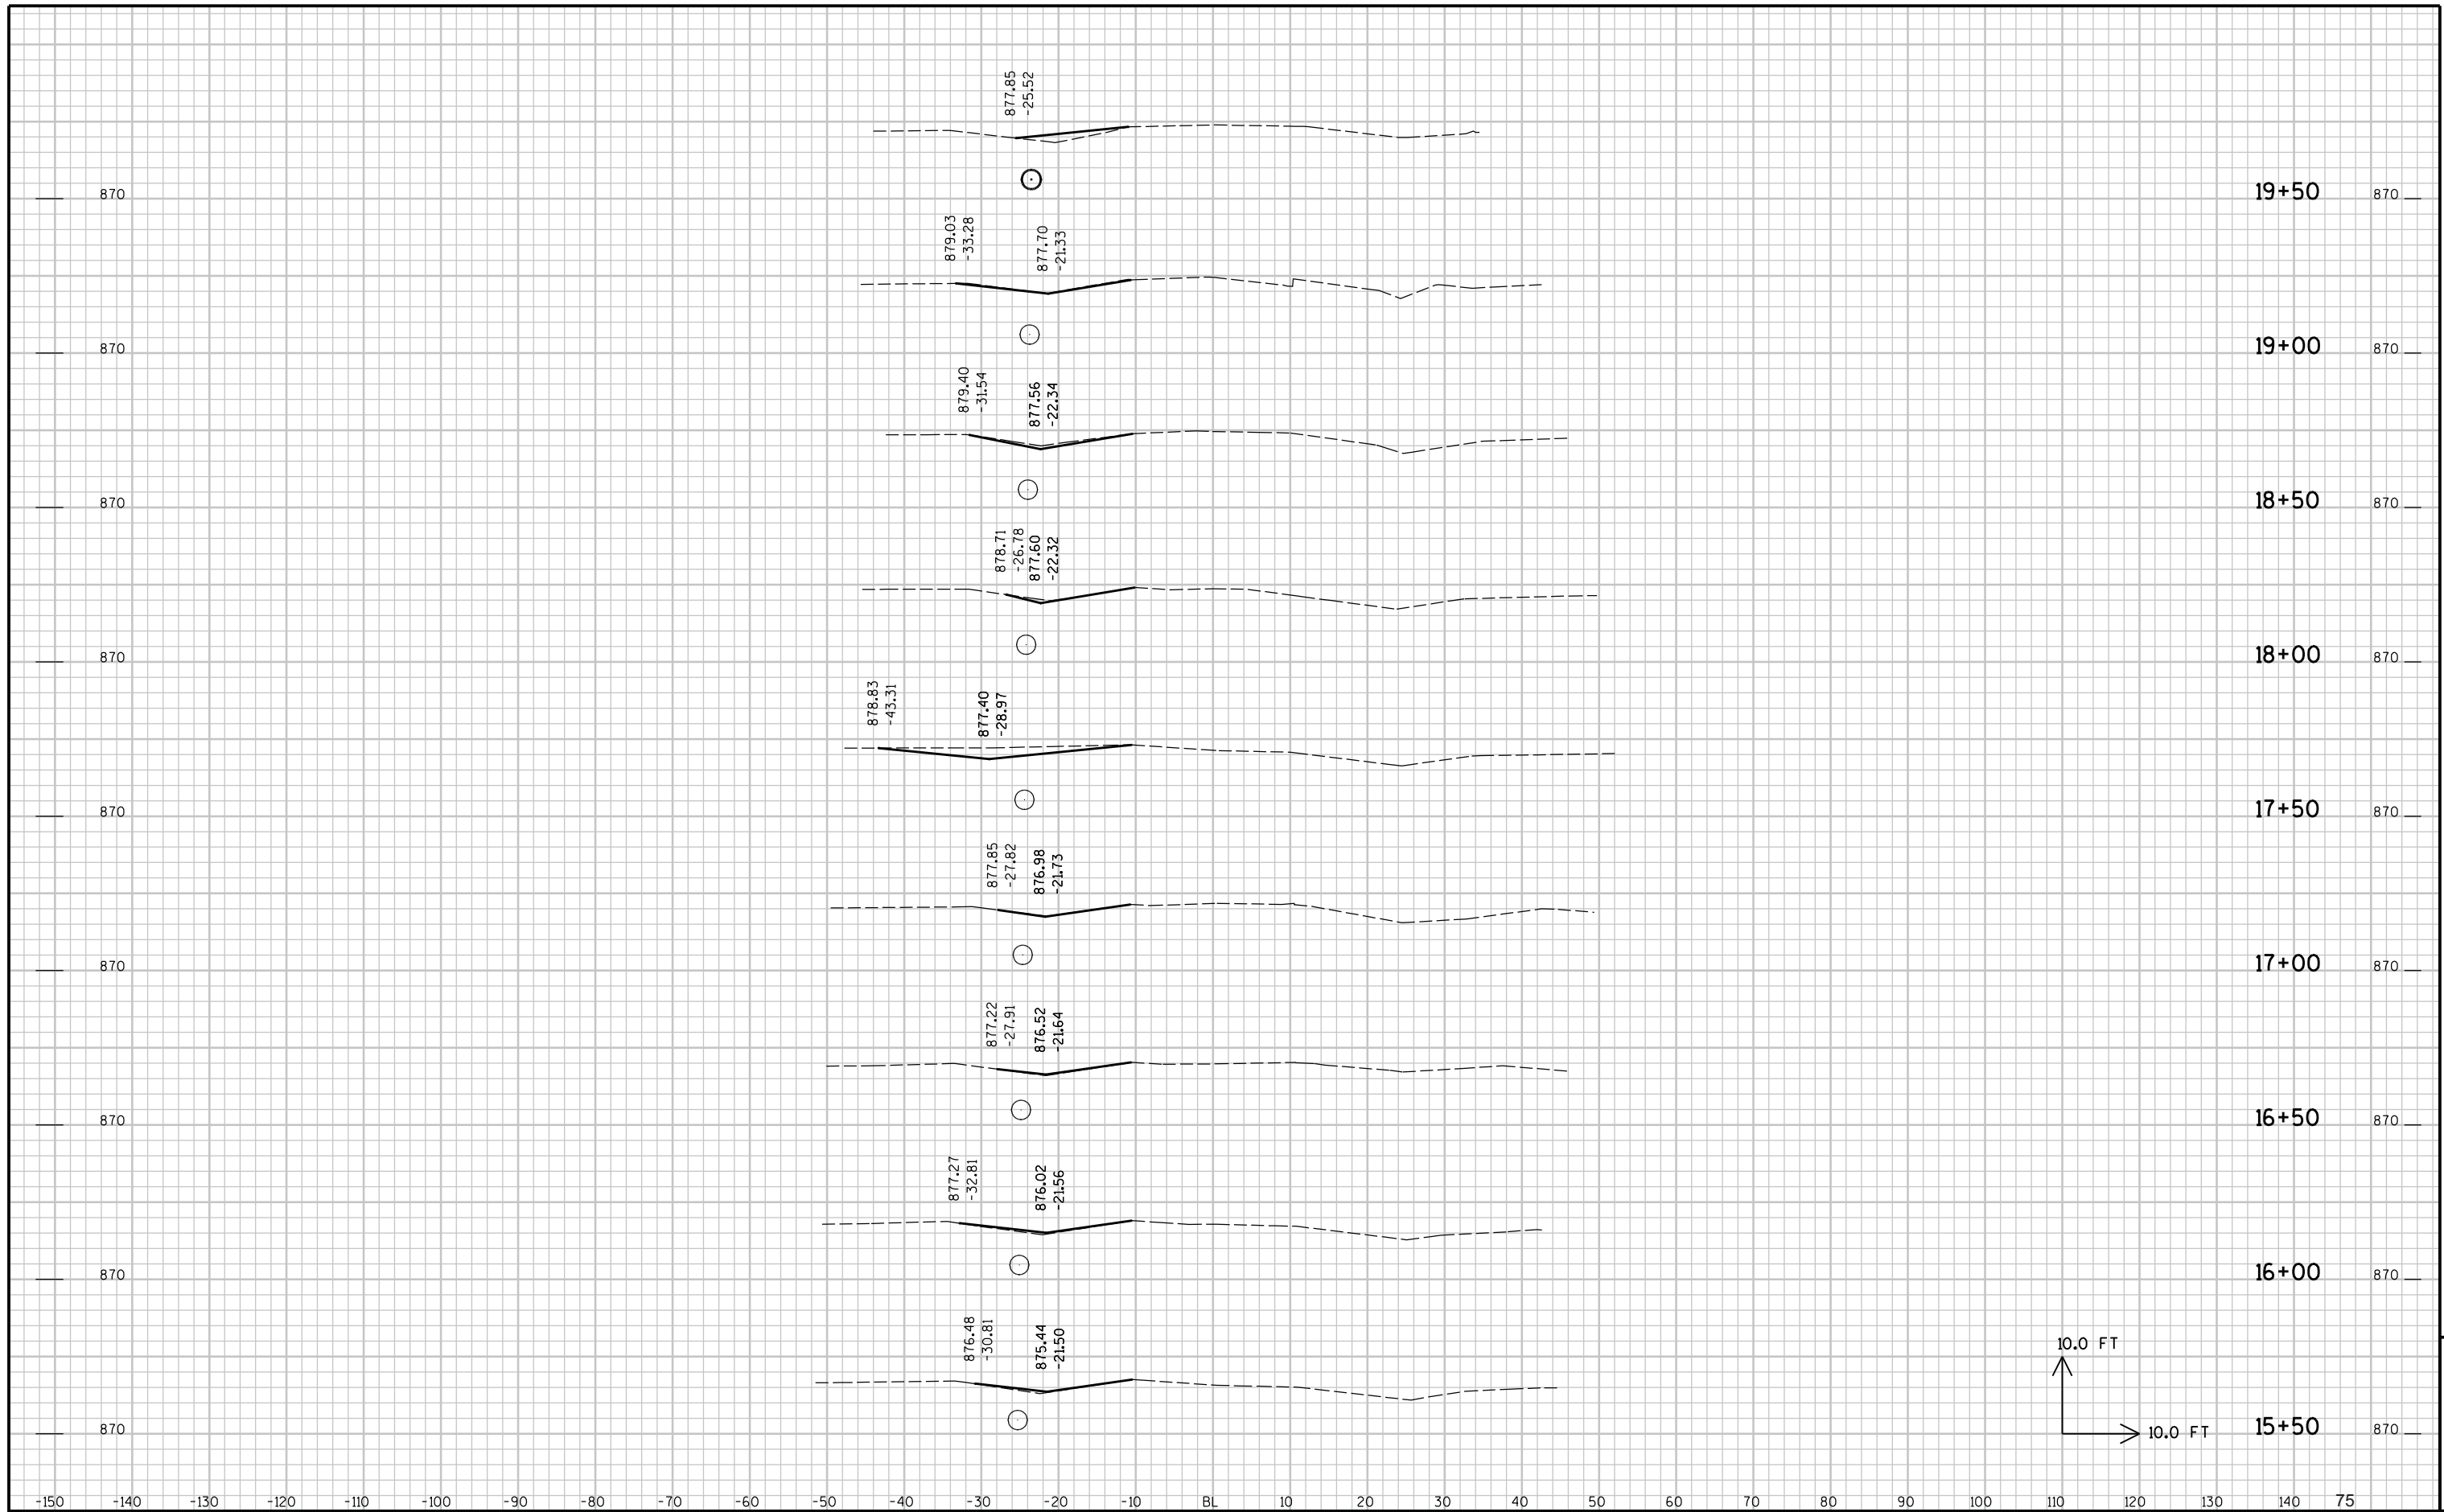

STATE PROJECT NO : HWY : CTH M COUNTY : WINNEBAGO CROSS SECTIONS - WEELAUNEE ROAD SHEET NO: 76 E

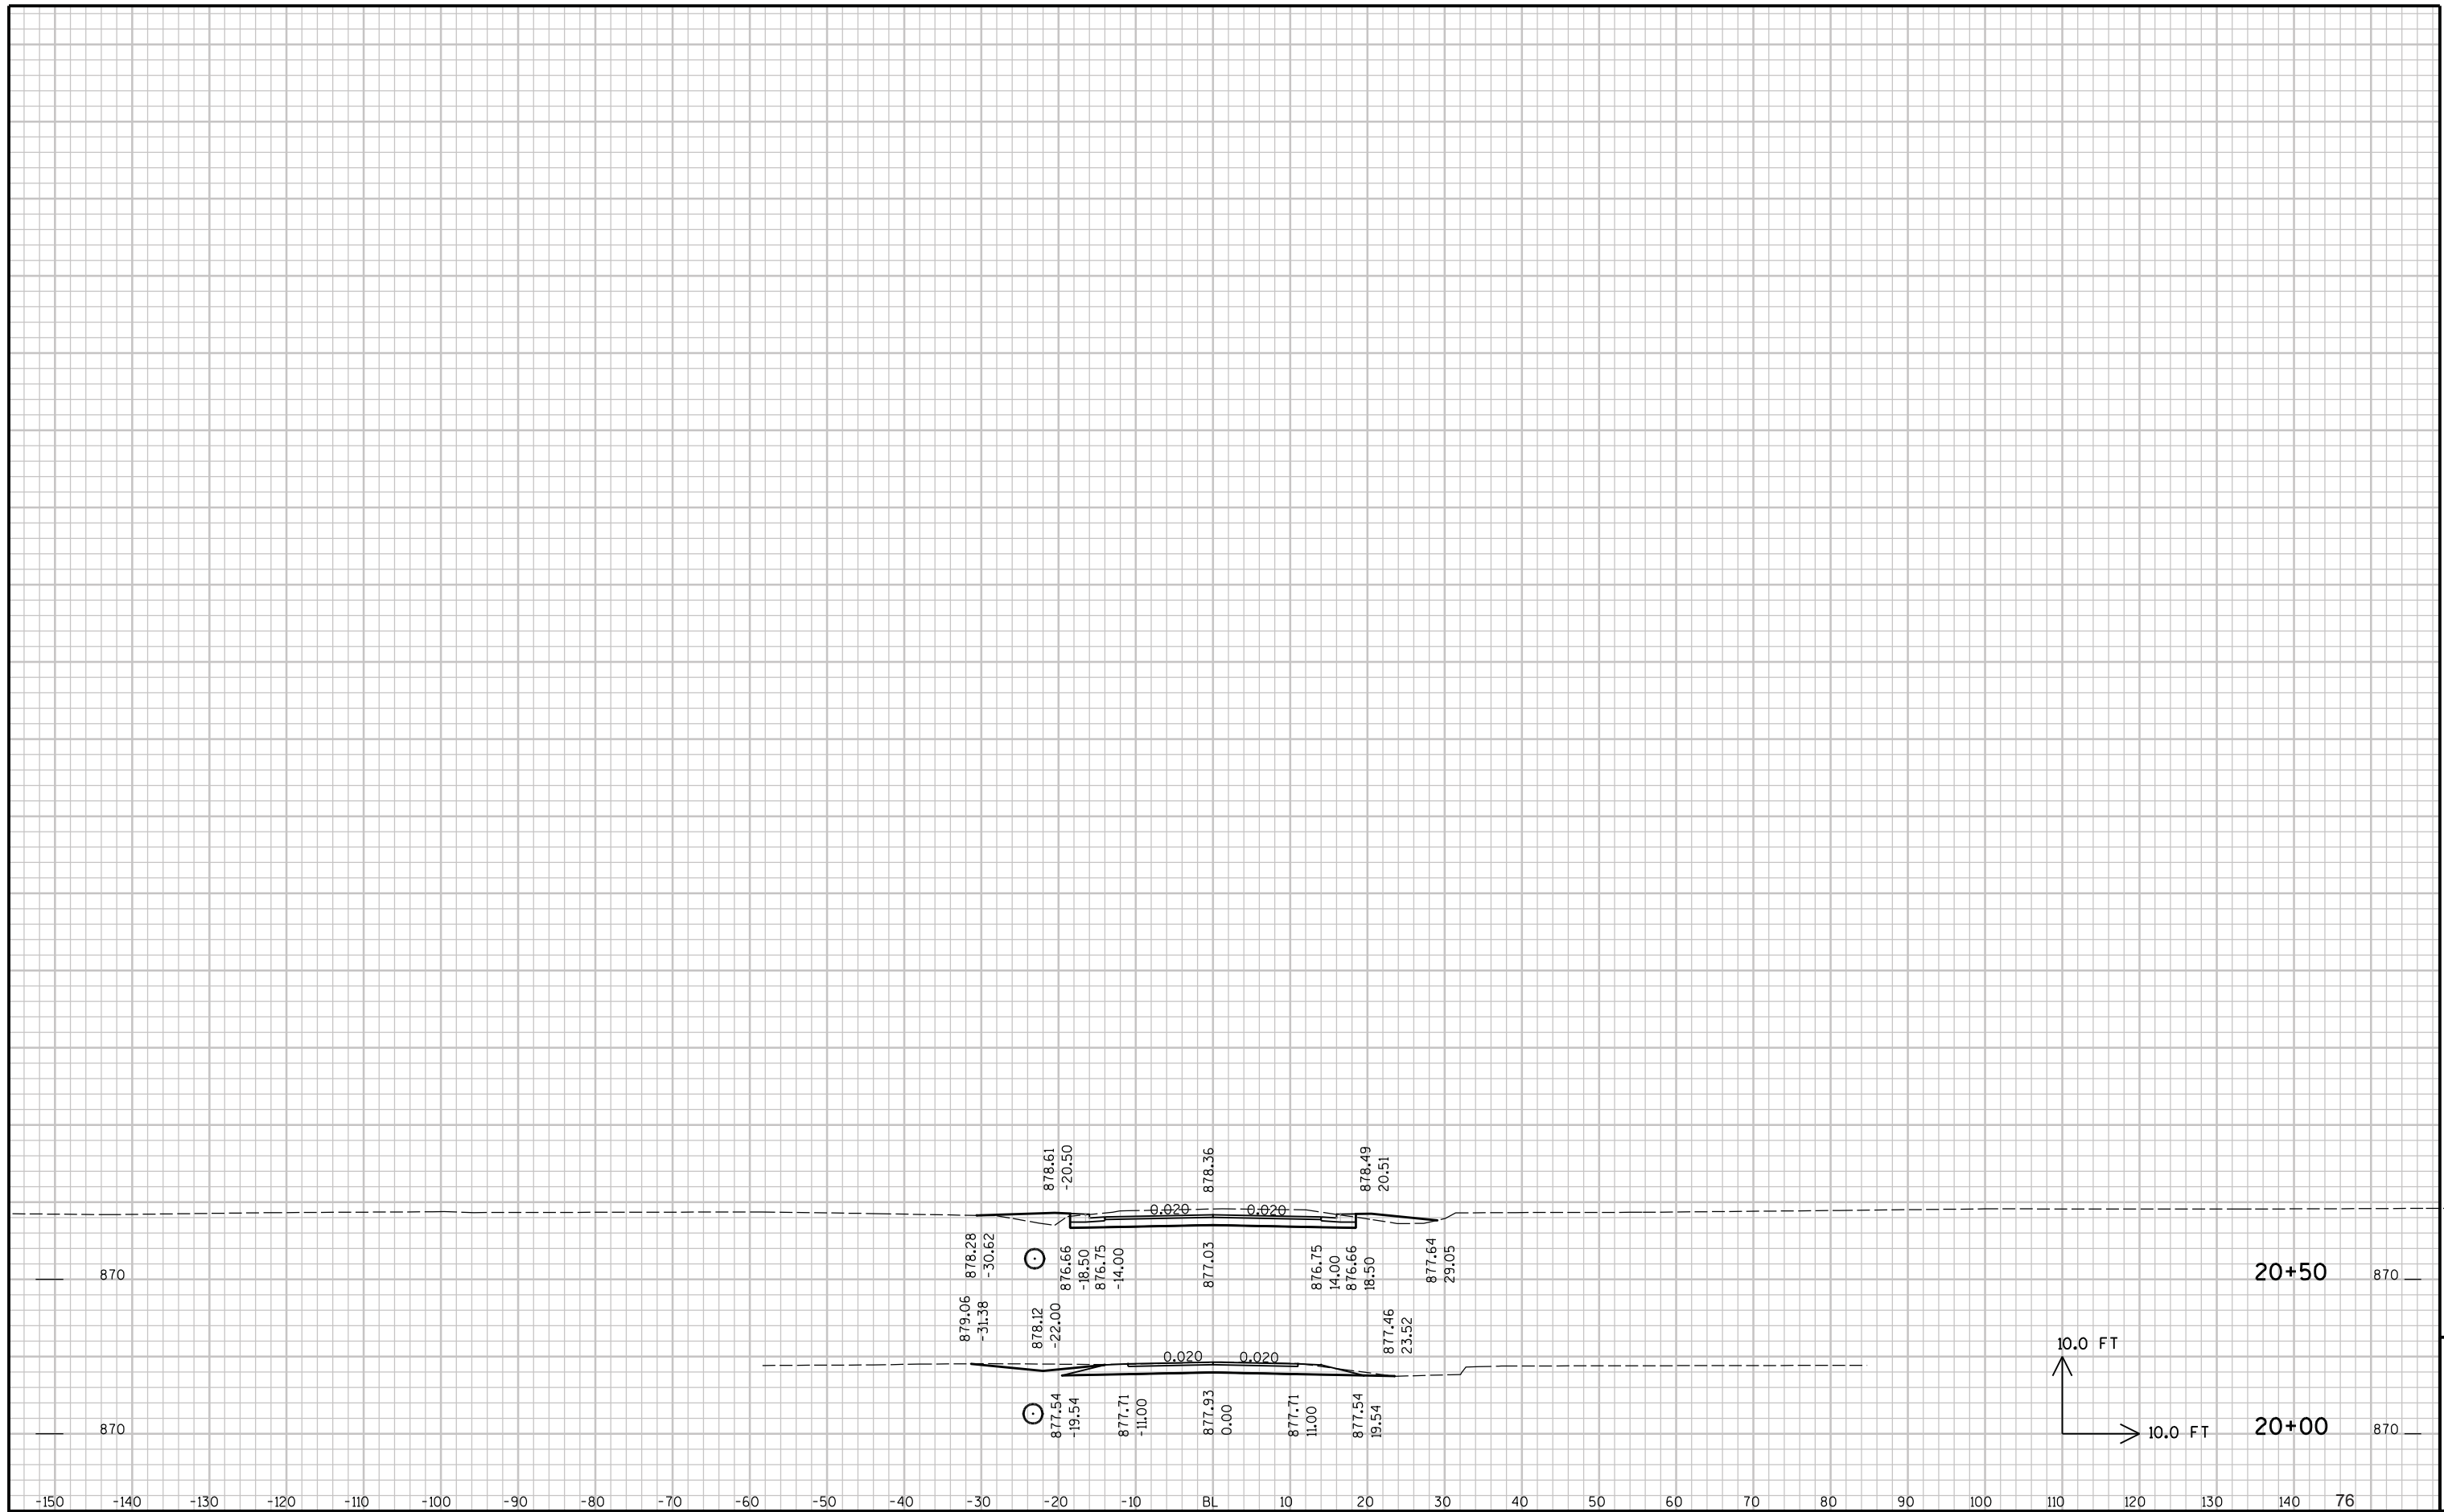

STATE PROJECT NO :

HWY : CTH M

COUNTY : WINNEBAGO

CROSS SECTIONS - WEELAUNEE ROAD

SHEET NO:

77

E