

SHEETS


- SHEET NO. 1-2 GENERAL CROSS SECTIONS
- SHEET NO. 3-4 ESTIMATE OF QUANTITIES
- SHEET NO. 5-6 MISCELLANEOUS QUANTITIES
- SHEET NO. 7-8 RIGHT OF WAY PLAT
- SHEET NO. 9-10 PLAN AND PROFILE STA.
- SHEET NO. 11-17 STANDARD DETAILS
- SHEET NO. 18-19 DRAINAGE STRUCTURES
- SHEET NO. 20-33 CROSS SECTIONS

WINNEBAGO
144

STATE OF WISCONSIN
STATE HIGHWAY COMMISSION OF WISCONSIN

COUNTY AND HIGHWAY	ROUTE AND SECTION	CLASS AND AGREEMENT		F.F.A. REGION DIVISION	SHEET NUMBER	TOTAL SHEETS
		STATE	FEDERAL			
706	7370		II.1	4 WIS.	1	33


PLAN AND PROFILE OF PROPOSED
RUSH LAKE - S.T.H. 116
C.T.H. "M"
WINNEBAGO COUNTY
PROJECT S0737(1)

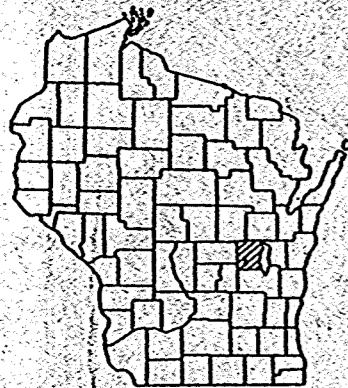

APPROVED FOR

Date _____ Title _____

PLAN 1 IN. = 100 FT.
PROFILE HOR. 1 IN. = 100 FT. VERT. 1 IN. = 10 FT.
CROSS SECTIONS HOR. 1 IN. = 5 FT. VERT. 1 IN. = 5 FT.

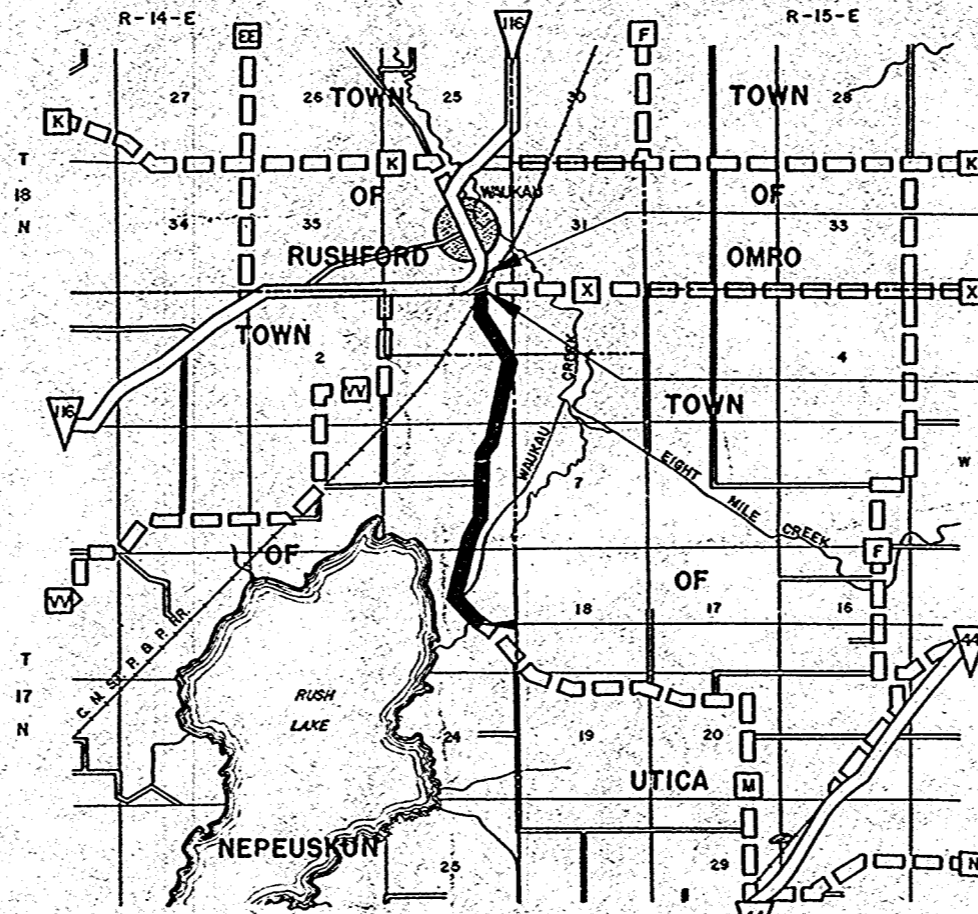

STA. 406+54 END
PROJ. S 0737(1)
1337' E. & 340' N. OF S. 1/4 COR.
SEC. 36, T. 18N, R. 14E.

STA. 401+0433 - STA. 401+28.87
EXCEPTION TO NET LENGTH

STA. 255+00 BEGIN
PROJ. S0737(1)
562' S. & 1366' W. OF E. 1/4 COR.
SEC. 13, T. 17N, R. 14E.

LAYOUT

SCALE ONE MILE

TOTAL NET LENGTH OF CENTERLINE = 2.865 MI.

CONVENTIONAL SIGNS

- | | | | |
|---------------------------|-------|-------------------------------|------------|
| STATE LINE | ----- | CULVERTS IN PLACE | ----- |
| COUNTY LINE | ----- | CULVERTS REQUIRED | ----- |
| TOWNSHIP OR RANGE LINE | ----- | DROP WILET | ----- |
| SECTION LINE | ----- | POWER POLE | ----- |
| NEW RIGHT OF WAY LINE | ----- | TELEPHONE OR TELEGRAPH POLE | ----- |
| PRESENT RIGHT OF WAY LINE | ----- | RIGHT OF WAY MARKERS | ----- |
| WIRE FENCE (WOVEN) | ----- | REFERENCE STAKE FOR HUBS ONLY | ----- |
| WIRE FENCE (BARBED) | ----- | MARSH | ----- |
| LOT LINE | ----- | HEDGE | ----- |
| CORPORATE OR CITY LIMITS | ----- | TREES | ----- |
| PROPERTY LINE | ----- | GROUND ELEVATION | NATUM LINE |
| TRAVELED WAY OR P.E. | ----- | GRADE ELEVATION | NATUM LINE |
| RAILROADS | ----- | | |
| BASE OR SURVEY LINE | ----- | | |

STATE HIGHWAY COMMISSION OF WISCONSIN
MADISON WIS.

SURVEYOR: R.D.N. BOOK NO. 237, P. 259
DISTRICT COMPUTER: L.J.L. & G. CHECKER
DISTRICT CHECKER: D.H.N. CORRECT

CORRECT:
DATE: 4/19/60 *[Signature]*
DISTRICT ENGINEER





RECOMMENDED FOR APPROVAL:
DATE: 4/14/60 *[Signature]*
DISTRICT ENGINEER

APPROVED:
DATE: 4/28/60 *[Signature]*
STATE HIGHWAY ENGINEER

DEPARTMENT OF COMMERCE
BUREAU OF PUBLIC ROADS


APPROVED: _____

S 0737(1)

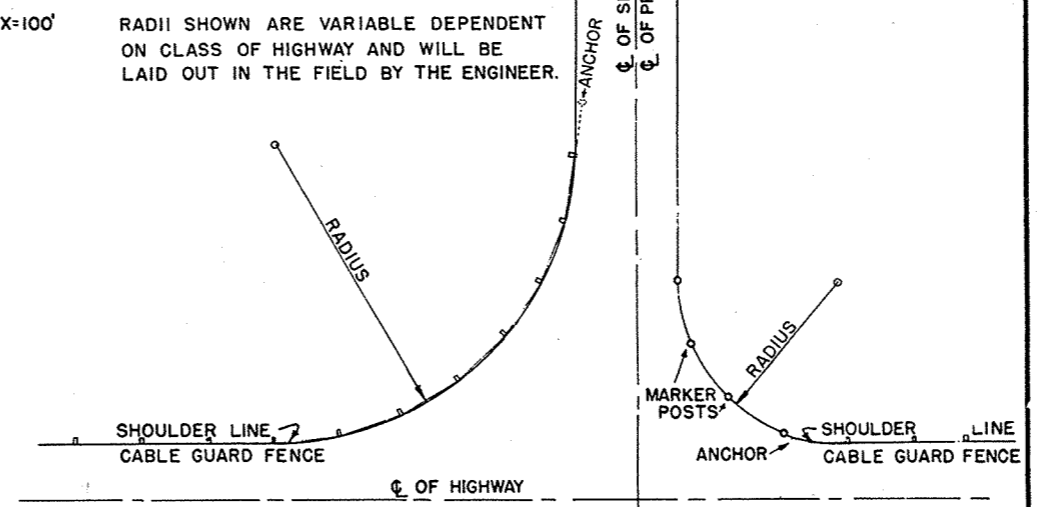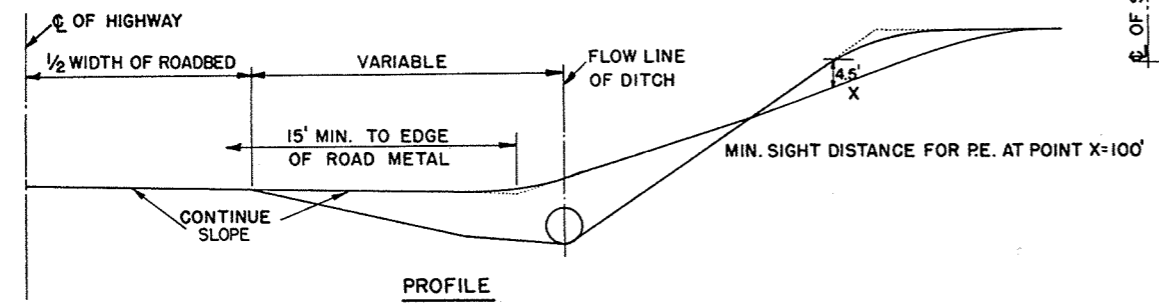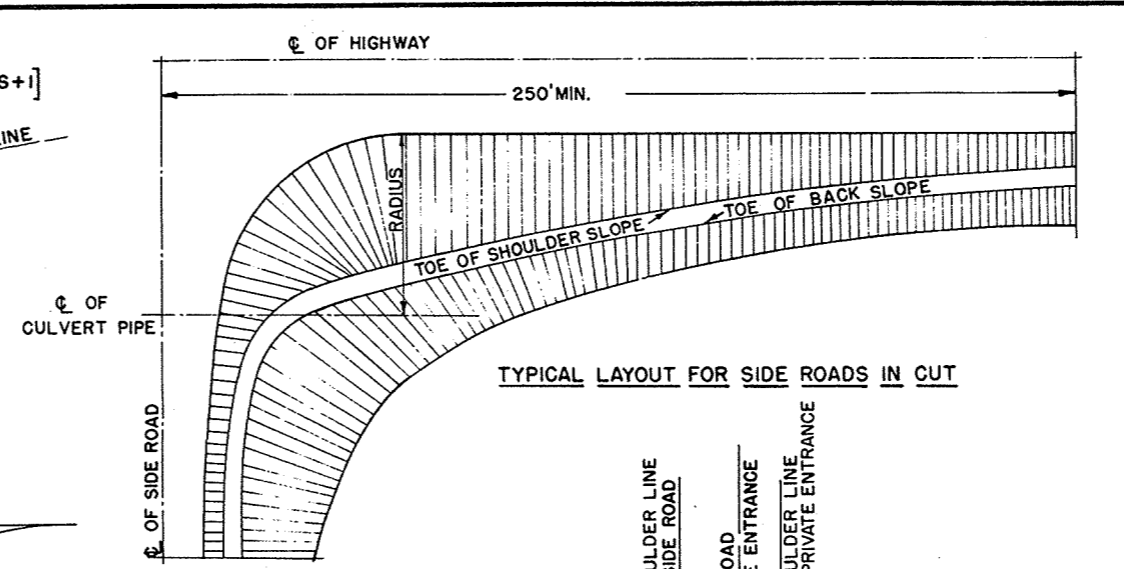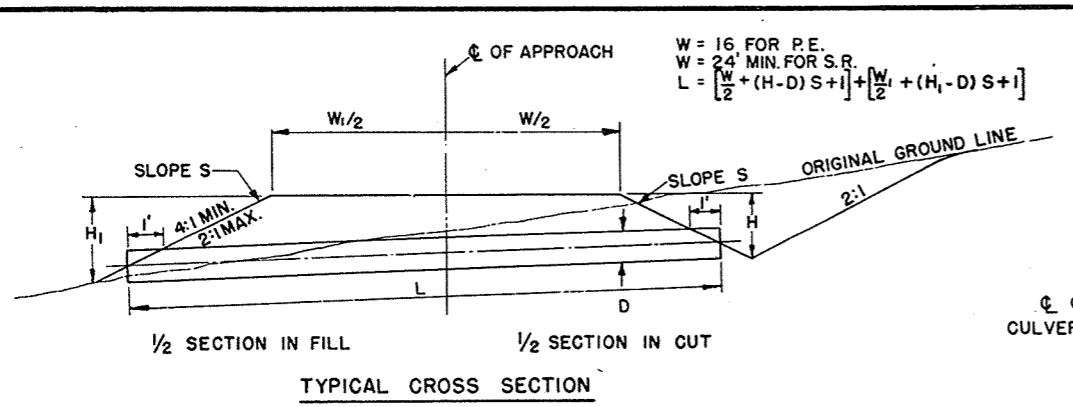

TYPICAL LAYOUT FOR PRIVATE ENTRANCES AND SIDE ROADS IN HIGH FILLS


DETAILS OF PRIVATE ENTRANCE AND SIDE ROAD APPROACHES	
STATE HIGHWAY COMMISSION OF WISC.	
RECOMMENDED FOR APPROVAL:	
<i>Frank Crane</i>	DESIGN ENGINEER
<i>W. Bluh</i>	CONSTRUCTION ENGINEER
DATE	
APPROVED: OCT. 1, 1945	
DRAWN <i>P. H. Ross</i>	STATE HIGHWAY ENGINEER
CHECKED	DATE

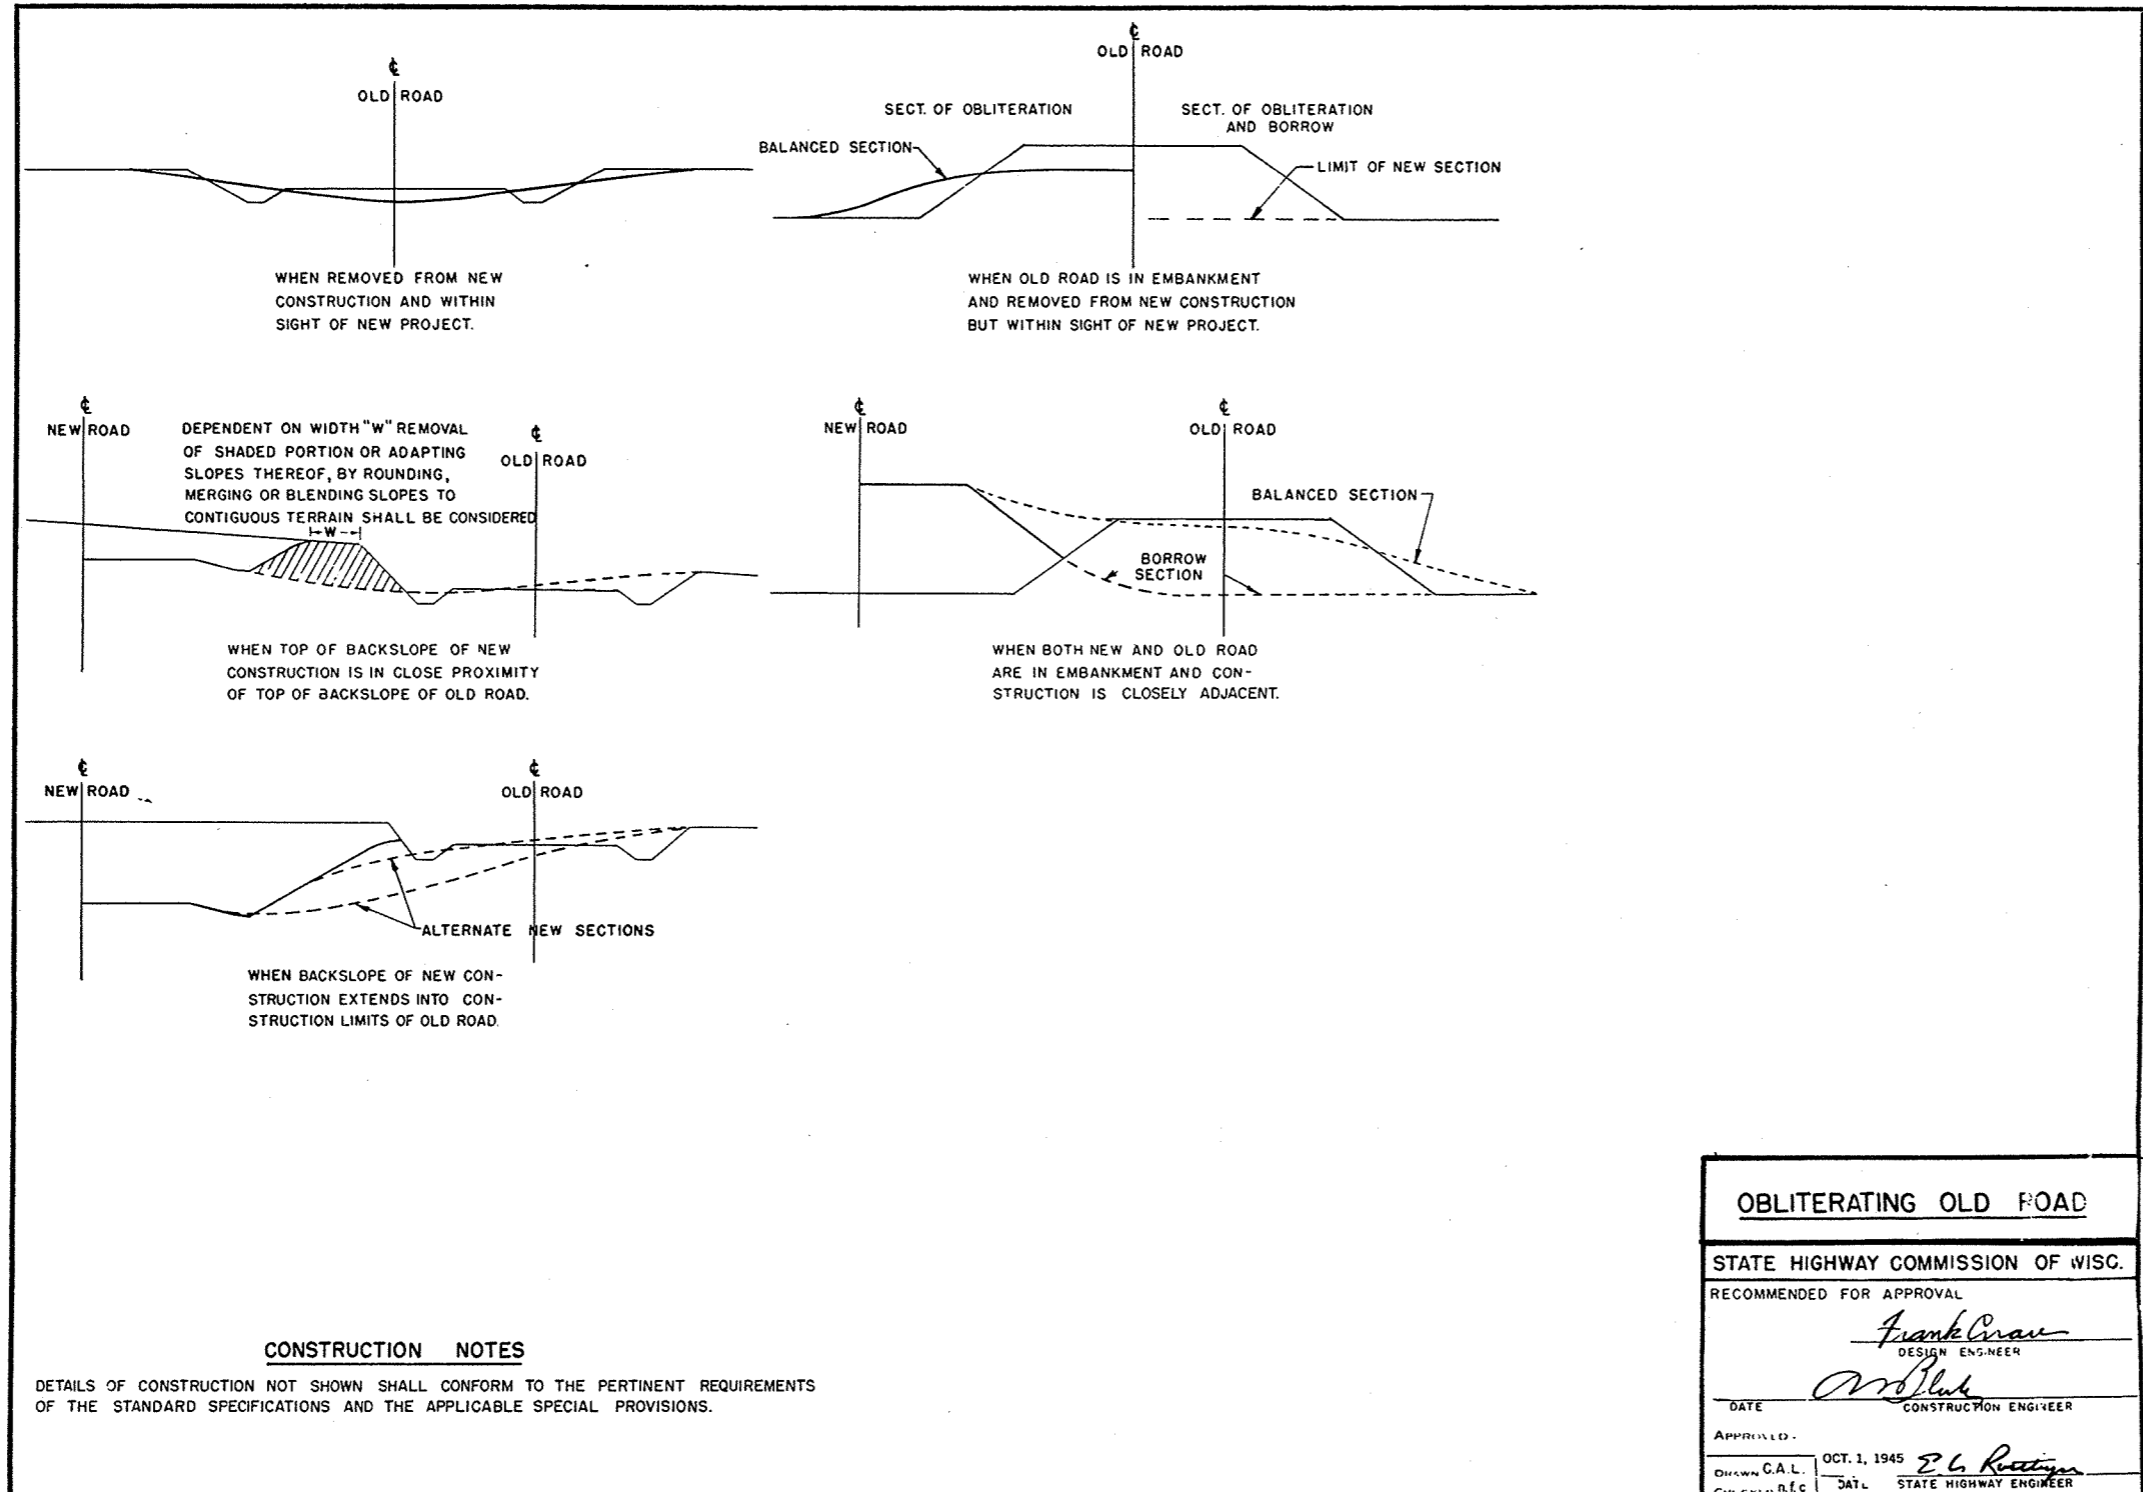

CONSTRUCTION NOTES

DETAILS OF CONSTRUCTION NOT SHOWN SHALL CONFORM TO THE PERTINENT REQUIREMENTS OF THE STANDARD SPECIFICATIONS AND THE APPLICABLE SPECIAL PROVISIONS.


OBLITERATING OLD ROAD	
STATE HIGHWAY COMMISSION OF WISC.	
RECOMMENDED FOR APPROVAL	
<i>Frank Crow</i> DESIGN ENGINEER	
<i>M. Bluh</i> CONSTRUCTION ENGINEER	
DATE	
APPROVED	
DRAWN C.A.L.	OCT. 1, 1945
CHECKED R.E.C.	<i>E. C. Reitzinger</i> STATE HIGHWAY ENGINEER

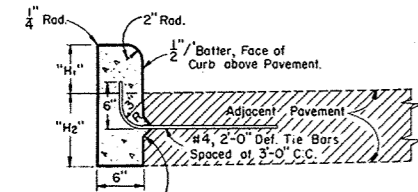

Tie Bar recess positioned in reverse when Concrete Curb is constructed first.
 "H₁" = 9" max. and 3 1/2" min. and shall be 6" unless otherwise shown on the plans.
 "H₂" = Same as adjacent pavement thickness for rigid pavement and 12" for other than rigid pavement (Tie Bars Omitted).

TYPE "A" (Including Tie Bars) TYPE "D" (Excluding Tie Bars)


CONCRETE CURB

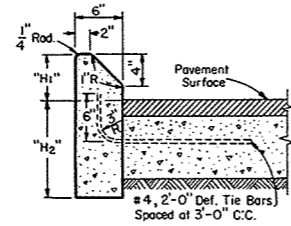

"H₁" = 9" Max. and 4" min. and shall be 6" unless otherwise shown on plans.
 "H₂" = Same as adjacent pavement thickness for rigid pavement and 12" for other than rigid pavement (Tie Bars Omitted).

TYPE "G" (Including Tie Bars) TYPE "J" (Excluding Tie Bars)

CONCRETE CURB
(Mountable Type)

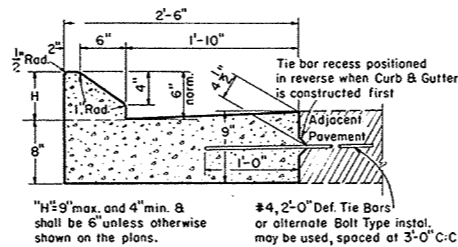


TYPE "G" (Including Tie Bars) TYPE "J" (Excluding Tie Bars)

CONCRETE CURB AND GUTTER
(Mountable Type)

GENERAL NOTES

Details of construction and materials not shown on this drawing shall conform to the pertinent requirements of the Standard Specifications Sections 2301 & 2521, and the applicable Special Provisions.


JOINTS - Joints shall not be sealed in concrete curb, concrete gutter, concrete curb and gutter, or concrete surface drains.

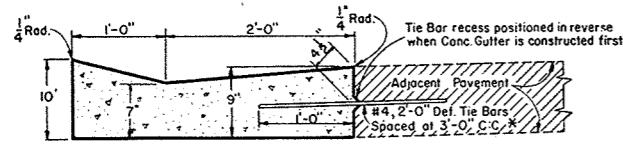


* Alternate Tie Bars or Bolt Type installations may be used as shown for Longitudinal Joints - See Std. No. 4-4.4.1

TYPE "A" (Including Tie Bars) TYPE "D" (Excluding Tie Bars)

CONCRETE GUTTER

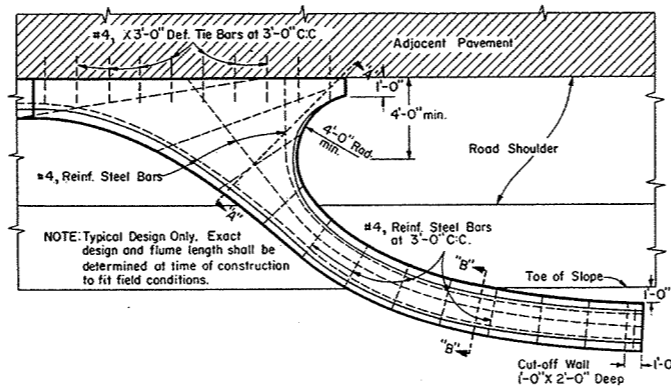


NOTE: Typical Design Only. Exact design and flume length shall be determined at time of construction to fit field conditions.

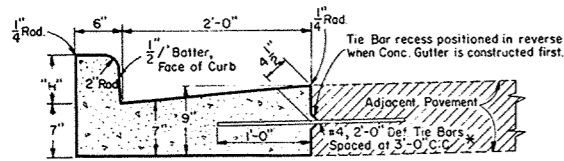

"H" = 9" Max., 3 1/2" Min. and shall be 6" unless otherwise shown on the plans.
 * Alternate Tie Bars or Bolt Type installations may be used as shown for Longitudinal Joints - See Std. Plate No. 4-4.4.1

TYPE "A" (Including Tie Bars) TYPE "D" (Excluding Tie Bars)

CONCRETE CURB AND GUTTER
(Barrier Type)

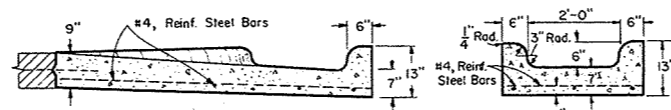

SECTION "A-A"

SECTION "B-B"

CONCRETE INLET OR DISCHARGE FOR CURB AND GUTTER SURFACE DRAIN

BID ITEMS -

- No. 2301-10 Concrete Surface Drains _____ Cu. Yds.
- No. 2521-1 Concrete Curb (Type) _____ Lin. Ft.
- No. 2521-6 Concrete Gutter (Type) _____ Lin. Ft.
- No. 2521-11 Concrete Curb and Gutter (Type and Size) _____ Lin. Ft.

**CONCRETE CURB, CONCRETE GUTTER
CONCRETE CURB AND GUTTER AND
CONCRETE SURFACE DRAINS**

STATE HIGHWAY COMMISSION OF WISCONSIN

RECOMMENDED FOR APPROVAL:


DATE 5/5/59

APPROVED:


DATE 5/6/59

J. S. Pelt ENGINEER OF DESIGN

E. C. Rostetter STATE HIGHWAY ENGINEER

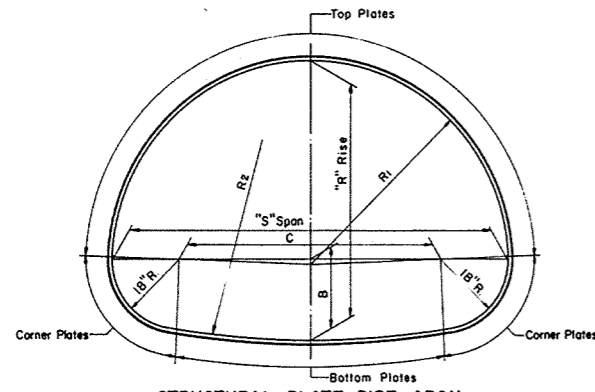

STRUCTURAL PLATE PIPE ARCH

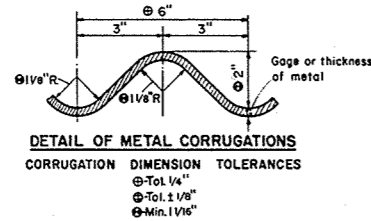

GENERAL NOTES

Details of construction not shown on this drawing shall conform to the pertinent requirements of the Standard Specifications, Sections 2412 and 3116 and the applicable Special Provisions.

TOLERANCES

Pipe Arch size dimensions are subject to manufacturing tolerances and the ratio of rise (R) to span (S) shall not exceed a tolerance of 5% plus or minus.

Metal corrugation dimension tolerances shall not exceed pertinent dimensions shown elsewhere on this drawing.

EMBANKMENT—Minimum for $\frac{1}{2}$ Culverts

For Flexible Type Pavement, the minimum depth of embankment or cover over top of Pipe Arch (finished construction) shall be "S/10 or 1'-0" minimum.

For Rigid Type Pavement, the minimum depth of embankment over top of Pipe Arch shall be "S/14 or a minimum of 6" cushion between pipe and pavement.

EMBANKMENT—Maximum for $\frac{1}{2}$ Culverts

The maximum depth of embankment shall be 15 feet (finished construction).

Adequate cover protection for Pipe Arches shall be provided at all times during construction operations to preclude any damage to structures.


Strutting of Pipe Arches will not be required during construction unless specifically called for on the plans or the applicable Special Provisions.

**TABLE OF PROPERTIES
STRUCTURAL PLATE PIPE ARCH**


SPAN Nominal Size	Dimensions taken from inside crests of corrugations							Table of Metal Gages—Minimum Acceptable																		
	Fabricators Size Min. Acceptable "S" Span—"R" Rise	R/S Ratio	Area Sq.Ft.	B In.	C In.	R1 In.	R2 In.	H-20 LOADING Depth of Embankment in Feet																		
								1	2	3	4	5	6	7	8	9	10	11	12	13	14	15				
6 Feet	6'-1" x 4'-7"	.75	22	21.0	37.0	36.7	76.4	12	12	12	12	12	12	12	12	12	12	12	12	12	12	12	12	12	10	10
7 "	7'-0" x 5'-1"	.73	28	21.4	48.0	42.3	104.5	10	12	12	12	12	12	12	12	12	12	12	12	12	12	12	12	12	10	10
8 "	7'-11" x 5'-7"	.70	35	21.7	59.0	47.7	138.4	10	10	10	12	12	12	12	12	12	12	12	12	12	12	12	10	10	10	10
9 "	8'-10" x 6'-1"	.69	43	21.8	70.0	53.0	179.2	10	10	10	10	10	10	10	10	10	10	10	10	10	10	10	10	8	8	8
10 "	9'-9" x 6'-7"	.67	52	21.9	81.0	58.3	228.0	8	8	10	10	10	10	10	10	10	10	10	10	8	8	8	8	8	8	7
11 "	10'-11" x 7'-1"	.65	61	25.1	95.0	65.8	180.8	8	8	8	10	10	10	10	10	10	8	8	8	8	8	8	8	7	7	5
12 "	11'-10" x 7'-7"	.64	71	25.2	106.0	71.1	217.0	7	8	8	8	8	8	8	8	8	8	8	8	7	7	5	5	5	3	3
13 "	12'-10" x 8'-4"	.65	85	24.0	118.0	77.2	315.2	5	7	8	8	8	8	8	8	8	8	8	7	7	5	5	3	3	1	1
14 "	13'-11" x 8'-7"	.62	93	28.9	131.0	84.4	220.8	5	5	7	7	8	8	8	8	7	7	5	5	3	3	1	1	1	1	1
15 "	14'-10" x 9'-1"	.61	105	28.9	142.0	89.5	254.9	3	5	5	7	7	7	7	7	5	3	3	1	1	1	1	1	1	1	1
16 "	15'-10" x 9'-10"	.62	122	27.4	154.0	95.4	339.1	1	3	5	5	7	7	7	5	3	3	1	1	1	1	1	1	1	1	1
16.5 "	16'-7" x 10'-1"	.61	131	28.7	163.0	99.8	333.8	1	3	3	5	5	5	3	1	1	1	1	1	1	1	1	1	1	1	1

Note: For sizes of Structural Plate Pipe Arch between those shown in the table, the gage shall be interpolated (based on table data) where possible; otherwise the gage of the next larger size shown in the table shall be used.

STRUCTURAL PLATE PIPE ARCH

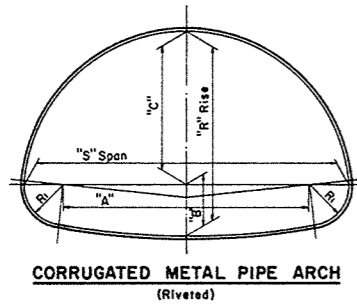

**CORRUGATED METAL PIPE ARCH
(Riveted)**

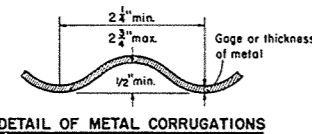

GENERAL NOTES

Details of construction not shown on this drawing shall conform to the pertinent requirements of the Standard Specifications, Sections 2411 and 3116 and the applicable Special Provisions.

TOLERANCES

Tolerance from the dimensions detailing size and shape will be permissible providing equivalent capacity and strength are attained.

EMBANKMENT—Minimum for $\frac{1}{2}$ Culverts

For Flexible Type Pavement, the minimum depth of embankment or cover over top of Pipe Arch (finished construction) shall be "S/10 or 9" minimum.

For Rigid Type Pavement, the minimum depth of embankment over top of Pipe Arch shall be "S/14 or a minimum of 3" cushion between pipe and pavement.

EMBANKMENT—Maximum for $\frac{1}{2}$ Culverts

The maximum depth of embankment shall be 10 feet (finished construction).

Adequate cover protection for Pipe Arches shall be provided at all times during construction operations to preclude any damage to structures.

**TABLE OF DIMENSIONS
CORRUGATED METAL PIPE ARCH**

CORRUGATED METAL PIPE ARCH										Round Pipe of Approx. Equal Periphery	
Gage (Min. Accept. Sp. In.)	"S" Span Inches	"R" Rise Inches	"A" Inches	"B" Inches	"C" Inches	R1 Inches	R/S Ratio	Area Sq.Ft.		Area Sq.Ft.	Diag. Inches
16	18	11	10	4 1/2	6 1/2	3 1/2	.61	1.1		1.23	15
16	22	13	14	4 3/4	8 1/4	4	.59	1.6		1.77	18
16	25	16	17	5 1/4	10 3/4	4	.64	2.2		2.41	21
14	29	18	20	5 1/2	12 1/2	4 1/2	.62	2.8		3.14	24
14	36	22	26	6 1/4	15 3/4	5	.61	4.4		4.91	30
12	43	27	32	7	20	5 1/2	.63	6.4		7.07	36
12	50	31	38	8	23	6	.62	8.7		9.62	42
12	58	36	44	9 1/4	26 3/4	7	.62	11.4		12.57	48
12	65	40	49	10 1/2	29 1/2	8	.62	14.3		15.90	54
10	72	44	54	11 3/4	32 1/4	9	.61	17.6		19.64	60

NOTE: All Dimensions measured from inside crest of corrugations.

CORRUGATED METAL PIPE ARCH

**STRUCTURAL PLATE PIPE ARCH
CORRUGATED METAL PIPE ARCH**

STATE HIGHWAY COMMISSION OF WISCONSIN

RECOMMENDED FOR APPROVAL:

5-27-57
DATE


J. S. Pelt
ENGINEER OF DESIGN

APPROVED:


5/28/57
DATE

E. C. Rustigan
STATE HIGHWAY ENGINEER


PLATE NO. 6-5.3.1

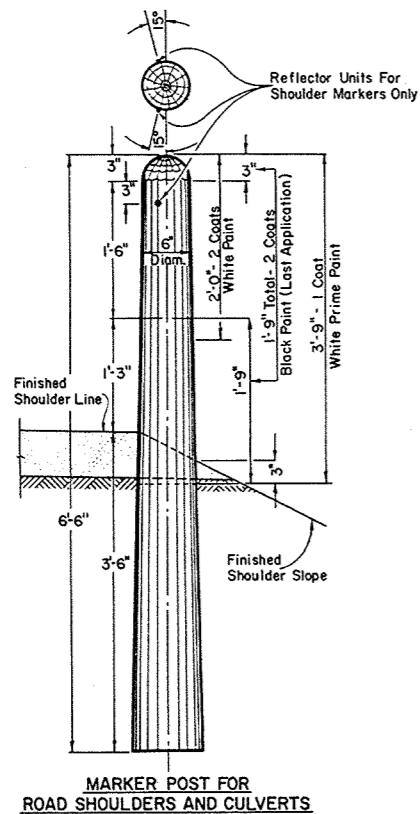


MARKER POST FOR ROAD SHOULDERS AND CULVERTS

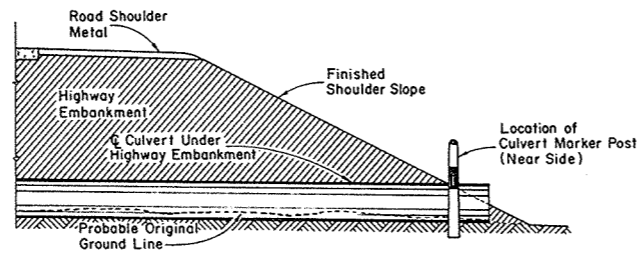

SECTION SHOWING RELATIVE LOCATION OF MARKER POST FOR CULVERTS

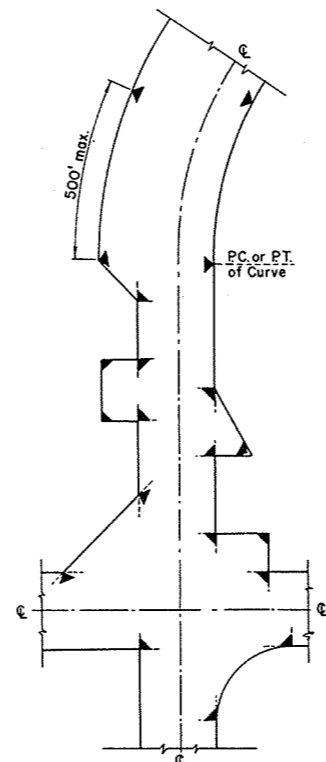


LOCATION DIAGRAM SHOWING TYPICAL LOCATIONS OF MARKER POSTS FOR RIGHT OF WAY

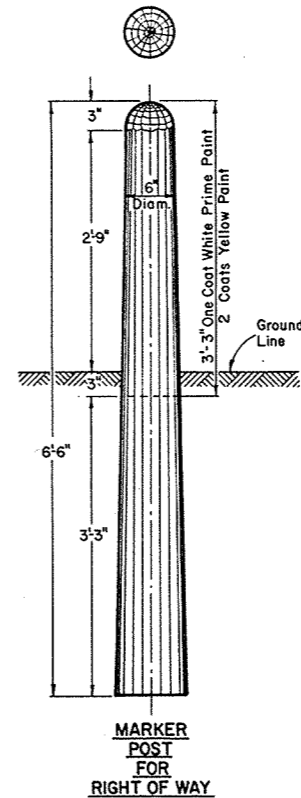

MARKER POST FOR RIGHT OF WAY

MARKER POST FOR RIGHT OF WAY

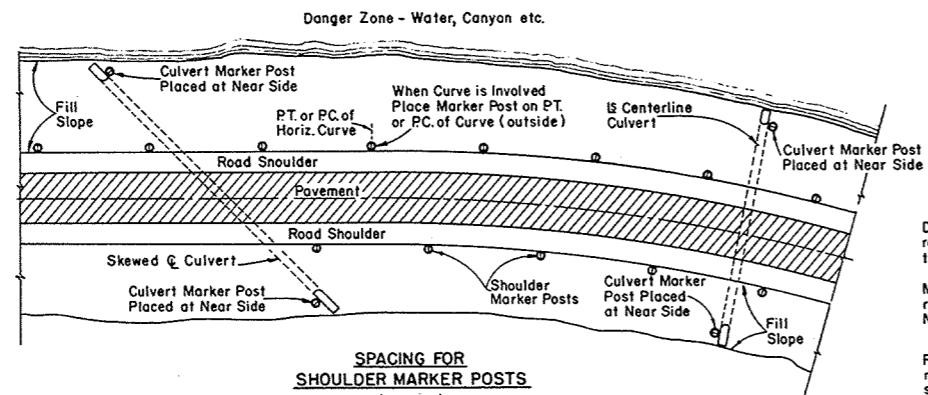

SPACING FOR SHOULDER MARKER POSTS
50' C:C for 100' to 500' Danger Zones
100' C:C for Over 500' Danger Zones

LOCATION DIAGRAM SHOWING RELATIVE LOCATIONS OF SHOULDER MARKER POSTS AND CULVERT MARKER POSTS

MARKER POSTS FOR ROAD SHOULDERS AND CULVERTS

GENERAL NOTES:

Details of Construction not shown on this drawing shall conform to the pertinent requirements of the Standard Specifications Sections 2523, 4124 and 4125 and the applicable Special Provisions.

All posts for Road Shoulder Markers, Culvert Markers and Right of Way Markers are identical except for Painting and Reflector Units. All Posts shall be round and untreated and shall be either Northern White Cedar, Southern Yellow Pine, Norway Pine, White Pine or Jack Pine.

MARKER POSTS FOR RIGHT OF WAY

Right of Way Marker Posts shall be erected in advance of Grading Operations. Posts may be shaped and painted prior to erection. Any damaged areas occurring to point surface during erection or other subsequent operations must be repainted prior to acceptance.

Posts shall be placed at the outer limits of the Highway Right of Way, but entirely within the Right of Way, and shall be so placed that the outer edge of the posts shall be tangent to the Right of Way line or lines extended. The exact location of all Right of Way Posts shall be staked in the field by the Engineer. Reflector Units for Right of Way Marker Posts will not be required.

REFLECTOR UNITS

Reflector Units shall have plastic crystal lens 7/8" in diameter. Unit assembly shall be a minimum of 7/8" in length. Reflector Units shall be furnished with flared expanding metal clips for wood mounting. Units shall be mounted in tightest fit possible and securely stayed in posts. Reflector Units shall be installed in Road Shoulder Marker Posts only.

BID ITEMS

No. 2523-5 Marker Posts.....Each
No. 2523-6 Marker Posts for Right of Way.....Each

MARKER POSTS & MARKER POSTS FOR RIGHT OF WAY

STATE HIGHWAY COMMISSION OF WISCONSIN

RECOMMENDED FOR APPROVAL

5/16/57
DATE


APPROVED:

5/16/57
DATE


J. L. Pelt
ENGINEER OF DESIGN

E. L. Rottling
STATE HIGHWAY ENGINEER


PLATE NO. 7-1.3.3.

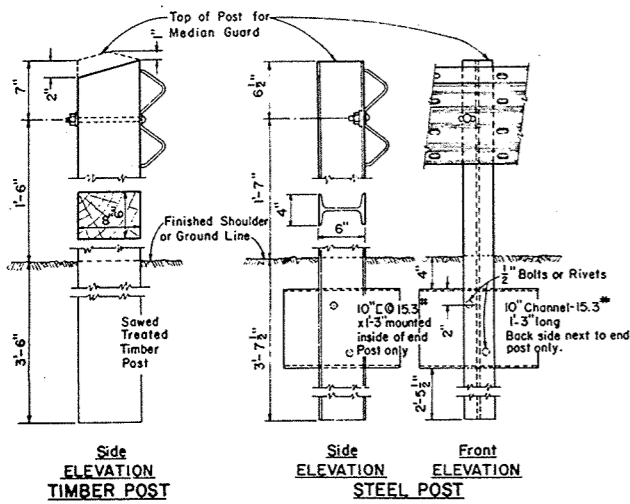


ALTERNATE TYPE POSTS FOR STEEL PLATE BEAM GUARD AND STEEL PLATE BEAM (MEDIAN) GUARD

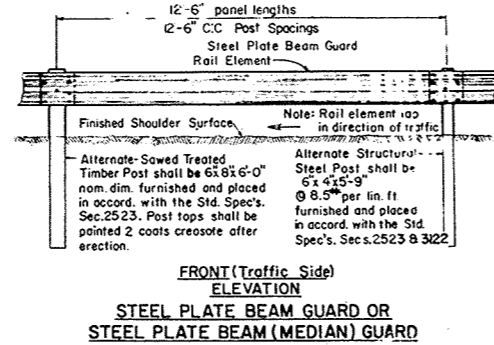


FRONT (Traffic Side) ELEVATION STEEL PLATE BEAM GUARD OR STEEL PLATE BEAM (MEDIAN) GUARD

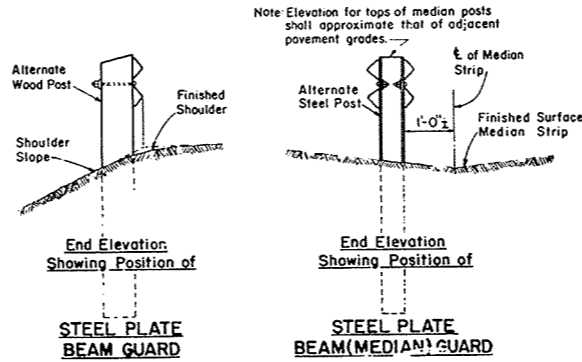

End Elevation Showing Position of STEEL PLATE BEAM GUARD and End Elevation Showing Position of STEEL PLATE BEAM (MEDIAN) GUARD

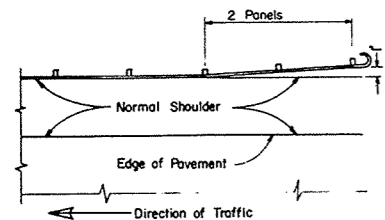


LOCATION DIAGRAM FOR STEEL PLATE BEAM GUARD INTERMEDIATE SECTIONS

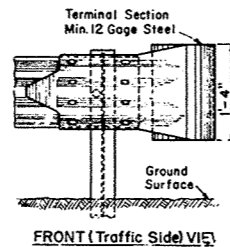


FRONT (Traffic Side) VIEW and PLAN VIEW

TERMINAL SECTION DETAILS FOR STEEL PLATE BEAM GUARD

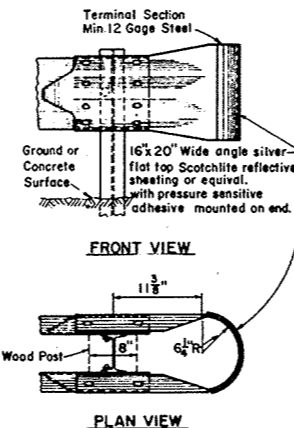


FRONT VIEW and PLAN VIEW


TERMINAL SECTION DETAILS FOR STEEL PLATE BEAM (MEDIAN) GUARD

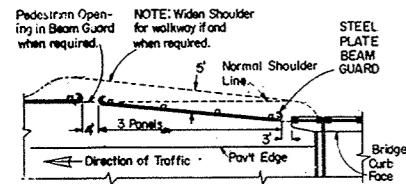


LOCATION DIAGRAM FOR STEEL PLATE BEAM GUARD AT BRIDGE EXITS

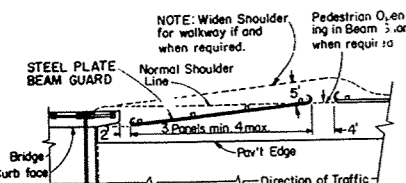


LOCATION DIAGRAM FOR STEEL PLATE BEAM GUARD AT BRIDGE APPROACHES

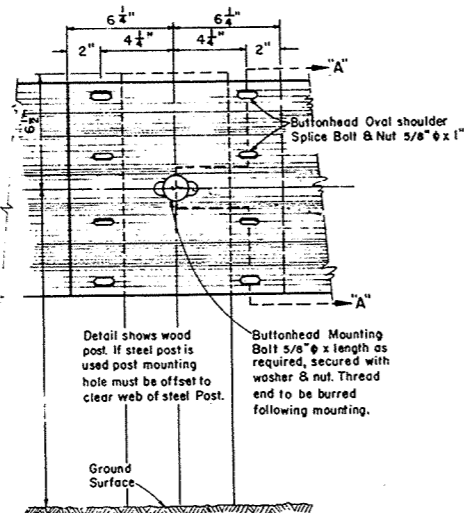

RAIL ELEMENT SPLICING & POST MOUNTING DETAILS

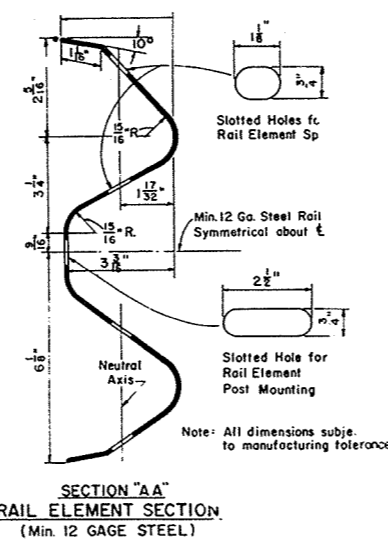

SECTION "AA" RAIL ELEMENT SECTION (Min. 12 GAGE STEEL)

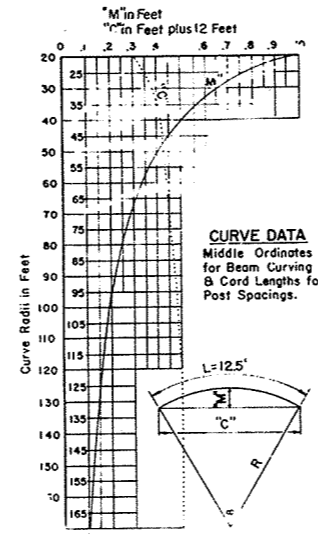

CURVE DATA Middle Ordinates for Beam Curving & Cord Lengths for Post Spacings.

GENERAL NOTES

Details of construction not shown on this drawing shall conform to the pertinent requirements of the Standard Specifications and the applicable Special Provisions. The Steel Plate Beam Guard or (Median) Guard shall consist of steel plate made of open hearth or electric furnace steel. Plates shall be blanked to proper shape, fabricated and ready for assembly when received in the field. The plates shall be true to plan dimensions and of uniform section. Warped or deformed plates will be rejected. The edges of the plates shall be rolled or rounded so that they present no sharp edges. All connections and splices shall be formed with flat round headed bolts, or similar detail so that no appreciable projection will be presented on the road side of the guard. The rail element shall be applied by lapping in the direction of traffic or by butt joint with splice plate. Plate ends in lap splices or plate ends and splice plate in butt splices shall make contact throughout the entire area of the splice.

TESTS

The elongation of a 2 inch specimen of the steel plate used in the rail element shall be not less than 12 percent tested in tension. The minimum tensile strength of the rail element shall, when tested in conjunction with splices and end connections, be 80,000 lbs. The rail element when loaded as a simple beam, freely supported at each end on 12'-0" centers shall support a concentrated load of 1,500 lbs., applied at the center point, with a maximum deflection of 2 1/2 inches and shall support a concentrated load of 2,000 lbs. when tested in like manner with a maximum deflection of 5 1/2 inches.

PAINTING (When not furnished galvanized)

SHOP COAT - Promptly following fabrication, the plates for steel rail element and steel posts shall be thoroughly cleaned and painted with red lead primer or, upon the Engineers approval, an alternate of rust inhibitive primer may be used. All parts, hardware and appurtenant fittings for the complete beam guard assembly shall likewise be painted.

FIELD COAT - Following erection the steel rail elements, parts, hardware appurtenant fittings and steel posts shall be painted in accord with Standard Specifications with aluminum paint as provided in Section 3125. Any damaged areas occurring to shop coat during transportation or erection shall be cleaned and pointed with red lead or an approved rust inhibitive primer prior to any field coat painting.

Where the steel plate elements make contact with the post mountings etc. all such areas which are inaccessible to paint after erection shall be pointed prior to erection. All threaded portions of fittings, fasteners and cut ends of bolts shall be pointed as specified immediately following erection.

CIRCULAR STEEL PLATE ELEMENT

Steel plate beam elements for beam guard or (median) guard for radii of 20 ft to 150 ft shall be shop-curved prior to shop coat painting. Steel plate beam elements shall be bent to true circular curvature, void of kinks. Kinks shall be cause for rejection. Steel plate beam elements shall have a minimum bending radius of 20 feet.

ALTERNATE POSTS

One type of post shall be used for Steel Plate Beam Guard and/or Steel Plate Beam (Median) Guard throughout the length of each project unless specific authorization is obtained from the Engineer to use alternate types.

GALVANIZED-ALTERNATE

Steel rail elements may be furnished galvanized. Spelter coating shall be the hot dip process in accord with AASHTO designation M36. Only one type surface treatment (either painted or galvanized) may be used throughout the length of each project unless specific authorization is obtained from the Engineer to do otherwise.

MEASUREMENT & PAYMENT

The items of "Class B" Steel Plate Beam Guard and "Class B" Steel Plate Beam (Median) Guard shall be measured and paid for at the contract unit price per linear foot, measured in place by length in linear feet from end to end - out to out of steel plate terminal sections, which price shall be full compensation for furnishing and placing all materials and performing all work to completion in accord with the plans and the Standard Specifications Section 2523 and the applicable Special Provisions.

BID ITEMS

No. 2523- 3 Steel Plate Beam Guard.....	Lin Ft.
No. 2523- 4 Steel Plate Beam (Median) Guard.....	Lin Ft.


STEEL PLATE BEAM GUARD & STEEL PLATE BEAM (MEDIAN) GUARD

STATE HIGHWAY COMMISSION OF WISCONSIN

RECOMMENDED FOR APPROVAL:

DATE: 7/16/59 J. J. Pelt ENGINEER OF DESIGN

DATE: 7/16/59 E. C. Rottiers STATE HIGHWAY ENGINEER

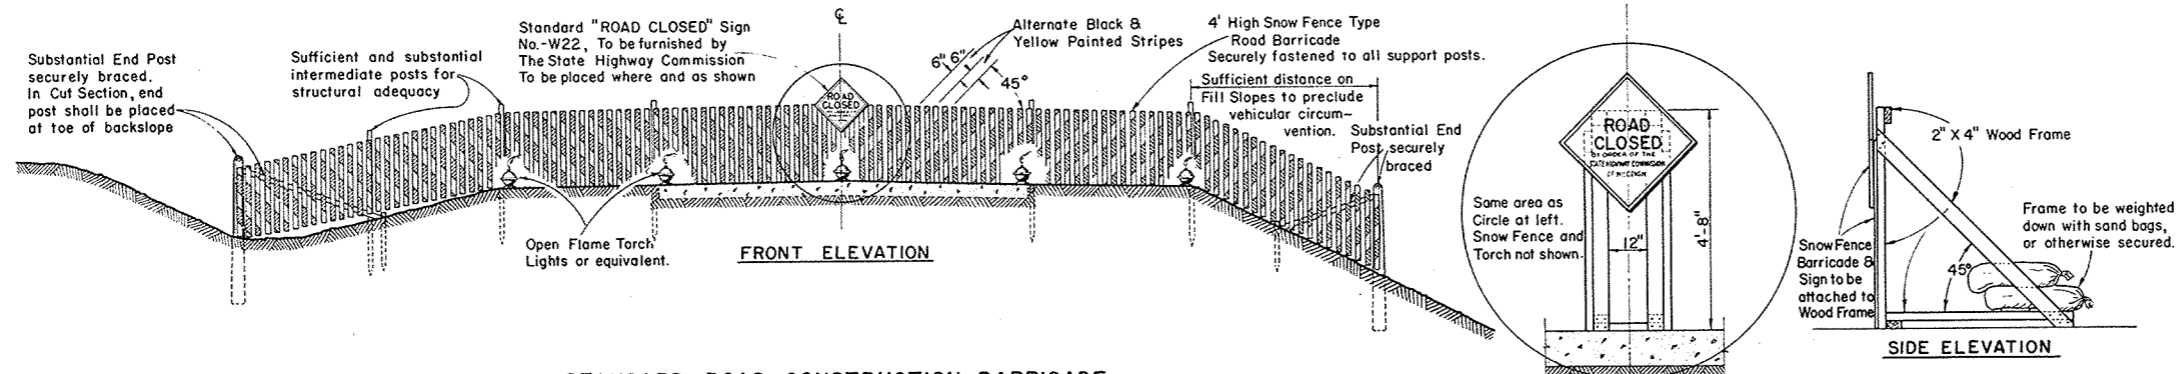

STANDARD ROAD CONSTRUCTION BARRICADE
SNOW FENCE TYPE-"A"

GENERAL NOTES

The Contractor shall construct, place and maintain barricades as shown on this drawing and as required by the Standard Specifications Section 1107 for the duration of the project. Barricades shall be painted and structurally maintained for maximum visibility at all times. Provision shall be made in the construction of barricades to provide for ingress and egress for local access as may be required.


ALTERNATE DESIGNS

Contractors may submit to the Engineer for approval, designs for Barricades other than shown on this drawing, and upon the Engineer's approval may be used as alternates.

MEASUREMENT & PAYMENT

All Barricades, unless otherwise provided for in the Plans and/or Special Provisions shall be furnished, placed, and maintained as noted above, and no additional compensation will be allowed but shall be construed to be included in the price bid for other items.

CONSTRUCTION BARRICADE	
STATE HIGHWAY COMMISSION OF WISCONSIN	
RECOMMENDED FOR APPROVAL:	
6/2/55 DATE	<i>J. d. Pelt</i> ENGINEER OF DESIGN
APPROVED:	
6/2/55 DATE	<i>E. C. Rutledge</i> STATE HIGHWAY ENGINEER

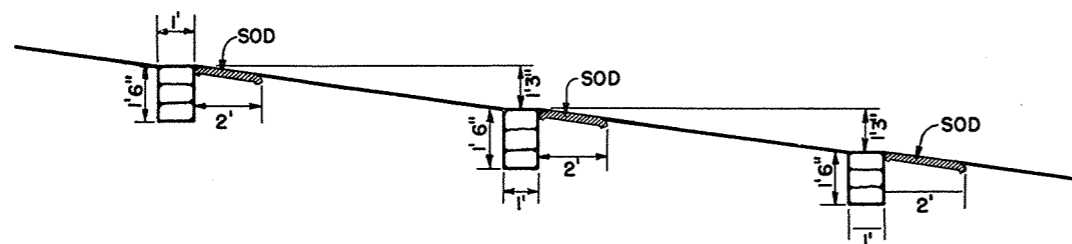


PROFILE OF DITCH GRADE




PROFILE OF DITCH GRADE

NOTE: NUMBER REQUIRED WILL BE DETERMINED BY VERTICAL SPACING.

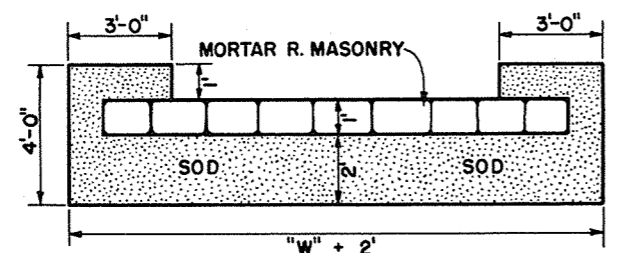


PLAN VIEW SHOWING SOD

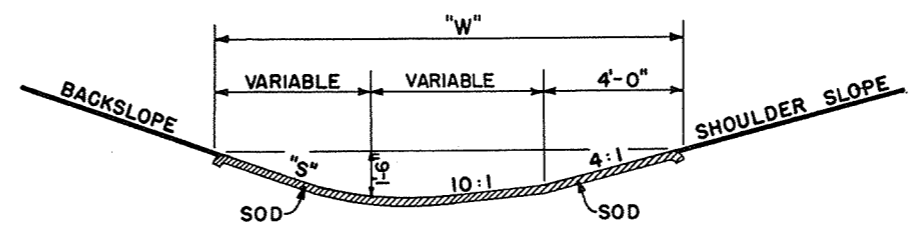

SECTION

SOD DITCH CHECKS

QUANTITIES		
"S"	"W"	EACH SQ. YD.
2:1	12'	8
3:1	13.5'	9
4:1	15'	10

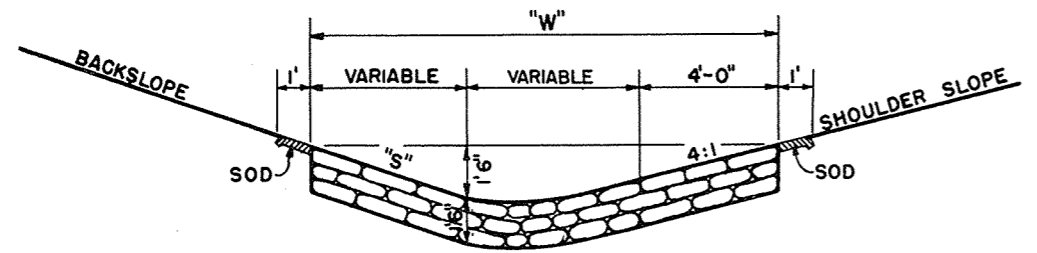

SECTION

MORTAR RUBBLE MASONRY

QUANTITIES			
"S"	"W"	SOD SQ. YD.	EACH CU. YD.
2:1	12'	4.0	0.67
3:1	13.5'	4.33	0.75
4:1	15'	4.67	0.83

CONSTRUCTION NOTES

DETAILS OF CONSTRUCTION NOT SHOWN SHALL CONFORM TO THE PERTINENT REQUIREMENTS OF THE STANDARD SPECIFICATIONS AND THE APPLICABLE SPECIAL PROVISIONS.

DITCH CHECKS

MORTAR RUBBLE MASONRY & SOD

STATE HIGHWAY COMMISSION OF WISC.

RECOMMENDED FOR APPROVAL:

Frank Crow
DESIGN ENGINEER


Bob
CONSTRUCTION ENGINEER

DATE:

APPROVED:

DRAWN DIV 9
CHECKED N.F.C.

E.L. Rottiers
STATE HIGHWAY ENGINEER

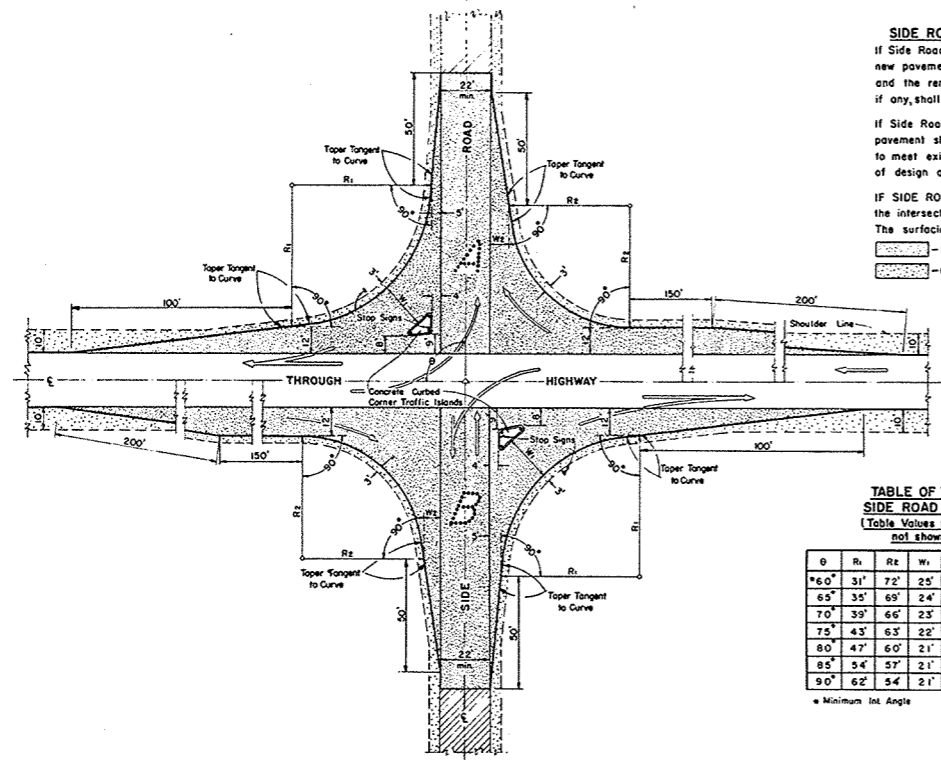


SIDE ROAD SURFACING NOTE
 If Side Road is not presently surfaced, new pavement shall be placed as shown, and the remainder to construction limits, if any, shall be gravel or crushed stone surfaced.
 If Side Road is presently paved, new pavement shall be placed only as necessary to meet existing pavement, and to limits of design as shown.
 IF SIDE ROAD IS THE CONSTRUCTION PROJECT, the intersection geometrics remain as shown. The surfacing shall be same as for the project.

— Pavement
 — Gravel or Crushed Stone

TABLE OF VALUES FOR VARIABLE SIDE ROAD INTERSECTION ANGLES
 (Table Values for Angles between 60° & 120° not shown shall be interpolated)

θ	R ₁	R ₂	W ₁	W ₂	θ	R ₁	R ₂	W ₁	W ₂
60°	31'	72'	25'	10'	95°	70'	52'	20'	8'
65°	35'	69'	24'	9'	100°	80'	50'	20'	8'
70°	39'	66'	23'	8'	105°	95'	48'	20'	8'
75°	43'	63'	22'	8'	110°	104'	46'	19'	8'
80°	47'	60'	21'	8'	115°	122'	44'	19'	8'
85°	54'	57'	21'	8'	120°	143'	42'	19'	8'
90°	62'	54'	21'	8'					

* Minimum Int. Angle ** Maximum Int. Angle

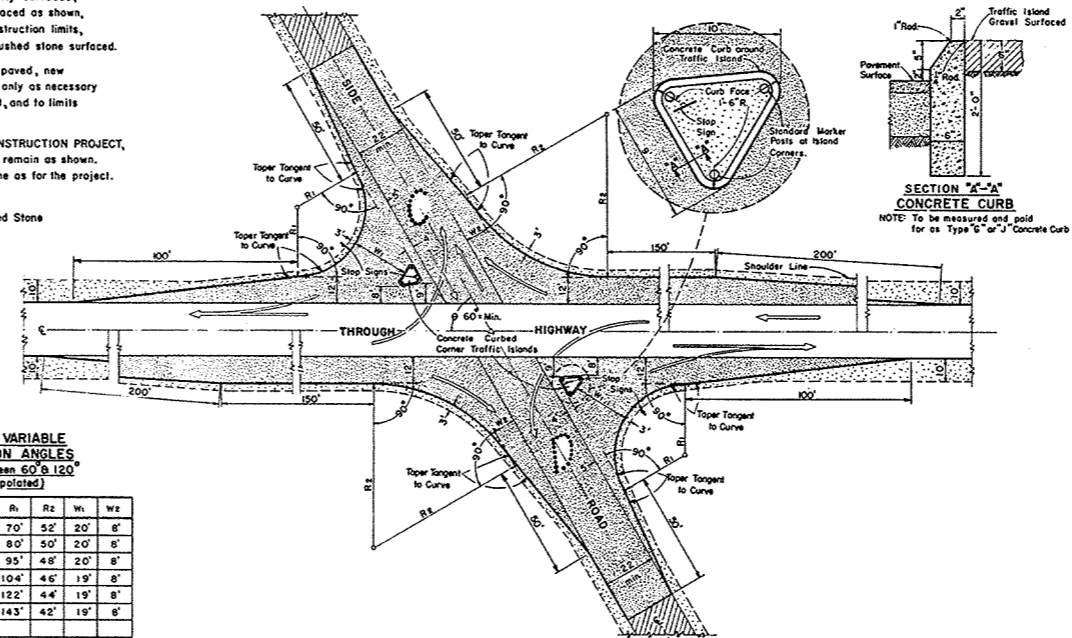

SECTION "A-A" CONCRETE CURB
 NOTE: To be measured and paid for as Type "C" or "J" Concrete Curb

MAJOR SIDE ROAD INTERSECTION DESIGN DETAILS

To be used only when current ADT on Through Highway is 1500 or over, and on Side Road is Over 200

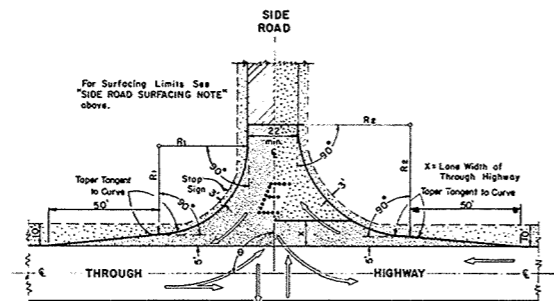


TABLE OF VALUES FOR VARIABLE SIDE ROAD INTERSECTION ANGLES
 (Table Values for Angles between 60° & 120° not shown shall be interpolated)

θ	R ₁	R ₂	θ	R ₁	R ₂
60°	40'	50'	95°	45'	49'
65°	40'	50'	100°	50'	48'
70°	40'	50'	105°	55'	47'
75°	40'	50'	110°	60'	46'
80°	40'	50'	115°	65'	45'
85°	40'	50'	**120°	70'	44'
90°	40'	50'			

* Minimum Int. Angle ** Maximum Int. Angle

MINOR SIDE ROAD INTERSECTION DESIGN DETAILS

To be used when current ADT on Through Highway is Less than 1500 or on Side Road is Less than 200

GENERAL NOTES
 Designs "A", "B", "C", "D", or "E" may be used interchangeably in combination or separately for any one complete intersection depending upon Traffic Volume, Intersection angle and Surfacing of each approach roadway.

Details on this drawing are for Minimum Design Only, and not applicable to Special Conditions, as shown elsewhere on the plans.


DESIGN & LAYOUT DETAILS FOR SIDE ROAD AT GRADE INTERSECTIONS (RURAL IN CHARACTER)

STATE HIGHWAY COMMISSION OF WISCONSIN

RECOMMENDED FOR APPROVAL
 DATE 1/17/58
 ENGINEER OF DESIGN
 APPROVED
 DATE 1/17/58
 STATE HIGHWAY ENGINEER

BENCH MARKS			
NO.	STATION	DESCRIPTION	ELEV.
29	250+10	PT MK CONC POR RAIL SW COR	60' RT 836.92
30	259+10	SPIKE IN 20' MAPLE	33' RT 832.88
31	264+40	TWIN WILLOW	75' RT 818.30
32	270+40	12' ELM	250' LT 827.21

S.P.R. ON-BOOK	PROJECT	SHEET NUMBER	TOTAL SHEETS
4	S 0737(1)	3	33

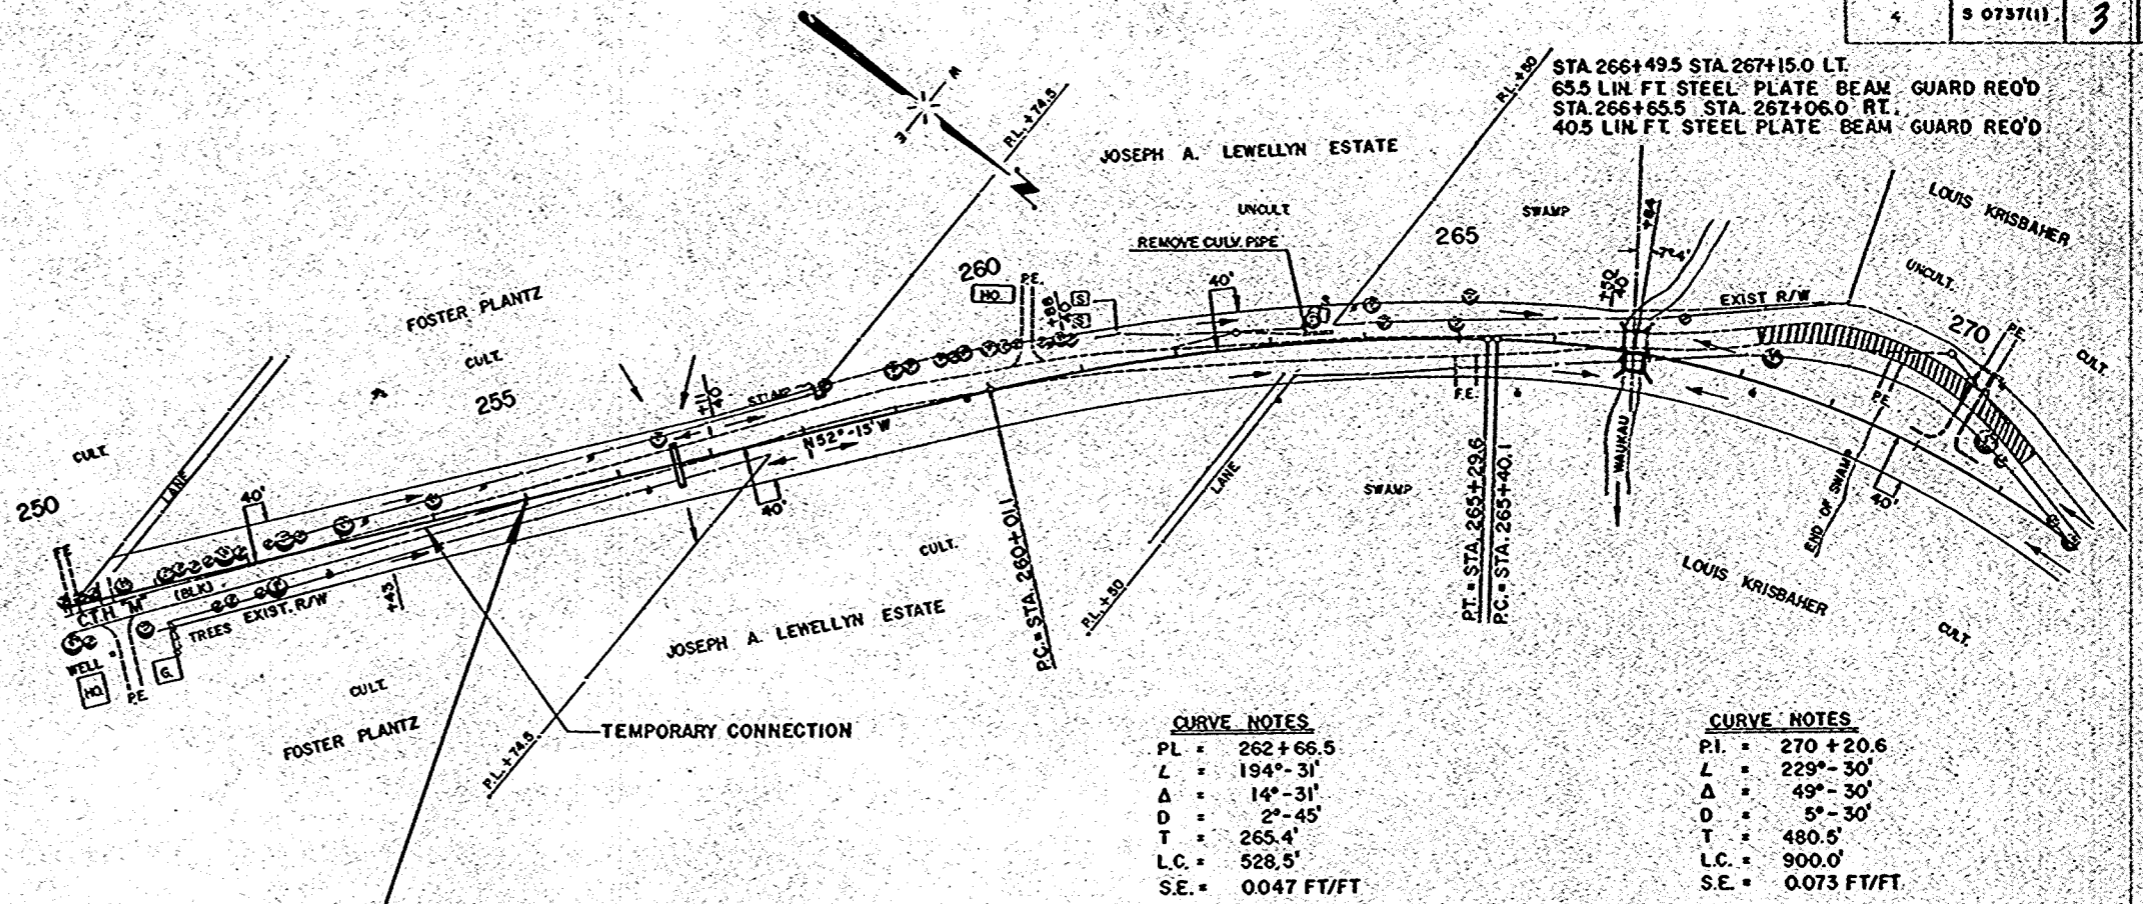

CURVE NOTES

PL = 262 + 66.5
 L = 194° - 31'
 Δ = 14° - 31'
 D = 2° - 45'
 T = 480.5'
 L.C. = 528.5'
 S.E. = 0.047 FT/FT

CURVE NOTES

PL = 270 + 20.6
 L = 229° - 30'
 Δ = 49° - 30'
 D = 5° - 30'
 T = 900.0'
 L.C. = 400.0'
 S.E. = 0.073 FT/FT

NET LENGTH OF CENTERLINE

STATION TO STATION	LIN FT	
255+00	270+00	1500'

UNC. EXC. = 504 C.Y.	UNC. EXC. = 610 C.Y.	UNC. EXC. = 1,572 C.Y.	UNC. EXC. = 3,868 C.Y.
FILL = 354 C.Y.	FILL = 427 C.Y.	FILL = 1,101 C.Y.	FILL = 3,068 C.Y.

GENERAL NOTES

DETAILS OF CONSTRUCTION NOT SHOWN SHALL CONFORM TO THE PERTINENT REQUIREMENTS OF THE STANDARD SPECIFICATIONS, STANDARD DRAWINGS AND THE SPECIAL PROVISIONS ATTACHED TO PROPOSALS.


CUBIC YARDS OF FILL SHOWN ON PLAN SHEETS PERTAINS TO EMBANKMENT CONSTRUCTED FROM UNCLASSIFIED AND BORROW EXCAVATION AND IS COMPUTED WITH A SHRINKAGE ALLOWANCE OF 20% TO 45%.

THE EXACT LOCATION OF PRIVATE ENTRANCES AND CULVERT PIPES SHALL BE DETERMINED BY THE ENGINEER IN THE FIELD.

LEGEND

UNC. EXC.	UNCLASSIFIED EXCAVATION
#	POWER POLE
⊕	TELEPHONE POLE
PE	PRIVATE ENTRANCE
EE	FIELD ENTRANCE
C.P.	CULVERT PIPE
D.G.	DITCH GRADE
F	FILL
→	DRAINAGE FLOW
▨	OLD ROAD OBLITERATION
PL	PROPERTY LINE
C.M.P.A.	CORROGATED METAL PIPE ARCH


STA. 255+00 BEGIN PROJ. S0737(1)

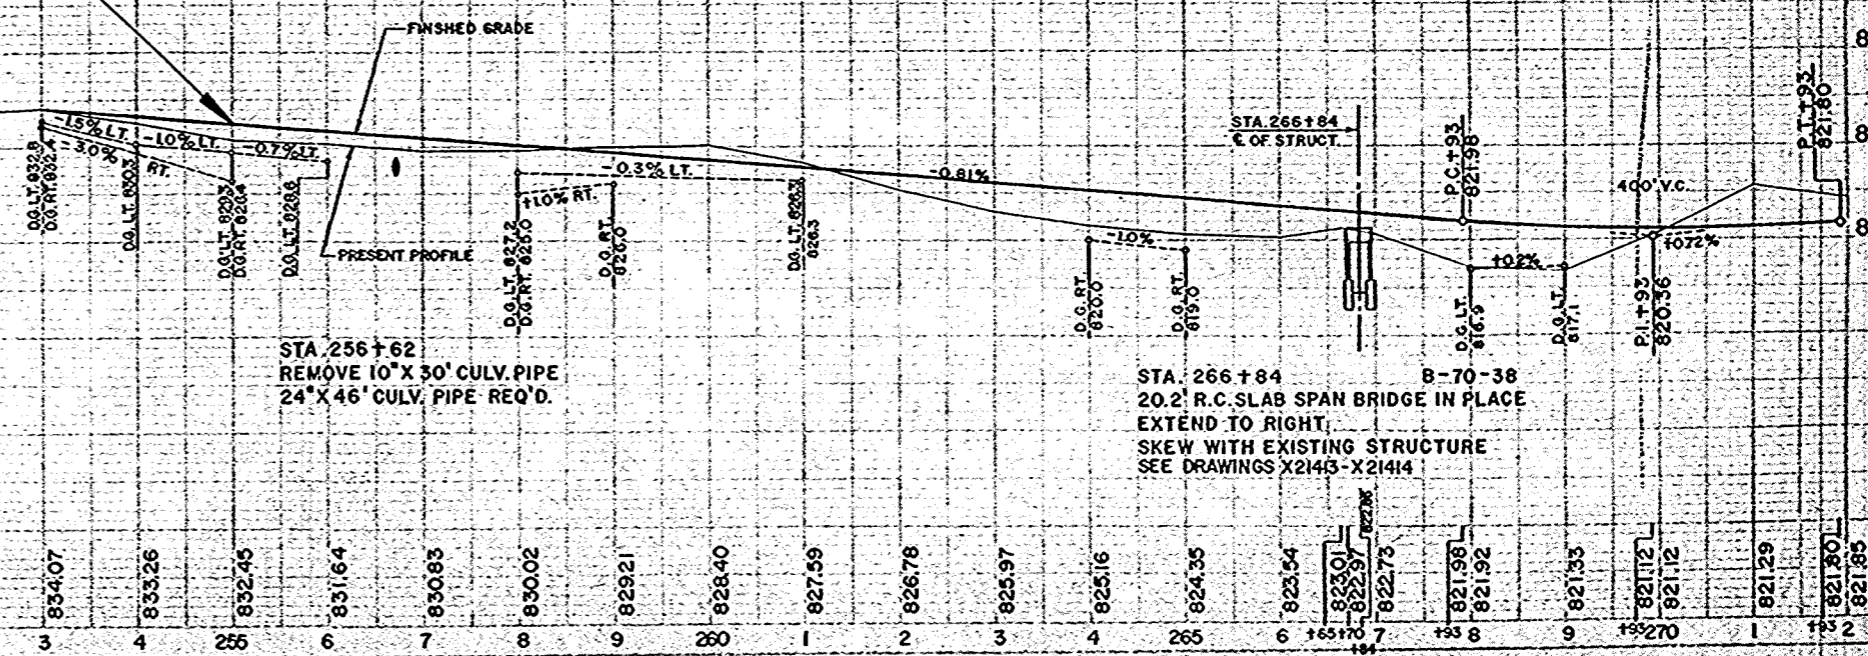

PLANNING DIVISION
 PROJECT NO. 257
 DATE 11-58

PROFILES DIVISION
 PROJECT NO. 257
 DATE 11-58

BENCH MARKS				
NO.	STATION	DESCRIPTION		ELEV.
32	270+40	SPIKE IN 12" ELM	250' LT	827.21
33	277+70	" " 30" "	58' LT	825.18
34	284+79	PT MK SW COR CONC SLAB	78' RT	823.83
35	289+50	SPIKE IN 18" BOX E	92' RT	827.92
36	299+34	" " GROVE 6-12" OAK 19'4" RT		824.18

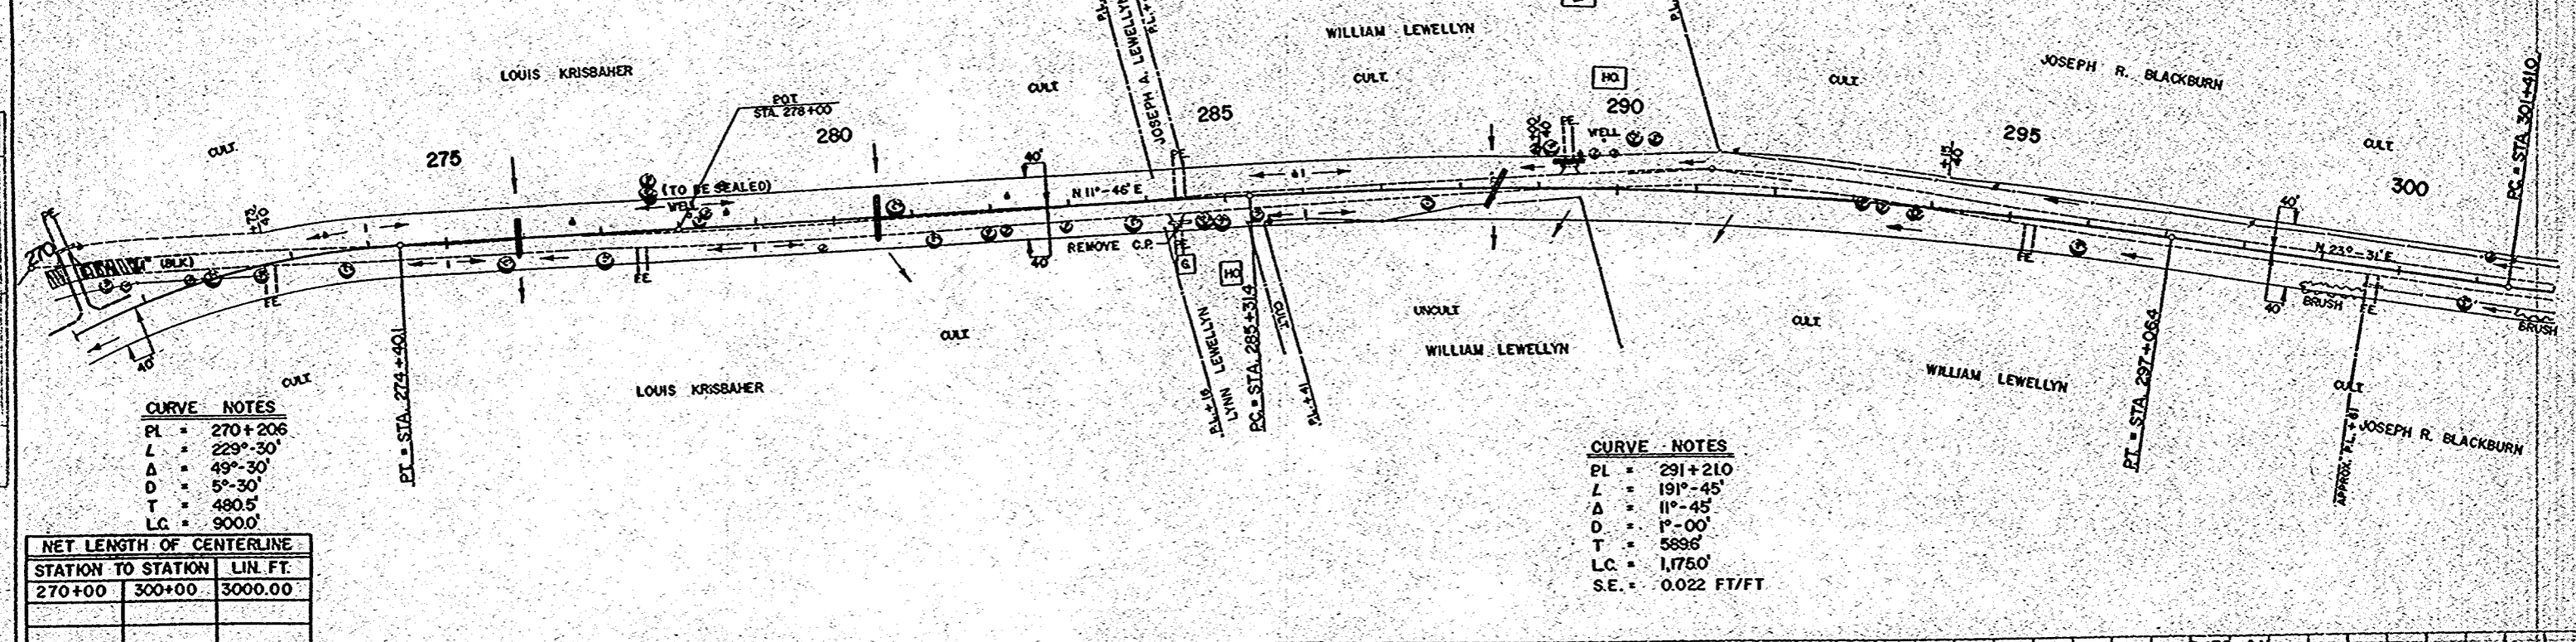


CURVE NOTES	
PL	= 270+206
L	= 229°-30'
Δ	= 49°-30'
D	= 5°-30'
T	= 480.5'
LC	= 900.0'

CURVE NOTES	
PL	= 291+210
L	= 191°-45'
Δ	= 11°-45'
D	= 1°-00'
T	= 5896'
LC	= 1,175.0'
SE	= 0.022 FT/FT

NET LENGTH OF CENTERLINE		
STATION TO STATION	LIN. FT.	
270+00	300+00	3000.00

UNC. EXC.	= 1,427 C.Y.	UNC. EXC.	= 171 C.Y.	UNC. EXC.	= 819 C.Y.	UNC. EXC.	= 3,170 C.Y.
FILL	= 1,104 C.Y.	FILL	= 546 C.Y.	FILL	= 571 C.Y.	FILL	= 2,388 C.Y.
		BORROW	= 511 C.Y.				

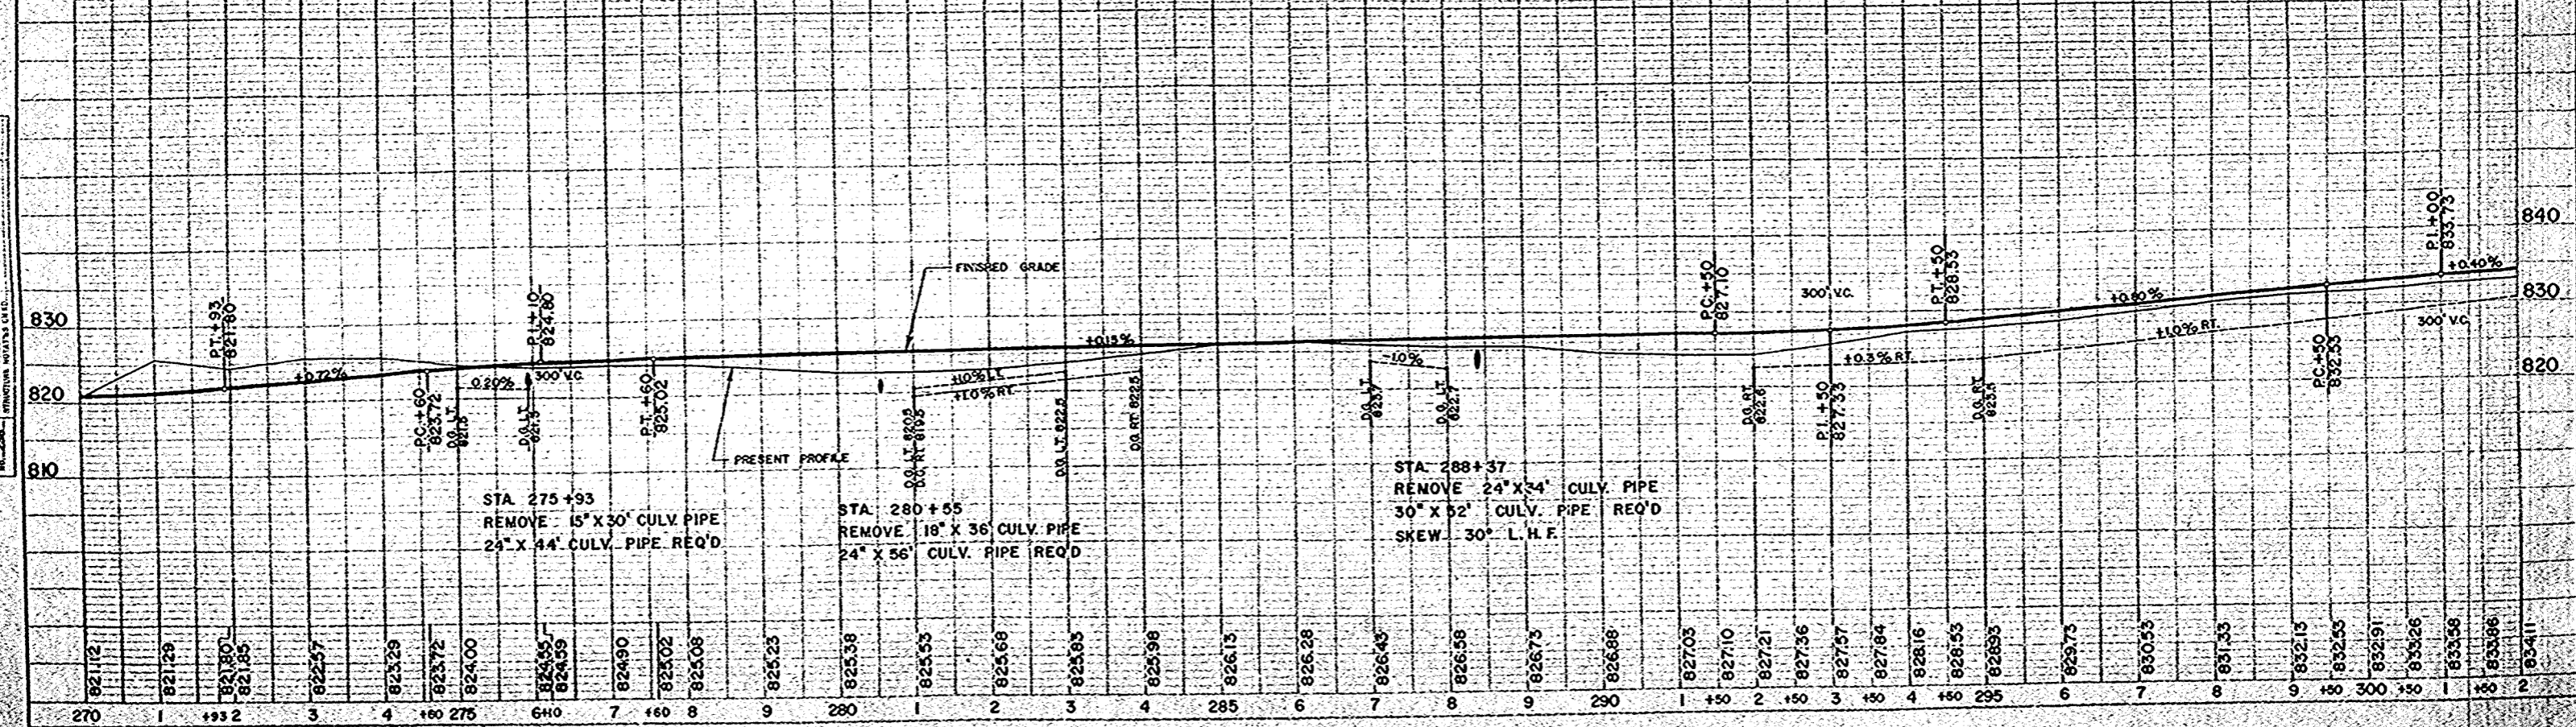

PLAN
 DATE: 11-30
 DRAWN: [Signature]
 CHECKED: [Signature]
 IN CHARGE: [Signature]


PROFILE
 DATE: 11-30
 DRAWN: [Signature]
 CHECKED: [Signature]
 IN CHARGE: [Signature]

STA. 318+70 SD. RD. LT.
REMOVE 24" X 45' CULV. PIPE
24" X 48' CULV. PIPE REQ'D.




NO	STATION	DESCRIPTION	ELEV
37	304+90	SPIKE IN 16" HICKORY 44 RT	833.42
38	310+45	" " 28" OAK 90 RT	833.68
39	314+45	" " 26" MAPLE 60 LT	834.33
40	320+06	" " 12" HICKORY 56 LT	828.80
41	327+78	" " CLUMP 10" ASH 90 LT	822.76

CURVE NOTES
 P.I. = 304+77.0
 L = 153'-36"
 A = 26'-24"
 D = 4'-00"
 T = 336.0'
 L.C. = 660.0'
 S.E. = 0.062 FT/FT.

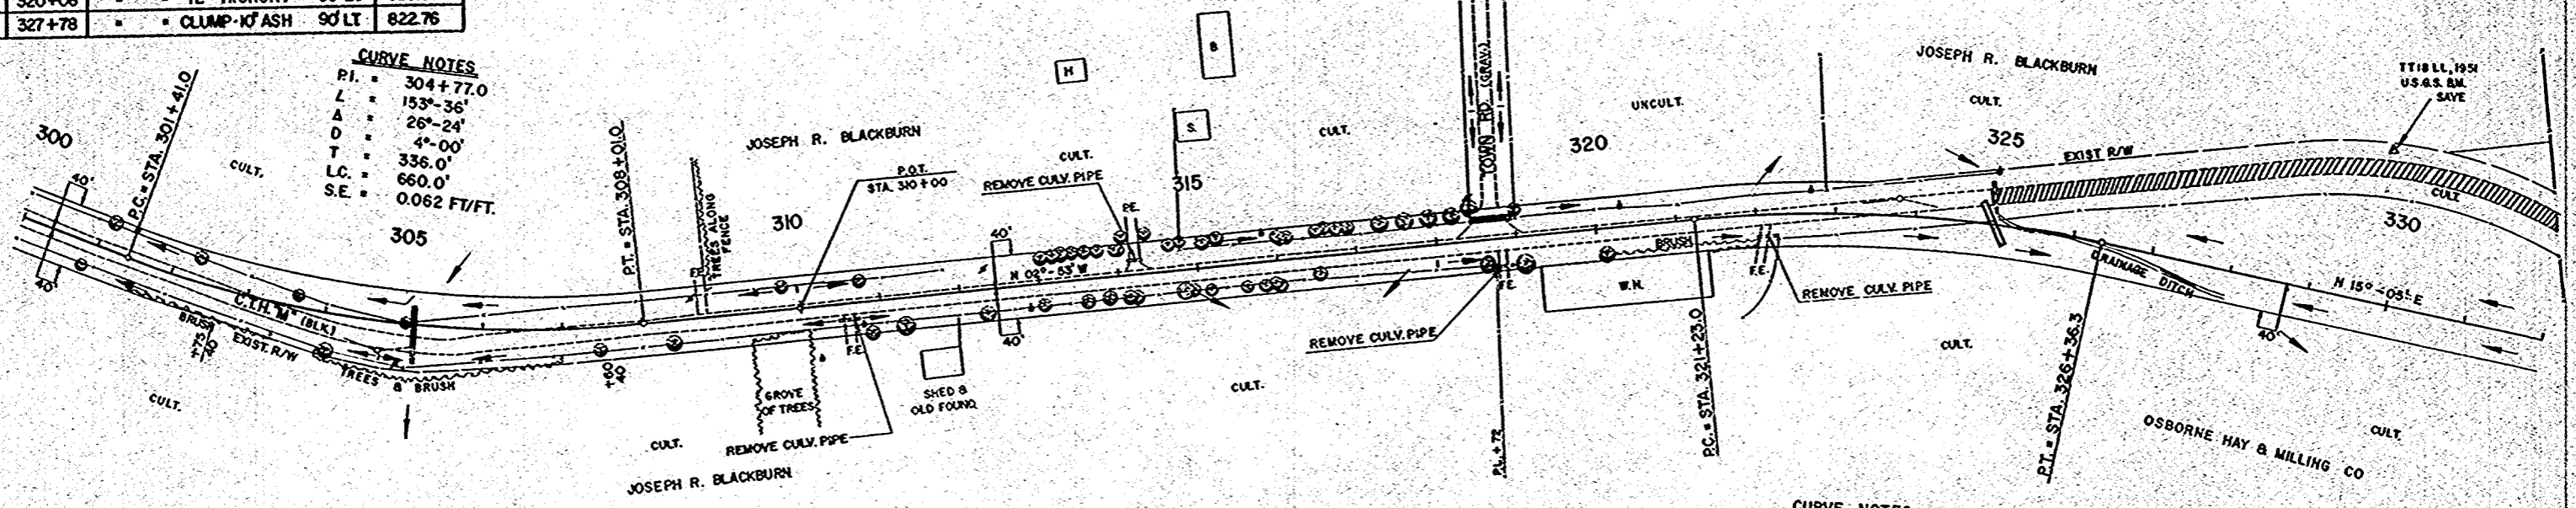


CURVE NOTES
 P.I. = 323+81.8
 L = 197'-58"
 A = 17'-58"
 D = 3'-30"
 T = 258.8'
 L.C. = 513.3'
 S.E. = 0.056 FT/FT.

STATION TO STATION	LEN FT	
300+00	330+00	3,000

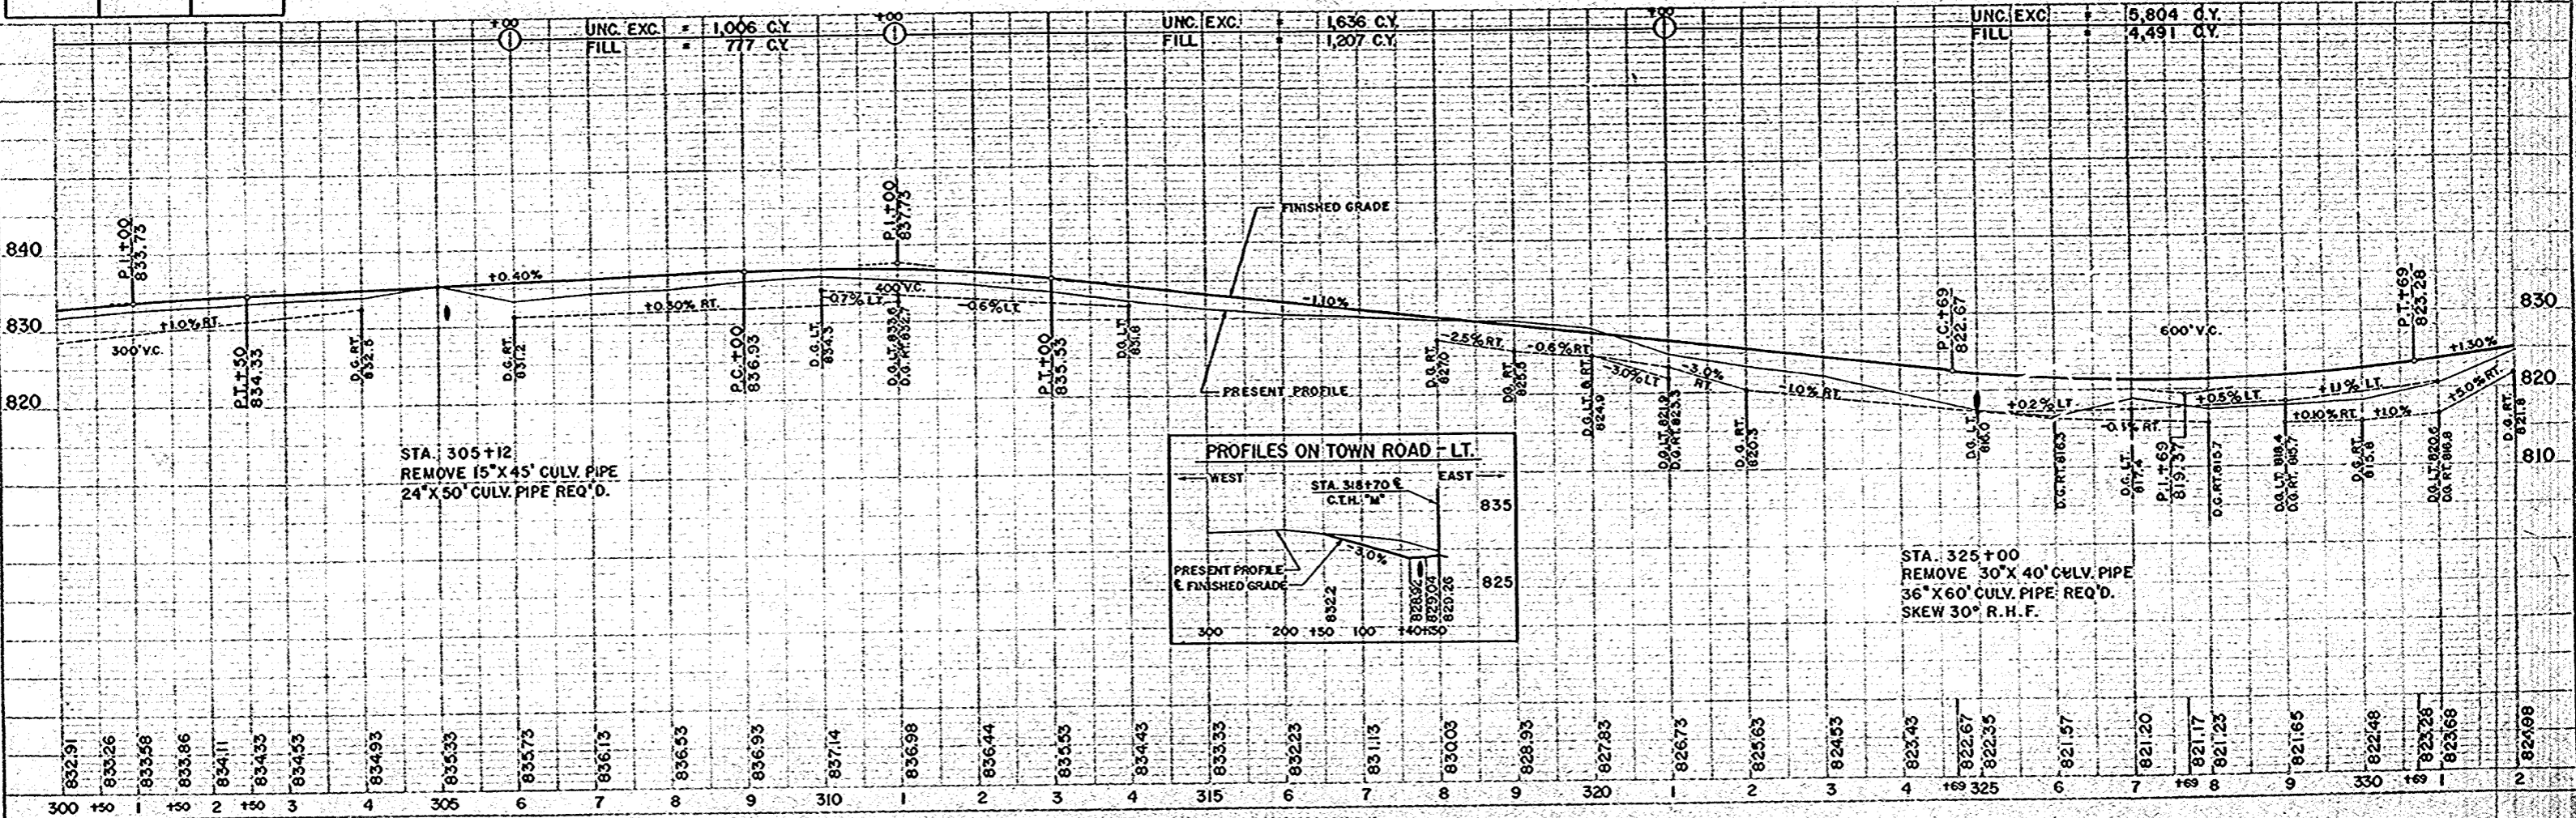

STA. 305+12
REMOVE 15" X 45' CULV. PIPE
24" X 50' CULV. PIPE REQ'D.

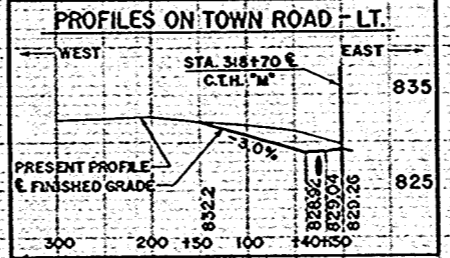

STA. 325+00
REMOVE 30" X 40' CULV. PIPE
36" X 60' CULV. PIPE REQ'D.
SKEW 30° R.H.F.


PLAN
 SURVEYED 10-55
 ADJUSTED 11-56
 NOTE BOOK NO. 237
 BY R.P.M.

PROFILE
 SURVEYED 10-55
 ADJUSTED 11-56
 NOTE BOOK NO. 238
 BY R.P.M.


NO.	STATION	DESCRIPTION	ELEV.
42	332+95	SPIKE IN 12" HICKORY 72' RT	824.66
43	335+90	" " 16" " 66' RT	828.23
44	341+24	" " 12" ELM 50' RT	832.31
45	346+35	" " 20" OAK 45' RT	835.20
46	354+90	" " 30" POPLAR 100' RT	845.61

CURVE NOTES

P.I. = 347+53.5
 L = 175° - 14'
 Δ = 4° - 46'
 D = 0° - 30'
 T = 477.0'
 L.C. = 953.3'
 S.E. = 0.015 FT/FT.

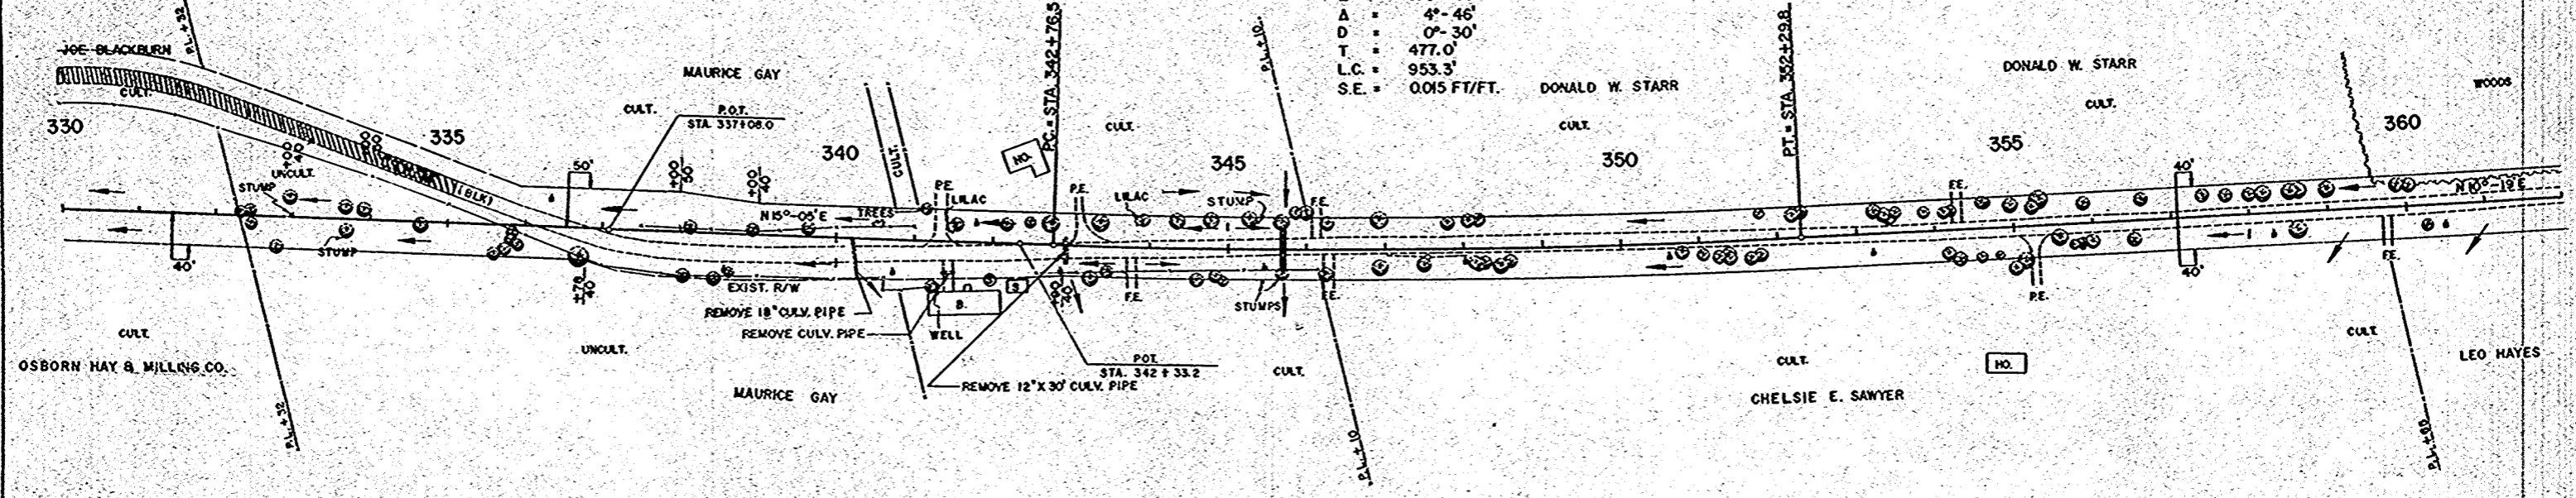

STATION TO STATION	LIN. FT	
330+00	360+00	3,000'

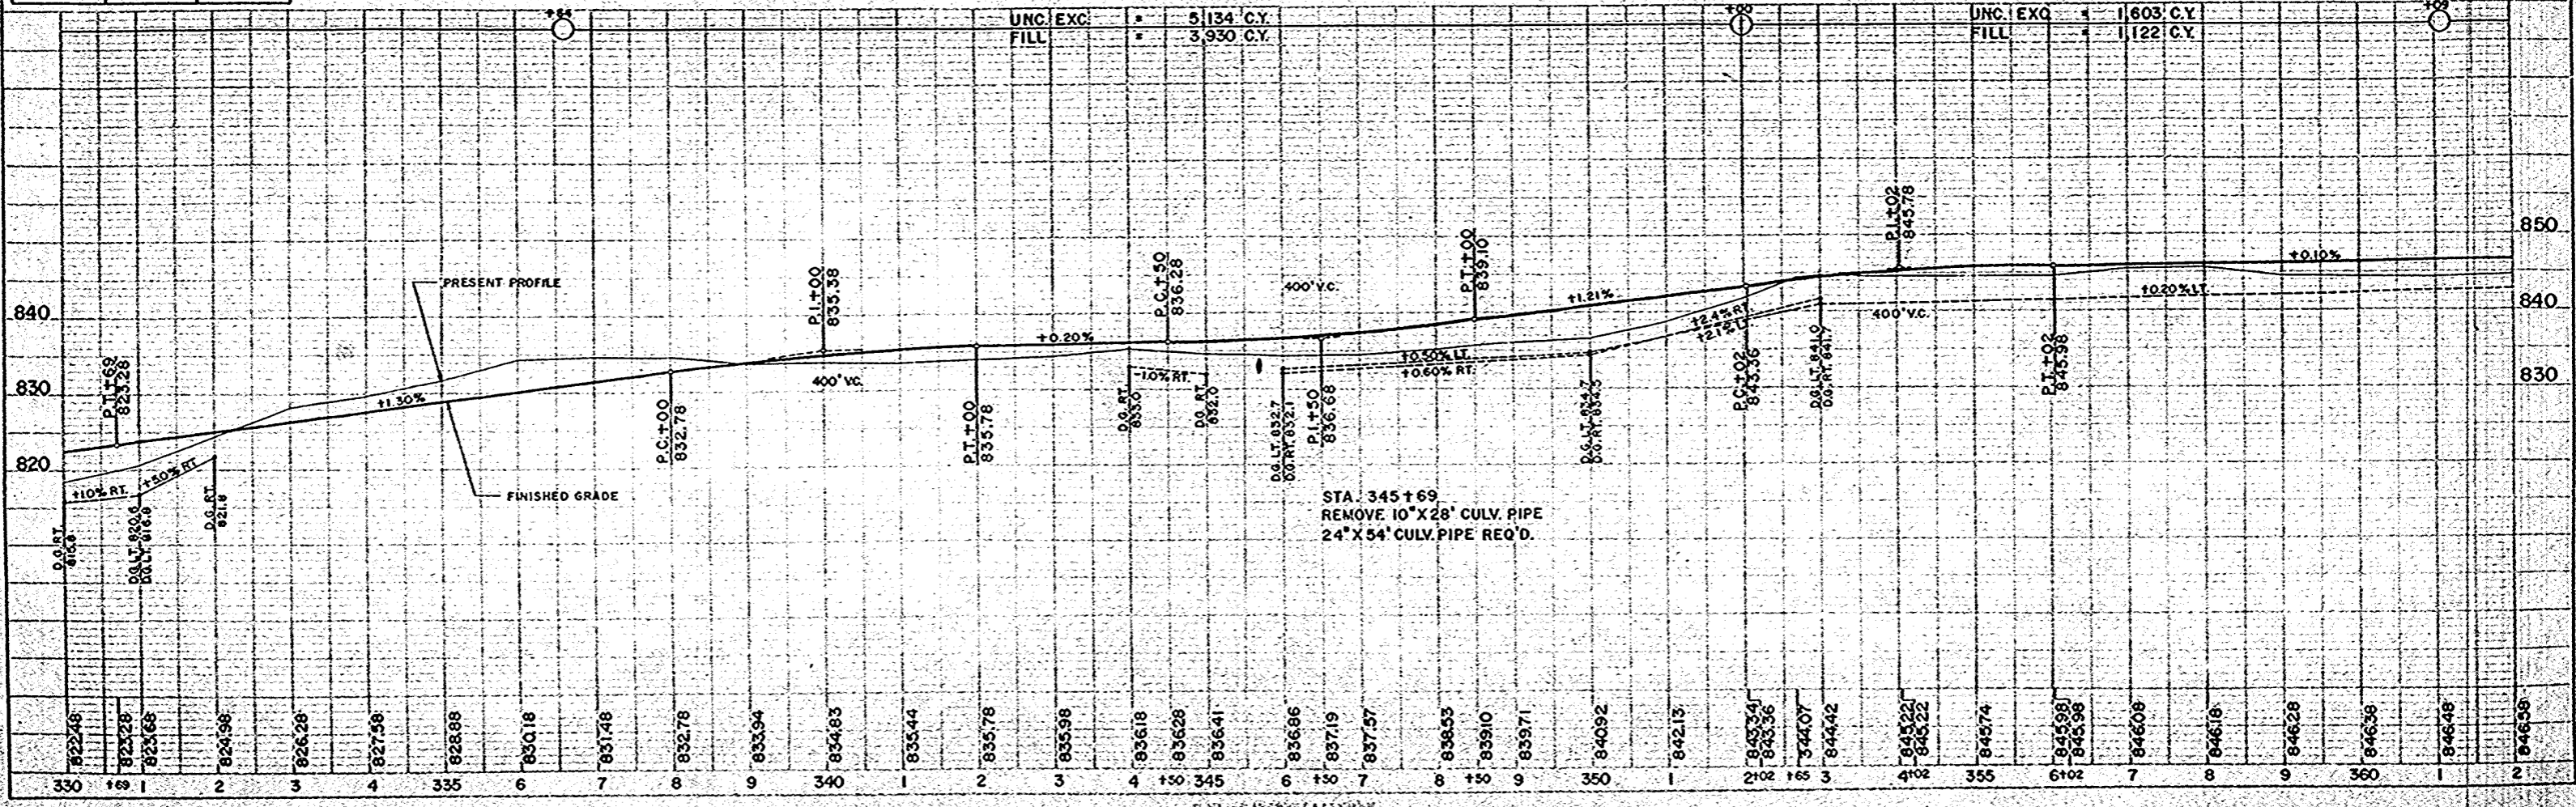


PLAN
 DIVISION
 DATE
 NO. 237

PROFILE
 DIVISION
 DATE
 NO. 237


BENCH MARKS			
NO	STATION	DESCRIPTION	ELEV
47	362+95	SPIKE IN 12" OAK	42 LT 845.76
48	366+50	" " 12" POPLAR	60 RT 848.08
49	372+88	" " 32" ELM	110 RT 845.00
50	380+22	PT MK SE COR BOT STEP	72 LT 851.93
51	389+35	SPIKE IN 30" ELM	42 LT 849.66

CURVE NOTES
 P.I. = 372+30.0
 L = 143'-48"
 Δ = 36°-12"
 D = 5'-00"
 T = 374.6'
 L.C. = 724.0'
 S.E. = 0.070 FT/FT.

CURVE NOTES
 P.I. = 365+38.4
 L = 171'-35"
 Δ = 8°-25"
 D = 1'-30"
 T = 281.1'
 L.C. = 561.1'
 S.E. = 0.027 FT/FT.

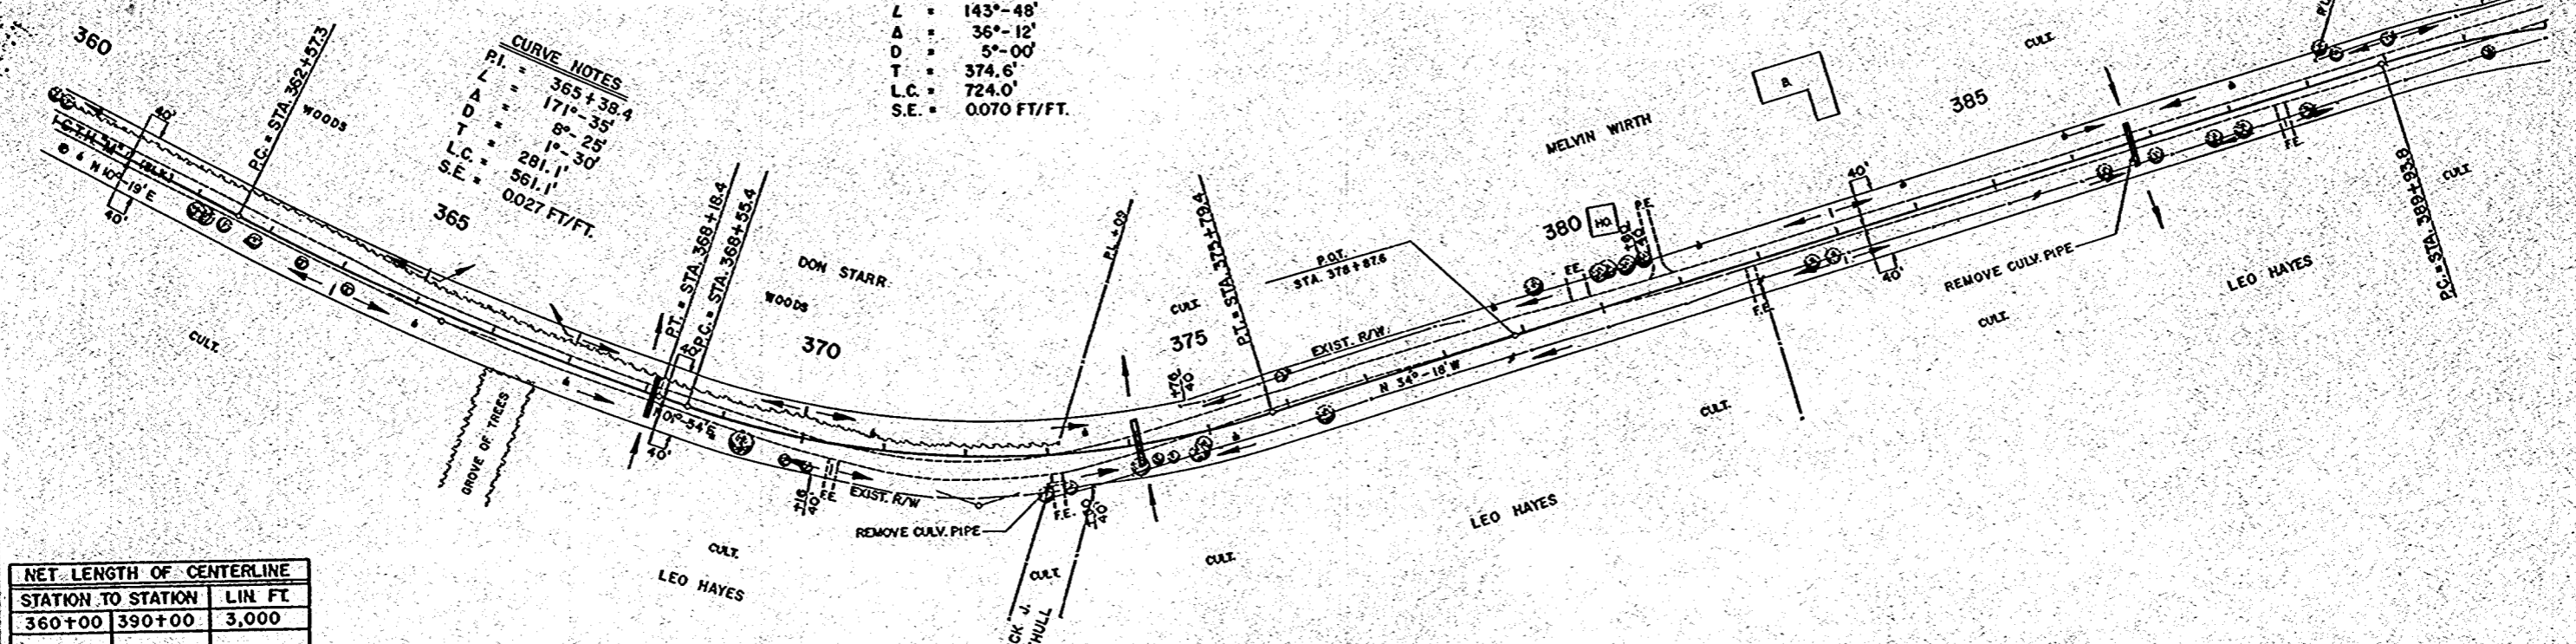

NET LENGTH OF CENTERLINE		
STATION TO STATION	LIN. FT.	
360+00	390+00	3,000

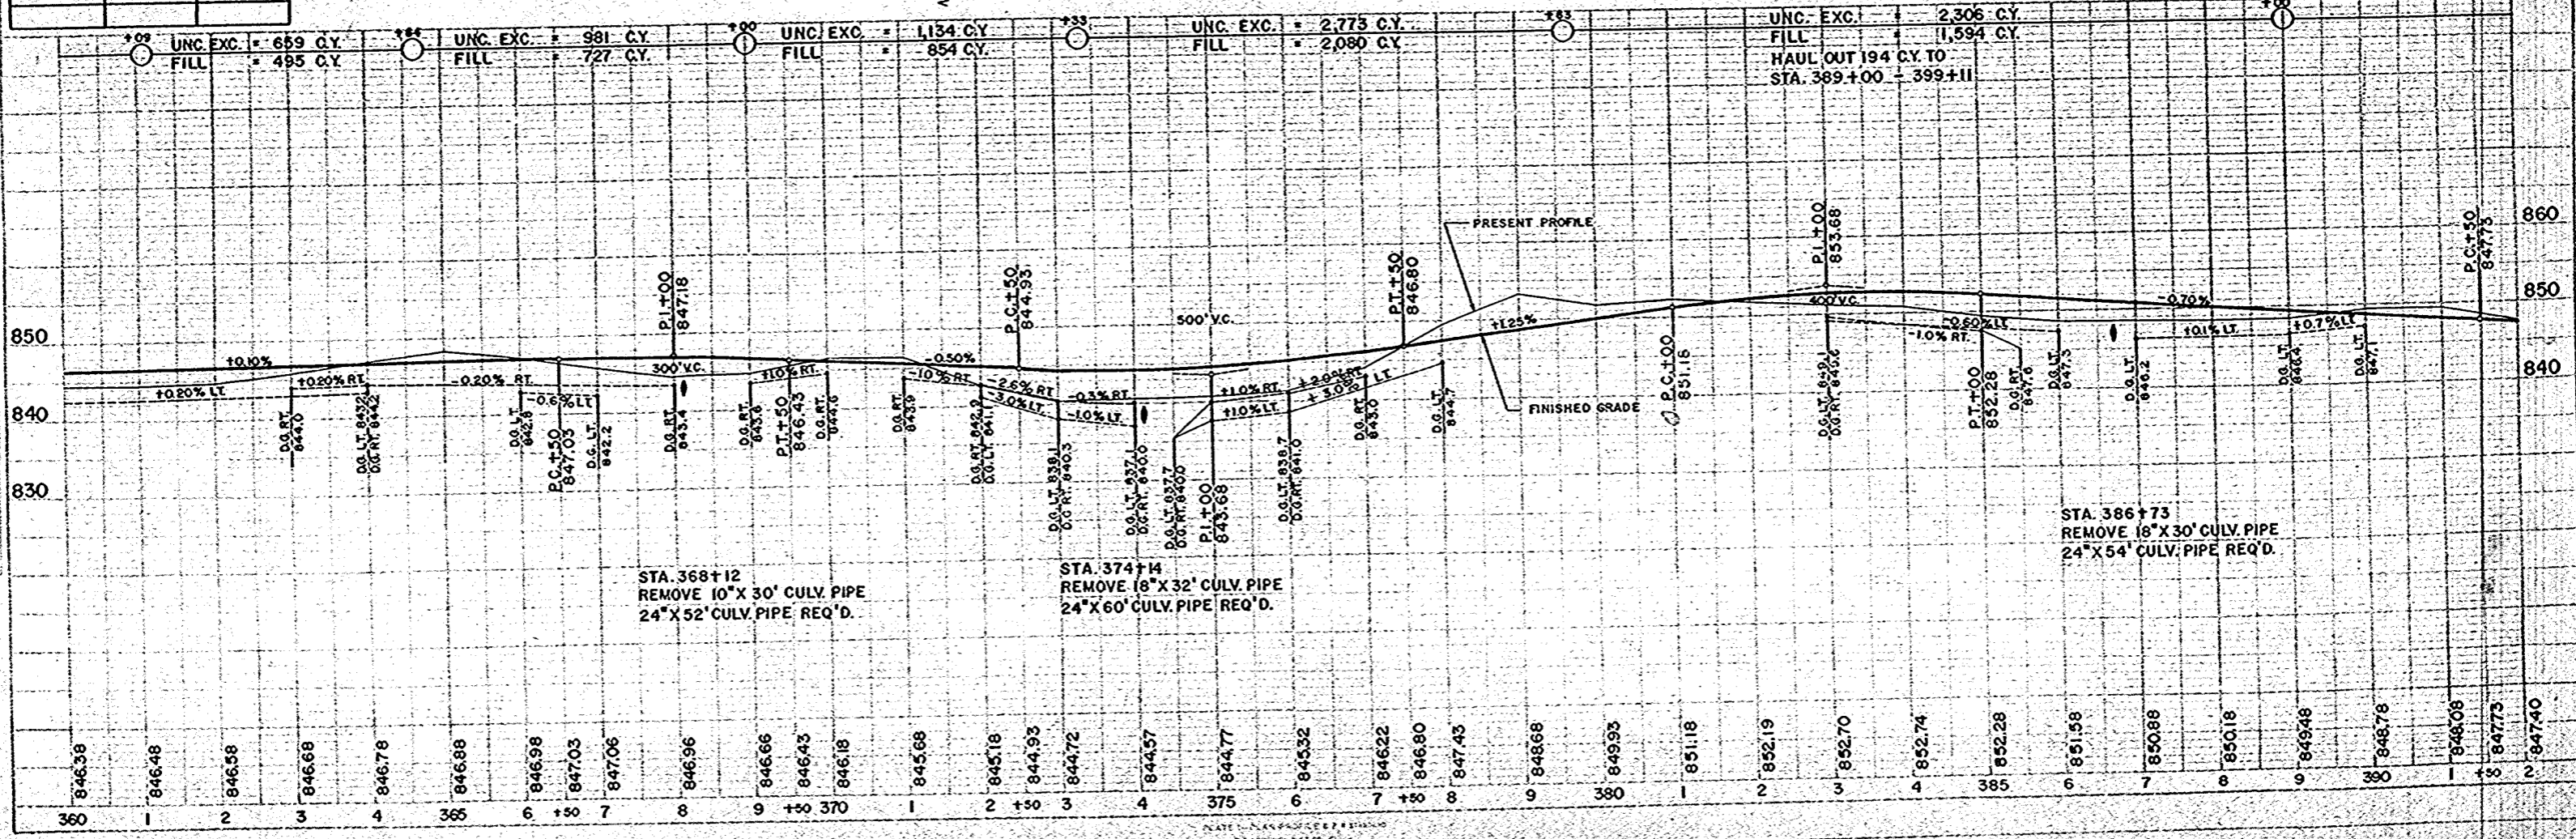

STA. 368+12
 REMOVE 10" X 30' CULV. PIPE
 24" X 52' CULV. PIPE REQ'D.

STA. 374+14
 REMOVE 18" X 32' CULV. PIPE
 24" X 60' CULV. PIPE REQ'D.


STA. 386+73
 REMOVE 18" X 30' CULV. PIPE
 24" X 54' CULV. PIPE REQ'D.

PLAN
 DATE 10-30-58
 BY R.E.K.

PROFILE
 DATE 10-30-58
 BY L.D.W.

BENCH MARKS			
NO.	STATION	DESCRIPTION	ELEV.
62	393+45	SPIKE IN 14" HICKORY	75 LT 849.58
63	398+95	" " 14" ASH	63 LT 843.86
64	403+20	PT MK SE COR CONC SLAB	24 LT 848.28
65	406+90	SPIKE IN 20" B. ELDER	60 LT 850.18

C.T.H. "M" - C.T.H. "X" INTERSECTION
 INTERSECTION DESIGN "E" REQ'D.
 (SEE STD. DRWG. 9-1.1.3)

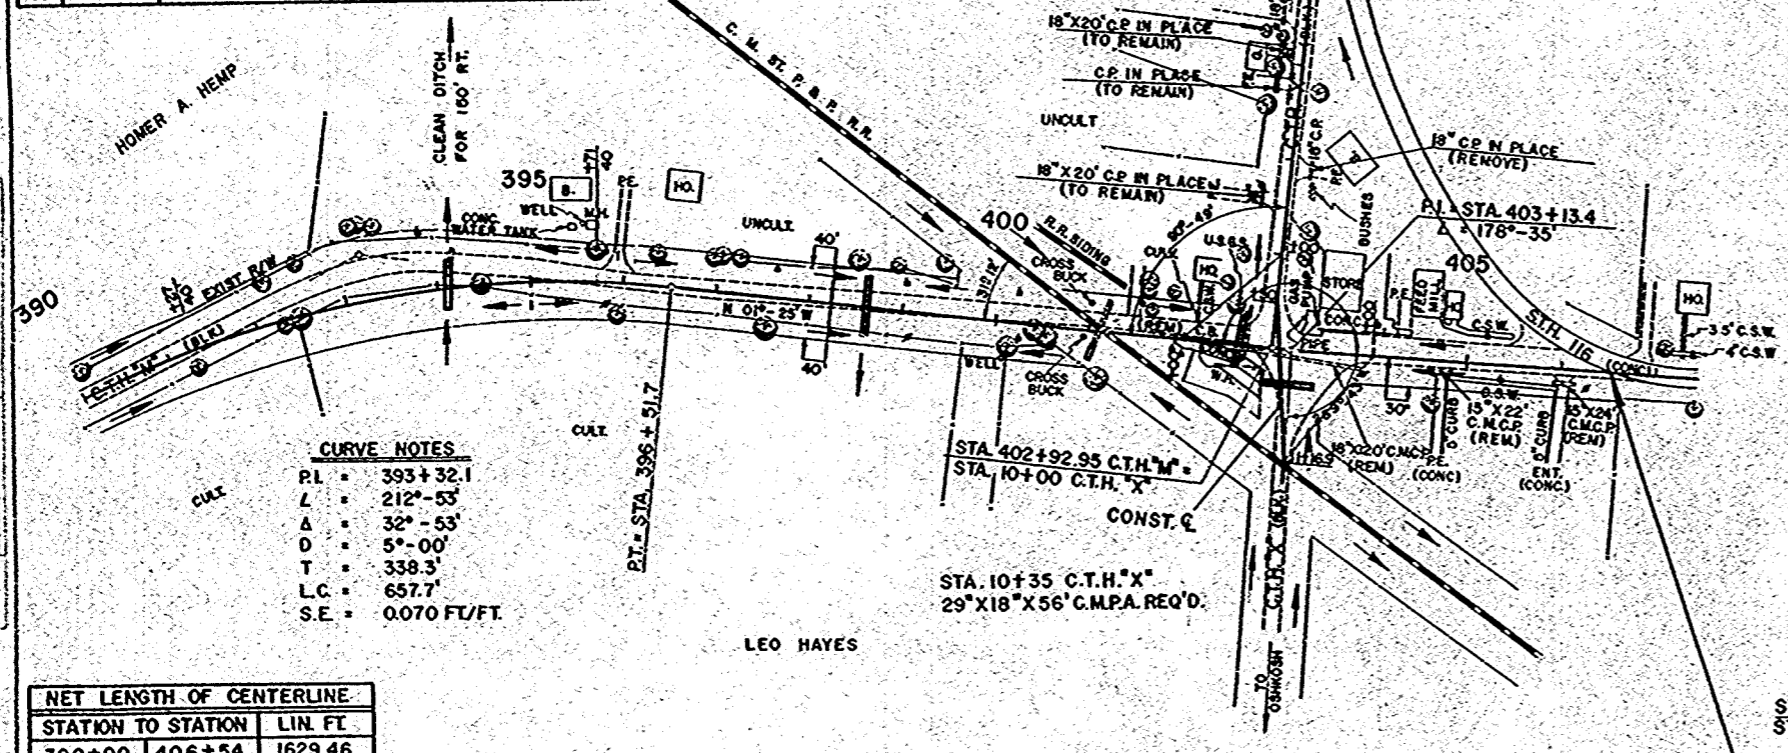

CURVE NOTES

PI =	393+32.1
L =	212'-53"
Δ =	32°-53'
D =	5°-00'
T =	338.3'
L.C. =	657.7'
S.E. =	0.070 FT/FT

NET LENGTH OF CENTERLINE



STATION TO STATION	LIN. FT.	
390+00	406+54	1629.46

DETAIL LAYOUT STA. 402+25 STA. 405+00

UNC. EXC. = 2,968 CY
 FILL = 2,385 CY
 HAUL IN 194 CY FROM
 STA. 379+63 - 389+00

UNC. EXC. = 1,014 CY
 FILL = 1,231 CY
 BORROW = 625 CY

STA. 406+54 END
 PROJ. S 0737 (1)

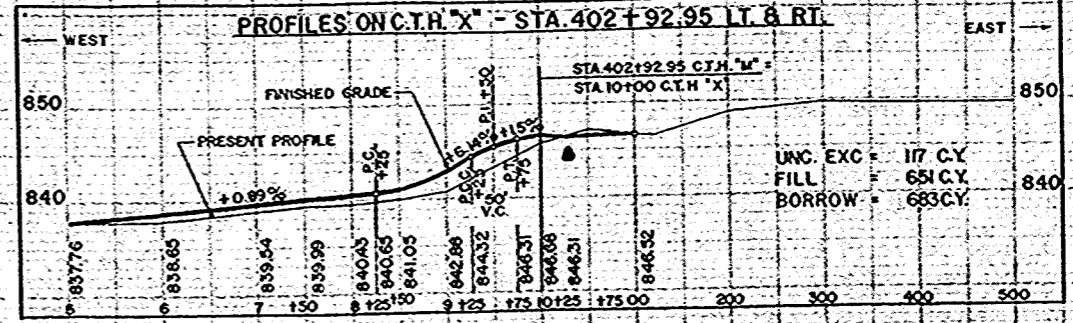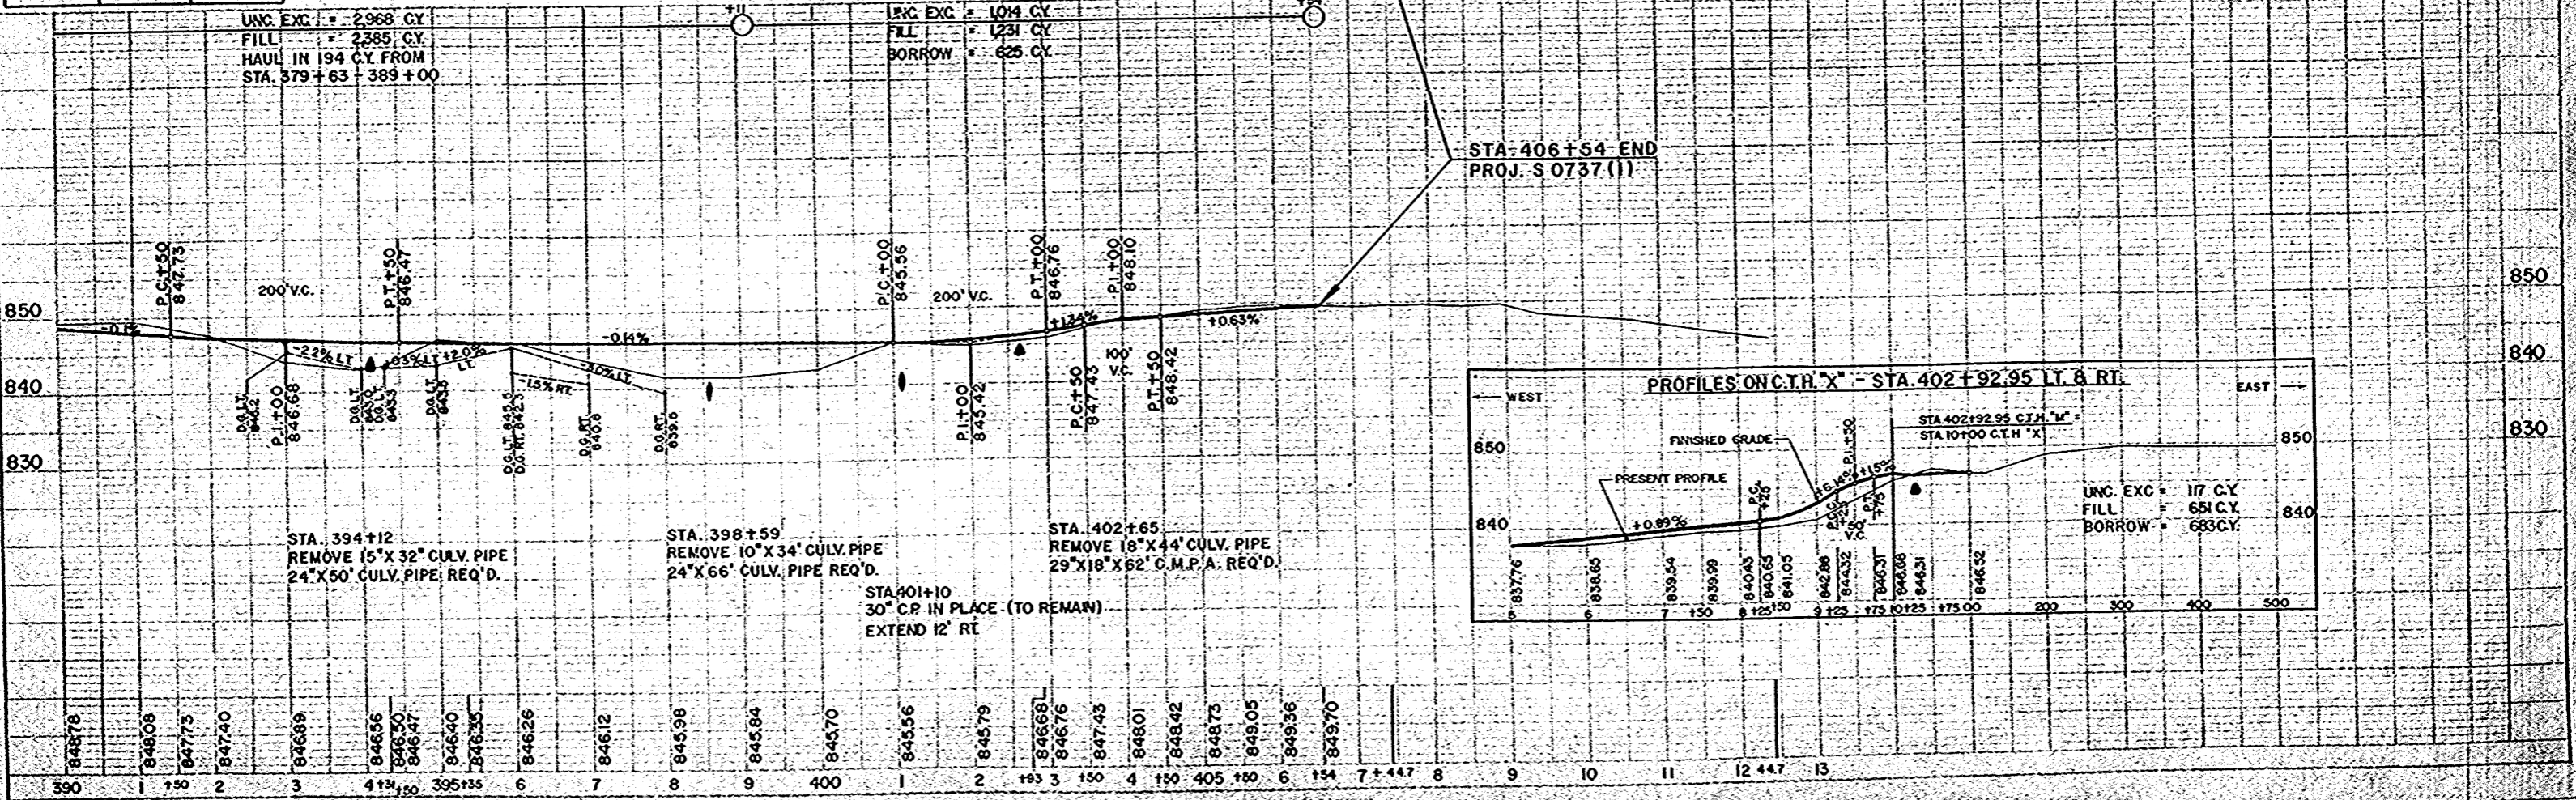


PLAN
 UNREVISED
 DATE: 10-27-59
 BY: [Signature]

PROFILE
 UNREVISED
 DATE: 10-27-59
 BY: [Signature]


BENCH MARK

NO	STATION	DESCRIPTION	ELEV.
31	266+40	SPIKE IN TWIN WILLOW TREE	818.30

COUNTY	ROUTE & SECTION	CLASS & AGREEMENT	F.P.D. DIVISION	PROJECT	SHEET NO.	TOTAL SHEETS
WINNEBAGO	737.0	11.1	4	56737(1)	18	33

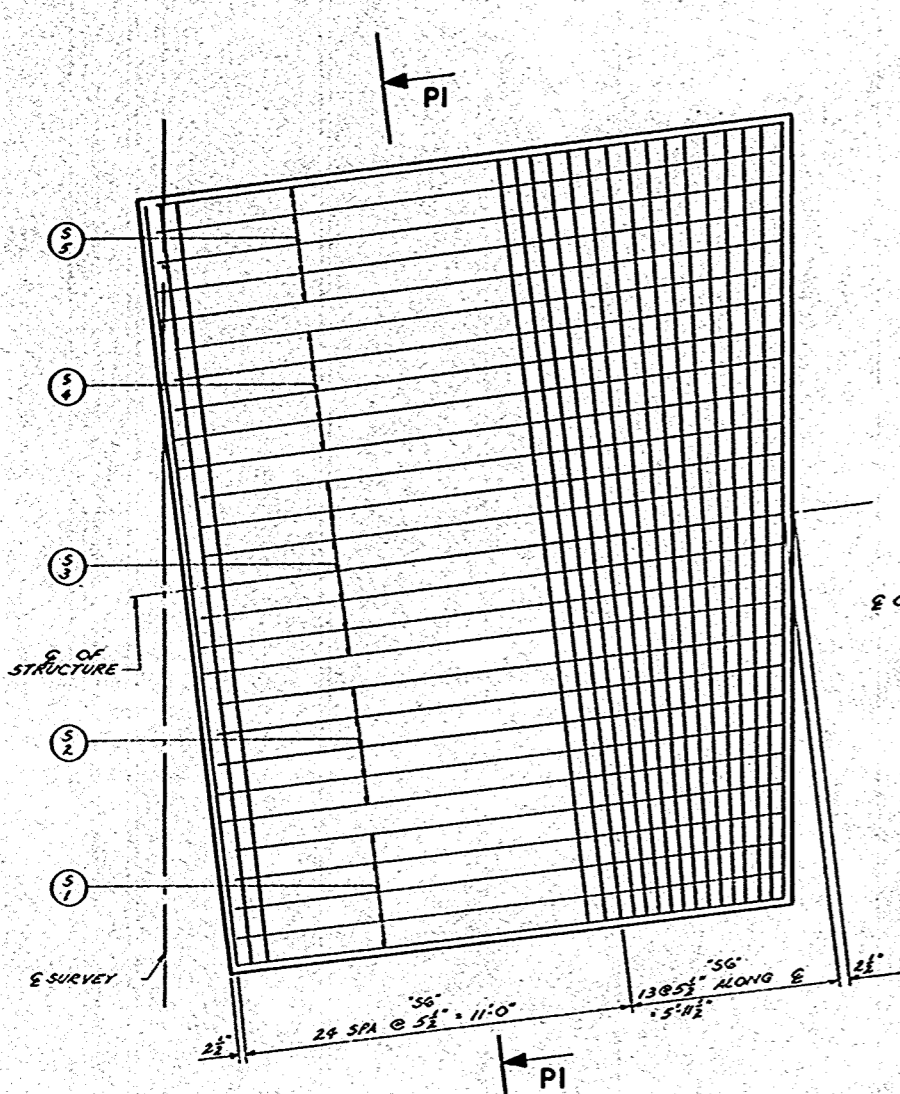

FLOOR PLAN
SHOWING REINFORCEMENT IN BOTTOM

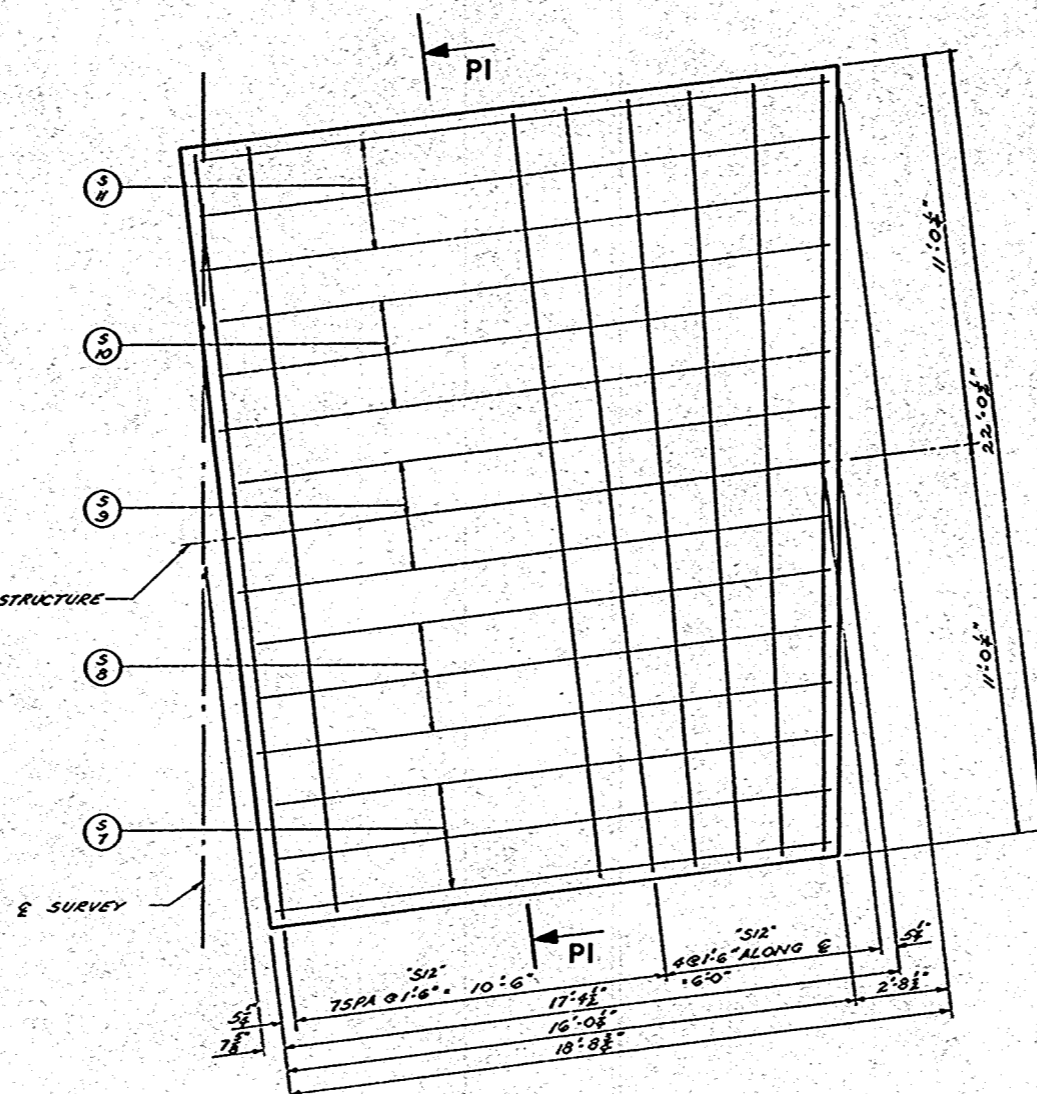

FLOOR PLAN
SHOWING REINFORCEMENT IN TOP

NOTE: ALTERNATE TOP TRANSVERSE BARS IN SLAB SHALL BE SUPPORTED BY INDIVIDUAL BAR CHAIRS AT APPROXIMATELY 3'-0" CENTERS. BOTTOM LONGITUDINAL BARS SHALL BE SUPPORTED BY CONTINUOUS BAR CHAIRS AT APPROXIMATELY 4'-0" CENTERS.


BILL OF BARS 3,040 #

POUR	CONC.	MARK	NO.	SIZE	LENGTH	SPACING	LOCATION	DET.
		S1	5	5	15'-6"	10	BOTTOM FLOOR TRANSVERSE	
		S2	5	5	16'-3"	10		
		S3	7	5	16'-9"	10		
		S4	5	5	17'-6"	10		
		S5	5	5	18'-0"	10		
		S6	39	8	21'-9"	5'	LONGITUDINAL	
		S7	3	4	15'-6"	1'-6"	TOP TRANSVERSE	
		S8	3	4	16'-3"	1'-6"		
		S9	3	4	16'-3"	1'-6"		
		S10	3	4	17'-3"	1'-6"		
		S11	3	4	18'-0"	1'-6"		
		S12	12	4	21'-9"	1'-6"	LONG.	
		S13	1	5	21'-9"	SHOWN	AT THE EXPANSION HOOK BOLTS	


GENERAL NOTES

DRAWINGS SHALL NOT BE SCALED. ALL CONCRETE MASONRY SHALL BE GRADE "AA". BEVEL ALL EXPOSED EDGES OF CONCRETE 1" UNLESS OTHERWISE SPECIFIED. THE USE OF STRUCTURAL GRADE BAR STEEL REINFORCEMENT IS PROHIBITED. BAR STEEL REINFORCEMENT SHALL BE IMBEDDED 2" CLEAR UNLESS OTHERWISE SHOWN OR NOTED. THE PILING FOR THE ABUTMENTS SHALL BE TREATED TIMBER PILING ESTIMATED 20'-0" LONG AND DRIVEN TO A BEARING VALUE OF 20 TONS PER PILE. ALL EXCAVATED VOLUME NOT OCCUPIED BY THE NEW STRUCTURE SHALL BE BACKFILLED WITH GRANULAR BACKFILL AT THE BACKFACE TO THE GROUND LINE WHICH EXISTED BEFORE EXCAVATION BEGAN. PAYMENT WILL BE MADE ONLY FOR MATERIAL ACTUALLY PLACED WITHIN THE LIMITS SPECIFIED IN "EXCAVATION FOR STRUCTURES". ABUTMENT BACKFILL NOT TO BE PLACED UNTIL SUPERSTRUCTURE IS COMPLETED. PRESERVE ALL EXISTING BAR STEEL AND INCORPORATE IT IN THE NEW STRUCTURE.


18 DRIVE & LOCATION OF N. ABUTMENT

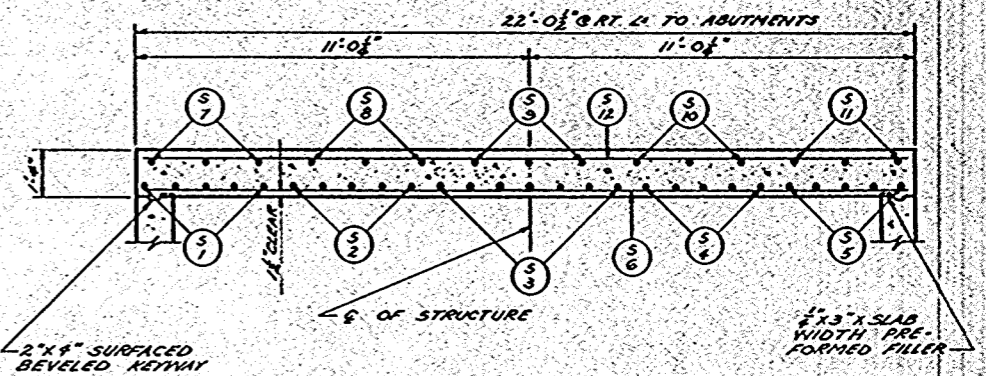

SECTION PI

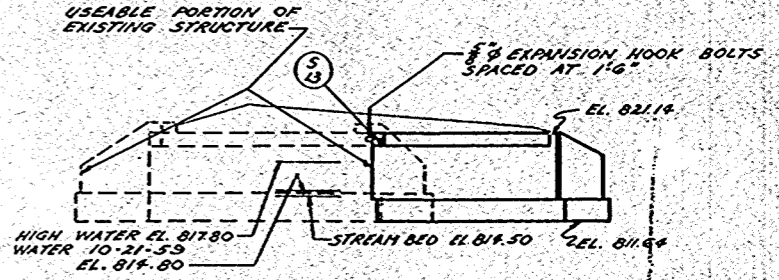

ELEVATION

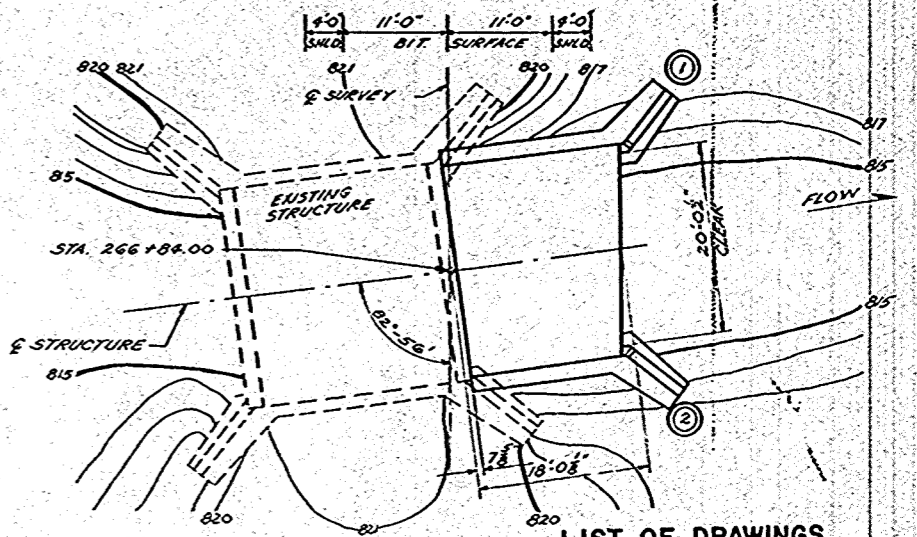

LAYOUT

ESTIMATED QUANTITIES

BID - ITEMS	UNIT	SUPER	N. ABUT.	S. ABUT.	TOTAL
EXCAVATION FOR STRUCTURES	CY		35	25	60
GRANULAR BACKFILL	CY		10	10	20
CONCRETE MASONRY	CY	18.9	19.3	12.8	60.0
BAR STEEL REINFORCEMENT	LB.	3,040	370	340	3,750
UNTREATED TIMBER TEST PILING (30'-0")	L.S.				1
TREATED TIMBER PILING DEL.	LF		220	200	420
TREATED TIMBER PILING DEL.	LF		220	200	420
PILE SHOES	EA.		11	10	21
NON BID - ITEMS					
FILLER	SIZE				3' x 3'
MEMBRANE WATERPROOFING	SF		10.5	10.5	21
EXPANSION HOOK BOLTS	REQD.	15			15

LIST OF DRAWINGS

REVISED	STATE HIGHWAY COMMISSION OF WISCONSIN
	SUPERSTRUCTURE & LAYOUT
	CO. WINNEBAGO NEPEUSKUN STA. 266+84.00
	SECTION 13 TOWN 17N RANGE 16E
	DIST. ON SPEC. AASHO 57 LOADING HIS SPEC. 1957
	DATES 1-4-60 DESIGN B.A. DRAWN BY CAD. W.L.
	SUBMITTED BY <i>W.B. Schult</i> ENGINEER OF RECORD
	APPROVED BY <i>E.L. Rostetter</i> STATE HIGHWAY ENGINEER
	STRUCTURE B - 70 - 38 SHEET 18 OF 2

X 21413

BILL OF BARS
(NORTH ABUTMENT) 370 #


FOUR MARK	NO.	SIZE	LENGTH	SPACING	LOCATION	DET.
FOOTING	C1	13	4	2-0	1-0	FOOTING & BODY WALL FR.
	C2	13	4	3-0	1-0	" " " " B.F.
	C3	1	4	7-3	SHOWN	WING FRONT FACE
	C4	1	4	6-3	"	" " " "
	C5	1	4	5-6	"	" " " "
	C6	3	4	5-6	1-0	" " " " BACK
	C7	2	4	6-9	1-0	" " " "
	C8	2	4	7-6	1-0	" " " "
BODY & WING WALLS	C9	13	4	6-9	1-0	BODY WALL FRONT FACE
	C10	7	4	5-6	3-0	" " " " BACK
	C11	8	4	13-0	1-6	" " " " B.F. & FR.
	C12	6	4	6-6	1-6	WING " " " "
	C13	4	4	5-0	1-6	" " " "
	C14	2	4	7-3	SHOWN	" " " " TOP

(SOUTH ABUTMENT) 340 #


FOUR MARK	NO.	SIZE	LENGTH	SPACING	LOCATION	DET.
FOOTING	H1	17	4	2-0	1-0	FOOTING & BODY WALL FR.
	H2	17	4	3-0	1-0	" " " " B.F.
	H3	1	4	7-3	SHOWN	WING FRONT FACE
	H4	1	4	6-3	"	" " " "
	H5	1	4	5-6	"	" " " "
	H6	3	4	5-6	1-0	" " " " BACK
	H7	2	4	6-9	1-0	" " " "
	H8	2	4	7-6	1-0	" " " "
BODY & WING WALLS	H9	17	4	6-9	1-0	BODY WALL FRONT FACE
	H10	7	4	5-6	3-0	" " " " BACK
	H11	8	4	13-0	1-6	" " " " B.F. & FR.
	H12	6	4	6-6	1-6	WING " " " "
	H13	4	4	5-0	1-6	" " " "
	H14	2	4	7-3	SHOWN	" " " " TOP

ESTIMATED CONC. MASONRY


UNIT	NORTH ABUT.	SOUTH ABUT.
FOOTINGS	0.5	1.7
BODY & WINGS	5.8	5.1
TOTAL	14.3	12.8

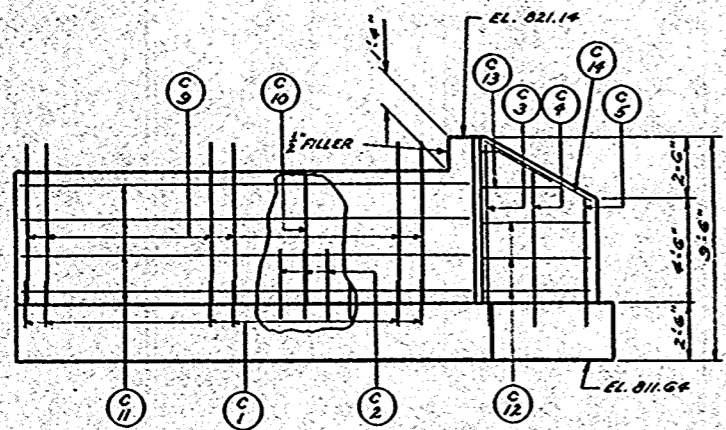


ELEVATION
N. ABUT.

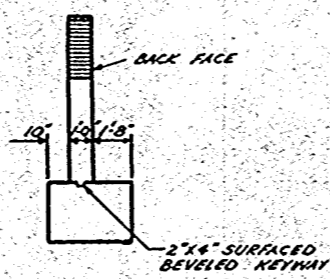

END VIEW

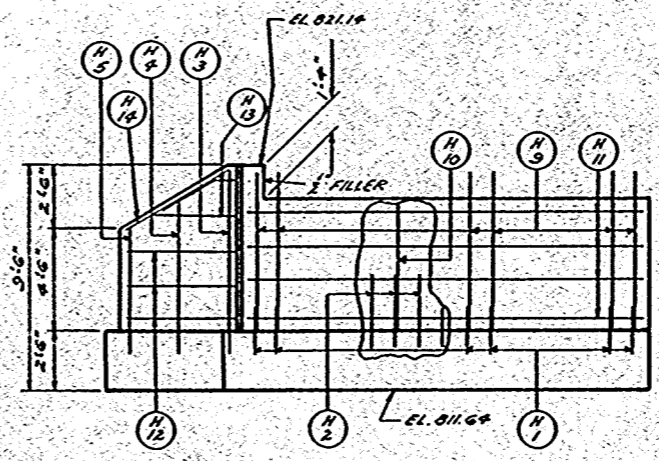


ELEVATION
S. ABUT.

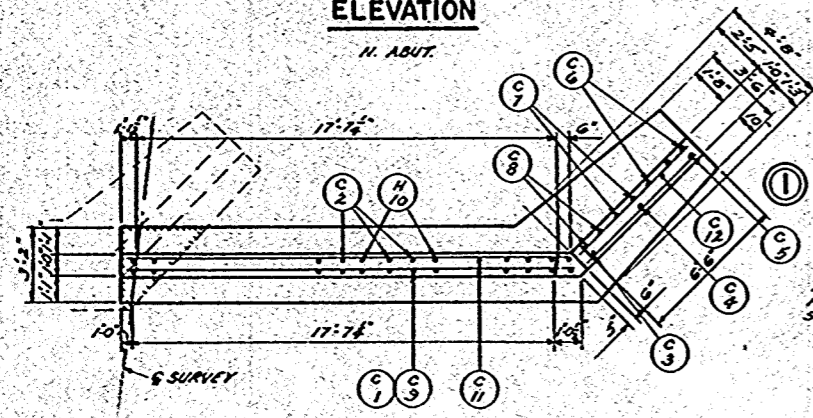


PLAN

NOTE: REMOVE SHADED PORTION OF EXISTING STRUCTURE


TREATED TIMBER PILING EST. 20'-0" LG.

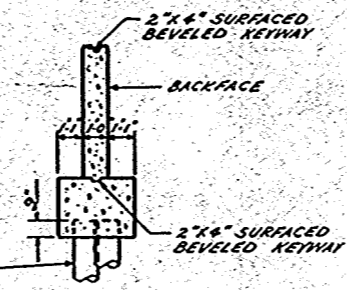


SECTION THRU BODY WALL

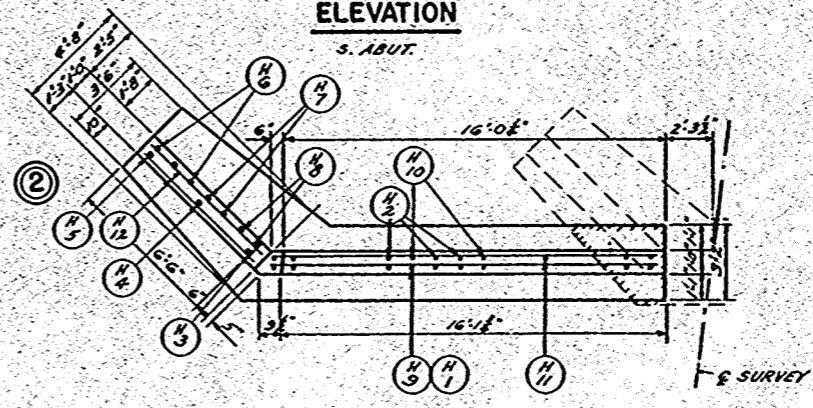


PLAN

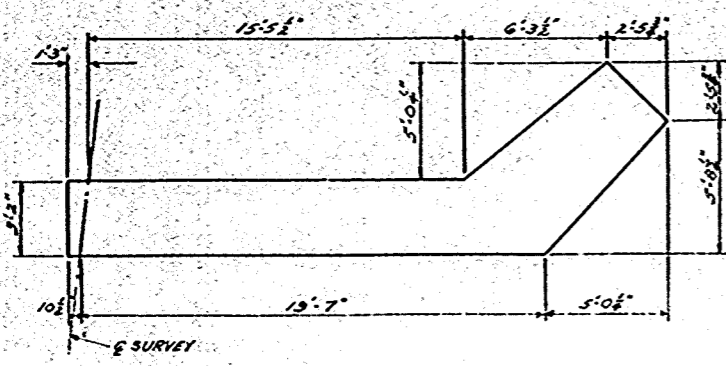


FOOTING PLAN

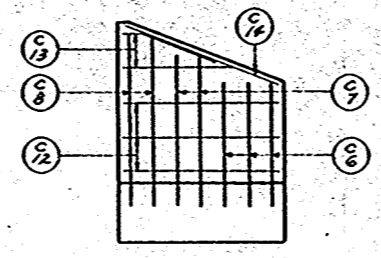


WING 1

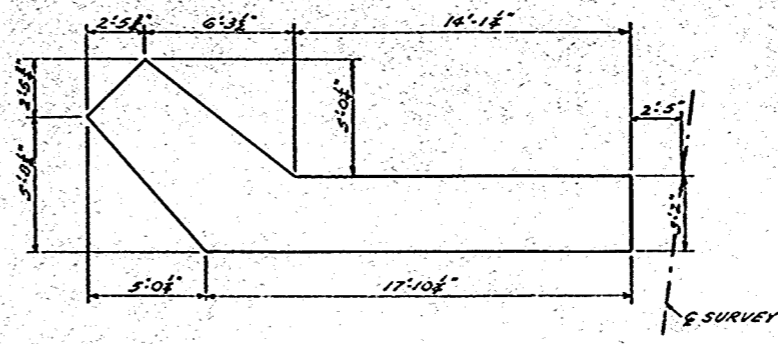


FOOTING PLAN

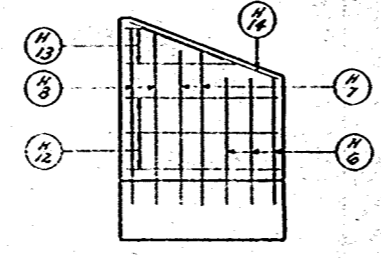


WING 2

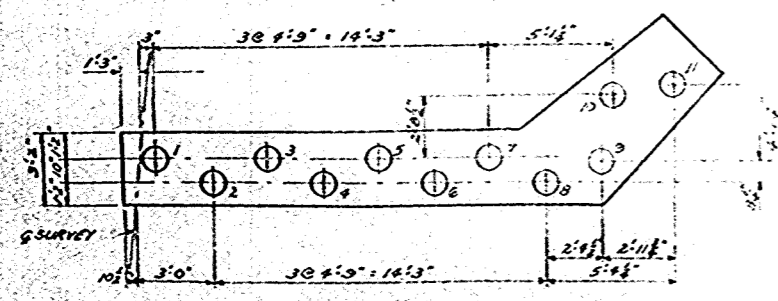

PILE PLAN

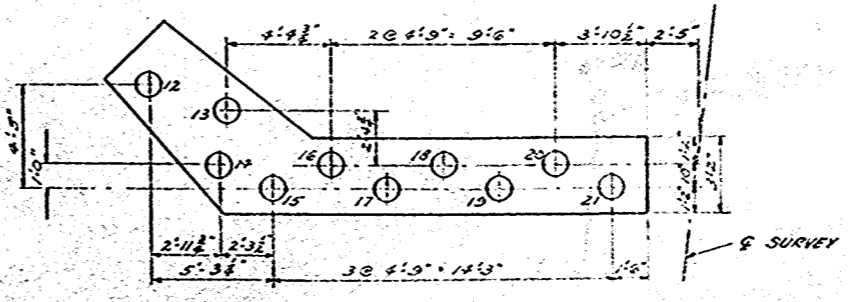


PILE PLAN

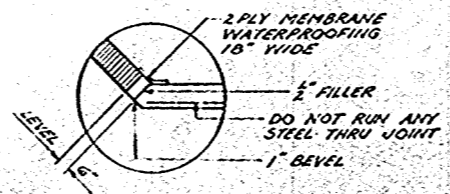

TYPICAL CORNER DETAIL

FINAL SURVEY
 DATE: 10-29-38
 SHEET NO. 238


ORIGINAL SURVEY
 DATE: 10-29-38
 SHEET NO. 238

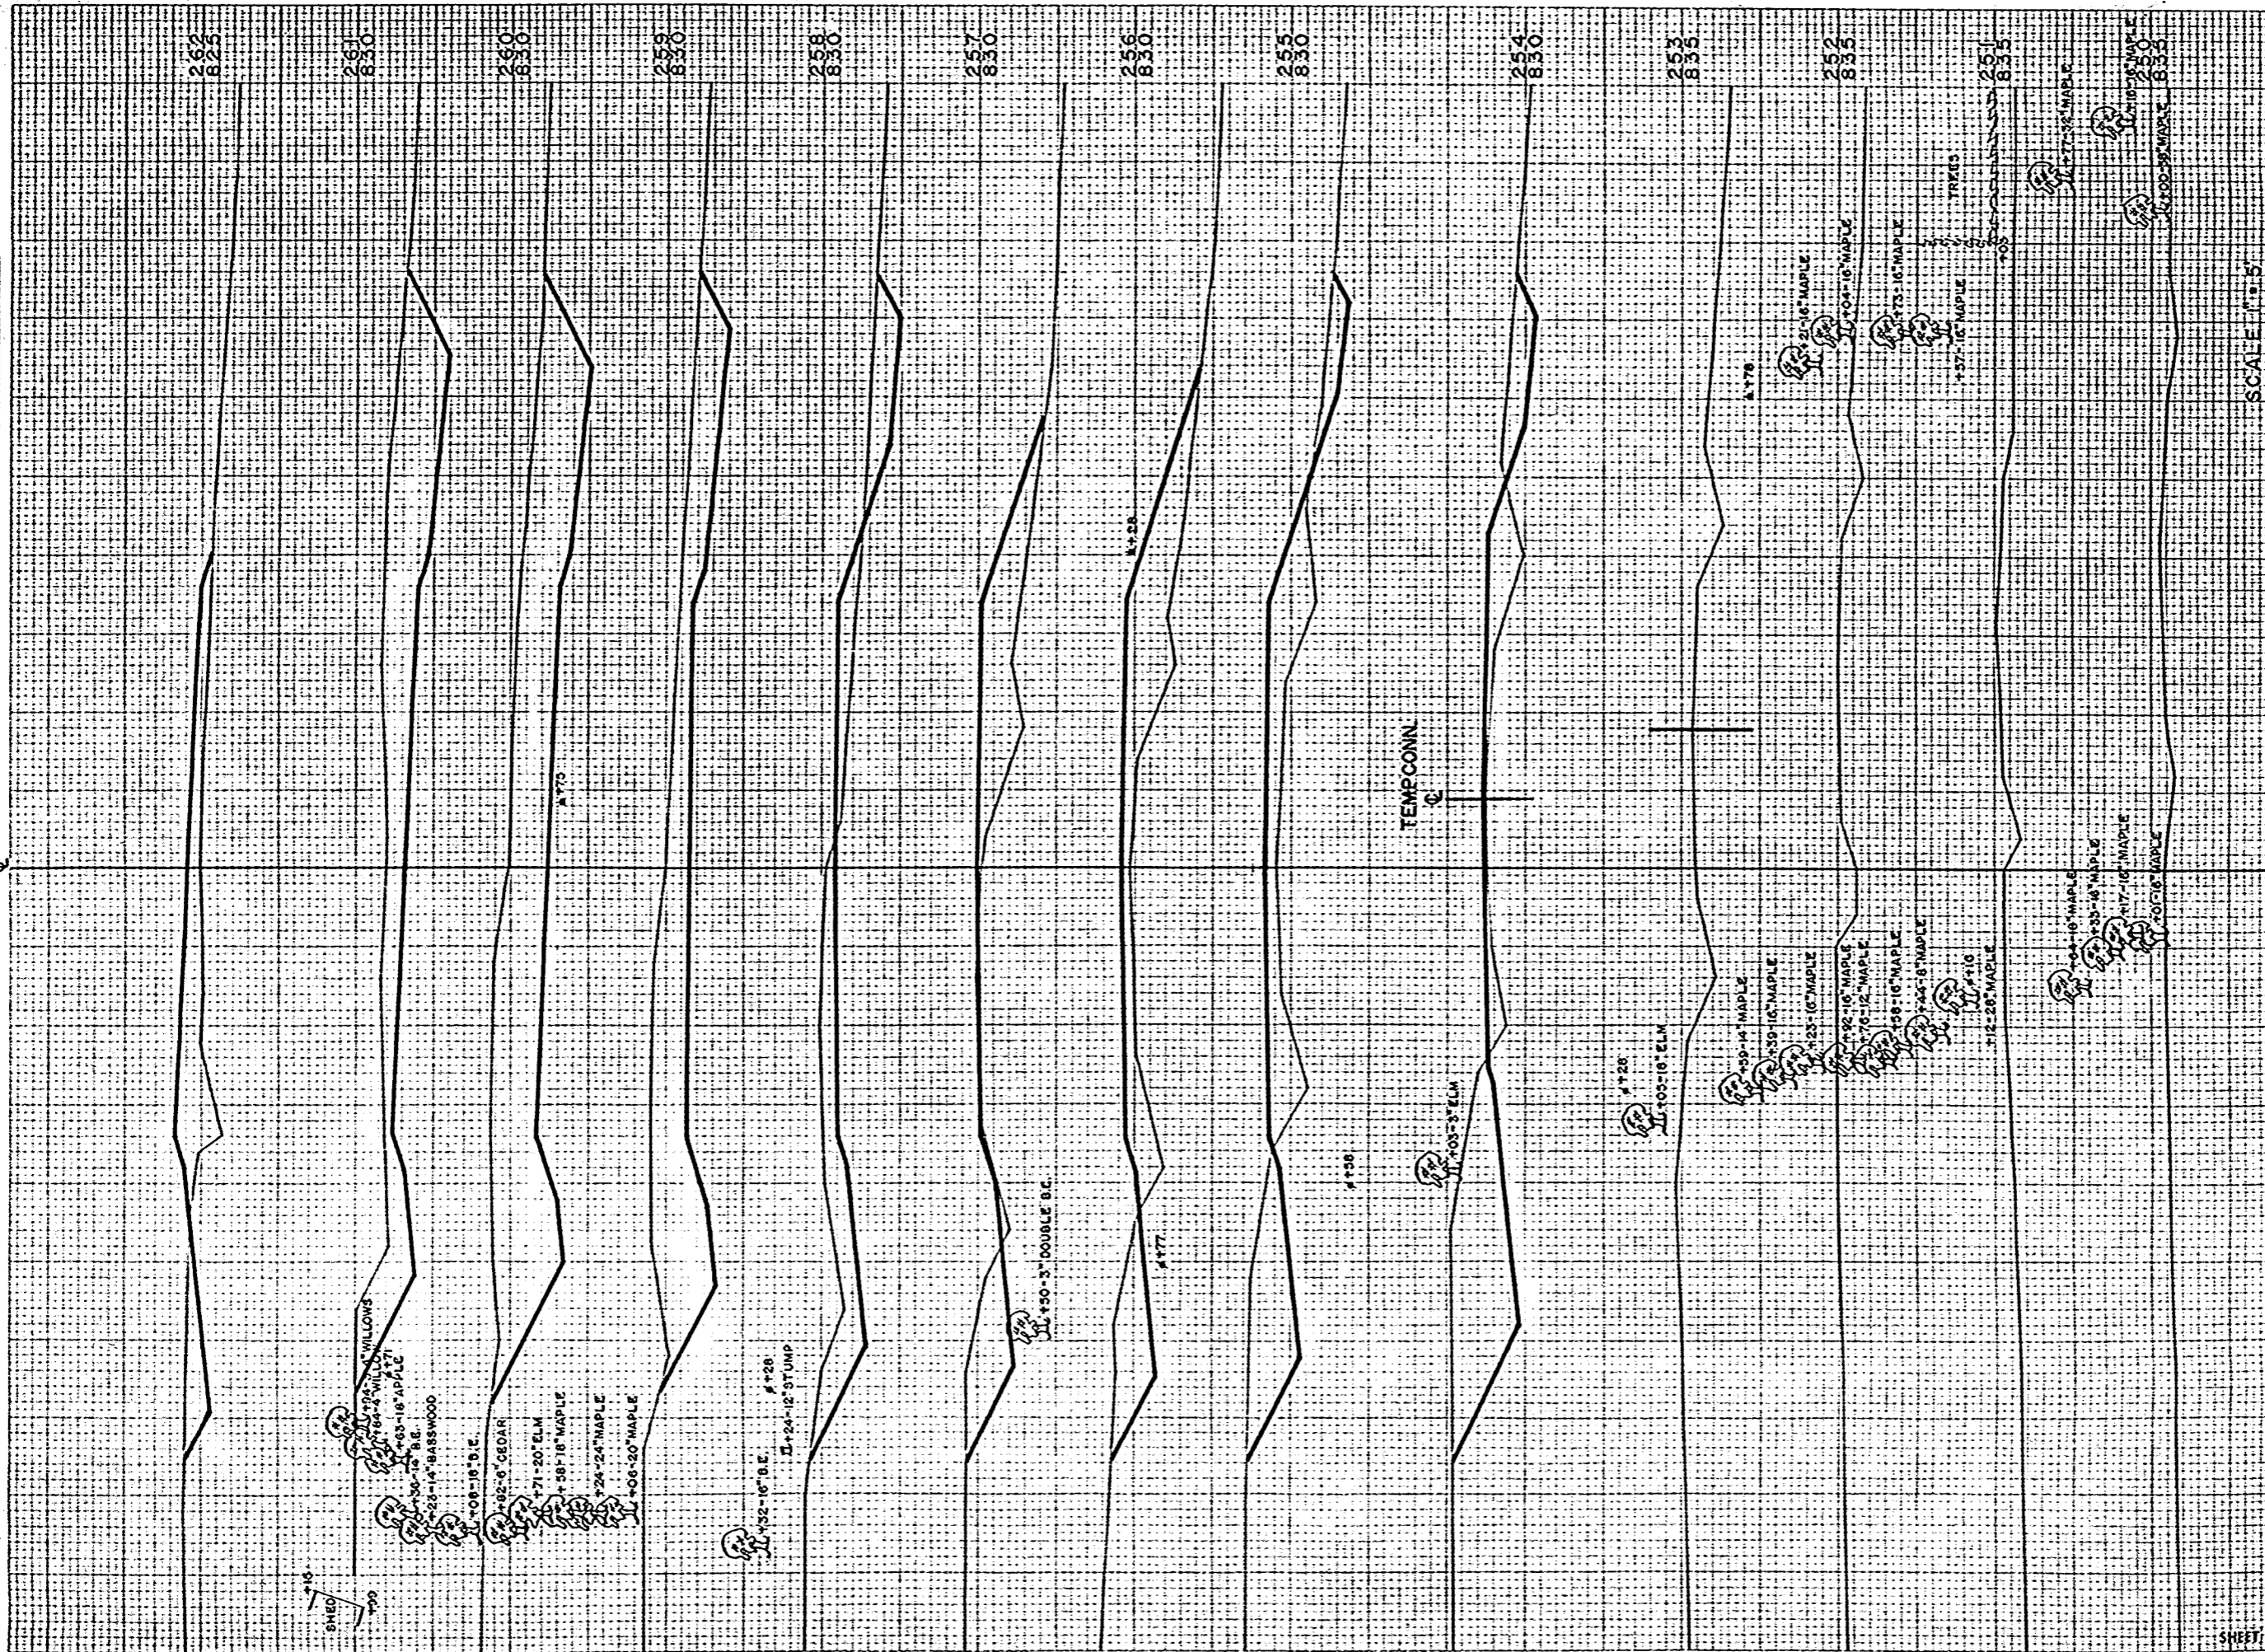

S.P.A. DISTRICT OFFICE		PROJECT		SHEET NO./PAGE		TOTAL SHEETS	
WIS. 4		S 0737 (1)		20		33	
STATION	DISTANCE	YARDAGE EXCAVATION		TOTAL			
		UNCLE					
253		157			46		
254		250			144		
255		137			231		
256		91			224		
257		169			115		
258		353			24		
259		613			0		
260		604			0		
261		254			85		
262							
SHEET TOTAL		2638			869		

DATE _____
 DRAWN BY _____
 CHECKED BY _____
 DATE _____
 NO. _____

DATE _____
 DRAWN BY _____
 CHECKED BY _____
 DATE _____
 NO. _____

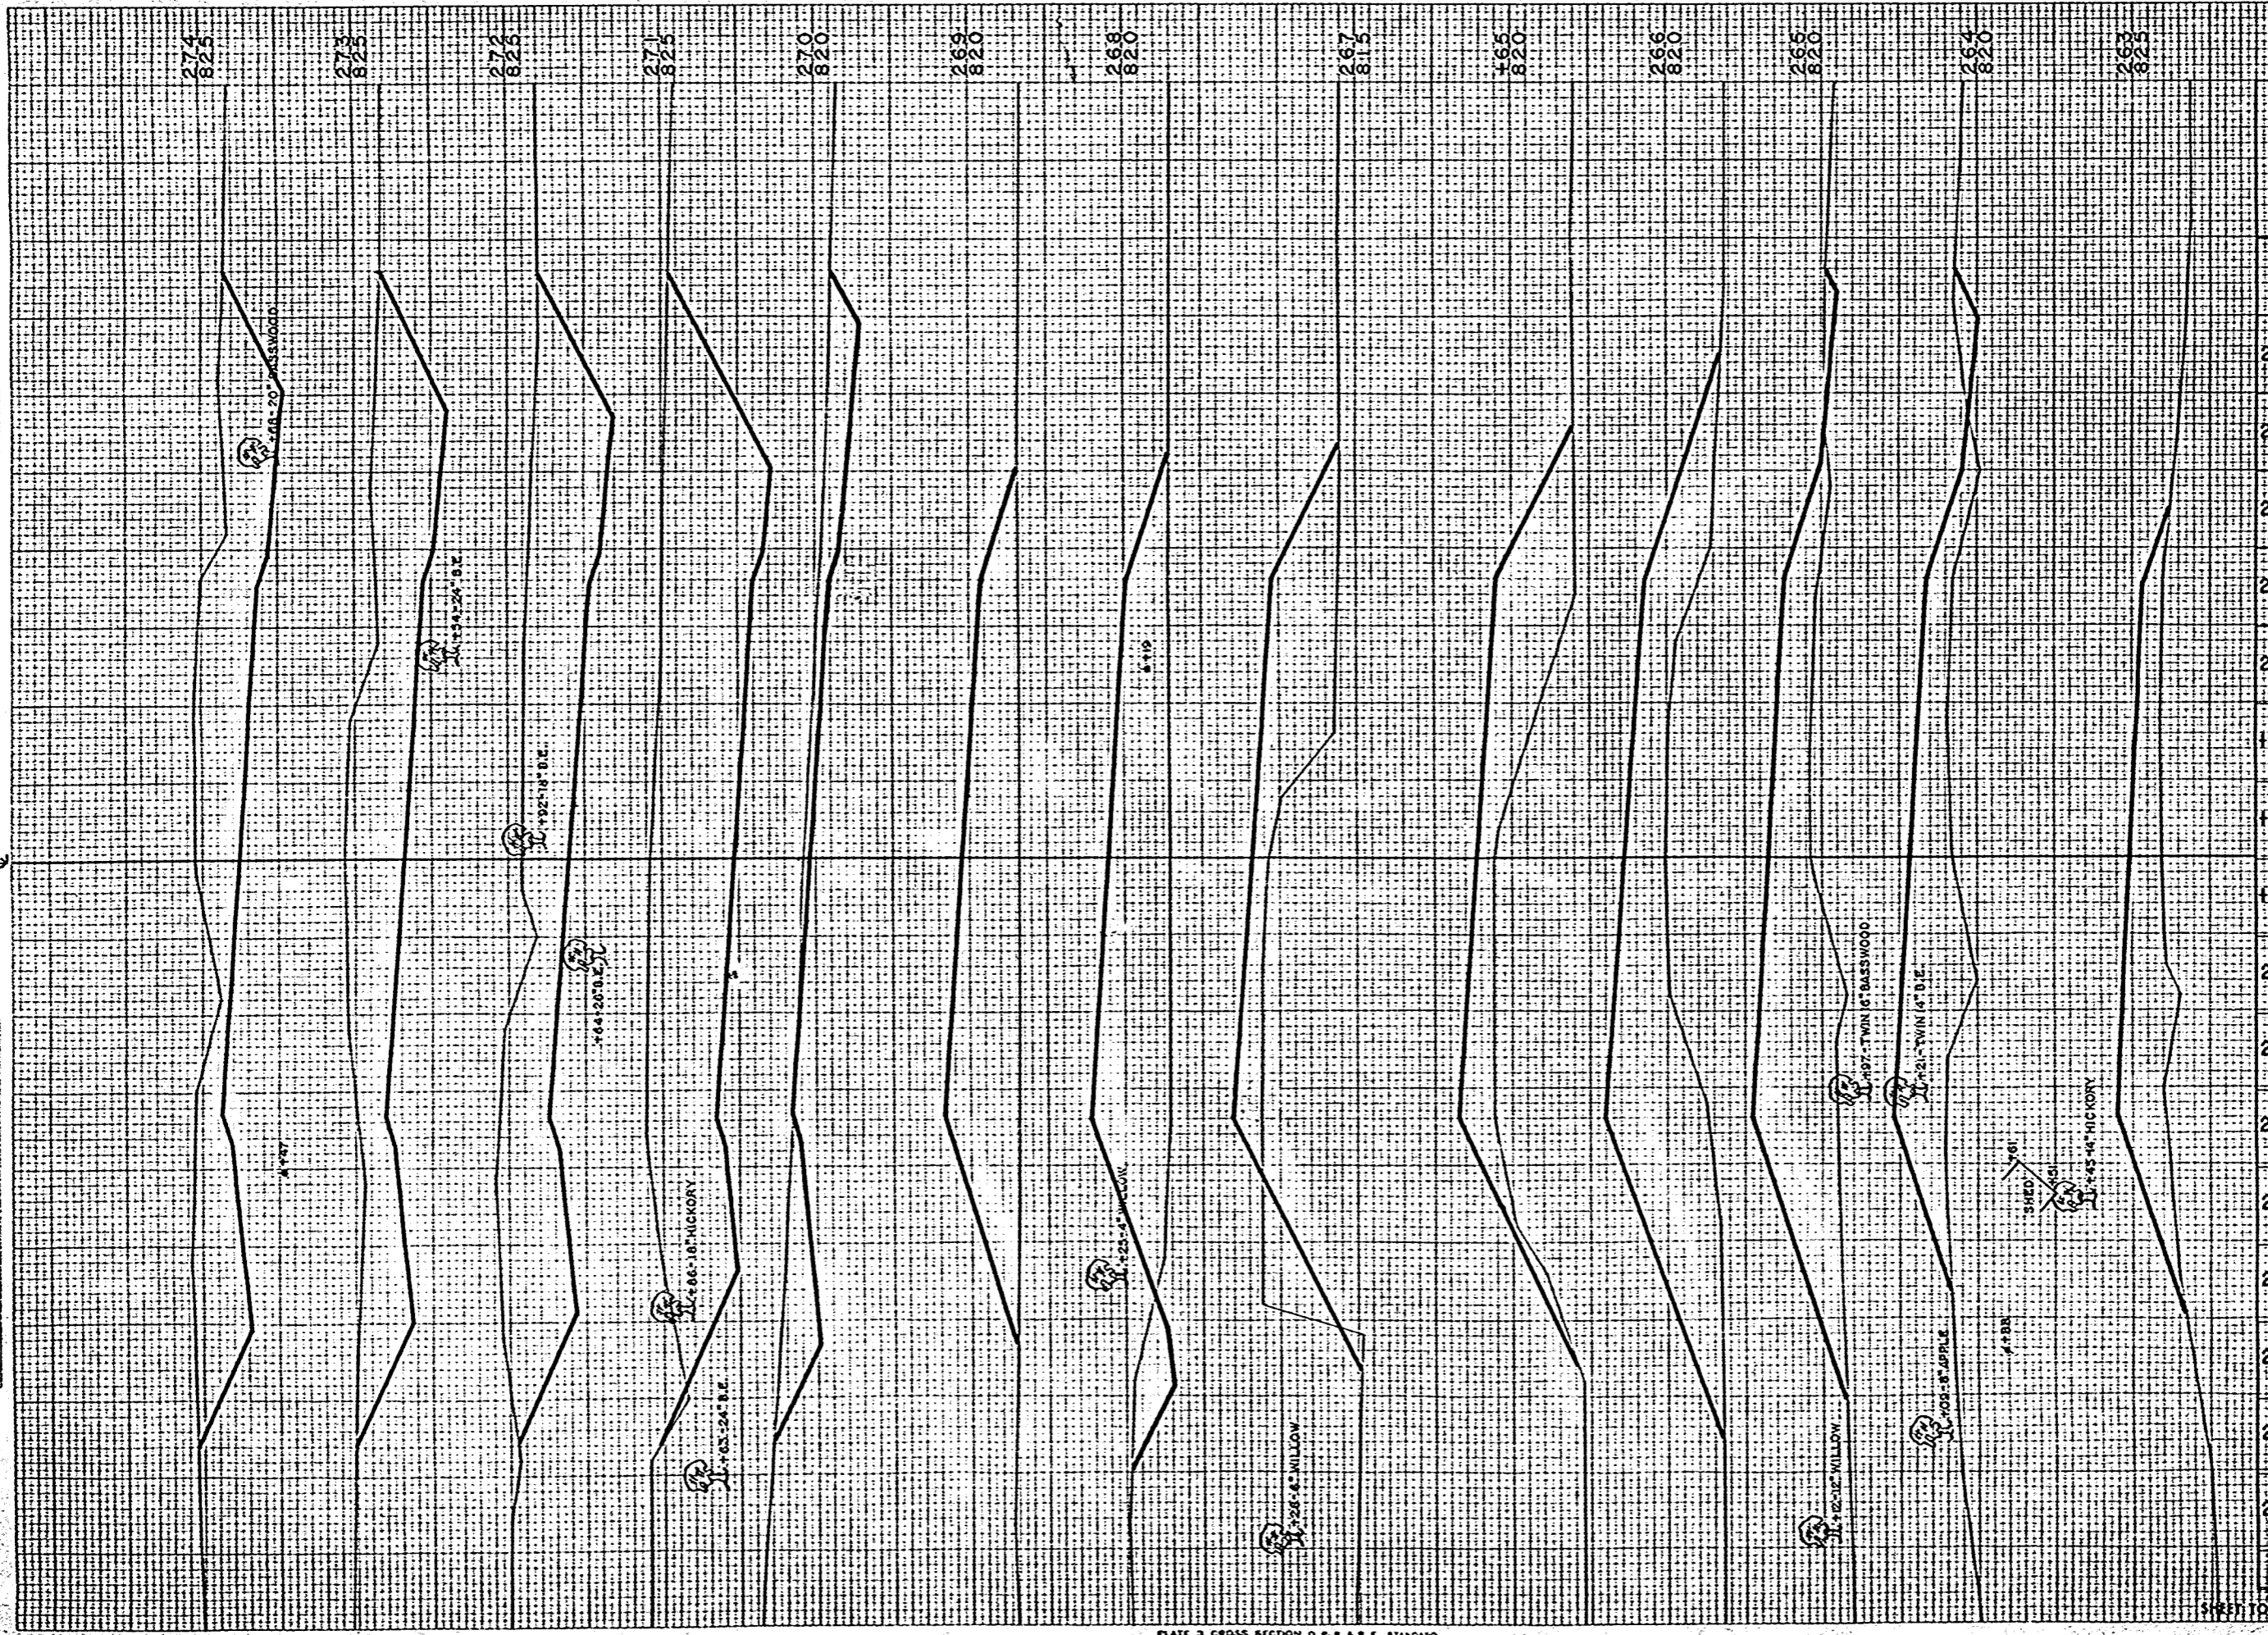


STATION	DISTANCE	YARDAGE	
		EXCAVATION	FILL
262	22		272
263	15		425
264	22		589
265	7		748
266	0		420
165	0		41
173			
196	2		18
267	69		559
268	30		663
269	131		326
270	783		2
271	1148		0
272	935		0
273	826		0
274			
SHEET TOTAL		3590	4081

B.P.A. DISTRICT OFFICE	PROJECT	SHEET NUMBER	TOTAL SHEETS
WS. 4	507370)	21	33

FINAL SURVEY
 PLATINUM
 NO. 238
 DATE
 10-29-20

ORIGINAL SURVEY
 PLATINUM
 NO. 238
 DATE
 10-29-20


S.P.A. DISTRICT OFFICE	PROJECT	SHEET NUMBER	TOTAL SHEETS
WS. 4	S 073701	22	33

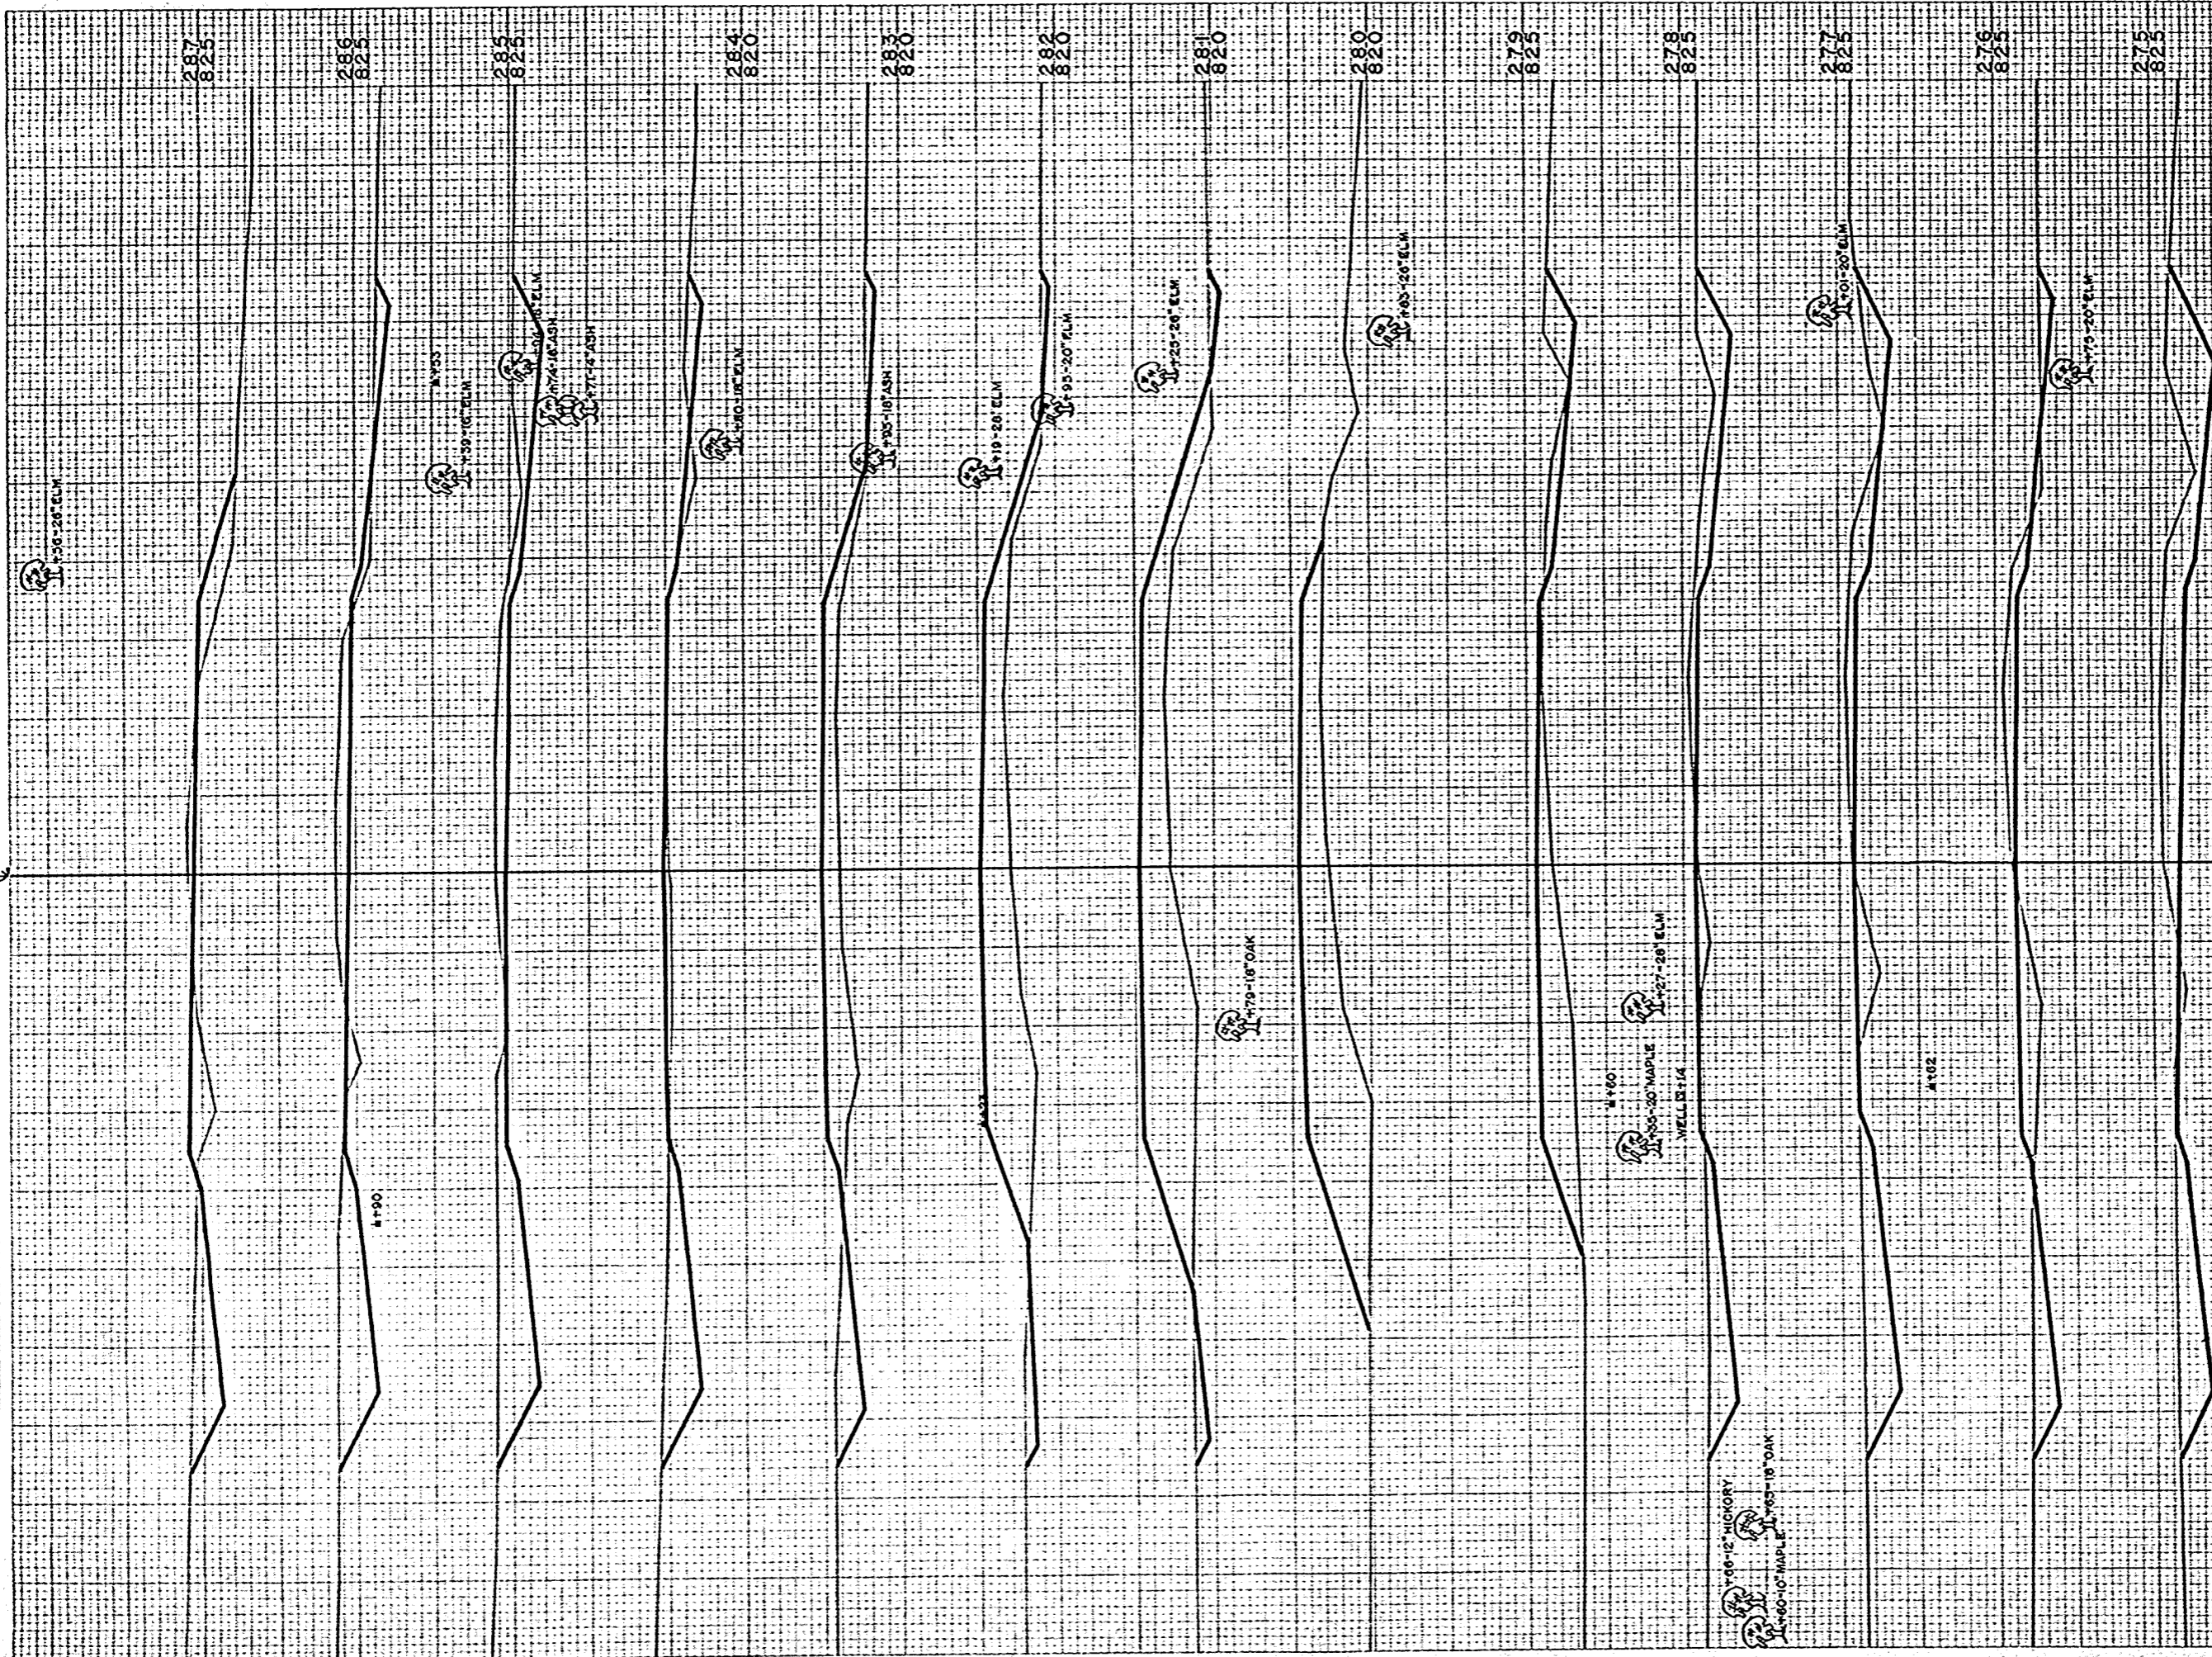

STATION	DISTANCE	YARDAGE EXCAVATION	
		FOOT	INCH
274	561	2	
275	243	39	
276	176	54	
277	198	30	
278	117	102	
279	26	276	
280	15	400	
281	32	378	
282	54	256	
283	102	113	
284	213	22	
285	252	11	
286	154	52	
287			
SHEET TOTAL	2143	1735	

FINAL SURVEY
 DRAWING NO. 238
 DATE

ORIGINAL SURVEY
 DRAWING NO. 238
 DATE

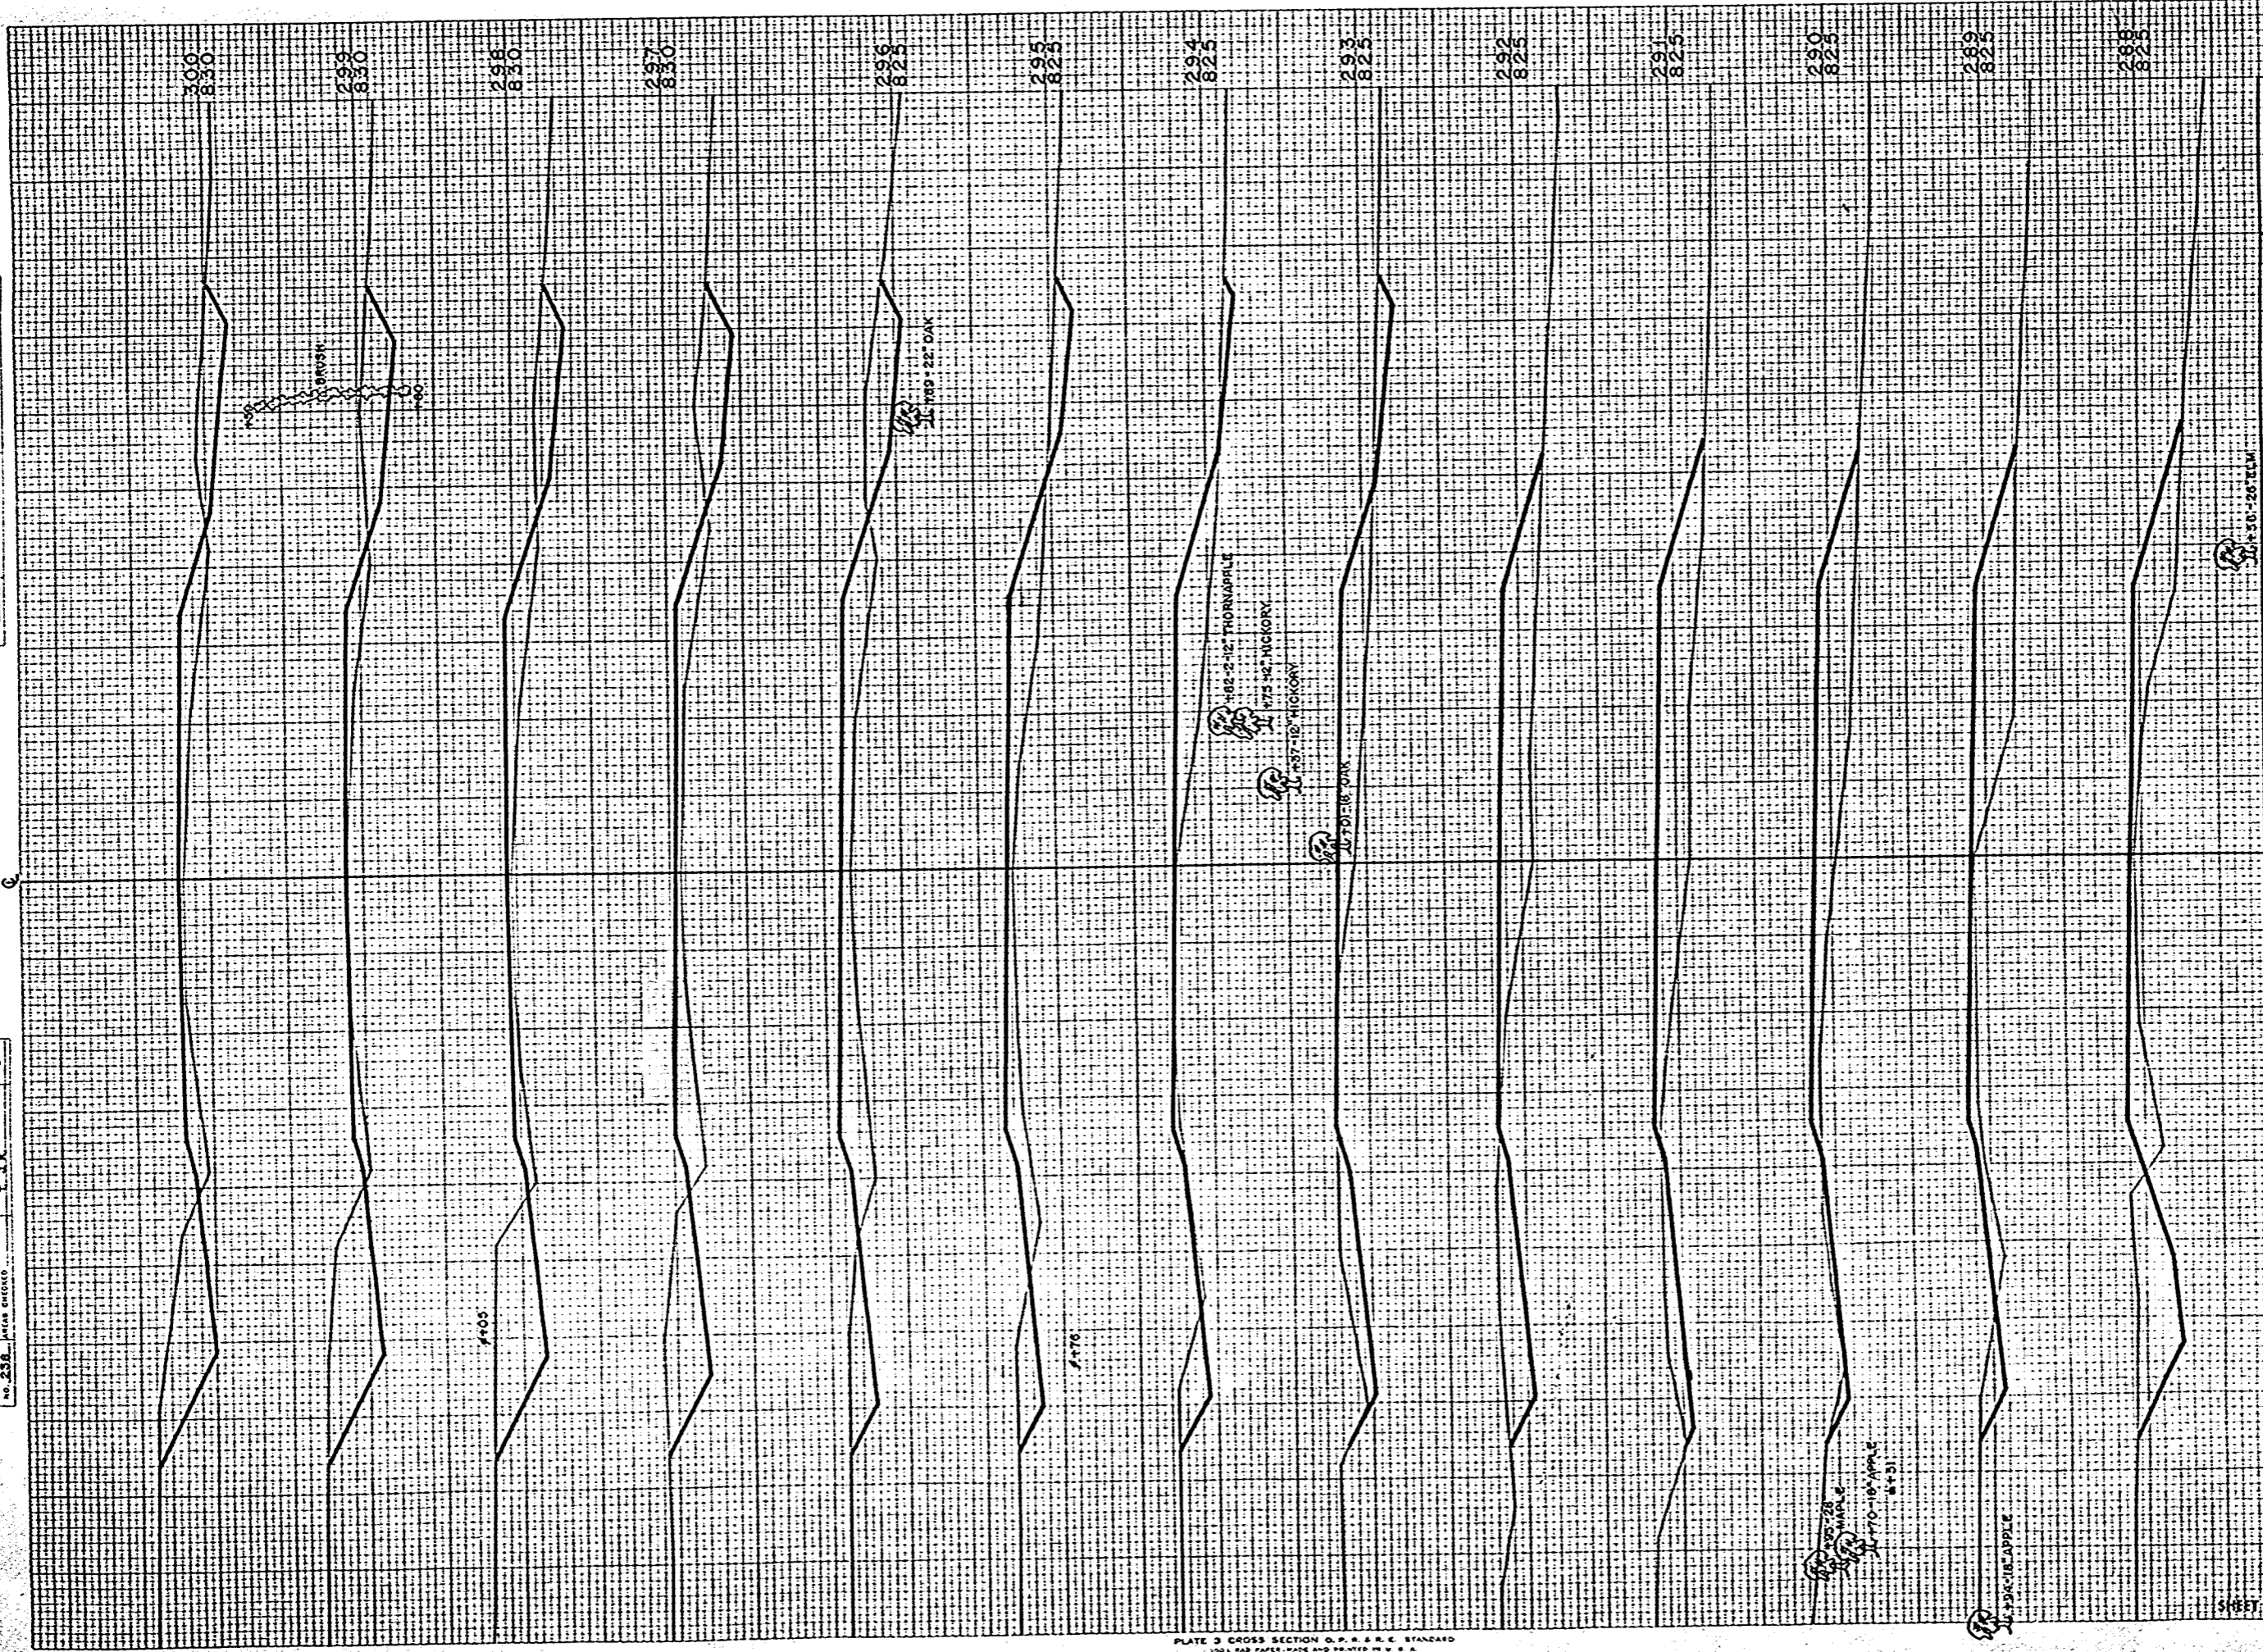


B.P. DISTRICT OFFICE	PROJECT	SHEET NUMBER	TOTAL SHEETS
WS. 4	507370)	23	33

STATION	DISTANCE	YARDAGE	
		UNC.	TOTAL
287			133
288	74		209
289	24		228
290	39		243
291	76		246
292	91		183
293	67		132
294	65		152
295	106		187
296	163		161
297	196		118
298	213		87
299	211		83
300			
SHEET TOTAL		1436	262

FINAL SURVEY
 DATE: 10-28-11
 NO. 238
 AREA: 238
 SHEET: 29

ORIGINAL SURVEY
 DATE: 10-28-11
 NO. 238
 AREA: 238
 SHEET: 29

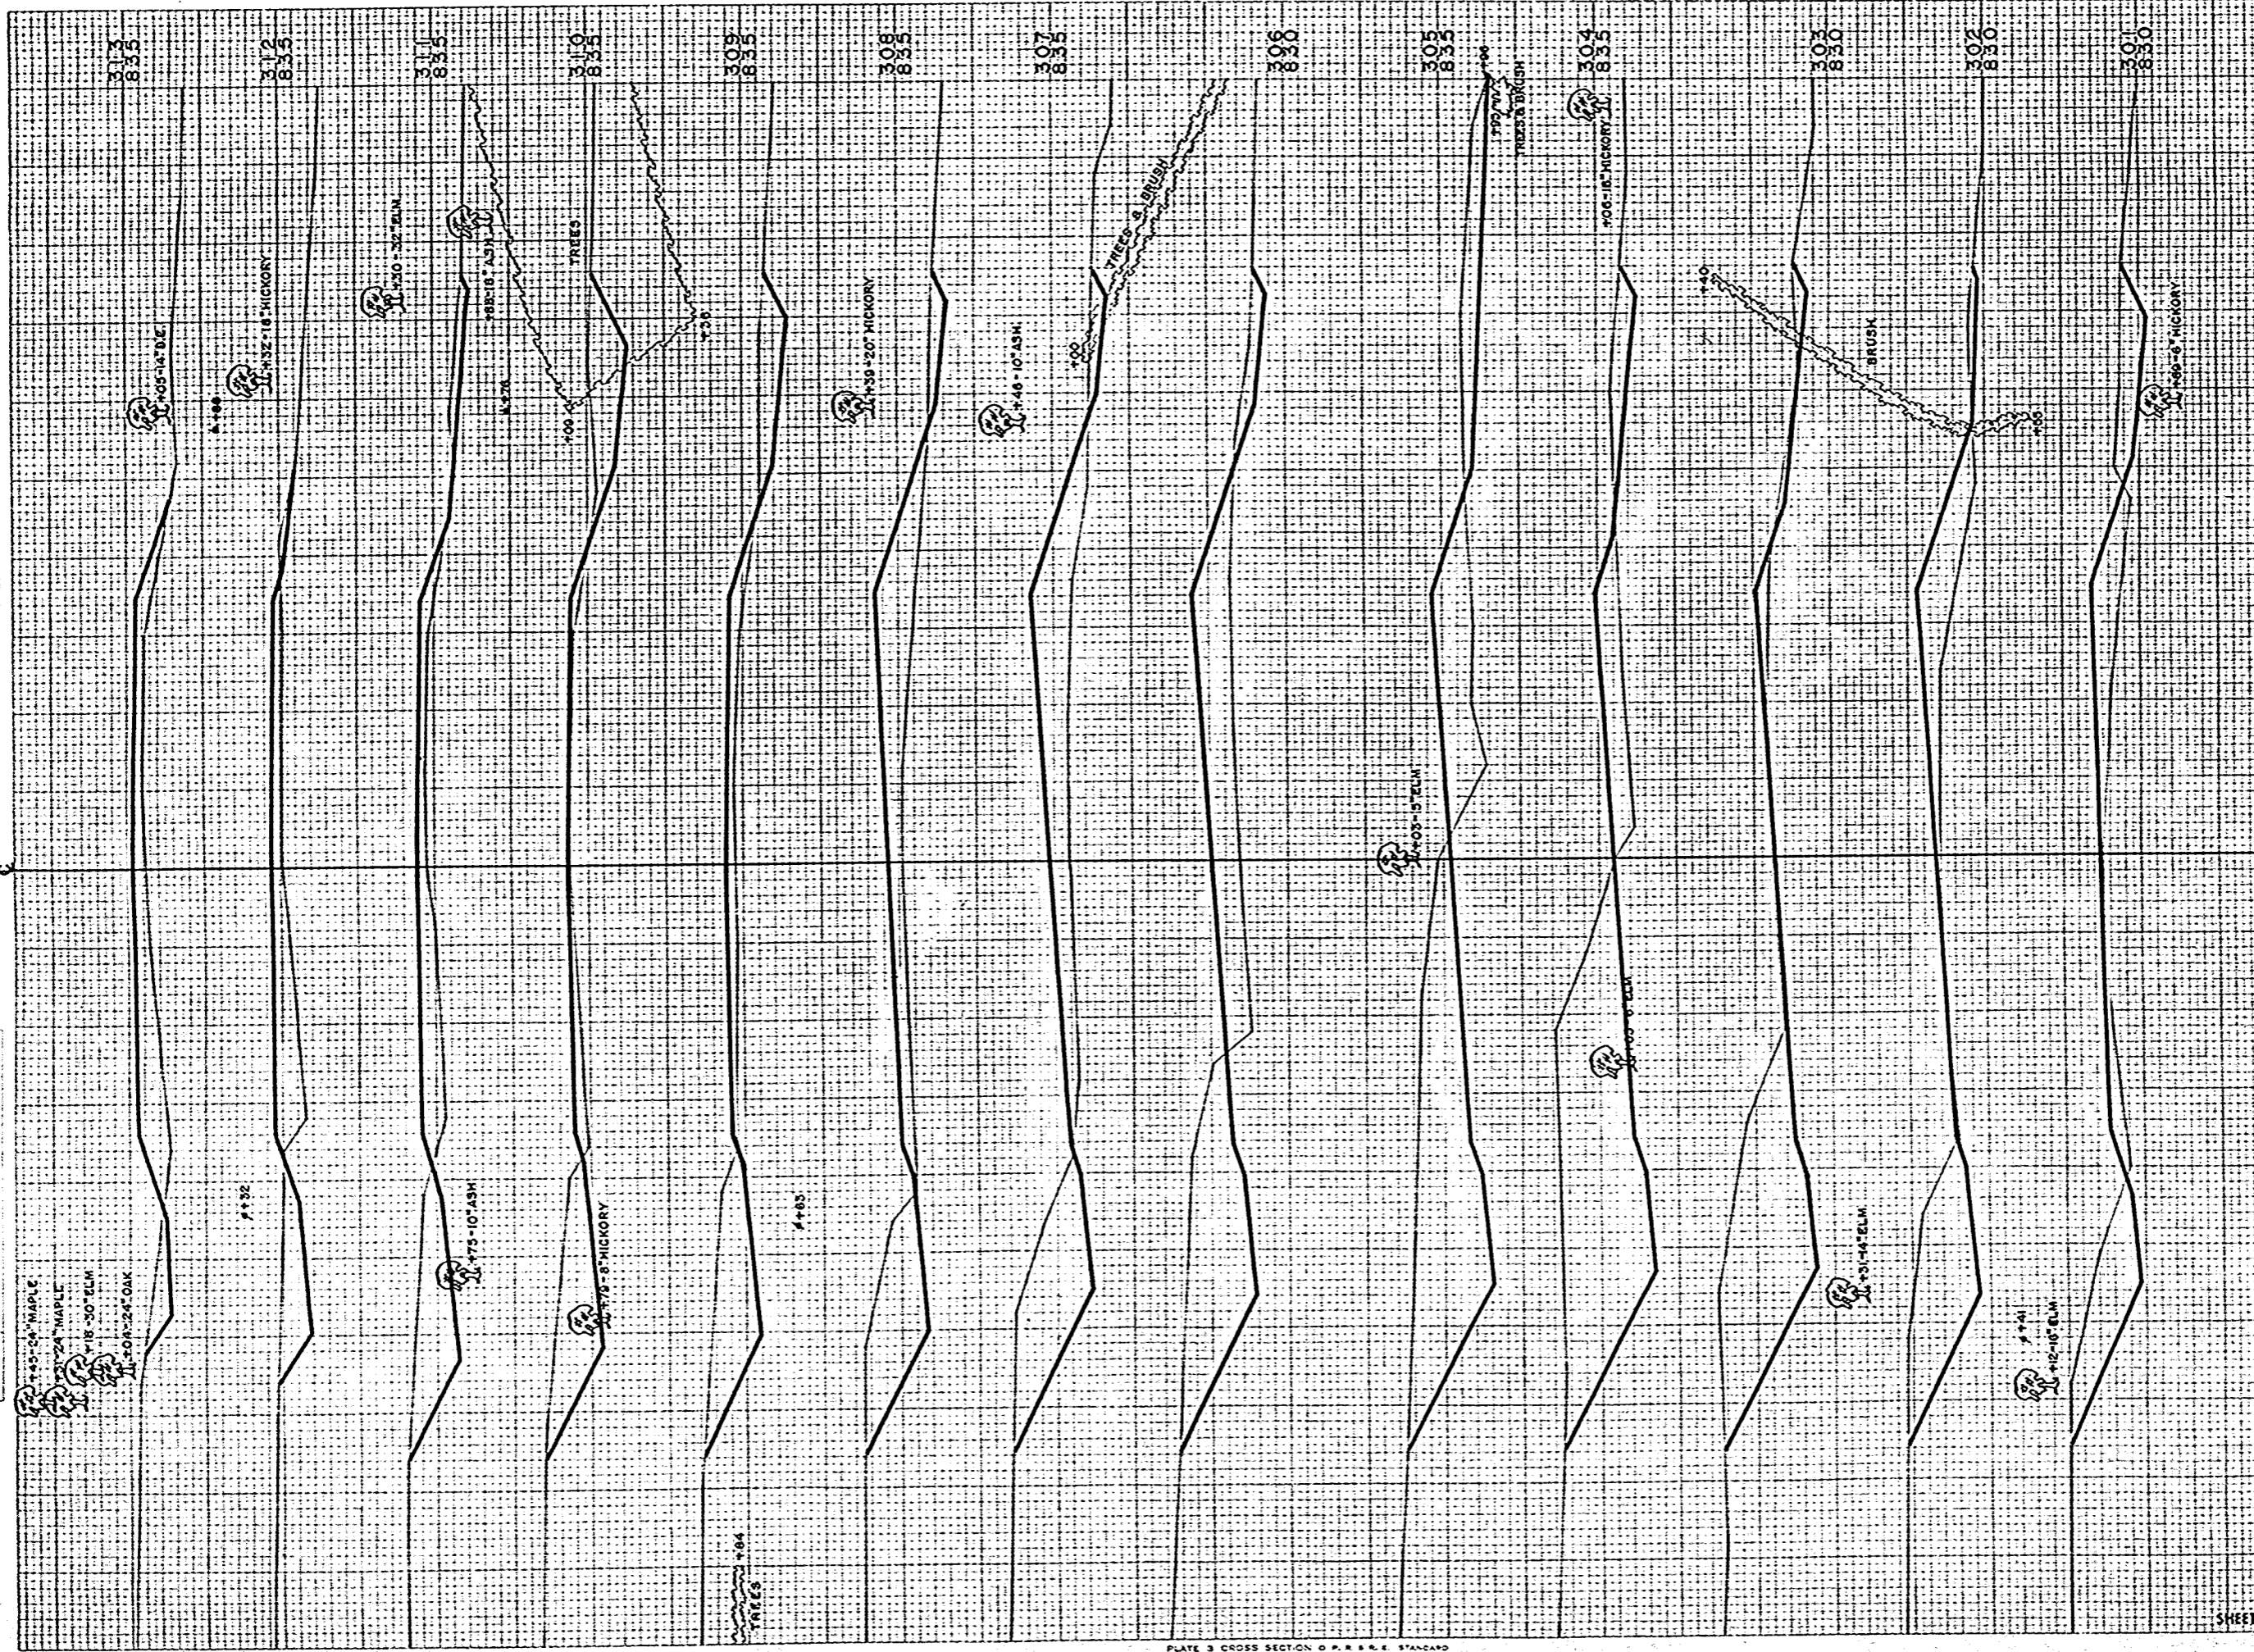


STATION	YARDAGE EXCAVATION	
	DISTANCE	YARDAGE
300	180	113
301	181	130
302	283	78
303	459	61
304	481	130
305	350	200
306	243	244
307	180	231
308	181	152
309	215	68
310	187	82
311	132	130
312	93	167
313		
SHEET TOTAL	3165	1786

R.P.A. DISTRICT OFFICE: WTS. 4
 PROJECT: S 0737(1)
 SHEET NUMBER: 29
 TOTAL SHEETS: 33

FINAL SURVEY PHOTO NOTE BOOK KEAR NEAR CHECKED


ORIGINAL SURVEY TRIPLATE NOTE BOOK KEAR NEAR CHECKED

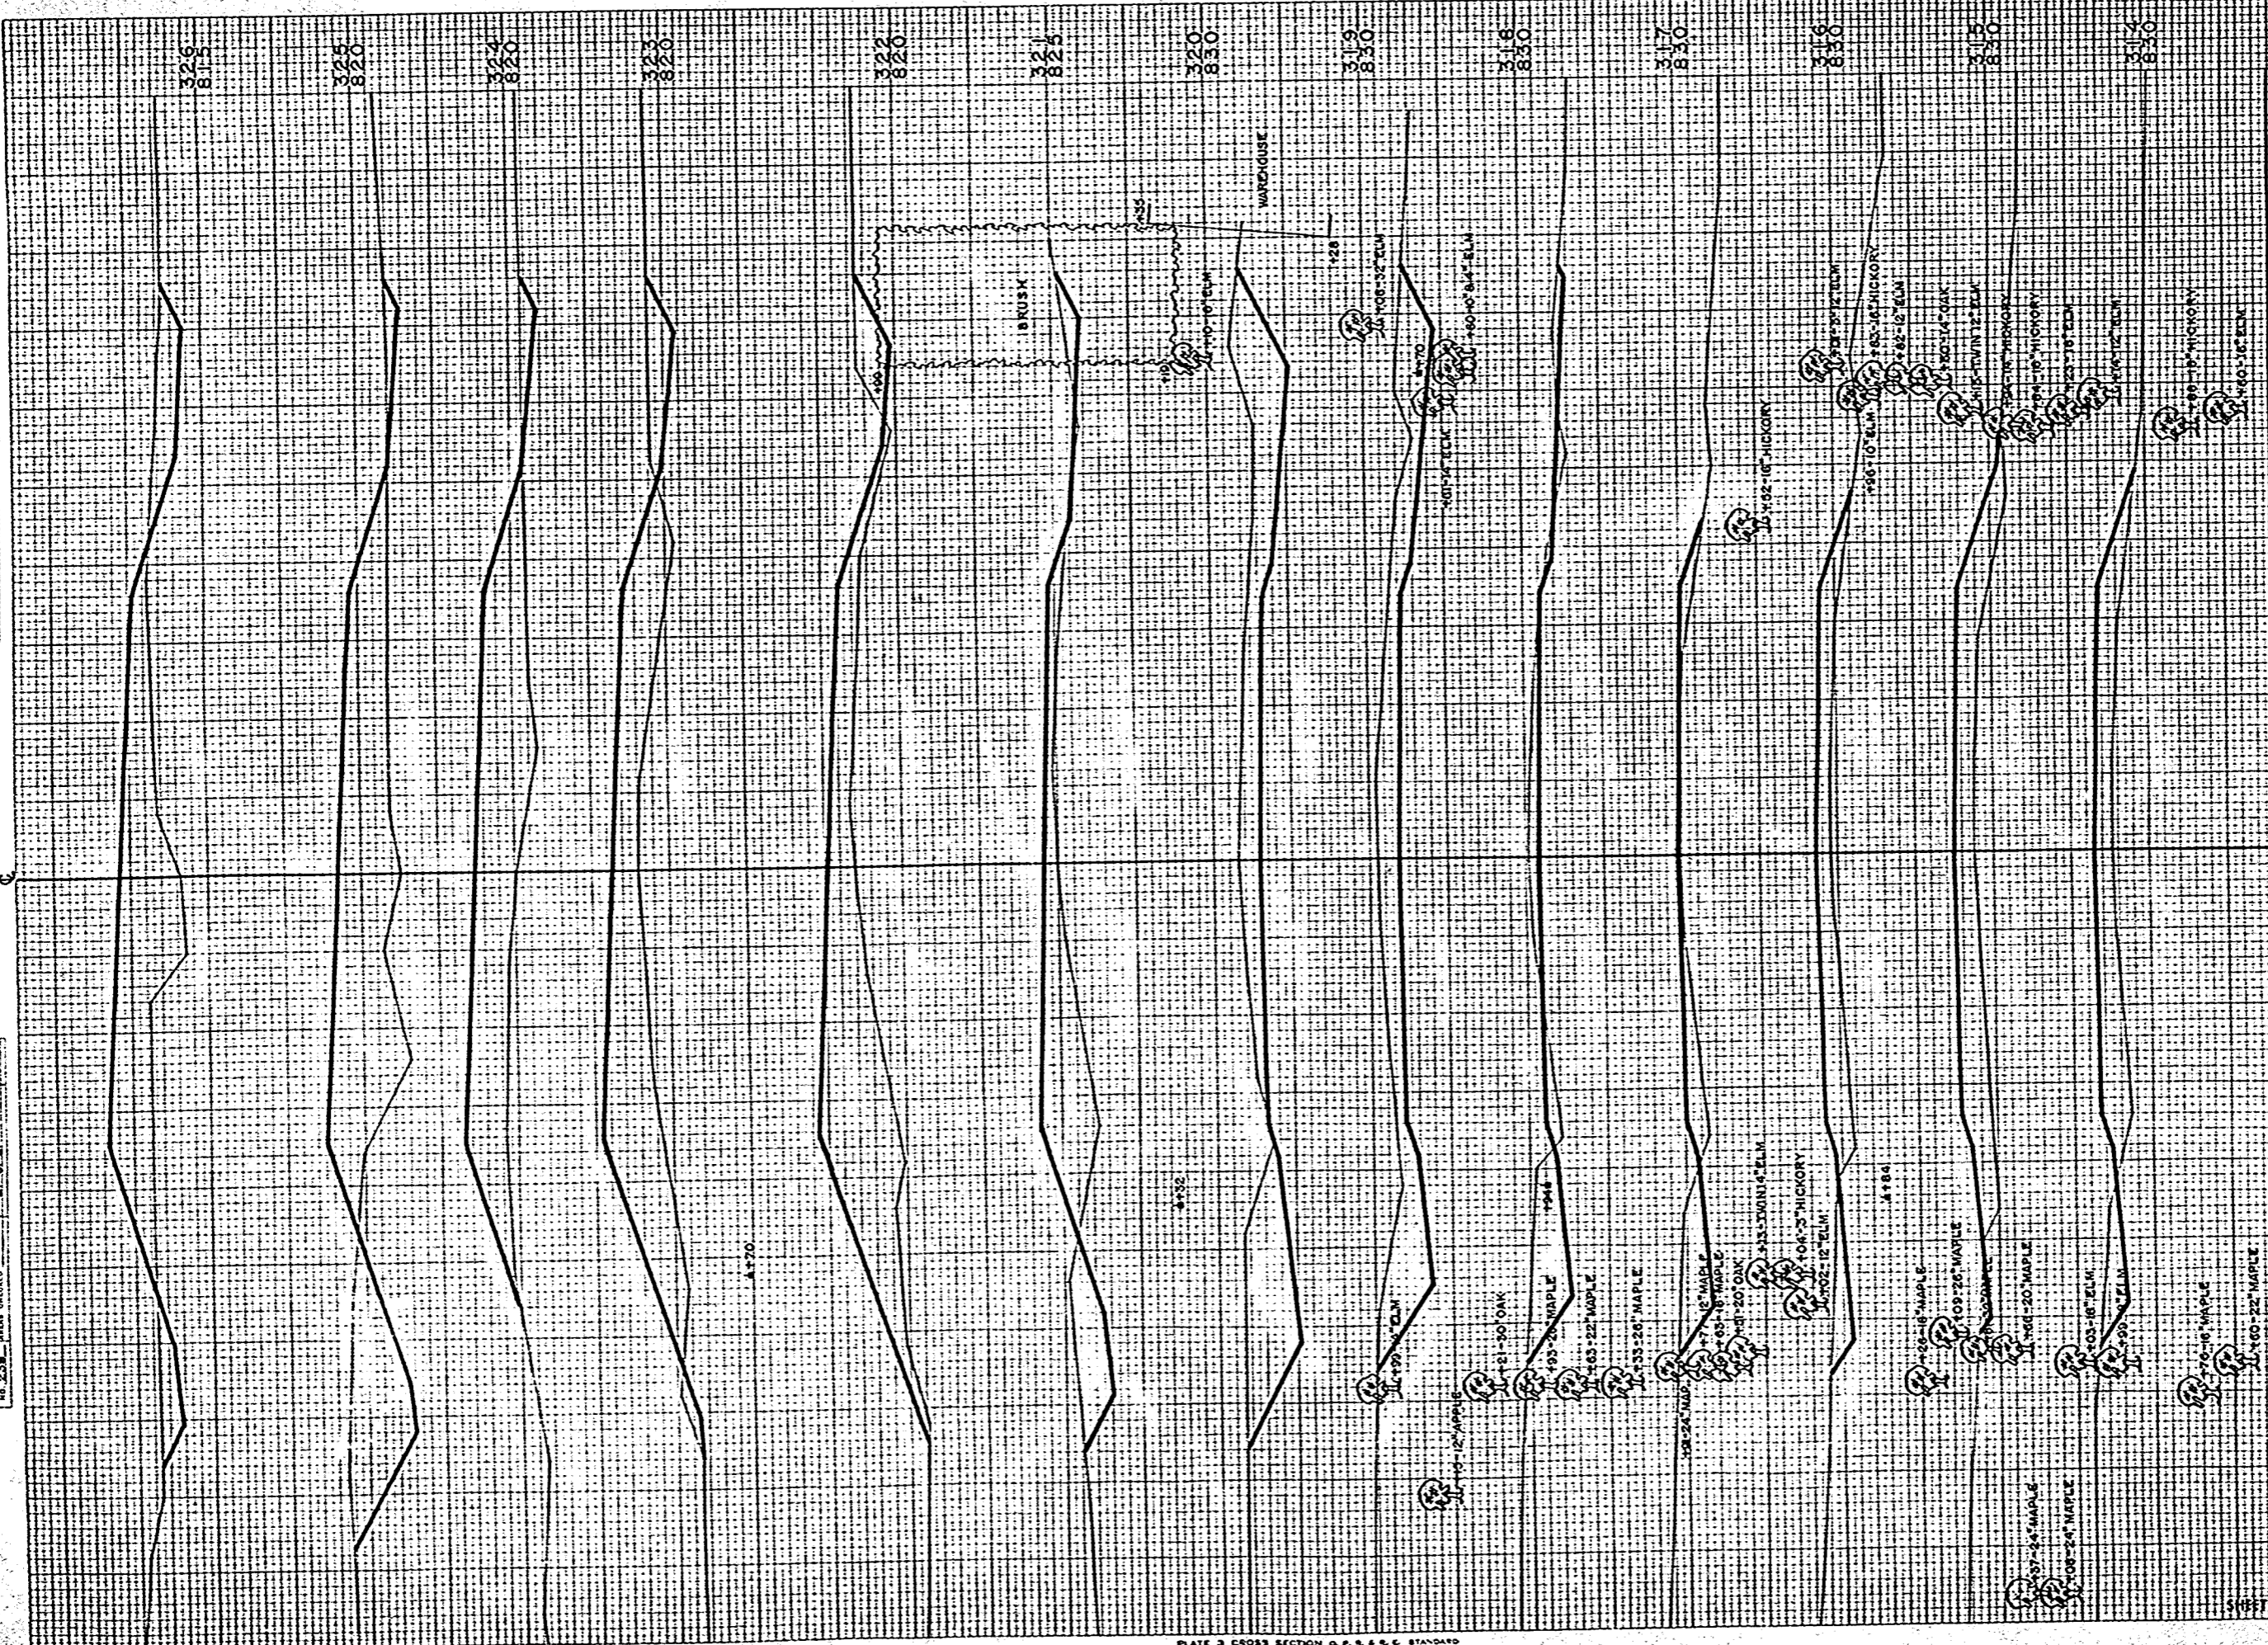

STATION	DISTANCE	YARDAGE EXCAVATION	TOTAL
313	74		36
314	54		226
315	44		204
316	78		11
317	144		45
318	31		13
319	437		0
320	269		17
321	67		359
322	50		476
323	39		457
324	63		491
325	54		465
326			
SHEET TOTAL		1684	3156

FINAL SURVEY
 NO. 238
 DATE 11-30-38
 BY J. L. B. & C. L. W.

ORIGINAL SURVEY
 NO. 238
 DATE 11-30-38
 BY J. L. B. & C. L. W.

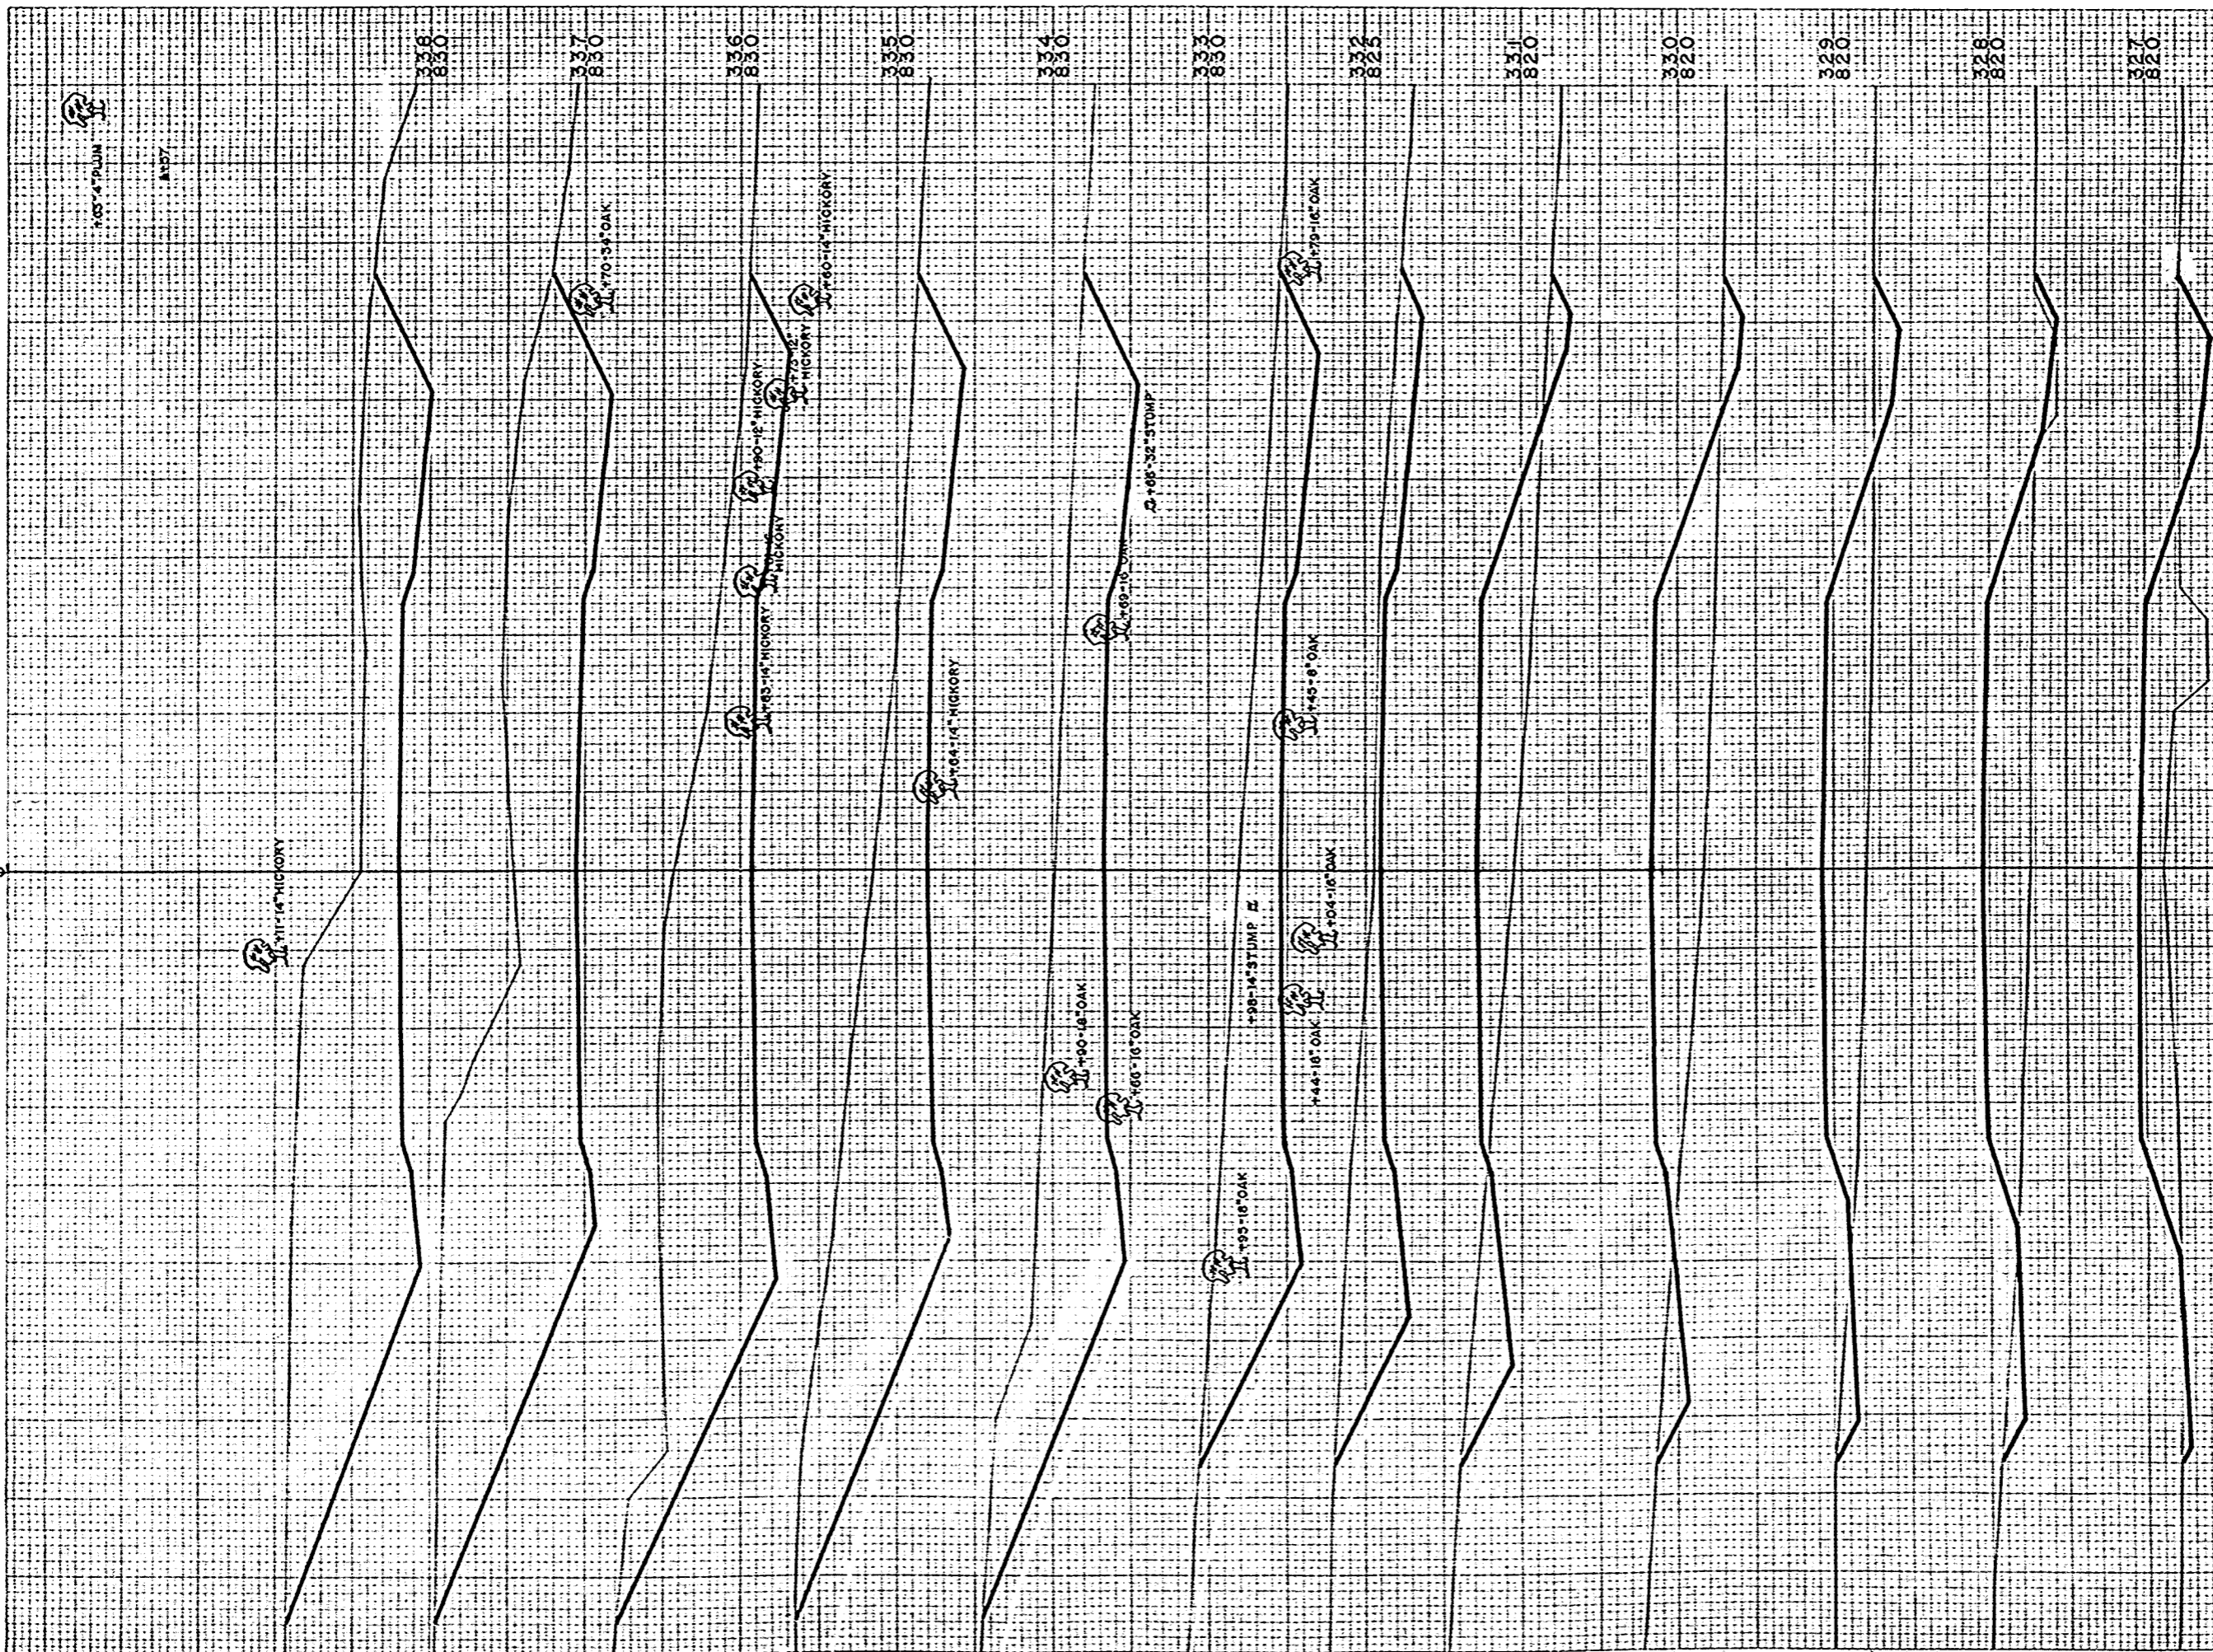


STATION	DISTANCE	YARDAGE	
		EXCAVATION	FILL
326			
327	41		372
328	61		396
329	59		430
330	76		456
331	104		419
332	280		172
333	615		0
334	941		0
335	1150		0
336	1252		0
337	1480		0
338	1530		0
SHEET TOTAL		7591	2245

R.F.A. DISTRICT OFFICE	PROJECT	SHEET NUMBER	TOTAL SHEETS
W.S. 4	S 073701	26	33

FINAL SURVEY REPORT
 DATE: 10-30-88
 DRAWN BY: J. J. J.
 CHECKED BY: J. J. J.
 NO. 2238


ORIGINAL SURVEY REPORT
 DATE: 10-30-88
 DRAWN BY: J. J. J.
 CHECKED BY: J. J. J.
 NO. 2238

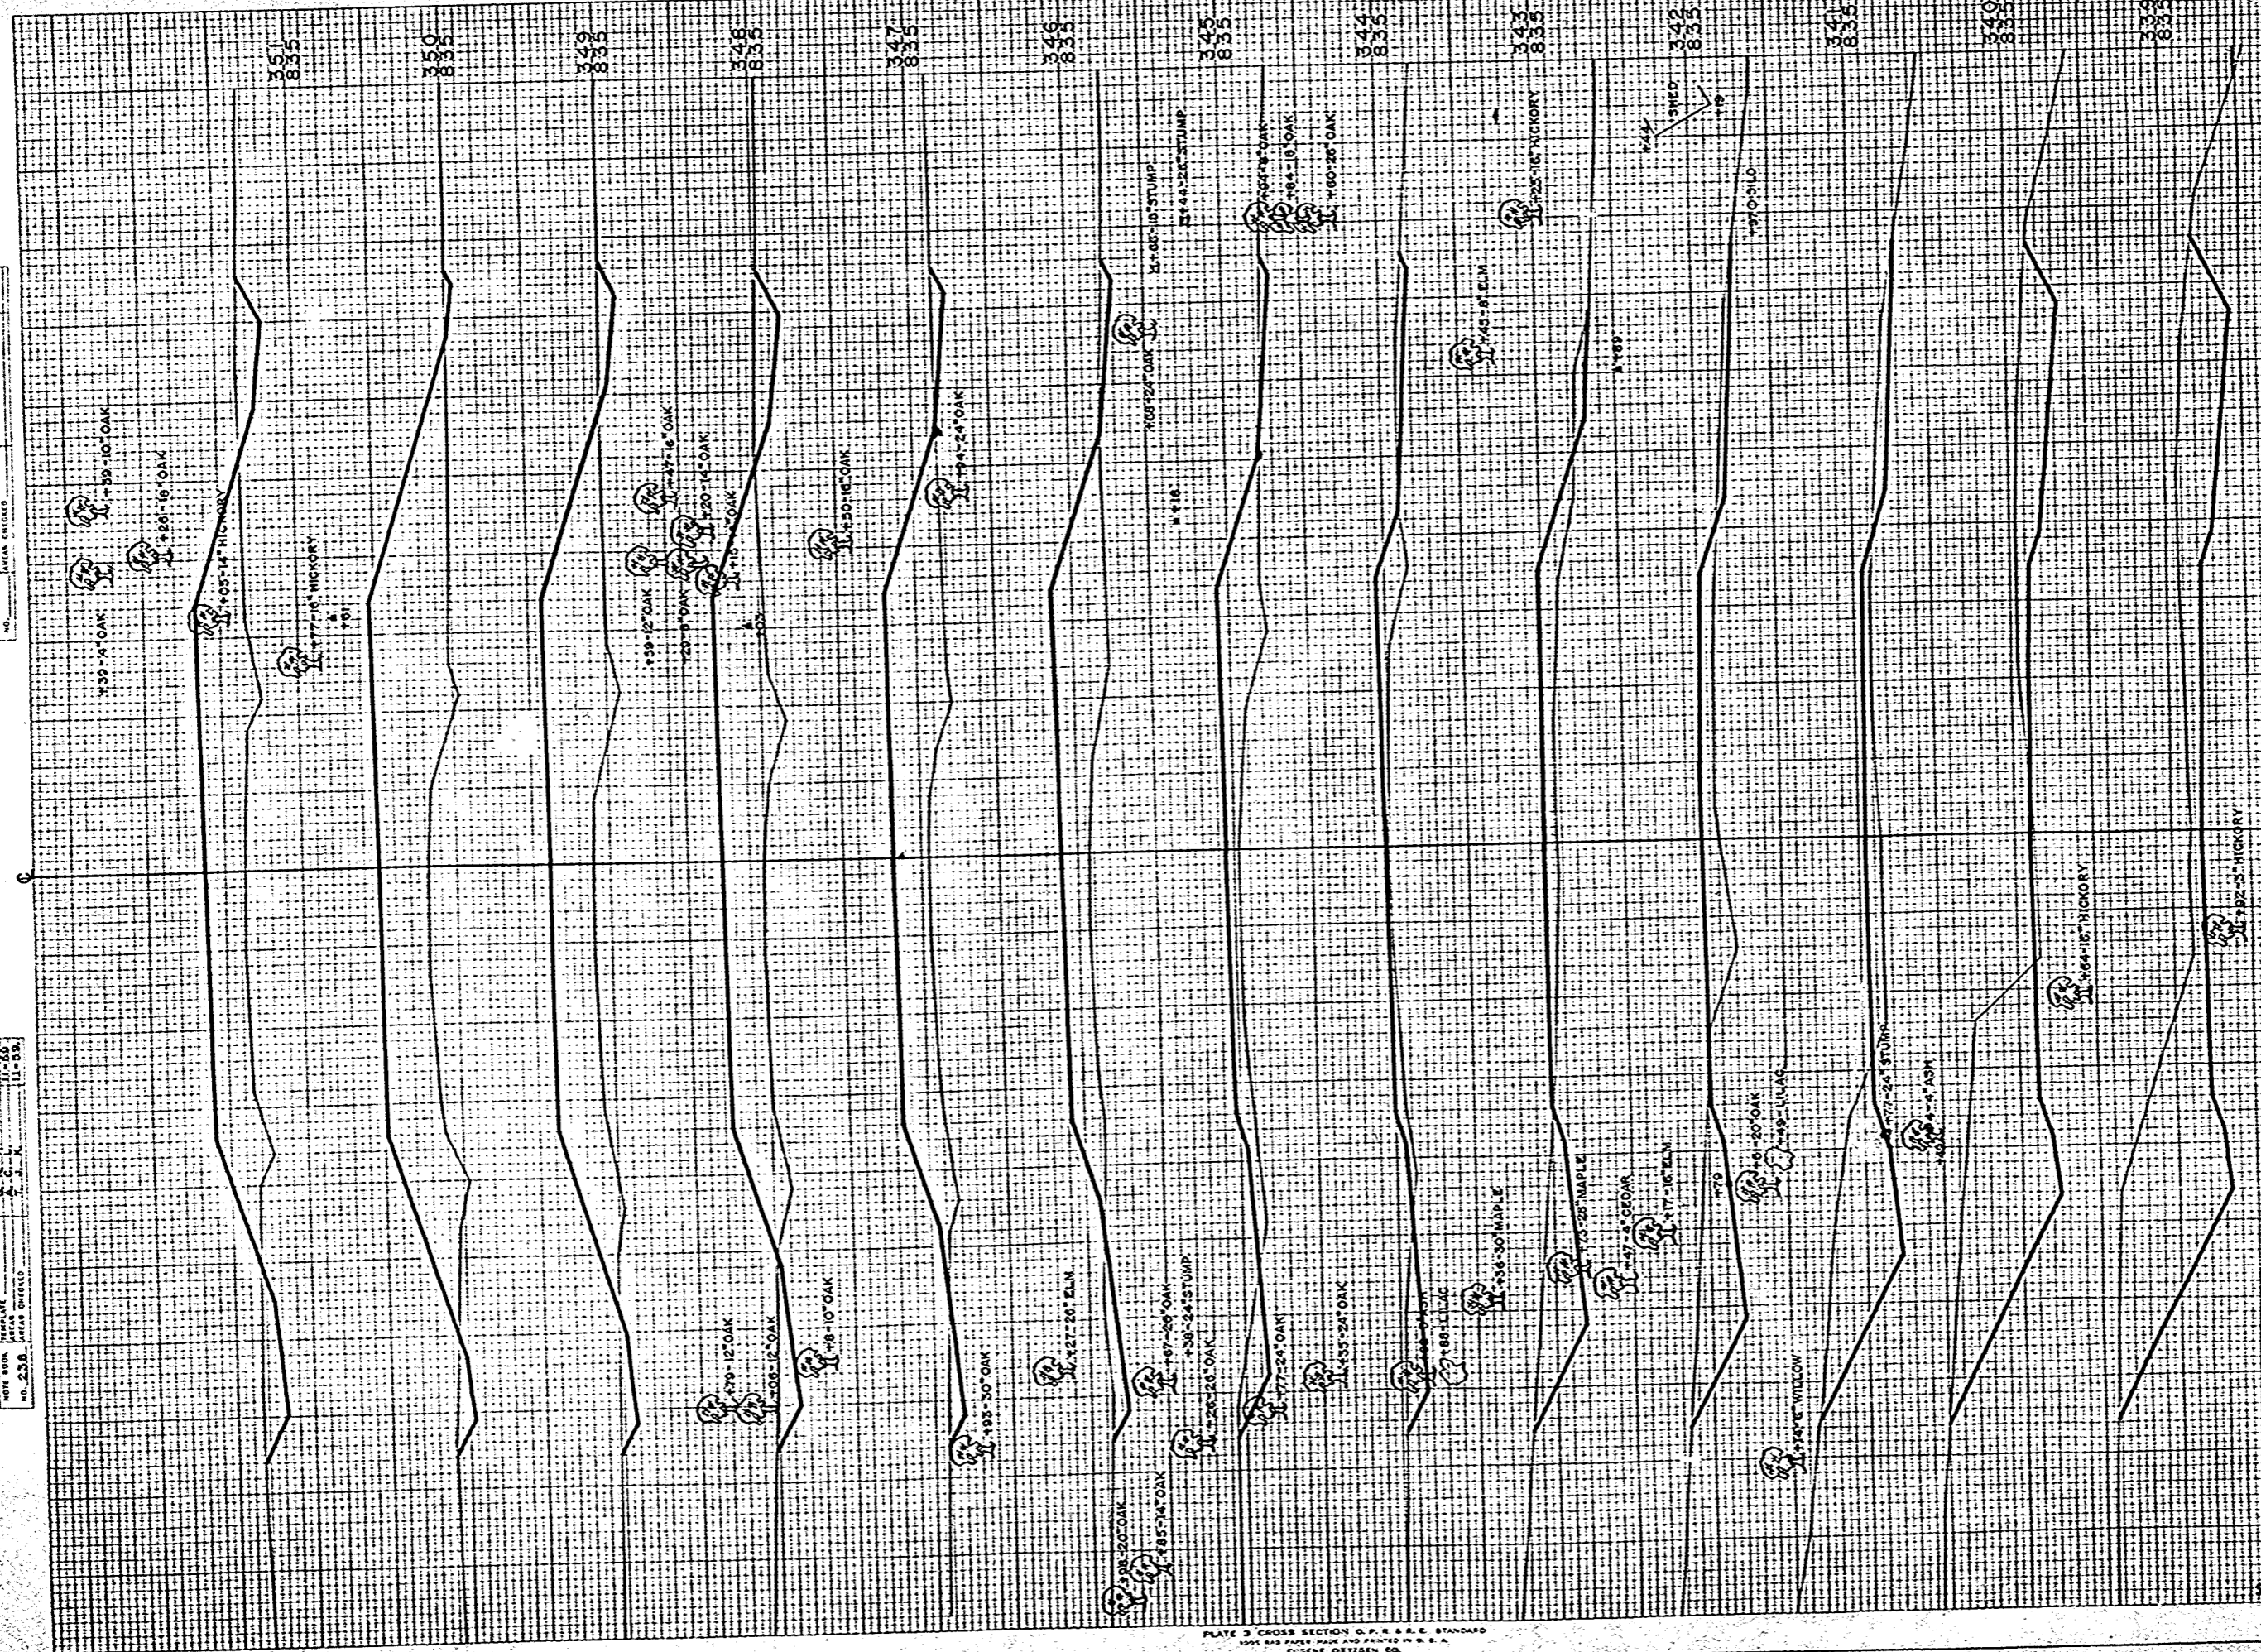

STATION	DISTANCE	YARDAGE	
		UNCL	FILL
338			
339	643		0
340	639		6
341	396		50
342	102		106
343	(4)		120
344	113		106
345	76		159
346	46		304
347	43		430
348	67		405
349	70		546
350	41		68
351	54		615
SHEET TOTAL	2913		2606

FINAL SURVEY
 DATE: 10-30-37
 DRAWN BY: J. D. N.
 CHECKED BY: J. D. N.
 NO. 238

ORIGINAL SURVEY
 DATE: 10-30-37
 DRAWN BY: J. D. N.
 CHECKED BY: J. D. N.
 NO. 238

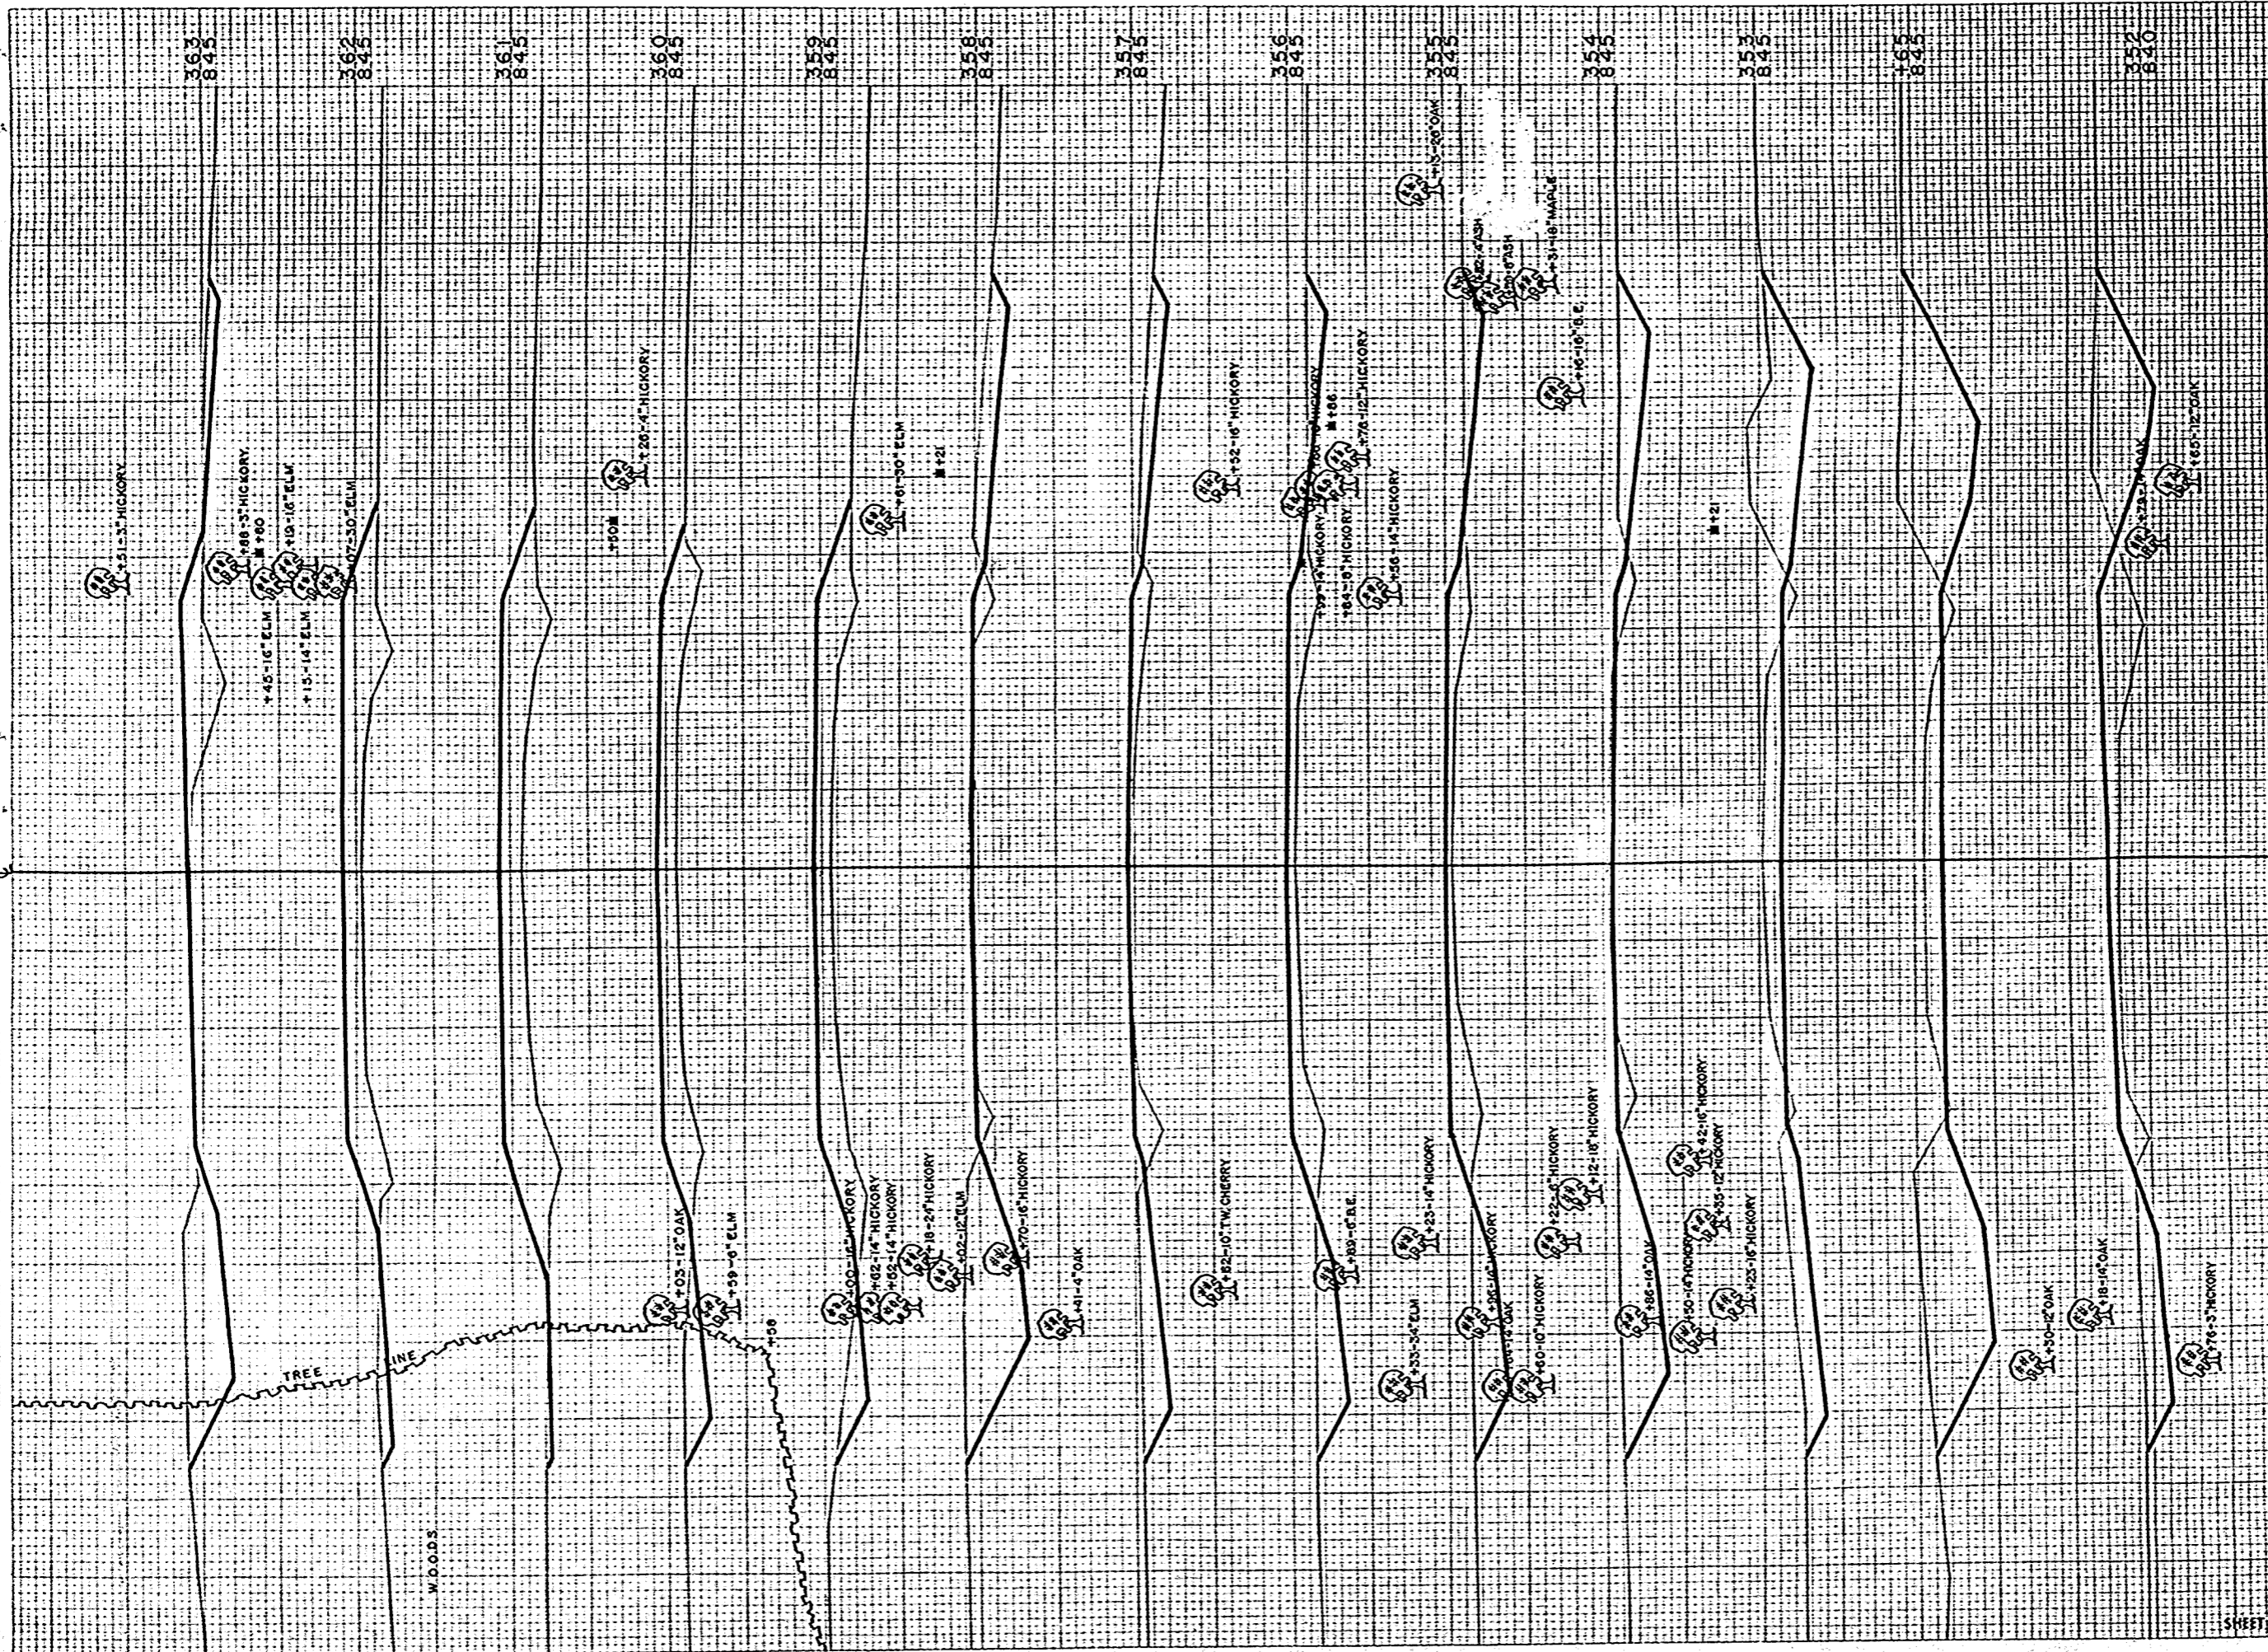


STATION	DISTANCE	YARDAGE	
		EXCAVATION	FILL
351	161		322
352	259		59
353	167		7
354	330		32
355	193		93
356	115		135
357	117		104
358	198		44
359	152		126
360	43		226
361	28		272
362	15		291
363	94		176
SHEET TOTAL	1872		1884

B.P.A. DISTRICT OFFICE
 PROJECT: S 0737(1)
 SHEET NUMBER: 28
 TOTAL SHEETS: 33

FINAL SURVEY
 DATE
 PROJECTED
 DATE
 BY
 CHECKED
 DATE


ORIGINAL SURVEY
 DATE
 PROJECTED
 DATE
 BY
 CHECKED
 DATE

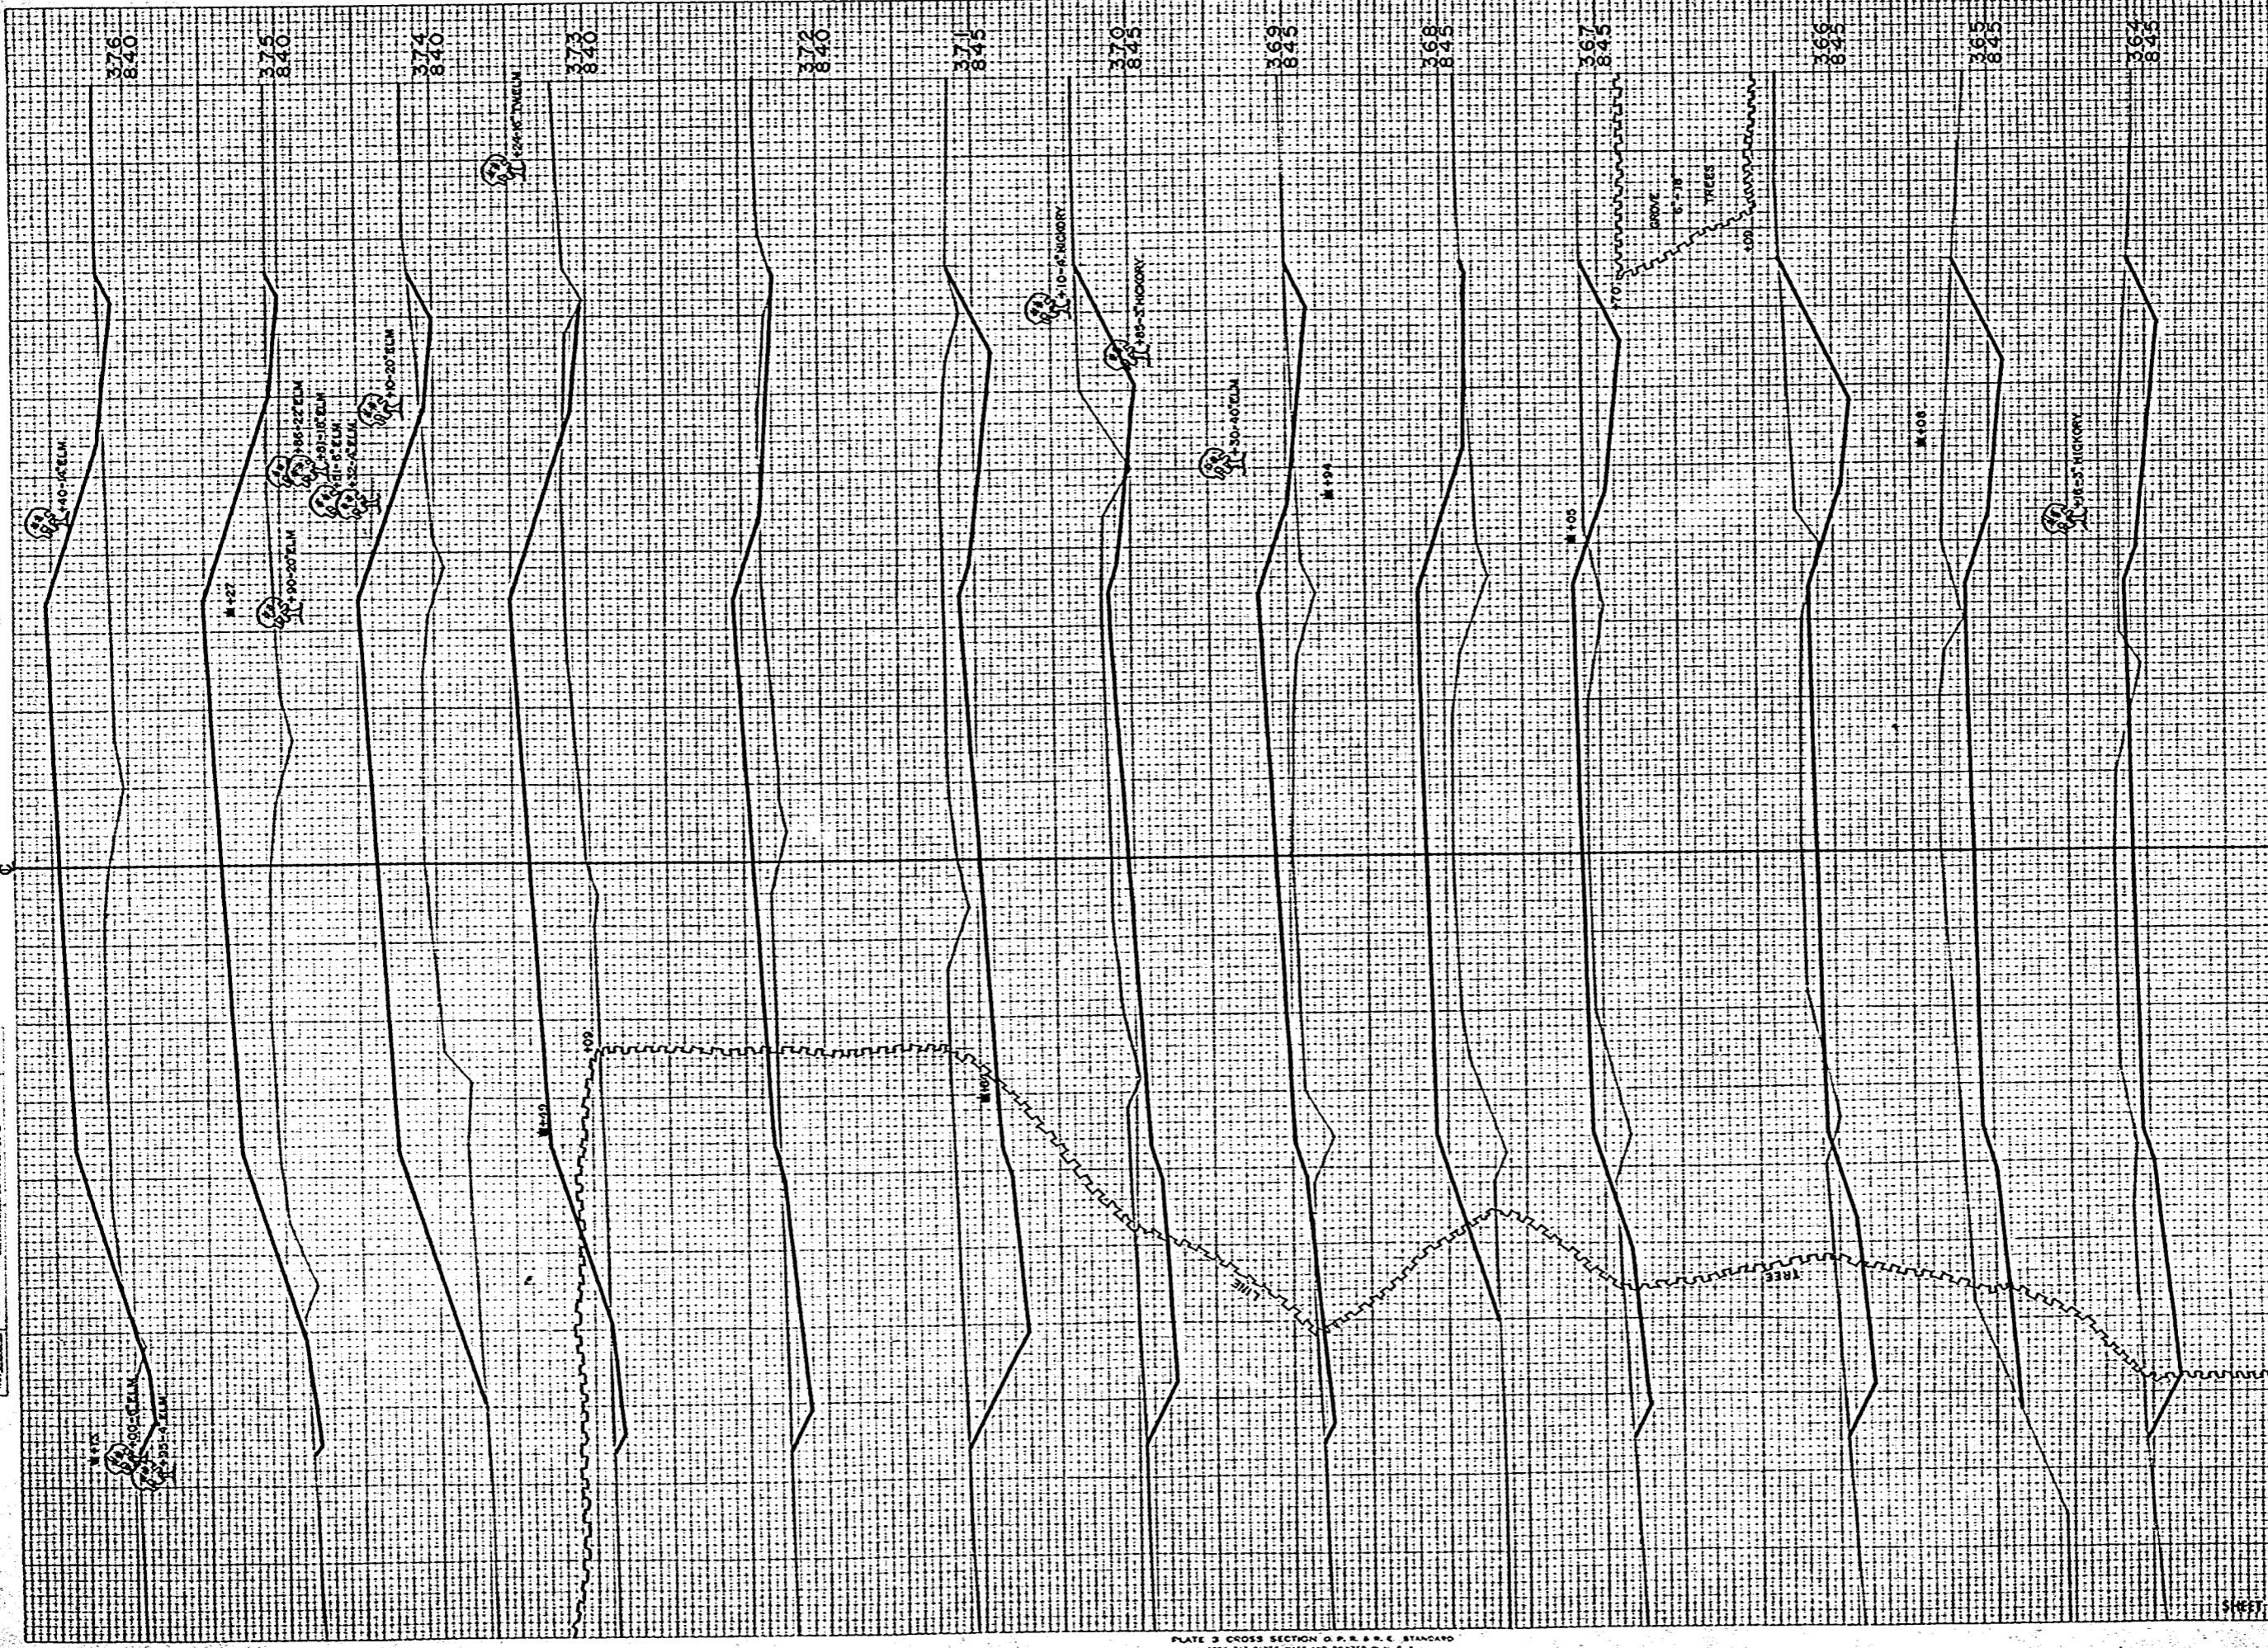

STATION	DISTANCE	YARDAGE	
		UNCL.	EXCAVATION
363		263	52
364		450	4
365		454	6
366		261	76
367		78	296
368		26	348
369		224	122
370		513	0
371		344	104
372		44	406
373		28	665
374		24	665
375		26	570
376			
SHEET TOTAL		2735	3314

FINAL SURVEY
 DATE: 10-30-59
 DRAWN BY: J. H. B. L. H.
 CHECKED BY: J. H. B. L. H.
 NO. 239

ORIGINAL DRAWING
 DATE: 10-30-59
 DRAWN BY: J. H. B. L. H.
 CHECKED BY: J. H. B. L. H.
 NO. 239

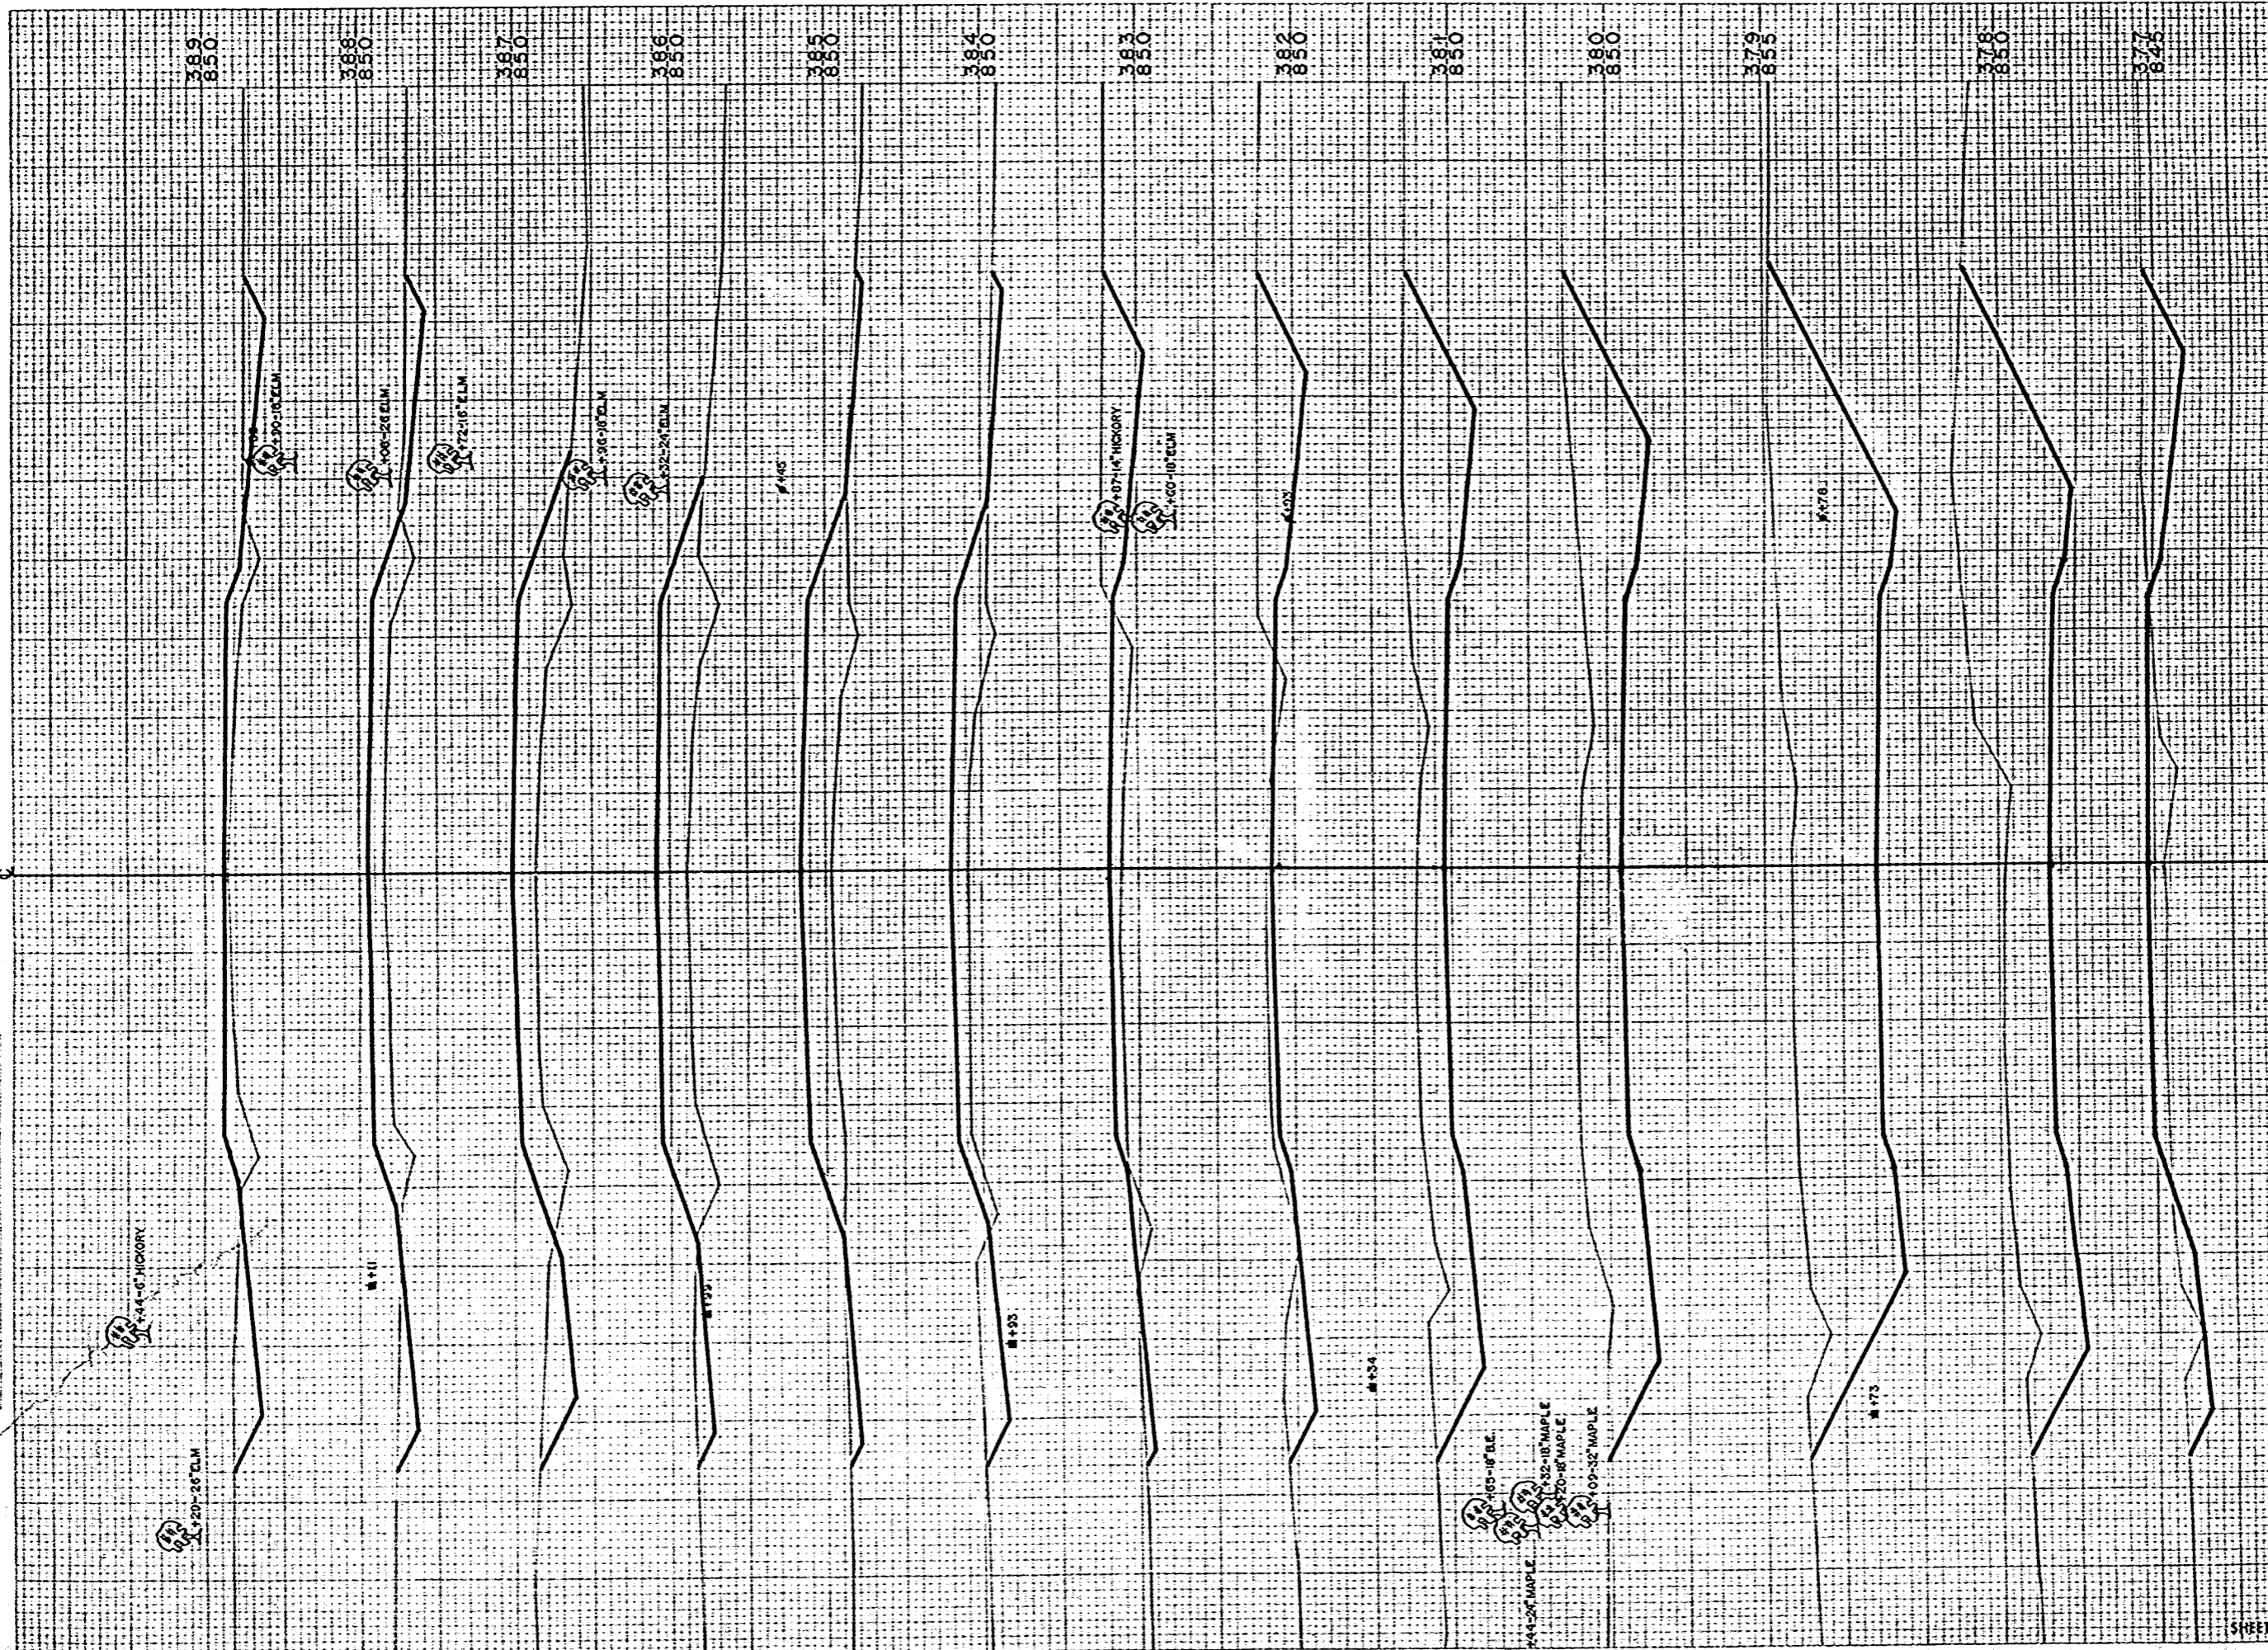


SPR. DISTRICT OFFICE
 PROJECT: S 0737 (1)
 SHEET NUMBER: 30
 TOTAL SHEETS: 33

STATION	YARDAGE	
	DISTANCE	EXCAVATION
376	169	335
377	633	67
378	257	0
379	1124	0
380	739	0
381	480	4
382	226	63
383	120	61
384	59	274
385	39	359
386	56	337
387	74	246
388	94	150
389		
SHEET TOTAL		1996

FINAL SURVEY	DATE
APPROVED	NO.
CHECKED	NO.
DRAWN	NO.

FINAL SURVEY	DATE
APPROVED	NO.
CHECKED	NO.
DRAWN	NO.

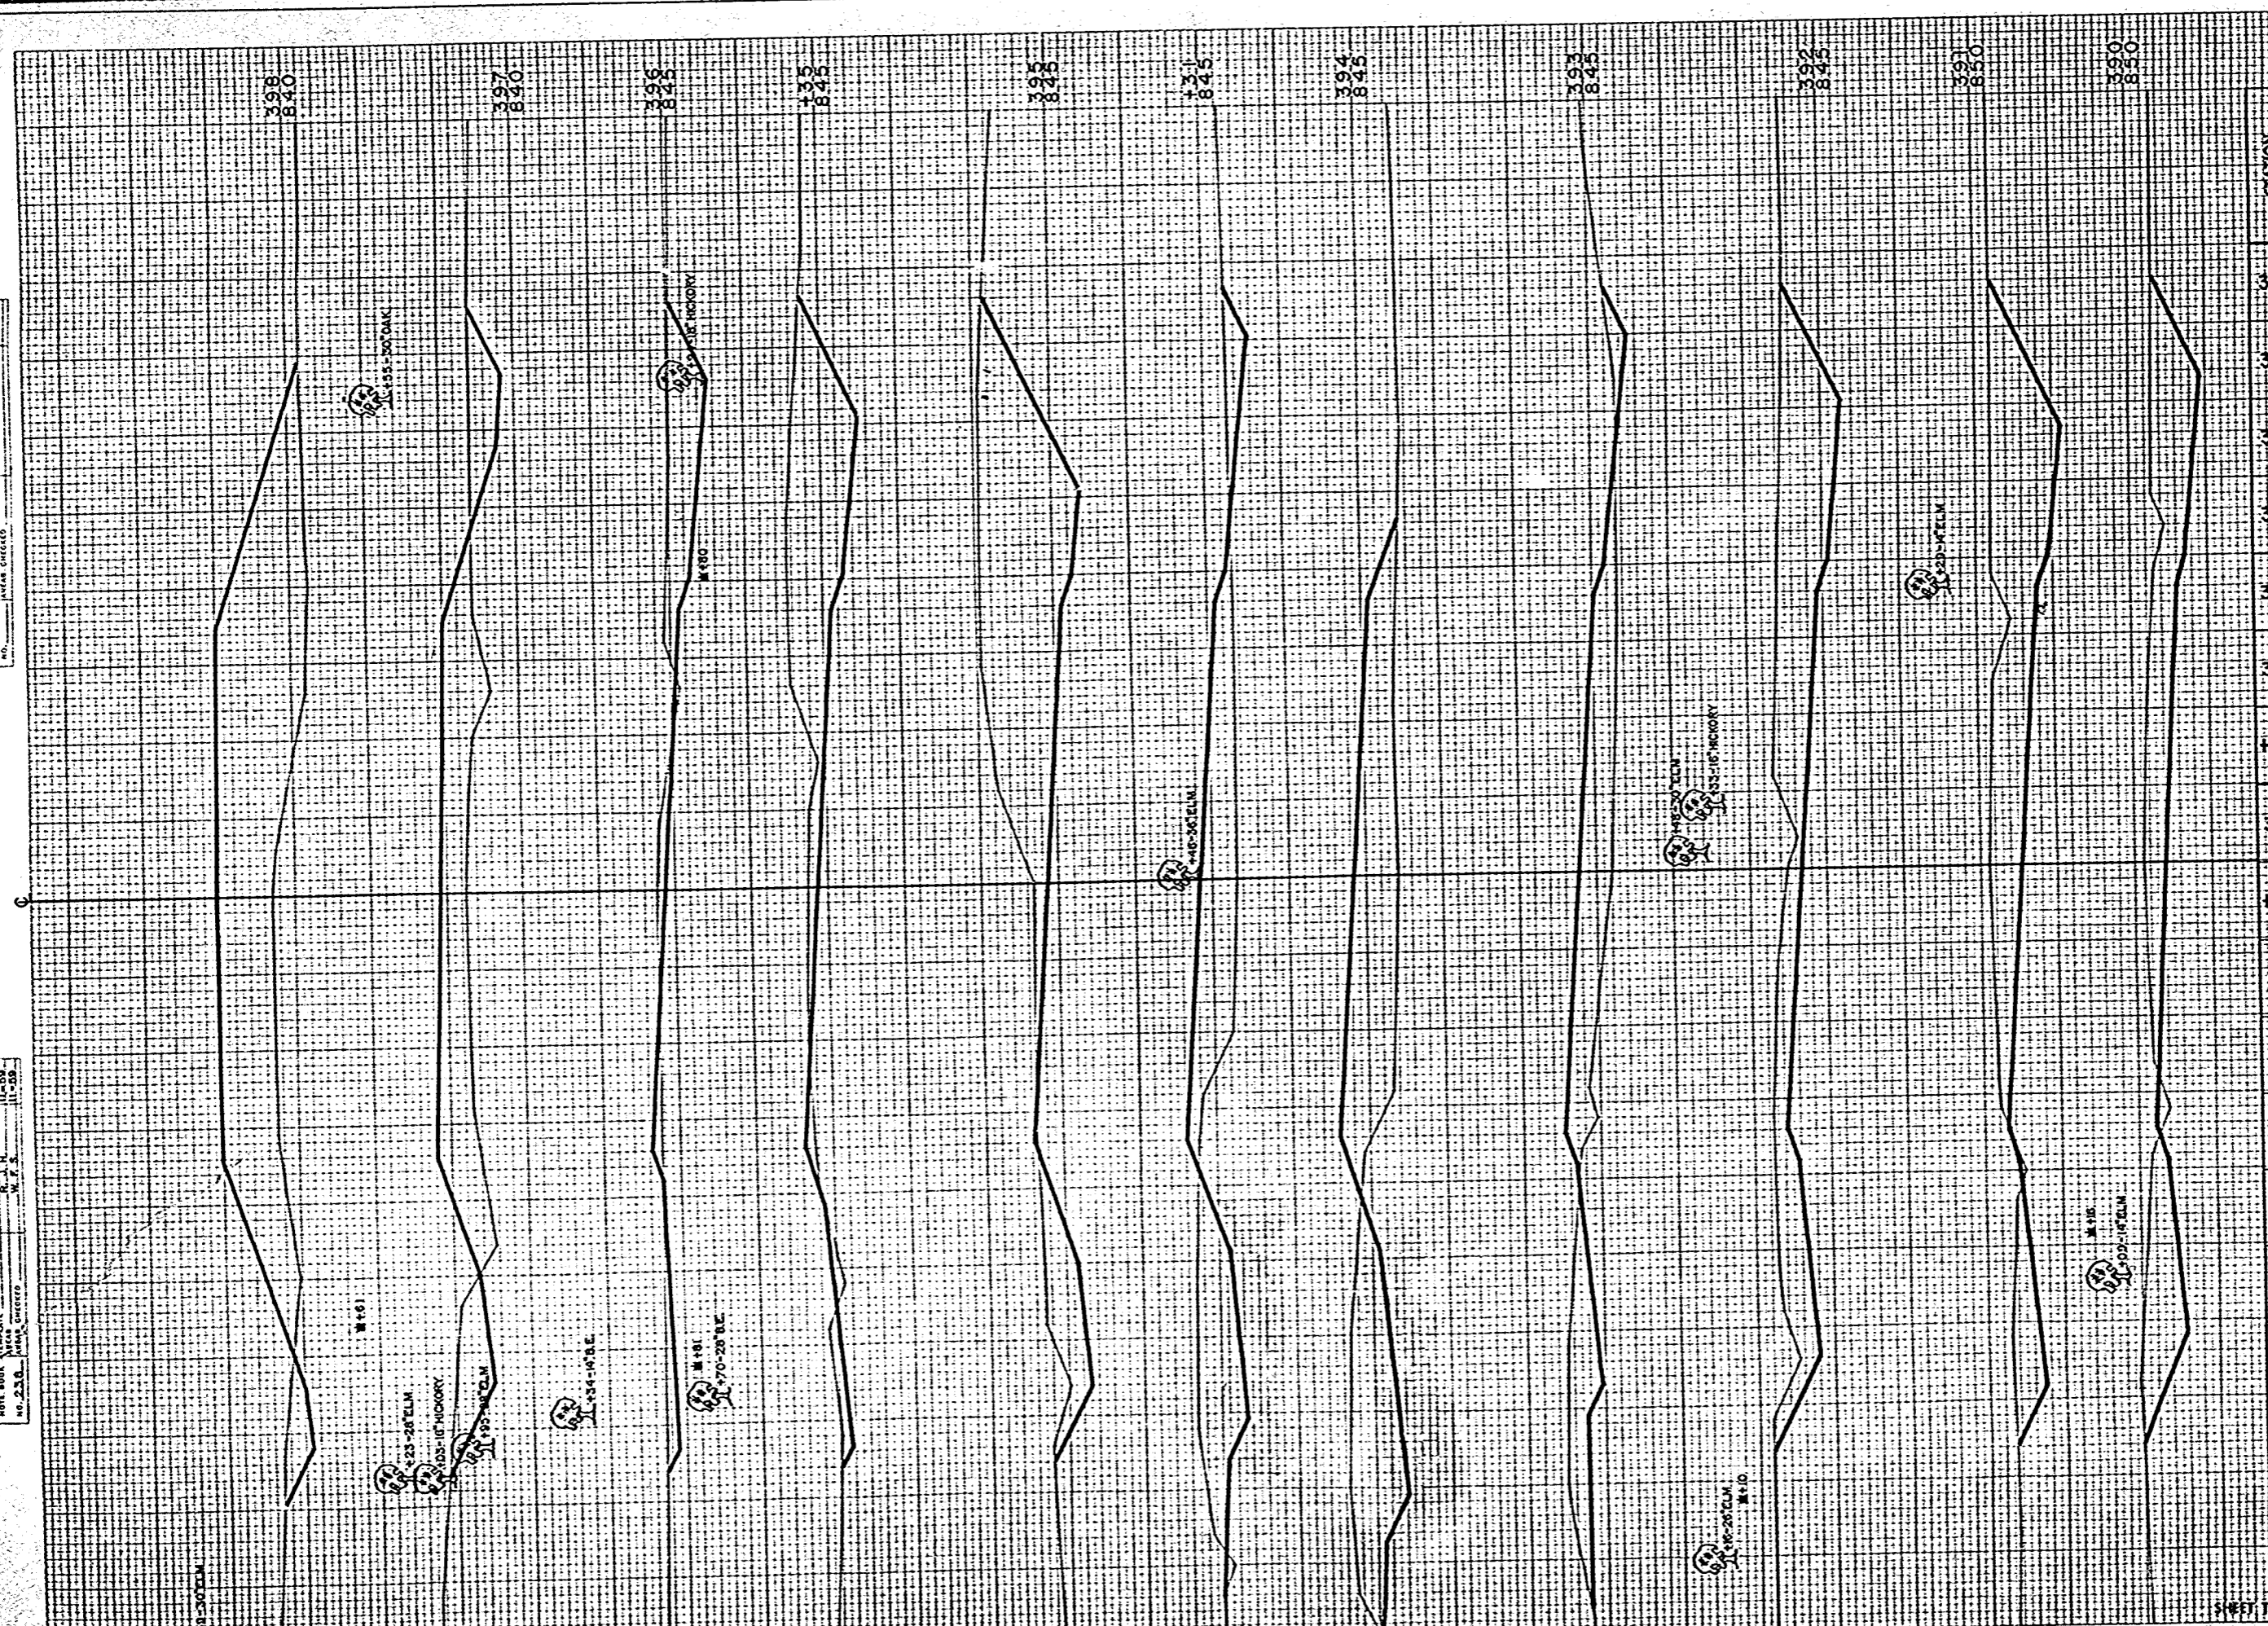


STATION	DISTANCE		YARDAGE
	UNC	CL	
389	281		57
390	504		6
391	554		2
392	333		135
393	215		335
394	85		102
431	337		89
395	191		4
435	165		15
396	172		63
397	93		580
398			
SHEET TOTAL			1488

STATE DISTRICT OFFICE	PROJECT	SHEET NUMBER	TOTAL SHEETS
WIS. 4	50737 (1)	31	33

FINAL SURVEY
 NO. 236
 DATE: 10-30-33
 BY: W. A. P. A.
 CHECKED: W. A. P. A.
 DATE: 11-28-33

ORIGINAL SURVEY
 NO. 236
 DATE: 10-30-33
 BY: W. A. P. A.
 CHECKED: W. A. P. A.
 DATE: 11-28-33

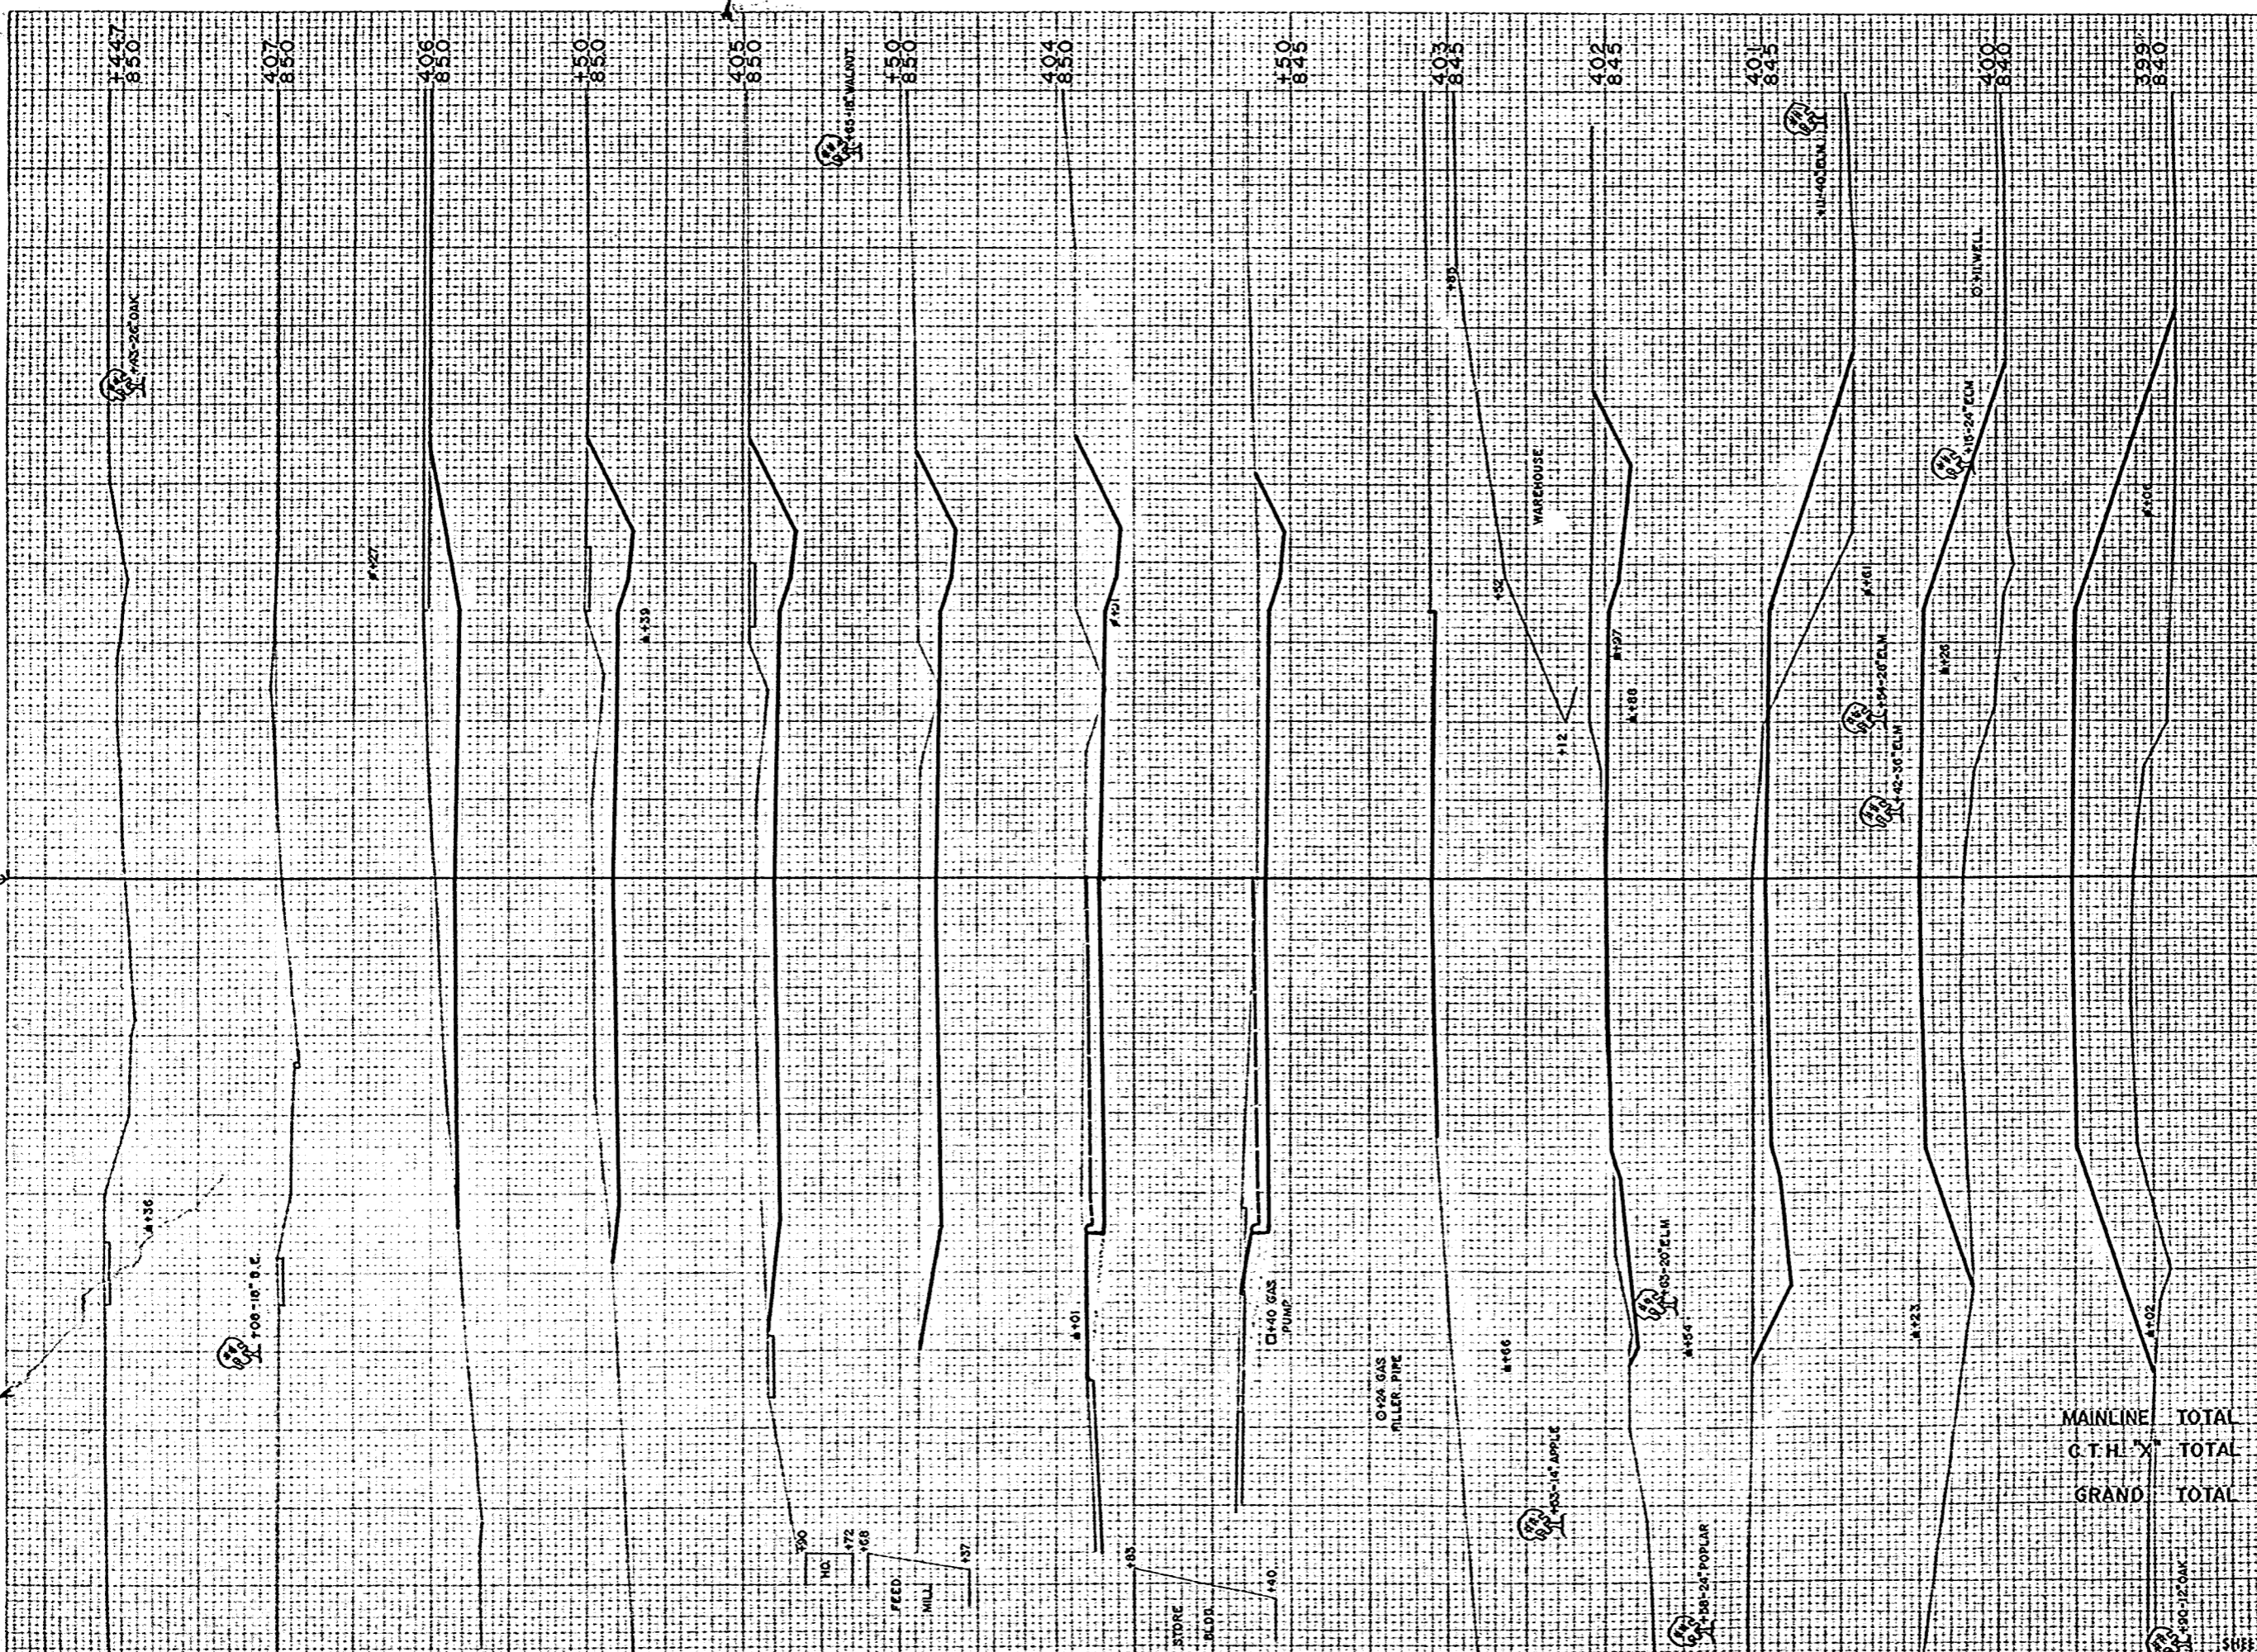


STATION	DISTANCE	YARDAGE EXCAVATION	TOTAL
398	0	0	689
399	0	0	765
400	89	0	389
401	174	0	85
402	89	0	0
403	39	0	0
150	93	0	0
404	106	0	0
150	107	0	0
405	128	0	0
150	126	0	0
406	63	0	0
407			
1447			
		YARDAGE SUMMARY	
		MAINLINE TOTAL	39,159
		G.T.H. TOTAL	117
		GRAND TOTAL	39,276
		SHEET TOTAL	1032
		TOTAL SHEETS	228

R.P.A. DISTRICT OFFICE
 WIS. 4
 PROJECT S 0737 (11)
 SHEET NUMBER 32
 TOTAL SHEETS 33

FINAL SURVEY - 100' TO 200' SCALE
 DATE: _____
 BY: _____
 CHECKED: _____

ORIGINAL SURVEY - 100' TO 200' SCALE
 DATE: _____
 BY: _____
 CHECKED: _____

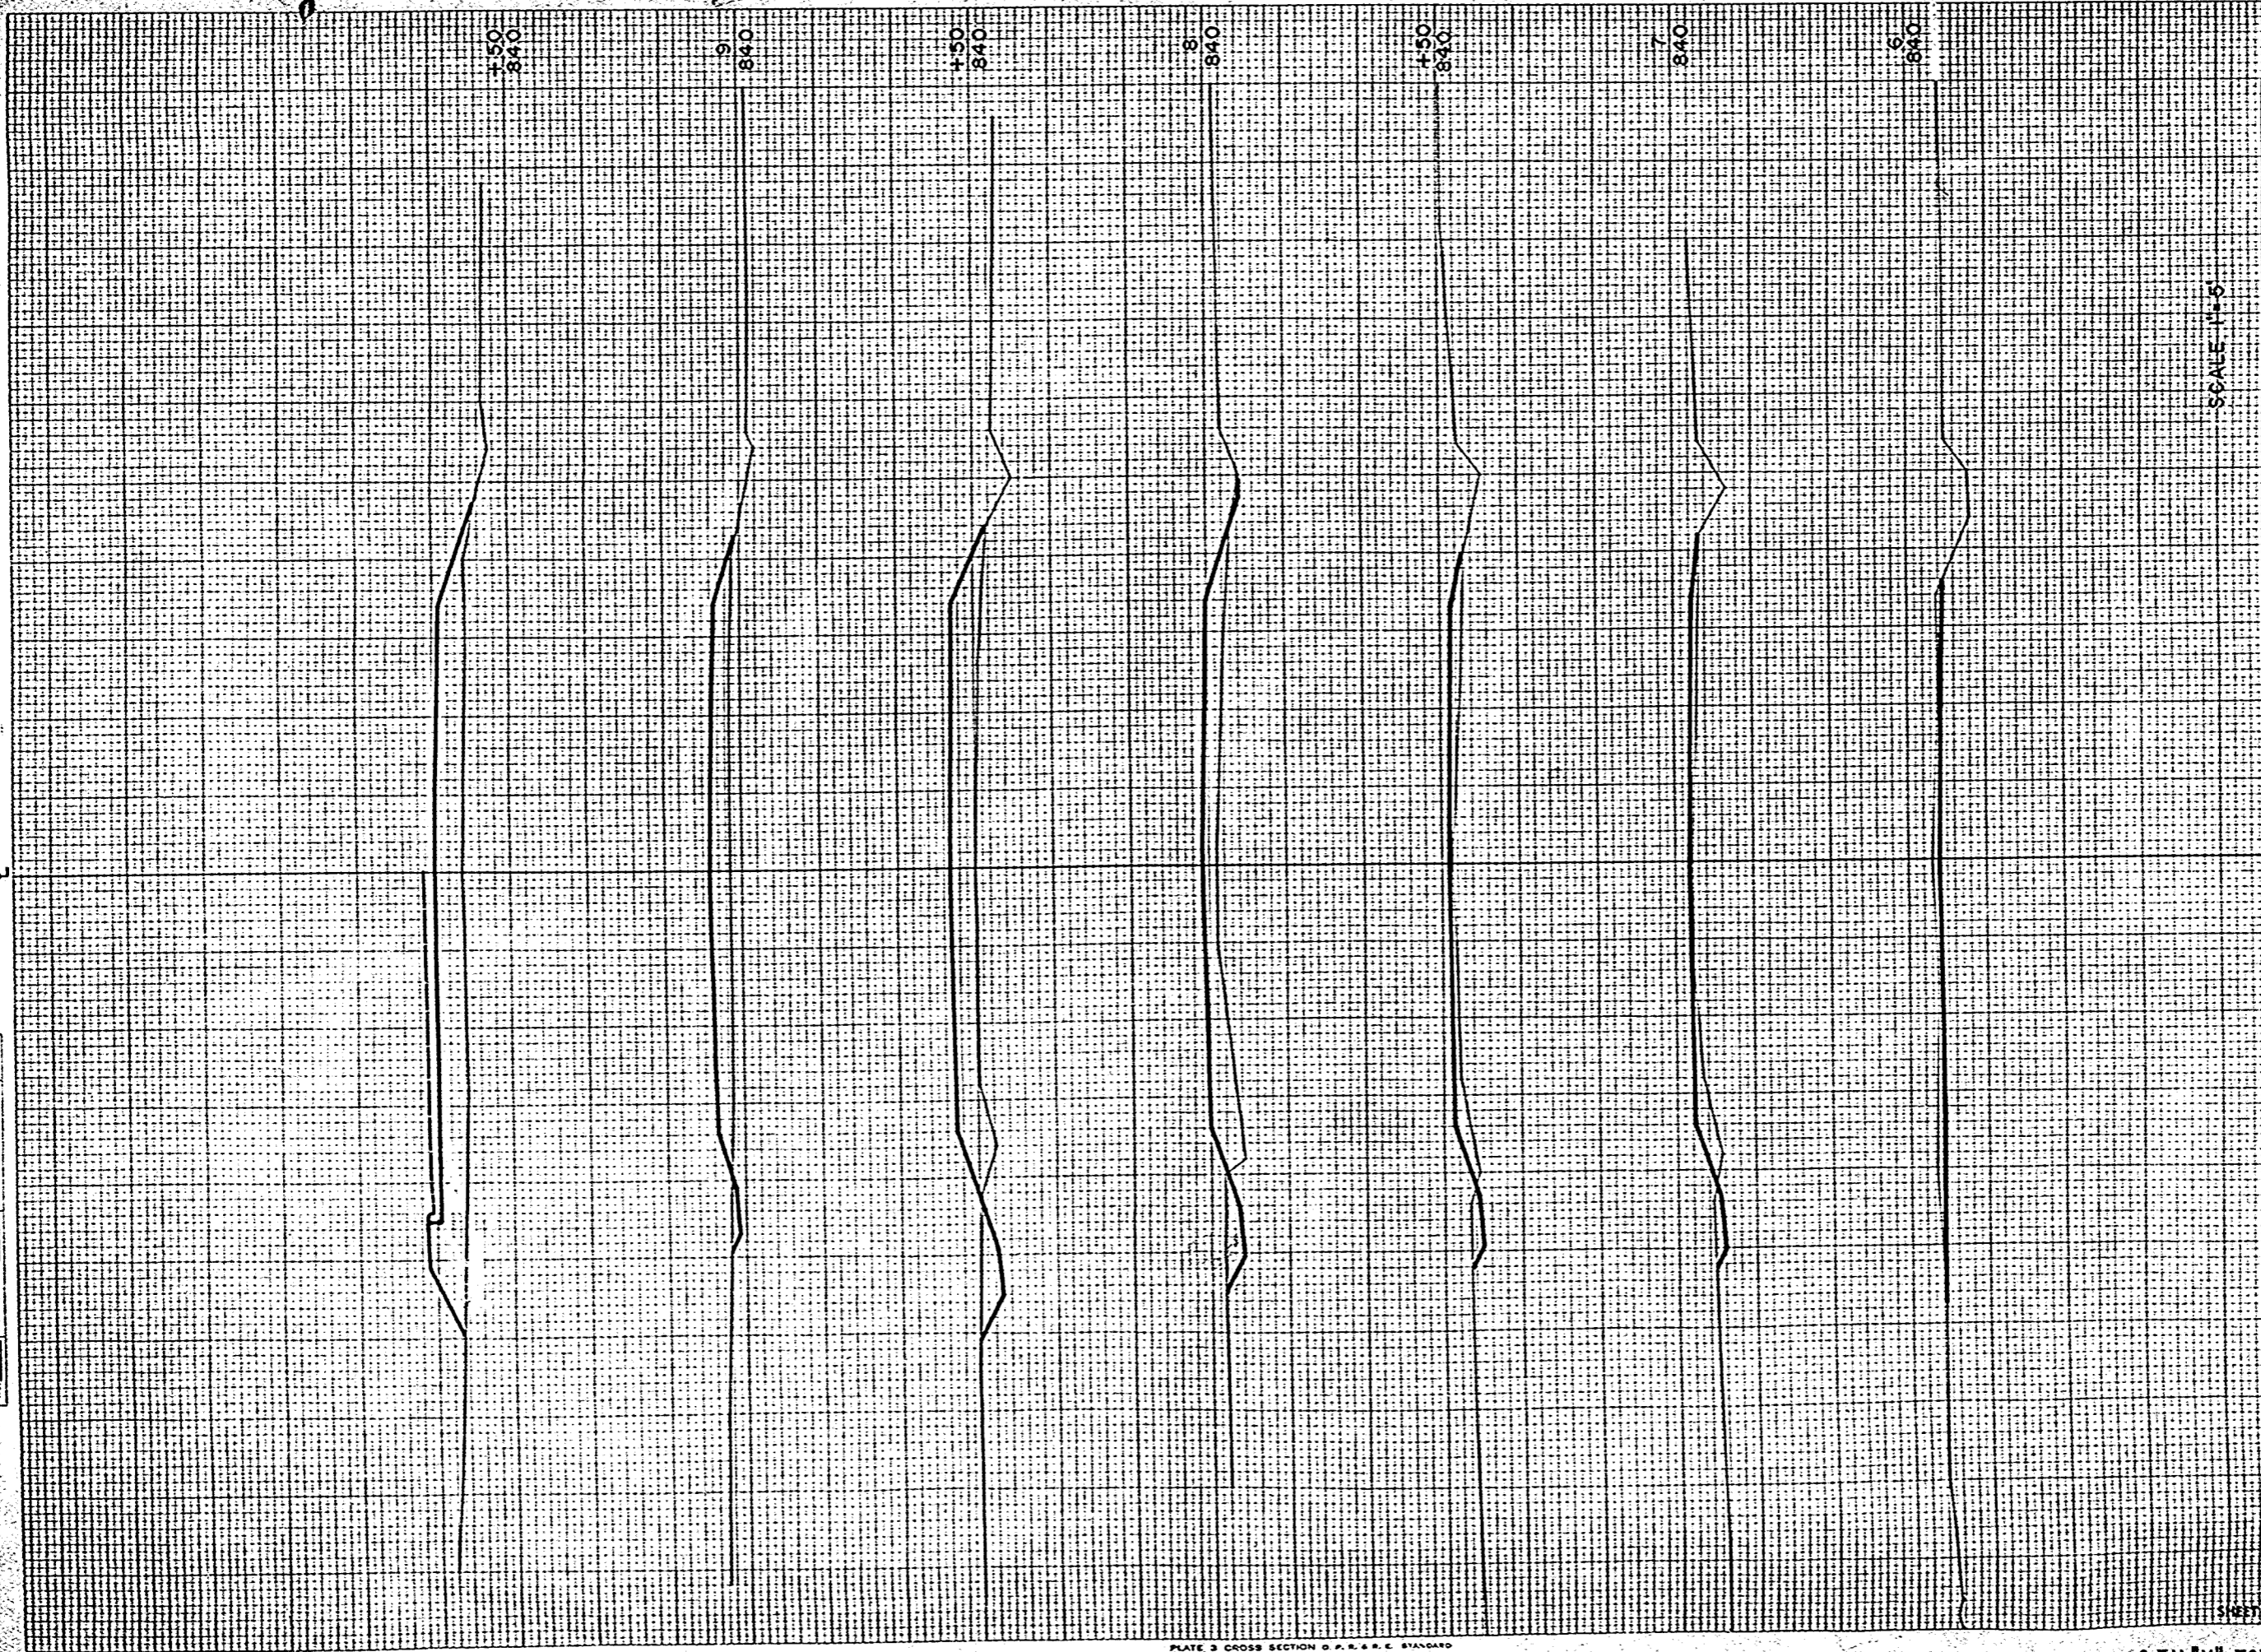

STATION	DISTANCE	UNCL	YARDAGE EXCAVATION	TOTAL
5				0
6	33			24
7	44			28
150	9			54
8	7			106
150	11			172
9	11			174
150	2			93
185	0			
SHEET TOTAL			17	68