

STANDARD DETAIL DRAWINGS

INLET COVERS TYPES A, H, A-S, & H-S	8A5-160
INLET COVERS TYPE B, B-A, C, MS, MS-A, & WM	8A5-16b
INLETS, TYPES 1, 2, 3, AND 4	8C1-5
INLETS, TYPES 8, 9, 10 AND 11	8C5-2
CONCRETE CURB, CONCRETE CURB AND GUTTER AND PAVEMENT TIES	8D1-13
EDGE DRAIN & CRUSHED AGGREGATE BASE COURSE, OPEN GRADED, NO. 1 OR NO. 2	8D15-3b
TYPICAL INSTALLATIONS OF EROSION BALES	8E8-2
SILT FENCE	8E9-5
INLET PROTECTION TYPE A, B AND C	8E10-1
TURBIDITY BARRIER	8E11-1
APRON ENDWALLS FOR CULVERT PIPE	8F1-11
APRON ENDWALLS FOR PIPE ARCH AND ELLIPTICAL PIPE	8F2-1
JOINT TIES FOR CONCRETE PIPE	8F4-5
STEEL APRON ENDWALLS FOR CULVERT PIPE AND PIPE ARCH SIDE DRAINS SLOPED SECTION	8F7-3
CONCRETE MASONRY ENDWALLS FOR CULVERT PIPE AND PIPE ARCH	8F10-1
AT-GRADE SIDE ROAD INTERSECTIONS, TYPES "B1", "B2", "C" AND "D" AND TEE INTERSECTION BYPASS LANE	9A1-11a
CONDUIT	9B2-6
PULL BOX	9B4-4
POLE MOUNTING FOR LIGHTING UNITS TYPE 5, (30 foot)	9E1-4d
NON-FREWAY LIGHTING UNIT POLE WIRING	9E3-2
MAINTENANCE CROSSOVER FOR FREEWAYS	11A1-3
SLOPE PAVING-STRUCTURES (CRUSHED AGGREGATE)	12A2-3
NAME PLATE-STRUCTURES	12A3-7
CONCRETE PAVEMENT LONGITUDINAL JOINTS AND PAVEMENT TIES	13C1-10
URBAN DOWNELO CONCRETE PAVEMENT	13C13-3
CLASS "B" STEEL PLATE BEAM GUARD	14B3-2
STEEL PLATE BEAM GUARD, CLASS "A", INSTALLATION & ELEMENTS	14B15-4a
STEEL PLATE BEAM GUARD, CLASS "A", INSTALLATION & ELEMENTS	14B15-4b
STEEL PLATE BEAM GUARD, CLASS "A" (AT BRIDGES, OBSTACLES AND SIDEROADS/DRIVEWAYS)	14B18-4a
STEEL THRIE BEAM STRUCTURE APPROACH	14B20-5a
STEEL THRIE BEAM STRUCTURE APPROACH, CONNECTION TO SQUARED END AND VERTICAL FACED PARAPETS	14B20-5b
CONCRETE BARRIER, SINGLE FACED (WITH ANCHORAGE)	14B22-3a & b
STEEL PLATE BEAM GUARD ENERGY ABSORBING TERMINAL	14B24-3a, b & c
MARKER POSTS FOR RIGHT-OF-WAY	15A1-7
MARKER POSTS, FLEXIBLE, FOR CULVERT END BARRICADES AND SIGNS FOR ROAD CLOSURES	15A3-1
TRAFFIC CONTROL, ADVANCE WARNING SIGNS, 45 M.P.H. OR GREATER	15C2-3
TWO-WAY UNDIVIDED ROAD OPEN TO TRAFFIC	15C4-1
PAVEMENT MARKING SYMBOLS	15C7-5a
PAVEMENT MARKING (MAINLINE)	15C8-9a
TRAFFIC CONTROL, WORK ON SHOULDER OR PARKING LANE, UNDIVIDED ROADWAY	15D28-1
TRAFFIC CONTROL, VEHICLE ENTRANCE/EXIT OR HAUL ROAD	15D29-1
LANDMARK REFERENCE MONUMENTS AND COVERS	16A1-6

UTILITIES

AMERICAN TRANSMISSION COMPANY LLC, A WISCONSIN LIMITED LIABILITY COMPANY
 ANDY EBERHARDT
 N19 W23993 RIDGEVIEW PARKWAY WEST
 P O BOX 47
 WAUKESHA WI 53187-0047
 262-506-6864 FAX 262-506-6711
 TRANSMISSION

AMERITECH
 CHARLES BARTELT
 70 E DIVISION STREET
 FOND DU LAC WI 54935
 920 929-1013 FAX 920 929-1064 PG 414 318-0479 CELL 920 948-2170
 TELEPHONE

ANR PIPELINE CO
 LARRY HUBER
 W3925 PIPELINE LANE
 EDEN WI 53019 53019
 (920-477-4211)EXT 13 (920-477-2113 - FAX)CELL 920-979-0060
 GAS

CHARTER COMMUNICATIONS
 TOM HARYCKI
 N8284 REED STREET
 RIPON WI 54971
 920-748-9222 920-960-3699
 TELEPHONE AND CABLETV

CITY OF OSHKOSH PUBLIC WORKS
 DAVID PATEK
 215 CHURCH AVENUE
 PO BOX 1130
 OSHKOSH WI 54902 1130
 920 236-5065
 SEWER AND WATER

NORLIGHT TELECOMMUNICATIONS INC
 JIM KOSTUCH
 275 NORTH CORPORATE DRIVE
 BROOKFIELD WI 53045-5818
 (262) 792-7935 FAX 262-792-7991
 TELECOMMUNICATIONS

TIME WARNER CABLE
 LARRY PIHLSTROM
 1001 KENNEDY AVENUE
 PO BOX 145
 KIMBERLY WI 54136-0145
 (920-831-9211)
 CABLETV

VILLAGE OF WINNECONNE
 JOHN ROGERS
 PO BOX 650
 30 SOUTH FIRST STREET
 WINNECONNE WI 54986
 SEWER AND WATER

WISCONSIN PUBLIC SERVICE
 MICHAEL CERKAS
 700 NORTH ADAMS STREET
 PO BOX 19001
 GREEN BAY WI 54307-9001
 920-433-4942 FAX 920-433-1360
 GAS AND ELECTRIC



Toll Free (800) 242-8511
 Milwaukee Area (414) 259-1181
 Hearing Impaired TDD (800) 542-2289
 www.DiggersHotline.com

GENERAL NOTES

THE CONTROL SURVEY FOR THIS PROJECT WAS CONDUCTED UNDER AND MET SPECIFICATIONS FOR THIRD ORDER CONTROL SURVEYS. COORDINATES AND BEARINGS SHOWN ON THIS PLAN ARE ORIENTED TO THE WISCONSIN COORDINATE SYSTEM, SOUTH ZONE (NAD 27). CURVE DATA SHOWN ON THE PLAN IS "ARC DEFINITION". COORDINATES SHOWN ON THIS PLAN ARE ENGLISH GROUND VALUES. ENGLISH GRID VALUES CAN BE OBTAINED BY MULTIPLYING GROUND VALUES BY 0.999997 AND ADDING TWO MILLION TO THE CONVERTED EAST VALUE. DISTANCES ARE GROUND LENGTHS AND CAN BE CONVERTED TO GRID LENGTHS BY MULTIPLYING THE DISTANCE BY 0.999997. ALL ELEVATIONS ON THIS PROJECT ARE REFERENCED TO THE NATIONAL GEODETIC VERTICAL DATUM OF 1929 (N.G.V.D.). LEDGE ROCK SOUNDINGS ARE ON FILE AND AVAILABLE FOR INSPECTION AT THE DEPARTMENT OF TRANSPORTATION, DISTRICT 3 OFFICE.

LIMITED EASEMENTS FOR P.E. CONSTRUCTION HAVE BEEN OBTAINED AND THESE RIGHTS HAVE BEEN EXTENDED TO THE CONTRACTOR. THE LOCATIONS OF EXISTING AND PROPOSED UTILITY FACILITIES AS SHOWN ON THE PLAN ARE APPROXIMATE. THERE MAY BE OTHER UTILITY FACILITIES WITHIN THE PROJECT AREA THAT ARE NOT SHOWN. NO TREES OR SHRUBS ARE TO BE REMOVED WITHOUT THE APPROVAL OF THE ENGINEER.

ALL EXISTING CULVERT PIPES WITHIN THE CONSTRUCTION LIMITS SHALL BE REMOVED EXCEPT AS OTHERWISE NOTED. THE ELEVATIONS SHOWN ON THE ROADWAY CROSS SECTIONS ARE EARTH GRADE ELEVATIONS AT THE REFERENCE LINE OF THE ROADWAY AND AT DITCH BOTTOMS.

THE LIMITS OF MARSH EXCAVATION AND MARSH DISPOSAL SHOWN ON THE CROSS SECTION SHEETS ARE APPROXIMATE. THE EXACT LIMITS SHALL BE DETERMINED BY THE ENGINEER IN THE FIELD. THE SHRINKAGE ALLOWANCE USED FOR MARSH EXCAVATION IS 50%, BASED ON ITS ORIGINAL POSITION.

EXCAVATION BELOW SUBGRADE (E.B.S.), AS SHOWN ON THE PLAN AND PROFILE SHEETS, SHALL BE MEASURED AND PAID FOR AS COMMON EXCAVATION. THE EXACT LIMITS AND LOCATIONS ARE TO BE DETERMINED BY THE ENGINEER IN THE FIELD.

EARTHWORK BALANCES AND HAULS AS SHOWN ON THE PLAN AND PROFILE SHEETS MAY BE REVISED WITH THE APPROVAL OF THE ENGINEER IF SUCH REVISIONS WILL FACILITATE THE CONTRACTOR'S PLAN OF OPERATION AND SATISFY THE REQUIREMENTS OF THE CONTRACT PLANS, SPECIFICATIONS AND SPECIAL PROVISIONS.

INLET AND DISCHARGE ELEVATIONS FOR DRAINAGE STRUCTURES SHOWN ON THE PLAN ARE APPROXIMATE AND SHALL BE DETERMINED BY THE ENGINEER IN THE FIELD.

REINFORCED CONCRETE APRON ENDWALLS AND ADJOINING TWO SECTIONS OF CONCRETE PIPE SHALL BE TIED TOGETHER AS SHOWN ON THE STANDARD DETAIL DRAWINGS AND AS LOCATED IN THE MISCELLANEOUS QUANTITIES. JOINT TIES SHALL BE INCIDENTAL TO VARIOUS ITEMS.

WHEN THE QUANTITY OF CRUSHED AGGREGATE BASE COURSE IS MEASURED FOR PAYMENT BY THE TON, THE DEPTH OR THICKNESS AS SHOWN ON THE PLAN IS APPROXIMATE AND THE ACTUAL THICKNESS WILL DEPEND UPON THE DISTRIBUTION OF THE MATERIAL AS DIRECTED BY THE ENGINEER IN THE FIELD.

THE EXACT LOCATIONS AND LIMITS OF PRIVATE AND FIELD ENTRANCES SHALL BE DETERMINED BY THE ENGINEER IN THE FIELD. THE MEDIAN EDGE OF PAVEMENT OF THE NORTHBOUND ROADWAY IS THE MAINLINE REFERENCE LINE.

CURB AND GUTTER RADII ARE SHOWN TO THE FRONT FACE OF CURB. CURB HEIGHTS AT THE END OF CURB AND GUTTER SHALL BE TAPERED FROM 0 TO 6 INCHES IN 6 FEET.

SHOULDERS SHALL BE PAVED FULL WIDTH IN LOCATIONS WHICH REQUIRE STEEL PLATE BEAM GUARD.

THE QUANTITY OF SALVAGED TOPSOIL WAS COMPUTED FROM MEASUREMENTS BETWEEN THE FINISHED SUBGRADE POINTS AND THE SLOPE INTERCEPTS AS SHOWN ON THE CROSS SECTIONS PLUS 5 FEET PER STATION FOR ROUNDING.

ALL DISTURBED AREAS WITHIN THE RIGHT-OF-WAY, EXCEPT THE AREAS BETWEEN THE SUBGRADE SHOULDER POINTS, SHALL BE FERTILIZED, SEEDED AND MULCHED.

DISTURBED AREAS THAT WERE PREVIOUSLY LAWNS SHALL BE SEEDED WITH SEED MIXTURE NO. 40.

RUNOFF COEFFICIENT FOR THIS PROJECT: EXISTING PAVEMENT .95 EXISTING SLOPES .36; NEW PAVEMENT .95 NEW SLOPES .36

TOTAL PROJECT AREA 287 ACRES. TOTAL AREA DISTURBED 254 ACRES. PRIOR TO ORDERING DRAINAGE PIPES AND STRUCTURES, THE CONTRACTOR SHALL VERIFY RELATED DRAINAGE INFORMATION IN THE PLAN WITH THE ENGINEER.

EROSION CONTROL MEASURES SHALL BE PLACED AS SHOWN ON THE EROSION CONTROL PLAN. THE EXACT LOCATIONS WILL BE DETERMINED IN THE FIELD BY THE ENGINEER.

THE CONTRACTOR SHALL NOTIFY THE DISTRICT TRAFFIC UNIT, 920-492-3512, TWO WEEKS PRIOR TO PROJECT COMPLETION TO ALLOW FOR THE PLACEMENT OF ANY PERMANENT SIGNING WHICH WAS REMOVED OR MOVED DURING CONSTRUCTION OPERATIONS.

ALL ARCHAEOLOGICAL SITES SHALL NOT BE DISTURBED.

COUNTY SURVEYOR OR SURVEYS CONTACT PERSON

JERRY L. BOUGIE - WINNEBAGO COUNTY
 WINNEBAGO COUNTY COURT HOUSE
 415 JACKSON STREET
 OSHKOSH, WISCONSIN 54902
 PHONE 920-236-4839

DNR AREA LIAISON



WISCONSIN DEPARTMENT OF NATURAL RESOURCES
 BOBBI JO DEFERE 920-303-5442
 JAMES P COUGHLIN CENTER
 625 EAST COUNTY ROAD Y, SUITE 700
 OSHKOSH, WISCONSIN 54901-9731

DETAIL SHEET INDEX

SHEET TITLE	SHEET NUMBER
GEN NOTES, UTILITIES, STANDARD DETAILS, ETC	2.1
PROJECT OVERVIEW	2.2
TYPICAL CROSS SECTIONS	2.3-2.10
CONSTRUCTION DETAILS	2.11-2.37
EROSION CONTROL	2.38-2.61
DRAIN TILE	2.62-2.67
LIGHTING	2.68-2.69
TRAFFIC CONTROL	2.70
ALIGNMENT DIAGRAM	2.71


LEVELS ON 1, 2, 3, 62, 63

LEVELS ON - 1.8, 2.1, 2.4, 2.5, 2.6, 6.2, 6.3

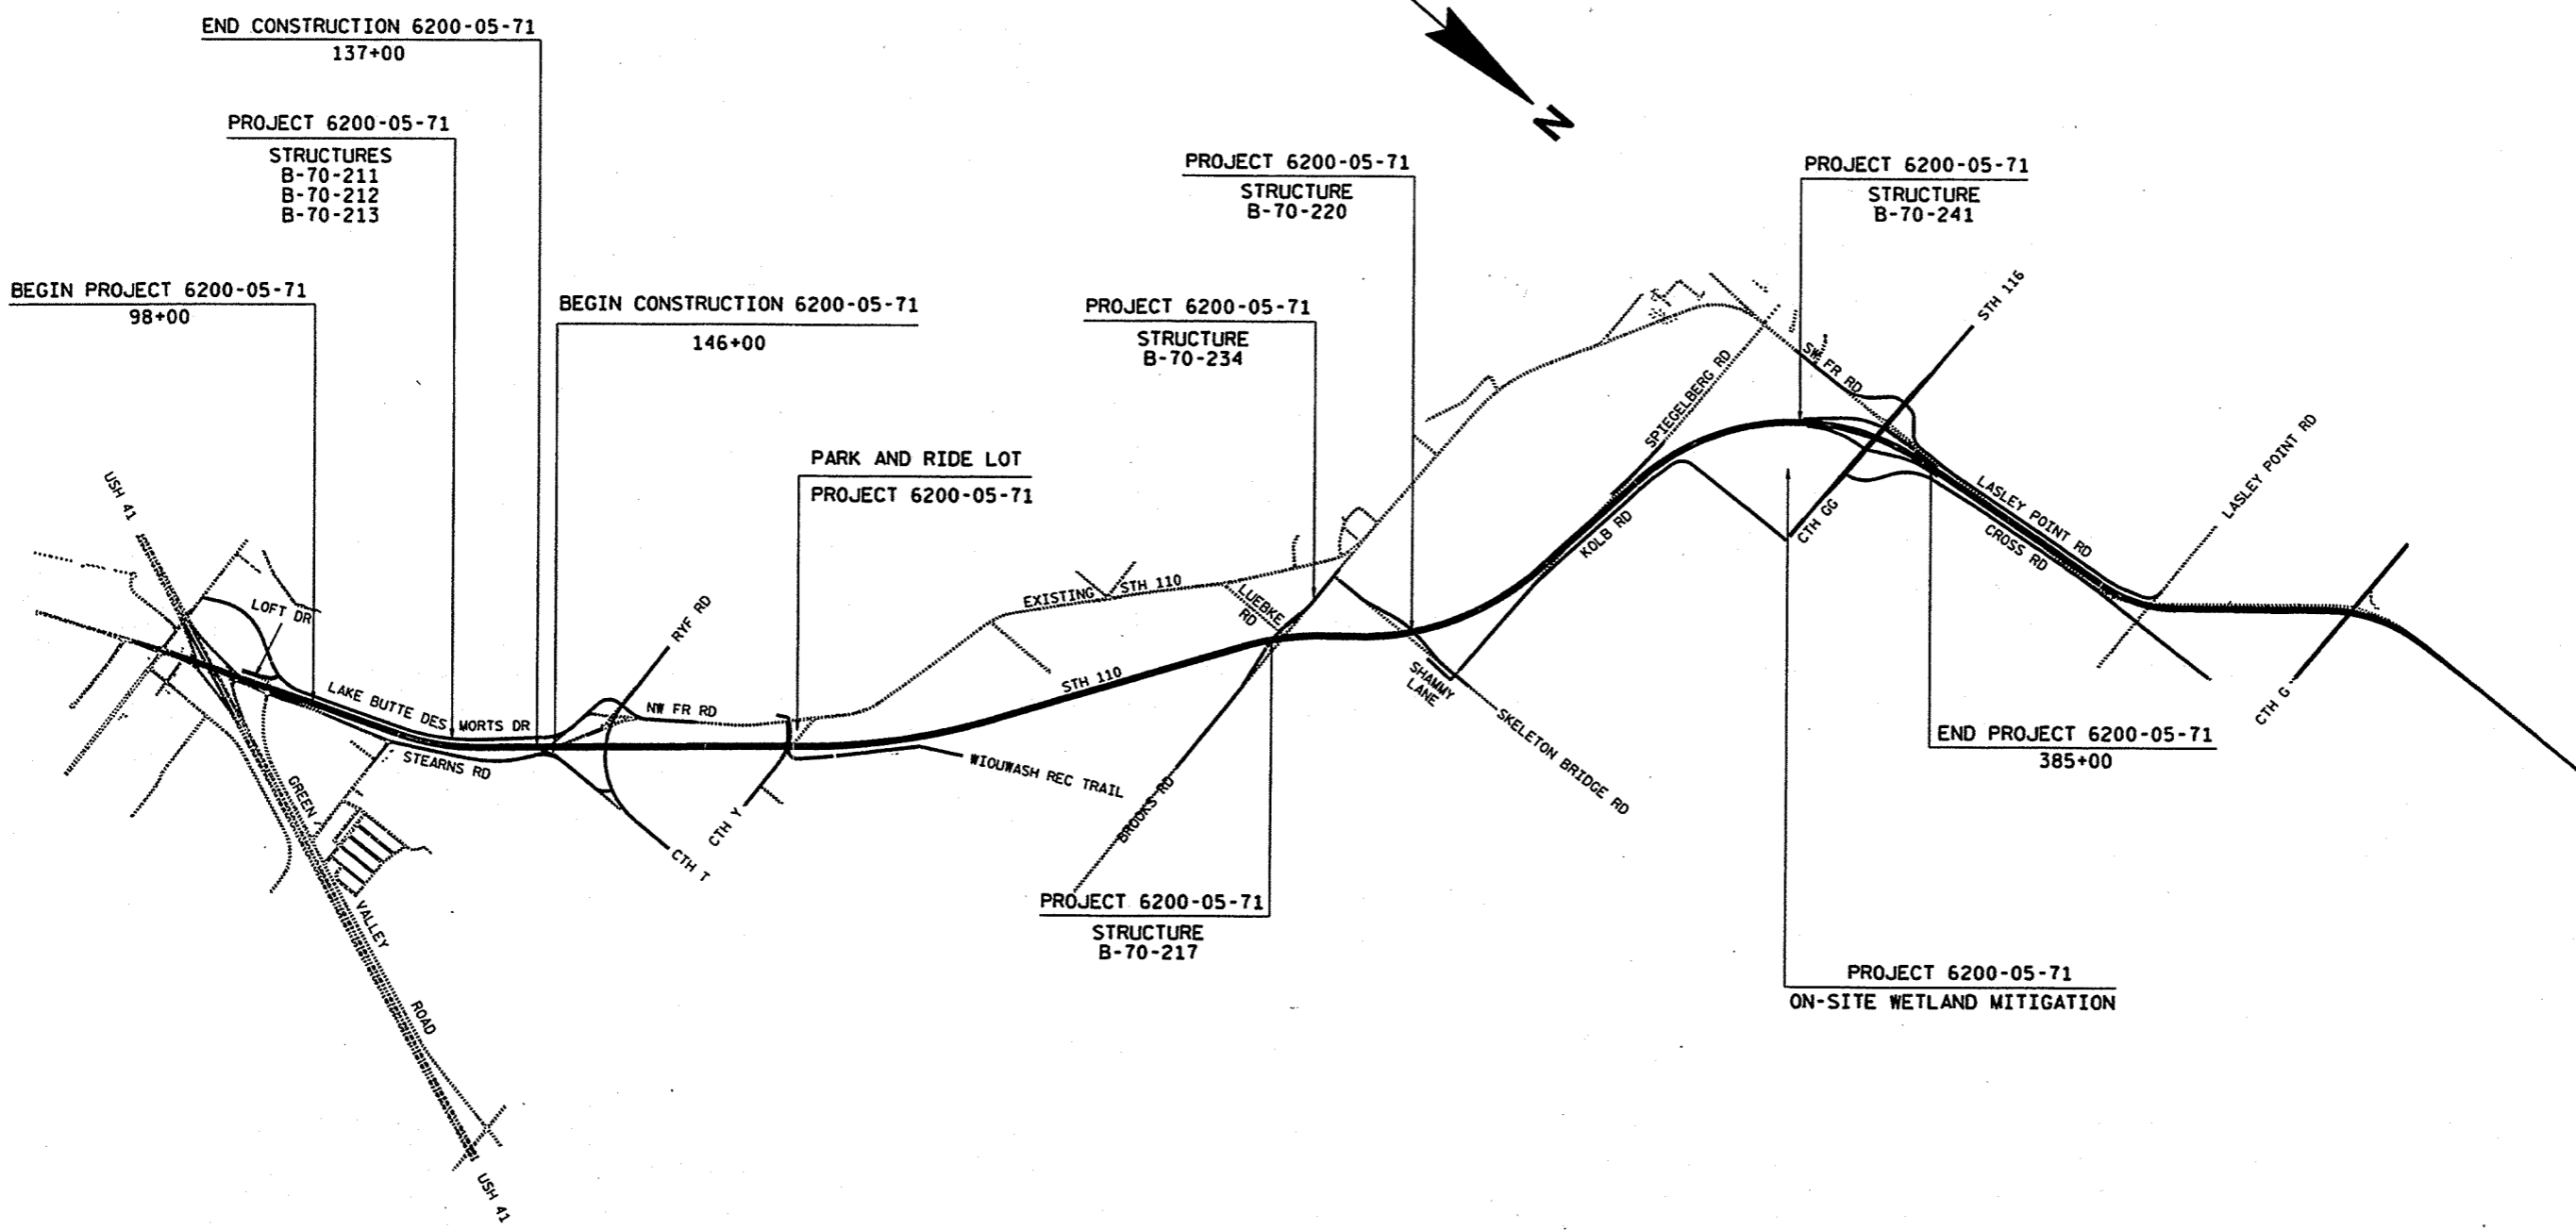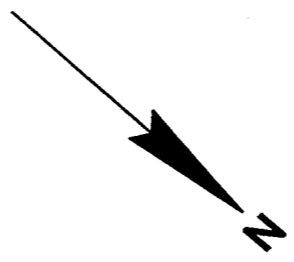

STATE PROJECT NUMBER: 6200-05-71	HWY: STH 110	COUNTY: WINNEBAGO	PROJECT OVERVIEW	SCALE, FEET	SHEET NO: 2.2	E
----------------------------------	--------------	-------------------	------------------	-------------	---------------	---


LEVELS ON - 1, 2, 3, 62, 63

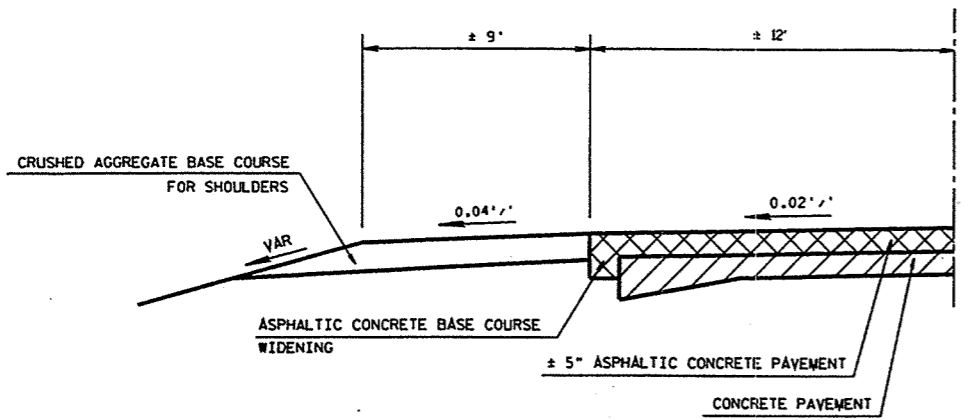

1/2 TYPICAL EXISTING CROSS SECTION FOR STH 110


STA ± 98+00 TO ± 122+00
 STA ± 146+00 TO ± 180+00
 STA ± 270+00 TO ± 385+00

NOTE: STATIONING SHOWN FOR EXISTING CROSS SECTIONS IS RELATIVE TO NEW CONSTRUCTION STATIONING

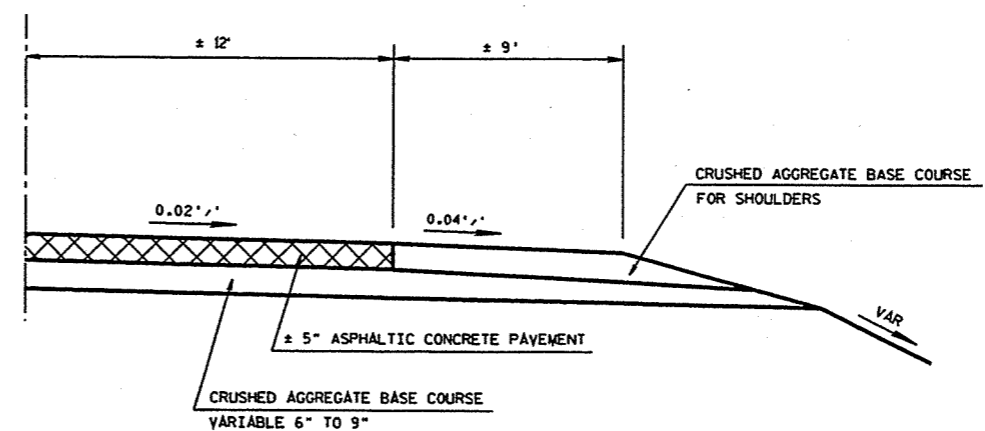


1/2 TYPICAL EXISTING CROSS SECTION FOR STH 110

STA ± 122+00 TO ± 137+00
 STA ± 180+00 TO ± 270+00

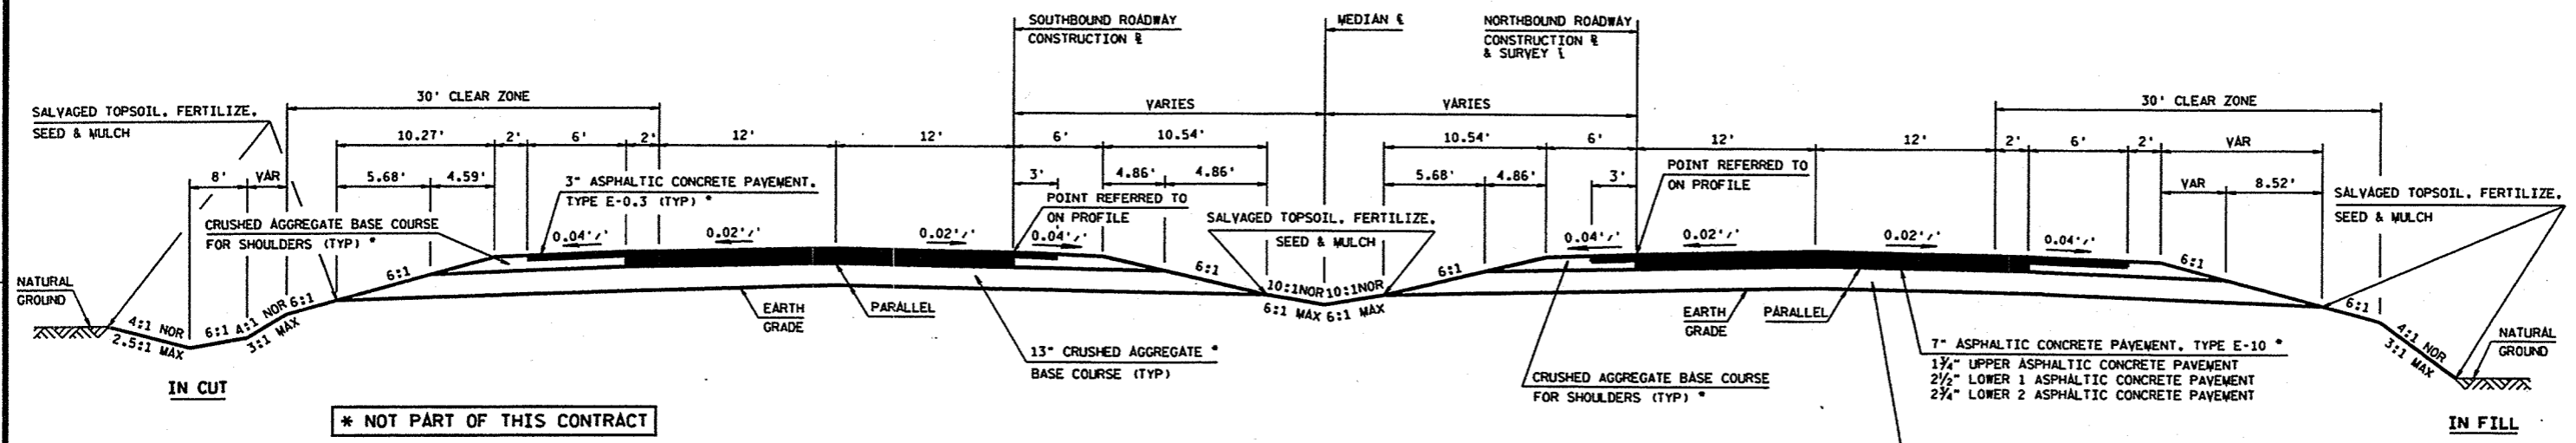

TYPICAL FINISHED CROSS SECTION FOR STH 110


STA 98+00 TO 105+00

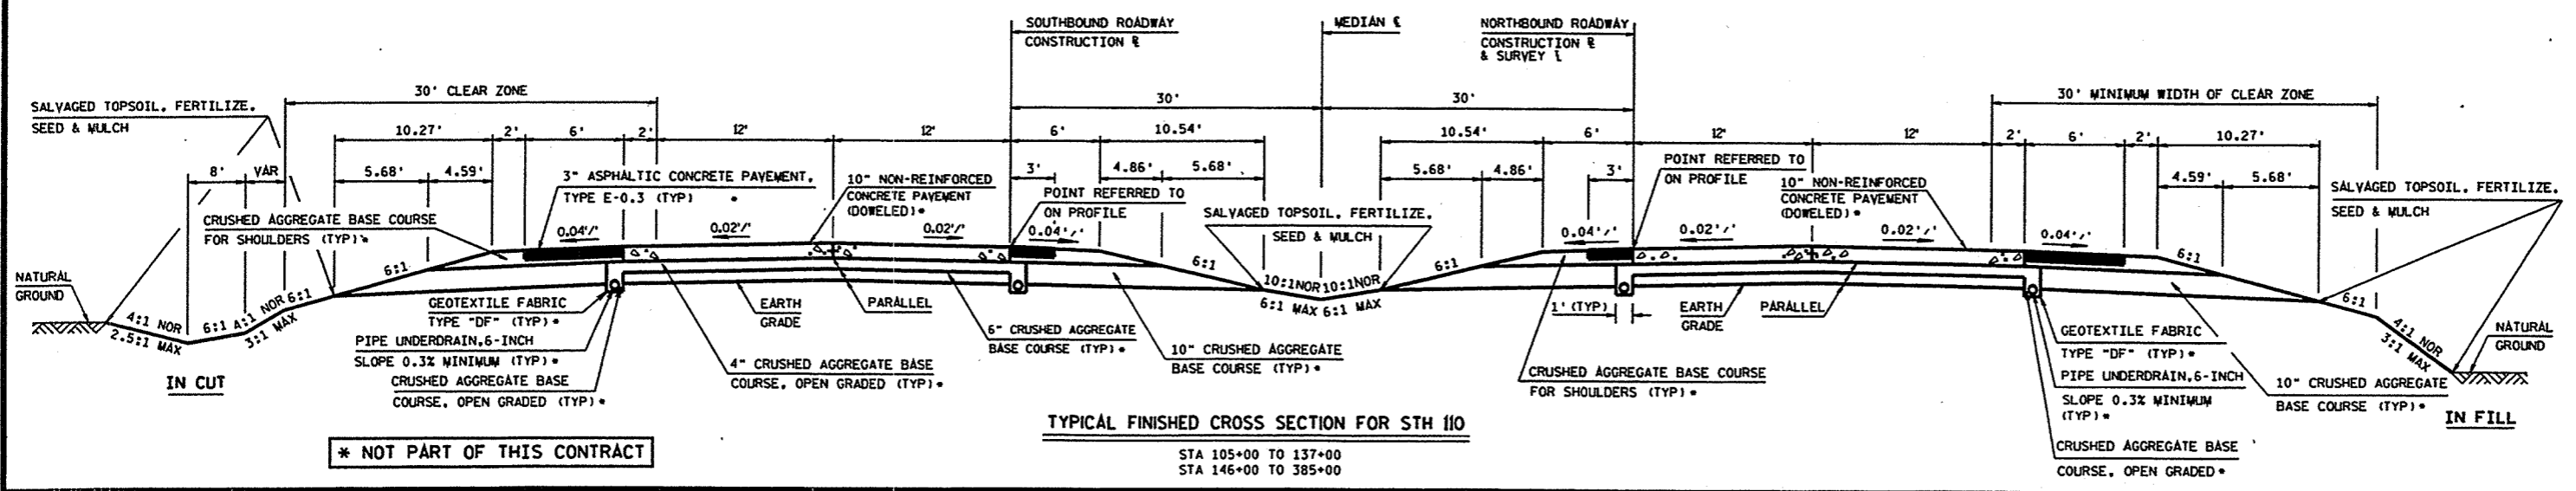

TYPICAL FINISHED CROSS SECTION FOR STH 110


STA 105+00 TO 137+00
 STA 146+00 TO 385+00

LEVELS ON: 1, 2, 3, 62, 63

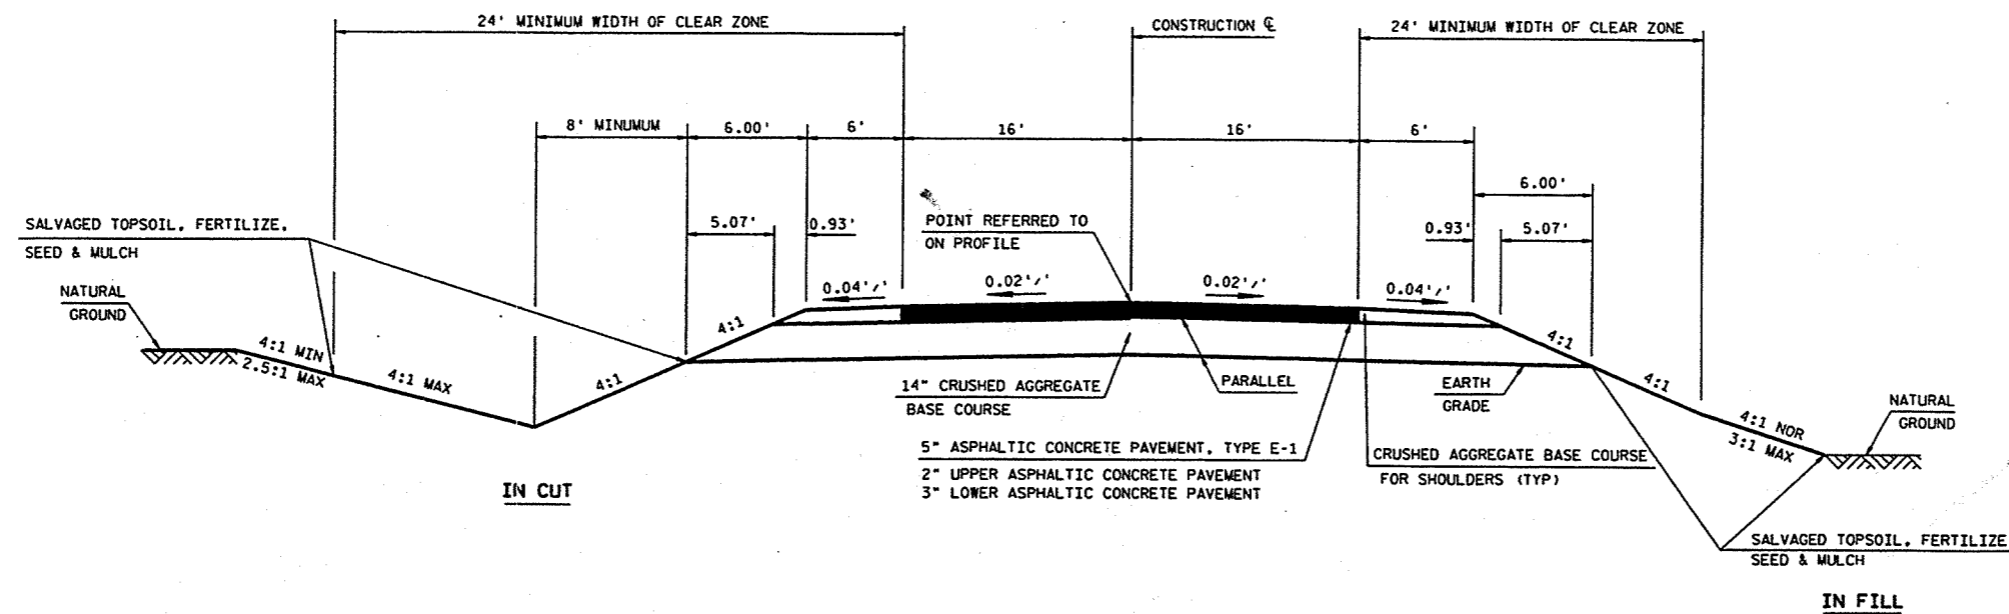

TYPICAL FINISHED CROSS SECTION FOR LAKE BUTTE DES MORTS DRIVE

STA 199+87.44 TO 205+00
STA 278+50 TO 281+89.35

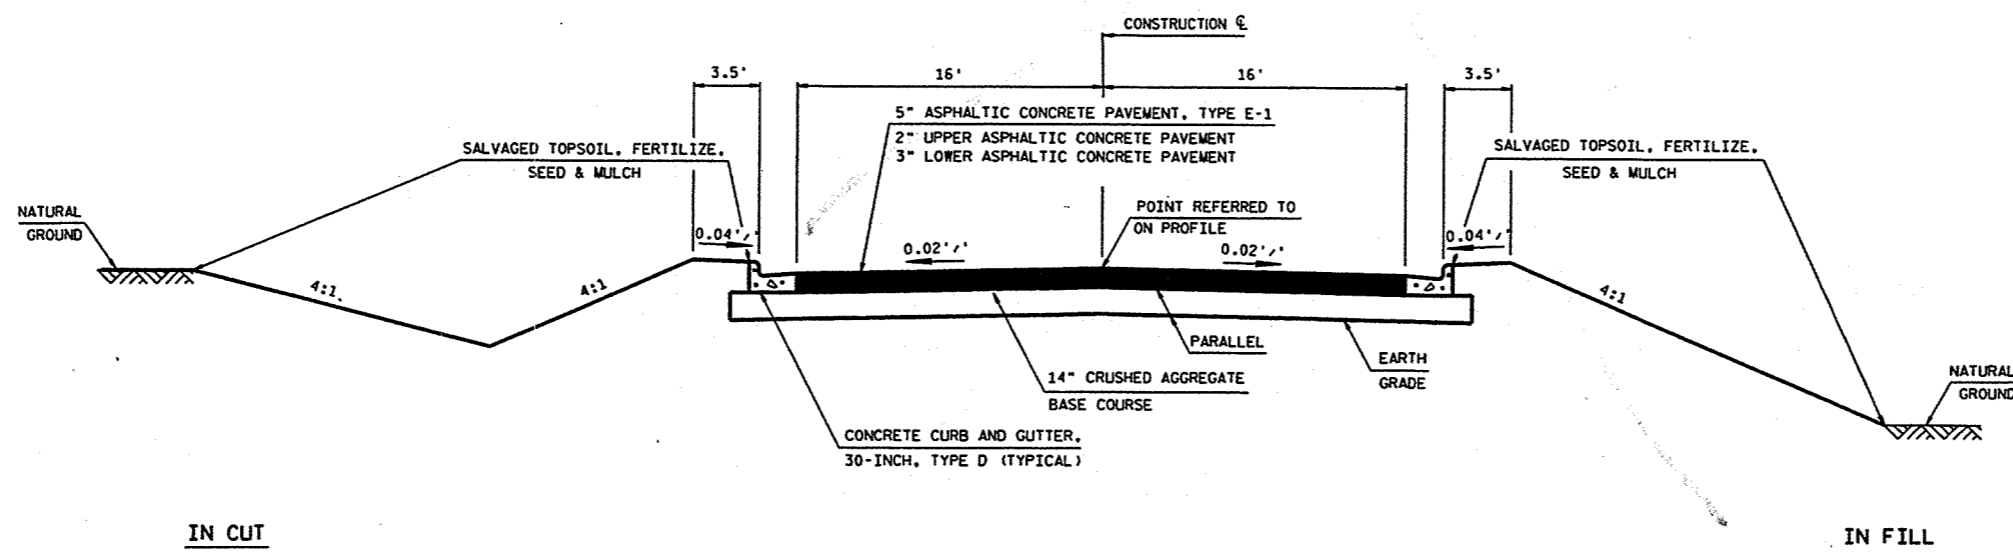

TYPICAL FINISHED CROSS SECTION FOR LAKE BUTTE DES MORTS DRIVE

STA 277+50 TO 278+50
STA 205+00 TO 241+00

STATE PROJECT NUMBER: 6200-05-71

HWY: STH 110

COUNTY: WINNEBAGO

TYPICAL CROSS SECTIONS

SCALE, FEET

SHEET NO: 2.4

E

FILE NAME: F:\d3_620005+200.dgn

PLOT DATE: 26-NOV-2001 14:07

ORG DATE: 12-21-00



PLOT NAME: 200z

Originator: DISTRICT 3 -- JD

PLOT SCALE: 10.030303:1.000000

WISDOT/CADDs SHEET 42


LEVELS ON : 1, 2, 3, 62, 63

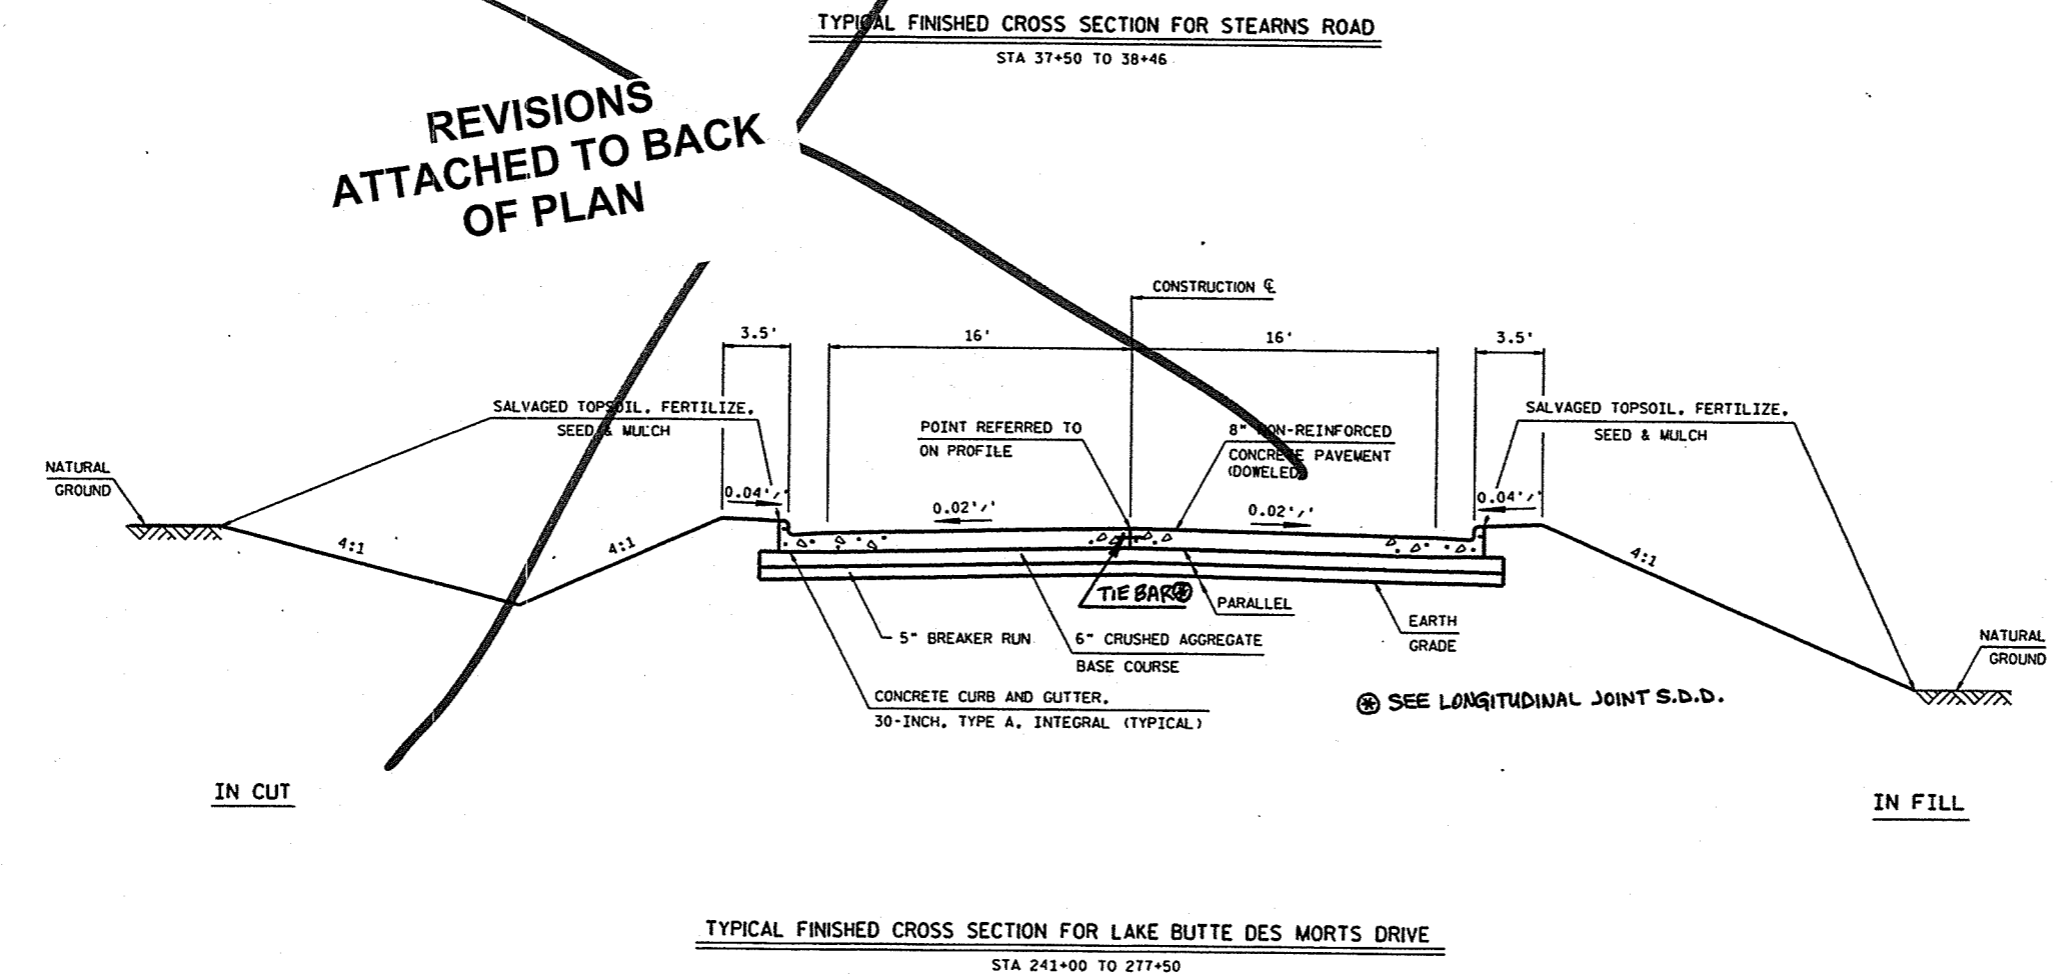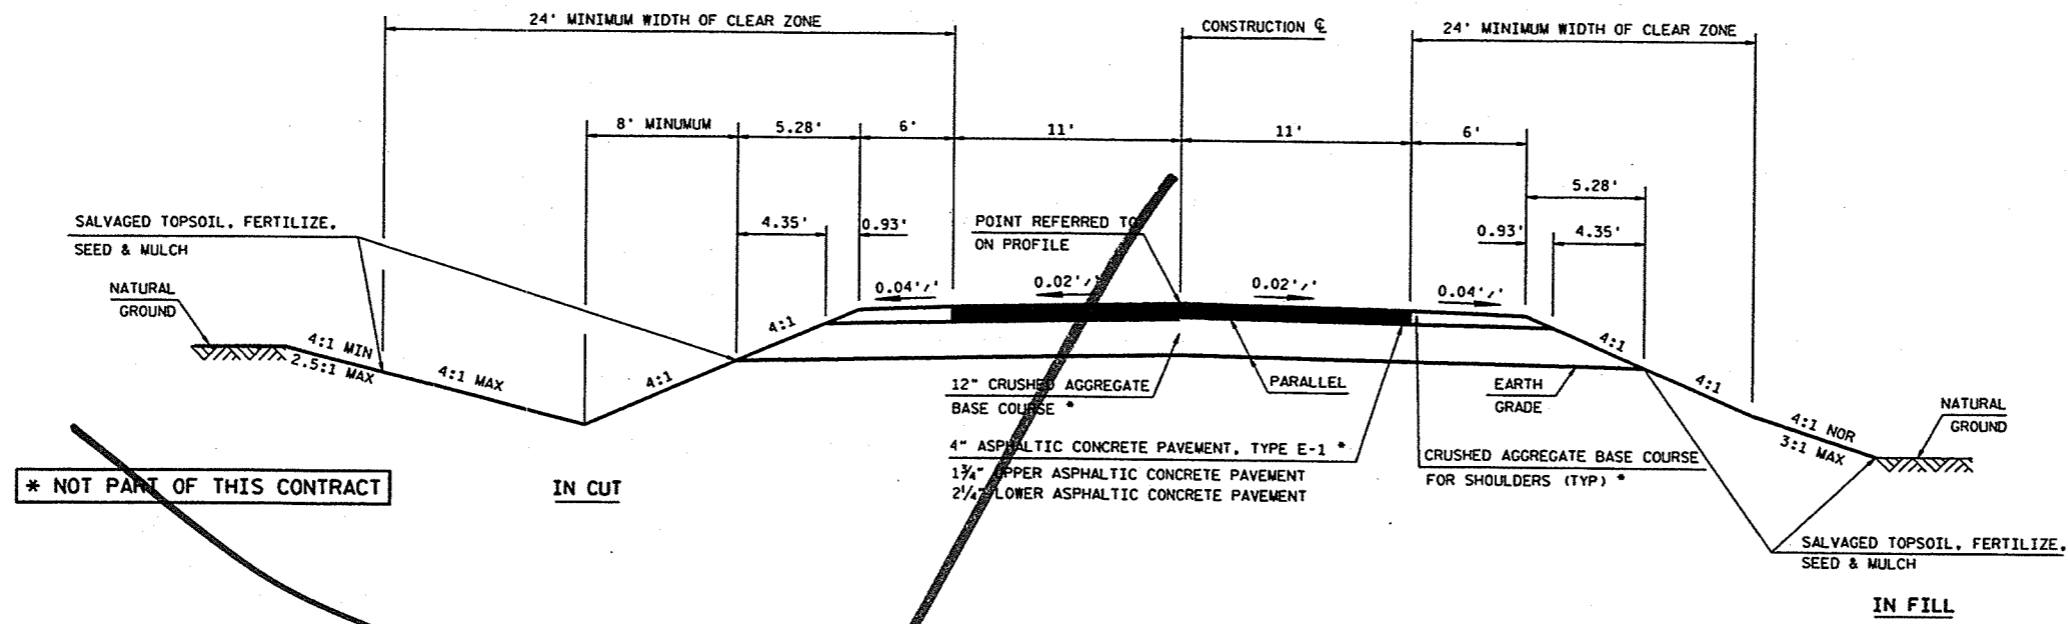


STATE PROJECT NUMBER: 6200-05-71 HWY: STH 110 COUNTY: WINNEBAGO TYPICAL CROSS SECTIONS SCALE, FEET SHEET NO: 2.5 E

FILE NAME : F:\d3_620005\200.dgn PLOT DATE: 27-NOV-2001 12:54 ORG DATE : 12-21-00 PLOT NAME : 200x Originator : DISTRICT 3 -- JD PLOT SCALE : 10.030303:1.000000 WISDOT/CADD SHEET 42

LEVELS ON - 1.2, 3.4, 5.6, 7.8, 9.9, 11.1, 12.2, 13.3, 14.4, 15.5, 16.6, 17.7, 18.8, 19.9, 20.0, 21.1, 22.2, 23.3, 24.4, 25.5, 26.6, 27.7, 28.8, 29.9, 30.0, 31.1, 32.2, 33.3, 34.4, 35.5, 36.6, 37.7, 38.8, 39.9, 40.0, 41.1, 42.2, 43.3, 44.4, 45.5, 46.6, 47.7, 48.8, 49.9, 50.0, 51.1, 52.2, 53.3, 54.4, 55.5, 56.6, 57.7, 58.8, 59.9, 60.0, 61.1, 62.2, 63.3

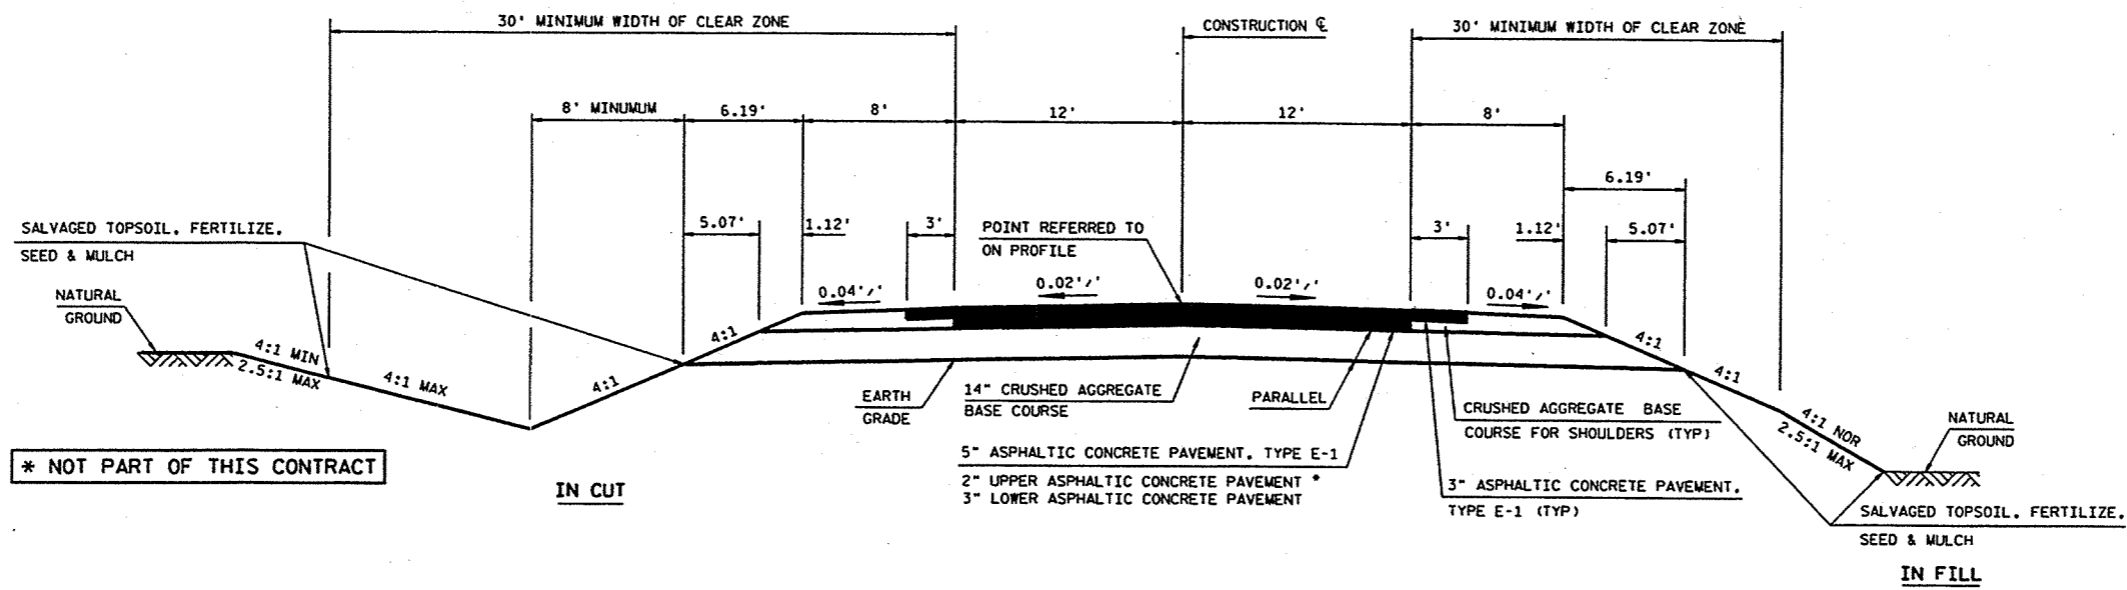


TYPICAL FINISHED CROSS SECTION NORTHWEST FRONTAGE ROAD AT CTH T
 STA 282+52.37 TO 291+00

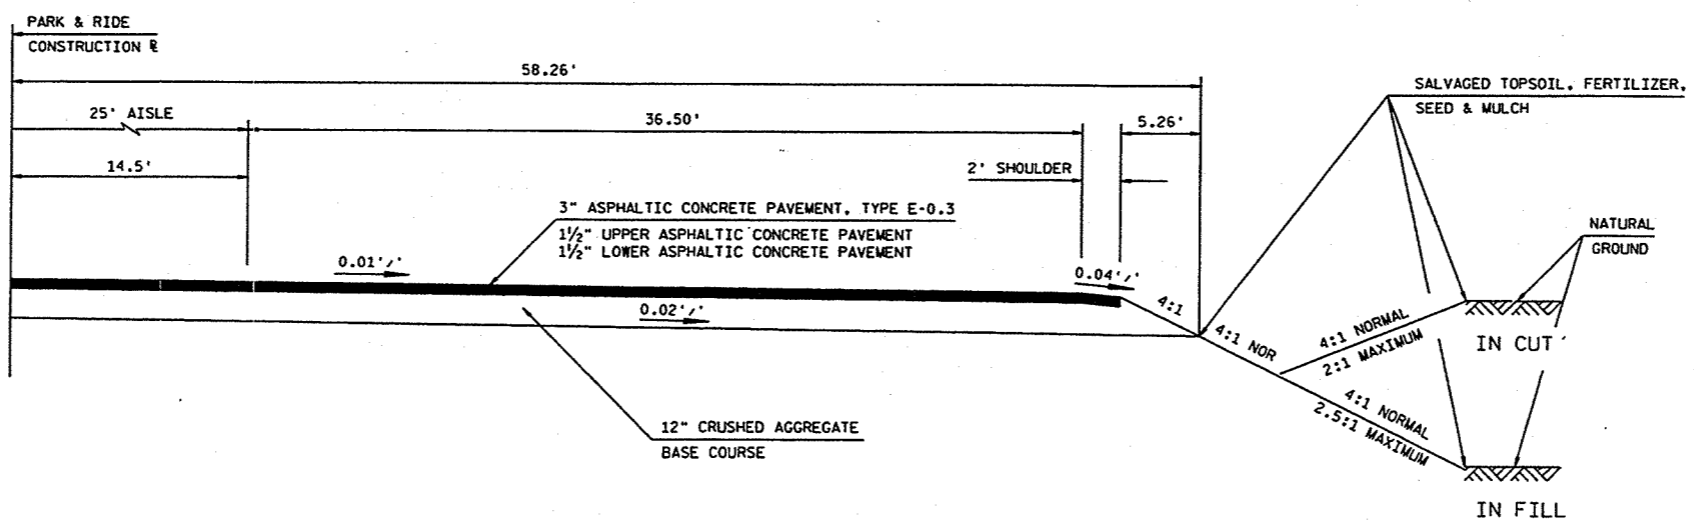


1/2 TYPICAL FINISHED CROSS SECTION FOR PARK & RIDE LOT (RECREATION TRAIL)
 20+52 TO 22+66

LEVELS ON - 1.0, 2.0, 3.0, 62.0, 63.0

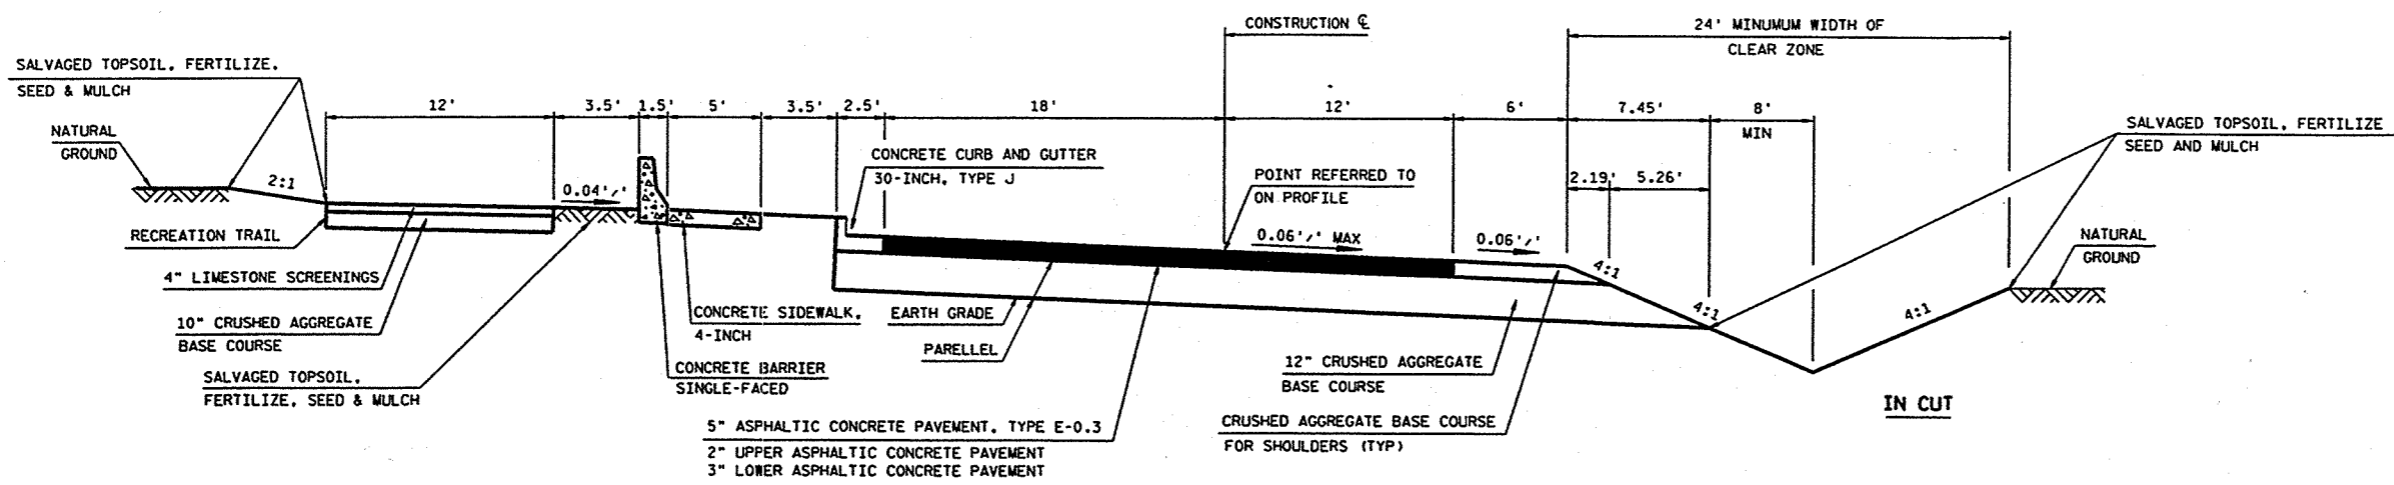

TYPICAL FINISHED CROSS SECTION FOR CTH Y AND WOUWASH TRAIL
STA 30+00 TO 34+50

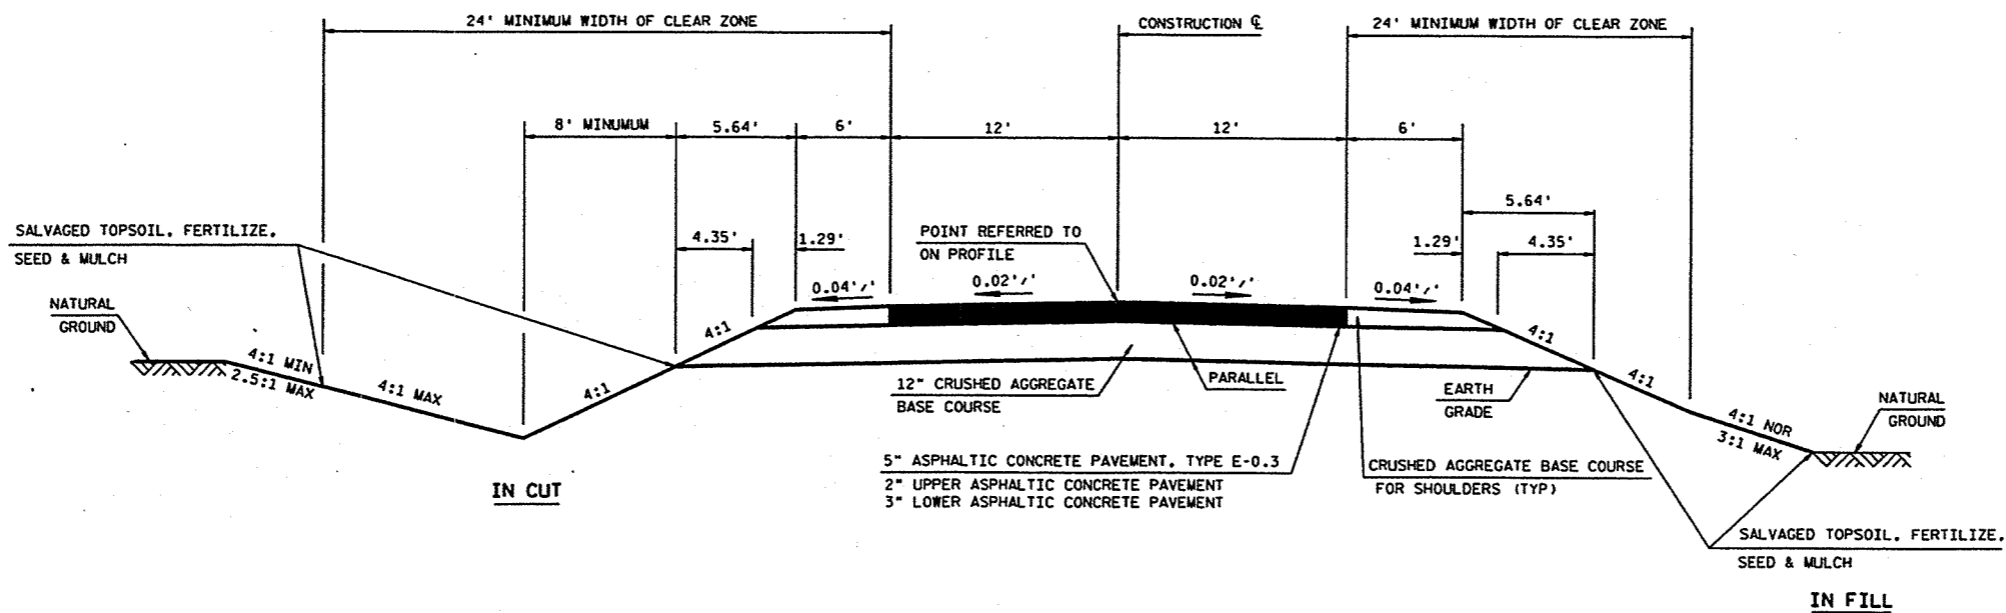

TYPICAL FINISHED CROSS SECTION FOR CTH Y
STA 34+50 TO 41+50

STATE PROJECT NUMBER: 6200-05-71

HWY: STH 110

COUNTY: WINNEBAGO

TYPICAL CROSS SECTIONS

SCALE, FEET

SHEET NO: 2.8

E

FILE NAME: F:\d3_620005\200.dgn

PLOT DATE: 29-NOV-2001 08:31

ORG DATE: 12-21-00


PLOT NAME: 200y

Originator: DISTRICT 3 -- JD

PLOT SCALE: 10.030303:1.000000


WISDOT/CADD SHEET 42

LEVELS ON - 1.8, 2.4, 3.0, 39.0, 40.0, 41.0, 42.0, 43.0, 44.0, 45.0, 46.0, 47.0, 48.0, 49.0, 50.0, 51.0, 52.0, 53.0, 54.0, 55.0, 56.0, 57.0, 58.0, 59.0, 60.0, 61.0, 62.0, 63.0

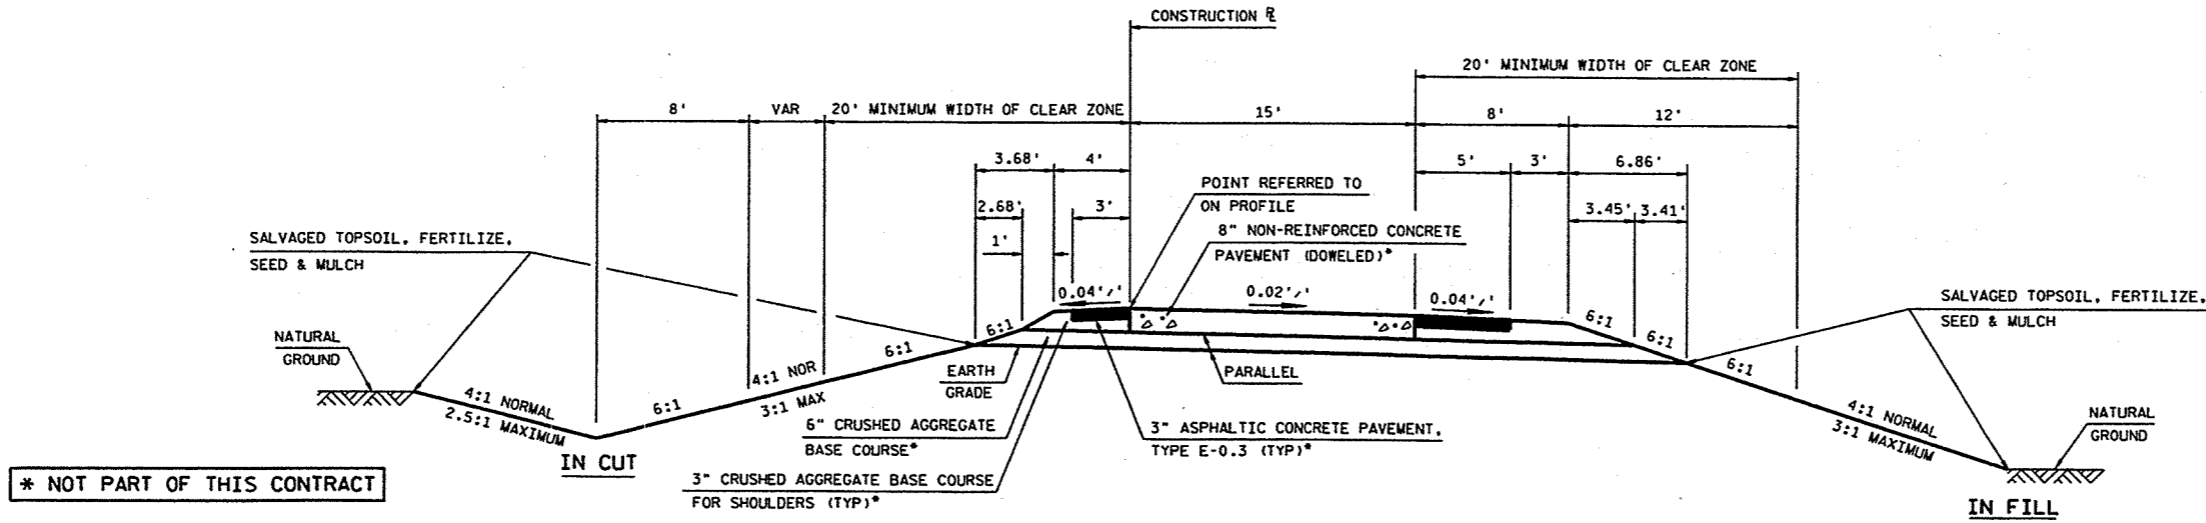


TYPICAL FINISHED CROSS SECTION FOR RAMPS AT STH 116 / CTH GG

STA 362+70 TO 373+19.71 (SOUTHEAST RAMP)
 STA 362+47.90 TO 376+08.24 (SOUTHWEST RAMP)
 STA 378+00 TO 386+64.57 (NORTHEAST RAMP)

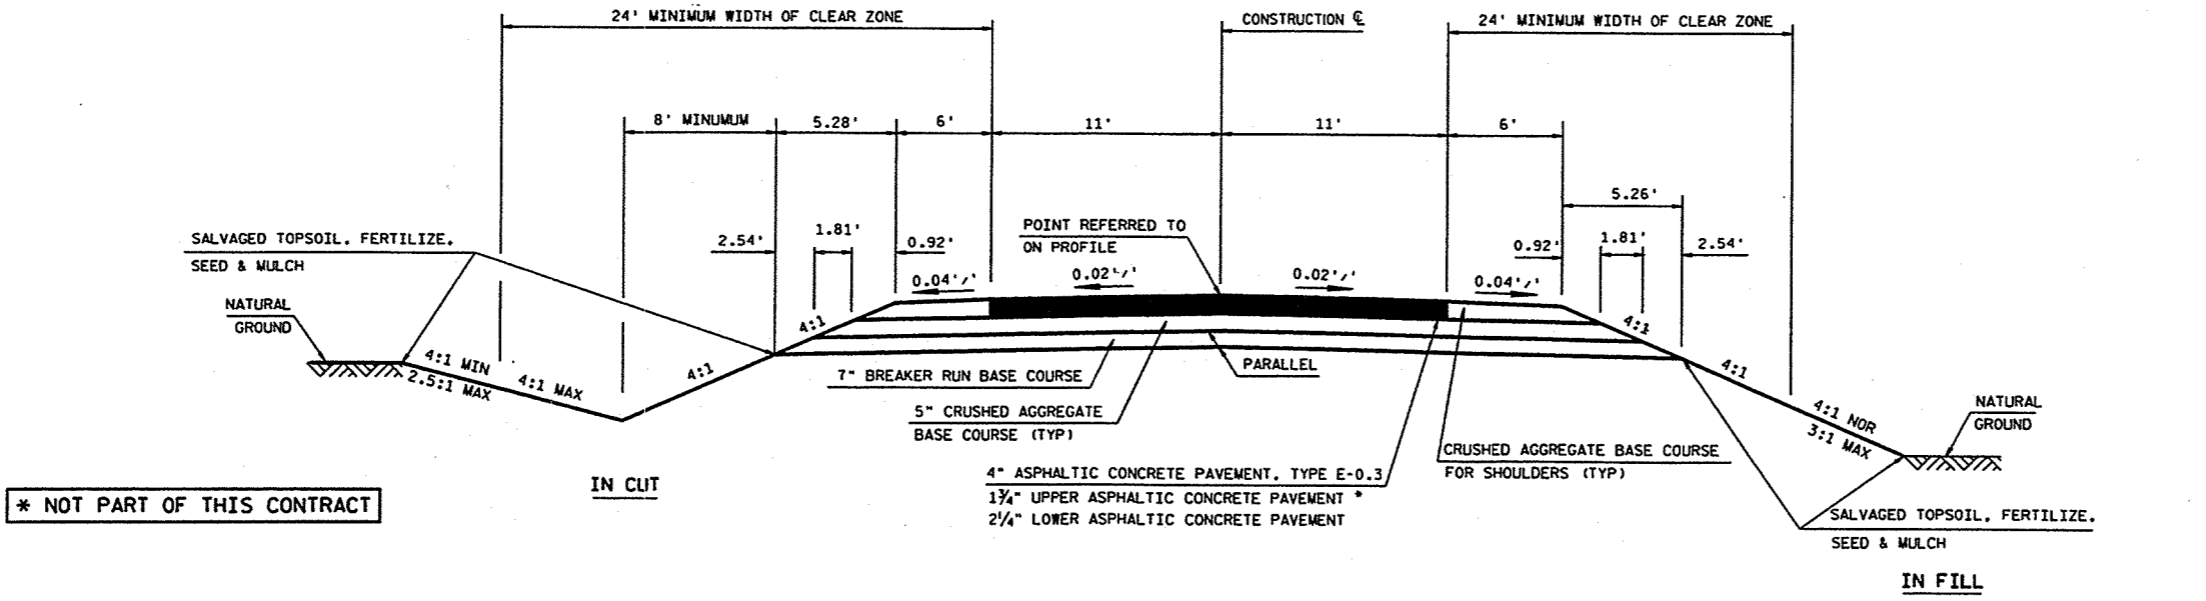


TYPICAL FINISHED CROSS SECTION FOR SOUTHWEST FRONTAGE ROAD AT STH 116

STA 13+00 TO 21+25

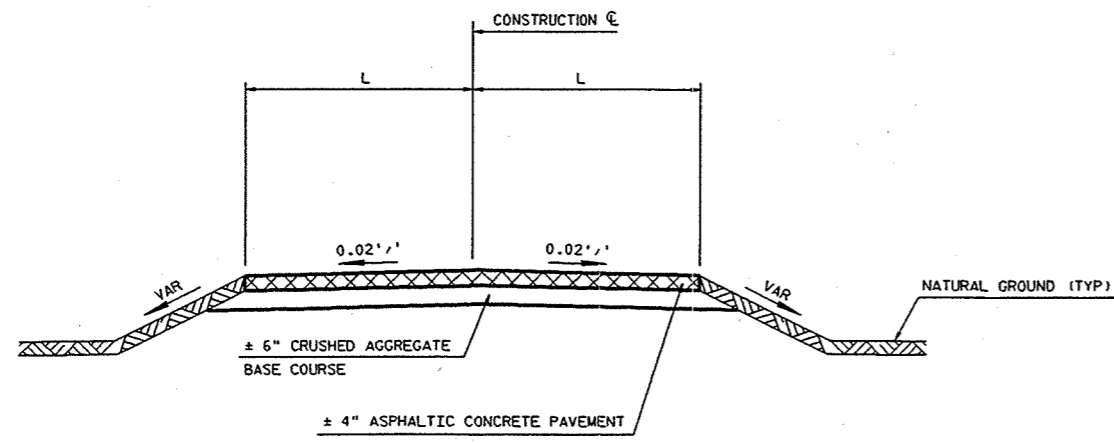


TYPICAL EXISTING CROSS SECTION FOR SIDE ROADS

- STA 3+00 TO 30+50 (BROOKS ROAD)
L=12'
- STA 3+00 TO 26+00 (SKELETON BRIDGE ROAD)
L= 8'
- STA 15+00 TO 72+92 (KOLB ROAD)
L=10'
- STA 10+00 TO 22+00 (SPIEGELBERG ROAD)
L=10'

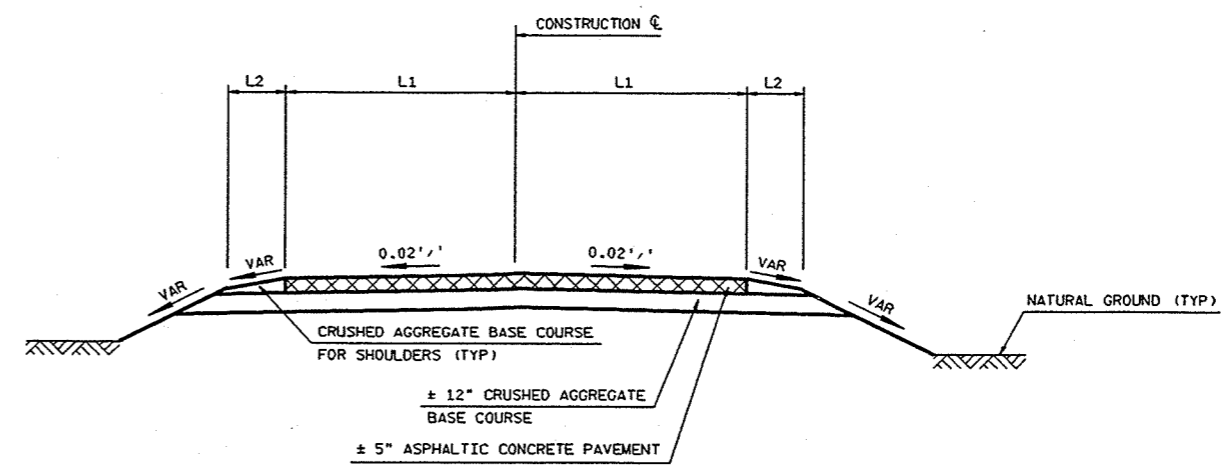


TYPICAL EXISTING CROSS SECTION FOR CTH Y

- STA 30+00 TO 41+50
L1=10'
L2=2'

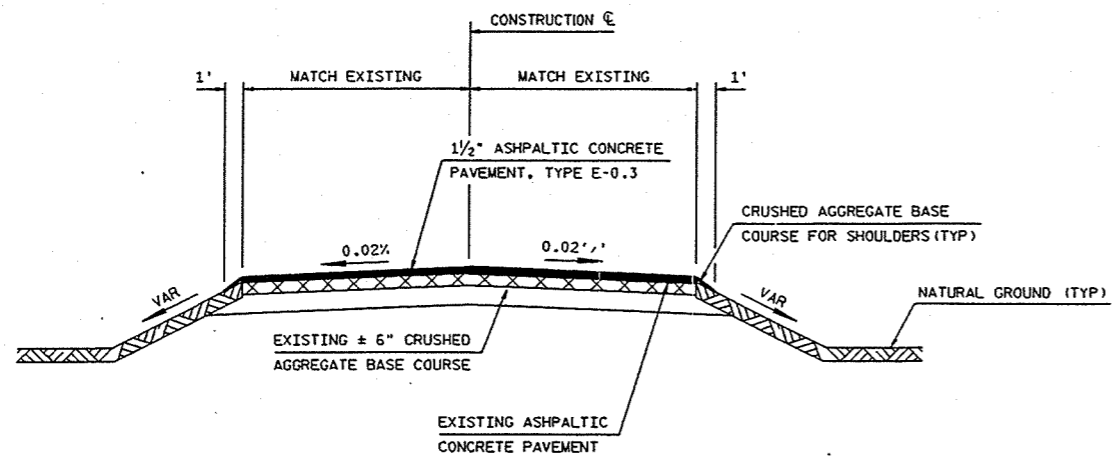

TYPICAL FINISHED CROSS SECTION FOR SKELETON BRIDGE ROAD
BROOKS ROAD TO STA 3+00

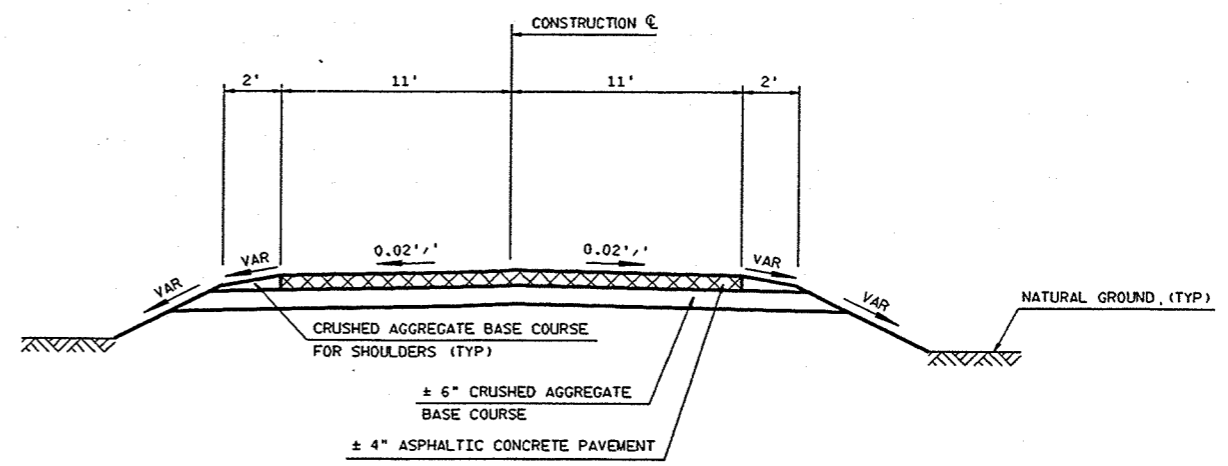

TYPICAL EXISTING CROSS SECTION FOR RYF ROAD

- STA 10+00 TO 26+00

NOTE: STATIONING SHOWN FOR EXISTING CROSS SECTIONS IS RELATIVE TO NEW CONSTRUCTION STATIONING.

LEVELS ON - 1, 2, 3, 62, 63

SOILS INFORMATION

GENERAL NOTES:

SURVEY LINE MIT6 USED FOR BASELINE AND OFFSETS.

BORINGS WERE MADE JANUARY 2001

THE MOISTURE CONTENT AND WATER TABLE WILL FLUCTUATE WITH SEASONAL CONDITIONS AND RAINFALL.

BORING NUMBER	SAMPLE NUMBER	LOCATION WETLAND MITIGATION SITE MIT6 BASE LINE	SAMPLE DEPTH FROM EXISTING GROUND FT	FIELD IDENTIFICATION	FIELD MOIST %	OPTIMUM %	+/- OF OPTIMUM	WATER TABLE EST.	P-200 %	LL PL PI			AASHTO CLASS.
										LL	PL	PI	
MB1	S-1	11+00 800' RT	8.0'	BROWN F-M SAND	6.1	13	-6.9	-	25.7	NP	-	-	A2-4
MB1	S-2	11+00 800' RT	13.0'	BROWN SILTY SAND	17.1	13	+4.1	-	13.7	NP	-	-	A2-4
MB2	S-1	8+00 800' RT	2.5'	REDDISH CLAY	22.5	18.9	+3.6	-	71.8	43.8	18.9	24.9	A7-6(13)
MB3	S-1	5+00 800' RT	4.0'	RED CLAY	19	15	+4.0	-	70.4	34.1	16	18.1	A6(10)
MB3	S-2	5+00 800' RT	8.0'	RED SILTY CLAY	17.8	15	+2.8	-	81.1	33.1	15.2	17.9	A6(11)
MB3	S-3	5+00 800' RT	13.0'	GREY SILT	22.3	12	+10.3	-	88.1	NP	-	-	A4(8)
MB4	S-1	2+00 800' RT	4.0'	RED CLAY TR GRAVEL	18.5	15	+3.5	-	69.8	30.9	14.9	16	A6(9)
MB4	S-2	2+00 800' RT	11.0'	RED CLAY TR GRAVEL	16.5	15	+1.5	-	69.8	31.7	14.6	17.1	A6(10)
MB5	S-1	11+00 500' RT	6.0'	REDDISH BR CLAY TR GRAVEL	19	15	+4.0	-	74.2	33.7	15.1	18.6	A6(11)
MB5	S-2	11+00 500' RT	12.0'	REDDISH BR CLAY TR GRAVEL	17.4	15	+2.4	-	70	31.8	11.7	20.1	A6(12)
MB6	S-1	8+00 500' RT	3.0'	RED CLAY	21.1	18.9	+2.2	-	76.1	46.6	19.4	27.2	A7-6(16)
MB6	S-2	8+00 500' RT	8.0'	RED CLAY TR GRAVEL	17.1	15	+2.1	-	73	28.2	15.2	13	A6(8)
MB6	S-3	8+00 500' RT	13.0'	RED CLAY TR GRAVEL	18.4	15	+3.4	-	80	33.9	14.9	19	A6(12)
MB7	S-1	5+00 500' RT	3.0'	SILTY CLAY TR GRAVEL	18.3	15	+3.3	-	66.9	26.8	19.7	7.1	A4(6)
MB7	S-2	5+00 500' RT	7.0'	SILTY CLAY TR GRAVEL	17.8	15	+2.8	-	77.1	31.7	14.2	17.5	A6(11)
MB8	S-1	2+00 500' RT	2.0'	SILTY SAND & GRAVEL	19.9	12	+7.9	-	70.3	NP	-	-	A4(7)
MB8	S-2	2+00 500' RT	3.0'	RED CLAY	36.1	25.8	+10.3	-	92.9	73.1	26.7	46.4	A7-6(20)
MB9	S-1	11+00 200' RT	3.0'	GREY MOTTLE CLAY	31.5	25.8	+5.7	-	98.8	70.4	24.9	45.5	A7-6(20)
MB9	S-2	11+00 200' RT	7.0'	RED BR SANDY CLAY	15.5	15	+0.5	-	58.7	17.8	12.3	5.5	A4(5)
MB10	S-1	8+00 200' RT	3.0'	RED CLAY	37	25.8	+11.2	-	95.4	65.9	25.5	40.4	A7-6(20)
MB10	S-2	8+00 200' RT	6.5'	RED CLAY	27.4	18.9	+8.5	-	100	48.9	21.6	27.3	A7-6(17)
MB11	S-1	5+00 200' RT	3.0'	RED CLAY	33.8	25.8	+8.0	-	96	66.6	23.7	42.9	A7-6(20)
MB12	S-1	2+00 200' RT	3.0'	GREY CLAY	27.6	25.8	+1.8	-	96.9	68.8	22.7	46.1	A7-6(20)
MB13	S-1	11+00 100' LT	3.0'	RED CLAY	28.9	18.9	+10.0	-	92.6	52.4	17.8	34.6	A7-6(18)
MB13	S-2	11+00 100' LT	6.0"	GREY CLAY	42.6	25.8	+20.8	-	98	67.6	28.3	39.4	A7-6(20)
MB14	S-1	8+00 100' LT	3.0'	RED CLAY	28.5	25.8	+2.7	-	97.9	70.7	35.2	35.5	A7-6(20)
MB14	S-2	8+00 100' LT	9.0'	REDDISH BR CLAYEY SILT	19.4	15	+4.4	-	88.6	23.8	13.6	10.2	A4(8)
MB15	S-1	5+00 100" LT	3.0'	RED CLAY	41.2	15	+26.2	-	95.5	32.7	16	16.7	A6(10)
MB16	S-1	5+00 100' LT	2.0'	RED CLAY	41.4	25.8	+15.6	-	97.2	74.6	27.8	46.8	A7-6(20)


HWY: STH 110

COUNTY: WINNEBAGO


STATE PROJECT NO: 6200-05-71

SHEET NO: 2.12


E

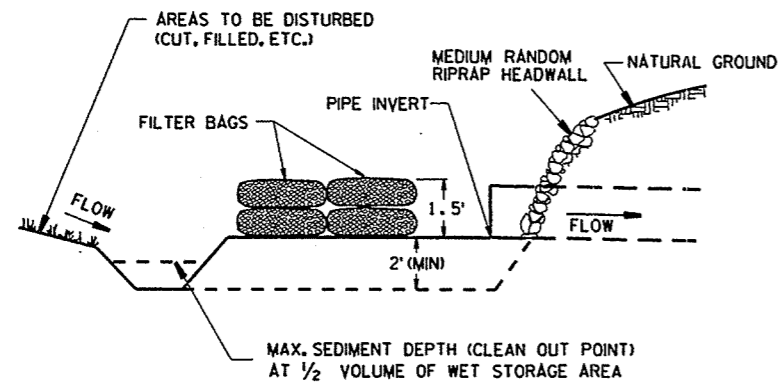


CULVERT INLET SEDIMENT TRAP
SECTION A-A

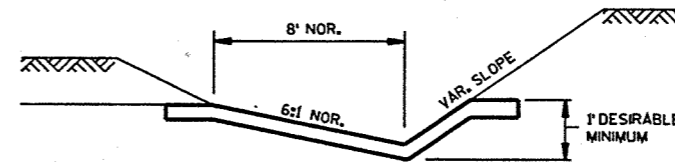


EROSION MAT DETAIL FOR DITCHES

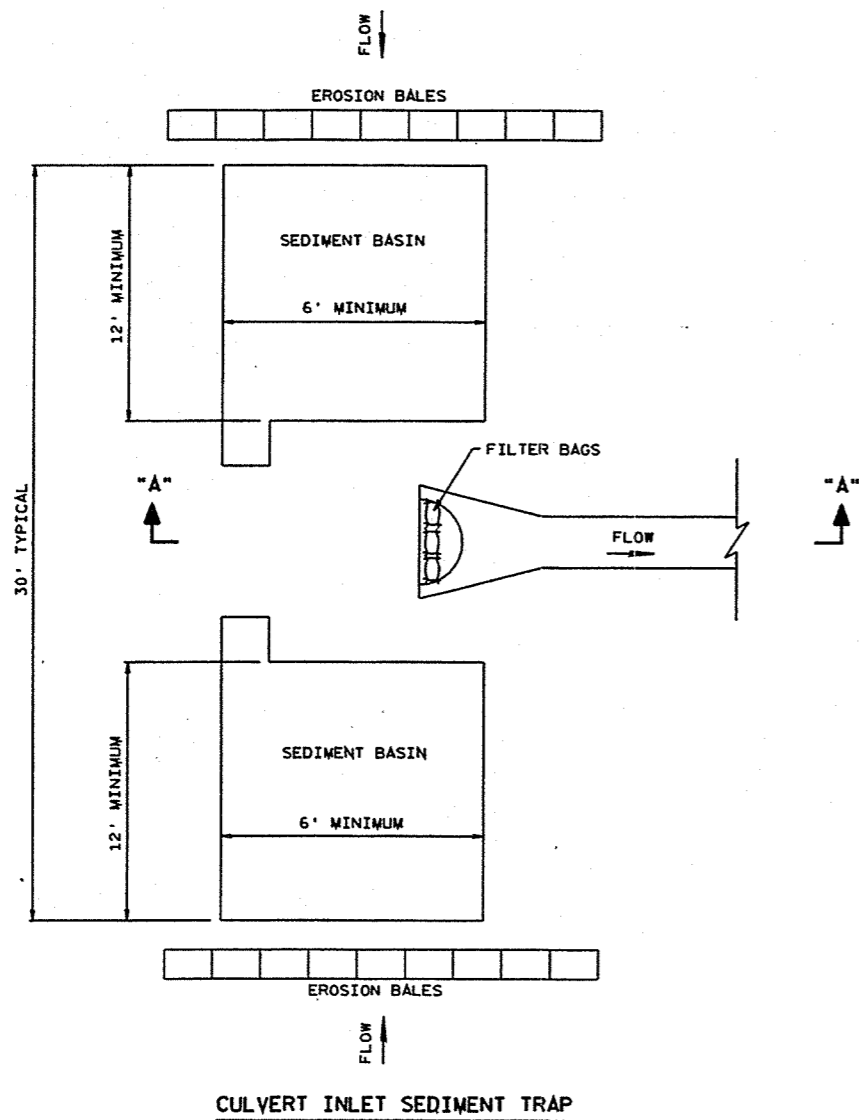

CULVERT INLET SEDIMENT TRAP

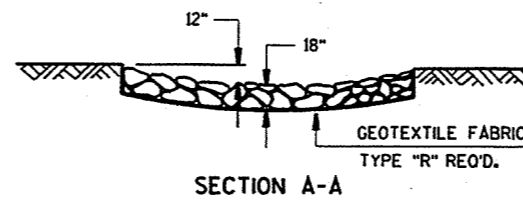


SECTION A-A

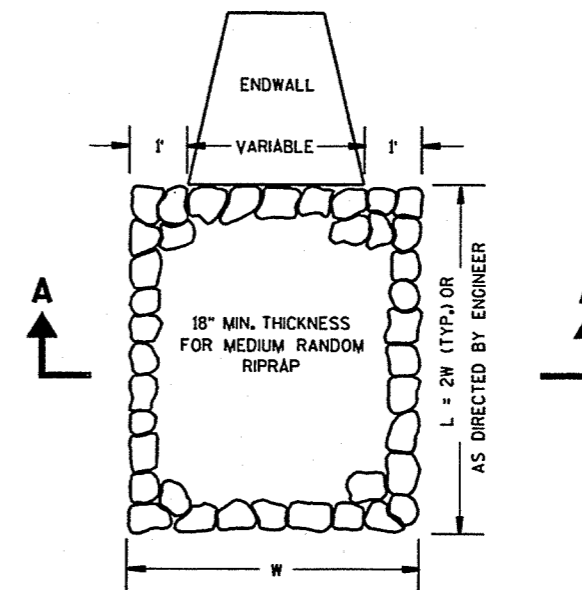


MEDIUM RANDOM RIPRAP TREATMENT AT CULVERTS

LEVELS ON - 1, 2, 3, 62, 63


LEVELS: 0W - 1, 2, 3, 62, 63

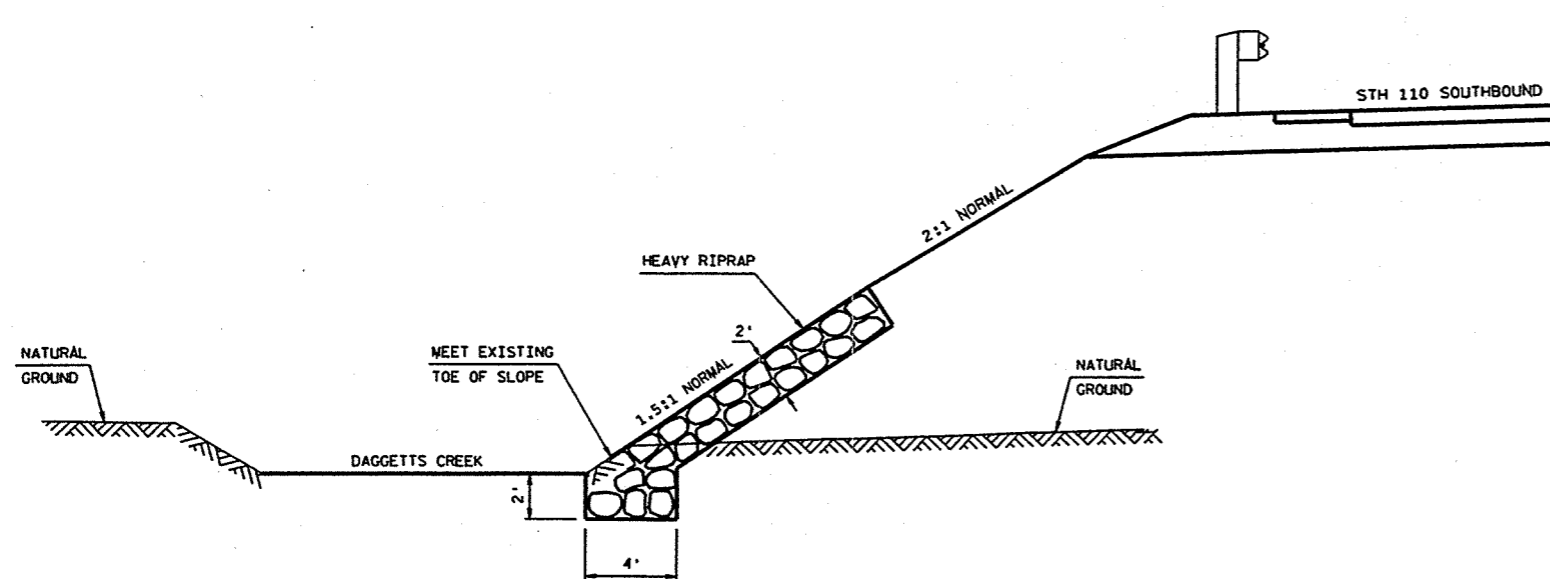



**EMBANKMENT DETAIL
NEAR DAGGETTS CREEK**
STA 278+40 - STA 279+10

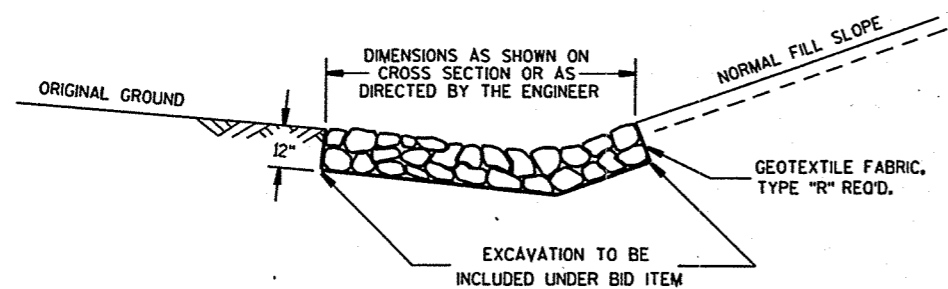


DETAIL FOR RIPRAP IN DITCHES

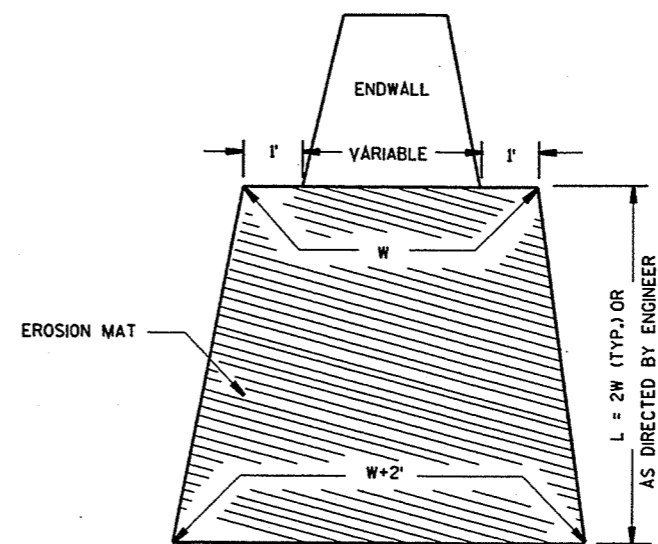

EROSION MAT TREATMENT AT CULVERTS

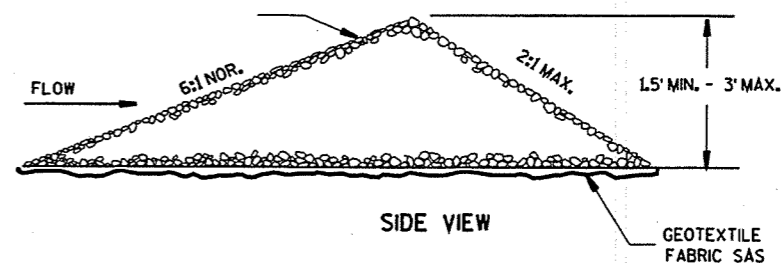
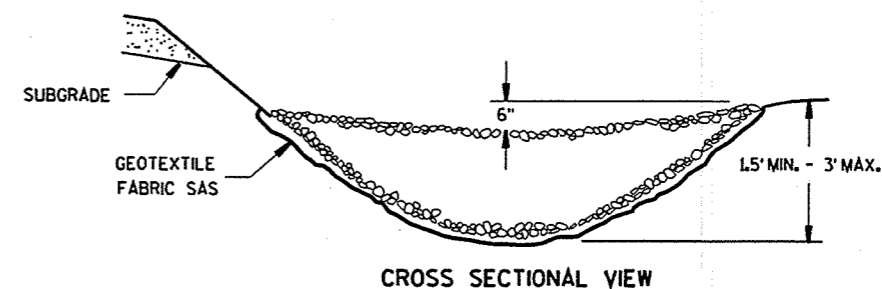


L = THE DISTANCE SUCH THAT POINTS
A AND B ARE OF EQUAL ELEVATION

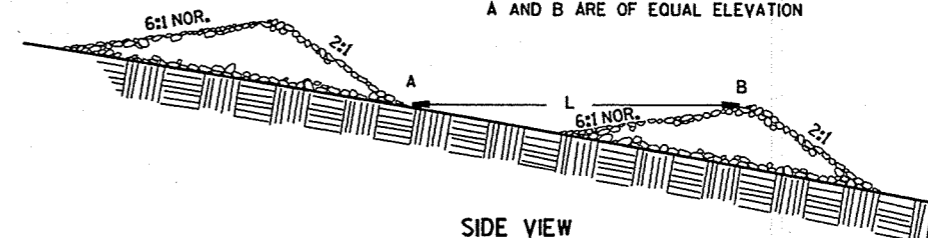


STONE OR ROCK DITCH CHECKS


LEVELS ON - 1, 2, 3, 62, 63

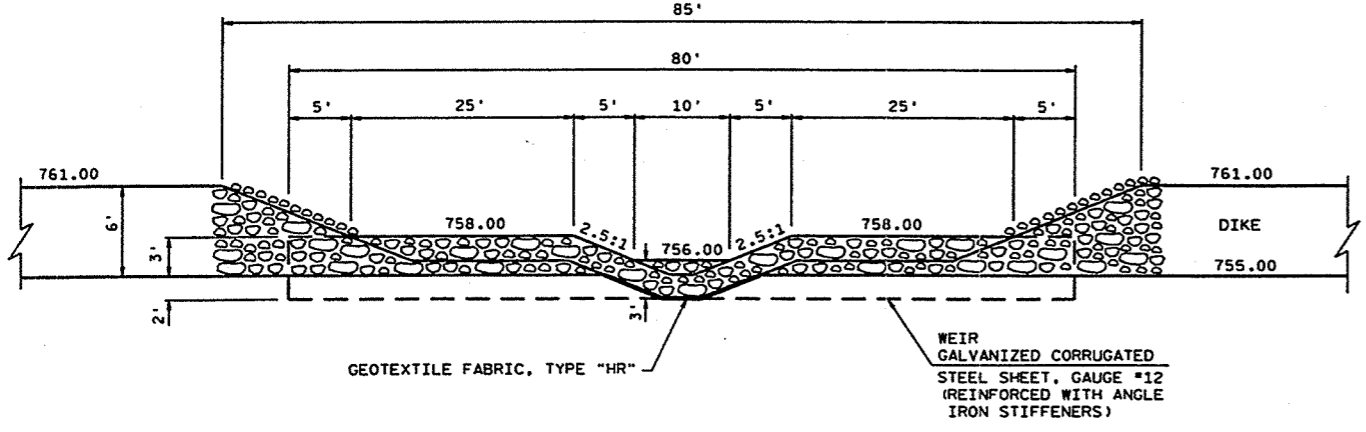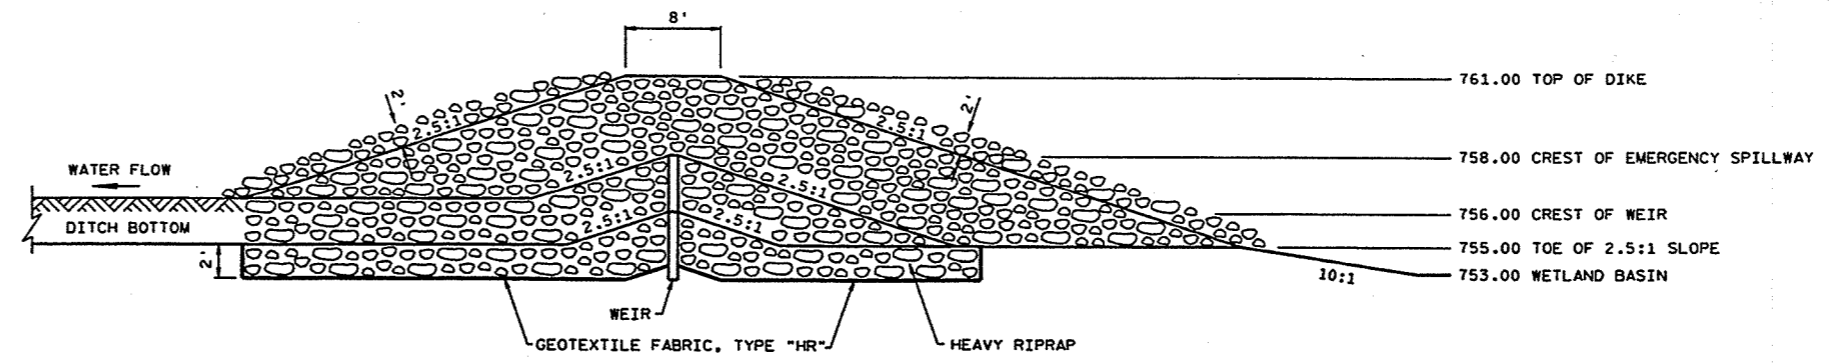

SECTION A-A

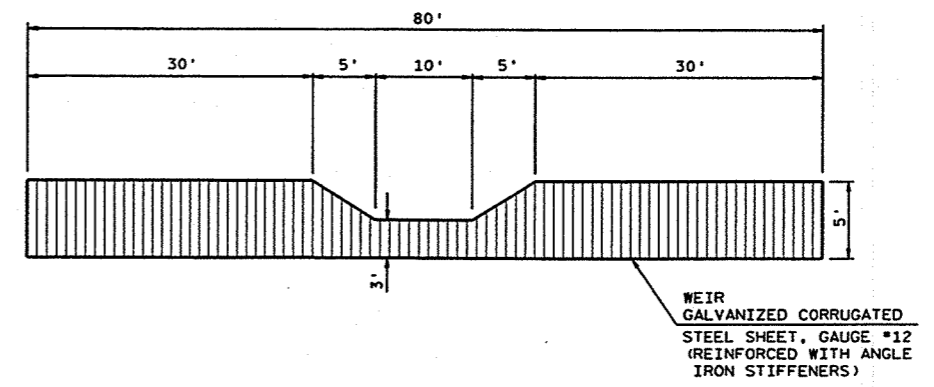




WEIR PLATE

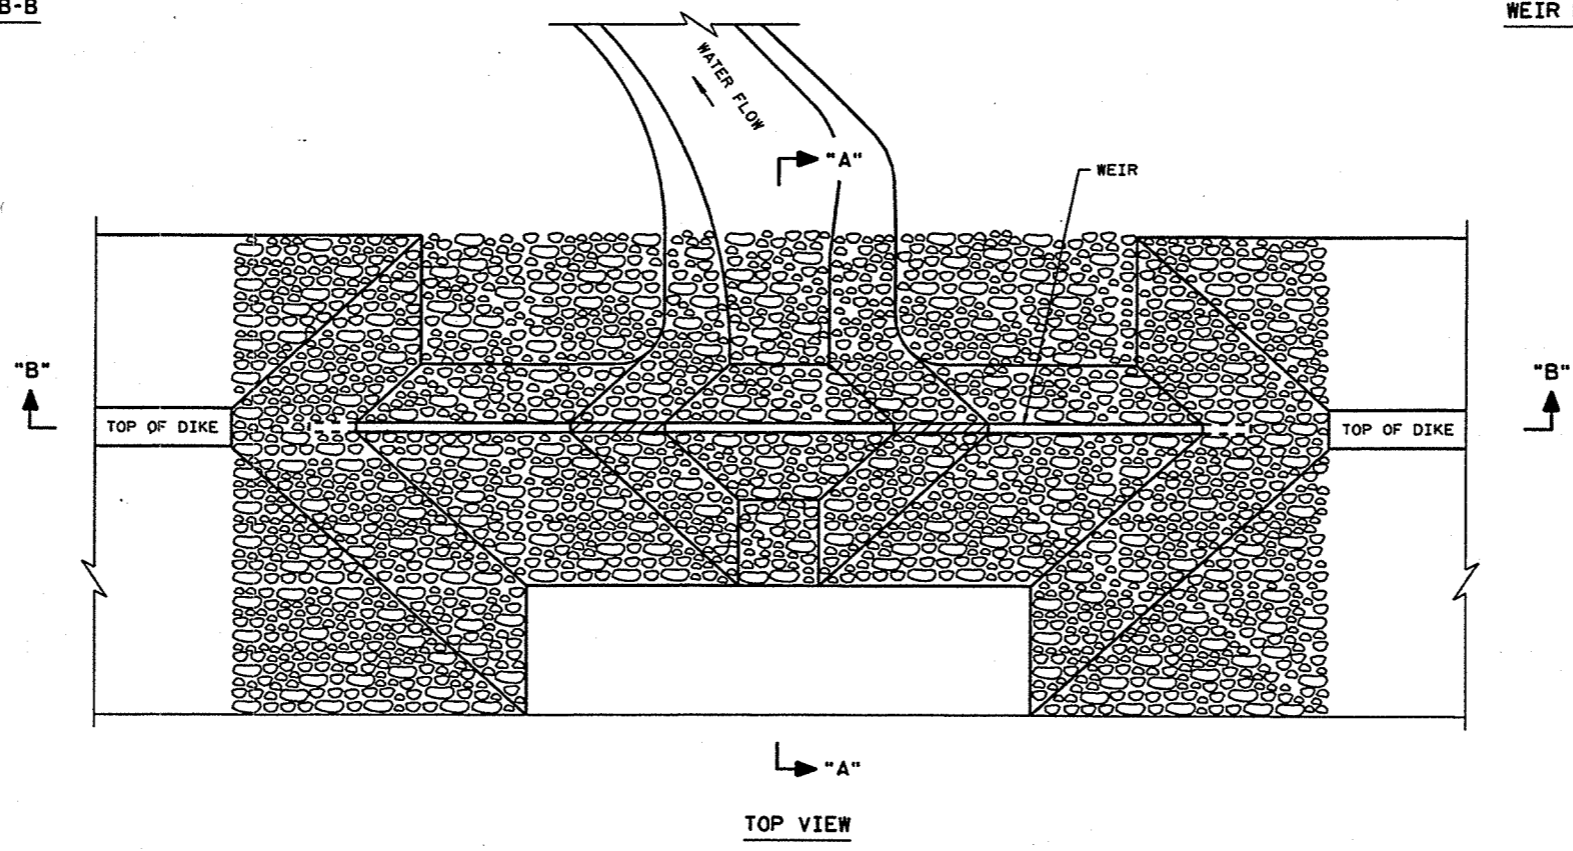

TOP VIEW

WEIR DETAIL FOR WETLAND MITIGATION SITE

LEVELS ON - 1.2, 3.4, 5.6, 7.8, 9.9, 11.0, 12.1, 62.7, 63.8

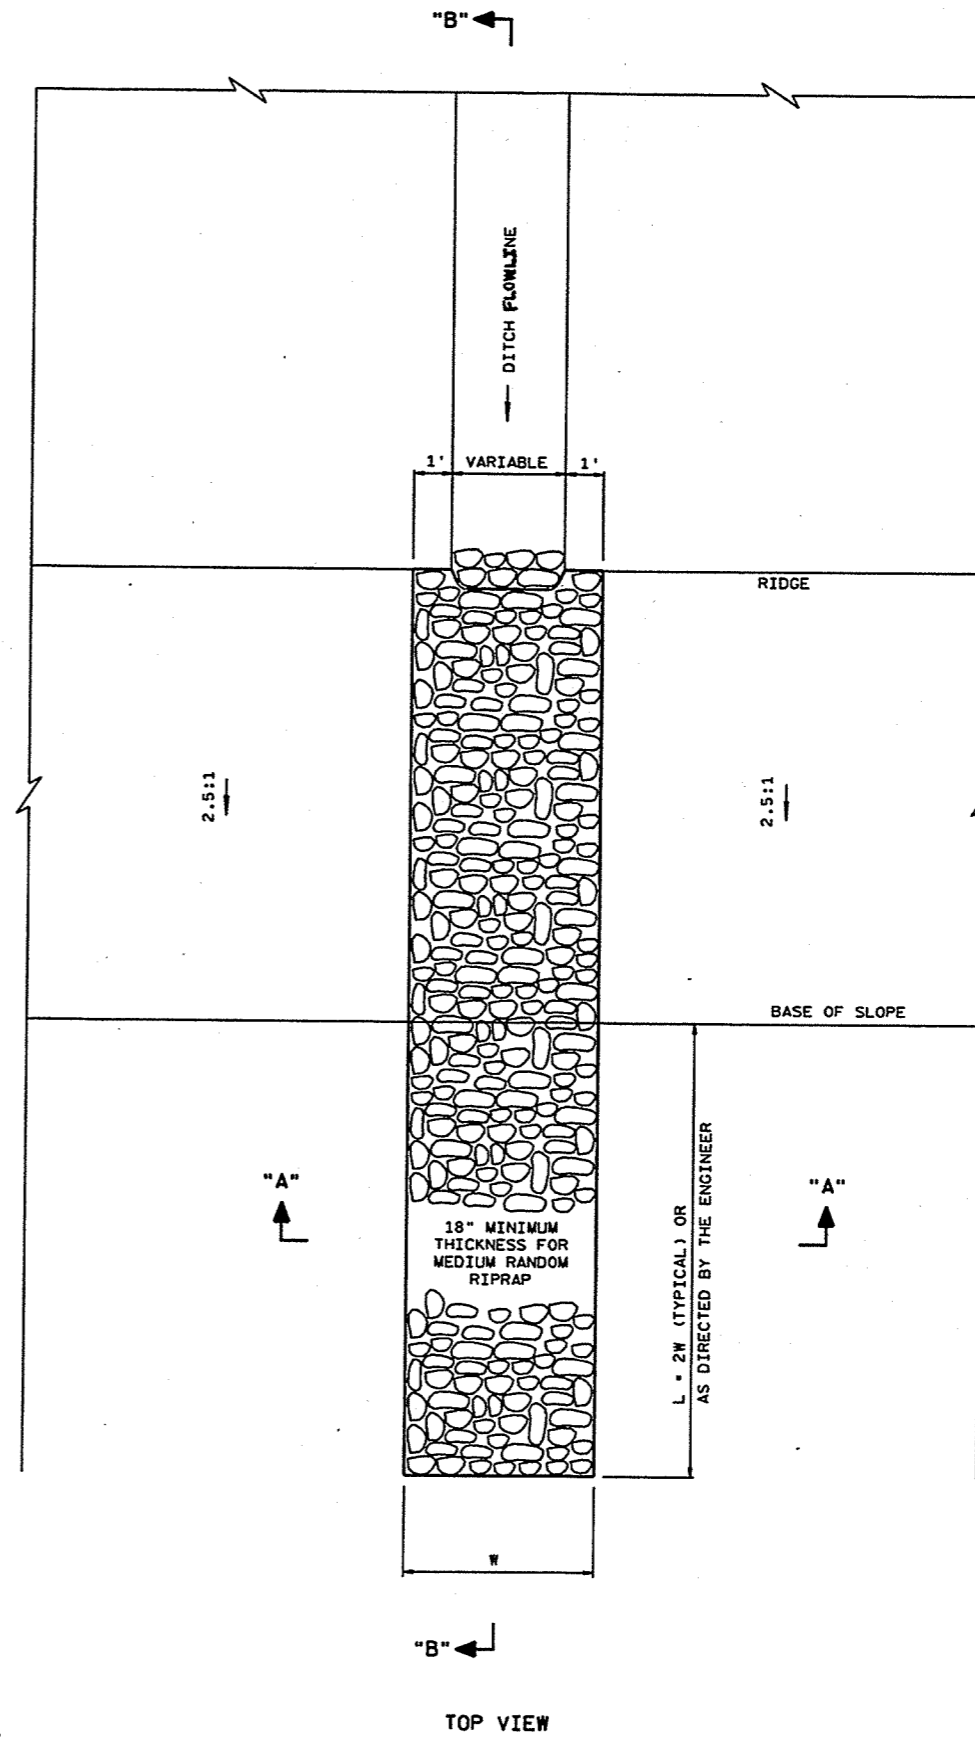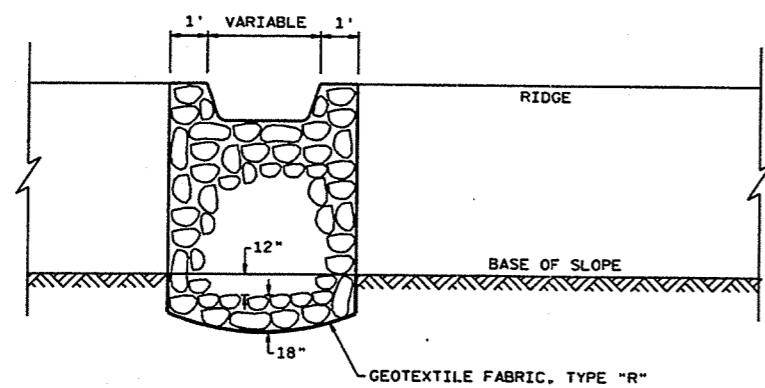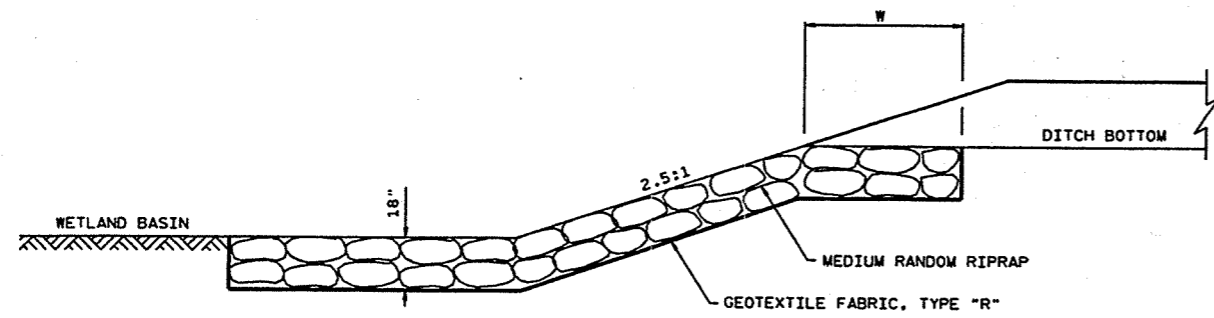

INLET DETAIL FOR WETLAND MITIGATION SITE

STATE PROJECT NUMBER: 6200-05-71

HWY: STH 110

COUNTY: WINNEBAGO

CONSTRUCTION DETAILS

SCALE, FEET 0 100 200

SHEET NO: 2.16

E

FILE NAME: F:\d3_620005\206.dgn

PLOT DATE: 21-JUN-2001 14:00


ORG DATE: 3-26-01

PLOT NAME: 206jd


Originator: DISTRICT 3

PLOT SCALE: 200.606061:1.000000

WISDOT/CADD SHEET 42

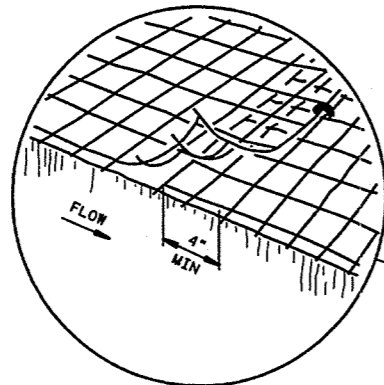


LAP JOINT

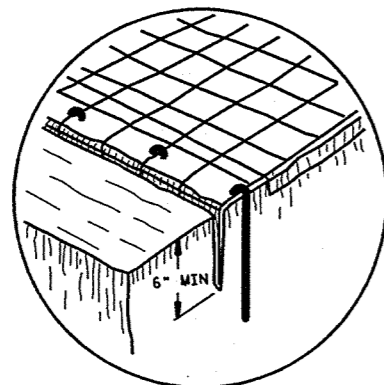


ANCHOR SLOT


AT UPPER MOST EDGE OF EROSION MAT
EMBEDDED IN THE SLOPE

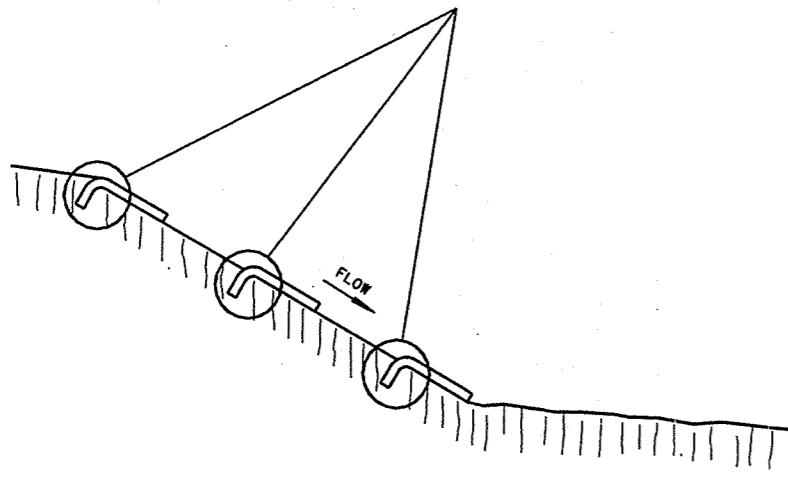

SECTION A-A

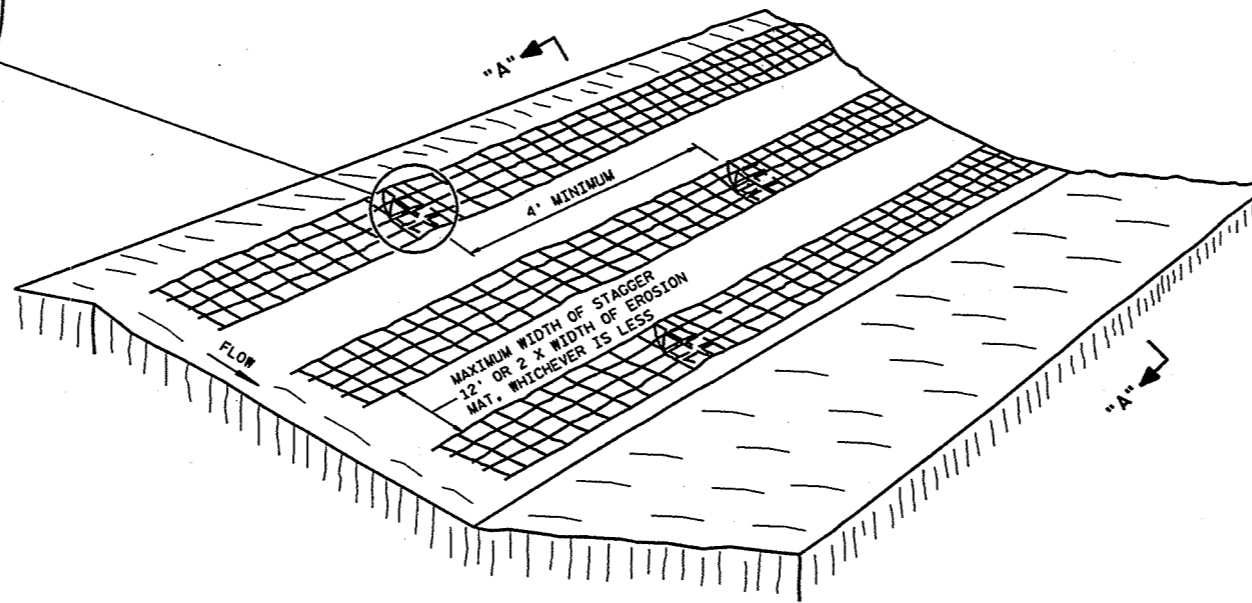

PERSPECTIVE

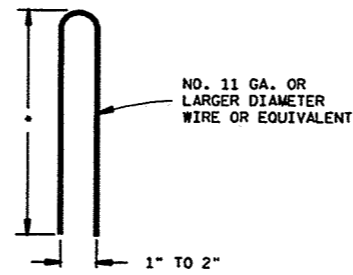

DETAIL OF
TYPICAL STAPLE

- * 6" MIN. FOR FIRM SOILS
- 12" MIN. FOR LOOSE SOILS
- 8" MIN. WHERE BOTH SOD AND MATS ARE USED

GENERAL NOTES

INSTALLATION IS TO BE USED ONLY IN DESIGNATED AREAS AS DIRECTED BY THE ENGINEER.

DETAILS OF CONSTRUCTION NOT SHOWN ON THIS DRAWING SHALL CONFORM TO THE PERTINENT REQUIREMENTS OF THE STANDARD SPECIFICATIONS.

EROSION MAT SHALL BE LAID TRANSVERSELY TO THE DIRECTION OF THE WATER FLOW.

DIMENSIONS SHALL BE ADJUSTED TO FIT THE SITE CONDITIONS AS DIRECTED BY THE ENGINEER.


TYPE AND CLASS OF EROSION MAT USED SHALL BE IN ACCORDANCE WITH THE PLANS OR AS DIRECTED BY THE ENGINEER.

EDGES OF THE EROSION MAT SHALL BE IMPRESSED IN THE SOIL.

LAP JOINTS ON ADJACENT STRIPS OF MATTING SHALL BE STAGGERED A MINIMUM OF 4 FEET APART.

DETAIL FOR STAGGERED EROSION MAT INSTALLATION FOR LARGE SLOPE COVERAGE

LEVELS ON: 1, 2, 3, 62, 63

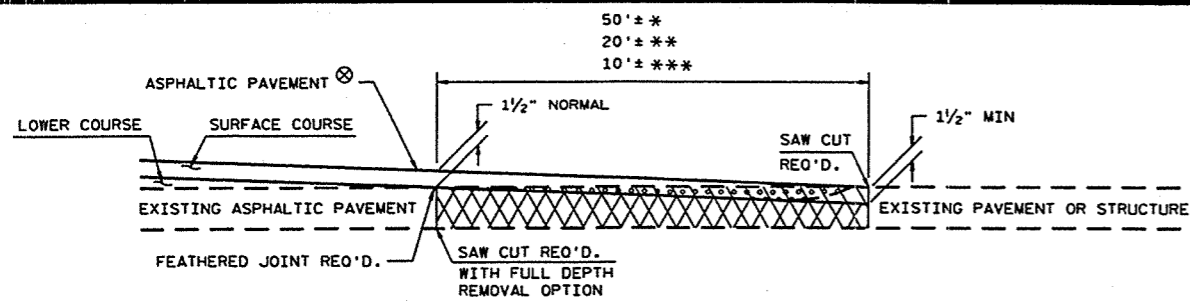


⊗ SEE TYPICAL CROSS SECTION FOR PAVEMENT TYPE AND THICKNESS OF INDIVIDUAL COURSES


- REMOVING ASPHALTIC SURFACE, BUTT JOINTS (FULL DEPTH REMOVAL OPTIONAL)
- ASPHALTIC WEDGING (FULL DEPTH REMOVAL OPTION)
- REMOVING ASPHALTIC SURFACE, BUTT JOINTS (MILLING OPTION)

BUTT JOINT DETAIL FOR NON-MILLED ASPHALTIC PAVEMENTS

- * MAINLINE
- ** SIDEROADS
- *** PRIVATE ENTRANCES

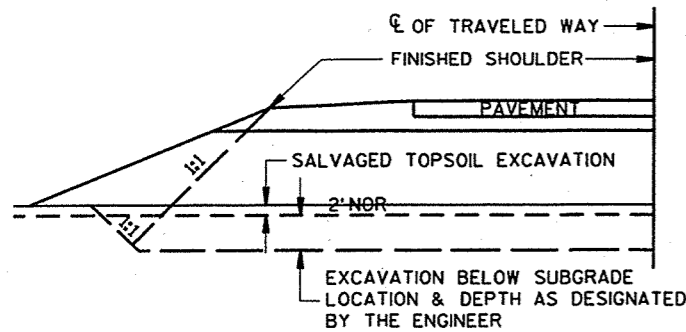


DETAIL FOR EXCAVATION BELOW SUBGRADE

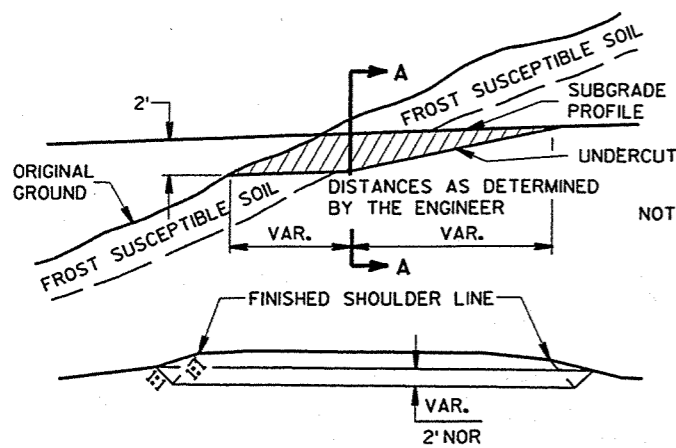


**SECTION A-A
CROSS SECTION SHOWING UNDERCUT
DETAIL FOR EXCAVATION BELOW
SUBGRADE AT CUTS**

NOTE: EXACT LOCATIONS AND EXTENT OF E.B.S. SECTIONS SHALL BE DETERMINED BY THE ENGINEER IN THE FIELD. E.B.S. AREA TO BE BACKFILLED WITH MATERIAL ACCEPTABLE TO THE ENGINEER. BACKFILL MUST BE HOMOGENEOUS WITH ADJOINING FILL MATERIAL. THE FILL SECTION WITHIN 100' OF THE MOUTH OF THE CUT MUST BE KEPT 2' BELOW SUBGRADE UNTIL E.B.S. IS COMPLETED.

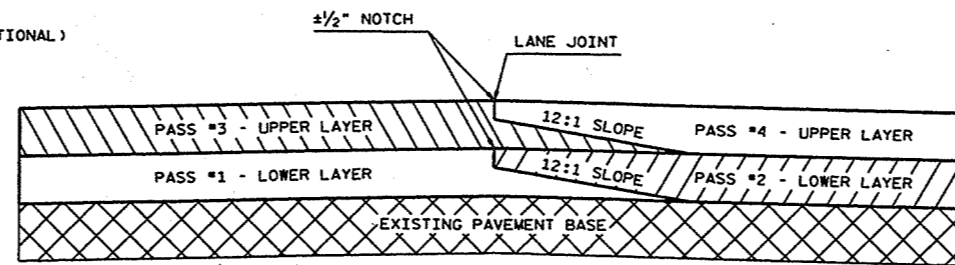



LOWER AND UPPER LAYERS

TYPICAL PAVEMENT CROSS SECTION OF TAPERED AND NOTCHED LONGITUDINAL JOINTS

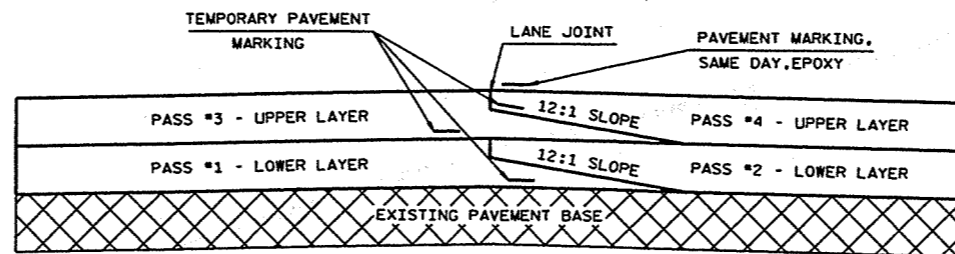


LOWER AND UPPER LAYERS

PAVEMENT MARKING DETAIL FOR TAPERED OVERLAPPING JOINTS IN ASPHALTIC PAVEMENTS

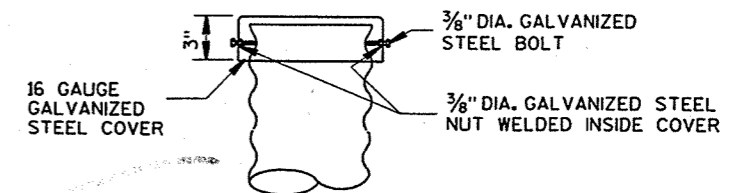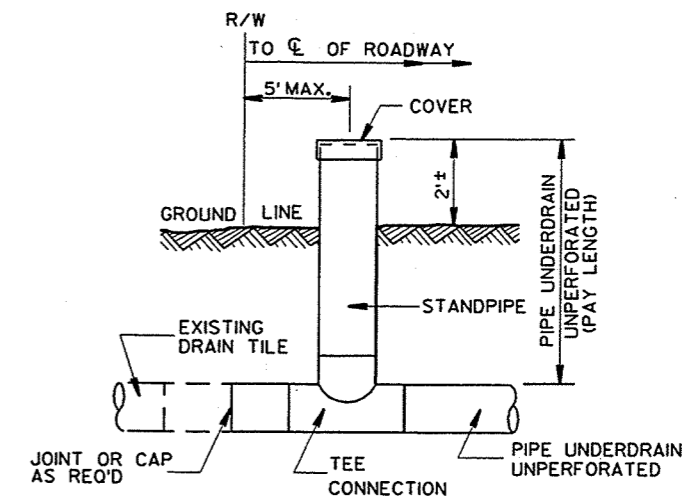


NOTE: THE COST OF FURNISHING AND INSTALLING THE CONNECTION TO THE UNDERDRAIN AND THE COVER SHALL BE CONSIDERED INCIDENTAL TO THE ITEM PIPE UNDERDRAIN, UNPERFORATED.

**INSPECTION STANDPIPE AIR VENT DETAIL
FOR FIELD TILE**

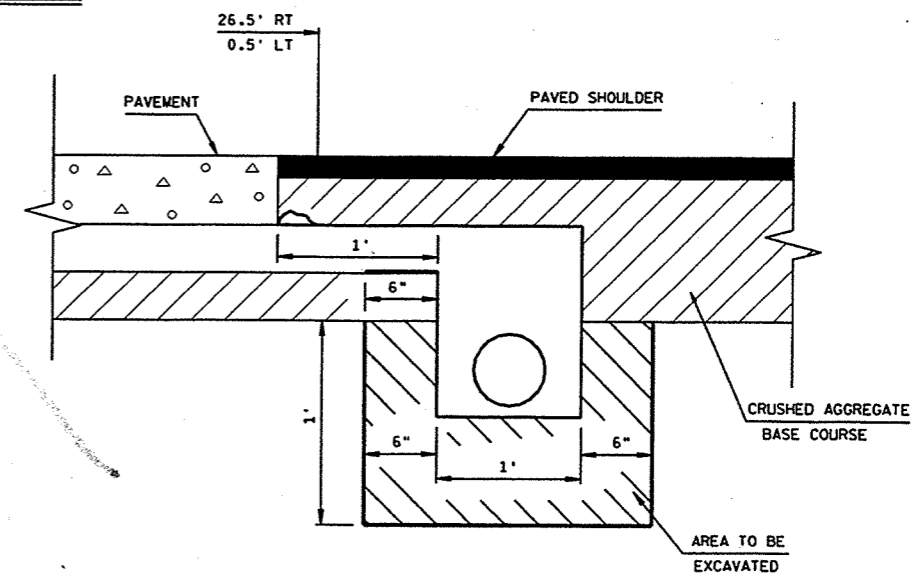


ROCK EXCAVATION FOR STORMSEWER


LEVELS: 01 - 1, 2, 3, 62, 63

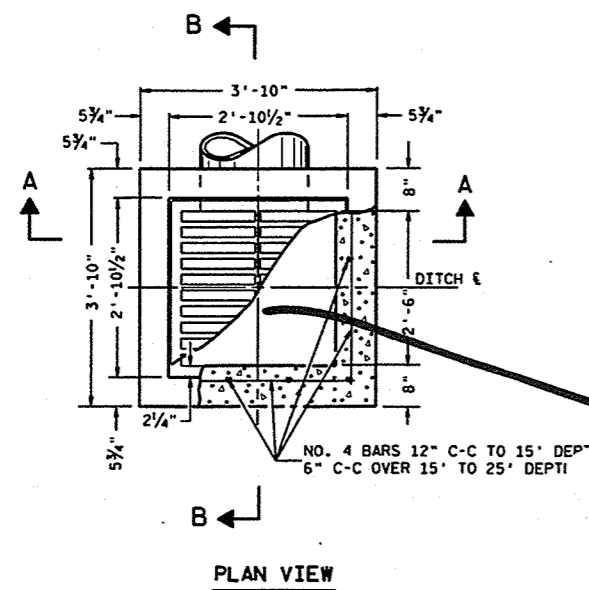

**REVISIONS
ATTACHED TO BACK
OF PLAN**

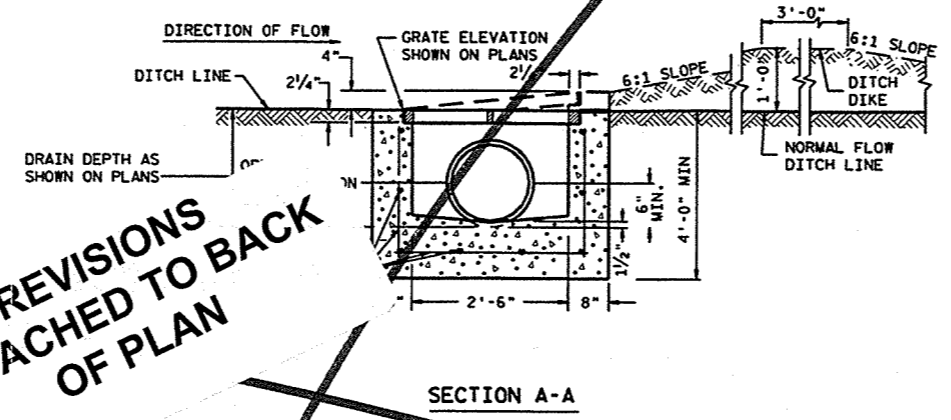

SECTION A-A

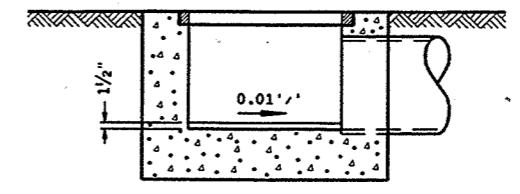

SECTION B-B

REINFORCED CONCRETE INLET TYPE 8, SPECIAL

GENERAL NOTES






DETAILS OF CONSTRUCTION, MATERIALS AND WORKMANSHIP NOT SHOWN ON THIS DRAWING SHALL CONFORM TO THE PERTINENT REQUIREMENTS OF THE STANDARD SPECIFICATIONS AND THE APPLICABLE SPECIAL PROVISIONS.

PRECAST REINFORCED CONCRETE INLET UNITS, IF USED, SHALL CONFORM TO THE REQUIREMENTS OF THE CATCH BASINS, MANHOLES AND INLETS SECTION OF THE STANDARD SPECIFICATIONS. UNLESS OTHERWISE AUTHORIZED IN WRITING BY THE ENGINEER, THE CONTRACTOR SHALL NOT ORDER AND DELIVER PRECAST INLET UNITS REQUIRED FOR THE PROJECT UNTIL A CORRECTED LIST OF SIZES IS FURNISHED BY THE ENGINEER.

ALL BAR STEEL REINFORCEMENT SHALL BE EMBEDDED 2 INCHES CLEAR UNLESS OTHERWISE SHOWN OR NOTED.


LEVELS ON - 1, 2, 3, 62, 63

LEVELS ON - 1, 2, 3, 62, 63

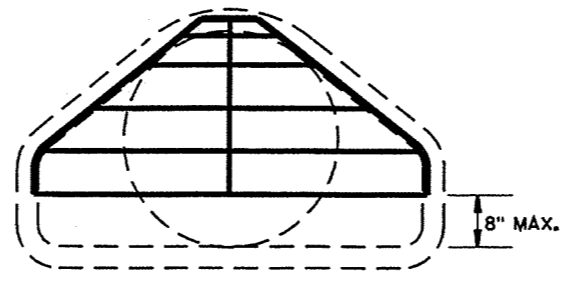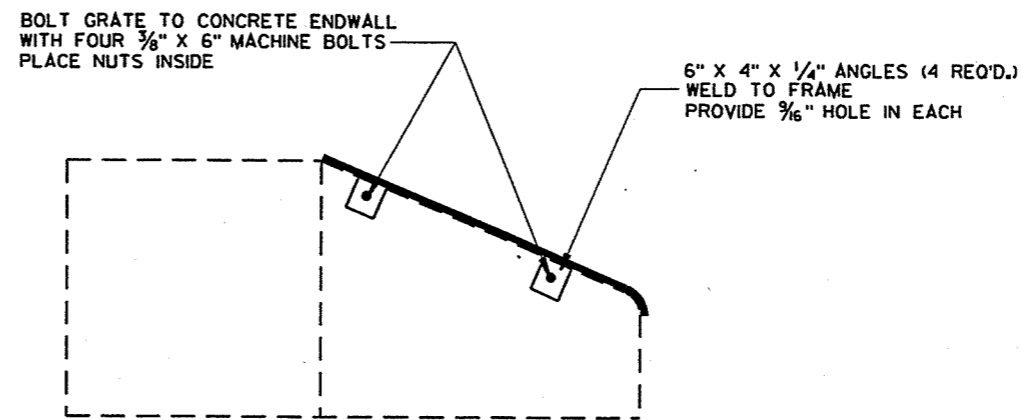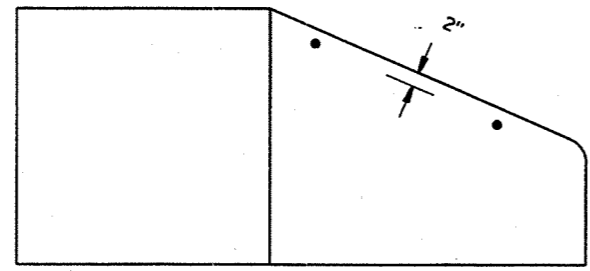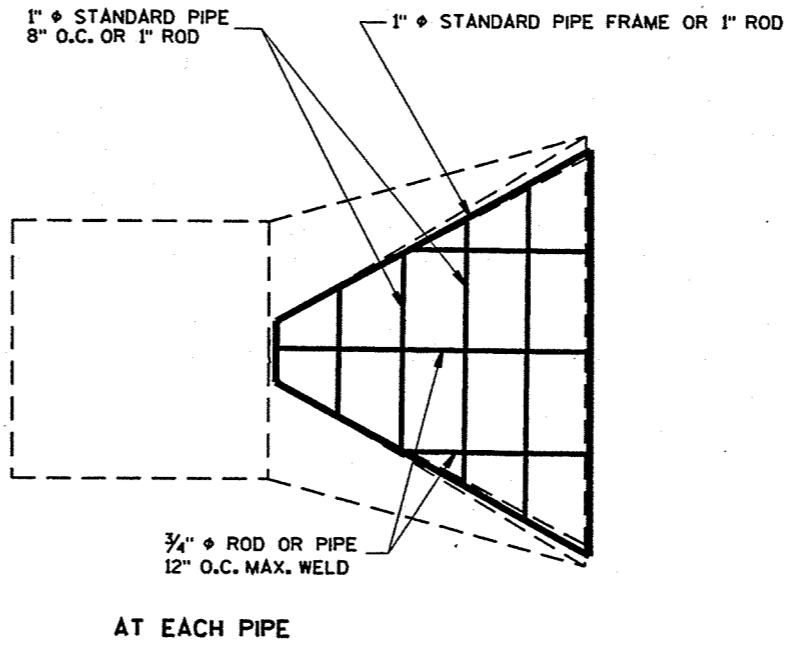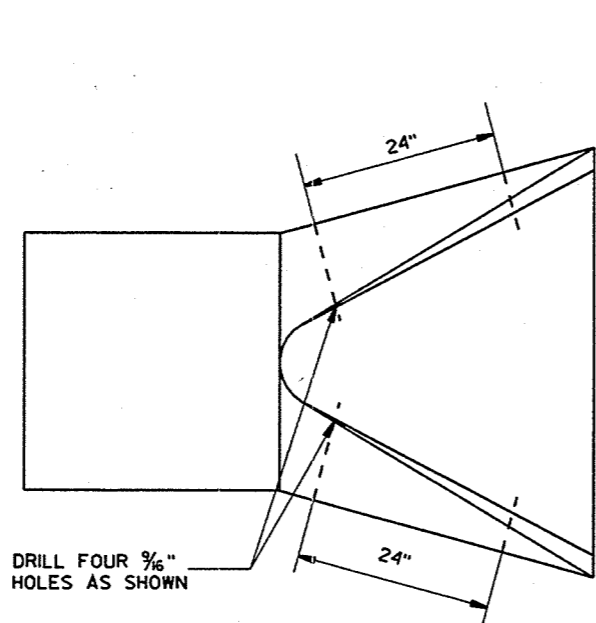


PIPE GRATE DETAIL

LEVELS ON - 1, 2, 3, 62, 63

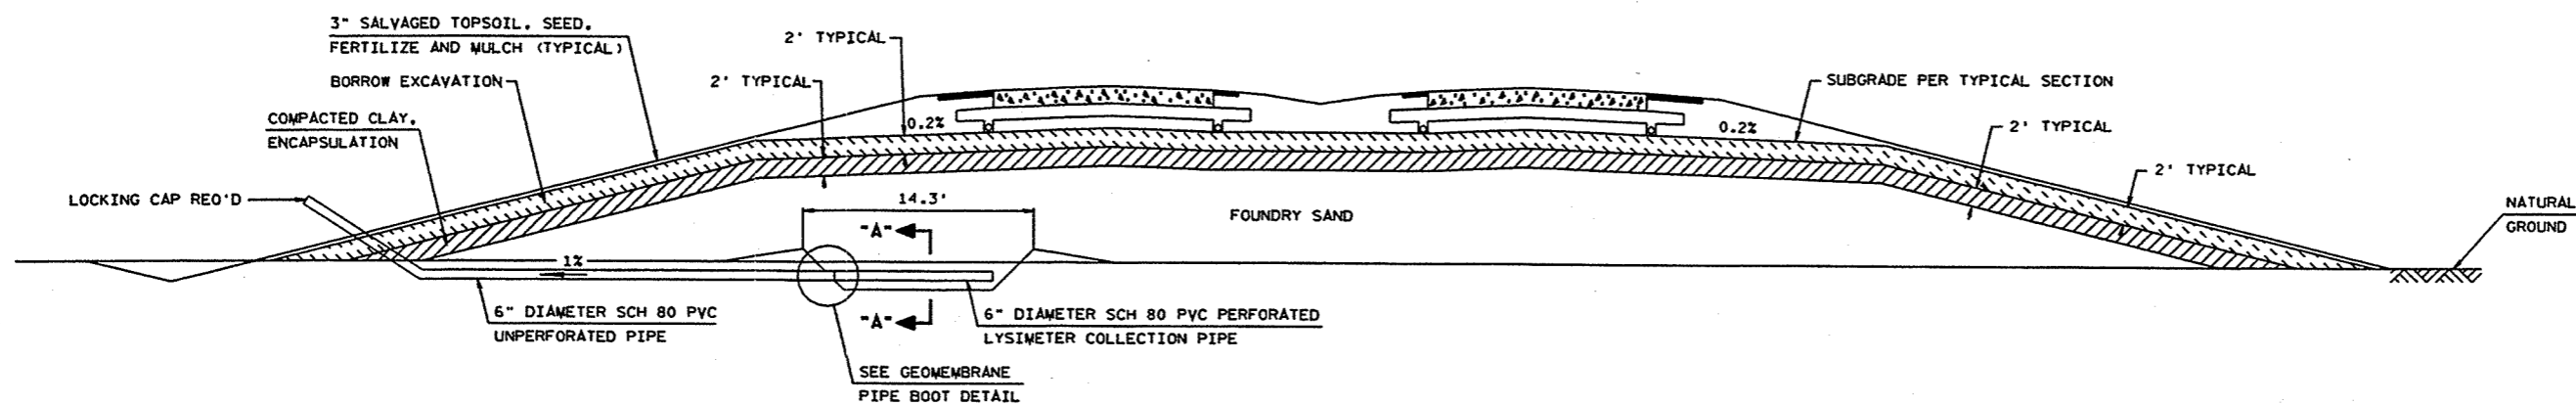


TYPICAL CROSS SECTION FOR FOUNDRY SAND PLACEMENT

STA 181+70 - STA 196+00 (STH 110)
LYSIMETER AT STA 188+50


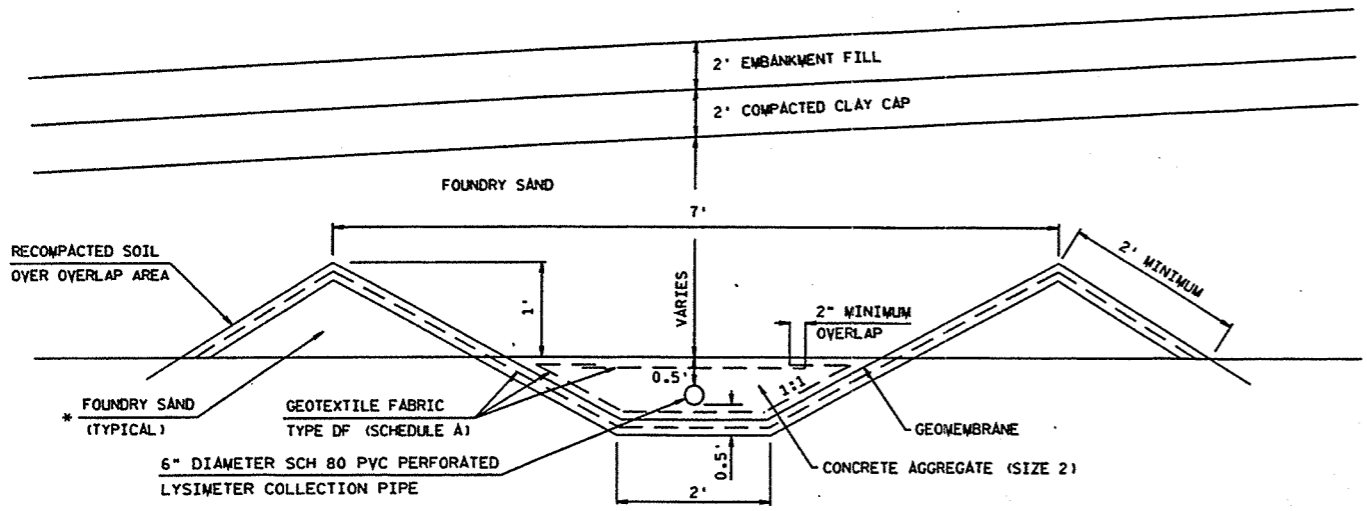


TYPICAL SECTION THRU LYSIMETER BELOW FOUNDRY SAND STRUCTURAL FILL (SECTION A-A)

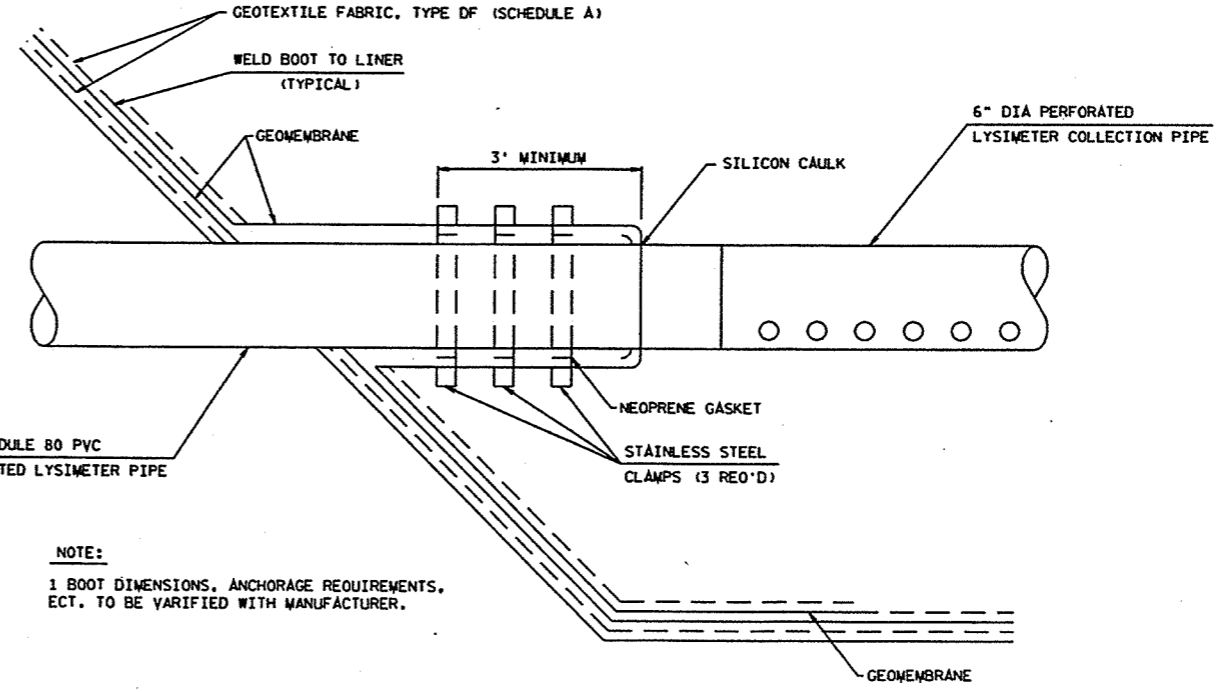


NOTE:
1. BOOT DIMENSIONS, ANCHORAGE REQUIREMENTS, ECT. TO BE VERIFIED WITH MANUFACTURER.


LEVELS ON - 1, 2, 3, 62, 63

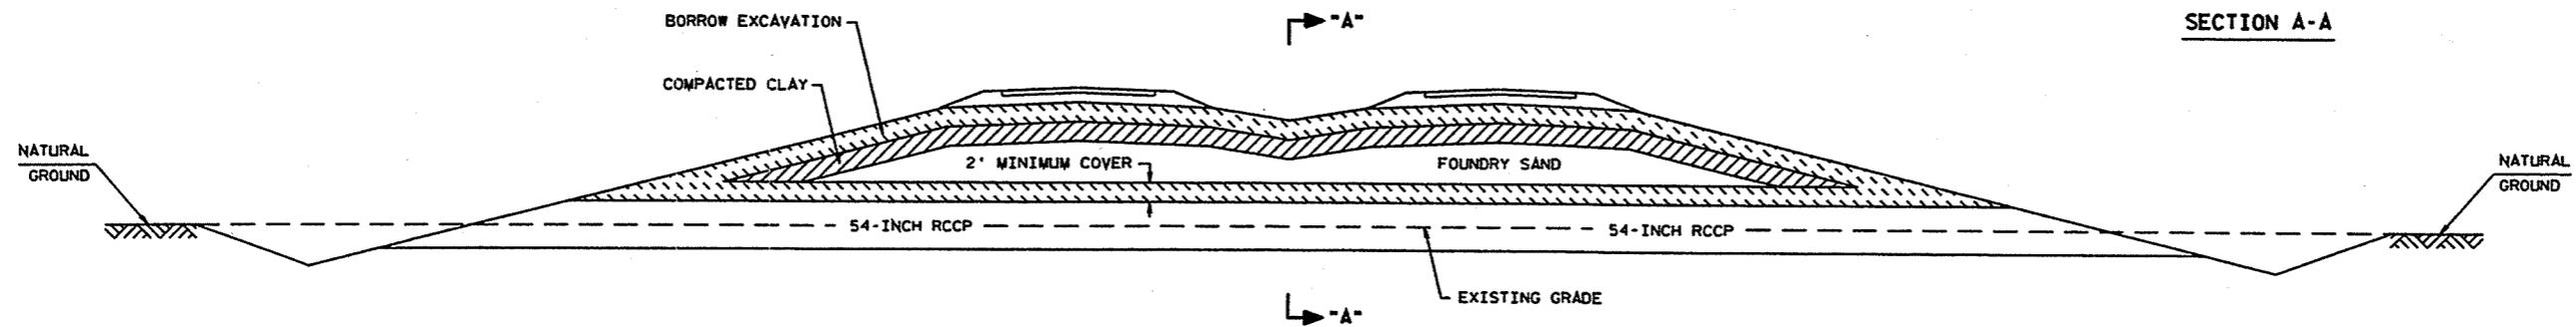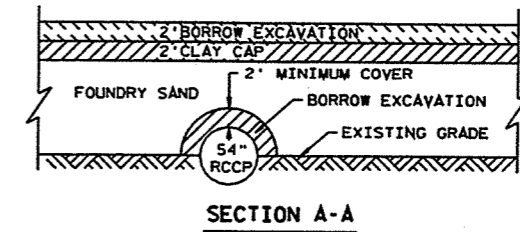

TYPICAL CROSS SECTION FOR COVER ON CROSSOVER PIPE
STA 188+00

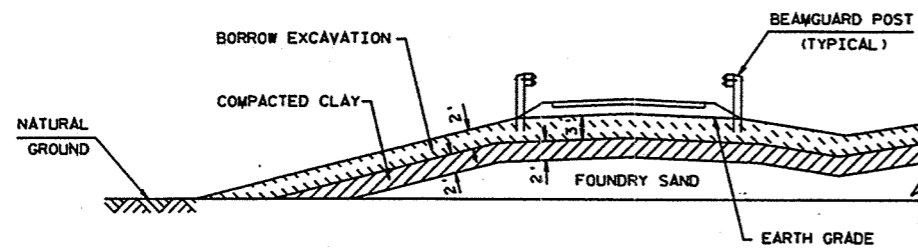


TYPICAL CROSS SECTION FOR COVER ON CLAY CAP FOR STH 110 SB LANE
STA 181+70 TO 183+00

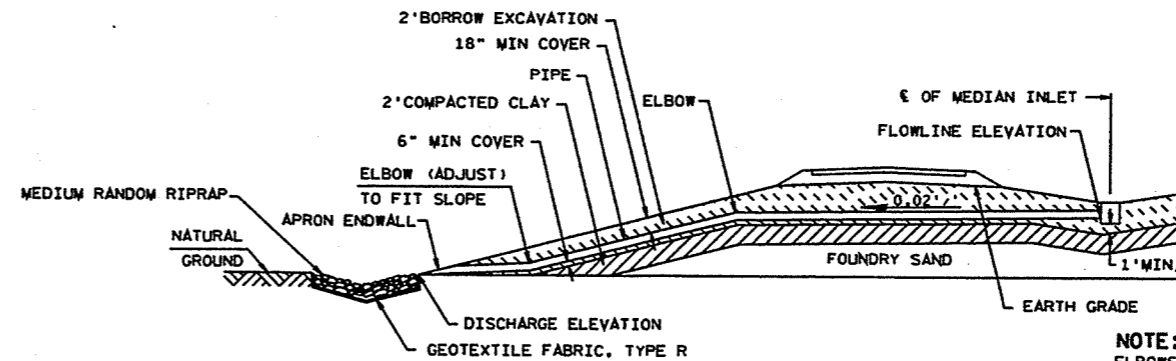


MEDIAN INLET TO DITCH BOTTOM WITH ELBOWS
STA 189+50

NOTE:
ELBOWS MEASURED AND PAID FOR AS PIPE

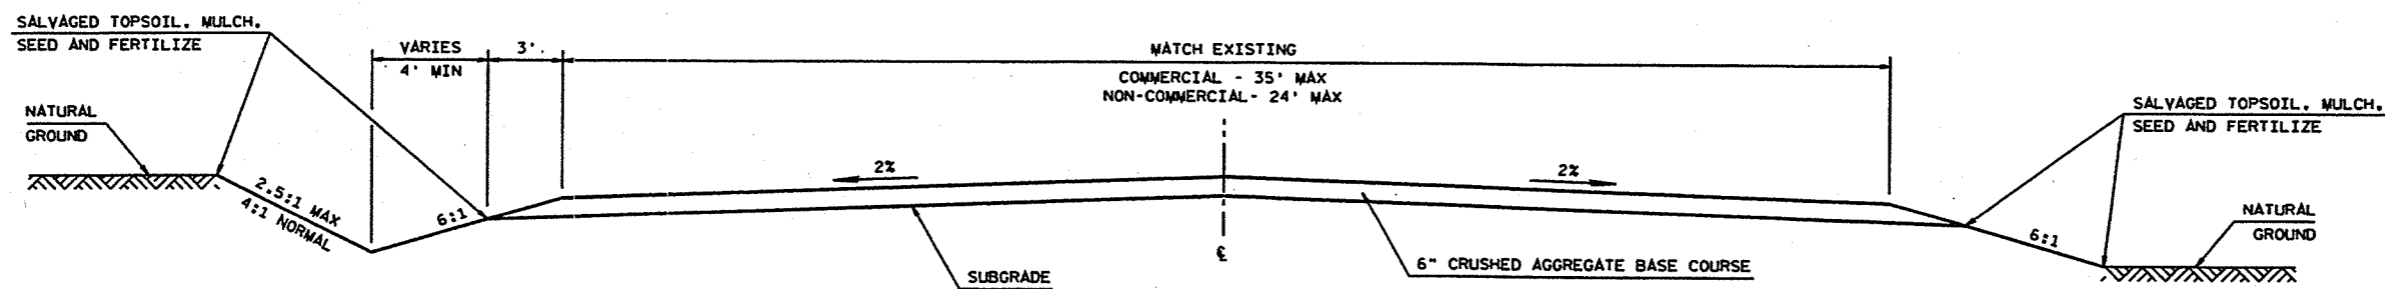


TYPICAL CROSS SECTION FOR PRIVATE DRIVES AND FIELD ENTRANCES

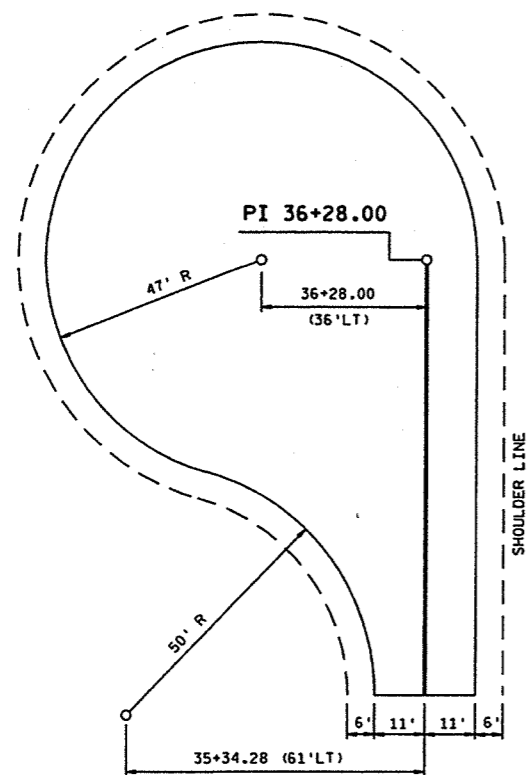

NOTE:
SEE PROPOSED TYPICAL CROSS SECTION
FOR APPLICABLE PAVEMENT STRUCTURE.


CUL-DE-SAC AT SHAMMY LANE

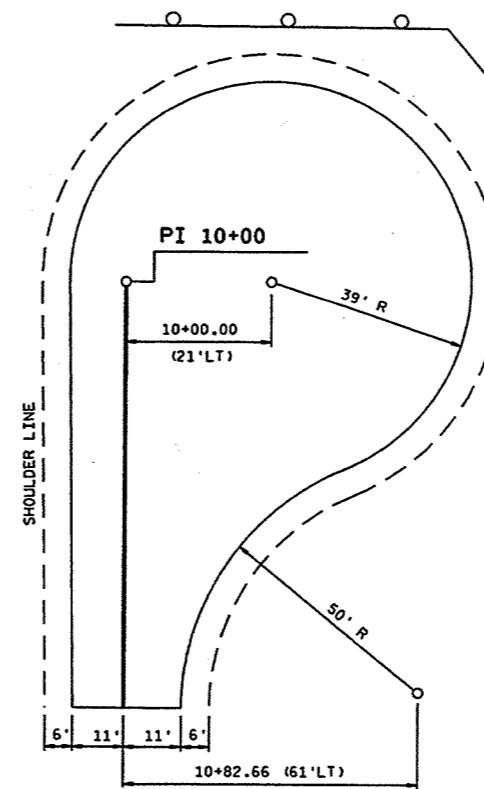

STEEL PLATE BEAM GUARD,
CLASS B REQ'D

NOTE:
SEE PROPOSED TYPICAL CROSS SECTION
FOR APPLICABLE PAVEMENT STRUCTURE.


CUL-DE-SAC AT SPIEGELBERG ROAD

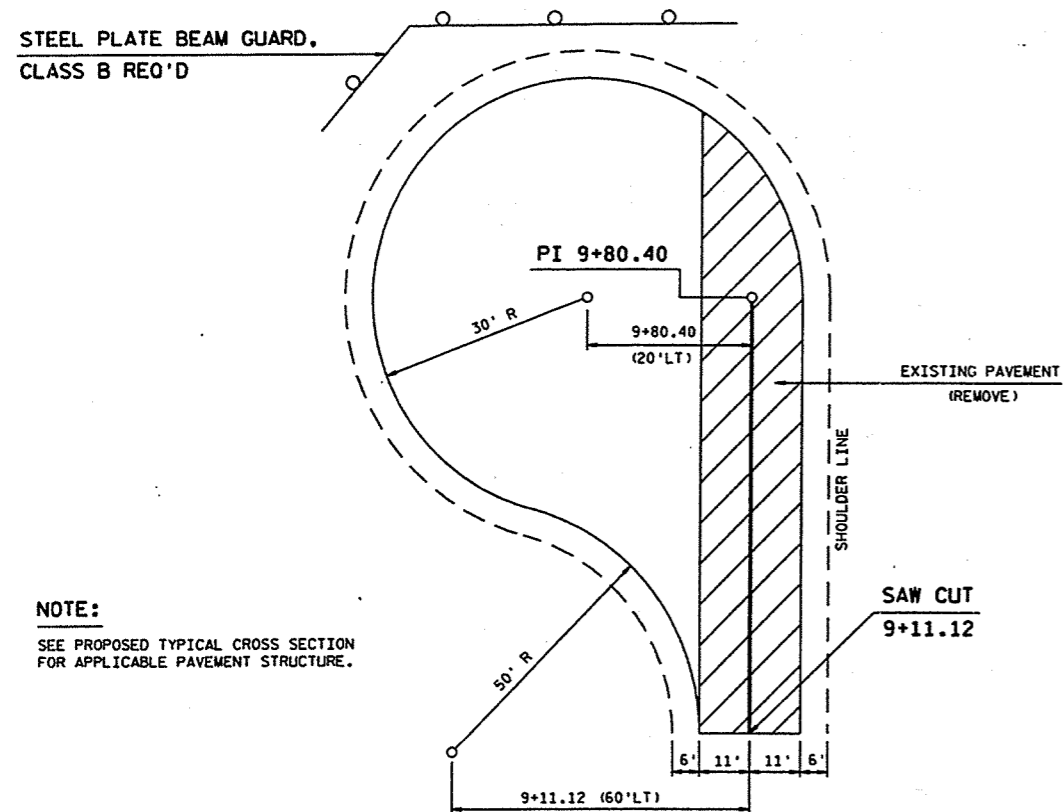

STEEL PLATE BEAM GUARD,
CLASS B REQ'D

NOTE:
SEE PROPOSED TYPICAL CROSS SECTION
FOR APPLICABLE PAVEMENT STRUCTURE.


CUL-DE-SAC AT LUEBKE ROAD

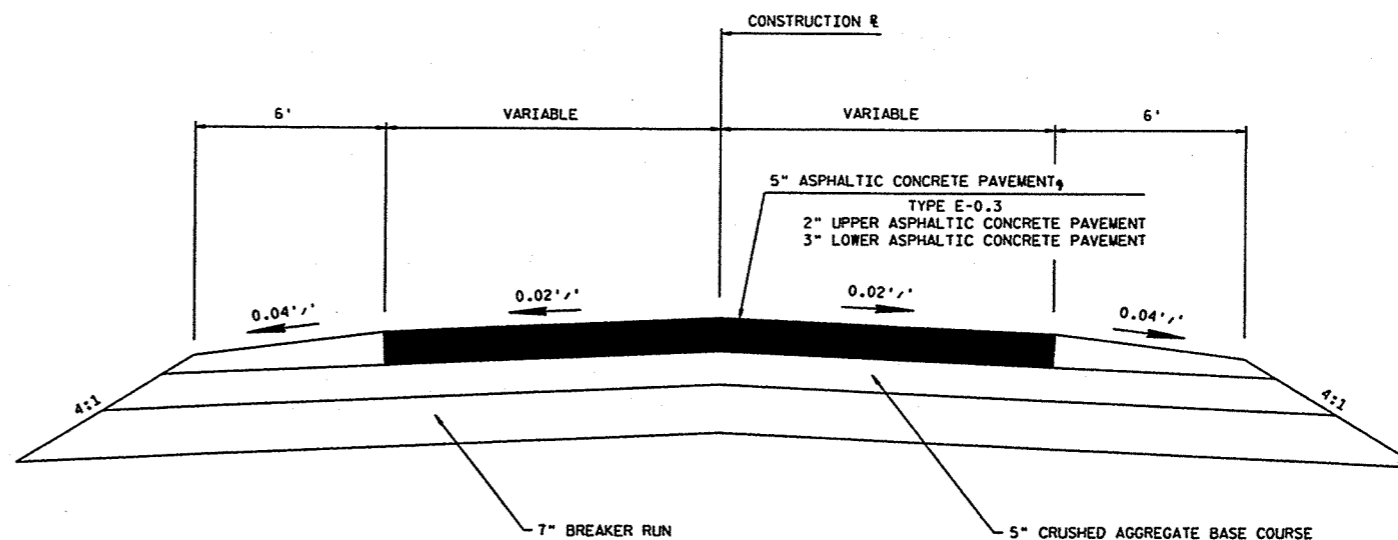

TYPICAL CROSS SECTION FOR SHAMMY LANE, SPIEGELBERG ROAD AND LUEBKE ROAD



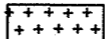
LEVELS ON: 1. 2. 3. 62. 63

LEVELS ON - 1, 2, 3, 62, 63

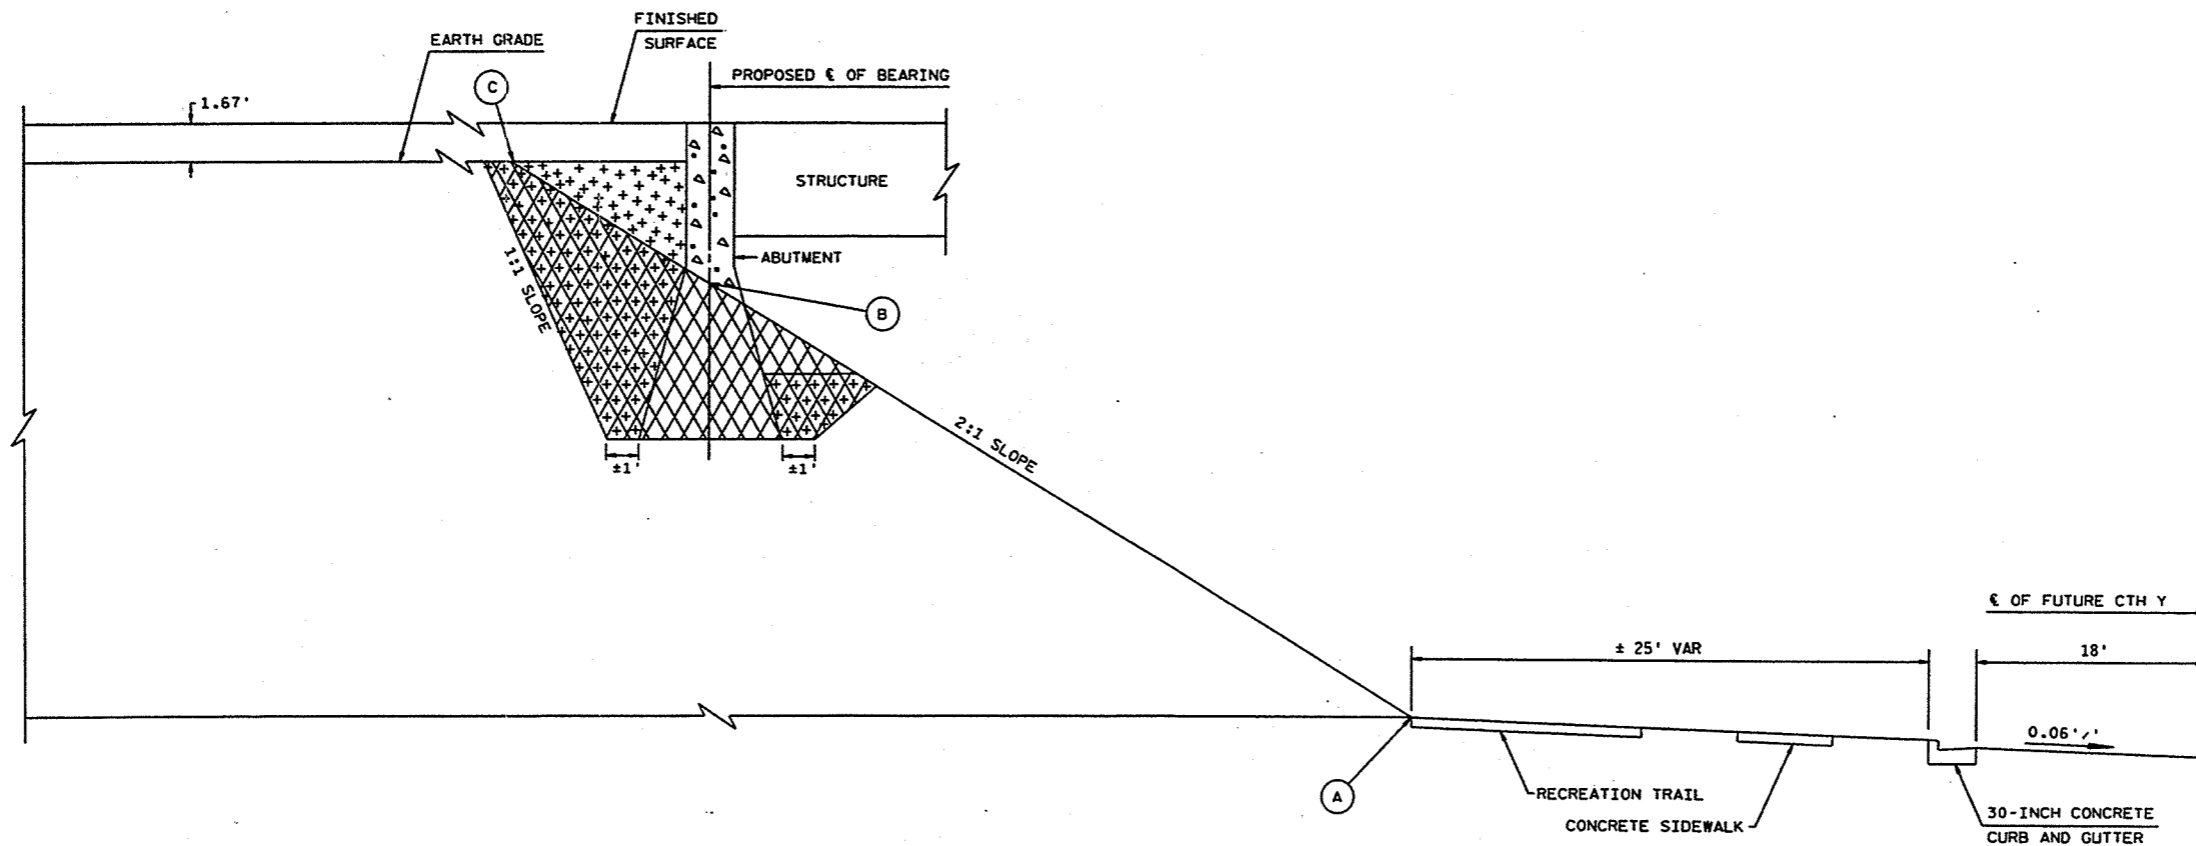


		(A)	(B)	(C)
B-70-215	STATION	179+50.50	179+79.42	179+91.20
NORTH ABUTMENT	ELEVATION	782.40	796.90	802+80
B-70-216	STATION	179+44.90	179+73.42	179+85.50
NORTH ABUTMENT	ELEVATION	782.40	796.60	802.60

LONGITUDINAL SECTION FOR NORTH ABUTMENT AT STH 110 OVER CTH Y



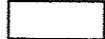
-  COMMON EXCAVATION OR BORROW FILL (BY GRADING CONTRACTOR)
-  EXCAVATION FOR STRUCTURE REQ'D (BY BRIDGE CONTRACTOR)
-  BACKFILL PLACED BY BRIDGE CONTRACTOR

LEVELS ON * 1.0 3.4 5.6 7.8 9.9 12.1 14.3 999.9

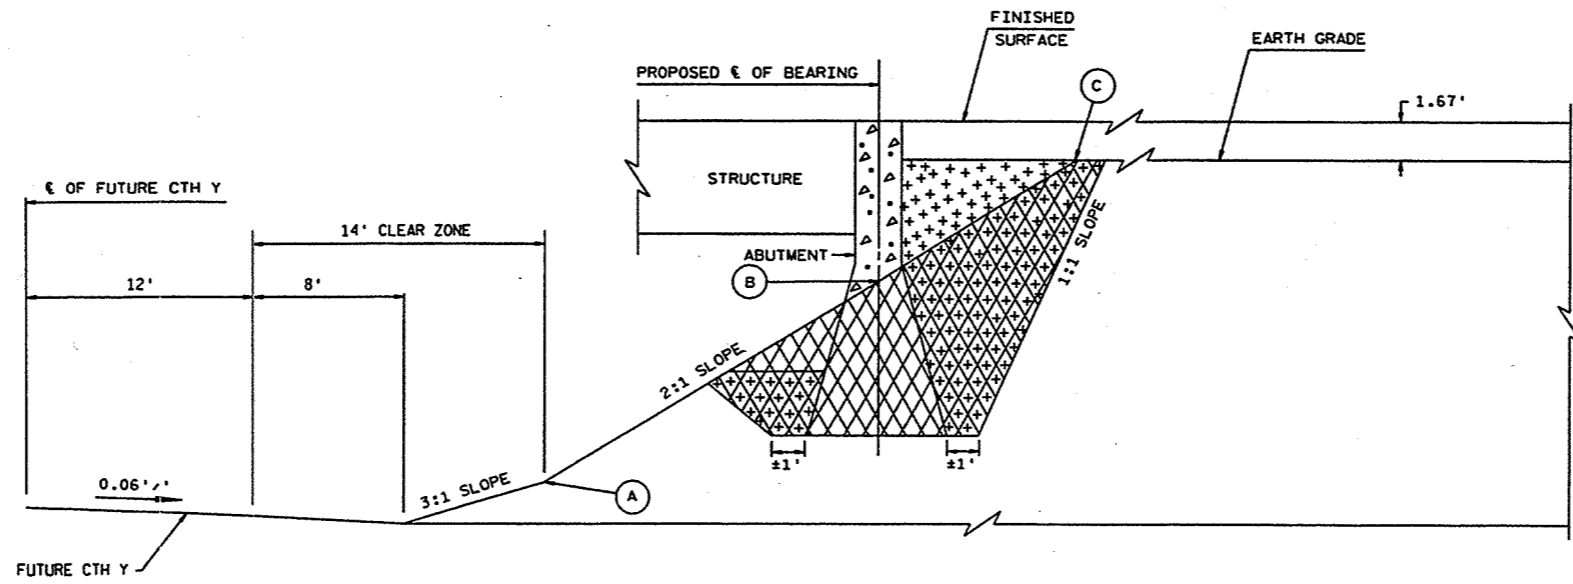


		(A)	(B)	(C)
B-70-215	STATION	178+74.50	178+41.42	178+30.60
SOUTH ABUTMENT	ELEVATION	780.80	796.10	801.70
B-70-216	STATION	178+59.00	178+27.42	178+15.70
SOUTH ABUTMENT	ELEVATION	780.70	796.50	801.70

LONGITUDINAL SECTION FOR SOUTH ABUTMENT AT STH 110 OVER CTH Y

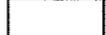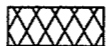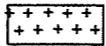

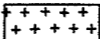
-  COMMON EXCAVATION OR BORROW FILL (BY GRADING CONTRACTOR)
-  EXCAVATION FOR STRUCTURE REQ'D (BY BRIDGE CONTRACTOR)
-  BACKFILL PLACED BY BRIDGE CONTRACTOR

LEVELS ON - 1, 2, 3, 62, 63

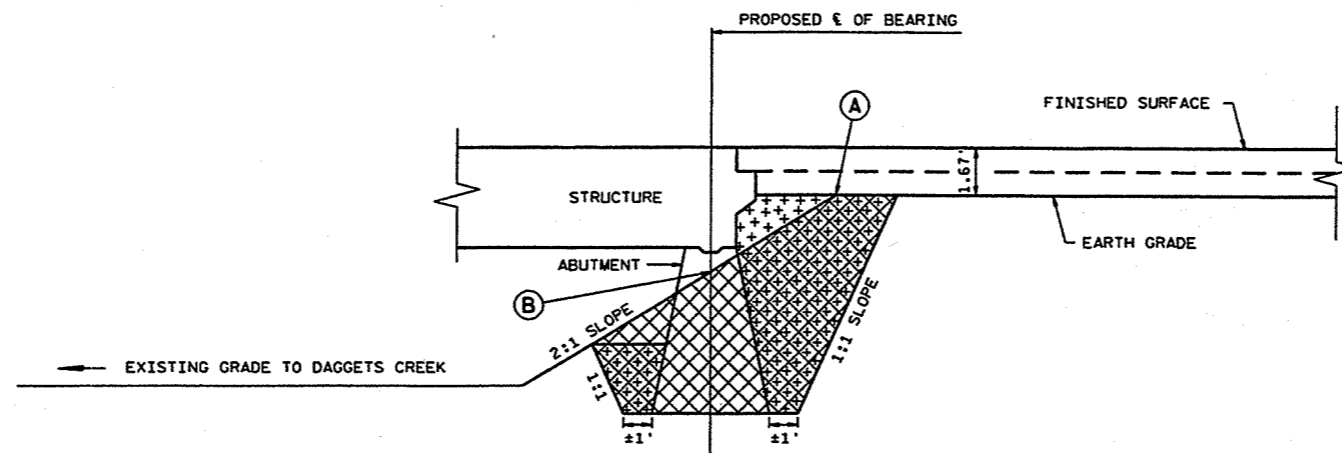

		(A)	(B)
B-70-218	STATION	282+04.75	282+09.75
EAST ABUTMENT	ELEVATION	765.80	763.30
B-70-219	STATION	282+48.95	282+51.75
EAST ABUTMENT	ELEVATION	765.40	764.00

LONGITUDINAL SECTION FOR EAST ABUTMENT AT STH 110 OVER DAGGETS CREEK

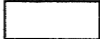-  COMMON EXCAVATION OR BORROW FILL (BY GRADING CONTRACTOR)
-  EXCAVATION FOR STRUCTURE REQ'D (BY BRIDGE CONTRACTOR)
-  BACKFILL PLACED BY BRIDGE CONTRACTOR


STATE PROJECT NUMBER: 6200-05-71

HWY: STH 110

COUNTY: WINNEBAGO


CONSTRUCTION DETAILS

SCALE, FEET

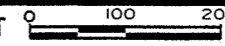



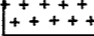
SHEET NO: 2.26 E

LEVELS ON - 1, 2, 3, 62, 63

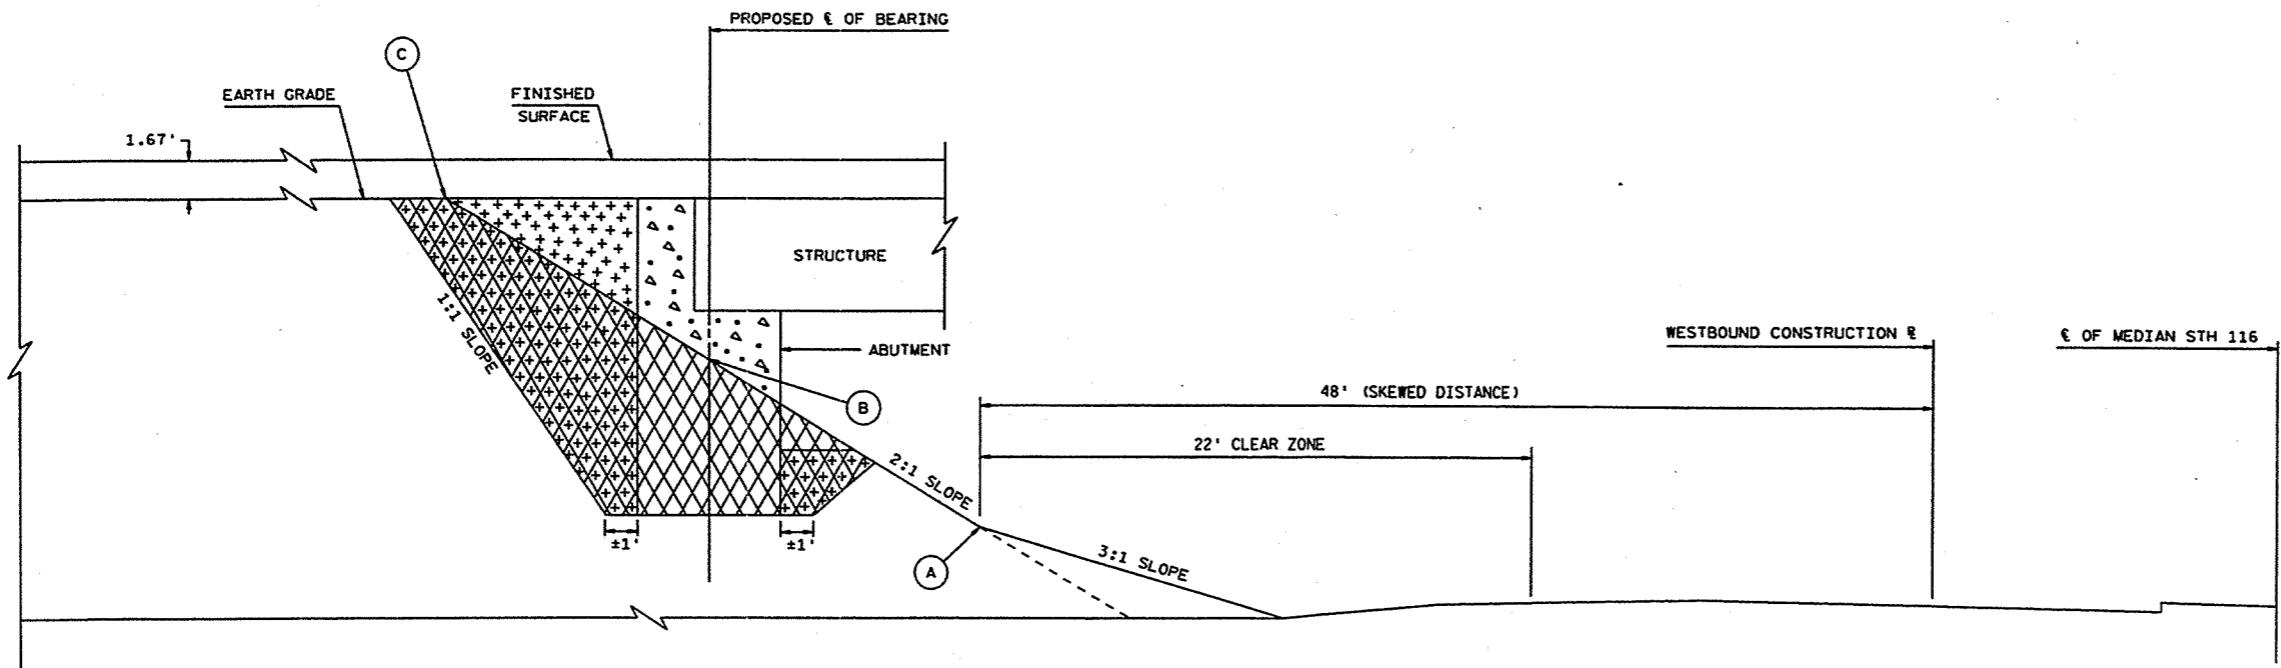


		(A)	(B)	(C)
B-70-221	STATION	375+80.50	376+16.90	376+25.70
NORTH ABUTMENT	ELEVATION	777.70	795.90	800.30
B-70-222	STATION	374+92.50	375+29.00	375+40.90
NORTH ABUTMENT	ELEVATION	775.80	794.00	799.90

LONGITUDINAL SECTION FOR NORTH ABUTMENT AT STH 110 OVER STH 116

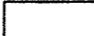

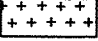
-  COMMON EXCAVATION OR BORROW FILL (BY GRADING CONTRACTOR)
-  EXCAVATION FOR STRUCTURE REQ'D (BY BRIDGE CONTRACTOR)
-  BACKFILL PLACED BY BRIDGE CONTRACTOR

LEVELS ON: 1, 2, 3, 62, 63

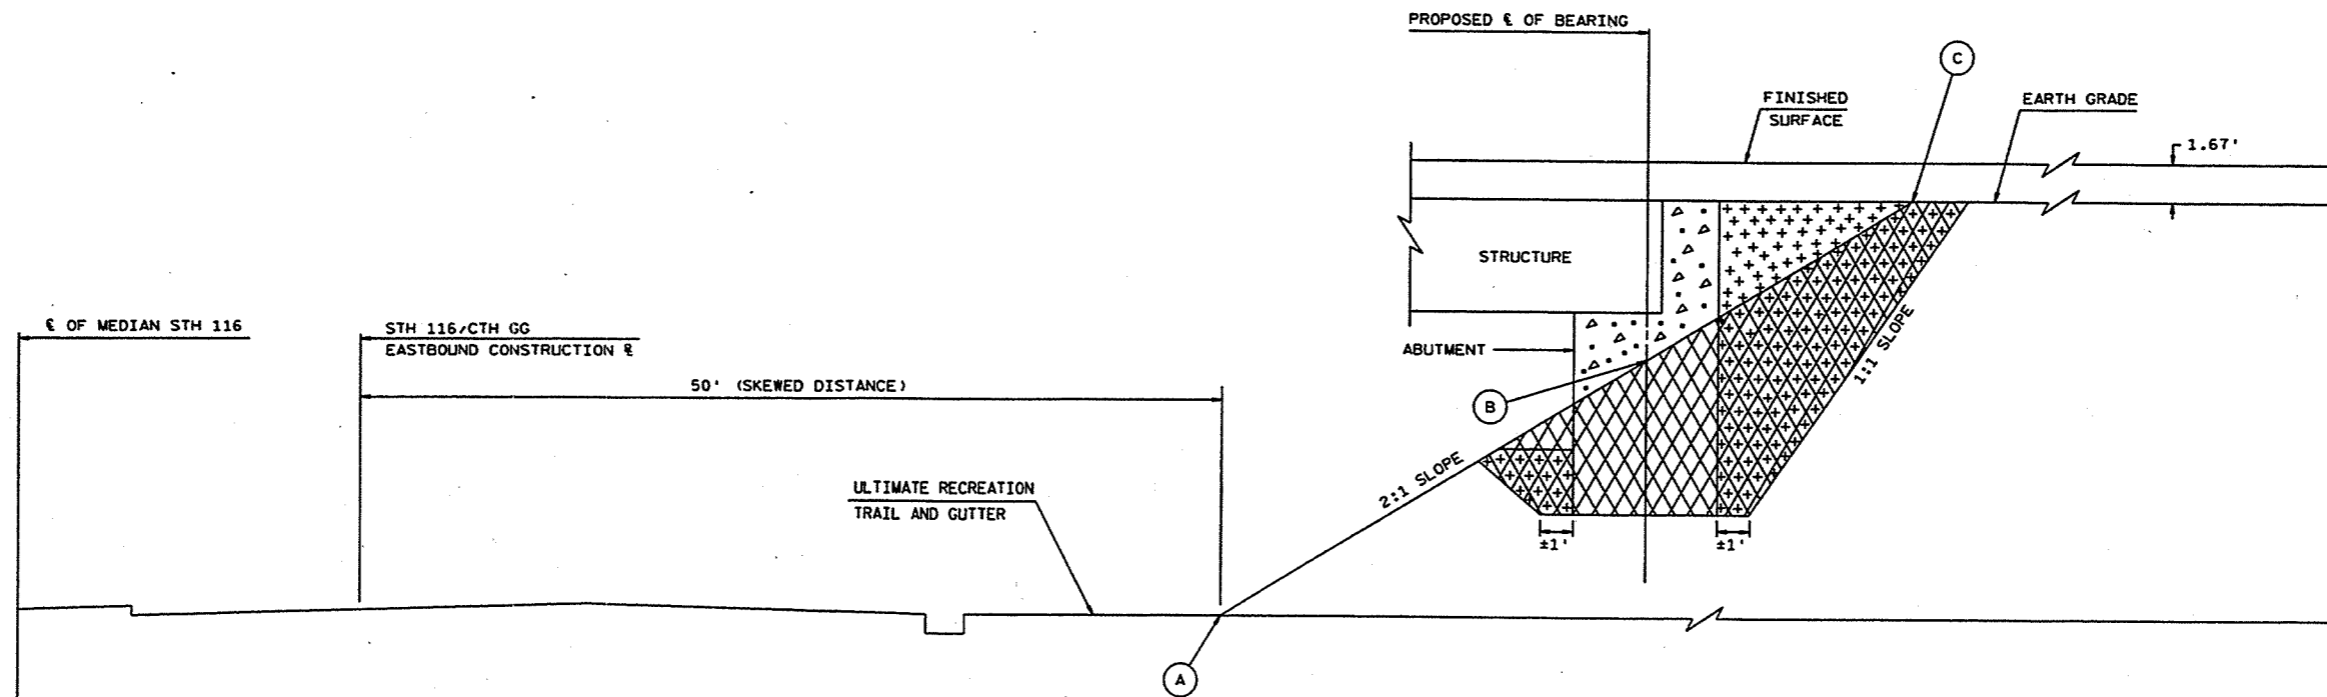

		(A)	(B)	(C)
B-70-221	STATION	374+44.00	374+09.20	374+00.30
SOUTH ABUTMENT	ELEVATION	774.90	792.60	797.00
B-70-222	STATION	373+56.00	373+20.90	373+08.90
SOUTH ABUTMENT	ELEVATION	773.20	790.70	796.70

LONGITUDINAL SECTION FOR SOUTH ABUTMENT AT STH 110 OVER STH 116

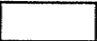
-  COMMON EXCAVATION OR BORROW FILL (BY GRADING CONTRACTOR)
-  EXCAVATION FOR STRUCTURE REQ'D (BY BRIDGE CONTRACTOR)
-  BACKFILL PLACED BY BRIDGE CONTRACTOR

STATE PROJECT NUMBER: 6200-05-71

HWY: STH 110

COUNTY: WINNEBAGO

CONSTRUCTION DETAILS

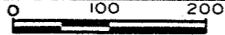SCALE, FEET 

SHEET NO: 2.28 E

FILE NAME: F:\d3_620005\206.dgn

PLOT DATE: 10-JUL-2001 07:21

ORG DATE: 11-9-00

PLOT NAME: 206hd

Originator: DISTRICT 3




PLOT SCALE: 200.606061:1.000000


WISDOT/CADD SHEET 42

LEVELS ON = 1, 2, 3, 62, 63

TYERS PE

HANSEN PE

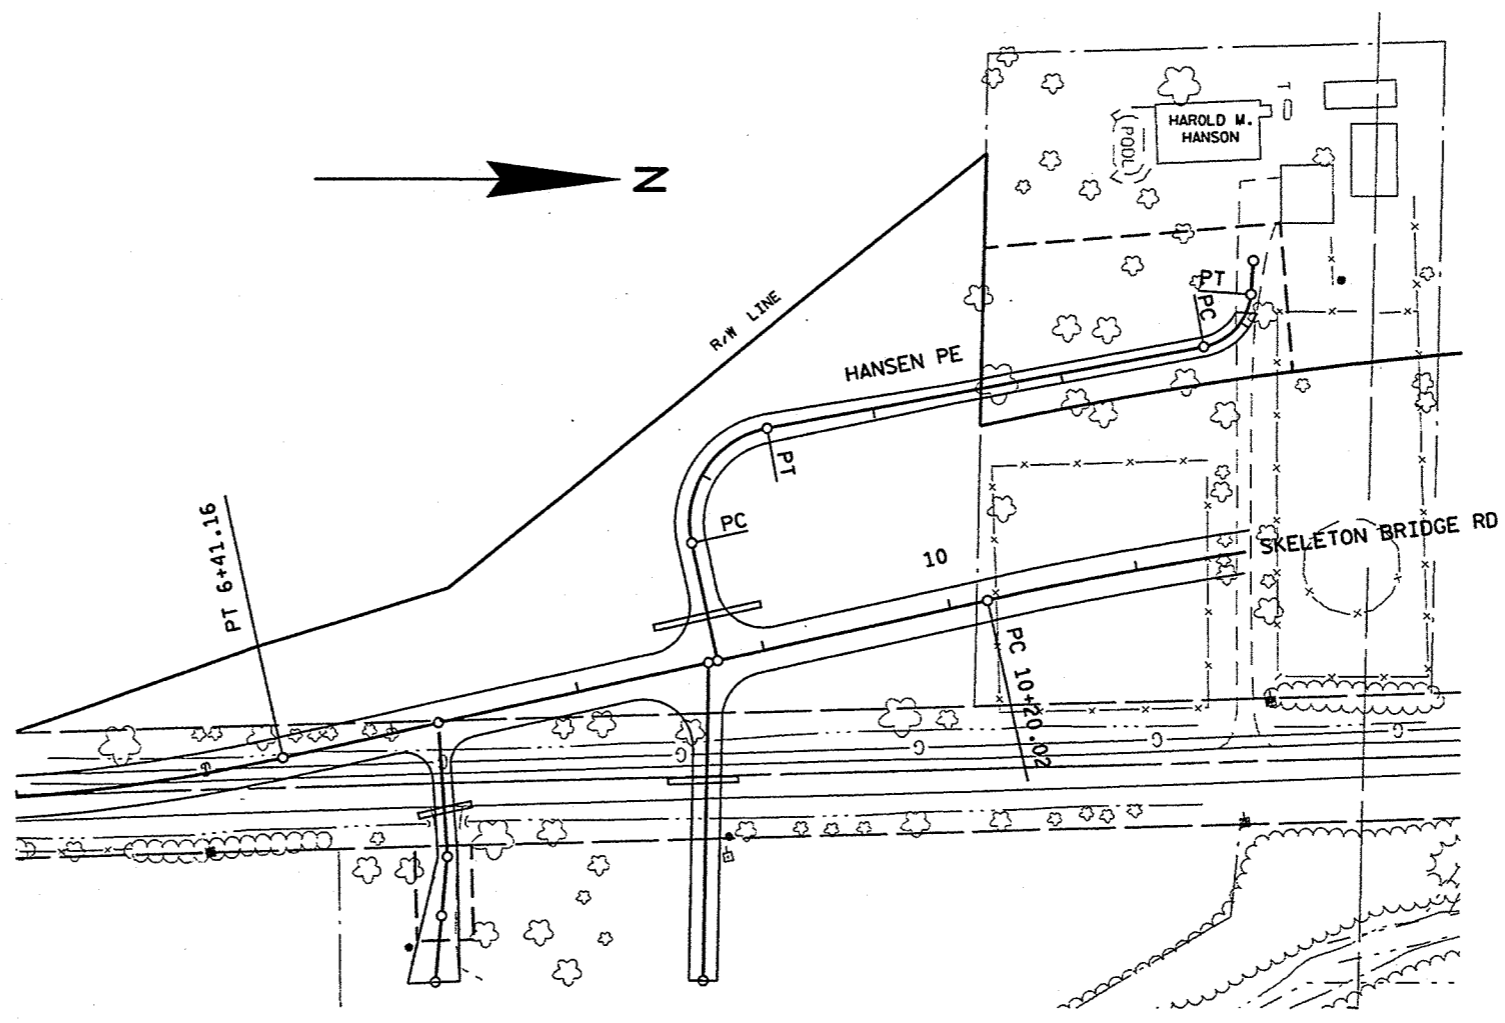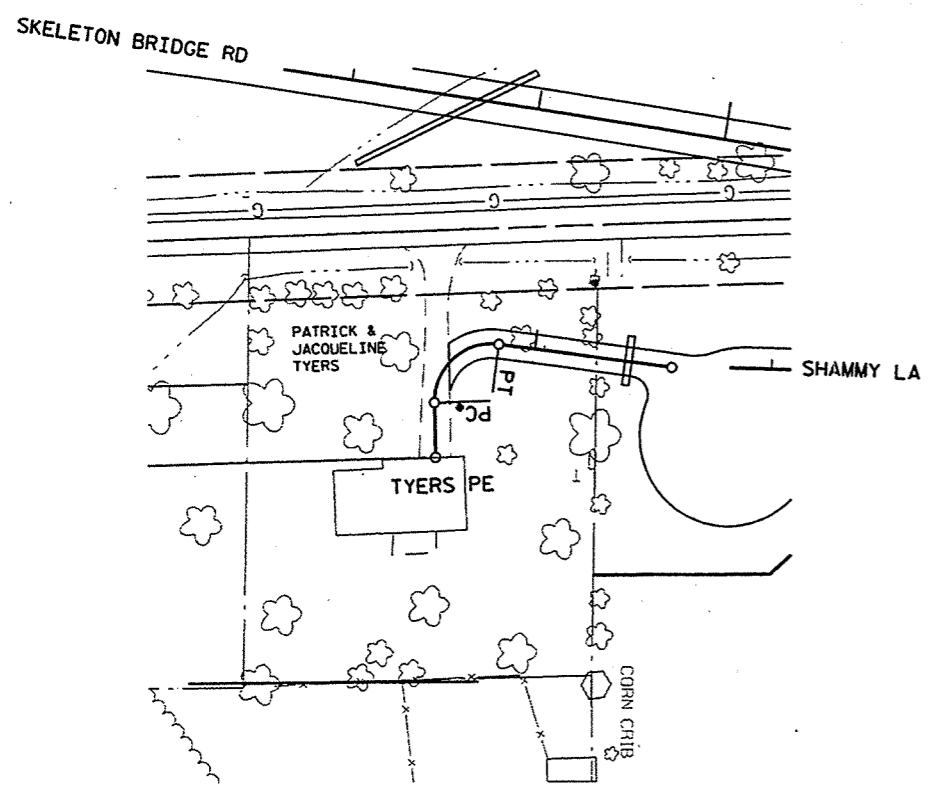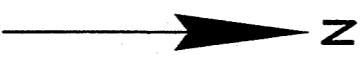

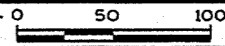
STATE PROJECT NUMBER: 6200-05-71	HWY: STH 110	COUNTY: WINNEBAGO	CONSTRUCTION DETAILS	SCALE, FEET 	SHEET NO: 2.29	E
----------------------------------	--------------	-------------------	----------------------	---	----------------	---

FILE NAME : F:\d3_620005\241.dgn PLOT DATE : 04-SEP-2001 13:28 ORG DATE : 8-30-01 PLOT NAME : 241ad Originator : DISTRICT 3 PLOT SCALE : 100.400000:1.000000 WISDOT/CADD SHEET 42

14/01/05 DW - 1, 2, 3, 62, 63


N

GRUNDY CE

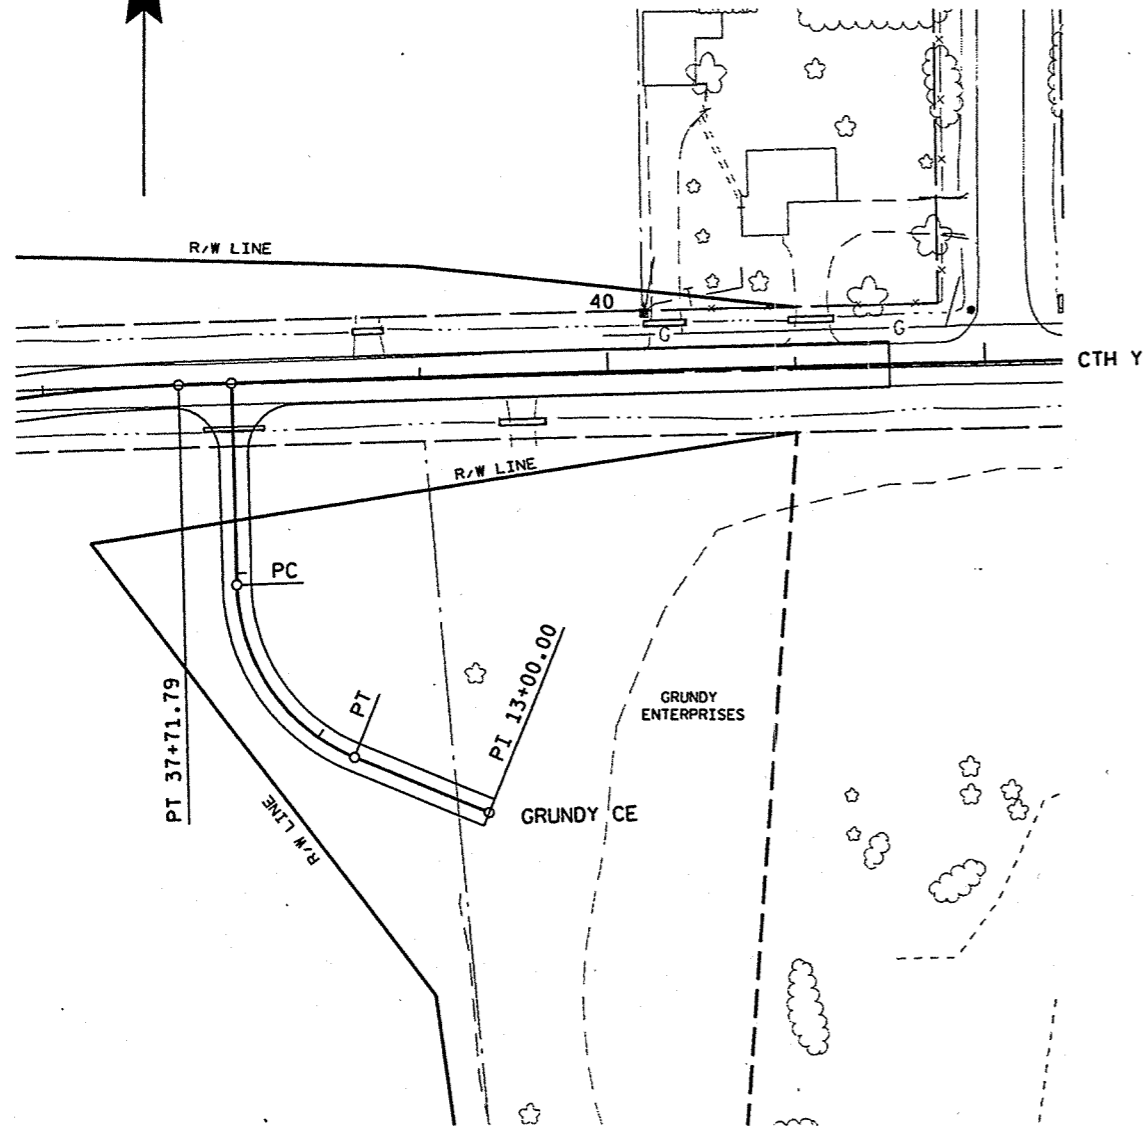

FORSETH PE AND FE

N

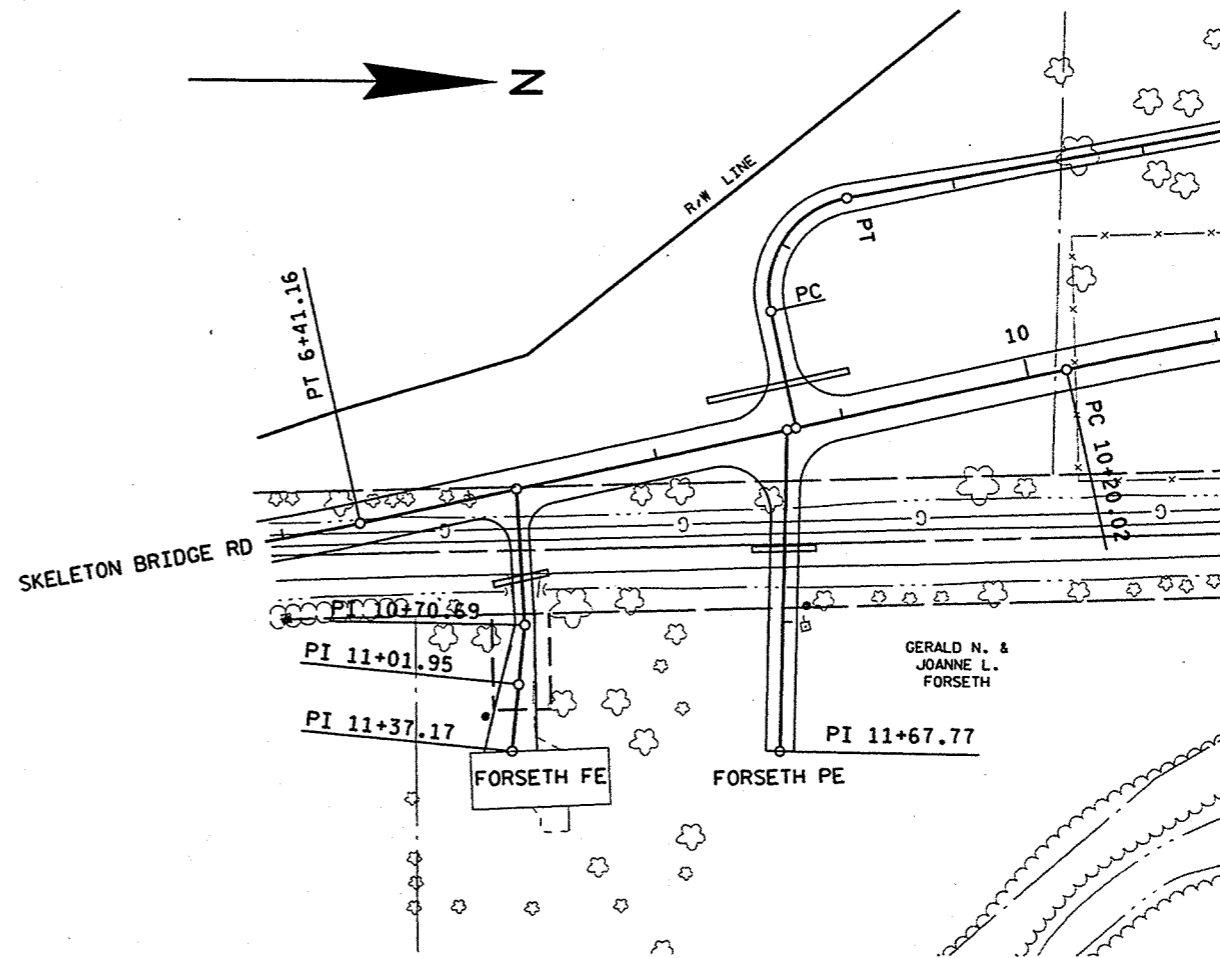

STATE PROJECT NUMBER:6200-05-71

HWY:STH 110

COUNTY:WINNEBAGO

CONSTRUCTION DETAILS

SCALE, FEET 0 50 100

SHEET NO: 2.30 E

FILE NAME : F:\d3_620005\241.dgn

PLOT DATE : 04-SEP-2001 13:28

ORG DATE : 8-30-01

PLOT NAME : 241bd


Originator : DISTRICT 3

PLOT SCALE : 100.400000:1.000000


WISDOT/CADDs SHEET 42

LEVELS ON - 1, 2, 3, 62, 63

SCHMOKER FE

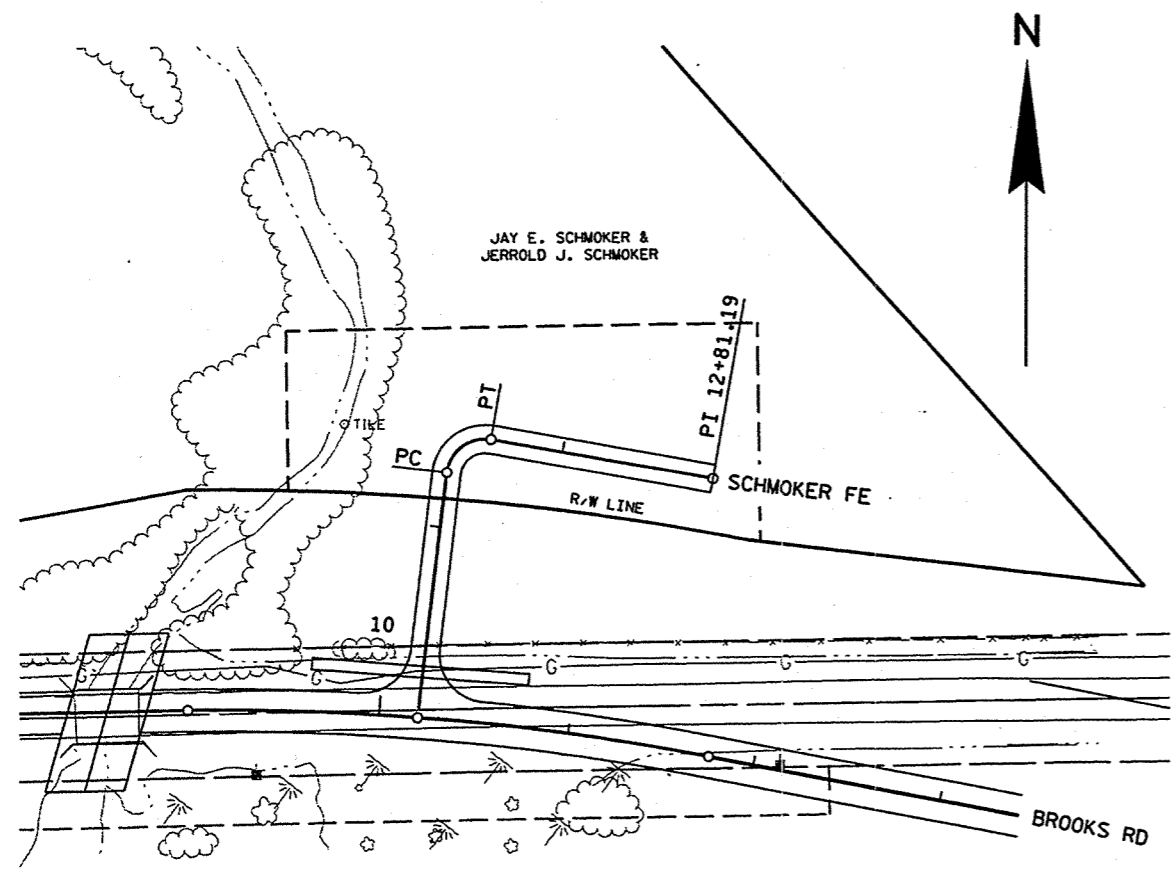

SCHMOKER PE (FRONT)

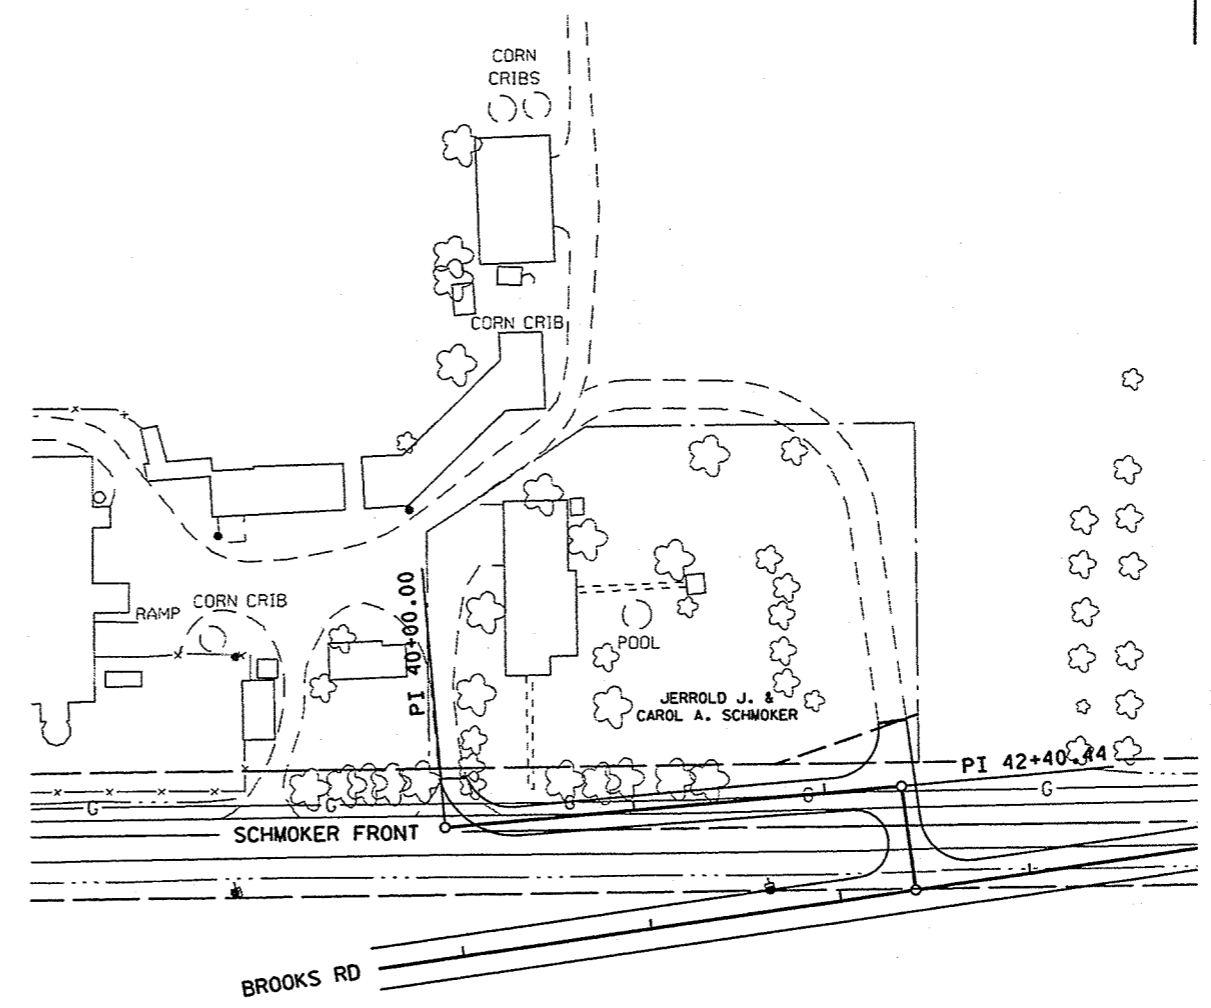

STATE PROJECT NUMBER: 6200-05-71

HWY: STH 110

COUNTY: WINNEBAGO

CONSTRUCTION DETAILS

SCALE, FEET 0 50 100

SHEET NO: 2.31 E

FILE NAME : F:\d3_620005\241.dgn

PLOT DATE : 20-SEP-2001 08:20

ORG DATE : 8-30-01

PLOT NAME : 24lcd


Originator : DISTRICT 3

PLOT SCALE : 100.400000:1.000000


WISDOT/CADD SHEET 42

LEVELS ON - 1, 2, 3, 62, 63

EWALD F.E

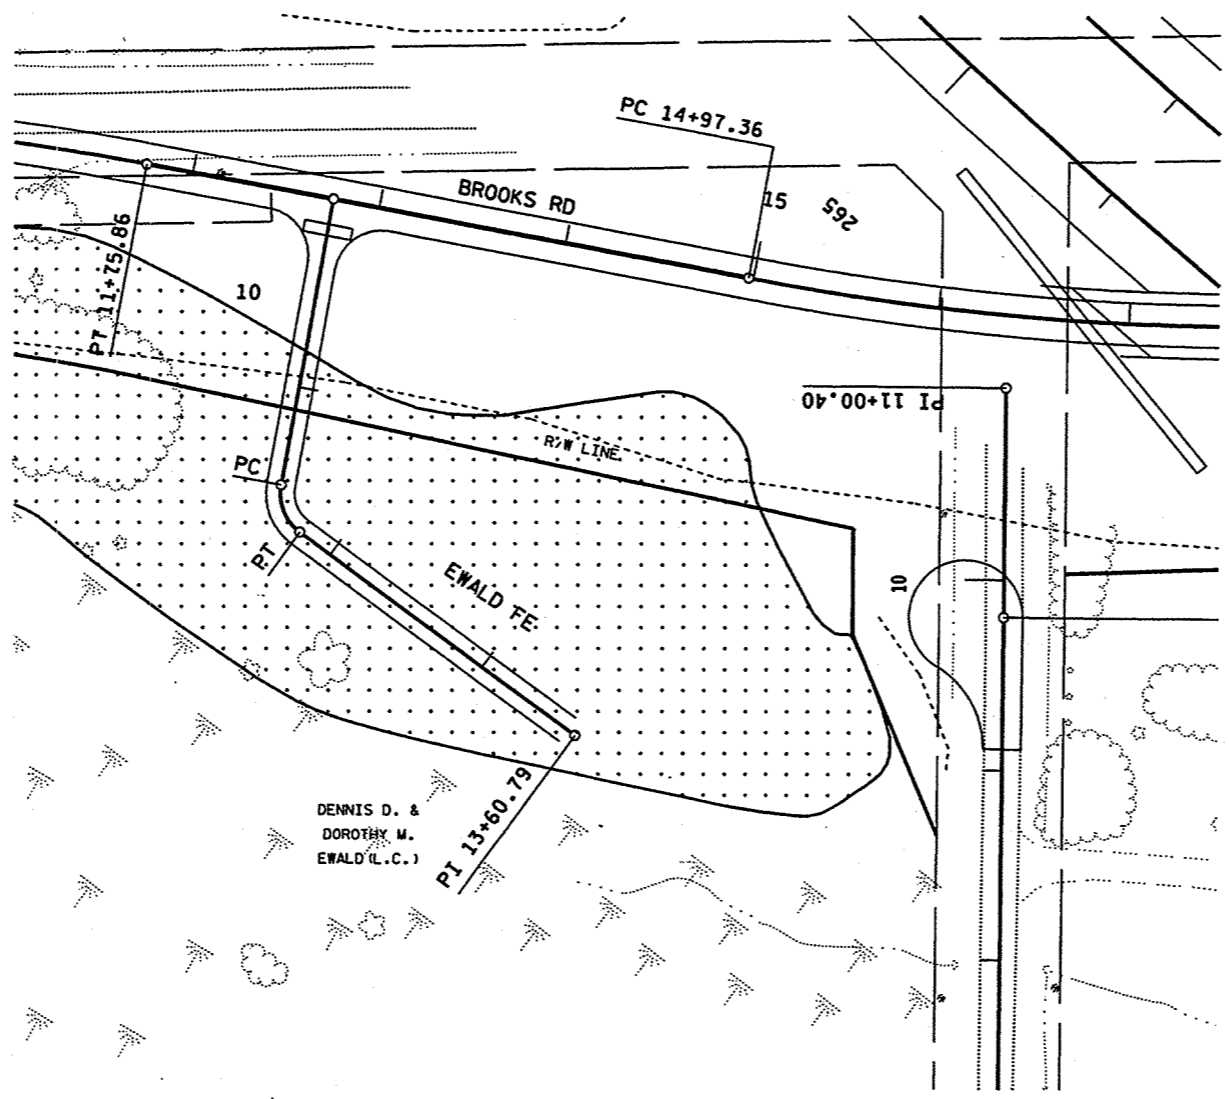


LEVELS ON = 1, 2, 3, 62, 63

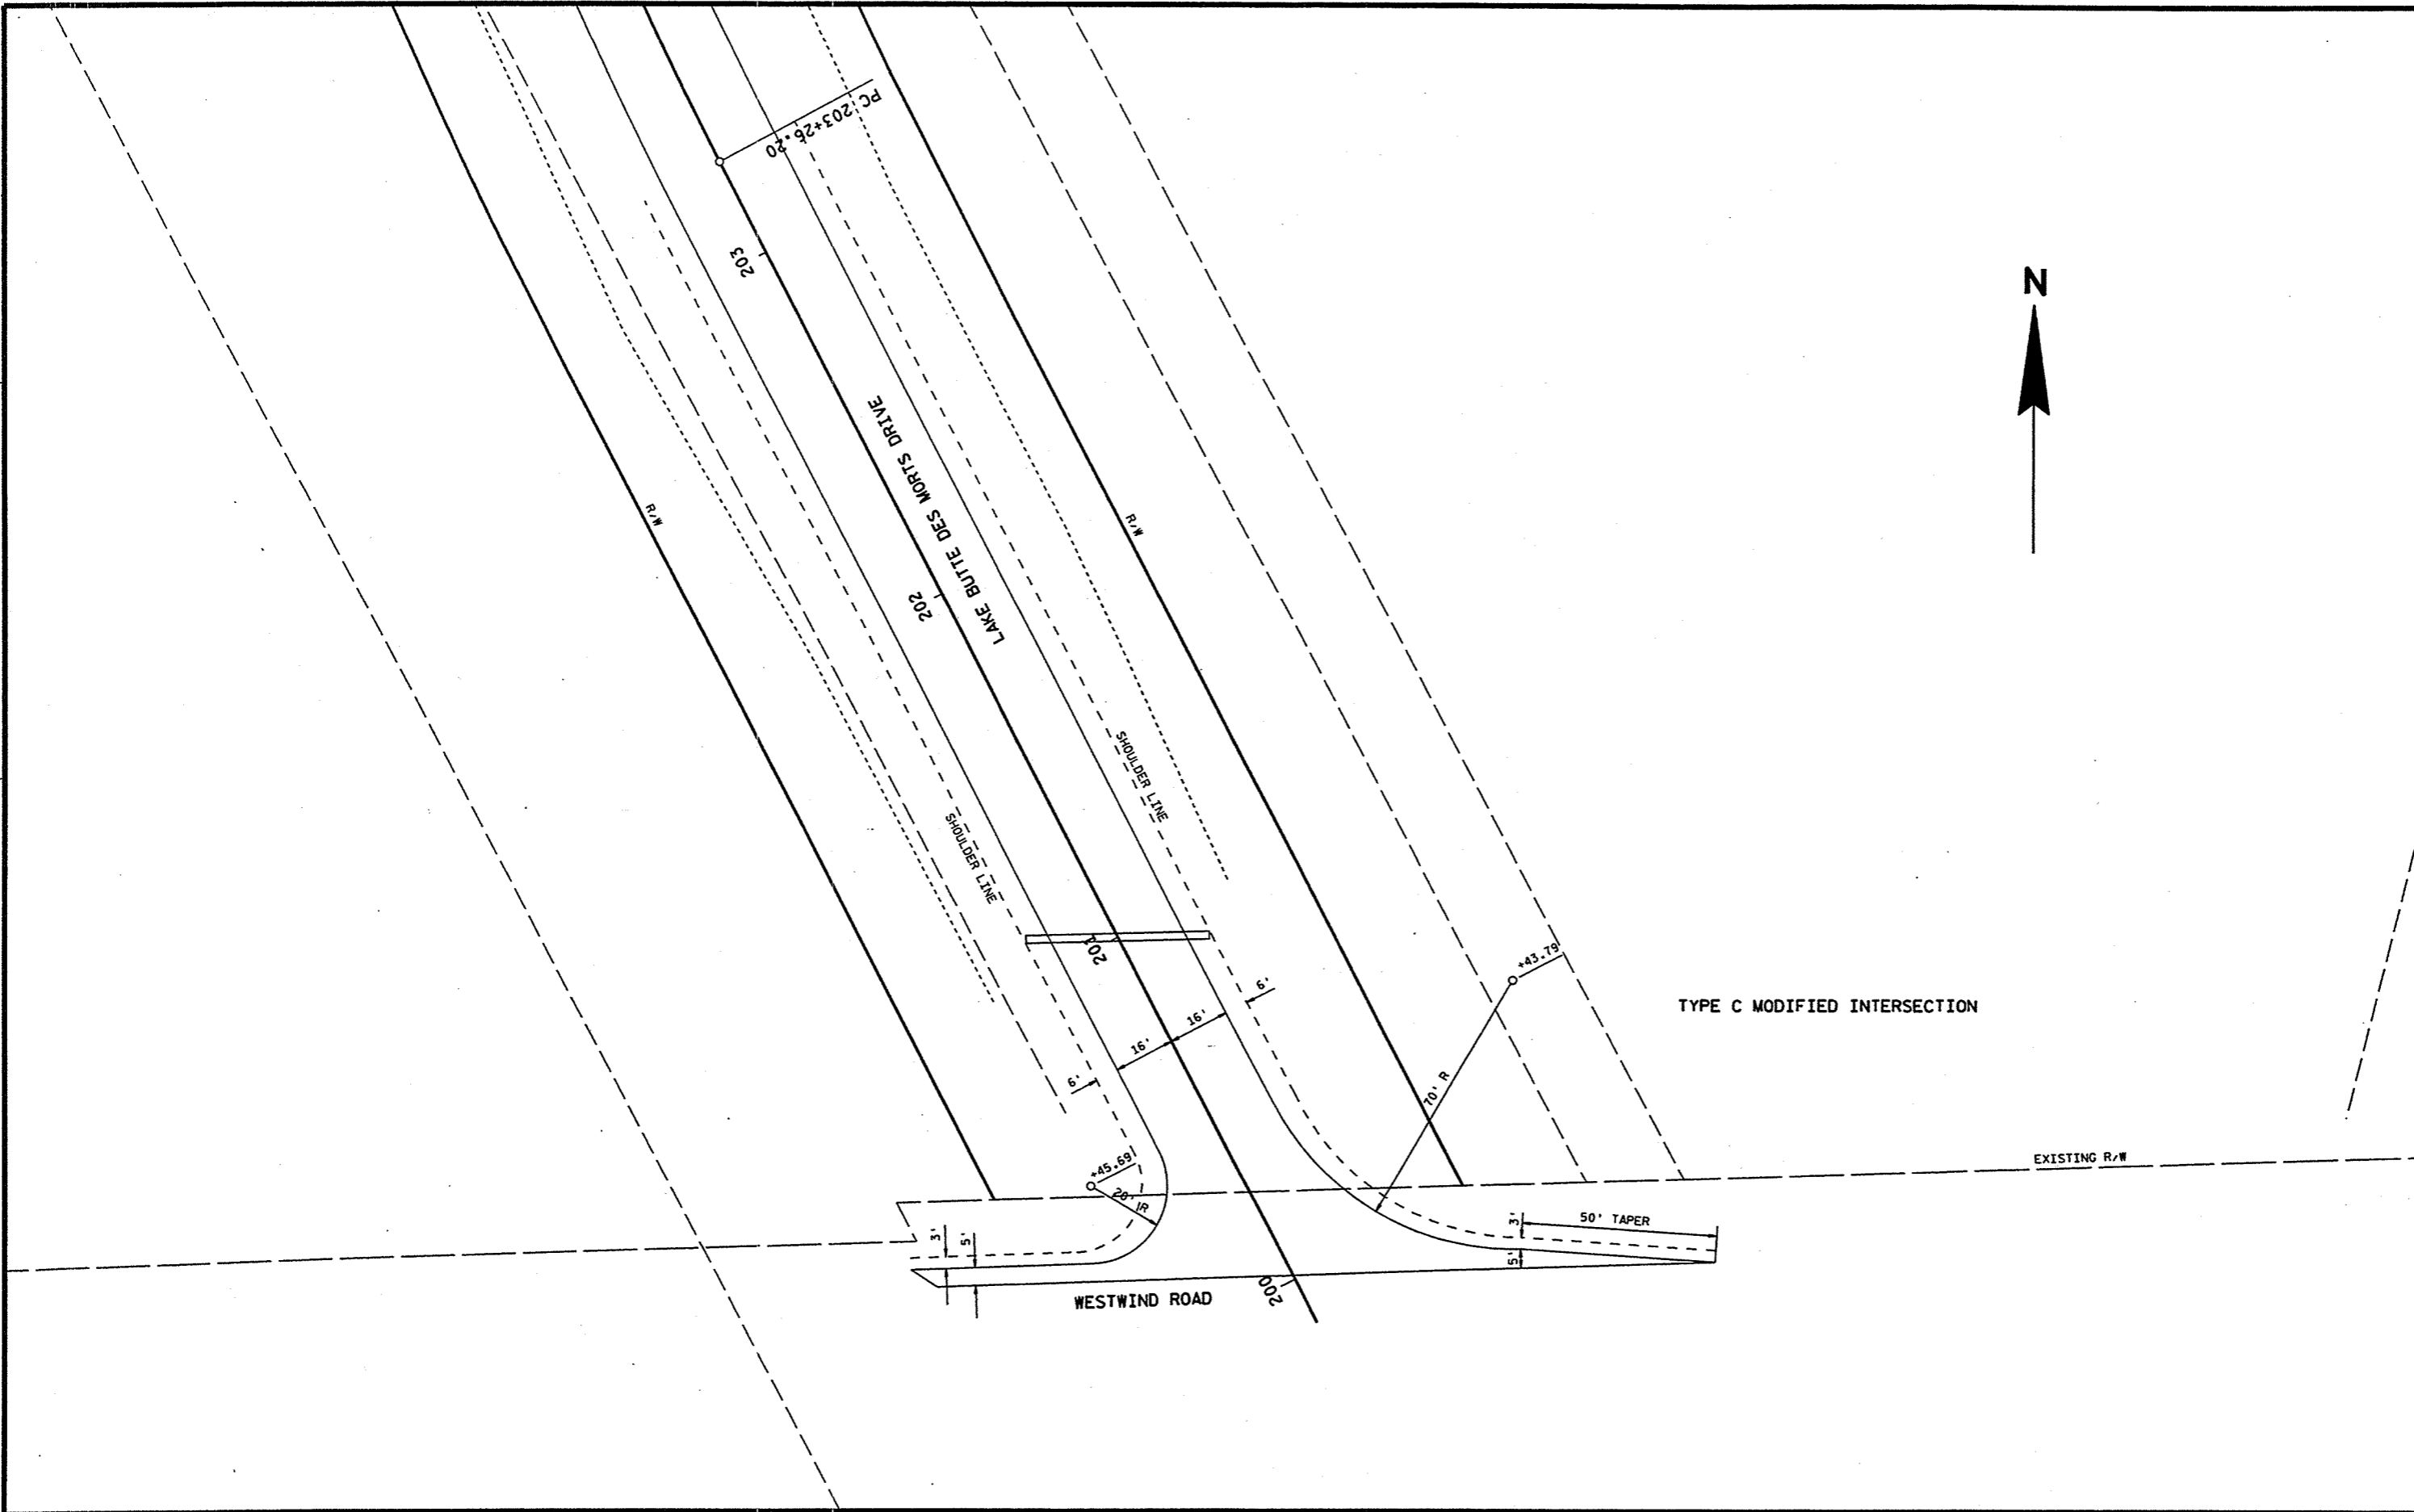

STATE PROJECT NUMBER: 6200-05-71	HWY: STH 110	COUNTY: WINNEBAGO	CONSTRUCTION DETAIL	SCALE, FEET	SHEET NO: 2.33	E
----------------------------------	--------------	-------------------	---------------------	-------------	----------------	---

FILE NAME : F:\d3_620005\021104_id.dgn	PLOT DATE: 26-NOV-2001 14:07	ORG DATE : 6-13-01	PLOT NAME : 021104 id	Originator : d3	PLOT SCALE : 40.121212:1.000000	WISDOT/CADD SHEET 42
--	------------------------------	--------------------	-----------------------	-----------------	---------------------------------	----------------------


LEVELS ON - 1.00, 2.00, 3.00, 62.00, 63.00

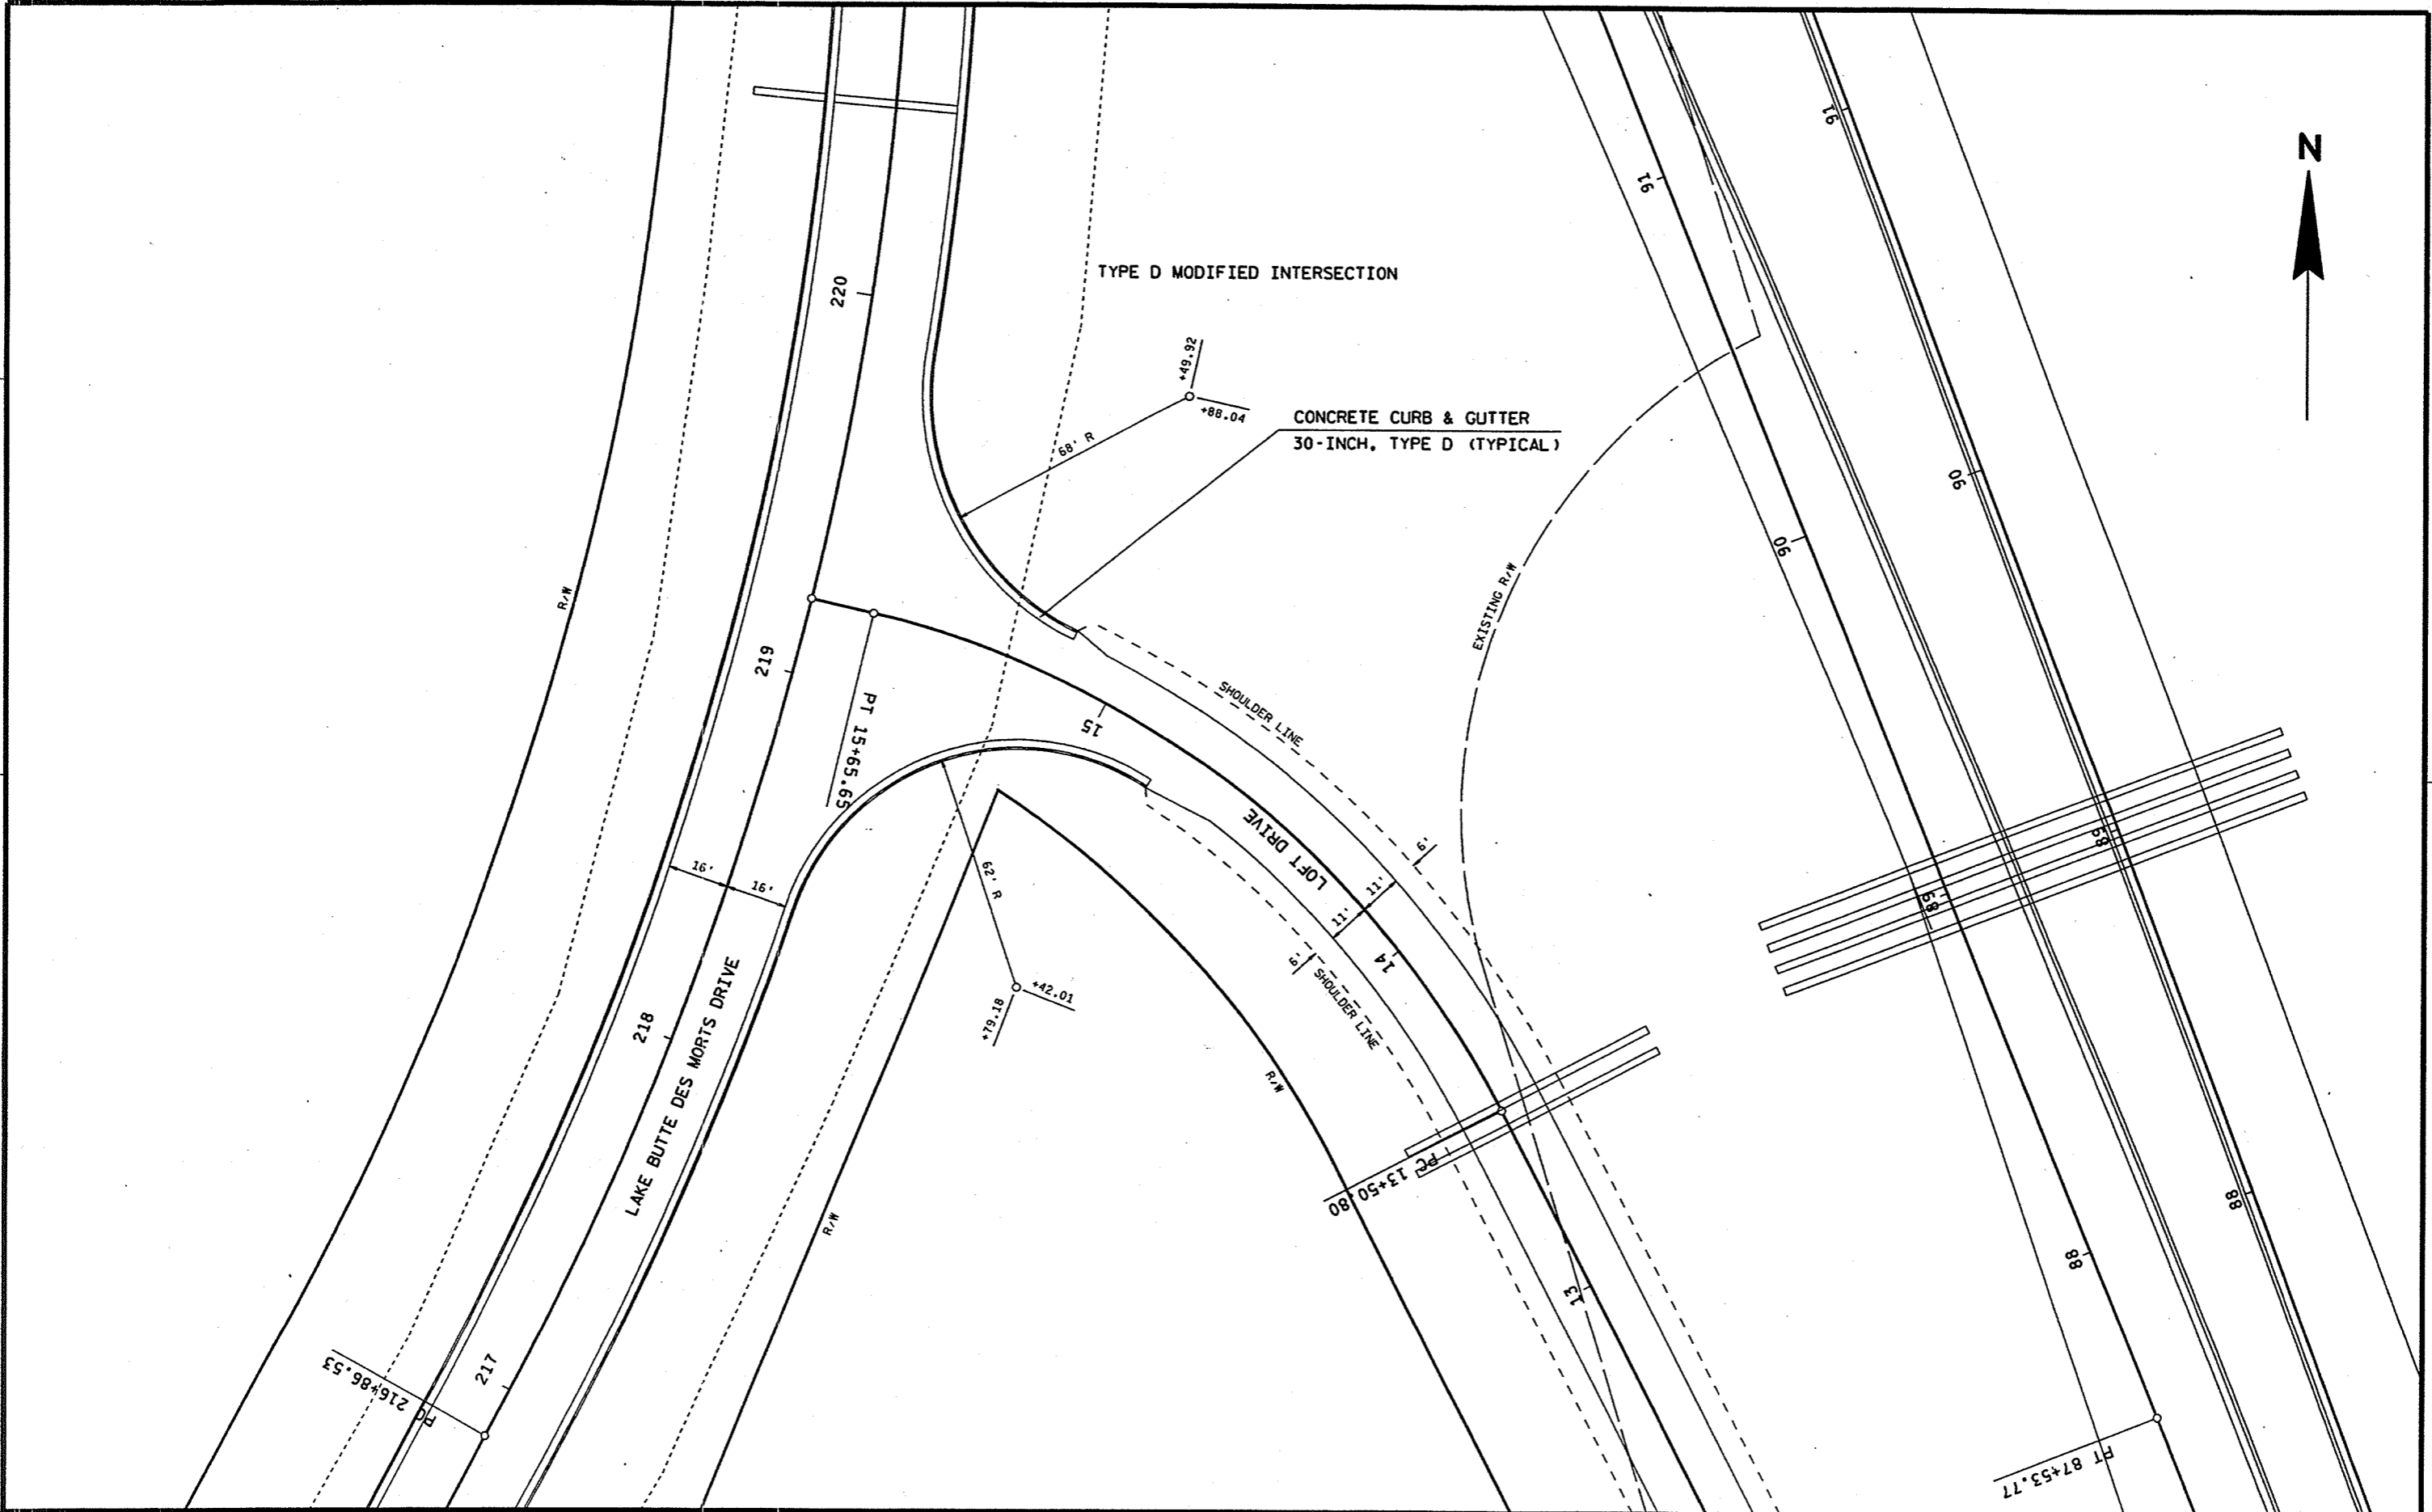


STATE PROJECT NUMBER: 6200-05-71	HWY: STH 110	COUNTY: WINNEBAGO	CONSTRUCTION DETAIL	SCALE, FEET 	SHEET NO: 2.34 E
----------------------------------	--------------	-------------------	---------------------	---	------------------

FILE NAME : F:\d3_620005\021105_id.dgn PLOT DATE: 27-NOV-2001 12:54 ORG DATE : 6-13-01 PLOT NAME : 021105 Id Originator : d3 PLOT SCALE : 40.121212:1.000000 WISDOT/CADD SHEET 42


LEVELS ON : 1.0, 3.0, 5.0, 7.0, 8.0, 9.0, 62.0, 63.0

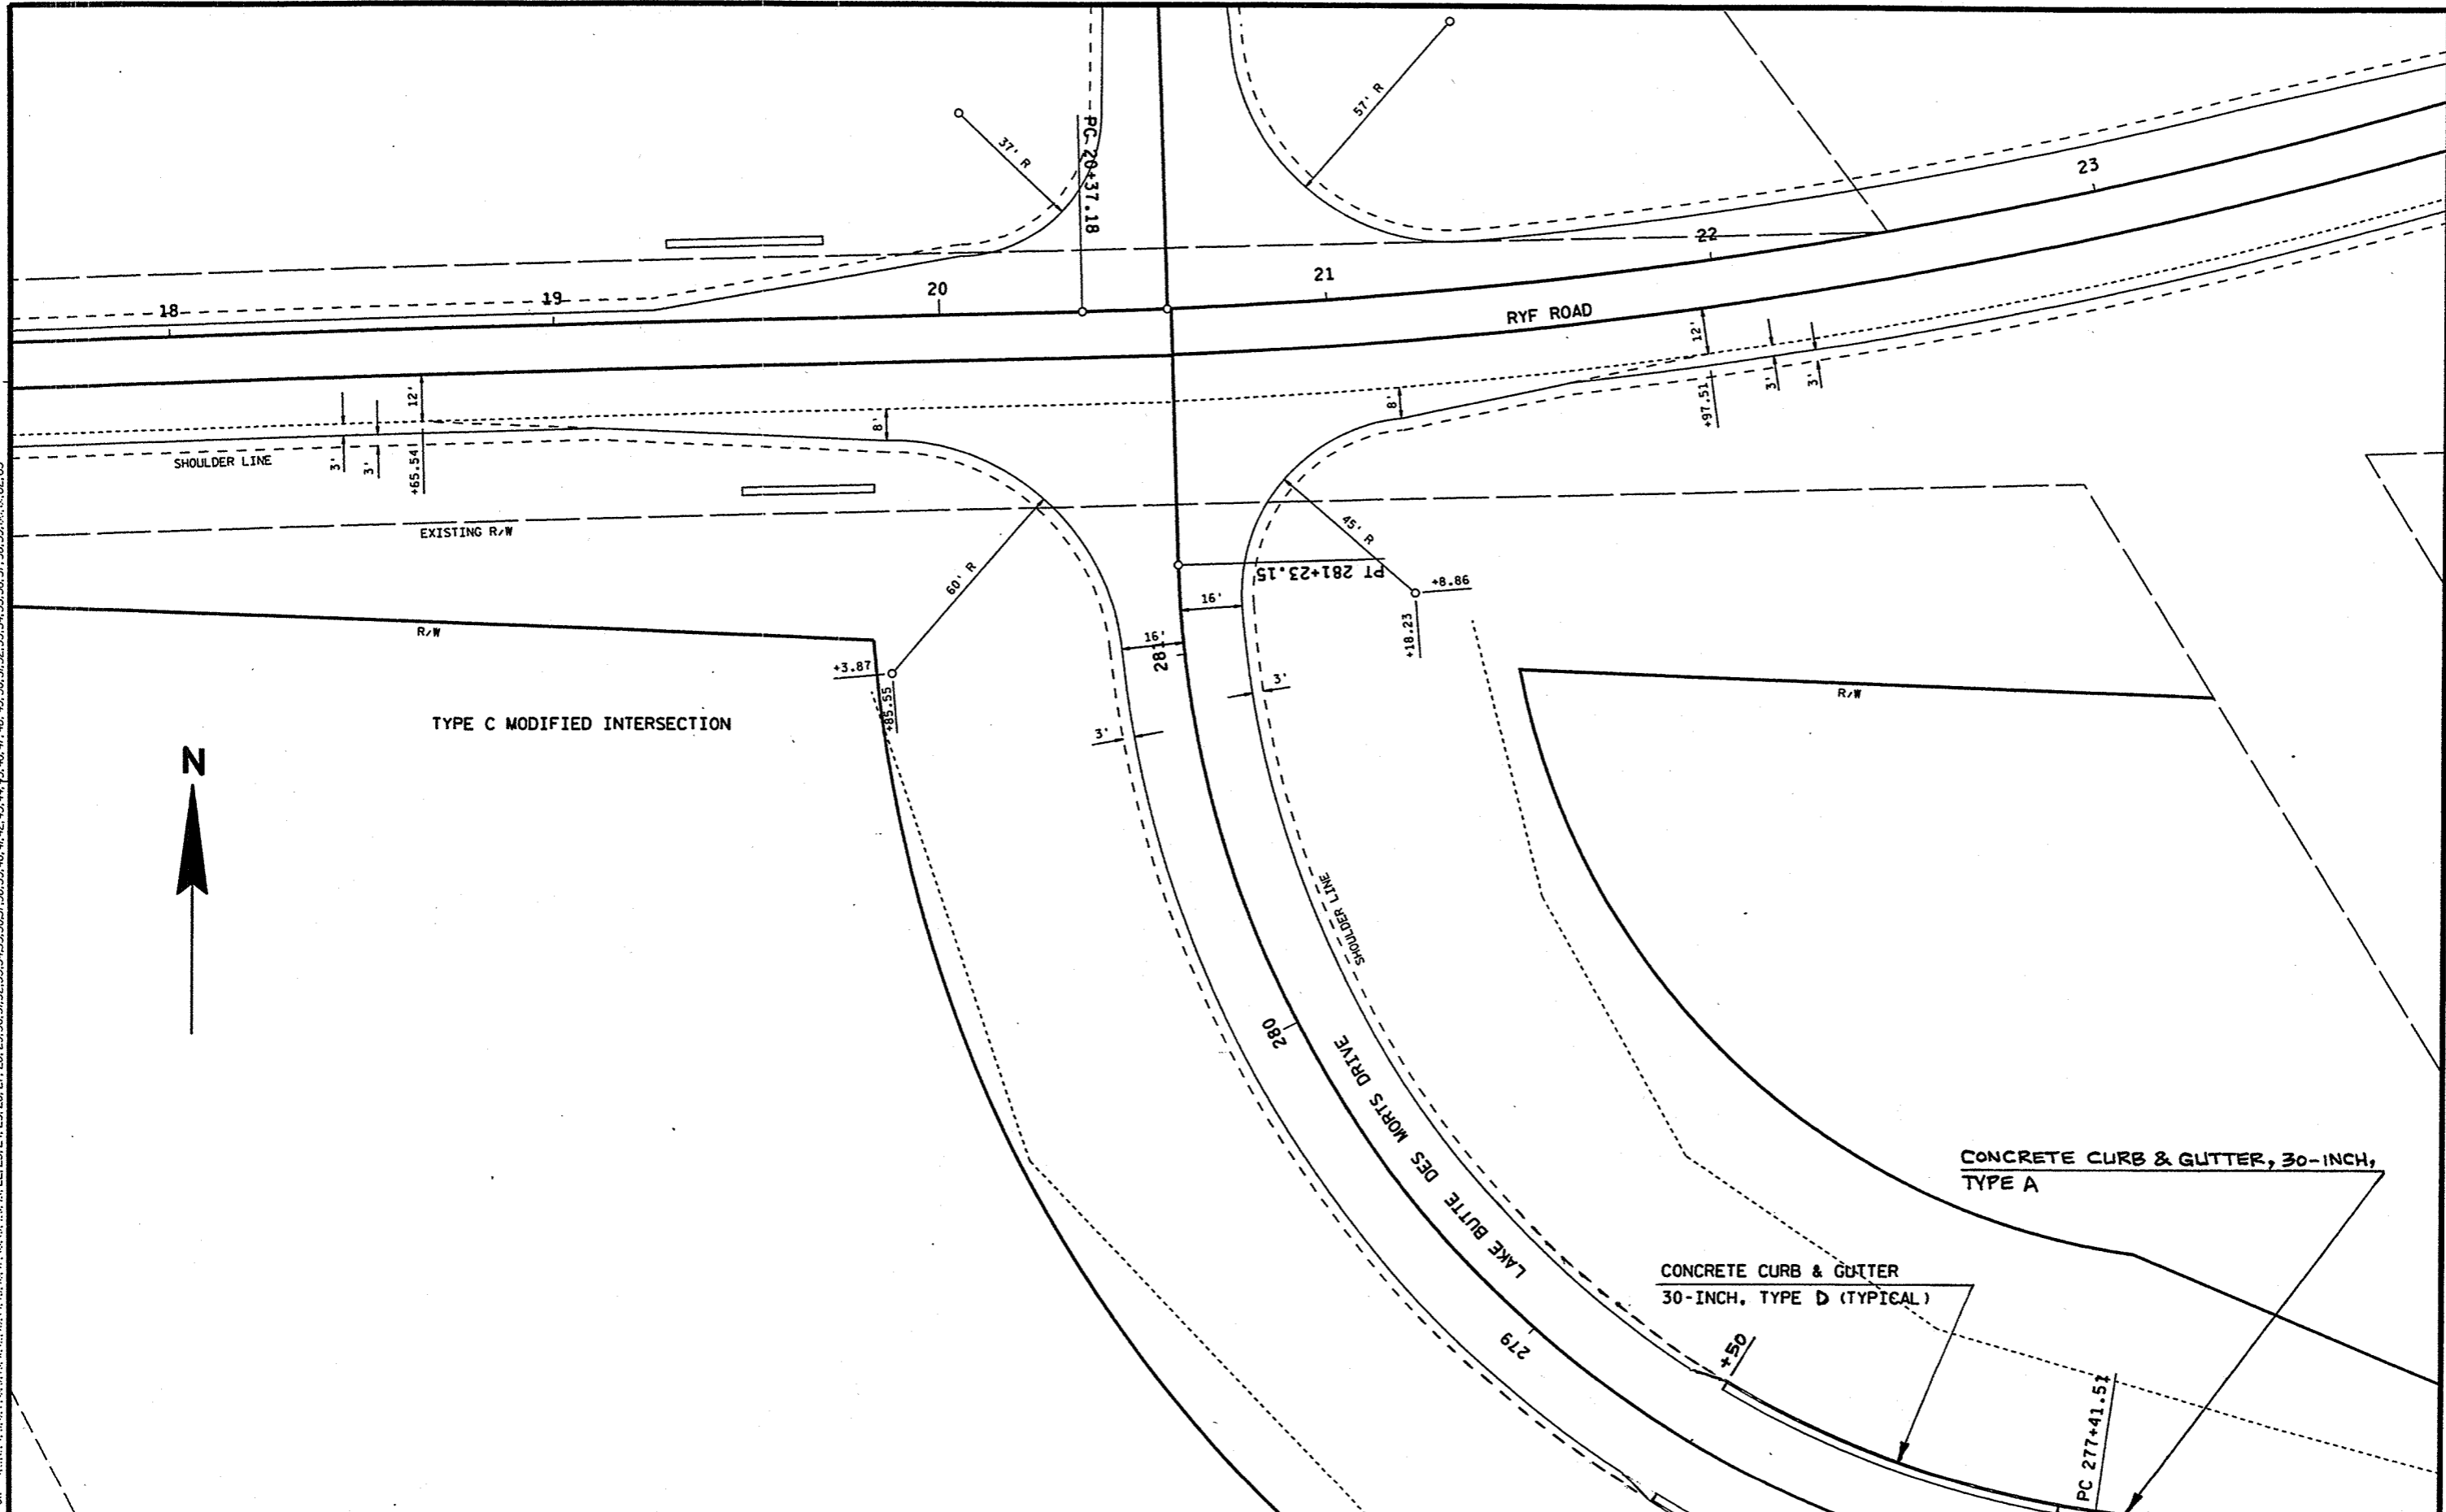

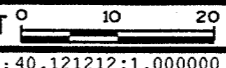
STATE PROJECT NUMBER: 6200-05-71 HWY: STH 110 COUNTY: WINNEBAGO CONSTRUCTION DETAIL SCALE, FEET  SHEET NO: 2.35 E

FILE NAME : F:\d3_620005\021103_id.dgn PLOT DATE: 12-SEP-2001 08:52 ORG DATE : 6-13-01 PLOT NAME : 021103 1d Originator : d3 PLOT SCALE : 40.121212:1.000000 WISDOT/CADD SHEET 42

LEVELS ON - 1.22, 3.4, 3.6, 7.8, 8.8, 10.8, 11.8, 13.8, 14.8, 15.8, 62.8, 63.8

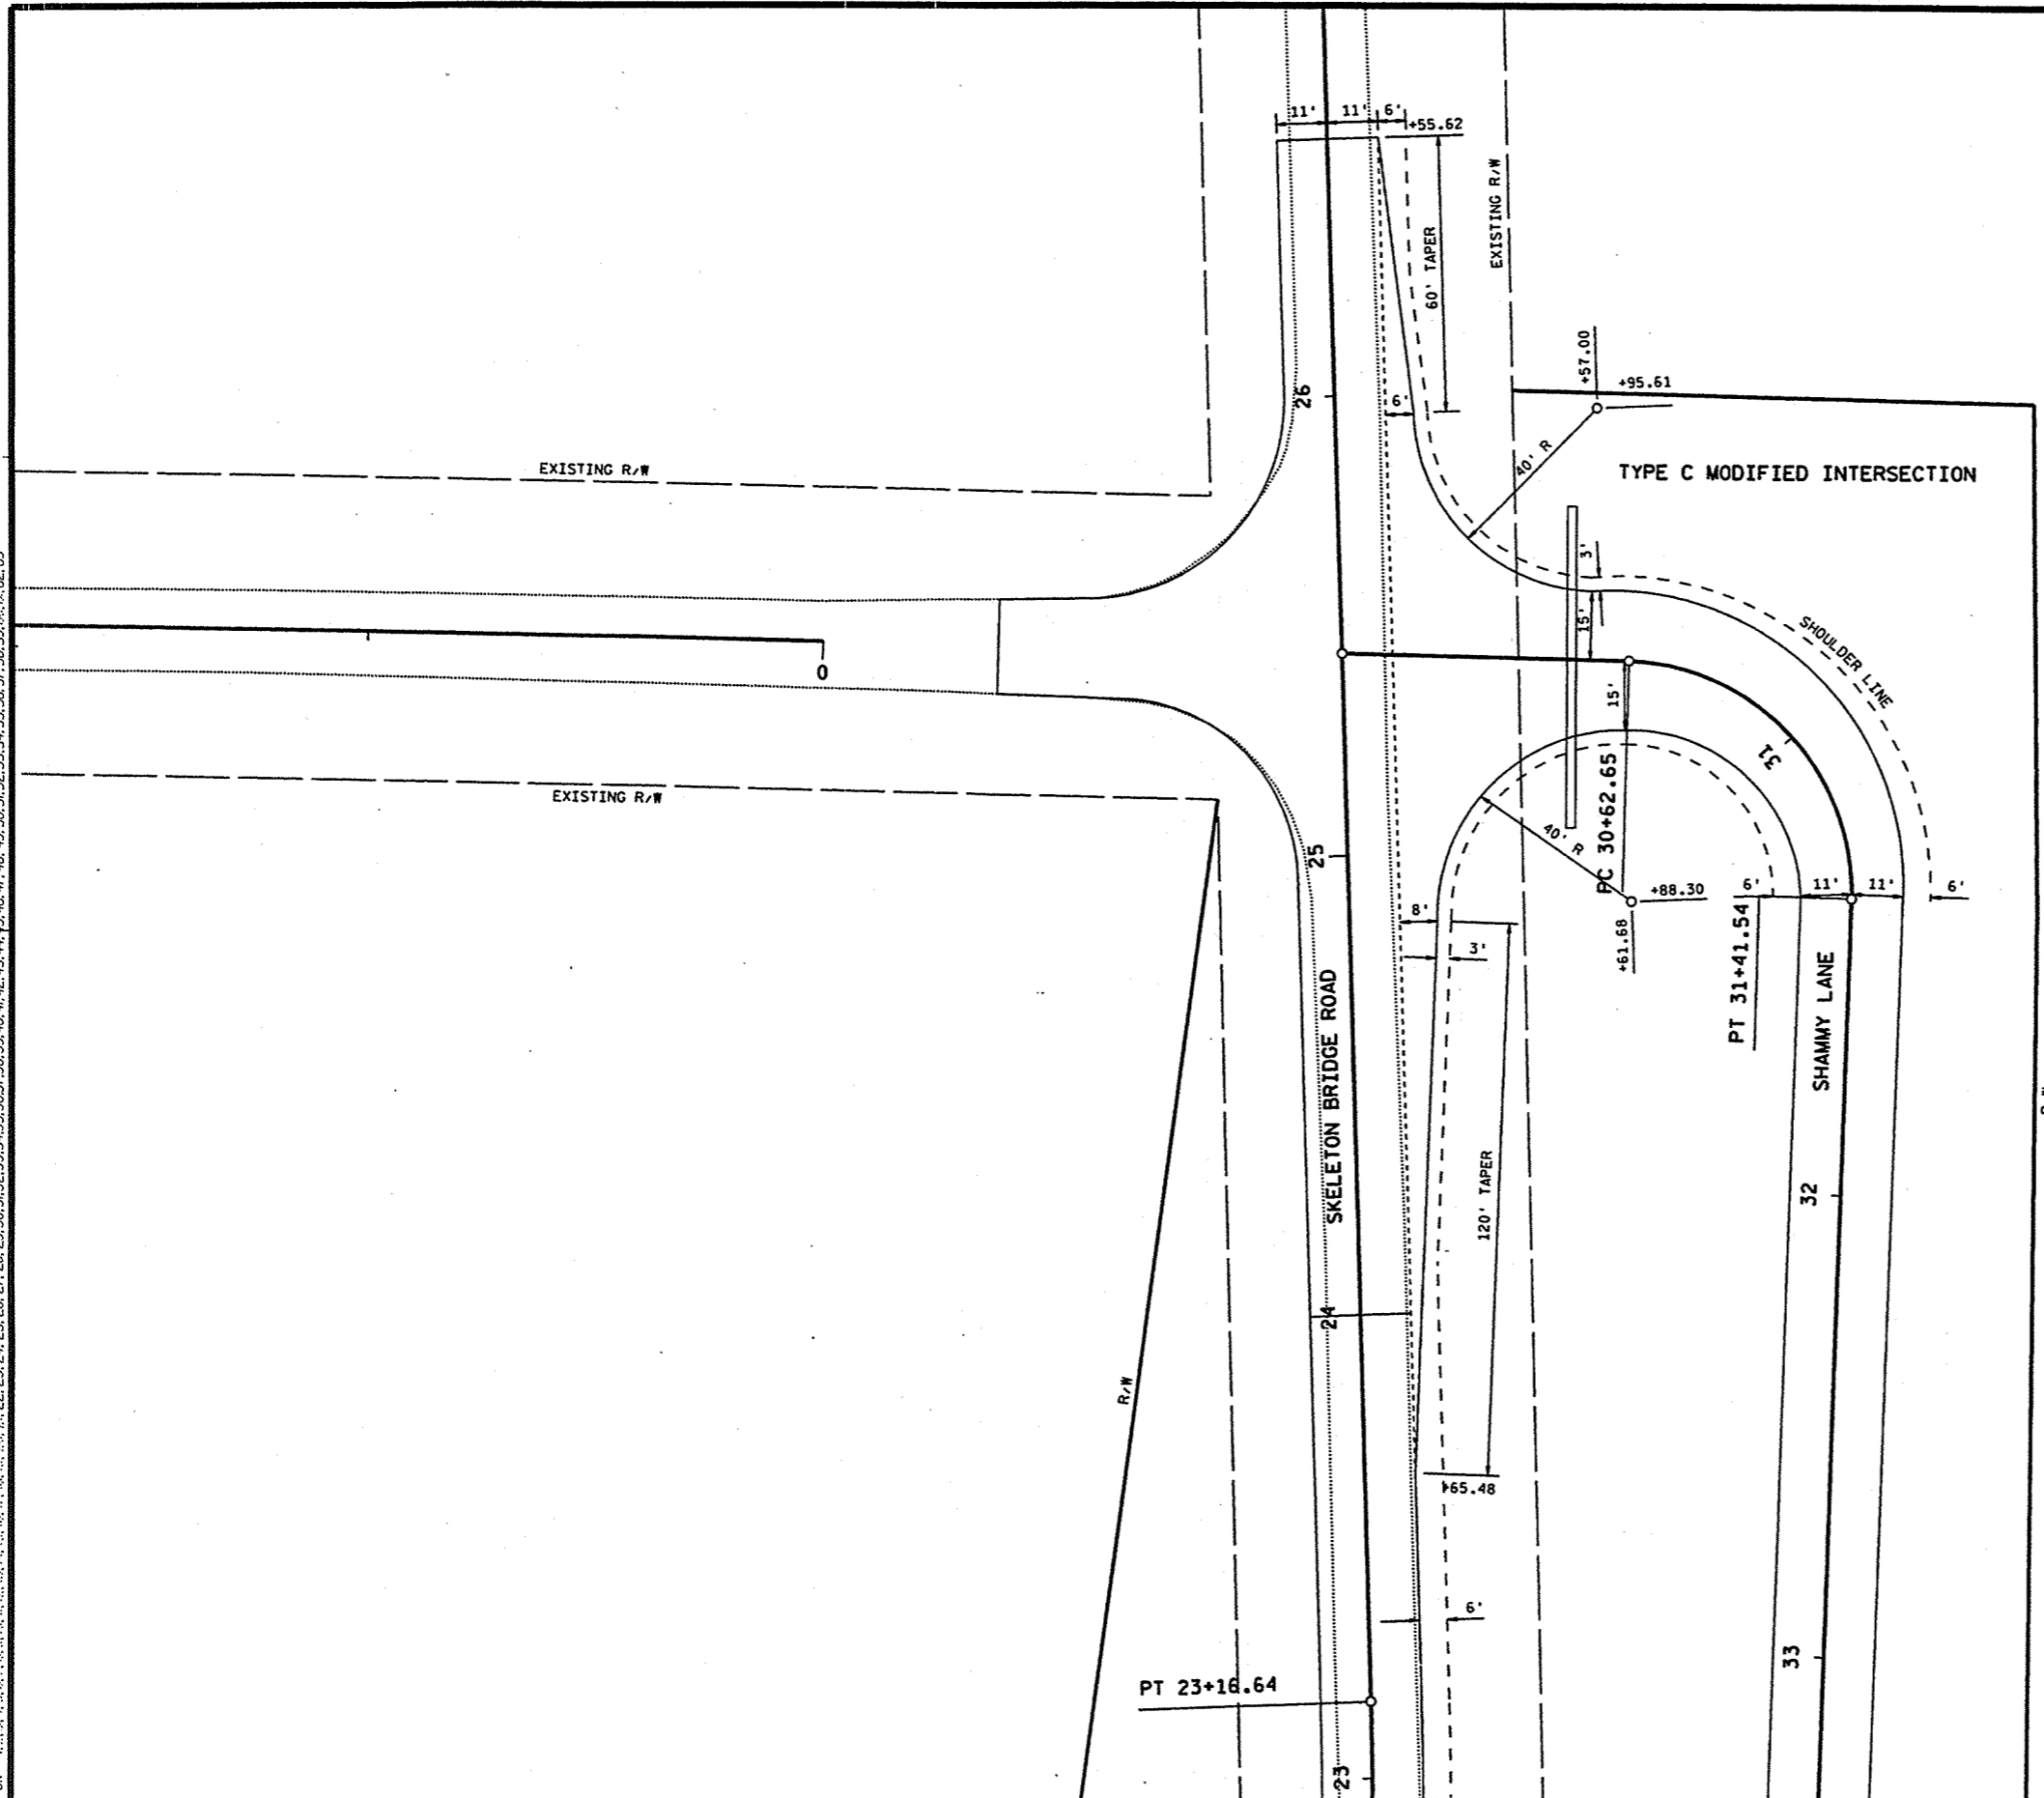


LEVELS ON - 1.23.24.25.26.27.28.29.30.31.32.33.34.35.36.37.38.39.40.41.42.43.44.45.46.48.49.50.51.52.53.54.55.56.57.58.59.60.61.62.63

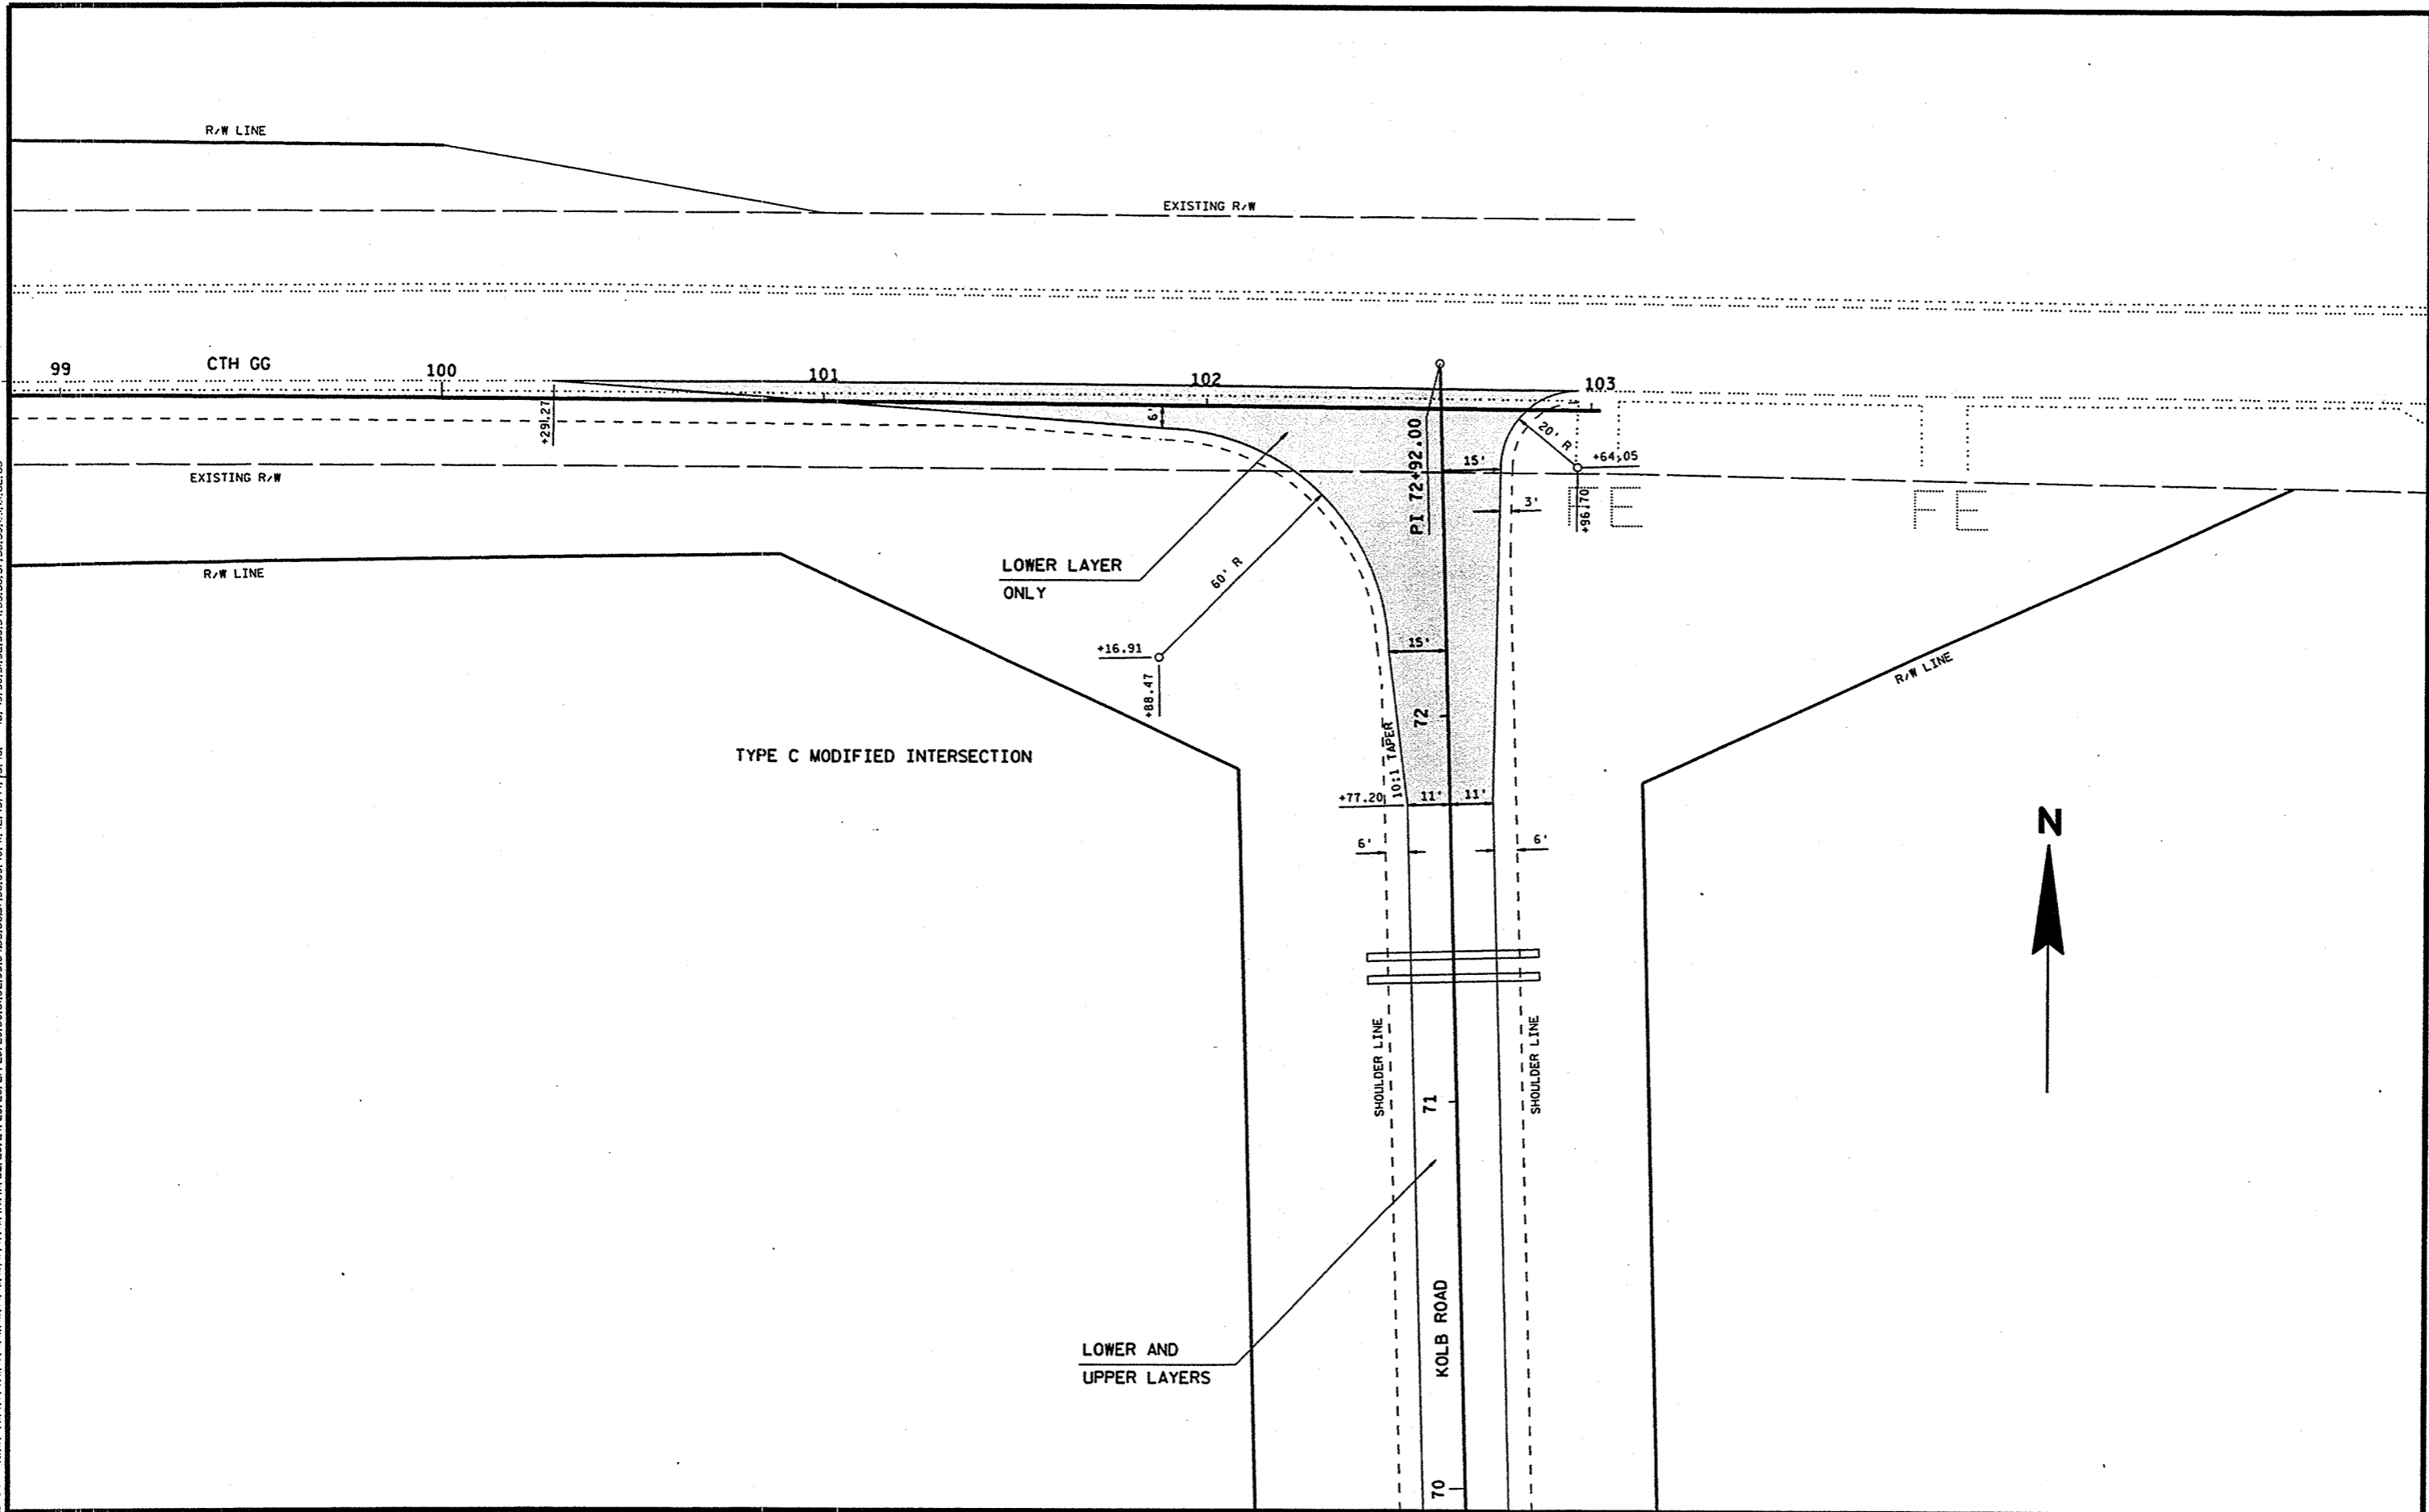

STATE PROJECT NUMBER: 6200-05-71	HWY: STH 110	COUNTY: WINNEBAGO	CONSTRUCTION DETAIL	SCALE, FEET	SHEET NO: 2.37 E
----------------------------------	--------------	-------------------	---------------------	-------------	------------------

FILE NAME : F:\d3_620005+021102_id.dgn PLOT DATE: 26-NOV-2001 14:08 ORG DATE : PLOT NAME : 0211021 id Originator : d3 PLOT SCALE : 40.121212:1.000000 WISDOT/CADD SHEET 42

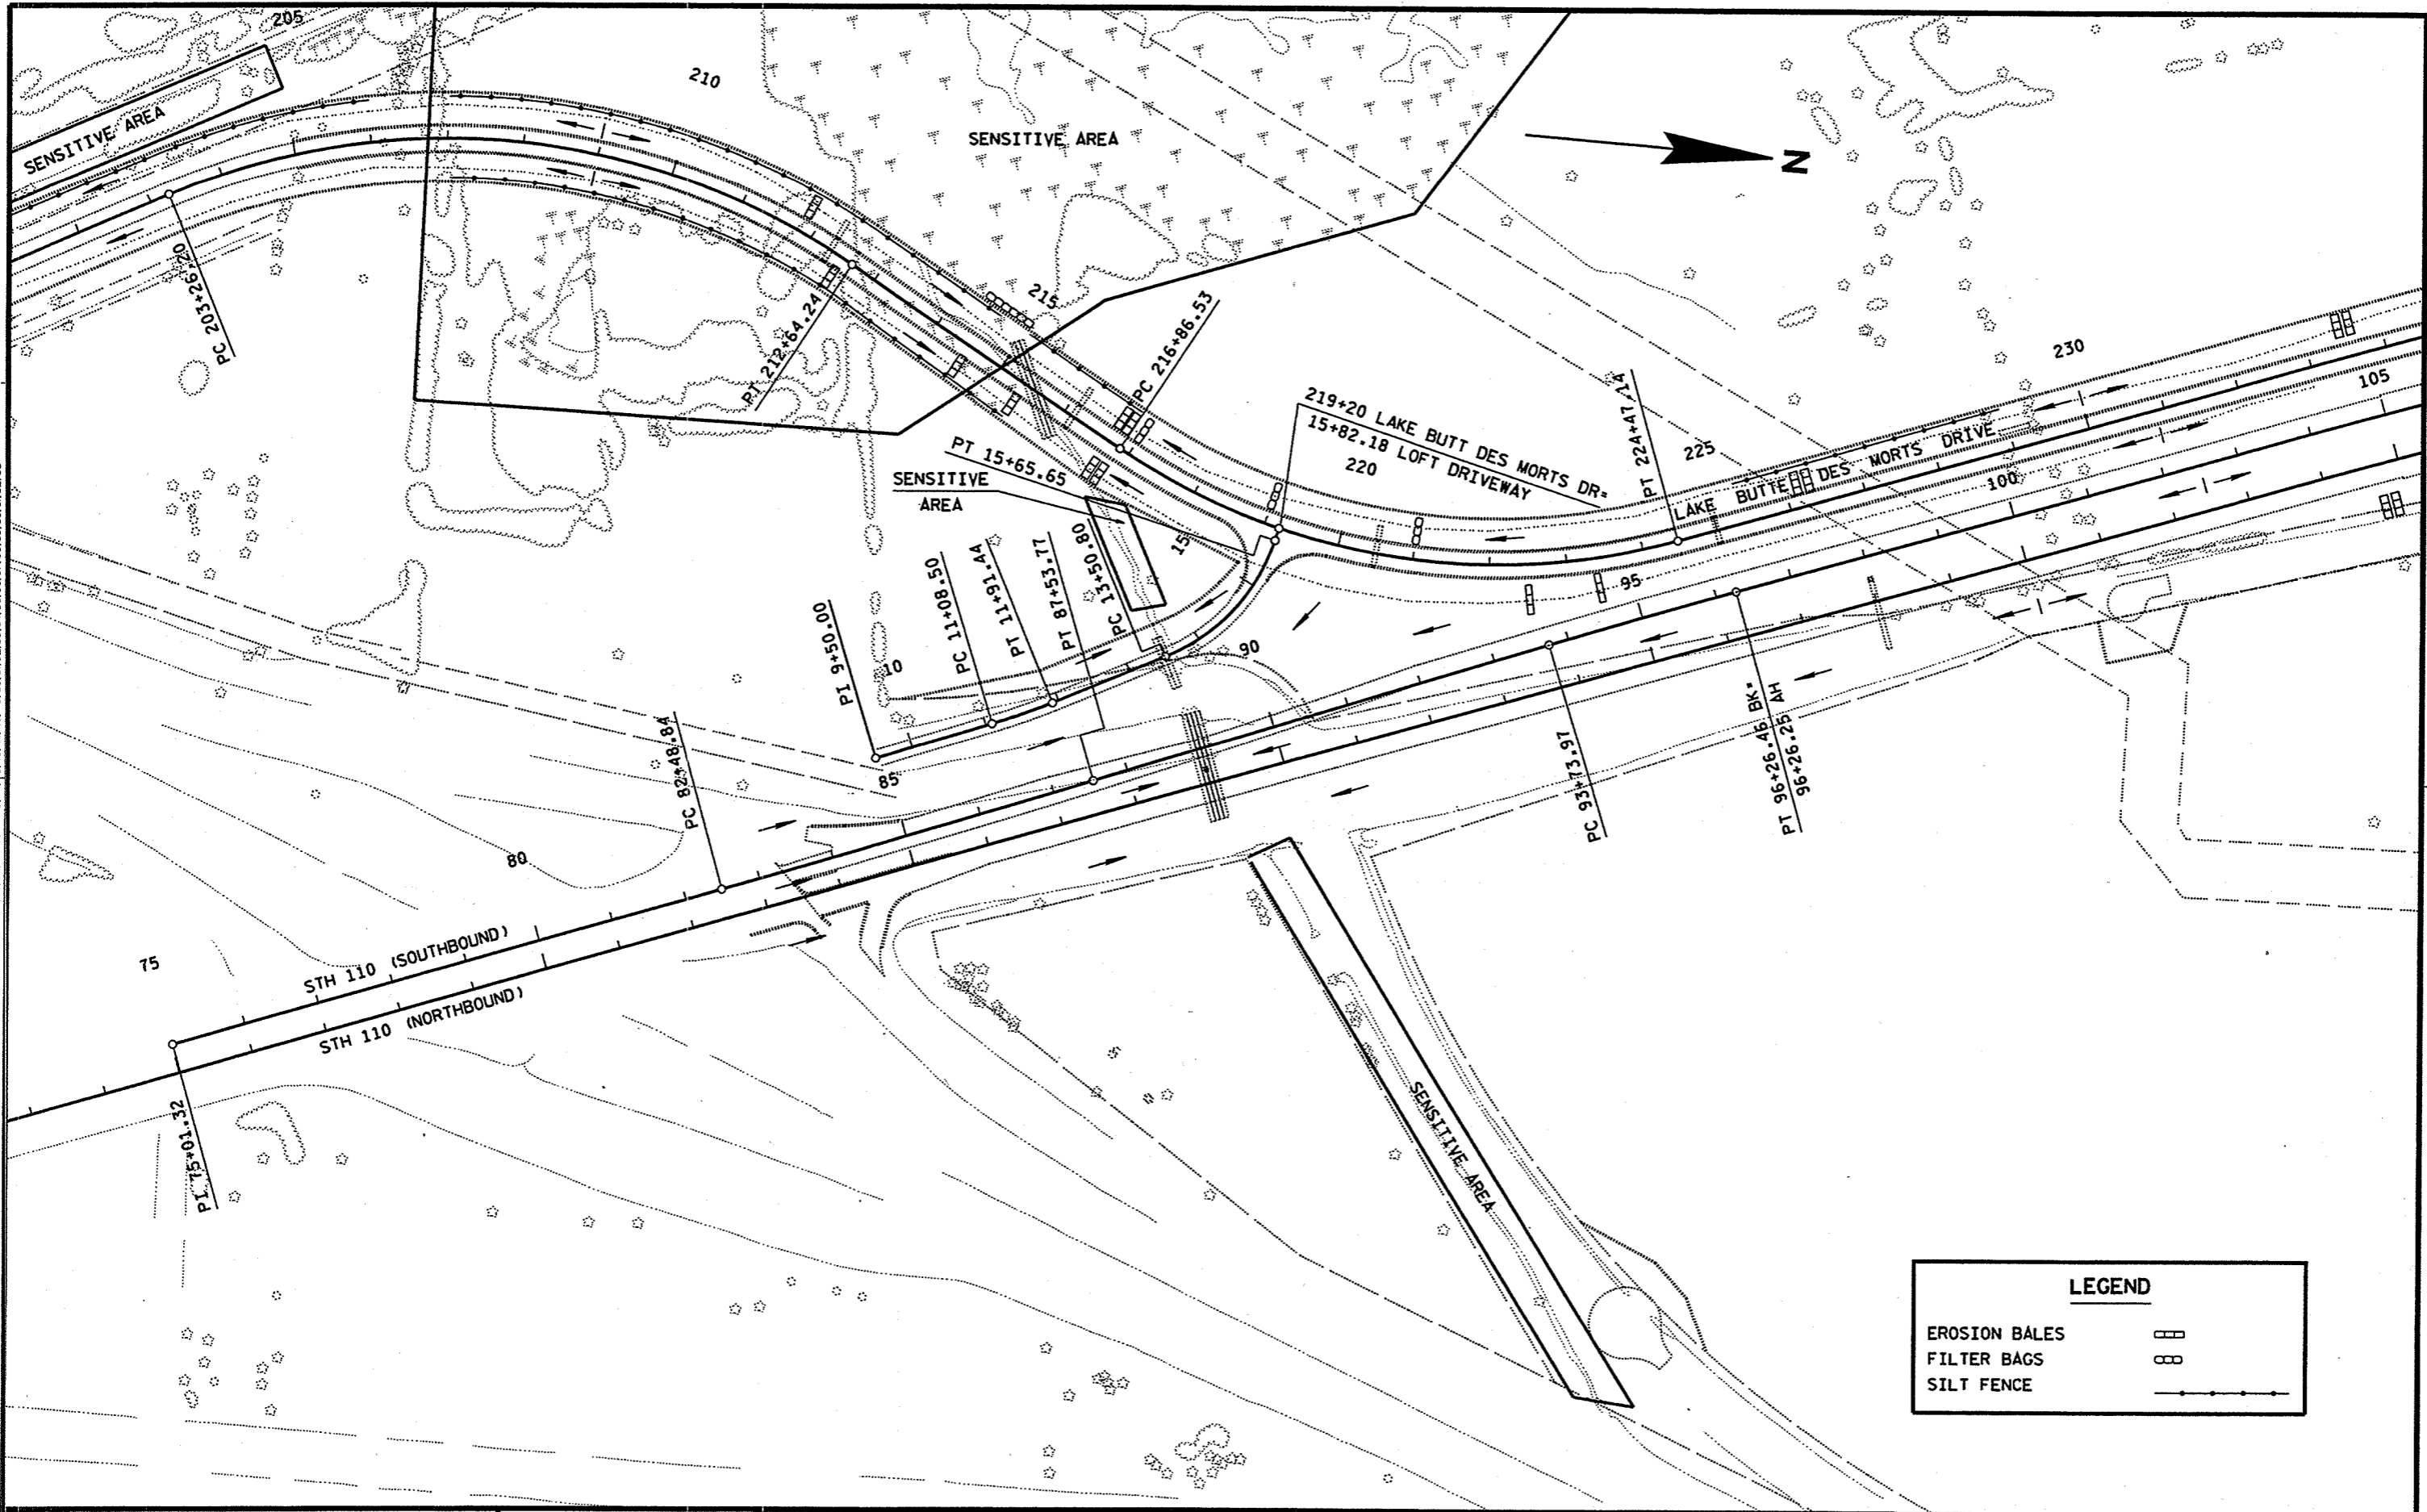


LEVELS ON - 1, 2, 3, 62, 63

LEGEND	
EROSION BALES	▬▬▬
FILTER BAGS	○
SILT FENCE	—+—+—+—+—+—+—+—+—+—

STATE PROJECT NUMBER: 6200-05-71 HWY: STH 110 COUNTY: WINNEBAGO EROSION CONTROL (TEMPORARY) SCALE, FEET SHEET NO: 238 E

FILE NAME : F:\d3_620005\210.dgn PLOT DATE: 11-JUL-2001 15:16 ORG DATE : 9/21/00 PLOT NAME : 210d71 Originator : DISTRICT 3 -- JD PLOT SCALE : 200.700000:1.000000 WISDOT/CADD SHEET 42

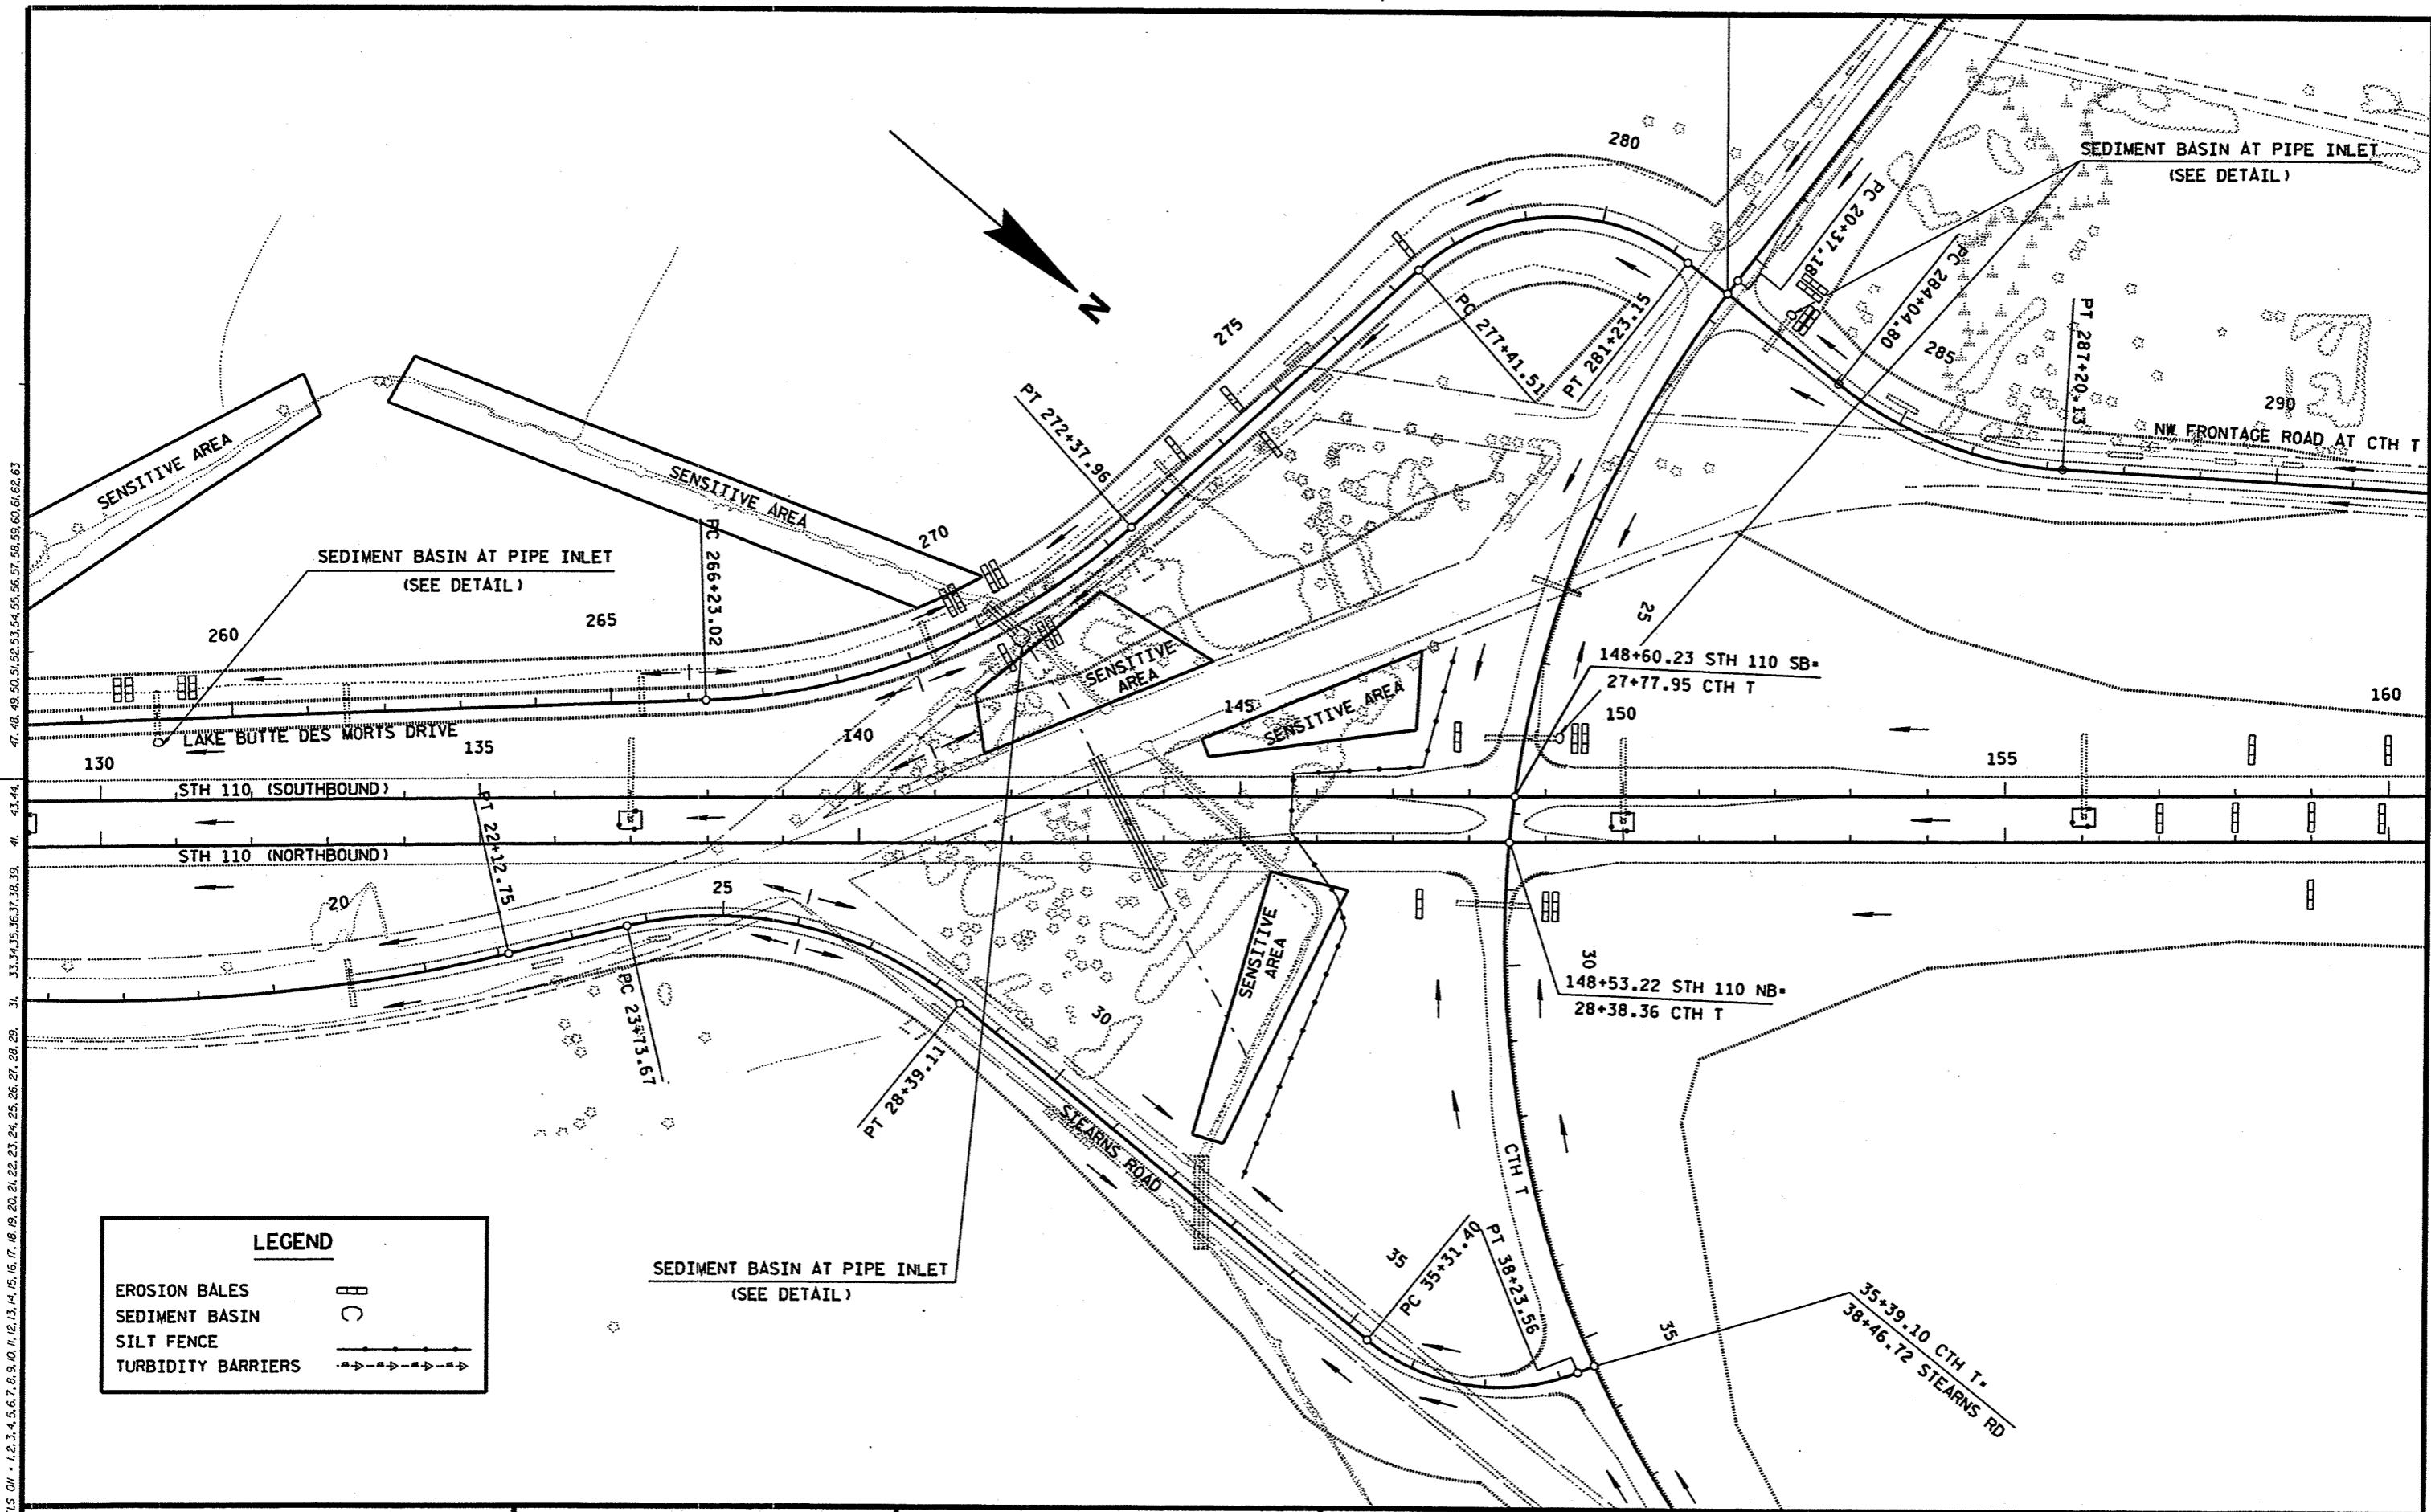


LEVELS ON - 1, 2, 3, 62, 63

LEGEND	
EROSION BALES	
SEDIMENT BASIN	
SILT FENCE	
TURBIDITY BARRIERS	

STATE PROJECT NUMBER: 6200-05-71 HWY: STH 110 COUNTY: WINNEBAGO EROSION CONTROL (TEMPORARY) SCALE, FEET SHEET NO: 2.40 E

FILE NAME: F:\d3_620005\212.dgn PLOT DATE: 11-JUL-2001 15:16 ORG DATE: 10/18/00 PLOT NAME: 212d71 Originator: DISTRICT 3 -- JD PLOT SCALE: 200.700000:1.000000 WISDOT/CADD SHEET 42

LEVELS ON * 1,2,3,4,5,6,7,8,9,10,11,12,13,14,15,16,17,18,19,20,21,22,23,24,25,26,27,28,29,30,31, 33,34,35,36,37,38,39,40,41,42,43,44,45,46,47,48,49,50,51,52,53,54,55,56,57,58,59,60,61,62,63

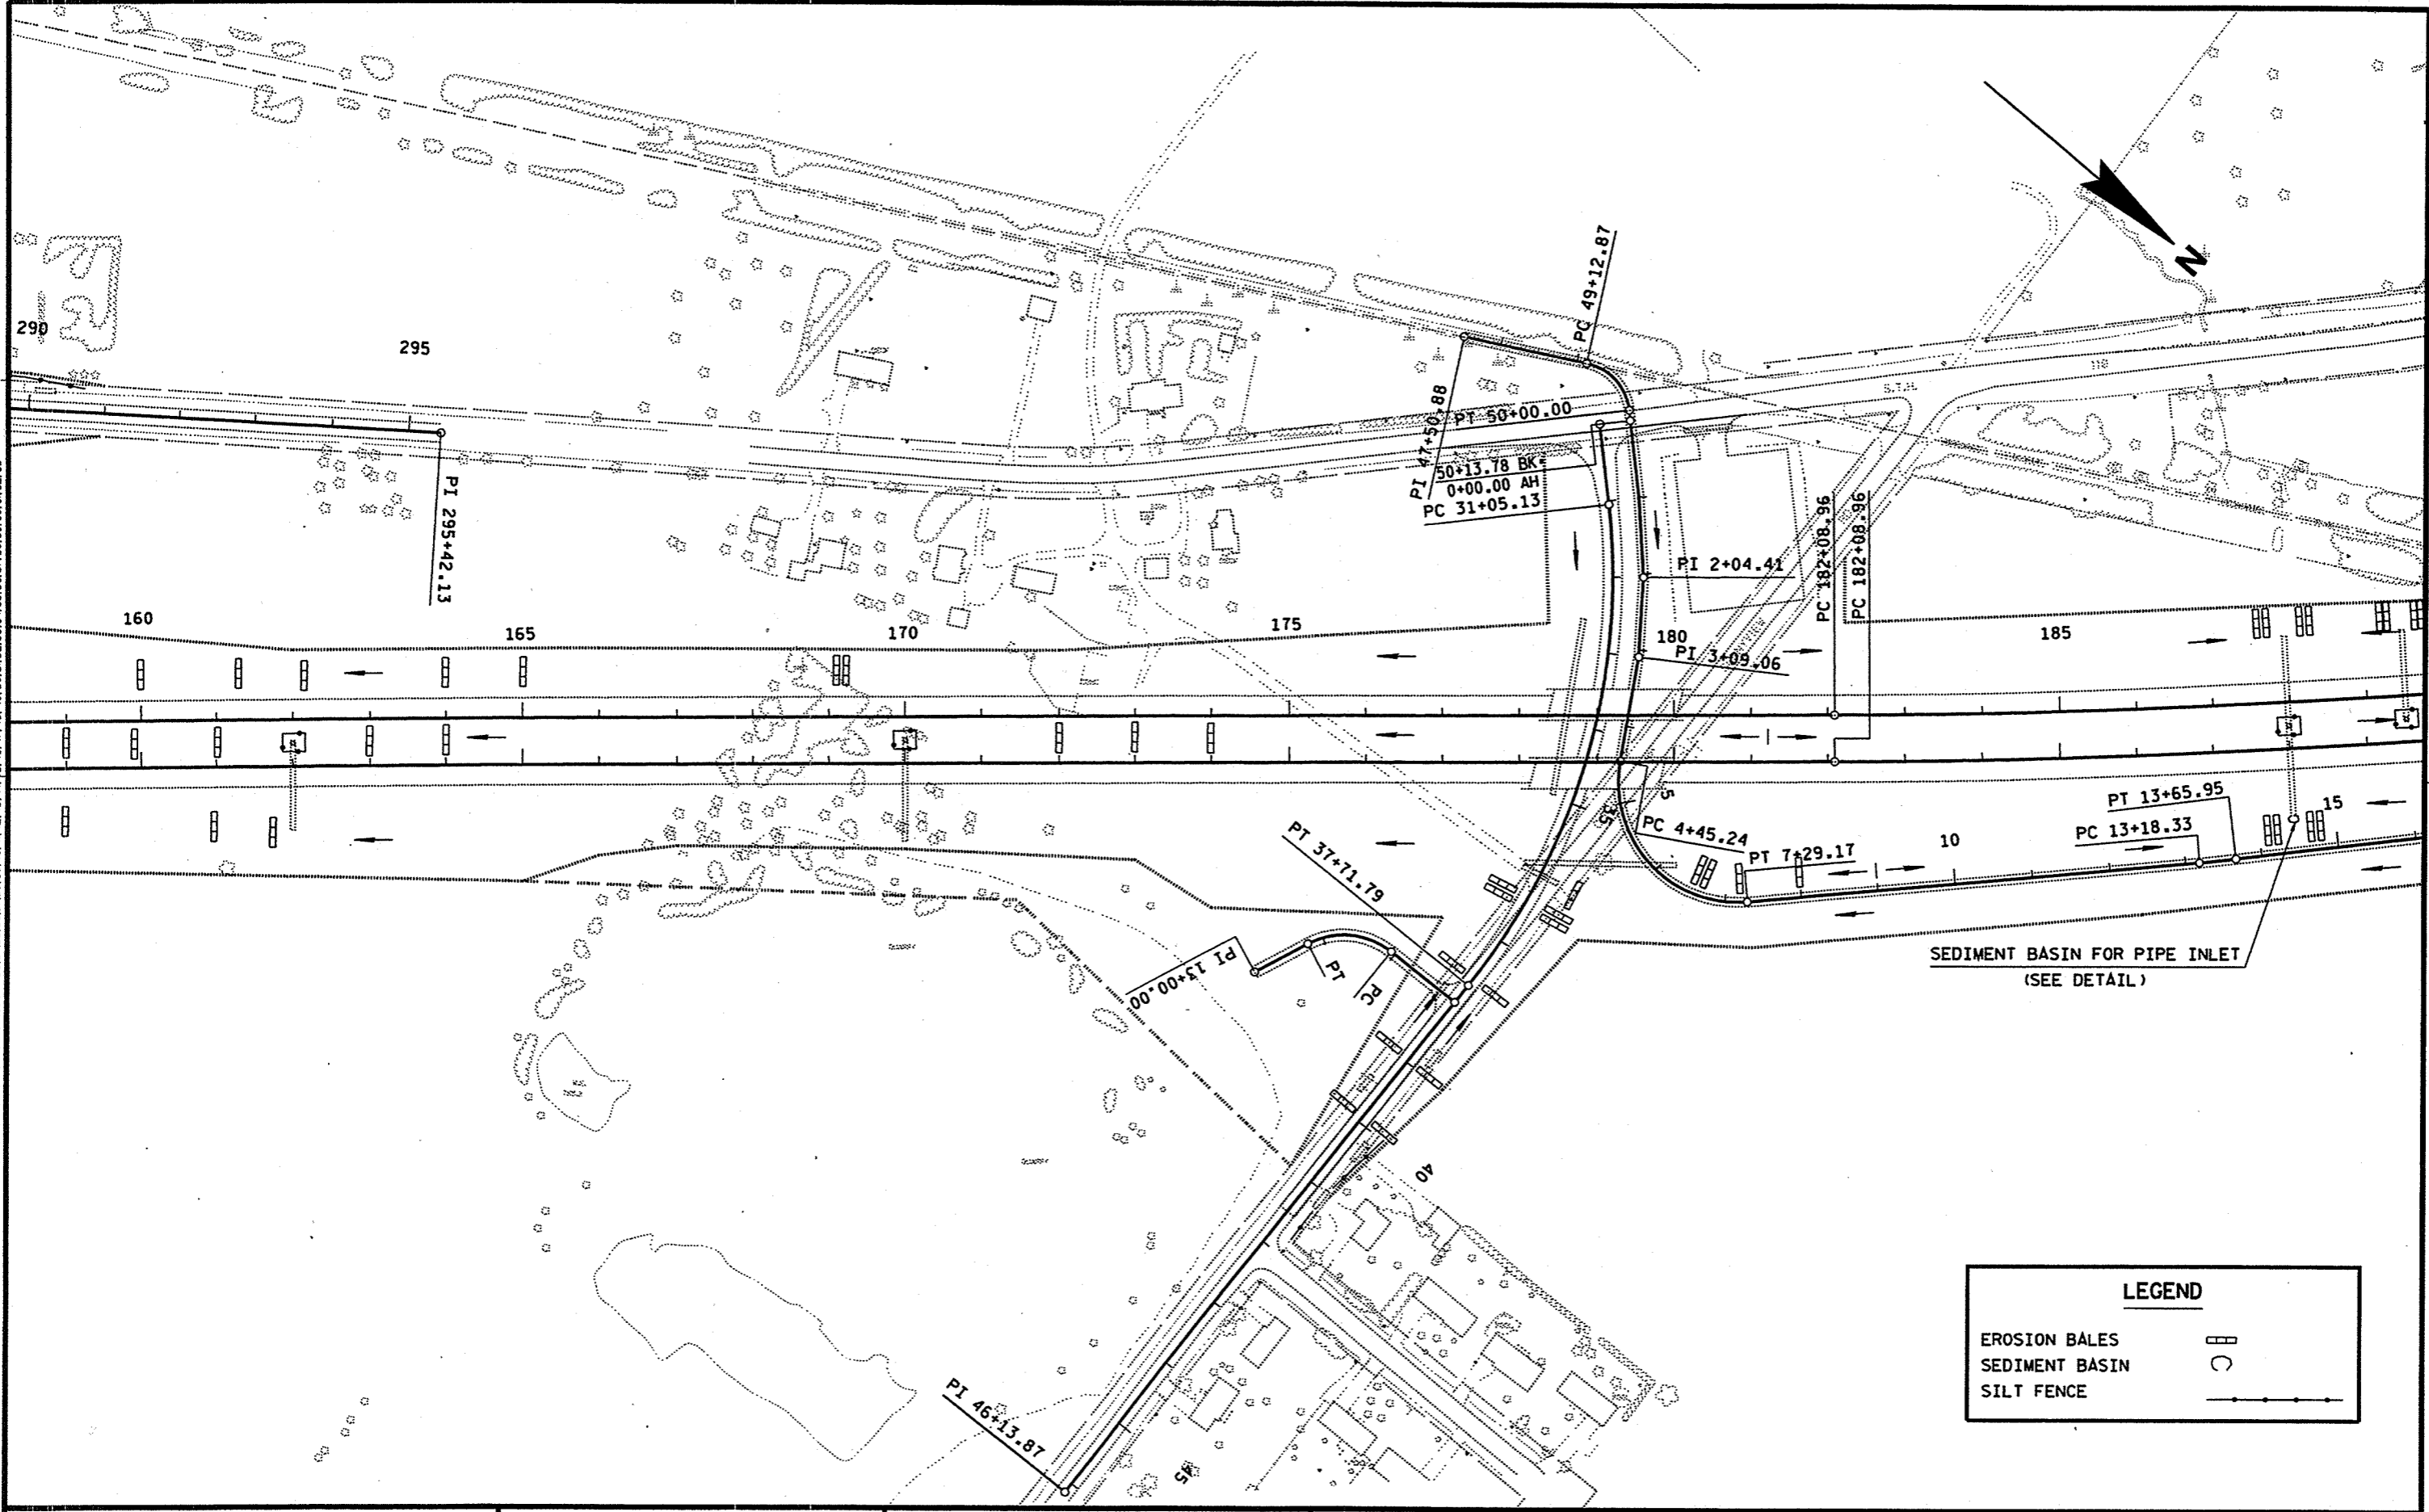


LEGEND

EROSION BALES	
SEDIMENT BASIN	
SILT FENCE	

STATE PROJECT NUMBER: 6200-05-71 HWY: STH 110 COUNTY: WINNEBAGO EROSION CONTROL (TEMPORARY) SCALE, FEET SHEET NO: 2.41 E

FILE NAME: F:\d3_620005+213.dgn PLOT DATE: 13-SEP-2001 08:33 ORG DATE: 10/31/00 PLOT NAME: 213d+71 Originator: DISTRICT 3 -- JD PLOT SCALE: 200.700000:1.000000 WISDOT/CADD SHEET 42

LEVELS ON - 1, 2, 3, 62, 63

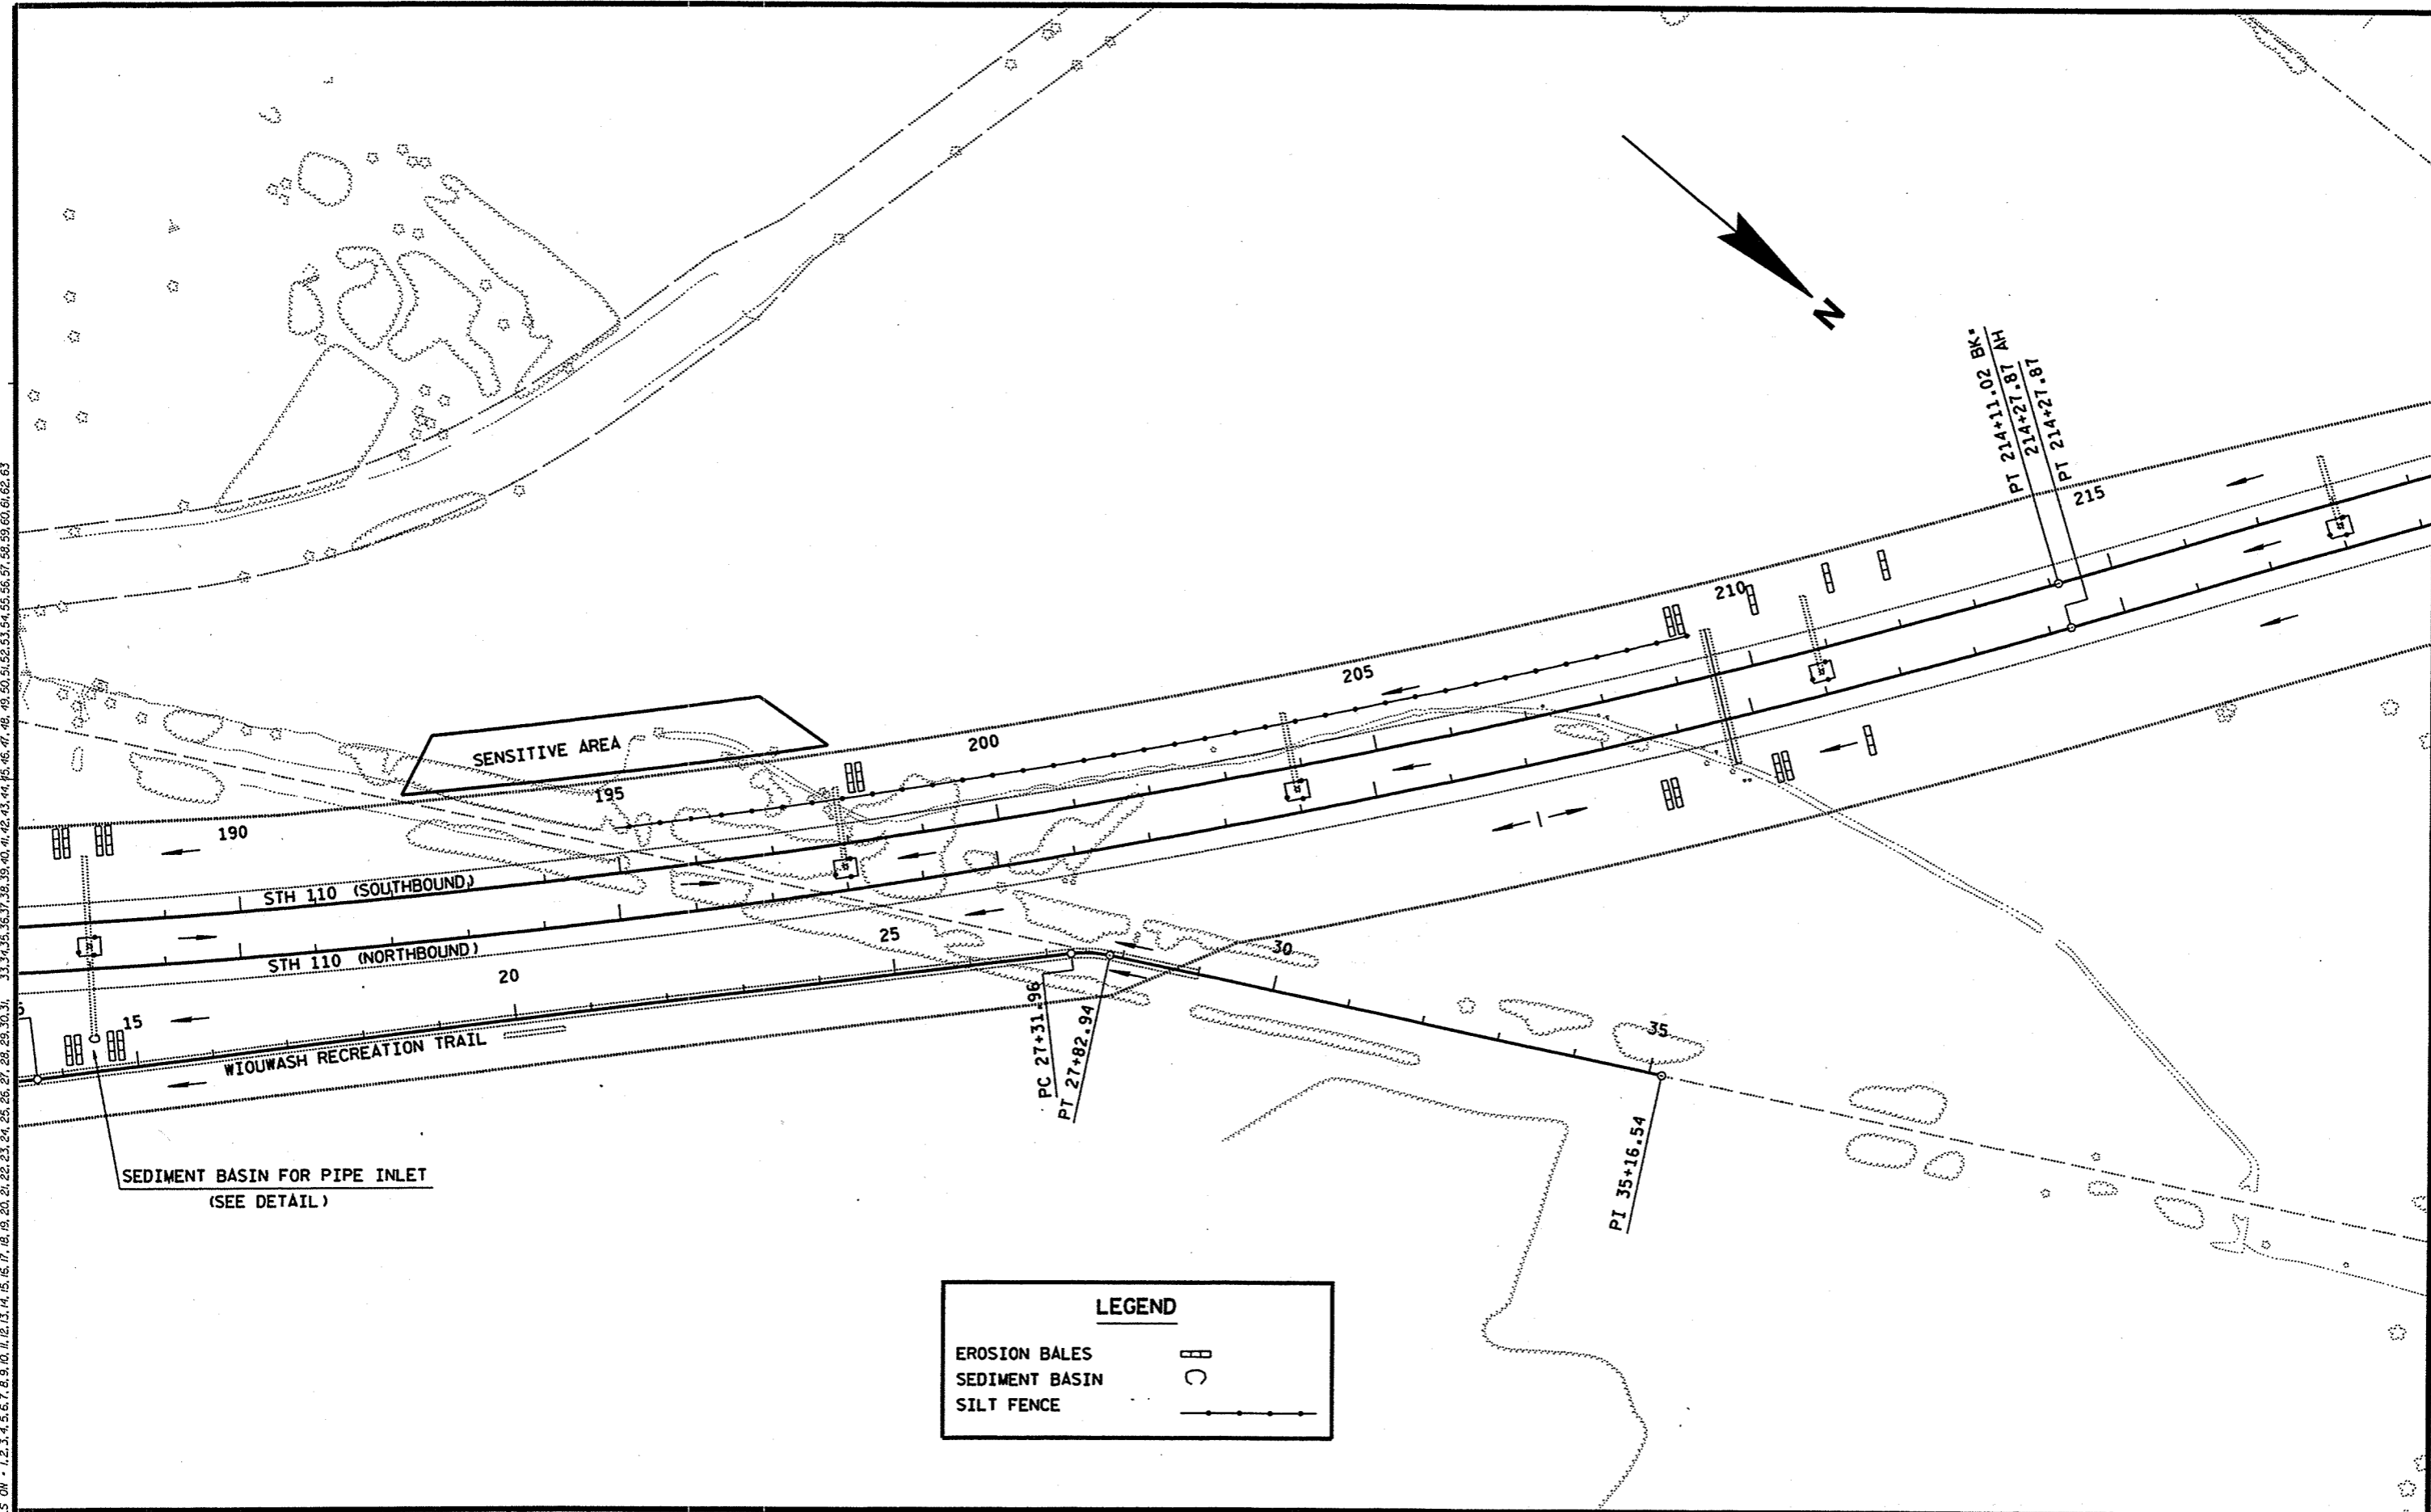


LEGEND	
EROSION BALES	▬
SEDIMENT BASIN	⊝
SILT FENCE	—•—•—•—•—

STATE PROJECT NUMBER: 6200-05-71 HWY: STH 110 COUNTY: WINNEBAGO EROSION CONTROL (TEMPORARY) SCALE, FEET SHEET NO: 2.42 E

FILE NAME : F:\d3_620005+214.dgn PLOT DATE: 27-JUN-2001 12:49 ORG DATE : 11/1/00 PLOT NAME : 214dt71 Originator : DISTRICT 3 -- JD PLOT SCALE : 200.700000:1.000000

LEVELS ON - 1,2,3,4,5,6,7,8,9,10,11,12,13,14,15,16,17,18,19,20,21,22,23,24,25,26,27,28,29,30,31, 33,34,35,36,37,38,39,40,41,42,43,44,45,46,47,48,49,50,51,52,53,54,55,56,57,58,59,60,61,62,63

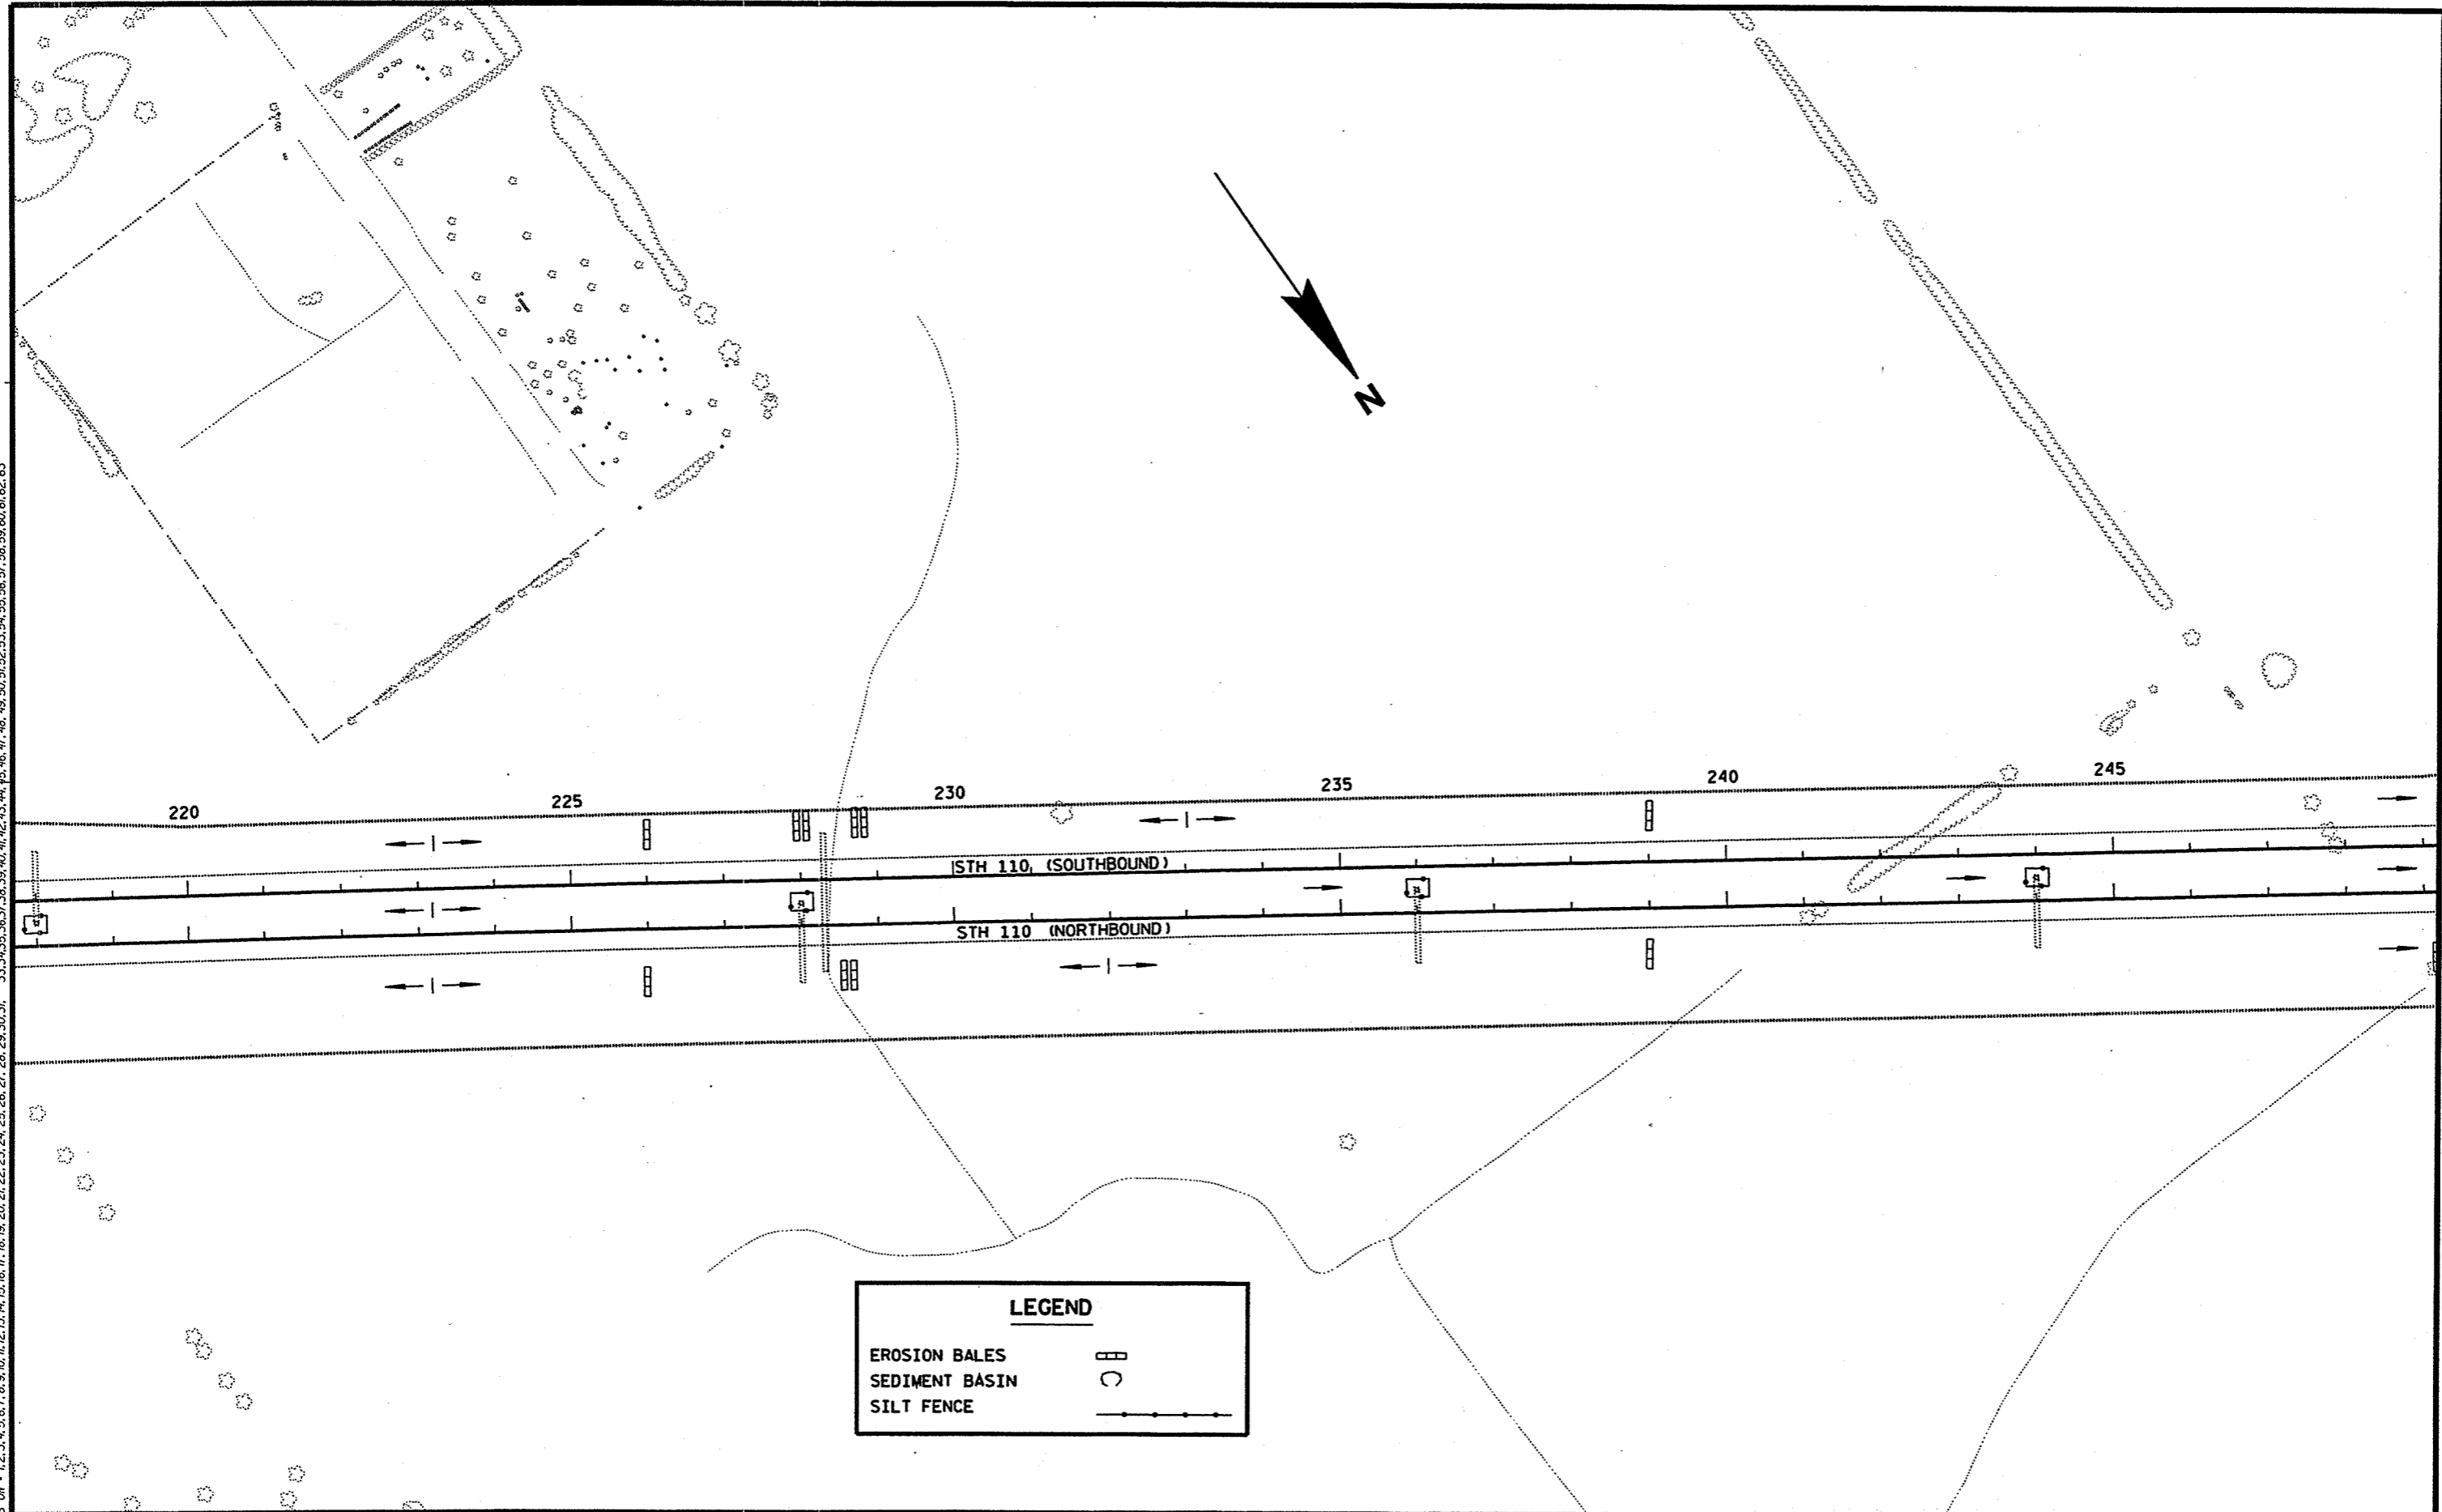


LEGEND

EROSION BALES	
SEDIMENT BASIN	
SILT FENCE	

STATE PROJECT NUMBER: 6200-05-71	HWY: STH 110	COUNTY: WINNEBAGO	EROSION CONTROL (TEMPORARY)	SCALE, FEET	SHEET NO: 2.43 E
----------------------------------	--------------	-------------------	-----------------------------	-------------	------------------

FILE NAME : F:\d3_620005\215.dgn PLOT DATE: 27-JUN-2001 09:58 ORG DATE : 11/1/00 PLOT NAME : 215dp71 Originator : DISTRICT 3 -- JD PLOT SCALE : 200.700000:1.000000 WISDOT/CADD SHEET 42

LEVELS ON - 1.2, 3, 4, 5, 33, 34, 35, 59, 61, 62, 63

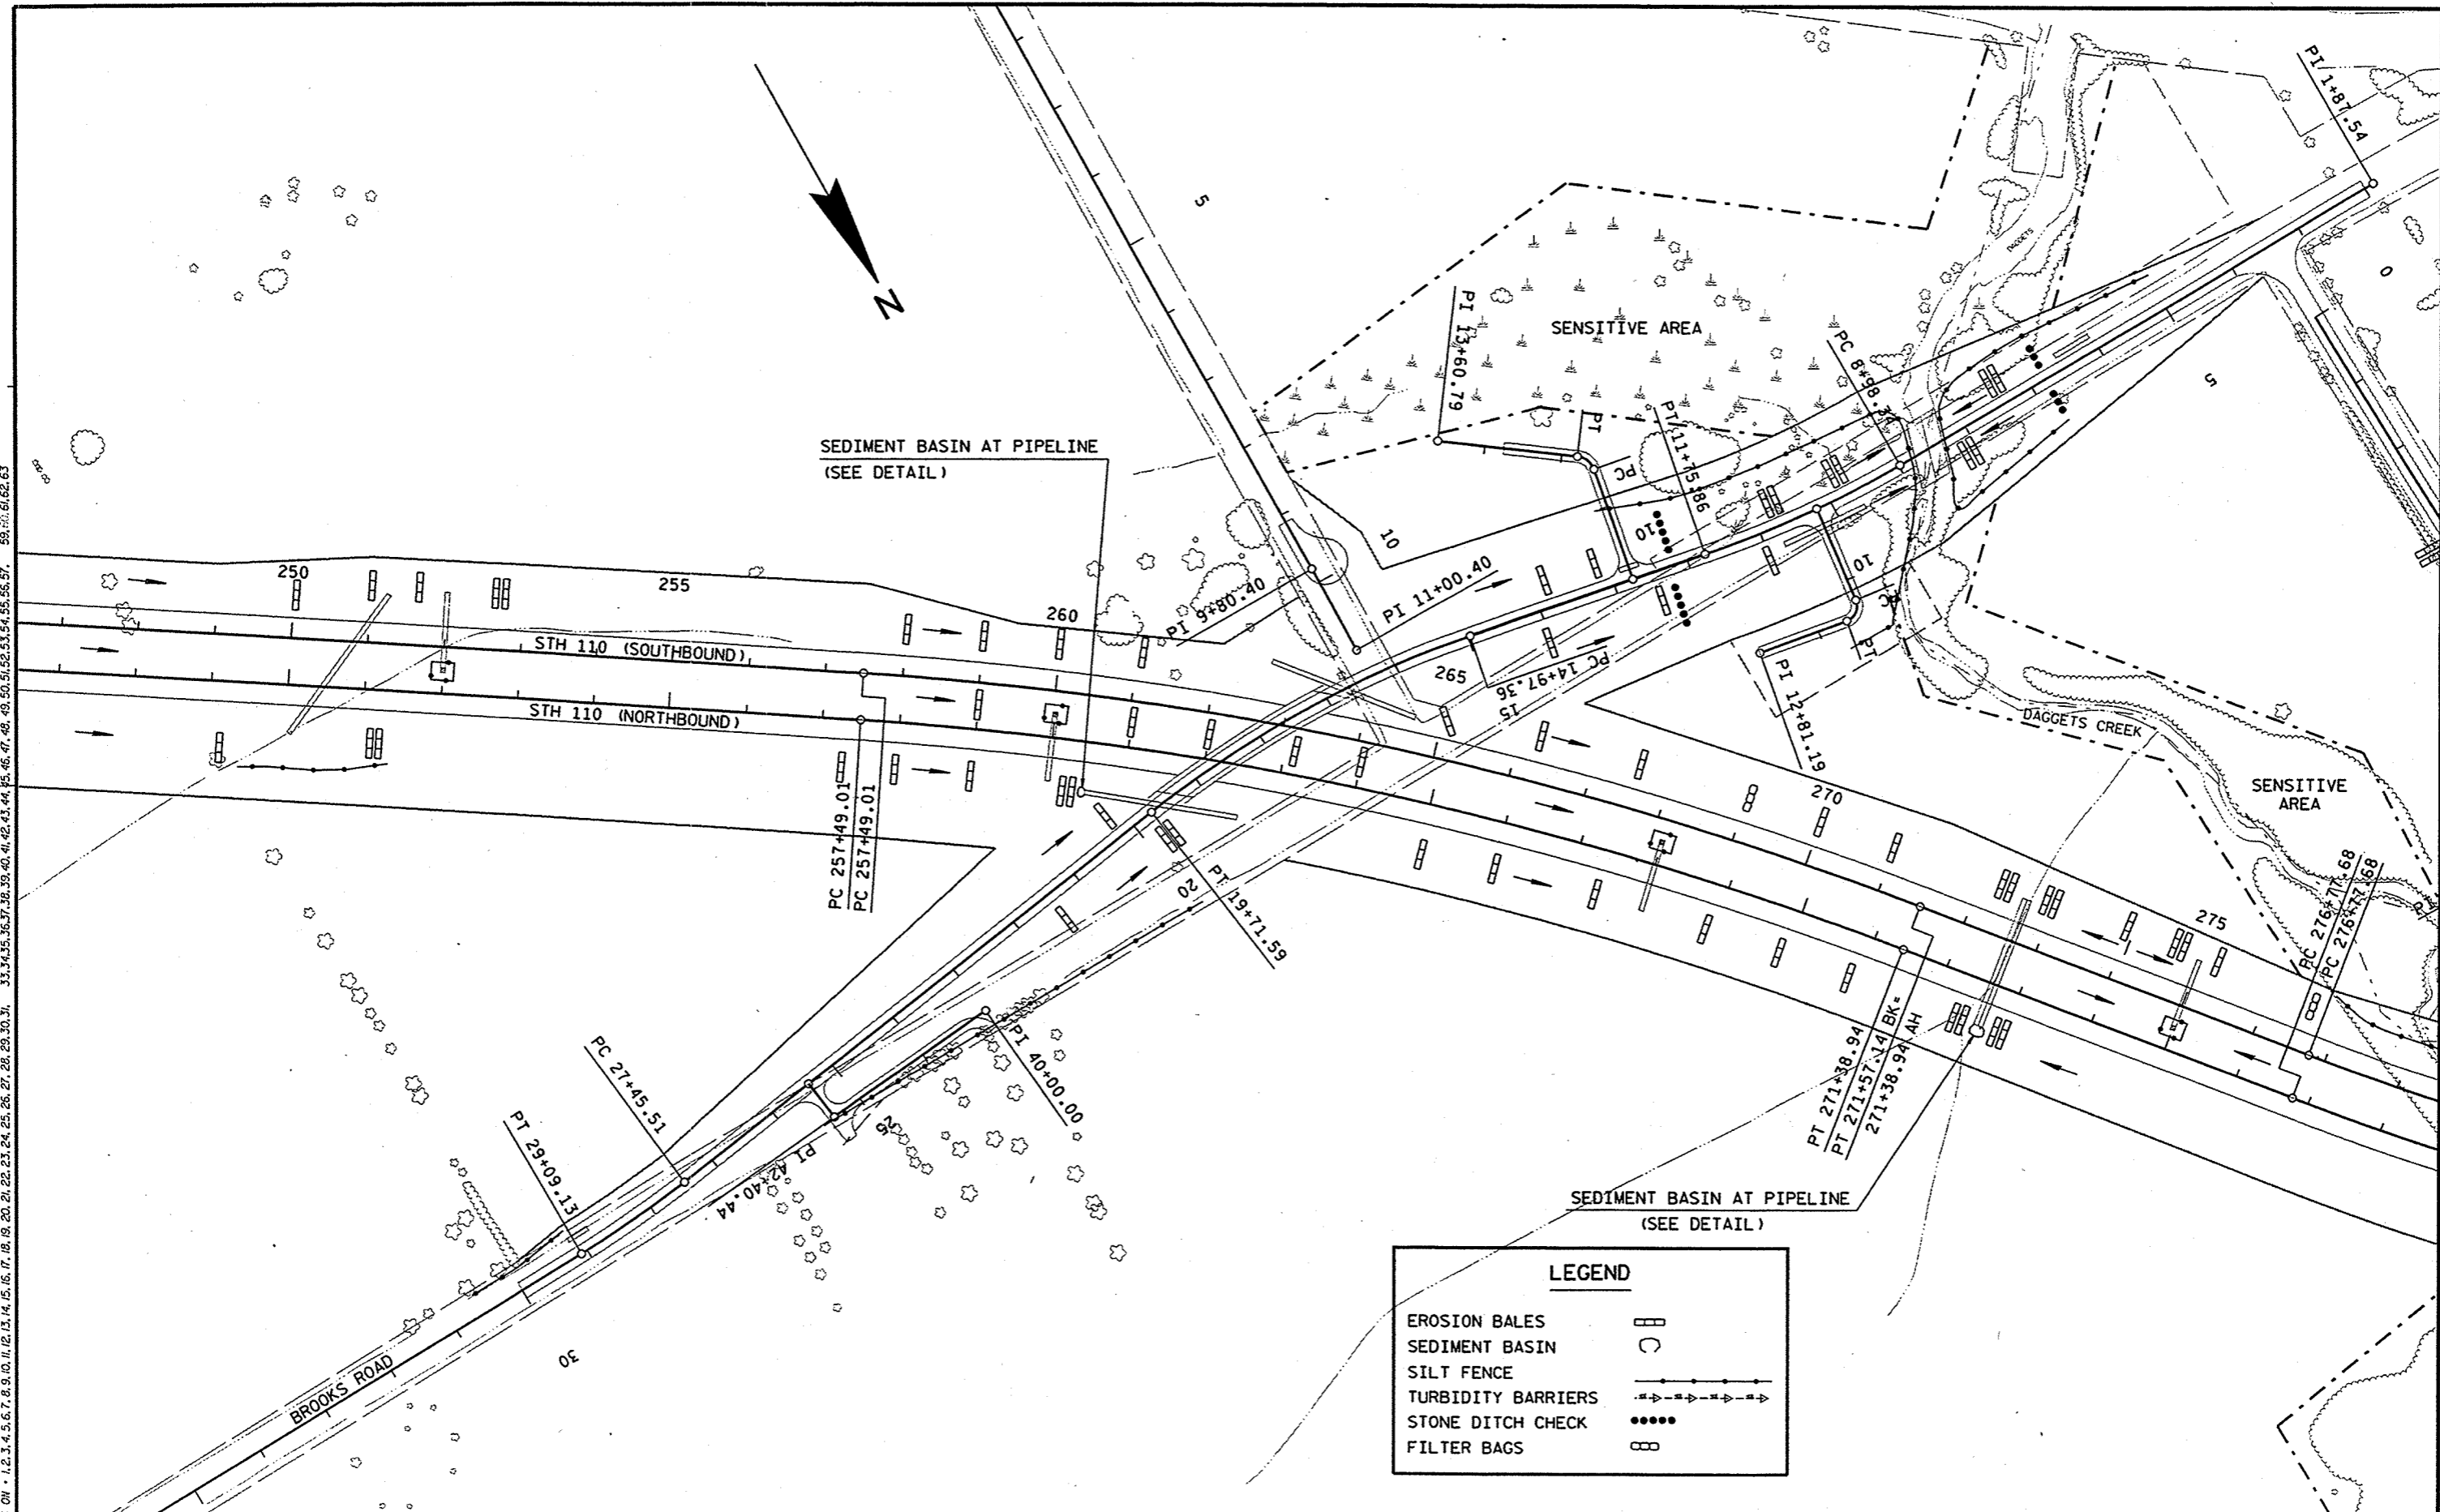


LEGEND	
EROSION BALES	▮
SEDIMENT BASIN	○
SILT FENCE	—●—
TURBIDITY BARRIERS	—+—+—+—+—+—
STONE DITCH CHECK	●●●●
FILTER BAGS	⊞


STATE PROJECT NUMBER: 6200-05-71 HWY: STH 110 COUNTY: WINNEBAGO EROSION CONTROL (TEMPORARY) SCALE, FEET SHEET NO: 2.44 E

FILE NAME: F:\d3_620005\216.dgn PLOT DATE: 27-NOV-2001 12:54 ORG DATE: 11/15/00 PLOT NAME: 216d71 Originator: DISTRICT 3 -- JD PLOT SCALE: 200.700000:1.000000 WISDOT/CADD SHEET 42

LEVELS ON - 1, 2, 3, 62, 63

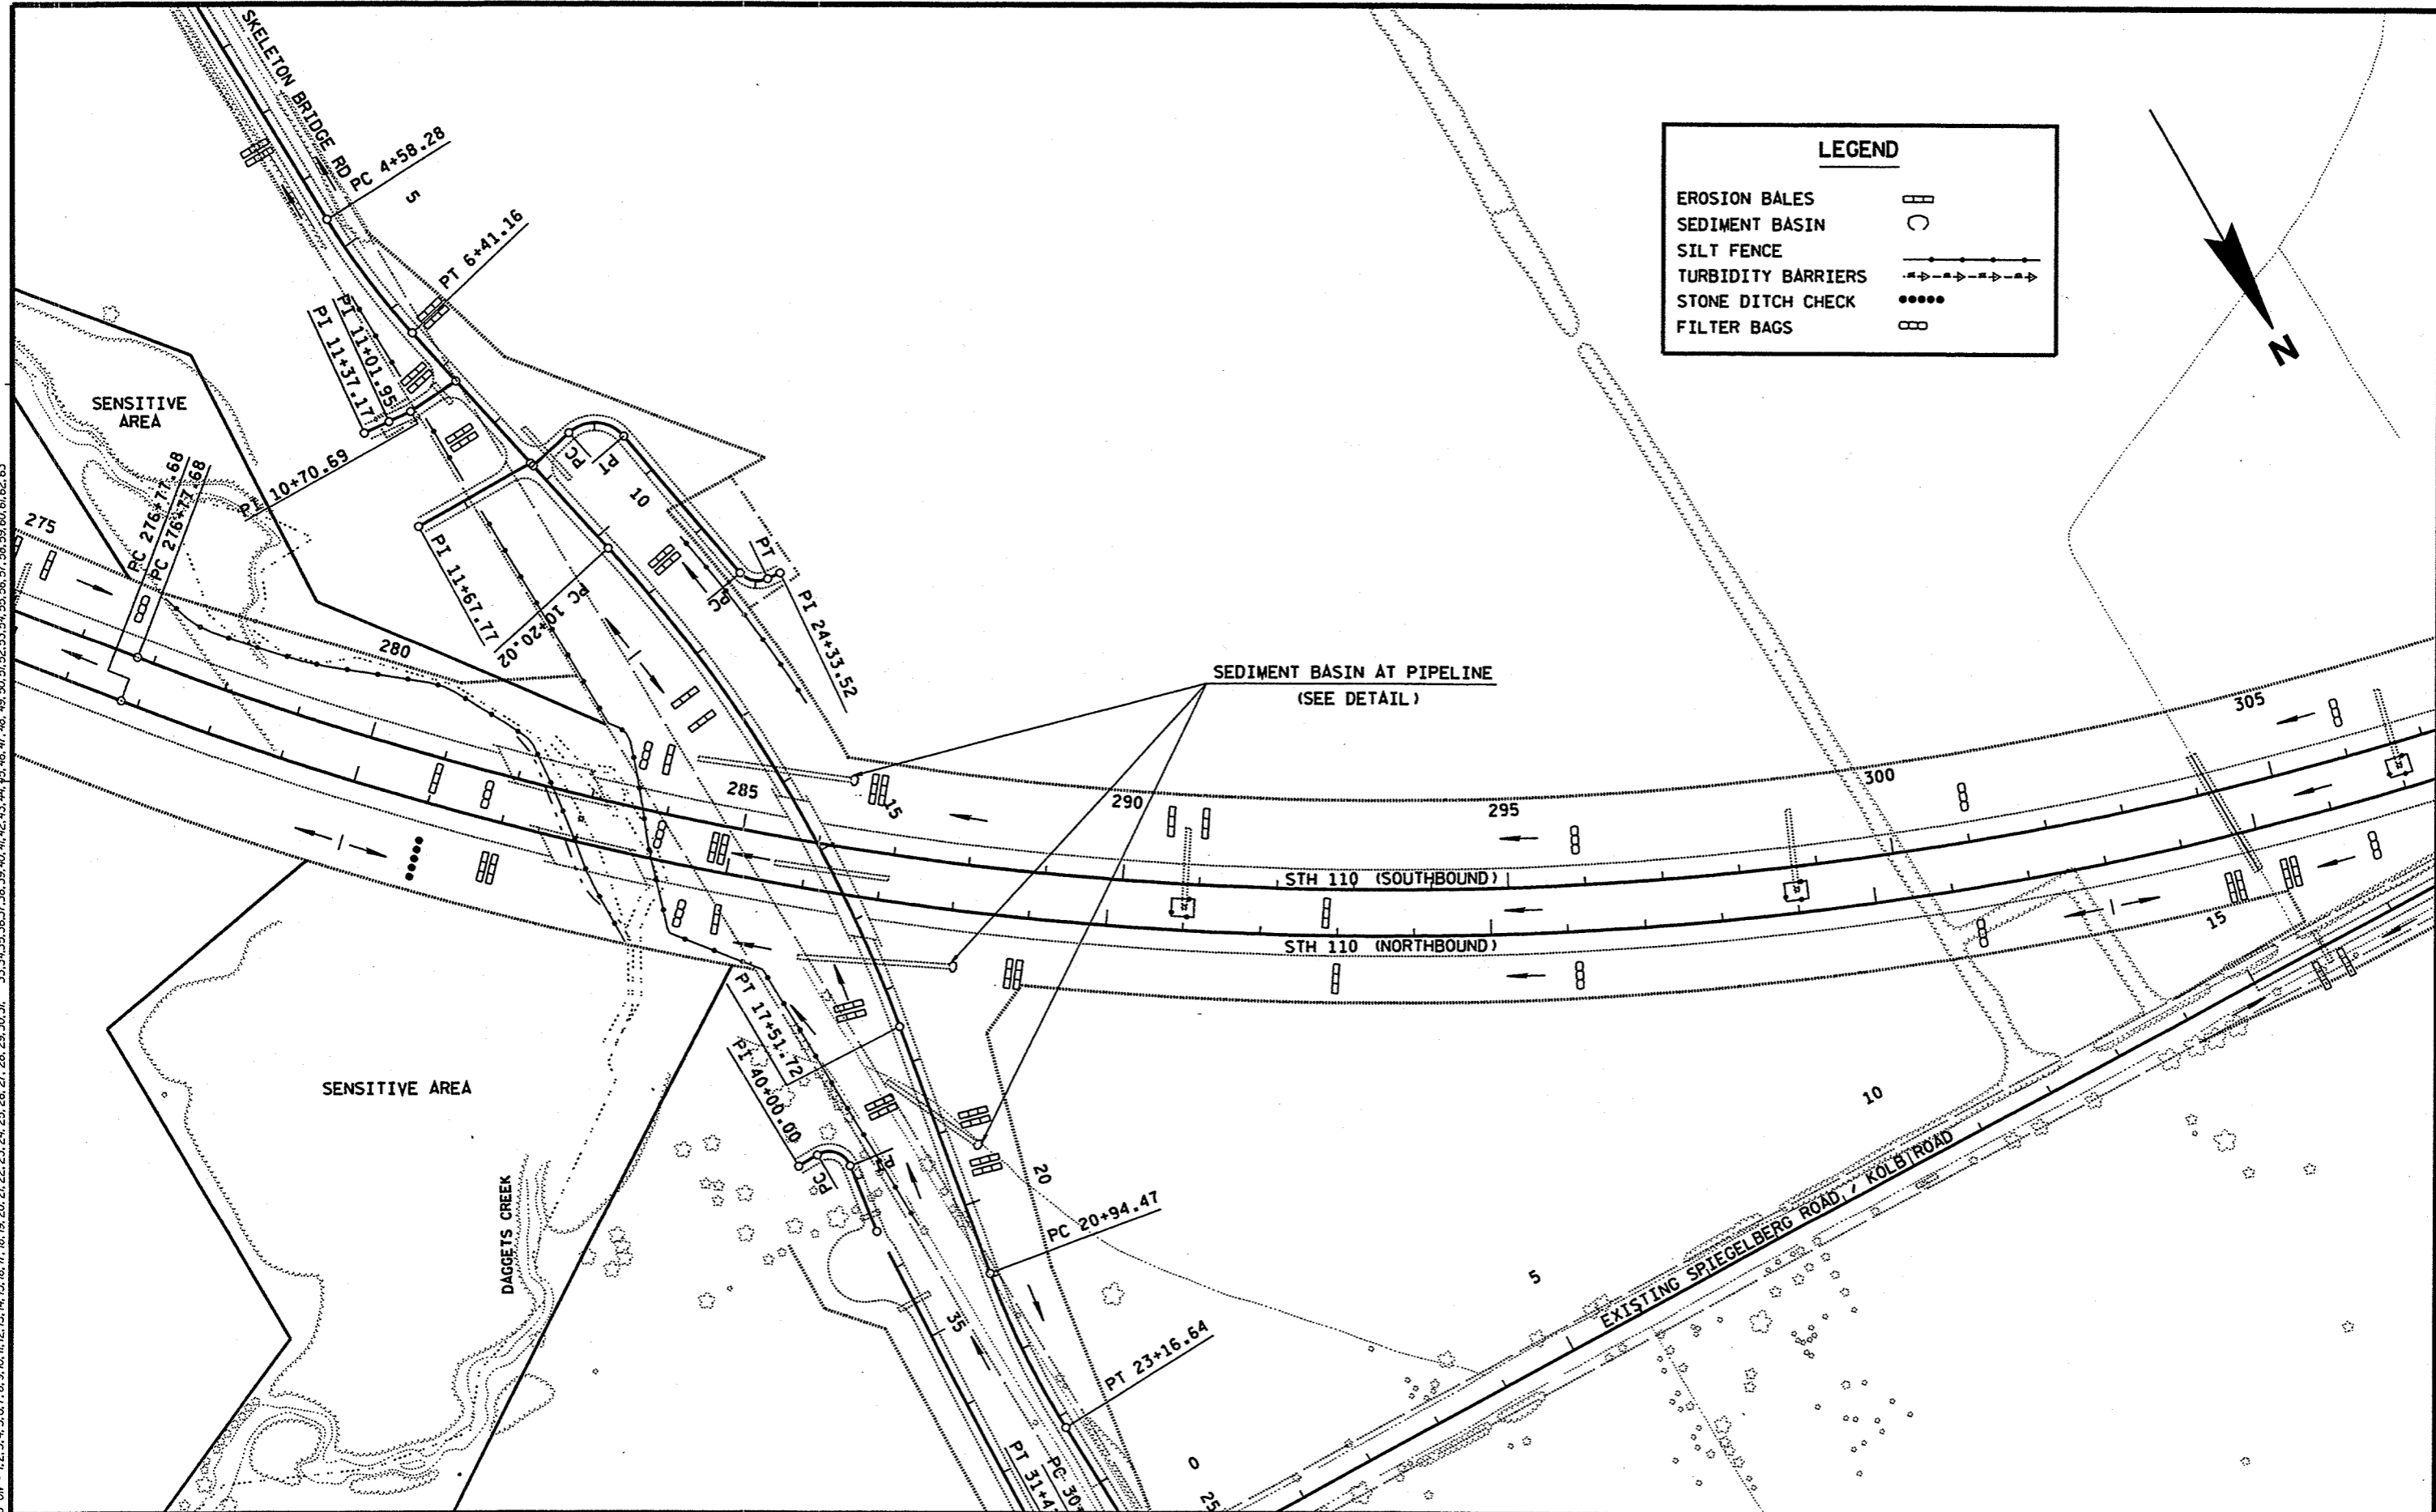

LEGEND	
EROSION BALES	
SEDIMENT BASIN	
SILT FENCE	
TURBIDITY BARRIERS	
STONE DITCH CHECK	
FILTER BAGS	

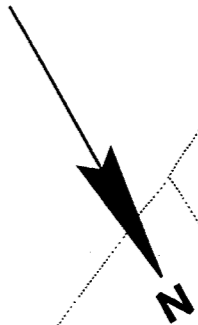

STATE PROJECT NUMBER: 6200-05-71

HWY: STH 110

COUNTY: WINNEBAGO

EROSION CONTROL (TEMPORARY)

SCALE, FEET

SHEET NO: 2.45 E

FILE NAME : F:\d3_620005\217.dgn

PLOT DATE: 31-JUL-2001 15:31

ORG DATE: 11/1/00


PLOT NAME : 217d171

Originator : DISTRICT 3 -- JD

PLOT SCALE : 200.700000:1.000000

WISDOT/CADDs SHEET 42


LEVELS ON - 1, 2, 3, 62, 63

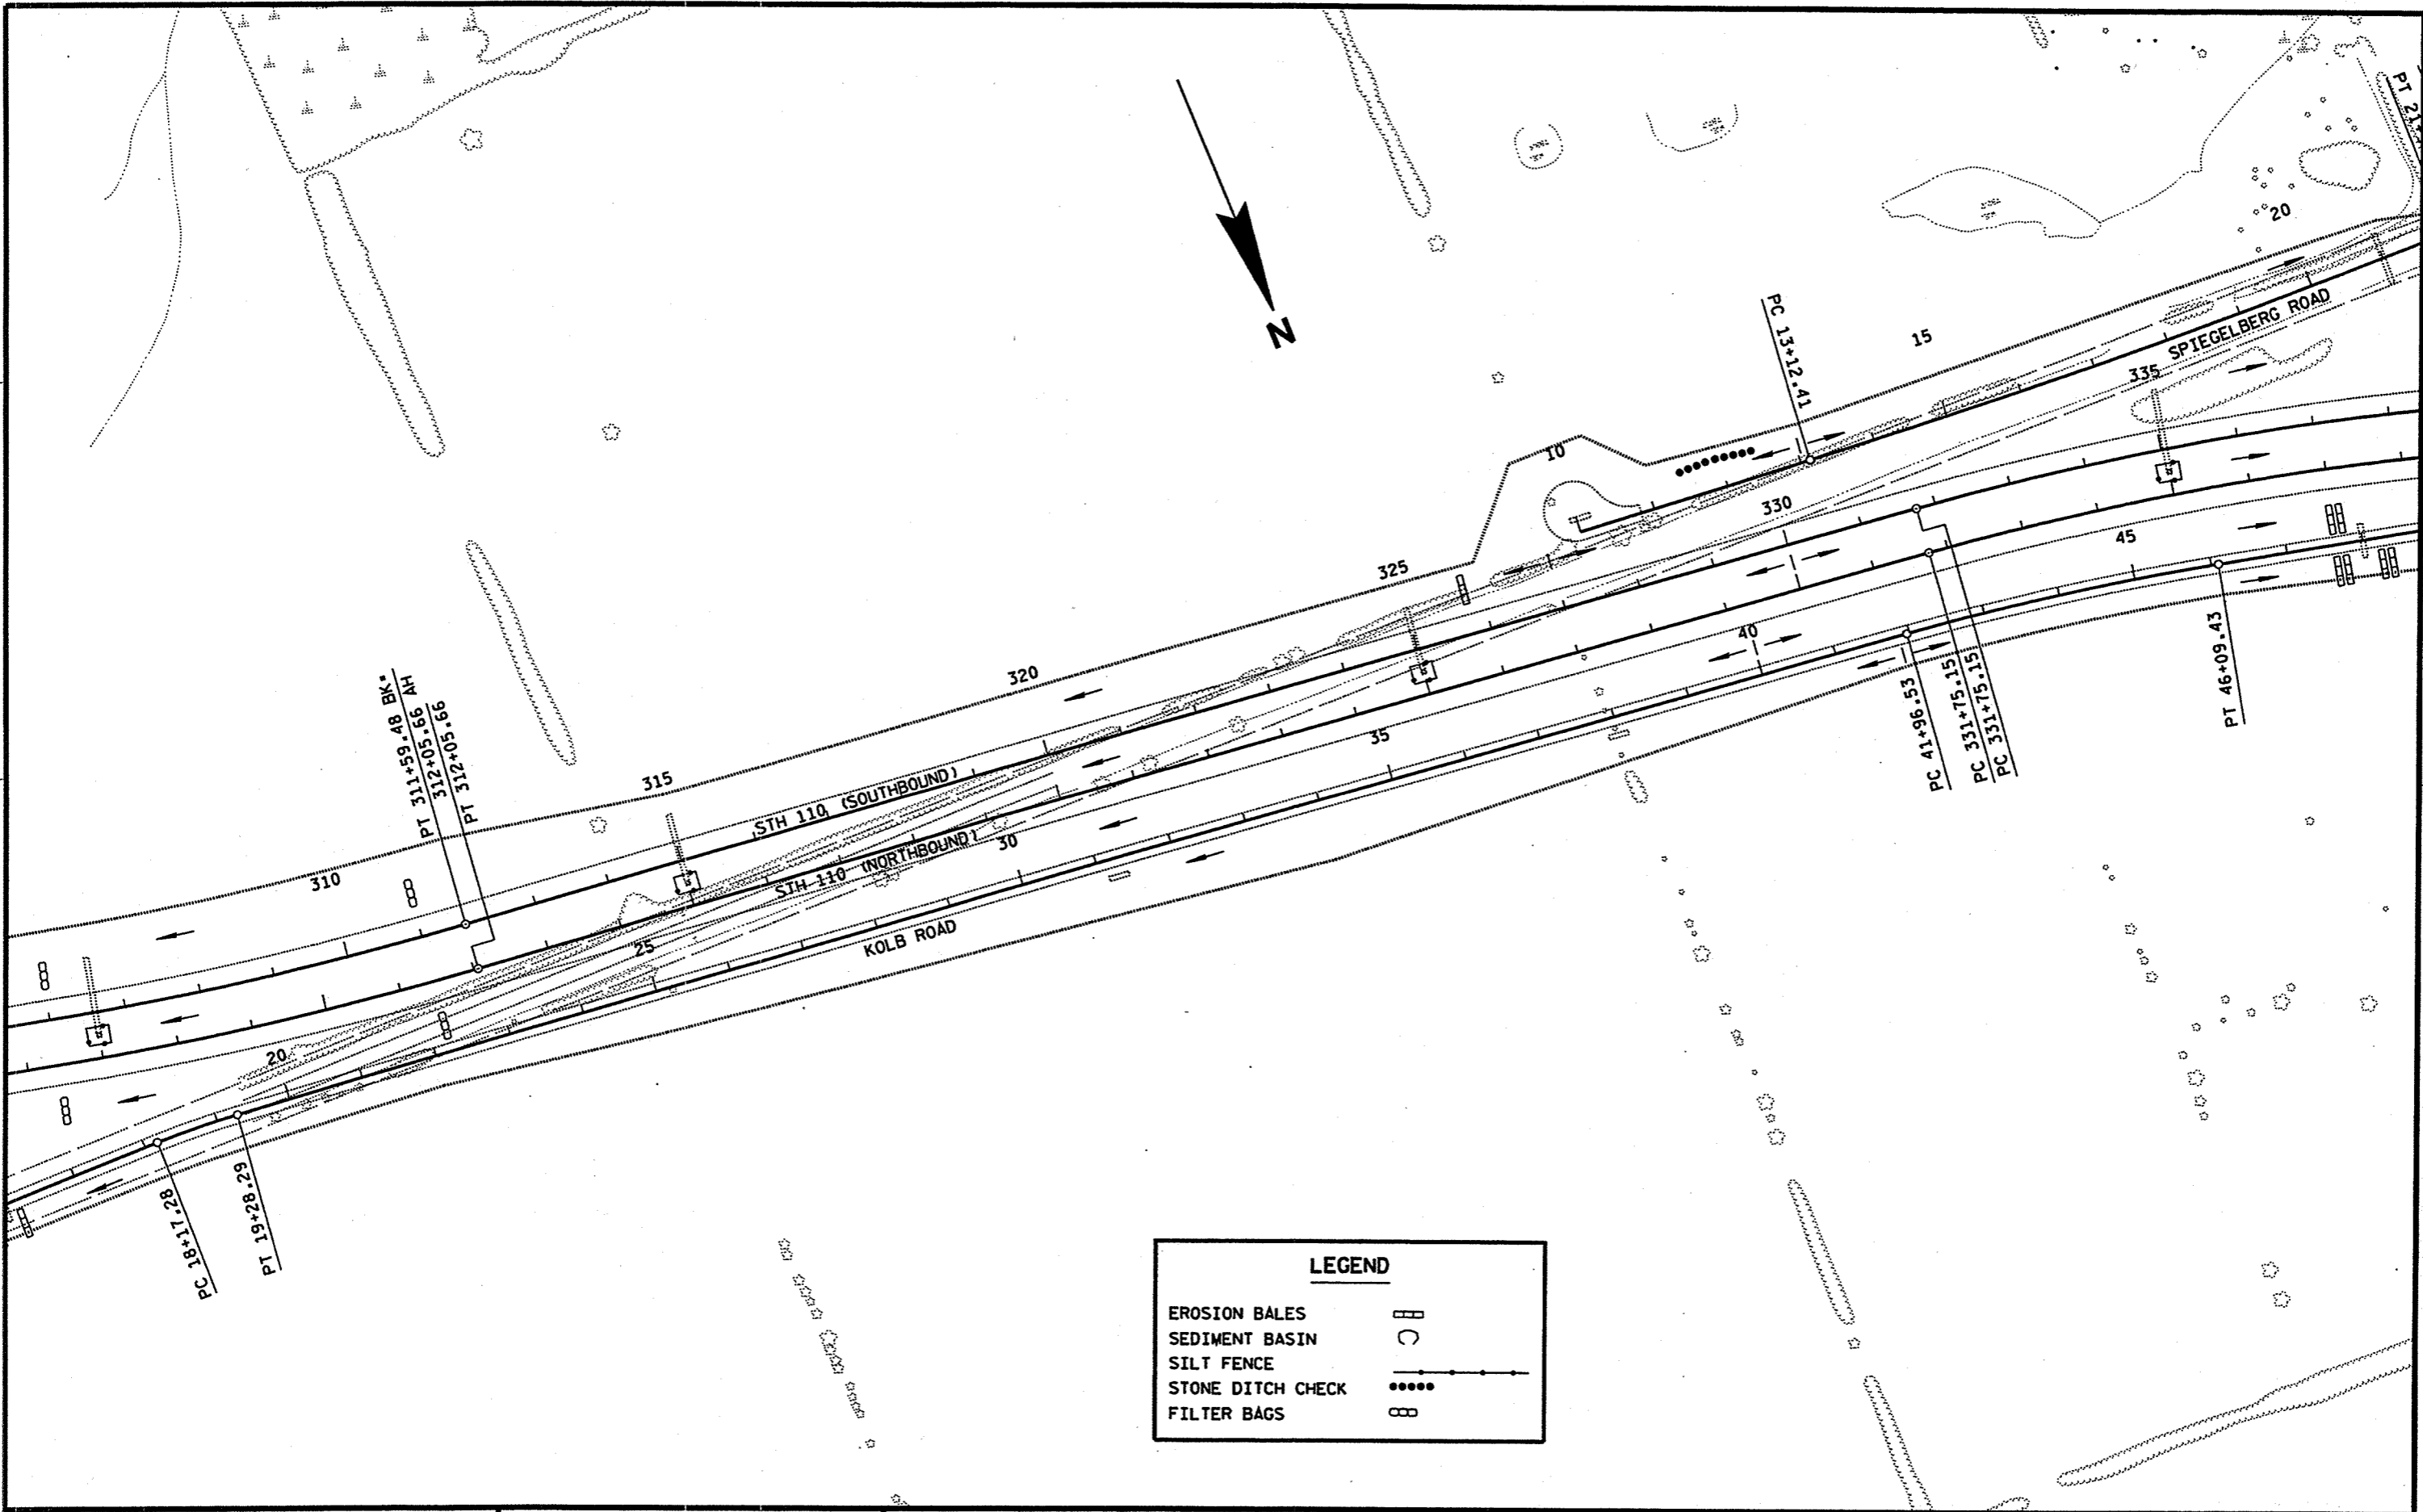

LEGEND	
EROSION BALES	
SEDIMENT BASIN	
SILT FENCE	
STONE DITCH CHECK	
FILTER BAGS	

STATE PROJECT NUMBER: 6200-05-71 HWY: STH 110 COUNTY: WINNEBAGO EROSION CONTROL (TEMPORARY) SCALE, FEET SHEET NO: 2.40 E

FILE NAME : F:\d3_620005\218.dgn PLOT DATE: 27-JUN-2001 12:49 ORG DATE : 11/1/00 PLOT NAME : 218dt71 Originator : DISTRICT 3 -- JD PLOT SCALE : 200.700000:1.000000 WISDOT/CADDS SHEET 42

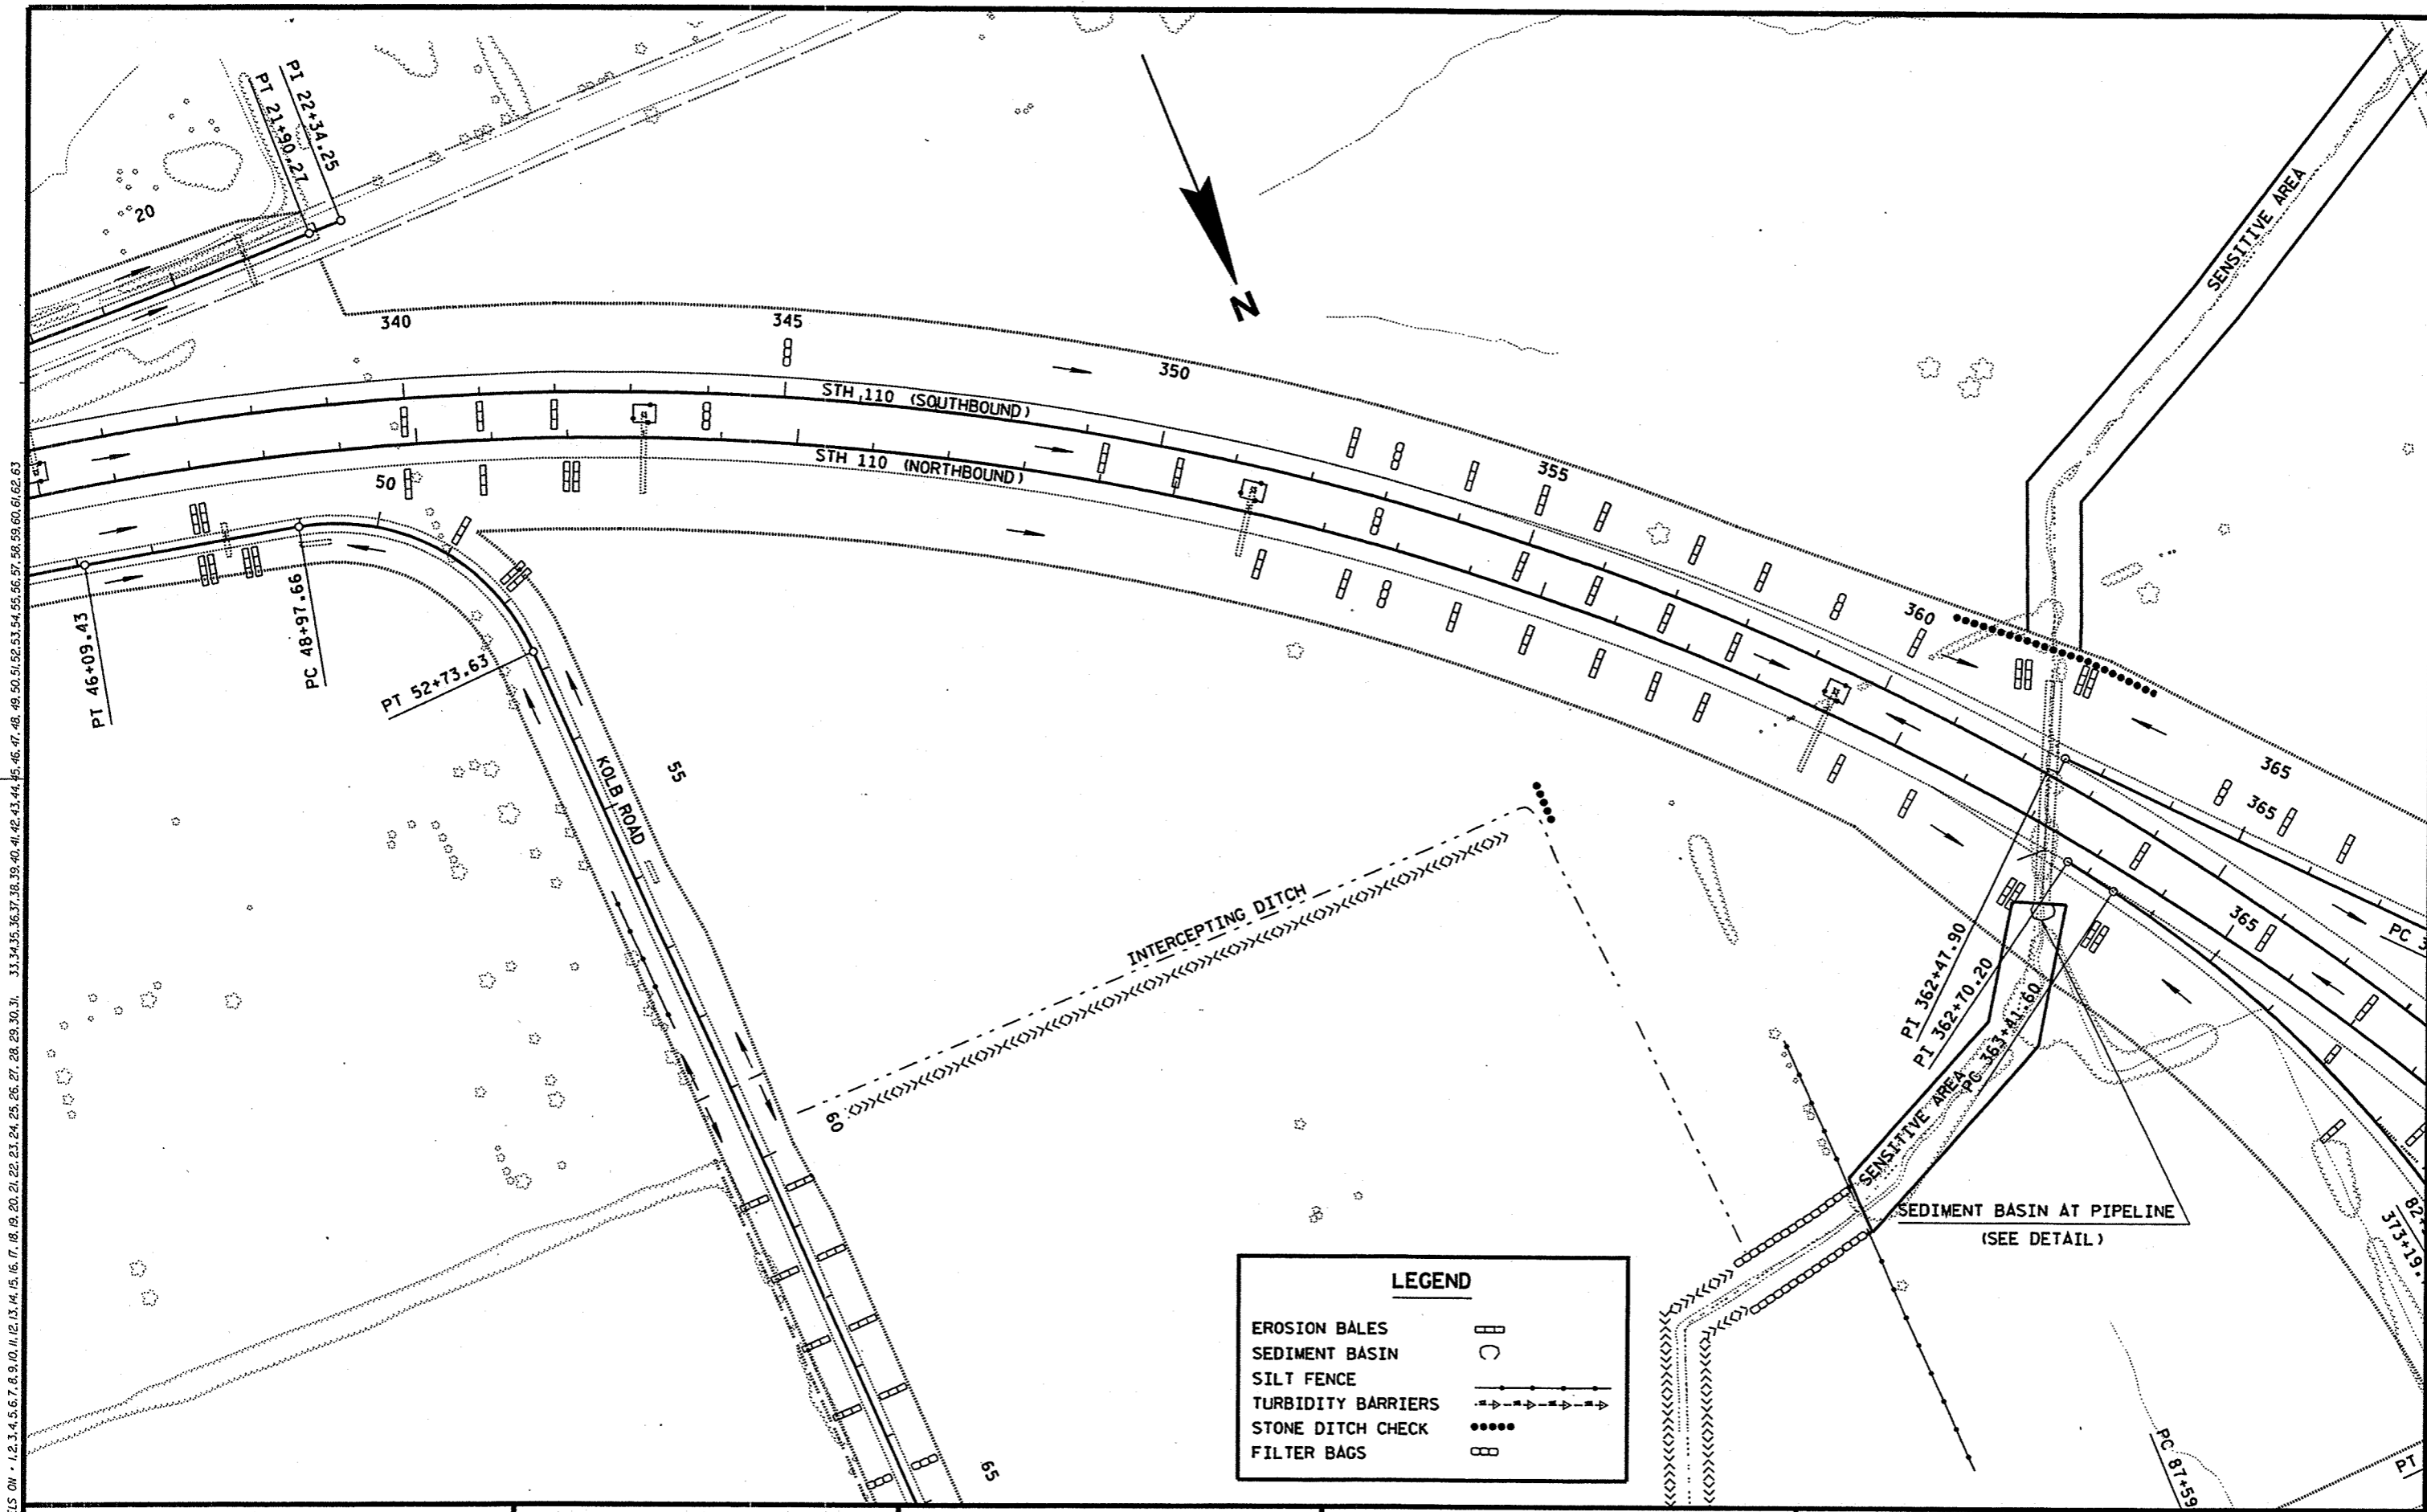

LEVELS ON - 1, 2, 3, 62, 63

STATE PROJECT NUMBER: 6200-05-71

HWY: STH 110

COUNTY: WINNEBAGO

EROSION CONTROL (TEMPORARY)

SCALE, FEET

SHEET NO: 2.47 E

FILE NAME : F:\d3_620005\219.dgn

PLOT DATE: 13-SEP-2001 08:38


ORG DATE : 11/1/00

PLOT NAME : 219d71

Originator : DISTRICT 3 -- JD

PLOT SCALE : 200.700000:1.000000

WISDOT/CADDs SHEET 42

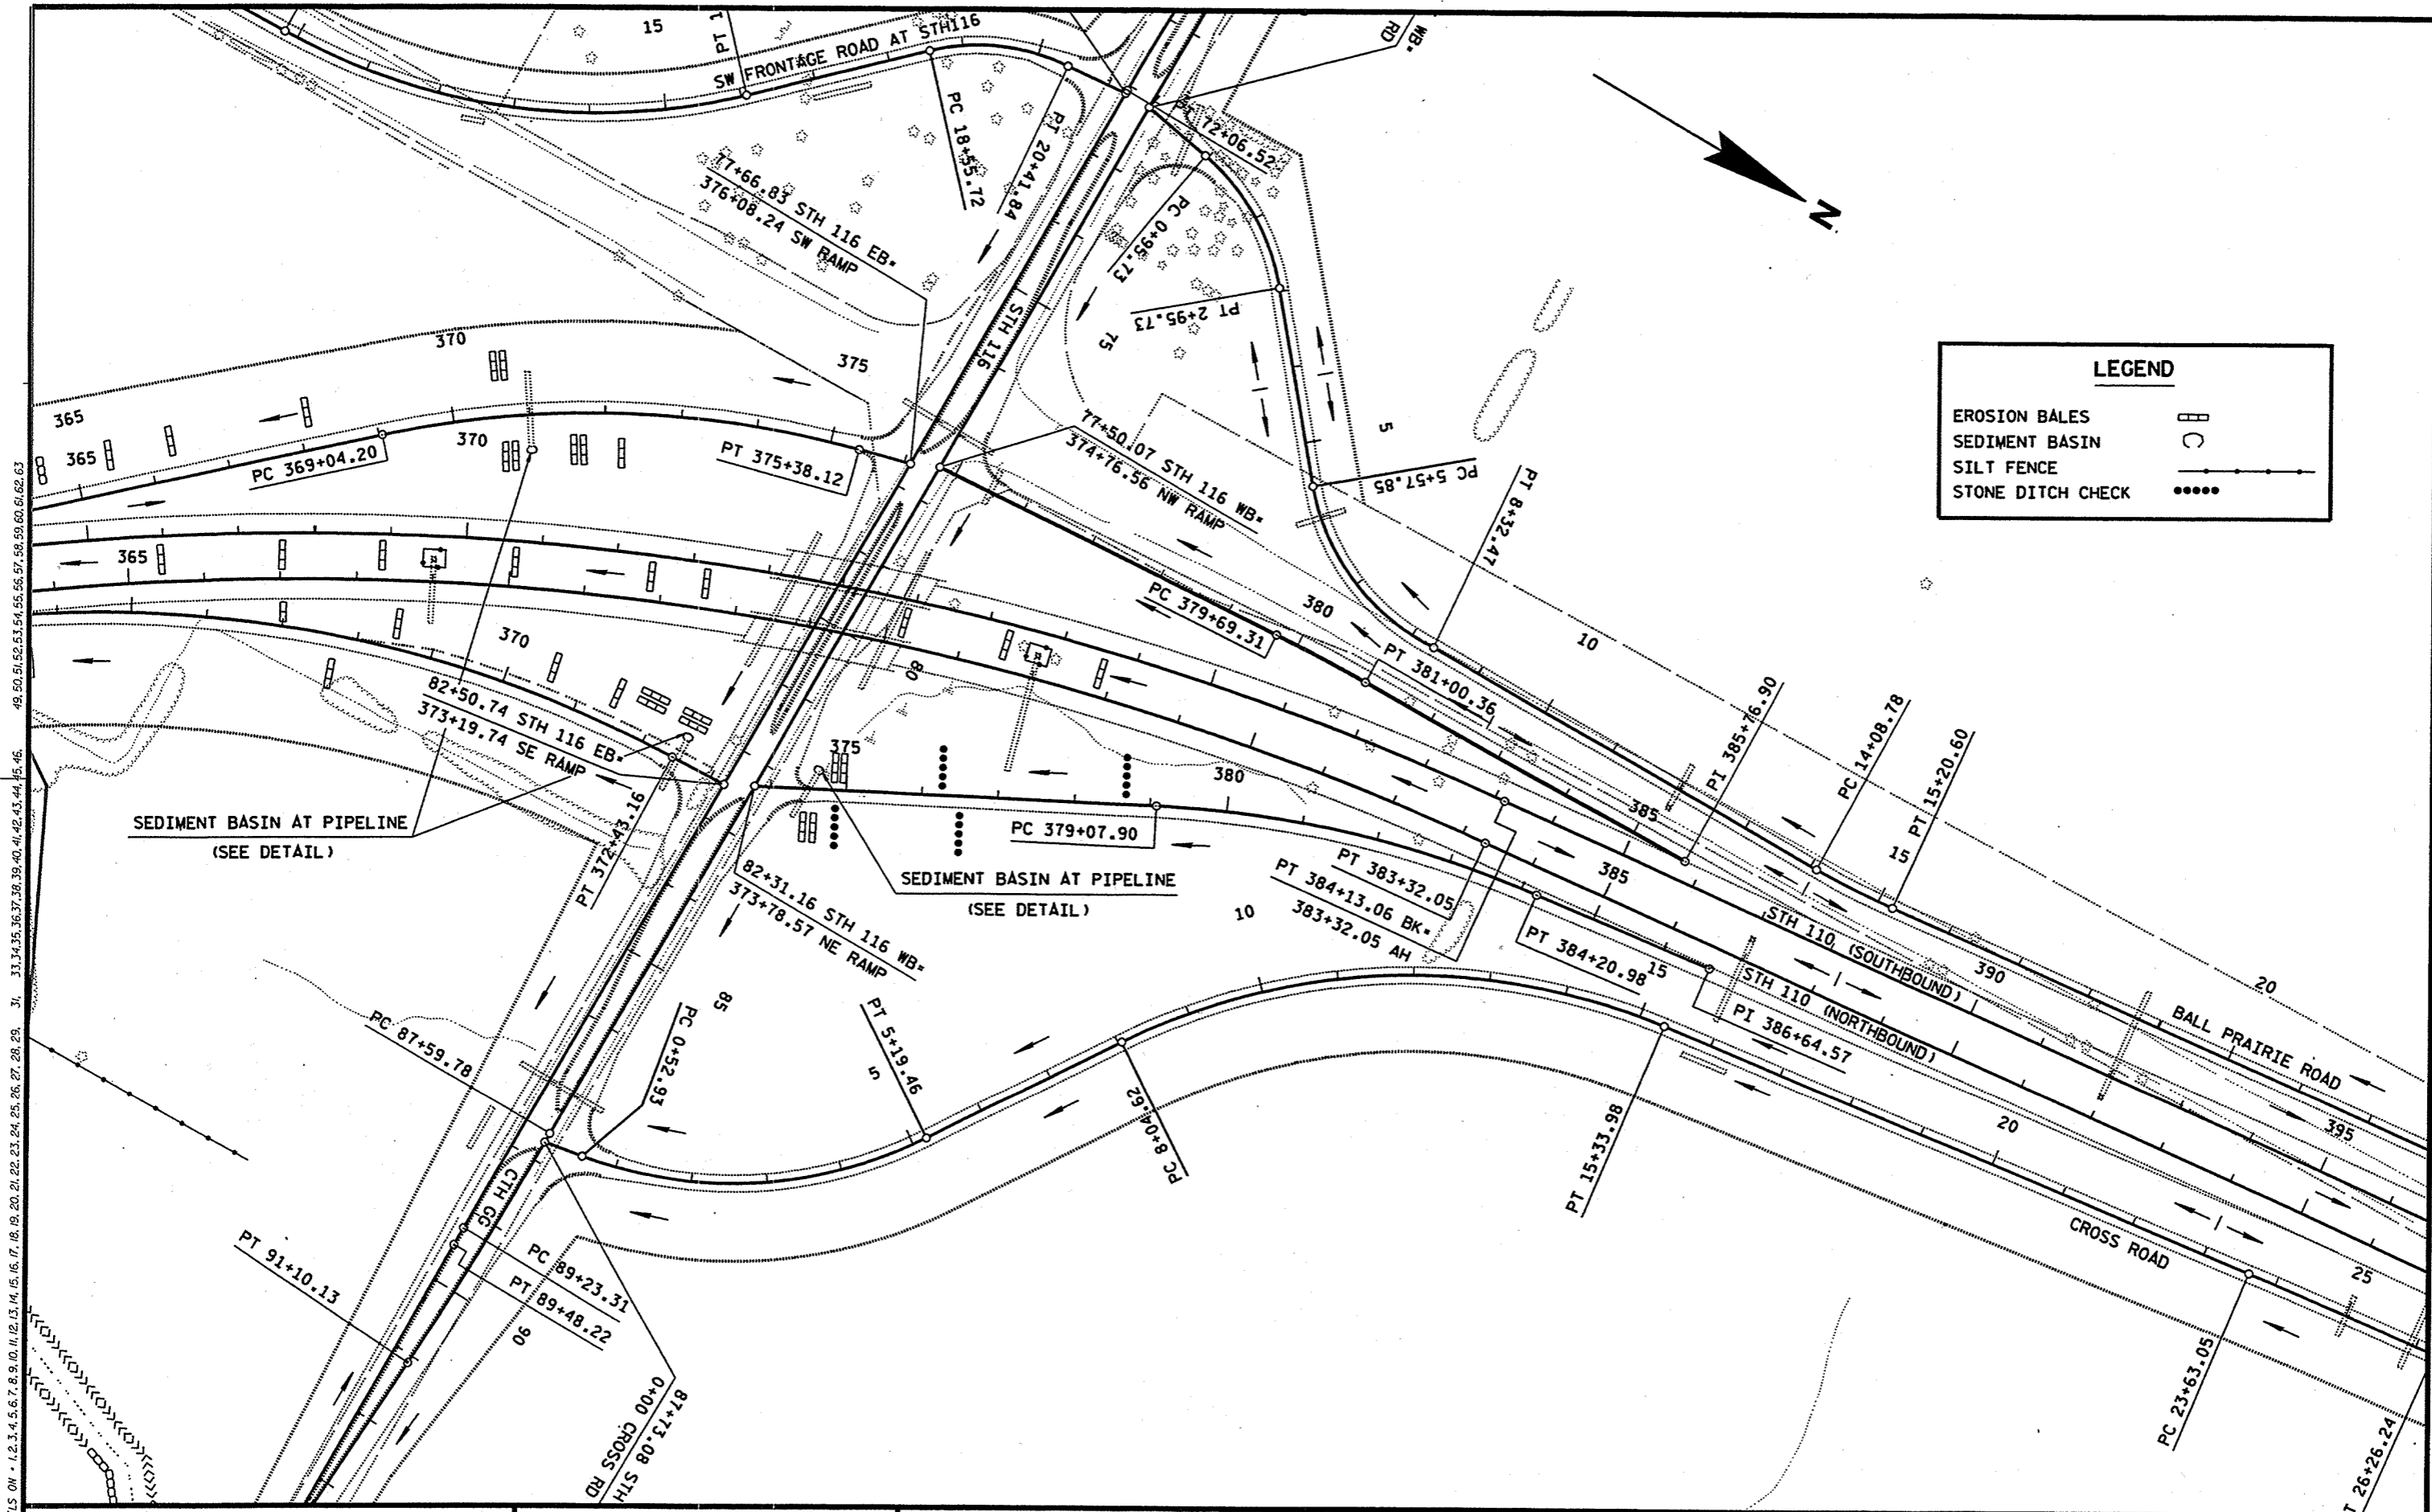


LEGEND	
EROSION BALES	
SEDIMENT BASIN	
SILT FENCE	
STONE DITCH CHECK	

LEVELS ON - 1, 2, 3, 62, 63

STATE PROJECT NUMBER: 6200-05-71	HWY: STH 110	COUNTY: WINNEBAGO	EROSION CONTROL (TEMPORARY)	SCALE, FEET	SHEET NO: 2.48 E
----------------------------------	--------------	-------------------	-----------------------------	-------------	------------------

FILE NAME : F:\d3_620005\220.dgn PLOT DATE : 11-JUL-2001 15:16 ORG DATE : 11/1/00 PLOT NAME : 220d71 Originator : DISTRICT 3 -- JD PLOT SCALE : 200.700000:1.000000 WISDOT/CADD SHEET 42


LEVELS ON 1, 2, 3, 46, 48, 50, 51, 52, 53, 54, 55, 56, 57, 58, 59, 60, 61, 62, 63

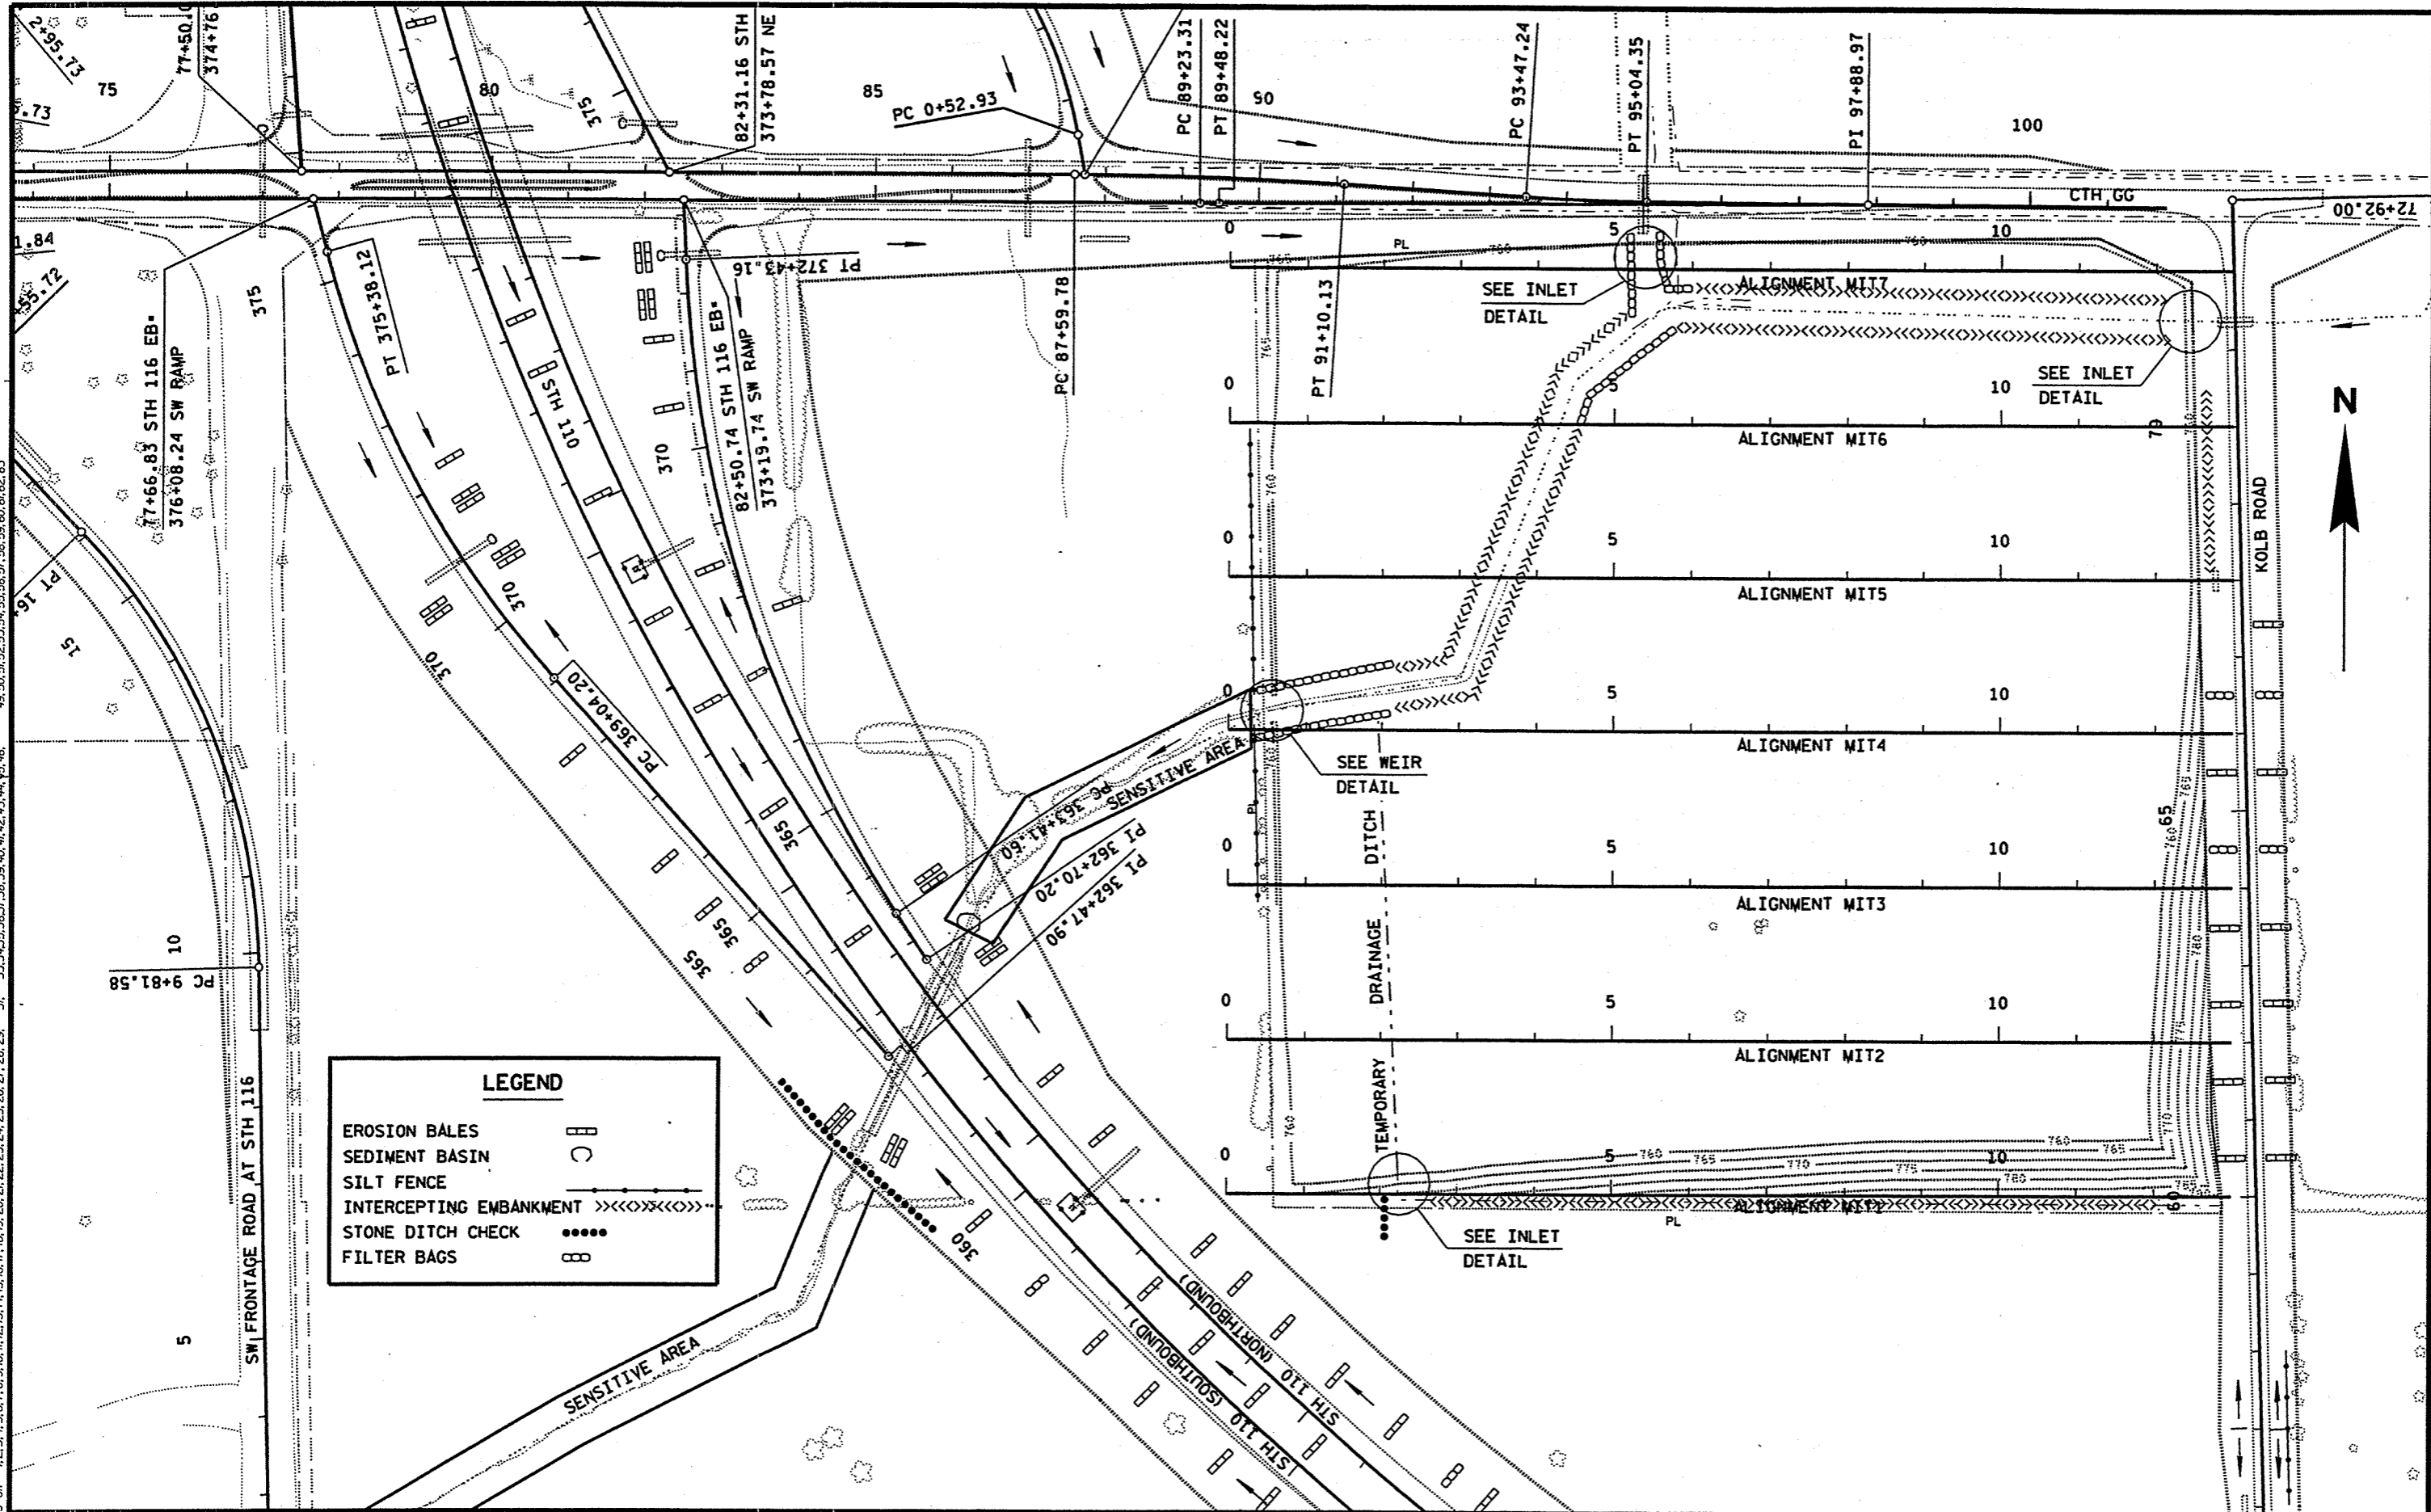

LEGEND	
EROSION BALES	▬
SEDIMENT BASIN	○
SILT FENCE	—
INTERCEPTING EMBANKMENT	>>>>>>
STONE DITCH CHECK	●●●●
FILTER BAGS	▬

STATE PROJECT NUMBER: 6200-05-71 HWY: STH 110 COUNTY: WINNEBAGO EROSION CONTROL (TEMPORARY) SCALE, FEET 0 100 200 SHEET NO: 2.49 E


FILE NAME: F:\d3_620005\220a.dgn PLOT DATE: 27-JUN-2001 09:58 ORG DATE: 3-6-01 PLOT NAME: 220ad71 Originator: DISTRICT 3 PLOT SCALE: 200.700000:1.000000 WISDOT/CADDS SHEET 42

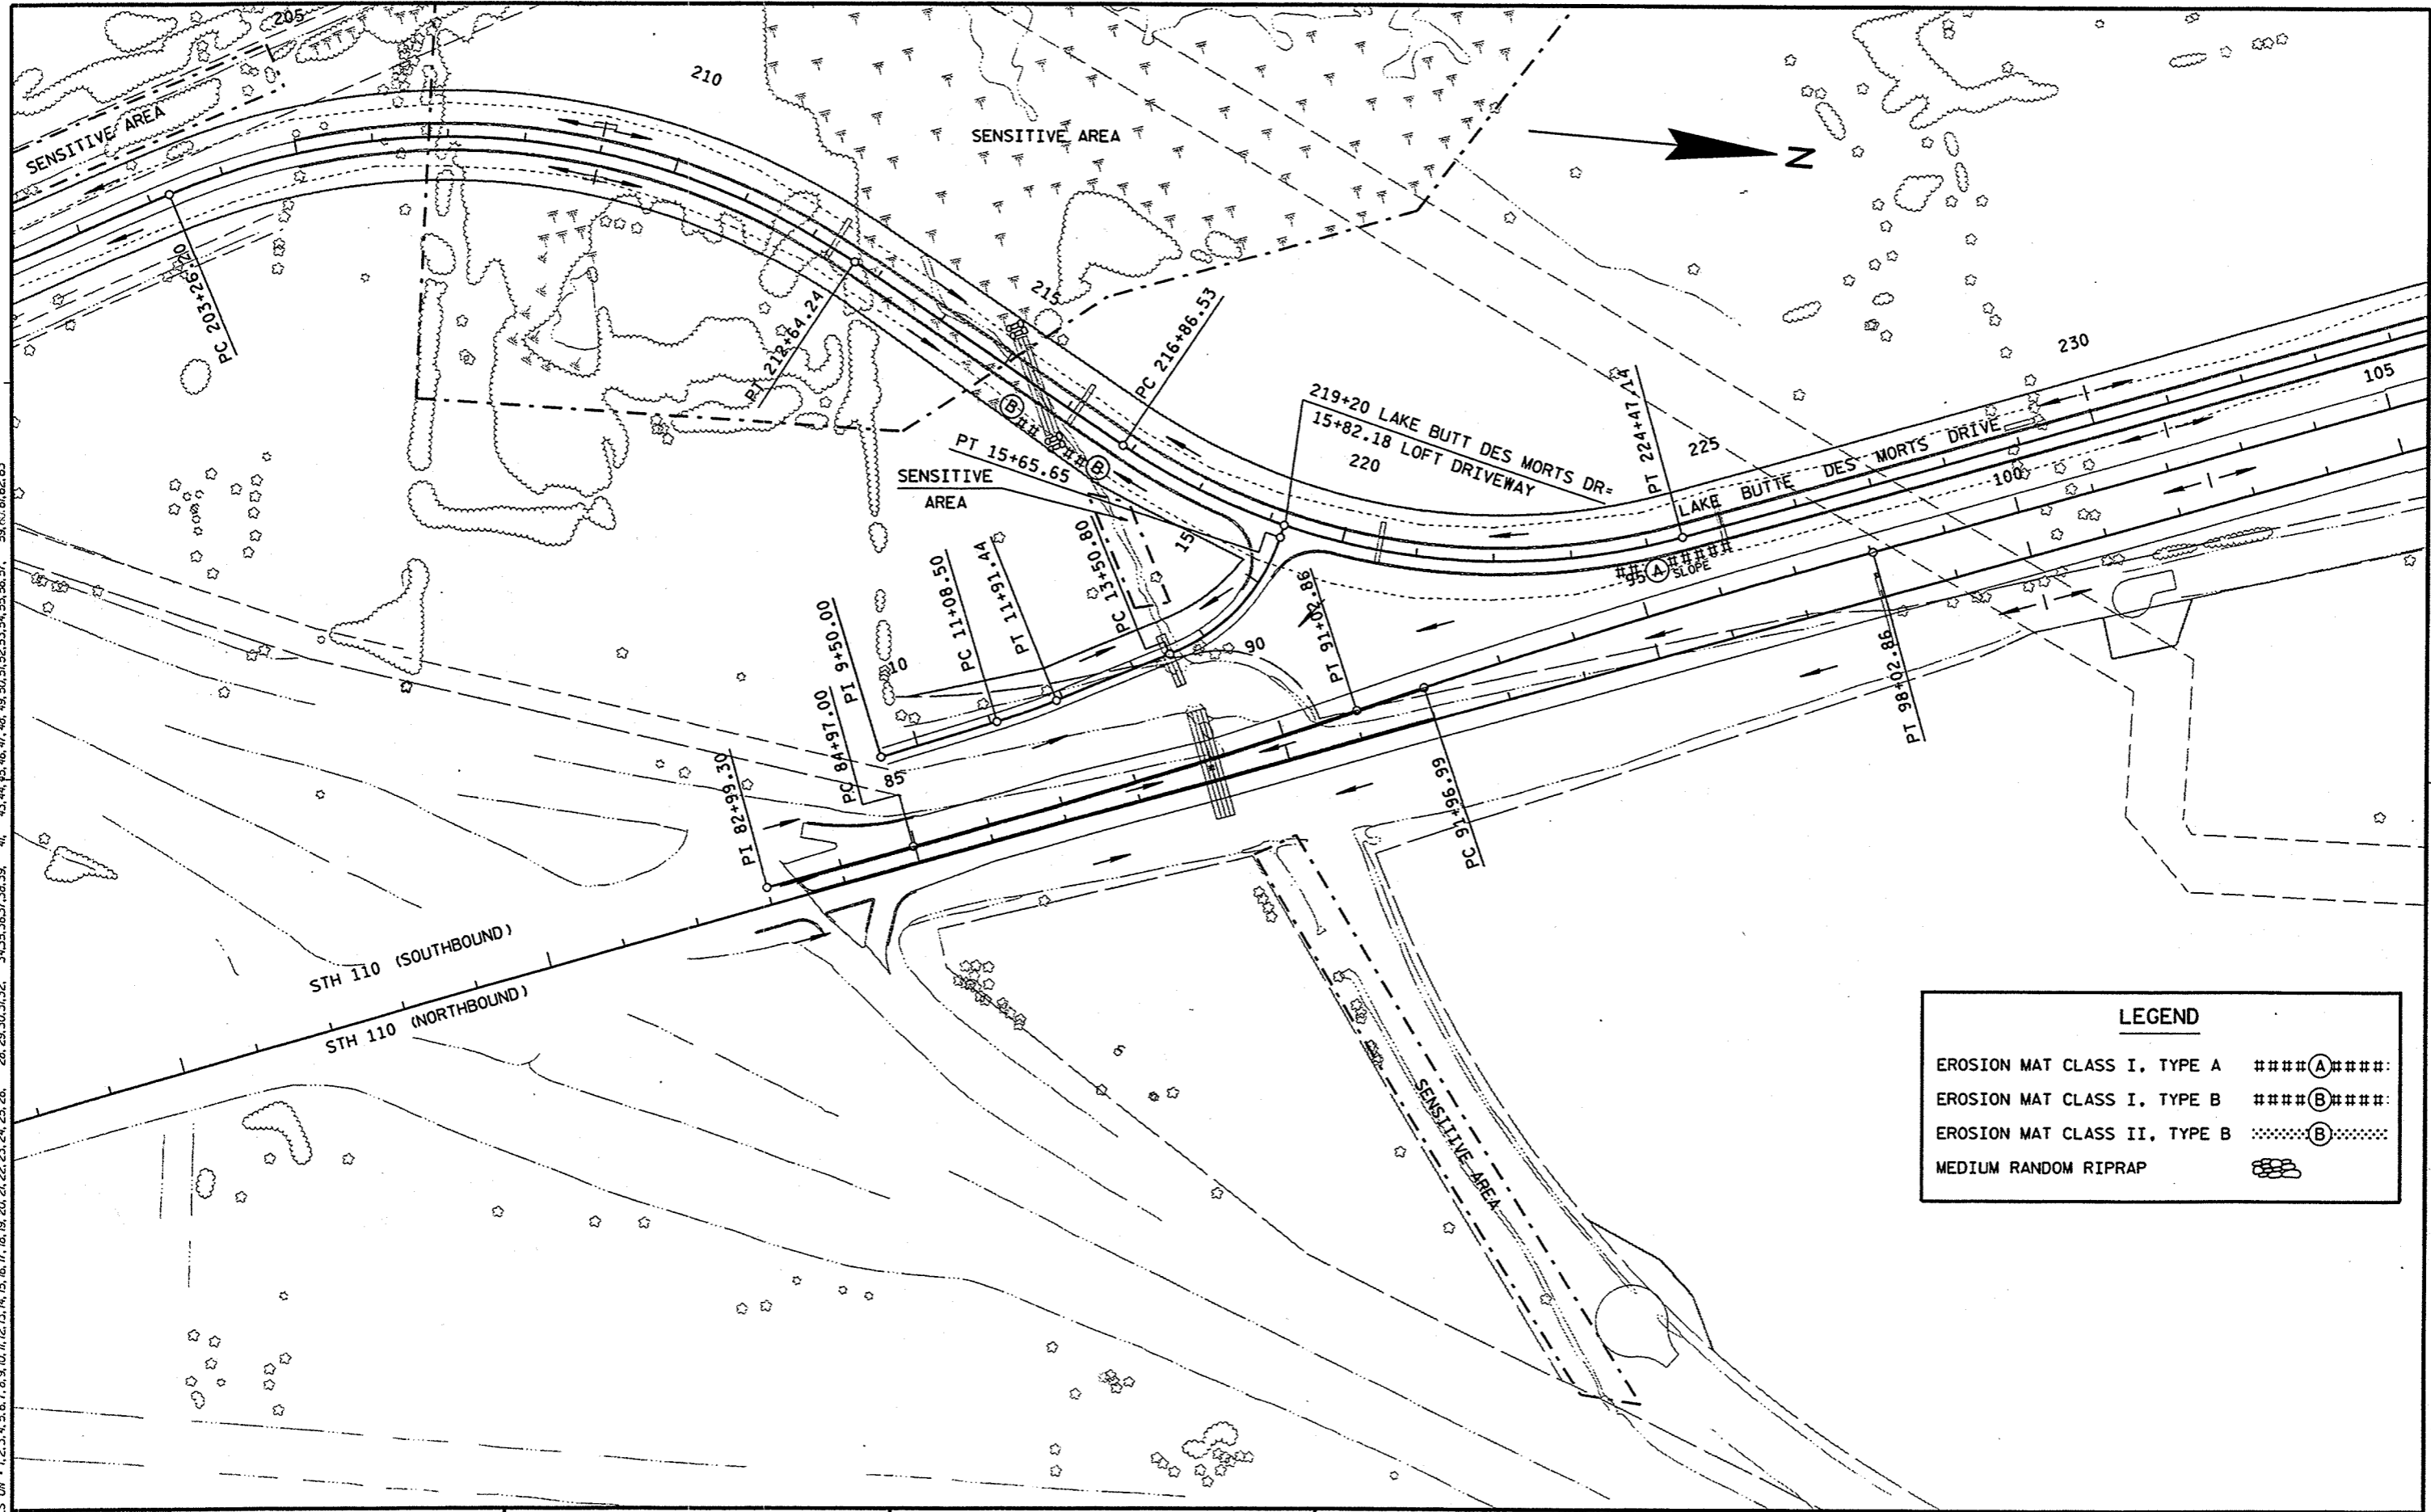


LEGEND	
EROSION MAT CLASS I, TYPE A	####(A)####
EROSION MAT CLASS I, TYPE B	####(B)####
EROSION MAT CLASS II, TYPE B	#####(B)#####
MEDIUM RANDOM RIPRAP	

LEVELS ON * 1,2,3,4,5,6,7,8,9,10,11,12,13,14,15,16,17,18,19,20,21,22,23,24,25,26, 28,29,30,31,32, 34,35,36,37,38,39, 41, 43,44,45,46,47,48, 49,50,51,52,53,54,55,56,57, 59,60,61,62,63

LEVELS ON - 1, 2, 3, 4, 5, 6, 7, 8, 9, 10, 11, 12, 13, 14, 15, 16, 17, 18, 19, 20, 21, 22, 23, 24, 25, 26, 28, 29, 30, 58, 60, 61, 62, 63

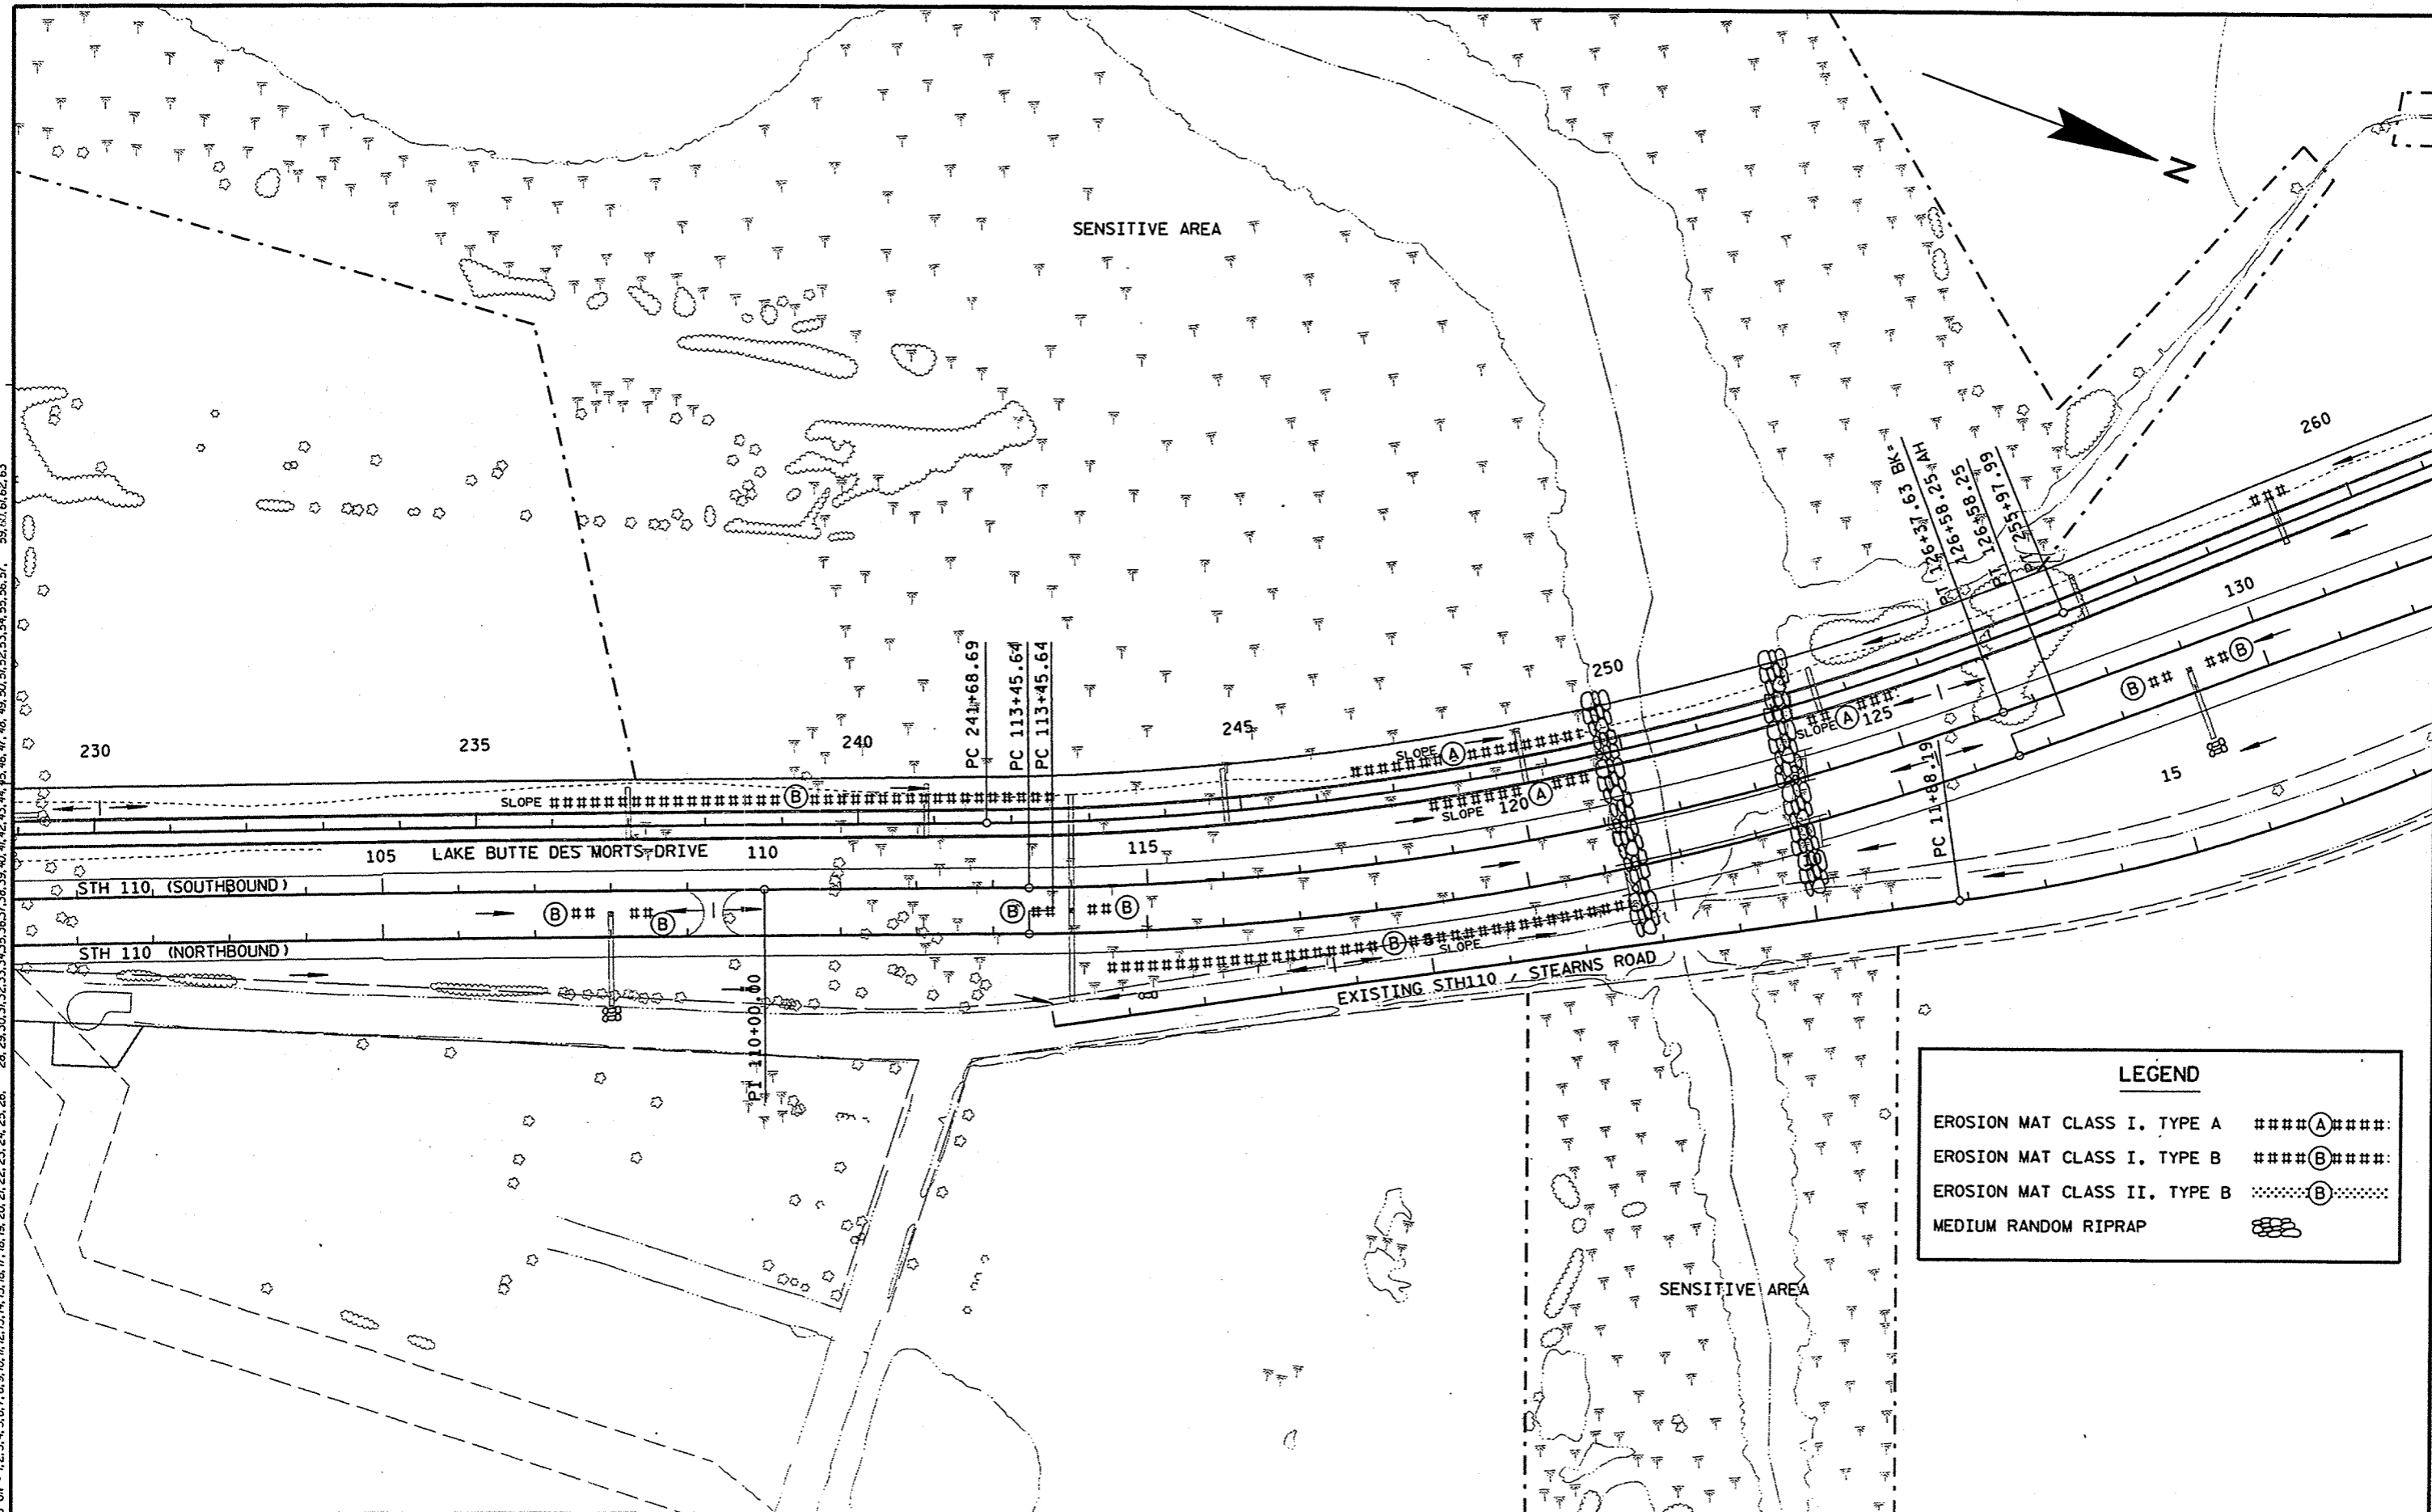

LEGEND	
EROSION MAT CLASS I, TYPE A	####(A)####
EROSION MAT CLASS I, TYPE B	####(B)####
EROSION MAT CLASS II, TYPE B	#####(B)#####
MEDIUM RANDOM RIPRAP	#####

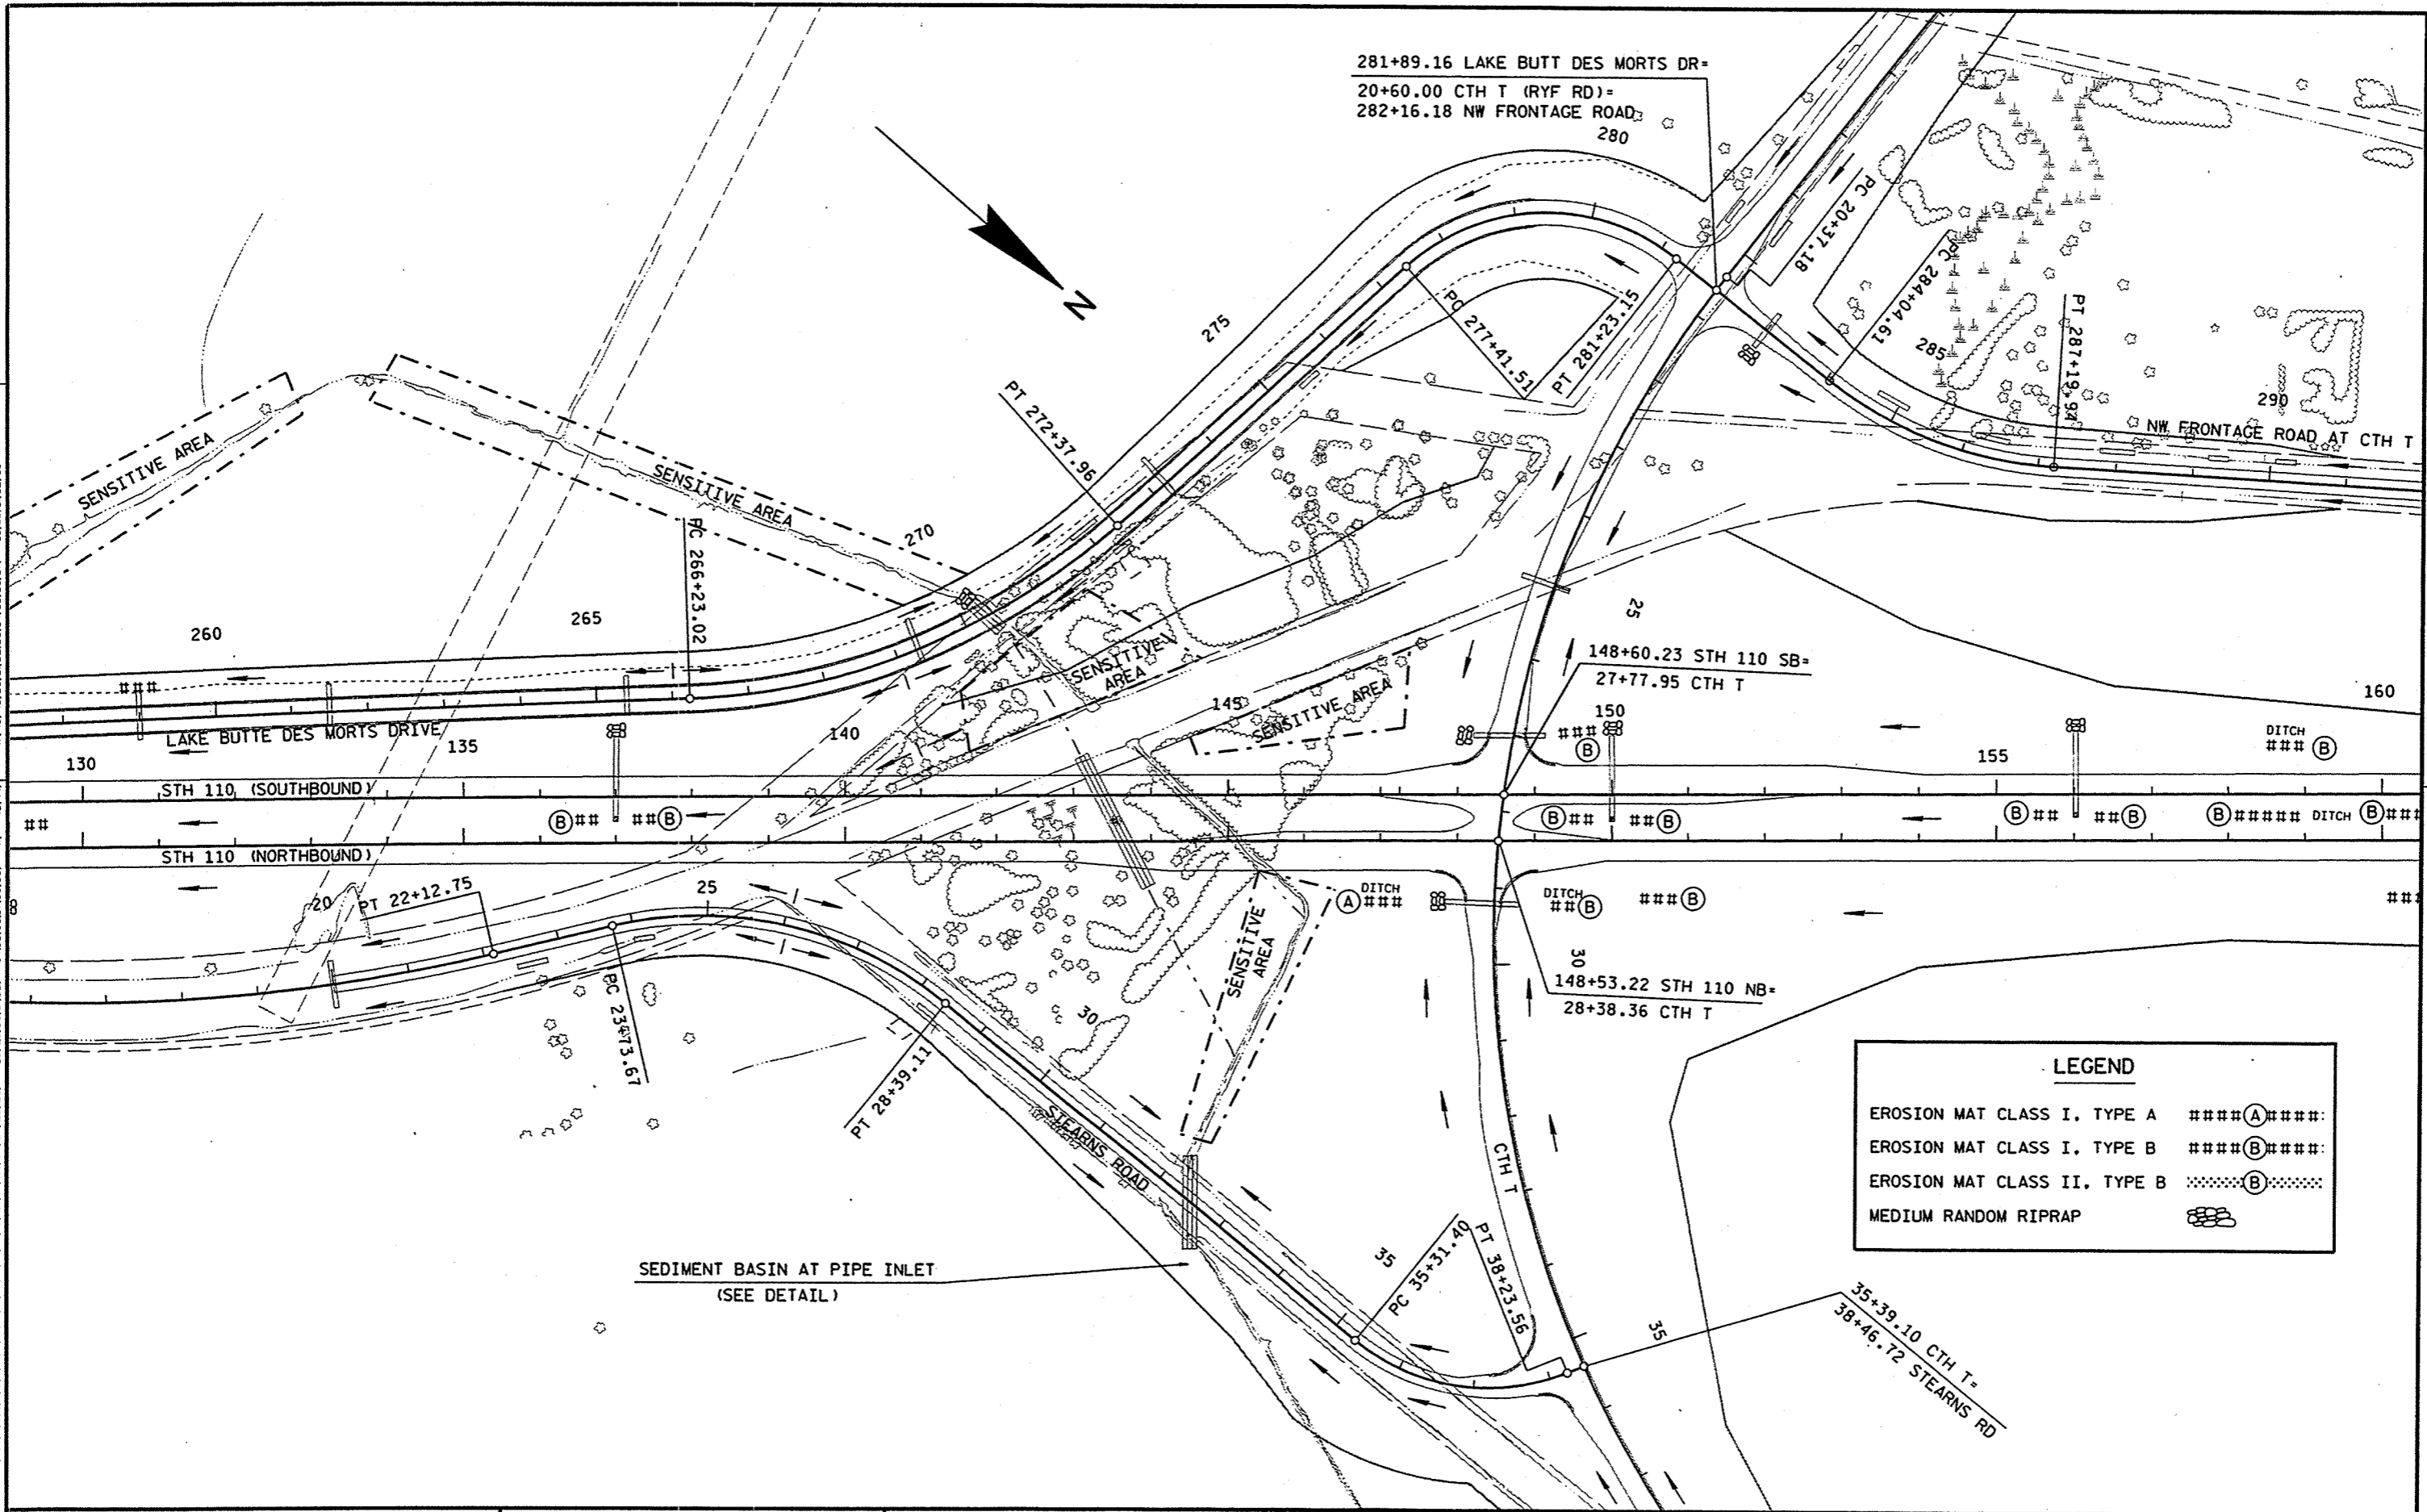


281+89.16 LAKE BUTTE DES MORTS DR=
 20+60.00 CTH T (RYF RD)=
 282+16.18 NW FRONTAGE ROAD=
 280

LEGEND	
EROSION MAT CLASS I, TYPE A	####(A)####
EROSION MAT CLASS I, TYPE B	####(B)####
EROSION MAT CLASS II, TYPE B	#####(B)#####
MEDIUM RANDOM RIPRAP	#####

SEDIMENT BASIN AT PIPE INLET
 (SEE DETAIL)


LEVELS ON - 1,2,3,4,5,6,7,8,9,10,11,12,13,14,15,16,17,18,19,20,21,22,23,24,25,26, 28,29,30,31,32, 34,35,36,37,38,39, 41, 43,44, 47,48,49,50,51,52,53,54,55,56,57, 59,60,61,62,63

LEVELS ON - 1,2,3,4,5,6,7,8,9,10,11,12,13,14,15,16,17,18,19,20,21,22,23,24,25,26, 28,29,30,31,32,33,34,35,36,37,38,39,40,41,42,43,44,45,46,47,48,49,50,51,52,53,54,55,56,57, 59,60,61,62,63

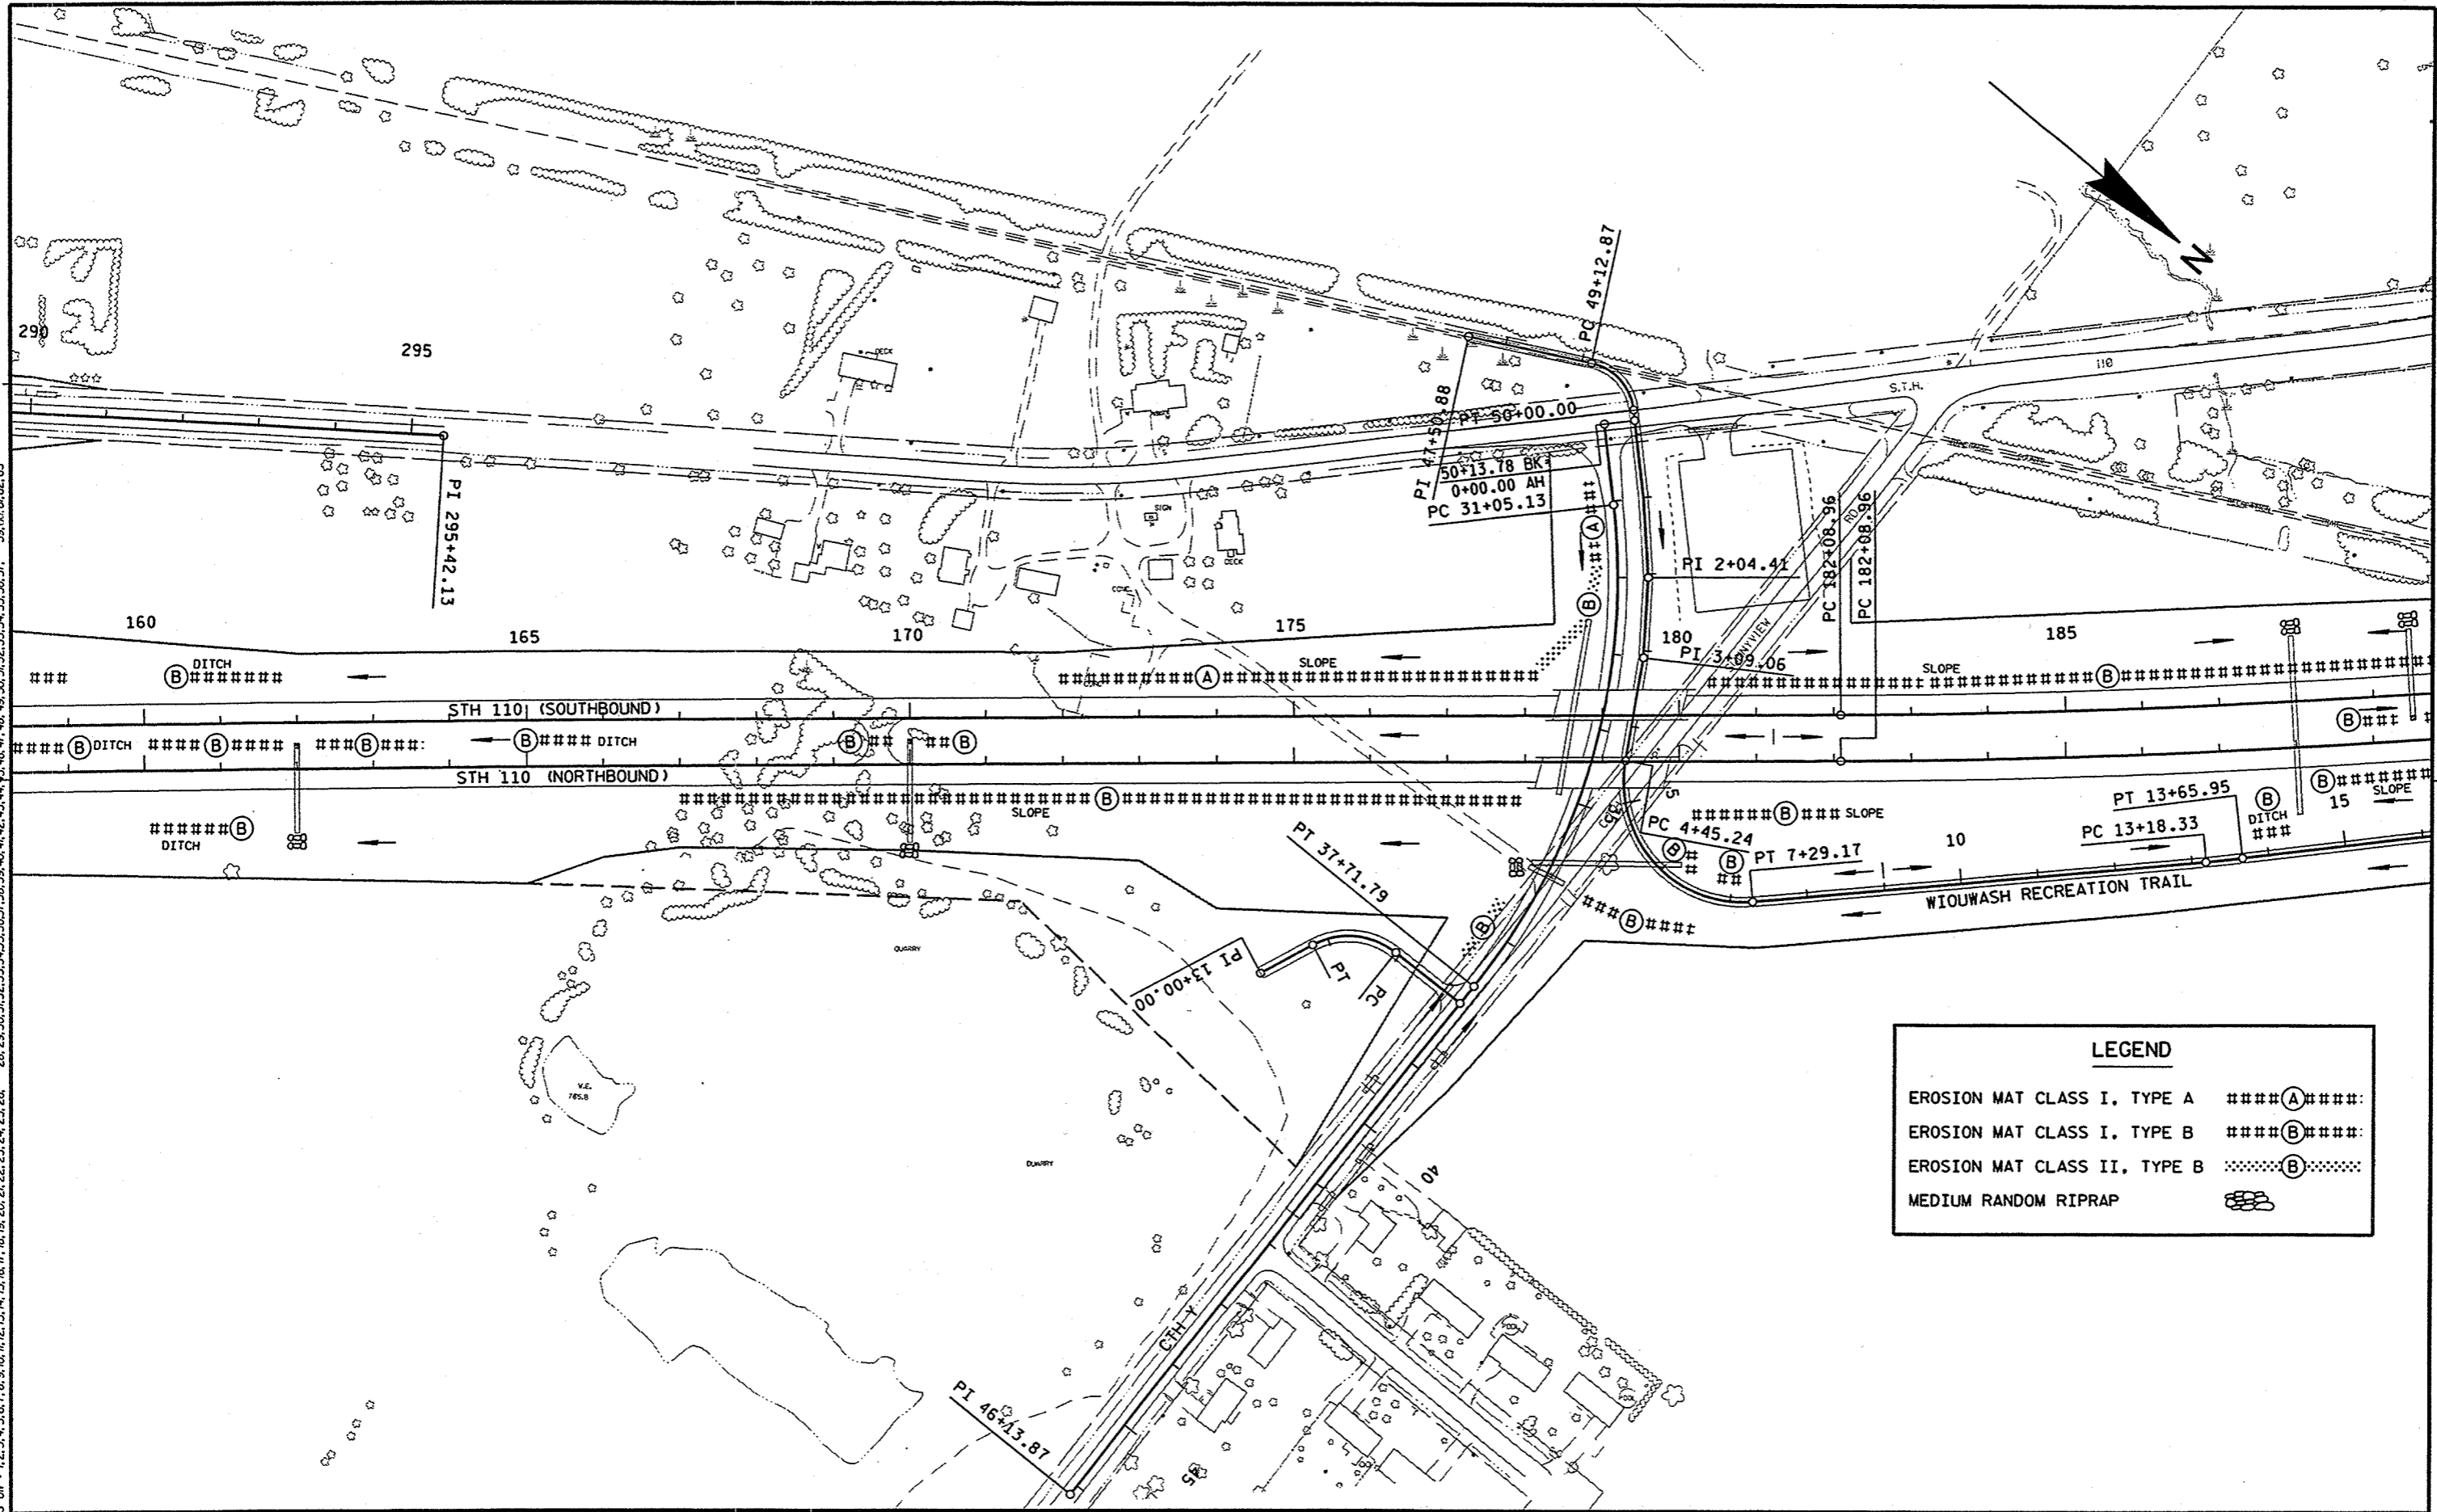


LEGEND	
EROSION MAT CLASS I, TYPE A	####(A)####
EROSION MAT CLASS I, TYPE B	####(B)####
EROSION MAT CLASS II, TYPE B	####(B)####
MEDIUM RANDOM RIPRAP	#####

LEVELS ON - 1, 2, 28, 29, 30, 59, 60, 61, 62, 63

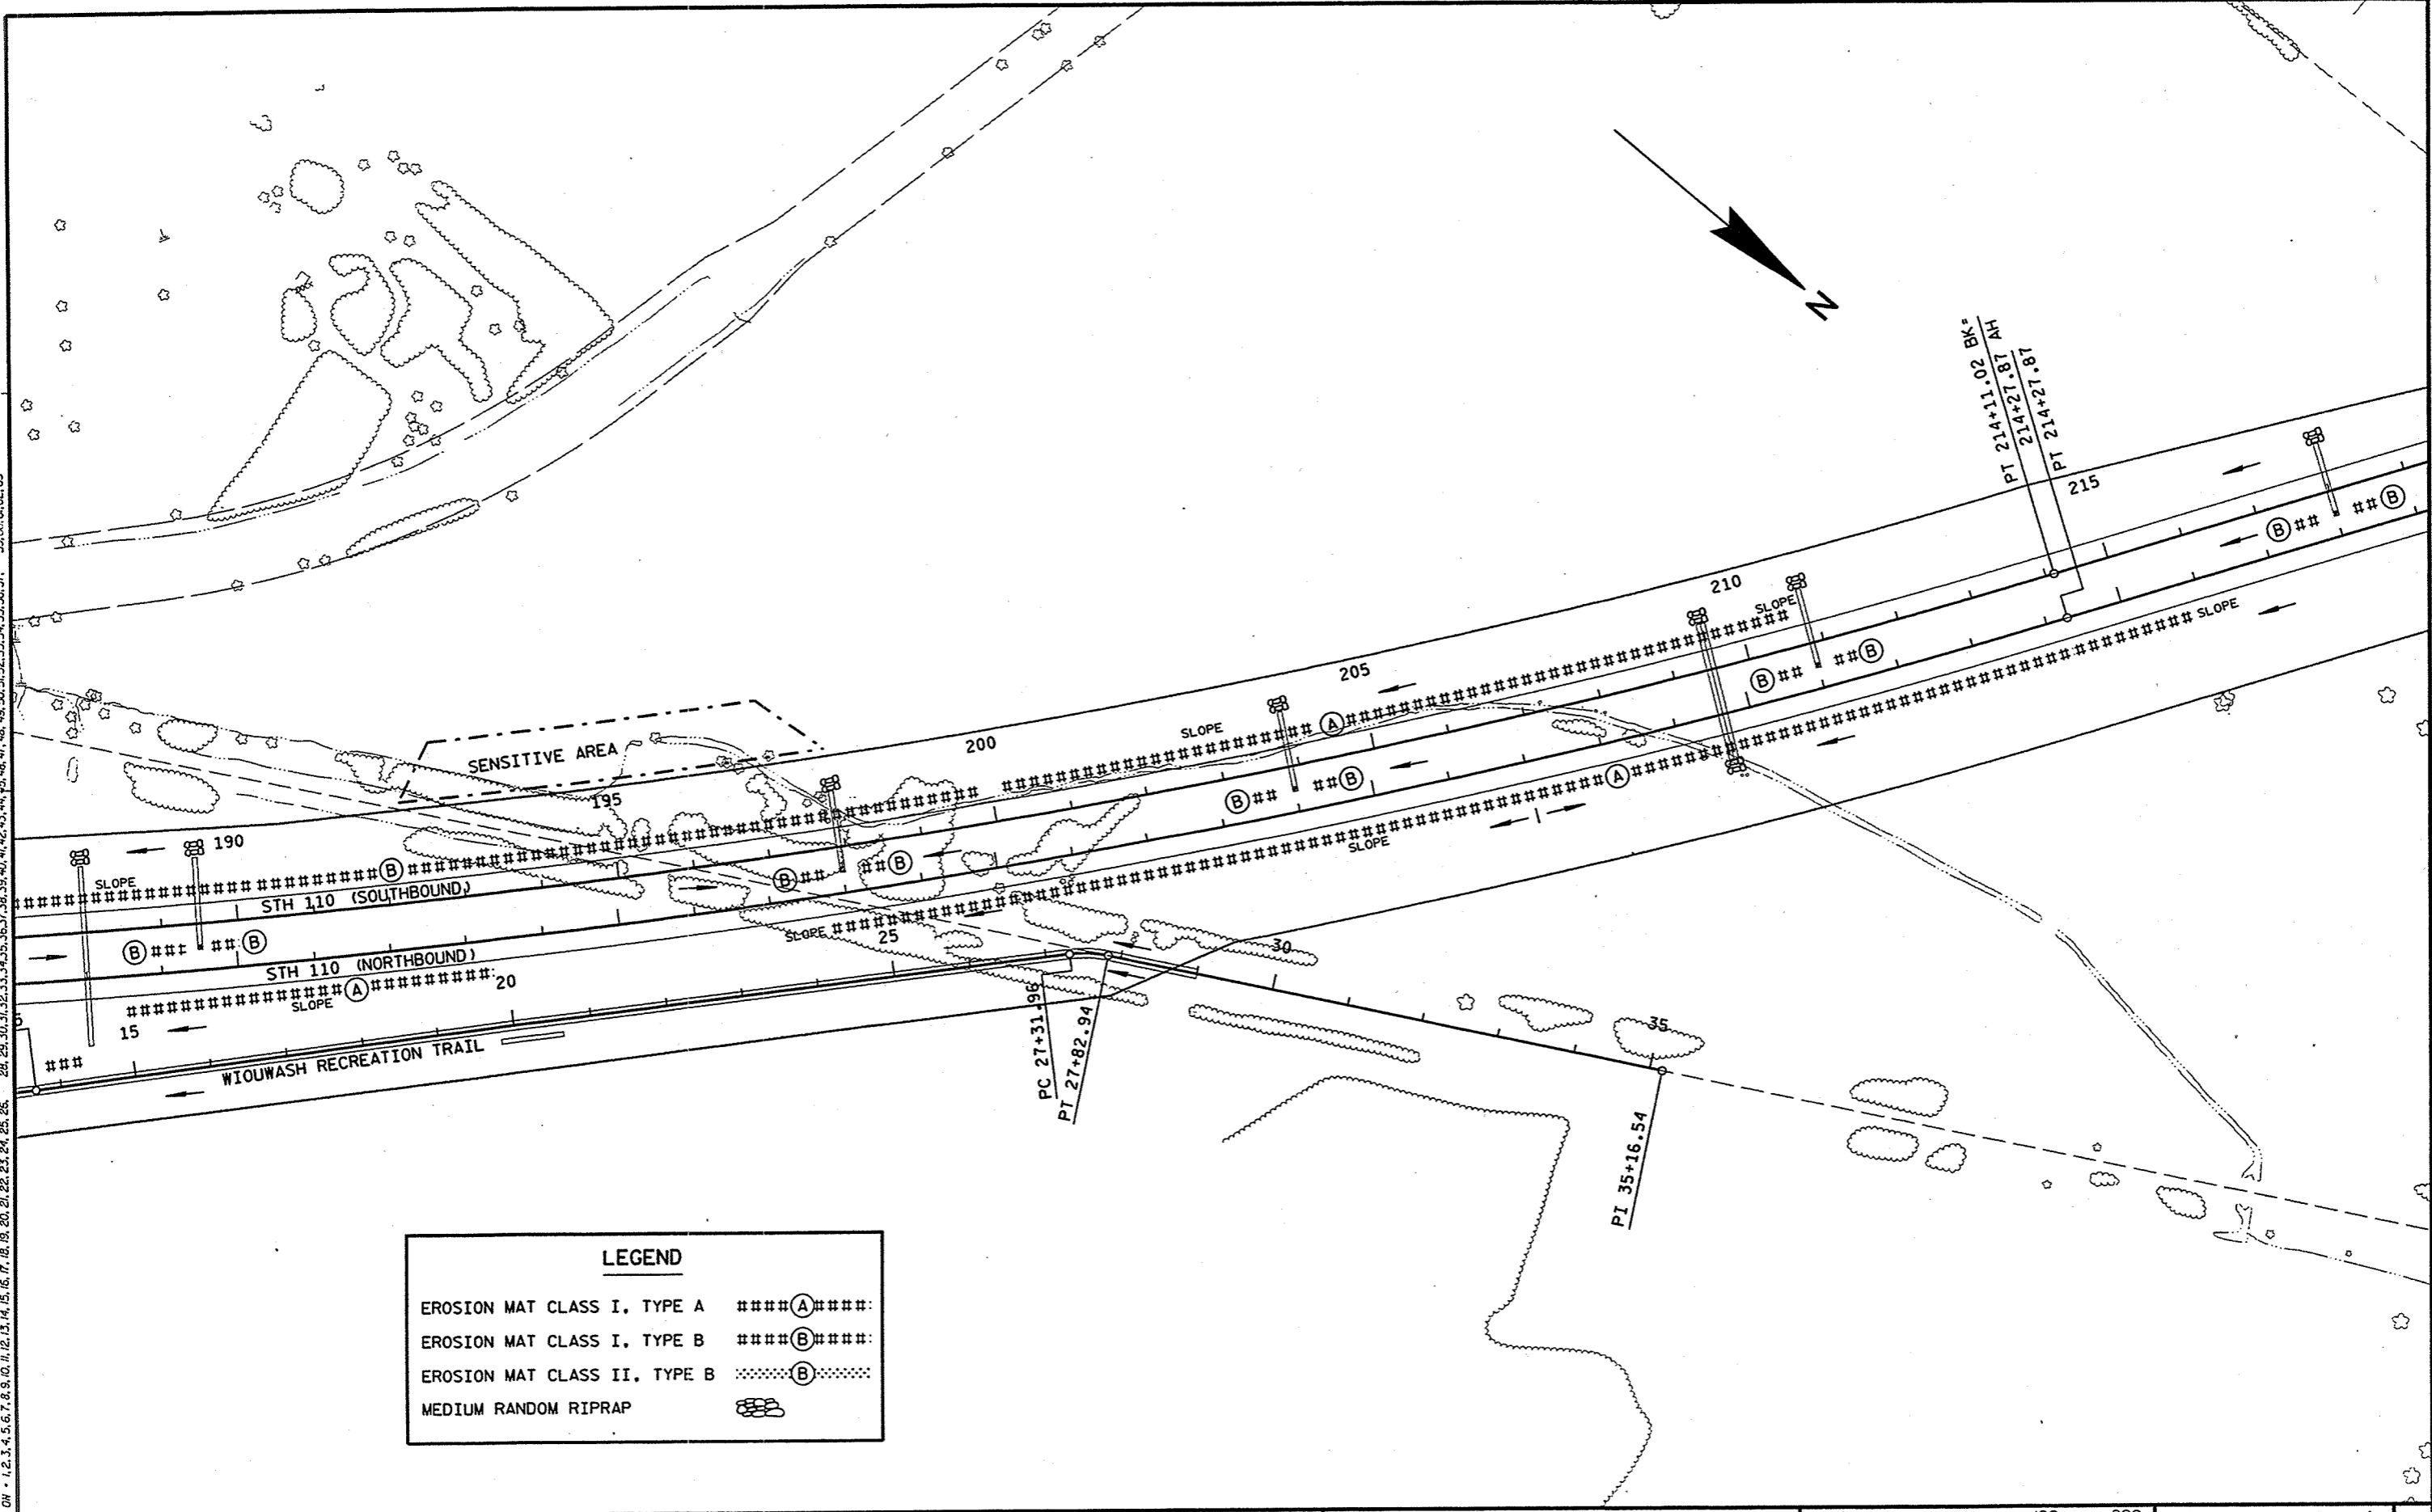

LEGEND	
EROSION MAT CLASS I, TYPE A	####(A)####
EROSION MAT CLASS I, TYPE B	####(B)####
EROSION MAT CLASS II, TYPE B	---(B)---
MEDIUM RANDOM RIPRAP	

LEVELS ON - 1, 2, 28, 29, 30, 59, 60, 61, 62, 63

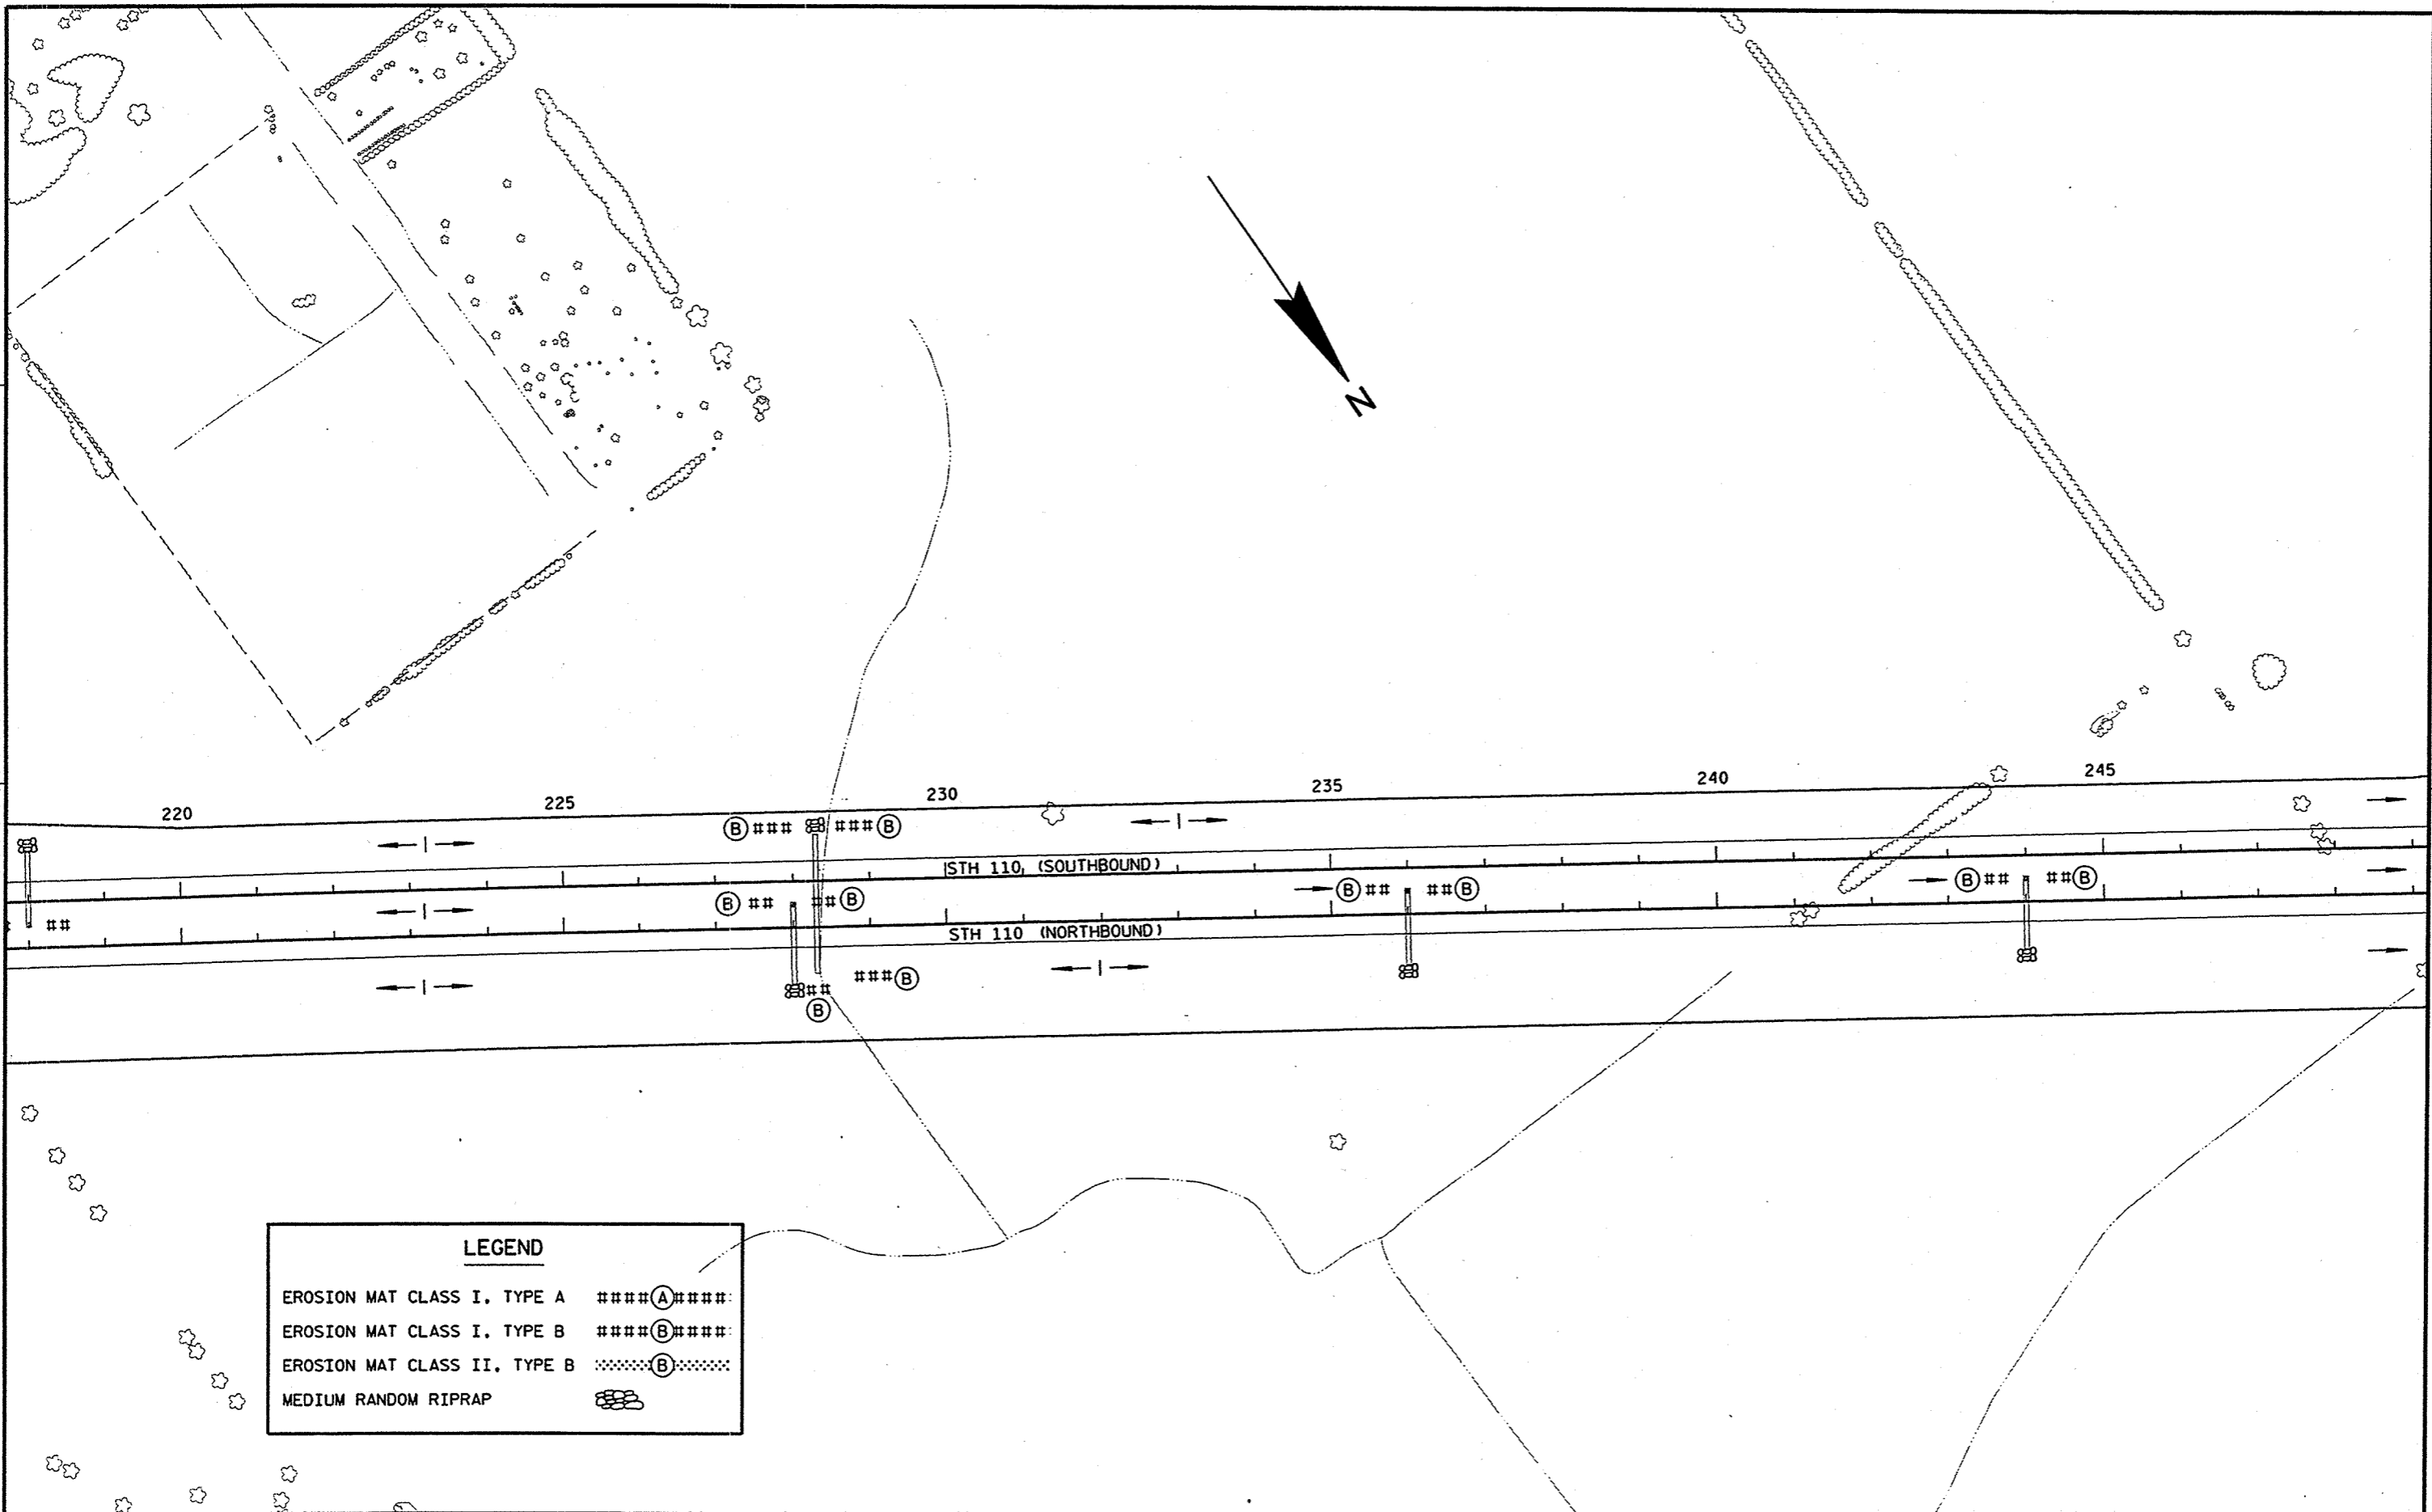


LEGEND	
EROSION MAT CLASS I, TYPE A	####(A)####
EROSION MAT CLASS I, TYPE B	####(B)####
EROSION MAT CLASS II, TYPE B	#####(B)#####
MEDIUM RANDOM RIPRAP	#####

STATE PROJECT NUMBER: 6200-05-71 HWY: STH 110 COUNTY: WINNEBAGO EROSION CONTROL (PERMANENT) SCALE, FEET 0 100 200 SHEET NO: 2.55 E


FILE NAME : F:\d3_620005\215.dgn PLOT DATE: 28-NOV-2001 13:09 ORG DATE : 11/1/00 PLOT NAME : 215dp71 Originator : DISTRICT 3 -- JD PLOT SCALE : 200.700000:1.000000

LEVELS ON - 1.2.3.4.5.6.7.8.9.10.11.12.13.14.15.16.17.18.19.20.21.22.23.24.25.26 28.29.30.31.32.33.34.35.36.37.38.39.40.41.42.43.44.45.46.47.48.49.50.51.52.53.54.55.56.57. 59.60.61.62.63

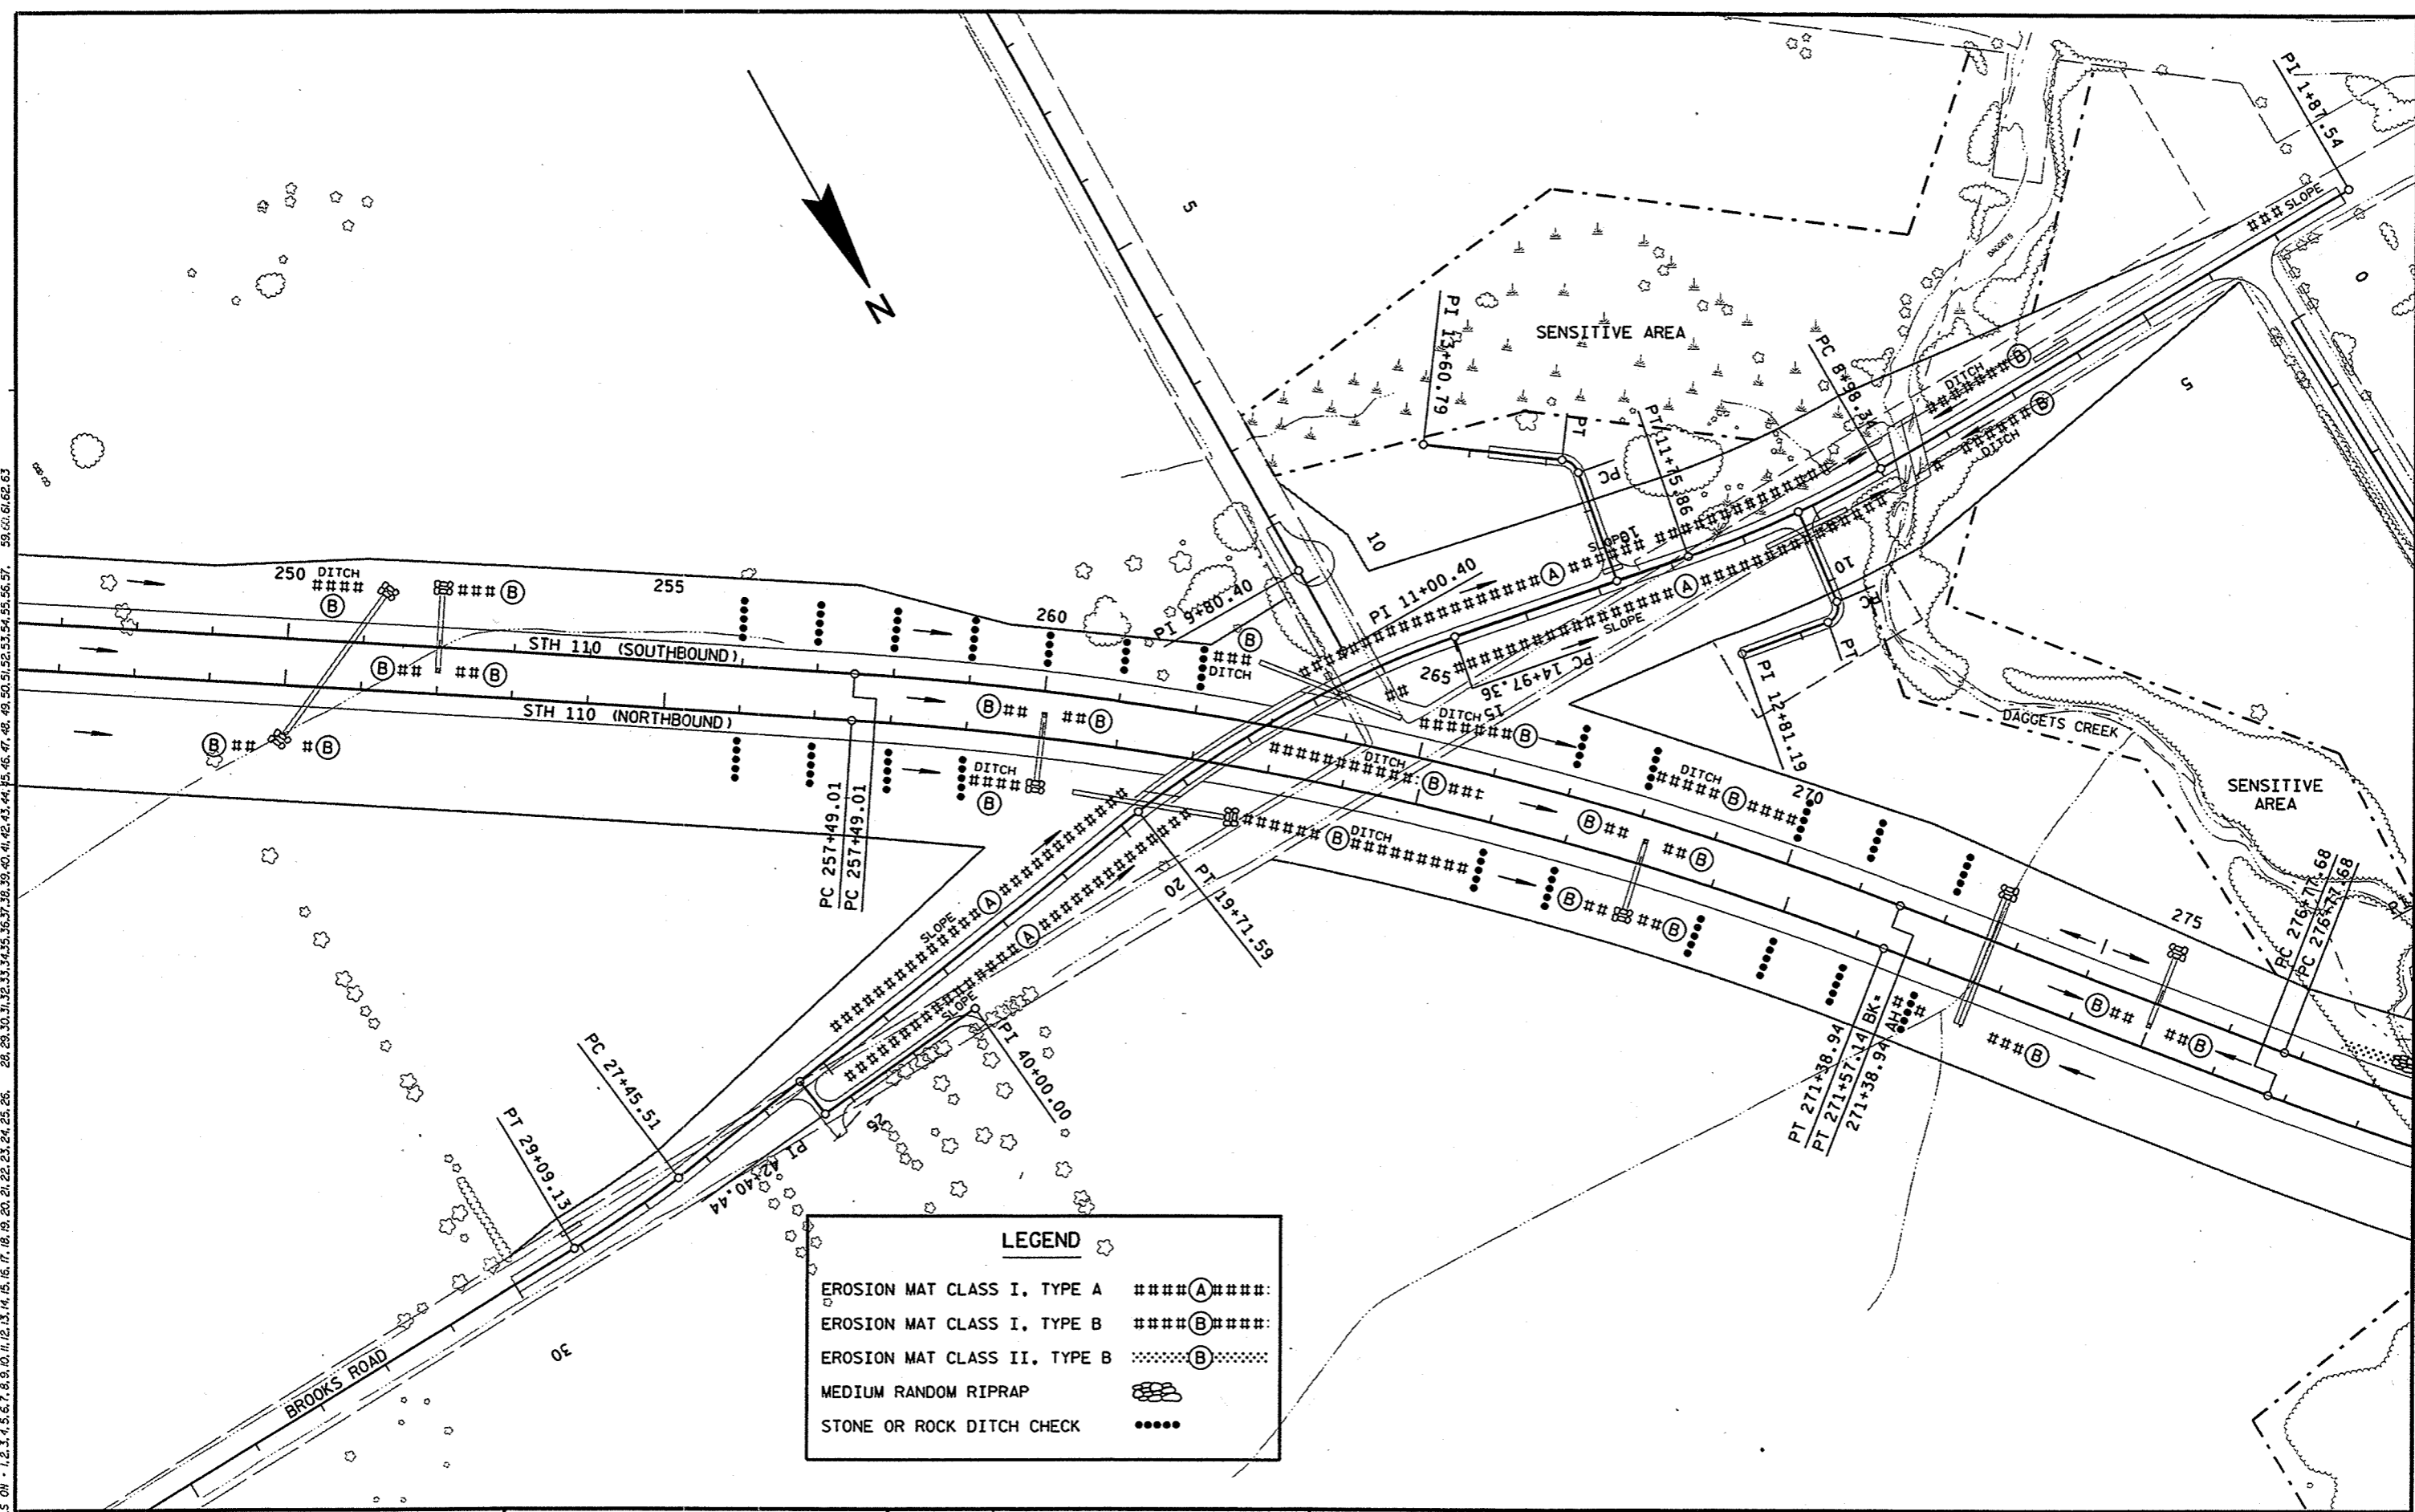


LEGEND	
EROSION MAT CLASS I, TYPE A	#####(A)#####
EROSION MAT CLASS I, TYPE B	#####(B)#####
EROSION MAT CLASS II, TYPE B(B).....
MEDIUM RANDOM RIPRAP	#####
STONE OR ROCK DITCH CHECK

LEGEND	
EROSION MAT CLASS I, TYPE A	####(A)####
EROSION MAT CLASS I, TYPE B	####(B)####
EROSION MAT CLASS II, TYPE B	#####(B)#####
MEDIUM RANDOM RIPRAP	

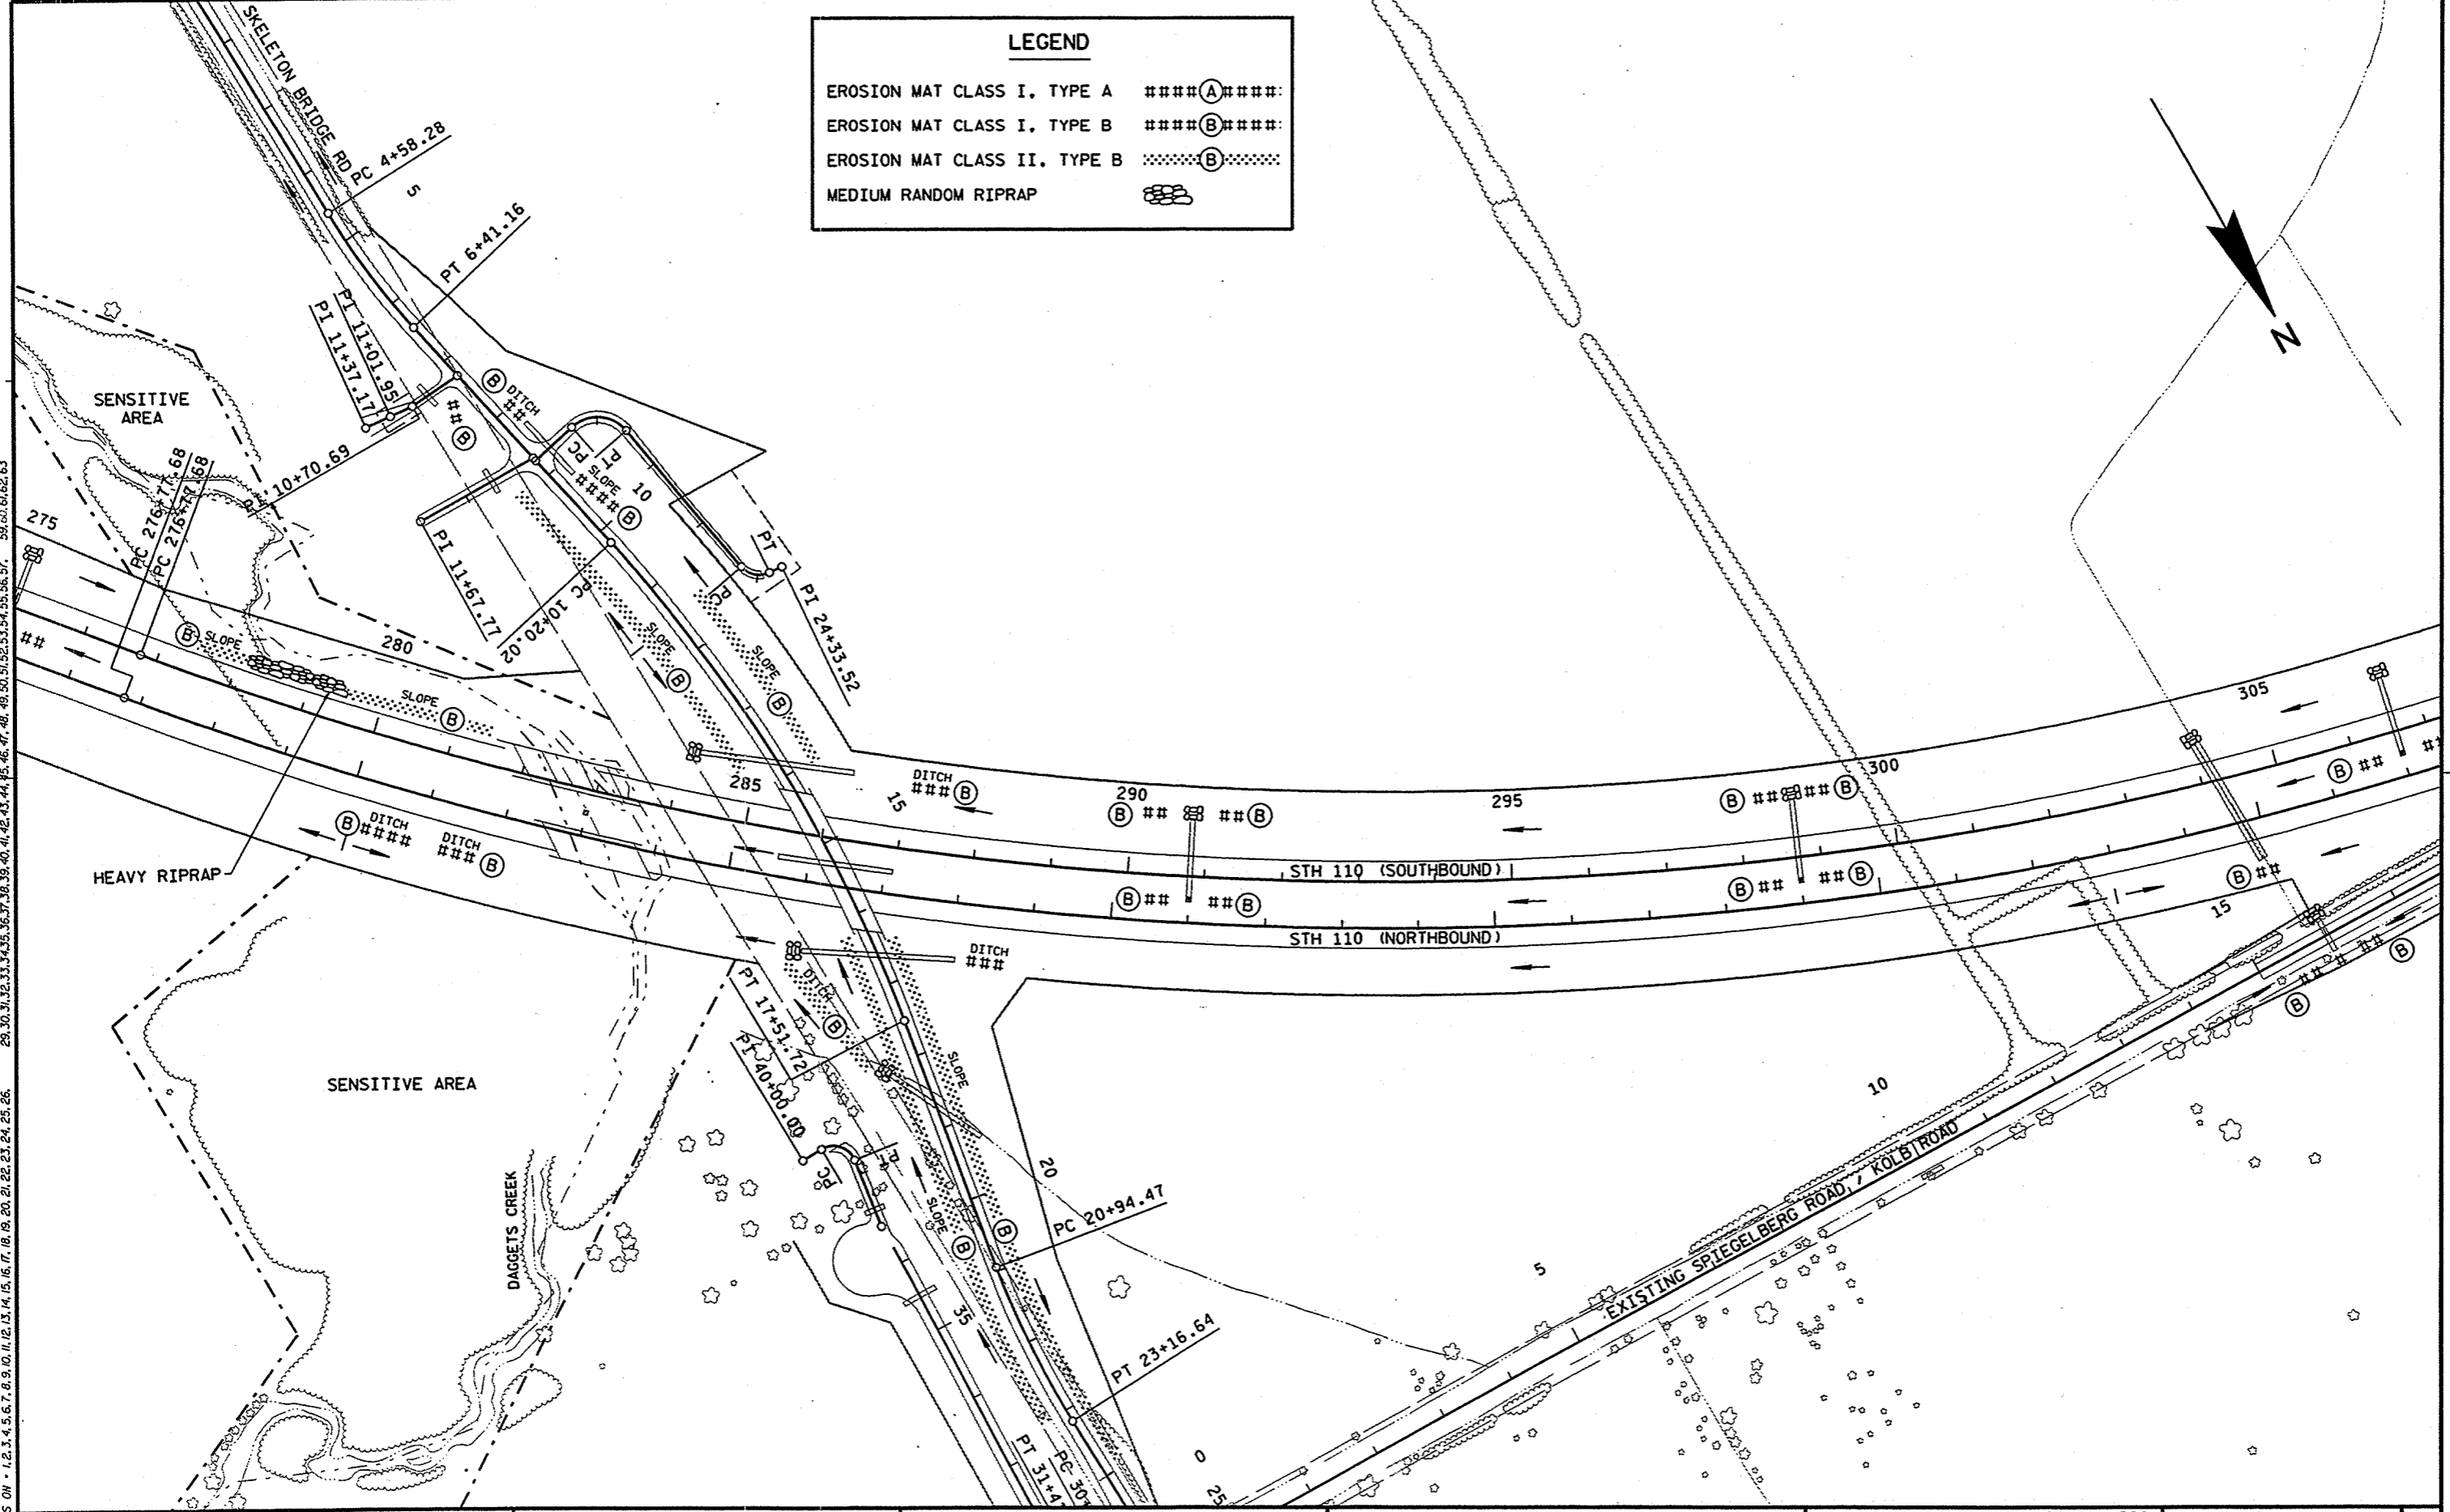


LEVELS ON - 1, 2, 3, 4, 5, 6, 7, 8, 9, 10, 11, 12, 13, 14, 15, 16, 17, 18, 19, 20, 21, 22, 23, 24, 25, 26, 29, 30, 31, 62, 63

LEVELS ON * 1,2,3,4,5,6,7,8,9,10,11,12,13,14,15,16,17,18,19,20,21,22,23,24,25,26, 28,29,30,31,32,33,34,35,36,37,38,39,40,41,42,43,44,45,46,47,48,49,50,51,52,53,54,55,56,57, 59,60,61,62,63

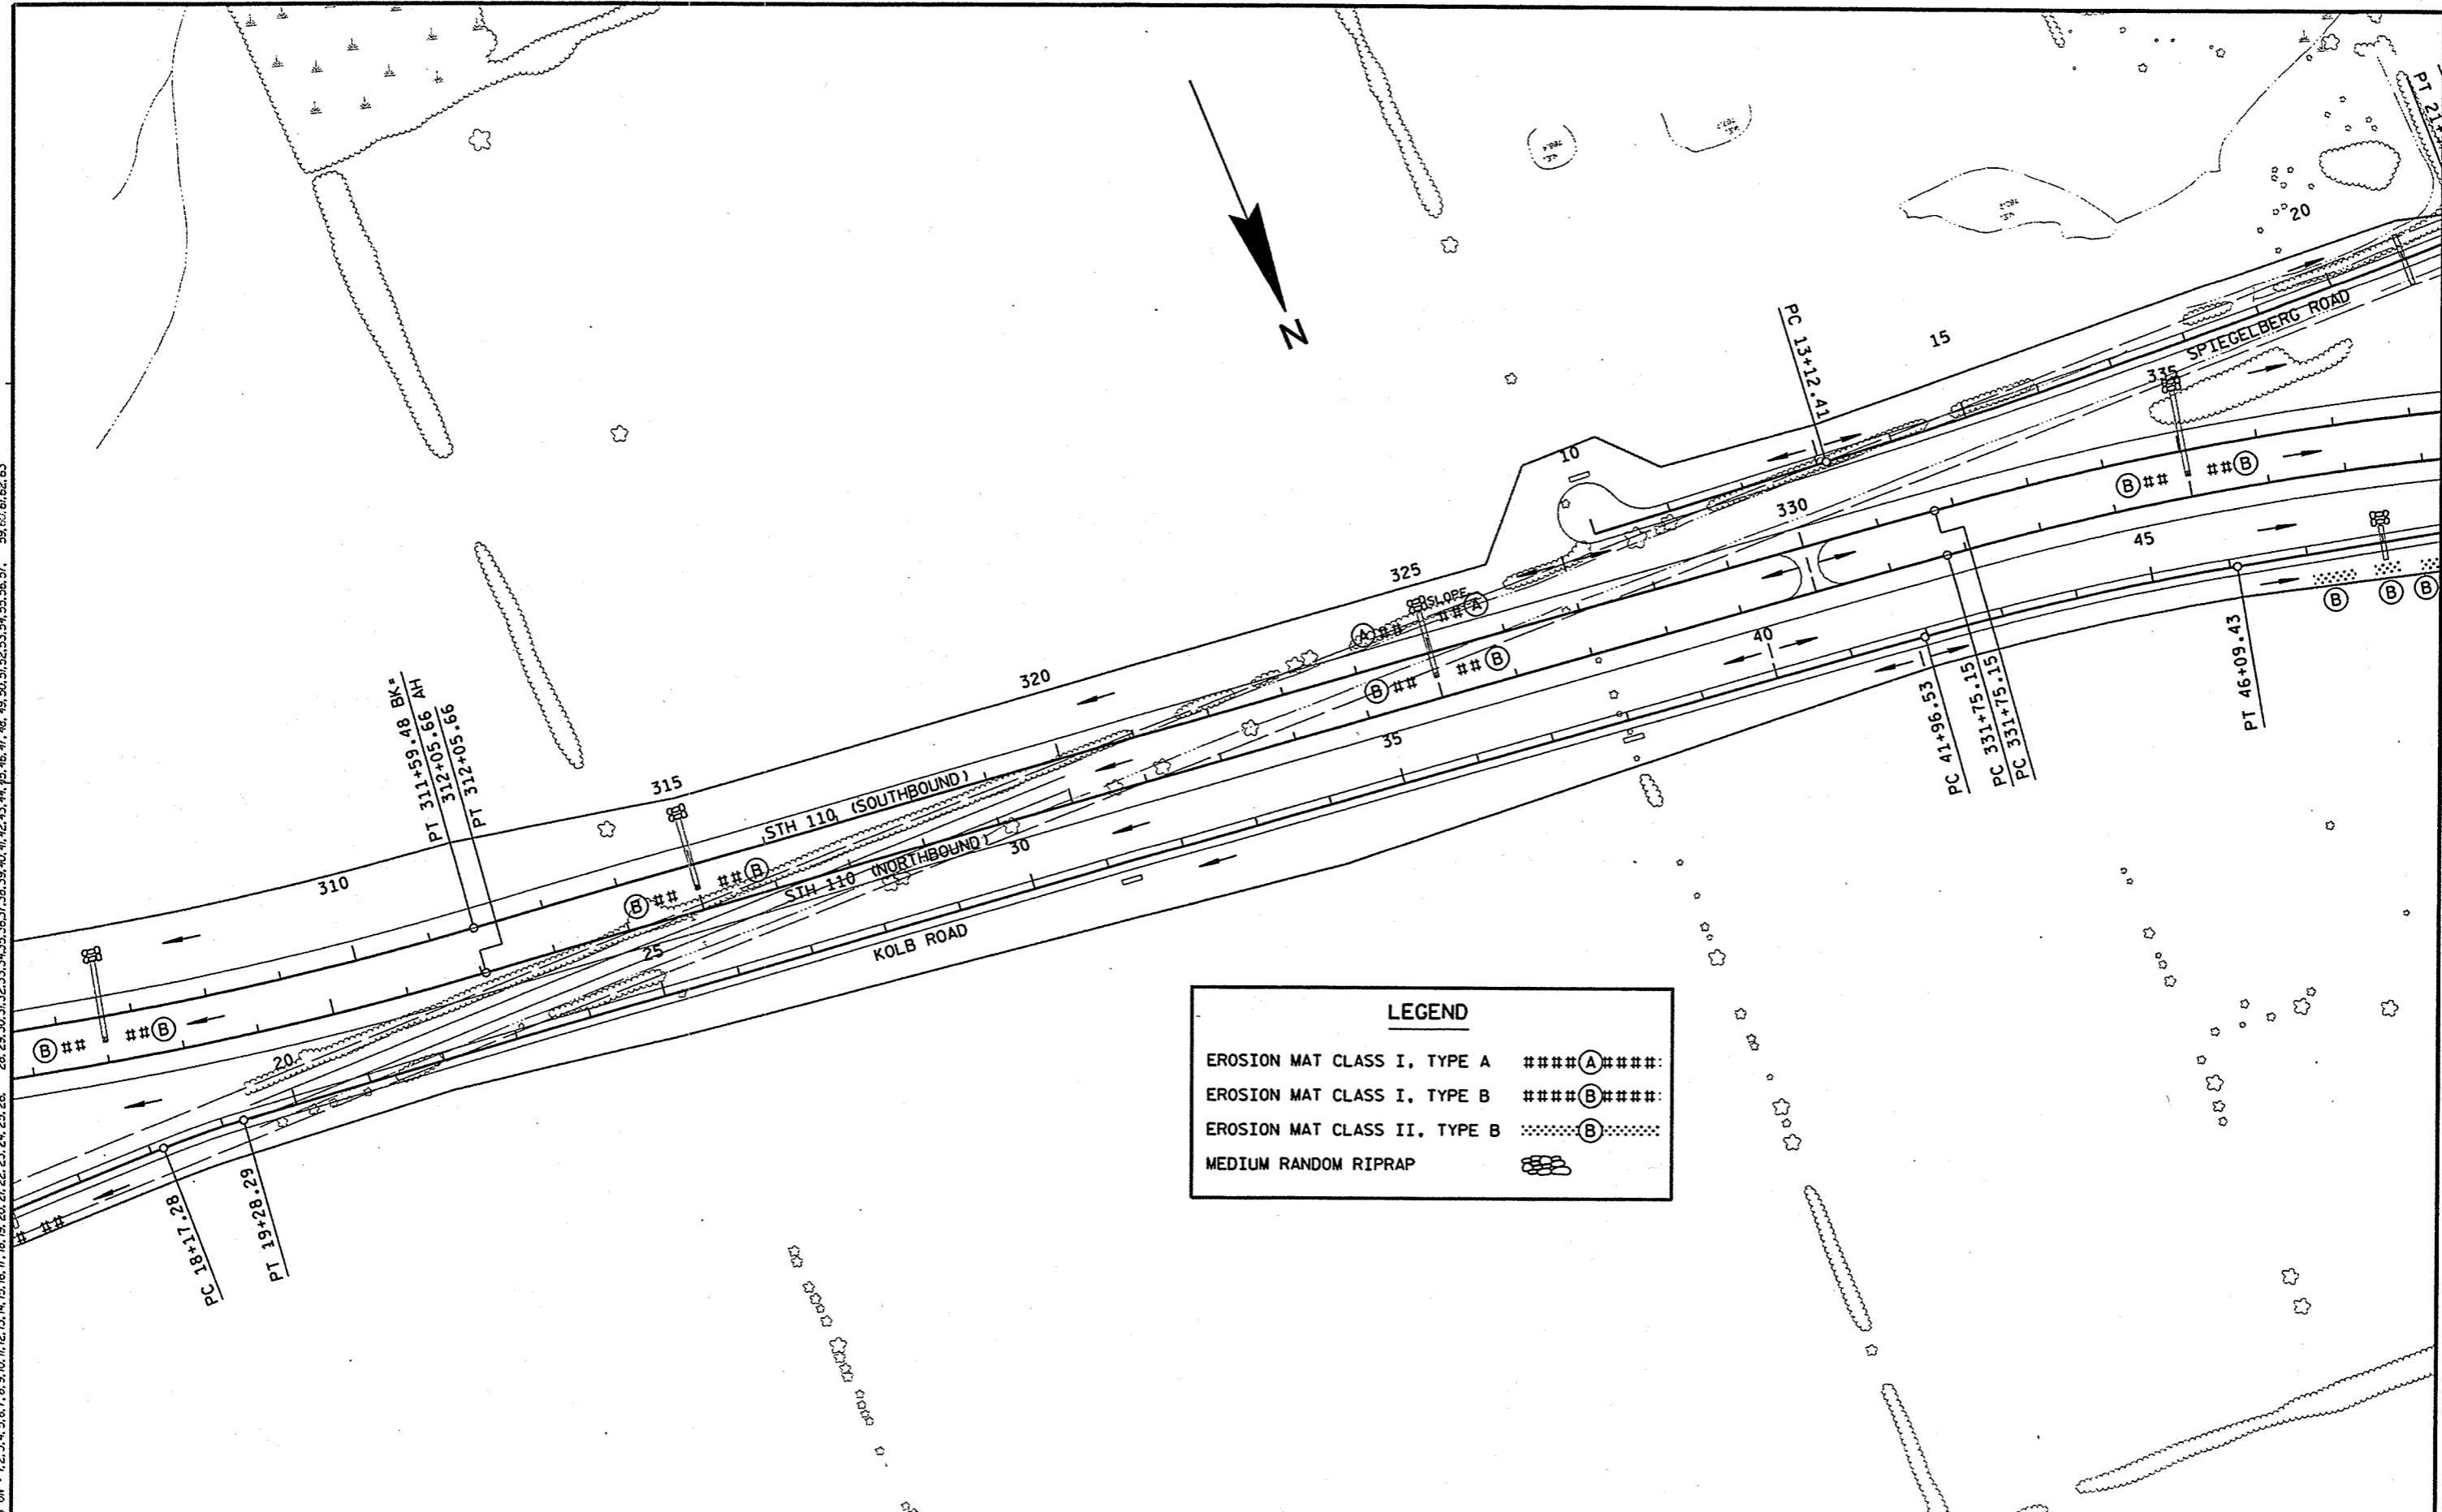


LEGEND	
EROSION MAT CLASS I, TYPE A	####(A)####
EROSION MAT CLASS I, TYPE B	####(B)####
EROSION MAT CLASS II, TYPE B	#####(B)#####
MEDIUM RANDOM RIPRAP	#####

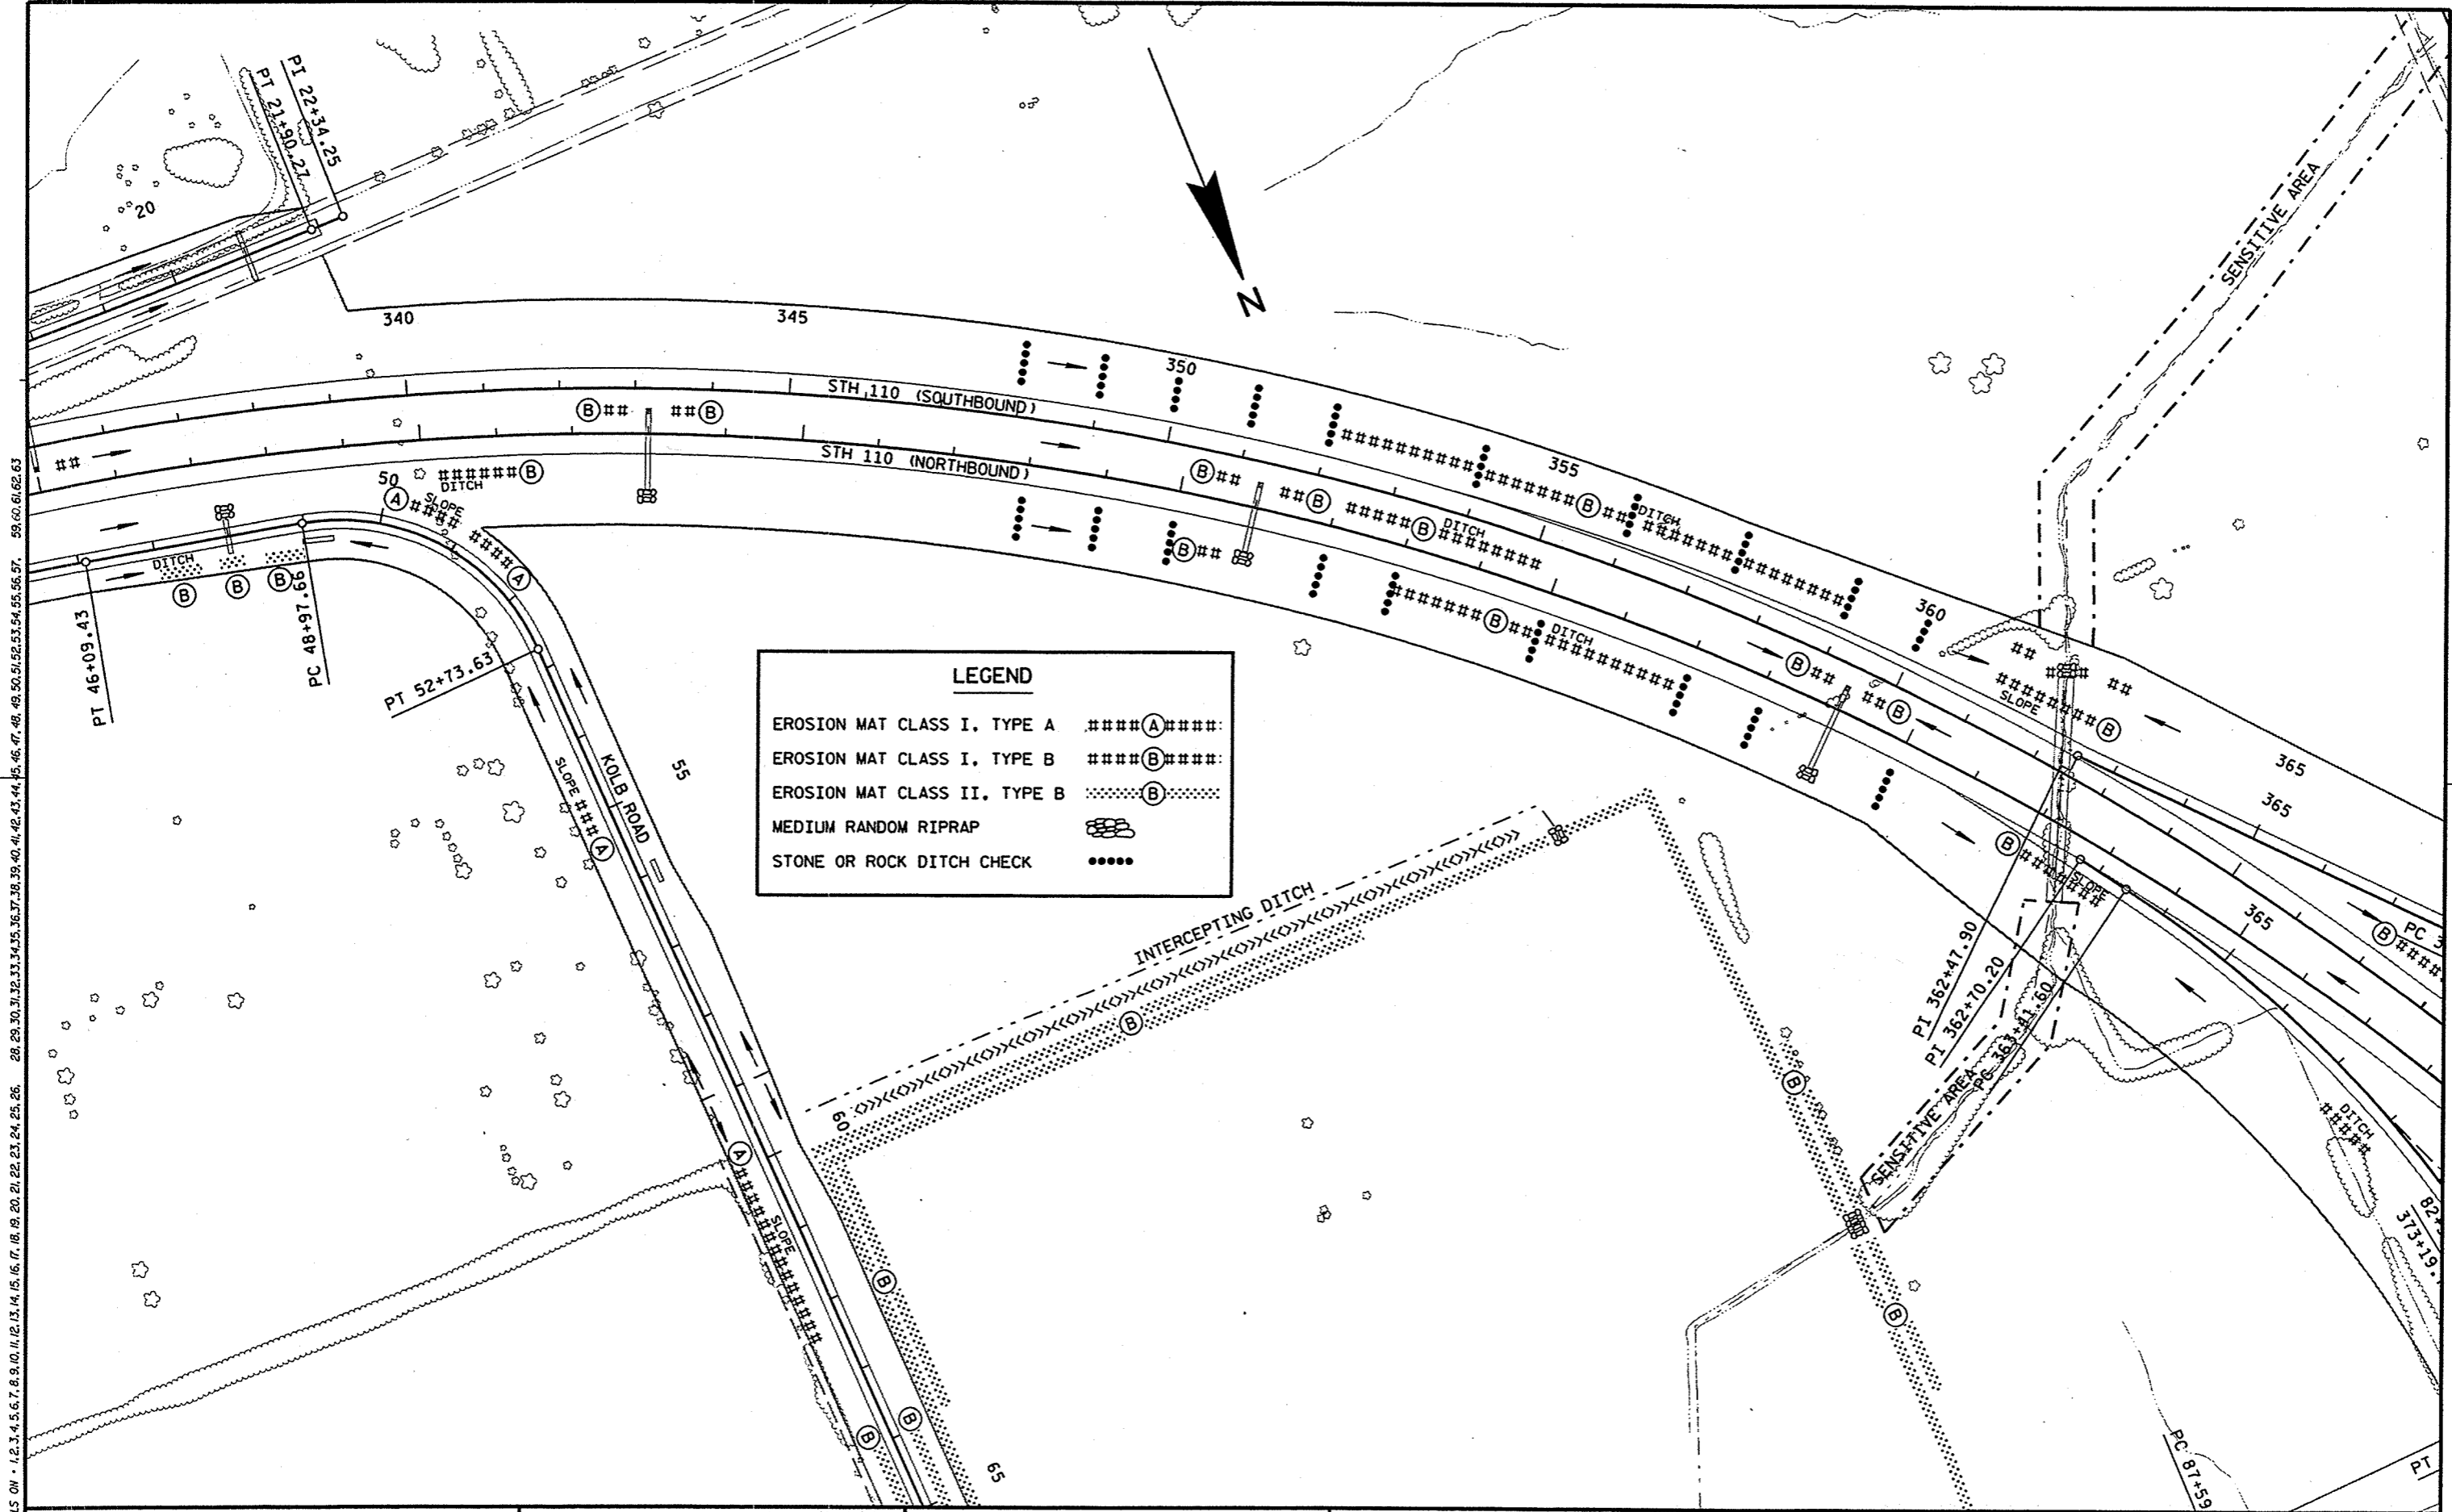

LEGEND	
EROSION MAT CLASS I, TYPE A	####(A)####
EROSION MAT CLASS I, TYPE B	####(B)####
EROSION MAT CLASS II, TYPE B(B).....
MEDIUM RANDOM RIPRAP	
STONE OR ROCK DITCH CHECK


STATE PROJECT NUMBER: 6200-05-71 HWY: STH 110 COUNTY: WINNEBAGO EROSION CONTROL (PERMANENT) SCALE, FEET SHEET NO: 2.59 E

FILE NAME : F:\d3_620005\219.dgn PLOT DATE: 28-NOV-2001 13:09 ORG DATE : 11/1/00 PLOT NAME : 219dp71 Originator : DISTRICT 3 -- JD PLOT SCALE : 200.700000:1.000000

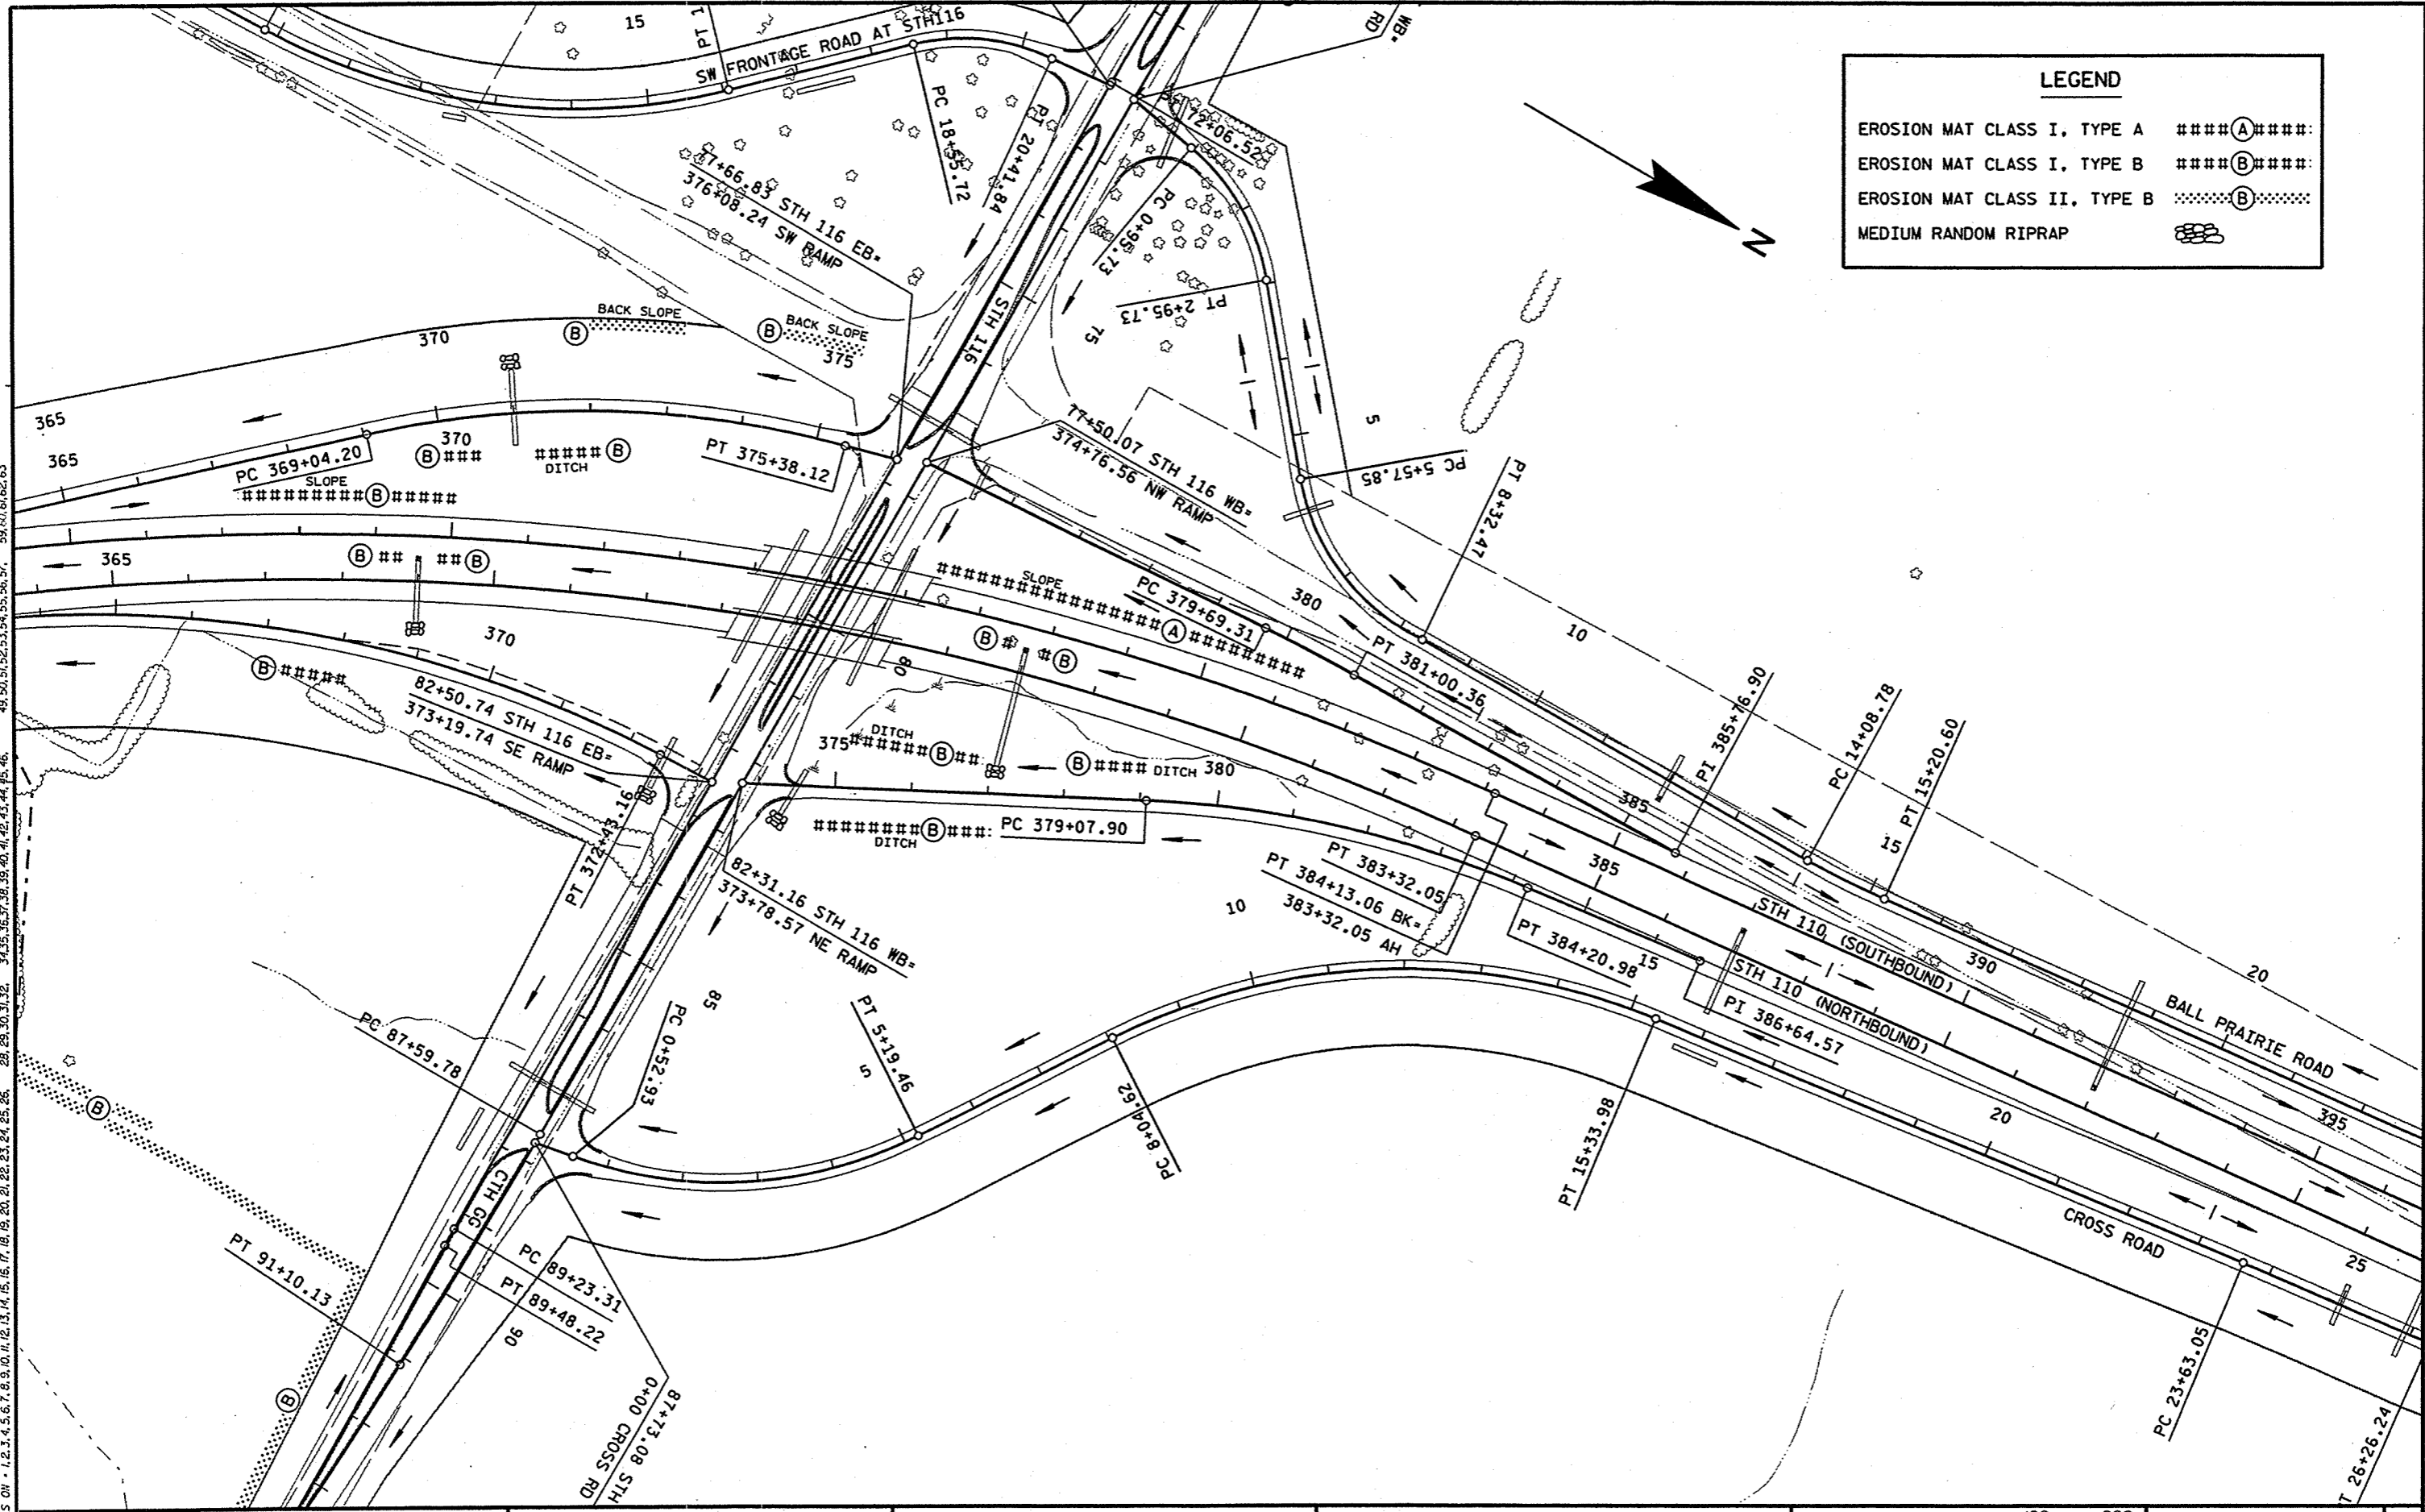

LEGEND	
EROSION MAT CLASS I, TYPE A	####(A)####
EROSION MAT CLASS I, TYPE B	####(B)####
EROSION MAT CLASS II, TYPE B	#####(B)#####
MEDIUM RANDOM RIPRAP	



LEVELS ON - 1, 2, 28, 29, 30, 31, 32, 34, 35, 36, 37, 38, 39, 40, 41, 42, 43, 44, 45, 46, 49, 50, 51, 52, 53, 54, 55, 56, 57, 59, 60, 61, 62, 63

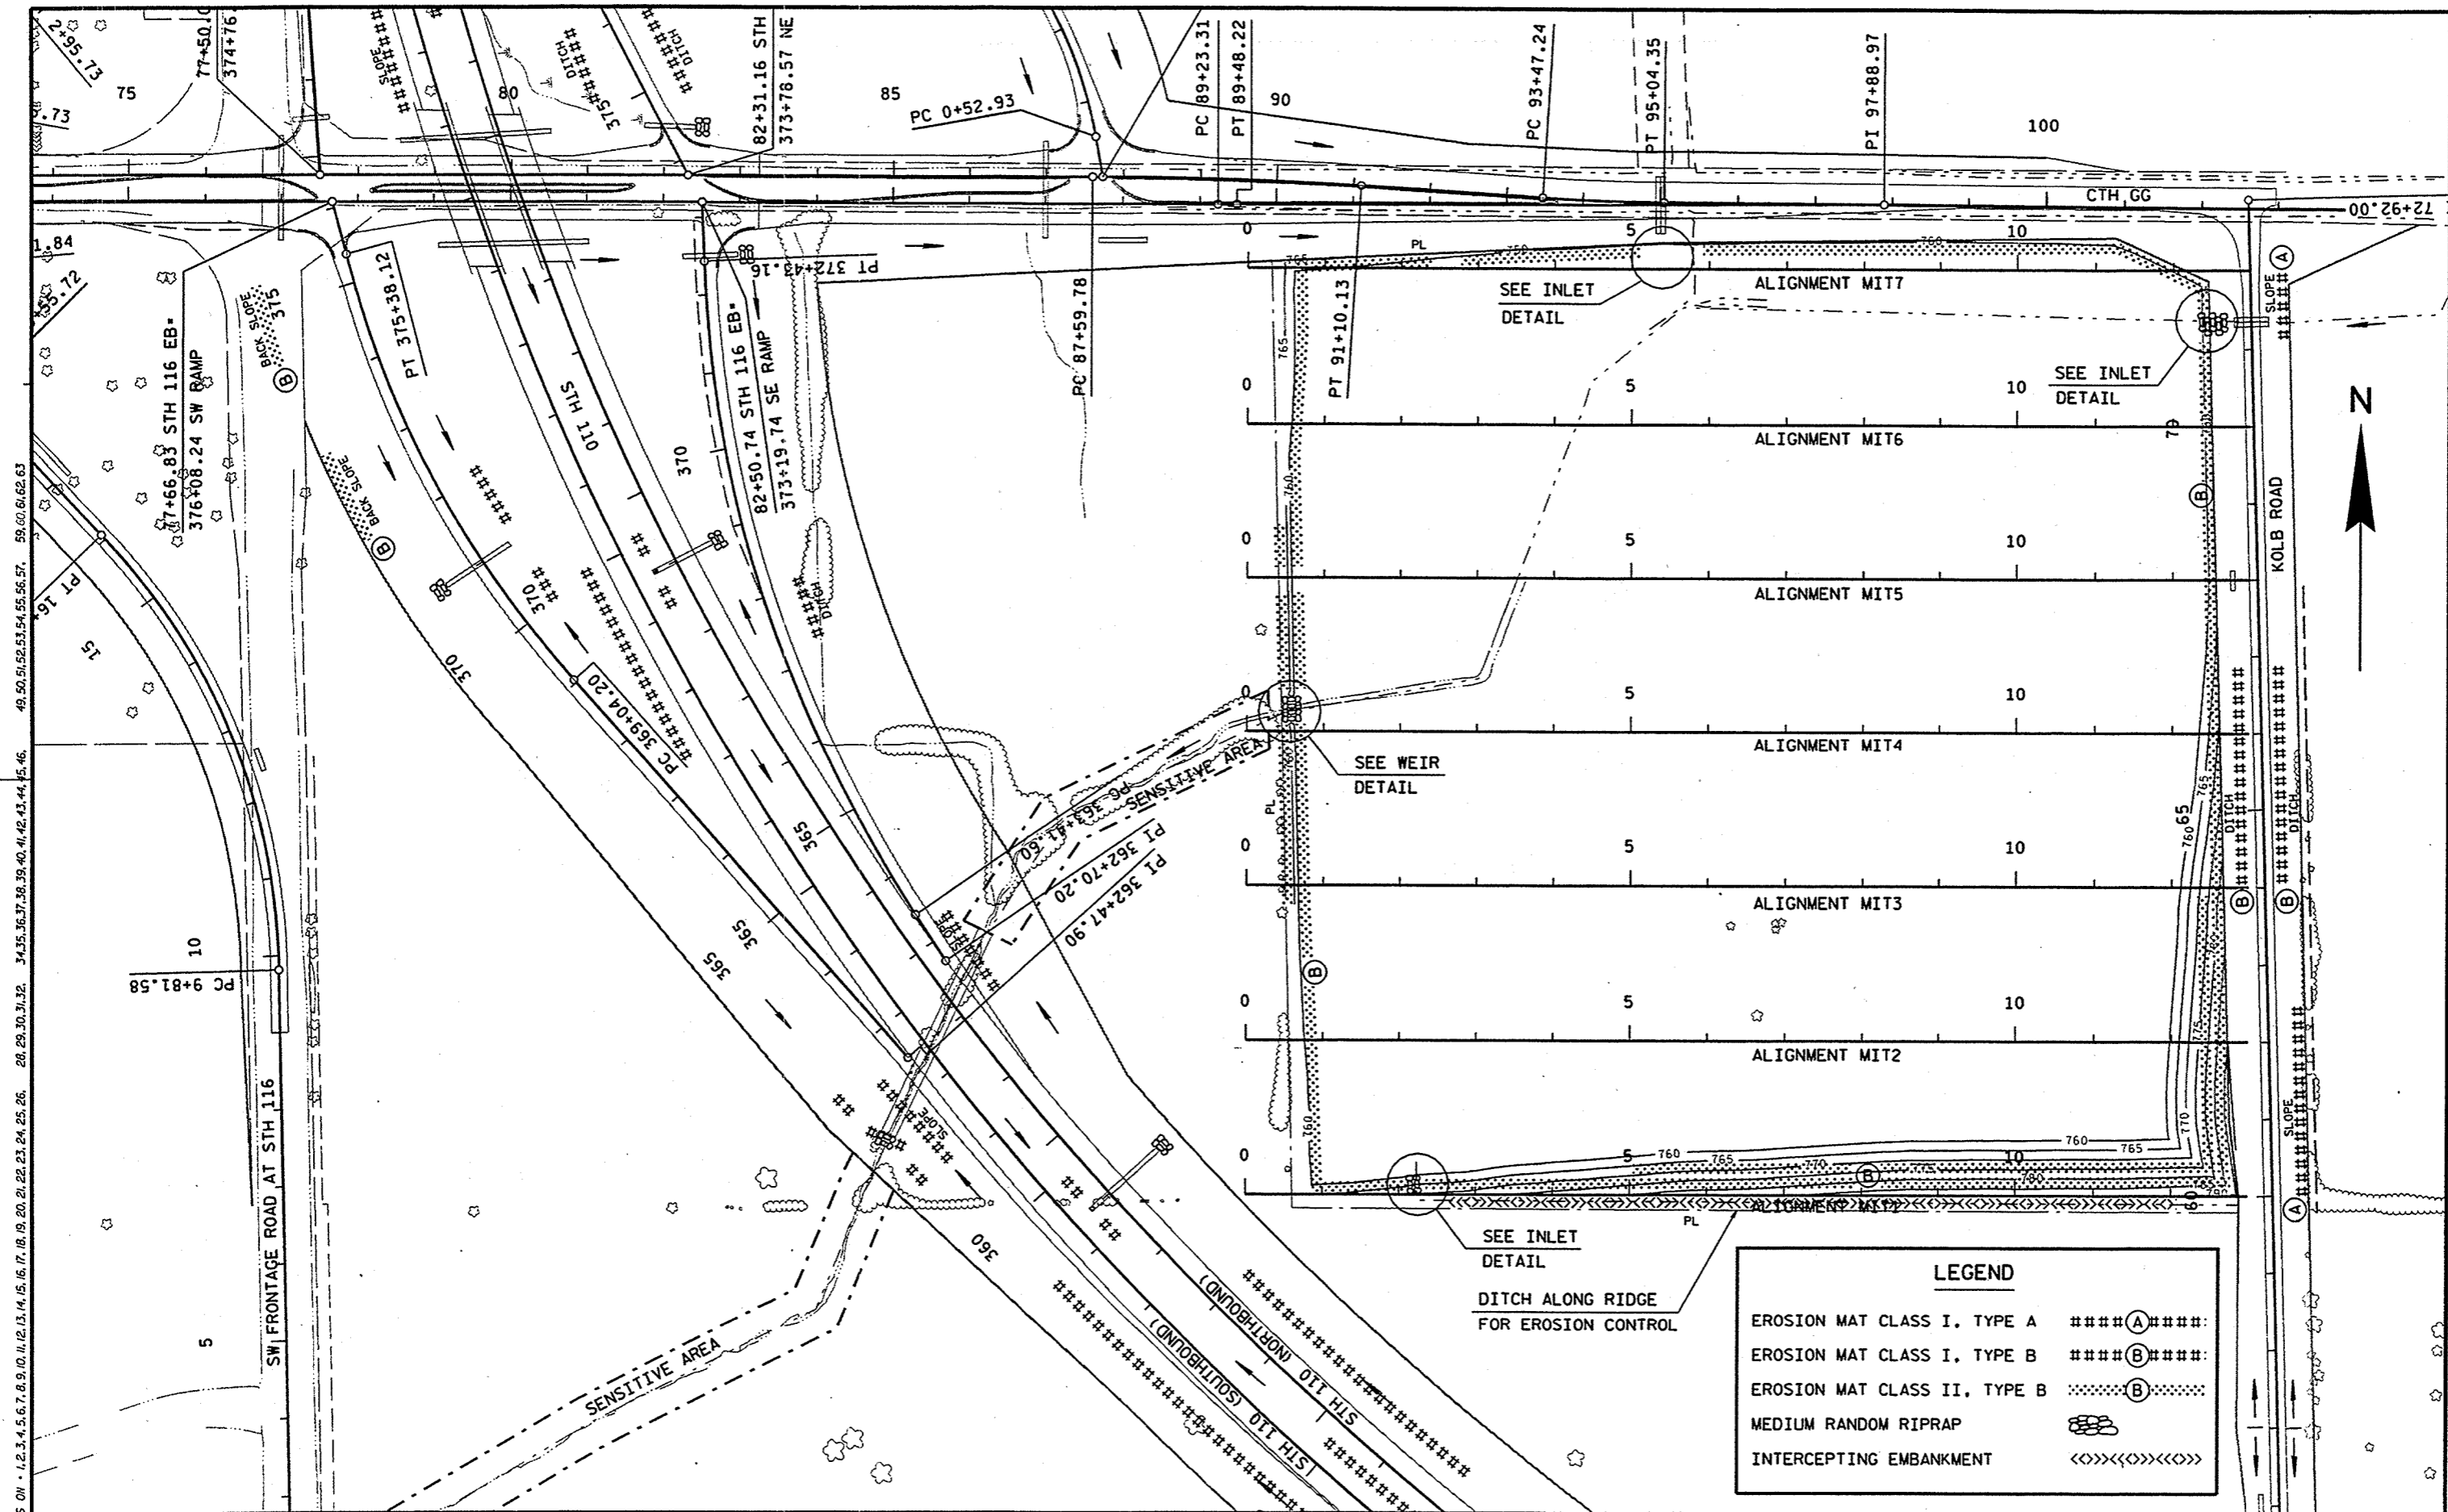

LEGEND	
EROSION MAT CLASS I, TYPE A	####(A)####
EROSION MAT CLASS I, TYPE B	####(B)####
EROSION MAT CLASS II, TYPE B(B).....
MEDIUM RANDOM RIPRAP	⊘⊘⊘⊘⊘
INTERCEPTING EMBANKMENT	<<<>>><<<>>>

STATE PROJECT NUMBER: 6200-05-71 HWY: STH 110 COUNTY: WINNEBAGO EROSION CONTROL (PERMANENT) SCALE, FEET 0 100 200 SHEET NO: 2.61 E

NOTE:
 EXISTING DRAIN TILE WHICH IS LOCATED
 WITHIN THE PROPOSED R/W SHALL BE
 ABANDONED.
 ALL LOCATIONS OF EXISTING AND PROPOSED
 DRAIN TILE ARE APPROXIMATE.

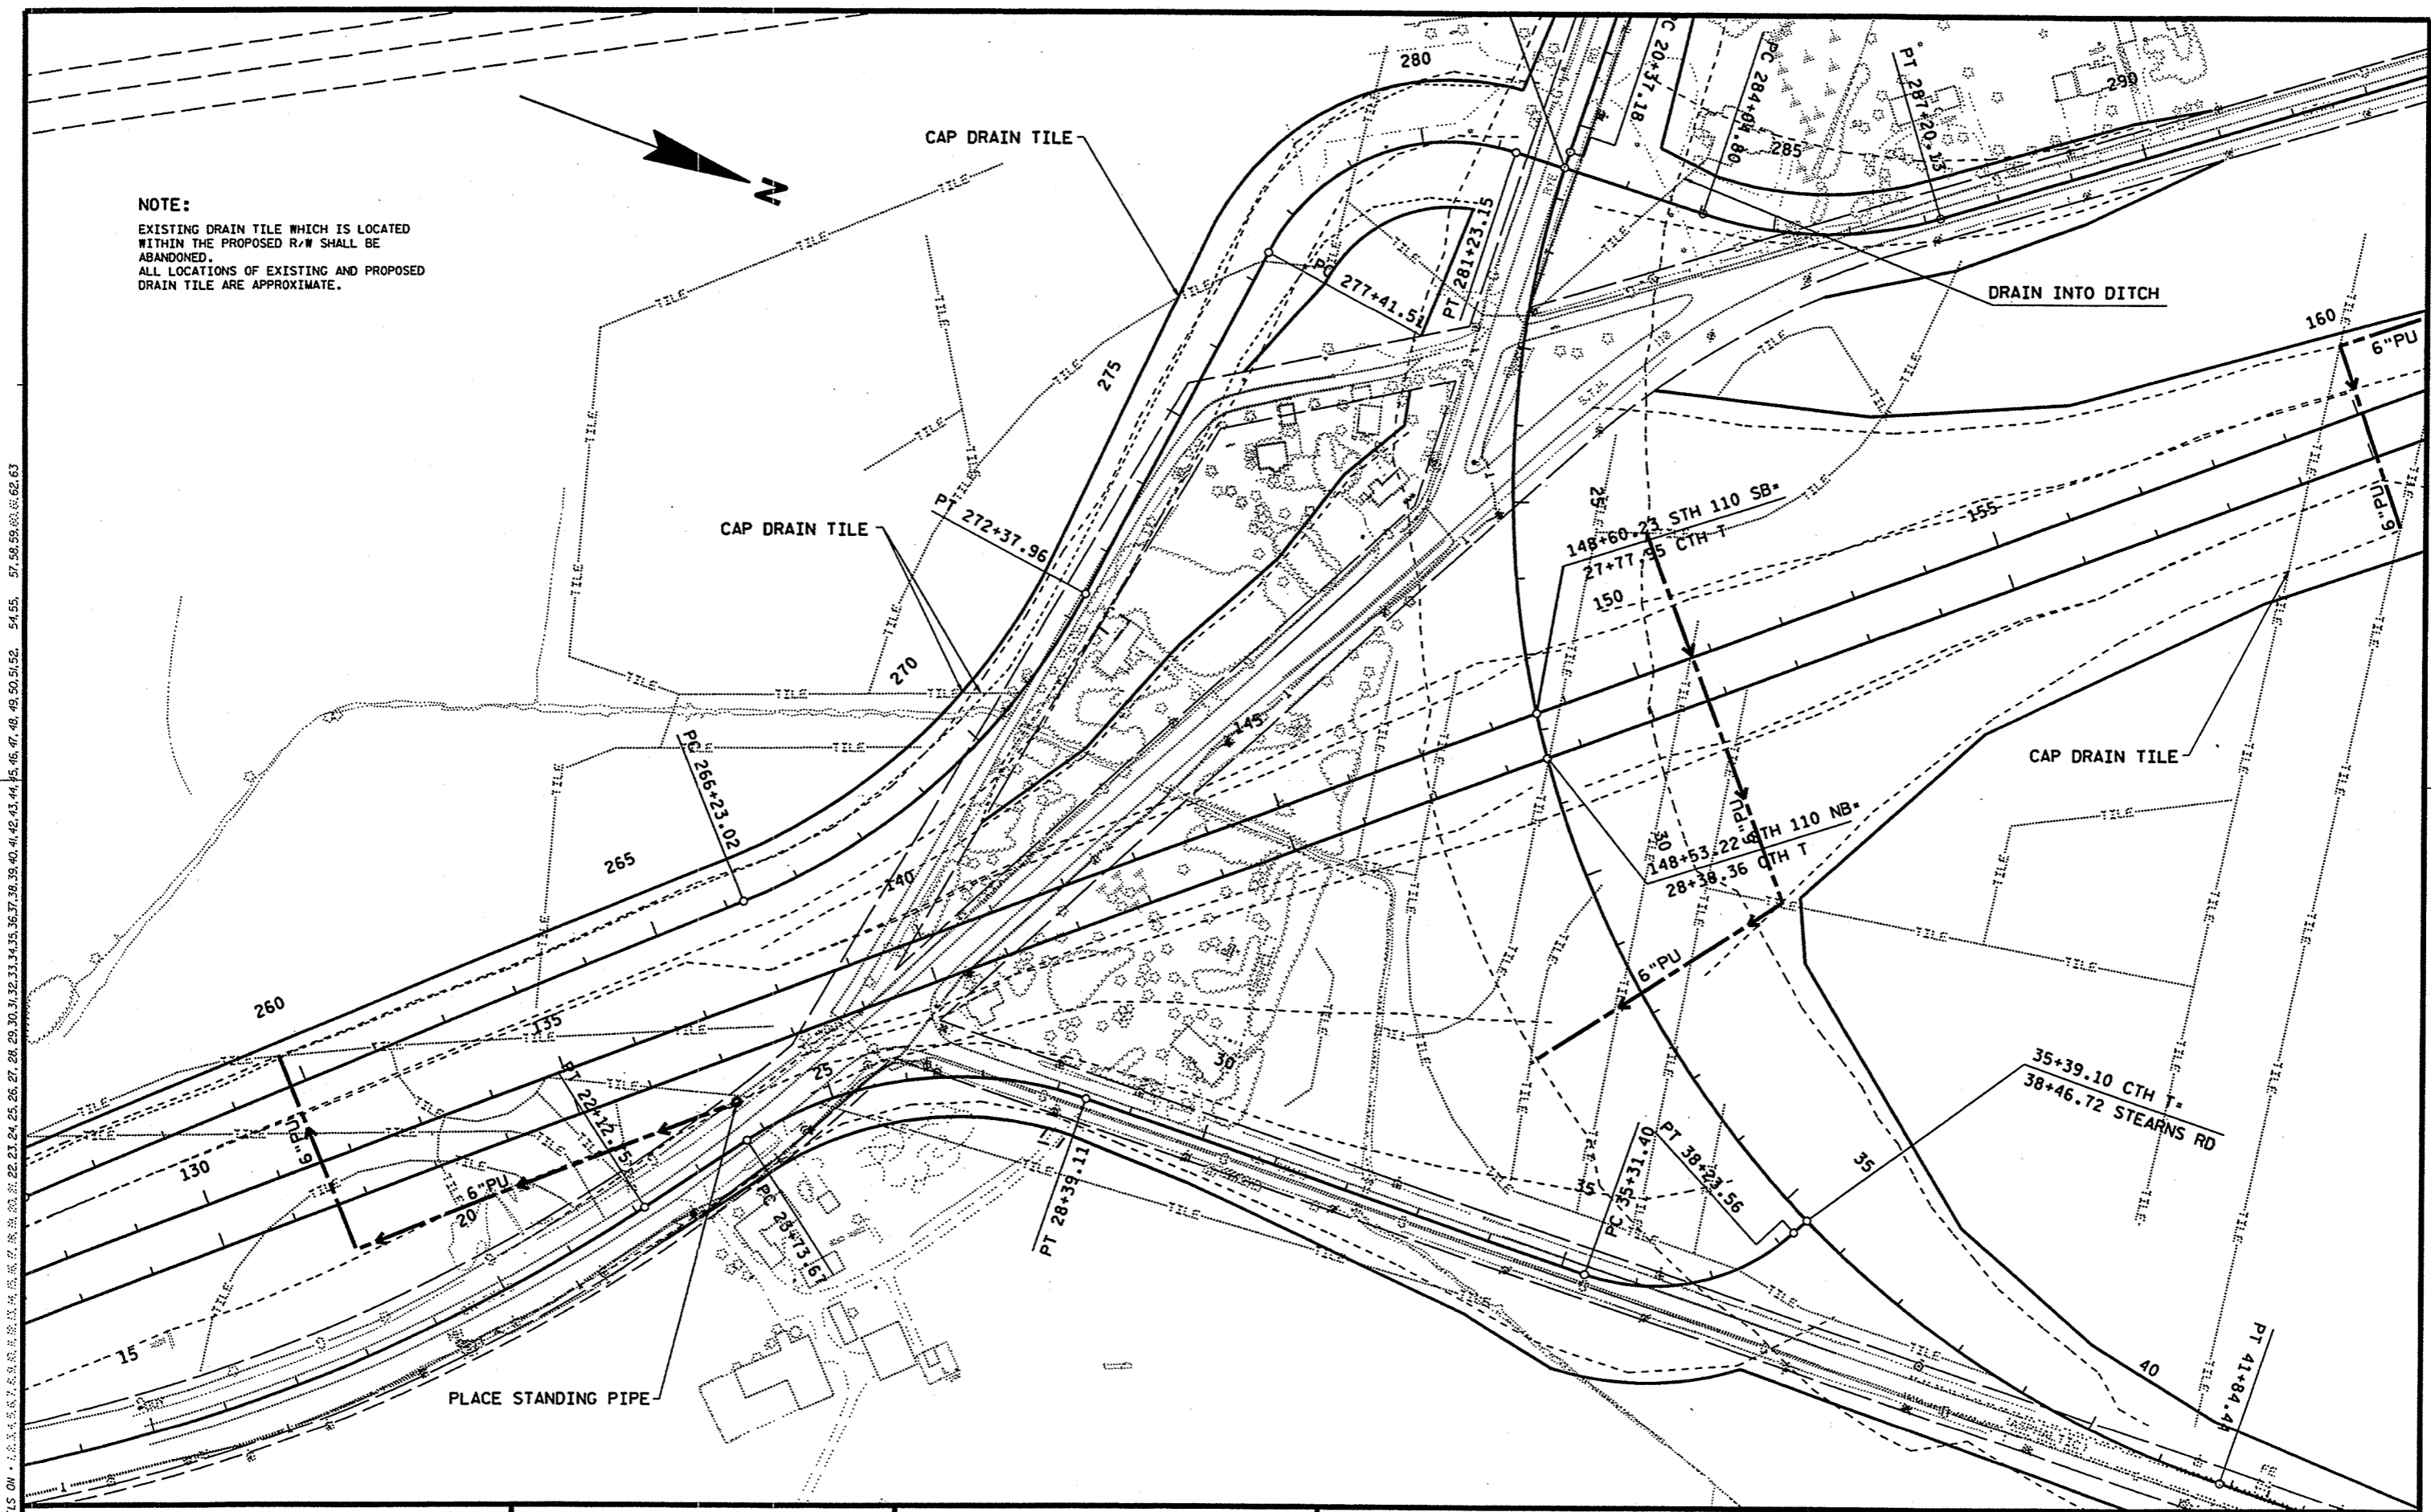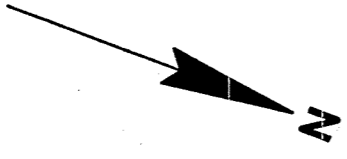


LEVELS ON - 1.2.3.4.5.6.7.8.9.10.11.12.13.14.15.16.17.18.19.20.21.22.23.24.25.26.27.28.29.30.31.32.33.34.35.36.37.38.39.40.41.42.43.44.45.46.47.48.49.50.51.52. 54.55. 57.58.59.60.61.62.63

STATE PROJECT NUMBER: 6200-05-71	HWY: STH 110	COUNTY: WINNEBAGO	CONSTRUCTION DETAIL - DRAIN TILE	SCALE, FEET	SHEET NO: 2.62 E
----------------------------------	--------------	-------------------	----------------------------------	-------------	------------------

FILE NAME : F:\d3_620005\224.dgn PLOT DATE : 29-JUN-2001 09:00 ORG DATE : 12-19-00 PLOT NAME : 224cd71 Originator : DISTRICT 3 PLOT SCALE : 200.700000:1.000000


LEVELS ON - 1.0, 1.5, 2.0, 99.5, 100.0

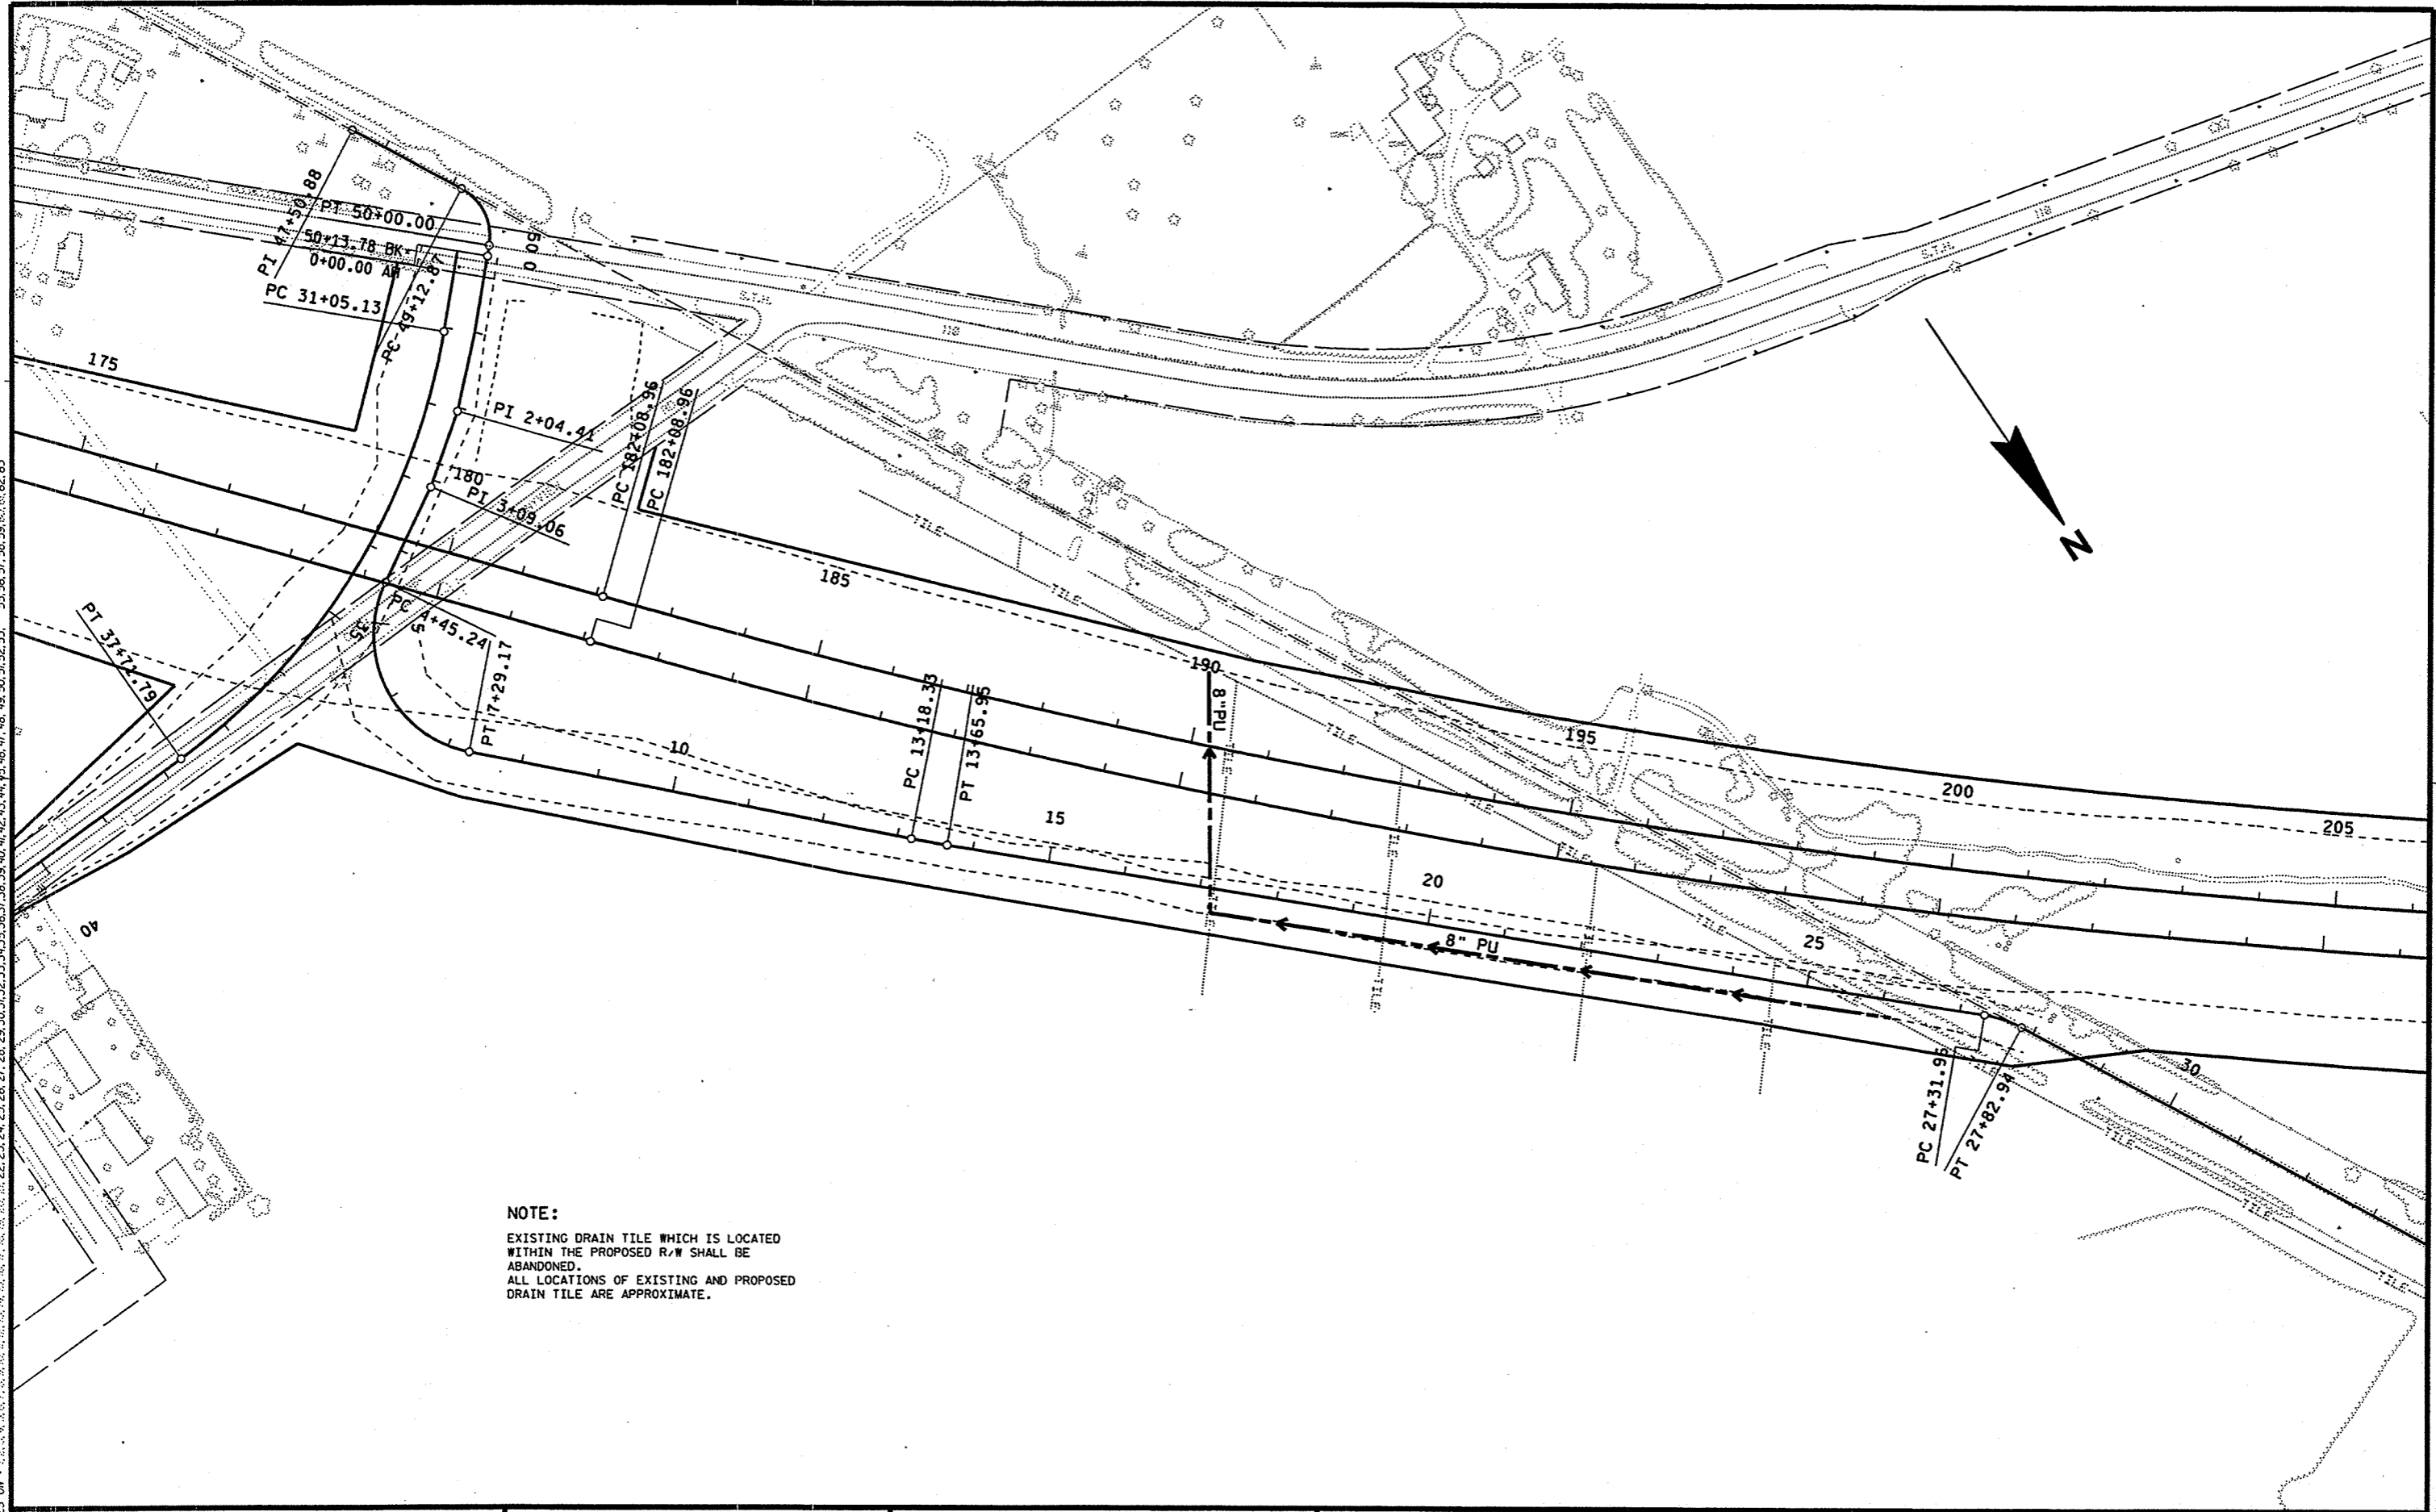

NOTE:
EXISTING DRAIN TILE WHICH IS LOCATED WITHIN THE PROPOSED R/W SHALL BE ABANDONED.
ALL LOCATIONS OF EXISTING AND PROPOSED DRAIN TILE ARE APPROXIMATE.

NOTE:
 EXISTING DRAIN TILE WHICH IS LOCATED
 WITHIN THE PROPOSED R/W SHALL BE
 ABANDONED.
 ALL LOCATIONS OF EXISTING AND PROPOSED
 DRAIN TILE ARE APPROXIMATE.

LEVELS ON - 1.0, 2.0, 3.0, 62.0, 63.0

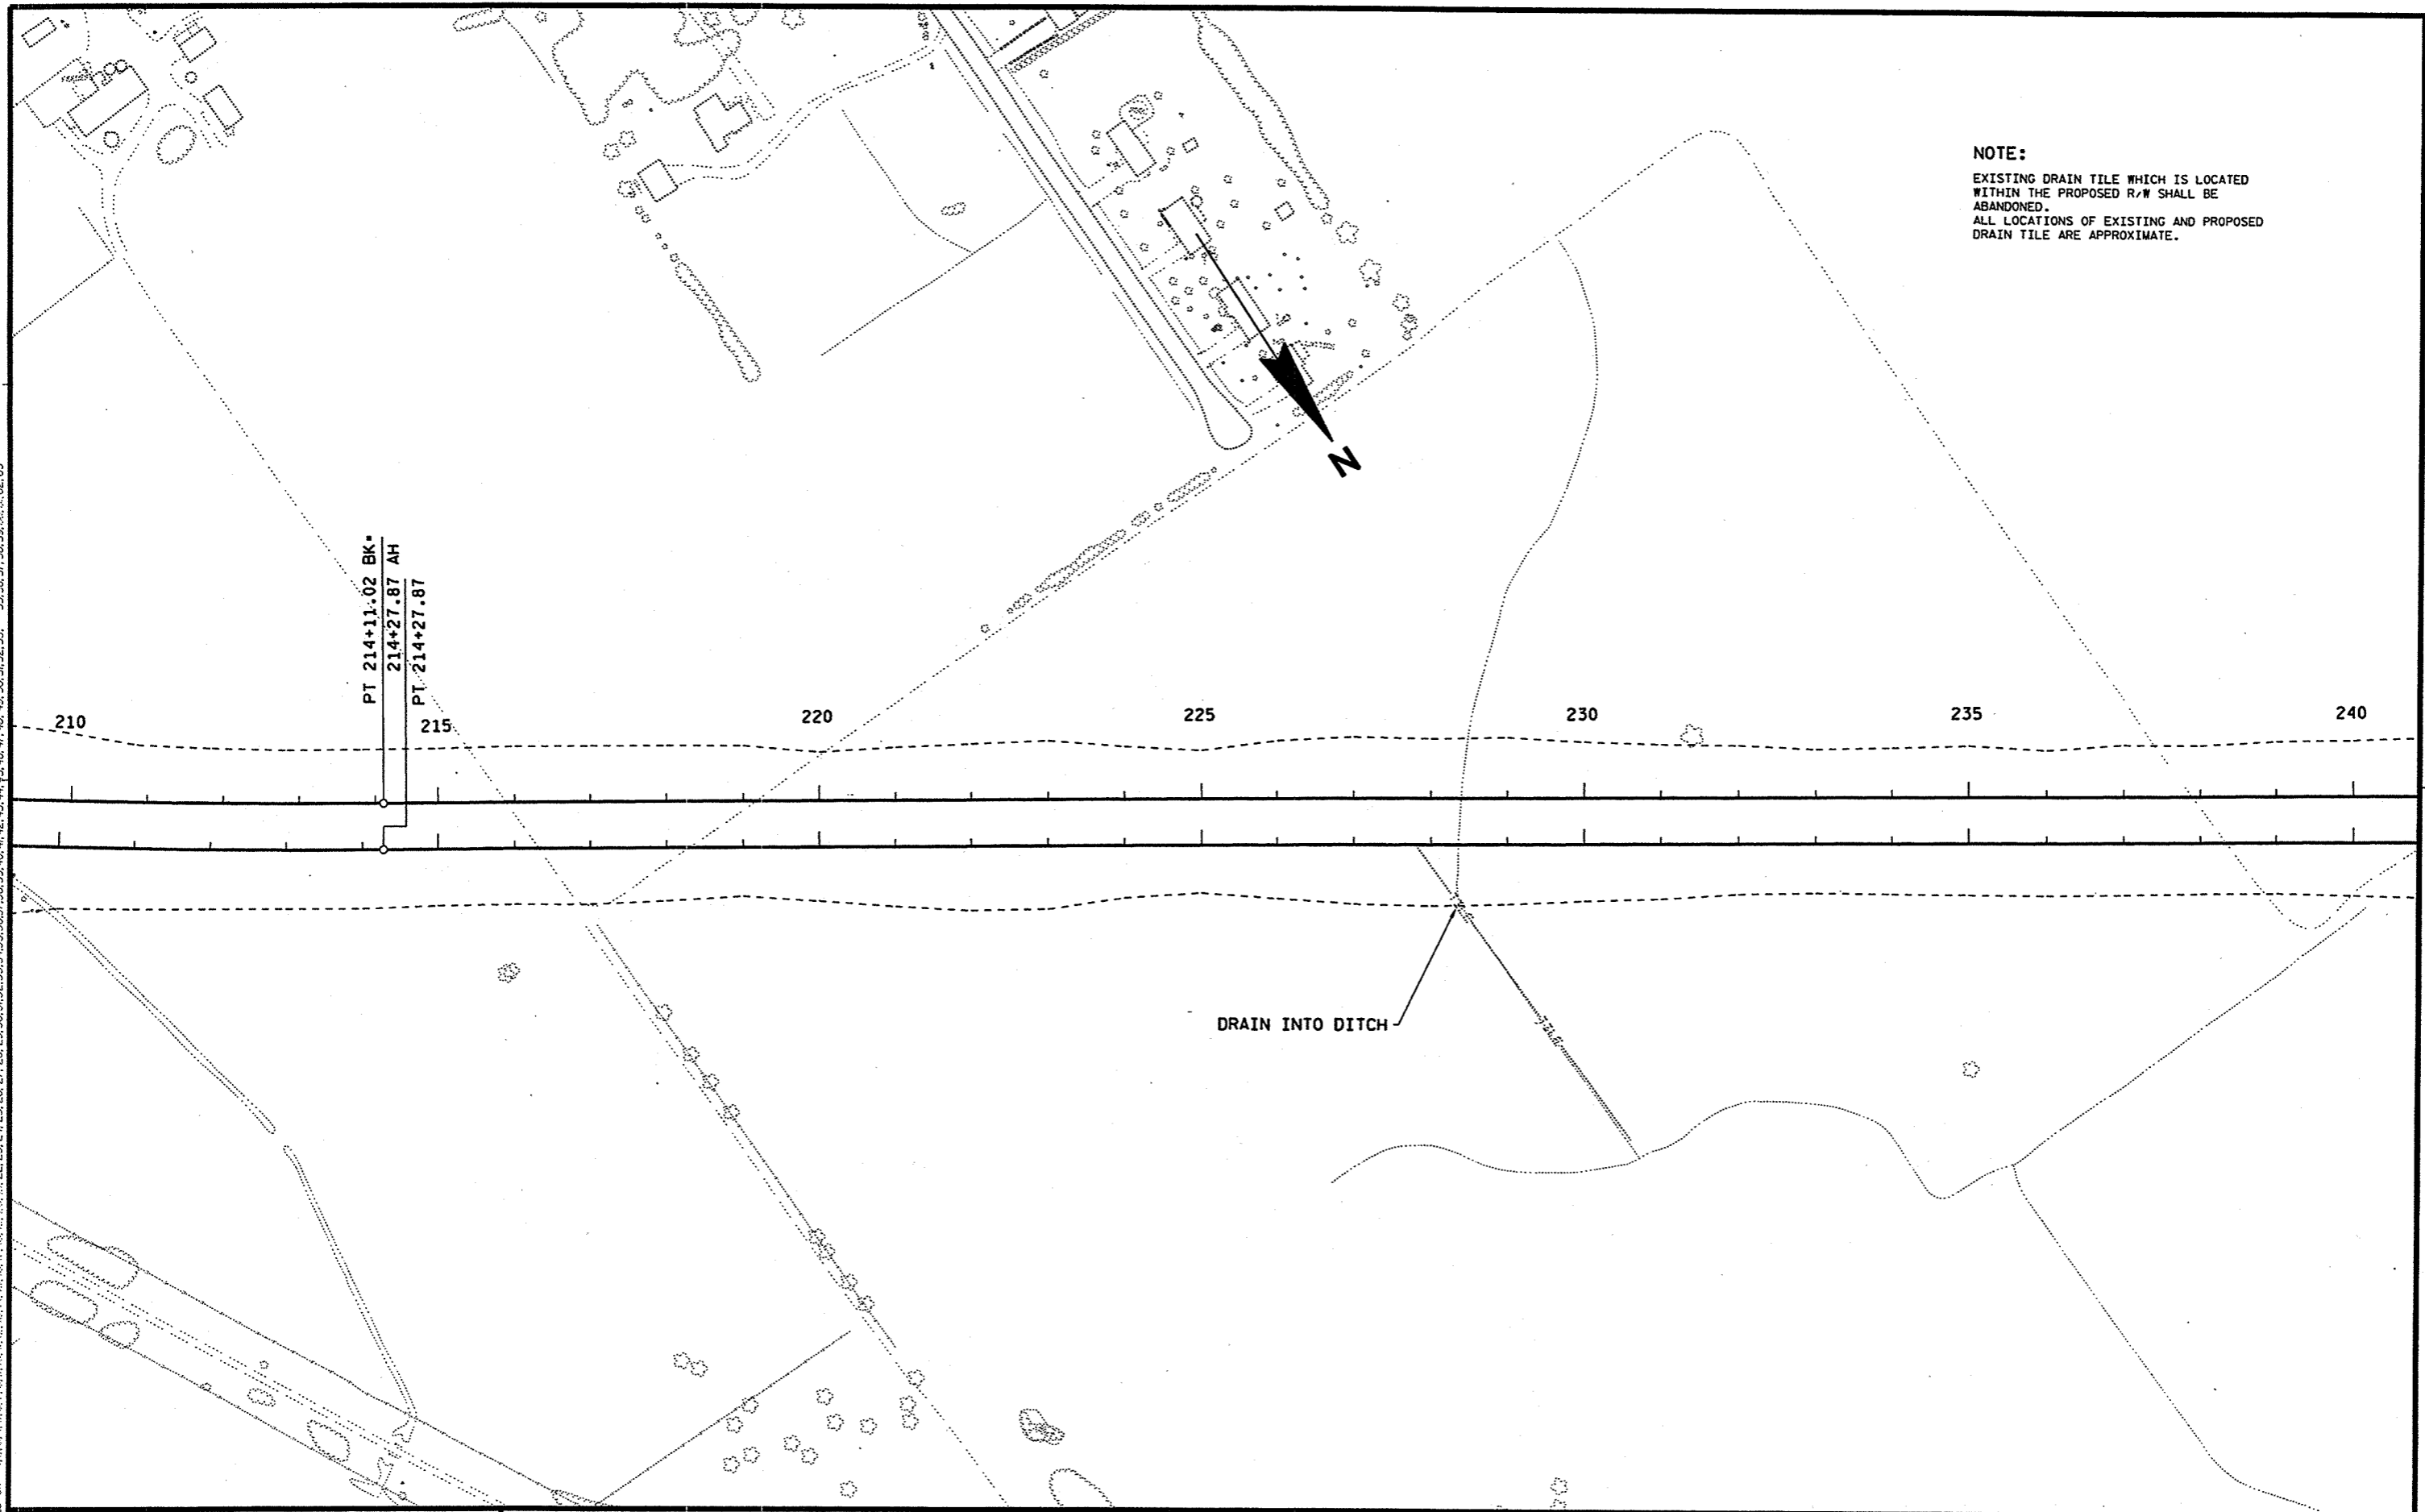


STATE PROJECT NUMBER: 6200-05-71	HWY: STH 110	COUNTY: WINNEBAGO	CONSTRUCTION DETAIL - DRAIN TILE	SCALE, FEET	SHEET NO: 264 E
----------------------------------	--------------	-------------------	----------------------------------	-------------	-----------------

FILE NAME : F:\d3_620005\224.dgn PLOT DATE: 21-MAY-2001 11:03 ORG DATE : 12-19-00 PLOT NAME : 224cd Originator : DISTRICT 3 PLOT SCALE : 200.700000:1.000000

NOTE:

EXISTING DRAIN TILE WHICH IS LOCATED
WITHIN THE PROPOSED R/W SHALL BE
ABANDONED.
ALL LOCATIONS OF EXISTING AND PROPOSED
DRAIN TILE ARE APPROXIMATE.


LEVELS ON : 1.0 3.0 4.0 5.0 63.0

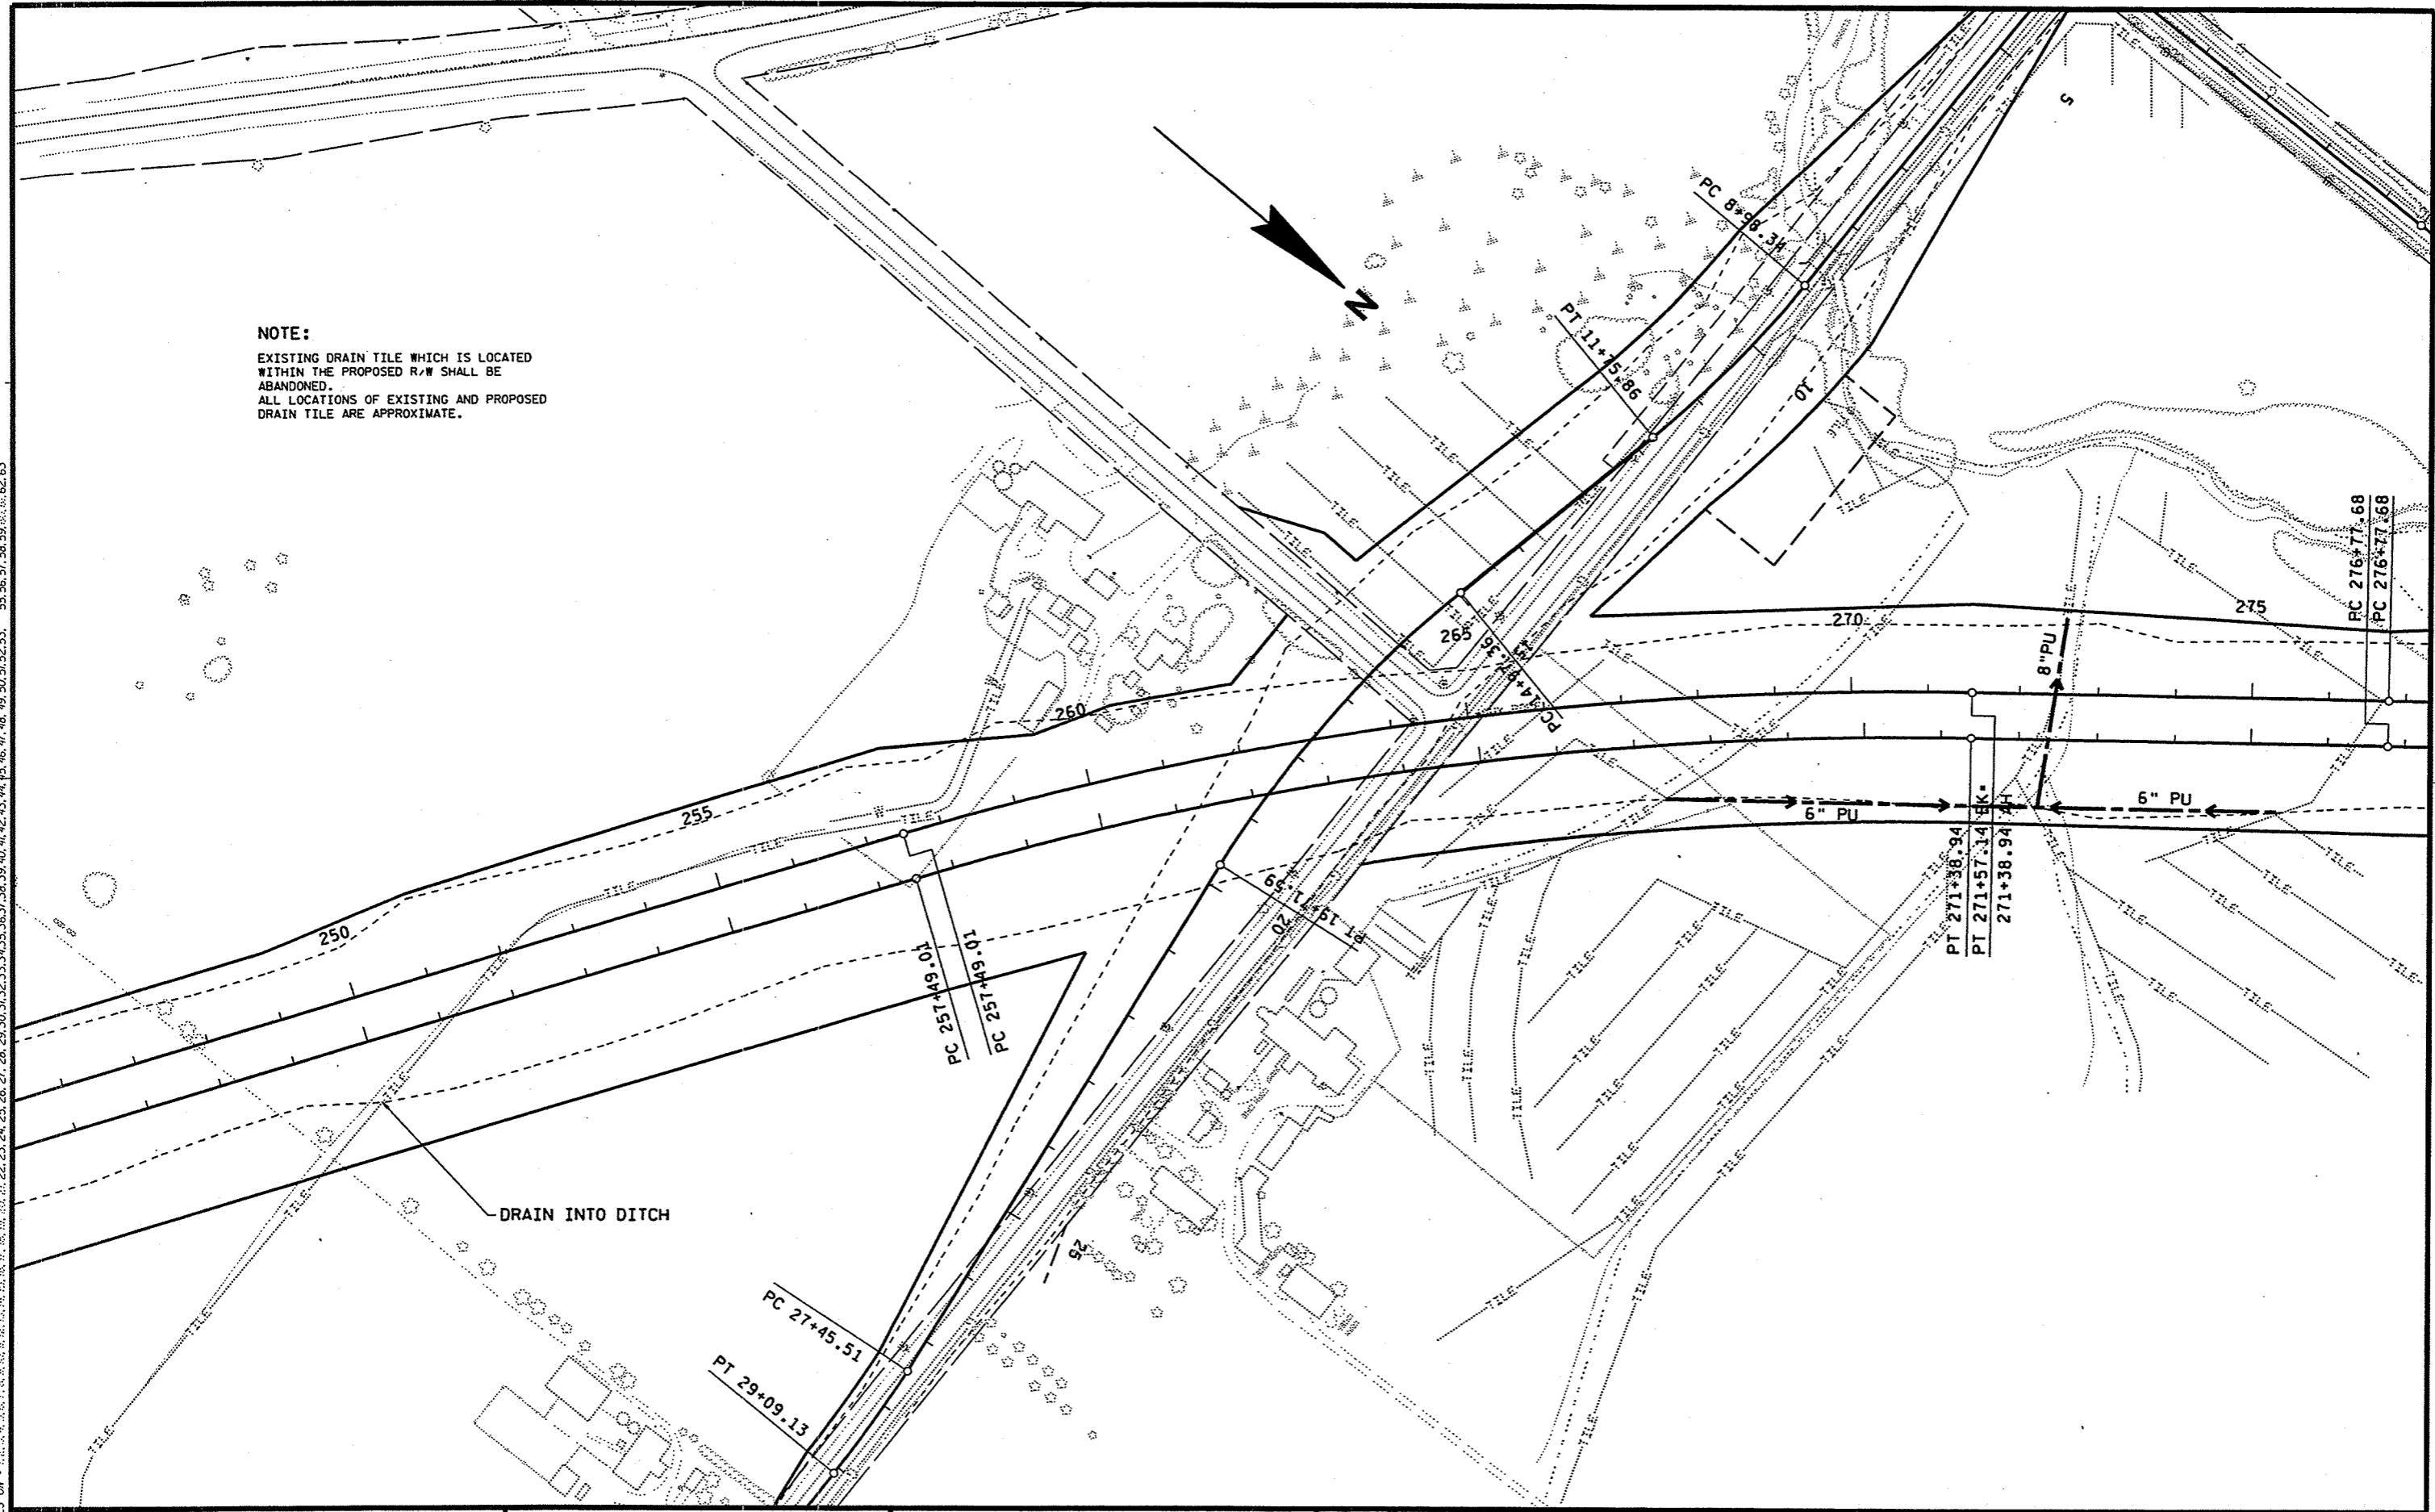

STATE PROJECT NUMBER: 6200-05-71 | HWY: STH 110 | COUNTY: WINNEBAGO | CONSTRUCTION DETAIL - DRAIN TILE | SCALE, FEET 0 100 200 | SHEET NO: 2.65 E

FILE NAME : F:\d3_620005+224.dgn | PLOT DATE: 21-MAY-2001 11:03 | ORG DATE : 12-19-00 | PLOT NAME : 224dd | Originator : DISTRICT 3 | PLOT SCALE : 200.700000:1.000000 | WSDOT/CADD SHEET 42


LEVELS ON - 1.2.3.4.5.6.7.8.9.10.11.12.13.14.15.16.17.18.19.20.21.22.23.24.25.26.27.28.29.30.31.32.33.34.35.36.37.38.39.40.41.42.43.44.45.46.47.48.49.50.51.52.53. 55.56.57.58.59.60.61.62.63

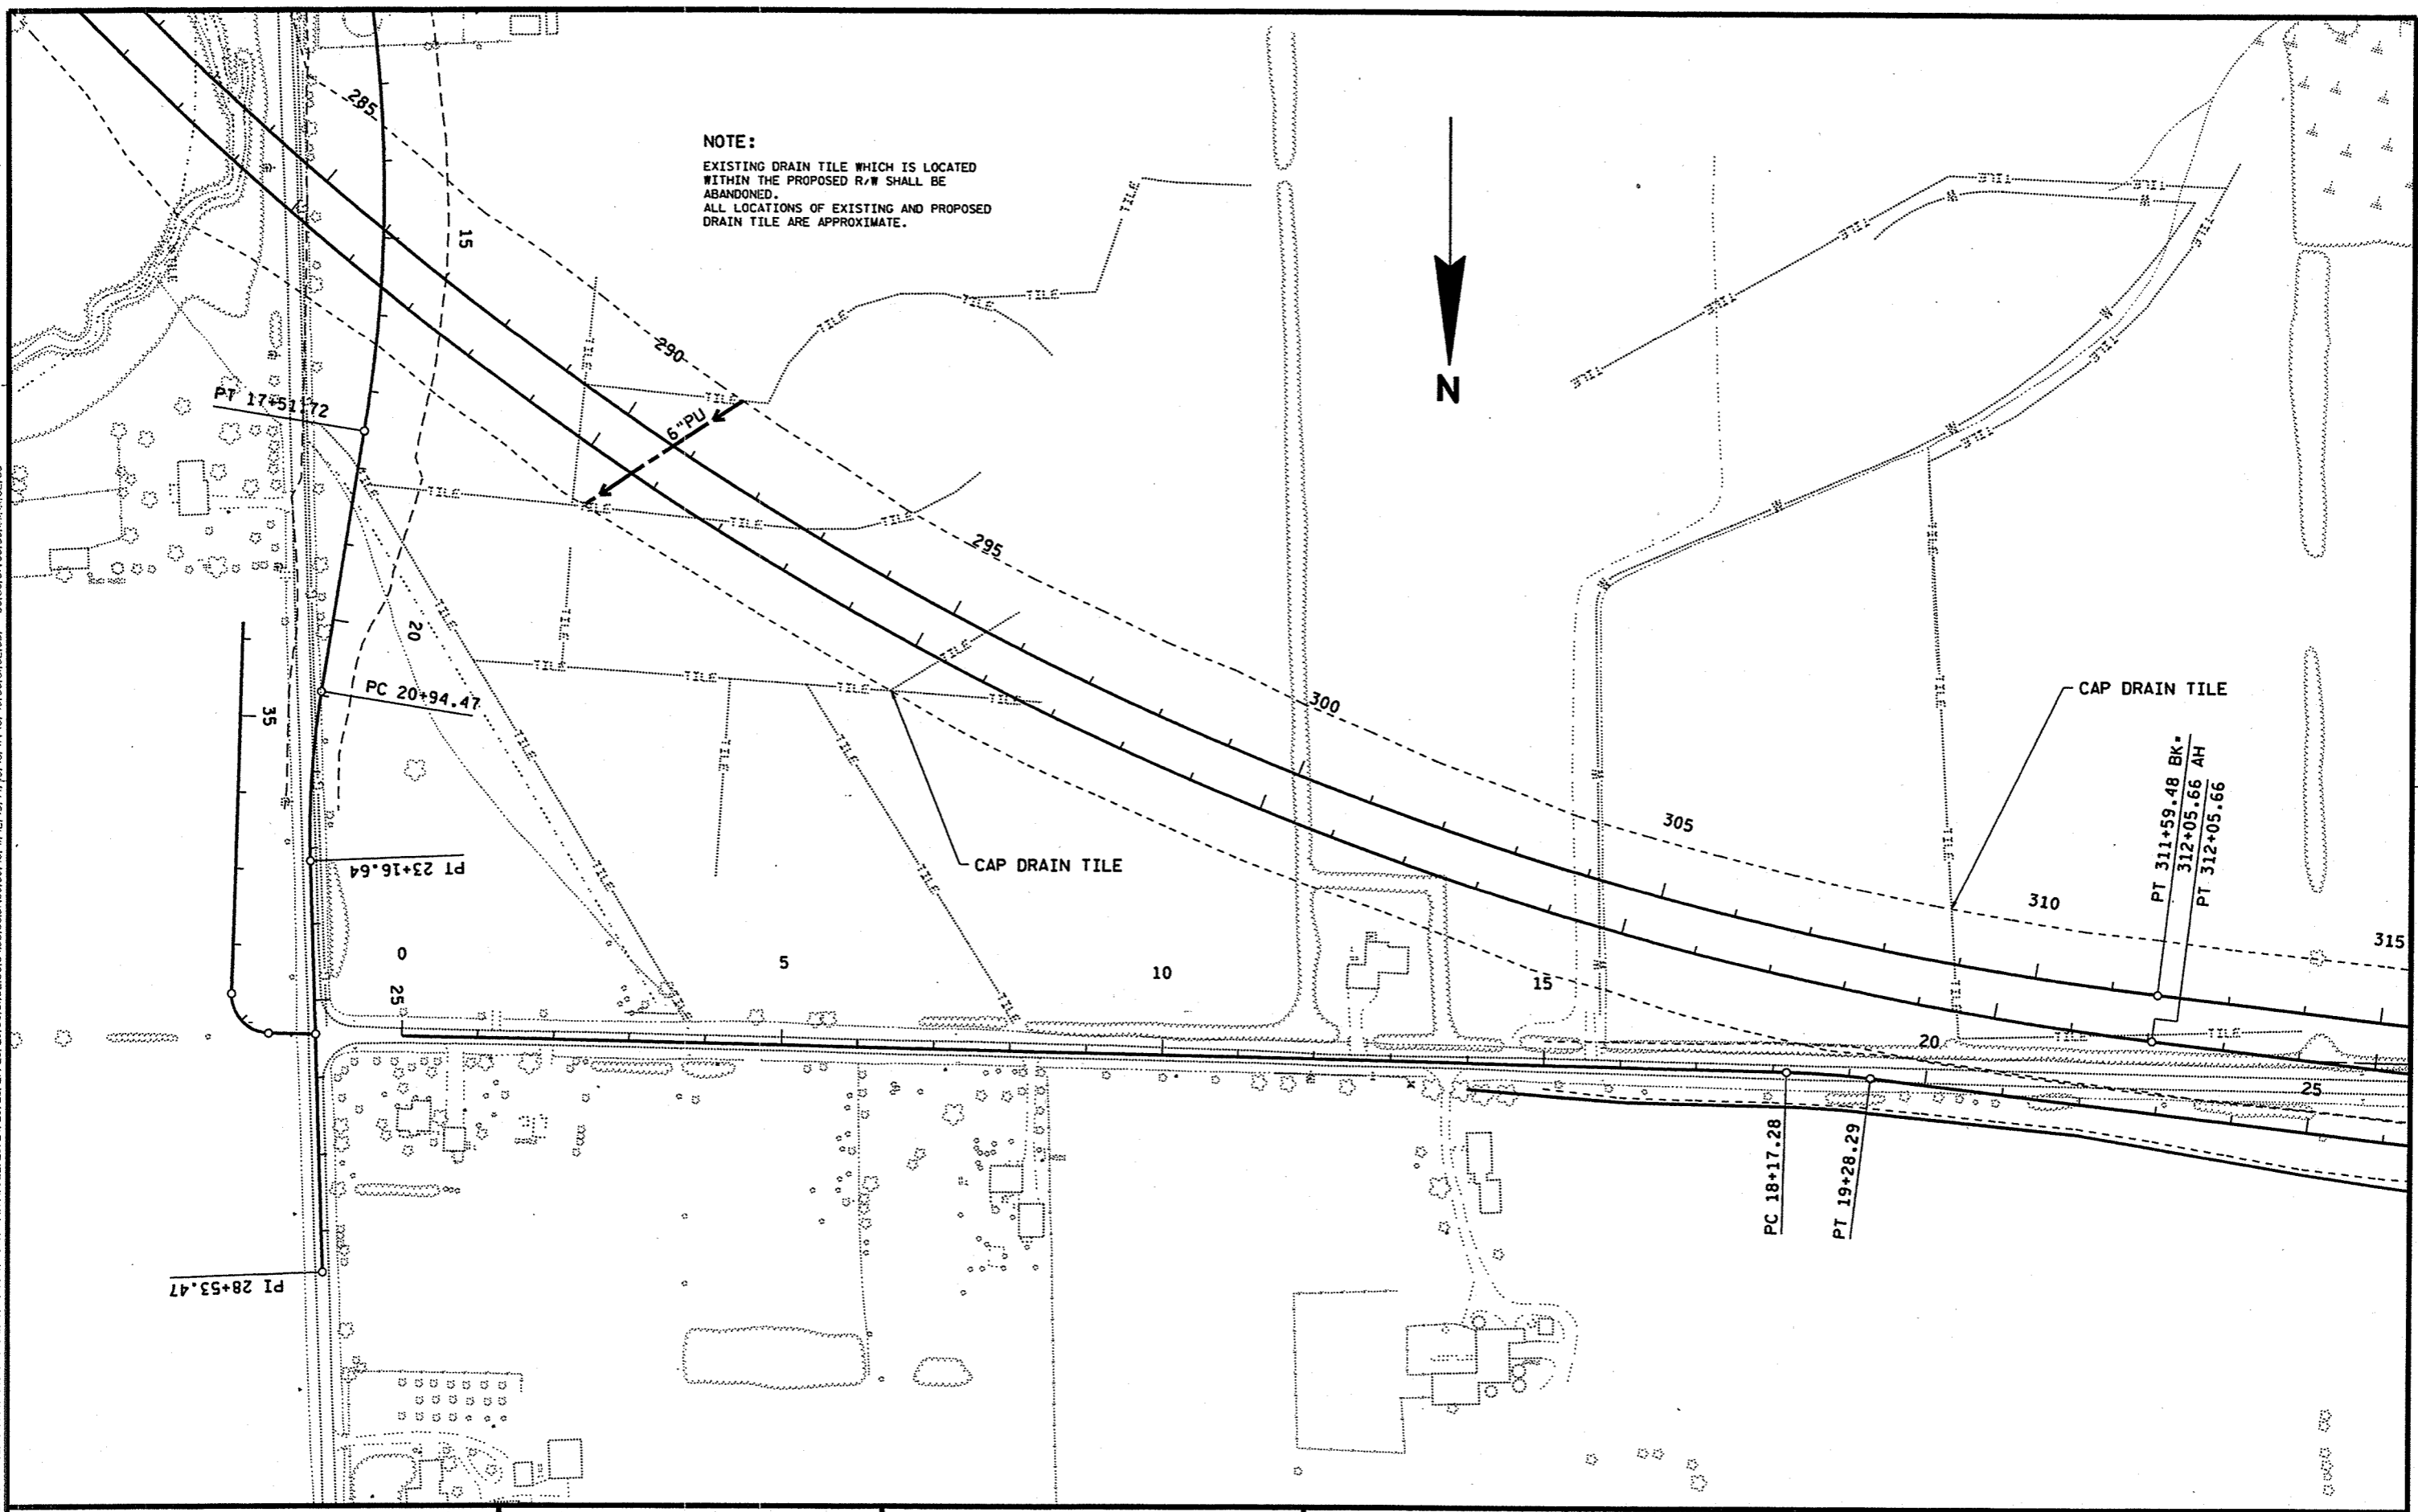

NOTE:
 EXISTING DRAIN TILE WHICH IS LOCATED
 WITHIN THE PROPOSED R/W SHALL BE
 ABANDONED.
 ALL LOCATIONS OF EXISTING AND PROPOSED
 DRAIN TILE ARE APPROXIMATE.



LEVELS ON * 1.0 2.0 3.0 63.0

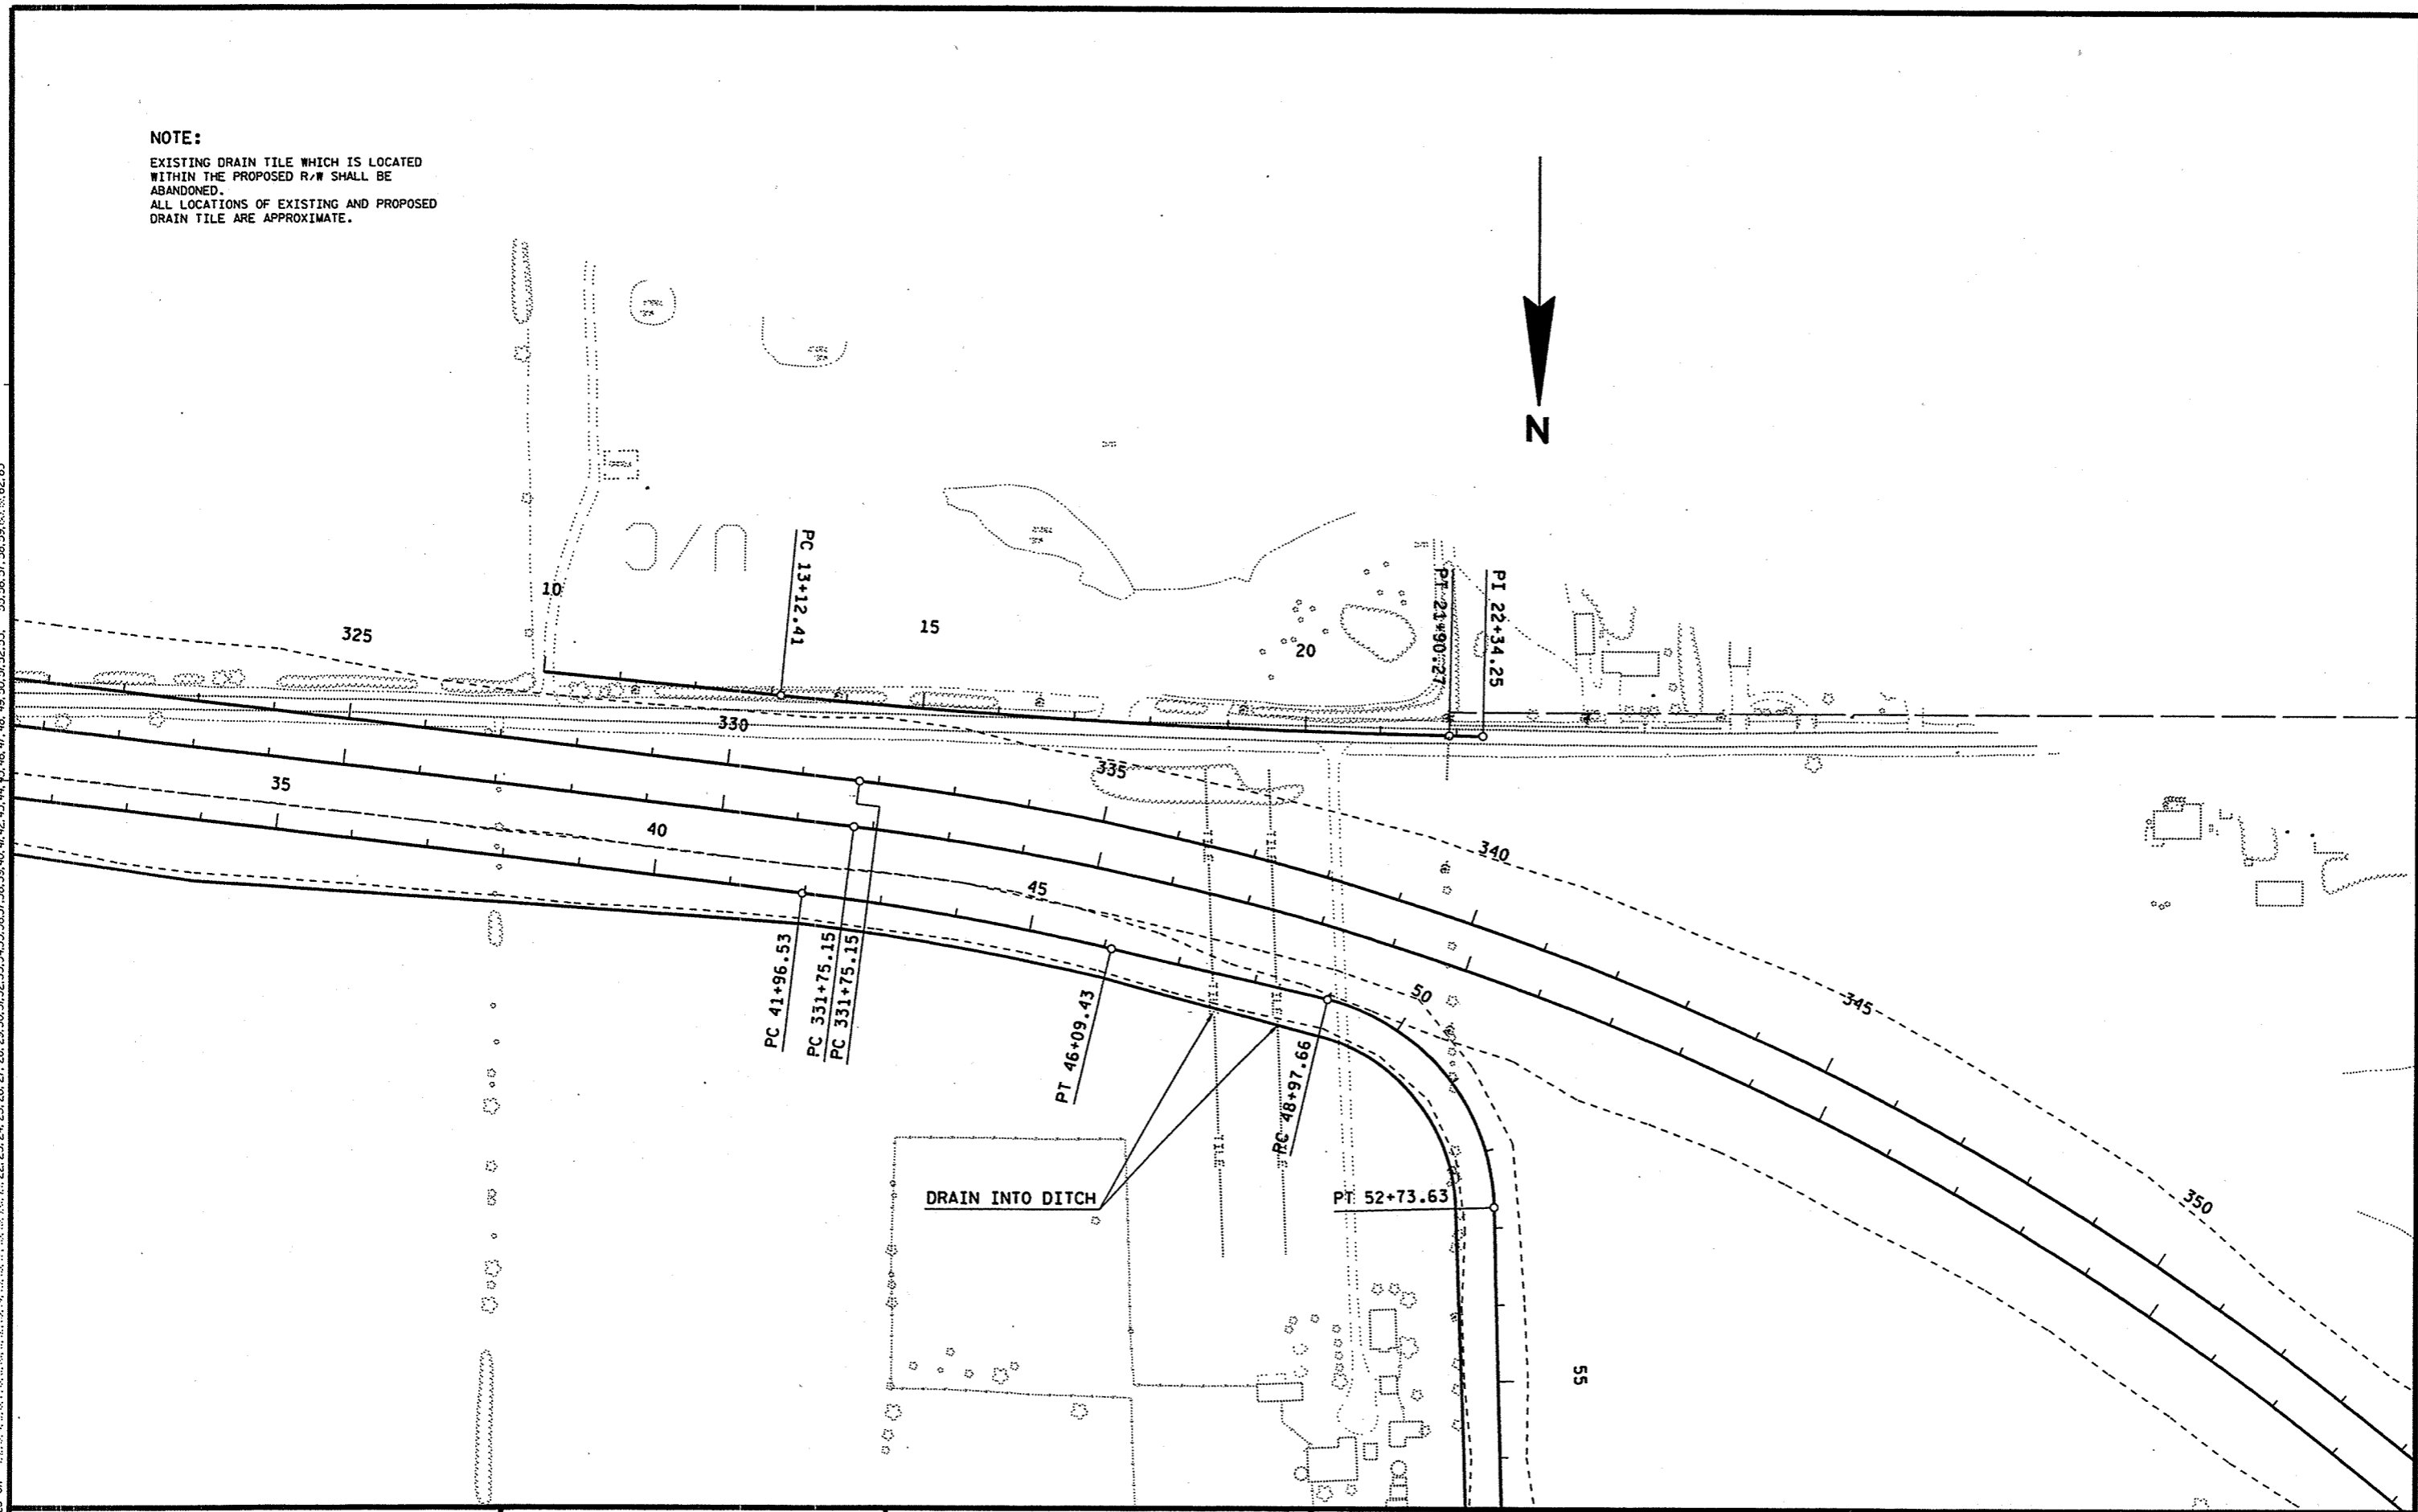

STATE PROJECT NUMBER: 6200-05-71	HWY: STH 110	COUNTY: WINNEBAGO	CONSTRUCTION DETAIL - DRAIN TILE	SCALE, FEET	SHEET NO: 2.67 E
----------------------------------	--------------	-------------------	----------------------------------	-------------	------------------



FILE NAME : F:\d3_620005\224.dgn PLOT DATE: 21-MAY-2001 11:04 ORG DATE : 4-23-01 PLOT NAME : 224fd Originator : DISTRICT 3 PLOT SCALE : 200.700000:1.000000

LEVELS ON - 1.0, 3.0, 3.0, 7.0, 8.0, 8.0, 13.0, 14.0, 15.0, 15.0, 17.0, 18.0, 18.0, 22.0, 23.0, 24.0, 60.0, 62.0, 63.0

NOTE:
WISDOT DISTRICT 3 ELECTRICAL UNIT WILL PROVIDE AND INSTALL THE ELECTRICAL SERVICE AND CONTROL STATION.

LEGEND

- PULL BOX, 24" X 36"
- ⊠ CONTROL STATION
- 2" CONDUIT, NON-METALLIC
- LUMINAIRE


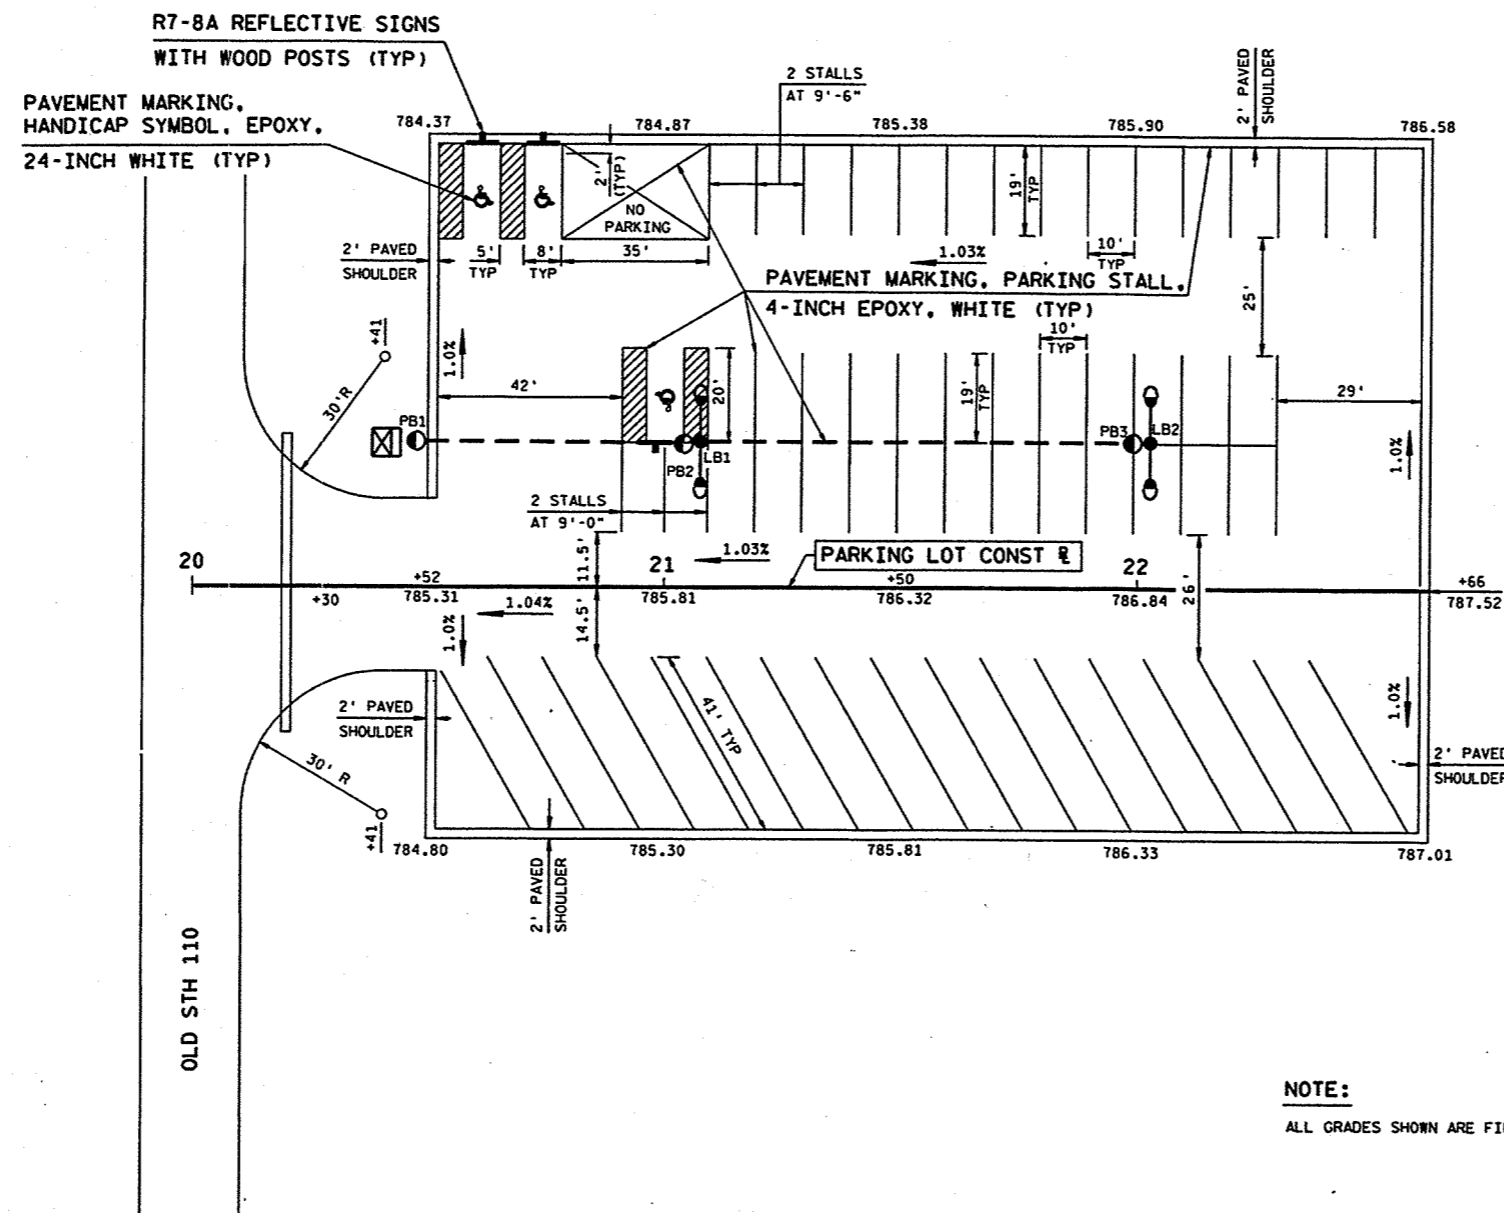
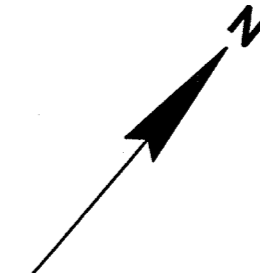


NOTE:
ALL GRADES SHOWN ARE FINISHED GRADES





LAYOUT, PAVEMENT MARKING AND LIGHTING FOR PARKING LOT
AT RECREATION TRAIL

**OLD STH 110 PARKING LOT
WINNEBAGO CO**

SIGNAL NO.	L561
DESIGNED BY	RJS
DATE	SHEET NO. OF

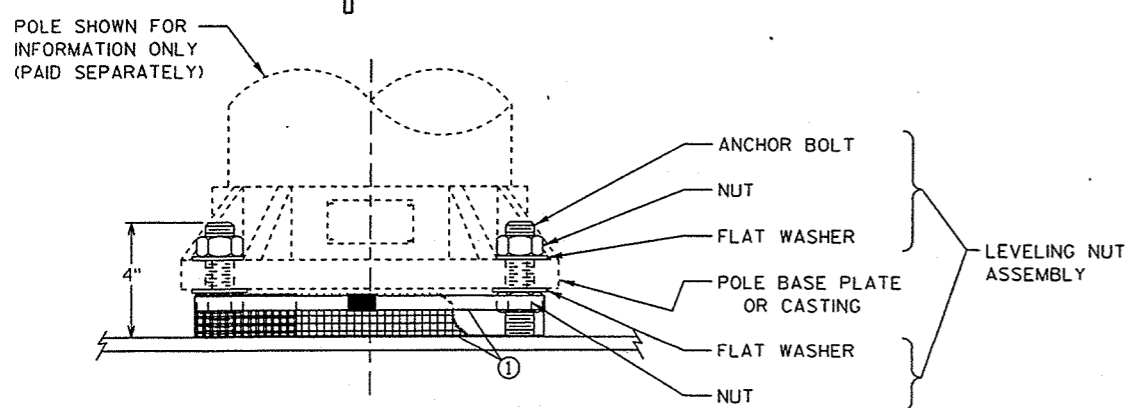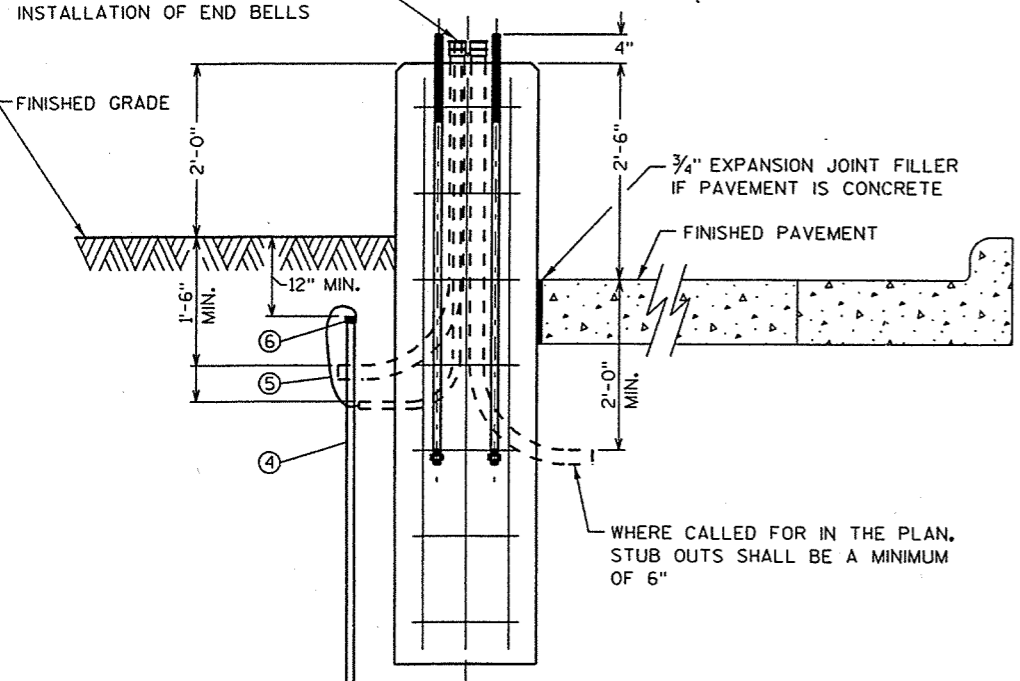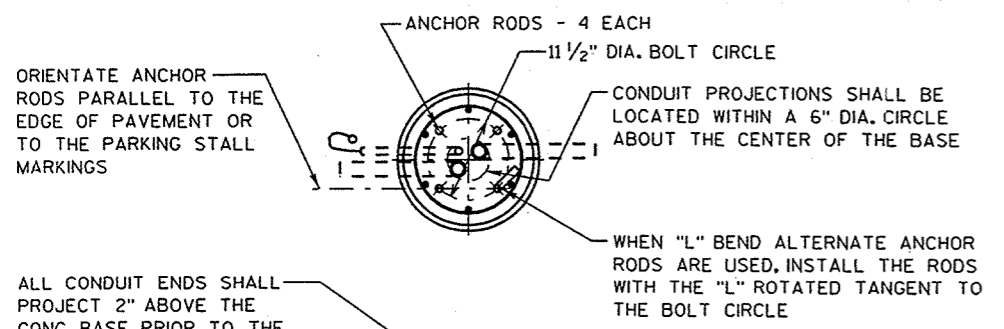

RAT SCREEN & LEVELING NUT DETAIL
(RAT SCREEN AND BANDING INCIDENTAL TO POLE, LEVELING NUT ASSEMBLIES INCIDENTAL TO CONCRETE BASE)

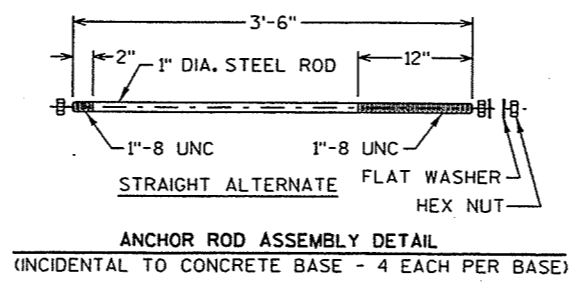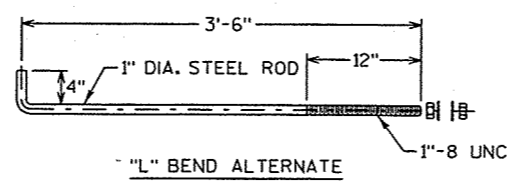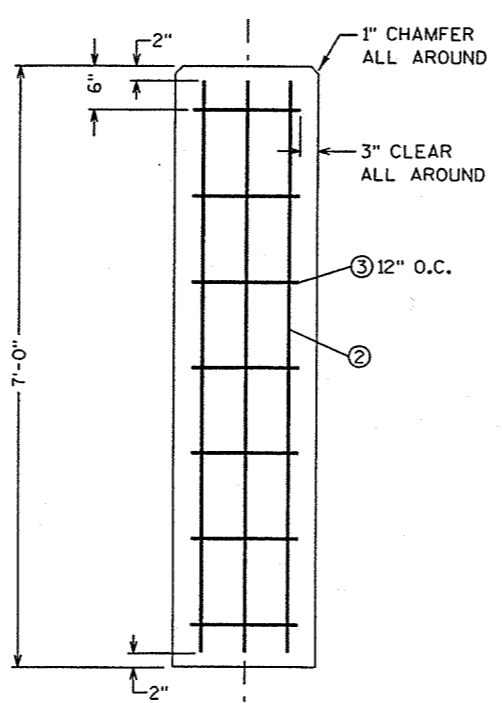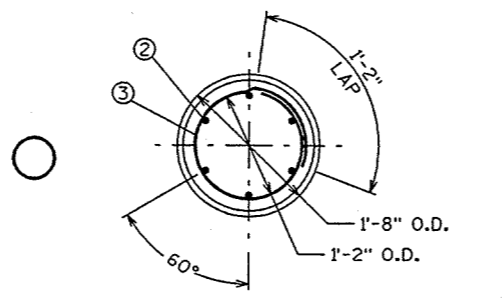

ANCHOR ROD ASSEMBLY DETAIL
(INCIDENTAL TO CONCRETE BASE - 4 EACH PER BASE)

GENERAL NOTES:

DETAILS OF CONSTRUCTION, MATERIALS AND WORKMANSHIP NOT SHOWN ON THIS DRAWING SHALL CONFORM TO THE PERTINENT REQUIREMENTS OF SECTION 654 OF THE STANDARD SPECIFICATIONS AND THE SPECIAL PROVISIONS.

CONCRETE BASES SHALL BE EXCAVATED BY USE OF A CIRCULAR AUGER. FORMING SHALL BE LIMITED TO 6" BELOW THE EXISTING GRADE. UNLESS LOOSE SOIL OR FILL IS ENCOUNTERED. FORMING SHALL BE STRIPPED AFTER CONCRETE HAS SET.

IF A BASE REQUIRES A DEEP FORM BECAUSE OF LOOSE SOIL OR FILL, THE FORM SHALL BE STRIPPED BEFORE BACK FILLING AROUND THE BASE. BACKFILL SHALL BE TAMPED TIGHT AGAINST THE STRIPPED CONCRETE BASE IN LAYERS OF 6" OR LESS.

TOP SURFACE OF CONCRETE BASES SHALL BE TROWEL FINISHED AND LEVEL.

THE NUMBER, SIZE, AND LOCATION OF LINE AND LOAD SIDE CONDUITS WILL BE SHOWN IN THE PLANS. NOTE, SOME BASES MAY HAVE MORE THAN ONE LOAD SIDE CONDUIT REQUIRED (SEE THE PLAN). ALL BASES SHALL HAVE A 1" CONDUIT FOR THE EQUIPMENT GROUNDING CONDUCTOR.

CONDUIT ENDS PROJECTING ABOVE THE BASE SHALL BE SUITABLY PLUGGED BEFORE THE CONCRETE IS POURED, TO PREVENT DEBRIS CONTAMINATION OF THE RACEWAY.

ENDS OF CONDUIT INSTALLED BELOW GRADE FOR FUTURE USE (STUB OUTS) SHALL BE PLUGGED.

THE EQUIPMENT GROUNDING CONDUCTOR SHALL BE INSTALLED WITH A MINIMUM OF 6'-6" OF SLACK MEASURED FROM THE TOP OF THE CONCRETE BASE TO THE END OF THE CONDUCTOR. THE SLACK SHALL BE NEATLY TIED IN A COIL THAT FITS INSIDE THE ANCHOR BOLT CIRCLE UNTIL THE LIGHT POLE IS INSTALLED. GREAT CARE SHALL BE EXERCISED TO AVOID DAMAGE TO THE CONDUCTOR.

THE MINIMUM DEPTH OF CONDUIT EXITING THE CONCRETE BASE AND INSTALLED BELOW THE TRAVELED WAY SHALL BE 24". THE MINIMUM DEPTH OF CONDUIT EXITING THE CONCRETE BASE THAT IS NOT INSTALLED BELOW THE TRAVELED WAY SHALL BE 18". THE MAXIMUM DEPTH OF ALL CONDUIT SHALL BE 36". THE MAXIMUM DEPTH MAY ONLY BE EXCEEDED WITH THE WRITTEN APPROVAL OF THE ENGINEER.

ANCHOR RODS SHALL NOT BE WELDED TO THE BAR STEEL REINF. HOWEVER, TIE WIRES MAY BE USED.




BAR STEEL REINF. SHALL BE "COATED HIGH STRENGTH BAR STEEL REINFORCEMENT".

- ① STAINLESS STEEL MESH (RAT SCREEN) AND 3/4" STAINLESS STEEL BANDING
- ② NO. 6 BAR STEEL REINF., 6'-8" LONG (6 EACH)
- ③ NO. 4 BAR STEEL REINF., 5'-0" LONG (7 EACH)
- ④ 5/8" x 8'-0" COPPER CLAD EQUIPMENT GROUNDING ELECTRODE (GROUND ROD) TOP OF ROD 12" MIN. BELOW FINISHED GRADE OR FINISHED PAVEMENT.
- ⑤ A NO. 4 AWG, STRANDED COPPER GROUNDING CONDUCTOR SHALL BE EXOTHERMICALLY WELDED TO THE EQUIPMENT GROUNDING ELECTRODE (GROUNDING ROD)
- ⑥ EXOTHERMIC WELD (CAD WELD)

CONCRETE BASE, TYPE 5, SPECIAL
(1" ANCHOR RODS, 11.5" BOLT CIRCLE, 4" PROJECTION)

PLOTTED BY: \$USER\$
PLOT DATE: \$DATE\$
FILE NAME: D2-L-DETAIL/CBT5SP.DGN


LEVELS ON - 1, 2, 3, 62, 63

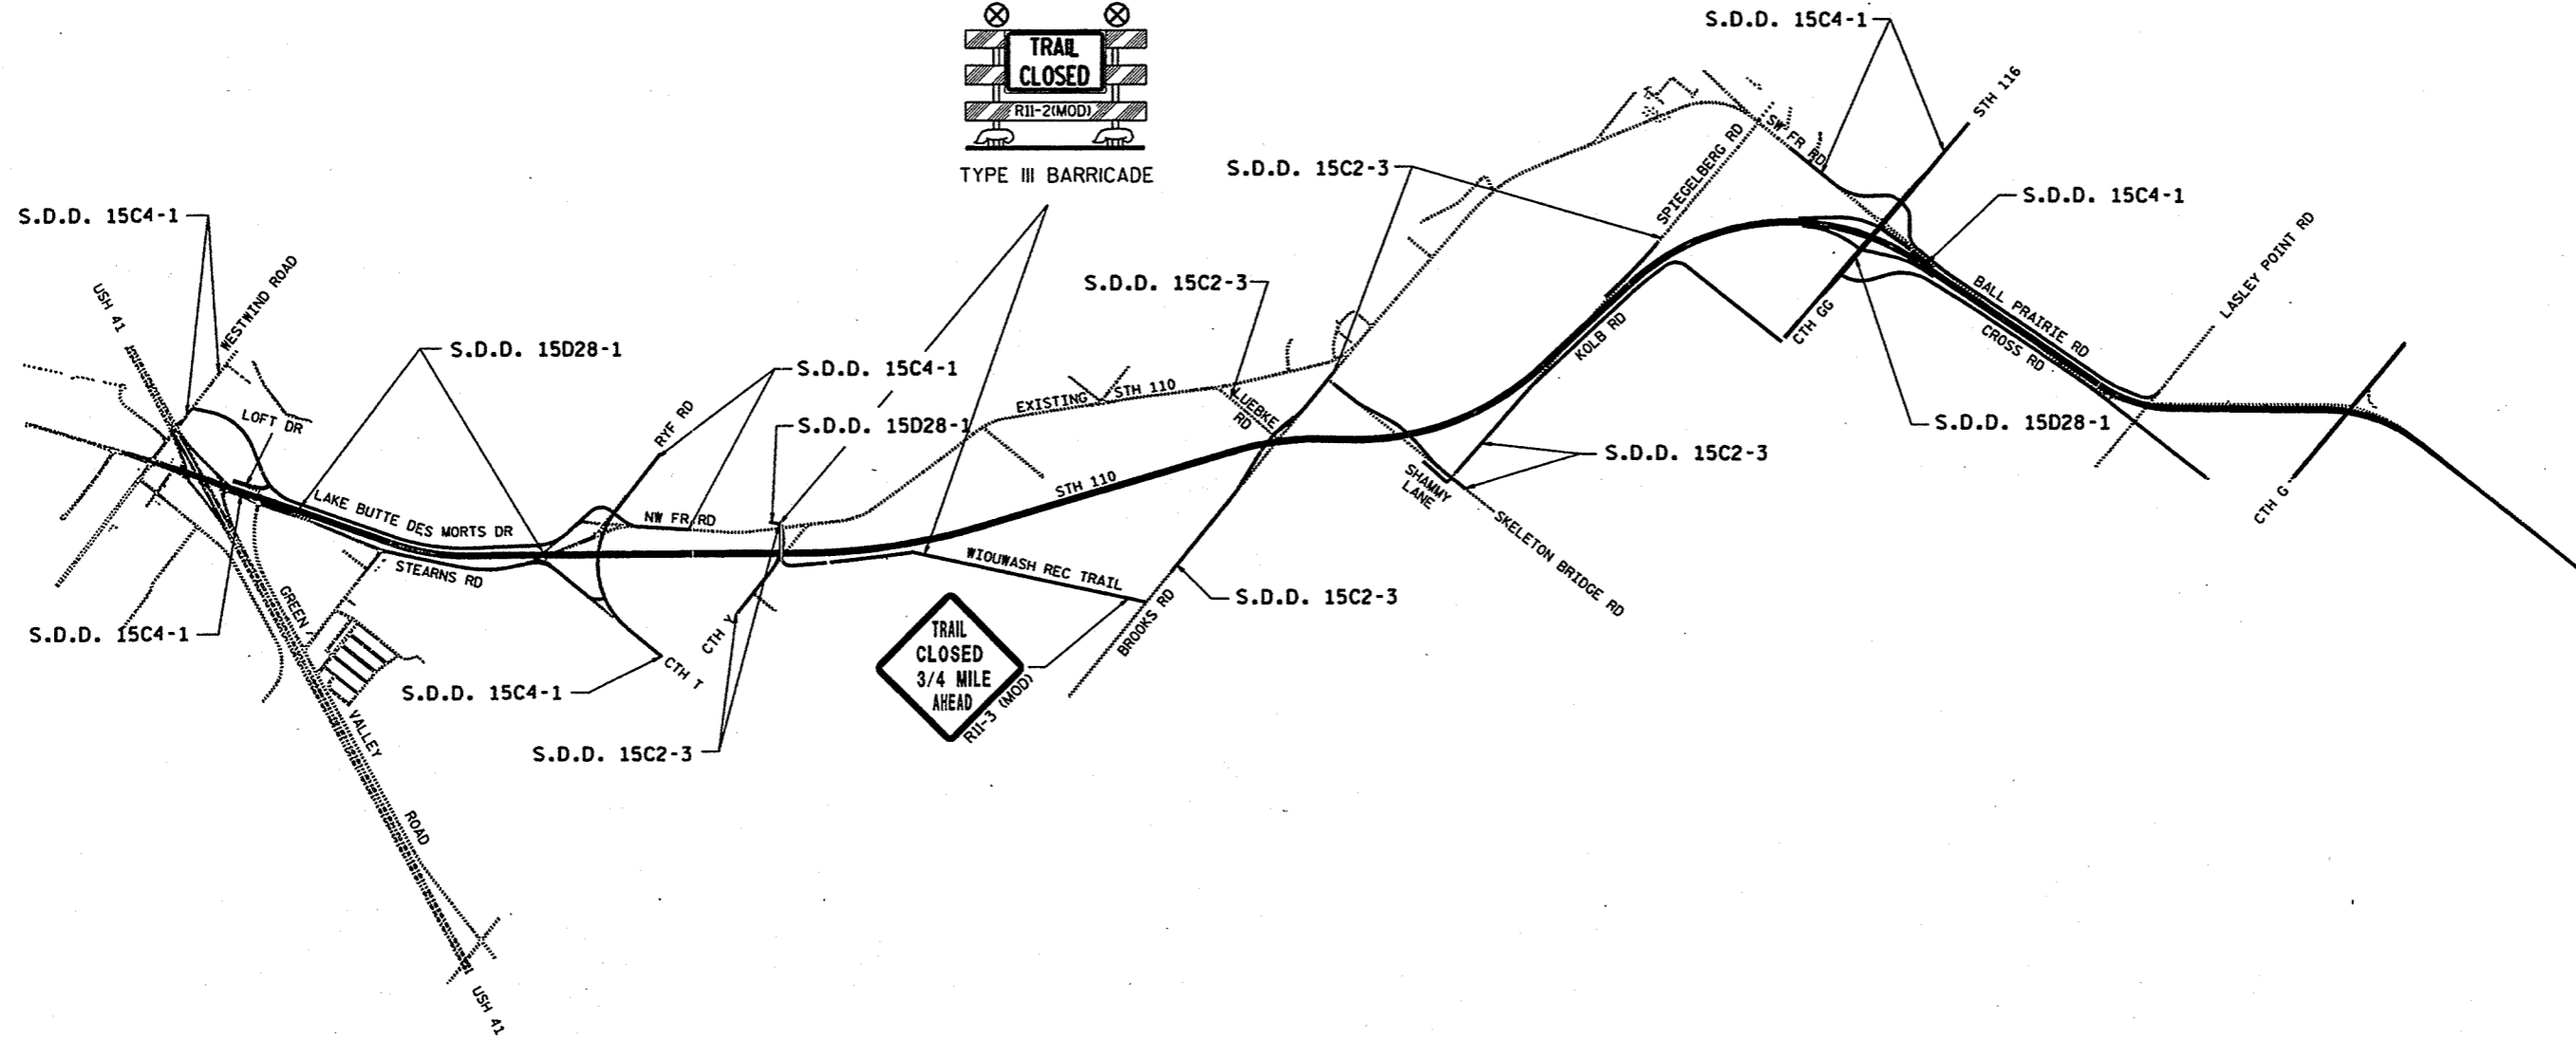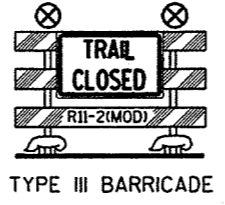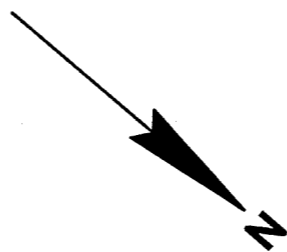

STATE PROJECT NUMBER: 6200-05-71 | HWY: STH 110 | COUNTY: WINNEBAGO | TRAFFIC CONTROL OVERVIEW | SCALE, FEET | SHEET NO: 2.70 | E

FILE NAME : F:\d3_620005\242.dgn | PLOT DATE: 17-SEP-2001 08:42 | ORG DATE : 9-13-01 | PLOT NAME : 242tc | Originator : DISTRICT 3 | PLOT SCALE : 3009.090947:1.000000 | WISDOT/CADD SHEET 42

LEVELS ON - 1.0, 2.0, 3.0, 62.0, 63.0

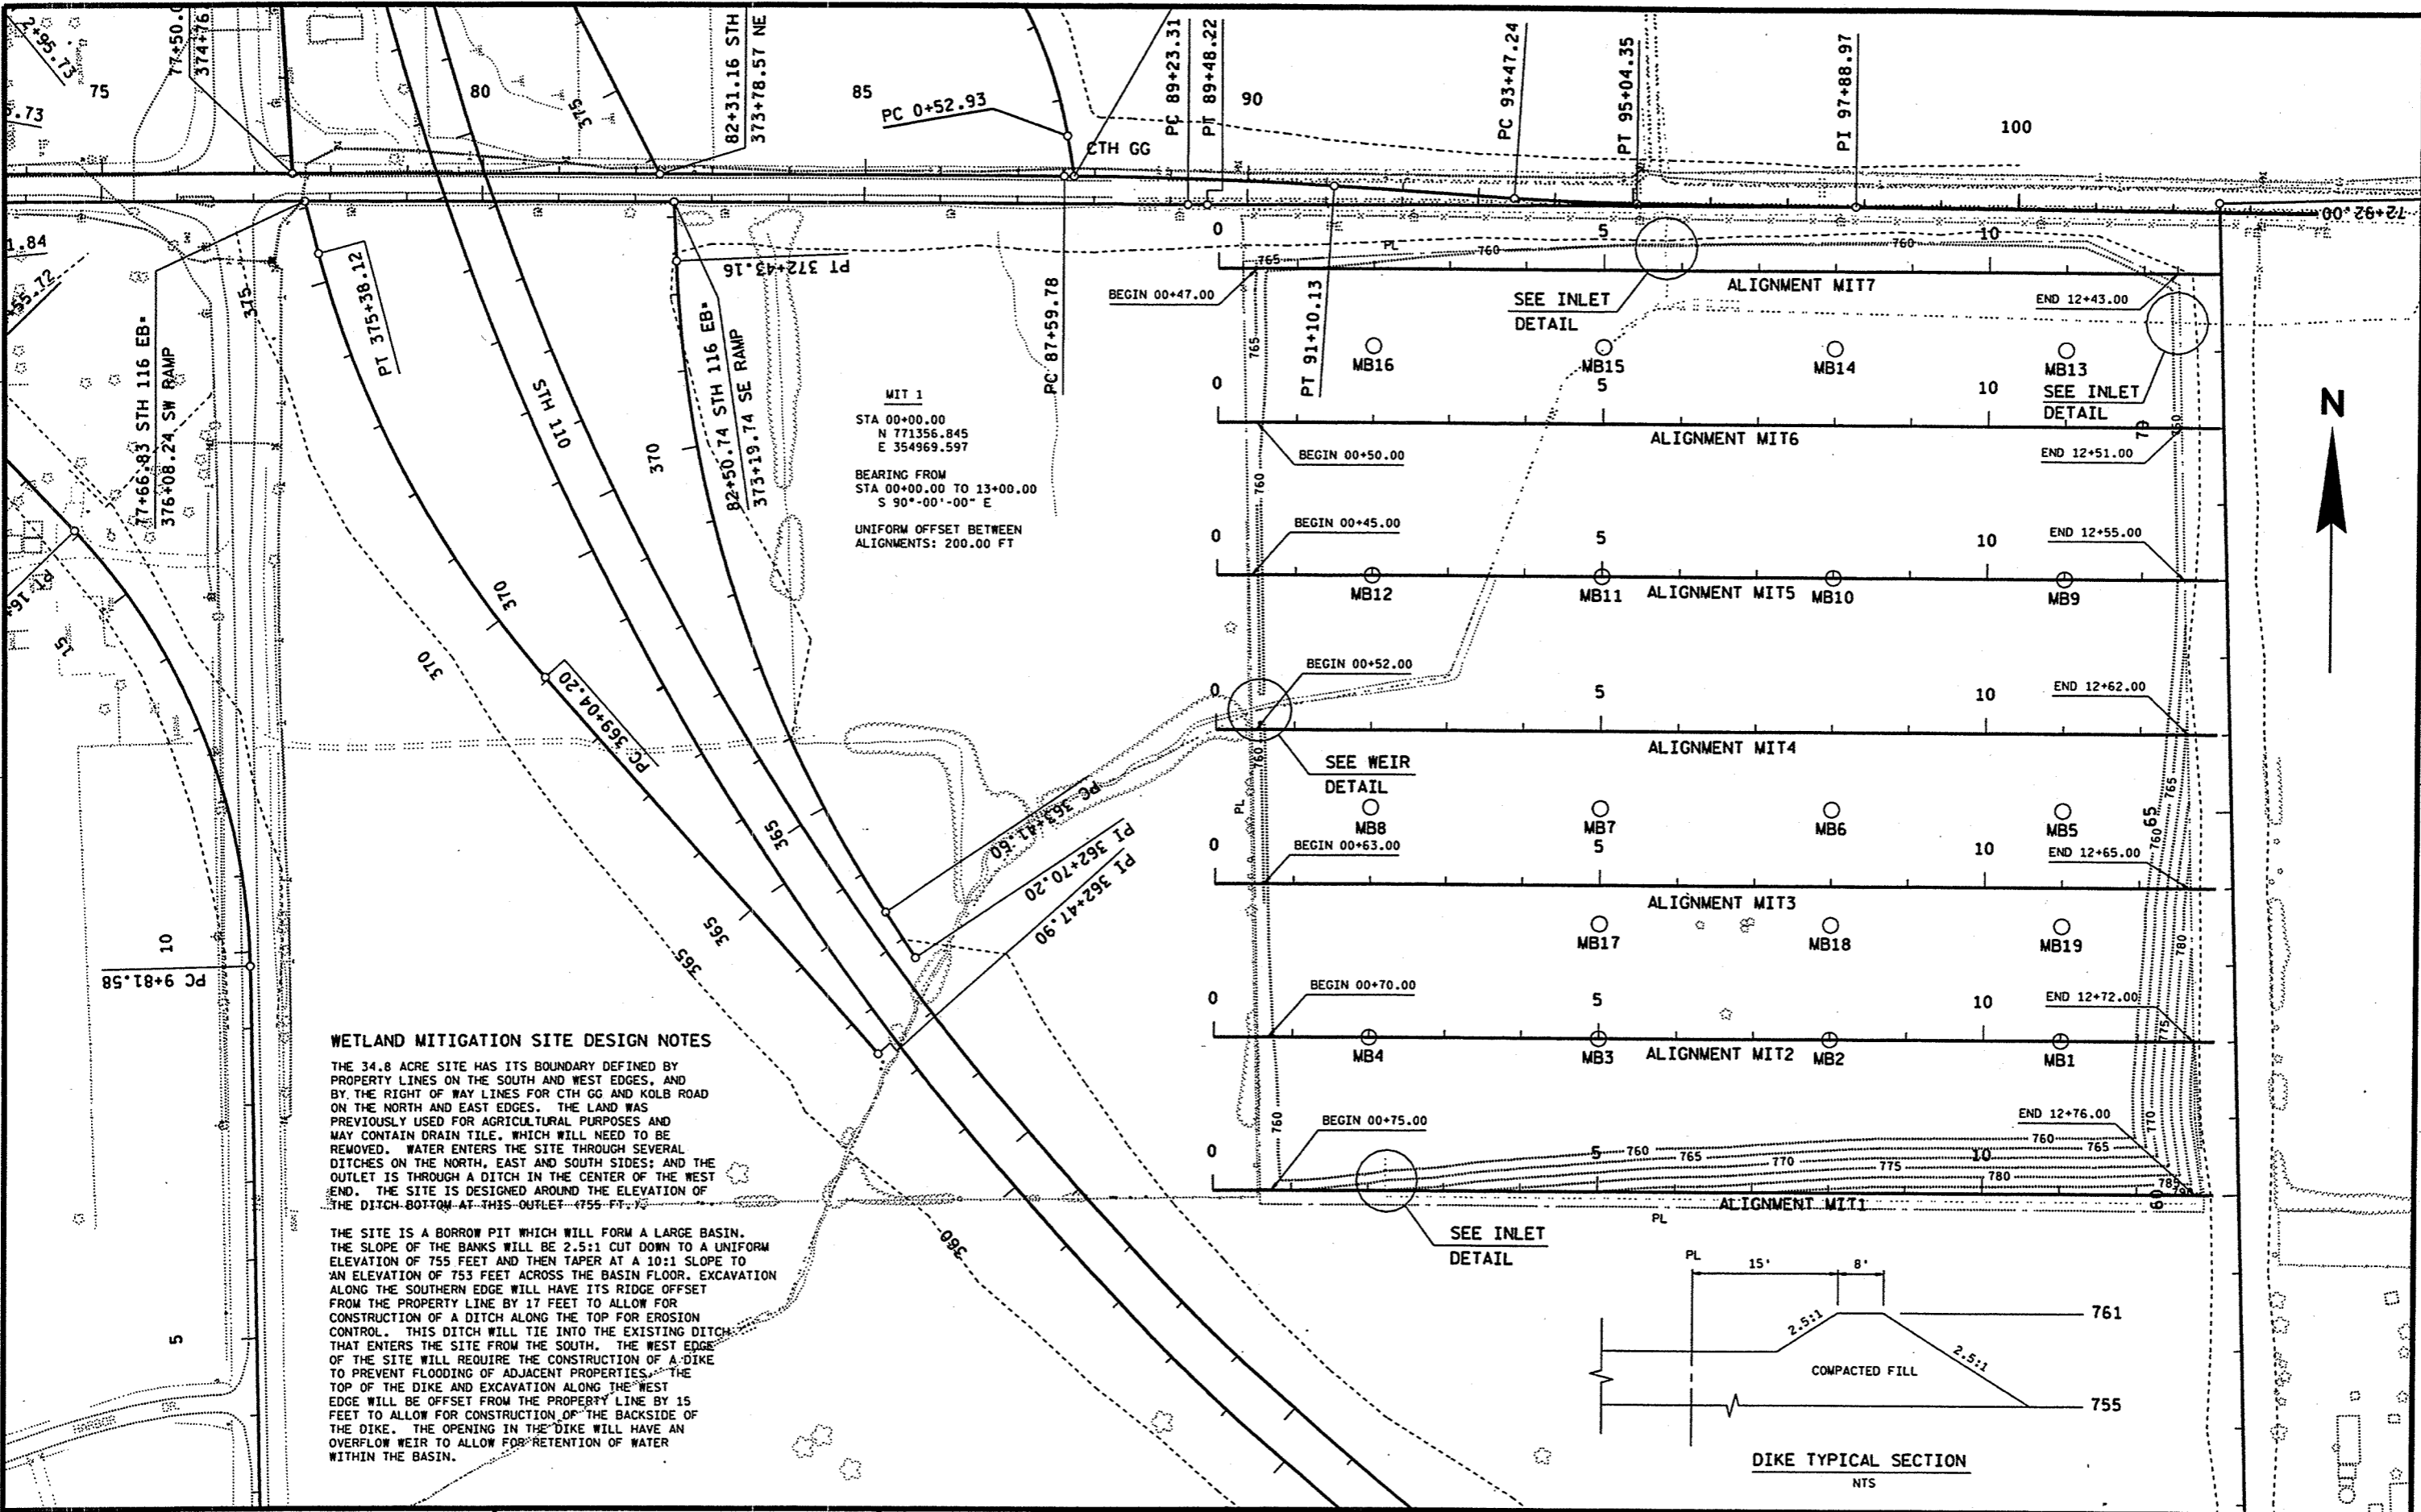


MIT 1
 STA 00+00.00
 N 771356.845
 E 354969.597
 BEARING FROM
 STA 00+00.00 TO 13+00.00
 S 90°-00'-00" E
 UNIFORM OFFSET BETWEEN
 ALIGNMENTS: 200.00 FT

WETLAND MITIGATION SITE DESIGN NOTES

THE 34.8 ACRE SITE HAS ITS BOUNDARY DEFINED BY PROPERTY LINES ON THE SOUTH AND WEST EDGES, AND BY THE RIGHT OF WAY LINES FOR CTH GG AND KOLB ROAD ON THE NORTH AND EAST EDGES. THE LAND WAS PREVIOUSLY USED FOR AGRICULTURAL PURPOSES AND MAY CONTAIN DRAIN TILE, WHICH WILL NEED TO BE REMOVED. WATER ENTERS THE SITE THROUGH SEVERAL DITCHES ON THE NORTH, EAST AND SOUTH SIDES; AND THE OUTLET IS THROUGH A DITCH IN THE CENTER OF THE WEST END. THE SITE IS DESIGNED AROUND THE ELEVATION OF THE DITCH BOTTOM AT THIS OUTLET (755 FT.)

THE SITE IS A BORROW PIT WHICH WILL FORM A LARGE BASIN. THE SLOPE OF THE BANKS WILL BE 2.5:1 CUT DOWN TO A UNIFORM ELEVATION OF 755 FEET AND THEN TAPER AT A 10:1 SLOPE TO AN ELEVATION OF 753 FEET ACROSS THE BASIN FLOOR. EXCAVATION ALONG THE SOUTHERN EDGE WILL HAVE ITS RIDGE OFFSET FROM THE PROPERTY LINE BY 17 FEET TO ALLOW FOR CONSTRUCTION OF A DITCH ALONG THE TOP FOR EROSION CONTROL. THIS DITCH WILL TIE INTO THE EXISTING DITCH THAT ENTERS THE SITE FROM THE SOUTH. THE WEST EDGE OF THE SITE WILL REQUIRE THE CONSTRUCTION OF A DIKE TO PREVENT FLOODING OF ADJACENT PROPERTIES. THE TOP OF THE DIKE AND EXCAVATION ALONG THE WEST EDGE WILL BE OFFSET FROM THE PROPERTY LINE BY 15 FEET TO ALLOW FOR CONSTRUCTION OF THE BACKSIDE OF THE DIKE. THE OPENING IN THE DIKE WILL HAVE AN OVERFLOW WEIR TO ALLOW FOR RETENTION OF WATER WITHIN THE BASIN.

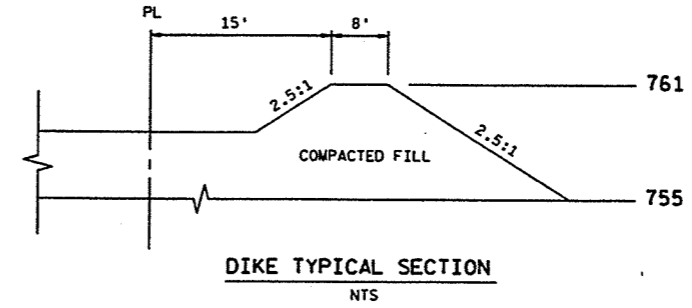

DATE 05DEC01

ESTIMATE OF QUANTITIES

SHEET: 3.1

LINE NUMBER	ITEM	ITEM DESCRIPTION	UNIT	TOTAL	6200-05-71 QUANTITY
0010	10843	RELATIONSHIP BAR CHART PROGRESS SCHEDULE	LS	1.00	1.00
0020	20101	CLEARING	STA.	193.00	193.00
0030	20102	CLEARING	I.D.	170.00	170.00
0040	20104	GRUBBING	STA.	151.00	151.00
0050	20105	GRUBBING	I.D.	152.00	152.00
0060	20330	REMOVING OLD CULVERTS	EACH	33.00	33.00
0070	20352	REMOVING OLD BRIDGE, STATION 8+60	LS	1.00	1.00
0080	20401	REMOVING PAVEMENT	S.Y.	1,735.00	1,735.00
0090	20411	REMOVING GUARDRAIL	L.F.	140.00	140.00
0100	20412	REMOVING FENCE	L.F.	4,600.00	4,600.00
0110	20417	REMOVING SEPTIC TANKS	EACH	4.00	4.00
0120	20419	REMOVING ASPHALTIC SURFACE, BUTT JOINTS	S.Y.	147.00	147.00
0130	20470	REMOVING BUILDINGS, PARCEL 1	LS	1.00	1.00
0140	20471	REMOVING BUILDINGS, PARCEL 3	LS	1.00	1.00
0150	20472	REMOVING BUILDINGS, PARCEL 5	LS	1.00	1.00
0160	20473	REMOVING BUILDINGS, PARCEL 20	LS	1.00	1.00
0170	20474	REMOVING BUILDINGS, PARCEL 12	LS	1.00	1.00
0180	20475	REMOVING BUILDINGS, PARCEL 2	LS	1.00	1.00
0190	20476	REMOVING BUILDINGS, PARCEL 44	LS	1.00	1.00
0200	20483	ABANDONING WELLS	EACH	4.00	4.00
0210	20484	SITE CLEARANCE, PARCEL 2	LS	1.00	1.00
0220	20485	SITE CLEARANCE, PARCEL 5	LS	1.00	1.00
0230	20486	SITE CLEARANCE, PARCEL 6	LS	1.00	1.00
0240	20487	SITE CLEARANCE, PARCEL 33	LS	1.00	1.00
0250	20501	COMMON EXCAVATION	C.Y.	351,265.00	351,265.00
0260	20502	ROCK EXCAVATION	C.Y.	180,194.00	180,194.00
0270	20505	MARSH EXCAVATION	C.Y.	35,715.00	35,715.00
0280	20610	EXCAVATION FOR STRUCTURES, BRIDGES B-70-211	LS	1.00	1.00
0290	20611	EXCAVATION FOR STRUCTURES, BRIDGES B-70-212	LS	1.00	1.00
0300	20612	EXCAVATION FOR STRUCTURES, BRIDGES B-70-213	LS	1.00	1.00
0310	20613	EXCAVATION FOR STRUCTURES, BRIDGES B-70-217	LS	1.00	1.00
0320	20614	EXCAVATION FOR STRUCTURES, BRIDGES B-70-220	LS	1.00	1.00

DATE 05DEC01

ESTIMATE OF QUANTITIES

SHEET: 3.2

LINE NUMBER	ITEM	ITEM DESCRIPTION	UNIT	TOTAL	6200-05-71 QUANTITY
0330	20620	EXCAVATION FOR STRUCTURES, CULVERTS B-70-234	LS	1.00	1.00
0340	20621	EXCAVATION FOR STRUCTURES, CULVERTS B-70-241	LS	1.00	1.00
0350	20801	BORROW EXCAVATION	C.Y.	110,587.00	110,587.00
0360	20811	SELECTED BORROW EXCAVATION	C.Y.	35,715.00	35,715.00
0370	21001	STRUCTURE BACKFILL	C.Y.	5,380.00	5,380.00
0380	21101	PREPARATION OF FOUNDATION FOR ASPHALTIC PAVING	LS	1.00	1.00
0390	21301	FINISHING ROADWAY	LS	1.00	1.00
0400	21401	OBLITERATING OLD ROAD	STA.	4.00	4.00
0410	30404	CRUSHED AGGREGATE BASE COURSE	TON	48,826.00	48,826.00
0420	30426	BREAKER RUN STONE	TON	29,160.00	29,160.00
0430	40204	ASPHALTIC MATERIAL FOR TACK COAT	GAL.	1,551.00	1,551.00
0440	40301	QMP, ASPHALTIC MIXTURE	TON	14,480.00	14,480.00
0450	40501	ASPHALTIC MATERIAL FOR PLANT MIXES	TON	882.00	882.00
0460	40721	ASPHALTIC CONCRETE PAVEMENT, TYPE E-0.3	TON	9,573.00	9,573.00
0470	40722	ASPHALTIC CONCRETE PAVEMENT, TYPE E-1	TON	4,907.00	4,907.00
0480	40728	DENSITY INCENTIVE, ASPHALTIC CONCRETE PAVEMENT	DOL	9,280.00	9,280.00
0490	41508	CONCRETE PAVEMENT, 8-INCH	S.Y.	12,978.00	12,978.00
0500	50201	CONCRETE MASONRY, BRIDGES	C.Y.	2,931.00	2,931.00
0510	50265	PROTECTIVE SURFACE TREATMENT	S.Y.	7,130.00	7,130.00
0520	50301	PRESTRESSED GIRDER, I TYPE, 28-INCH	L.F.	4,940.00	4,940.00
0530	50307	PRESTRESSED GIRDER, I TYPE, 54-INCH	L.F.	3,214.00	3,214.00
0540	50401	CONCRETE MASONRY, CULVERTS	C.Y.	1,261.00	1,261.00
0550	50405	CONCRETE MASONRY, RETAINING WALLS	C.Y.	96.00	96.00
0560	50409	CONCRETE MASONRY, ENDWALLS	C.Y.	12.00	12.00
0570	50504	HIGH STRENGTH BAR STEEL REINFORCEMENT, BRIDGES	LB.	161,062.00	161,062.00
0580	50505	HIGH STRENGTH BAR STEEL REINFORCEMENT, CULVERTS	LB.	43,650.00	43,650.00
0590	50511	COATED HIGH STRENGTH BAR STEEL REINFORCEMENT, BRIDGES	LB.	462,805.00	462,805.00
0600	50513	COATED HIGH STRENGTH BAR STEEL REINFORCEMENT, RETAINING WALLS	LB.	9,580.00	9,580.00
0610	50626	NON-LAMINATED ELASTOMERIC BEARING PADS	EACH	163.00	163.00
0620	50640	STEEL DIAPHRAGMS, STRUCTURE B-70-211	EACH	30.00	30.00

DATE 05DEC01

ESTIMATE OF QUANTITIES

SHEET: 3.3

LINE NUMBER	ITEM	ITEM DESCRIPTION	UNIT	TOTAL	6200-05-71 QUANTITY
0630	50641	STEEL DIAPHRAGMS, STRUCTURE B-70-212	EACH	25.00	25.00
0640	50642	STEEL DIAPHRAGMS, STRUCTURE B-70-213	EACH	25.00	25.00
0650	50643	STEEL DIAPHRAGMS, STRUCTURE B-70-217	EACH	24.00	24.00
0660	50644	STEEL DIAPHRAGMS, STRUCTURE B-70-220	EACH	24.00	24.00
0670	51030	CAST IN PLACE CONCRETE PILING, DELIVERED AND DRIVEN, 10 3/4-INCH	L.F.	2,825.00	2,825.00
0680	51031	CAST IN PLACE CONCRETE PILING, DELIVERED AND DRIVEN, 12-INCH	L.F.	6,080.00	6,080.00
0690	51121	STEEL PILING, DELIVERED AND DRIVEN, HP 10-INCH 42 POUND	L.F.	1,780.00	1,780.00
0700	51605	RUBBERIZED MEMBRANE WATERPROOFING	S.Y.	222.00	222.00
0710	52003	CULVERT PIPE, CLASS III, 18-INCH	L.F.	2,068.00	2,068.00
0720	52005	CULVERT PIPE, CLASS III, 24-INCH	L.F.	46.00	46.00
0730	52007	CULVERT PIPE, CLASS III, 30-INCH	L.F.	780.00	780.00
0740	52023	CULVERT PIPE, CLASS IV, 18-INCH	L.F.	350.00	350.00
0750	52027	CULVERT PIPE, CLASS IV, 30-INCH	L.F.	400.00	400.00
0760	52029	CULVERT PIPE, CLASS IV, 36-INCH	L.F.	342.00	342.00
0770	52061	APRON ENDWALLS FOR CULVERT PIPE, 18-INCH	EACH	34.00	34.00
0780	52065	APRON ENDWALLS FOR CULVERT PIPE, 30-INCH	EACH	7.00	7.00
0790	52067	APRON ENDWALLS FOR CULVERT PIPE, 36-INCH	EACH	2.00	2.00
0800	52105	CORRUGATED STEEL CULVERT PIPE, 18-INCH	L.F.	92.00	92.00
0810	52136	CORRUGATED STEEL PIPE ARCH, 21X15-INCH	L.F.	48.00	48.00
0820	52140	CORRUGATED STEEL PIPE ARCH, 42X29-INCH	L.F.	96.00	96.00
0830	52142	CORRUGATED STEEL PIPE ARCH, 57X38-INCH	L.F.	640.00	640.00
0840	52151	STEEL APRON ENDWALLS FOR CULVERT PIPE, 24-INCH	EACH	2.00	2.00
0850	52166	STEEL APRON ENDWALLS FOR PIPE ARCH, 42X29-INCH	EACH	2.00	2.00
0860	52178	STEEL APRON ENDWALLS FOR CULVERT PIPE, SLOPED SECTION, 18-INCH	EACH	42.00	42.00
0870	52180	STEEL APRON ENDWALLS FOR CULVERT PIPE, SLOPED SECTION, 24-INCH	EACH	2.00	2.00
0880	52181	STEEL APRON ENDWALLS FOR CULVERT PIPE, SLOPED SECTION, 30-INCH	EACH	3.00	3.00
0890	52182	STEEL APRON ENDWALLS FOR CULVERT PIPE, SLOPED SECTION, 36-INCH	EACH	2.00	2.00
0900	52191	STEEL APRON ENDWALLS FOR PIPE ARCH, SLOPED SECTION, 21X15-INCH	EACH	2.00	2.00

DATE 05DEC01

ESTIMATE OF QUANTITIES

SHEET: 3.4

LINE NUMBER	ITEM	ITEM DESCRIPTION	UNIT	TOTAL	6200-05-71 QUANTITY
0910	52197	STEEL APRON ENDWALLS FOR PIPE ARCH, SLOPED SECTION, 57X38-INCH	EACH	4.00	4.00
0920	52203	REINFORCED CONCRETE CULVERT PIPE, CLASS III, 18-INCH	L.F.	1,454.00	1,454.00
0930	52205	REINFORCED CONCRETE CULVERT PIPE, CLASS III, 24-INCH	L.F.	408.00	408.00
0940	52212	REINFORCED CONCRETE CULVERT PIPE, CLASS III, 54-INCH	L.F.	596.00	596.00
0950	52227	REINFORCED CONCRETE CULVERT PIPE, CLASS IV, 18-INCH	L.F.	1,328.00	1,328.00
0960	52260	REINFORCED CONCRETE APRON ENDWALLS FOR CULVERT PIPE, 12-INCH	EACH	16.00	16.00
0970	52262	REINFORCED CONCRETE APRON ENDWALLS FOR CULVERT PIPE, 18-INCH	EACH	32.00	32.00
0980	52264	REINFORCED CONCRETE APRON ENDWALLS FOR CULVERT PIPE, 24-INCH	EACH	6.00	6.00
0990	52266	REINFORCED CONCRETE APRON ENDWALLS FOR CULVERT PIPE, 30-INCH	EACH	6.00	6.00
1000	52270	REINFORCED CONCRETE APRON ENDWALLS FOR CULVERT PIPE, 54-INCH	EACH	6.00	6.00
1010	52340	REINFORCED CONCRETE HORIZONTAL ELLIPTICAL CULVERT PIPE, CLASS HE-III, 29X45-INCH	L.F.	344.00	344.00
1020	52342	REINFORCED CONCRETE HORIZONTAL ELLIPTICAL CULVERT PIPE, CLASS HE-III, 34X53-INCH	L.F.	400.00	400.00
1030	52344	REINFORCED CONCRETE HORIZONTAL ELLIPTICAL CULVERT PIPE, CLASS HE-III, 43X68-INCH	L.F.	352.00	352.00
1040	52365	REINFORCED CONCRETE APRON ENDWALLS FOR HORIZONTAL ELLIP. CULVERT PIPE, 29X45-INCH	EACH	4.00	4.00
1050	52367	REINFORCED CONCRETE APRON ENDWALLS FOR HORIZONTAL ELLIP. CULVERT PIPE, 34X53-INCH	EACH	4.00	4.00
1060	52369	REINFORCED CONCRETE APRON ENDWALLS FOR HORIZONTAL ELLIP. CULVERT PIPE, 43X68-INCH	EACH	4.00	4.00
1070	60113	CONCRETE GUTTER 24-INCH	L.F.	455.00	455.00
1080	60133	CONCRETE CURB AND GUTTER, 30-INCH, TYPE D	L.F.	7,400.00	7,400.00
1090	60136	CONCRETE CURB AND GUTTER, 30-INCH, TYPE J	L.F.	450.00	450.00
1100	60204	CONCRETE SIDEWALK, 4-INCH	S.F.	2,350.00	2,350.00
1110	60302	CONCRETE BARRIER, SINGLE-FACED	L.F.	450.00	450.00
1120	60405	SLOPE PAVING, CRUSHED AGGREGATE	S.Y.	310.00	310.00
1130	60602	HEAVY RIPRAP	C.Y.	886.00	886.00
1140	60604	MEDIUM RANDOM RIPRAP	C.Y.	585.00	585.00

LINE NUMBER	ITEM	ITEM DESCRIPTION	UNIT	TOTAL	6200-05-71 QUANTITY
1150	60721	ROCK EXCAVATION FOR STORM SEWER	C.Y.	15.00	15.00
1160	60825	REINFORCED CONCRETE PIPE, CLASS III, STORM SEWER, 12-INCH	L.F.	937.00	937.00
1170	61122	INLETS, TYPE 3	EACH	30.00	30.00
1180	61123	INLETS, TYPE 8	EACH	17.00	17.00
1190	61124	INLETS, TYPE 9	EACH	1.00	1.00
1200	61167	INLET COVERS, TYPE H	EACH	30.00	30.00
1210	61170	INLET COVERS, TYPE MS	EACH	33.00	33.00
1220	61201	PIPE UNDERDRAIN, 6-INCH	L.F.	4,030.00	4,030.00
1230	61202	PIPE UNDERDRAIN, 8-INCH	L.F.	1,145.00	1,145.00
1240	61211	PIPE UNDERDRAIN, UNPERFORATED, 6-INCH	L.F.	165.00	165.00
1250	61251	DRAIN TILE EXPLORATION	L.F.	4,290.00	4,290.00
1260	61407	STEEL THRIE BEAM STRUCTURE APPROACH	L.F.	397.80	397.80
1270	61408	STEEL PLATE BEAM GUARD, CLASS A	L.F.	150.00	150.00
1280	61409	STEEL PLATE BEAM GUARD, CLASS B	L.F.	200.00	200.00
1290	61422	MARKER POSTS FOR RIGHT-OF-WAY	EACH	246.00	246.00
1300	61433	ANCHOR ASSEMBLIES FOR STEEL PLATE BEAM GUARD	EACH	20.00	20.00
1310	61435	STEEL PLATE BEAM GUARD, ENERGY ABSORBING TERMINAL	EACH	12.00	12.00
1320	61801	MAINTENANCE AND REPAIR OF HAUL ROADS	LS	1.00	1.00
1330	61910	MOBILIZATION	LS	1.00	1.00
1340	62111	LANDMARK REFERENCE MONUMENTS AND CAST IRON COVERS	EACH	60.00	60.00
1350	62401	WATER	MGAL	662.00	662.00
1360	62501	TOPSOIL	S.Y.	3,492.00	3,492.00
1370	62505	SALVAGED TOPSOIL	S.Y.	567,248.00	567,248.00
1380	62703	MULCHING	TON	308.00	308.00
1390	62811	EROSION BALES, DELIVERED	EACH	2,019.00	2,019.00
1400	62812	EROSION BALES, INSTALLED	EACH	2,019.00	2,019.00
1410	62815	SILT FENCE, DELIVERED	L.F.	19,625.00	19,625.00
1420	62816	SILT FENCE, INSTALLED	L.F.	19,625.00	19,625.00
1430	62817	SILT FENCE MAINTENANCE	L.F.	19,625.00	19,625.00
1440	62819	MOBILIZATIONS, EROSION CONTROL	EACH	6.00	6.00
1450	62820	CLEANING SEDIMENT BASINS	C.Y.	187.00	187.00
1460	62821	MOBILIZATIONS, EMERGENCY EROSION CONTROL	EACH	4.00	4.00

LINE NUMBER	ITEM	ITEM DESCRIPTION	UNIT	TOTAL	6200-05-71 QUANTITY
1470	62822	EROSION MAT, DELIVERED, CLASS I, TYPE A	S.Y.	34,000.00	34,000.00
1480	62823	EROSION MAT, INSTALLED, CLASS I, TYPE A	S.Y.	34,000.00	34,000.00
1490	62824	EROSION MAT, DELIVERED, CLASS I, TYPE B	S.Y.	40,960.00	40,960.00
1500	62825	EROSION MAT, INSTALLED, CLASS I, TYPE B	S.Y.	40,960.00	40,960.00
1510	62832	EROSION MAT, DELIVERED, CLASS II, TYPE B	S.Y.	67,850.00	67,850.00
1520	62833	EROSION MAT, INSTALLED, CLASS II, TYPE B	S.Y.	67,850.00	67,850.00
1530	62860	TURBIDITY BARRIERS	S.Y.	558.00	558.00
1540	62866	SOIL STABILIZER, TYPE B	ACRE	4.80	4.80
1550	62872	INLET PROTECTION, TYPE C	EACH	30.00	30.00
1560	62905	FERTILIZER, TYPE B	CWT.	464.00	464.00
1570	63003	SEEDING, TEMPORARY	LB.	19,726.00	19,726.00
1580	63008	SEEDING, MIXTURE NO. 10	LB.	5,056.00	5,056.00
1590	63010	SEEDING, MIXTURE NO. 30	LB.	8,423.00	8,423.00
1600	63011	SEEDING, MIXTURE NO. 40	LB.	163.00	163.00
1610	63013	SEEDING, MIXTURE NO. 60	LB.	1,673.00	1,673.00
1620	63401	WOOD POSTS, 4X4-INCH X 10-FT.	EACH	3.00	3.00
1630	63702	SIGNS, TYPE II, REFLECTIVE	S.F.	4.50	4.50
1640	64220	FIELD OFFICE, TYPE C	LS	1.00	1.00
1650	64301	TRAFFIC CONTROL	LS	1.00	1.00
1660	64313	TRAFFIC CONTROL, DRUMS	DAYS	21,840.00	21,840.00
1670	64318	TRAFFIC CONTROL, BARRICADES, TYPE III	DAYS	14,710.00	14,710.00
1680	64321	TRAFFIC CONTROL, WARNING LIGHTS, TYPE A	DAYS	22,020.00	22,020.00
1690	64326	TRAFFIC CONTROL, SIGNS	DAYS	15,800.00	15,800.00
1700	64503	GEOTEXTILE FABRIC, TYPE DF	S.Y.	3,636.00	3,636.00
1710	64505	GEOTEXTILE FABRIC, TYPE R	S.Y.	1,672.00	1,672.00
1720	64506	GEOTEXTILE FABRIC, TYPE HR	S.Y.	1,075.00	1,075.00
1730	64507	GEOTEXTILE FABRIC, TYPE C	S.Y.	1,800.00	1,800.00
1740	64602	PAVEMENT MARKING, 4-INCH, EPOXY	L.F.	36,546.00	36,546.00
1750	64750	PAVEMENT MARKING, SYMBOLS, EPOXY	EACH	3.00	3.00
1760	64786	PAVEMENT MARKING, PARKING STALL, EPOXY	L.F.	2,477.00	2,477.00
1770	65045	CONSTRUCTION STAKING, SUBGRADE	L.F.	85,338.00	85,338.00
1780	65050	CONSTRUCTION STAKING, CRUSHED AGGREGATE BASE COURSE	L.F.	23,007.00	23,007.00

LINE NUMBER	ITEM	ITEM DESCRIPTION	UNIT	TOTAL	6200-05-71 QUANTITY
1790	65055	CONSTRUCTION STAKING, CURB, GUTTER, AND CURB AND GUTTER	L.F.	7,158.00	7,158.00
1800	65070	CONSTRUCTION STAKING, CONCRETE PAVEMENT	L.F.	2,650.00	2,650.00
1810	65219	NONMETALLIC CONDUIT, SCHEDULE 40, 2-INCH	L.F.	165.00	165.00
1820	65306	PULL BOXES, STEEL, 24X36-INCH	EACH	3.00	3.00
1830	65566	ELECTRICAL WIRE, LIGHTING, NO. 12	L.F.	1,260.00	1,260.00
1840	65705	POLES, TYPE 5	EACH	2.00	2.00
1850	65905	LUMINAIRES, UTILITY, 250 WATTS	EACH	4.00	4.00
1860	65927	LUMINAIRE ARMS, SINGLE MEMBER, 4 1/2-INCH CLAMP, 8-FOOT	EACH	4.00	4.00
1870	66501	SAWING EXISTING PAVEMENT	L.F.	517.00	517.00
1880	90004	MISC 90004A BORROW PIT TRACKING PAD	LS	1.00	1.00
1890	90004	MISC 90004B ASBESTOS REMOVAL	LS	1.00	1.00
1900	90005	MISC 90005A WEIR PLATE	EACH	1.00	1.00
1910	90005	MISC 90005B EROSION CONTROL, FILTER BAGS, DELIVERED	EACH	1,689.00	1,689.00
1920	90005	MISC 90005C EROSION CONTROL, FILTER BAGS, INSTALLED	EACH	1,689.00	1,689.00
1930	90005	MISC 90005D EROSION CONTROL FILTER BAGS, MAINTAINED	EACH	1,689.00	1,689.00
1940	90005	MISC 90005E BASIN LYSIMETER	EACH	1.00	1.00
1950	90005	MISC 90005F STONE OR ROCK DITCH CHECKS	EACH	83.00	83.00
1960	90005	MISC 90005G CONCRETE BASE, TYPE 5, SPECIAL	EACH	2.00	2.00
1970	90005	MISC 90005H INLETS, TYPE 8, SPECIAL	EACH	14.00	14.00
1980	90030	MISC 90030A CONCRETE CURB AND GUTTER, 30-INCH, TYPE D, INTEGRAL	L.F.	6,329.00	6,329.00
1990	90030	MISC 90030B, CHAIN LINK FENCE, 10 FT.	L.F.	284.00	284.00
2000	90031	MISC 90031A MECHANICALLY STABILIZED EARTH CONCRETE PANEL WALL, R-70-7	S.F.	1,765.00	1,765.00
2010	90031	MISC 90031B MECHANICALLY STABILIZED EARTH CONCRETE PANEL WALL, R-70-8	S.F.	1,405.00	1,405.00
2020	90031	MISC 90031C TEMPORARY SHORING	S.F.	300.00	300.00
2030	90031	MISC 90031D ANTI-GRAFFITI COATING, STRUCTURE R-70-7	S.F.	1,765.00	1,765.00
2040	90031	MISC 90031E ANTI-GRAFFITI COATING, STRUCTURE R-70-8	S.F.	1,380.00	1,380.00
2050	90033	MISC 90033A JOINT SEALING	S.Y.	12,978.00	12,978.00
2060	90034	MISC 90034A QUALITY MANAGEMENT PROGRAM, SUBGRADE	C.Y.	1,000,197.00	1,000,197.00
2070	90034	MISC 90034B SEDIMENT BASIN EXCAVATION	C.Y.	187.00	187.00

DATE 05DEC01

ESTIMATE OF QUANTITIES

SHEET: 3.8

LINE NUMBER	ITEM	ITEM DESCRIPTION	UNIT	TOTAL	6200-05-71 QUANTITY
2080	90034	MISC 90034C CLAY LINER	C.Y.	4,843.00	4,843.00
2090	90034	MISC 90034D PLACING INDUSTRIAL FOUNDRY SAND	C.Y.	80,164.00	80,164.00
2100	90034	MISC 90034E CLAY ENCAPSULATION	C.Y.	22,144.00	22,144.00
2110	90034	MISC 90034F SPIEGELBERG WETLAND MITIGATION BORROW SITE	C.Y.	538,345.00	538,345.00
2120	90035	MISC 90035A HAULING INDUSTRIAL FOUNDRY SAND	TON	154,242.00	154,242.00
2130	90035	MISC 90035B LIMESTONE SCREENING	TON	890.00	890.00
2140	90365	QMP, BASE COURSES	TON	48,826.00	48,826.00
2150	90401	QMP, PLACEMENT OF CONCRETE	P.D.	10.00	10.00
2160	90421	QMP, AGGREGATE FOR CONCRETE PAVEMENT	S.Y.	12,978.00	12,978.00
2170	90501	QMP, READY MIXED CONCRETE MASONRY FOR BRIDGES, 5 CYLINDERS	C.Y.	2,931.00	2,931.00
2180	90502	QMP, BRIDGE STRENGTH INCENTIVE, CONCRETE MASONRY	DOL	29,310.00	29,310.00
2190	90590	PIPE GRATES	EACH	2.00	2.00
2200	90616	MARKER POSTS, FLEXIBLE, FOR CULVERT END	EACH	100.00	100.00
2210	90637	SAFETY FENCE	L.F.	4,050.00	4,050.00

ALL ITEMS & QUANTITIES ON THIS SHEET ARE
FOR CATEGORY 0010, UNLESS OTHERWISE NOTED.

CLEARING AND GRUBBING

STATION - STATION	LOCATION	20101 CLEARING		20102 GRUBBING	
		STA.	I.D.	STA.	I.D.
100+00 - 101+00	STH 110 SB	1		1	
110+00 - 111+00	STH 110 SB	1			
123+00 - 124+00	STH 110 SB	1		1	
125+00 - 128+00	STH 110 SB	3		3	
146+00 - 147+00	STH 110 SB	1		1	
168+00 - 171+00	STH 110 SB	3		3	
192+00 - 194+00	STH 110 SB	2			
194+00 - 203+00	STH 110 SB	7		7	
207+00 - 208+00	STH 110 SB		6		6
231+00 - 232+00	STH 110 SB	1		1	
241+00 - 244+00	STH 110 SB	3		3	
247+00 - 248+00	STH 110 SB	1		1	
248+00 - 249+00	STH 110 SB		8		8
260+00 - 261+00	STH 110 SB	1		1	
277+00 - 281+00	STH 110 SB	4		4	
281+00 - 283+00	STH 110 SB	3			
283+00 - 286+00	STH 110 SB	3		3	
299+00 - 300+00	STH 110 SB	1		1	
317+00 - 327+00	STH 110 SB	10		10	
334+00 - 337+00	STH 110 SB	3		3	
338+00 - 339+00	STH 110 SB		10		10
98+00 - 103+00	STH 110 NB	5		5	
105+00 - 106+00	STH 110 NB		5		5
106+00 - 113+00	STH 110 NB	7			
113+00 - 114+00	STH 110 NB		8		
123+00 - 124+00	STH 110 NB	1		1	
125+00 - 126+00	STH 110 NB	1		1	
166+00 - 173+00	STH 110 NB	7		7	
195+00 - 202+00	STH 110 NB	7		7	
209+00 - 210+00	STH 110 NB	1		1	
216+00 - 217+00	STH 110 NB		8		8
240+00 - 241+00	STH 110 NB		7		7
241+00 - 242+00	STH 110 NB	1		1	
278+00 - 286+00	STH 110 NB	8		8	
300+00 - 303+00	STH 110 NB	3		3	
308+00 - 311+00	STH 110 NB	3		3	
311+00 - 312+00	STH 110 NB		8		8
312+00 - 317+00	STH 110 NB	5		5	
338+00 - 340+00	STH 110 NB	2		2	
356+00 - 357+00	STH 110 SB	1		1	
362+00 - 363+00	STH 110 SB	1			
377+00 - 378+00	STH 110 SB	1			
381+00 - 382+00	STH 110 SB		10		
383+00 - 384+00	STH 110 SB	1		1	
358+00 - 359+00	STH 110 NB		6		6
SUBTOTAL:		104	76	89	58

STATION - STATION	LOCATION	20101 CLEARING		20102 GRUBBING	
		STA.	I.D.	STA.	I.D.
362+00 - 363+00	STH 110 NB	1			
383+00 - 384+00	STH 110 NB	1		1	
201+00 - 202+00	LAKE BUTTE DES MORTS DRIVE		9		9
202+00 - 203+00	LAKE BUTTE DES MORTS DRIVE	1		1	
203+00 - 204+00	LAKE BUTTE DES MORTS DRIVE		6		6
204+00 - 205+00	LAKE BUTTE DES MORTS DRIVE	1		1	
205+00 - 206+00	LAKE BUTTE DES MORTS DRIVE	1		1	
206+00 - 207+00	LAKE BUTTE DES MORTS DRIVE		6		6
207+00 - 208+00	LAKE BUTTE DES MORTS DRIVE		6		6
208+00 - 209+00	LAKE BUTTE DES MORTS DRIVE		6		6
209+00 - 210+00	LAKE BUTTE DES MORTS DRIVE		10		10
210+00 - 211+00	LAKE BUTTE DES MORTS DRIVE		6		6
211+00 - 214+00	LAKE BUTTE DES MORTS DRIVE	3		3	
228+00 - 230+00	LAKE BUTTE DES MORTS DRIVE	2		2	
252+00 - 253+00	LAKE BUTTE DES MORTS DRIVE		11		11
253+00 - 254+00	LAKE BUTTE DES MORTS DRIVE	1		1	
254+00 - 257+00	LAKE BUTTE DES MORTS DRIVE	2		2	
270+00 - 275+00	LAKE BUTTE DES MORTS DRIVE	5		5	
22+00 - 27+00	RECREATION TRAIL	5		5	
30+00 - 31+00	CTH Y	1		1	
5+00 - 6+00	BROOKS ROAD		8		8
6+00 - 8+00	BROOKS ROAD	2		2	
8+00 - 12+00	BROOKS ROAD	4			
16+00 - 17+00	BROOKS ROAD	1			
20+00 - 21+00	BROOKS ROAD	6			
1+00 - 2+00	SKELETON BRIDGE ROAD		8		8
3+00 - 8+00	SKELETON BRIDGE ROAD	5		5	
8+00 - 13+00	SKELETON BRIDGE ROAD	5			
16+00 - 23+00	SKELETON BRIDGE ROAD	7			
23+00 - 25+00	SKELETON BRIDGE ROAD	2		2	
39+00 - 40+00	TYERS DRIVEWAY	1		1	
10+00 - 15+00	SPIEGELBERG ROAD	5		5	
15+00 - 16+00	SPIEGELBERG ROAD		10		10
18+00 - 19+00	SPIEGELBERG ROAD		8		8
10+00 - 16+00	KOLB ROAD	6		6	
17+00 - 25+00	KOLB ROAD	8		8	
25+00 - 27+00	KOLB ROAD	2		2	
49+00 - 51+00	KOLB ROAD	2		2	
52+00 - 53+00	KOLB ROAD	1		1	
14+00 - 17+00	SW FRONTAGE ROAD @ STH 116	3		3	
18+00 - 20+00	SW FRONTAGE ROAD @ STH 116	2		2	
365+00 - 366+00	SE RAMP @ STH 116	1			
367+00 - 369+00	SE RAMP @ STH 116	2			
SUBTOTAL:		89	94	62	94
TOTALS:		193	170	151	152

MISCELLANEOUS QUANTITIES

HWY: STH 110

COUNTY: WINNEBAGO

STATE PROJECT NO: 6200-05-71

SHEET NO:

3A E

ALL ITEMS & QUANTITIES ON THIS SHEET ARE FOR CATEGORY 0010, UNLESS OTHERWISE NOTED.

REMOVING CULVERT PIPE

STATION	LOCATION	20330 EACH	SIZE	TYPE	REMARKS
89+00	EXISTING STH 110	2	60 INCH x 135 FEET	STEEL	CROSS DRAIN
183+00	EXISTING STH 110 / CTH Y	1	24 INCH x 50 FEET	STEEL	CROSS DRAIN
183+00	EXISTING STH 110 / CTH Y	1	24 INCH x 30 FEET	STEEL	F.E.
316+00	EXISTING STH 110, LT.	1	18 INCH	CONCRETE	F.E.
325+00	EXISTING STH 110	1	18 INCH x 22 FEET	STEEL	CROSS DRAIN
327+50	EXISTING STH 110, LT.	1	18 INCH x 20 FEET	STEEL	C.E.
373+50	EXISTING STH 110, LT.	1	18 INCH x 20 FEET	STEEL	P.E.
375+00	N.W. RAMP @ STH 116	1	36 INCH	STEEL	CROSS DRAIN
13+53	LOFT DRIVEWAY	2	60 INCH x 75 FEET	STEEL	CROSS DRAIN
20+00	STEARNS ROAD, RT.	1	24 INCH	STEEL	F.E.
24+00	STEARNS ROAD, RT.	1	12 INCH x 20 FEET	STEEL	P.E.
25+00	STEARNS ROAD, RT.	1	18 INCH	STEEL	F.E.
286+30	N.W. FRONTAGE ROAD @ CTH T	1	18 INCH x 34 FEET	STEEL	P.E.
288+00	N.W. FRONTAGE ROAD @ CTH T	1	18 INCH x 30 FEET	STEEL	P.E.
289+35	N.W. FRONTAGE ROAD @ CTH T	1	18 INCH x 25 FEET	STEEL	P.E.
290+20	N.W. FRONTAGE ROAD @ CTH T	1	18 INCH x 20 FEET	STEEL	P.E.
34+30	CTH Y, LT.	1	18 INCH x 17 FEET	STEEL	F.E.
36+00	CTH Y, RT.	1	18 INCH x 20 FEET	STEEL	C.E.
39+00	CTH Y, RT.	1	12 INCH	STEEL	F.E.
40+00	CTH Y, RT.	1	18 INCH	STEEL	P.E.
264+50	LUEBKE ROAD	1	18 INCH x 50 FEET	STEEL	CROSS DRAIN
6+30	BROOKS ROAD, RT.	1	24 INCH x 30 FEET	STEEL	P.E.
7+25	SKELETON BRIDGE ROAD, RT.	1	18 INCH x 18 FEET	STEEL	P.E.
11+60	SKELETON BRIDGE ROAD, LT.	1	18 INCH x 20 FEET	STEEL	P.E.
17+90	SKELETON BRIDGE ROAD, RT.	1	36 INCH x 40 FEET	STEEL	CROSS DRAIN
18+50	SKELETON BRIDGE ROAD, RT.	1	24 INCH x 20 FEET	STEEL	P.E.
19+00	SPIEGELBERG ROAD	1	24 INCH x 25 FEET	STEEL	CROSS DRAIN
20+30	SPIEGELBERG ROAD, RT.	1	12 INCH x 25 FEET	STEEL	P.E.
4+40	MITIGATION SITE (MIT 6)	1	48" x 19 FEET	STEEL	F.E.
	PARCEL 2 - LARUE	1	18" x 28 FEET	STEEL	C.E.
	PARCEL 2 - LARUE	1	12" x 40 FEET	STEEL	CROSS DRAIN

TOTAL: 33

REMOVING PAVEMENT

STATION - STATION	LOCATION	20401 S.Y.
269+00 - 275+50	LAKE BUTTE DES MORTS DRIVE	1,735

TOTAL: 1,735

REMOVING GUARDRAIL

STATION - STATION	LOCATION	20411 L.F.
8+20 - 8+90	BROOKS ROAD LT. & RT.	140

TOTAL: 140

REMOVING FENCE

STATION - STATION	LOCATION	20412 L.F.
211+50 - 214+50	LAKE BUTTE DES MORTS DRIVE	170
100+56 - 100+94	STH 110 NB	200
101+03 - 113+66	STH 110 NB	1,480
195+00 - 201+00	STH 110	600
256+00 - 260+00	STH 110	550
	BROOKS ROAD	100
264+00 - 268+00	STH 110	600
	STH 110 AND STH 116	900

TOTAL: 4,600

REMOVING SEPTIC TANKS

LOCATION	20417 REMOVING SEPTIC TANKS, EACH
PARCEL 1, KONTOS SEPTIC TANK	1
PARCEL 3, DODD SEPTIC TANK	1
PARCEL 20, MAKI SEPTIC TANK	1
PARCEL 11, WRIGHT SEPTIC TANK	1

TOTAL: 4

REMOVING ASPHALTIC SURFACE, BUTT JOINTS

STATION	LOCATION	20419 S.Y.
3+00	BROOKS ROAD	49
25+50	SKELETON BRIDGE ROAD (ON KOLB ROAD)	49
26+00	SKELETON BRIDGE ROAD	49

TOTAL: 147

REMOVING BUILDINGS

LOCATION	20470, 20471, 20472, 20473, 20474 REMOVING BUILDINGS, LS.
PARCEL 1, KONTOS BUILDING	1
PARCEL 3, DODD FARM BUILDINGS	1
PARCEL 5, SEBERO SHED	1
PARCEL 20, MAKI HOUSE AND GARAGE	1
PARCEL 12, GRUNDY BOATHOUSE	1
PARCEL 2, LARUE BUILDINGS	1
PARCEL 44, PASCARELLA BUILDING	1

ABANDONING WELLS

LOCATION	20483 ABANDONING WELLS, EACH
PARCEL 1, KONTOS WELL	1
PARCEL 3, DODD WELL	1
PARCEL 20, MAKI WELL	1
PARCEL 44, PASCARELLA WELL	1
TOTAL:	4

SITE CLEARANCE

LOCATION	20484, 20485, 20486, 20487 SITE CLEARANCE, PARCEL, L.S.
PARCEL 2, MILLER SLAB	1
PARCEL 5, SEBERO SLAB	1
PARCEL 6, MEINEN SLAB	1
PARCEL 33, EWALD	1
TOTAL:	4

EARTHWORK QUANTITIES

MAINLINE BALANCE NUMBER	ROADWAY	STATION - STATION	20501		20502	20505	20801	20811	90034A	90034C	90034D	90034E	90034F
			COMMON EXC. C.Y.	E.B.S. EXC. (1) C.Y.	ROCK EXC. (2) C.Y.	MARSH EXC. (3) C.Y.	BORROW EXC. (4) C.Y.	SELECT BORROW EXC. (5) C.Y.	QUALITY MANAGEMENT PROGRAM SUBGRADE C.Y.	CLAY LINER C.Y.	PLACING INDUSTRIAL FOUNDRY SAND (6) C.Y.	CLAY ENCAPSULATION (7) C.Y.	SPIEGELBERG WETLAND MITIGATION BORROW SITE C.Y.
1	STH 110	98+00 - 137+00	4,437				23,673	101,894	23,673	106,331			
	LAKE BUTTE DES MORTS DRIVE	200+00 - 281+89	7,971				12,042		12,042	7,971			
	STEARNS RD.	37+50 - 38+10.72	36					416		452			
2	STH 110	146+00 - 224+00	51,502	5,180	19,211					56,682		80,164	
	N.W. FR. @ CTH T	282+88 - 290+50	4,280							4,280			
	CTH T	26+00 - 38+00	2,689	1,690						4,379			
	CTH Y	30+00 - 41+50	20,459		5,433					20,459			
	REC TRAIL	0+00 - 35+00	13,485		525					13,485			
	REC.TRAIL PARKING	20+00 - 22+66	1,134							1,134			
3	STH 110	224+00 - 284+00	63,272	12,340	15,945					75,612			
	BROOKS ROAD	3+00 - 30+50	1,785							1,785			
	LUEBKE ROAD	8+50 - 10+30	178							178			
4	STH 110	284+00 - 362+00	88,656	19,420						108,076			
	SKELETON BRIDGE ROAD	1+00 - 28+00	1,660							1,660			
	SHAMMY LANE	30+17 - 36+78	1,043							1,043			
	KOLB ROAD	15+00 - 72+00	19,154	5,770						24,924			
	SPIEGELBERG ROAD	10+00 - 22+00	1,621							1,621			
5	STH 110	362+00 - 385+00	1,321							1,321			
	N.E. RAMP @ STH 116	378+00 - 386+64.5	412							412			
	S.E. RAMP @ STH 116	362+70 - 372+88	1,901							1,901			
	S.W RAMP @ STH 116	362+48 - 374+00	8,198							8,198			
	S.W FR. RD. @ STH 116	13+00 - 21+25	10,434							10,434			
	DRIVEWAYS AND F.E.'S		1,237				8,277			9,514			
	SPIEGELBERG WETLAND SITE				139,080					538,345	4,843		538,345
SUBTOTAL			306,865	44,400									
TOTAL			351,265		180,194	35,715	110,587	35,715	1,000,197	4,843	80,164	22,144	538,345

**REVISIONS
ATTACHED TO BACK
OF PLAN**

- NOTE: (1) E.B.S. EXC. SHALL BE PAID FOR AS COMMON EXCAVATION
 (2) ROCK EXCAVATION EXPANSION FACTOR = 1.10%
 (3) MARSH EXCAVATION FILL FACTOR = 50%
 (4) BORROW EXCAVATION FACTOR = 1.15%
 (5) EXPANSION FACTOR FOR SELECT BORROW = 1.10 %
 (6) EXPANSION FACTOR FOR FOUNDRY SAND = 1.10 %
 (7) EXPANSION FACTOR FOR CLAY = 1.25 %

NOTE:
 SELECT BORROW, MARSH EXCAVATION, CLAY LINER, CLAY ENCAPSULATION
 AND FOUNDRY SAND SHALL NOT BE PART OF THE QMP PROGRAM.

ALL ITEMS & QUANTITIES ON THIS SHEET ARE
 FOR CATEGORY 0010, UNLESS OTHERWISE NOTED.

ALL ITEMS & QUANTITIES ON THIS SHEET ARE FOR CATEGORY 0010, UNLESS OTHERWISE NOTED.

PREPARATION OF FOUNDATION FOR ASPHALT PAVING

STATION	-	STATION	LOCATION	21101 L.S.
BROOKS ROAD	-	3+00	SKELETON BRIDGE ROAD	1

OBLITERATING OLD ROAD

LOCATION	21401 STA.	REMARKS
OLD CTH Y	4.0	GRADING LIMITS TO EXISTING STH 110
TOTAL:		4.0

BREAKER RUN SUMMARY

STATION - STATION	LOCATION	30426 BREAKER RUN TON
205+00 - 249+65.91	LAKE BUTTE DES MORTS DRIVE	4,750
252+25.91 - 277+50	LAKE BUTTE DES MORTS DRIVE	1,950
3+00 - 16+86.04	BROOKS ROAD	2,250
19+35.53 - 30+00	BROOKS ROAD	1,700
3+00 - 13+88.46	SKELETON BRIDGE ROAD	1,740
16+52.45 - 26+00	SKELETON BRIDGE ROAD	1,510
30+00 - 35+34	SHAMMY LANE	860
15+00 - 72+92	KOLB ROAD	9,250
10+82 - 22+00	SPEIGELBERG ROAD	1,780
	LUEBKE ROAD CUL-DE-SAC	220
	SHAMMY LANE CUL-DE-SAC	450
	SPEIGELBERG ROAD CUL-DE-SAC	300
13+00 - 21+25	SW FRONTAGE ROAD @ STH 116	1,350
TOTAL:		28,110

CRUSHED AGGREGATE BASE COURSE AND WATER

STATION - STATION	LOCATION	30404 CRUSHED AGGREGATE BASE COURSE		62401 CRUSHED AGGREGATE WATER		90365 QMP, BASE COURSES TON
		MAINLINE TON	SHOULDER TON	COMPACTION MGAL.	DUST CONTROL MGAL.	
199+87.44 - 205+00	LAKE BUTTE DES MORTS DRIVE	980	170	12	5	1,150
205+00 - 249+65.91	LAKE BUTTE DES MORTS DRIVE	6,450		65	26	6,450
252+25.97 - 277+50	LAKE BUTTE DES MORTS DRIVE	3,650		37	15	3,650
277+50 - 279+20	LAKE BUTTE DES MORTS DRIVE	580		6	3	580
279+20 - 281+89.35	LAKE BUTTE DES MORTS DRIVE	750	90	9	4	840
3+00 - 16+86.04	BROOKS ROAD	1,650	450	22	8	2,100
19+35.53 - 30+00	BROOKS ROAD	1,250	340	16	7	1,590
3+00 - 13+88.46	SKELETON BRIDGE ROAD	1,300	350	17	7	1,650
16+52.45 - 26+00	SKELETON BRIDGE ROAD	1,150	310	15	6	1,460
30+00 - 35+34	SHAMMY LANE	710	170	9	4	880
15+00 - 72+92	KOLB ROAD	6,870	1,850	88	35	8,720
10+82 - 22+00	SPEIGELBERG ROAD	1,300	360	17	7	1,660
282+52.37 - 291+00	NW FRONTAGE ROAD AT CTH T	3,500	400	39	16	3,900
30+00 - 34+50	CTH Y	1,700	130	18	8	1,830
34+50 - 41+50	CTH Y	2,250	270	26	10	2,520
	LUEBKE ROAD CUL-DE-SAC	140	50	2	1	190
	SHAMMY LANE CUL-DE-SAC	290	100	4	2	390
	SPEIGELBERG ROAD CUL-DE-SAC	210	50	3	1	260
13+00 - 21+25	SW FRONTAGE ROAD @ STH 116	960	350	14	5	1,310
	FIELD ENTRANCES	734				734
	COMMERCIAL ENTRANCES	425				425
	PRIVATE ENTRANCES	1,812				1,812
SUBTOTAL:		38,661	5,440	419	170	44,101
TOTAL:		44,101		588		

CRUSHED AGGREGATE BASE COURSE AND WATER

CATEGORY 0100

STATION - STATION	LOCATION	30404 CRUSHED AGGREGATE BASE COURSE		62401 CRUSHED AGGREGATE WATER		90365 QMP, BASE COURSES TON
		MAINLINE TON	SHOULDER TON	COMPACTION MGAL.	DUST CONTROL MGAL.	
	RECREATION TRAIL CONNECTION	75		8		75
0+00 - 29+00	RECREATION TRAIL	2,150		22	9	2,150
	OLD STH 110 PARKING LOT	2,500		25	10	2,500
SUBTOTAL:		4,725	0	55	19	4,725
TOTAL:		4,725		74		4,725

MISCELLANEOUS QUANTITIES

HWY: STH 110

COUNTY: WINNEBAGO

STATE PROJECT NO: 6200-05-71

SHEET NO:

3D E

ALL ITEMS & QUANTITIES ON THIS SHEET ARE FOR CATEGORY 0010, UNLESS OTHERWISE NOTED.

ASPHALTIC SUMMARY

STATION - STATION	LOCATION	40721 ASPHALTIC CONCRETE PAVEMENT TYPE E-0.3 TON	40722 ASPHALTIC CONCRETE PAVEMENT TYPE E-1 TON	40204 ASPHALTIC MATERIAL FOR TACK COAT GALLON	40501 ASPHALTIC MATERIAL FOR PLANT MIXES, 6% TON	40301 QUALITY MANAGEMENT PROGRAM ASPHALTIC MIXTURE TON
199+87 - 241+00	LAKE BUTTE DES MORTS DRIVE		4,283	376	257	4,283
277+50 - 281+89	LAKE BUTTE DES MORTS DRIVE		504	45	31	504
282+52 - 285+00	NW FRONTAGE ROAD @ CTH T		120		8	120
30+00 - 41+50	CTH	1,075		100	66	1,075
	LUEBKE ROAD CUL-DE-SAC	140		20	9	140
3+00 - 16+86.04	BROOKS ROAD	780		90	47	780
19+35 - 30+00	BROOKS ROAD	600		70	36	600
BROOKS ROAD - 3+00	SKELETON BRIDGE ROAD	105		30	6	105
3+00 - 13+88.46	SKELETON BRIDGE ROAD	615		70	37	615
16+52 - 26+00	SKELETON BRIDGE ROAD	535		60	33	535
10+00 - 11+10	FORSETH DRIVEWAY	39			3	39
30+00 - 35+34	SHAMMY LANE	365		50	23	365
	SHAMMY LANE CUL-DE-SAC	240		30	15	240
15+00 - 72+92	KOLB ROAD	3,354		420	206	3,354
10+82 - 22+00	SPIEGELBERG ROAD	630		70	38	630
	SPIEGELBERG ROAD CUL-DE-SAC	175		20	11	175
13+00 - 21+25	SW FRONTAGE ROAD @ STH 116	270				270
TOTAL:		8,923	4,907	1		

REVISIONS
ATTACHED TO BACK
OF PLAN

ASPHALTIC SUMMARY

CATEGORY 0100

STATION - STATION	LOCATION	40721 ASPHALTIC CONCRETE PAVEMENT TYPE E-0.3 TON	40204 ASPHALTIC MATERIAL FOR TACK COAT GALLON	40501 ASPHALTIC MATERIAL FOR PLANT MIXES, 6% TON	40301 QUALITY MANAGEMENT PROGRAM ASPHALTIC MIXTURE TON
	OLD STH 110 PARKING LOT	650	100	39	650
TOTAL:		650	100	39	650

CONCRETE PAVEMENT, 8-INCH

STATION - STATION	LOCATION	41508 CONCRETE PAVEMENT, 8-INCH S.Y.	90421 QMP, AGGREGATE FOR CONCRETE PAVEMENT S.Y.	CATEGORY 0110 90033A JOINT SEALING S.Y.
241+00 - 277+50	LAKE BUTTE DES MORTS DRIVE	12,978	12,978	12,978
TOTAL:		12,978	12,978	12,978

MISCELLANEOUS QUANTITIES

HWY: STH 110

COUNTY: WINNEBAGO

STATE PROJECT NO: 6200-05-71

SHEET NO:

3E E

ALL ITEMS & QUANTITIES ON THIS SHEET ARE
FOR CATEGORY 0010, UNLESS OTHERWISE NOTED.

PRIVATE/FIELD ENTRANCE PIPE SUMMARY

STATION	LOCATION	TYPE	** 52003 CP CLASS III 18" FT	THICKNESS STEEL (IN.)	THICKNESS ALUM. (IN.)	52061 CP APRON ENDWALLS 18" EACH	** 52178 SCPSS APRON ENDWALLS 18" EACH
209+00	LAKE BUTTE DES MORTS DRIVE LT.	P.E.	30	0.064	0.060	2	
209+00	LAKE BUTTE DES MORTS DRIVE RT.	P.E.	30	0.064	0.060	2	
229+07	LAKE BUTTE DES MORTS DRIVE LT.	P.E.	40	0.064	0.060	2	
272+00	LAKE BUTTE DES MORTS DRIVE LT.	F.E.	40	0.064	0.060	2	
272+25	LAKE BUTTE DES MORTS DRIVE RT.	P.E.	26	0.064	0.060	2	
275+50	LAKE BUTTE DES MORTS DRIVE RT.	P.E.	30	0.064	0.060	2	
284+90	N.W. FRONTAGE ROAD @ CTH T LT.	P.E.	44	0.064	0.060		2
38+00	CTH Y RT.	C.E.	42	0.064	0.060		2
38+75	CTH Y LT.	F.E.	26	0.064	0.060		2
39+55	CTH Y RT.	F.E.	26	0.064	0.060		2
40+30	CTH Y LT.	P.E.	30	0.064	0.060		2
41+10	CTH Y LT.	P.E.	28	0.064	0.060		2
20+22	OLD STH 110 PARKING LOT	C.E.	80	0.064	0.060		2
6+29	BROOKS ROAD RT.	F.E.	50	0.064	0.060	2	
10+20	BROOKS ROAD LT.	F.E.	116	0.064	0.060	2	
10+20	BROOKS ROAD RT.	F.E.	164	0.064	0.060	2	
12+75	BROOKS ROAD RT.	F.E.	154	0.064	0.060	2	
29+00	BROOKS ROAD RT.	F.E.	30	0.064	0.060		2
7+25	SKELETON BRIDGE ROAD RT.	P.E.	50	0.064	0.060	2	
8+70	SKELETON BRIDGE ROAD RT.	F.E.	66	0.064	0.060	2	
8+75	SKELETON BRIDGE ROAD LT.	P.E.	90	0.064	0.060	2	
25+45	SKELETON BRIDGE ROAD RT.	P.E.	70	0.064	0.060		2
41+50	TYERS DRIVEWAY	P.E.	26	0.064	0.060	2	
31+25	KOLB ROAD RT.	F.E.	26	0.064	0.060	2	
38+00	KOLB ROAD RT.	F.E.	26	0.064	0.060	2	
49+17	KOLB ROAD RT.	P.E.	40	0.064	0.060		2
56+00	KOLB ROAD LT.	F.E.	30	0.064	0.060		2
68+00	KOLB ROAD LT.	P.E.	56	0.064	0.060	2	
10+05	SPIEGELBERG ROAD RT.	C.E.	30	0.064	0.060		2
17+32	S.W. FRONTAGE ROAD @ STH 116 RT.	C.E.	76	0.064	0.06		2
TOTAL:			1,572			34	26

** MORE LISTED ELSEWHERE

MISCELLANEOUS QUANTITIES

HWY: STH 110

COUNTY: WINNEBAGO

STATE PROJECT NO: 6200-05-71

SHEET NO:

37 E

ALL ITEMS & QUANTITIES ON THIS SHEET ARE FOR CATEGORY 0010, UNLESS OTHERWISE NOTED.

CROSS DRAIN AND SIDEROAD PIPE SUMMARY (PIPES)

STATION	LOCATION	52203	52227	**	52023	52105	52205	52005	52007	52027	52029	52212	52136	52140	52340	52342	52142	52344	THICKNESS		INLET ELEV.	DISCH. ELEV.	
		RCCP III	RCCP IV	CP III	CP IV	CSCP III	RCCP III	CP III	CP III	CP IV	CP IV	RCCP III	CSPA	CSPA	RCHECP III	RCHECP III	CSPA	RCHECP III	STEEL INCHES	ALUM. INCHES			
108+00	STH 110 MEDIAN	18	18	18	18	24	24	24	30	30	36	54	21 x 15	42x 29	45 x 29	53 x 34	57 x 38	68 x 43			751.80	751.48	
114+00	STH 110						270														748.10	747.59	
129+00	STH 110 MEDIAN	84																			749.02	748.76	
137+00	STH 110 MEDIAN		110																		751.55	751.21	
150+00	STH 110 MEDIAN		86																		756.62	756.29	
156+00	STH 110 MEDIAN	86																			762.53	762.26	
162+00	STH 110 MEDIAN	100																			772.06	771.75	
170+00	STH 110 MEDIAN		82																		786.27	786.01	
178+50	STH 110							230												0.079	0.075	777.10	776.60
188+00	STH 110											232										785.00	783.00
189+50	STH 110 MEDIAN		120																		796.49	785.21	
198+00	STH 110 MEDIAN	108																			788.80	788.46	
204+00	STH 110 MEDIAN	94																			791.06	790.77	
209+60	STH 110											364									792.00	791.50	
211+00	STH 110 MEDIAN	86																			796.70	796.43	
218+00	STH 110 MEDIAN		82																		800.02	799.76	
228+00	STH 110 MEDIAN	88																			798.48	798.20	
228+30	STH 110															180					797.20	796.80	
236+00	STH 110 MEDIAN		84																		796.91	796.65	
244+00	STH 110 MEDIAN	84																			793.66	793.40	
250+45	STH 110																220				789.20	788.50	
252+00	STH 110 MEDIAN	84																			788.29	788.03	
260+00	STH 110 MEDIAN		76																		778.72	778.48	
268+00	STH 110 MEDIAN		84																		762.50	762.24	
272+65	STH 110																	352			755.63	755.00	
275+00	STH 110 MEDIAN	84																			757.74	757.48	
291+00	STH 110 MEDIAN		90																		767.01	766.73	
299+00	STH 110 MEDIAN		90																		772.63	771.79	
304+75	STH 110														344						776.30	775.70	
307+00	STH 110 MEDIAN		90																		777.90	776.96	
315+00	STH 110 MEDIAN	80																			782.92	782.67	
325+00	STH 110 MEDIAN	84																			786.42	786.16	
335+00	STH 110 MEDIAN	94																			785.40	785.11	
343+00	STH 110 MEDIAN		86																		783.00	782.73	
351+00	STH 110 MEDIAN		78																		776.12	775.87	
359+00	STH 110 MEDIAN		86																		763.00	762.73	
369+00	STH 110 MEDIAN		84																		782.40	782.14	
373+50	STH 110								196											0.079	0.075	772.70	770.80
375+00	STH 110								196											0.079	0.075	772.70	772.00
377+00	STH 110 MEDIAN	98																			794.00	793.69	
201+00	LAKE BUTTE DES MORTS DRIVE												48							0.064		750.70	750.60

CONTINUED ON NEXT SHEET

** MORE LISTED ELSEWHERE

SHEET 1 OF 2

MISCELLANEOUS QUANTITIES

HWY: STH 110

COUNTY: WINNEBAGO

STATE PROJECT NO: 6200-05-71

SHEET NO:

39 E

FILE NAME: Q:\MISC.QUANTITIES\6200-05-71\ENGSHEET1.PPT

ORIGINATOR:

ORIG. DATE:

REV. DATE:

ALL ITEMS & QUANTITIES ON THIS SHEET ARE FOR CATEGORY 0010, UNLESS OTHERWISE NOTED.

CROSS DRAIN AND SIDEROAD PIPE SUMMARY (PIPES) - CONTINUED

STATION	LOCATION	52203	52227	**	52023	52105	52205	52005	52007	52027	52029	52212	52136	52140	52340	52342	52142	52344	THICKNESS		INLET ELEV.	DISCH. ELEV.
		RCCP III	RCCP IV	CP III	CP IV	CSCP III	RCCP III	CP III	CP III	CP IV	CP IV	RCCP III	CSPA	CSPA	RCHECP III	RCHECP III	CSPA	RCHECP III	STEEL INCHES	ALUM. INCHES		
		18 L.F.	18 L.F.	18 L.F.	18 L.F.	24 L.F.	24 L.F.	24 L.F.	30 L.F.	30 L.F.	36 L.F.	54 L.F.	21 x 15 L.F.	42x 29 L.F.	45 x 29 L.F.	53 x 34 L.F.	57 x 38 L.F.	68 x 43 L.F.				
215+50	LAKE BUTTE DES MORTS DRIVE																390		0.109		750.65	750.20
263+00	LAKE BUTTE DES MORTS DRIVE			62															0.064	0.060	751.10	750.30
270+30	LAKE BUTTE DES MORTS DRIVE																160		0.109		753.40	751.15
25+00	CTH T								64										0.079	0.075	756.00	755.00
27+00	CTH T					92													0.064		754.00	753.60
29+20	CTH T												96						0.079		754.45	754.05
283+00	NW FRONTAGE ROAD @ CTH T			54															0.079	0.075	762.40	760.30
35+85	CTH Y			196															0.064	0.060	782.00	777.02
36+00	CTH Y								50										0.079	0.075	780.50	777.02
16+75	BROOKS ROAD				200														0.079	0.105	780.70	776.90
19+50	BROOKS ROAD										200								0.079	0.105	777.60	774.50
13+80	SKELETON BRIDGE ROAD									200									0.079	0.075	763.90	762.60
15+30	SKELETON BRIDGE ROAD				150														0.079	0.105	767.20	766.15
16+60	SKELETON BRIDGE ROAD									200									0.079	0.075	769.17	766.00
18+70	SKELETON BRIDGE ROAD										142								0.079	0.105	766.35	764.80
30+50	SHAMMY LANE			70															0.064	0.060	773.10	772.50
35+50	SHAMMY LANE			46															0.064	0.060	767.69	767.51
16+00	KOLB ROAD							46											0.064	0.075	777.80	777.60
48+00	KOLB ROAD								44										0.079	0.075	785.90	785.70
71+35	KOLB ROAD																90		0.109		760.96	760.79
21+00	SPIEGELBERG ROAD			68															0.064	0.060	782.10	780.53
374+50	NE RAMP @ STH 116							66													770.60	770.30
371+00	SW RAMP @ STH 116	98																			772.70	769.60
372+50	SE RAMP @ STH 116							72													770.50	769.00
TOTAL:		1,454	1,328	496	350	92	408	46	780	400	342	596	48	96	344	400	640	352				

** MORE LISTED ELSEWHERE

SHEET 2 OF 2

MISCELLANEOUS QUANTITIES

HWY: STH 110

COUNTY: WINNEBAGO

STATE PROJECT NO: 6200-05-71

SHEET NO:

34 E

ALL ITEMS & QUANTITIES ON THIS SHEET ARE FOR CATEGORY 0010, UNLESS OTHERWISE NOTED.

CROSS DRAIN AND SIDEROAD PIPE SUMMARY (ENDWALLS)

STATION	LOCATION	52262	**	52180	52151	52264	52065	52181	52266	52067	52182	52270	52191	52166	52365	52367	52197	52369	
		RCCP	52178 SCPSS	SCPSS	CP	RCCP	CP	SCPSS	RCCP	CP	SCPSS	RCCP	SCPSS	SPA	RCHECP	RCHECP	SCPSS	RCHECP	
		APRON ENDWALLS																	
		18	18	24	24	24	30	30	30	36	36	54	21 x 15	42 x 29	45 x 29	53 x 34	57 x 38	68 x 43	
		EACH	EACH	EACH	EACH	EACH	EACH	EACH	EACH	EACH	EACH	EACH	EACH	EACH	EACH	EACH	EACH	EACH	
108+00	STH 110 MEDIAN	1																	
114+00	STH 110					2													
129+00	STH 110 MEDIAN	1																	
137+00	STH 110 MEDIAN	1																	
150+00	STH 110 MEDIAN	1																	
156+00	STH 110 MEDIAN	1																	
162+00	STH 110 MEDIAN	1																	
170+00	STH 110 MEDIAN	1																	
178+50	STH 110								2										
188+00	STH 110											2							
189+50	STH 110 MEDIAN	1																	
198+00	STH 110 MEDIAN	1																	
204+00	STH 110 MEDIAN	1																	
209+60	STH 110											4							
211+00	STH 110 MEDIAN	1																	
218+00	STH 110 MEDIAN	1																	
228+00	STH 110 MEDIAN	1																	
228+30	STH 110																		
236+00	STH 110 MEDIAN	1														2			
244+00	STH 110 MEDIAN	1																	
250+45	STH 110																2		
252+00	STH 110 MEDIAN	1																	
260+00	STH 110 MEDIAN	1																	
268+00	STH 110 MEDIAN	1																	
272+65	STH 110																		4
275+00	STH 110 MEDIAN	1																	
291+00	STH 110 MEDIAN	1																	
299+00	STH 110 MEDIAN	1																	
304+75	STH 110														4				
307+00	STH 110 MEDIAN	1																	
315+00	STH 110 MEDIAN	1																	
325+00	STH 110 MEDIAN	1																	
335+00	STH 110 MEDIAN	1																	
343+00	STH 110 MEDIAN	1																	
351+00	STH 110 MEDIAN	1																	
359+00	STH 110 MEDIAN	1																	
369+00	STH 110 MEDIAN	1																	
373+50	STH 110								2										
375+00	STH 110								2										
377+00	STH 110 MEDIAN	1																	
201+00	LAKE BUTTE DES MORTS DRIVE												2						

CONTINUED ON NEXT SHEET

SHEET 1 OF 2

MISCELLANEOUS QUANTITIES

HWY: STH 110

COUNTY: WINNEBAGO

STATE PROJECT NO: 6200-05-71

SHEET NO:

31 E

FILE NAME: Q:\MISC.QUANTITIES\6200-05-71\ENGSHEET1.PPT

ORIGINATOR:

ORIG. DATE:

REV. DATE:

ALL ITEMS & QUANTITIES ON THIS SHEET ARE
FOR CATEGORY 0010, UNLESS OTHERWISE NOTED.

CROSS DRAIN AND SIDEROAD PIPE SUMMARY (ENDWALLS) - CONTINUED

STATION	LOCATION	**																
		52262 RCCP	52178 SCPSS	52180 SCPSS	52151 CP	52264 RCCP	52065 CP	52181 SCPSS	52266 RCCP	52067 CP	52182 SCPSS	52270 RCCP	52191 SCPSS	52166 SPA	52365 RCHECP	52367 RCHECP	52197 SCPSS	52369 RCHECP
APRON ENDWALLS																		
		18 EACH	18 EACH	24 EACH	24 EACH	24 EACH	30 EACH	30 EACH	30 EACH	36 EACH	36 EACH	54 EACH	21 x 15 EACH	42 x 29 EACH	45 x 29 EACH	53 x 34 EACH	57 x 38 EACH	68 x 43 EACH
215+50	LAKE BUTTE DES MORTS DRIVE																	
263+00	LAKE BUTTE DES MORTS DRIVE		2															
270+30	LAKE BUTTE DES MORTS DRIVE																	
25+00	CTH T						1	1										
27+00	CTH T				2													
29+20	CTH T													2				
283+00	NW FRONTAGE ROAD @ CTH T		2															
35+85	CTH Y		2															
36+00	CTH Y						2											
16+75	BROOKS ROAD		2															
19+50	BROOKS ROAD									2								
13+80	SKELETON BRIDGE ROAD						2											
15+30	SKELETON BRIDGE ROAD		2															
16+60	SKELETON BRIDGE ROAD						2											
18+70	SKELETON BRIDGE ROAD								2									
30+50	SHAMMY LANE		2															
35+50	SHAMMY LANE		2															
16+00	KOLB ROAD			2														
48+00	KOLB ROAD						2											
71+35	KOLB ROAD																4	
21+00	SPIEGELBERG ROAD		2															
374+50	NE RAMP @ STH 116					2												
371+00	SW RAMP @ STH 116	2																
372+50	SE RAMP @ STH 116					2												
TOTAL:		32	16	2	2	6	7	3	6	2	2	6	2	2	4	4	4	4

** MORE LISTED ELSEWHERE

ALL ITEMS & QUANTITIES ON THIS SHEET ARE FOR CATEGORY 0010, UNLESS OTHERWISE NOTED.

CROSS DRAIN AND SIDEROAD PIPE SUMMARY (MISCELLANEOUS)

STATION	LOCATION	50409 CONCRETE MASONRY, ENDWALLS C.Y.	90590 PIPE GRATES EACH	* JOINT TIES EACH	90616 MARKER POSTS FLEXIBLE EACH	** 60604 MEDIUM RANDOM RIPRAP C.Y.	** 64505 GEO. FABRIC TYPE R S.Y.	REMARKS
108+00	STH 110 MEDIAN			4	1	3	12	
114+00	STH 110			8	2			MEDIAN DRAIN TIE-IN
129+00	STH 110 MEDIAN			4	1	3	12	
137+00	STH 110 MEDIAN			4	1	3	12	
150+00	STH 110 MEDIAN			4	1	3	12	
156+00	STH 110 MEDIAN			4	1	3	12	
162+00	STH 110 MEDIAN			4	1	3	12	
170+00	STH 110 MEDIAN			4	1	3	12	
178+50	STH 110			8	2			10° LHF
188+00	STH 110			8	2	3	12	
189+50	STH 110 MEDIAN			4	1	3	12	SEE CONSTRUCTION DETAIL
198+00	STH 110 MEDIAN			4	1	3	12	
204+00	STH 110 MEDIAN			4	1	3	12	
209+60	STH 110			16	2	21	54	2 PIPES AT 182'
211+00	STH 110 MEDIAN			4	1	3	12	
218+00	STH 110 MEDIAN			4	1	3	12	
228+00	STH 110 MEDIAN			4	1	3	12	
228+30	STH 110			8	2	9	26	
236+00	STH 110 MEDIAN			4	1	3	12	
244+00	STH 110 MEDIAN			4	1	3	12	
250+45	STH 110			8	2	9	26	33° LHF
252+00	STH 110 MEDIAN			4	1	3	12	
260+00	STH 110 MEDIAN			4	1	3	12	
268+00	STH 110 MEDIAN			4	1	3	12	
272+65	STH 110			16	2	21	54	2 PIPES AT 176'
275+00	STH 110 MEDIAN			4	1	3	12	
291+00	STH 110 MEDIAN			4	1	3	12	
299+00	STH 110 MEDIAN			4	1	3	12	
304+75	STH 110		2	16	2	8	24	2 - 45" x 29" PIPES AT 172' - 17° RHF
307+00	STH 110 MEDIAN			4	1	3	12	
315+00	STH 110 MEDIAN			4	1	3	12	
325+00	STH 110 MEDIAN			4	1	3	12	
335+00	STH 110 MEDIAN			4	1	3	12	
343+00	STH 110 MEDIAN			4	1	3	12	
351+00	STH 110 MEDIAN			4	1	3	12	
359+00	STH 110 MEDIAN			4	1	3	12	
369+00	STH 110 MEDIAN			4	1	3	12	
373+50	STH 110			8	2			20° LHF
375+00	STH 110			8	2			15° LHF
377+00	STH 110 MEDIAN			4	1	3	12	
201+00	LAKE BUTTE DES MORTS DRIVE				2			26° LHF

CONTINUED ON NEXT SHEET

* NON-BID ITEM FOR INFORMATION ONLY
** MORE LISTED ELSEWHERE

SHEET 1 OF 2

MISCELLANEOUS QUANTITIES

HWY: STH 110

COUNTY: WINNEBAGO

STATE PROJECT NO: 6200-05-71

SHEET NO:

3K E

ALL ITEMS & QUANTITIES ON THIS SHEET ARE
FOR CATEGORY 0010, UNLESS OTHERWISE NOTED.

CROSS DRAIN AND SIDEROAD PIPE SUMMARY (MISCELLANEOUS) - CONTINUED

STATION	LOCATION	50409 CONCRETE MASONRY, ENDWALLS C.Y.	90590 PIPE GRATES EACH	* JOINT TIES EACH	90616 MARKER POSTS FLEXIBLE EACH	** 60604 MEDIUM RANDOM RIPRAP C.Y.	** 64505 GEO. FABRIC TYPE R S.Y.	REMARKS
215+50	LAKE BUTTE DES MORTS DRIVE	6			2	84	212	3 PIPES AT 130' - 53° RHF
263+00	LAKE BUTTE DES MORTS DRIVE				2			
270+30	LAKE BUTTE DES MORTS DRIVE	6			2	21	56	3 PIPES AT 53' - 23° RHF
25+00	CTH T				2			
27+00	CTH T				2	5	16	11° RHF
29+20	CTH T				2	8	25	
283+00	NW FRONTAGE ROAD @ CTH T				2	4	13	
35+85	CTH Y				2			25° RHF
36+00	CTH Y				2	5	17	
16+75	BROOKS ROAD				2			43° RHF
19+50	BROOKS ROAD				2	4	13	43° RHF
13+80	SKELETON BRIDGE ROAD				2	6	19	40° LHF
15+30	SKELETON BRIDGE ROAD				2			36° LHF
16+60	SKELETON BRIDGE ROAD				2	6	19	27° LHF
18+70	SKELETON BRIDGE ROAD				2	7	21	55° LHF
30+50	SHAMMY LANE				2			
35+50	SHAMMY LANE				2			
16+00	KOLB ROAD				2	4	13	
48+00	KOLB ROAD				2	6	19	
71+35	KOLB ROAD				2	72	173	2 PIPES AT 45'
21+00	SPIEGELBERG ROAD				2			
374+50	NE RAMP @ STH 116			8	2	4	15	29° LHF
371+00	SW RAMP @ STH 116			8	2	3	12	
372+50	SE RAMP @ STH 116			8	2	4	15	
TOTAL:		12	2	248	100	404	1,214	

* NON-BID ITEM, FOR INFORMATION ONLY
** MORE LISTED ELSEWHERE

SHEET 2 OF 2

MISCELLANEOUS QUANTITIES

HWY: STH 110

COUNTY: WINNEBAGO

STATE PROJECT NO: 6200-05-71

SHEET NO:

31 E

FILE NAME: Q:\MISC.QUANTITIES\6200-05-71\ENGSHEET1.PPT

ORIGINATOR:

ORIG. DATE:

REV. DATE:

ALL ITEMS & QUANTITIES ON THIS SHEET ARE FOR CATEGORY 0010, UNLESS OTHERWISE NOTED.

CONCRETE GUTTER, 24-INCH

STATION - STATION	LOCATION	60113 L.F.
247+82 - 248+95	LAKE BUTTE DES MORTS DRIVE	230
252+98 - 254+10	LAKE BUTTE DES MORTS DRIVE	225
TOTAL:		455

CONCRETE SIDEWALK, 4-INCH

STATION - STATION	LOCATION	60204 S.F.
30+00 - 34+50	CTH Y	2,350
TOTAL:		2,350

CONCRETE BARRIER, SINGLE FACED

STATION - STATION	LOCATION	60302 S.F.
30+00 - 34+50	CTH Y	450
TOTAL:		450

CONCRETE CURB AND GUTTER

STATION - STATION	LOCATION	60133 30-INCH TYPE D L.F.	60136 30-INCH TYPE J L.F.	90030A 30-INCH TYPE D INTEGRAL L.F.
205+00 - 241+00	LAKE BUTTE DES MORTS DRIVE	7200		
241+00 - 247+82	LAKE BUTTE DES MORTS DRIVE			1,364
248+95 - 249+65	LAKE BUTTE DES MORTS DRIVE			140
252+27 - 252+98	LAKE BUTTE DES MORTS DRIVE			145
254+10 - 277+50	LAKE BUTTE DES MORTS DRIVE			4,680
277+50 - 278+50	LAKE BUTTE DES MORTS DRIVE	200		
30+00 - 34+50	CTH Y		450	
TOTAL:		7,400	450	6,329

RIPRAP ITEMS

STATION - STATION	LOCATION	60602 HEAVY RIPRAP C.Y.	** 60604 MEDIUM RANDOM RIPRAP C.Y.	** 64505 GEO. FABRIC TYPE R S.Y.	64506 GEO. FABRIC TYPE HR S.Y.
	WETLAND MITIGATION SITE INLET (SOUTH)		60.3	155.8	
	WETLAND MITIGATION SITE INLET (NORTH)		45.9	119.7	
	WETLAND MITIGATION SITE INLET (EAST)		74.8	182.6	
	WETLAND MITIGATION SITE INLET (WIER)	125			175
278+10 - 278+50	STH 110 SB, LT.	39			
278+50 - 279+20	STH 110 SB, LT.	83			
279+20 - 279+60	STH 110 SB, LT.	54			
TOTAL:		301	181	458	175

** MORE LISTED ELSEWHERE

ROCK EXCAVATION FOR STORM SEWER

STATION - STATION	LOCATION	60721 ROCK EXCAVATION FOR STORM SEWER C.Y.
259+00 - 260+00	STH 110 NB	15
TOTAL:		15

STORM SEWER SUMMARY

FROM	TO	60825 RCP CLASS III STORM SEWER 12" L.F.	INLET ELEVATION	DISCHARGE ELEVATION
43	44	35	753.21	752.16
44	45	26	752.06	744.26
46	47	35	752.36	751.22
47	48	26		
49	50	35		
50	51	20		
52	53	35		
53	54	25		
55	56	35		
56	57	33	749.66	749.00
58	59	35	749.14	748.44
59	60	35	748.34	747.64
61	62	35	749.12	748.42
62	63	39	748.32	747.54
64	65	35	748.49	747.79
65	66	38	747.69	746.93
67	68	35	748.25	747.55
68	69	24	747.45	746.97
70	71	35	749.36	748.40
71	72	25	748.30	747.61
73	74	35	749.70	749.35
74	75	20	749.25	749.05
76	77	35	750.34	750.10
77	78	19	750.00	749.87
79	80	35	752.00	751.65
80	81	15	751.55	751.40
82	83	35	753.19	752.14
83	84	25	752.04	751.29
85	86	35	756.62	755.92
86	87	27	755.82	755.28
88	73	15	750.30	749.70
TOTAL:		937		

REVISIONS ATTACHED TO BACK OF PLAN

MISCELLANEOUS QUANTITIES

HWY: STH 110

COUNTY: WINNEBAGO

STATE PROJECT NO: 6200-05-71

SHEET NO:

3M | E

ALL ITEMS & QUANTITIES ON THIS SHEET ARE FOR CATEGORY 0010, UNLESS OTHERWISE NOTED.

INLETS AND ENDWALLS

STR. NO.	STATION	OFFSET	LOCATION	GRATE ELEVATION	TOP OF STRUCTURE ELEVATION	FLOWLINE ELEVATION	INV. DEPTH FT	61122 INLETS TYPE 3 EACH	61167 INLET COVERS TYPE H EACH	52260 RCCP A.E.W. 12" EACH
43	212+30	17'RT.	LAKE BUTTE DES MORTS DRIVE	757.09	756.21	753.21	3.00	1	1	
44	212+30	17'LT.	LAKE BUTTE DES MORTS DRIVE	757.09	756.21	752.06	4.15	1	1	
45	212+30	43'LT.	LAKE BUTTE DES MORTS DRIVE			744.26				1
46	216+12	17'RT.	LAKE BUTTE DES MORTS DRIVE	756.23	755.36	752.36	3.00	1	1	
47	216+12	17'LT.	LAKE BUTTE DES MORTS DRIVE	756.23	755.36	751.21	4.14	1	1	
48	216+12	43'LT.	LAKE BUTTE DES MORTS DRIVE			743.41				1
49	220+50	17'RT.	LAKE BUTTE DES MORTS DRIVE	757.31	756.44	753.44	2.99	1	1	
50	220+50	17'LT.	LAKE BUTTE DES MORTS DRIVE	757.31	756.44	752.68	3.76	1	1	
51	220+50	37'LT.	LAKE BUTTE DES MORTS DRIVE			752.30				1
52	225+00	17'RT.	LAKE BUTTE DES MORTS DRIVE	760.07	759.20	756.20	3.00	1	1	
53	225+00	17'LT.	LAKE BUTTE DES MORTS DRIVE	760.07	759.20	754.98	4.22	1	1	
54	225+00	42'LT.	LAKE BUTTE DES MORTS DRIVE			754.18				1
55	237+00	17'RT.	LAKE BUTTE DES MORTS DRIVE	761.20	760.33	750.46	9.87	1	1	
56	237+00	17'LT.	LAKE BUTTE DES MORTS DRIVE	761.20	760.33	749.66	10.67	1	1	
57	237+00	50'LT.	LAKE BUTTE DES MORTS DRIVE			749.00				1
58	240+90	17'RT.	LAKE BUTTE DES MORTS DRIVE	759.33	758.46	749.14	9.32	1	1	
59	240+90	17'LT.	LAKE BUTTE DES MORTS DRIVE	759.33	758.46	748.34	10.12	1	1	
60	240+90	52'LT.	LAKE BUTTE DES MORTS DRIVE			747.64				1
61	244+80	17'RT.	LAKE BUTTE DES MORTS DRIVE	757.46	756.59	749.12	7.47	1	1	
62	244+80	17'LT.	LAKE BUTTE DES MORTS DRIVE	757.46	756.59	748.32	8.26	1	1	
63	244+80	56'LT.	LAKE BUTTE DES MORTS DRIVE			747.54				1
64	248+70	17'RT.	LAKE BUTTE DES MORTS DRIVE	755.58	754.71	748.49	6.22	1	1	
65	248+70	17'LT.	LAKE BUTTE DES MORTS DRIVE	755.58	754.71	747.69	7.01	1	1	
66	248+70	55'LT.	LAKE BUTTE DES MORTS DRIVE			746.93				1
67	252+60	17'RT.	LAKE BUTTE DES MORTS DRIVE	753.84	752.97	748.25	4.72	1	1	
68	252+60	17'LT.	LAKE BUTTE DES MORTS DRIVE	753.84	752.97	747.45	5.51	1	1	
69	252+60	41'LT.	LAKE BUTTE DES MORTS DRIVE			746.97				1
70	256+24	17'RT.	LAKE BUTTE DES MORTS DRIVE	753.23	752.36	749.36	3.00	1	1	
71	256+24	17'LT.	LAKE BUTTE DES MORTS DRIVE	753.23	752.36	748.30	4.06	1	1	
72	256+24	42'LT.	LAKE BUTTE DES MORTS DRIVE			747.61				1
73	259+00	17'RT.	LAKE BUTTE DES MORTS DRIVE	753.57	752.70	749.70	3.00	1	1	
74	259+00	17'LT.	LAKE BUTTE DES MORTS DRIVE	753.57	752.70	749.25	3.45	1	1	
75	259+00	37'LT.	LAKE BUTTE DES MORTS DRIVE			749.05				1
76	261+50	17'RT.	LAKE BUTTE DES MORTS DRIVE	754.21	753.34	750.34	3.00	1	1	
77	261+50	17'LT.	LAKE BUTTE DES MORTS DRIVE	754.21	753.34	750.00	3.34	1	1	
78	261+50	36'LT.	LAKE BUTTE DES MORTS DRIVE			749.87				1
79	265+40	17'RT.	LAKE BUTTE DES MORTS DRIVE	755.19	754.57	752.00	2.57	1	1	
80	265+40	17'LT.	LAKE BUTTE DES MORTS DRIVE	755.19	754.57	751.55	3.02	1	1	
81	265+40	32'LT.	LAKE BUTTE DES MORTS DRIVE			751.40				1
82	269+30	17'RT.	LAKE BUTTE DES MORTS DRIVE	757.06	756.19	753.19	2.99	1	1	
83	269+30	17'LT.	LAKE BUTTE DES MORTS DRIVE	757.06	756.19	752.04	4.14	1	1	
84	269+30	42'LT.	LAKE BUTTE DES MORTS DRIVE			751.29				1
85	273+20	17'RT.	LAKE BUTTE DES MORTS DRIVE	761.38	760.51	756.62	3.88	1	1	
86	273+20	17'LT.	LAKE BUTTE DES MORTS DRIVE	761.38	760.51	755.82	4.68	1	1	
87	273+20	44'LT.	LAKE BUTTE DES MORTS DRIVE			755.28				1
88	259+00	32' RT.	LAKE BUTTE DES MORTS DRIVE			750.30				1

TOTAL:

30 30 16

MISCELLANEOUS QUANTITIES

HWY: STH 110

COUNTY: WINNEBAGO

STATE PROJECT NO: 6200-05-71

SHEET NO:

3N E

ALL ITEMS & QUANTITIES ON THIS SHEET ARE
FOR CATEGORY 0010, UNLESS OTHERWISE NOTED.

MEDIAN DRAINAGE PIPES, INLETS AND COVERS

STATION	LOCATION	GRATE ELEVATION	FLOWLINE ELEVATION	INV. DEPTH L.F.	61123 INLETS TYPE 8 EACH	90005H INLETS TYPE 8 SPECIAL EACH	61124 INLETS TYPE 9 EACH	61170 COVER TYPE MS EACH	DIRECTION OF OUTLET	REMARKS
98+00	STH 110 MEDIAN	758.00	755.92	2.08		1		1	NORTHBOUND LANE	
108+00	STH 110 MEDIAN	757.80	751.80	6.00	1			1	NORTHBOUND LANE	
114+00	STH 110 MEDIAN	756.13	747.86	8.27			1	2	SOUTHBOUND LANE	TAP INTO CROSS-OVER PIPE
129+00	STH 110 MEDIAN	751.10	749.02	2.08		1		1	NORTHBOUND LANE	
137+00	STH 110 MEDIAN	753.63	751.55	2.08		1		1	SOUTHBOUND LANE	CROSS TO 2ND DITCH (LBDM DRIVE)
150+00	STH 110 MEDIAN	758.70	756.62	2.08		1		1	SOUTHBOUND LANE	
156+00	STH 110 MEDIAN	765.53	762.53	3.00	1			1	SOUTHBOUND LANE	
162+00	STH 110 MEDIAN	775.06	772.06	3.00	1			1	NORTHBOUND LANE	
170+00	STH 110 MEDIAN	788.35	786.27	2.08		1		1	NORTHBOUND LANE	
189+50	STH 110 MEDIAN	798.57	796.49	2.08		1		1	SOUTHBOUND LANE	SEE CONSTRUCTION DETAIL
198+00	STH 110 MEDIAN	794.80	788.80	6.00	1			1	SOUTHBOUND LANE	
204+00	STH 110 MEDIAN	797.06	791.06	6.00	1			1	SOUTHBOUND LANE	
211+00	STH 110 MEDIAN	799.70	796.70	3.00	1			1	SOUTHBOUND LANE	
218+00	STH 110 MEDIAN	802.10	800.02	2.08		1		1	SOUTHBOUND LANE	
228+00	STH 110 MEDIAN	801.48	798.48	3.00	1			1	NORTHBOUND LANE	
236+00	STH 110 MEDIAN	798.99	796.91	2.08		1		1	NORTHBOUND LANE	
244+00	STH 110 MEDIAN	795.74	793.66	2.08		1		1	NORTHBOUND LANE	
252+00	STH 110 MEDIAN	791.29	788.29	3.00	1			1	SOUTHBOUND LANE	
260+00	STH 110 MEDIAN	780.80	778.72	2.08		1		1	NORTHBOUND LANE	
268+00	STH 110 MEDIAN	765.50	762.50	3.00	1			1	NORTHBOUND LANE	
275+00	STH 110 MEDIAN	759.82	757.74	2.08		1		1	SOUTHBOUND LANE	
291+00	STH 110 MEDIAN	770.01	767.01	3.00	1			1	SOUTHBOUND LANE	
299+00	STH 110 MEDIAN	775.63	772.63	3.00	1			1	SOUTHBOUND LANE	
307+00	STH 110 MEDIAN	780.90	777.90	3.00	1			1	SOUTHBOUND LANE	
315+00	STH 110 MEDIAN	785.00	782.92	2.08		1		1	SOUTHBOUND LANE	
325+00	STH 110 MEDIAN	788.50	786.42	2.08		1		1	SOUTHBOUND LANE	
335+00	STH 110 MEDIAN	788.40	785.40	3.00	1			1	SOUTHBOUND LANE	
343+00	STH 110 MEDIAN	786.00	783.00	3.00	1			1	NORTHBOUND LANE	
351+00	STH 110 MEDIAN	778.20	776.12	2.08		1		1	NORTHBOUND LANE	
359+00	STH 110 MEDIAN	766.00	763	3.00	1			1	NORTHBOUND LANE	OUTLET HIGH ON SLOPE
369+00	STH 110 MEDIAN	785.40	782.4	3.00	1			1	NORTHBOUND LANE	OUTLET HIGH ON SLOPE
377+00	STH 110 MEDIAN	800.00	794	6.00	1			1	NORTHBOUND LANE	OUTLET HIGH ON SLOPE
TOTAL:					17	14	1	33		

MISCELLANEOUS QUANTITIES

HWY: STH 110

COUNTY: WINNEBAGO

STATE PROJECT NO: 6200-05-71

SHEET NO:

30 E

ALL ITEMS & QUANTITIES ON THIS SHEET ARE FOR CATEGORY 0010, UNLESS OTHERWISE NOTED.

PIPE UNDERDRAIN SUMMARY

STATION - STATION	LOCATION	61201 PIPE UNDERDRAIN 6-INCH L.F.	61202 PIPE UNDERDRAIN 8-INCH L.F.	61211 PIPE UNDERDRAIN, UNPERFORATED, 6-INCH L.F.	64503 GEOTEXTILE FABRIC TYPE DF S.Y.
131+60	STH 110 NB & SB	270			188
131+60 - 137+00	STH 110 NB, RT.	540			375
137+00	STH 110 NB, RT.			5	
31+70	CTH T	390			271
150+75	STH 110 NB & SB	520			361
160+05	STH 110 NB & SB	250			174
160+00 - 162+00	STH 110 NB, LT.	200			139
190+40	STH 110 NB & SB	310			215
267+40 - 275+30	STH 110 NB, RT.	790			549
272+40	STH 110 NB & SB		250		174
290+65	STH 110 NB & SB	250			174
17+20 - 26+15	RECREATION TRAIL, RT.		895		622
TOTAL:		3,520	1,145	5	3,240

BEAM GUARD SUMMARY

STATION - STATION	LOCATION	61407 STEEL THRIVE BEAM STRUCTURE APPROACH L.F.	61408 STEEL PLATE BEAM GUARD CLASS A L.F.	61409 STEEL PLATE BEAM GUARD CLASS B L.F.	61435 STEEL PLATE BEAM GUARD ENERGY ABSORBING TERMINAL EACH
248+69.46 - 249+64.61	LAKE BUTTE DES MORTS DRIVE, RT.	33.15			1
248+61.46 - 249+44.61	LAKE BUTTE DES MORTS DRIVE, LT.	33.15			1
252+39.17 - 253+22.32	LAKE BUTTE DES MORTS DRIVE, RT.	33.15			1
252+47.17 - 253+30.32	LAKE BUTTE DES MORTS DRIVE, LT.	33.15			1
15+63.30 - 16+83.95	BROOKS ROAD, RT.	33.15	37.5		1
16+00.80 - 16+83.95	BROOKS ROAD, LT.	33.15			1
19+37.25 - 20+20.40	BROOKS ROAD, RT.	33.15			1
19+37.25 - 20+57.90	BROOKS ROAD, LT.	33.15	37.5		1
12+51.85 - 13+72.50	SKELETON BRIDGE ROAD, RT.	33.15	37.5		1
12+89.35 - 13+72.50	SKELETON BRIDGE ROAD, LT.	33.15			1
16+66.36 - 17+49.51	SKELETON BRIDGE ROAD, RT.	33.15			1
16+74.36 - 17+95.01	SKELETON BRIDGE ROAD, LT.	33.15	37.5		1
	LUEBKE ROAD CUL-DE-SAC			100	
	SPIEGELBERG ROAD CUL-DE-SAC			100	
TOTAL:		397.8	150	200	12

DRAIN TILE EXPLORATION

STATION - STATION	LOCATION	61251 L.F.
256+50 - 260+50	LAKE BUTTE DES MORTS DRIVE, LT.	400
269+00 - 271+00	LAKE BUTTE DES MORTS DRIVE, LT.	200
276+50 - 277+50	LAKE BUTTE DES MORTS DRIVE, LT.	100
31+50 - 32+50	CTH T, RT.	100
24+50 - 26+50	CTH T, LT.	200
283+00 - 284+00	NW FRONTAGE ROAD @ CTH T	100
150+00 - 151+50	STH 110 NB, RT.	150
159+50 - 161+00	STH 110 NB, RT.	150
159+50 - 162+00	STH 110 NB, LT.	250
189+00 - 191+00	STH 110 NB, LT.	200
228+00 - 229+00	STH 110 NB, RT.	100
249+50 - 250+50	STH 110 NB, RT.	100
267+00 - 268+00	STH 110 NB, RT.	100
271+00 - 273+00	STH 110 NB, RT.	200
272+00 - 273+00	STH 110 NB, LT.	100
275+00 - 276+00	STH 110 NB, RT.	100
291+00 - 292+00	STH 110 NB, LT.	100
294+50 - 295+50	STH 110 NB, RT.	100
308+50 - 309+50	STH 110 NB, LT.	100
17+00 - 26+50	RECREATION TRAIL, RT.	950
15+50 - 16+50	CROSS ROAD, RT.	100
	UNDISTRIBUTED	390
TOTAL:		4,290

LANDMARK REFERENCE MONUMENTS AND CAST IRON COVERS

CORNER	SECTION	TOWN	RANGE	62111 LANDMARK REFERENCE MONUMENTS AND CAST IRON COVERS EACH
NW	34	T-19-N	R-16-E	4
W 1/4	34	T-19-N	R-16-E	4
CENTER	33	T-19-N	R-16-E	4
N 1/4	33	T-19-N	R-16-E	4
E 1/4	29	T-19-N	R-16-E	4
N 1/4	29	T-19-N	R-16-E	4
NW	29	T-19-N	R-16-E	4
E 1/4	19	T-19-N	R-16-E	4
CENTER	19	T-19-N	R-16-E	4
W 1/4	19	T-19-N	R-16-E	4
NW	19	T-19-N	R-16-E	4
N 1/4	24	T-19-N	R-15-E	4
CENTER	13	T-19-N	R-15-E	4
E 1/4	11	T-19-N	R-15-E	4
NE	11	T-19-N	R-15-E	4
TOTAL:				60

MISCELLANEOUS QUANTITIES

HWY: STH 110

COUNTY: WINNEBAGO

STATE PROJECT NO: 6200-05-71

SHEET NO:

3P E

ALL ITEMS & QUANTITIES ON THIS SHEET ARE FOR CATEGORY 0010, UNLESS OTHERWISE NOTED.

RIGHT-OF-WAY MARKER POST SUMMARY

STATION	LEFT OFFSET	LOCATION	61422 EACH	PLATE REQUIRED
151+47.37	403.37	STH 110	1	X
154+00	275	STH 110	1	X
156+50	200	STH 110	1	X
159+25	175	STH 110	1	
162+00	150	STH 110	1	X
166+00	150	STH 110	1	X
169+00	147.5	STH 110	1	
172+00	145	STH 110	1	X
178+31.89	403.41	STH 110	1	X
178+37.6	179.71	STH 110	1	X
182+22.04	180	STH 110	1	X
182+22.61	265.03	STH 110	1	X
186+50	221.89	STH 110	1	
190+64.93	180	STH 110	1	X
194+03.22	180	STH 110	1	X
199+00	180	STH 110	1	
204+00	180	STH 110	1	
209+00	180	STH 110	1	
214+27.85	180	STH 110	1	X
217+13.93	165	STH 110	1	
220+00	150	STH 110	1	X
225+00	150	STH 110	1	
230+00	150	STH 110	1	
235+00	150	STH 110	1	
240+00	150	STH 110	1	
245+00	150	STH 110	1	
249+00	150	STH 110	1	X
251+00	170	STH 110	1	X
254+24.51	172.5	STH 110	1	
257+49.01	175	STH 110	1	X
259+41.44	140.61	STH 110	1	X
260+46.11	154.58	STH 110	1	X
262+00	150	STH 110	1	X
271+38.94	175	STH 110	1	X
274+08.31	162.5	STH 110	1	
276+77.68	150	STH 110	1	X
281+00	160	STH 110	1	X
282+49.78	207.28	STH 110	1	X
289+00	175	STH 110	1	X
292+00	175	STH 110	1	
295+00	175	STH 110	1	
SUBTOTAL:			41	

STATION	LEFT OFFSET	LOCATION	61422 EACH	PLATE REQUIRED
298+00	175	STH 110	1	
301+00	175	STH 110	1	
304+00	175	STH 110	1	
307+00	175	STH 110	1	
310+00	175	STH 110	1	
312+05.66	175	STH 110	1	X
315+00	150	STH 110	1	X
318+00	150	STH 110	1	
321+00	150	STH 110	1	X
326+00	150	STH 110	1	X
326+80	260	STH 110	1	X
327+80	270	STH 110	1	X
328+50	210	STH 110	1	X
335+50	260	STH 110	1	X
338+00	310	STH 110	1	X
338+77.44	312.73	STH 110	1	X
338+96.02	249.83	STH 110	1	X
339+20.87	175	STH 110	1	X
342+00	175	STH 110	1	
345+00	175	STH 110	1	
348+00	175	STH 110	1	
351+00	175	STH 110	1	
354+00	175	STH 110	1	
200+53.85	60	LAKE BUTTES DES MORTS DRIVE	1	X
203+26.2	60	LAKE BUTTES DES MORTS DRIVE	1	X
206+50	60	LAKE BUTTES DES MORTS DRIVE	1	
209+50	60	LAKE BUTTES DES MORTS DRIVE	1	
212+64.24	60	LAKE BUTTES DES MORTS DRIVE	1	X
216+86.53	60	LAKE BUTTES DES MORTS DRIVE	1	X
221+00	60	LAKE BUTTES DES MORTS DRIVE	1	
224+47.14	60	LAKE BUTTES DES MORTS DRIVE	1	X
228+00	60	LAKE BUTTES DES MORTS DRIVE	1	
231+00	60	LAKE BUTTES DES MORTS DRIVE	1	X
234+00	60	LAKE BUTTES DES MORTS DRIVE	1	
237+00	60	LAKE BUTTES DES MORTS DRIVE	1	X
241+68.69	60	LAKE BUTTES DES MORTS DRIVE	1	X
244+00	60	LAKE BUTTES DES MORTS DRIVE	1	
247+00	60	LAKE BUTTES DES MORTS DRIVE	1	
250+00	60	LAKE BUTTES DES MORTS DRIVE	1	
253+00	60	LAKE BUTTES DES MORTS DRIVE	1	
255+97.99	60	LAKE BUTTES DES MORTS DRIVE	1	X
SUBTOTAL:			41	

STATION	LEFT OFFSET	LOCATION	61422 EACH	PLATE REQUIRED
259+50	60	LAKE BUTTES DES MORTS DRIVE	1	
263+00	60	LAKE BUTTES DES MORTS DRIVE	1	
266+23.02	60	LAKE BUTTES DES MORTS DRIVE	1	X
269+25	60	LAKE BUTTES DES MORTS DRIVE	1	
272+37.96	60	LAKE BUTTES DES MORTS DRIVE	1	X
277+41.51	80	LAKE BUTTES DES MORTS DRIVE	1	X
281+10	80	LAKE BUTTES DES MORTS DRIVE	1	X
32+50	205	CTH T	1	X
37+00	130	CTH T	1	X
284+04.8	52	N.W. FRONTAGE ROAD AT CTH T	1	X
287+20.13	52	N.W. FRONTAGE ROAD AT CTH T	1	X
290+00	47	N.W. FRONTAGE ROAD AT CTH T	1	X
291+00	35.84	N.W. FRONTAGE ROAD AT CTH T	1	X
3+70.56	30.7	BROOKS ROAD	1	X
8+98.28	115.69	BROOKS ROAD	1	X
11+75.86	115	BROOKS ROAD	1	X
13+85.96	130	BROOKS ROAD	1	X
5+00	33	SKELETON BRIDGE ROAD	1	X
6+41.58	60	SKELETON BRIDGE ROAD	1	X
7+45.45	67.9	SKELETON BRIDGE ROAD	1	X
10+35.44	90	SKELETON BRIDGE ROAD	1	X
10+65.02	229.51	SKELETON BRIDGE ROAD	1	X
12+25	90	SKELETON BRIDGE ROAD	1	
14+15.73	90	SKELETON BRIDGE ROAD	1	X
18+00	105	SKELETON BRIDGE ROAD	1	X
21+15.02	81.08	SKELETON BRIDGE ROAD	1	X
25+13.07	28.14	SKELETON BRIDGE ROAD	1	X
51+15.2	45	SPIEGELBERG ROAD	1	X
52+73.63	45	SPIEGELBERG ROAD	1	X
56+00	45	SPIEGELBERG ROAD	1	X
57+00	55	SPIEGELBERG ROAD	1	X
60+00	45	SPIEGELBERG ROAD	1	X
61+00	55	SPIEGELBERG ROAD	1	X
66+00	55	SPIEGELBERG ROAD	1	
71+87.62	55	SPIEGELBERG ROAD	1	X
357+00	175	STH 110	1	X
361+90.82	228.65	STH 110	1	X
365+00	268.41	STH 110	1	
368+00.67	307.07	STH 110	1	X
372+51.73	366.13	STH 110	1	X
SUBTOTAL:			40	

CONTINUED ON NEXT SHEET

ALL ITEMS & QUANTITIES ON THIS SHEET ARE FOR CATEGORY 0010, UNLESS OTHERWISE NOTED.

RIGHT-OF-WAY MARKER POST SUMMARY - CONTINUED

STATION	RIGHT OFFSET	LOCATION	61422 EACH	PLATE REQUIRED
100+65.16	156.59	STH 110	1	X
100+68.39	101.26	STH 110	1	X
101+50.01	161.58	STH 110	1	X
101+85.61	108.58	STH 110	1	X
151+00	285	STH 110	1	X
154+00	165	STH 110	1	X
158+00	130	STH 110	1	X
161+50	140	STH 110	1	
165+00	150	STH 110	1	X
170+00	170	STH 110	1	X
173+50	185	STH 110	1	
175+01.72	523.84	STH 110	1	X
175+53.24	565.1	STH 110	1	X
177+00	200	STH 110	1	X
177+00	425	STH 110	1	X
178+75	230	STH 110	1	X
181+00	240	STH 110	1	X
186+00	205	STH 110	1	X
189+50	190	STH 110	1	
193+00	175	STH 110	1	X
197+00	181.48	STH 110	1	
201+17.52	188.24	STH 110	1	X
202+85.24	150	STH 110	1	X
206+50	150	STH 110	1	
210+50	150	STH 110	1	
214+27.85	150	STH 110	1	X
219+00	150	STH 110	1	
224+00	150	STH 110	1	
229+00	150	STH 110	1	
234+00	150	STH 110	1	
239+00	150	STH 110	1	
244+00	150	STH 110	1	
249+00	150	STH 110	1	
254+00	150	STH 110	1	
257+49.01	150	STH 110	1	X
259+40.668	150	STH 110	1	X
263+25.96	110	STH 110	1	X
267+30	110	STH 110	1	
271+38.94	110	STH 110	1	X
274+08.58	107.5	STH 110	1	
276+77.68	105	STH 110	1	X
280+00	108.66	STH 110	1	
283+00	112.07	STH 110	1	
285+58.37	115	STH 110	1	X
289+00	87	STH 110	1	X
SUBTOTAL			45	

STATION	RIGHT OFFSET	LOCATION	61422 EACH	PLATE REQUIRED
292+00	87	STH 110	1	
295+00	87	STH 110	1	
298+00	87	STH 110	1	
301+00	87	STH 110	1	
303+51.06	189.07	STH 110	1	X
303+68.52	252.46	STH 110	1	X
304+00	87	STH 110	1	
305+20.45	87	STH 110	1	X
305+31.15	130.85	STH 110	1	X
305+55.3	212.22	STH 110	1	X
307+59.15	165.62	STH 110	1	X
308+61.27	151.35	STH 110	1	X
311+24.31	133.85	STH 110	1	X
314+21.94	148.24	STH 110	1	X
319+00	161.73	STH 110	1	
323+21.92	173.63	STH 110	1	X
327+50	152.32	STH 110	1	
331+18.47	133.98	STH 110	1	X
335+40	139.99	STH 110	1	X
338+39.56	143.22	STH 110	1	X
340+99.1	296.47	STH 110	1	X
344+00	118	STH 110	1	
347+00	118	STH 110	1	
350+00	118	STH 110	1	
353+00	118	STH 110	1	
200+00.92	50	LAKE BUTTE DES MORTS DRIVE	1	X
203+26.2	50	LAKE BUTTE DES MORTS DRIVE	1	X
206+50	50	LAKE BUTTE DES MORTS DRIVE	1	
209+50	50	LAKE BUTTE DES MORTS DRIVE	1	
212+64.24	50	LAKE BUTTE DES MORTS DRIVE	1	X
216+86.53	60	LAKE BUTTE DES MORTS DRIVE	1	X
218+85.45	60	LAKE BUTTE DES MORTS DRIVE	1	X
269+32.36	79	LAKE BUTTES DES MORTS DRIVE	1	X
270+80	112	LAKE BUTTES DES MORTS DRIVE	1	X
272+37.96	140	LAKE BUTTES DES MORTS DRIVE	1	X
274+00	200	LAKE BUTTES DES MORTS DRIVE	1	X
275+35	225	LAKE BUTTES DES MORTS DRIVE	1	X
276+29.1	265	LAKE BUTTES DES MORTS DRIVE	1	X
276+72.48	250	LAKE BUTTES DES MORTS DRIVE	1	X
277+41	230	LAKE BUTTE DES MORTS DRIVE	1	X
277+41.51	85	LAKE BUTTE DES MORTS DRIVE	1	X
280+80	85	LAKE BUTTE DES MORTS DRIVE	1	X
36+08.45	200	CTH T	1	X
285+67.59	80.68	N.W. FRONTAGE ROAD AT CTH T	1	X
287+20.13	70	N.W. FRONTAGE ROAD AT CTH T	1	X
SUBTOTAL			45	

STATION	RIGHT OFFSET	LOCATION	61422 EACH	PLATE REQUIRED
289+00	60	N.W. FRONTAGE ROAD AT CTH T	1	X
291+00	29.72	N.W. FRONTAGE ROAD AT CTH T	1	X
3+38.31	36.34	BROOKS ROAD	1	X
6+20	73.03	BROOKS ROAD	1	
8+98.51	109.31	BROOKS ROAD	1	X
11+75.86	110	BROOKS ROAD	1	X
15+70.61	120	BROOKS ROAD	1	X
15+76.93	175	BROOKS ROAD	1	X
16+26.34	275	BROOKS ROAD	1	X
16+75	132.35	BROOKS ROAD	1	X
27+44.28	42.75	BROOKS ROAD	1	X
29+09.01	45	BROOKS ROAD	1	X
29+88.74	35.07	BROOKS ROAD	1	X
19+67.45	235.66	SKELETON BRIDGE ROAD	1	X
20+60	220	SKELETON BRIDGE ROAD	1	X
21+10	155	SKELETON BRIDGE ROAD	1	X
24+84.57	149.54	SKELETON BRIDGE ROAD	1	X
25+93.59	151.88	SKELETON BRIDGE ROAD	1	X
26+00	38.44	SKELETON BRIDGE ROAD	1	X
56+00	46.83	SPIEGELBERG ROAD	1	X
61+00	47.81	SPIEGELBERG ROAD	1	
66+00	48.78	SPIEGELBERG ROAD	1	
71+81.46	49.92	SPIEGELBERG ROAD	1	X
72+53.98	220.36	SPIEGELBERG ROAD	1	X
356+00	118	STH 110	1	
358+00	118	STH 110	1	
360+00	118	STH 110	1	X
363+37.6	173.71	STH 110	1	X
367+50	247.1	STH 110	1	
371+56.93	319.52	STH 110	1	X
13+00	50	S.W. FRONTAGE ROAD AT STH 116	1	
16+07.9	50	S.W. FRONTAGE ROAD AT STH 116	1	X
18+55.72	50	S.W. FRONTAGE ROAD AT STH 116	1	X
20+42.8	50	S.W. FRONTAGE ROAD AT STH 116	1	X
SUBTOTAL			34	
TOTAL:			246	

ALL ITEMS & QUANTITIES ON THIS SHEET ARE FOR CATEGORY 0010, UNLESS OTHERWISE NOTED.

EROSION BALE SUMMARY

STATION	LOCATION	62811 EROSION BALES DELIVERED EACH	62812 EROSION BALES INSTALLED EACH	REMARKS
105+00	STH 110 NB, RT.	10	10	
121+00	STH 110	30	30	2 CHECKS PER DITCH
123+00	STH 110 NB, RT.	10	10	
124+00	STH 110	20	20	2 CHECKS PER DITCH
126+00	STH 110 NB, RT.	5	5	
148+50	STH 110	10	10	
149+00	STH 110	20	20	
157+00	STH 110 MEDIAN	5	5	
158+00	STH 110 MEDIAN	5	5	
158+00	STH 110 SB, LT.	5	5	
159+00	STH 110 MEDIAN	5	5	
159+00	STH 110 NB, RT.	5	5	
160+00	STH 110 MEDIAN	5	5	
160+00	STH 110 SB, LT.	5	5	
161+00	STH 110	15	15	
162+00	STH 110	10	10	
163+00	STH 110 MEDIAN	5	5	
164+00	STH 110 MEDIAN & SB, LT.	10	10	
165+00	STH 110 SB, LT.	5	5	
169+00	STH 110 SB, LT.	10	10	
172+00	STH 110 MEDIAN	5	5	
173+00	STH 110 MEDIAN	5	5	
174+00	STH 110 MEDIAN	5	5	
188+00	STH 110	40	40	2 CHECKS ON SIDE OF CULVERT
198+00	STH 110 SB, LT.	10	10	
209+00	STH 110	20	20	
210+00	STH 110 NB, RT.	10	10	
210+00	STH 110 SB, LT.	5	5	
211+00	STH 110	10	10	
212+00	STH 110 SB, LT.	5	5	
226+00	STH 110	10	10	
228+00	STH 110 SB, LT.	10	10	
229+00	STH 110	20	20	
239+00	STH 110	10	10	
249+00	STH 110 NB, RT.	5	5	
250+00	STH 110 SB, LT.	5	5	
251+00	STH 110 NB, RT.	10	10	
251+00	STH 110 SB, LT.	5	5	
251+50	STH 110 SB, LT.	5	5	
253+00	STH 110 SB, LT.	10	10	
257+00	STH 110 NB, RT.	5	5	
258+00	STH 110	10	10	
259+00	STH 110	15	15	
SUBTOTAL:		430	430	

STATION	LOCATION	62811 EROSION BALES DELIVERED EACH	62812 EROSION BALES INSTALLED EACH
260+00	STH 110 SB, LT.	5	5
260+00	STH 110 NB, RT.	10	10
261+00	STH 110 SB RT. & LT.	10	10
262+00	STH 110 MEDIAN	5	5
263+00	STH 110 MEDIAN	5	5
264+00	STH 110 MEDIAN	5	5
265+00	STH 110	10	10
266+00	STH 110	10	10
267+00	STH 110	10	10
269+00	STH 110 NB, RT.	5	5
270+00	STH 110	10	10
271+00	STH 110	10	10
272+50	STH 110	20	20
273+00	STH 110	20	20
274+00	STH 110 SB, LT.	5	5
274+50	STH 110 SB, LT.	10	10
275+00	STH 110 SB, LT.	5	5
281+00	STH 110 MEDIAN	5	5
282+00	STH 110 NB, RT.	10	10
284+00	STH 110 SB, LT.	5	5
285+00	STH 110 NB LT. & RT.	10	10
287+00	STH 110 SB, LT.	10	10
289+00	STH 110 NB, RT.	10	10
290+50	STH 110 SB, LT.	5	5
291+00	STH 110 SB, LT.	5	5
293+00	STH 110 NB LT. & RT.	10	10
304+00	STH 110 NB, RT.	10	10
305+00	STH 110 NB, RT.	10	10
326+00	STH 110 SB, LT.	5	5
340+00	STH 110 NB LT. & RT.	10	10
341+00	STH 110 NB LT. & RT.	10	10
342+00	STH 110 MEDIAN	5	5
342+00	STH 110 NB, RT.	10	10
349+00	STH 110 MEDIAN	5	5
350+00	STH 110 MEDIAN	5	5
351+00	STH 110 NB, RT.	5	5
352+00	STH 110	10	10
354+00	STH 110	10	10
355+00	STH 110	15	15
356+00	STH 110	15	15
357+00	STH 110	15	15
358+00	STH 110	15	15
359+00	STH 110 SB, LT.	5	5
SUBTOTAL:		385	385

CONTINUED ON NEXT SHEET

SHEET 1 OF 2

MISCELLANEOUS QUANTITIES

HWY: STH 110

COUNTY: WINNEBAGO

STATE PROJECT NO: 6200-05-71

SHEET NO:

39 E

ALL ITEMS & QUANTITIES ON THIS SHEET ARE FOR CATEGORY 0010, UNLESS OTHERWISE NOTED.

EROSION BALE SUMMARY-CONTINUED

STATION	LOCATION	62811 EROSION BALES DELIVERED EACH	62812 EROSION BALES INSTALLED EACH	REMARKS
360+00	STH 110	10	10	
361+00	STH 110 NB, RT.	5	5	
361+00	STH 110 SB, LT.	10	10	
361+50	STH 110 SB, LT.	10	10	
362+00	STH 110 NB, RT.	10	10	
363+50	STH 110 NB, RT.	10	10	
363+50	STH 110 MEDIAN	5	5	
365+50	STH 110 MEDIAN	5	5	
367+00	STH 110 MEDIAN	5	5	
368+00	STH 110 MEDIAN	5	5	
370+00	STH 110 MEDIAN	5	5	
372+00	STH 110 MEDIAN	5	5	
372+50	STH 110 MEDIAN	5	5	
375+00	STH 110 MEDIAN	5	5	
376+50	STH 110 MEDIAN	5	5	
373+00	STH 110 MEDIAN	5	5	
212+00	LAKE BUTTE DES MORTS DRIVE, RT.	5	5	
212+50	LAKE BUTTE DES MORTS DRIVE, LT.	5	5	
214+50	LAKE BUTTE DES MORTS DRIVE, LT.	5	5	
215+50	LAKE BUTTE DES MORTS DRIVE, LT.	5	5	
217+00	LAKE BUTTE DES MORTS DRIVE	20	20	2 CHECKS PER DITCH
222+50	LAKE BUTTE DES MORTS DRIVE, LT.	5	5	
223+50	LAKE BUTTE DES MORTS DRIVE, LT.	5	5	
226+00	LAKE BUTTE DES MORTS DRIVE, RT.	10	10	
234+00	LAKE BUTTE DES MORTS DRIVE, LT.	10	10	
249+00	LAKE BUTTE DES MORTS DRIVE, LT.	10	10	
253+00	LAKE BUTTE DES MORTS DRIVE, LT.	10	10	
258+50	LAKE BUTTE DES MORTS DRIVE, LT.	10	10	
259+50	LAKE BUTTE DES MORTS DRIVE, LT.	10	10	
270+00	LAKE BUTTE DES MORTS DRIVE, LT.	10	10	
270+00	LAKE BUTTE DES MORTS DRIVE, RT.	5	5	
275+00	LAKE BUTTE DES MORTS DRIVE	20	20	2 CHECKS PER DITCH
273+50	LAKE BUTTE DES MORTS DRIVE, LT.	5	5	
274+50	LAKE BUTTE DES MORTS DRIVE	10	10	
277+50	LAKE BUTTE DES MORTS DRIVE, LT.	5	5	
283+00	NW FRONTAGE ROAD AT CTH T	20	20	
36+00	CTH Y, LT.	5	5	
36+50	CTH Y	20	20	
38+00	CTH Y	10	10	
39+00	CTH Y	10	10	
40+00	CTH Y	10	10	
6+50	RECREATION TRAIL	10	10	
7+00	RECREATION TRAIL	5	5	
SUBTOTAL:		360	360	

STATION	LOCATION	62811 EROSION BALES DELIVERED EACH	62812 EROSION BALES INSTALLED EACH
8+00	RECREATION TRAIL	5	5
7+50	BROOKS ROAD, RT.	10	10
8+00	BROOKS ROAD, LT.	10	10
10+00	BROOKS ROAD, RT.	10	10
11+00	BROOKS ROAD, RT.	10	10
11+00	BROOKS ROAD, LT.	5	5
12+50	BROOKS ROAD, LT.	5	5
13+00	BROOKS ROAD, RT.	5	5
14+00	BROOKS ROAD	10	10
20+00	BROOKS ROAD, LT.	10	10
20+00	BROOKS ROAD, RT.	5	5
21+50	BROOKS ROAD, LT.	5	5
4+00	SKELETON BRIDGE ROAD, RT.	10	10
6+00	SKELETON BRIDGE ROAD, LT.	10	10
7+00	SKELETON BRIDGE ROAD, RT.	10	10
8+00	SKELETON BRIDGE ROAD, RT.	10	10
11+00	SKELETON BRIDGE ROAD, LT.	10	10
12+00	SKELETON BRIDGE ROAD, RT.	5	5
13+00	SKELETON BRIDGE ROAD, RT.	5	5
17+00	SKELETON BRIDGE ROAD, RT.	10	10
18+00	SKELETON BRIDGE ROAD, RT.	10	10
19+00	SKELETON BRIDGE ROAD, LT.	10	10
19+50	SKELETON BRIDGE ROAD, LT.	10	10
15+50	KOLB ROAD, RT.	5	5
16+50	KOLB ROAD, RT.	5	5
47+50	KOLB ROAD	20	20
48+00	KOLB ROAD, RT.	10	10
51+00	KOLB ROAD, LT.	5	5
52+00	KOLB ROAD, LT.	10	10
60+50	KOLB ROAD	10	10
61+50	KOLB ROAD	10	10
62+50	KOLB ROAD	10	10
63+50	KOLB ROAD	10	10
65+50	KOLB ROAD	10	10
67+50	KOLB ROAD, RT.	5	5
365+50	SW RAMP AT STH 116, LT.	5	5
367+00	SW RAMP AT STH 116, LT.	5	5
368+00	SW RAMP AT STH 116, LT.	5	5
371+00	SW RAMP AT STH 116	20	20
372+00	SW RAMP AT STH 116, RT.	10	10
372+50	SW RAMP AT STH 116, RT.	5	5
363+50	SE RAMP AT STH 116, RT.	10	10
367+00	SE RAMP AT STH 116, LT.	5	5
SUBTOTAL:		365	365

STATION	LOCATION	62811 EROSION BALES DELIVERED EACH	62812 EROSION BALES INSTALLED EACH
368+00	SE RAMP AT STH 116, RT.	5	5
368+50	SE RAMP AT STH 116, LT.	5	5
370+50	SE RAMP AT STH 116, LT.	5	5
371+50	SE RAMP AT STH 116, LT.	5	5
372+00	SE RAMP AT STH 116, LT.	10	10
372+50	SE RAMP AT STH 116, LT.	10	10
369+50	NE RAMP AT STH 116, RT.	10	10
370+00	NE RAMP AT STH 116, LT.	10	10
UNDISTRIBUTED		419	419
SUBTOTAL:		479	479
TOTAL:		2,019	2,019

ALL ITEMS & QUANTITIES ON THIS SHEET ARE
FOR CATEGORY 0010, UNLESS OTHERWISE NOTED.

SILT FENCE SUMMARY

STATION - STATION	LOCATION	62815 SILT FENCE DELIVERED L.F.	62816 SILT FENCE INSTALLED L.F.	62817 SILT FENCE MAINTENANCE L.F.	REMARKS
98+00 -	STH 110 MEDIAN	20	20	20	
107+00 -	STH 110 MEDIAN	20	20	20	
112+00 - 121+00	STH 110 NB, RT.	900	900	900	
121+00 -	STH 110	350	350	350	
123+00 -	STH 110	500	500	500	
122+50 - 126+00	STH 110 NB, RT.	350	350	350	
129+00 -	STH 110 MEDIAN	20	20	20	
137+00 -	STH 110 MEDIAN	20	20	20	
150+00 -	STH 110 MEDIAN	20	20	20	
156+00 -	STH 110 MEDIAN	20	20	20	
162+00 -	STH 110 MEDIAN	20	20	20	
170+00 -	STH 110 MEDIAN	20	20	20	
189+50 -	STH 110 MEDIAN	20	20	20	
195+00 - 209+00	STH 110 SB, LT.	1,400	1,400	1,400	
198+00 -	STH 110 MEDIAN	20	20	20	
204+00 -	STH 110 MEDIAN	20	20	20	
211+00 -	STH 110 MEDIAN	20	20	20	
218+00 -	STH 110 MEDIAN	20	20	20	
228+00 -	STH 110 MEDIAN	20	20	20	
236+00 -	STH 110 MEDIAN	20	20	20	
244+00 -	STH 110 MEDIAN	20	20	20	
249+00 - 251+00	STH 110 NB, RT.	200	200	200	
252+00 -	STH 110 MEDIAN	20	20	20	
260+00 -	STH 110 MEDIAN	20	20	20	
268+00 -	STH 110 MEDIAN	20	20	20	
275+00 -	STH 110 MEDIAN	20	20	20	
277+00 - 284+00	STH 110	1,000	1,000	1,000	ALONG DAGGETS CREEK
SUBTOTAL:		5,100	5,100	5,100	

STATION - STATION	LOCATION	62815 SILT FENCE DELIVERED L.F.	62816 SILT FENCE INSTALLED L.F.	62817 SILT FENCE MAINTENANCE L.F.	REMARKS
291+00 -	STH 110 MEDIAN	20	20	20	
299+00 -	STH 110 MEDIAN	20	20	20	
306+00 -	STH 110 MEDIAN	20	20	20	
315+00 -	STH 110 MEDIAN	20	20	20	
325+00 -	STH 110 MEDIAN	20	20	20	
335+00 -	STH 110 MEDIAN	20	20	20	
343+00 -	STH 110 MEDIAN	20	20	20	
351+00 -	STH 110 MEDIAN	20	20	20	
359+00	STH 110 MEDIAN	20	20	20	
369+00	STH 110 MEDIAN	20	20	20	
377+00	STH 110 MEDIAN	20	20	20	
200+00 - 206+00	LAKE BUTTE DES MORTS DRIVE, LT.	600	600	600	
207+00 - 214+75	LAKE BUTTE DES MORTS DRIVE, LT.	780	780	780	
207+00 - 215+50	LAKE BUTTE DES MORTS DRIVE, RT.	850	850	850	
215+00 - 217+00	LAKE BUTTE DES MORTS DRIVE, LT.	200	200	200	
225+00 - 229+00	LAKE BUTTE DES MORTS DRIVE, LT.	400	400	400	
236+00 - 245+50	LAKE BUTTE DES MORTS DRIVE, LT.	950	950	950	
252+00 - 258+00	LAKE BUTTE DES MORTS DRIVE, LT.	600	600	600	
145+00 - 148+00	CTH T	900	900	900	
5+00 - 8+00	BROOKS ROAD	900	900	900	
9+00 - 13+00	BROOKS ROAD	1,200	1,200	1,200	
20+00 - 26+00	BROOKS ROAD	600	600	600	
6+00 - 20+00	SKELETON BRIDGE ROAD, RT.	1,400	1,400	1,400	ALONG OLD ROADWAY
11+00 - 13+00	SKELETON BRIDGE ROAD, LT.	200	200	200	
56+00 - 58+00	KOLB ROAD, RT.	200	200	200	
0+50	WETLAND MITIGATION SITE (MIT 3-6)	600	600	600	ALONG WEST SIDE
UNDISTRIBUTED		3,925	3,925	3,925	
SUBTOTAL:		14,525	14,525	14,525	
TOTAL:		19,625	19,625	19,625	

MISCELLANEOUS QUANTITIES

HWY: STH 110

COUNTY: WINNEBAGO

STATE PROJECT NO: 6200-05-71

SHEET NO:

31 E

CLEANING SEDIMENT BASINS & SEDIMENT BASIN EXCAVATION

STATION	LOCATION	62820 CLEANING SEDIMENT BASINS CY	90034 SEDIMENT BASIN EXCAVATION CY
188+00	STH 110	11	11
272+65	STH 110	11	11
362+25	STH 110	11	11
259+00	LAKE BUTTE DES MORTS DRIVE	11	11
270+30	LAKE BUTTE DES MORTS DRIVE	11	11
27+00	CTH T	11	11
283+00	NW FRONTAGE ROAD @ CTH T	11	11
19+50	BROOKS ROAD	11	11
13+80	SKELETON BRIDGE ROAD	11	11
16+60	SKELETON BRIDGE ROAD	11	11
18+70	SKELETON BRIDGE ROAD	11	11
25+00	CROSS ROAD	11	11
77+00	STH 116	11	11
87+00	STH 116	11	11
374+50	NE RAMP @ STH 116	11	11
371+00	SW RAMP @ STH 116	11	11
372+50	SE RAMP @ STH 116	11	11
TOTAL:		187	187

EROSION MAT CLASS I TYPE A

STATION - STATION	LOCATION	62822 DELIVERED S.Y.	62823 INSTALLED S.Y.	REMARKS
147+00 - 147+70	STH 110 NB, RT.	100	100	
172+00 - 178+00	STH 110 SB, LT.	540	540	STAGGERED INSTALLATION
188+50 - 193+50	STH 110 NB, RT.	670	670	STAGGERED INSTALLATION
197+50 - 216+00	STH 110 NB, RT.	1,650	1,650	STAGGERED INSTALLATION
200+00 - 211+00	STH 110 SB, LT.	980	980	STAGGERED INSTALLATION
376+00 - 381+00	STH 110 SB, LT.	670	670	STAGGERED INSTALLATION
223+60 - 225+10	LAKE BUTTE DES MORTS DRIVE, RT.	250	250	
246+50 - 249+50	LAKE BUTTE DES MORTS DRIVE, LT.	300	300	
252+20 - 253+50	LAKE BUTTE DES MORTS DRIVE, RT.	300	300	
30+50 - 32+00	CTH Y, RT.	200	200	STAGGERED INSTALLATION
0+50 - 1+50	BROOKS ROAD, RT.	120	120	
9+00 - 16+00	BROOKS ROAD, LT.	6,250	6,250	
9+00 - 17+00	BROOKS ROAD, RT.	7,150	7,150	
19+50 - 25+00	BROOKS ROAD, LT.	3,700	3,700	
20+00 - 24+50	BROOKS ROAD, RT.	2,500	2,500	
50+00 - 52+00	KOLB ROAD, LT.	450	450	
54+50 - 55+50	KOLB ROAD, RT.	230	230	
60+00 - 62+50	KOLB ROAD, RT.	560	560	
71+00 - 72+00	KOLB ROAD, LT.	230	230	
118+50 - 121+00	STH 110 SB, LT.	230	230	
124+00 - 125+00	STH 110 SB, LT.	90	90	
324+50 - 325+50	STH 110 SB, LT.	90	90	
	UNDISTRIBUTED	6,740	6,740	
TOTAL:		34,000	34,000	

ALL ITEMS & QUANTITIES ON THIS SHEET ARE FOR CATEGORY 0010, UNLESS OTHERWISE NOTED.

MOBILIZATION, EROSION CONTROL

LOCATION	62819 MOBILIZATION, EROSION CONTROL EACH
STH 110	6
TOTAL:	6

EROSION MAT CLASS I TYPE B

STATION - STATION	LOCATION	62824 DELIVERED S.Y.	62825 INSTALLED S.Y.	REMARKS
107+50 - 108+50	STH 110 MEDIAN	140	140	
113+50 - 114+50	STH 110 MEDIAN	140	140	
114+50 - 121+00	STH 110 NB, RT.	2,200	2,200	
128+50 - 129+50	STH 110 MEDIAN	140	140	
136+50 - 137+50	STH 110 MEDIAN	140	140	
149+20 - 150+00	STH 110 SB, LT.	110	110	
149+30 - 150+80	STH 110 NB, RT.	200	200	
149+50 - 150+50	STH 110 MEDIAN	140	140	
155+50 - 156+50	STH 110 MEDIAN	140	140	
158+00 - 159+00	STH 110 MEDIAN	140	140	
158+50 - 159+00	STH 110 SB, LT.	70	70	
160+00 - 163+50	STH 110 MEDIAN	470	470	
160+00 - 161+00	STH 110 NB, RT.	140	140	
160+50 - 162+00	STH 110 SB, LT.	200	200	
165+00 - 166+00	STH 110 MEDIAN	140	140	
167+00 - 178+00	STH 110 NB, RT.	2,450	2,450	STAGGERED INSTALLATION
169+50 - 170+50	STH 110 MEDIAN	140	140	
180+00 - 200+00	STH 110 SB, LT.	8,900	8,900	
180+50 - 182+00	STH 110 NB, RT.	270	270	STAGGERED INSTALLATION
189+00 - 190+00	STH 110 MEDIAN	140	140	
188+50 - 193+50	STH 110 NB, RT.	270	270	STAGGERED INSTALLATION
197+50 - 198+50	STH 110 MEDIAN	140	140	
203+50 - 204+50	STH 110 MEDIAN	140	140	
210+50 - 211+50	STH 110 MEDIAN	140	140	
217+50 - 218+50	STH 110 MEDIAN	140	140	
227+50 - 228+50	STH 110 MEDIAN	140	140	
227+50 - 229+00	STH 110 SB, LT.	200	200	
228+00 - 229+30	STH 110 NB, RT.	180	180	
235+50 - 236+50	STH 110 MEDIAN	140	140	
SUBTOTAL:		17,900	17,900	

CONTINUED ON NEXT PAGE

MISCELLANEOUS QUANTITIES

HWY: STH 110

COUNTY: WINNEBAGO

STATE PROJECT NO: 6200-05-71

SHEET NO:

3V E

ALL ITEMS & QUANTITIES ON THIS SHEET ARE
FOR CATEGORY 0010, UNLESS OTHERWISE NOTED.

EROSION MAT CLASS I TYPE B - CONTINUED

STATION - STATION	LOCATION	62824 DELIVERED S.Y.	62825 INSTALLED S.Y.
243+50 - 244+50	STH 110 MEDIAN	140	140
249+30 - 250+50	STH 110 NB, RT.	160	160
250+20 - 253+00	STH 110 SB, LT.	380	380
251+50 - 252+50	STH 110 MEDIAN	140	140
259+00 - 260+00	STH 110 NB, RT.	140	140
259+50 - 260+50	STH 110 MEDIAN	140	140
262+00 - 262+50	STH 110 SB, LT.	70	70
262+50 - 266+00	STH 110 NB, RT.	470	470
263+00 - 266+00	STH 110 MEDIAN	400	400
265+00 - 266+00	STH 110 SB, LT.	140	140
267+50 - 268+50	STH 110 MEDIAN	140	140
267+50 - 268+50	STH 110 NB, RT.	140	140
268+00 - 270+00	STH 110 SB, LT.	270	270
273+00 - 273+50	STH 110 NB, RT.	70	70
274+50 - 275+50	STH 110 MEDIAN	140	140
280+00 - 282+00	STH 110 NB, RT.	270	270
287+00 - 288+00	STH 110 SB, LT.	140	140
290+50 - 291+50	STH 110 MEDIAN	140	140
290+50 - 291+50	STH 110 SB, LT.	140	140
298+50 - 299+50	STH 110 MEDIAN	140	140
298+50 - 299+50	STH 110 SB, LT.	140	140
305+00 -	STH 110 NB, RT.	70	70
306+50 - 307+50	STH 110 MEDIAN	140	140
314+50 - 315+50	STH 110 MEDIAN	140	140
324+50 - 325+50	STH 110 MEDIAN	140	140
334+50 - 335+50	STH 110 MEDIAN	140	140
340+00 - 341+00	STH 110 NB, RT.	140	140
342+50 - 343+50	STH 110 MEDIAN	140	140
350+50 - 351+50	STH 110 MEDIAN	140	140
350+50 - 351+00	STH 110 NB, RT.	70	70
SUBTOTAL:		5,030	5,030

STATION - STATION	LOCATION	62824 DELIVERED S.Y.	62825 INSTALLED S.Y.	REMARKS
352+00 - 354+00	STH 110 SB, LT.	270	270	
352+50 - 354+00	STH 110 MEDIAN	200	200	
353+00 - 354+00	STH 110 NB, RT.	140	140	
354+00 - 359+00	STH 110 SB, LT.	670	670	
354+00 - 355+00	STH 110 MEDIAN	140	140	
354+00 - 357+00	STH 110 NB, RT.	400	400	
358+50 - 359+50	STH 110 MEDIAN	140	140	
361+00 - 362+00	STH 110 SB, LT.	140	140	
362+00 - 363+00	STH 110 NB, RT.	140	140	
367+00 - 370+00	STH 110 SB, LT.	400	400	
368+50 - 369+50	STH 110 MEDIAN	140	140	
376+50 - 377+50	STH 110 MEDIAN	140	140	
215+50 - 216+70	LAKE BUTTE DES MORTS DRIVE, RT.	160	160	
236+00 - 242+50	LAKE BUTTE DES MORTS DRIVE, LT.	2,900	2,900	
36+00 -	CTH Y LT.	200	200	
6+00 -	RECREATION TRAIL, LT.	70	70	
7+00 -	RECREATION TRAIL, LT.	70	70	
13+80 - 14+50	RECREATION TRAIL, LT.	100	100	
7+00 - 8+00	BROOKS ROAD LT. & RT.	270	270	
7+00 - 7+50	SKELETON BRIDGE ROAD, RT.	70	70	
8+00 - 8+50	SKELETON BRIDGE ROAD, LT.	70	70	
9+00 - 10+00	SKELETON BRIDGE ROAD, LT.	140	140	
15+00 - 16+50	KOLB ROAD, RT.	200	200	
367+00 - 368+00	SE RAMP AT STH 116, RT.	540	540	STAGGERED INSTALLATION
370+00 - 372+00	SW RAMP AT STH 116, RT.	670	670	BACKSLOPE
375+00 - 377+00	NE RAMP AT STH 116, LT & RT.	1,150	1,150	
378+50 - 379+50	NE RAMP AT STH 116, LT.	280	280	
UNDISTRIBUTED		8,220	8,220	
SUBTOTAL:		18,030	18,030	
TOTAL:		40,960	40,960	

MISCELLANEOUS QUANTITIES

HWY: STH 110

COUNTY: WINNEBAGO

STATE PROJECT NO: 6200-05-71

SHEET NO:

3W E

ALL ITEMS & QUANTITIES ON THIS SHEET ARE FOR CATEGORY 0010, UNLESS OTHERWISE NOTED.

LANDSCAPING

STATION TO STATION	LOCATION	62501 TOPSOIL S.Y.	62505 SALVAGED TOPSOIL S.Y.	63003 SEEDING TEMPORARY LB.	63008 SEEDING MIXTURE NO. 10 LB.	63010 SEEDING MIXTURE NO. 30 LB.	63011 SEEDING MIXTURE NO. 40 LB.	63013 SEEDING MIXTURE NO. 60 LB.	62905 FERTILIZER TYPE B CWT.	62703 MULCHING TON	62866 SOIL STABILIZER, TYPE B ACRE
98+00 - 137+00	STH 110		33,222	919	86	478		23	21.3	14	
146+00 - 203+00	STH 110		96,852	2678	1,119	699			66.7	41	
203+00 - 260+00	STH 110		68,800	1902	567	704			44.0	30	
260+00 - 317+00	STH 110		70,156	1940	592	699			44.9	30	
317+00 - 354+00	STH 110		42,089	1164	321	454			26.9	18	
200+43 - 249+60	LAKE BUTTE DES MORTS DRIVE		31,947	883		588			20.4	14	
252+27 - 281+13	LAKE BUTTE DES MORTS DRIVE		21,417	592		394			13.7	9	
37+50 - 38+00	STEARNS ROAD		360	10		7			0.2	0	
26+00 - 38+00	CTH T		5,545	153		102			3.5	2	
282+50 - 285+00	NW FRONTAGE ROAD @ CTH T		1,928	53	5	31			1.2	1	
30+56 - 41+00	CTH Y		8,643	239	31	128			5.5	4	
5+00 - 28+00	RECREATION TRAIL		11,489	318		211			7.4	5	
20+50 - 22+66	OLD STH 110 PARKING LOT		790	22		15			0.5	0	
8+50 - 10+30	LUEBKE ROAD		462	13		9			0.3	0	
3+00 - 30+50	BROOKS ROAD		30,089	832	210	343			19.3	13	
10+50 -	EWALD FIELD ENTRANCE		2,349	65	16	28			1.5	1	
10+25	WOKERS FIELD ENTRANCE		2,312	64	15	28			1.5	1	
	WOKERS BACK DRIVEWAY	835		23			31		0.5	0	
	WOKERS FRONT DRIVEWAY	351		10			14		0.2	0	
	SKELETON BRIDGE ROAD		25,072	693	191	270			16.0	11	
	HANSEN DRIVEWAY	2035		56			75		1.3	1	
	SHAMMY LANE		2,346	65		43			1.5	1	
	TYERS DRIVEWAY	271		7			10		0.2	0	
	KOLB ROAD		28,143	778		518			18.0	12	
10+00 - 22+00	SPIEGELBERG ROAD		5,497	152		101			3.5	2	
354+00 - 385+00	STH 110		40,630	1123	373	385			27.3	20	
13+00 - 20+93	S.W. FRONTAGE ROAD @ STH 116		5,854	162	10	97			3.7	2	
374+19 - 386+64.8	NE RAMP @ STH 116		6,490	179		119			4.2	3	
362+48 - 378+70	SW RAMP @ STH 116		15,615	432	125	162			10	7	
362+70.2 - 372+88	SE RAMP @ STH 116		9,151	253	44	125			5.9	4	
	WETLAND MITIGATION SITE, SLOPED AREA			0	340						3.8
	WETLAND MITIGATION SITE, FLAT AREA			0				1315			
	UNDISTRIBUTED			3,945	1,011	1,685	33	335	93	62	1
	TOTAL:	3,492	567,248	19,726	5,056	8,423	163	1,673	464	308	4.8

REVISIONS ATTACHED TO BACK OF PLAN

*NOTE: SEEDING APPLICATION:
 0.0184 LB/SY FOR SEEDING MIXTURE NO. 10 AND 30
 0.009 LB/SY FOR SEEDING MIXTURE NO. 60
 0.0368 LB/SY FOR SEEDING MIXTURE NO. 40
 0.0277 LB/SY FOR TEMPORARY SEEDING
 FERTILIZER APPLICATION IS 0.00064 CWT/SY
 MULCH IS APPLIED AT A RATE OF 0.000426 TON/SY

TRAFFIC CONTROL SUMMARY

LOCATION	SERVICE PERIOD DAYS	64313 DRUMS		64318 BARRICADES TYPE III		64321 WARNING LIGHTS TYPE A		64326 SIGNS		REMARKS
		QTY	DAYS	QTY	DAYS	QTY	DAYS	NUM	DAYS	
STH 110 STA. 98+00-137+00	210	50	10500					1	210	
STH 110 STA. 83+00-93+00	210							5	1050	ROAD WORK SERIES AND END ROAD WORK
LAKE BUTTE DES MORTS DRIVE	210			3	630	4	840	1	210	
WESTWIND ROAD (EAST AND WEST OF LAKE BUTTE DES MORTS DRIVE)	210							4	840	ROAD WORK AHEAD
CTH T (EAST OF STH 110)	210							2	420	ROAD WORK AHEAD
RYF ROAD (WEST OF STH 110)	210							2	420	ROAD WORK AHEAD
CTH Y	210			10	2100	12	2520	4	840	ROAD CLOSED
EXISTING STH 110 (CTH Y)	210	20	4200					2	420	RIGHT SHOULDER CLOSED
REC TRAIL	210			2	420	4	840	3	630	TRAIL CLOSED
EXISTING STH 110 (NW FRONTAGE ROAD)	400			5	2000	6	2400	4	1600	ROAD WORK SERIES AND END ROAD WORK
LUEBKE ROAD (SOUTH OF BROOKS ROAD)	210			3	630	4	840	2	420	ROAD CLOSED
BROOKS ROAD (EAST AND WEST OF PROPOSED STH 110)	210			7	1470	13	2730	8	1680	ROAD CLOSED LOCAL TRAFFIC ONLY
SKELETON BRIDGE ROAD (NORTH AND SOUTH OF PROPOSED STH 110)	210			7	1470	13	2730	6	1260	ROAD CLOSED LOCAL TRAFFIC ONLY
KOLB ROAD (EAST OF PROPOSED STH 110)	210			7	1470	13	2730	6	1260	ROAD CLOSED LOCAL TRAFFIC ONLY
KOLB ROAD (STH 116 INTERSECTION)	210			5	1050	6	1260			ROAD CLOSED
SPIEGELBERG ROAD (WEST OF PROPOSED STH 110)	210			7	1470	13	2730	6	1260	ROAD CLOSED LOCAL TRAFFIC ONLY
EXISTING STH 110 (SW FRONTAGE ROAD)	400			5	2000	6	2400	4	1600	ROAD WORK SERIES AND END ROAD WORK
STH 116 (WEST OF STH 110)	210							2	420	ROAD WORK AHEAD
CTH GG (EAST OF STH 110)	210	34	7140					2	420	ROAD WORK AHEAD
STH 110 STA. 390+00-400+00	210							5	1050	ROAD WORK SERIES AND END ROAD WORK
TOTALS				21840		14710		22020	15800	

NON-METALLIC CONDUIT, SCHEDULE 40

CATEGORY 0100

FROM	TO	65219 2-INCH L.F.
CB	PB1	5
PB1	PB2	60
PB2	PB3	100

TOTAL: 165

PULL BOXES, STEEL

CATEGORY 0100

LOCATION	65306 24 x 36 INCH EACH
OLD STH 110 PARKING LOT	3

TOTAL: 3

POLES

CATEGORY 0100

LOCATION	65705 POLES TYPE 5 EACH
OLD STH 110 PARKING LOT	2

TOTAL: 2

ELECTRICAL WIRE, LIGHTING, NO. 12

CATEGORY 0100

FROM	TO	65566 FEEDER CONDUCTOR (BLACK) L.F.	65566 EQUIPMENT GROUNDING CONDUCTOR (GREEN) L.F.
CB	PB1	20	10
PB1	PB2	120	60
PB2	LB1	40	20
LB1	LUMINAIRES	180	90
LB1	PB2	40	20
PB2	PB3	220	110
PB3	LB2	40	20
LB2	LUMINAIRES	180	90

SUB-TOTALS: 840 420

TOTAL: 1,260

LIGHTING SUMMARY

CATEGORY 0100

LOCATION	65927 LUMINAIRE ARMS SINGLE MEMBER 4-1/2 INCH CLAMP 8 FOOT EACH	65905 LUMINAIRES UTILITY 250 WATTS EACH
OLD STH 110 PARKING LOT	4	4

TOTALS: 4 4

ALL ITEMS & QUANTITIES ON THIS SHEET ARE FOR CATEGORY 0010, UNLESS OTHERWISE NOTED.

MISCELLANEOUS QUANTITIES

HWY: STH 110

COUNTY: WINNEBAGO

STATE PROJECT NO: 6200-05-71

SHEET NO:

3Y E

ALL ITEMS & QUANTITIES ON THIS SHEET ARE FOR CATEGORY 0010, UNLESS OTHERWISE NOTED.

EROSION MAT TYPE II B

STATION - STATION	LOCATION	62832 DELIVERED S.Y.	62833 INSTALLED S.Y.	REMARKS
277+50 - 278+00	STH 110 SB, LT.	120	120	
279+50 - 281+50	STH 110 SB, LT.	670	670	
32+00 - 33+70	CTH Y, RT.	230	230	STAGGERED INSTALLATION
36+50 - 37+50	CTH Y, RT.	140	140	STAGGERED INSTALLATION
9+00 - 14+00	SKELETON BRIDGE ROAD, RT.	3,350	3,350	
11+50 - 14+00	SKELETON BRIDGE ROAD, LT.	1,400	1,400	
16+50 - 24+00	SKELETON BRIDGE ROAD, RT. & LT.	20,000	20,000	
16+00 - 18+00	SKELETON BRIDGE ROAD, RT.	270	270	
47+00 - 49+00	KOLB ROAD, RT.	270	270	
64+00 - 67+00	KOLB ROAD, RT. & LT.	800	800	
0+25 - 1+00	WETLAND MITIGATION SITE (MIT 1-7)	6,700	6,700	WEST SIDE - STAGGERED INSTALLATION
12+00 - 12+75	WETLAND MITIGATION SITE (MIT 1-7)	6,700	6,700	EAST SIDE
1+00 - 12+50	WETLAND MITIGATION SITE (MIT 1)	10,300	10,300	STAGGERED INSTALLATION
0+73 - 12+50	WETLAND MITIGATION SITE (MIT 7)	3,950	3,950	
372+00 - 375+00	SW RAMP AT STH 116, LT.	1,350	1,350	BACKSLOPE
	UNDISTRIBUTED	11,600	11,600	
TOTAL:		67,850	67,850	

TURBIDITY BARRIERS

STATION	LOCATION	62860 TURBIDITY BARRIERS S.Y.
121+50	STH 110 SOUTH ABUTMENT	223
123+50	STH 110 NORTH ABUTMENT	223
	UNDISTRIBUTED	112
TOTAL:		558

INLET PROTECTION, TYPE C

NO.	STATION	OFFSET	LOCATION	62872 EACH
43	212+30	17' RT.	LAKE BUTTE DES MORTS DRIVE	1
44	212+30	17' LT.	LAKE BUTTE DES MORTS DRIVE	1
46	216+12	17' RT.	LAKE BUTTE DES MORTS DRIVE	1
47	216+12	17' LT.	LAKE BUTTE DES MORTS DRIVE	1
49	220+50	17' RT.	LAKE BUTTE DES MORTS DRIVE	1
50	220+50	17' LT.	LAKE BUTTE DES MORTS DRIVE	1
52	225+00	17' RT.	LAKE BUTTE DES MORTS DRIVE	1
53	225+00	17' LT.	LAKE BUTTE DES MORTS DRIVE	1
55	237+00	17' RT.	LAKE BUTTE DES MORTS DRIVE	1
56	237+00	17' LT.	LAKE BUTTE DES MORTS DRIVE	1
58	240+90	17' RT.	LAKE BUTTE DES MORTS DRIVE	1
59	240+90	17' LT.	LAKE BUTTE DES MORTS DRIVE	1
61	244+80	17' RT.	LAKE BUTTE DES MORTS DRIVE	1
62	244+80	17' LT.	LAKE BUTTE DES MORTS DRIVE	1
64	248+70	17' RT.	LAKE BUTTE DES MORTS DRIVE	1
65	248+70	17' LT.	LAKE BUTTE DES MORTS DRIVE	1
67	252+60	17' RT.	LAKE BUTTE DES MORTS DRIVE	1
68	252+60	17' LT.	LAKE BUTTE DES MORTS DRIVE	1
70	256+24	17' RT.	LAKE BUTTE DES MORTS DRIVE	1
71	256+24	17' LT.	LAKE BUTTE DES MORTS DRIVE	1
73	259+00	17' RT.	LAKE BUTTE DES MORTS DRIVE	1
74	259+00	17' LT.	LAKE BUTTE DES MORTS DRIVE	1
76	261+50	17' RT.	LAKE BUTTE DES MORTS DRIVE	1
77	261+50	17' LT.	LAKE BUTTE DES MORTS DRIVE	1
79	265+40	17' RT.	LAKE BUTTE DES MORTS DRIVE	1
80	265+40	17' LT.	LAKE BUTTE DES MORTS DRIVE	1
82	269+30	17' RT.	LAKE BUTTE DES MORTS DRIVE	1
83	269+30	17' LT.	LAKE BUTTE DES MORTS DRIVE	1
85	273+20	17' RT.	LAKE BUTTE DES MORTS DRIVE	1
86	273+20	17' LT.	LAKE BUTTE DES MORTS DRIVE	1
TOTAL:				30

SIGNS

CATEGORY 0100

LOCATION	63401 WOOD POST 4x4-INCH 10 FT EACH	63702 SIGNS, TYPE II REFLECTIVE S.F.	SIGN DIMENSIONS	REMARKS
OLD STH 110 PARKING LOT	3	4.5	12" x 18"	R7-8A
TOTAL:	3	4.5		

MISCELLANEOUS QUANTITIES

HWY: STH 110

COUNTY: WINNEBAGO

STATE PROJECT NO: 6200-05-71

SHEET NO:

32 E

ALL ITEMS & QUANTITIES ON THIS SHEET ARE FOR CATEGORY 0010, UNLESS OTHERWISE NOTED.

PAVEMENT MARKING

STATION - STATION	LOCATION	64602 4-INCH EPOXY EDGELINE (WHITE) SOLID L.F.	64602 4-INCH EPOXY CENTERLINE (YELLOW) SOLID L.F.	64602 4-INCH EPOXY CENTERLINE (YELLOW) DASHED L.F.
199+87.441 - 281+89.35	LAKE BUTTE DES MORTS DR.	16,404	16,404	
30+00 - 41+50	CTH Y	2,300	1,150	288
SUBTOTAL:		18,704	17,554	288
TOTAL:			36,546	

PAVEMENT MARKING

CATEGORY 0100

STATION - STATION	LOCATION	64750 PAVEMENT MARKING, HANDICAP SYMBOL, EPOXY 24-INCH WHITE EACH	64786 PAVEMENT MARKING, PARKING STALL, EPOXY 4-INCH WHITE L.F.
20+30	OLD STH 110 PARKING LOT		
20+60	OLD STH 110 PARKING LOT	1	
20+75	OLD STH 110 PARKING LOT	1	
21+00	OLD STH 110 PARKING LOT	1	
20+30 - 22+45	OLD STH 110 PARKING LOT		2,477
TOTAL:		3	2,477

CONSTRUCTION STAKING

STATION - STATION	LOCATION	65045 CONSTRUCTION STAKING, SUBGRADE L.F.	65050 CONSTRUCTION STAKING, CRUSHED AGGREGATE BASE COURSE L.F.	65055 CONSTRUCTION STAKING, CURB AND GUTTER L.F.	65070 CONSTRUCTION STAKING, CONCRETE PAVEMENT L.F.
98+00 - 137+00	STH 110	7280			
146+00 - 385+00	STH 110	46860			
199+87.44 - 205+00	LAKE BUTTE DES MORTE DRIVE	513	513		
205+00 - 249+64.61	LAKE BUTTE DES MORTE DRIVE	4465	4465	4465	
241+00 - 277+50	LAKE BUTTE DES MORTE DRIVE				2650
252+27.17 - 279+20	LAKE BUTTE DES MORTE DRIVE	2693	2693	2693	
279+20 - 281+89.35	LAKE BUTTE DES MORTE DRIVE	270	270		
37+50 - 38+46.724	STEARNS ROAD	100			
26+00 - 38+00	CTH T	1200	1200		
282+52.372 - 291+00	N.W. FRONTAGE ROAD @ CTH T	848	848		
30+00 - 41+50	CTH Y	1150			
0+00 - 29+00	RECREATION TRAIL	2900			
20+10 - 22+66	OLD STH 110 PARKING LOT	256			
3+00 - 30+00	BROOKS ROAD	2447	2447		
3+00 - 26+00	SKELETON BRIDGE ROAD	2035	2035		
30+00 - 36+28	SHAMMY LANE	628			
30+00 - 35+34	SHAMMY LANE		534		
15+00 - 72+91.996	KOLB ROAD	5792	5792		
10+90 - 22+00	SPIEGELBERG ROAD	1110	1110		
13+00 - 21+25	S.W. FRONTAGE ROAD @ STH 116	825	830		
362+70 - 373+19.71	S.E. RAMP @ STH 116	1050			
362+47.902 - 376+08.238	S.W. RAMP @ STH 116	1360			
373+78.572 - 386+64.565	N.E. RAMP @ STH 116	1286			
8+90 - 9+80	LUEBKE ROAD CUL-DE-SAC	90	90		
35+38 - 36+28	SHAMMY LANE CUL-DE-SAC	90	90		
10+00 - 10+90	SPIEGELBERG ROAD CUL-DE-SAC	90	90		
TOTAL:		85,338	23,007	7,158	2,650

BORROW PIT TRACKING PAD

LOCATION	90004A BORROW PIT TRACKING PAD

REVISIONS
ATTACHED TO BACK
OF PLAN

SAWING EXISTING PAVEMENT

STATION	LOCATION	66501 L.F.	REMARKS
199+87.44	LAKE BUTTE DES MORTS DRIVE	32	CONST. LIMITS
281+89.35	LAKE BUTTE DES MORTS DRIVE	32	CONST. LIMITS
282+52.37	NW FRONTAGE ROAD AT CTH T	30	CONST. LIMITS
	OLD CTH Y AT EXISTING STH 110	100	
30+00	CTH Y	24	CONST. LIMITS
41+50	CTH	20	CONST. LIMITS
3+00	BROOKS ROAD	24	CONST. LIMITS
30+00	BROOKS ROAD	24	CONST. LIMITS
25+50	SKELETON BRIDGE ROAD	20	ON KOLB ROAD
26+00	SKELETON BRIDGE ROAD	16	CONST. LIMITS
15+00	KOLB ROAD	20	CONST. LIMITS
10+00	SPIEGELBERG ROAD	20	DRIVEWAY
22+00	SPIEGELBERG ROAD	20	CONST. LIMITS
72+91.99	KOLB ROAD	75	CONST. LIMITS
9+00	SW FRONTAGE ROAD AT STH 116	30	CONST. LIMITS
21+25	SW FRONTAGE ROAD AT STH 116	30	CONST. LIMITS
TOTAL:		517	

MISCELLANEOUS QUANTITIES

HWY: STH 110

COUNTY: WINNEBAGO

STATE PROJECT NO: 6200-05-71

SHEET NO:

3AA | E

ALL ITEMS & QUANTITIES ON THIS SHEET ARE FOR CATEGORY 0010, UNLESS OTHERWISE NOTED.

EROSION CONTROL FILTER BAG SUMMARY

STATION	LOCATION	90005B EROSION CONTROL FILTER BAGS DELIVERED EACH	90005C EROSION CONTROL FILTER BAGS INSTALLED EACH	90005D EROSION CONTROL FILTER BAGS MAINTAINED EACH	REMARKS
188+00	STH 110 NB, RT.	6	6	6	CULVERT INLET
260+00	STH 110 NB, RT.	6	6	6	CULVERT INLET
269+00	STH 110 SB, LT.	15	15	15	
272+65	STH 110 NB, RT.	12	12	12	CULVERT INLETS
276+70	STH 110 SB, LT.	15	15	15	
281+80	STH 110 MEDIAN	15	15	15	
284+00	STH 110	45	45	45	3 DITCHES
286+30	STH 110 SB, LT.	6	6	6	CULVERT INLET
288+00	STH 110 NB, RT.	6	6	6	CULVERT INLET
296+00	STH 110	30	30	30	2 DITCHES
301+00	STH 110	30	30	30	2 DITCHES
306+00	STH 110	30	30	30	2 DITCHES
311+00	STH 110	30	30	30	2 DITCHES
344+00	STH 110 MEDIAN	15	15	15	
345+00	STH 110 SB, LT.	15	15	15	
353+00	STH 110	45	45	45	3 DITCHES
358+50	STH 110 SB, LT.	15	15	15	
363+00	STH 110 NB, RT.	12	12	12	CULVERT INLET
215+00	LAKE BUTTE DES MORTS DRIVE, LT.	30	30	30	
217+00	LAKE BUTTE DES MORTS DRIVE, LT.	15	15	15	
219+00	LAKE BUTTE DES MORTS DRIVE, LT.	15	15	15	
221+00	LAKE BUTTE DES MORTS DRIVE, LT.	15	15	15	
259+00	LAKE BUTTE DES MORTS DRIVE, RT.	4	4	4	CULVERT INLET
270+00	LAKE BUTTE DES MORTS DRIVE, RT.	18	18	18	CULVERT INLETS
26+00	CTH T	4	4	4	CULVERT INLET
283+00	NW FRONTAGE ROAD AT CTH T	4	4	4	CULVERT INLET
19+00	SKELETON BRIDGE ROAD, LT.	6	6	6	CULVERT INLET
64+50	KOLB ROAD	30	30	30	2 DITCHES
66+50	KOLB ROAD	30	30	30	2 DITCHES
364+50	SW RAMP AT STH 116, LT.	15	15	15	
371+00	SW RAMP AT STH 116, RT.	4	4	4	CULVERT INLET
372+50	SE RAMP AT STH 116, LT.	4	4	4	CULVERT INLET
374+50	NE RAMP AT STH 116, LT.	4	4	4	CULVERT INLET
87+00	CTH GG, LT.	4	4	4	CULVERT INLET
0+50	WETLAND MITIAGTION SITE (MIT 4)	400	400	400	BOTH SIDES OF WATERWAY
4+50	WETLAND MITIAGTION SITE (MIT 6)	200	200	200	ALONG WATERWAY
5+00	WETLAND MITIGATION SITE (MIT 7)	200	200	200	BOTH SIDES OF INLET
	UNDISTRIBUTED	339	339	339	
TOTAL:		1,689	1,689	1,689	

WIER PLATE*

LOCATION	90005A WIER PLATE EACH
WETLAND MITIGATION SITE	1
TOTAL:	1

*REFER TO CONSTRUCTION DETAILS FOR DIMENSIONS AND MATERIAL REQUIREMENTS.

STONE OR ROCK DITCH CHECK SUMMARY

STATION - STATION	LOCATION	90005F STONE OR ROCK DITCH CHECKS EACH	REMARKS
6+70 -	BROOKS ROAD	2	1 PER DITCH
12+20 -	BROOKS ROAD	2	1 PER DITCH
256+00 - 272+00	STH 110 NB, RT.	10	
256+00 - 272+00	STH 110 SB, LT.	12	
11+50 - 12+50	SPIEGELBERG ROAD	5	ALONG DITCH
281+00 -	STH 110 NB	1	1 PER DITCH
348+00 - 360+00	STH 110 NB, RT.	9	
348+00 - 360+00	STH 110 SB, LT.	10	
360+00 - 362+50	STH 110 SB, LT.	10	
375+00 -	NE RAMP AT STH 116, RT.	1	
376+50 -	NE RAMP AT STH 116	2	
378+50 -	NE RAMP AT STH 116, LT.	1	
2+00 -	WETLAND MITIGATION SITE (MIT 1)	1	
	UNDISTRIBUTED	17	
TOTAL:		83	

CONCRETE BASES

CATEGORY 0100

LOCATION	90005G TYPE 5 SPECIAL EACH
OLD STH 110 PARKING LOT	2
TOTAL:	2

MISCELLANEOUS QUANTITIES

HWY: STH 110

COUNTY: WINNEBAGO

STATE PROJECT NO: 6200-05-71

SHEET NO:

3BB E

ALL ITEMS & QUANTITIES ON THIS SHEET ARE FOR CATEGORY 0010, UNLESS OTHERWISE NOTED.

SAFETY FENCE

STATION - STATION	LOCATION	90637 SAFETY FENCE L.F.
249+60 - 254+50	STH 110 SB, LT.	490
256+70 - 259+40	STH 110 NB, RT.	270
10+30 - 15+00	BROOKS ROAD, RT.	470
21+60 - 29+80	BROOKS ROAD, RT.	820
267+80 - 271+30	STH 110 NB, RT.	350
270+60 - 272+60	STH 110 SB, LT.	200
00+00 - 5+30	SKELETON BRIDGE ROAD, LT.	530
316+00 - 320+70	STH 110 SB, LT.	470
48+50 - 53+00	CROSS ROAD, RT.	450
TOTAL:		4,050

LIMESTONE SCREENING SUMMARY

CATEGORY 0100

STATION - STATION	LOCATION	90035B LIMESTONE SCREENING TON
	RECREATION TRAIL CONNECTION	30
0+00 - 29+00	RECREATION TRAIL	860
TOTAL:		890

BASIN LYSIMETER

CATEGORY 0090

STATION	LOCATION	90005E BASIN LYSIMETER EACH
188+50	STH 110 SB, 40' LT.	1
TOTAL		1

BASIN LYSIMETER ESTIMATED QUANTITIES**

6" DIA. SCH. 80 PVC PERFORATED PIPE	10 L.F.
6" DIA. SCH. 80 PVC UNPERFORATED PIPE	80 L.F.
GEOMEMBRANE	400 S.F.
GEOTEXTILE FABRIC, TYPE DF	500 S.F.
CONCRETE AGGREGATE (SIZE #2)	3 C.Y.
LOCKING CAP	1 EACH
PIPE BOOT	1 EACH

** ESTIMATED QUANTITIES TO CONSTRUCT ONE BASIN LYSIMETER (EACH) AT STA. 188+00 ARE FOR INFORMATION ONLY. ALL FITTINGS AND HARDWARE NECESSARY TO CONSTRUCT BASIN LYSIMETER ARE NOT INCLUDED IN ESTIMATED QUANTITIES BUT ARE INCLUDED IN BASIN LYSIMETER BID ITEM.

MISCELLANEOUS QUANTITIES

HWY: STH 110

COUNTY: WINNEBAGO

STATE PROJECT NO: 6200-05-71

SHEET NO:

300 E

R/W PROJECT NUMBER 6200-05-24	SHEET NUMBER 4.0	TOTAL SHEETS
FEDERAL PROJECT NUMBER		
PLAT OF RIGHT OF WAY REQUIRED FOR USH 41 - CTH T		
STH 110	WINNEBAGO	

6200-05-71/4.1

CONVENTIONAL SIGNS AND ABBREVIATIONS


AC.	ACRES	PED	PEDESTAL
AC. REM.	ACRES REMAINING	O	R/W MONUMENT
A.P.	ACCESS POINT	P.L.	PROPERTY LINE
B.	BARN	P.L.E.	PERMANENT LIMITED EASEMENT
BLDG.	BUILDING	R.	RANGE
CO.	COMPANY	RD.	ROAD
CORP.	CORPORATION	R/W	RIGHT OF WAY
C.T.H.	COUNTY TRUNK HIGHWAY	S.	SHED
D.	DEED	S.T.H.	STATE TRUNK HIGHWAY
E.	EAST	T.	TOWN
ET. AL.	AND OTHERS	TEMP.	TEMPORARY
G.	GARAGE	T.I.	TEMPORARY INTEREST
GN	GRID NORTH	VOL.	VOLUME
H.	HOUSE	W.	WEST
INC.	INCORPORATED	WIS.	WISCONSIN
L.C.	LAND CONTRACT		
N	NORTH		

COMPENSABLE NON-COMPENSABLE

POWER POLE	■	□
TELEPHONE POLE	⌘	⌘
SIGN	■	□
TELEPHONE PEDESTAL	■	□

NO ACCESS (BY ACQUISITION)	
NO ACCESS (BY STATUTORY AUTHORITY)	●●●●●
NO ACCESS (BY PREVIOUS PROJECT OR COVENANT)	◆◆◆◆◆

GN

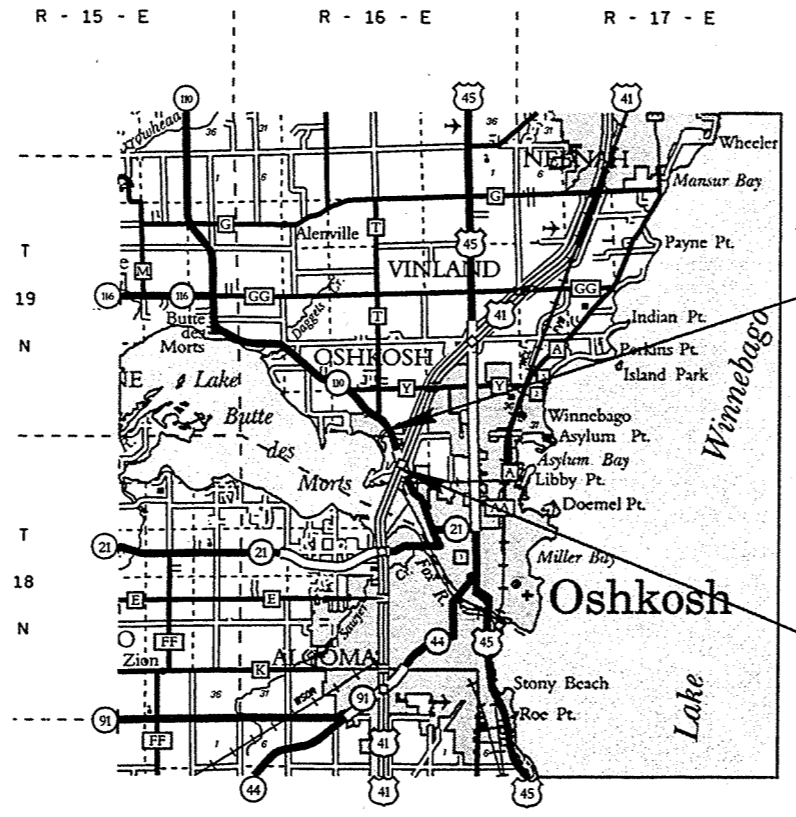


END RELOCATION ORDER

**PROJECT 6200-05-24
STATION 114+00**
1328.73 FEET N 87°-13'-47" W OF THE
N 1/4 CORNER OF SECTION 3,
TOWNSHIP 18 NORTH, RANGE 16 EAST.
N = 757,065.937
E = 373,733.885

BEGIN RELOCATION ORDER

**PROJECT 6200-05-24
STATION 70+10.40**
1383.97 FEET S 6°-0'-49" E OF THE
CENTER OF SECTION 3,
TOWNSHIP 18 NORTH, RANGE 16 EAST.
N = 752,958.700
E = 375,282.802

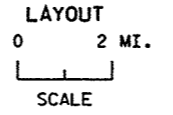

TOTAL NET LENGTH OF CENTERLINE = 0.89 MI.

NOTES

COORDINATES AND BEARINGS ON THIS PLAT ARE ORIENTED TO THE WISCONSIN COORDINATE SYSTEM SOUTH ZONE (NAD 27). ALL PLAT COORDINATES ARE ENGLISH GROUND DATA & CAN BE CONVERTED TO ENGLISH GRID BY MULTIPLYING BY THE PROVIDED GRID FACTOR AND ADDING TWO MILLION TO THE CONVERTED EAST VALUE. ALL PLAT DISTANCES ARE GROUND LENGTHS AND MAY BE CONVERTED TO GRID LENGTHS BY MULTIPLYING THE DISTANCE BY THE PROVIDED GRID FACTOR.

RIGHT OF WAY BOUNDARIES ARE DEFINED WITH COURSES OF THE PERIMETER OF THE HIGHWAY LANDS REFERENCED TO THE US PUBLIC LAND SURVEY OR OTHER SURVEYS OF PUBLIC RECORD.

RIGHT OF WAY MONUMENTS ARE TYPE 2 AND ARE PLACED PRIOR TO OR AT THE TIME OF LAND TITLE TRANSFER.


RIGHT OF WAY BOUNDARIES ARE DEFINED WITH COURSES OF THE PERIMETER OF THE HIGHWAY LANDS REFERENCED TO THE US PUBLIC LAND SURVEY OR OTHER SURVEYS OF PUBLIC RECORD.

REVISION DATE 12-21-00	STATE OF WISCONSIN DEPARTMENT OF TRANSPORTATION
	APPROVED:
	DATE: _____ DISTRICT DIRECTOR

PLOT SCALE: 10560
PLOT NAME: 103
REV. DATE: 08-11-99
ORIGINATOR: DIST. 3






LEVELS ON - 1, 2, 3, 62, 63

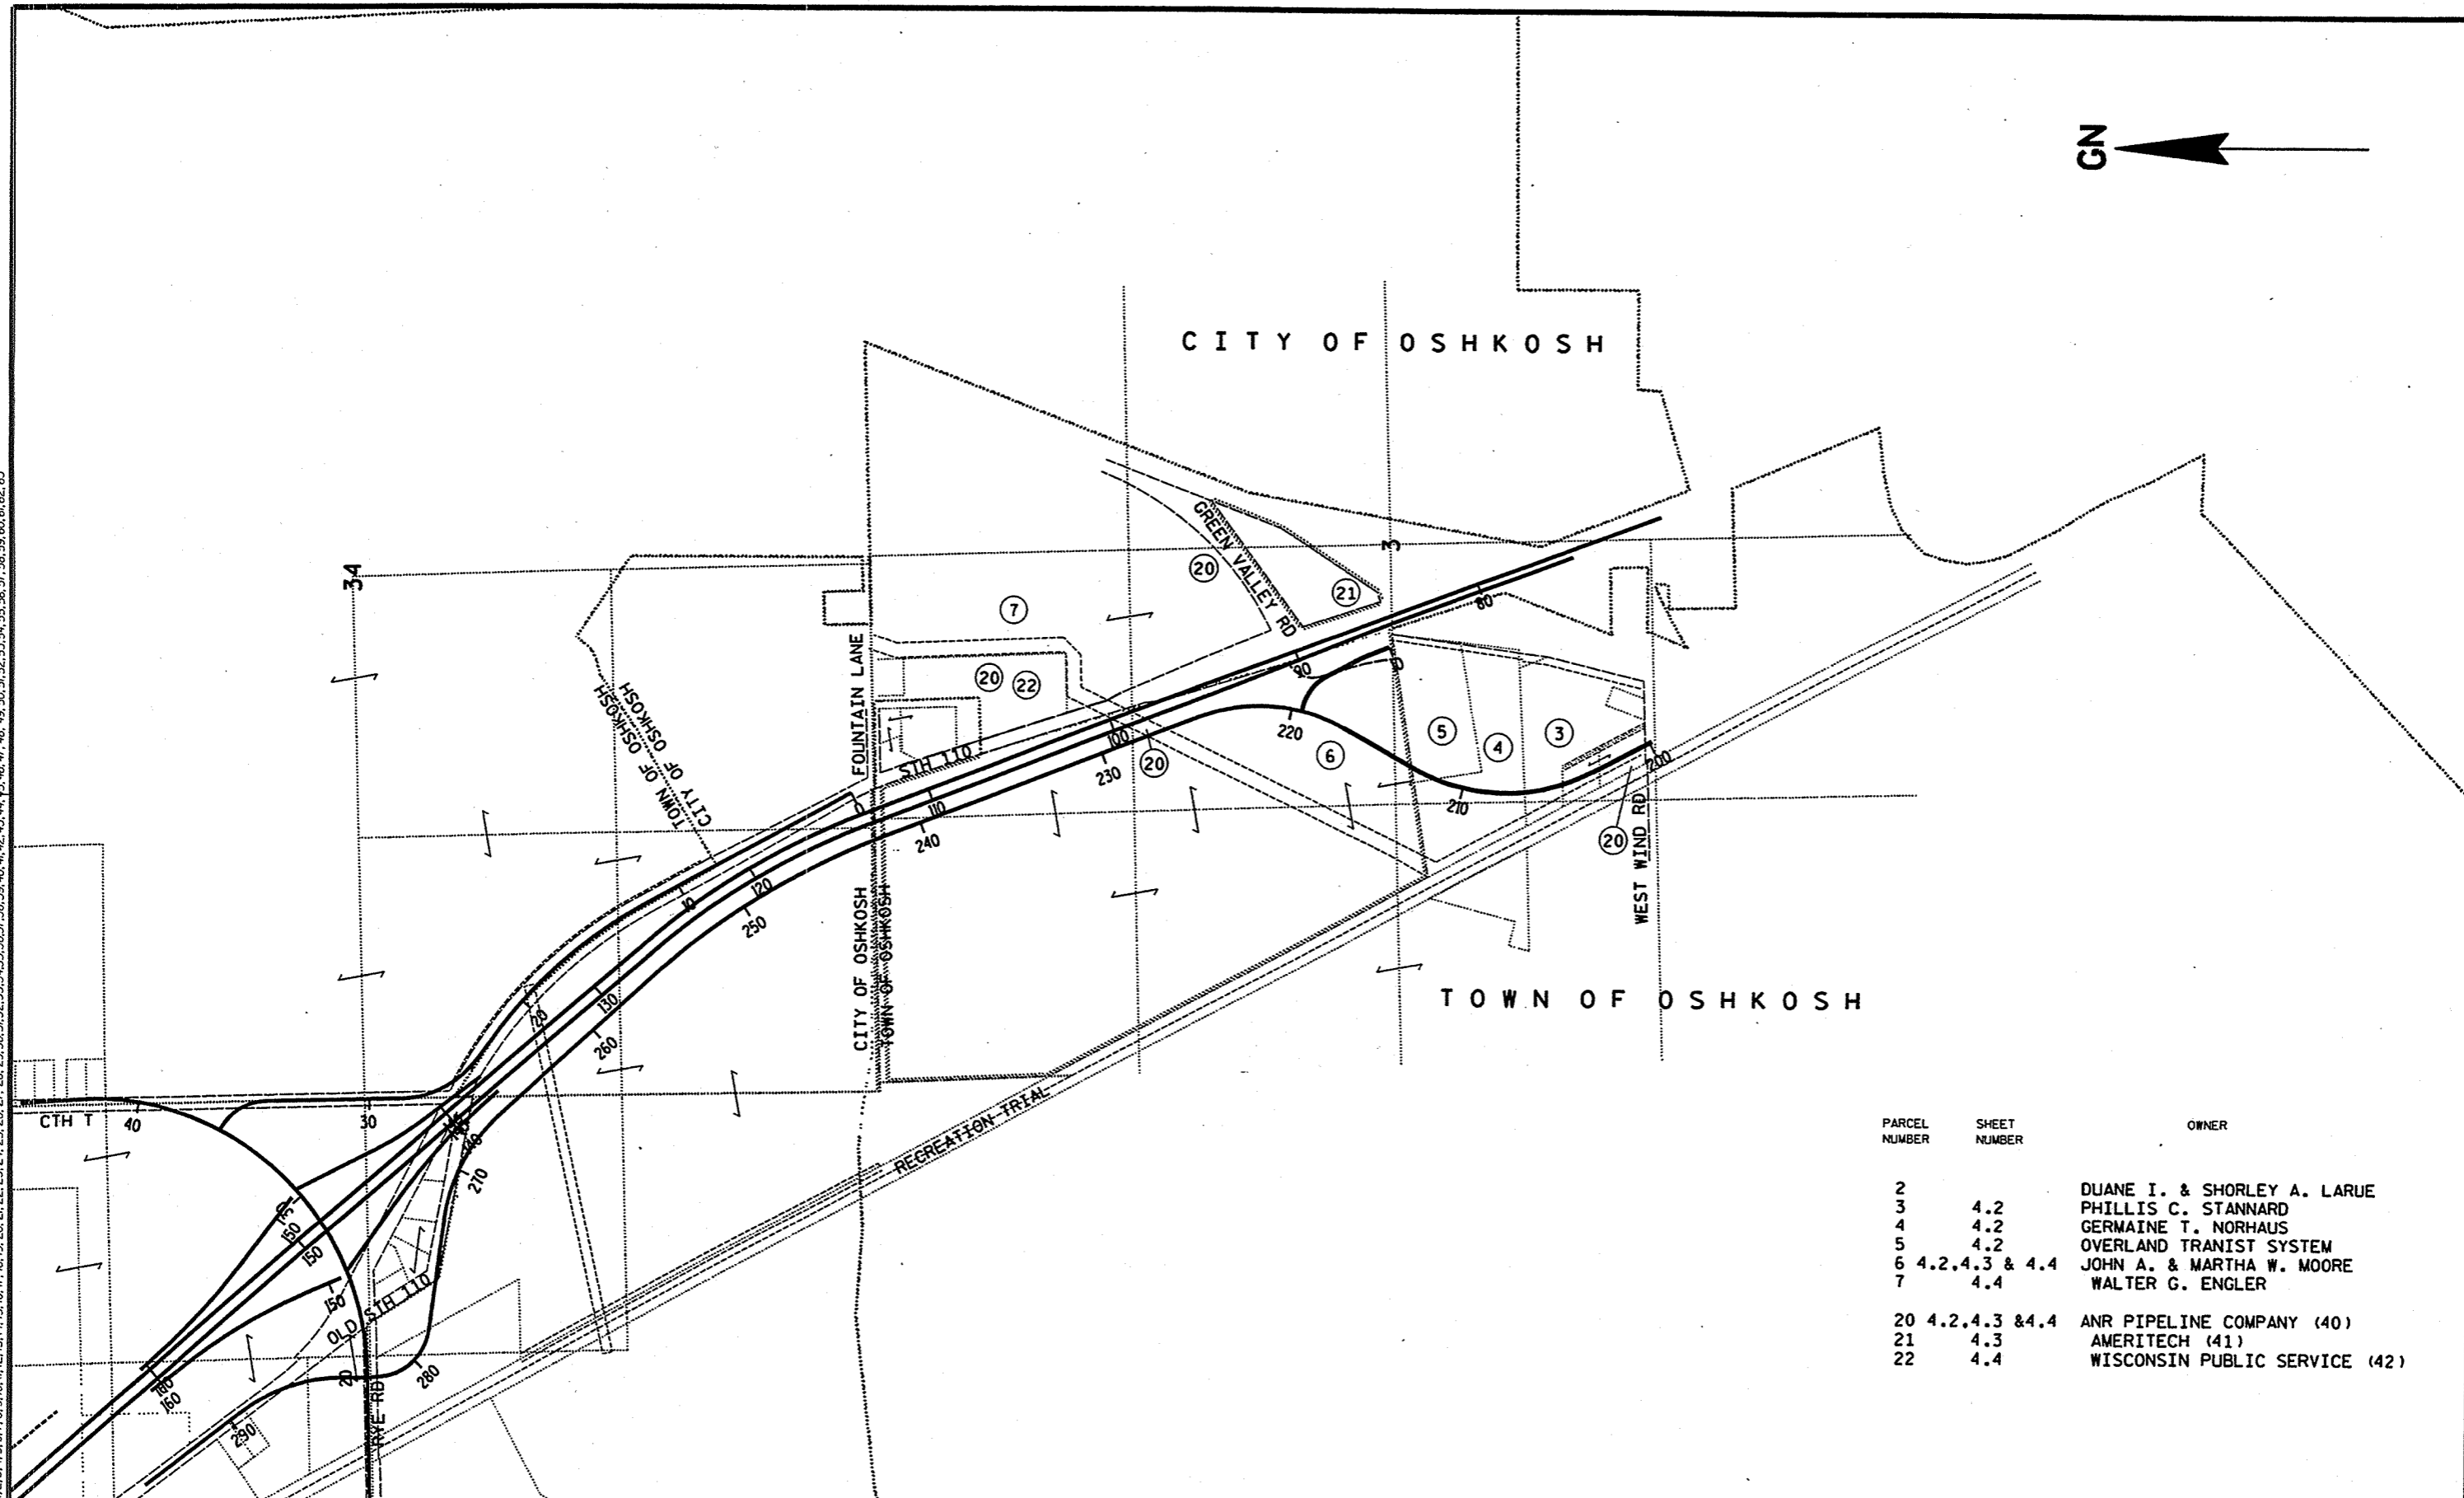

PARCEL NUMBER	SHEET NUMBER	OWNER
2		DUANE I. & SHORLEY A. LARUE
3	4.2	PHILLIS C. STANNARD
4	4.2	GERMAINE T. NORHAUS
5	4.2	OVERLAND TRANIST SYSTEM
6	4.2, 4.3 & 4.4	JOHN A. & MARTHA W. MOORE
7	4.4	WALTER G. ENGLER
20	4.2, 4.3 & 4.4	ANR PIPELINE COMPANY (40)
21	4.3	AMERITECH (41)
22	4.4	WISCONSIN PUBLIC SERVICE (42)

REVISION DATE 12-21-00	DATE 8-11-99	NOT TO SCALE	HWY: STH 110	CONSTRUCTION PROJECT NUMBER 6200-05-71	PS&E SHEET NO: 4.2
			COUNTY: WINNEBAGO	STATE R/W PROJECT NUMBER 6200-05-24	PLAT SHEET NO: 4.1
					E

LEVELS ON 1, 2, 3, 62, 63

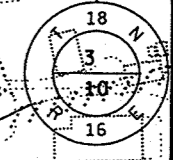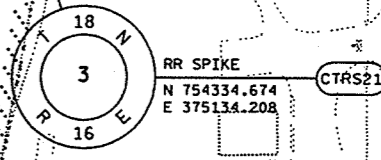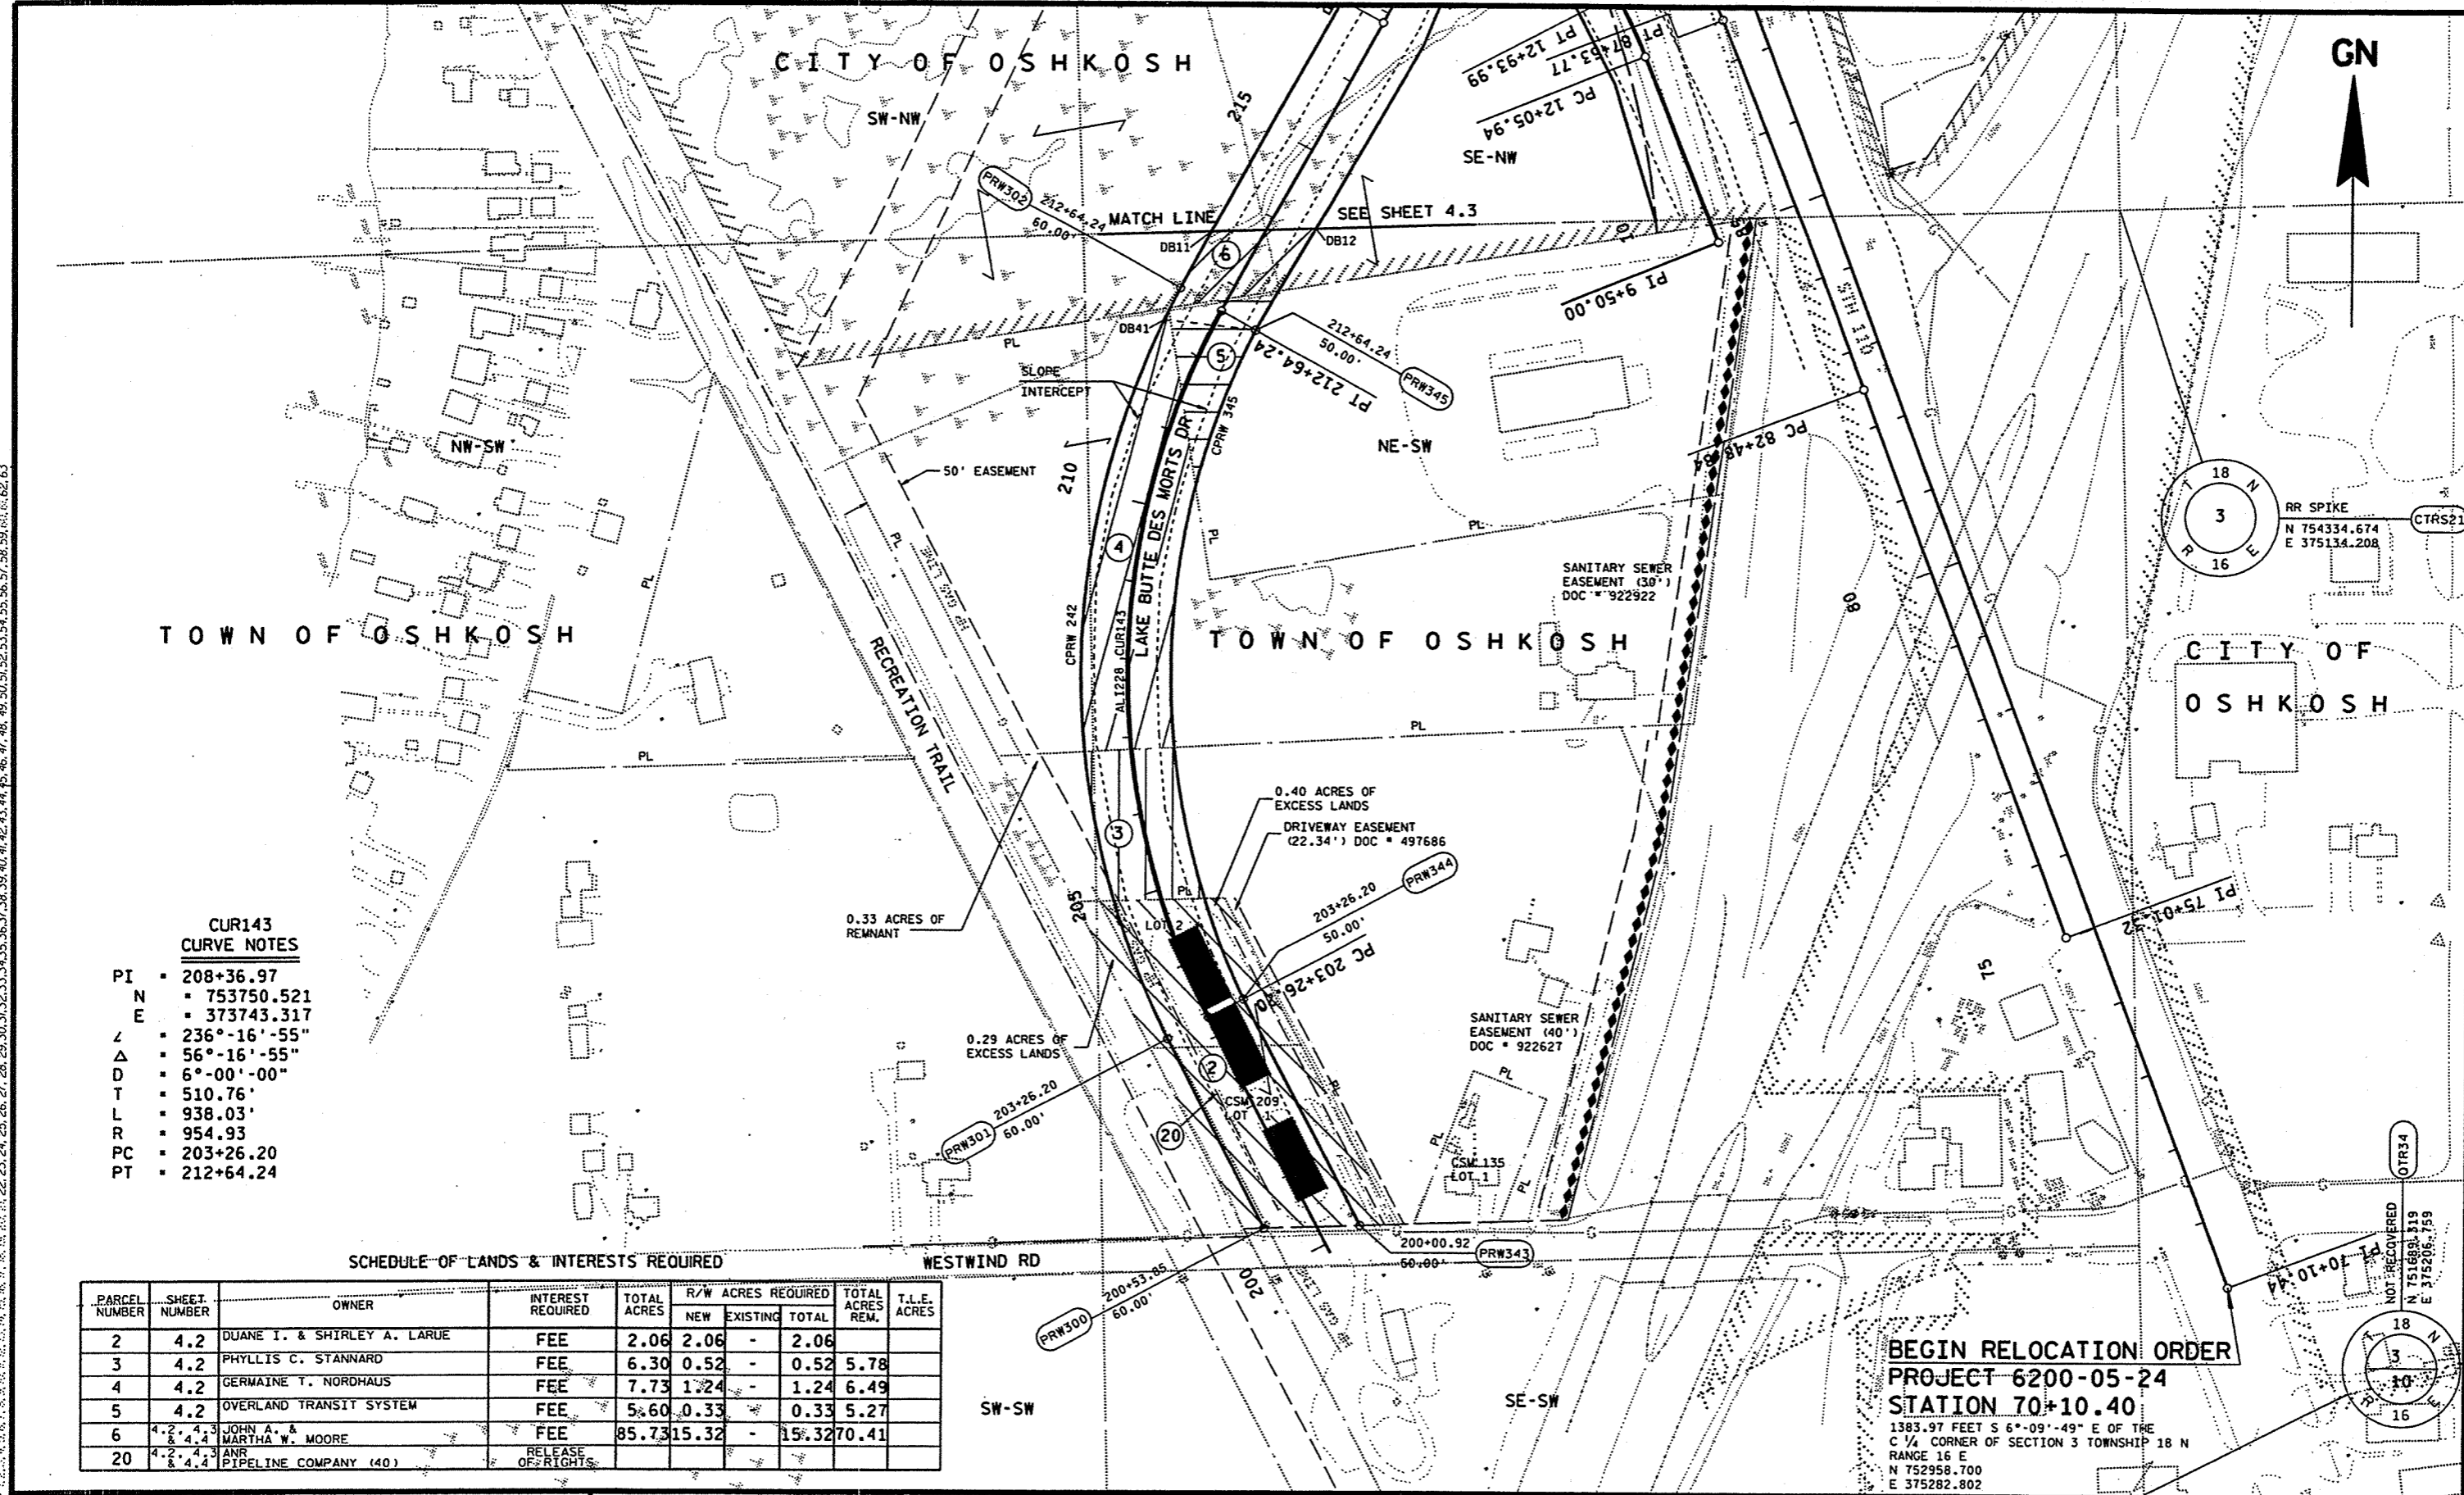

**CUR143
CURVE NOTES**

PI • 208+36.97
N • 753750.521
E • 373743.317

∠ • 236°-16'-55"
Δ • 56°-16'-55"
D • 6°-00'-00"
T • 510.76'
L • 938.03'
R • 954.93'
PC • 203+26.20
PT • 212+64.24

SCHEDULE OF LANDS & INTERESTS REQUIRED

PARCEL NUMBER	SHEET NUMBER	OWNER	INTEREST REQUIRED	TOTAL ACRES	R/W ACRES REQUIRED			TOTAL ACRES REM.	T.L.E. ACRES
					NEW	EXISTING	TOTAL		
2	4.2	DUANE I. & SHIRLEY A. LARUE	FEE	2.06	2.06	-	2.06		
3	4.2	PHYLLIS C. STANNARD	FEE	6.30	0.52	-	0.52	5.78	
4	4.2	GERMAINE T. NORDHAUS	FEE	7.73	1.24	-	1.24	6.49	
5	4.2	OVERLAND TRANSIT SYSTEM	FEE	5.60	0.33	-	0.33	5.27	
6	4.2, 4.3, 4.4	JOHN A. & MARTHA W. MOORE	FEE	85.73	15.32	-	15.32	70.41	
20	4.2, 4.3, 4.4	ANR PIPELINE COMPANY (40)	RELEASE OF RIGHTS						

BEGIN RELOCATION ORDER
PROJECT 6200-05-24
STATION 70+10.40
 1383.97 FEET S 6°-09'-49" E OF THE
 C 1/4 CORNER OF SECTION 3 TOWNSHIP 18 N
 RANGE 16 E
 N 752958.700
 E 375282.802

REVISION DATE 12-21-00	DATE: 8-11-99	SCALE, FEET 0 100 200	HWY: STH 110	CONSTRUCTION PROJECT NUMBER: 6200-05-71	PS&E SHEET NO: 4.3
	GRID FACTOR: 0.999997		COUNTY: WINNEBAGO	STATE R/W PROJECT NUMBER: 6200-05-24	PLAT SHEET NO: 4.2

SCHEDULE OF LANDS & INTERESTS REQUIRED

PARCEL NUMBER	SHEET NUMBER	OWNER	INTEREST REQUIRED	TOTAL ACRES	R/W ACRES REQUIRED			TOTAL ACRES REM.	T.L.E. ACRES
					NEW	EXISTING	TOTAL		
1*	4.3	MELVIN R. GUST, ET AL	FEE	4.81	4.81	-	4.81	-	
6	4.3	JOHN A. & MARTHA W. MOORE	FEE	SEE SHEET	4.2				
7	4.3 & 4.4	WALTER G. ENGLER	FEE ACCESS RIGHTS	33.43	0.25	-	0.25	33.18	
20	4.2 & 4.4	ANR PIPELINE COMPANY (40)	RELEASE OF RIGHTS						
21	4.3	AMERITECH (41)	RELEASE OF RIGHTS						

FRACT. NW-NW

CLOFT3 CURVE NOTES

PI = 12+50.00
 N = 754567.650
 E = 374511.759
 Δ = 174°16'-35"
 D = 5°-43'-24"
 T = 6°-30'-00"
 L = 44.06'
 R = 88.05'
 PC = 881.47'
 PT = 12+05.94

C BS3801 CURVE NOTES

PI = 90+10.65
 N = 755268.262
 E = 374347.933
 Δ = 181°-15'-37"
 D = 1°-15'-37"
 T = 0°-30'-00"
 L = 126.04'
 R = 252.06'
 PC = 11459.16'
 PT = 88+84.62

CUR144 CURVE NOTES

PI = 220+92.33
 N = 754923.968
 E = 374387.961
 Δ = 130°-33'-36"
 D = 49°-26'-24"
 T = 6°-30'-00"
 L = 405.81'
 R = 760.62'
 PC = 881.47'
 PT = 216+86.53

C BS3800 CURVE NOTES

PI = 80+10.40
 N = 754340.318
 E = 374721.302
 Δ = 179°-22'-11"
 D = 0°-37'-19"
 T = 0°-15'-00"
 L = 126.05'
 R = 252.09'
 PC = 22918.31'
 PT = 78+84.36

CITY OF OSHKOSH

ANR PIPELINE EASEMENT (75') VOL 841 PG 119-123


CLOFT2 CURVE NOTES

PI = 14+90.85
 N = 754781.094
 E = 374400.018
 Δ = 135°-59'-56"
 D = 44°-00'-04"
 T = 25°-00'-00"
 L = 92.60'
 R = 176.00'
 PC = 229.18'
 PT = 13+98.25

ACCESS RIGHTS ACQUIRED UNDER PROJECT F 03-2 (33)


* PARCEL ACQUIRED DOC # 1076918 DATED 10-25-99

GN

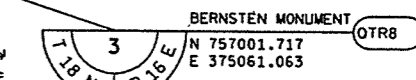


CUR151 CURVE NOTES
 PI = 2+18.30
 N = 755276.944
 E = 375225.890
 Δ = 191°-25'-27"
 D = 11°-25'-27"
 T = 2°-37'-31"
 L = 218.30'
 R = 435.15'
 PC = 0+00.00
 PT = 4+35.15

SE-NW
 PT 4+35.148
 N 755132.150
 E 375062.524

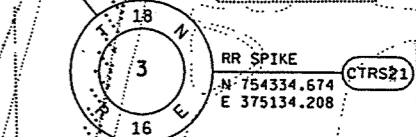

LEVELS ON: 1.0, 2.0, 3.0, 62.0, 63.0

REVISION DATE 12-21-00	DATE: 8-11-99	SCALE: FEET 0 100 200	HWY: STH 110	CONSTRUCTION PROJECT NUMBER: 6200-05-71	PS&E SHEET NO: 4.4
GRID FACTOR: 0.999997			COUNTY: WINNEBAGO	STATE R/W PROJECT NUMBER: 6200-05-24	PLAT SHEET NO: 4.3

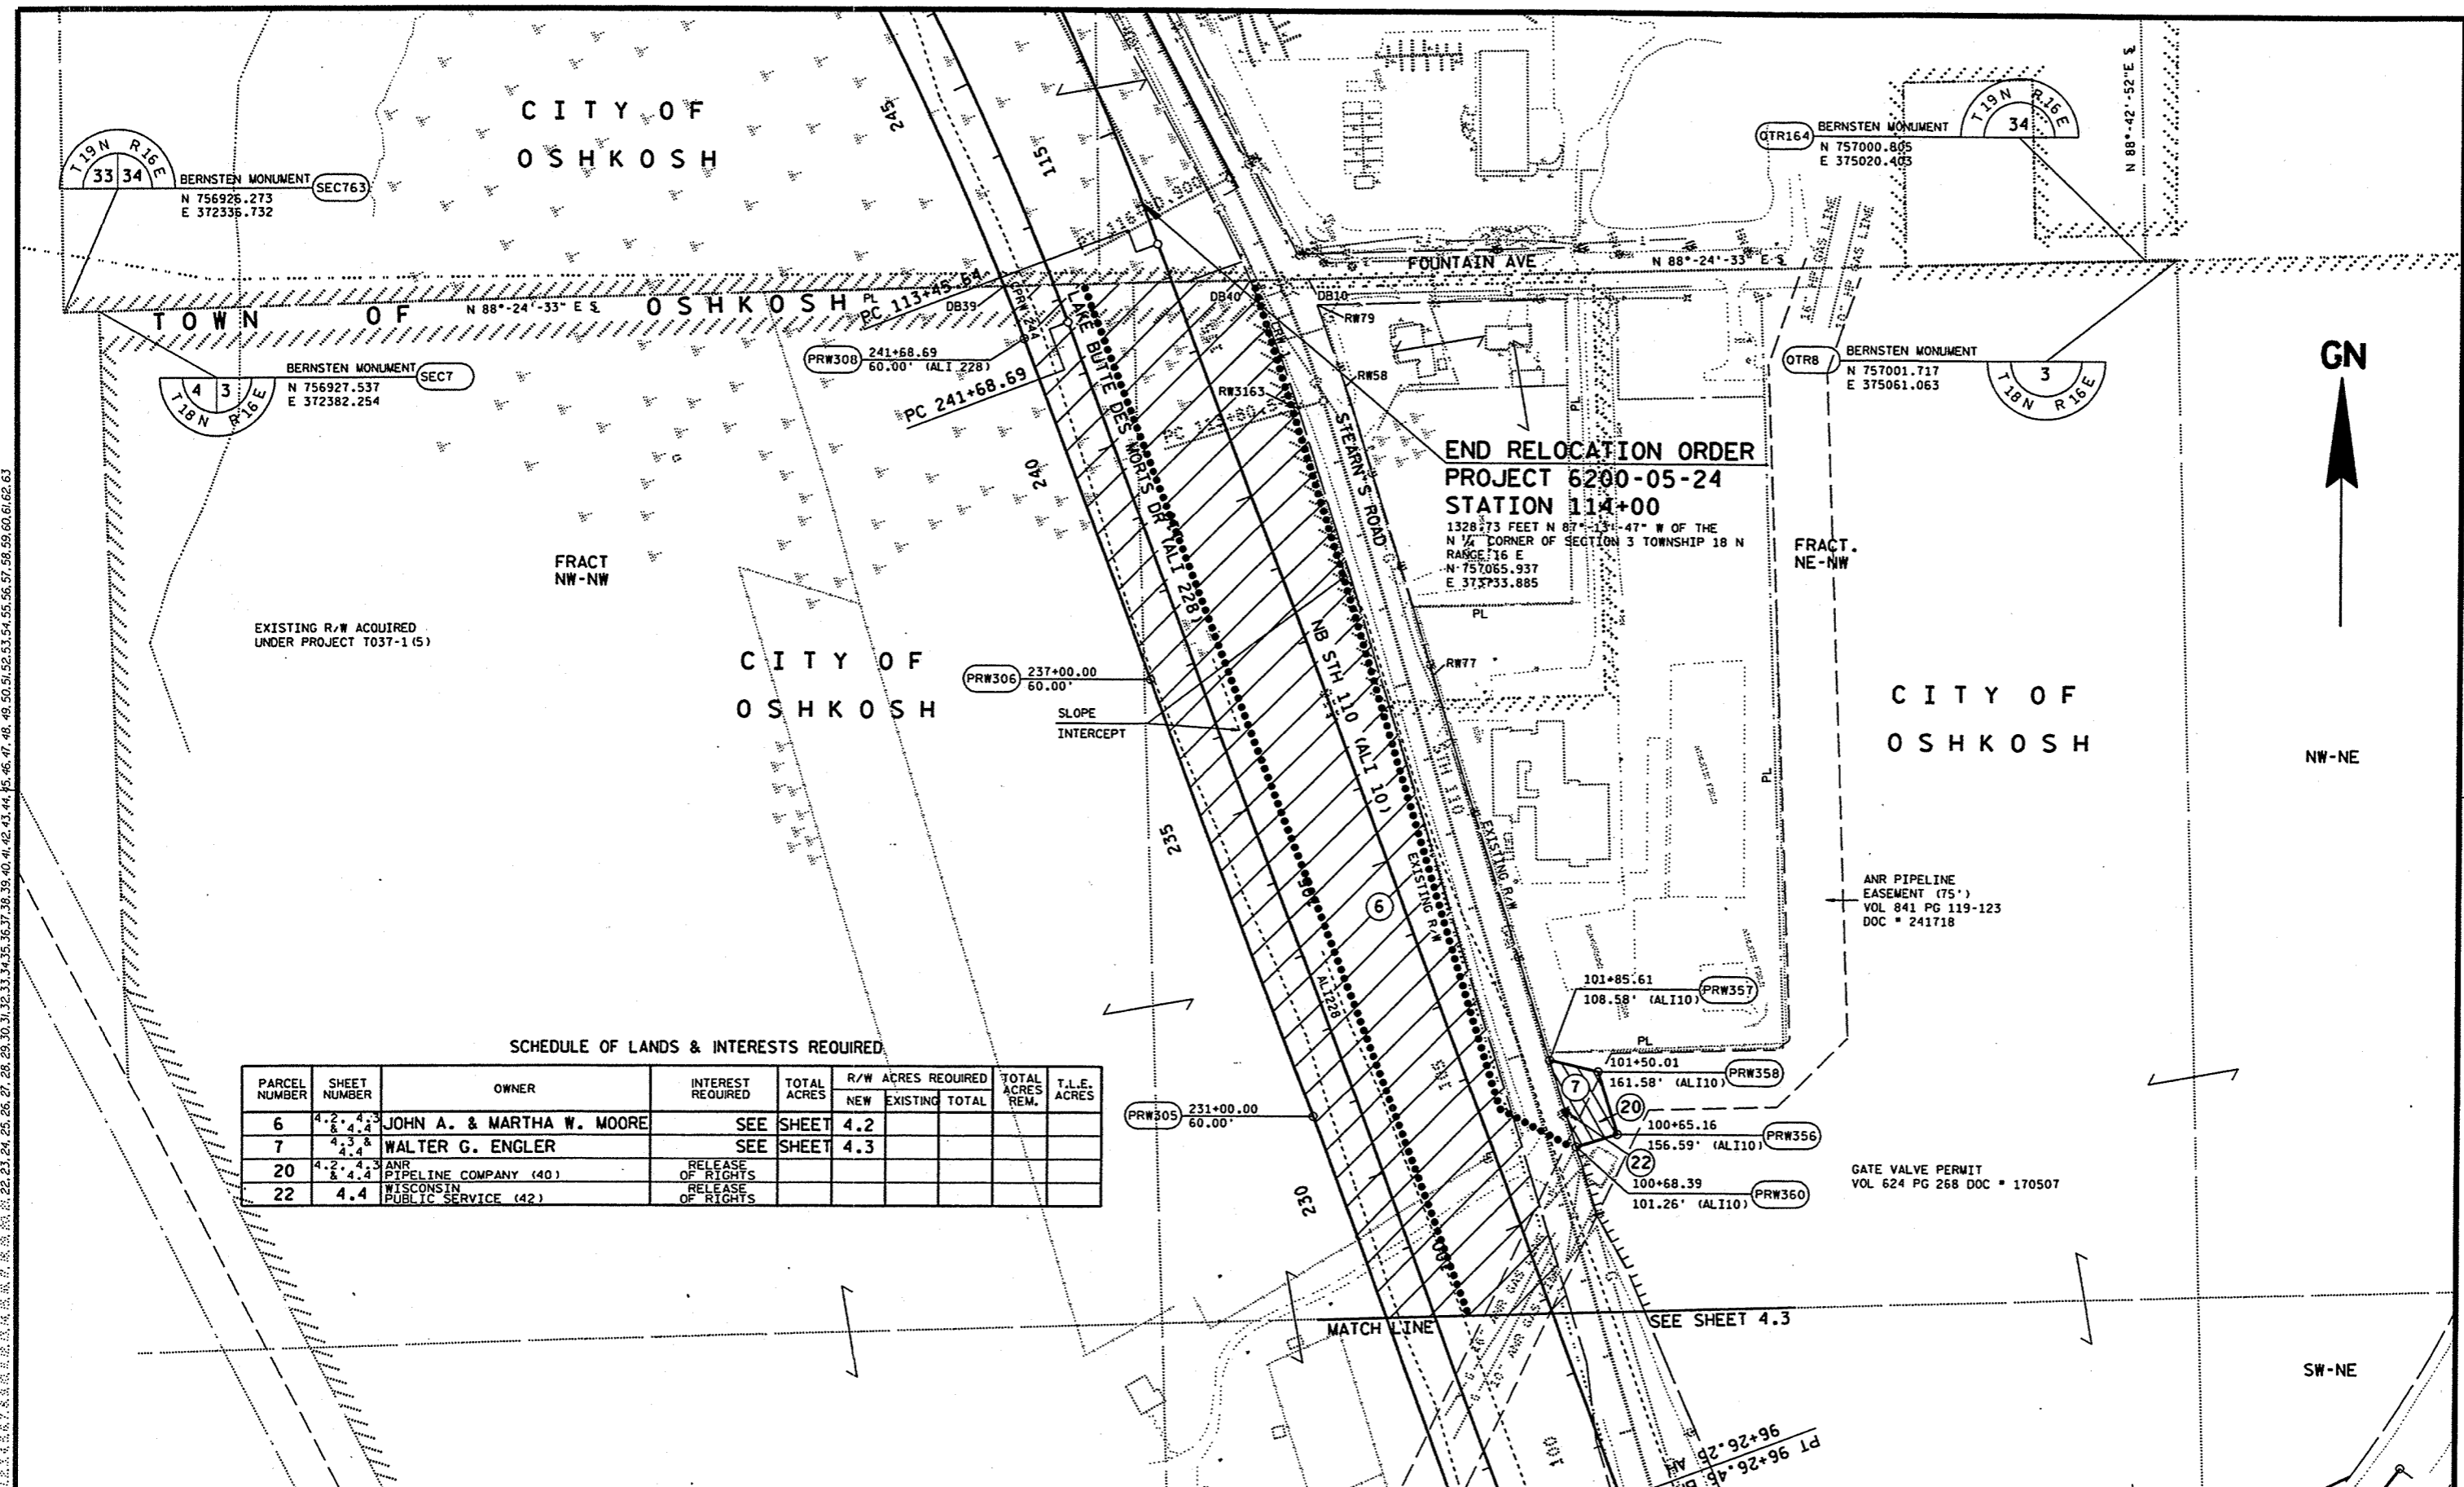

END RELOCATION ORDER
PROJECT 6200-05-24
STATION 114+00
 1328.73 FEET N 87°-15'-47" W OF THE
 N 1/4 CORNER OF SECTION 3 TOWNSHIP 18 N
 RANGE 16 E
 N 757065.937
 E 372733.885

SCHEDULE OF LANDS & INTERESTS REQUIRED

PARCEL NUMBER	SHEET NUMBER	OWNER	INTEREST REQUIRED	TOTAL ACRES	R/W ACRES REQUIRED			TOTAL ACRES REM.	T.I.E. ACRES
					NEW	EXISTING	TOTAL		
6	4.2, 4.3, 4.4	JOHN A. & MARTHA W. MOORE	SEE SHEET	4.2					
7	4.3 & 4.4	WALTER G. ENGLER	SEE SHEET	4.3					
20	4.2, 4.3 & 4.4	ANR PIPELINE COMPANY (40)	RELEASE OF RIGHTS						
22	4.4	WISCONSIN PUBLIC SERVICE (42)	RELEASE OF RIGHTS						

LEVELS ON - 1.2, 2.3, 2.4, 2.5, 6.2, 6.3

REVISION DATE 12-21-00	DATE: 8-11-99	SCALE, FEET 0 100 200	HWY: STH 110	CONSTRUCTION PROJECT NUMBER: 6200-05-71	PS&E SHEET NO: 4.5
	GRID FACTOR: 0.999997		COUNTY: WINNEBAGO	STATE R/W PROJECT NUMBER: 6200-05-24	PLAT SHEET NO: 4.4

LEVELS ON - 1.2.3.4.5.6.7.8.9.10.11.12.13.14.15.16.17.18.19.20.21.22.23.24.25.26.27.28.29.30.31.32.33.34.35.36.37.38.39.40.41.42.43.44.45.46.47.48.49.50.51.52.53.54.55.56.57.58.59.60.61.62.63

Parcel 2-5 (DB1)		
DISTANCE FEET	BEARING	GROUND COORDINATES
CTRS21	1026.617' S 88°14'54" W	N 754334.674 E 375134.208
DB12	149.384' S 30°08'21" W	N 754303.295 E 374108.071
PRW345-PC CPRW345		N 754174.107 E 374033.066
ARC = 884.93' L.C. = 853.61' L.C.B. = S 0°38'30" W R. = 954.93'		
PRW344-PT CPR345	325.281' S 27°29'58" E	N 753320.553 E 374023.507
PRW343	122.073' S 88°11'50" W	N 753032.024 E 374173.701
PRW300	272.349' N 27°29'58" W	N 753028.184 E 374051.689
PRW301-PC CPRW242		N 753269.762 E 373925.935
ARC = 996.97' L.C. = 957.37' L.C.B. = N 0°38'30" E R. = 1014.930'		
PRW302-PT CPRW242	82.373' N 28°46'57" E	N 754227.070 E 373936.656
DB11	131.816' N 88°14'54" E	N 754299.266 E 373976.317
DB12		N 754303.295 E 374108.072

Parcel 6 (DB3)		
DISTANCE FEET	BEARING	GROUND COORDINATES
OTR8	1188.427' S 88°25'11" W	N 757001.717 E 375061.063
DB40-PC CRW1		N 756968.941 E 373873.088
ARC = 175.038' L.C. = 174.951' L.C.B. = S 20°27'56" E R. = 1604.020'		
RW3163-PT CRW1	1280.425' S 17°15'52" E	N 756805.032 E 373934.259
RW54	101.435' S 7°29'54" E	N 755582.296 E 374314.266
RW53	400.911' S 17°08'47" E	N 755481.729 E 374327.503
RW56	255.935' S 17°34'18" E	N 755098.637 E 374445.697
RW3076-PC RW16		N 754854.644 E 374522.964
ARC = 195.527' L.C. = 179.754' L.C.B. = S 23°07'46" W R. = 138.790'		
DUM178-PT RW16	162.520' S 16°58'06" E	N 754689.338 E 374452.354
RW57-PC CRW2		N 754533.894 E 374499.784
ARC = 221.908' L.C. = 221.536' L.C.B. = S 11°13'12" E R. = 1105.920'		
RW55-PT CRW2	182.345' N 16°50'42" W	N 754316.592 E 374542.890
PRW342	159.354' N 27°18'02" W	N 754491.113 E 374490.049
PRW341-PC CPRW346		N 754632.717 E 374416.960
ARC = 139.311' L.C. = 137.503' L.C.B. = N 41°36'02" W R. = 249.112'		
PRW340-PT CPRW346	212.012' S 22°19'03" W	N 754735.540 E 374325.667
PRW346	422.408' S 30°08'21" W	N 754539.409 E 374245.158
PRW345	118.090' N 85°52'13" W	N 754174.107 E 374033.066
DB41-PC CPRW245		N 754186.716 E 373915.650
ARC = 45.498' L.C. = 45.494' L.C.B. = N 27°29'54" E R. = 1014.930'		
PRW302-PT CPRW245	422.290' N 28°46'57" E	N 754227.070 E 373936.656
PRW303-PC CPRW241		N 754597.188 E 374139.983
ARC = 708.843' L.C. = 687.056' L.C.B. = N 4°03'45" E R. = 821.474'		
PRW304-PT CPRW241	652.858' N 20°39'27" W	N 755282.517 E 374188.658
PRW305	600.000' N 20°39'27" W	N 755893.400 E 373958.343
PRW306	468.687' N 20°39'27" W	N 756454.823 E 373746.674
PRW308-PC CPRW244		N 756893.376 E 373581.331
ARC = 71.734' L.C. = 71.733' L.C.B. = N 21°31'21" W R. = 3879.720'		
DB39-PT CPRW244	318.196' N 88°24'33" E	N 756960.107 E 373555.014
DB40		N 756968.941 E 373873.088

Parcel 7 (DB2)		
DISTANCE FEET	Bearing	GROUND COORDINATES
OTR8	1115.795' S 88°25'13" W	N 757001.717 E 375061.063
DB10	34.721' S 19°28'56" E	N 756970.957 E 373945.692
RW79	110.787' S 19°28'56" E	N 756938.224 E 373957.272
RW58	390.113' S 17°22'03" E	N 756833.781 E 373994.223
RW77	516.742' S 17°17'24" E	N 756461.454 E 374110.672
PRW357	63.845' S 76°46'14" E	N 755968.062 E 374264.251
PRW358	85.000' S 17°17'24" E	N 755953.451 E 374326.402
PRW356	55.000' S 72°42'37" W	N 755872.292 E 374351.664
PRW360	117.422' N 17°17'23" W	N 755855.946 E 374299.149
PRW357		N 755968.062 E 374264.251

6200-05-24 SW-NE SEC. 3

ENV2 Point CTRS21

Distance 926.223'

Bearing N 1°34'16" W

Ground Coordinates N 754334.674 E 375134.208

DB48 30.198' N 88°25'45" E N 755260.549 E 375108.816

PRW378 110.221' N 23°34'45" E N 755261.377 E 375139.002

PRW384 61.654' N 43°06'12" E N 755362.395 E 375183.092

PRW385 75.965' N 64°12'56" E N 755407.410 E 375225.221

TRANSPOSED CURVE CUR150 PC-PRW387

L.C. = 236.593'
 L.C.B. = S 40°48'30" W
 Radius = 1592.020'
 ARC = 236.811'

PT-PRW378 N 755261.377 E 375139.002

REVISION DATE 12-21-00	DATE 8-11-99	NOT TO SCALE	HWY: STH 110	CONSTRUCTION PROJECT NUMBER 6200-05-71	PS&E SHEET NO: 4.6
			COUNTY: WINNEBAGO	STATE R/W PROJECT NUMBER 6200-05-24	PS&E SHEET NO: 4.5

CONVENTIONAL SIGNS AND ABBREVIATIONS

AC.	ACRES	PED	PEDESTAL
AC. REM.	ACRES REMAINING	O	R/W MONUMENT
A.P.	ACCESS POINT	P.L.	PROPERTY LINE
B.	BARN	P.L.E.	PERMANENT LIMITED EASEMENT
BLDG.	BUILDING	R.	RANGE
CO.	COMPANY	RD.	ROAD
CORP.	CORPORATION	R/W	RIGHT OF WAY
C.T.H.	COUNTY TRUNK HIGHWAY	S.	SHED
D.	DEED	S.T.H.	STATE TRUNK HIGHWAY
E.	EAST	T.	TOWN
ET. AL.	AND OTHERS	TEMP.	TEMPORARY
G.	GARAGE	T.I.	TEMPORARY INTEREST
GN	GRID NORTH	VOL.	VOLUME
H.	HOUSE	W.	WEST
INC.	INCORPORATED	WIS.	WISCONSIN
L.C.	LAND CONTRACT		
N	NORTH		

R/W PROJECT NUMBER 6200-05-21	SHEET NUMBER 4.0	TOTAL SHEETS
FEDERAL PROJECT NUMBER		
PLAT OF RIGHT OF WAY REQUIRED FOR CTH T - LASLEY POINT ROAD		
STH 110	WINNEBAGO	


6200-05-21 / 4.7

PLOT SCALE: 10560
PLOT NAME: 103
REV. DATE: 8-3-99
ORIGINATOR: DIST. 3

COMPENSABLE NON-COMPENSABLE


POWER POLE	■	□
TELEPHONE POLE	■	□
SIGN	■	□
TELEPHONE PEDESTAL	■	□

NO ACCESS (BY ACQUISITION)	
NO ACCESS (BY STATUTORY AUTHORITY)	●●●●●
NO ACCESS (BY PREVIOUS PROJECT OR COVENANT)	◆◆◆◆◆

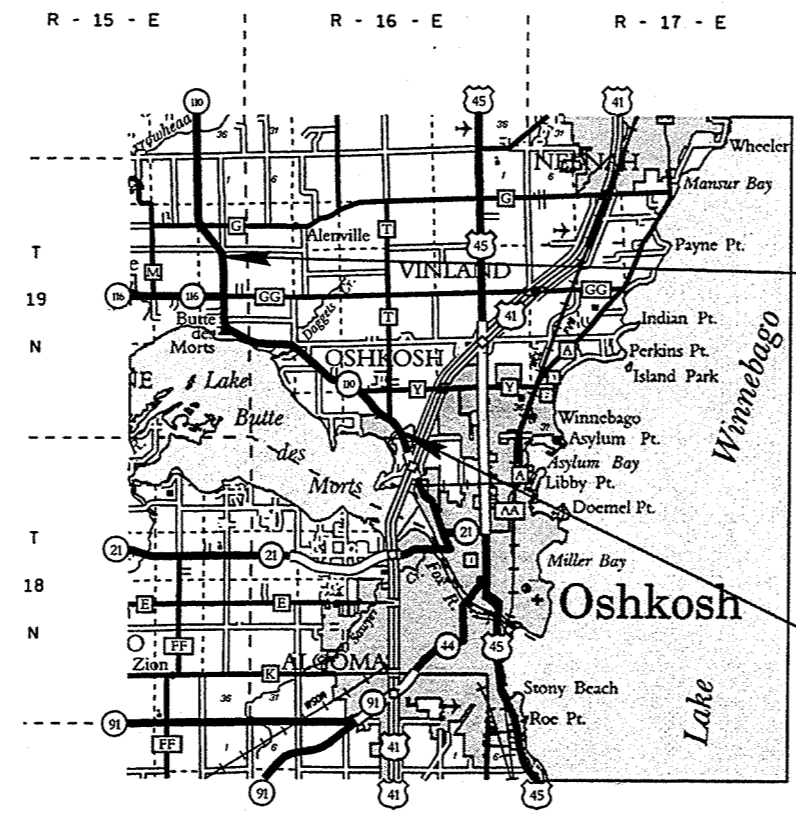

END RELOCATION ORDER
PROJECT 6200-05-21
STATION 405+00
425.48 FEET N 3°-45'-05" W OF THE CENTER OF SECTION 13, TOWNSHIP 19 NORTH, RANGE 15 EAST.
N = 775,719.299
E = 353,570.533

BEGIN RELOCATION ORDER
PROJECT 6200-05-21
STATION 112+50
1276.17 FEET S 86°-35'-09" W OF THE NORTH 1/4 CORNER OF SECTION 3, TOWNSHIP 18 NORTH, RANGE 16 EAST.
N = 756,925.159
E = 373,787.155

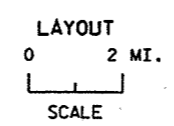

TOTAL NET LENGTH OF CENTERLINE = 5.54 MI.

NOTES

COORDINATES AND BEARINGS ON THIS PLAT ARE ORIENTED TO THE WISCONSIN COORDINATE SYSTEM SOUTH ZONE (NAD 27). ALL PLAT COORDINATES ARE ENGLISH GROUND DATA & CAN BE CONVERTED TO ENGLISH GRID BY MULTIPLYING BY THE PROVIDED GRID FACTOR AND ADDING TWO MILLION TO THE CONVERTED EAST VALUE. ALL PLAT DISTANCES ARE GROUND LENGTHS AND MAY BE CONVERTED TO GRID LENGTHS BY MULTIPLYING THE DISTANCE BY THE PROVIDED GRID FACTOR.


RIGHT OF WAY BOUNDARIES ARE DEFINED WITH COURSES OF THE PERIMETER OF THE HIGHWAY LANDS REFERENCED TO THE US PUBLIC LAND SURVEY OR OTHER SURVEYS OF PUBLIC RECORD.

RIGHT OF WAY MONUMENTS ARE TYPE 2 AND ARE PLACED PRIOR TO OR AT THE TIME OF LAND TITLE TRANSFER.

RIGHT OF WAY BOUNDARIES ARE DEFINED WITH COURSES OF THE PERIMETER OF THE HIGHWAY LANDS REFERENCED TO THE US PUBLIC LAND SURVEY OR OTHER SURVEYS OF PUBLIC RECORD.


REVISION DATE 02-03-99 07-23-99 09-11-01	STATE OF WISCONSIN DEPARTMENT OF TRANSPORTATION APPROVED: DATE: _____ DISTRICT DIRECTOR
---	---

LEVELS ON - 1,2,3,4,5,6,7,8,9,10,11,12,13,14,15,16,17,18,19,20,21,22,23,24,25,26,27,28,29,30,31,32,33,34,35,36,37,38,39,40,41,42,43,44,45,46,47,48,49,50,51,52,53,54,55,56,57,58,59,60,61,62,63

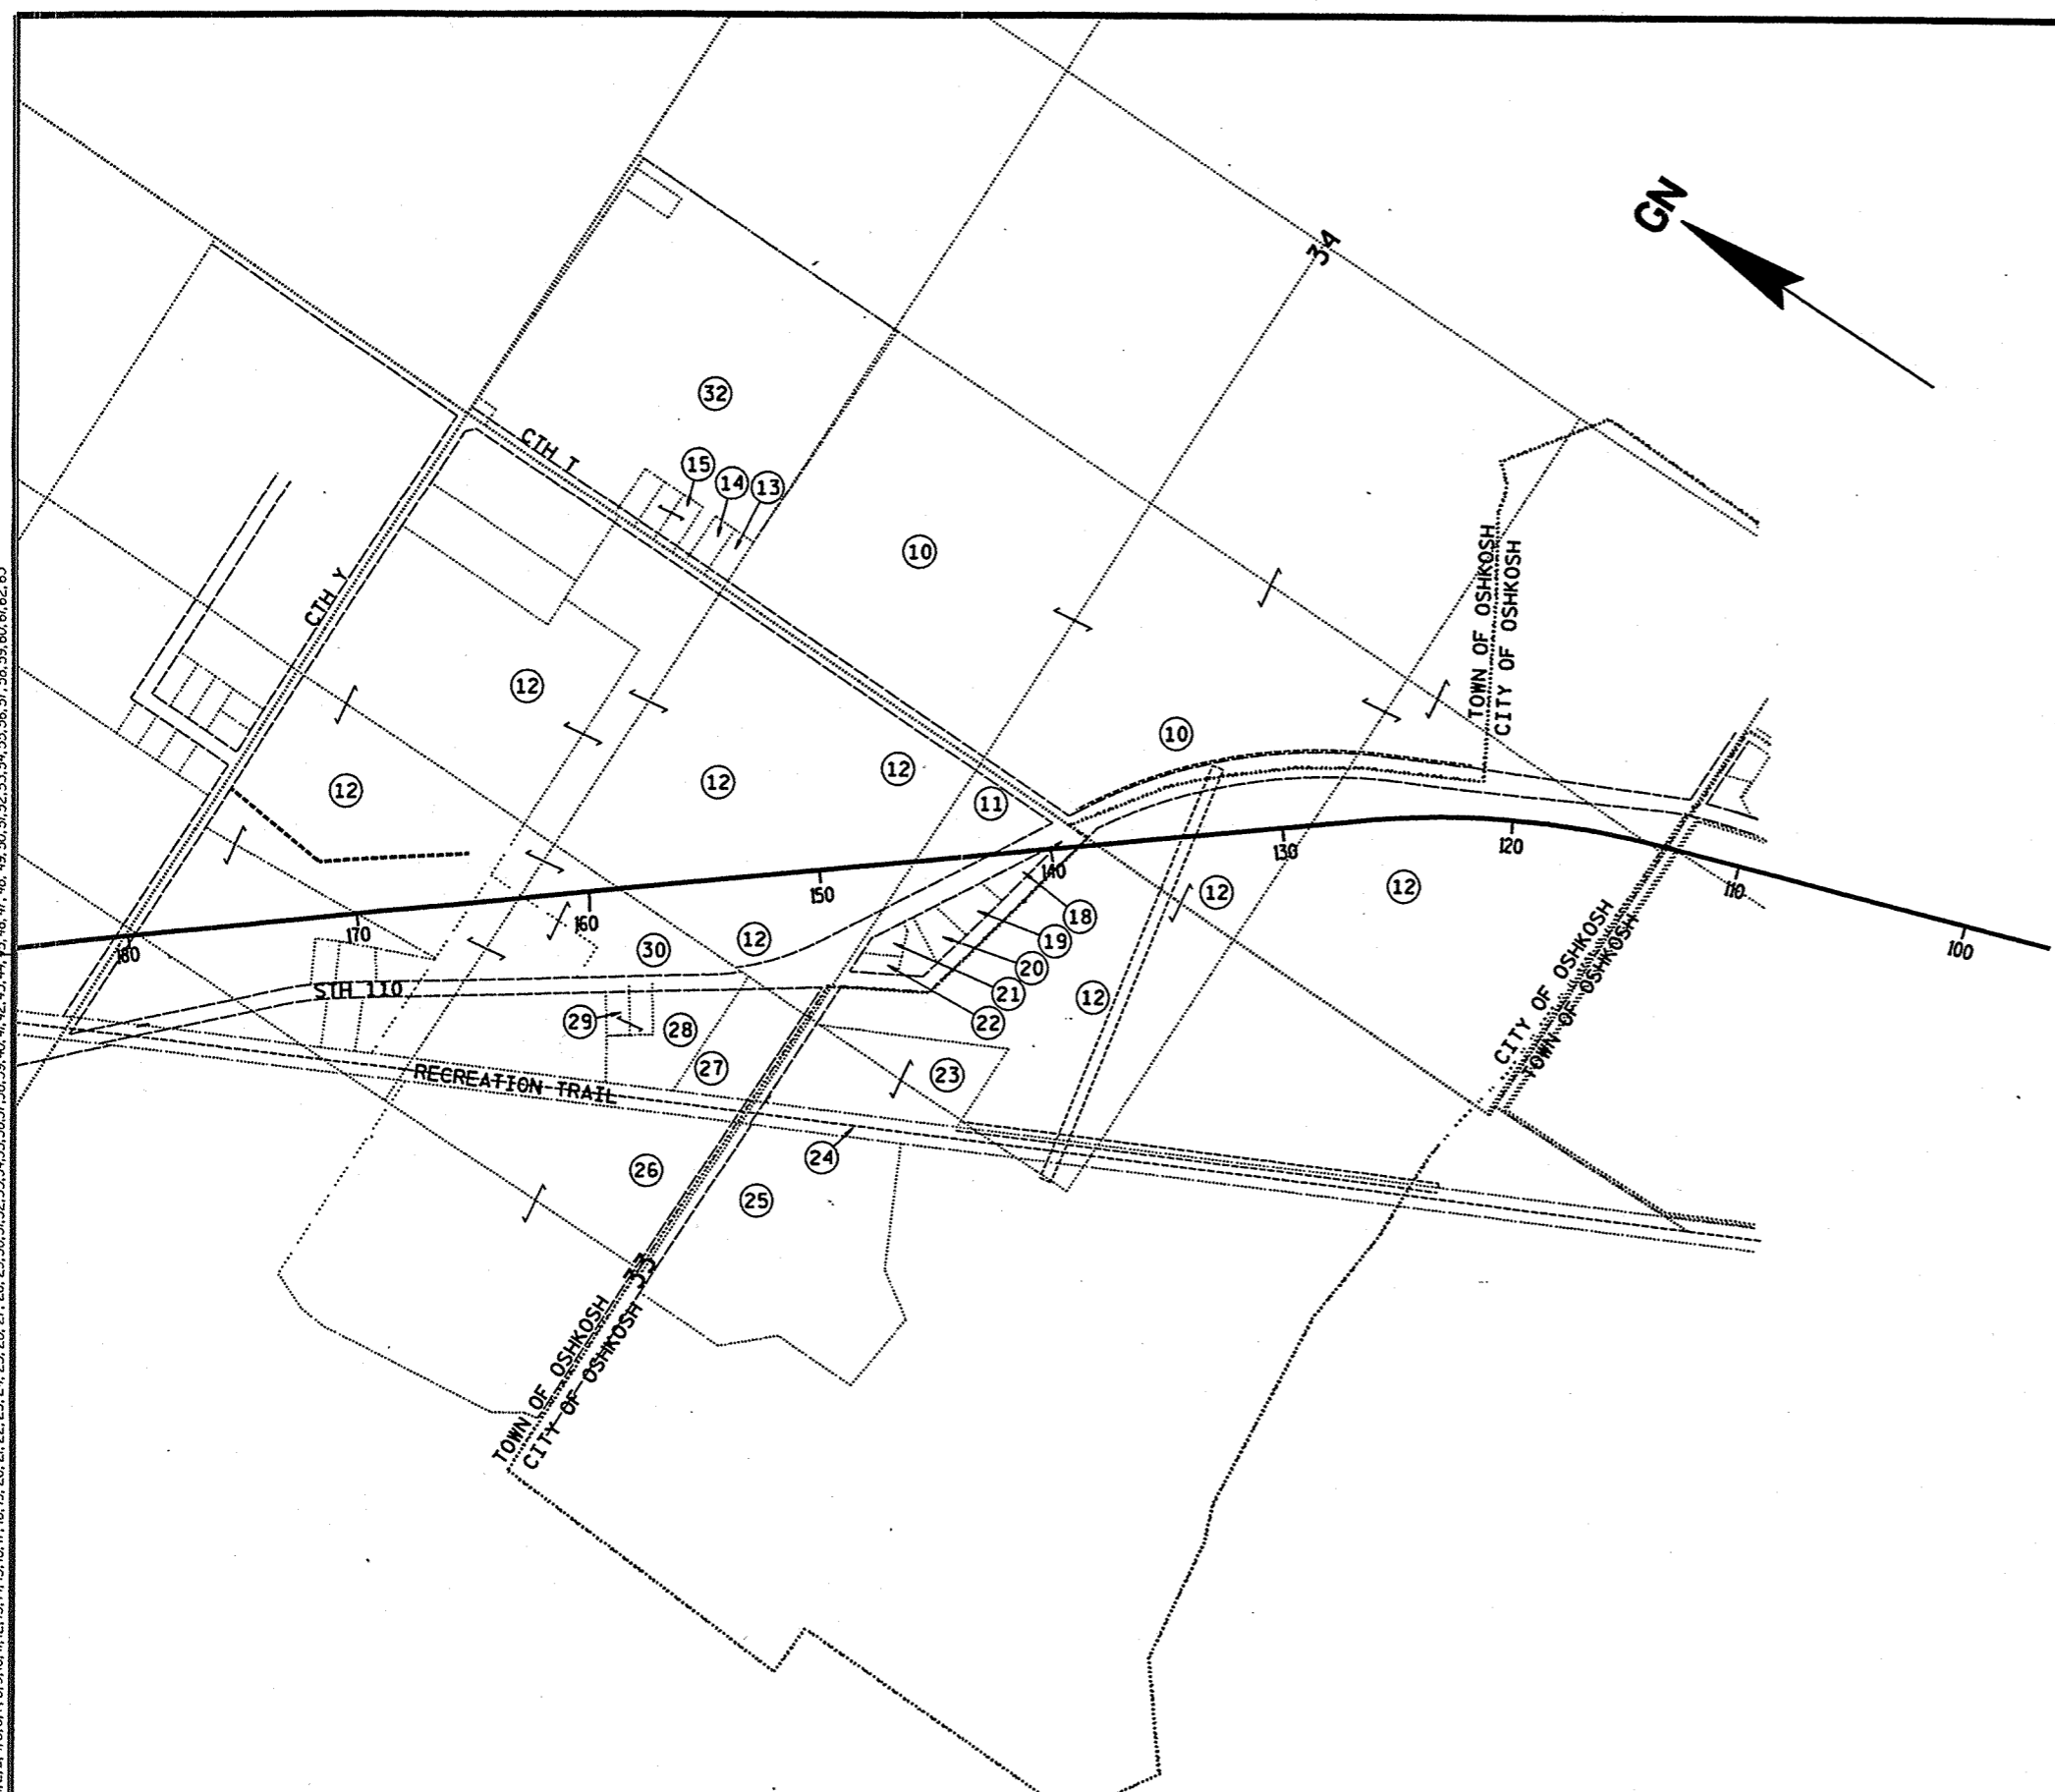

PARCEL NUMBER	SHEET NUMBER	OWNER
1	4.16	GEORGE J. KONTOS
*2		RONALD D. MILLER HAS BEEN REMOVED AND PLACED ON 6200-05-23
3.	4.16-4.18&4.20	GEORGE H. DODD
4	4.8-4.11	ESTATE OF ELDOR SCHULTZ
5	4.16	RAYMOND F. & WENDY L. SEBERO
6	4.16	CLARENCE W. & PHYLLIS M. MEINEN
7		
8		
9		
10	4.5&4.6	PAMELA A. & TIMOTHY P. LESNICK
11	4.5	CLARENCE L. WRIGHT
12	4.4-4.7&4.19	GRUNDY ENTERPRISES, INC. (L.C.)
13	4.19	MARGARET L. OUAUST
14	4.19	LINDA S. GRAF
15	4.19	HENRY G. BARGENOUAUST
16		
17		
18	4.5	HELEN HEWITT, ETAL
19	4.5	JOHN A. RYF
20	4.5	RICHARD G. MAKI JR. & LORI M. PIEROUET
21	4.5	DOROTHY E. STIEG
22	4.5	ROBERT J. & BARBARA ANN WINKLER
23	4.5	CASTLE-PIERCE PRINTING CO.
24	4.6,4.8&4.9	WINNEBAGO COUNTY (REC. TRAIL)
25	4.6	COMMUNITY CHURCH, INC.
26	4.6	OSHKOSH AREA SCHOOL DISTRICT
27	4.6	MARY LADWIG
28	4.6	NORMAN & NANCY REICHENBERGER
29	4.6	RICHARD L. & JAUQUELINE GERLACH
30	4.6	DAVID W. & KAREN K. JACOBSON
31	4.8	ROBERT E. KRUMENAUER
32	4.8,4.9&4.19	GRUNDY FARMS, INC.
33	4.11&4.12	DENNIS D. & DOROTHY M. EWALD (L.C.)
34	4.11-4.13	JAY E. SCHMOKER & JERROLD SCHMOKER
35	4.12	GERALD N. & JOANNE L. FORSETH
36	4.12-4.14	WILLIAM H. OVERTON
37	4.12	HAROLD M. HANSON
38	4.13	THOMAS B. & SUSAN L. KERR
39	4.14	NICHOLAS M. & JEAN A. KOLB
40	4.20	KURT R. & MICHELLE M. THEIN
41		
42	4.15	ROBERT W. SPIEGELBERG
43	4.16	LAKEWIND CORPORATION
44	4.17	DAVID A. & SANDRA J. PASCARELLA
45	4.20	DORIS EASTMAN & JANET ZIENTARA
46	4.14	WINNECONNE-BUTTE DES MORTS JOINT COMMISSION
47	4.20	CHARLES M. FARREY
48	4.11	JERROLD J. & CAROL A. SCHMOKER
49	4.13	PATRICK & JACQUELINE TYERS
50	4.13	HOWARD BECK
60	4.5	CITY OF OSHKOSH PUBLIC WORKS (45)
61	4.5	WISCONSIN PUBLIC SERVICE (GAS) (46)
62	4.5,4.7-4.9, 4.16,4.17&4.20	AMERICAN TRANSMISSION CORP (47)
63	4.6,4.8,4.12, 4.16 & 4.17	AMERITECH (48)
64	4.6 & 4.14	WISCONSIN PUBLIC SERVICE (DISTRIBUTION) (49)


REVISION DATE 02-03-99 07-23-99 NC 09-11-01NC	DATE 11-17-95	NOT TO SCALE	HWY: STH 110 COUNTY: WINNEBAGO	CONSTRUCTION PROJECT NUMBER 6200-05-71 STATE R/W PROJECT NUMBER 6200-05-21	PS&E SHEET NO: 4.8 PLAT SHEET NO: 4.1	E
--	---------------	--------------	-----------------------------------	---	--	---

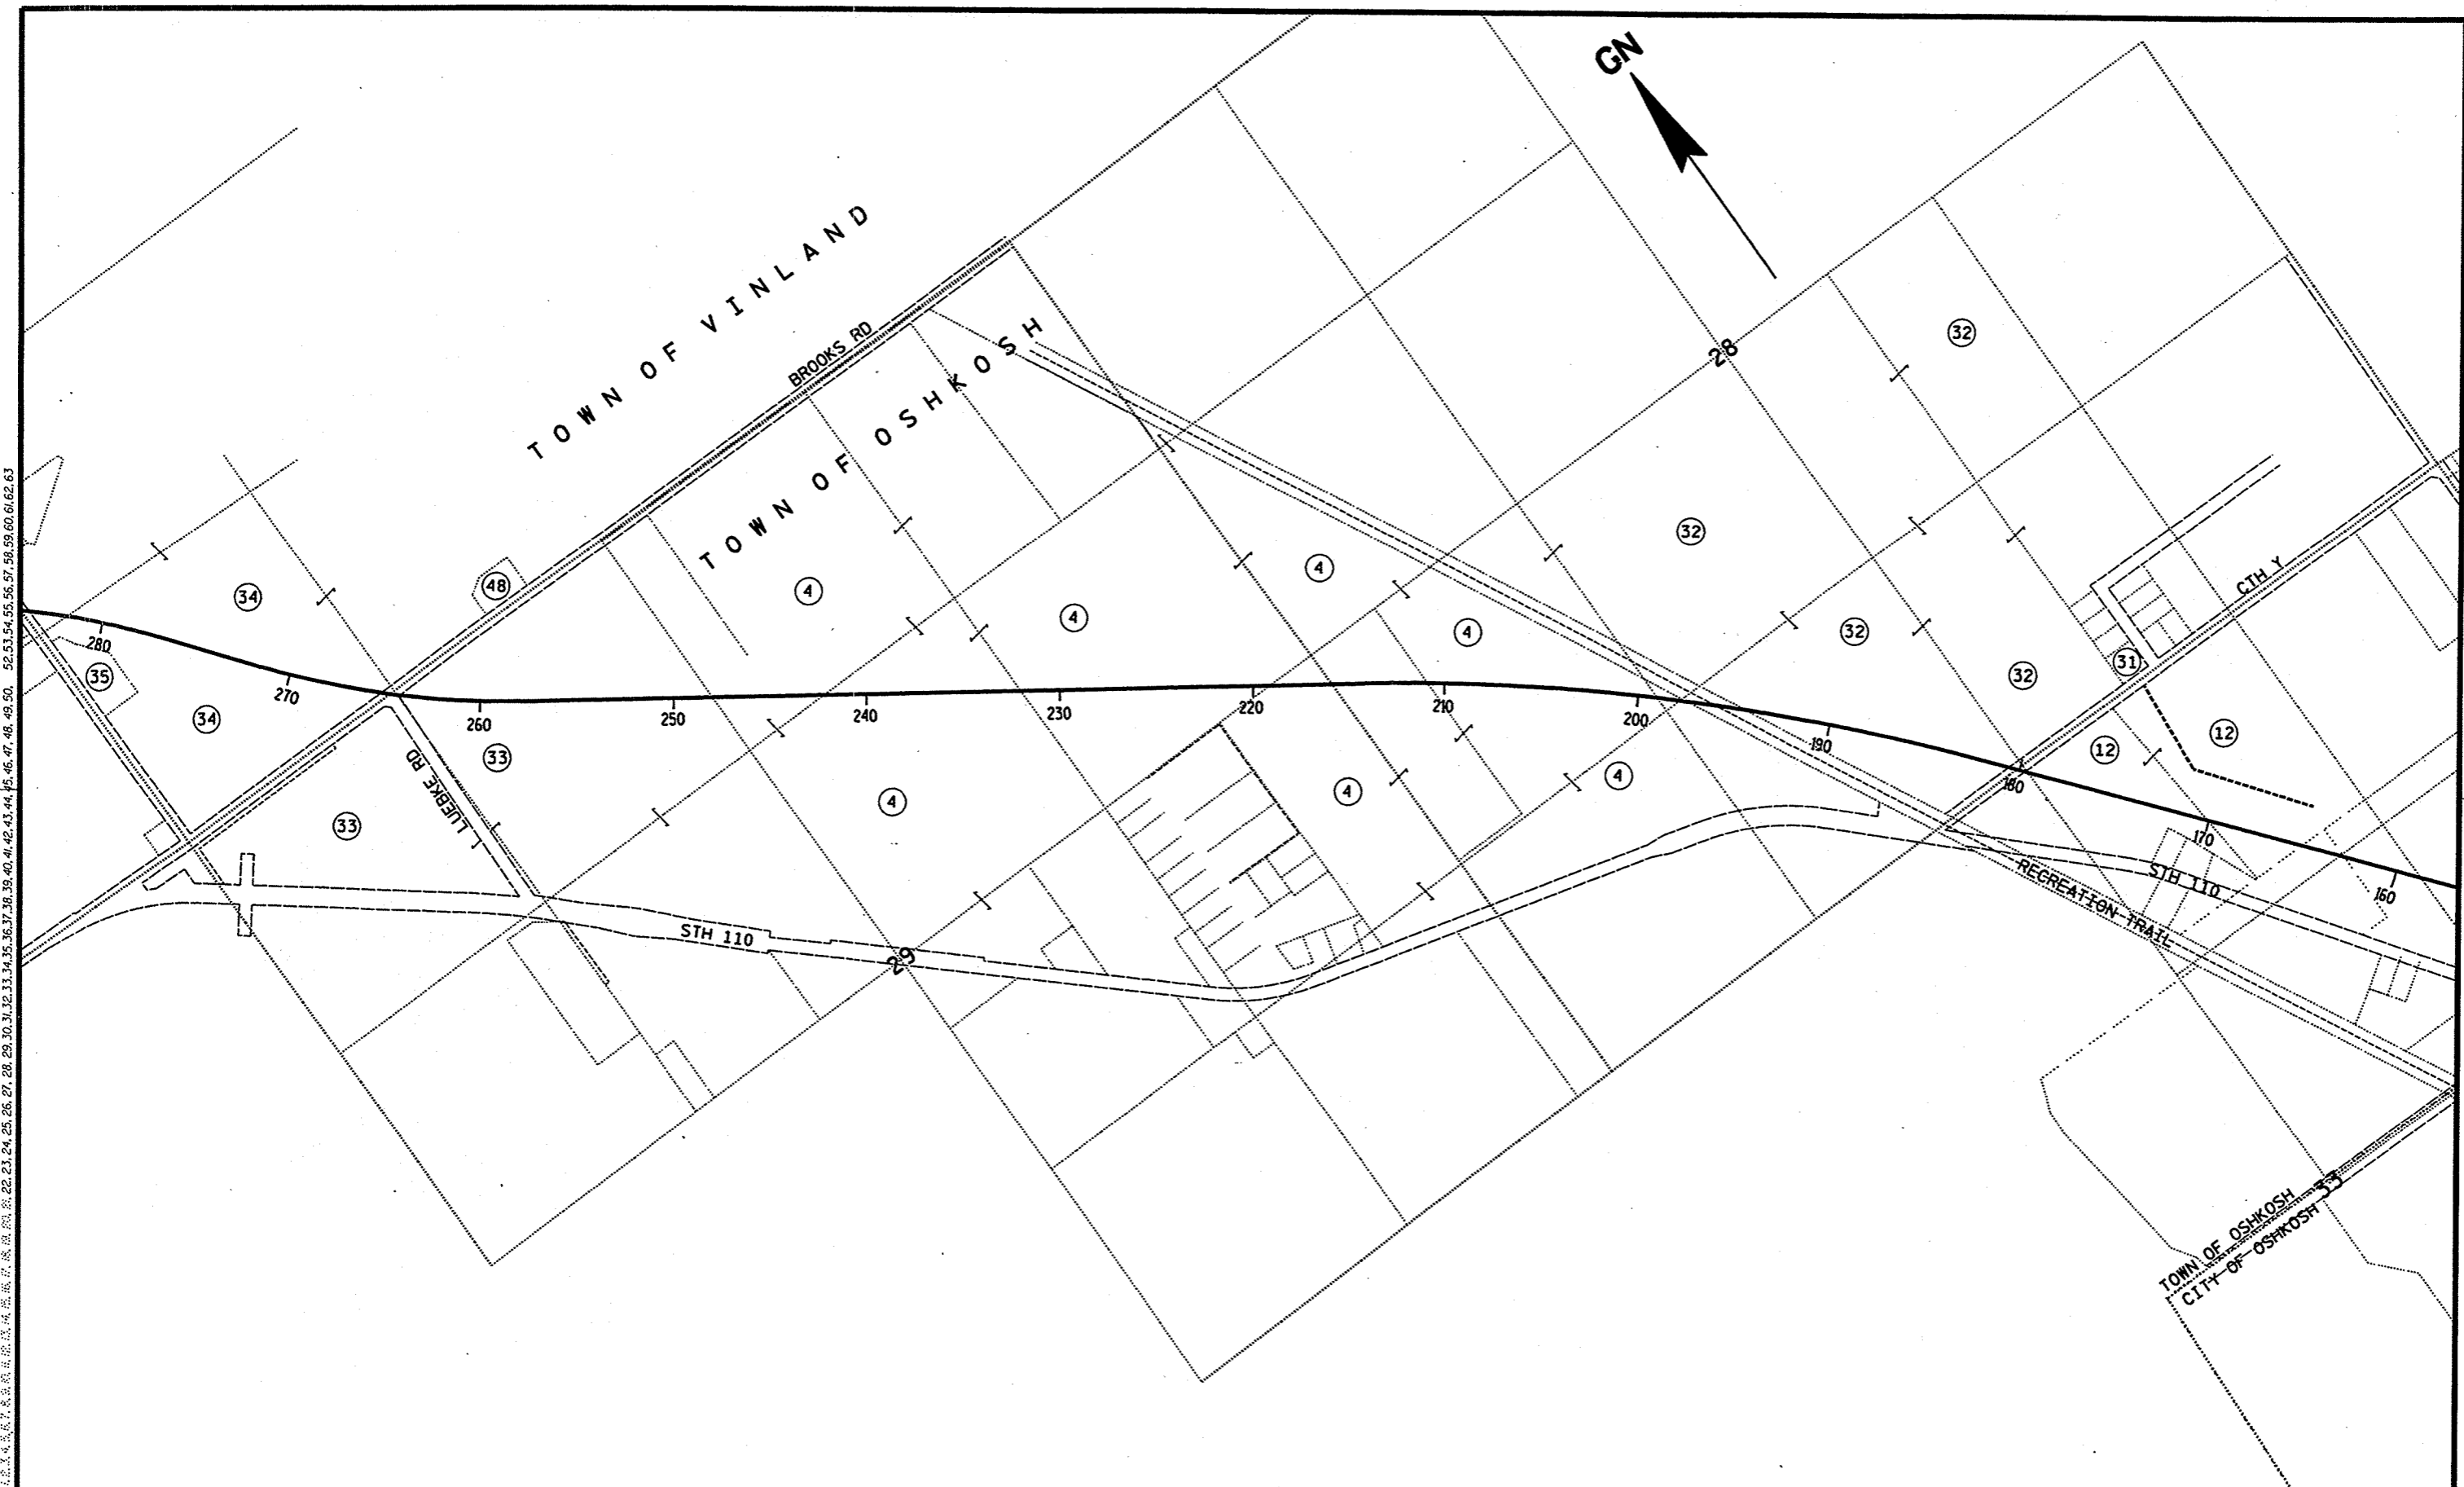

LEVELS ON - 1.0, 2.0, 3.0, 62.0, 63.0


REVISION DATE 02-03-99 07-23-99 NC 09-11-01 NC	DATE 11-17-95	NOT TO SCALE	HWY: STH 110 COUNTY: WINNEBAGO	CONSTRUCTION PROJECT NUMBER 6200-05-71 STATE R/W PROJECT NUMBER 6200-05-21	PS&E SHEET NO: 4.9 PLAT SHEET NO: 4.2	E
---	---------------	--------------	-----------------------------------	---	--	---

LEVELS ON : 1, 2, 3, 62, 63

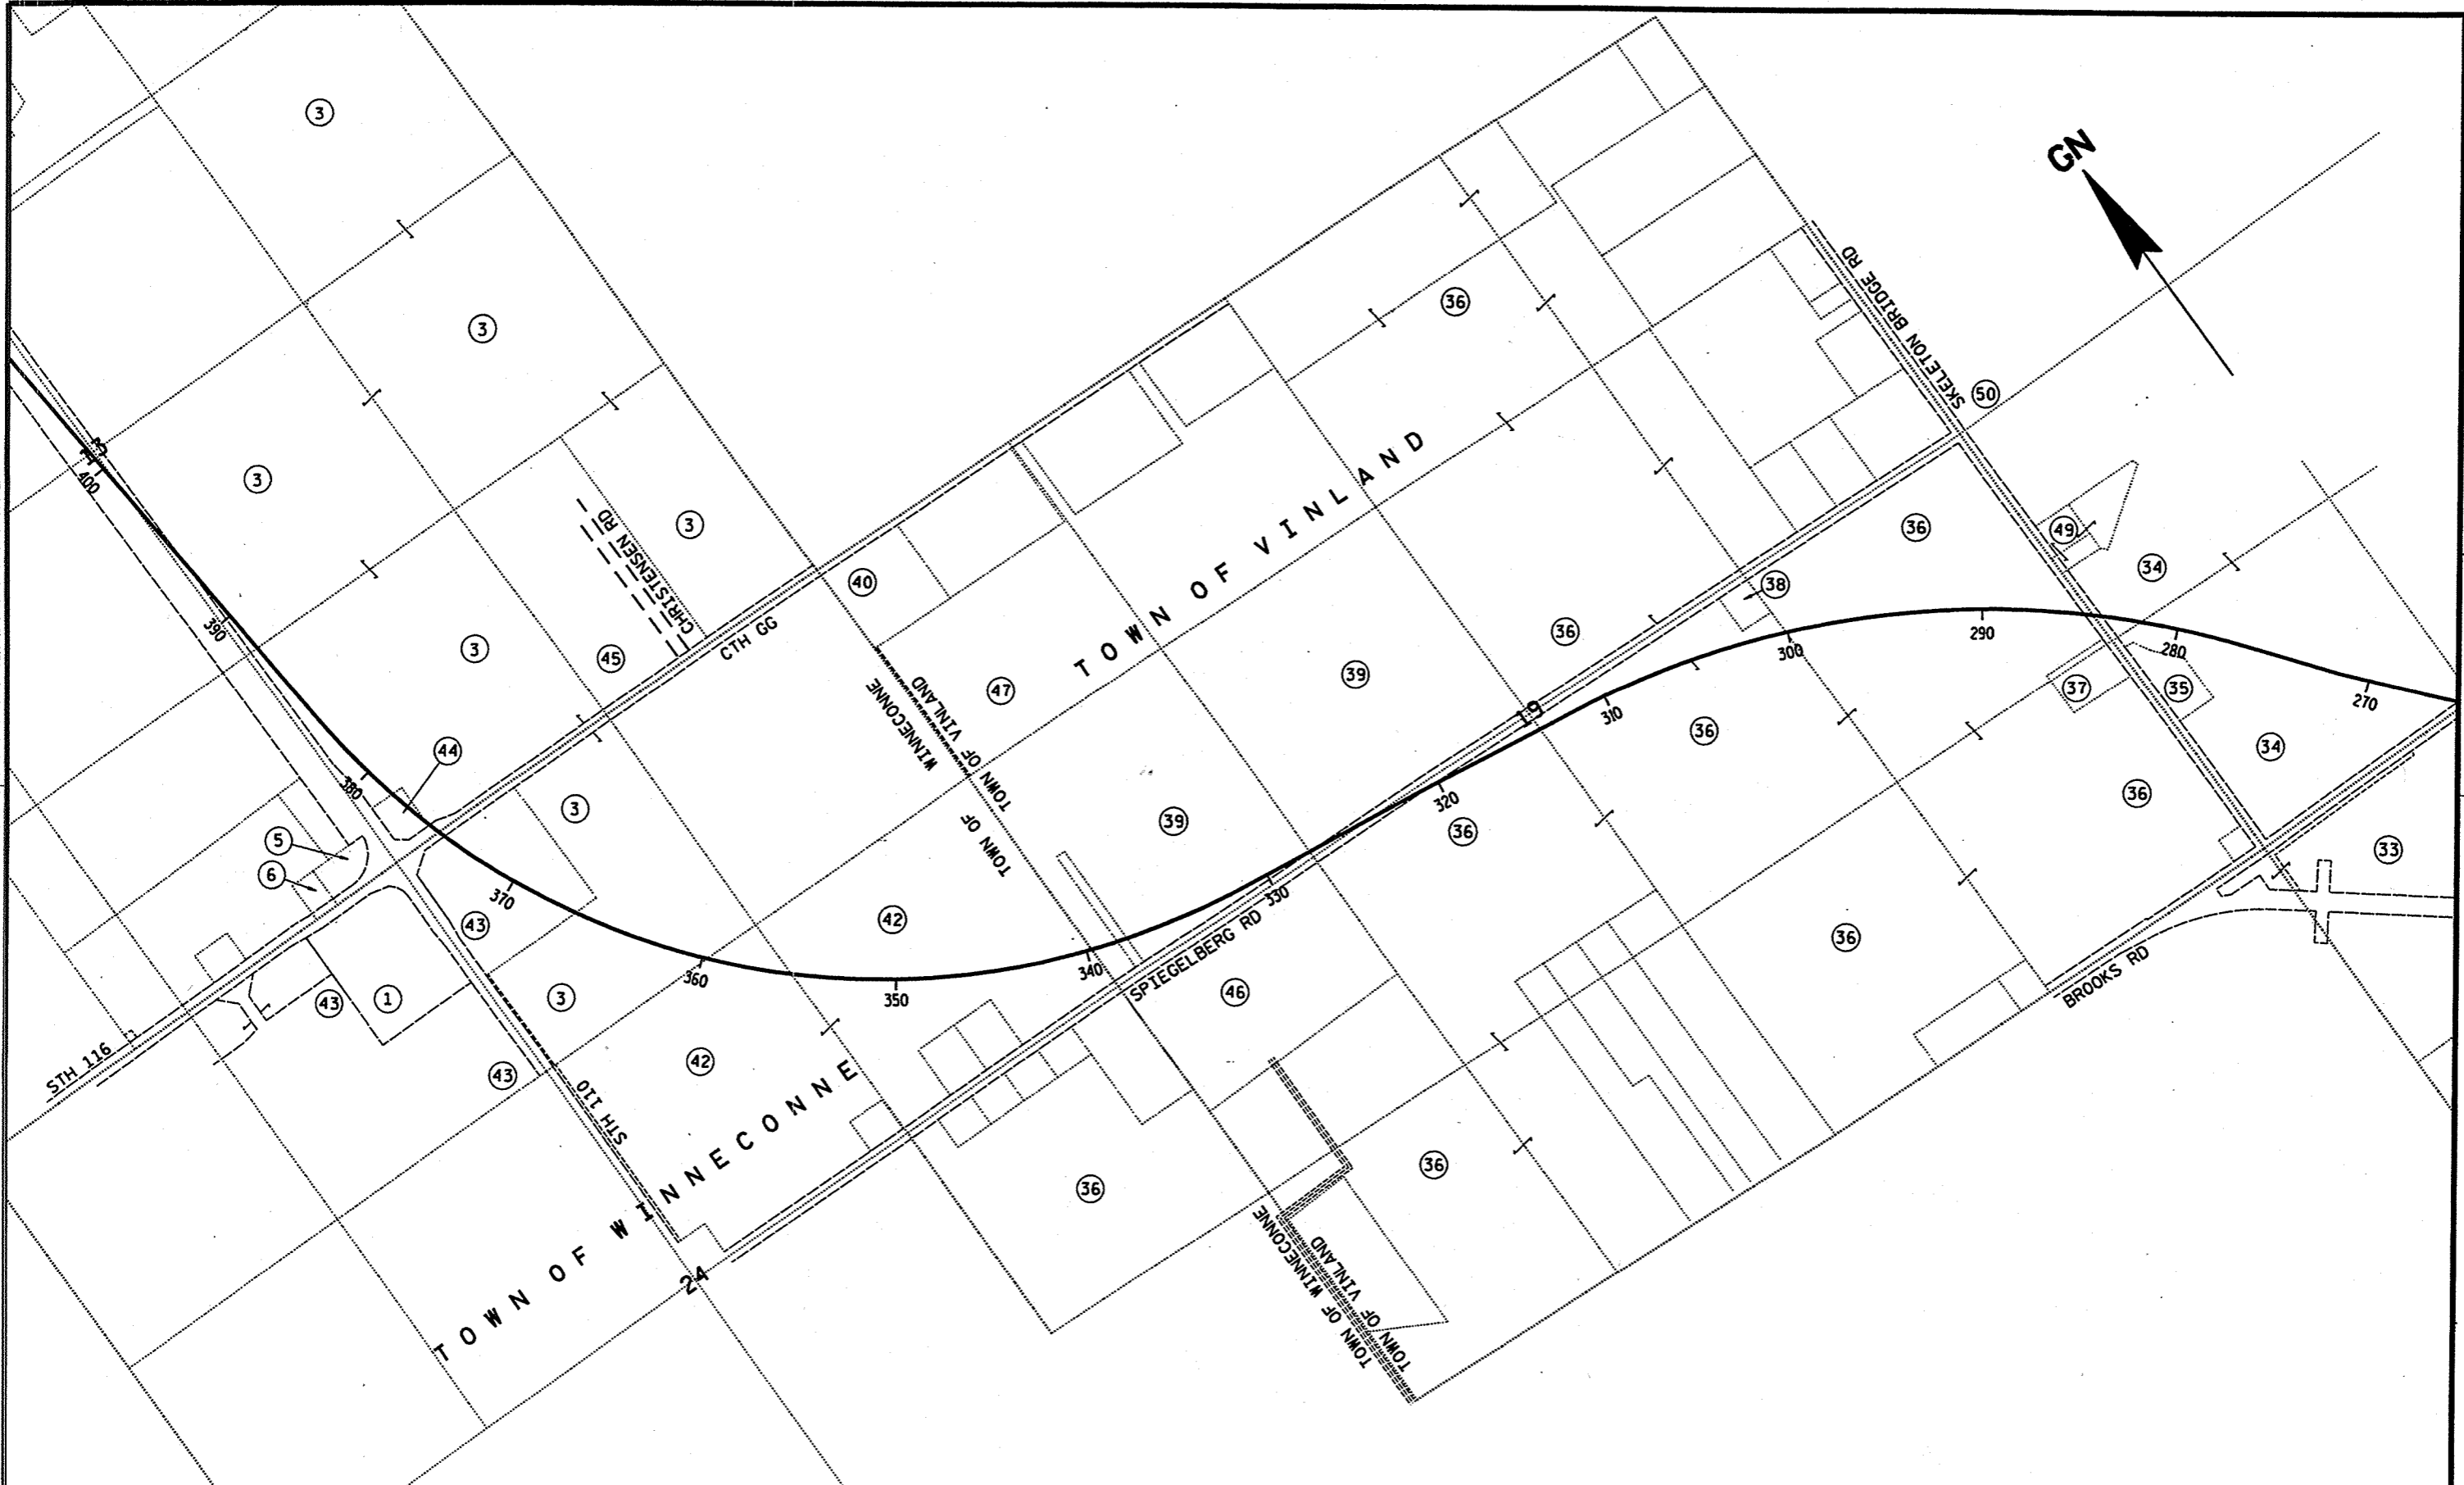

REVISION DATE 02-03-99 07-23-99 NC 09-11-01NC	DATE 11-17-95	NOT TO SCALE	HWY: STH 110 COUNTY: WINNEBAGO	CONSTRUCTION PROJECT NUMBER 6200-05-71 STATE R/W PROJECT NUMBER 6200-05-21	PS&E SHEET NO: 4.10 PLAT SHEET NO: 4.3	E
--	---------------	--------------	-----------------------------------	---	---	---

MATCH LINE
SEE SHEET 4.5

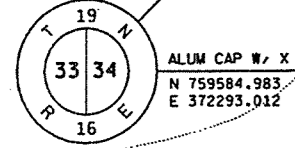

ALUM CAP W. X.
N 759584.983
E 372293.012

OTR150

PARCEL NUMBER	SHEET NUMBER	OWNER	INTEREST REQUIRED	ACRES	R/W ACRES REQUIRED			TOTAL ACRES REM.	T.L.E. ACRES
					NEW	EXISTING	TOTAL		
12	4.4-4.7 & 4.19-4.21	GRUNDY ENTERPRISES (LC)	FEE & ACCESS RIGHTS	309.58	56.03	-	56.08	253.5	3.13

SCHEDULE OF SIGNS		
SIGN NUMBER	SHEET NUMBER	SIGN OWNER
12-1	4	ORDE, INC.

STH 110
CURVE 10
CURVE NOTES

PI = 120+08.477
N = 757635.392
E = 373519.593
L = 160°-18'-39"
Δ = 19°-41'-21"
D = 1°-30'-00"
T = 662.84'
L = 1312.61'
R = 3819.72'


LAKE BUTTE DES MORTS DR
CURVE 145
CURVE NOTES

PI = 248+91.797
N = 757591.162
E = 373382.374
L = 158°-33'-37"
Δ = 21°-26'-23"
D = 1°-30'-00"
T = 723.11'
L = 1429.31'
R = 3819.72'
PC = 241+68.69
PT = 255+97.99

BEGIN RELOCATION ORDER
PROJECT 6200-05-21
STATION 112+50.
1276.17 FEET S 86°-35'-09" OF THE
N 1/4 CORNER OF SECTION 3 TOWNSHIP 18 N
RANGE 16 E
N 756925.716
E 373787.155

EXISTING R/W ACQUIRED
UNDER PROJECT T037-1 (5)

LEVELS ON - 1.2, 2.3, 3.4, 4.5, 5.6, 6.7, 7.8, 8.9, 9.0, 10.1, 11.2, 12.3, 13.4, 14.5, 15.6, 16.7, 17.8, 18.9, 19.0, 20.1, 21.2, 22.3, 23.4, 24.5, 25.6, 26.7, 27.8, 28.9, 29.0, 30.1, 31.2, 32.3, 33.4, 34.5, 35.6, 36.7, 37.8, 38.9, 39.0, 40.1, 41.2, 42.3, 43.4, 44.5, 45.6, 46.7, 47.8, 48.9, 50.1, 51.2, 52.3, 53.4, 54.5, 55.6, 56.7, 57.8, 58.9, 59.0, 60.1, 61.2, 62.3, 63.4, 64.5, 65.6, 66.7, 67.8, 68.9, 69.0, 70.1, 71.2, 72.3, 73.4, 74.5, 75.6, 76.7, 77.8, 78.9, 79.0, 80.1, 81.2, 82.3, 83.4, 84.5, 85.6, 86.7, 87.8, 88.9, 89.0, 90.1, 91.2, 92.3, 93.4, 94.5, 95.6, 96.7, 97.8, 98.9, 99.0, 100.1, 101.2, 102.3, 103.4, 104.5, 105.6, 106.7, 107.8, 108.9, 109.0, 110.1, 111.2, 112.3, 113.4, 114.5, 115.6, 116.7, 117.8, 118.9, 119.0, 120.1, 121.2, 122.3, 123.4, 124.5, 125.6, 126.7, 127.8, 128.9, 129.0, 130.1, 131.2, 132.3, 133.4, 134.5, 135.6, 136.7, 137.8, 138.9, 139.0, 140.1, 141.2, 142.3, 143.4, 144.5, 145.6, 146.7, 147.8, 148.9, 149.0, 150.1, 151.2, 152.3, 153.4, 154.5, 155.6, 156.7, 157.8, 158.9, 159.0, 160.1, 161.2, 162.3, 163.4, 164.5, 165.6, 166.7, 167.8, 168.9, 169.0, 170.1, 171.2, 172.3, 173.4, 174.5, 175.6, 176.7, 177.8, 178.9, 179.0, 180.1, 181.2, 182.3, 183.4, 184.5, 185.6, 186.7, 187.8, 188.9, 189.0, 190.1, 191.2, 192.3, 193.4, 194.5, 195.6, 196.7, 197.8, 198.9, 199.0, 200.1, 201.2, 202.3, 203.4, 204.5, 205.6, 206.7, 207.8, 208.9, 209.0, 210.1, 211.2, 212.3, 213.4, 214.5, 215.6, 216.7, 217.8, 218.9, 219.0, 220.1, 221.2, 222.3, 223.4, 224.5, 225.6, 226.7, 227.8, 228.9, 229.0, 230.1, 231.2, 232.3, 233.4, 234.5, 235.6, 236.7, 237.8, 238.9, 239.0, 240.1, 241.2, 242.3, 243.4, 244.5, 245.6, 246.7, 247.8, 248.9, 249.0, 250.1, 251.2, 252.3, 253.4, 254.5, 255.6, 256.7, 257.8, 258.9, 259.0, 260.1, 261.2, 262.3, 263.4, 264.5, 265.6, 266.7, 267.8, 268.9, 269.0, 270.1, 271.2, 272.3, 273.4, 274.5, 275.6, 276.7, 277.8, 278.9, 279.0, 280.1, 281.2, 282.3, 283.4, 284.5, 285.6, 286.7, 287.8, 288.9, 289.0, 290.1, 291.2, 292.3, 293.4, 294.5, 295.6, 296.7, 297.8, 298.9, 299.0, 300.1, 301.2, 302.3, 303.4, 304.5, 305.6, 306.7, 307.8, 308.9, 309.0, 310.1, 311.2, 312.3, 313.4, 314.5, 315.6, 316.7, 317.8, 318.9, 319.0, 320.1, 321.2, 322.3, 323.4, 324.5, 325.6, 326.7, 327.8, 328.9, 329.0, 330.1, 331.2, 332.3, 333.4, 334.5, 335.6, 336.7, 337.8, 338.9, 339.0, 340.1, 341.2, 342.3, 343.4, 344.5, 345.6, 346.7, 347.8, 348.9, 349.0, 350.1, 351.2, 352.3, 353.4, 354.5, 355.6, 356.7, 357.8, 358.9, 359.0, 360.1, 361.2, 362.3, 363.4, 364.5, 365.6, 366.7, 367.8, 368.9, 369.0, 370.1, 371.2, 372.3, 373.4, 374.5, 375.6, 376.7, 377.8, 378.9, 379.0, 380.1, 381.2, 382.3, 383.4, 384.5, 385.6, 386.7, 387.8, 388.9, 389.0, 390.1, 391.2, 392.3, 393.4, 394.5, 395.6, 396.7, 397.8, 398.9, 399.0, 400.1, 401.2, 402.3, 403.4, 404.5, 405.6, 406.7, 407.8, 408.9, 409.0, 410.1, 411.2, 412.3, 413.4, 414.5, 415.6, 416.7, 417.8, 418.9, 419.0, 420.1, 421.2, 422.3, 423.4, 424.5, 425.6, 426.7, 427.8, 428.9, 429.0, 430.1, 431.2, 432.3, 433.4, 434.5, 435.6, 436.7, 437.8, 438.9, 439.0, 440.1, 441.2, 442.3, 443.4, 444.5, 445.6, 446.7, 447.8, 448.9, 449.0, 450.1, 451.2, 452.3, 453.4, 454.5, 455.6, 456.7, 457.8, 458.9, 459.0, 460.1, 461.2, 462.3, 463.4, 464.5, 465.6, 466.7, 467.8, 468.9, 469.0, 470.1, 471.2, 472.3, 473.4, 474.5, 475.6, 476.7, 477.8, 478.9, 479.0, 480.1, 481.2, 482.3, 483.4, 484.5, 485.6, 486.7, 487.8, 488.9, 489.0, 490.1, 491.2, 492.3, 493.4, 494.5, 495.6, 496.7, 497.8, 498.9, 499.0, 500.1, 501.2, 502.3, 503.4, 504.5, 505.6, 506.7, 507.8, 508.9, 509.0, 510.1, 511.2, 512.3, 513.4, 514.5, 515.6, 516.7, 517.8, 518.9, 519.0, 520.1, 521.2, 522.3, 523.4, 524.5, 525.6, 526.7, 527.8, 528.9, 529.0, 530.1, 531.2, 532.3, 533.4, 534.5, 535.6, 536.7, 537.8, 538.9, 539.0, 540.1, 541.2, 542.3, 543.4, 544.5, 545.6, 546.7, 547.8, 548.9, 549.0, 550.1, 551.2, 552.3, 553.4, 554.5, 555.6, 556.7, 557.8, 558.9, 559.0, 560.1, 561.2, 562.3, 563.4, 564.5, 565.6, 566.7, 567.8, 568.9, 569.0, 570.1, 571.2, 572.3, 573.4, 574.5, 575.6, 576.7, 577.8, 578.9, 579.0, 580.1, 581.2, 582.3, 583.4, 584.5, 585.6, 586.7, 587.8, 588.9, 589.0, 590.1, 591.2, 592.3, 593.4, 594.5, 595.6, 596.7, 597.8, 598.9, 599.0, 600.1, 601.2, 602.3, 603.4, 604.5, 605.6, 606.7, 607.8, 608.9, 609.0, 610.1, 611.2, 612.3, 613.4, 614.5, 615.6, 616.7, 617.8, 618.9, 619.0, 620.1, 621.2, 622.3, 623.4, 624.5, 625.6, 626.7, 627.8, 628.9, 629.0, 630.1, 631.2, 632.3, 633.4, 634.5, 635.6, 636.7, 637.8, 638.9, 639.0, 640.1, 641.2, 642.3, 643.4, 644.5, 645.6, 646.7, 647.8, 648.9, 649.0, 650.1, 651.2, 652.3, 653.4, 654.5, 655.6, 656.7, 657.8, 658.9, 659.0, 660.1, 661.2, 662.3, 663.4, 664.5, 665.6, 666.7, 667.8, 668.9, 669.0, 670.1, 671.2, 672.3, 673.4, 674.5, 675.6, 676.7, 677.8, 678.9, 679.0, 680.1, 681.2, 682.3, 683.4, 684.5, 685.6, 686.7, 687.8, 688.9, 689.0, 690.1, 691.2, 692.3, 693.4, 694.5, 695.6, 696.7, 697.8, 698.9, 699.0, 700.1, 701.2, 702.3, 703.4, 704.5, 705.6, 706.7, 707.8, 708.9, 709.0, 710.1, 711.2, 712.3, 713.4, 714.5, 715.6, 716.7, 717.8, 718.9, 719.0, 720.1, 721.2, 722.3, 723.4, 724.5, 725.6, 726.7, 727.8, 728.9, 729.0, 730.1, 731.2, 732.3, 733.4, 734.5, 735.6, 736.7, 737.8, 738.9, 739.0, 740.1, 741.2, 742.3, 743.4, 744.5, 745.6, 746.7, 747.8, 748.9, 749.0, 750.1, 751.2, 752.3, 753.4, 754.5, 755.6, 756.7, 757.8, 758.9, 759.0, 760.1, 761.2, 762.3, 763.4, 764.5, 765.6, 766.7, 767.8, 768.9, 769.0, 770.1, 771.2, 772.3, 773.4, 774.5, 775.6, 776.7, 777.8, 778.9, 779.0, 780.1, 781.2, 782.3, 783.4, 784.5, 785.6, 786.7, 787.8, 788.9, 789.0, 790.1, 791.2, 792.3, 793.4, 794.5, 795.6, 796.7, 797.8, 798.9, 799.0, 800.1, 801.2, 802.3, 803.4, 804.5, 805.6, 806.7, 807.8, 808.9, 809.0, 810.1, 811.2, 812.3, 813.4, 814.5, 815.6, 816.7, 817.8, 818.9, 819.0, 820.1, 821.2, 822.3, 823.4, 824.5, 825.6, 826.7, 827.8, 828.9, 829.0, 830.1, 831.2, 832.3, 833.4, 834.5, 835.6, 836.7, 837.8, 838.9, 839.0, 840.1, 841.2, 842.3, 843.4, 844.5, 845.6, 846.7, 847.8, 848.9, 849.0, 850.1, 851.2, 852.3, 853.4, 854.5, 855.6, 856.7, 857.8, 858.9, 859.0, 860.1, 861.2, 862.3, 863.4, 864.5, 865.6, 866.7, 867.8, 868.9, 869.0, 870.1, 871.2, 872.3, 873.4, 874.5, 875.6, 876.7, 877.8, 878.9, 879.0, 880.1, 881.2, 882.3, 883.4, 884.5, 885.6, 886.7, 887.8, 888.9, 889.0, 890.1, 891.2, 892.3, 893.4, 894.5, 895.6, 896.7, 897.8, 898.9, 899.0, 900.1, 901.2, 902.3, 903.4, 904.5, 905.6, 906.7, 907.8, 908.9, 909.0, 910.1, 911.2, 912.3, 913.4, 914.5, 915.6, 916.7, 917.8, 918.9, 919.0, 920.1, 921.2, 922.3, 923.4, 924.5, 925.6, 926.7, 927.8, 928.9, 929.0, 930.1, 931.2, 932.3, 933.4, 934.5, 935.6, 936.7, 937.8, 938.9, 939.0, 940.1, 941.2, 942.3, 943.4, 944.5, 945.6, 946.7, 947.8, 948.9, 949.0, 950.1, 951.2, 952.3, 953.4, 954.5, 955.6, 956.7, 957.8, 958.9, 959.0, 960.1, 961.2, 962.3, 963.4, 964.5, 965.6, 966.7, 967.8, 968.9, 969.0, 970.1, 971.2, 972.3, 973.4, 974.5, 975.6, 976.7, 977.8, 978.9, 979.0, 980.1, 981.2, 982.3, 983.4, 984.5, 985.6, 986.7, 987.8, 988.9, 989.0, 990.1, 991.2, 992.3, 993.4, 994.5, 995.6, 996.7, 997.8, 998.9, 999.0, 1000.1, 1001.2, 1002.3, 1003.4, 1004.5, 1005.6, 1006.7, 1007.8, 1008.9, 1009.0, 1010.1, 1011.2, 1012.3, 1013.4, 1014.5, 1015.6, 1016.7, 1017.8, 1018.9, 1019.0, 1020.1, 1021.2, 1022.3, 1023.4, 1024.5, 1025.6, 1026.7, 1027.8, 1028.9, 1029.0, 1030.1, 1031.2, 1032.3, 1033.4, 1034.5, 1035.6, 1036.7, 1037.8, 1038.9, 1039.0, 1040.1, 1041.2, 1042.3, 1043.4, 1044.5, 1045.6, 1046.7, 1047.8, 1048.9, 1049.0, 1050.1, 1051.2, 1052.3, 1053.4, 1054.5, 1055.6, 1056.7, 1057.8, 1058.9, 1059.0, 1060.1, 1061.2, 1062.3, 1063.4, 1064.5, 1065.6, 1066.7, 1067.8, 1068.9, 1069.0, 1070.1, 1071.2, 1072.3, 1073.4, 1074.5, 1075.6, 1076.7, 1077.8, 1078.9, 1079.0, 1080.1, 1081.2, 1082.3, 1083.4, 1084.5, 1085.6, 1086.7, 1087.8, 1088.9, 1089.0, 1090.1, 1091.2, 1092.3, 1093.4, 1094.5, 1095.6, 1096.7, 1097.8, 1098.9, 1099.0, 1100.1, 1101.2, 1102.3, 1103.4, 1104.5, 1105.6, 1106.7, 1107.8, 1108.9, 1109.0, 1110.1, 1111.2, 1112.3, 1113.4, 1114.5, 1115.6, 1116.7, 1117.8, 1118.9, 1119.0, 1120.1, 1121.2, 1122.3, 1123.4, 1124.5, 1125.6, 1126.7, 1127.8, 1128.9, 1129.0, 1130.1, 1131.2, 1132.3, 1133.4, 1134.5, 1135.6, 1136.7, 1137.8, 1138.9, 1139.0, 1140.1, 1141.2, 1142.3, 1143.4, 1144.5, 1145.6, 1146.7, 1147.8, 1148.9, 1149.0, 1150.1, 1151.2, 1152.3, 1153.4, 1154.5, 1155.6, 1156.7, 1157.8, 1158.9, 1159.0, 1160.1, 1161.2, 1162.3, 1163.4, 1164.5, 1165.6, 1166.7, 1167.8, 1168.9, 1169.0, 1170.1, 1171.2, 1172.3, 1173.4, 1174.5, 1175.6, 1176.7, 1177.8, 1178.9, 1179.0, 1180.1, 1181.2, 1182.3, 1183.4, 1184.5, 1185.6, 1186.7, 1187.8, 1188.9, 1189.0, 1190.1, 1191.2, 1192.3, 1193.4, 1194.5, 1195.6, 1196.7, 1197.8, 1198.9, 1199.0, 1200.1, 1201.2, 1202.3, 1203.4, 1204.5, 1205.6, 1206.7, 1207.8, 1208.9, 1209.0, 1210.1, 1211.2, 1212.3, 1213.4, 1214.5, 1215.6, 1216.7, 1217.8, 1218.9, 1219.0, 1220.1, 1221.2, 1222.3, 1223.4, 1224.5, 1225.6, 1226.7, 1227.8, 1228.9, 1229.0, 1230.1, 1231.2, 1232.3, 1233.4, 1234.5, 1235.6, 1236.7, 1237.8, 1238.9, 1239.0, 1240.1, 1241.2, 1242.3, 1243.4, 1244.5, 1245.6, 1246.7, 1247.8, 1248.9, 1249.0, 1250.1, 1251.2, 1252.3, 1253.4, 1254.5, 1255.6, 1256.7, 1257.8, 1258.9, 1259.0, 1260.1, 1261.2, 1262.3, 1263.4, 1264.5, 1265.6, 1266.7, 1267.8, 1268.9, 1269.0, 1270.1, 1271.2, 1272.3, 1273.4, 1274.5, 1275.6, 1276.7, 1277.8, 1278.9, 1279.0, 1280.1, 1281.2, 1282.3, 1283.4, 1284.5, 1285.6, 1286.7, 1287.8, 1288.9, 1289.0, 1290.1, 1291.2, 1292.3, 1293.4, 1294.5, 1295.6, 1296.7, 1297.8, 1298.9, 1299.0, 1300.1, 1301.2, 1302.3, 1303.4, 1304.5, 1305.6, 1306.7, 1307.8, 1308.9, 1309.0, 1310.1, 1311.2, 1312.3, 1313.4, 1314.5, 1315.6, 1316.7, 1317.8, 1318.9, 1319.0, 1320.1, 1321.2, 1322.3, 1323.4, 1324.5, 1325.6, 1326.7, 1327.8, 1328.9, 1329.0, 1330.1, 1331.2, 1332.3, 1333.4, 1334.5, 1335.6, 1336.7, 1337.8, 1338.9, 1339.0, 1340.1, 1341.2, 1342.3, 1343.4, 1344.5, 1345.6, 1346.7, 1347.8, 1348.9, 1349.0, 1350.1, 1351.2, 1352.3, 1353.4, 1354.5, 1355.6, 1356.7, 1357.8, 1358.9, 1359.0, 1360.1, 1361.2, 1362.3, 1363.4, 1364.5, 1365.6, 1366.7, 1367.8, 1368.9, 1369.0, 1370.1, 1371.2, 1372.3, 1373.4, 1374.5, 1375.6, 1376.7, 1377.8, 1378.9, 1379.0, 1380.1, 1381.2, 1382.3, 1383.4, 1384.5, 1385.6, 1386.7, 1387.8, 1388.9, 1389.0, 1390.1, 1391.2, 1392.3, 1393.4, 1394.5, 1395.6, 1396.7, 1397.8, 1398.9, 1399.0, 1400.1, 1401.2, 1402.3, 1403.4, 1404.5, 1405.6, 1406.7, 1407.8, 1408.9, 1409.0, 1410.1, 1411.2, 1412.3, 1413.4, 1414.5, 1415.6, 1416.7, 1417.8, 1418.9, 1419.0, 1420.1, 1421.2, 1422.3, 1423.4, 1424.5, 1425.6, 1426.7, 1427.8, 1428.9, 1429.0, 1430.1, 1431.2, 1432.3, 1433.4, 1434.5, 1435.6, 1436.7, 1437.8, 1438.9, 1439.0, 1440.1, 1441.2, 1442.3, 1443.4, 1444.5, 1445.6, 1446.7, 1447.8, 1448.9, 1449.0, 1450.1, 1451.2, 1452.3, 1453.4, 1454.5, 1455.6, 1456.7, 1457.8, 1458.9, 1459.0, 1460.1, 1461.2, 1462.3, 1463.4, 1464.5, 1465.6, 1466.7, 1467.8, 1468.9, 1469.0, 1470.1, 1471.2, 1472.3, 1473.4, 1474.5, 1475.6, 1476.7, 1477.8, 1478.9, 1479.0, 1480.1, 1481.2, 1482.3, 1483.4, 1484.5, 1485.6, 1486.7, 1487.8, 1488.9, 1489.0, 1490.1, 1491.2, 1492.3, 1493.4, 1494.5, 1495.6, 1496.7, 1497.8, 1498.9, 1499.0, 1500.1, 1501.2, 1502.3, 1503.4, 1504.5, 1505.6, 1506.7, 1507.8, 1508.9, 1509.0, 1510.1, 1511.2, 1512.3, 1513.4, 1514.5, 1515.6

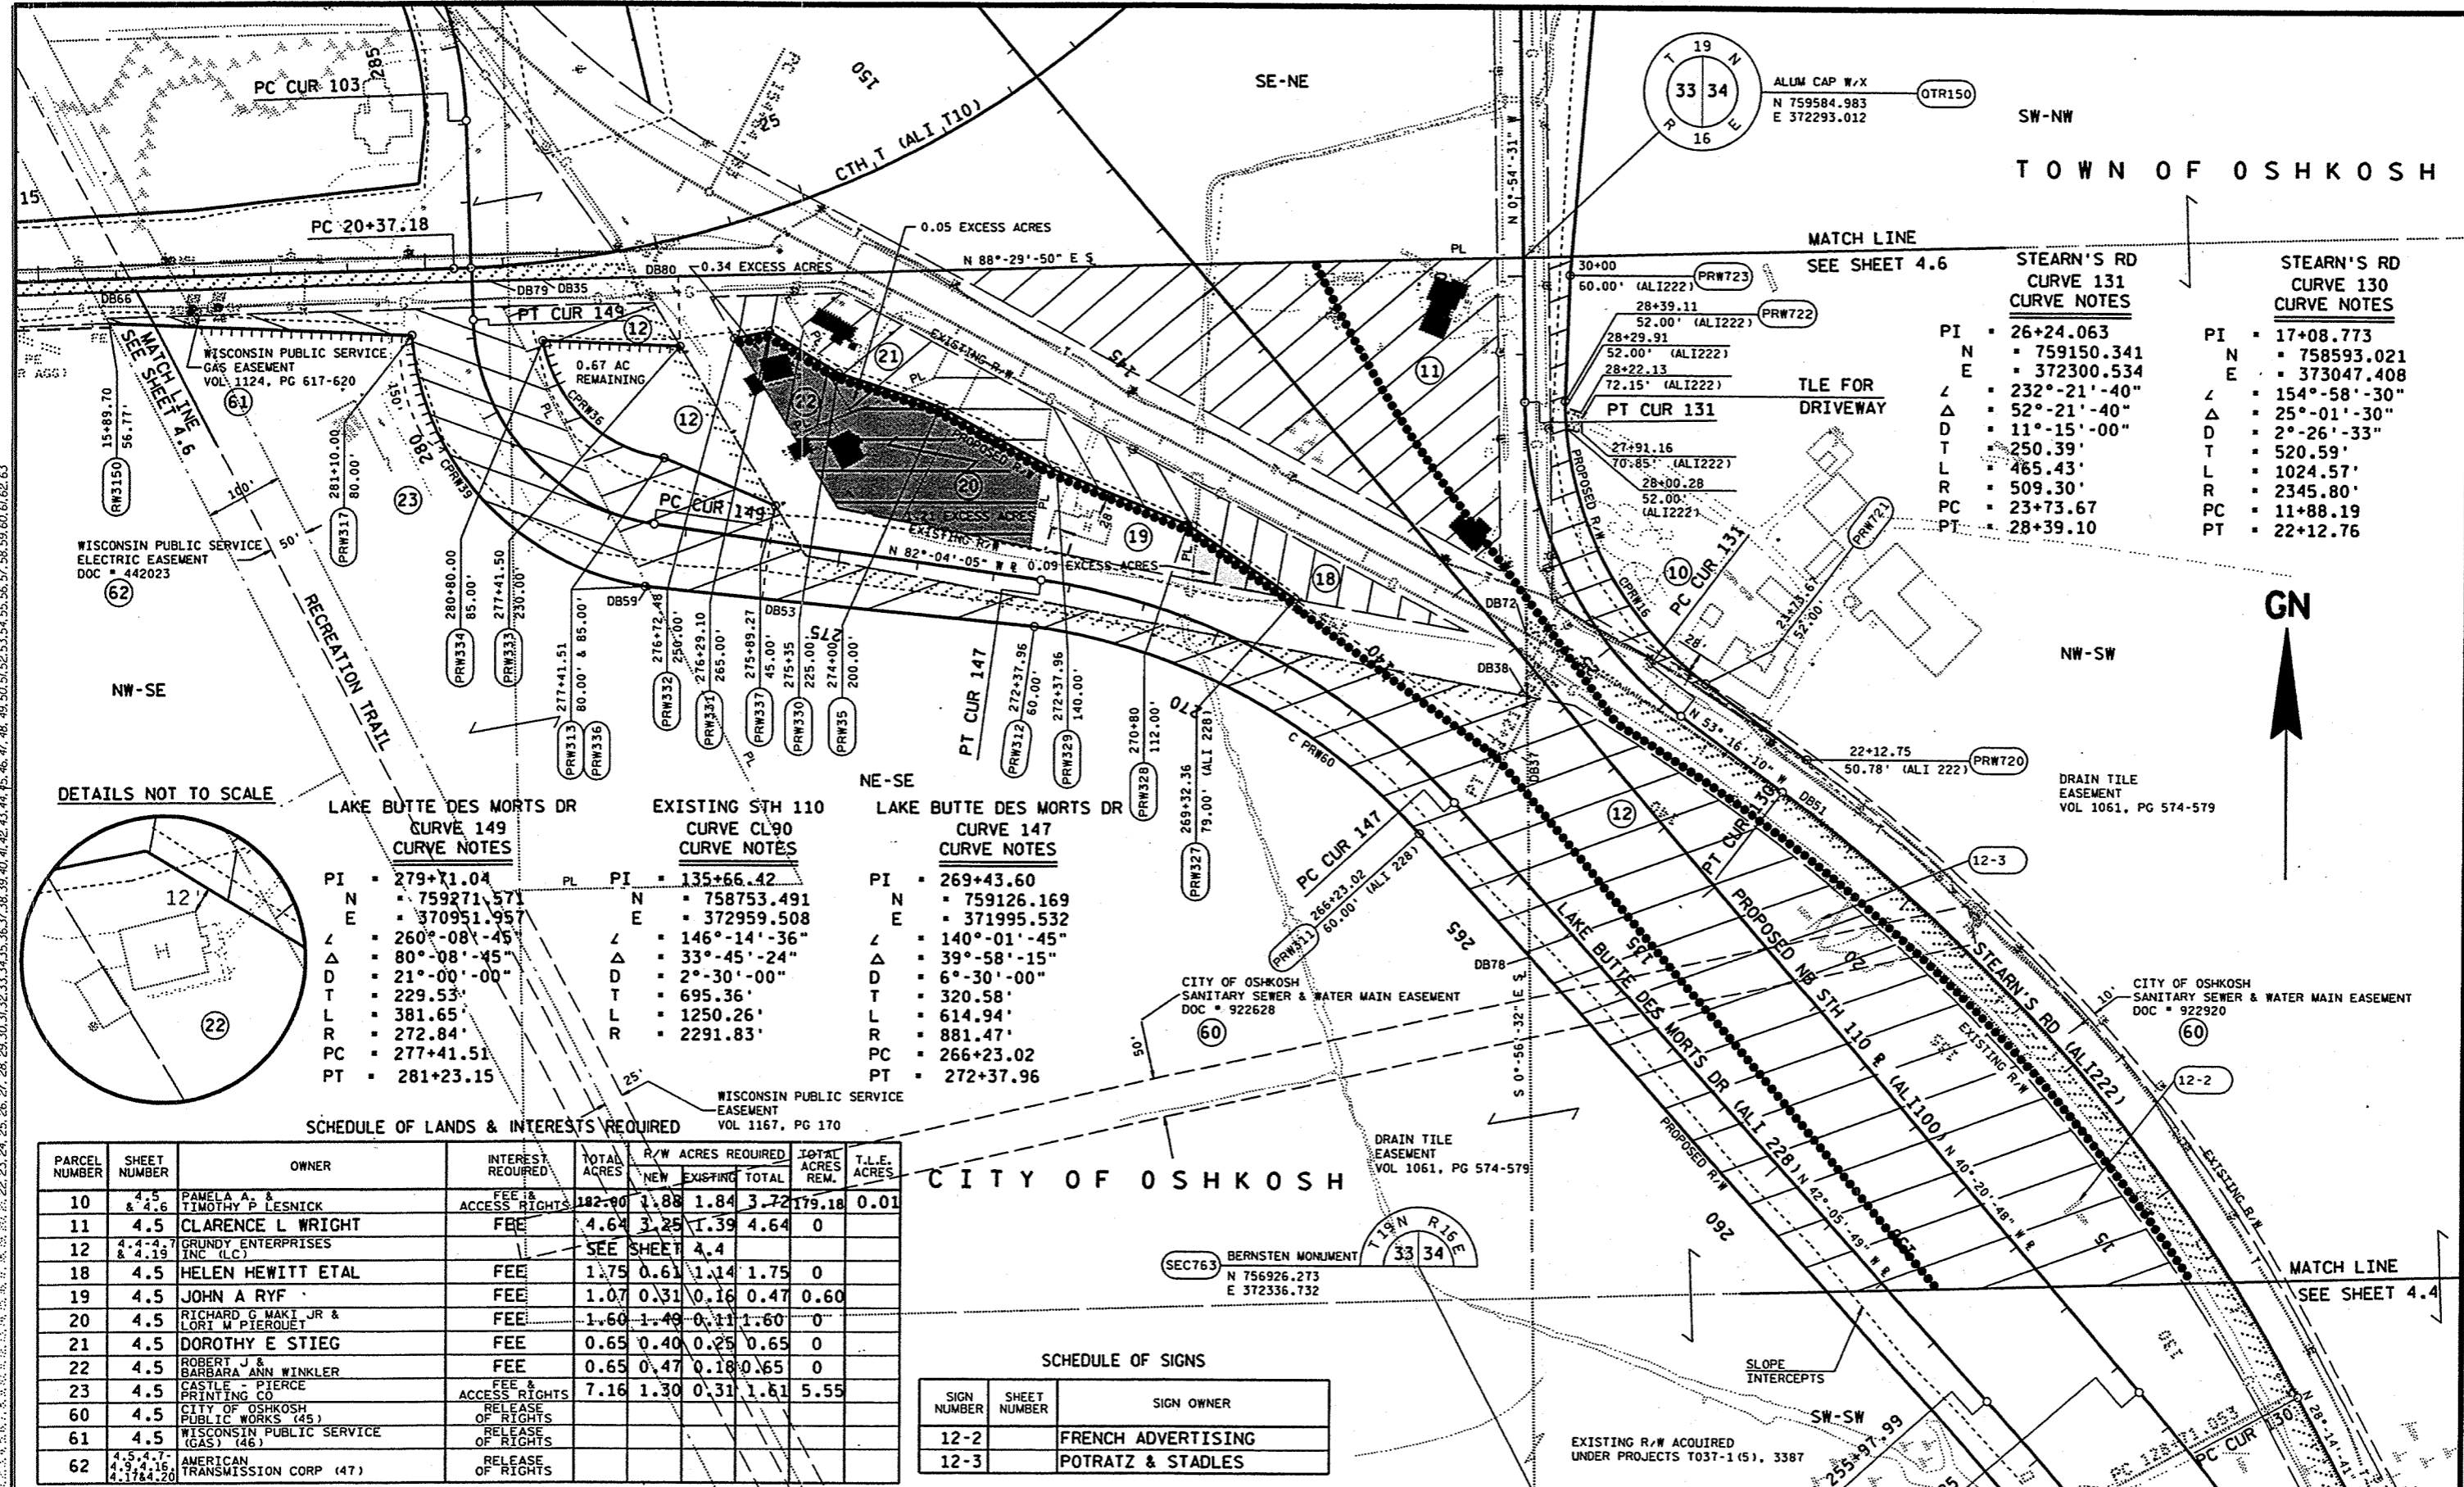

STEARN'S RD CURVE 131 CURVE NOTES

PI	26+24.063
N	759150.341
E	372300.534
∠	232°-21'-40"
Δ	52°-21'-40"
D	11°-15'-00"
T	250.39'
L	465.43'
R	509.30'
PC	23+73.67
PT	28+39.10

STEARN'S RD CURVE 130 CURVE NOTES

PI	17+08.773
N	758593.021
E	373047.408
∠	154°-58'-30"
Δ	25°-01'-30"
D	2°-26'-33"
T	520.59'
L	1024.57'
R	2345.80'
PC	11+88.19
PT	22+12.76

LAKE BUTTE DES MORTS DR CURVE 149 CURVE NOTES


PI	279+71.04
N	759271.571
E	370951.957
∠	260°-08'-45"
Δ	80°-08'-45"
D	21°-00'-00"
T	229.53'
L	381.65'
R	272.84'
PC	277+41.51
PT	281+23.15

EXISTING STH 110 CURVE 149 CURVE NOTES

PI	135+66.42
N	758753.491
E	372959.508
∠	146°-14'-36"
Δ	33°-45'-24"
D	2°-30'-00"
T	695.36'
L	1250.26'
R	2291.83'

LAKE BUTTE DES MORTS DR CURVE 147 CURVE NOTES

PI	269+43.60
N	759126.169
E	371995.532
∠	140°-01'-45"
Δ	39°-58'-15"
D	6°-30'-00"
T	320.58'
L	614.94'
R	881.47'
PC	266+23.02
PT	272+37.96

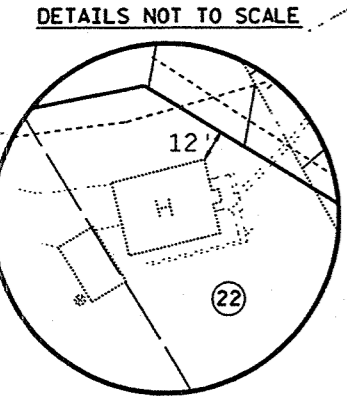

SCHEDULE OF LANDS & INTERESTS REQUIRED

PARCEL NUMBER	SHEET NUMBER	OWNER	INTEREST REQUIRED	TOTAL ACRES			T.L.E. ACRES
				NEW	EXISTING	TOTAL	
10	4.5 & 4.6	PAMELA A. & TIMOTHY P LESNICK	FEE & ACCESS RIGHTS	1.82	1.88	3.72	0.01
11	4.5	CLARENCE L WRIGHT	FEE	4.64	1.39	4.64	0
12	4.4-4.7 & 4.19	GRUNDY ENTERPRISES INC (LC)	SEE SHEET 4.4	4.4			
18	4.5	HELEN HEWITT ETAL	FEE	1.75	1.14	1.75	0
19	4.5	JOHN A RYF	FEE	1.07	0.16	0.47	0.60
20	4.5	RICHARD G MAKI JR & LORI M PIERQUET	FEE	1.60	0.11	1.60	0
21	4.5	DOROTHY E STIEG	FEE	0.65	0.25	0.65	0
22	4.5	ROBERT J & BARBARA ANN WINKLER	FEE	0.65	0.18	0.65	0
23	4.5	CASTLE - PIERCE PRINTING CO	FEE & ACCESS RIGHTS	7.16	1.30	1.61	5.55
60	4.5	CITY OF OSHKOSH PUBLIC WORKS (45)	RELEASE OF RIGHTS				
61	4.5	WISCONSIN PUBLIC SERVICE (GAS) (46)	RELEASE OF RIGHTS				
62	4.5, 4.7, 4.9, 4.15, 4.17 & 4.20	AMERICAN TRANSMISSION CORP (47)	RELEASE OF RIGHTS				


CITY OF OSHKOSH

SCHEDULE OF SIGNS

SIGN NUMBER	SHEET NUMBER	SIGN OWNER
12-2		FRENCH ADVERTISING
12-3		POTRATZ & STADLES

REVISION DATE: 09-11-01	DATE:	SCALE, FEET: 0 100 200	HWY: STH 110	CONSTRUCTION PROJECT NUMBER: 6200-05-71	PS&E SHEET NO: 4.12
GRID FACTOR: 0.999997			COUNTY: WINNEBAGO	STATE R/W PROJECT NUMBER: 6200-05-21	PLAT SHEET NO: 4.5

LEVELS ON: 1, 2, 3, 62, 63

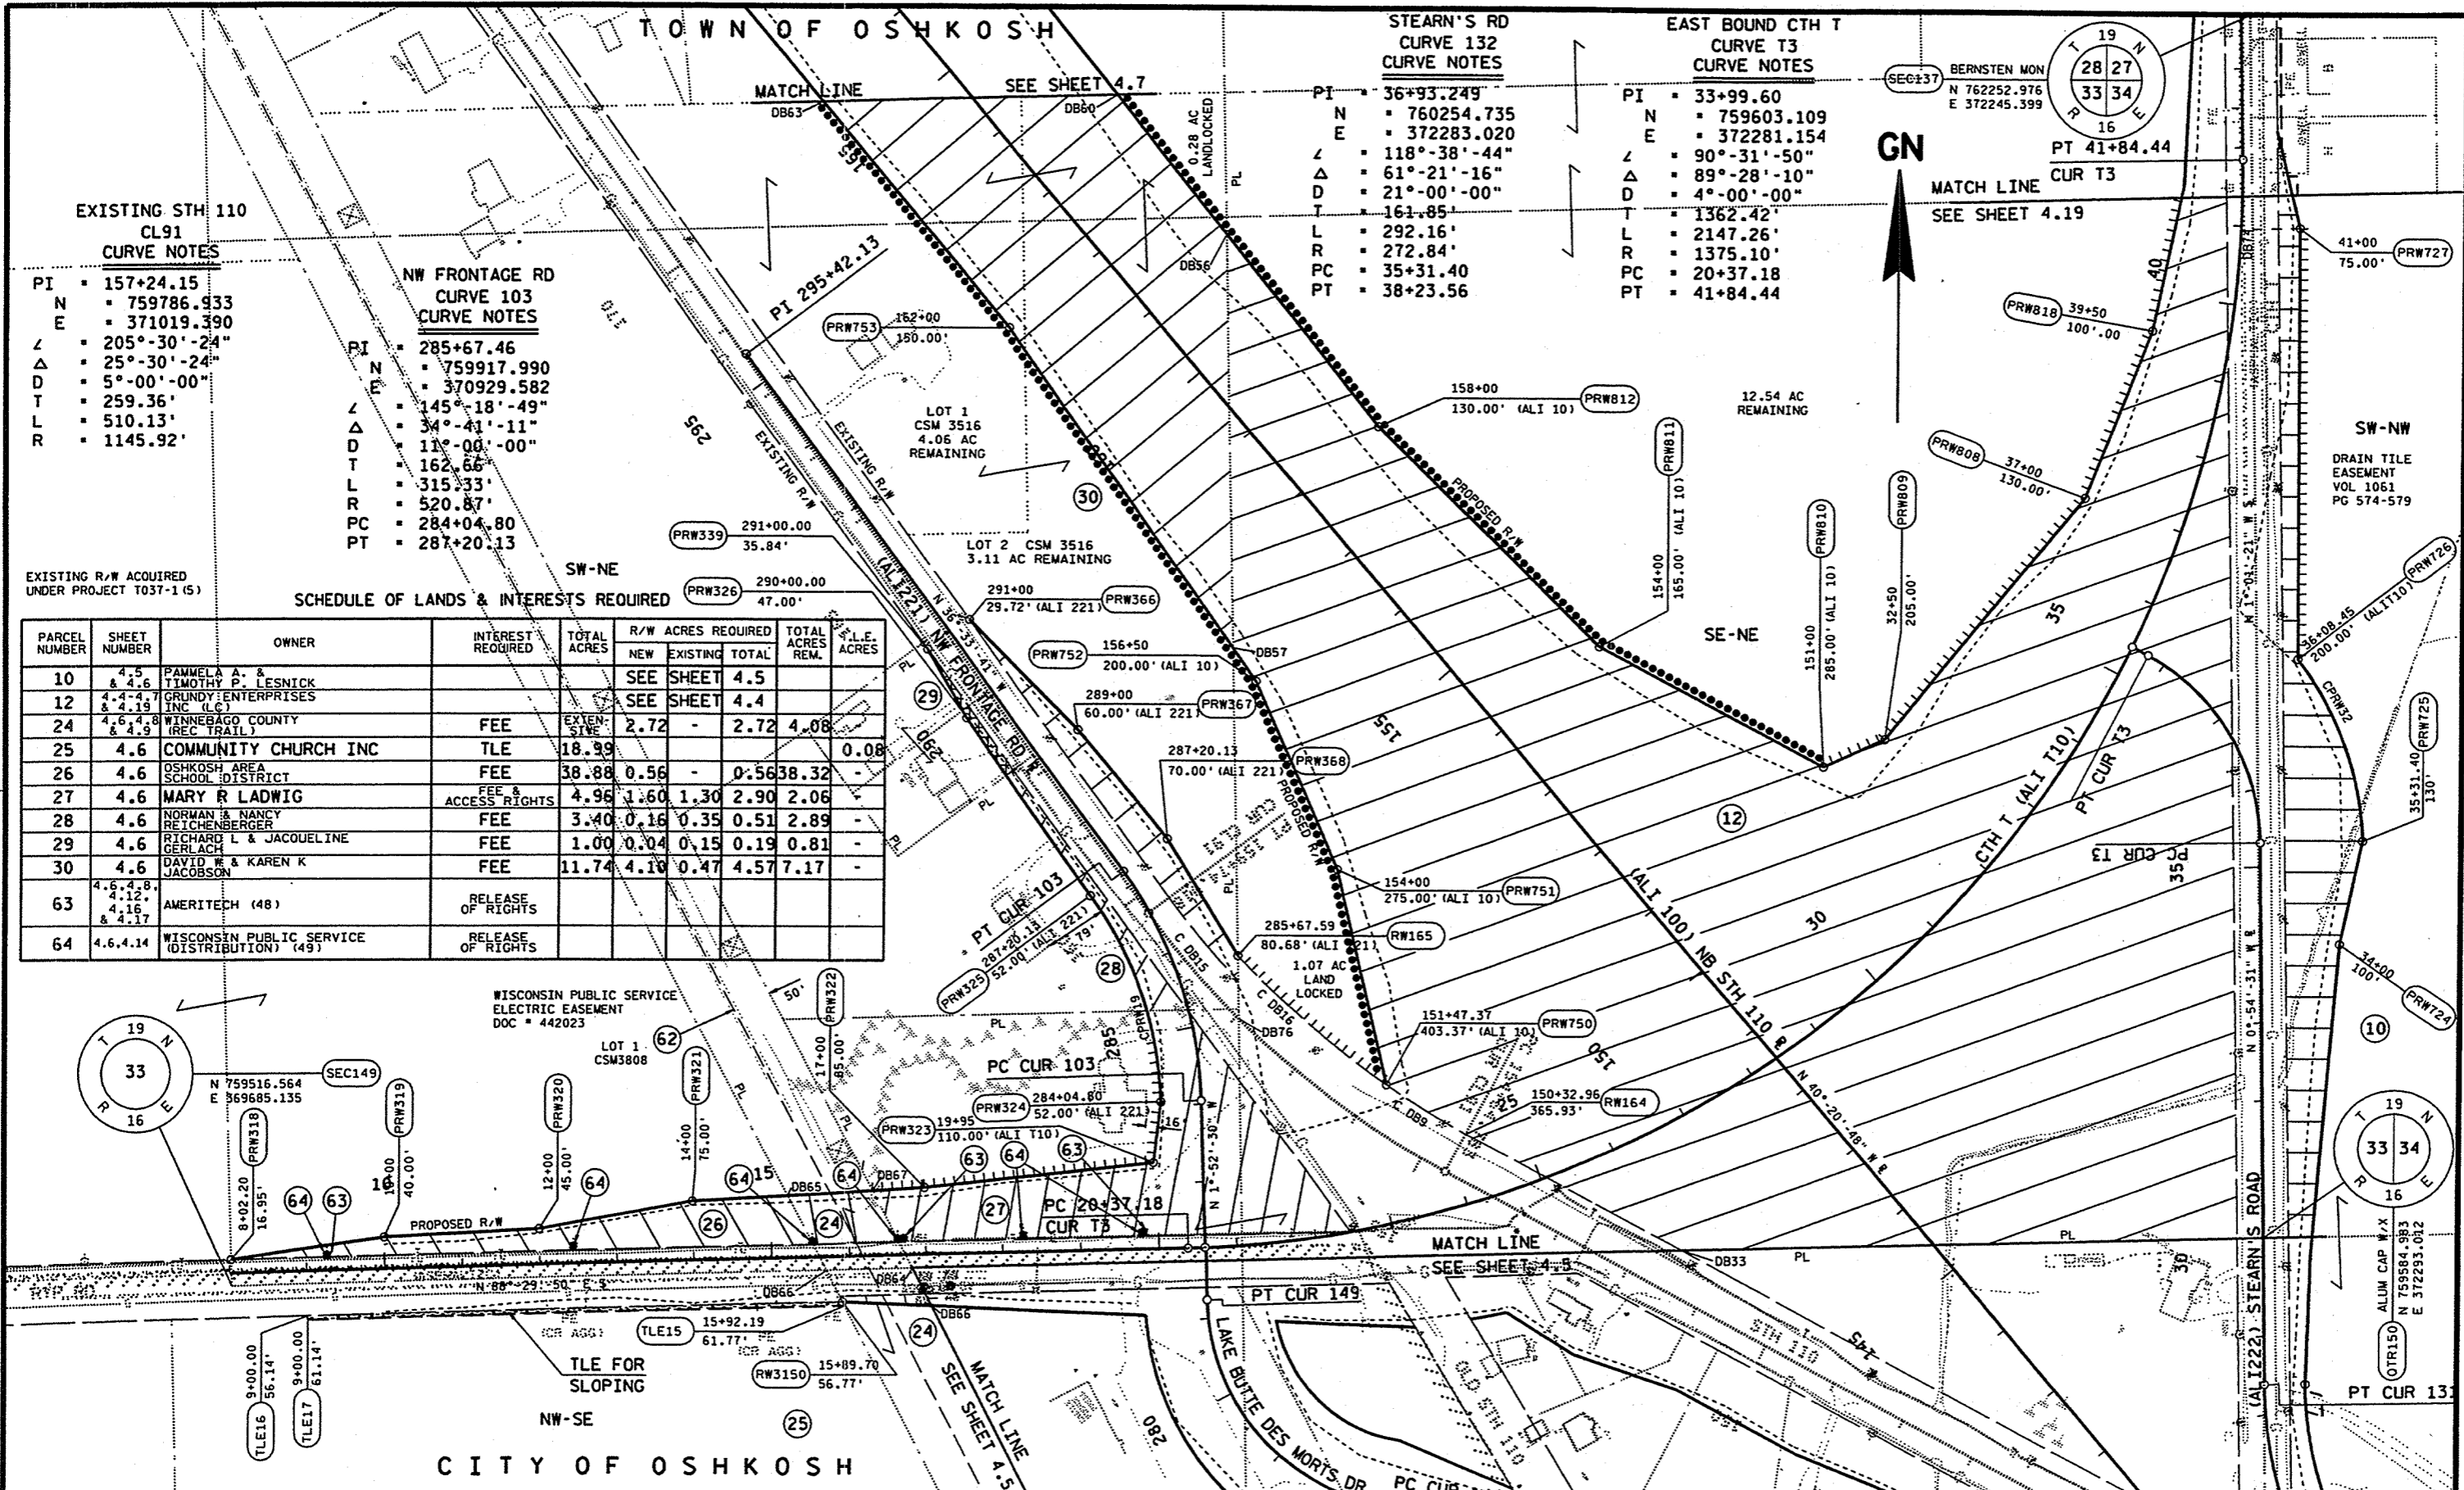



REVISION DATE 09-11-01 NC	DATE: 11-17-95	SCALE, FEET 0 100 200	HWY: STH 110	CONSTRUCTION PROJECT NUMBER: 6200-05-71	PS&E SHEET NO: 4.13
GRID FACTOR: 0.999997			COUNTY: WINNEBAGO	STATE R/W PROJECT NUMBER: 6200-05-21	PLAT SHEET NO: 4.6

LEVELS ON 1, 2, 3, 62, 63

TOWN OF OSHKOSH


SCHEDULE OF LANDS & INTERESTS REQUIRED

PARCE NUMBER	SHEET NUMBER	OWNER	INTEREST REQUIRED	TOTAL ACRES	R/W ACRES REQUIRED			TOTAL ACRES REM.	T.L.E. ACRES
					NEW	EXISTING	TOTAL		
12	4.4	GRUNDY ENTERPRISES INC (LC)			SEE SHEET	4.4			
62	4.4	AMERICAN TRANSMISSION CORP (47)							

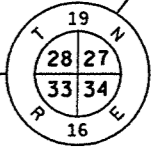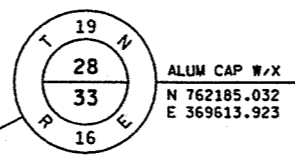

CTH Y CURVE 169 CURVE NOTES

PI = 34+56.724
 N = 762185.929
 E = 369673.480
 Δ = 225°-00'-00"
 D = 45°-00'-00"
 T = 6°-45'-00"
 L = 351.60'
 R = 666.67'
 PC = 848.83'
 PT = 31+05.13
 PT = 37+71.80

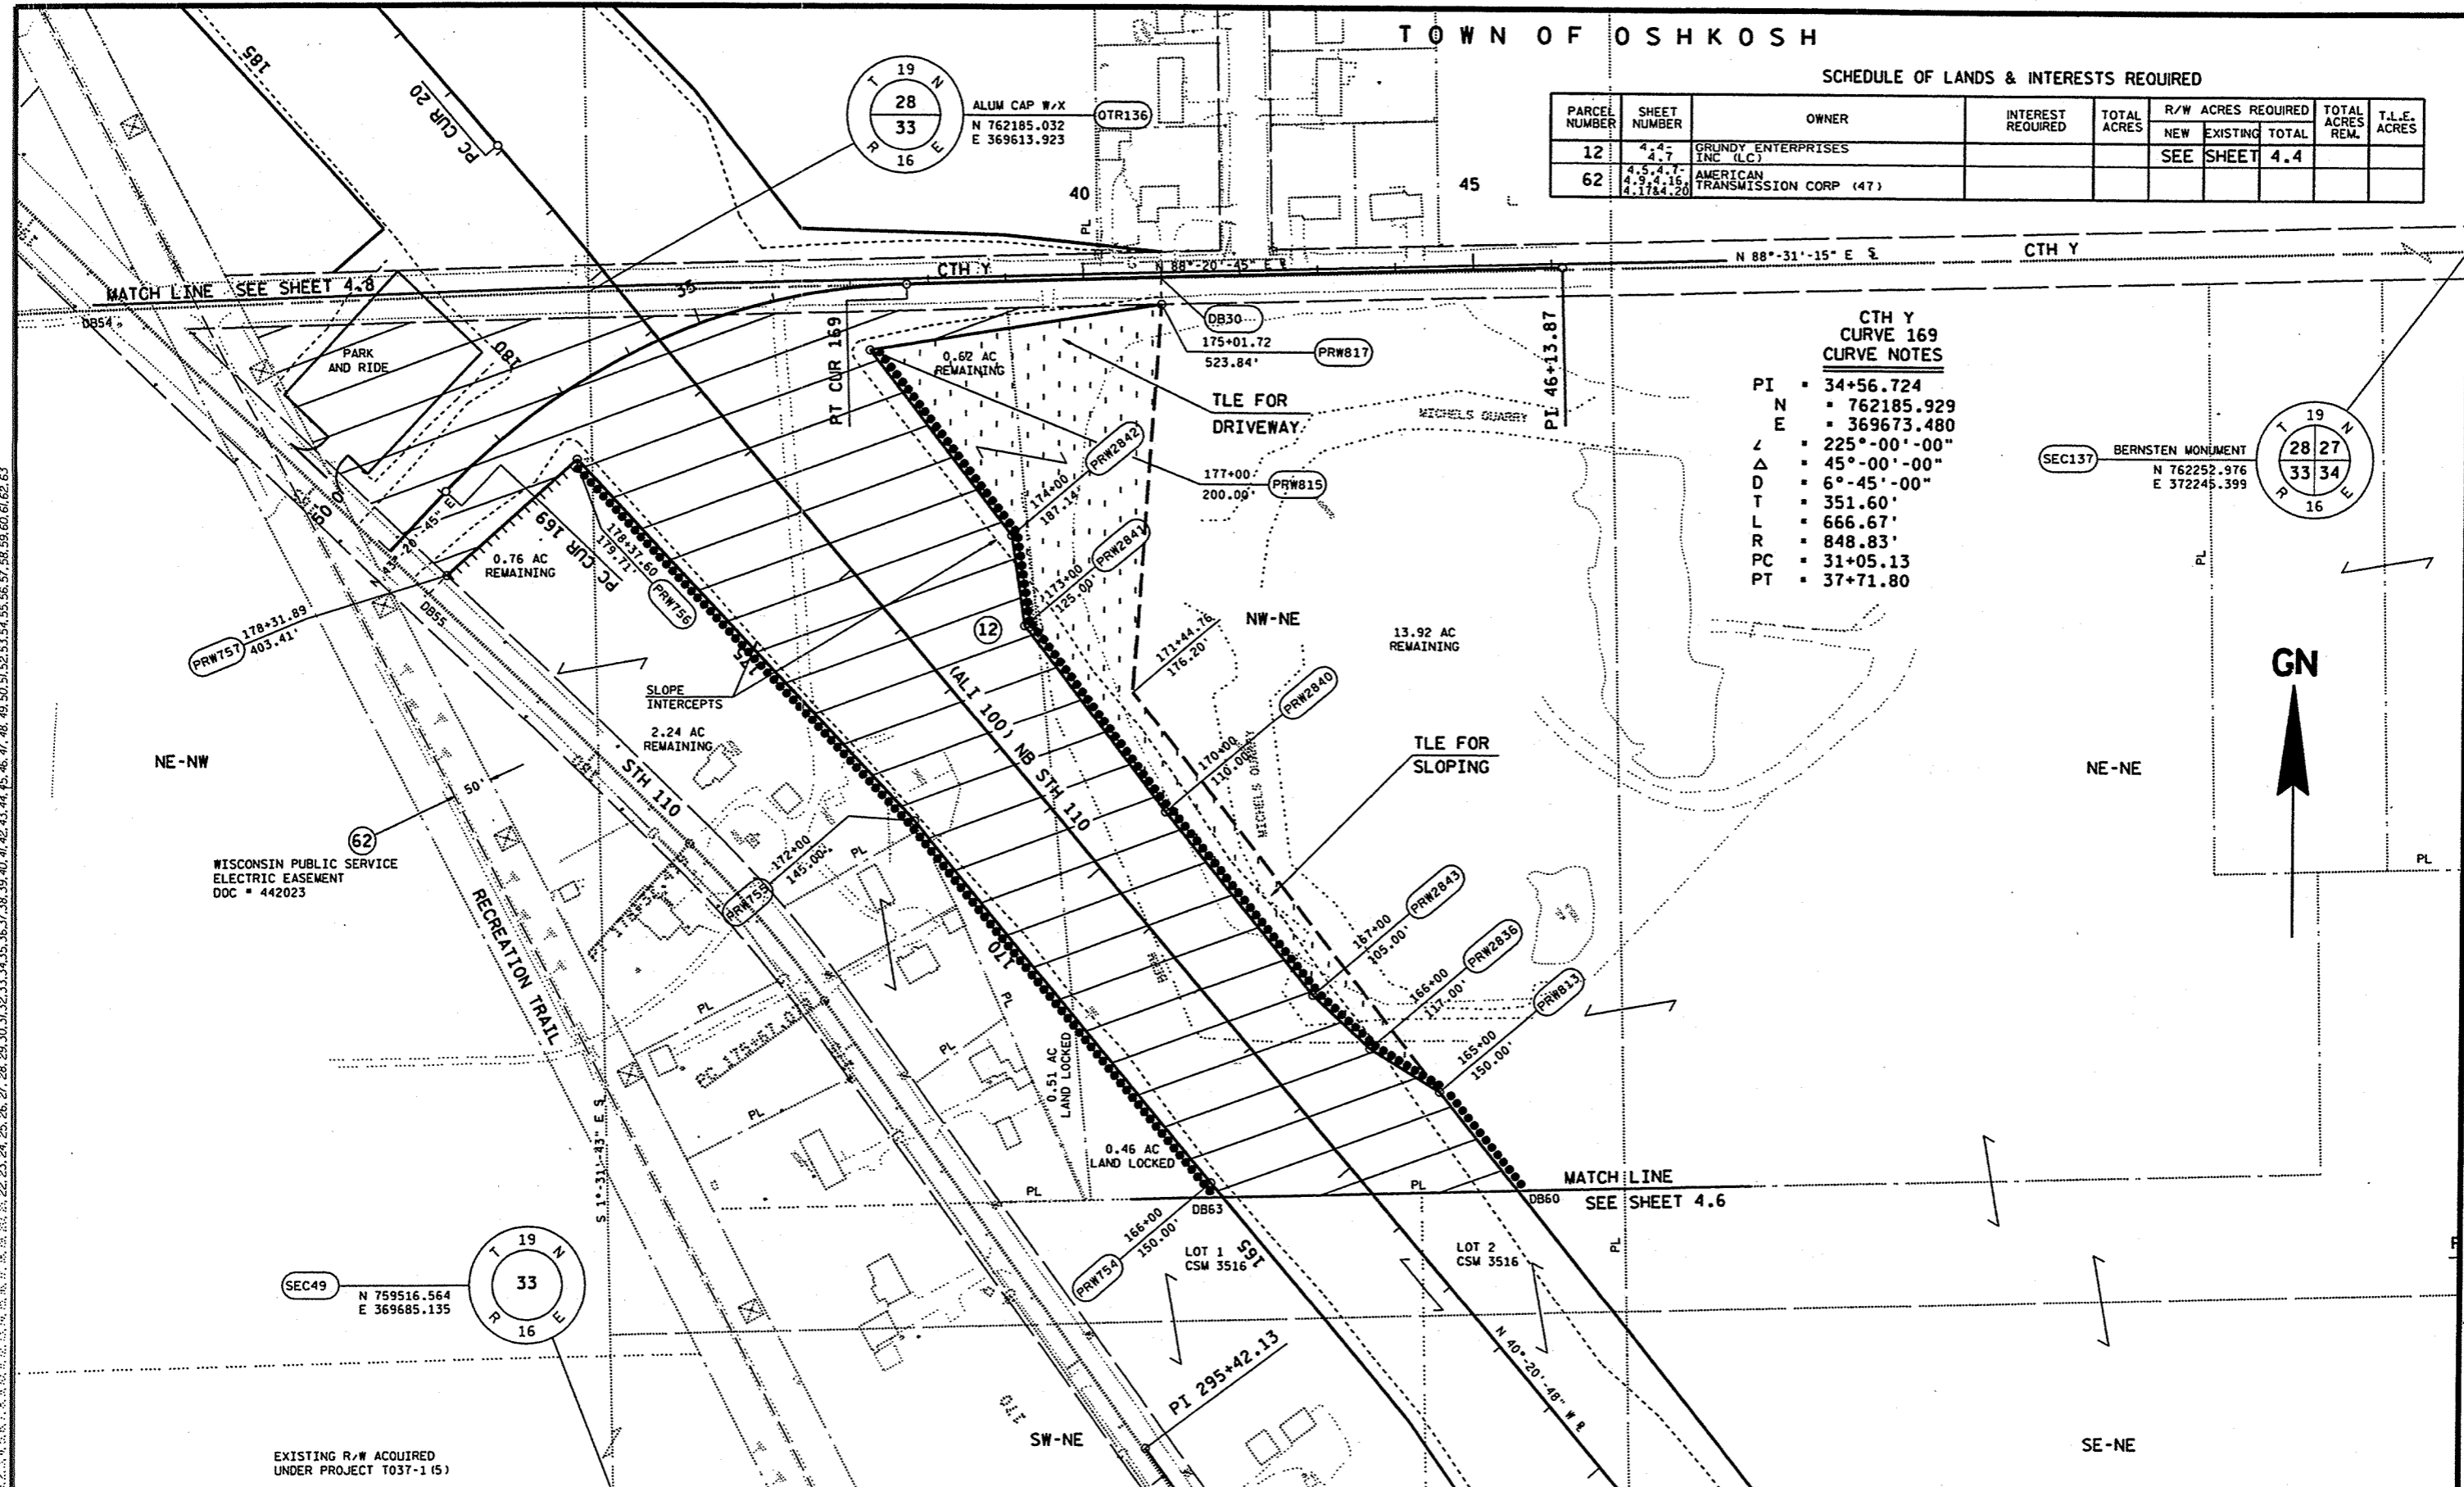

LEVELS ON 1. 2. 3. 63.

REVISION DATE 09-11-01	DATE: 11-17-95	SCALE: FEET 0 100 200	HWY: STH 110	CONSTRUCTION PROJECT NUMBER: 6200-05-71	PS&E SHEET NO: 4.14
	GRID FACTOR: 0.999997		COUNTY: WINNEBAGO	STATE R/W PROJECT NUMBER: 6200-05-21	PLAT SHEET NO: 4.7


TOWN OF OSHKOSH

SCHEDULE OF LANDS & INTERESTS REQUIRED

PARCEL NUMBER	SHEET NUMBER	OWNER	INTEREST REQUIRED	TOTAL ACRES	R/W ACRES REQUIRED			TOTAL ACRES REM.	T.I.E. ACRES
					NEW	EXISTING	TOTAL		
4	4.8-4.9	ESTATE OF ELDOR O SCHULTZ	FEE	295.62	34.61	-	34.61	261.11	
24	4.6-4.9	WINNEBAGO COUNTY	SEE SHEET		4.6				
31	4.8	ROBERT E. KRUMENAUER	FEE	0.71	0.01	-	0.01	0.70	
32	4.8, 4.9 & 4.19	GRUNDY FARMS INC	FEE & ACCESS RIGHTS	140.49	14.37	0.76	15.13	125.24	0.01
62	4.5, 4.7, 4.9, 4.16 & 4.17	AMERICAN TRANSMISSION CORP (47)	RELEASE OF RIGHTS						
63	4.6, 4.8, 4.12, 4.16 & 4.17	AMERITECH (48)	RELEASE OF RIGHTS						

CURVE 20 CURVE NOTES

PI = 198+29.082
 N = 763605.768
 E = 368447.996
 L = 163°-54'-20"
 Δ = 16°-05'-40"
 D = 0°-30'-00"
 T = 1620.13'
 L = 3218.92'
 R = 11459.16'
 PC = 182+08.96
 PT = 214+27.87

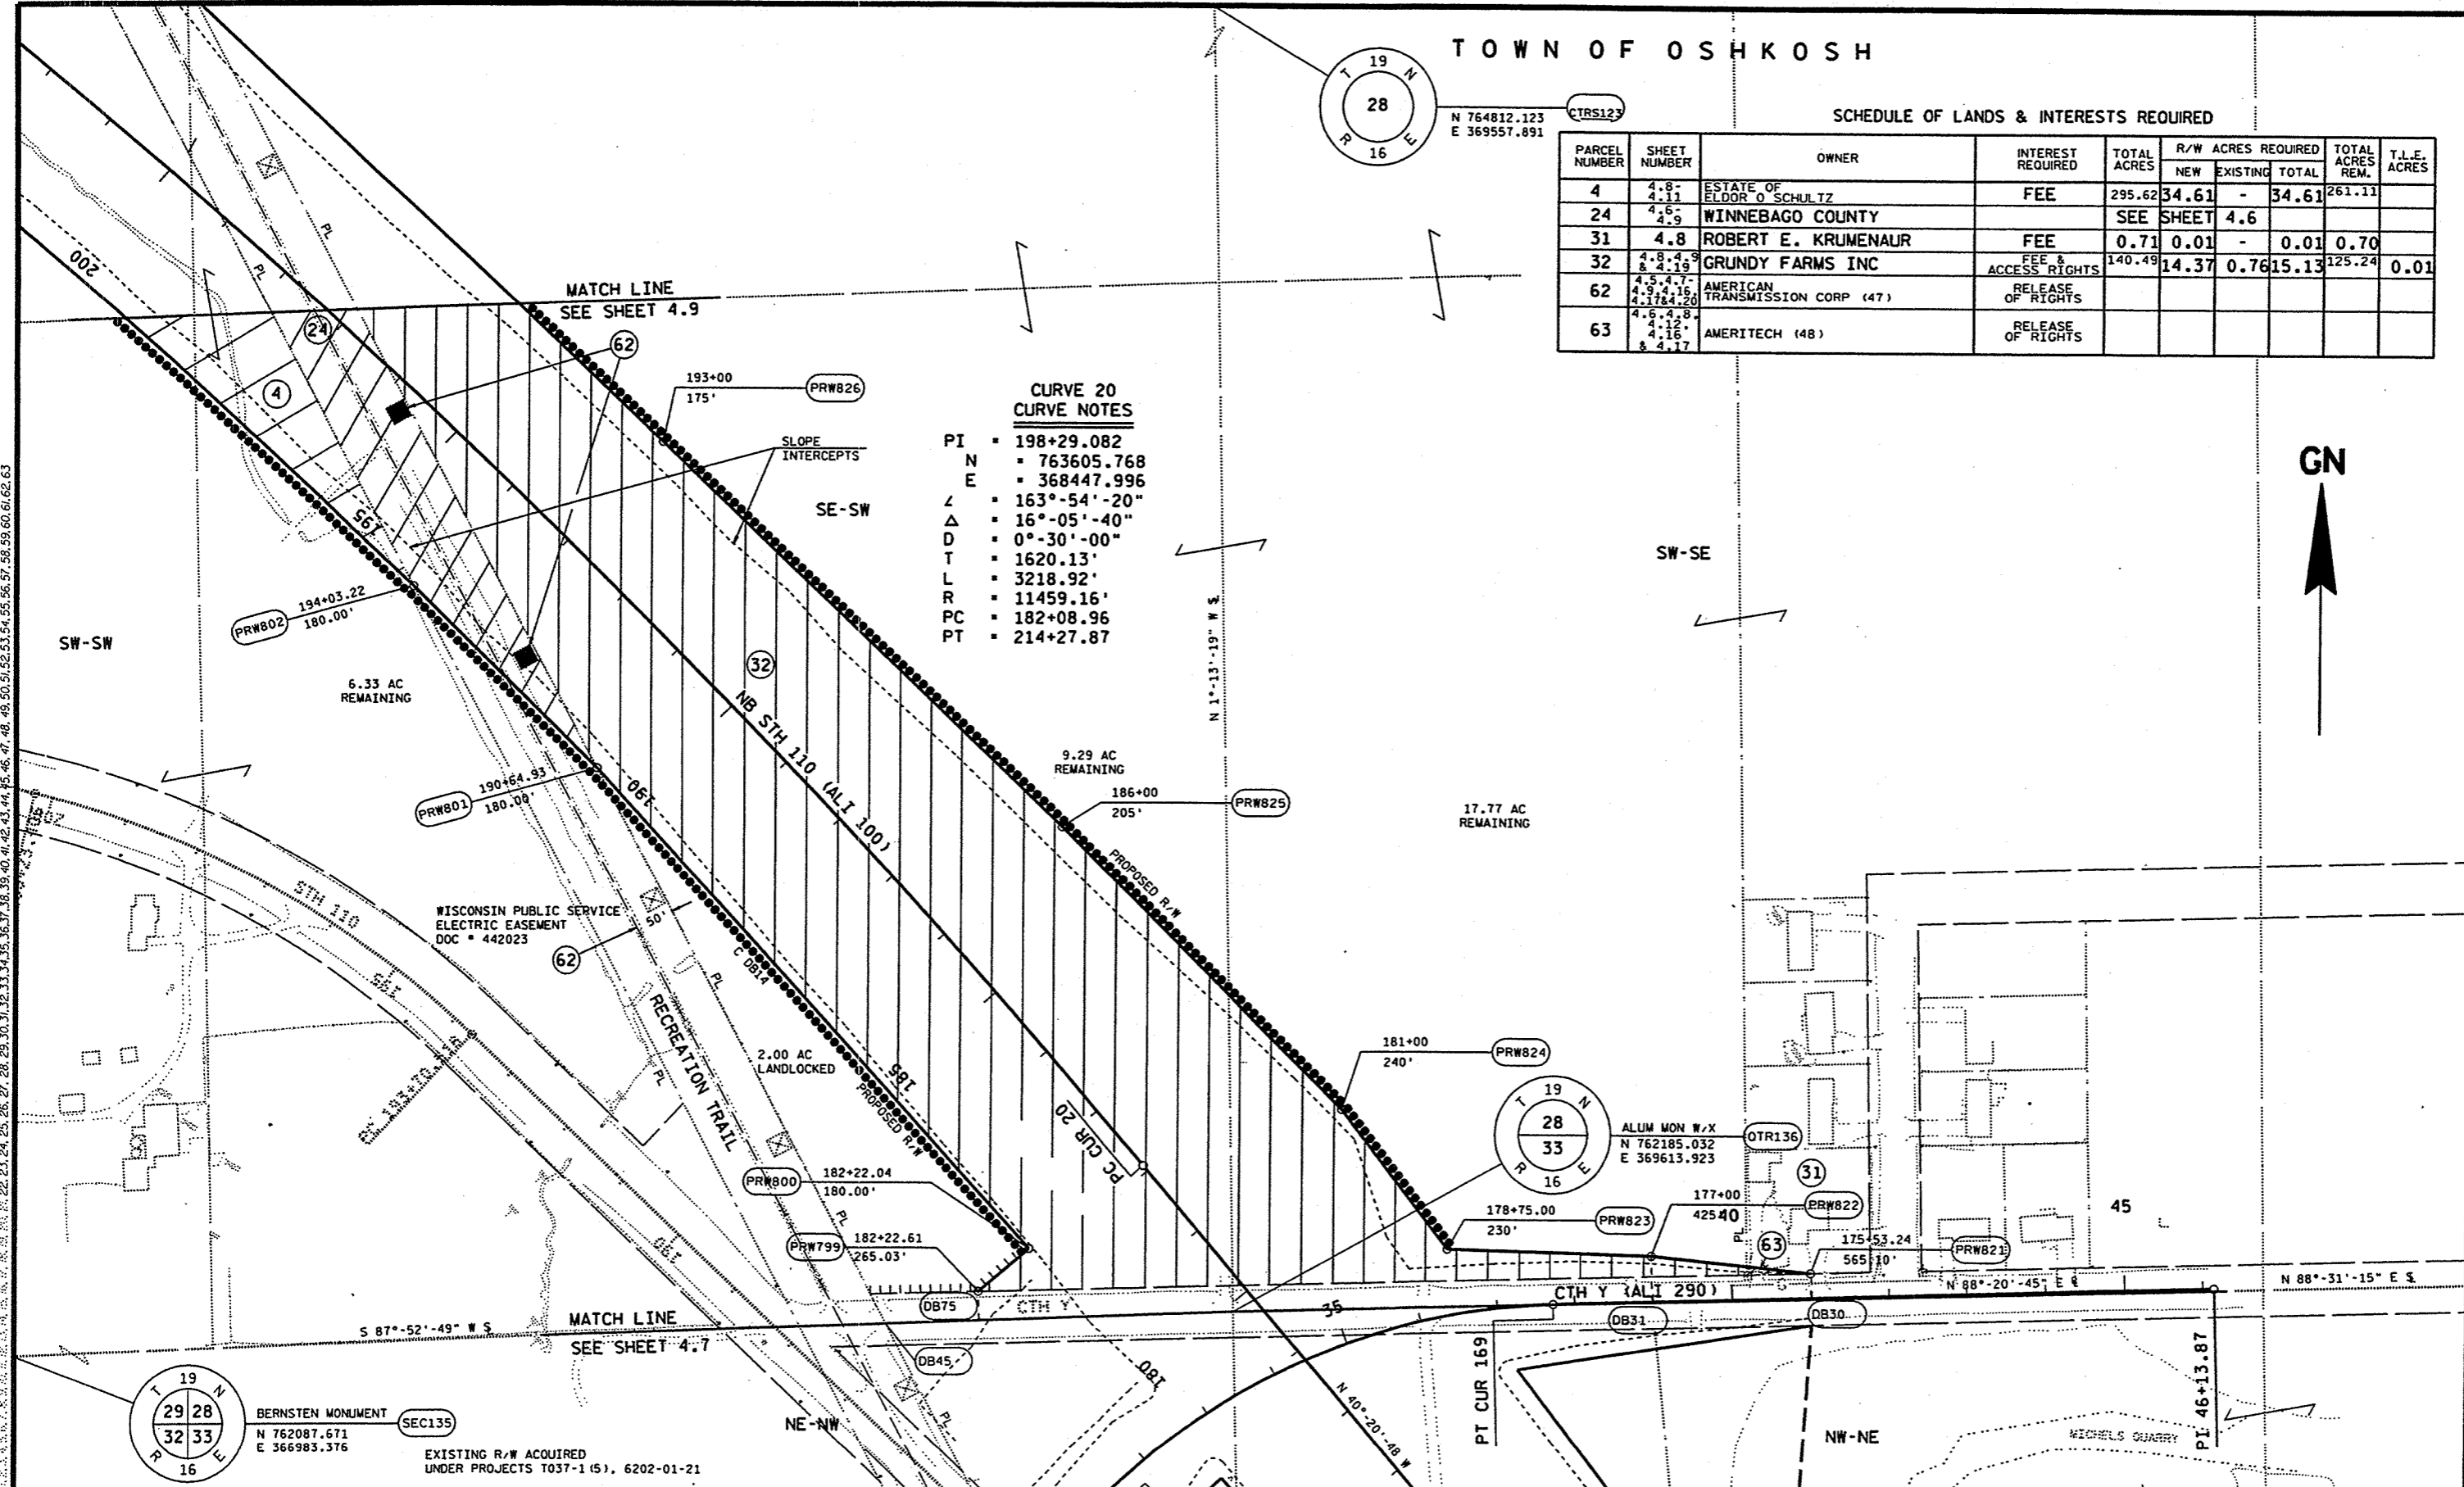

LEVELS ON 1, 2, 3, 62, 63


REVISION DATE 09-11-01	DATE: 11-17-95	SCALE, FEET 0 100 200	HWY: STH 110	CONSTRUCTION PROJECT NUMBER: 6200-05-71	PS&E SHEET NO: 4.15
GRID FACTOR: 0.999997			COUNTY: WINNEBAGO	STATE R/W PROJECT NUMBER: 6200-05-21	PLAT SHEET NO: 4.8

SCHEDULE OF LANDS & INTERESTS REQUIRED SE-NW




PARCEL NUMBER	SHEET NUMBER	OWNER	INTEREST REQUIRED	TOTAL ACRES	R/W ACRES REQUIRED			TOTAL ACRES REM.	T.L.E. ACRES
					NEW	EXISTING	TOTAL		
4	4.8-4.11	ESTATE OF ELDOR O SCHULTZ			SEE SHEET		4.8		
24	4.6-4.9	WINNEBAGO COUNTY			SEE SHEET		4.6		
32	4.8-4.9 & 2.19	GRUNDY FARMS INC			SEE SHEET		4.8		
62	4.5-4.7, 4.9-4.16, 4.17&4.20	AMERICAN TRANSMISSION CORP (47)	RELEASE OF RIGHTS						

TOWN OF OSHKOSH

N 88°-08'-20" E 1/4

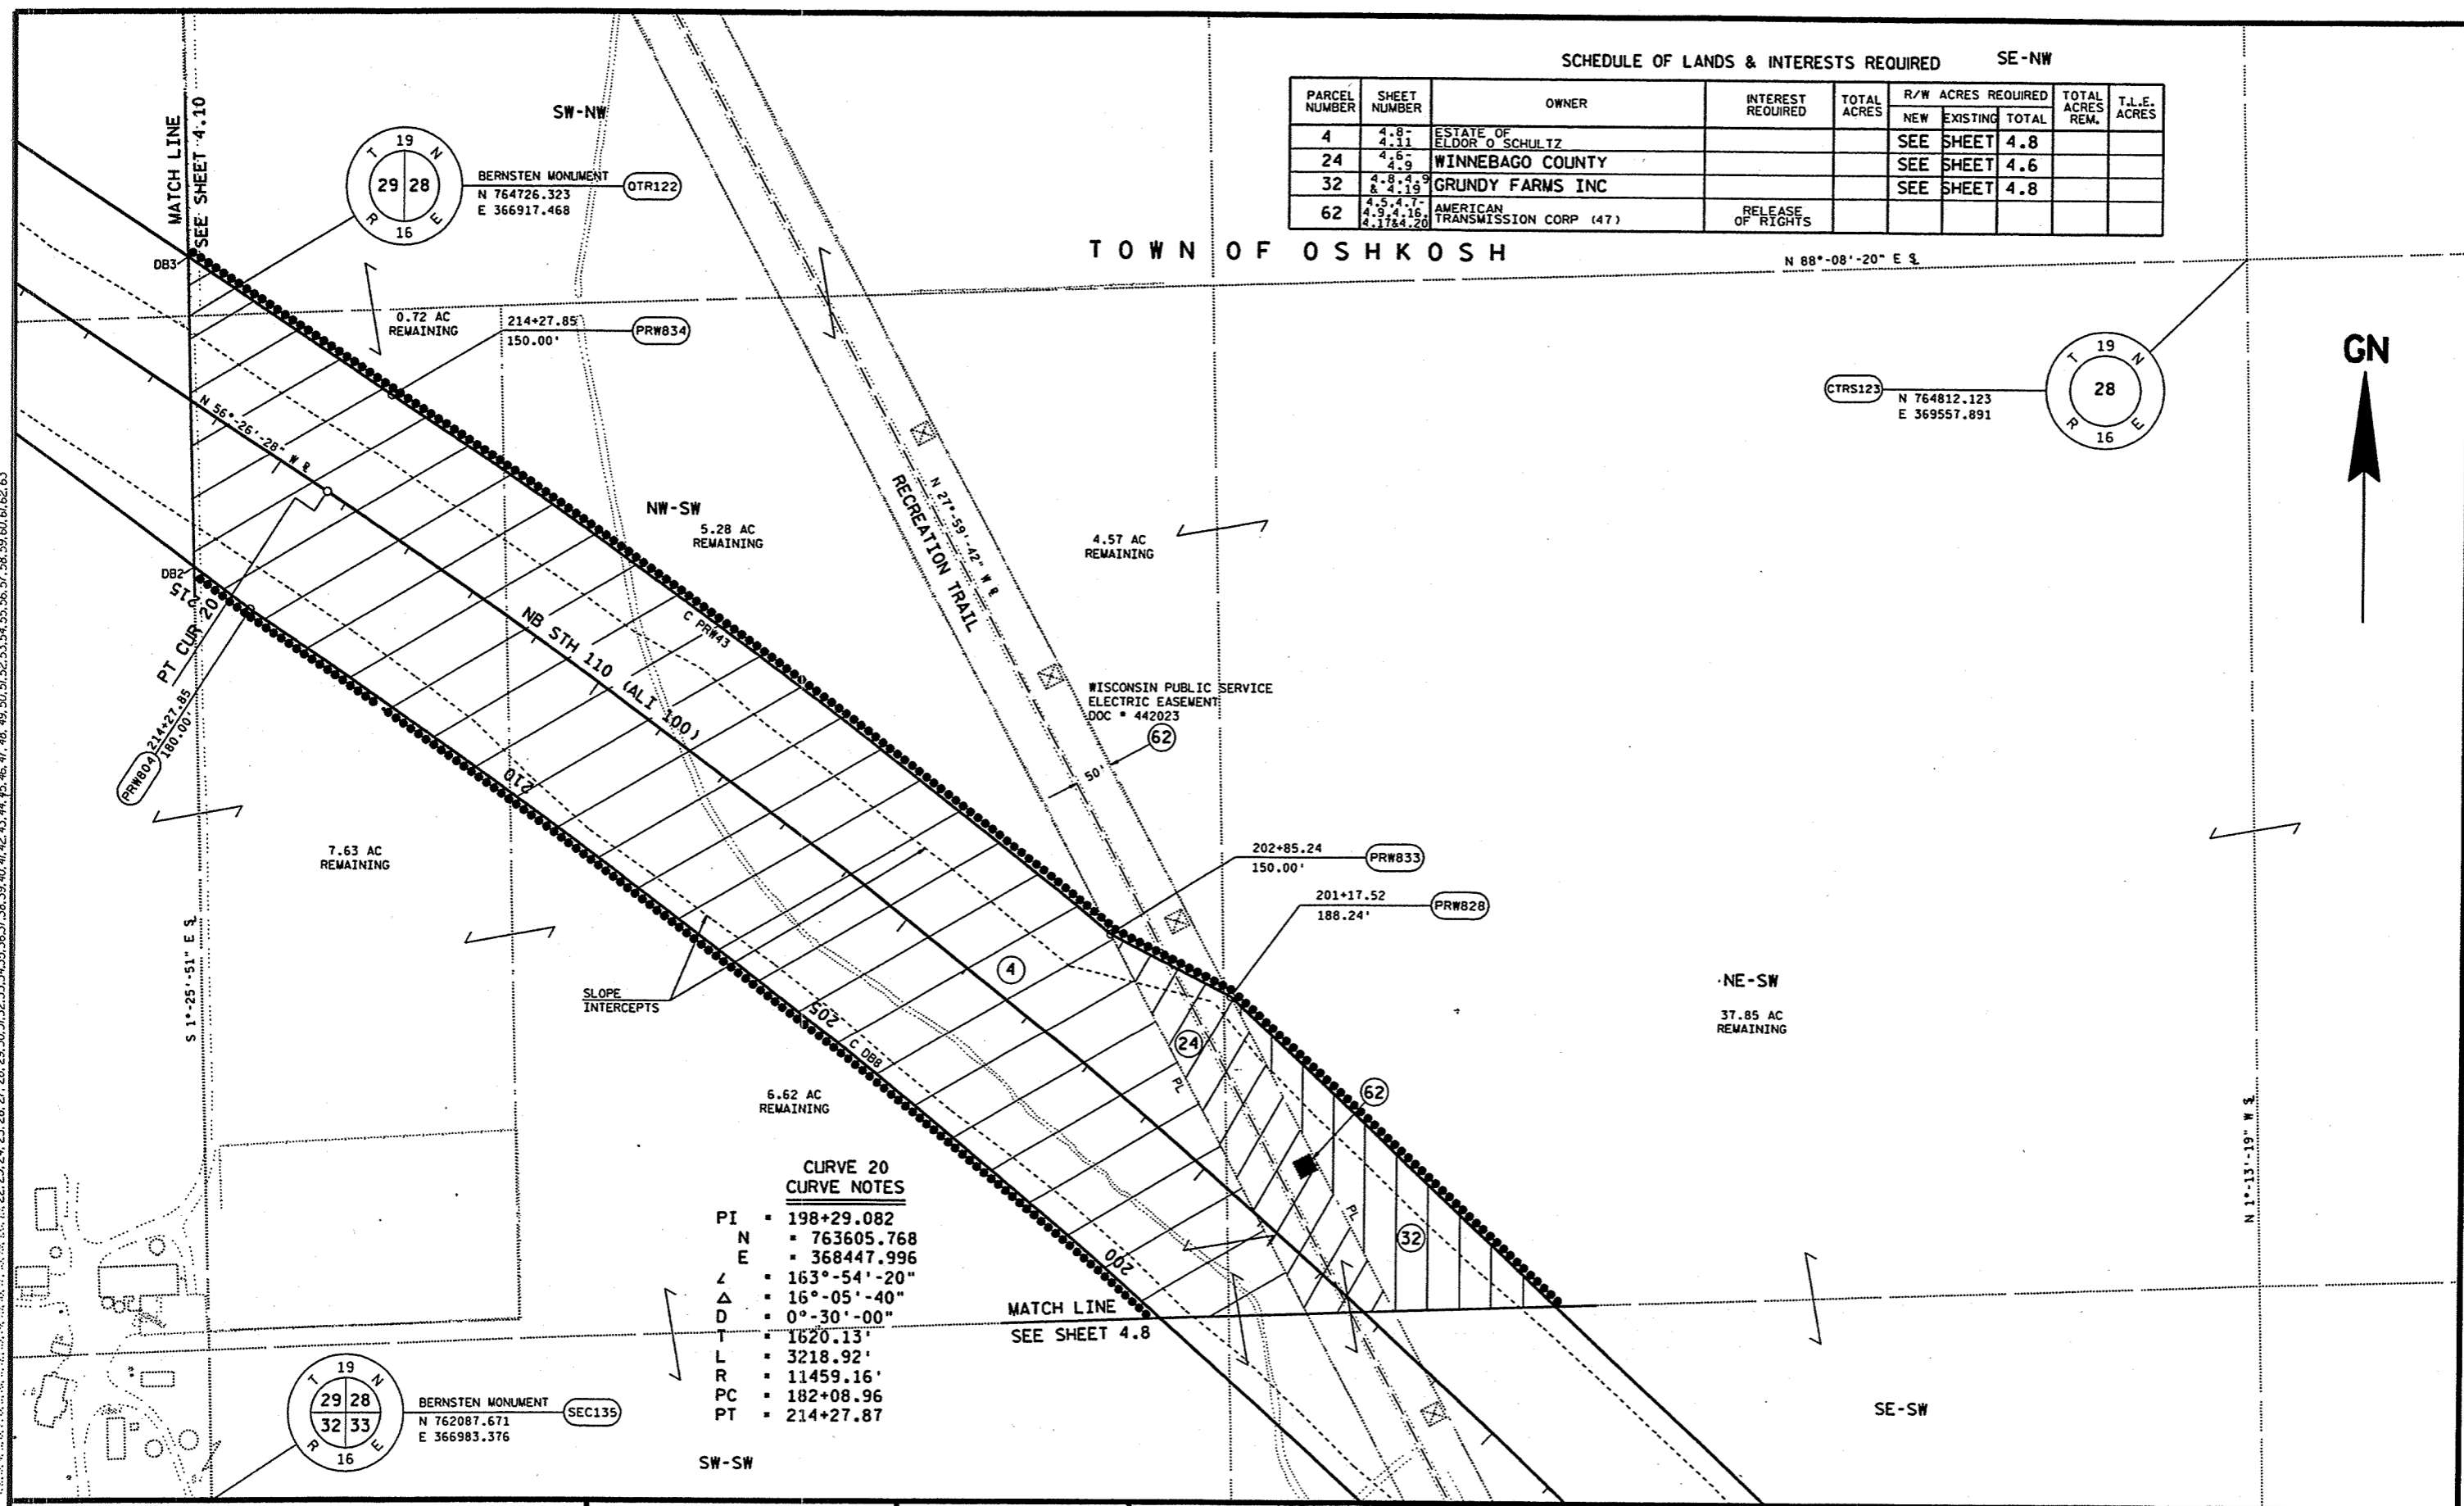


CURVE 20 CURVE NOTES
 PI = 198+29.082
 N = 763605.768
 E = 368447.996
 L = 163°-54'-20"
 Δ = 16°-05'-40"
 D = 0°-30'-00"
 T = 1620.13'
 L = 3218.92'
 R = 11459.16'
 PC = 182+08.96
 PT = 214+27.87

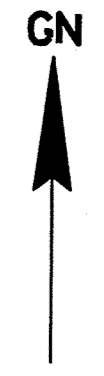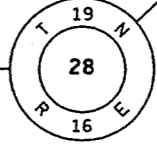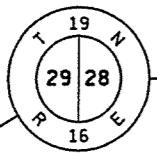

LEVELS ON: 1.0, 2.0, 3.0, 62.0, 63.0

REVISION DATE 09-11-01NC	DATE: 11-17-95	SCALE: FEET 0 100 200	HWY: STH 110	CONSTRUCTION PROJECT NUMBER: 6200-05-71	PS&E SHEET NO: 4.16
GRID FACTOR: 0.999997			COUNTY: WINNEBAGO	STATE R/W PROJECT NUMBER: 6200-05-21	PLAT SHEET NO: 4.9

LEVELS ON 1, 2, 3, 62, 63

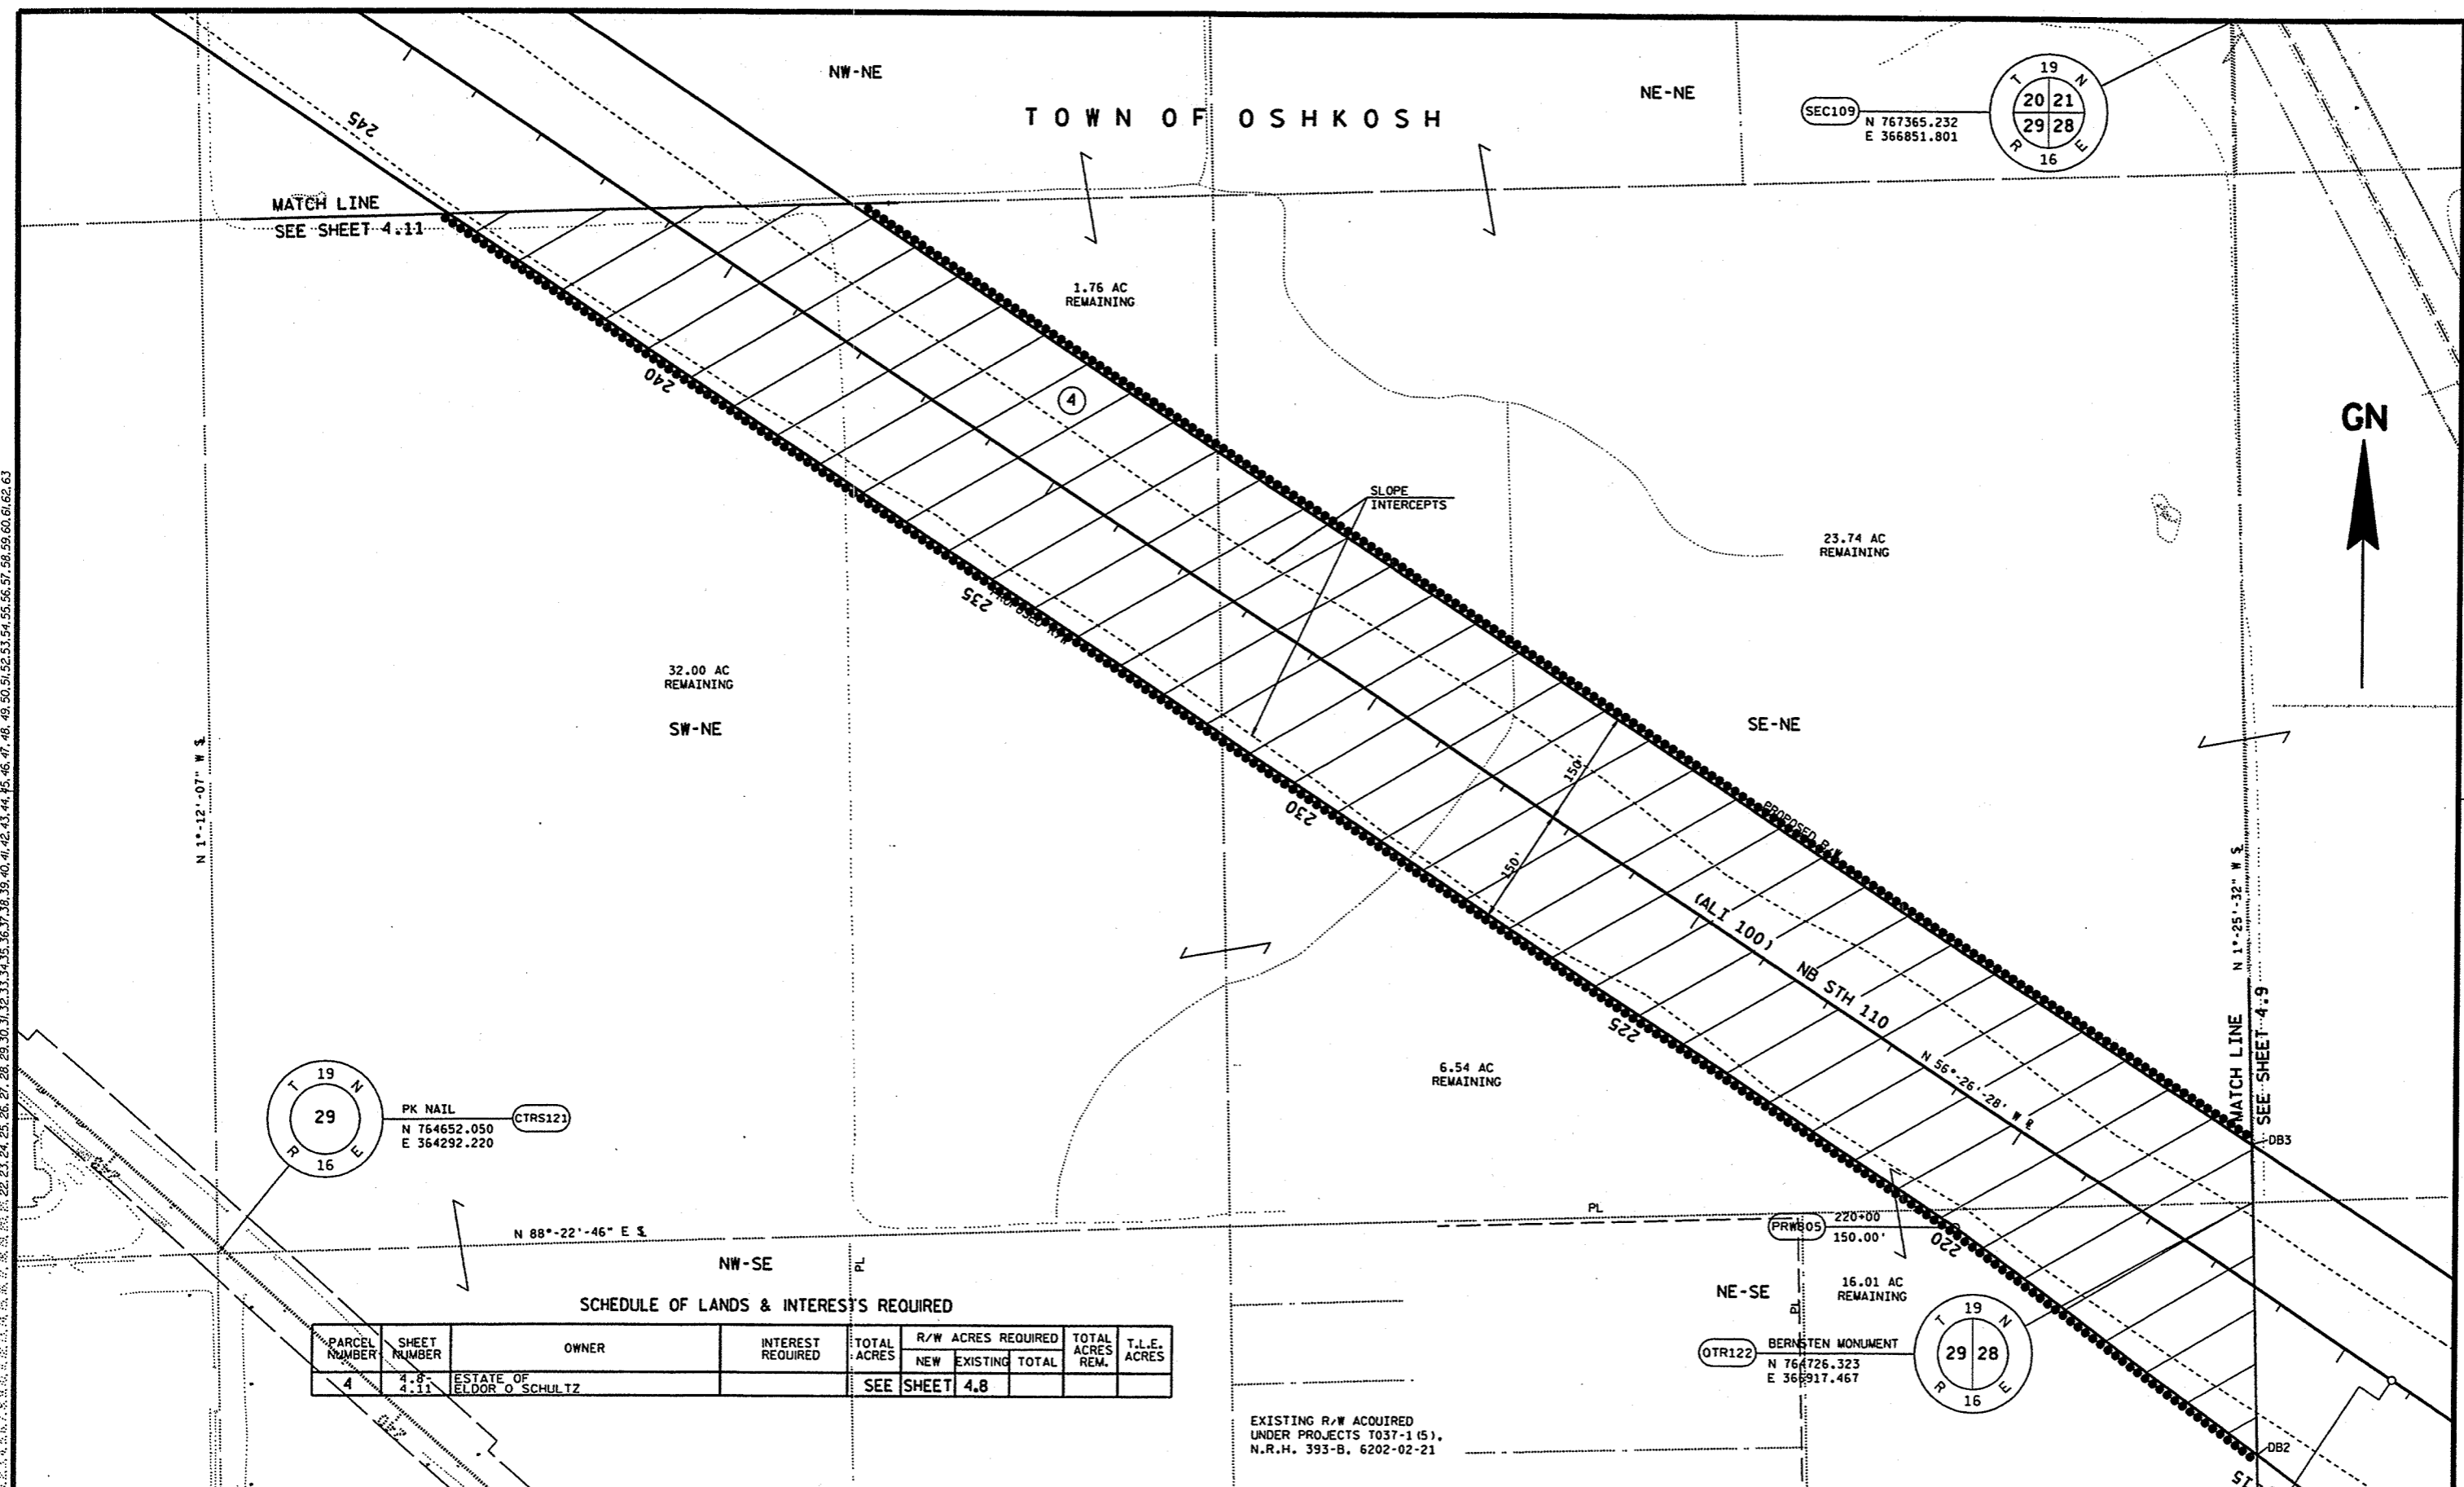

SCHEDULE OF LANDS & INTERESTS REQUIRED


PARCEL NUMBER	SHEET NUMBER	OWNER	INTEREST REQUIRED	TOTAL ACRES	R/W ACRES REQUIRED			TOTAL ACRES REM.	T.L.E. ACRES
					NEW	EXISTING	TOTAL		
4	4.8 4.11	ESTATE OF ELDOR O SCHULTZ		SEE SHEET	4.8				

EXISTING R/W ACQUIRED UNDER PROJECTS T037-1 (5), N.R.H. 393-B. 6202-02-21

REVISION DATE 09-11-01 NC	DATE: 11-17-95	SCALE, FEET 0 100 200	HWY: STH 110	CONSTRUCTION PROJECT NUMBER: 6200-05-71	PS&E SHEET NO: 4.17
	GRID FACTOR: 0.999997		COUNTY: WINNEBAGO	STATE R/W PROJECT NUMBER: 6200-05-21	PLAT SHEET NO: 4.10

TOWN OF VINLAND

TOWN OF OSHKOSH

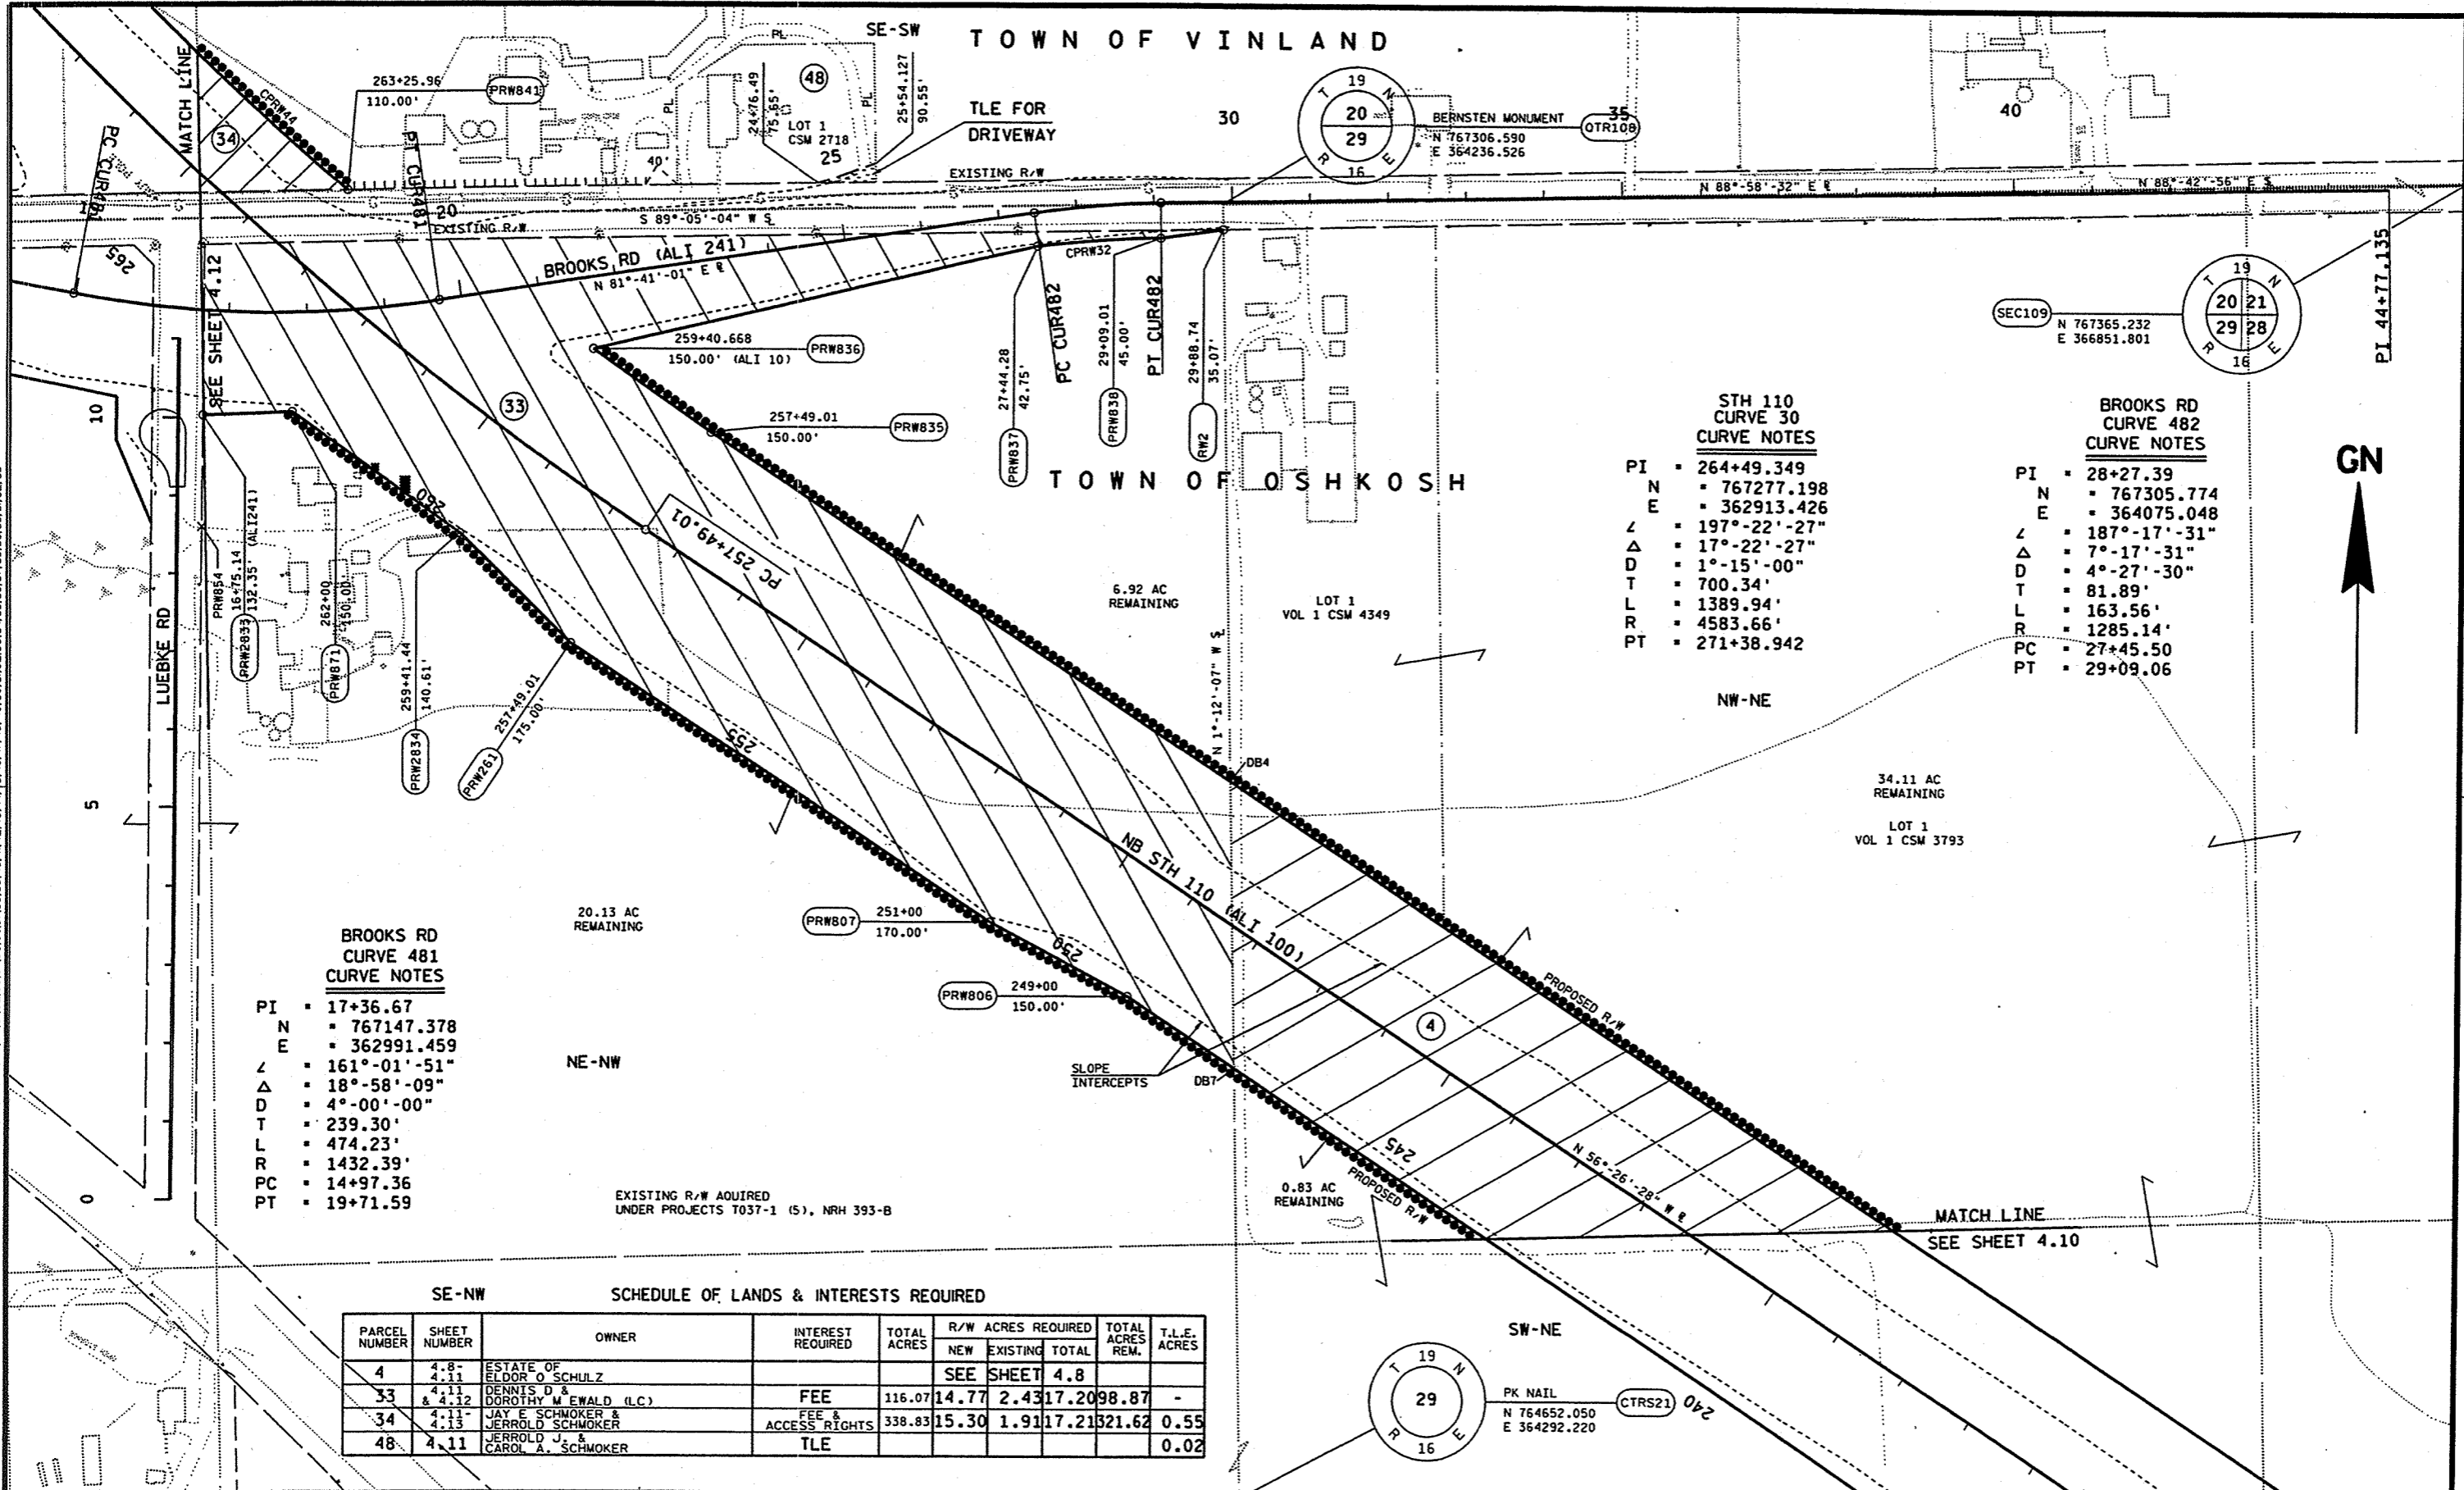

**STH 110
CURVE 30
CURVE NOTES**

PI = 264+49.349
 N = 767277.198
 E = 362913.426
 Δ = 197°-22'-27"
 Δ = 17°-22'-27"
 D = 1°-15'-00"
 T = 700.34'
 L = 1389.94'
 R = 4583.66'
 PT = 271+38.942

**BROOKS RD
CURVE 482
CURVE NOTES**

PI = 28+27.39
 N = 767305.774
 E = 364075.048
 Δ = 187°-17'-31"
 Δ = 7°-17'-31"
 D = 4°-27'-30"
 T = 81.89'
 L = 163.56'
 R = 1285.14'
 PC = 27+45.50
 PT = 29+09.06

**BROOKS RD
CURVE 481
CURVE NOTES**

PI = 17+36.67
 N = 767147.378
 E = 362991.459
 Δ = 161°-01'-51"
 Δ = 18°-58'-09"
 D = 4°-00'-00"
 T = 239.30'
 L = 474.23'
 R = 1432.39'
 PC = 14+97.36
 PT = 19+71.59

SE-NW SCHEDULE OF LANDS & INTERESTS REQUIRED

PARCEL NUMBER	SHEET NUMBER	OWNER	INTEREST REQUIRED	TOTAL ACRES	R/W ACRES REQUIRED			TOTAL ACRES REM.	T.L.E. ACRES
					NEW	EXISTING	TOTAL		
4	4.8-4.11	ESTATE OF ELDOR O SCHULZ			SEE SHEET 4.8				
33	4.11 & 4.12	DENNIS D & DOROTHY M EWALD (LC)	FEE	116.07	14.77	2.43	17.20	98.87	
34	4.11-4.13	JAY E SCHMOKER & JERROLD SCHMOKER	FEE & ACCESS RIGHTS	338.83	15.30	1.91	17.21	321.62	0.55
48	4.11	JERROLD J & CAROL A. SCHMOKER	TLE						0.02

LEVELS ON 1.2, 3.4, 5.6, 7.8, 9.0, 10.1, 11.2, 12.3, 13.4, 14.5, 15.6, 16.7, 17.8, 18.9, 19.0, 20.1, 21.2, 22.3, 23.4, 24.5, 25.6, 26.7, 27.8, 28.9, 29.0, 30.1, 31.2, 32.3, 33.4, 34.5, 35.6, 36.7, 37.8, 38.9, 39.0, 40.1, 41.2, 42.3, 43.4, 44.5, 45.6, 46.7, 47.8, 48.9, 49.0, 50.1, 51.2, 52.3, 53.4, 54.5, 55.6, 56.7, 57.8, 58.9, 59.0, 60.1, 61.2, 62.3

REVISION DATE 09-11-01	DATE: 11-17-95	SCALE: FEET 0 100 200	HWY: STH 110	CONSTRUCTION PROJECT NUMBER: 6200-05-71	PS&E SHEET NO: 4.18
GRID FACTOR: 0.999997			COUNTY: WINNEBAGO	STATE R/W PROJECT NUMBER: 6200-05-21	PLAT SHEET NO: 4.11

LEVELS ON - 1.0, 2.0, 3.0, 62.0, 63.0

**SKELETON BRIDGE RD
CURVE 140
CURVE NOTES**

PI = 5+50.000
N = 767927.011
E = 361586.995
∠ = 169°-01'-39"
Δ = 10°-58'-21"
D = 6°-00'-00"
T = 91.72'
L = 182.88'
R = 954.93'

**SKELETON BRIDGE RD
CURVE 141
CURVE NOTES**

PI = 13+90.413
N = 768747.522
E = 361402.605
∠ = 201°-57'-04"
Δ = 21°-57'-04"
D = 3°-00'-00"
T = 370.39'
L = 731.70'
R = 1909.86'

**STH 110
CURVE 30
CURVE NOTES**

PI = 264+49.349
N = 767277.198
E = 362913.426
∠ = 197°-22'-27"
Δ = 17°-22'-27"
D = 1°-15'-00"
T = 700.34'
L = 1389.94'
R = 4583.66'
PC = 257+49.006

**CURVE 40
CURVE NOTES**

PI = 295+34.241
N = 769680.685
E = 360962.465
∠ = 135°-54'-01"
Δ = 44°-05'-59"
D = 1°-15'-00"
T = 1856.56'
L = 3527.98'
R = 4583.66'
PC = 276+77.68

SCHEDULE OF LANDS & INTERESTS REQUIRED


PARCEL NUMBER	SHEET NUMBER	OWNER	INTEREST REQUIRED	TOTAL ACRES	R/W ACRES REQUIRED			TOTAL ACRES REM.	T.L.E. ACRES
					NEW	EXISTING	TOTAL		
33	4.11 & 4.12	DENNIS D & DOROTHY M EWALD (LC)			SEE SHEET 4.11				
34	4.11-4.13	JAY E SCHMOKER & JERROLD SCHMOKER			SEE SHEET 4.11				
35	4.12	GERALD N & JOANNE L FORSETH	FEE & TLE	2.09	0.03	-	0.03	2.06	0.03
36	4.12-4.14	WILLIAM H OVERTON	FEE	494.49	22.95	4.01	26.96	467.53	-
37	4.12	HAROLD M HANSON	FEE & TLE	2.05	0.90	0.18	1.80	0.97	0.20
63	4.6, 4.8, 4.12, 4.16 & 4.17	AMERITECH (48)	RELEASE OF RIGHTS						

**BROOKS RD
CURVE 480
CURVE NOTES**

PI = 10+37.58
N = 767276.778
E = 362303.523
∠ = 191°-23'-00"
Δ = 11°23'-00"
D = 4°-06'-06"
T = 139.22'
L = 277.53'
R = 1396.89'
PC = 8+98.36
PT = 11+75.89

EXISTING R/W REQUIRED UNDER PROJECTS NRH 393-B, 6202-02-21

REVISION DATE 09-II-OINC	DATE: 11-17-95	SCALE: FEET 0 100 200	HWY: STH 110	CONSTRUCTION PROJECT NUMBER: 6200-05-71	PS&E SHEET NO: 4.19
	GRID FACTOR: 0.999997		COUNTY: WINNEBAGO	STATE R/W PROJECT NUMBER: 6200-05-21	PLAT SHEET NO: 4.12

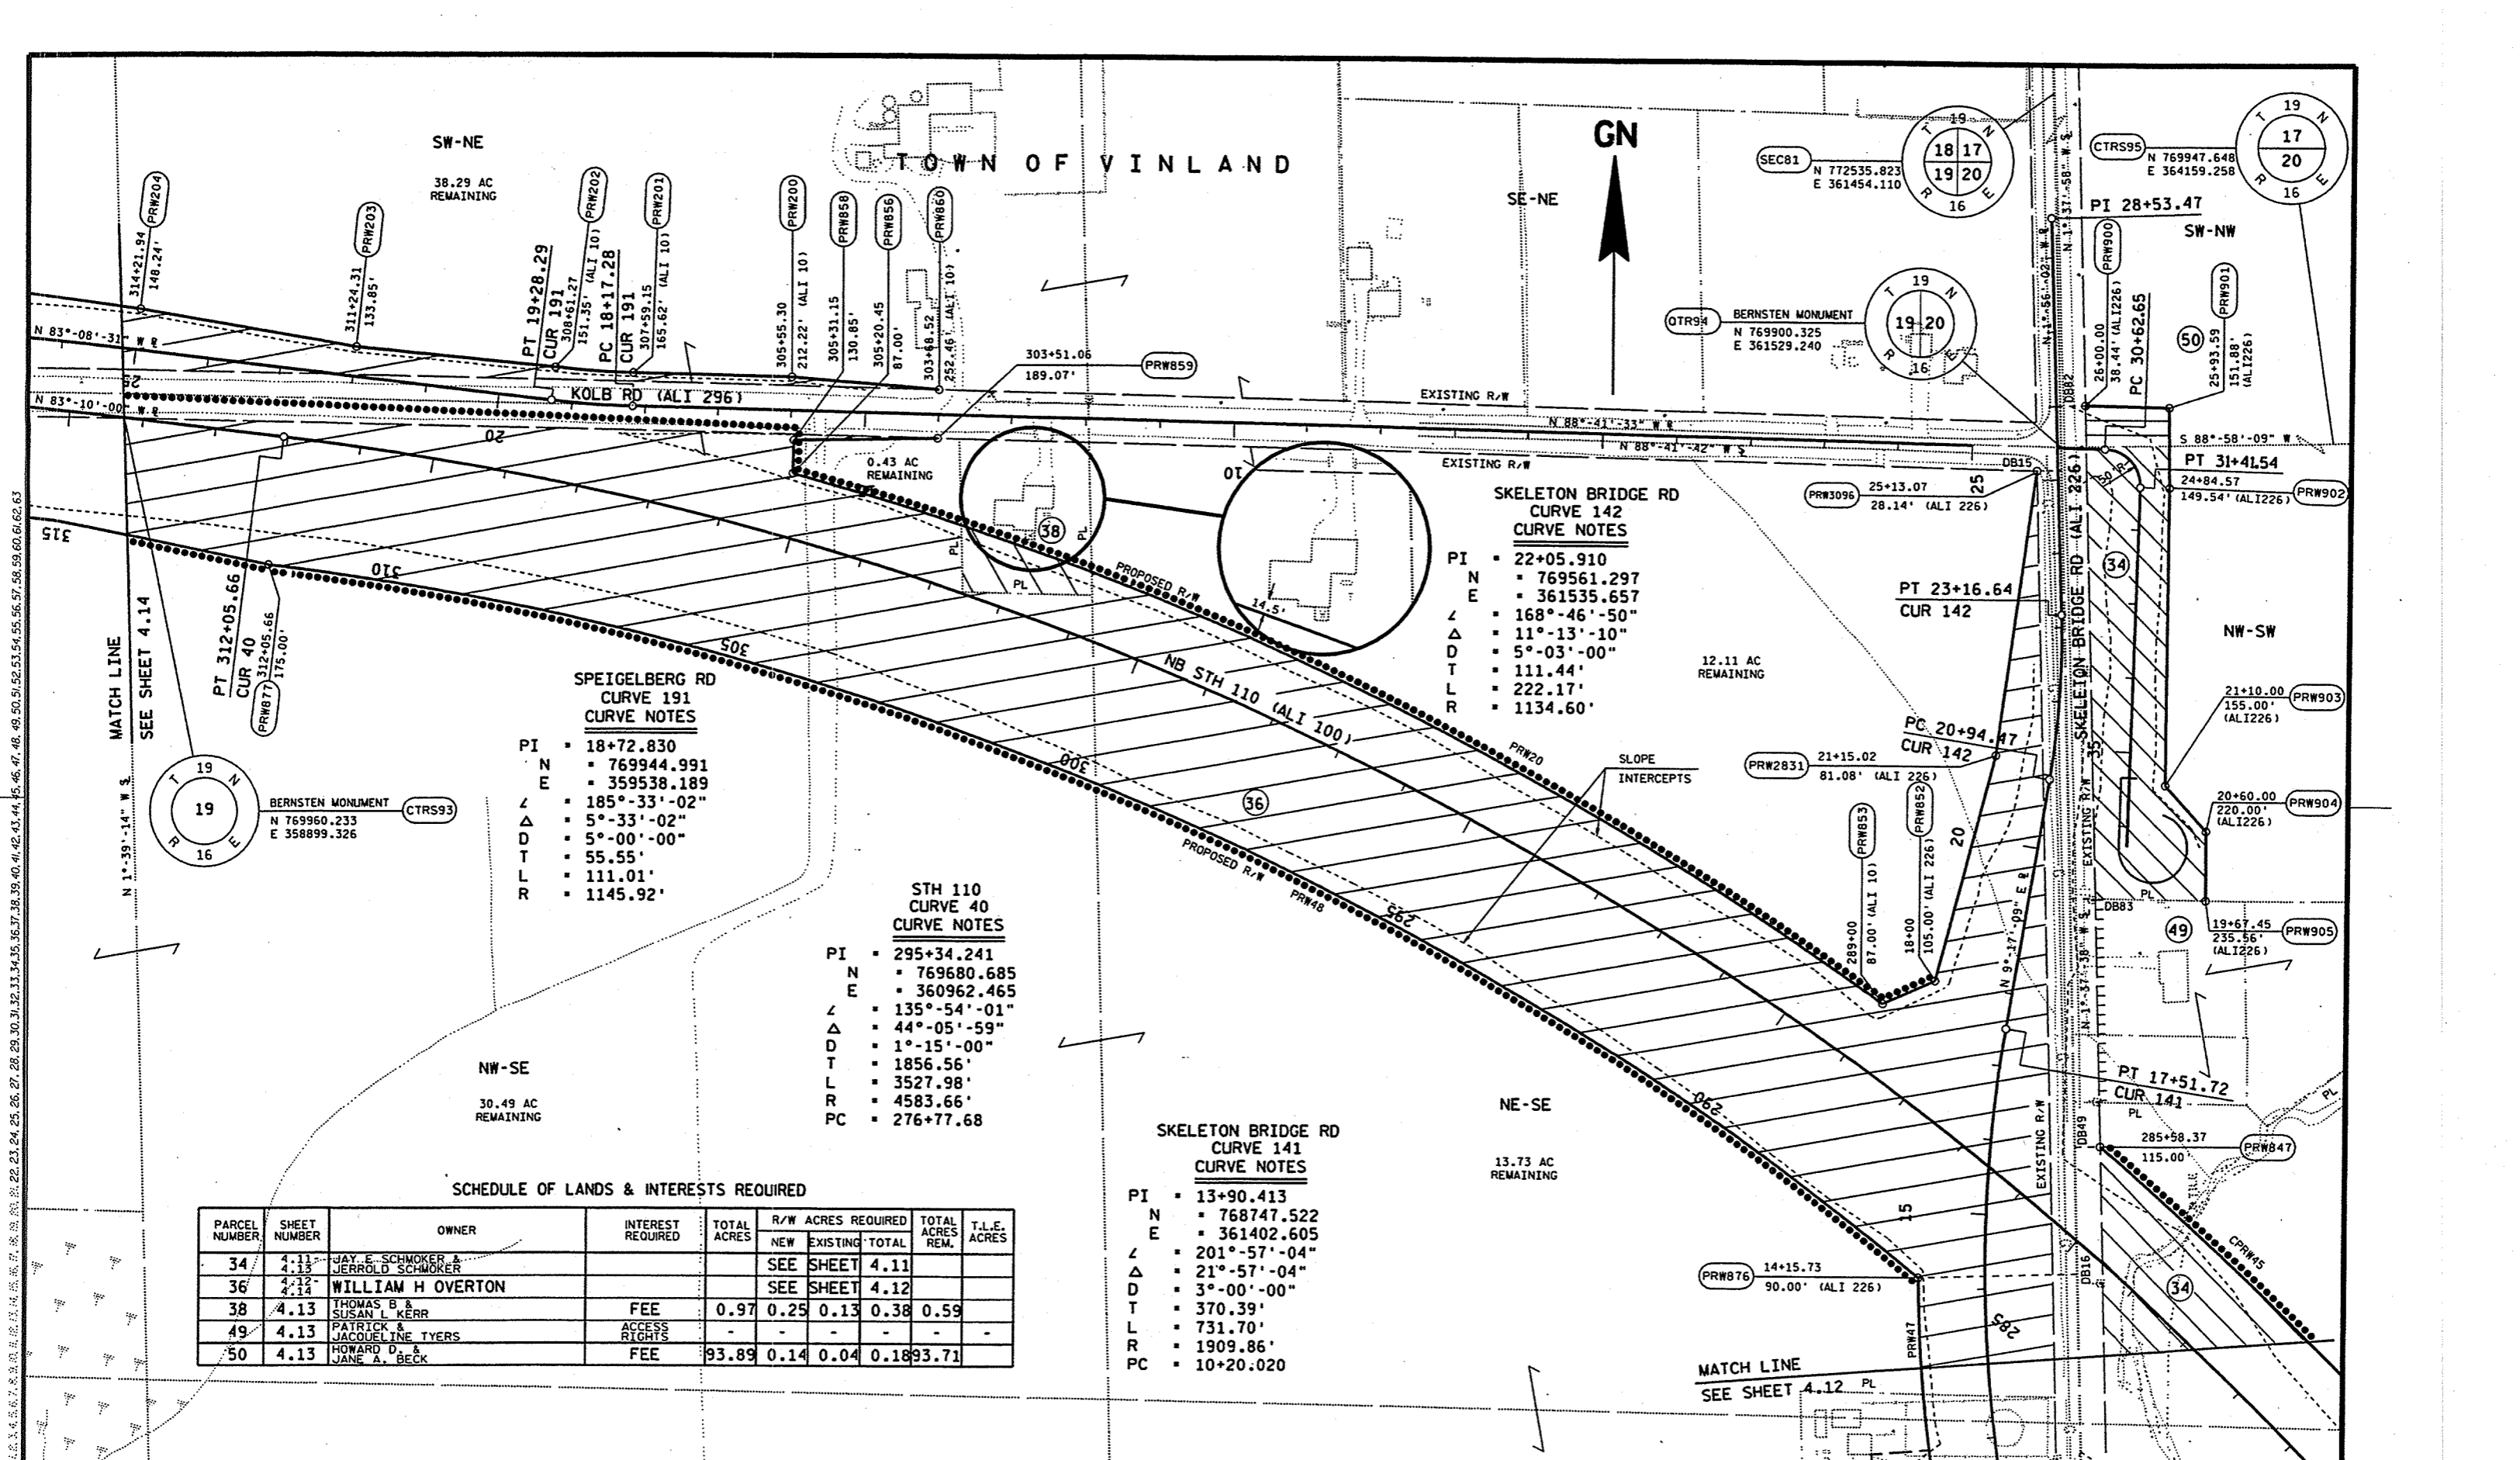

**SPEIGELBERG RD
CURVE 191
CURVE NOTES**

PI = 18+72.830
 N = 769944.991
 E = 359538.189
 L = 185°-33'-02"
 Δ = 5°-33'-02"
 D = 5°-00'-00"
 T = 55.55'
 L = 111.01'
 R = 1145.92'

**STH 110
CURVE 40
CURVE NOTES**

PI = 295+34.241
 N = 769680.685
 E = 360962.465
 L = 135°-54'-01"
 Δ = 44°-05'-59"
 D = 1°-15'-00"
 T = 1856.56'
 L = 3527.98'
 R = 4583.66'
 PC = 276+77.68

**SKELETON BRIDGE RD
CURVE 142
CURVE NOTES**

PI = 22+05.910
 N = 769561.297
 E = 361535.657
 L = 168°-46'-50"
 Δ = 11°-13'-10"
 D = 5°-03'-00"
 T = 111.44'
 L = 222.17'
 R = 1134.60'


**SKELETON BRIDGE RD
CURVE 141
CURVE NOTES**

PI = 13+90.413
 N = 768747.522
 E = 361402.605
 L = 201°-57'-04"
 Δ = 21°-57'-04"
 D = 3°-00'-00"
 T = 370.39'
 L = 731.70'
 R = 1909.86'
 PC = 10+20.020

SCHEDULE OF LANDS & INTERESTS REQUIRED

PARCEL NUMBER	SHEET NUMBER	OWNER	INTEREST REQUIRED	TOTAL ACRES	R/W ACRES REQUIRED			TOTAL ACRES REM.	T.L.E. ACRES
					NEW	EXISTING	TOTAL		
34	4.11	JAY E. SCHMOKER & JERROLD SCHMOKER			SEE SHEET 4.11				
36	4.12	WILLIAM H OVERTON			SEE SHEET 4.12				
38	4.13	THOMAS B & SUSAN L KERR	FEE	0.97	0.25	0.13	0.38	0.59	
49	4.13	PATRICK & JACQUELINE TYERS	ACCESS RIGHTS	-	-	-	-	-	
50	4.13	HOWARD D & JANE A. BECK	FEE	93.89	0.14	0.04	0.18	93.71	

REVISION DATE 09-11-01NC	DATE: 11-17-95	SCALE, FEET 0 100 200	HWY: STH 110	CONSTRUCTION PROJECT NUMBER: 6200-05-71	PS&E SHEET NO: 4.20
GRID FACTOR: 0.999997			COUNTY: WINNEBAGO	STATE R/W PROJECT NUMBER: 6200-05-21	PLAT SHEET NO: 4.13

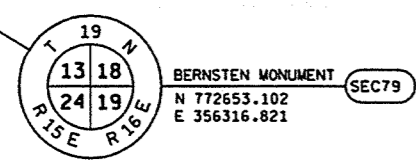


BERNSTEN MONUMENT
N 772653.102
E 356316.821

FRACTIONAL NW-NW

SCHEDULE OF LANDS & INTERESTS REQUIRED NE-NW

PARCEL NUMBER	SHEET NUMBER	OWNER	INTEREST REQUIRED	TOTAL ACRES	R/W ACRES REQUIRED			TOTAL ACRES REM.	T.L.E. ACRES
					NEW	EXISTING	TOTAL		
36	4.12-4.14	WILLIAM H OVERTON			SEE SHEET	4.12			
39	4.14	NICHOLAS W & JEAN A KOLB	FEE	75.57	12.43	1.90	14.33	61.24	
46	4.14	WINNECONNE-BUTTE DES MORTS JOINT COMMISSION	FEE	21.09	1.28	0.91	2.19	18.90	-
64	4.6.4.14	WISCONSIN PUBLIC SERVICE (DISTRIBUTION) (49)	RELEASE OF RIGHTS						

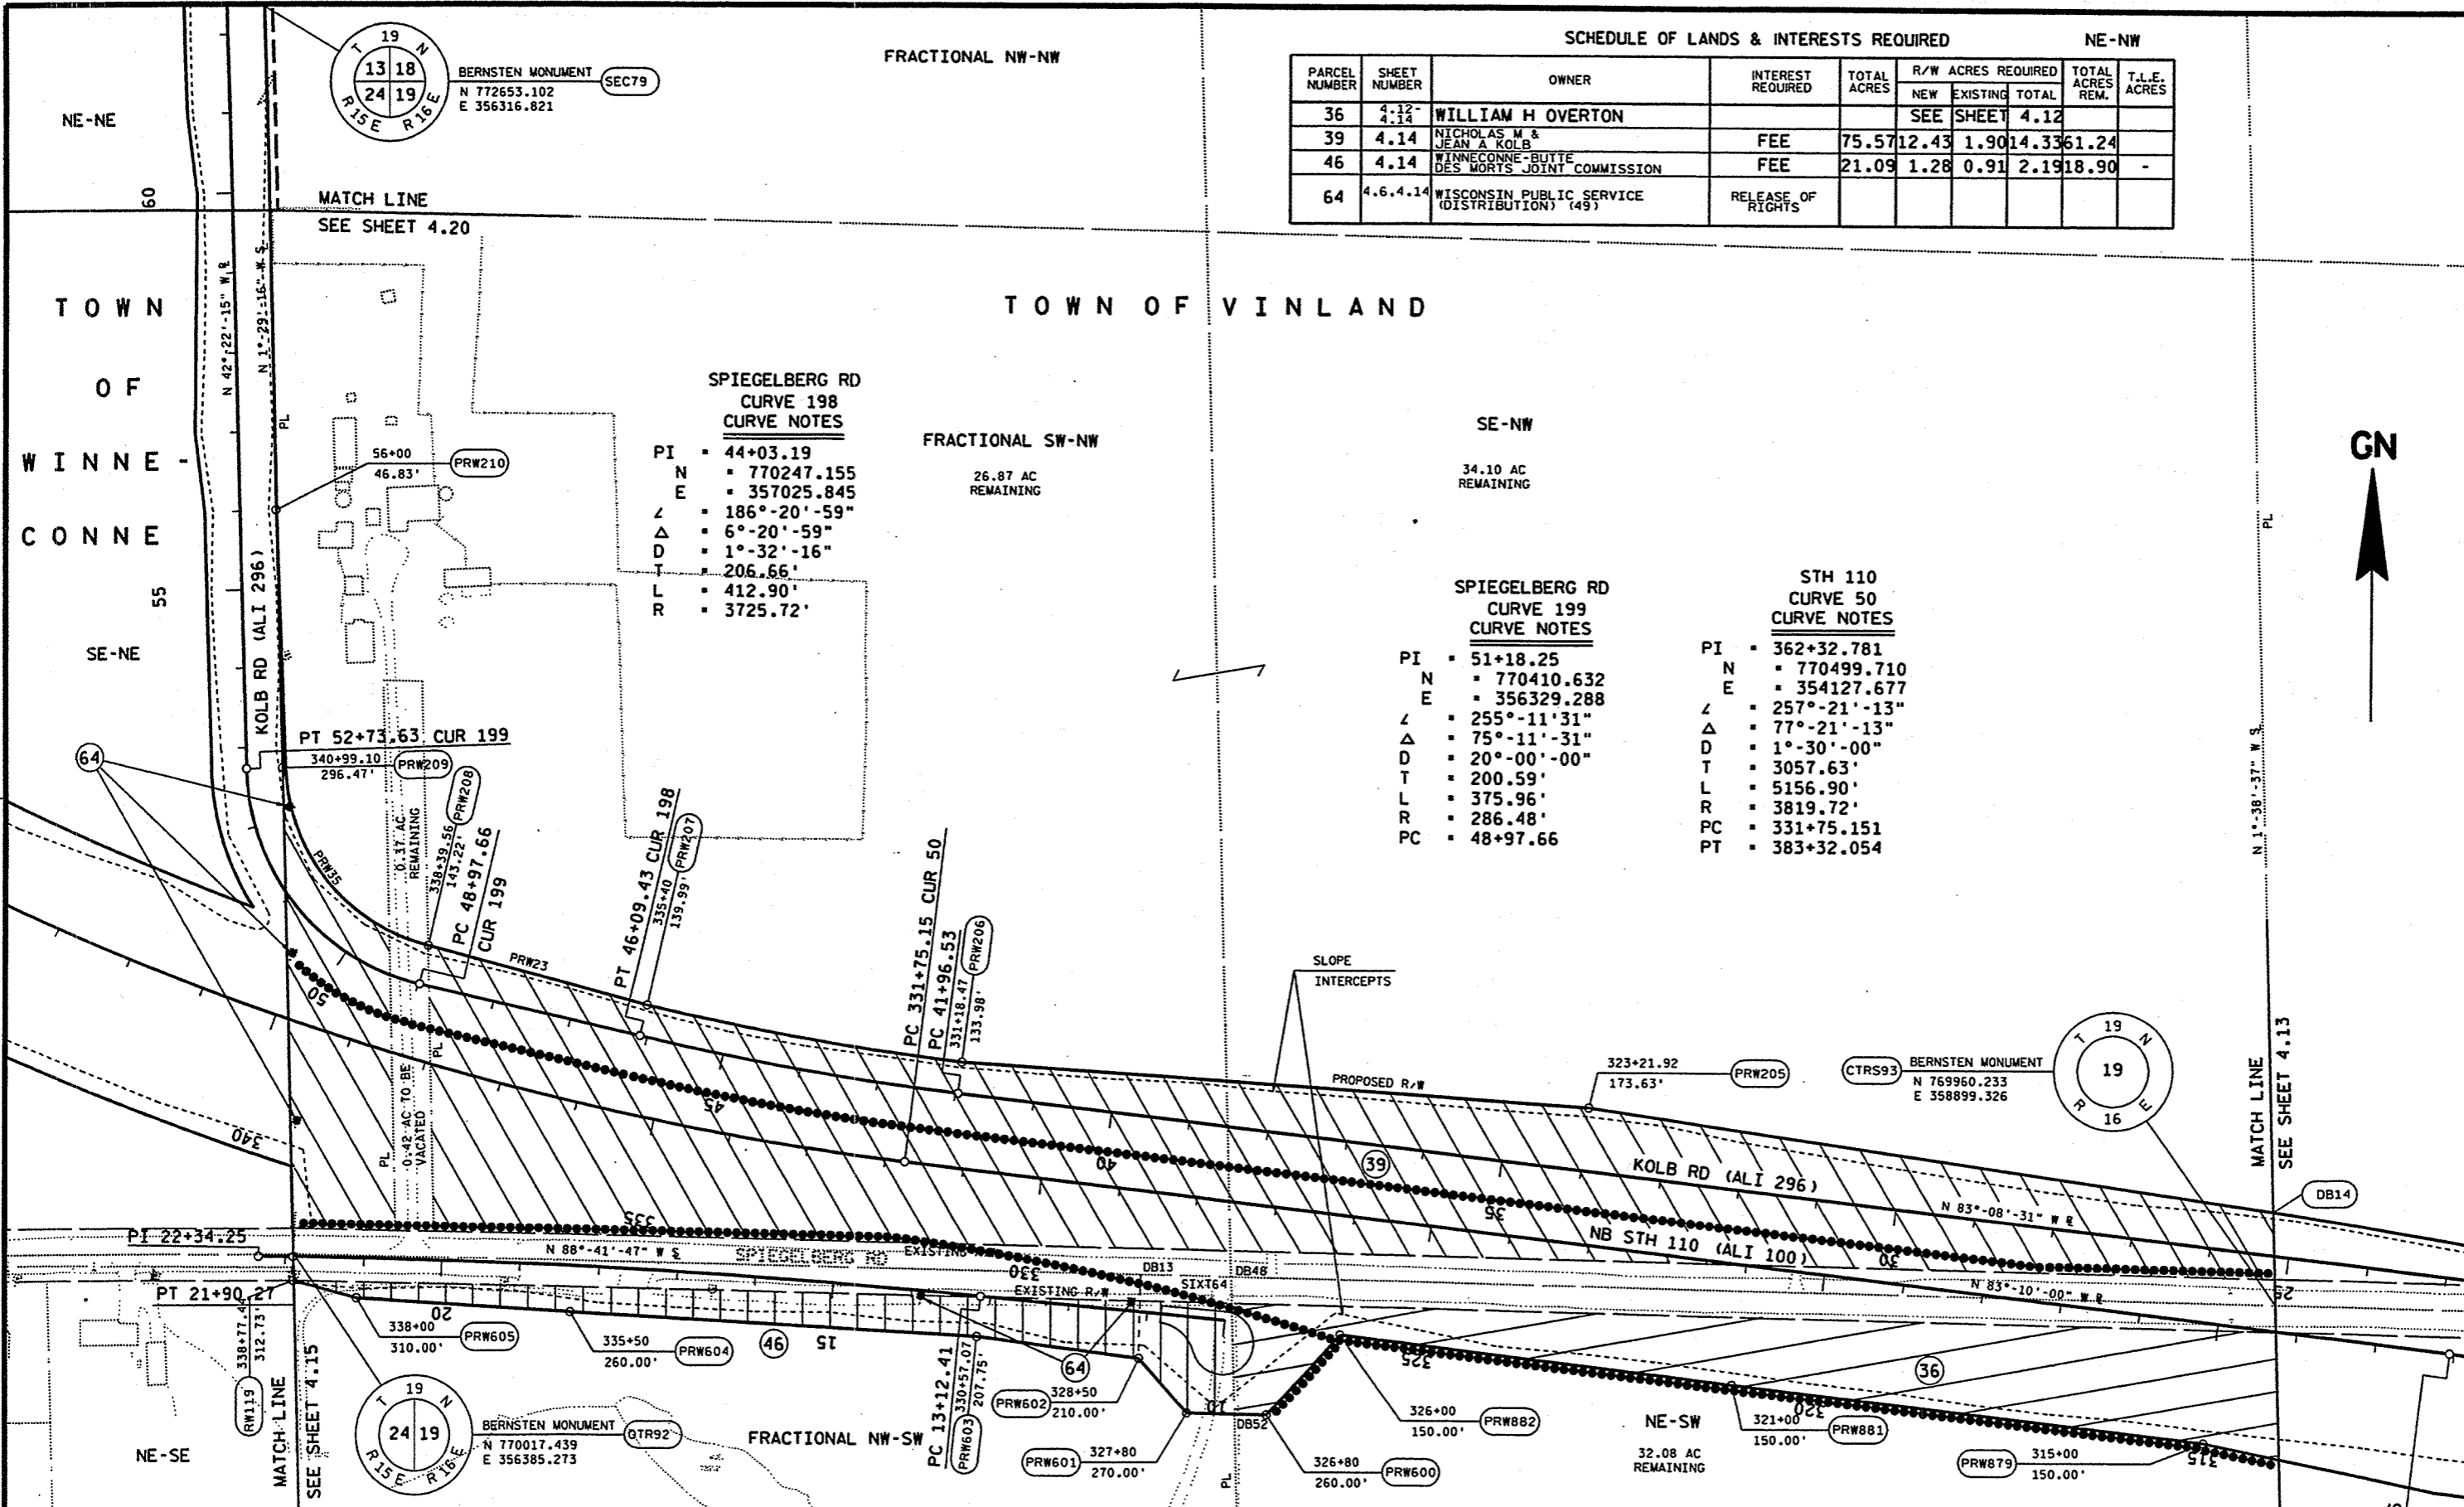

SPIEGELBERG RD
CURVE 198
CURVE NOTES
PI = 44+03.19
N = 770247.155
E = 357025.845
∠ = 186°-20'-59"
Δ = 6°-20'-59"
D = 1°-32'-16"
T = 206.66'
L = 412.90'
R = 3725.72'

FRACTIONAL SW-NW
26.87 AC
REMAINING


SE-NW
34.10 AC
REMAINING

SPIEGELBERG RD
CURVE 199
CURVE NOTES
PI = 51+18.25
N = 770410.632
E = 356329.288
∠ = 255°-11'-31"
Δ = 75°-11'-31"
D = 20°-00'-00"
T = 200.59'
L = 375.96'
R = 286.48'
PC = 48+97.66

STH 110
CURVE 50
CURVE NOTES
PI = 362+32.781
N = 770499.710
E = 354127.677
∠ = 257°-21'-13"
Δ = 77°-21'-13"
D = 1°-30'-00"
T = 3057.63'
L = 5156.90'
R = 3819.72'
PC = 331+75.151
PT = 383+32.054



LEVELS ON 1.2, 2.3, 3.4, 4.5, 5.6, 6.7, 7.8, 8.9, 9.0, 10.1, 11.2, 12.3, 13.4, 14.5, 15.6, 16.7, 17.8, 18.9, 19.0, 20.1, 21.2, 22.3, 23.4, 24.5, 25.6, 26.7, 27.8, 28.9, 29.0, 30.1, 31.2, 32.3, 33.4, 34.5, 35.6, 36.7, 37.8, 38.9, 39.0, 40.1, 41.2, 42.3, 43.4, 44.5, 45.6, 46.7, 47.8, 48.9, 49.0, 50.1, 51.2, 52.3, 53.4, 54.5, 55.6, 56.7, 57.8, 58.9, 59.0, 60.1, 61.2, 62.3, 63.4, 64.5, 65.6, 66.7, 67.8, 68.9, 69.0, 70.1, 71.2, 72.3, 73.4, 74.5, 75.6, 76.7, 77.8, 78.9, 79.0, 80.1, 81.2, 82.3, 83.4, 84.5, 85.6, 86.7, 87.8, 88.9, 89.0, 90.1, 91.2, 92.3, 93.4, 94.5, 95.6, 96.7, 97.8, 98.9, 99.0, 100.1, 101.2, 102.3, 103.4, 104.5, 105.6, 106.7, 107.8, 108.9, 109.0, 110.1, 111.2, 112.3, 113.4, 114.5, 115.6, 116.7, 117.8, 118.9, 119.0, 120.1, 121.2, 122.3, 123.4, 124.5, 125.6, 126.7, 127.8, 128.9, 129.0, 130.1, 131.2, 132.3, 133.4, 134.5, 135.6, 136.7, 137.8, 138.9, 139.0, 140.1, 141.2, 142.3, 143.4, 144.5, 145.6, 146.7, 147.8, 148.9, 149.0, 150.1, 151.2, 152.3, 153.4, 154.5, 155.6, 156.7, 157.8, 158.9, 159.0, 160.1, 161.2, 162.3, 163.4, 164.5, 165.6, 166.7, 167.8, 168.9, 169.0, 170.1, 171.2, 172.3, 173.4, 174.5, 175.6, 176.7, 177.8, 178.9, 179.0, 180.1, 181.2, 182.3, 183.4, 184.5, 185.6, 186.7, 187.8, 188.9, 189.0, 190.1, 191.2, 192.3, 193.4, 194.5, 195.6, 196.7, 197.8, 198.9, 199.0, 200.1, 201.2, 202.3, 203.4, 204.5, 205.6, 206.7, 207.8, 208.9, 209.0, 210.1, 211.2, 212.3, 213.4, 214.5, 215.6, 216.7, 217.8, 218.9, 219.0, 220.1, 221.2, 222.3, 223.4, 224.5, 225.6, 226.7, 227.8, 228.9, 229.0, 230.1, 231.2, 232.3, 233.4, 234.5, 235.6, 236.7, 237.8, 238.9, 239.0, 240.1, 241.2, 242.3, 243.4, 244.5, 245.6, 246.7, 247.8, 248.9, 249.0, 250.1, 251.2, 252.3, 253.4, 254.5, 255.6, 256.7, 257.8, 258.9, 259.0, 260.1, 261.2, 262.3, 263.4, 264.5, 265.6, 266.7, 267.8, 268.9, 269.0, 270.1, 271.2, 272.3, 273.4, 274.5, 275.6, 276.7, 277.8, 278.9, 279.0, 280.1, 281.2, 282.3, 283.4, 284.5, 285.6, 286.7, 287.8, 288.9, 289.0, 290.1, 291.2, 292.3, 293.4, 294.5, 295.6, 296.7, 297.8, 298.9, 299.0, 300.1, 301.2, 302.3, 303.4, 304.5, 305.6, 306.7, 307.8, 308.9, 309.0, 310.1, 311.2, 312.3, 313.4, 314.5, 315.6, 316.7, 317.8, 318.9, 319.0, 320.1, 321.2, 322.3, 323.4, 324.5, 325.6, 326.7, 327.8, 328.9, 329.0, 330.1, 331.2, 332.3, 333.4, 334.5, 335.6, 336.7, 337.8, 338.9, 339.0, 340.1, 341.2, 342.3, 343.4, 344.5, 345.6, 346.7, 347.8, 348.9, 349.0, 350.1, 351.2, 352.3, 353.4, 354.5, 355.6, 356.7, 357.8, 358.9, 359.0, 360.1, 361.2, 362.3, 363.4, 364.5, 365.6, 366.7, 367.8, 368.9, 369.0, 370.1, 371.2, 372.3, 373.4, 374.5, 375.6, 376.7, 377.8, 378.9, 379.0, 380.1, 381.2, 382.3, 383.4, 384.5, 385.6, 386.7, 387.8, 388.9, 389.0, 390.1, 391.2, 392.3, 393.4, 394.5, 395.6, 396.7, 397.8, 398.9, 399.0, 400.1, 401.2, 402.3, 403.4, 404.5, 405.6, 406.7, 407.8, 408.9, 409.0, 410.1, 411.2, 412.3, 413.4, 414.5, 415.6, 416.7, 417.8, 418.9, 419.0, 420.1, 421.2, 422.3, 423.4, 424.5, 425.6, 426.7, 427.8, 428.9, 429.0, 430.1, 431.2, 432.3, 433.4, 434.5, 435.6, 436.7, 437.8, 438.9, 439.0, 440.1, 441.2, 442.3, 443.4, 444.5, 445.6, 446.7, 447.8, 448.9, 449.0, 450.1, 451.2, 452.3, 453.4, 454.5, 455.6, 456.7, 457.8, 458.9, 459.0, 460.1, 461.2, 462.3, 463.4, 464.5, 465.6, 466.7, 467.8, 468.9, 469.0, 470.1, 471.2, 472.3, 473.4, 474.5, 475.6, 476.7, 477.8, 478.9, 479.0, 480.1, 481.2, 482.3, 483.4, 484.5, 485.6, 486.7, 487.8, 488.9, 489.0, 490.1, 491.2, 492.3, 493.4, 494.5, 495.6, 496.7, 497.8, 498.9, 499.0, 500.1, 501.2, 502.3, 503.4, 504.5, 505.6, 506.7, 507.8, 508.9, 509.0, 510.1, 511.2, 512.3, 513.4, 514.5, 515.6, 516.7, 517.8, 518.9, 519.0, 520.1, 521.2, 522.3, 523.4, 524.5, 525.6, 526.7, 527.8, 528.9, 529.0, 530.1, 531.2, 532.3, 533.4, 534.5, 535.6, 536.7, 537.8, 538.9, 539.0, 540.1, 541.2, 542.3, 543.4, 544.5, 545.6, 546.7, 547.8, 548.9, 549.0, 550.1, 551.2, 552.3, 553.4, 554.5, 555.6, 556.7, 557.8, 558.9, 559.0, 560.1, 561.2, 562.3, 563.4, 564.5, 565.6, 566.7, 567.8, 568.9, 569.0, 570.1, 571.2, 572.3, 573.4, 574.5, 575.6, 576.7, 577.8, 578.9, 579.0, 580.1, 581.2, 582.3, 583.4, 584.5, 585.6, 586.7, 587.8, 588.9, 589.0, 590.1, 591.2, 592.3, 593.4, 594.5, 595.6, 596.7, 597.8, 598.9, 599.0, 600.1, 601.2, 602.3, 603.4, 604.5, 605.6, 606.7, 607.8, 608.9, 609.0, 610.1, 611.2, 612.3, 613.4, 614.5, 615.6, 616.7, 617.8, 618.9, 619.0, 620.1, 621.2, 622.3, 623.4, 624.5, 625.6, 626.7, 627.8, 628.9, 629.0, 630.1, 631.2, 632.3, 633.4, 634.5, 635.6, 636.7, 637.8, 638.9, 639.0, 640.1, 641.2, 642.3, 643.4, 644.5, 645.6, 646.7, 647.8, 648.9, 649.0, 650.1, 651.2, 652.3, 653.4, 654.5, 655.6, 656.7, 657.8, 658.9, 659.0, 660.1, 661.2, 662.3, 663.4, 664.5, 665.6, 666.7, 667.8, 668.9, 669.0, 670.1, 671.2, 672.3, 673.4, 674.5, 675.6, 676.7, 677.8, 678.9, 679.0, 680.1, 681.2, 682.3, 683.4, 684.5, 685.6, 686.7, 687.8, 688.9, 689.0, 690.1, 691.2, 692.3, 693.4, 694.5, 695.6, 696.7, 697.8, 698.9, 699.0, 700.1, 701.2, 702.3, 703.4, 704.5, 705.6, 706.7, 707.8, 708.9, 709.0, 710.1, 711.2, 712.3, 713.4, 714.5, 715.6, 716.7, 717.8, 718.9, 719.0, 720.1, 721.2, 722.3, 723.4, 724.5, 725.6, 726.7, 727.8, 728.9, 729.0, 730.1, 731.2, 732.3, 733.4, 734.5, 735.6, 736.7, 737.8, 738.9, 739.0, 740.1, 741.2, 742.3, 743.4, 744.5, 745.6, 746.7, 747.8, 748.9, 749.0, 750.1, 751.2, 752.3, 753.4, 754.5, 755.6, 756.7, 757.8, 758.9, 759.0, 760.1, 761.2, 762.3, 763.4, 764.5, 765.6, 766.7, 767.8, 768.9, 769.0, 770.1, 771.2, 772.3, 773.4, 774.5, 775.6, 776.7, 777.8, 778.9, 779.0, 780.1, 781.2, 782.3, 783.4, 784.5, 785.6, 786.7, 787.8, 788.9, 789.0, 790.1, 791.2, 792.3, 793.4, 794.5, 795.6, 796.7, 797.8, 798.9, 799.0, 800.1, 801.2, 802.3, 803.4, 804.5, 805.6, 806.7, 807.8, 808.9, 809.0, 810.1, 811.2, 812.3, 813.4, 814.5, 815.6, 816.7, 817.8, 818.9, 819.0, 820.1, 821.2, 822.3, 823.4, 824.5, 825.6, 826.7, 827.8, 828.9, 829.0, 830.1, 831.2, 832.3, 833.4, 834.5, 835.6, 836.7, 837.8, 838.9, 839.0, 840.1, 841.2, 842.3, 843.4, 844.5, 845.6, 846.7, 847.8, 848.9, 849.0, 850.1, 851.2, 852.3, 853.4, 854.5, 855.6, 856.7, 857.8, 858.9, 859.0, 860.1, 861.2, 862.3, 863.4, 864.5, 865.6, 866.7, 867.8, 868.9, 869.0, 870.1, 871.2, 872.3, 873.4, 874.5, 875.6, 876.7, 877.8, 878.9, 879.0, 880.1, 881.2, 882.3, 883.4, 884.5, 885.6, 886.7, 887.8, 888.9, 889.0, 890.1, 891.2, 892.3, 893.4, 894.5, 895.6, 896.7, 897.8, 898.9, 899.0, 900.1, 901.2, 902.3, 903.4, 904.5, 905.6, 906.7, 907.8, 908.9, 909.0, 910.1, 911.2, 912.3, 913.4, 914.5, 915.6, 916.7, 917.8, 918.9, 919.0, 920.1, 921.2, 922.3, 923.4, 924.5, 925.6, 926.7, 927.8, 928.9, 929.0, 930.1, 931.2, 932.3, 933.4, 934.5, 935.6, 936.7, 937.8, 938.9, 939.0, 940.1, 941.2, 942.3, 943.4, 944.5, 945.6, 946.7, 947.8, 948.9, 949.0, 950.1, 951.2, 952.3, 953.4, 954.5, 955.6, 956.7, 957.8, 958.9, 959.0, 960.1, 961.2, 962.3, 963.4, 964.5, 965.6, 966.7, 967.8, 968.9, 969.0, 970.1, 971.2, 972.3, 973.4, 974.5, 975.6, 976.7, 977.8, 978.9, 979.0, 980.1, 981.2, 982.3, 983.4, 984.5, 985.6, 986.7, 987.8, 988.9, 989.0, 990.1, 991.2, 992.3, 993.4, 994.5, 995.6, 996.7, 997.8, 998.9, 999.0, 1000.1, 1001.2, 1002.3, 1003.4, 1004.5, 1005.6, 1006.7, 1007.8, 1008.9, 1009.0, 1010.1, 1011.2, 1012.3, 1013.4, 1014.5, 1015.6, 1016.7, 1017.8, 1018.9, 1019.0, 1020.1, 1021.2, 1022.3, 1023.4, 1024.5, 1025.6, 1026.7, 1027.8, 1028.9, 1029.0, 1030.1, 1031.2, 1032.3, 1033.4, 1034.5, 1035.6, 1036.7, 1037.8, 1038.9, 1039.0, 1040.1, 1041.2, 1042.3, 1043.4, 1044.5, 1045.6, 1046.7, 1047.8, 1048.9, 1049.0, 1050.1, 1051.2, 1052.3, 1053.4, 1054.5, 1055.6, 1056.7, 1057.8, 1058.9, 1059.0, 1060.1, 1061.2, 1062.3, 1063.4, 1064.5, 1065.6, 1066.7, 1067.8, 1068.9, 1069.0, 1070.1, 1071.2, 1072.3, 1073.4, 1074.5, 1075.6, 1076.7, 1077.8, 1078.9, 1079.0, 1080.1, 1081.2, 1082.3, 1083.4, 1084.5, 1085.6, 1086.7, 1087.8, 1088.9, 1089.0, 1090.1, 1091.2, 1092.3, 1093.4, 1094.5, 1095.6, 1096.7, 1097.8, 1098.9, 1099.0, 1100.1, 1101.2, 1102.3, 1103.4, 1104.5, 1105.6, 1106.7, 1107.8, 1108.9, 1109.0, 1110.1, 1111.2, 1112.3, 1113.4, 1114.5, 1115.6, 1116.7, 1117.8, 1118.9, 1119.0, 1120.1, 1121.2, 1122.3, 1123.4, 1124.5, 1125.6, 1126.7, 1127.8, 1128.9, 1129.0, 1130.1, 1131.2, 1132.3, 1133.4, 1134.5, 1135.6, 1136.7, 1137.8, 1138.9, 1139.0, 1140.1, 1141.2, 1142.3, 1143.4, 1144.5, 1145.6, 1146.7, 1147.8, 1148.9, 1149.0, 1150.1, 1151.2, 1152.3, 1153.4, 1154.5, 1155.6, 1156.7, 1157.8, 1158.9, 1159.0, 1160.1, 1161.2, 1162.3, 1163.4, 1164.5, 1165.6, 1166.7, 1167.8, 1168.9, 1169.0, 1170.1, 1171.2, 1172.3, 1173.4, 1174.5, 1175.6, 1176.7, 1177.8, 1178.9, 1179.0, 1180.1, 1181.2, 1182.3, 1183.4, 1184.5, 1185.6, 1186.7, 1187.8, 1188.9, 1189.0, 1190.1, 1191.2, 1192.3, 1193.4, 1194.5, 1195.6, 1196.7, 1197.8, 1198.9, 1199.0, 1200.1, 1201.2, 1202.3, 1203.4, 1204.5, 1205.6, 1206.7, 1207.8, 1208.9, 1209.0, 1210.1, 1211.2, 1212.3, 1213.4, 1214.5, 1215.6, 1216.7, 1217.8, 1218.9, 1219.0, 1220.1, 1221.2, 1222.3, 1223.4, 1224.5, 1225.6, 1226.7, 1227.8, 1228.9, 1229.0, 1230.1, 1231.2, 1232.3, 1233.4, 1234.5, 1235.6, 1236.7, 1237.8, 1238.9, 1239.0, 1240.1, 1241.2, 1242.3, 1243.4, 1244.5, 1245.6, 1246.7, 1247.8, 1248.9, 1249.0, 1250.1, 1251.2, 1252.3, 1253.4, 1254.5, 1255.6, 1256.7, 1257.8, 1258.9, 1259.0, 1260.1, 1261.2, 1262.3, 1263.4, 1264.5, 1265.6, 1266.7, 1267.8, 1268.9, 1269.0, 1270.1, 1271.2, 1272.3, 1273.4, 1274.5, 1275.6, 1276.7, 1277.8, 1278.9, 1279.0, 1280.1, 1281.2, 1282.3, 1283.4, 1284.5, 1285.6, 1286.7, 1287.8, 1288.9, 1289.0, 1290.1, 1291.2, 1292.3, 1293.4, 1294.5, 1295.6, 1296.7, 1297.8, 1298.9, 1299.0, 1300.1, 1301.2, 1302.3, 1303.4, 1304.5, 1305.6, 1306.7, 1307.8, 1308.9, 1309.0, 1310.1, 1311.2, 1312.3, 1313.4, 1314.5, 1315.6, 1316.7, 1317.8, 1318.9, 1319.0, 1320.1, 1321.2, 1322.3, 1323.4, 1324.5, 1325.6, 1326.7, 1327.8, 1328.9, 1329.0, 1330.1, 1331.2, 1332.3, 1333.4, 1334.5, 1335.6, 1336.7, 1337.8, 1338.9, 1339.0, 1340.1, 1341.2, 1342.3, 1343.4, 1344.5, 1345.6, 1346.7, 1347.8, 1348.9, 1349.0, 1350.1, 1351.2, 1352.3, 1353.4, 1354.5, 1355.6, 1356.7, 1357.8, 1358.9, 1359.0, 1360.1, 1361.2, 1362.3, 1363.4, 1364.5, 1365.6, 1366.7, 1367.8, 1368.9, 1369.0, 1370.1, 1371.2, 1372.3, 1373.4, 1374.5, 1375.6, 1376.7, 1377.8, 1378.9, 1379.0, 1380.1, 1381.2, 1382.3, 1383.4, 1384.5, 1385.6, 1386.7, 1387.8, 1388.9, 1389.0, 1390.1, 1391.2, 1392.3, 1393.4, 1394.5, 1395.6, 1396.7, 1397.8, 1398.9, 1399.0, 1400.1, 1401.2, 1402.3, 1403.4, 1404.5, 1405.6, 1406.7, 1407.8, 1408.9, 1409.0, 1410.1, 1411.2, 1412.3, 1413.4, 1414.5, 1415.6, 1416.7, 1417.8, 1418.9, 1419.0, 1420.1, 1421.2, 1422.3, 1423.4, 1424.5, 1425.6, 1426.7, 1427.8, 1428.9, 1429.0, 1430.1, 1431.2, 1432.3, 1433.4, 1434.5, 1435.6, 1436.7, 1437.8, 1438.9, 1439.0, 1440.1, 1441.2, 1442.3, 1443.4, 1444.5, 1445.6, 1446.7, 1447.8, 1448.9, 1449.0, 1450.1, 1451.2, 1452.3, 1453.4, 1454.5, 1455.6, 1456.7, 1457.8, 1458.9, 1459.0, 1460.1, 1461.2, 1462.3, 1463.4, 1464.5, 1465.6, 1466.7, 1467.8, 1468.9, 1469.0, 1470.1, 1471.2, 1472.3, 147

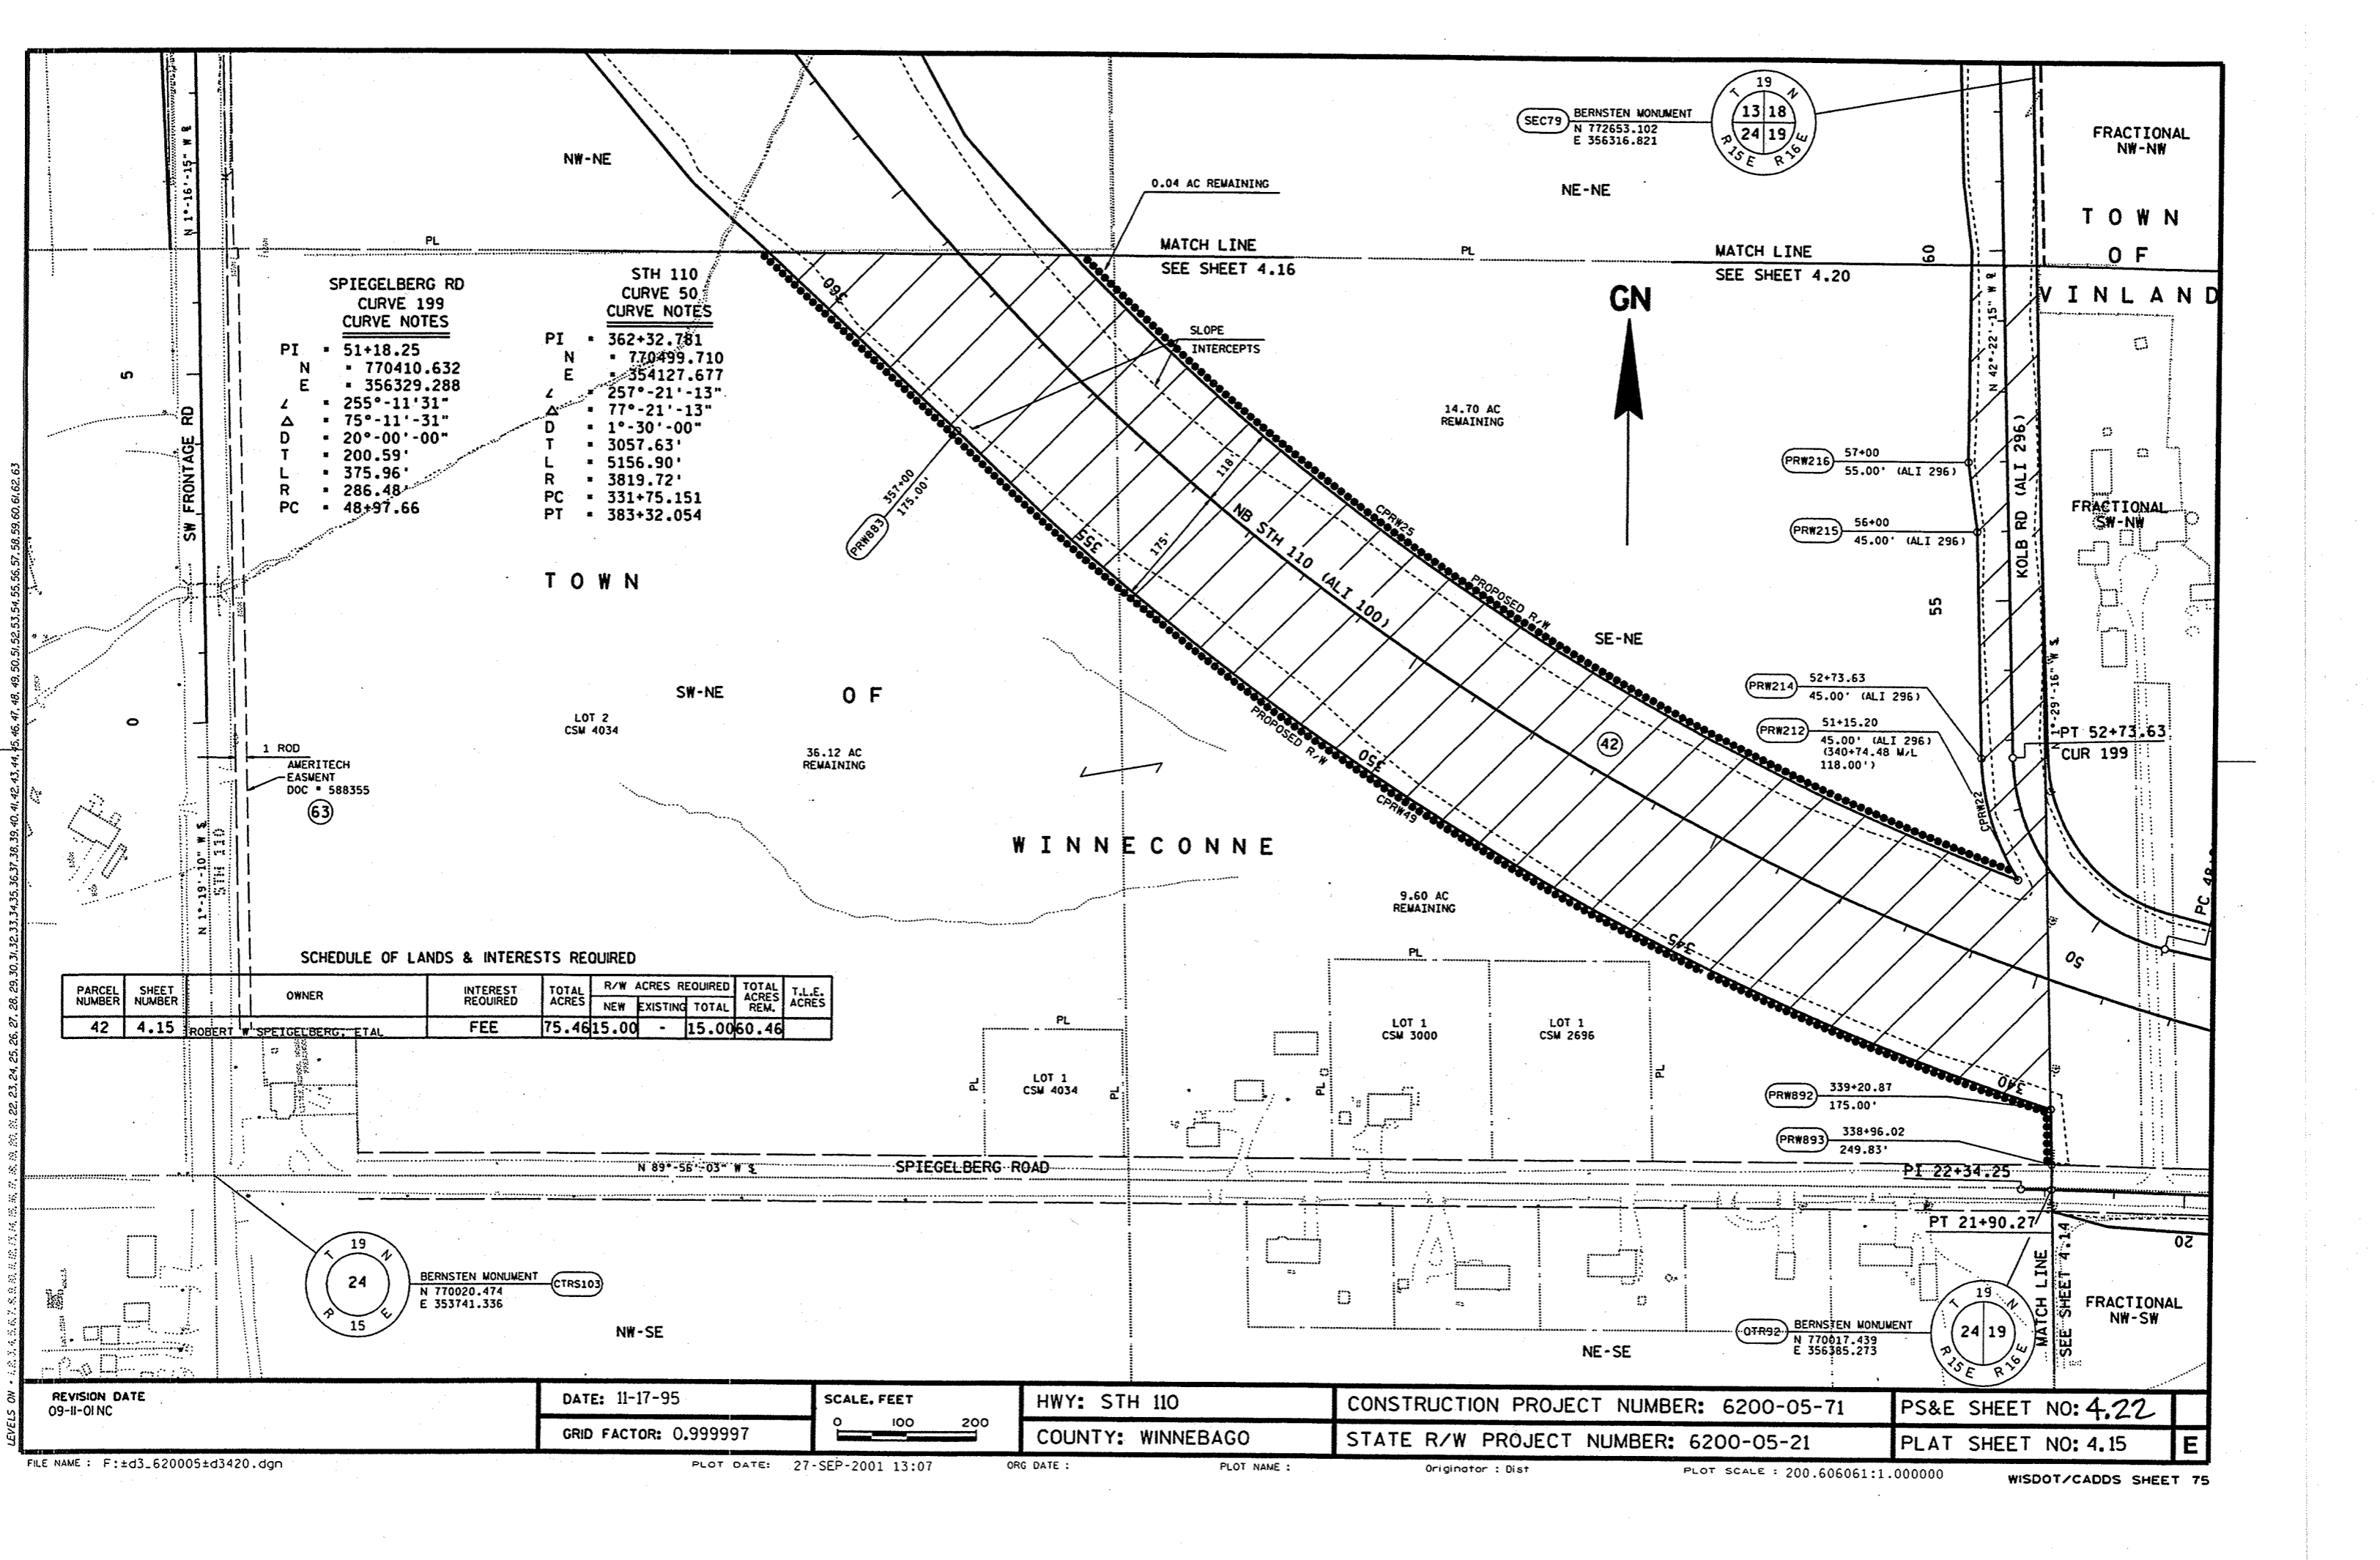

**SPIEGELBERG RD
CURVE 199
CURVE NOTES**

PI ▪ 51+18.25
N ▪ 770410.632
E ▪ 356329.288
L ▪ 255°-11'-31"
Δ ▪ 75°-11'-31"
D ▪ 20°-00'-00"
T ▪ 200.59'
L ▪ 375.96'
R ▪ 286.48'
PC ▪ 48+97.66

**STH 110
CURVE 50
CURVE NOTES**


PI ▪ 362+32.781
N ▪ 770499.710
E ▪ 354127.677
L ▪ 257°-21'-13"
Δ ▪ 77°-21'-13"
D ▪ 1°-30'-00"
T ▪ 3057.63'
L ▪ 5156.90'
R ▪ 3819.72'
PC ▪ 331+75.151
PT ▪ 383+32.054

SCHEDULE OF LANDS & INTERESTS REQUIRED

PARCEL NUMBER	SHEET NUMBER	OWNER	INTEREST REQUIRED	TOTAL ACRES	R/W ACRES REQUIRED			TOTAL ACRES REM.	T.L.E. ACRES
					NEW	EXISTING	TOTAL		
42	4.15	ROBERT W. SPIEGELBERG, ETAL	FEE	75.46	15.00	-	15.00	60.46	

LEVELS ON 1. 2. 3. 62. 63

REVISION DATE 09-11-01-NC	DATE: 11-17-95	SCALE, FEET 0 100 200	HWY: STH 110	CONSTRUCTION PROJECT NUMBER: 6200-05-71	PS&E SHEET NO: 4.22
	GRID FACTOR: 0.999997		COUNTY: WINNEBAGO	STATE R/W PROJECT NUMBER: 6200-05-21	PLAT SHEET NO: 4.15

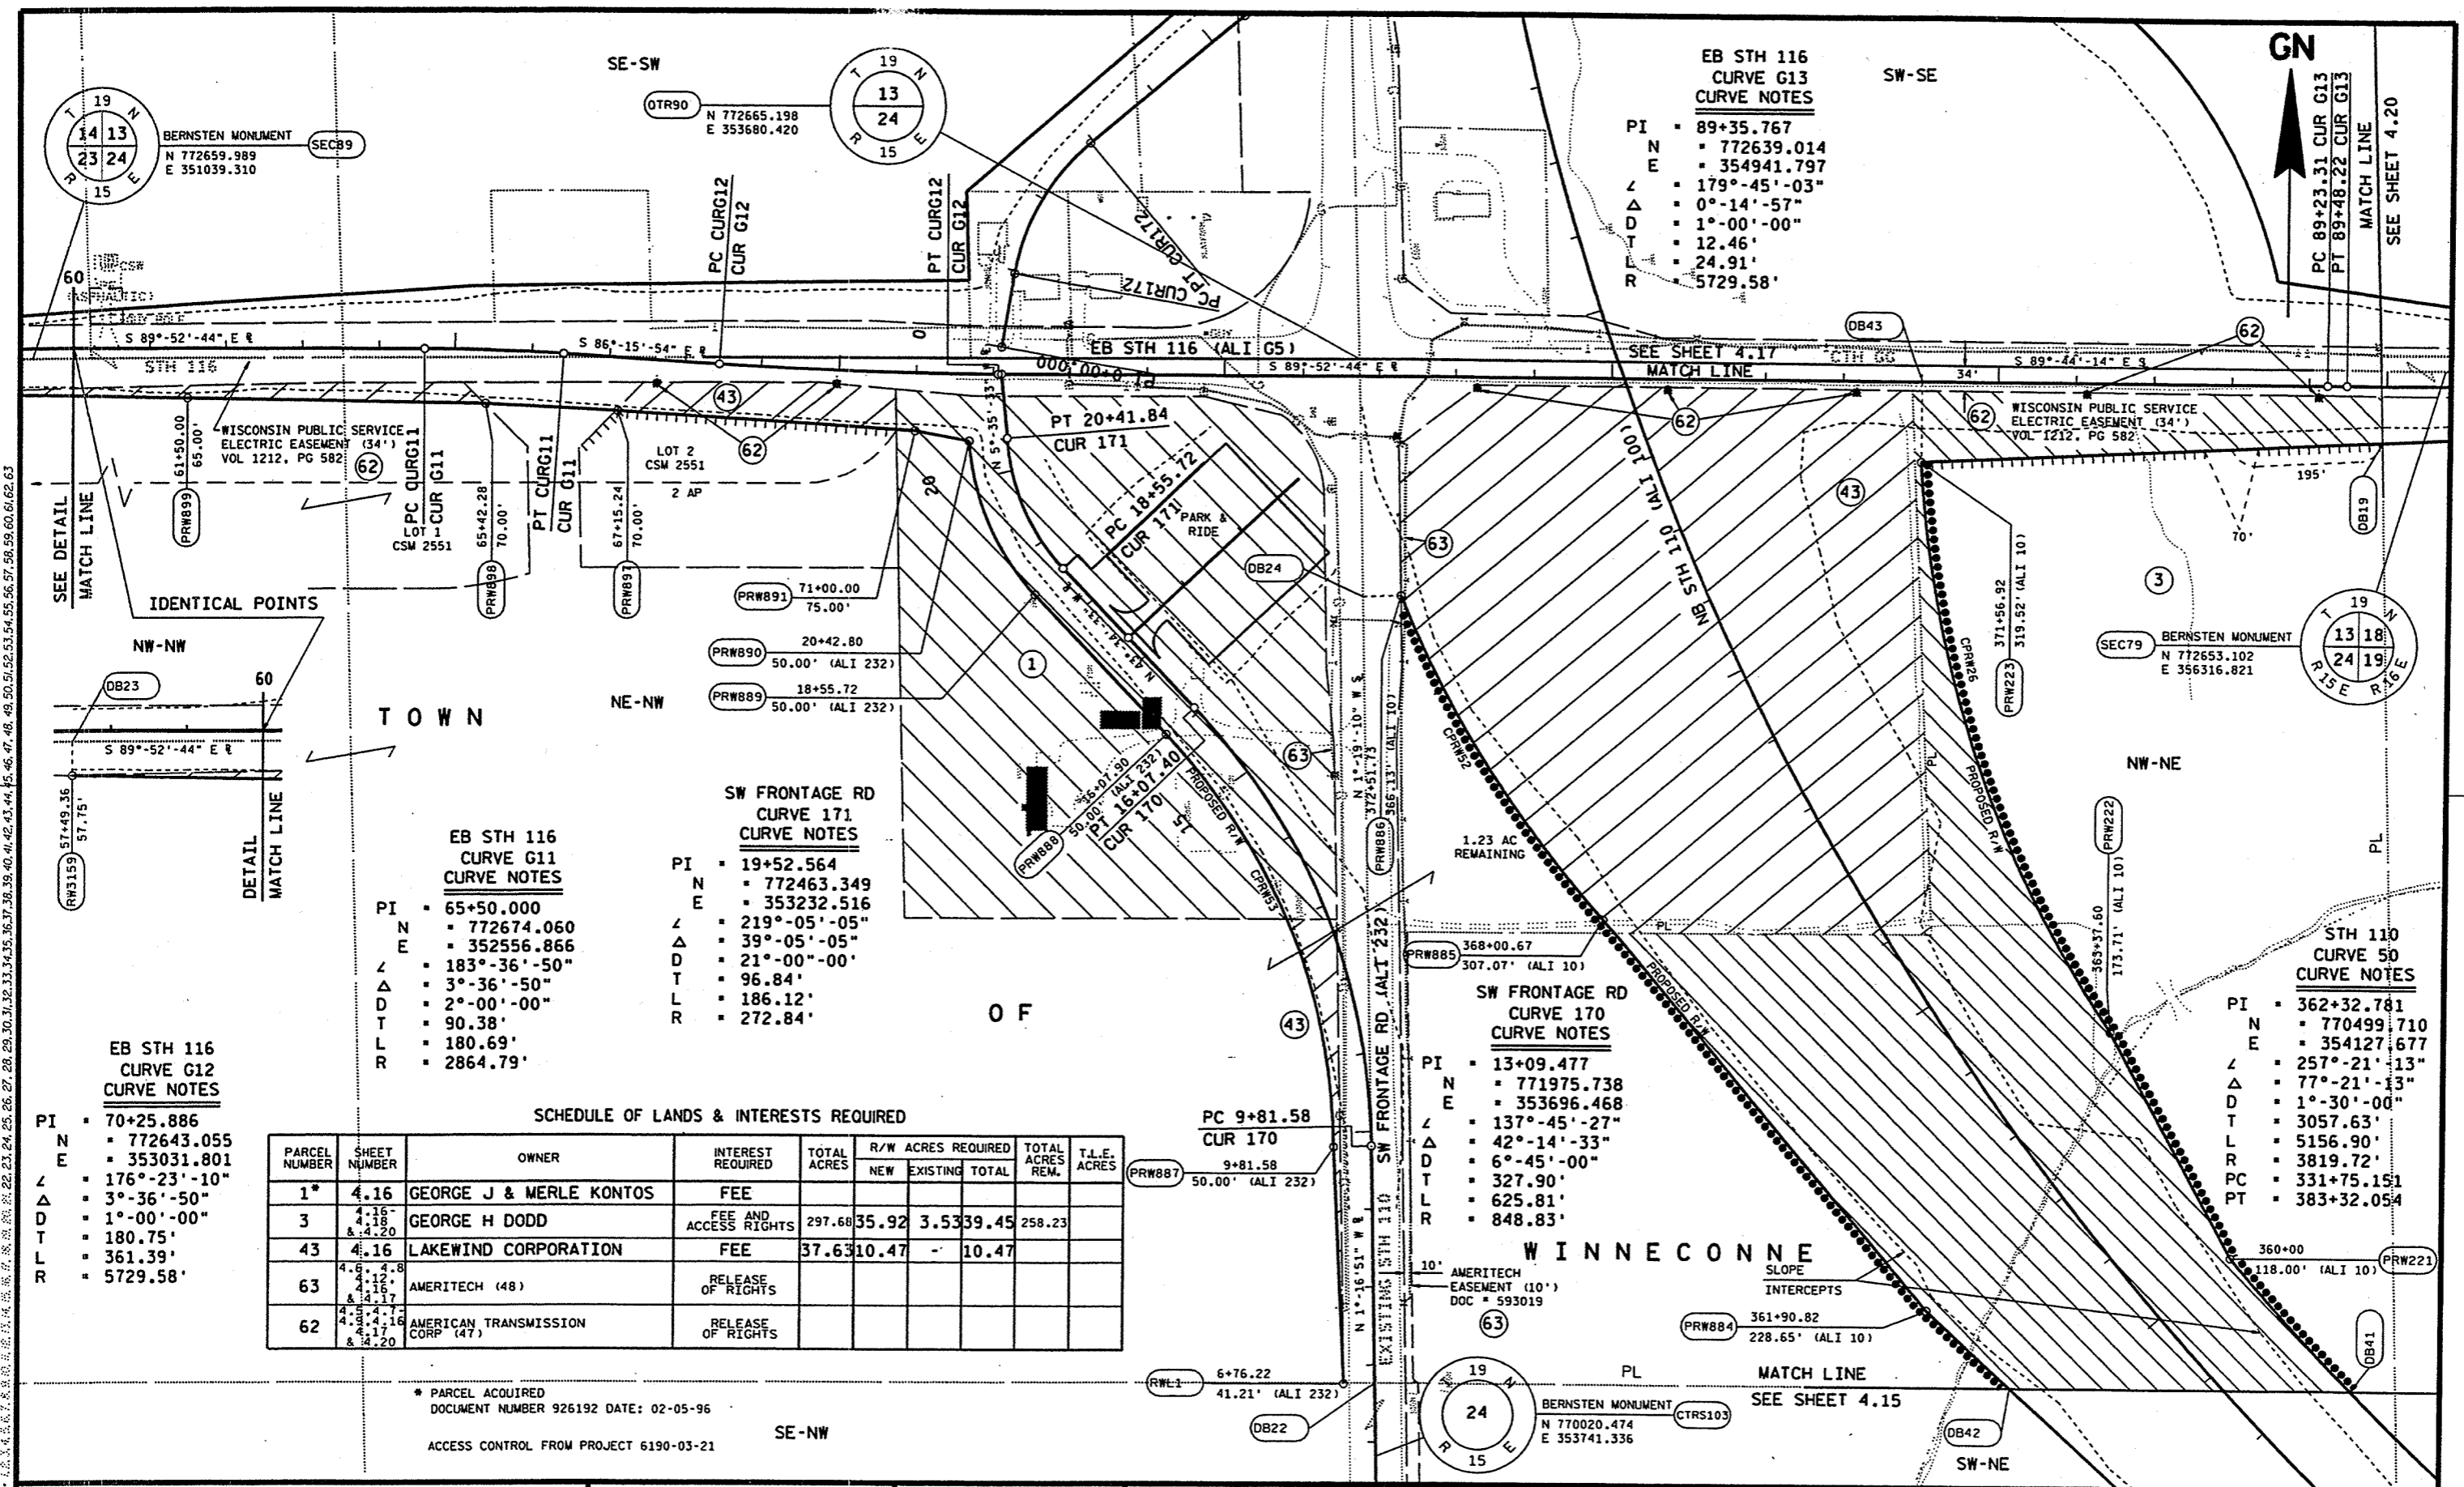

**EB STH 116
CURVE G11
CURVE NOTES**

PI = 65+50.000
 N = 772674.060
 E = 352556.866
 Δ = 183°-36'-50"
 Δ = 3°-36'-50"
 D = 2°-00'-00"
 T = 90.38'
 L = 180.69'
 R = 2864.79'

**SW FRONTAGE RD
CURVE 171
CURVE NOTES**

PI = 19+52.564
 N = 772463.349
 E = 353232.516
 Δ = 219°-05'-05"
 Δ = 39°-05'-05"
 D = 21°-00'-00"
 T = 96.84'
 L = 186.12'
 R = 272.84'

**SW FRONTAGE RD
CURVE 170
CURVE NOTES**

PI = 13+09.477
 N = 771975.738
 E = 353696.468
 Δ = 137°-45'-27"
 Δ = 42°-14'-33"
 D = 6°-45'-00"
 T = 327.90'
 L = 625.81'
 R = 848.83'

**STH 110
CURVE 50
CURVE NOTES**

PI = 362+32.781
 N = 770499.710
 E = 354127.677
 Δ = 257°-21'-13"
 Δ = 77°-21'-13"
 D = 1°-30'-00"
 T = 3057.63'
 L = 5156.90'
 R = 3819.72'
 PC = 331+75.151
 PT = 383+32.054

SCHEDULE OF LANDS & INTERESTS REQUIRED

PARCEL NUMBER	SHEET NUMBER	OWNER	INTEREST REQUIRED	TOTAL ACRES	R/W ACRES REQUIRED			TOTAL ACRES REM.	T.L.E. ACRES
					NEW	EXISTING	TOTAL		
1*	4.16	GEORGE J & MERLE KONTOS	FEE						
3	4.16	GEORGE H DODD	FEE AND ACCESS RIGHTS	297.68	35.92	3.53	39.45	258.23	
43	4.16	LAKEWIND CORPORATION	FEE	37.63	10.47	-	10.47		
63	4.16	AMERITECH (48)	RELEASE OF RIGHTS						
62	4.16	AMERICAN TRANSMISSION CORP (47)	RELEASE OF RIGHTS						

* PARCEL ACQUIRED
 DOCUMENT NUMBER 926192 DATE: 02-05-95
 ACCESS CONTROL FROM PROJECT 6190-03-21

REVISION DATE 09-II-OINC	DATE: 11-17-95	SCALE, FEET 0 100 200	HWY: STH 110	CONSTRUCTION PROJECT NUMBER: 6200-05-71	PS&E SHEET NO: 4.23
GRID FACTOR: 0.999997			COUNTY: WINNEBAGO	STATE R/W PROJECT NUMBER: 6200-05-21	PLAT SHEET NO: 4.16

NE-SW
SCHEDULE OF LANDS & INTERESTS REQUIRED

PARCEL NUMBER	SHEET NUMBER	OWNER	INTEREST REQUIRED	TOTAL ACRES	R/W ACRES REQUIRED			TOTAL ACRES REM.	T.L.E. ACRES
					NEW	EXISTING	TOTAL		
3	4.16 & 4.17	GEORGE H DODD		SEE SHEET	4.16				
**5	4.17	RAYMOND F & WENDY L SEBERO	FEE						
6	4.17	CLARENCE W & PHYLIS M MEINEN	FEE	0.53	0.53	-	0.53		
44	4.17	DAVID A & SANDRA J PASCARELLA	FEE	1.00	1.00	-	1.00		
62	4.16 & 4.20	AMERICAN TRANSMISSION CORP (47)	RELEASE OF RIGHTS						
63	4.16 & 4.17	AMERITECH (48)	RELEASE OF RIGHTS						

**PARCEL ACQUIRED
DOCUMENT NUMBER 1054025 DATE: 04-13-99

TOWN

**CUR174
CURVE NOTES**

PI = 16+66.76
N = 773987.401
E = 353628.047
Δ = 175°-31'-38"
L = 4°-28'-22"
D = 4°-00'-00"
T = 55.94'
R = 111.82'
L = 1432+.39'
PC = 14+10.82
PT = 15+22.64

**EB STH 116
CURVE G13
CURVE NOTES**

PI = 89+35.767
N = 772639.014
E = 354941.797
Δ = 179°-45'-03"
L = 0°-14'-57"
D = 1°-00'-00"
T = 12.46'
R = 24.91'
L = 5729.58'

**EB STH 116
CURVE G11
CURVE NOTES**

PI = 65+50.000
N = 772674.060
E = 352556.866
Δ = 183°-36'-50"
L = 3°-36'-50"
D = 2°-00'-00"
T = 90.38'
R = 180.69'
L = 2864.79'

**EB STH 116
CURVE G12
CURVE NOTES**

PI = 70+25.886
N = 772643.055
E = 353031.801
Δ = 176°-23'-10"
L = 3°-36'-50"
D = 1°-00'-00"
T = 180.75'
R = 361.39'
L = 5729.58'

**CUR172
CURVE NOTES**

PI = 2+00.00
N = 772875.625
E = 353251.634
Δ = 220°-00'-00"
L = 40°-00'-00"
D = 20°-00'-00"
T = 104.27'
R = 200.00'
L = 286.50'
PC = 0+95.73
PT = 2+95.73

**CUR173
CURVE NOTES**


PI = 7+06.74
N = 773206.840
E = 353646.359
Δ = 120°-39'-22"
L = 51°-20'-38"
D = 18°-00'-00"
T = 153.00'
R = 285.24'
L = 318.31'
PC = 5+53.74
PT = 8+38.98

PARCELS TO BE ACQUIRED
UNDER PROJECT 6200-05-23

DOC # 1103394
8-15-00

DOC # 1054025
4-13-99

LEVELS ON: 1, 2, 3, 62, 63

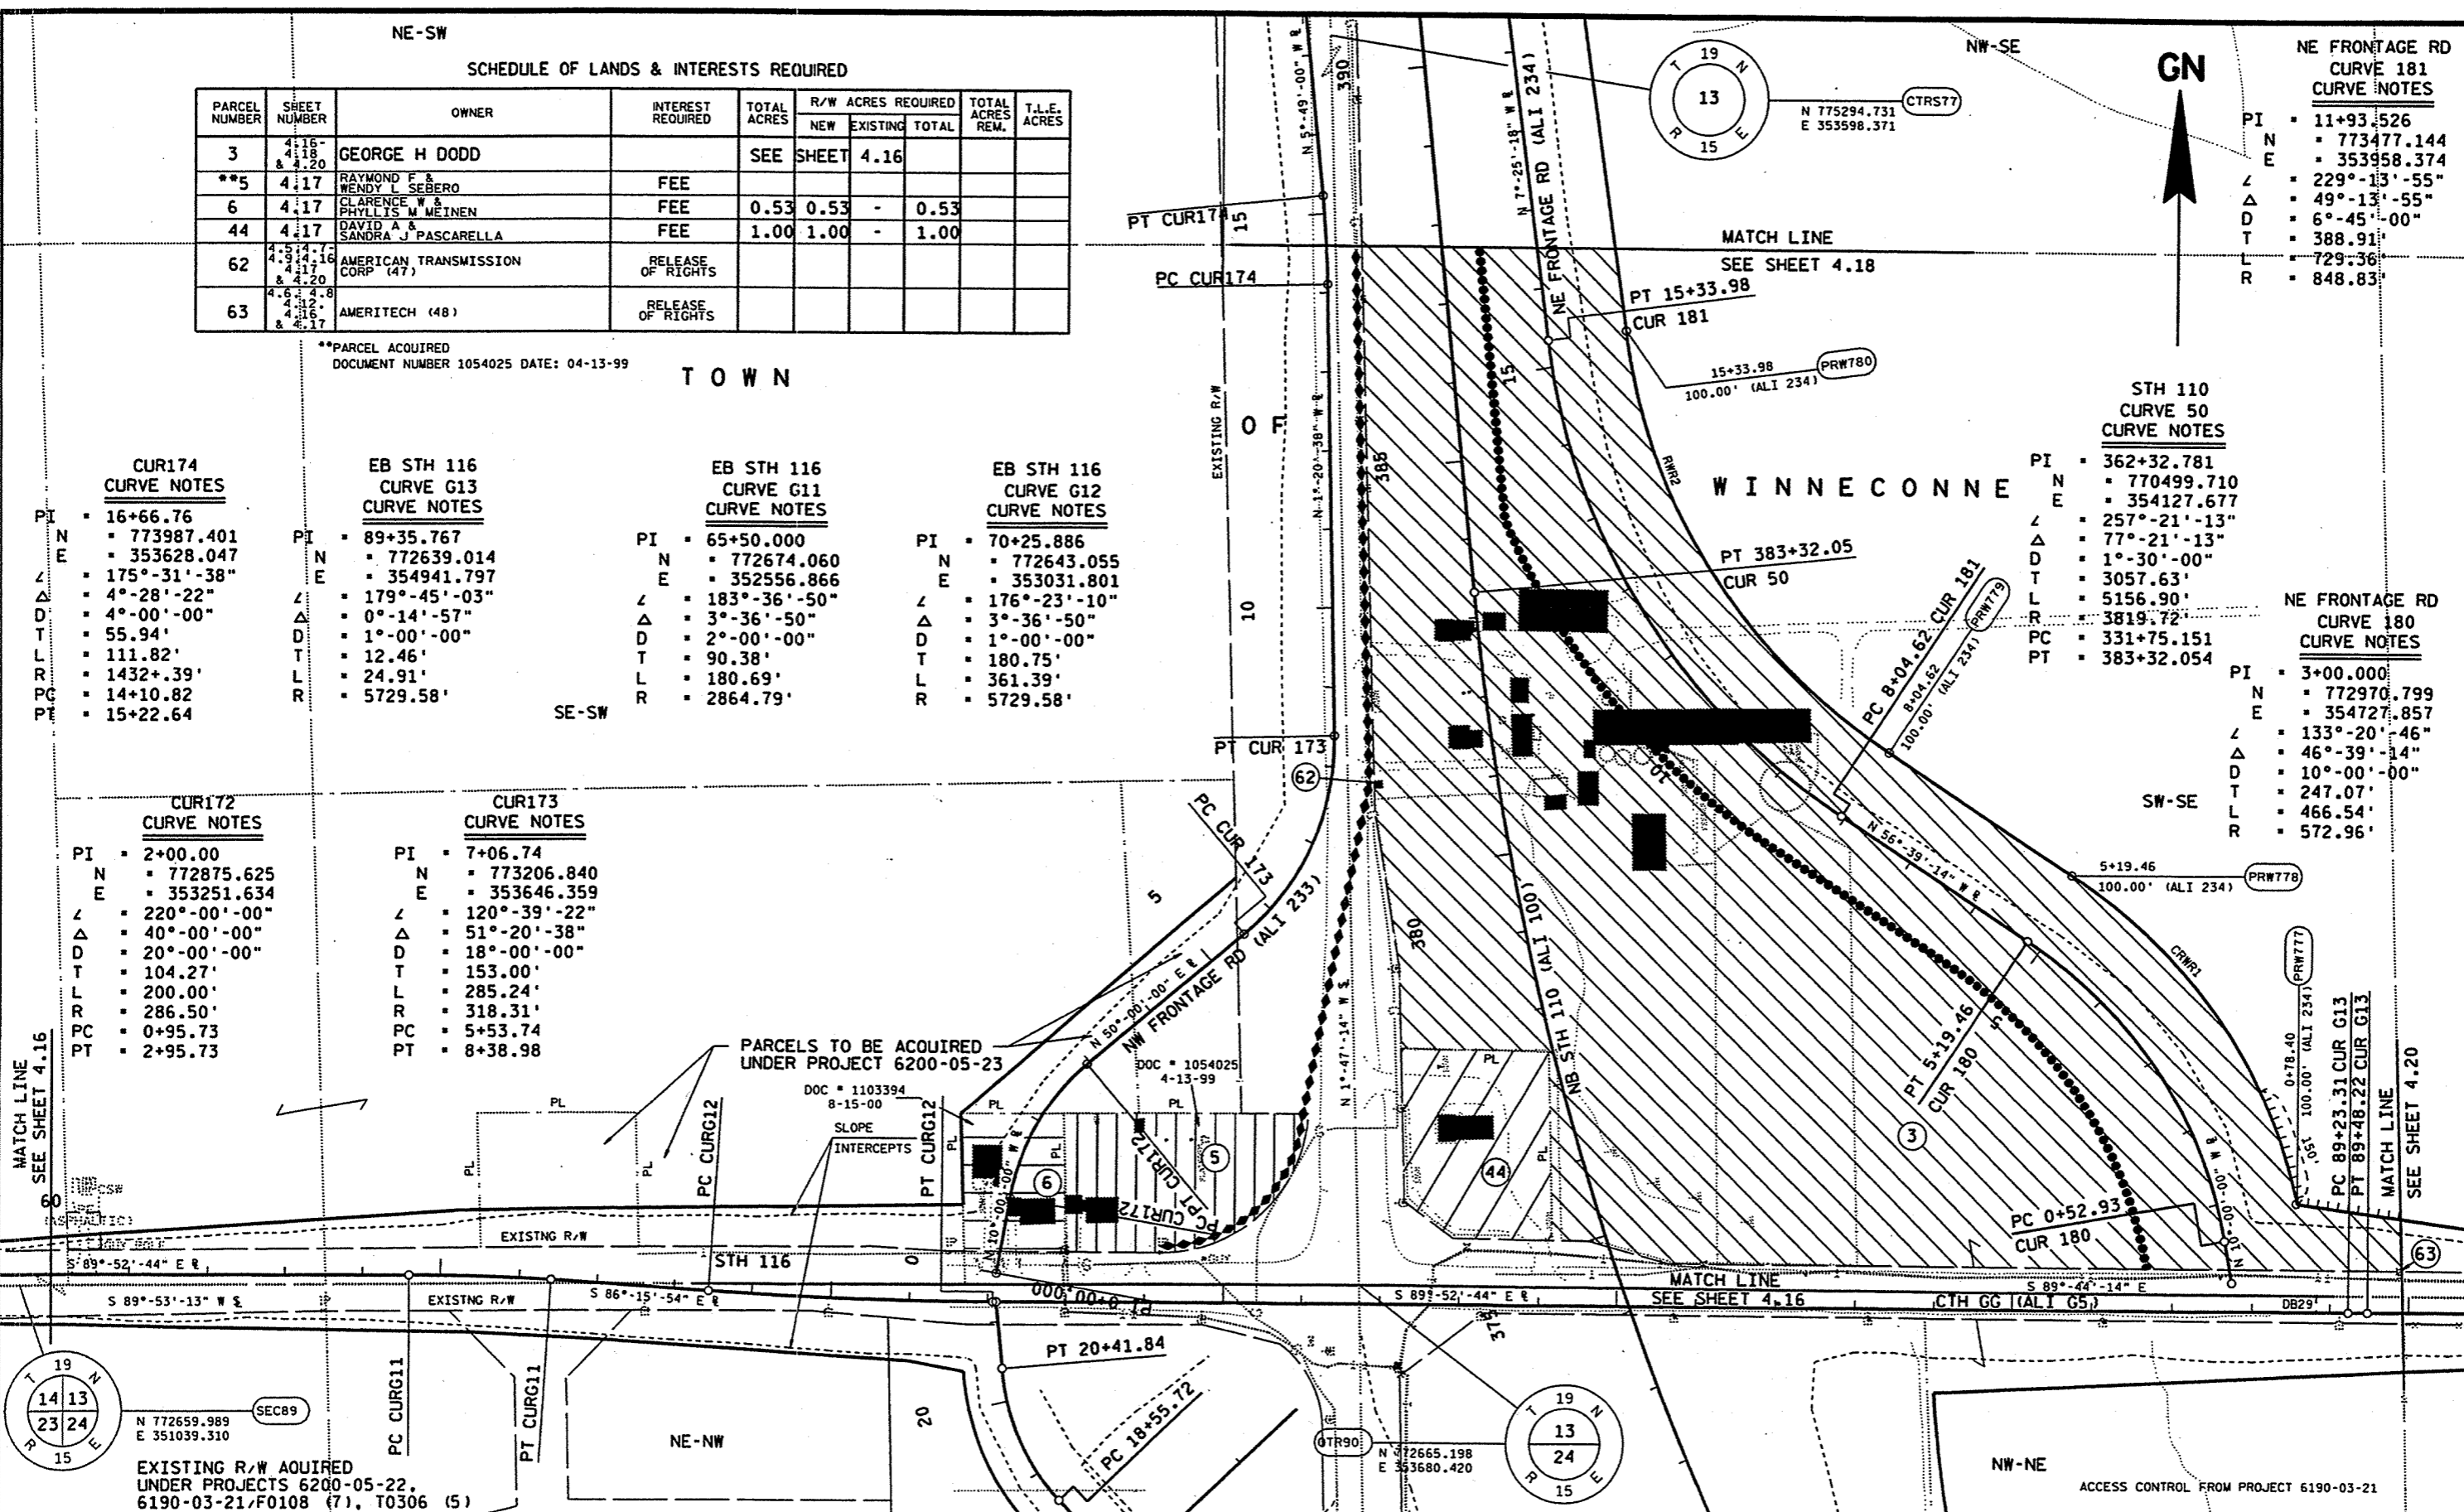

**NE FRONTAGE RD
CURVE 181
CURVE NOTES**

PI = 11+93.526
N = 773477.144
E = 353958.374
Δ = 229°-13'-55"
L = 49°-13'-55"
D = 6°-45'-00"
T = 388.91'
R = 729.36'
L = 848.83'

**STH 110
CURVE 50
CURVE NOTES**


PI = 362+32.781
N = 770499.710
E = 354127.677
Δ = 257°-21'-13"
L = 77°-21'-13"
D = 1°-30'-00"
T = 3057.63'
R = 5156.90'
L = 3819.72'
PC = 331+75.151
PT = 383+32.054

**NE FRONTAGE RD
CURVE 180
CURVE NOTES**

PI = 3+00.000
N = 772970.799
E = 354727.857
Δ = 133°-20'-46"
L = 46°-39'-14"
D = 10°-00'-00"
T = 247.07'
R = 466.54'
L = 572.96'

REVISION DATE 09-11-01	DATE: 11-17-95	SCALE: FEET 0 100 200	HWY: STH 110	CONSTRUCTION PROJECT NUMBER: 6200-05-71	PS&E SHEET NO: 4.24
	GRID FACTOR: 0.999997		COUNTY: WINNEBAGO	STATE R/W PROJECT NUMBER: 6200-05-21	PLAT SHEET NO: 4.17

LEVELS ON 1, 2, 3, 62, 63

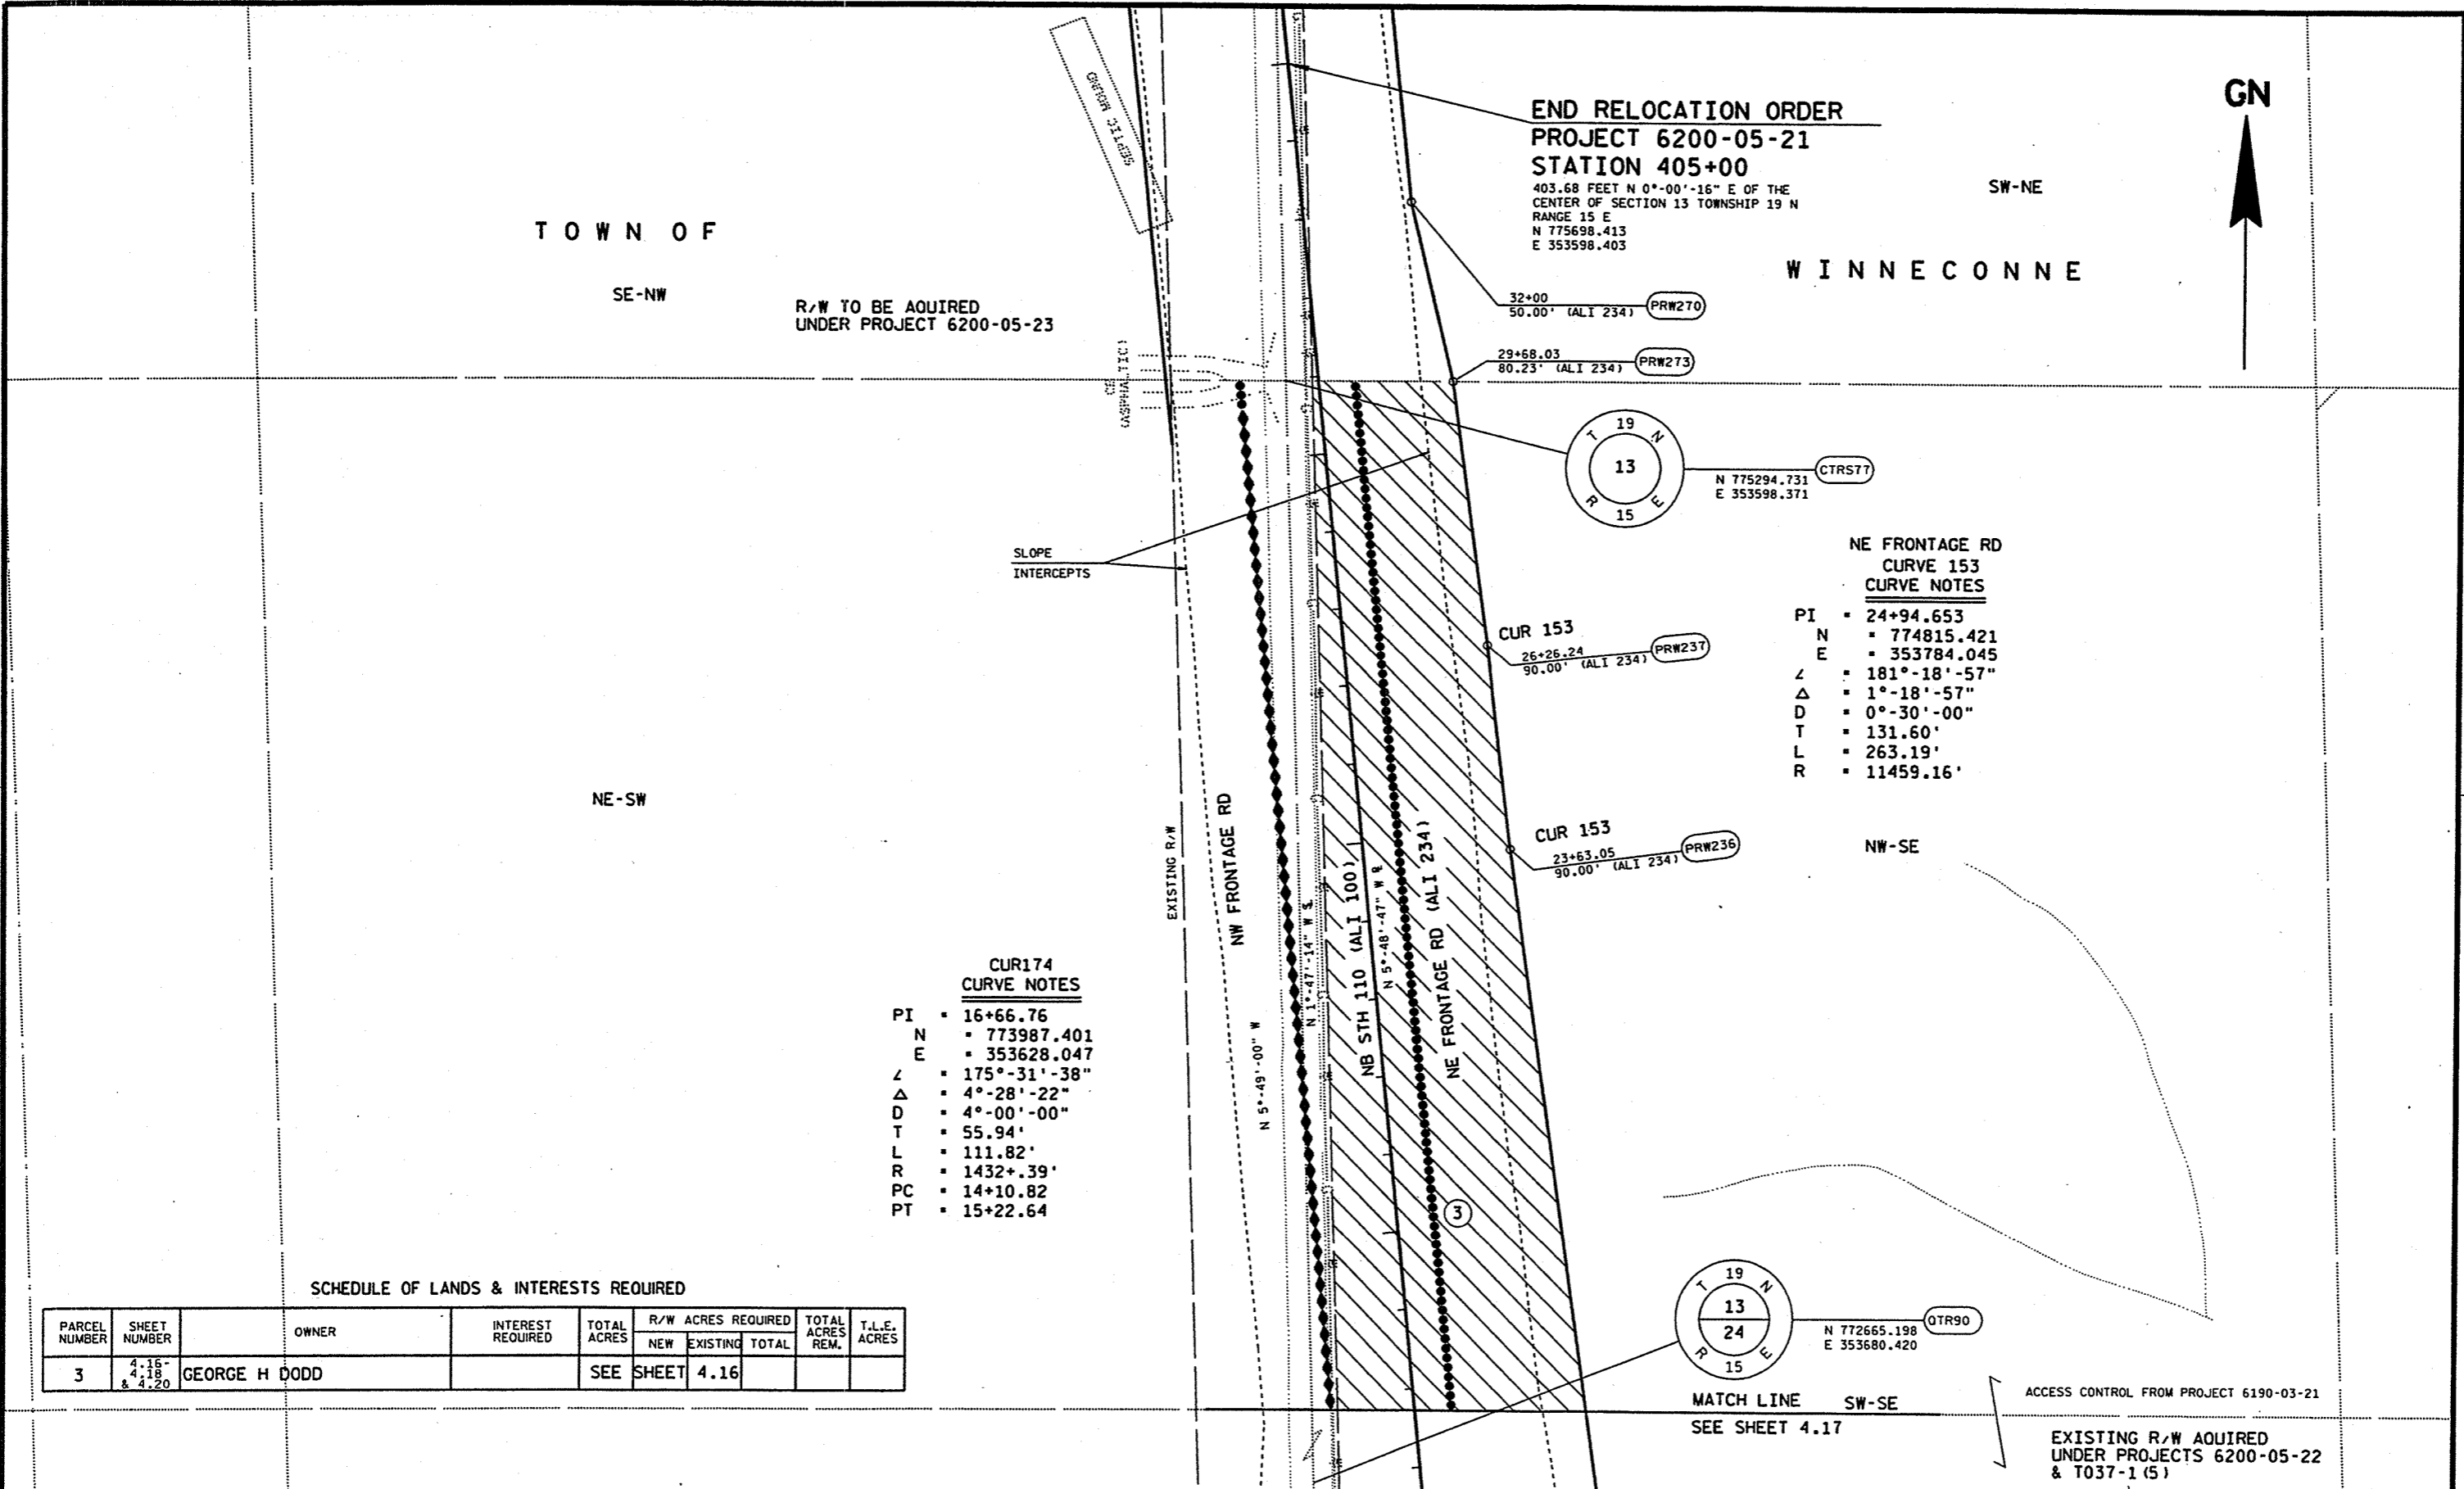

TOWN OF

SE-NW

R/W TO BE ACQUIRED
UNDER PROJECT 6200-05-23

NE-SW

END RELOCATION ORDER
PROJECT 6200-05-21
STATION 405+00
403.68 FEET N 0°-00'-16" E OF THE
CENTER OF SECTION 13 TOWNSHIP 19 N
RANGE 15 E
N 775698.413
E 353598.403

SW-NE

WINNECONNE

GN

NE FRONTAGE RD
CURVE 153
CURVE NOTES

PI = 24+94.653
N = 774815.421
E = 353784.045
Z = 181°-18'-57"
Δ = 1°-18'-57"
D = 0°-30'-00"
T = 131.60'
L = 263.19'
R = 11459.16'

CUR174
CURVE NOTES

PI = 16+66.76
N = 773987.401
E = 353628.047
Z = 175°-31'-38"
Δ = 4°-28'-22"
D = 4°-00'-00"
T = 55.94'
L = 111.82'
R = 1432+.39'
PC = 14+10.82
PT = 15+22.64

SCHEDULE OF LANDS & INTERESTS REQUIRED

PARCEL NUMBER	SHEET NUMBER	OWNER	INTEREST REQUIRED	TOTAL ACRES	R/W ACRES REQUIRED			TOTAL ACRES REM.	T.L.E. ACRES
					NEW	EXISTING	TOTAL		
3	4.16-4.18 & 4.20	GEORGE H DODD		SEE SHEET	4.16				

MATCH LINE SW-SE
SEE SHEET 4.17


ACCESS CONTROL FROM PROJECT 6190-03-21

EXISTING R/W ACQUIRED
UNDER PROJECTS 6200-05-22
& T037-1 (5)

REVISION DATE 09-11-01	DATE: 11-17-95	SCALE, FEET 0 100 200	HWY: STH 110	CONSTRUCTION PROJECT NUMBER: 6200-05-71	PS&E SHEET NO: 4.25
GRID FACTOR: 0.999997			COUNTY: WINNEBAGO	STATE R/W PROJECT NUMBER: 6200-05-21	PLAT SHEET NO: 4.18

SE-SE

SEC137 BERNSTEN MON
N 762252.976
E 372245.399

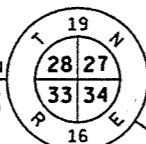

GN

SCHEDULE OF LANDS & INTERESTS REQUIRED

PARCEL NUMBER	SHEET NUMBER	OWNER	INTEREST REQUIRED	TOTAL ACRES	R/W ACRES REQUIRED			TOTAL ACRES REM.	T.L.E. ACRES
					NEW	EXISTING	TOTAL		
12	4.4-4.7 & 4.19	GRUNDY ENTERPRISES INC (LC)		SEE SHEET	4.4				
13	4.19	MARGARET L. QUAST	FEE & TLE	0.54	0.02	0.08	0.10	0.44	0.008
14	4.19	LINDA S. GRAF	TLE						0.005
15	4.19	HENRY G. BARGENQUAST	TLE						0.01
32	4.8-4.9 & 4.19	GRUNDY FARMS, INC		SEE SHEET	4.8				

TOWN

NE-NE

NW-NW

EAST BOUND CTH T
CURVE T3
CURVE NOTES

- PI 33+99.60
- N 759603.109
- E 372281.154
- Δ 90°-31'-50"
- ∠ 89°-28'-10"
- D 4°-00'-00"
- T 1362.42'
- L 2147.26'
- R 1375.10'
- PC 20+37.18
- PT 41+84.44

PRW829 46+75
21.39'

PRW820 46+00
45.00'

PRW819 41+50
75.00'

PT 41+84.44

CUR T3

45+03.83 TLE12
44.60'

44+03.82 TLE10
49.50'

42+20 TLE FOR SLOPING
75.00' PRW728


41+97.51
49.60'

41+63.67
57.46'

41+63.83
69.46'

41+40.04
70.05'

41+39.85
63.61'

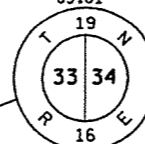

ALUM CAP W/X
N 759584.983
E 372293.012

OTR150

MATCH LINE
SEE SHEET 4.6

DRAIN TILE EASEMENT
VOL 1061, PG 576-579

OSHKOSH

REVISION DATE
09-11-01NC

DATE: 11-17-95


SCALE, FEET

HWY: STH 110

CONSTRUCTION PROJECT NUMBER: 6200-05-71

PS&E SHEET NO: 4.26

GRID FACTOR: 0.999997

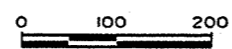


COUNTY: WINNEBAGO

STATE R/W PROJECT NUMBER: 6200-05-21

PLAT SHEET NO: 4.19

E

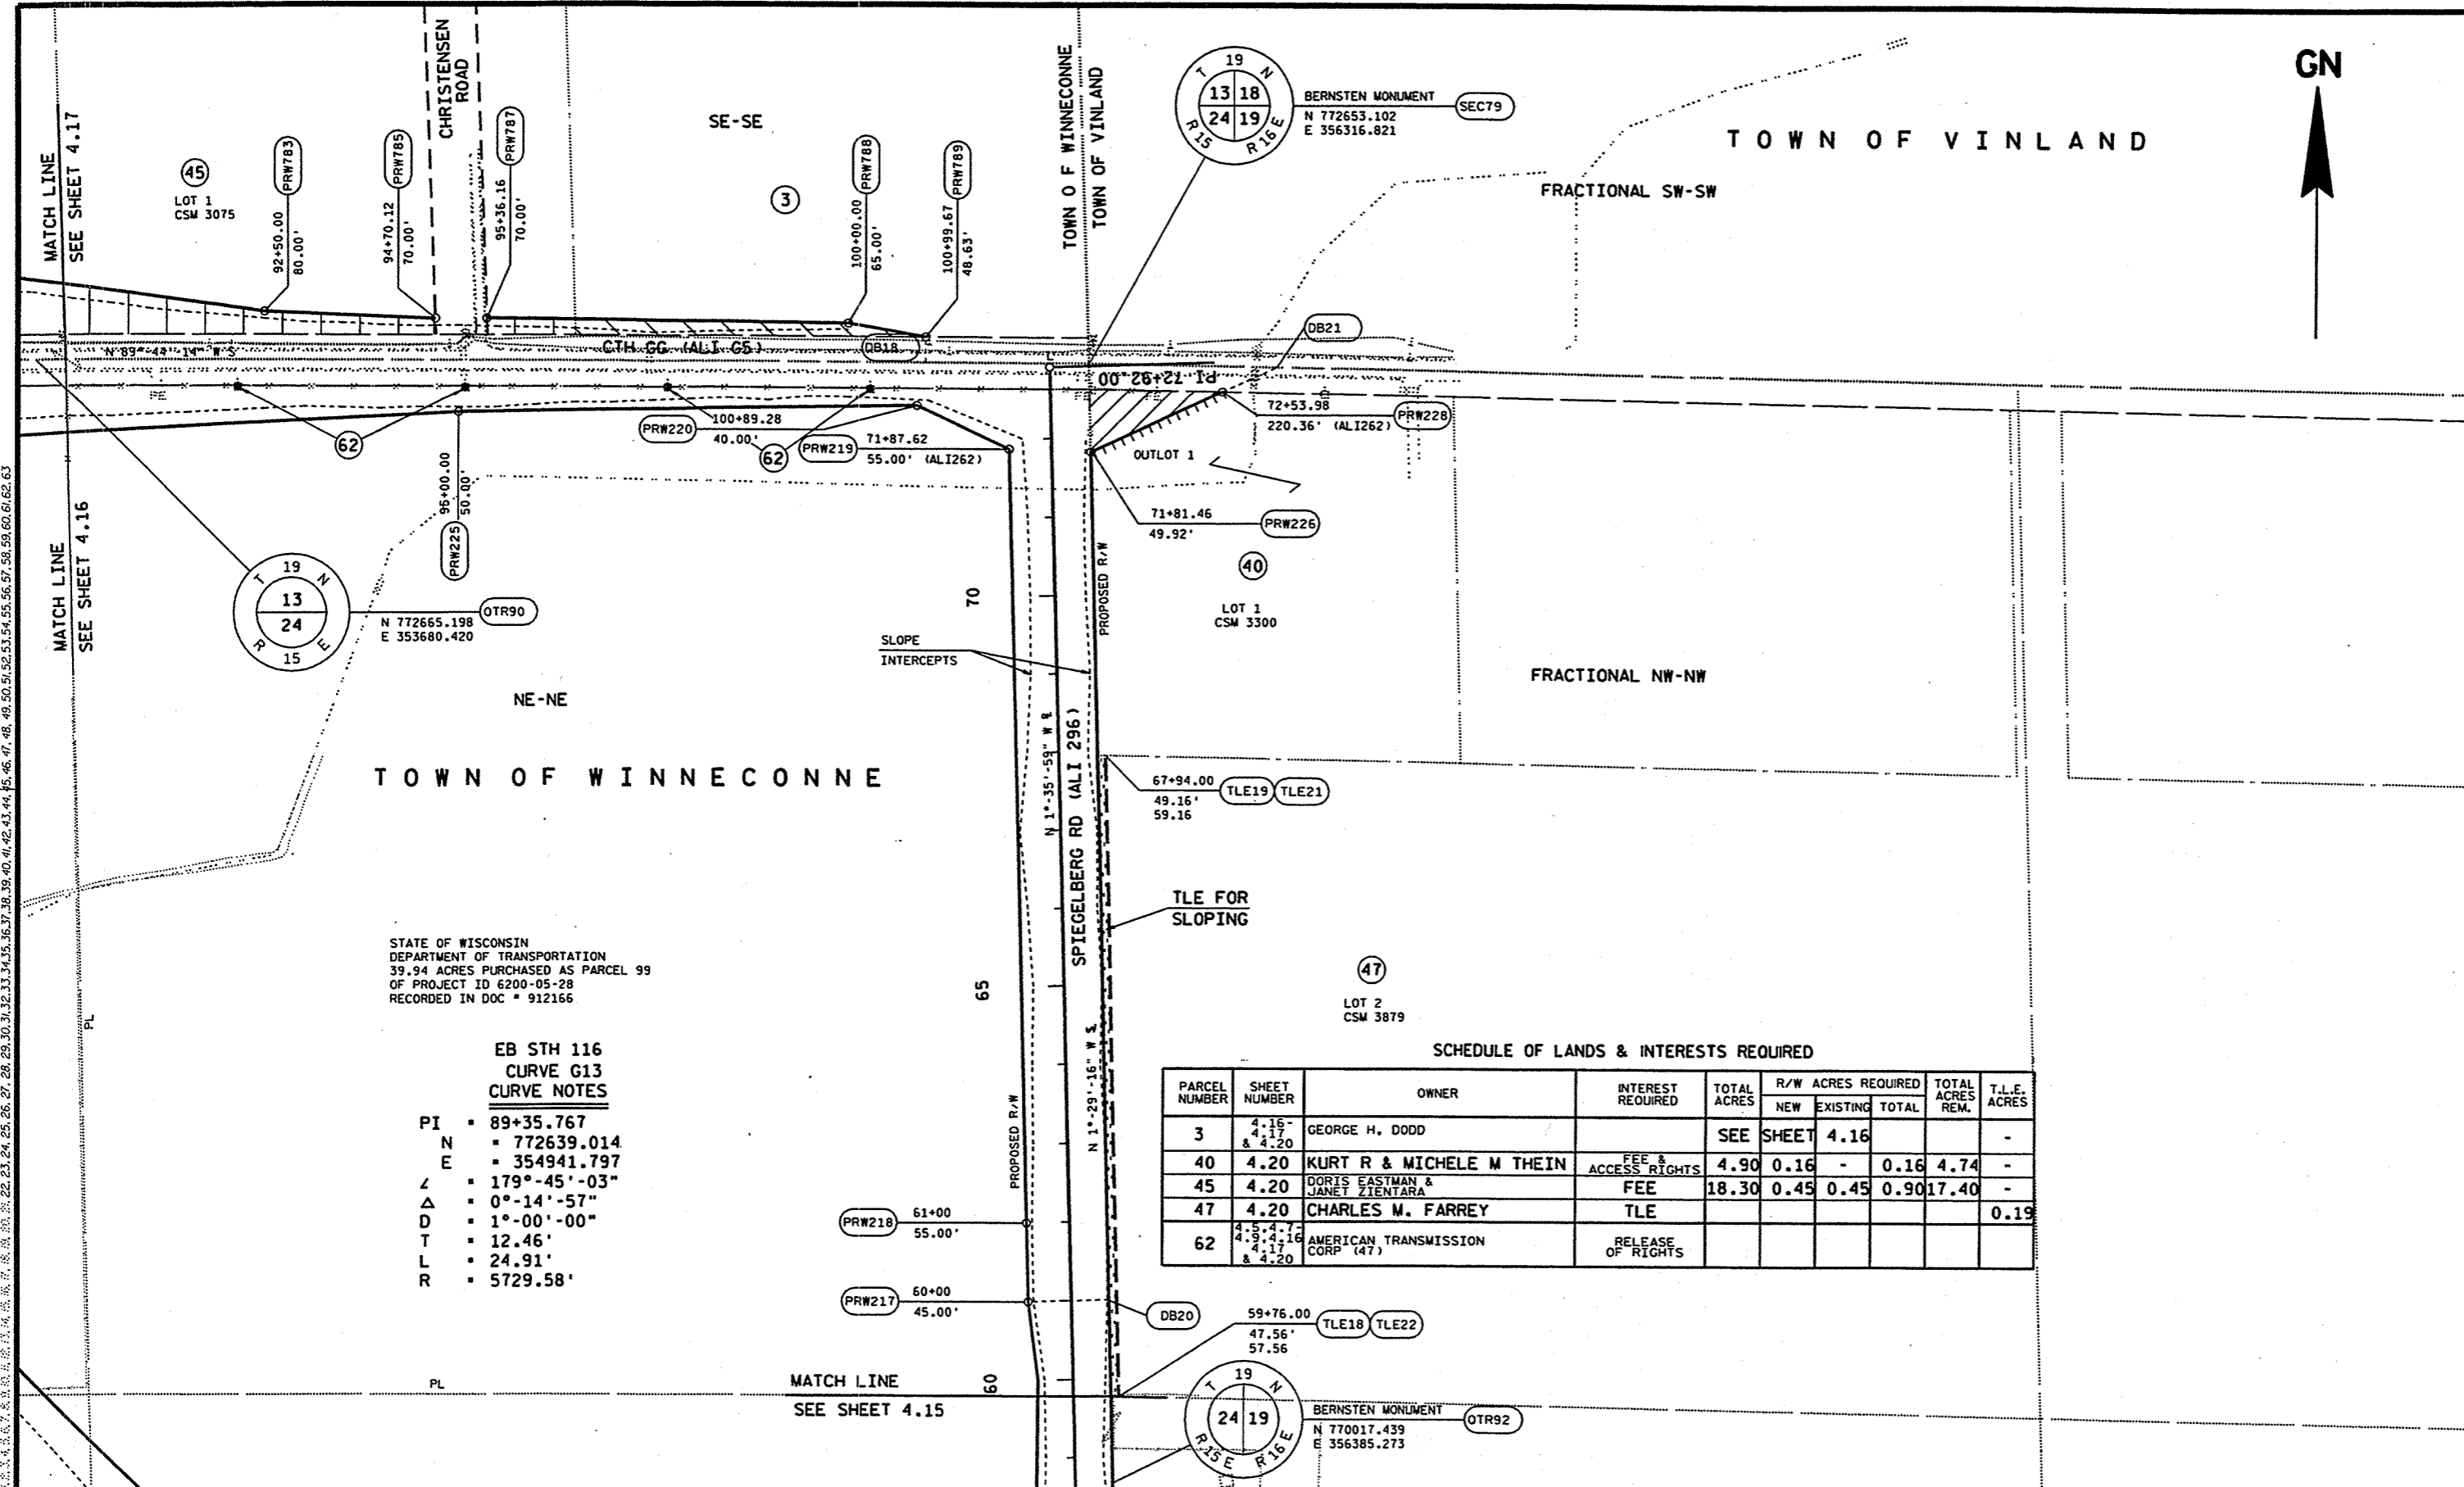

LEVELS ON - 1.00, 2.00, 3.00, 62.00, 63.00

STATE OF WISCONSIN
DEPARTMENT OF TRANSPORTATION
39.94 ACRES PURCHASED AS PARCEL 99
OF PROJECT ID 6200-05-28
RECORDED IN DOC # 912166

**EB STH 116
CURVE G13
CURVE NOTES**

- PI ■ 89+35.767
- N ■ 772639.014
- E ■ 354941.797
- ∠ ■ 179°-45'-03"
- Δ ■ 0°-14'-57"
- D ■ 1°-00'-00"
- T ■ 12.46'
- L ■ 24.91'
- R ■ 5729.58'

SCHEDULE OF LANDS & INTERESTS REQUIRED

PARCEL NUMBER	SHEET NUMBER	OWNER	INTEREST REQUIRED	TOTAL ACRES	R/W ACRES REQUIRED			TOTAL ACRES REM.	T.L.E. ACRES
					NEW	EXISTING	TOTAL		
3	4.16-4.17 & 4.20	GEORGE H. DODD		SEE SHEET 4.16					-
40	4.20	KURT R & MICHELE M THEIN	FEE & ACCESS RIGHTS	4.90	0.16	-	0.16	4.74	-
45	4.20	DORIS EASTMAN & JANET ZIENTARA	FEE	18.30	0.45	0.45	0.90	17.40	-
47	4.20	CHARLES M. FARREY	TLE						0.19
62	4.5, 4.7, 4.9, 4.16, 4.17 & 4.20	AMERICAN TRANSMISSION CORP (47)	RELEASE OF RIGHTS						

REVISION DATE 09-11-01 NC	DATE: 11-17-95	SCALE, FEET 0 100 200	HWY: STH 110	CONSTRUCTION PROJECT NUMBER: 6200-05-71	PS&E SHEET NO: 4.27
	GRID FACTOR: 0.999997		COUNTY: WINNEBAGO	STATE R/W PROJECT NUMBER: 6200-05-21	PLAT SHEET NO: 4.20

LEVELS ON - 1.2, 3.3, 4.6, 7.8, 8.8, 9.9, 11.0, 61.6, 62.7

Parcel 2 (DB2)

	DISTANCE FEET	BEARING	GROUND COORDINATES
OTR122			N 764726.323 E 366917.467
DB3	76.02'	N 1°25'32" W	N 764802.322 E 366915.576
DB4	3196.35'	N 56°26'28" W	N 766569.243 E 364251.996
DB1	395.60'	S 1°12'07" E	N 766173.732 E 364260.294
PRW37 - PC DB1			N 764477.219 E 366817.736
ARC	129.81'		
L.C.	129.81'		
L.C.B.	S 56°06'42" E		
R.	11284.16'		
PT DB1 - DB2			N 764404.838 E 366925.497
OTR122	321.59'	N 1°25'51" W	N 764726.323 E 366917.467

Parcel 3 Section 13 (DB3)

	DISTANCE FEET	BEARING	GROUND COORDINATES
OTR90	2425.65'	S 89°44'14" E	N 772665.198 E 353680.420
DB18	32.86'	N 0°05'44" E	N 772654.069 E 356106.043
PRW789	101.01'	N 80°11'20" W	N 772686.928 E 356106.098
PRW788	464.58'	N 89°13'59" W	N 772704.139 E 356006.568
PRW787	66.04'	S 89°52'08" W	N 772710.358 E 355542.031
PRW785	220.34'	N 87°31'36" W	N 772710.207 E 355475.989
PRW783	396.22'	N 82°05'56" W	N 772719.716 E 355255.851
PC RWR1-PRW777			N 772774.180 E 354863.394
ARC	518.04'		
L.C.	505.35'		
L.C.B.	N 34°36'01" W		
R.	672.96'		
PT RWR1	285.16'	N 56°39'14" W	N 773190.148 E 354576.434
PC RWR2			N 773346.900 E 354338.222
ARC	643.43'		
L.C.	623.82'		
L.C.B.	N 32°02'15" W		
R.	748.83'		
PT RWR2	829.13'	N 8°06'46" W	N 773875.714 E 354007.300
PC PRW50			N 774696.546 E 353890.291
ARC	261.13'		
L.C.	261.12'		
L.C.B.	N 6°45'50" W		
R.	11369.16'		
PT PRW50	341.92'	N 7°44'34" W	N 774955.850 E 353859.537
AR1	215.10'	N 89°58'48" W	N 775294.656 E 353813.471
CTRS77	2630.81'	S 1°47'14" E	N 775294.731 E 353598.371
OTR90			N 772665.198 E 353680.420

Parcel 3 Section 24 (DB3D1)

	DISTANCE FEET	BEARING	GROUND COORDINATES
OTR90			N 772665.198 E 353680.420
SIX31	1318.21'	S 89°44'14" E	N 772659.150 E 354998.620
DB19	93.78	S 1°24'12" E	N 772565.400 E 355000.917
PC DB7-PRW223	594.93'	S 87°10'53" W	N 772536.146 E 354406.709
ARC	787.69'		
L.C.	778.58'		
L.C.B.	S 18°51'14" E		
R.	1492.02'		
PT DB7-PRW222	329.33'	S 28°32'00" E	N 771799.345 E 354658.310
PC DB6-PRW221			N 771510.011 E 354815.624
ARC	232.14'		
L.C.	232.10'		
L.C.B.	S 42°35'26" E		
R.	3701.72'		
PT DB6-DB41	439.05'	N 89°50'21" W	N 771339.137 E 354972.699
DB42	147.38'	N 47°31'54" W	N 771340.368 E 354533.654
PRW884	656.60'	N 40°11'43" W	N 771439.877 E 354424.939
PC PRW52-PRW886			N 771941.417 E 354001.174
ARC	496.42'		
L.C.	494.06'		
L.C.B.	N 32°15'18" W		
R.	1468.14'		
PT PRW52-PRW886	50.02'	S 88°40'50" W	N 772359.231 E 353737.500
DB24	307.20'	N 1°19'10" W	N 772358.080 E 353687.494
OTR90			N 772665.198 E 353680.420

Parcel 4 (DB4) Sec. 29

	DISTANCE FEET	BEARING	GROUND COORDINATES
OTR122			N 764726.323 E 366917.467
DB3	76.02'	N 1°25'32" W	N 764802.322 E 366915.576
DB4	3196.35'	N 56°26'28" W	N 766569.243 E 364251.996
DB7	365.17'	S 1°12'07" E	N 766204.156 E 364259.656
PRW805	2734.34'	S 56°26'28" E	N 764692.632 E 366538.233
DB2	482.49'	S 53°22'56" E	N 764404.838 E 366925.497
OTR122	321.59'	N 1°25'51" W	N 764726.323 E 366917.467

Parcel 4 (DB4S1) Sec. 28

	DISTANCE FEET	BEARING	GROUND COORDINATES
OTR122			N 764726.323 E 366917.467
DB3	76.02'	N 1°25'32" W	N 764802.322 E 366915.576
DB4	318.34'	S 56°26'28" E	N 764626.346 E 367180.855
PC PRW43			N 763939.463 E 368111.998
ARC	1157.56'		
L.C.	1157.08'		
L.C.B.	S 53°35'05" E		
R.	11609.16'		
PT PRW43-PRW833	940.36'	S 27°59'42" E	N 763109.132 E 368553.398
PRW802-PC DB8			N 764351.351 E 366998.433
ARC	1992.82'		
L.C.	1990.23'		
L.C.B.	N 51°22'47" W		
R.	11279.16'		
PT DB8	90.45'	N 53°44'45" W	N 764404.838 E 366925.497
DB2	321.59'	N 1°25'51" W	N 764726.323 E 366917.467
OTR122			N 764726.323 E 366917.467

Parcel 10 (DB10)

	DISTANCE FEET	BEARING	GROUND COORDINATES
OTR150			N 759584.983 E 372293.012
DB72	480.74'	S 0°56'32" E	N 759104.303 E 372300.916
PC DB12	50.83'	S 61°57'26" E	N 759080.404 E 372345.783
ARC	334.55'		
L.C.	334.25'		
L.C.B.	S 57°46'31" E		
R.	2291.83'		
PT CDB12-DB51	53.51'	N 36°43'50" E	N 758902.167 E 372628.547
PRW720	160.92'	N 52°50'06" W	N 758945.055 E 372660.550
PC PRW16			N 759042.271 E 372532.309
ARC	417.91'		
L.C.	403.52'		
L.C.B.	N 27°05'21" W		
R.	457.30'		
PT PRW16	161.09'	N 1°56'17" E	N 759401.524 E 372348.557
PRW723	402.00'	N 4°48'07" E	N 759562.525 E 372354.005
PRW724	134.78'	N 11°57'09" E	N 759963.109 E 372387.657
PRW725-PC PRW32			N 760094.964 E 372415.570
ARC	249.56'		
L.C.	245.59'		
L.C.B.	N 19°52'39" W		
R.	402.84'		
PT PRW32-PRW726	551.71'	N 0°08'55" W	N 760325.920 E 372332.068
PRW727	127.59'	N 13°33'16" W	N 760877.631 E 372330.636
PRW728	33.00'	S 88°58'39" W	N 761001.663 E 372300.734
DB71	1416.32'	S 1°01'21" E	N 761001.075 E 372267.740
OTR150			N 759584.983 E 372293.012

Parcel 12 IN SEC. 34 (DB12A2)

	DISTANCE FEET	BEARING	GROUND COORDINATES
SEC763	1219.18'	N 88°24'33" E	N 756926.273 E 372336.732
DB39	353.31'	N 88°24'33" E	N 756960.119 E 373555.439
DB40-PC DB10			N 756969.928 E 373908.608
ARC	145.03'		
L.C.	144.98'		
L.C.B.	N 25°39'50" W		
R.	1637.02'		
PT DB10	825.07'	N 28°12'07" W	N 757100.609 E 373845.817
CL3642	355.08'	N 28°12'02" W	N 757827.733 E 373455.906
PC CL90			N 758140.668 E 373288.108
ARC	1350.26'		
L.C.	1330.82'		
L.C.B.	N 45°04'44" W		
R.	2291.83'		
PT CL90	50.83'	N 61°57'26" W	N 759080.404 E 372345.783
DB72	413.22'	S 0°56'32" E	N 759104.303 E 372300.916
DB78	813.53'	S 42°05'49" E	N 758691.138 E 372307.710
PC DB11			N 758087.493 E 372853.089
ARC	1334.83'		
L.C.	1328.26'		
L.C.B.	S 31°55'22" E		
R.	3879.72'		
PT DB11-DB39			N 756960.119 E 373555.439

REVISION DATE

DATE

NOT TO SCALE

HWY: STH 110

CONSTRUCTION PROJECT NUMBER 6200-05-71

PS&E SHEET NO: 4.28

COUNTY: WINNEBAGO

STATE R/W PROJECT NUMBER 6200-05-21

PS&E SHEET NO: 4.21

E

Parcel 12 E1/2-NE1/4 SEC. 33 (DB12B)

Parcel 12 Section 33 (DB12D2)

Parcel 23 (DB23)

	DISTANCE FEET	BEARING	GROUND COORDINATES
OTR150	1871.32'	N 1°01'21" W	N 759584.983 E 372293.012
DB44	33.00'	S 88°58'39" W	N 761456.001 E 372259.622
PRW829	78.63'	S 16°26'53" W	N 761455.413 E 372226.628
PRW820	449.15'	S 2°51'26" W	N 761380.002 E 372204.365
PRW819	188.76'	S 12°10'03" W	N 760931.412 E 372181.976
PRW818	230.72'	S 21°23'32" W	N 760746.890 E 372142.191
PRW808	400.32'	S 39°11'15" W	N 760532.065 E 372058.036
PRW809	86.00'	S 65°26'56" W	N 760221.782 E 371805.088
PRW810	323.11'	N 62°08'53" W	N 760186.046 E 371726.859
PRW811	401.53'	N 45°20'50" W	N 760337.000 E 371441.179
PRW812	312.92'	N 38°42'36" W	N 760619.197 E 371155.540
DB56	530.40'	S 1°16'32" E	N 760863.376 E 370959.846
DB57	51.22'	S 35°09'08" E	N 760333.112 E 370971.653
PRW752	261.01'	S 23°38'50" E	N 760291.231 E 371001.145
PRW751	283.37'	S 13°24'35" E	N 760052.140 E 371105.836
PRW750-PC DB9			N 759776.491 E 371171.554
ARC	120.43'		
L.C.	120.38'		
L.C.B.	S 58°28'14.06" E		
R.	1145.92'		
PT DB9	314.80'	S 61°57'26" E	N 759713.540 E 371274.162
DB33	741.26'	N 88°29'50" E	N 759565.542 E 371552.004
OTR150			N 759584.983 E 372293.012

	DISTANCE FEET	BEARING	GROUND COORDINATES
OTR150	560.37'	S 0°56'32" E	N 759584.983 E 372293.012
DB38	333.60'	S 0°56'32" E	N 759024.690 E 372302.225
DB78	211.50'	N 42°05'49" W	N 758691.138 E 372307.710
PRW311-PC PRW60			N 758848.074 E 372165.922
ARC	573.08'		
L.C.	561.53'		
L.C.B.	N 62°04'57" W		
R.	821.47'		
PT PRW60-PRW312	500.95'	N 84°20'33" W	N 759110.982 E 371669.742
DB59	441.40'	N 27°59'42" W	N 759160.367 E 371171.233
DB79	244.75'	N 88°29'50" E	N 759550.116 E 370964.044
DB80	88.87'	S 1°30'10" E	N 759556.535 E 371208.711
PRW333	178.62'	N 87°52'13" W	N 759467.695 E 371211.042
PRW334-PC PRW36			N 759474.333 E 371032.546
ARC	233.04'		
L.C.	218.38'		
L.C.B.	S 46°31'34.04" E		
R.	187.84'		
PT PRW36-PRW336	157.41'	S 67°20'48" E	N 759324.084 E 371191.020
PRW337	73.60'	S 31°31'03" E	N 759263.457 E 371336.285
RW155	944.03'	S 79°15'12" E	N 759200.719 E 371374.757
DB38			N 759024.690 E 372302.225

	DISTANCE FEET	BEARING	GROUND COORDINATES
OTR150	1262.93'	S 88°29'50" W	N 759584.983 E 372293.012
DB35	77.55'	S 1°30'10" E	N 759551.860 E 371030.512
PRW334-PC PRW36			N 759474.333 E 371032.546
ARC	233.04'		
L.C.	218.38'		
L.C.B.	S 46°31'34" E		
R.	187.84'		
PT PRW36-PRW336			N 759324.084 E 371191.020
PRW337	157.41'	S 67°20'48" E	N 759263.457 E 371336.285
DB53	118.86'	S 5°39'27" W	N 759145.177 E 371324.567
PRW313-PC PRW39	157.08'	N 84°20'33" W	N 759160.662 E 371168.250
ARC	476.54'		
L.C.	441.14'		
L.C.B.	N 43°22'34" W		
R.	352.84'		
PT PRW39-PRW317	392.14'	N 87°40'21" W	N 759481.308 E 370865.283
RW3150	44.69'	N 27°59'42" W	N 759497.235 E 370473.465
DB66	578.22'	N 88°29'50" E	N 759536.695 E 370452.487
DB35			N 759551.860 E 371030.512

Parcel 12 SEC. 33 (DB12C1)

	DISTANCE FEET	BEARING	GROUND COORDINATES
OTR136	447.53'	S 87°52'49" W	N 762185.032 E 369613.923
DB45	213.94'	S 27°59'42" E	N 762168.479 E 369166.696
DB46	228.87'	S 46°38'46" E	N 761979.571 E 369267.119
PRW757	223.77'	S 48°11'29" W	N 761822.451 E 369433.536
PRW756	638.55'	N 43°27'46" W	N 761971.629 E 369600.333
PRW755	600.02'	N 39°52'09" W	N 761508.159 E 370039.578
PRW754	24.05'	N 40°20'48" W	N 761047.637 E 370424.213
L58	379.30'	S 88°30'33" W	N 761029.310 E 370439.781
L62	162.07'	N 38°42'36" W	N 761039.178 E 370818.952
PRW813	105.30'	N 58°36'33" W	N 761165.645 E 370717.596
PRW2836	100.72'	N 47°11'22" W	N 761220.495 E 370627.705
PRW2843	300.04'	N 39°23'30" W	N 761288.940 E 370553.819
PRW2840	300.38'	N 37°29'03" W	N 761520.820 E 370363.406
PRW2841	117.74'	N 8°29'20" W	N 761759.174 E 370180.616
PRW2842	300.28'	N 37°53'33" W	N 761875.620 E 370163.236
PRW815	379.72'	N 81°07'52" E	N 762112.586 E 369978.812
PRW817	33.00'	N 1°49'45" W	N 762171.129 E 370353.991
DB30	739.26'	S 88°31'15" W	N 762204.113 E 370352.938
OTR136			N 762185.032 E 369613.923

Parcel 13 (DB13)

	DISTANCE FEET	BEARING	GROUND COORDINATES
OTR150	1291.77'	N 1°01'21" W	N 759584.983 E 372293.012
DB74	60.68'	N 88°58'39" E	N 760876.548 E 372269.963
PRW727	127.59'	N 13°33'16" W	N 760877.631 E 372330.636
PRW728	33.00'	S 88°58'39" W	N 761001.663 E 372300.734
DB71	124.55'	S 1°01'21" E	N 761001.075 E 372267.740
DB74			N 760876.548 E 372269.963

Parcel 24 Sec. 33 (DB24)

	DISTANCE FEET	BEARING	GROUND COORDINATES
OTR150	1841.16'	S 88°29'50" W	N 759584.983 E 372293.012
DB66	107.02'	N 27°59'42" W	N 759536.695 E 370452.487
DB65	109.92'	N 86°32'08" E	N 759631.193 E 370402.253
DB67	164.56'	S 27°59'42" E	N 759637.835 E 370511.974
DB68	115.85'	N 87°40'21" W	N 759497.235 E 370473.465
RW3150	44.69'	N 27°59'42" W	N 759536.695 E 370452.487
DB66			N 759536.695 E 370452.487

Parcel 24 Sec. 28 (DB24B1)

	DISTANCE FEET	BEARING	GROUND COORDINATES
OTR136	447.53'	S 87°52'49" W	N 762185.032 E 369613.923
DB45	800.87'	N 27°59'42" W	N 762168.479 E 369166.696
PRW801	1115.02'	N 27°59'42" W	N 762875.638 E 368790.774
PRW828	174.44'	N 62°58'20" W	N 763860.192 E 368267.390
PRW833	940.36'	S 27°59'42" E	N 763939.463 E 368111.998
PRW802	332.97'	S 45°28'20" E	N 763109.132 E 368553.398
PRW801			N 762875.638 E 368790.774

Parcel 26 (DB26)

	DISTANCE FEET	BEARING	GROUND COORDINATES
OTR150	1841.16'	S 88°29'50" W	N 759584.983 E 372293.012
DB66	767.62'	S 88°29'50" W	N 759536.695 E 370452.487
CTRS149	33.00'	N 1°31'43" W	N 759516.564 E 369685.135
PRW318	199.14'	N 81°47'52" E	N 759549.552 E 369684.255
PRW319	200.06'	N 87°00'45" E	N 759577.963 E 369881.356
PRW320	202.24'	N 79°54'50" E	N 759588.389 E 370081.147
PRW321	122.22'	N 86°32'08" E	N 759623.807 E 370280.259
DB65	107.02'	S 27°59'42" E	N 759631.193 E 370402.253
DB66			N 759536.695 E 370452.487

REVISION DATE	DATE	NOT TO SCALE	HWY: STH 110	CONSTRUCTION PROJECT NUMBER 6200-05-71	PS&E SHEET NO: 4.29
			COUNTY: WINNEBAGO	STATE R/W PROJECT NUMBER 6200-05-21	PS&E SHEET NO: 4.22

LEVELS ON - 1, 2, 3, 62, 63

LEVELS ON: 1. 2. 3. 62. 63

Parcels 27, 28 & 29 (DB27)

	DISTANCE FEET	BEARING	GROUND COORDINATES
OTR150	741.26'	S 88°29'50" W	N 759584.983 E 372293.012
DB33	988.16'	S 88°29'50" W	N 759565.542 E 371552.004
DB64	111.22'	N 27°59'42" W	N 759539.626 E 370564.181
DB67	68.03'	N 86°32'08" E	N 759637.835 E 370511.974
PRW322	296.06'	N 83°36'03" E	N 759641.946 E 370579.877
PRW323	79.26'	N 6°24'21" E	N 759674.944 E 370874.089
PRW324-PC PRW19			N 759753.711 E 370882.933
ARC	283.85'		
L.C.	279.54'		
L.C.B.	N 19°13'05" W		
R.	468.87'		
PT PRW19-PRW325	279.92'	N 35°32'16" W	N 760017.669 E 370790.919
PRW326	100.62'	N 30°11'41" W	N 760245.446 E 370628.220
PRW339	65.63'	N 53°26'19" E	N 760332.414 E 370577.614
PRW366	202.27'	S 45°09'11" E	N 760371.506 E 370630.325
PRW367	180.15'	S 39°44'36" E	N 760228.862 E 370773.733
PRW368	174.30'	S 31°38'45" E	N 760090.342 E 370888.912
RW165-PC RW12			N 759941.956 E 370980.363
ARC	373.80'		
L.C.	372.14'		
L.C.B.	S 52°08'11" E		
R.	1145.92'		
PT RW12-RW164	314.80'	S 61°57'26" E	N 759713.540 E 371274.162
DB33			N 759565.542 E 371552.004

Parcel 30 (DB30)

	DISTANCE FEET	BEARING	GROUND COORDINATES
OTR136	1316.18'	N 88°31'15" E	N 762185.032 E 369613.923
SIXT17	1355.96'	S 1°16'32" E	N 762219.004 E 370929.661
DB56	530.40'	S 1°16'32" E	N 760863.376 E 370959.846
DB57	501.05'	N 35°09'08" W	N 760333.112 E 370971.653
PRW753	375.95'	N 40°20'48" W	N 760742.780 E 370683.176
DB63	379.30'	N 88°30'33" E	N 761039.178 E 370818.952
DB60	225.29'	S 38°42'36" E	N 760863.376 E 370959.846

Parcel 30 in Lot 2 (DB30A1)

	DISTANCE FEET	BEARING	GROUND COORDINATES
DB57	391.25'	S 1°16'32" E	N 760333.112 E 370971.653
RW165	81.27'	S 1°16'32" E	N 759941.956 E 370980.363
DB76-PC DB15			N 759860.708 E 370982.172
ARC	178.63'		
L.C.	178.45'		
L.C.B.	N 40°54'58" W		
R.	1145.92'		
PT DB15	441.94'	N 36°27'01" W	N 759995.559 E 370865.294
DB77	34.36'	N 53°26'19" E	N 760351.040 E 370602.728
PRW366	202.27'	S 45°09'11" E	N 760371.506 E 370630.325
PRW367	180.15'	S 39°44'36" E	N 760228.862 E 370773.733
PRW368	174.30'	S 31°38'45" E	N 760090.342 E 370888.912
RW165			N 759941.956 E 370980.363

Parcel 31 (DB31)

	DISTANCE FEET	BEARING	GROUND COORDINATES
OTR136	539.19'	N 88°31'15" E	N 762185.032 E 369613.923
DB31	59.36'	N 2°32'55" W	N 762198.949 E 370152.934
PRW822	202.90'	S 84°00'57" E	N 762258.254 E 370150.294
PRW821	33.00'	S 1°28'45" E	N 762237.101 E 370352.086
DB30	200.07'	S 88°31'15" W	N 762204.113 E 370352.938
DB31			N 762198.949 E 370152.934

Parcel 32 (DB32)

	DISTANCE FEET	BEARING	GROUND COORDINATES
OTR136	739.26'	N 88°31'15" E	N 762185.032 E 369613.923
DB30	33.00'	N 1°28'45" W	N 762204.113 E 370352.938
PRW821	202.90'	N 84°00'57" W	N 762237.101 E 370352.086
PRW822	262.01'	N 88°26'26" W	N 762258.254 E 370150.294
PRW823	225.22'	N 37°48'06" W	N 762265.384 E 369888.379
PRW824	508.64'	N 45°03'31" W	N 762443.340 E 369750.334
PRW825	712.13'	N 46°27'55" W	N 762802.633 E 369390.304
PRW826	507.60'	N 47°03'07" W	N 763293.142 E 368874.043
PRW827	322.81'	N 46°44'41" W	N 763638.985 E 368502.497
PRW828	1115.02'	S 27°59'42" E	N 763860.192 E 368267.390
PRW801-PC DB14			N 762875.638 E 368790.774
ARC	829.44'		
L.C.	829.25'		
L.C.B.	S 42°31'12" E		
R.	11279.16'		
PT DB14-PRW800	85.03'	S 49°49'23" W	N 762264.442 E 369351.222
PRW799	36.65'	S 2°07'11" E	N 762209.582 E 369286.252
DB75	326.54'	N 87°52'49" E	N 762172.954 E 369287.607
OTR136			N 762185.032 E 369613.923

Parcel 33 (DB33)

	DISTANCE FEET	BEARING	GROUND COORDINATES
SEC107	33.00'	S 1°07'52" E	N 767264.518 E 361604.124
RW81	564.27'	S 83°17'59" E	N 767231.524 E 361604.775
CURVE PRW58			N 767165.689 E 362165.192
ARC	256.21'		
L.C.	255.81'		
L.C.B.	S 84°53'51" E		
R.	1322.39'		
PT PRW58	400.93'	S 78°12'31" E	N 767142.938 E 362419.985
PRW863	55.44'	S 0°22'32" W	N 767061.010 E 362812.451
PRW855	115.18'	S 23°16'56" E	N 767005.572 E 362812.088
PRW857	66.17'	S 85°37'00" E	N 766899.771 E 362857.614
PRW854	142.85'	N 0°19'51" E	N 766894.714 E 362923.586
PRW2833	114.92'	N 88°11'41" E	N 767037.563 E 362924.410
PRW871	266.89'	S 54°26'10" E	N 767041.184 E 363039.278
PRW2834	201.99'	S 45°26'13" E	N 766885.960 E 363256.381
PRW861	649.03'	S 56°52'57" E	N 766744.223 E 363400.296
PRW807	201.00'	S 62°09'06" E	N 766389.623 E 363943.889
PRW806	165.66'	S 56°26'28" E	N 766295.731 E 364121.609
DB7	365.17'	N 1°12'07" W	N 766204.156 E 364259.656
DB8	806.46'	N 56°26'28" W	N 766569.243 E 364251.996
PRW835	185.38'	N 55°14'36" W	N 767015.051 E 363579.954
PRW836	586.10'	N 77°06'45" E	N 767120.733 E 363427.652
PC PRW42			N 767251.455 E 363998.993
ARC	159.12'		
L.C.	159.06'		
L.C.B.	N 86°06'44" E		
R.	1592.02'		
PT PRW42	80.34'	N 81°52'23" E	N 767262.240 E 364157.684
RW2	33.00'	N 1°12'07" W	N 767273.597 E 364237.218
OTR108	2632.74'	S 89°05'04" W	N 767306.590 E 364236.526
SEC107			N 767264.518 E 361604.124

Parcel 34 & 35 (DB34)

	DISTANCE FEET	BEARING	GROUND COORDINATES
SEC107	32.59'	N 89°05'04" E	N 767264.518 E 361604.124
DB10	33.41'	N 0°54'56" W	N 767265.039 E 361636.707
RW82	535.27'	N 80°04'37" E	N 767298.442 E 361636.173
PC PRW46			N 767390.682 E 362163.433
ARC	299.80'		
L.C.	299.33'		
L.C.B.	S 84°53'51" E		
R.	1547.39'		
PT PRW46	210.63'	S 83°25'55" E	N 767364.061 E 362461.578
PRW868	499.40'	N 42°04'29" W	N 767339.968 E 362670.830
PRW869	539.32'	N 36°24'36" W	N 767710.661 E 362336.179
PRW873	408.02'	N 43°06'34" W	N 768144.697 E 362016.062
PRW870	151.34'	N 63°29'07" W	N 768442.571 E 361737.225
PRW872	33.05'	S 88°22'20" W	N 768510.136 E 361601.799
DB50	443.89'	N 1°37'38" W	N 768509.197 E 361568.762
DB49	33.07'	N 88°22'22" E	N 768952.905 E 361556.156
CURVE PRW45			N 768953.844 E 361589.212
ARC	902.79'		
L.C.	901.40'		
L.C.B.	S 44°34'17" E		
R.	4698.66'		
PT PRW45	538.76'	S 38°32'07" E	N 768311.707 E 362221.811
PC PRW44			N 767890.276 E 362557.456
ARC	793.47'		
L.C.	792.43'		
L.C.B.	S 44°08'53" E		
R.	4473.66'		
PT PRW44	33.09'	S 0°54'56" E	N 767321.671 E 363109.399
DB11	1506.00'	S 89°05'04" W	N 767288.584 E 363109.928
SEC107			N 767264.518 E 361604.124

Parcel 34 & 50 (DB50)

	DISTANCE FEET	BEARING	GROUND COORDINATES
OTR94	55.93'	N 1°37'13" W	N 769900.325 E 361529.240
DB82	33.10'	N 88°22'47" E	N 769956.236 E 361527.658
PRW900	113.62'	S 88°41'51" E	N 769957.172 E 361560.749
PRW901	109.04'	S 0°42'12" E	N 769954.589 E 361674.344
PRW902	401.82'	S 0°19'45" W	N 769845.558 E 361675.682
PRW903	83.41'	S 42°02'28" E	N 769443.747 E 361673.373
L334	93.85'	S 0°15'22" E	N 769381.800 E 361729.231
PRW905	183.11'	N 89°07'00" W	N 769287.948 E 361729.650
DB83	609.80'	N 1°37'38" W	N 769290.771 E 361546.557
OTR94			N 769900.325 E 361529.240

REVISION DATE

DATE

NOT TO SCALE

HWY: STH 110

CONSTRUCTION PROJECT NUMBER 6200-05-71

PS&E SHEET NO: 4.30

COUNTY: WINNEBAGO

STATE R/W PROJECT NUMBER 6200-05-21

PS&E SHEET NO: 4.23

E

LEVELS ON - 1.2.3.4.5.6.7.8.9.10.11.12.13.14.15.16.17.18.19.20.21.22.23.24.25.26.27.28.29.30.31.32.33.34.35.36.37.38.39.40.41.42.43.44.45.46.47.48.49.50.51.52.53.54.55.56.57.58.59.60.61.62.63

Table with columns: POINT, DISTANCE, BEARING, GROUND COORDINATES. Includes data for Parcel 36 (DB36) and various curve details like L.C., L.C.B., Radius, and ARC.

Table with columns: POINT, DISTANCE, BEARING, GROUND COORDINATES. Includes data for Parcel 37 (DB37) and various curve details.

Table with columns: POINT, DISTANCE, BEARING, GROUND COORDINATES. Includes data for Parcel 42 (DB42) and various curve details.

Table with columns: POINT, DISTANCE, BEARING, GROUND COORDINATES. Includes data for Parcel 38 (DB38) and various curve details.

Table with columns: POINT, DISTANCE, BEARING, GROUND COORDINATES. Includes data for Parcel 43 (DB43) and various curve details.

Table with columns: POINT, DISTANCE, BEARING, GROUND COORDINATES. Includes data for Parcel 39 (DB39) and various curve details.

Table with columns: POINT, DISTANCE, BEARING, GROUND COORDINATES. Includes data for Parcel 40 (DB40) VISION CORNER and various curve details.

Summary table with columns: REVISION DATE, DATE, NOT TO SCALE, HWY: STH 110, COUNTY: WINNEBAGO, CONSTRUCTION PROJECT NUMBER 6200-05-71, STATE R/W PROJECT NUMBER 6200-05-21, PS&E SHEET NO: 4.31, PS&E SHEET NO: 4.24, E.

LEVELS ON : 1, 2, 3, 62, 63

Parcel 45 (DB45)

SECT9	DISTANCE FEET	BEARING	GROUND COORDINATES	
DB29	1451.77'	N 89°44'14" W	N 772653.102 E	356316.821
PRW777	114.43'	N 0°50'06" W	N 772659.763 E	354865.062
PRW783	396.22'	S 82°05'56" E	N 772774.180 E	354863.394
PRW785	220.34'	S 87°31'36" E	N 772719.716 E	355255.851
PRW787	66.04'	N 89°52'08" E	N 772710.207 E	355475.989
PRW788	464.58'	S 89°13'59" E	N 772710.358 E	355542.031
PRW789	101.01'	S 80°11'20" E	N 772704.139 E	356006.568
DB18	32.86'	S 0°05'44" W	N 772686.928 E	356106.098
SECT9	210.78'	S 89°44'14" E	N 772654.069 E	356106.043
			N 772653.102 E	356316.821

Parcel 46 (DB46)

	DISTANCE FEET	BEARING	GROUND COORDINATES	
OTR92	1194.70'	S 88°41'47" E	N 770017.439 E	356385.273
DB48	170.71'	S 1°40'55" E	N 769990.261 E	357579.667
DB52	60.88'	N 88°52'38" W	N 769819.621 E	357584.678
PRW601	92.20'	N 42°33'56" W	N 769820.814 E	357523.807
PRW602	207.08'	N 82°32'37" W	N 769888.716 E	357461.443
PRW603	518.83'	N 86°46'18" W	N 769915.590 E	357256.110
PRW604	273.21'	N 86°12'30" W	N 769944.807 E	356738.106
PRW605	83.79'	N 75°04'51" W	N 769962.875 E	356465.490
RW119	33.00'	N 1°18'13" E	N 769984.448 E	356384.522
OTR92			N 770017.439 E	356385.273

REVISION DATE	DATE	NOT TO SCALE	HWY: STH 110	CONSTRUCTION PROJECT NUMBER 6200-05-71	PS&E SHEET NO: 4.32
			COUNTY: WINNEBAGO	STATE R/W PROJECT NUMBER 6200-05-21	PS&E SHEET NO: 4.25

R/W PROJECT NUMBER 6200-05-23	SHEET NUMBER 4.0	TOTAL SHEETS
FEDERAL PROJECT NUMBER		
PLAT OF RIGHT OF WAY REQUIRED FOR STH 116 - CTH G		
STH 110	WINNEBAGO	

6200-05-71 / 4.33

CONVENTIONAL SIGNS AND ABBREVIATIONS


AC.	ACRES	PED	PEDESTAL
AC. REM.	ACRES REMAINING	O	R/W MONUMENT
A.P.	ACCESS POINT	P.L.	PROPERTY LINE
B.	BARN	P.L.E.	PERMANENT LIMITED EASEMENT
BLDG.	BUILDING	R.	RANGE
CO.	COMPANY	RD.	ROAD
CORP.	CORPORATION	R/W	RIGHT OF WAY
C.T.H.	COUNTY TRUNK HIGHWAY	S.	SHED
D.	DEED	S.T.H.	STATE TRUNK HIGHWAY
E.	EAST	T.	TOWN
ET. AL.	AND OTHERS	TEMP.	TEMPORARY
G.	GARAGE	T.I.	TEMPORARY INTEREST
GN	GRID NORTH	VOL.	VOLUME
H.	HOUSE	W.	WEST
INC.	INCORPORATED	WIS.	WISCONSIN
L.C.	LAND CONTRACT		
N	NORTH		

COMPENSABLE NON-COMPENSABLE

POWER POLE	■	□
TELEPHONE POLE	⊕	⊕
SIGN	■	□
TELEPHONE PEDESTAL	■	□

NO ACCESS (BY ACQUISITION)	
NO ACCESS (BY STATUTORY AUTHORITY)	●●●●●
NO ACCESS (BY PREVIOUS PROJECT OR COVENANT)	◆◆◆◆◆

GN

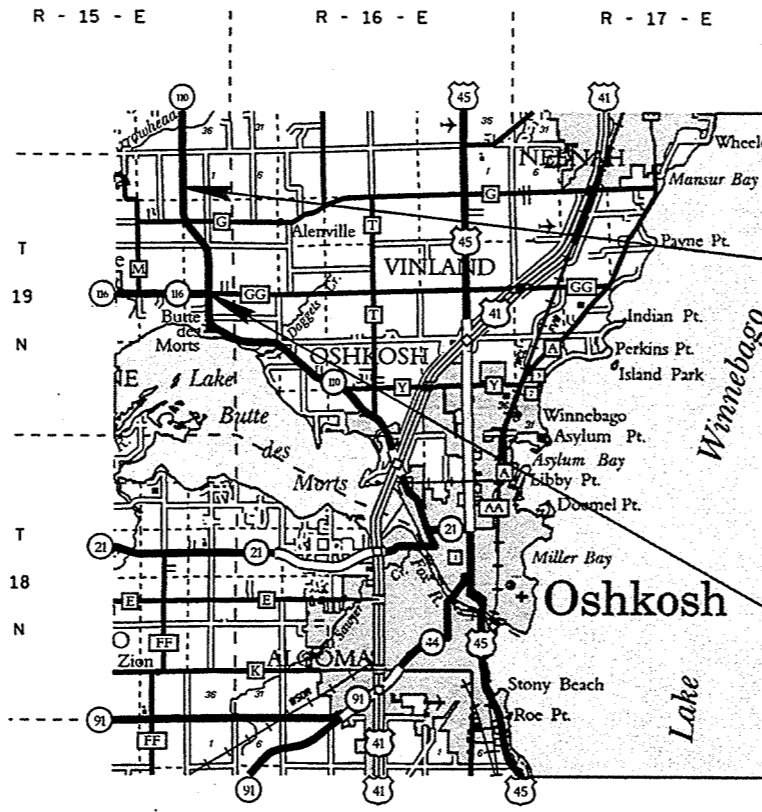

END RELOCATION ORDER

**PROJECT 6200-05-23
STATION 495+00**
707.22 FEET S 5°-05'-50" E OF THE
SOUTHEAST CORNER OF SECTION 1,
TOWNSHIP 19 NORTH, RANGE 15 EAST.
N = 783,859.066
E = 350,677.649

BEGIN RELOCATION ORDER

**PROJECT 6200-05-23
STATION 374+30.40**
333.42 FEET S 89°-44'-14" E OF THE
SOUTH 1/4 CORNER OF SECTION 13,
TOWNSHIP 19 NORTH, RANGE 15 EAST.
N = 772,580.889
E = 353,979.405


NOTES

COORDINATES AND BEARINGS ON THIS PLAT ARE ORIENTED TO THE WISCONSIN COORDINATE SYSTEM SOUTH ZONE (NAD 27). ALL PLAT COORDINATES ARE ENGLISH GROUND DATA & CAN BE CONVERTED TO ENGLISH GRID BY MULTIPLYING BY THE PROVIDED GRID FACTOR AND ADDING TWO MILLION TO THE CONVERTED EAST VALUE. ALL PLAT DISTANCES ARE GROUND LENGTHS AND MAY BE CONVERTED TO GRID LENGTHS BY MULTIPLYING THE DISTANCE BY THE PROVIDED GRID FACTOR.

RIGHT OF WAY BOUNDARIES ARE DEFINED WITH COURSES OF THE PERIMETER OF THE HIGHWAY LANDS REFERENCED TO THE US PUBLIC LAND SURVEY OR OTHER SURVEYS OF PUBLIC RECORD.

RIGHT OF WAY MONUMENTS ARE TYPE 2 AND ARE PLACED PRIOR TO OR AT THE TIME OF LAND TITLE TRANSFER.

RIGHT OF WAY BOUNDARIES ARE DEFINED WITH COURSES OF THE PERIMETER OF THE HIGHWAY LANDS REFERENCED TO THE US PUBLIC LAND SURVEY OR OTHER SURVEYS OF PUBLIC RECORD.

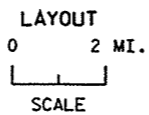

TOTAL NET LENGTH OF CENTERLINE = 2.31 MI.

REVISION DATE	STATE OF WISCONSIN DEPARTMENT OF TRANSPORTATION
	APPROVED:
	DATE: _____ DISTRICT DIRECTOR

PLOT SCALE: 10560

PLOT NAME: 105

REV. DATE: 12-27-00

ORIGINATOR: DIST. 3

SCHEDULE OF LANDS & INTERESTS REQUIRED


AREAS SHOWN IN THE TOTAL ACRES COLUMN MAY BE APPROXIMATE AND ARE DERIVED FROM TAX ROLLS OR OTHER AVAILABLE SOURCES AND MAY NOT INCLUDE LANDS OF THE OWNER WHICH ARE NOT CONTIGUOUS TO THE AREA TO BE ACQUIRED.

PARCEL NUM.	SHEET NUM.	OWNER
1	4.3, 4.4	BRIAN R. FUHS
*2	4.6	RONALD D. MILLER
3	4.3,4.4,4.6	LAKE BREEZE LLC
4	4.5	LAKE BREEZE ENTERPRISES
5	4.5	ROBERT & CAROL BEISER
6	4.5	ROBERT R. & MURIEL I. RADTK
8	4.5	CEMETERY
9	4.5	PAUL T. WINTER
10	4.6	BARBARA A. ZELLER
11	4.6	JEFFERY H. POLLEI
12	4.6	BRUCE A. & CHERYL E. KMECHECK
13	4.6	BRIAN M. & JULIE A. HALL
14	4.6,4.7,4.8	FLORENCE ROMBERG
15	4.4	ROBERT W. FUHS & BRIGITTE FUHS
16	4.7,4.8	GAY R. & ALICE H. ANDERSON
17	4.7	STEVEN P. BROWN
20	4.9	JEFFERY W. & VALORI A. SOHRWEIDE
21	4.9	WAYNE A. & EDNA M. SOHRWEIDE
22	4.9	DAVID A. & BARBARA A. ROZEK
23	4.9	CROSS FARM, J. CROSS, DON & DAVE SLEIK
24	4.4	JAMES & MARY SELLE
25	4.6	TIMOTHY J. DOEHLING & DIANE M. DOEHLING
27	4.6	ALAN M. & PAULA S. LONG
28	4.3	LAKE BREEZE ENTERPRISES
100	4.4,4.5,4.7,4.8,4.9	AMERITECH (43)
101	4.8 & 4.9	WISCONSIN PUBLIC SERVICE CORPORATION (44)

LEVELS ON 1, 2, 3, 62, 63


REVISION DATE	DATE 8-4-99	NOT TO SCALE	HWY: STH 110	CONSTRUCTION PROJECT NUMBER 6200-05-71	PS&E SHEET NO: 4.34
			COUNTY: WINNEBAGO	STATE R/W PROJECT NUMBER 6200-05-23	PLAT SHEET NO: 4.1
					E

LEVELS ON: 1, 2, 3, 62, 63

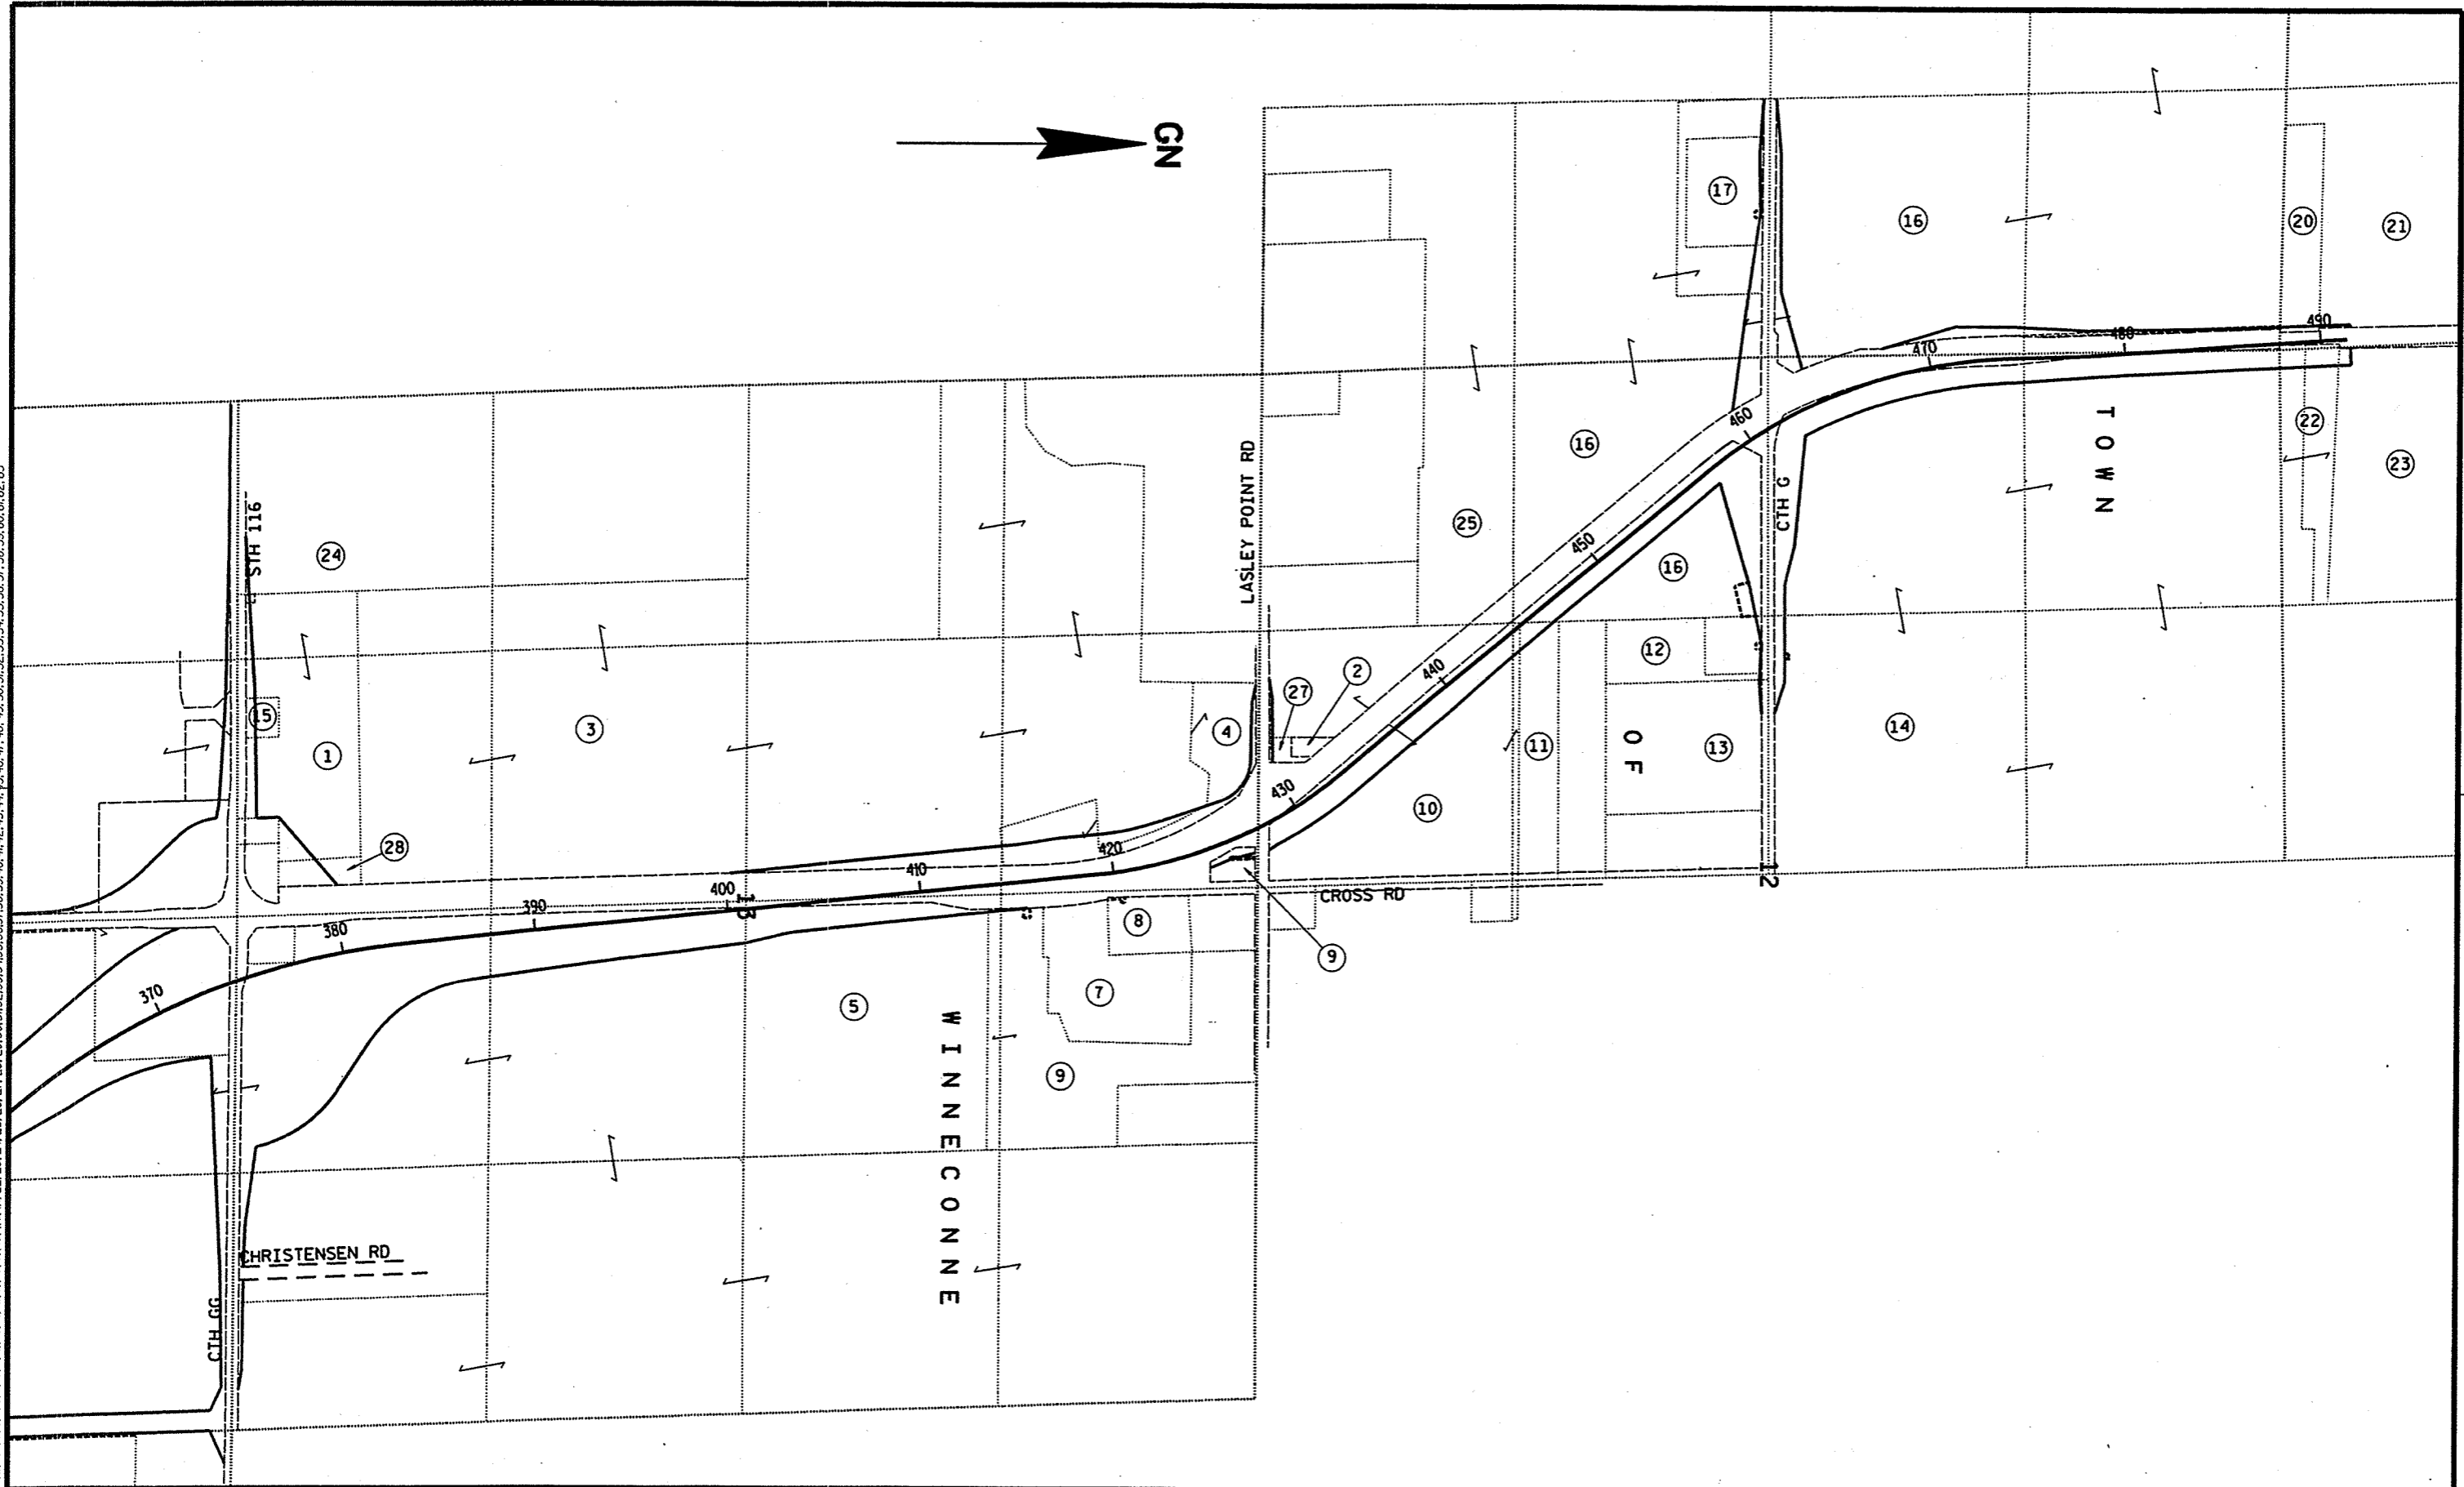

REVISION DATE	DATE 8-4-99	NOT TO SCALE	HWY: STH 110	CONSTRUCTION PROJECT NUMBER 6200-05-71	PS&E SHEET NO: 4.35
			COUNTY: WINNEBAGO	STATE R/W PROJECT NUMBER 6200-05-23	PLAT SHEET NO: 4.2

LEVELS ON - 1.0, 2.0, 3.0, 62.0, 63.0

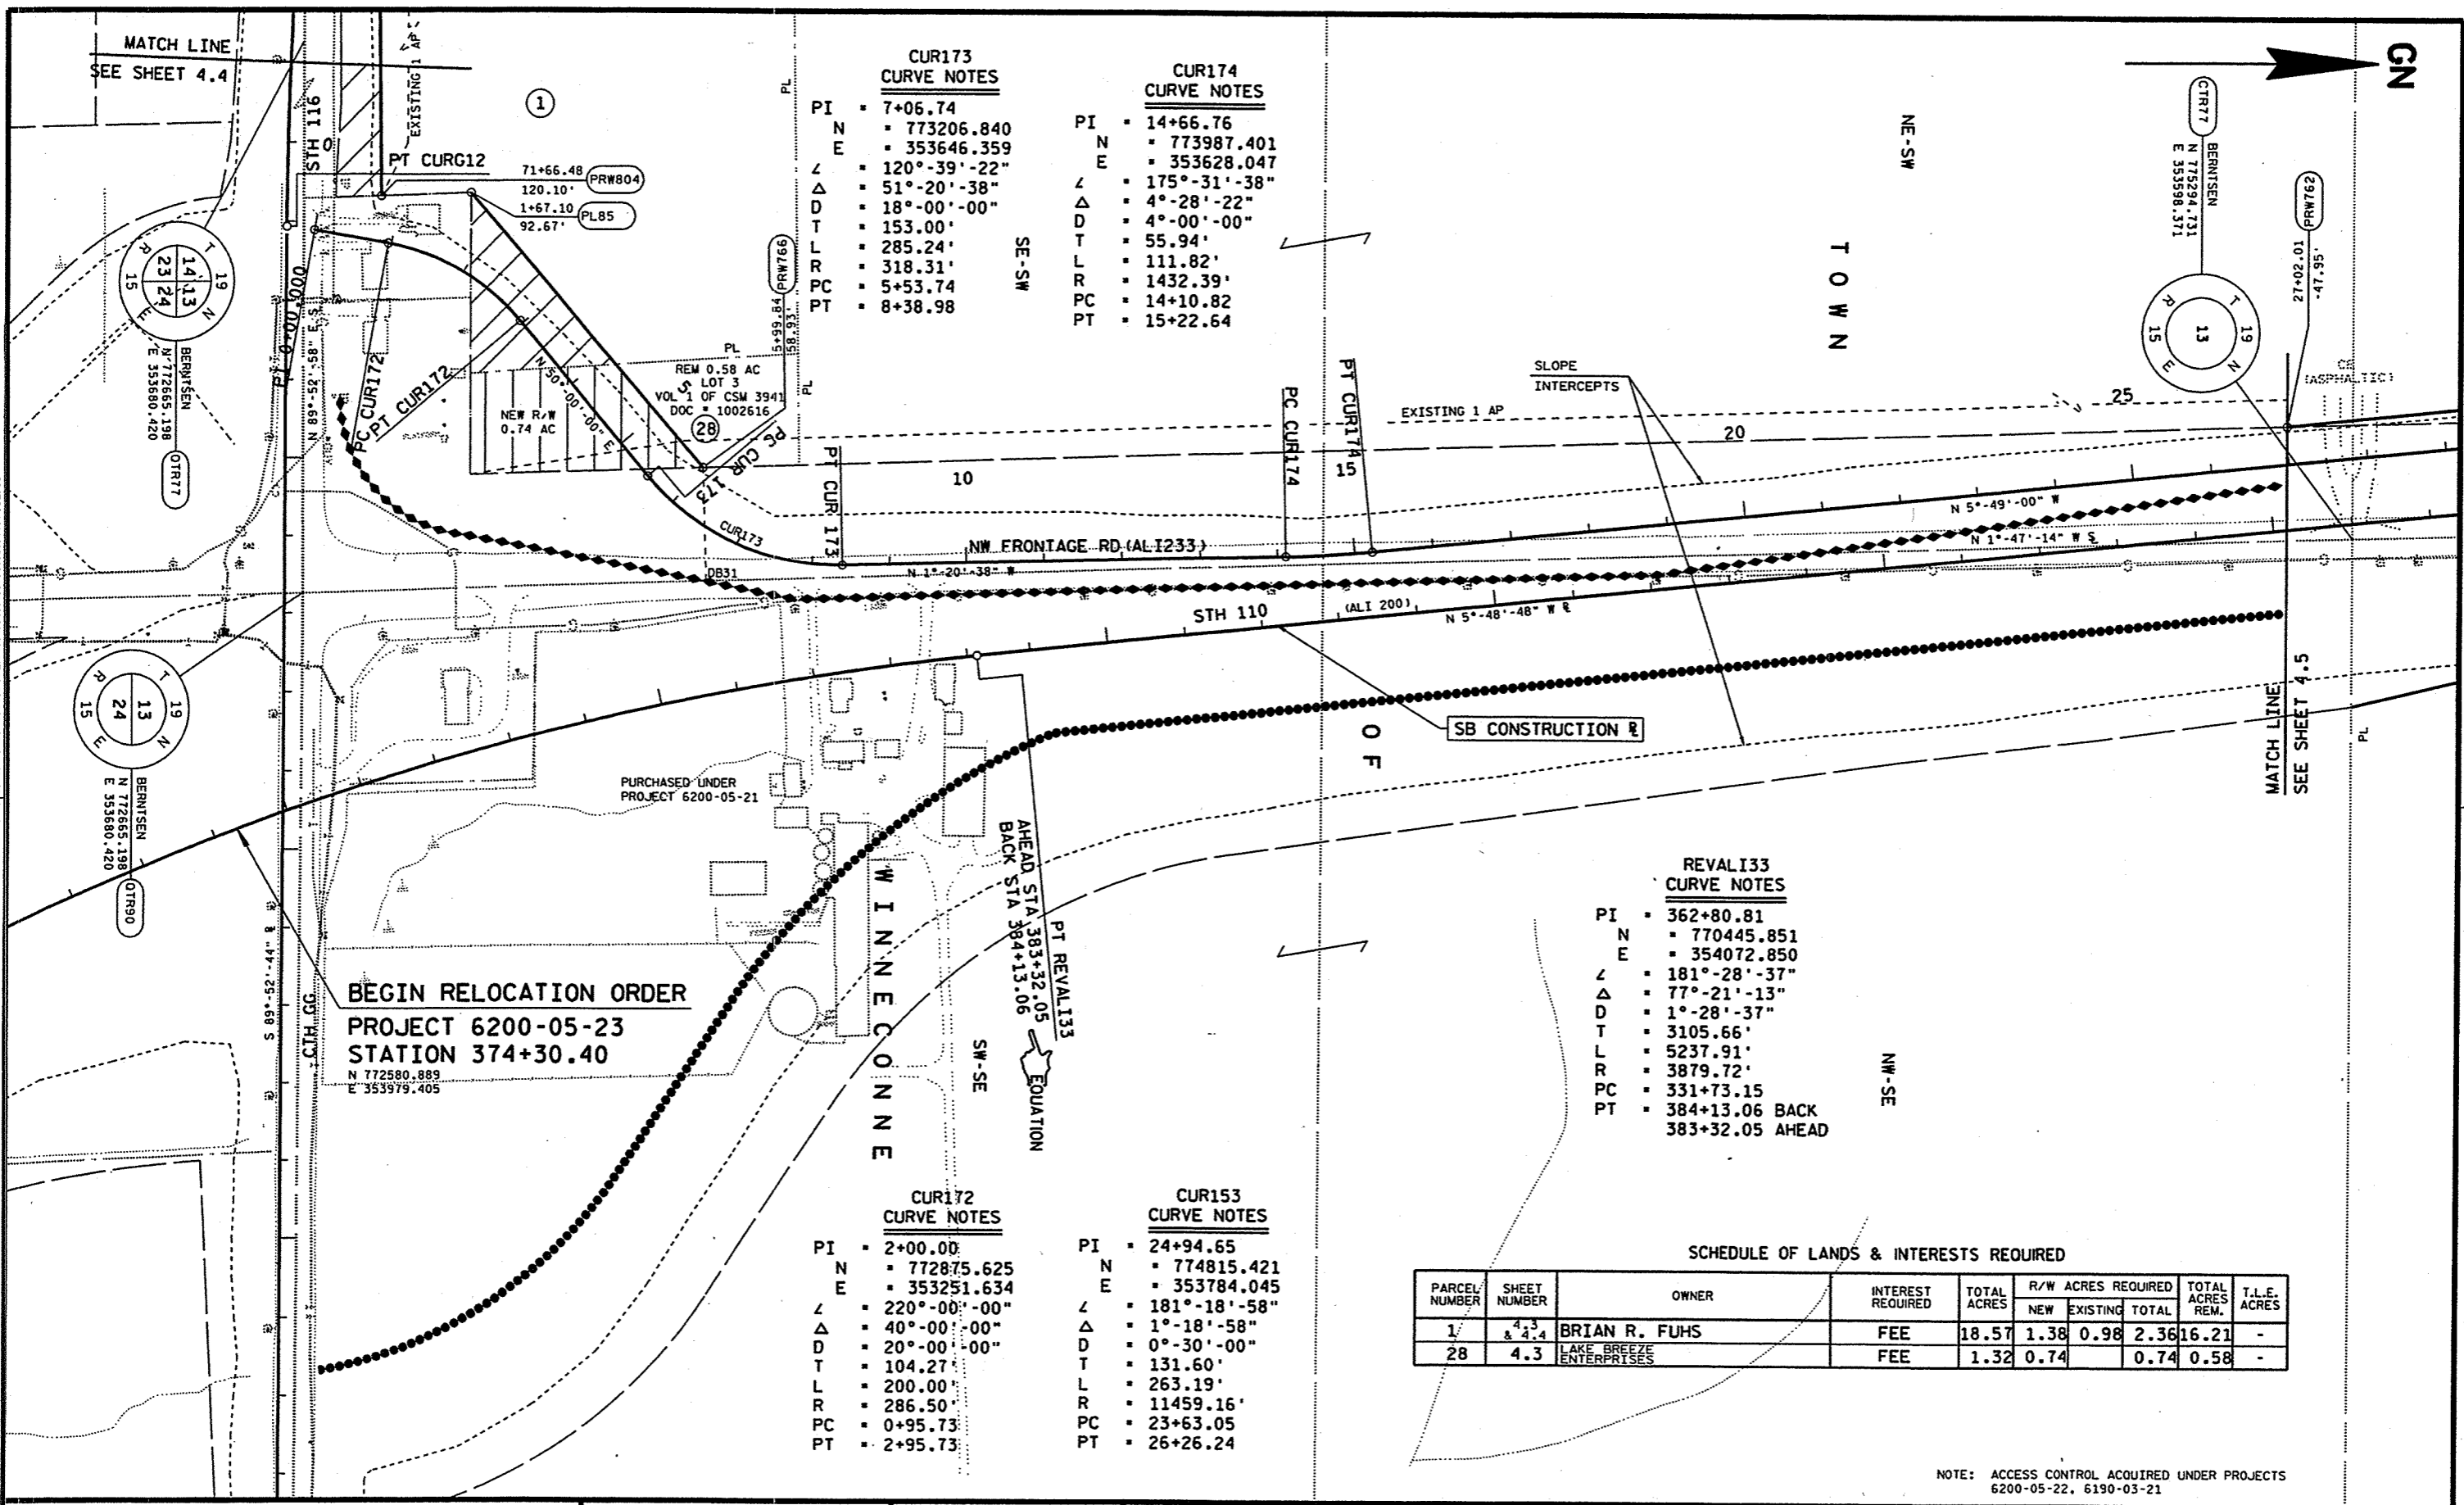

**CUR173
CURVE NOTES**
 PI = 7+06.74
 N = 773206.840
 E = 353646.359
 Δ = 120°-39'-22"
 D = 51°-20'-38"
 T = 18°-00'-00"
 L = 153.00'
 R = 285.24'
 PC = 318.31'
 PT = 5+53.74
 SE-SW

**CUR174
CURVE NOTES**
 PI = 14+66.76
 N = 773987.401
 E = 353628.047
 Δ = 175°-31'-38"
 D = 4°-28'-22"
 T = 4°-00'-00"
 L = 55.94'
 R = 111.82'
 PC = 1432.39'
 PT = 14+10.82
 NE-SW

**CUR172
CURVE NOTES**
 PI = 2+00.00
 N = 772875.625
 E = 353251.634
 Δ = 220°-00'-00"
 D = 40°-00'-00"
 T = 20°-00'-00"
 L = 104.27'
 R = 200.00'
 PC = 286.50'
 PT = 0+95.73
 SW-SE

**CUR153
CURVE NOTES**
 PI = 24+94.65
 N = 774815.421
 E = 353784.045
 Δ = 181°-18'-58"
 D = 1°-18'-58"
 T = 0°-30'-00"
 L = 131.60'
 R = 263.19'
 PC = 11459.16'
 PT = 23+63.05
 SW-SE

**REVAL133
CURVE NOTES**
 PI = 362+80.81
 N = 770445.851
 E = 354072.850
 Δ = 181°-28'-37"
 D = 77°-21'-13"
 T = 1°-28'-37"
 L = 3105.66'
 R = 5237.91'
 PC = 3879.72'
 PT = 331+73.15
 384+13.06 BACK
 383+32.05 AHEAD
 NW-SE

SCHEDULE OF LANDS & INTERESTS REQUIRED

PARCEL NUMBER	SHEET NUMBER	OWNER	INTEREST REQUIRED	TOTAL ACRES	R/W ACRES REQUIRED			TOTAL ACRES REM.	T.L.E. ACRES
					NEW	EXISTING	TOTAL		
1/	4.3 & 4.4	BRIAN R. FUHS	FEE	18.57	1.38	0.98	2.36	16.21	-
28	4.3	LAKE BREEZE ENTERPRISES	FEE	1.32	0.74		0.74	0.58	-


NOTE: ACCESS CONTROL ACQUIRED UNDER PROJECTS 6200-05-22, 6190-03-21

REVISION DATE	DATE: 8-4-99	SCALE: FEET 0 100 200	HWY: STH 110	CONSTRUCTION PROJECT NUMBER: 6200-05-71	PS&E SHEET NO: 4.36
	GRID FACTOR: 0.999997		COUNTY: WINNEBAGO	STATE R/W PROJECT NUMBER: 6200-05-23	PLAT SHEET NO: 4.3

SCHEDULE OF LANDS & INTERESTS REQUIRED

PARCEL NUMBER	SHEET NUMBER	OWNER	INTEREST REQUIRED	TOTAL ACRES	R/W ACRES REQUIRED			TOTAL ACRES REM.	T.L.E. ACRES
					NEW	EXISTING	TOTAL		
1	4.3 & 4.9	BRIAN R. FUHS	FEE	SEE SHEET	4.3				-
15	4.4	ROBERT W. FUHS & BRIGITTE FUHS	FEE	0.78	0.22		0.22	0.56	-
24	4.4	JAMES & MARY SELLE	FEE	147.4	0.06	0.30	0.36	147.04	-
100	4.4, 4.5, & 4.9	AMERITECH (43)	RELEASE OF RIGHTS						

CURG11 CURVE NOTES		CURG12 CURVE NOTES	
PI	65+50.00	PI	70+25.89
N	772674.060	N	772643.055
E	352556.866	E	353031.801
∠	183°-36'-50"	∠	177°-31'-28"
Δ	3°-36'-50"	Δ	3°-36'-50"
D	2°-00'-00"	D	1°-00'-00"
T	90.38'	T	180.75'
L	180.69'	L	361.39'
R	2864.79'	R	5729.58'
PC	64+59.62	PC	68+45.13
PT	66+40.32	PT	72+06.52

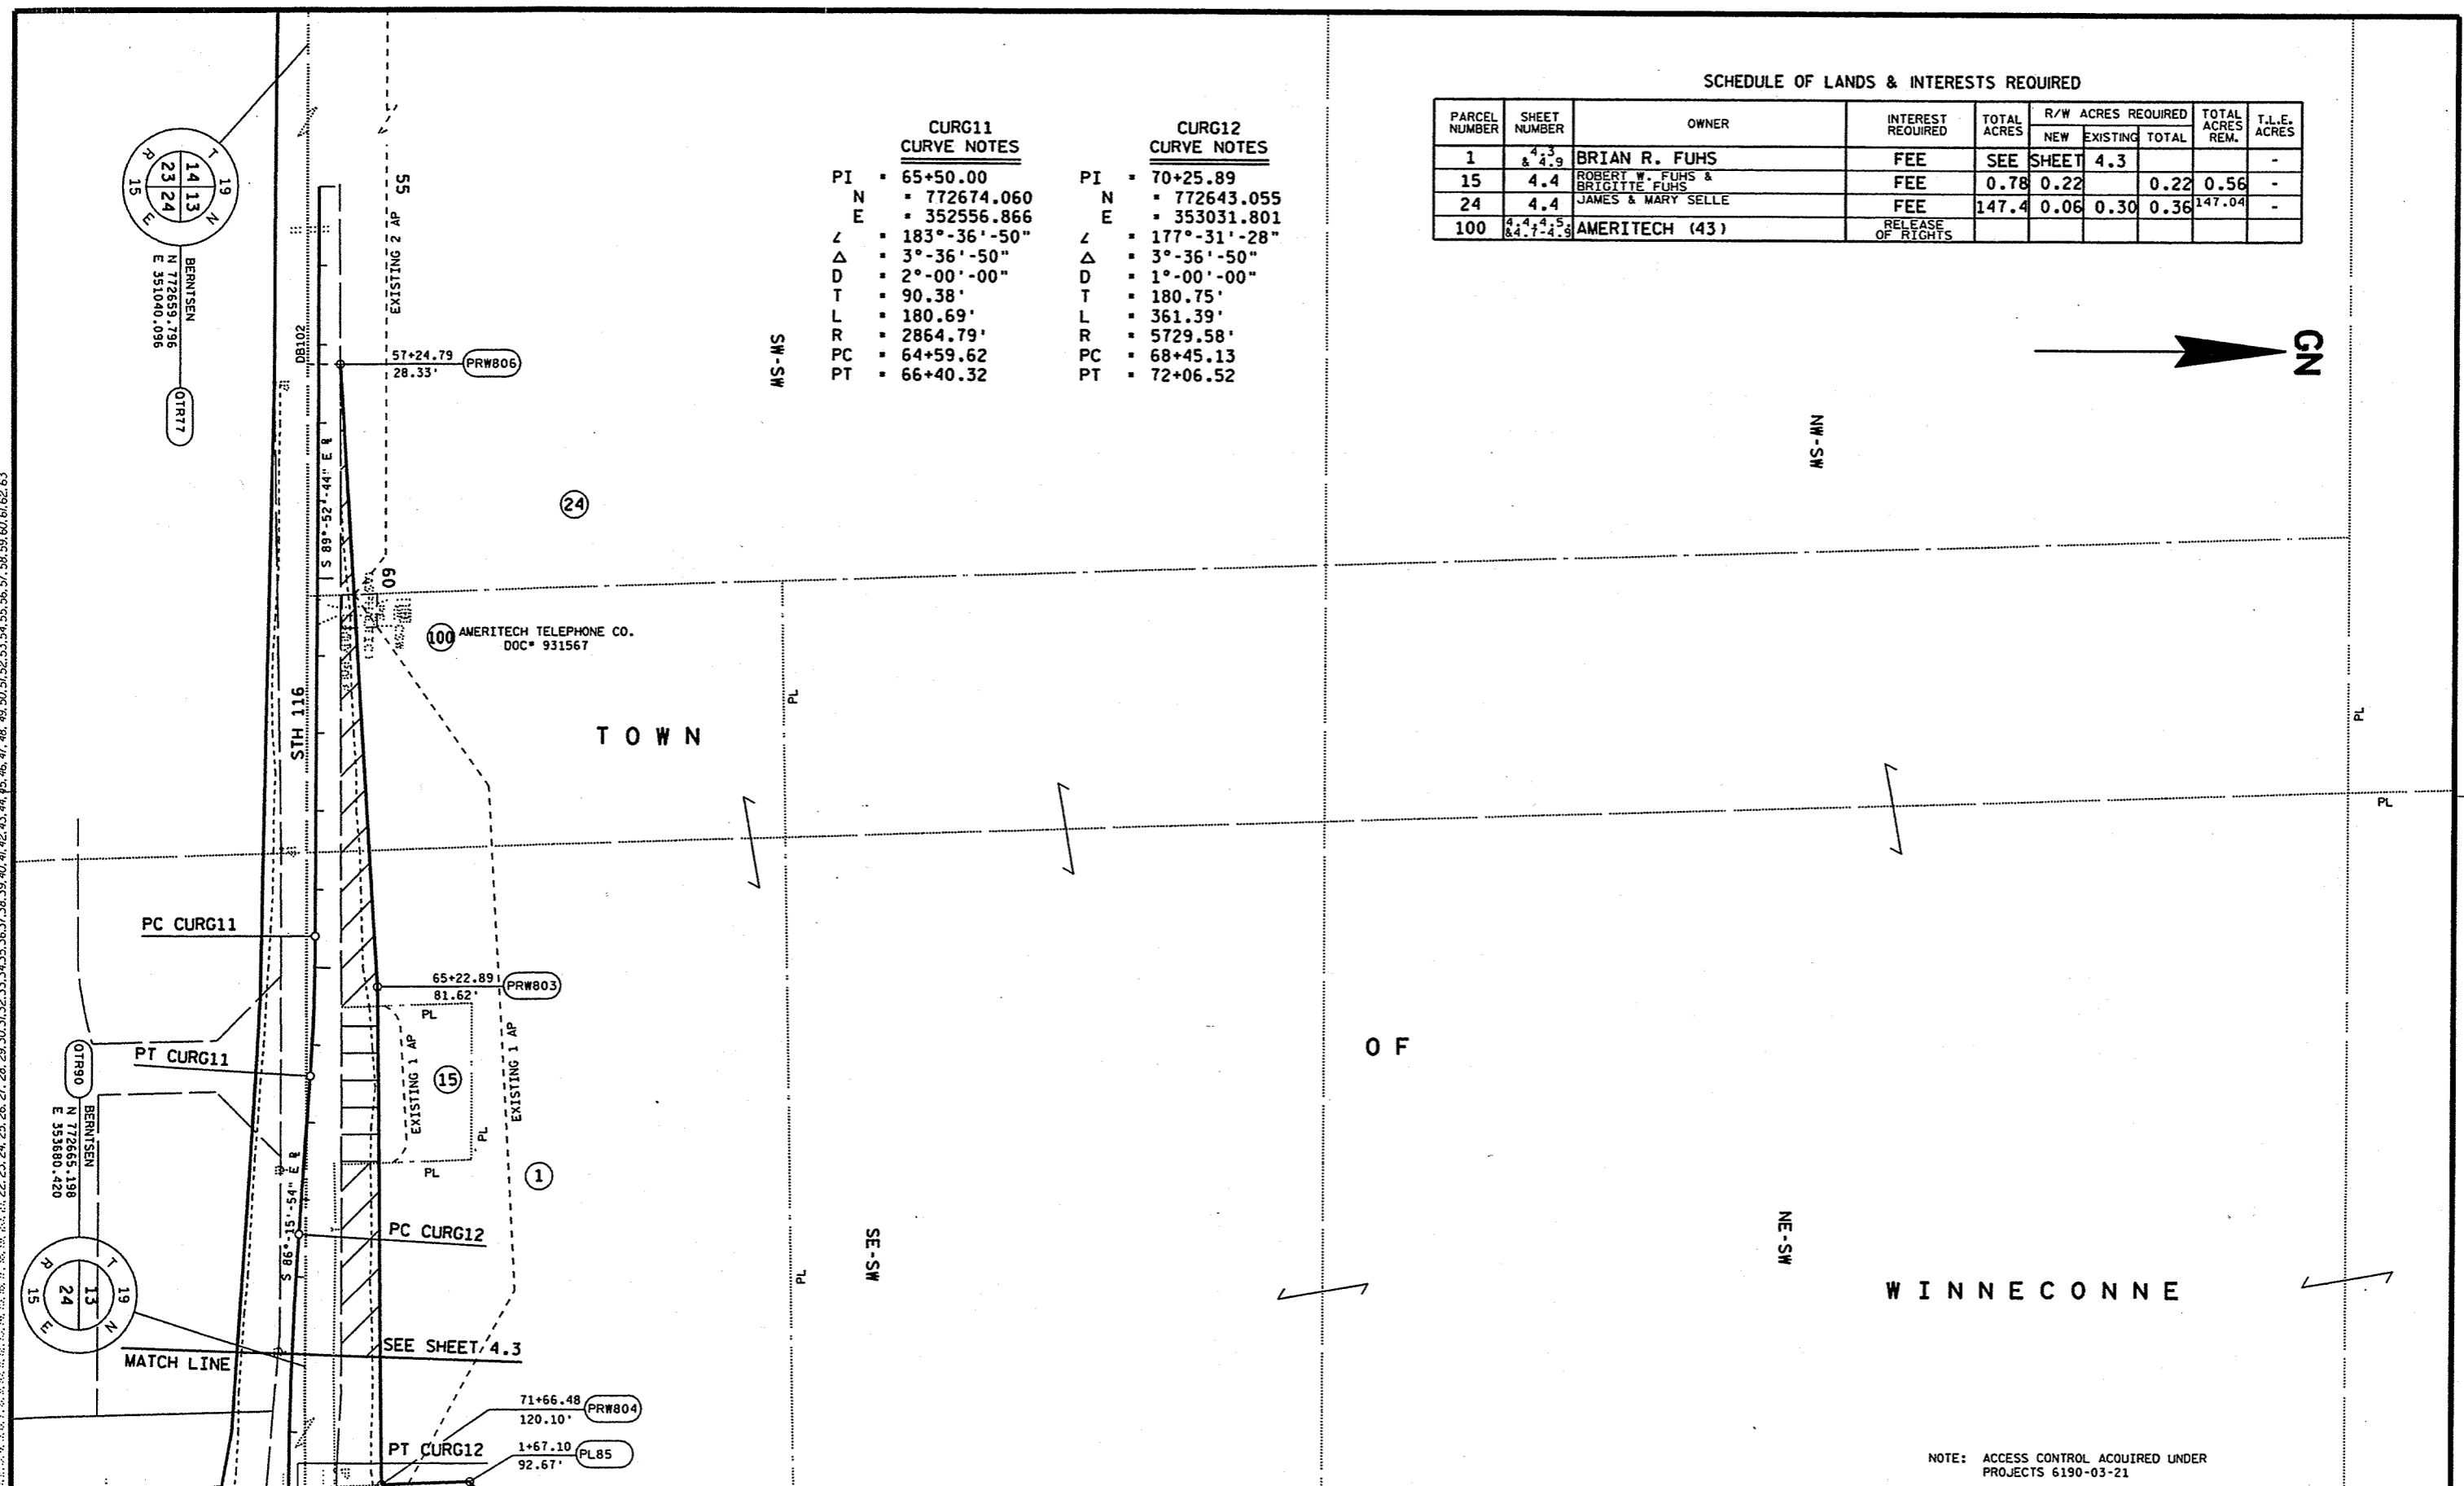

LEVELS ON 1.2, 1.3, 1.4, 6.2, 6.3

NOTE: ACCESS CONTROL ACQUIRED UNDER PROJECTS 6190-03-21

REVISION DATE	DATE: 8-4-99	SCALE, FEET 0 100 200	HWY: STH 110	CONSTRUCTION PROJECT NUMBER: 6200-05-71	PS&E SHEET NO: 4.37
	GRID FACTOR: 0.999997		COUNTY: WINNEBAGO	STATE R/W PROJECT NUMBER: 6200-05-23	PLAT SHEET NO: 4.4

TOWN

SCHEDULE OF LANDS & INTERESTS REQUIRED

PARCEL NUMBER	SHEET NUMBER	OWNER	INTEREST REQUIRED	TOTAL ACRES	R/W ACRES REQUIRED			TOTAL ACRES REM.	T.L.E. ACRES
					NEW	EXISTING	TOTAL		
3	4.5	LAKE BREEZE LCC	FEE & ACCESS	151.82	2.17	11.14	13.31	149.82	-
4	4.5	LAKE BREEZE ENTERPRISES	FEE	7.53	2.46	-	2.46	5.07	-
5	4.5	ROBERT CAROL BEISER	FEE	38.00	2.87	1.16	4.03	35.13	-
6	4.5	ROBERT R. & MURIEL T. RADTKE	FEE & TLE	20.21	0.03	0.34	0.37	19.84	0.03
8	4.5	CEMETERY	TLE	3.00	-	-	-	3.00	0.03
9	4.5	PAUL T. WINTER	FEE	1.05	0.22	0.23	0.45	0.60	-
100	4.4, 4.5, 4.6, 4.7, 4.8	AMERITECH (43)	RELEASE OF RIGHTS	-	-	-	-	-	-

CUR182 CURVE NOTES

PI = 46+98.29
 N = 777006.568
 E = 353549.656
 Δ = 183°-59'-04"
 Δ = 3°-59'-04"
 D = 0°-45'-00"
 T = 265.74'
 L = 531.56'
 R = 7639.44'
 PC = 44+32.55
 PT = 49+63.81

CUR175 CURVE NOTES

PI = 47+96.44
 N = 777299.994
 E = 353290.591
 Δ = 166°-51'-01"
 Δ = 13°-08'-59"
 D = 4°-00'-00"
 T = 165.10'
 L = 328.74'
 R = 1432.39'
 PC = 46+31.34
 PT = 49+60.08


CUR176 CURVE NOTES

PI = 54+88.74
 N = 777956.079
 E = 353065.114
 Δ = 108°-30'-26"
 Δ = 71°-29'-34"
 D = 20°-00'-00"
 T = 206.21'
 L = 357.46'
 R = 286.48'
 PC = 52+82.53
 PT = 56+39.99

REVAL134 CURVE NOTES


PI = 426+01.31
 N = 777782.837
 E = 353325.880
 Δ = 182°-34'-02"
 Δ = 33°-44'-21"
 D = 2°-34'-02"
 T = 676.79'
 L = 1314.23'
 R = 2231.83'
 PC = 419+24.52
 PT = 432+38.75

LEVELS ON - 1.2.3.4.5.6.7.8.9.10.11.12.13.14.15.16.17.18.19.20.21.22.23.24.25.26.27.28.29.30.31.32.33.34.35.36.37.38.39.40.41.42.43.44.45.46.47.48.49.50.51.52.53.54.55.56.57.58.59.60.61.62.63

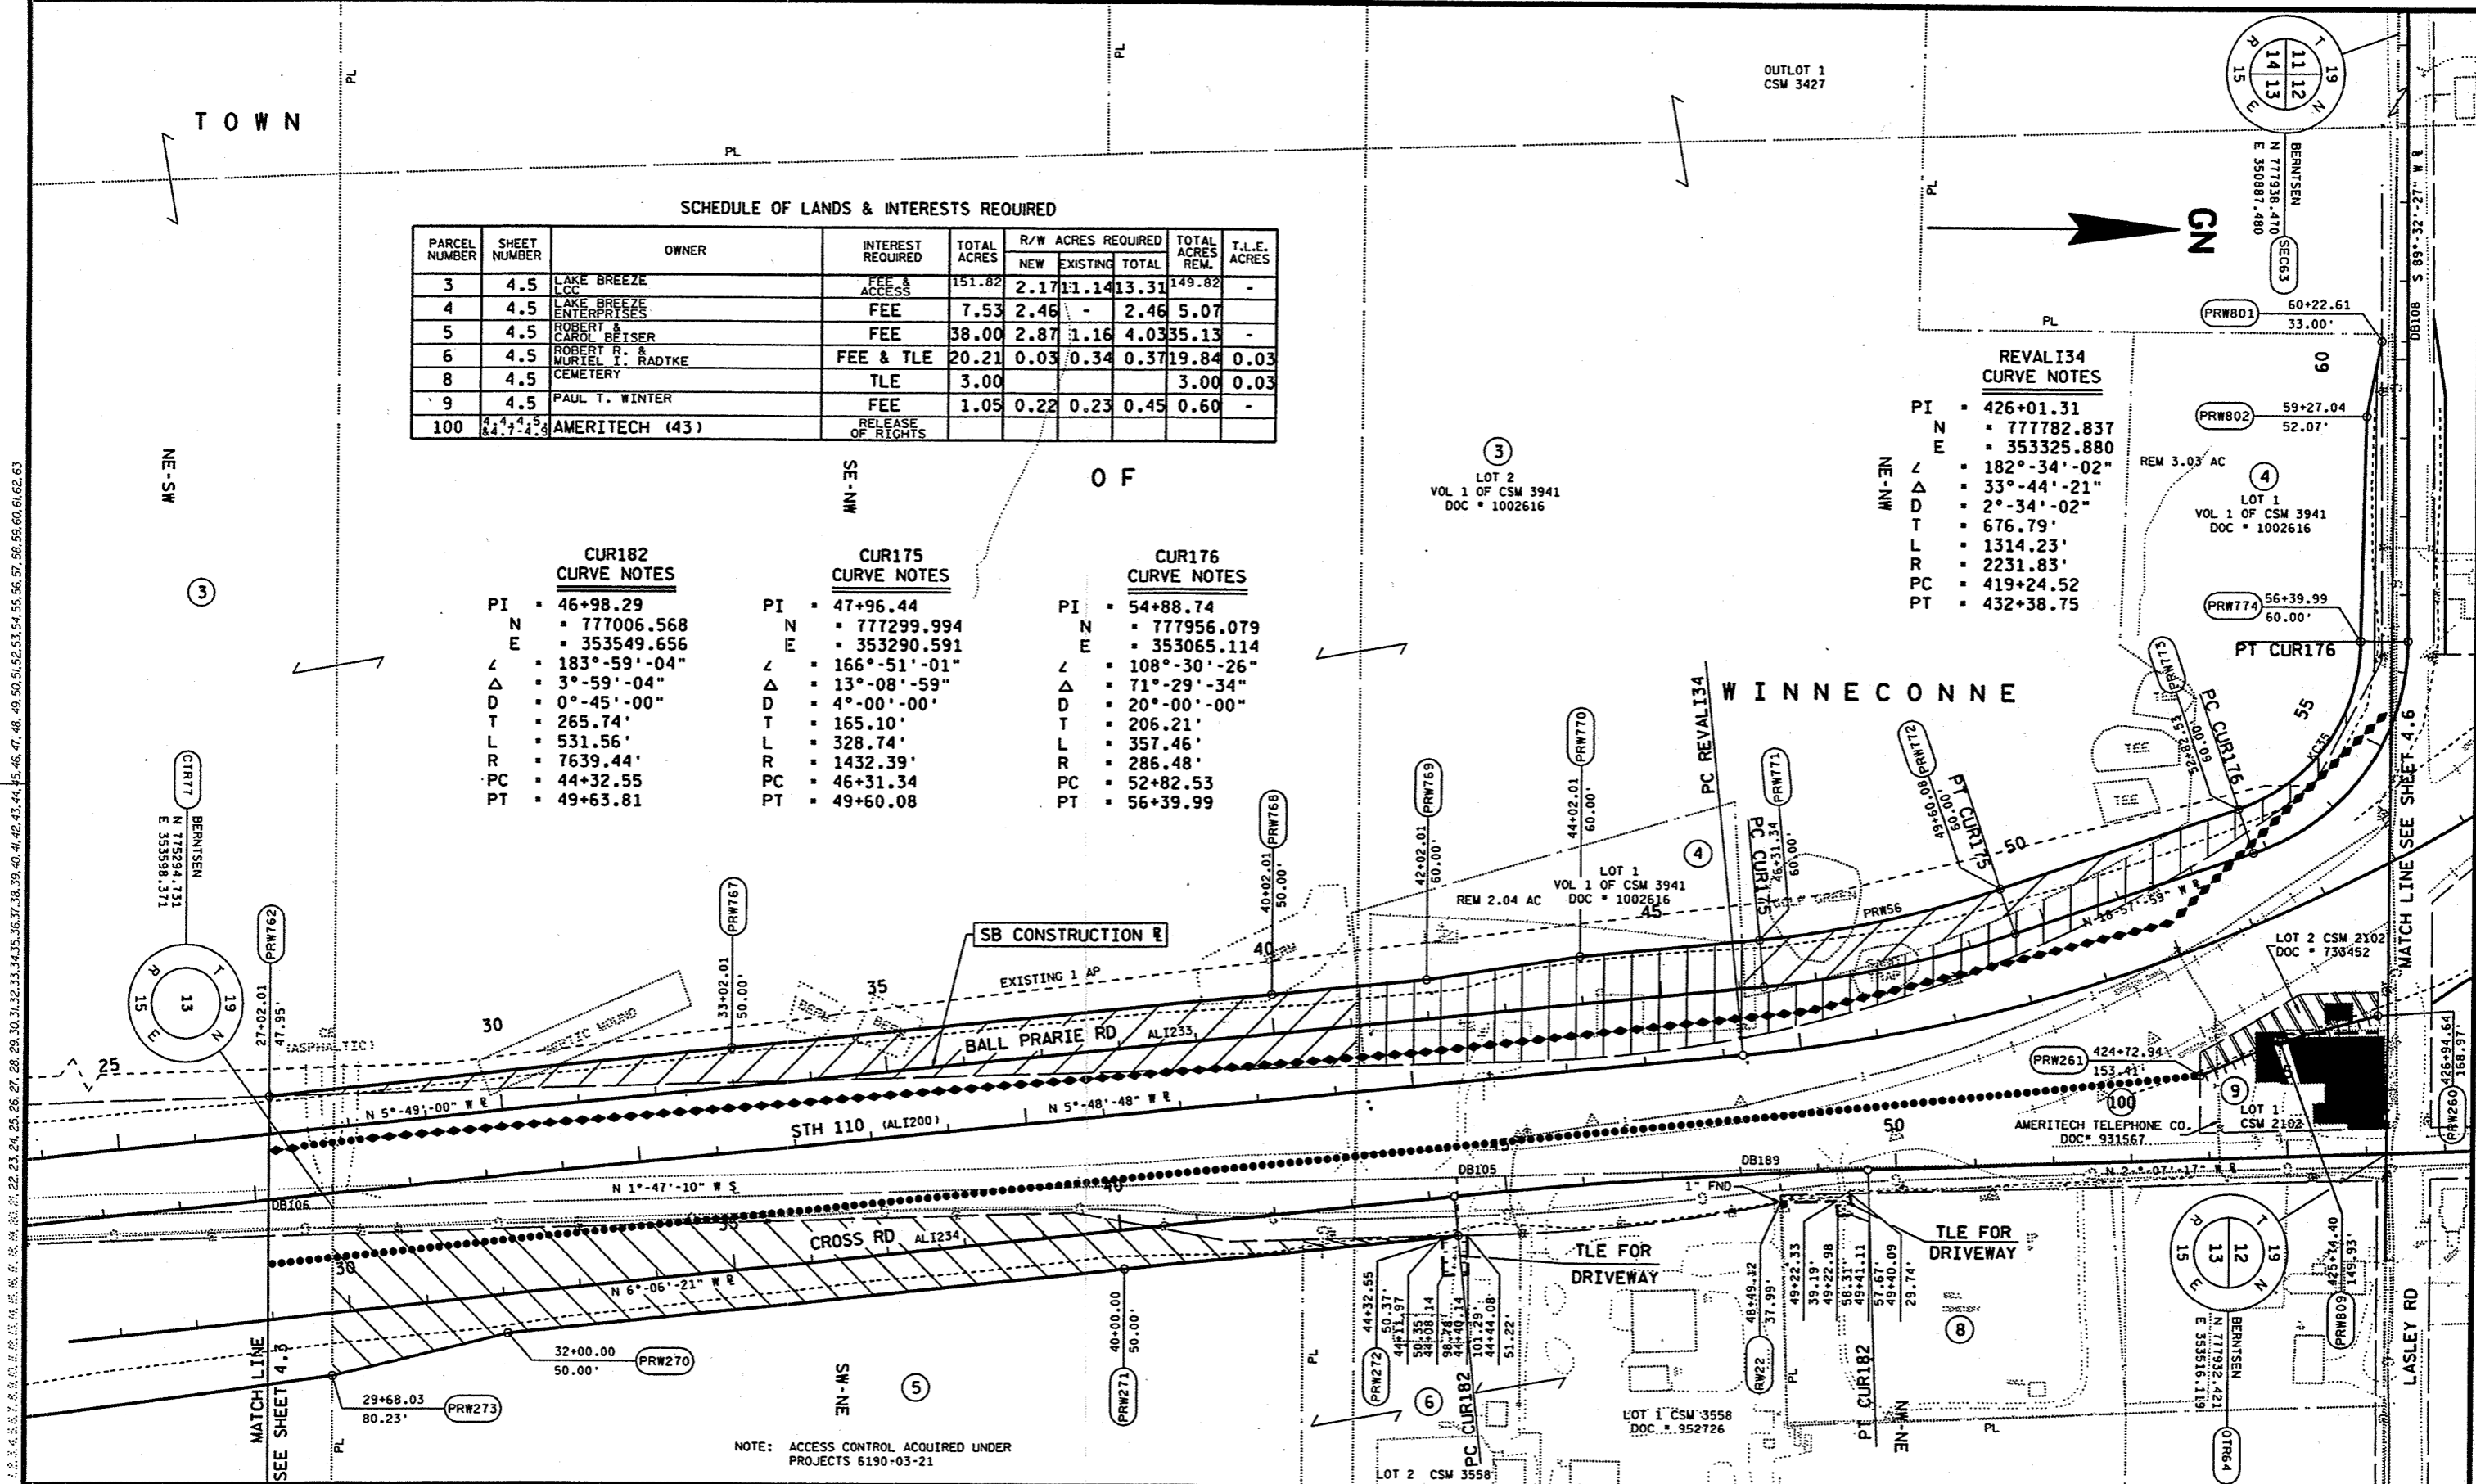

NOTE: ACCESS CONTROL ACQUIRED UNDER PROJECTS 6190-03-21

REVISION DATE	DATE: 8-4-99	SCALE, FEET 0 100 200	HWY: STH 110	CONSTRUCTION PROJECT NUMBER: 6200-05-71	PS&E SHEET NO: 4.38
	GRID FACTOR: 0.999997		COUNTY: WINNEBAGO	STATE R/W PROJECT NUMBER: 6200-05-23	PLAT SHEET NO: 4.5

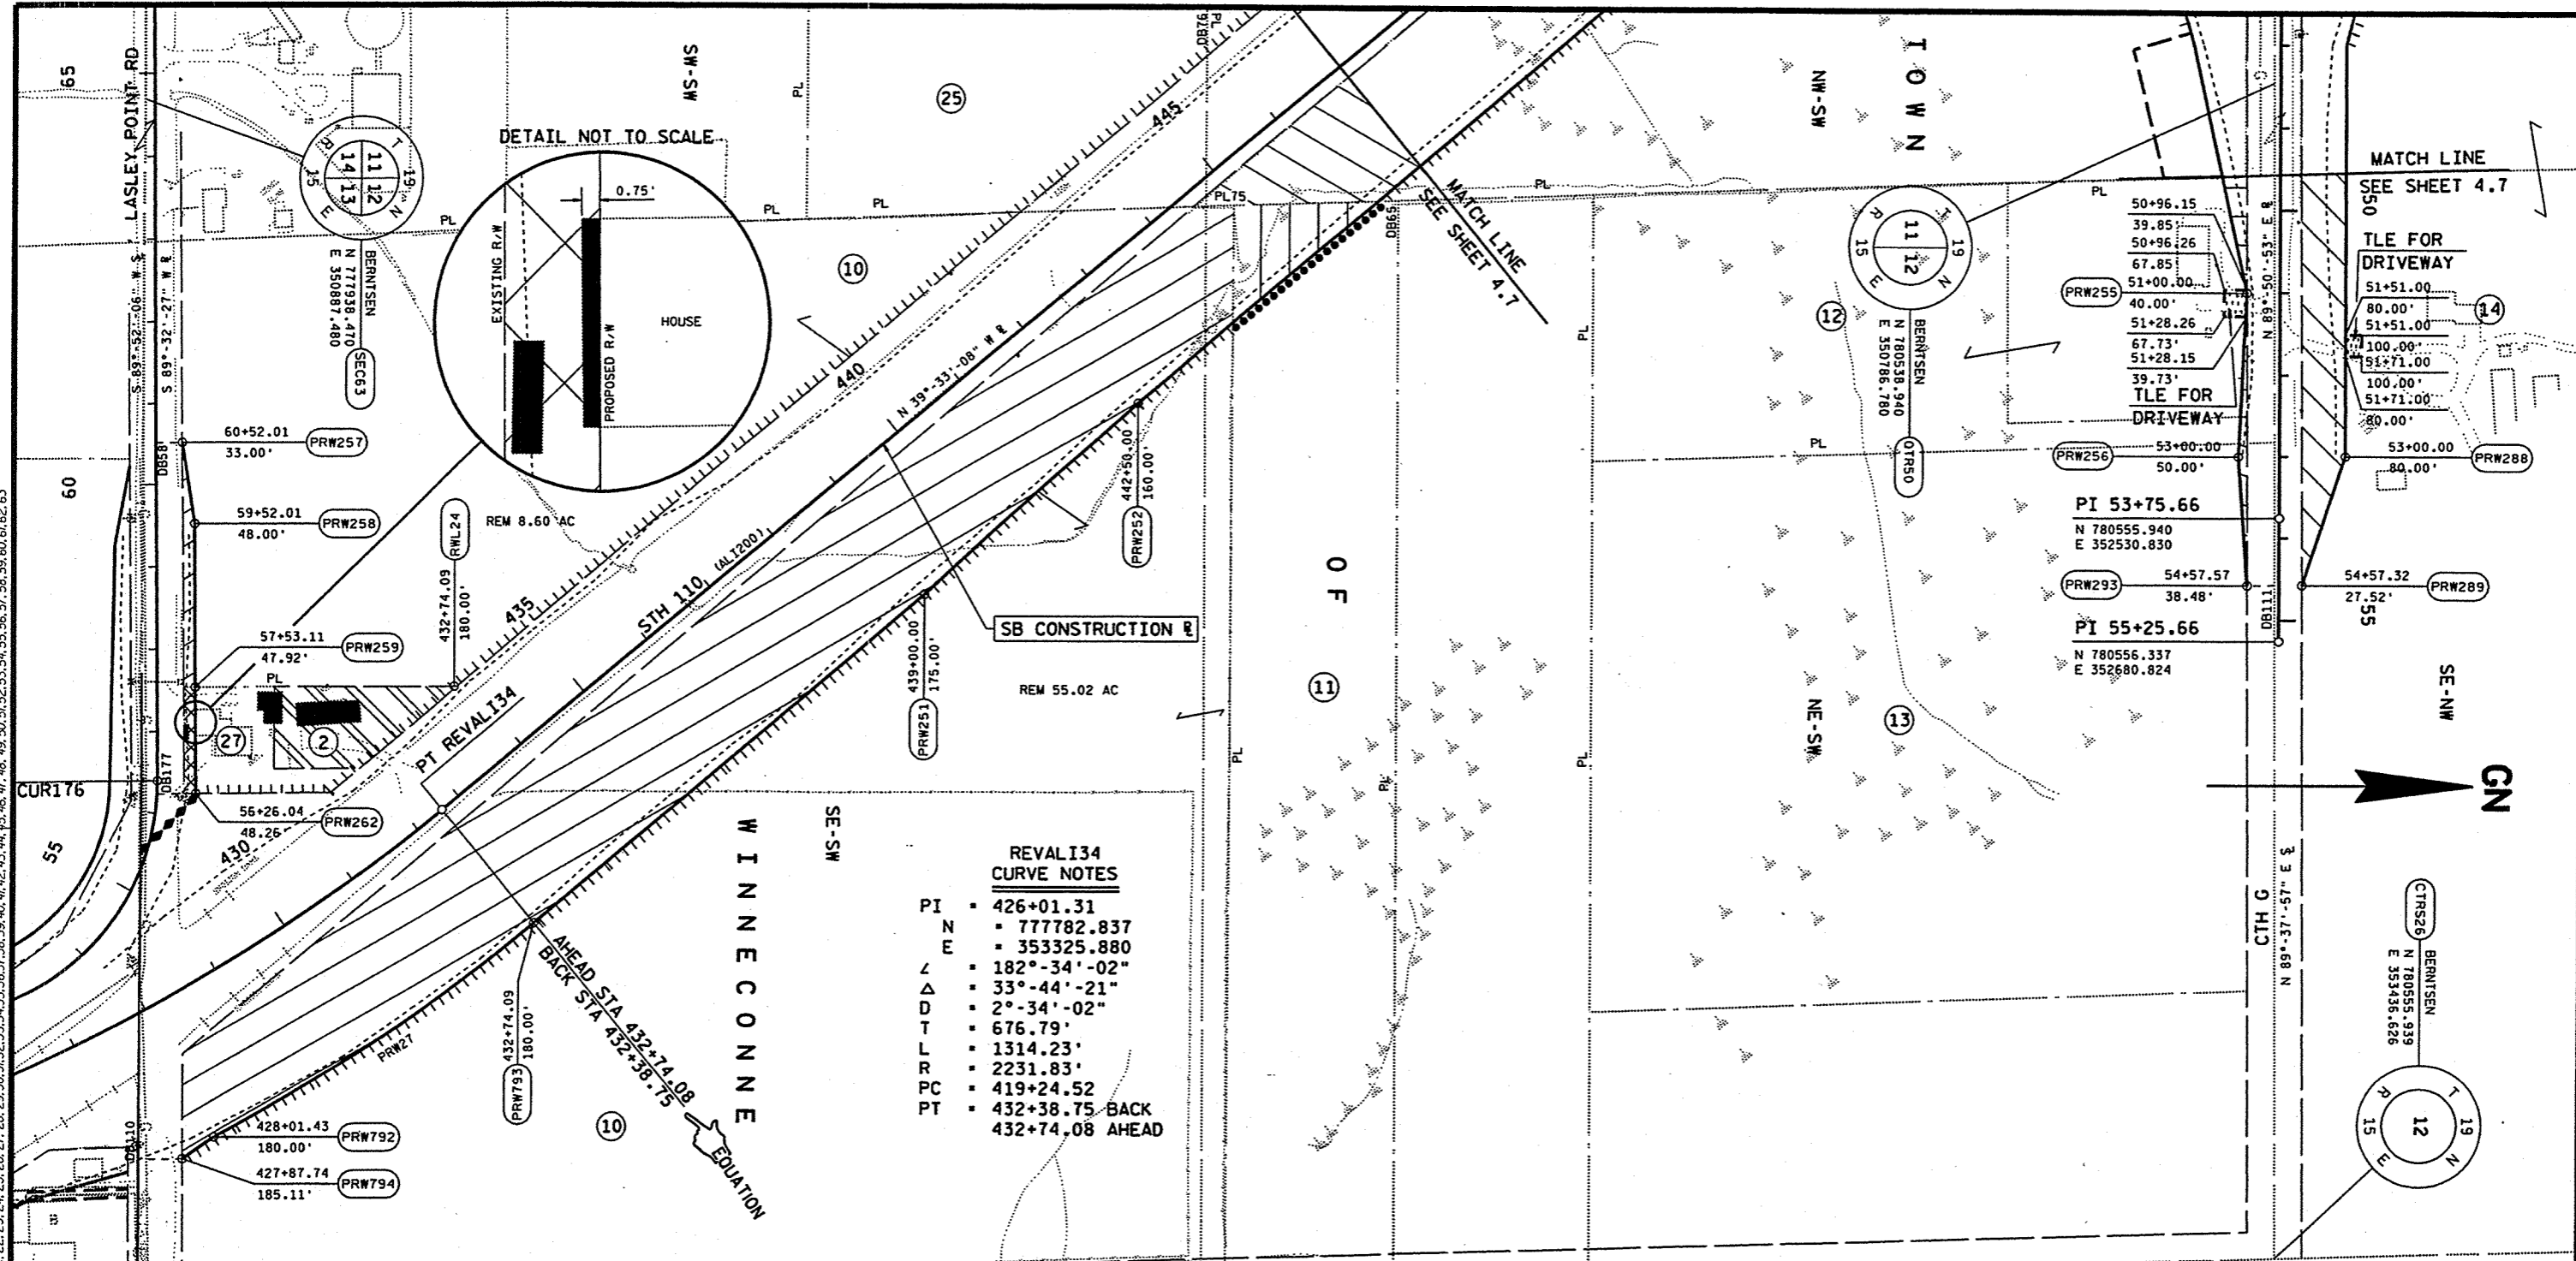

**REVAL 134
CURVE NOTES**


PI N 426+01.31
 E 777782.837
 353325.880
 Δ 182°-34'-02"
 Δ 33°-44'-21"
 D 2°-34'-02"
 T 676.79'
 L 1314.23'
 R 2231.83'
 PC 419+24.52
 PT 432+38.75 BACK
 432+74.08 AHEAD

SCHEDULE OF LANDS & INTERESTS REQUIRED

PARCEL NUMBER	SHEET NUMBER	OWNER	INTEREST REQUIRED	TOTAL ACRES	R/W ACRES REQUIRED			TOTAL ACRES REM.	T.L.E. ACRES
					NEW	EXISTING	TOTAL		
2*	4.6	RONALD D. MILLER							
10	4.6	BARBARA A. ZELLER	FEE & ACCESS	74.59	5.49	5.28	10.97	63.62	-
11	4.6	JEFFERY H. POLLET	FEE & ACCESS	7.18	0.29	0	0.29	6.89	-
12	4.6	BRUCE A. & CHERYL E. KMECHECK	FEE & TLE	5.96	0.07	0.24	0.31	5.89	0.02
13	4.6	BRIAN M. & JULIE A. HALL	FEE	12.35	0.02	0.13	0.15	12.20	-
14	4.6	FLORENCE ROMBERG	FEE, TLE & ACCESS	157.0	9.44	5.42	14.86	142.14	0.01
25	4.6	TIMOTHY J. DOEHLING & DIANE M. DOEHLING	ACCESS						
27	4.6	ALAN M. & PAULA S. LONG	FEE & ACCESS	0.84	0.04	0.46	0.50	0.34	-

* PARCEL ACQUIRED DOCUMENT NUMBER 1039886 DATE: 12-23-98

REVISION DATE	DATE: 8-4-99	SCALE: FEET 0 100 200	HWY: STH 110	CONSTRUCTION PROJECT NUMBER: 6200-05-71	PS&E SHEET NO: 4.39
	GRID FACTOR: 0.999997		COUNTY: WINNEBAGO	STATE R/W PROJECT NUMBER: 6200-05-23	PLAT SHEET NO: 4.6

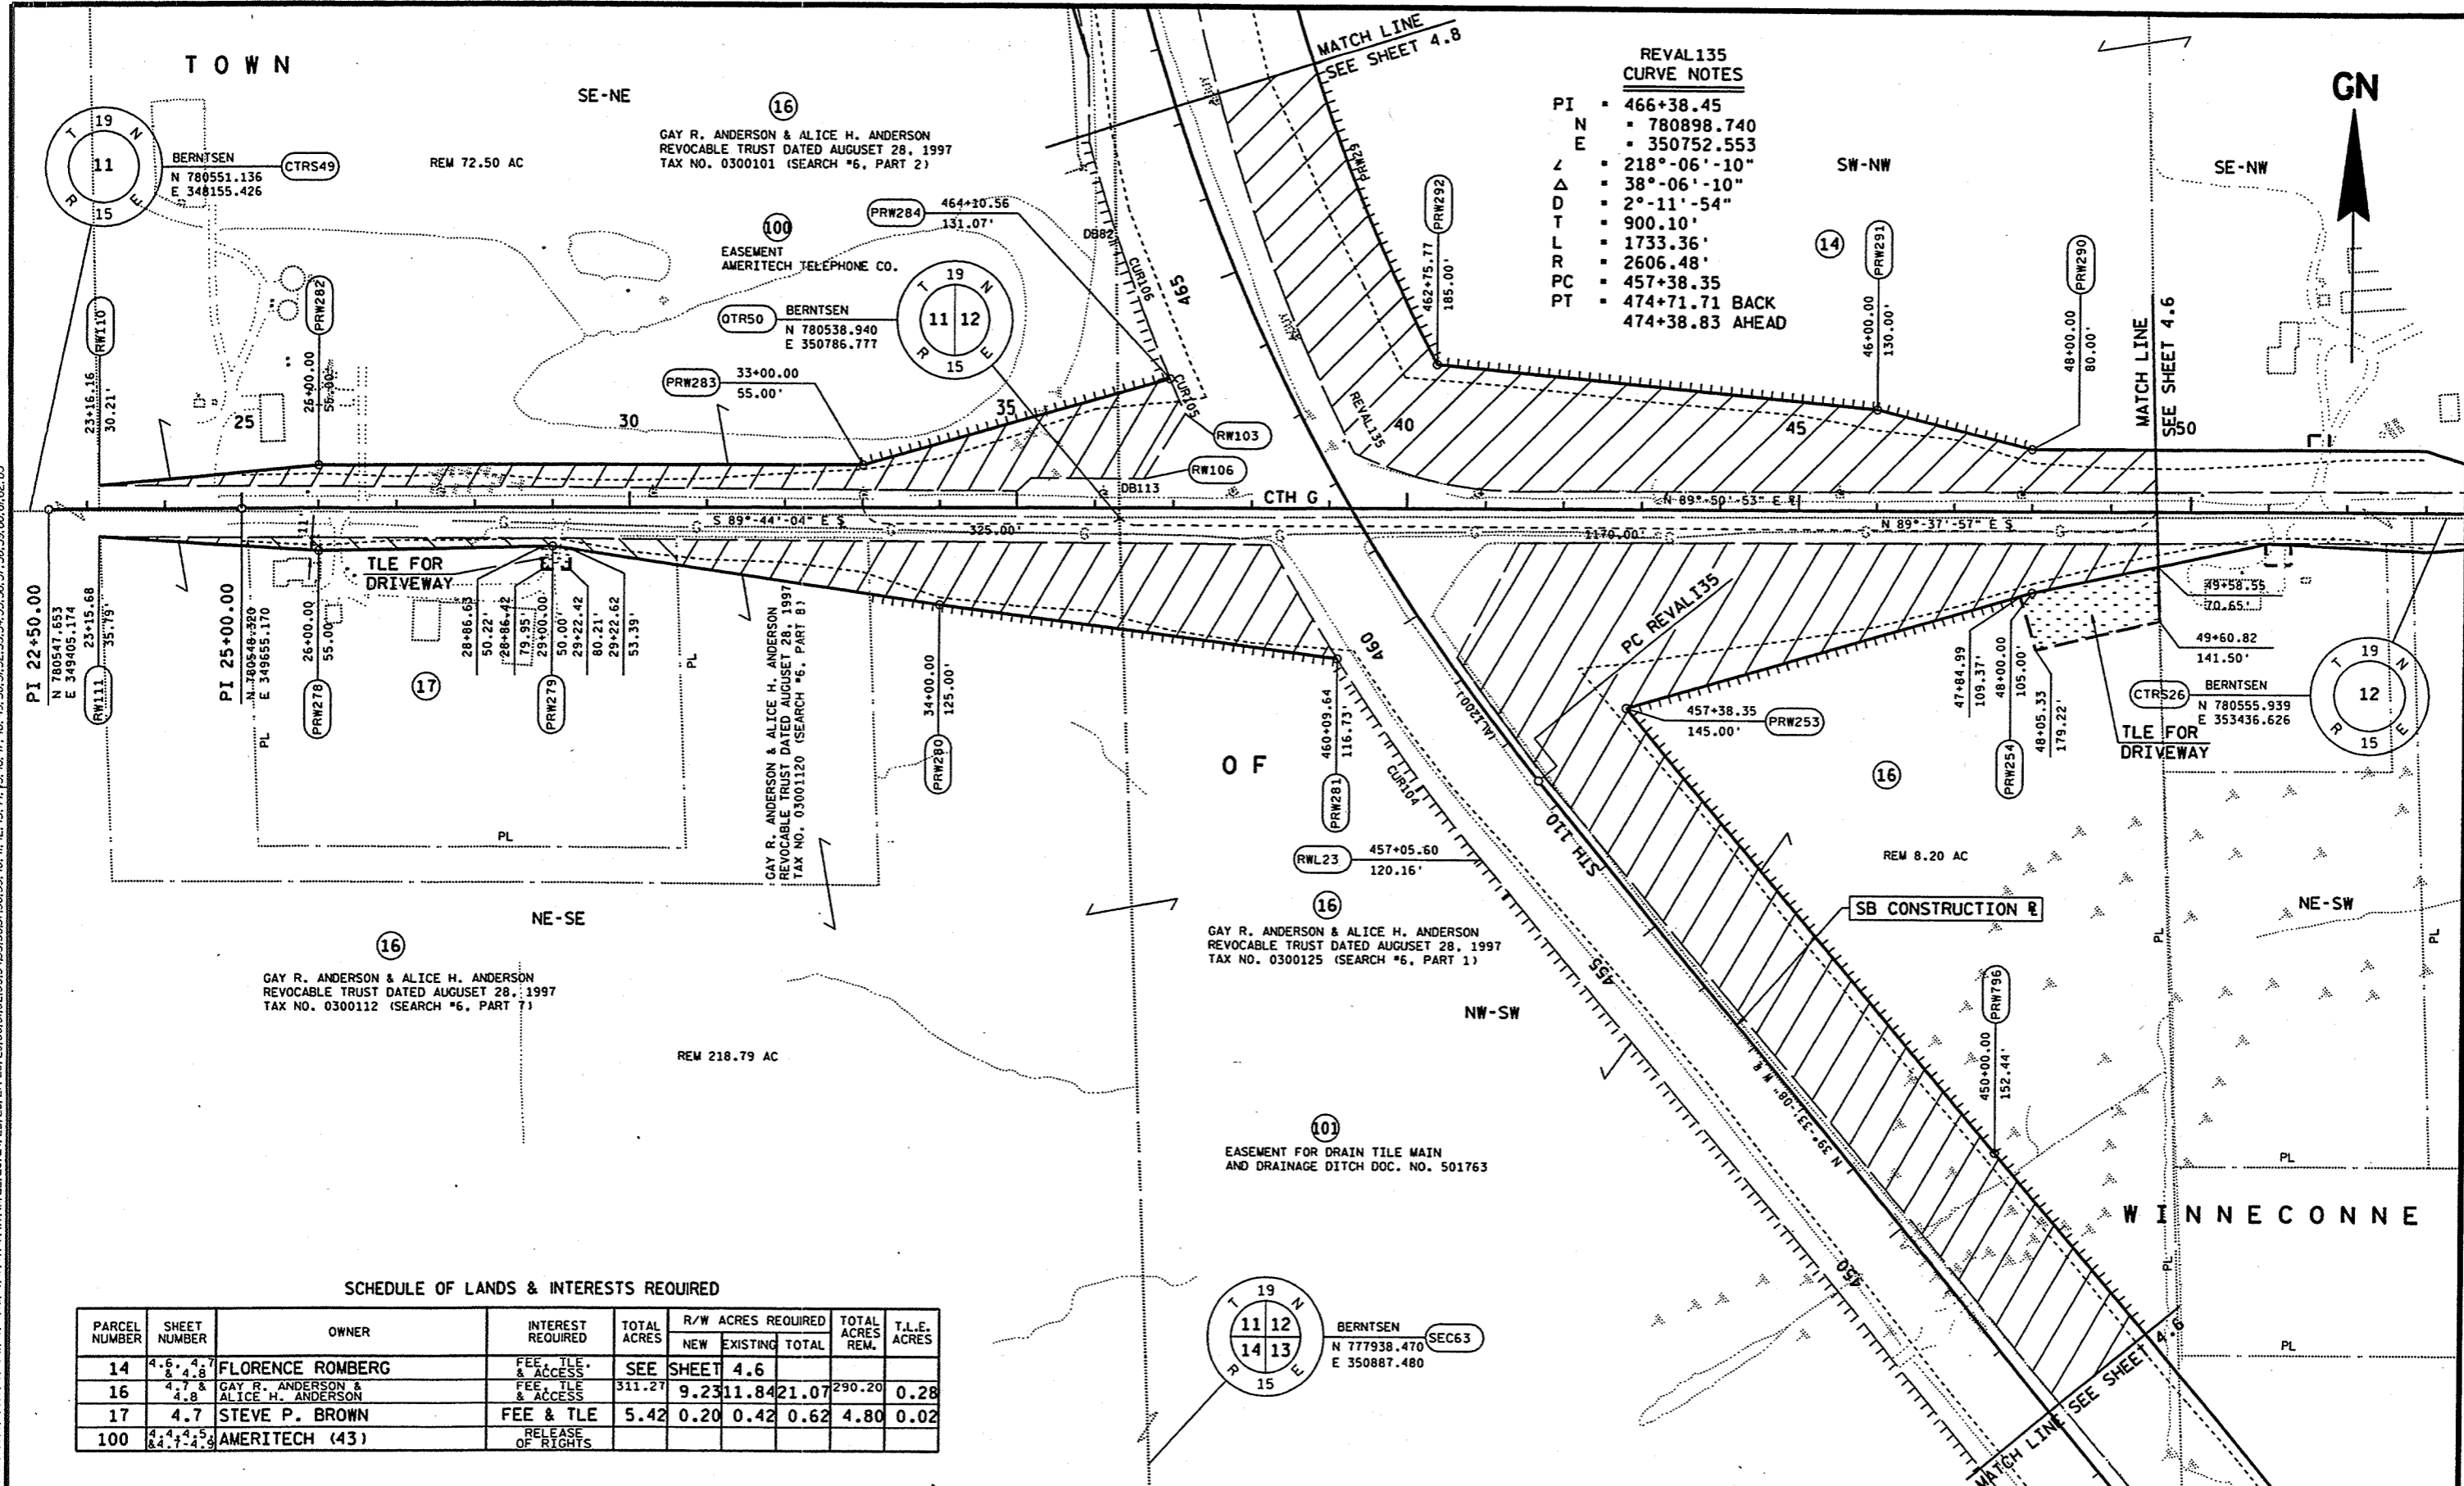

REVAL 135 CURVE NOTES

PI	466+38.45
N	780898.740
E	350752.553
∠	218°-06'-10"
Δ	38°-06'-10"
D	2°-11'-54"
T	900.10'
L	1733.36'
R	2606.48'
PC	457+38.35
PT	474+71.71 BACK 474+38.83 AHEAD

SCHEDULE OF LANDS & INTERESTS REQUIRED

PARCEL NUMBER	SHEET NUMBER	OWNER	INTEREST REQUIRED	TOTAL ACRES	R/W ACRES REQUIRED			TOTAL ACRES REM.	T.L.E. ACRES
					NEW	EXISTING	TOTAL		
14	4.6, 4.7 & 4.8	FLORENCE ROMBERG	FEE, TILE & ACCESS	SEE SHEET 4.6					
16	4.7 & 4.8	GAY R. ANDERSON & ALICE H. ANDERSON	FEE, TILE & ACCESS	311.27	9.23	11.84	21.07	290.20	0.28
17	4.7	STEVE P. BROWN	FEE & TILE	5.42	0.20	0.42	0.62	4.80	0.02
100	4.4, 4.5 & 4.7-4.8	AMERITECH (43)	RELEASE OF RIGHTS						

REVISION DATE	DATE: 8-4-99	SCALE, FEET 0 100 200	HWY: STH 110	CONSTRUCTION PROJECT NUMBER: 6200-05-71	PS&E SHEET NO: 440
	GRID FACTOR: 0.999997		COUNTY: WINNEBAGO	STATE R/W PROJECT NUMBER: 6200-05-23	PLAT SHEET NO: 4.7

LEVELS ON - 1, 2, 3, 62, 63

TOWN

GN

**REVAL135
CURVE NOTES**
 PI = 466+38.45
 N = 780898.740
 E = 350752.553
 Δ = 218°-06'-10"
 Δ = 38°-06'-10"
 D = 2°-11'-54"
 T = 900.10'
 L = 1733.36'
 R = 2606.48'
 PC = 457+38.35
 PT = 474+71.71 BACK
 474+38.83 AHEAD

**PRW29
CURVE NOTES**
 PI = 20+02.62
 N = 781237.930
 E = 350929.030
 Δ = 206°-17'-21"
 Δ = 26°-17'-21"
 D = 2°-21'-58"
 T = 565.48'
 L = 1111.05'
 R = 2421.48'
 PC = 14+37.13
 PT = 25+48.19

SCHEDULE OF LANDS & INTERESTS REQUIRED

PARCEL NUMBER	SHEET NUMBER	OWNER	INTEREST REQUIRED	TOTAL ACRES	R/W ACRES REQUIRED			TOTAL ACRES REM.	T.L.E. ACRES
					NEW	EXISTING	TOTAL		
14	4.6, 4.7 & 4.8	FLORENCE ROMBERG	FEE, TLE & ACCESS	SEE SHEET	4.6				
16	4.7 & 4.8	GAY R. ANDERSON & ALICE H. ANDERSON	FEE, TLE & ACCESS	SEE SHEET	4.7				
100	4.4, 4.5 & 4.9	AMERITECH (43)	RELEASE OF RIGHTS						
101	4.8 & 4.9	WISCONSIN PUBLIC SERVICE CORPORATION (44)	RELEASE OF RIGHTS						

REN 72.50 AC

10' EASEMENT
AMERITECH TELEPHONE CO.
DOC NO. 845907

SB CONSTRUCTION

O F

MATCH LINE SEE SHEET 4.9

WINNECONNE

EQUATION PT 474+71.71 BK
474+38.83 AH REVAL135

MN-MS
MATCH LINE SEE SHEET 4.7

STH 110 (ALI200) N 1°-26'-58" W R

N 1°-00'-52" W E

465

470

475

480


485

490

495

REVISION DATE	DATE: 8-4-99	SCALE, FEET 0 100 200	HWY: STH 110	CONSTRUCTION PROJECT NUMBER: 6200-05-71	PS&E SHEET NO: 4.41
	GRID FACTOR: 0.999997		COUNTY: WINNEBAGO	STATE R/W PROJECT NUMBER: 6200-05-23	PLAT SHEET NO: 4.8

LEVELS ON 1, 2, 3, 62, 63

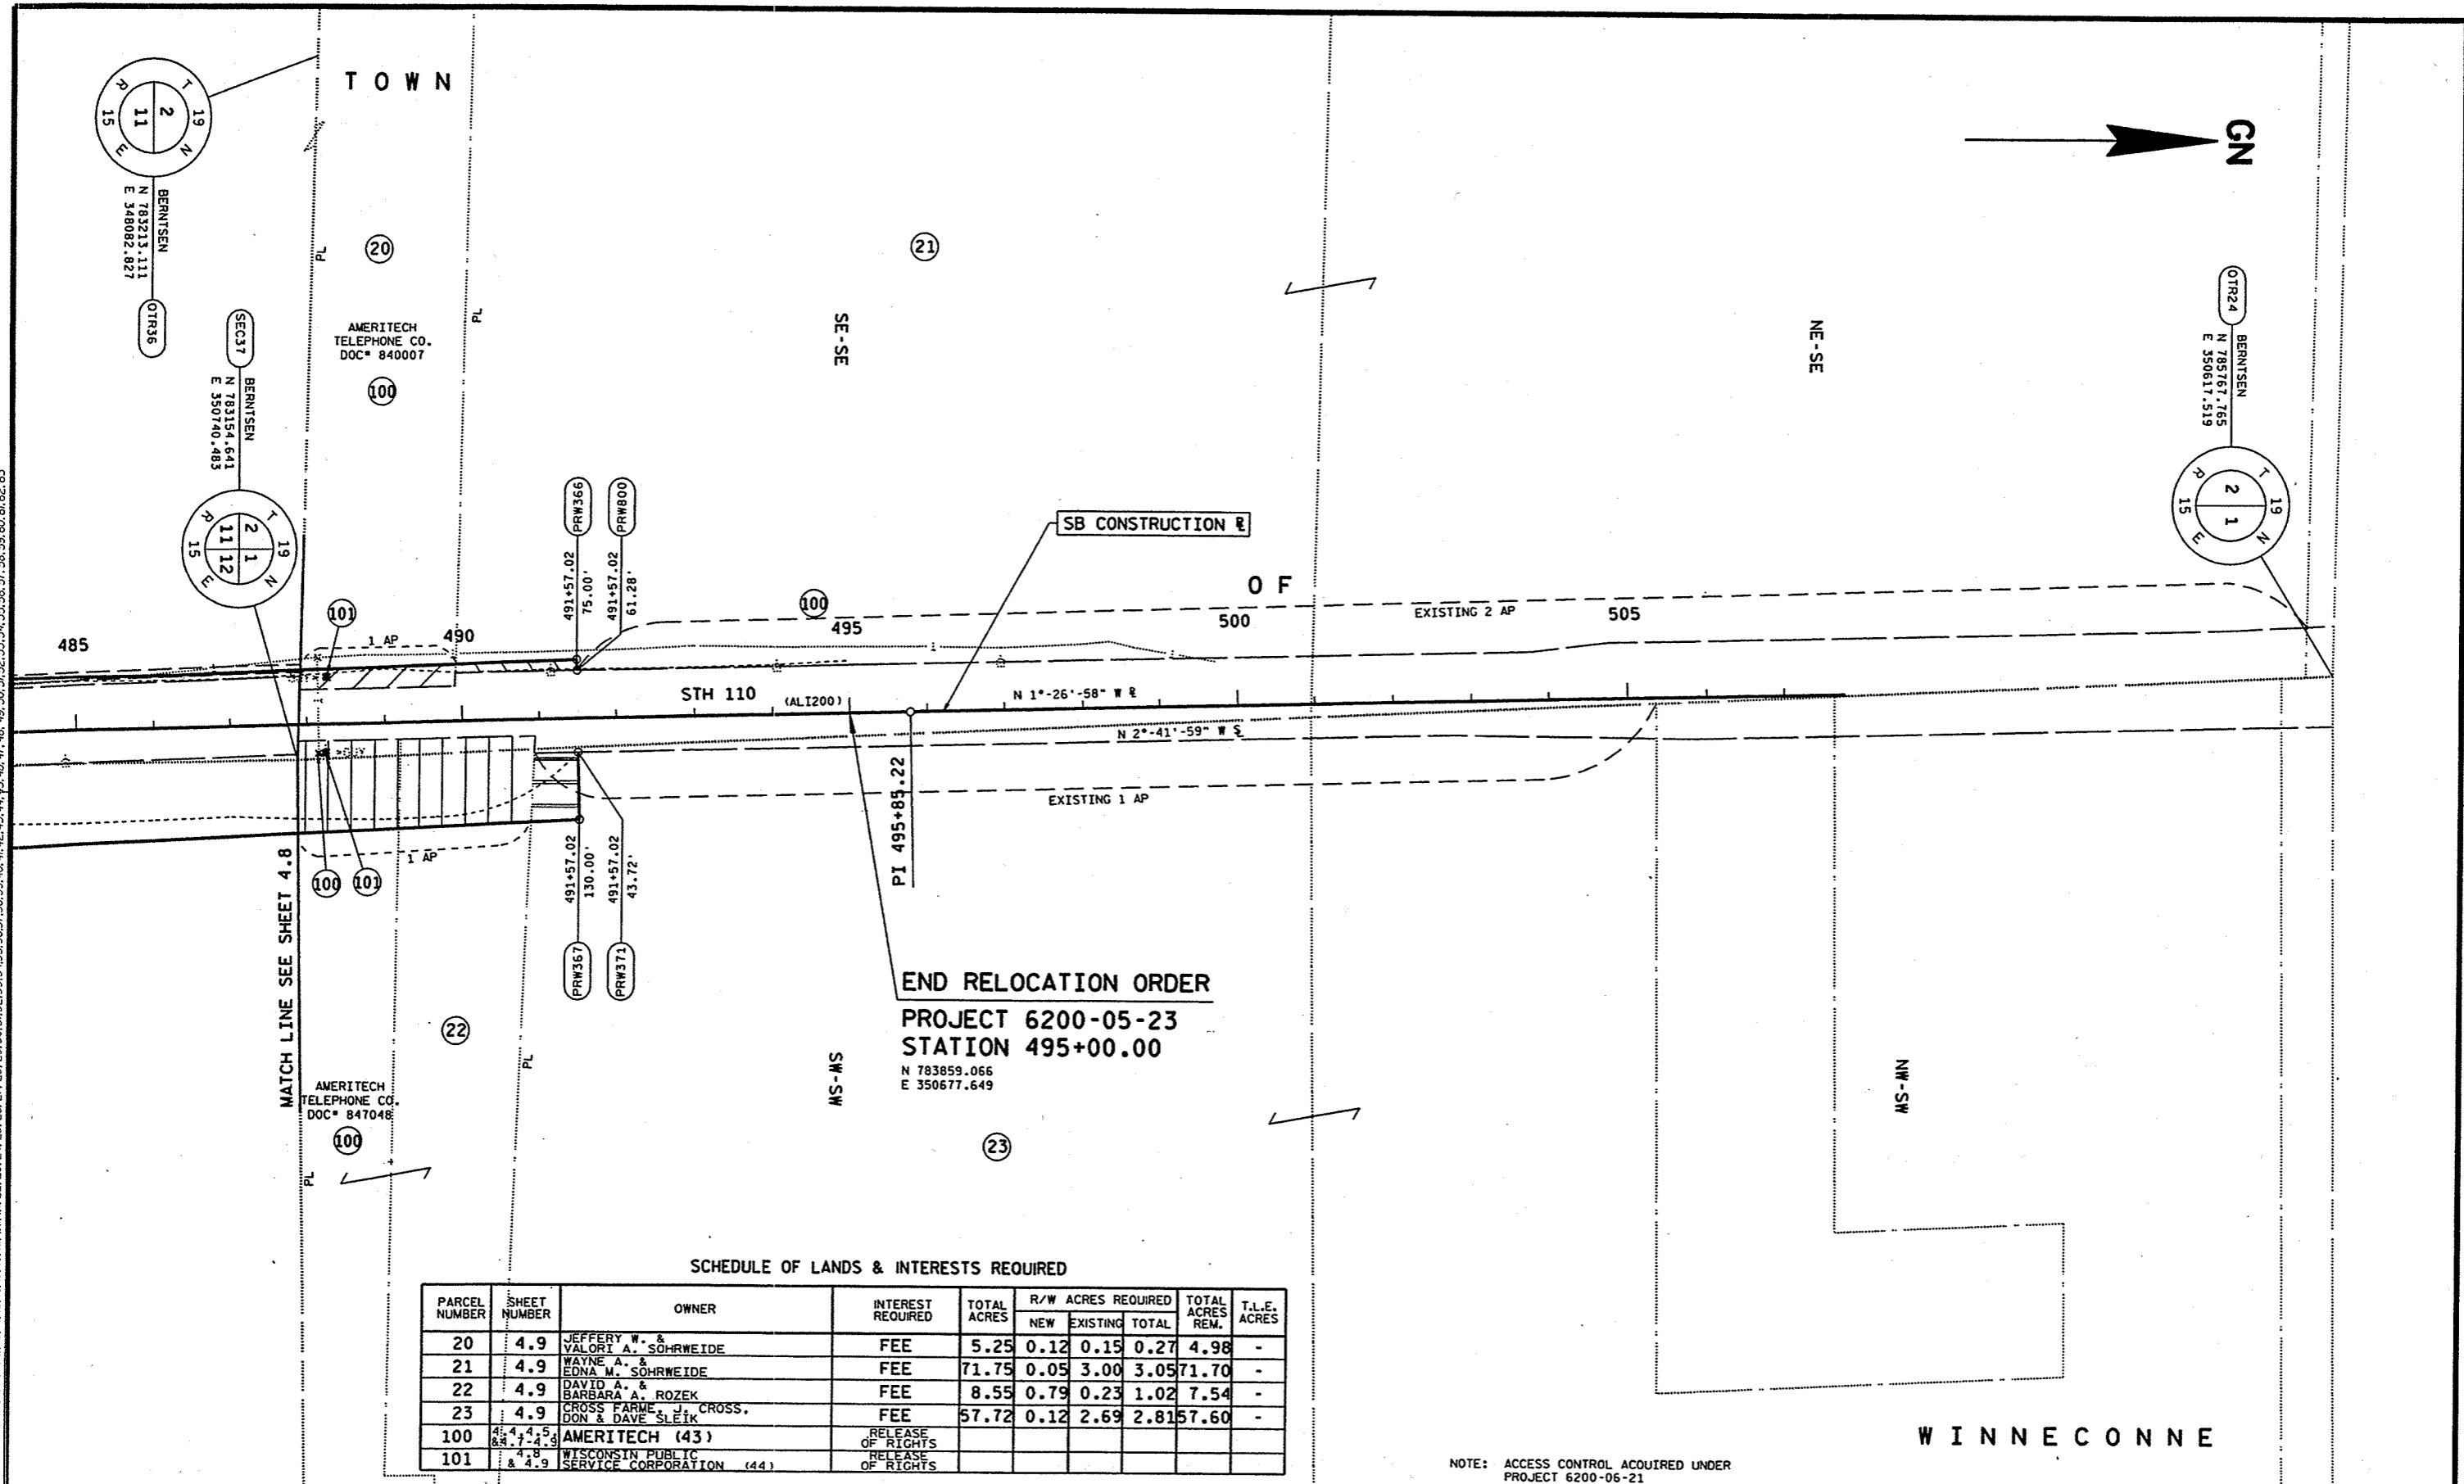

END RELOCATION ORDER
PROJECT 6200-05-23
STATION 495+00.00
 N 783859.066
 E 350677.649

SCHEDULE OF LANDS & INTERESTS REQUIRED

PARCEL NUMBER	SHEET NUMBER	OWNER	INTEREST REQUIRED	TOTAL ACRES	R/W ACRES REQUIRED			TOTAL ACRES REM.	T.L.E. ACRES
					NEW	EXISTING	TOTAL		
20	4.9	JEFFERY W. & VALORI A. SOHRWEIDE	FEE	5.25	0.12	0.15	0.27	4.98	-
21	4.9	WAYNE A. & EDNA M. SOHRWEIDE	FEE	71.75	0.05	3.00	3.05	71.70	-
22	4.9	DAVID A. & BARBARA A. ROZEK	FEE	8.55	0.79	0.23	1.02	7.54	-
23	4.9	CROSS FARM, DON & DAVE SLETA	FEE	57.72	0.12	2.69	2.81	57.60	-
100	4.4, 4.5, 4.8, 4.9	AMERITECH (43)	RELEASE OF RIGHTS						
101	4.8 & 4.9	WISCONSIN PUBLIC SERVICE CORPORATION (44)	RELEASE OF RIGHTS						

NOTE: ACCESS CONTROL ACQUIRED UNDER PROJECT 6200-06-21

REVISION DATE	DATE: 8-4-99	SCALE, FEET 0 100 200	HWY: STH 110	CONSTRUCTION PROJECT NUMBER: 6200-05-71	PS&E SHEET NO: 4.42
	GRID FACTOR: 0.999997		COUNTY: WINNEBAGO	STATE R/W PROJECT NUMBER: 6200-05-23	PLAT SHEET NO: 4.9

LEVELS ON: 1.2, 3.4, 5.6, 7, 8, 9, 62, 63

ENV1 PLAN SHEET 4.3 & 4.4 PARCELS 1.4,15,24

POINT	DISTANCE	BEARING	GROUND COORDINATES	
QTR90	1948.527'	S 89°52'58" W	N 772665.198 E	353680.420
DB102	42.926'	N 0°14'32" W	N 772661.212 E	351731.897
PRW806	801.627'	N 86°21'41" E	N 772704.137 E	351731.716
PRW803	641.949'	N 89°12'27" E	N 772755.013 E	352531.727
PRW804	115.227'	N 1°47'03" W	N 772763.892 E	353173.615
PL85	460.061'	N 49°10'59" E	N 772879.063 E	353170.027
PRW766	146.090'	N 88°12'46" E	N 773179.779 E	353518.202
DB103	519.390'	S 1°47'14" E	N 773184.335 E	353664.221
QTR90				

ENV2 PLAN SHEET 4.2 PARCEL 5,6

POINT	DISTANCE	BEARING	GROUND COORDINATES	
QTR64	1187.640'	S 1°47'10" E	N 777932.421 E	353516.119
DB105	74.900'	N 88°12'50" E	N 776675.174 E	353555.324
PRW272	432.550'	S 6°03'26" E	N 776677.662 E	353635.124
PRW271	800.000'	S 6°06'21" E	N 776317.559 E	353673.645
PRW270	233.930'	S 13°31'52" E	N 775522.097 E	353758.737
PRW273	215.100'	N 89°58'48" W	N 775294.656 E	353813.471
CTRS77	1451.340'	N 1°47'10" W	N 775294.731 E	353598.371
DB105				

PAR3 PLAN SHEET 4.5 PARCEL 3

POINT	DISTANCE	BEARING	GROUND COORDINATES	
QTR64	2717.704'	S 1°47'10" E	N 777932.421 E	353516.119
DB106	145.747'	S 88°12'46" W	N 775216.037 E	353600.826
PRW762	600.004'	N 6°00'45" W	N 775211.492 E	353455.150
PRW767	700.000'	N 5°49'00" W	N 775808.195 E	353392.303
PRW768	200.000'	N 5°49'00" W	N 776504.591 E	353321.361
PRW769	200.000'	N 5°49'00" W	N 776703.561 E	353301.092
PRW770	229.330'	N 5°49'00" W	N 776901.518 E	353270.874
CURVE PRW56 PC			N 777129.667 E	353247.632
PT CURVE PRW56			N 777436.626 E	353180.190
CURVE PRW57 PC			N 777741.565 E	353075.392
PT CURVE PRW57			N 777894.428 E	352859.394
PRW802	287.158'	N 88°52'37" W	N 777900.056 E	352572.291
PRW801	97.455'	N 79°10'27" W	N 777918.361 E	352476.570
DB108	16.451'	N 0°07'54" E	N 777934.811 E	352476.608
QTR64	1039.514'	S 89°52'06" E		

L.C. = 314.281'
L.C.B. = N 12°23'30" W
Radius = 1372.390'
ARC = 314.972'

L.C. = 264.617'
L.C.B. = N 54°42'46" W
Radius = 216.480'
ARC = 284.694'

PAR4 PLAN SHEET 4.5 PARCEL 4 (LOT 1 OF CSM3941)

POINT	DISTANCE	BEARING	GROUND COORDINATES	
QTR64	1319.664'	S 1°47'40" E	N 777932.421 E	353516.119
SIX35	247.203'	N 89°54'37" W	N 776613.404 E	353557.439
DB117	90.234'	N 5°49'00" W	N 776613.791 E	353310.236
PRW769	200.250'	N 8°40'45" W	N 776703.561 E	353301.092
PRW770	206.721'	N 5°49'00" W	N 776901.518 E	353270.874
DB38	70.409'	N 86°32'10" E	N 777107.174 E	353249.924
CURVE CUR100 PC			N 777111.428 E	353320.204

L.C. = 584.460'
L.C.B. = N 21°35'12" W
Radius = 1713.860'
ARC = 587.330'

PT	CURVE CUR100	DISTANCE	BEARING	GROUND COORDINATES	
		91.644'	N 18°57'59" W	N 777654.896 E	353105.177
	CURVE KC35 PC			N 777741.565 E	353075.392
				N 777894.428 E	352859.394

L.C. = 264.617'
L.C.B. = N 54°42'46" W
Radius = 226.48'
ARC = 282.60'

PT	CURVE KC35	DISTANCE	BEARING	GROUND COORDINATES	
		287.158'	N 88°52'37" W	N 777900.056 E	352572.291
	PRW802	97.455'	N 79°10'27" W	N 777918.361 E	352476.570
	PRW801	16.451'	N 0°07'54" E	N 777934.811 E	352476.608
	DB108	1039.514'	S 89°52'06" E		
	QTR64				

PAR9 PLAN SHEET 4.2 PARCEL 9

POINT	DISTANCE	BEARING	GROUND COORDINATES	
QTR64	237.250'	S 1°47'40" E	N 777932.421 E	353516.119
RWR1	106.552'	S 89°52'39" W	N 777695.287 E	353523.548
PRW261	30.000'	S 89°45'36" W	N 777695.060 E	353416.996
CURVE RW4 PC			N 777694.934 E	353386.996
PT CURVE RW4			N 777821.081 E	353312.855
DB50	30.463'	S 89°52'06" E	N 777932.897 E	353309.052
DB104	12.606'	S 0°07'54" W	N 777932.827 E	353339.516
PRW260	128.099'	S 15°31'13" E	N 777920.221 E	353339.487
PRW809	110.538'	S 23°01'25" E	N 777796.792 E	353373.763
PRW261				

L.C. = 146.321'
L.C.B. = N 30°26'40" W
Radius = 1965.000'
ARC = 146.355'

ENV5 PLAN SHEET 4.3 PARCEL 10,27

POINT	DISTANCE	BEARING	GROUND COORDINATES	
QTR64	641.454'	N 89°52'06" W	N 777932.421 E	353516.119
DB177	428.139'	N 89°52'06" W	N 777933.896 E	352874.666
DB58	49.243'	N 0°07'54" E	N 777934.880 E	352446.528
PRW257	101.119'	N 81°00'36" E	N 777984.123 E	352446.642
PRW258	198.897'	N 89°33'51" E	N 777999.924 E	352546.518
PRW259	129.419'	N 89°33'51" E	N 778001.437 E	352745.409
PRW262	68.525'	S 0°07'54" W	N 778002.421 E	352874.824
DB177				

ENV4 PLAN SHEET 4.6 PARCEL 10,11

POINT	DISTANCE	BEARING	GROUND COORDINATES	
QTR64	192.570'	N 89°52'06" W	N 777932.421 E	353516.119
DB110	448.744'	N 89°52'06" W	N 777932.864 E	353323.549
DB123	53.660'	N 0°07'54" E	N 777933.896 E	352874.806
RWL21	180.832'	N 0°24'28" W	N 777987.555 E	352874.930
RWL22	200.802'	N 39°56'15" W	N 778168.383 E	352873.643
RWL24	903.113'	N 39°56'15" W	N 778322.347 E	352744.737
DB125	226.775'	N 1°59'28" W	N 779014.804 E	352164.981
DB126	210.797'	N 1°59'28" W	N 779241.442 E	352157.103
DB127	383.322'	S 40°07'47" E	N 779452.112 E	352149.779
PRW252	350.321'	S 42°00'23" E	N 779159.029 E	352396.837
PRW251	625.936'	S 40°00'36" E	N 778898.715 E	352631.277
CURVE PRW27 PC			N 778419.290 E	353033.703
PT CURVE PRW27			N 778027.833 E	353297.136
PRW794	47.538'	S 33°56'22" E	N 777988.393 E	353323.677
DB110	55.530'	S 0°07'54" W	N 777932.864 E	353323.549

L.C. = 471.842'
L.C.B. = S 33°56'19" E
Radius = 2411.830'
ARC = 472.598'

REVISION DATE	DATE 8-4-99	NOT TO SCALE	HWY: STH 110	CONSTRUCTION PROJECT NUMBER 6200-05-71	PS&E SHEET NO: 4.43
			COUNTY: WINNEBAGO	STATE R/W PROJECT NUMBER 6200-05-23	PLAT SHEET NO: 4.10
					E

LEVELS ON: 1, 2, 3, 62, 63

POINT	DISTANCE	ENVI6 PLAN SHEET 4.6 PARCEL 12,13,16,17 BEARING	GROUND COORDINATES	
OTR50	1825.880'	N 89°37'57" E	N 780538.940 E	350786.777
DB111	32.979'	S 0°22'03" E	N 780550.653 E	352612.620
PRW293	157.987'	S 85°40'02" W	N 780517.675 E	352612.831
PRW256	200.250'	N 87°17'22" W	N 780505.739 E	352455.296
PRW255	306.961'	S 77°37'23" W	N 780515.208 E	352255.270
PRW254	539.866'	S 73°36'28" W	N 780449.413 E	351955.443
PRW253	738.382'	S 40°07'47" E	N 780297.057 E	351437.521
PRW796	366.716'	S 40°07'47" E	N 779732.499 E	351913.423
DB65	210.790'	S 1°55'45" E	N 779452.112 E	352149.779
PL75	181.330'	S 89°52'52" W	N 779241.442 E	352156.875
DB76	1124.099'	N 39°56'15" W	N 779241.065 E	351975.546
CURVE CUR104			N 780102.962 E	351253.928
PC		L.C. = 316.197' L.C.B. = N 36°15'37" W Radius = 2465.000' ARC = 316.414'		
PT			N 780357.924 E	351066.912
CURVE CUR104	515.883'	N 82°27'02" W	N 780425.702 E	350555.501
PRW280	505.594'	N 81°37'16" W	N 780499.376 E	350055.304
PRW279	300.042'	S 88°53'36" W	N 780493.581 E	349755.318
PRW278	284.968'	N 86°17'11" W	N 780512.038 E	349470.949
RW3107	66.001'	N 0°15'53" E	N 780578.038 E	349471.254
RW430	284.920'	N 84°51'24" E	N 780603.581 E	349755.027
PRW282	700.000'	N 89°50'53" E	N 780605.436 E	350455.024
PRW283	410.366'	N 74°11'10" E	N 780717.267 E	350849.859
CURVE CUR105			N 780672.530 E	350869.257
PC		L.C. = 48.762' L.C.B. = S 23°26'26.7" E Radius = 2490.000' ARC = 48.763'		
PT			N 780672.530 E	350869.257
CURVE CUR105	98.421'	S 31°41'30" W	N 780588.784 E	350817.551
RW106	31.659'	N 89°43'54" W	N 780588.932 E	350785.892
DB113	50.000'	S 1°00'50" E		
OTR50				

POINT	DISTANCE	ENVI4 PLAN SHEET 4.6 & 4.7 PARCEL 14 BEARING	GROUND COORDINATES	
OTR50	50.000'	N 1°00'50" W	N 780538.940 E	350786.777
DB81	31.659'	S 89°43'54" E	N 780588.932 E	350785.892
RW106	98.421'	N 31°41'30" E	N 780588.784 E	350817.551
CURVE CUR106			N 780672.530 E	350869.257
PC		L.C. = 246.211' L.C.B. = N 21°10'05" W Radius = 2490.000' ARC = 246.312'		
PT			N 780902.128 E	350780.349
CURVE CUR106	2252.866'	N 1°00'50" W	N 783154.641 E	350740.483
SEC37	94.258'	N 89°05'02" E	N 783156.148 E	350834.729
DB83	781.987'	S 2°54'23" E	N 782375.167 E	350874.379
PRW372	573.357'	S 4°02'07" E	N 781803.231 E	350914.726
CURVE PRW29			N 780737.432 E	351192.227
PC		L.C. = 1101.333' L.C.B. = S 14°35'38" E Radius = 2421.480' ARC = 1111.053'		
PT			N 780737.432 E	351192.227
CURVE PRW29	565.137'	S 84°33'46" E	N 780683.882 E	351754.821
PRW291	206.155'	S 76°06'56" E	N 780634.413 E	351954.953
PRW290	500.000'	N 89°50'53" E	N 780635.738 E	352454.951
PRW288	165.840'	S 71°42'10" E	N 780583.673 E	352612.407
PRW289	33.021'	S 0°22'10" E	N 780550.653 E	352612.620
DB111	1825.880'	S 89°37'57" W		
OTR50				

POINT	DISTANCE	PAR16 PLAN SHEET 4.8 PARCEL 16 BEARING	GROUND COORDINATES	
SEC37	2028.937'	S 1°00'50" E	N 783154.641 E	350740.483
DB116	33.000'	S 88°59'10" W	N 781126.022 E	350776.387
RW109	386.097'	N 17°12'34" W	N 781125.438 E	350743.392
PRW360	301.774'	N 0°07'30" E	N 781494.249 E	350629.159
PRW361	365.461'	N 2°53'32" E	N 781796.022 E	350629.817
PRW368	799.124'	N 1°02'56" W	N 782161.018 E	350648.258
PRW365	197.317'	N 2°18'07" W	N 782960.008 E	350633.629
DB84	114.807'	S 88°44'23" E	N 783157.166 E	350625.704
SEC37				

POINT	DISTANCE	ENVI7 PLAN SHEET 4.9 PARCEL 22,23 BEARING	GROUND COORDINATES	
SEC37	56.727'	N 88°44'23" W	N 783154.641 E	350740.483
DB87	304.327'	N 1°24'21" W	N 783155.889 E	350683.770
DB115	33.169'	N 88°35'39" E	N 783460.124 E	350676.303
RW62	22.050'	S 87°41'40" E	N 783460.938 E	350709.462
RW61	57.272'	N 1°27'51" W	N 783460.051 E	350731.495
PRW371	86.279'	N 88°33'02" E	N 783517.304 E	350730.031
PRW367	363.807'	S 2°54'23" E	N 783519.486 E	350816.283
DB83	94.258'	S 89°05'02" W	N 783156.148 E	350834.729
SEC37				

POINT	DISTANCE	ENVI0 PLAN SHEET 4.9 PARCEL 20 & 21 BEARING	GROUND COORDINATES	
SEC37	56.727'	N 88°44'23" W	N 783154.641 E	350740.483
DB87	58.080'	N 88°44'23" W	N 783155.889 E	350683.770
DB84	357.423'	N 2°18'07" W	N 783157.166 E	350625.704
PRW366	13.717'	N 88°33'02" E	N 783514.301 E	350611.348
PRW800	158.026'	S 1°23'07" E	N 783514.648 E	350625.061
RW3120	50.000'	S 88°44'23" E	N 783356.668 E	350628.881
DB89	199.740'	S 1°24'21" E	N 783355.569 E	350678.869
DB87				

REVISION DATE

DATE 8-4-99

NOT TO SCALE

HWY: STH 110

CONSTRUCTION PROJECT NUMBER 6200-05-71

PS&E SHEET NO: 4.4A



COUNTY: WINNEBAGO

STATE R/W PROJECT NUMBER 6200-05-23



PLAT SHEET NO: 4.11

E



LEVELS ON : 1, 2, 3, 62, 63

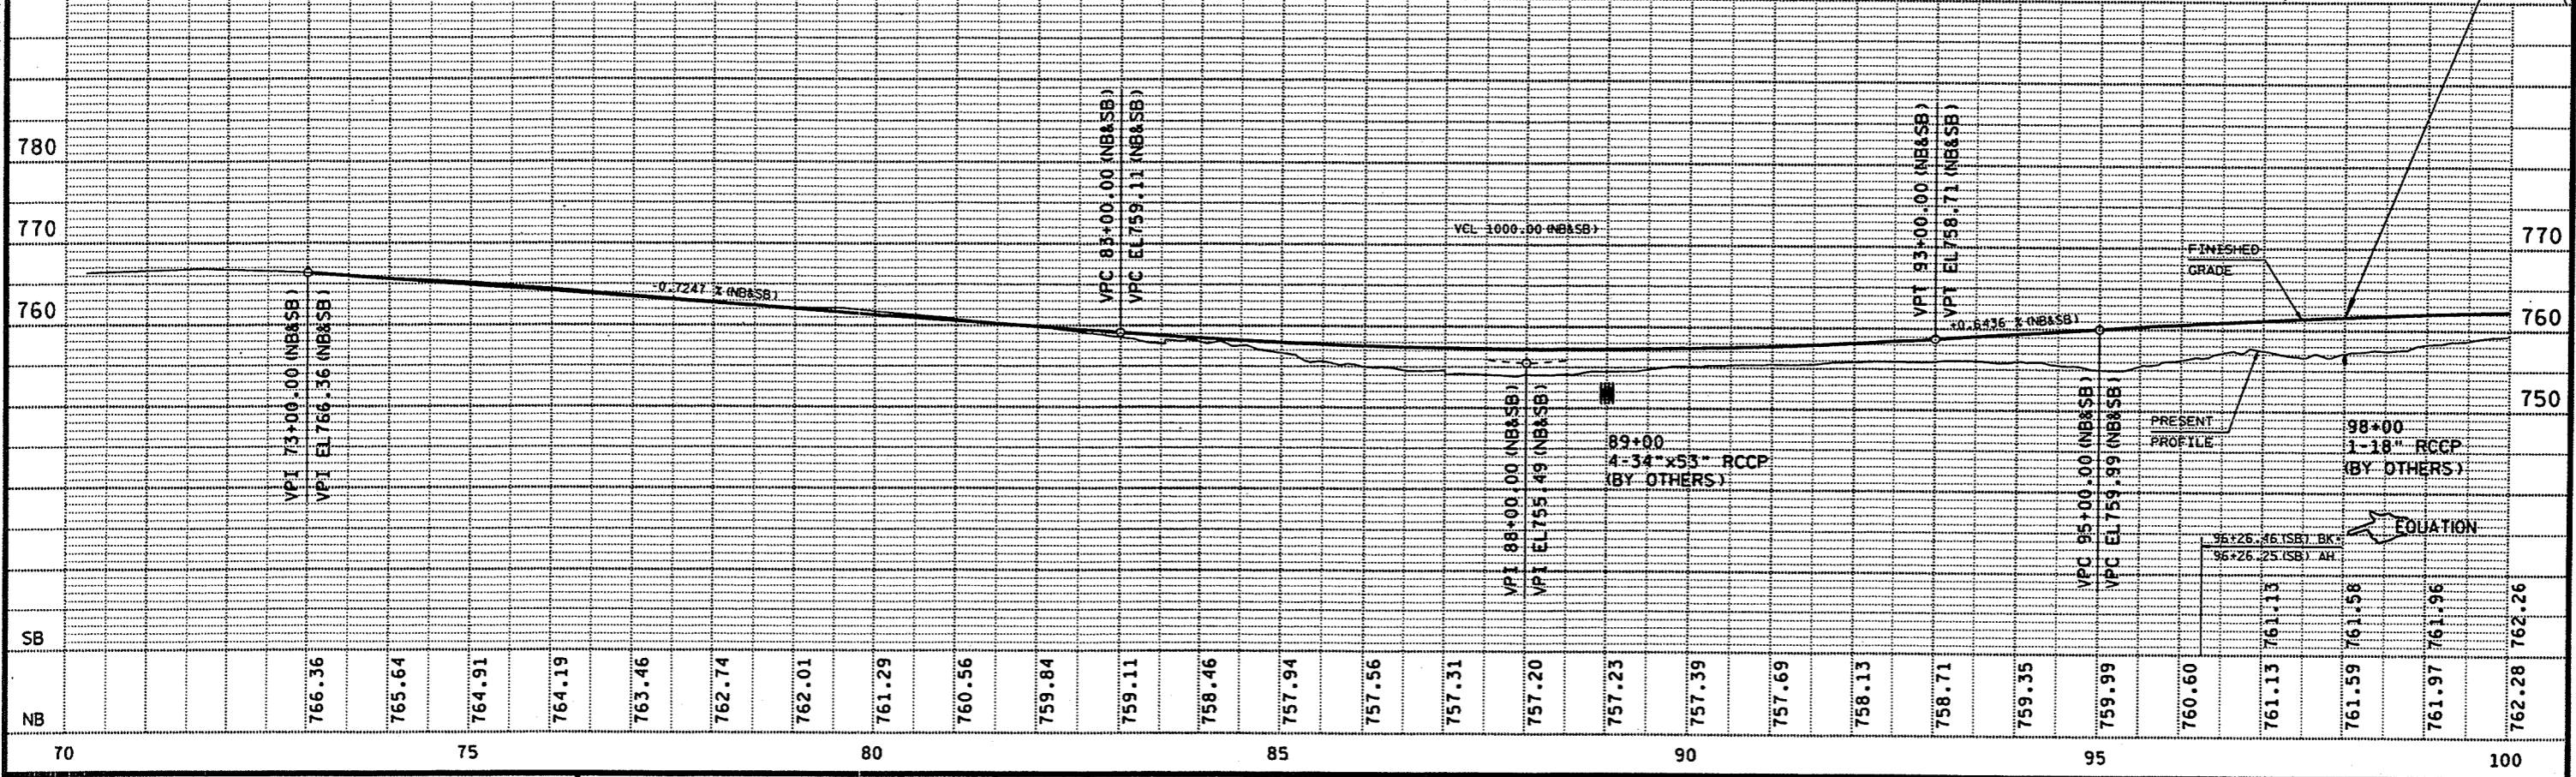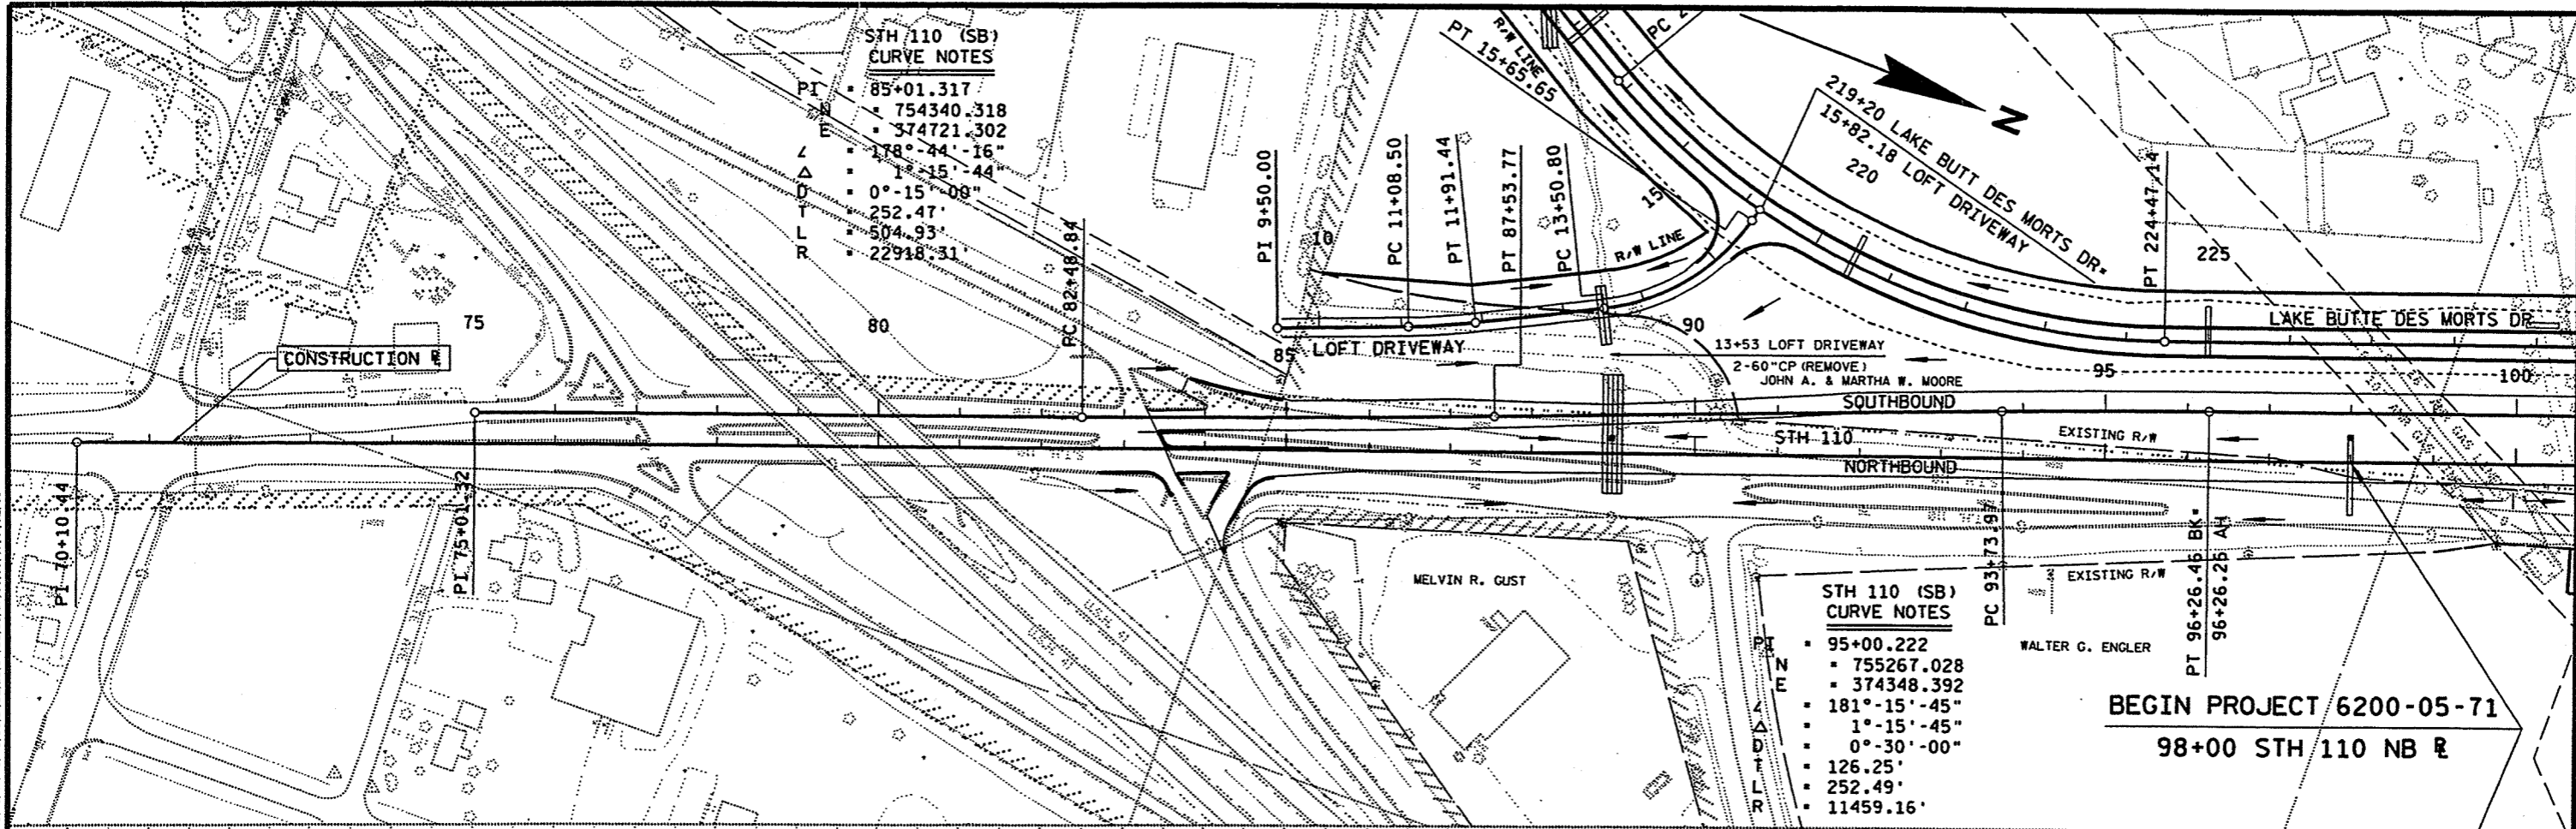

STATE PROJECT NUMBER: 6200-05-71 HWY: STH 110 COUNTY: WINNEBAGO STH 110 SHEET NO: **S.1** **E**

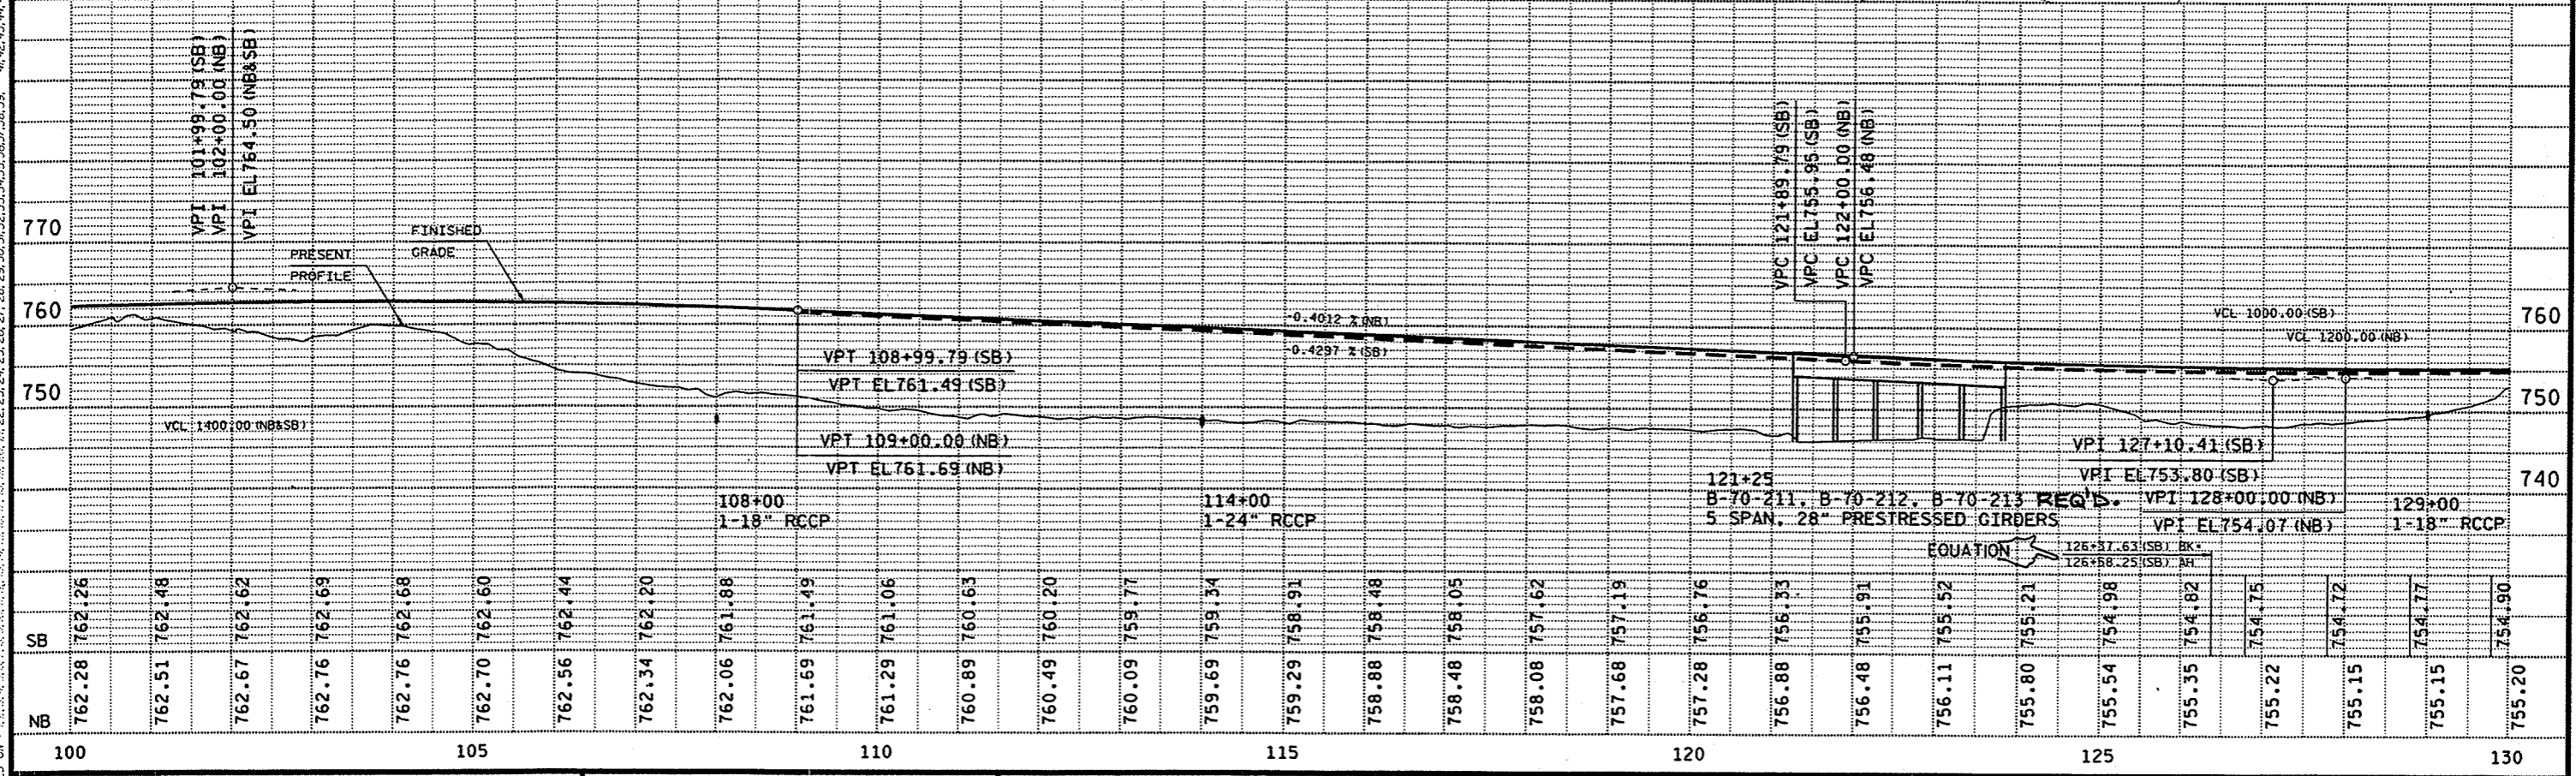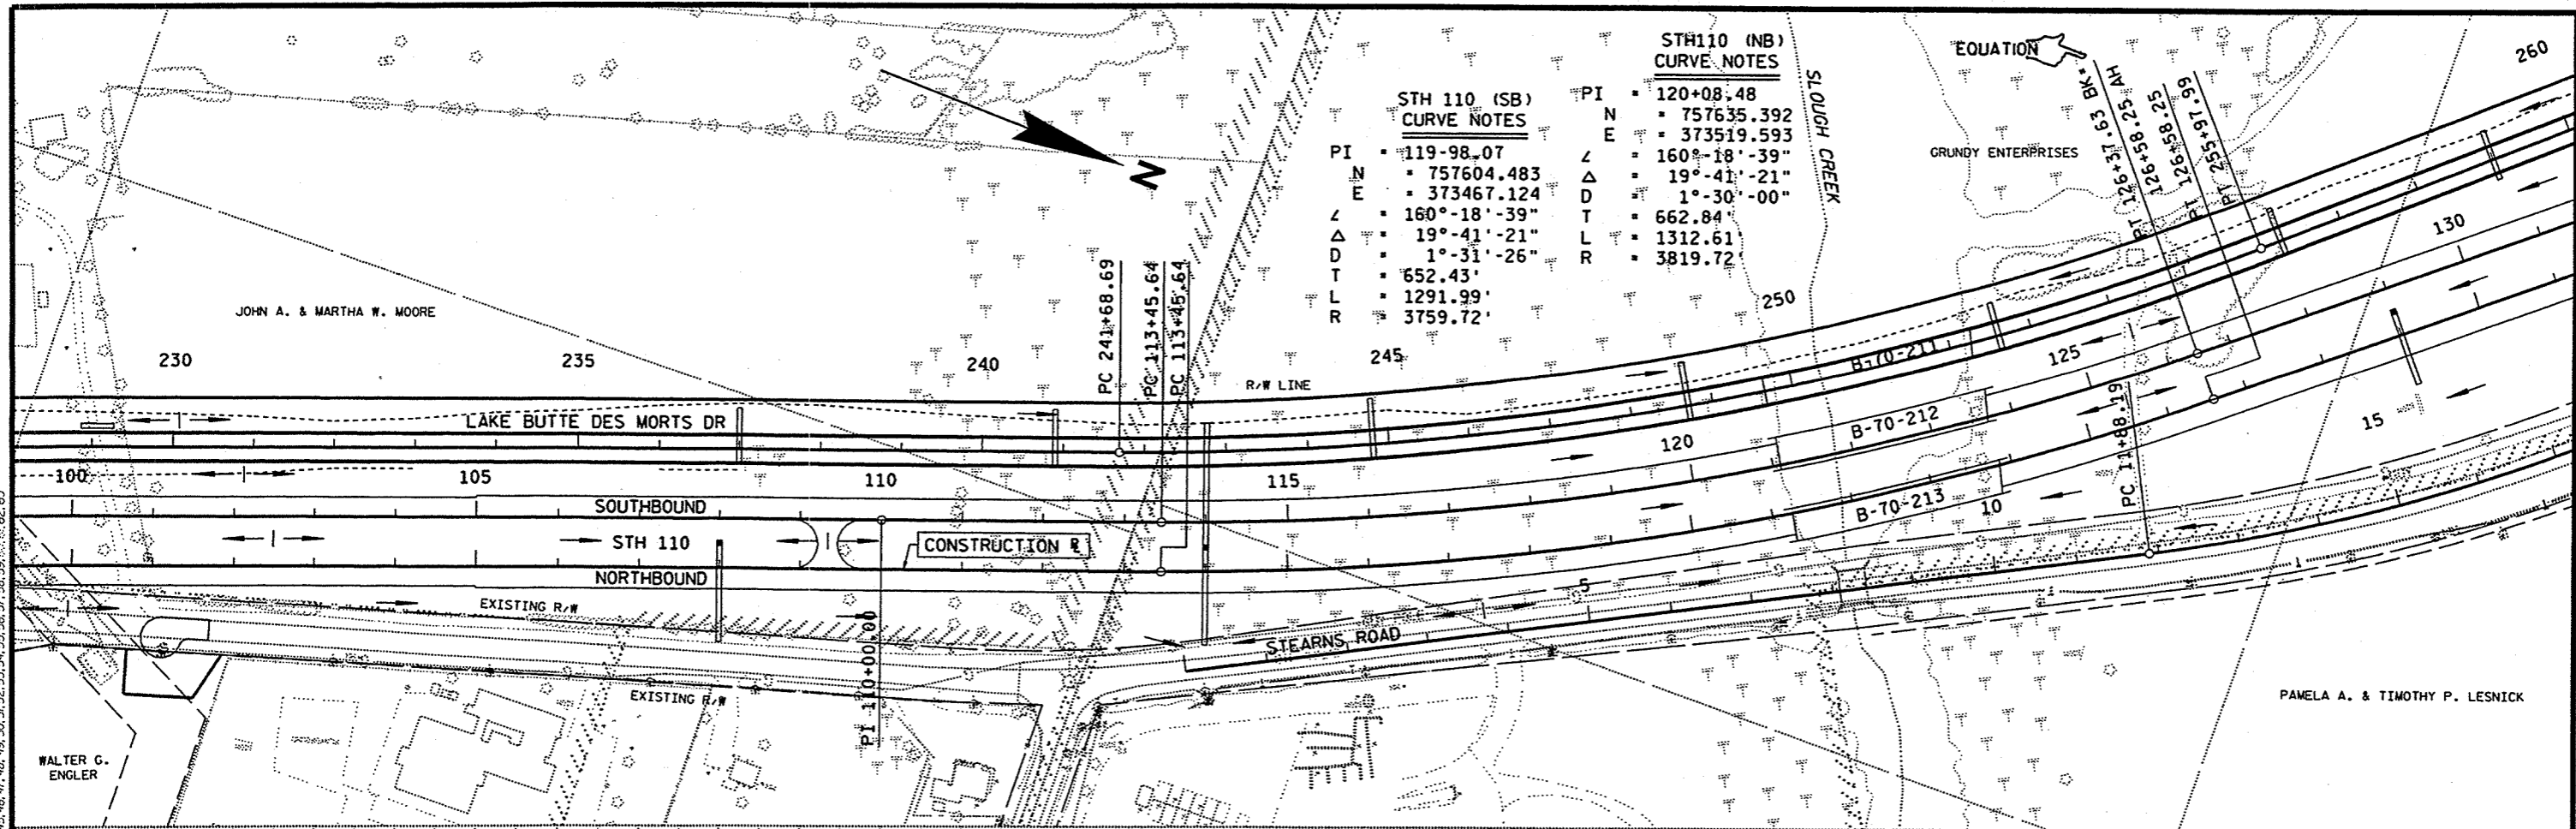


STATE PROJECT NUMBER: 6200-05-71 HWY: STH 110 COUNTY: WINNEBAGO STH 110 SHEET NO: 5/2 E

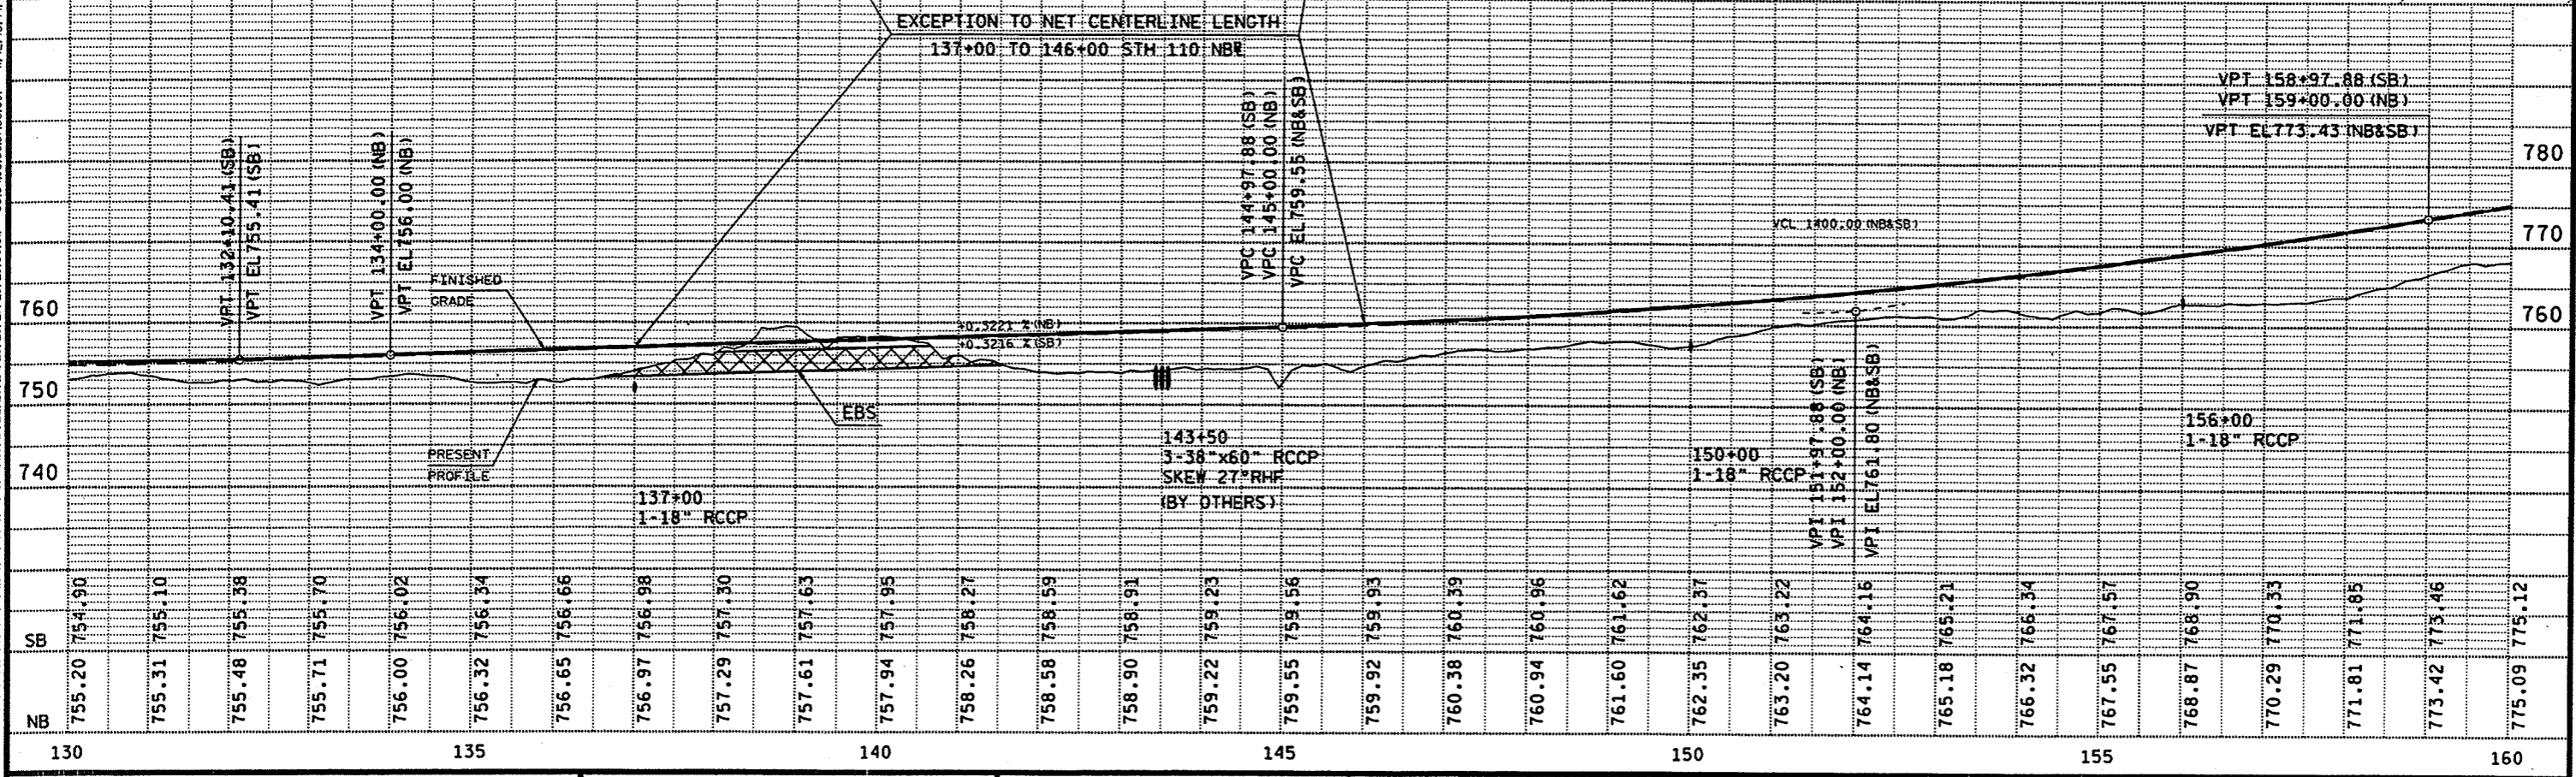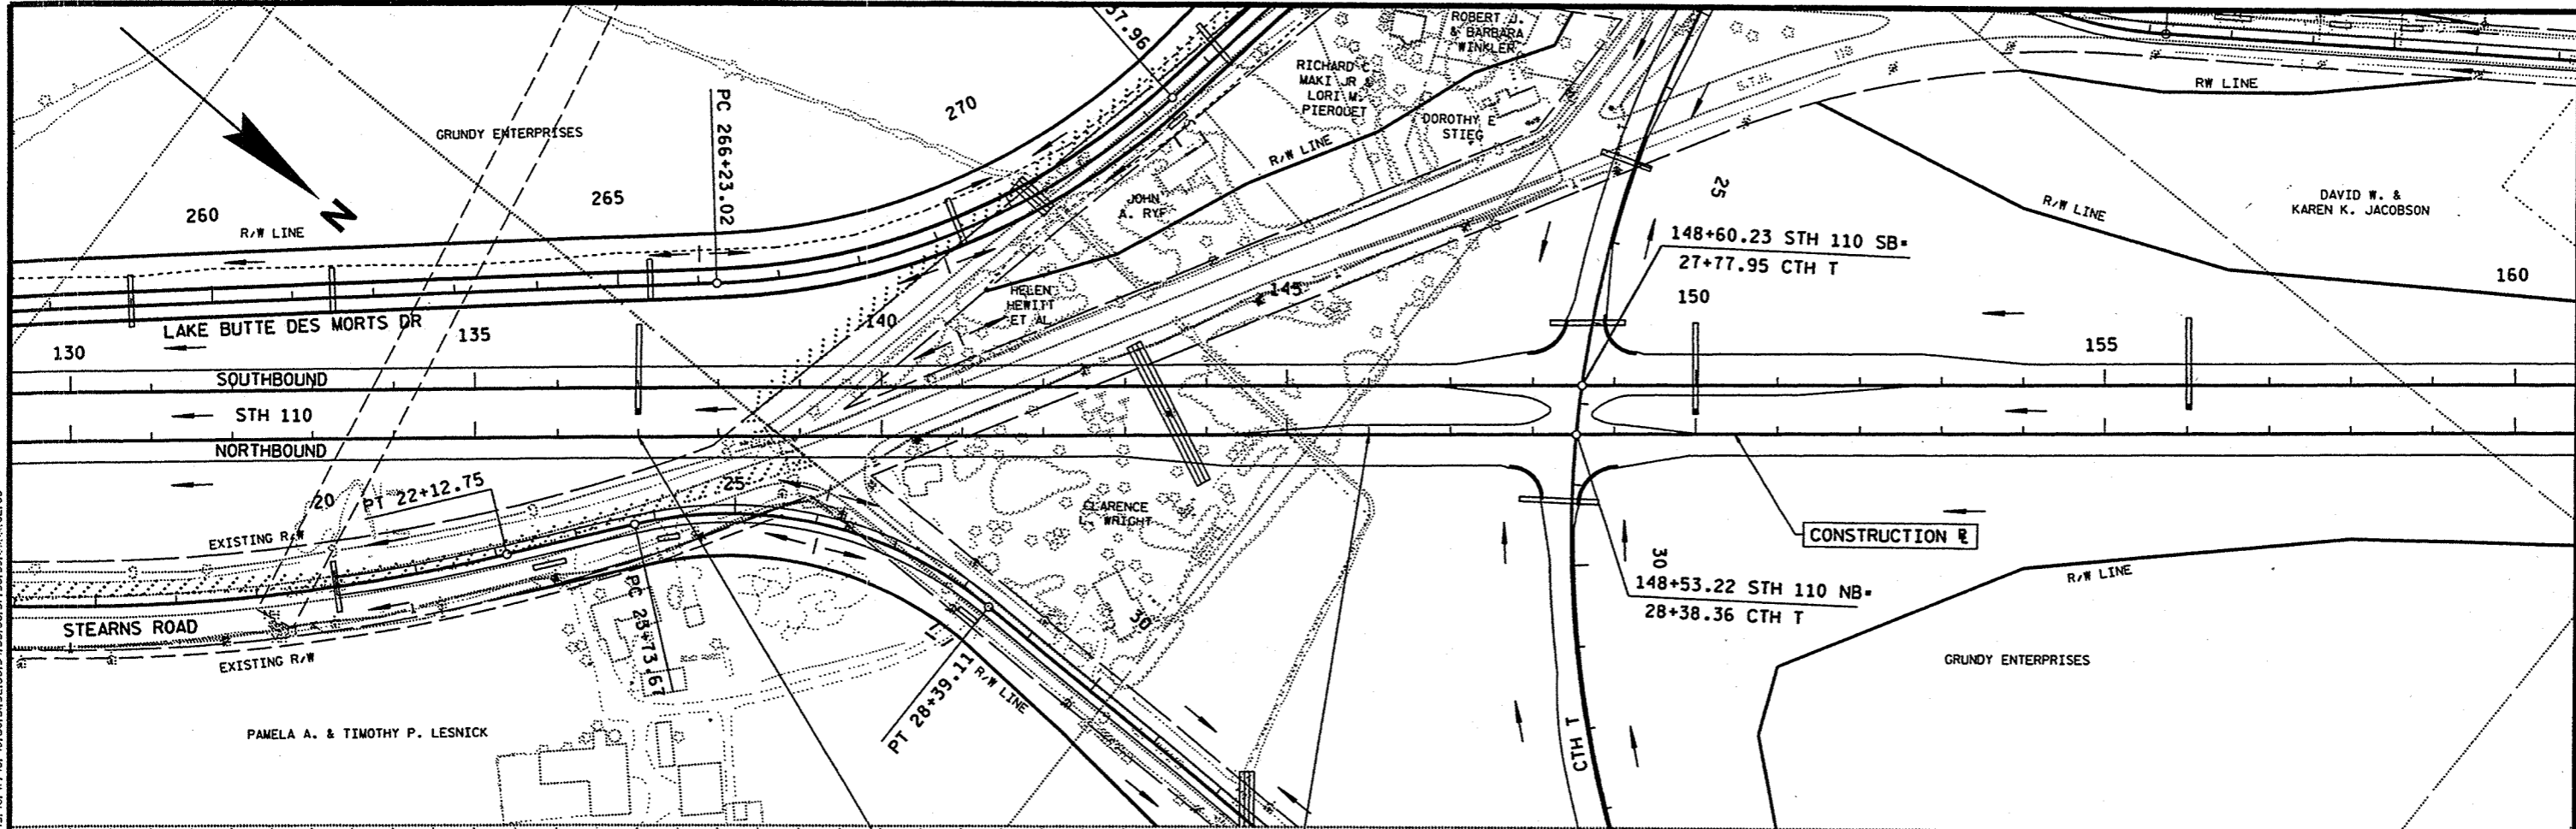

STATE PROJECT NUMBER: 6200-05-71 HWY: STH 110 COUNTY: WINNEBAGO STH 110 SHEET NO: 53 E

FILE NAME: F:\d3_620005\d3503.dgn PLOT DATE: 26-SEP-2001 10:26 ORG DATE: PLOT NAME: d3503d71 Originator: DISTRICT 3 PLOT SCALE: 200.700000:1.000000 WISDOT/CADD SHEET 40

LEVELS ON - 1.0, 1.5, 2.0, 99.5, 100.0

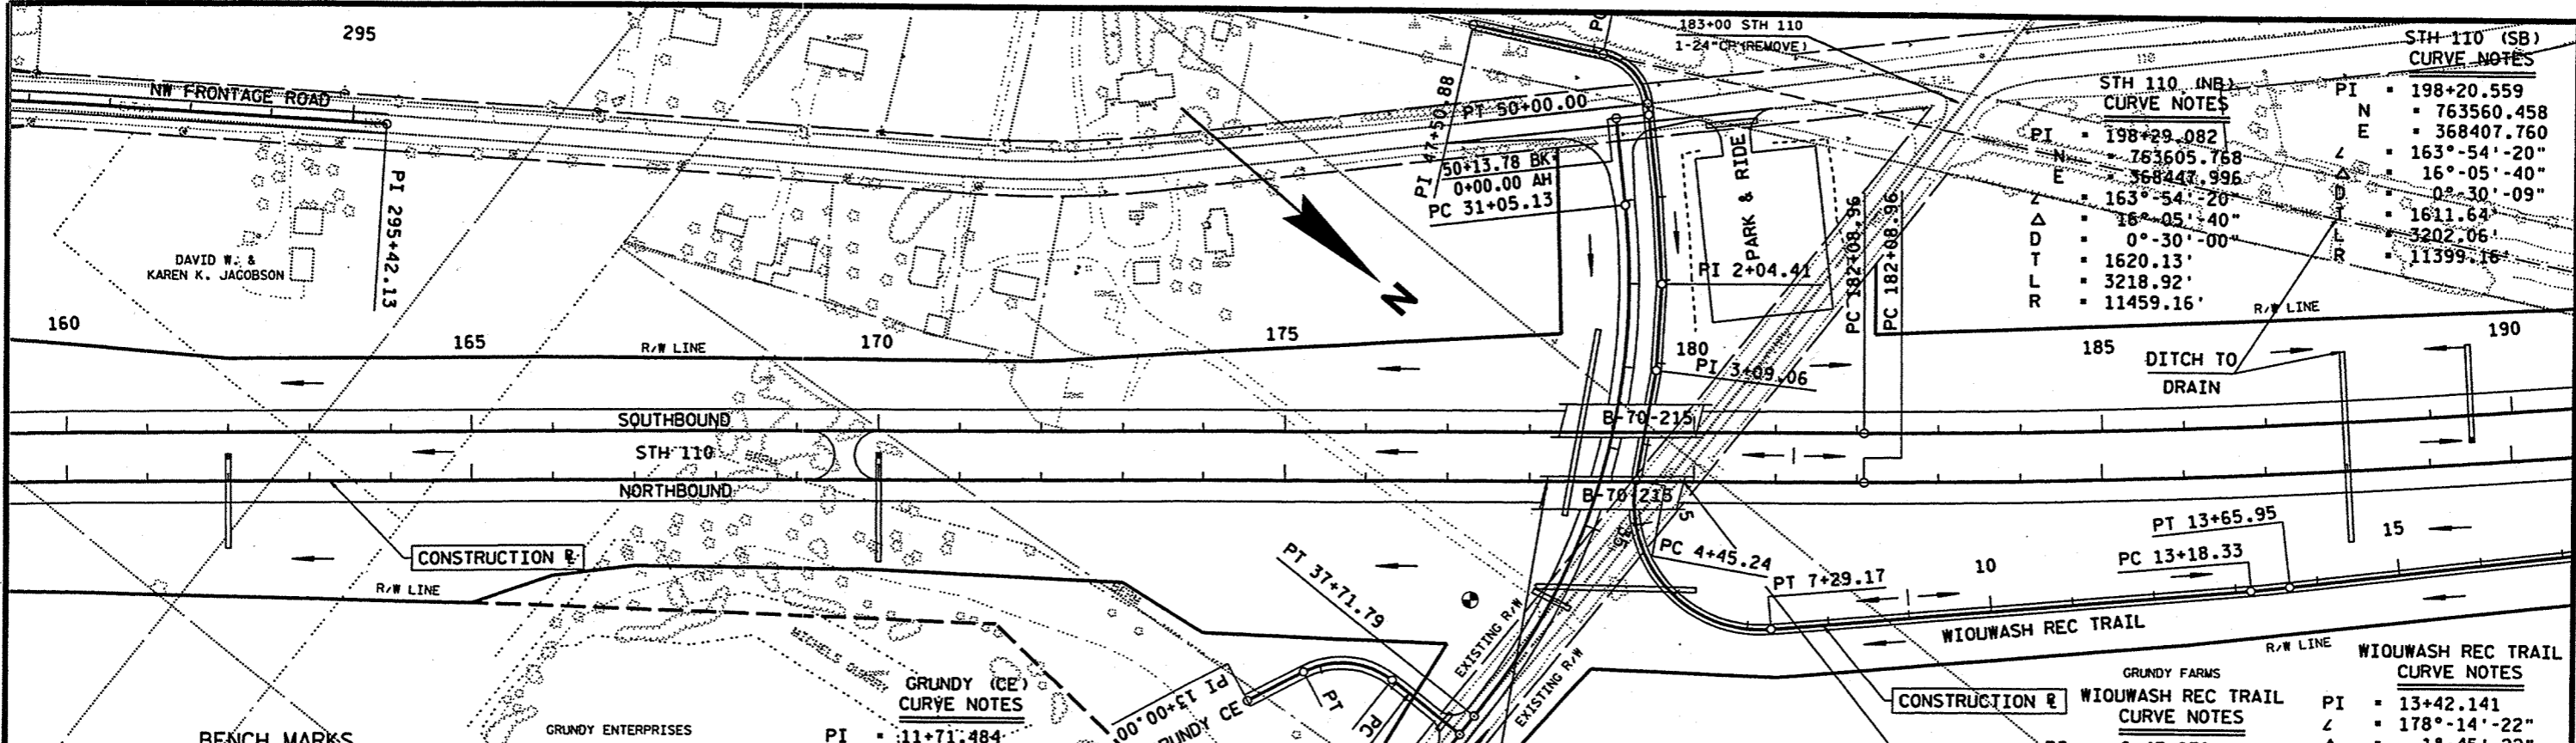

STH 110 (SB) CURVE NOTES

PI	198+20.559
N	763560.458
E	368407.760
L	163°-54'-20"
D	16°-05'-40"
T	0°-30'-09"
L	1611.64'
R	3202.06'
R	11399.16'

GRUNDY (CE) CURVE NOTES


PI	11+71.484
L	113°-37'-40"
Δ	66°-22'-20"
D	57°-17'-45"
T	65.40'
L	115.84'
R	100.00'
PC	11+06.081
PT	12+21.922

WIOUWASH REC TRAIL CURVE NOTES

PI	13+42.141
L	178°-14'-22"
Δ	1°-45'-22"
D	3°-41'-47"
T	23.81'
L	47.62'
R	1550.00'

BENCH MARKS

NO.	STATION	DESCRIPTION	ELEV.
606		SP IN PP #31 ALONG RR GRADE 150' LT OF EXISTING STH 110	782.57

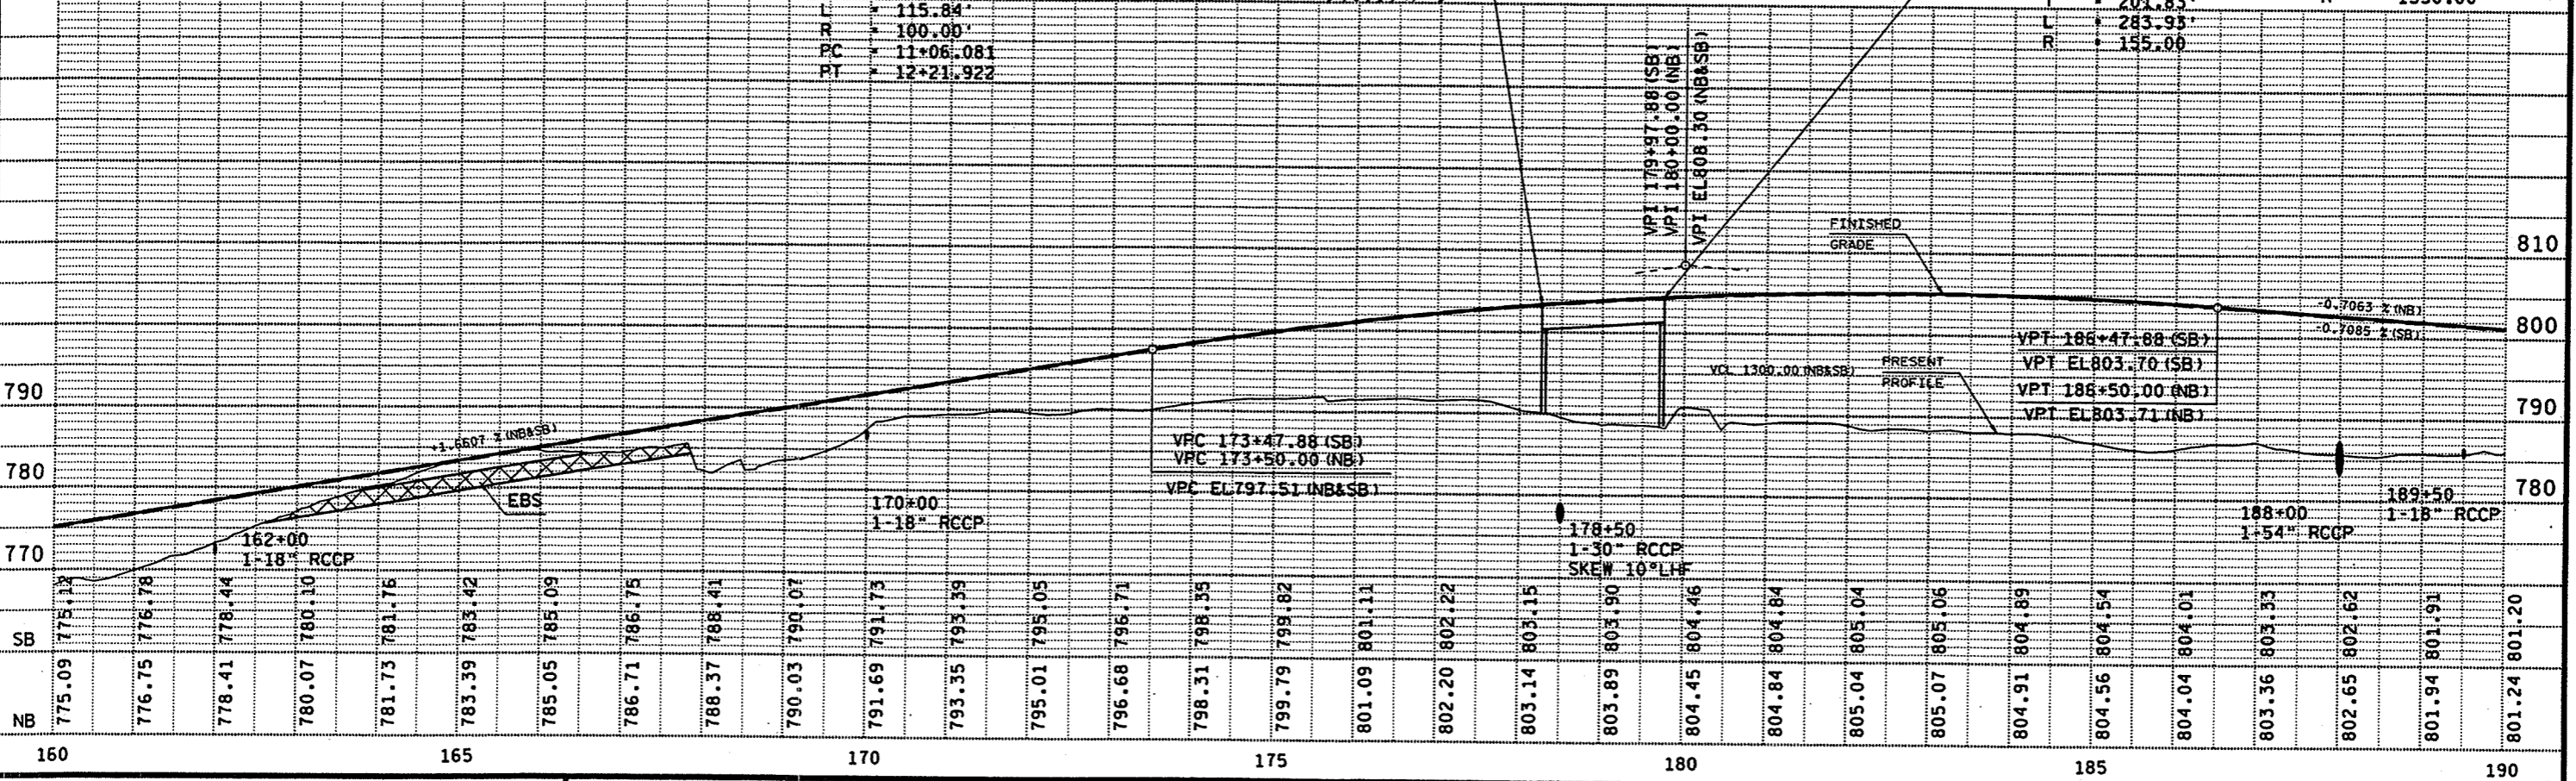

STATE PROJECT NUMBER: 6200-05-71 HWY: STH 110 COUNTY: WINNEBAGO STH 110 SHEET NO: 54 E

LEVELS ON 1, 2, 3, 62, 63

STH 110 (NB)
CURVE NOTES

PI ▪ 198+29.082
N ▪ 763605.768
E ▪ 368447.996
∠ ▪ 163°-54'-20"
Δ ▪ 16°-05'-40"
D ▪ 0°-30'-00"
T ▪ 1620.13'
L ▪ 3218.92'
R ▪ 11459.16'

STH 110 (SB)
CURVE NOTES



PI ▪ 198+20.559
N ▪ 763560.458
E ▪ 368407.760
∠ ▪ 163°-54'-20"
Δ ▪ 16°-05'-40"
D ▪ 0°-30'-09"
T ▪ 1611.64'
L ▪ 3202.06'
R ▪ 11399.16'

WIOUWASH REC TRAIL
CURVE NOTES

PI ▪ 27+57.685
∠ ▪ 198°-50'-44"
Δ ▪ 18°-50'-44"
D ▪ 36°-57'-54"
T ▪ 25.72'
L ▪ 50.98'
R ▪ 155.00'



BENCH MARKS

NO.	STATION	DESCRIPTION	ELEV.
6036	192+00	PK IN PP 36 100' LT SB STH 110	788.02
6037	202+00	PK IN PP 210' RT NB STH 110	797.31

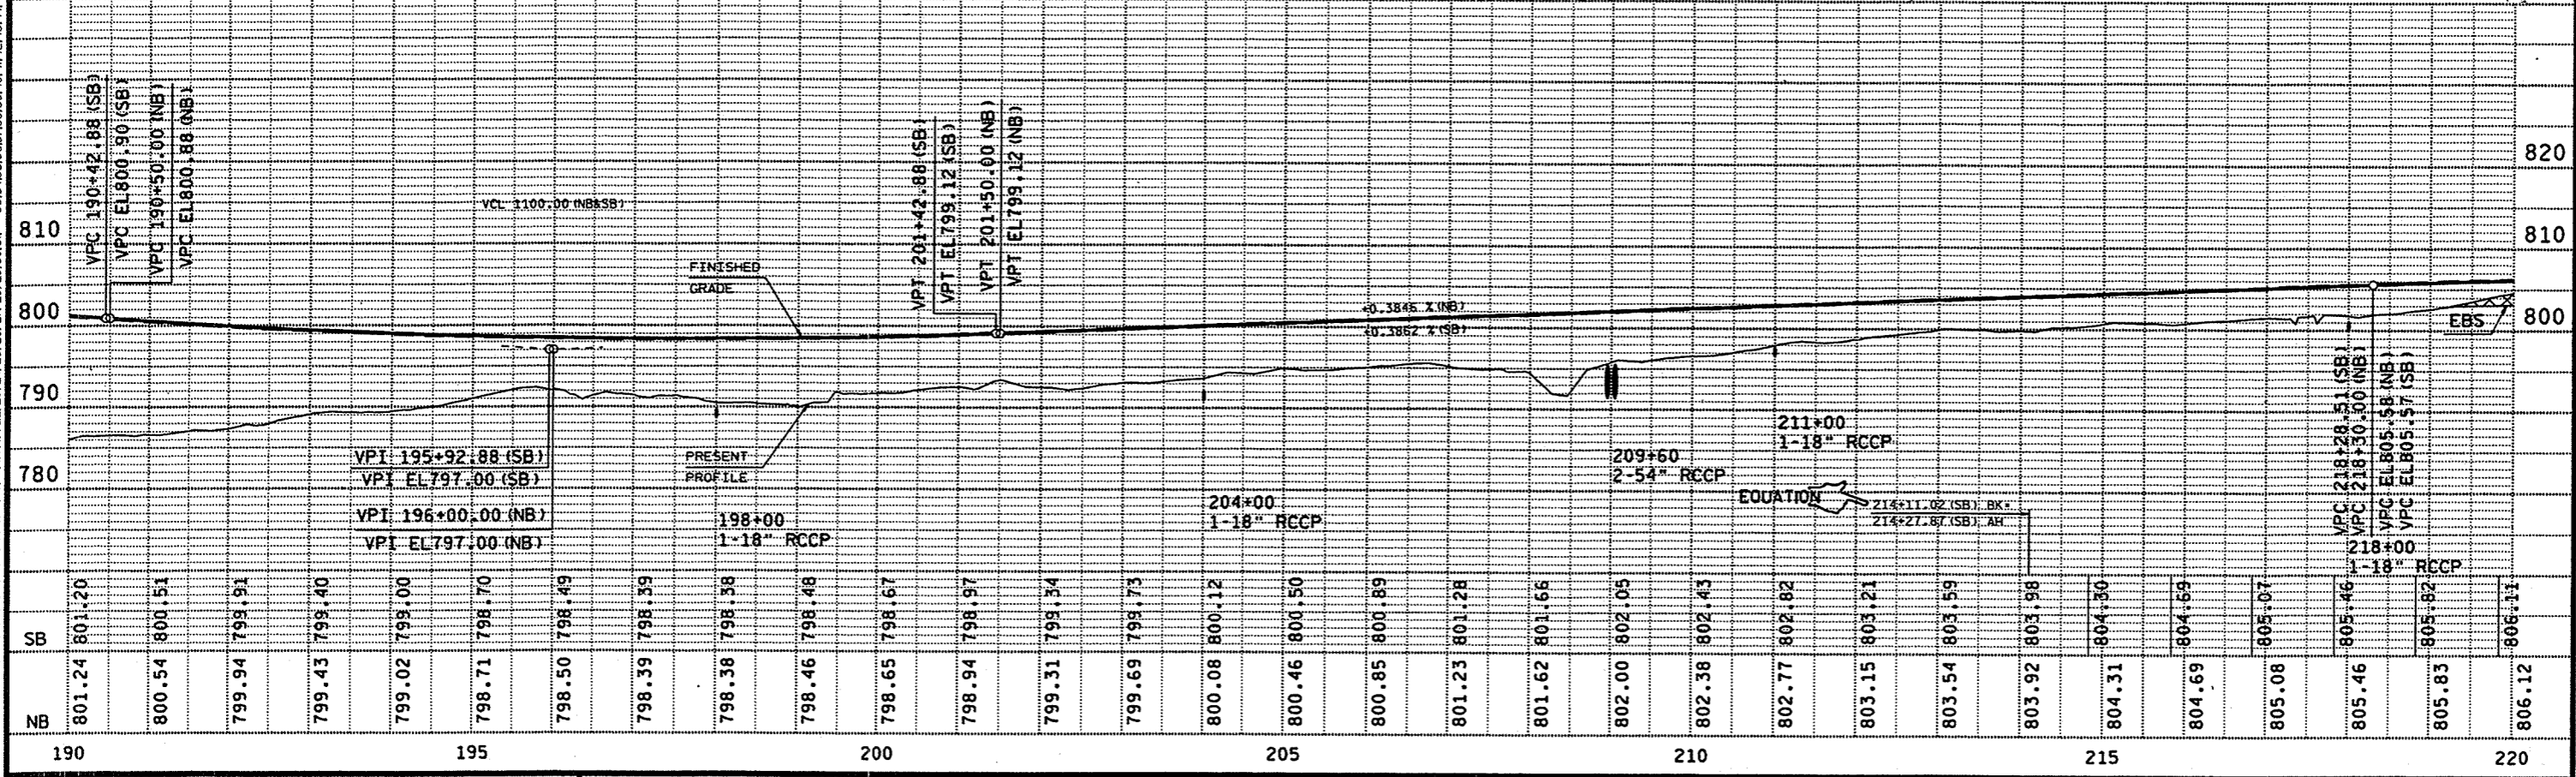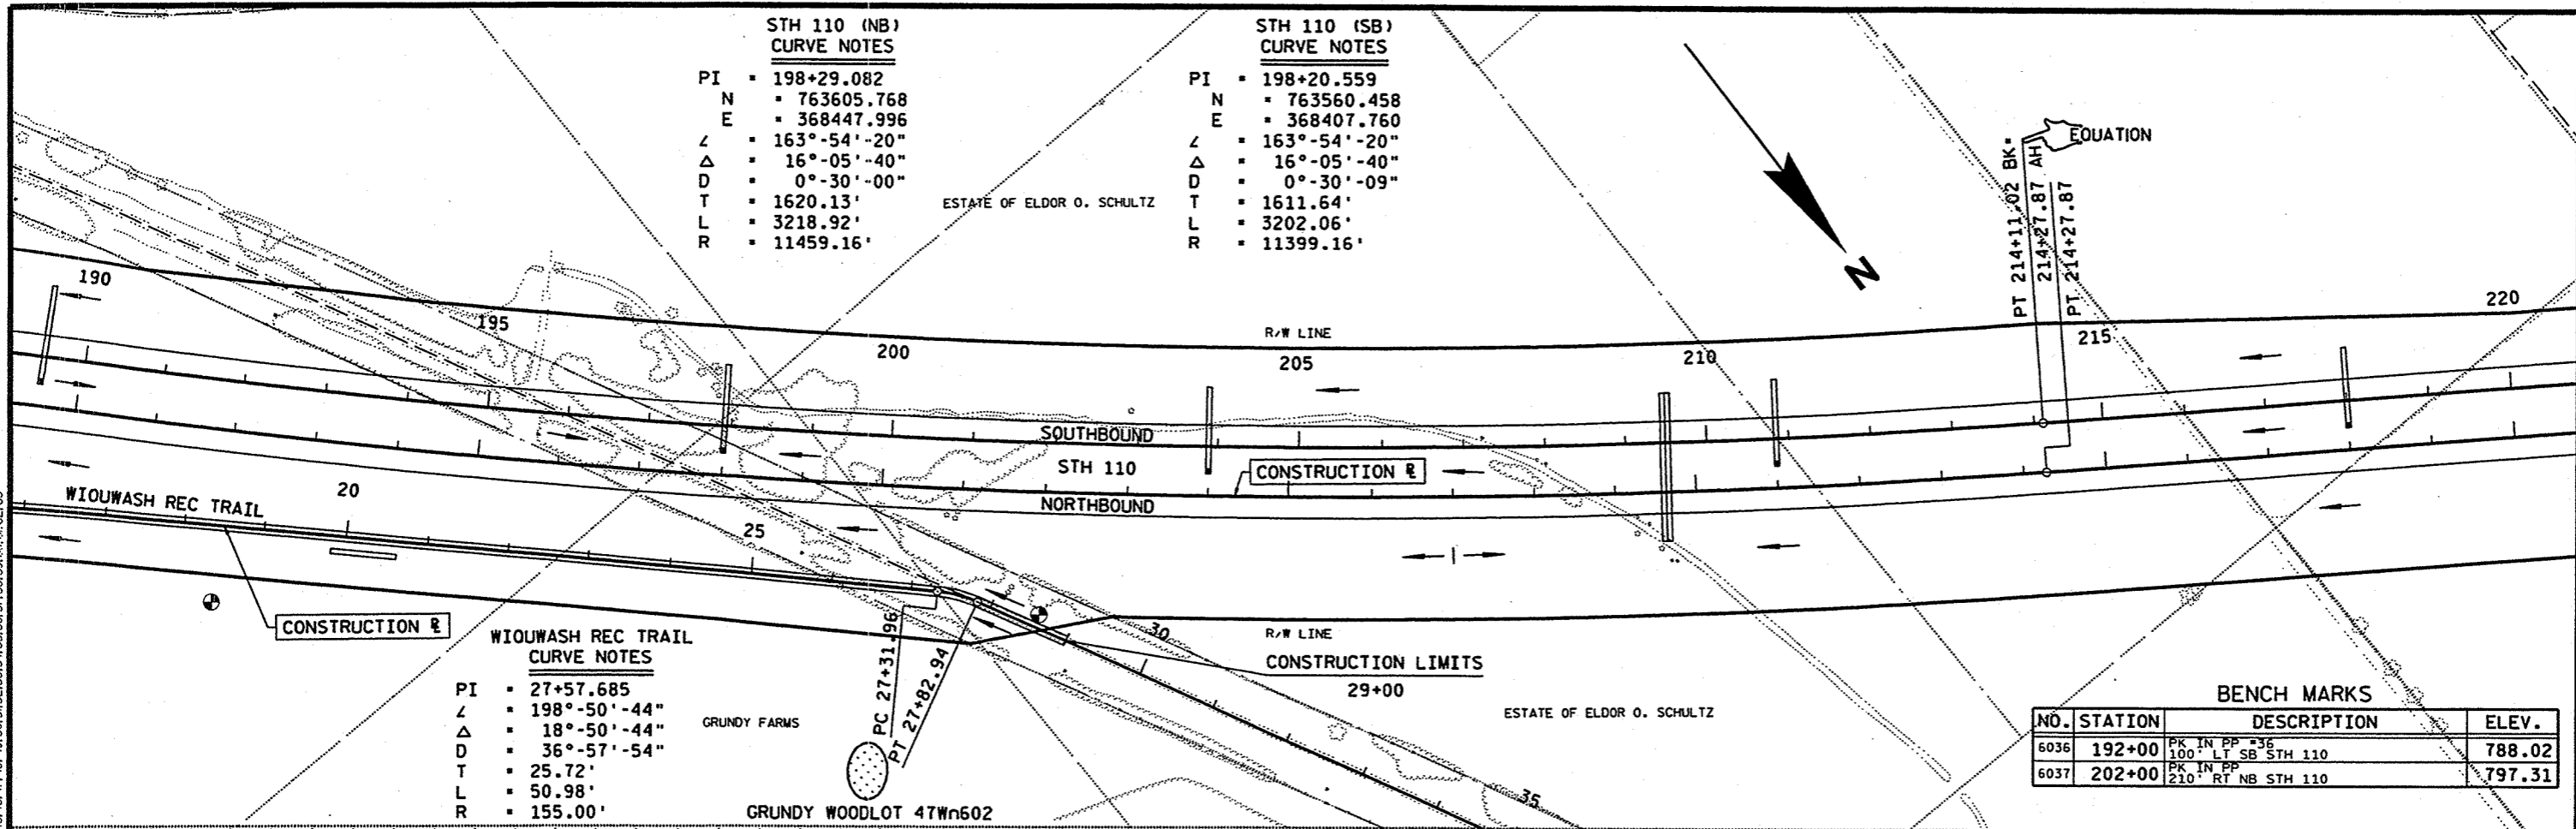

STATION	NB	SB
190	801.24	801.20
	800.54	800.51
	799.94	799.91
	799.43	799.40
195	799.02	799.00
	798.71	798.70
	798.50	798.49
	798.39	798.39
	798.38	798.38
	798.46	798.48
	798.65	798.67
	798.94	798.97
	799.31	799.34
	799.69	799.73
	800.08	800.12
	800.46	800.50
	800.85	800.89
	801.23	801.28
	801.62	801.66
	802.00	802.05
	802.38	802.43
	802.77	802.82
	803.15	803.21
	803.54	803.59
	803.92	803.98
	804.31	804.30
	804.69	804.69
	805.08	805.07
	805.46	805.46
	805.83	805.82
220	806.12	806.11


STATE PROJECT NUMBER: 6200-05-71 HWY: STH 110 COUNTY: WINNEBAGO STH 110 SHEET NO: 5.5 E

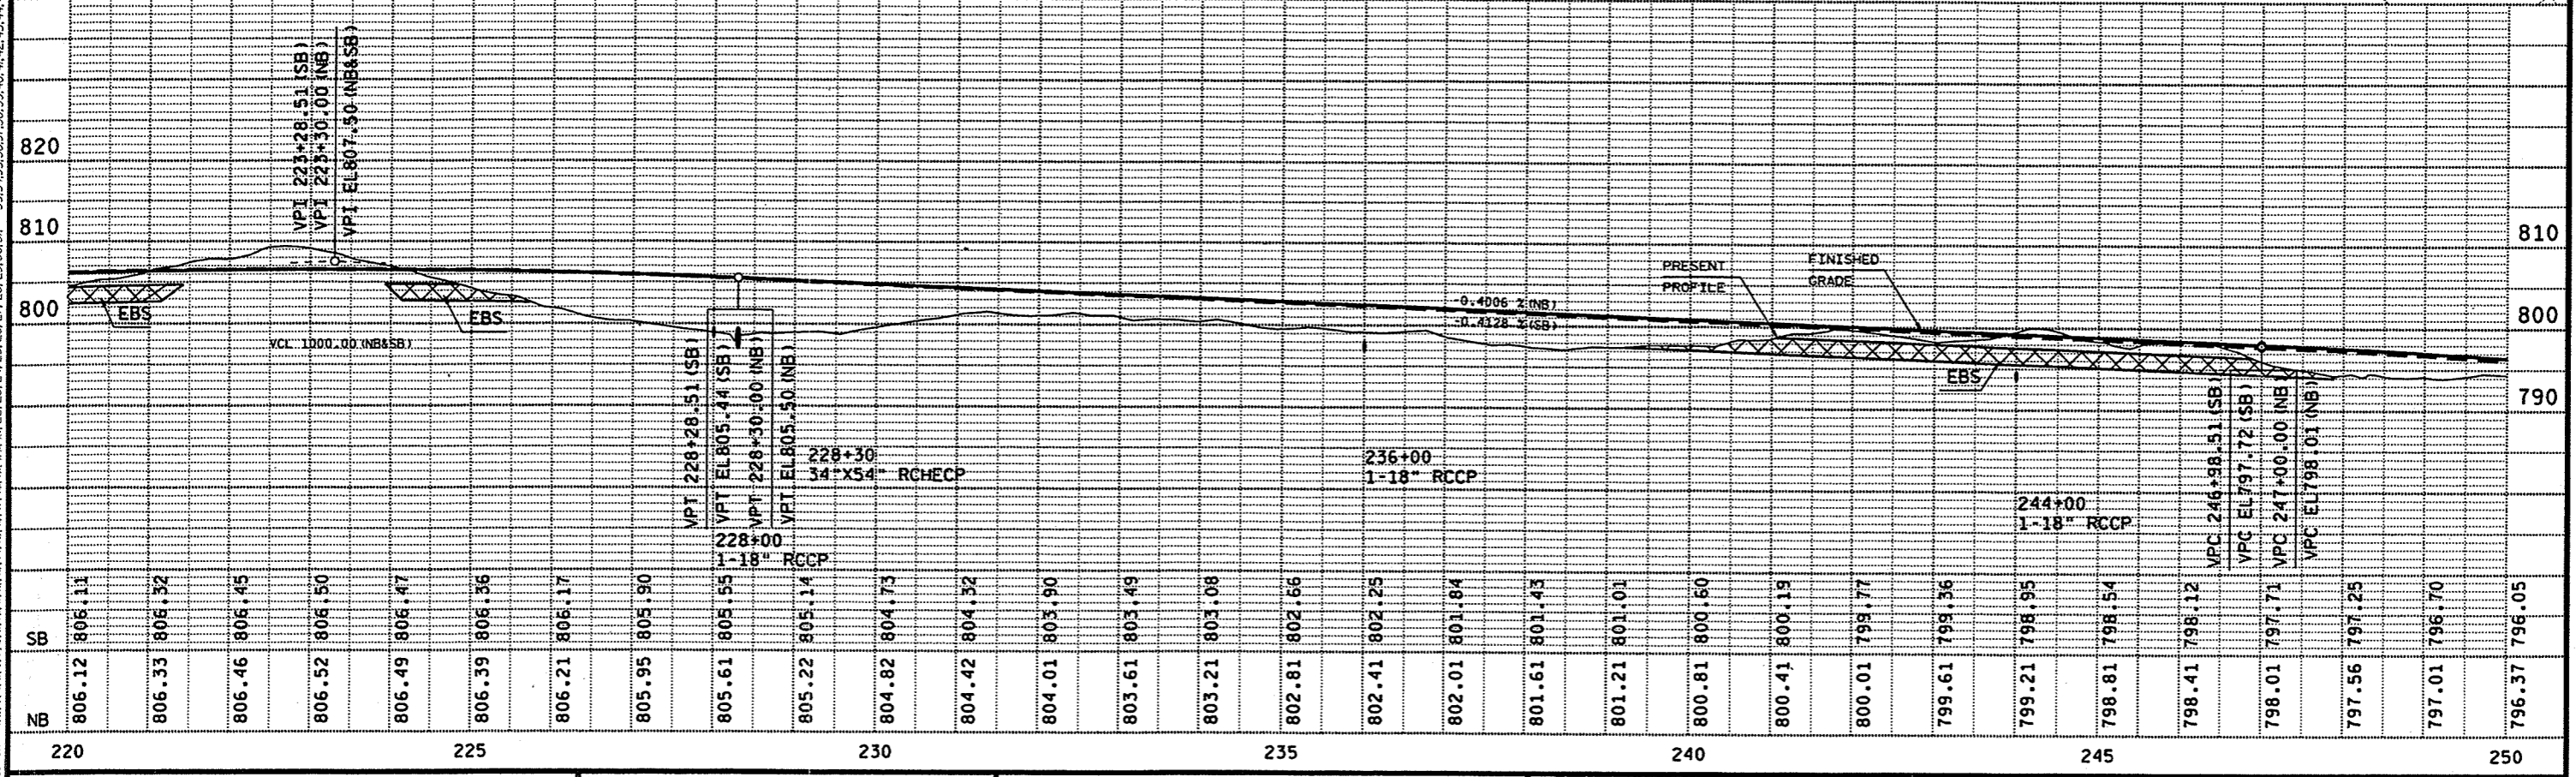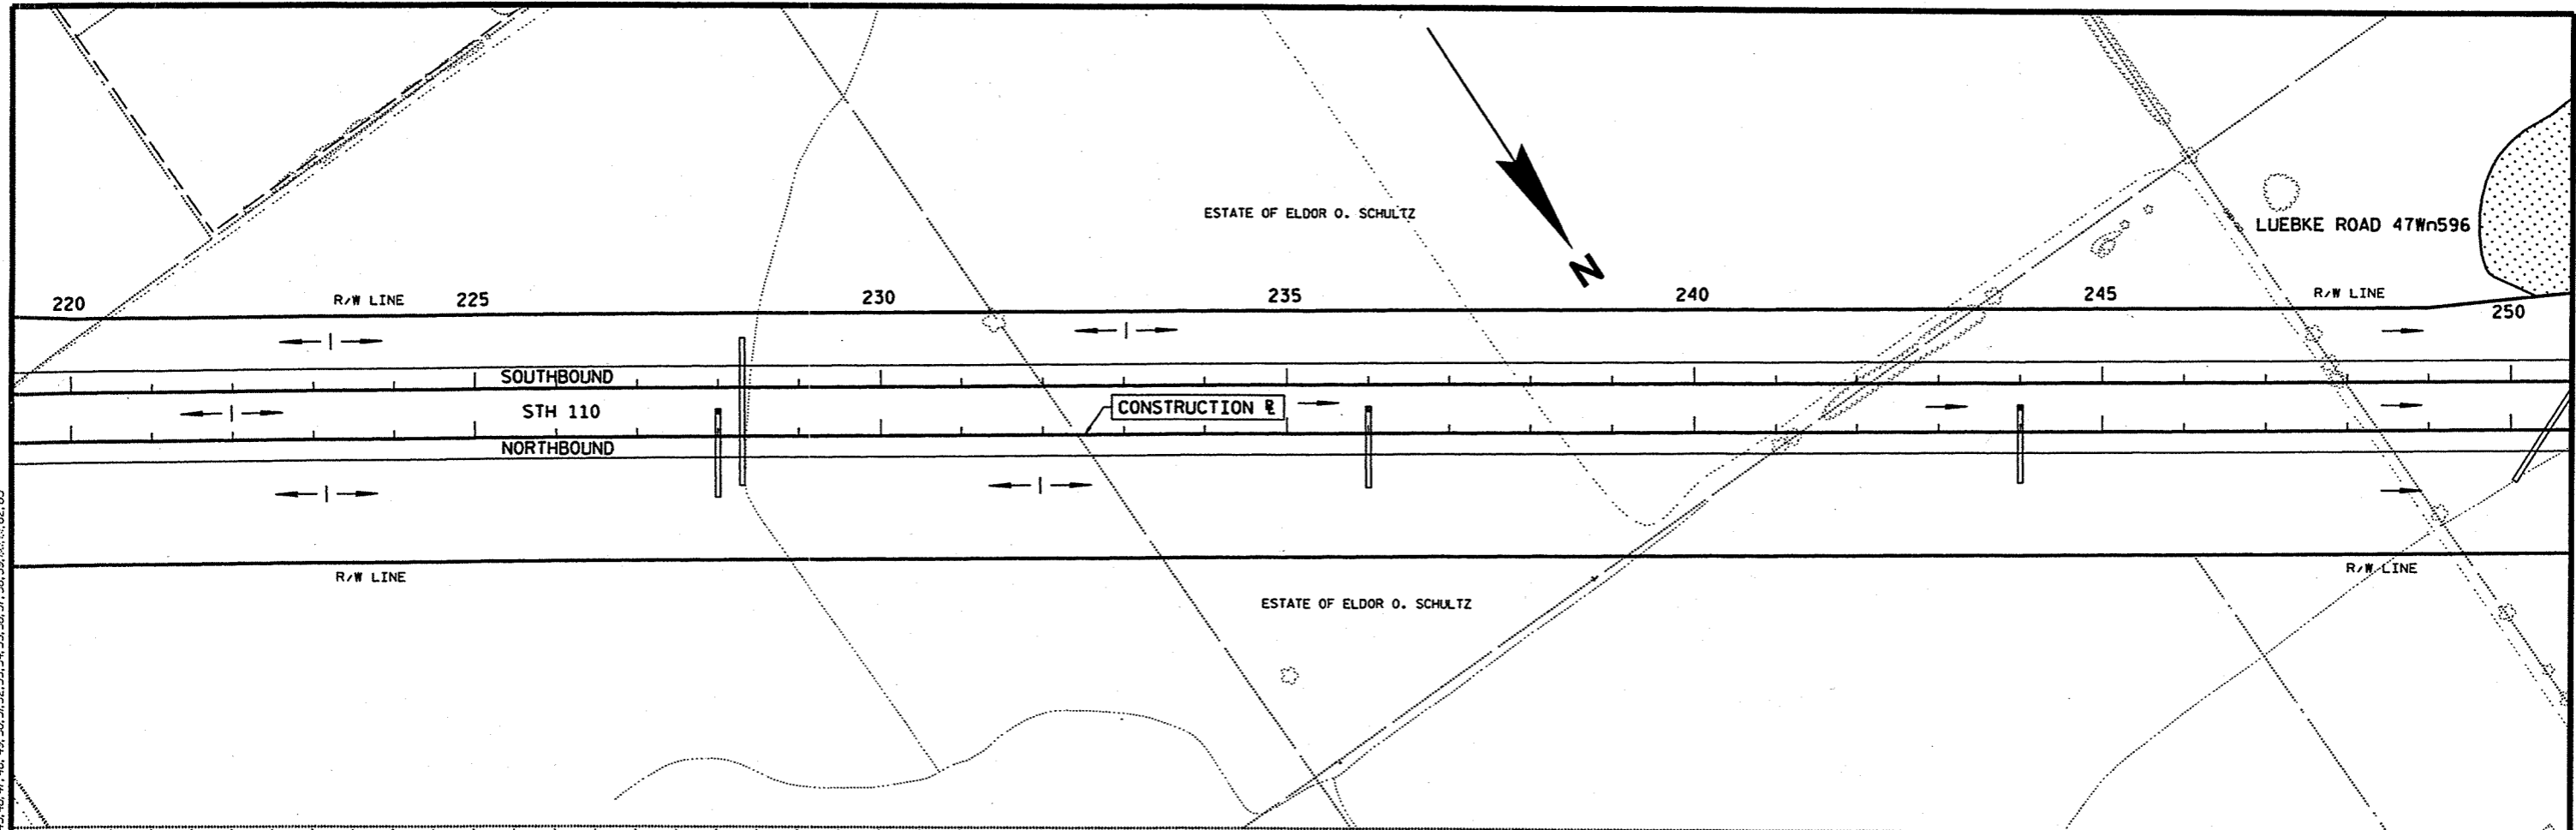

STATE PROJECT NUMBER: 6200-05-71 HWY: STH 110 COUNTY: WINNEBAGO STH 110 SHEET NO: 5.6 E


FILE NAME : F:\d3_620005\d3506.dgn PLOT DATE: 17-SEP-2001 11:17 ORG DATE : PLOT NAME : d3506d71 Originator : DISTRICT 3 PLOT SCALE : 200.700000:1.000000 WISDOT/CADDs SHEET 40

LEVELS ON - 1.0, 1.5, 2.0, 99.5, 100.0


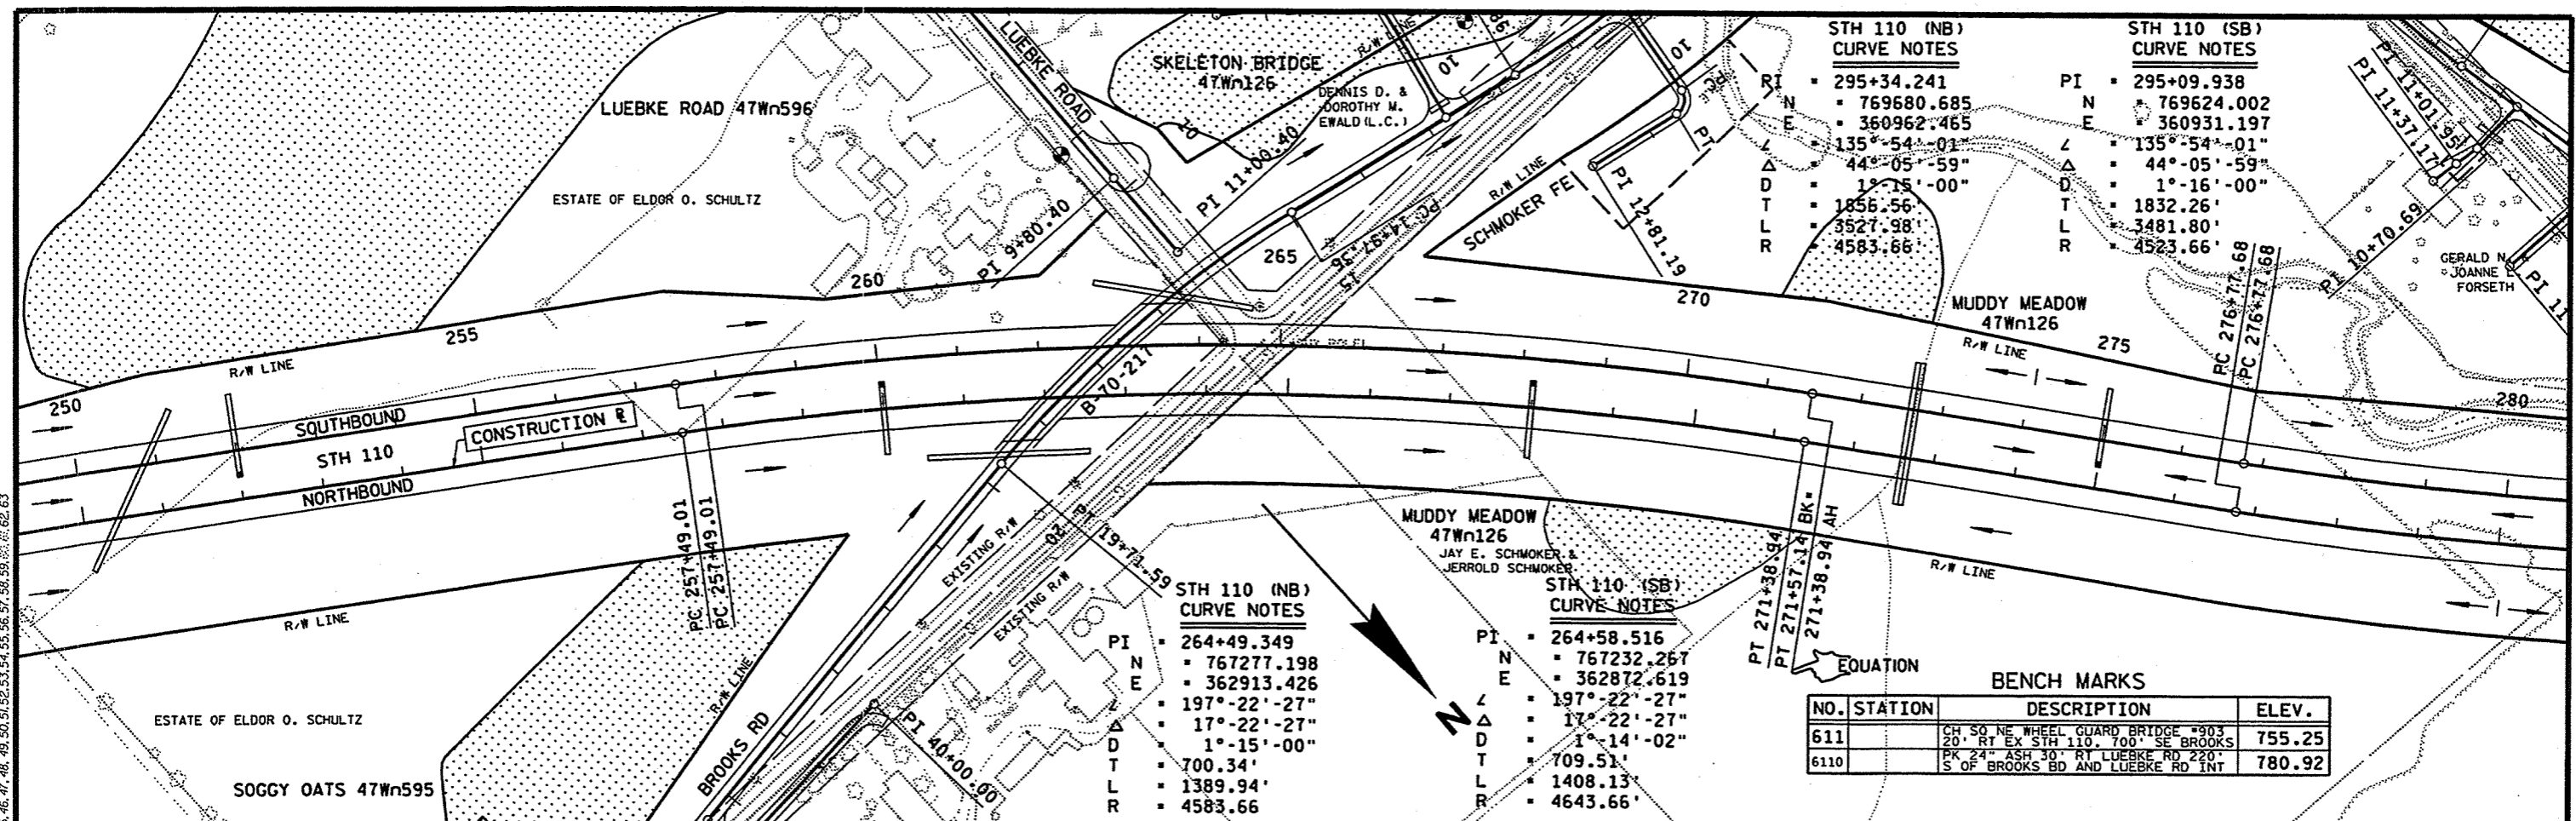


BENCH MARKS

NO.	STATION	DESCRIPTION	ELEV.
611		CH 50 NE WHEEL GUARD BRIDGE #903 20' RT EX STH 110, 700' SE BROOKS	755.25
6110		PK 24' ASH 30' RT LUEBKE RD 220' S OF BROOKS BD AND LUEBKE RD INT	780.92

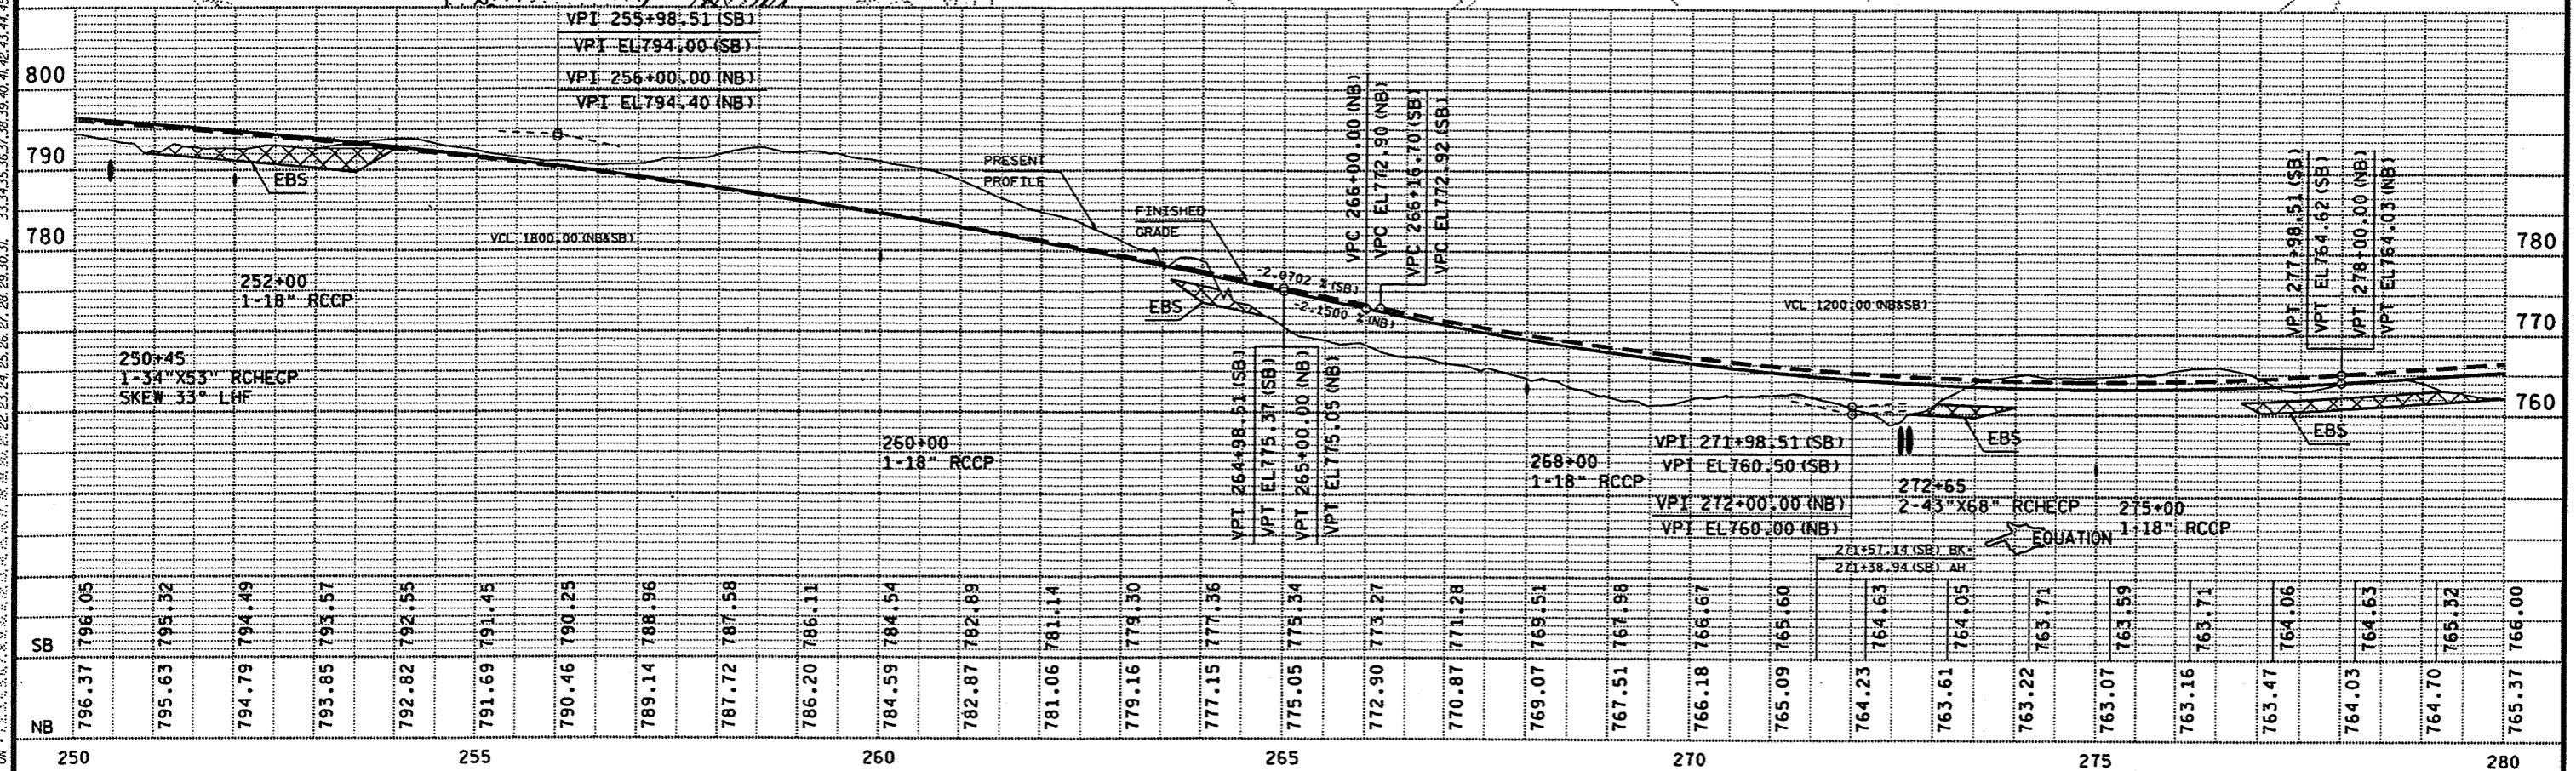

Station	SB Elevation	NB Elevation
250	796.37	796.05
251	795.63	795.52
252	794.79	794.49
253	793.85	793.57
254	792.82	792.55
255	791.69	791.45
256	790.46	790.25
257	789.14	788.96
258	787.72	787.58
259	786.20	786.11
260	784.59	784.54
261	782.87	782.89
262	781.06	781.14
263	779.16	779.30
264	777.15	777.36
265	775.05	775.34
266	772.90	773.27
267	770.87	771.28
268	769.07	769.51
269	767.51	767.98
270	766.18	766.67
271	765.09	765.60
272	764.25	764.63
273	763.61	764.05
274	763.22	763.71
275	763.07	763.59
276	763.16	763.71
277	763.47	764.06
278	764.03	764.53
279	764.70	765.32
280	765.37	766.00

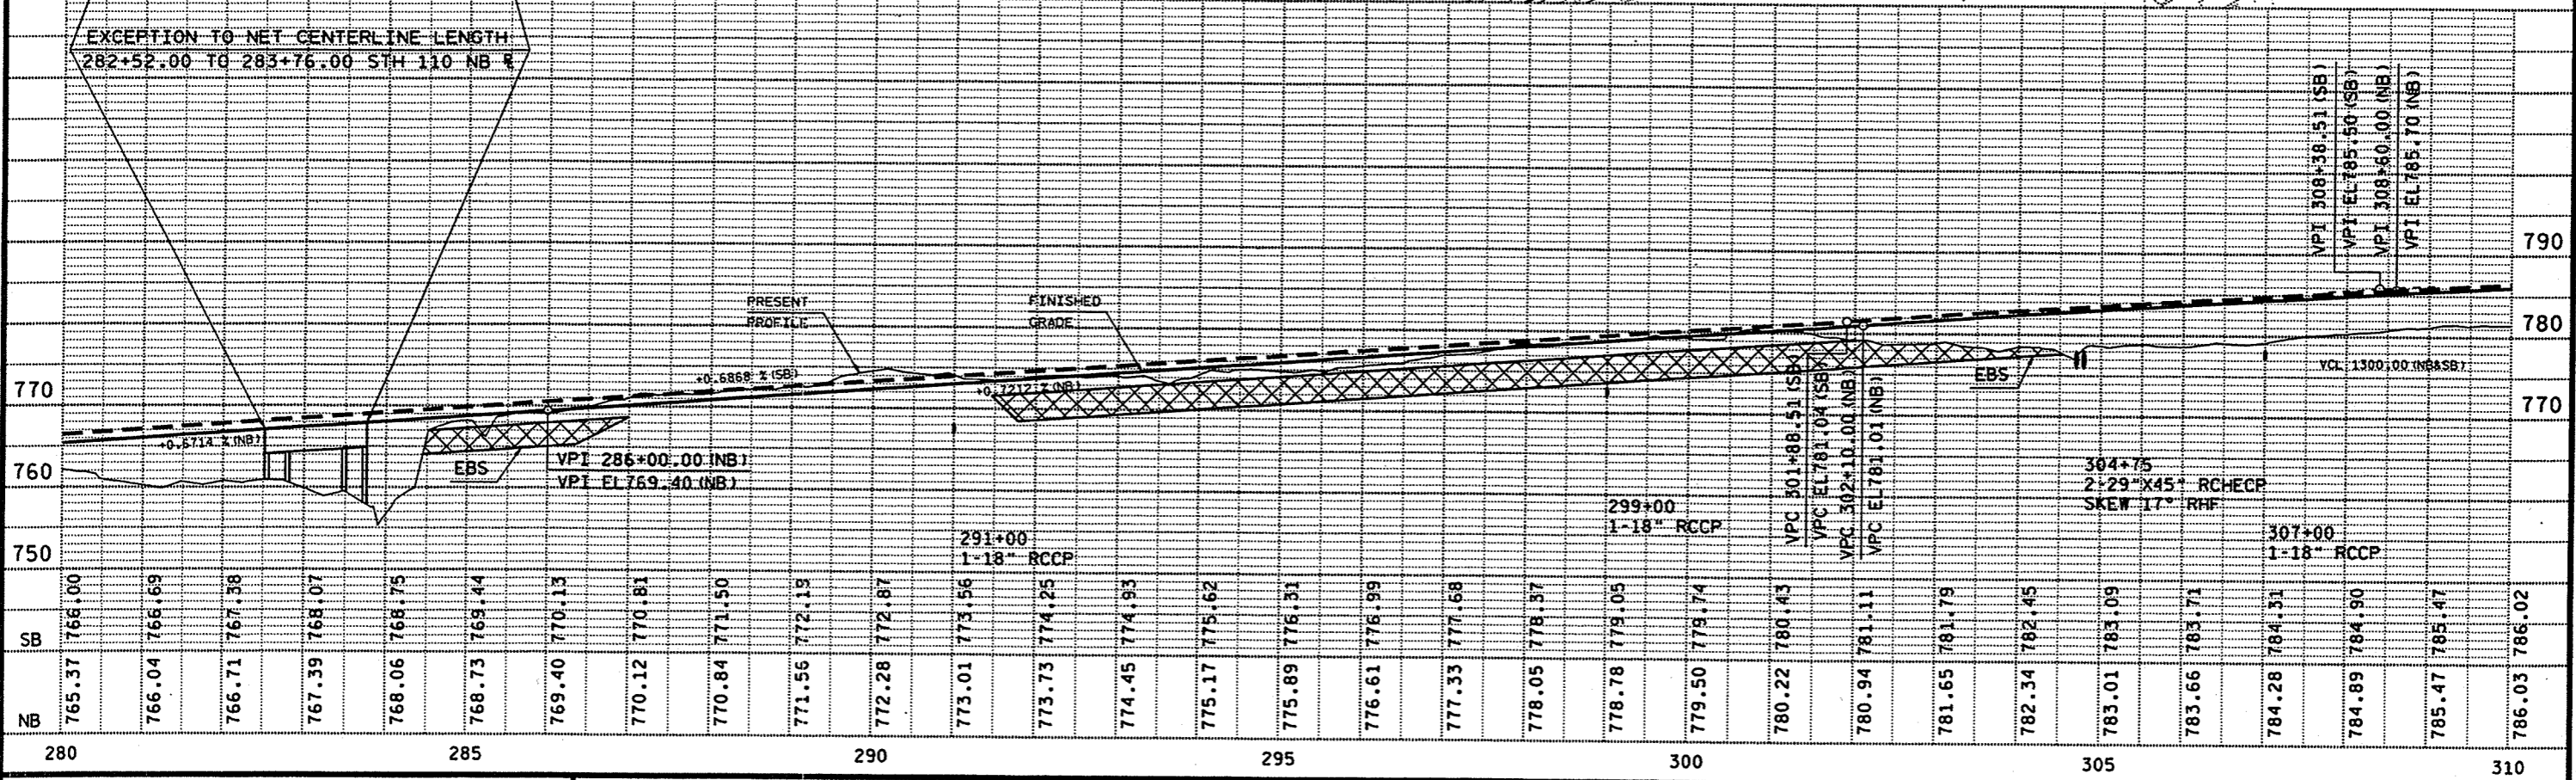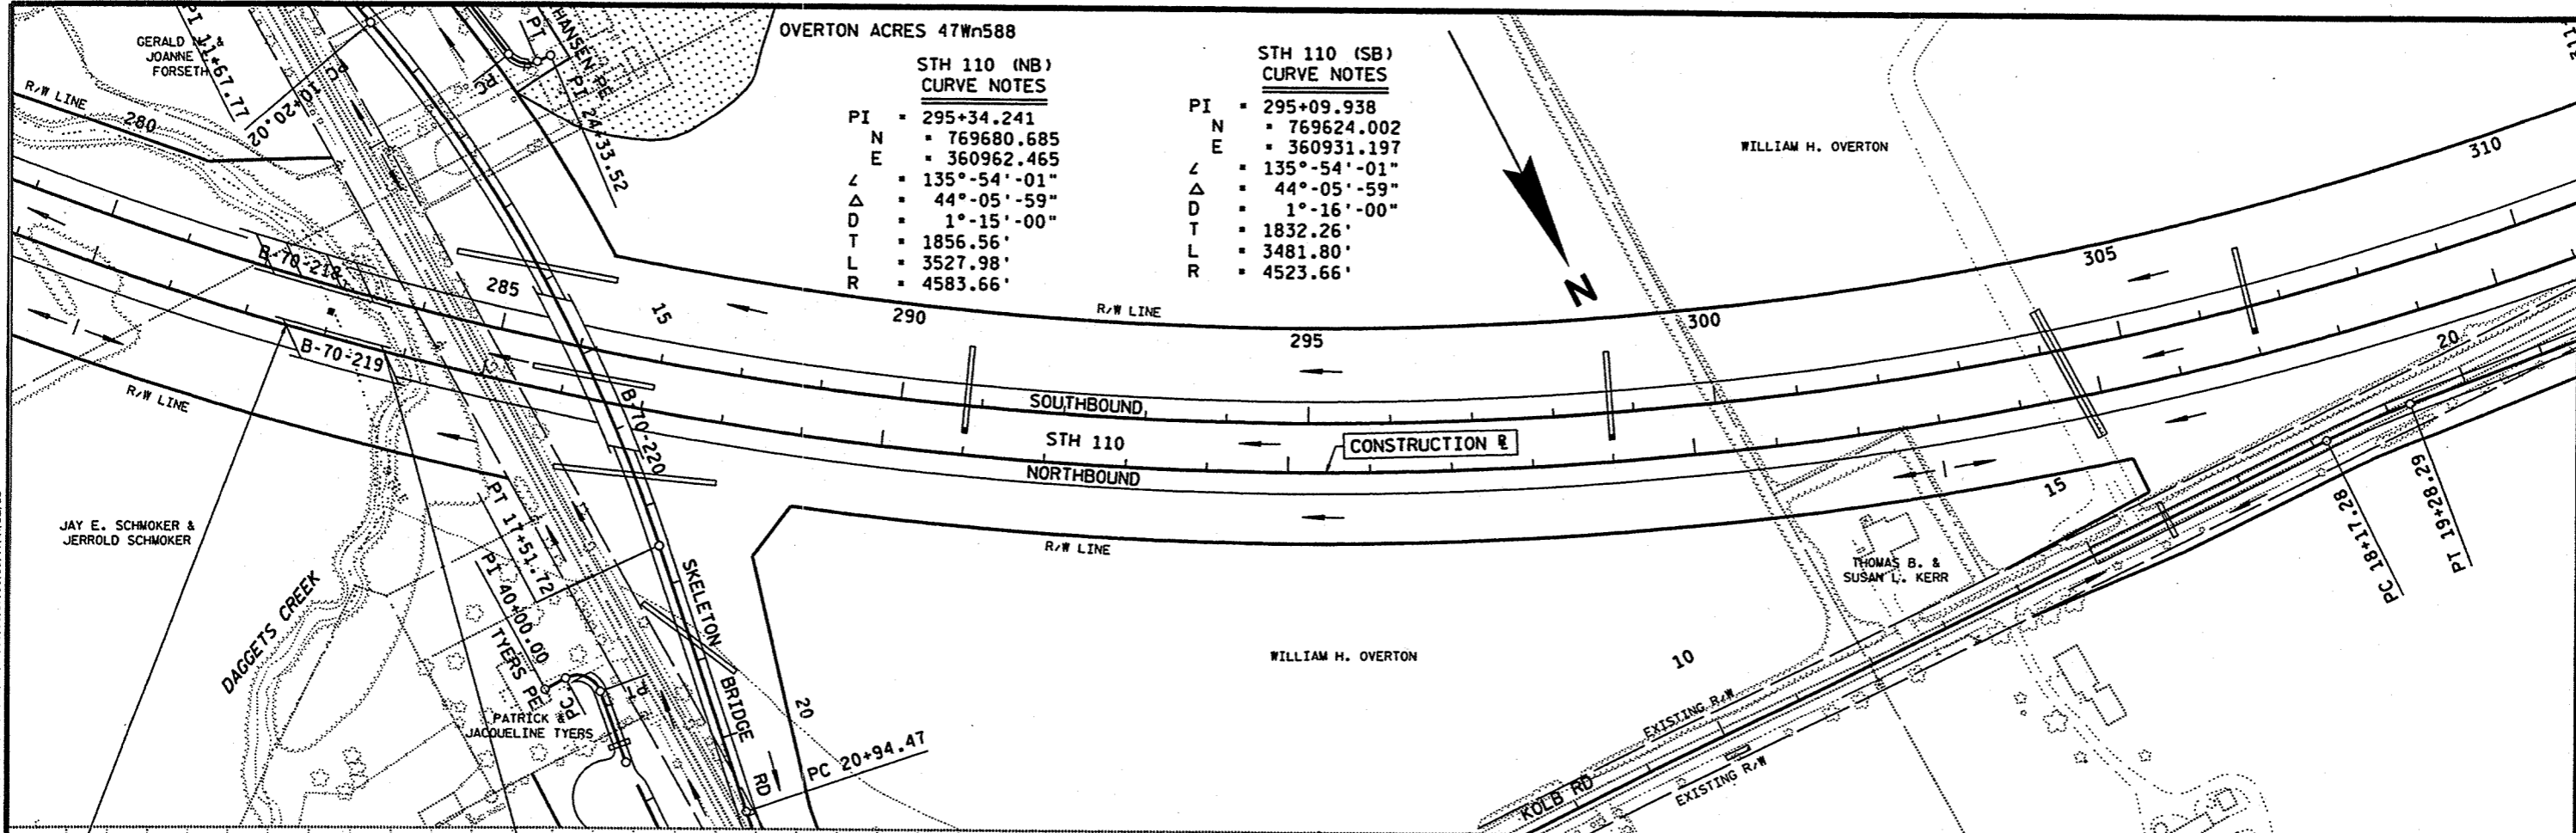

LEVELS ON 1, 2, 3, 62, 63

**STH 110 (NB)
CURVE NOTES**

PI N 295+34.241
 E 769680.685
 360962.465
 Δ 135°-54'-01"
 D 44°-05'-59"
 T 1°-15'-00"
 L 1856.56'
 R 3527.98'
 4583.66'

**STH 110 (SB)
CURVE NOTES**

PI N 295+09.938
 E 769624.002
 360931.197
 Δ 135°-54'-01"
 D 44°-05'-59"
 T 1°-16'-00"
 L 1832.26'
 R 3481.80'
 4523.66'

**SPIEGELBERG ROAD
CURVE NOTES**

PI N 17+51.557
 Δ 175°-36'-39"
 D 4°-23'-23"
 T 0°-30'-0"
 L 439.15'
 R 877.86'
 11459.16'
 15

**STH 110 (NB)
CURVE NOTES**



PI N 362+32.781
 E 770499.710
 354127.677
 Δ 257°-21'-13"
 D 77°-21'-13"
 T 1°-29'-60"
 L 3057.63'
 R 5156.90'
 3819.72'
 PT 383+32.05

**STH 110 (SB)
CURVE NOTES**

PI N 362+80.811
 E 770445.851
 354072.850
 Δ 257°-21'-13"
 D 77°-21'-13"
 T 1°-28'-36"
 L 3105.66'
 R 5237.91'
 3879.72'


BENCH MARKS

NO.	STATION	DESCRIPTION	ELEV.
6120	326+50	SPIKE IN 36" OAK, 70' LT SB STH 110, 100' E DRIVEWAY TO WINNECONNE - BUTTE DES MORTS SEWAGE PLANT	790.97
6121	339+00	BK NL 6" STUMP 3' UP FROM GROUND 250' LT SB STH 110	

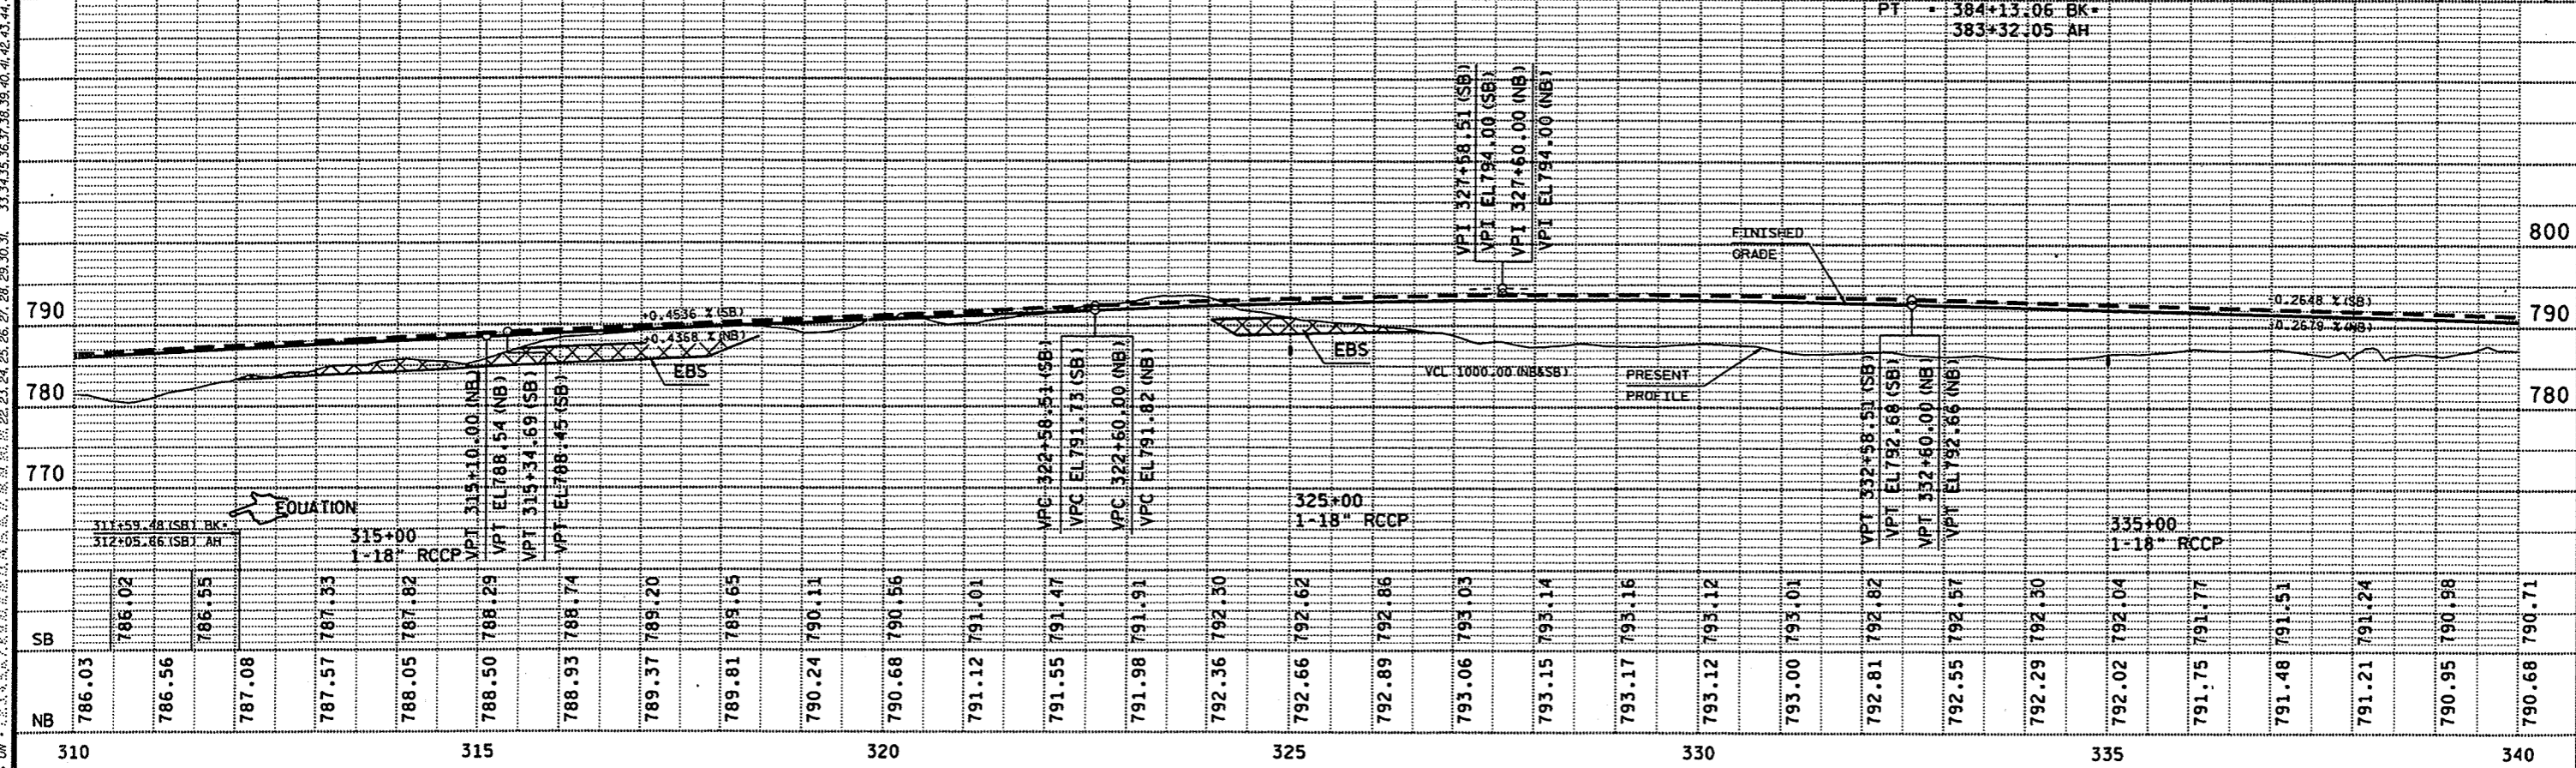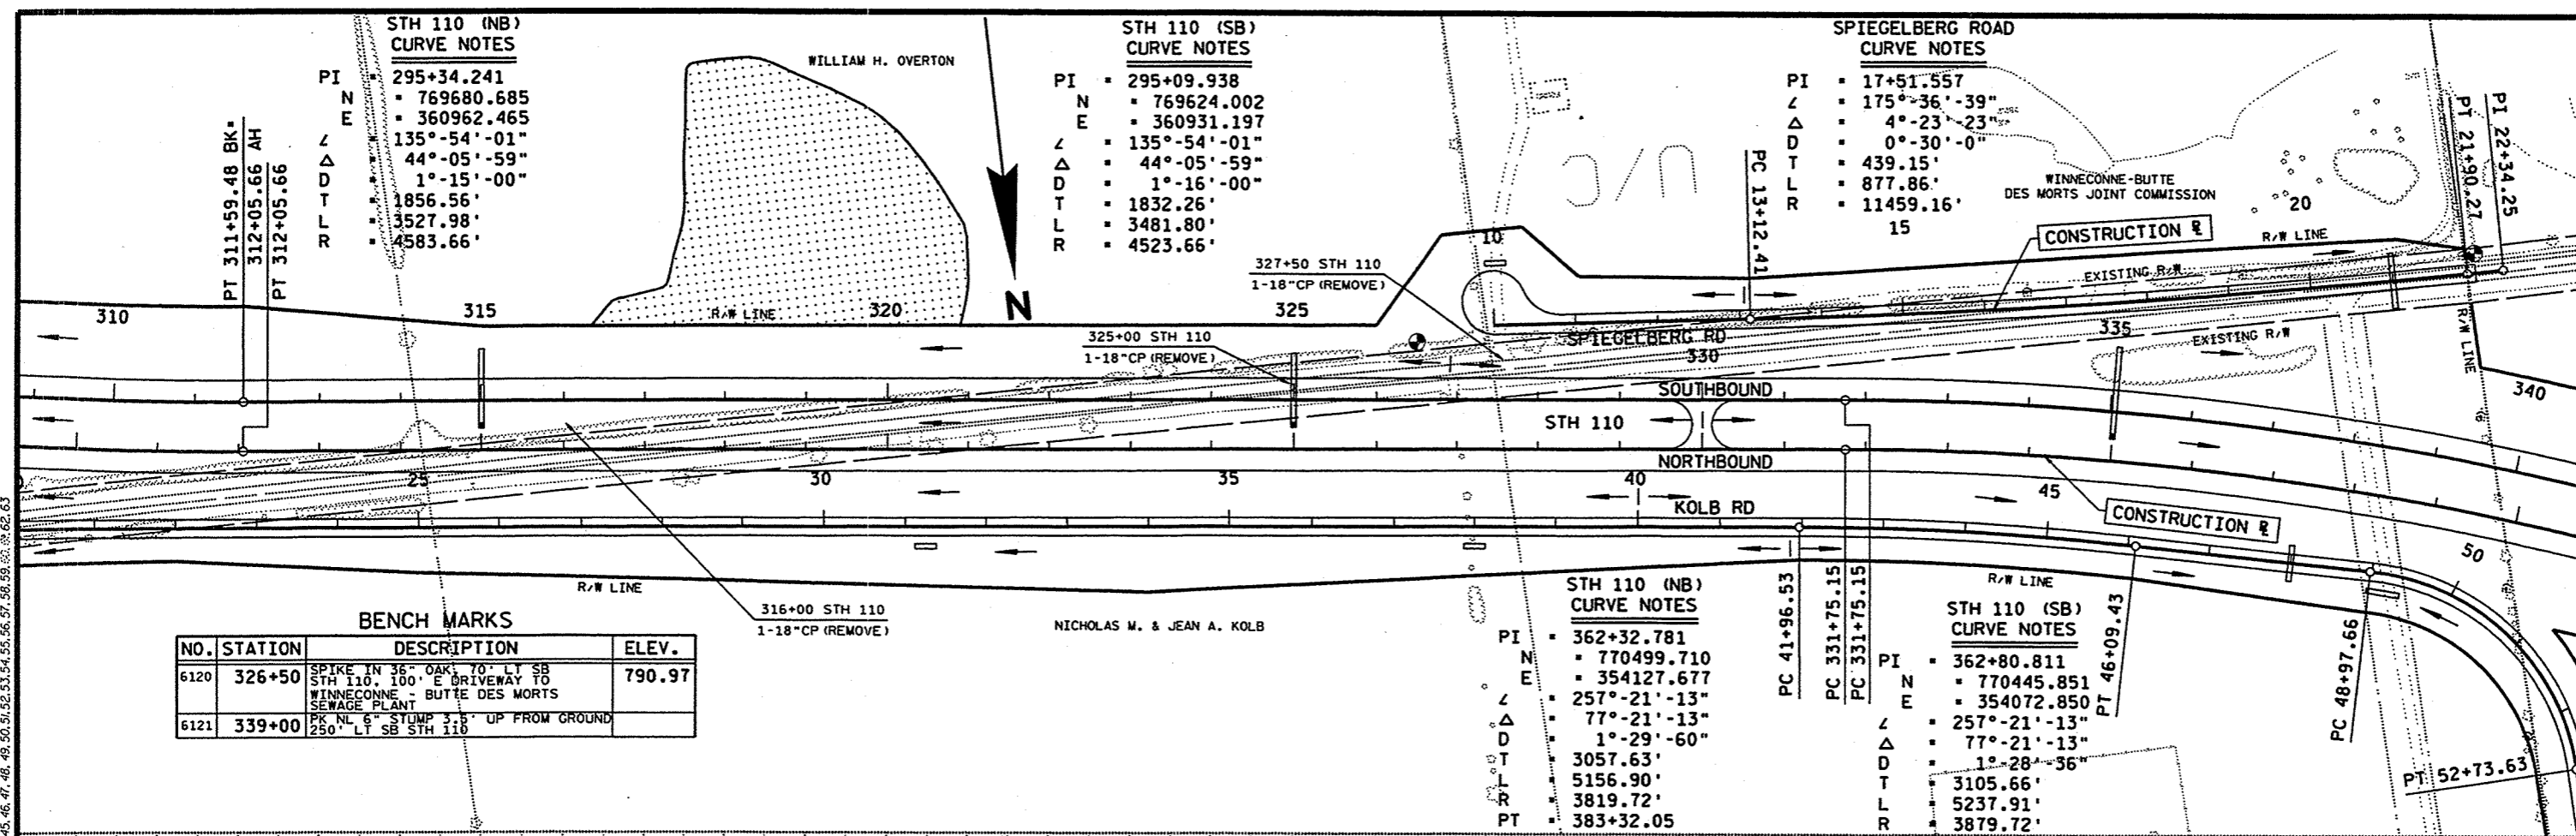

STATE PROJECT NUMBER: 6200-05-71	HWY: STH 110	COUNTY: WINNEBAGO	STH 110	SHEET NO: 59	E
----------------------------------	--------------	-------------------	---------	--------------	---

BENCH MARKS			
NO.	STATION	DESCRIPTION	ELEV.
617		PM NW WW CATTLE PASS, 24' RT STH 110 & 0.6 MI SE STH 116	782.20
6122		PK IN PP *1915-24R-46 SE QUAD STH 110 - SPIEGELBERG RD	763.39

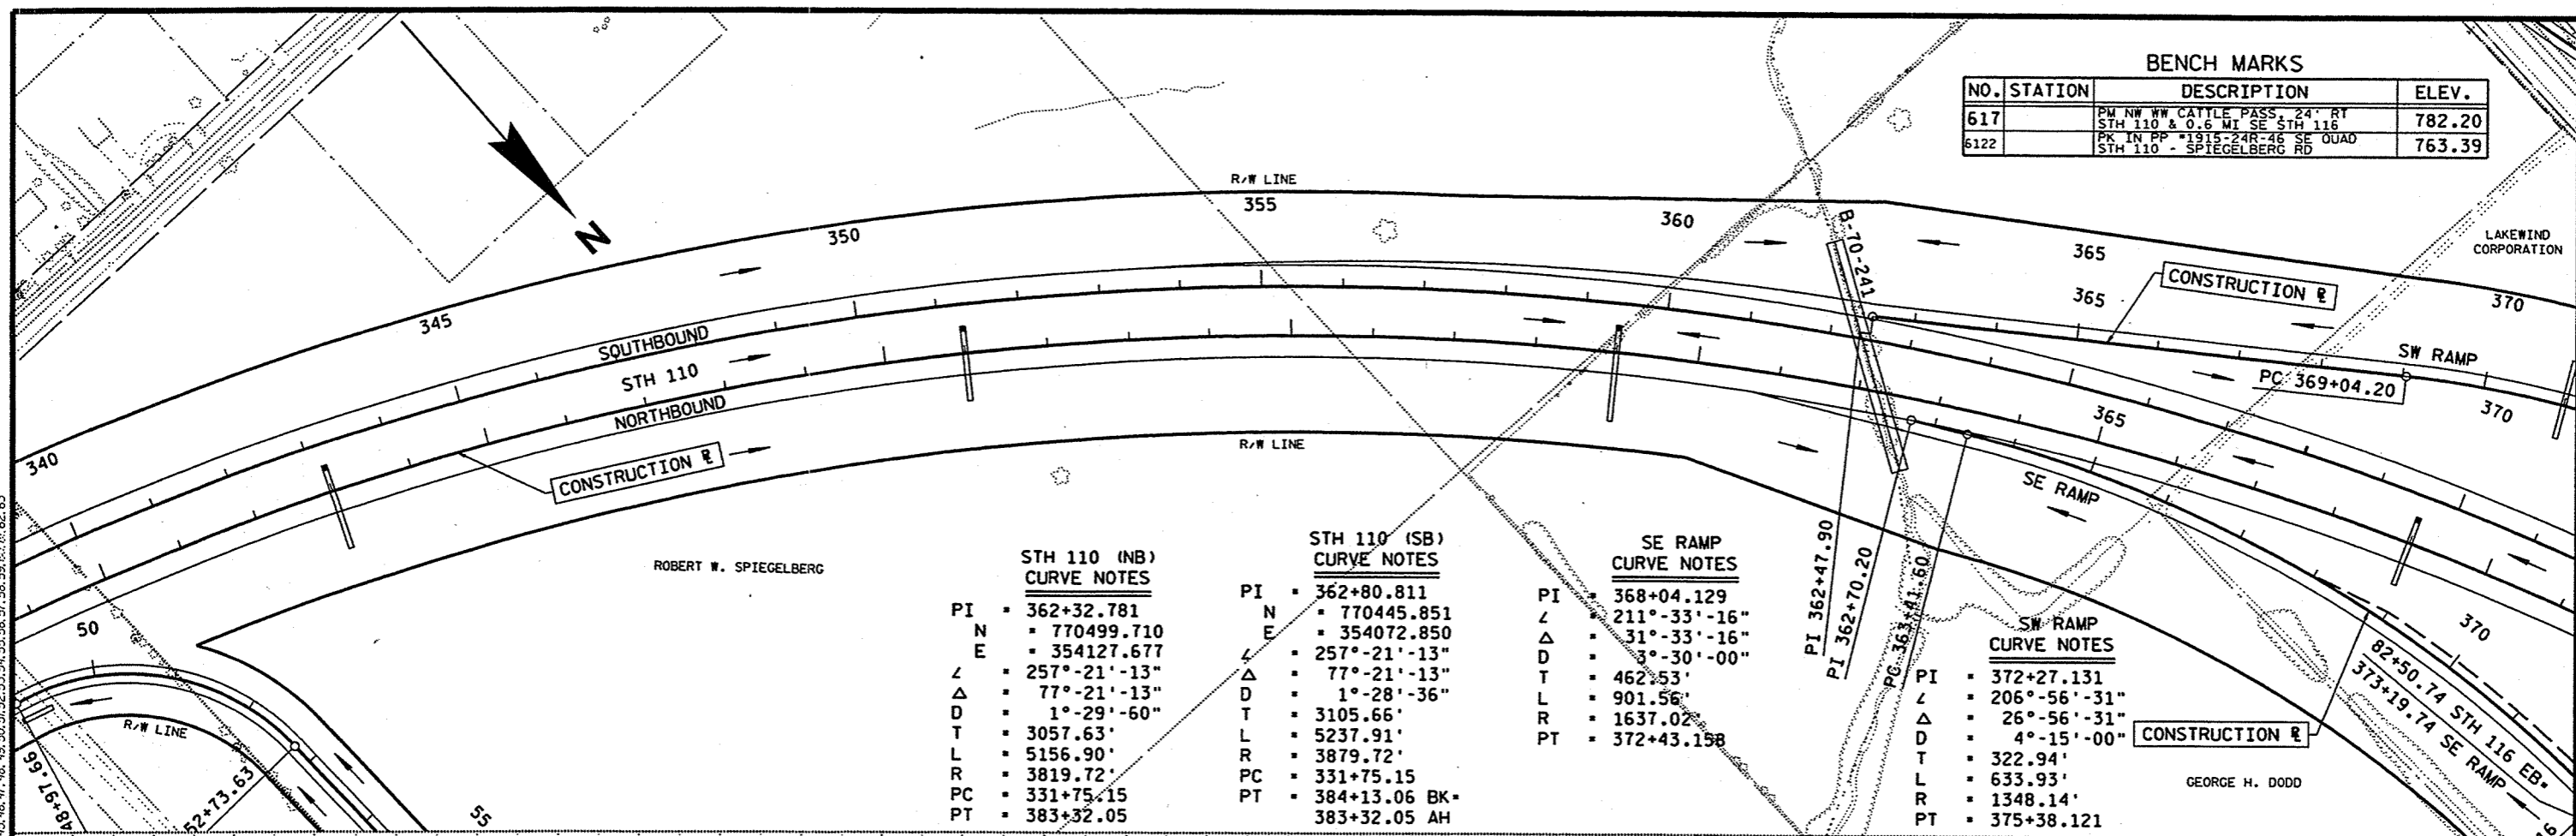

ROBERT W. SPIEGELBERG

STH 110 (NB)
CURVE NOTES

PI	362+32.781
N	770499.710
E	354127.677
∠	257°-21'-13"
Δ	77°-21'-13"
D	1°-29'-60"
T	3057.63'
L	5156.90'
R	3819.72'
PC	331+75.15
PT	383+32.05

STH 110 (SB)
CURVE NOTES


PI	362+80.811
N	770445.851
E	354072.850
∠	257°-21'-13"
Δ	77°-21'-13"
D	1°-28'-36"
T	3105.66'
L	5237.91'
R	3879.72'
PC	331+75.15
PT	384+13.06 BK- 383+32.05 AH

SE RAMP
CURVE NOTES

PI	368+04.129
∠	211°-33'-16"
Δ	31°-33'-16"
D	3°-30'-00"
T	462.53'
L	901.56'
R	1637.02'
PT	372+43.158

SW RAMP
CURVE NOTES



PI	372+27.131
∠	206°-56'-31"
Δ	26°-56'-31"
D	4°-15'-00"
T	322.94'
L	633.93'
R	1348.14'
PT	375+38.121


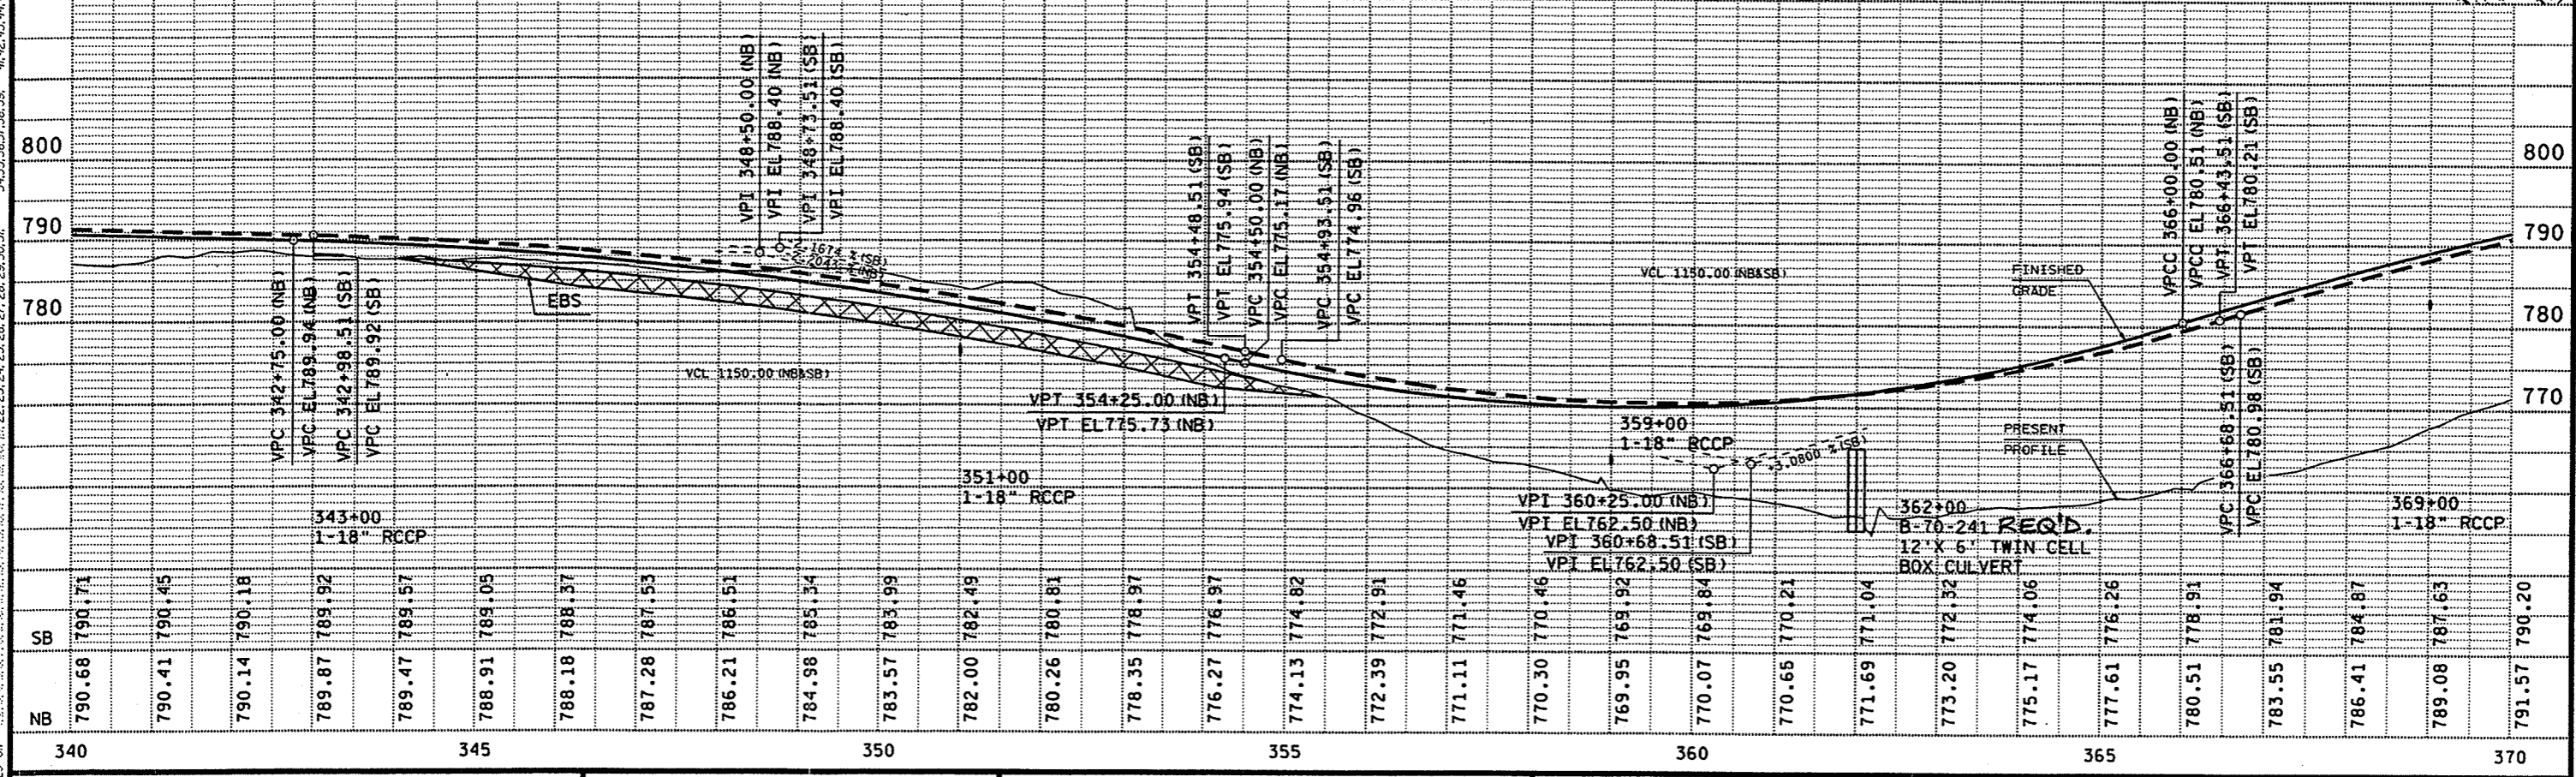


STATION	SB ELEVATION	NB ELEVATION
340	790.68	790.71
	790.41	790.45
	790.14	790.18
	789.87	789.92
	789.47	789.51
345	788.91	789.05
	788.18	788.31
	787.28	787.53
	786.21	786.51
	784.98	785.34
	783.57	783.99
350	782.00	782.49
	780.26	780.81
	778.35	778.91
	776.27	776.91
	774.13	774.82
	772.39	772.91
	771.11	771.46
360	770.30	770.46
	769.95	769.92
	770.07	769.84
	770.65	770.21
	771.69	771.04
	773.20	772.52
	775.17	774.06
	777.61	776.26
365	780.51	778.91
	783.55	781.94
	786.41	784.87
	789.08	787.63
370	791.57	790.20

STATE PROJECT NUMBER: 6200-05-71 HWY: STH 110 COUNTY: WINNEBAGO STH 110 SHEET NO: 5.10 E

FILE NAME: F:\d3_620005\d3510.dgn PLOT DATE: 27-NOV-2001 12:54 ORG DATE: PLOT NAME: d3510d71 Originator: DISTRICT 3 PLOT SCALE: 200.700000:1.000000 WISDOT/CADD SHEET 40

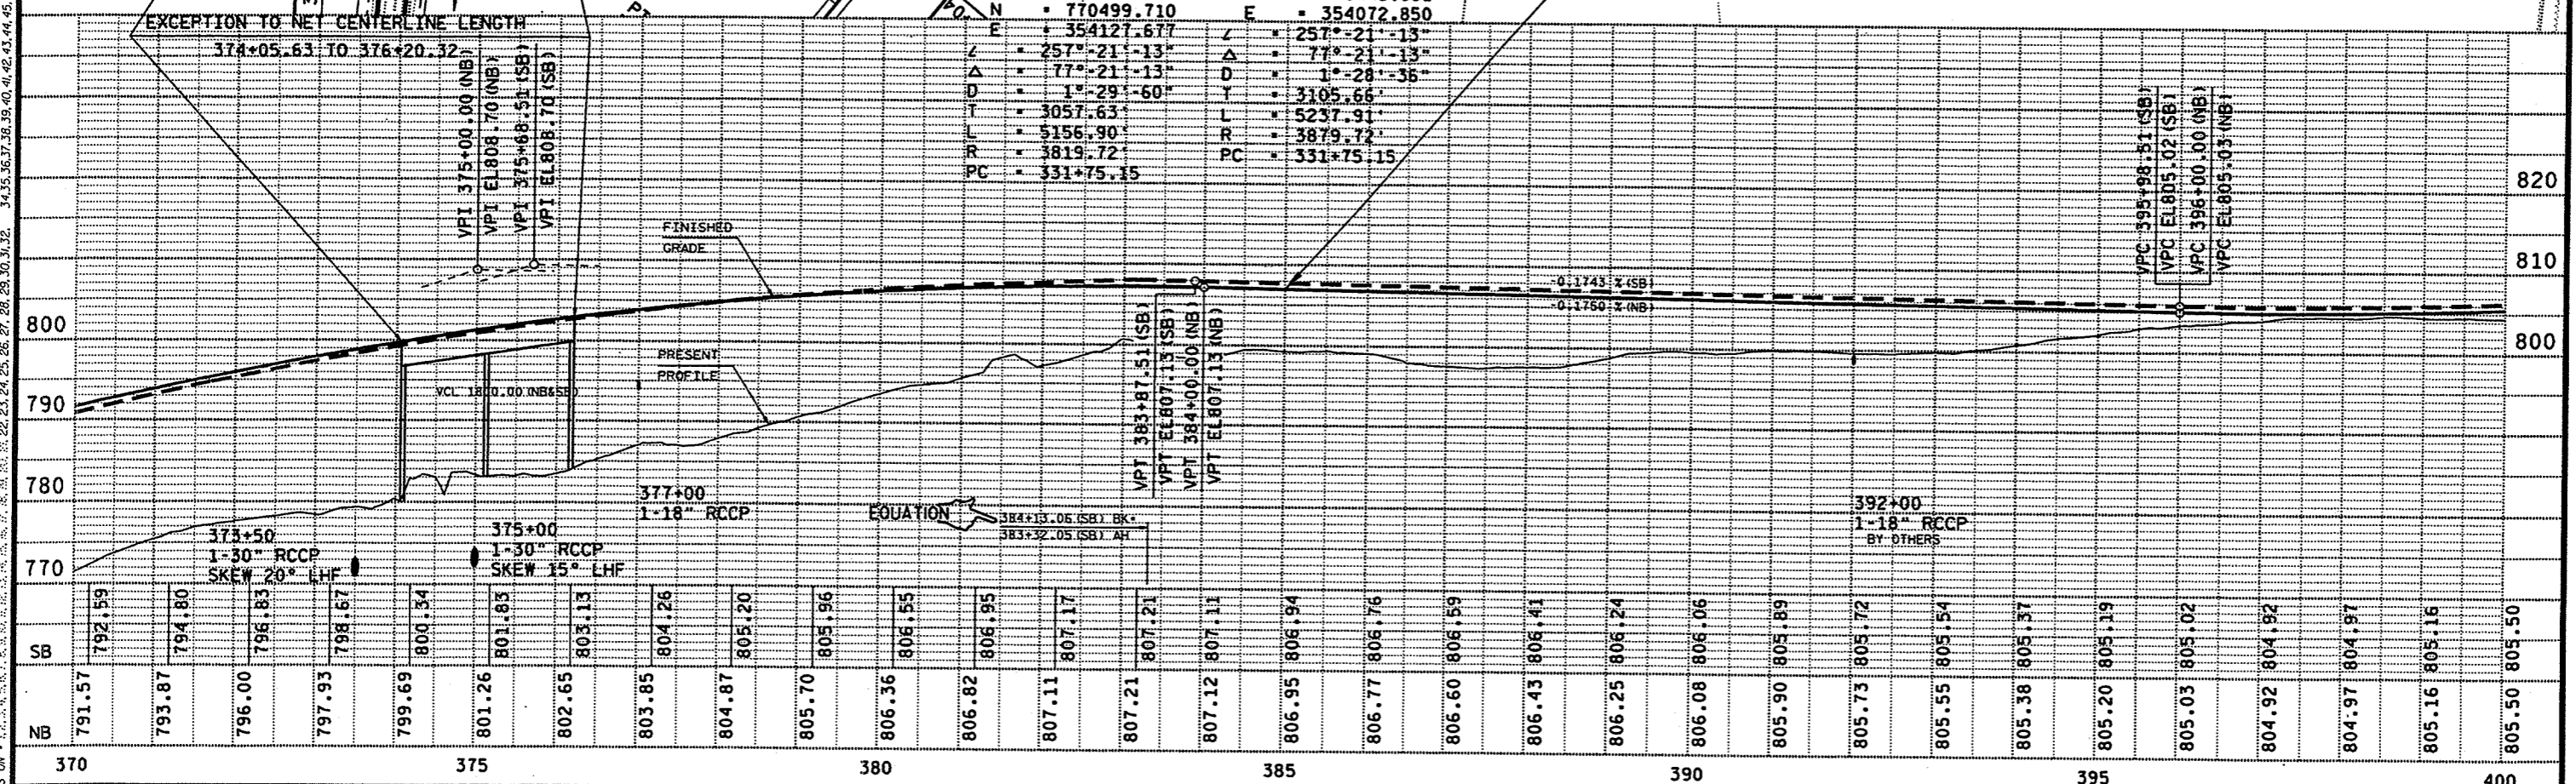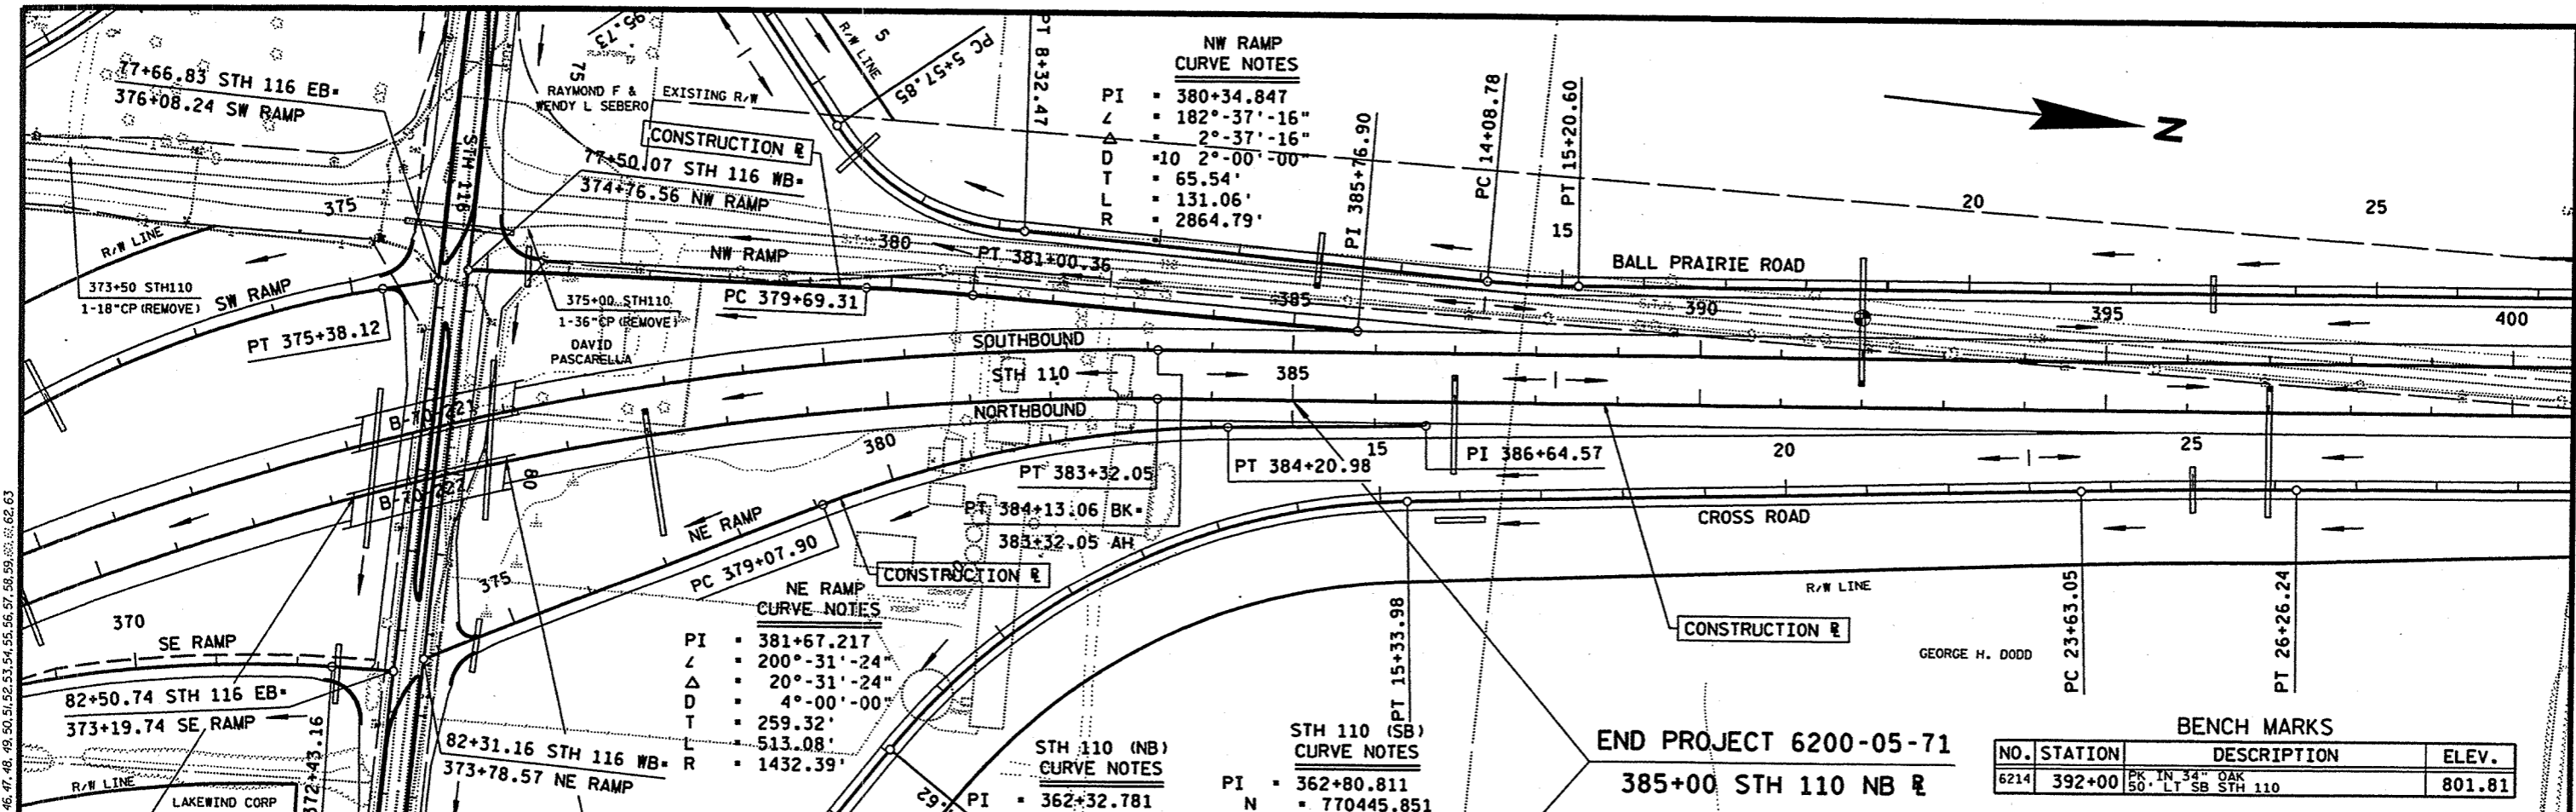


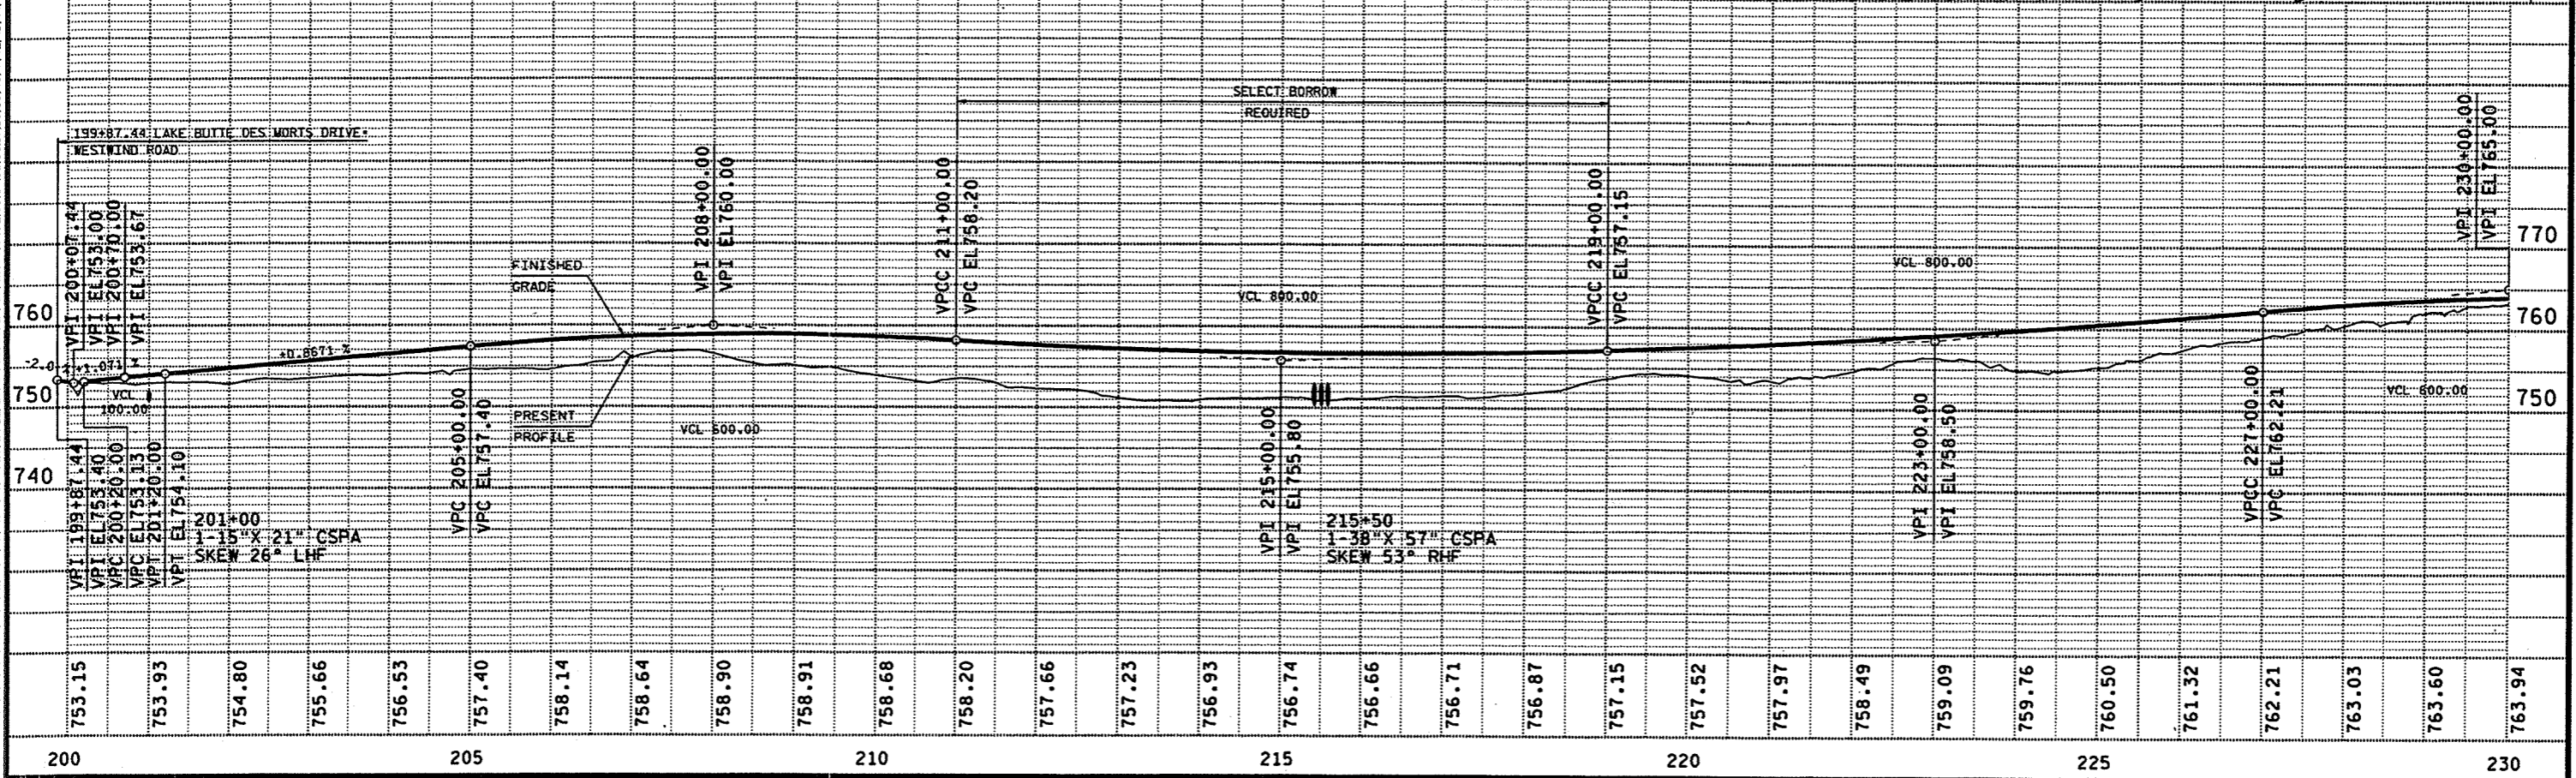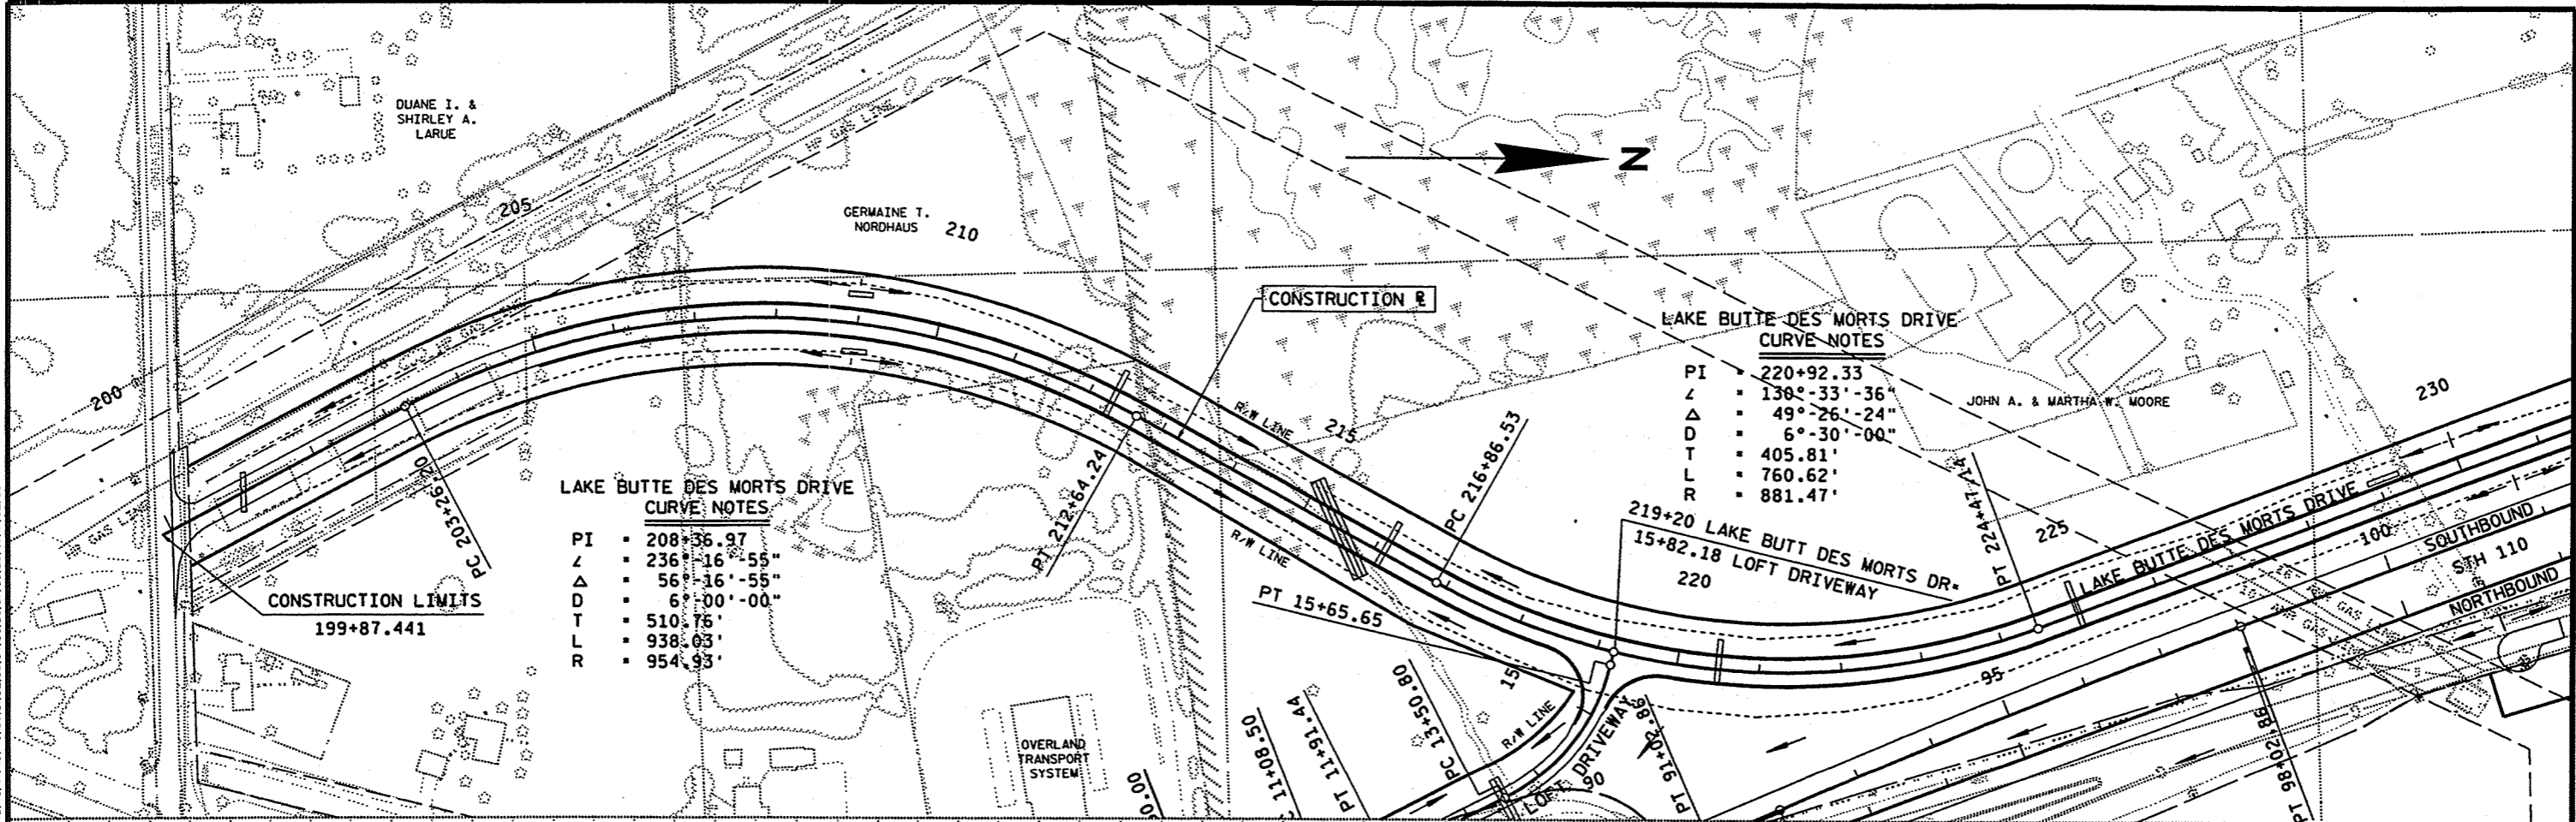

STATE PROJECT NUMBER: 6200-05-71 HWY: STH 110 COUNTY: WINNEBAGO LAKE BUTTE DES MORTS DRIVE SHEET NO: 5.12 E

FILE NAME: F:\sd3_620005+d3516.dgn PLOT DATE: 26-NOV-2001 14:08 ORG DATE: PLOT NAME: d3516d Originator: DISTRICT 3 PLOT SCALE: 200.606061:1.000000


WISDOT/CADDs SHEET 40

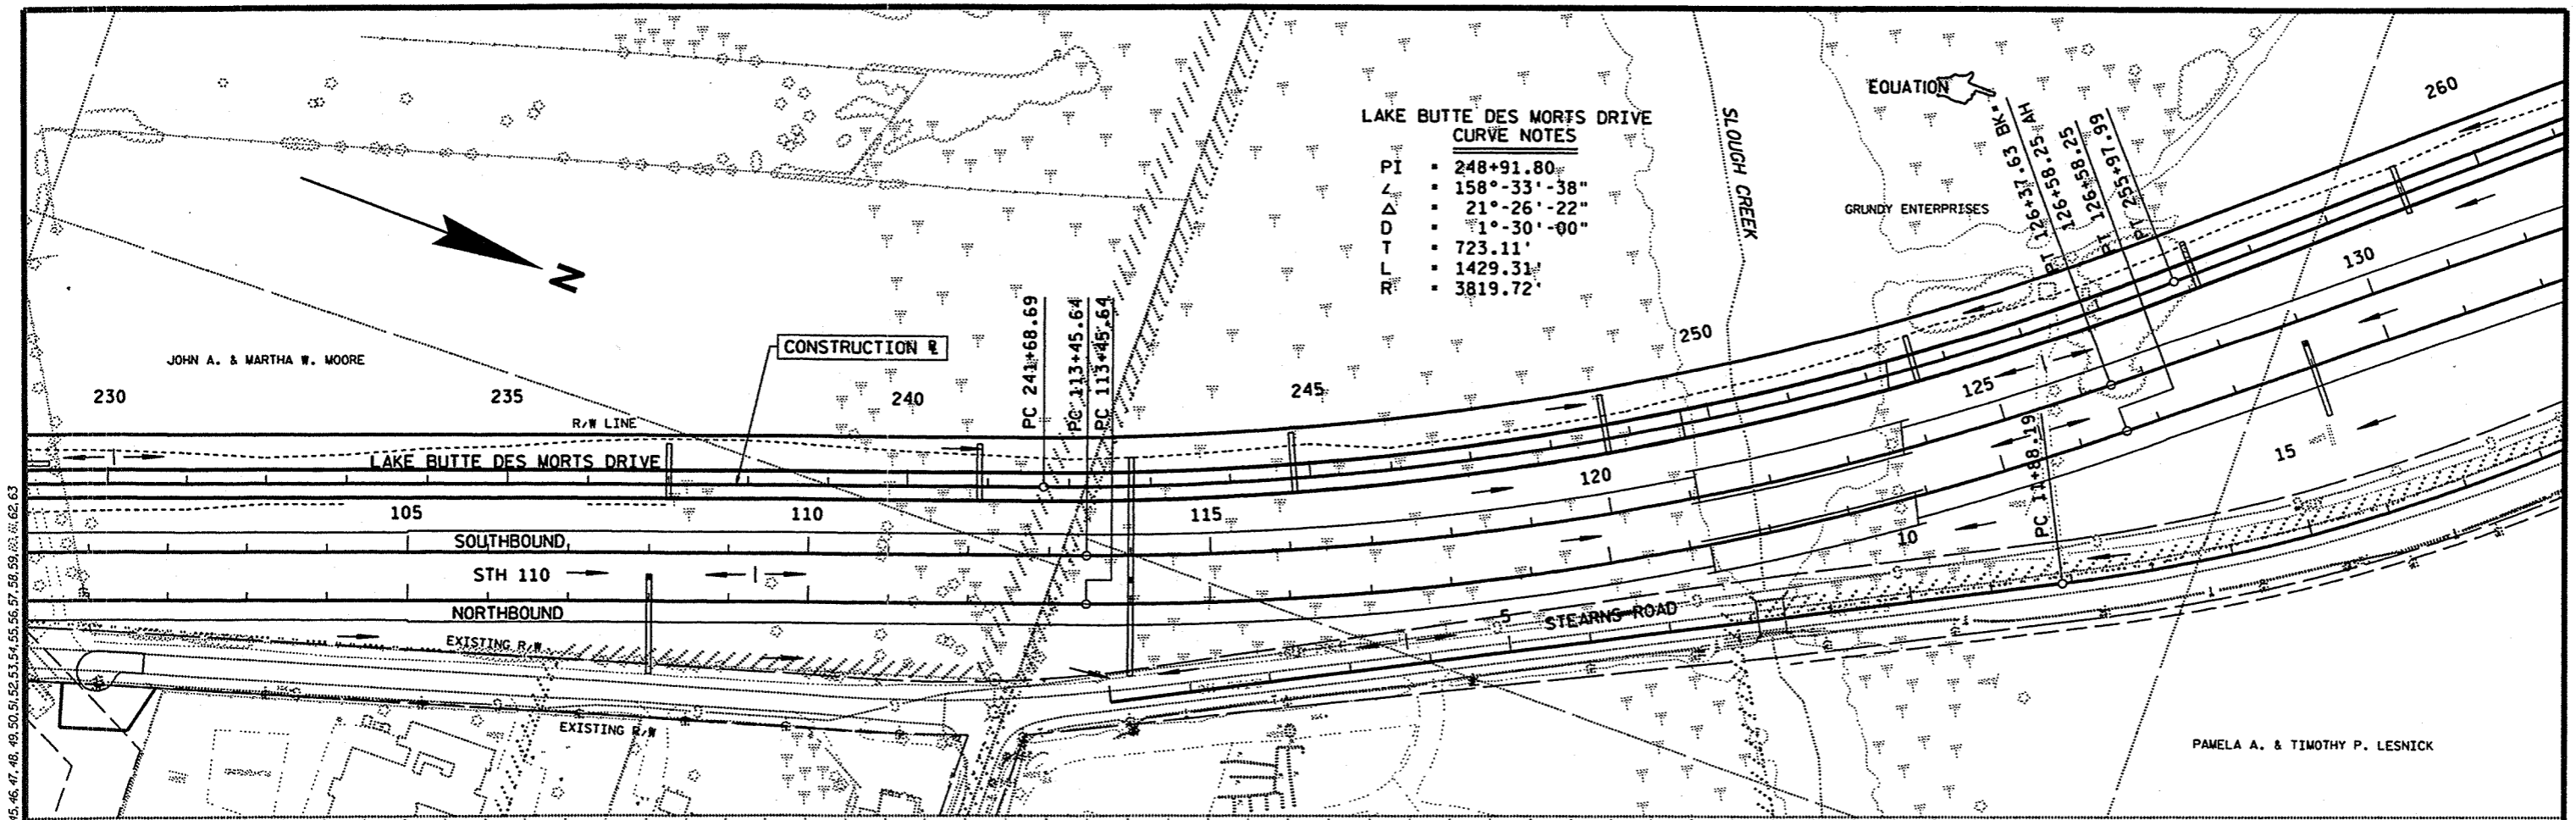

**LAKE BUTTE DES MORTS DRIVE
CURVE NOTES**

PI	248+91.80
Δ	158°-33'-38"
Δ	21°-26'-22"
D	1°-30'-00"
T	723.11'
L	1429.31'
R	3819.72'

LEVELS ON - 1, 2, 3, 62, 63


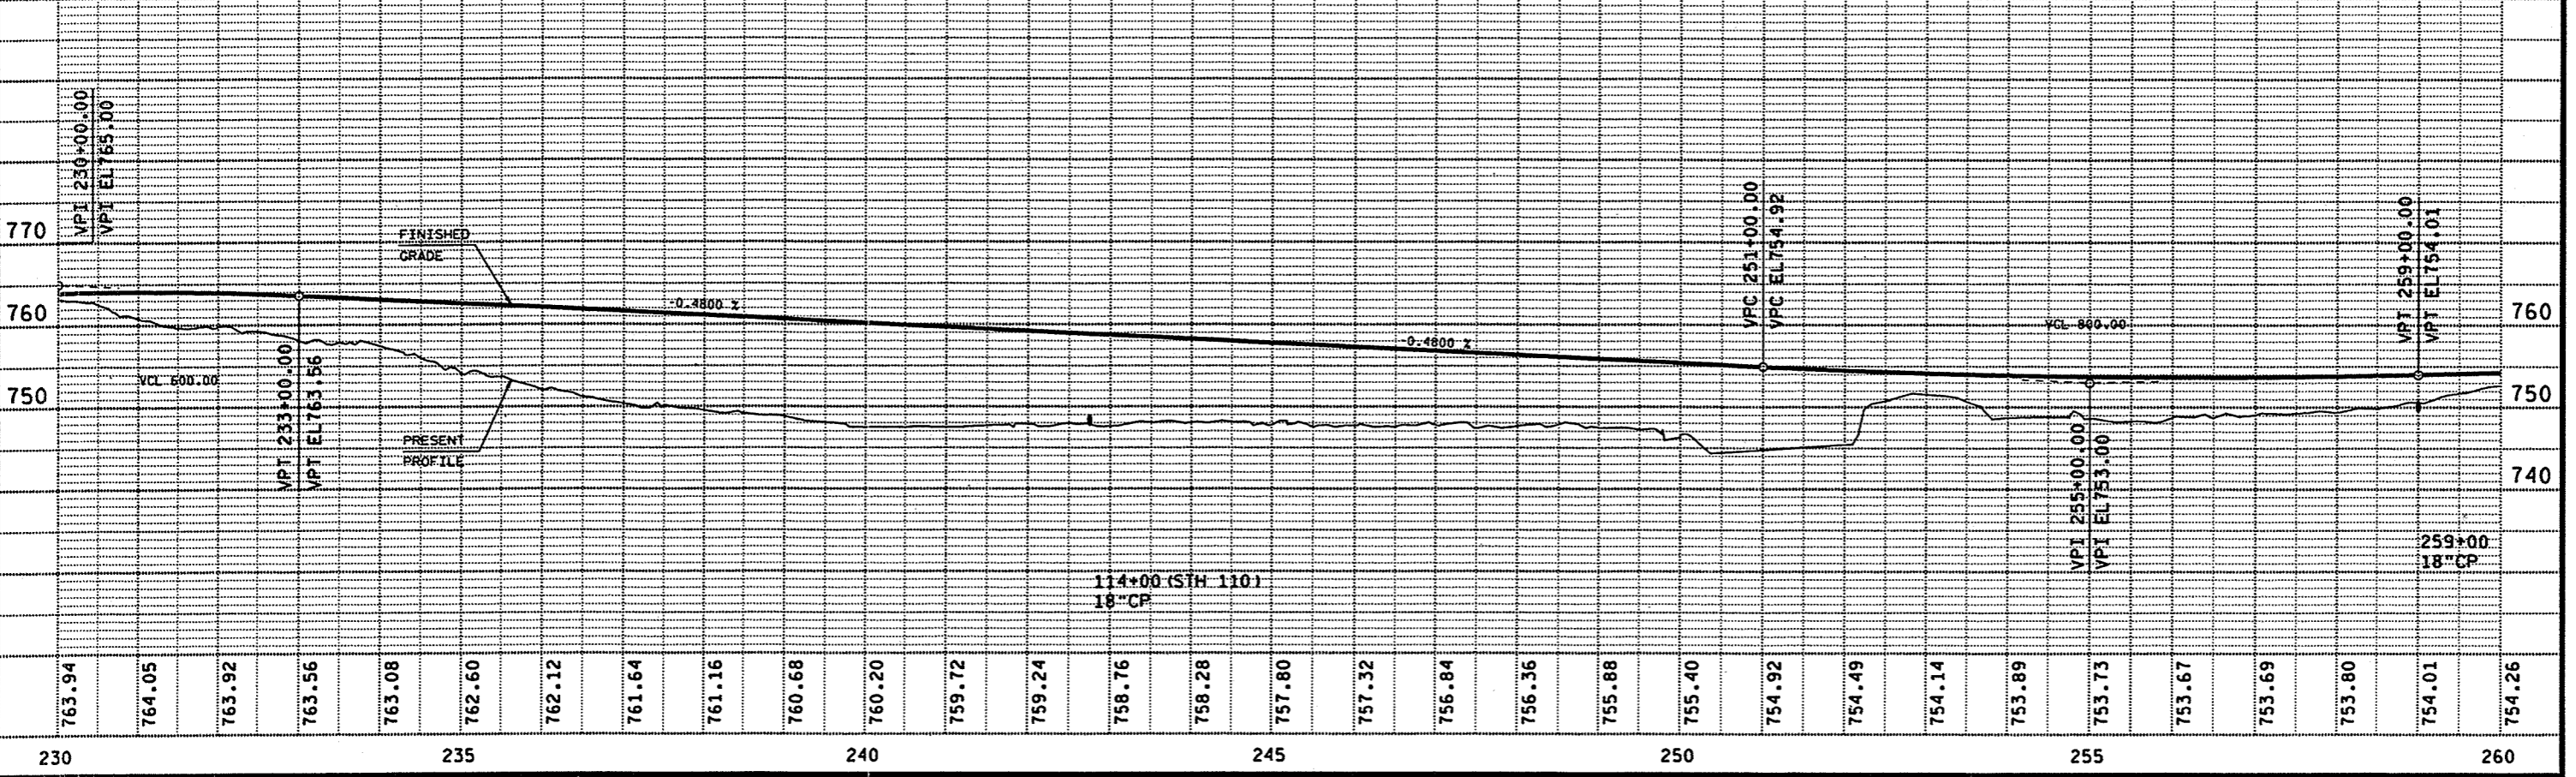


230	235	240	245	250	255	260
-----	-----	-----	-----	-----	-----	-----

STATE PROJECT NUMBER: 6200-05-71 HWY: STH 110 COUNTY: WINNEBAGO LAKE BUTTE DES MORTS DRIVE SHEET NO: 513 E

FILE NAME: F:\d3_620005\d3517.dgn PLOT DATE: 24-JUL-2001 10:41 ORG DATE: PLOT NAME: d3517d Originator: district 3 PLOT SCALE: 200.606085:1.000000 WISDOT/CADS SHEET 40

LEVELS ON: 1, 2, 3, 62, 63

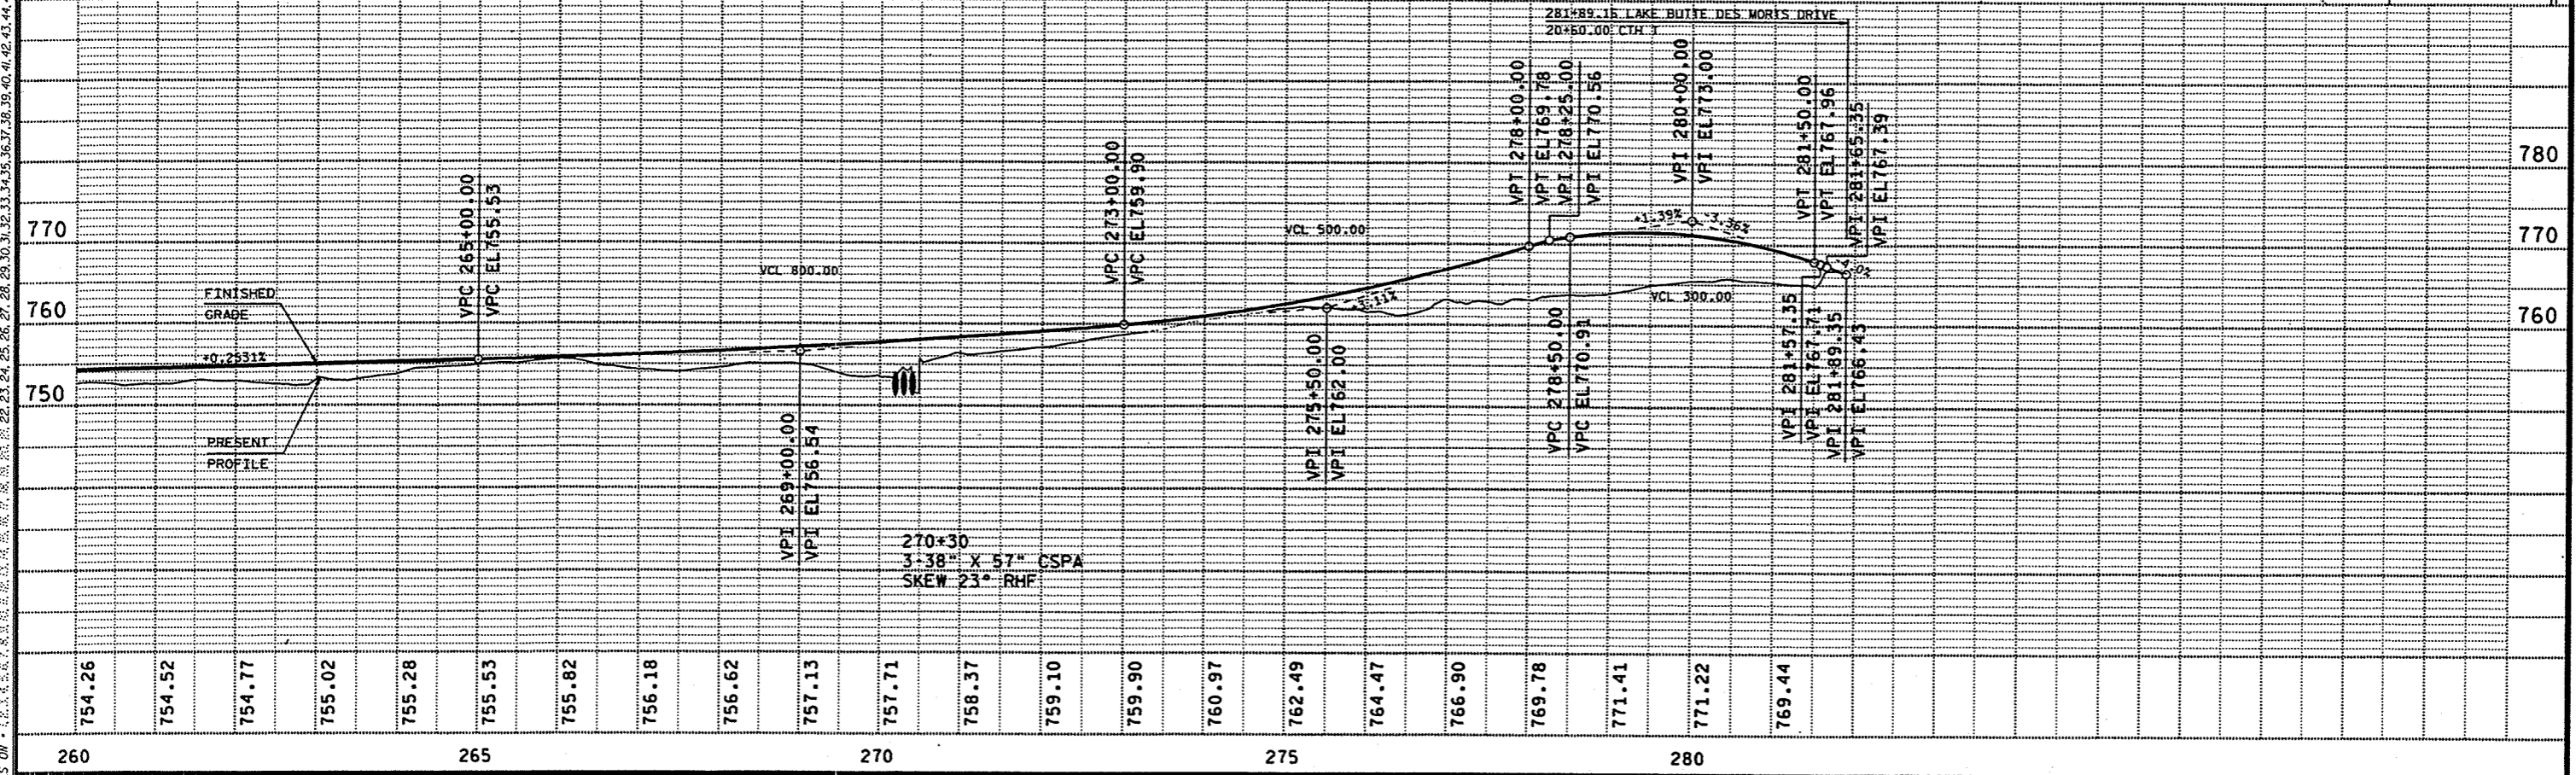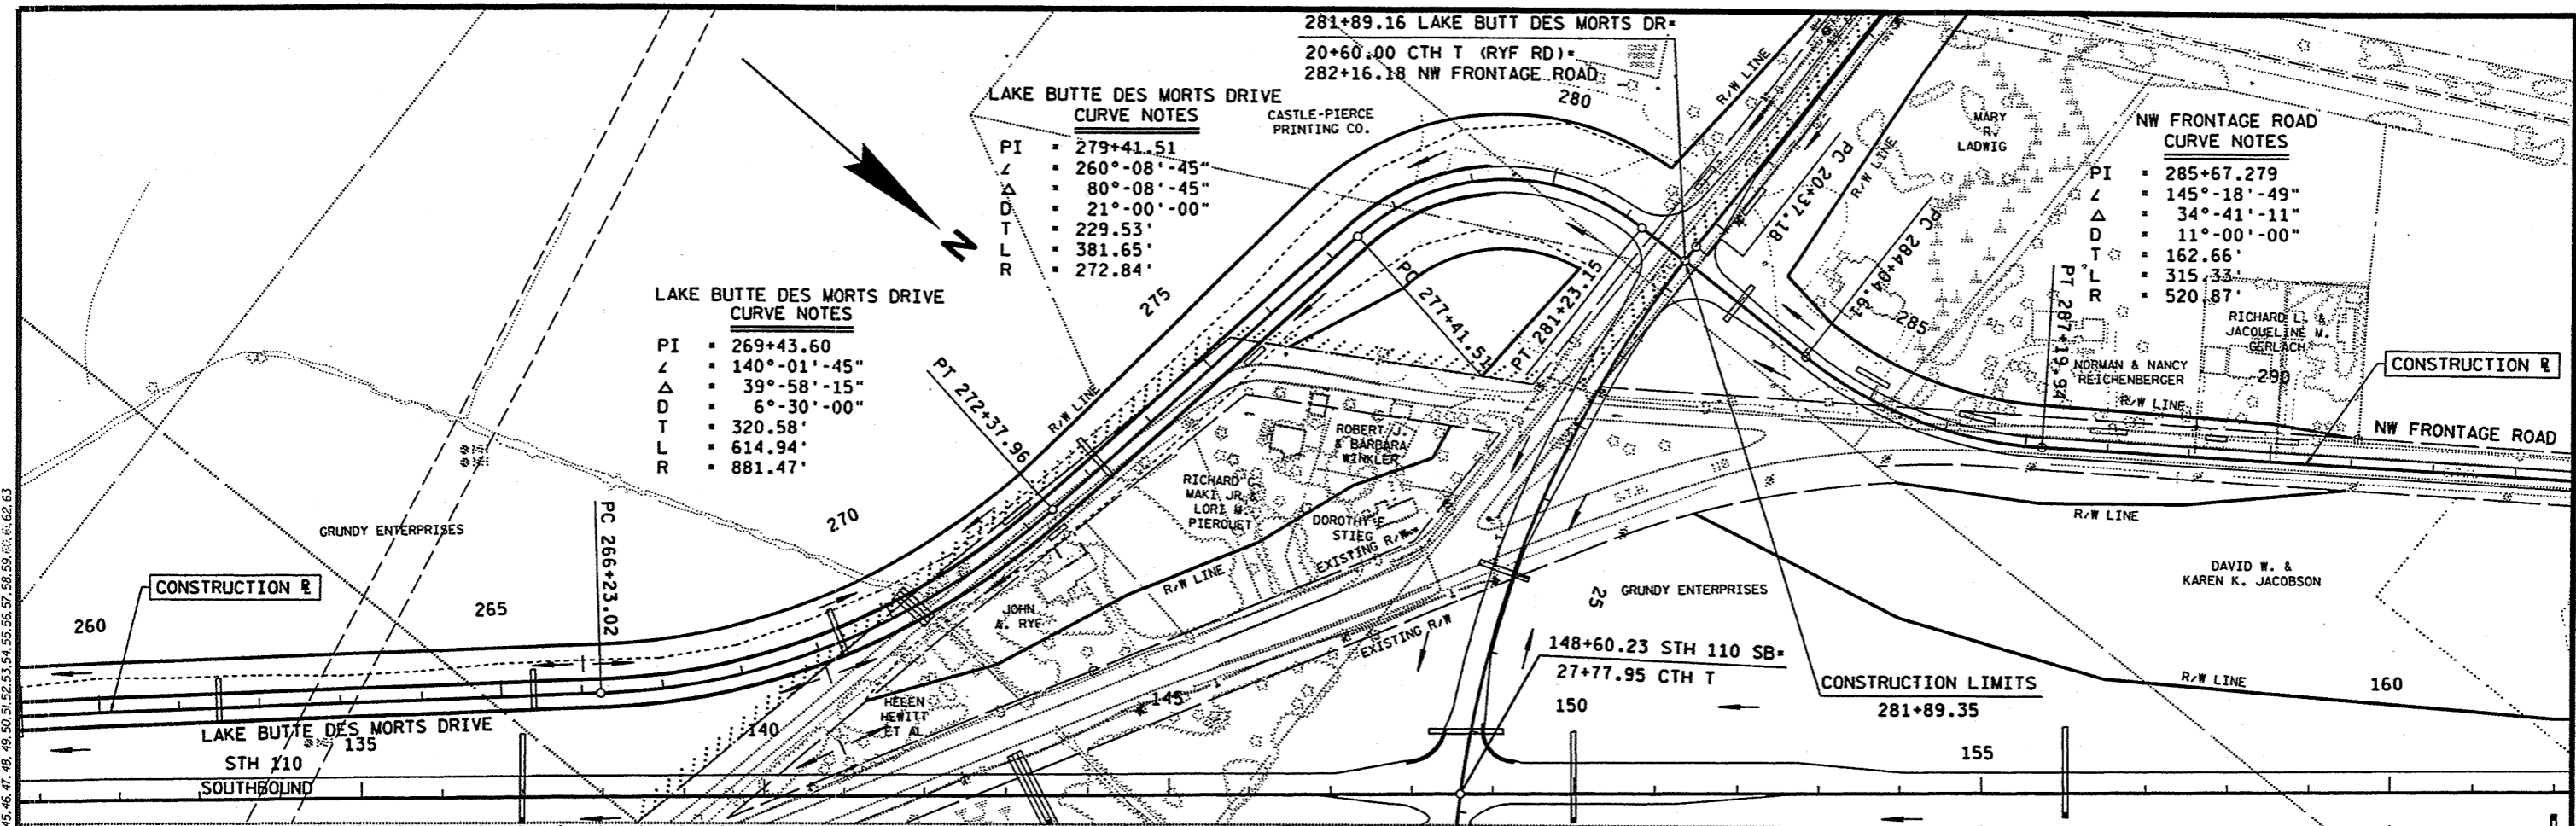


STATE PROJECT NUMBER: 6200-05-71 HWY: STH 110 COUNTY: WINNEBAGO LAKE BUTTE DES MORTS DRIVE SHEET NO: 5,14 E

FILE NAME: F:\d3_620005\d3518.dgn PLOT DATE: 26-NOV-2001 14:07 ORG DATE: PLOT NAME: d3518d Originator: DISTRICT 3 PLOT SCALE: 200.606070:1.000000

WISDOT/CADD SHEET 40

LEVELS ON - 1.0, 1.5, 2.0, 62.5, 63.0

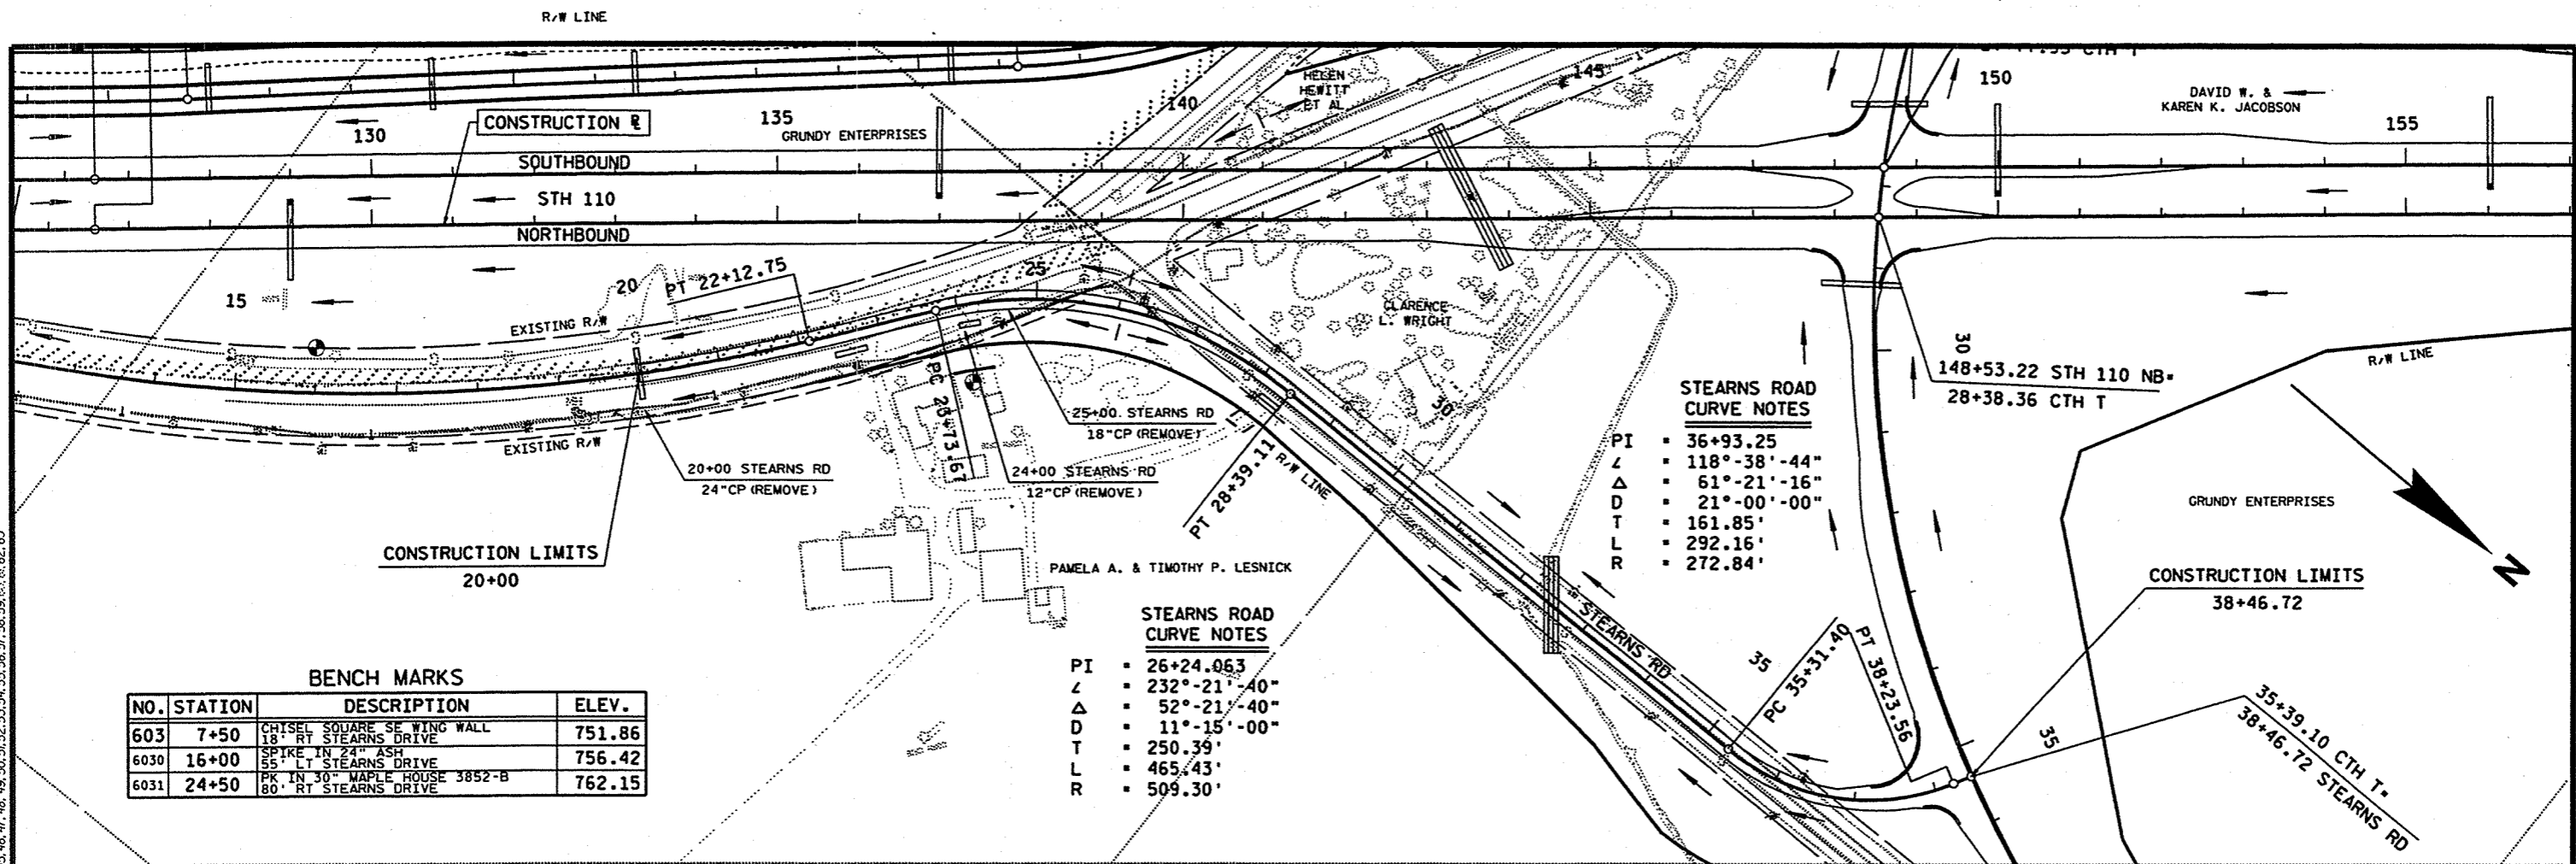

BENCH MARKS


NO.	STATION	DESCRIPTION	ELEV.
603	7+50	CHISEL SQUARE SE WING WALL 18' RT STEARNS DRIVE	751.86
6030	16+00	SPIKE IN 24" ASH 55' LT STEARNS DRIVE	756.42
6031	24+50	PK IN 30" MAPLE HOUSE 3852-B 80' RT STEARNS DRIVE	762.15

STEARNS ROAD CURVE NOTES

PI	26+24.063
L	232°-21'-40"
Δ	52°-21'-40"
D	11°-15'-00"
T	250.39'
L	465.43'
R	509.30'

STEARNS ROAD CURVE NOTES

PI	36+93.25
L	118°-38'-44"
Δ	61°-21'-16"
D	21°-00'-00"
T	161.85'
L	292.16'
R	272.84'

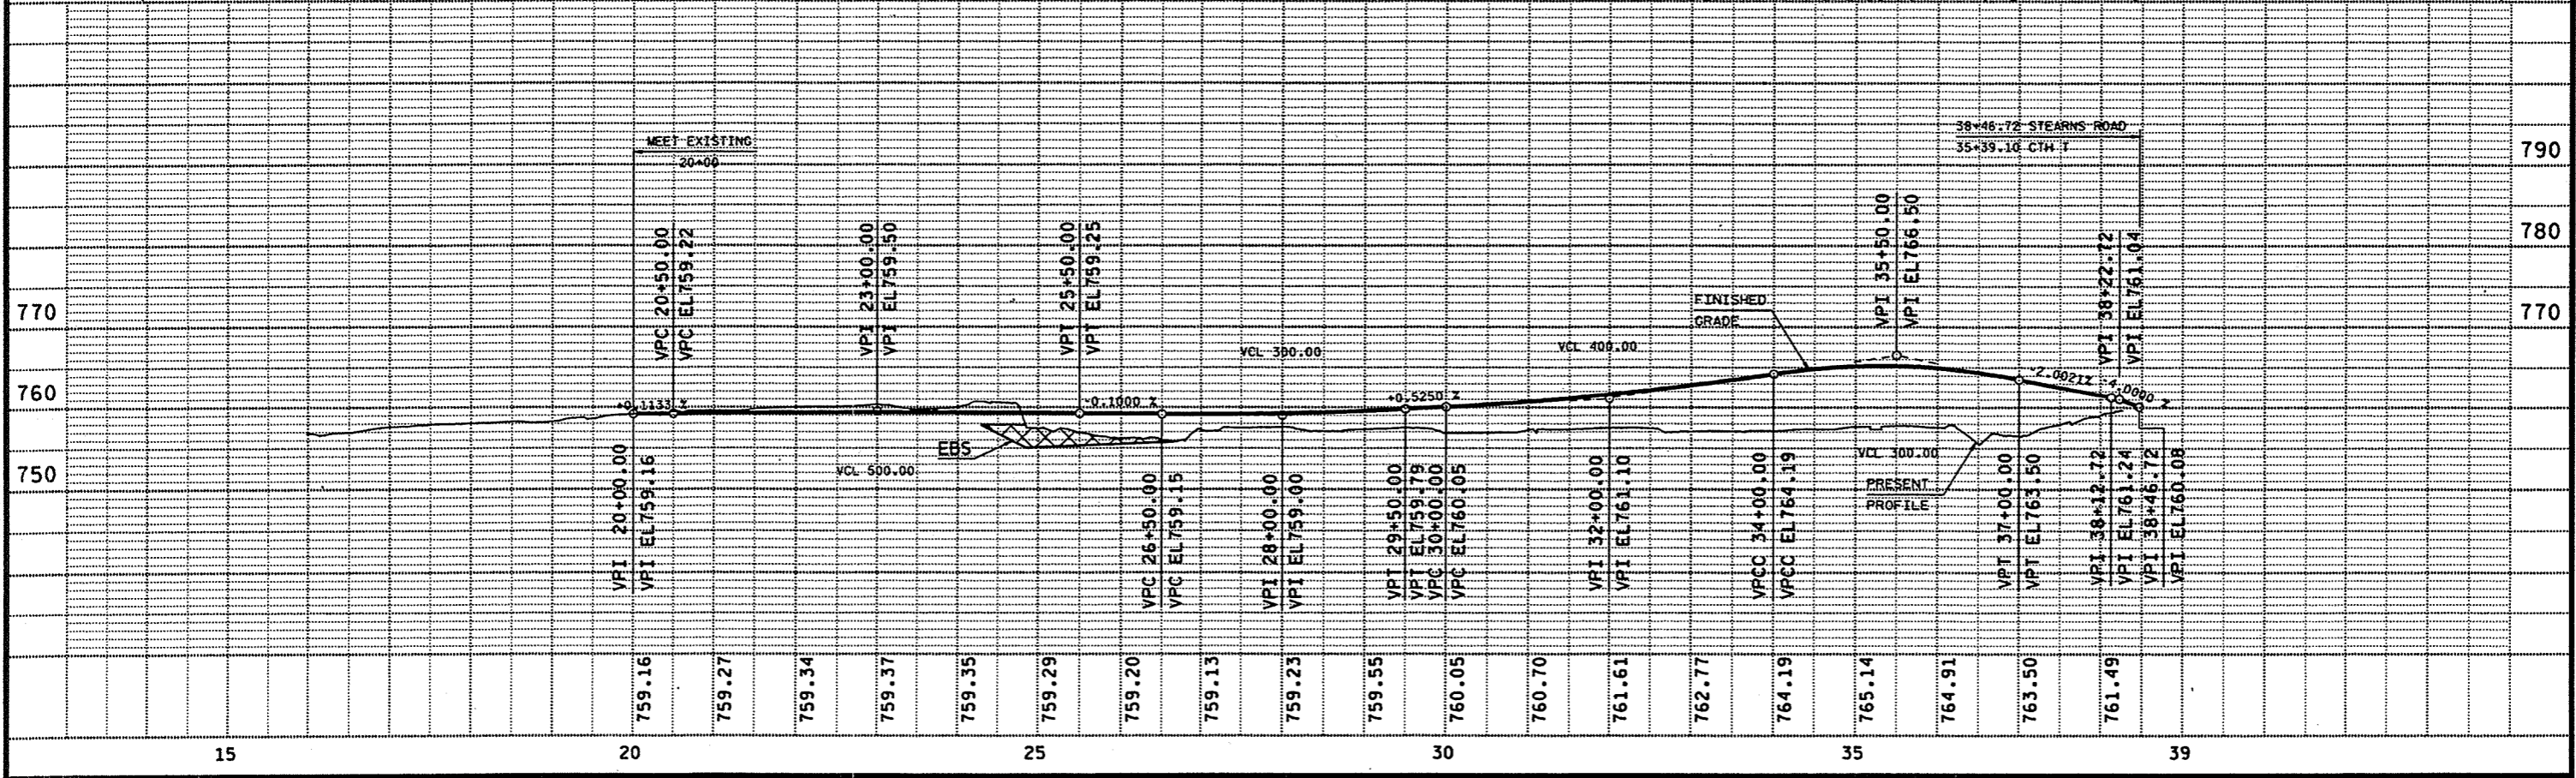

STATE PROJECT NUMBER: 6200-05-71 HWY: STH 110 COUNTY: WINNEBAGO STEARNS ROAD SHEET NO: 5.15 E





CTH T
CURVE NOTES

PI	33+99.60
Z	90°-31'-50"
Δ	89°-28'-10"
D	4°-10'-00"
T	1362.42'
L	2147.26'
R	1375.10'
PT	41+84.44

BENCH MARKS

NO.	STATION	DESCRIPTION	ELEV.
605	23+00	TOP STEEL BAR 18" HICKORY 58' LT STH 110, 50' N CTH T	766.08



LEVELS ON - 1 2 3 4 5 6 7 8 9 10 11 12 13 14 15 16 17 18 19 20 21 22 23 24 25 26 27 28 29 30 31 32 33 34 35 36 37 38 39 40 41 42 43 44 45 46 47 48 49 50 51 52 53 54 55 56 57 58 59 60 61 62 63

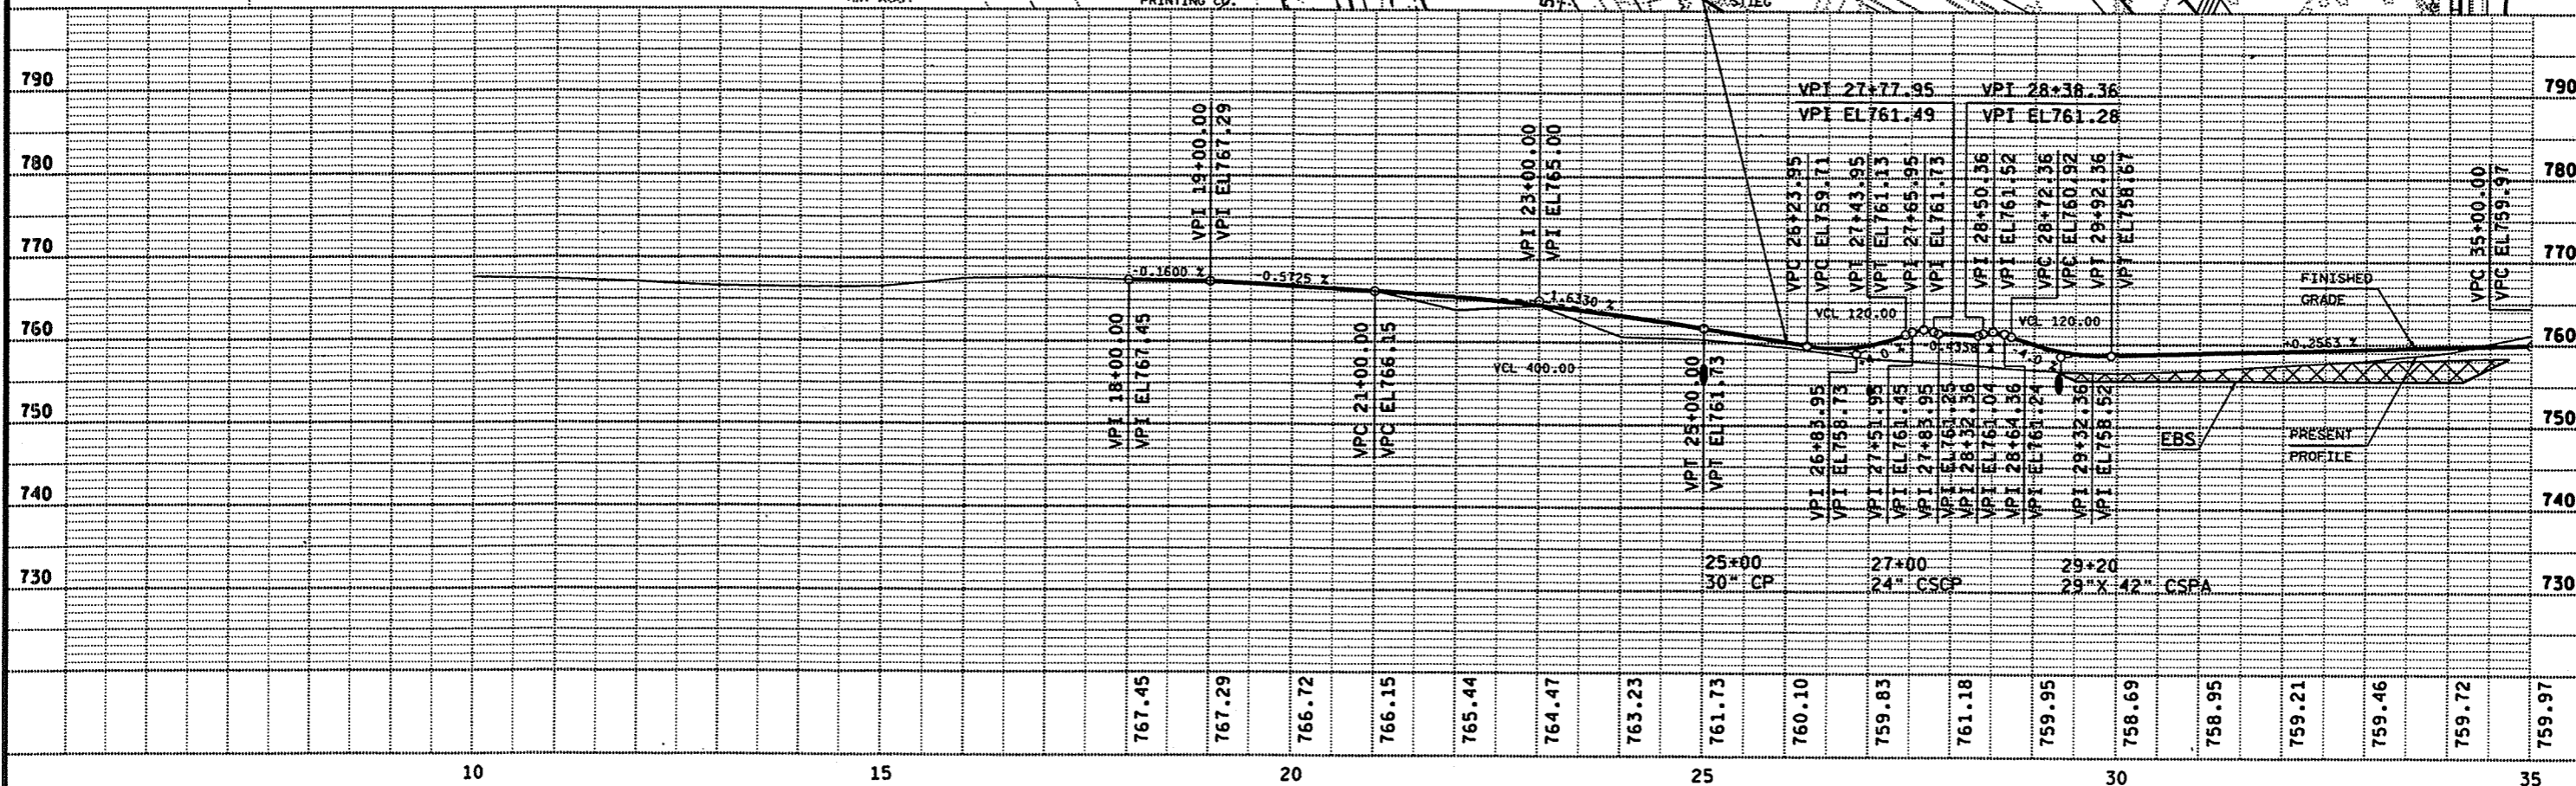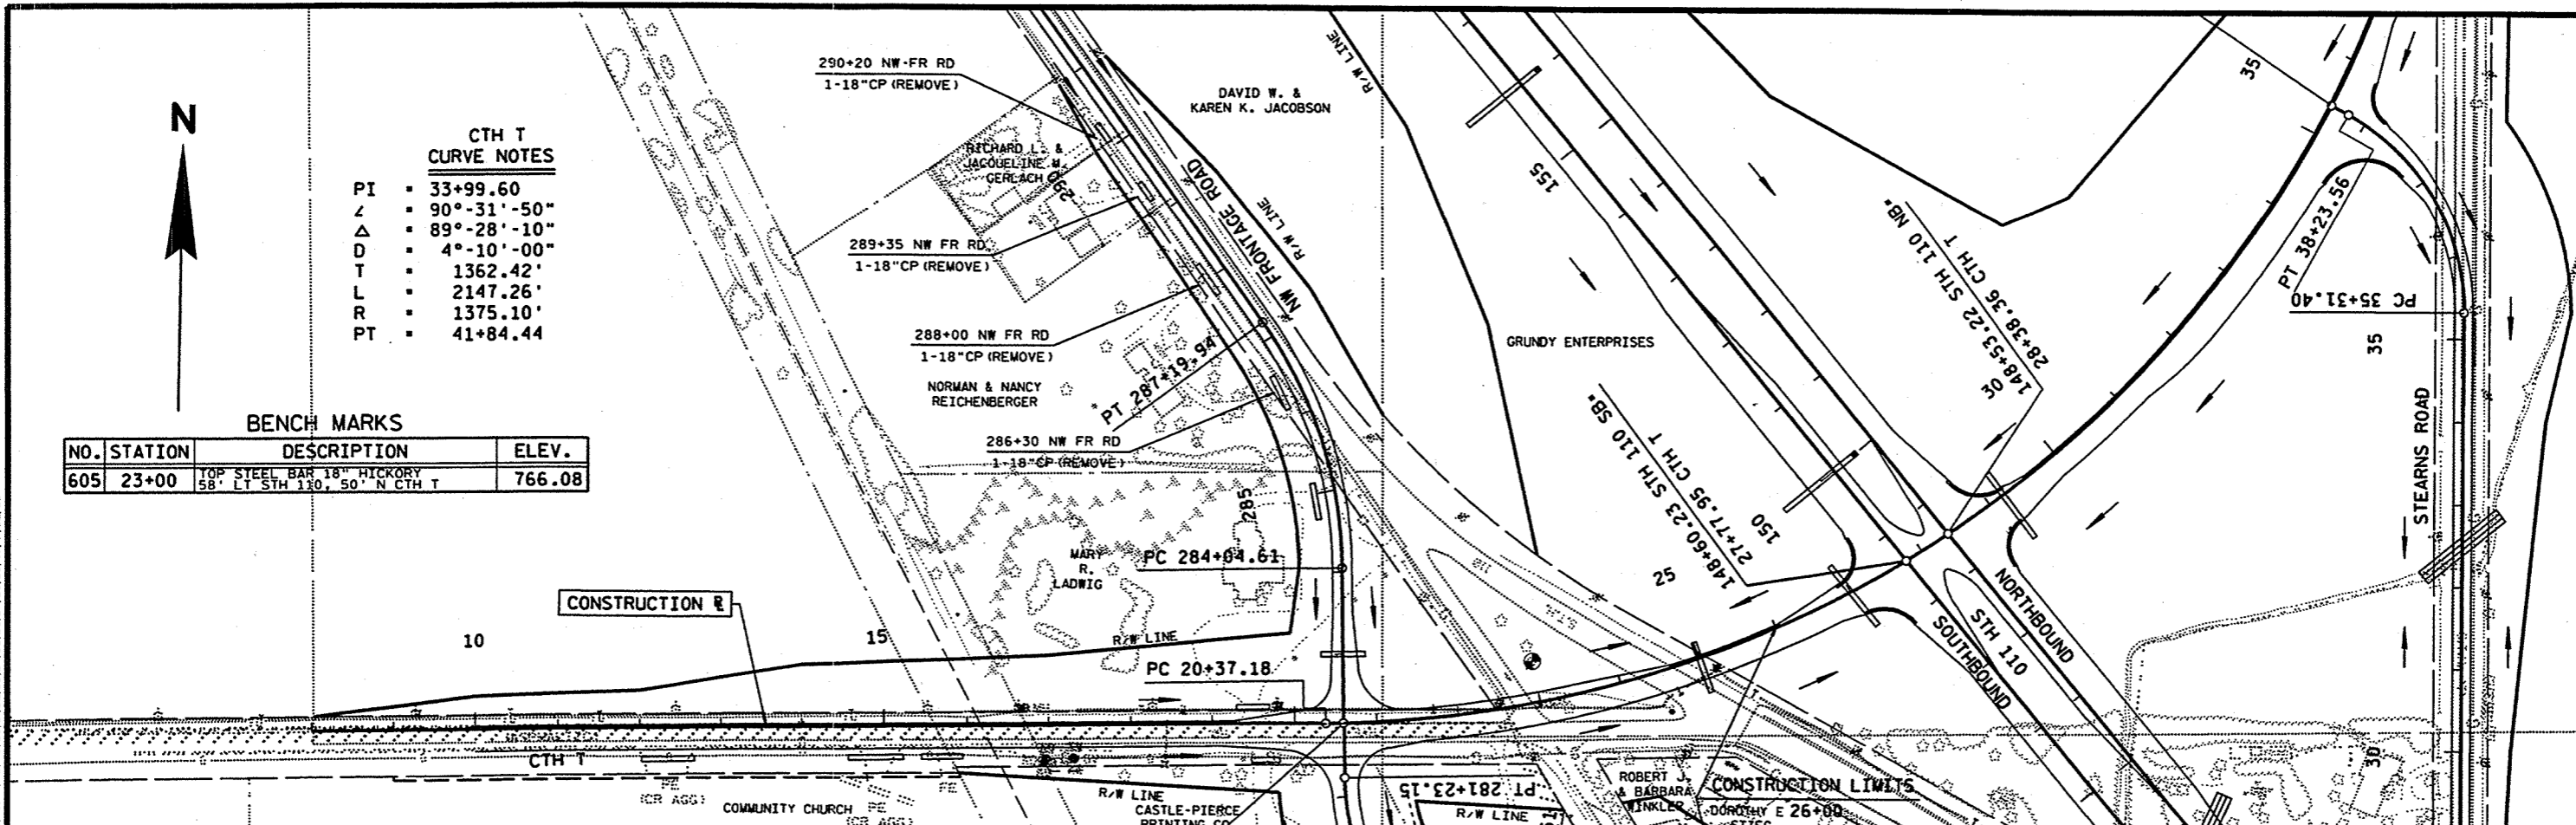

10	15	20	25	30	35
----	----	----	----	----	----

STATE PROJECT NUMBER: 6200-05-71 HWY: STH 110 COUNTY: WINNEBAGO CTH T SHEET NO: 516 E

BENCH MARKS			
NO.	STATION	DESCRIPTION	ELEV.
6033	47+00	SE CORNER PORCH HOUSE #2168 150' LT. CTH Y	796.07
6034	40+00	PK IN 24" HICKORY 30' LT. CTH Y	798.63
6035	30+50	300' LT. CTH Y	785.70

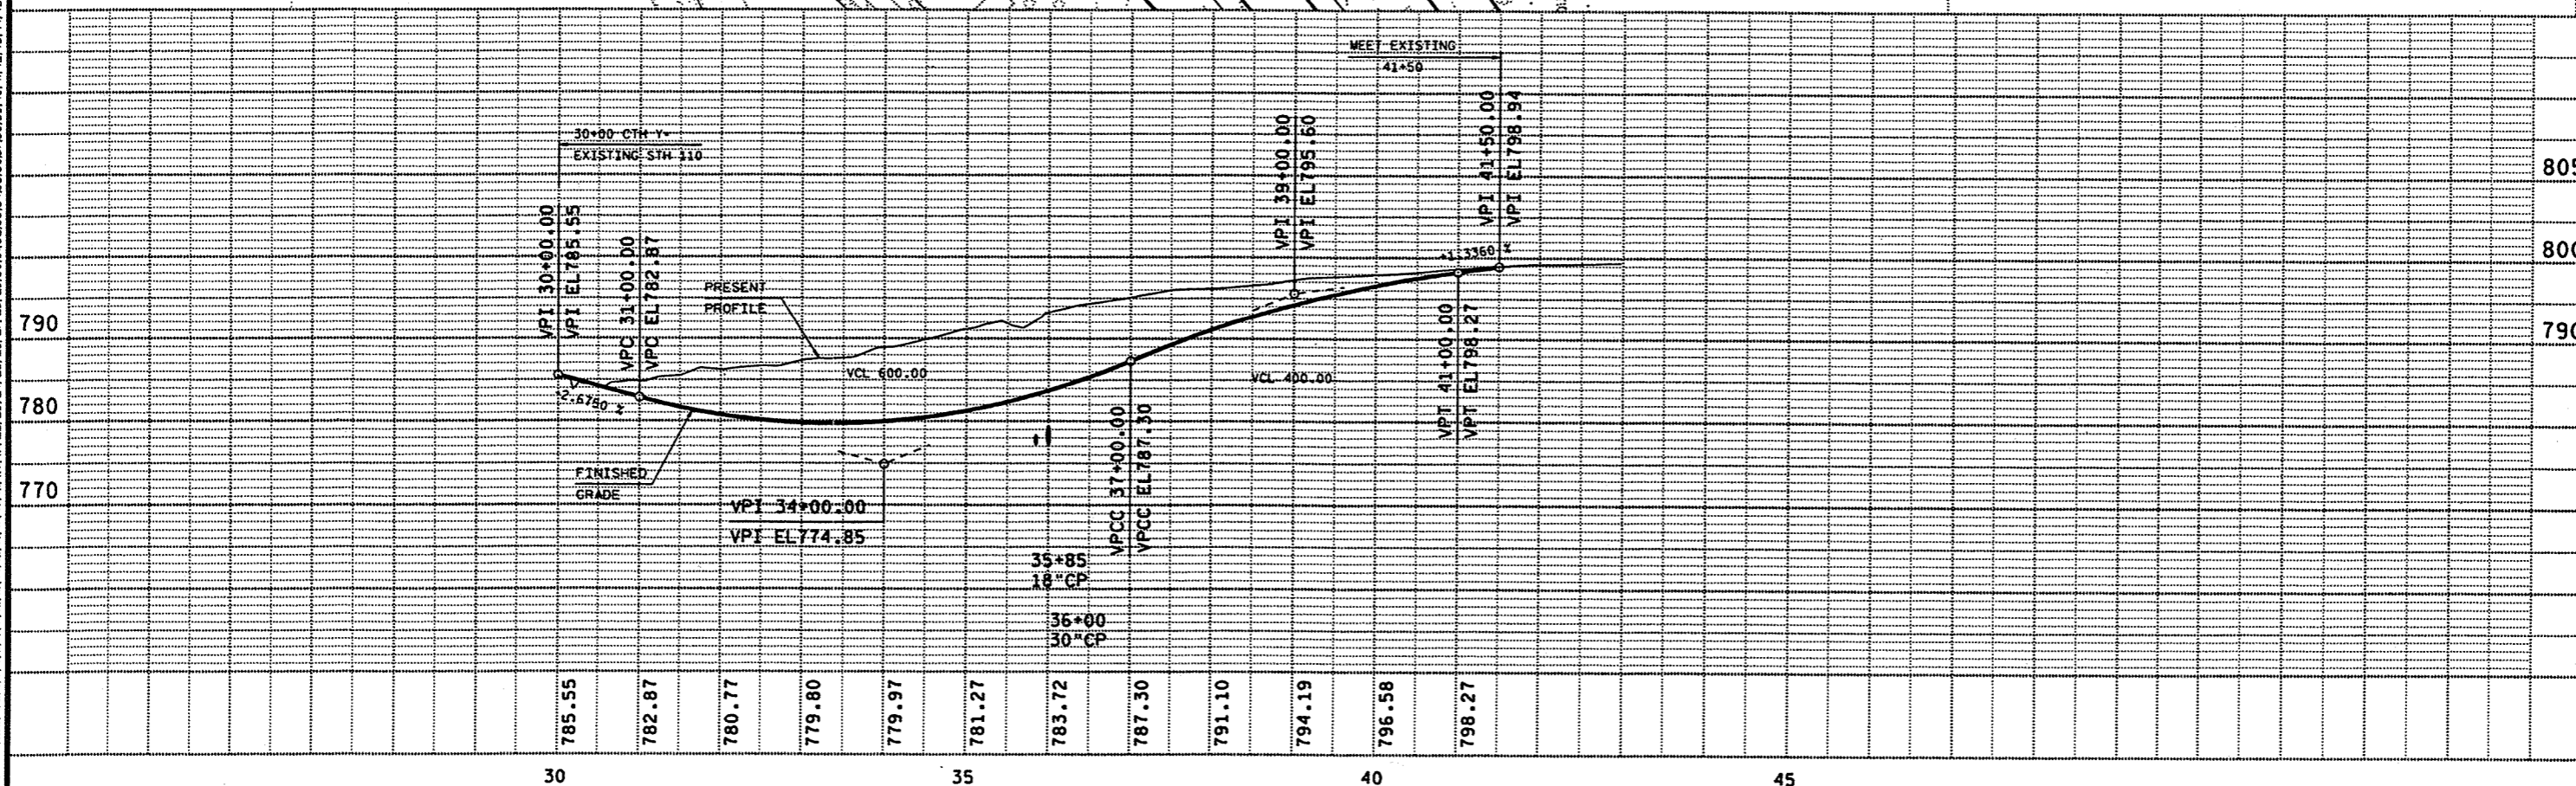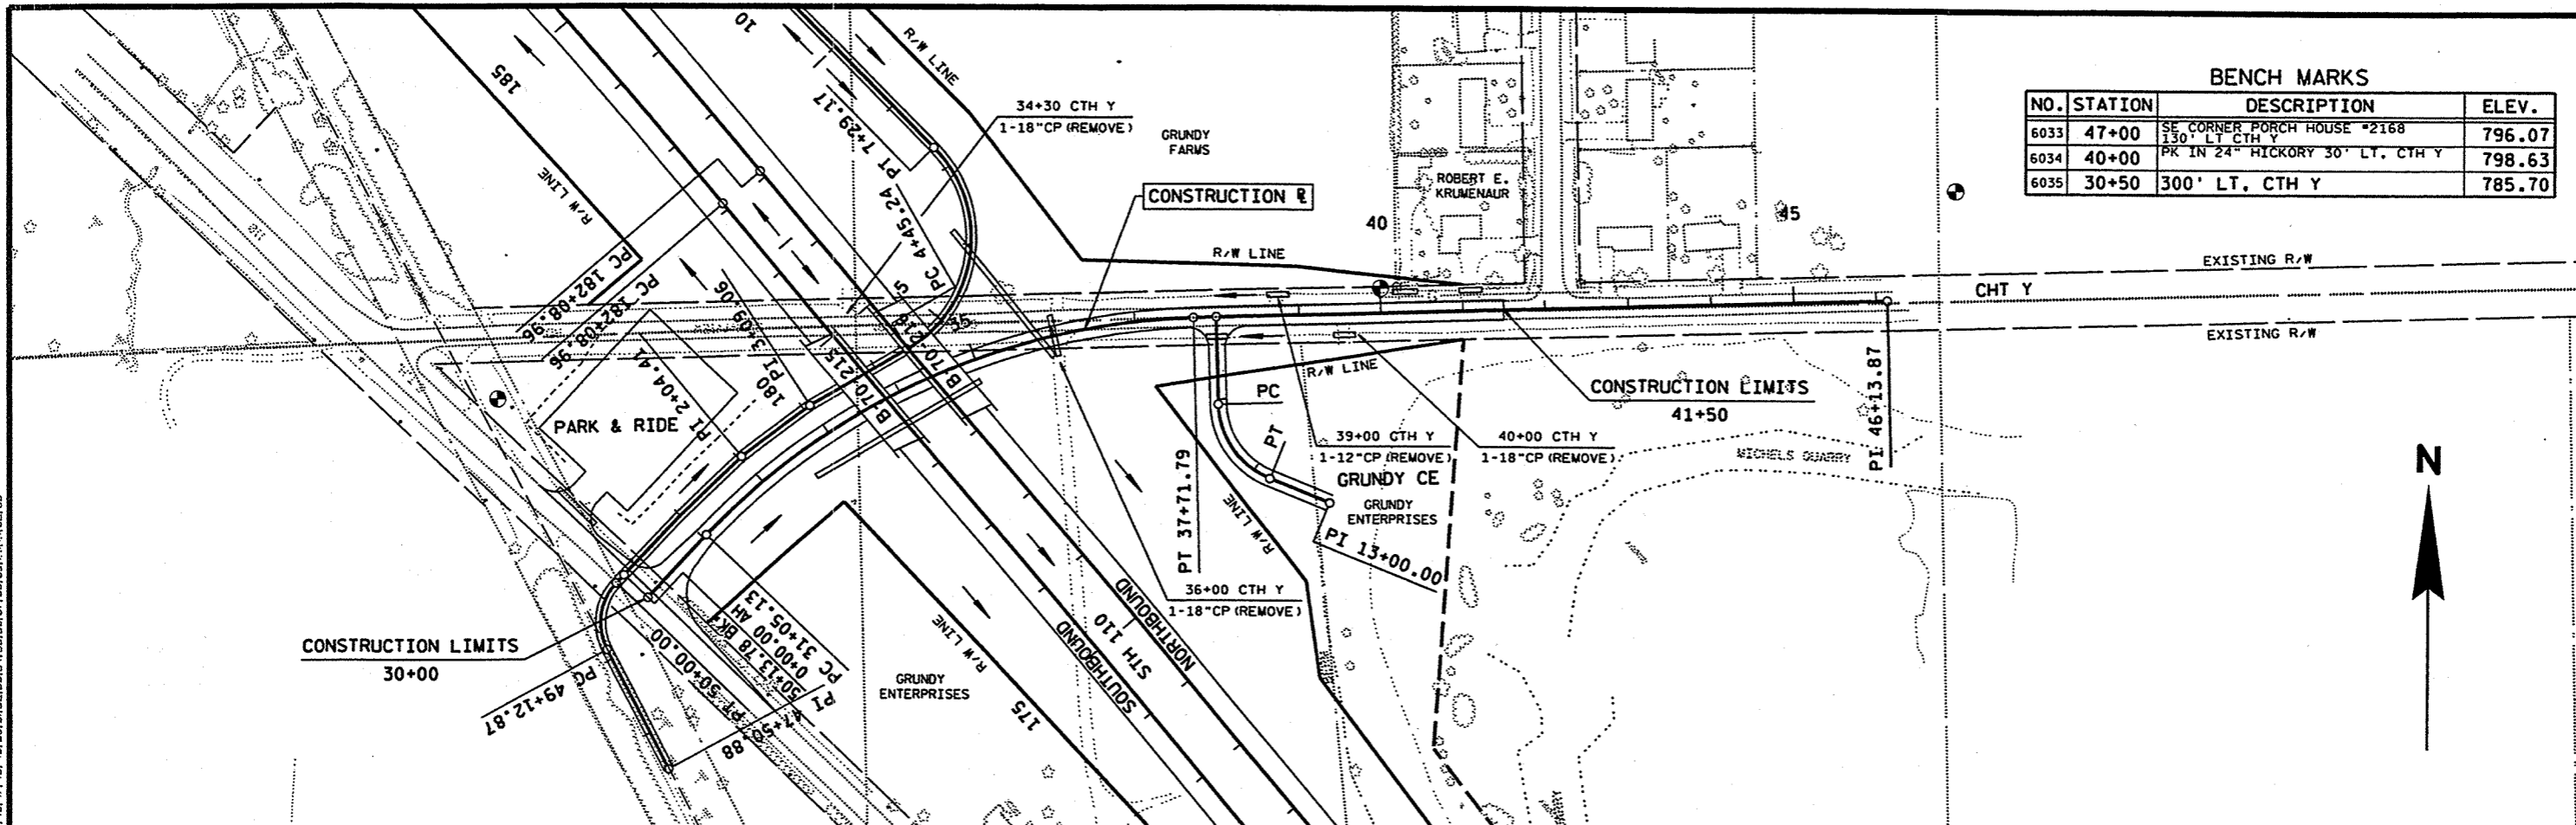

LEVELS ON - 1, 2, 3, 62, 63

STATE PROJECT NUMBER: 6200-05-71 | HWY: STH 110 | COUNTY: WINNEBAGO | CTH Y | SHEET NO: 5.18 | E

FILE NAME: F:\d3_620005\d3524.dgn | PLOT DATE: 24-JUL-2001 10:42 | ORG DATE: 1-30-01 | PLOT NAME: d3524d | Originator: DISTRICT 3 | PLOT SCALE: 200.700000:1.000000

WISDOT/CADD SHEET 40

SCHMOKER FE CURVE NOTES

PI	11+49.988
Z	273°-05'-35"
Δ	93°-05'-35"
D	286°-28'-44"
T	21.11'
L	32.50'
R	20.00'
PC	11+28.878
PT	11+61.373

BROOKS RD CURVE NOTES



PI	17+36.67
Z	161°-01'-51"
Δ	18°-58'-09"
D	4°-00'-00"
T	239.30'
L	474.23'
R	1432.39'

SCHMOKER PE (MAIN) CURVE NOTES

PI	12+64.531
Z	98°-36'-39"
Δ	81°-23'-21"
D	75°-23'-40"
T	64.50'
L	106.54'
R	75.00'
PC	12+00.033
PT	13+06.571


BENCH MARKS

NO.	STATION	DESCRIPTION	ELEV.
6111	23+00	PK MARK SE CORNER RETAINING WALL BARN YARD, 20' LT BROOKS RD	790.91
6112	32+00	SW CORNER PORCH HOUSE #4280 100' LT BROOKS RD	816.65
100	39+00	BASE 100' TYPE RED CAP 20' LT BROOKS RD	824.85
6113	8+74	PT MARK CHISELED SO SE CNR WHEEL GUARD 15' RT BROOKS RD (BX CLVRT)	754.68
6114	2+50	PK MARK 30" STUMP 40' RT BROOKS RD	756.06

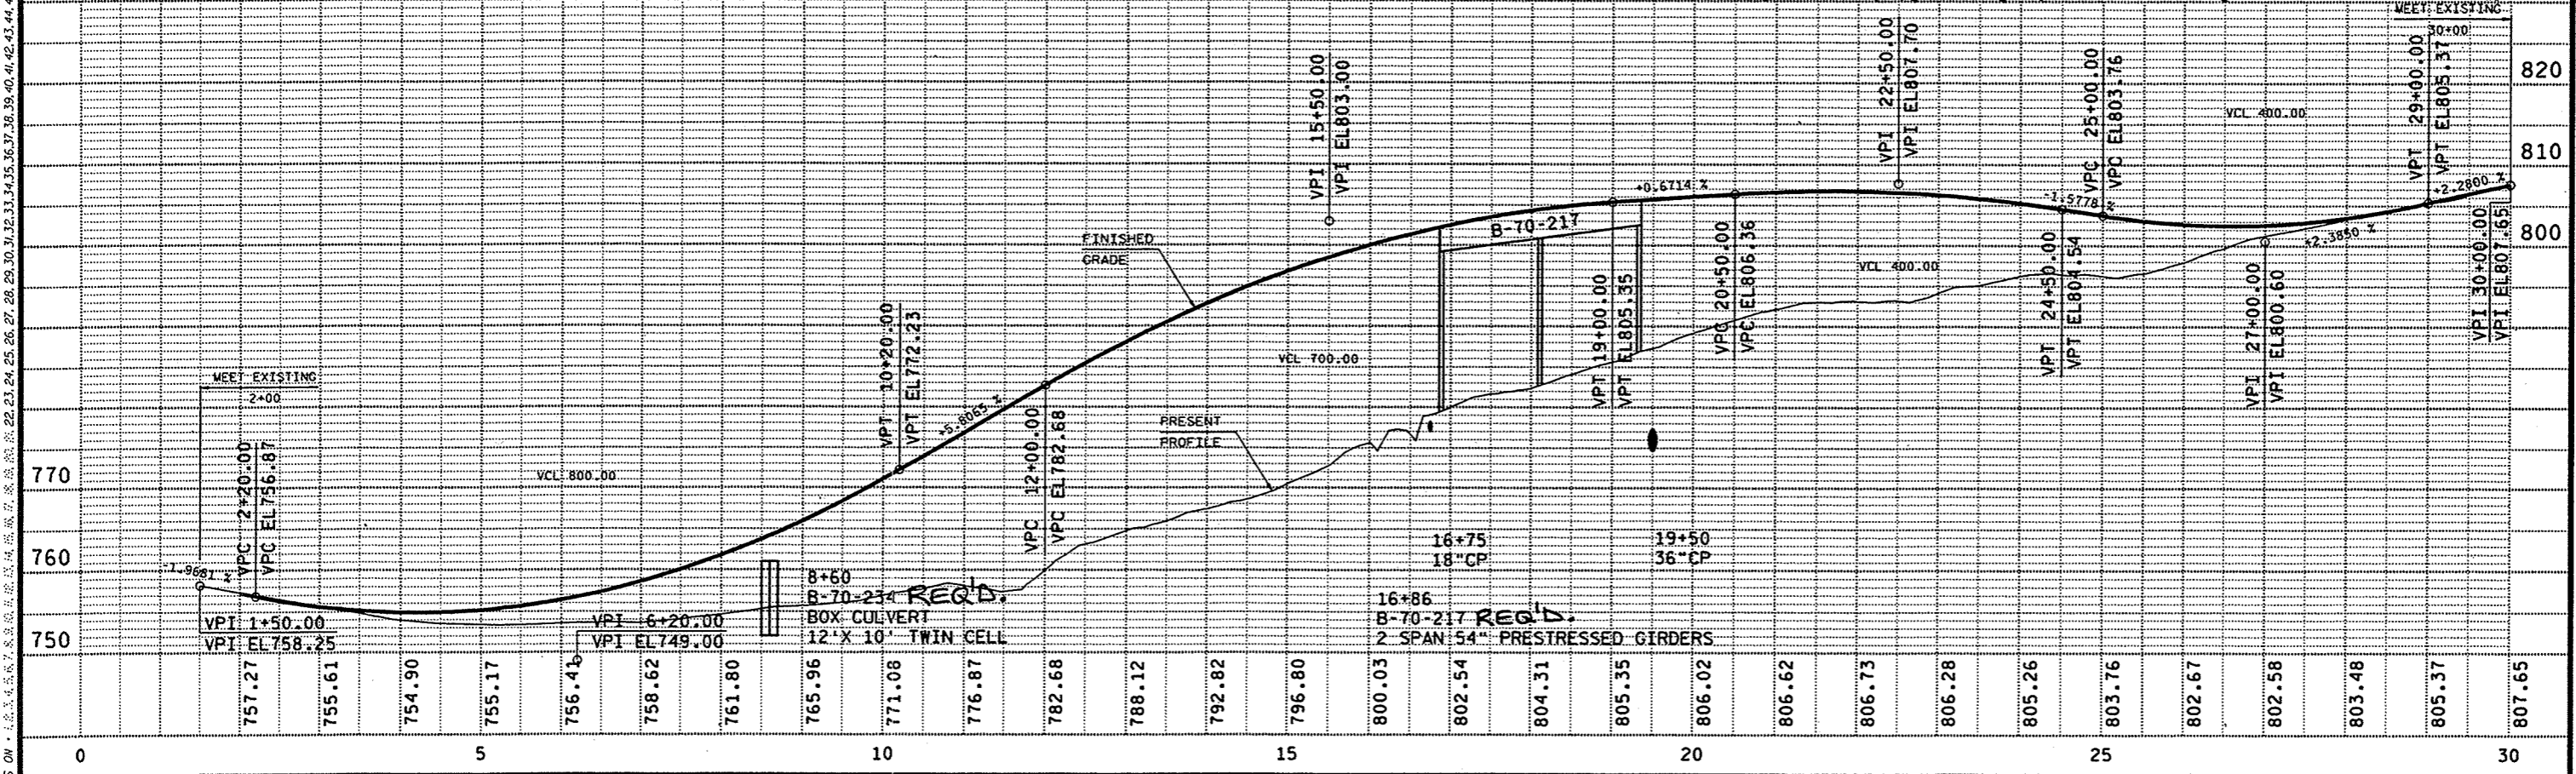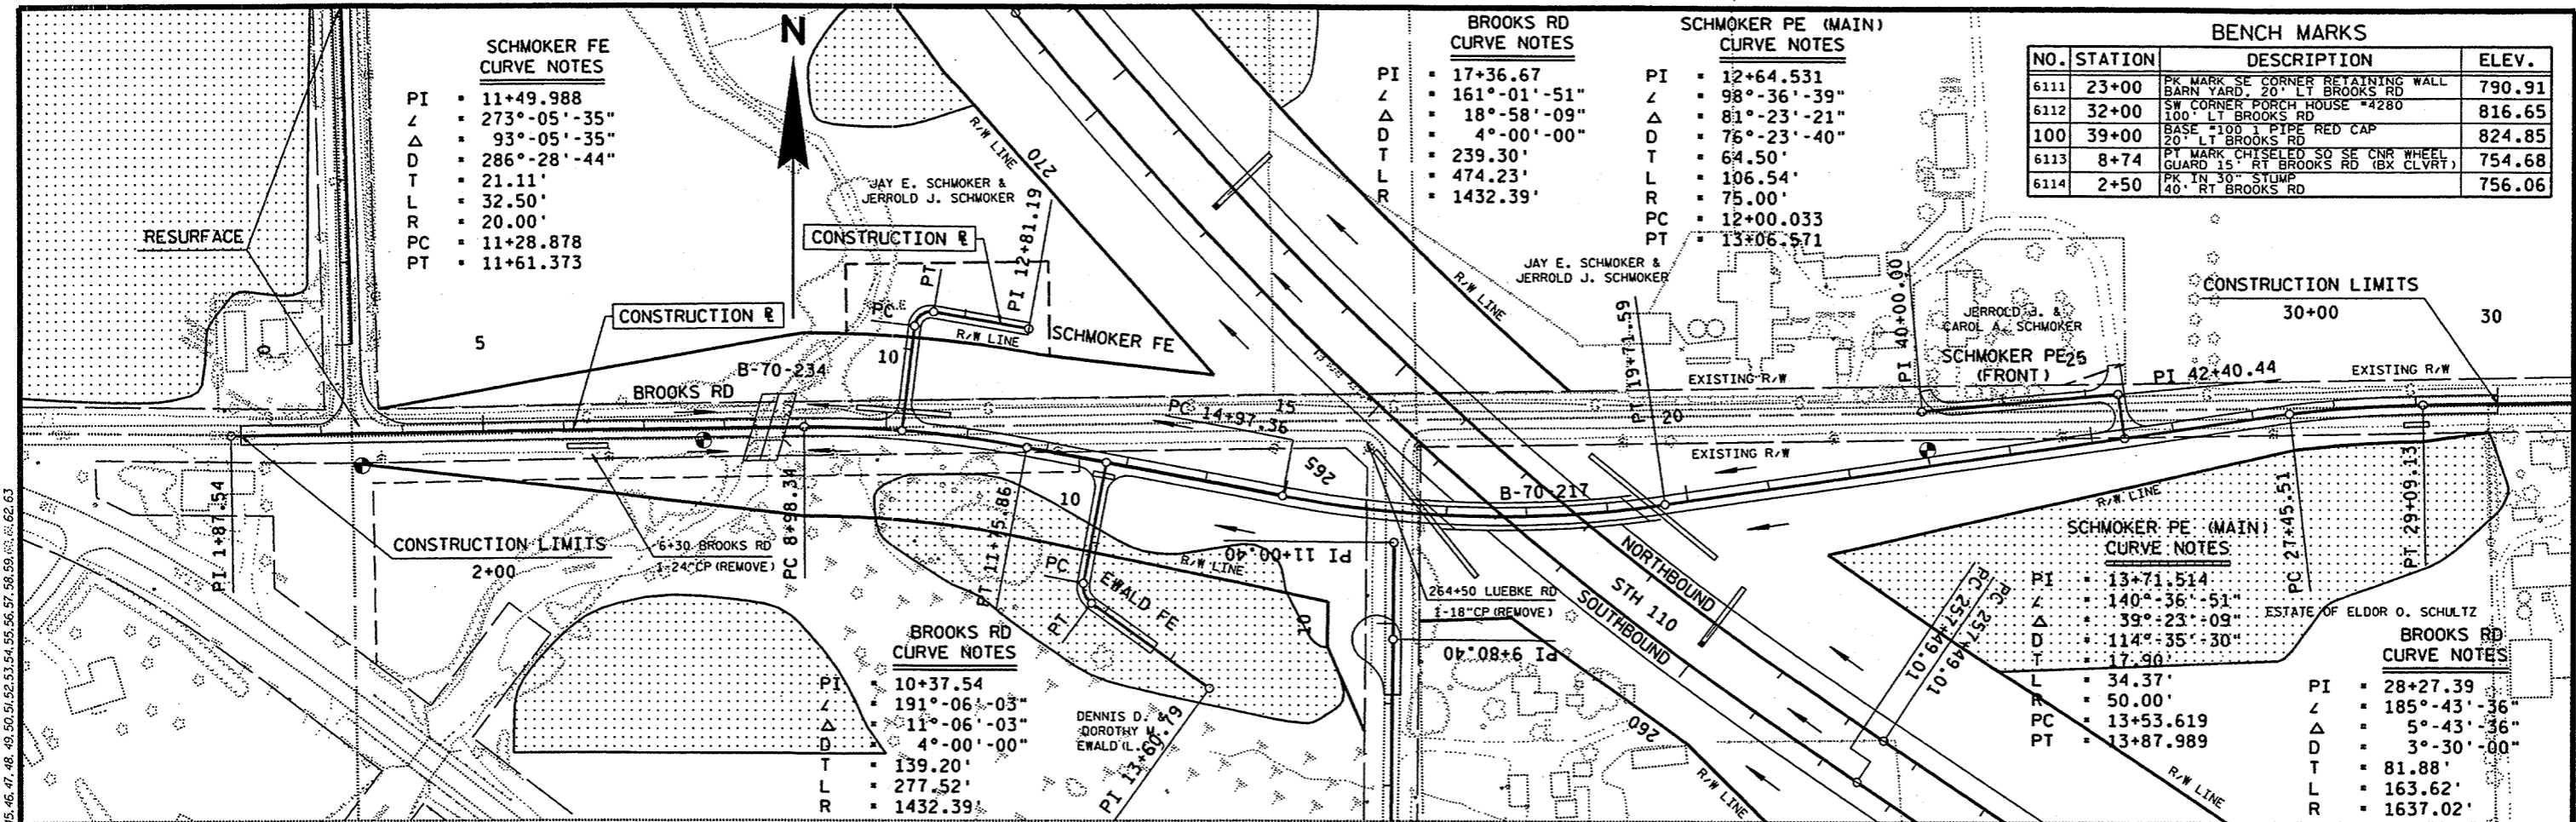


STATE PROJECT NUMBER: 6200-05-71 HWY: STH 110 COUNTY: WINNEBAGO BROOKS ROAD SHEET NO: 5.19 E

LEVELS ON: 1, 2, 3, 62, 63


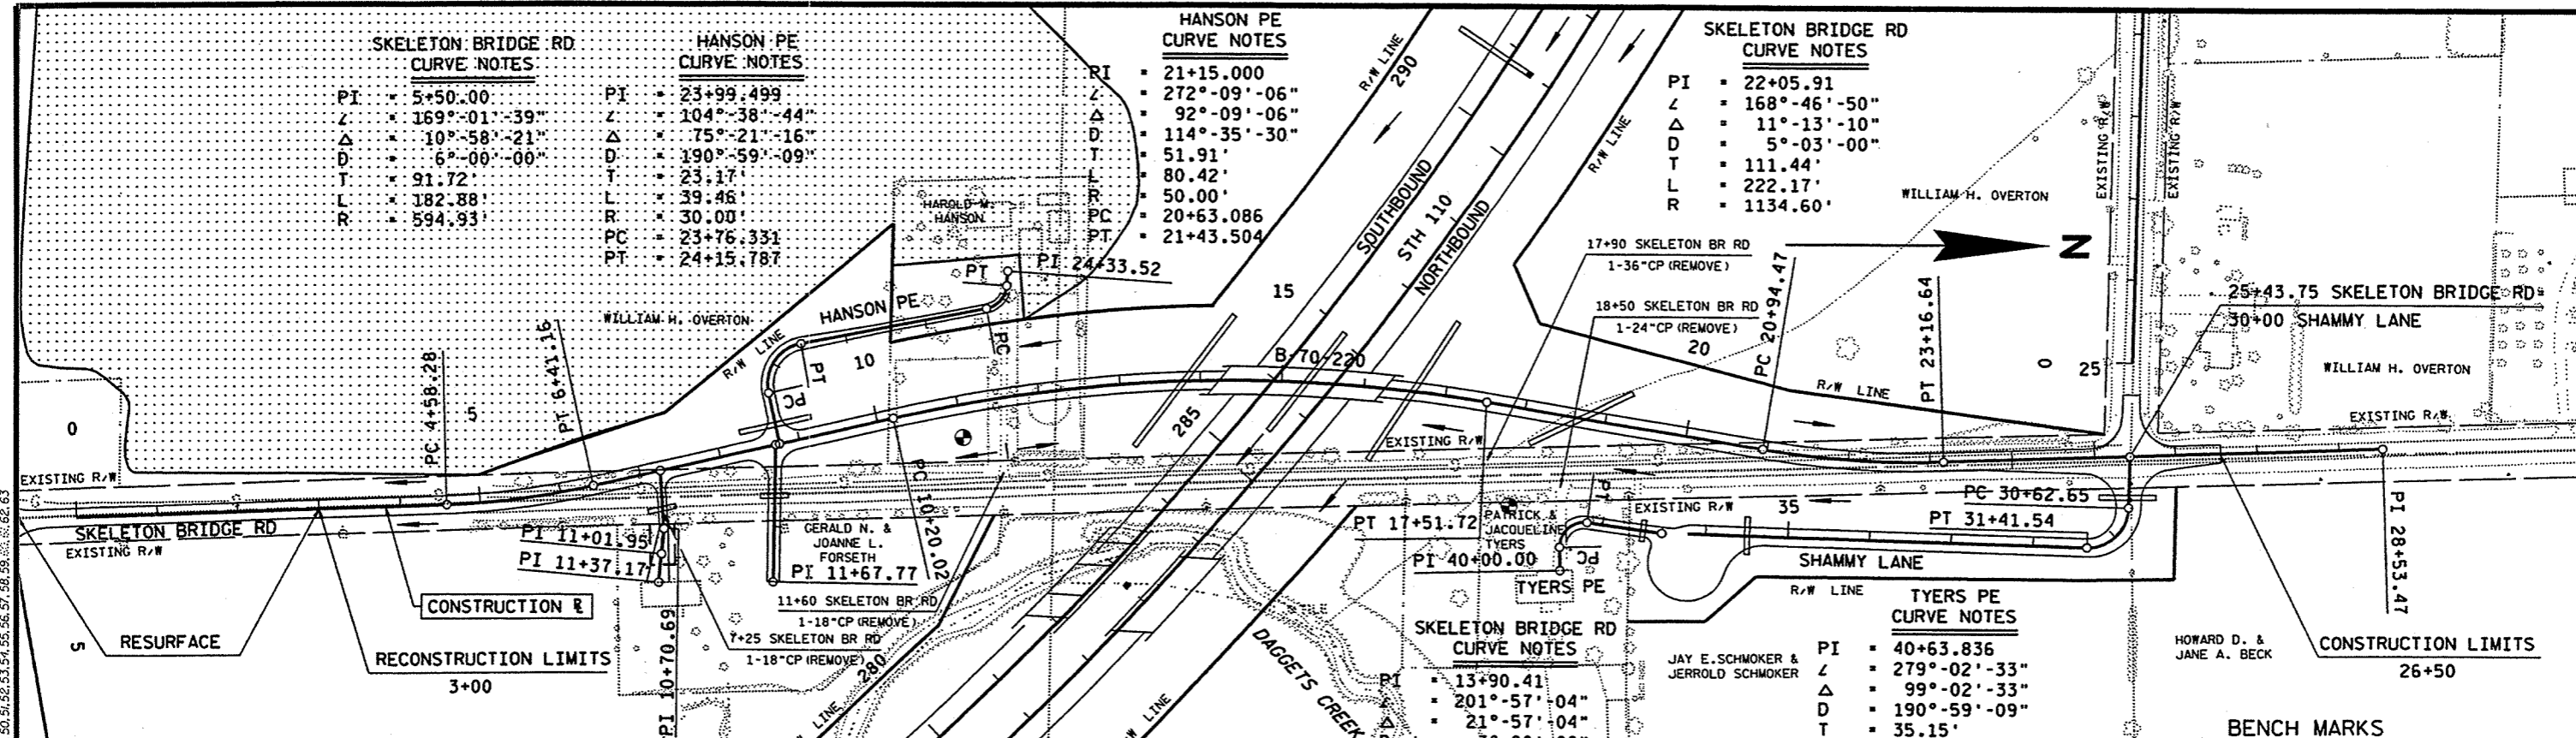


BENCH MARKS

NO.	STATION	DESCRIPTION	ELEV.
6115	11+00	SPIKE IN 18" HICKORY, 40' RT EXISTING SKELETON BRIDGE RD	767.39
6116	18+00	120' RT EXISTING SKELETON BRIDGE	769.97

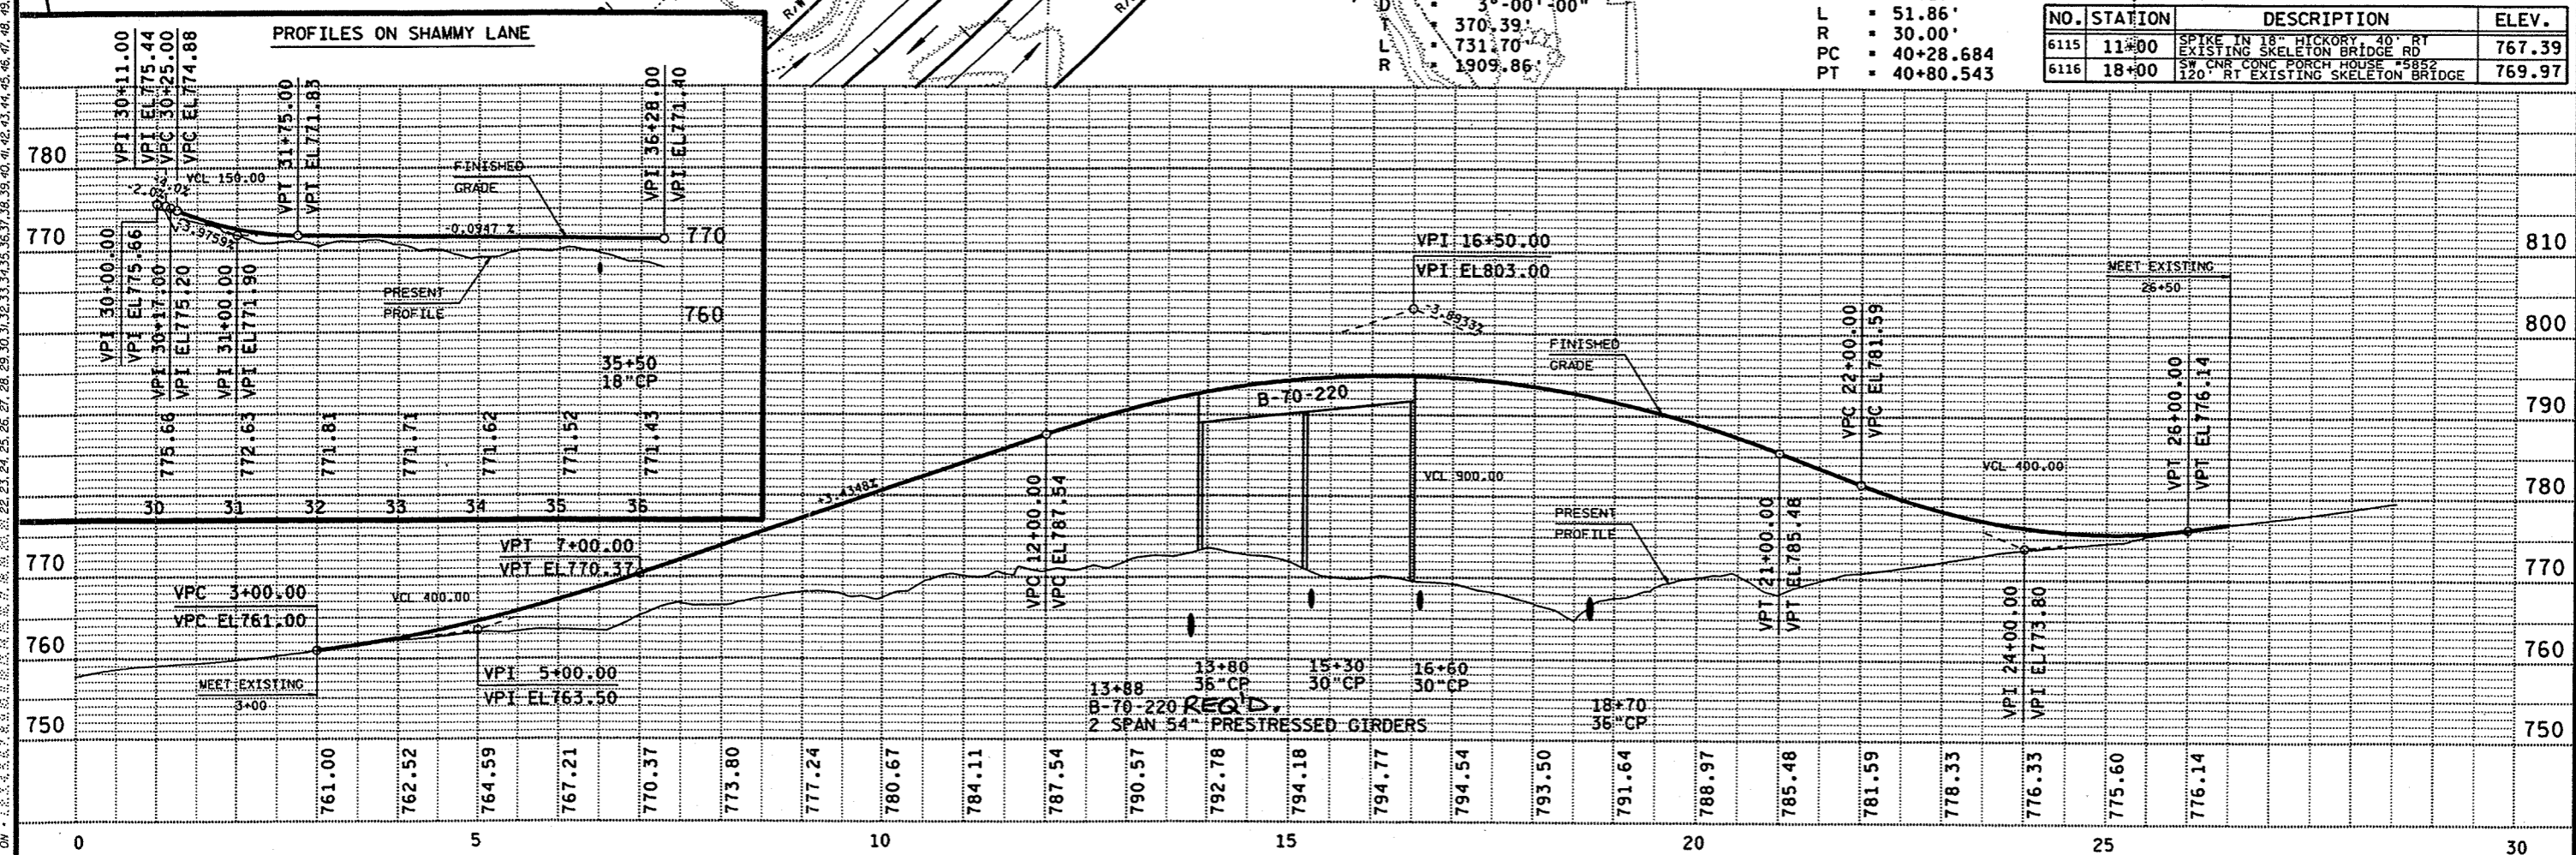

STATE PROJECT NUMBER: 6200-05-71 HWY: STH 110 COUNTY: WINNEBAGO SKELETON BRIDGE ROAD SHEET NO: 5.20 E

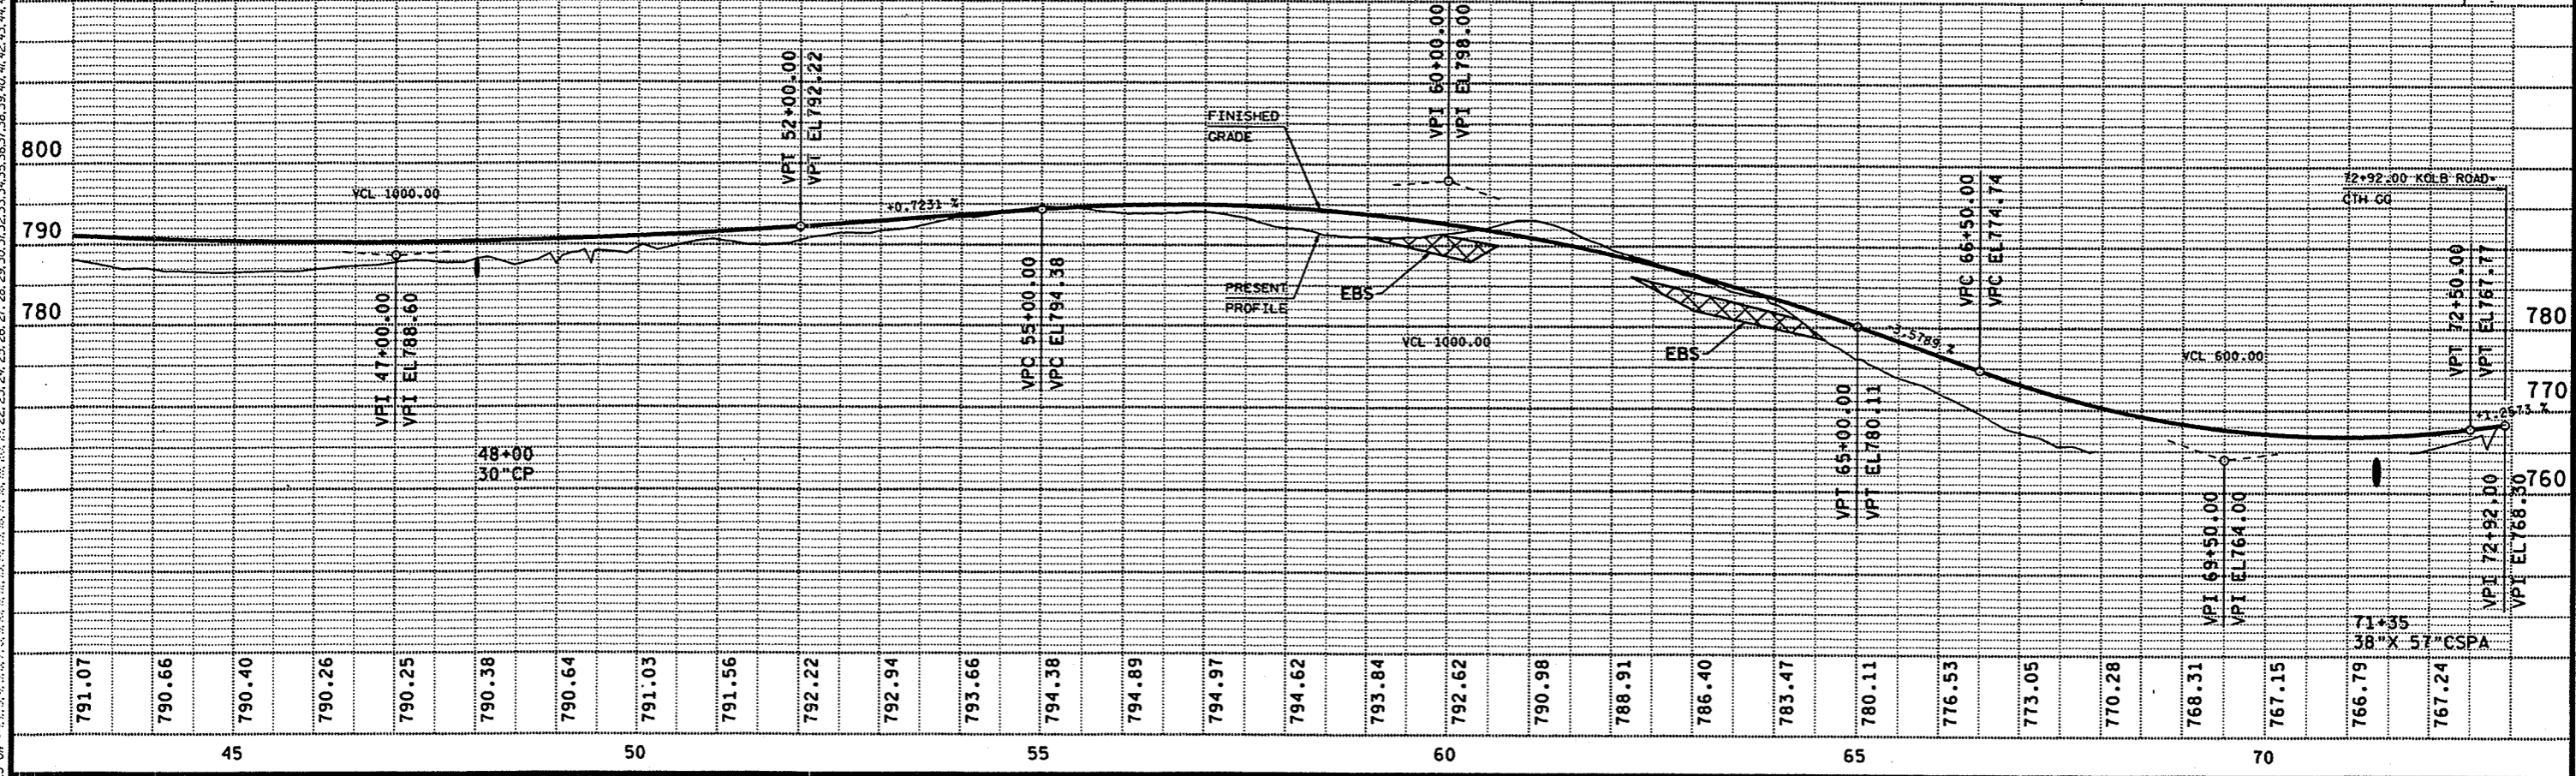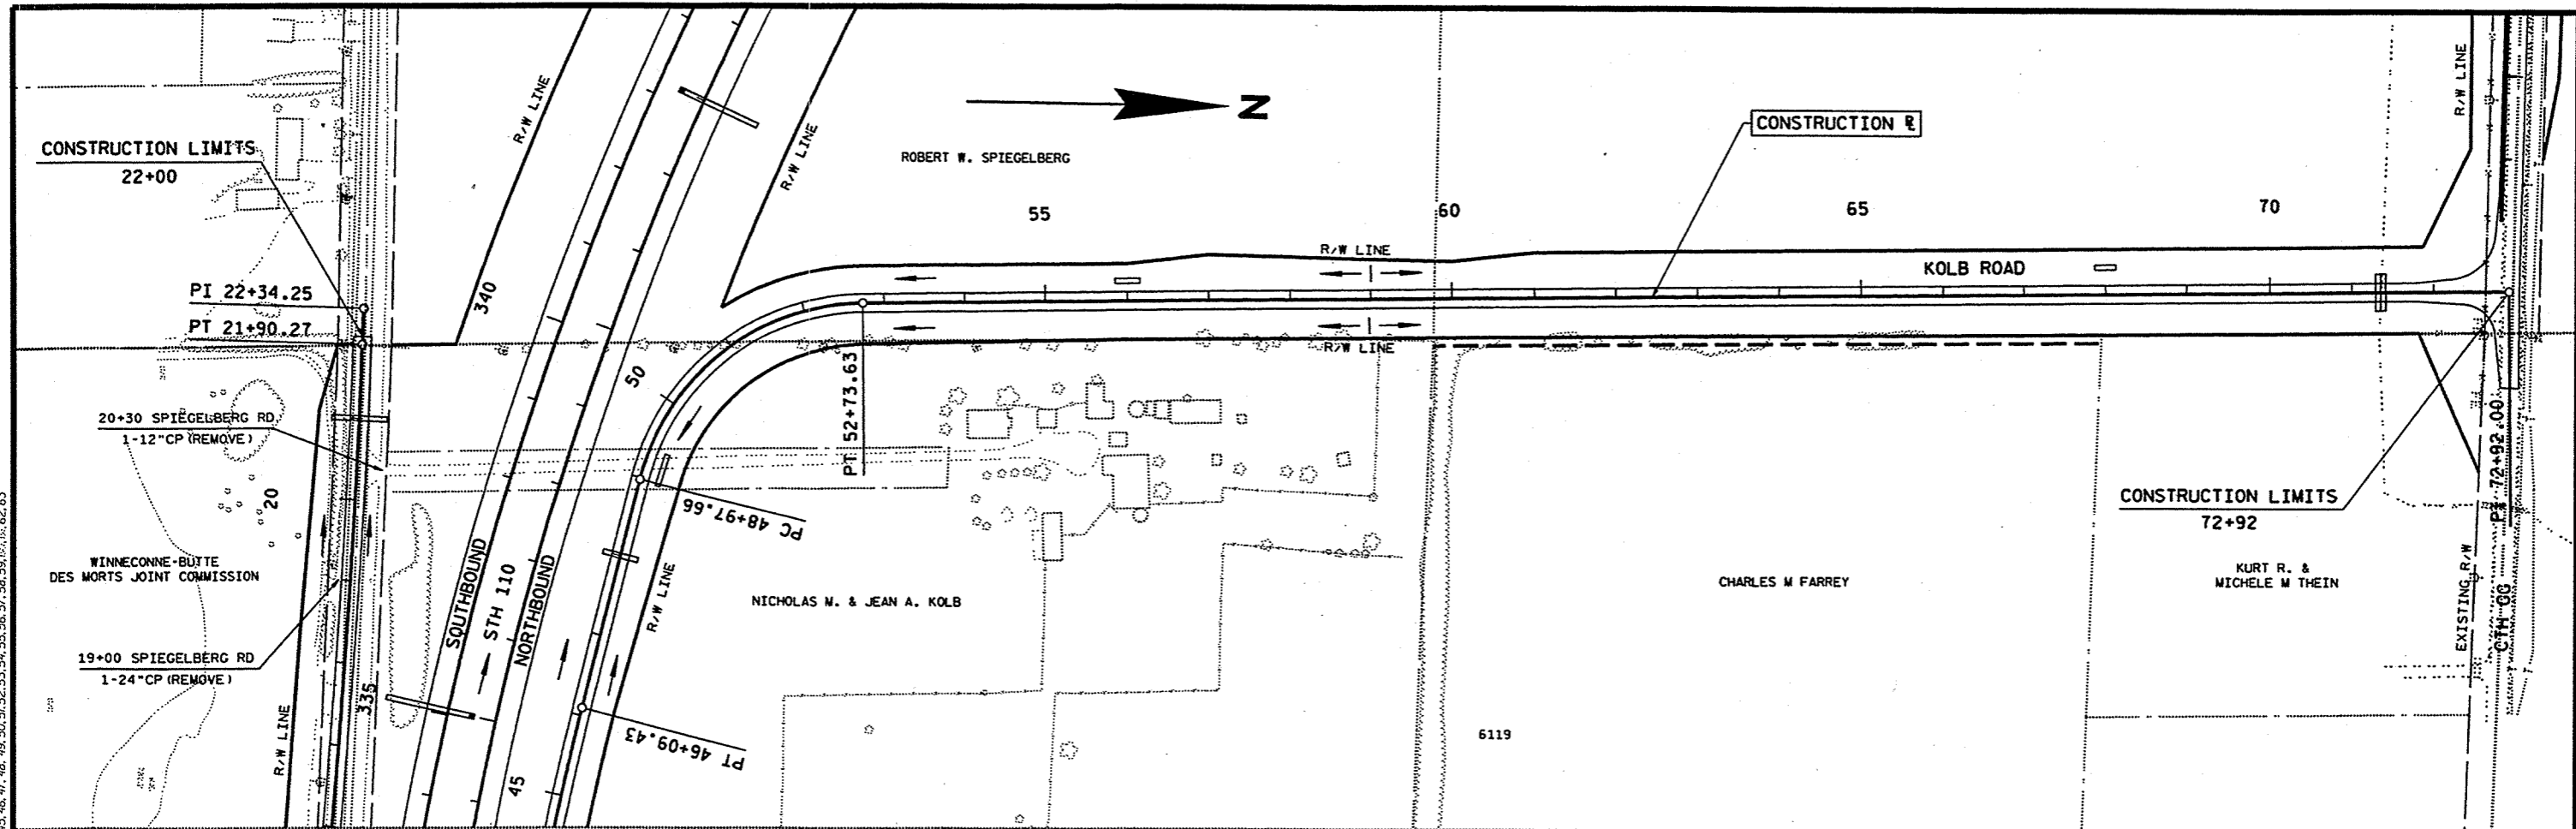


STATE PROJECT NUMBER: 6200-05-71 HWY: STH 110 COUNTY: WINNEBAGO KOLB ROAD SHEET NO: 5.22 E

FILE NAME : F:\d3_620005\d3526.dgn PLOT DATE: 24-JUL-2001 10:42 ORG DATE : 1-30-01 PLOT NAME : d3526d Originator : DISTRICT 3 PLOT SCALE : 200.700000:1.000000 WISDOT/CADS SHEET 40

LEVELS ON : 1.2, 3.4, 5.6, 7.8, 9.0, 11.2, 13.4, 3306.8, 3309

PROFILES ON NORTHWEST FRONTAGE ROAD

PROFILES ON SPIEGELBERG RD

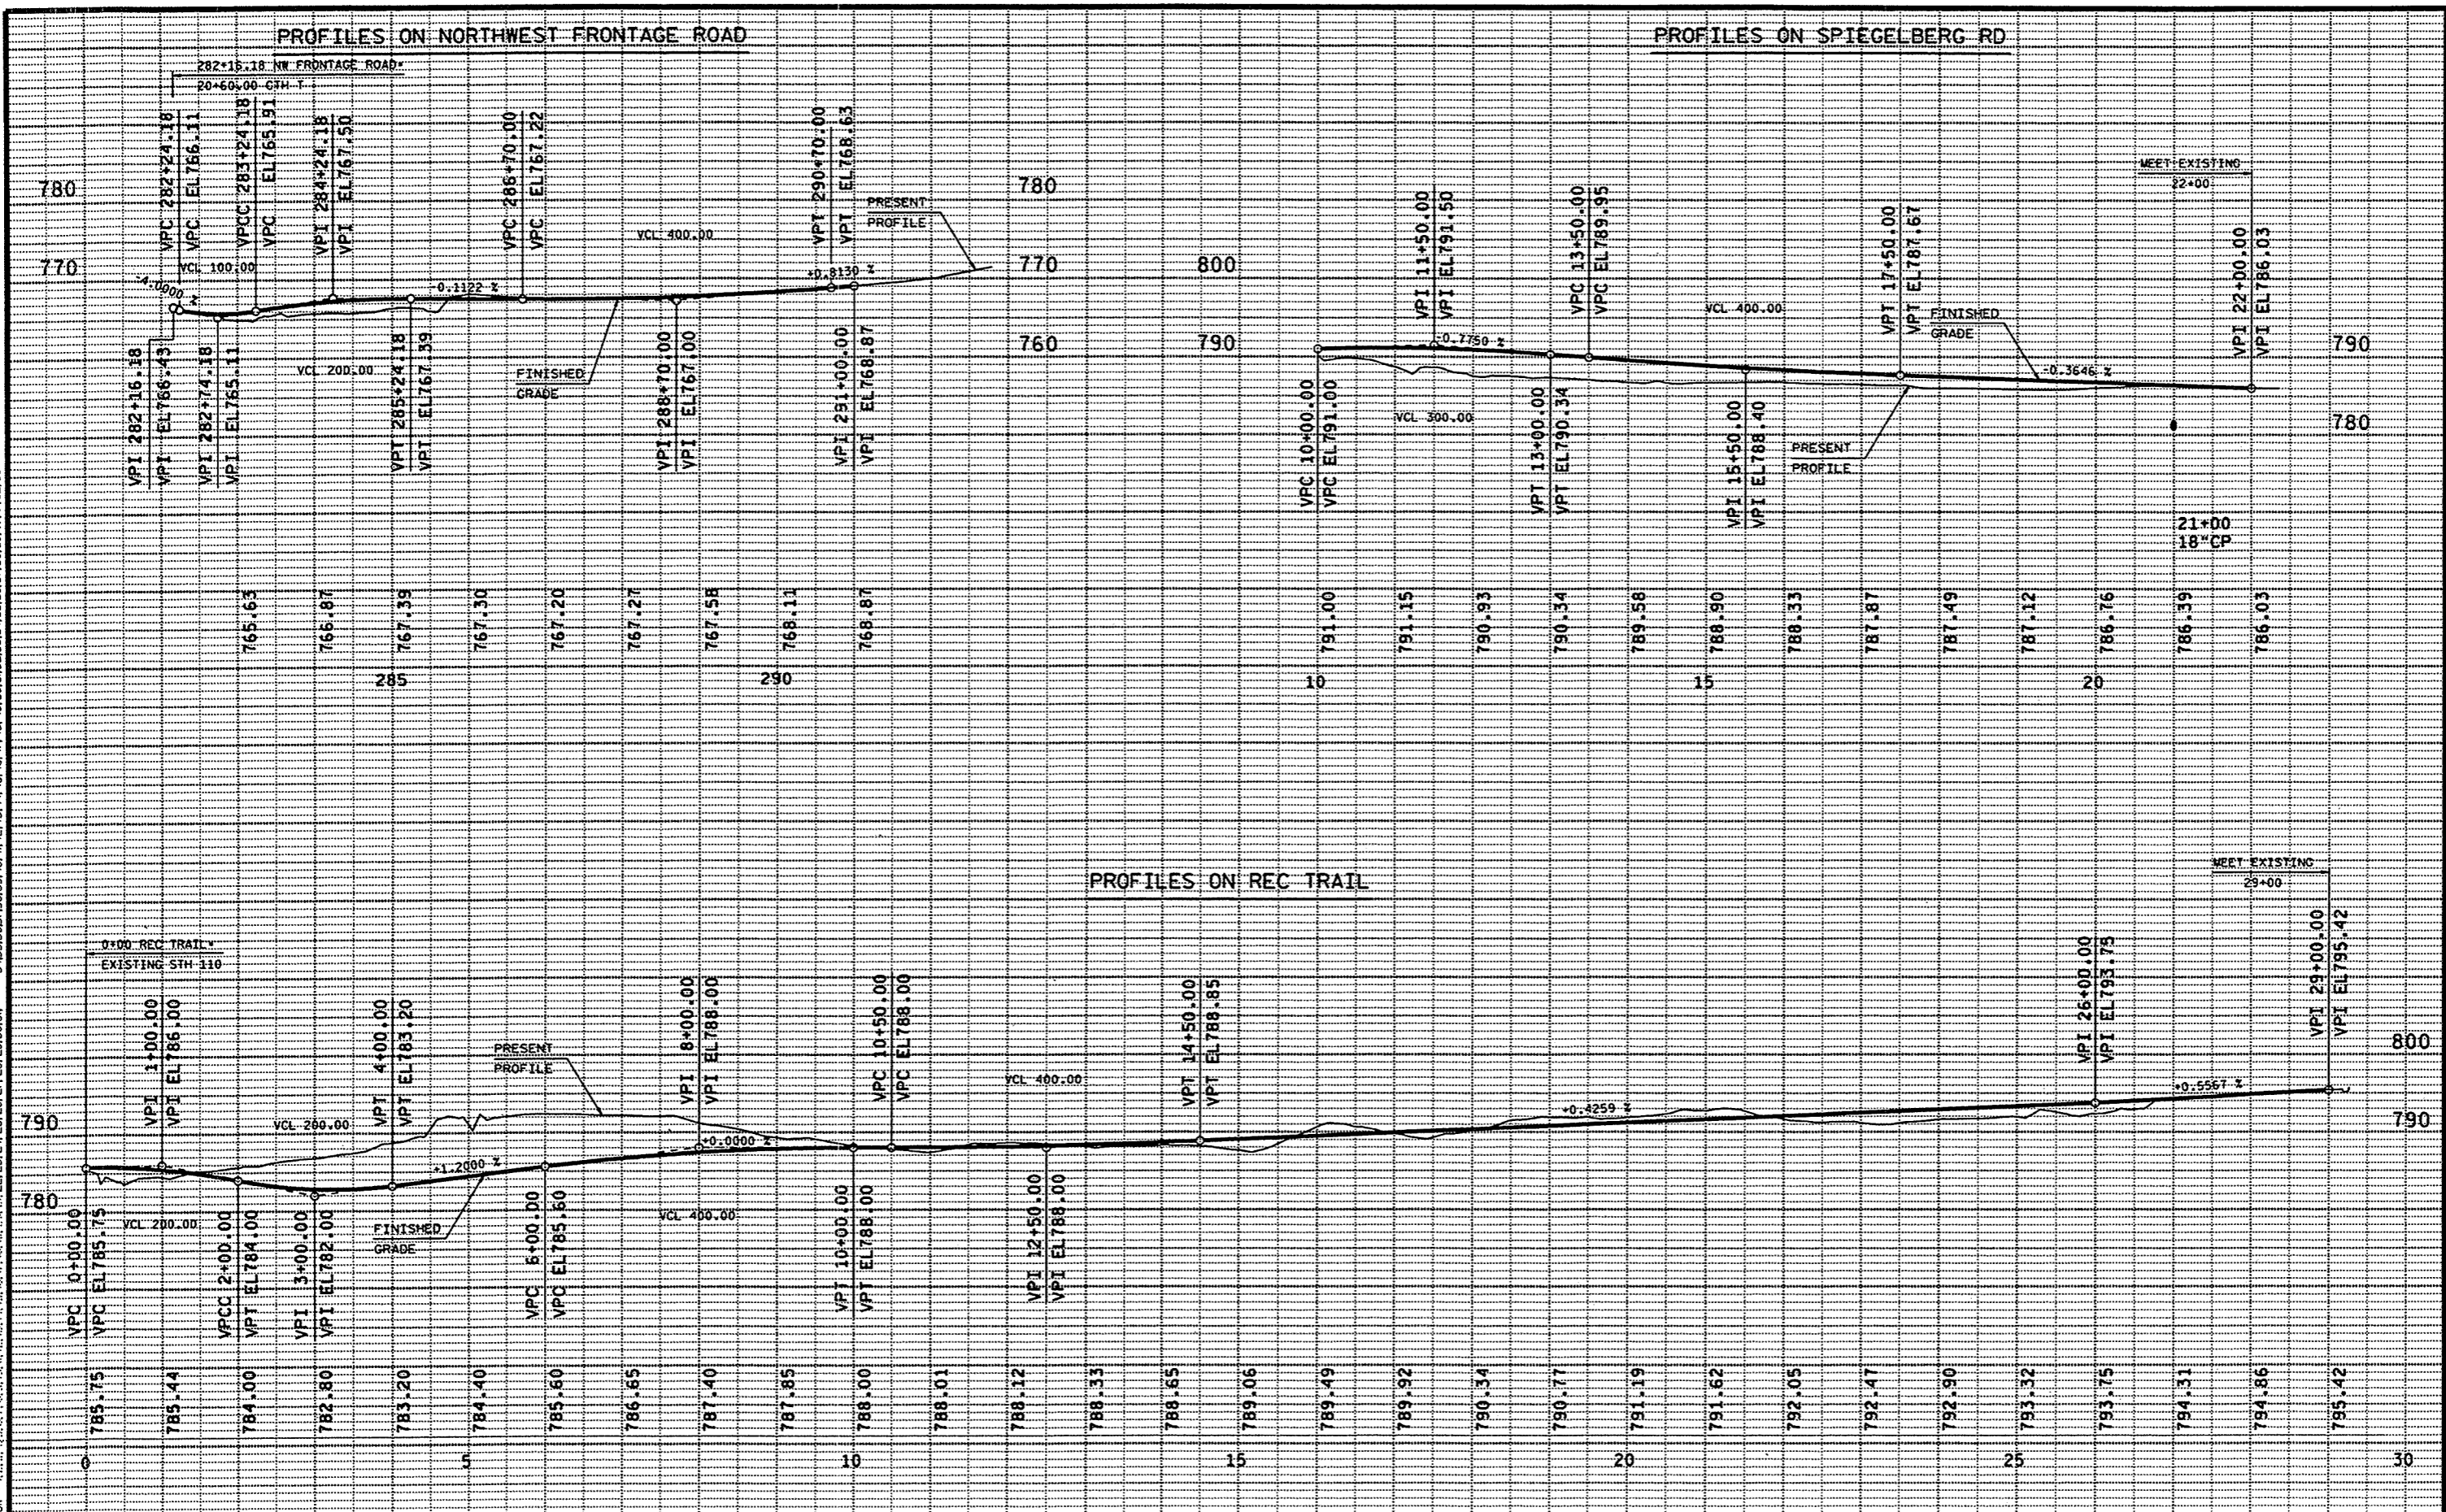

LEVELS ON: 1.0, 1.5, 2.0, 99.5, 100.0


LEVELS ON - 1, 2, 3, 62, 63

PROFILES ON NW RAMP AT STH 116

PROFILES ON NE RAMP AT STH 116

PROFILES ON SW RAMP AT STH 116

PROFILES ON SE RAMP AT STH 116

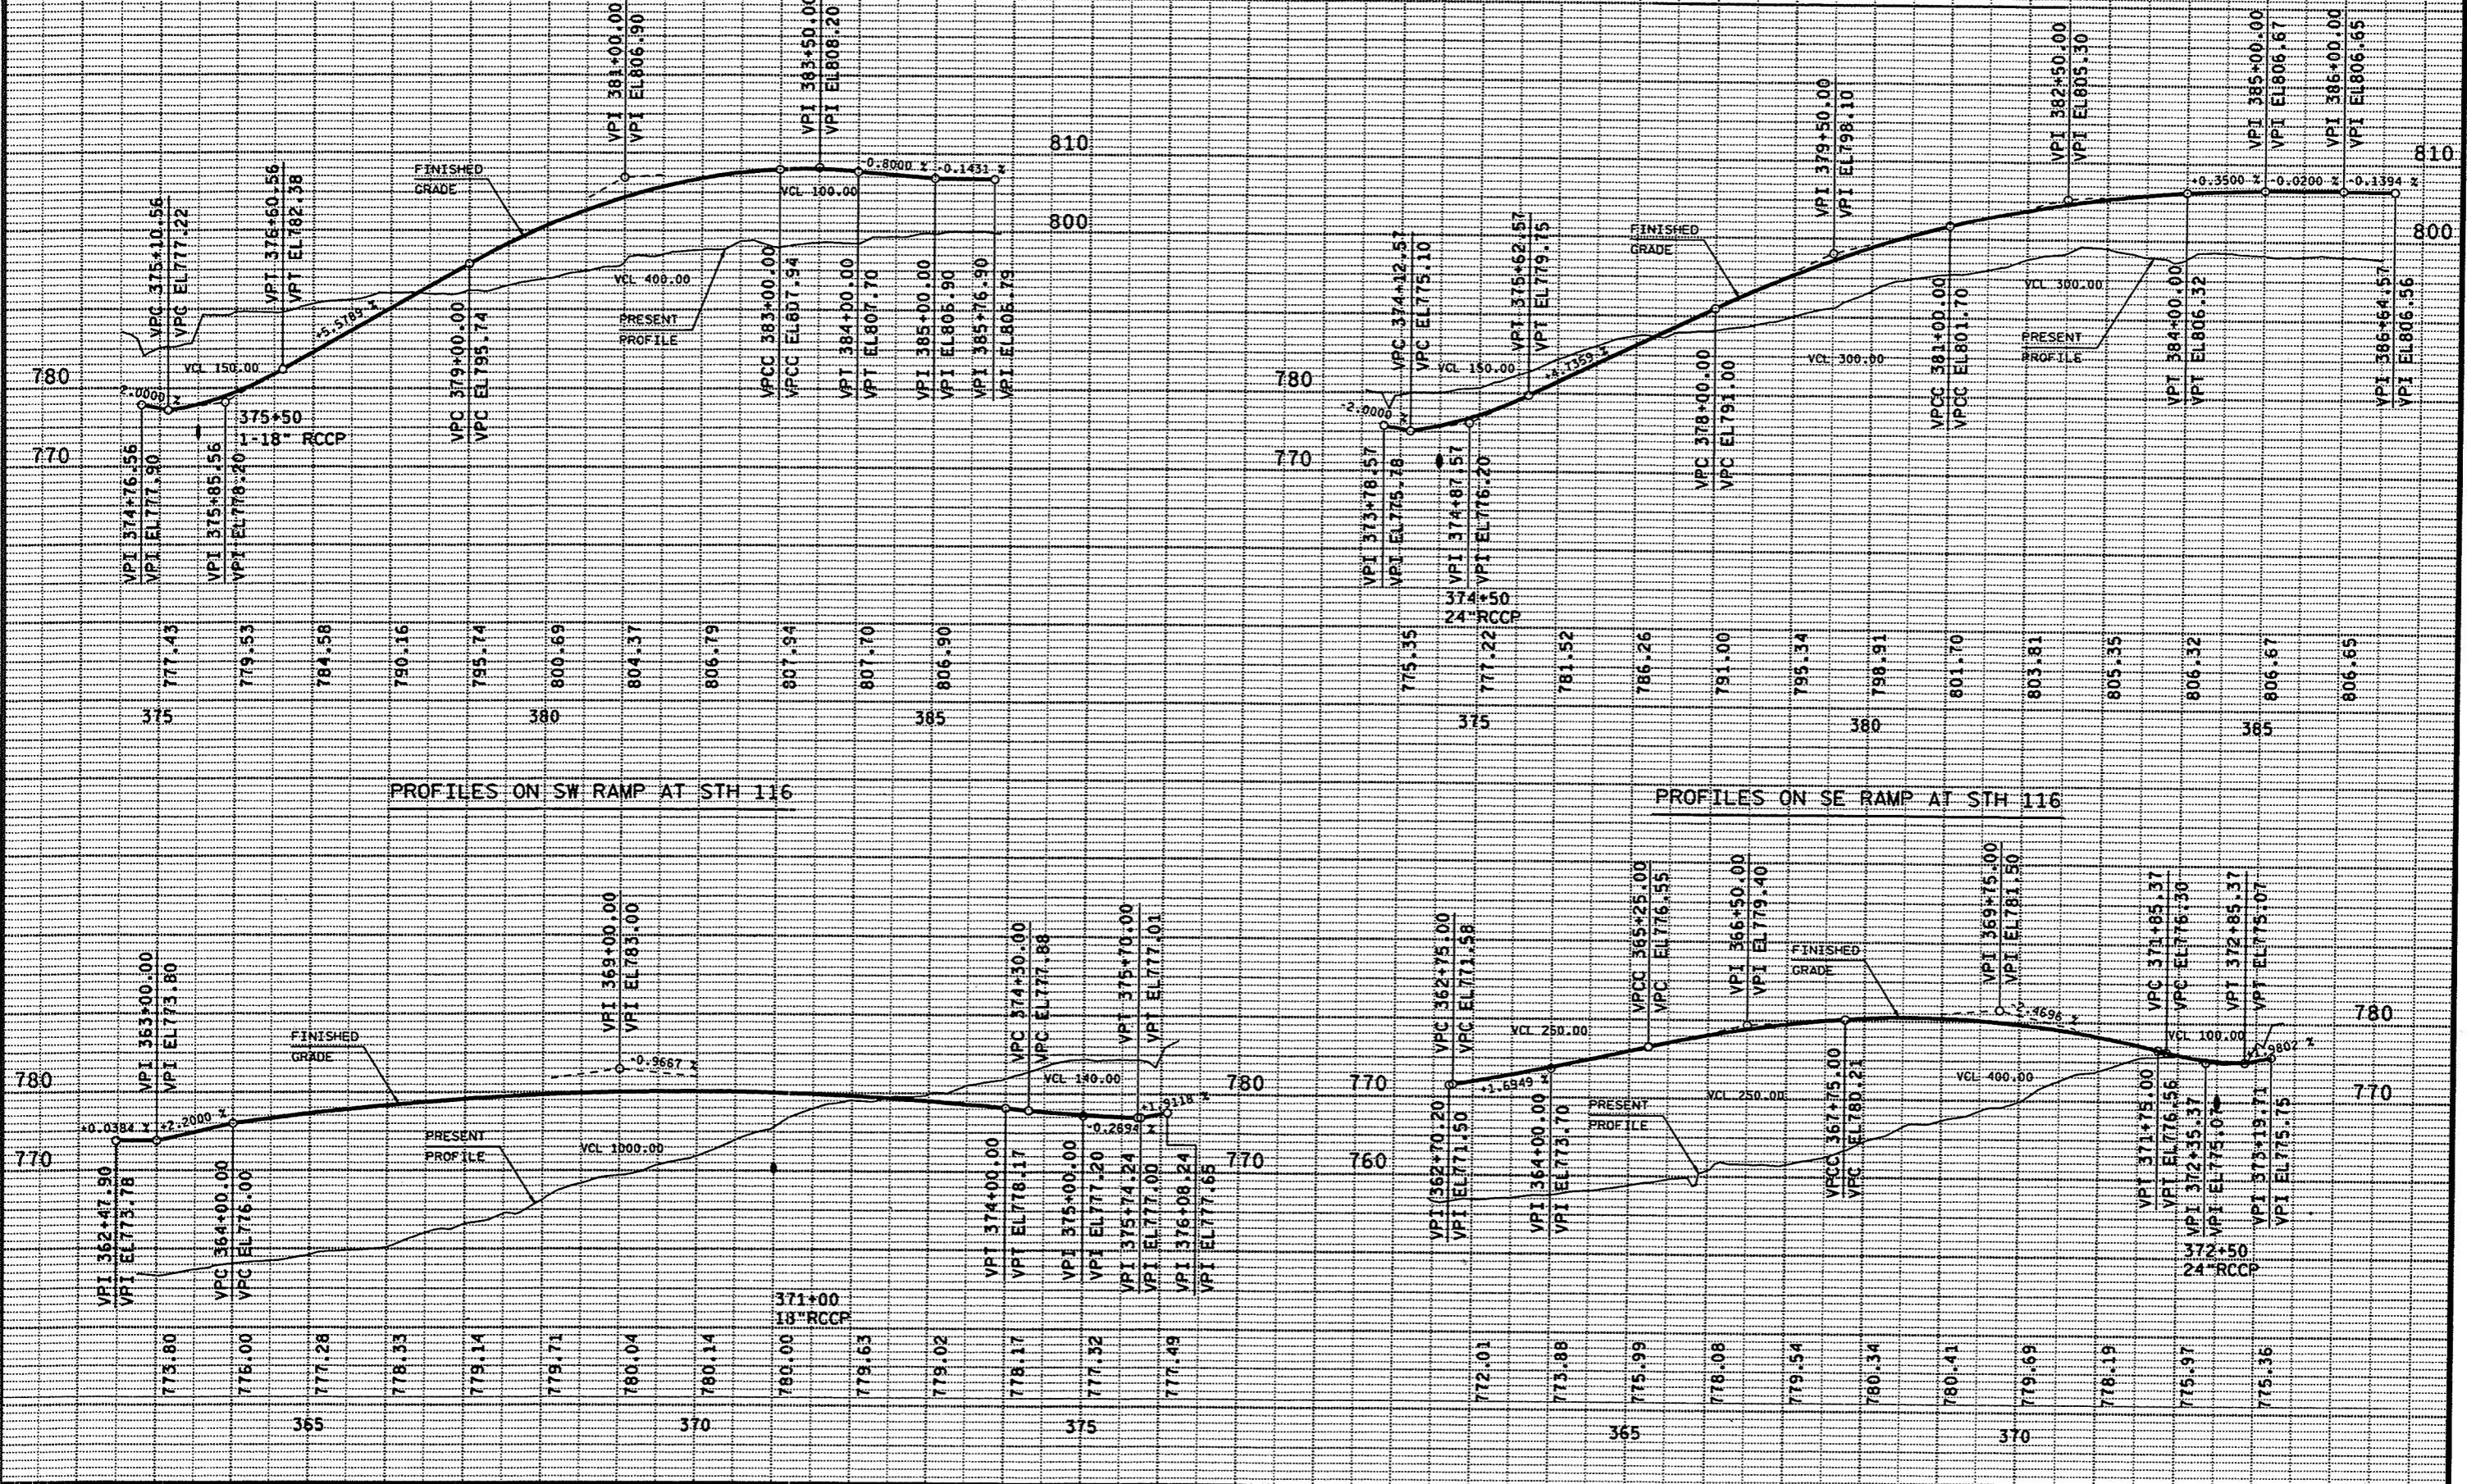


STATE PROJECT NUMBER: 6200-05-71	HWY: STH 110	COUNTY: WINNEBAGO	PROFILES	SHEET NO: 5.24 E
----------------------------------	--------------	-------------------	----------	------------------


FILE NAME : F:\d3_620005\d3536.dgn PLOT DATE: 14-SEP-2001 08:27 ORG DATE : 2-1-01 PLOT NAME : d3536cd71 Originator : DISTRICT 3 PLOT SCALE : 200.700000:1.000000 WISDOT/CADD SHEET 40

LEVELS ON - 1, 2, 3, 62, 63


PROFILES ON FORSETH PE

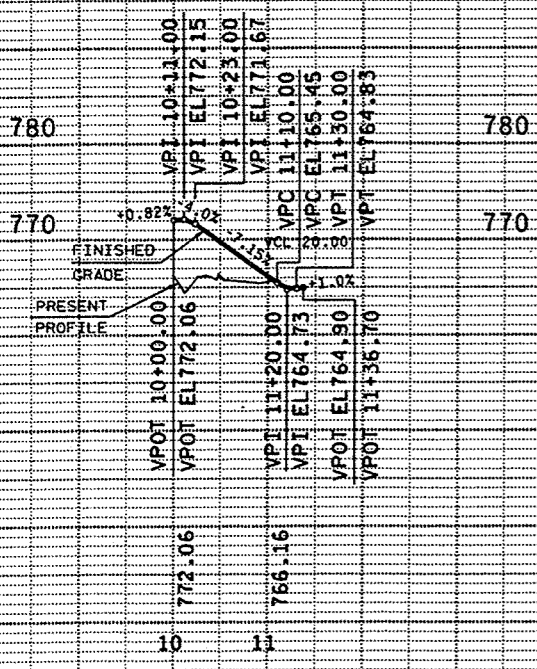


PROFILES ON GRUNDY CE

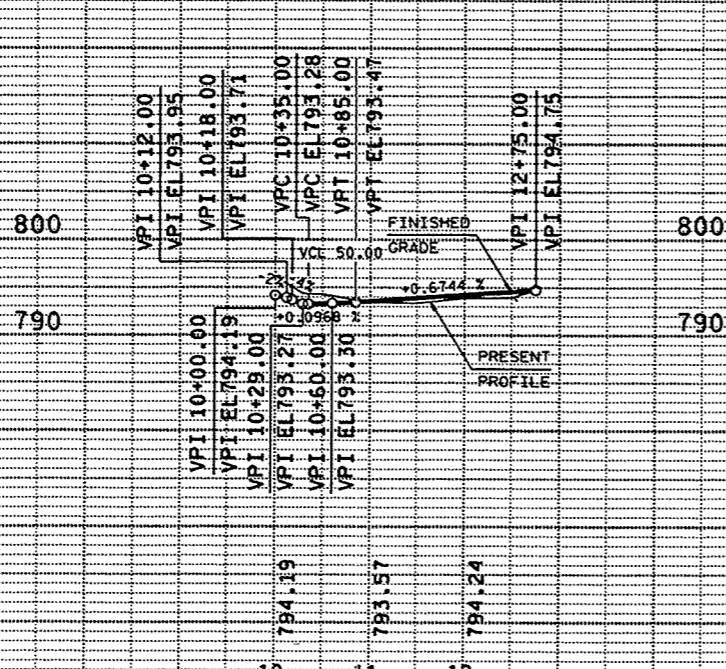


PROFILES ON TYERS PE

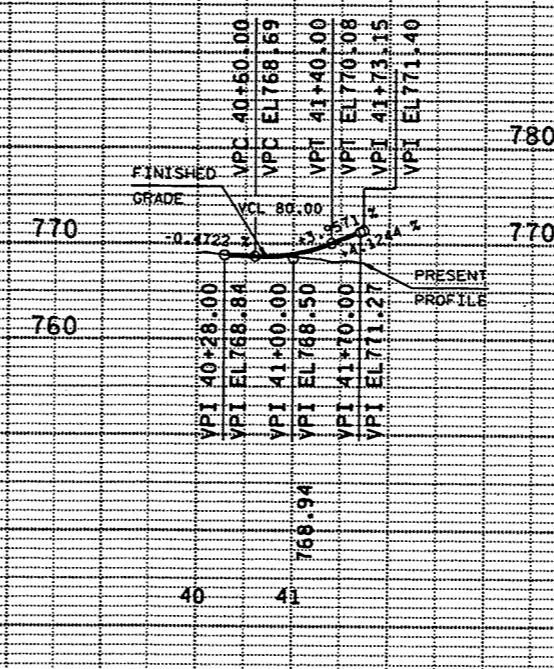


PROFILES ON HANSEN PE

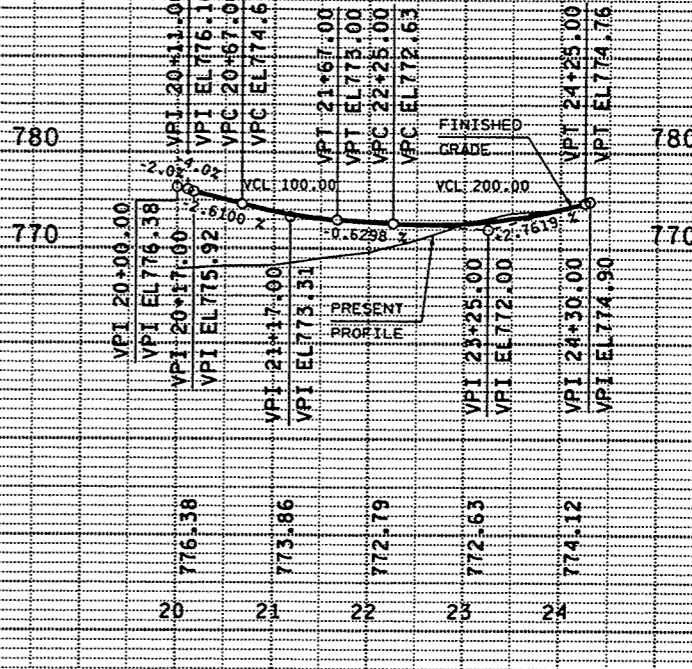


PROFILES ON FORSETH FE

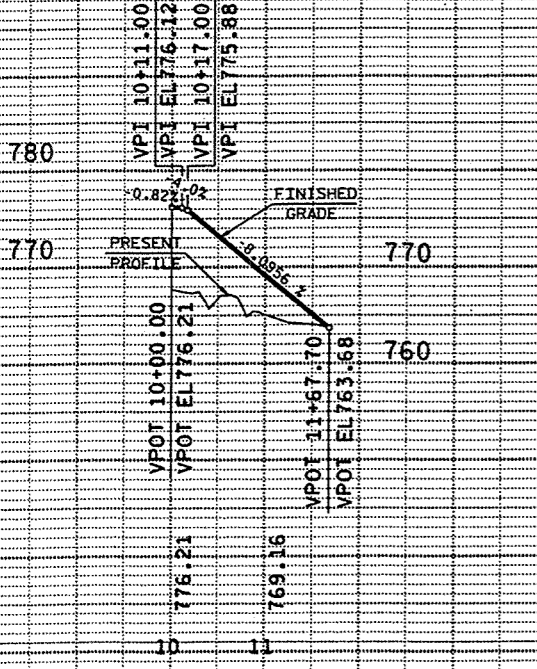


PROFILES ON SCHMOKER FE

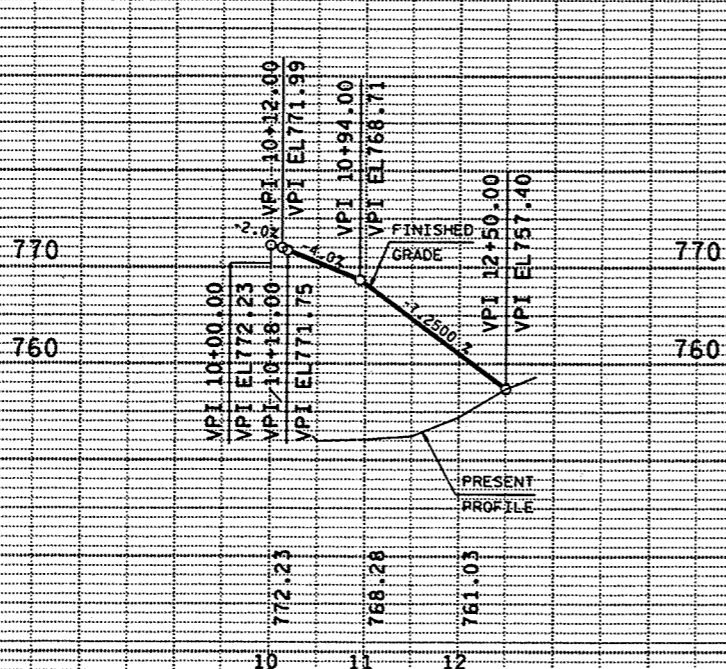

PROFILES ON SCHMOKER PE (FRONT)

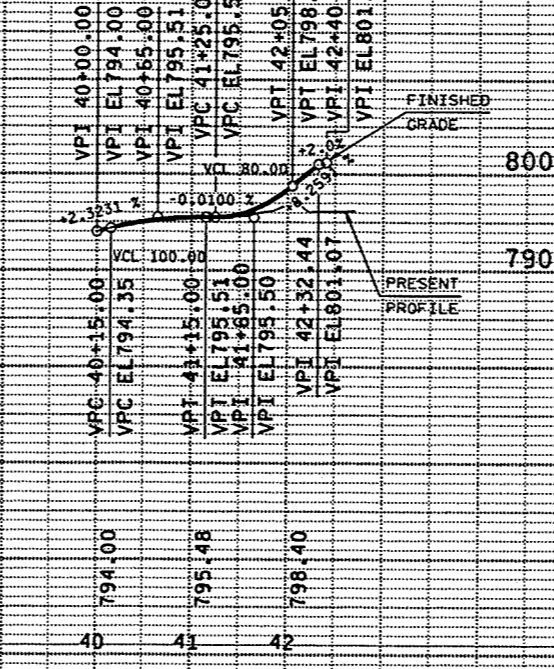

PROFILES ON EWALD F.E.

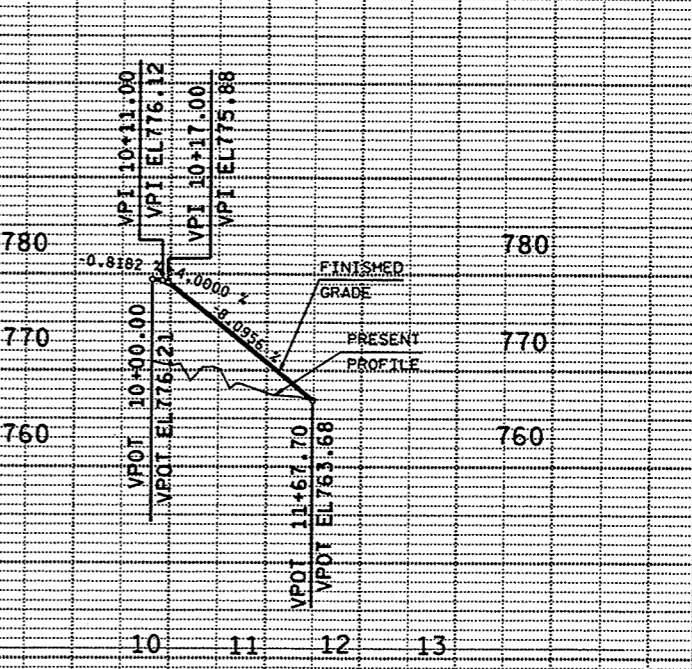

STATE PROJECT NUMBER: 6200-05-71

HWY: STH 110

COUNTY: WINNEBAGO

DRIVEWAY PROFILES

SHEET NO: 5.25 E

FILE NAME : F:\d3_620005\03536.dgn

PLOT DATE: 27-SEP-2001 13:40

ORG DATE : 2-1-01



PLOT NAME : d3536bd71

Originator : DISTRICT 3


PLOT SCALE : 200.606061:1.000000

WSDOT/CADD SHEET 40

NOTE:
GRATE IS REVERSIBLE.

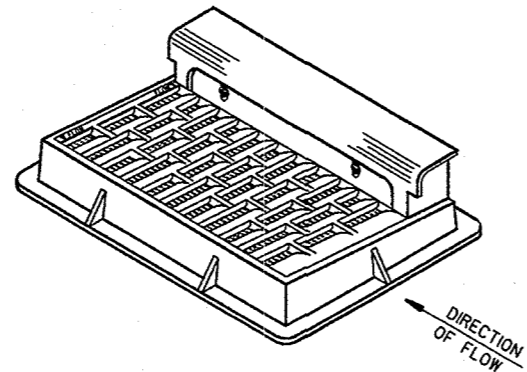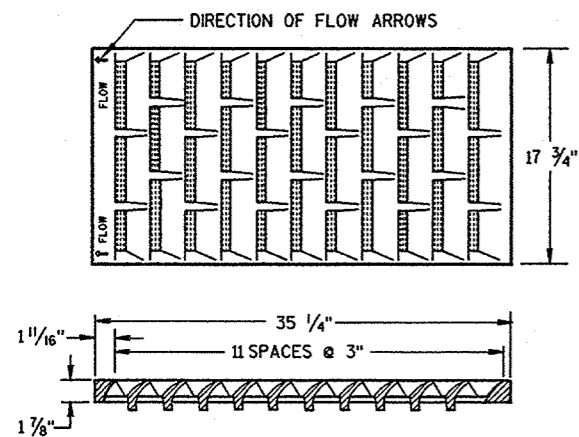


NOTE: CURB BOX HEIGHT ADJUSTABLE 6" TO 9"

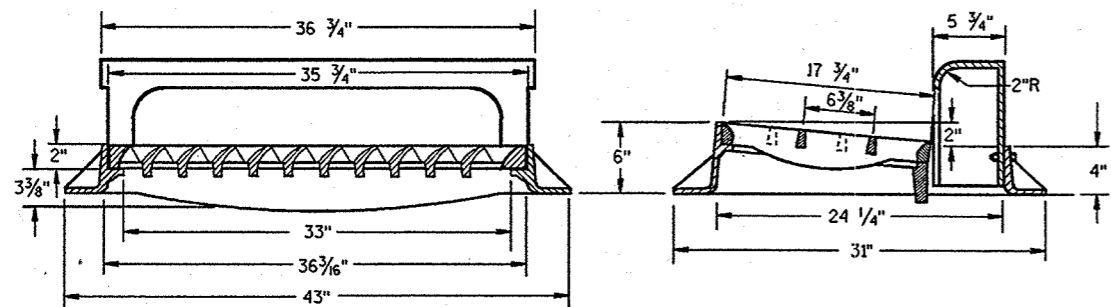

TYPE "H"

(APPROXIMATE WEIGHT 422 LBS.)
 FRAME..... 175 LBS.
 GRATE..... 138 LBS.
 CURB BOX..... 109 LBS.

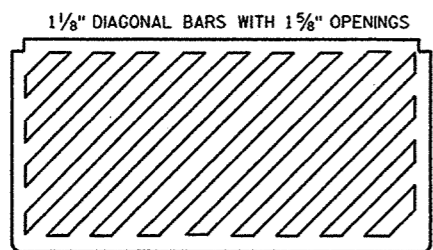

**SPECIAL GRATE FOR
TYPE "H" COVER**

(MEASURES 35 1/4" X 17 3/4" X 2")
 (APPROXIMATE WEIGHT 172 LBS.)
 GRATE..... 172 LBS.
 (NOTED AS TYPE H-S ON DRAINAGE TABLE)




GENERAL NOTES

DETAILS OF CONSTRUCTION, MATERIALS AND WORKMANSHIP NOT SHOWN ON THIS DRAWING SHALL CONFORM TO THE PERTINENT REQUIREMENTS OF THE STANDARD SPECIFICATIONS AND THE APPLICABLE SPECIAL PROVISIONS.


DETAIL DRAWINGS FOR PROPOSED ALTERNATE DESIGNS FOR CATCH BASIN, MANHOLE AND INLET COVERS SHALL BE SUBMITTED TO THE ENGINEER FOR APPROVAL PROVIDING THAT SUCH ALTERNATE DESIGNS MAKE PROVISION FOR EQUIVALENT CAPACITY AND STRENGTH.

ROUND FRAMES AND COVERS SHALL HAVE CONTINUOUSLY MACHINED BEARING SURFACES TO PREVENT ROCKING AND RATTLING.

THE ACTUAL WEIGHT OF COVERS MAY VARY WITHIN 5 PERCENT, PLUS OR MINUS, OF THE APPROXIMATE WEIGHT.

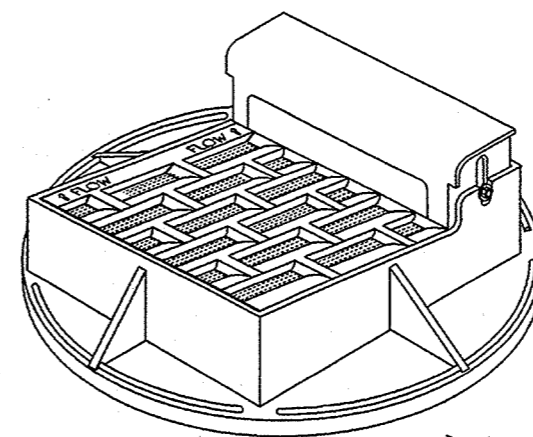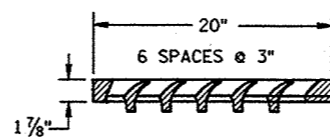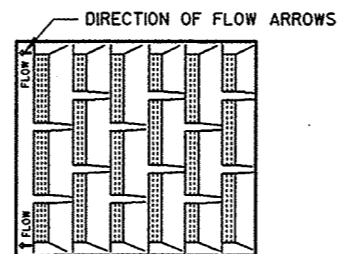


NOTE:
GRATE IS REVERSIBLE.

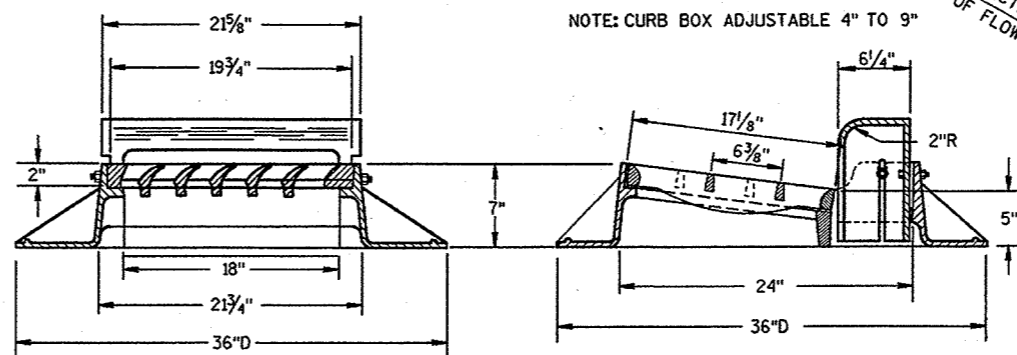

TYPE "A"

(APPROXIMATE WEIGHT 325 LBS.)
 FRAME..... 157 LBS.
 GRATE..... 84 LBS.
 CURB BOX..... 84 LBS.

1" DIAGONAL BARS
WITH 1 1/2" OPENINGS

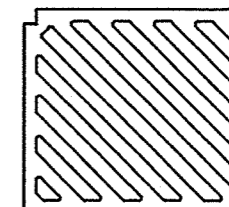

**SPECIAL GRATE FOR
TYPE "A" COVER**

(MEASURES 19 3/4" X 17" X 1 7/8")
 GRATE..... 84 LBS.
 (NOTED AS TYPE A-S ON DRAINAGE TABLE)



S.D.D. 8 A 5-16d

**INLET COVERS
TYPE A, H, A-S, & H-S**


STATE OF WISCONSIN
DEPARTMENT OF TRANSPORTATION

APPROVED
10/04/99
DATE
[Signature]
CHIEF ROADWAY DEVELOPMENT ENGINEER
FHWA



S.D.D. 8 A 5-16d

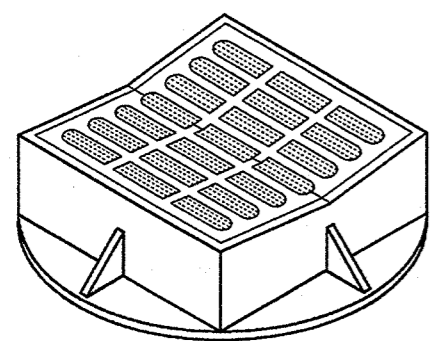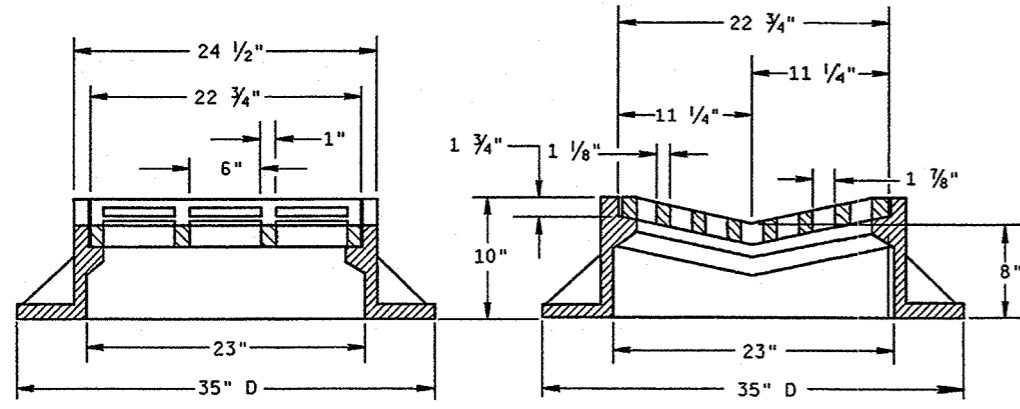

TYPE "B"
 (APPROXIMATE WEIGHT 395 LBS.)
 FRAME.....285 LBS.
 GRATE.....110 LBS.

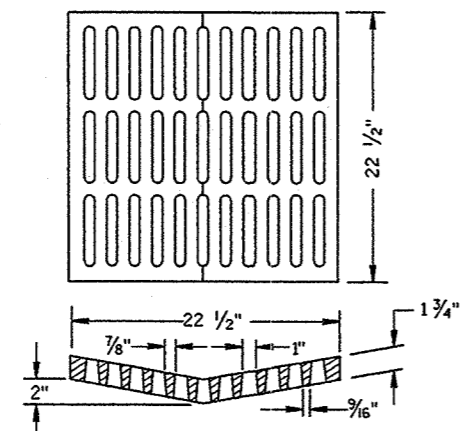


ALTERNATIVE GRATE FOR TYPE "B" COVER
 (APPROXIMATE GRATE WEIGHT 125 LBS.)
 GRATE.....125 LBS.
 USE WHERE PEDESTRIAN OR BICYCLE TRAFFIC IS POSSIBLE.
 NOTED AS TYPE B-A ON THE DRAINAGE TABLE

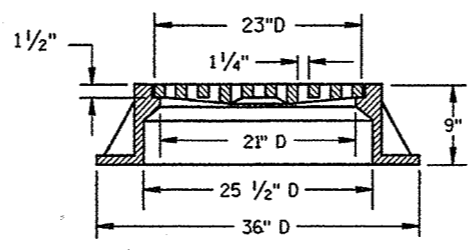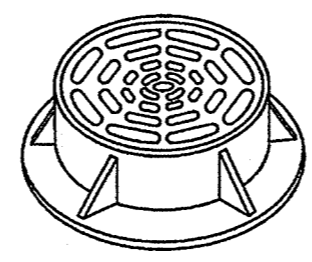


TYPE "C"
 (APPROXIMATE WEIGHT 340 LBS.)
 FRAME.....235 LBS.
 GRATE.....105 LBS.


GENERAL NOTES
 DETAILS OF CONSTRUCTION, MATERIALS AND WORKMANSHIP NOT SHOWN ON THIS DRAWING SHALL CONFORM TO THE PERTINENT REQUIREMENTS OF THE STANDARD SPECIFICATIONS AND THE APPLICABLE SPECIAL PROVISIONS.
 DETAIL DRAWINGS FOR PROPOSED ALTERNATE DESIGNS FOR CATCH BASIN, MANHOLE AND INLET COVERS SHALL BE SUBMITTED TO THE ENGINEER FOR APPROVAL PROVIDING THAT SUCH ALTERNATE DESIGNS MAKE PROVISION FOR EQUIVALENT CAPACITY AND STRENGTH.
 ROUND FRAMES AND COVERS SHALL HAVE CONTINUOUSLY MACHINED BEARING SURFACES TO PREVENT ROCKING AND RATTLING.
 THE ACTUAL WEIGHT OF COVERS MAY VARY WITHIN 5 PERCENT, PLUS OR MINUS, OF THE APPROXIMATE WEIGHT.

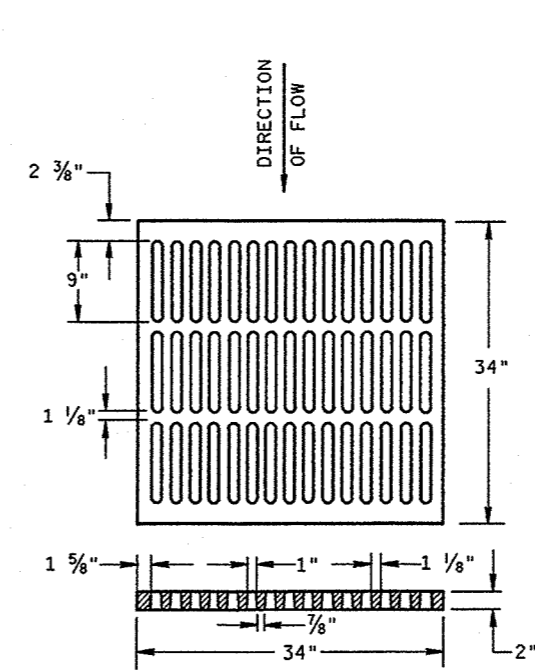


ALTERNATIVE TYPE "MS"
 (APPROXIMATE GRATE WEIGHT 365 LBS.)
 GRATE.....365 LBS.
 USE WHERE PEDESTRIAN OR BICYCLE TRAFFIC IS PERMITTED
 NOTED AS TYPE MS-A ON THE DRAINAGE TABLE

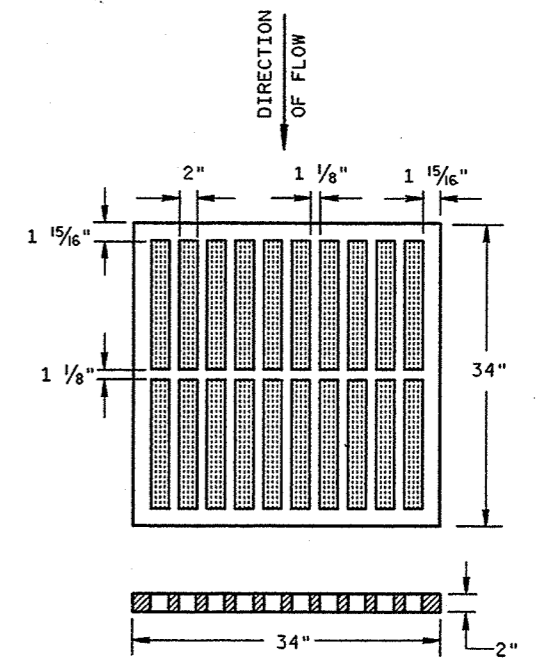

TYPE "MS"
 (APPROXIMATE GRATE WEIGHT 270 LBS.)
 GRATE.....270 LBS.
 USE ON FREEWAYS AND EXPRESSWAYS
 NOTED AS TYPE MS ON DRAINAGE TABLE

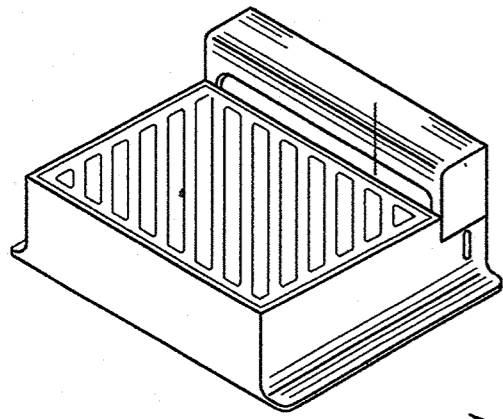

DIAGONAL SLOTS, SHALL BE ORIENTED TO THE DIRECTION OF FLOW AS ILLUSTRATED. GRATES ARE MANUFACTURED TO BE REVERSIBLE.

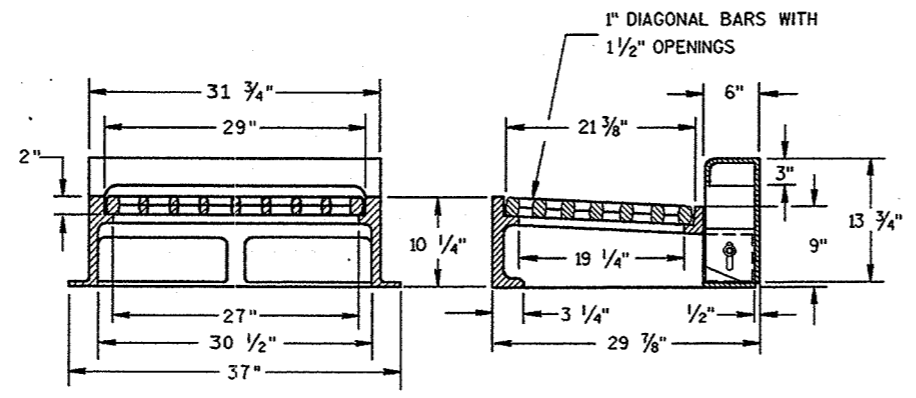

NOTE: CURB BOX HEIGHT ADJUSTABLE 6" TO 9"

TYPE "WM"
 (APPROXIMATE WEIGHT 670 LBS.)
 FRAME.....360 LBS.
 GRATE.....160 LBS.
 CURB BOX.....150 LBS.


INLET COVERS
 TYPE B, B-A, C, MS, MS-A, & WM

STATE OF WISCONSIN
 DEPARTMENT OF TRANSPORTATION


APPROVED *Ray L. Johnson*
 DATE 10/04/99 CHIEF ROADWAY DEVELOPMENT ENGINEER
 FHWA

S.D.D. 8 A 5-16b

*SELECTION OF SQUARE OR CIRCULAR DESIGN WILL BE BASED ON THE PIPE SIZES AND THE INLET COVER BEING UTILIZED

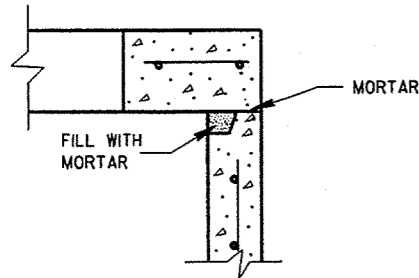

DETAIL "A"

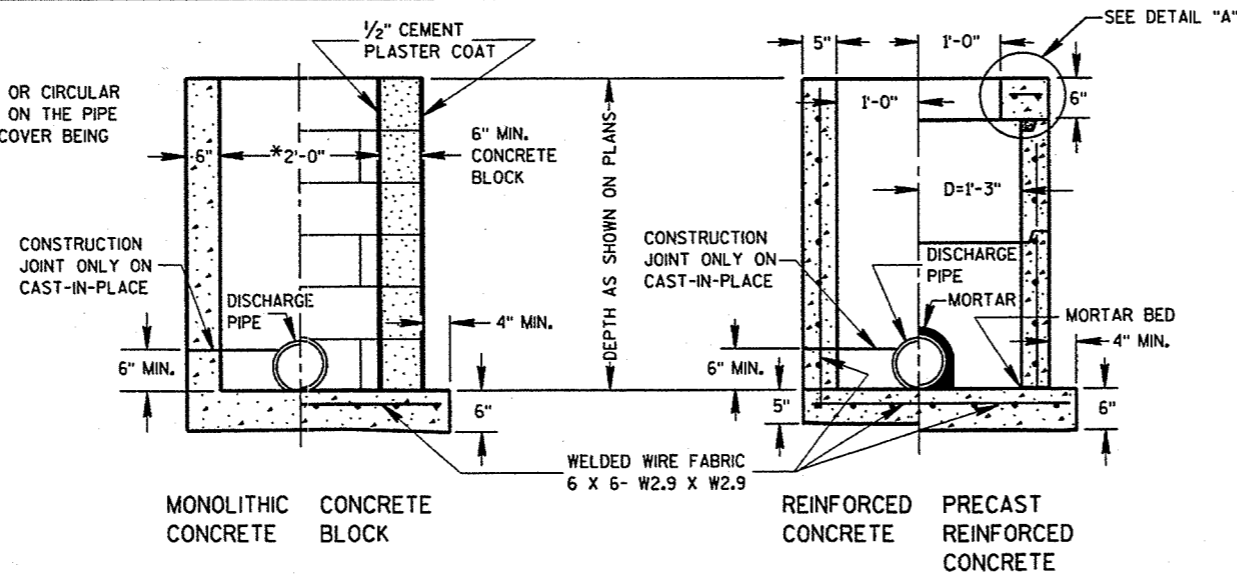

INLETS TYPE 1

GENERAL NOTES

DETAILS OF CONSTRUCTION, MATERIALS AND WORKMANSHIP NOT SHOWN ON THIS DRAWING SHALL CONFORM TO THE PERTINENT REQUIREMENTS OF THE STANDARD SPECIFICATIONS AND THE APPLICABLE SPECIAL PROVISIONS.

DETAILED DRAWINGS FOR PROPOSED ALTERNATE DESIGNS FOR UNDERGROUND DRAINAGE STRUCTURES SHALL BE SUBMITTED TO THE ENGINEER FOR APPROVAL PROVIDING THAT SUCH ALTERNATE DESIGNS MAKE PROVISION FOR EQUIVALENT CAPACITY AND STRENGTH.

ALL PRECAST INLET UNITS SHALL CONFORM TO THE PERTINENT REQUIREMENTS OF AASHTO DESIGNATION M 199.

ALL DRAINAGE STRUCTURES ARE DESIGNATED ON THE PLANS AS "MANHOLES 1-C", "CATCH BASINS 1-B", "INLETS 3-H", ETC. THE FIRST DIGIT DESIGNATES THE MASONRY PORTION OF THE STRUCTURE, AND THE FOLLOWING LETTER DESIGNATES THE TYPE OF COVER TO BE USED TO COMPRISE THE COMPLETE UNIT.


PRECAST REINFORCED BASES SHALL BE PLACED ON A BED OF MATERIAL AT LEAST 6 INCHES IN DEPTH, WHICH MEETS THE REQUIREMENTS OF GRANULAR BACKFILL. THIS BEDDING SHALL BE COMPACTED AND PROVIDE UNIFORM SUPPORT FOR THE ENTIRE AREA OF THE BASE.

PRECAST REINFORCED CONCRETE FLAT SLAB TOPS MAY BE USED ON THE STRUCTURES. THE TOPS SHALL BE INSTALLED ON A BED OF MORTAR.


ALL BAR STEEL REINFORCEMENT SHALL BE EMBEDDED 2 INCHES CLEAR UNLESS OTHERWISE SHOWN OR NOTED.

PRECAST REINFORCED CONCRETE RISERS SHALL BE PLACED WITH TONGUE DOWN.


- ① USE 2'-6" OPENING FOR TYPE 2 INLETS, 3'-0" OPENING FOR TYPE 3 INLETS, AND 2'-11" FOR TYPE 4 INLETS.
- ② USE 2'-0" OPENING FOR TYPE 1, 2 & 3 INLETS, 2'-6 1/2" OPENING FOR TYPE 4 INLETS.

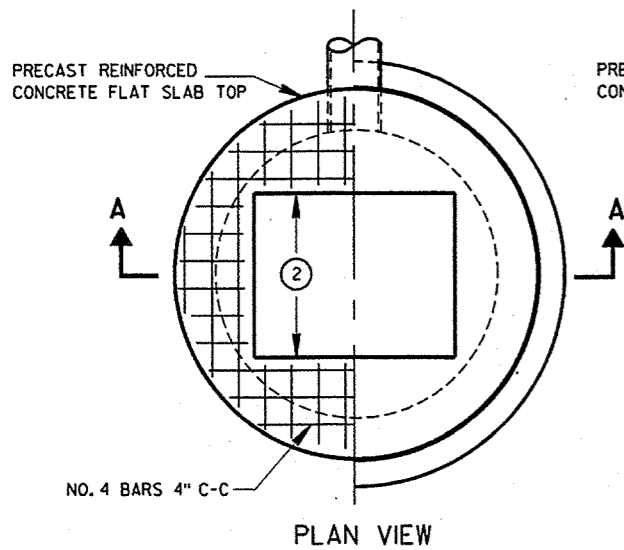


PLAN VIEW

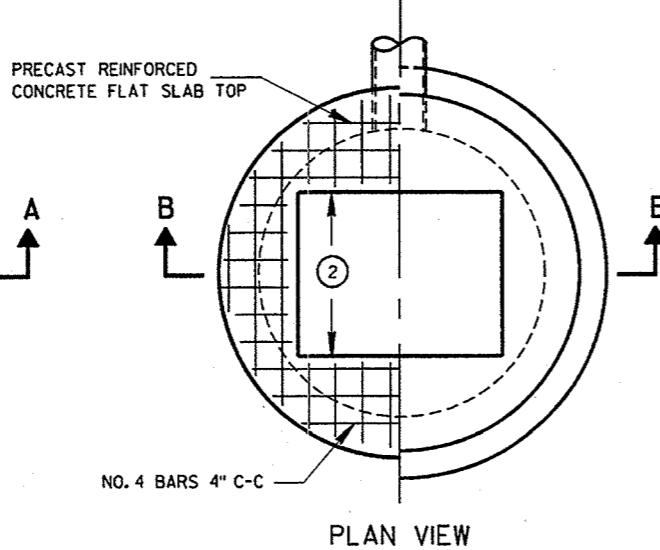


PLAN VIEW

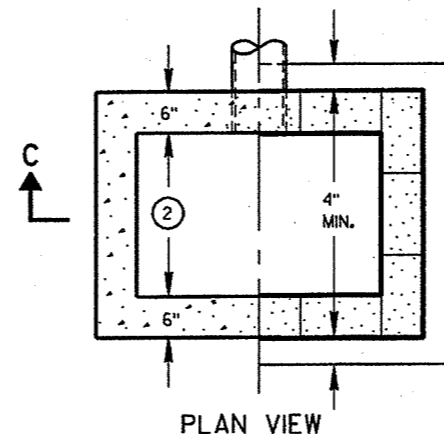

PLAN VIEW

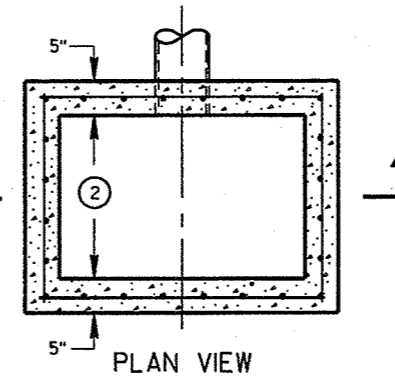


PLAN VIEW

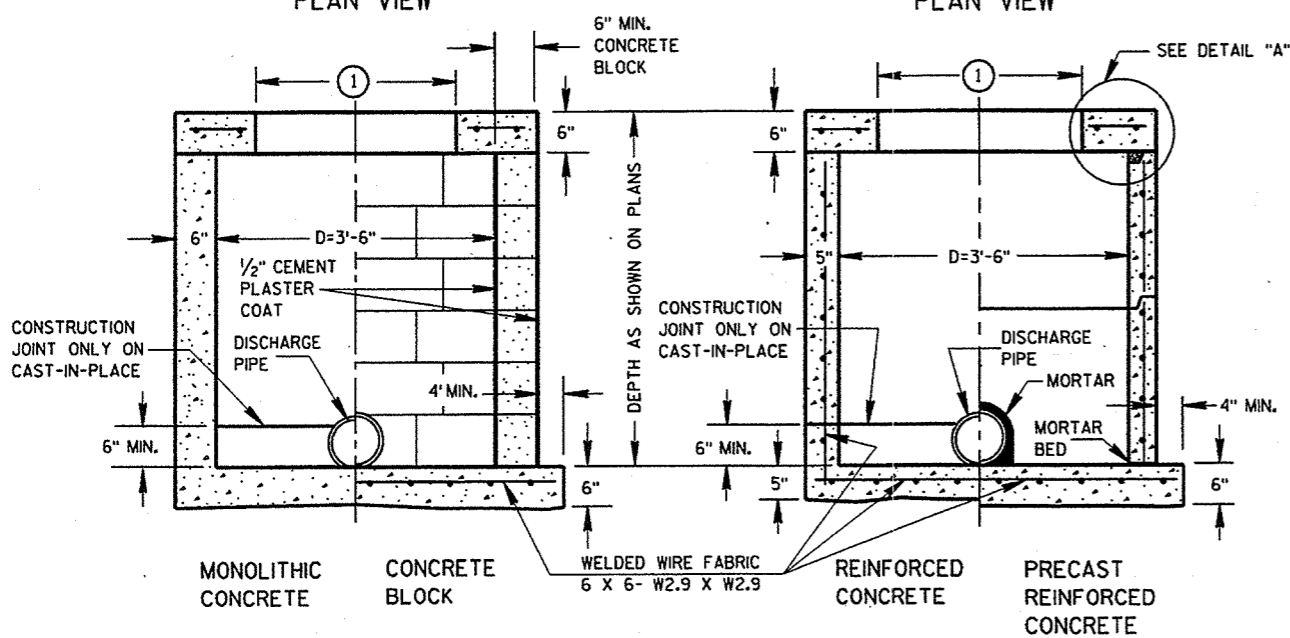

SECTION A-A

SECTION B-B

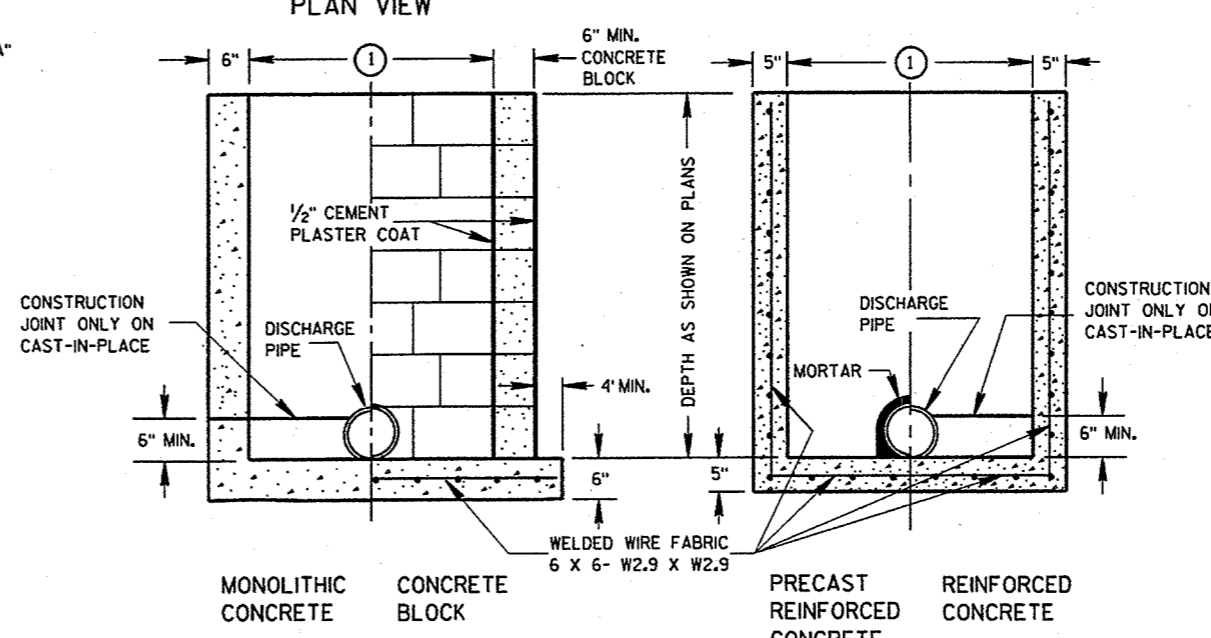

MONOLITHIC CONCRETE CONCRETE BLOCK PRECAST REINFORCED CONCRETE REINFORCED CONCRETE

SECTION C-C

SECTION D-D

INLETS TYPE 2, 3 & 4

INLETS TYPE 1, 2, 3 & 4

STATE OF WISCONSIN
DEPARTMENT OF TRANSPORTATION

APPROVED
DATE 8/26/84
Roy L. Hineman
CHIEF ROADWAY DEVELOPMENT ENGINEER

S.D.D. 8 C 1-5

S.D.D. 8 C 1-5

GENERAL NOTES


DETAILS OF CONSTRUCTION, MATERIALS AND WORKMANSHIP NOT SHOWN ON THIS DRAWING SHALL CONFORM TO THE PERTINENT REQUIREMENTS OF THE STANDARD SPECIFICATIONS AND THE APPLICABLE SPECIAL PROVISIONS.

DETAILED DRAWINGS FOR PROPOSED ALTERNATE DESIGNS FOR INLETS WHICH MAY INCLUDE PRECAST REINFORCED CONCRETE INLETS, SHALL BE SUBMITTED TO THE ENGINEER FOR APPROVAL PROVIDING THAT SUCH ALTERNATE DESIGNS MAKE PROVISION FOR EQUIVALENT CAPACITY AND STRENGTH.


PRECAST REINFORCED CONCRETE INLET UNITS, IF USED, SHALL CONFORM TO THE REQUIREMENTS OF THE CATCH BASINS, MANHOLES AND INLETS SECTION OF THE STANDARD SPECIFICATIONS. UNLESS OTHERWISE AUTHORIZED IN WRITING BY THE ENGINEER, THE CONTRACTOR SHALL NOT ORDER AND DELIVER PRECAST INLET UNITS REQUIRED FOR THE PROJECT UNTIL A CORRECTED LIST OF SIZES IS FURNISHED BY THE ENGINEER.

ALL INLETS ARE DESIGNATED ON THE PLANS AS "INLETS, 8-MS", ETC. THIS DESIGNATION IS INTERPRETED TO MEAN THAT THE NUMBER, OR FIRST DIGIT DESIGNATES THE MASONRY PORTION OF THE STRUCTURE AND THE FOLLOWING LETTER DESIGNATES THE TYPE OF COVER OR IRON CASTING TO BE USED THEREWITH TO COMPRISE THE COMPLETE UNIT.

ALL BAR STEEL REINFORCEMENT SHALL BE EMBEDDED 2 INCHES CLEAR UNLESS OTHERWISE SHOWN OR NOTED.

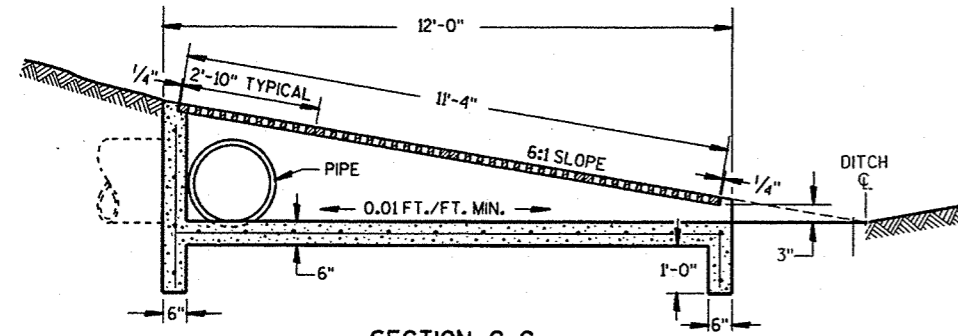


SECTION G-G

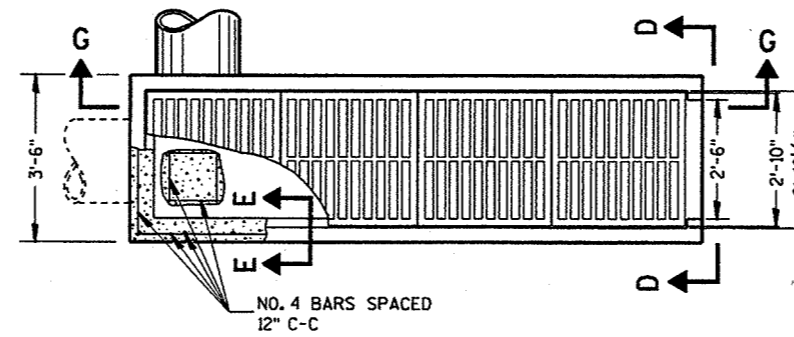


PLAN VIEW

REINFORCED CONCRETE INLET TYPE 11

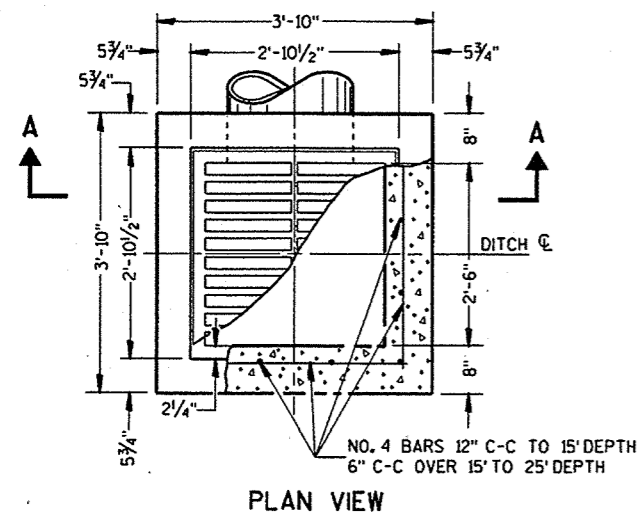


PLAN VIEW

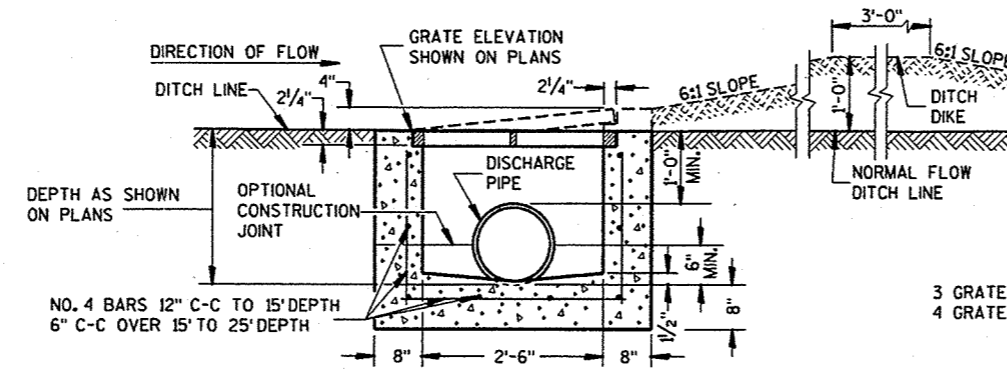


SECTION A-A


REINFORCED CONCRETE INLET TYPE 8

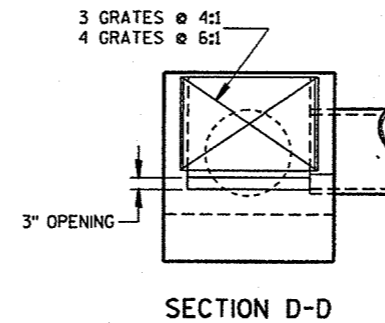

SECTION D-D

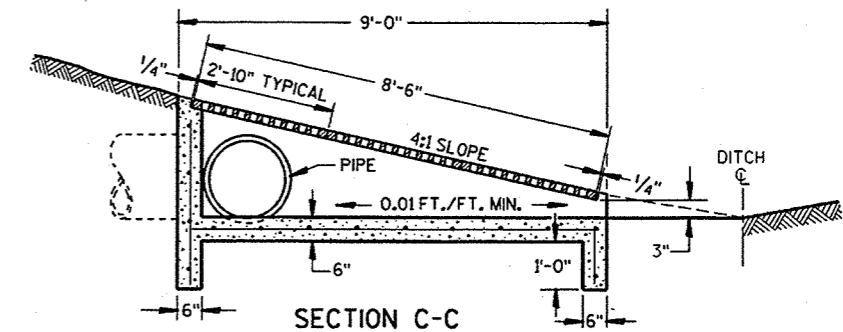


SECTION C-C

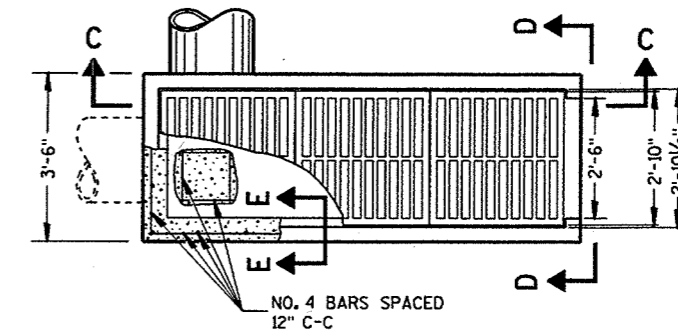


PLAN VIEW

REINFORCED CONCRETE INLET TYPE 10

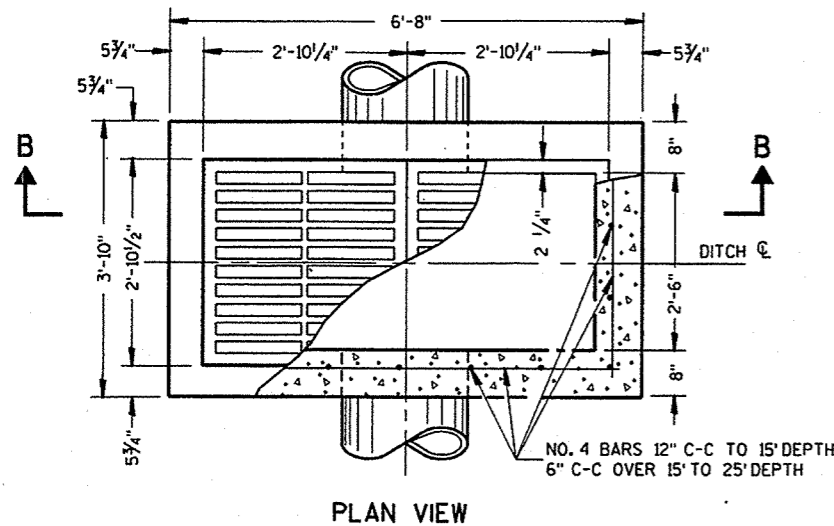


PLAN VIEW

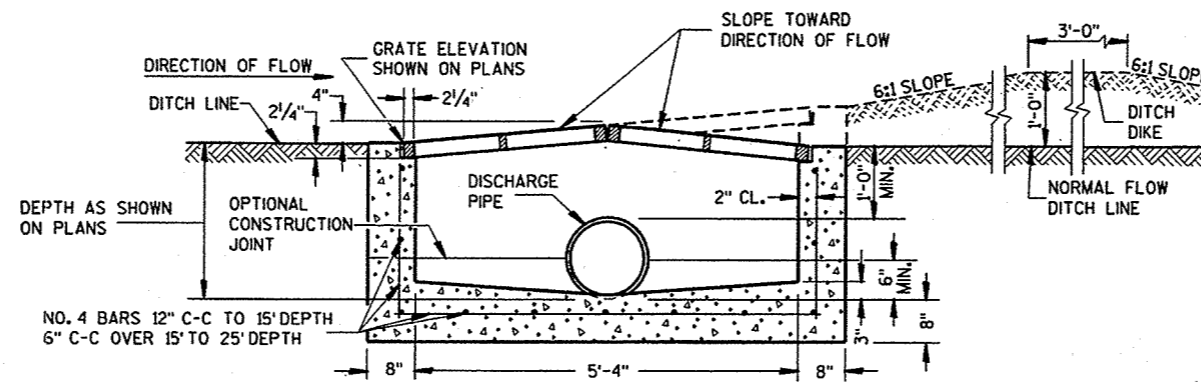

SECTION B-B

REINFORCED CONCRETE INLET TYPE 9

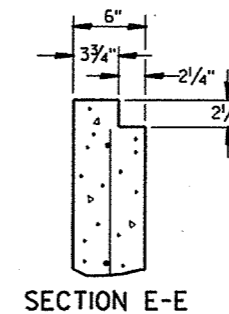


SECTION E-E

INLETS TYPE 8, 9, 10 AND 11


STATE OF WISCONSIN
DEPARTMENT OF TRANSPORTATION

APPROVED
8/10/94
DATE
R. J. [Signature]
CHIEF ROADWAY DEVELOPMENT ENGINEER


FHWA

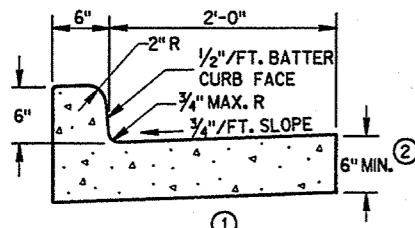


TYPES A & D

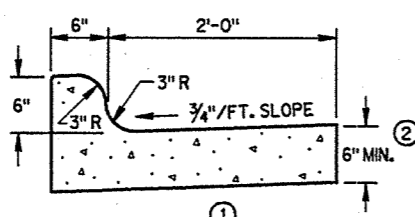


TYPES K & L

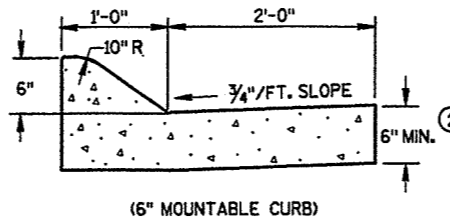


(6" MOUNTABLE CURB)

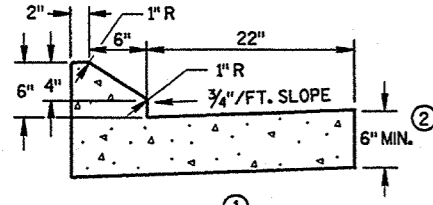

TYPES G & J

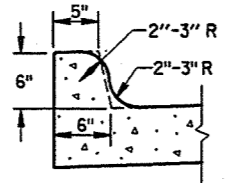


OPTIONAL CURB SHAPE FOR TYPES K & L

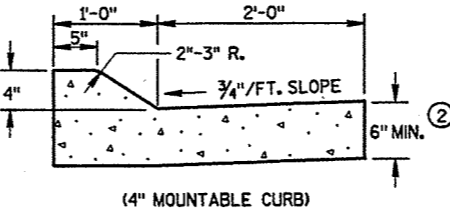


(4" MOUNTABLE CURB)

TYPES A & D
CONCRETE CURB & GUTTER 36"


CONCRETE CURB & GUTTER 30"

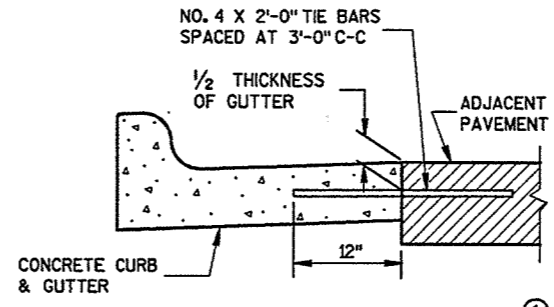


TYPICAL TIE BAR LOCATION

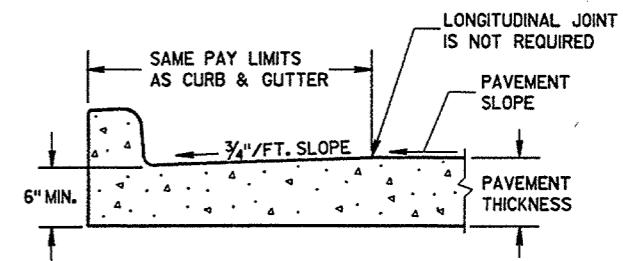

PARTIAL SECTION OF PAVEMENT WITH INTEGRAL CURB & GUTTER

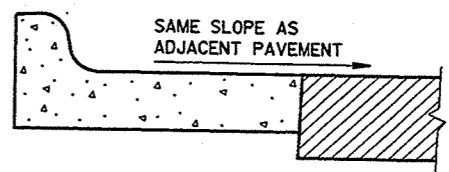

REVERSE SLOPE GUTTER (TYPICAL FOR ALL CURB & GUTTER TYPES)

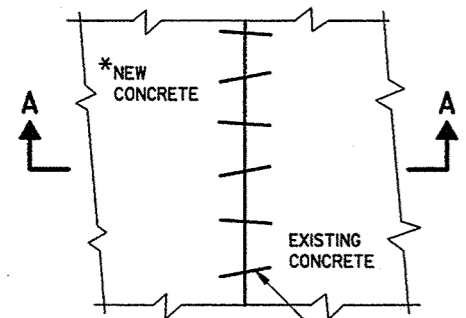


PLAN VIEW


*NEW CURB & GUTTER, SURFACE DRAINS, CONCRETE PAVEMENT OR OTHER NEW CONCRETE.

NO. 6 X 12" DEF. BARS SPACED 3'-0" C-C, INSTALLED ON 6:1 SKEW HORIZONTALLY. DIRECTION OF SKEW ALTERNATING AFTER EVERY ONE OR TWO BARS.


THE HOLE FOR THE BAR SHALL BE DRILLED TO A DEPTH OF 7" AND TO SUCH A DIAMETER AS TO PROVIDE A TIGHT DRIVEN FIT

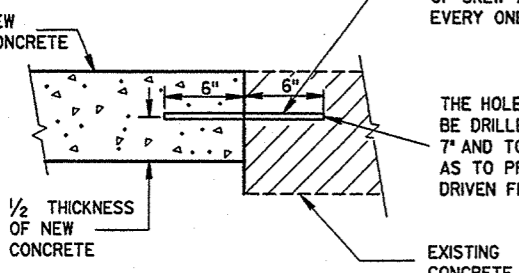


SECTION A-A PAVEMENT TIES

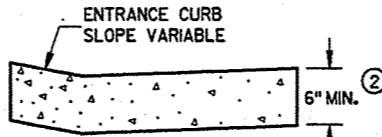

DRIVEWAY ENTRANCE CURB (WHEN DIRECTED BY THE ENGINEER)

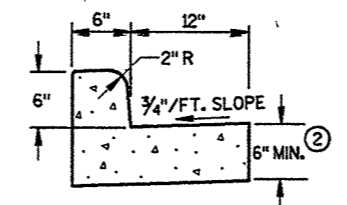


TYPES A & D
CONCRETE CURB & GUTTER 18"

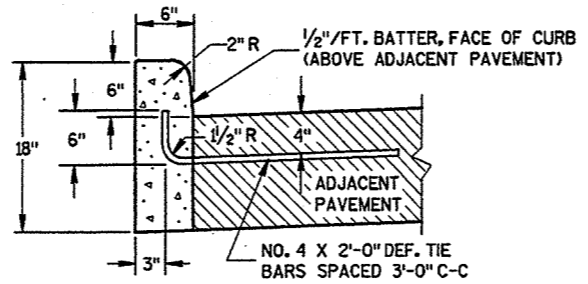

TYPES A & D

CONCRETE CURB

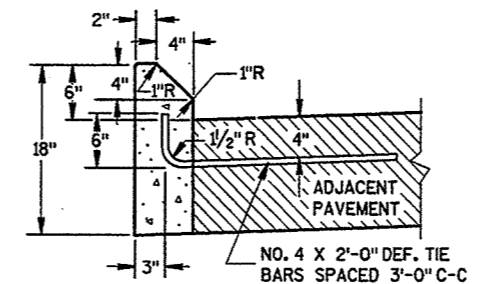

TYPES G & J

GENERAL NOTES

DETAILS OF CONSTRUCTION, MATERIALS AND WORKMANSHIP NOT SHOWN ON THIS DRAWING SHALL CONFORM TO THE PERTINENT REQUIREMENTS OF THE CONTRACT.

PAVEMENT TIES AND TIE BARS SHALL BE EPOXY COATED IN CONFORMANCE WITH SUBSECTION 505.2.6.2 OF THE STANDARD SPECIFICATIONS.

INTEGRAL CURB & GUTTER SHALL CONFORM TO THE DETAILS SHOWN FOR CONCRETE CURB & GUTTER INCLUDING THE TRANSVERSE GUTTER SLOPE. A LONGITUDINAL CONSTRUCTION JOINT IS NOT REQUIRED WITH INTEGRAL CURB AND GUTTER.


WHERE THE TRANSVERSE JOINTS IN THE PAVEMENT ARE REQUIRED TO BE SEALED, THE JOINTS IN THE INTEGRAL CURB AND GUTTER SHALL BE SEALED TO THE FACE OF CURB WITH THE SAME TYPE OF SEALANT. THE COST OF FURNISHING AND INSTALLING THIS SEALANT SHALL BE INCIDENTAL TO THE ITEM CONCRETE CURB AND GUTTER.


UNLESS OTHERWISE SHOWN ON THE TYPICAL CROSS SECTIONS, THE BASE COURSE AND UNCLASSIFIED EXCAVATION LIMITS ARE 2'-0" BEHIND THE BACK OF CURBS.

- ① TIE BARS ARE REQUIRED FOR CURB AND GUTTER TYPES A, G AND K.
- ② THE BOTTOM OF CURB AND GUTTER MAY BE CONSTRUCTED EITHER LEVEL OR PARALLEL TO THE SLOPE OF THE SUBGRADE OR BASE COURSE PROVIDED A 6" MINIMUM GUTTER THICKNESS IS MAINTAINED.
- ③ WHEN REVERSE SLOPE GUTTER IS REQUIRED, THE LOCATION(S) WILL BE SHOWN ELSEWHERE IN THE PLAN.

CONCRETE CURB, CONCRETE CURB & GUTTER AND PAVEMENT TIES

STATE OF WISCONSIN DEPARTMENT OF TRANSPORTATION

APPROVED 04/16/99 DATE

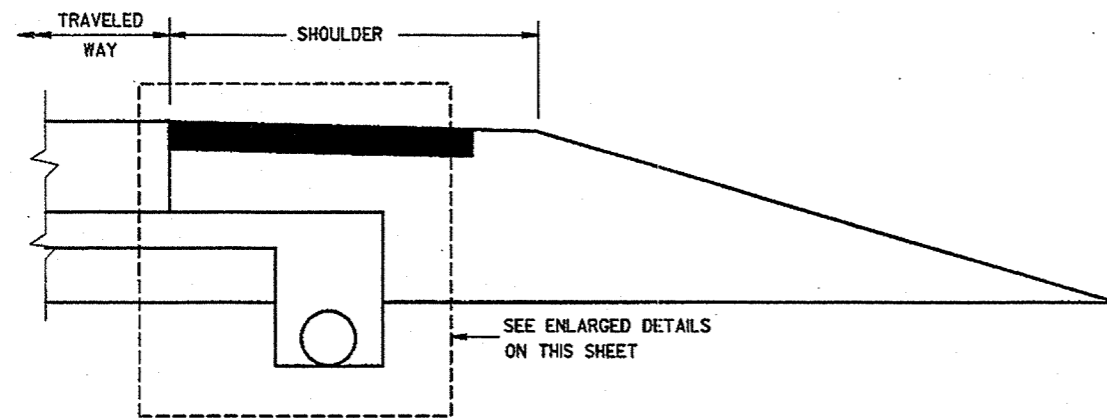 CHIEF ROADWAY DEVELOPMENT ENGINEER
 FHWA




RURAL CROSS SECTION

NOTES


THE DIMENSIONS SHOWN ON THE TYPICAL CROSS SECTIONS WILL GOVERN IN THE EVENT THERE IS A CONFLICT WITH THE DETAILS SHOWN ON THIS DRAWING.

PIPE UNDERDRAIN SHALL BE LAID PARALLEL TO THE GRADE OF THE ROADWAY.


- ① THE GRADATION OF THE OPEN GRADED BASE COURSE SHALL BE EITHER NO. 1 OR NO. 2 AS SPECIFIED ELSEWHERE IN THE CONTRACT.
- ② TRENCH BACKFILL WILL BE PAID FOR AS CRUSHED AGGREGATE BASE COURSE, OPEN GRADED NO. 1 OR NO. 2 AS SPECIFIED.
- ③ FOLD OVER EXCESS GEOTEXTILE FABRIC AT THIS LOCATION.
- ④ TOTAL FABRIC WIDTH IS 6'-3" FOR PAYMENT.

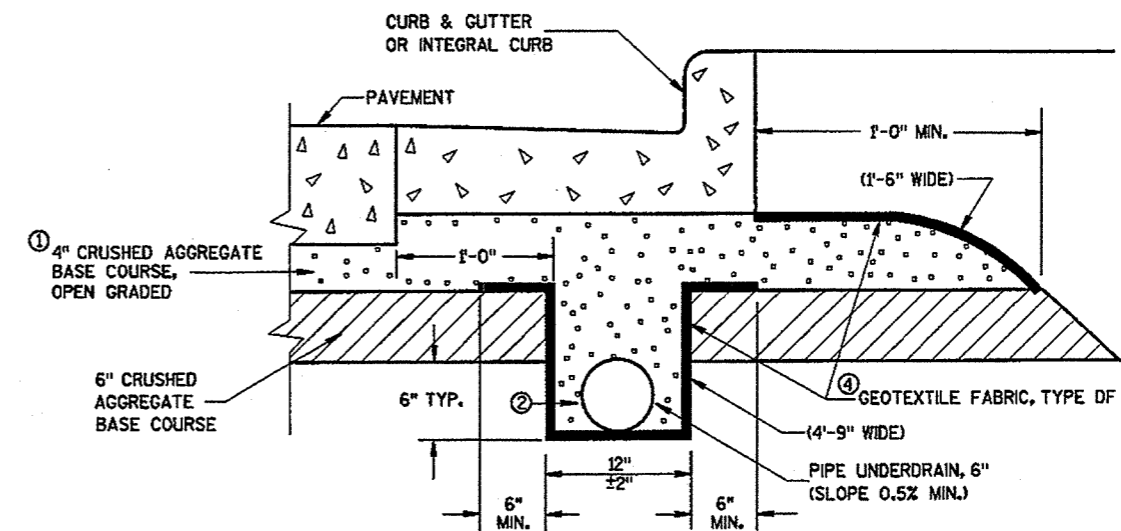

EDGEDRAIN IN URBAN ROADWAY

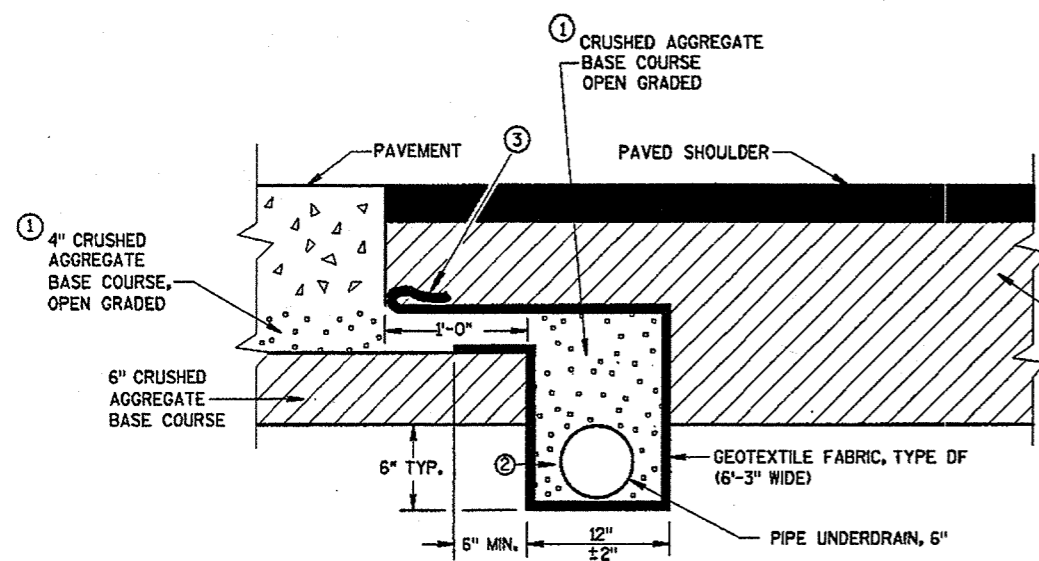

POST PAVING INSTALLATION
(QUANTITIES ARE BASED ON THIS DETAIL)

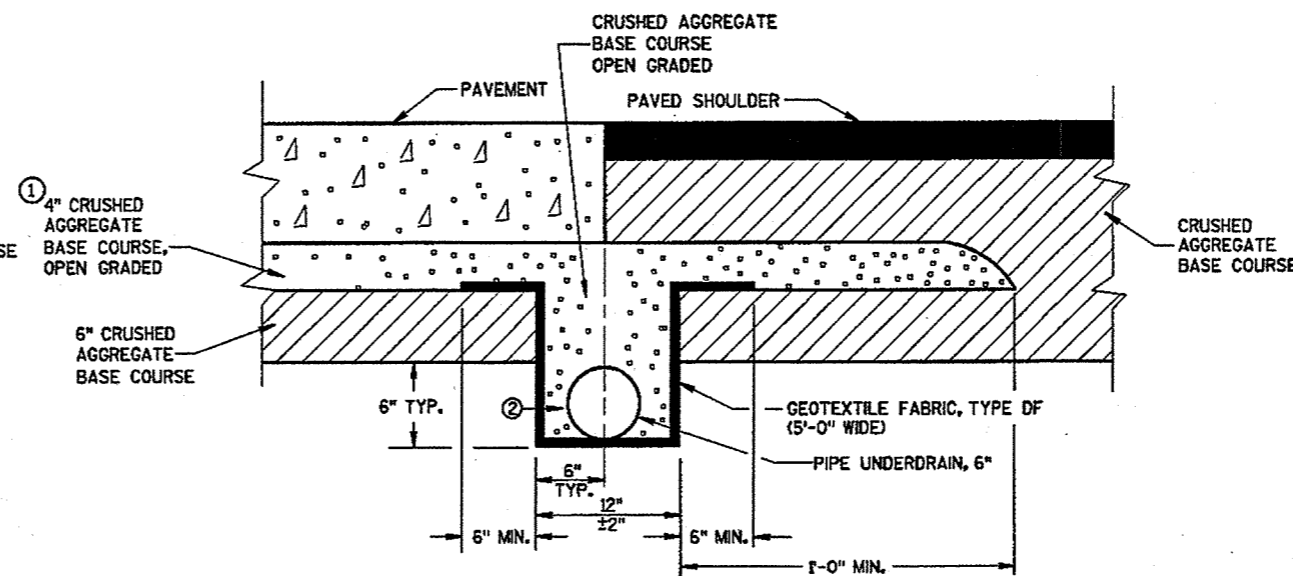

PRE-PAVING INSTALLATION ALTERNATE


EDGEDRAIN IN RURAL ROADWAY

EDGEDRAIN AND CRUSHED AGGREGATE BASE COURSE, OPEN GRADED, NO. 1 OR NO. 2	
STATE OF WISCONSIN DEPARTMENT OF TRANSPORTATION	
APPROVED 01/13/99 DATE	 CHIEF ROADWAY DEVELOPMENT ENGINEER
FHWA	


S.D.D. 8 D 15-3b

S.D.D. 8 D 15-3b

NOTE: ATTACH GEOTEXTILE FABRIC, TYPE FF TO THE TOP OF STAKES AND CROSS BRACINGS.

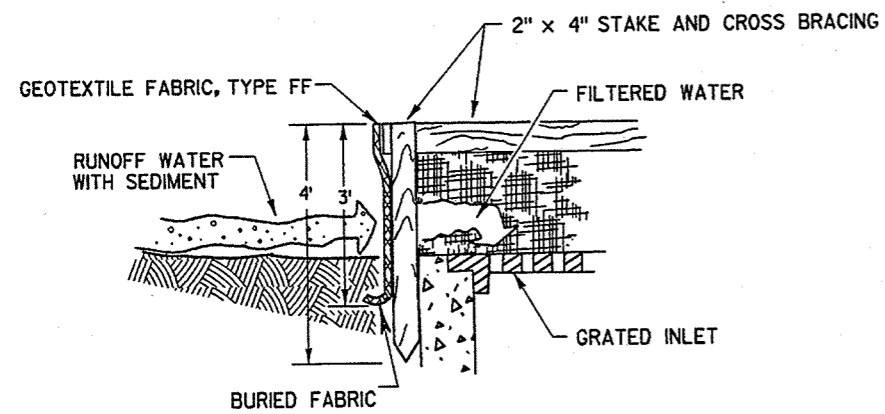


INLET PROTECTION, TYPE A

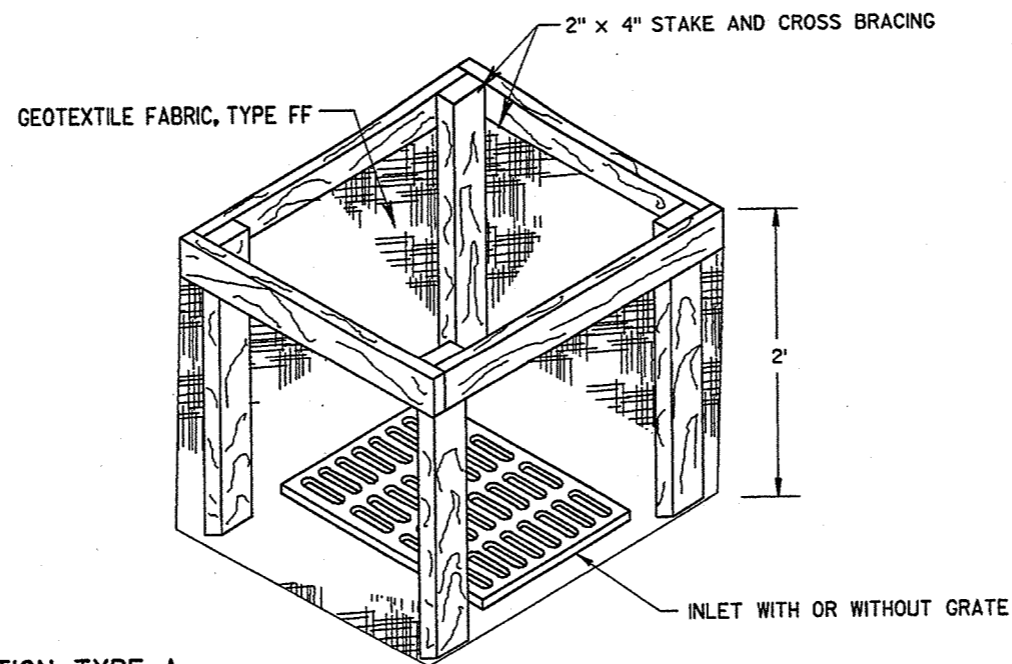


GENERAL NOTES:

FABRIC SHALL BE REPLACED AT THE ENGINEERS DISCRETION. THE WOOD SHALL NOT BLOCK THE ENTIRE HEIGHT OF THE CURB BOX. MANUFACTURED ALTERNATIVES APPROVED AND LISTED ON THE DEPARTMENT'S EROSION CONTROL PRODUCT ACCEPTABILITY LIST MAY BE SUBSTITUTED. WHEN REMOVING OR MAINTAINING INLET PROTECTION, CARE SHALL BE TAKEN SO THAT THE SEDIMENT TRAPPED ON THE GEOTEXTILE FABRIC DOES NOT FALL INTO THE INLET. ANY MATERIAL FALLING INTO THE INLET SHALL BE REMOVED IMMEDIATELY.

- ① FABRIC SIZE SHALL BE 8" (MIN) GREATER ON ALL SIDES OF THE INLET COVER TO PROVIDE A HAND HOLD WHEN MAINTENANCE OR REMOVAL IS REQUIRED.
- ② FOR INLET PROTECTION, TYPE C, WITH A CURB BOX, AN ADDITIONAL 18" OF FABRIC IS WRAPPED AROUND THE WOOD AND SECURED WITH STAPLES.



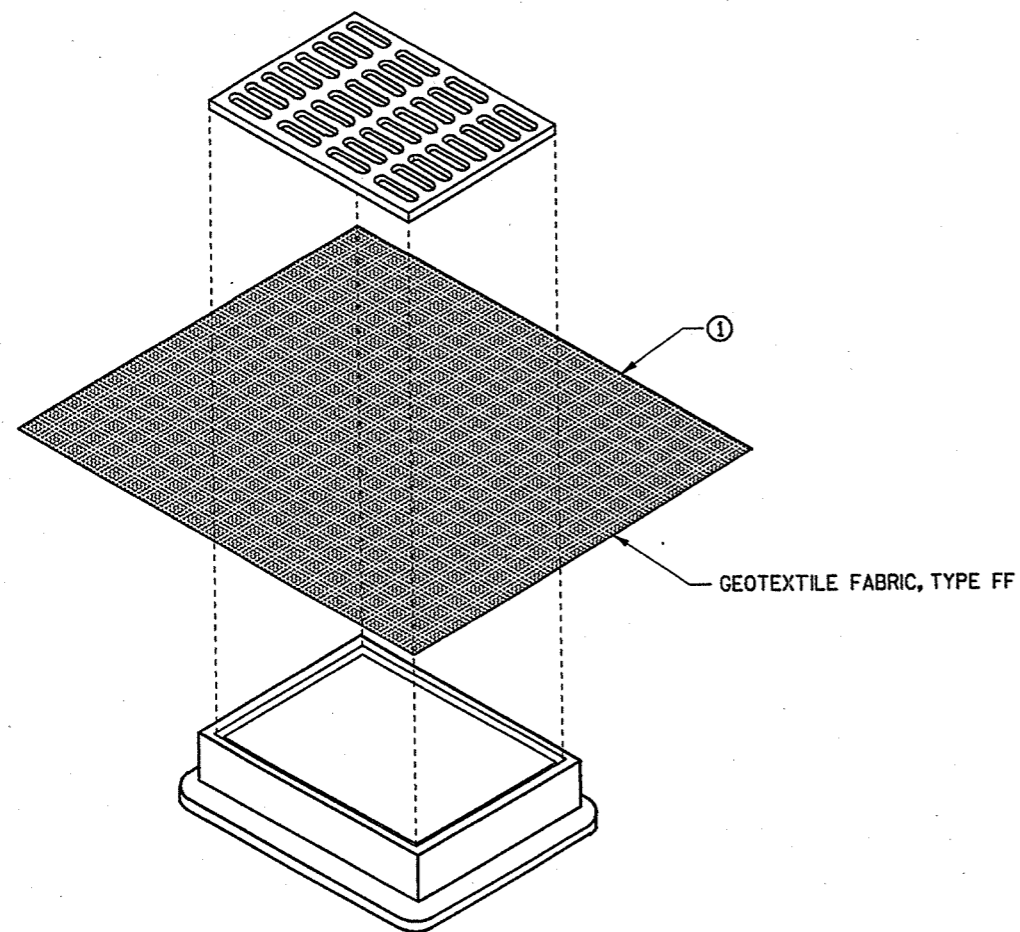


INLET PROTECTION, TYPE B (WITHOUT CURB BOX)
(CAN BE INSTALLED ON ANY INLET TYPE)

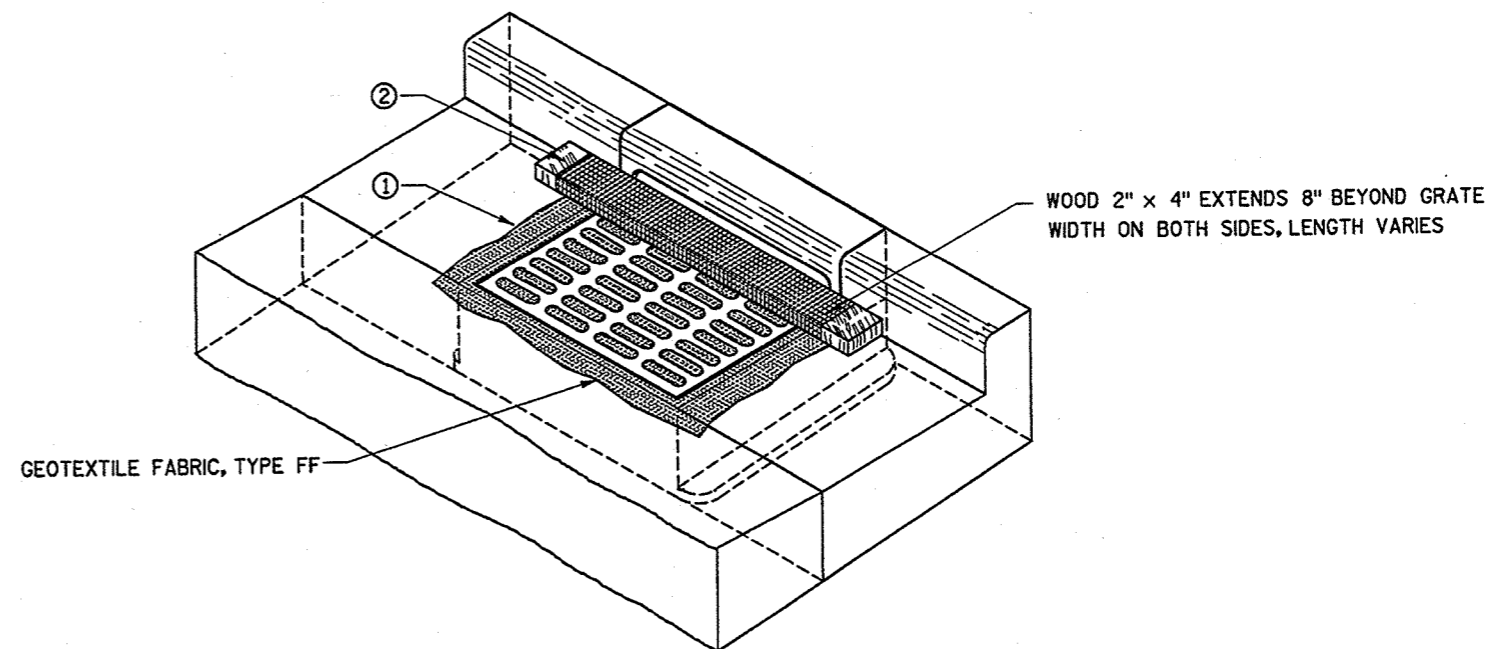


INLET PROTECTION, TYPE C (WITH CURB BOX)

INLET PROTECTION TYPE A, B AND C	
STATE OF WISCONSIN DEPARTMENT OF TRANSPORTATION	
APPROVED 03/06/00 DATE	<i>[Signature]</i> CHIEF ROADWAY DEVELOPMENT ENGINEER
FHWA	

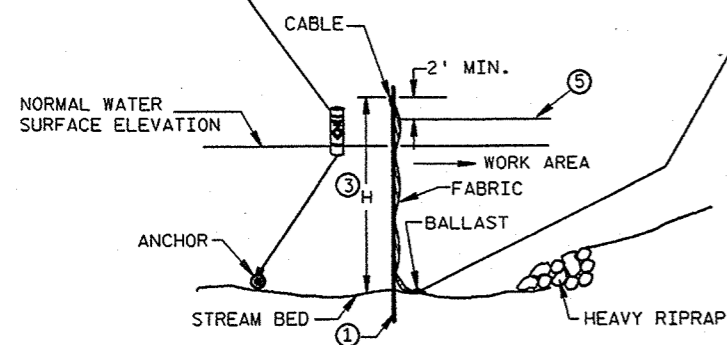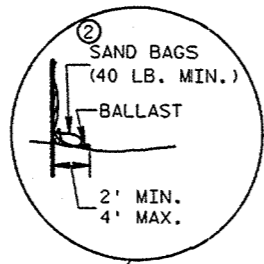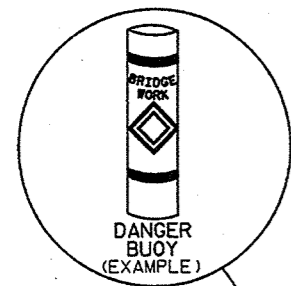

SECTION A-A

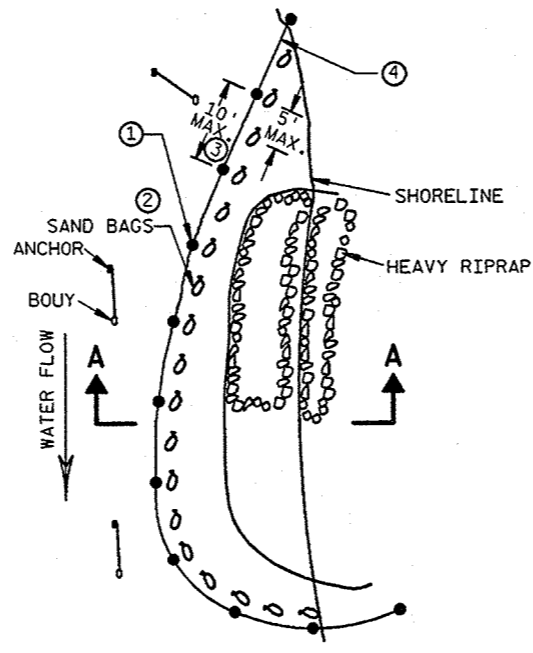

PLAN VIEW


GENERAL NOTES

DETAILS OF CONSTRUCTION, MATERIALS AND WORKMANSHIP NOT SHOWN ON THIS DRAWING SHALL CONFORM TO THE PERTINENT REQUIREMENTS OF THE STANDARD SPECIFICATIONS AND THE APPLICABLE SPECIAL PROVISIONS.


- ① DRIVEN STEEL POSTS, PIPES, OR CHANNELS. LENGTH SHALL BE SUFFICIENT TO SECURELY SUPPORT BARRIER AT HIGH WATER ELEVATIONS.
- ② SANDBAGS TO BE USED AS ADDITIONAL BALLAST WHEN ORDERED BY THE ENGINEER TO MEET ADVERSE FIELD CONDITIONS.
- ③ WHEN BARRIER HEIGHT, H, EXCEEDS 8 FT., POST SPACING MAY NEED TO BE DECREASED.
- ④ IN WATERWAYS SUBJECT TO FLUCTUATING WATER ELEVATIONS, PROVISIONS SHOULD BE MADE TO ALLOW THE WATER TO EQUALIZE ON EACH SIDE OF THE BARRIER. THIS MAY BE ACCOMPLISHED BY LEAVING A PORTION OF THE BARRIER OPEN ON THE UPSTREAM END.
- ⑤ ESTIMATED HIGH WATER ELEVATION DURING CONSTRUCTION PERIOD.

TURBIDITY BARRIER MAY BE REMOVED AT THE ENGINEERS DISCRETION, WHEN PERMANENT EROSION CONTROL MEASURES HAVE BEEN ESTABLISHED.


TURBIDITY BARRIER PLACEMENT DETAIL

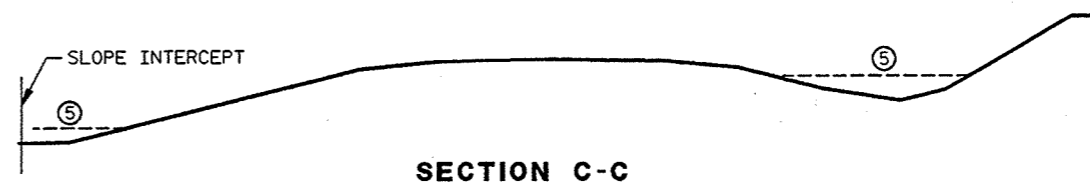

SECTION C-C

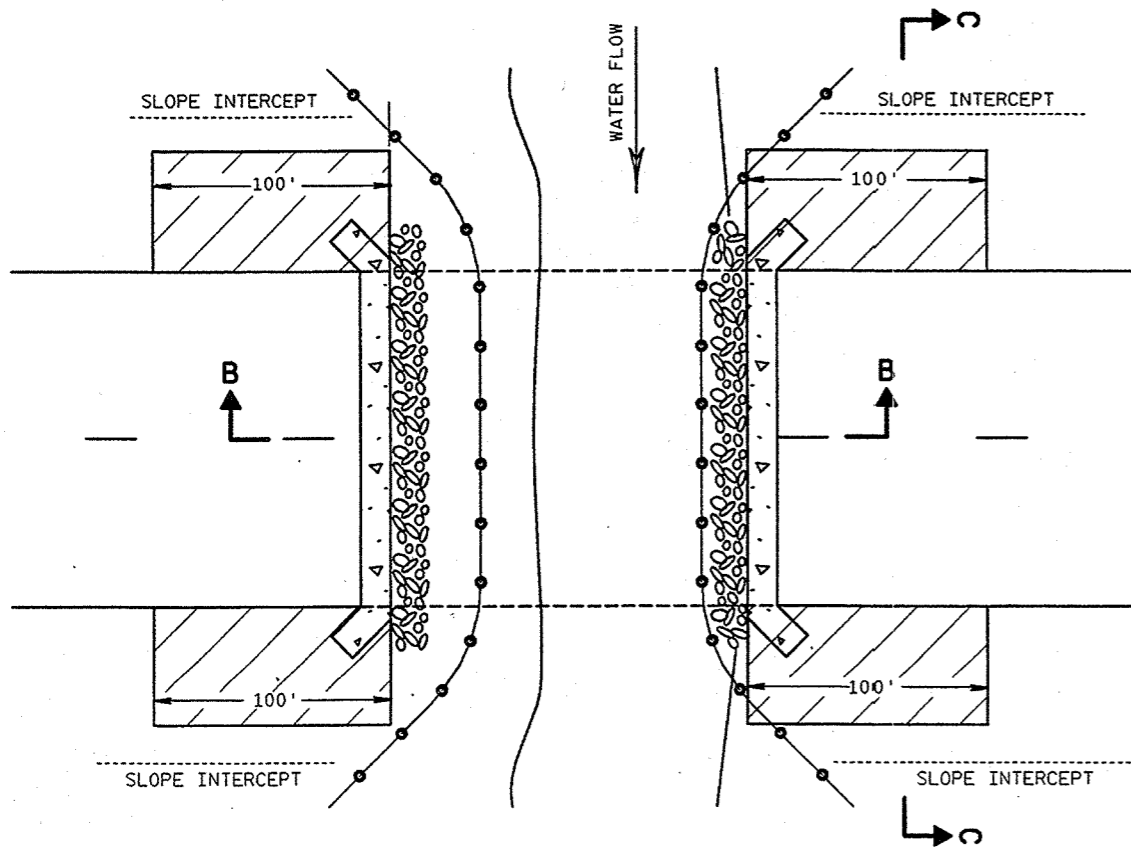


PLAN VIEW
TURBIDITY BARRIER DETAIL SHOWING EROSION CONTROL PLACEMENT

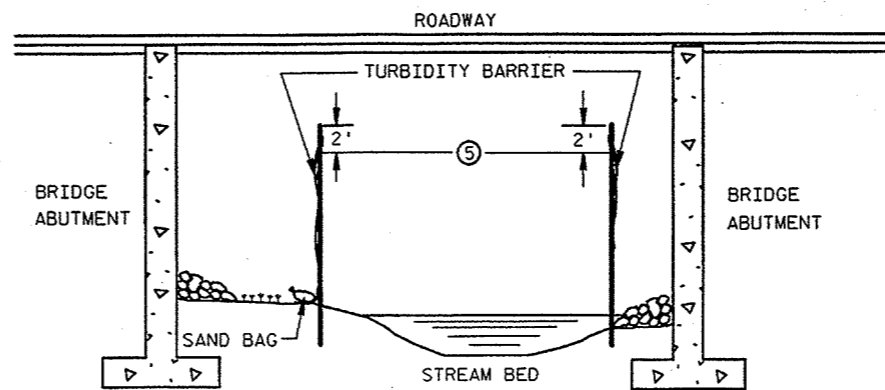


SECTION B-B

TURBIDITY BARRIER	
STATE OF WISCONSIN DEPARTMENT OF TRANSPORTATION	
APPROVED 03/06/00 DATE	 CHIEF ROADWAY DEVELOPMENT ENGINEER
FHWA	

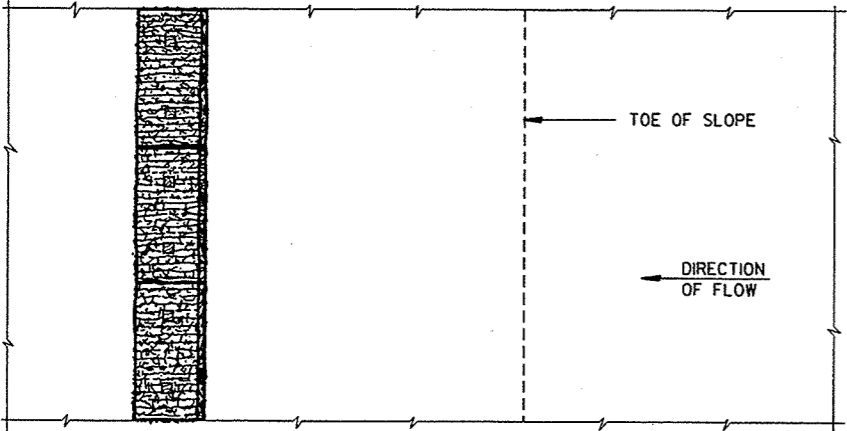


PLAN VIEW

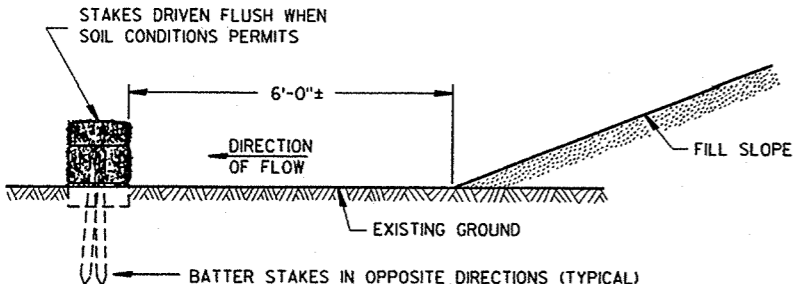


FRONT ELEVATION

WHEN EXISTING GROUND SLOPES AWAY FROM FILL SLOPE


EROSION BALES FOR SHEET FLOW

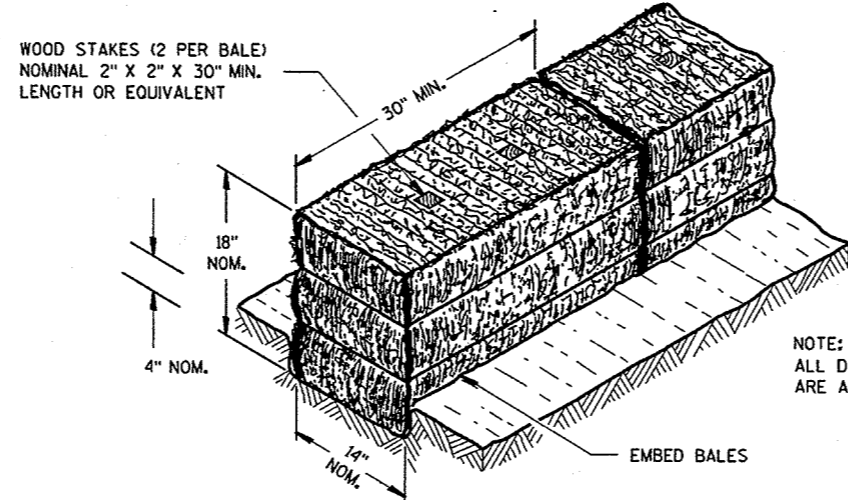

NOTE:
ALL DIMENSIONS
ARE APPROXIMATE

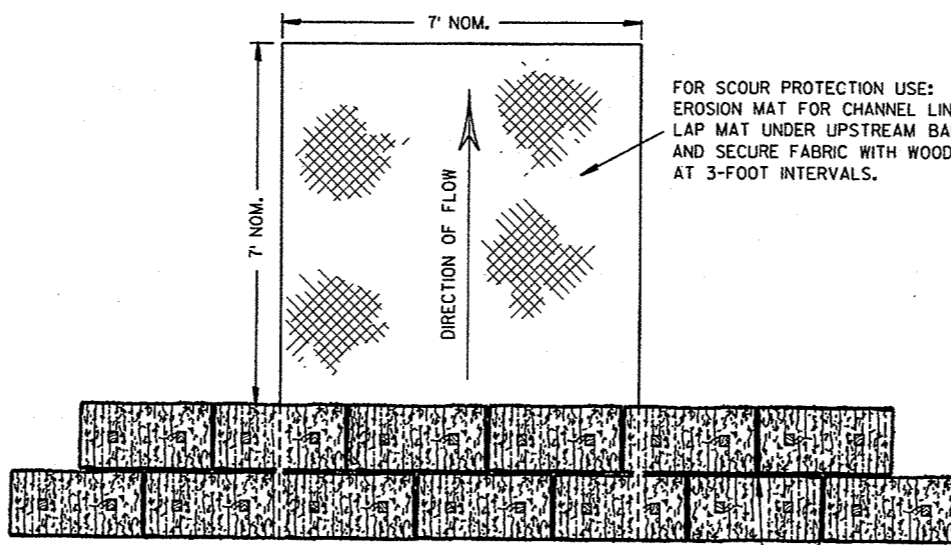

PLAN VIEW

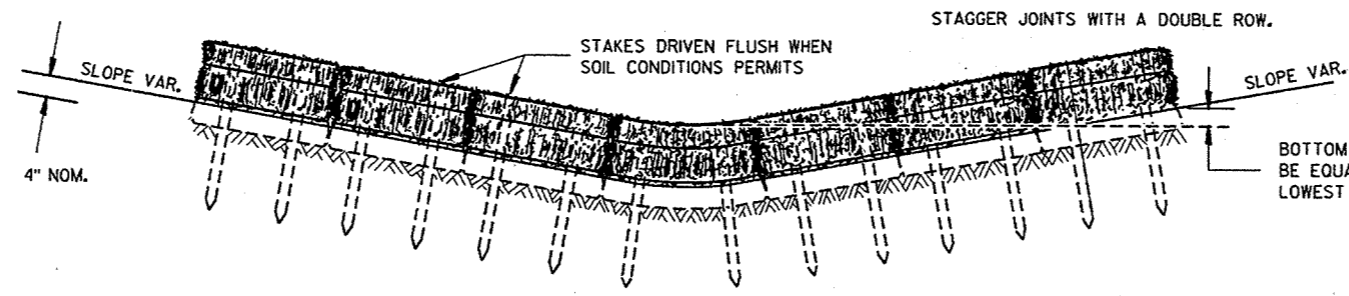


FRONT ELEVATION

EROSION BALES FOR CHANNEL FLOW

GENERAL NOTES

DETAILS OF CONSTRUCTION, MATERIALS AND WORKMANSHIP NOT SHOWN ON THIS DRAWING SHALL CONFORM TO THE PERTINENT REQUIREMENTS OF THE STANDARD SPECIFICATIONS AND THE APPLICABLE SPECIAL PROVISIONS.

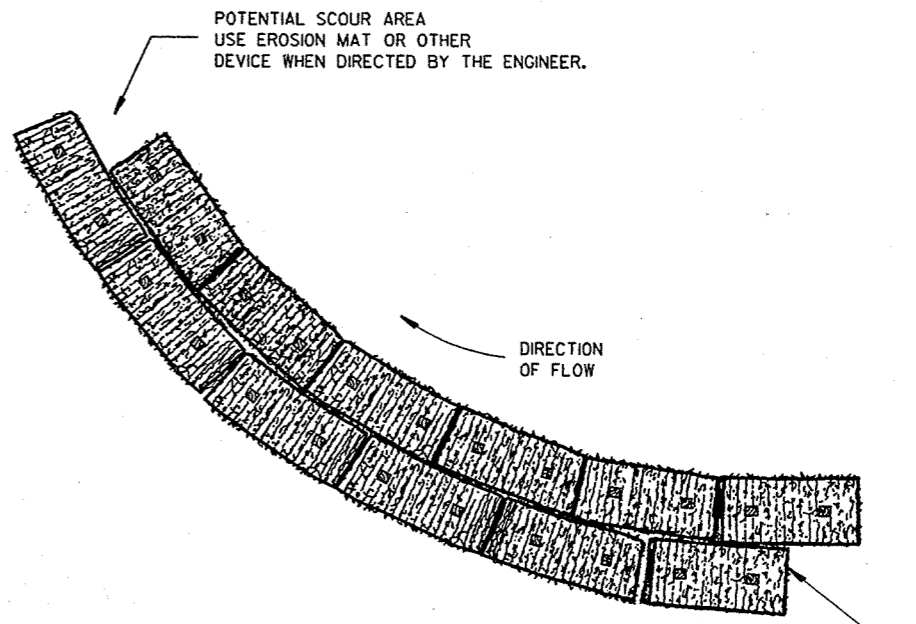

PLAN VIEW

EROSION BALES WHEN ALTERING THE DIRECTION OF FLOW

END TREATMENT ON SLOPES TO BE SIMILAR TO CHANNEL FLOW DETAIL.


TYPICAL INSTALLATIONS OF EROSION BALES

STATE OF WISCONSIN
DEPARTMENT OF TRANSPORTATION


APPROVED
DATE *1/29/04*
FHW
Raymond J. ...
CHIEF ROADWAY DEVELOPMENT ENGINEER

S.D.D. 8 E 8-2

S.D.D. 8 E 8-2

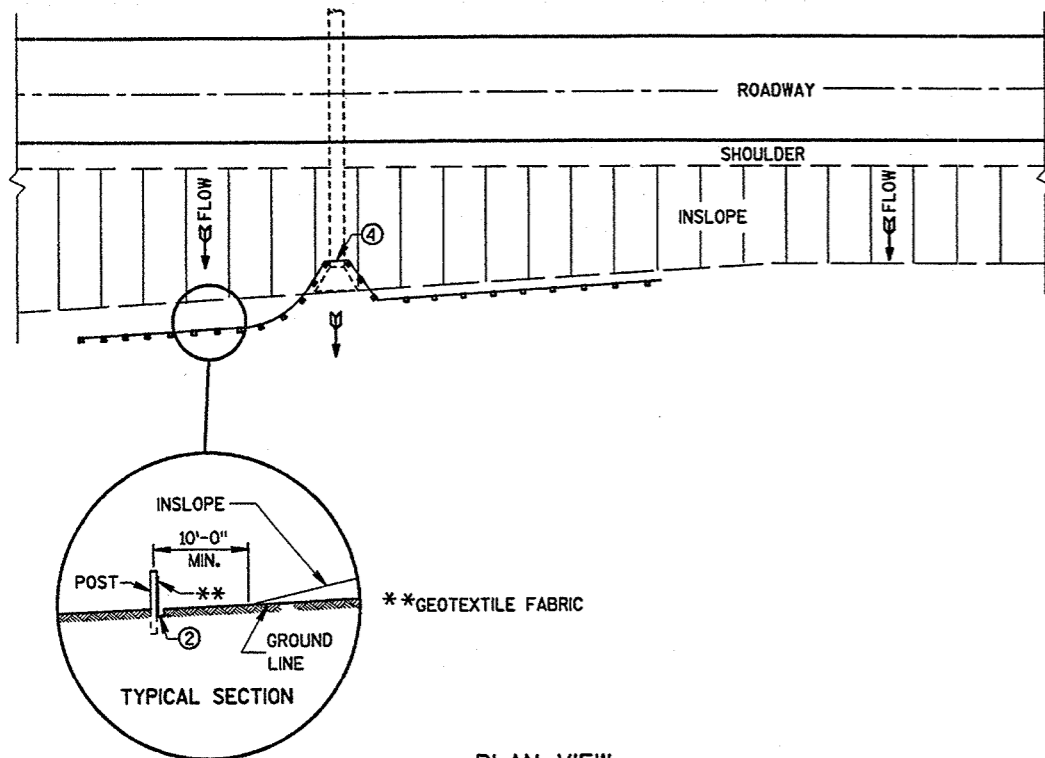


PLAN VIEW
TYPICAL APPLICATION OF SILT FENCE

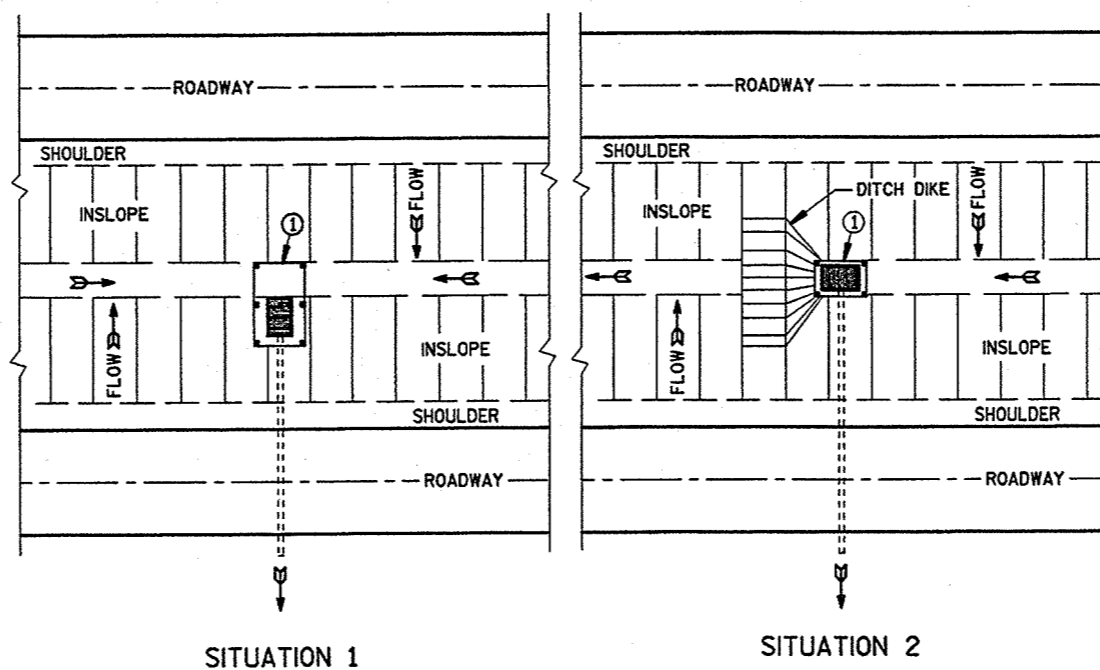

SITUATION 1 SITUATION 2
PLAN VIEW
SILT FENCE AT MEDIAN SURFACE DRAINS


GENERAL NOTES

- DETAILS OF CONSTRUCTION NOT SHOWN ON THIS DRAWING SHALL CONFORM TO THE PERTINENT REQUIREMENTS OF THE STANDARD SPECIFICATIONS AND APPLICABLE SPECIAL PROVISIONS.
- ① HORIZONTAL BRACE REQUIRED WITH 2" X 4" WOODEN FRAME OR EQUIVALENT AT TOP OF POSTS.
 - ② TRENCH SHALL BE A MINIMUM OF 4" WIDE & 6" DEEP TO BURY AND ANCHOR THE GEOTEXTILE FABRIC. FOLD MATERIAL TO FIT TRENCH AND BACKFILL & COMPACT TRENCH WITH EXCAVATED SOIL.
 - ③ WOOD POSTS SHALL BE A MINIMUM SIZE OF 1 1/8" X 1 1/8" OF OAK OR HICKORY.
 - ④ SILT FENCE TO EXTEND ACROSS THE TOP OF THE PIPE.

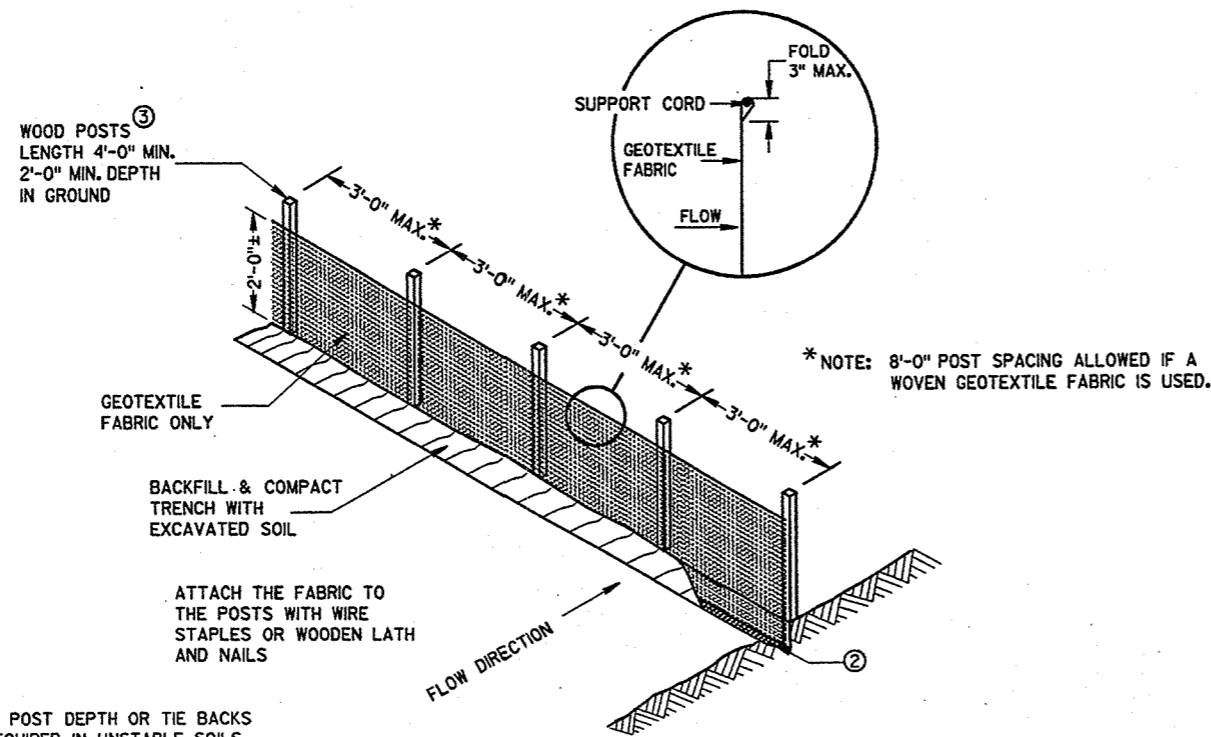


NOTE: ADDITIONAL POST DEPTH OR TIE BACKS MAY BE REQUIRED IN UNSTABLE SOILS

SILT FENCE

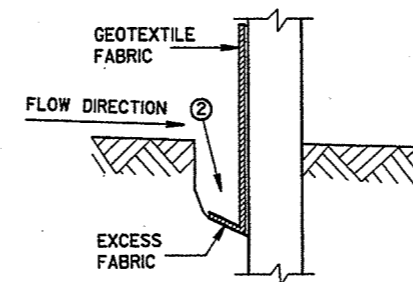


TRENCH DETAIL

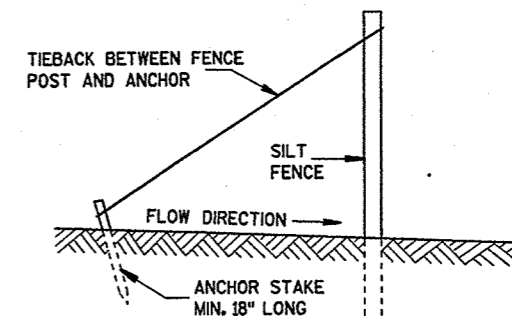

SILT FENCE TIE BACK
(WHEN REQUIRED BY THE ENGINEER)

SILT FENCE	
STATE OF WISCONSIN DEPARTMENT OF TRANSPORTATION	
APPROVED 03/06/00 DATE	<i>Roy L. [Signature]</i> CHIEF ROADWAY DEVELOPMENT ENGINEER
FHWA	

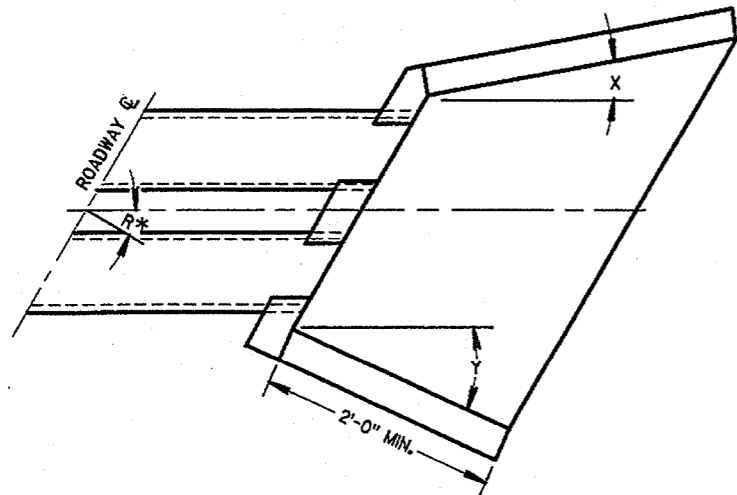

WINGWALL ANGLE DETAILS

INLET			OUTLET		
R*	X	Y	R*	X	Y
0 - 7°	30°	30°	0 - 15°	15°	15°
8 - 22°	25°	"	16 - 45°	10°	"
23 - 37°	20°	"	46 - 75°	5°	"
38 - 52°	15°	"	OVER 75°	0°	"
53 - 67°	10°	"			
68 - 82°	5°	"			
OVER 82°	0°	"			

*R = NUMBER OF DEGREES RIGHT OR LEFT HAND FORWARD

GENERAL NOTES

DETAILS OF CONSTRUCTION, MATERIALS AND WORKMANSHIP NOT SHOWN ON THIS DRAWING SHALL CONFORM TO THE PERTINENT REQUIREMENTS OF THE STANDARD SPECIFICATIONS AND THE APPLICABLE SPECIAL PROVISIONS.


FILL SLOPES FLATTER THAN 2 1/2:1 SHALL BE WARPED TO MEET THE TOP OF THE WINGWALLS.

ALL STEEL REINFORCEMENT AND WELDED STEEL WIRE FABRIC SHALL BE EMBEDDED 2 INCHES CLEAR UNLESS OTHERWISE NOTED.


① MINIMUM REINFORCEMENT SHALL BE 6" X 6" - W4.0 X W4.0 OR NO. 3 BARS SPACED 12" C-C IN BOTH DIRECTIONS.

② THE SPACE BETWEEN PIPES SHALL BE AS FOLLOWS:


DIAMETER OR SPAN	SPACE
UP TO AND INCLUDING 48"	2'-0"
OVER 48" TO 72"	1/2 DIA. OR SPAN
OVER 72"	3'-0"

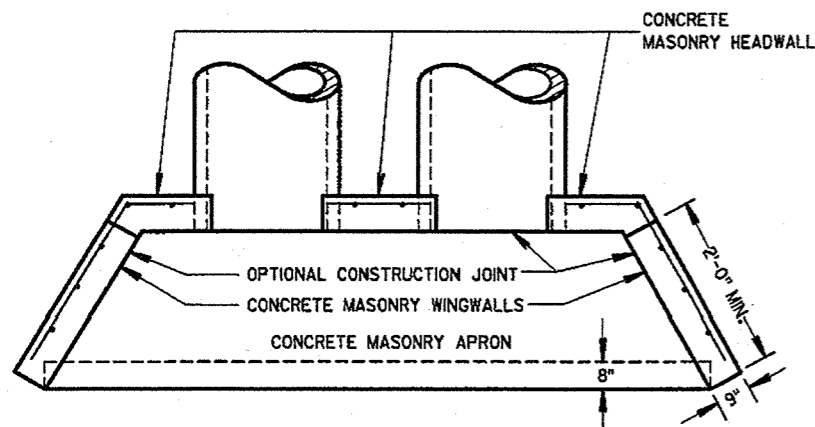


PLAN VIEW
CULVERT PIPE AND PIPE ARCH

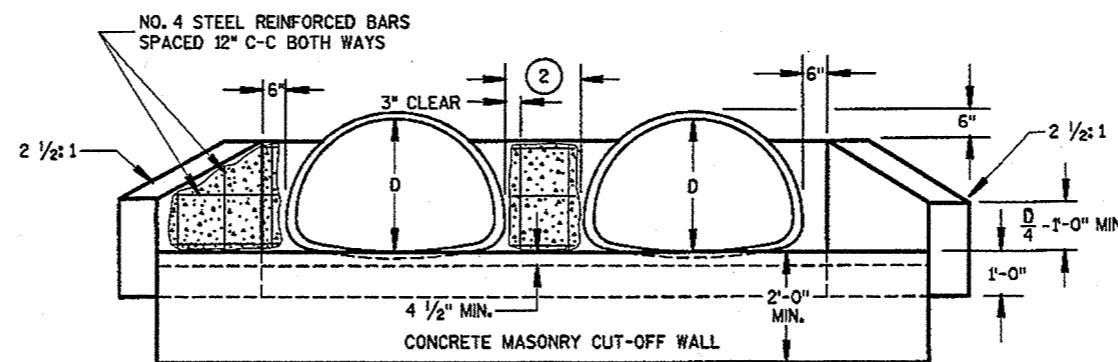

END ELEVATION
PIPE ARCH

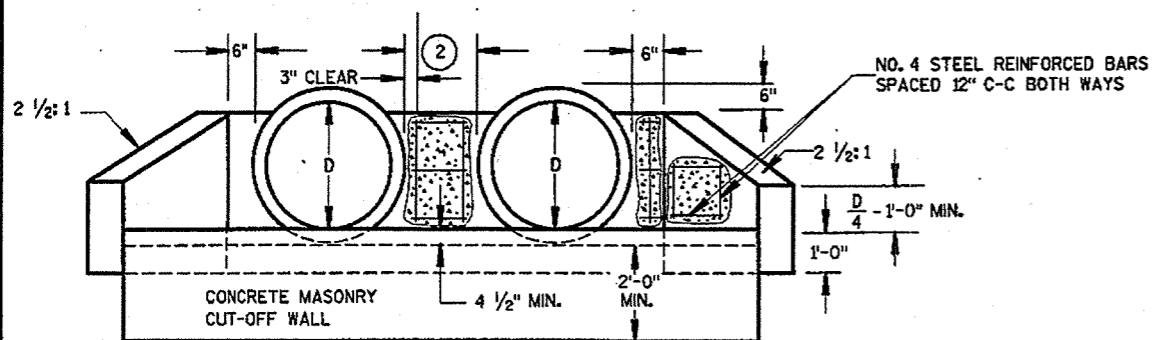

END ELEVATION
CULVERT PIPE

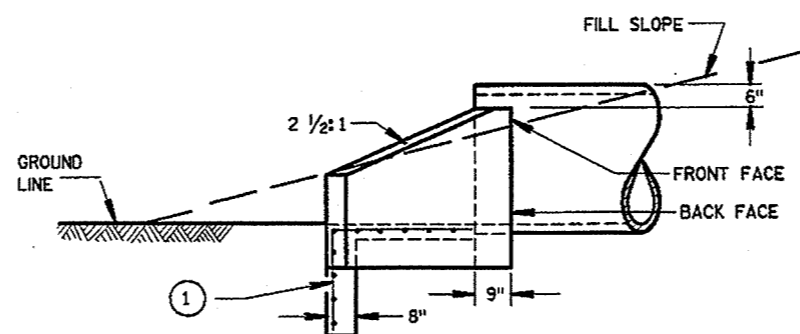

SIDE ELEVATION
CULVERT PIPE AND PIPE ARCH

CONCRETE MASONRY ENDWALLS FOR
CULVERT PIPE AND PIPE ARCH

STATE OF WISCONSIN
DEPARTMENT OF TRANSPORTATION

APPROVED
9/14/98
DATE
[Signature]
CHIEF ROADWAY DEVELOPMENT ENGINEER

FHWA

S.D.D. 8 F 10-1


S.D.D. 8 F 10-1

METAL APRON ENDWALLS											
PIPE DIA. (IN.)	MIN. THICK. (Inches)		DIMENSIONS (Inches)							APPROX. SLOPE	BODY
	STEEL	ALUM.	A (±1")	B (MAX.)	H (±1")	L (±1 1/2")	L1 (1)	L2 (1)	W (±2")		
12	.064	.060	6	6	6	21	12	17 1/2	24	2 1/2 to 1	1 Pc.
15	.064	.060	7	8	6	26	14	21 3/4	30	2 1/2 to 1	1 Pc.
18	.064	.060	8	10	6	31	15	28 1/4	36	2 1/2 to 1	1 Pc.
21	.064	.060	9	12	6	36	18	29 3/8	42	2 1/2 to 1	1 Pc.
24	.064	.075	10	13	6	41	18	37 1/4	48	2 1/2 to 1	1 Pc.
30	.079	.075	12	16	8	51	18	52 1/4	60	2 1/2 to 1	1 Pc.
36	.079	.105	14	19	9	60	24	59 3/4	72	2 1/2 to 1	2 Pc.
42	.109	.105	16	22	11	69	24	75 5/8	84	2 1/2 to 1	2 Pc.
48	.109	.105	18	27	12	78	24	81	90	2 1/4 to 1	3 Pc.
54	.109	.105	18	30	12	84	30	85 1/2	102	2 1/4 to 1	3 Pc.
60	.109x	.105x	18	33	12	87	—	—	114	2 to 1	3 Pc.
66	.109x	.105x	18	36	12	87	—	—	120	2 to 1	3 Pc.
72	.109x	.105x	18	39	12	87	—	—	126	2 to 1	3 Pc.
78	.109x	.105x	18	42	12	87	—	—	132	1 1/2 to 1	3 Pc.
84	.109x	.105x	18	45	12	87	—	—	138	1 1/2 to 1	3 Pc.
90	.109x	.105x	18	37	12	87	—	—	144	1 1/2 to 1	3 Pc.
96	.109x	.105x	18	35	12	87	—	—	150	1 1/2 to 1	3 Pc.

* EXCEPT CENTER PANEL SEE GENERAL NOTES


REINFORCED CONCRETE APRON ENDWALLS									
PIPE DIA. (IN.)	DIMENSIONS (Inches)							APPROX. SLOPE	
	T	A	B	C	D	E	G		
12	2	4	24	48 1/8	72 1/8	24	2	3 to 1	
15	2 1/4	6	27	46	73	30	2 1/4	3 to 1	
18	2 1/2	9	27	46	73	36	2 1/2	3 to 1	
21	2 3/4	9	36	37 1/2	73 1/2	42	2 3/4	3 to 1	
24	3	9 1/2	43 1/2	30	73 1/2	48	3	3 to 1	
27	3 1/4	10 1/2	49 1/2	24	73 1/2	54	3 1/4	3 to 1	
30	3 1/2	12	54	19 3/4	73 1/2	60	3 1/2	3 to 1	
36	4	15	63	34 3/4	97 3/4	72	4	3 to 1	
42	4 1/2	21	63	35	98	84	4 1/2	3 to 1	
48	5	24	72	26	98	84	5	3 to 1	
54	5 1/2	27	65	33 1/4-35	98 1/4-100	90	5 1/2	2 3/4 to 1	
60	6	30-35	60	39	99	96	5	2 to 1	
66	6 1/2	24-30	72-78	21-27	99	102	5 1/2	2 to 1	
72	7	24-36	78	21	99	108	6	2 to 1	
78	7 1/2	24-36	78	21	99	114	6 1/2	2 to 1	
84	8	36	90 1/2	21	111 1/2	120	6 1/2	1 1/2 to 1	
90	8 1/2	41	87 1/2	21	111 1/2	132	6 1/2	1 1/2 to 1	

* MINIMUM
** MAXIMUM

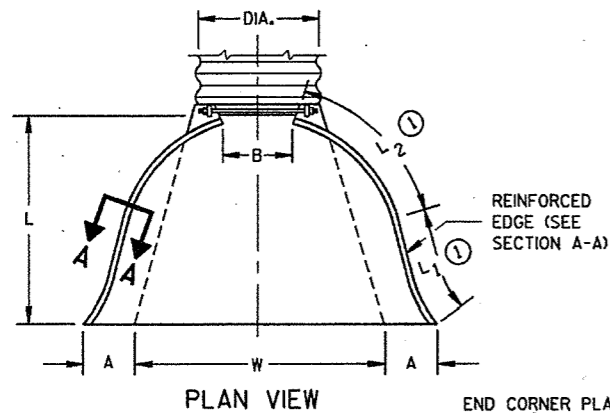


PLAN VIEW


END CORNER PLATES MAY BE FASTENED TO APRON PROPER BY BOLTS, RIVETS, OR RESISTANCE SPOT WELDS WHICH WILL HOLD THE SURFACES TIGHTLY TOGETHER

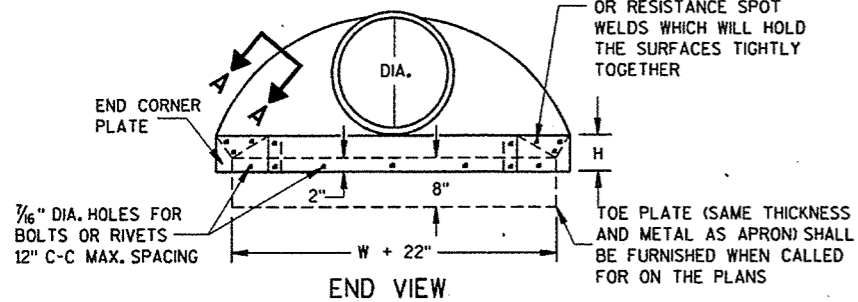


END VIEW

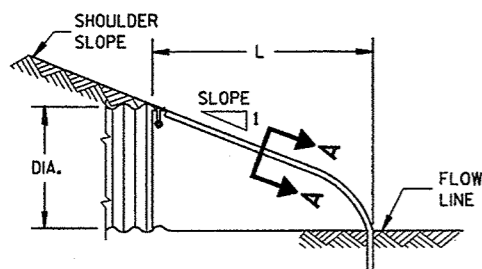


SIDE ELEVATION
METAL ENDWALLS

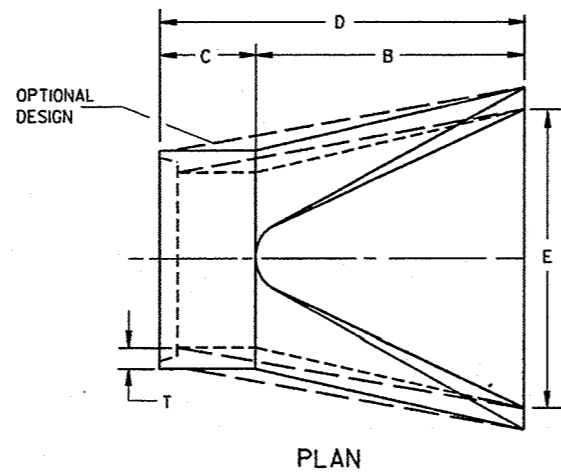


PLAN

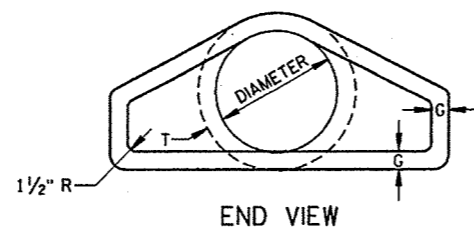


END VIEW

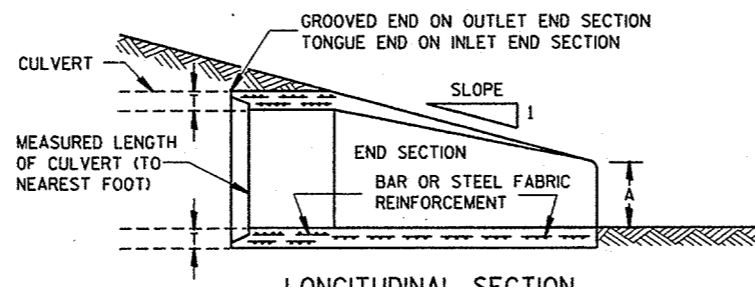


LONGITUDINAL SECTION
CONCRETE ENDWALLS

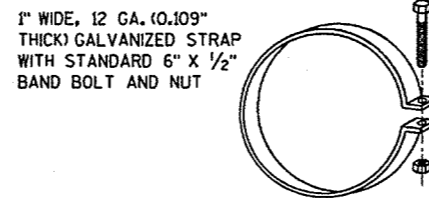


ALTERNATE FOR TYPE 1 CONNECTION
END SECTION CONNECTOR STRAP

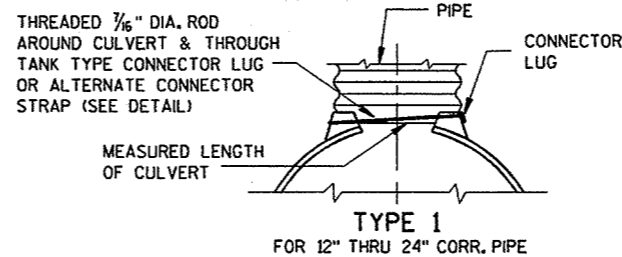


TYPE 1
FOR 12\"/>

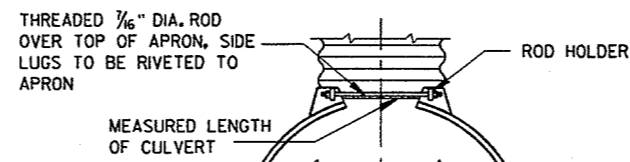

TYPE 2
FOR 30\"/>

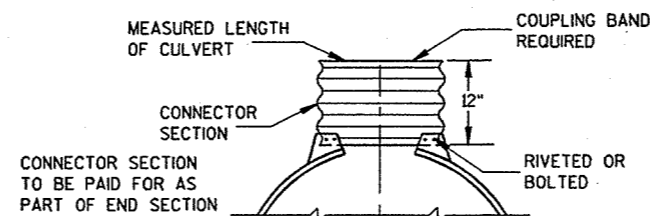

TYPE 3
FOR 42\"/>

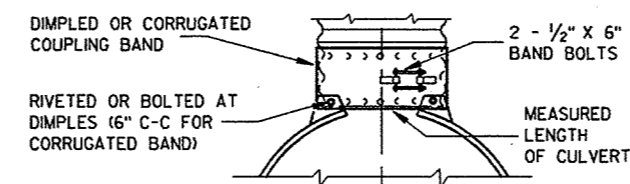

TYPE 5

ALTERNATE FOR:
ALL SIZES CORRUGATED CIRCULAR PIPE


NOTE: DIMPLED BAND FITS OVER OUTSIDE OF ENDWALL, AND CORRUGATED BAND FITS INSIDE ENDWALL. DIMPLED BAND MAY BE USED WITH HELICALLY CORRUGATED PIPE.

FOR CIRCUMFERENTIALLY CORRUGATED PIPE USE ENDWALL CONNECTION DETAILS 1, 2, 3 OR 5 AS APPLICABLE.

FOR HELICALLY CORRUGATED PIPE USE ENDWALL CONNECTION DETAILS 1, 2 OR 5.

FOR HELICALLY CORRUGATED PIPES WITH TWO CIRCUMFERENTIAL CORRUGATIONS AT EACH END USE ENDWALL CONNECTION DETAILS 1, 2 OR 3.

CONNECTION DETAILS

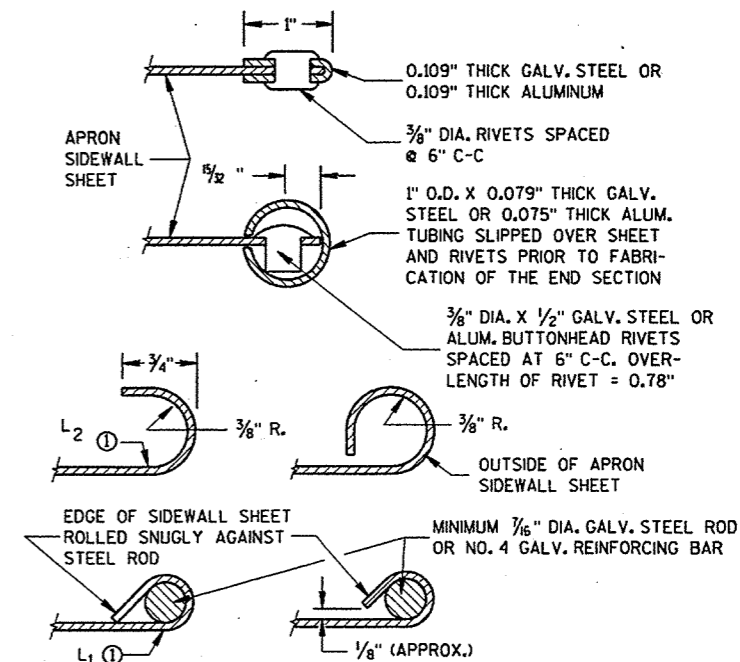

SECTION A-A

GENERAL NOTES

DETAILS OF CONSTRUCTION, MATERIALS AND WORKMANSHIP NOT SHOWN ON THIS DRAWING SHALL CONFORM TO THE PERTINENT REQUIREMENTS OF THE STANDARD SPECIFICATIONS AND THE APPLICABLE SPECIAL PROVISIONS.

CONCRETE CULVERT ENDWALLS MAY NOT BE USED WITH GALVANIZED STEEL OR ALUMINUM CULVERT PIPE OR VISE VERSA. GALVANIZED STEEL OR ALUMINUM ENDWALLS SHALL NORMALLY BE INSTALLED ON CULVERT PIPE OF THE SAME METAL.

ALL THREE PIECE STEEL APRON ENDWALLS FOR 60\"/>

LAP SEAMS SHALL BE TIGHTLY JOINED BY GALVANIZED RIVETS OR BOLTS FOR STEEL UNITS AND ALUMINUM RIVETS AND BOLTS FOR ALUMINUM UNITS. FOR THE 60\"/>


WHERE TWO OR MORE PIPES WITH APRON ENDWALLS ARE LAID ADJACENT TO EACH OTHER, THEY SHALL BE SEPARATED BY A DISTANCE SUFFICIENT TO PROVIDE A MINIMUM CLEARANCE OF 6 INCHES BETWEEN APRON ENDWALLS.

① FOR PIPE SIZES UP TO 60\"/>


APRON ENDWALLS FOR CULVERT PIPE

STATE OF WISCONSIN
DEPARTMENT OF TRANSPORTATION

APPROVED
11/30/94
DATE
CHIEF ROADWAY DEVELOPMENT ENGINEER
FHWA

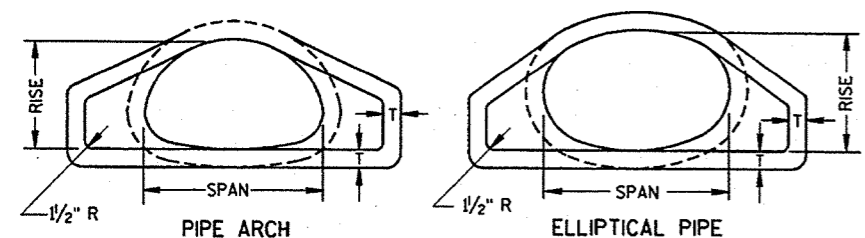


END VIEW

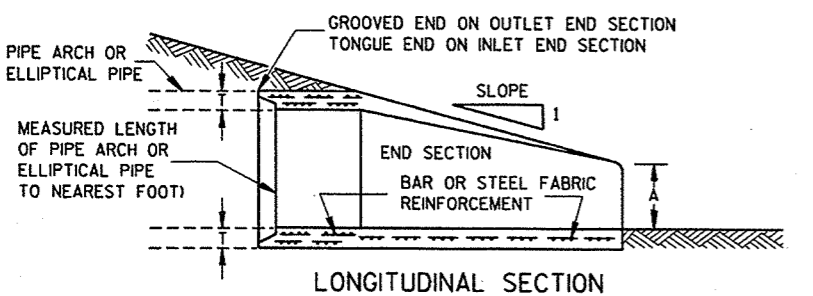

LONGITUDINAL SECTION

CONCRETE ENDWALLS

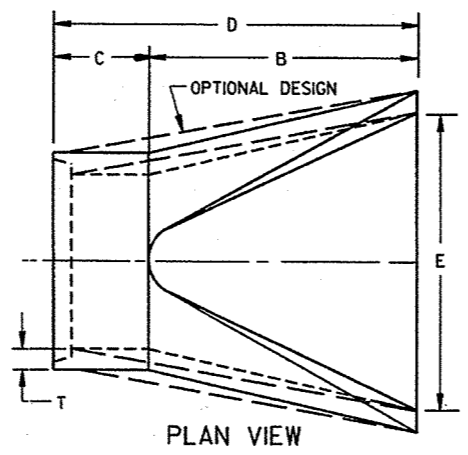

PLAN VIEW

2- 2/3" X 1/2" CORRUGATIONS

EQUIV. DIA. (Inches)	(Inches)		MIN. THICK. (Inches)		DIMENSIONS (Inches)							APPROX. SLOPE	BODY
	SPAN	RISE	STEEL	ALUM.	A (±1")	B (MAX.)	H (±1")	L (±1/2")	L1 (±1")	L2 (±1")	W (±2")		
15	17	13	.064	.060	7	9	6	19	14	16	30	2 1/2 to 1	1 Pc.
18	21	15	.064	.060	7	10	6	23	14	19 1/2	36	2 1/2 to 1	1 Pc.
21	24	18	.064	.060	8	12	6	28	18	21 1/4	42	2 1/2 to 1	1 Pc.
24	28	20	.064	.060	9	14	6	32	18	27 1/2	48	2 1/2 to 1	1 Pc.
30	35	24	.079	.075	10	16	6	39	18	37 1/2	60	2 1/2 to 1	1 Pc.
36	42	29	.079	.075	12	18	8	46	24	45 3/8	75	2 1/2 to 1	1 Pc.
42	49	33	.109	.105	13	21	9	53	24	54 1/4	85	2 1/2 to 1	2 Pc.
48	57	38	.109	.105	18	26	12	63	24	68	90	2 1/2 to 1	3 Pc.
54	64	43	.109	.105	18	30	12	70	24	72 3/4	102	2 1/2 to 1	3 Pc.
60	71	47	.109*	.105*	18	33	12	77	30	82 1/4	114	2 1/2 to 1	3 Pc.
66	77	52	.109*	.105*	18	36	12	77	—	—	126	2 to 1	3 Pc.
72	83	57	.109*	.105*	18	39	12	77	—	—	138	2 to 1	3 Pc.

3" X 1" CORRUGATIONS

EQUIV. DIA. (Inches)	(Inches)		MIN. THICK. (Inches)		DIMENSIONS (Inches)							APPROX. SLOPE	BODY
	SPAN	RISE	STEEL	ALUM.	A (±1")	B (MAX.)	H (±1")	L (±1/2")	L1 (±1")	L2 (±1")	W (±2")		
48	53	41	.109	.105	18	26	12	63	24	72 3/4	90	2 1/2 to 1	2 Pc.
54	60	46	.109	.105	18	30	12	70	30	82 1/4	102	2 to 1	2 Pc.
60	66	51	.109*	.105*	18	33	12	77	—	—	114	1 1/2 to 1	3 Pc.
66	73	55	.109*	.105*	18	36	12	77	—	—	126	1 1/2 to 1	3 Pc.
72	81	59	.109*	.105*	18	39	12	77	—	—	138	2 to 1	3 Pc.
78	87	63	.109*	.105*	22	38	12	77	—	—	148	1 1/2 to 1	3 Pc.
84	95	67	.109*	.105*	22	34	12	77	—	—	162	1 1/2 to 1	3 Pc.
90	103	71	.109*	.105*	22	38	12	77	—	—	174	1 1/2 to 1	3 Pc.
96	112	75	.109*	.105*	24	40	12	77	—	—	174	1 1/2 to 1	3 Pc.

NOTE: ALL SPLICES TO BE LAP RIVETED OR BOLTED. * EXCEPT CENTER PANEL SEE GENERAL NOTES

REINFORCED CONCRETE PIPE ARCH

EQUIV. DIA. (Inches)	DIMENSIONS (Inches)								APPROX. SLOPE
	**SPAN	**RISE	T	A	B	C	D	E	
24	29	18	3	8 1/2	39	33	72	48	3 to 1
30	36	22	3 1/2	9 1/2	50	46	96	60	3 to 1
36	44	27	4	11 1/8	60	36	96	72	3 to 1
42	51	31	4 1/2	15 1/8	60	36	96	78	3 to 1
48	58	36	5	21	60	36	96	84	3 to 1
54	65	40	5 1/2	25 1/2	60	36	96	90	3 to 1
60	73	45	6	31	60	36	96	96	3 to 1
72	88	54	7	31	60	39	99	120	2 to 1
84	102	62	8	28 1/2	83	19	102	144	2 to 1

REINFORCED CONCRETE ELLIPTICAL PIPE

EQUIV. DIA. (Inches)	DIMENSIONS (Inches)								APPROX. SLOPE
	**SPAN	**RISE	T	A	B	C	D	E	
24	30	19	3 1/4	8 1/2	39	33	72	48	3 to 1
30	38	24	3 3/4	9 1/2	54	18	72	60	3 to 1
36	45	29	4 1/2	11 1/8	60	24	84	72	2 1/2 to 1
42	53	34	5	15 1/4	60	36	96	78	2 1/2 to 1
48	60	38	5 1/2	21	60	36	96	84	2 1/2 to 1
54	68	43	6	25 1/2	60	36	96	90	2 1/2 to 1
60	76	48	6 1/2	30	60	36	96	96	2 1/2 to 1

**NOMINAL SIZE

GENERAL NOTES

DETAILS OF CONSTRUCTION, MATERIALS AND WORKMANSHIP NOT SHOWN ON THIS DRAWING SHALL CONFORM TO THE PERTINENT REQUIREMENTS OF THE STANDARD SPECIFICATIONS AND THE APPLICABLE SPECIAL PROVISIONS.


CONCRETE APRON ENDWALLS MAY NOT BE USED WITH GALVANIZED STEEL OR ALUMINUM CULVERT PIPE OR VISE VERSA. GALVANIZED STEEL OR ALUMINUM APRON ENDWALLS SHALL NORMALLY BE INSTALLED ON CULVERT PIPE OF THE SAME METAL.

ALL THREE PIECE STEEL APRON ENDWALLS FOR 66" X 51" PIPE ARCH AND LARGER SHALL HAVE 0.109" SIDES AND 0.138" CENTER PANELS. ALL THREE PIECE ALUMINUM APRON ENDWALLS FOR 66" X 51" PIPE ARCH AND LARGER SHALL HAVE 0.105" SIDES AND 0.134" CENTER PANELS. THE WIDTH OF CENTER PANELS SHALL BE GREATER THAN 20 PERCENT OF THE PIPE ARCH PERIMETER.


LAP SEAMS SHALL BE TIGHTLY JOINED BY GALVANIZED RIVETS OR BOLTS FOR STEEL UNITS AND ALUMINUM RIVETS AND BOLTS FOR ALUMINUM UNITS. FOR THE 77" X 52" THROUGH 112" X 75" APRON ENDWALL SIZES, THE REINFORCED EDGES AND CENTER PANEL SEAMS SHALL BE FURTHER REINFORCED WITH GALVANIZED STEEL OR ALUMINUM STIFFENER ANGLES. THE ANGLES SHALL BE ATTACHED BY GALVANIZED NUTS AND BOLTS FOR STEEL UNITS AND ALUMINUM NUTS AND BOLTS FOR ALUMINUM UNITS.

WHERE TWO OR MORE PIPES WITH APRON ENDWALLS ARE LAID ADJACENT TO EACH OTHER, THEY SHALL BE SEPARATED BY A DISTANCE SUFFICIENT TO PROVIDE A MINIMUM CLEARANCE OF 6 INCHES BETWEEN APRON ENDWALLS.


① FOR PIPE ARCH SIZES UP TO 73" X 55" A 180° ROLLED EDGE MAY BE USED INSTEAD OF STEEL ROD REINFORCEMENT. SEE SECTION A-A.

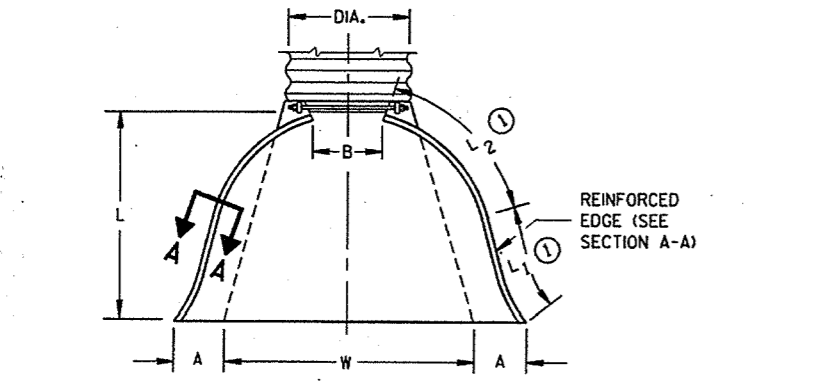


PLAN VIEW

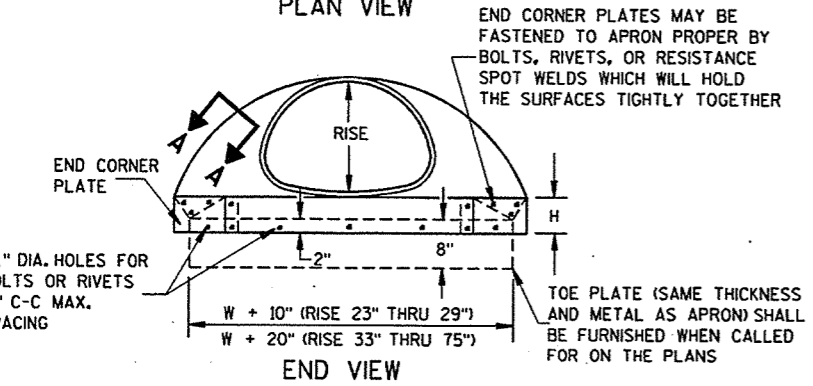


END VIEW

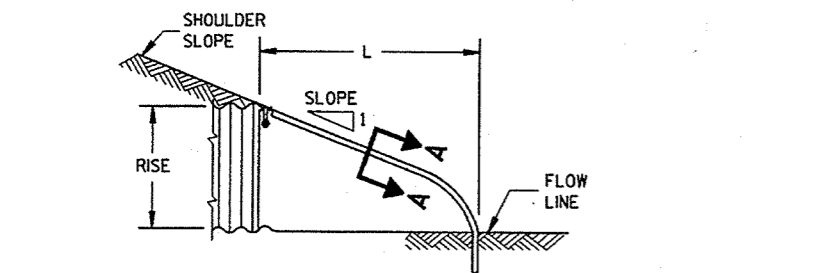

SIDE ELEVATION METAL ENDWALLS

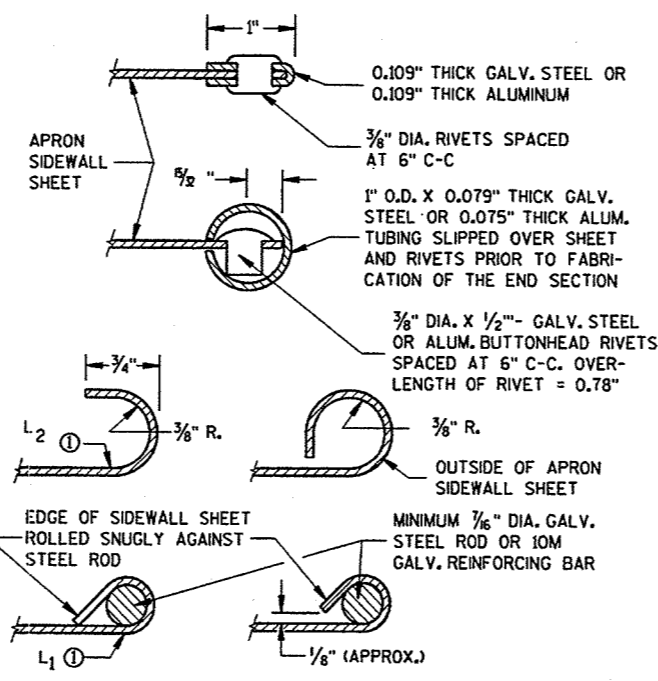

SECTION A-A

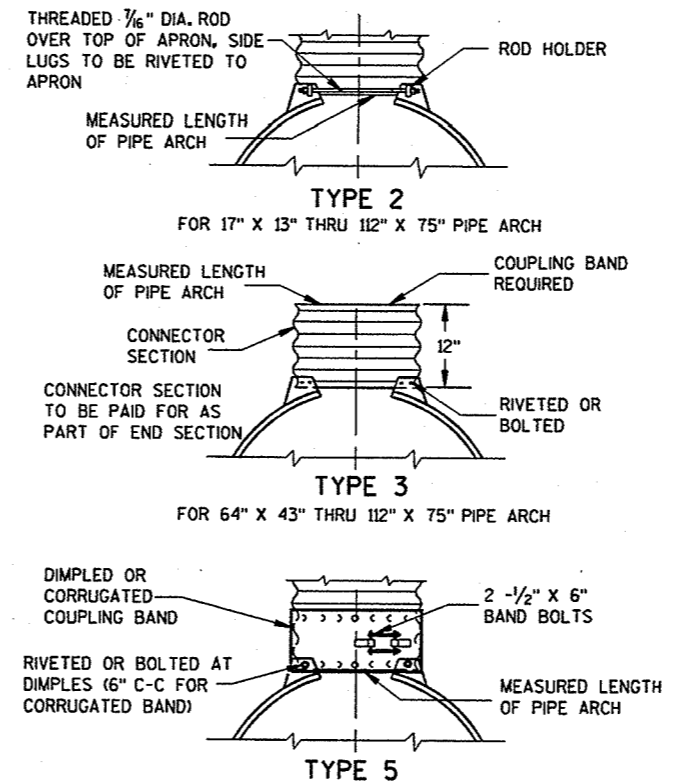

CONNECTION DETAILS

NOTE: DIMPLED BAND FITS OVER OUTSIDE OF ENDWALL, AND CORRUGATED BAND FITS INSIDE ENDWALL.


APRON ENDWALLS FOR PIPE ARCH AND ELLIPTICAL PIPE

STATE OF WISCONSIN
DEPARTMENT OF TRANSPORTATION


APPROVED
11/30/94
DATE

Roy L. Thompson
CHIEF ROADWAY DEVELOPMENT ENGINEER

FHWA

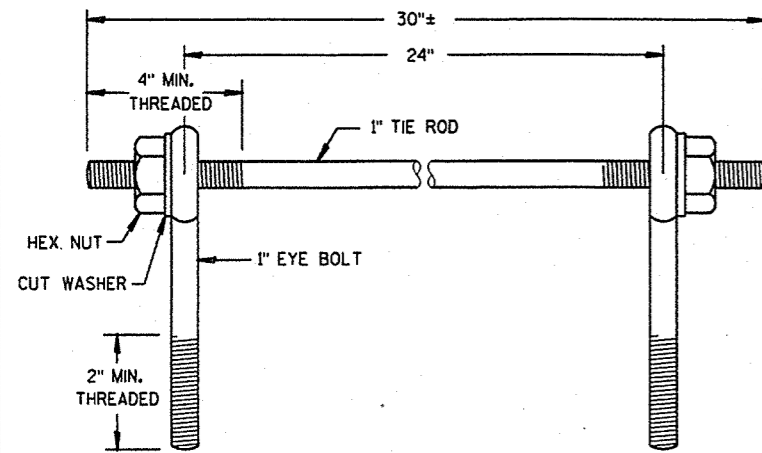

EYE BOLTS AND TIE ROD

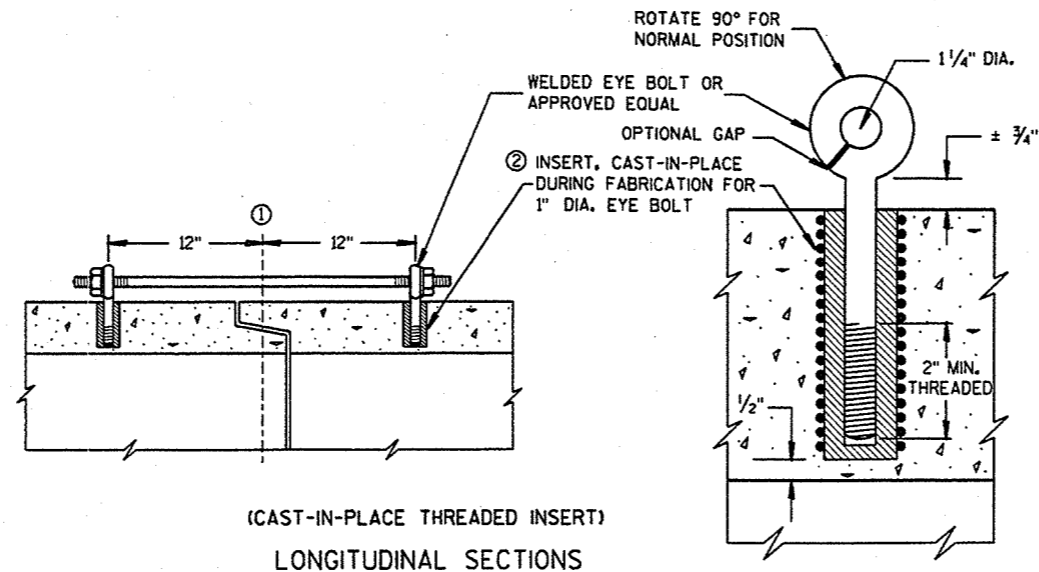

(CAST-IN-PLACE THREADED INSERT)
LONGITUDINAL SECTIONS


GENERAL NOTES

CONCRETE CULVERT PIPE SHALL BE TIED TOGETHER IN THE MANNER ILLUSTRATED BY THIS DETAIL AT LOCATIONS DESIGNATED ON THE PLAN. THE CONTRACTOR MAY USE EITHER ALTERNATE 1, 2 OR 3 FOR DRAINAGE STRUCTURES. ONLY ALTERNATE 1 AND 3 MAY BE USED FOR CATTLE PASSES. UNLESS OTHERWISE STATED IN THE CONTRACT THE MATERIALS, FABRICATION AND WORK NECESSARY TO TIE CULVERT PIPE AS INDICATED ON THE PLANS AND BY THIS DETAIL WILL BE CONSIDERED INCIDENTAL TO CULVERT PIPE, REINFORCED CONCRETE CULVERT PIPE, OR REINFORCED CONCRETE PIPE CATTLE PASS.


DETAILED DRAWINGS FOR PROPOSED ALTERNATE DESIGNS FOR JOINT TIES SHALL BE SUBMITTED TO THE ENGINEER FOR APPROVAL.

- ① C OF TONGUE AND GROOVE OR BELL AND SPIGOT JOINTS.
- ② THE INSIDE OF THE THREADED INSERTS SHALL BE CLEAN TO ALLOW THE INSERTION OF THREADED EYE BOLTS.
- ③ HOLES SHALL BE CAST-IN-PLACE OR DRILLED 12" FROM C OF TONGUE AND GROOVE.
- ④ BOLT PROJECTION INSIDE OF PIPE SHALL NOT EXCEED 2".
- ⑤ ROD DIAMETER + 1 INCH.
- ⑥ LENGTH ADEQUATE TO EXTEND TO WITHIN 1/2 INCH OF THE INNER SURFACE OF THE PIPE.

EYE BOLT AND TIE ROD ASSEMBLY (ALTERNATE NO. 1)

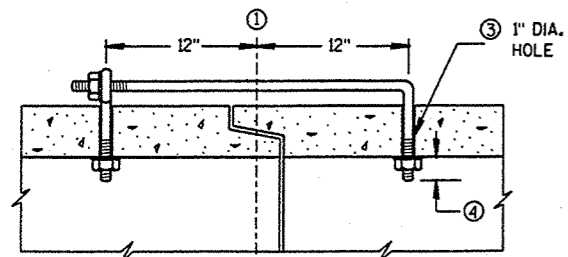

(TONGUE & GROOVE PIPE)

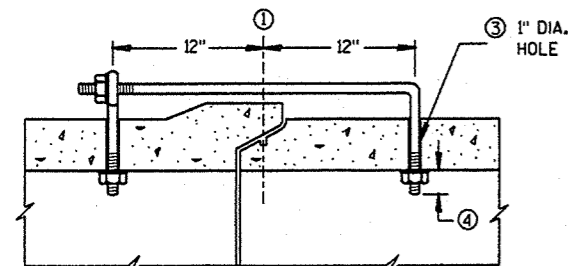

(MODIFIED BELL PIPE)
LONGITUDINAL SECTION


EYE BOLT DIMENSION TABLE

PIPE SIZE	L = LENGTH	
	TONGUE & GROOVE PIPE	MODIFIED BELL PIPE
18" TO 24"	4 1/2"	6 1/4"
30"	5"	7"
36"	5 1/2"	7"
42"	6"	
48"	6 1/2"	
60"	7 1/2"	
66"	8"	

ADJUSTABLE TIE ROD TABLE

PIPE DIAMETER	TIE ROD DIAMETER	D	L ₁	N
12-60	5/8	5/8	5	1/2
66-84	3/4	3/4	5	1/2
90-108	1	1	7	1 1/8

DIMENSIONS SHOWN ARE IN INCHES

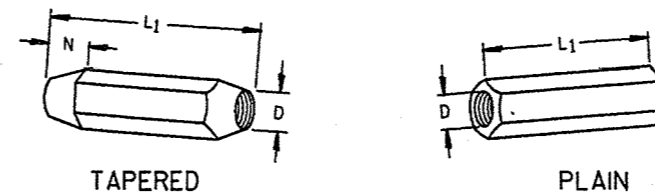


TAPERED

PLAIN


RIGHT AND LEFT THREADS

SLEEVE NUTS

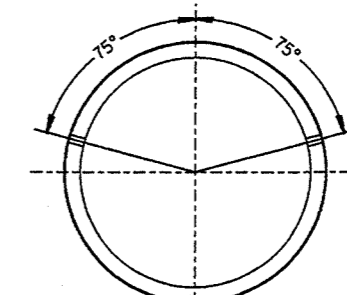


PLACEMENT OF (2) CAST-IN-PLACE INSERTS OR HOLES DURING FABRICATION FOR PIPE SECTIONS REQUIRING TIE RODS

TRANSVERSE SECTION

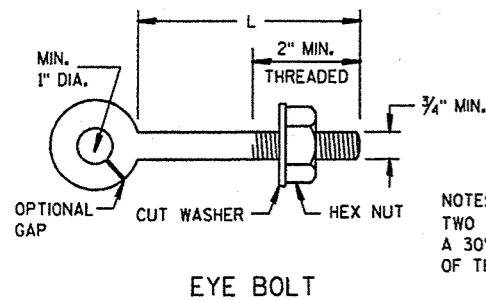


EYE BOLT

NOTE: TWO EYE BOLTS MAY BE USED WITH A 30" LONG THREADED ROD IN LIEU OF THE 90° BENT TIE ROD.

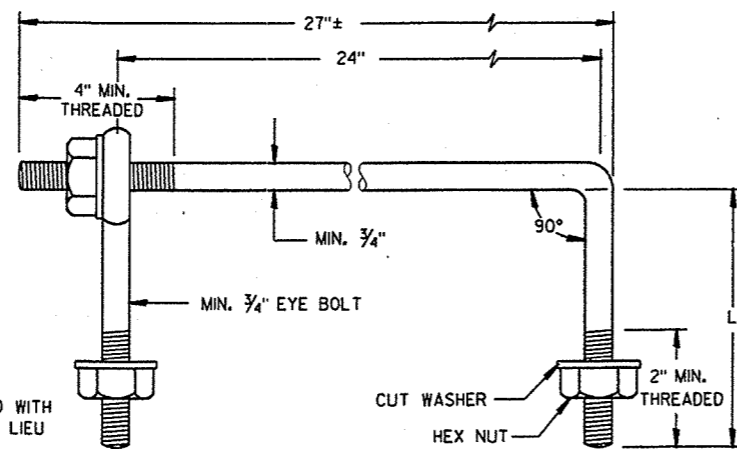

EYE BOLT AND TIE ROD

(JOINT TIES FOR 18" TO 66" DIA. CONCRETE PIPE)
EYE BOLT AND TIE ROD ASSEMBLY (ALTERNATE NO. 2)

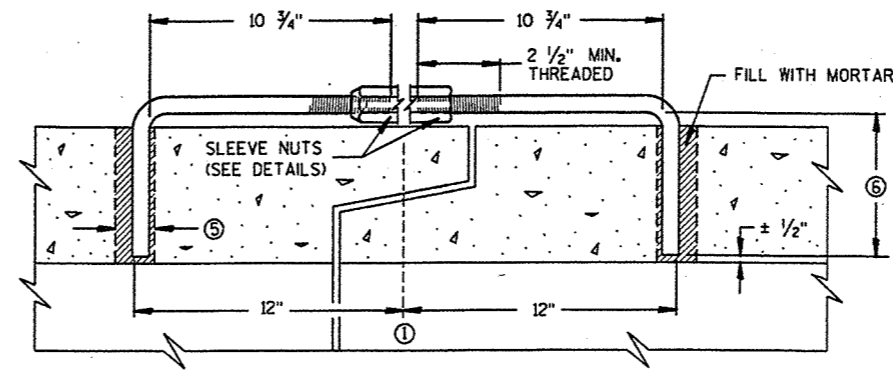

LONGITUDINAL SECTION

(JOINT TIES FOR 12" TO 108" DIA. CONCRETE PIPE)

ADJUSTABLE TIE ROD (ALTERNATE NO. 3)


JOINT TIES FOR CONCRETE PIPE

STATE OF WISCONSIN
DEPARTMENT OF TRANSPORTATION

APPROVED
DATE 9/18/92


STATE DESIGN ENGINEER FOR HWYS

FHWA

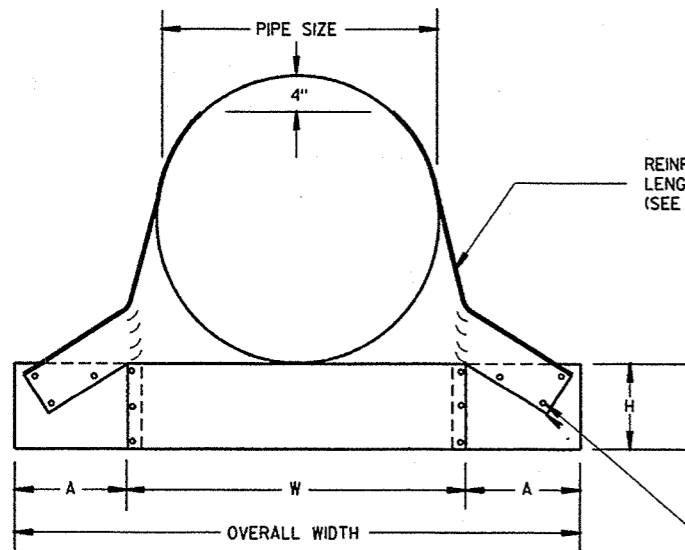

FRONT VIEW

BOLTS, RIVETS, OR RESISTANCE SPOT WELDS WHICH WILL HOLD THE SURFACES TIGHTLY TOGETHER

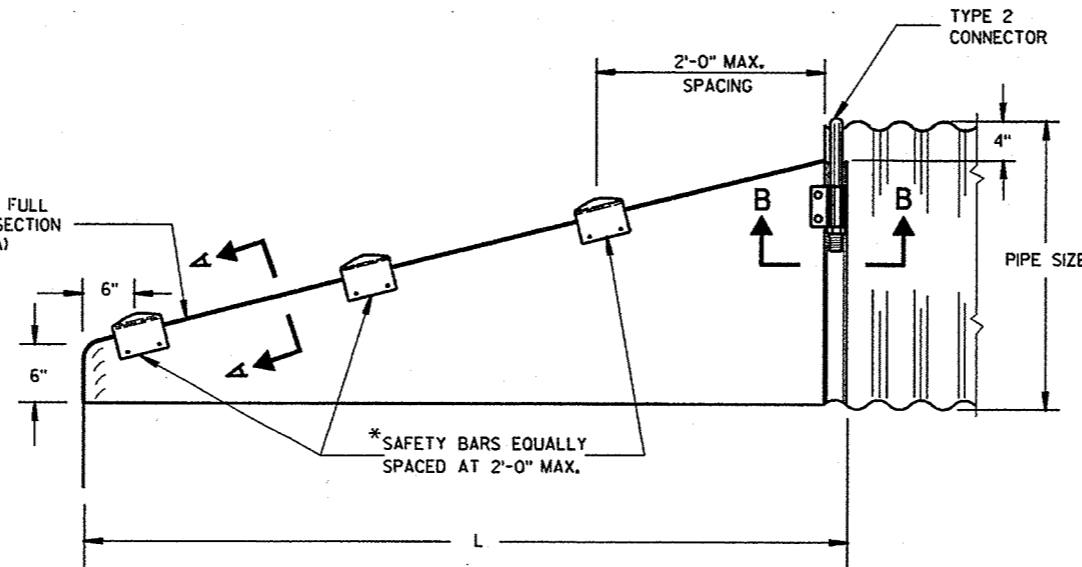


SIDE VIEW


*SAFETY BARS EQUALLY SPACED AT 2'-0" MAX.

*NOTE: THREE SAFETY BARS ARE SHOWN. ACTUAL NUMBER OF BARS REQUIRED AT A 2'-0" C-C MAX. SPACING WILL VARY DEPENDING ON THE LENGTH OF THE END SECTION.


3" GALVANIZED PIPE, FLATTEN ENDS, THEN BEND OUTSIDE 4" TO MATCH END SECTION SIDES.

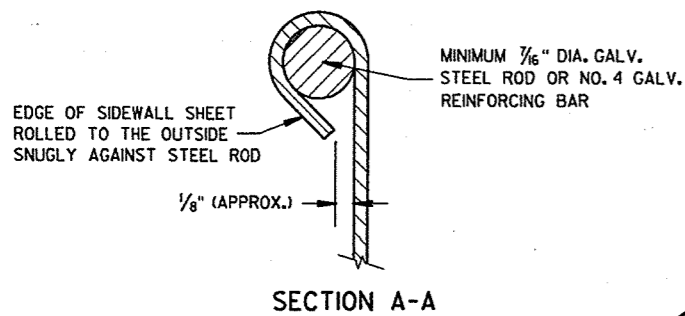


SECTION A-A

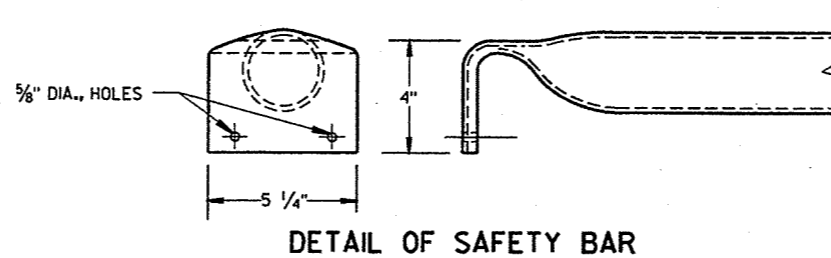


DETAIL OF SAFETY BAR

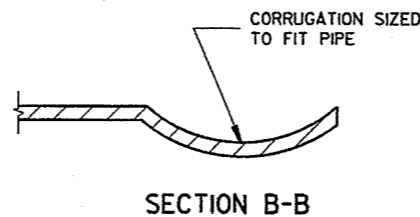

SECTION B-B

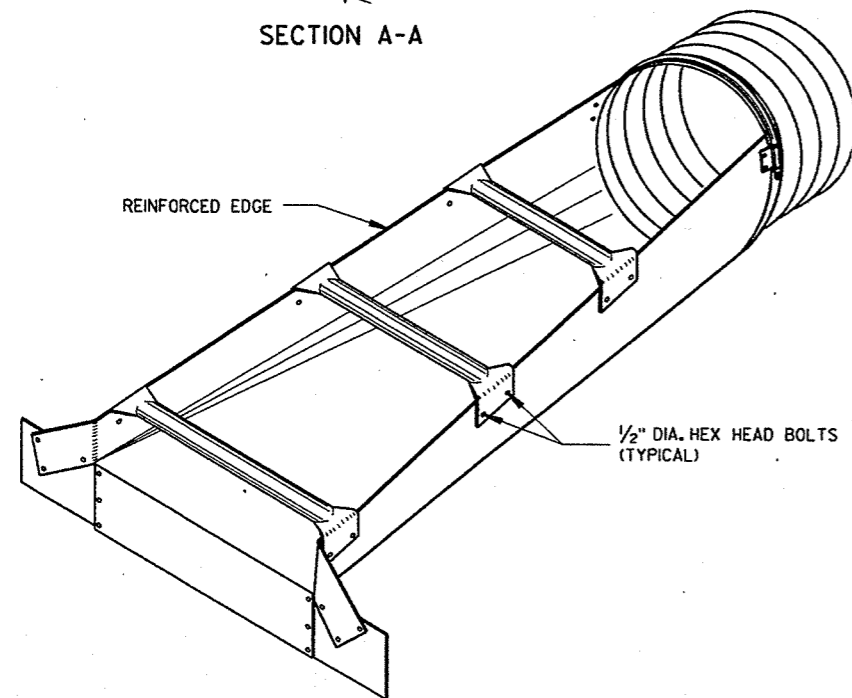


ISOMETRIC VIEW

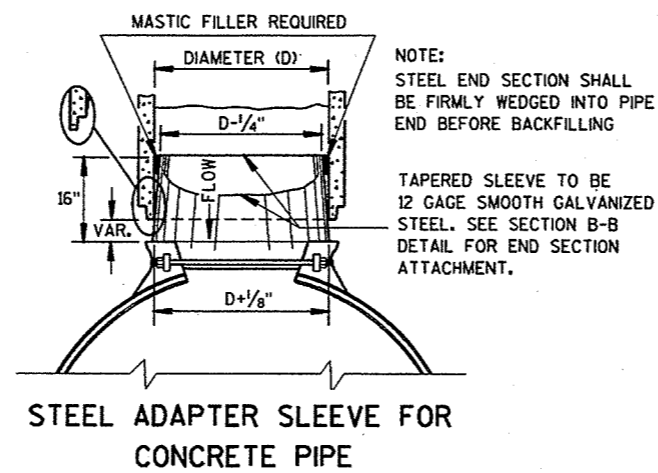

STEEL ADAPTER SLEEVE FOR CONCRETE PIPE

NOTE: STEEL END SECTION SHALL BE FIRMLY WEDGED INTO PIPE END BEFORE BACKFILLING
TAPERED SLEEVE TO BE 12 GAGE SMOOTH GALVANIZED STEEL. SEE SECTION B-B DETAIL FOR END SECTION ATTACHMENT.

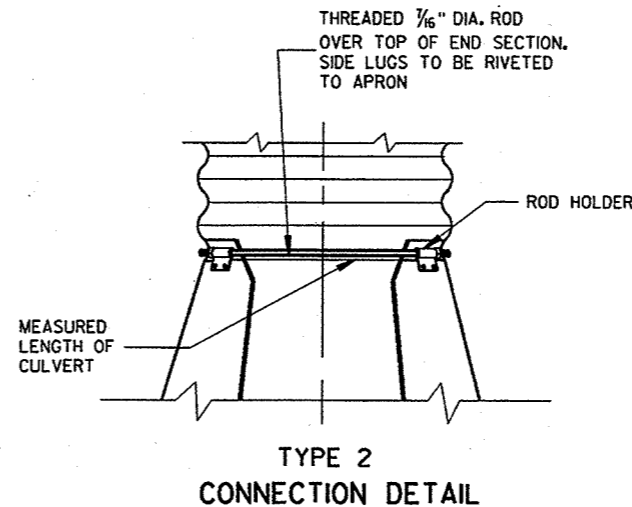

TYPE 2 CONNECTION DETAIL

GENERAL NOTES

DETAILS OF CONSTRUCTION, MATERIALS AND WORKMANSHIP NOT SHOWN ON THIS DRAWING SHALL CONFORM TO THE PERTINENT REQUIREMENTS OF THE STANDARD SPECIFICATIONS AND THE APPLICABLE SPECIAL PROVISIONS.

SLOPED END SECTIONS SHALL CONFORM TO THE REQUIREMENTS OF THE STANDARD SPECIFICATIONS, SECTION 521 FOR STEEL APRON ENDWALLS.

SAFETY BARS SHALL BE FABRICATED FROM GALVANIZED STEEL PIPE MEETING THE REQUIREMENTS OF ASTM A-53, GRADE B, SCHEDULE 40 OR APPROVED EQUAL.


STEEL APRON ENDWALLS FOR CULVERT PIPE							
PIPE DIA. (IN.)	MIN. THICK. (Inches)	DIMENSIONS (Inches)				L DIMENSIONS	
		A	H	W	OVERALL WIDTH	SLOPE	LENGTH INCHES
15	.064	8	6	21	37	6:1	30
18	.064	8	6	24	40	6:1	48
21	.064	8	6	27	43	6:1	66
24	.064	8	6	30	46	6:1	84
30	.109	12	9	36	60	6:1	120
36	.109	12	9	42	66	6:1	156
42	.109	16	12	48	80	5.63 TO 1	180
48	.109	16	12	54	86	4.74 TO 1	180
54	.109	16	12	60	92		

STEEL APRON ENDWALLS FOR PIPE ARCH									
EQUIV. DIA. (Inches)	(Inches)		MIN. THICK. (Inches)	DIMENSIONS (Inches)			L DIMENSIONS		
	SPAN	RISE		A	H	W	OVERALL WIDTH	SLOPE	LENGTH INCHES
15	17	13	.064	8	6	23	39	6:1	18
18	21	15	.064	8	6	27	43	6:1	30
21	24	18	.064	8	6	30	46	6:1	48
24	28	20	.064	8	6	34	50	6:1	60
30	35	24	.079	12	9	41	65	6:1	84
36	42	29	.109	12	9	48	72	6:1	114
42	49	33	.109	16	12	55	87	6:1	138
48	57	38	.109	16	12	63	95	6:1	168
54	64	43	.109	16	12	70	102	5.45 TO 1	180


STEEL APRON ENDWALLS FOR CULVERT PIPE AND PIPE ARCH SIDE DRAINS SLOPED SECTION

STATE OF WISCONSIN DEPARTMENT OF TRANSPORTATION

APPROVED 4/17/95 DATE *Roy D. Thompson* CHIEF ROADWAY DEVELOPMENT ENGINEER
FHWA

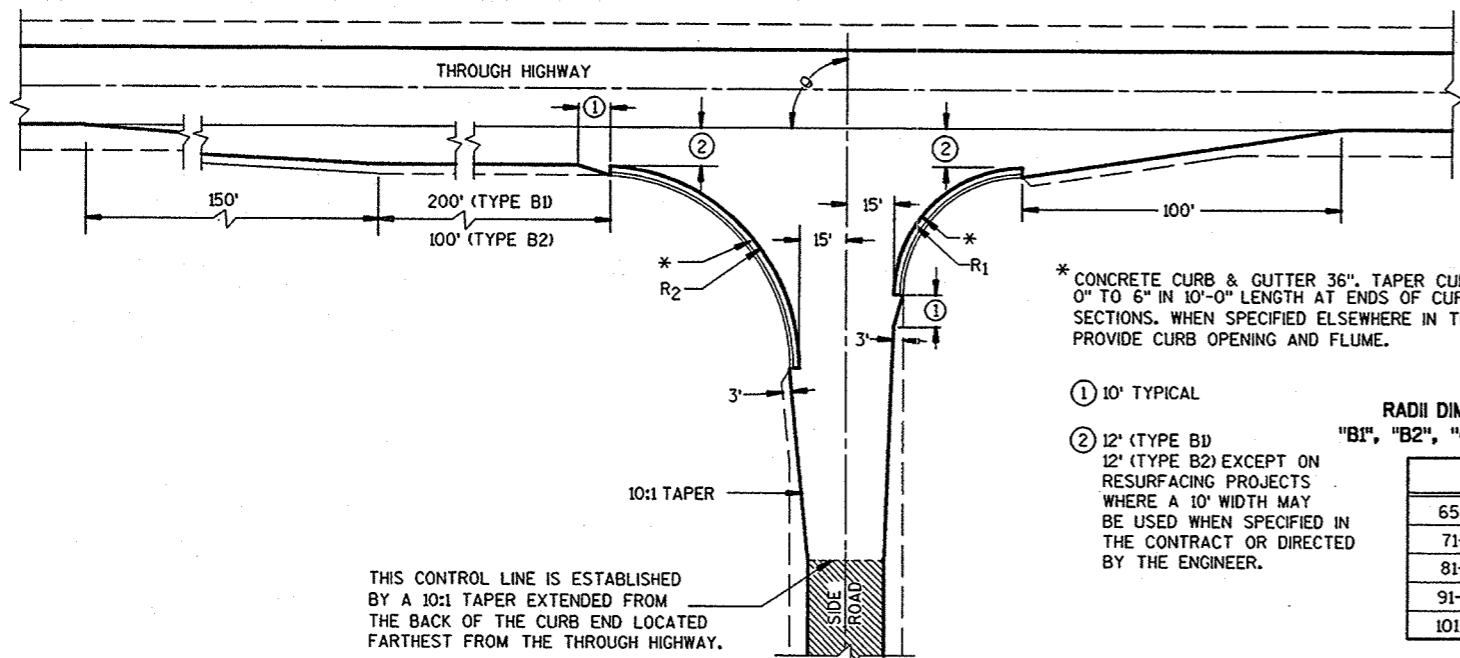

TYPE "B1" AND "B2"

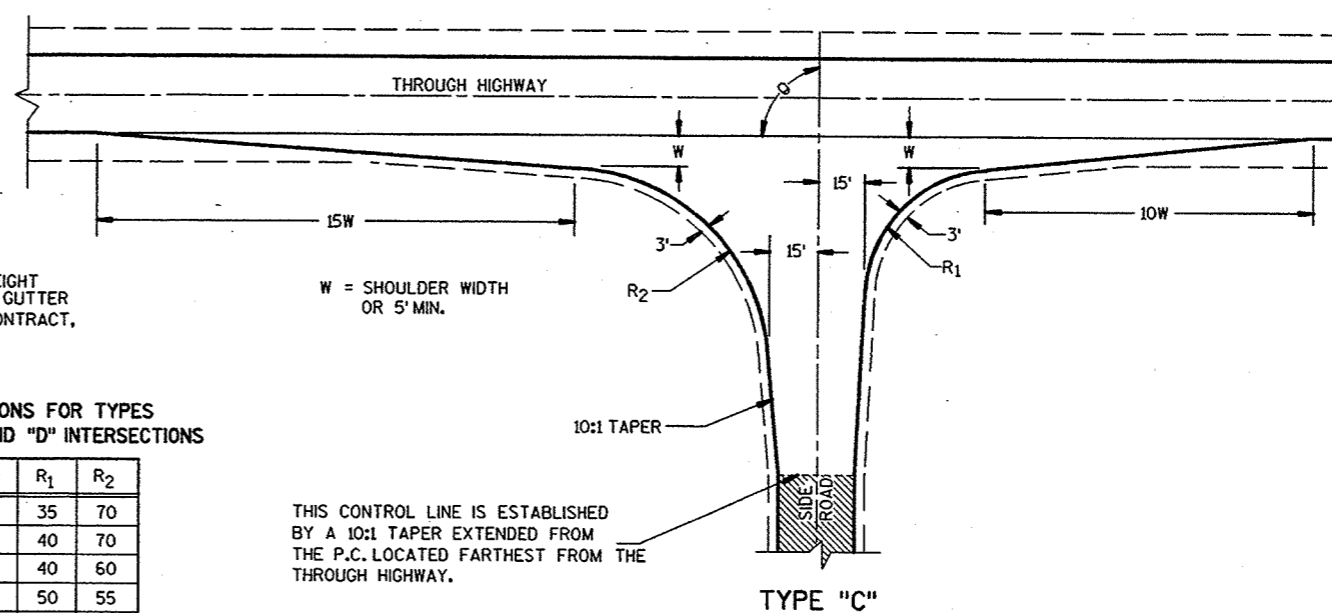

TYPE "C"

* CONCRETE CURB & GUTTER 36". TAPER CURB HEIGHT 0" TO 6" IN 10'-0" LENGTH AT ENDS OF CURB & GUTTER SECTIONS. WHEN SPECIFIED ELSEWHERE IN THE CONTRACT, PROVIDE CURB OPENING AND FLUME.

- ① 10' TYPICAL
- ② 12' (TYPE B1)
12' (TYPE B2) EXCEPT ON RESURFACING PROJECTS WHERE A 10' WIDTH MAY BE USED WHEN SPECIFIED IN THE CONTRACT OR DIRECTED BY THE ENGINEER.

RADII DIMENSIONS FOR TYPES "B1", "B2", "C" AND "D" INTERSECTIONS

θ	R ₁	R ₂
65-70	35	70
71-80	40	70
81-90	40	60
91-100	50	55
101-110	60	45

THIS CONTROL LINE IS ESTABLISHED BY A 10:1 TAPER EXTENDED FROM THE P.C. LOCATED FARTHEST FROM THE THROUGH HIGHWAY.

GENERAL NOTES

DESIGNS MAY BE USED INTERCHANGEABLY IN COMBINATION OR SEPARATELY FOR ANY ONE COMPLETE INTERSECTION DEPENDING UPON INTERSECTION ANGLE AND SURFACING OF EACH APPROACH ROADWAY.


SIDE ROAD SURFACING NOTE

WHEN THE SIDE ROAD IS NOT PRESENTLY PAVED, PAVEMENT SHALL BE PLACED TO THE LIMITS SHOWN UNLESS OTHERWISE PROVIDED IN THE CONTRACT. WHERE THE CONSTRUCTION LIMITS ARE BEYOND THE PAVING LIMITS, CRUSHED AGGREGATE SURFACING SHALL BE PLACED BETWEEN THE PAVING LIMITS AND CONSTRUCTION LIMITS.


WHEN THE SIDE ROAD IS PRESENTLY PAVED, NEW PAVEMENT SHALL BE PLACED TO THE LIMITS OF DESIGN AS SHOWN AND BEYOND, IF NECESSARY, TO MEET EXISTING PAVEMENT.

WHEN THE SIDE ROAD IS THE CONSTRUCTION PROJECT, THE INTERSECTION SURFACING SHALL BE THE SAME AS FOR THE PROJECT.

EXISTING SURFACE

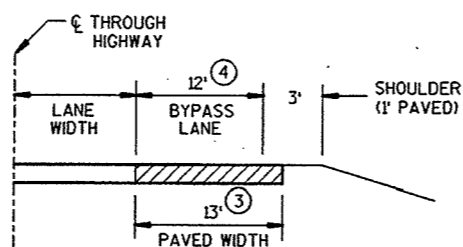


SECTION A-A
(SHOWING BYPASS LANE AND SHOULDER)

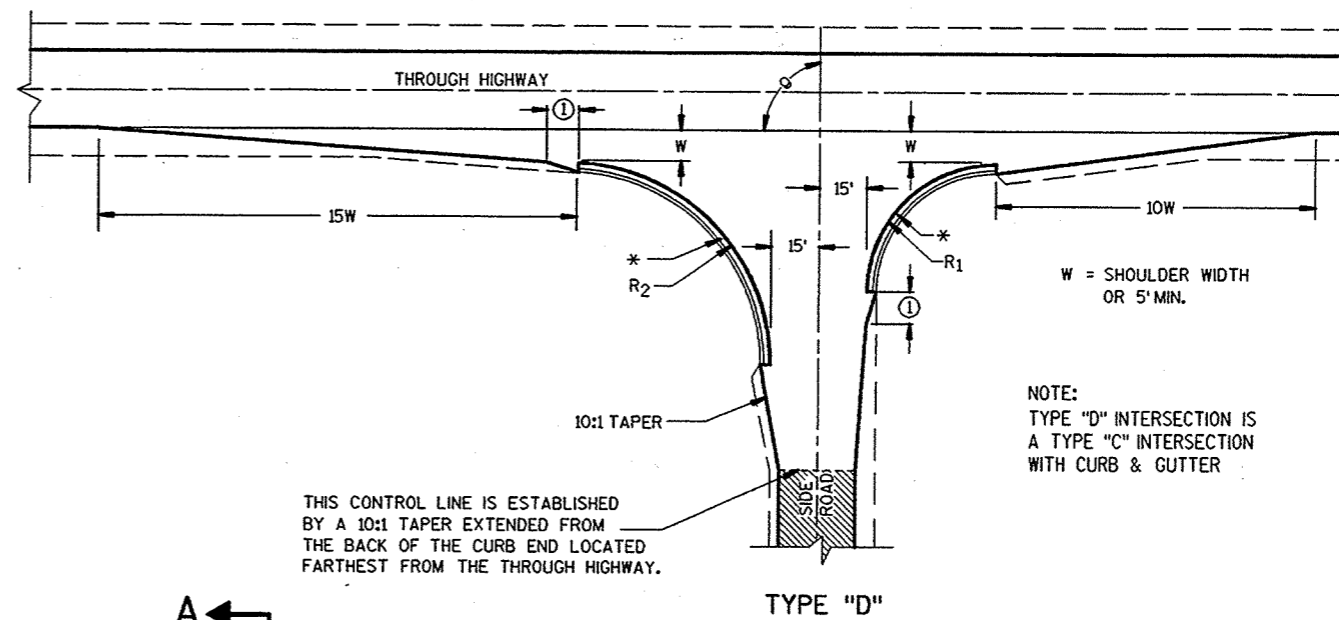

TYPE "D"

NOTE:
TYPE "D" INTERSECTION IS A TYPE "C" INTERSECTION WITH CURB & GUTTER

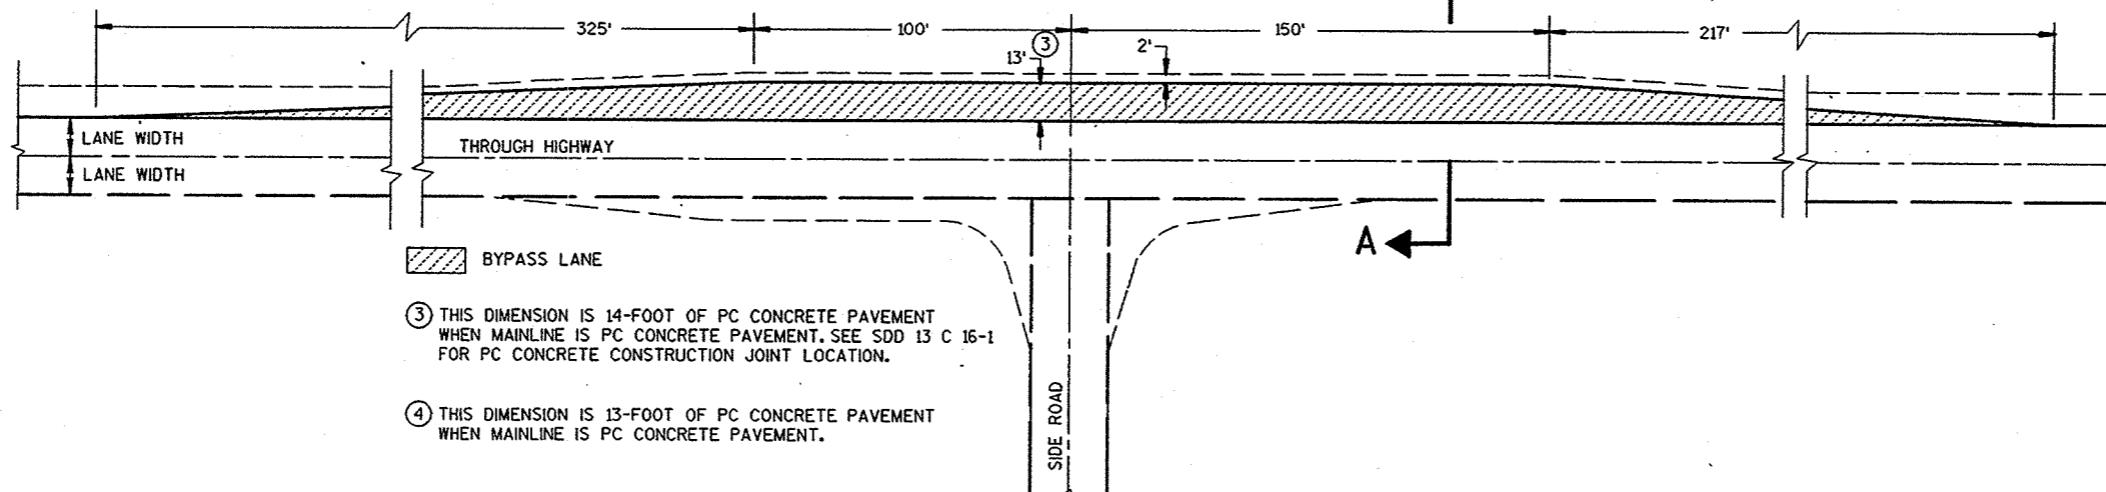

BYPASS LANE


③ THIS DIMENSION IS 14-FOOT OF PC CONCRETE PAVEMENT WHEN MAINLINE IS PC CONCRETE PAVEMENT. SEE SDD 13 C 16-1 FOR PC CONCRETE CONSTRUCTION JOINT LOCATION.

④ THIS DIMENSION IS 13-FOOT OF PC CONCRETE PAVEMENT WHEN MAINLINE IS PC CONCRETE PAVEMENT.


TEE INTERSECTION BYPASS LANE DETAIL

AT-GRADE SIDE ROAD INTERSECTION, TYPES "B1", "B2", "C" AND "D" AND TEE INTERSECTION BYPASS LANE

STATE OF WISCONSIN
DEPARTMENT OF TRANSPORTATION

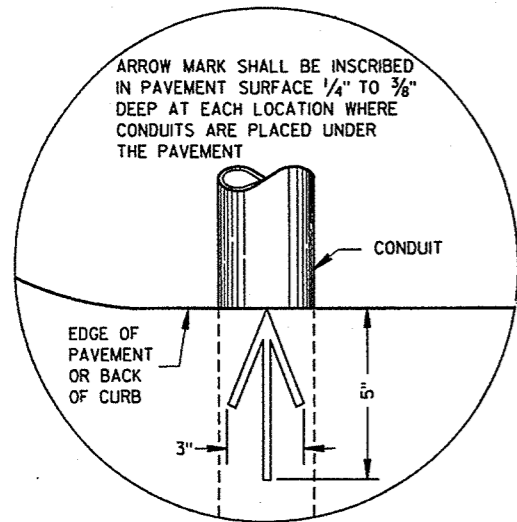


PLAN VIEW
ARROW MARK

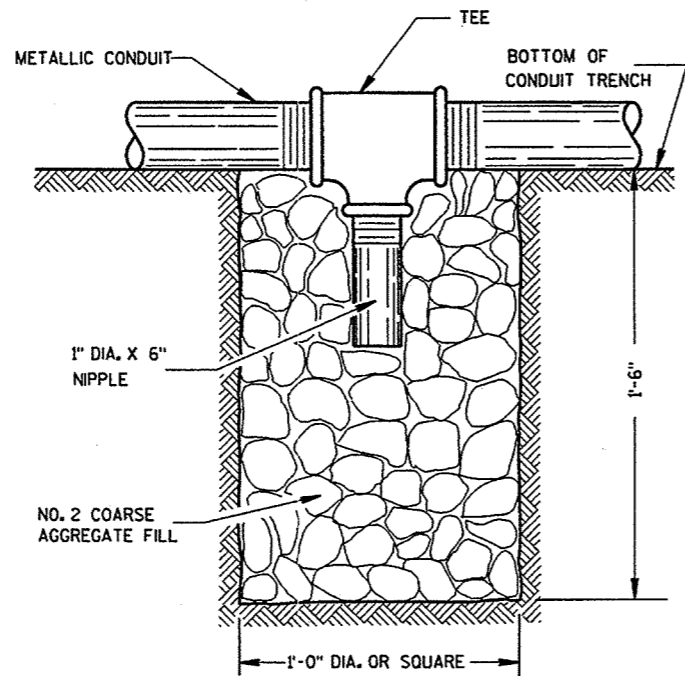

NOTE: INSTALL AT LOCATIONS WHERE METALLIC CONDUITS CANNOT BE PITCHED TO DRAIN INTO A PULL BOX.

DRAIN SUMP FOR METALLIC CONDUIT

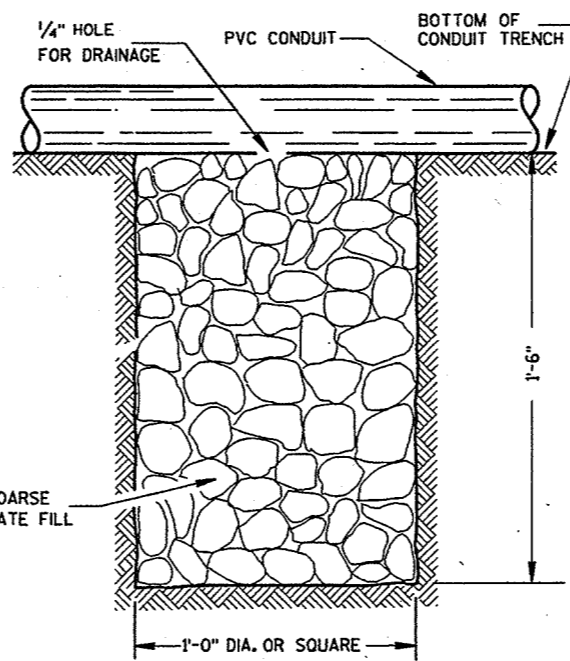

NOTE: INSTALL AT LOCATIONS WHERE PVC CONDUITS CANNOT BE PITCHED TO DRAIN INTO A PULL BOX.

DRAIN SUMP FOR PVC CONDUIT

GENERAL NOTES

DETAILS OF CONSTRUCTION, MATERIALS AND WORKMANSHIP NOT SHOWN ON THIS DRAWING SHALL CONFORM TO THE PERTINENT REQUIREMENTS OF THE CONTRACT.

METALLIC (STANDARD SPECIFICATION 652.2.2) OR NONMETALLIC (STANDARD SPECIFICATION 652.2.3) CONDUIT SHALL BE FURNISHED AND PLACED AS SHOWN.

DEPTH OF CONDUIT INSTALLED BELOW THE TRAVELED WAY SHALL BE 24 INCHES MINIMUM AND 36 INCHES MAXIMUM.

DEPTH OF CONDUIT INSTALLED THAT IS NOT BELOW THE TRAVELED WAY SHALL BE 18 INCHES MINIMUM AND 36 INCHES MAXIMUM.

ANY EXCEPTION TO THE MAXIMUM DEPTH SHALL BE ONLY WITH THE WRITTEN APPROVAL OF THE ENGINEER.

THE TRENCH SHALL NOT BE BACKFILLED PRIOR TO INSPECTION OF THE CONDUIT.

ALL METALLIC CONDUIT RACEWAY ENDS SHALL BE REAMED AND THREADED.

ALL METALLIC CONDUIT IN WHICH WIRE OR CABLE IS TO BE INSTALLED SHALL BE BUSHED WITH APPROVED THREADED BUSHINGS BEFORE INSTALLATION OF THE WIRE OR CABLE.

ALL METALLIC CONDUITS IN WHICH WIRE OR CABLE IS NOT TO BE INSTALLED SHALL BE CAPPED WITH THREADED PROTECTIVE CAPS, AS APPROVED BY THE ENGINEER.

ALL NONMETALLIC CONDUIT SHALL BE CAPPED OR PLUGGED IMMEDIATELY AFTER INSTALLATION AND SHALL REMAIN CAPPED OR PLUGGED UNTIL WIRE/CABLES ARE INSTALLED.

NONMETALLIC CONDUITS IN WHICH WIRE OR CABLE IS NOT BEING INSTALLED SHALL REMAIN CAPPED OR PLUGGED.

BENDING OF PVC ELECTRICAL CONDUIT SHALL BE ACCOMPLISHED BY USING A BLANKET OR EMERSION TYPE TANK DESIGNED FOR THE PURPOSE OF BENDING PVC ELECTRICAL CONDUIT.

ALL CUT ENDS SHALL BE TRIMMED INSIDE AND OUTSIDE TO REMOVE ALL ROUGH EDGES ON NONMETALLIC CONDUIT. (SEE NEC 347.5)

WHEN REQUIRED TO CONNECT NONMETALLIC CONDUIT TO METALLIC CONDUIT, ONLY U.L. LISTED ADAPTER FITTINGS SHALL BE USED.


PRIOR TO CONDUIT ACCEPTANCE, CONDUIT CAPS OR PLUGS SHALL BE REMOVED, AND THE CAPS, PLUGS AND CONDUIT ENDS SHALL BE THOROUGHLY CLEANED AND THEN THE CAPS OR PLUGS REINSTALLED TO ENSURE THAT THE CAPS OR PLUGS CAN BE EASILY REMOVED IN THE FUTURE.

ALL CONDUIT BEING FURNISHED AND INSTALLED SHALL HAVE THE U.L. LABEL FIRMLY ATTACHED.

CONDUIT RUNS SHALL BE THE SAME SIZE OF CONDUIT FROM ONE END TO THE OTHER (FROM PULL BOX TO PULL BOX-OR-JUNCTION BOX TO JUNCTION BOX-OR-BASE TO BASE, ETC.).

POLY ROPE OR A PULL WIRE SHALL BE INSTALLED AS STATED IN THE STANDARD SPECIFICATION, ITEM 652.3.1.1.

ALL CONDUIT RUNS SHALL BE STRAIGHT (WITHOUT BENDS) FROM PULL BOX TO PULL BOX, PULL BOX TO BASE AND BASE TO BASE AS SHOWN ON THE PLANS UNLESS OTHERWISE APPROVED BY THE PROJECT ENGINEER.

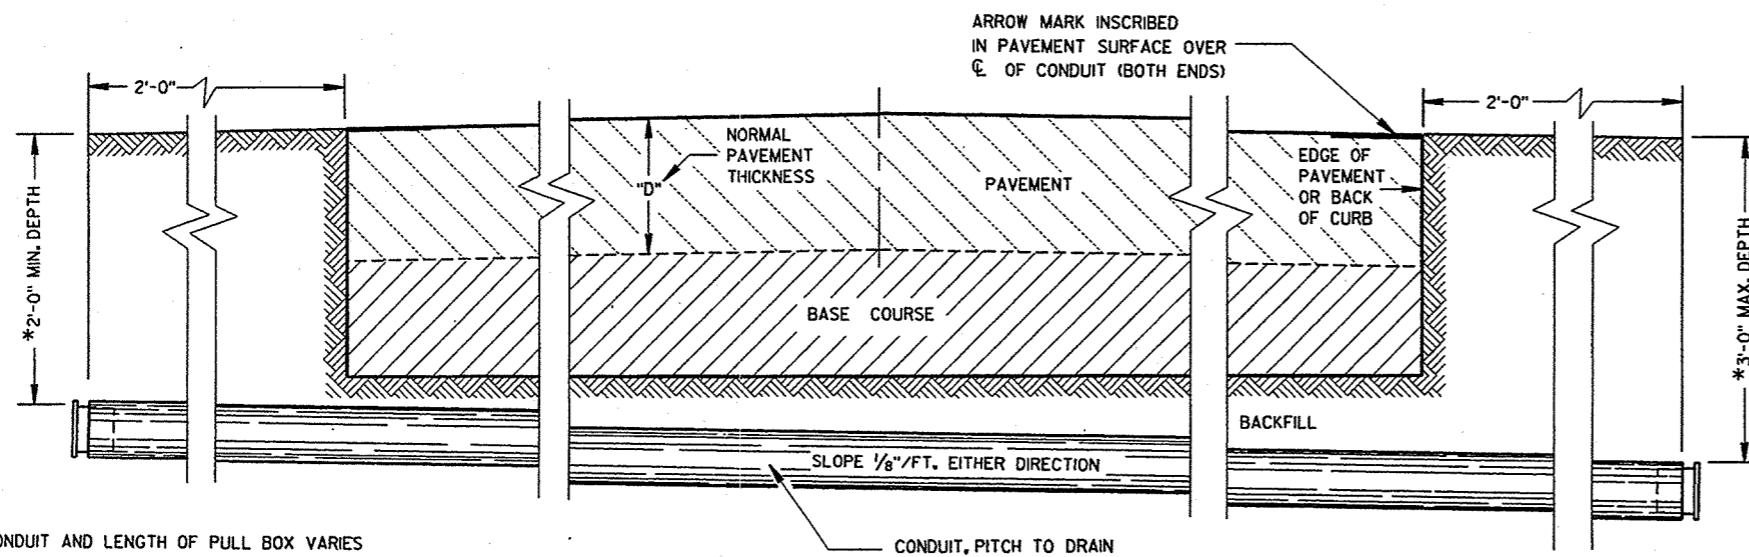

*DEPTH OF CONDUIT AND LENGTH OF PULL BOX VARIES WITH HEIGHT OF CURB USED. ALSO SEE PULL BOX S.D.D. 984

SIDE ELEVATION
DETAIL FOR CONDUIT UNDER PAVED HIGHWAYS

CONDUIT	
STATE OF WISCONSIN DEPARTMENT OF TRANSPORTATION	
APPROVED 1961/96 DATE	 STATE ELECTRICAL ENGINEER FOR HIGHWAYS
FHWA	

TABLE OF NOMINAL DIMENSIONS AND WEIGHTS

DIMENSION IN INCHES	TYPE OF PIPE										
	CORRUGATED STEEL									POLYETHYLENE SDR 32.5	
PIPE DIAMETER (INSIDE)	A	12	12	12	18	18	18	24	24	24	12
PIPE LENGTH **	B	24	30	36	24	30	36	36	42	48	24
WALL THICKNESS	C	0.064	0.064	0.064	0.064	0.064	0.064	0.064	0.064	0.064	0.4
COVER	D	10 1/4	10 1/4	10 1/4	16 1/4	16 1/4	16 1/4	22 1/4	22 1/4	22 1/4	10 1/4
FRAME	E	14 1/2	14 1/2	14 1/2	20 1/2	20 1/2	20 1/2	26 1/2	26 1/2	26 1/2	14 1/2
FRAME	F	8 1/2	8 1/2	8 1/2	14 1/2	14 1/2	14 1/2	20 1/2	20 1/2	20 1/2	8 1/2
FRAME	G	11 1/2	11 1/2	11 1/2	17 1/2	17 1/2	17 1/2	23 1/2	23 1/2	23 1/2	11 1/2
WEIGHT IN POUNDS *											
FRAME AND COVER		60	60	60	110	110	110	155	155	155	60

* THE ACTUAL WEIGHT OF THE MANHOLE FRAME AND COVER MAY VARY WITHIN 5 PERCENT PLUS OR MINUS OF THE WEIGHTS SHOWN.

** NORMALLY USED LENGTHS. THE PROJECT ENGINEER SHALL DETERMINE IF PIPE LENGTHS, OTHER THAN THOSE SPECIFIED, SHALL BE USED, TO A MAXIMUM OF 48" (CONTINUOUS LENGTH, NON-SPLICED). THE ADDITIONAL LENGTH SHALL BE INCIDENTAL TO THE PULL BOX BID PRICE.

GENERAL NOTES

DETAILS OF CONSTRUCTION, MATERIALS AND WORKMANSHIP NOT SHOWN ON THIS DRAWING SHALL CONFORM TO THE PERTINENT REQUIREMENTS OF THE CONTRACT.

ALL FRAMES AND COVERS SHALL BE HEAVY DUTY TYPE, SUITABLE FOR VEHICULAR TRAFFIC LOADS.

POLYETHYLENE PULL BOXES SHALL NOT BE INSTALLED IN CONCRETE OR ASPHALTIC PAVEMENT. PULL BOXES LOCATED IN THE ROADWAY SHALL HAVE LOCKING COVERS.

ENTRANCE HOLES INTO PULL BOXES SHALL BE CUT WITH A CIRCULAR HOLE SAW OR HYDRAULIC CONDUIT PUNCH. HOLE SIZE SHALL BE THE OUTSIDE DIAMETER OF THE CONDUIT THAT IS TO FIT IN THE OPENING PLUS NO MORE THAN 1/4".

THE CONTRACTOR SHALL NOT INSTALL WIRE IN ANY PULL BOX UNTIL ITS INSTALLATION HAS BEEN INSPECTED AND ACCEPTED BY THE ENGINEER.

GROUNDING LUGS (MECHANICAL CONNECTORS) SHALL BE U.L. LISTED AND APPROVED FOR USE WITH COPPER WIRE. THE MECHANICAL CONNECTION (INSIDE AND OUTSIDE) TO THE PULL BOX, SHALL BE TOTALLY AND PERMANENTLY SEALED WITH A SILICONE OR RUBBERIZED CAULKING COMPOUND AS APPROVED BY THE ENGINEER.

GROUNDING LUGS ARE NOT REQUIRED IN PULL BOXES WHEN VOLTAGES OF LESS THAN 50 VOLTS AC ARE THE ONLY VOLTAGES ENCOUNTERED IN THE BOXES.

DRAIN DUCT SHALL BE MEASURED AND PAID FOR SEPARATELY.


RODENT WIRE SCREEN SHALL BE 1/8" STAINLESS STEEL MESH AND BE INSTALLED WITH A STAINLESS STEEL HOSE CLAMP OF SUFFICIENT SIZE.

ALL METALLIC CONDUIT IN WHICH WIRE AND/OR CABLE IS TO BE INSTALLED, SHALL BE BUSHED BEFORE INSTALLATION OF THE WIRE AND/OR CABLE.

S.D.D. 9B2, "CONDUIT", APPLIES TO THIS DRAWING.

WHEN PULL BOXES ARE INSTALLED FOR FUTURE USE, DO NOT INSTALL THE EQUIPMENT GROUNDING LUG, THE EQUIPMENT GROUNDING ELECTRODE AND THE EQUIPMENT GROUNDING CONDUCTOR SHALL BE REQUIRED AND INSTALLED UNDER A FUTURE WIRING CONTRACT.

IF PULL BOX EQUIPMENT GROUNDING IS REQUIRED USING AN EQUIPMENT GROUNDING ELECTRODE IN EACH PULL BOX, THE EQUIPMENT GROUNDING ELECTRODE SHALL BE 3/8" X 8'-0", COPPERCLAD AND BE EXOTHERMICALLY WELDED TO A #4 AWG, COPPER, STRANDED WIRE (BARE OR GREEN INSULATED). THE #4 AWG WIRE SHALL BE 4 FEET IN LENGTH, NEATLY COILED, TAPED AND AVAILABLE FOR USE WHEN REQUIRED.

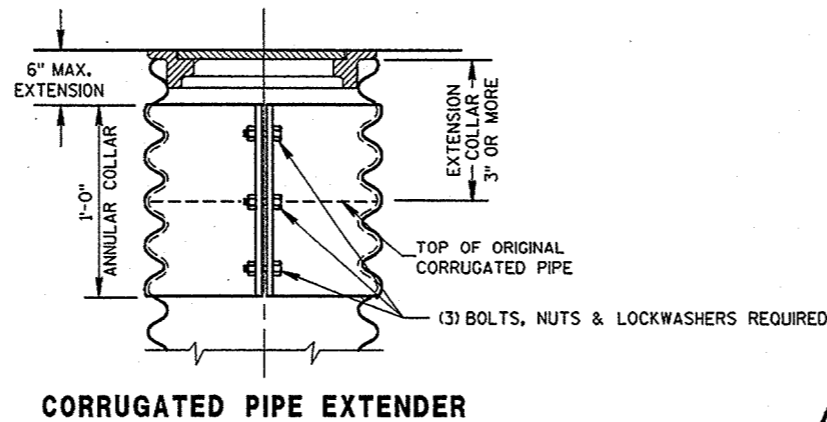

CORRUGATED PIPE EXTENDER




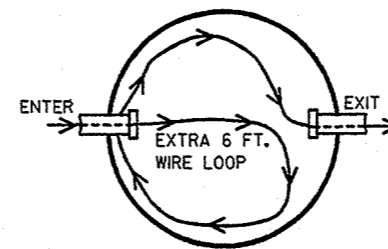


ILLUSTRATION OF WIRE/CABLE PLACEMENT IN PULLBOX

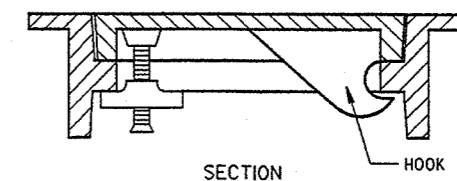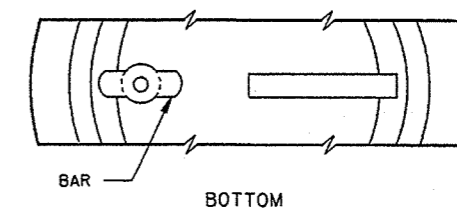


ALTERNATE COVER (LOCKING)


TIGHTENING BAR TYPE

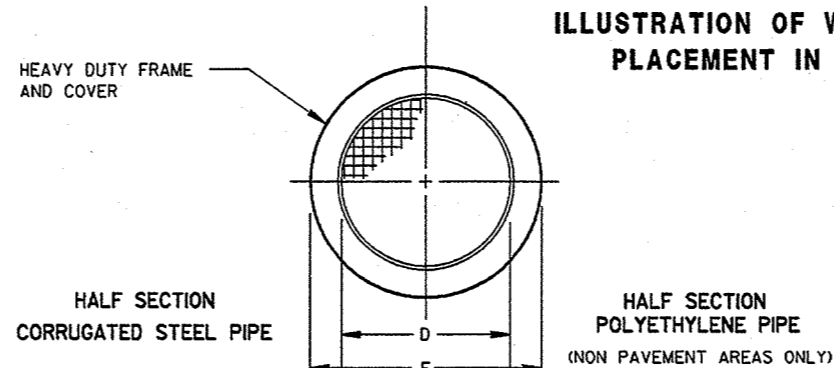

WHEN A PULL BOX IS INSTALLED IN CRUSHED AGGREGATE SHOULDERS, PLACE IT 2-3 INCHES BELOW GRADE AND COVER IT WITH 2-3 INCHES OF CRUSHED AGGREGATE

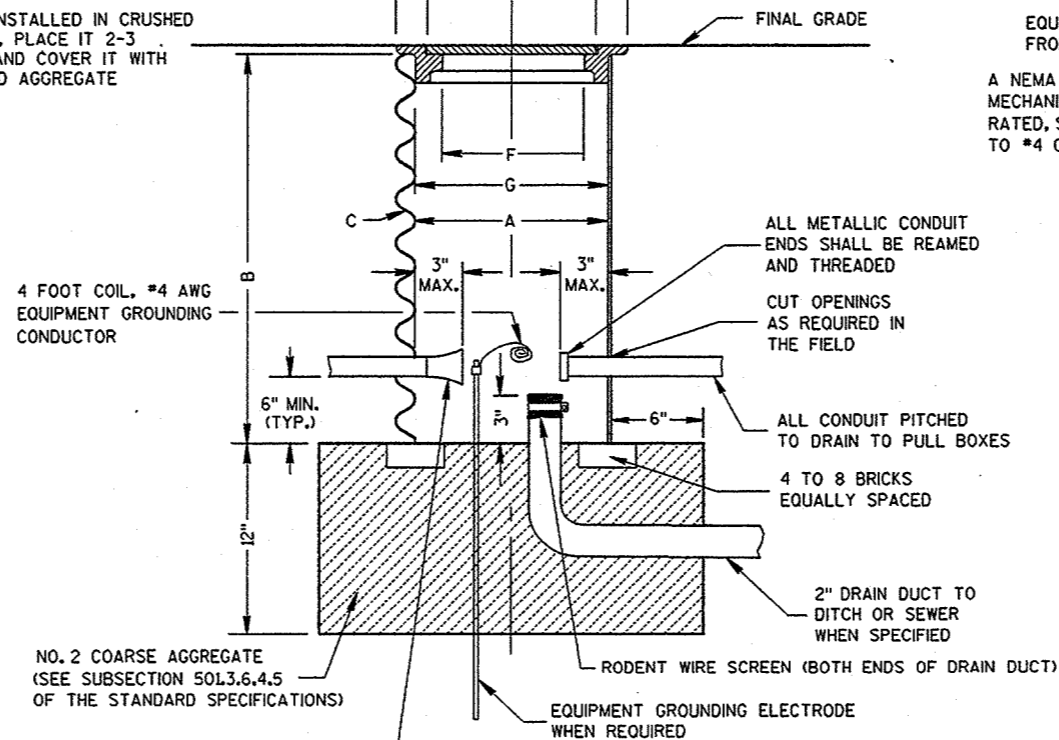



PULL BOX

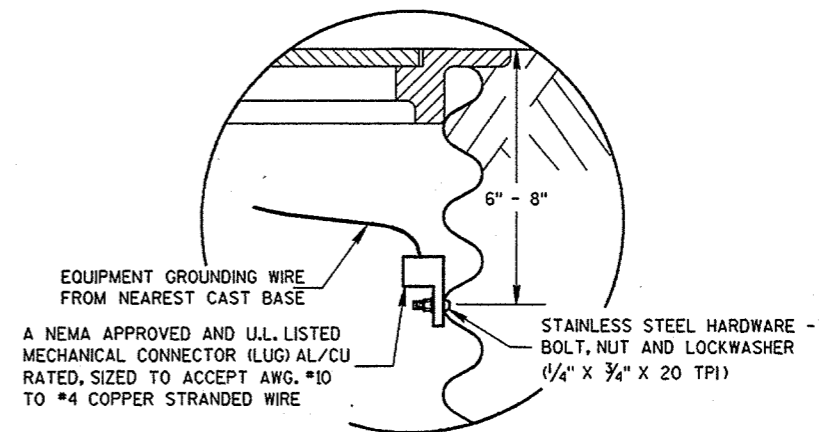


EQUIPMENT GROUNDING LUG AND LOCATION IN STEEL PULL BOXES

PULL BOX	
STATE OF WISCONSIN DEPARTMENT OF TRANSPORTATION	
APPROVED 9/10/99 DATE	<i>Brian Steed</i> STATE ELECTRICAL ENGINEER FOR HIGHWAYS
FHWA	


* RISE FOR 4' ARM SHALL BE 2'-0".

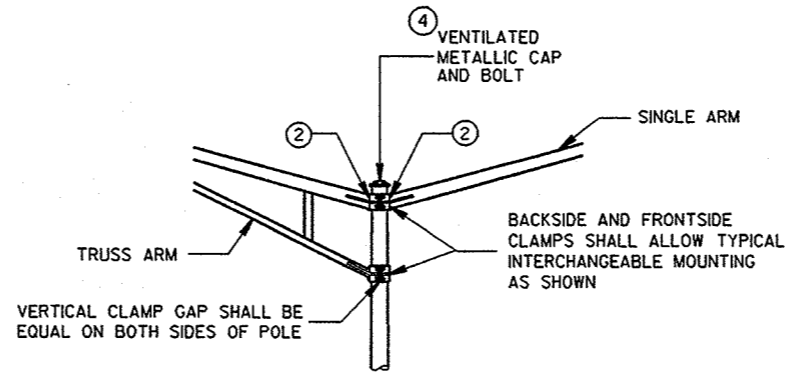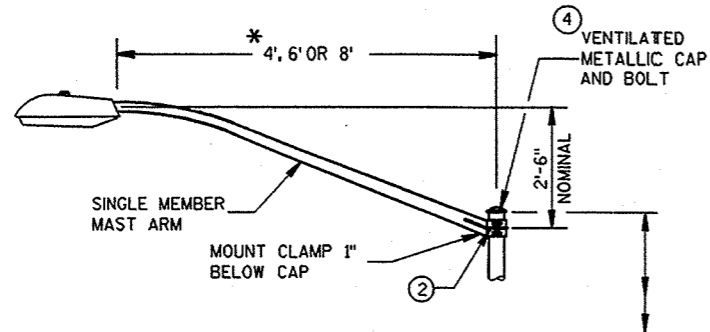

INTERCHANGEABLE MOUNTING DETAIL

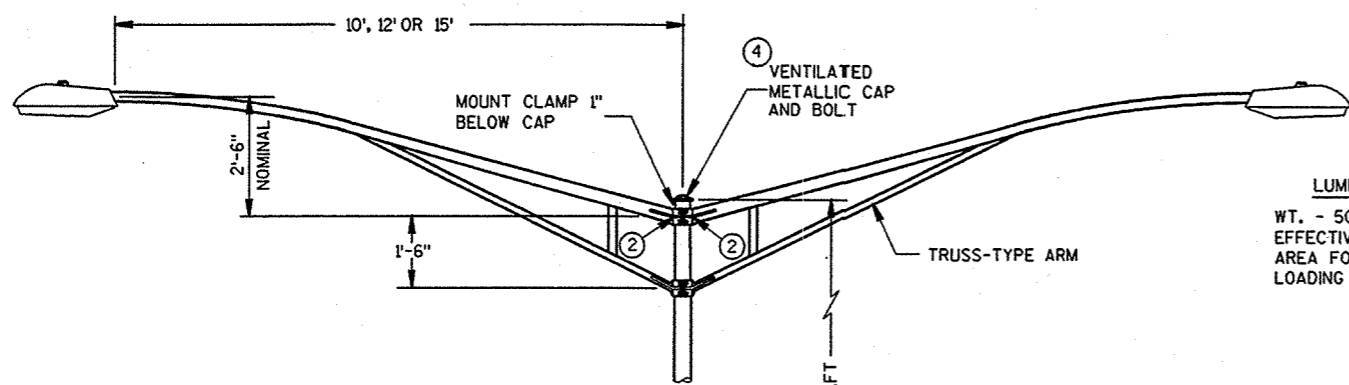

LUMINAIRE
WT. - 50 LBS.
EFFECTIVE PROJECTED
AREA FOR WIND
LOADING = 1.5 SQ. FT.

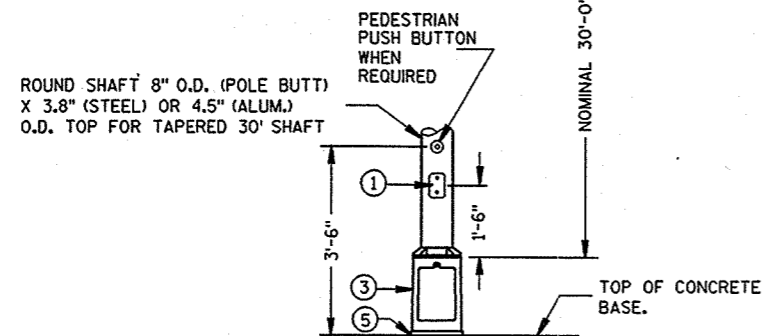

TYPE 5 POLE MOUNTING CONFIGURATION
(MAXIMUM LOAD)
LIGHTING ONLY

GENERAL NOTES

DETAILS OF CONSTRUCTION, MATERIALS AND WORKMANSHIP NOT SHOWN ON THIS DRAWING SHALL CONFORM TO THE PERTINENT REQUIREMENTS OF THE CONTRACT.
ALL TYPE 5 POLE MOUNTINGS SHALL BE DESIGNED TO INCLUDE TWIN 15' ARMS WITH LUMINAIRES.

POLES SHALL BE GALVANIZED STEEL OR ALUMINUM, AS CALLED FOR IN THE CONTRACT.

TYPE 5 ALUMINUM POLES SHALL BE CONSTRUCTED OF 6063-T6 ALUMINUM ALLOY. SLEEVING INSIDE THE POLE IS NOT ACCEPTABLE.


THE SLIPFITTER END OF THE LUMINAIRE MAST ARM SHALL BE A NOMINAL 2 3/8 INCHES IN OUTSIDE DIAMETER. THE STRAIGHT PORTION OF THE SLIPFITTER END OF THE LUMINAIRE ARM SHALL BE A NOMINAL 12 INCHES IN LENGTH.

WHEN TRANSFORMER BASES ARE USED, WIRE CONNECTIONS SHALL BE MADE IN THE TRANSFORMER BASE.


- ① 4" x 6" REINFORCED HANDHOLE & COVER ASSEMBLY WITH 2 (TWO) 1/4" x 3/4" - 20 TPI HEX HEAD STAINLESS STEEL BOLTS.
- ② GROMMETS, 1" CHASE NIPPLES OR 1" CLOSE CONDUIT NIPPLES WITH BUSHINGS SHALL BE PROVIDED FOR 1 1/8" HOLE IN POLE SHAFT FOR WIRING.
- ③ CAST ALUMINUM TRANSFORMER BASE, WHEN REQUIRED.
- ④ FURNISH AND INSTALL VENTILATED, CAST, METALLIC (ALUMINUM ALLOY) CAPS. FASTEN CAPS WITH ONE (1) 1/4" x 3/4" - 20 TPI STAINLESS STEEL, HEX HEAD BOLT.
- ⑤ SHIMMING, IF NEEDED, SHALL BE LOCATED BETWEEN THE CONCRETE FOUNDATION AND THE TRANSFORMER BASE.

POLE MOUNTINGS FOR
LIGHTING UNITS, TYPE 5
(30 FEET)


STATE OF WISCONSIN
DEPARTMENT OF TRANSPORTATION

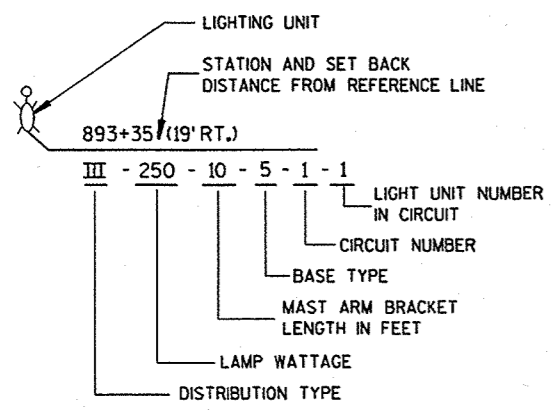



LIGHTING UNIT CODE
(TYPICAL)

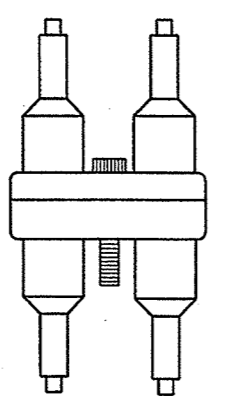

DETAIL "A"
DOUBLE POLE

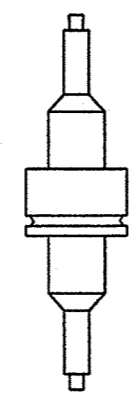


DETAIL "B"
SINGLE POLE

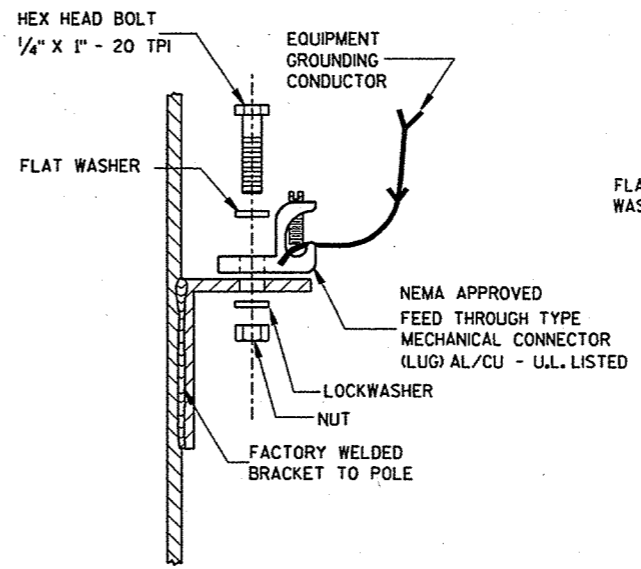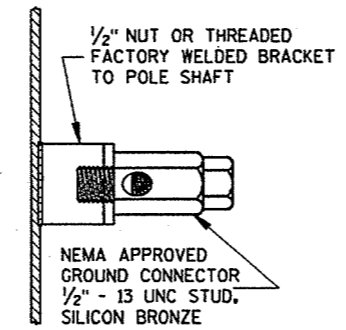


TYPICAL GROUNDING CONNECTIONS
NUT, BOLT, WASHERS AND LOCKWASHERS SHALL BE STAINLESS STEEL

GENERAL NOTES

DETAILS OF CONSTRUCTION, MATERIALS AND WORKMANSHIP NOT SHOWN ON THIS DRAWING SHALL CONFORM TO THE PERTINENT REQUIREMENTS OF THE CONTRACT.
THE EQUIPMENT GROUNDING CONNECTOR SHALL BE TAPED WITH 3 WRAPS (MINIMUM) OF APPROVED RUBBER TAPE AND THEN 3 WRAPS (MINIMUM) OF APPROVED VINYL TAPE TO COVER SHARP WIRE ENDS AFTER THE CONNECTION IS COMPLETED.

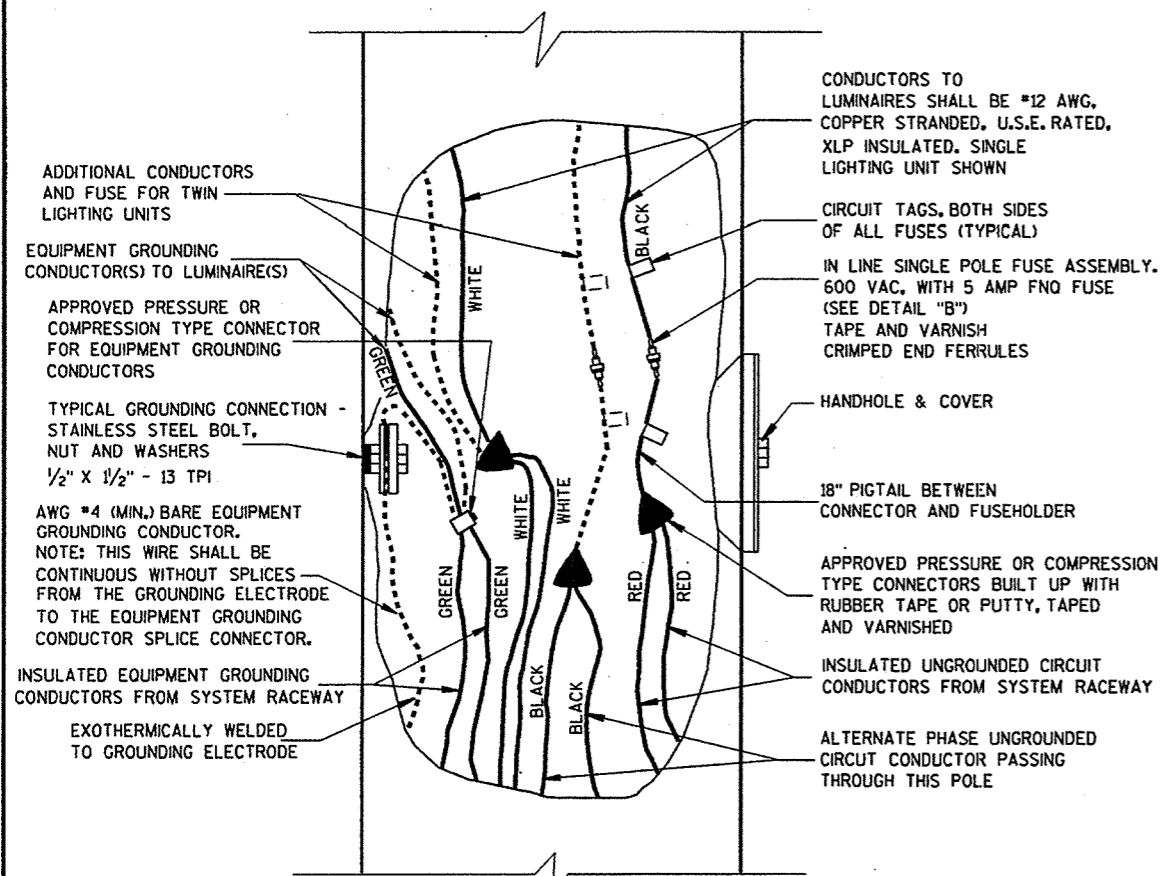


3 WIRE - 120, 240 OR 480 VAC (UNGROUNDING CONDUCTOR)
WITH GROUNDING CONDUCTOR AND
WITH EQUIPMENT GROUNDING CONDUCTOR

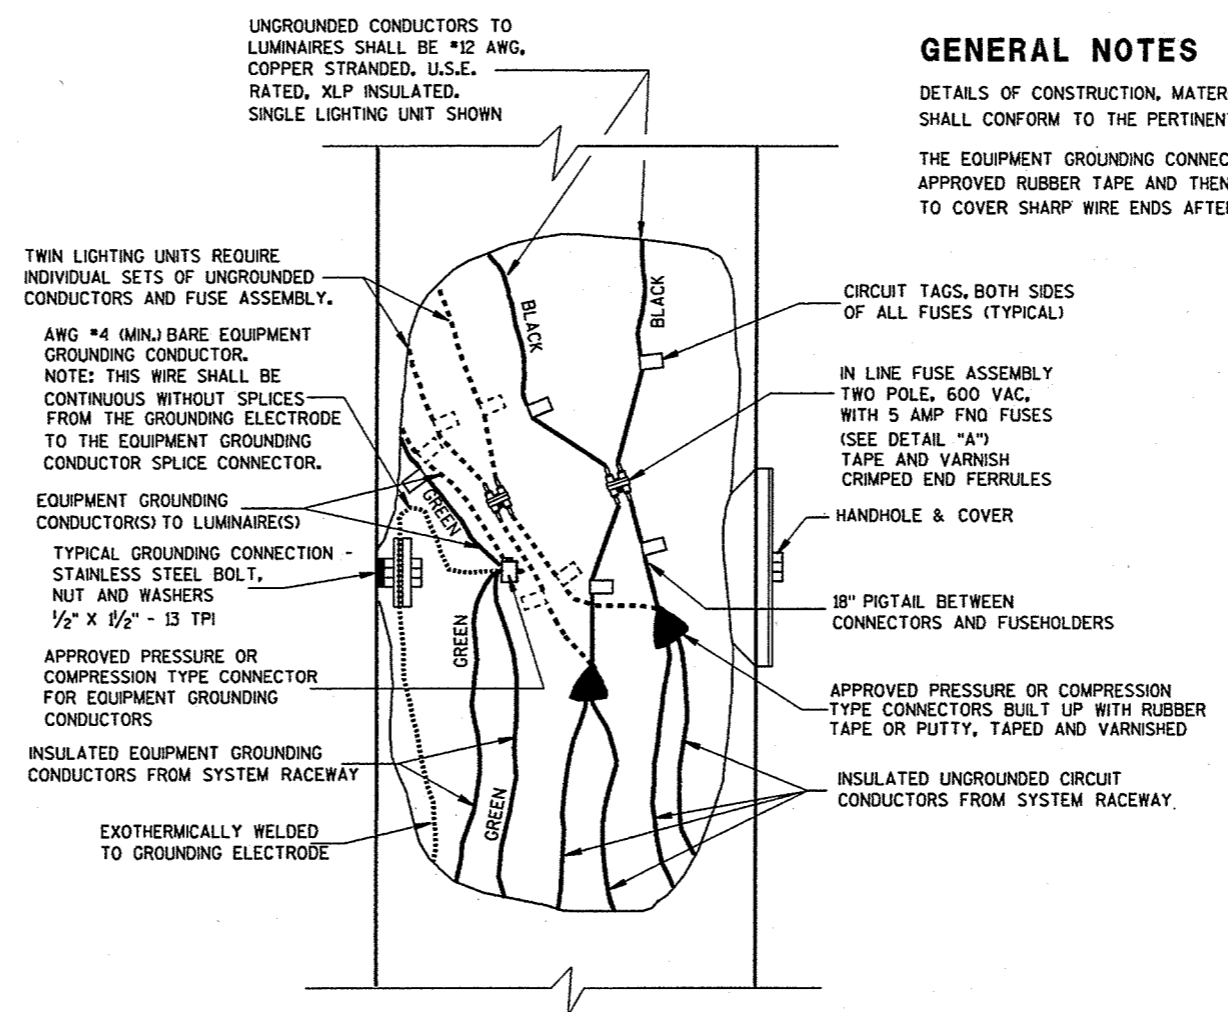


2 WIRE - 240 OR 480 VAC (UNGROUNDING CONDUCTORS)
WITH EQUIPMENT GROUNDING CONDUCTOR

NON-FREWAY LIGHTING UNIT POLE WIRING	
STATE OF WISCONSIN DEPARTMENT OF TRANSPORTATION	
APPROVED 10/21/96 DATE	<i>Dale J. [Signature]</i> STATE ELECTRICAL ENGINEER FOR HIGHWAYS
FHWA	

S.D.D. 9 E 3-2

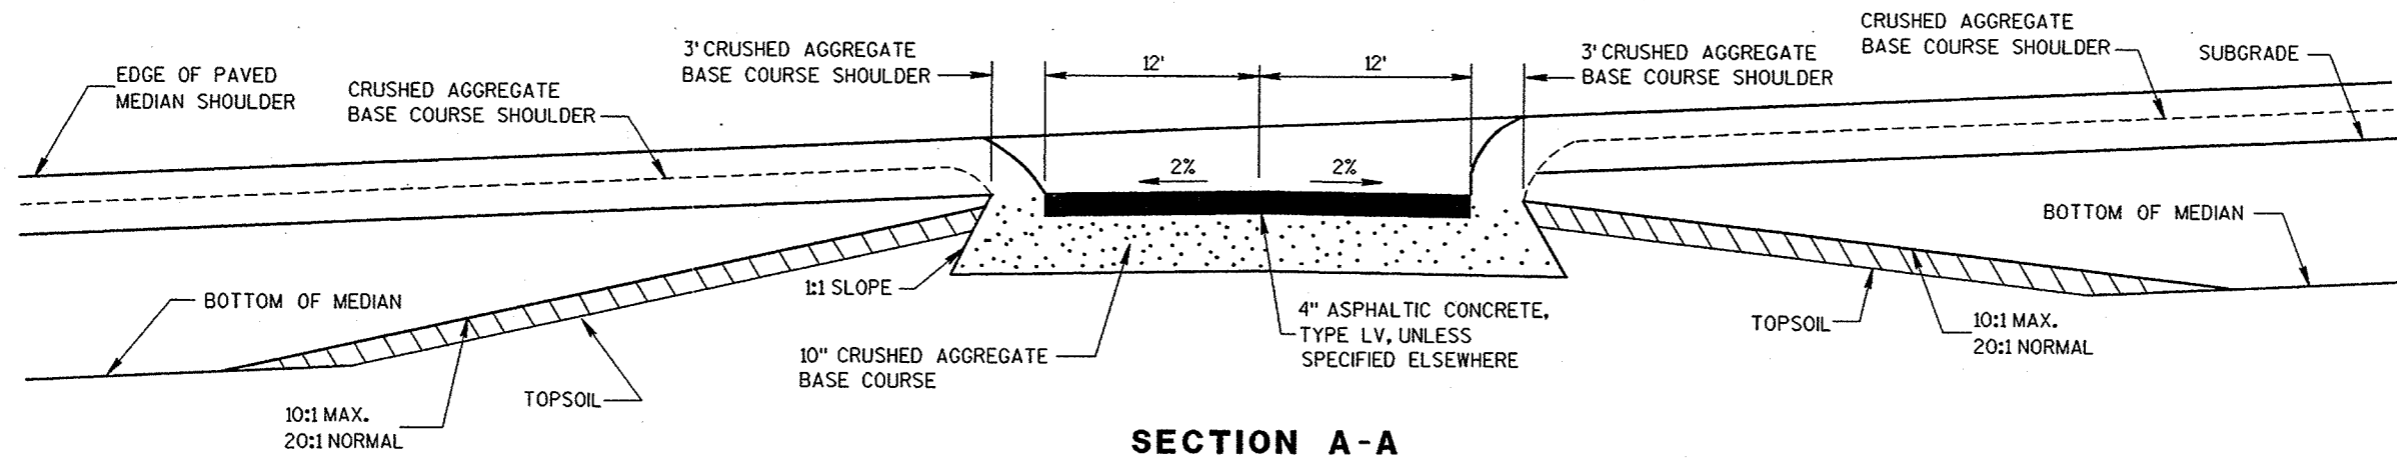

SECTION A-A

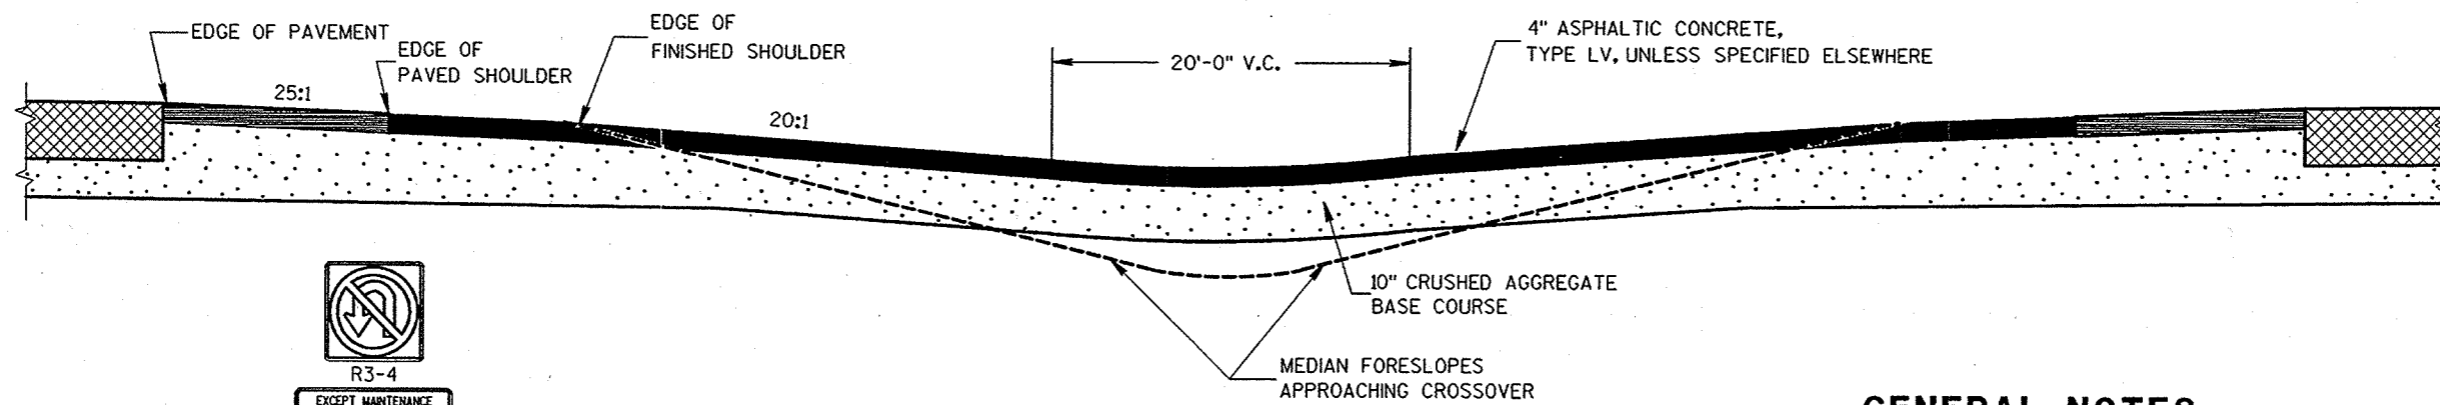

SECTION B-B




GENERAL NOTES

DETAILS OF CONSTRUCTION, MATERIALS AND WORKMANSHIP NOT SHOWN ON THIS DRAWING SHALL CONFORM TO THE PERTINENT REQUIREMENTS OF THE STANDARD SPECIFICATIONS AND THE APPLICABLE SPECIAL PROVISIONS.

INSTALL SIGNS R3-4 AND R3-4A IN LOCATION SHOWN.


SIGNING DETAILS AND SPECIFICATIONS ARE PROVIDED ELSEWHERE IN THE CONTRACT.

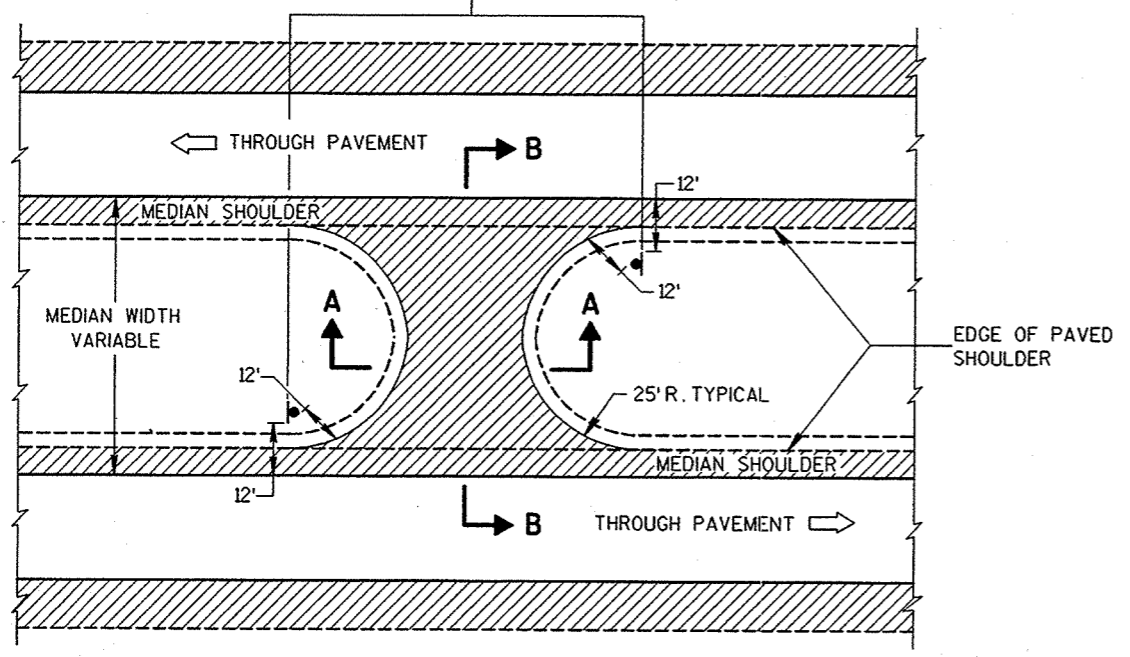


PLAN VIEW

MAINTENANCE CROSSOVER FOR FREEWAYS	
STATE OF WISCONSIN DEPARTMENT OF TRANSPORTATION	
APPROVED 01/06/98 DATE	<i>Paul J. Thomas</i> CHIEF ROADWAY DESIGN ENGINEER
FHWA	


S.D.D. 11A 1-3

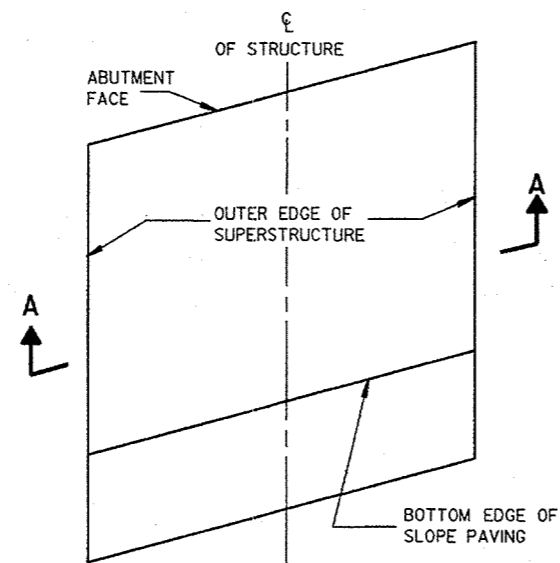

PLAN VIEW

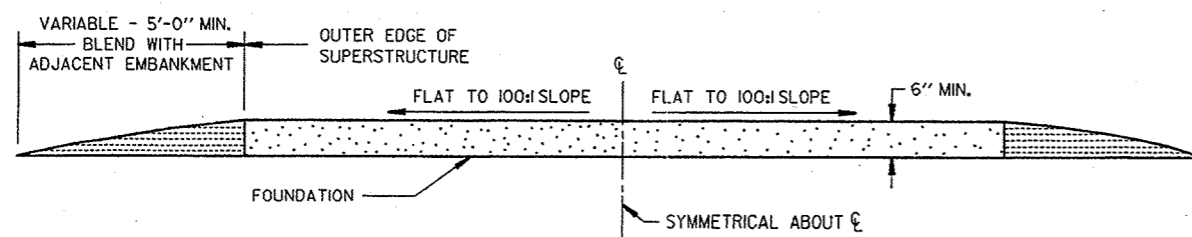

SECTION A-A

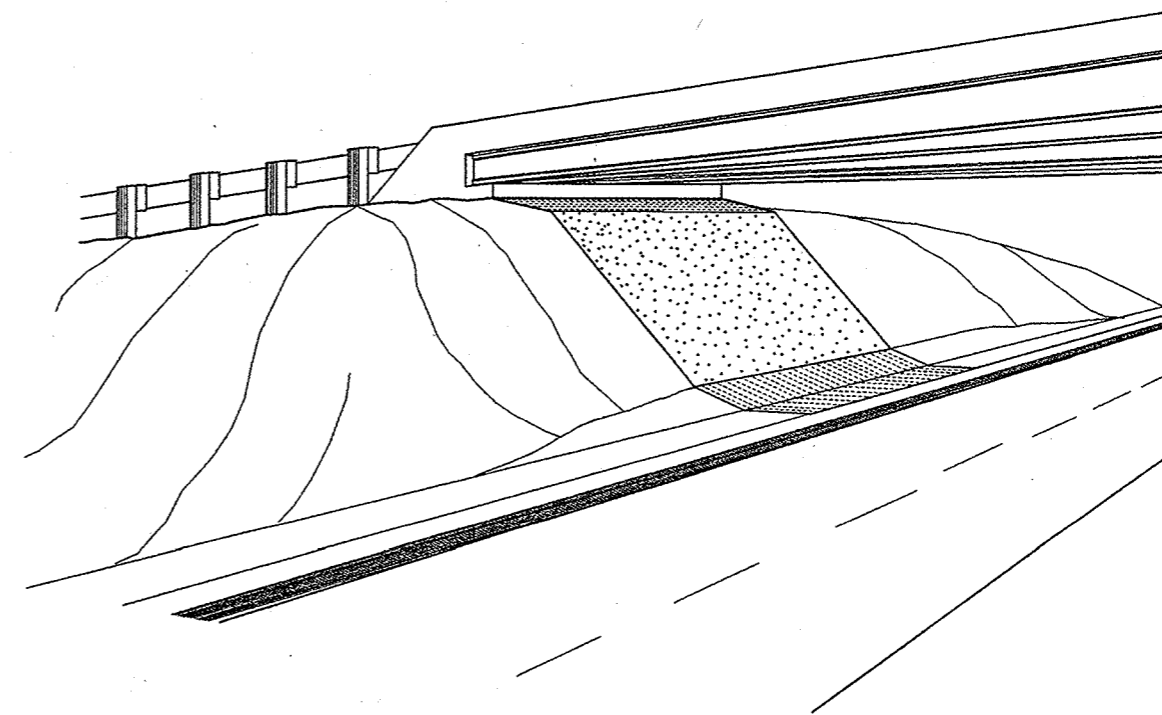


GENERAL NOTES

DETAILS OF CONSTRUCTION, MATERIALS AND WORKMANSHIP NOT SHOWN ON THIS DRAWING SHALL CONFORM TO THE PERTINENT REQUIREMENTS OF THE STANDARD SPECIFICATIONS AND THE APPLICABLE SPECIAL PROVISIONS.


WOOD FORMS MAY BE LEFT IN PLACE WHEN OF A QUALITY ACCEPTABLE TO THE ENGINEER.

- ① DIMENSIONS, SLOPES AND SLOPE LIMITS ARE DETAILED ON THE STRUCTURE PLANS.
- ② MATCH EXISTING FINISH OR FINISH AS SHOWN ELSEWHERE IN THE CONTRACT.

SLOPE PAVING UNDER STRUCTURES

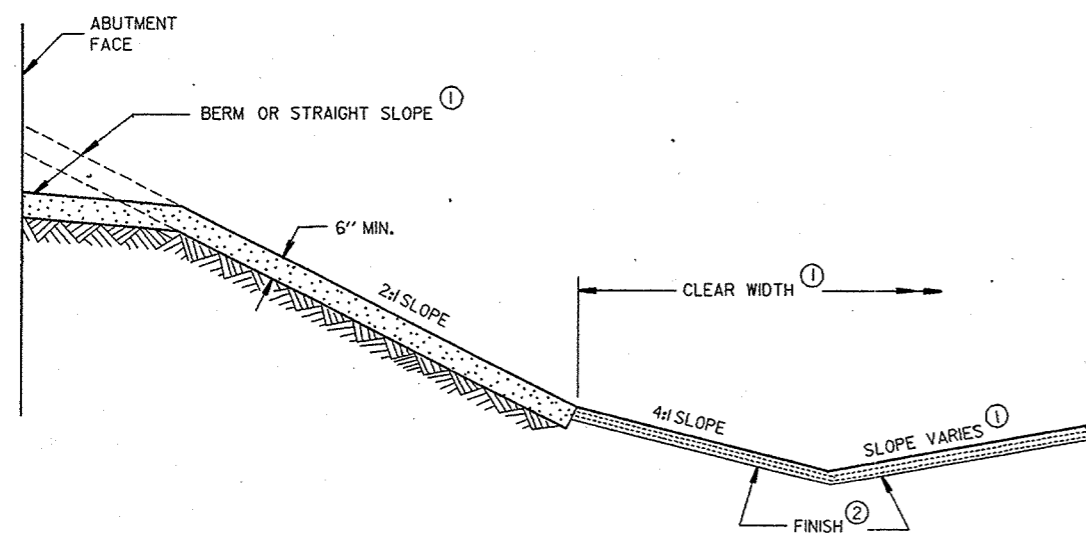

STANDARD CROSS SECTION

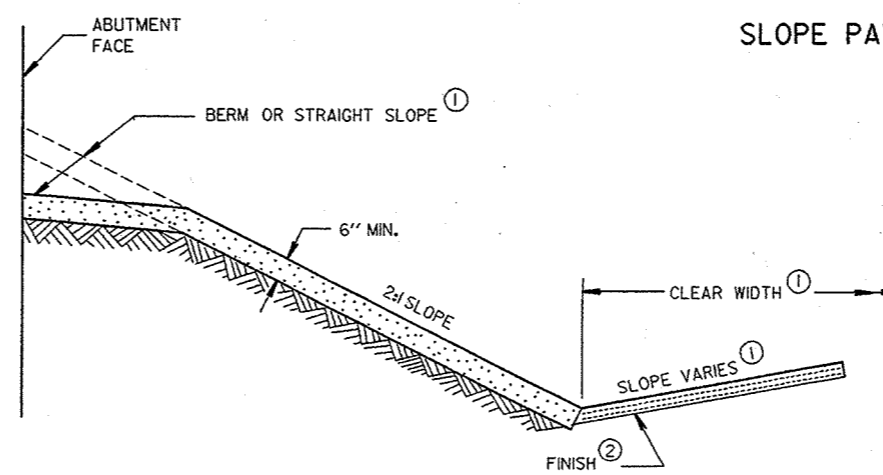

ALTERNATE CROSS SECTION

SLOPE PAVING - STRUCTURES
(CRUSHED AGGREGATE)

STATE OF WISCONSIN
DEPARTMENT OF TRANSPORTATION


APPROVED
9-21-84
DATE

D. J. Strand
CHIEF DESIGN ENGINEER


FHWA

S.D.D. 12 A 2-3

S.D.D. 12 A 2-3

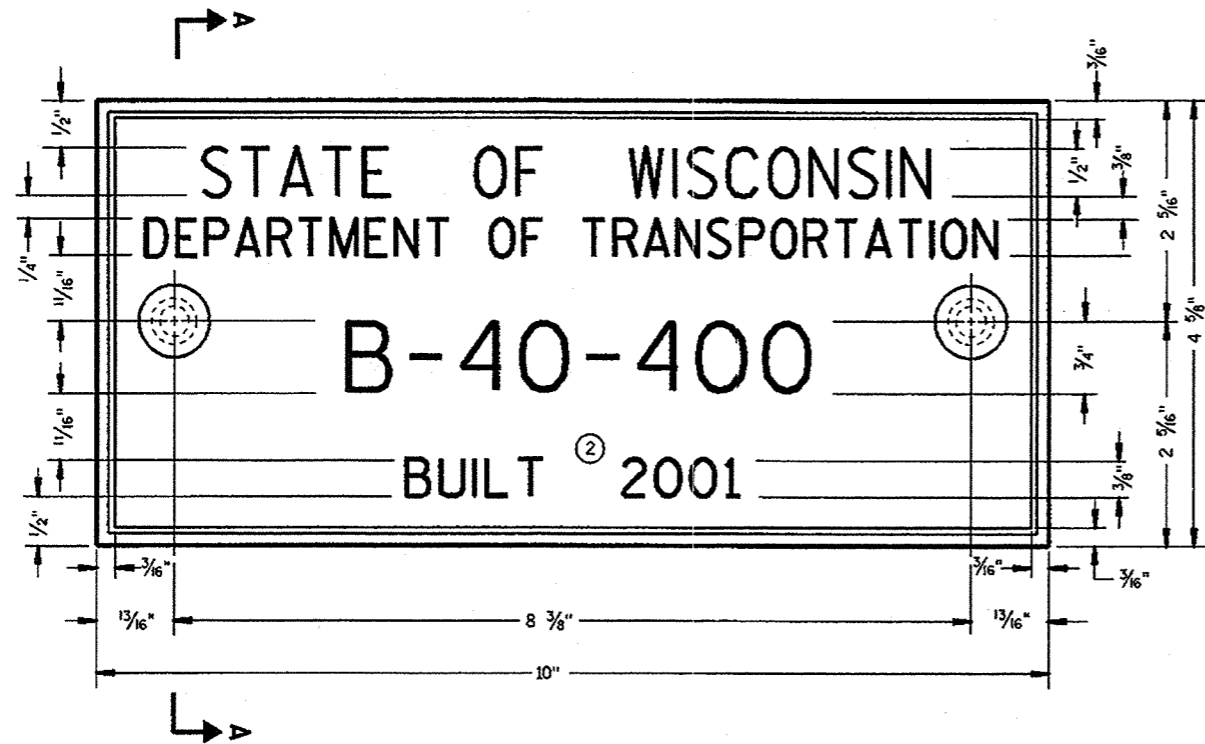

TYPICAL NAME PLATE
(BRIDGES, CULVERTS, AND RETAINING WALLS)

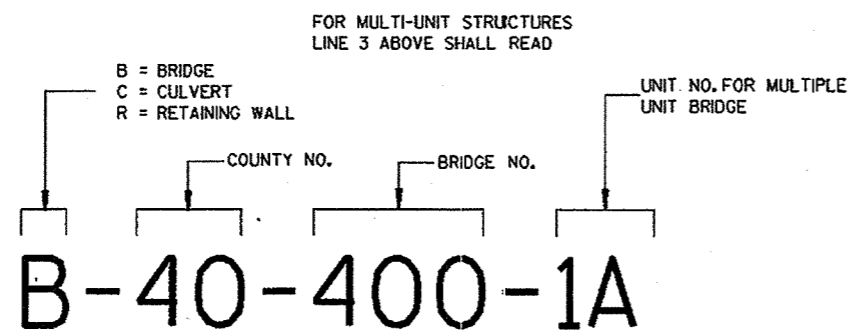


NUMBERING DESIGNATION
MULTI-UNIT STRUCTURES

GENERAL NOTES


NAME PLATES TO BE INSTALLED ON BRIDGES, CULVERTS, AND RETAINING WALLS SHALL CONFORM TO THE REQUIREMENTS OF SECTION 506.2.4 OF THE STANDARD SPECIFICATIONS.

THE BRIDGE NUMBER AND YEAR BUILT SHOWN ON THIS DRAWING ARE EXAMPLES ONLY. SEE CONSTRUCTION PLANS FOR INDIVIDUAL NUMBERING AND YEAR BUILT.


- ① EPOXY RESIN SHALL BE FROM AN APPROVED MANUFACTURER AND USED IN ACCORDANCE WITH MANUFACTURER'S RECOMMENDATIONS.
- ② REHABILITATION OF AN EXISTING STRUCTURE SHOULD USE THE DATE OF ORIGINAL STRUCTURE CONSTRUCTION.

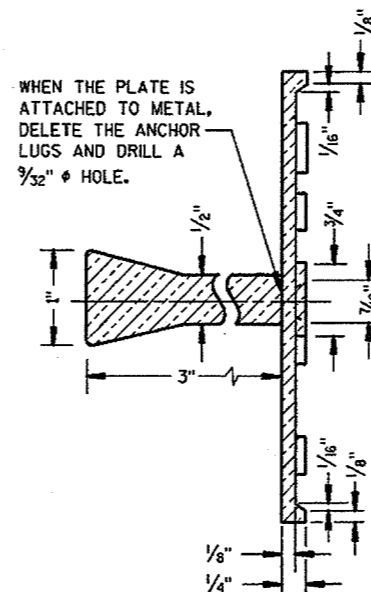

SECTION A-A

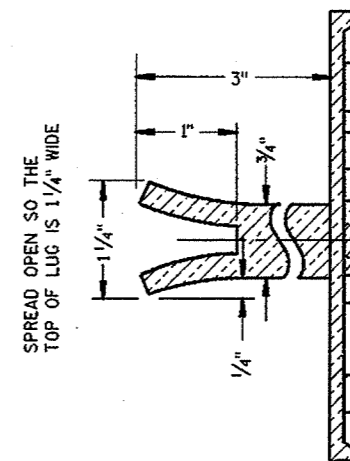


ALTERNATE LUG

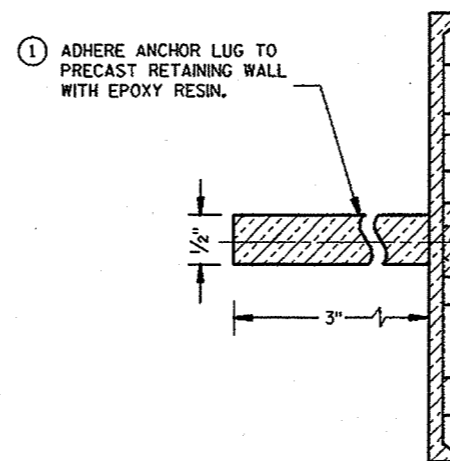


ALTERNATE LUG
(FOR ATTACHMENT TO PRECAST STRUCTURES)


NAME PLATE (STRUCTURES)	
STATE OF WISCONSIN DEPARTMENT OF TRANSPORTATION	
APPROVED <i>W. J. Woods</i> DATE	<i>S. W. Woods</i> CHIEF STRUCTURAL DEVELOPMENT ENGINEER
FHWA	

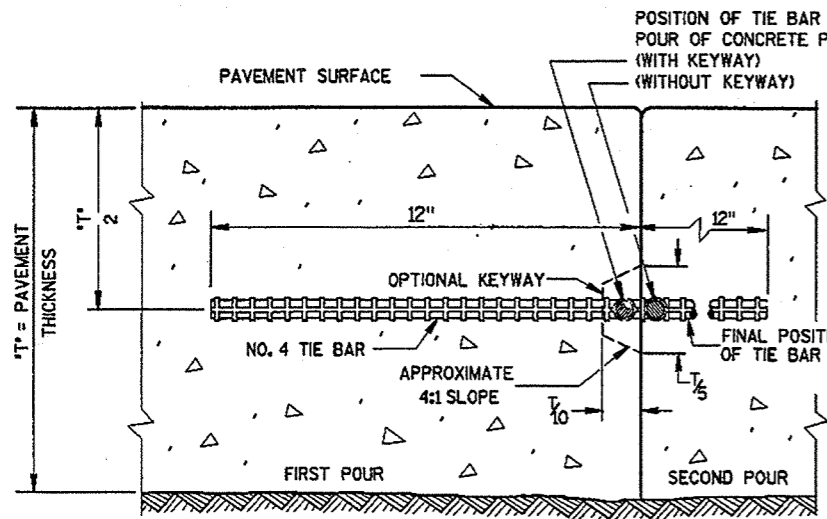

CONSTRUCTION JOINT

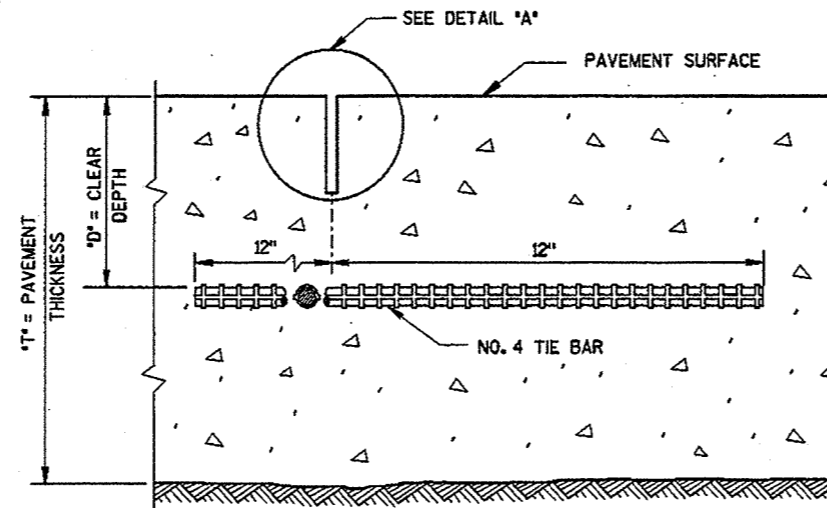

SAWED JOINT

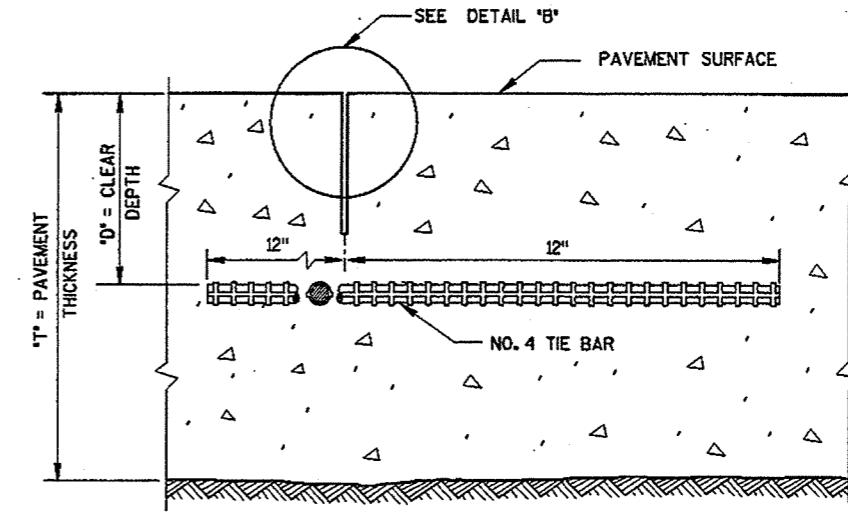

RIBBON JOINT


GENERAL NOTES

DETAILS OF CONSTRUCTION NOT SHOWN ON THIS DRAWING SHALL CONFORM TO THE PERTINENT REQUIREMENTS OF THE STANDARD SPECIFICATIONS AND THE APPLICABLE SPECIAL PROVISIONS.

DETAILS "A" AND "B" ARE EQUAL ALTERNATES UNLESS OTHERWISE SPECIFIED IN THE CONTRACT.


LONGITUDINAL JOINTS SHALL NOT BE SEALED OR FILLED.

TIE BAR SPACINGS ARE VALID ONLY FOR PAVEMENT WIDTHS IN THE TABLE. FOR WIDER PAVEMENTS, TIED CONCRETE SHOULDERS OR RAMPS, THE TIE BAR SPACING SHALL BE AS SHOWN ON THE PLANS.

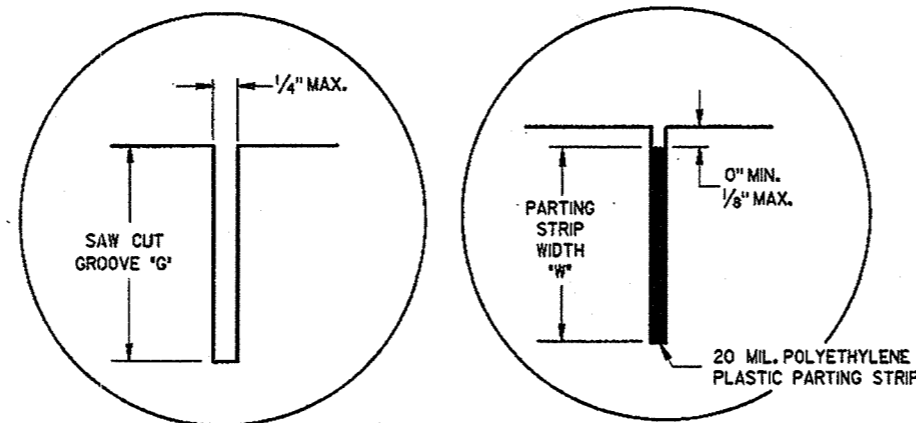


DETAIL "A"

DETAIL "B"

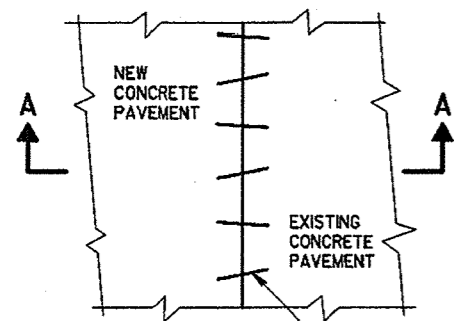

PLAN VIEW

NO. 6 TIE BARS SPACED 3'-0" C-C, INSTALLED ON 6:1 SKEW HORIZONTALLY. DIRECTION OF SKEW ALTERNATING AFTER EVERY ONE OR TWO BARS.

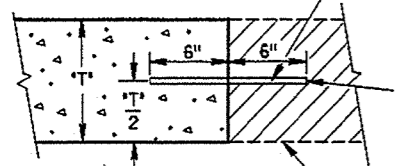


THE HOLE FOR THE BAR SHALL BE DRILLED TO A DEPTH OF 7" AND TO SUCH A DIAMETER AS TO PROVIDE A TIGHT DRIVEN FIT.

EXIST. CONC. PAVEMENT

**SECTION A-A
PAVEMENT TIES**

PAVEMENT THICKNESS "T"	CLEAR DEPTH "D"	SAW CUT GROOVE "G"	MAXIMUM TIE BAR SPACING "S"		PARTING STRIP WIDTH "W"
			24' OR 26'	30'	
6, 6 1/2"	3" ± 1/2"	2"	48"	42"	2"
7, 7 1/2"	3 1/4" ± 1"	2 1/4"	45"	36"	2 1/4"
8, 8 1/2"	3 3/4" ± 1"	2 1/2"	39"	30"	2 1/2"
9, 9 1/2"	4 1/4" ± 1"	3"	33"	27"	3"
10, 10 1/2"	4 3/4" ± 1"	3 1/4"	30"	24"	3 1/4"
11, 11 1/2"	5 1/4" ± 1"	3 3/4"	27"	21"	3 3/4"
12"	5 3/4" ± 1"	4"	24"	21"	4"

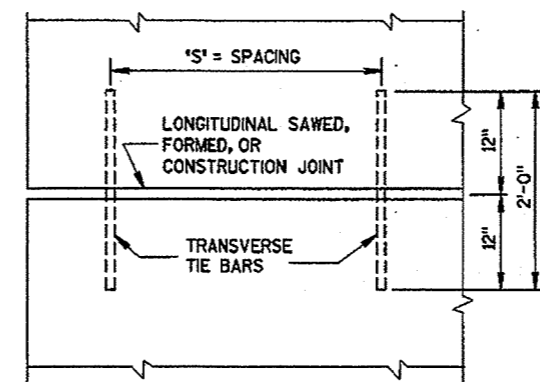

**PLAN VIEW
SHOWING LOCATION OF TIE BARS**

**CONCRETE PAVEMENT
LONGITUDINAL JOINTS
AND PAVEMENT TIES**


STATE OF WISCONSIN
DEPARTMENT OF TRANSPORTATION

APPROVED


9-24-98
DATE

FHWA

[Signature]
CHIEF PAVEMENTS & RESEARCH ENGINEER

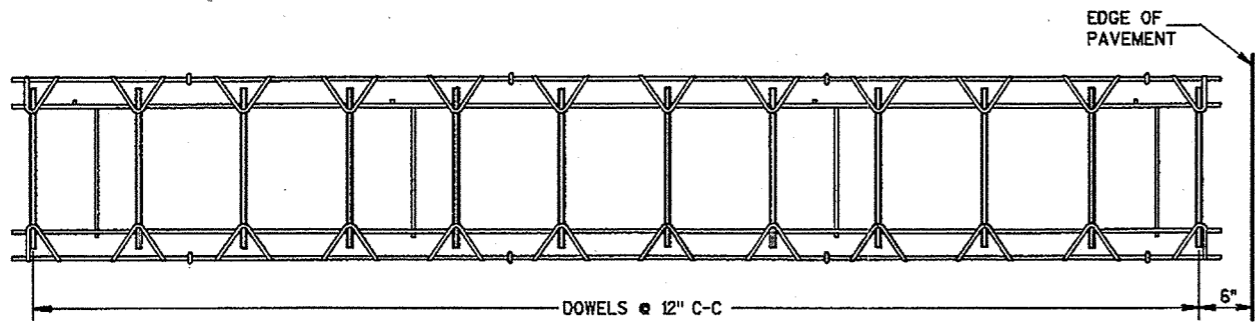


PLAN VIEW

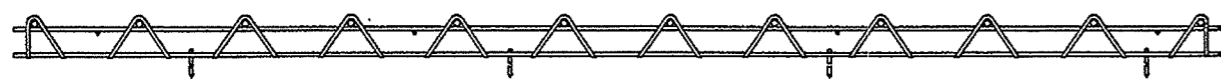


SIDE VIEW

CONTRACTION JOINT DOWEL ASSEMBLY

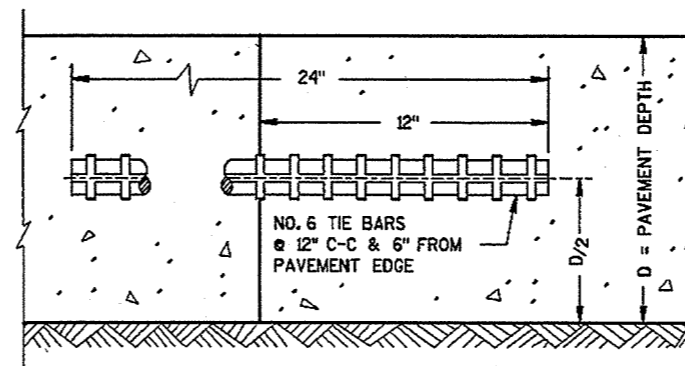

CONSTRUCTION JOINT

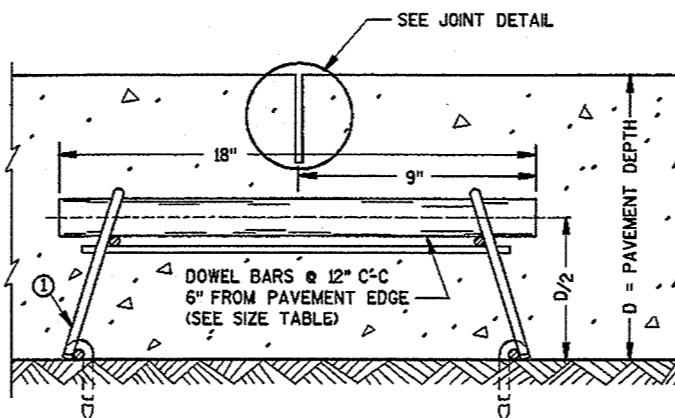


DOWELED CONTRACTION JOINT

PAVEMENT DEPTH, DOWEL BAR SIZE AND JOINT SPACING TABLE


PAVEMENT DEPTH (D)	DOWEL BAR DIAMETER	CONTRACTION JOINT SPACING
6", 6 1/2"	1 1/4"	12'
7", 7 1/2"	1 1/4"	14'
8", 8 1/2"	1 1/4"	15'
9", 9 1/2"	1 1/4"	15'
10" & ABOVE	1 1/2"	18'

1 1/4" DIA. X 18" DOWEL BARS ANCHORED INTO EXISTING PAV'T. (SEE NOTE 2)

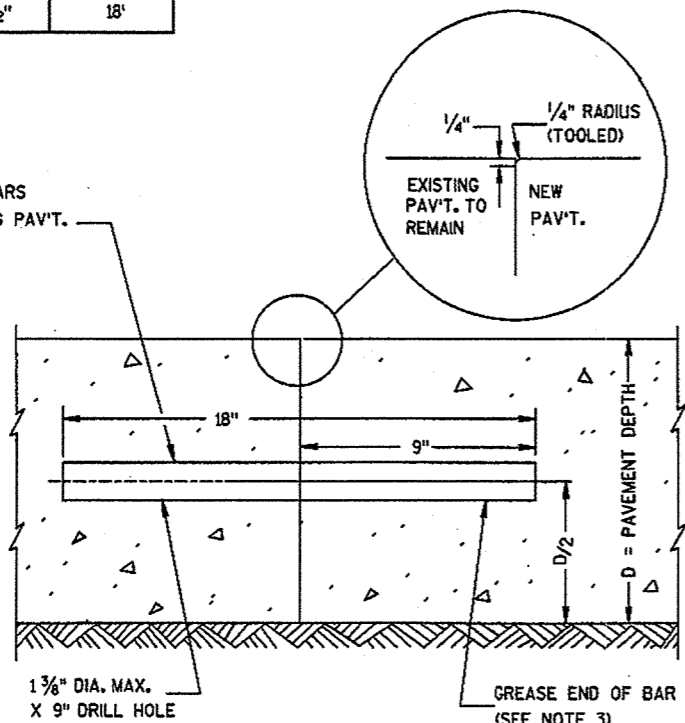


TRANSVERSE CONTRACTION JOINTS ABUTTING EXISTING PAVEMENT

DOWEL BAR DETAIL

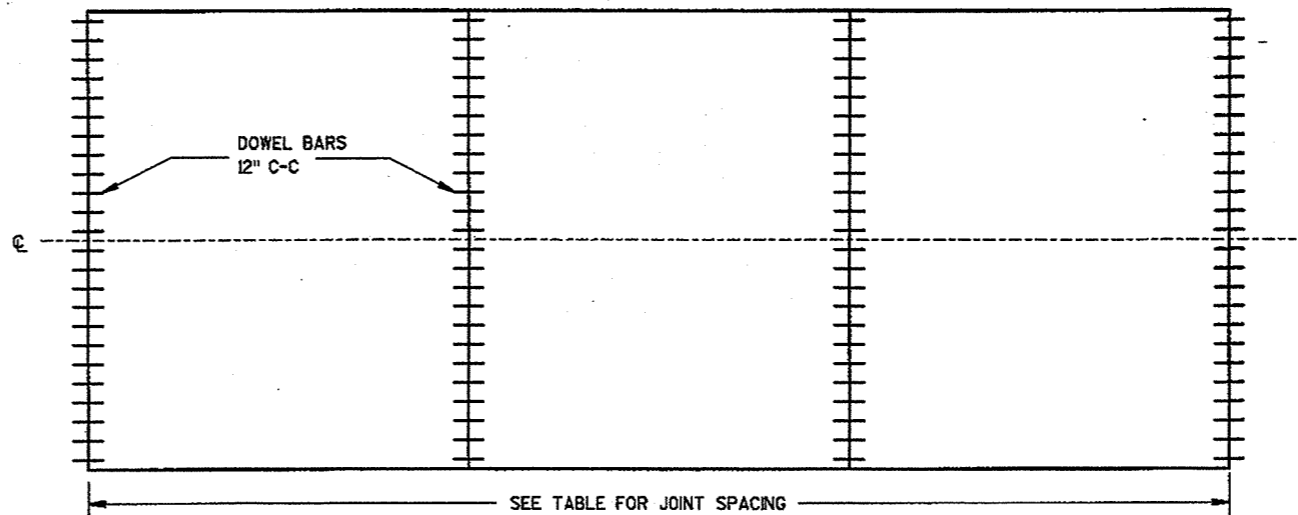

CONTRACTION JOINT LOCATIONS

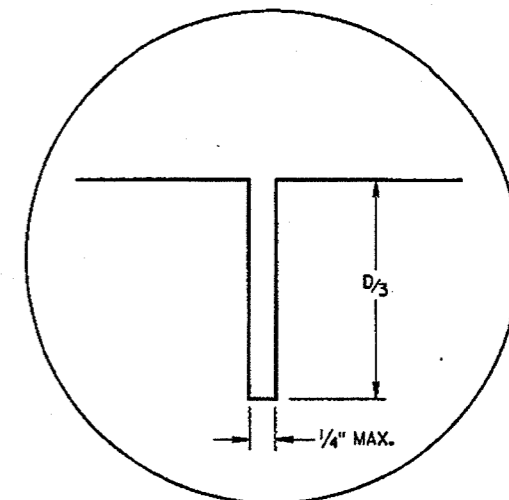

JOINT DETAIL

GENERAL NOTES

DETAILS OF CONSTRUCTION NOT SHOWN ON THIS DRAWING SHALL CONFORM TO THE STANDARD SPECIFICATIONS AND SPECIAL PROVISIONS.

CONTRACTION JOINTS

UNLESS OTHERWISE SPECIFIED, CONTRACTION JOINTS SHALL BE NORMAL TO THE CENTERLINE. THE LOCATION OF CONTRACTION JOINTS THRU INTERSECTIONS SHALL BE AS SHOWN ON THE PLANS OR AS DIRECTED BY THE ENGINEER.

CONTRACTION JOINTS SHALL NOT BE SEALED OR FILLED.

DOWEL BARS SHALL BE INSTALLED PARALLEL TO THE PAVEMENT CENTERLINE AND SURFACE.

CONSTRUCTION JOINTS

CONSTRUCTION JOINTS SHALL BE A MINIMUM OF 4 FEET FROM THE NEAREST CONTRACTION JOINT AND ALIGNED EITHER PARALLEL TO CONTRACTION JOINTS OR AT 90° TO THE CENTERLINE.

TIE BARS MAY BE INSERTED THROUGH THE HEADER BOARD AFTER THE CONCRETE HAS BEEN POURED.

- ① ALTERNATIVE DESIGNS OF THE DOWEL ASSEMBLY MAY BE USED WHEN APPROVED BY THE ENGINEER. MECHANICAL DOWEL BAR IMPLANTERS MAY BE USED INSTEAD OF DOWEL ASSEMBLIES.
- ② DOWEL BARS SHALL BE ANCHORED INTO DRILL HOLES WITH AN APPROVED EPOXY GROUT.
- ③ THE FREE END OF DOWEL BARS SHALL RECEIVE A THIN UNIFORM COATING OF BOND BREAKING GREASE.
- ④ DOWEL BARS INSTALLED BY DRILLING SHALL BE SPACED 1'-3" ON CENTER. THE GROUPING OF DOWEL BARS SHALL BE CENTERED INSIDE THE SLAB BASED ON ALL THE FOLLOWING SITUATIONS:

BETWEEN THE EDGES OF PAVEMENTS WITHOUT LONGITUDINAL JOINTS OR BETWEEN THE EDGE OF PAVEMENT AND NEAREST LONGITUDINAL JOINT OR BETWEEN TWO ADJACENT LONGITUDINAL JOINTS.

THE CLEAR DISTANCE FROM THE EDGE OF PAVEMENT OR LONGITUDINAL JOINT TO THE NEAR EDGE OF DOWEL BAR NEAREST THAT EDGE OR JOINT SHALL BE A MINIMUM OF 6 INCHES AND A MAXIMUM OF 14 INCHES.

**URBAN DOWELED
CONCRETE PAVEMENT**

STATE OF WISCONSIN
DEPARTMENT OF TRANSPORTATION

APPROVED
9-24-98
DATE

[Signature]
CHIEF PAVEMENTS & RESEARCH ENGINEER

FHWA

GENERAL NOTES

DETAILS OF CONSTRUCTION, MATERIALS AND WORKMANSHIP NOT SHOWN ON THIS DRAWING SHALL CONFORM TO THE PERTINENT REQUIREMENTS OF THE STANDARD SPECIFICATIONS, AND THE APPLICABLE SPECIAL PROVISIONS.


- ① W6 X 9 OR W6 X 8.5 STEEL POSTS AND NOTCHED PLASTIC BLOCKOUTS ARE ACCEPTABLE ALTERNATIVES FOR 6" X 8" WOOD POSTS WITH WOOD OR PLASTIC BLOCKOUTS. USE APPROVED NOTCHED PLASTIC BLOCKOUTS WITH STEEL POSTS. DO NOT MIX STEEL POSTS AND WOOD POSTS IN A SINGLE INSTALLATION.
- ② USE STRUCTURAL STEEL POSTS CONFORMING TO AASHTO M183. GALVANIZE ACCORDING TO AASHTO M 111 EITHER SET THE POSTS IN DRILLED HOLES OR DRIVE TO GRADE. REMOVE MUSHROOMING CAUSED BY DRIVING AND REPAIR DAMAGED SPALTER COATING ON GALVANIZED POSTS.
- ③ INSTALL STEEL POSTS WITH HOLES ON APPROACHING TRAFFIC SIDE.
- ④ USE EITHER WOOD OR APPROVED PLASTIC BLOCKOUTS ON WOOD POSTS.
- ⑤ WHEN SPECIFIED IN THE PLANS, THE 2-FOOT MINIMUM TO HINGE POINT MAY BE REDUCED OR ELIMINATED IF EXISTING CONDITIONS DO NOT PERMIT THE DESIRABLE EARTHWORK.

INCREASE POST LENGTH TO PROVIDE A MINIMUM EMBEDMENT OF 3'-6" IF THE SHOULDER HINGE POINT IS LOCATED IN FRONT OF THE POST.


- ⑥ IF ROCK IS ENCOUNTERED DURING EXCAVATION, THE ENGINEER MAY APPROVE USING A 12 INCH DIAMETER POST HOLE EXTENDING 20 INCHES DEEP INTO THE ROCK. PLACE GRANULAR MATERIAL IN THE BOTTOM OF THE HOLE APPROXIMATELY 2 1/2 INCHES DEEP. CUT THE POSTS TO LENGTH AND PLACE IN THE HOLE. BACKFILL WITH MATERIAL EXCAVATED FROM THE HOLE AND COMPACT ADEQUATELY.

INSTALL BEAM GUARD SECTIONS AND ALL NECESSARY HARDWARE ACCORDING TO THE APPLICABLE PLAN AND CURRENT STANDARD AND SUPPLEMENTAL SPECIFICATIONS.


ALL DIMENSIONS ARE SUBJECT TO MANUFACTURER'S TOLERANCES EXCEPT WHERE ALLOWABLE TOLERANCES ARE SHOWN.

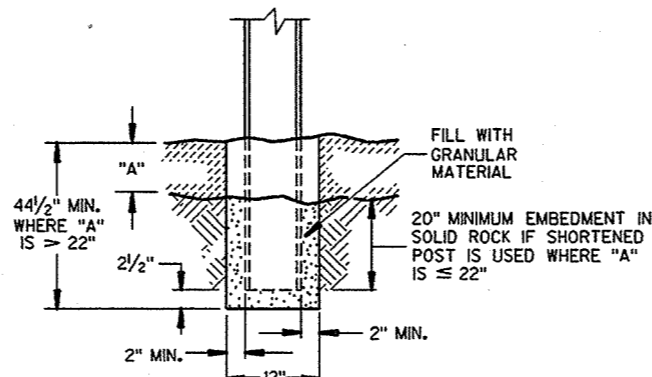


END VIEW SETTING STEEL OR WOOD POST IN ROCK ⑥

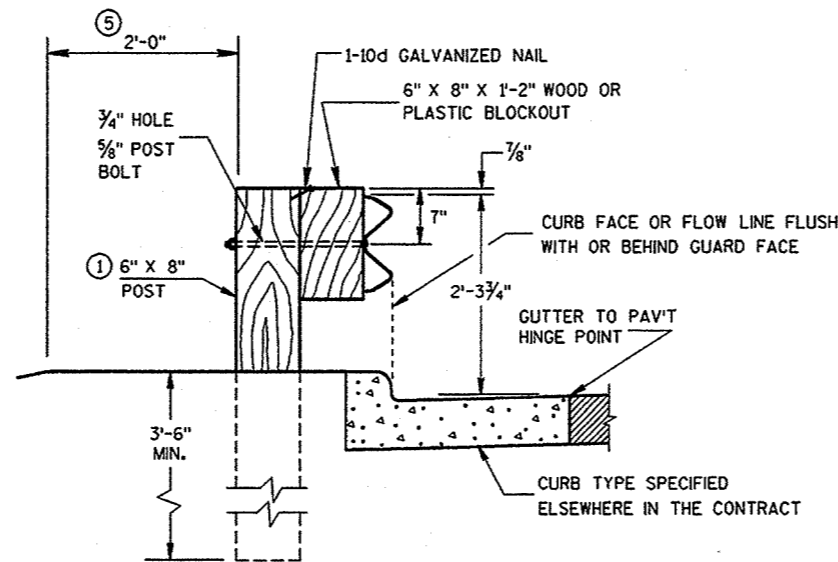


END VIEW LOCATED ALONG A CURBED ROADWAY

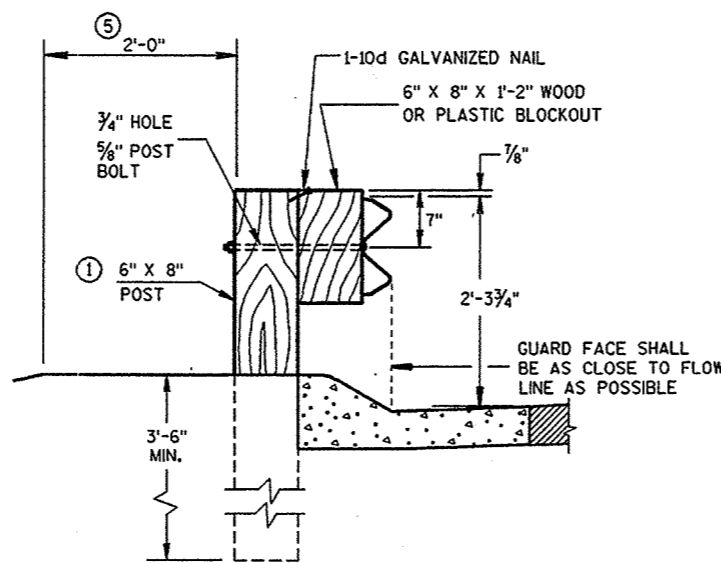


END VIEW LOCATED ALONG A MOUNTABLE CURBED ROADWAY

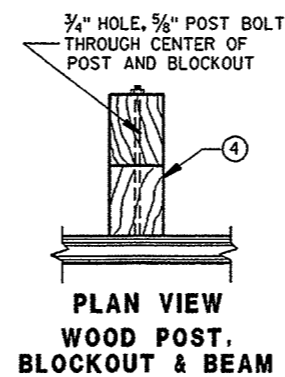

PLAN VIEW WOOD POST, BLOCKOUT & BEAM

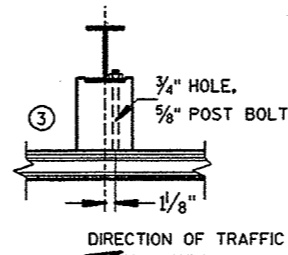


PLAN VIEW STEEL POST, NOTCHED PLASTIC BLOCKOUT & BEAM

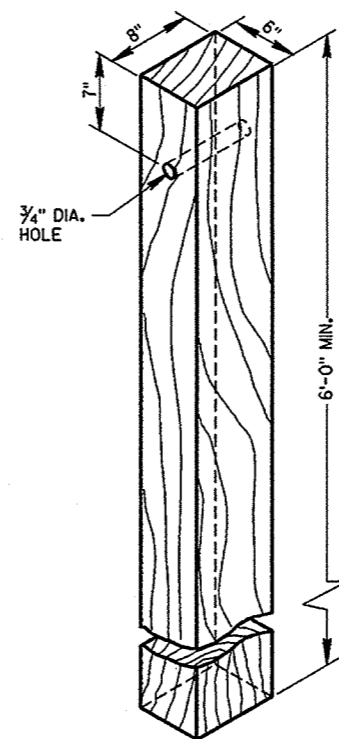


WOOD POST (6" X 8") NOMINAL

OPTIONAL 1 3/16" DIA. HOLE FOR HANDLING DURING GALVANIZING. (ONE PERMITTED)

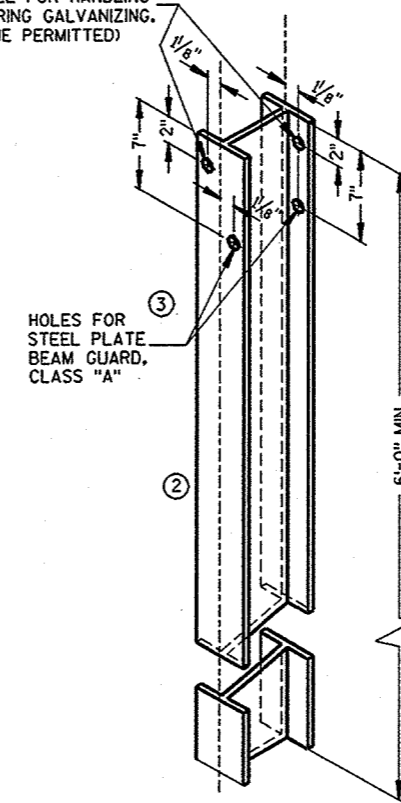


STEEL POST & HOLE PUNCHING DETAIL (W6 X 9) ①

ALL HOLES 1 3/16" DIAMETER EXCEPT AS NOTED

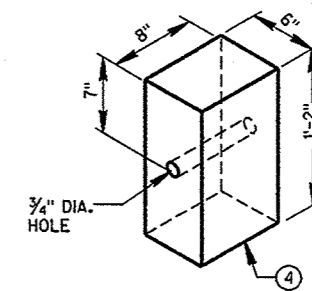

WOOD OR PLASTIC BLOCKOUT FOR WOOD POSTS

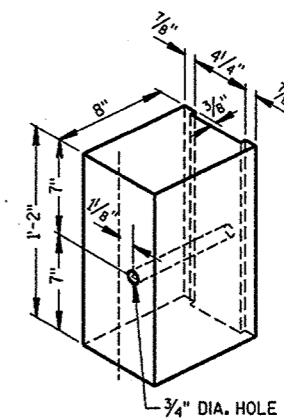


NOTCHED PLASTIC BLOCKOUT FOR STEEL POSTS


STEEL PLATE BEAM GUARD, CLASS 'A' INSTALLATION & ELEMENTS

STATE OF WISCONSIN DEPARTMENT OF TRANSPORTATION


TYPICAL INSTALLATION OF STEEL PLATE BEAM GUARD

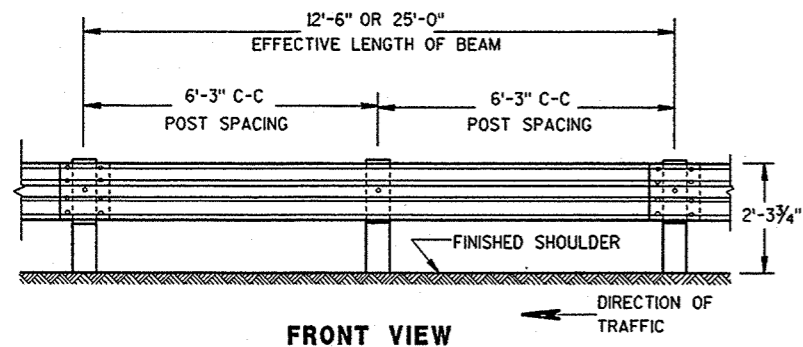


FRONT VIEW

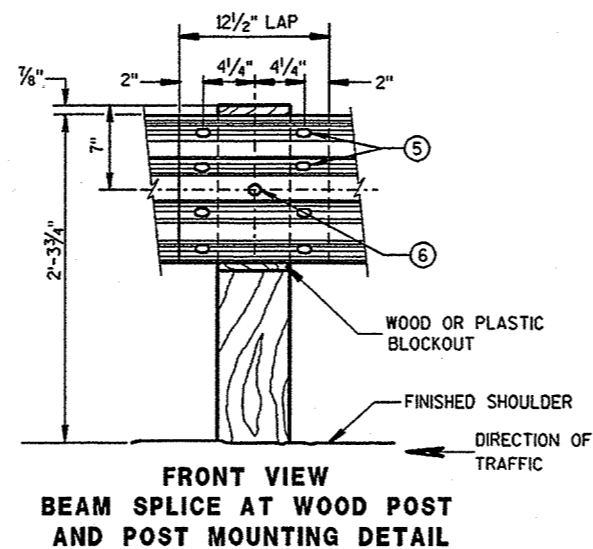

FRONT VIEW
BEAM SPLICE AT WOOD POST
AND POST MOUNTING DETAIL

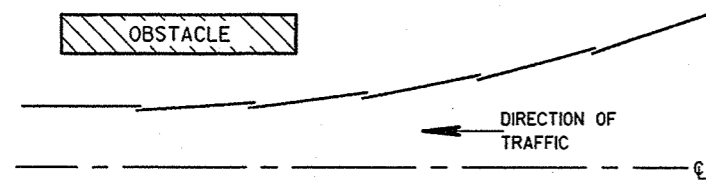

PLAN VIEW
BEAM LAPPING DETAIL

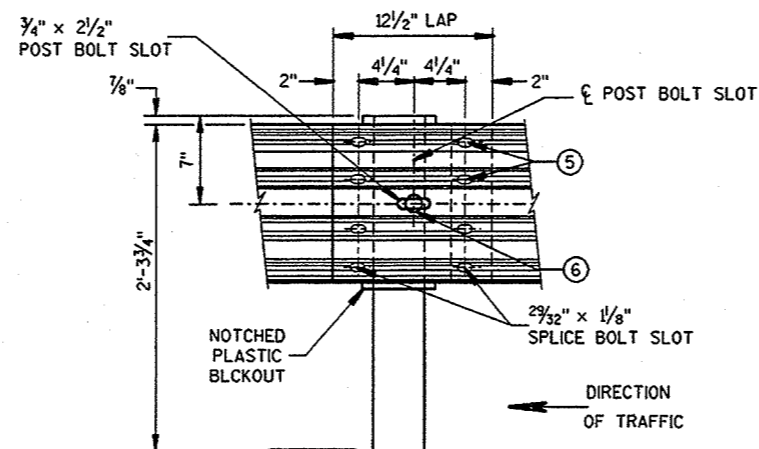


FRONT VIEW
BEAM SPLICE AT STEEL POST



TYPICAL SPLICING DETAILS OF STEEL PLATE BEAM GUARD

REFLECTOR SPACING ②


	BEAM GUARD LENGTH	REFLECTOR SPACING	NO. SURFACES REFLECTORIZED	MIN. NO. REFLECTORS
ONE WAY TRAFFIC	< 200'	50' C-C	1	3
	> 200'	100' C-C	1	3
TWO WAY TRAFFIC	< 200'	25' C-C	1 ③	6
	> 200'	50' C-C	1	6
TWO WAY TRAFFIC	< 200'	50' C-C	2 ④	3
	> 200'	100' C-C	2	3

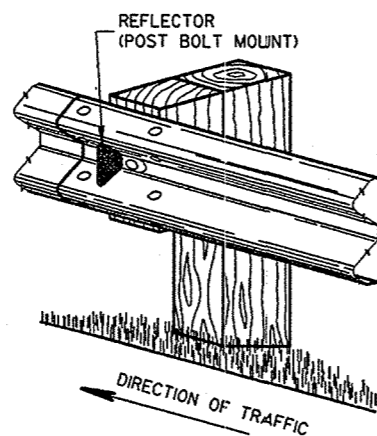

ONE SIDED REFLECTOR DETAIL AND TYPICAL INSTALLATION ①

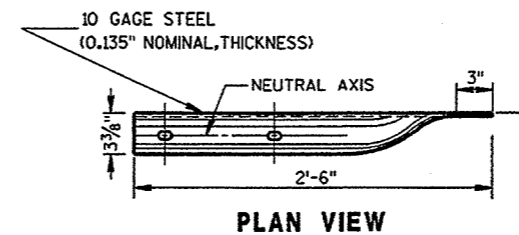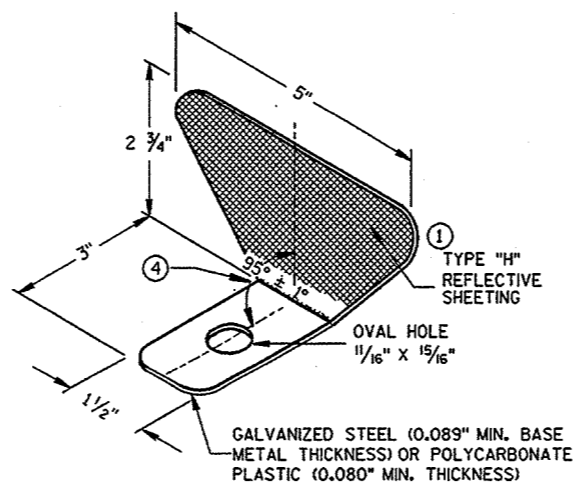


PLAN VIEW

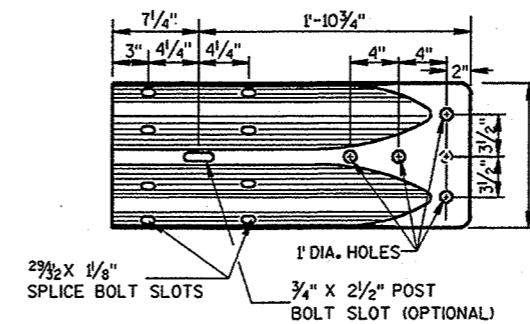

FRONT VIEW

W BEAM TERMINAL CONNECTOR
(USE ONLY ON THE TRAFFIC EXIT END OF ONE WAY BRIDGES)

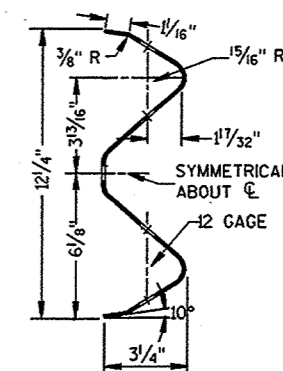

SECTION THRU W BEAM


GENERAL NOTES

- ① PROVIDE TYPE "H" SILVER REFLECTIVE SHEETING ON ALL REFLECTORS EXCEPT THOSE LOCATED ALONG THE LEFT EDGE OF ONE-WAY ROADWAYS, WHICH SHALL BE PROVIDED WITH TYPE "H" YELLOW REFLECTIVE SHEETING.
- ② DO NOT INSTALL REFLECTORS ON THE FIRST 50 FEET OF THE APPROACH END OF THE ENERGY ABSORBING TERMINAL.
- ③ REVERSE EVERY OTHER REFLECTOR FOR 2-WAY VISIBILITY. THE CONTRACTOR MAY FURNISH TWO-SIDED REFLECTORS IN LIEU OF ONE-SIDED REFLECTORS.
- ④ PROVIDE AN ANGLE OF BEND OF 90° ± 1° FOR TWO-SIDED REFLECTORS.
- ⑤ 8 - 5/8" φ X 1 1/4" BUTTON HEAD BOLTS WITH OVAL SHOULDERS & RECESS NUTS.
- ⑥ 5/8" φ X 1'-6" BUTTON HEAD BOLT AND RECESS NUT WITH ROUND WASHER UNDER NUT.


STEEL PLATE BEAM GUARD,
CLASS 'A',
INSTALLATION & ELEMENTS

STATE OF WISCONSIN
DEPARTMENT OF TRANSPORTATION

APPROVED
12/08/00 DATE *John Havelburg*
CHIEF ROADWAY DEVELOPMENT ENGINEER
FHWA

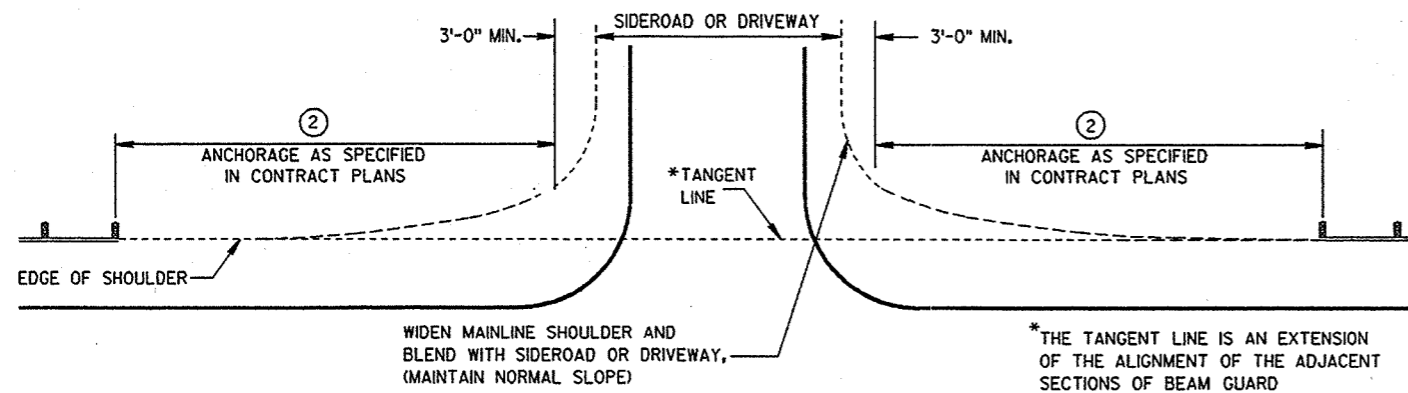

BEAM GUARD AT SIDEROADS OR DRIVEWAYS

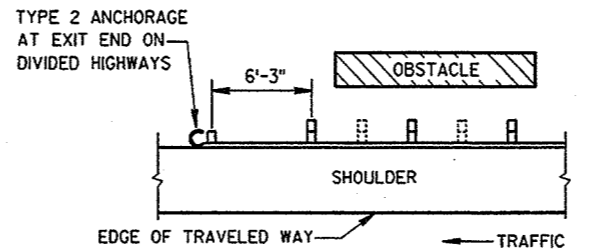

**BEAM GUARD AT OBSTACLES
EXIT END - ONE WAY TRAFFIC**

GENERAL NOTES

DETAILS OF CONSTRUCTION, MATERIALS AND WORKMANSHIP NOT SHOWN ON THIS DRAWING SHALL CONFORM TO THE PERTINENT REQUIREMENTS OF THE STANDARD SPECIFICATIONS AND THE APPLICABLE SPECIAL PROVISIONS.


W6 X 9 OR W6 X 8.5 STEEL POSTS WITH NOTCHED PLASTIC BLOCKOUTS ARE ACCEPTABLE ALTERNATIVES FOR 6" X 8" WOOD POSTS WITH WOOD OR PLASTIC BLOCKOUTS. USE APPROVED NOTCHED PLASTIC BLOCKOUTS WITH STEEL POSTS.

THE LOCATIONS AND LENGTHS OF BEAM GUARD ARE SHOWN ELSEWHERE IN THE PLAN.


- ① USE STEEL THRIE BEAM STRUCTURAL APPROACH (STBSA).
- ② USE AN APPROVED END TREATMENT FOR THE TRAFFIC APPROACH SIDE OF BRIDGE/OBSTACLES. USE TYPE 2 ANCHORAGE ONLY AT THE DOWNSTREAM ENDS OF BEAM GUARD LOCATED ALONG ROADWAYS WITH ONE WAY TRAFFIC.

**③ DESIGN DEFLECTION OF
W-BEAM BARRIER SYSTEM**

LATERAL DISTANCE TO FIXED OBJECT	POST SPACING
3'-6" TO 4'-6"	3' - 1/2"
4'-6" AND OVER	6' - 3"

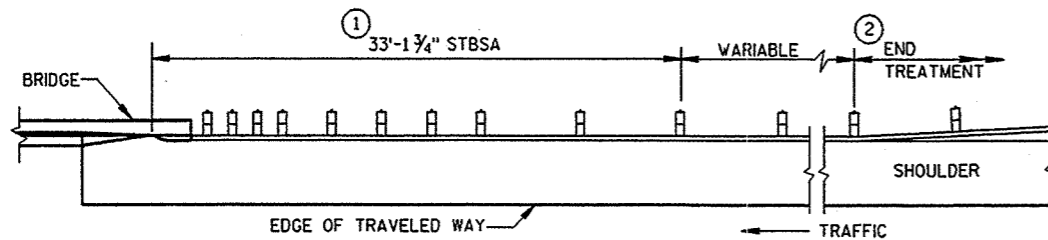


BEAM GUARD AT FULL WIDTH BRIDGES

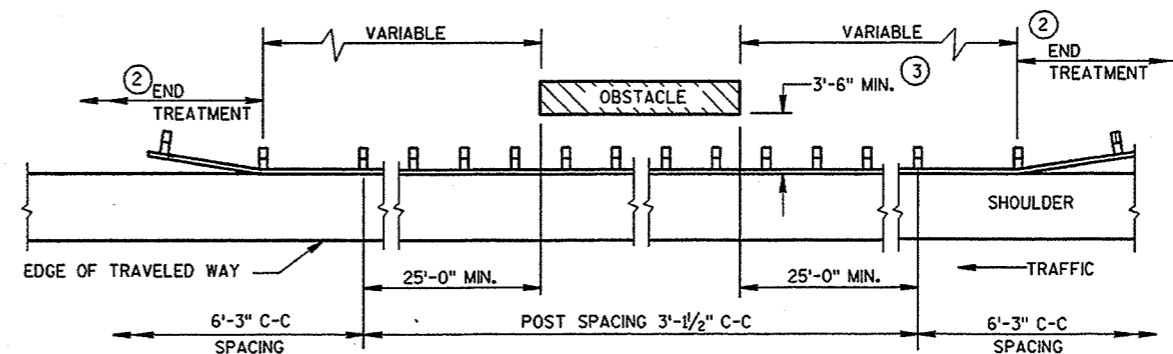



BEAM GUARD AT OSBSTACLES - TWO WAY TRAFFIC

(RAIL TO OBSTACLE CLEARANCE 3'-6" TO 4'-6")

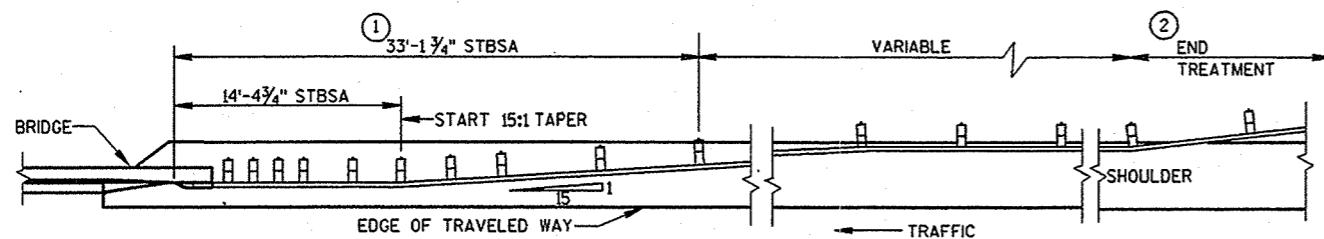

**BEAM GUARD AT NARROW BRIDGES
(FLARED TO SHOULDER EDGE, THEN PARALLEL TO ROADWAY)**

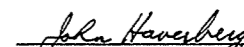STEEL PLATE BEAM GUARD, CLASS 'A' (AT BRIDGES, OBSTACLES AND SIDEROADS/DRIVEWAYS)	
STATE OF WISCONSIN DEPARTMENT OF TRANSPORTATION	
APPROVED 12/08/00 DATE	 JOHN HAVERBERG CHIEF ROADWAY DEVELOPMENT ENGINEER
<small>FHWA</small>	

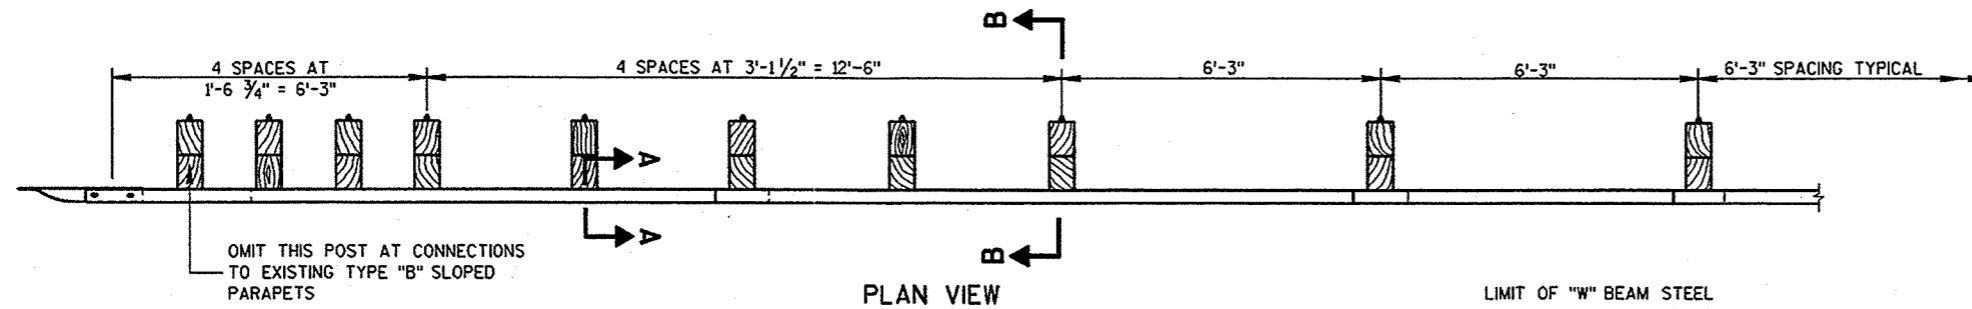

GENERAL NOTES

DETAILS OF CONSTRUCTION, MATERIALS AND WORKMANSHIP NOT SHOWN ON THIS DRAWING SHALL CONFORM TO THE PERTINENT REQUIREMENTS OF THE STANDARD SPECIFICATIONS AND THE APPLICABLE SPECIAL PROVISIONS.








FURNISH AND CONSTRUCT THRIE BEAM STRUCTURAL APPROACH ACCORDING TO THE REQUIREMENTS OF SECTION 614 OF THE STANDARD SPECIFICATIONS. THRIE BEAM SECTIONS SHALL CONFORM TO THE REQUIREMENTS OF AASHTO DESIGNATION M180, CLASS "A", TYPE 2.

BOLT THE THRIE BEAM TO ALL POSTS AND BLOCKOUTS. DRILL OR PUNCH BOLT HOLES IN THE BEAM IF THE POST SPACING IS LESS THAN 6'-3".

DO NOT USE STEEL POSTS AND NOTCHED PLASTIC BLOCKOUTS IN THE STEEL THRIE BEAM STRUCTURAL APPROACH AND THE TRANSITION SECTION OF STEEL PLATE BEAM GUARD, CLASS "A" INSTALLATIONS.

IF ROCK IS ENCOUNTERED DURING EXCAVATION, THE ENGINEER MAY APPROVE USING A 12 INCH DIAMETER POST HOLE EXTENDING 20 INCHES DEEP INTO THE ROCK. PLACE GRANULAR MATERIAL IN THE BOTTOM OF THE HOLE APPROXIMATELY 2 1/2 INCHES DEEP. CUT THE POSTS TO LENGTH AND PLACE IN THE HOLE. BACKFILL WITH MATERIAL EXCAVATED FROM THE HOLE AND COMPACT ADEQUATELY.

- ① INCREASE POST LENGTH TO PROVIDE A MINIMUM EMBEDMENT OF 4'-0" IF THE SHOULDER HINGE POINT IS LOCATED IN FRONT OF THE POST.
- ② BRIDGE RAILING TYPE "W" DO NOT REQUIRE A TERMINAL CONNECTOR.
- ③ WHEN SPECIFIED IN THE PLANS, THE CONTRACTOR MAY REDUCE OR ELIMINATE THE 2 FOOT MINIMUM TO HINGE POINT IF EXISTING CONDITIONS DO NOT PERMIT THE DESIRABLE EARTHWORK.

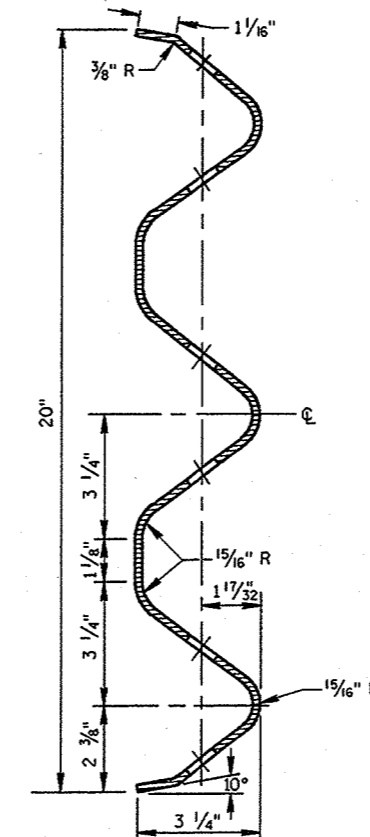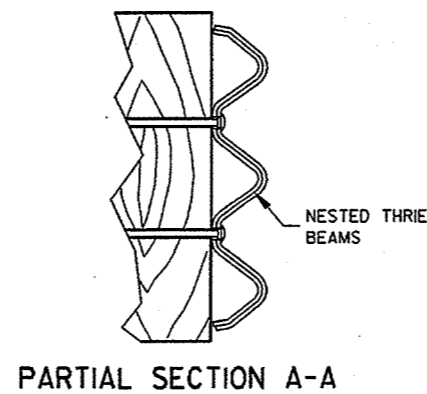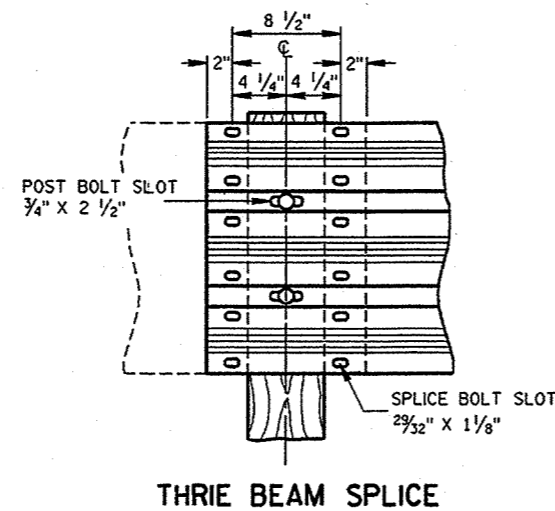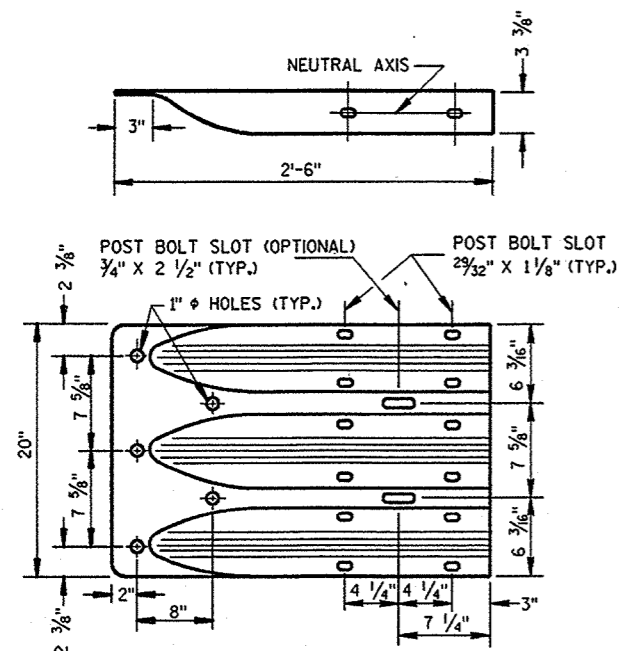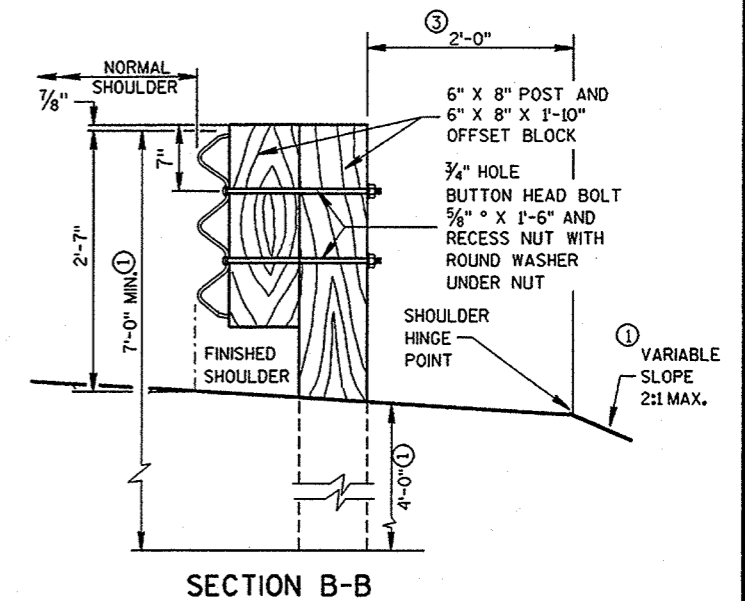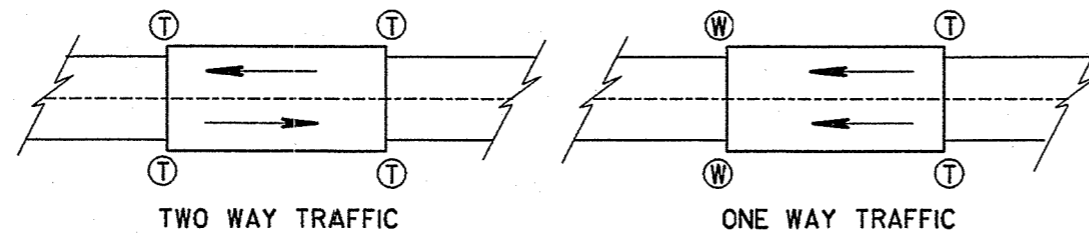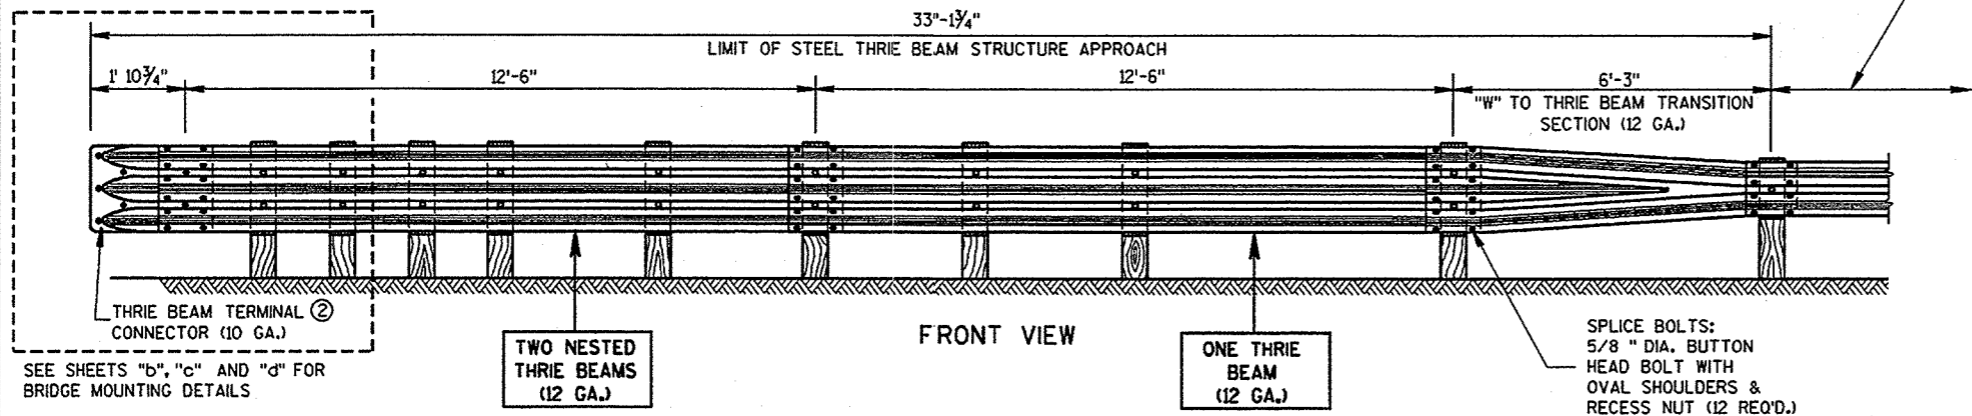

STEEL THRIE BEAM STRUCTURE APPROACH






STATE OF WISCONSIN DEPARTMENT OF TRANSPORTATION

GENERAL NOTES


THESE ARE TYPICAL CONNECTION DETAILS. ADJUST THE POSITION OF CONNECTIONS TO EXISTING BRIDGES TO FIT THE ACTUAL BRIDGE AND SITE DIMENSIONS.

BOLTS, PLATES, NUTS AND WASHERS SHALL CONFORM TO THE REQUIREMENTS OF ASTM SPECIFICATION A 325, AND BE GALVANIZED IN ACCORDANCE WITH ASTM A 153.

- ① INCLUDE THE PAYMENT FOR DRILLING BOLT HOLES THROUGH THE PARAPET, AND THE BACKUP PLATE AND ALL BOLTS, NUTS AND WASHERS IN THE ITEM "STEEL THRIE BEAM STRUCTURAL APPROACH".
 - ② EACH BOLT AT THE BACK FACE OF THE PARAPET REQUIRES A HARDENED ROUND STEEL WASHER WITH A 2 1/4" O.D. X 5/32" THICK.
 - ③ THE RECESS FOR A W-BEAM CONNECTION, WHICH EXISTS ON SOME PARAPETS OF THIS TYPE, SHALL BE FILLED WITH A TREATED TIMBER BLOCKOUT. BLOCKOUT SIZE IS 1'-6" X 2'-0" X 3 1/2".
 - ④ W6 X 9 OR W6 X 8.5 STEEL POSTS AND NOTCHED PLASTIC BLOCKOUTS ARE ACCEPTABLE ALTERNATIVES FOR 6" X 8" WOOD POST WITH WOOD OR PLASTIC BLOCKOUTS. USE APPROVED NOTCHED PLASTIC BLOCKOUTS WITH STEEL POSTS.
- DO NOT USE STEEL POSTS AND NOTCHED PLASTIC BLOCKOUTS IN THE STEEL THRIE BEAM STRUCTURAL APPROACH AND THE TRANSITION SECTION OF STEEL PLATE BEAM GUARD, CLASS "A" INSTALLATIONS.

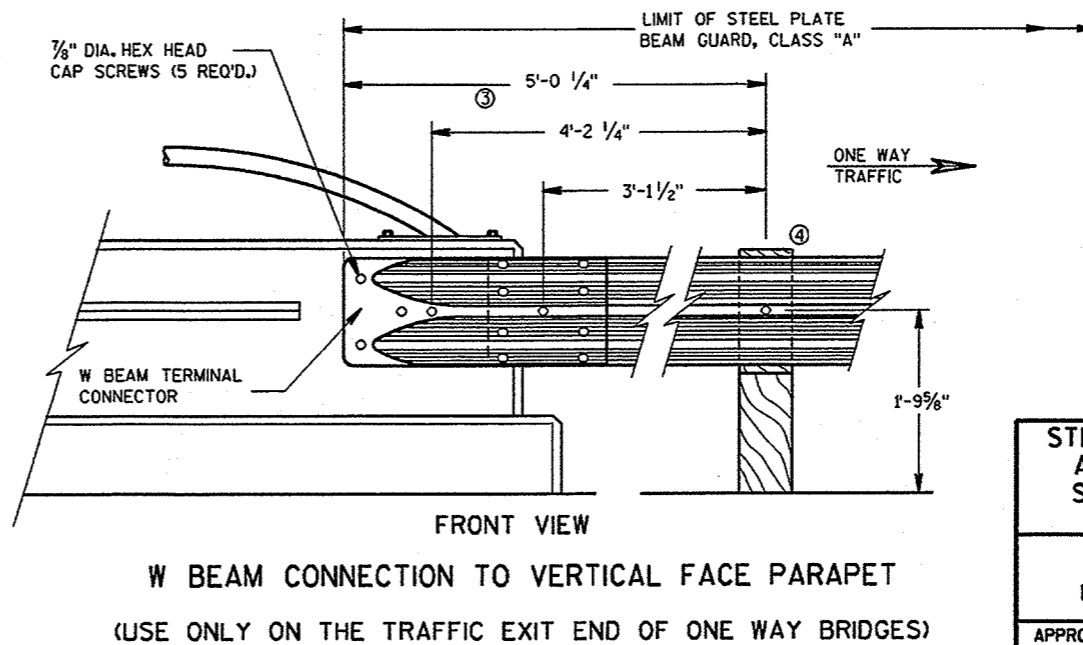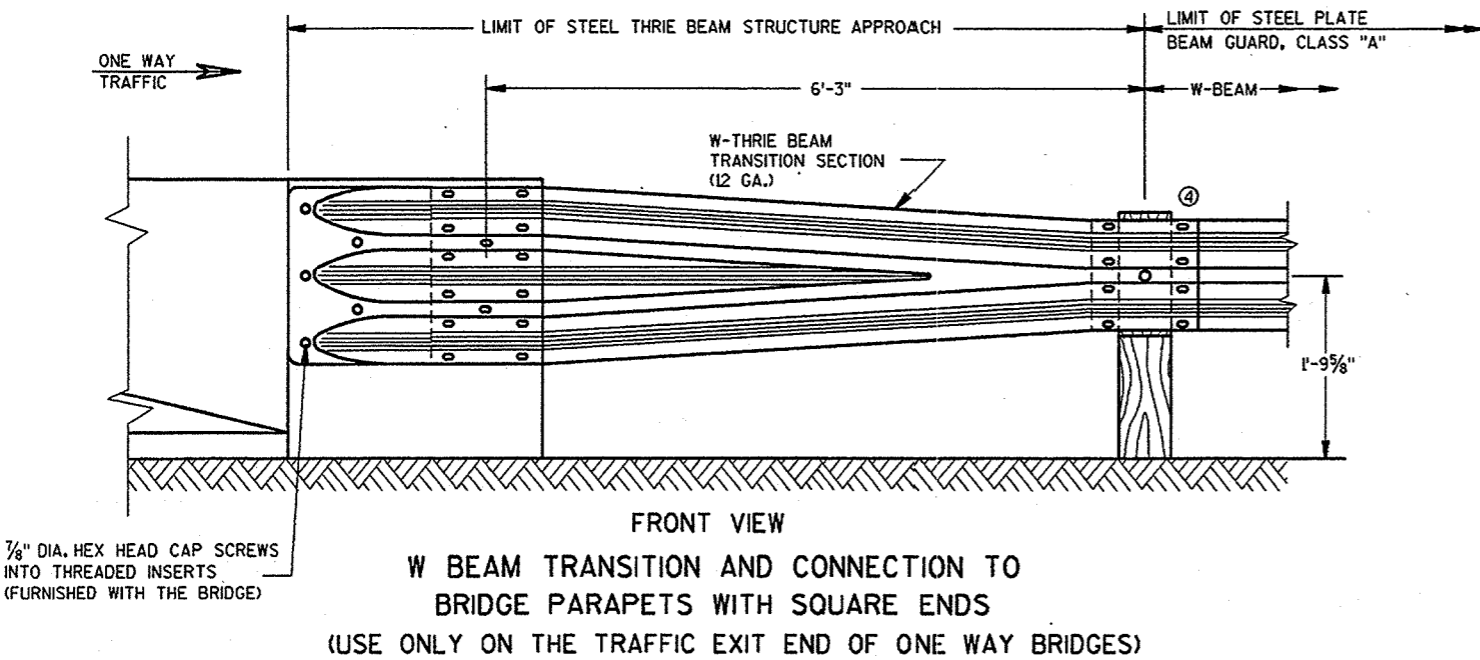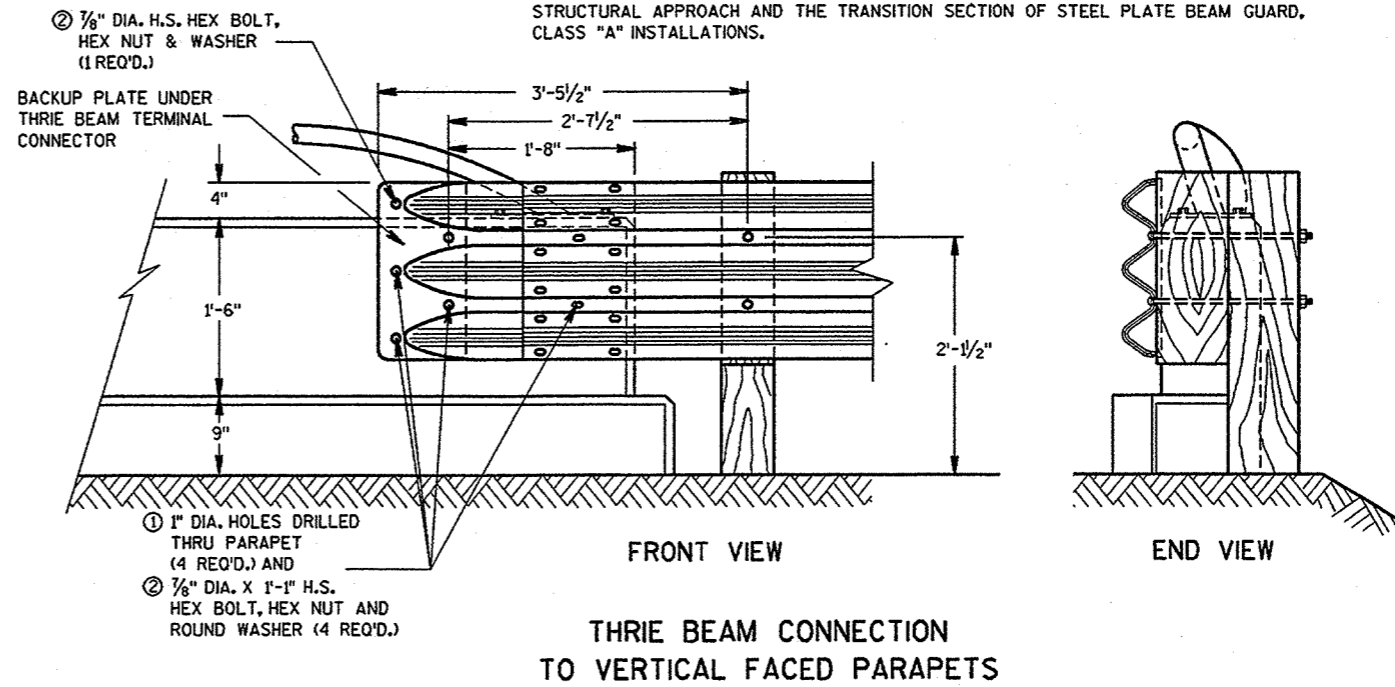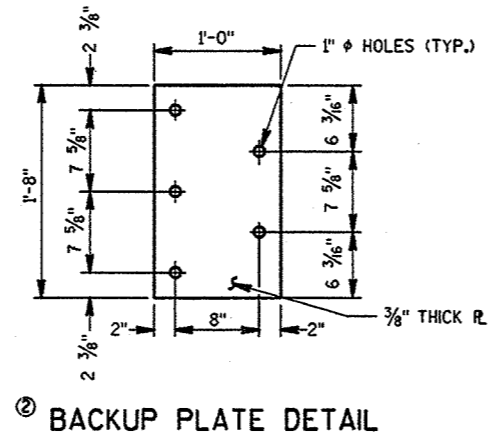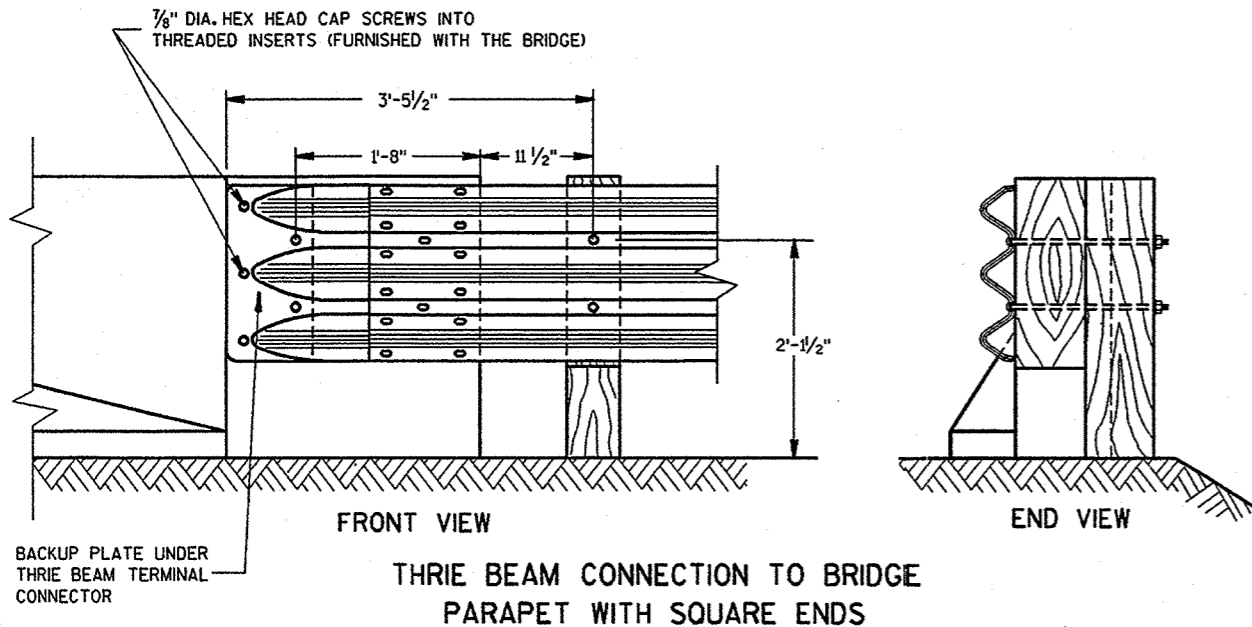


STEEL THRIE BEAM STRUCTURE APPROACH, CONNECTION TO SQUARE END AND VERTICAL FACED PARAPETS	
STATE OF WISCONSIN DEPARTMENT OF TRANSPORTATION	
APPROVED 12/08/00 DATE	<i>John Hamberg</i> CHIEF ROADWAY DEVELOPMENT ENGINEER
FHWA	

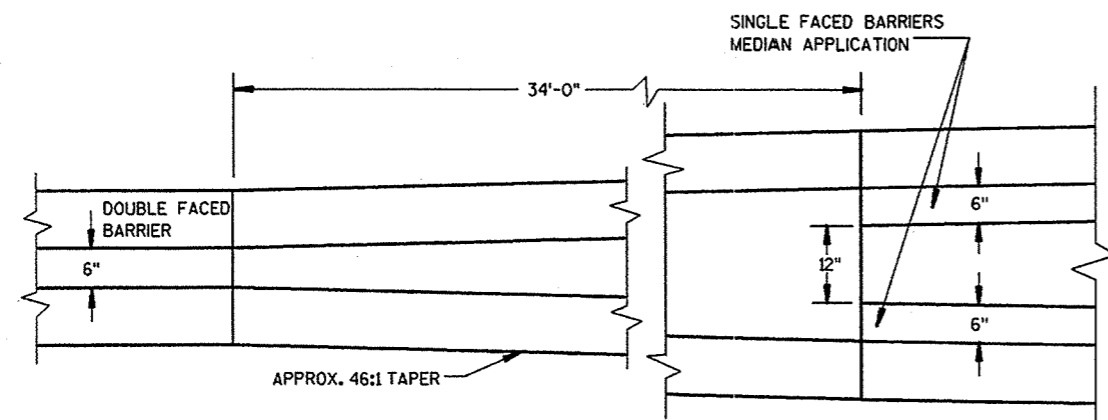


PLAN VIEW


TRANSITION DETAILS OF DOUBLE FACED TO SINGLE FACED CONCRETE MEDIAN BARRIER
(FOOTINGS ARE NOT SHOWN)

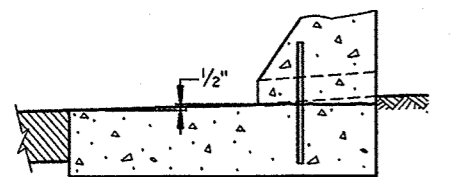


HIGH SIDE CONCRETE BARRIER DETAIL

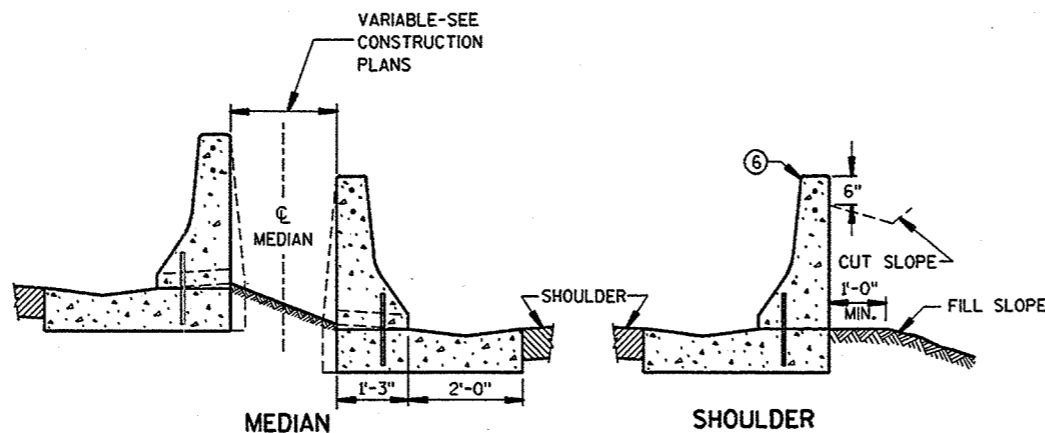


TYPICAL APPLICATIONS

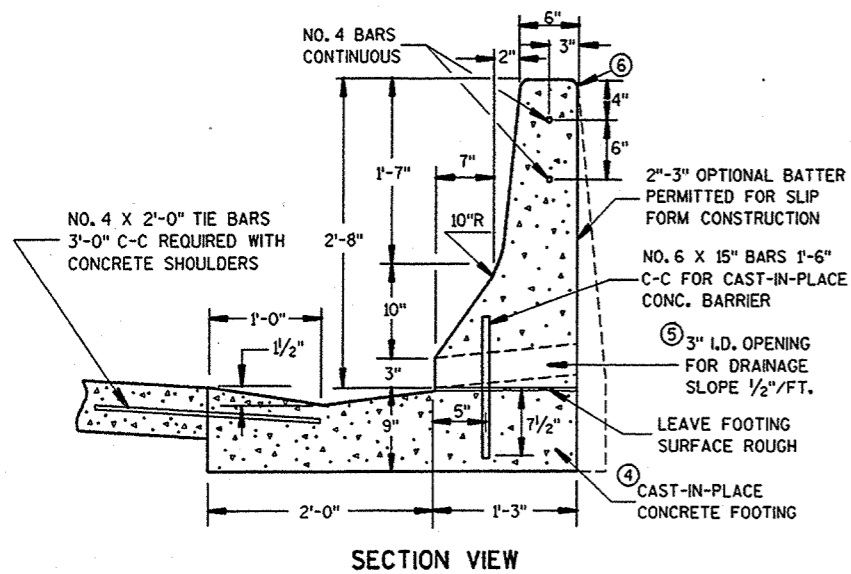

SECTION VIEW

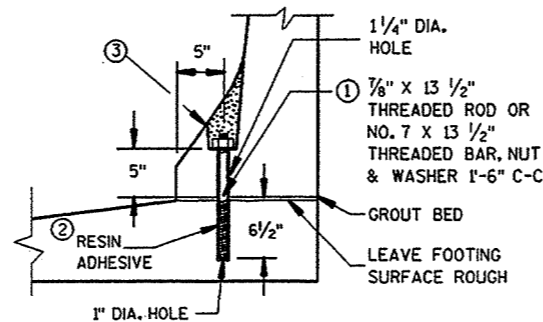

ANCHORAGE DETAIL FOR PRECAST CONCRETE ALTERNATE

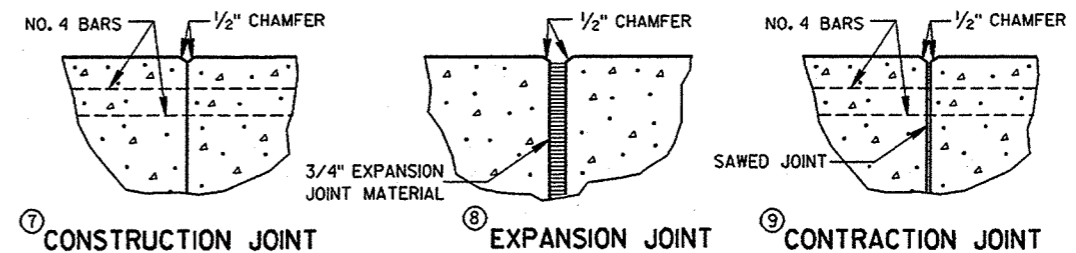

JOINT DETAILS

GENERAL NOTES

DETAILS OF CONSTRUCTION, MATERIALS AND WORKMANSHIP NOT SHOWN ON THIS DRAWING SHALL CONFORM TO THE PERTINENT REQUIREMENTS OF THE STANDARD SPECIFICATIONS AND SPECIAL PROVISIONS.

PRECAST UNITS SHALL BE FIRMLY BUTTED TOGETHER IN A CONTINUOUS LINE AND BE INTERCONNECTED BY VERTICAL MALE-FEMALE SHEAR CONNECTORS FORMED IN THE BARRIER ENDS.

SPICES OF LONGITUDINAL BARS SHALL BE MADE WITH BARS LAPPED AT LEAST 18-INCHES AND FIRMLY TIED OR FASTENED TOGETHER.

ALL BAR STEEL REINFORCEMENT SHALL CONFORM TO REQUIREMENTS OF AASHTO M31, GRADE 60.


- ① THREADED RODS SHALL MEET THE REQUIREMENTS OF ASTM A572, GRADE 50, AND BE THREADED A MINIMUM LENGTH OF 2 1/2 INCHES AT THE TOP AND 6 1/2 INCHES AT THE BOTTOM. NO. 7 REINFORCEMENT BARS SHALL MEET THE REQUIREMENTS OF AASHTO M31, GRADE 60 AND BE THREADED A MINIMUM LENGTH OF 2 1/2 INCHES AT THE TOP. THE THREADED ROD OR NO. 7 REINFORCEMENT BAR, NUTS AND WASHERS SHALL BE GALVANIZED IN ACCORDANCE WITH ASTM A153. NUTS SHALL BE TORQUED TO 300 FOOT POUNDS.
- ② THE RESIN ADHESIVE SHALL BE MADE BY AN APPROVED MANUFACTURER AND CERTIFIED TO PROVIDE A PULLOUT STRENGTH OF 19,000 POUNDS FOR THE ANCHORS AND CONCRETE EMBEDMENT SHOWN.
- ③ BLOCKED OUT OPENINGS SHALL BE FILLED WITH A COMMERCIAL NON-SHRINK GROUT AFTER BARRIER IS INSTALLED.
- ④ BARRIER SHALL BE INSTALLED ON A CONCRETE SHOULDER INSTEAD OF THE CONCRETE FOOTING WHEN SPECIFIED OR SHOWN ELSEWHERE IN CONTRACT.
- ⑤ OPENINGS FOR DRAINAGE SHALL BE PLACED AT LOW POINTS OF VERTICAL CURVES OR WHERE DIRECTED BY THE ENGINEER.
- ⑥ 3/4-INCH BEVEL OR 1-INCH RADIUS (TYPICAL).
- ⑦ NO. 4 BARS SHALL BE CONTINUED THROUGH CONSTRUCTION JOINTS.
- ⑧ EXPANSION JOINTS SHALL BE PLACED AT EXISTING EXPANSION JOINTS IN THE PAVEMENT AND AT STRUCTURES. SEE REINFORCEMENT AT BARRIER END DETAIL.
- ⑨ SAWED CONTRACTION JOINTS SHALL BE PROVIDED ACROSS THE FULL WIDTH OF THE BARRIER FOOTING, AND IN FRONT, TOP AND BACK FACE OF THE BARRIER AT EXISTING PAVEMENT JOINTS AND AT UNIFORM INTERVALS BETWEEN WITH A MAXIMUM SPACING OF 25 FEET.

**CONCRETE BARRIER,
SINGLE-FACED
(WITH ANCHORAGE)**


STATE OF WISCONSIN
DEPARTMENT OF TRANSPORTATION

S.D.D. 14 B 22-30

S.D.D. 14 B 22-30

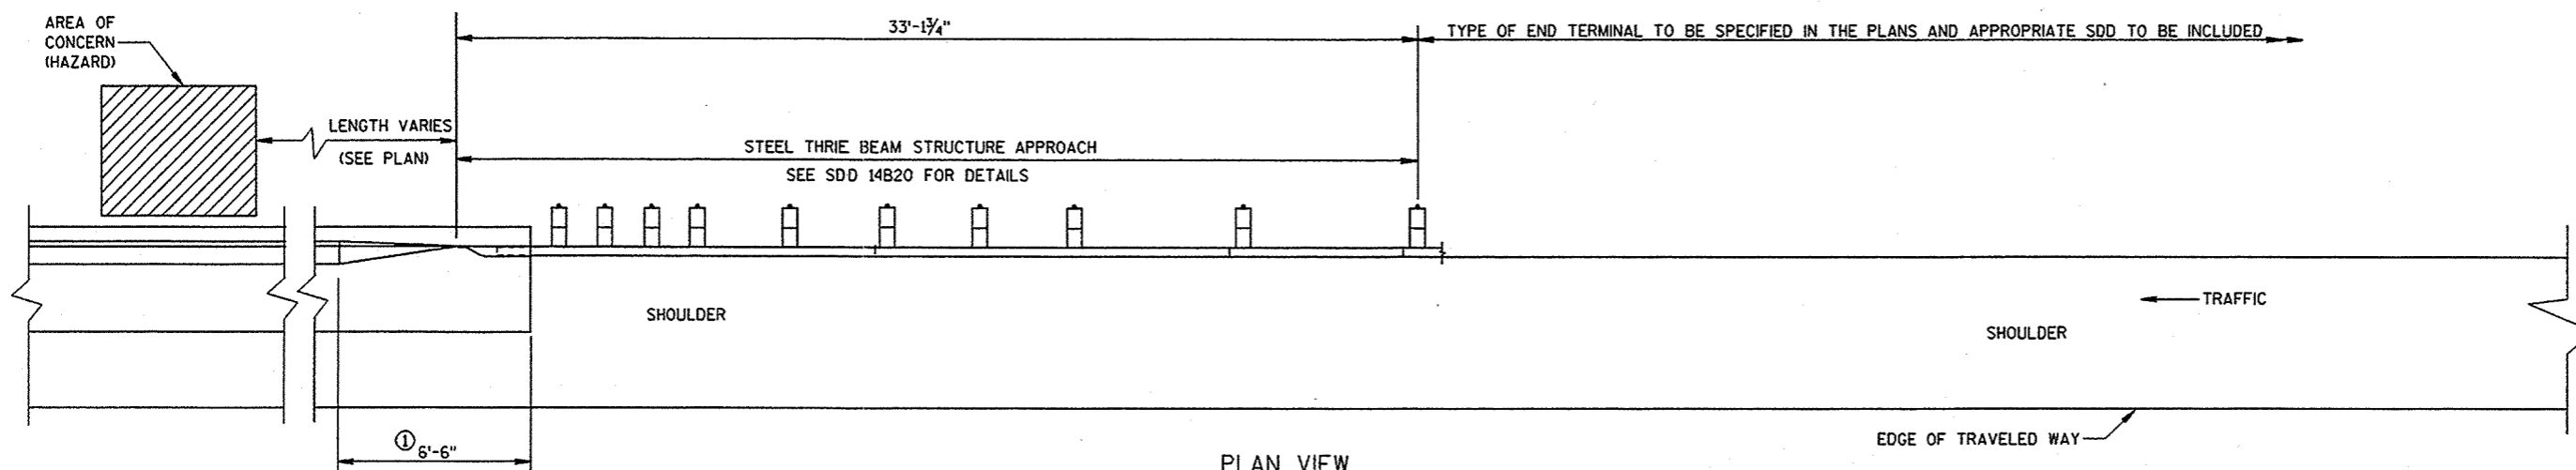

PLAN VIEW
**TRANSITION TO STEEL PLATE BEAM GUARD
 AND END TERMINAL**

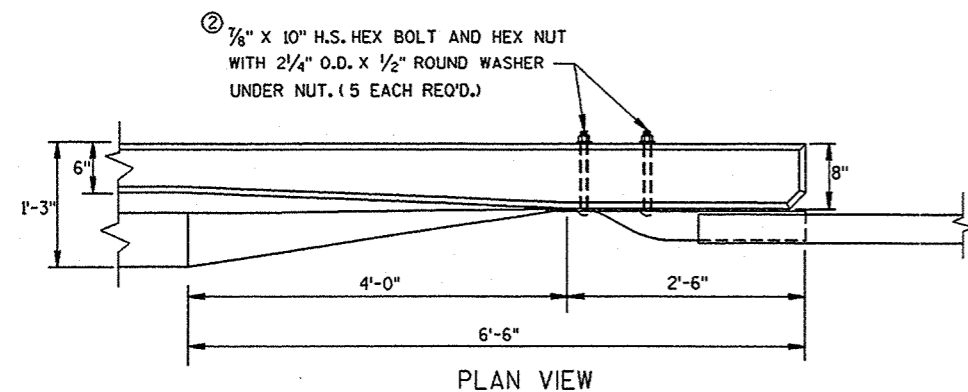


PLAN VIEW


GENERAL NOTES

- ① A SPECIAL END IS REQUIRED ON THE CONCRETE BARRIER TO TRANSITION TO A CONNECTION WITH THE STEEL THRIE BEAM STRUCTURE APPROACH. SEE THE DETAILS ON THIS SHEET.
- ② HIGH STRENGTH BOLTS SHALL MEET REQUIREMENTS OF ASTM A325.
- ③ REINFORCEMENT REQUIRED AT EXPANSION JOINTS AND WHERE CONCRETE BARRIER IS TERMINATED.
- ④ PLACE REINFORCEMENT SUCH THAT IT WILL NOT CONFLICT WITH THE BOLT HOLES IN THE THRIE BEAM TERMINAL CONNECTOR.

DO NOT USE STEEL POSTS AND NOTCHED PLASTIC BLOCKOUTS IN THE STEEL THRIE BEAM STRUCTURAL APPROACH AND THE TRANSITION SECTION OF STEEL PLATE BEAM GUARD, CLASS "A" INSTALLATIONS.

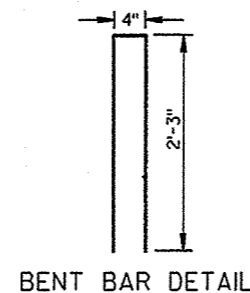


BENT BAR DETAIL

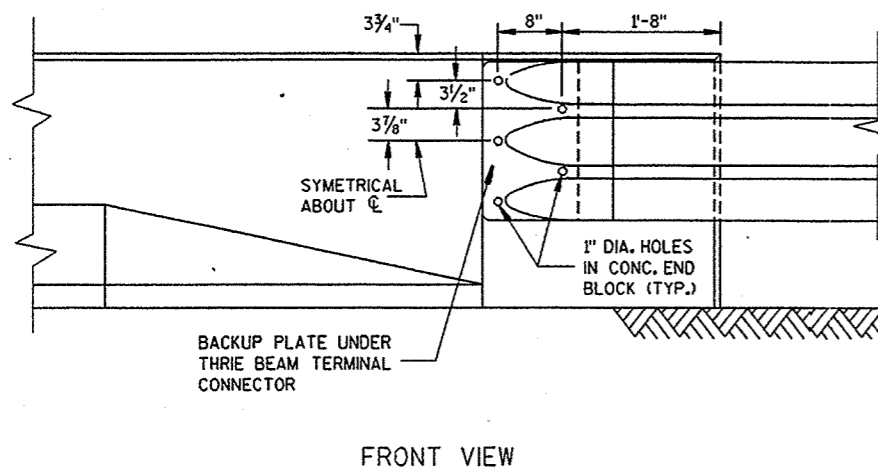

FRONT VIEW

CONCRETE BARRIER TRANSITION TO THRIE BEAM

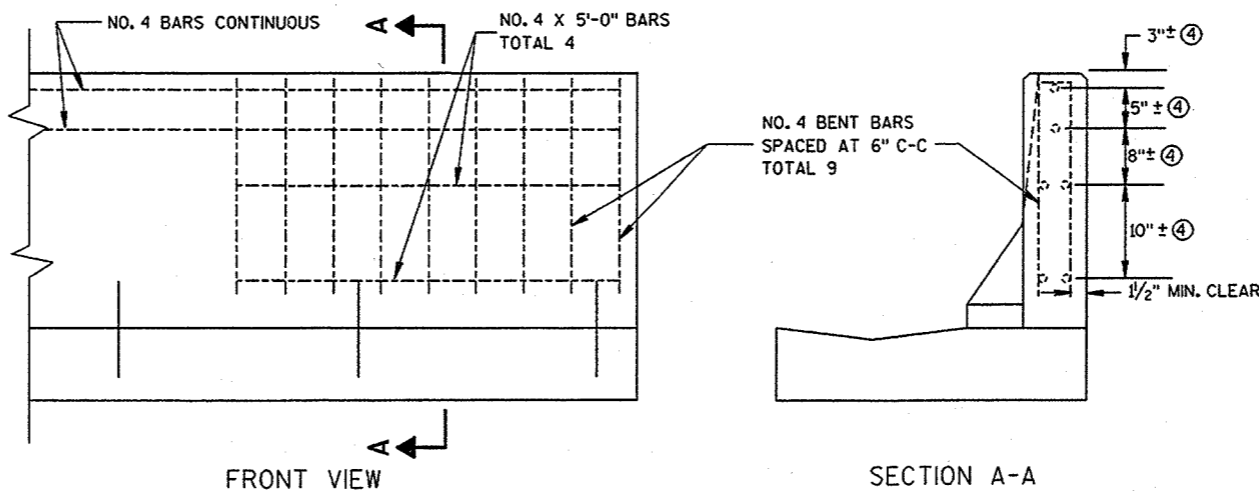


FRONT VIEW

③ **REINFORCEMENT AT BARRIER END**

CONCRETE BARRIER, SINGLE-FACED (WITH ANCHORAGE)	
STATE OF WISCONSIN DEPARTMENT OF TRANSPORTATION	
APPROVED 12/08/00 DATE	 CHIEF ROADWAY DEVELOPMENT ENGINEER
FHWA	

S.D.D. 14 B 22-3b


S.D.D. 14 B 22-3b

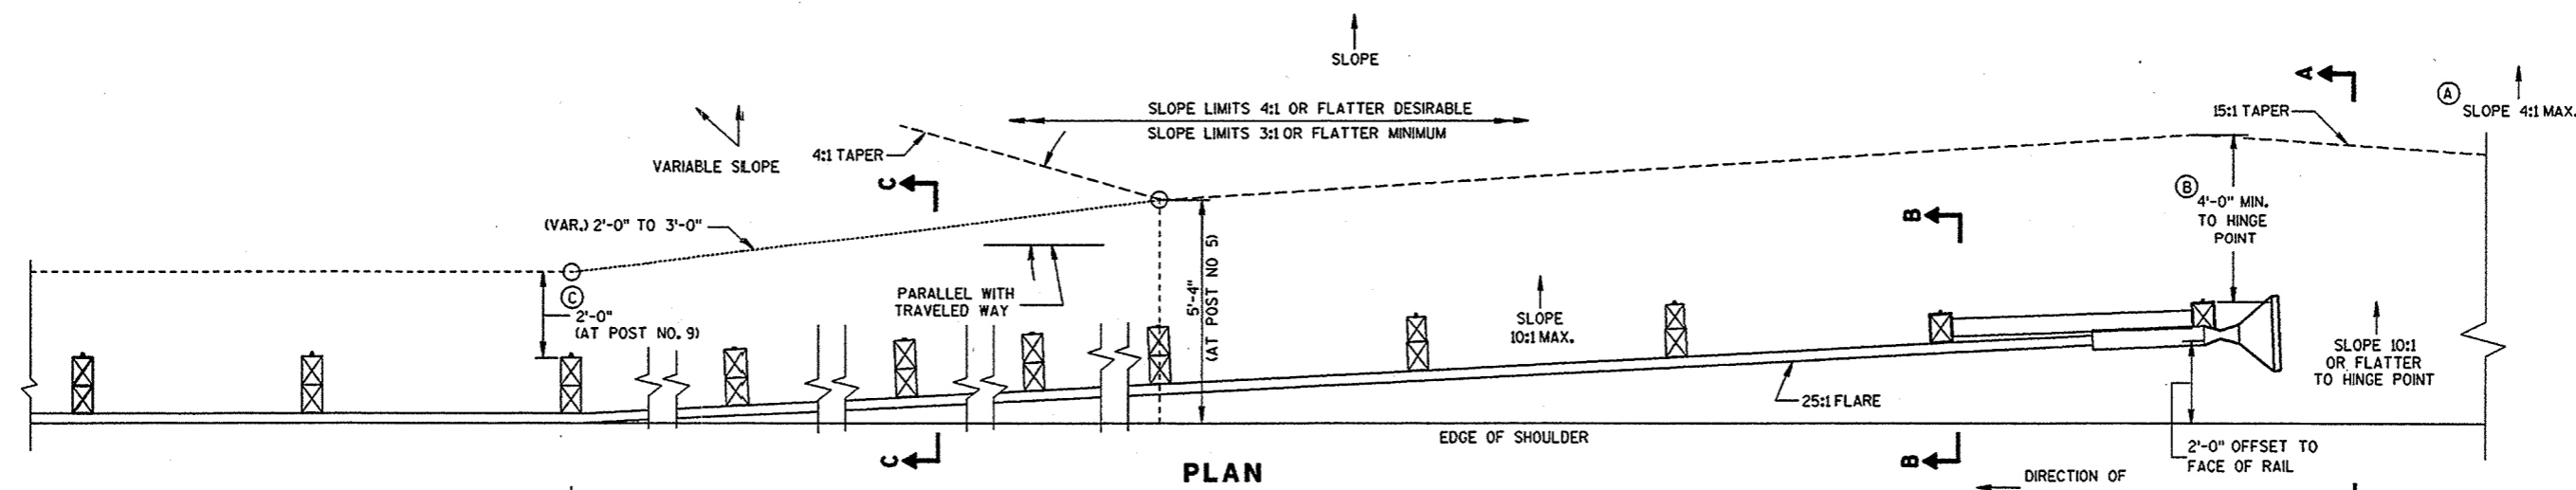


PLAN

BILL OF MATERIALS


NOTE NO.	QTY.	DESCRIPTION
①	4	WOOD BREAKAWAY TERMINAL POST: 5 1/2" X 7 1/2" X 3'-9"
②	4	STEEL TUBE: TS 8" X 6" X 0.188", 4'-6" LONG
③	4	SOIL PLATE: 2'-0" X 1'-6" X 1/4"
④	4	WOOD BREAKAWAY CRT POST: 6" X 8" X 6'-0"
⑤	6	WOOD OFFSET BLOCKS: 6" X 8" X 1'-2"
⑥	1	PIPE SLEEVE: 2" X 5 1/2" STANDARD PIPE
⑦	1	BEARING PLATE
⑧	1	BCT CABLE ASSEMBLY
⑨	1	CABLE ANCHOR BOX
⑩	1	STRUT & YOKE
⑪	1	STEEL PLATE BEAM, END PANEL 12 GA. 13'-6 1/2" LONG FOR SKT-350 & ET-2000
⑫	3	STEEL PLATE BEAM: 12 GA. 13'-6 1/2"
⑬	1	ET-2000 GUARDRAIL EXTRUDER OR SKT-350 IMPACT HEAD; AS FURNISHED BY MANUFACTURER
⑭	1	REFLECTIVE SHEETING: 18" X 18"

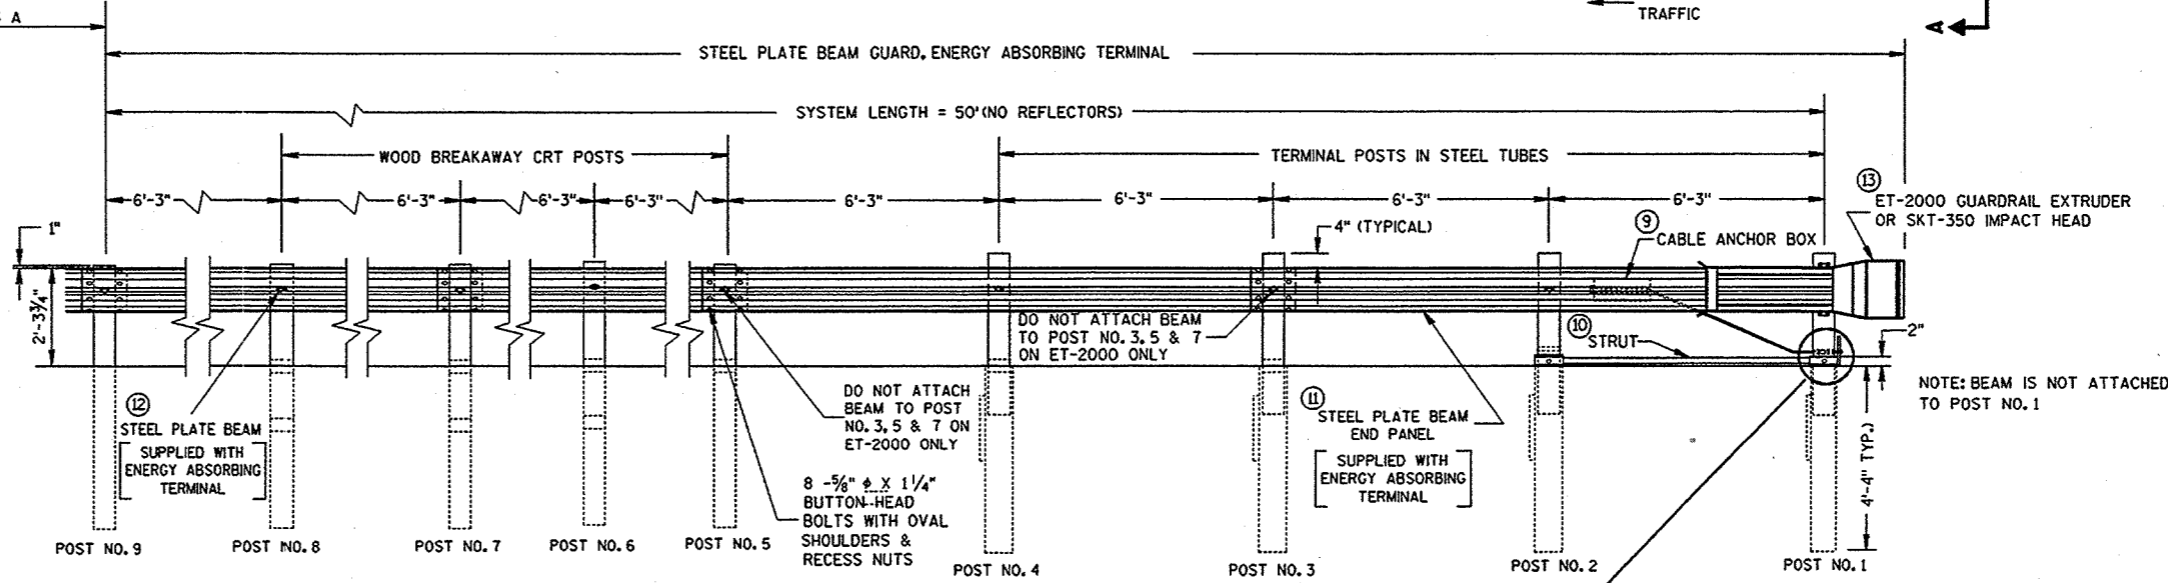


ELEVATION

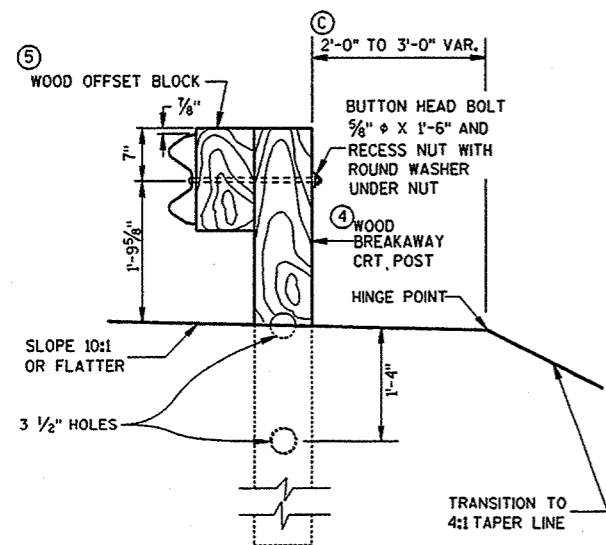

SECTION C-C
TYPICAL AT POST NOS. 5-8 INC.

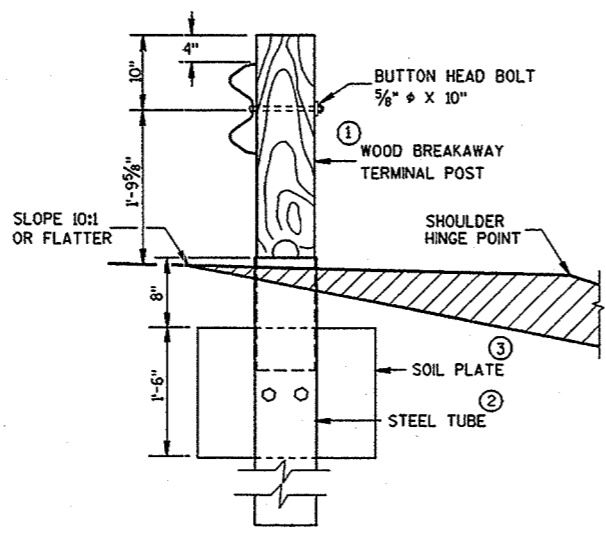

SECTION B-B
TYPICAL AT POST NO. 2
(ADD WOOD OFFSET BLOCK AT POST 3 & 4)

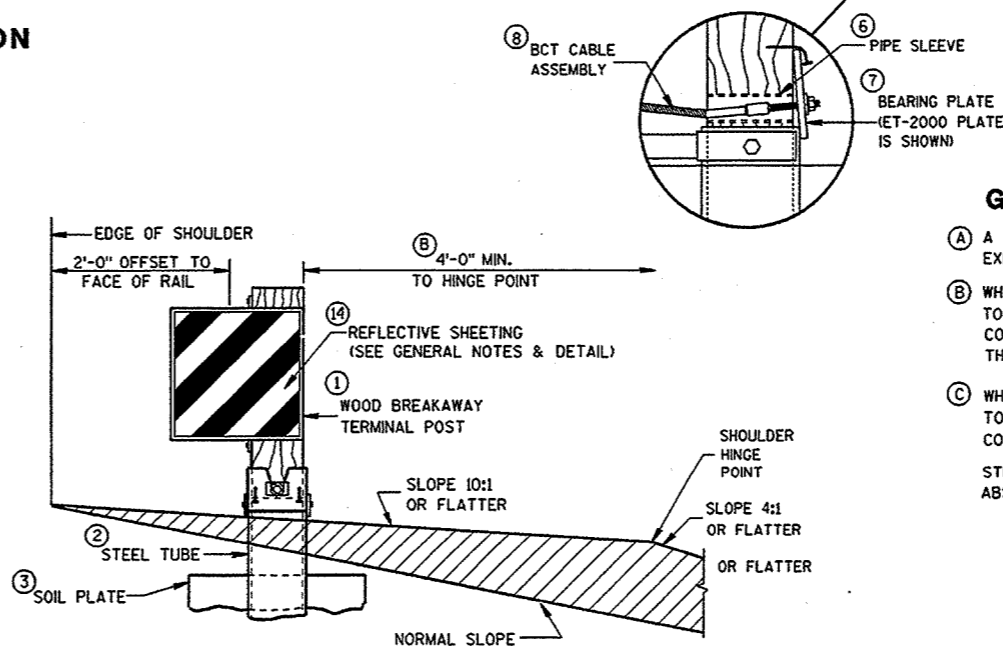

SECTION A-A
TYPICAL AT POST NO. 1

GENERAL NOTES


- (A) A 3:1 OR FLATTER SLOPE MAY BE USED FOR INSTALLATION ON EXISTING HIGHWAYS.
- (B) WHEN SPECIFIED ELSEWHERE IN THE CONTRACT THE 4-FOOT MINIMUM TO HINGE POINT, MAY BE REDUCED OR ELIMINATED WHERE EXISTING CONDITIONS WILL NOT PERMIT THE DESIRABLE EARTHWORK. SIMILARLY THE 15:1 TAPER MAY BE REDUCED TO 4:1.
- (C) WHEN SPECIFIED ELSEWHERE IN THE CONTRACT THE 2-FOOT MINIMUM TO HINGE POINT, MAY BE REDUCED OR ELIMINATED WHERE EXISTING CONDITIONS WILL NOT PERMIT THE DESIRABLE EARTHWORK. STEEL POSTS SHALL NOT BE ALLOWED FOR USE WITH ENERGY ABSORBING TERMINALS.

**STEEL PLATE BEAM GUARD
ENERGY ABSORBING TERMINAL**


STATE OF WISCONSIN
DEPARTMENT OF TRANSPORTATION

S.D.D. 14 B 24-30


S.D.D. 14 B 24-30

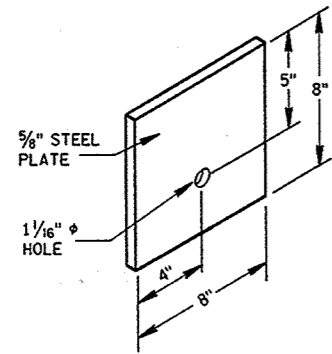


STEEL BEARING PLATE (SKT-350)

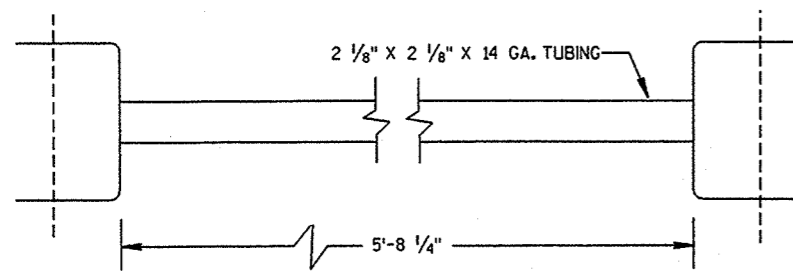

STRUT DETAIL (SKT-350)

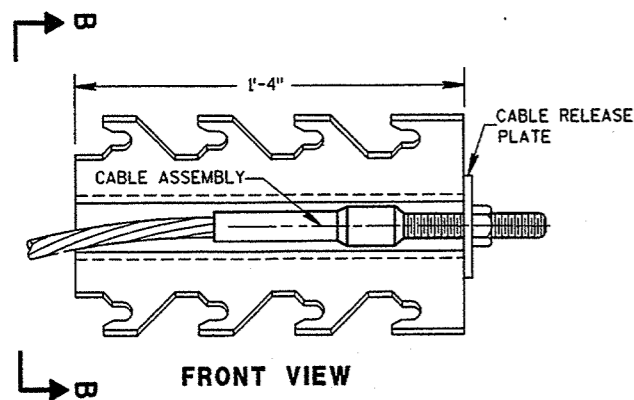


FRONT VIEW

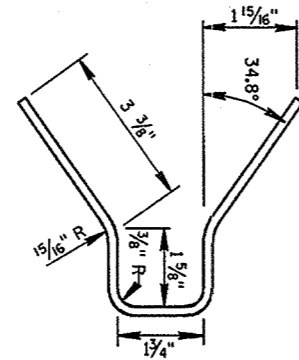

SECTION B-B

CABLE ANCHOR BOX (SKT-350)


(SKT-350)

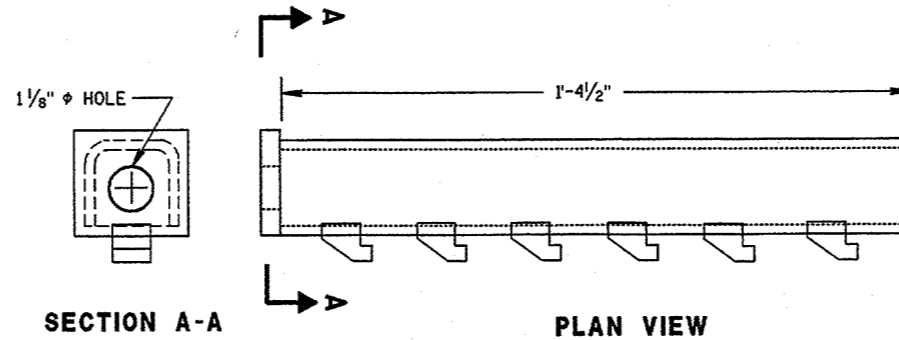


SECTION A-A

PLAN VIEW


CABLE ANCHOR BOX (ET-2000)

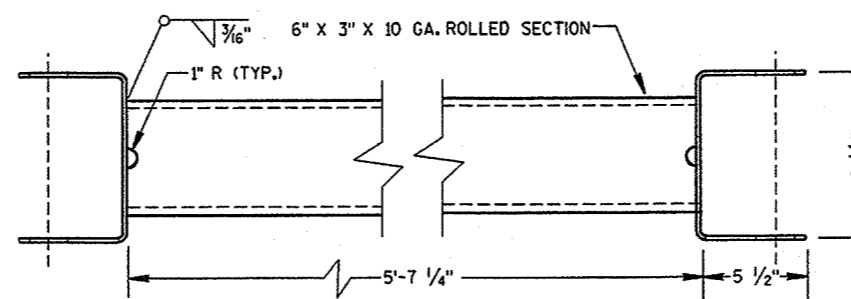

STRUT DETAIL (ET-2000)

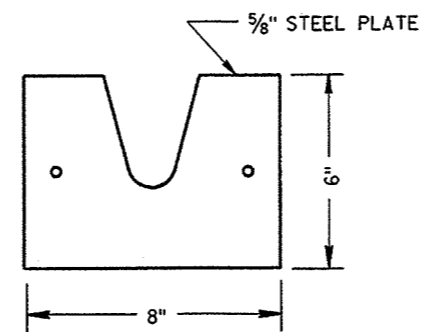


STEEL BEARING PLATE (ET-2000)

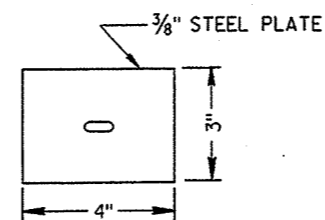


BEARING PLATE WASHER (ET-2000)


(ET-2000)

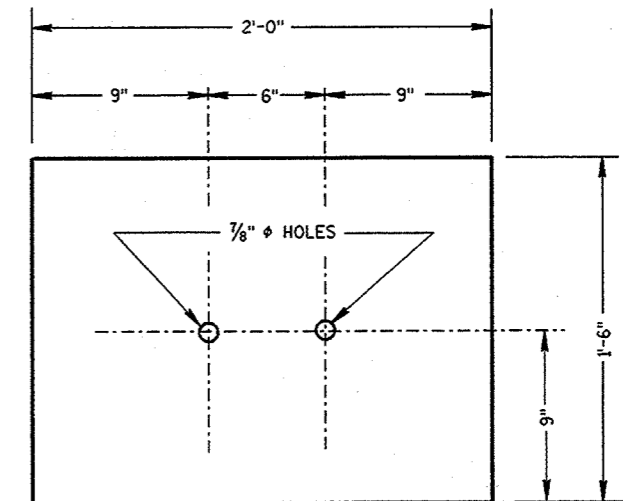


SOIL PLATE (SKT-350 & ET-2000)

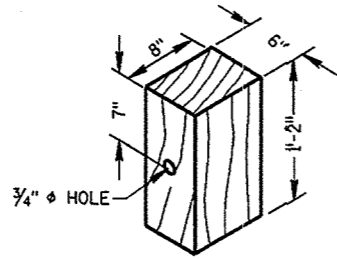


WOOD OFFSET BLOCK
REQ'D. AT ALL POSTS EXCEPT POST NO'S 1 & 2

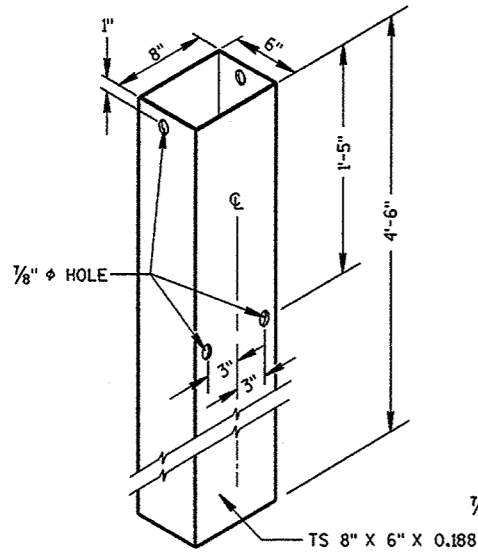

STEEL TUBE
(POSTS NO. 1-4)
THE STEEL TUBE SHALL CONFORM TO REQUIREMENTS OF ASTM A500

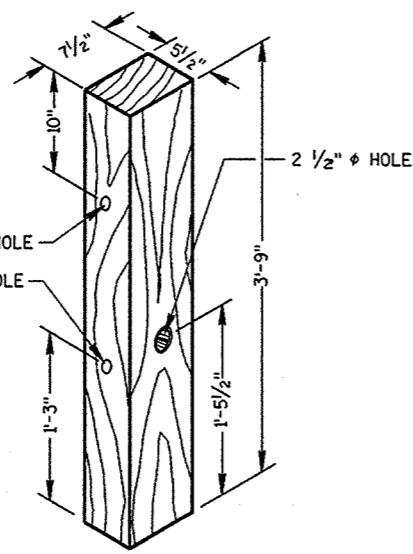

TERMINAL POST
(POSTS NO. 1-4)

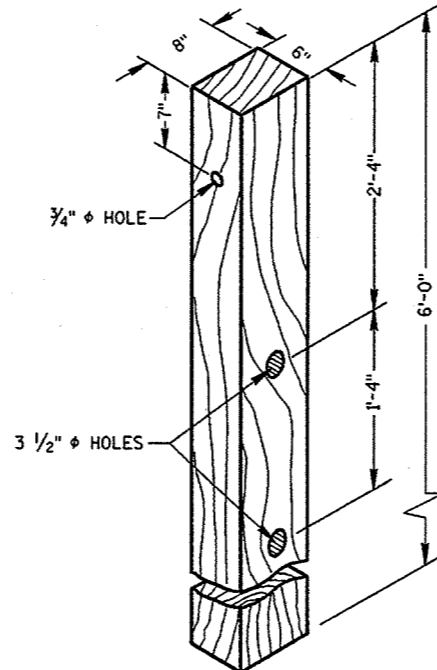

CRT POST
(POSTS NO'S 5-8)

WOOD BREAKAWAY POSTS

GENERAL NOTES

DETAILS OF CONSTRUCTION, MATERIALS AND WORKMANSHIP NOT SHOWN ON THIS DRAWING SHALL CONFORM TO THE PERTINENT REQUIREMENTS OF THE STANDARD SPECIFICATIONS, APPLICABLE SPECIAL PROVISIONS AND MANUFACTURERS INSTRUCTIONS.

STEEL PLATE BEAM GUARD ENERGY ABSORBING TERMINAL SHALL BE EITHER THE EXTRUDER TERMINAL (ET-2000), OR THE SEQUENTIAL KINKING TERMINAL (SKT-350). THE CONTRACTOR SHALL NOT INTERMIX PROPRIETARY PRODUCT MATERIALS.

THE "ET-2000" IS AVAILABLE FROM SYRO, INC., 2524 N. STEMMONS FREEWAY, DALLAS TEXAS 75207. TELEPHONE 1-800-835-6086 OR 1-800-644-7976


THE "SKT-350" IS AVAILABLE FROM ROAD SYSTEMS, INC., 7631 NEW CASTLE DRIVE, FRANKFORT, ILLINOIS 60423. TELEPHONE (815) 464-5917

THE ET-2000, AND SKT-350 END TERMINALS SHALL BE INSTALLED IN ACCORDANCE WITH THE MANUFACTURER'S INSTRUCTIONS.

STEEL PLATE BEAM GUARD, ENERGY ABSORBING TERMINAL SHALL BE PAID FOR AT THE CONTRACT UNIT PRICE EACH, WHICH SHALL INCLUDE HARDWARE, STEEL PLATE BEAM GUARD, POSTS, REFLECTIVE SHEETING AND INSTALLATION AS SHOWN.

REFLECTIVE SHEETING - SHALL CONFORM TO ASTM SPECIFICATION D4956-93b, REFLECTIVE SHEETING TYPE III, BACKING CLASS 4, PERFORMANCE REQUIREMENT TYPE III. THE MESSAGE AND LINES SHALL BE APPLIED TO THE SIGNS BY THE SILK SCREEN STENCIL PROCESS USING A BLACK OR DARK STENCIL PASTE AS A TYPE APPROVED BY THE MANUFACTURER OF THE FACE MATERIAL TO WHICH IT IS TO BE APPLIED. MESSAGE UNITS CUT FROM NONREFLECTIVE SHEETING AND APPLIED TO THE SIGN FACE ARE NOT ACCEPTABLE. AFTER THE APPROACH END OF THE STEEL PLATE BEAM GUARD INSTALLATION IS COMPLETE, CLEAN THE AREA WHERE THE REFLECTIVE SHEETING WILL BE APPLIED IN ACCORDANCE WITH THE MANUFACTURERS RECOMMENDATION. ONCE CLEAN, APPLY REFLECTIVE SHEETING DIRECTLY TO THE STEEL PLATE BEAM GUARD AS SHOWN. THE CONTRACTOR SHALL TURN OVER THE MANUFACTURERS WARRANTY FOR THE REFLECTIVE SHEETING TO THE DEPARTMENT FOR POTENTIAL DEALING WITH THE MANUFACTURER. PAYMENT OF REFLECTIVE SHEETING IS INCIDENTAL TO STEEL PLATE BEAM GUARD, ENERGY ABSORBING TERMINAL.

WHEN ROCK IS ENCOUNTERED DURING EXCAVATION, A 12 INCH DIA. POST HOLE EXTENDING 20 INCHES DEEP INTO THE ROCK MAY BE USED IF APPROVED BY THE ENGINEER. GRANULAR MATERIAL SHALL BE PLACED IN THE BOTTOM OF THE HOLE APPROXIMATELY 2 1/2" INCHES DEEP TO PROVIDE DRAINAGE. THE SOIL TUBES SHALL BE FIELD CUT TO LENGTH, PLACED IN THE HOLE AND BACKFILLED WITH ADEQUATELY COMPACTED MATERIAL EXCAVATED FROM THE HOLE.

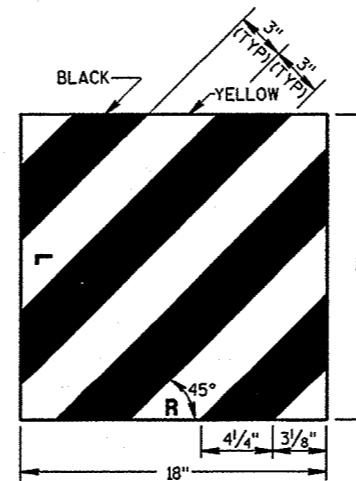


REFLECTIVE SHEETING DETAIL

**STEEL PLATE BEAM GUARD
ENERGY ABSORBING TERMINAL**



STATE OF WISCONSIN
DEPARTMENT OF TRANSPORTATION

APPROVED
12/08/00
DATE
John Havelberg
CHIEF ROADWAY DEVELOPMENT ENGINEER
FHWA

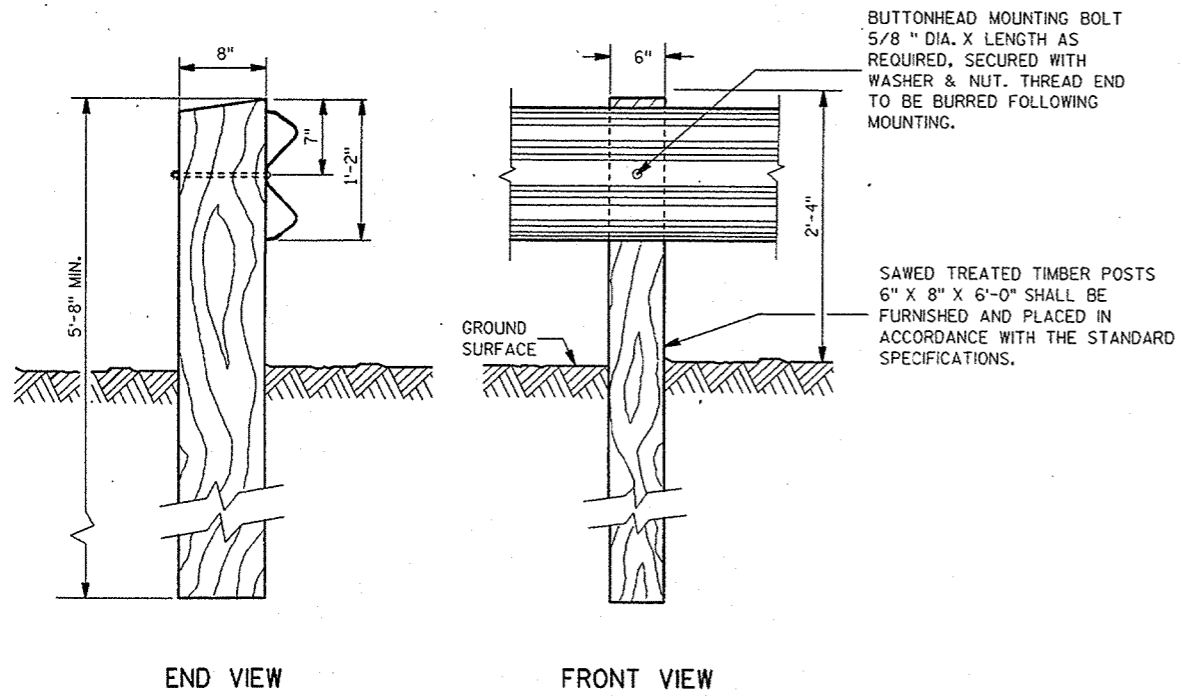

BUTTONHEAD MOUNTING BOLT
5/8" DIA. X LENGTH AS
REQUIRED, SECURED WITH
WASHER & NUT. THREAD END
TO BE BURRED FOLLOWING
MOUNTING.


SAWED TREATED TIMBER POSTS
6" X 8" X 6'-0" SHALL BE
FURNISHED AND PLACED IN
ACCORDANCE WITH THE STANDARD
SPECIFICATIONS.

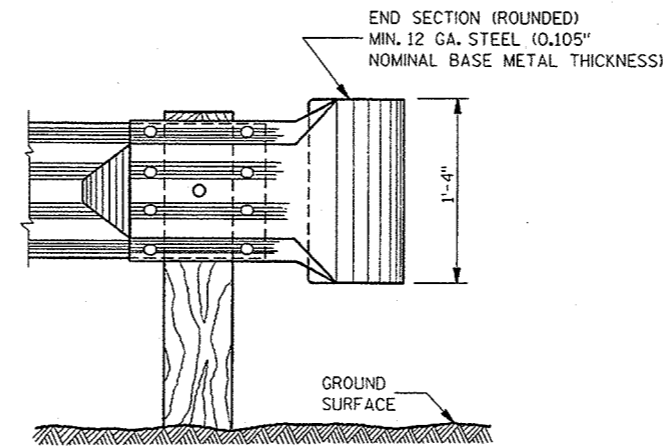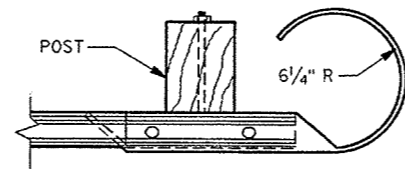


END SECTION (ROUNDED) DETAILS

GENERAL NOTES


DETAILS OF CONSTRUCTION, MATERIALS AND WORKMANSHIP NOT SHOWN ON THIS DRAWING SHALL CONFORM TO THE STANDARD SPECIFICATIONS AND THE APPLICABLE SPECIAL PROVISIONS.

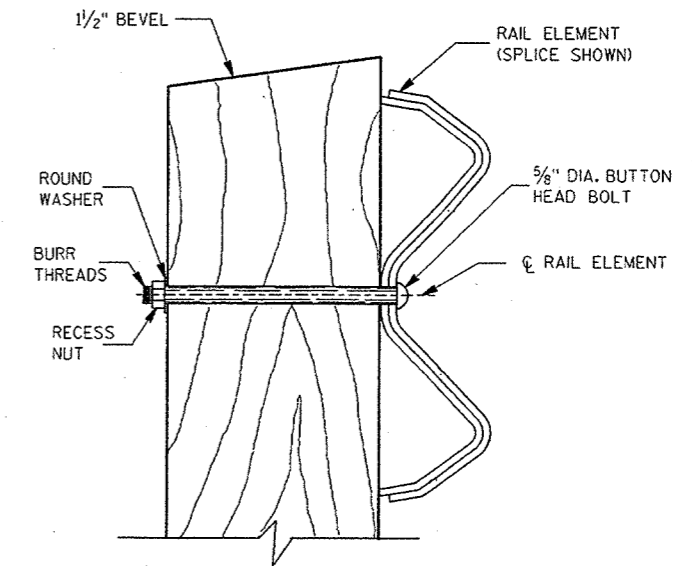


BUTTON HEAD BOLT DETAIL

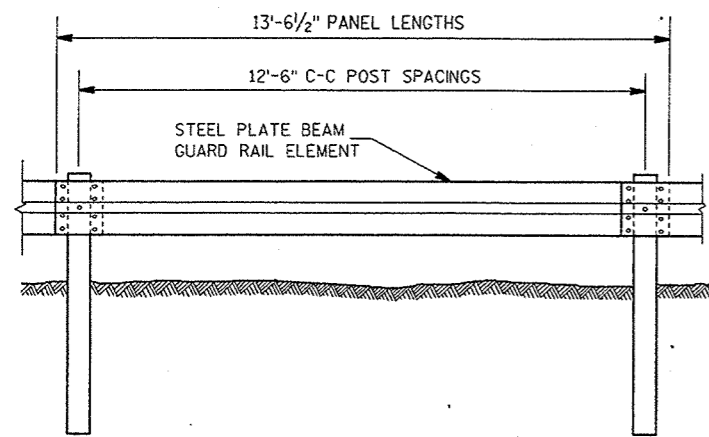

FRONT VIEW
POST DETAIL

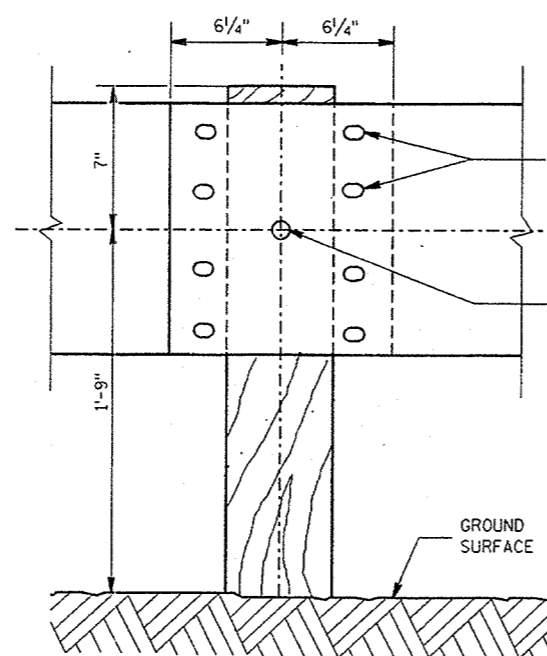


RAIL ELEMENT SPLICING
AND POST MOUNTING DETAIL

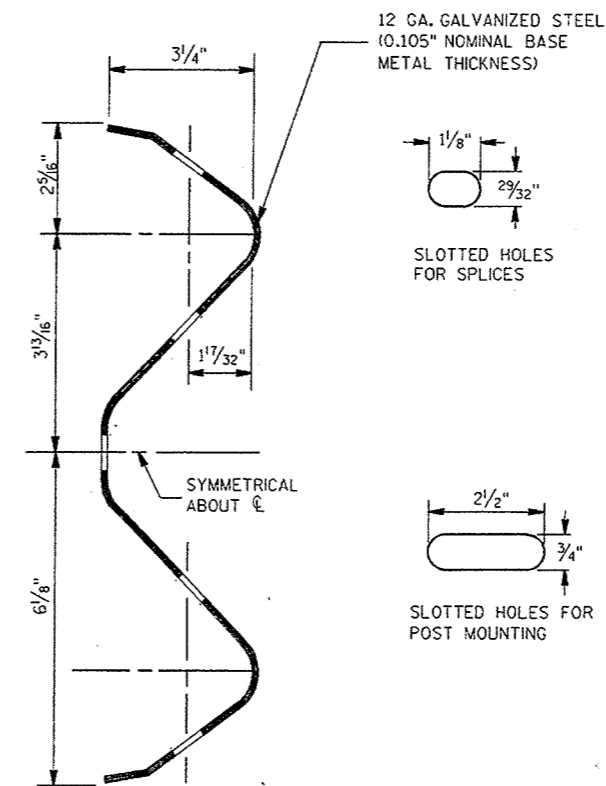


SECTION THRU RAIL ELEMENT


STEEL PLATE BEAM GUARD CLASS B	
STATE OF WISCONSIN DEPARTMENT OF TRANSPORTATION	
APPROVED 3-25-85 DATE	<i>W.D. Strand</i> CHIEF DESIGN ENGINEER
FHWA	

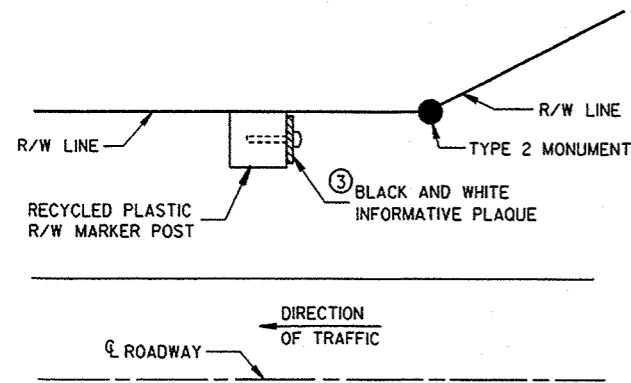

PLAN VIEW
TYPICAL LOCATION ④

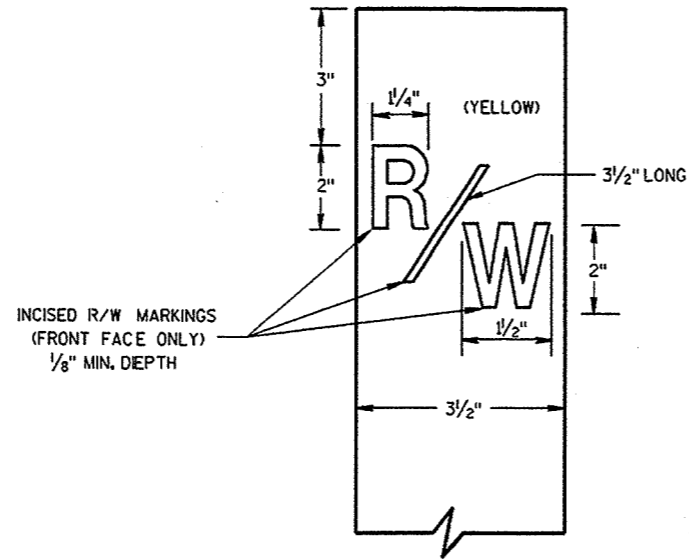

RECYCLED PLASTIC
RIGHT-OF-WAY MARKER POST
FRONT FACE

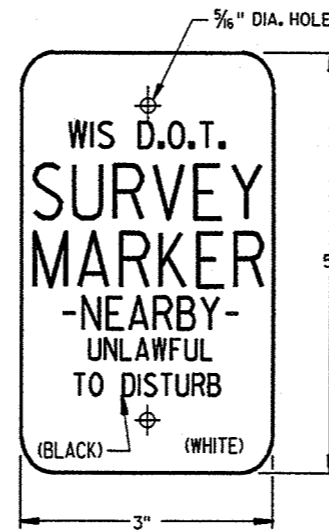


INFORMATIVE PLAQUE ③

GENERAL NOTES


DETAILS OF CONSTRUCTION, MATERIALS AND WORKMANSHIP NOT SHOWN ON THIS DRAWING SHALL CONFORM TO THE PERTINENT REQUIREMENTS OF THE STANDARD SPECIFICATIONS AND THE APPLICABLE SPECIAL PROVISIONS.

- ① POSTS SHOULD BE DRIVEN 2'-6" INTO THE GROUND.
- ② IN HEAVY SOILS, IT IS RECOMMENDED A 3" PILOT HOLE BE DRILLED INTO THE GROUND BEFORE DRIVING THE POST.
- ③ INFORMATIVE PLAQUES WILL BE FURNISHED BY THE DEPARTMENT OF TRANSPORTATION AND BE PLACED ON THE SIDE OF THE POST FACING THE TYPE 2 MONUMENT.
- ④ A MARKER POST FOR RIGHT-OF-WAY SHALL BE PLACED ADJACENT TO EACH TYPE 2 MONUMENT TO SERVE AS A GUARD POST, AND AT OTHER LOCATIONS AS SHOWN ON THE PLANS OR AS DIRECTED BY THE ENGINEER.


MARKING & SIGNING DETAILS

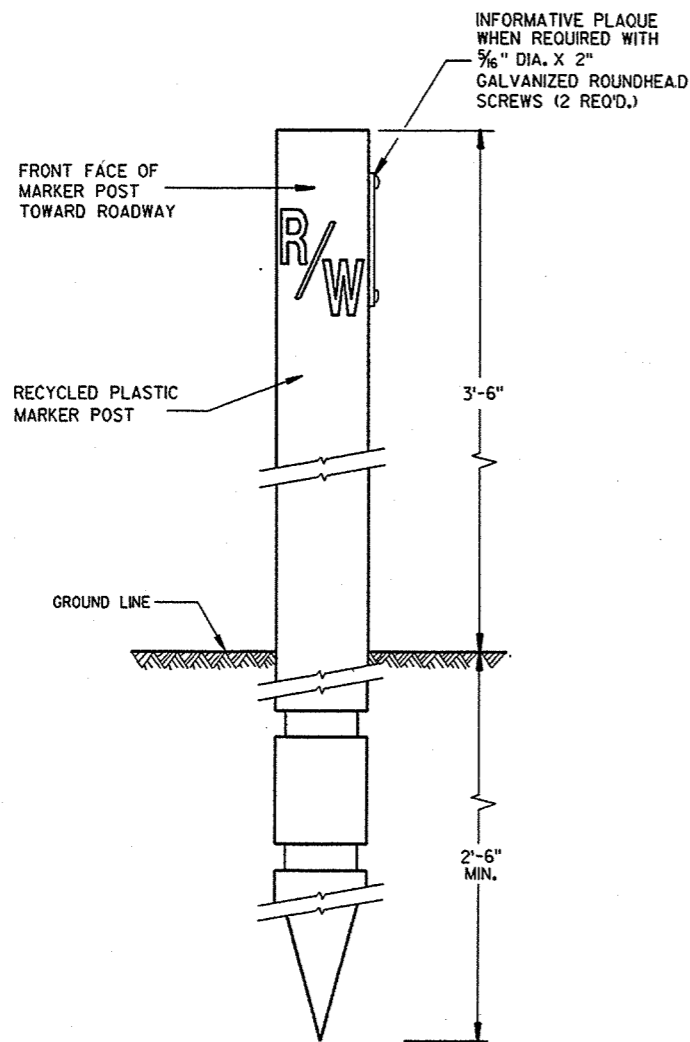


FRONT VIEW
TYPICAL INSTALLATION ①②

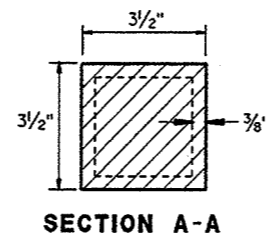

SECTION A-A

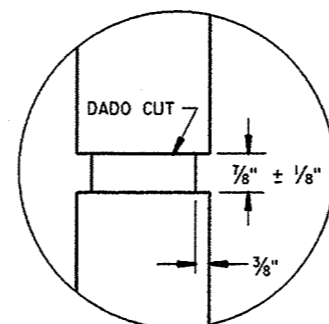


DADO CUT DETAIL

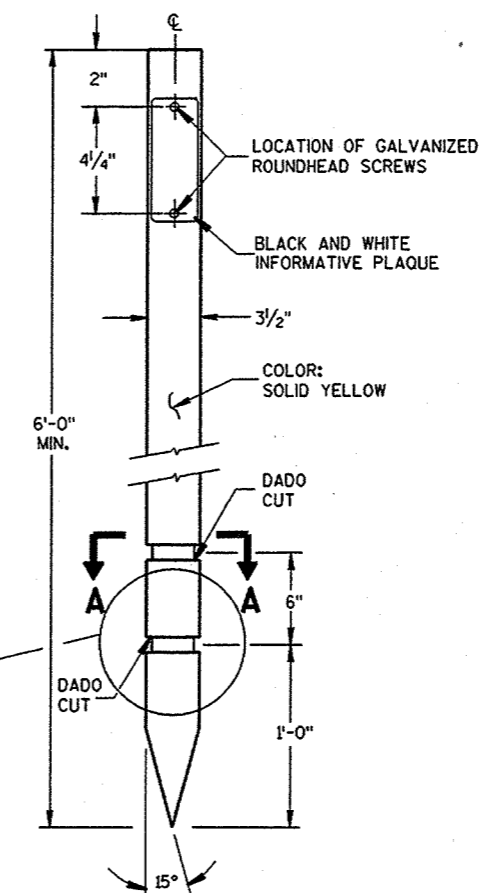


SIDE VIEW
STANDARD RECYCLED
PLASTIC MARKER POST

MARKER POST FOR RIGHT-OF-WAY	
STATE OF WISCONSIN DEPARTMENT OF TRANSPORTATION	
APPROVED 3/9/61 DATE	<i>Kenneth J. Bruckner</i> CHIEF SURVEYING AND MAPPING ENGINEER
FHWA	


S.D.D. 15 A 1-7

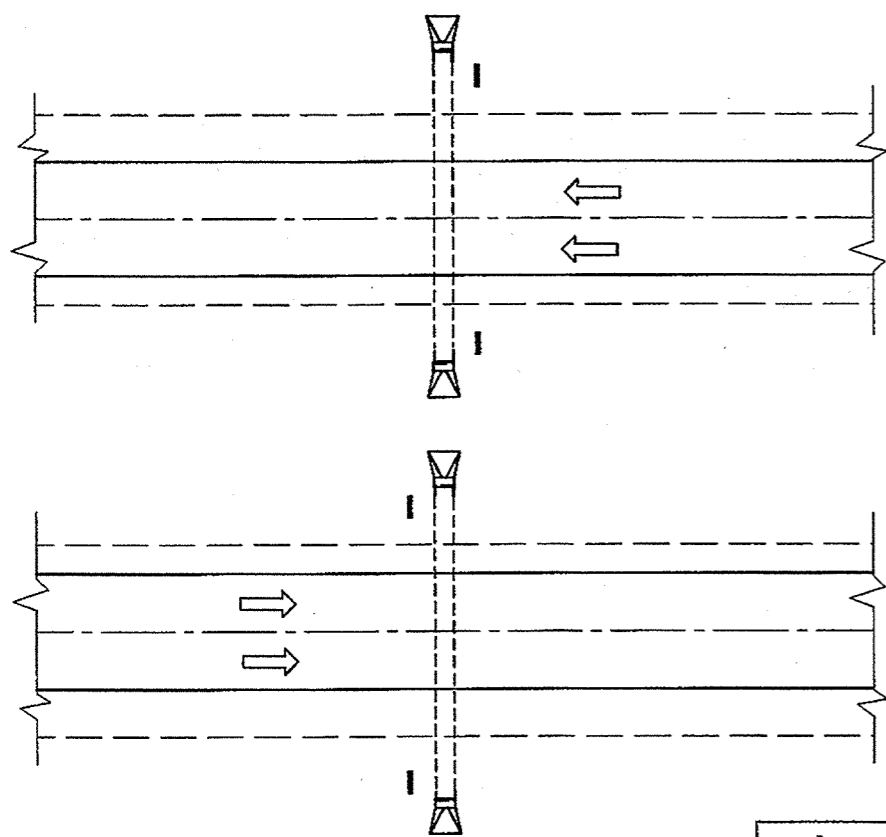


PLAN VIEW
DIVIDED HIGHWAY

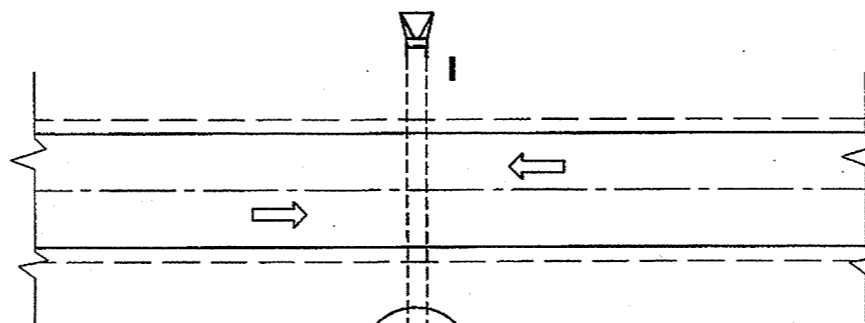

PLAN VIEW
UNDIVIDED HIGHWAY

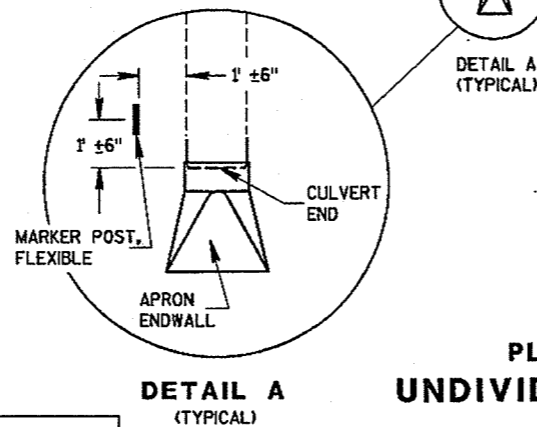


DETAIL A
(TYPICAL)

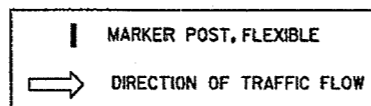


FLEXIBLE MARKER POST LOCATION

GENERAL NOTES


DETAILS OF CONSTRUCTION, MATERIALS AND WORKMANSHIP NOT SHOWN ON THIS DRAWING SHALL CONFORM TO THE PERTINENT REQUIREMENTS OF THE STANDARD SPECIFICATIONS AND THE APPLICABLE SPECIAL PROVISIONS.

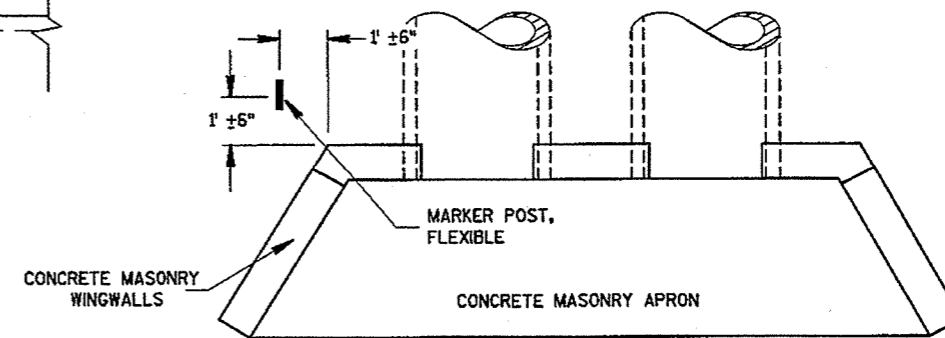


PLAN VIEW
CONCRETE MASONRY ENDWALLS FOR
CULVERT PIPE AND PIPE ARCH

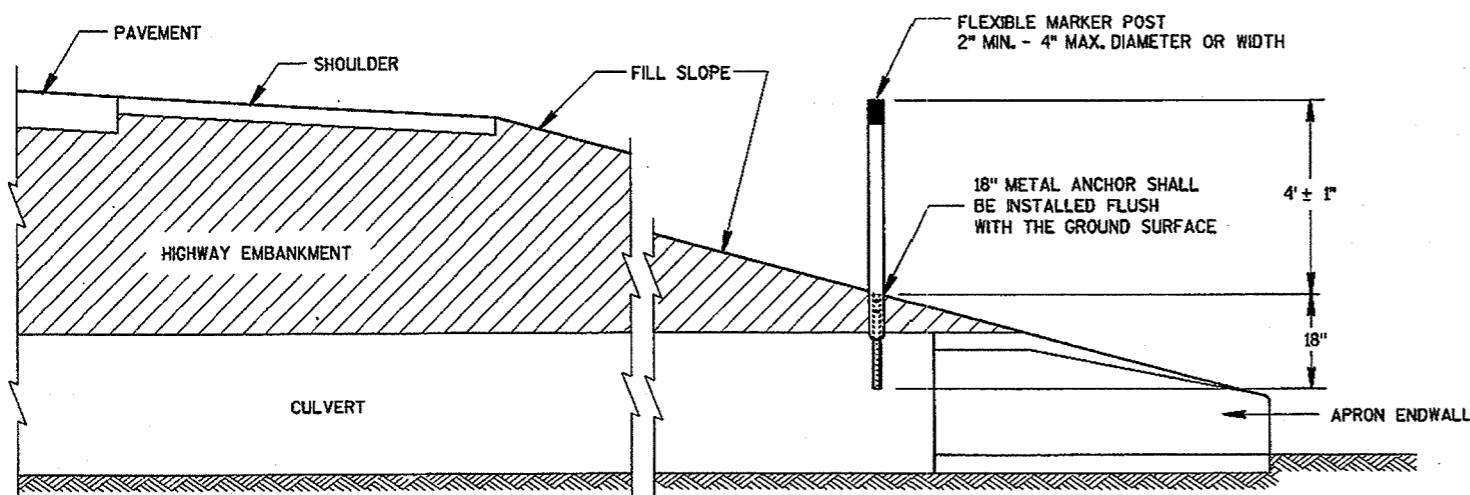

CROSS SECTION
FLEXIBLE MARKER POST

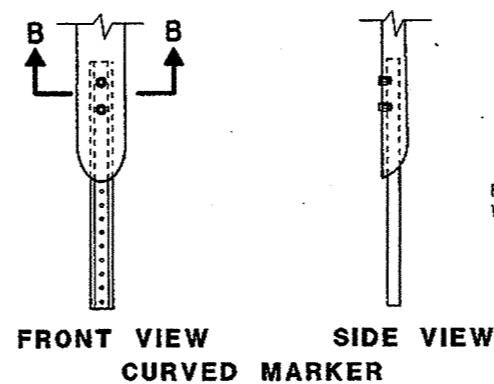


FRONT VIEW SIDE VIEW
CURVED MARKER

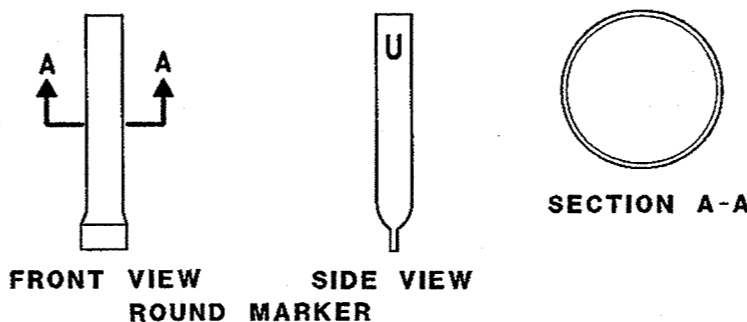

FRONT VIEW SIDE VIEW
ROUND MARKER


FLEXIBLE MARKER POST ANCHORS

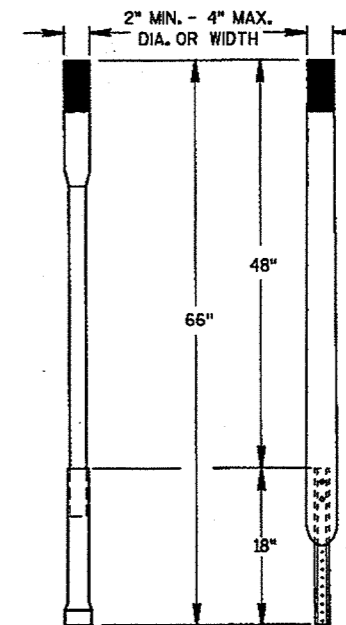


ALTERNATE 1 ALTERNATE 2
FLEXIBLE MARKER POST

MARKER POST, FLEXIBLE, FOR CULVERT END	
STATE OF WISCONSIN DEPARTMENT OF TRANSPORTATION	
APPROVED 10/01/98 DATE	 CHIEF ROADWAY DEVELOPMENT ENGINEER
FHWA	


S.D.D. 15 A 3-1

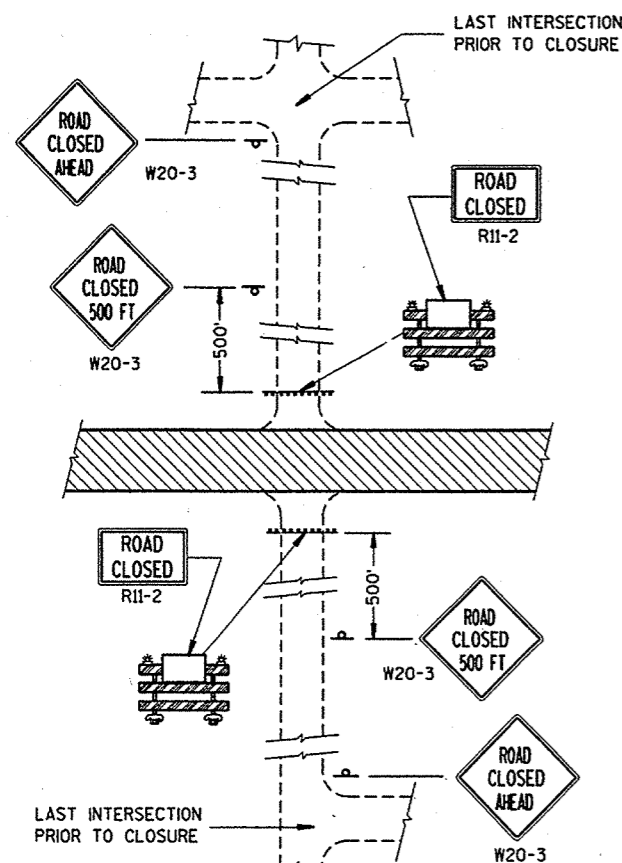

DETAIL 1
(NO ACCESS TO PROJECT)

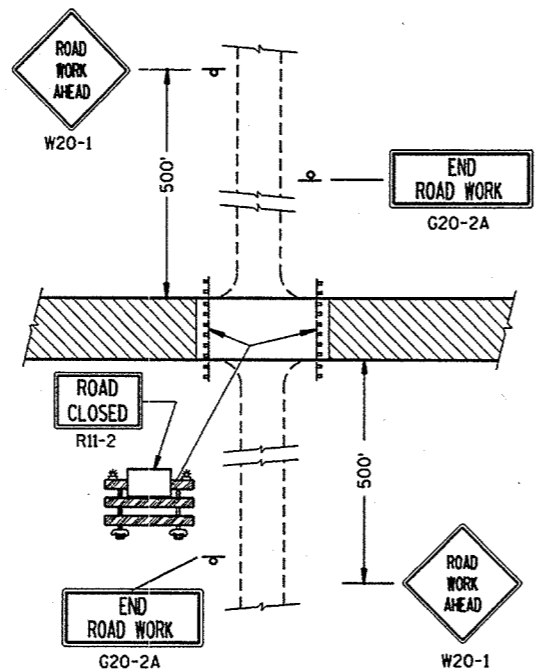

DETAIL 2
(PUBLIC CROSS-TRAFFIC MAINTAINED,
NO ACCESS TO PROJECT).

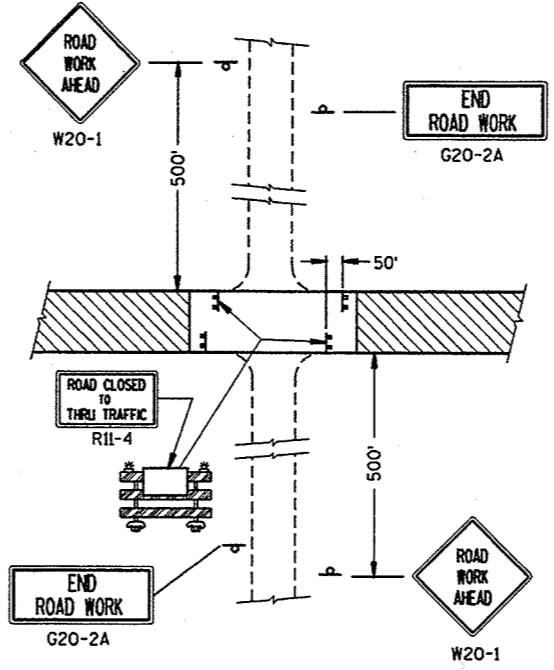

DETAIL 3
(PUBLIC CROSS-TRAFFIC MAINTAINED, CONTRACTOR,
LOCAL BUSINESS AND RESIDENT ACCESS).

GENERAL NOTES

DETAILS OF TRAFFIC CONTROL DEVICES AND THEIR LOCATION NOT SHOWN ON THIS DRAWING SHALL CONFORM TO THE PERTINENT REQUIREMENTS OF THE WISCONSIN MANUAL OF TRAFFIC CONTROL DEVICES, THE PLANS, SPECIFICATIONS AND CONTRACT.

SIGN AND BARRICADE LOCATIONS MAY BE ADJUSTED IN THE FIELD AS DIRECTED BY THE ENGINEER. ANY EXISTING TRAFFIC SIGNS THAT CONFLICT WITH THIS WORK SHALL BE COVERED AS DIRECTED BY THE ENGINEER. ALL "STOP" OR OTHER REGULATORY SIGNS ON THE SIDE ROADS SHALL NOT BE DISTURBED, EXCEPT WHEN NECESSARY TO COMPLETE THE WORK. THE SIGNS MUST THEN BE IMMEDIATELY REESTABLISHED.

ALL TYPE III BARRICADES SHALL HAVE RAILS REFLECTORIZED ON BOTH FACES. STRIPES SHALL BE PROPERLY SLOPED DOWN TOWARD THE TRAFFIC SIDE OR AS SHOWN IN THE ROAD CLOSURE BARRICADE DETAIL FOR FULL ROAD CLOSURES. TYPE "A" LOW INTENSITY FLASHING WARNING LIGHTS SHALL BE VISIBLE ON BOTH SIDES OF THE BARRICADE.


THE ROAD CLOSED SIGN (R11-2), ROAD CLOSED _____ MILES AHEAD SIGN (R11-3) AND THE ROAD CLOSED TO THRU TRAFFIC SIGN (R11-4) SHALL BE ATTACHED ONLY TO THE TOP RAIL OF THE TYPE III BARRICADE. THE SIGNS SHALL NOT COVER MIDDLE RAIL.

TYPE "H" REFLECTIVE SHEETING SHALL BE USED ON ALL BARRICADES, TYPE I, II AND III, AND ON ALL R11-2, R11-3 AND R11-4 SIGNS.


ALL SIGNS SHALL BE 48" X 48" UNLESS OTHERWISE NOTED BELOW:
R11-2, "ROAD CLOSED" SIGNS SHALL BE 48" X 30".
R11-3, AND R11-4 SIGNS SHALL BE 60" X 30".
G20-2A SIGNS SHALL BE 48" X 24".

- 1 TWO WARNING LIGHTS SHALL BE PROVIDED ON THE CENTER BARRICADE AND AT LEAST ONE WARNING LIGHT SHALL BE PROVIDED ON EACH OF THE OTHER BARRICADES WITHIN THE ROADWAY LIMITS. SPACING OF THE WARNING LIGHTS SHALL BE UNIFORM TO THE EDGE OF ROADWAY AS SHOWN.
- 2 THESE SIGNS AND BARRICADES ARE NOT REQUIRED IF ROAD CLOSURE BEGINS AT INTERSECTION.
- 3 FOR ROAD CLOSURE WITH LOCAL ACCESS TO PROJECT. SEE LANE CLOSURE BARRICADE DETAIL
- 4 FOR ROAD CLOSURE WITHOUT LOCAL ACCESS TO PROJECT. SEE ROAD CLOSURE BARRICADE DETAIL.
- 5 ONE-WAY LIGHTS SHALL BE PROVIDED ON ALL ADVANCE WARNING SIGNS. THE UNIT SHALL BE POSITIONED SUCH THAT THE LIGHT SOURCE IS OUTSIDE THE SIGN FACE AND AT THE TOP OF THE SIGN.


SIDEROAD CLOSURES

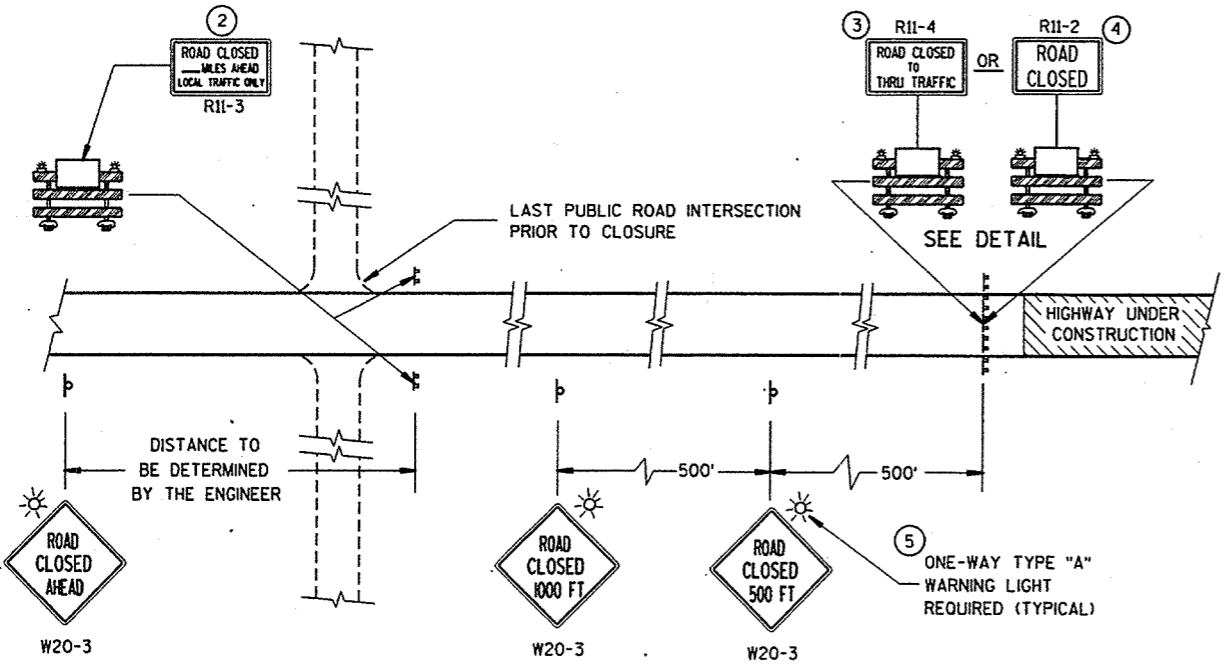

MAINLINE CLOSURE

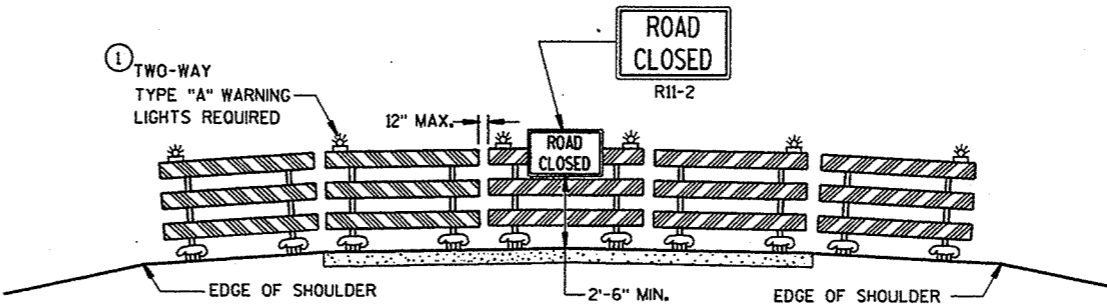

ROAD CLOSURE BARRICADE DETAIL

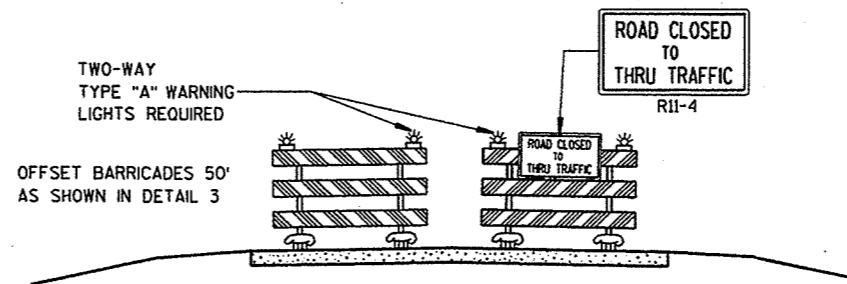

LANE CLOSURE BARRICADE DETAIL


LEGEND

- ⊥ POST MOUNTED WARNING SIGN
- ⊥ TYPE III BARRICADES WITH TYPE "H" REFLECTIVE SHEETING
- ☀ TYPE "A" LOW INTENSITY FLASHING WARNING LIGHT (FOR NIGHT USE)
- ▨ WORK AREA

BARRICADES AND SIGNS FOR ROAD CLOSURES	
STATE OF WISCONSIN DEPARTMENT OF TRANSPORTATION	
APPROVED 8-10-95 DATE	<i>Charles J. Spang</i> for DIRECTOR, OFFICE OF TRAFFIC
FHWA	

S.D.D. 15 C 2-3


S.D.D. 15 C 2-3

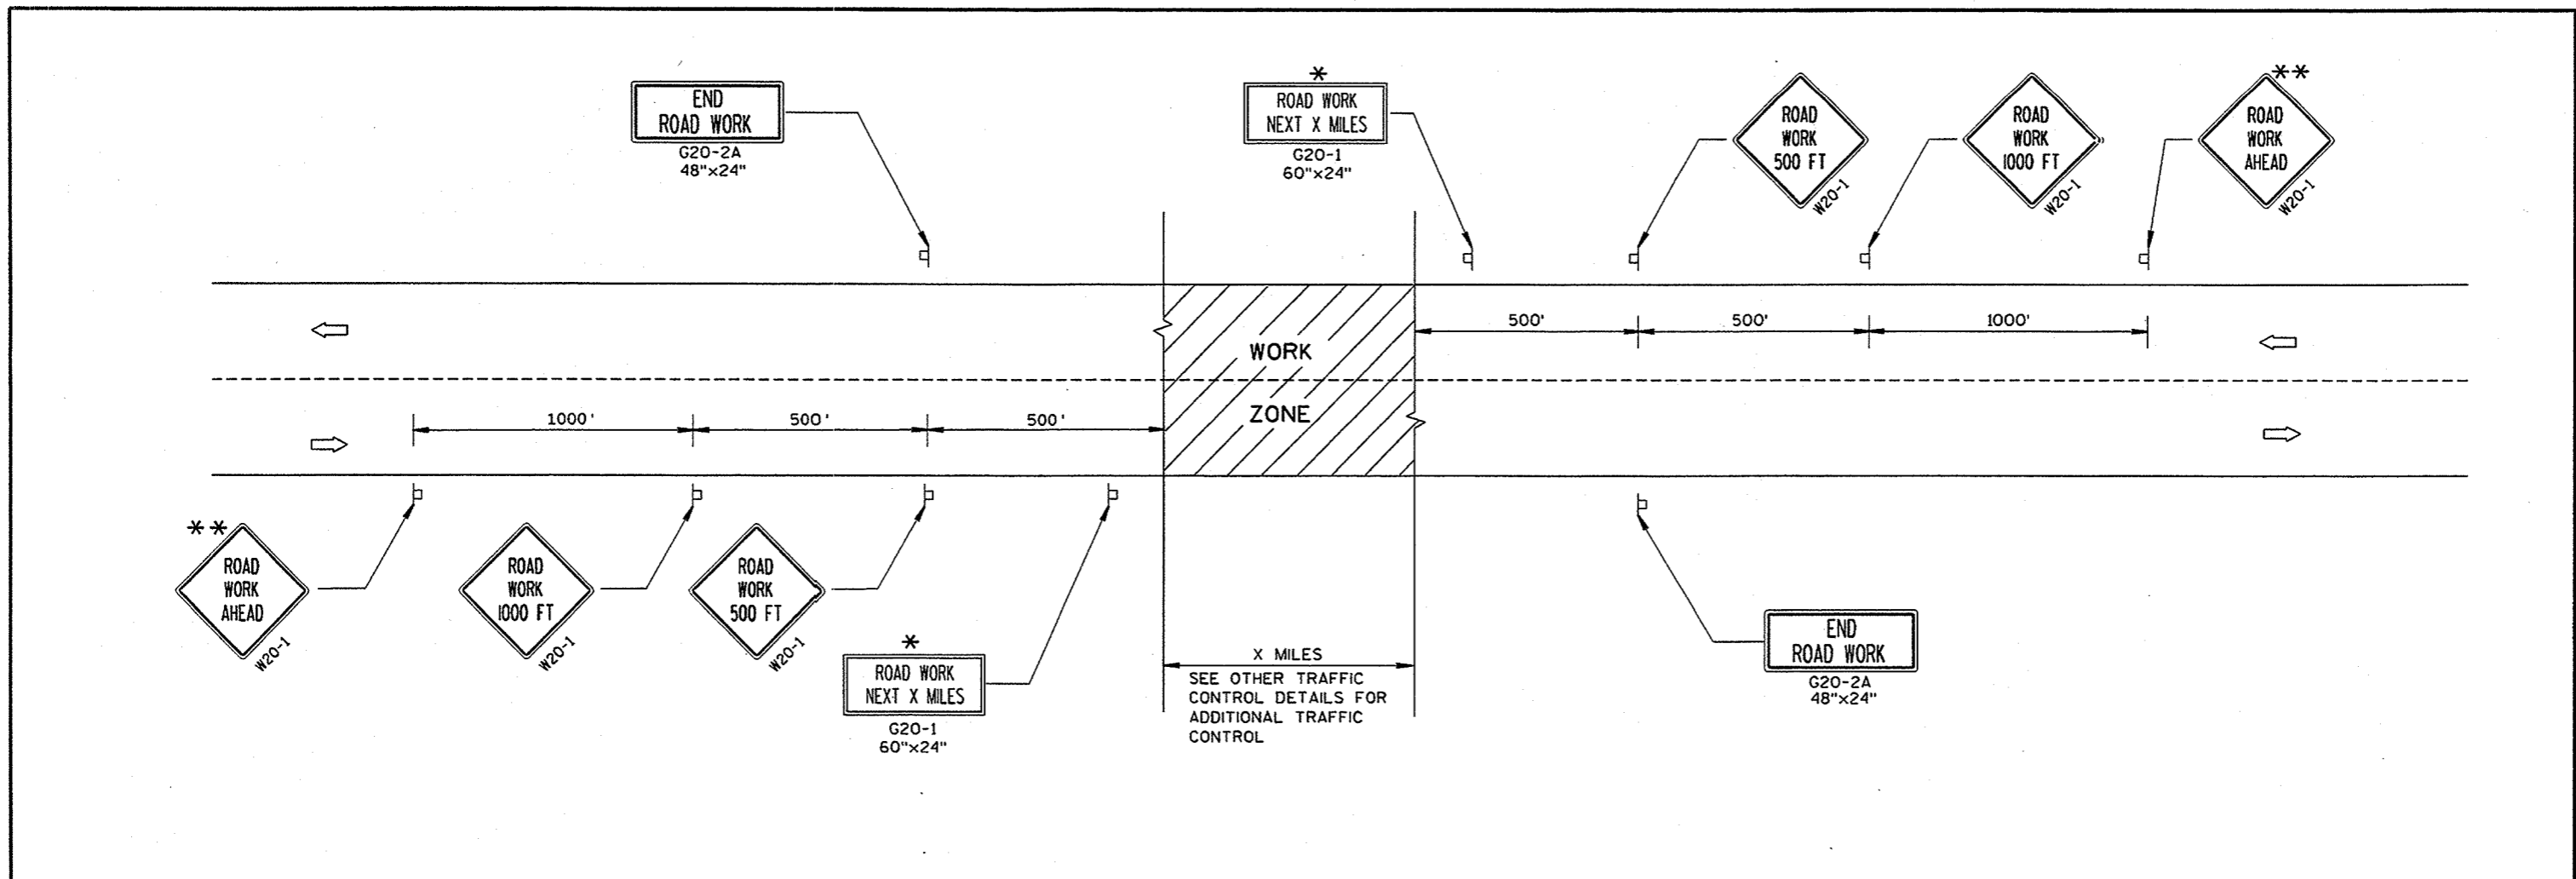

TYPICAL SIDEROAD APPROACH WARNING SIGN DETAIL

GENERAL NOTES

- THE EXACT NUMBER, LOCATION, AND SPACING OF ALL SIGNS AND DEVICES SHALL BE ADJUSTED TO FIT FIELD CONDITIONS.
- THE SPACING BETWEEN TRAFFIC CONTROL SIGNS SHOULD BE ADJUSTED TO NOT CONFLICT WITH AND SHOULD PROVIDE A MINIMUM OF 200 FEET (500 FEET DESIRABLE) CLEARANCE TO EXISTING SIGNS THAT WILL REMAIN IN PLACE.
- ALL SIGNS ARE 48"x48" UNLESS OTHERWISE NOTED.
- SIGNS THAT WILL BE IN PLACE LESS THAN 7 CONTINUOUS DAYS AND NIGHTS MAY BE MOUNTED ON PORTABLE SUPPORTS.
- IF A "STOP" SIGN MUST BE REMOVED FOR A WORK OPERATION, A TEMPORARY "STOP" SIGN SHALL BE PLACED PRIOR TO THE SIGN REMOVAL, OR A FLAGGER SHALL BE PROVIDED UNTIL THE SIGN IS RE-ESTABLISHED.
- * OMIT G20-1 SIGNS IF LENGTH OF WORK AREA IS 2 MILES OR LESS.
- ** PLACE ADDITIONAL W20-1 "ROAD WORK AHEAD" SIGN IF WORK AREA WITHIN THE PROJECT IS SEPARATED BY MORE THAN 2 MILES FROM PREVIOUS WORK AREA OR SIGNING.







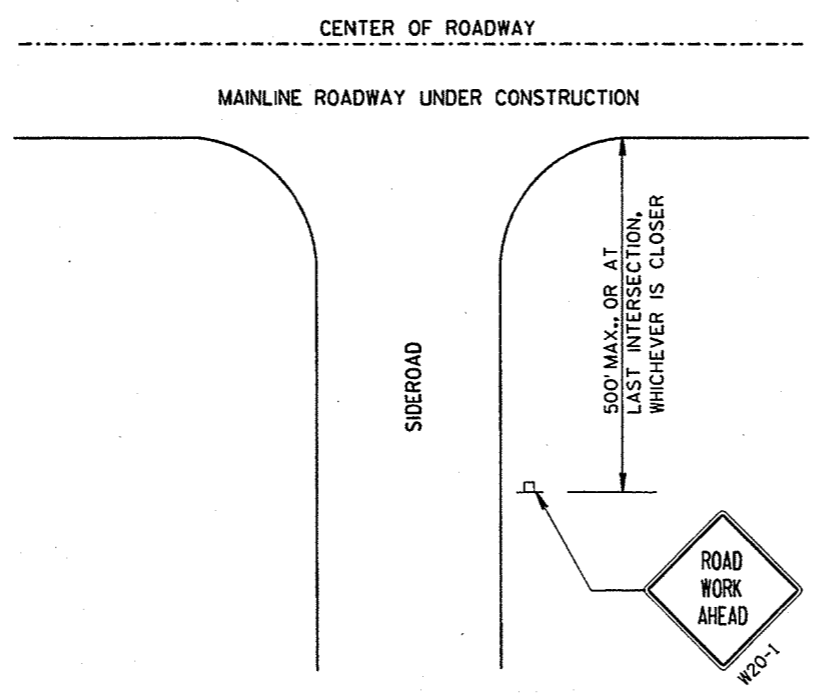


LEGEND




- POST MOUNTED SIGN
- ⇨ DIRECTION OF TRAFFIC FLOW

<p>TRAFFIC CONTROL, ADVANCE WARNING SIGNS 45 M.P.H. OR GREATER TWO-WAY UNDIVIDED ROAD OPEN TO TRAFFIC</p>	
<p>STATE OF WISCONSIN DEPARTMENT OF TRANSPORTATION</p>	
<p>APPROVED 5/23/00 DATE</p>	<p><i>Chester J. Spang</i> CHIEF SIGNS AND MARKING ENGINEER</p>
<p>FHWA</p>	


S.D.D. 15 C 4-1

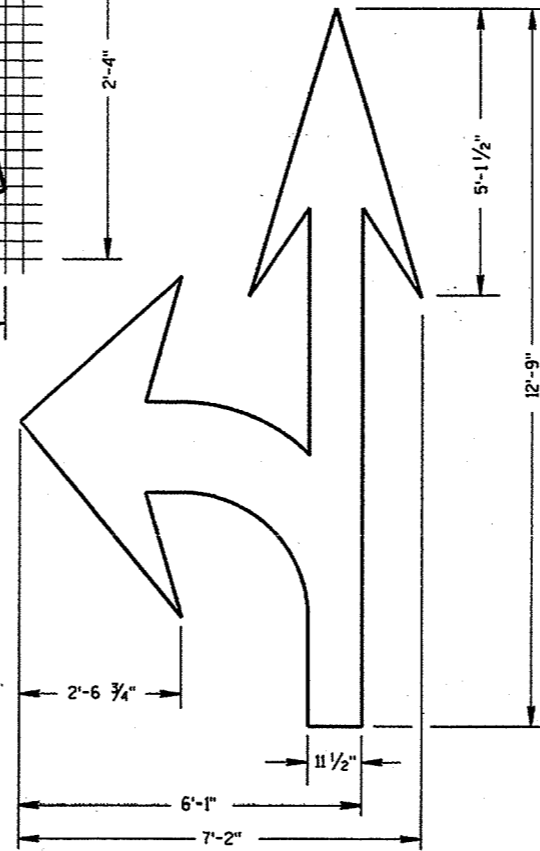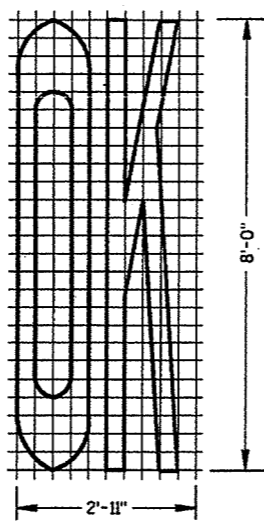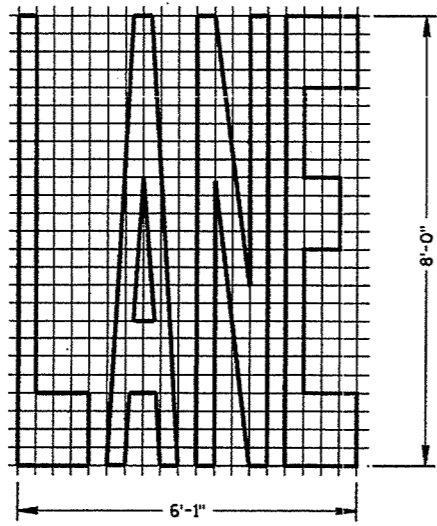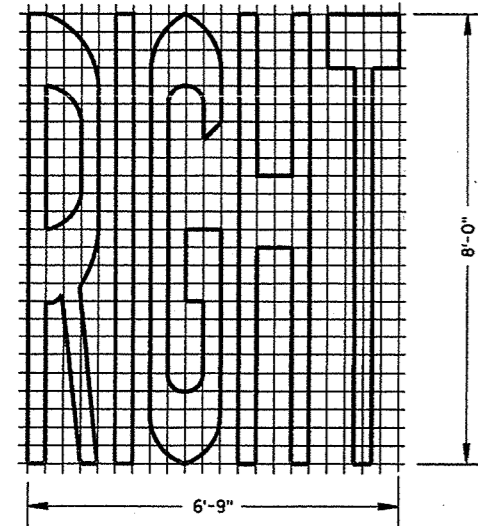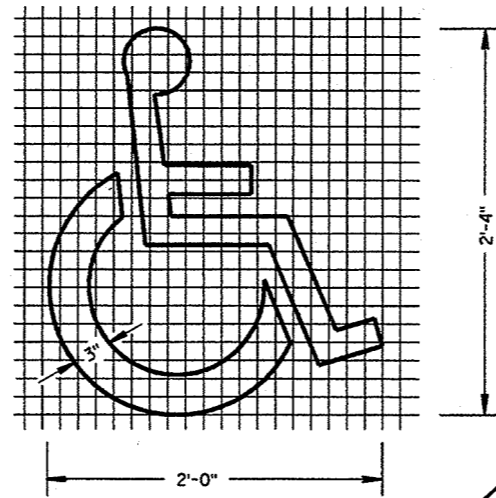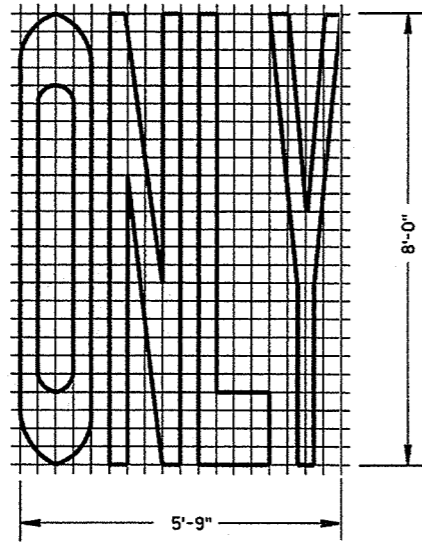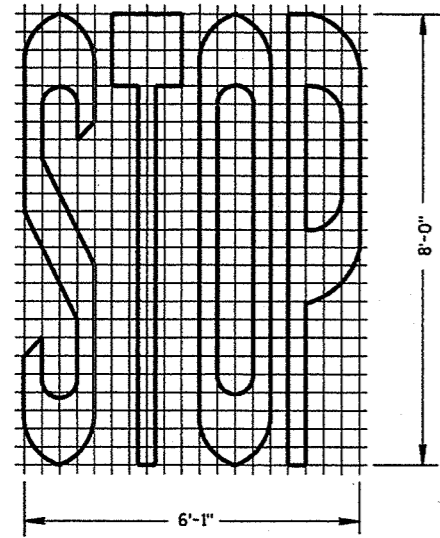

TYPE 3

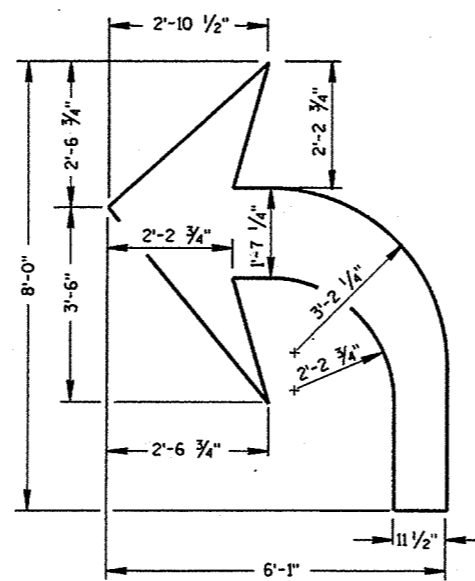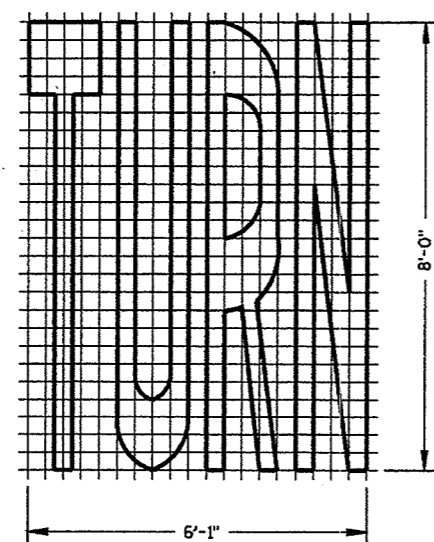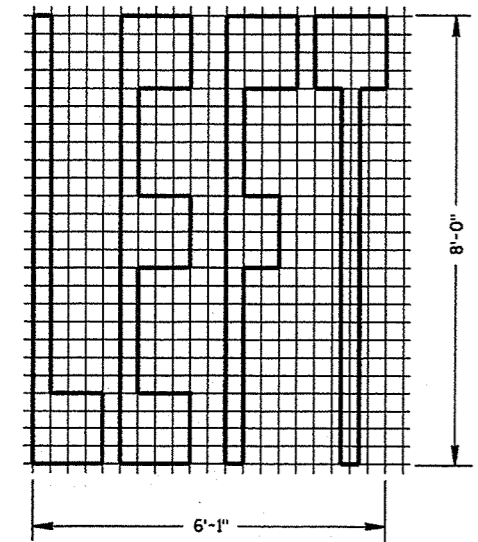

TYPE 2

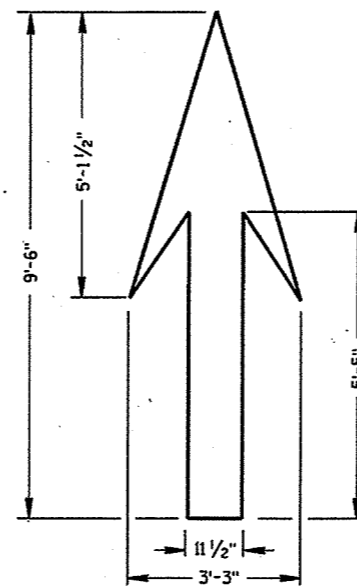


TYPE 1

GENERAL NOTES


DETAILS OF INSTALLATION, MATERIALS AND WORKMANSHIP NOT SHOWN ON THIS DRAWING SHALL CONFORM TO THE PERTINENT REQUIREMENTS OF THE STANDARD SPECIFICATIONS AND APPLICABLE SPECIAL PROVISIONS.

ALL LETTERS AND SYMBOLS SHALL BE IN CONFORMANCE WITH REQUIREMENTS INCLUDED IN "STANDARD ALPHABETS FOR HIGHWAY SIGNS AND PAVEMENT MARKING" BY THE FEDERAL HIGHWAY ADMINISTRATION. ALL LETTERS, ARROWS AND SYMBOLS SHALL BE WHITE AND REFLECTORIZED.

A DETAILED DRAWING OF THE HANDICAPPED PARKING SYMBOL IS ILLUSTRATED IN THE "STANDARD HIGHWAY SIGNS MANUAL" BY THE FEDERAL HIGHWAY ADMINISTRATION.

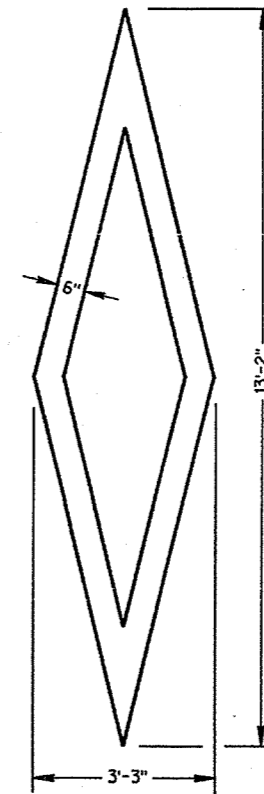

PREFERENTIAL LANE SYMBOL

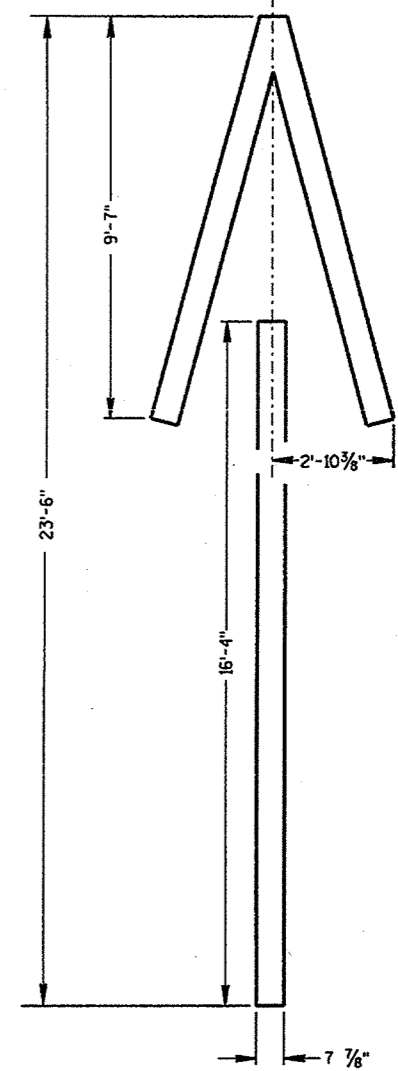

TYPE 4

PAVEMENT MARKING SYMBOLS


STATE OF WISCONSIN
DEPARTMENT OF TRANSPORTATION

APPROVED


7-28-95
DATE

FHWA

Charles J. Spang
for DIRECTOR, OFFICE OF TRAFFIC

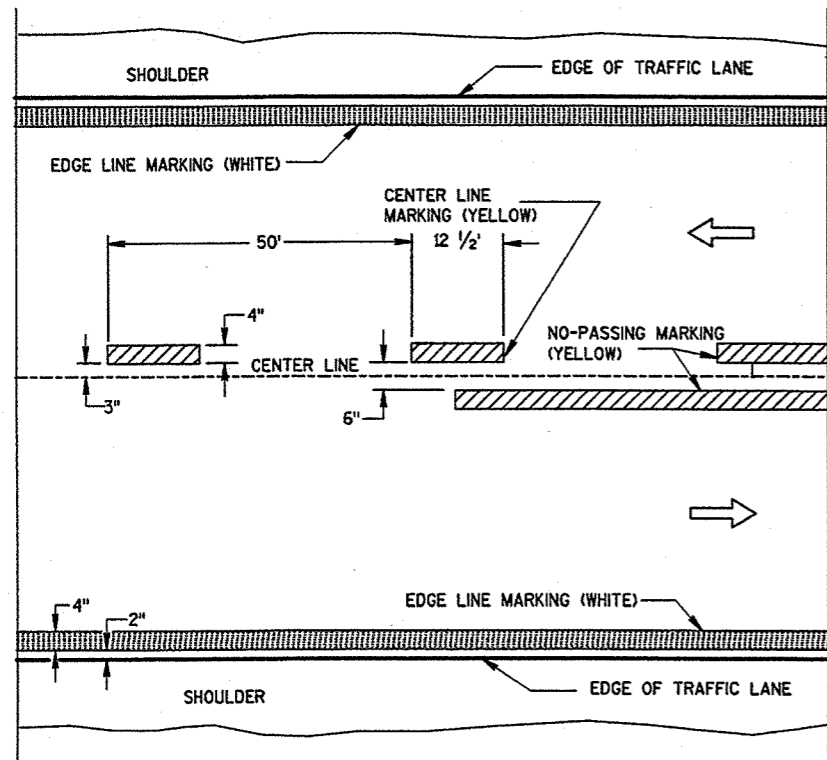

TWO WAY TRAFFIC

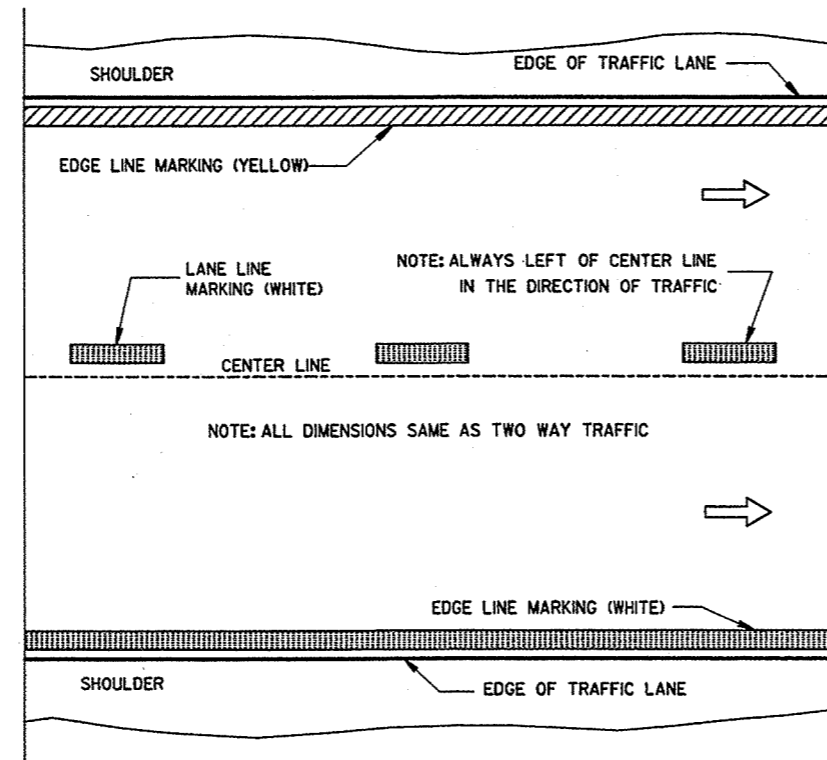

ONE WAY TRAFFIC

PERMANENT PAVEMENT MARKING


GENERAL NOTES

DETAILS OF CONSTRUCTION NOT SHOWN ON THIS DRAWING SHALL CONFORM TO STANDARD SPECIFICATIONS AND SPECIAL PROVISIONS.


- ① HALF CYCLE LENGTHS (25'±) WITH 2' MINIMUM STRIPE LENGTHS SHALL BE PROVIDED ON ROADWAYS (INCLUDING TEMPORARY TRAVELED WAYS) WITH REVERSE CURVATURE, CURVATURE OF OVER 5 DEGREES OR WHEN DIRECTED BY THE ENGINEER TO MARK UNUSUAL ALIGNMENT OF THE TRAVELED WAY.
- ② NO PASSING ZONE TEMPORARY PAVEMENT MARKING IS REQUIRED TO BE PLACED, WHERE APPROPRIATE, ALONG WITH CENTERLINE TEMPORARY PAVEMENT MARKING WHEN A SAME DAY PERMANENT PAVEMENT MARKING ITEM IS INCLUDED IN THE CONTRACT.

NOTE

ARROW SYMBOL (→) SHOWS DIRECTION OF TRAVEL

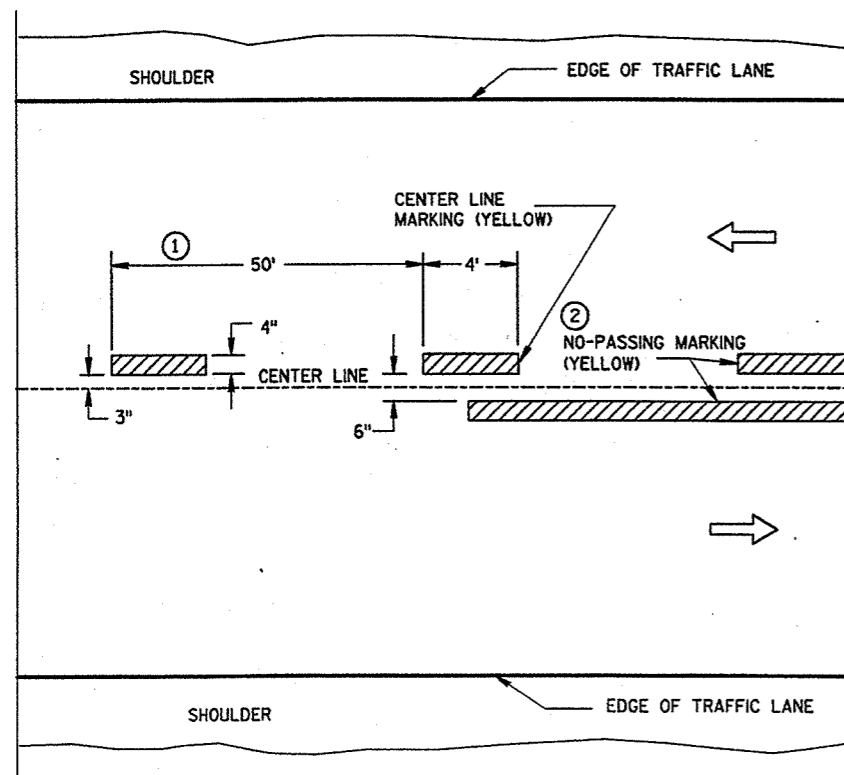

TWO WAY TRAFFIC

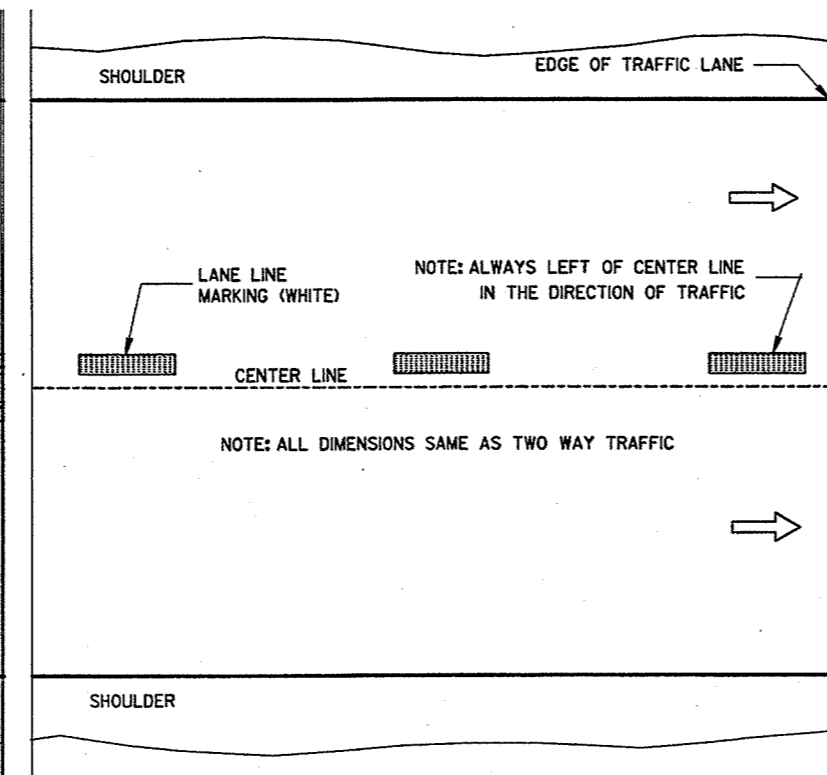

ONE WAY TRAFFIC

TEMPORARY (INTERMEDIATE) PAVEMENT MARKING
(SHOWS CYCLE FOR TEMPORARY CENTER LINE OR TEMPORARY LANE LINE MARKING)

PAVEMENT MARKING (MAINLINE)	
STATE OF WISCONSIN DEPARTMENT OF TRANSPORTATION	
APPROVED 2-17-00 DATE	<i>Christa J. Spang</i> CHIEF SIGNS AND MARKING ENGINEER
FHWA	

S.D.D. 15 C 8-9a

GENERAL NOTES

THE EXACT NUMBER, LOCATION AND SPACING OF ALL SIGNS AND DEVICES SHALL BE ADJUSTED TO FIT FIELD CONDITIONS AS APPROVED BY THE ENGINEER.

ALL SIGNS ARE 48" X 48" UNLESS OTHERWISE NOTED. IF NECESSARY DUE TO SPACE CONSTRAINTS IN URBAN AREAS, 36" X 36" SIGNS MAY BE USED IF APPROVED BY DISTRICT TRAFFIC UNIT.

"W0" SIGNS ARE THE SAME AS "W" SIGNS EXCEPT THE BACKGROUND IS ORANGE.

SIGNS THAT WILL BE IN PLACE LESS THAN 7 CONTINUOUS DAYS AND NIGHTS MAY BE MOUNTED ON PORTABLE SUPPORTS.

ANY SIGNS TEMPORARY OR EXISTING, WHICH CONFLICT WITH TRAFFIC CONTROL "IN USE" SHALL BE REMOVED OR COVERED AS NEEDED AND AS APPROVED BY THE ENGINEER.

W20-1 AND G20-2A SIGNS ARE NOT REQUIRED IF THE WORK AREA IS WITHIN A LARGER WORK ZONE WHERE THESE SIGNS ARE ALREADY PRESENT. G20-2A SIGNS MAY ALSO BE OMITTED IF DURATION OF WORK IS LESS THAN 7 CONTINUOUS DAYS AND NIGHTS.


CHANNELIZING DEVICES PLACED ADJACENT TO THE WORK AREA SHALL BE PULLED BACK FROM THE TRAVEL LANE WHEN WORK IS NOT IN PROGRESS.

TABLE A

S	SHOULDER TAPER LENGTH (FEET)				BUFFER SPACE (FEET)
	4	6	8	10	
30	20	30	40	50	85
35	30	45	55	70	120
40	40	55	75	90	170
45	60	90	120	150	220
50	70	100	135	170	280
55	75	110	150	185	335

W = SHOULDER WIDTH (FEET)
S = NON-CONSTRUCTION SPEED LIMIT (MPH)

SHOULDER TAPER LENGTH
 $= \frac{WS}{3}$ AT 45 MPH OR GREATER
 $= \frac{WS^2}{180}$ AT 40 MPH OR LESS

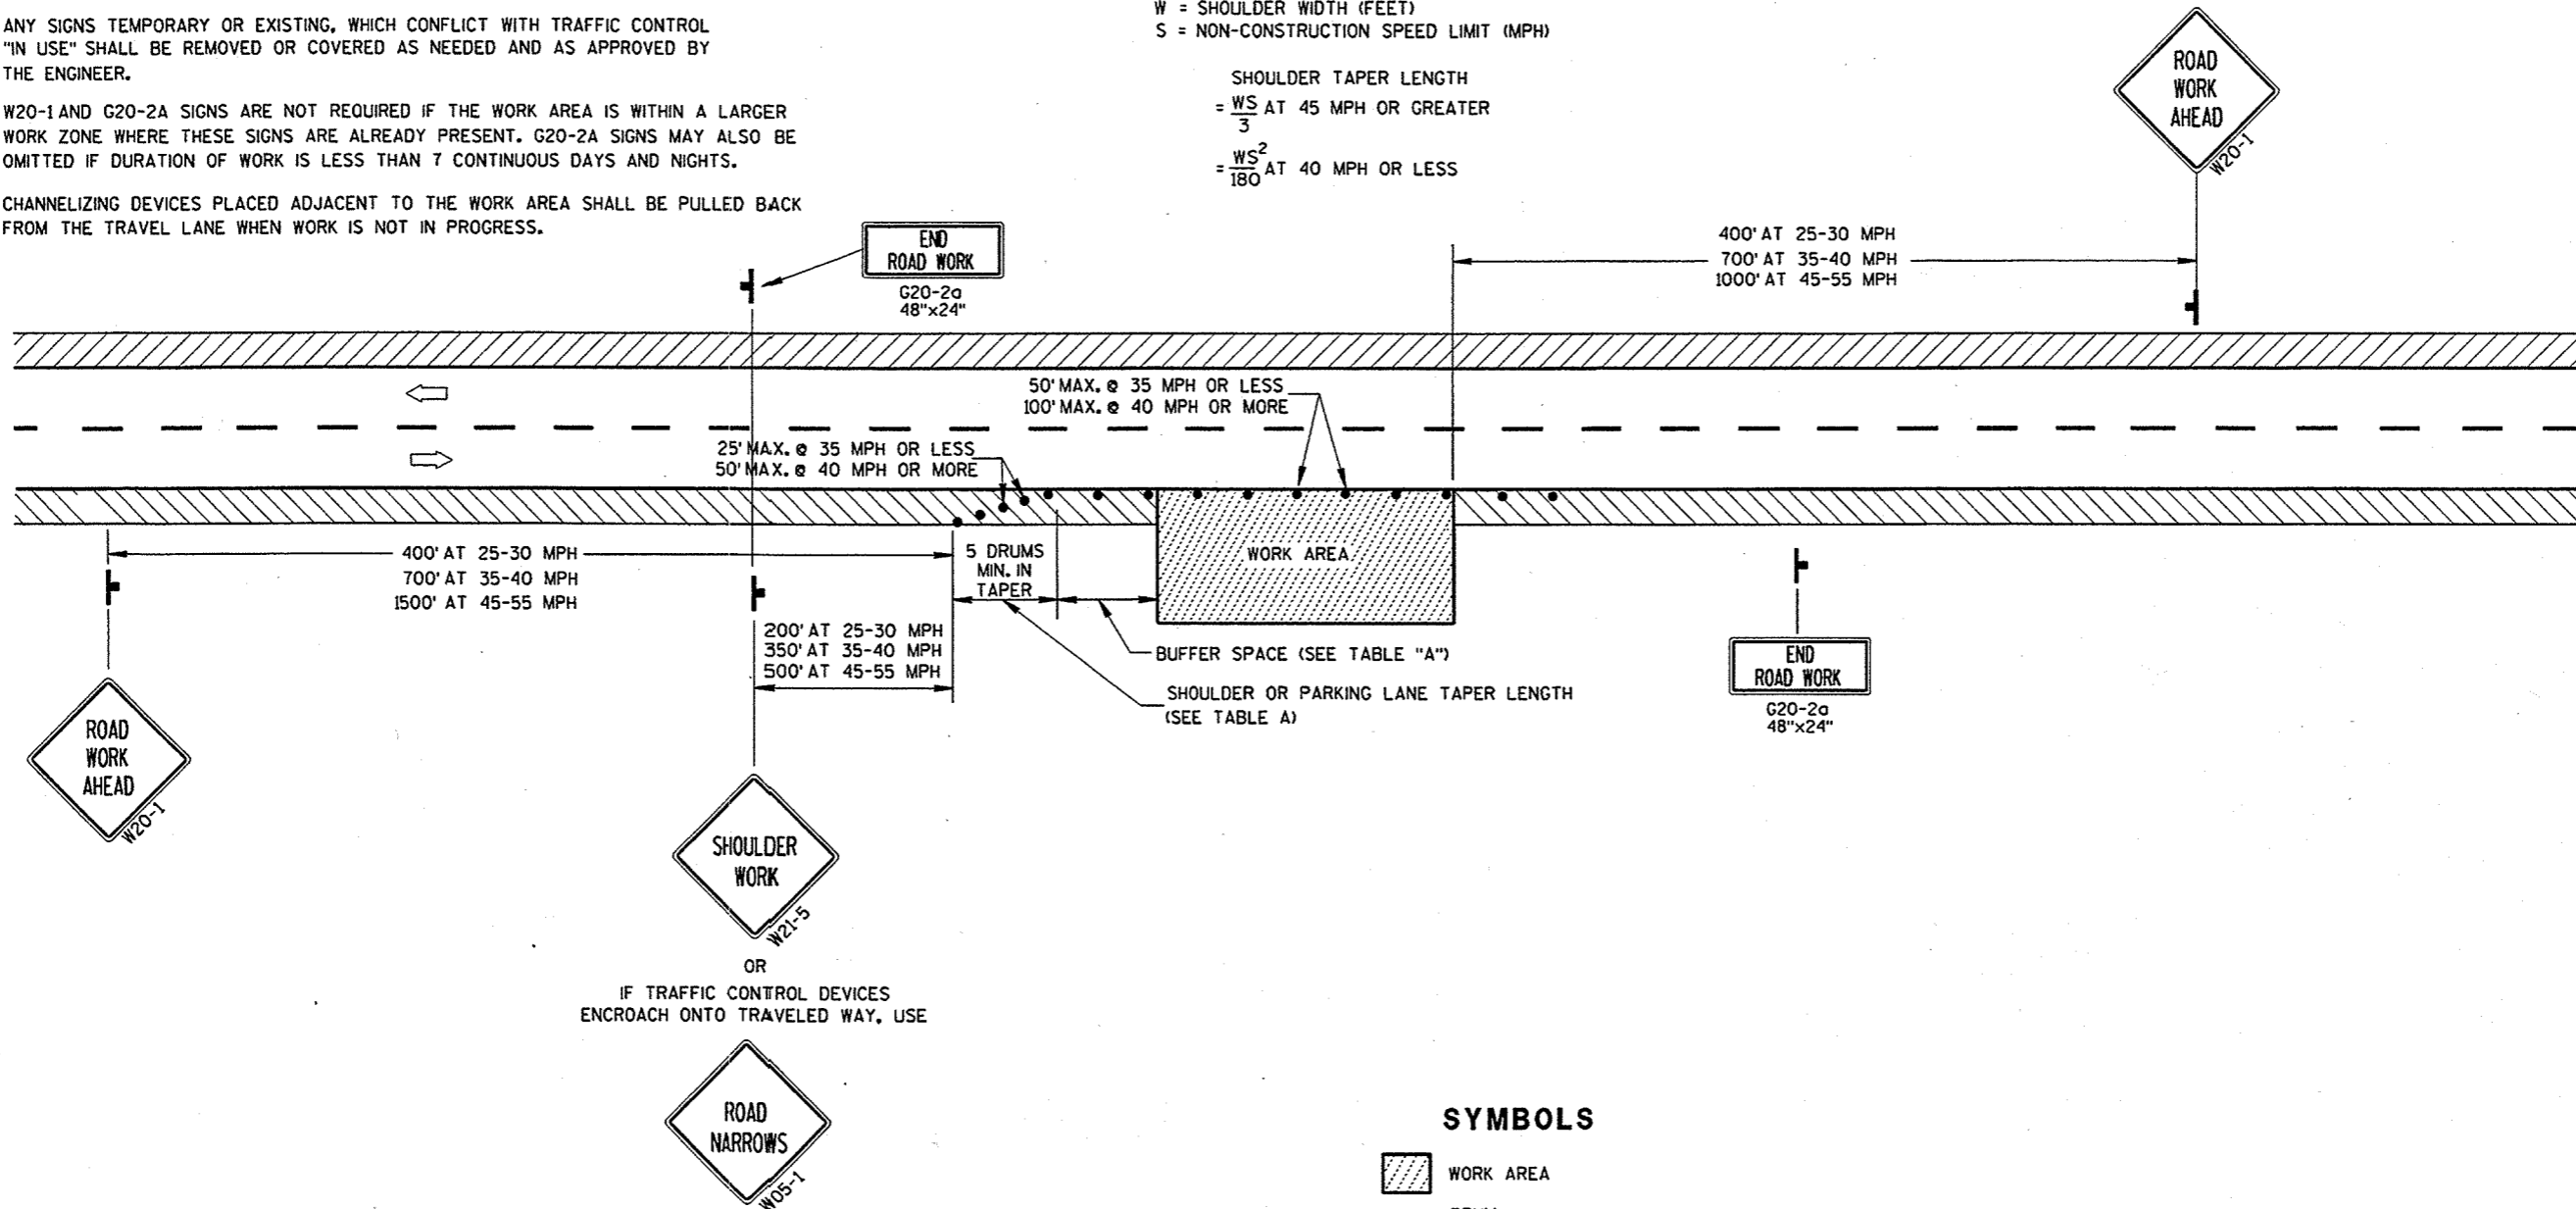

SYMBOLS


- WORK AREA
- DRUM
- POST MOUNTED SIGN
- DIRECTION OF TRAFFIC FLOW

**TRAFFIC CONTROL,
WORK ON SHOULDER OR
PARKING LANE,
UNDIVIDED ROADWAY**



STATE OF WISCONSIN
DEPARTMENT OF TRANSPORTATION

APPROVED
5/23/00 DATE *Christa J. Spang*
CHIEF SIGNS AND MARRING ENGINEER

FHWA

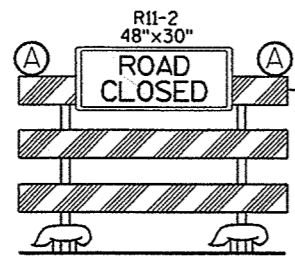

VEHICLE ENTRANCE/EXIT OR HAUL ROAD

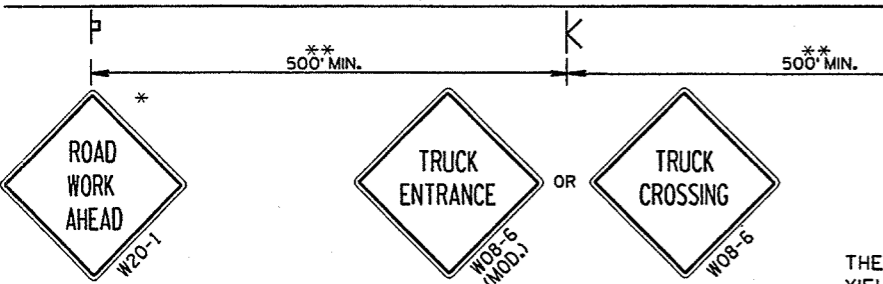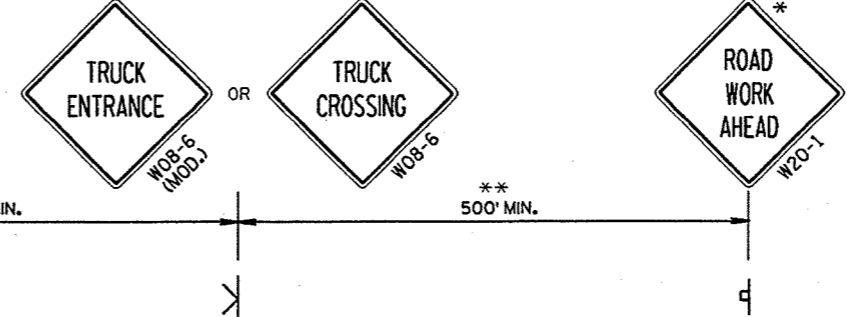

INSTALL TYPE III (8' EQUIVALENT) BARRICADES WHEN HAUL ROAD NOT IN USE (TYPICAL)

VEHICLE ENTRANCE/EXIT OR HAUL ROAD

THE ABOVE DETAIL TO BE USED WHEN CONSTRUCTION VEHICLE TRAFFIC YIELDS TO THE FREE FLOW OF MAINLINE OR RAMP TRAFFIC

LEGEND

- SIGN ON PORTABLE SUPPORT
- POST MOUNTED SIGN
- TYPE III BARRICADE (8 FOOT EQUIVALENT) WITH/WITHOUT SIGN
- FLAGGER, EQUIPPED WITH STOP/SLOW PADDLE FASTENED ON SUPPORT STAFF
- WARNING LIGHT, TYPE A, (LOW-INTENSITY FLASHING)
- DIRECTION OF TRAFFIC FLOW

GENERAL NOTES :

THE EXACT NUMBER, LOCATION, AND SPACING OF ALL SIGNS AND DEVICES (AND THE LOCATION OF ALL FLAGGERS) SHALL BE ADJUSTED TO FIT FIELD CONDITIONS AS APPROVED BY THE ENGINEER.

WHEN ACTIVITY REFLECTED BY THE SIGN IS NOT CURRENTLY TAKING PLACE, THE HIGHWAY SHALL BE RESTORED TO NORMAL CONDITION AND THE SIGNS SHALL BE REMOVED, COVERED OR TURNED AWAY FROM TRAFFIC.

WHEN A SIDE ROAD OR RAMP INTERSECTS WITHIN THE ADVANCE SIGNING AREA, ADDITIONAL TRAFFIC CONTROLS SHALL BE PROVIDED AS SPECIFIED IN THE PLANS AND/OR THE SPECIAL PROVISIONS OR AS APPROVED BY THE ENGINEER.

* THESE SIGNS ARE TO BE USED ONLY WHEN VEHICLE ENTRANCE/EXIT CONDITIONS ARE SEPARATED BY MORE THAN 2 MILES FROM PREVIOUS WORK AREA OR SIGNING OR AS ORDERED BY THE ENGINEER.

** 500' SHOWN IS FOR ROADWAYS WITH A NON-CONSTRUCTION REGULATORY SPEED LIMIT OF 45 MPH OR MORE. FOR 35-40 MPH, USE 350', FOR 25-30 MPH, USE 200'.

ALL SIGNS ARE 48"x48" UNLESS OTHERWISE NOTED.


"W0" IS THE SAME AS "W" EXCEPT THE BACKGROUND IS ORANGE.

SIGN LAYOUTS SHALL BE IN ACCORDANCE WITH THE FHWA'S MANUAL OF STANDARD HIGHWAY SIGNS OR THE WISCONSIN STANDARD SIGN PLATES.


THE FIRST ADVANCE WARNING SIGN AND THE W20-7b SIGN SHOULD TYPICALLY BE LOCATED IN ADVANCE OF THE ANTICIPATED TRAFFIC BACKUP OR QUEUE.

FLAGGERS SHALL BE IN SIGHT OF EACH OTHER OR IN DIRECT COMMUNICATION AT ALL TIMES. THEY SHALL BE EQUIPPED WITH STOP/SLOW PADDLES FASTENED ON SUPPORT STAFFS.

WARNING SIGNS THAT WILL BE IN PLACE LESS THAN 7 CONTINUOUS DAYS AND NIGHTS MAY BE MOUNTED ON PORTABLE SUPPORTS.

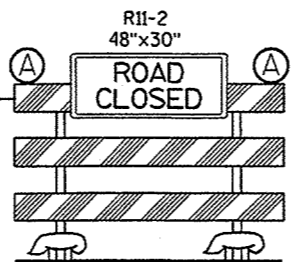

VEHICLE ENTRANCE/EXIT OR HAUL ROAD

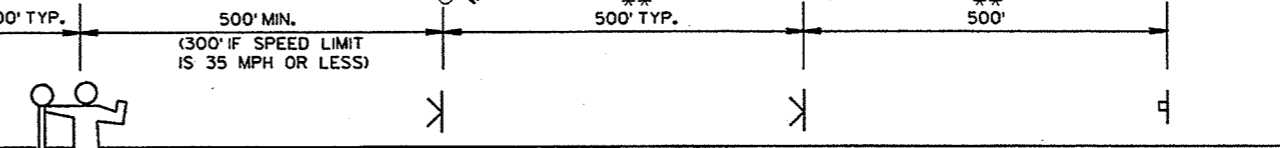


INSTALL TYPE III (8' EQUIVALENT) BARRICADES WHEN HAUL ROAD NOT IN USE (TYPICAL)

VEHICLE ENTRANCE/EXIT OR HAUL ROAD


THIS DETAIL TO BE USED WHEN CONSTRUCTION WORK INCLUDING TRUCKING ACTIVITY REQUIRES MAINLINE TRAFFIC TO BE TEMPORARILY STOPPED IN ONE OR BOTH DIRECTIONS. DELAY TO HIGHWAY TRAFFIC SHALL BE MINIMIZED.

TRAFFIC CONTROL, VEHICLE ENTRANCE/EXIT OR HAUL ROAD	
STATE OF WISCONSIN DEPARTMENT OF TRANSPORTATION	
APPROVED	
DATE	5/22/00
CHIEF SIGNS AND MARKING ENGINEER	
FHWA	


S.D.D. 15 D 29-1

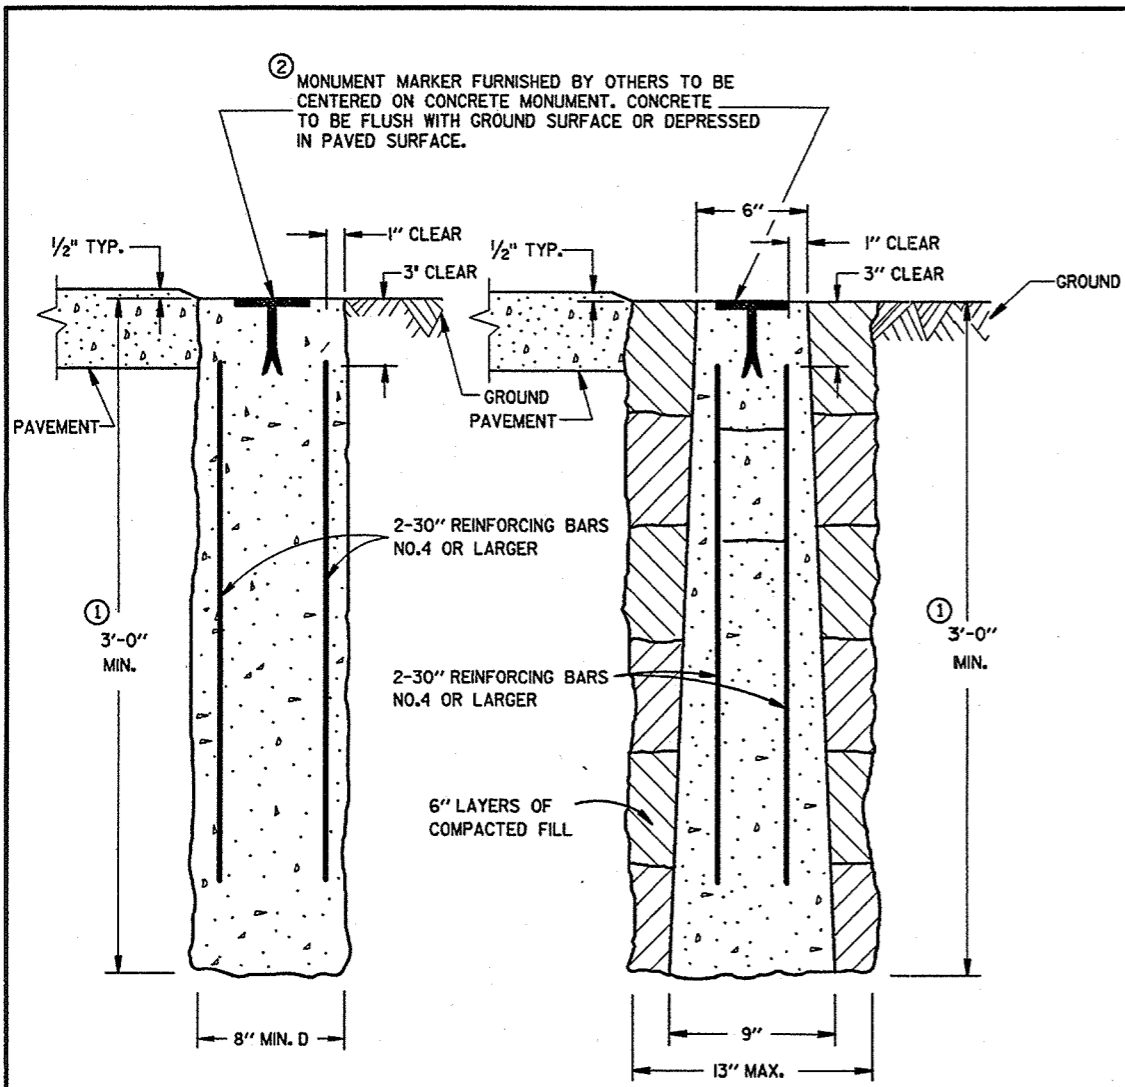

CAST-IN-PLACE
PRECAST
CONCRETE MONUMENTS
TYPE A

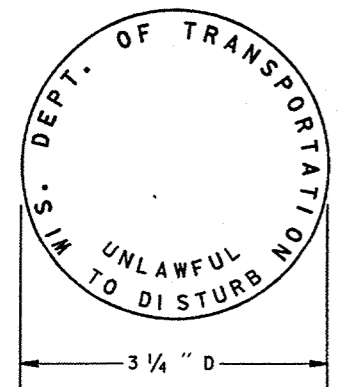

WIS DOT MONUMENT MARKER LOGO
FOR TYPES "A", "C" & "D"

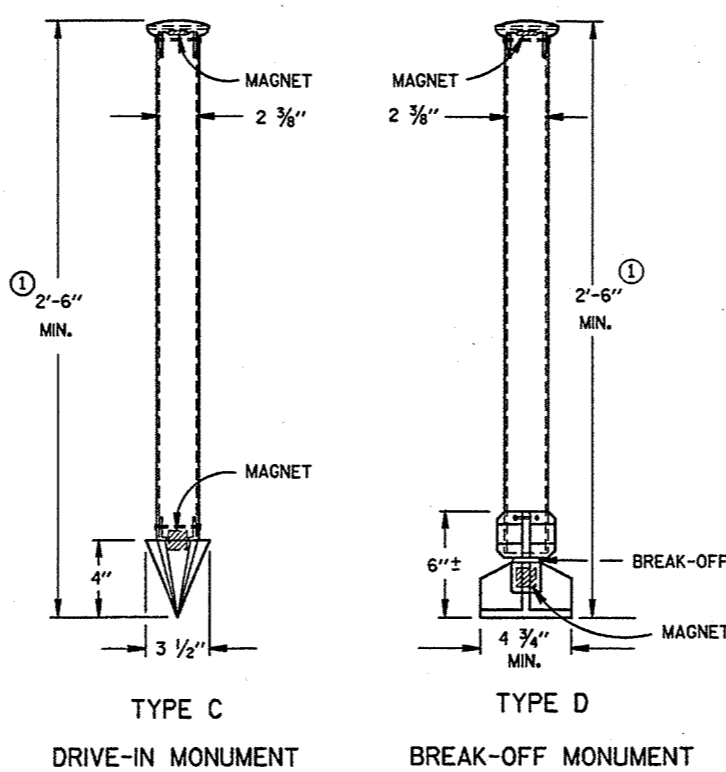

ALUMINUM MONUMENTS
(INCLUDES MARKER)

GENERAL NOTES

DETAILS OF CONSTRUCTION, MATERIALS AND WORKMANSHIP NOT SHOWN ON THIS DRAWING SHALL CONFORM TO THE PERTINENT REQUIREMENTS OF THE STANDARD SPECIFICATIONS AND THE APPLICABLE SPECIAL PROVISIONS.

DETAILED DRAWINGS OF PROPOSED ALTERNATE DESIGNS FOR METAL MONUMENTS OR MONUMENT COVERS SHALL BE SUBMITTED TO THE ENGINEER FOR APPROVAL.

INSTALLED METAL MONUMENTS MUST BE EASILY DETECTED WITH A DIP NEEDLE. INSERT PERMANENT MAGNETS SHALL BE ATTACHED NEAR THE TOP AND BOTTOM OF THOSE MONUMENTS CONSTRUCTED OF A METAL ALLOY WHICH IS NOT ATTRACTIVE TO A DIP NEEDLE.

THE CAST IRON MONUMENT COVER SHALL BE A "NON-ROCKING" TYPE. ADJUSTMENT OF THE COVER TO GRADE MAY BE ACCOMPLISHED BY THE USE OF MORTAR AND BRICK, OR BY EITHER PRECAST OR CAST-IN-PLACE REINFORCED CONCRETE GRADE RINGS.


MONUMENTS SHALL BE LOCATED AND PLACED AT THE DIRECTION OF THE ENGINEER.

ALUMINUM MONUMENTS AND MONUMENT COVERS SHALL BE MADE FROM AN ALUMINUM AND MAGNESIUM ALLOY AS DETERMINED BY THE MANUFACTURER.


THE MONUMENT COVERS DETAILED ON THIS DRAWING ARE NOT EQUAL ALTERNATES. MONUMENT COVERS SHALL BE CAST IRON UNLESS ALUMINUM IS SPECIFIED ELSEWHERE IN THE CONTRACT.

MONUMENT SHALL BE CAST-IN-PLACE CONCRETE UNLESS PRECAST CONCRETE OR ALUMINUM MONUMENTS ARE SPECIFIED IN THE CONTRACT OR PERMITTED BY THE ENGINEER.


- ① MINIMUM LENGTH SHALL BE 4'-0" FOR MONUMENTS INSTALLED IN PAVED AREAS.
- ② AN OFFICIAL COUNTY MONUMENT MARKER SUPPLIED BY A COUNTY MAY BE REQUIRED FOR SOME SECTION CORNERS AND WITNESS MONUMENTS INSTEAD OF THIS WIS DOT MARKER.

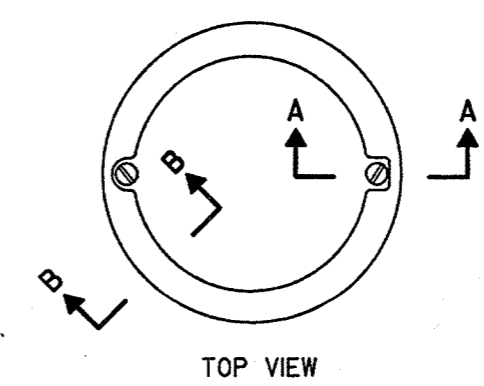

TOP VIEW

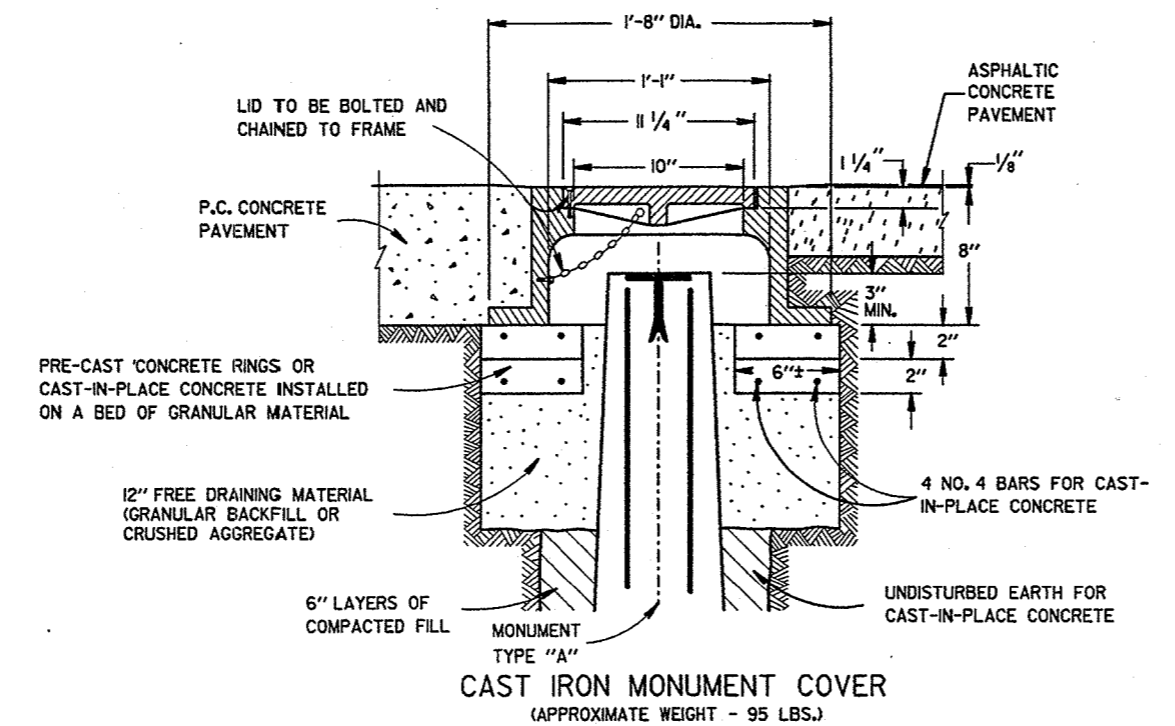

CAST IRON MONUMENT COVER
(APPROXIMATE WEIGHT - 95 LBS.)

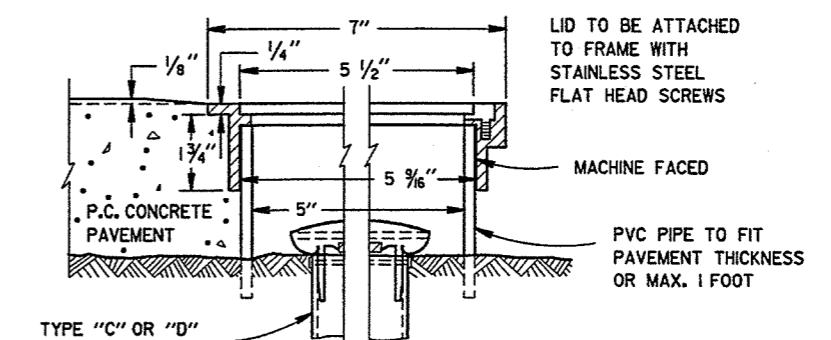

SECTION B-B SECTION A-A
ALUMINUM MONUMENT COVER

(APPROXIMATE WEIGHT 2 LBS)
(FOR CONCRETE PAVEMENT ONLY)

LANDMARK REFERENCE MONUMENTS AND COVERS	
STATE OF WISCONSIN DEPARTMENT OF TRANSPORTATION	
APPROVED 9/22/99 DATE	 CHIEF ROADWAY DEVELOPMENT ENGINEER
FHWA	

URBAN AREA





RURAL AREA (See Note 2)

GENERAL NOTES

1. Sign assemblies wider than 4 feet or larger than 20 sq. ft. shall be mounted on multiple posts. See plate A4-4 for typical installations.
2. For expressway and freeways installations, the minimum mounting height is 7'-3" ± or 6'-3" ± depending upon the existence of a sub-sign.
3. For Route Marker assemblies or J panels, the minimum mounting height is 7'-3" ± or 5'-3" ± depending upon urban/rural area.
4. The (±) tolerance for the mounting height is 3 inches.

POST EMBEDMENT DEPTH

Area of Sign Installation (Sq. Ft.)	D (Min)
20 or Less	4'
Greater than 20	5'

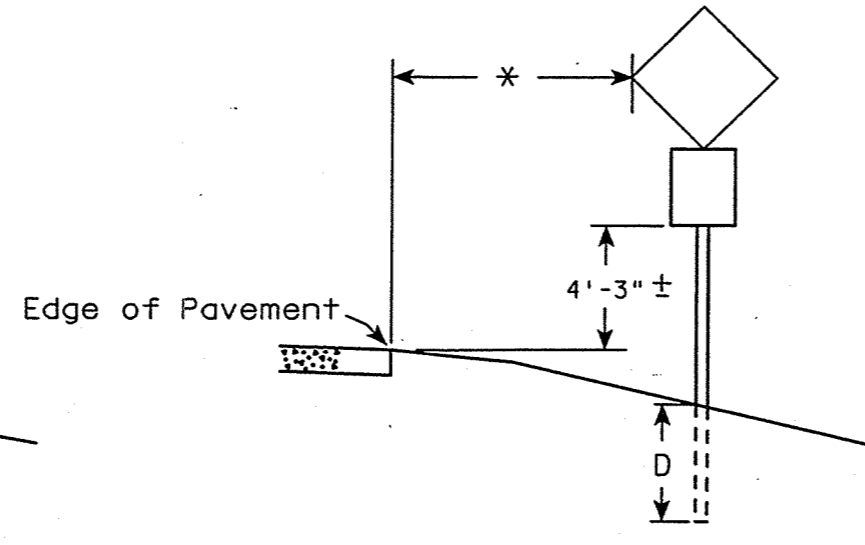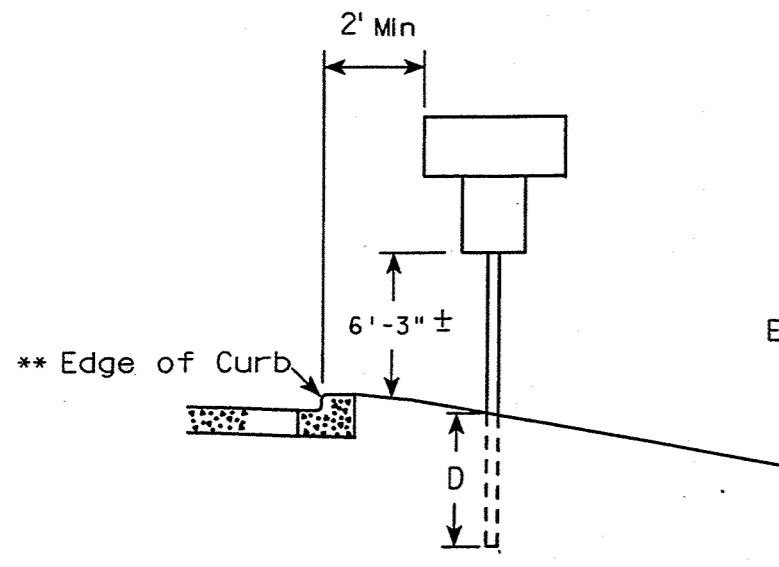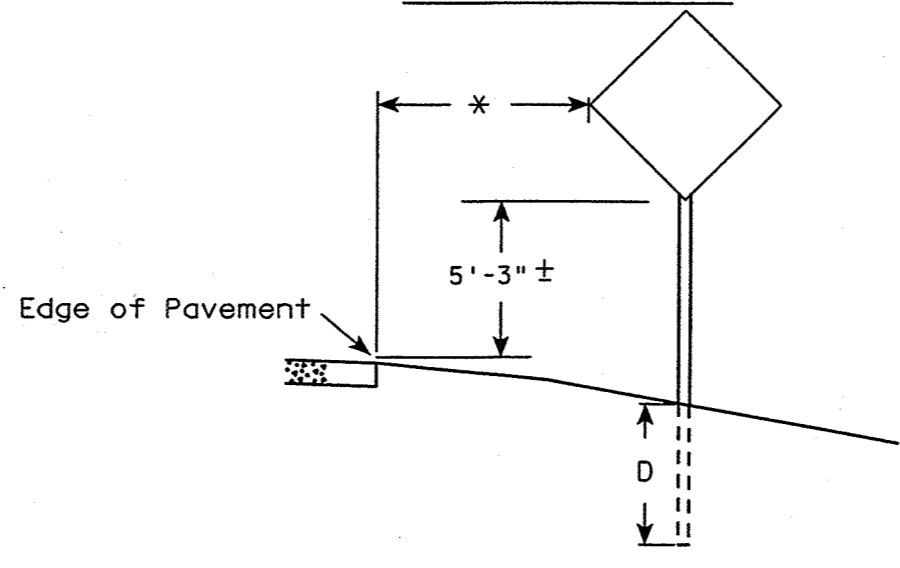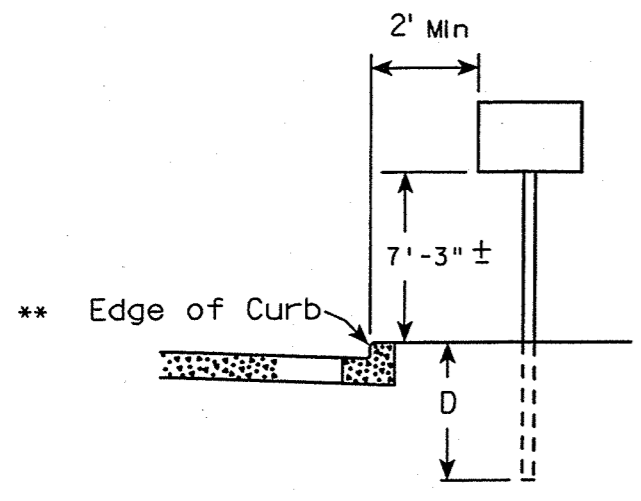

** The existence of curb and gutter does not in itself mandate the vertical clearance illustrated. That height is typically where there is sidewalk adjacent to the roadway or parking is permitted.


* 6 feet from edge of a paved shoulder or 12 feet from the edge of pavement (edgeline location), whichever is greater unless directed by project engineer.

TYPICAL INSTALLATION OF PERMANENT TYPE II SIGNS ON SINGLE POSTS

WISCONSIN DEPT OF TRANSPORTATION

APPROVED *Chester J. Spang*
for State Traffic Engineer

DATE 05/12/98 PLATE NO. A4-3.11

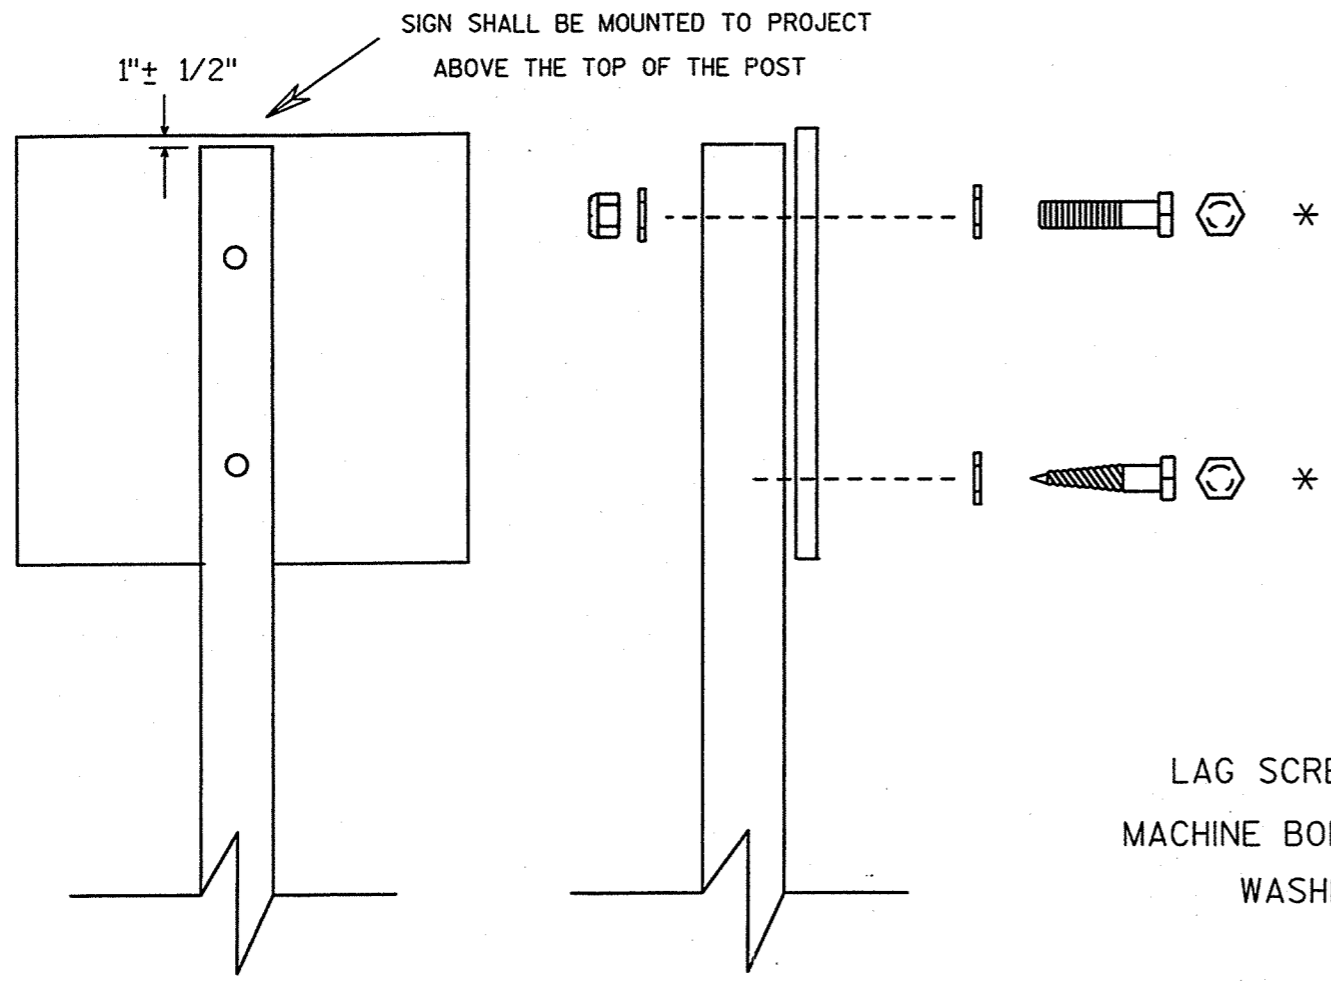

SIGN SHALL BE MOUNTED TO PROJECT
ABOVE THE TOP OF THE POST


1" ± 1/2"

Nuts, bolts and lags used for mounting signs shall have hexagonal heads and shall be either :

- Hot dip or mechanically galvanized in accordance with ASTM Designation: A 153, Class D, or
- Cadmium plated in accordance with ASTM Designation : B 766 TYPE 3, Class 12, or
- Electro-galvanized in accordance with ASTM Designation : B 633, TYPE III, SC 3.

Threads on bolts and nuts shall be manufactured with sufficient allowance for the cadmium plate or galvanized coating to permit the nuts to run freely on the bolts.

- LAG SCREWS - 3/8" X 3"
- MACHINE BOLTS - 5/16" X 6-1/2" or 7" Length w/ nuts
- WASHERS - 1" O.D. X 3/8" I.D. X 1/16" STEEL for signs 24x24 and smaller.
1-1/4" O.D. X 3/8" I.D. X 1/16" STEEL for signs 24x30 to 36x48.
1-1/2" O.D. X 7/16" I.D. X 1/16" STEEL for signs 48x48 and larger.
1-1/4" O.D. X 3/8" I.D. X .080 TEFLON for all Type H signs.

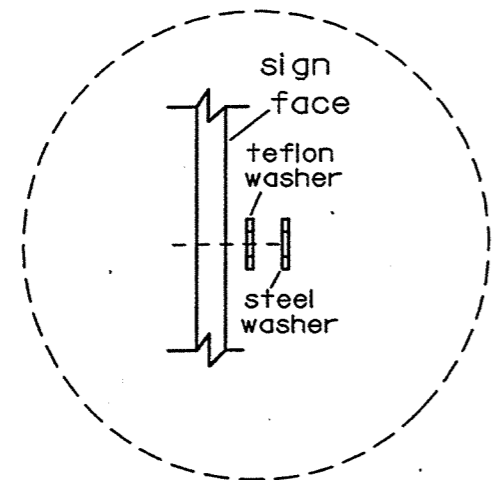

Washer Placement when Sign Has Type H Face

* Two different fastening systems are shown for illustration purposes only. On any individual sign, either one or the other system shall be used unless otherwise indicated in the special provisions.

ATTACHMENT OF SIGNS TO WOOD POSTS	
WISCONSIN DEPT OF TRANSPORTATION	
APPROVED	<i>Christen J. Spang</i> for State Traffic Engineer
DATE 4/3/96	PLATE NO. A4-8.3

PLOT NAME: 50.59
 PLOT SCALE: 2:1
 FILE NAME: A48
 ORIGINATOR: Don Kluever
 LEVELS ON: 2
 R

NOTES

1. Sign is Type II - Reflective - reference WIS DOT Standard Specification for HIGHWAY and STRUCTURE CONSTRUCTION latest edition.
2. Color:
Background - Sign is white; paraplegic background is blue.
Message - Legend and border are green; paraplegic symbol is white
3. Message Series - Lines 1 & 2 are Series B
Lines 3, 4, 5 & 6 are Series C
4. Corners may be square or rounded when base material is plywood but borders shall be rounded as shown. When base material is metal, the corners and borders shall be rounded.



R7-8A

Metric equivalent for this sign is:

SIZE	
1	
2	300 mm X 450 mm
3	450 mm X 600 mm
4	
5	

SIZE	A	B	C	D	E	F	G	H	I	J	K	L	M	N	O	P	Q	R	S	T	U	V	W	X	Y	Z	Area sq. ft.	Area sq. m.
1																												
2	12	18	1 1/8	3/8	3/8	2	5	1/2	1 1/2	3/4	5/8	3/8	1 3/8	1 1/4	4	5/8		3 1/2	4 3/8	4	2 1/2	3	3 7/8	1 1/4	1/4	4 3/4	1.5	.14
3	18	24	1 1/8	3/8	1/2	3	6	3/4	2	7/8	5/8	1/2	1 7/8	2	5	3/4		4 5/8	6 1/2	5 3/8	3	4 1/2	5 7/8	1 1/2	1/4	6 3/8	3.0	.27
4																												
5																												

STANDARD SIGN
R7-8A

WISCONSIN DEPT OF TRANSPORTATION

APPROVED

Christa J Spary
for State Traffic Engineer

DATE 2/8/99

PLATE NO. R7-8A.4

DESIGN DATA

LIVE LOAD:

DESIGN RATING: HS-20
 INVENTORY RATING: HS-21
 OPERATIONAL RATING: HS-38
 MAXIMUM STANDARD PERMIT VEHICLE LOAD = 250 KIPS.
 STRUCTURE IS DESIGNED FOR A FUTURE WEARING SURFACE OF 20 POUNDS PER SQUARE FOOT.

ULTIMATE DESIGN STRESSES:

CONCRETE MASONRY SLAB — $f'_c = 4,000$ P.S.I. ALL OTHER — $f'_c = 3,500$ P.S.I.
 BAR STEEL REINFORCEMENT; GRADE 60 — $f_y = 60,000$ P.S.I.
 28" PRESTRESSED GIRDERS, CONCRETE MASONRY — $f'_c = 7,500$ P.S.I.
 STRANDS- 0.6" ϕ WITH ULTIMATE TENSILE STRENGTH OF 270,000 P.S.I.

FOUNDATION DATA

ABUTMENTS TO BE SUPPORTED ON 10 3/4" CAST-IN-PLACE CONCRETE PILING DRIVEN TO A MINIMUM BEARING VALUE OF 55 TONS PER PILE. ESTIMATED 65'-0" LONG.

PIER TO BE SUPPORTED ON 12" ϕ CAST-IN-PLACE CONCRETE PILING DRIVEN TO A MINIMUM BEARING VALUE OF 55 TONS PER PILE. ESTIMATED 60'-0" LONG. (0.375" MIN. WALL THICKNESS IS REQ'D FOR ALL PIER PILING.)

HYDRAULIC DATA

100 YEAR FREQUENCY

$Q_{100} = 2,800$ C.F.S.
 VEL. = 3.9 F.P.S.
 HW. = EL. 749.6
 WATERWAY AREA = 724.4 SQ. FT.
 DRAINAGE AREA = 8.4 SQ. MI.
 ROAD OVERTOPPING = NA
 SCOUR CRITICAL CODE = 5

TRAFFIC VOLUME

LAKE BUTTE DES MORTS DRIVE
 A.D.T. = 2,200 (2023)
 R.D.S. = 35 M.P.H.

BRIDGE OFFICE CONTACTS :
 KENT BAHLER (608) 266-8490
 MIKE WILLIAMS (608) 266-5089

CURVE DATA


SB. LANE S.T.H. 110	NB. LANE S.T.H. 110
P.I. = STA. 119+98.07	P.I. = STA. 120+08.48
$\Delta = 19^\circ-41'-20.8"$	$\Delta = 19^\circ-41'-20.8"$
$D = 1^\circ-31'-26.2"$	$D = 1^\circ-30'-00"$
$T = 652.43'$	$T = 662.84'$
$L = 1291.99'$	$L = 1312.61'$
$R = 3759.72'$	$R = 3819.72'$
S.E. = 0.046%	S.E. = 0.046%
P.C. = STA. 113+45.64	P.C. = STA. 113+45.64
P.T. = STA. 126+37.63	P.T. = STA. 126+58.25

LAKE BUTTE DES MORTS DRIVE


P.I. = STA. 248+91.80
 $\Delta = 21^\circ-26'-22.5"$
 $D = 1^\circ-30'-00"$
 $T = 723.11'$
 $L = 1429.31'$
 $R = 3819.72'$
 S.E. = N.C.
 P.C. = STA. 241+68.69
 P.T. = STA. 255+97.99

ABUTMENT STATIONS

ABUTMENT	B-70-211 STATION	B-70-212 STATION	B-70-213 STATION
END OF SLAB	249+64.61	121+09.47	121+23.76
¢ BRG. SOUTH ABUT.	249+65.86	121+10.72	121+25.01
¢ BRG. NORTH ABUT.	252+25.92	123+70.78	123+85.07
END OF SLAB	252+27.17	123+72.03	123+86.32

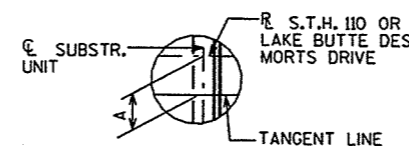


LOCATION	DIM. A (ALONG ¢ SUBSTR. UNIT)		
	B-70-211	B-70-212	B-70-213
SOUTH ABUT.	1'-7 3/4"	2'-3"	2'-2 1/2"
PIER 1	5 3/4"	9 3/4"	9 5/8"
PIER 2	1 1/8"	1 1/8"	1 1/8"
PIER 3	3"	1 1/8"	1 1/8"
PIER 4	1'-2 1/2"	9 3/4"	9 5/8"
NORTH ABUT.	2'-10 3/8"	2'-3"	2'-2 1/2"

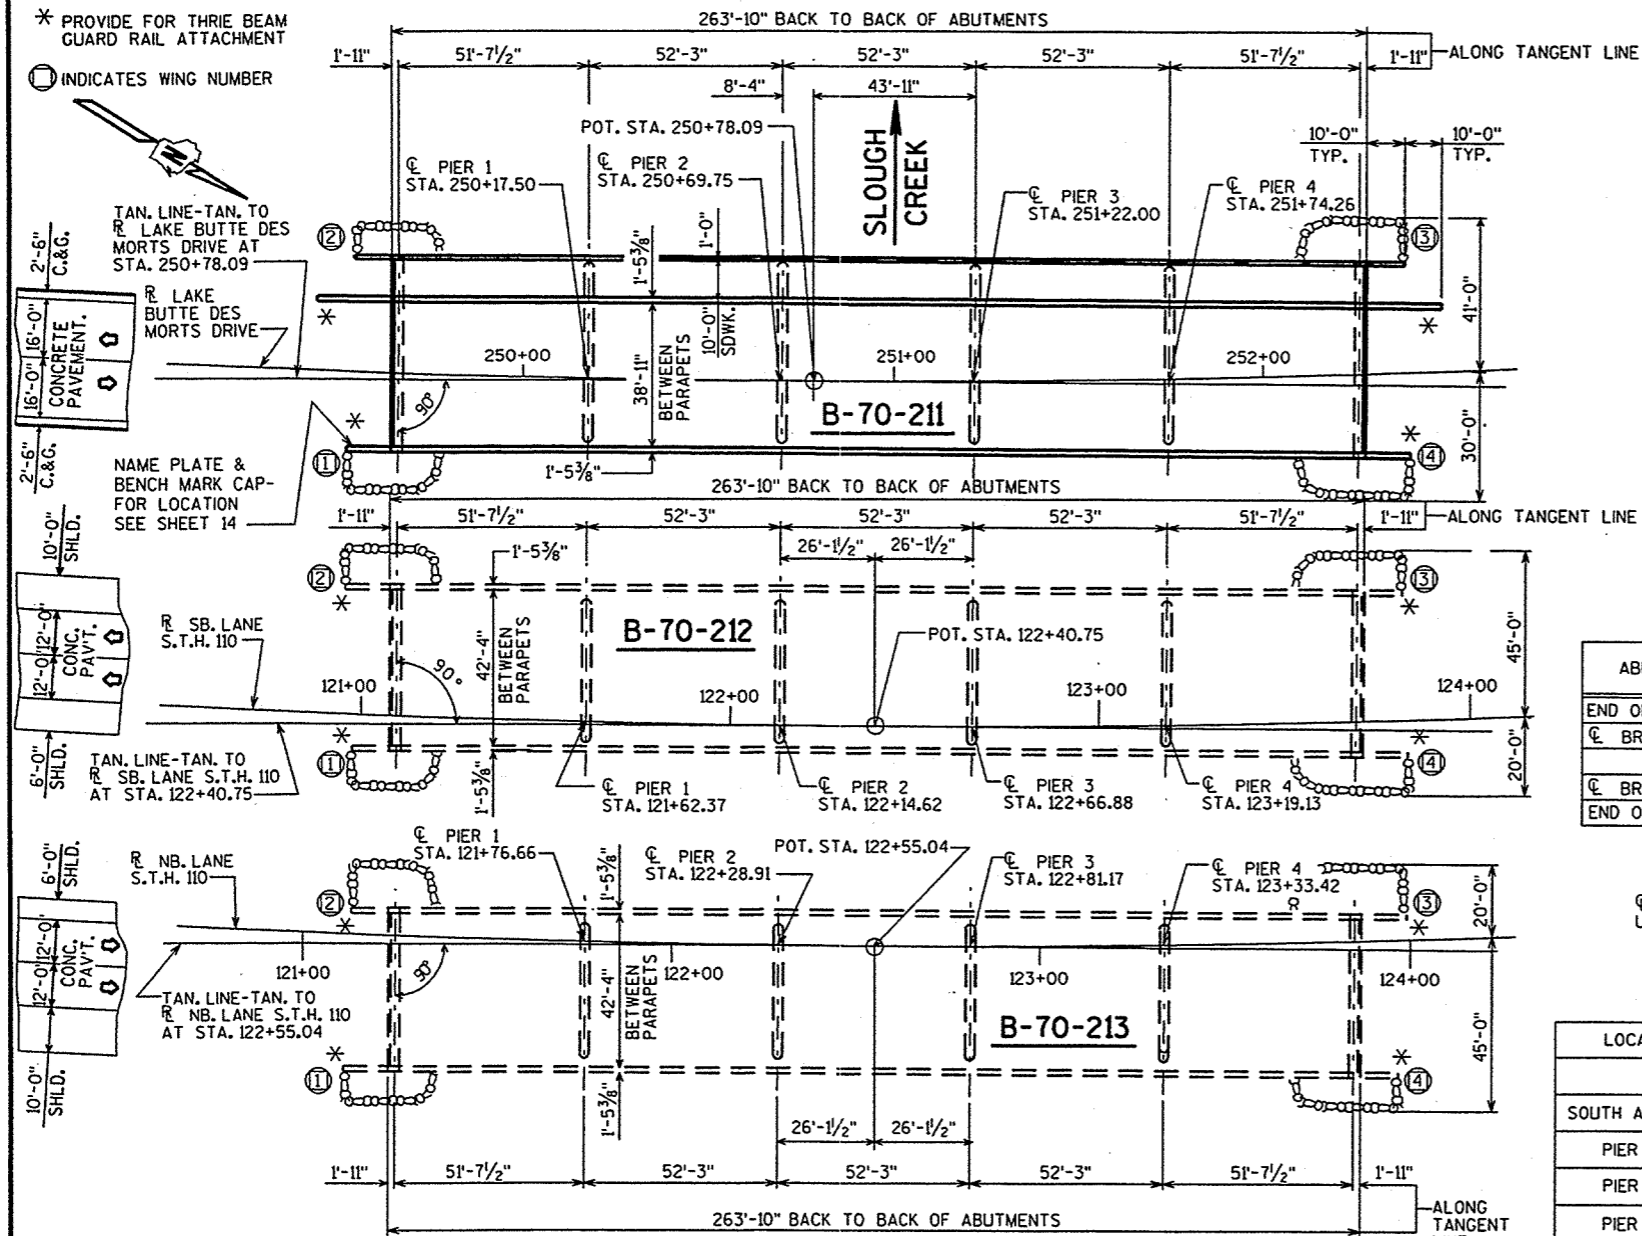

PLAN

5 SPAN-28" PRESTRESSED GIRDERS

NOTE:
 WING LENGTHS ARE 10'-0" FOR WINGS 2&3 AND 12'-0" FOR WINGS 1&4 (TYPICAL FOR B-70-212 & 213).

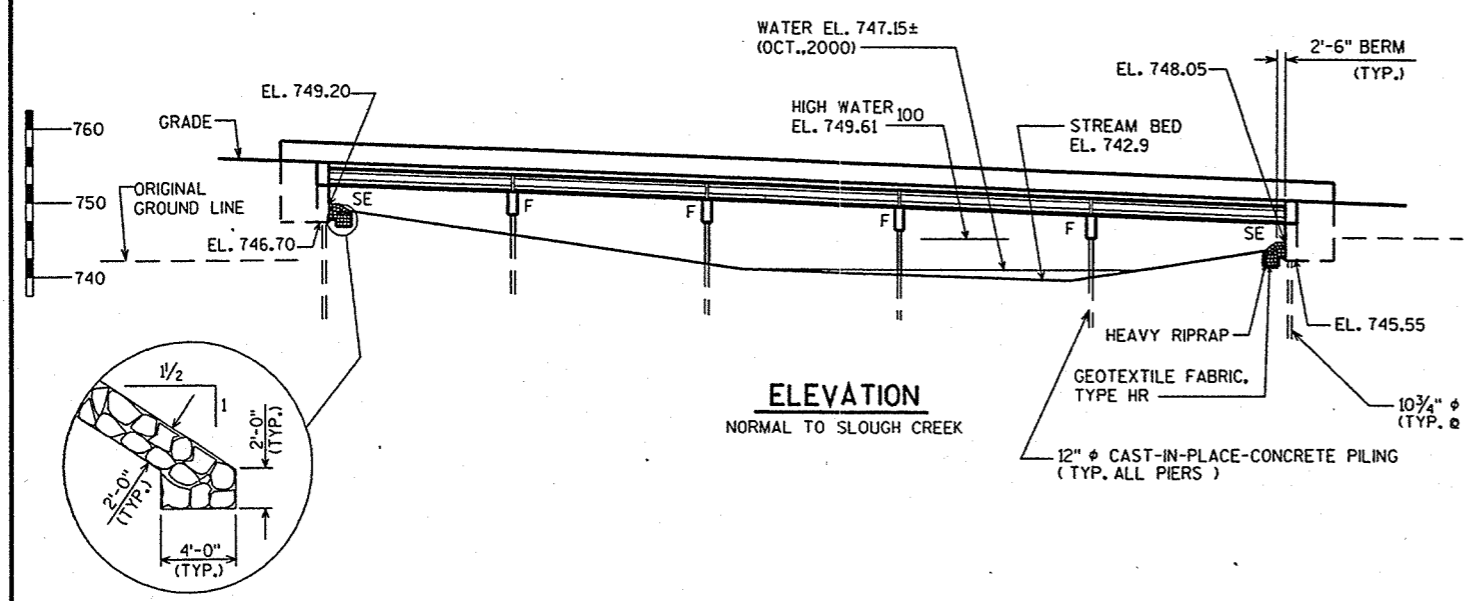


ELEVATION

NORMAL TO SLOUGH CREEK


LIST OF DRAWINGS

- GENERAL PLAN
- CROSS SECTION & QUANTITIES
- SUBSURFACE EXPLORATION
- SOUTH ABUTMENT
- SOUTH ABUTMENT DETAILS
- NORTH ABUTMENT
- NORTH ABUTMENT DETAILS
- PIERS 1 THRU 4
- 28" PRESTRESSED GIRDER DETAILS
- STEEL DIAPHRAGM
- SUPERSRUCTURE
- SUPERSRUCTURE DETAILS
- SLOPE FACE PARAPET 'LF' (WEST SIDE)
- SLOPE FACE PARAPET 'LF' (EAST SIDE)
- FENCING DETAILS

NO.	DATE	REVISION	BY
Plans Prepared By WISDOT STRUCTURES DESIGN			
STRUCTURE B-70-211			
LAKE BUTTE DES MORTS DRIVE OVER SLOUGH CREEK			
COUNTY	WINNEBAGO	TOWN	OSHKOSH
DESIGN SPEC.	AASHTO STD. SPEC. 1998	LOAD	HS-20
DESIGNED BY	MGW	DRAWN BY	CRJ
APPROVED	11-13-01 CHIEF STRUCTURAL DESIGN ENGINEER		DATE
GENERAL PLAN			SHEET 1 OF 15
			DATE: JULY '01

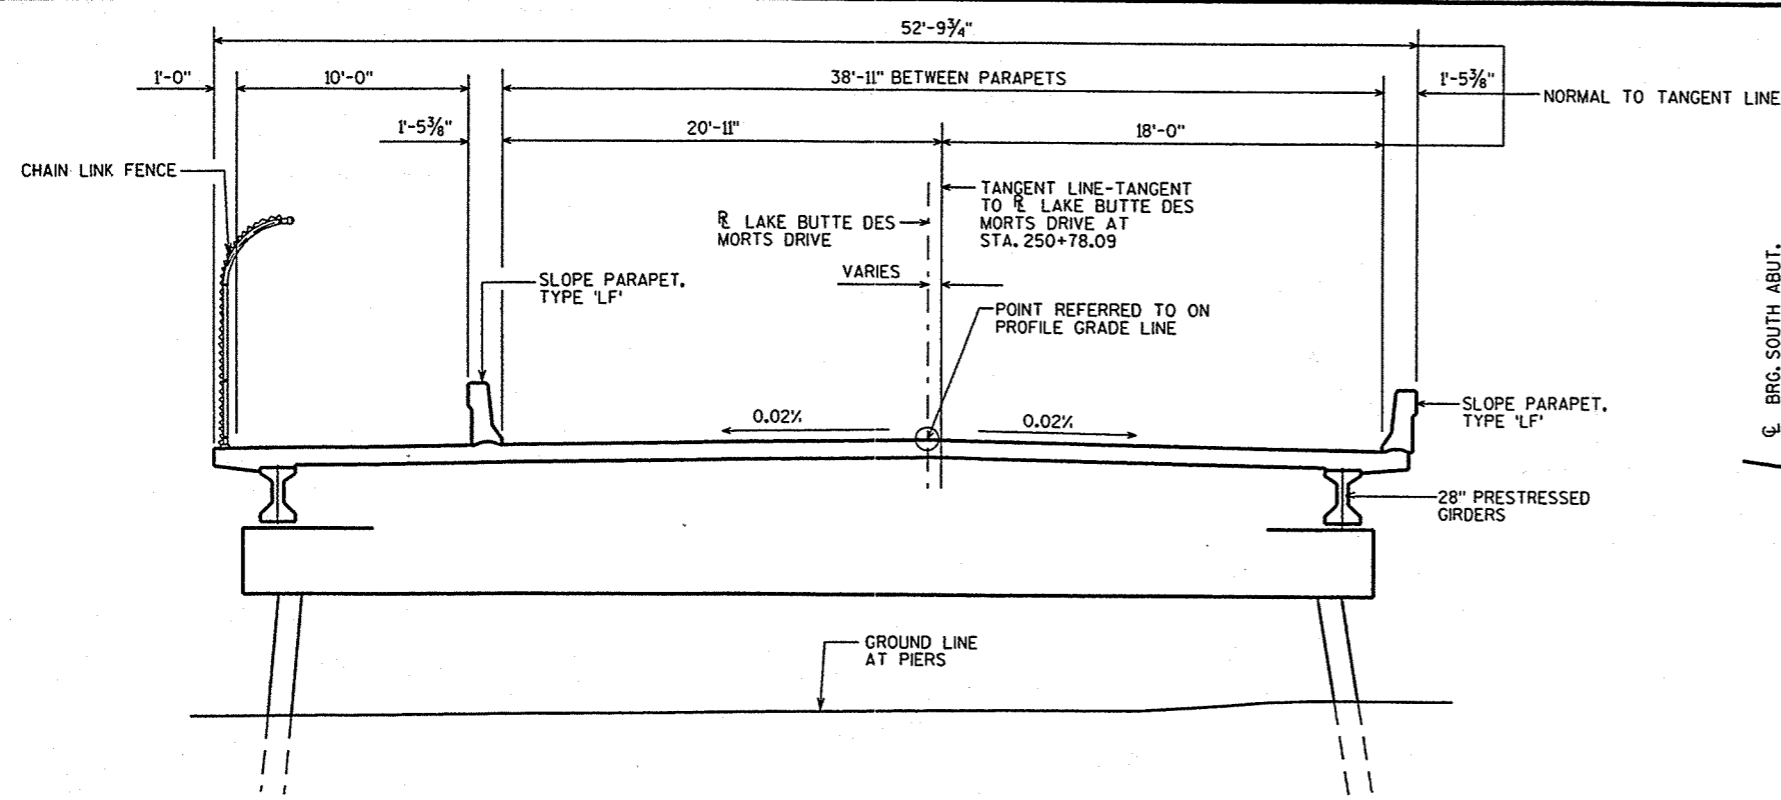

CROSS SECTION THRU ROADWAY LOOKING NORTH

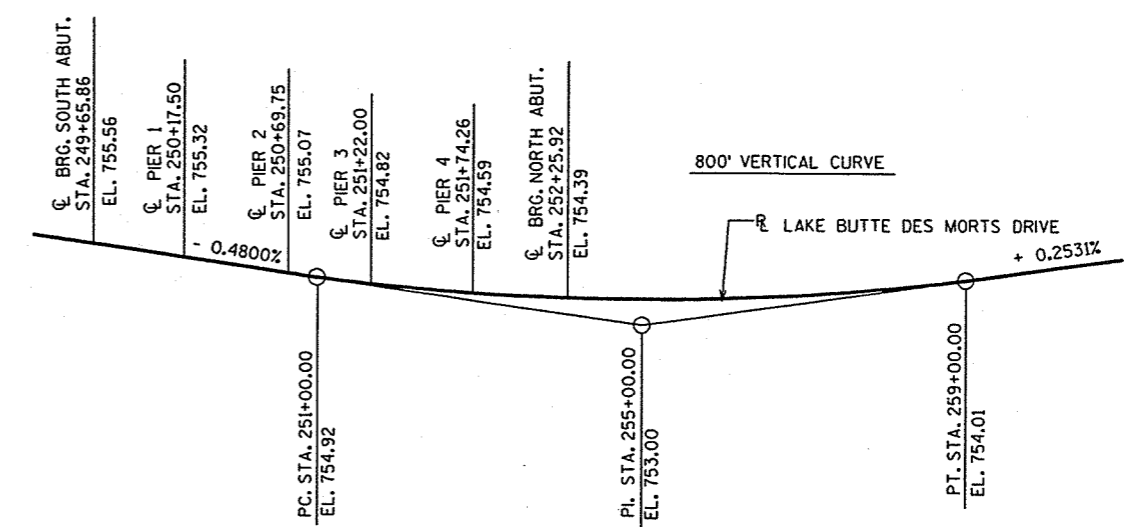

PROFILE GRADE LINE LAKE BUTTE DES MORTS DRIVE

TOTAL ESTIMATED QUANTITIES

BID ITEMS	UNIT	SUPER.	SOUTH ABUT.	NORTH ABUT.	PIER 1	PIER 2	PIER 3	PIER 4	TOTALS
EXCAVATION FOR STRUCTURES, BRIDGES, B-70-211	L.S.								1
STRUCTURE BACKFILL	C.Y.		160	160					320
CONCRETE MASONRY, BRIDGES	C.Y.	486	54	54	19	19	19	19	670
PROTECTIVE SURFACE TREATMENT	S.Y.	1,800							1,800
PRESTRESSED GIRDER, I TYPE, 28-INCH	L.F.	1,820							1,820
HIGH-STRENGTH BAR STEEL REINFORCEMENT, BRIDGES	LB.		3,190	3,190	5,070	5,070	5,070	5,070	26,660
COATED HIGH-STRENGTH BAR STEEL REINFORCEMENT, BRIDGES	LB.	103,370	1,650	1,650					106,670
NON-LAMINATED ELASTOMERIC BEARING PADS	EACH	42							42
STEEL DIAPHRAGMS, STRUCTURE B-70-211	EACH	30							30
CAST-IN-PLACE CONCRETE PILING, DELIVERED AND DRIVEN, 10 1/4-INCH	L.F.		520	520					1,040
CAST-IN-PLACE CONCRETE PILING, DELIVERED AND DRIVEN, 12-INCH	L.F.				540	540	540	540	2,160
RUBBERIZED MEMBRANE WATERPROOFING	S.Y.		14	14					28
HEAVY RIPRAP	C.Y.		65	65					130
PIPE UNDERDRAIN, 6-INCH	L.F.		70	70					140
PIPE UNDERDRAIN, UNPERFORATED, 6-INCH	L.F.		20	20					40
GEOTEXTILE FABRIC, TYPE DF	S.Y.		50	50					100
GEOTEXTILE FABRIC, TYPE HR	S.Y.		110	110					220
ANCHOR ASSEMBLIES FOR STEEL PLATE BEAM GUARD	EACH	4							4
OMP, READY MIXED CONCRETE MASONRY FOR BRIDGES	C.Y.	486	54	54	19	19	19	19	670
OMP, MASONRY STRENGTH INCENTIVE, READY-MIXED CONCRETE	DOL.								6,700
CHAIN LINK FENCE 10 FOOT	L.F.	284							284
NON-BID ITEMS									
FILLER	SIZE								1/2" & 3/4"

GENERAL NOTES

DRAWINGS SHALL NOT BE SCALED.
 BAR STEEL REINFORCEMENT SHALL BE EMBEDDED 2" CLEAR UNLESS OTHERWISE SHOWN OR NOTED.
 ELASTOMERIC BEARING PADS NEED NOT BE INDIVIDUALLY MOLDED PROVIDED THE CUT EDGES ARE SMOOTH AND TRUE.
 AT THE BACKFACE OF ABUTMENT ALL VOLUME WHICH CANNOT BE IN PLACE BEFORE ABUTMENT CONSTRUCTION AND NOT OCCUPIED BY THE NEW STRUCTURE SHALL BE BACKFILLED WITH STRUCTURE BACKFILL.
 THE FIRST OR FIRST TWO DIGITS OF THE BAR MARK SIGNIFIES THE BAR SIZE.
 AT ABUTMENTS, CONCRETE POURED UNDER WATER WILL BE ALLOWED AND SHALL BE DONE IN ACCORDANCE WITH SECTION 502.3.6.3 OF THE STANDARD SPECIFICATIONS.
 THE GRADATION OF THE STRUCTURE BACKFILL SHALL MEET THE REQUIREMENTS OF SECTION 209.2.2 OF THE STANDARD SPECIFICATIONS FOR GRADE 1 MATERIAL.

NO.	DATE	REVISION	BY
STATE OF WISCONSIN DEPARTMENT OF TRANSPORTATION STRUCTURES DESIGN SECTION			
STRUCTURE B-70-211			
CONST. SPEC.	1996	DRAWN BY	CRJ
		PLANS C.K'D.	MGW
CROSS SECTION & QUANTITIES			SHEET 2

FILE: GEN2.DGN
SCALE = 4

STH 110 OVER SLOUGH CREEK
 USH 41 TO STH 116, WINNEBAGO COUNTY

STATE PROJECT NUMBER
6200-05-71

SHEET NO.
8.3

ABBREVIATIONS
 F— FINE M— MEDIUM C— COARSE
 WS— WEATHERED SO— SOUND

MATERIAL SYMBOLS

TOPSOIL	SILT	SANDSTONE
SAND	PEAT	LIMESTONE
GRAVEL	CLAY	IGNEOUS ROCK

LEGEND OF PROBING

PROBING NO.
 STA.
 ELEVATION
 95/6=95 BLOWS FOR 6" PENETRATION PROBING TAKEN WITH A 350# WT. FALLING 18" ON A 2" O.D. POINT.

7 AVERAGE BLOWS PER FOOT
 REFUSAL 95/6

LEGEND OF BORING

ELEV. BORING NO.
 STA.

UNCONFINED STRENGTH → 7.7
 BLOWS PER FT. USING 140# WT. FALLING 30"
 WASH SAMPLE

SHELBY TUBE — S.T.

GROUND WATER ELEVATION

NO GROUND WATER OBSERVED ABOVE THIS ELEVATION

SANDY GRAVEL
 SAND
 SILTY CLAY
 SO
 LIMESTONE

UNLESS OTHERWISE SPECIFIED, THE BLOWS PER FOOT AT THE LOCATIONS INDICATED ARE BASED ON DRIVING A O.D. XL 4" I.D. SPLIT SPOON SAMPLER WITH A 140# HAMMER HAVING A FREE FALL OF 30". THE BLOW COUNT IS TAKEN IN UNDISTURBED SOIL IMMEDIATELY BELOW A CASED OR OPEN HOLE ELIMINATING SIDE FRICTION ON THE DRIVE PIPE.

SUBSURFACE EXPLORATION FOR FOUNDATION DESIGN AND BIDDERS INFORMATION

TO OBTAIN RELATIVE DATA CONCERNING THE CHARACTER OF MATERIAL IN AND UPON WHICH THE FOUNDATION MIGHT BE BUILT, BORINGS AND/OR SOUNDINGS WERE MADE AT POINTS APPROXIMATELY AS INDICATED ON THIS DRAWING. THE DATA PRESENTED HEREIN REPRESENTS THE FINDINGS OF THE SUBSURFACE EXPLORATIONS MADE. HOWEVER, BECAUSE THE DEPTHS INVESTIGATED ARE LIMITED AND THE AREA OF THE BORINGS AND/OR SOUNDINGS IS VERY SMALL IN RELATION TO THE ENTIRE AREA, THE DIVISION OF HIGHWAYS DOES NOT WARRANT CONDITIONS BELOW THE DEPTHS INVESTIGATED OR THAT THE CLASSIFICATION OF MATERIAL ENCOUNTERED IN THESE INVESTIGATIONS IS NECESSARILY TYPICAL OF THE ENTIRE SITE.

NO.	DATE	REVISION	BY

STATE OF WISCONSIN
 DEPARTMENT OF TRANSPORTATION
 STRUCTURES DESIGN SECTION


STRUCTURE B-70-211

CONST. SPEC.	1996	DRAWN BY	CRJ	PLANS CK'D.	AGW
--------------	------	----------	-----	-------------	-----


SUBSURFACE EXPLORATION





SHEET 3

FILE: 211SOIL S.DGN
 SCALE = 19:2

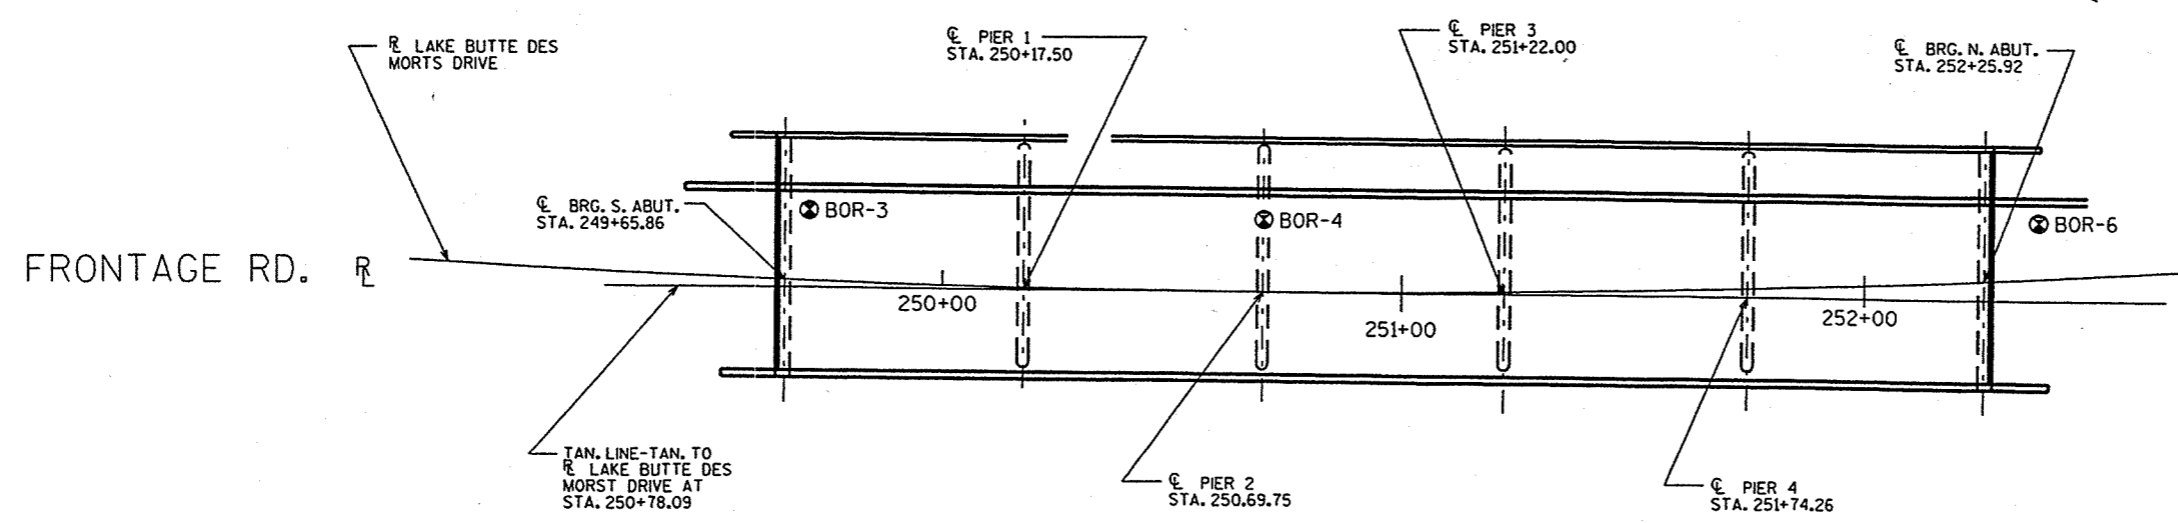

* VERTICAL SCALE 1:2

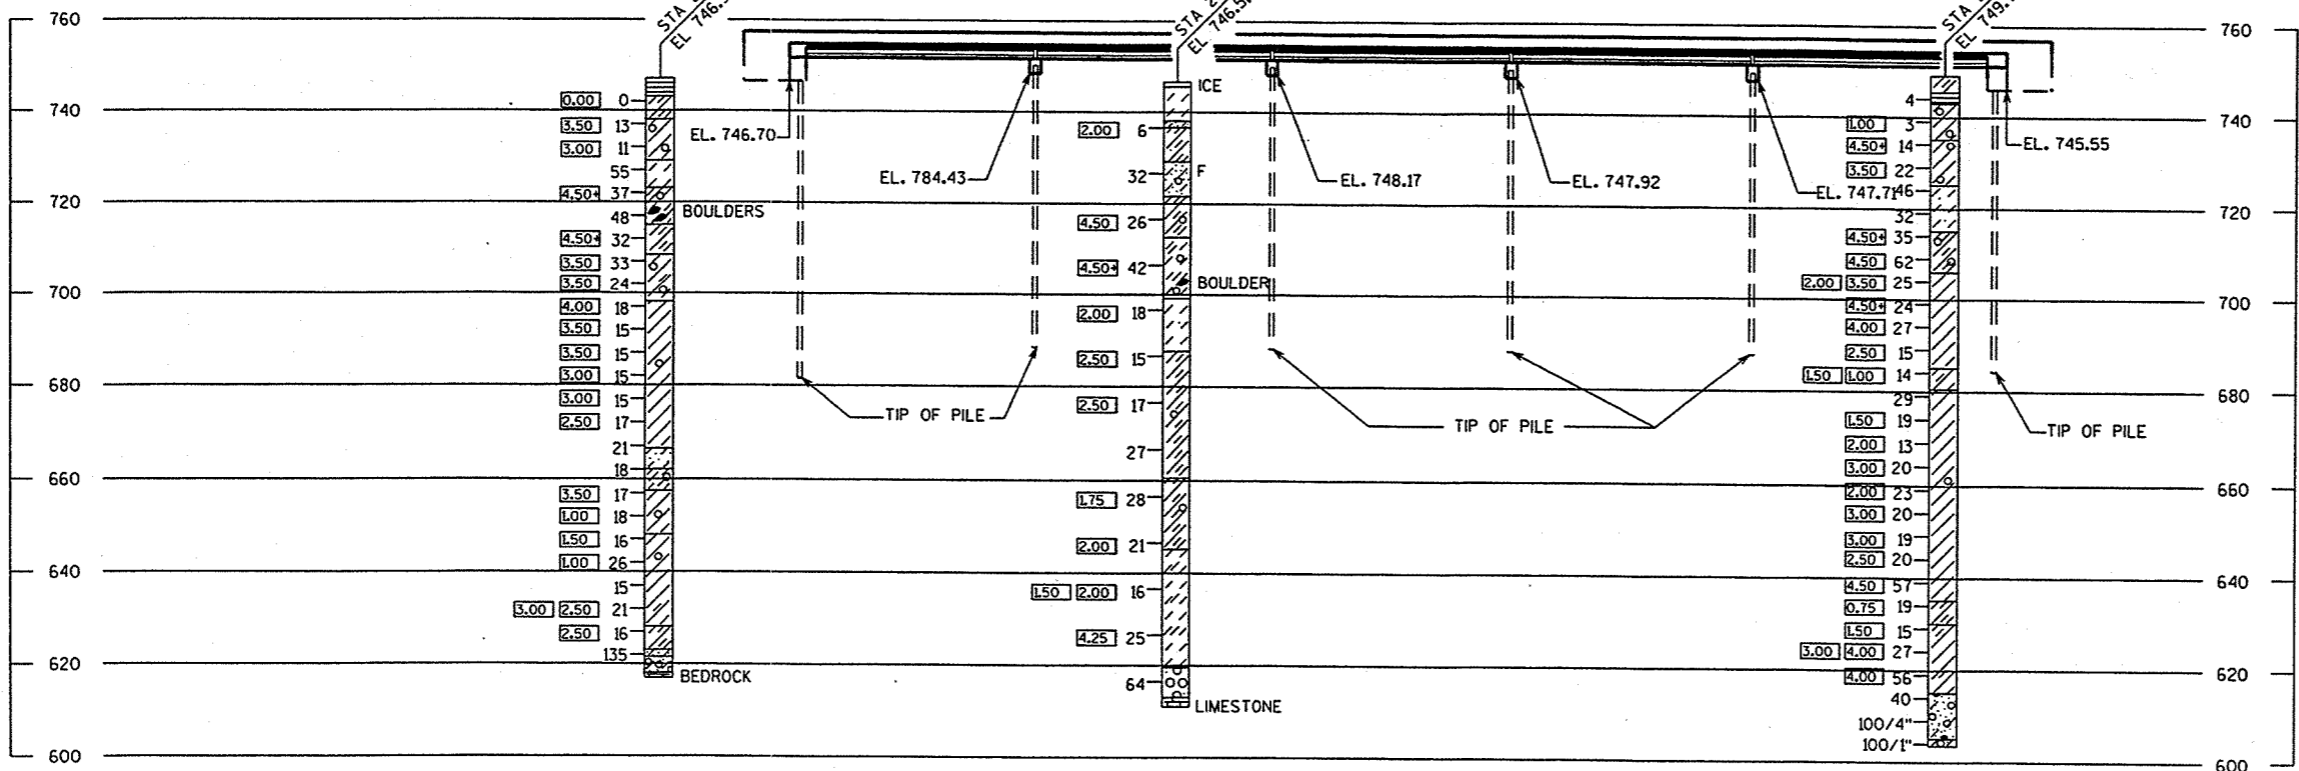


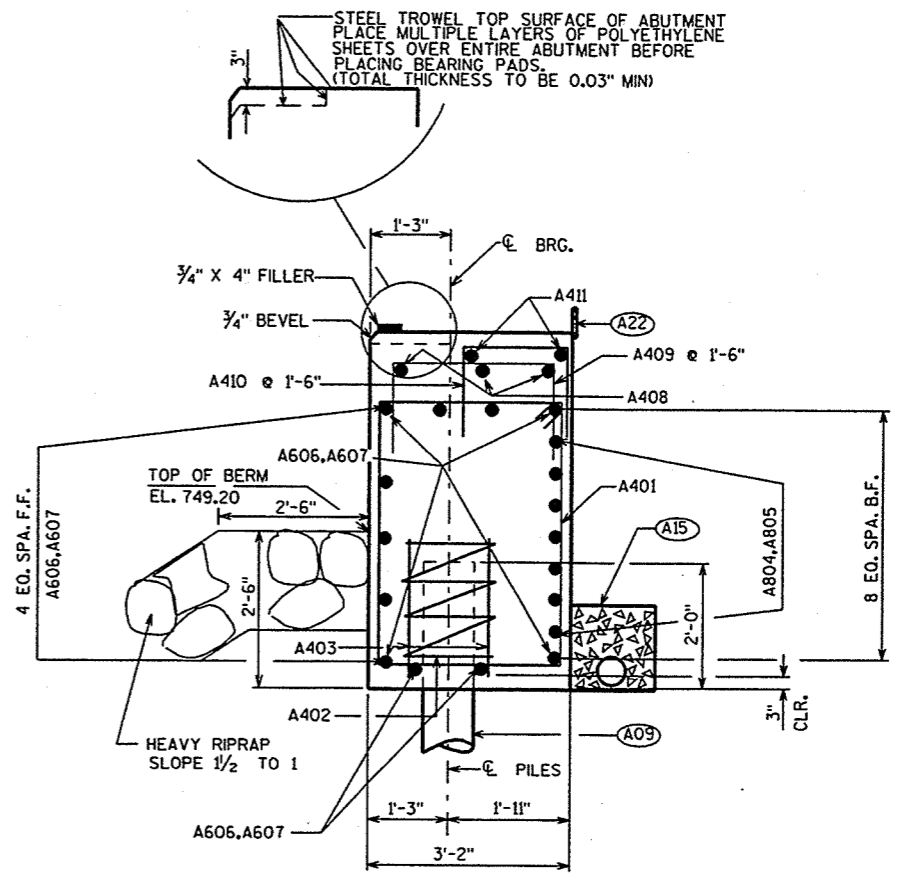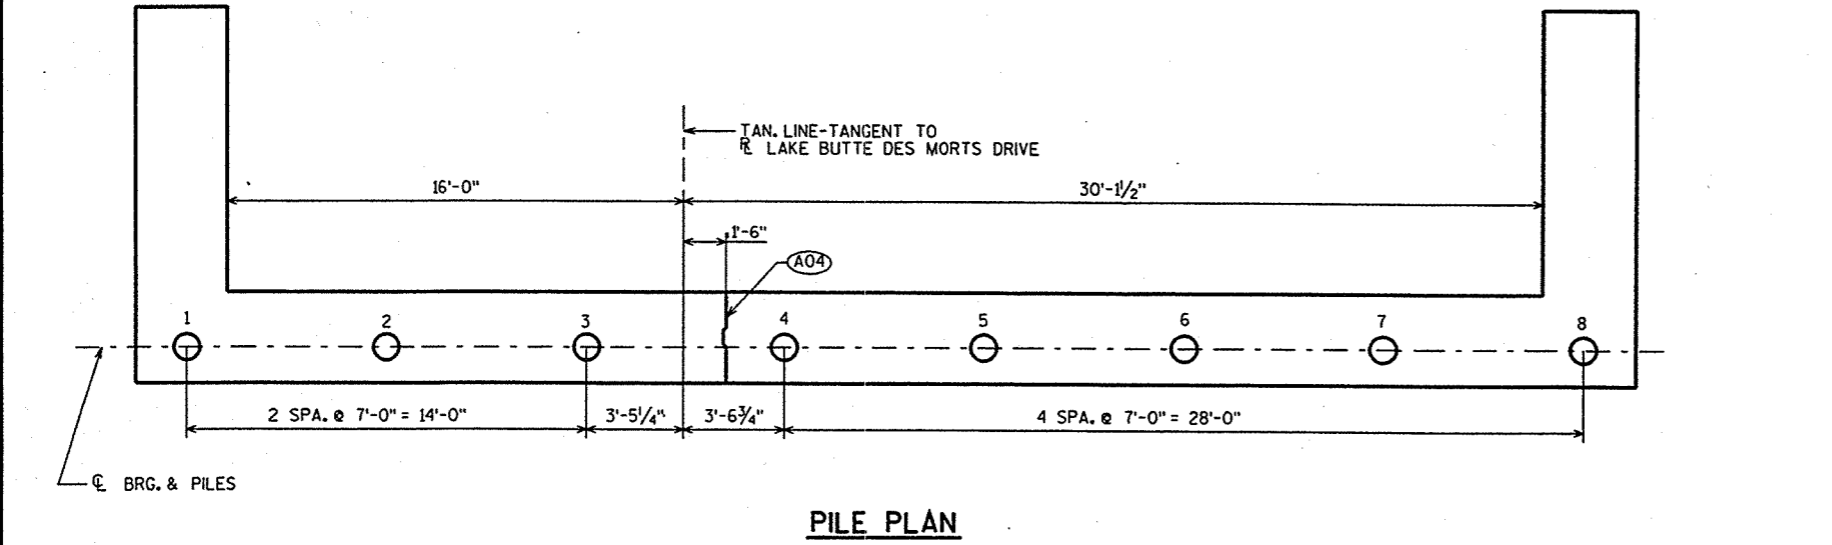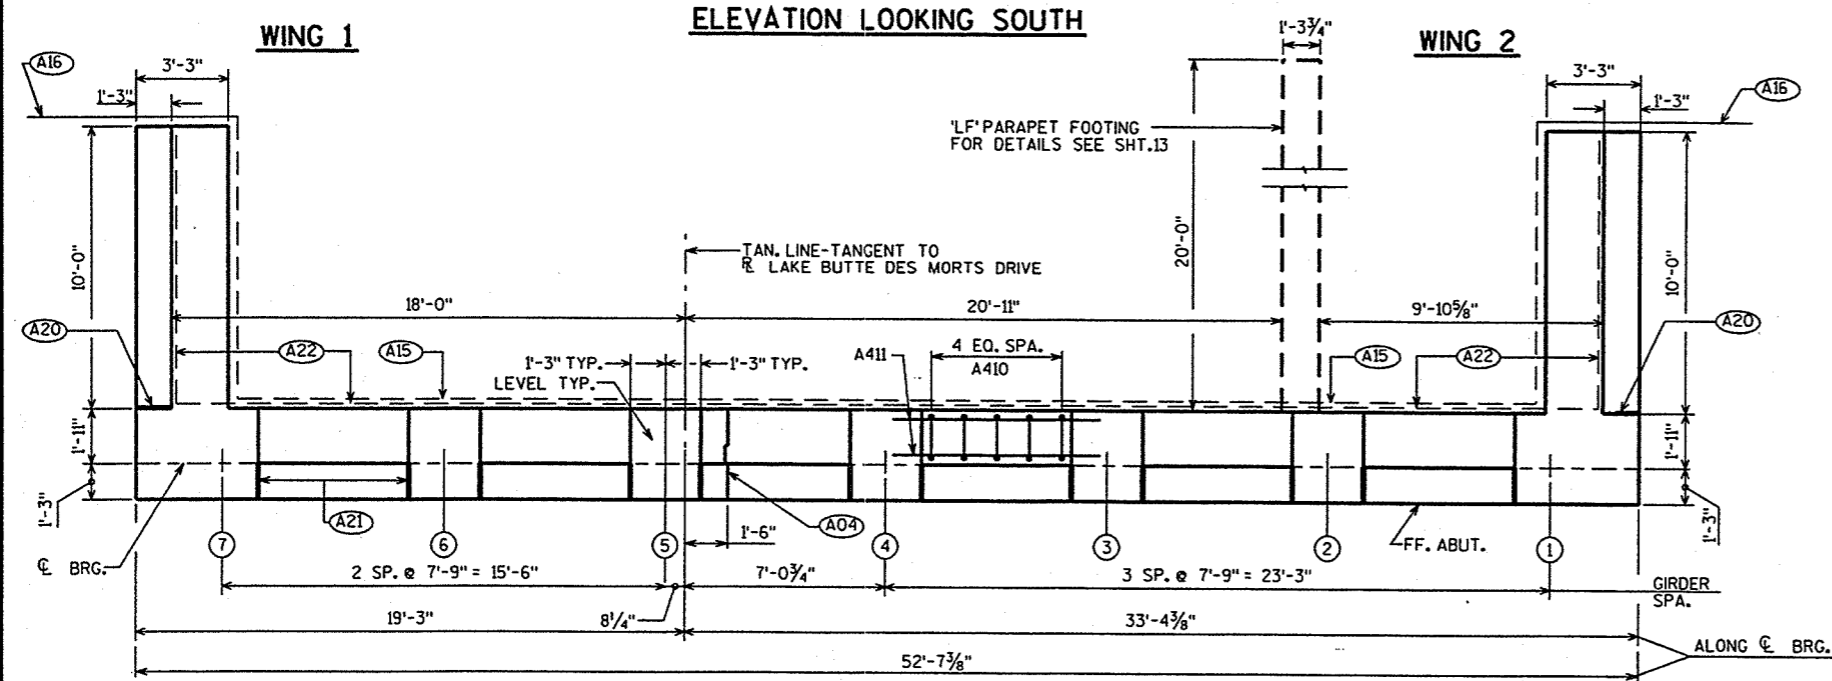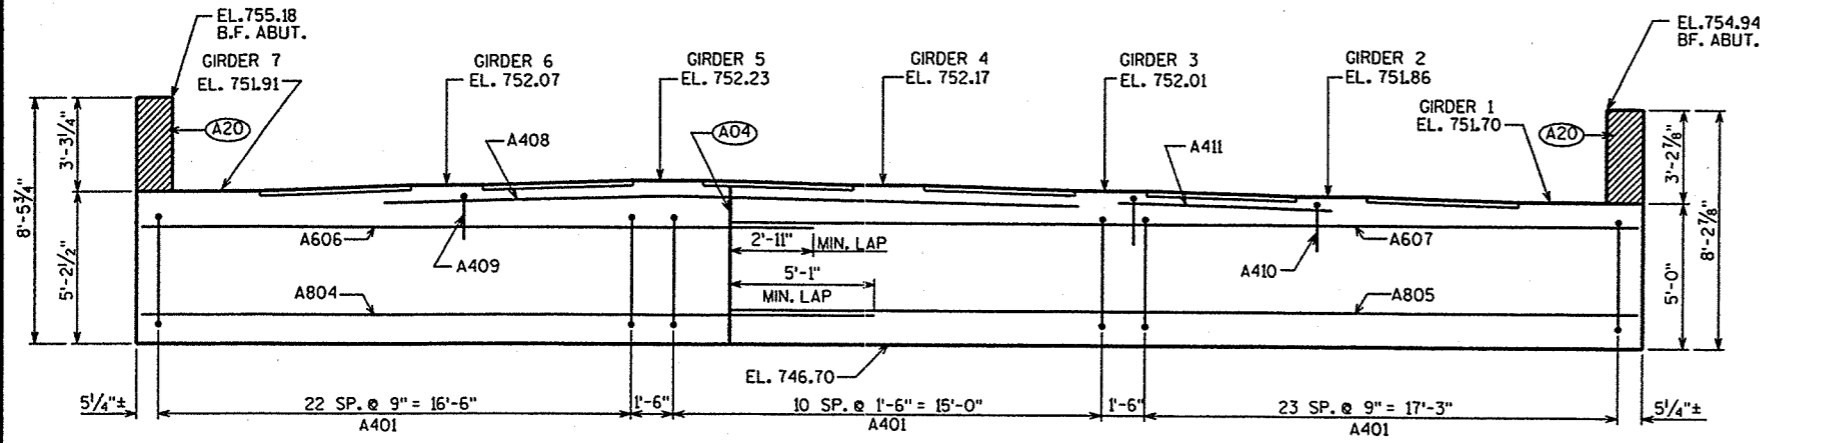


SECTION THRU BODY

- (A04) VERT. CONSTRUCTION JOINT: KEYWAY FORMED BY A BEVELED 2 x 8. (3/4" "V" GROOVE @ THE FRONT FACE) (R.M.W. @ BACKFACE).
- (A09) SUPPORT ABUTMENT ON 10 3/4" DIA. CAST-IN-PLACE CONCRETE PILING, ESTIMATED 65'-0" LONG, AND DRIVEN TO A MIN. BRG. VALUE OF 55 TONS PER PILE.
- (A15) PIPE UNDERDRAINS, 6 INCH. SLOPE TO DRAIN, ENCLOSED IN 1'-6" X 1'-6" AREA OF SIZE 1 COARSE AGGREGATE (INCLUDED IN UNDERDRAIN BID ITEM) WRAPPED IN GEOTEXTILE FABRIC, TYPE DF.
- (A16) PIPE UNDERDRAIN, 6 INCH, UNPERFORATED, TO SUITABLE DRAINAGE.
- (A20) 1/2" FILLER (INCLUDED IN WING LENGTH): SEAL EXPOSED HORIZ. & VERT. SURFACES OF 1/2" FILLER WITH NON-STAINING GRAY NON-BITUMINOUS JOINT SEALER, (1" DEEP AND HOLD 1/8" BELOW SURFACE OF CONCRETE), EXTEND SEALER 3" BELOW GUTTER LINE AT INSIDE FACE.
- (A21) 3/4" CORK UP VERT. FACES OF BEAM SEATS.
- (A22) 18" (RMW) RUBBERIZED MEMBRANE WATERPROOFING SEAL ALL HORIZ. & VERT. JOINTS AT BACKFACE.


NO.	DATE	REVISION	BY
STATE OF WISCONSIN DEPARTMENT OF TRANSPORTATION STRUCTURES DESIGN SECTION			
STRUCTURE B-70-211			
CONST. SPEC.	1996	DRAWN BY CRJ	PLANS CKD. MGW
SOUTH ABUTMENT			SHEET 4

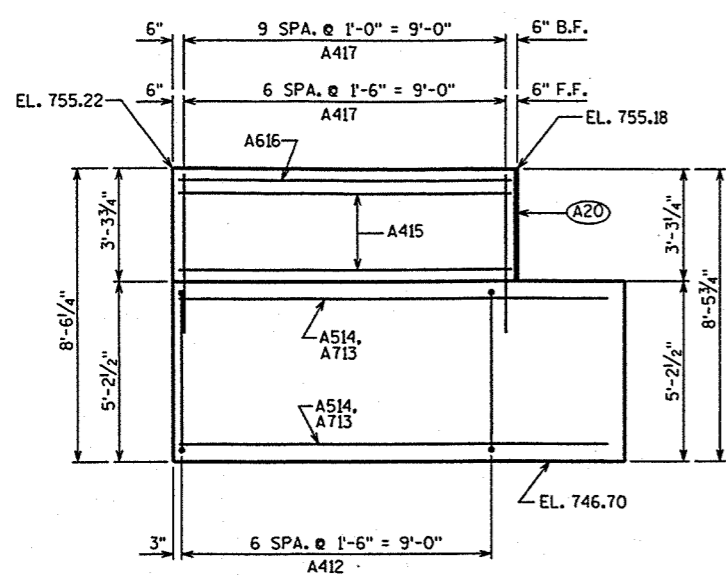


WING 1 ELEVATION

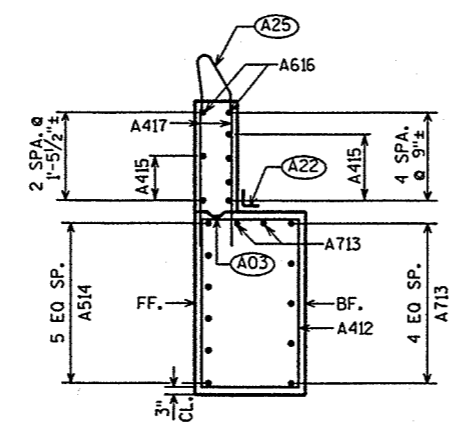

WING 1 SECTION

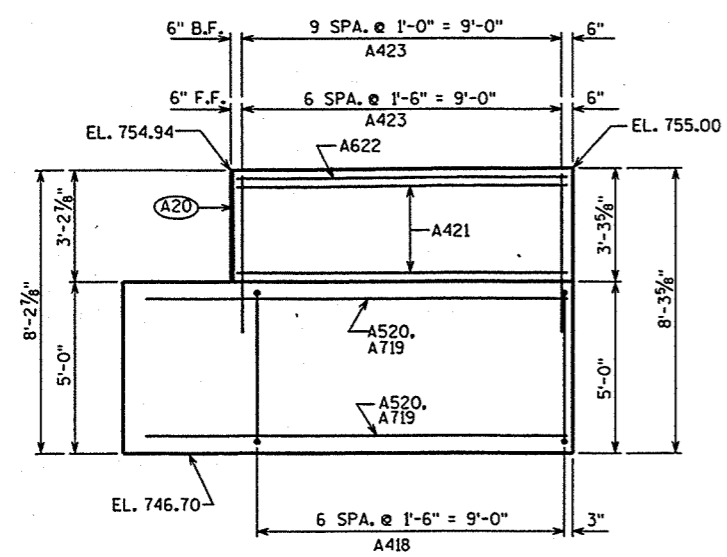

WING 2 ELEVATION

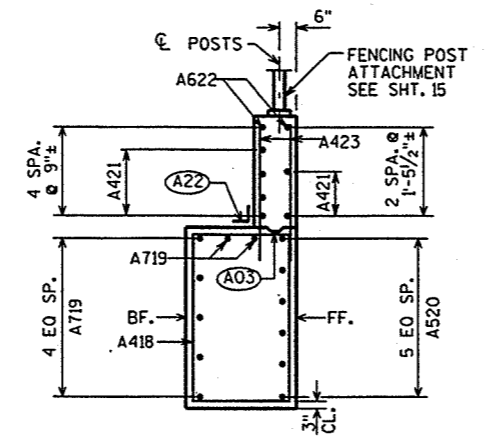



WING 2 SECTION

- (A03) OPTIONAL CONST. JOINT: KEYWAY FORMED BY BEVELED 2 x 6. (18" R.M.W. @ B.F. & 3/4" "V" GROOVE @ F.F. IF JOINT IS USED).
- (A20) 1/2" FILLER (INCLUDED IN WING LENGTH): SEAL EXPOSED HORIZ. & VERT. SURFACES OF 1/2" FILLER WITH NON-STAINING GRAY NON-BITUMINOUS JOINT SEALER. (1" DEEP AND HOLD 1/8" BELOW SURFACE OF CONCRETE). EXTEND SEALER 3" BELOW GUTTER LINE AT INSIDE FACE.
- (A22) 18" (RMW) RUBBERIZED MEMBRANE WATERPROOFING SEAL ALL HORIZ. & VERT. JOINTS AT BACKFACE.
- (A25) FOR PPT. BARS & DIMENSION SEE PARAPET SHT. 14

BILL OF BARS





NOTE: THE FIRST OR FIRST TWO DIGITS OF THE BAR MARK SIGNIFIES THE BAR SIZE.

BAR MARK	COAT	NO. REQ'D.	LENGTH	BENT	BAR SERIES	LOCATION
A401		58	14'-10"	X		BODY-STIRRUPS
A402		8	28'-0"	X		PILES-1 PER BODY PILE
A403		16	2'-3"			PILES-2 PER BODY PILE
A804		7	25'-8"			BODY-HORIZ.-B.F.
A805		7	31'-9"			BODY-HORIZ.-B.F.
A606		11	23'-6"			BODY-HORIZ.
A607		11	31'-9"			BODY-HORIZ.
A408		3	24'-0"			BODY-HORIZ.-OVER GIRDERS 4-6
A409		17	5'-10"	X		BODY-VERT-OVER GIRDERS 4-6
A410		30	3'-11"	X		BODY-BTW.-BEAM SEATS-VERT.
A411		12	7'-3"			BODY-BTW.-BEAM SEATS-HORIZ.
A412	X	7	16'-0"	X		WING 1-STIRRUPS
A713	X	7	12'-8"			WING 1-HORIZ.-B.F.
A514	X	6	12'-10"			WING 1-HORIZ.-F.F.
A415	X	6	9'-8"			WING 1-HORIZ.-F.F.-B.F.
A616	X	2	9'-8"			WING 1-TOP-HORIZ.
A417	X	17	4'-8"			WING 1-VERT.-F.F.-B.F.
A418	X	7	15'-6"	X		WING 2-STIRRUPS
A719	X	7	12'-8"			WING 2-HORIZ.-B.F.
A520	X	6	12'-10"			WING 2-HORIZ.-F.F.
A421	X	6	9'-8"			WING 2-HORIZ.-F.F.-B.F.
A622	X	2	9'-8"			WING 2-TOP-HORIZ.
A423	X	17	4'-8"			WING 2-VERT.-F.F.-B.F.

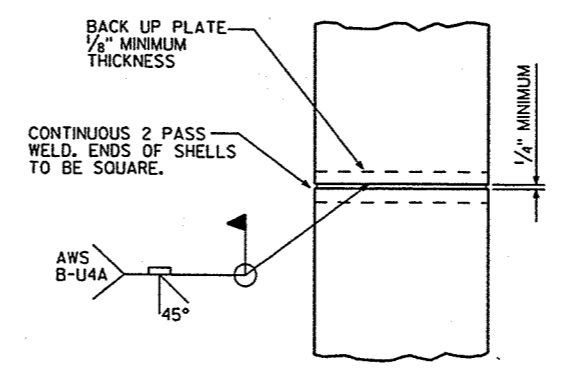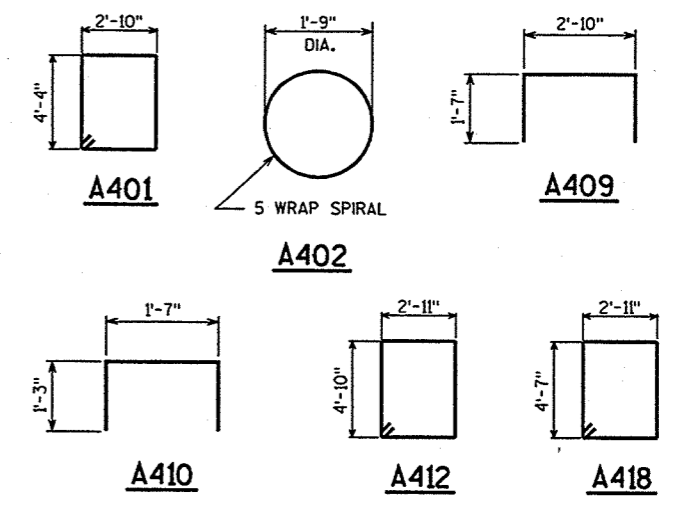


PILE SPLICE DETAIL

NO.	DATE	REVISION	BY
STATE OF WISCONSIN DEPARTMENT OF TRANSPORTATION STRUCTURES DESIGN SECTION			
STRUCTURE B-70-211			
CONST. SPEC.	1996	DRAWN BY CRJ	PLANS CKD. MGW
SOUTH ABUTMENT DETAILS			SHEET 5

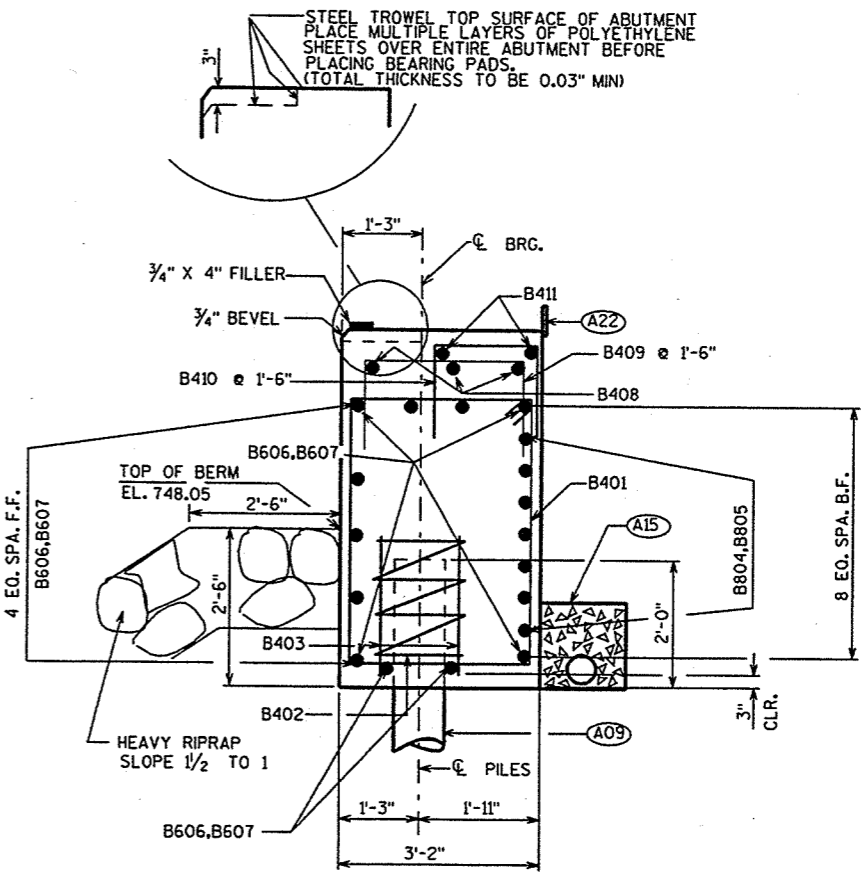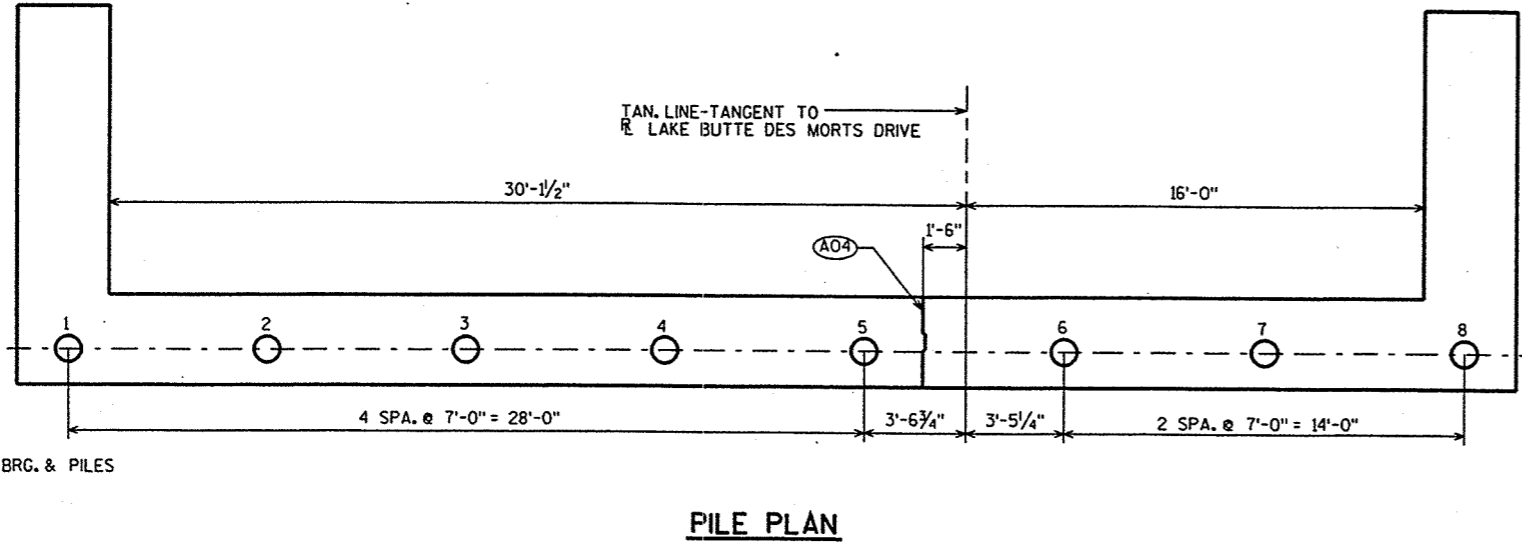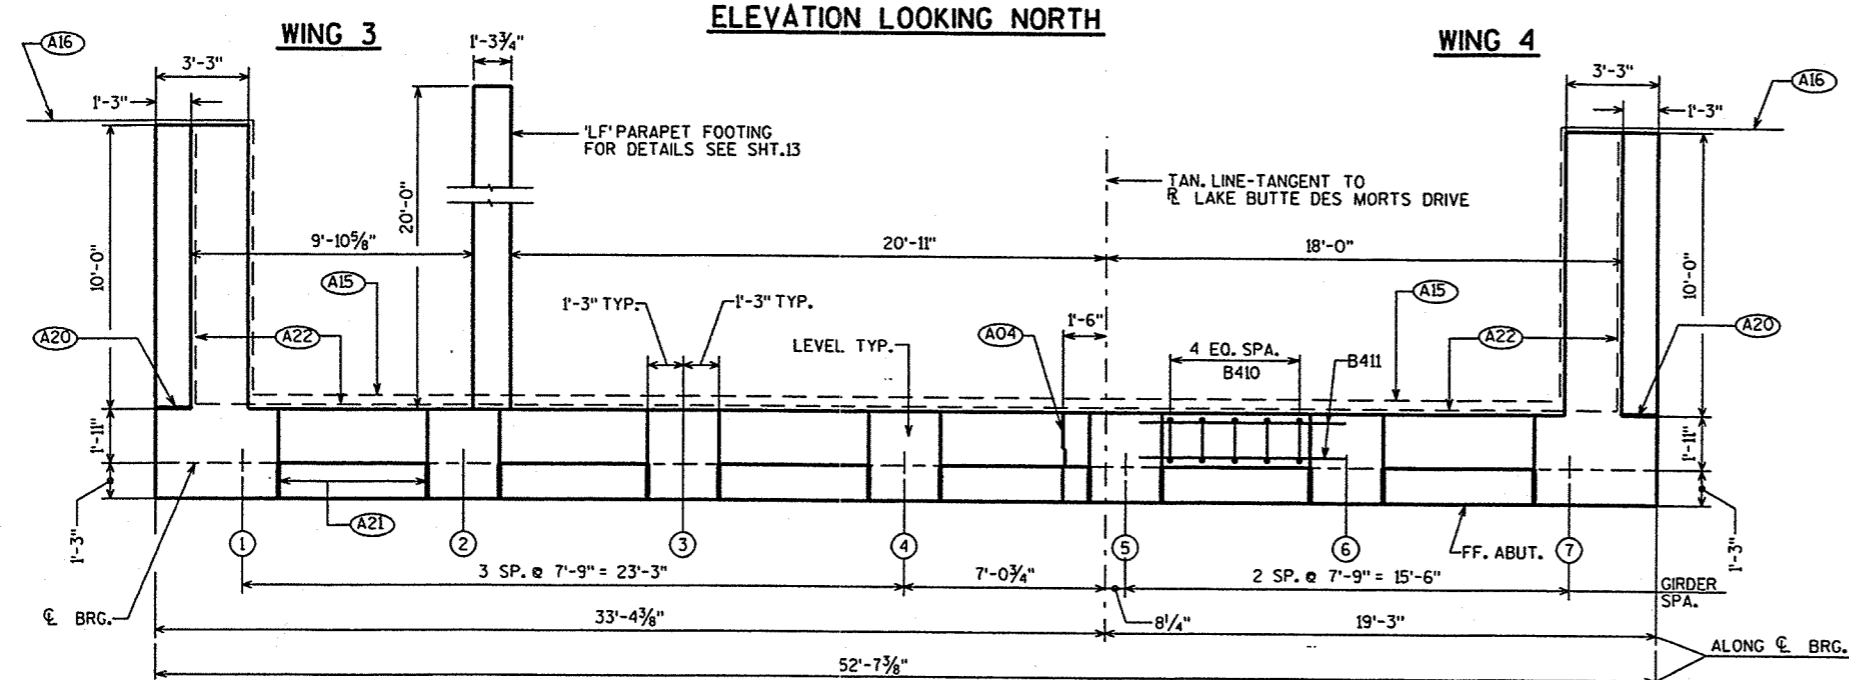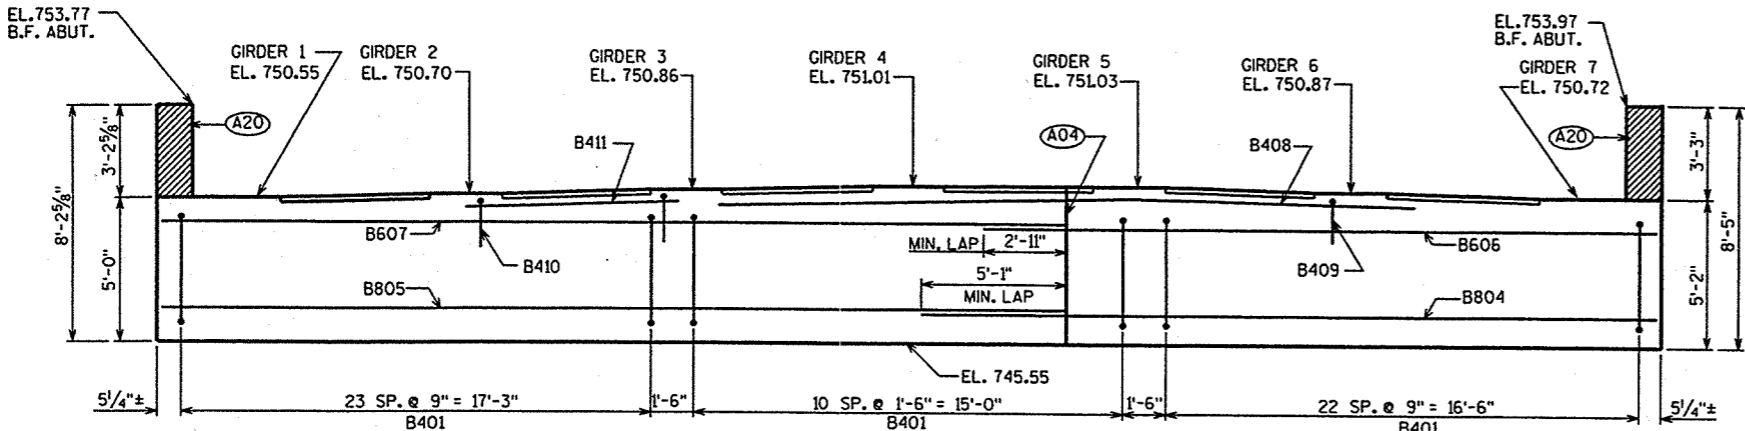


- A04 VERT. CONSTRUCTION JOINT: KEYWAY FORMED BY A BEVELED 2 X 8. (3/4" "V" GROOVE @ THE FRONT FACE) (R.M.W. @ BACKFACE).
- A09 SUPPORT ABUTMENT ON 10 3/4" DIA. CAST-IN-PLACE CONCRETE PILING, ESTIMATED 65'-0" LONG, AND DRIVEN TO A MIN. BRG. VALUE OF 55 TONS PER PILE.
- A15 PIPE UNDERDRAINS, 6 INCH. SLOPE TO DRAIN. ENCLOSED IN 1'-6" X 1'-6" AREA OF SIZE 1 COARSE AGGREGATE (INCLUDED IN UNDERDRAIN BID ITEM) WRAPPED IN GEOTEXTILE FABRIC, TYPE DF.
- A16 PIPE UNDERDRAIN, 6 INCH, UNPERFORATED. TO SUITABLE DRAINAGE.
- A20 1/2" FILLER (INCLUDED IN WING LENGTH); SEAL EXPOSED HORIZ. & VERT. SURFACES OF 1/2" FILLER WITH NON-STAINING GRAY NON-BITUMINOUS JOINT SEALER. (1" DEEP AND HOLD 1/8" BELOW SURFACE OF CONCRETE). EXTEND SEALER 3" BELOW GUTTER LINE AT INSIDE FACE.
- A21 3/4" CORK UP VERT. FACES OF BEAM SEATS.
- A22 18" (RMW) RUBBERIZED MEMBRANE WATERPROOFING SEAL ALL HORIZ. & VERT. JOINTS AT BACKFACE.

NO.	DATE	REVISION	BY
STATE OF WISCONSIN DEPARTMENT OF TRANSPORTATION STRUCTURES DESIGN SECTION			
STRUCTURE B-70-211			
CONSTR. SPEC.	1996	DRAWN BY CRJ	PLANS CKD. M6W
NORTH ABUTMENT			SHEET 6

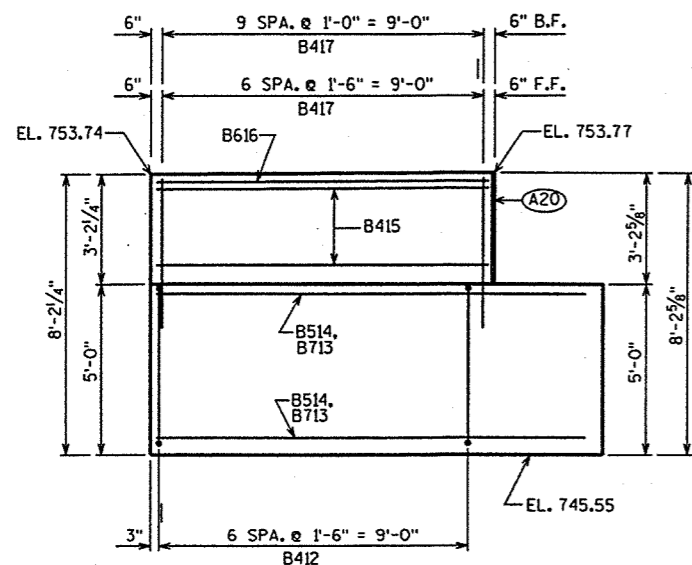

WING 3 ELEVATION

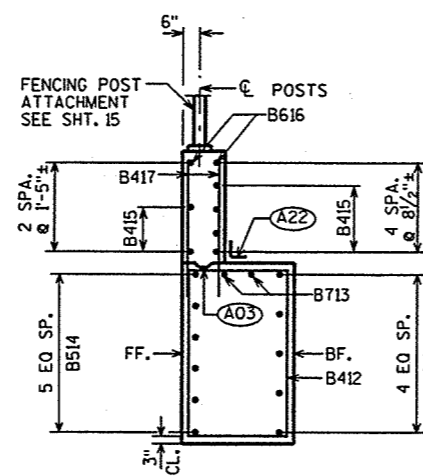


WING 3 SECTION

- (A03) OPTIONAL CONST. JOINT: KEYWAY FORMED BY BEVELED 2 x 6, (18\"/>


BILL OF BARS

NOTE: THE FIRST OR FIRST TWO DIGITS OF THE BAR MARK SIGNIFIES THE BAR SIZE.


BAR MARK	COAT	NO. REQ'D.	LENGTH	BEND	BAR SERIES	LOCATION
B401		58	14'-10"	X		BODY-STIRRUPS
B402		8	28'-0"	X		PILES-1 PER BODY PILE
B403		16	2'-3"			PILES-2 PER BODY PILE
B804		7	25'-8"			BODY-HORIZ.-B.F.
B805		7	31'-9"			BODY-HORIZ.-B.F.
B606		11	23'-6"			BODY-HORIZ.
B607		11	31'-9"			BODY-HORIZ.
B408		3	24'-0"			BODY-HORIZ.-OVER GIRDERS 4-6
B409		17	5'-10"	X		BODY-VERT.-OVER GIRDERS 4-6
B410		30	3'-11"	X		BODY-BTW.-BEAM SEATS-VERT.
B411		12	7'-3"			BODY-BTW.-BEAM SEATS-HORIZ.
B412	X	7	15'-6"	X		WING 3-STIRRUPS
B713	X	7	12'-8"			WING 3-HORIZ.-B.F.
B514	X	6	12'-10"			WING 3-HORIZ.-F.F.
B415	X	6	9'-8"			WING 3-HORIZ.-F.F.-B.F.
B616	X	2	9'-8"			WING 3-TOP-HORIZ.
B417	X	17	4'-7"			WING 3-VERT.-F.F.-B.F.
B418	X	7	15'-10"	X		WING 4-STIRRUPS
B719	X	7	12'-8"			WING 4-HORIZ.-B.F.
B520	X	6	12'-10"			WING 4-HORIZ.-F.F.
B421	X	6	9'-8"			WING 4-HORIZ.-F.F.-B.F.
B622	X	2	9'-8"			WING 4-TOP-HORIZ.
B423	X	17	4'-7"			WING 4-VERT.-F.F.-B.F.

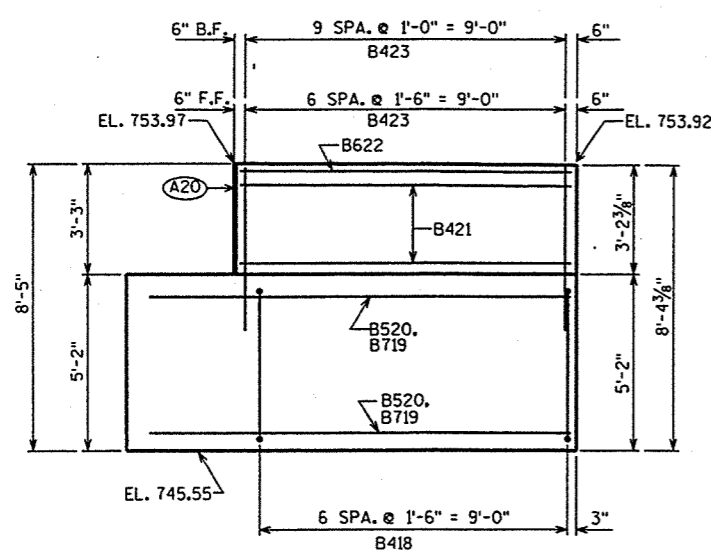


WING 4 ELEVATION

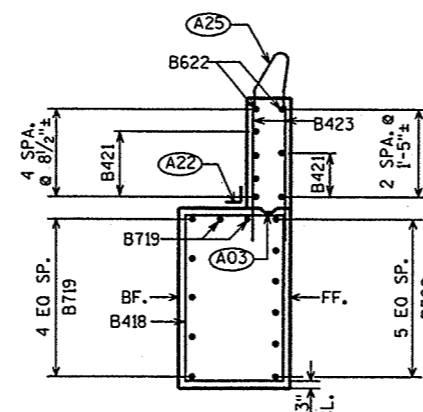

WING 4 SECTION

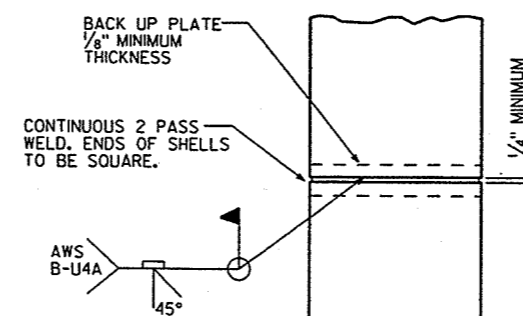

PILE SPLICE DETAIL

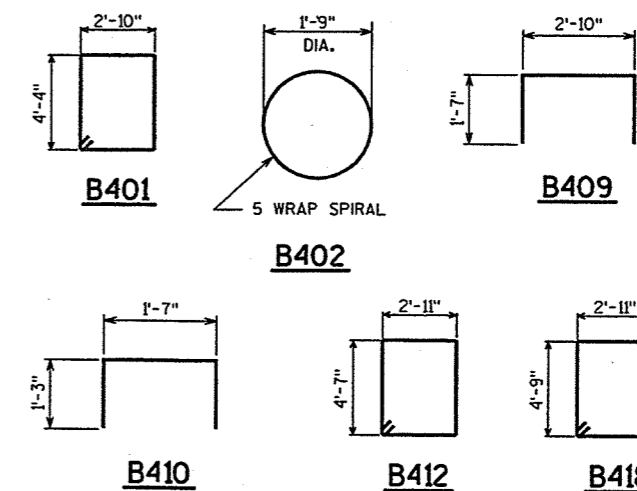

NO.	DATE	REVISION	BY
STATE OF WISCONSIN DEPARTMENT OF TRANSPORTATION STRUCTURES DESIGN SECTION			
STRUCTURE		B-70-211	
CONST. SPEC.	1996	DRAWN BY	CRJ
		PLANS CKD.	MGW
NORTH ABUTMENT DETAILS			SHEET 7

PIER ELEVATIONS

	ELEV. "A"	ELEV. "B"	ELEV. "C"	ELEV. "D"	ELEV. "E"	ELEV. "F"	ELEV. "G"	ELEV. "H"	ELEV. "I"
PIER 1	751.43	751.59	751.74	751.89	752.00	751.85	751.69	748.43	750.18
PIER 2	751.17	751.32	751.48	751.63	751.76	751.61	751.45	748.17	749.92
PIER 3	750.92	751.08	751.23	751.39	751.51	751.35	751.20	747.92	749.67
PIER 4	750.71	750.87	751.03	751.18	751.26	751.11	750.95	747.71	749.46

NOTE: P505 BARS MAY BE PLACED AFTER CONCRETE IS POURED, BUT BEFORE ITS INITIAL SET HAS TAKEN PLACE.

STATE PROJECT NUMBER

6200-05-71


SHEET NO.

8.8


BILL OF BARS

NOTE: THE FIRST OR FIRST TWO DIGITS OF THE BAR MARK SIGNIFIES THE BAR SIZE.


BAR MARK	COAT	PIER 1	PIER 2	PIER 3	PIER 4	LENGTH	BENT	BAR SERIES	LOCATION
P601		8	8	8	8	26'-10"			CAP-HORIZ.-BTM.
P502		4	4	4	4	26'-7"			CAP-HORIZ.-SIDES
P603		8	8	8	8	28'-11"	X		CAP-HORIZ.-TOP
P504		44	44	44	44	11'-0"	X		CAP STIRRUPS
P505		30	30	30	30	2'-0"			CAP-DOWELS
P506		2	2	2	2	5'-6"	X		CAP-ENDS
P407		3	3	3	3	34'-7"			CAP-HORIZ.
P408		35	35	35	35	5'-7"	X		CAP-VERT.
P709		54	54	54	54	30'-0"			PILES-VERT.
P310		144	144	144	144	3'-8"	X		PILES-HORIZ.

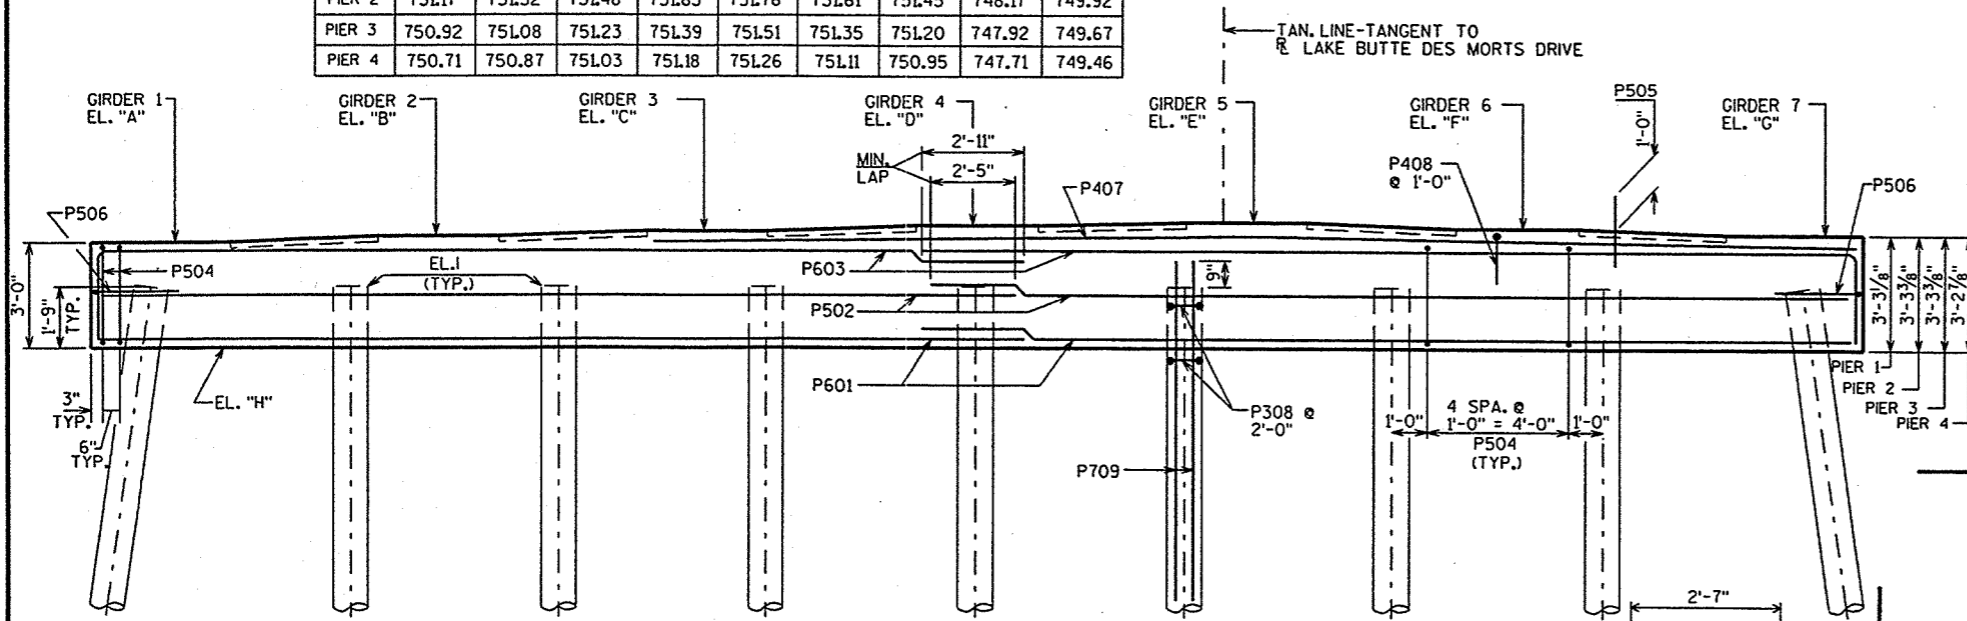

PIER ELEVATION LOOKING NORTH

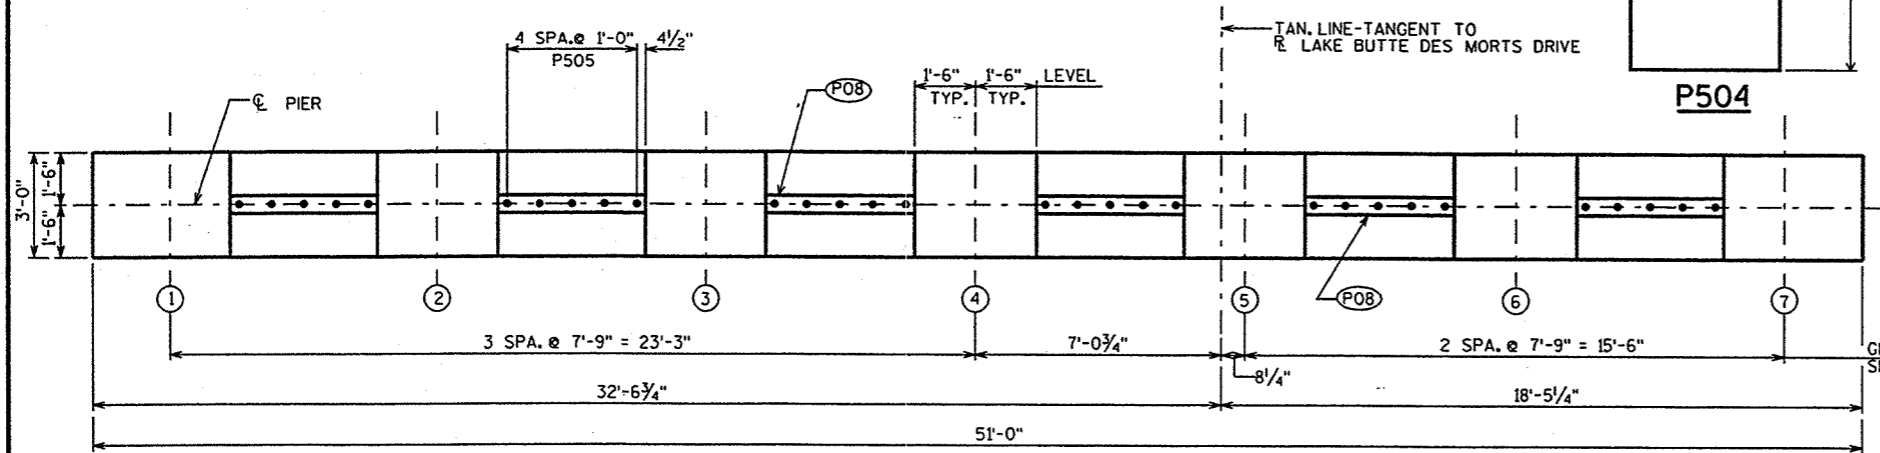


PLAN

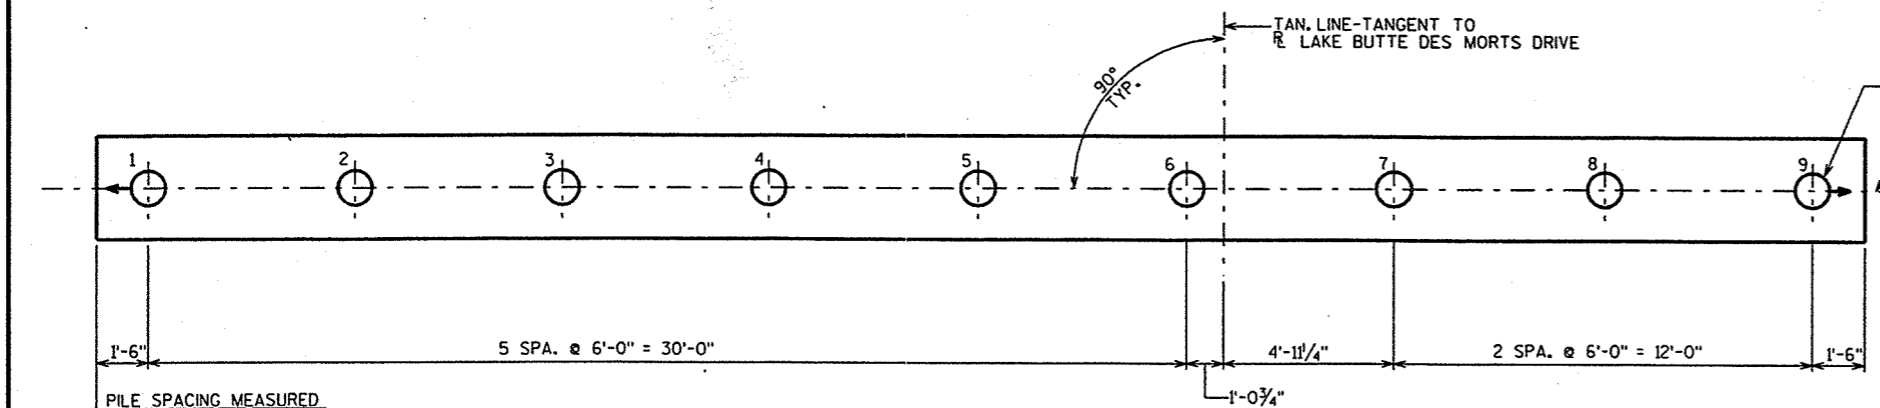

PILE PLAN

INDICATES BATTERED PILE. BATTER 2" PER FOOT IN DIRECTION SHOWN.

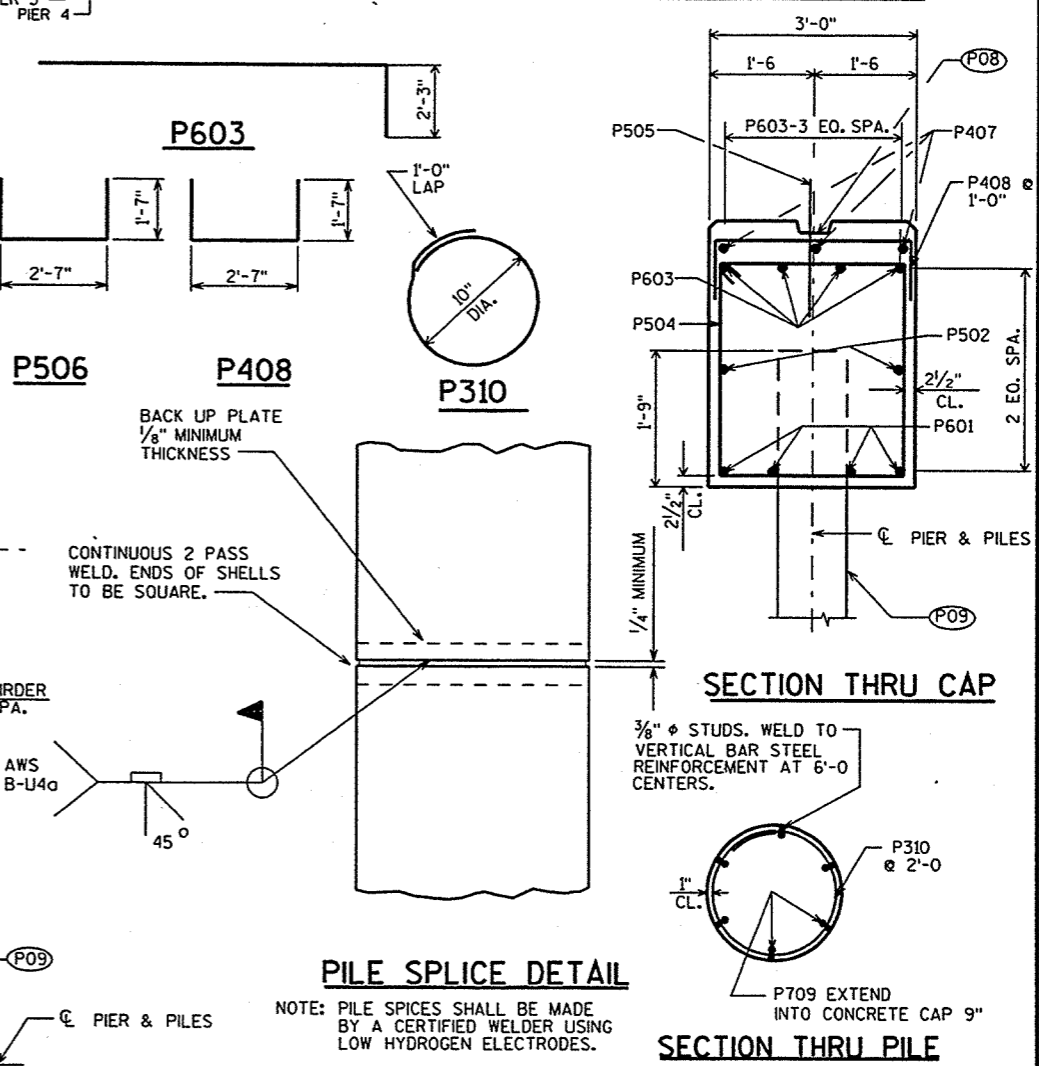

SECTION THRU CAP

SECTION THRU PILE

PILE SPLICE DETAIL

NOTE: PILE SPLICES SHALL BE MADE BY A CERTIFIED WELDER USING LOW HYDROGEN ELECTRODES.

- (P09) SUPPORT PIER ON 12" DIA. CAST-IN-PLACE CONCRETE PILING, ESTIMATED 60'-0" LONG AND DRIVEN TO A MIN. BRG. VALUE OF 55 TONS PER PILE. (.375" MIN. WALL THICKNESS REQ'D. FOR ALL PILING.) (TYP. ALL PIERS)
- (P08) KEYED CONSTRUCTION JOINT-FORMED BY BEVELED 2 x 6 BETWEEN BEAM SEATS.

NO.	DATE	REVISION	BY
STATE OF WISCONSIN DEPARTMENT OF TRANSPORTATION STRUCTURES DESIGN SECTION			
STRUCTURE B-70-211			
CONST. SPEC.	1996	DRAWN BY CRJ	PLANS CK'D. MGW
PIERS 1 THRU 4			SHEET 8

FILE= 21PIER.DGN
SCALE = 2.666

GIRDER NOTES

TOP OF GIRDER TO BE ROUGH FLOATED AND BROOMED TRANSVERSELY, EXCEPT THE OUTSIDE 2" OF GIRDER, WHICH SHALL BE TROWEL FINISHED.

THE GIRDERS SHALL BE PROVIDED WITH A SUITABLE LIFTING DEVICE FOR HANDLING AND ERECTING THE GIRDERS.

PRESTRESSING STRANDS SHALL BE 0.6"Ø - 7 WIRE LOW-RELAXATION STRANDS WITH AN ULTIMATE STRENGTH OF 270,000 PSI AND SHALL BE FLUSH WITH THE ENDS OF THE GIRDER.

BEND EACH END OF #4 STIRRUPS 4½" AND #5 STIRRUPS 6".

FOR DIAPHRAGM INSERT & CONNECTION DETAILS SEE "STEEL DIAPHRAGM" SHEET.


ALL GIRDERS SHALL BE CAST FULL LENGTH AS SHOWN.

SPACING SHOWN FOR #4 STIRRUPS IS FOR GRADE 60 REINFORCEMENT. IF THE FABRICATOR WANTS TO BUILD A BAR STEEL CAGE BY WELDING LONGITUDINAL REINFORCEMENT TO THE #4 STIRRUPS, 2 OPTIONS ARE AVAILABLE:


1. USE ASTM A706, GRADE 60 REINFORCEMENT AND THE STIRRUP SPACING AS SHOWN ON THE PLANS.
2. USE ASTM A615, GRADE 40 REINFORCEMENT AND A MODIFIED STIRRUP SPACING SUBMITTED TO AND APPROVED BY THE STRUCTURES DEVELOPMENT SECTION.

AN ALTERNATE EQUIVALENT OF WELDED WIRE FABRIC (WWF) MAY BE SUBSTITUTED FOR THE STIRRUP REINFORCEMENT SHOWN, UPON APPROVAL OF THE STRUCTURES DEVELOPMENT SECTION.


WELDED WIRE FABRIC SHALL CONFORM TO THE REQUIREMENTS OF ASTM A497.

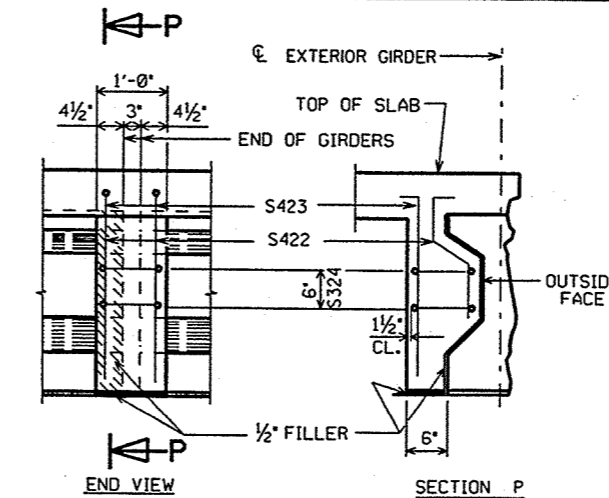

PILASTER DETAILS AT PIERS

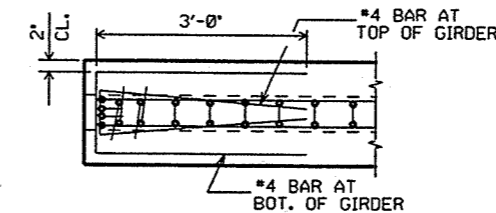

TOP VIEW OF GIRDER ENDS


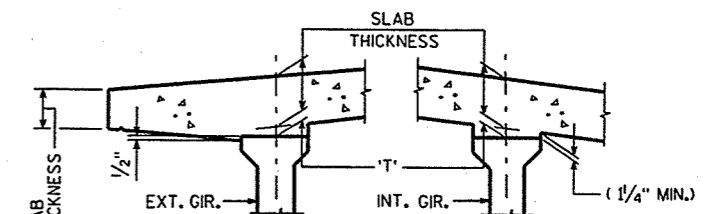


SLAB HAUNCH DETAIL

IF 1¼" MINIMUM HAUNCH HEIGHT AT EDGE OF GIRDER CANNOT BE MAINTAINED, THE GRADE LINE MAY BE REVISED BY THE ENGINEER AT THE OPTION OF THE CONTRACTOR. THE PLAN SLAB THICKNESS SHALL BE HELD. NOTIFY BRIDGE OFFICE FOR HAUNCH HEIGHTS OVER 4".

TO DETERMINE 'T', ELEV. OF TOP OF GIR'S. AT CL OF SUBSTRUCTURE UNITS & AT ¼ POINTS OF EACH SPAN SHALL BE TAKEN. THEN FOLLOW THIS PROCESS:


- TOP OF DECK ELEV. AT FINAL GRADE
 - TOP OF GIRDER ELEVATION
 - + DEAD LOAD DEFLECTION
 - SLAB THICKNESS
- = HAUNCH HEIGHT 'T'

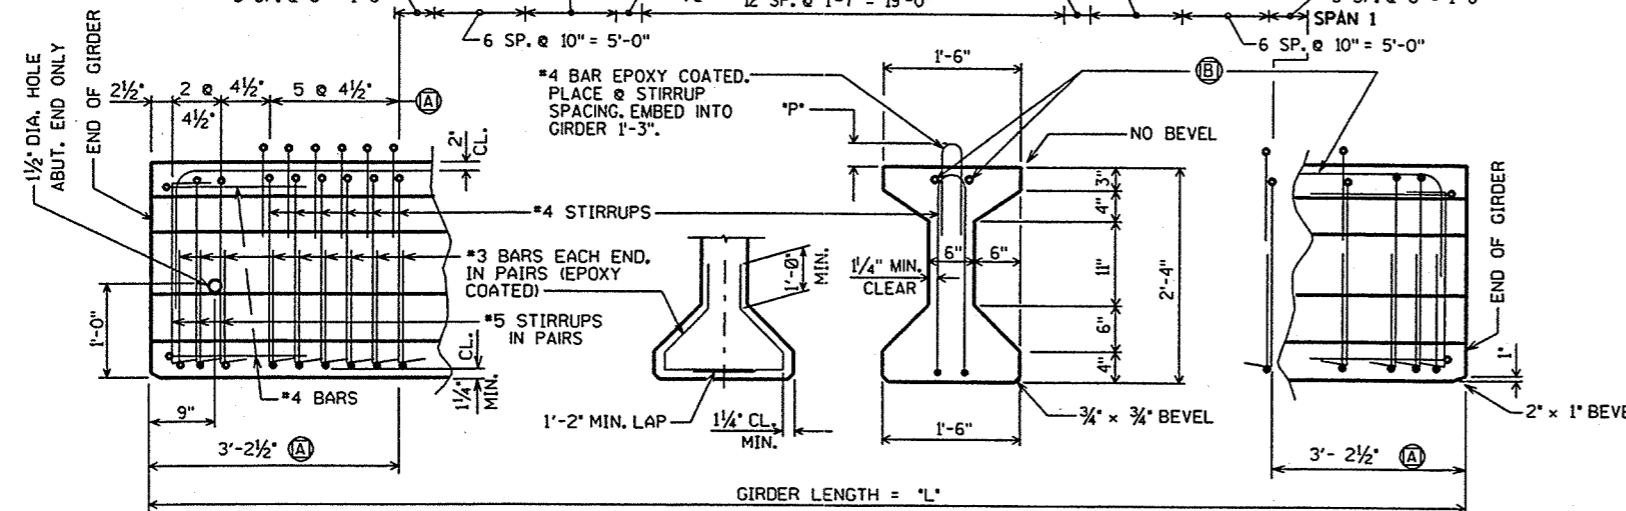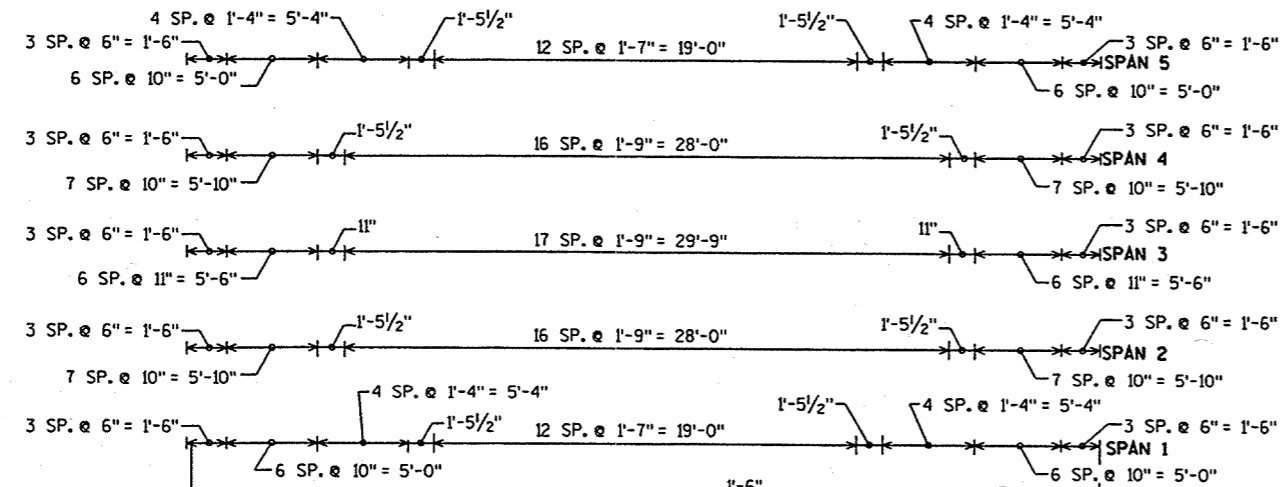

SIDE VIEW & TYP. SECTION IN SPAN


(A) DETAIL TYP. AT EACH END

(B) 2-#4 BARS BEND DOWN 16 BAR DIA. AT ENDS
1'-11" MIN. LAP (TYP. ALL SPANS)

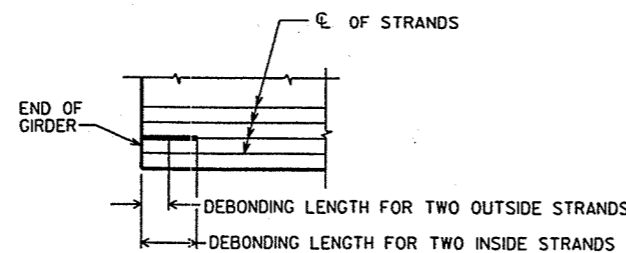


BOND BREAKER DETAIL


SHOWING LENGTHS OF DEBONDING FROM END OF GIRDER.

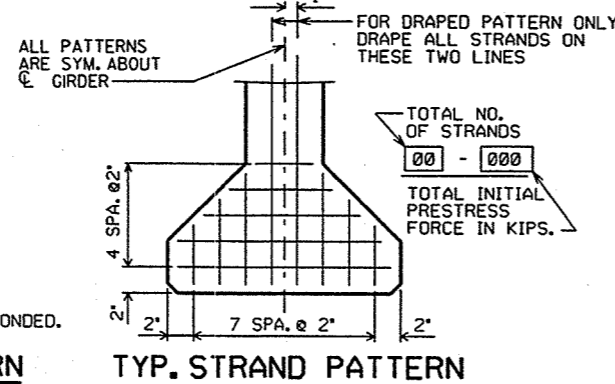

TYP. STRAND PATTERN

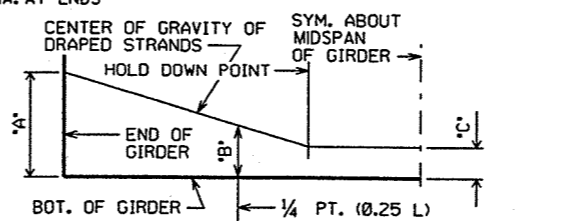

DRAPED STRAND PROFILE

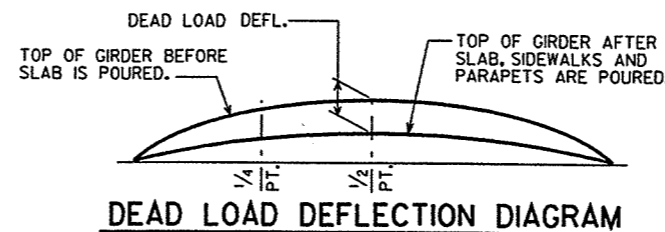

DEAD LOAD DEFLECTION DIAGRAM

*MINIMUM CYLINDER STRENGTH OF CONCRETE @ TIME OF TRANSFER OF PRESTRESS FORCE.

SPAN	GIRDER LENGTH "L"	DEAD LOAD DEFL. (IN.)					CONC. STRGTH. f'c (P.S.I.)	"P"	DIA. OF STRAND	DRAPED PATTERN (IN.)					UNDRAPED PATTERN	
		1/8	1/4	3/8	1/2	TOTAL NO. OF STRANDS				f'ci (P.S.I.) *	f'ci (IN.)			TOTAL NO. OF STRANDS	f'ci (P.S.I.) *	
											"A" MIN.	"B" MAX.	"C"			
1	52.00	0.33	0.57	0.71	0.76	7500	6	0.60	12	5500	25.00	8.50	11.25	3.00	0	0
2	52.00	0.35	0.59	0.74	0.79	7500	6	0.60	12	5500	25.00	8.50	11.25	3.00	0	0
3	52.00	0.35	0.59	0.74	0.79	7500	6	0.60	12	5500	25.00	8.50	11.25	3.00	0	0
4	52.00	0.35	0.59	0.74	0.79	7500	6	0.60	12	5500	25.00	8.50	11.25	3.00	0	0
5	52.00	0.33	0.57	0.71	0.76	7500	6	0.60	12	5500	25.00	8.50	11.25	3.00	0	0

NO.	DATE	REVISION	BY
STATE OF WISCONSIN DEPARTMENT OF TRANSPORTATION STRUCTURES DESIGN SECTION			
STRUCTURE B-70-211			
CONST. SPEC.	1996	DRAWN BY	CRJ
		PLANS CKD.	MGW
28" PRESTRESSED GIRDER DETAILS			SHEET 9

NOTES

ALL DIAPHRAGM MATERIAL NOT EMBEDDED IN THE CONCRETE GIRDER SHALL BE PAID FOR AT THE UNIT PRICE BID FOR "STEEL DIAPHRAGM", STRUCTURE, EACH.


EACH DIAPHRAGM BETWEEN GIRDERS SHALL CONSTITUTE ONE UNIT.

ALL DIAPHRAGM STRUCTURAL STEEL SHALL BE ASTM A709 GRADE 36. ALL BOLTS, NUTS AND WASHERS SHALL BE ASTM A325 TYPE 1.


ALL DIAPHRAGM STRUCTURAL STEEL SHOWN SHALL BE HOT-DIPPED GALVANIZED. ALL BOLTS, NUTS AND WASHERS SHALL BE HOT-DIPPED GALVANIZED IN ACCORDANCE WITH ASTM A153 CLASS C. GALVANIZED NUTS SHALL BE TAPPED OVERSIZE IN ACCORDANCE WITH THE REQUIREMENTS OF ASTM A563 AND SHALL MEET THE REQUIREMENTS OF SUPPLEMENTARY REQUIREMENT S1 OF ASTM A563, LUBRICANT AND TEST FOR COATED NUTS.

TABLE


GIRDER HEIGHT	DIM. "A"	DIM. "B"	DIM. "L"	DIM. "X"
28"	1'-0 7/8"	5 7/8"	9 1/2"	2 1/4"

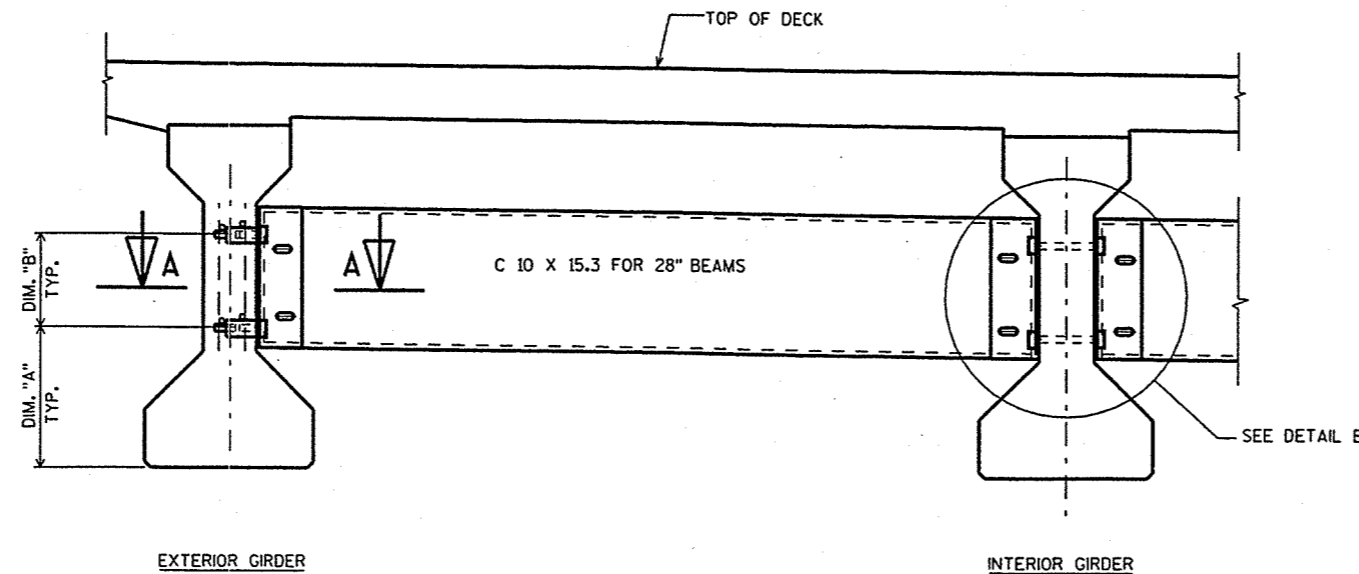

PART TRANSVERSE SECTION AT DIAPHRAGM

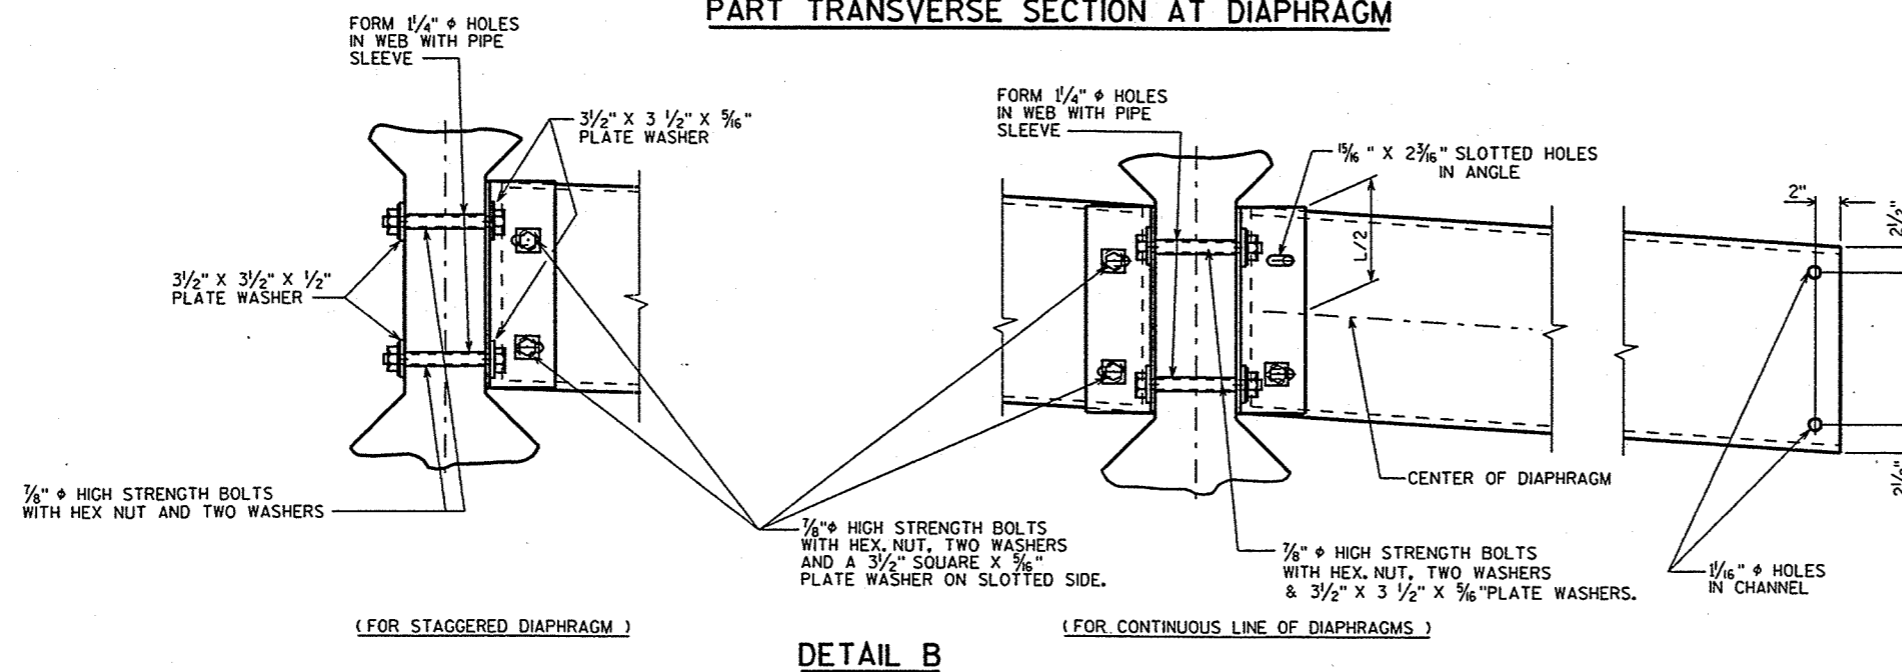


DETAIL B

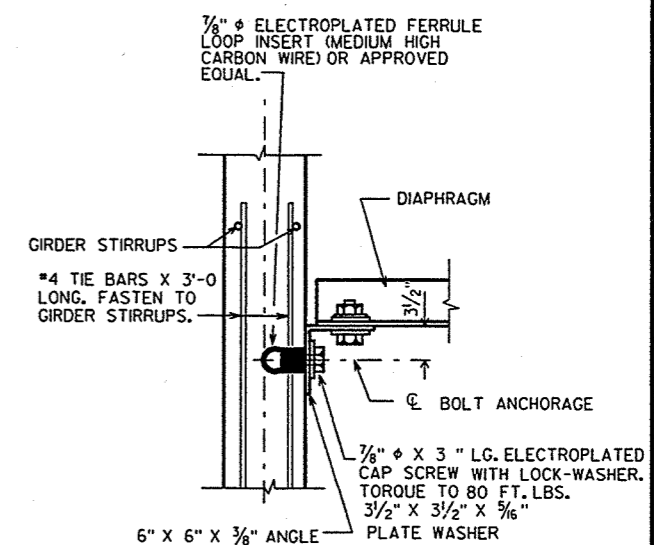

SECT. A-A


(FOR EXTERIOR ATTACHMENT)

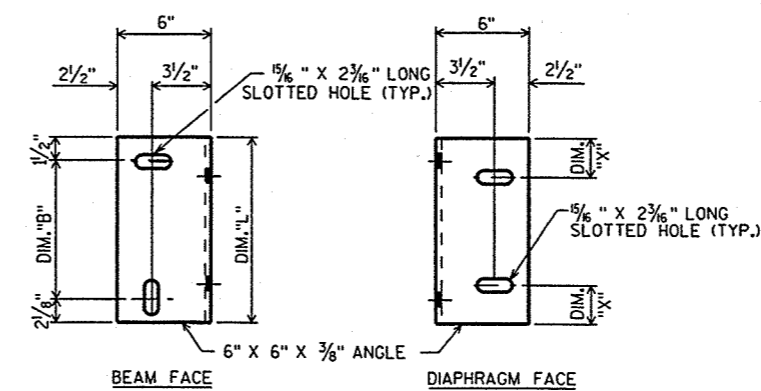



DIAPHRAGM SUPPORT

NO.	DATE	REVISION	BY
STATE OF WISCONSIN DEPARTMENT OF TRANSPORTATION STRUCTURES DESIGN SECTION			
STRUCTURE		B-70-211	
CONST. SPEC.	1996	DRAWN BY	CRJ
PLANS CKD.			MGN
STEEL DIAPHRAGM			SHEET 10


FILE= 211DIA-DGN
SCALE = 1

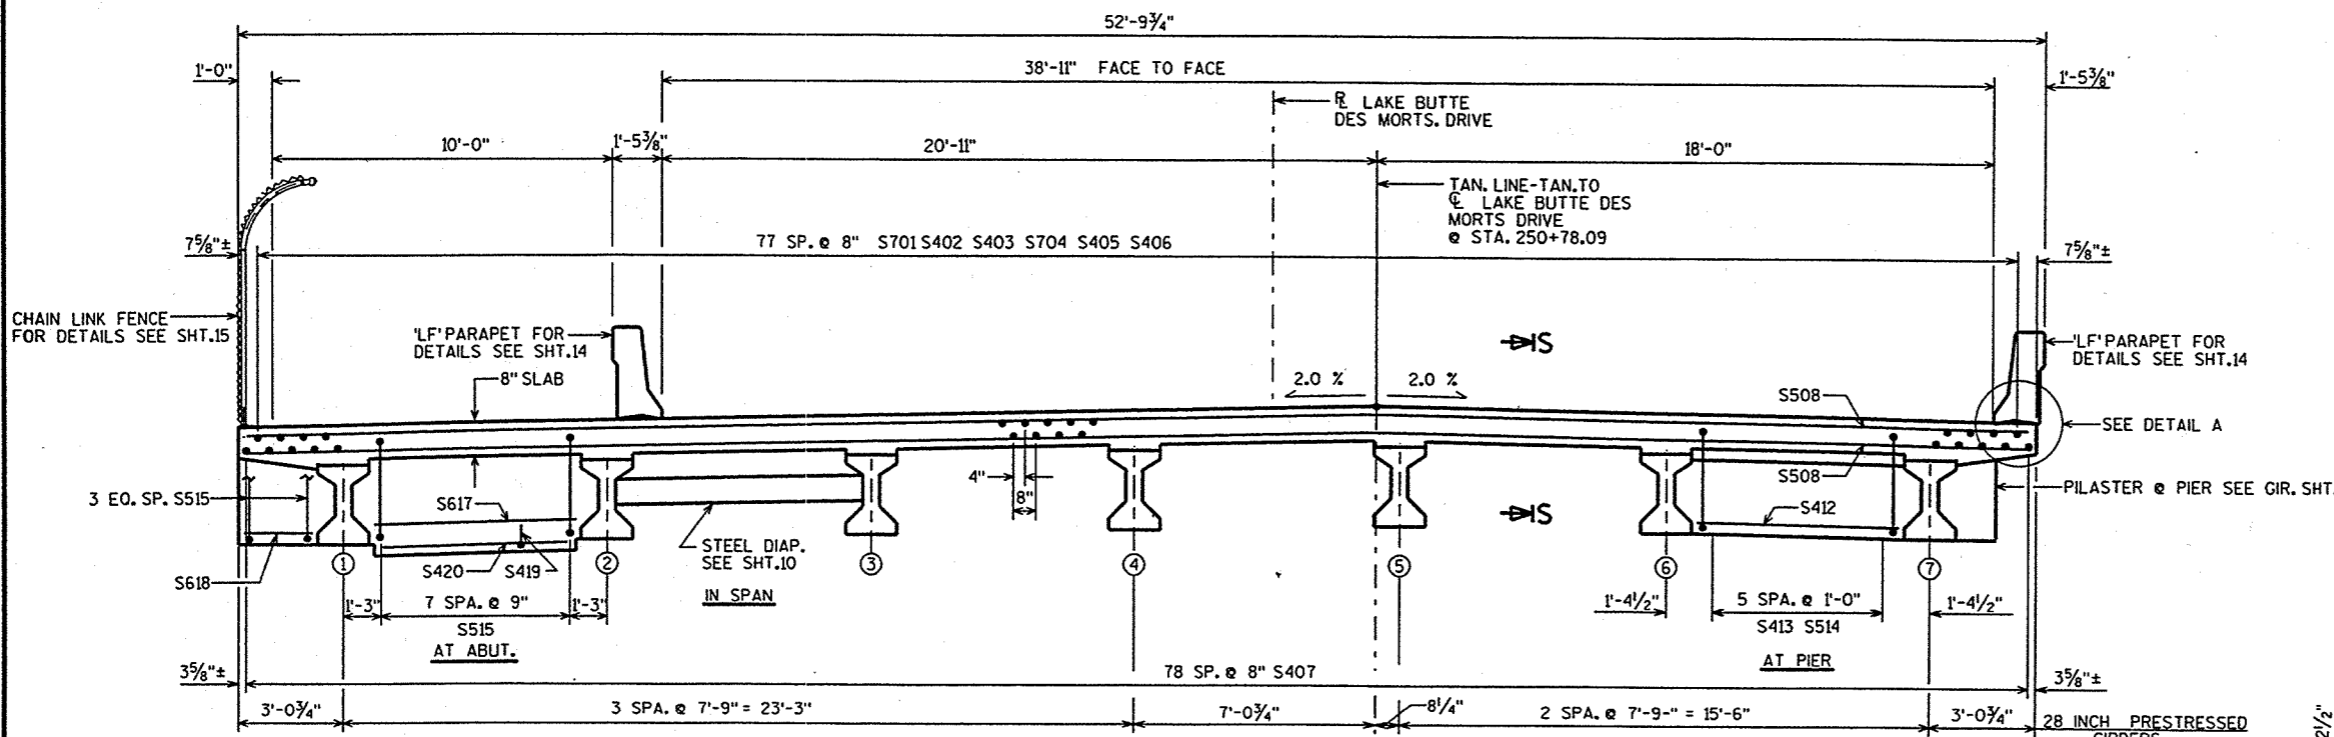

CROSS SECTION THRU ROADWAY
(LOOKING NORTH)

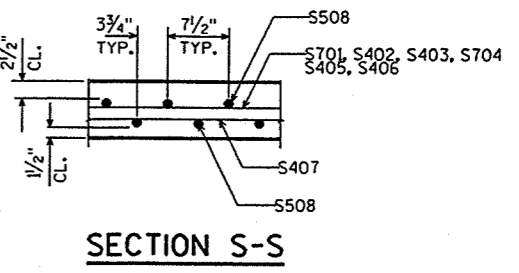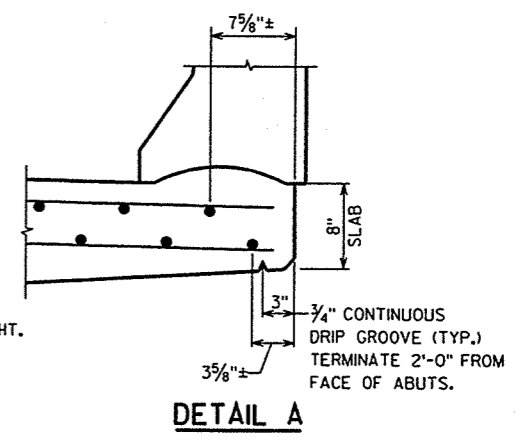

SECTION S-S

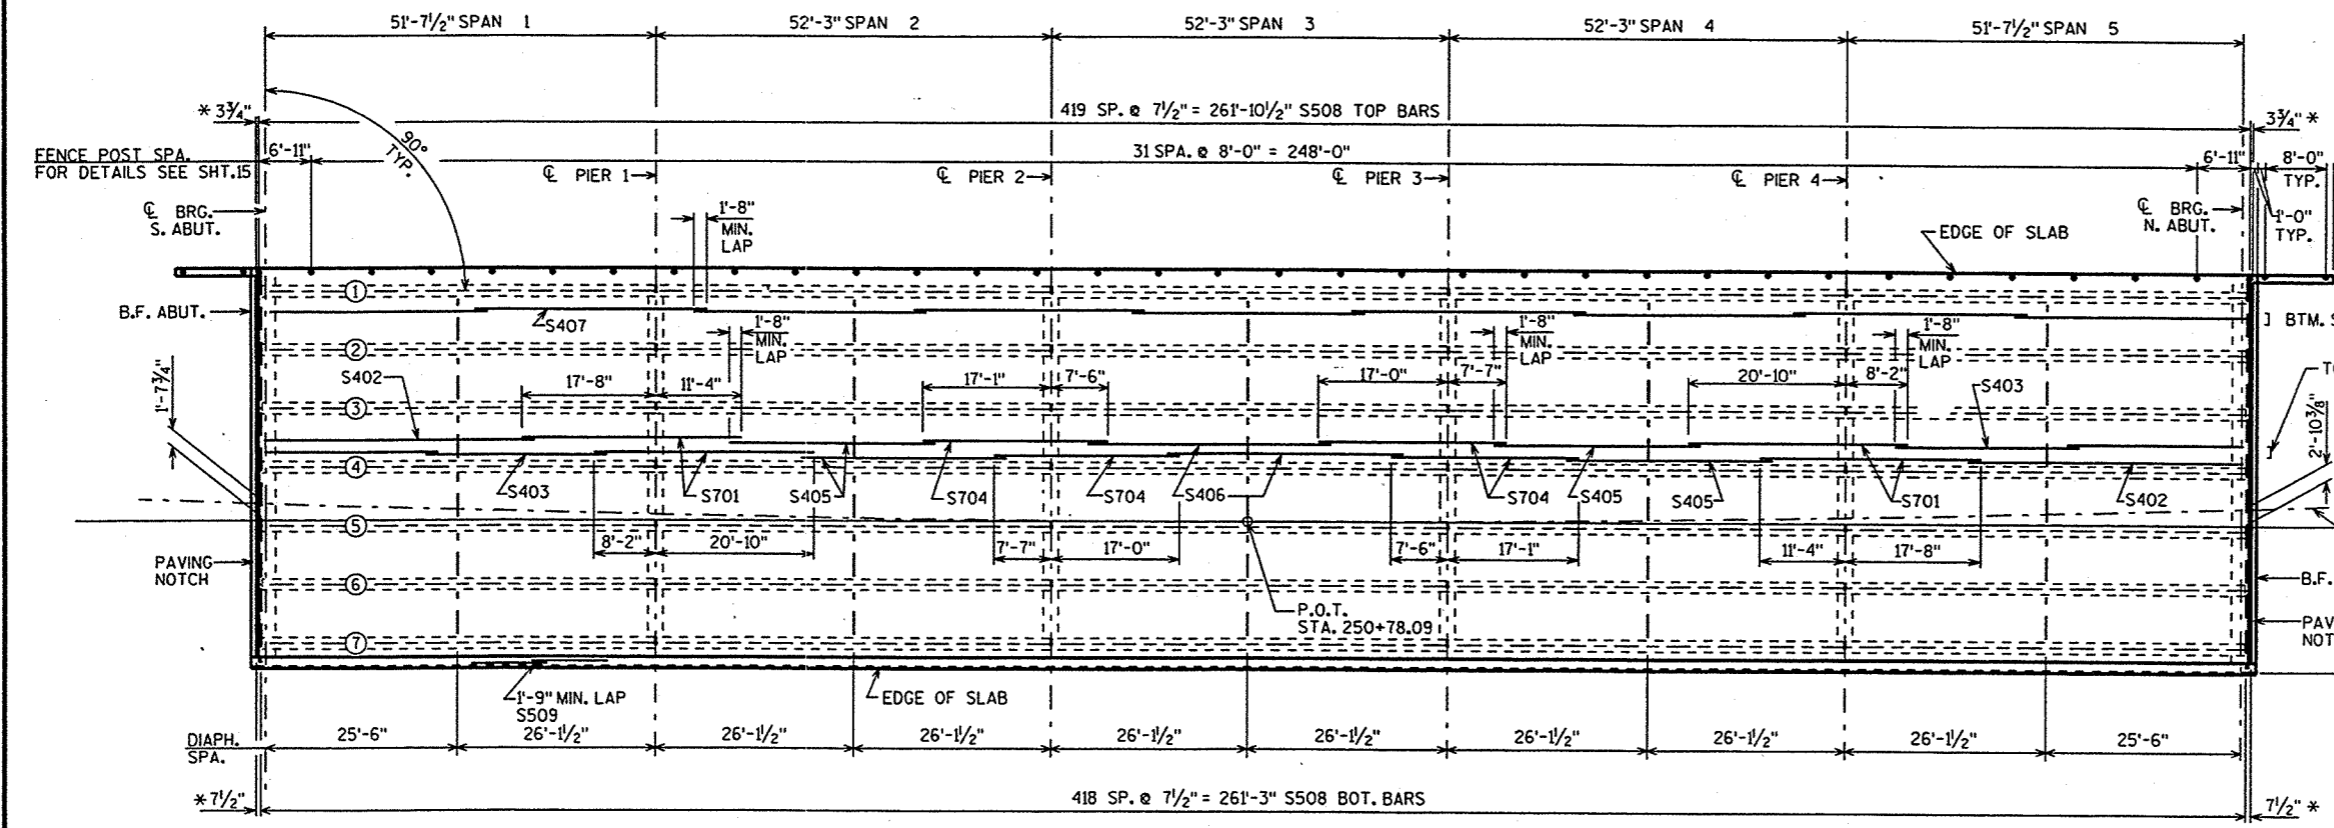


PLAN

*DISTANCE MEASURED TO
END OF SLAB (AT PAVING NOTCH)


NO.	DATE	REVISION	BY
STATE OF WISCONSIN DEPARTMENT OF TRANSPORTATION STRUCTURES DESIGN SECTION			
STRUCTURE B-70-211			
CONST. SPEC.	1996	DRAWN BY CRJ	PLANS CK'D. MGW
SUPERSTRUCTURE			SHEET 11

BILL OF BARS



BAR MARK	COY	NO. REQ'D.	LENGTH	BENT	BAR SERIES	LOCATION
S701	X	156	29'-0"			LONGITUDINAL CONTINUITY
S402	X	78	36'-8"			LONGITUDINAL TOP
S403	X	156	23'-11"			LONGITUDINAL TOP
S704	X	156	24'-7"			LONGITUDINAL CONTINUITY
S405	X	156	27'-2"			LONGITUDINAL TOP
S406	X	78	31'-1"			LONGITUDINAL TOP
S407	X	711	30'-9"			LONGITUDINAL BOTTOM
S508	X	839	52'-3"			TRANSVERSE TOP AND BOTTOM
S509	X	70	39'-2"			PARAPET LF-HORIZ.
S510	X	792	4'-10"	X		PARAPET LF-VERT.
S511	X	792	4'-9"	X		PARAPET LF-VERT.
S412	X	240	5'-11"			PIER DIAPHRAGM-HORIZ.
S413	X	144	10'-2"	X		PIER DIAPHRAGM-VERT.
S514	X	144	8'-2"	X		PIER DIAPHRAGM-VERT.
S515	X	112	12'-9"	X		ABUT. DIAPHRAGM-VERT.
S616	X	20	27'-10"			ABUT. DIAPHRAGM-HORIZ.
S617	X	36	5'-11"			ABUT. DIAPHRAGM-HORIZ.
S618	X	12	2'-0"			ABUT. DIAPHRAGM-HORIZ.
S419	X	72	3'-3"	X		ABUT. DIAPHRAGM-VERT.
S420	X	24	4'-11"			ABUT. DIAPHRAGM-HORIZ.
S521	X	28	6'-0"			ABUT. DIAPHRAGM AT GIRDERS
S422	X	16	2'-9"	X		PIER PILASTER
S423	X	16	3'-3"	X		PIER PILASTER
S324	X	16	3'-4"	X		PIER PILASTER

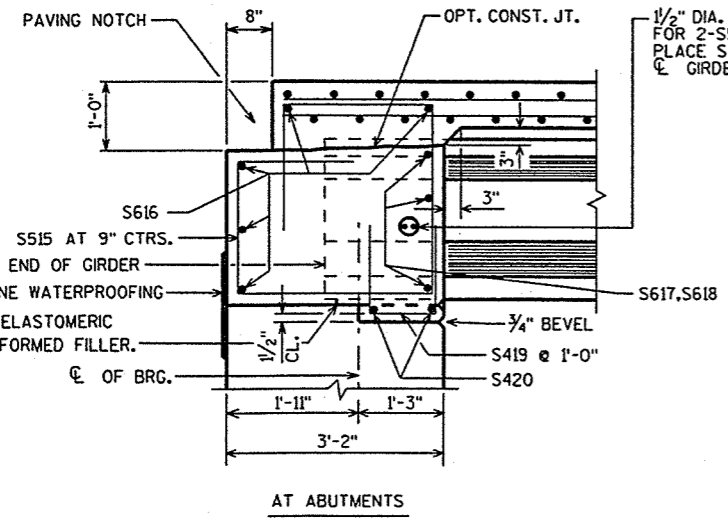


PART LONGIT. SECTION

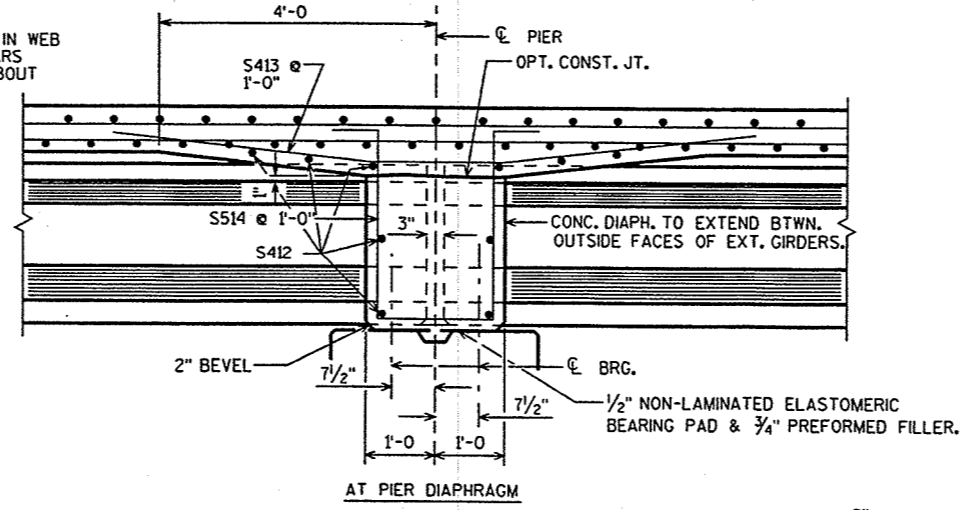

AT PIER DIAPHRAGM

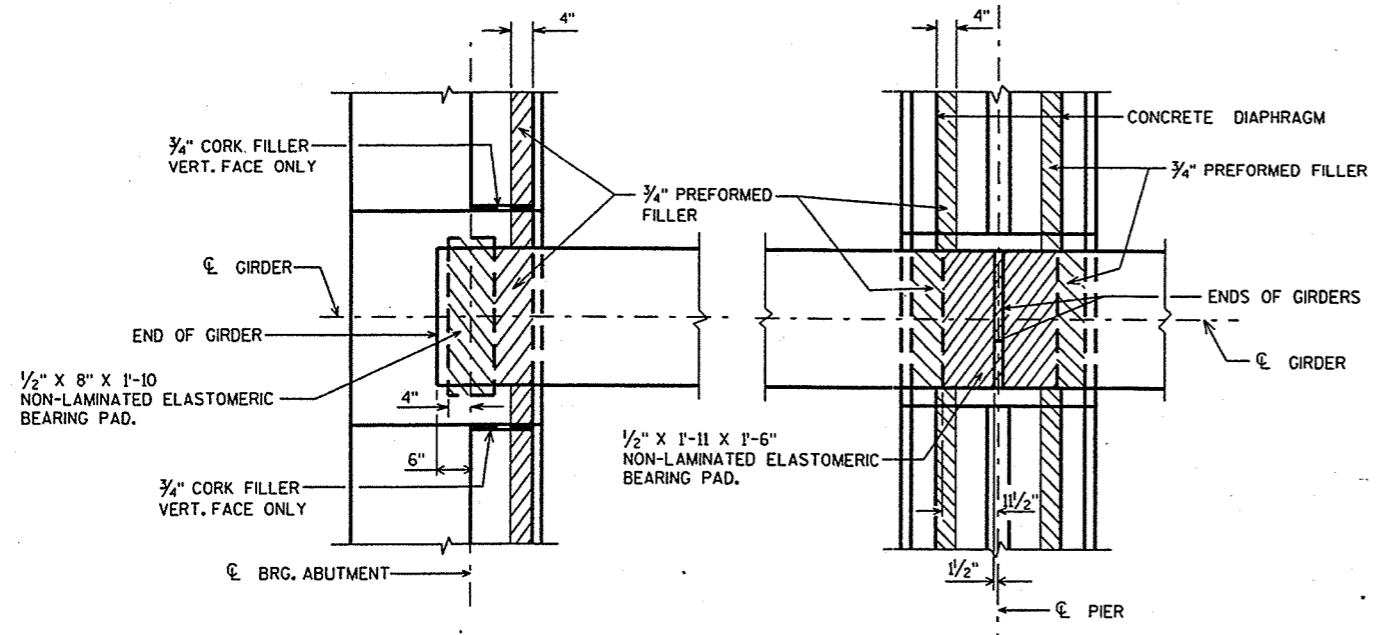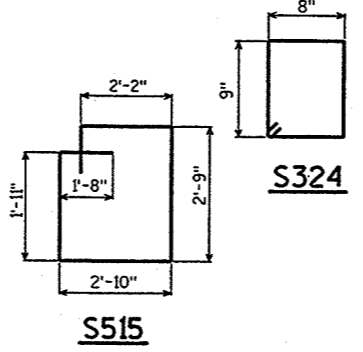

BEARING PAD DETAIL

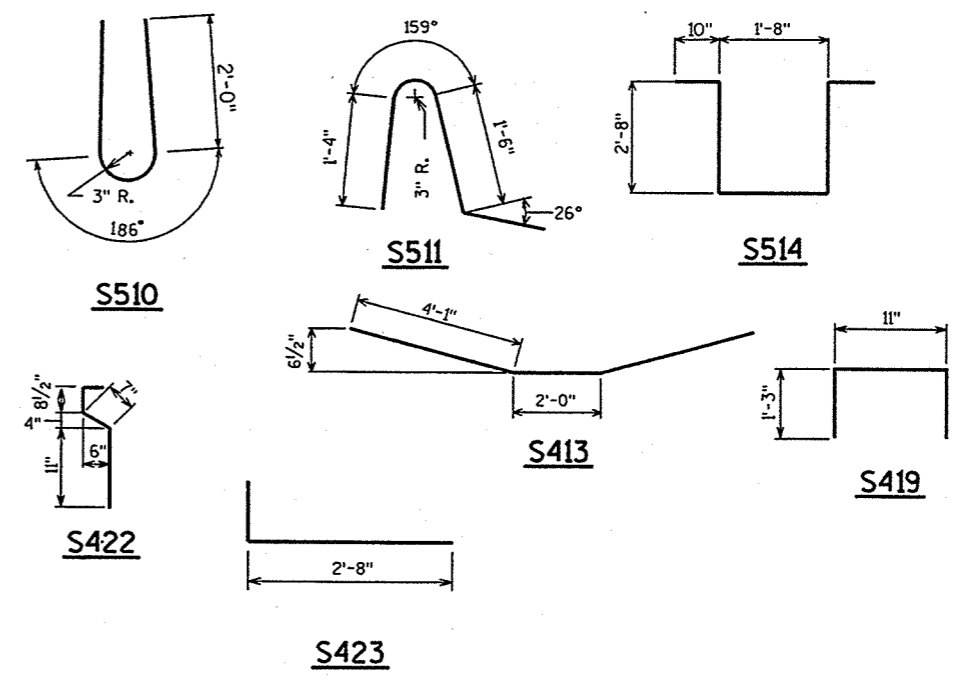

TOP OF DECK ELEVATIONS

	S. ABUT.	1/4	2/4	3/4	PIER 1	1/4	2/4	3/4	PIER 2	1/4	2/4	3/4	PIER 3	1/4	2/4	3/4	PIER 4	1/4	2/4	3/4	N. ABUT.
GIR. 1	754.99	754.93	754.86	754.79	754.72	754.65	754.59	754.52	754.46	754.40	754.33	754.27	754.21	754.16	754.10	754.05	754.00	753.96	753.91	753.87	753.84
GIR. 2	755.15	755.08	755.01	754.94	754.88	754.81	754.74	754.68	754.61	754.55	754.49	754.43	754.37	754.31	754.26	754.21	754.16	754.11	754.07	754.03	753.99
GIR. 3	755.30	755.23	755.16	755.10	755.03	754.96	754.90	754.83	754.77	754.71	754.64	754.58	754.52	754.47	754.42	754.36	754.32	754.27	754.23	754.19	754.15
GIR. 4	755.46	755.39	755.32	755.25	755.18	755.12	755.05	754.99	754.92	754.86	754.80	754.74	754.68	754.62	754.57	754.52	754.47	754.43	754.38	754.34	754.30
GIR. 5	755.52	755.46	755.41	755.35	755.29	755.23	755.17	755.11	755.05	754.99	754.93	754.86	754.80	754.74	754.67	754.61	754.55	754.49	754.43	754.38	754.32
GIR. 6	755.36	755.31	755.25	755.19	755.14	755.08	755.02	754.96	754.90	754.83	754.77	754.71	754.64	754.58	754.52	754.46	754.40	754.34	754.28	754.22	754.16
GIR. 7	755.20	755.15	755.09	755.04	754.98	754.92	754.86	754.80	754.74	754.68	754.62	754.55	754.49	754.43	754.36	754.30	754.24	754.18	754.13	754.07	754.01


NO.	DATE	REVISION	BY
STATE OF WISCONSIN DEPARTMENT OF TRANSPORTATION STRUCTURES DESIGN SECTION			
STRUCTURE		B-70-211	
CONST. SPEC.	1996	DRAWN BY	CRJ
SUPERSTRUCTURE DETAILS		SHEET 12	

FILE= 21USUP2.DGN
SCALE = 1:333


1 2 4 6 7 12 16 19 20

BILL OF BARS


BAR MARK	COAT	S. ABUT.	N. ABUT.	LENGTH	BENT	LOCATION
K501	X	14	14	4'-7"	X	PARAPET VERT.
K502	X	8	8	3'-2"	X	PARAPET VERT.
K503	X	21	21	4'-8"	X	PARAPET VERT.
K504	X	4	4	20'-3"		PARAPET HORIZ.
K505	X	35	35	4'-10"	X	PARAPET VERT.
K506	X	1	1	20'-3"	X	PARAPET HORIZ.
K407		20	20	7'-7"	X	PARAPET FTG.-VERT.
K408		4	4	20'-3"		PARAPET FTG.-HORIZ.
K409		4	4	19'-8"		PARAPET FTG.-HORIZ.

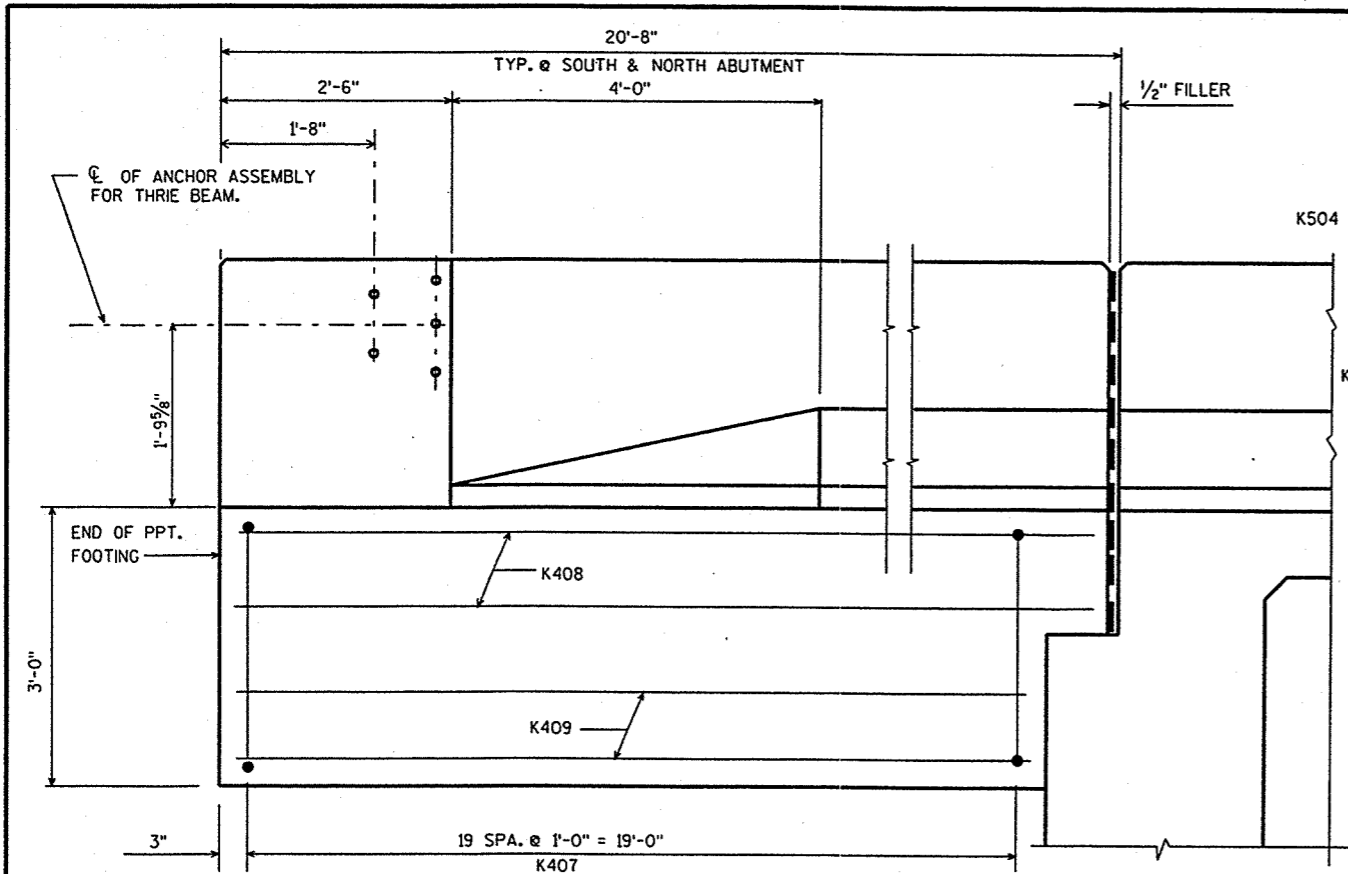


INSIDE ELEVATION

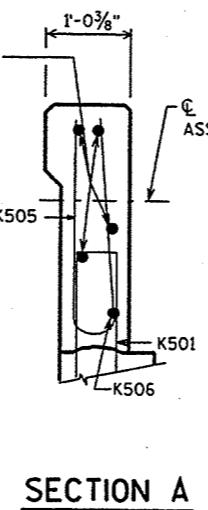



SECTION A

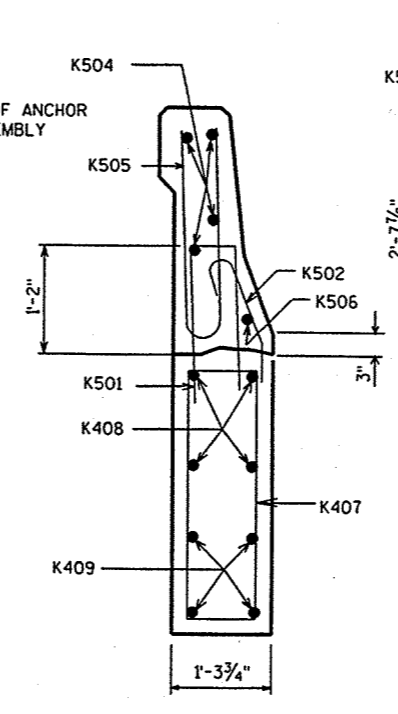

SECTION B

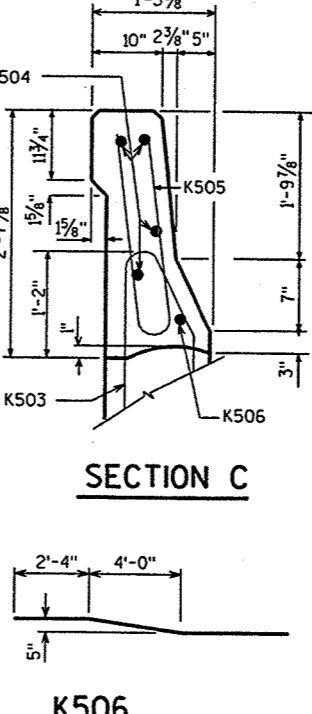


SECTION C

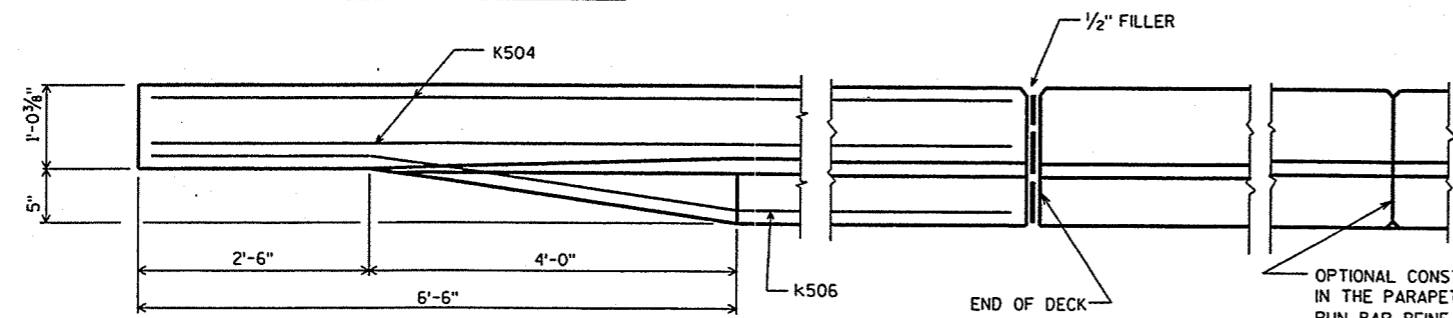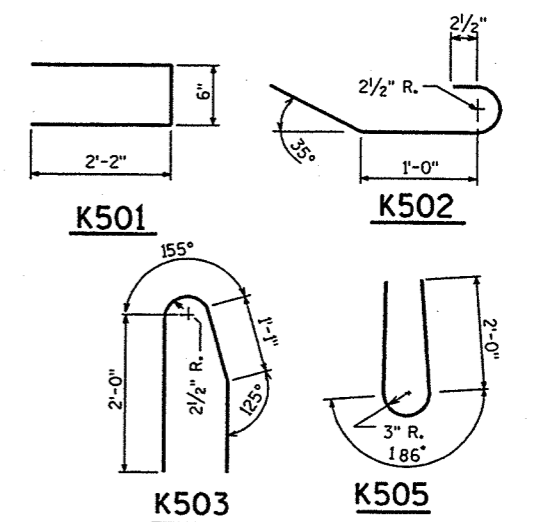


PLAN

OPTIONAL CONSTRUCTION JOINTS IN THE PARAPETS MAY BE USED. RUN BAR REINF THRU THE JOINT. LAP LONGIT. BARS A MIN. OF 1'-9" MIN. JOINT SPACING OF 80'-0" DEFINE CONST. JOINT WITH A 3/4" V-GROOVE.

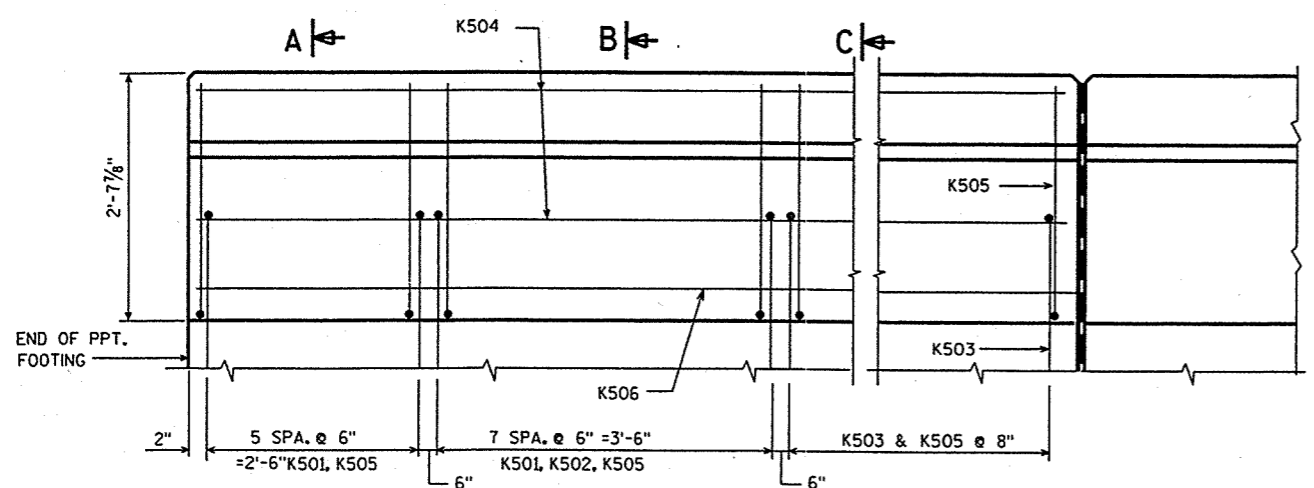

OUTSIDE ELEVATION

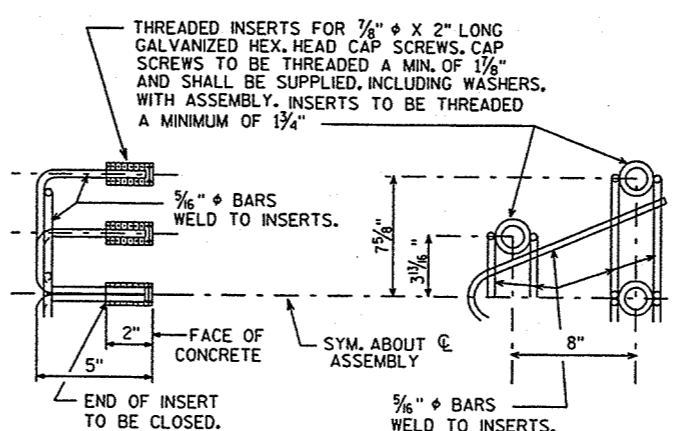

DETAIL OF ANCHOR ASSEMBLY

NOTE: HEX. HEAD CAP SCREWS & WASHERS TO BE GALVANIZED IN ACCORDANCE WITH AASHTO M232 CLASS C.


NO.	DATE	REVISION	BY
STATE OF WISCONSIN DEPARTMENT OF TRANSPORTATION STRUCTURES DESIGN SECTION			
STRUCTURE B-70-211			
CONST. SPEC.	1996	DRAWN BY CRJ	PLANS CKD. M&W
SLOPE FACE PARAPET 'LF' (WEST SIDE)			SHEET 13

FILE= 211PPTWS.DGN
SCALE = 1


BILL OF BARS

FOR ABUTMENT PARAPETS


BAR MARK	COAT	S. ABUT.	N. ABUT.	LENGTH	BENT	LOCATION
R501	X	14	14	4'-7"	X	PARAPET VERT.
R502	X	8	8	3'-2"	X	PARAPET VERT.
R503	X	5	5	4'-8"	X	PARAPET VERT.
R504	X	4	4	9'-8"		PARAPET HORIZ.
R505	X	19	19	4'-10"	X	PARAPET VERT.
R506	X	1	1	9'-8"	X	PARAPET HORIZ.

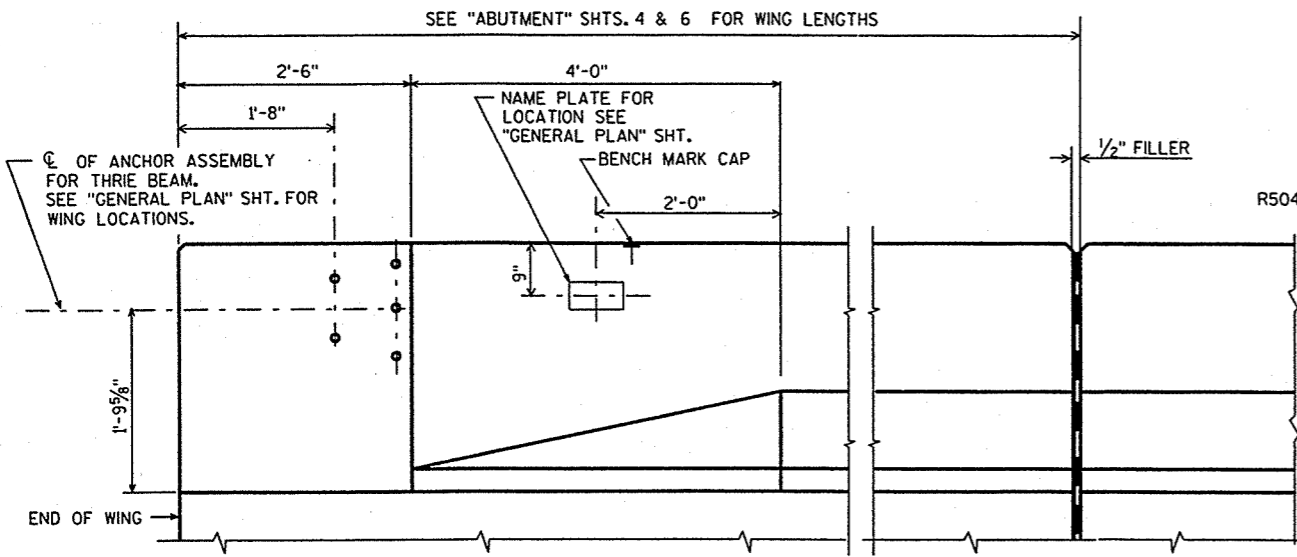


INSIDE ELEVATION

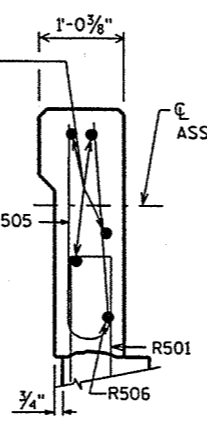


SECTION A

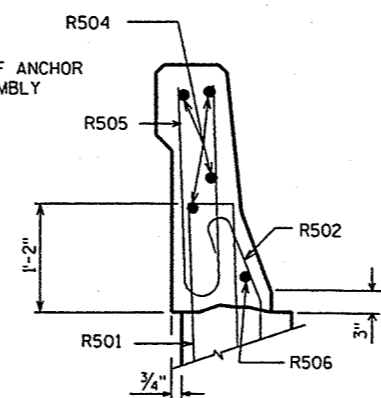


SECTION B

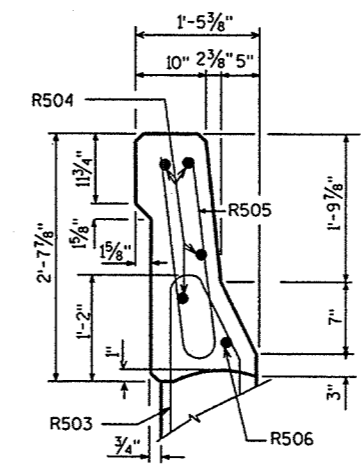


SECTION C

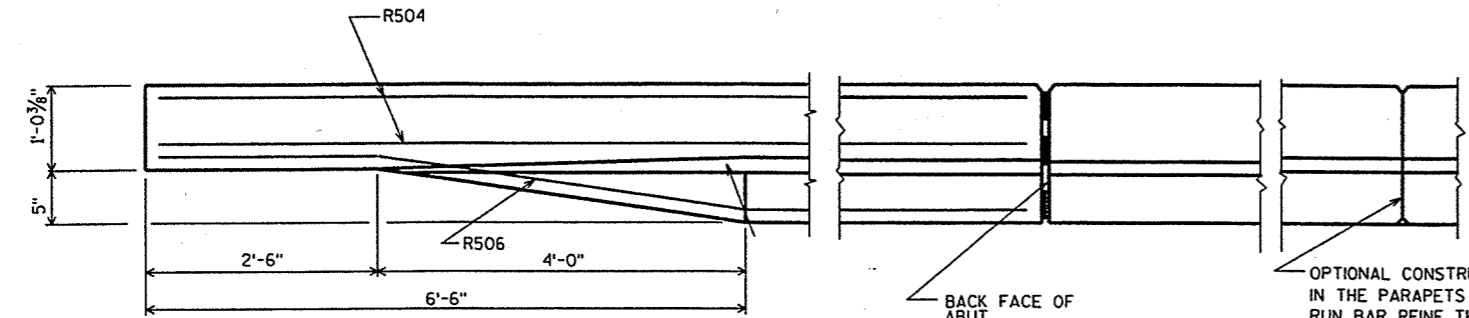


PLAN

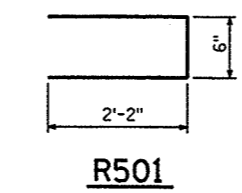


R501

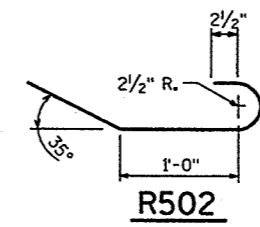


R502

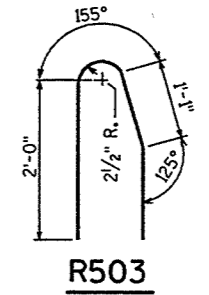

R503

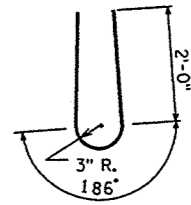


R505

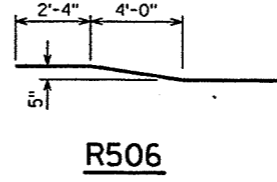


R506


OPTIONAL CONSTRUCTION JOINTS IN THE PARAPETS MAY BE USED. RUN BAR REINF THRU THE JOINT. LAP LONGIT. BARS A MIN. OF 1'-9" MIN. JOINT SPACING OF 80'-0" DEFINE CONST. JOINT WITH A 3/4" V GROOVE.

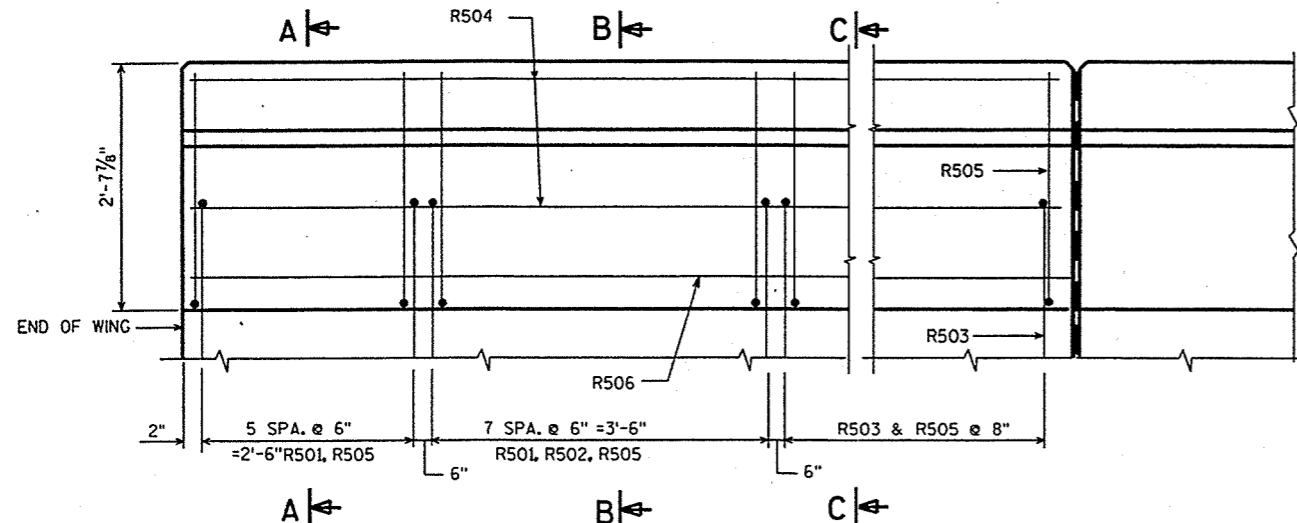

OUTSIDE ELEVATION

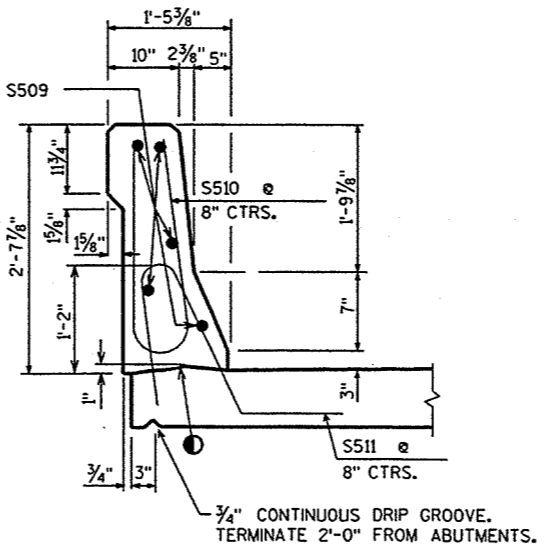

SECTION THRU PARAPET ON BRIDGE

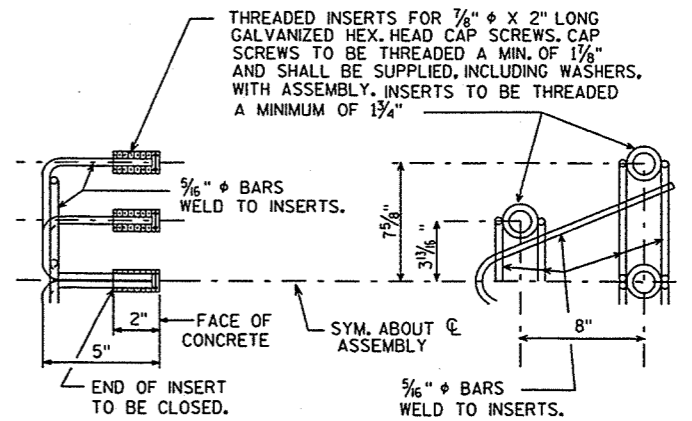

DETAIL OF ANCHOR ASSEMBLY

NOTE: HEX. HEAD CAP SCREWS & WASHERS TO BE GALVANIZED IN ACCORDANCE WITH AASHTO M232 CLASS C.

● CONST. JOINT - STRIKE OFF AS SHOWN.


NO.	DATE	REVISION	BY
STATE OF WISCONSIN DEPARTMENT OF TRANSPORTATION STRUCTURES DESIGN SECTION			
STRUCTURE B-70-211			
CONST. SPEC.	1996	DRAWN BY CRJ	PLANS CKD. M6W
SLOPED FACE PARAPET 'LF' (EAST SIDE)			SHEET 14

FILE= 211PPT.DGN
SCALE = 1


12
7
9

GENERAL NOTES

- POSTS ARE TO BE SET VERTICAL.
- KNUCKLE TOP AND BOTTOM OF 2" MESH CHAIN LINK FENCING.
- ALL FENCING COMPONENTS SHALL BE GALVANIZED STEEL OR APPROVED ALTERNATE LISTED BELOW.
- ALL RAILS, POSTS AND SLEEVES ARE STANDARD WEIGHT PIPE, SCHEDULE 40.
- PLACE ALL NUTS ON OUTSIDE OF FENCE.
- TOP RAIL SHALL BE CONTINUOUS OVER INTERIOR POSTS. MINIMUM LENGTH OF TOP RAIL BETWEEN SPLICES SHALL BE 20'-0". PLACE TOP RAIL SPLICES NEAR 1/4 POINTS OF POST SPACING. NO. 9 GAGE TIES AT 9" SPACING REQ'D. ON RAILS & POSTS WITHOUT STRETCHER BARS.
- ALTERNATE FENCING MATERIALS ARE ALLUMINUM, ALUMINUM COATED STEEL AND APPROVED COLOR COATING SYSTEMS. IF ALTERNATE MATERIALS ARE USED FOR POSTS & RAILS, THESE ELEMENTS SHOULD BE DESIGNED.

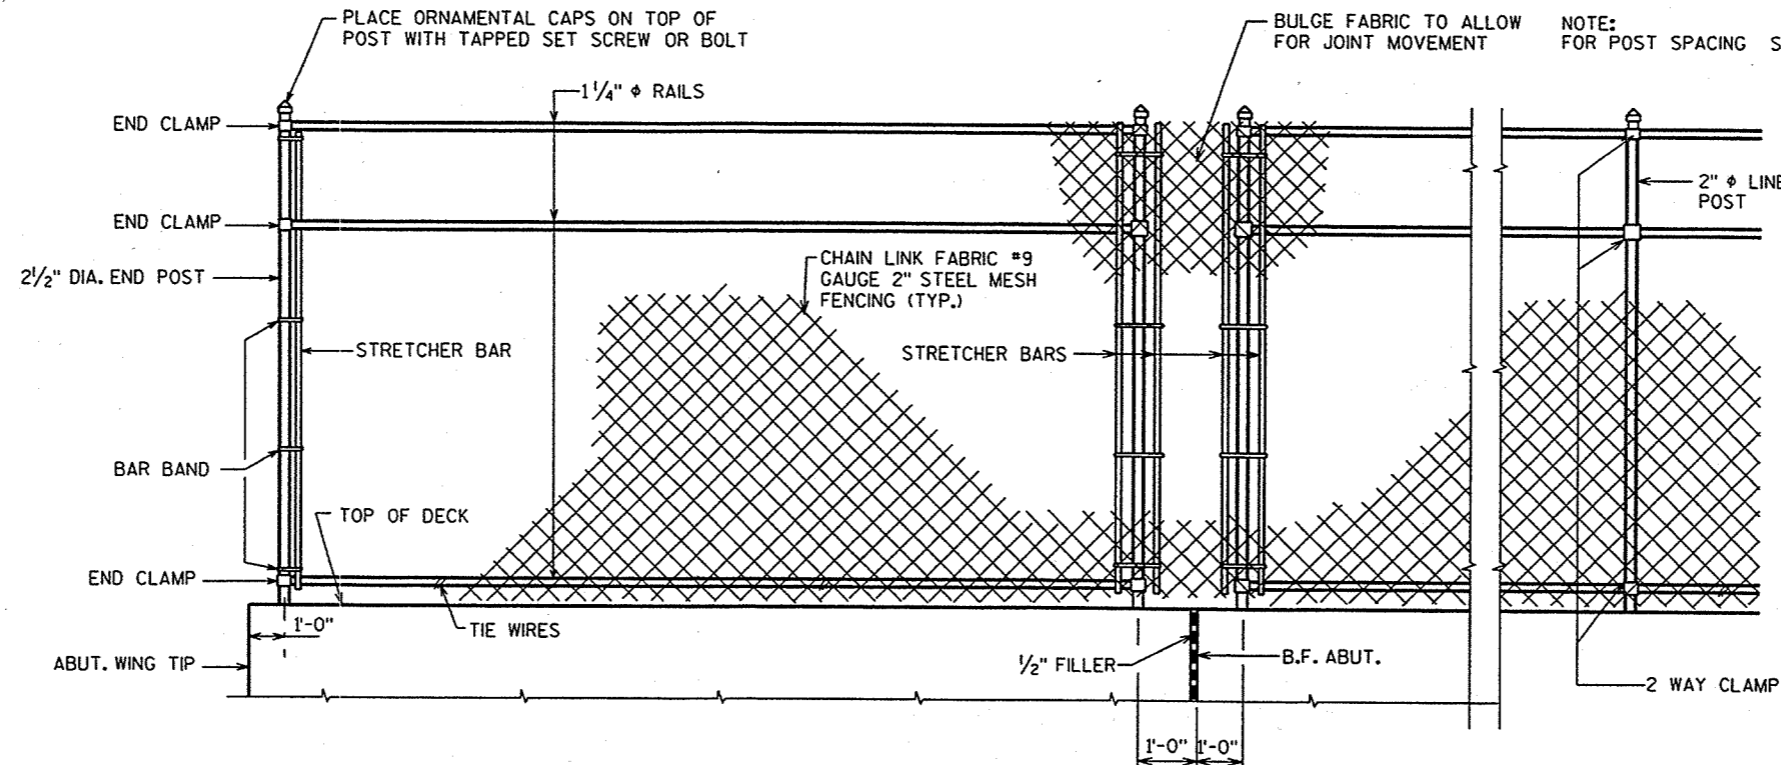


FENCE PART ELEVATION

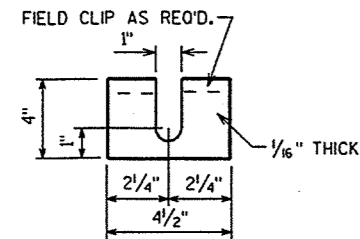


POST SHIM DETAILS

SHIMS REQUIRED ONLY WHEN POSTS ARE WELDED TO BASE PLATES. PROVIDE 4 SHIMS PER POST.

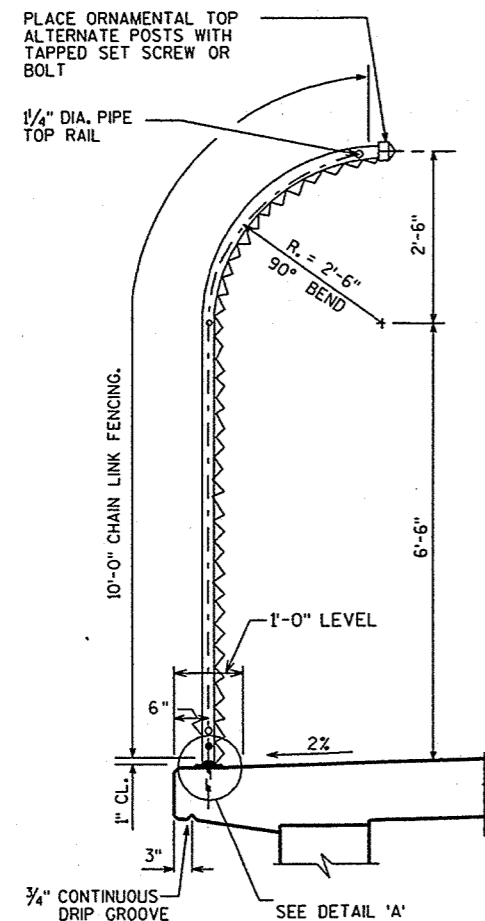


SECTION THRU FENCE

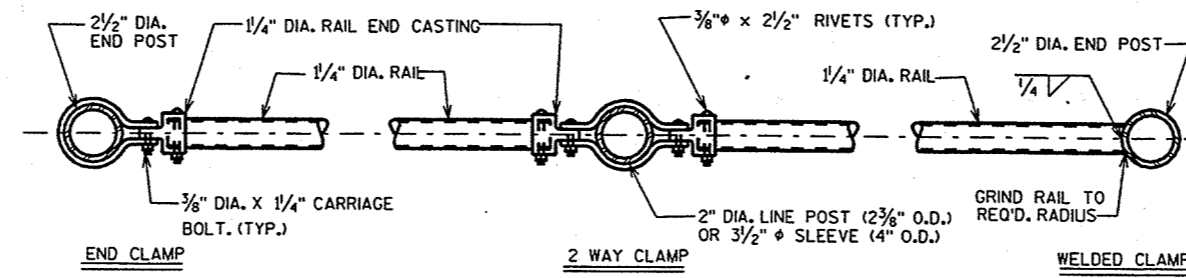

PLAN OF RAILING

NOTE: PLACE ALL NUTS ON OUTSIDE OF FENCE USE HARDWARE AS DETAILED

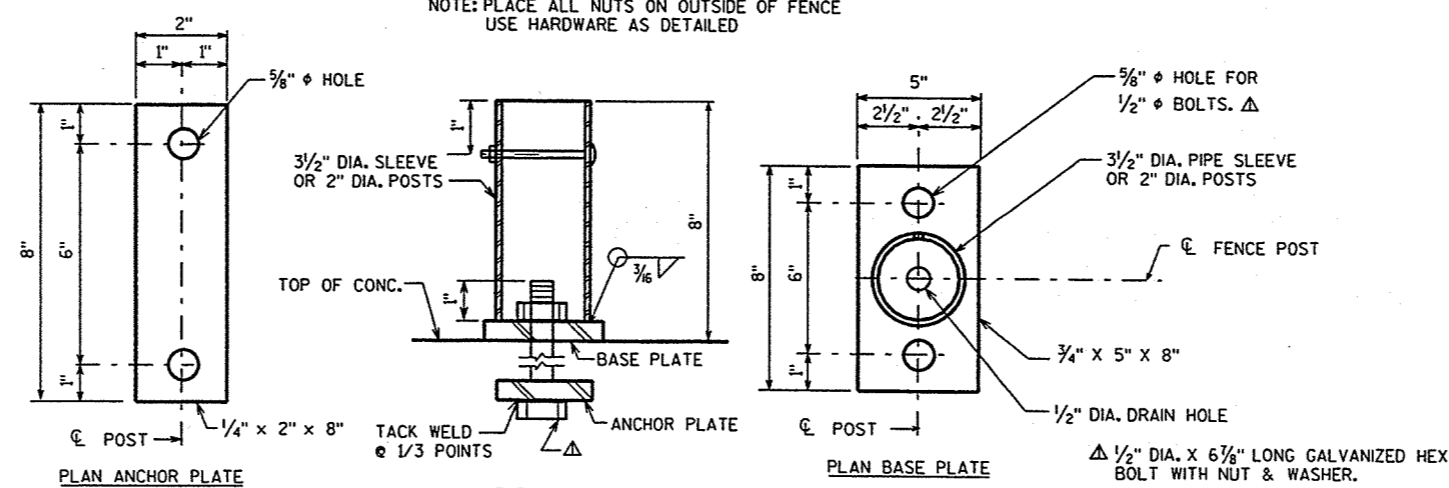

POST ATTACHMENT

UNIT SHALL BE GALV. AFTER FABRICATION

NOTE: IN LIEU OF USING THE 3 1/2" φ SLEEVE, THE 2" φ FENCE POST MAY BE WELDED TO THE BASE PLATE.

NO.	DATE	REVISION	BY
STATE OF WISCONSIN DEPARTMENT OF TRANSPORTATION STRUCTURES DESIGN SECTION			
STRUCTURE B-70-211			
CONST. SPEC.	1996	DRAWN BY CRJ	PLANS CKD. M&W
FENCING DETAILS			SHEET 15

FILE= 21CHAINLINK.DGN
SCALE = 5.833

STATE PROJECT NUMBER	SHEET NO.
6200-05-71	8.10

* PROVIDE FOR THREE BEAM GUARD RAIL ATTACHMENT
 ○ INDICATES WING NUMBER

CURVE DATA

SB. LANE S.T.H. 110	NB. LANE S.T.H. 110
P.L. = STA. 119+98.07	P.L. = STA. 120+08.48
$\Delta = 19^\circ-41'-20.8''$	$\Delta = 19^\circ-41'-20.8''$
$D = 1^\circ-31'-26.2''$	$D = 1^\circ-30'-00''$
$T = 652.43'$	$T = 662.84'$
$L = 1291.99'$	$L = 1312.61'$
$R = 3759.72'$	$R = 3819.72'$
S.E. = 0.046%	S.E. = 0.046%
P.C. = STA. 113+45.64	P.C. = STA. 113+45.64
P.T. = STA. 126+37.63	P.T. = STA. 126+58.25

DESIGN DATA

LIVE LOAD:
 DESIGN RATING: HS-20
 INVENTORY RATING: HS-21
 OPERATIONAL RATING: HS-38
 MAXIMUM STANDARD PERMIT VEHICLE LOAD = 250 KIPS.
 STRUCTURE IS DESIGNED FOR A FUTURE WEARING SURFACE OF 20 POUNDS PER SQUARE FOOT.

ULTIMATE DESIGN STRESSES:
 CONCRETE MASONRY SLAB — $f'_c = 4,000$ P.S.I. ALL OTHER — $f'_c = 3,500$ P.S.I.
 BAR STEEL REINFORCEMENT, GRADE 60 — $f_y = 60,000$ P.S.I.
 28" PRESTRESSED GIRDERS, CONCRETE MASONRY — $f'_c = 7,500$ P.S.I.
 STRANDS- 0.6" ϕ WITH ULTIMATE TENSILE STRENGTH OF 270,000 P.S.I.

FRONTAGE ROAD

P.I. = STA. 248+91.80
$\Delta = 21^\circ-26'-22.5''$
$D = 1^\circ-30'-00''$
$T = 723.11'$
$L = 1429.31'$
$R = 3819.72'$
S.E. = 0.028%
P.C. = STA. 241+68.69
P.T. = STA. 255+97.99

ABUTMENT STATIONS

ABUTMENT	B-70-211	B-70-212	B-70-213
END OF SLAB	249+64.61	121+09.47	121+23.76
CL BRG. SOUTH ABUT.	249+65.86	121+10.72	121+25.01
CL BRG. NORTH ABUT.	252+25.92	123+70.78	123+85.07
END OF SLAB	252+27.17	123+72.03	123+86.32

FOUNDATION DATA

ABUTMENTS TO BE SUPPORTED ON 10 3/4" DIA. CAST-IN-PLACE PILING DRIVEN TO A MINIMUM BEARING VALUE OF 55 TONS PER PILE. SOUTH ABUTMENT ESTIMATED 65'-0" LONG, NORTH ABUTMENT ESTIMATED 65'-0" LONG.



PIERS TO BE SUPPORTED ON 12" DIA. CAST-IN-PLACE PILING (.375 IN. MINIMUM WALL THICKNESS) DRIVEN TO A MINIMUM BEARING VALUE OF 55'-0" TONS PER PILE.
 PIER 1 - ESTIMATED 60'-0" LONG,
 PIER 2 - ESTIMATED 60'-0" LONG,
 PIER 3 - ESTIMATED 60'-0" LONG,
 PIER 4 - ESTIMATED 65'-0" LONG.

HYDRAULIC DATA

100 YEAR FREQUENCY
 $Q_{100} = 2,800$ C.F.S.
 VEL. = 3.9 F.P.S.
 HW. = EL. 749.6
 WATERWAY AREA = 724.4 SQ. FT.
 DRAINAGE AREA = 8.4 SQ. MI.
 ROAD OVERTOPPING = NA
 SCOUR CRITICAL CODE = 5

TRAFFIC VOLUME


SOUTHBOUND S.T.H. 110
 A.D.T. = 34,000 (2023)
 R.D.S. = 70 M.P.H.

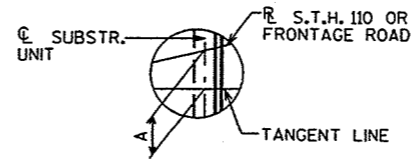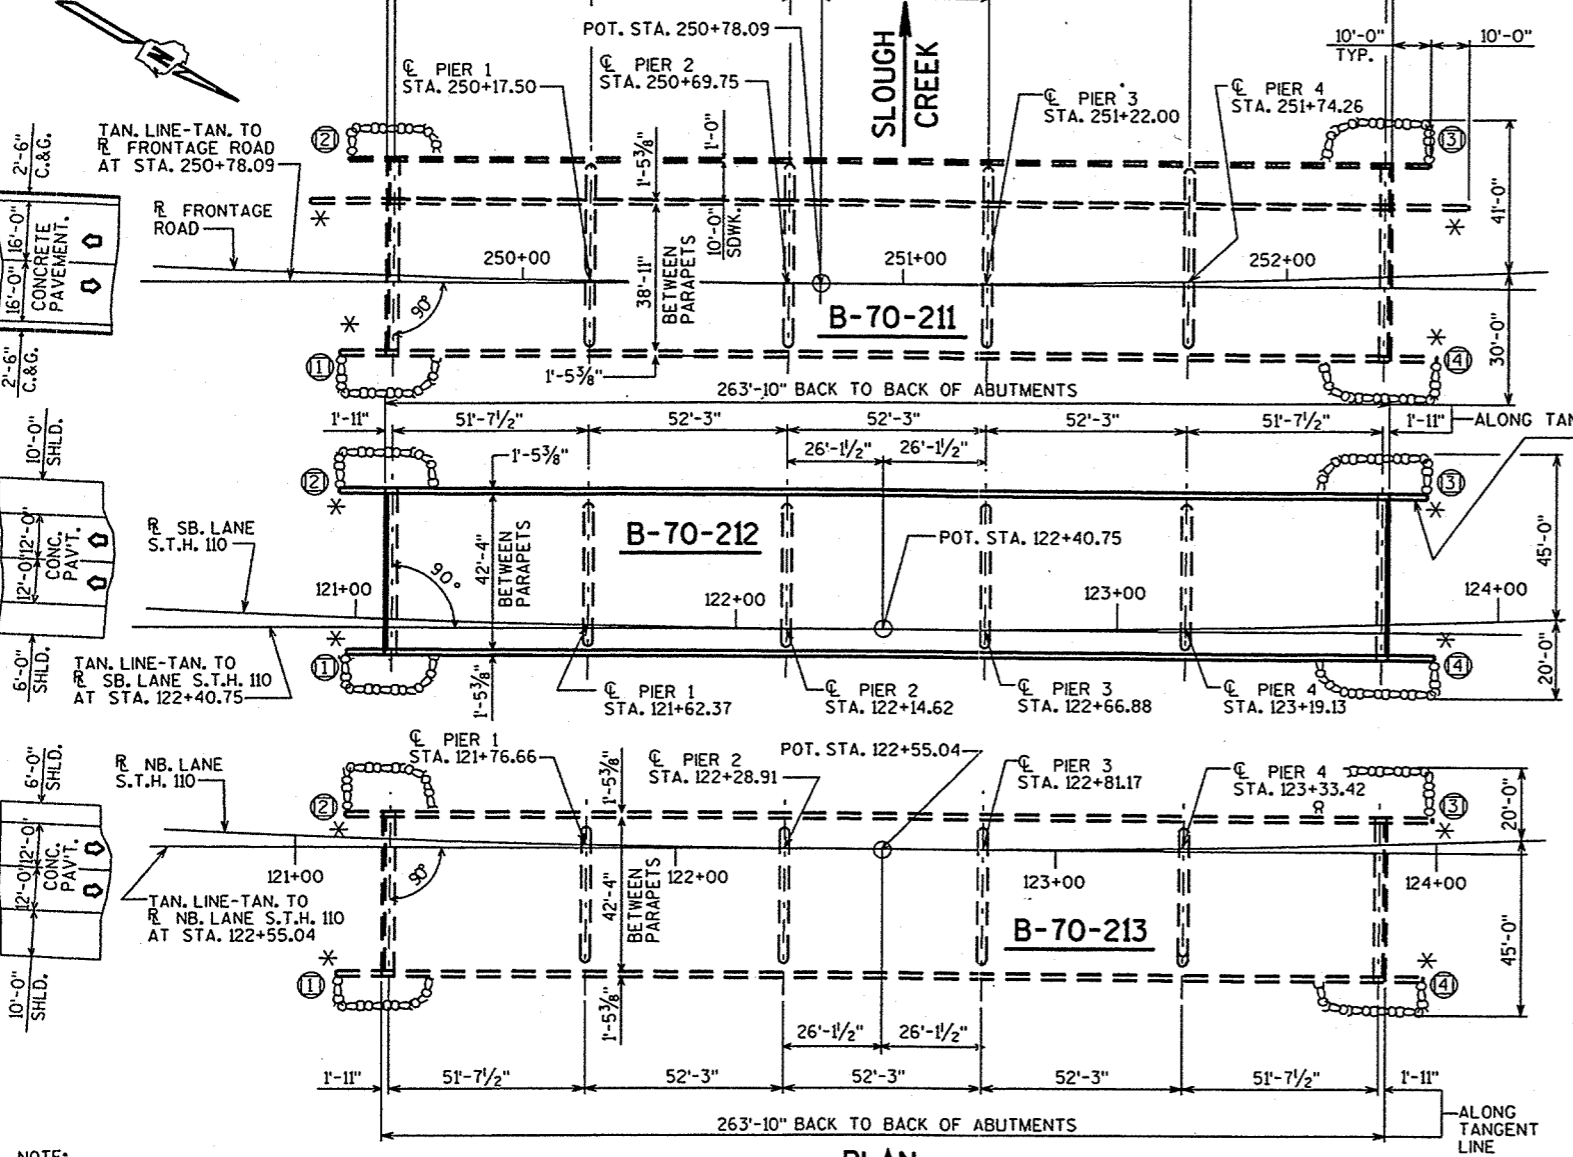

LOCATION	DIM. A (ALONG CL SUBSTR. UNIT)		
	B-70-211	B-70-212	B-70-213
SOUTH ABUT.	1'-7 3/4"	2'-3"	2'-2 1/2"
PIER 1	5 3/4"	9 3/4"	9 5/8"
PIER 2	1/8"	1/8"	1/8"
PIER 3	3"	1/8"	1/8"
PIER 4	1'-2 1/2"	9 3/4"	9 5/8"
NORTH ABUT.	2'-10 3/8"	2'-3"	2'-2 1/2"

NOTE:
 WING LENGTHS ARE 10'-0" FOR WINGS 2 & 3 AND 12'-0" FOR WINGS 1 & 4 (TYPICAL FOR B-70-212 & B-70-213).

PLAN
 5 SPAN-28" PRESTRESSED GIRDERS

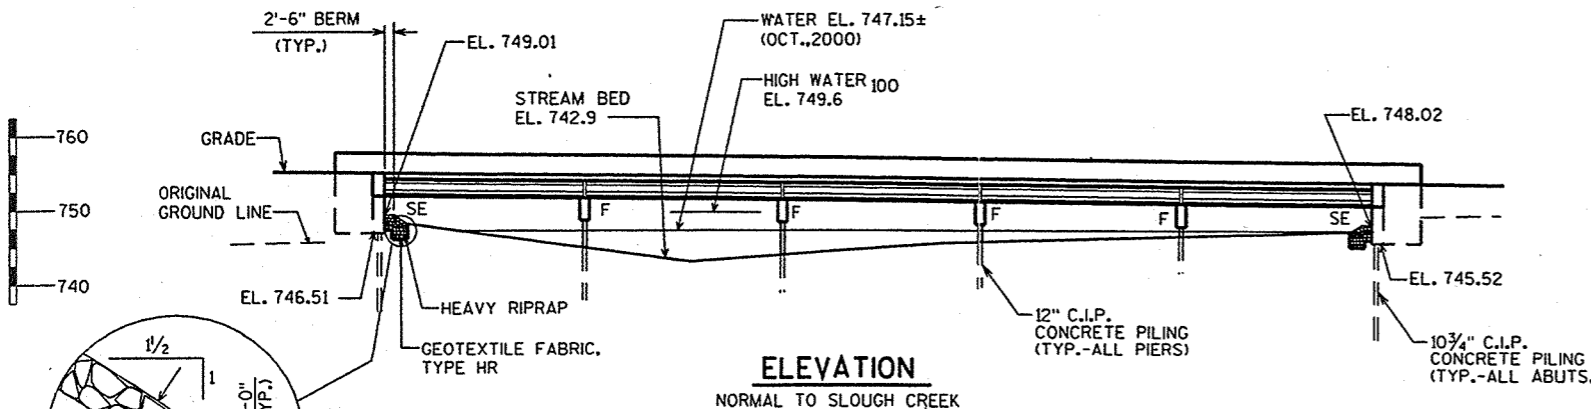

ELEVATION
 NORMAL TO SLOUGH CREEK

LIST OF DRAWINGS

1. GENERAL PLAN
2. CROSS SECTION & QUANTITIES
3. SUBSURFACE EXPLORATION
4. SOUTH ABUTMENT
5. SOUTH ABUTMENT DETAILS
6. NORTH ABUTMENT
7. NORTH ABUTMENT DETAILS
8. PIERS 1 THRU 4
9. 28" PRESTRESSED GIRDER DETAILS
10. STEEL DIAPHRAGM
11. SUPERSTRUCTURE
12. SUPERSTRUCTURE DETAILS
13. SLOPED FACED PARAPET 'LF'

BRIDGE OFFICE CONTACT = KENT BAHLER (608)-266-8490
 BRIDGE OFFICE CONTACT = CHARLES R. JUDD (608)-266-4547

NO.	DATE	REVISION	BY

Plans Prepared By **WISDOT**
STRUCTURES DESIGN


STRUCTURE B-70-212
 SOUTHBOUND S.T.H. 110 OVER SLOUGH CREEK

COUNTY	WINNEBAGO	TOWN	OSHKOSH
DESIGN SPEC.	AASHTO STD. SPEC. 1998	LOAD	HS-20
DESIGNED BY	MGW	DESIGN CKD.	SDR
DRAWN BY	DDS	PLANS CKD.	CRJ


APPROVED *[Signature]* 11-13-01
 CHIEF STRUCTURAL DESIGN ENGINEER DATE

GENERAL PLAN

SHEET 1 OF 13
 DATE: JULY '01

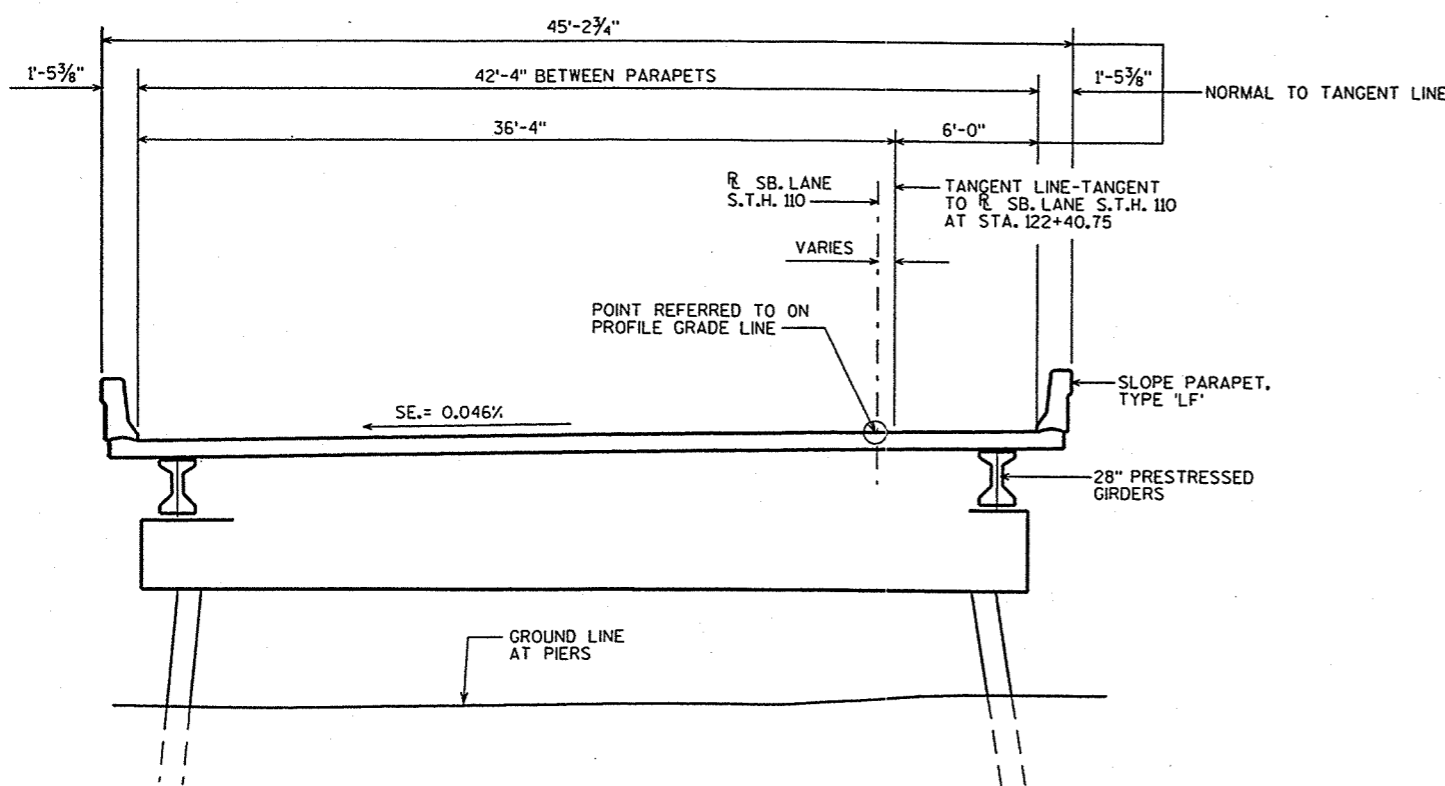

CROSS SECTION THRU ROADWAY LOOKING NORTH

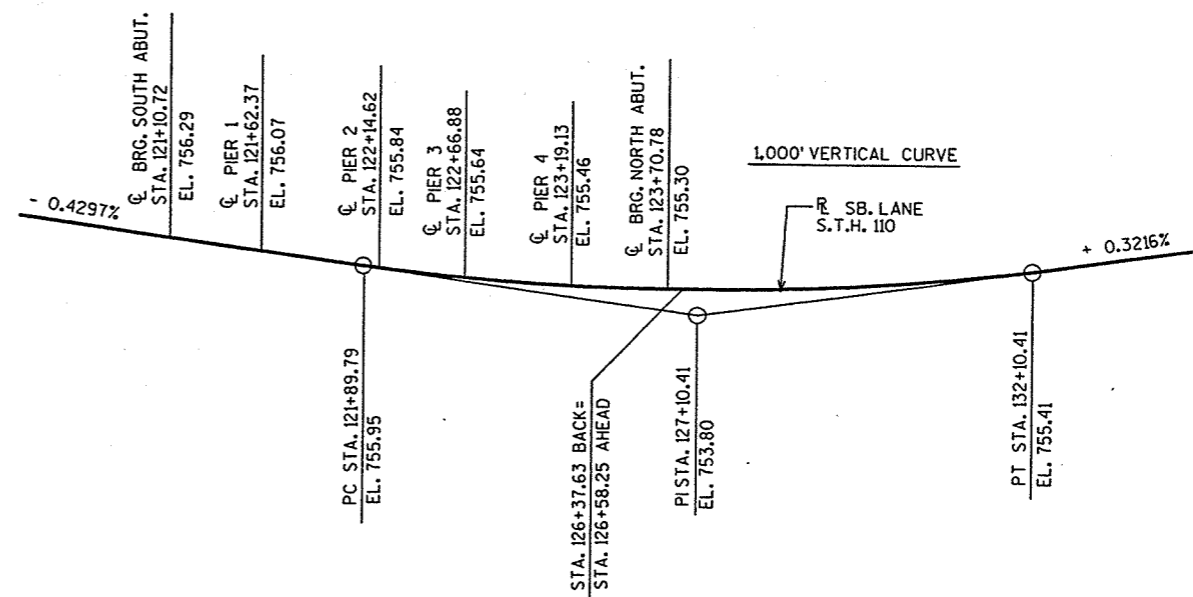

PROFILE GRADE LINE SB. LANE S.T.H. 110

TOTAL ESTIMATED QUANTITIES

BID ITEMS	UNIT	SUPER.	SOUTH ABUT.	NORTH ABUT.	PIER 1	PIER 2	PIER 3	PIER 4	TOTALS
EXCAVATION FOR STRUCTURES, BRIDGES, B-70-212	L.S.	---	---	---	---	---	---	---	1
STRUCTURE BACKFILL	C.Y.	---	154	154	---	---	---	---	308
CONCRETE MASONRY, BRIDGES	C.Y.	430	53	53	14	14	14	14	592
PROTECTIVE SURFACE TREATMENT	S.Y.	1460	---	---	---	---	---	---	1460
PRESTRESSED GIRDER, I TYPE, 28-INCH	L.F.	1560	---	---	---	---	---	---	1560
HIGH-STRENGTH BAR STEEL REINFORCEMENT, BRIDGES	LB.	---	2260	2260	4270	4270	4270	4270	21600
COATED HIGH-STRENGTH BAR STEEL REINFORCEMENT, BRIDGES	LB.	89930	1535	1530	---	---	---	---	92995
NON-LAMINATED ELASTOMERIC BEARING PADS	EACH	36	---	---	---	---	---	---	36
STEEL DIAPHRAGMS, STRUCTURE B-70-212	EACH	25	---	---	---	---	---	---	25
CAST-IN-PLACE CONCRETE PILING, DELIVERED AND DRIVEN, 10 3/4"	L.F.	---	455	455	---	---	---	---	910
CAST-IN-PLACE CONCRETE PILING, DELIVERED AND DRIVEN, 12"	L.F.	---	---	---	480	480	480	520	1960
RUBBERIZED MEMBRANE WATERPROOFING	S.Y.	---	8	8	---	---	---	---	16
HEAVY RIPRAP	C.Y.	---	65	45	---	---	---	---	110
PIPE UNDERDRAIN, 6-INCH	L.F.	---	61	61	---	---	---	---	122
PIPE UNDERDRAIN, UNPERFORATED, 6-INCH	L.F.	---	20	20	---	---	---	---	40
GEOTEXTILE FABRIC, TYPE DF	S.Y.	---	48	48	---	---	---	---	96
GEOTEXTILE FABRIC, TYPE HR	S.Y.	---	105	90	---	---	---	---	195
ANCHOR ASSEMBLIES FOR STEEL PLATE BEAM GUARD	EACH	4	---	---	---	---	---	---	4
OMP, READY MIXED CONCRETE MASONRY FOR BRIDGES	C.Y.	430	53	53	14	14	14	14	592
OMP, MASONRY STRENGTH INCENTIVE, READY-MIXED CONCRETE	DOL.	---	---	---	---	---	---	---	5920
NON-BID ITEMS									
FILLER	SIZE	---	---	---	---	---	---	---	1/2" & 3/4"

GENERAL NOTES



DRAWINGS SHALL NOT BE SCALED.
 BAR STEEL REINFORCEMENT SHALL BE EMBEDDED 2" CLEAR UNLESS OTHERWISE SHOWN OR NOTED.
 ELASTOMERIC BEARING PADS NEED NOT BE INDIVIDUALLY MOLDED PROVIDED THE CUT EDGES ARE SMOOTH AND TRUE.
 AT THE BACKFACE OF ABUTMENT ALL VOLUME WHICH CANNOT BE IN PLACE BEFORE ABUTMENT CONSTRUCTION AND NOT OCCUPIED BY THE NEW STRUCTURE SHALL BE BACKFILLED WITH STRUCTURE BACKFILL.
 THE FIRST OR FIRST TWO DIGITS OF THE BAR MARK SIGNIFIES THE BAR SIZE.
 AT ABUTMENTS CONCRETE POURED UNDER WATER WILL BE ALLOWED AND SHALL BE DONE IN ACCORDANCE WITH SECTION 502.3.6.3 OF THE STANDARD SPECIFICATIONS.
 THE GRADATION OF THE STRUCTURE BACKFILL SHALL MEET THE REQUIREMENTS OF SECTION 209.2.2 OF THE STANDARD SPECIFICATIONS FOR GRADE 1 MATERIAL.

NO.	DATE	REVISION	BY
STATE OF WISCONSIN DEPARTMENT OF TRANSPORTATION STRUCTURES DESIGN SECTION			
STRUCTURE B-70-212			
CONST. SPEC.	1996	DRAWN BY	DDS
		PLANS CKD.	CRJ
CROSS SECTION & QUANTITIES			SHEET 2

FILE= PREPLAN.DGN
SCALE = 4

STH 110 OVER SLOUGH CREEK
 USH 41 TO STH 116, WINNEBAGO COUNTY

SLOUGH
 CREEK

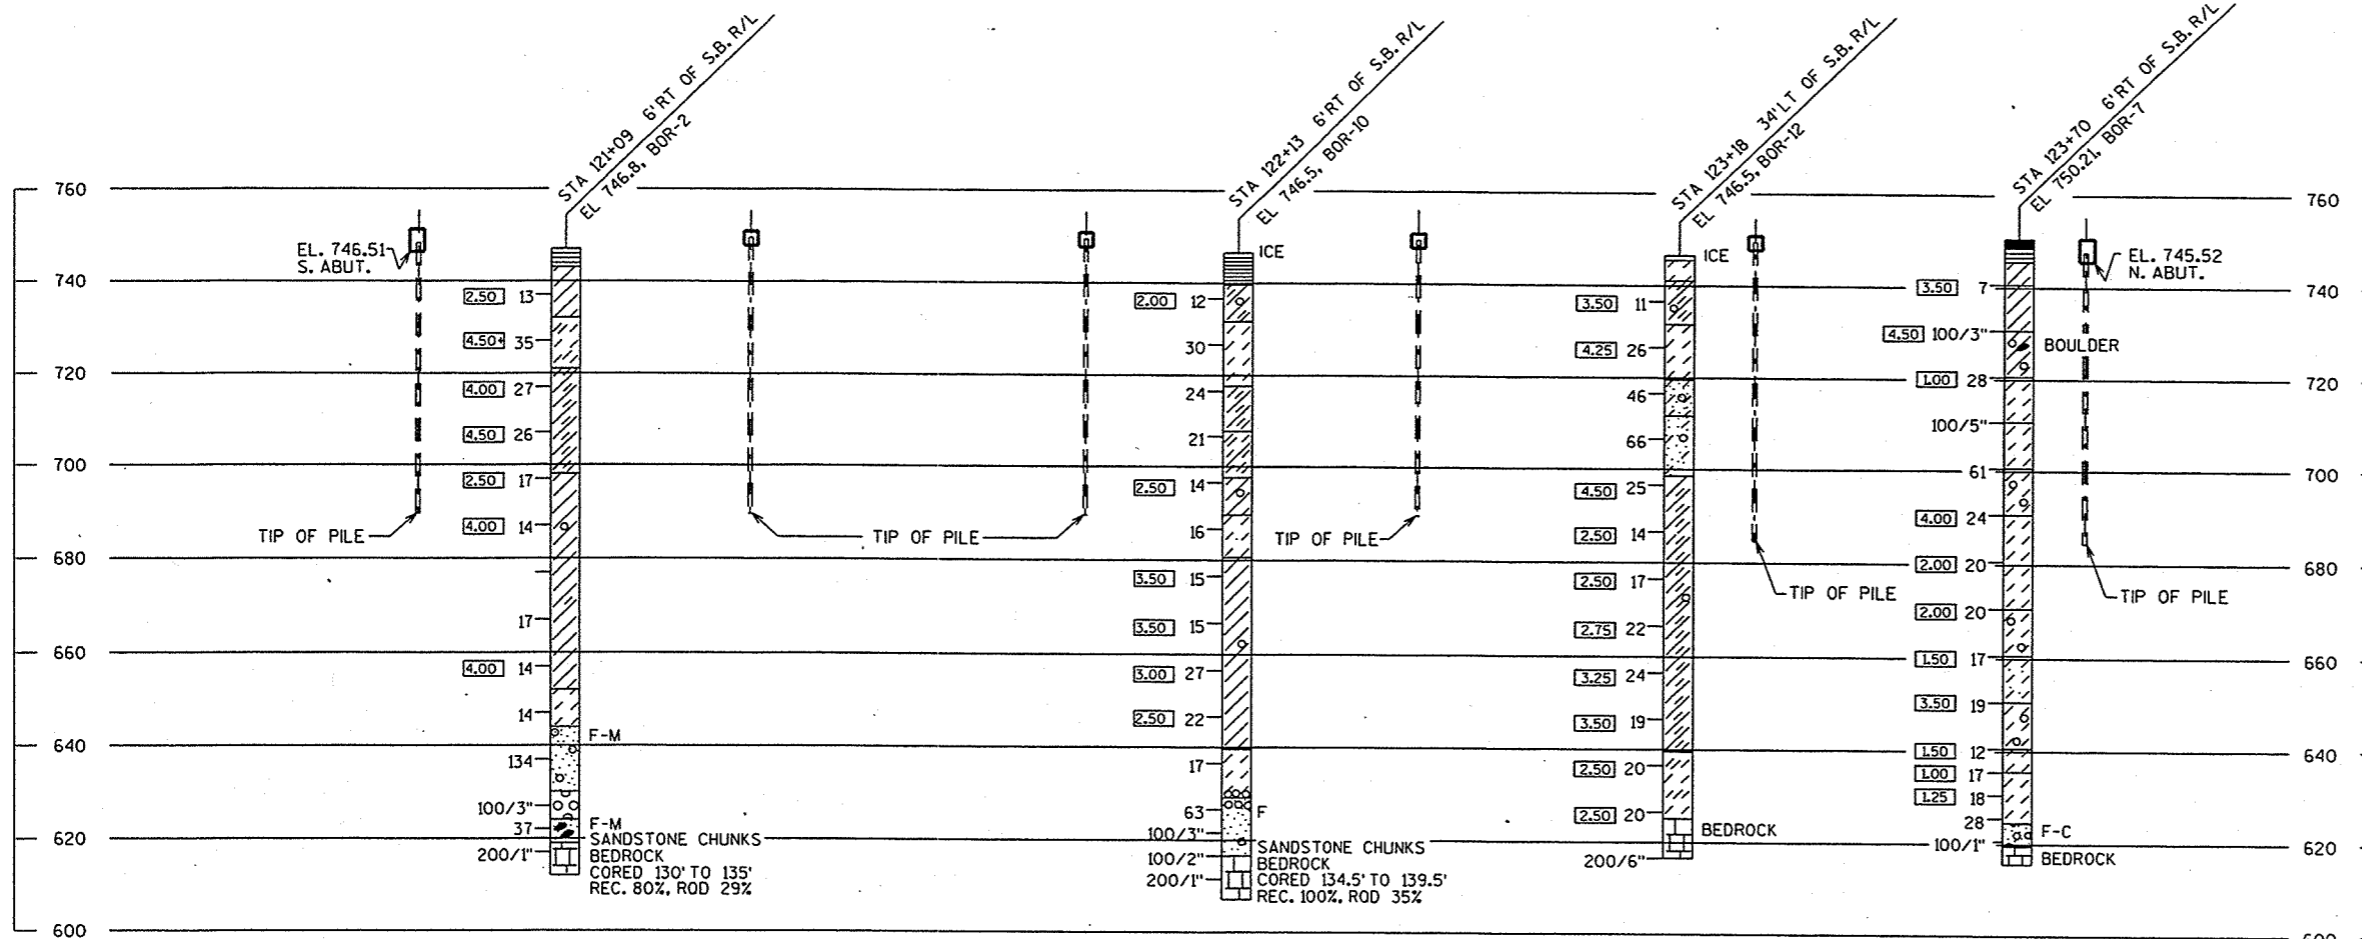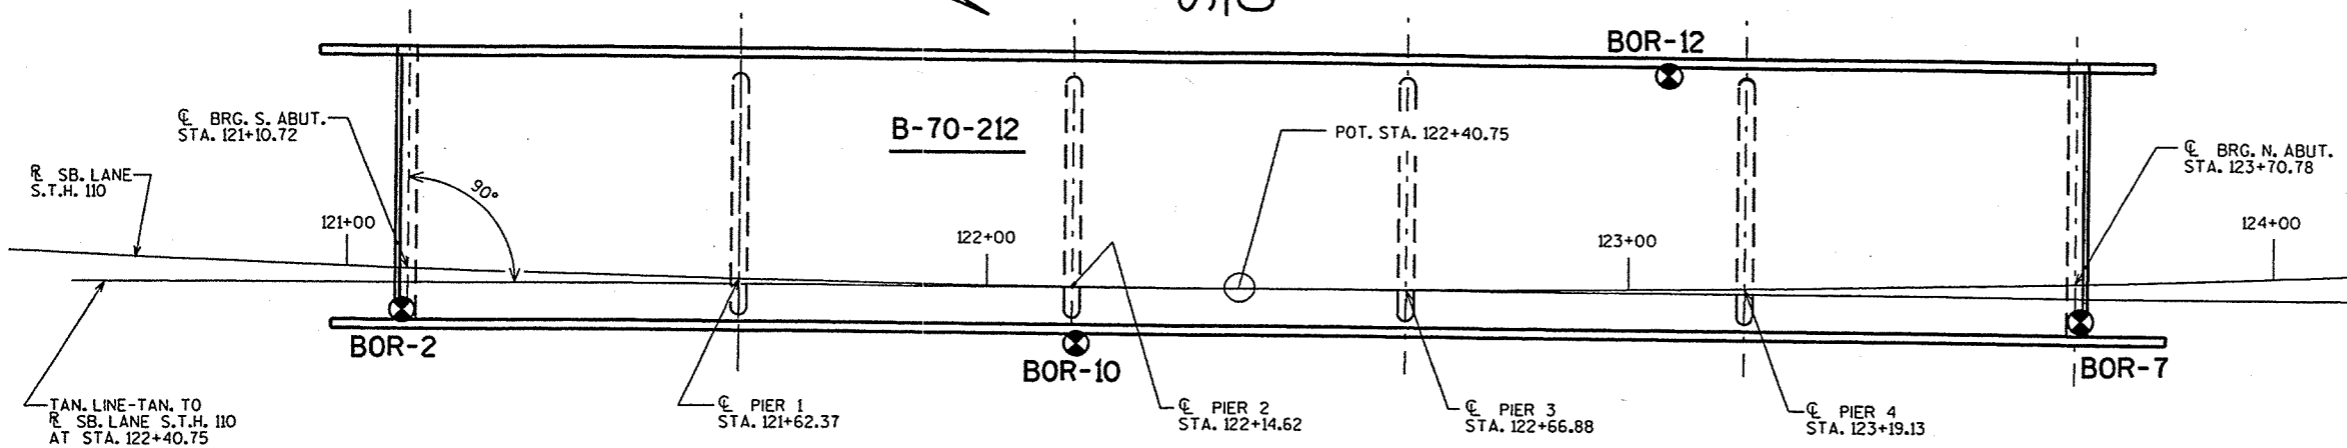

STATE PROJECT NUMBER
6200-05-71

SHEET NO.
8.18

ABBREVIATIONS
 F— FINE M— MEDIUM C— COARSE
 WS— WEATHERED SO— SOUND

MATERIAL SYMBOLS

TOPSOIL	SILT	SANDSTONE
SAND	PEAT	LIMESTONE
GRAVEL	CLAY	IGNEOUS ROCK

LEGEND OF PROBING

PROBING NO.
 STA.
 ELEVATION

95/6=95 BLOWS FOR 6"
 PENETRATION
 PROBING TAKEN WITH A
 350# WT.
 FALLING 18" ON A 2"
 O.D. POINT.

7 AVERAGE BLOWS PER FOOT
 REFUSAL 95/6

LEGEND OF BORING

BORING NO.
 STA.
 ELEV.

UNCONFINED STRENGTH → 7.7
 BLOWS PER FT. USING 140# WT. FALLING 30"
 WASH SAMPLE

SANDY GRAVEL
 F. BOULDERS OR COBBLES
 SAND
 SILTY CLAY
 LIMESTONE

SHELBY TUBE— S.T.
 GROUND WATER ELEVATION
 NO GROUND WATER OBSERVED ABOVE THIS ELEVATION



UNLESS OTHERWISE SPECIFIED, THE BLOWS PER FOOT AT THE LOCATIONS INDICATED ARE BASED ON DRIVING A O.D. X1 4" I.D. SPLIT SPOON SAMPLER WITH A 140# HAMMER HAVING A FREE FALL OF 30". THE BLOW COUNT IS TAKEN IN UNDISTURBED SOIL IMMEDIATELY BELOW A CASED OR OPEN HOLE ELIMINATING SIDE FRICTION ON THE DRIVE PIPE.

SUBSURFACE EXPLORATION FOR FOUNDATION DESIGN AND BIDDERS INFORMATION

TO OBTAIN RELATIVE DATA CONCERNING THE CHARACTER OF MATERIAL IN AND UPON WHICH THE FOUNDATION MIGHT BE BUILT, BORINGS AND/OR SOUNDINGS WERE MADE AT POINTS APPROXIMATELY AS INDICATED ON THIS DRAWING. THE DATA PRESENTED HEREIN REPRESENTS THE FINDINGS OF THE SUBSURFACE EXPLORATIONS MADE. HOWEVER, BECAUSE THE DEPTHS INVESTIGATED ARE LIMITED AND THE AREA OF THE BORINGS AND/OR SOUNDINGS IS VERY SMALL IN RELATION TO THE ENTIRE AREA, THE DIVISION OF HIGHWAYS DOES NOT WARRANT CONDITIONS BELOW THE DEPTHS INVESTIGATED OR THAT THE CLASSIFICATION OF MATERIAL ENCOUNTERED IN THESE INVESTIGATIONS IS NECESSARILY TYPICAL OF THE ENTIRE SITE.


NO.	DATE	REVISION	BY
STATE OF WISCONSIN DEPARTMENT OF TRANSPORTATION STRUCTURES DESIGN SECTION			
STRUCTURE B-70-212			
CONST. SPEC.	1996	DRAWN BY DDS	PLANS CK'D. CRJ
SUBSURFACE EXPLORATION			SHEET 3

FILE= 70212SOILS.DGN
 SCALE =

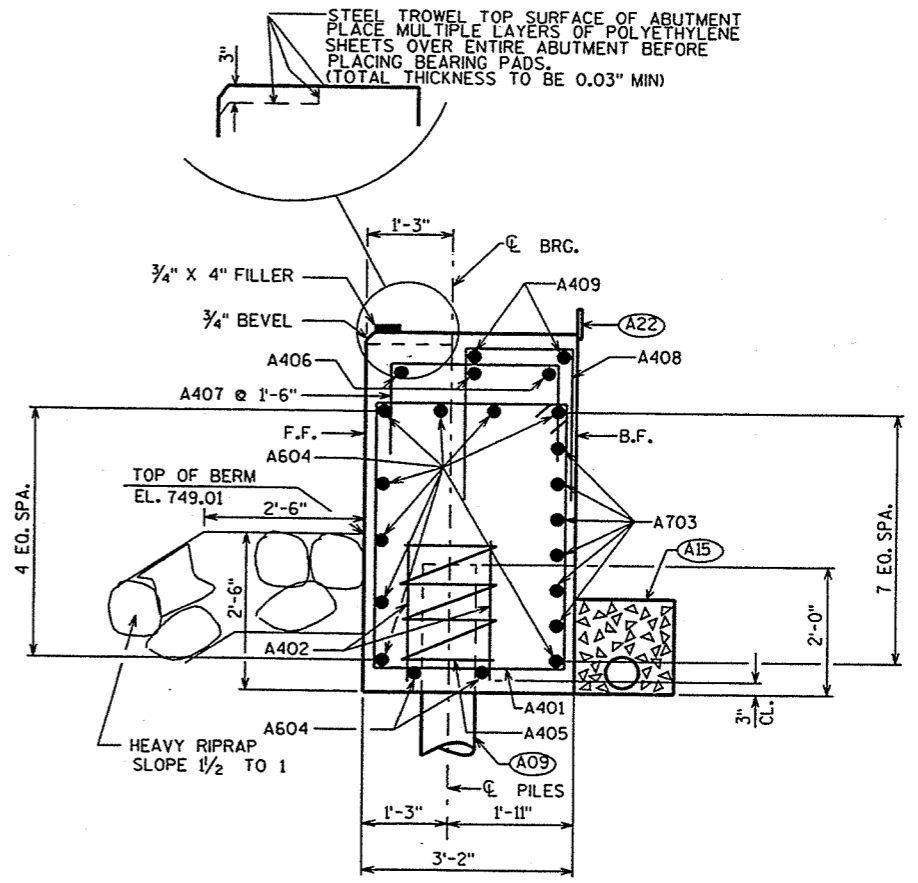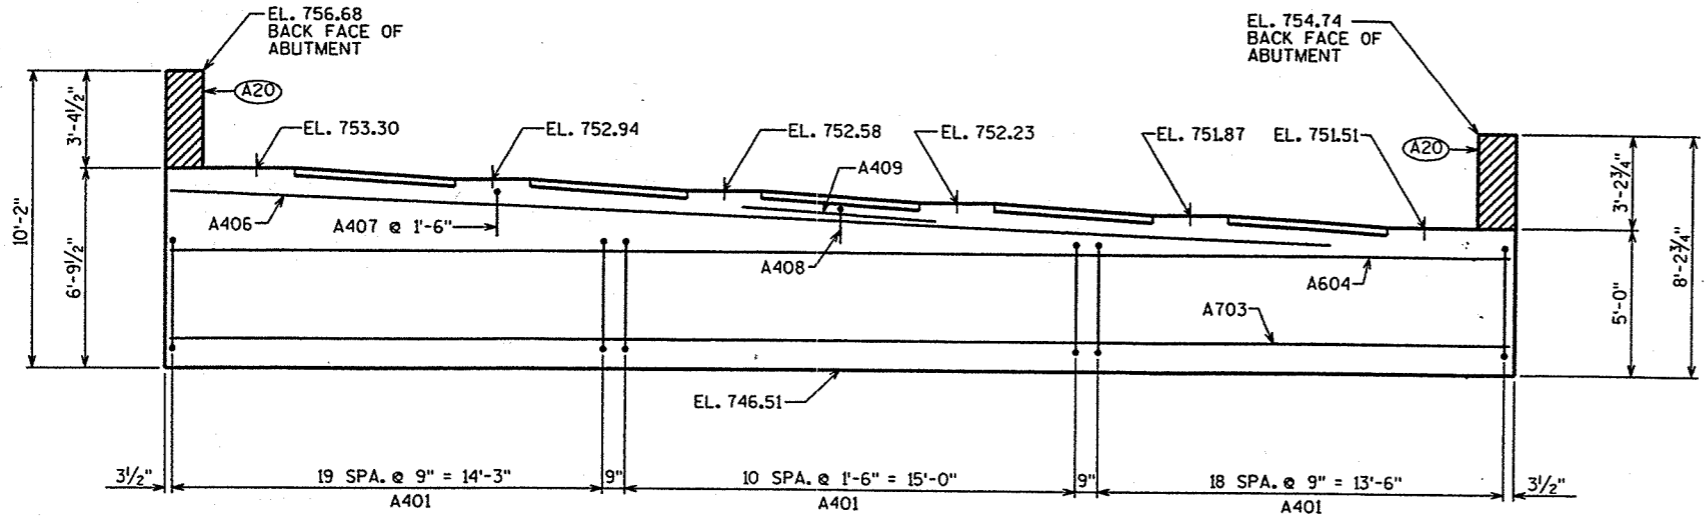


SECTION THRU BODY

- (A09) SUPPORT ABUTMENT ON 10 3/4" DIA. CAST-IN-PLACE CONCRETE PILING, ESTIMATED 65'-0" LONG, AND DRIVEN TO A MIN. BRG. VALUE OF 55 TONS PER PILE.
- (A15) PIPE UNDERDRAINS, 6 INCH, SLOPE TO DRAIN, ENCLOSED IN 1'-6" X 1'-6" AREA OF SIZE 1 COARSE AGGREGATE (INCLUDED IN UNDERDRAIN BID ITEM) WRAPPED IN GEOTEXTILE FABRIC, TYPE DF.
- (A16) PIPE UNDERDRAIN, 6 INCH, UNPERFORATED, TO SUITABLE DRAINAGE.
- (A20) 1/2" FILLER (INCLUDED IN WING LENGTH): SEAL EXPOSED HORIZ. & VERT. SURFACES OF 1/2" FILLER WITH NON-STAINING GRAY NON-BITUMINOUS JOINT SEALER. (1" DEEP AND HOLD 1/8" BELOW SURFACE OF CONCRETE), EXTEND SEALER 3" BELOW GUTTER LINE AT INSIDE FACE.
- (A21) 3/4" CORK UP VERT. FACES OF BEAM SEATS.
- (A22) 18" (RMW) RUBBERIZED MEMBRANE WATERPROOFING SEAL ALL HORIZ. & VERT. JOINTS AT BACKFACE.

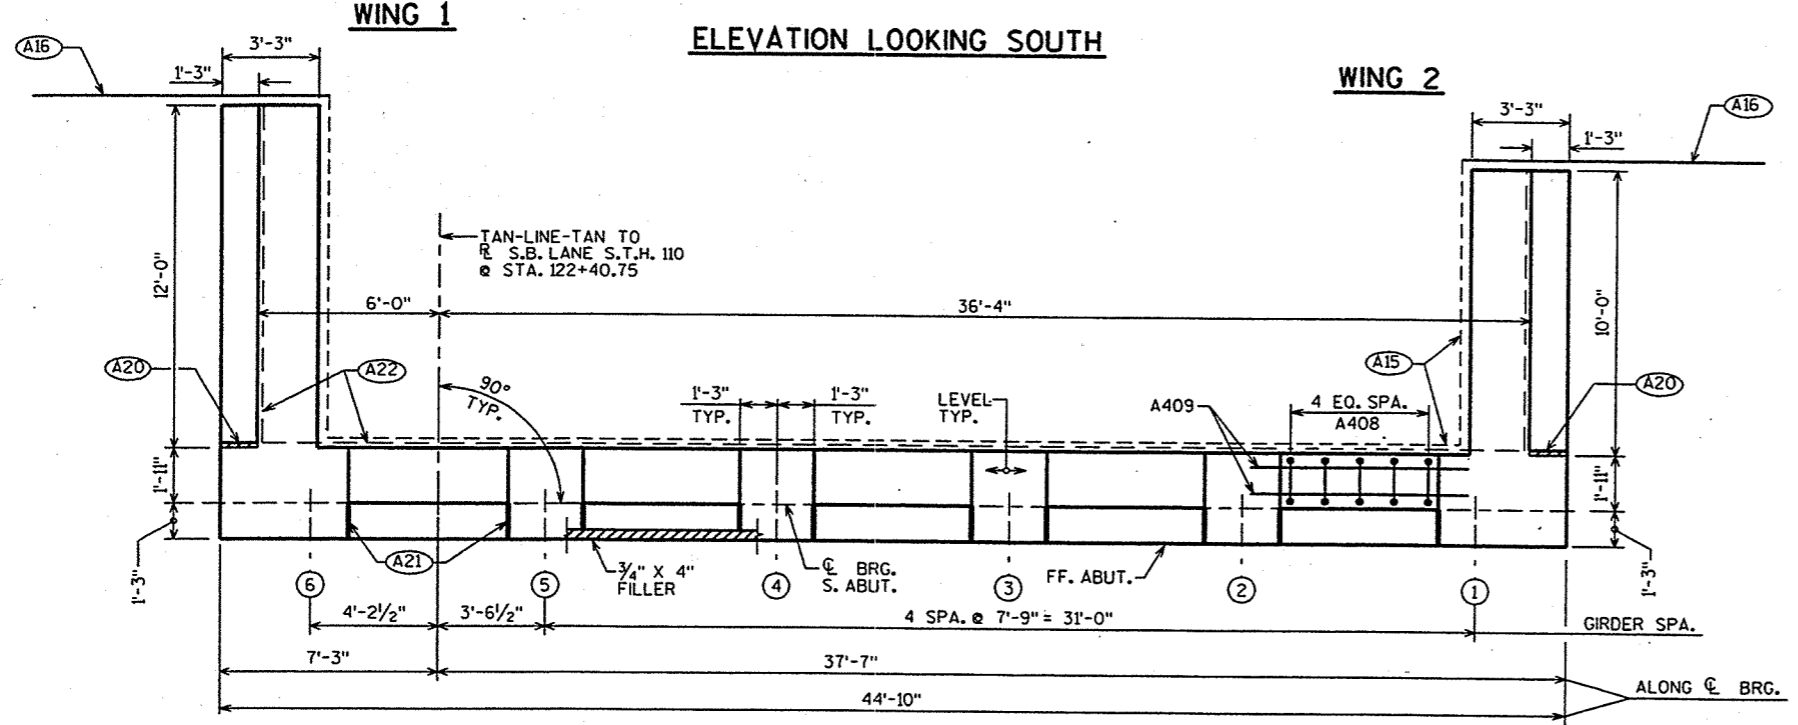


PLAN

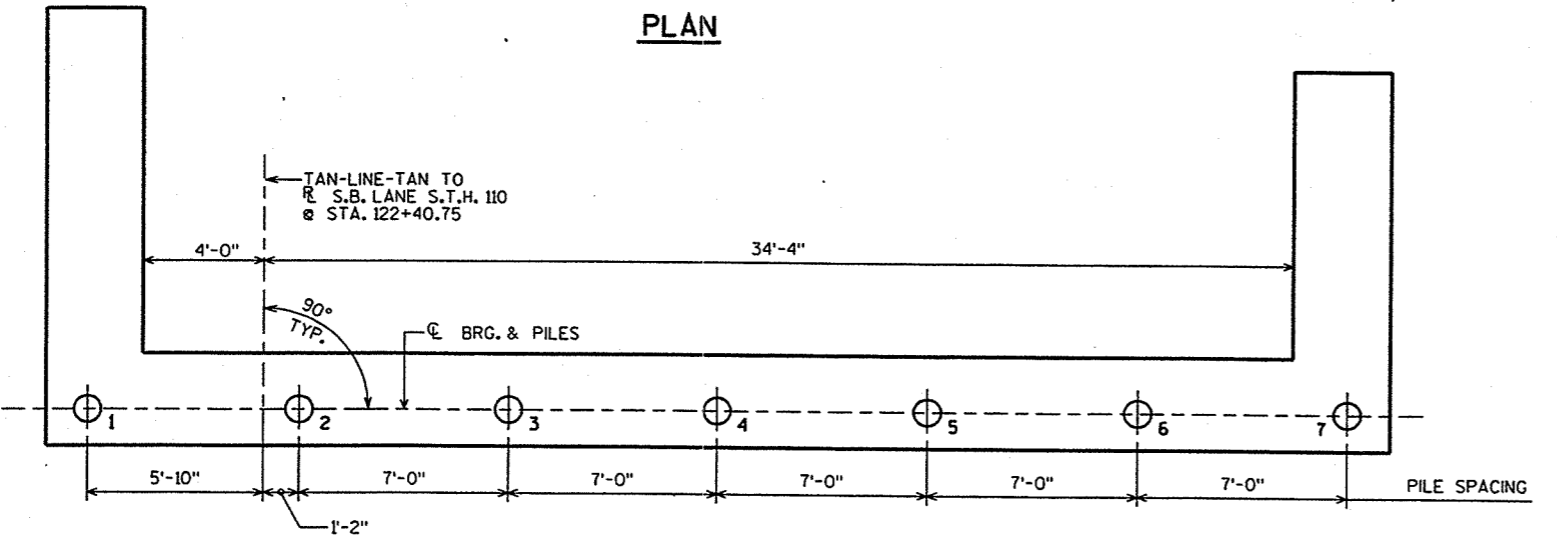


PILE PLAN

NO.	DATE	REVISION	BY
STATE OF WISCONSIN DEPARTMENT OF TRANSPORTATION STRUCTURES DESIGN SECTION			
STRUCTURE B-70-212			
CONST. SPEC.	1996	DRAWN BY	DDS
		PLANS CK'D.	CRJ
SOUTH ABUTMENT			SHEET 4

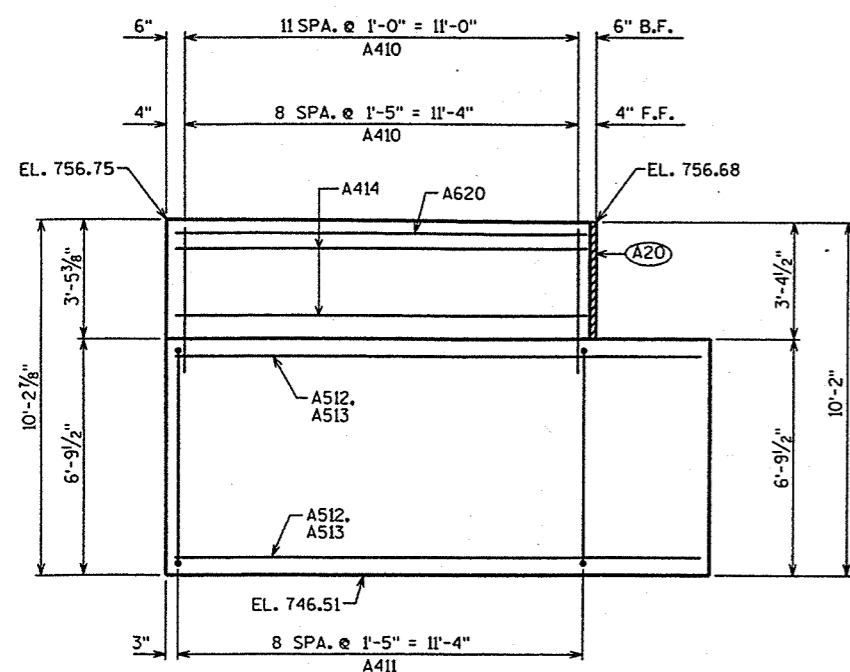

WING 1 ELEVATION

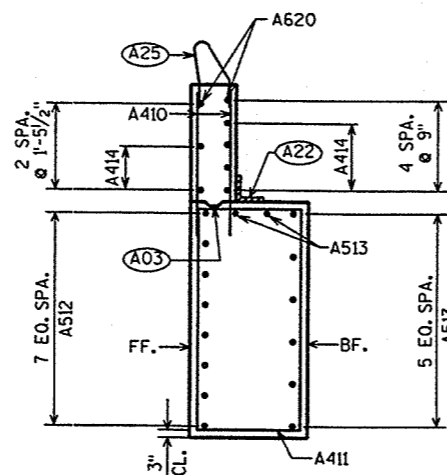


WING 1 SECTION

- (A03) OPTIONAL CONST. JOINT: KEYWAY FORMED BY BEVELED 2 x 6, (18" R.M.W. @ B.F. & 3/4" "V" GROOVE @ F.F. IF JOINT IS USED).
- (A20) 1/2" FILLER (INCLUDED IN WING LENGTH): SEAL EXPOSED HORIZ. & VERT. SURFACES OF 1/2" FILLER WITH NON-STAINING GRAY NON-BITUMINOUS JOINT SEALER. (1" DEEP AND HOLD 1/8" BELOW SURFACE OF CONCRETE). EXTEND SEALER 3" BELOW GUTTER LINE AT INSIDE FACE.
- (A22) 18" (RMW) RUBBERIZED MEMBRANE WATERPROOFING SEAL ALL HORIZ. & VERT. JOINTS AT BACKFACE.
- (A25) FOR PARAPET BARS & DIMENSION SEE PARAPET SHT. 13


BILL OF BARS

NOTE: THE FIRST OR FIRST TWO DIGITS OF THE BAR MARK SIGNIFIES THE BAR SIZE.


BAR MARK	COAT	NO. REQ'D.	LENGTH	BENT	BAR SERIES	LOCATION
A401		50	14'-10"	X		BODY-STIRRUPS
A402		14	2'-3"			PILES- 2 PER BODY PILE
A703		6	44'-6"			BODY-HORIZ.-B.F.
A604		11	44'-6"			BODY-HORIZ.-F.F.
A405		7	28'-0"	X		PILES-1 PER BODY PILE
A406		3	38'-6"			BODY-HORIZ. OVER GIRS. 2-6
A407		26	8'-0"	X		BODY-VERT. OVER GIRS. 2-6
A408		25	3'-11"	X		BODY-VERT. (BETWEEN BEAM SEATS)
A409		10	7'-3"			BODY-HORIZ. (BETWEEN GIRDERS)
A410	X	21	4'-10"			WING 1-VERT.-F.F.-B.F.
A411	X	9	19'-0"	X		WING 1-STIRRUP
A512	X	8	14'-10"			WING 1-HORIZ.-F.F.
A513	X	8	13'-7"			WING 1-HORIZ.-B.F.
A414	X	6	11'-8"			WING 1-HORIZ.-F.F.-B.F.
A415	X	17	4'-10"			WING 2-VERT.-F.F.-B.F.
A416	X	8	15'-6"	X		WING 2-STIRRUP
A517	X	6	12'-10"			WING 2-HORIZ.-F.F.
A718	X	7	12'-8"			WING 2-HORIZ.-B.F.
A419	X	6	9'-8"			WING 2-HORIZ.-F.F.-B.F.
A620	X	2	11'-8"			WING 1-HORIZ.
A621	X	2	9'-8"			WING 2-HORIZ.

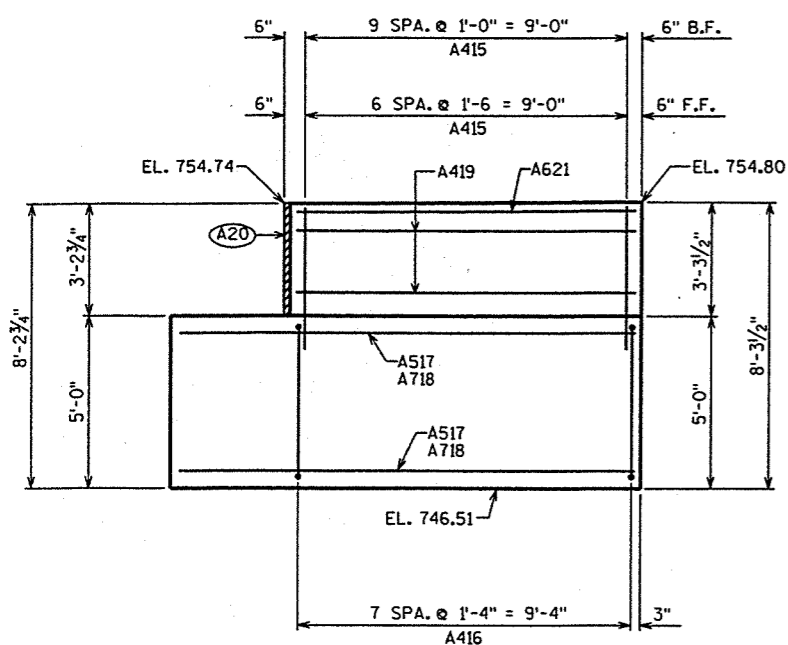


WING 2 ELEVATION

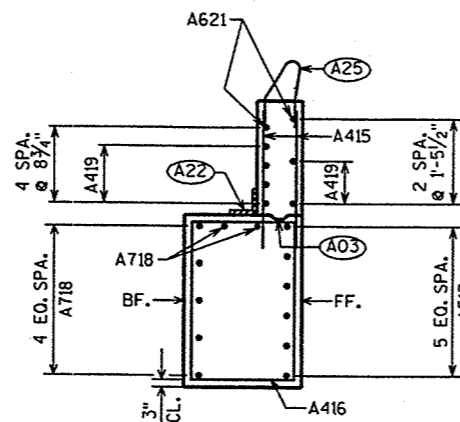





WING 2 SECTION

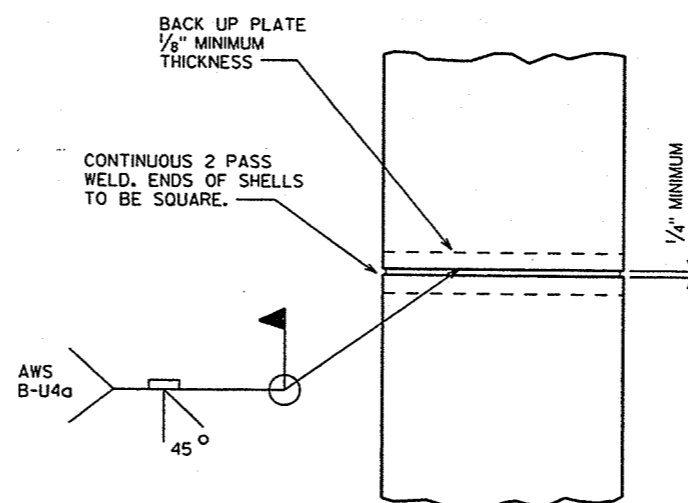

PILE SPLICE DETAIL

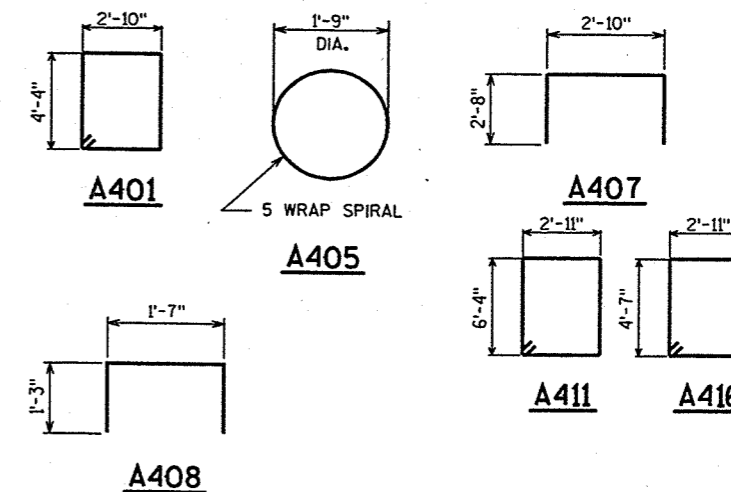

NO.	DATE	REVISION	BY
STATE OF WISCONSIN DEPARTMENT OF TRANSPORTATION STRUCTURES DESIGN SECTION			
STRUCTURE B-70-212			
CONST. SPEC.	1996	DRAWN BY	DDS
		PLANS CKD.	CRJ
SOUTH ABUTMENT DETAILS			SHEET 5

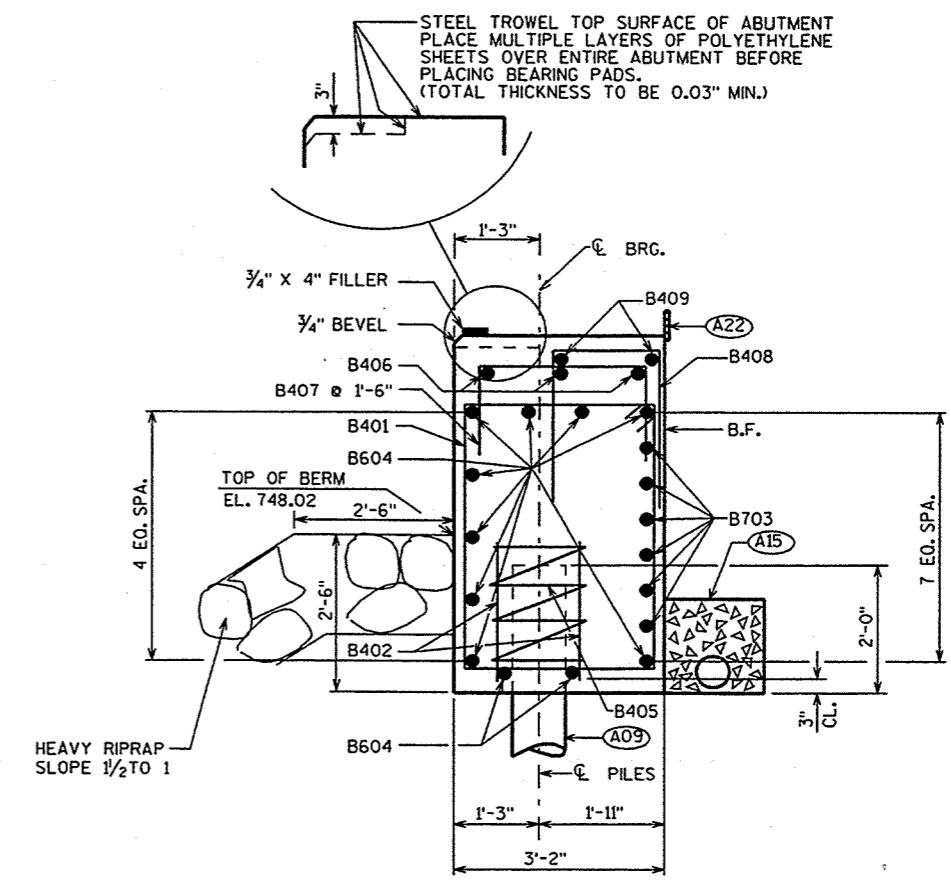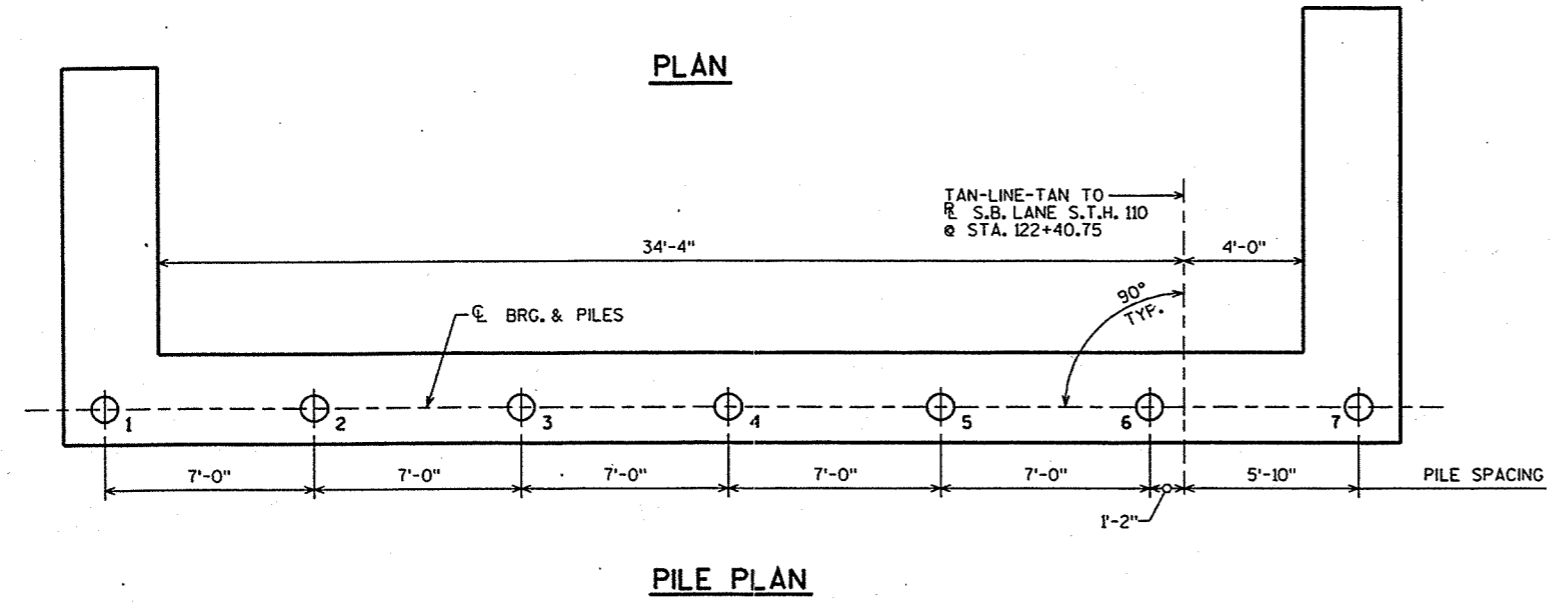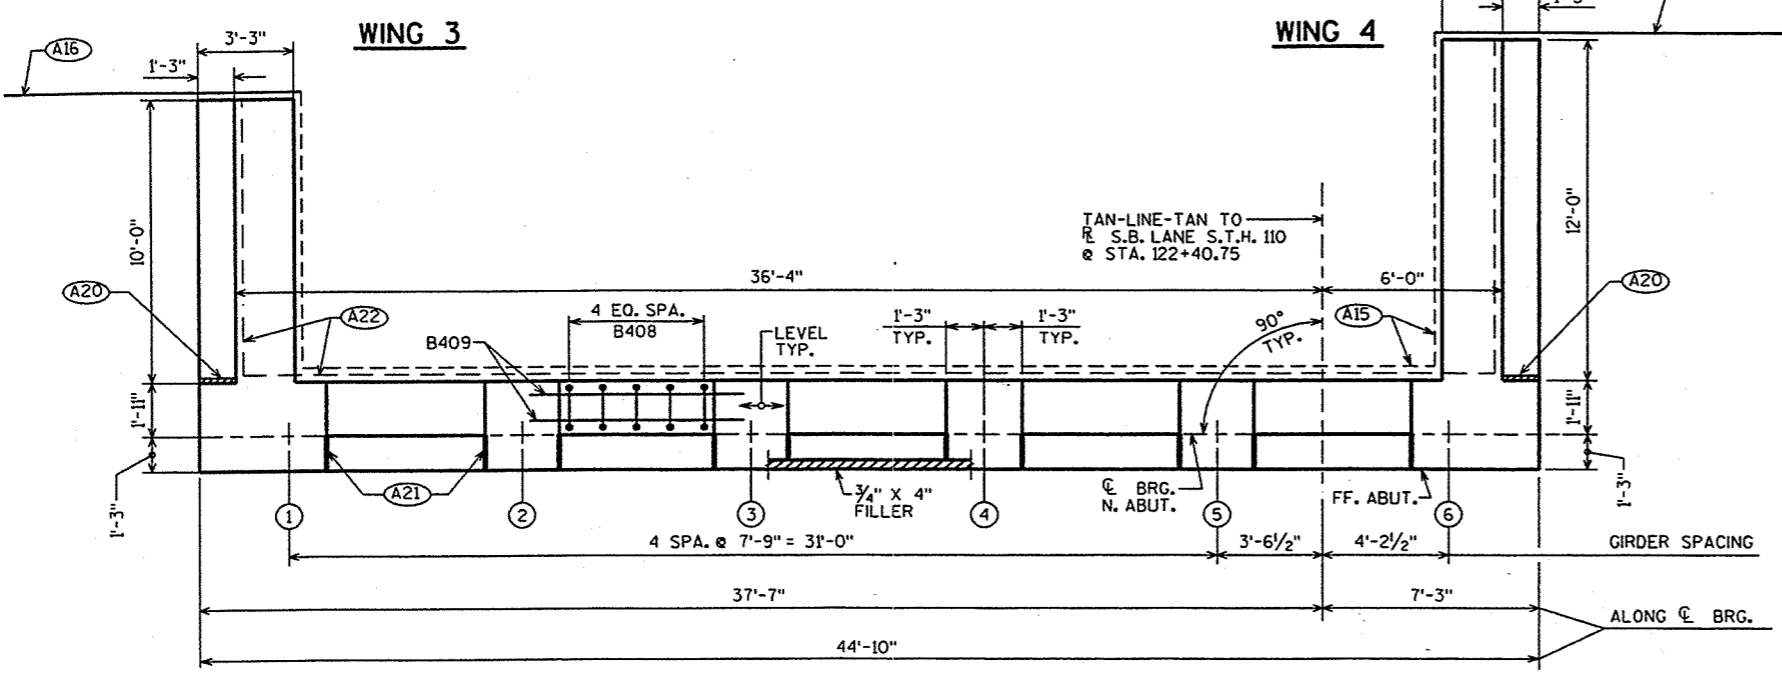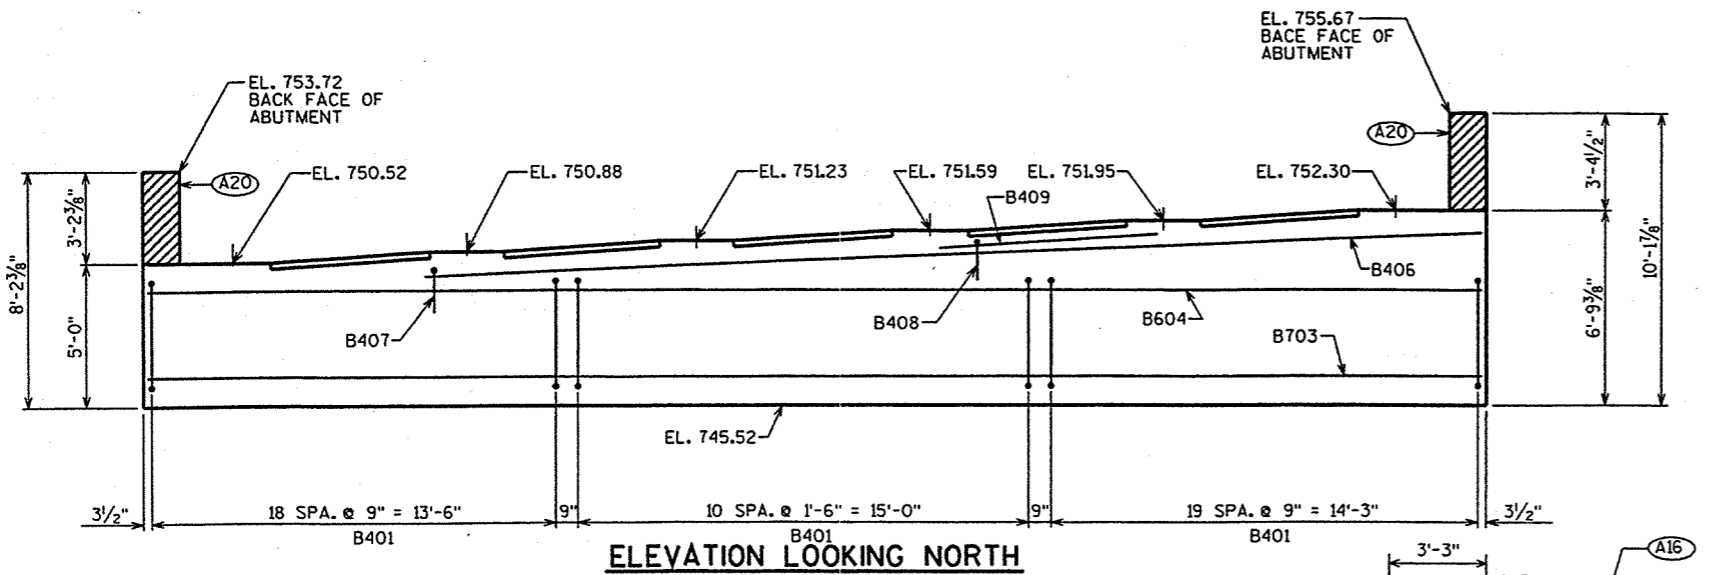

SECTION THRU BODY

- (A09) SUPPORT ABUTMENT ON 10 3/4" DIA. CAST-IN-PLACE CONCRETE PILING, ESTIMATED 65'-0" LONG, AND DRIVEN TO A MIN. BRG. VALUE OF 55 TONS PER PILE.
- (A15) PIPE UNDERDRAINS, 6 INCH. SLOPE TO DRAIN, ENCLOSED IN 1'-6" X 1'-6" AREA OF SIZE 1 COARSE AGGREGATE (INCLUDED IN UNDERDRAIN BID ITEM) WRAPPED IN GEOTEXTILE FABRIC, TYPE DF.
- (A16) PIPE UNDERDRAIN, 6 INCH, UNPERFORATED, TO SUITABLE DRAINAGE.
- (A20) 1/2" FILLER (INCLUDED IN WING LENGTH); SEAL EXPOSED HORIZ. & VERT. SURFACES OF 1/2" FILLER WITH NON-STAINING GRAY NON-BITUMINOUS JOINT SEALER, (1" DEEP AND HOLD 1/8" BELOW SURFACE OF CONCRETE), EXTEND SEALER 3" BELOW GUTTER LINE AT INSIDE FACE.
- (A21) 3/4" CORK UP VERT. FACES OF BEAM SEATS.
- (A22) 18" (RMW) RUBBERIZED MEMBRANE WATERPROOFING SEAL ALL HORIZ. & VERT. JOINTS AT BACKFACE.


NO.	DATE	REVISION	BY
STATE OF WISCONSIN DEPARTMENT OF TRANSPORTATION STRUCTURES DESIGN SECTION			
STRUCTURE		B-70-212	
CONST. SPEC.	1996	DRAWN BY	ODS
		PLANS CK'D.	CRJ
NORTH ABUTMENT			SHEET 6

- (A03) OPTIONAL CONST. JOINT: KEYWAY FORMED BY BEVELED 2 x 6, (18" R.M.W. @ B.F. & 3/4" "V" GROOVE @ F.F. IF JOINT IS USED).
- (A20) 1/2" FILLER (INCLUDED IN WING LENGTH); SEAL EXPOSED HORIZ. & VERT. SURFACES OF 1/2" FILLER WITH NON-STAINING GRAY NON-BITUMINOUS JOINT SEALER. (1" DEEP AND HOLD 1/8" BELOW SURFACE OF CONCRETE). EXTEND SEALER 3" BELOW GUTTER LINE AT INSIDE FACE.
- (A22) 18" (RMW) RUBBERIZED MEMBRANE WATERPROOFING SEAL ALL HORIZ. & VERT. JOINTS AT BACKFACE.
- (A25) FOR PARAPET BARS & DIMENSION SEE PARAPET SHT. 13


BILL OF BARS

NOTE: THE FIRST OR FIRST TWO DIGITS OF THE BAR MARK SIGNIFIES THE BAR SIZE.


BAR MARK	COAT	NO. REQ'D.	LENGTH	BENT	BAR SERIES	LOCATION
B401		50	14'-10"	X		BODY-STIRRUPS
B402		14	2'-3"			PILES-2 PER BODY PILE
B703		6	44'-6"			BODY-HORIZ.-B.F.
B604		11	44'-6"			BODY-HORIZ.-F.F.
B405		7	28'-0"	X		PILES-1 PER BODY PILE
B406		3	38'-6"			BODY-HORIZ.-OVER GIRS. 2-6
B407		26	8'-0"	X		BODY-TOP-OVER GIRS. 2-6
B408		25	3'-11"	X		BODY-VERT. (BETWEEN BEAM SEATS)
B409		10	7'-3"			BODY-HORIZ. (BETWEEN GIRDERS)
B410	X	17	4'-6"			WING 3-VERT.-F.F.-B.F.
B411	X	8	15'-6"	X		WING 3-STIRRUP
B512	X	6	12'-10"			WING 3-HORIZ.-F.F.
B713	X	7	12'-8"			WING 3-HORIZ.-B.F.
B414	X	6	9'-8"			WING 3-HORIZ.-F.F.-B.F.
B415	X	21	4'-8"			WING 4-VERT.-F.F.-B.F.
B416	X	9	19'-0"	X		WING 4-STIRRUP
B517	X	8	14'-10"			WING 4-HORIZ.-F.F.
B518	X	8	13'-7"			WING 4-HORIZ.-B.F.
B419	X	6	11'-8"			WING 4-HORIZ.-F.F.-B.F.
B620	X	2	9'-8"			WING 3-HORIZ.
B621	X	2	11'-8"			WING 4-HORIZ.

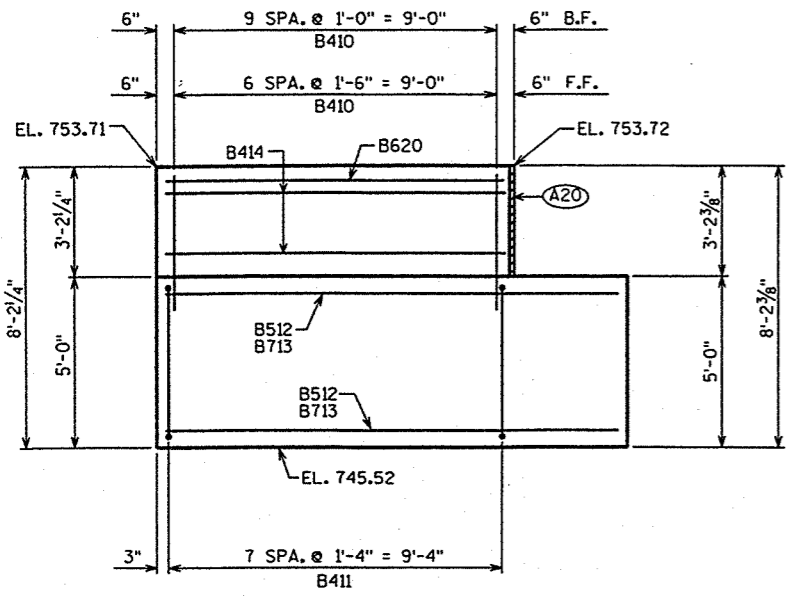


WING 3 ELEVATION

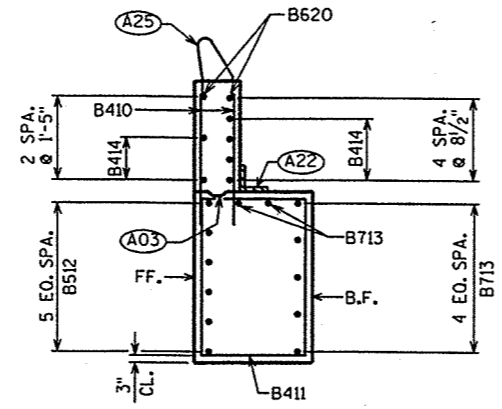


WING 3 SECTION

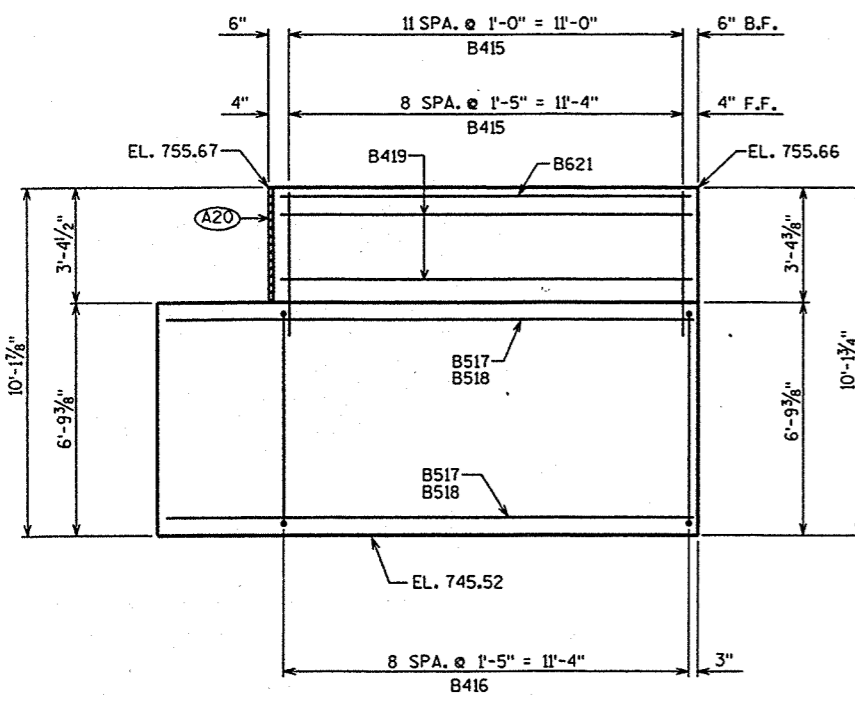


WING 4 ELEVATION

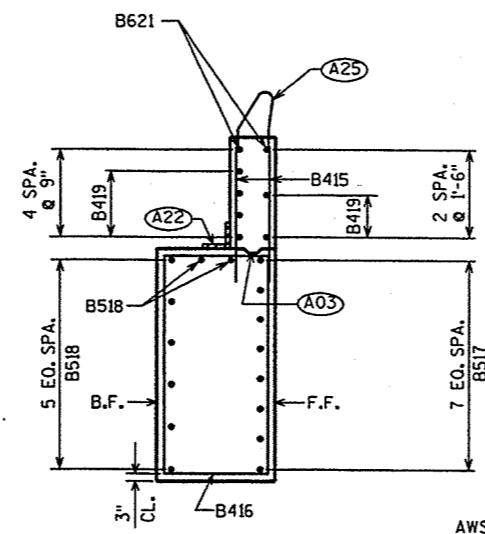

WING 4 SECTION

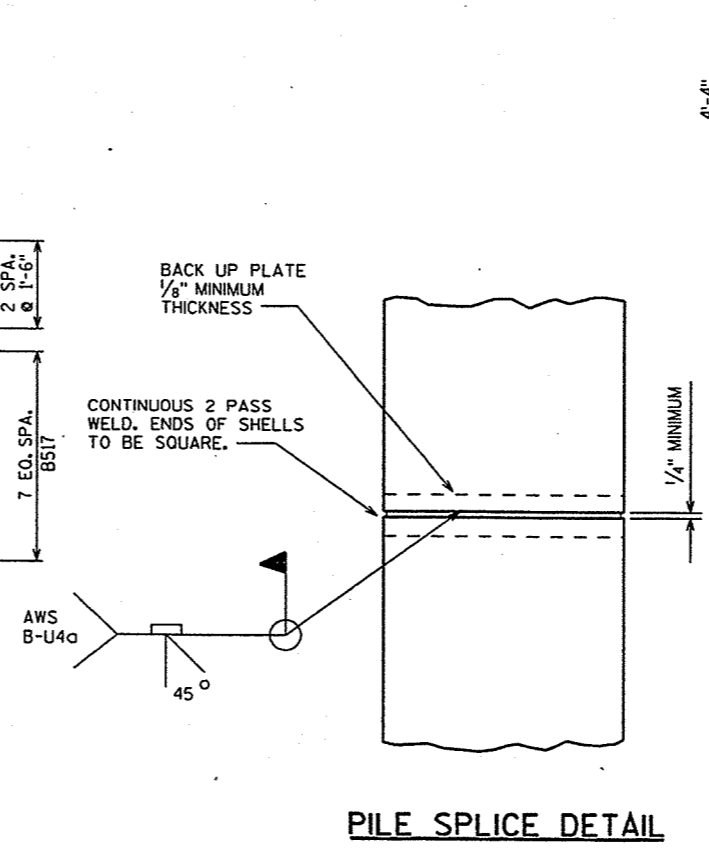

PILE SPLICE DETAIL

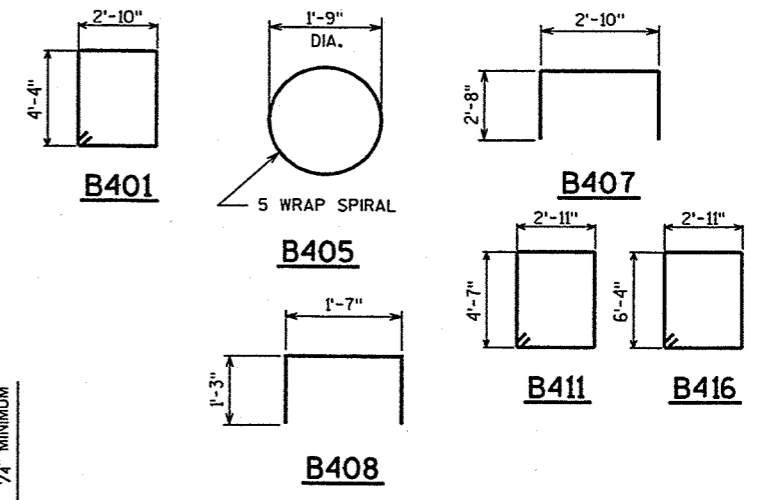

NO.	DATE	REVISION	BY
STATE OF WISCONSIN DEPARTMENT OF TRANSPORTATION STRUCTURES DESIGN SECTION			
STRUCTURE B-70-212			
CONST. SPEC.	1996	DRAWN BY DDS	PLANS CKD. CRJ
NORTH ABUTMENT DETAILS			SHEET 7

PIER ELEVATIONS


	ELEV. "A"	ELEV. "B"	ELEV. "C"	ELEV. "D"	ELEV. "E"	ELEV. "F"	ELEV. "G"	ELEV. "H"
PIER #1	751.23	751.58	751.94	752.30	752.67	753.01	748.23	750.01
PIER #2	750.97	751.33	751.68	752.04	752.41	752.75	747.97	749.75
PIER #3	750.76	751.12	751.48	751.83	752.20	752.55	747.76	749.55
PIER #4	750.61	750.97	751.33	751.68	752.05	752.40	747.61	749.40

STATE PROJECT NUMBER	SHEET NO.
6200-05-71	8.23







NOTE: THE FIRST OR FIRST TWO DIGITS OF THE BAR MARK SIGNIFIES THE BAR SIZE.

BILL OF BARS

BAR MARK	COUNT	NO. REQ'D.				LENGTH	BENT	BAR SERIES	LOCATION
		PIER 1	PIER 2	PIER 3	PIER 4				
P501	39	39	39	39	11'-0"	X		CAP-STIRRUPS	
P602	4	4	4	4	42'-6"			CAP-BOTTOM-HORIZ.	
P503	2	2	2	2	42'-6"			CAP-SIDES-HORIZ.	
P504	25	25	25	25	2'-0"			CAP-DOWELS	
P505	2	2	2	2	5'-2"	X		CAP-ENDS	
PT06	48	48	48	48	30'-0"			PILES-VERT.	
P307	128	128	128	128	3'-8"	X		PILES-HORIZ.	
P608	8	8	8	8	24'-9"	X		CAP-TOP-HORIZ.	

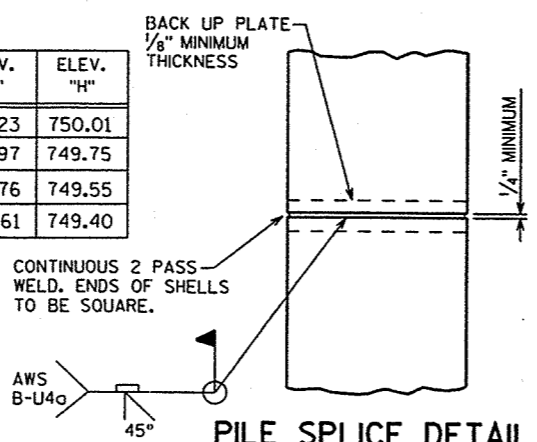

- (P03) P504 BARS @ 1'-0" CTRS. BETWEEN BEAM SEATS. MAY BE PLACED AFTER CONCRETE IS POURED BUT BEFORE INITIAL SET HAS TAKEN PLACE. (EMBED 1'-0" INTO CONC.)
- (P08) KEYED CONSTRUCTION JOINT-FORMED BY BEVELED 2 x 6 BETWEEN BEAM SEATS.
- (P09) SUPPORT PIERS ON 12" DIA. CAST-IN-PLACE CONCRETE PILING, DRIVEN TO A MIN. BRG. VALUE OF 55 TONS PER PILE. (.375" MIN. WALL THK. REQ'D. FOR ALL PILING.) (TYP. ALL PIERS)
- PIER #1 - ESTIMATED LENGTH 60'-0"
PIER #2 - ESTIMATED LENGTH 60'-0"
PIER #3 - ESTIMATED LENGTH 60'-0"
PIER #4 - ESTIMATED LENGTH 65'-0"
- (P10) INDICATES PILE BATTERED 2" PER FT. IN DIRECTION OF ARROW.

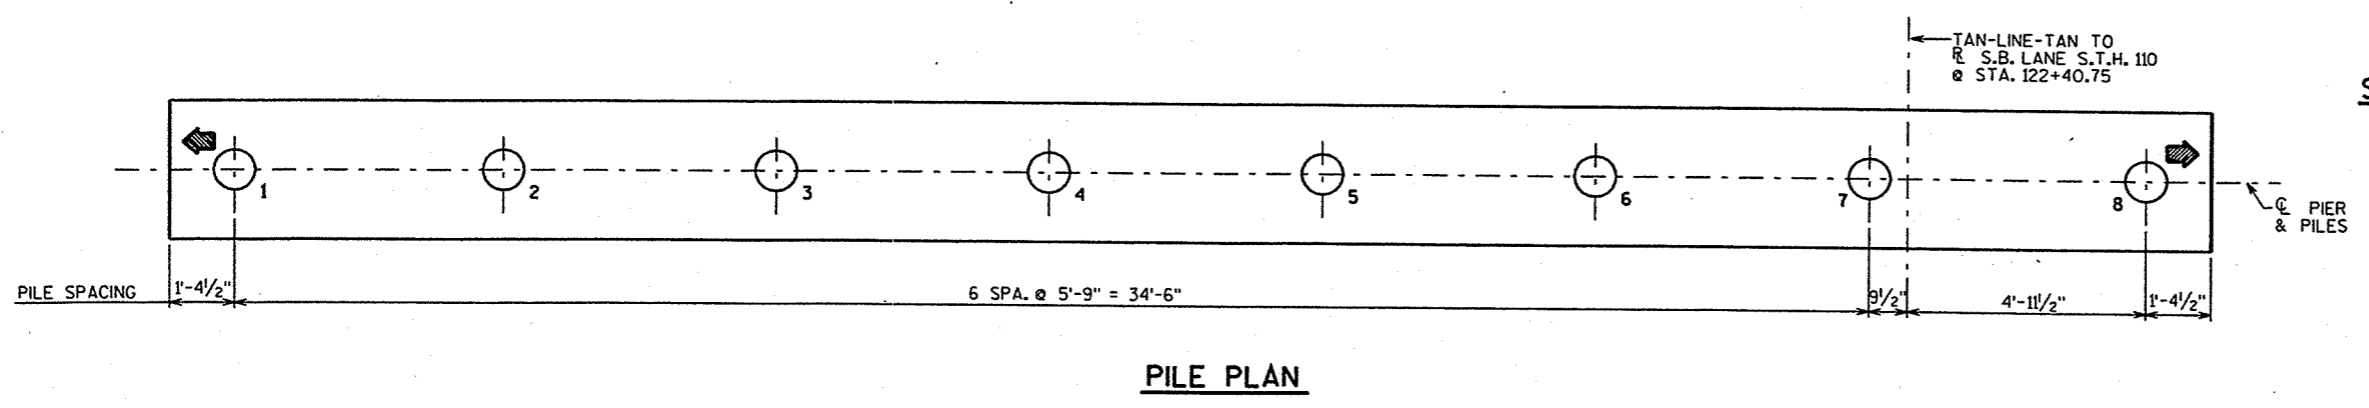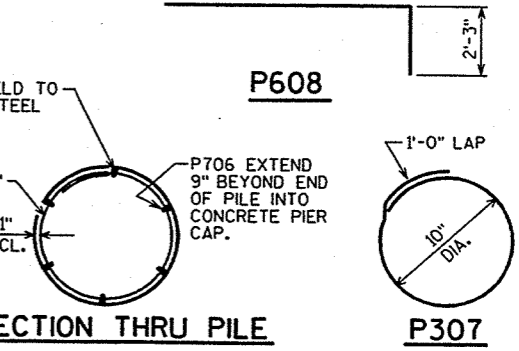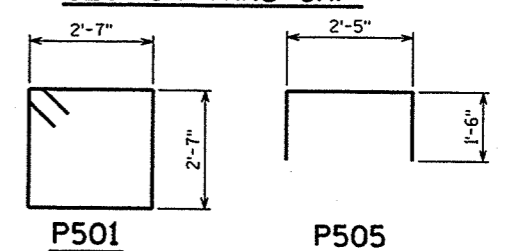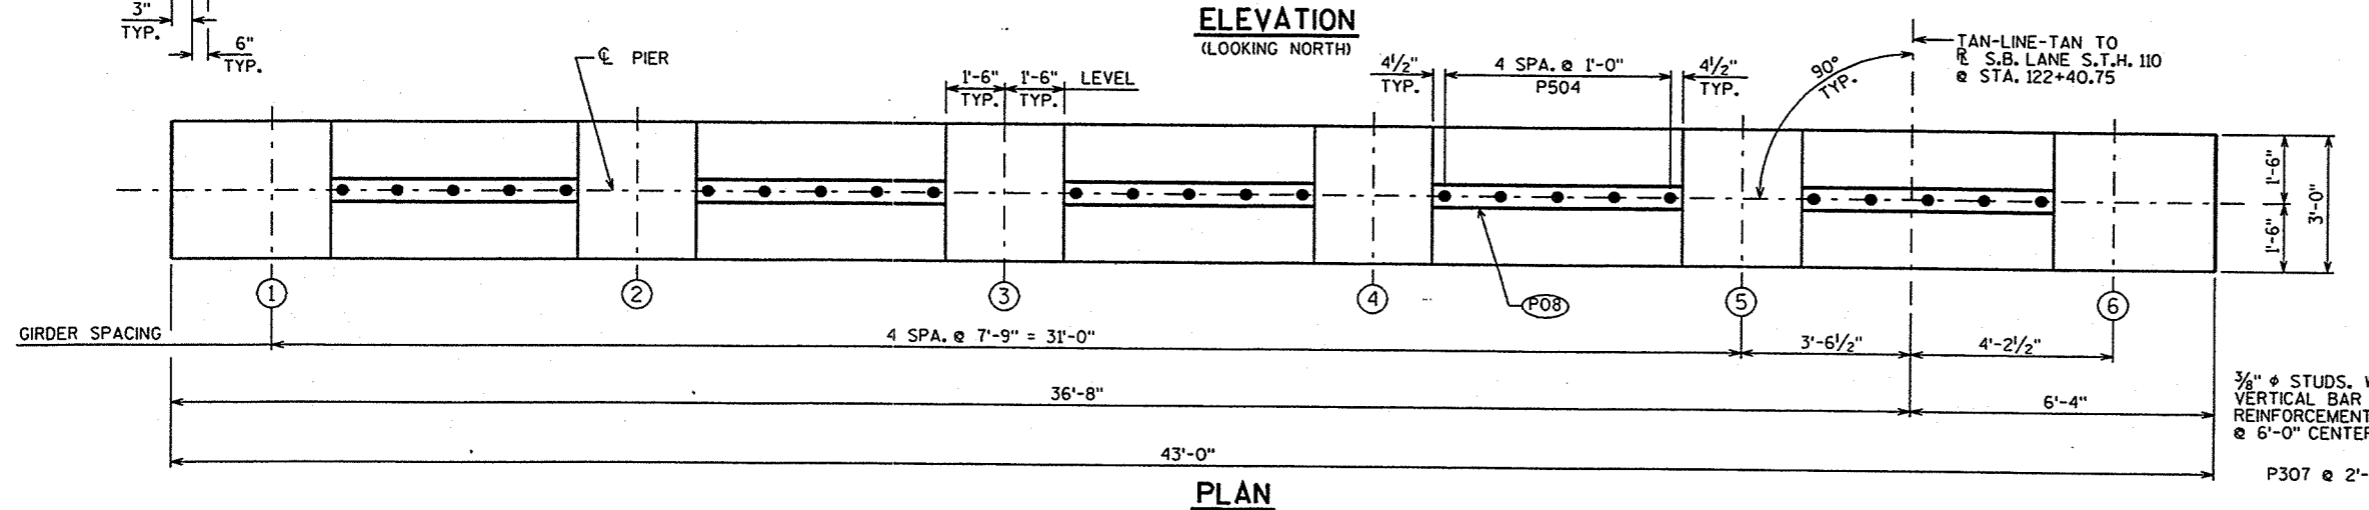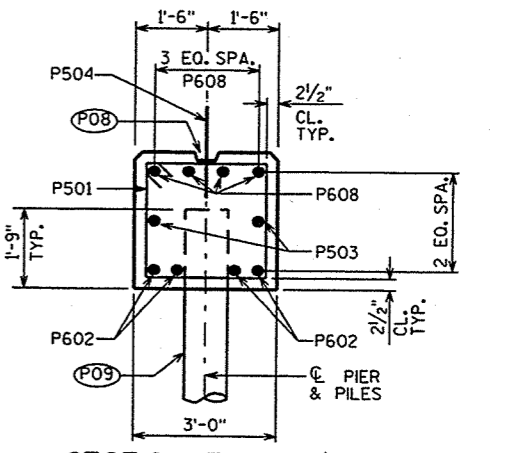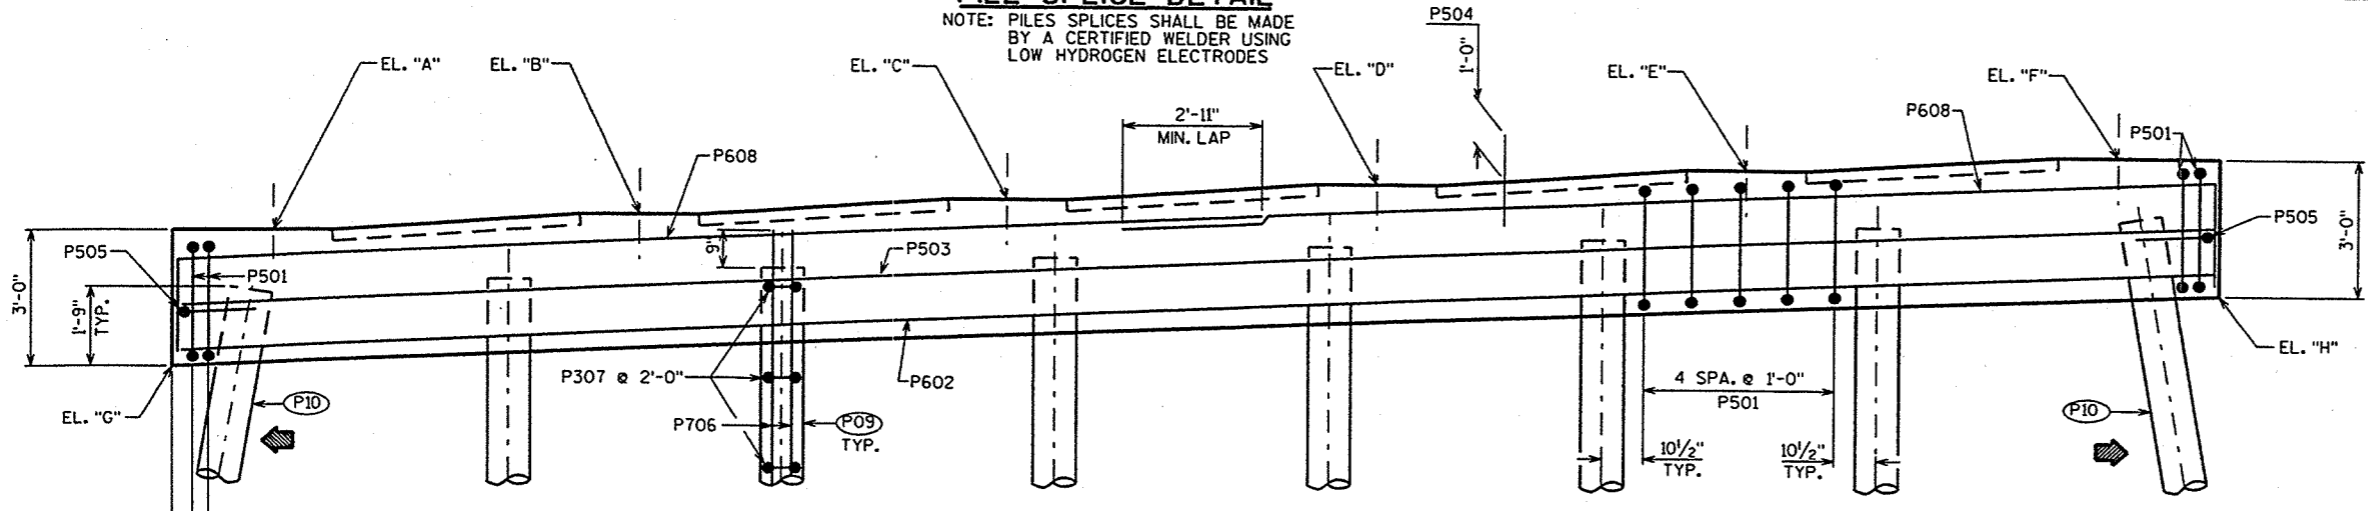

NO.	DATE	REVISION	BY
STATE OF WISCONSIN DEPARTMENT OF TRANSPORTATION STRUCTURES DESIGN SECTION			
STRUCTURE B-70-212			
CONST. SPEC.	1996	DRAWN BY DDS	PLANS CK'D. CRJ
PIERS 1 THRU 4			SHEET 8

FILE= 70212PIER.DGN
SCALE = 2

GIRDER NOTES

TOP OF GIRDER TO BE ROUGH FLOATED AND BROOMED TRANSVERSELY, EXCEPT THE OUTSIDE 2" OF GIRDER, WHICH SHALL BE TROWEL FINISHED.

THE GIRDERS SHALL BE PROVIDED WITH A SUITABLE LIFTING DEVICE FOR HANDLING AND ERECTING THE GIRDERS.

PRESTRESSING STRANDS SHALL BE 0.6"φ - 7 WIRE LOW-RELAXATION STRANDS WITH AN ULTIMATE STRENGTH OF 270,000 psi AND SHALL BE FLUSH WITH THE ENDS OF THE GIRDER.

BEND EACH END OF #4 STIRRUPS 4½" AND #5 STIRRUPS 6".

FOR DIAPHRAGM INSERT & CONNECTION DETAILS SEE "STEEL DIAPHRAGM" SHEET.





ALL GIRDERS SHALL BE CAST FULL LENGTH AS SHOWN.

SPACING SHOWN FOR #4 STIRRUPS IS FOR GRADE 60 REINFORCEMENT, IF THE FABRICATOR WANTS TO BUILD A BAR STEEL CAGE BY WELDING LONGITUDINAL REINFORCEMENT TO THE #4 STIRRUPS, 2 OPTIONS ARE AVAILABLE:

1. USE ASTM A706, GRADE 60 REINFORCEMENT AND THE STIRRUP SPACING AS SHOWN ON THE PLANS.
2. USE ASTM A615, GRADE 40 REINFORCEMENT AND A MODIFIED STIRRUP SPACING SUBMITTED TO AND APPROVED BY THE STRUCTURES DEVELOPMENT SECTION.


AN ALTERNATE EQUIVALENT OF WELDED WIRE FABRIC (WWF) MAY BE SUBSTITUTED FOR THE STIRRUP REINFORCEMENT SHOWN, UPON APPROVAL OF THE STRUCTURES DEVELOPMENT SECTION.

WELDED WIRE FABRIC SHALL CONFORM TO THE REQUIREMENTS OF ASTM A497.

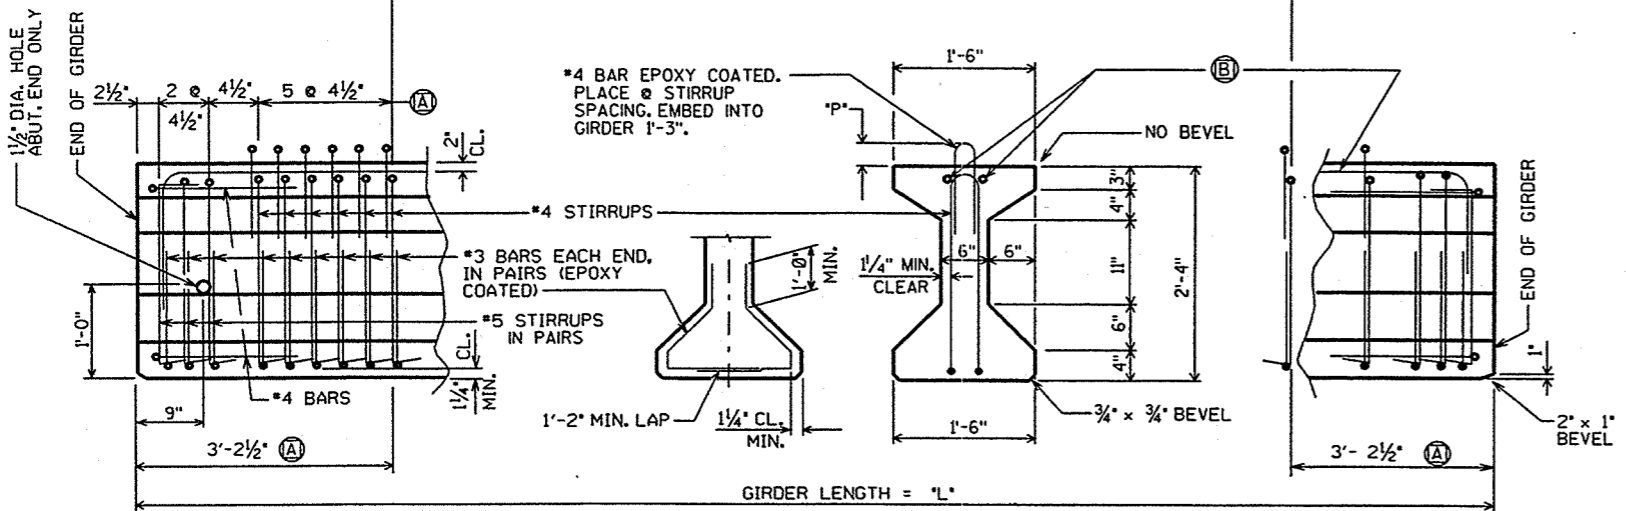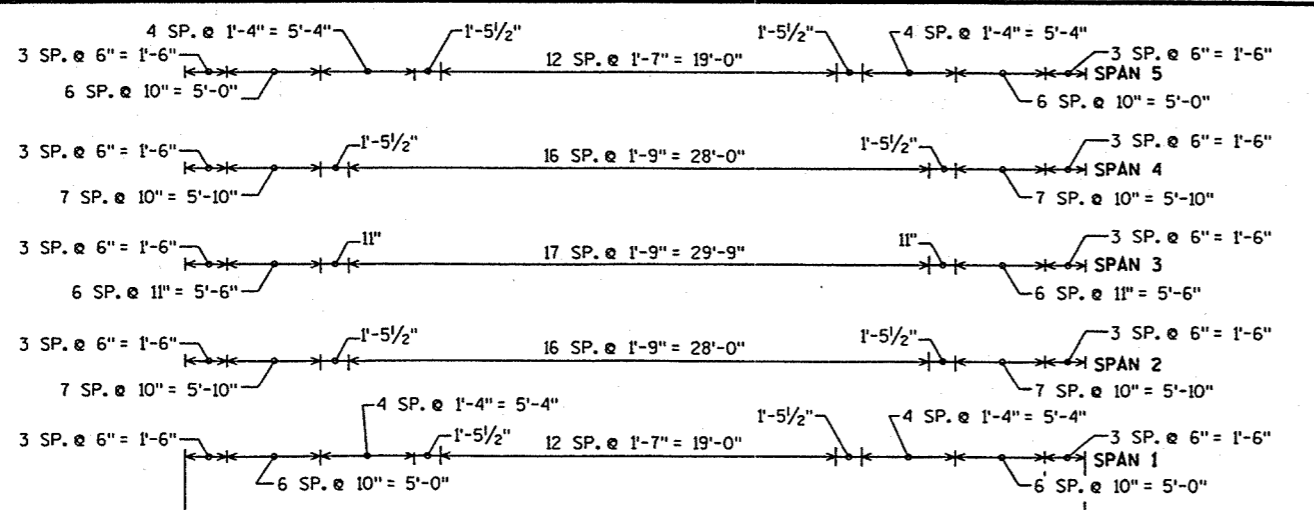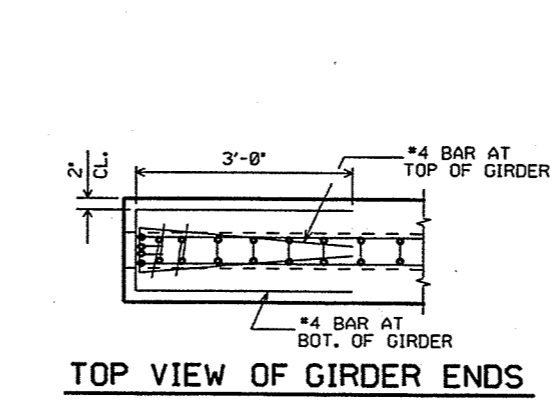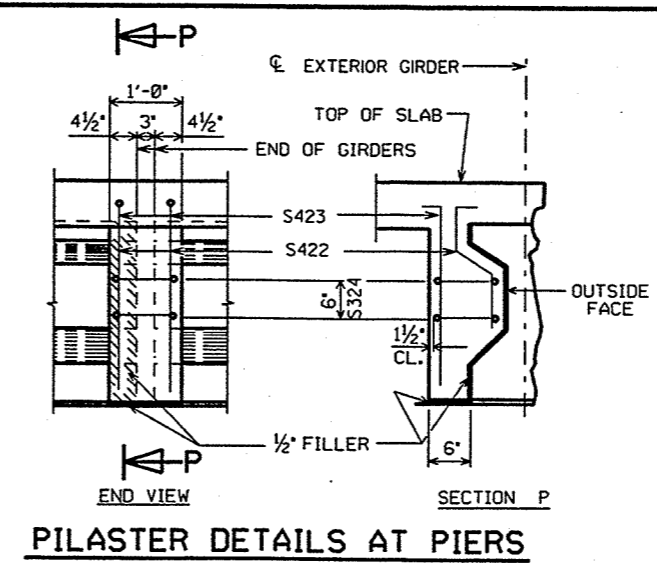


SIDE VIEW & TYP. SECTION IN SPAN


- Ⓐ DETAIL TYP. AT EACH END
- Ⓑ 2-#4 BARS BEND DOWN 16 BAR DIA. AT ENDS 1'-1" MINIMUM LAP (TYP. - ALL SPANS)

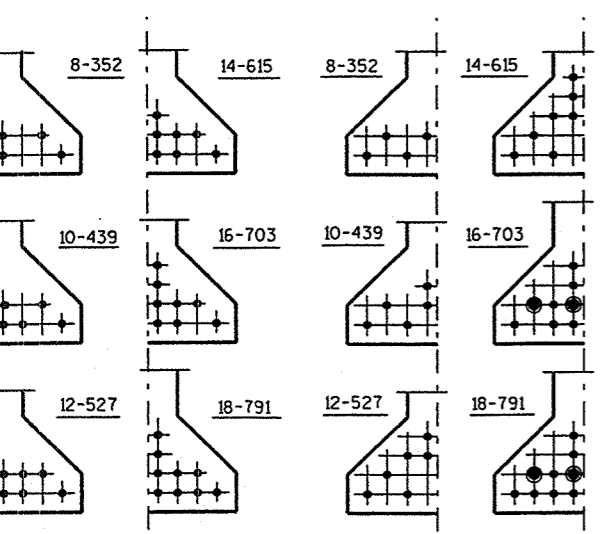


DRAPED PATTERN UNDRAPED PATTERN

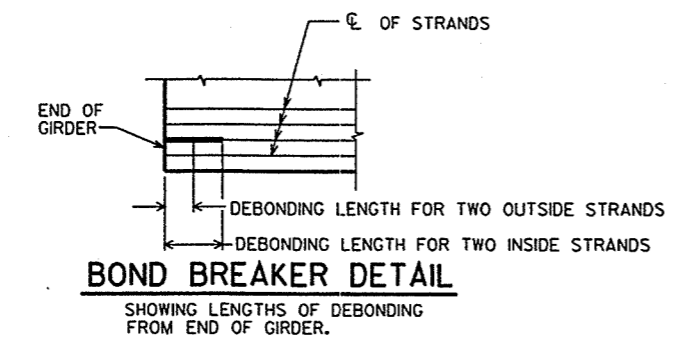


BOND BREAKER DETAIL

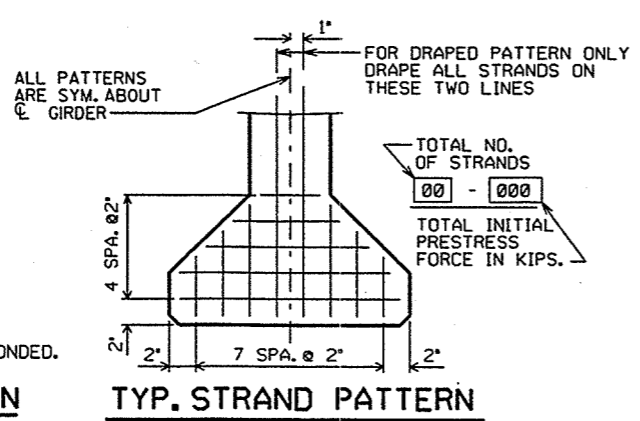


TYP. STRAND PATTERN

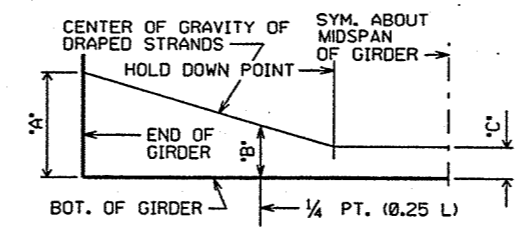

DRAPED STRAND PROFILE

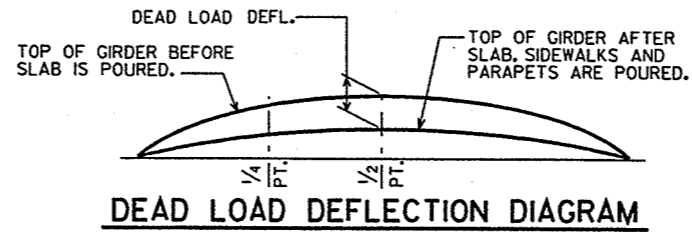

DEAD LOAD DEFLECTION DIAGRAM

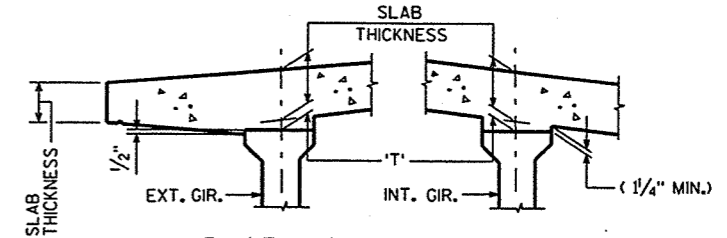

SLAB HAUNCH DETAIL

IF 1¼" MINIMUM HAUNCH HEIGHT AT EDGE OF GIRDER CANNOT BE MAINTAINED, THE GRADE LINE MAY BE REVISED BY THE ENGINEER AT THE OPTION OF THE CONTRACTOR. THE PLAN SLAB THICKNESS SHALL BE HELD. NOTIFY BRIDGE OFFICE FOR HAUNCH HEIGHTS OVER 4".

TO DETERMINE 'T', ELEV. OF TOP OF GIR'S. AT CL OF SUBSTRUCTURE UNITS & AT ¼ POINTS OF EACH SPAN SHALL BE TAKEN. THEN FOLLOW THIS PROCESS:

- TOP OF DECK ELEV. AT FINAL GRADE
- TOP OF GIRDER ELEVATION
- + DEAD LOAD DEFLECTION
- SLAB THICKNESS
- = HAUNCH HEIGHT 'T'

*MINIMUM CYLINDER STRENGTH OF CONCRETE @ TIME OF TRANSFER OF PRESTRESS FORCE.

SPAN	GIRDER LENGTH "L"	DEAD LOAD DEF. (IN.)				CONC. STRGTH. f'c (P.S.I.)	"P"	DIA. OF STRAND	DRAPED PATTERN (IN.)				UNDRAPED PATTERN			
		1/8	1/4	3/8	1/2				f'ci (P.S.I.)	TOTAL NO. OF STRANDS	"A"	"B" MIN.	"B" MAX.	"C"	TOTAL NO. OF STRANDS	f'ci (P.S.I.)
1	52.00	0.33	0.57	0.71	0.76	7500	6	0.60	12	5500	25.00	8.50	11.25	3.00	0	0
2	52.00	0.35	0.59	0.74	0.79	7500	6	0.60	12	5500	25.00	8.50	11.25	3.00	0	0
3	52.00	0.35	0.59	0.74	0.79	7500	6	0.60	12	5500	25.00	8.50	11.25	3.00	0	0
4	52.00	0.35	0.59	0.74	0.79	7500	6	0.60	12	5500	25.00	8.50	11.25	3.00	0	0
5	52.00	0.33	0.57	0.71	0.76	7500	6	0.60	12	5500	25.00	8.50	11.25	3.00	0	0

NO.	DATE	REVISION	BY
STATE OF WISCONSIN DEPARTMENT OF TRANSPORTATION STRUCTURES DESIGN SECTION			
STRUCTURE		B-70-212	
CONSTR. SPEC.	1996	DRAWN BY	DDS
PLANS CKD.			CRS
28" PRESTRESSED GIRDER DETAILS			SHEET 9

NOTES


ALL DIAPHRAGM MATERIAL NOT EMBEDDED IN THE CONCRETE GIRDER SHALL BE PAID FOR AT THE UNIT PRICE BID FOR "STEEL DIAPHRAGM", STRUCTURE, EACH.

EACH DIAPHRAGM BETWEEN GIRDERS SHALL CONSTITUTE ONE UNIT. ALL DIAPHRAGM STRUCTURAL STEEL SHALL BE ASTM A709 GRADE 36. ALL BOLTS, NUTS AND WASHERS SHALL BE ASTM A325 TYPE 1.


ALL DIAPHRAGM STRUCTURAL STEEL SHOWN SHALL BE HOT-DIPPED GALVANIZED. ALL BOLTS, NUTS AND WASHERS SHALL BE HOT-DIPPED GALVANIZED IN ACCORDANCE WITH ASTM A153 CLASS C. GALVANIZED NUTS SHALL BE TAPPED OVERSIZE IN ACCORDANCE WITH THE REQUIREMENTS OF ASTM A563 AND SHALL MEET THE REQUIREMENTS OF SUPPLEMENTARY REQUIREMENT S1 OF ASTM A563, LUBRICANT AND TEST FOR COATED NUTS.

TABLE


GIRDER HEIGHT	DIM. "A"	DIM. "B"	DIM. "L"	DIM. "X"
28"	1'-0 7/8"	5 7/8"	9 1/2"	2 1/4"
36"	1'-2 7/8"	9 7/8"	11 1/2"	3 1/4"
45"	1'-5 3/8"	11 7/8"	14 1/2"	4 1/4"
54"	1'-7 7/8"	14 5/8"	18 1/2"	5 1/4"
54W"	1'-9 1/8"	17 5/8"	22 1/2"	6 1/4"

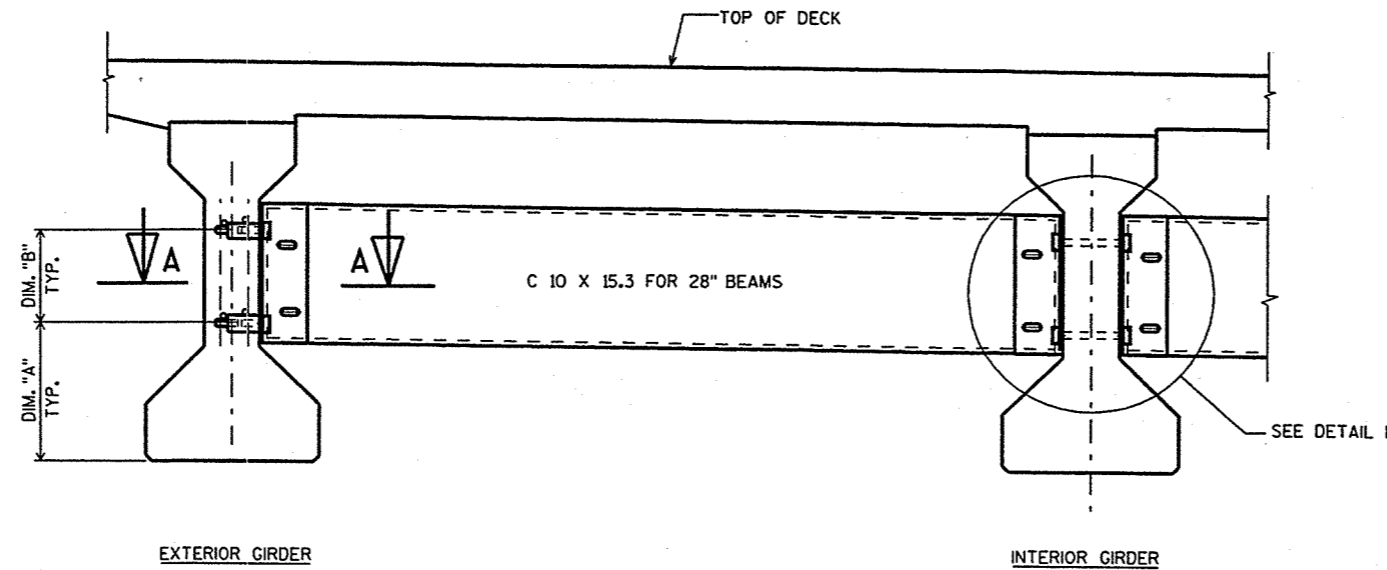

PART TRANSVERSE SECTION AT DIAPHRAGM

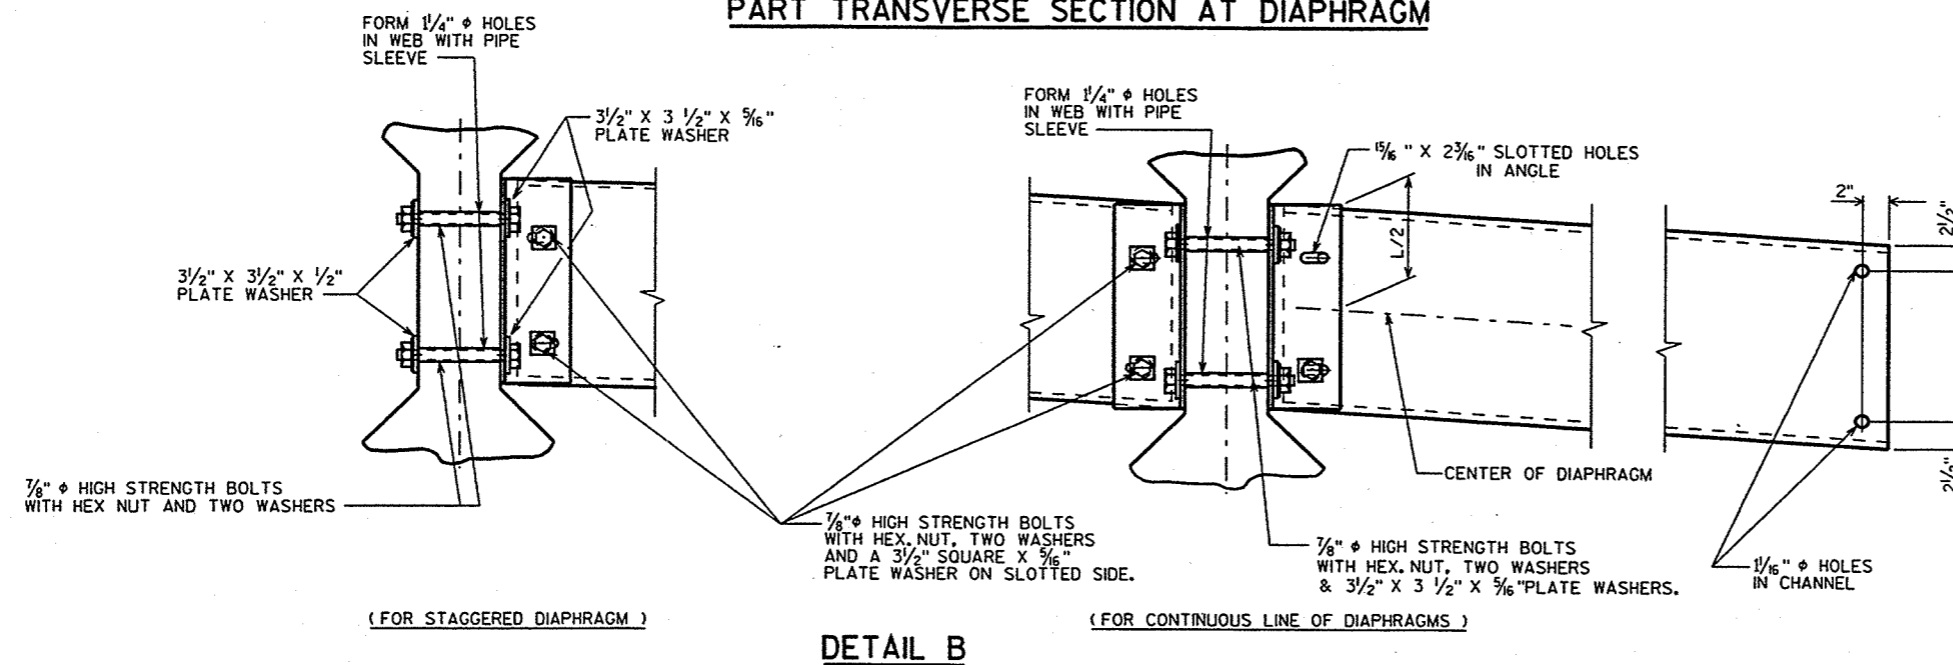


DETAIL B

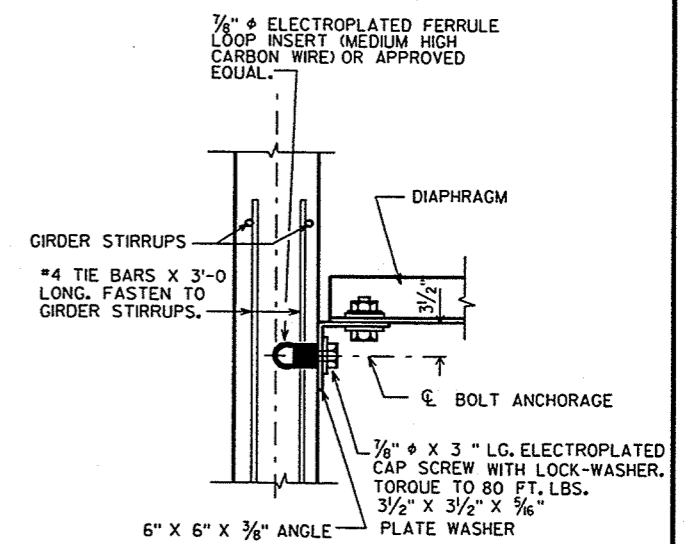

SECT. A-A

(FOR EXTERIOR ATTACHMENT)

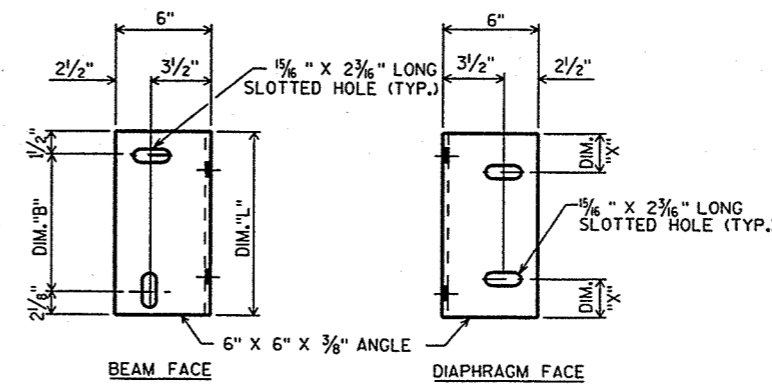

DIAPHRAGM SUPPORT

NO.	DATE	REVISION	BY
STATE OF WISCONSIN DEPARTMENT OF TRANSPORTATION STRUCTURES DESIGN SECTION			
STRUCTURE		B-70-212	
CONST. SPEC.	1996	DRAWN BY	DDS
		PLANS CKD.	CRJ
STEEL DIAPHRAGM			SHEET 10

FILE= 70212DIA.DGN
SCALE =




SCALE = 12.000000 ' / IN

STATE PROJECT NUMBER

6200-05-71


SHEET NO.

8.26

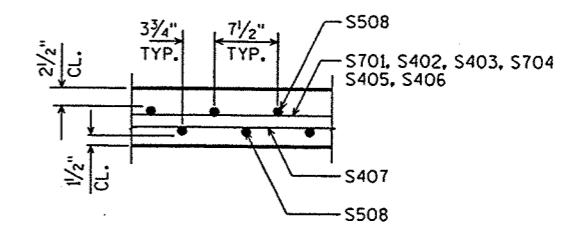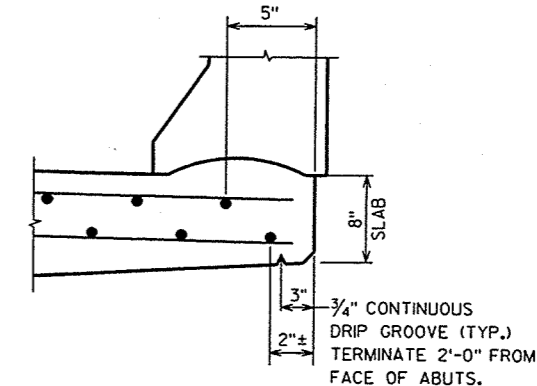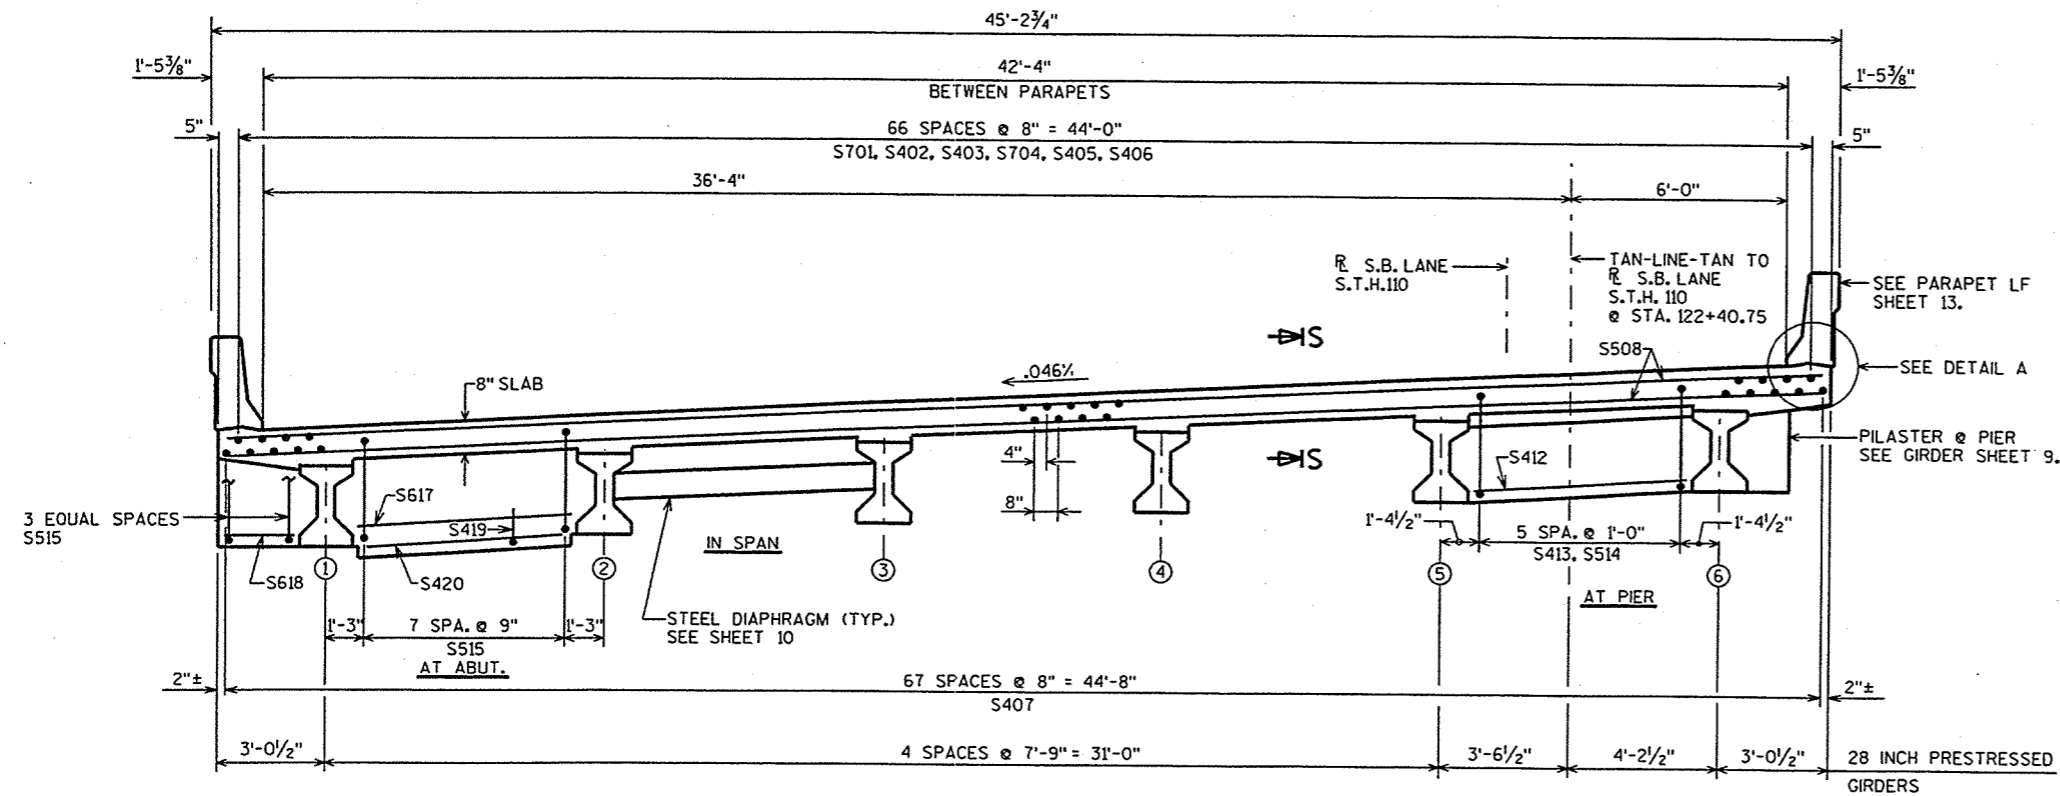


* DISTANCE MEASURED TO END OF SLAB @ PAVING NOTCH.

** TAN-LINE-TAN TO R S.B. LANE S.T.H. 110 @ STA. 122+40.75

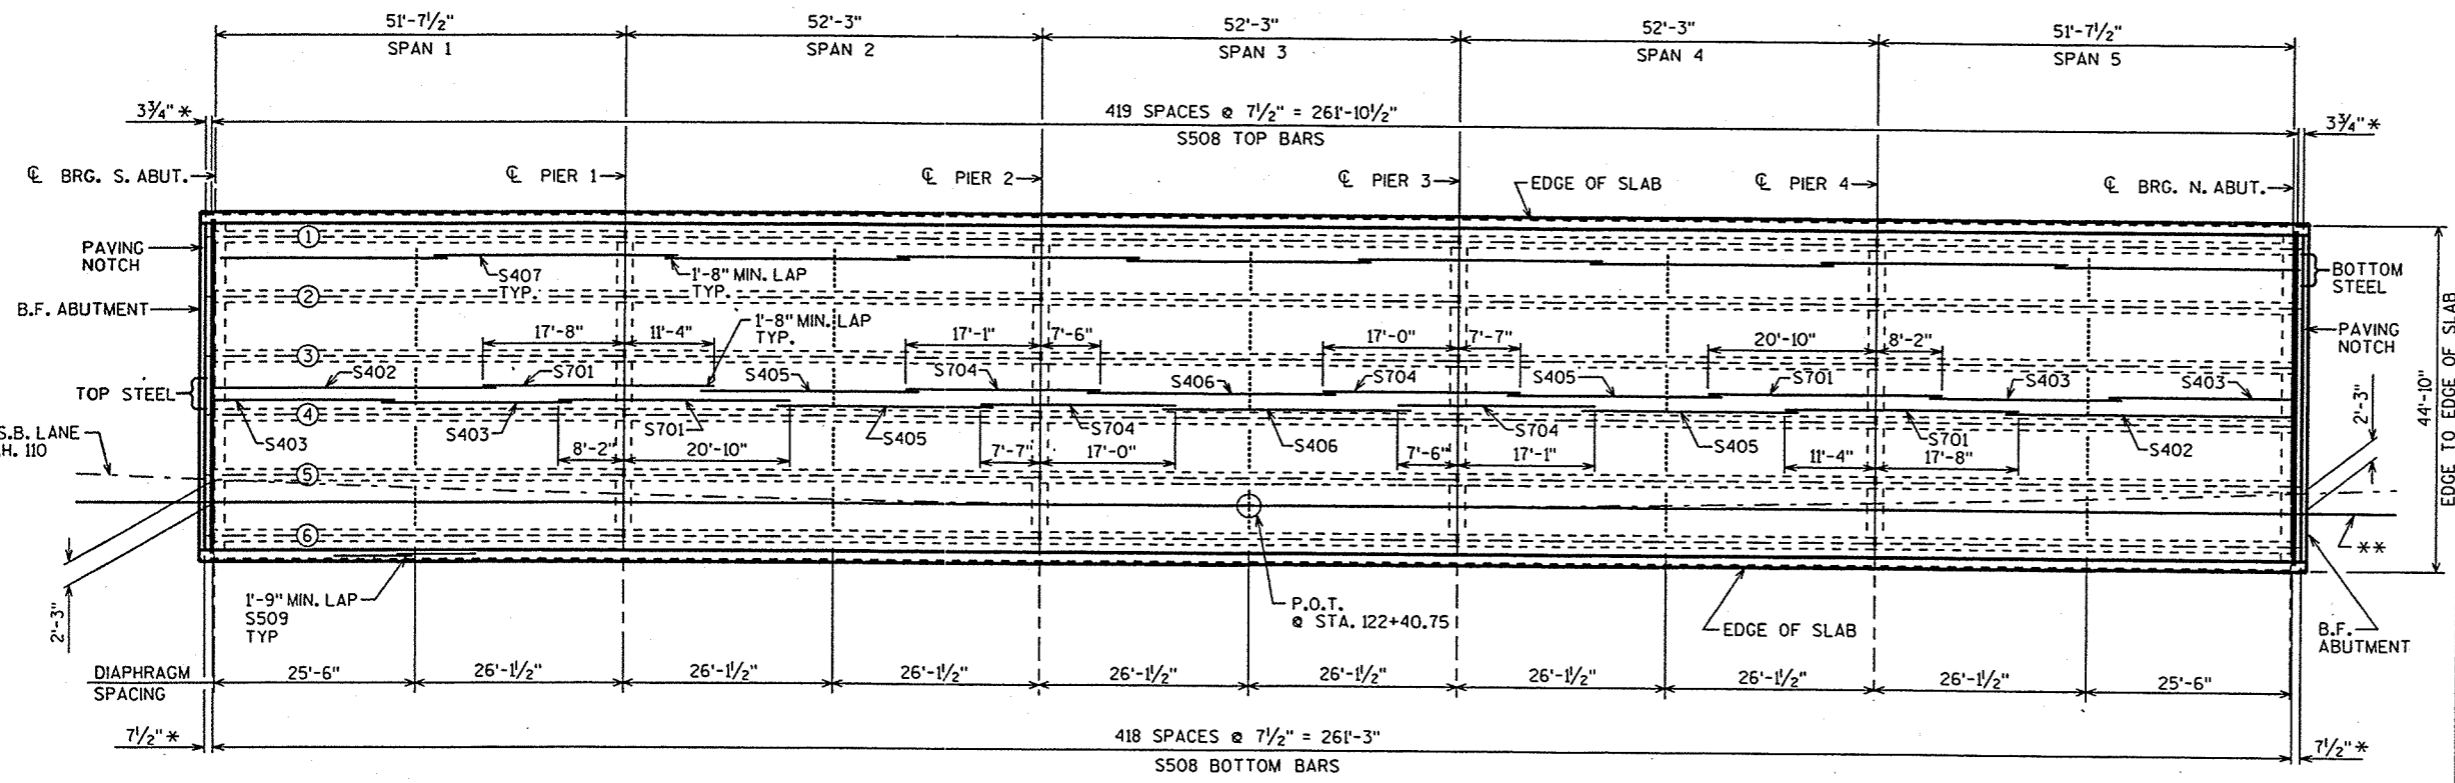

NO.	DATE	REVISION	BY
STATE OF WISCONSIN DEPARTMENT OF TRANSPORTATION STRUCTURES DESIGN SECTION			
STRUCTURE		B-70-212	
CONST. SPEC.	1996	DRAWN BY	DDS
SUPERSTRUCTURE		PLANS CKD.	CRS
SHEET 11			

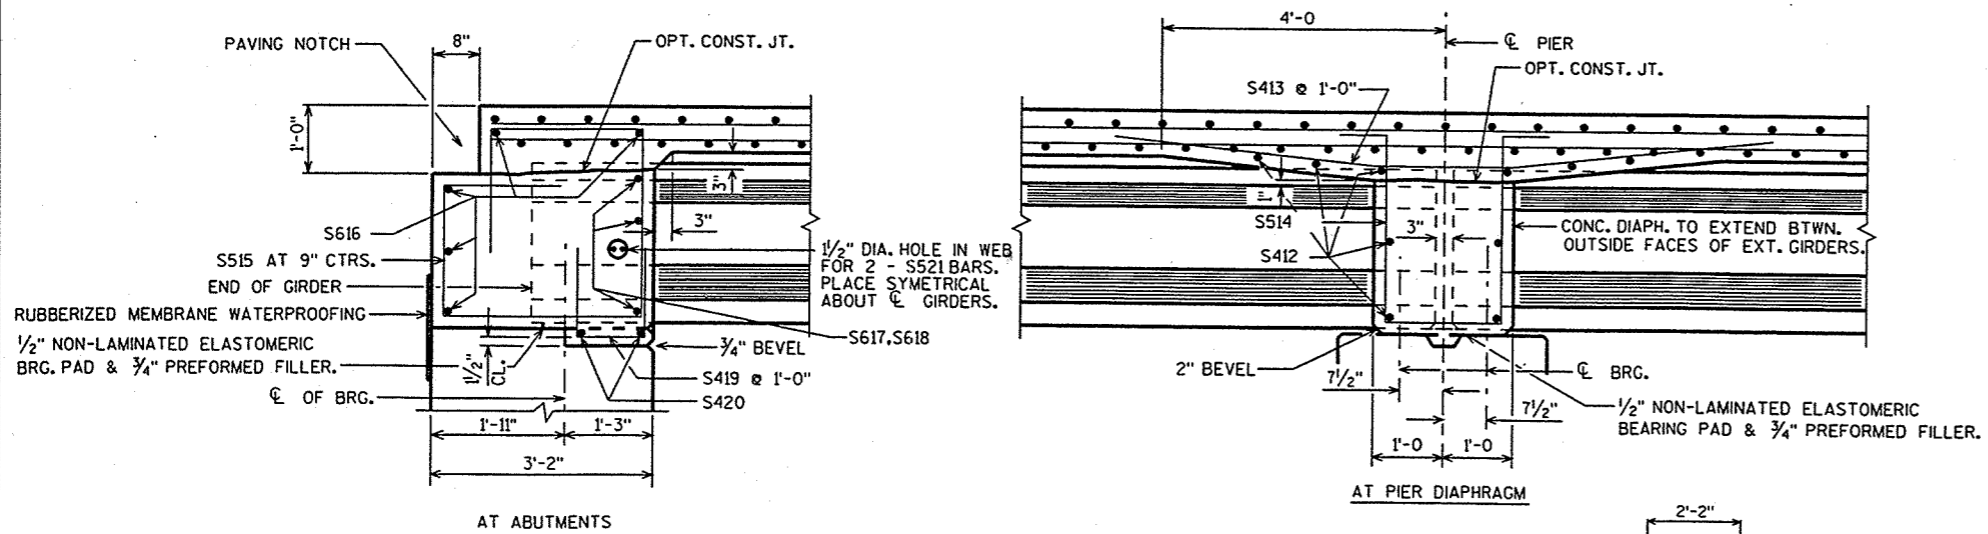


PART LONGIT. SECTION

BILL OF BARS


NOTE: THE FIRST OR FIRST TWO DIGITS OF THE BAR MARK SIGNIFIES THE BAR SIZE.

BAR MARK	COAT	NO. REQ'D.	LENGTH	BENT	BAR SERIES	LOCATION
S701	X	134	29'-0"			LONGITUDINAL CONTINUITY
S402	X	67	36'-8"			LONGITUDINAL TOP
S403	X	134	23'-11"			LONGITUDINAL TOP
S704	X	134	24'-7"			LONGITUDINAL CONTINUITY
S405	X	134	27'-2"			LONGITUDINAL TOP
S406	X	67	31'-1"			LONGITUDINAL TOP
S407	X	612	30'-9"			LONGITUDINAL BOTTOM
S508	X	839	44'-6"			TRANSVERSE TOP AND BOTTOM
S509	X	70	39'-2"			PARAPET LF-HORIZ.
S510	X	792	4'-10"	X		PARAPET LF-VERT.
S511	X	792	4'-9"	X		PARAPET LF-VERT.
S412	X	200	5'-11"			PIER DIAPHRAGM-HORIZ.
S413	X	120	10'-2"	X		PIER DIAPHRAGM-VERT.
S514	X	120	8'-2"	X		PIER DIAPHRAGM-VERT.
S515	X	96	12'-9"	X		ABUT. DIAPHRAGM-VERT.
S616	X	20	24'-0"			ABUT. DIAPHRAGM-HORIZ.
S617	X	30	5'-11"			ABUT. DIAPHRAGM-HORIZ.
S618	X	12	2'-0"			ABUT. DIAPHRAGM-HORIZ.
S419	X	60	3'-3"	X		ABUT. DIAPHRAGM-VERT.
S420	X	20	4'-11"			ABUT. DIAPHRAGM-HORIZ.
S521	X	24	6'-0"			ABUT. DIAPHRAGM @ GIRDERS
S422	X	16	2'-9"	X		PIER PILASTER
S423	X	16	3'-3"	X		PIER PILASTER
S324	X	16	3'-4"	X		PIER PILASTER

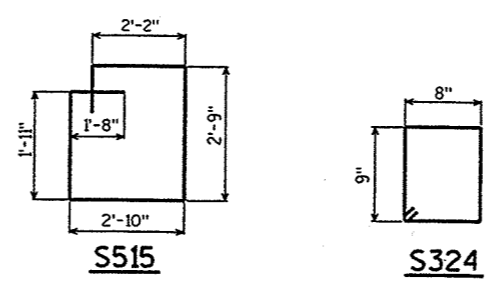


TOP OF DECK ELEVATIONS

	S. ABUT.	1/4	2/4	3/4	PIER 1	1/4	2/4	3/4	PIER 2	1/4	2/4	3/4	PIER 3	1/4	2/4	3/4	PIER 4	1/4	2/4	3/4	N. ABUT.
GIR. 1	754.81	754.73	754.66	754.59	754.52	754.45	754.38	754.32	754.26	754.20	754.15	754.10	754.05	754.01	753.97	753.94	753.90	753.87	753.85	753.83	753.81
GIR. 2	755.16	755.09	755.01	754.94	754.87	754.81	754.74	754.68	754.62	754.56	754.51	754.46	754.41	754.37	754.33	754.29	754.26	754.23	754.20	754.18	754.16
GIR. 3	755.52	755.44	755.37	755.30	755.23	755.16	755.10	755.03	754.97	754.92	754.86	754.81	754.77	754.72	754.68	754.65	754.62	754.59	754.56	754.54	754.52
GIR. 4	755.87	755.80	755.73	755.65	755.59	755.52	755.45	755.39	755.33	755.27	755.22	755.17	755.12	755.08	755.04	755.01	754.97	754.94	754.92	754.90	754.88
GIR. 5	756.23	756.15	756.08	756.01	755.94	755.87	755.81	755.75	755.69	755.63	755.58	755.53	755.48	755.44	755.40	755.36	755.33	755.30	755.28	755.25	755.23
GIR. 6	756.58	756.51	756.44	756.37	756.30	756.23	756.16	756.10	756.04	755.99	755.93	755.88	755.84	755.79	755.76	755.72	755.69	755.66	755.63	755.61	755.59

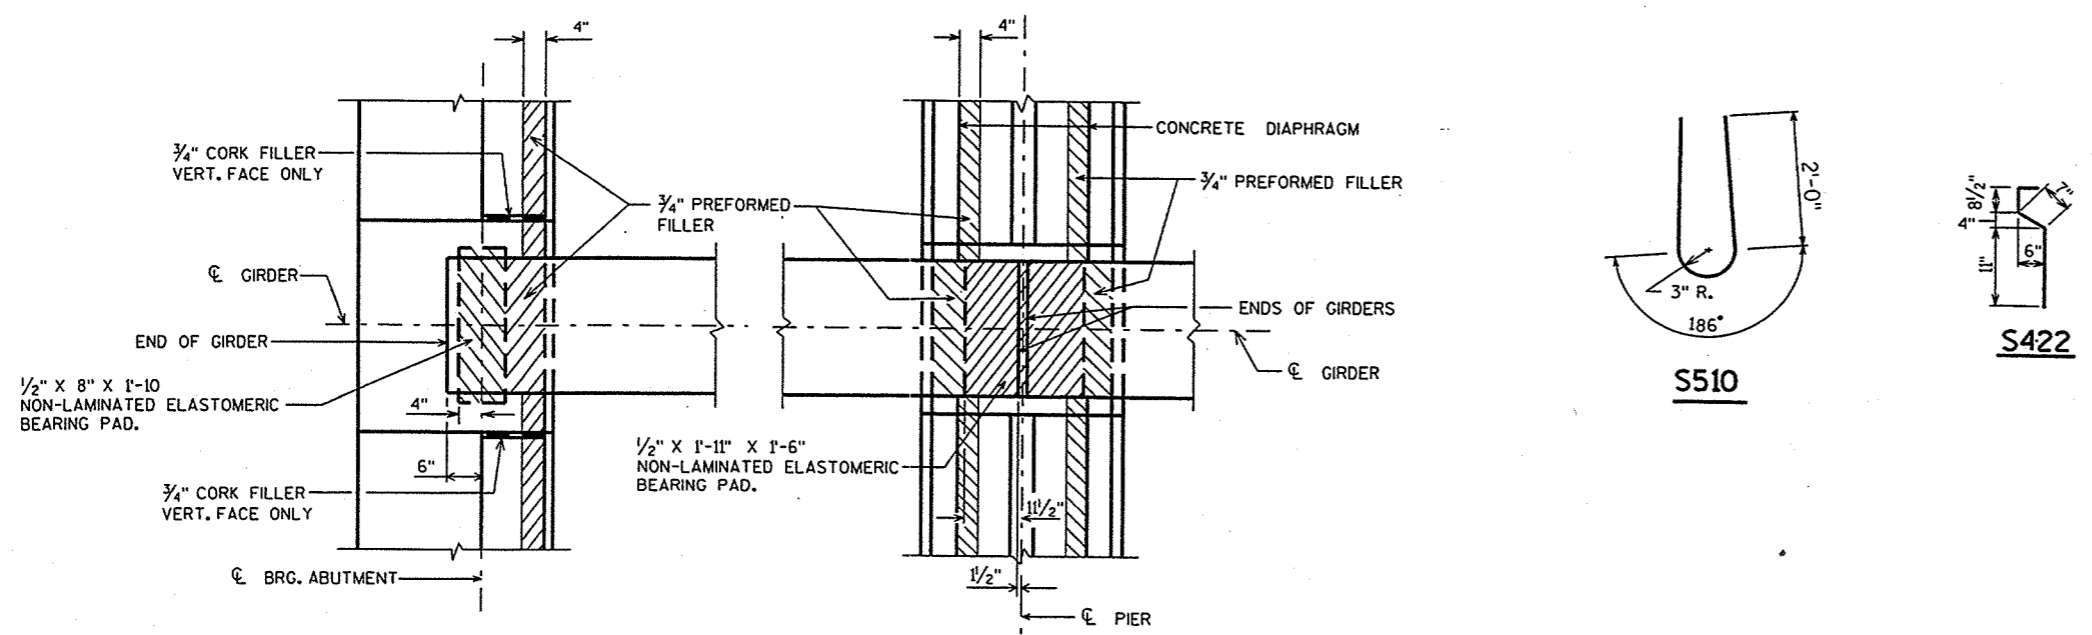


BEARING PAD DETAIL

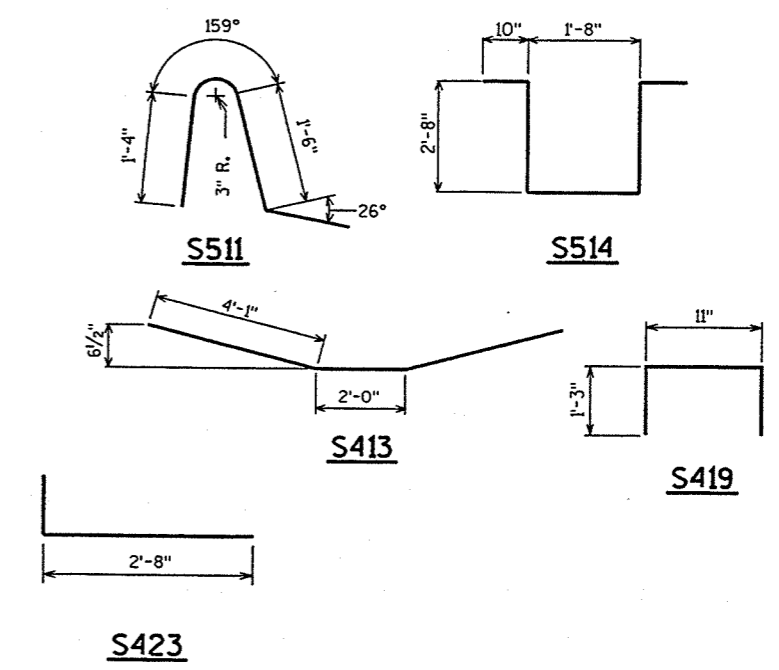


NO.	DATE	REVISION	BY
STATE OF WISCONSIN DEPARTMENT OF TRANSPORTATION STRUCTURES DESIGN SECTION			
STRUCTURE		B-70-212	
CONST. SPEC.	1996	DRAWN BY	DDS
SUPERSTRUCTURE DETAILS		PLANS CKD.	CRJ
SHEET 12			


FILE: 70212SUPERDET.DGN
SCALE = 1:333

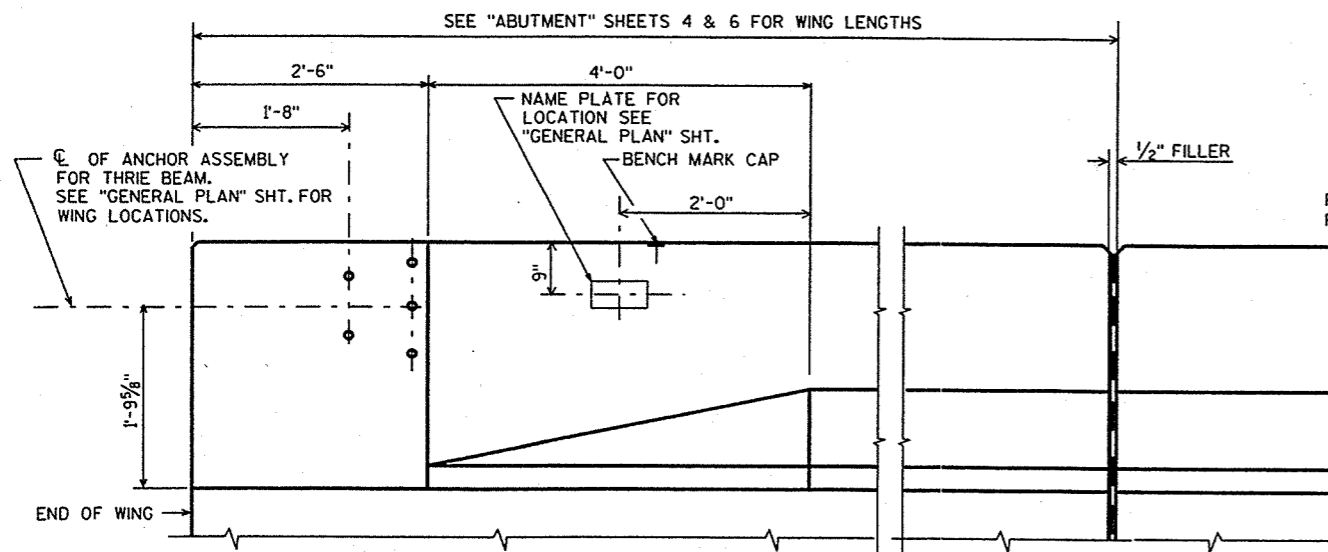


INSIDE ELEVATION

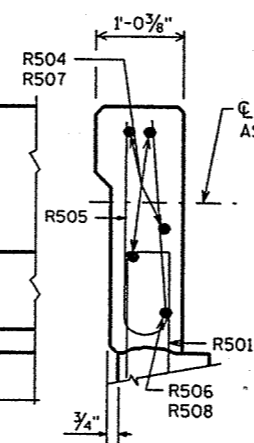

SECTION A

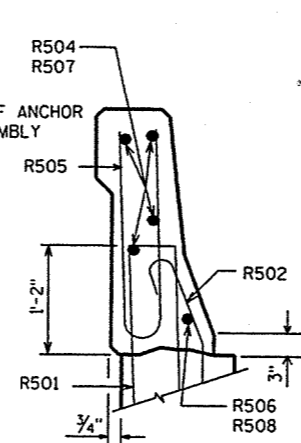

SECTION B

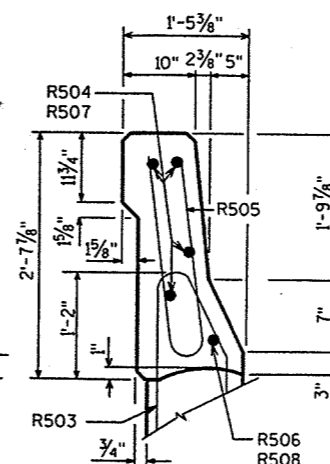


SECTION C


BILL OF BARS

FOR ABUTMENT PARAPETS

BAR MARK	COAT	S. ABUT.	N. ABUT.	LENGTH	BENT	LOCATION
R501	X	28	28	4'-7"	X	PARAPET VERT.
R502	X	16	16	3'-2"	X	PARAPET VERT.
R503	X	13	13	4'-8"	X	PARAPET VERT.
R504	X	4	4	1'-8"		PARAPET HORIZ.-WINGS 1 & 4
R505	X	41	41	4'-10"	X	PARAPET VERT.
R506	X	1	1	1'-8"	X	PARAPET HORIZ.-WINGS 1 & 4
R507	X	4	4	9'-8"		PARAPET HORIZ.-WINGS 2 & 3
R508	X	1	1	9'-8"	X	PARAPET HORIZ.-WINGS 2 & 3

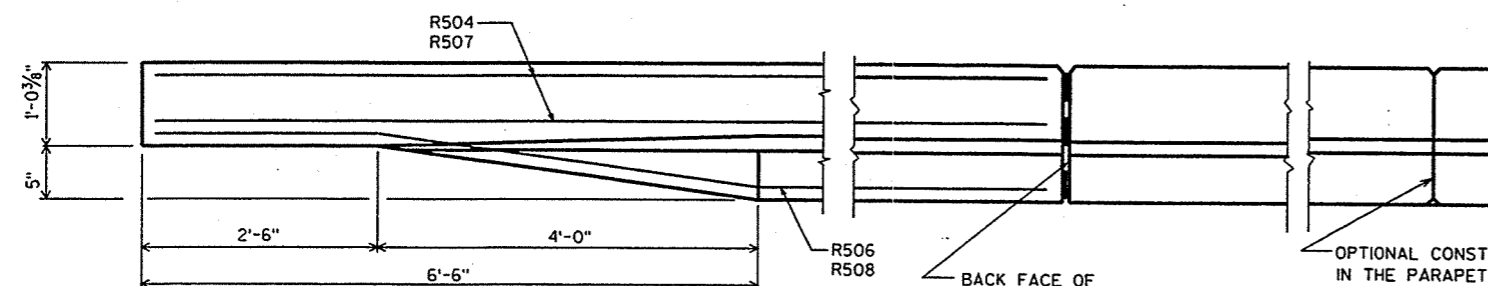

PLAN

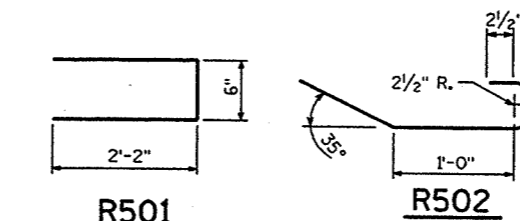


R501

R502

R503


R505

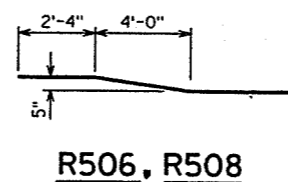

R506, R508


OPTIONAL CONSTRUCTION JOINTS IN THE PARAPETS MAY BE USED. RUN BAR REINF THRU THE JOINT. LAP LONGIT. BARS A MIN. OF 1'-9" MIN. JOINT SPACING OF 80'-0" DEFINE CONST. JOINT WITH A 3/4" 'V' GROOVE.

THREADED INSERTS FOR 7/8" x 2" LONG GALVANIZED HEX. HEAD CAP SCREWS. CAP SCREWS TO BE THREADED A MIN. OF 1/8" AND SHALL BE SUPPLIED, INCLUDING WASHERS, WITH ASSEMBLY. INSERTS TO BE THREADED A MINIMUM OF 1 3/4"

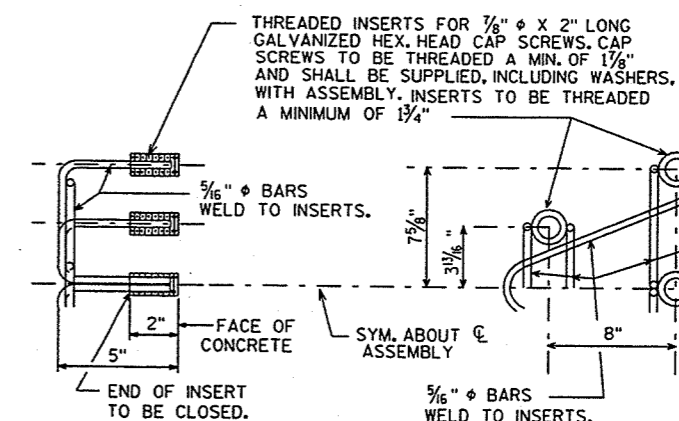


DETAIL OF ANCHOR ASSEMBLY

NOTE: HEX. HEAD CAP SCREWS & WASHERS TO BE GALVANIZED IN ACCORDANCE WITH AASHTO M232 CLASS C.

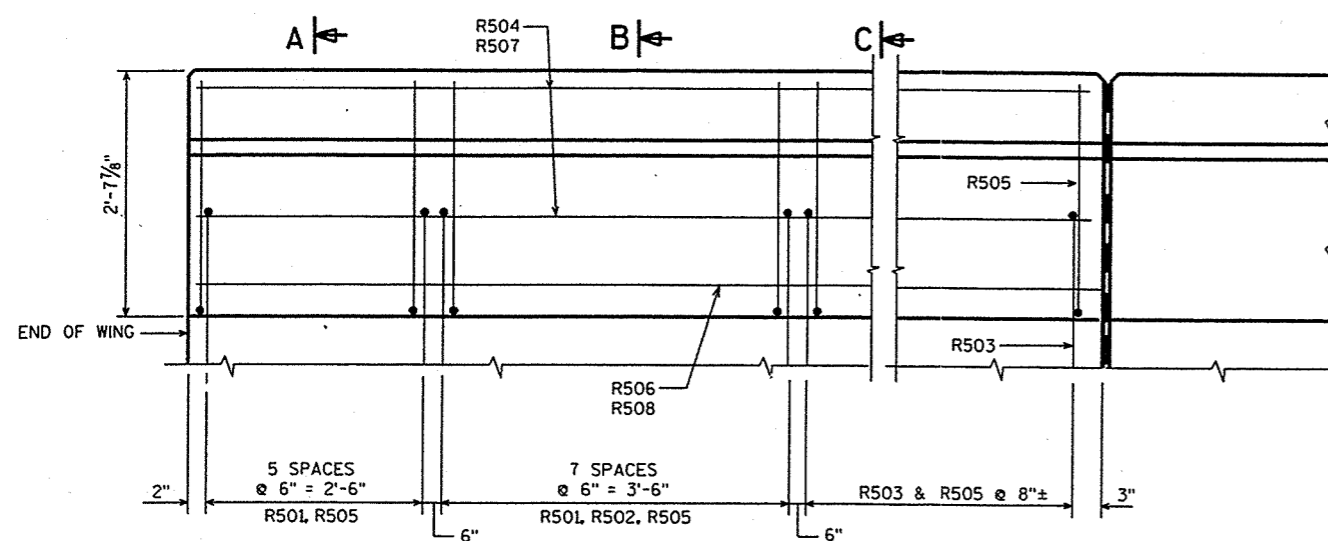

OUTSIDE ELEVATION

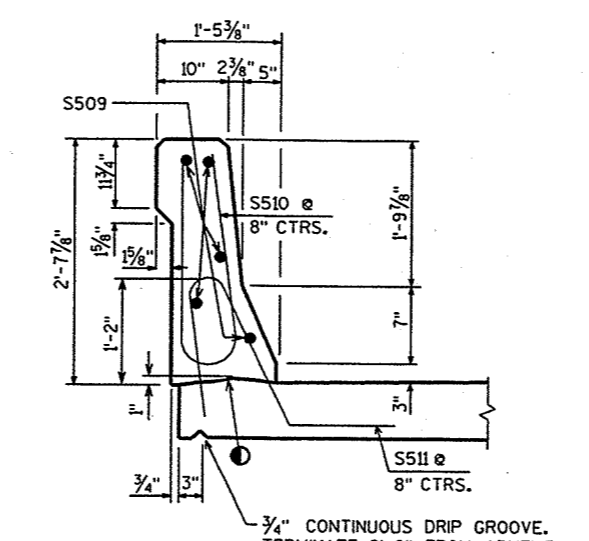

SECTION THRU PARAPET ON BRIDGE

CONST. JOINT - STRIKE OFF AS SHOWN.

NO.	DATE	REVISION	BY
STATE OF WISCONSIN DEPARTMENT OF TRANSPORTATION STRUCTURES DESIGN SECTION			
STRUCTURE B-70-212			
CONST. SPEC.	1996	DRAWN BY DDS	PLANS CK'D. CRJ
SLOPED FACE PARAPET LF			SHEET 13

FILE= 70212PP.DGN
SCALE =

STATE PROJECT NUMBER	SHEET NO.
6200-05-71	8.29

CURVE DATA

SB. LANE S.T.H. 110	NB. LANE S.T.H. 110
P.I. = STA. 119+98.07	P.I. = STA. 120+08.48
$\Delta = 19^{\circ}-41'-20.8''$	$\Delta = 19^{\circ}-41'-20.8''$
$D = 1^{\circ}-31'-26.2''$	$D = 1^{\circ}-30'-00''$
$T = 652.43'$	$T = 662.84'$
$L = 1291.99'$	$L = 1312.61'$
$R = 3759.72'$	$R = 3819.72'$
S.E. = 0.046%	S.E. = 0.046%
P.C. = STA. 113+45.64	P.C. = STA. 113+45.64
P.T. = STA. 126+37.63	P.T. = STA. 126+58.25

DESIGN DATA

LIVE LOAD:
 DESIGN RATING: HS-20
 INVENTORY RATING: HS-21
 OPERATIONAL RATING: HS-38
 MAXIMUM STANDARD PERMIT VEHICLE LOAD = 250 KIPS.
 STRUCTURE IS DESIGNED FOR A FUTURE WEARING SURFACE OF 20 POUNDS PER SQUARE FOOT.

ULTIMATE DESIGN STRESSES:
 CONCRETE MASONRY SLAB — $f'_c = 4,000$ P.S.I. ALL OTHER — $f'_c = 3,500$ P.S.I.
 BAR STEEL REINFORCEMENT, GRADE 60 — $f_y = 60,000$ P.S.I.
 28" PRESTRESSED GIRDERS, CONCRETE MASONRY — $f'_c = 7,500$ P.S.I.
 STRANDS — .06" ϕ WITH ULTIMATE TENSILE STRENGTH OF 270,000 P.S.I.

FOUNDATION DATA

ABUTMENTS TO BE SUPPORTED ON 10 3/4" DIA. CAST-IN-PLACE PILING DRIVEN TO A MINIMUM BEARING VALUE OF 55 TONS PER PILE. SOUTH ABUTMENT ESTIMATED 60'-0" LONG. NORTH ABUTMENT ESTIMATED 65'-0" LONG.

PIERS TO BE SUPPORTED ON 12" CAST-IN-PLACE PILING (.375" MINIMUM WALL THICKNESS) DRIVEN TO A MINIMUM BEARING VALUE OF 55 TONS PER PILE.
 PIER 1 ESTIMATED 60'-0" LONG,
 PIER 2 ESTIMATED 60'-0" LONG,
 PIER 3 ESTIMATED 60'-0" LONG,
 PIER 4 ESTIMATED 65'-0" LONG.

HYDRAULIC DATA


100 YEAR FREQUENCY
 $Q_{100} = 2,800$ C.F.S.
 VEL. = 3.9 F.P.S.
 HW. = EL. 749.6
 WATERWAY AREA = 724.4 SQ. FT.
 DRAINAGE AREA = 8.4 SQ. MI.
 ROAD OVERTOPPING = NA
 SCOUR CRITICAL CODE = 5

TRAFFIC VOLUME


S.T.H. 110
 A.D.T. = 34,000 (2023)
 R.D.S. = 70 M.P.H.

ABUTMENT STATIONS


ABUTMENT	B-70-211	B-70-212	B-70-213
END OF SLAB	249+64.61	121+09.47	121+23.76
¢ BRG. SOUTH ABUT.	249+65.86	121+10.72	121+25.01
¢ BRG. NORTH ABUT.	252+25.92	123+70.78	123+85.07
END OF SLAB	252+27.17	123+72.03	123+86.32

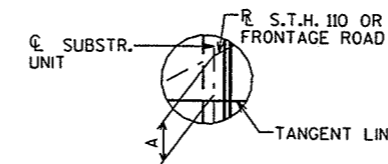

LOCATION	DIM. A (ALONG ¢ SUBSTR. UNIT)		
	B-70-211	B-70-212	B-70-213
SOUTH ABUT.	1'-7 3/4"	2'-3"	2'-2 1/2"
PIER 1	5 3/4"	9 3/4"	9 5/8"
PIER 2	1/8"	1/8"	1/8"
PIER 3	3"	1/8"	1/8"
PIER 4	1'-2 1/2"	9 3/4"	9 5/8"
NORTH ABUT.	2'-10 3/8"	2'-3"	2'-2 1/2"

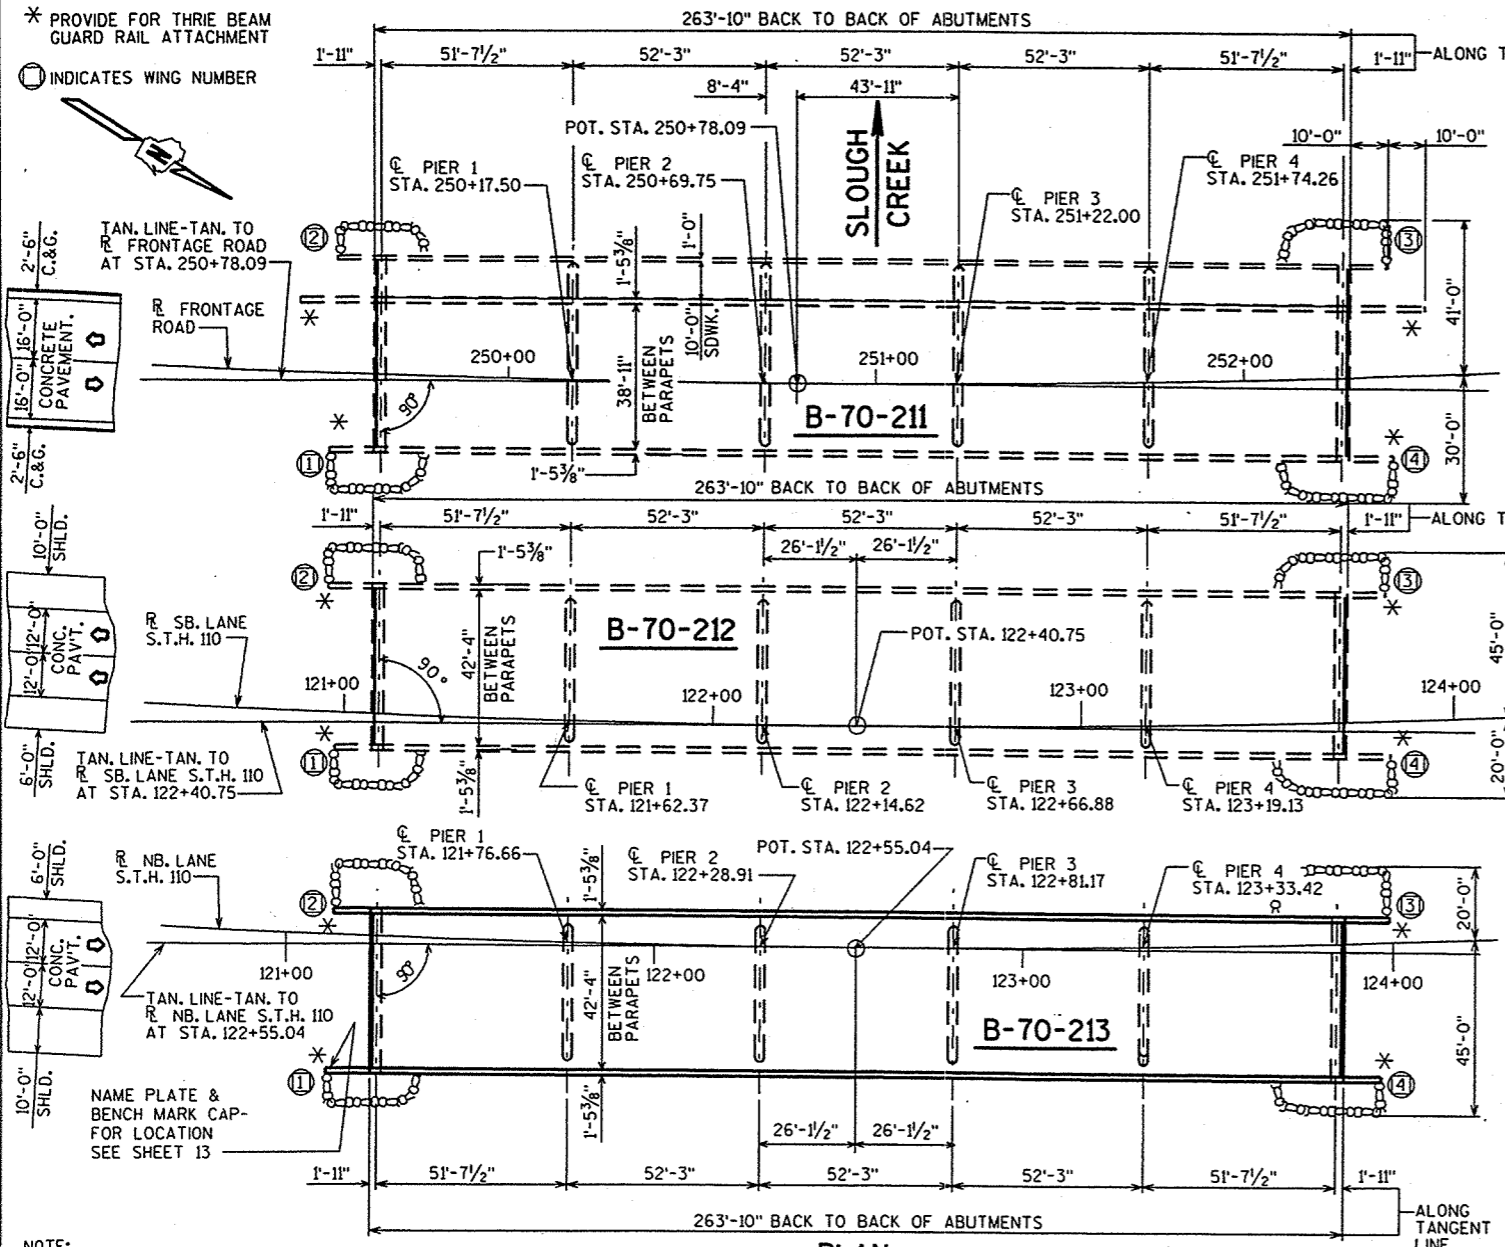

PLAN
 5 SPAN-28" PRESTRESSED GIRDERS

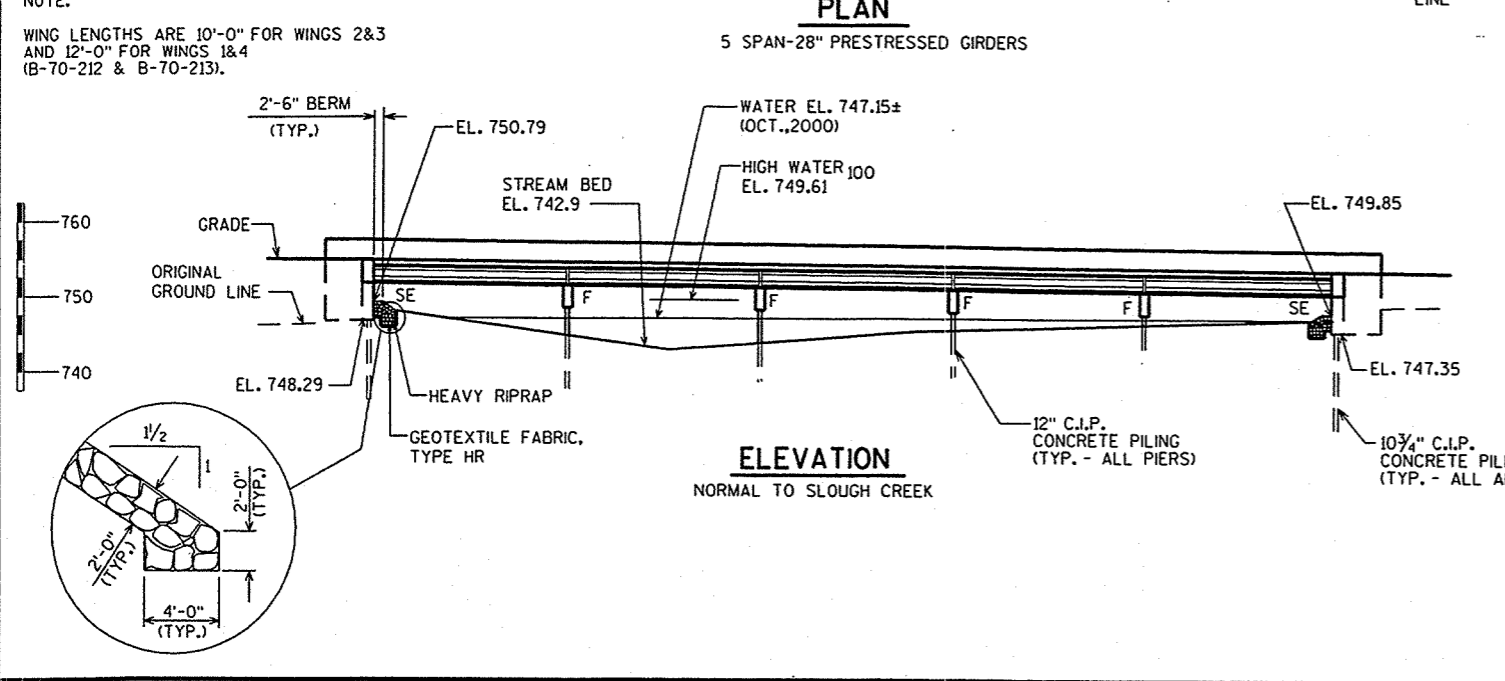

ELEVATION
 NORMAL TO SLOUGH CREEK

NOTE:
 WING LENGTHS ARE 10'-0" FOR WINGS 2&3 AND 12'-0" FOR WINGS 1&4 (B-70-212 & B-70-213).

LIST OF DRAWINGS

- GENERAL PLAN
- CROSS SECTION & QUANTITIES
- SUBSURFACE EXPLORATION
- SOUTH ABUTMENT
- SOUTH ABUTMENT DETAILS
- NORTH ABUTMENT
- NORTH ABUTMENT DETAILS
- PIERS 1 THRU 4
- 28" PRESTRESSED GIRDER DETAILS
- STEEL DIAPHRAGM
- SUPERSTRUCTURE
- SUPERSTRUCTURE DETAILS
- SLOPED FACED PARAPET 'LF'

BRIDGE OFFICE CONTACT = KENT BAHLER (608) 266-8490
 BRIDGE OFFICE CONTACT = CHARLES R. JUDD (608)-266-4547

NO.	DATE	REVISION	BY

Plans Prepared By **WISDOT**
STRUCTURES DESIGN

STRUCTURE B-70-213
 NORTHBOUND S.T.H. 110 OVER SLOUGH CREEK

COUNTY	WINNEBAGO	TOWN	OSHKOSH
--------	-----------	------	---------


DESIGN SPEC.	AASHTO STD. SPEC. 1998	LOAD	HS-20	CONST. SPEC.	1996
--------------	------------------------	------	-------	--------------	------

DESIGNED BY	MGW	DESIGN CK'D.	SDR	DRAWN BY	DDS	PLANS CK'D.	CRJ
-------------	-----	--------------	-----	----------	-----	-------------	-----


APPROVED: *[Signature]* 11-13-01
 CHIEF STRUCTURAL DESIGN ENGINEER DATE

GENERAL PLAN	SHEET 1 OF 13
	DATE: JULY '01

FILE= PREPLAN.DGN SCALE = 25

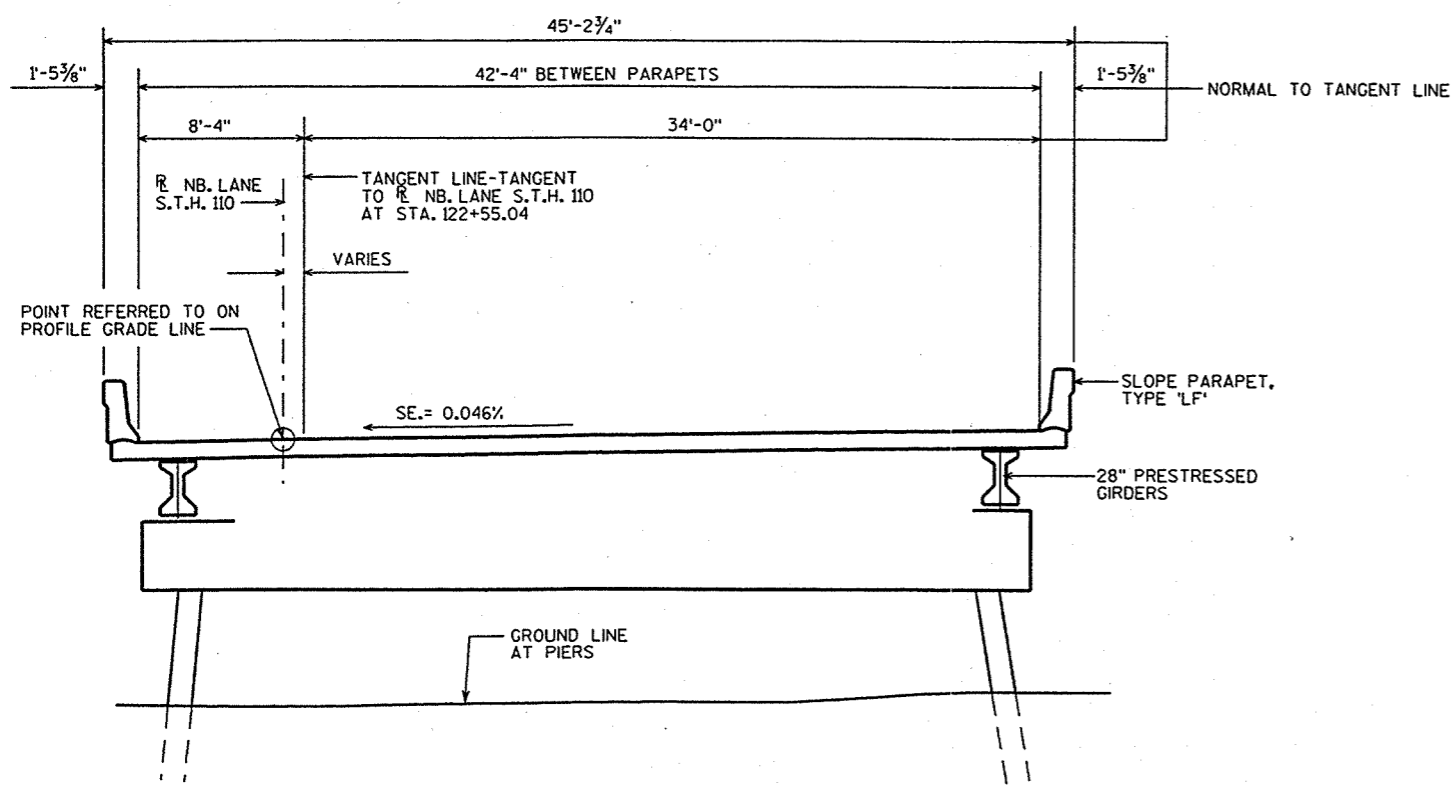

CROSS SECTION THRU ROADWAY LOOKING NORTH

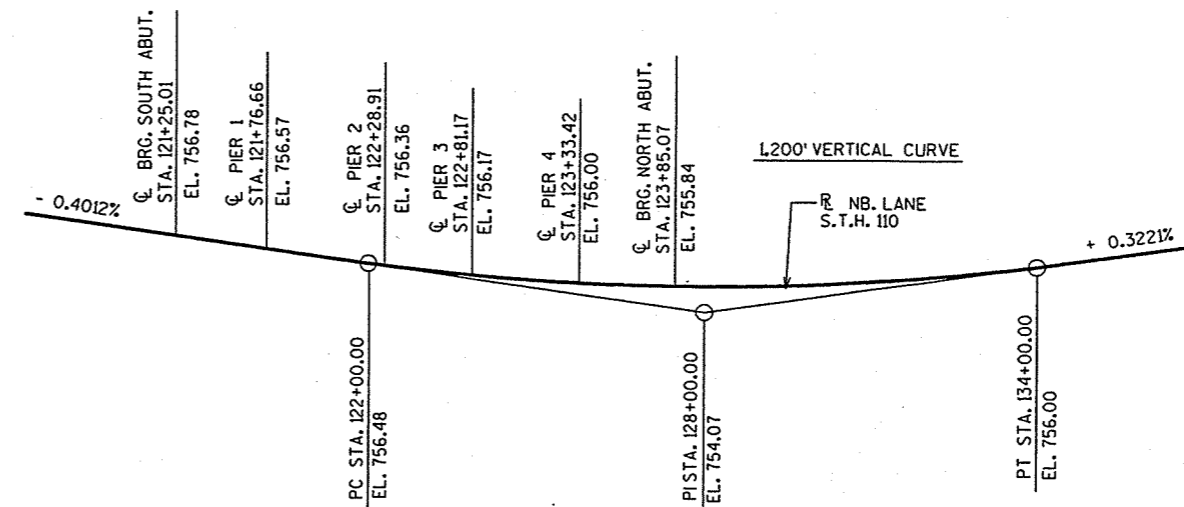

PROFILE GRADE LINE NB. LANE S.T.H. 110

TOTAL ESTIMATED QUANTITIES

BID ITEMS	UNIT	SUPER.	SOUTH ABUT.	NORTH ABUT.	PIER 1	PIER 2	PIER 3	PIER 4	TOTALS
EXCAVATION FOR STRUCTURES, BRIDGES, B-70-213	L.S.								1
STRUCTURE BACKFILL	C.Y.		154	154					308
CONCRETE MASONRY, BRIDGES	C.Y.	430	53	53	14	14	14	14	592
PROTECTIVE SURFACE TREATMENT	S.Y.	1460							1460
PRESTRESSED GIRDER, I TYPE, 28-INCH	L.F.	1560							1560
HIGH-STRENGTH BAR STEEL REINFORCEMENT, BRIDGES	LB.		2260	2260	4270	4270	4270	4270	21600
COATED HIGH-STRENGTH BAR STEEL REINFORCEMENT, BRIDGES	LB.	89930	1530	1530					92990
NON-LAMINATED ELASTOMERIC BEARING PADS	EACH	36							36
STEEL DIAPHRAGMS, STRUCTURE B-70-213	EACH	25							25
CAST-IN-PLACE CONCRETE PILING, DELIVERED AND DRIVEN, 10 3/4"	L.F.		420	455					875
CAST-IN-PLACE CONCRETE PILING, DELIVERED AND DRIVEN, 12"	L.F.				480	480	480	520	1960
RUBBERIZED MEMBRANE WATERPROOFING	S.Y.		8	8					16
HEAVY RIPRAP	C.Y.		80	60					140
PIPE UNDERDRAIN, 6-INCH	L.F.		61	61					122
PIPE UNDERDRAIN, UNPERFORATED, 6-INCH	L.F.		20	20					40
GEOTEXTILE FABRIC, TYPE DF	S.Y.		48	48					96
GEOTEXTILE FABRIC, TYPE HR	S.Y.		135	105					240
ANCHOR ASSEMBLIES FOR STEEL PLATE BEAM GUARD	EACH	4							4
OMP, READY MIXED CONCRETE MASONRY FOR BRIDGES	C.Y.	430	53	53	14	14	14	14	592
OMP, MASONRY STRENGTH INCENTIVE, READY-MIXED CONCRETE	DOL.								5920
NON-BID ITEMS									
FILLER	SIZE								1/2" & 3/4"

GENERAL NOTES

DRAWINGS SHALL NOT BE SCALED.
 BAR STEEL REINFORCEMENT SHALL BE EMBEDDED 2" CLEAR UNLESS OTHERWISE SHOWN OR NOTED.
 ELASTOMERIC BEARING PADS NEED NOT BE INDIVIDUALLY MOLDED PROVIDED THE CUT EDGES ARE SMOOTH AND TRUE.
 AT THE BACKFACE OF ABUTMENT ALL VOLUME WHICH CANNOT BE IN PLACE BEFORE ABUTMENT CONSTRUCTION AND NOT OCCUPIED BY THE NEW STRUCTURE SHALL BE BACKFILLED WITH STRUCTURE BACKFILL.
 THE EXISTING GROUND LINE SHALL BE USED AS THE UPPER LIMITS OF EXCAVATION AT THE PIERS.
 THE FIRST OR FIRST TWO DIGITS OF THE BAR MARK SIGNIFIES THE BAR SIZE.
 AT ABUTMENTS AND PIER(S), CONCRETE POURED UNDER WATER WILL BE ALLOWED AND SHALL BE DONE IN ACCORDANCE WITH SECTION 502.3.6.3 OF THE STANDARD SPECIFICATIONS.
 THE GRADATION OF THE STRUCTURE BACKFILL SHALL MEET THE REQUIREMENTS OF SECTION 209.2.2 OF THE STANDARD SPECIFICATIONS FOR GRADE 1 MATERIAL.

NO.	DATE	REVISION	BY
STATE OF WISCONSIN DEPARTMENT OF TRANSPORTATION STRUCTURES DESIGN SECTION			
STRUCTURE B-70-213			
CONST. SPEC.	1996	DRAWN BY	DDS
PLANS CKD.			CRJ
CROSS SECTION & QUANTITIES			SHEET 2

FILE= 70213QUANT.DGN
SCALE = 4

STH 110 OVER SLOUGH CREEK
 USH 41 TO STH 116, WINNEBAGO COUNTY

SLOUGH
 CREEK

STATE PROJECT NUMBER
6200-05-71

SHEET NO.
8.31

ABBREVIATIONS
 F—FINE M—MEDIUM C—COARSE
 WS—WEATHERED SO—SOUND

MATERIAL SYMBOLS

TOPSOIL	SILT	SANDSTONE
SAND	PEAT	LIMESTONE
GRAVEL	CLAY	IGNEOUS ROCK

LEGEND OF PROBING

PROBING NO.
 STA.
 ELEVATION
 7 AVERAGE BLOWS PER FOOT

95/6=95 BLOWS FOR 6" PENETRATION
 PROBING TAKEN WITH A 350*WT. FALLING 18" ON A 2" O.D. POINT.
 REFUSAL 95/6

LEGEND OF BORING

BORING NO.
 STA.
 ELEV.

UNCONFINED STRENGTH → 7.7
 BLOWS PER FT. USING 140* WT. FALLING 30"
 WASH SAMPLE



SANDY GRAVEL
 BOULDERS OR COBBLES
 SAND
 SILTY CLAY
 LIMESTONE

SHELBY TUBE—S.T.
 GROUND WATER ELEVATION
 NO GROUND WATER OBSERVED ABOVE THIS ELEVATION

UNLESS OTHERWISE SPECIFIED, THE BLOWS PER FOOT AT THE LOCATIONS INDICATED ARE BASED ON DRIVING A O.D. XL 4" I.D. SPLIT SPOON SAMPLER WITH A 140* HAMMER HAVING A FREE FALL OF 30". THE BLOW COUNT IS TAKEN IN UNDISTURBED SOIL IMMEDIATELY BELOW A CASED OR OPEN HOLE ELIMINATING SIDE FRICTION ON THE DRIVE PIPE.

SUBSURFACE EXPLORATION FOR FOUNDATION DESIGN AND BIDDERS INFORMATION

TO OBTAIN RELATIVE DATA CONCERNING THE CHARACTER OF MATERIAL IN AND UPON WHICH THE FOUNDATION MIGHT BE BUILT, BORINGS AND/OR SOUNDINGS WERE MADE AT POINTS APPROXIMATELY AS INDICATED ON THIS DRAWING. THE DATA PRESENTED HEREIN REPRESENTS THE FINDINGS OF THE SUBSURFACE EXPLORATIONS MADE. HOWEVER, BECAUSE THE DEPTHS INVESTIGATED ARE LIMITED AND THE AREA OF THE BORINGS AND/OR SOUNDINGS IS VERY SMALL IN RELATION TO THE ENTIRE AREA, THE DIVISION OF HIGHWAYS DOES NOT WARRANT CONDITIONS BELOW THE DEPTHS INVESTIGATED OR THAT THE CLASSIFICATION OF MATERIAL ENCOUNTERED IN THESE INVESTIGATIONS IS NECESSARILY TYPICAL OF THE ENTIRE SITE.

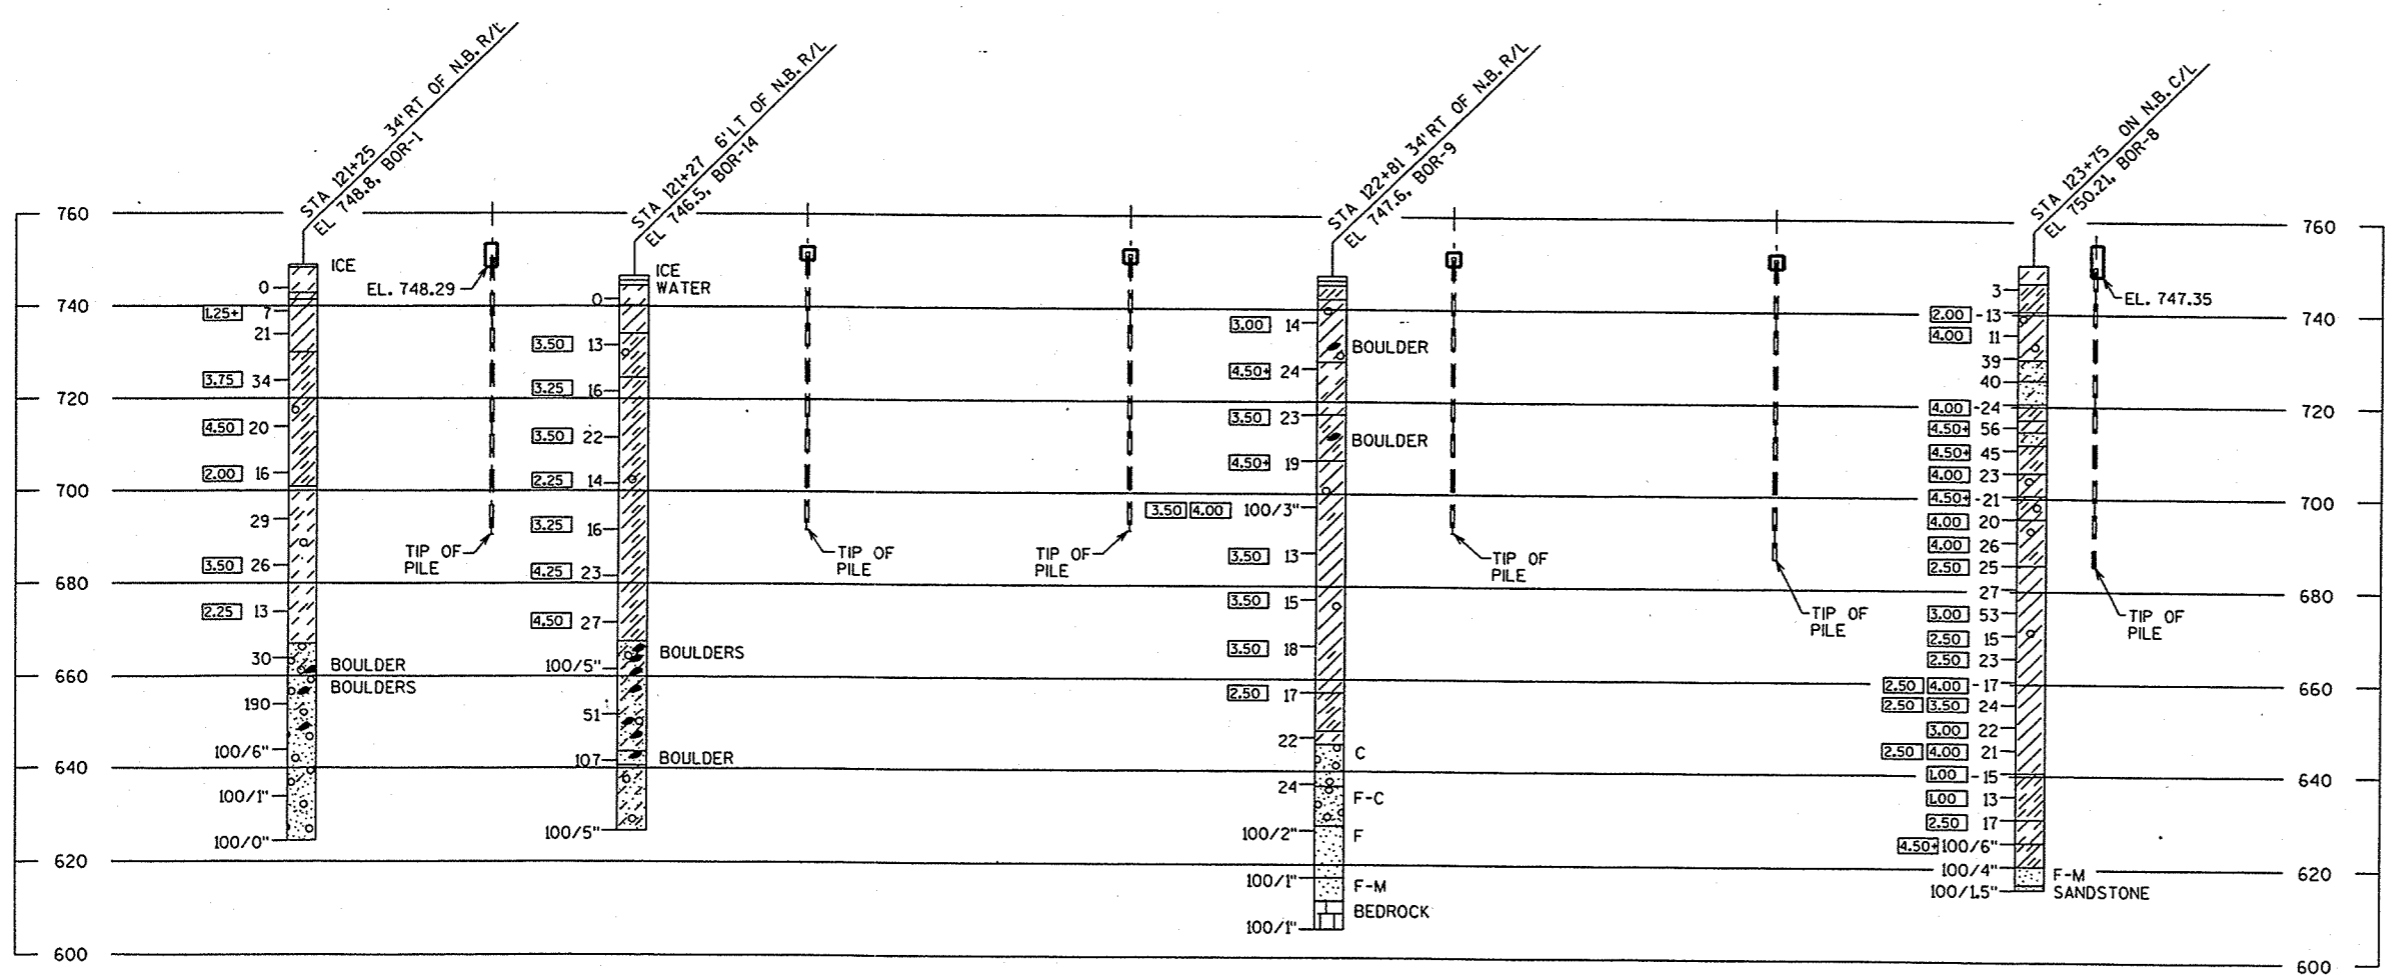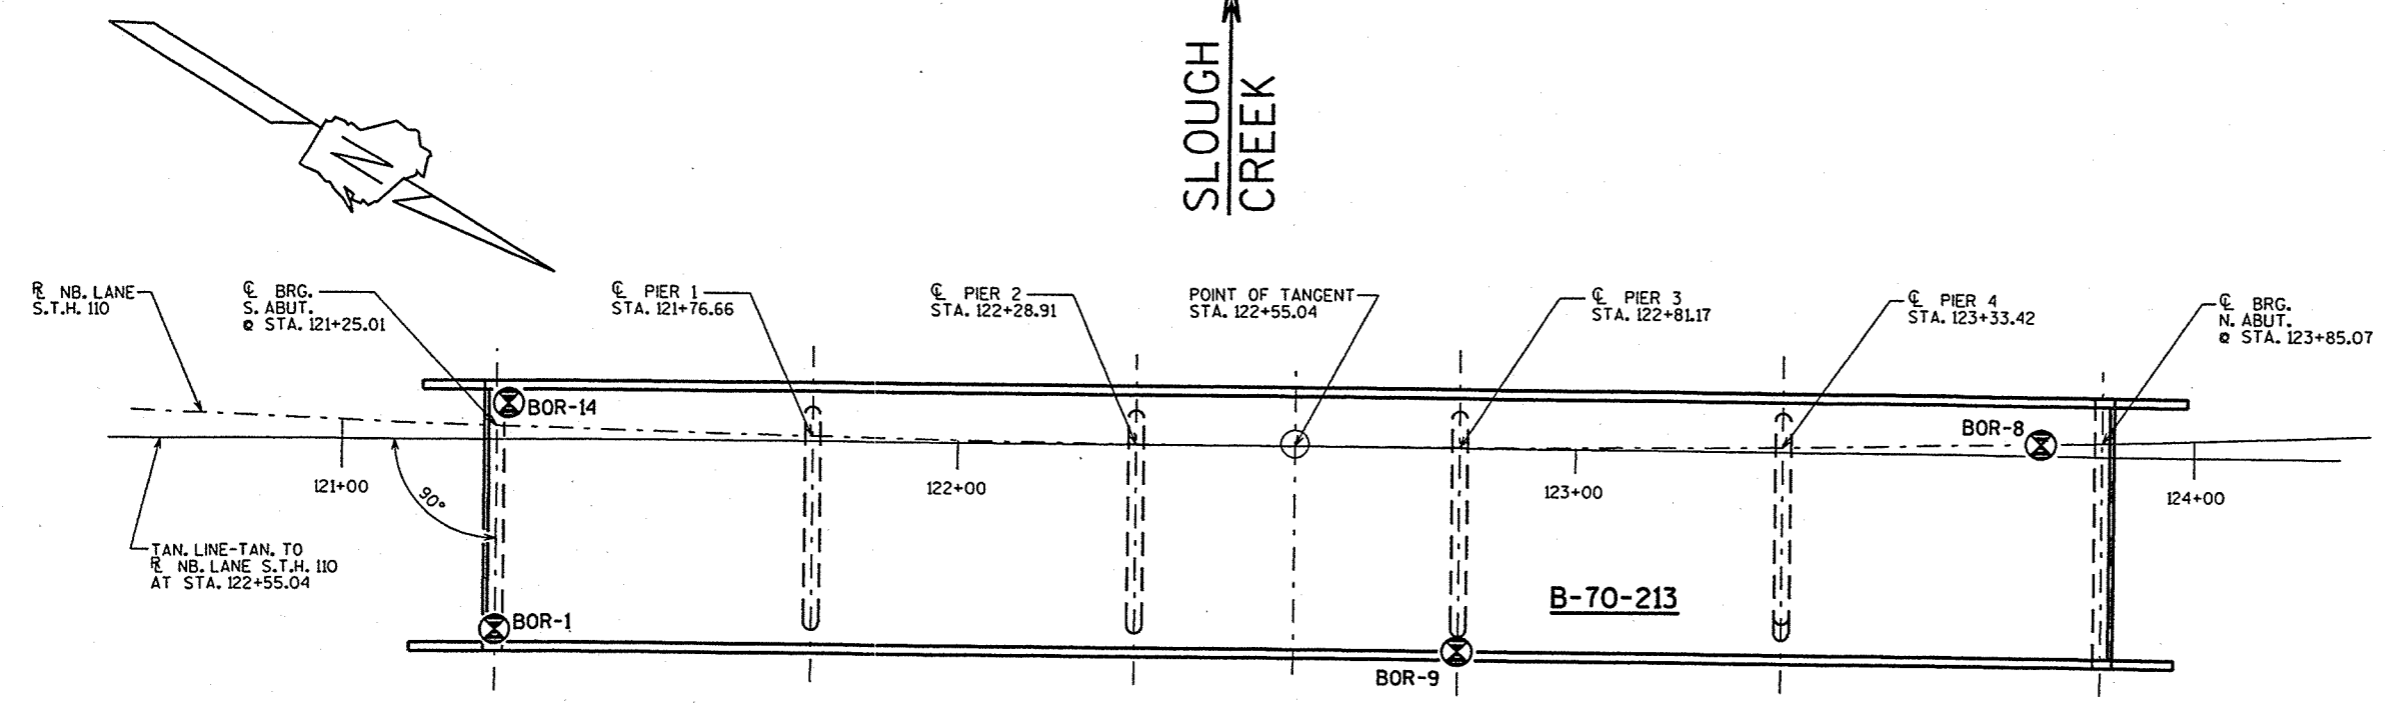

NO.	DATE	REVISION	BY


STATE OF WISCONSIN
 DEPARTMENT OF TRANSPORTATION
 STRUCTURES DESIGN SECTION

STRUCTURE B-70-213


CONST. SPEC. 1996 DRAWN BY DDS PLANS CK'D. **CRJ**

SUBSURFACE EXPLORATION SHEET 3


FILE: 70213SOILS.DGN
 SCALE = 24

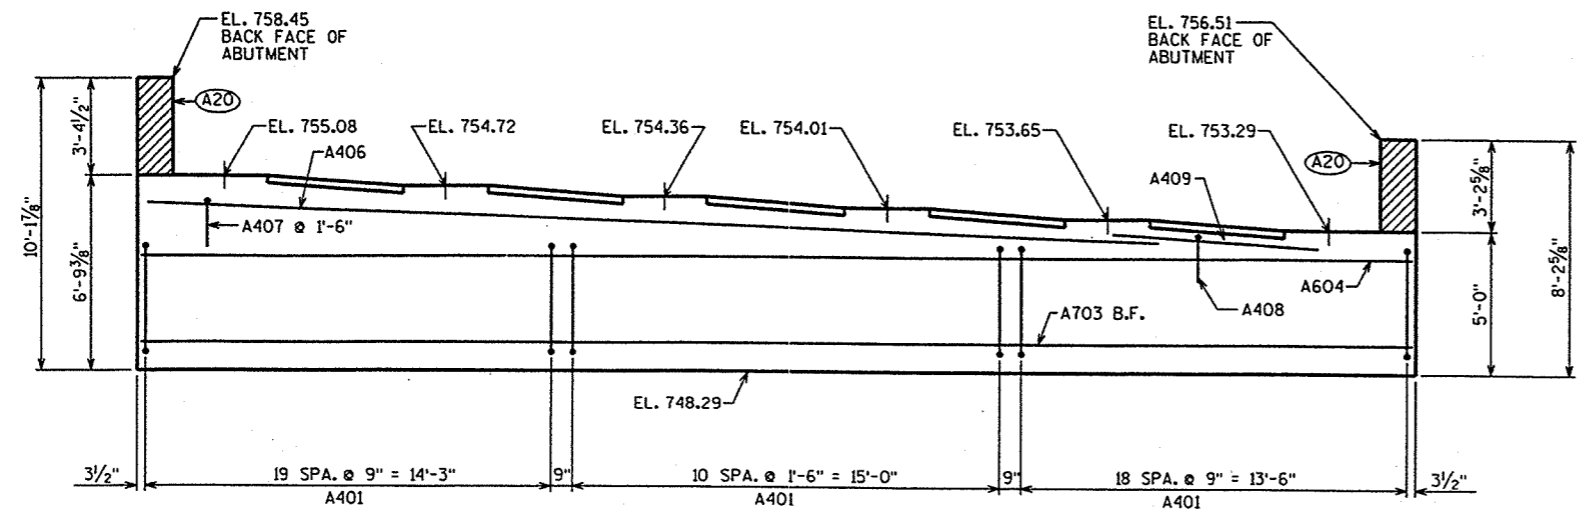


ELEVATION LOOKING SOUTH

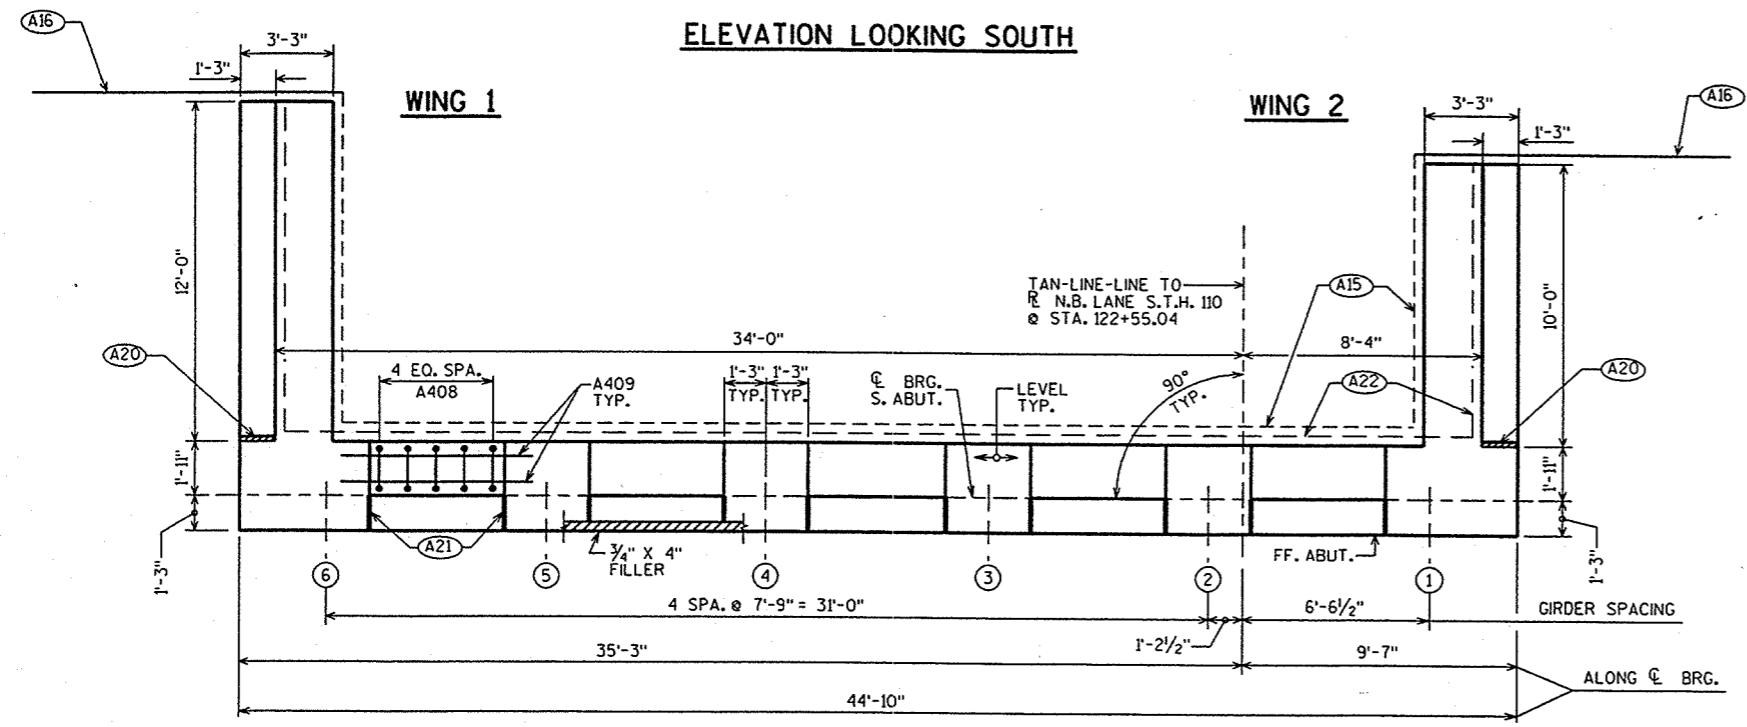

PLAN

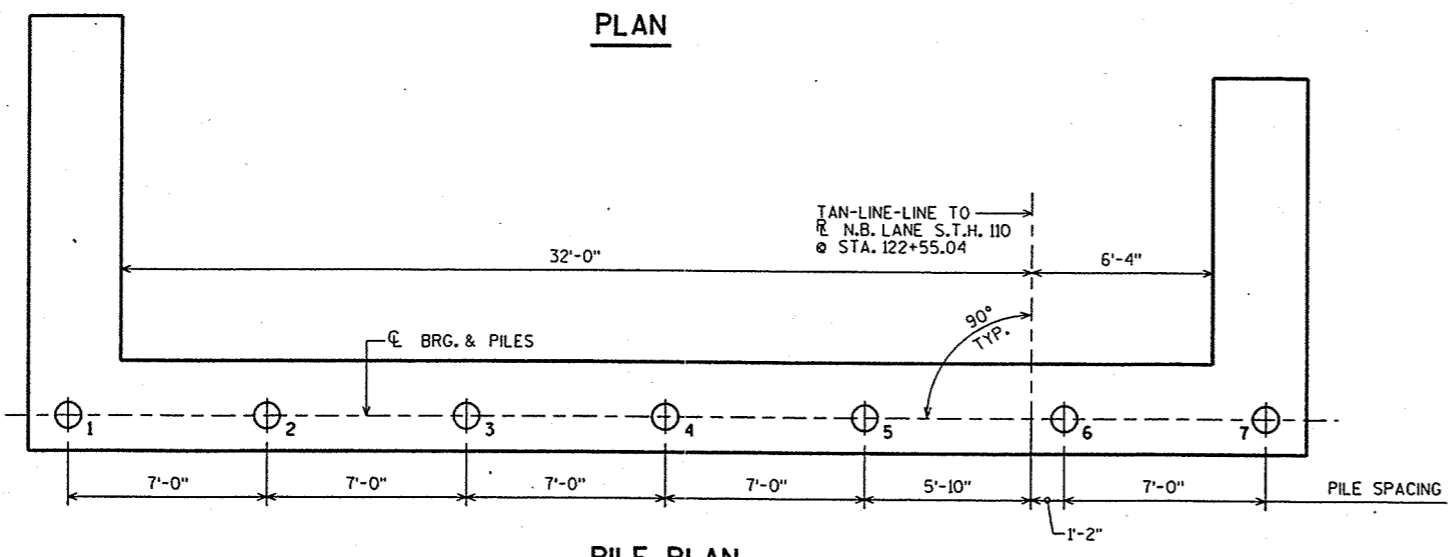


PILE PLAN

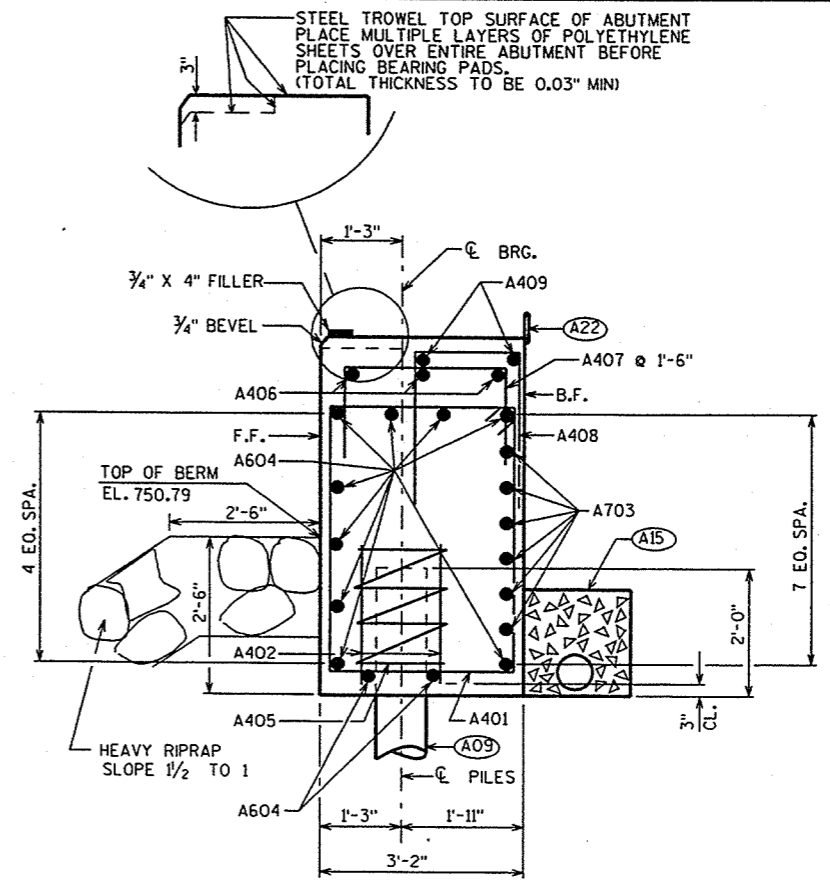


SECTION THRU BODY

- (A09) SUPPORT ABUTMENT ON 10 3/4" DIA. CAST-IN-PLACE CONCRETE PILING, ESTIMATED 60'-0" LONG, AND DRIVEN TO A MIN. BRG. VALUE OF 55 TONS PER PILE.
- (A15) PIPE UNDERDRAIN, 6 INCH. SLOPE TO DRAIN. ENCLOSED IN 1'-6" X 1'-6" AREA OF SIZE 1 COARSE AGGREGATE (INCLUDED IN UNDERDRAIN BID ITEM) WRAPPED IN GEOTEXTILE FABRIC, TYPE DF.
- (A16) PIPE UNDERDRAIN, 6 INCH, UNPERFORATED. TO SUITABLE DRAINAGE.
- (A20) 1/2" FILLER (INCLUDED IN WING LENGTH); SEAL EXPOSED HORIZ. & VERT. SURFACES OF 1/2" FILLER WITH NON-STAINING GRAY NON-BITUMINOUS JOINT SEALER. (1" DEEP AND HOLD 1/8" BELOW SURFACE OF CONCRETE). EXTEND SEALER 3" BELOW GUTTER LINE AT INSIDE FACE.
- (A21) 3/4" CORK UP VERT. FACES OF BEAM SEATS.
- (A22) 18" (RMW) RUBBERIZED MEMBRANE WATERPROOFING SEAL ALL HORIZ. & VERT. JOINTS AT BACKFACE.

NO.	DATE	REVISION	BY
STATE OF WISCONSIN DEPARTMENT OF TRANSPORTATION STRUCTURES DESIGN SECTION			
STRUCTURE B-70-213			
CONST. SPEC.	1996	DRAWN BY DDS	PLANS CKD. CRJ
SOUTH ABUTMENT			SHEET 4

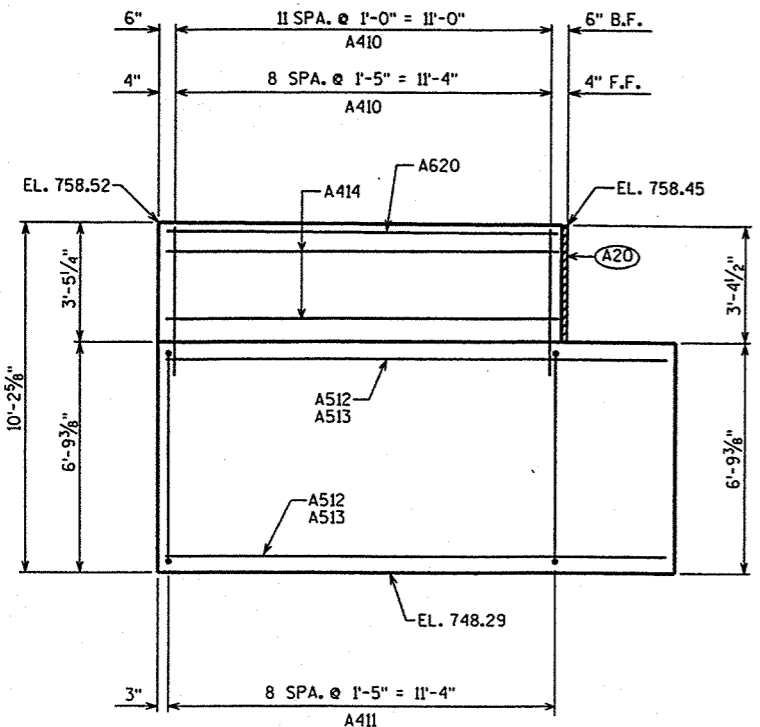

WING 1 ELEVATION

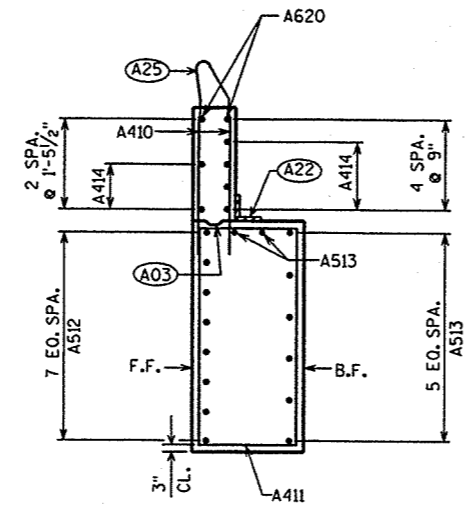


WING 1 SECTION

- (A03) OPTIONAL CONST. JOINT: KEYWAY FORMED BY BEVELED 2 x 6. (18" R.M.W. @ B.F. & 3/4" "V" GROOVE @ F.F. IF JOINT IS USED).
- (A20) 1/2" FILLER (INCLUDED IN WING LENGTH); SEAL EXPOSED HORIZ. & VERT. SURFACES OF 1/2" FILLER WITH NON-STAINING GRAY NON-BITUMINOUS JOINT SEALER. (1" DEEP AND HOLD 1/8" BELOW SURFACE OF CONCRETE). EXTEND SEALER 3" BELOW GUTTER LINE AT INSIDE FACE.
- (A22) 18" (RMW) RUBBERIZED MEMBRANE WATERPROOFING SEAL ALL HORIZ. & VERT. JOINTS AT BACKFACE.
- (A25) FOR PARAPET BARS & DIMENSION SEE PARAPET SHT. 13


BILL OF BARS

NOTE: THE FIRST OR FIRST TWO DIGITS OF THE BARMARK SIGNIFIES THE BAR SIZE.


BAR MARK	CO.	NO. REQ'D.	LENGTH	BENT	BAR SERIES	LOCATION
A401		50	14'-10"	X		BODY-STIRRUPS
A402		14	2'-3"			PILES- 2 PER BODY PILE
A703		6	44'-6"			BODY-HORIZ.-B.F.
A604		11	44'-6"			BODY-HORIZ.-F.F.
A405		7	28'-0"	X		PILES-1 PER BODY PILE
A406		3	38'-6"			BODY-HORIZ.-OVER GIRS. 2-6
A407		26	8'-0"	X		BODY-VERT.-OVER GIRS. 2-6
A408		25	3'-11"	X		BODY-VERT.-BETWEEN BEAM SEATS
A409		10	7'-3"			BODY-HORIZ.-BETWEEN GIRDERS
A410	X	21	4'-8"			WING 1-VERT.-F.F.-B.F.
A411	X	9	19'-0"	X		WING 1-STIRRUP
A512	X	8	14'-10"			WING 1-HORIZ.-F.F.
A513	X	8	13'-7"			WING 1-HORIZ.-B.F.
A414	X	6	11'-8"			WING 1-HORIZ.-F.F.-B.F.
A415	X	17	4'-8"			WING 2-VERT.-F.F.-B.F.
A416	X	8	15'-6"	X		WING 2-STIRRUP
A517	X	6	12'-10"			WING 2-HORIZ.-F.F.
A718	X	7	12'-8"			WING 2-HORIZ.-B.F.
A419	X	6	9'-8"			WING 2-HORIZ.-F.F.-B.F.
A620	X	2	11'-8"			WING 1-HORIZ.
A621	X	2	9'-8"			WING 2-HORIZ.

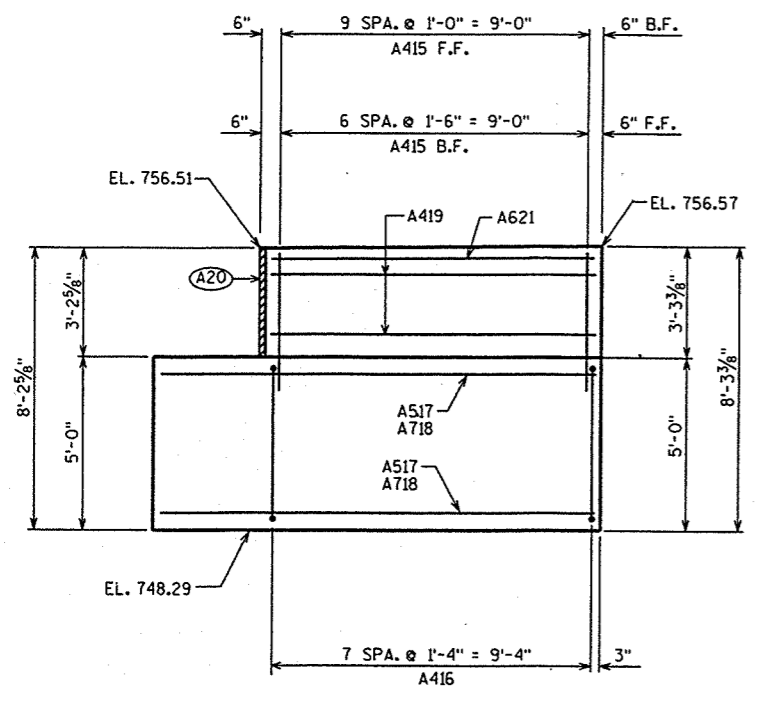


WING 2 ELEVATION

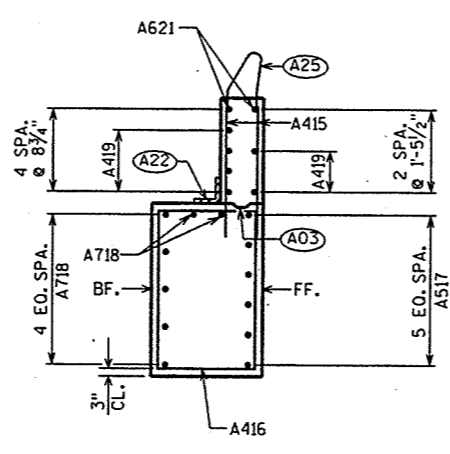


WING 2 SECTION

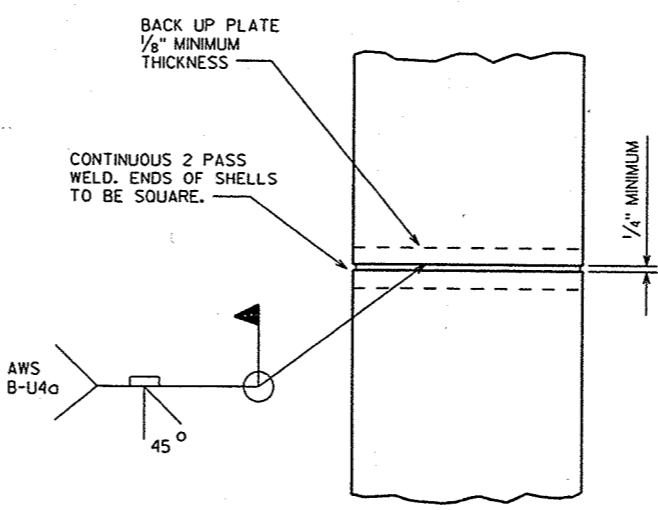


PILE SPLICE DETAIL

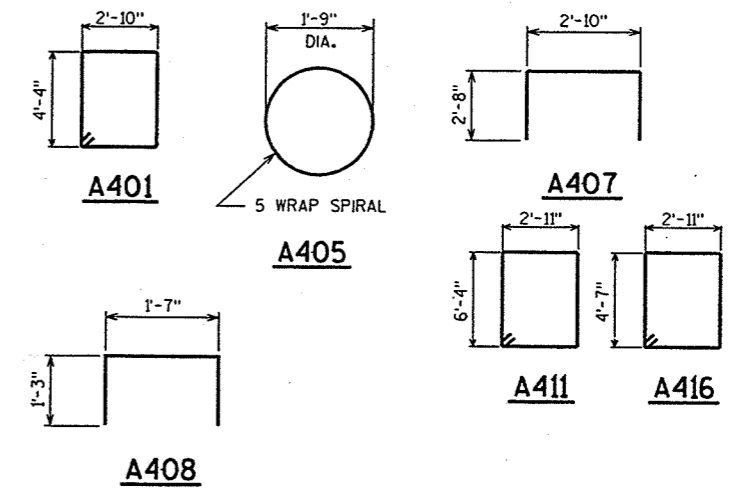


NO.	DATE	REVISION	BY
STATE OF WISCONSIN DEPARTMENT OF TRANSPORTATION STRUCTURES DESIGN SECTION			
STRUCTURE B-70-213			
CONST. SPEC.	1996	DRAWN BY	DDS
		PLANS CKD.	CRJ
SOUTH ABUTMENT DETAILS			SHEET 5

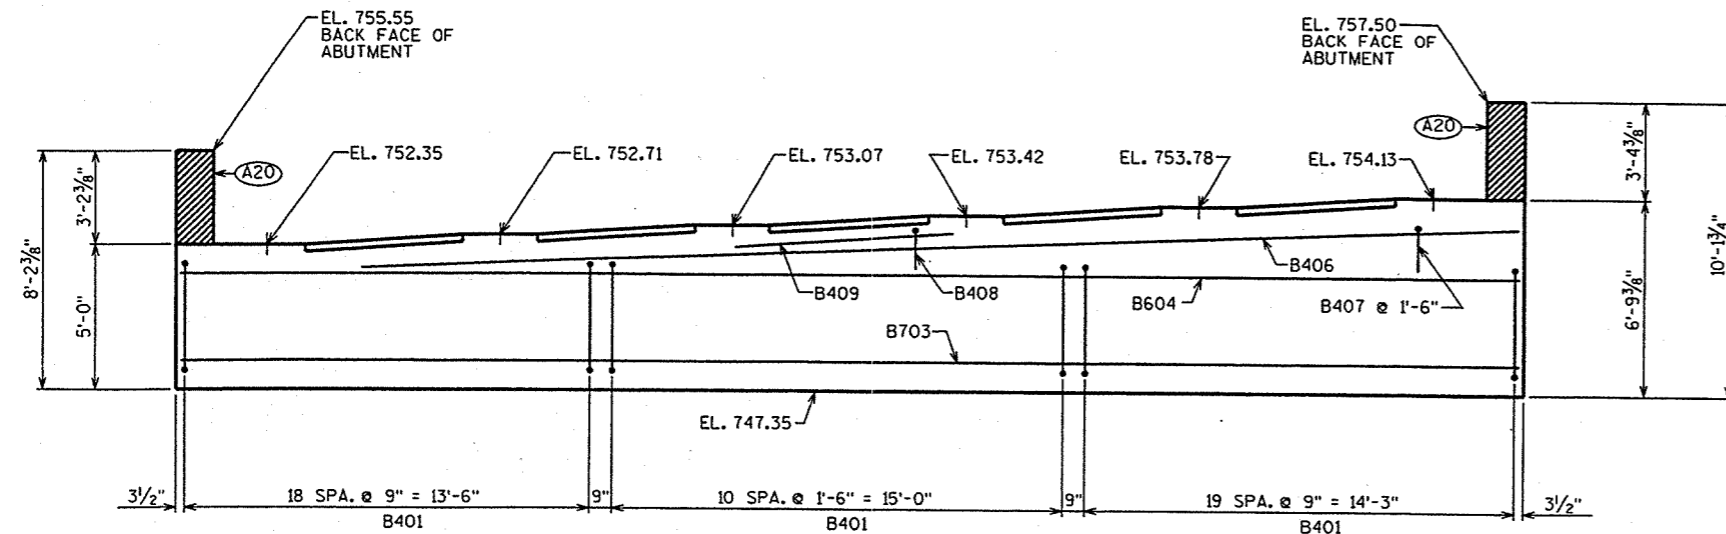


ELEVATION LOOKING NORTH

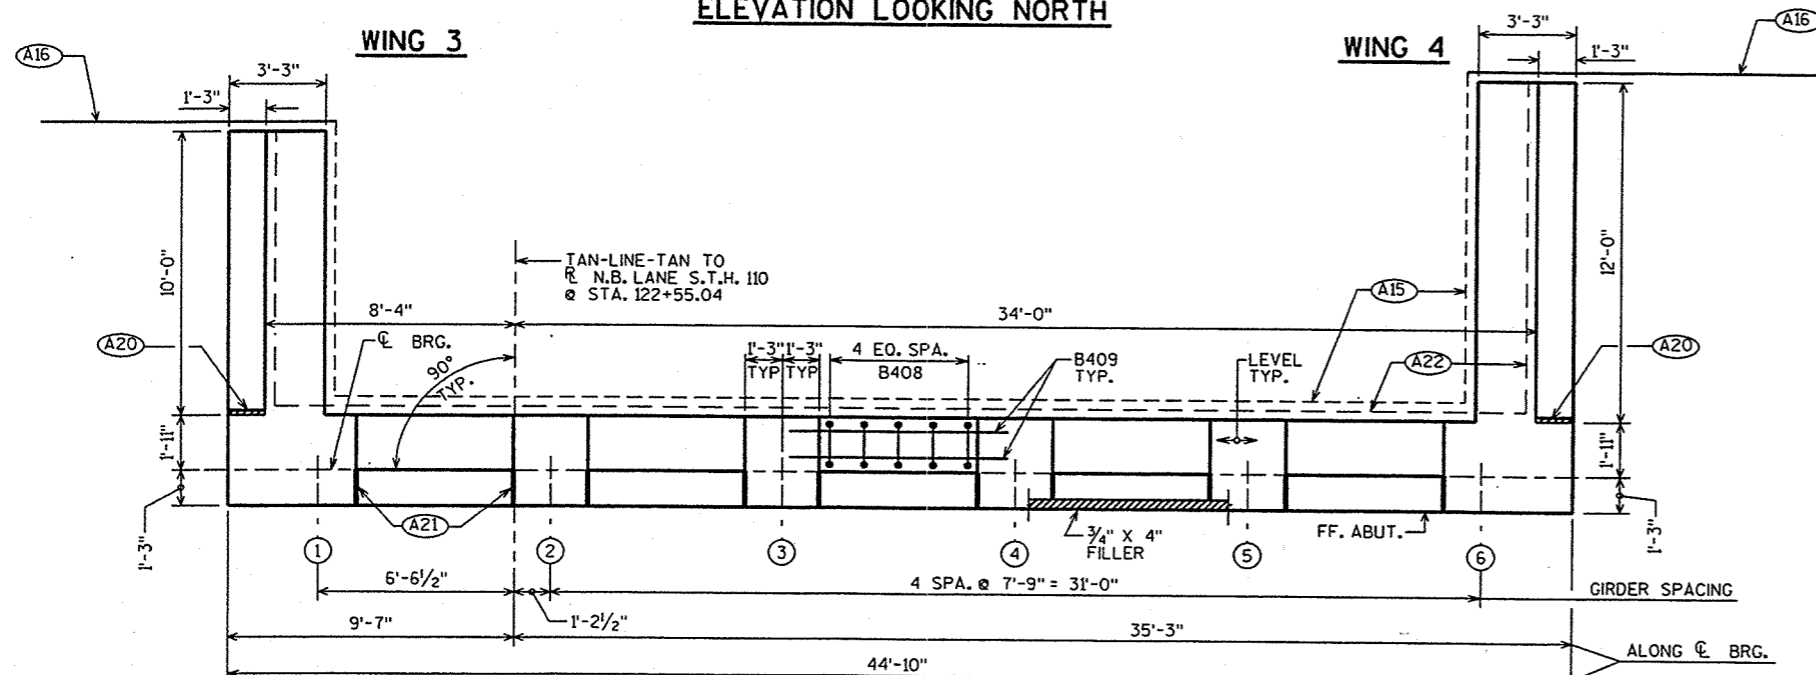

PLAN

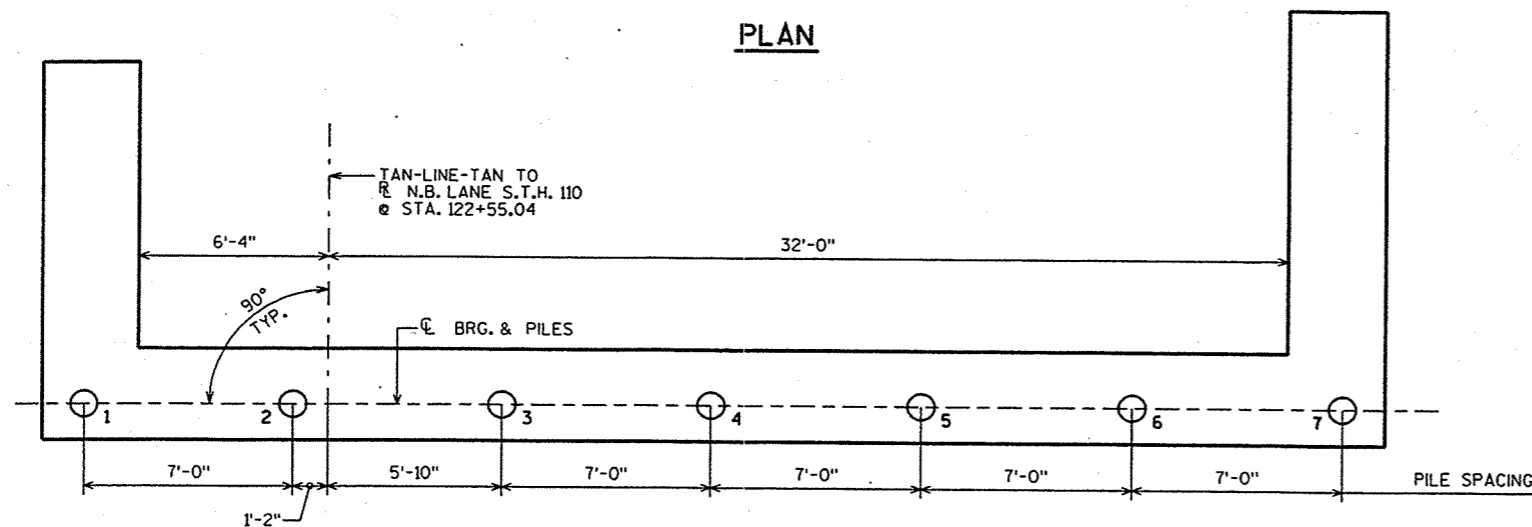


PILE PLAN

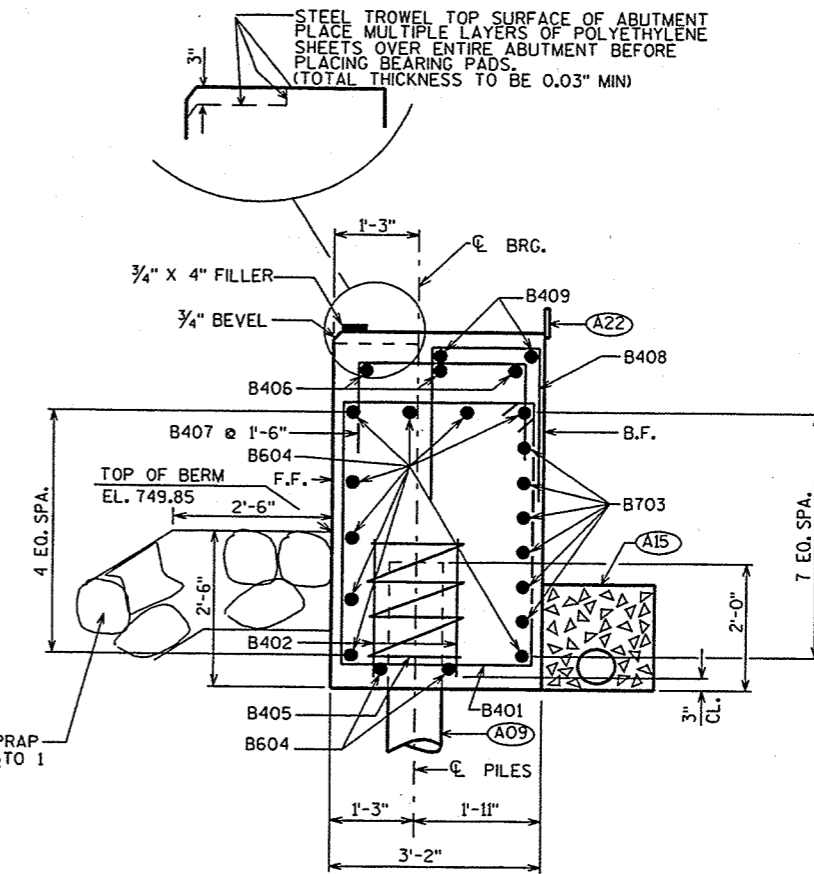


SECTION THRU BODY

- (A09) SUPPORT ABUTMENT ON 10 3/4" DIA. CAST-IN-PLACE CONCRETE PILING, ESTIMATED 65'-0" LONG, AND DRIVEN TO A MIN. BRG. VALUE OF 55 TONS PER PILE.
- (A15) PIPE UNDERDRAINS, 6 INCH, SLOPE TO DRAIN, ENCLOSED IN 1'-6" X 1'-6" AREA OF SIZE 1 COARSE AGGREGATE (INCLUDED IN UNDERDRAIN BID ITEM) WRAPPED IN GEOTEXTILE FABRIC, TYPE DF.
- (A16) PIPE UNDERDRAIN, 6 INCH, UNPERFORATED, TO SUITABLE DRAINAGE.
- (A20) 1/2" FILLER (INCLUDED IN WING LENGTH); SEAL EXPOSED HORIZ. & VERT. SURFACES OF 1/2" FILLER WITH NON-STAINING GRAY NON-BITUMINOUS JOINT SEALER, (1" DEEP AND HOLD 1/8" BELOW SURFACE OF CONCRETE), EXTEND SEALER 3" BELOW GUTTER LINE AT INSIDE FACE.
- (A21) 3/4" CORK UP VERT. FACES OF BEAM SEATS.
- (A22) 18" (RMW) RUBBERIZED MEMBRANE WATERPROOFING SEAL ALL HORIZ. & VERT. JOINTS AT BACKFACE.


NO.	DATE	REVISION	BY
STATE OF WISCONSIN DEPARTMENT OF TRANSPORTATION STRUCTURES DESIGN SECTION			
STRUCTURE B-70-213			
CONST. SPEC.	1996	DRAWN BY	DDS
		PLANS CK'D.	CRJ
NORTH ABUTMENT			SHEET 6

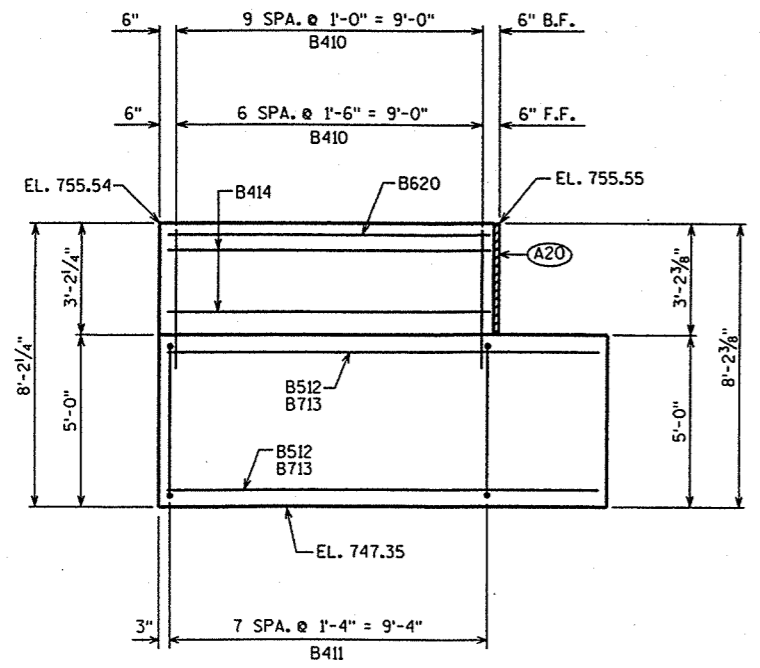


WING 3 ELEVATION

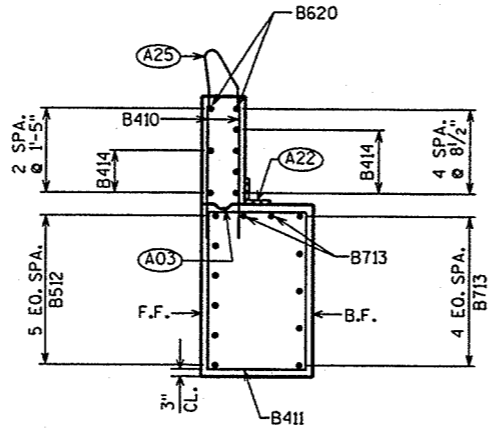

WING 3 SECTION

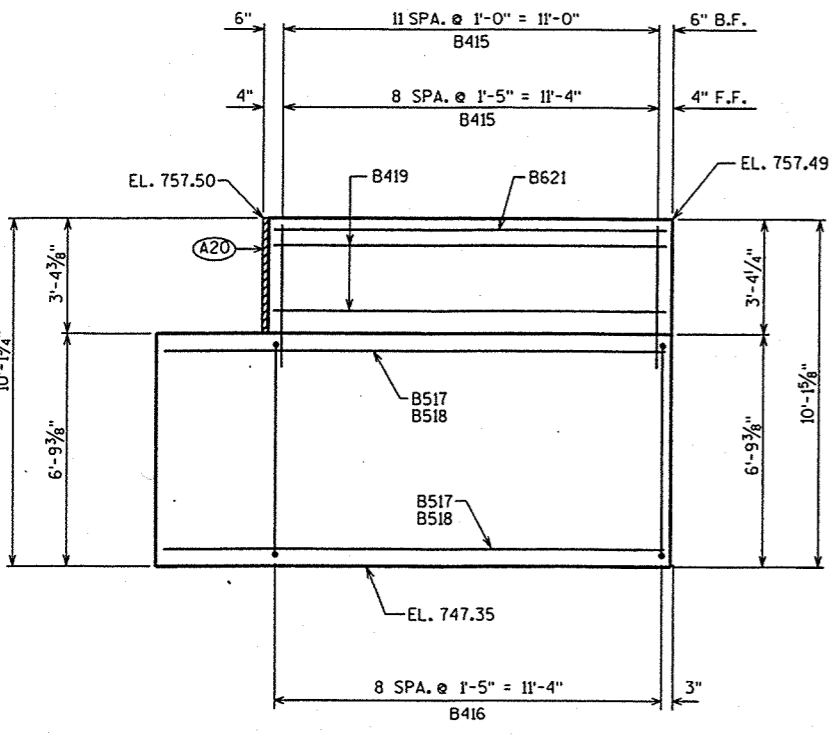

WING 4 ELEVATION

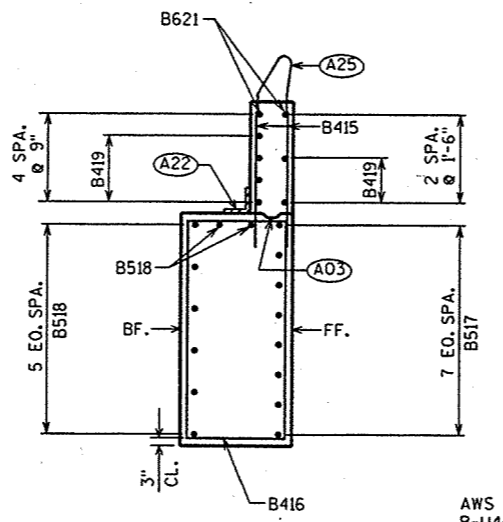


WING 4 SECTION

- (A03) OPTIONAL CONST. JOINT: KEYWAY FORMED BY BEVELED 2 x 6, (18" R.M.W. @ B.F. & 3/4" "V" GROOVE @ F.F. IF JOINT IS USED).
- (A20) 1/2" FILLER (INCLUDED IN WING LENGTH); SEAL EXPOSED HORIZ. & VERT. SURFACES OF 1/2" FILLER WITH NON-STAINING GRAY NON-BITUMINOUS JOINT SEALER. (1" DEEP AND HOLD 1/8" BELOW SURFACE OF CONCRETE). EXTEND SEALER 3" BELOW GUTTER LINE AT INSIDE FACE.
- (A22) 18" (RMW) RUBBERIZED MEMBRANE WATERPROOFING SEAL ALL HORIZ. & VERT. JOINTS AT BACKFACE.
- (A25) FOR PARAPET BARS & DIMENSION SEE PARAPET SHT. 13


BILL OF BARS

NOTE: THE FIRST OR FIRST TWO DIGITS OF THE BAR MARK SIGNIFIES THE BAR SIZE.

BAR MARK	COAT	NO. REQ'D.	LENGTH	BENT	BAR SERIES	LOCATION
B401		50	14'-10"	X		BODY-STIRRUPS
B402		14	2'-3"			PILES- 2 PER BODY PILE
B703		6	44'-6"			BODY-HORIZ.-B.F.
B604		11	44'-6"			BODY-HORIZ.-F.F.
B405		7	28'-0"	X		PILES-1 PER BODY PILE
B406		3	38'-6"			BODY-HORIZ.-OVER GIRS. 2-6
B407		26	8'-0"	X		BODY-TOP-OVER GIRS. 2-6
B408		25	3'-11"	X		BODY-VERT.-BETWEEN BEAM SEATS
B409		10	7'-3"			BODY-HORIZ.-BETWEEN BEAM SEATS
B410	X	17	4'-6"			WING 3-VERT.-F.F.-B.F.
B411	X	8	15'-6"	X		WING 3-STIRRUP
B512	X	6	12'-10"			WING 3-HORIZ.-F.F.
B713	X	7	12'-8"			WING 3-HORIZ.-B.F.
B414	X	6	9'-8"			WING 3-HORIZ.-F.F.-B.F.
B415	X	21	4'-8"			WING 4-VERT.-F.F.-B.F.
B416	X	9	19'-0"	X		WING 4-STIRRUP
B517	X	8	14'-10"			WING 4-HORIZ.-F.F.
B518	X	8	13'-7"			WING 4-HORIZ.-B.F.
B419	X	6	11'-8"			WING 4-HORIZ.-F.F.-B.F.
B620	X	2	9'-8"			WING 3-HORIZ.
B621	X	2	11'-8"			WING 4-HORIZ.

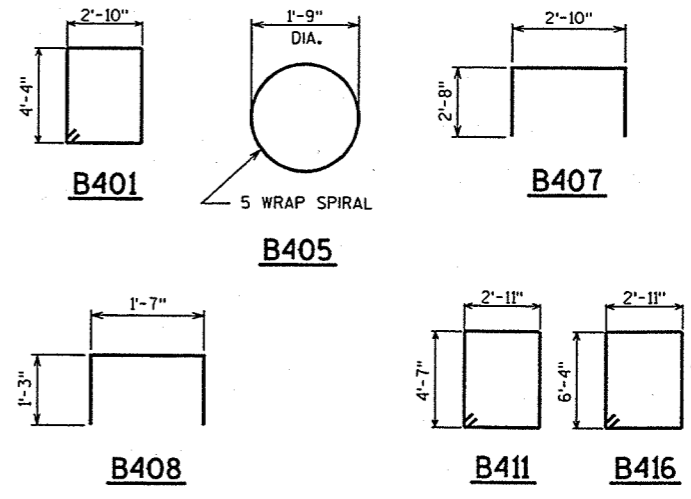

PILE SPLICE DETAIL

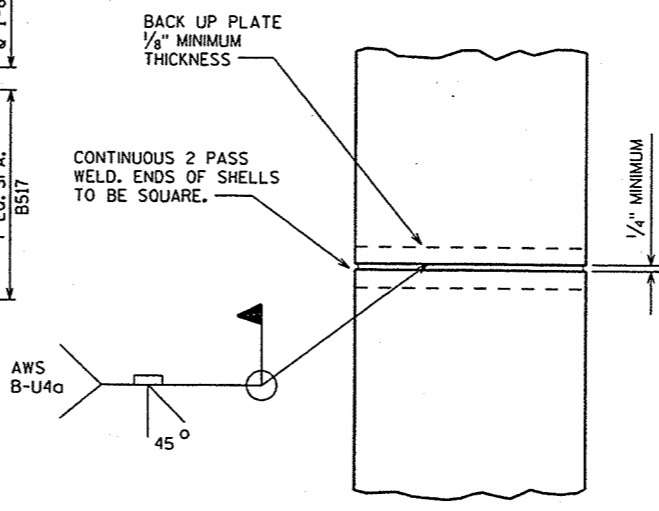

NO.	DATE	REVISION	BY
STATE OF WISCONSIN DEPARTMENT OF TRANSPORTATION STRUCTURES DESIGN SECTION			
STRUCTURE B-70-213			
CONST. SPEC.	1996	DRAWN BY	DDS
		PLANS CKD.	CRT
NORTH ABUTMENT DETAILS			SHEET 7

PIER ELEVATIONS

	ELEV. "A"	ELEV. "B"	ELEV. "C"	ELEV. "D"	ELEV. "E"	ELEV. "F"	ELEV. "G"	ELEV. "H"
PIER #1	753.02	753.37	753.73	754.08	754.44	754.80	750.02	751.80
PIER #2	752.78	753.13	753.49	753.85	754.20	754.56	749.78	751.56
PIER #3	752.58	752.94	753.30	753.65	754.01	754.37	749.58	751.37
PIER #4	752.44	752.80	753.16	753.51	753.87	754.23	749.44	751.23

STATE PROJECT NUMBER

6200-05-71

SHEET NO.

8.36

BILL OF BARS

NOTE: THE FIRST OR FIRST TWO DIGITS OF THE BAR MARK SIGNIFIES THE BAR SIZE.

BAR MARK	COAT	NO. REQ'D.				LENGTH	BENT	BAR SERIES	LOCATION
		PIER 1	PIER 2	PIER 3	PIER 4				
P501		39	39	39	39	11'-0"	X		CAP-STIRRUPS
P602		4	4	4	4	42'-6"			CAP-BOTTOM-HORIZ.
P503		2	2	2	2	42'-6"			CAP-SIDES-HORIZ.
P504		25	25	25	25	2'-0"			CAP-DOWELS
P505		2	2	2	2	5'-2"	X		CAP-ENDS
P706		48	48	48	48	30'-0"			PILES-VERT.
P307		128	128	128	128	3'-8"	X		PILES-HORIZ.
P608		8	8	8	8	24'-9"	X		CAP-TOP-HORIZ.

BACK UP PLATE
1/8" MINIMUM THICKNESS

CONTINUOUS 2 PASS WELD. ENDS OF SHELLS TO BE SQUARE.


AWS B-U4g

PILE SPlice DETAIL


NOTE: PILES SPLICES SHALL BE MADE BY A CERTIFIED WELDER USING LOW HYDROGEN ELECTRODES

- (P03) P504 BARS @ 1'-0" CTRS. BETWEEN BEAM SEATS. MAY BE PLACED AFTER CONCRETE IS POURED BUT BEFORE INITIAL SET HAS TAKEN PLACE. (EMBED 1'-0" INTO CONC.)
- (P08) KEYED CONSTRUCTION JOINT-FORMED BY BEVELED 2 x 6 BETWEEN BEAM SEATS.
- (P09) SUPPORT PIERS ON 12" DIA. CAST-IN-PLACE CONCRETE PILING, DRIVEN TO A MIN. BRG. VALUE OF 55 TONS PER PILE. (.375" MIN. WALL THICKNESS REQ'D. FOR ALL PILING) (TYP. ALL PIERS.)
- (P10) INDICATES PILE BATTERED 2" PER FT. IN DIRECTION OF ARROW.



PIER #1 - ESTIMATED LENGTH 60'-0"
PIER #2 - ESTIMATED LENGTH 60'-0"
PIER #3 - ESTIMATED LENGTH 60'-0"
PIER #4 - ESTIMATED LENGTH 65'-0"

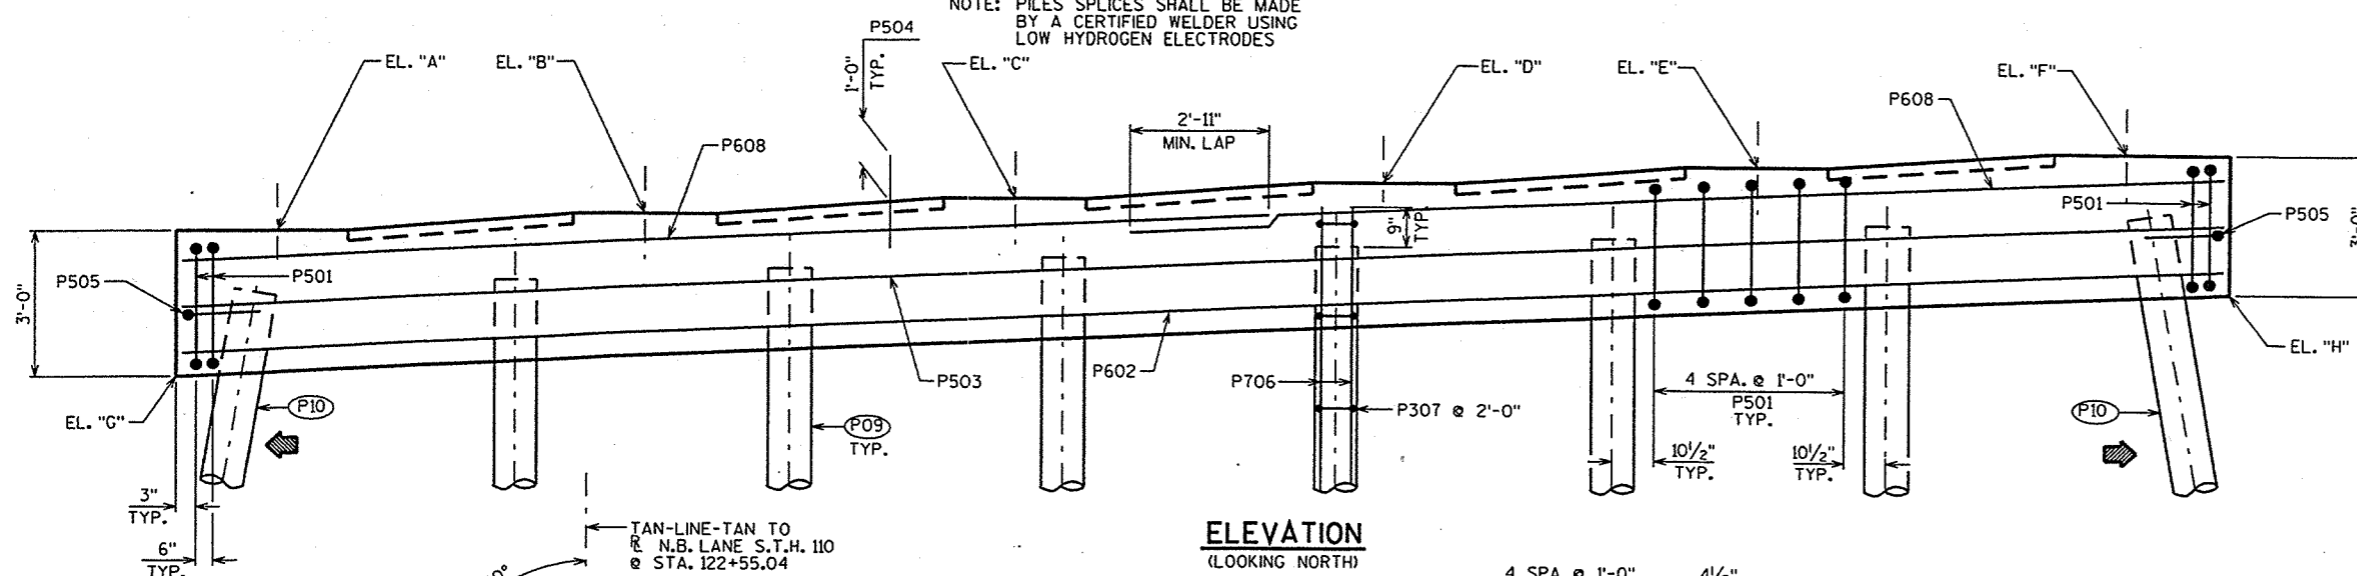

ELEVATION
(LOOKING NORTH)

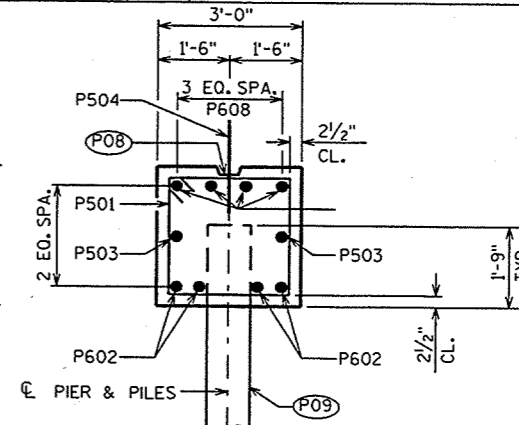


SECTION THRU CAP

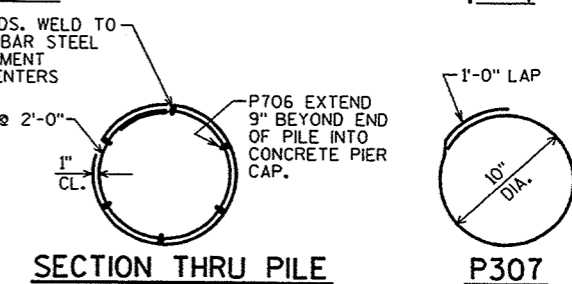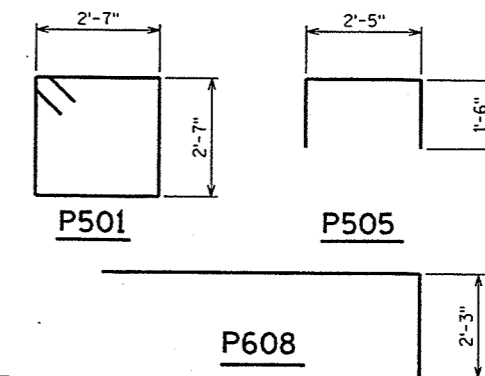


SECTION THRU PILE

P307

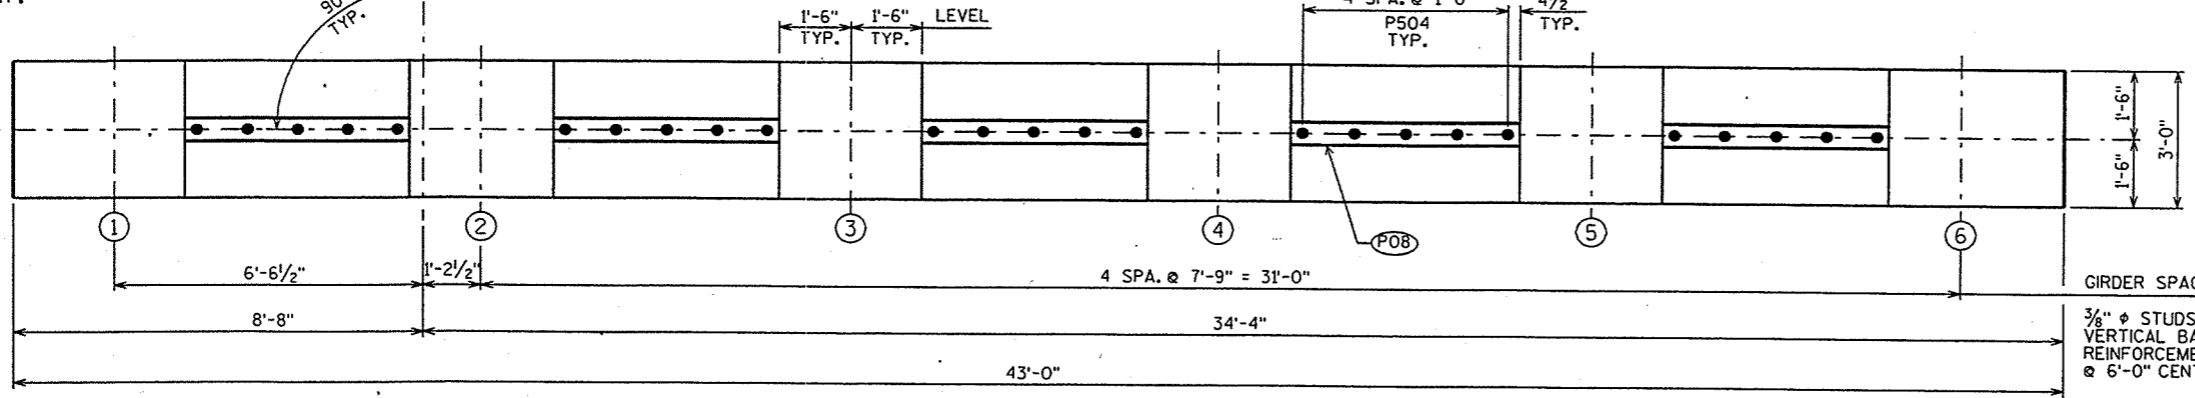

PLAN

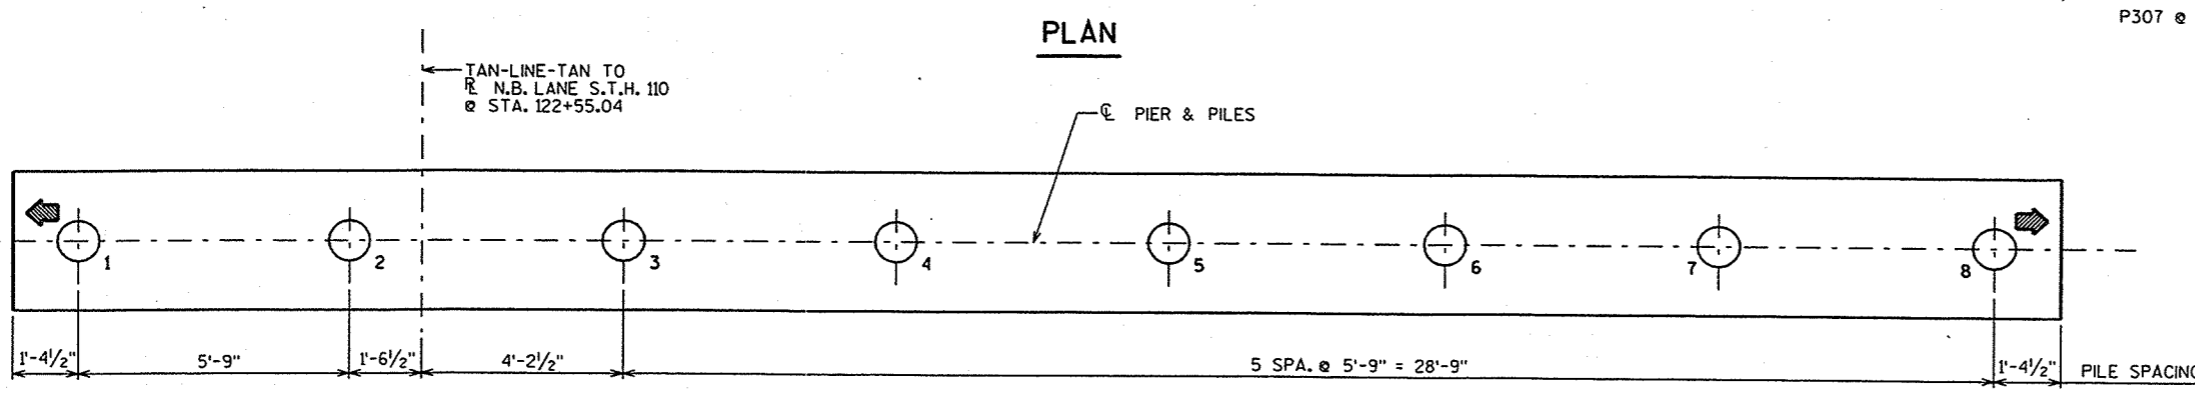


PILE PLAN

NO.	DATE	REVISION	BY
STATE OF WISCONSIN DEPARTMENT OF TRANSPORTATION STRUCTURES DESIGN SECTION			
STRUCTURE B-70-213			
CONST. SPEC.	1996	DRAWN BY DDS	PLANS CKD. CRJ
PIERS 1 THRU 4			SHEET 8


FILE= 70213PIER.DGN
SCALE = 2

GIRDER NOTES



- TOP OF GIRDER TO BE ROUGH FLOATED AND BROOMED TRANSVERSELY, EXCEPT THE OUTSIDE 2" OF GIRDER, WHICH SHALL BE TROWEL FINISHED.
- THE GIRDERS SHALL BE PROVIDED WITH A SUITABLE LIFTING DEVICE FOR HANDLING AND ERECTING THE GIRDERS.
- PRESTRESSING STRANDS SHALL BE 0.6" - 7 WIRE LOW-RELAXATION STRANDS WITH AN ULTIMATE STRENGTH OF 270,000 PSI AND SHALL BE FLUSH WITH THE ENDS OF THE GIRDER.
- BEND EACH END OF #4 STIRRUPS 4 1/2" AND #5 STIRRUPS 6".
- FOR DIAPHRAGM INSERT & CONNECTION DETAILS SEE "STEEL DIAPHRAGM" SHEET.
- ALL GIRDERS SHALL BE CAST FULL LENGTH AS SHOWN.
- SPACING SHOWN FOR #4 STIRRUPS IS FOR GRADE 60 REINFORCEMENT, IF THE FABRICATOR WANTS TO BUILD A BAR STEEL CAGE BY WELDING LONGITUDINAL REINFORCEMENT TO THE #4 STIRRUPS, 2 OPTIONS ARE AVAILABLE:
 - USE ASTM A706, GRADE 60 REINFORCEMENT AND THE STIRRUP SPACING AS SHOWN ON THE PLANS.
 - USE ASTM A615, GRADE 40 REINFORCEMENT AND A MODIFIED STIRRUP SPACING SUBMITTED TO AND APPROVED BY THE STRUCTURES DEVELOPMENT SECTION.
- AN ALTERNATE EQUIVALENT OF WELDED WIRE FABRIC (WWF) MAY BE SUBSTITUTED FOR THE STIRRUP REINFORCEMENT SHOWN, UPON APPROVAL OF THE STRUCTURES DEVELOPMENT SECTION.
- WELDED WIRE FABRIC SHALL CONFORM TO THE REQUIREMENTS OF ASTM A497.

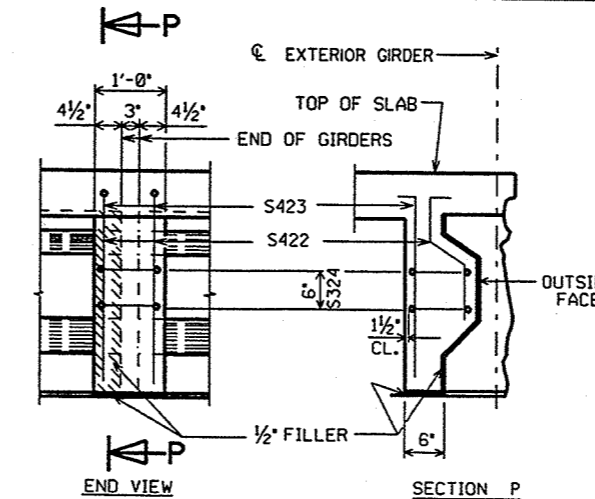

PILASTER DETAILS AT PIERS

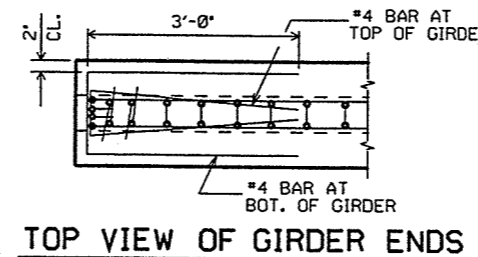


TOP VIEW OF GIRDER ENDS

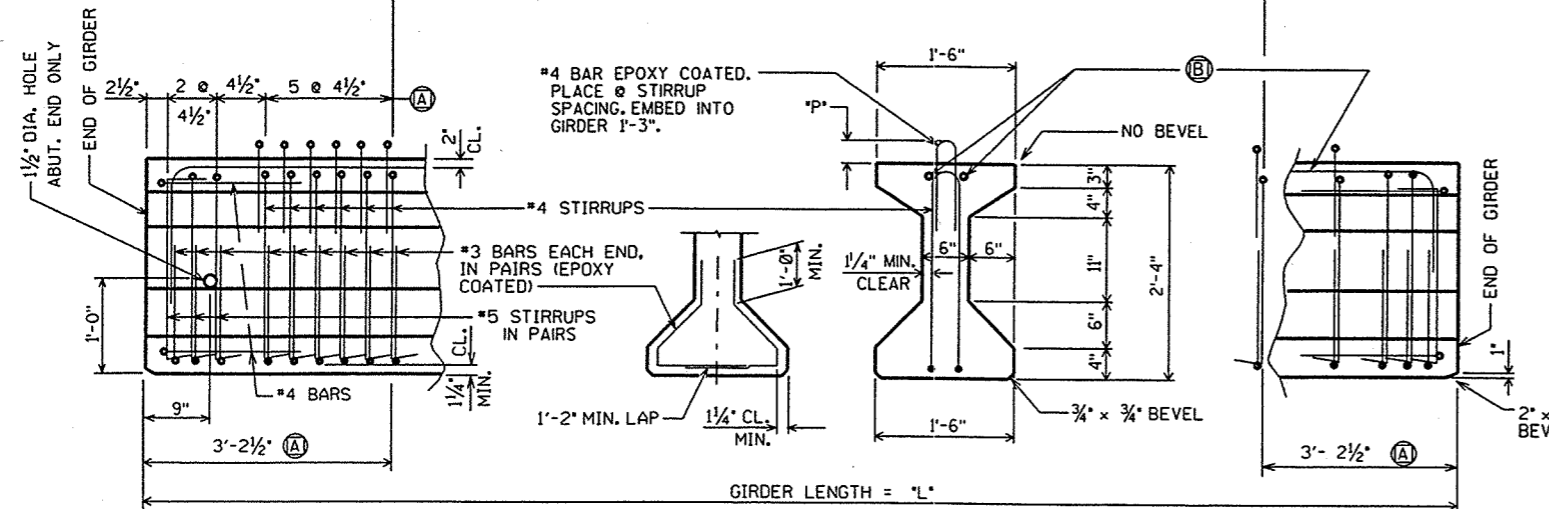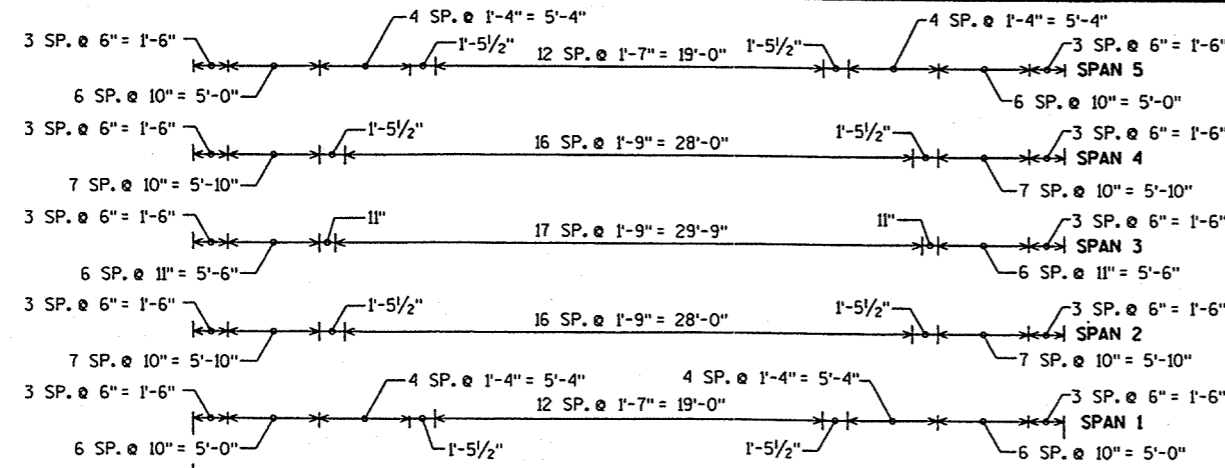


SIDE VIEW & TYP. SECTION IN SPAN


- (A) DETAIL TYP. AT EACH END
- (B) 2-#4 BARS BEND DOWN 16 BAR DIA. AT ENDS 1'-11" MIN. LAP (TYP.-ALL SPANS)

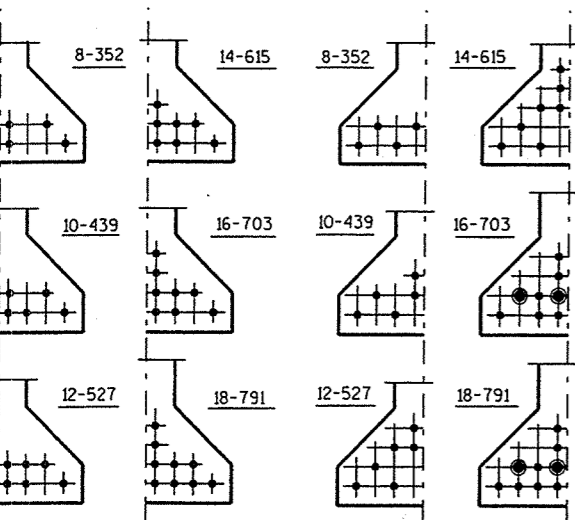


DRAPED PATTERN UNDRAPED PATTERN

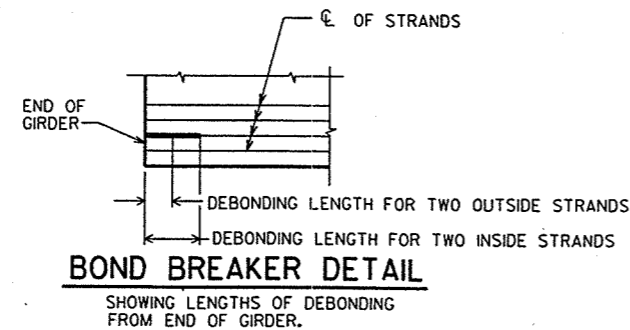


BOND BREAKER DETAIL

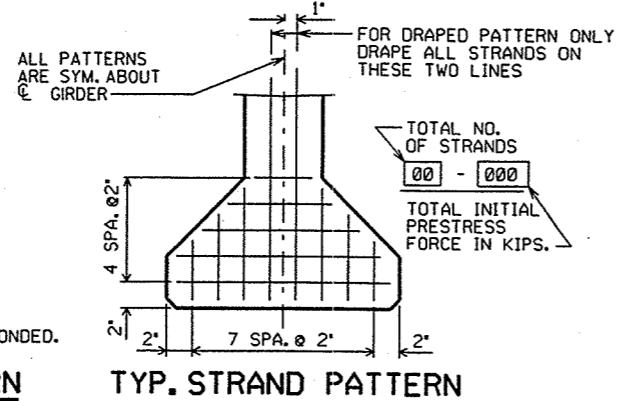


TYP. STRAND PATTERN

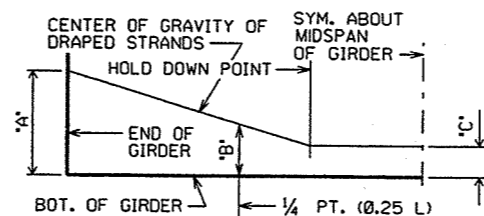

DRAPED STRAND PROFILE

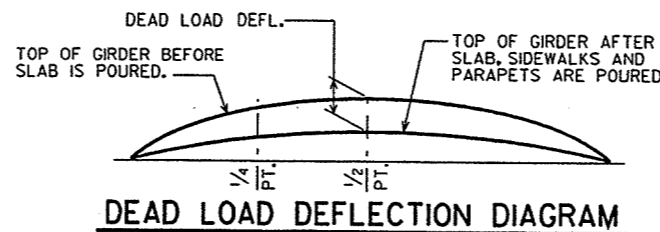

DEAD LOAD DEFLECTION DIAGRAM

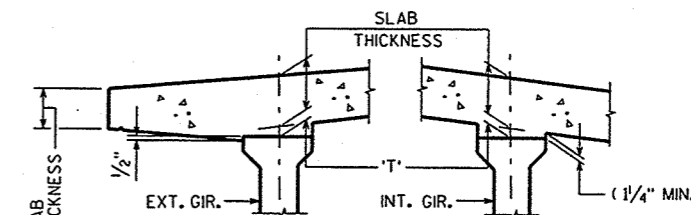

SLAB HAUNCH DETAIL

IF 1/4" MINIMUM HAUNCH HEIGHT AT EDGE OF GIRDER CANNOT BE MAINTAINED, THE GRADE LINE MAY BE REVISED BY THE ENGINEER AT THE OPTION OF THE CONTRACTOR. THE PLAN SLAB THICKNESS SHALL BE HELD. NOTIFY BRIDGE OFFICE FOR HAUNCH HEIGHTS OVER 4".

TO DETERMINE 'T' ELEV. OF TOP OF GIRS. AT CL OF SUBSTRUCTURE UNITS & AT 1/4" POINTS OF EACH SPAN SHALL BE TAKEN. THEN FOLLOW THIS PROCESS:

- TOP OF DECK ELEV. AT FINAL GRADE
- TOP OF GIRDER ELEVATION
- + DEAD LOAD DEFLECTION
- SLAB THICKNESS
- = HAUNCH HEIGHT 'T'


* MINIMUM CYLINDER STRENGTH OF CONCRETE @ TIME OF TRANSFER OF PRESTRESS FORCE.

SPAN	GIRDER LENGTH "L"	DEAD LOAD DEFL. (IN.)					CONC. STGRTH. f'c (P.S.I.)	"P"	DIA. OF STRAND	DRAPED PATTERN (IN.)					UNDRAPED PATTERN	
		1/8	1/4	3/8	1/2	TOTAL NO. OF STRANDS				f'ci (P.S.I.) *	"A"	"B" MIN.	"B" MAX.	"C"	TOTAL NO. OF STRANDS	f'ci (P.S.I.) *
1	52.00	0.33	0.57	0.71	0.76	7500	6	0.60	12	5500	25.00	8.50	11.25	3.00	0	0
2	52.00	0.35	0.59	0.74	0.79	7500	6	0.60	12	5500	25.00	8.50	11.25	3.00	0	0
3	52.00	0.35	0.59	0.74	0.79	7500	6	0.60	12	5500	25.00	8.50	11.25	3.00	0	0
4	52.00	0.35	0.59	0.74	0.79	7500	6	0.60	12	5500	25.00	8.50	11.25	3.00	0	0
5	52.00	0.33	0.57	0.71	0.76	7500	6	0.60	12	5500	25.00	8.50	11.25	3.00	0	0

NO.	DATE	REVISION	BY
STATE OF WISCONSIN DEPARTMENT OF TRANSPORTATION STRUCTURES DESIGN SECTION			
STRUCTURE B-70-213			
CONST. SPEC.	1996	DRAWN BY	DDS
		PLANS CKD.	CRS
28" PRESTRESSED GIRDER DETAILS			SHEET 9

TABLE

GIRDER HEIGHT	DIM. "A"	DIM. "B"	DIM. "L"	DIM. "X"
28"	1'-0 7/8"	5 7/8"	9 1/2"	2 1/4"
36"	1'-2 7/8"	9 7/8"	11 1/2"	3 1/4"
45"	1'-5 7/8"	11 7/8"	14 1/2"	4 1/4"
54"	1'-8 7/8"	14 7/8"	17 1/2"	5 1/4"
54W"	1'-9 1/8"	15 7/8"	18 1/2"	5 3/4"

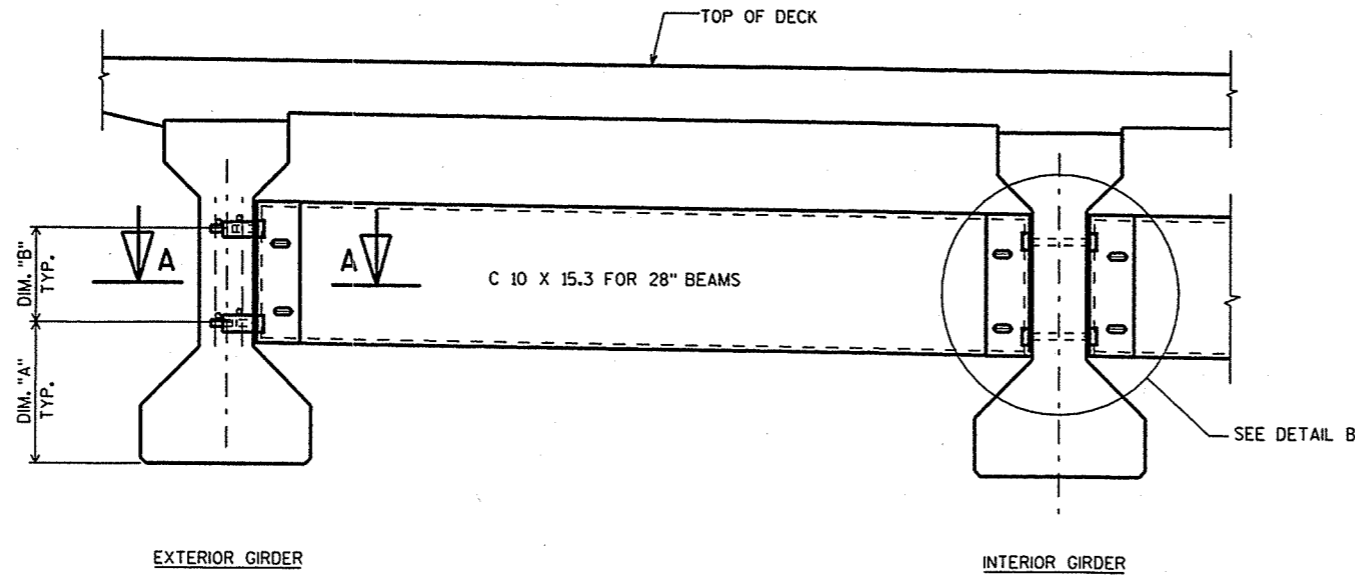

NOTES



ALL DIAPHRAGM MATERIAL NOT EMBEDDED IN THE CONCRETE GIRDER SHALL BE PAID FOR AT THE UNIT PRICE BID FOR "STEEL DIAPHRAGM", STRUCTURE, EACH.

EACH DIAPHRAGM BETWEEN GIRDERS SHALL CONSTITUTE ONE UNIT.


ALL DIAPHRAGM STRUCTURAL STEEL SHALL BE ASTM A709 GRADE 36. ALL BOLTS, NUTS AND WASHERS SHALL BE ASTM A325 TYPE 1.

ALL DIAPHRAGM STRUCTURAL STEEL SHOWN SHALL BE HOT-DIPPED GALVANIZED. ALL BOLTS, NUTS AND WASHERS SHALL BE HOT-DIPPED GALVANIZED IN ACCORDANCE WITH ASTM A153 CLASS C. GALVANIZED NUTS SHALL BE TAPPED OVERSIZE IN ACCORDANCE WITH THE REQUIREMENTS OF ASTM A563 AND SHALL MEET THE REQUIREMENTS OF SUPPLEMENTARY REQUIREMENT S1 OF ASTM A563, LUBRICANT AND TEST FOR COATED NUTS.

PART TRANSVERSE SECTION AT DIAPHRAGM

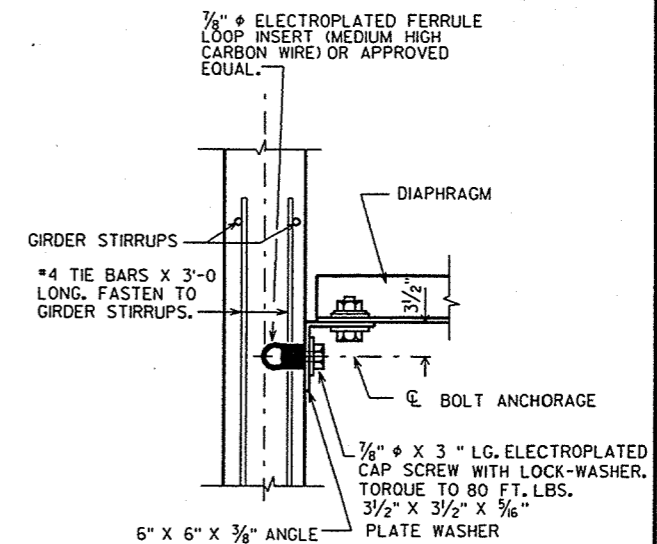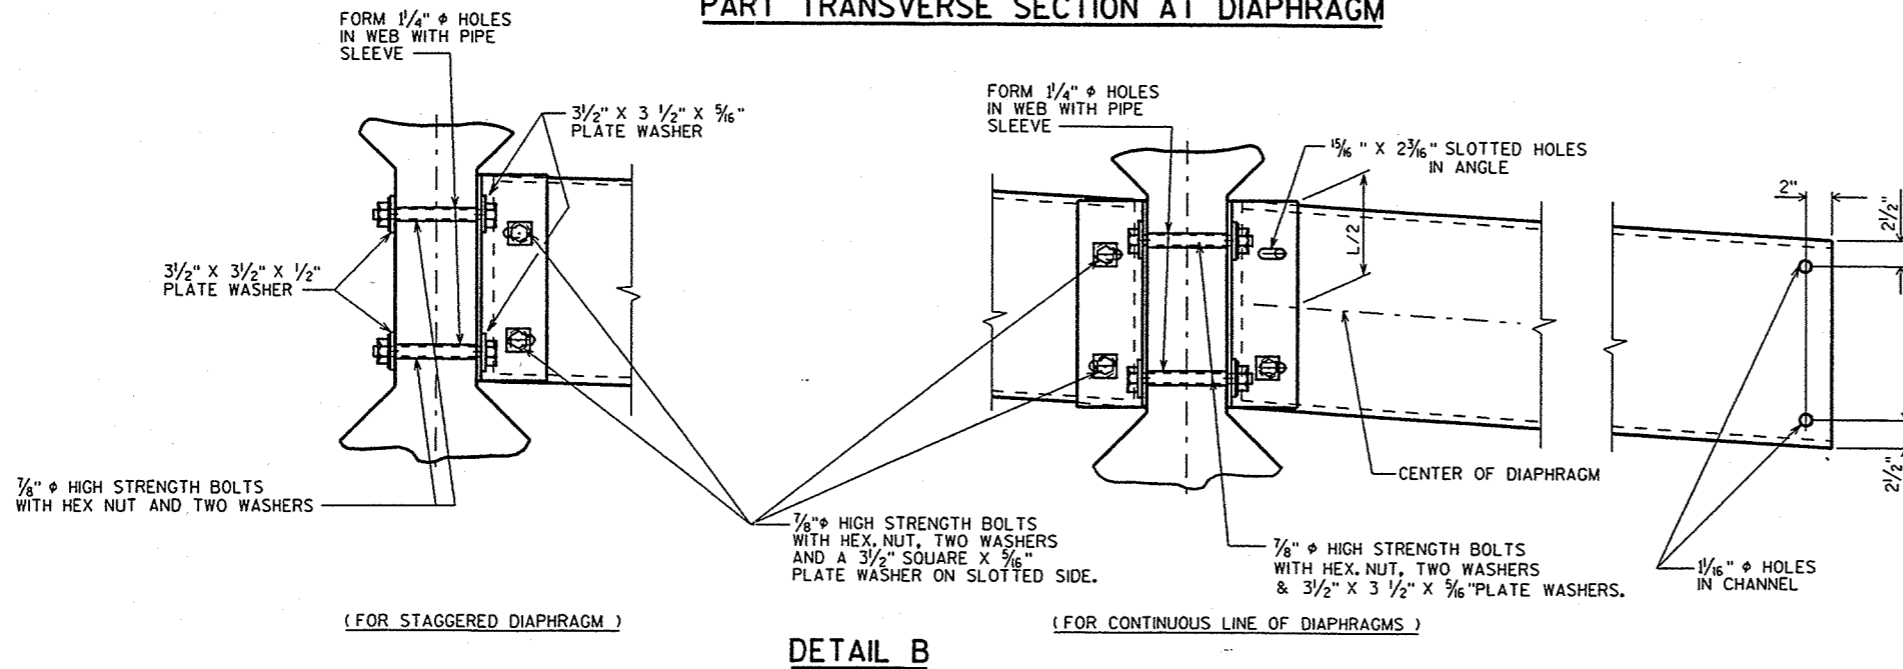

SECT. A-A
(FOR EXTERIOR ATTACHMENT)

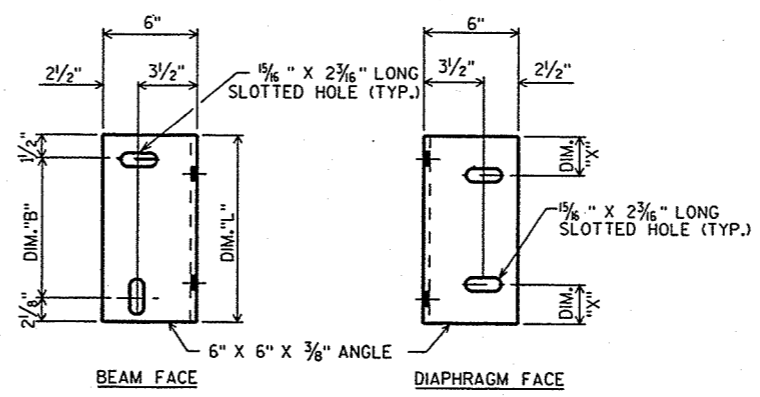


DIAPHRAGM SUPPORT

NO.	DATE	REVISION	BY
STATE OF WISCONSIN DEPARTMENT OF TRANSPORTATION STRUCTURES DESIGN SECTION			
STRUCTURE		B-70-213	
CONST. SPEC.	1996	DRAWN BY	DDS
		PLANS CR'D.	CRS
STEEL DIAPHRAGM		SHEET 10	


FILE= 70213DIA.DGN
SCALE = 1

SCALE = 12.000000 ' / IN


STATE PROJECT NUMBER	SHEET NO.
6200-05-71	8.39

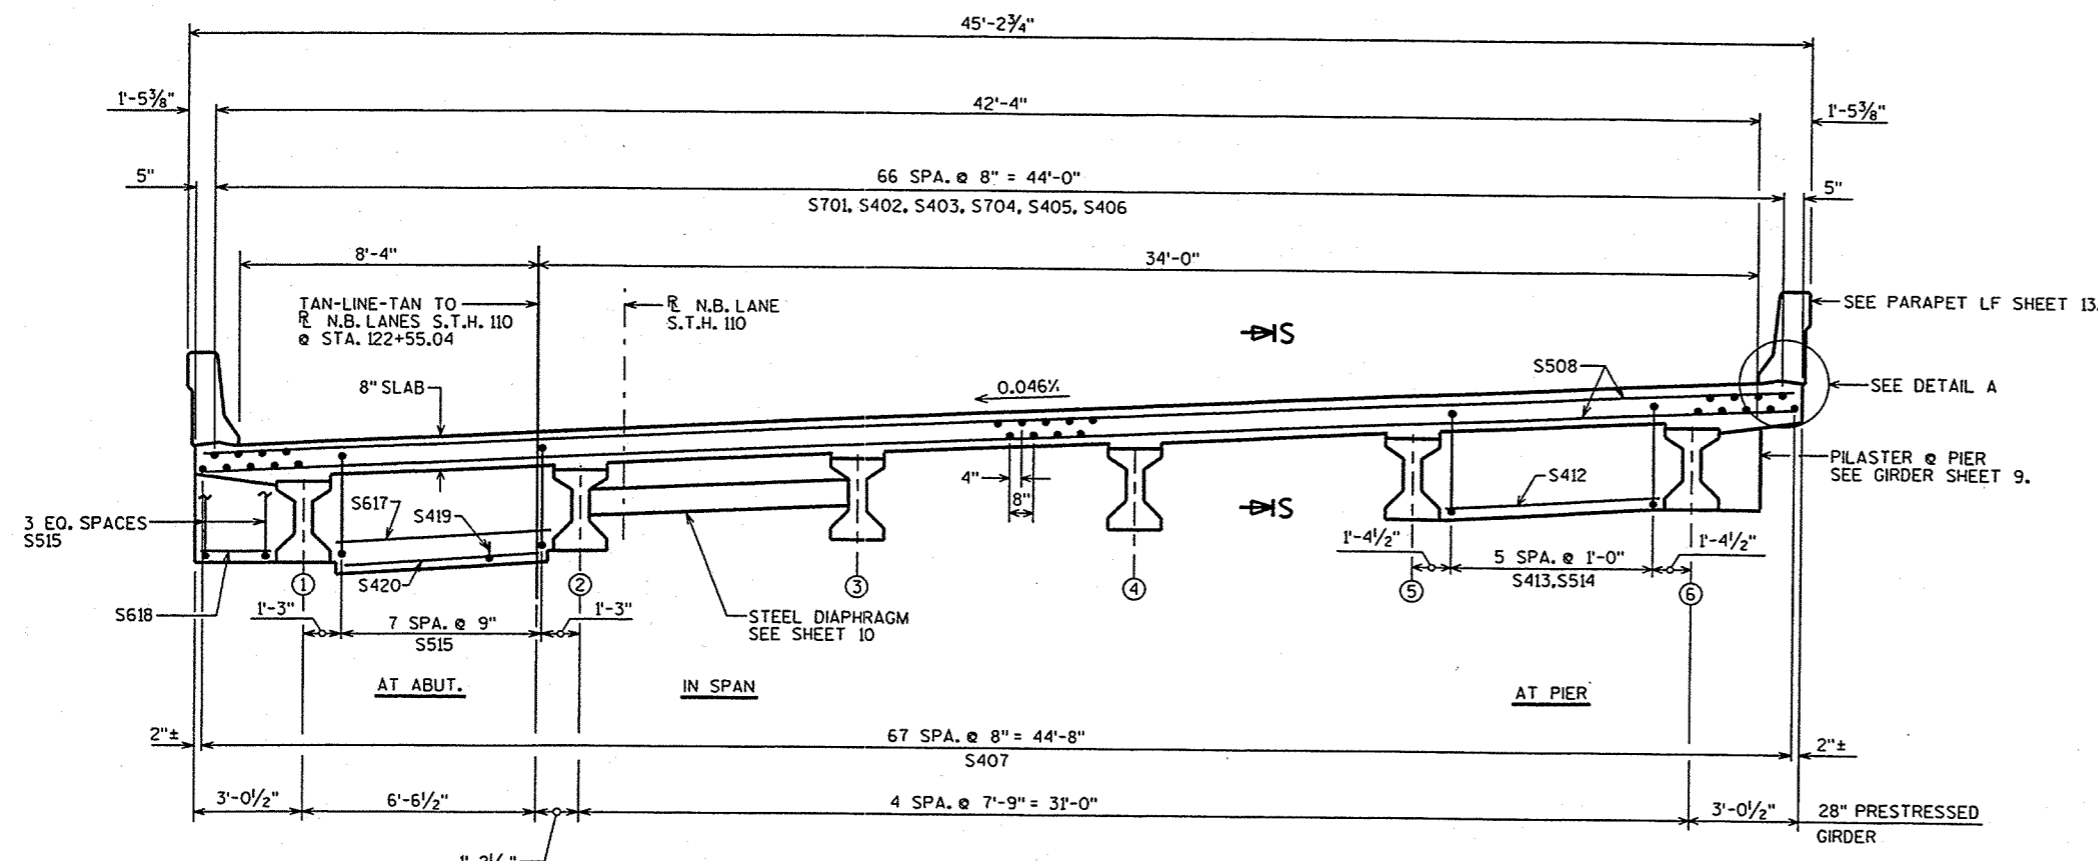


CROSS SECTION THRU ROADWAY
(LOOKING NORTH)

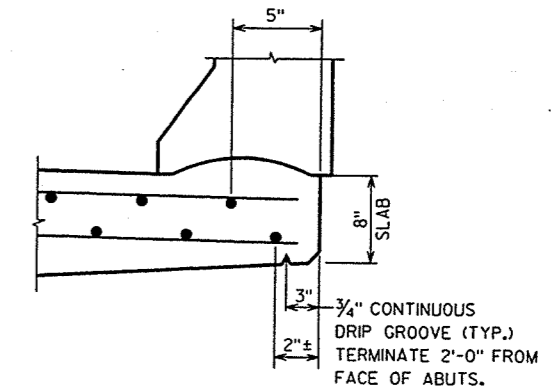

DETAIL A

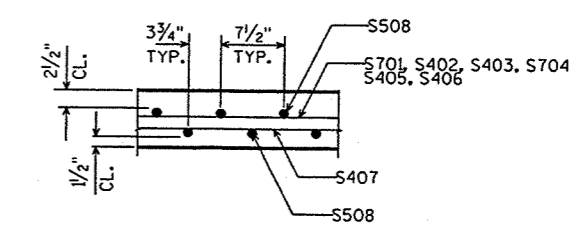


SECTION S-S

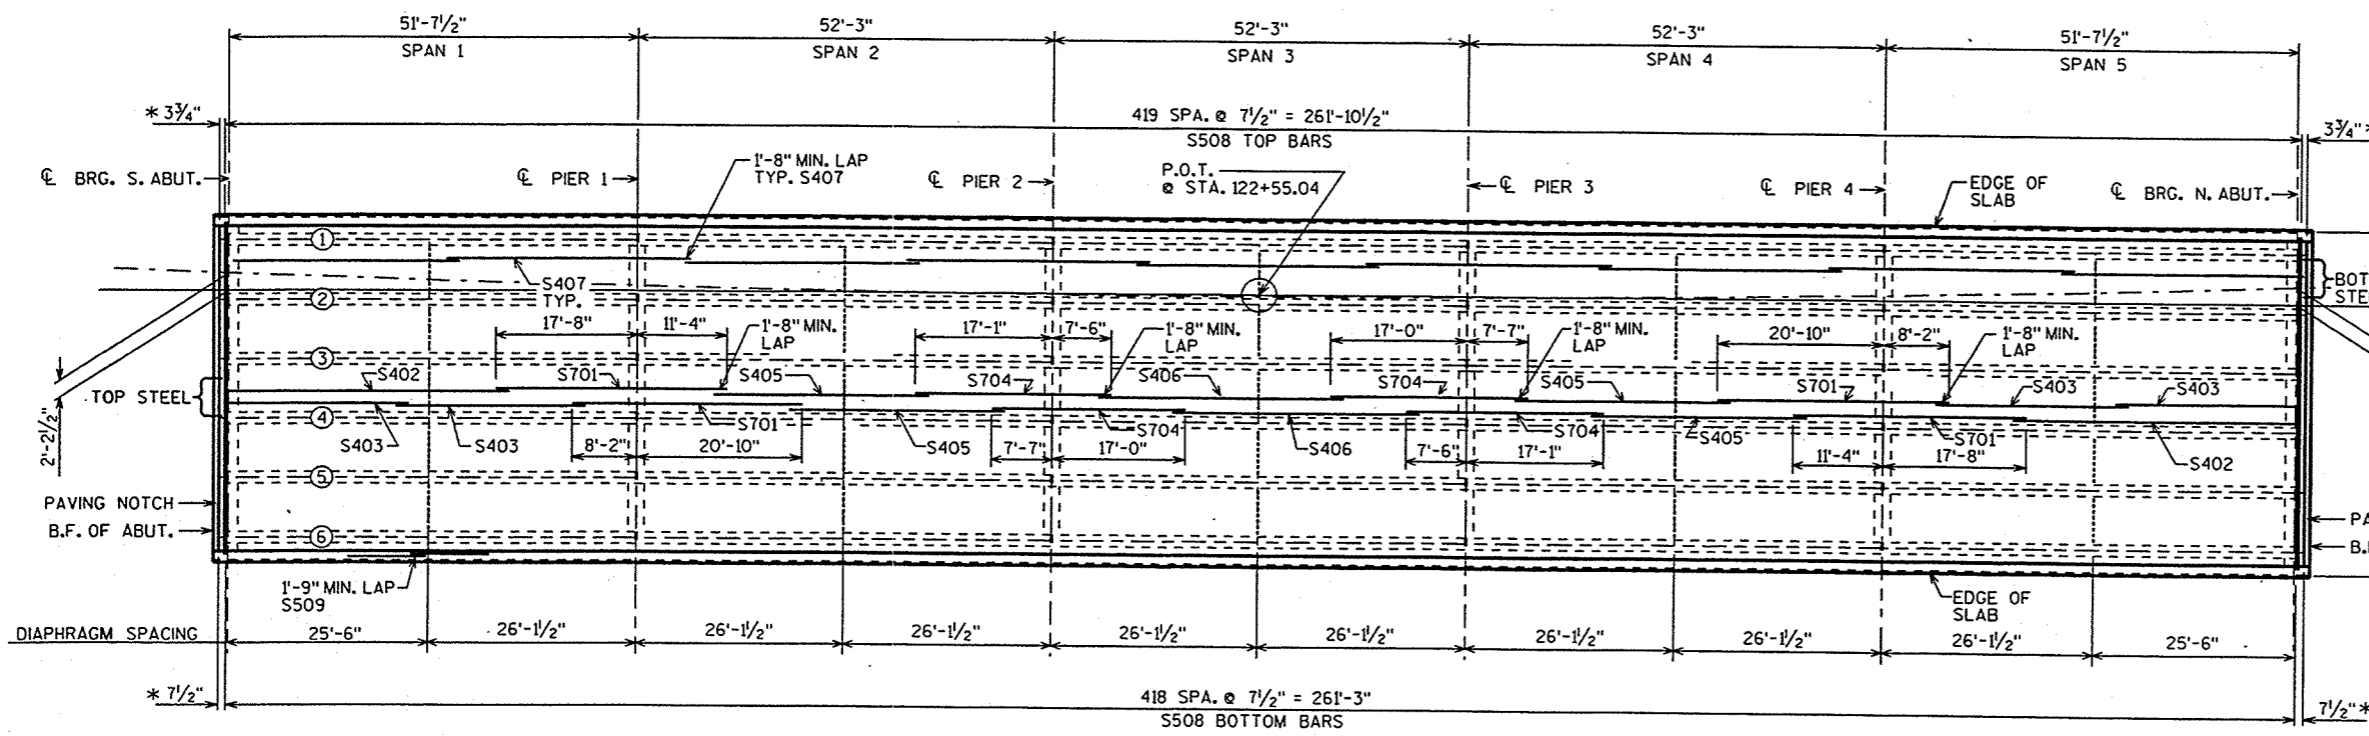



PLAN

* DISTANCE MEASURED TO END OF SLAB (@ PAVING NOTCH)

NO.	DATE	REVISION	BY
STATE OF WISCONSIN DEPARTMENT OF TRANSPORTATION STRUCTURES DESIGN SECTION			
STRUCTURE B-70-213			
CONST. SPEC.	1996	DRAWN BY DDS	PLANS CKD. CRT
SUPERSTRUCTURE			SHEET 11

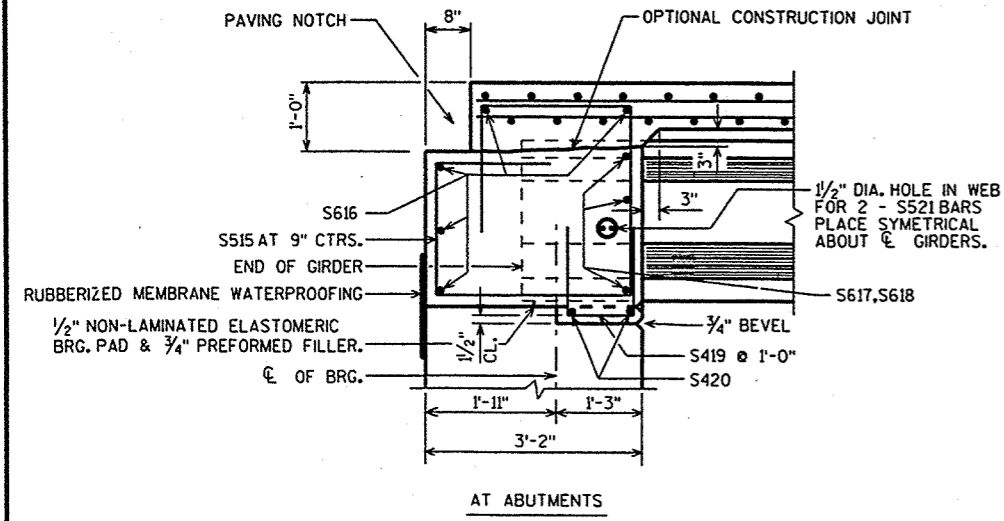

PART LONGIT. SECTION

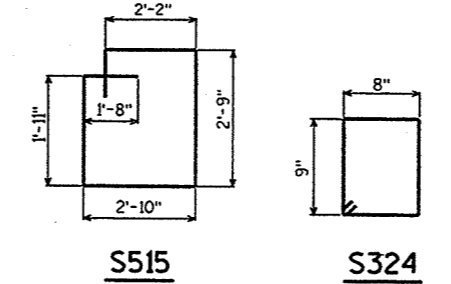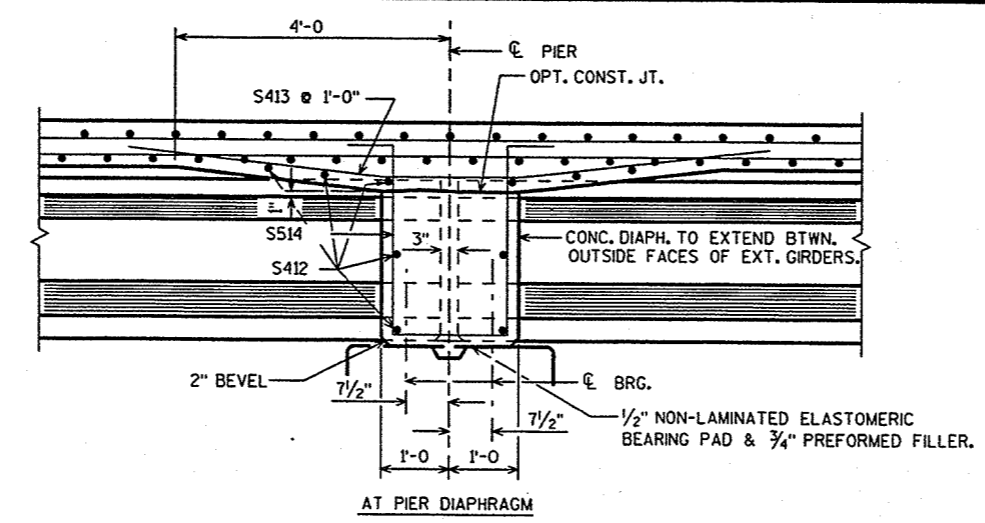

S515

S324


TOP OF DECK ELEVATIONS

	S. ABUT.	1/4	2/4	3/4	PIER 1	1/4	2/4	3/4	PIER 2	1/4	2/4	3/4	PIER 3	1/4	2/4	3/4	PIER 4	1/4	2/4	3/4	N. ABUT.	
GIR. 1	756.58	756.51	756.44	756.37	756.31	756.24	756.18	756.12	756.07	756.01	755.96	755.92	755.87	755.83	755.80	755.76	755.73	755.70	755.68	755.66	755.64	755.64
GIR. 2	756.93	756.86	756.80	756.73	756.66	756.60	756.54	756.48	756.42	756.37	756.32	756.27	756.23	756.19	756.15	756.12	756.09	756.06	756.04	756.01	756.00	756.00
GIR. 3	757.29	757.22	757.15	757.08	756.96	756.89	756.84	756.78	756.73	756.68	756.63	756.59	756.55	756.51	756.48	756.45	756.42	756.39	756.39	756.37	756.35	756.35
GIR. 4	757.65	757.57	757.51	757.44	757.37	757.31	757.25	757.19	757.14	757.08	757.03	756.99	756.94	756.90	756.87	756.83	756.80	756.77	756.75	756.73	756.71	756.71
GIR. 5	758.00	757.93	757.86	757.80	757.73	757.67	757.61	757.55	757.49	757.44	757.39	757.34	757.30	757.26	757.22	757.19	757.16	757.13	757.11	757.09	757.07	757.07
GIR. 6	758.36	758.29	758.22	758.15	758.09	758.02	757.96	757.90	757.85	757.80	757.75	757.70	757.66	757.62	757.58	757.55	757.52	757.49	757.46	757.44	757.42	757.42


BILL OF BARS

NOTE: THE FIRST OR FIRST TWO DIGITS OF THE BAR MARK SIGNIFIES THE BAR SIZE.

BAR MARK	COAT	NO. REQ'D.	LENGTH	BENT	BAR SERIES	LOCATION
S701	X	134	29'-0"			LONGITUDINAL CONTINUITY
S402	X	67	36'-8"			LONGITUDINAL TOP
S403	X	134	23'-11"			LONGITUDINAL TOP
S704	X	134	24'-7"			LONGITUDINAL CONTINUITY
S405	X	134	27'-2"			LONGITUDINAL TOP
S406	X	67	31'-1"			LONGITUDINAL TOP
S407	X	612	30'-9"			LONGITUDINAL BOTTOM
S508	X	839	44'-6"			TRANSVERSE TOP AND BOTTOM
S509	X	70	39'-2"			PARAPET LF-HORIZ.
S510	X	792	4'-10"	X		PARAPET LF-VERT.
S511	X	792	4'-9"	X		PARAPET LF-VERT.
S412	X	200	5'-11"			PIER DIAPHRAGM-HORIZ.
S413	X	120	10'-2"	X		PIER DIAPHRAGM-VERT.
S514	X	120	8'-2"	X		PIER DIAPHRAGM-VERT.
S515	X	96	12'-9"	X		ABUT. DIAPHRAGM-VERT.
S616	X	20	24'-0"			ABUT. DIAPHRAGM-HORIZ.
S617	X	30	5'-11"			ABUT. DIAPHRAGM-HORIZ.
S618	X	12	2'-0"			ABUT. DIAPHRAGM-HORIZ.
S419	X	60	3'-3"	X		ABUT. DIAPHRAGM-VERT.
S420	X	20	4'-11"			ABUT. DIAPHRAGM-HORIZ.
S521	X	24	6'-0"			ABUT. DIAPHRAGM @ GIRDERS
S422	X	16	2'-9"	X		PIER PILASTER
S423	X	16	3'-3"	X		PIER PILASTER
S324	X	16	3'-4"	X		PIER PILASTER

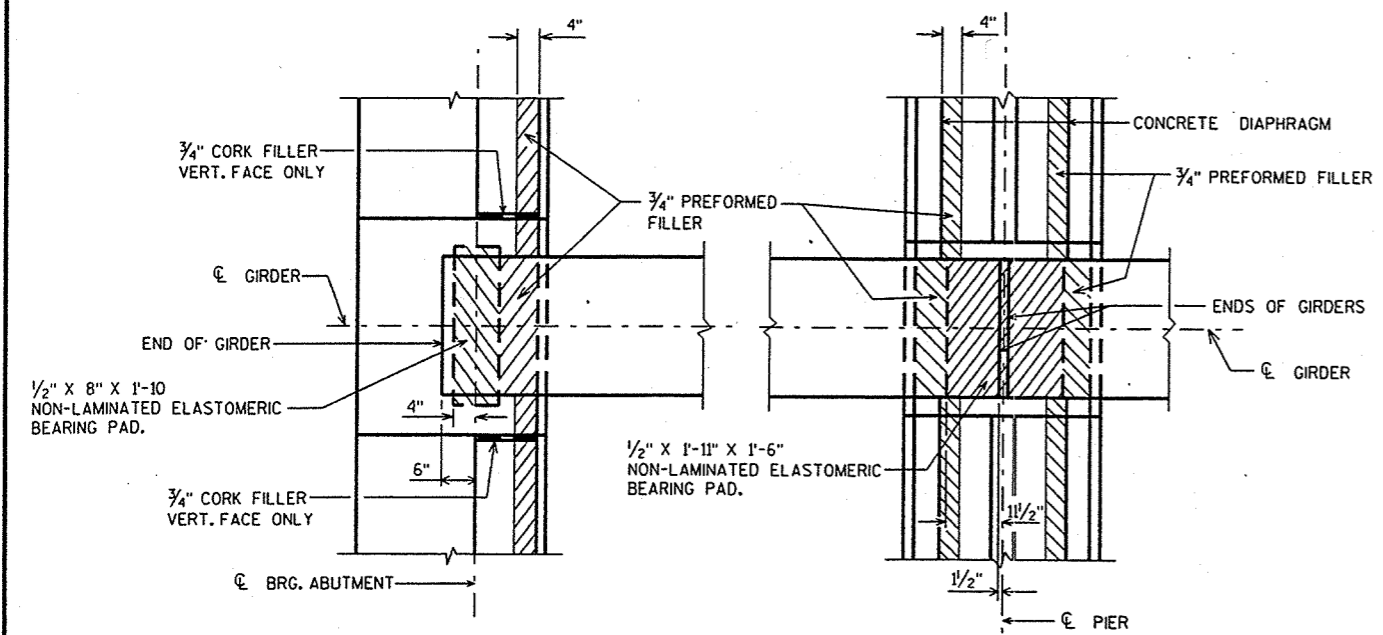

BEARING PAD DETAIL

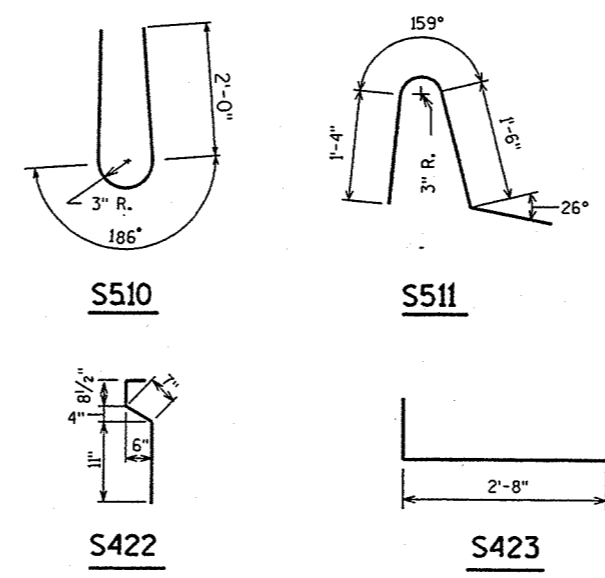


S510

S511

S422

S423

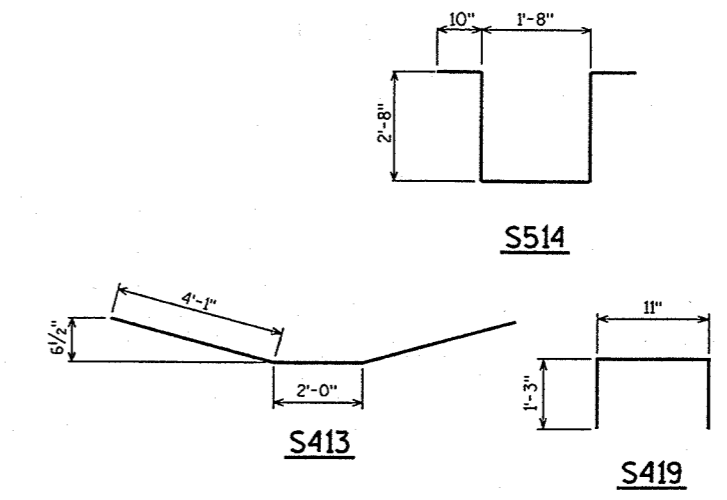


S514

S413


S419

NO.	DATE	REVISION	BY
STATE OF WISCONSIN DEPARTMENT OF TRANSPORTATION STRUCTURES DESIGN SECTION			
STRUCTURE		B-70-213	
CONST. SPEC.	1996	DRAWN BY	DDS
SUPERSTRUCTURE DETAILS		PLANS CK'D.	CRA
SHEET 12			


FILE= 70213SUPERDET.DGN
SCALE = 1:333

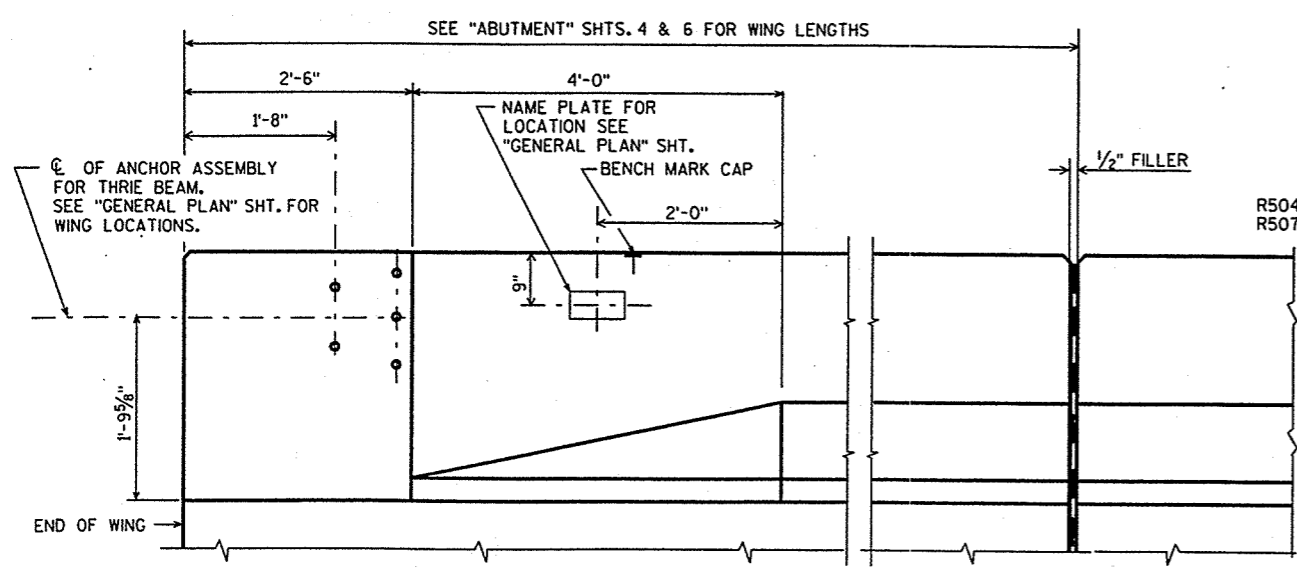

INSIDE ELEVATION

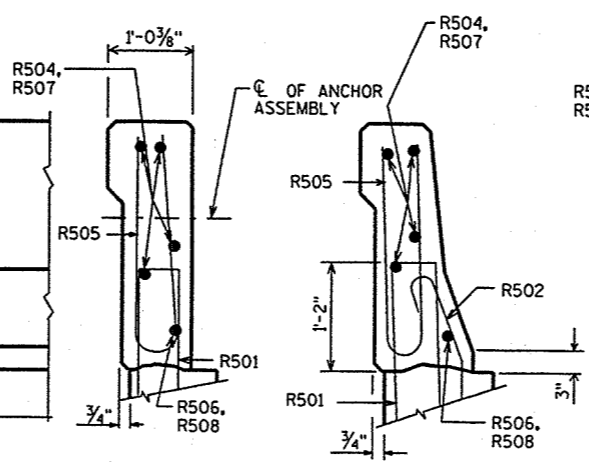


SECTION A SECTION B

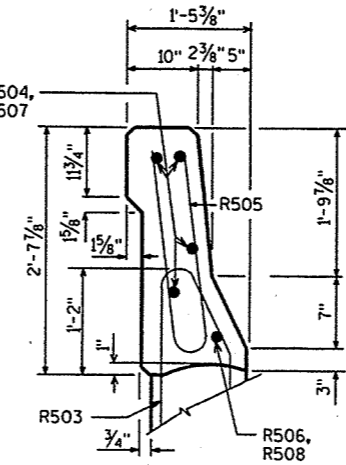


SECTION C

BILL OF BARS
FOR ABUTMENT PARAPETS

BAR MARK	COAT	S. ABUT.	N. ABUT.	LENGTH	BENT	LOCATION
R501	X	28	28	4'-7"	X	PARAPET VERT.
R502	X	16	16	3'-2"	X	PARAPET VERT.
R503	X	13	13	4'-8"	X	PARAPET VERT.
R504	X	4	4	11'-8"		PARAPET HORIZ. - WINGS 1 & 4
R505	X	41	41	4'-10"	X	PARAPET VERT.
R506	X	1	1	11'-8"	X	PARAPET HORIZ. - WINGS 1 & 4
R507	X	4	4	9'-8"		PARAPET HORIZ. - WINGS 2 & 3
R508	X	1	1	9'-8"	X	PARAPET HORIZ. - WINGS 2 & 3

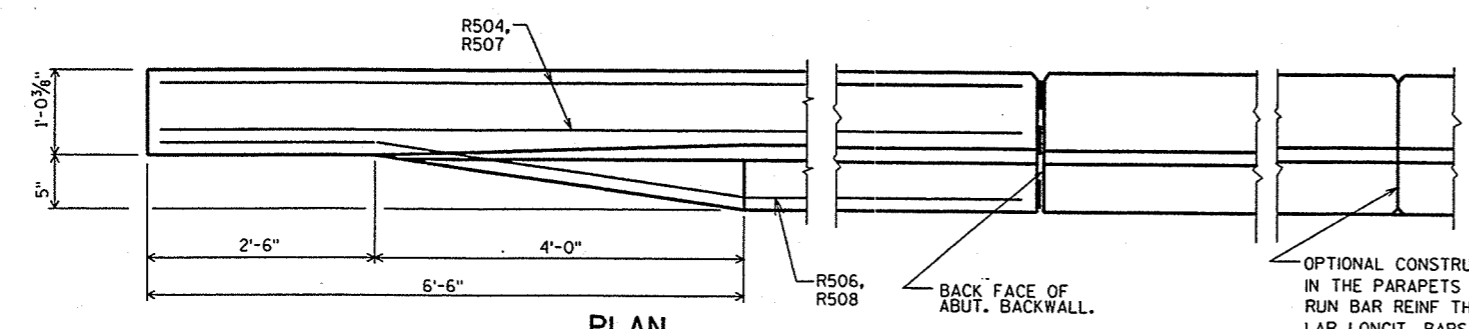


PLAN

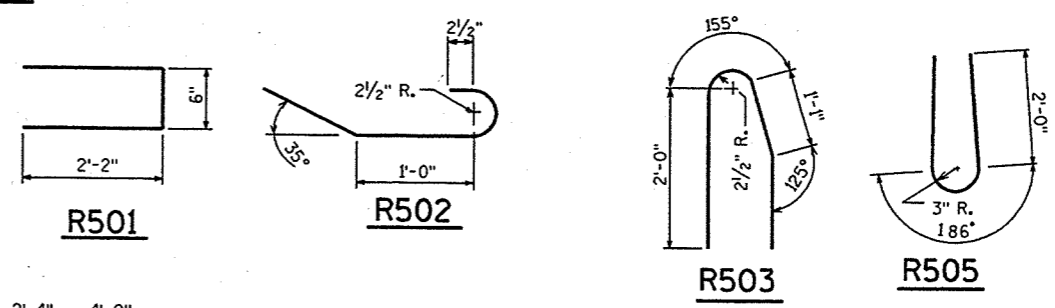


R501 R502 R503 R505


OPTIONAL CONSTRUCTION JOINTS IN THE PARAPETS MAY BE USED. RUN BAR REINF THRU THE JOINT. LAP LONGIT. BARS A MIN. OF 1'-9" MIN. JOINT SPACING OF 80'-0" DEFINE CONST. JOINT WITH A 3/4" 'V' GROOVE.

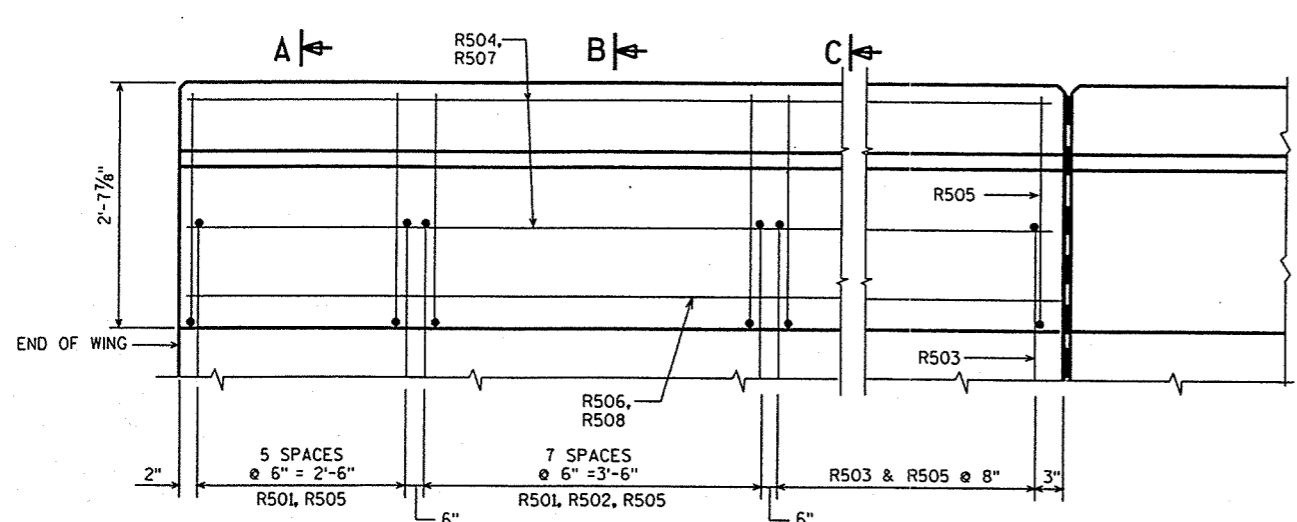

OUTSIDE ELEVATION

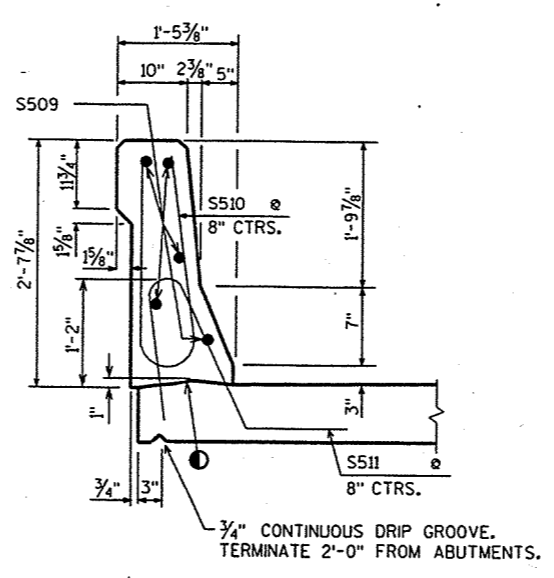

SECTION THRU PARAPET ON BRIDGE

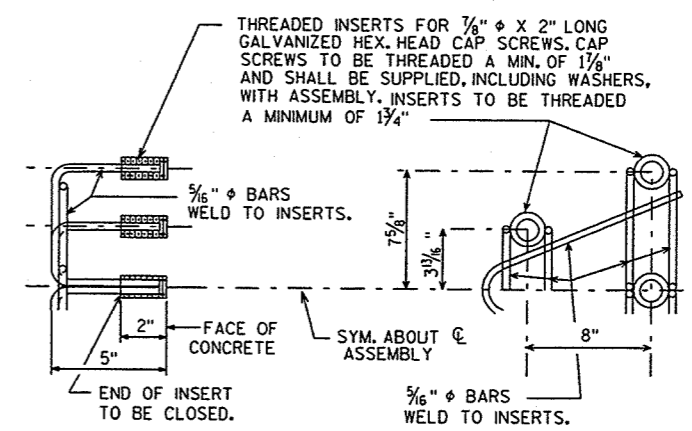

DETAIL OF ANCHOR ASSEMBLY

NOTE: HEX. HEAD CAP SCREWS & WASHERS TO BE GALVANIZED IN ACCORDANCE WITH AASHTO M232 CLASS C.

● CONST. JOINT - STRIKE OFF AS SHOWN.

NO.	DATE	REVISION	BY

STATE OF WISCONSIN
DEPARTMENT OF TRANSPORTATION
STRUCTURES DESIGN SECTION

STRUCTURE B-70-213

CONST. SPEC. 1996 DRAWN BY DDS PLANS CKD. CRT

SLOPED FACE PARAPET LF SHEET 13

STATE PROJECT NUMBER	SHEET NO.
6200-05-71	8.42

DESIGN DATA

LIVE LOAD:
 DESIGN RATING: HS-20
 INVENTORY RATING: HS-23
 OPERATIONAL RATING: HS-53
 MAXIMUM STANDARD PERMIT VEHICLE LOAD = 250 KIPS.
 STRUCTURE IS DESIGNED FOR A FUTURE WEARING SURFACE OF 20 POUNDS PER SQUARE FOOT.

ULTIMATE DESIGN STRESSES:
 CONCRETE MASONRY SLAB — $f'_c = 4,000$ P.S.I. ALL OTHER — $f'_c = 3,500$ P.S.I.
 BAR STEEL REINFORCEMENT, GRADE 60 — $f_y = 60,000$ P.S.I.
 54" PRESTRESSED GIRDERS, CONCRETE MASONRY — $f'_c = 8,000$ P.S.I.
 STRANDS- .6" ϕ WITH ULTIMATE TENSILE STRENGTH OF 270,000 P.S.I.

FOUNDATION DATA

ABUTMENTS TO BE SUPPORTED ON HP10 X 42 STEEL PILING DRIVEN TO A MINIMUM BEARING VALUE OF 55 TONS PER PILE. ESTIMATED 25'-0" LONG AT WEST ABUTMENT AND 20'-0" LONG AT EAST ABUTMENT


PIER TO BE SUPPORTED ON SPREAD FOOTINGS. THE FOOTINGS ARE DESIGNED TO PLACE A MAX. LOAD OF 10 TSF ON THE UNDERLYING ROCK. ROCK AT FTG. ELEV. IS ESTIMATED TO HAVE AN ALLOWABLE BEARING CAPACITY OF 10 TSF.

TRAFFIC VOLUME



BROOKS ROAD	S.T.H. 110
A.D.T.=1400 (2022)	A.D.T.=18,950 (2022)
R.D.S.=50 M.P.H.	R.D.S.=70 M.P.H.

CURVE DATA

BROOKS ROAD	SB. LANE S.T.H. 110	NB. LANE S.T.H. 110
P.I. = STA. 17+36.67	P.I. = STA. 264+58.52	P.I. = STA. 264+49.35
$\Delta = 18^\circ-58'-09"$	$\Delta = 17^\circ-22'-27"$	$\Delta = 17^\circ-22'-27"$
$D = 4^\circ-00'-00"$	$D = 1^\circ-14'-02"$	$D = 1^\circ-15'-00"$
$T = 239.30'$	$T = 709.51'$	$T = 700.34'$
$L = 474.23'$	$L = 1408.13'$	$L = 1389.94'$
$R = 1432.39'$	$R = 4643.66'$	$R = 4583.66'$
S.E. = 0.052%	S.E. = 0.04%	S.E. = 0.04%
P.C. = STA. 14+97.36	P.C. = STA. 257+49.01	P.C. = STA. 257+49.01
P.T. = STA. 19+71.59	P.T. = STA. 271+57.14	P.T. = STA. 271+38.94

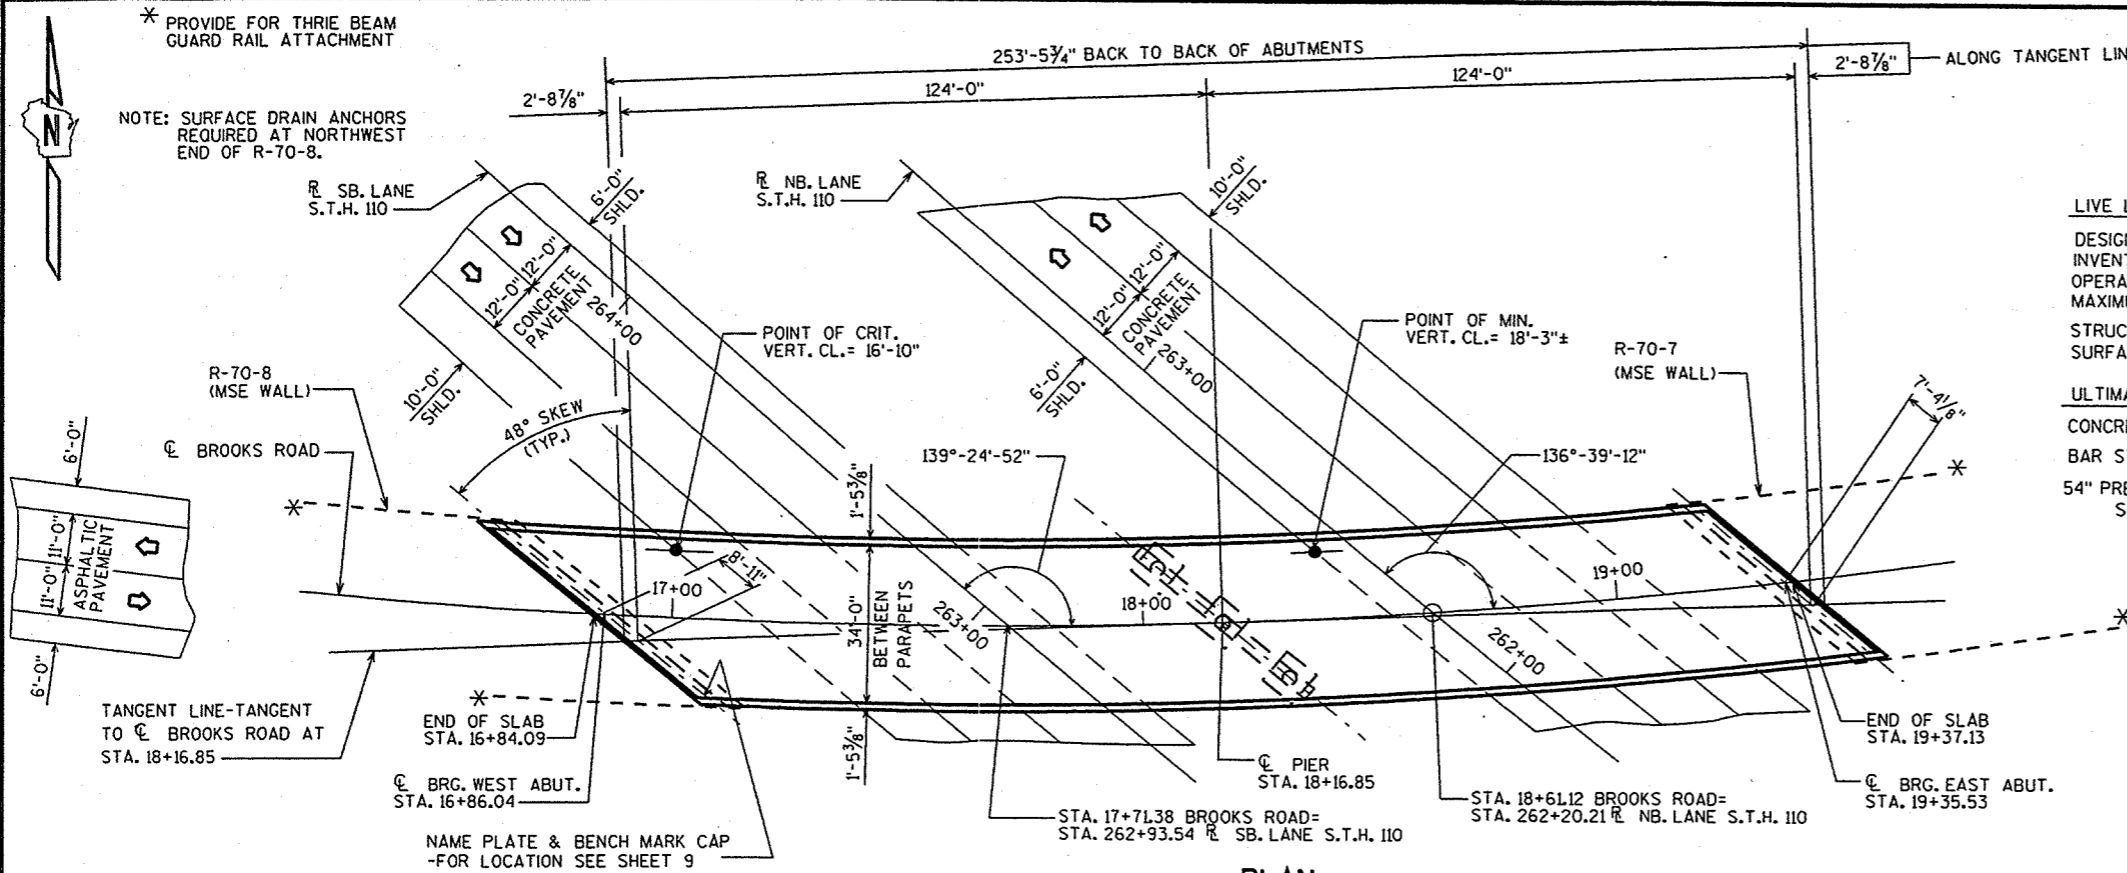

PLAN
 2 SPAN-54" PRESTRESSED GIRDERS

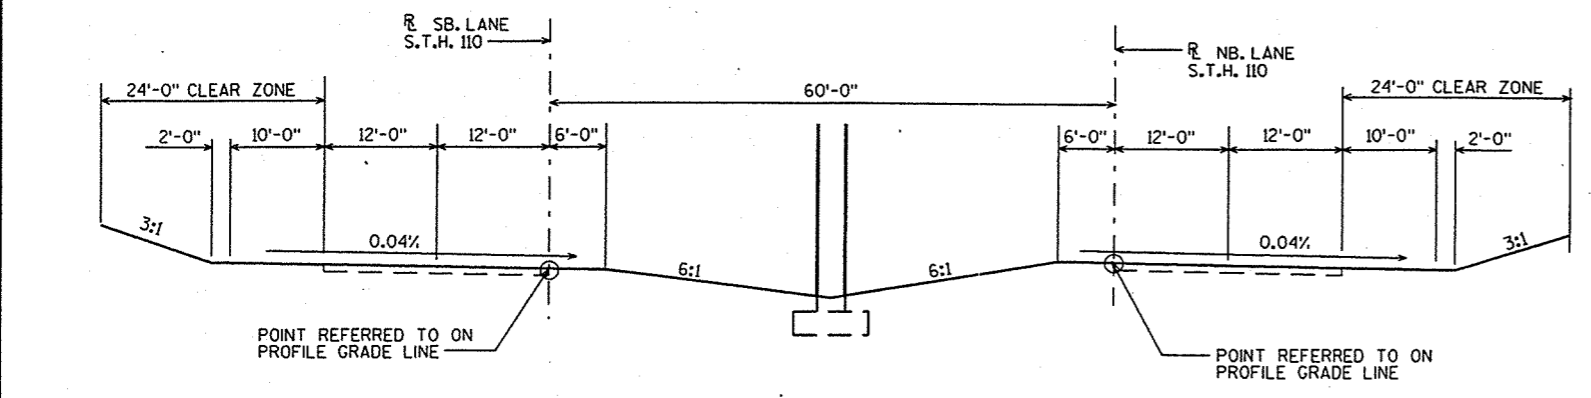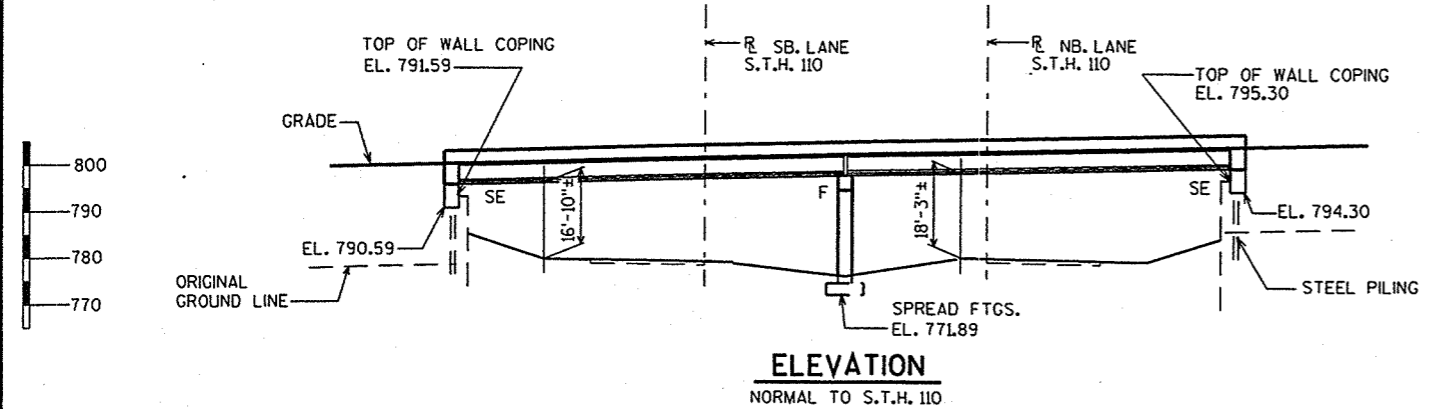


TYPICAL SECTION THRU S.T.H. 110

LIST OF DRAWINGS

1. GENERAL PLAN
2. CROSS SECTION & QUANTITIES
3. SUBSURFACE EXPLORATION
4. WEST ABUTMENT
5. EAST ABUTMENT
6. PIER
7. 54" PRESTRESSED GIRDER DETAILS
8. STEEL DIAPHRAGM
9. FRAMING PLAN
10. SUPERSTRUCTURE DETAILS
11. SUPERSTRUCTURE
12. SUPERSTRUCTURE DETAILS

NO.	DATE	REVISION	BY
Plans Prepared By WISDOT STRUCTURES DESIGN			
STRUCTURE B-70-217			
BROOKS ROAD OVER S.T.H. 110			
COUNTY	WINNEBAGO	TOWN/VILLAGE	VINLAND
DESIGN SPEC.	AASHTO STD. SPEC. 1998	LOAD	HS-20
CONST. SPEC.		CONST. SPEC.	1996
DESIGNED BY	SDR	DRAWN BY	BJ
CK'D.	MCW	PLANS CK'D.	S.C.K.
APPROVED	11-13-01 CHIEF STRUCTURAL DESIGN ENGINEER		DATE
GENERAL PLAN		SHEET 1 OF 12	DATE: OCT. '01

FILE = PREPLAN.DGN
 SCALE = 20

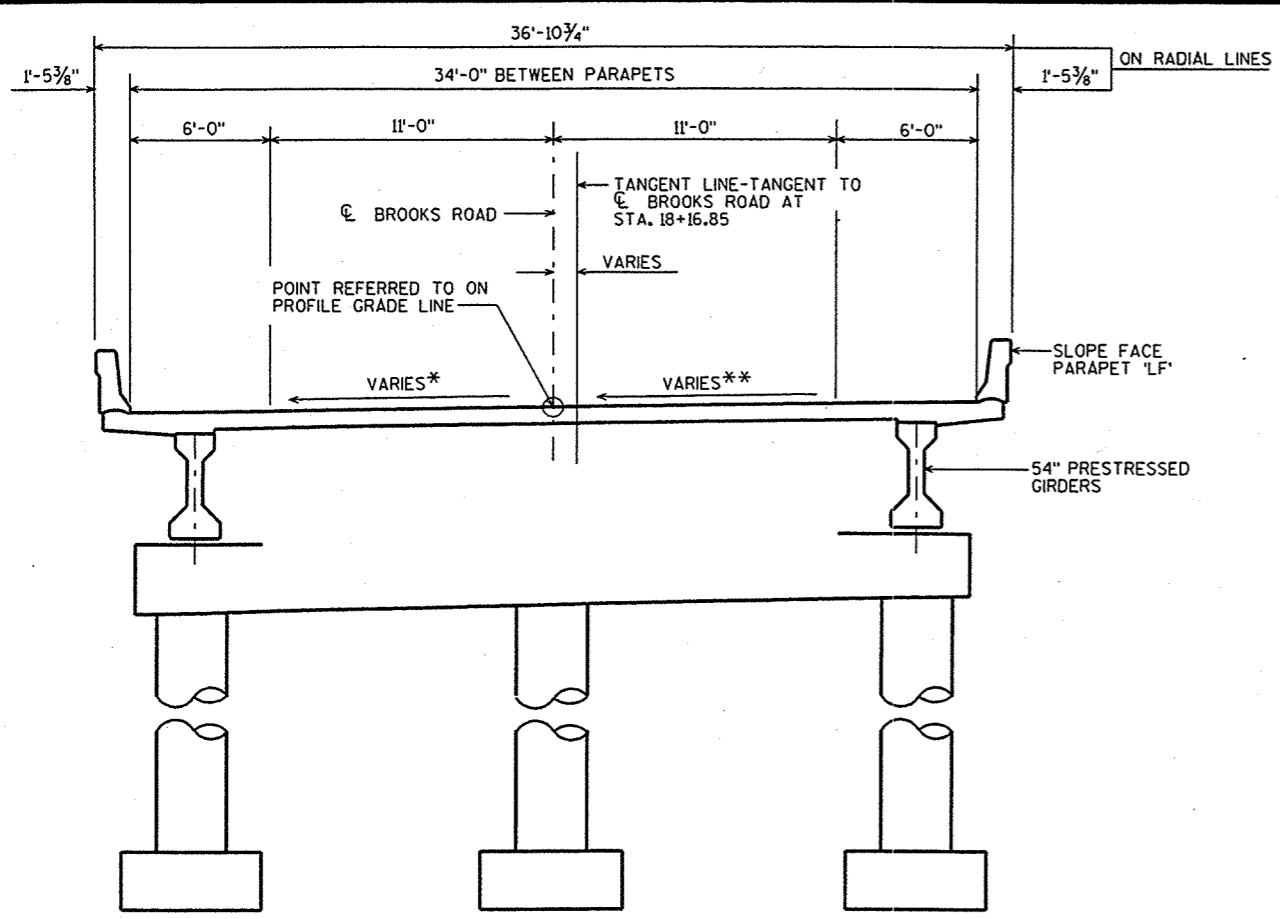


CROSS SECTION THRU ROADWAY LOOKING EAST

* 0.052% STA. 15+47.36 TO STA. 19+21.59
0.02% AT STA. 20+14.92


** 0.052% STA. 15+47.36 TO STA. 19+21.59
0.00% AT STA. 20+71.59

TOTAL ESTIMATED QUANTITIES


BID ITEMS	UNIT	SUPER.	WEST ABUT.	PIER	EAST ABUT.	TOTALS
EXCAVATION FOR STRUCTURES, BRIDGES, B-70-217	L.S.					1
STRUCTURE BACKFILL	C.Y.		304		250	554
CONCRETE MASONRY, BRIDGES	C.Y.	373	46	64	36	519
PROTECTIVE SURFACE TREATMENT	S.Y.	1160				1160
PRESTRESSED GIRDER, I TYPE, 54-INCH	L.F.	1749				1749
HIGH-STRENGTH BAR STEEL REINFORCEMENT, BRIDGES	LB.		3030	1510	2470	7010
COATED HIGH-STRENGTH BAR STEEL REINFORCEMENT, BRIDGES	LB.	66400		18360		84760
NON-LAMINATED ELASTOMERIC BEARING PADS	EACH	28				28
STEEL DIAPHRAGMS, STRUCTURE, B-70-217	EACH	24				24
STEEL PILING, DELIVERED AND DRIVEN, HP 10-INCH 42 POUND	L.F.		275		200	475
RUBBERIZED MEMBRANE WATERPROOFING	S.Y.		11		9	20
OMP, READY MIXED CONCRETE MASONRY FOR BRIDGES	C.Y.	373	46	64	36	519
OMP, MASONRY STRENGTH INCENTIVE, READY-MIXED CONCRETE	DOL.					5190
SLOPE PAVING, CRUSHED AGGREGATE	S.Y.		14		11	25
NON-BID ITEMS						
FILLER	SIZE				1/2" & 3/4"	

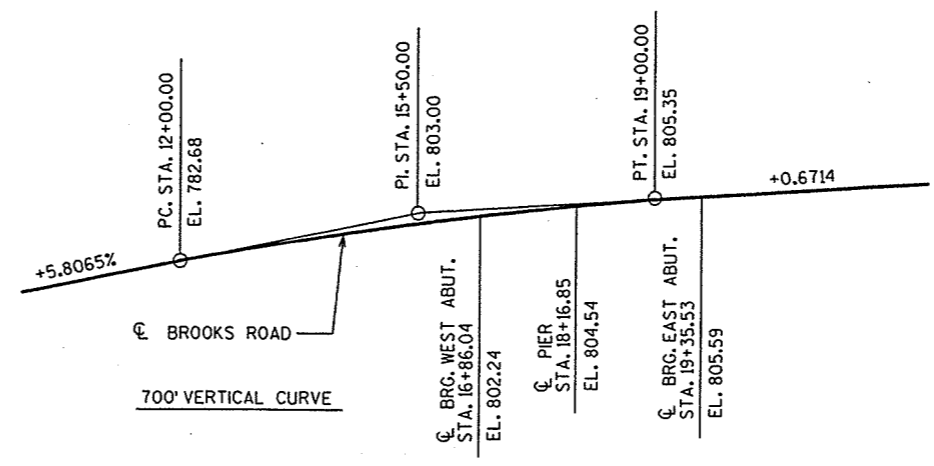

PROFILE GRADE LINE BROOKS ROAD

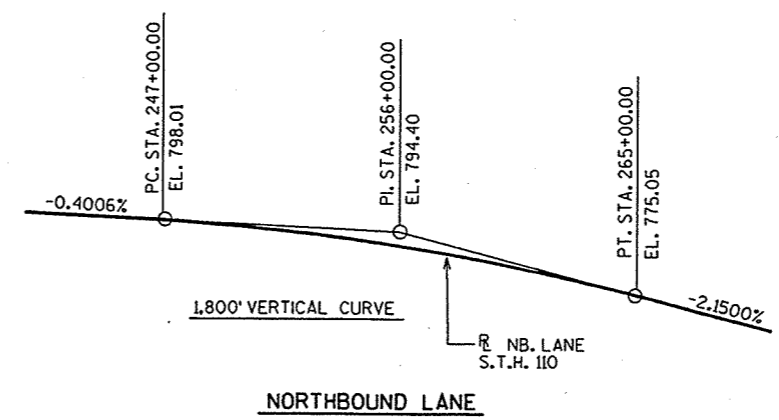

NORTHBOUND LANE

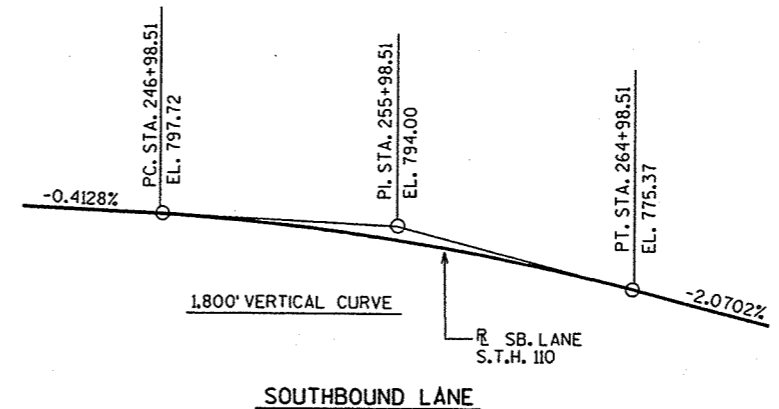

SOUTHBOUND LANE

PROFILE GRADE LINE S.T.H. 110

GENERAL NOTES

DRAWINGS SHALL NOT BE SCALED.
 BAR STEEL REINFORCEMENT SHALL BE EMBEDDED 2" CLEAR UNLESS OTHERWISE SHOWN OR NOTED.
 ELASTOMERIC BEARING PADS NEED NOT BE INDIVIDUALLY MOLDED PROVIDED THE CUT EDGES ARE SMOOTH AND TRUE.
 AT THE BACKFACE OF ABUTMENT ALL VOLUME WHICH CANNOT BE IN PLACE BEFORE ABUTMENT CONSTRUCTION AND NOT OCCUPIED BY THE NEW STRUCTURE SHALL BE BACKFILLED WITH STRUCTURE BACKFILL.
 THE FIRST OR FIRST TWO DIGITS OF THE BAR MARK SIGNIFIES THE BAR SIZE.
 THE EXISTING GROUNDLINE SHALL BE USED AS THE UPPER LIMITS OF EXCAVATION AT THE PIER.

NO.	DATE	REVISION	BY
STATE OF WISCONSIN DEPARTMENT OF TRANSPORTATION STRUCTURES DESIGN SECTION			
STRUCTURE B-70-217			
CONST. SPEC.	1996	DRAWN BY	BJ PLANS CK'D. J.C.K.
CROSS SECTION & QUANTITIES			SHEET 2

FILE= PREPLAN.DGN
 SCALE = 4"

STH 110 UNDER BROOKS RD.
 USH 41 TO CTH GG, WINNEBAGO COUNTY

STATE PROJECT NUMBER SHEET NO.

6200-05-71

8.44

ABBREVIATIONS
 F— FINE M— MEDIUM C— COARSE
 WS— WEATHERED SO— SOUND

MATERIAL SYMBOLS
 TOPSOIL SAND GRAVEL SILT PEAT CLAY SANDSTONE LIMESTONE IGNEOUS ROCK



LEGEND OF PROBING
 PROBING NO. STA. ELEVATION
 95/6=95 BLOWS FOR 6" PENETRATION PROBING TAKEN WITH A 350*WT. FALLING 18" ON A 2" O.D. POINT. REFUSAL 95/6

LEGEND OF BORING
 UNCONFINED STRENGTH [7.7] BLOWS PER FT. USING 140* WT. FALLING 30" WASH SAMPLE SHELBY TUBE— S.T. GROUND WATER ELEVATION NO GROUND WATER OBSERVED ABOVE THIS ELEVATION SANDY GRAVEL BOULDERS OR COBBLES SAND SILTY CLAY SO LIMESTONE

UNLESS OTHERWISE SPECIFIED, THE BLOWS PER FOOT AT THE LOCATIONS INDICATED ARE BASED ON DRIVING A O.D. XL 4" I.D. SPLIT SPOON SAMPLER WITH A 140* HAMMER HAVING A FREE FALL OF 30". THE BLOW COUNT IS TAKEN IN UNDISTURBED SOIL IMMEDIATELY BELOW A CASED OR OPEN HOLE ELIMINATING SIDE FRICTION ON THE DRIVE PIPE.

SUBSURFACE EXPLORATION FOR FOUNDATION DESIGN AND BIDDERS INFORMATION

TO OBTAIN RELATIVE DATA CONCERNING THE CHARACTER OF MATERIAL IN AND UPON WHICH THE FOUNDATION MIGHT BE BUILT, BORINGS AND/OR SOUNDINGS WERE MADE AT POINTS APPROXIMATELY AS INDICATED ON THIS DRAWING. THE DATA PRESENTED HEREIN REPRESENTS THE FINDINGS OF THE SUBSURFACE EXPLORATIONS MADE. HOWEVER, BECAUSE THE DEPTHS INVESTIGATED ARE LIMITED AND THE AREA OF THE BORINGS AND/OR SOUNDINGS IS VERY SMALL IN RELATION TO THE ENTIRE AREA, THE DIVISION OF HIGHWAYS DOES NOT WARRANT CONDITIONS BELOW THE DEPTHS INVESTIGATED OR THAT THE CLASSIFICATION OF MATERIAL ENCOUNTERED IN THESE INVESTIGATIONS IS NECESSARILY TYPICAL OF THE ENTIRE SITE.

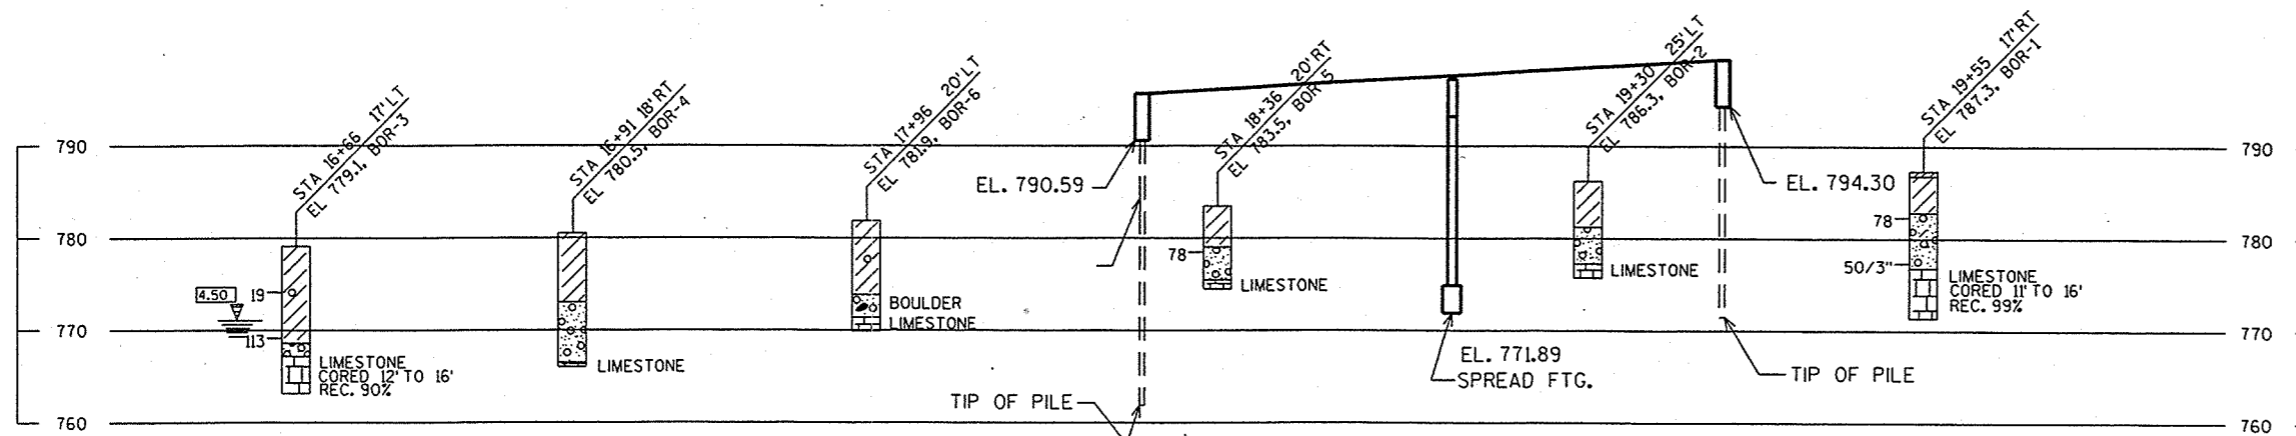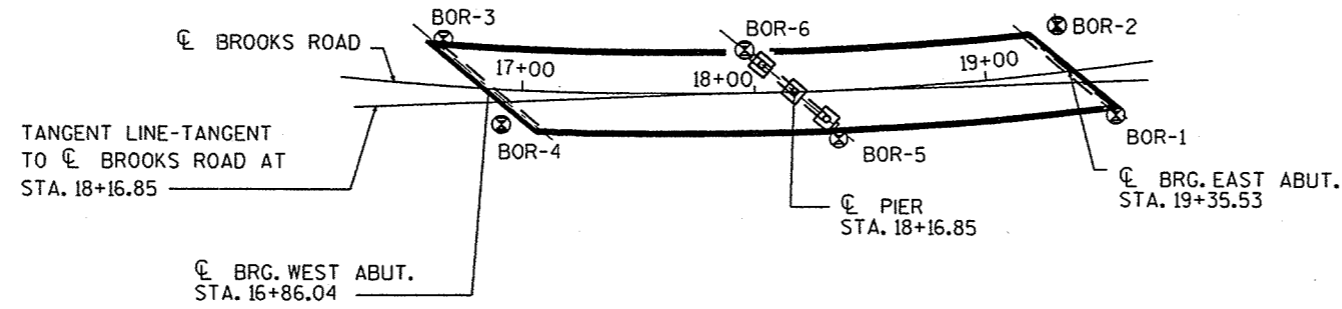

NO.	DATE	REVISION	BY
STATE OF WISCONSIN DEPARTMENT OF TRANSPORTATION STRUCTURES DESIGN SECTION			
STRUCTURE B-70-217			
CONST. SPEC.	1996	DRAWN BY V.J.W.	PLANS C.K.D.
SUBSURFACE EXPLORATION		SHEET 3	


FILE SCALE =

SLOPING BEAM SEAT ELEVATIONS


GIRDER	A	B	C	D
1	795.51	795.59	795.58	795.66
2	795.96	796.04	796.03	796.11
3	796.40	796.48	796.47	796.55
4	796.84	796.92	796.91	796.99
5	797.28	797.36	797.35	797.43
6	797.71	797.79	797.78	797.86
7	798.14	798.22	798.21	798.29

* @ GIRDER AT @ BRG. W. ABUT. ELEV.


● VERT. CONST. JT. - KEYWAY FORMED BY BEVELED 2" X 8" 3/4" V-GROOVE ON FF. ABUTMENT.

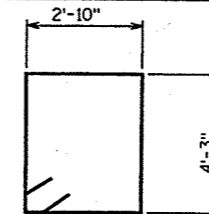

A401

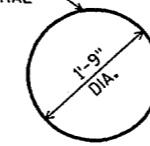

A402


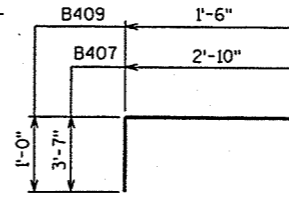


A407, A409


BILL OF BARS

NOTE: THE FIRST OR FIRST TWO DIGITS OF THE BAR MARK SIGNIFIES THE BAR SIZE.

BAR MARK	COAT	NO. REQ'D.	LENGTH	BENT	BAR SERIES	LOCATION
A401		69	14'-8"	X		BODY - VERT.
A402		11	28'-0"	X		BODY - 1 PER PILE
A403		22	2'-3"			BODY - 2 PER PILE
A604		34	32'-4"			BODY - HORIZ.
A405		2	29'-6"			BODY - TOP - HORIZ.
A406		6	27'-0"			BODY - TOP - HORIZ.
A407		35	9'-10"	X		BODY - TOP - VERT.
A408		12	5'-9"			BETW BEAM SEATS
A409		18	3'-5"	X		BETW BEAM SEATS

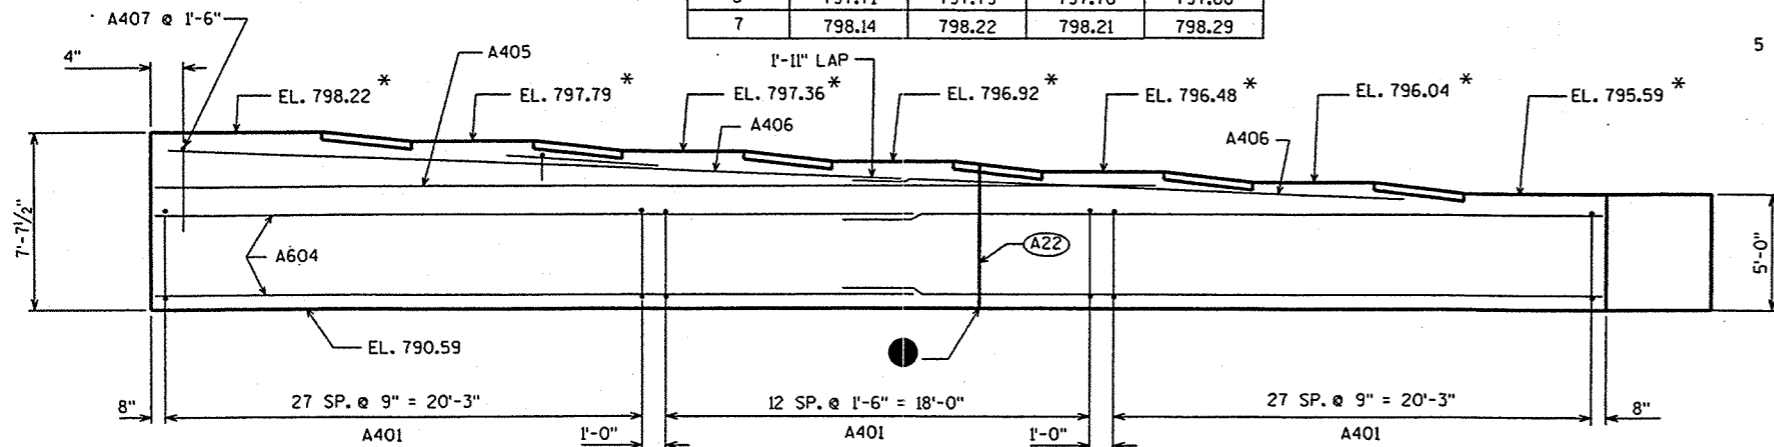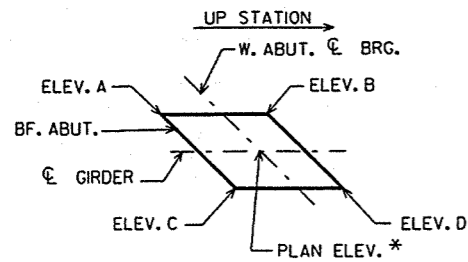


ELEVATION LOOKING WEST

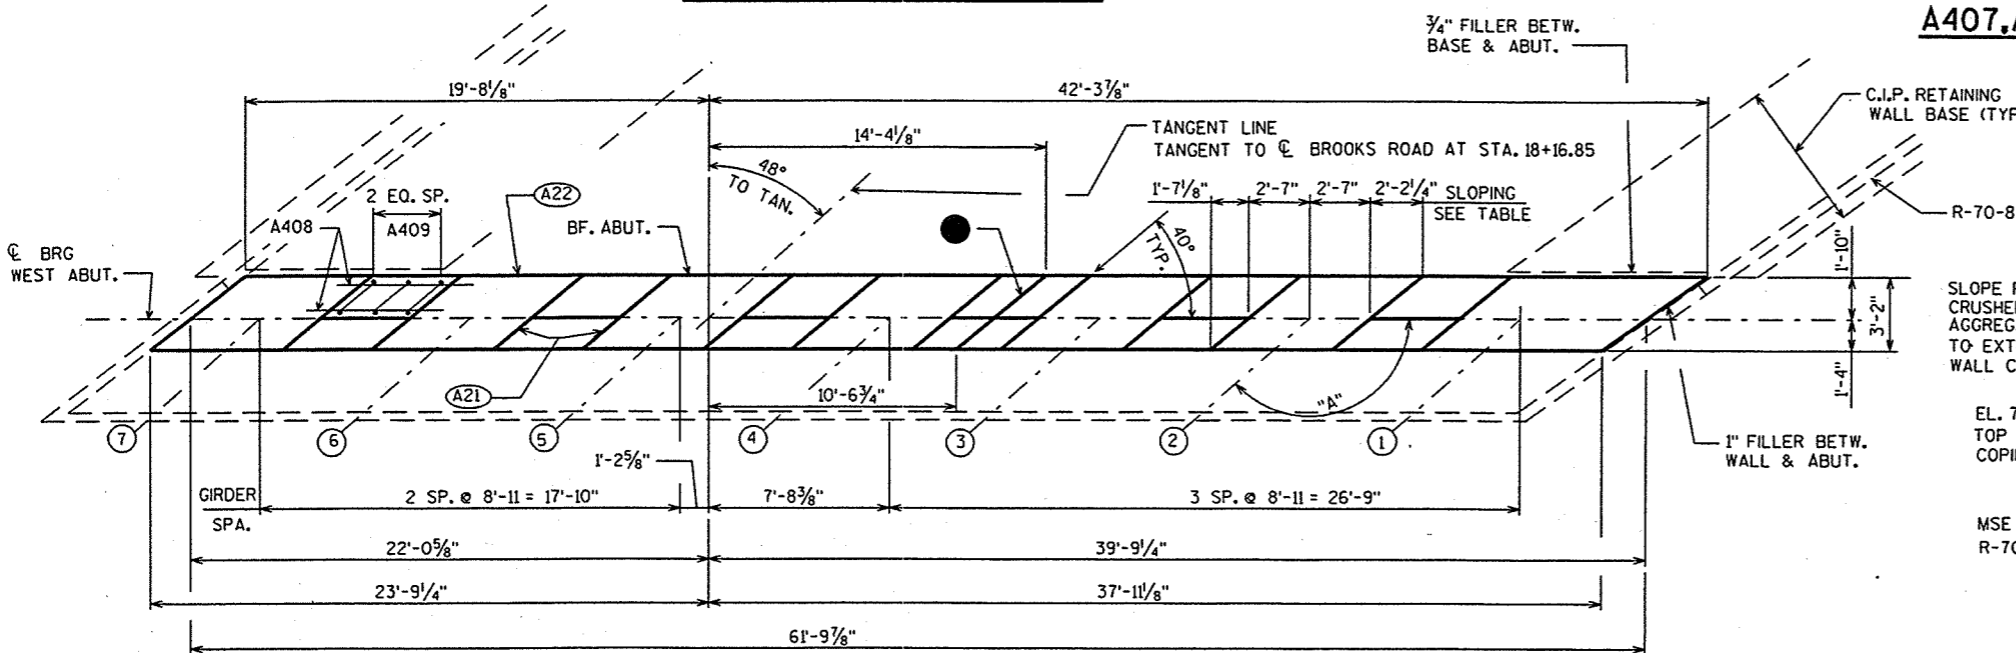


PLAN

"A" - FOR GIRDER ANGLES SEE SH. 9.

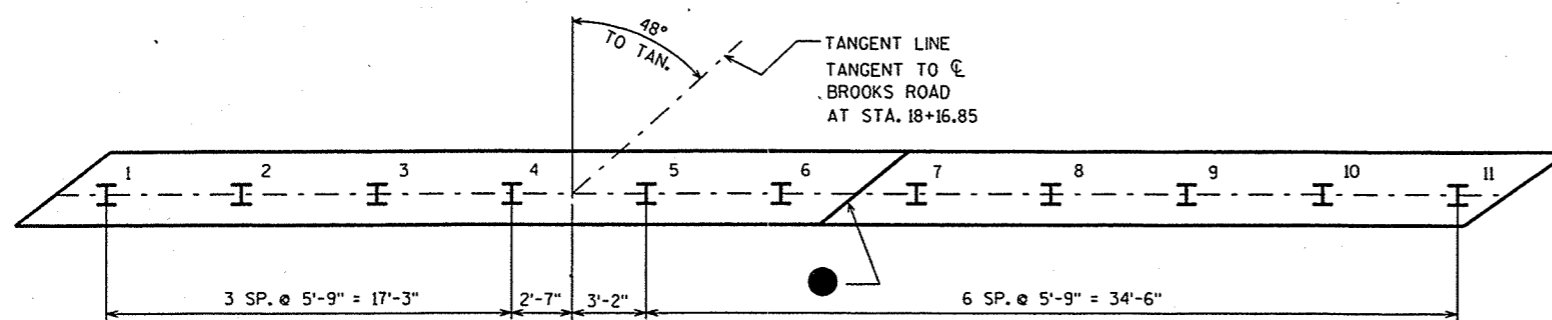

PILE PLAN

STEEL TROWEL TOP SURFACE OF ABUTMENT PLACE MULTIPLE LAYERS OF POLYETHYLENE SHEETS OVER ENTIRE ABUTMENT BEFORE PLACING BEARING PADS (TOTAL THICKNESS TO BE 0.03" MIN)

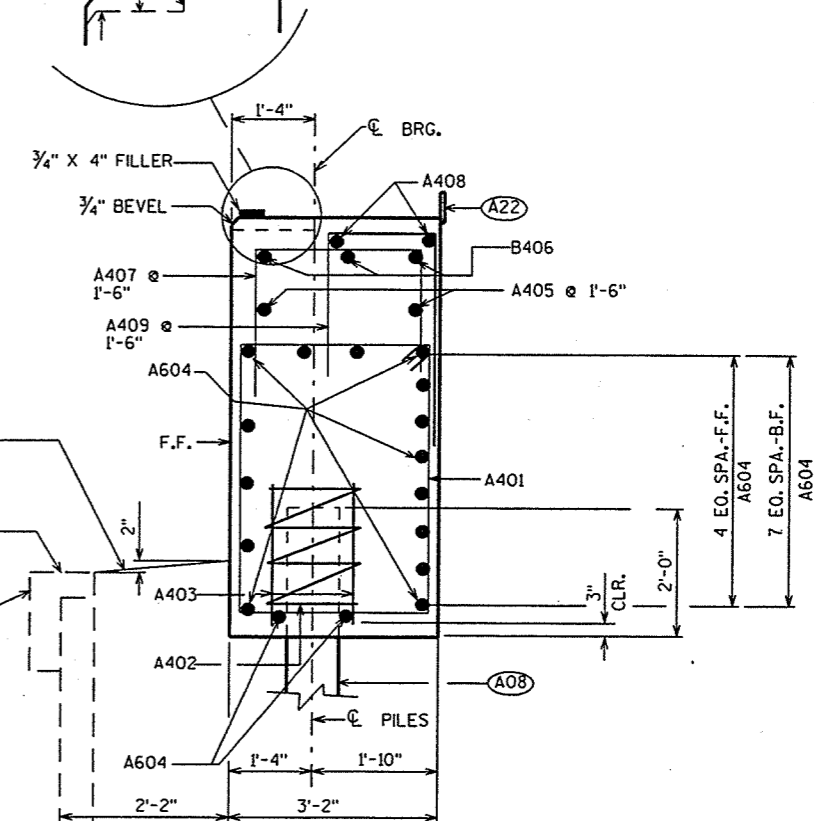

SECTION THRU BODY



- (A08) SUPPORT ABUTMENT ON HP 10 x 42 STEEL PILING, ESTIMATED 25'-0" LONG, & DRIVEN TO A MIN. BRG. VALUE OF 55 TONS PER PILE.
- (A21) 3/4" CORK UP VERT. FACES OF BEAM SEATS.
- (A22) 18" (RMW) RUBBERIZED MEMBRANE WATERPROOFING SEAL ALL HORIZ. & VERT. JOINTS AT BACKFACE.

NO.	DATE	REVISION	BY
STATE OF WISCONSIN DEPARTMENT OF TRANSPORTATION STRUCTURES DESIGN SECTION			
STRUCTURE B-70-217			
CONST. SPEC.	1996	DRAWN BY BJ	PLANS CKD. J.C.K.
WEST ABUTMENT			SHEET 4


SLOPING BEAM SEAT ELEVATIONS

GIRDER	A	B	C	D
1	799.27	799.31	799.30	799.33
2	799.60	799.64	799.63	799.66
3	799.91	799.95	799.94	799.97
4	800.21	800.25	800.24	800.27
5	800.49	800.53	800.52	800.55
6	800.75	800.79	800.78	800.81
7	800.99	801.03	801.02	801.05

* CL GIRDER AT CL BRG. E. ABUT. ELEV.

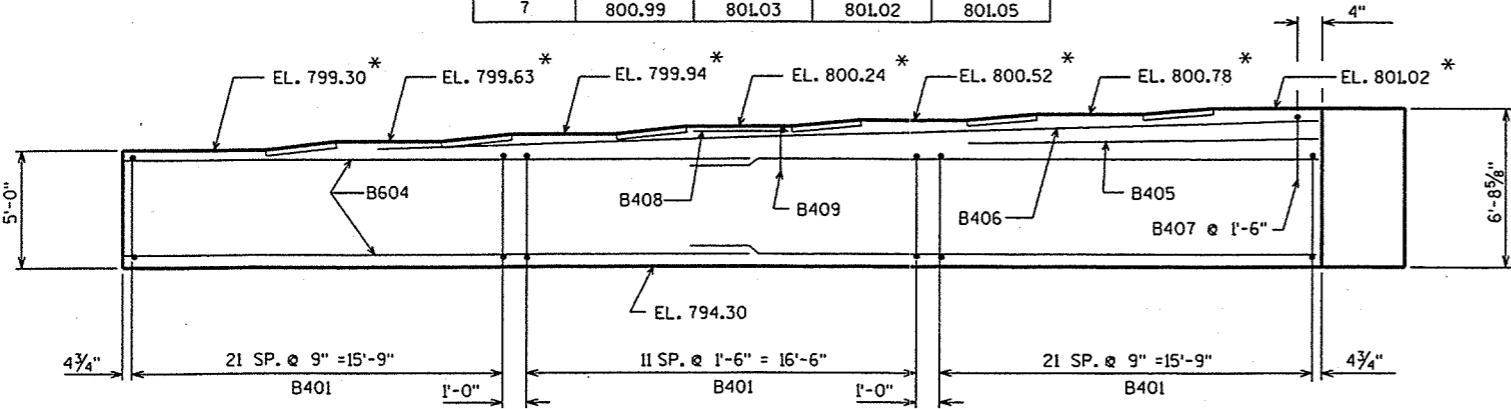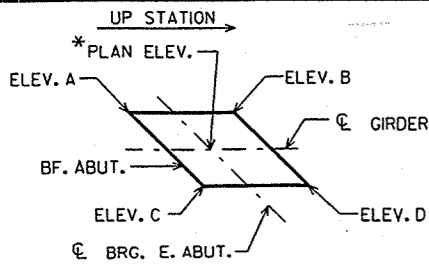


ELEVATION LOOKING EAST

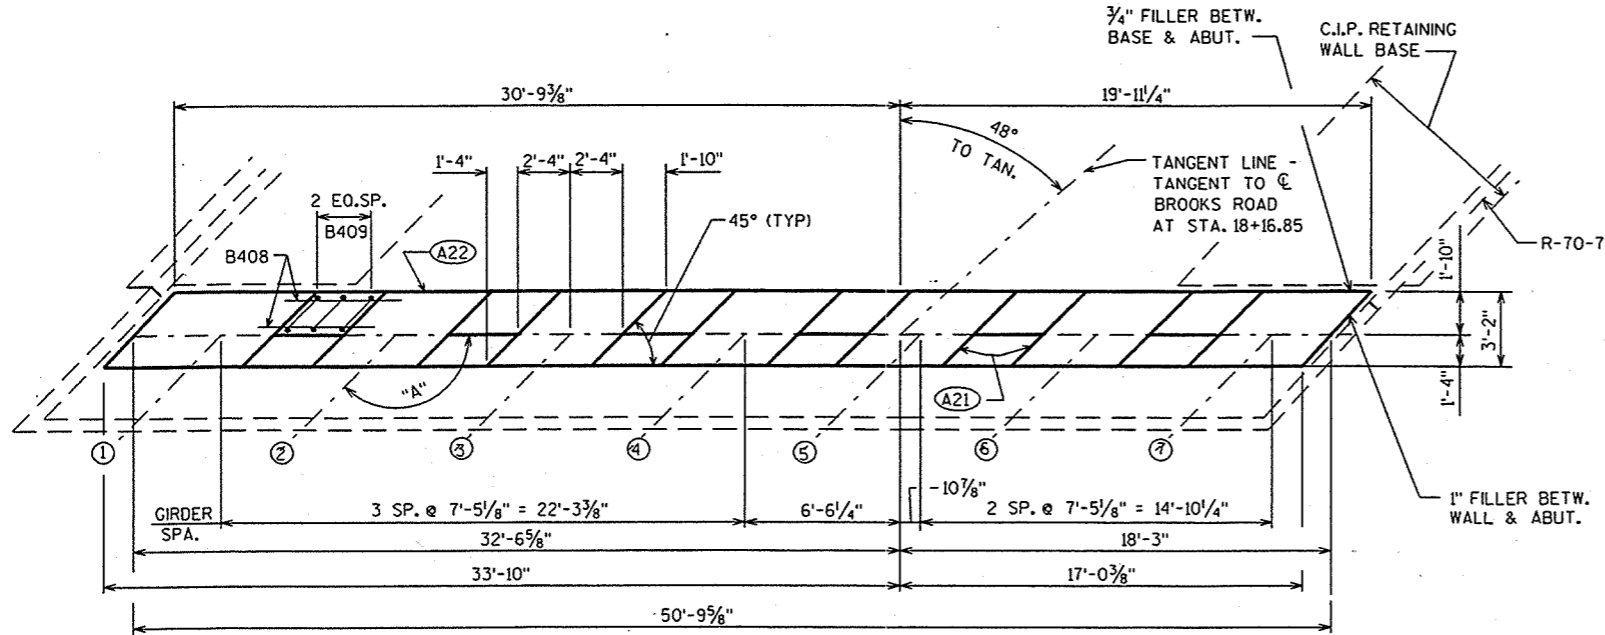


PLAN

"A" - FOR GIRDER ANGLES SEE SHT. 9.

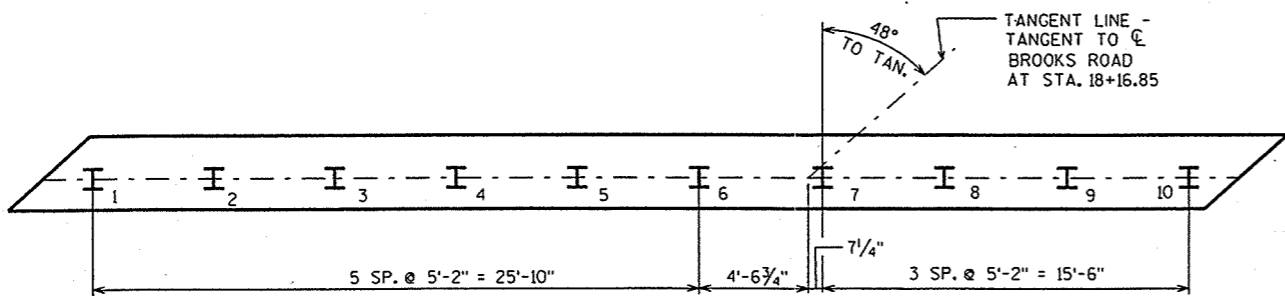



PILE PLAN

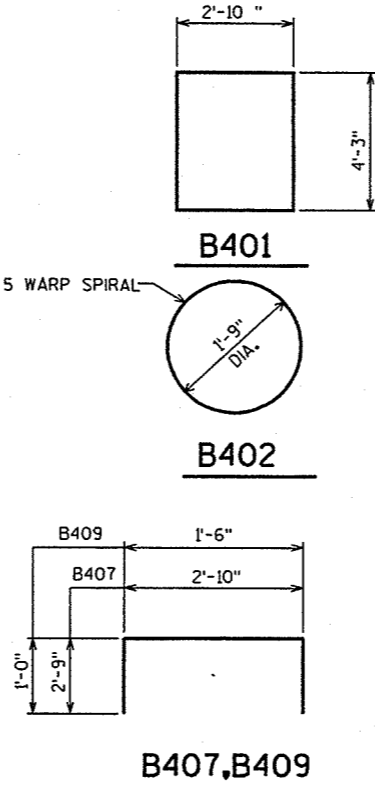

BILL OF BARS

NOTE: THE FIRST OR FIRST TWO DIGITS OF THE BAR MARK SIGNIFIES THE BAR SIZE.

BAR MARK	COAT	NO. REQ'D.	LENGTH	BENT	BAR SERIES	LOCATION
B401		56	14'-8"	X		BODY - VERT.
B402		10	28'-0"	X		BODY - 1 PER PILE
B403		20	2'-3"			BODY - 2 PER PILE
B604		34	26'-9"			BODY - HORIZ.
B405		2	20'-0"			BODY - TOP - HORIZ.
B406		3	42'-0"			BODY - TOP - HORIZ.
B407		28	8'-2"	X		BODY - TOP - VERT.
B408		12	4'-9"			BETW BEAM SEATS
B409		18	3'-5"	X		BETW BEAM SEATS

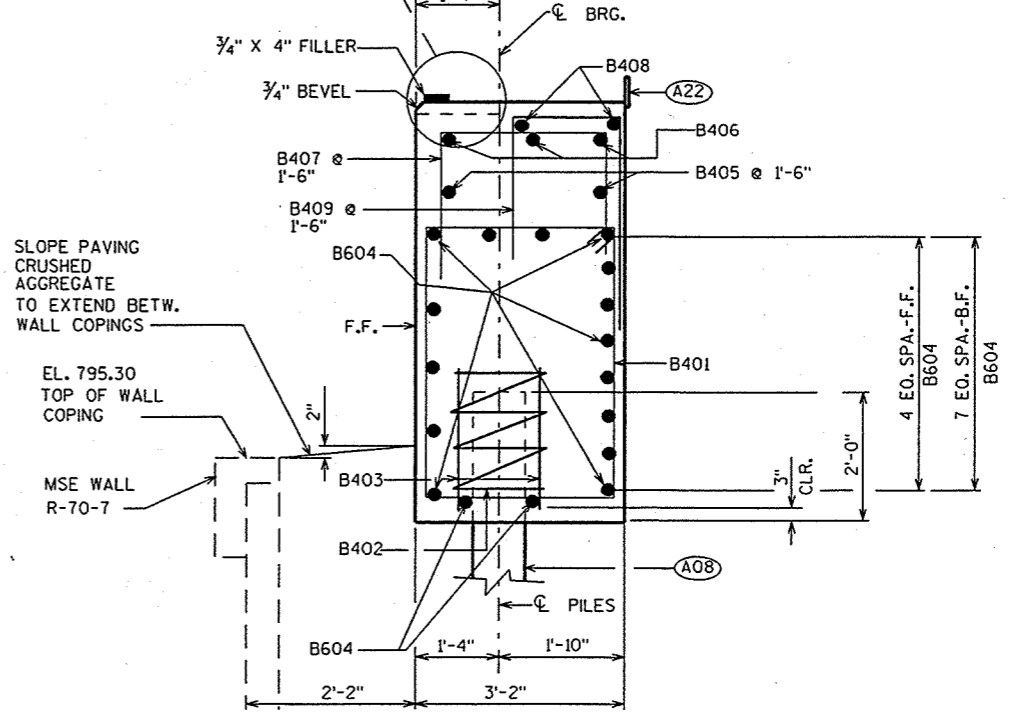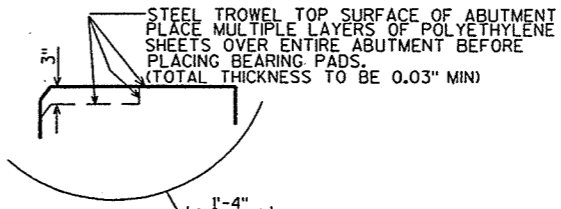


SECTION THRU BODY

- (A08) SUPPORT ABUTMENT ON HP 10 x 42 STEEL PILING, ESTIMATED 20'-0" LONG, & DRIVEN TO A MIN. BRG. VALUE OF 55 TONS PER PILE.
- (A21) 3/4" CORK UP VERT. FACES OF BEAM SEATS.
- (A22) 18" (RMW) RUBBERIZED MEMBRANE WATERPROOFING SEAL ALL HORIZ. & VERT. JOINTS AT BACKFACE.


NO.	DATE	REVISION	BY
STATE OF WISCONSIN DEPARTMENT OF TRANSPORTATION STRUCTURES DESIGN SECTION			
STRUCTURE B-70-217			
CONST. SPEC.	1996	DRAWN BY	BJ
		PLANS CK'D.	J.C.K.
EAST ABUTMENT			SHEET 5

FILE= 21TEABUT.DGN
SCALE = 4

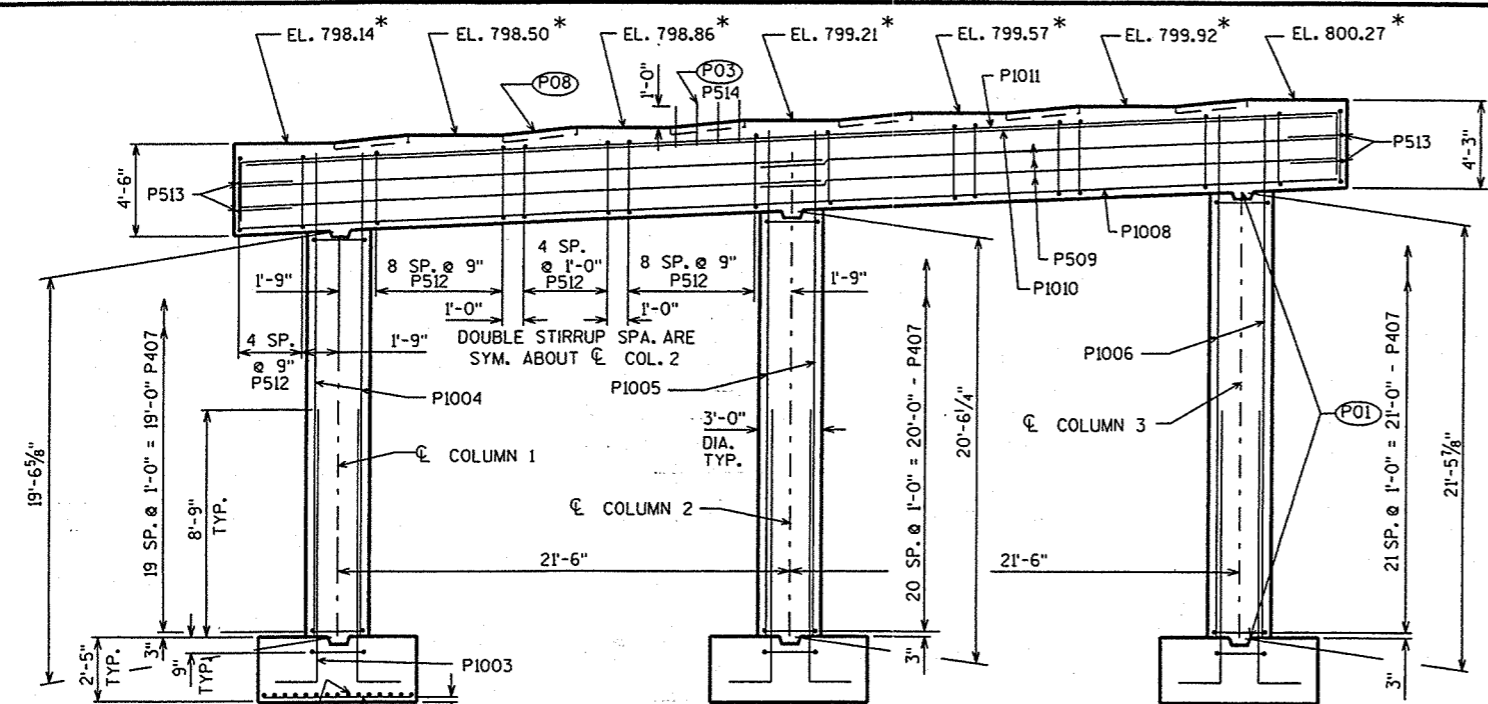

ELEVATION
LOOKING EAST

* \bar{C} GIRDER & \bar{C} PIER ELEV.

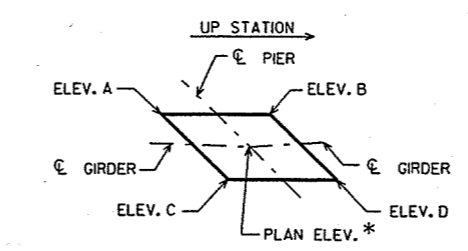

SLOPING BEAM SEAT ELEVATIONS


GIRDER	A	B	C	D
1	798.08	798.15	798.13	798.17
2	798.44	798.51	798.49	798.53
3	798.80	798.87	798.85	798.89
4	799.15	799.22	799.20	799.24
5	799.51	799.58	799.56	799.60
6	799.86	799.93	799.91	799.95
7	800.21	800.28	800.26	800.30

BILL OF BARS

NOTE: THE FIRST OR FIRST TWO DIGITS OF THE BAR MARK SIGNIFIES THE BAR SIZE.


BAR MARK	QTY	NO. REQ'D.	LENGTH	BEND	BUND.	LOCATION
P701		48	7'-8"			FOOTINGS
P702		48	7'-8"			FOOTINGS
P1003	X	72	13'-0"	X	X	FOOTINGS AND COLUMNS
P1004	X	24	23'-0"		X	COLUMN 1 - VERT.
P1005	X	24	24'-0"		X	COLUMN 2 - VERT.
P1006	X	24	25'-0"		X	COLUMN 3 - VERT.
P407	X	66	10'-0"	X		COLUMNS - HOOPS
P1008	X	8	52'-7"			CAP - HORIZ. - BOTTOM
P509	X	8	27'-9"			CAP - HORIZ. SIDES
P1010	X	5	52'-2"		X	CAP - HORIZ. - TOP
P1011	X	7	58'-3"	X	X	CAP - HORIZ. - TOP
P512	X	112	12'-6"	X		CAP - STIRRUPS
P513	X	4	5'-8"	X		CAP - ENDS
P514	X	24	2'-0"			CAP - DOWELS

THE FOOTINGS ARE DESIGNED TO PLACE A MAXIMUM LOAD OF 10 TSF ON THE UNDERLYING ROCK. ROCK AT FOOTING ELEVATION IS ESTIMATED TO HAVE AN ALLOWABLE BEARING CAPACITY OF 10 TSF.

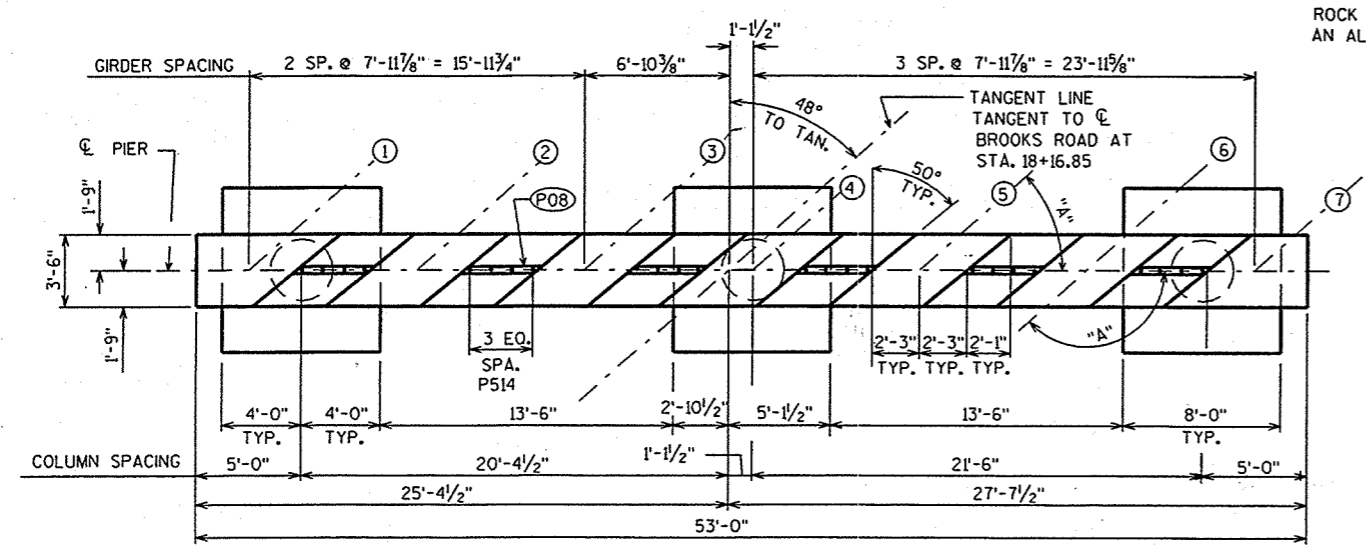


PLAN


"A" FOR GIRDER ANGLES SEE SHT. 9.

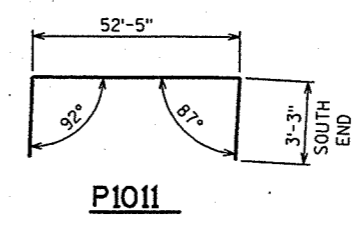


P1011

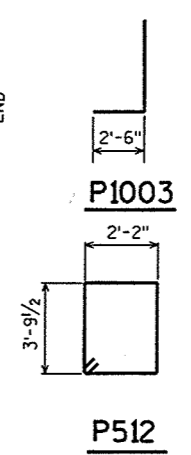


P1003

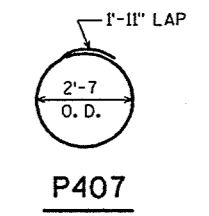


P407

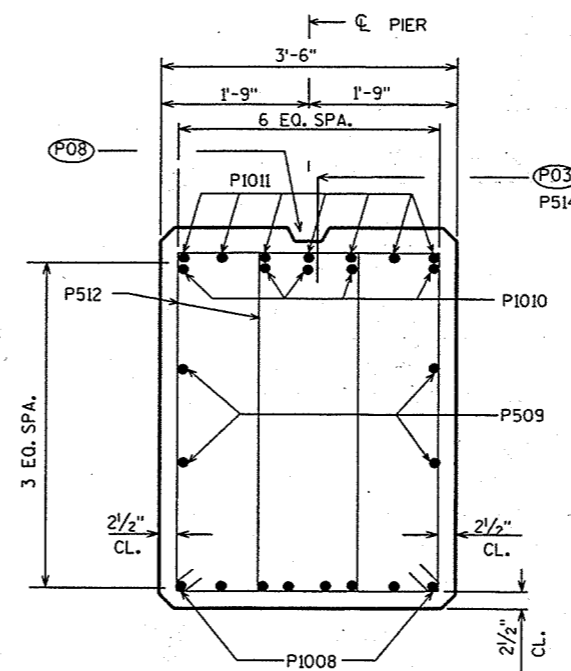


SECTION THRU CAP

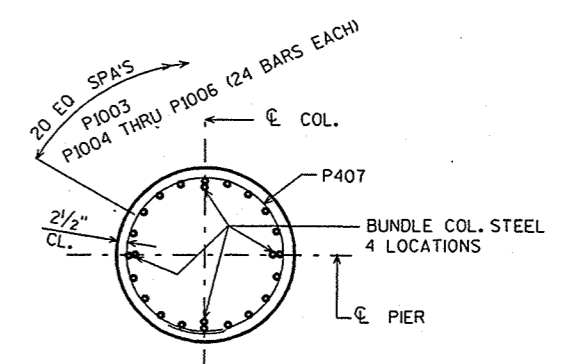

SECT. THRU COL.

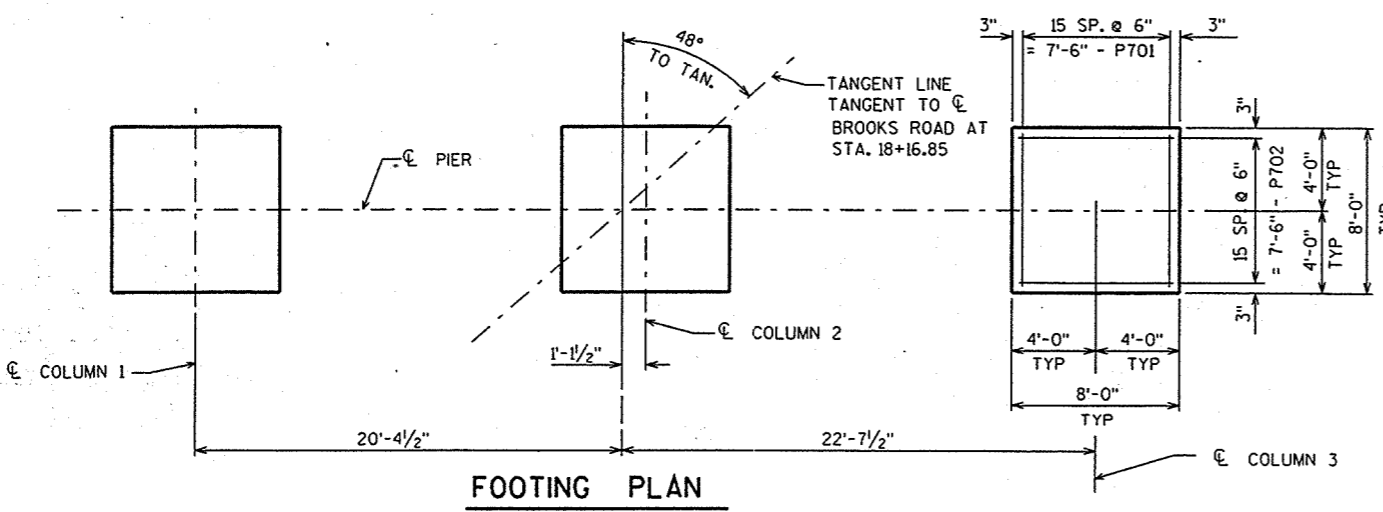

FOOTING PLAN

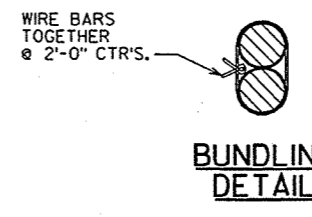

BUNDLING DETAIL

- (P01) 1'-3" X 1'-3" X 2" CONSTRUCTION JOINT FORMED BY BEVELED KEYWAY.
- (P03) BARS @ 1'-0" CTRS. BETWEEN BEAM SEATS. MAY BE PLACED AFTER CONCRETE IS POURED BUT BEFORE INITIAL SET HAS TAKEN PLACE. (EMBED 1'-0" INTO CONC.)
- (P08) KEYED CONSTRUCTION JOINT-FORMED BY BEVELED 2 X 6 BETWEEN BEAM SEATS.

NO.	DATE	REVISION	BY
STATE OF WISCONSIN DEPARTMENT OF TRANSPORTATION STRUCTURES DESIGN SECTION			
STRUCTURE B-70-217			
CONST. SPEC.	1996	DRAWN BY	BJ
			PLANS CK'D. J.C.K.
PIER			SHEET 6

GIRDER NOTES

TOP OF GIRDER TO BE ROUGH FLOATED AND BROOMED TRANSVERSELY, EXCEPT THE OUTSIDE 2" OF GIRDER, WHICH SHALL BE TROWEL FINISHED.

THE GIRDERS SHALL BE PROVIDED WITH A SUITABLE LIFTING DEVICE FOR HANDLING AND ERECTING THE GIRDERS.

PRESTRESSING STRANDS SHALL BE 0.6"φ - 7 WIRE LOW-RELAXATION STRANDS WITH AN ULTIMATE STRENGTH OF 270,000 PSI AND SHALL BE FLUSH WITH THE ENDS OF THE GIRDER.

BEND EACH END OF #4 STIRRUPS 4 1/2" AND #6 STIRRUPS 6 1/2".

FOR DIAPHRAGM INSERT & CONNECTION DETAILS SEE "STEEL DIAPHRAGM" SHEET.

ALL GIRDERS SHALL BE CAST FULL LENGTH AS SHOWN.


SPACING SHOWN FOR #4 STIRRUPS IS FOR GRADE 60 REINFORCEMENT, IF THE FABRICATOR WANTS TO BUILD A BAR STEEL CAGE BY WELDING LONGITUDINAL REINFORCEMENT TO THE #4 STIRRUPS, 2 OPTIONS ARE AVAILABLE:

- USE ASTM A706, GRADE 60 REINFORCEMENT AND THE STIRRUP SPACING AS SHOWN ON THE PLANS.
- USE ASTM A615, GRADE 40 REINFORCEMENT AND A MODIFIED STIRRUP SPACING SUBMITTED TO AND APPROVED BY THE STRUCTURES DEVELOPMENT SECTION.


AN ALTERNATE EQUIVALENT OF WELDED WIRE FABRIC (WWF) MAY BE SUBSTITUTED FOR THE STIRRUP REINFORCEMENT SHOWN, UPON APPROVAL OF THE STRUCTURES DEVELOPMENT SECTION.

WELDED WIRE FABRIC SHALL CONFORM TO THE REQUIREMENTS OF ASTM A497.


ENDS OF STRANDS SHALL BE PAINTED WITH NON-STAINING GRAY NON-BITUMINOUS JOINT SEALER. (THIS APPLIES ONLY TO THOSE ENDS OF GIRDERS THAT ARE FINALLY EXPOSED.)

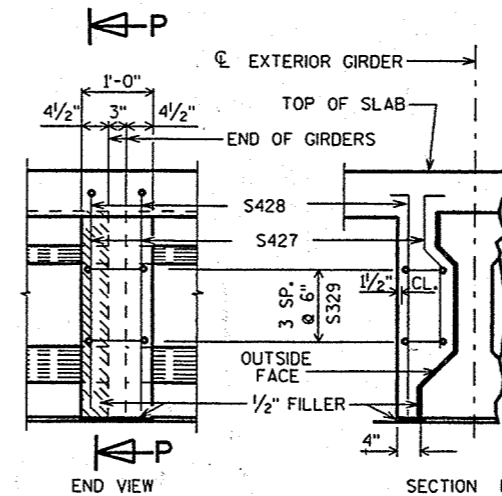

PILASTER DETAILS AT PIERS

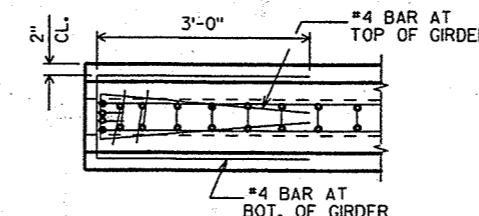


TOP VIEW OF GIRDER ENDS

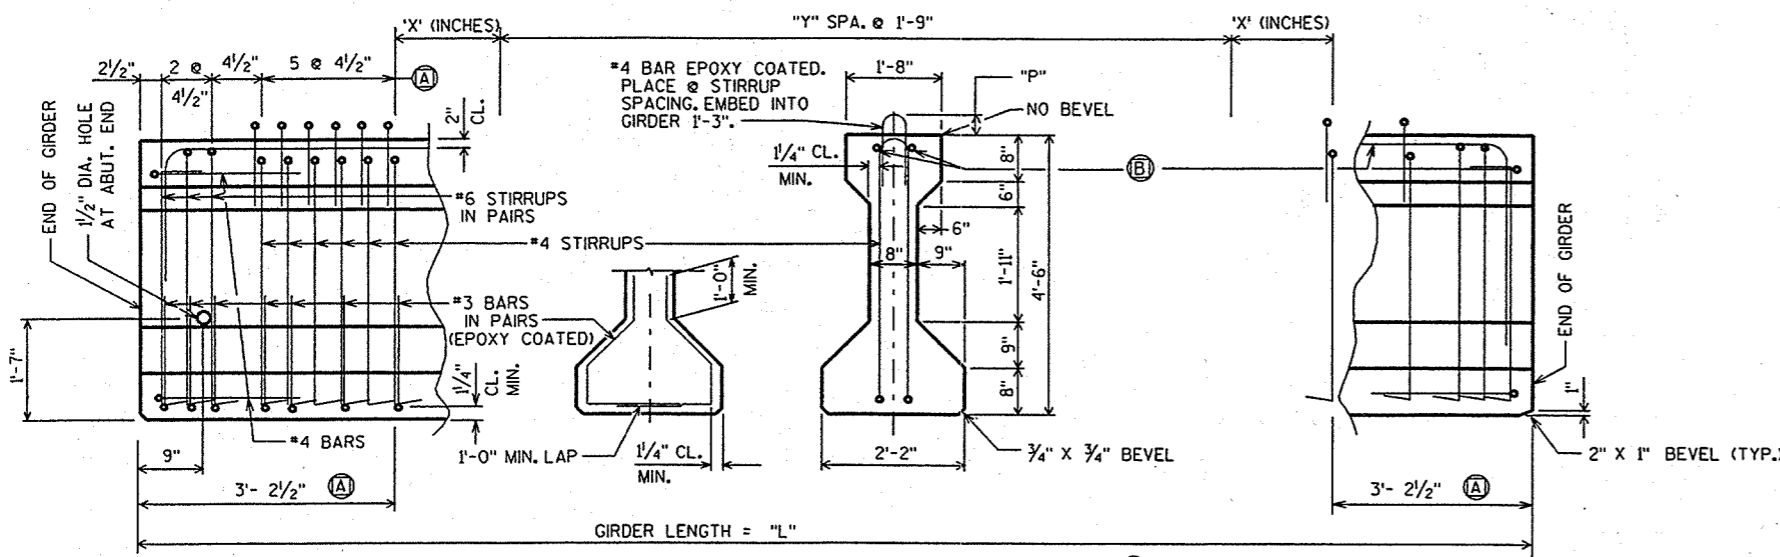


SIDE VIEW & TYP. SECTION IN SPAN


Ⓐ DETAIL TYP. AT EACH END
 Ⓑ 2-BARS BEND DOWN 16 BAR DIA. AT ENDS USE NO. 4 BARS

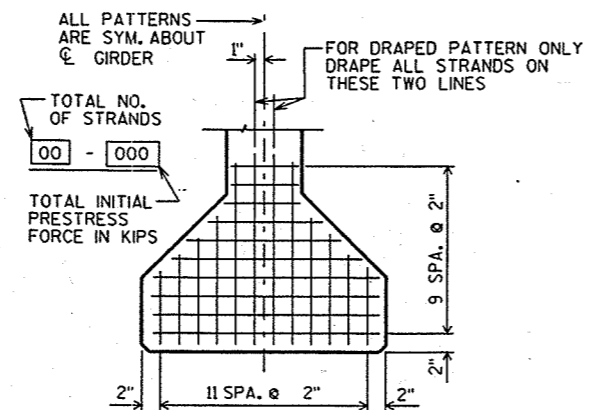


TYP. STRAND PATTERN

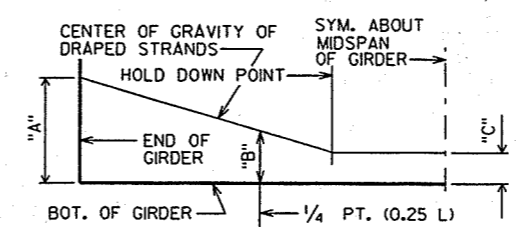

DRAPED STRAND PROFILE

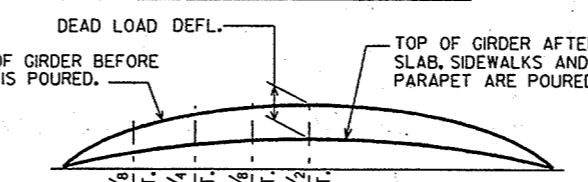

DEAD LOAD DEFLECTION DIAGRAM

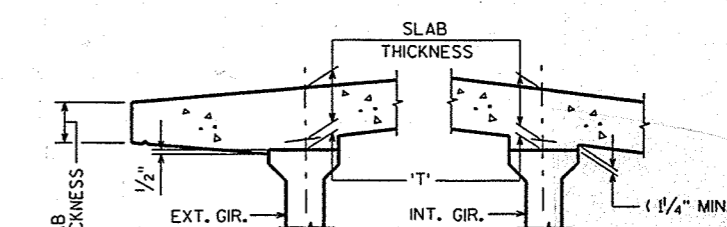


SLAB HAUNCH DETAIL

IF 1/4" MINIMUM HAUNCH HEIGHT AT EDGE OF GIRDER CANNOT BE MAINTAINED, THE GRADE LINE MAY BE REVISED BY THE ENGINEER AT THE OPTION OF THE CONTRACTOR. THE PLAN SLAB THICKNESS SHALL BE HELD. NOTIFY BRIDGE OFFICE FOR HAUNCH HEIGHTS OVER 4".

TO DETERMINE 'T', ELEV. OF TOP OF GIR'S. AT CL. OF SUBSTRUCTURE UNITS & AT 1/8 POINTS OF EACH SPAN SHALL BE TAKEN. THEN FOLLOW THIS PROCESS:

TOP OF DECK ELEV. AT FINAL GRADE
 - TOP OF GIRDER ELEVATION
 + DEAD LOAD DEFLECTION
 - SLAB THICKNESS
 = HAUNCH HEIGHT 'T'

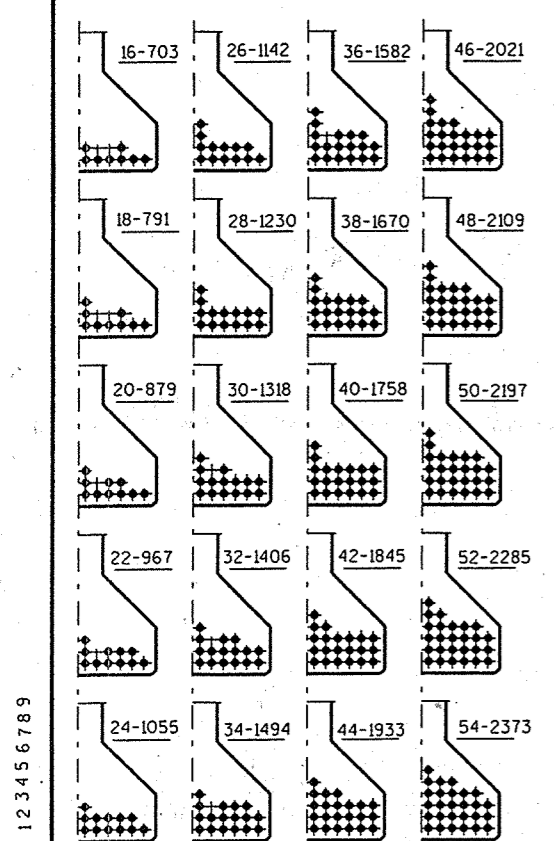

DRAPED PATTERN

GIRDER DATA				
GIRDER	GIRDER LENGTH "L"	"X"	"Y"	
SPAN 1, GIR. 1	133'-2 5/8"	1'-3 5/16"	71	
SPAN 1, GIR. 2	132'-6"	11"	71	
SPAN 1, GIR. 3	131'-9 3/8"	1'-5 3/16"	70	
SPAN 1, GIR. 4	131'-0 3/4"	1'-0 1/8"	70	
SPAN 1, GIR. 5	130'-4 1/8"	1'-7 1/16"	69	
SPAN 1, GIR. 6	129'-7 5/8"	1'-2 1/4"	69	
SPAN 1, GIR. 7	128'-11 1/4"	10 5/8"	69	
SPAN 2, GIR. 1	120'-0 1/8"	1'-8 1/16"	63	
SPAN 2, GIR. 2	119'-7 1/4"	1'-5 5/8"	63	
SPAN 2, GIR. 3	119'-2 1/2"	1'-3 1/4"	63	
SPAN 2, GIR. 4	118'-9 5/8"	1'-0 1/16"	63	
SPAN 2, GIR. 5	118'-4 7/8"	10 1/16"	63	
SPAN 2, GIR. 6	118'-0 1/8"	1'-6 3/16"	62	
SPAN 2, GIR. 7	117'-7 1/4"	1'-4 1/8"	62	

* MINIMUM CYLINDER STRENGTH OF CONCRETE @ TIME OF TRANSFER OF PRESTRESS FORCE.

GIRDER DATA															
SPAN	GIRDER LENGTH "L"	DEAD LOAD DEFL. (IN.)				CONC. STRGTH. F'c (P.S.I.)	"P"	DIA. OF STRAND	TOTAL NO. OF STRANDS	F'ci (P.S.I.) *	DRAPED PATTERN (IN.)				UNDRAPED PATTERN TOTAL NO. OF STRANDS
		1/8	1/4	3/8	1/2						"A"	"B" MIN.	"B" MAX.	"C"	
1	SEE TABLE	1/8	1/8	2 3/8	2 1/2	8000	6"	0.6"	38	5400	48	16.5	19.5	6	
2	SEE TABLE	3/4	1 1/4	1 1/2	1 5/8	8000	6"	0.6"	30	4800	49	16	19	5	

NO.	DATE	REVISION	BY
STATE OF WISCONSIN DEPARTMENT OF TRANSPORTATION STRUCTURES DESIGN SECTION			
STRUCTURE B-70-217			
CONST. SPEC.	1996	DRAWN BY	BJ PLANS CKD. J.C.K.
54" PRESTRESSED GIRDER DETAILS			SHEET 7

LV = 123456789

FILE = 654.DGN
 SCALE = 3-00