
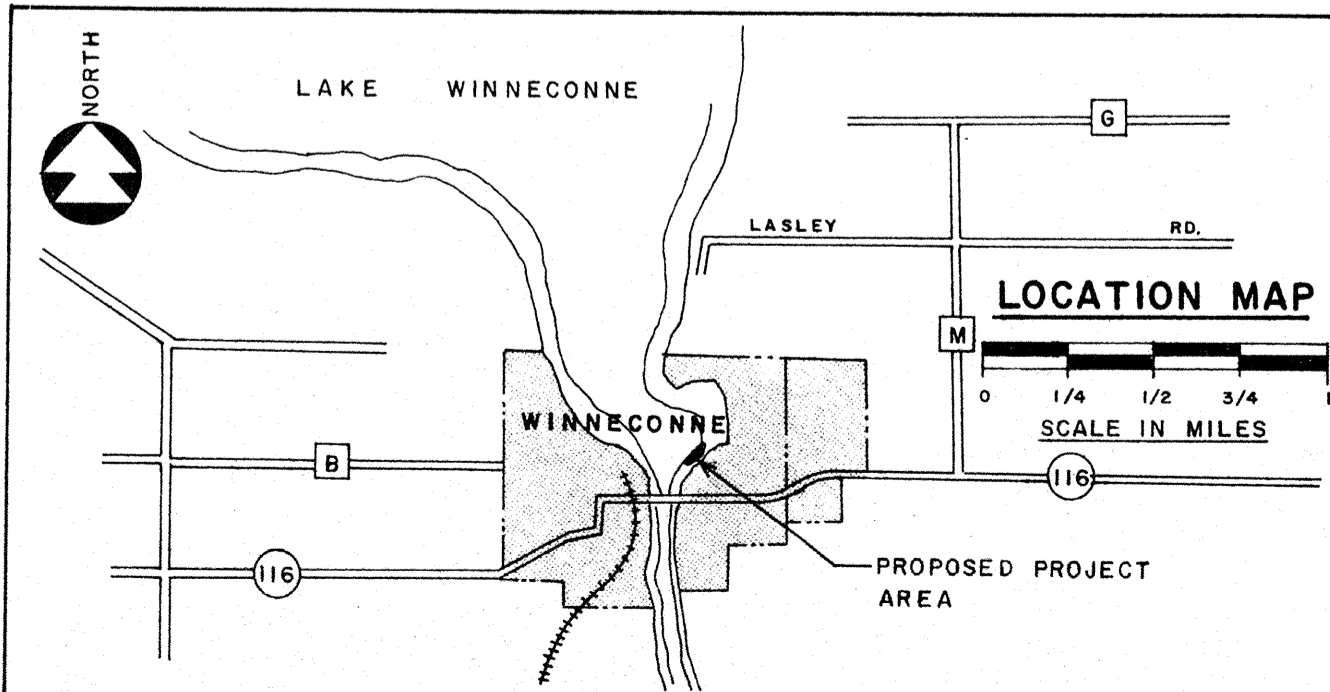
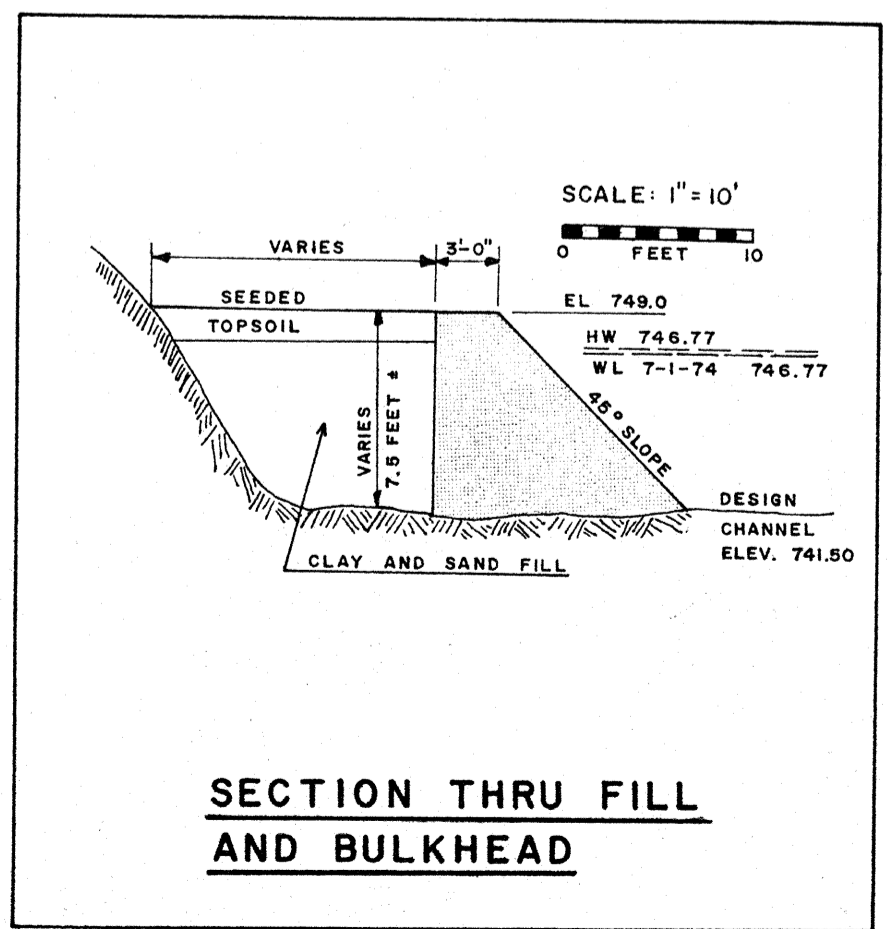
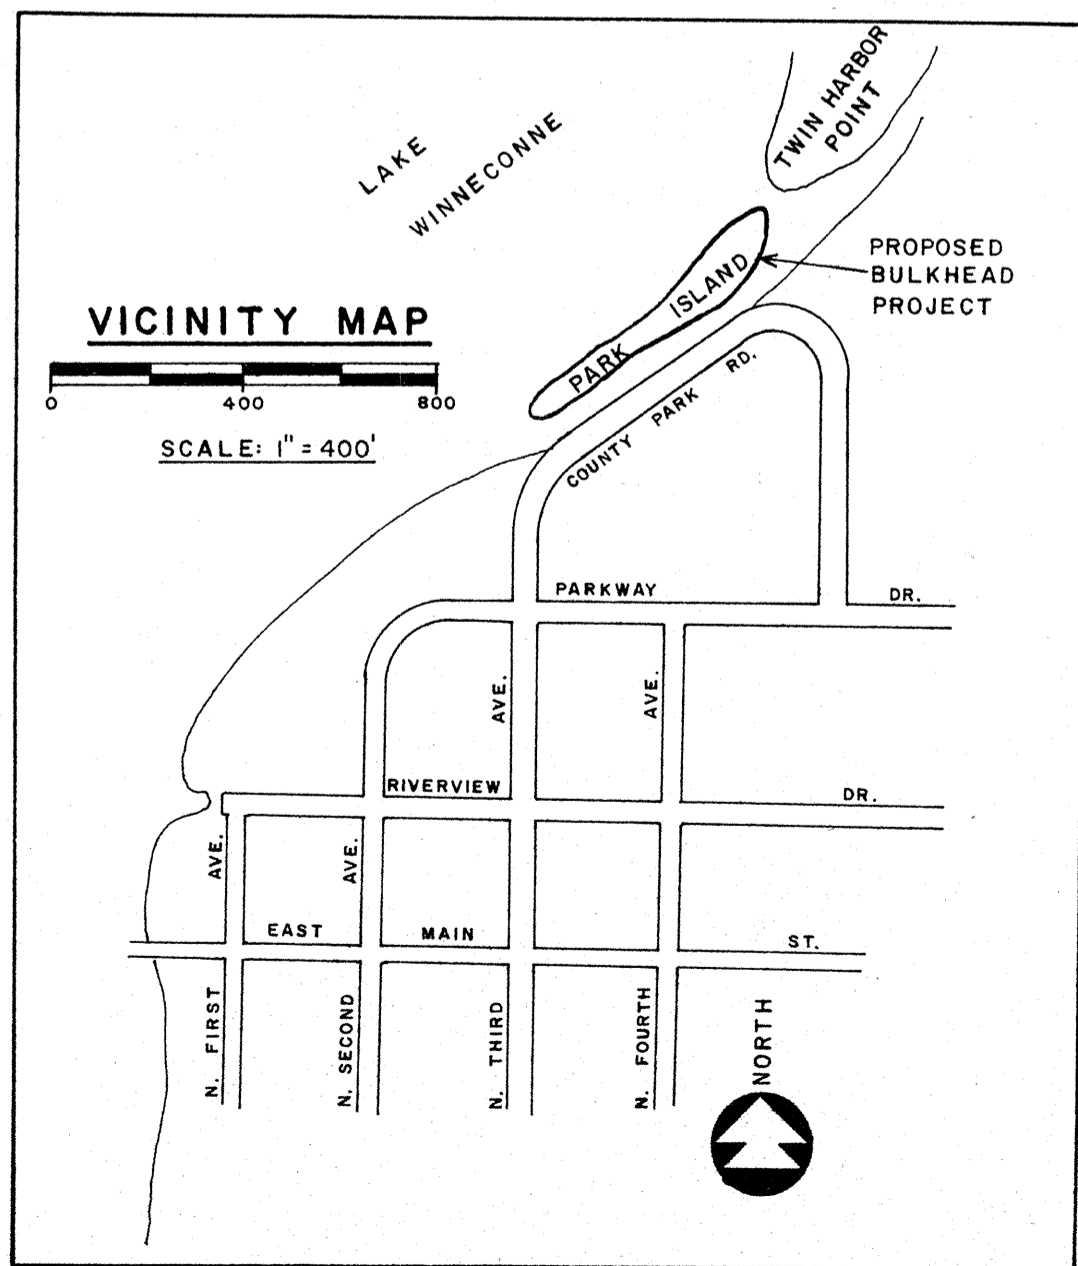


**PLAN VIEW**

SCALE: 1" = 40'


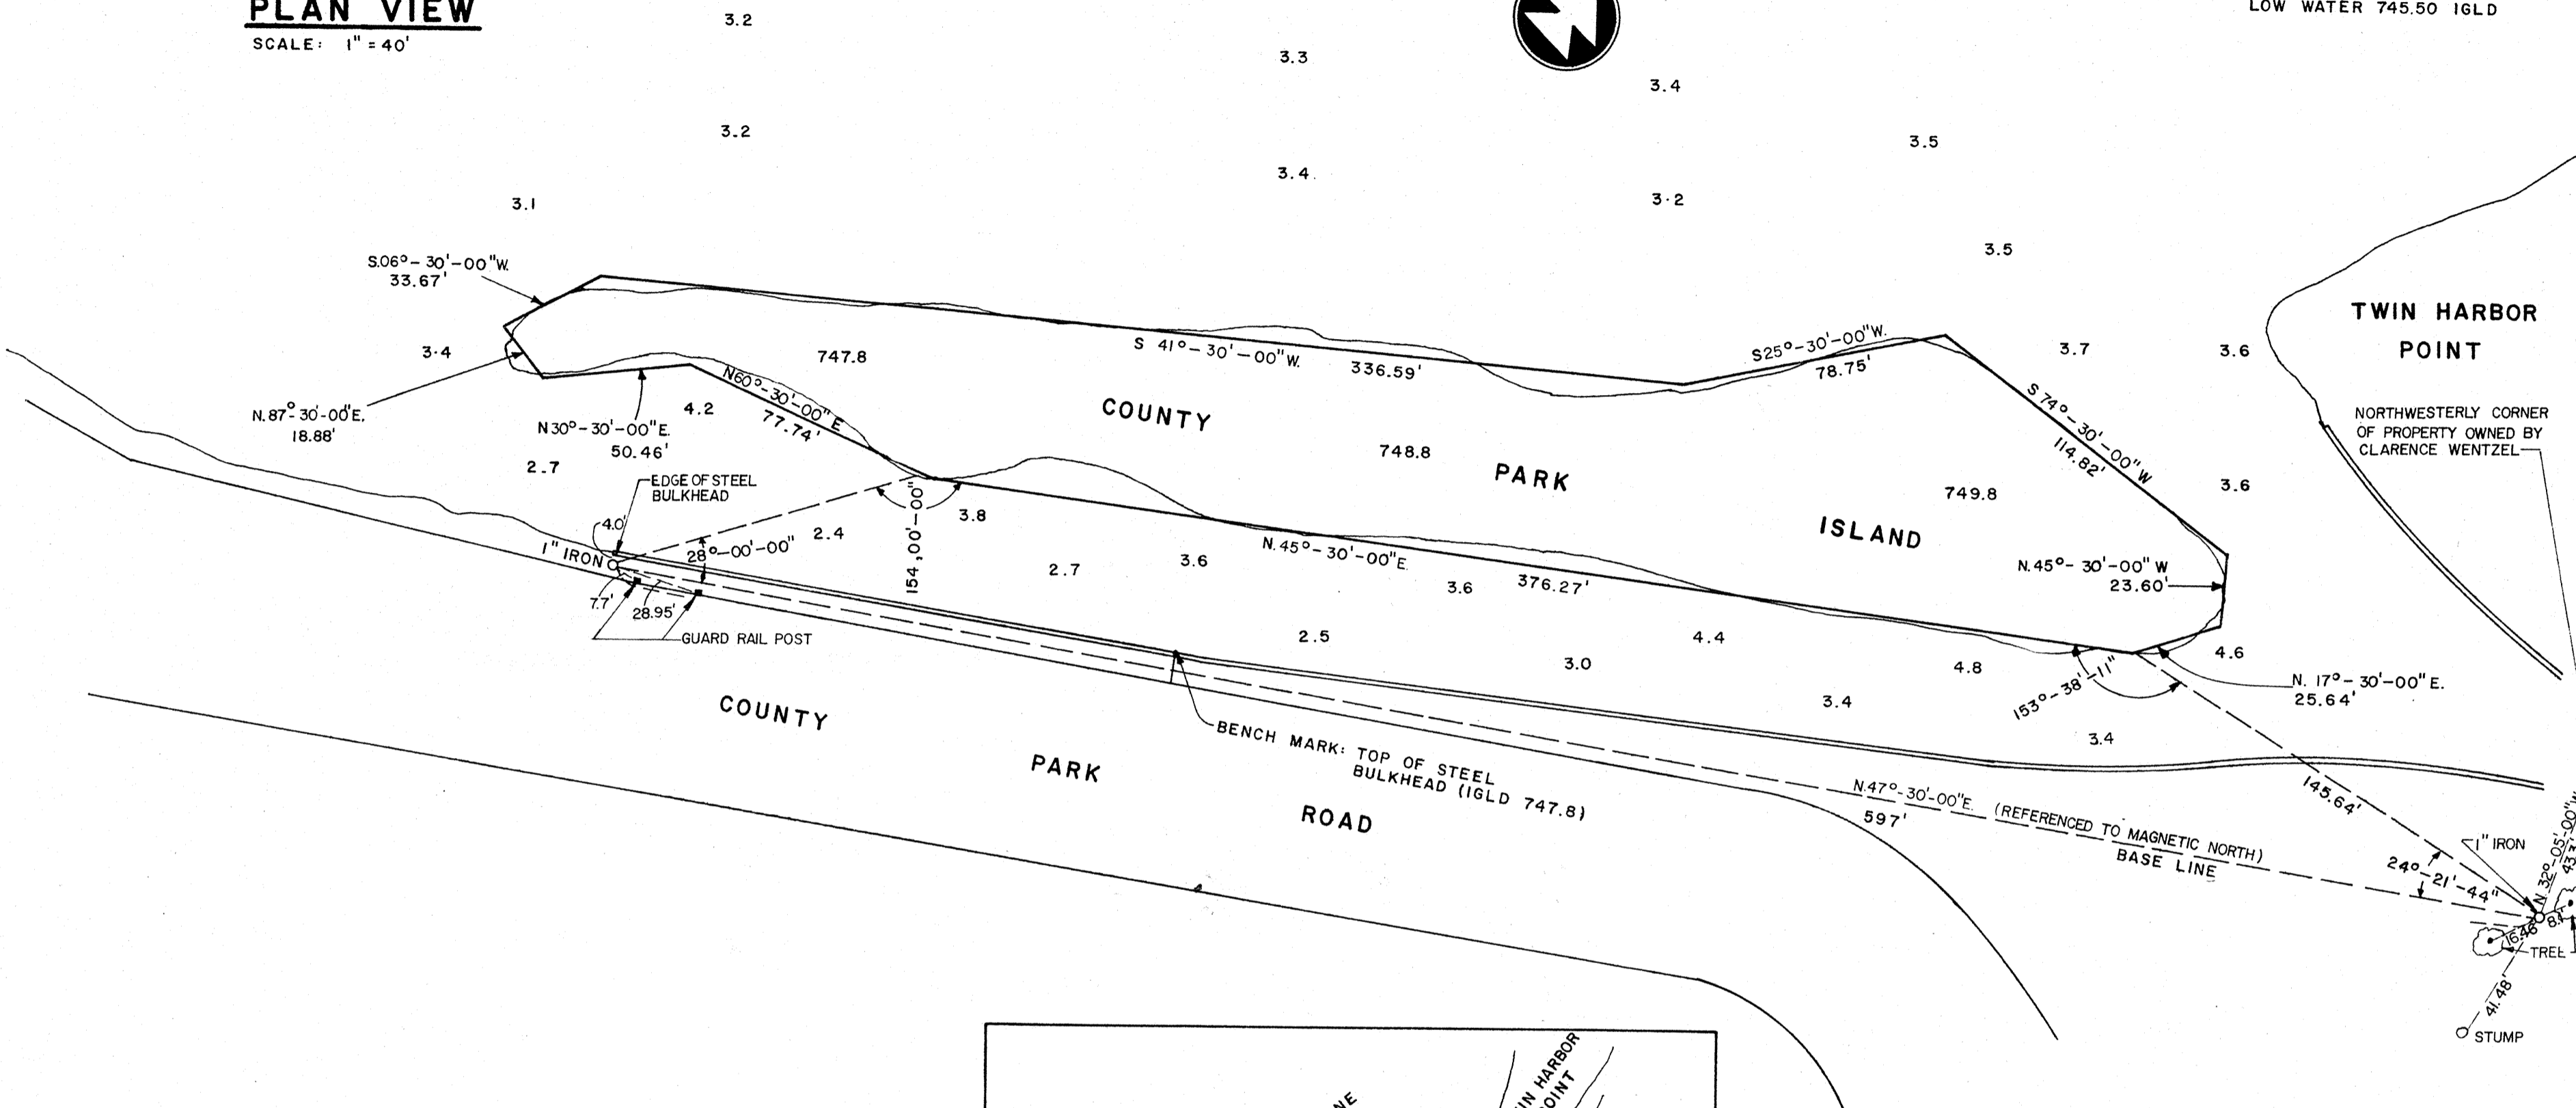


DESIGNED J.G.S.  
DRAWN J.M.H.  
CHECKED J.G.S.  
DATE 8-1-75


OF SHEETS  
FILE NO. 111-2-17



PLAN SURVEYED, PLOTTED, CHECKED, BY DATE  
 NOTE BOOK GRADES CHECKED, NO. STRUCTURE DATUMS CHECKED, RT. OF WAY CHECKED, NO.

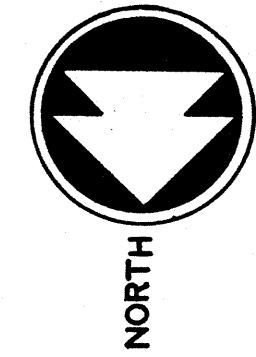
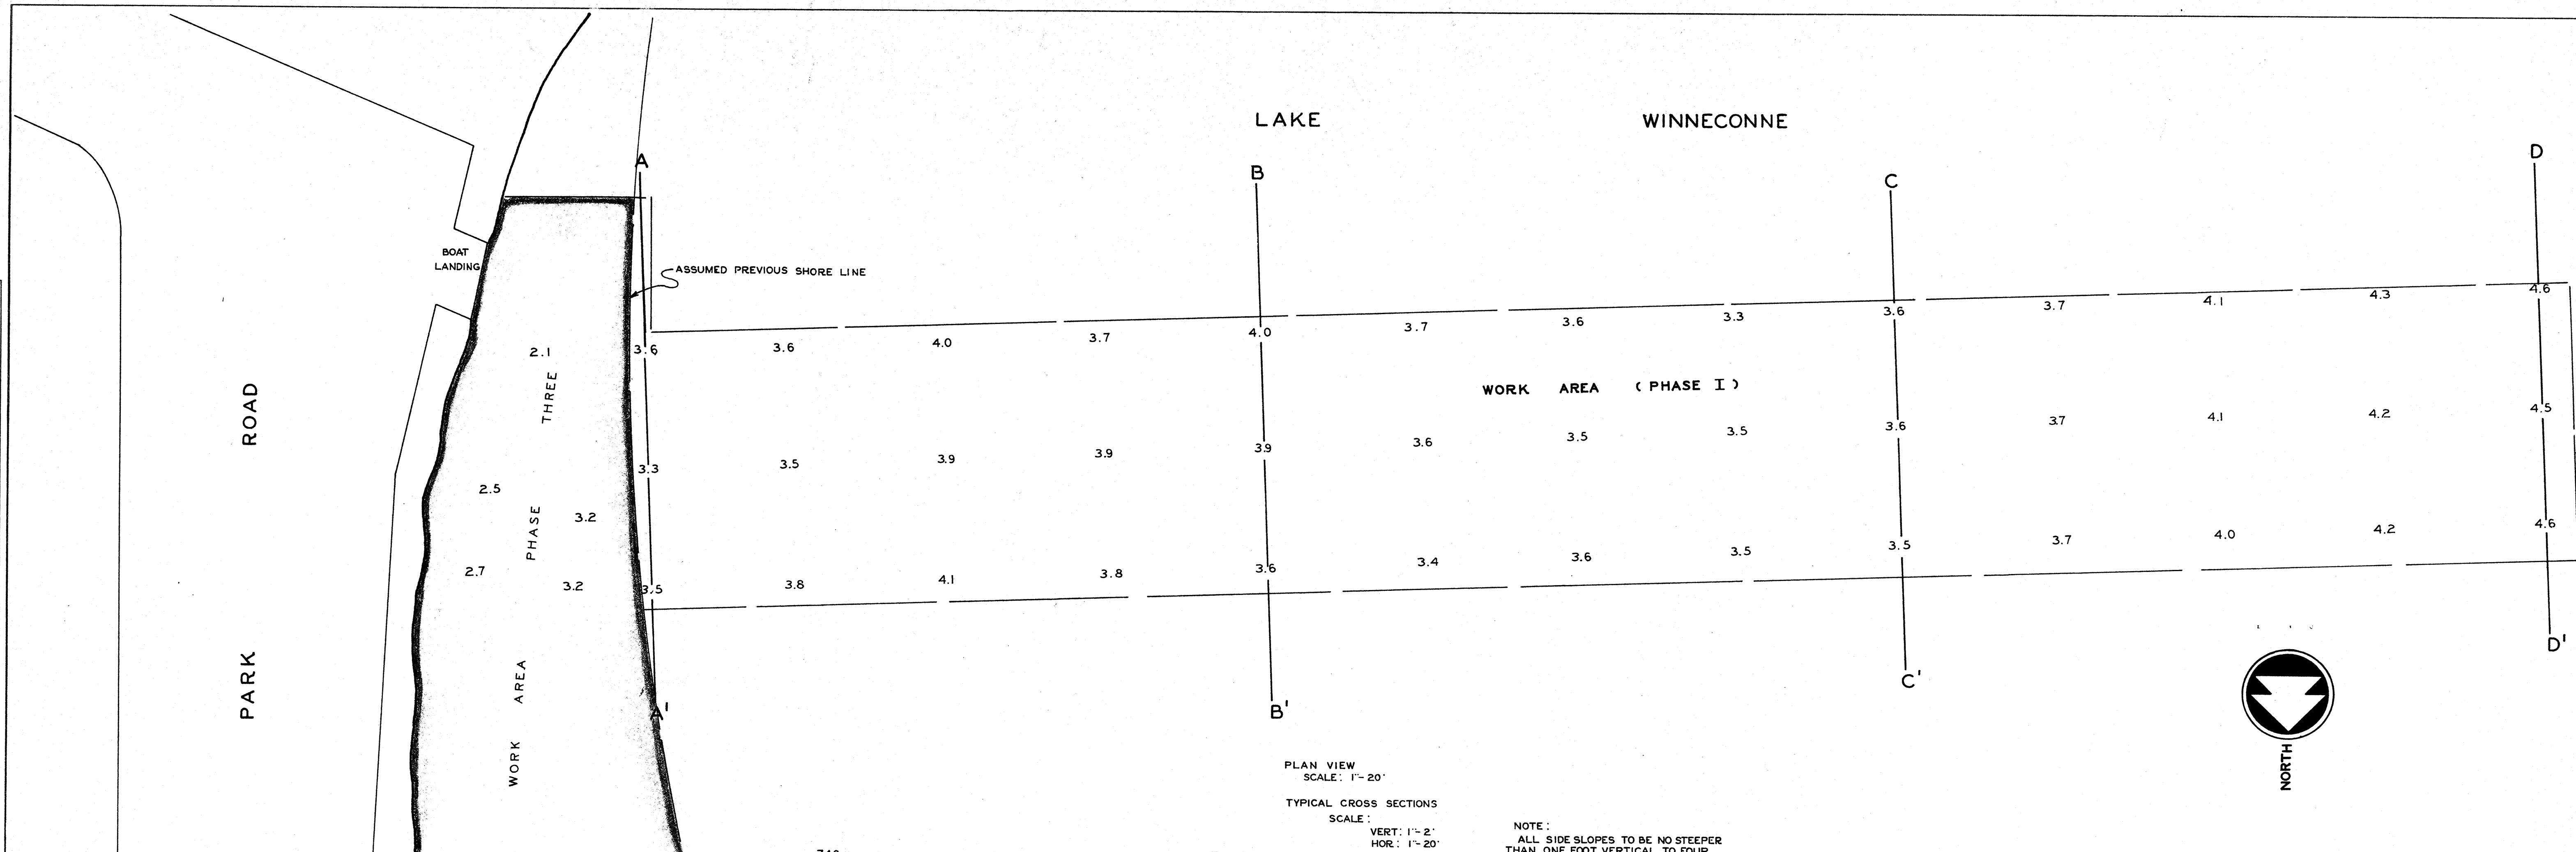


PROFILE SURVEYED, PLOTTED, CHECKED, BY DATE  
 NOTE BOOK GRADES CHECKED, NO. STRUCTURE DATUMS CHECKED, NO.

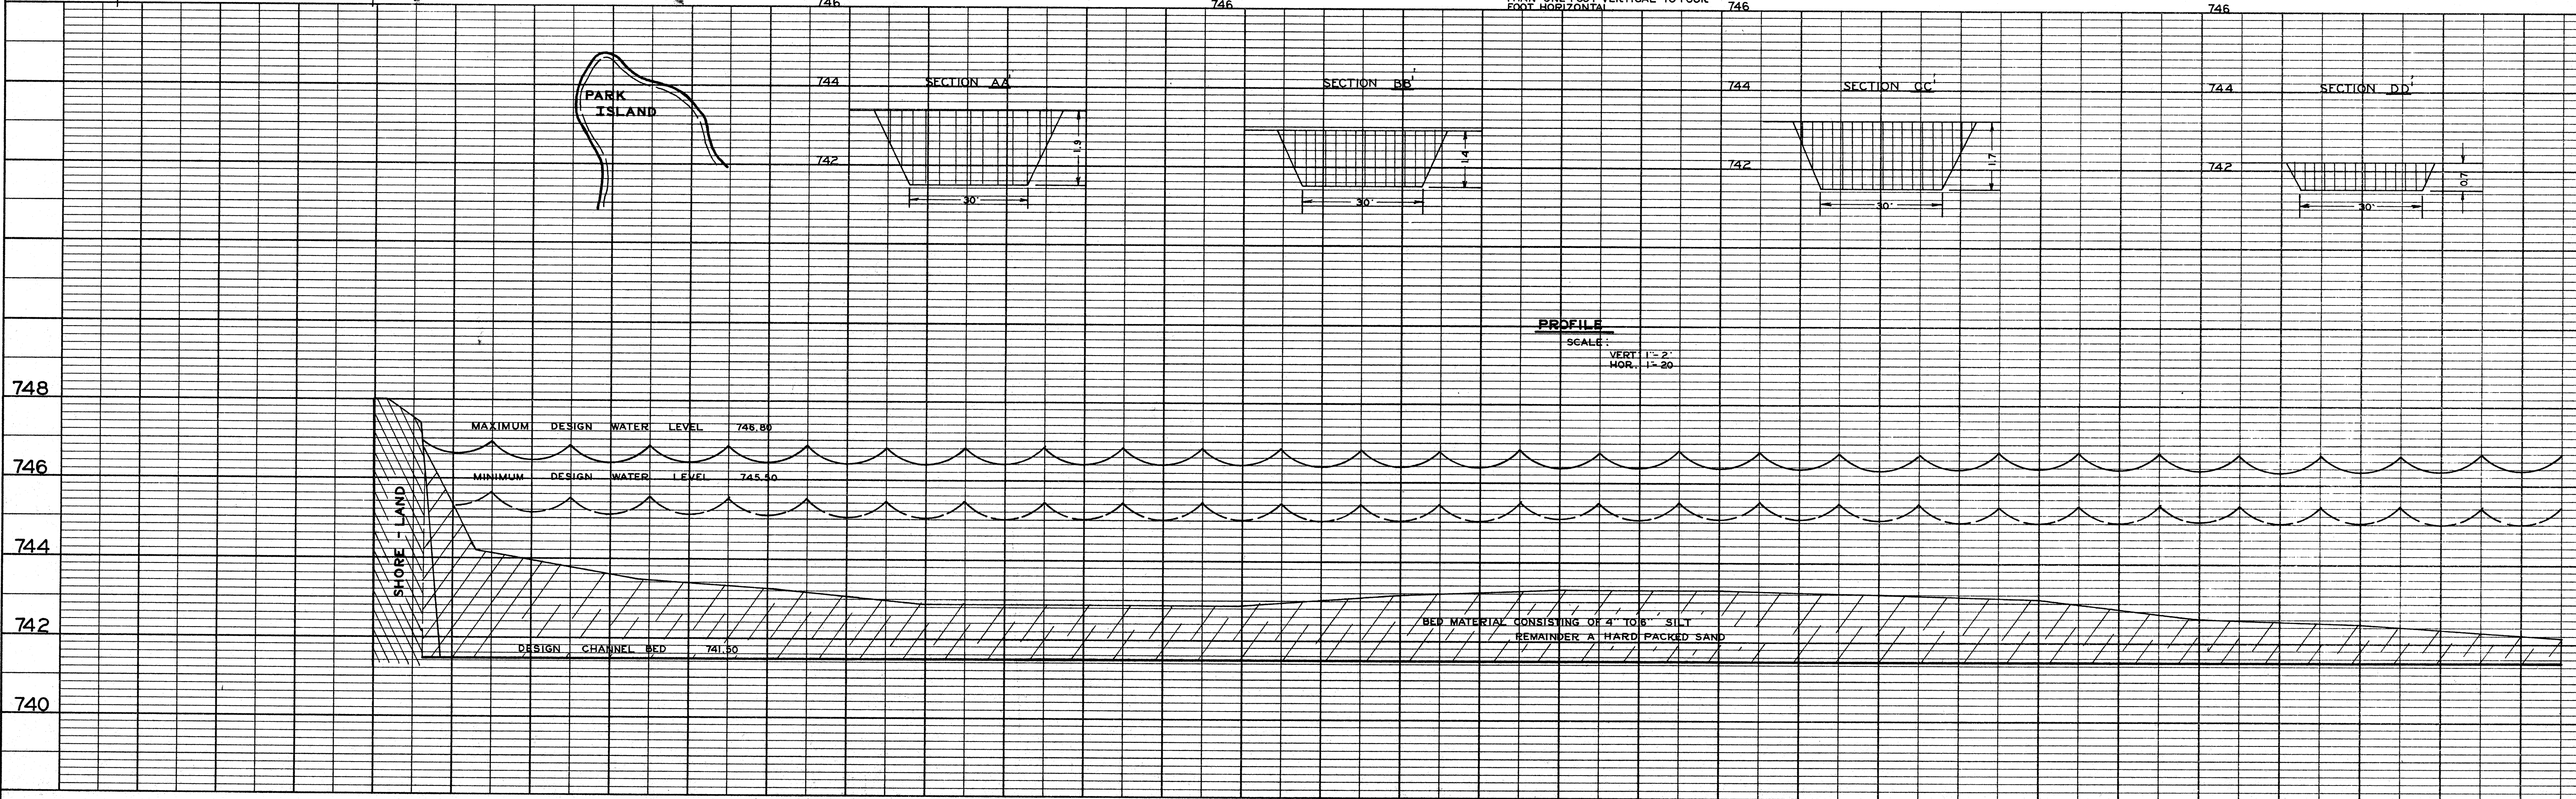

DATE: \_\_\_\_\_ BY: \_\_\_\_\_  
 SURVEYED: \_\_\_\_\_ GRADES CHECKED: \_\_\_\_\_  
 NOTE BOOK: \_\_\_\_\_ I.M.S. NOTED: \_\_\_\_\_  
 ALIGNMENT CHECKED: \_\_\_\_\_ STRUCTURE NOTATIONS CHECKED: \_\_\_\_\_  
 RT. OF WAY CHECKED: \_\_\_\_\_ NO. \_\_\_\_\_

DATE: \_\_\_\_\_ BY: \_\_\_\_\_  
 SURVEYED: \_\_\_\_\_ GRADES CHECKED: \_\_\_\_\_  
 NOTE BOOK: \_\_\_\_\_ I.M.S. NOTED: \_\_\_\_\_  
 ALIGNMENT CHECKED: \_\_\_\_\_ STRUCTURE NOTATIONS CHECKED: \_\_\_\_\_  
 RT. OF WAY CHECKED: \_\_\_\_\_ NO. \_\_\_\_\_

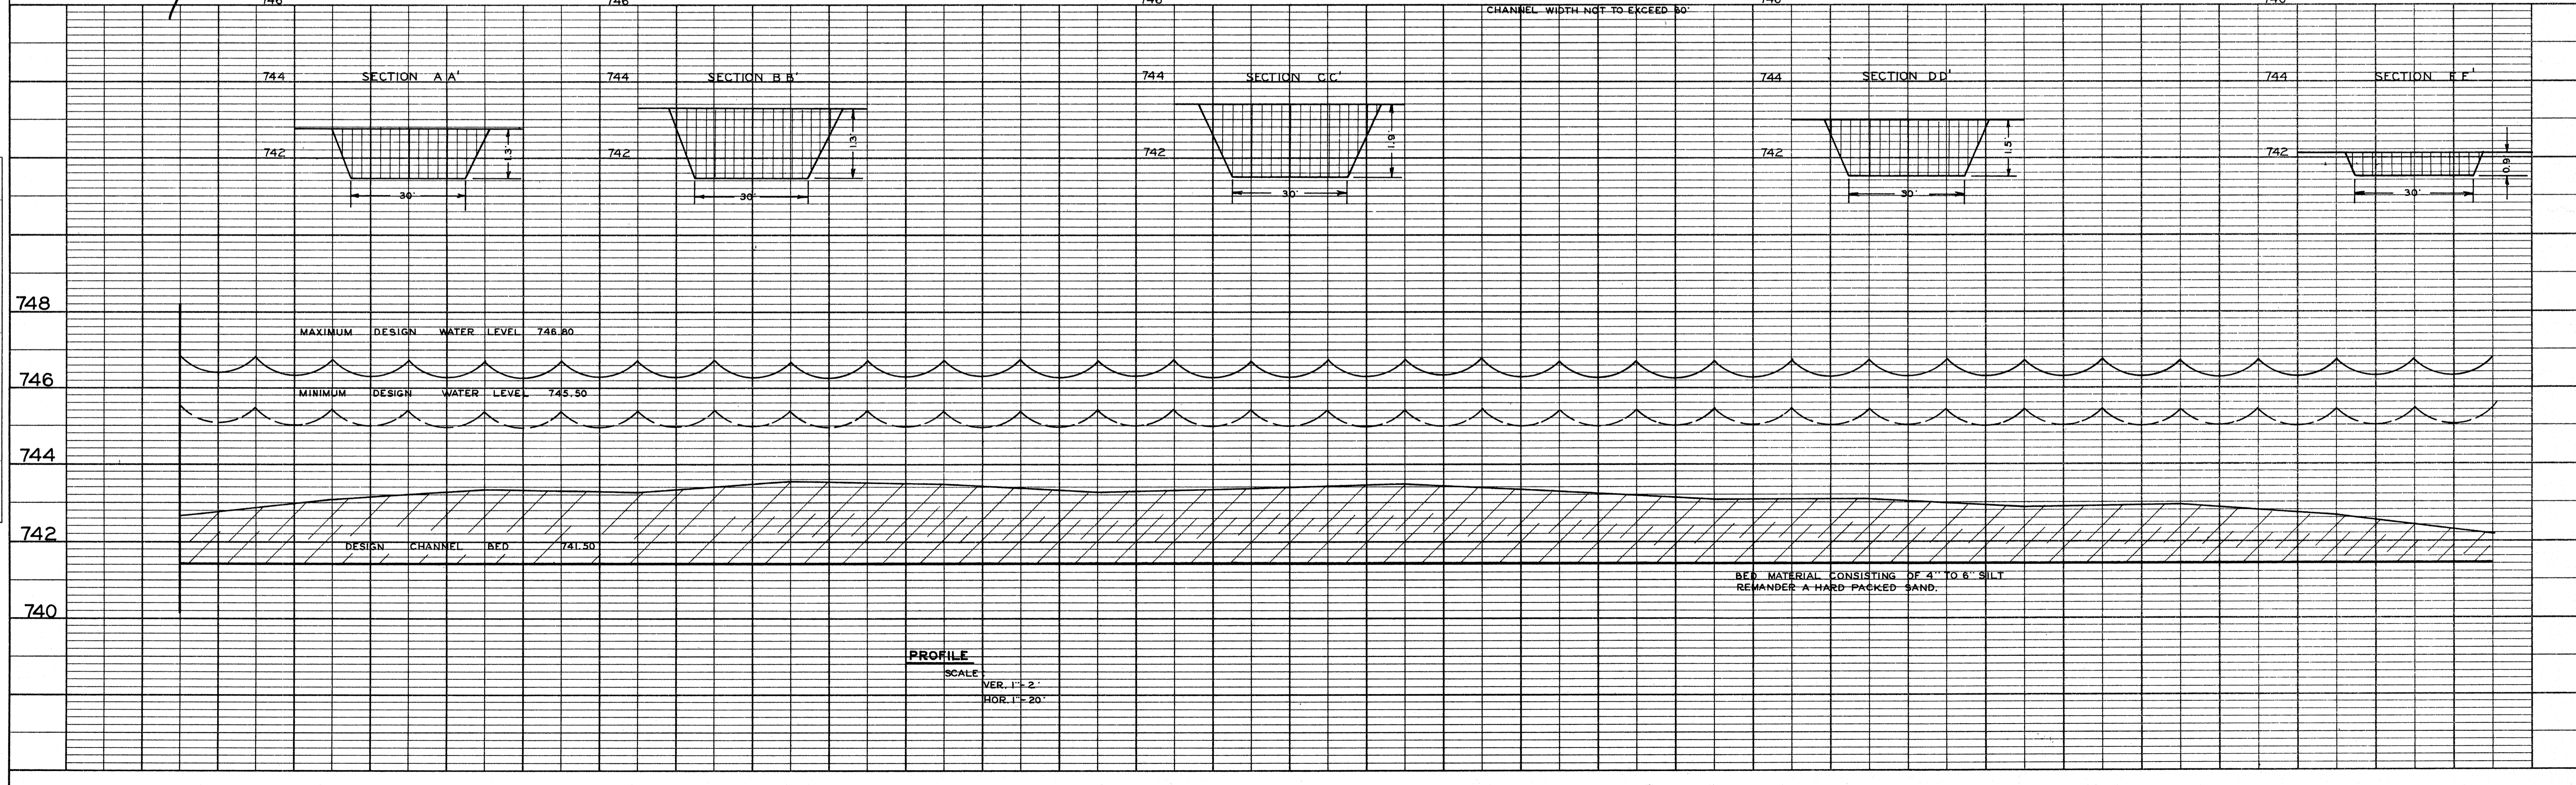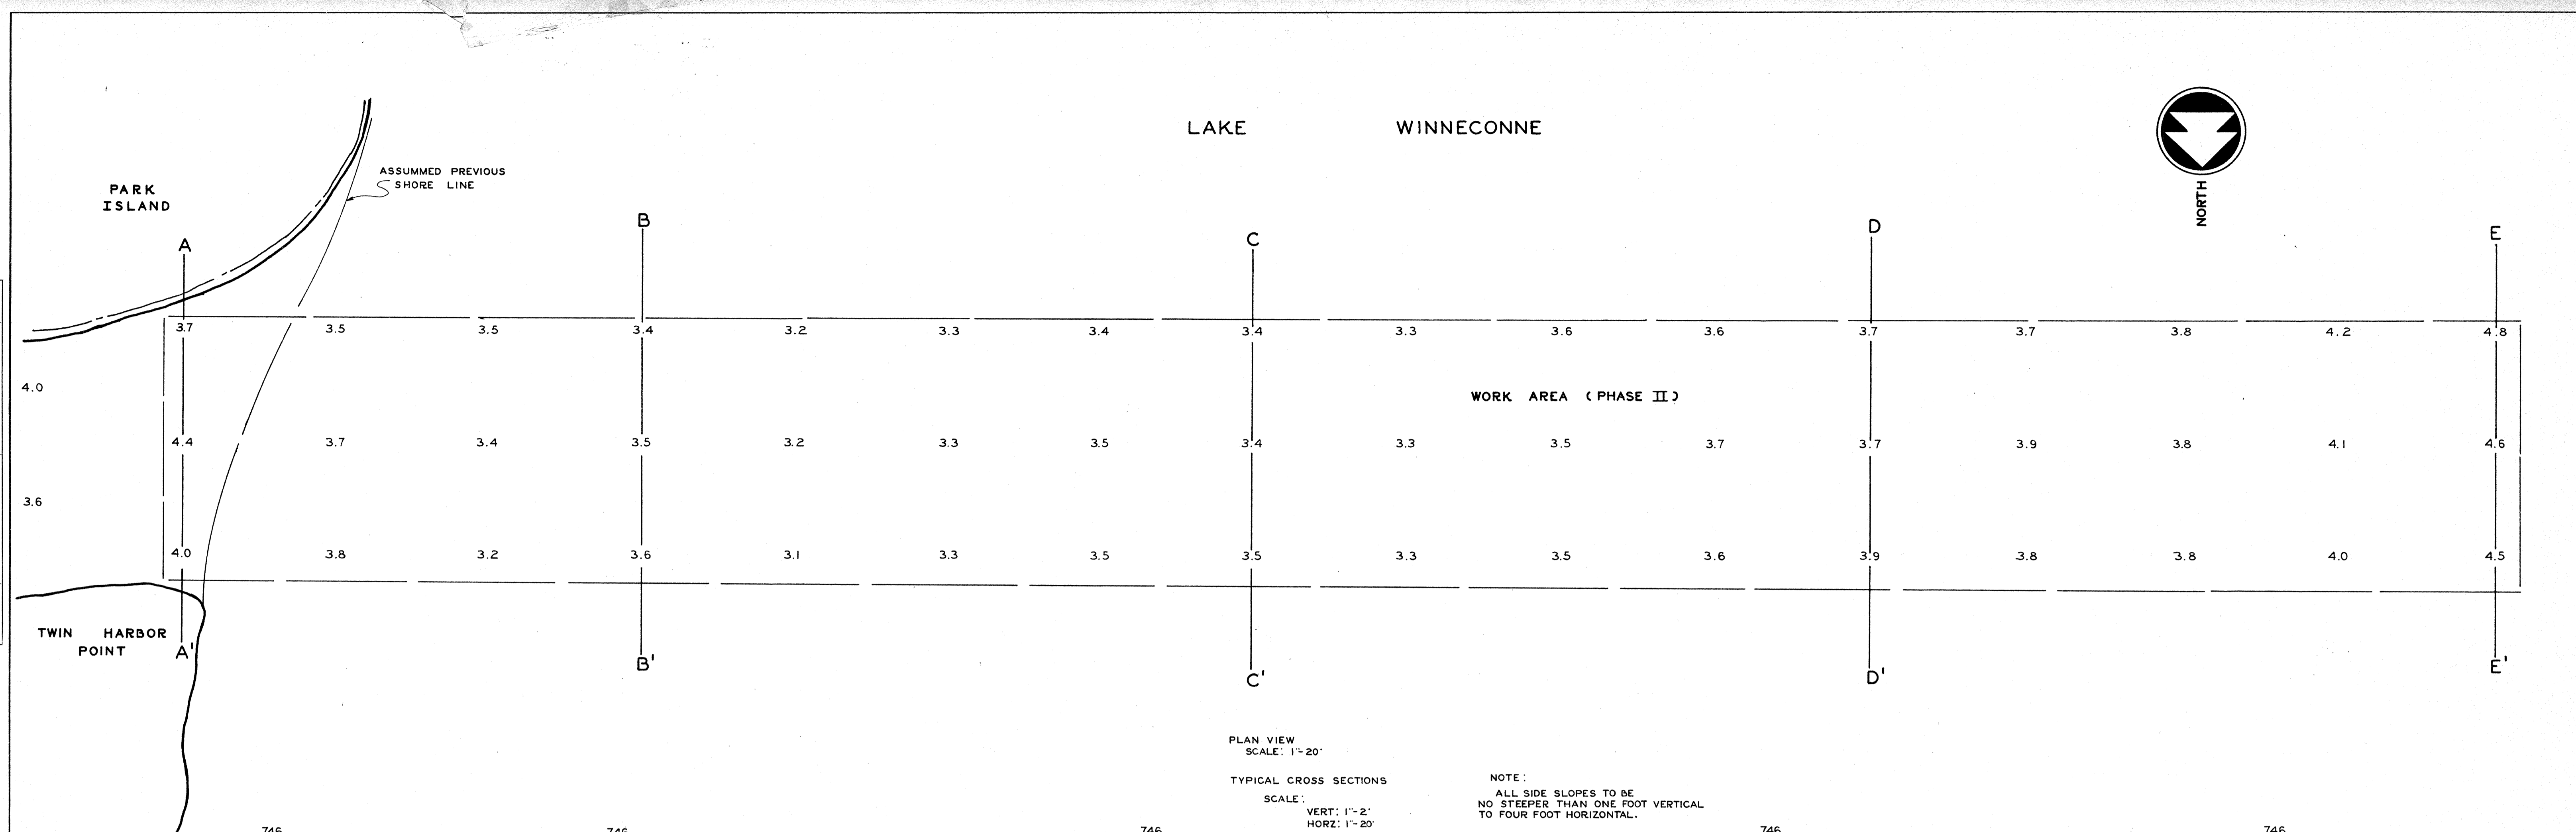

DATE  
BY  
SURVEYED  
NOTE BOOK  
ALIGNMENT CHECKED  
RT. OF WAY CHECKED  
NO.

DATE  
BY  
SURVEYED  
NOTE BOOK  
GRADE CHECKED  
STRUCTURE NOTING CHECKED  
NO.

