

NO.	OWNER	LOCATION OF PARCEL	ACRES REQ'D.	RODS OF FENCE TO MOVE	RODS OF FENCE TO BUILD
1	E.C. MEILAHN	SW - NW SEC. 14, T.17 N. R.15 E.	0.70		
2	H. J. JONES	SW - NW " 14, " "	0.53		
3	MRS. PISCHKE	SE - NW " 14, " "	0.16		10
4	E.C. MEILAHN	SW - SE " 11, " "	0.35	40	
5	E. PANSIE	SE - NE " 12, " "	0.15	21	
6	J. KOSSEL, EST.	NW - SW " 7, " R. 16 E.	0.06	10	
7	J. PANSIE	SW - NW " 7, " "	0.21	36	
8	J. PANSIE	NE - SE " 12, " R. 15 E.	0.10	20	
3-A	A. KOEHLER	E 1/2 - NW " 14, " "	5.79		228
3-B	A. E. GIBBERD	NW - NE " 14, " "	3.05	7	42
3-C	G. MAHLKE	SW - SE " 11, " "	0.06	9	

LOCATION SKETCH  
 SCALE IN FEET 0 0.5 1.0  
 SCALE IN MILES 0 0.5 1.0

REVISED JULY 7, 1938  
 REVISED APRIL 18, 1938

PLAT OF RIGHT OF WAY REQUIRED  
 DIVISION JOB NO. 3629  
 FISK RELOCATION & PANSIE CURVE ROAD  
 S.T.H.NO. 44 WINNEBAGO COUNTY

SCALE  
 0 400' 800'




BENCH MARKS			
NO.	STATION	DESCRIPTION	ELEV.
1	1+75	SPIKE IN 18" IRONWOOD 25' LT.	107.15
2	13+00	SPIKE IN 18" MAPLE 72' RT.	101.31

FED. ROAD DIST. NO.	STATE	STATE PROJ. NO.	SHEET NO.	TOTAL SHEETS
4	WIS.	3629	5	


DIVISION JOB NO. 3629

DATE	3-36
BY	M.W.F.
CHECKED	H.J.G.
NOTED	L.W.E.
NO. 8460	

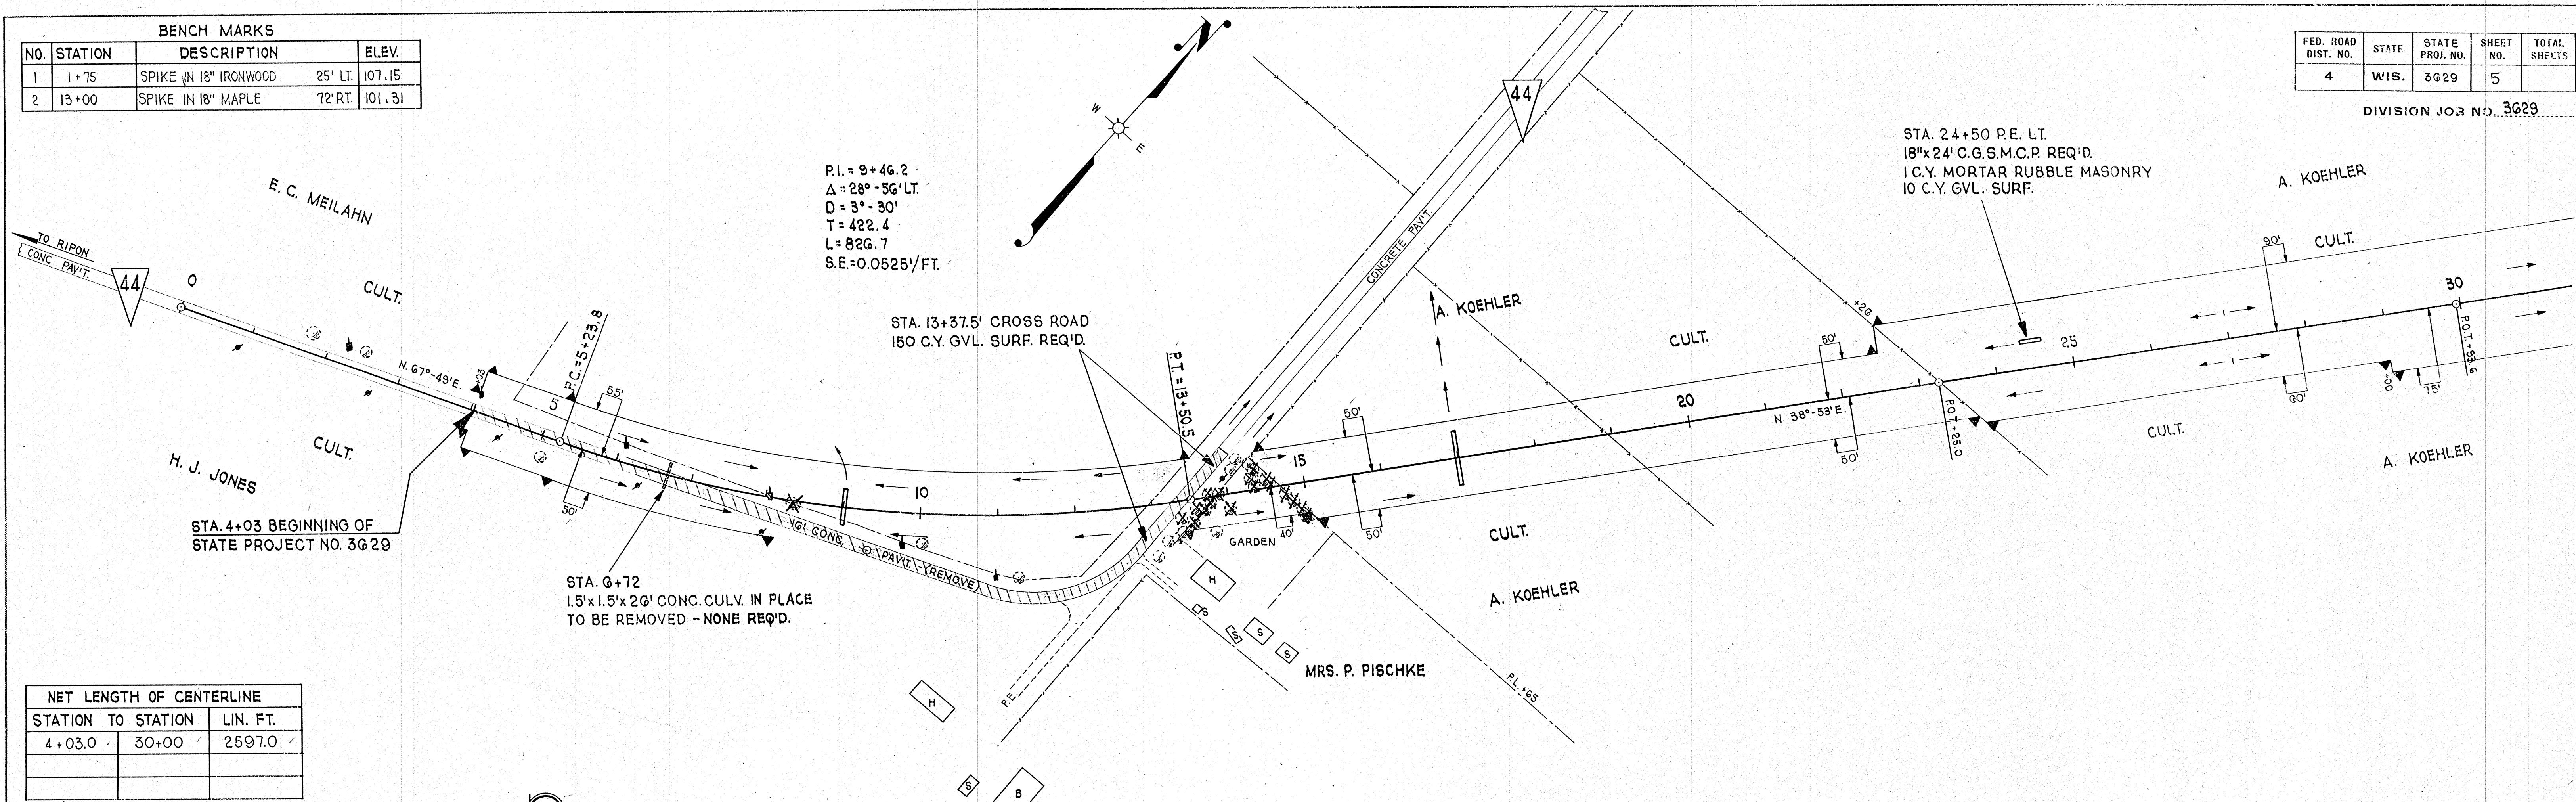

NET LENGTH OF CENTERLINE	
STATION TO STATION	LIN. FT.
4+03.0	30+00
	2597.0

DATE	3-36
BY	M.W.F.
CHECKED	H.J.G.
NOTED	L.L.B.
NO. 8461	

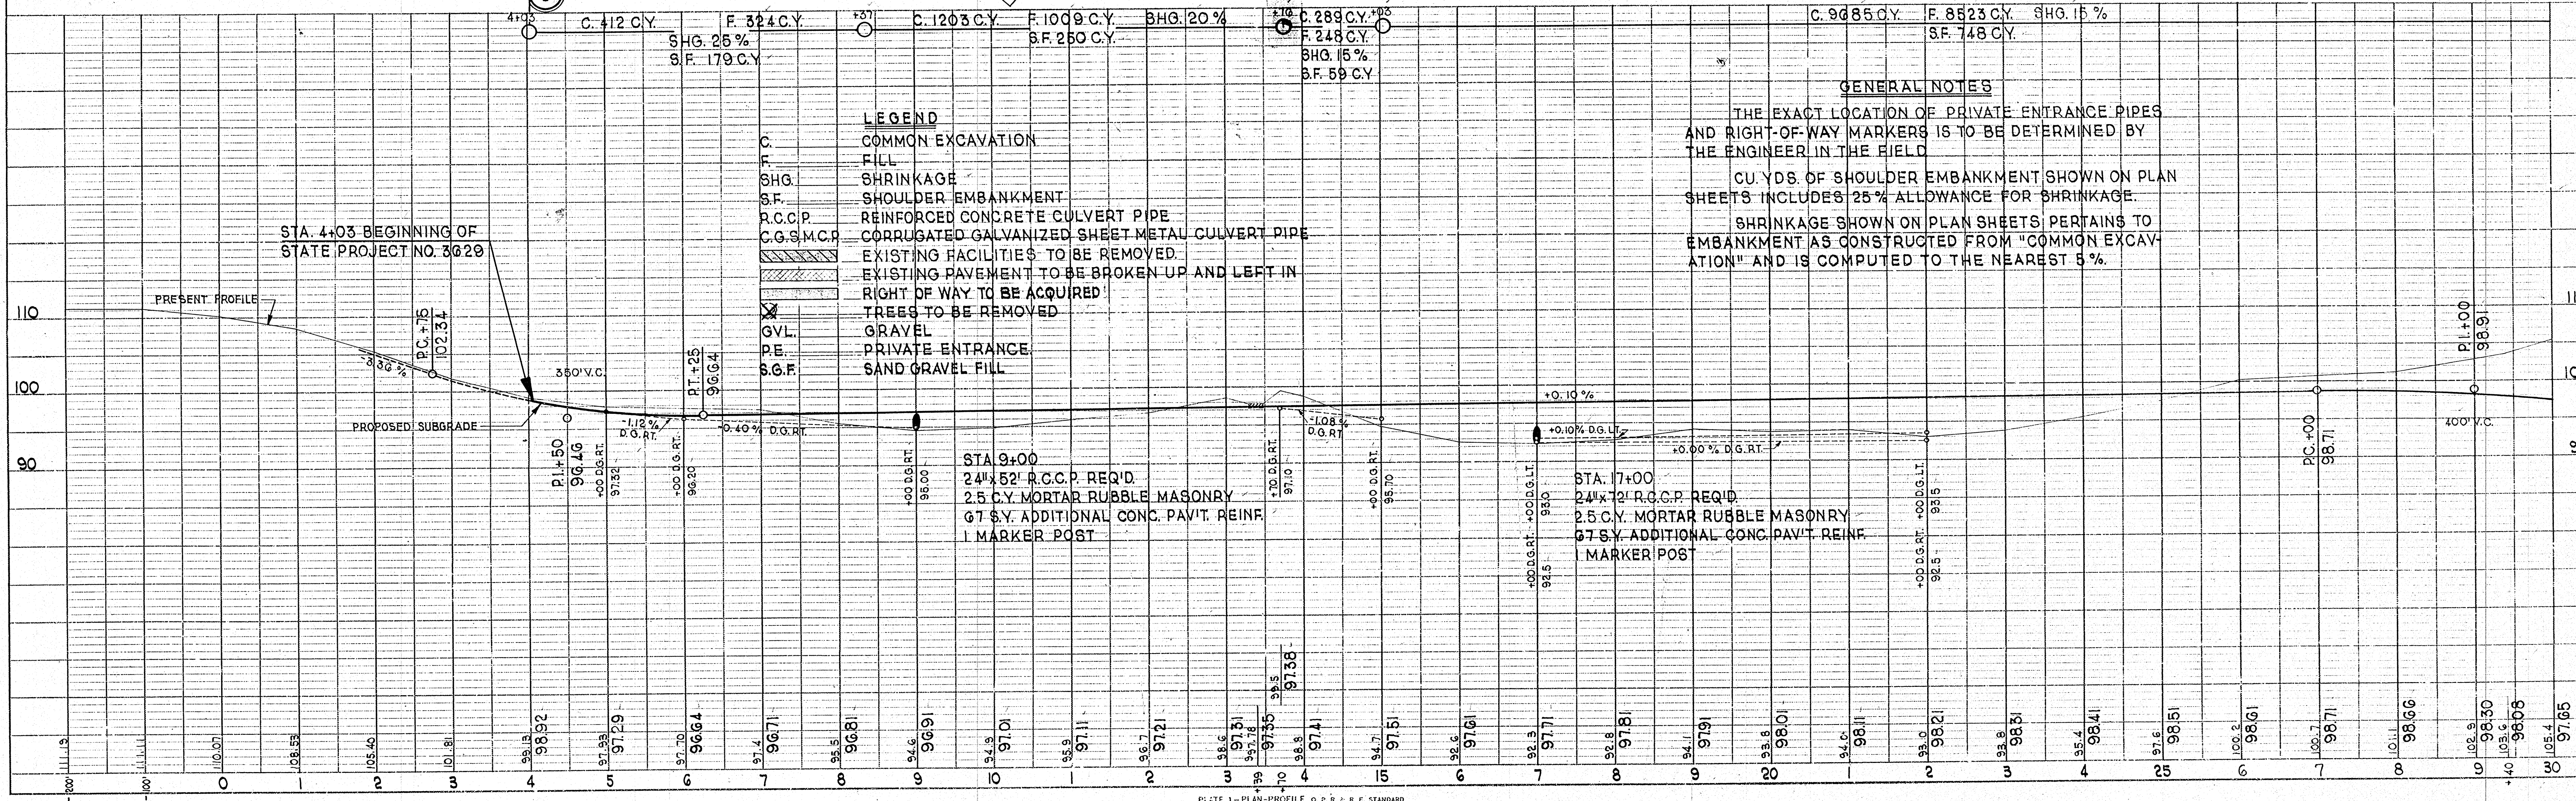

- LEGEND**
- C. COMMON EXCAVATION
  - F. FILL
  - SHG. SHRINKAGE
  - S.F. SHOULDER EMBANKMENT
  - R.C.C.P. REINFORCED CONCRETE CULVERT PIPE
  - C.G.S.M.C.P. CORRUGATED GALVANIZED SHEET METAL CULVERT PIPE
  - EXISTING FACILITIES TO BE REMOVED
  - EXISTING PAVEMENT TO BE BROKEN UP AND LEFT IN RIGHT OF WAY TO BE ACQUIRED
  - TREES TO BE REMOVED
  - GVL. GRAVEL
  - P.E. PRIVATE ENTRANCE
  - S.G.F. SAND GRAVEL FILL

**GENERAL NOTES**

THE EXACT LOCATION OF PRIVATE ENTRANCE PIPES AND RIGHT-OF-WAY MARKERS IS TO BE DETERMINED BY THE ENGINEER IN THE FIELD.

CU.YDS. OF SHOULDER EMBANKMENT SHOWN ON PLAN SHEETS INCLUDES 25% ALLOWANCE FOR SHRINKAGE.

SHRINKAGE SHOWN ON PLAN SHEETS PERTAINS TO EMBANKMENT AS CONSTRUCTED FROM "COMMON EXCAVATION" AND IS COMPUTED TO THE NEAREST 5%.





BENCH MARKS			
NO.	STATION	DESCRIPTION	ELEV.
3	33+05	SPIKE IN 4" APPLE	35' RT. 97.95
4	41+40	SPIKE IN 12" ASH	18' RT. 88.99

FED. ROAD DIST. NO.	STATE	STATE PROJ. NO.	SHEET NO.	TOTAL SHEETS
4	WIS.	3629	6	

DIVISION JOB NO. 3629



DATE	BY
3-28	M.W.E.
3-28	H.J.G.
3-28	J.T.B.
3-28	L.W.E.
3-28	H.C.A.

DATE	BY
3-28	M.W.E.
3-28	H.J.G.
3-28	J.T.B.
3-28	L.W.E.
3-28	H.C.A.

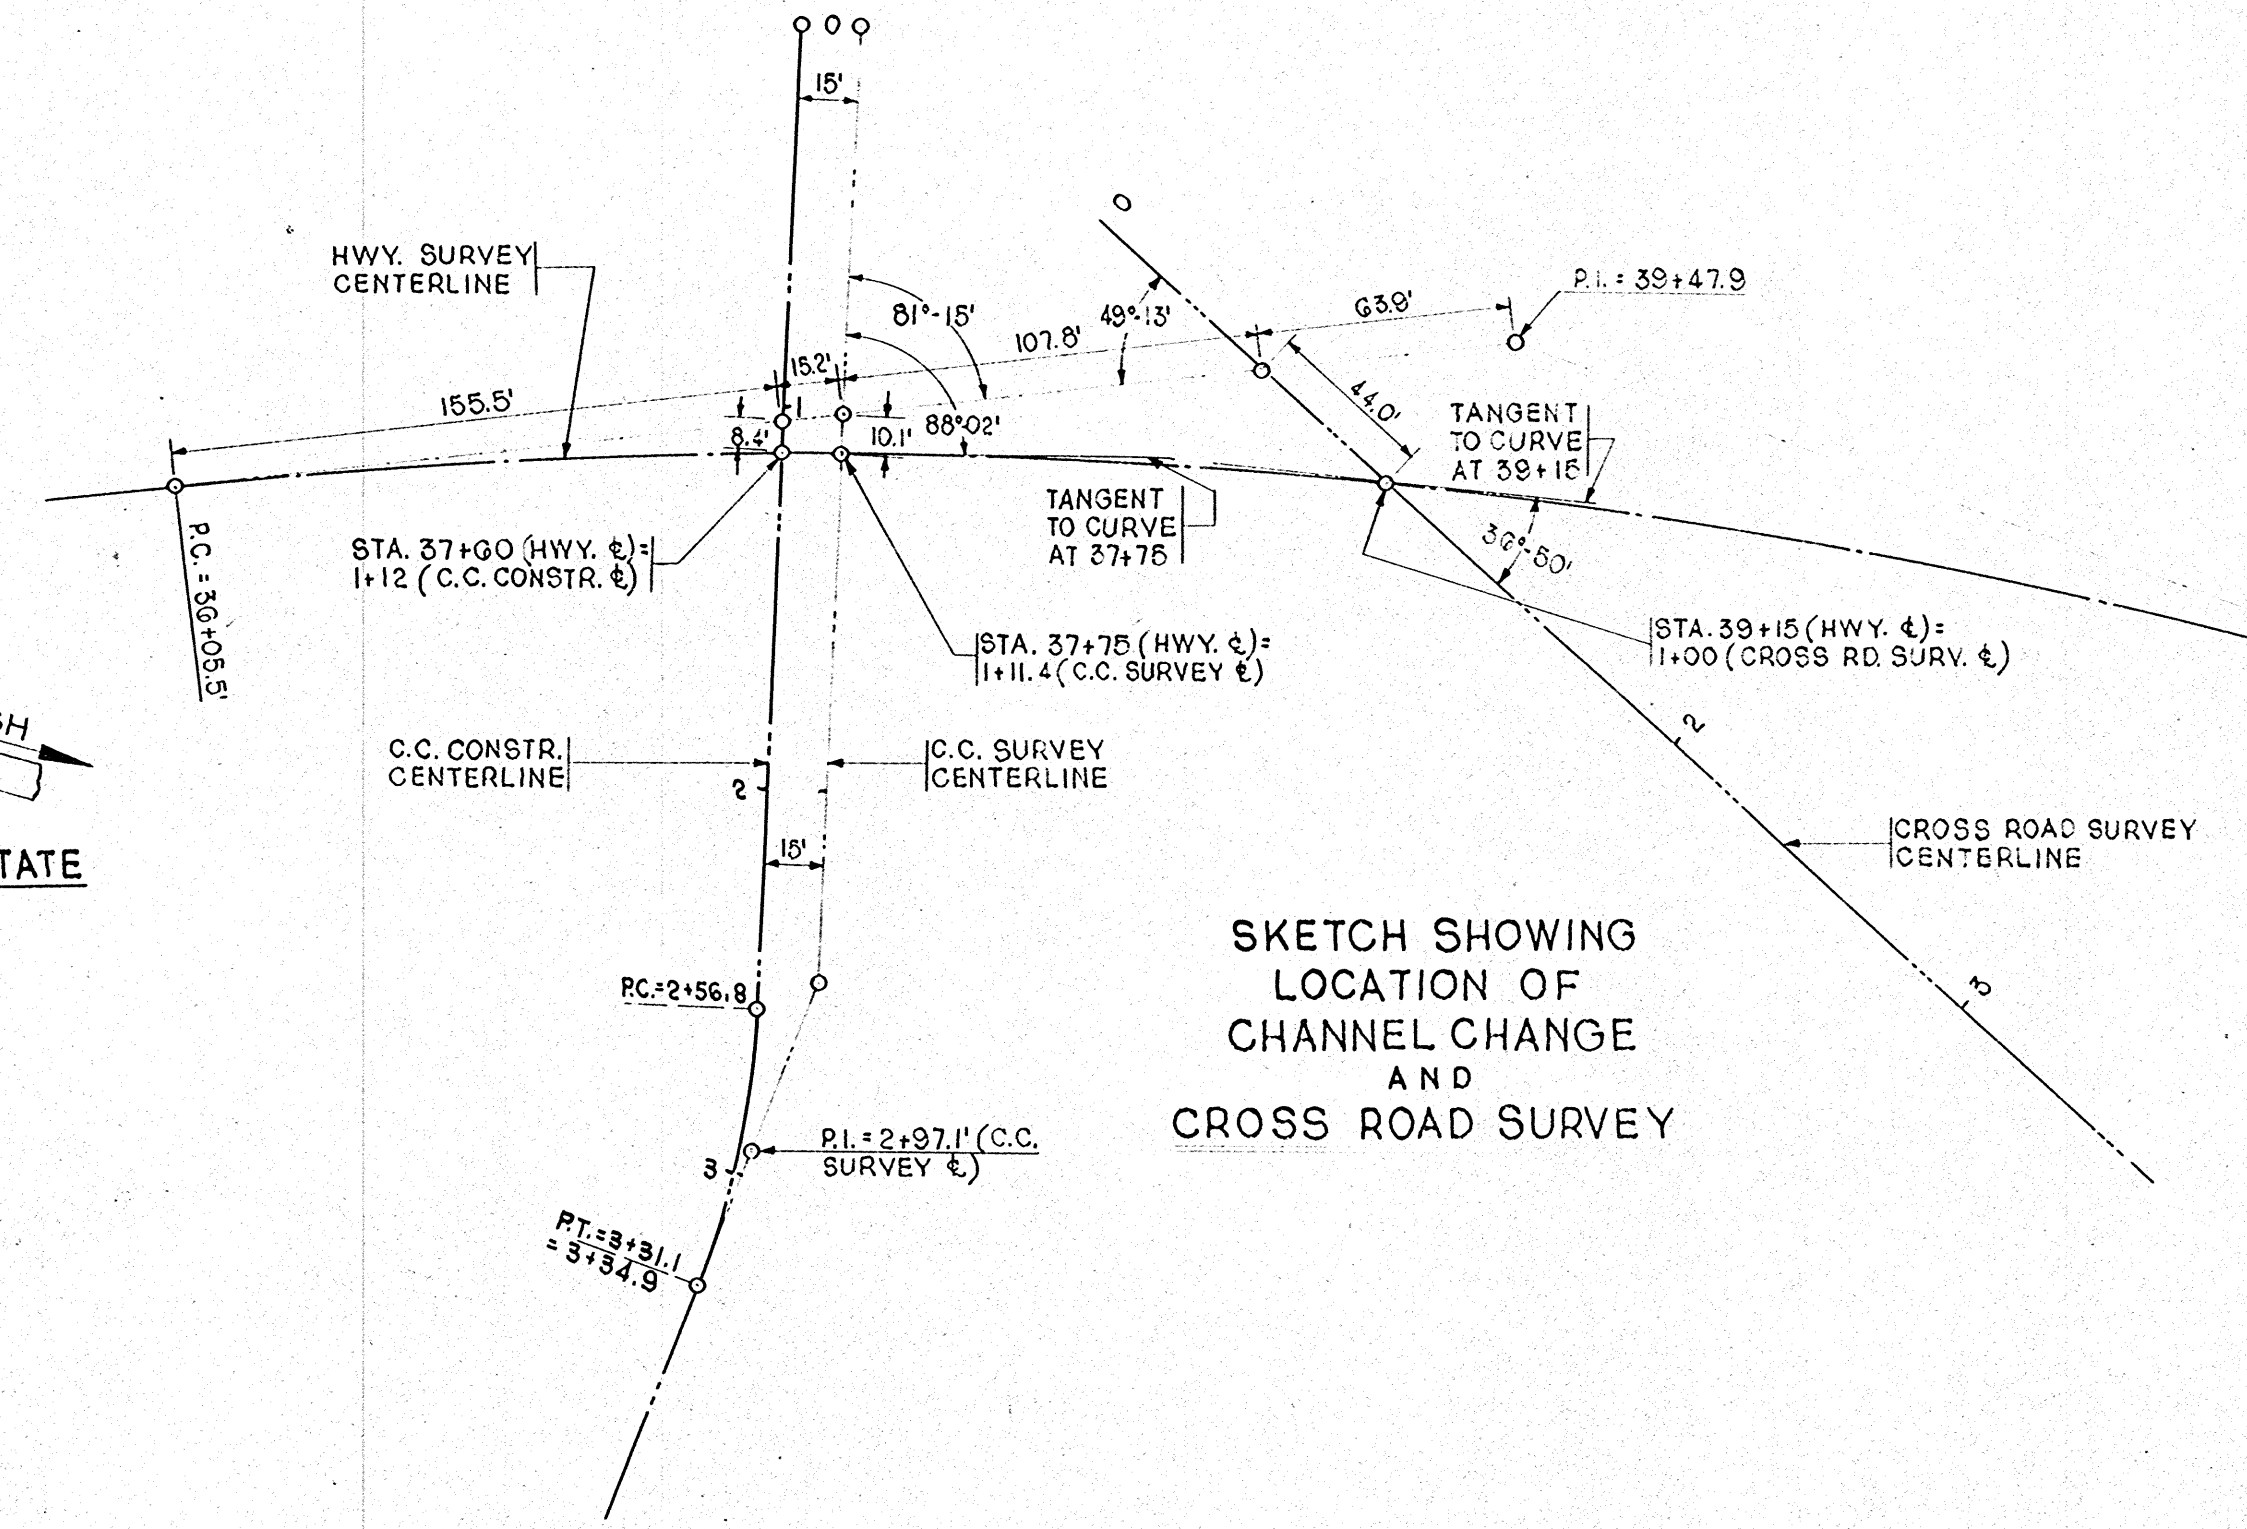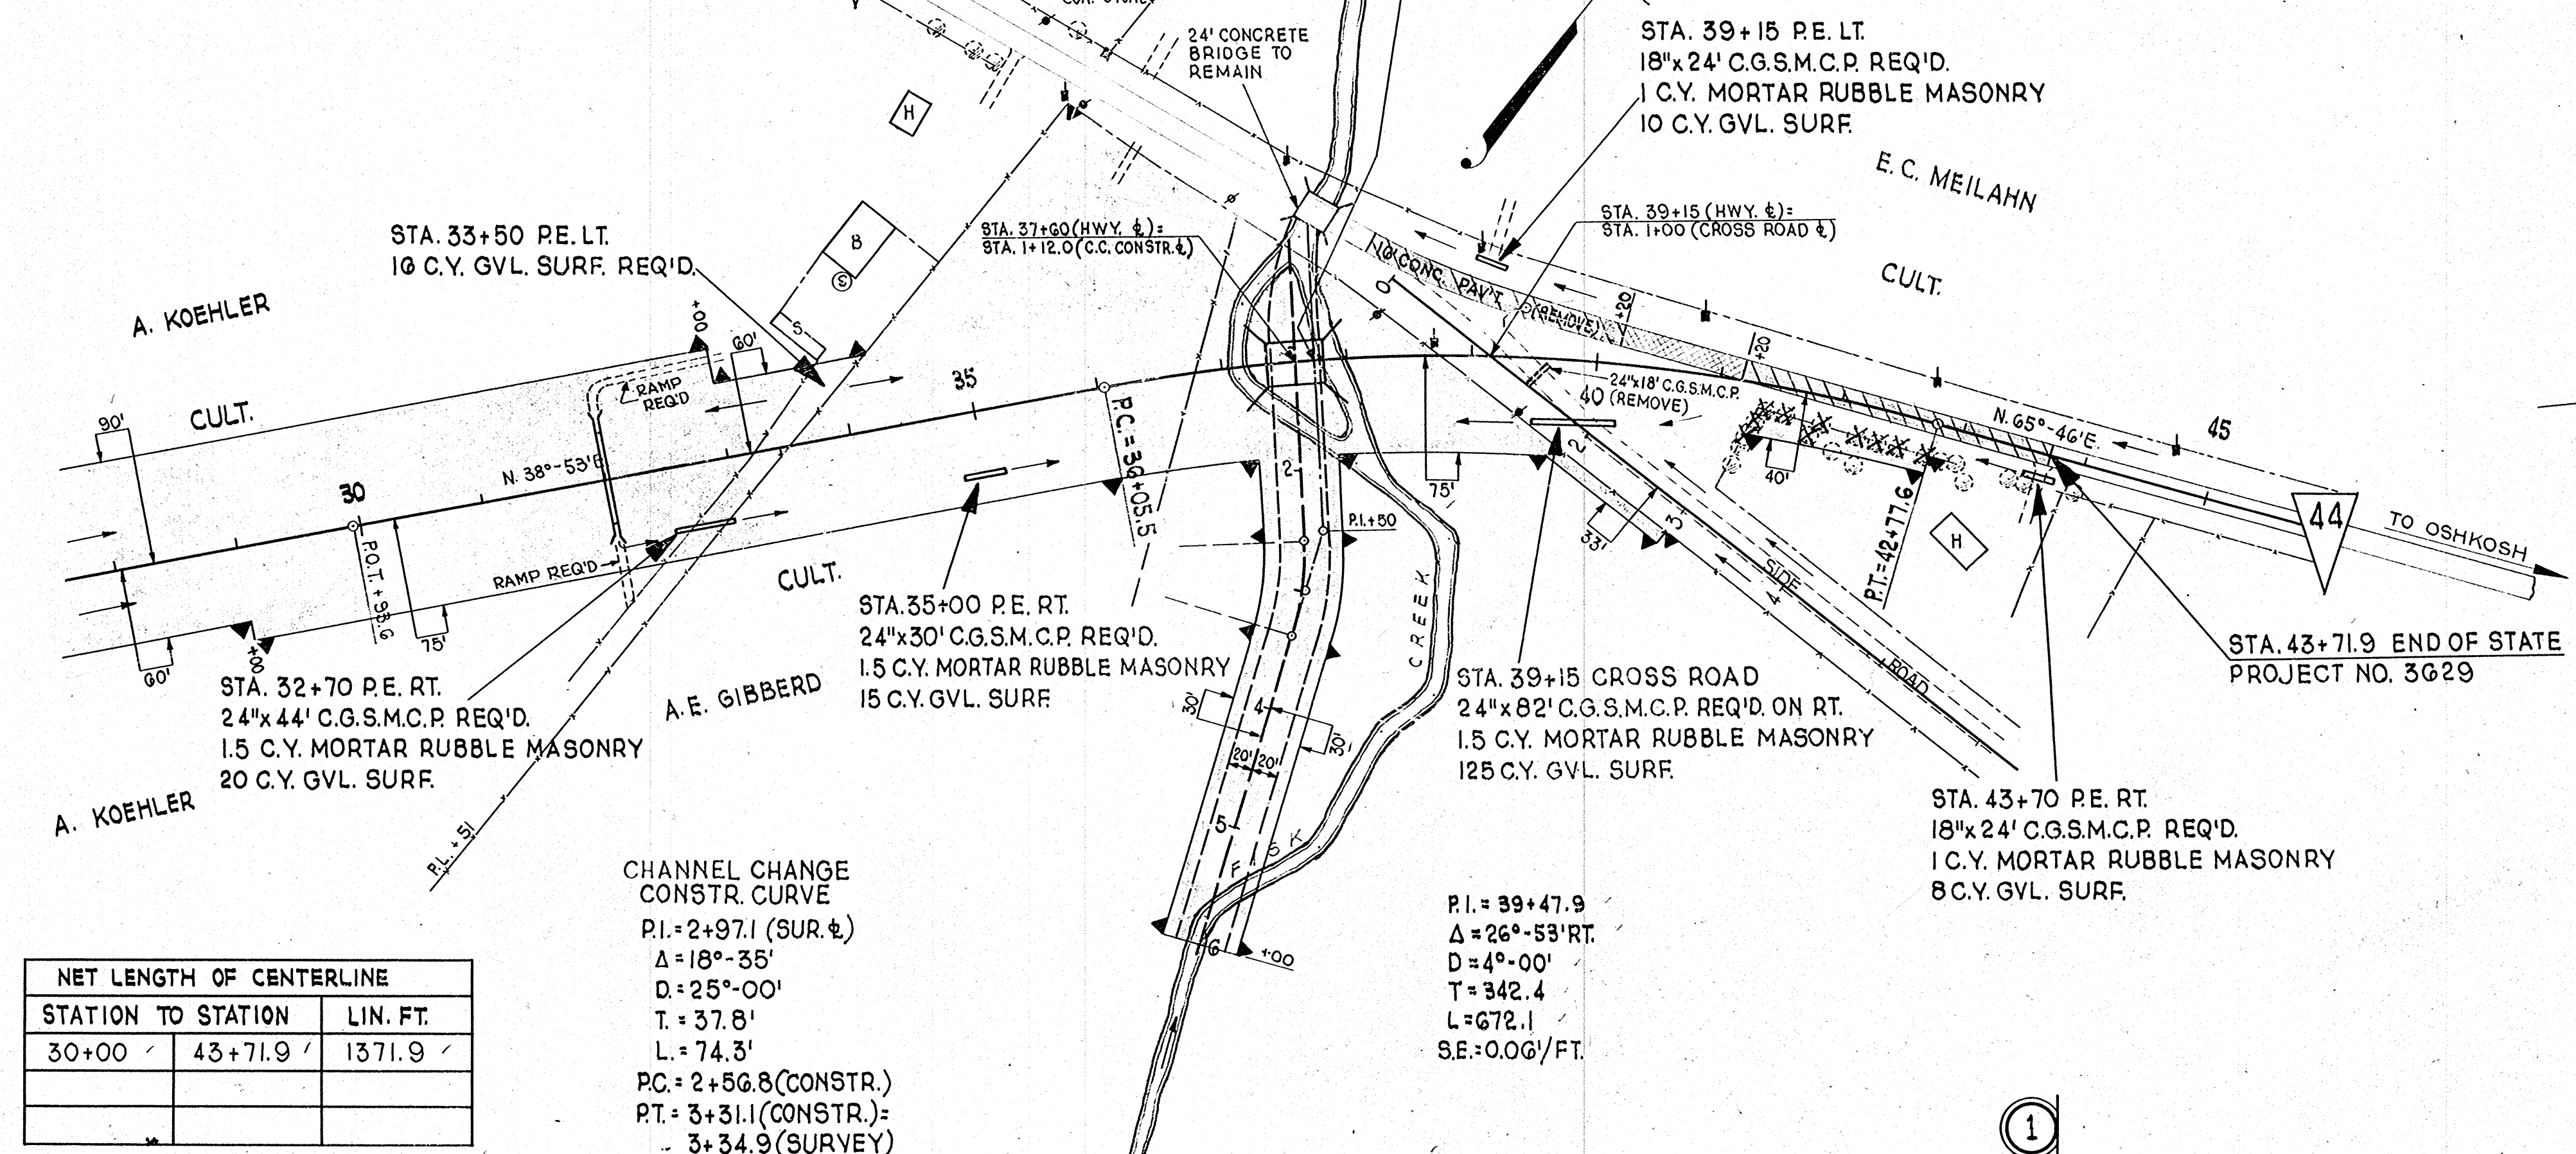


NET LENGTH OF CENTERLINE		
STATION TO STATION	LIN. FT.	
30+00	43+71.9	1371.9

CHANNEL CHANGE CONSTR. CURVE  
 P.I. = 39+47.9 (SUR. C.)  
 Δ = 26°-53' RT.  
 D = 4°-00'  
 T = 342.4  
 L = 672.1  
 SE = 0.06'/FT.  
 PC = 2+56.8 (CONSTR.)  
 PT = 3+31.1 (CONSTR.)  
 PI = 39+47.9

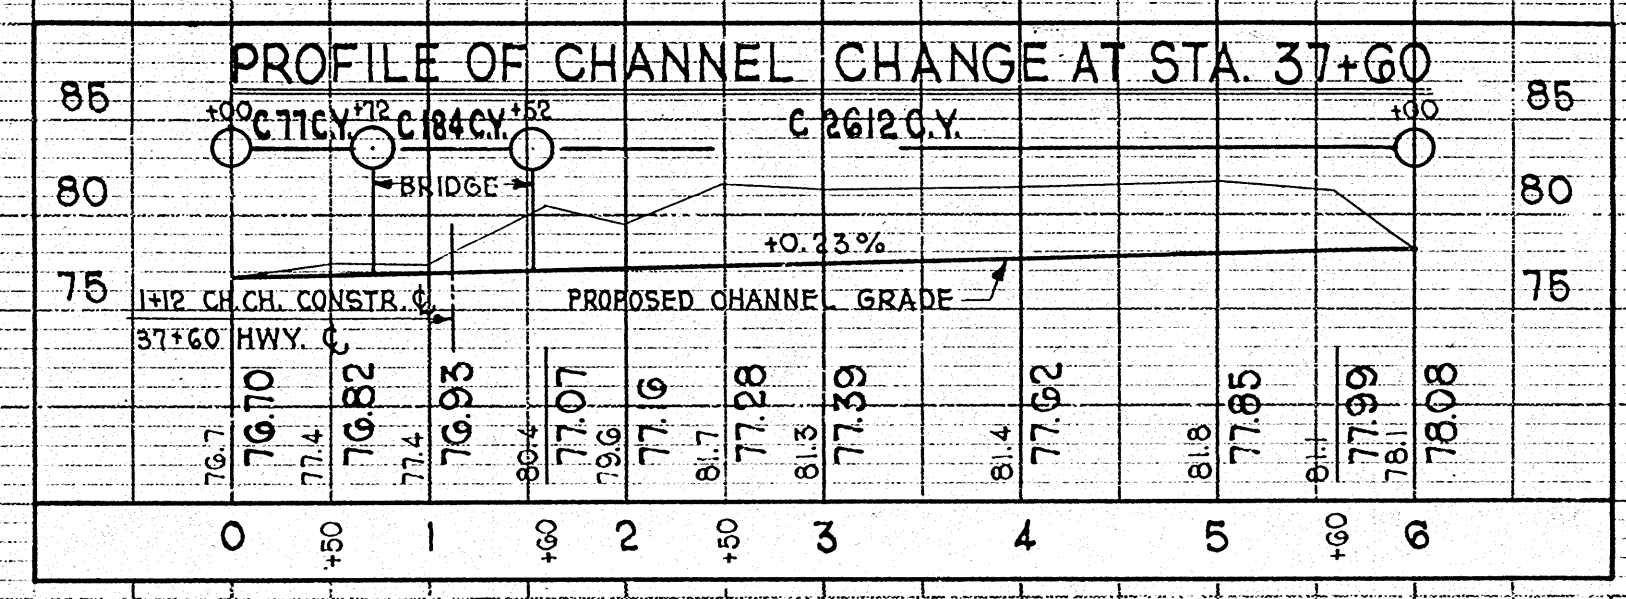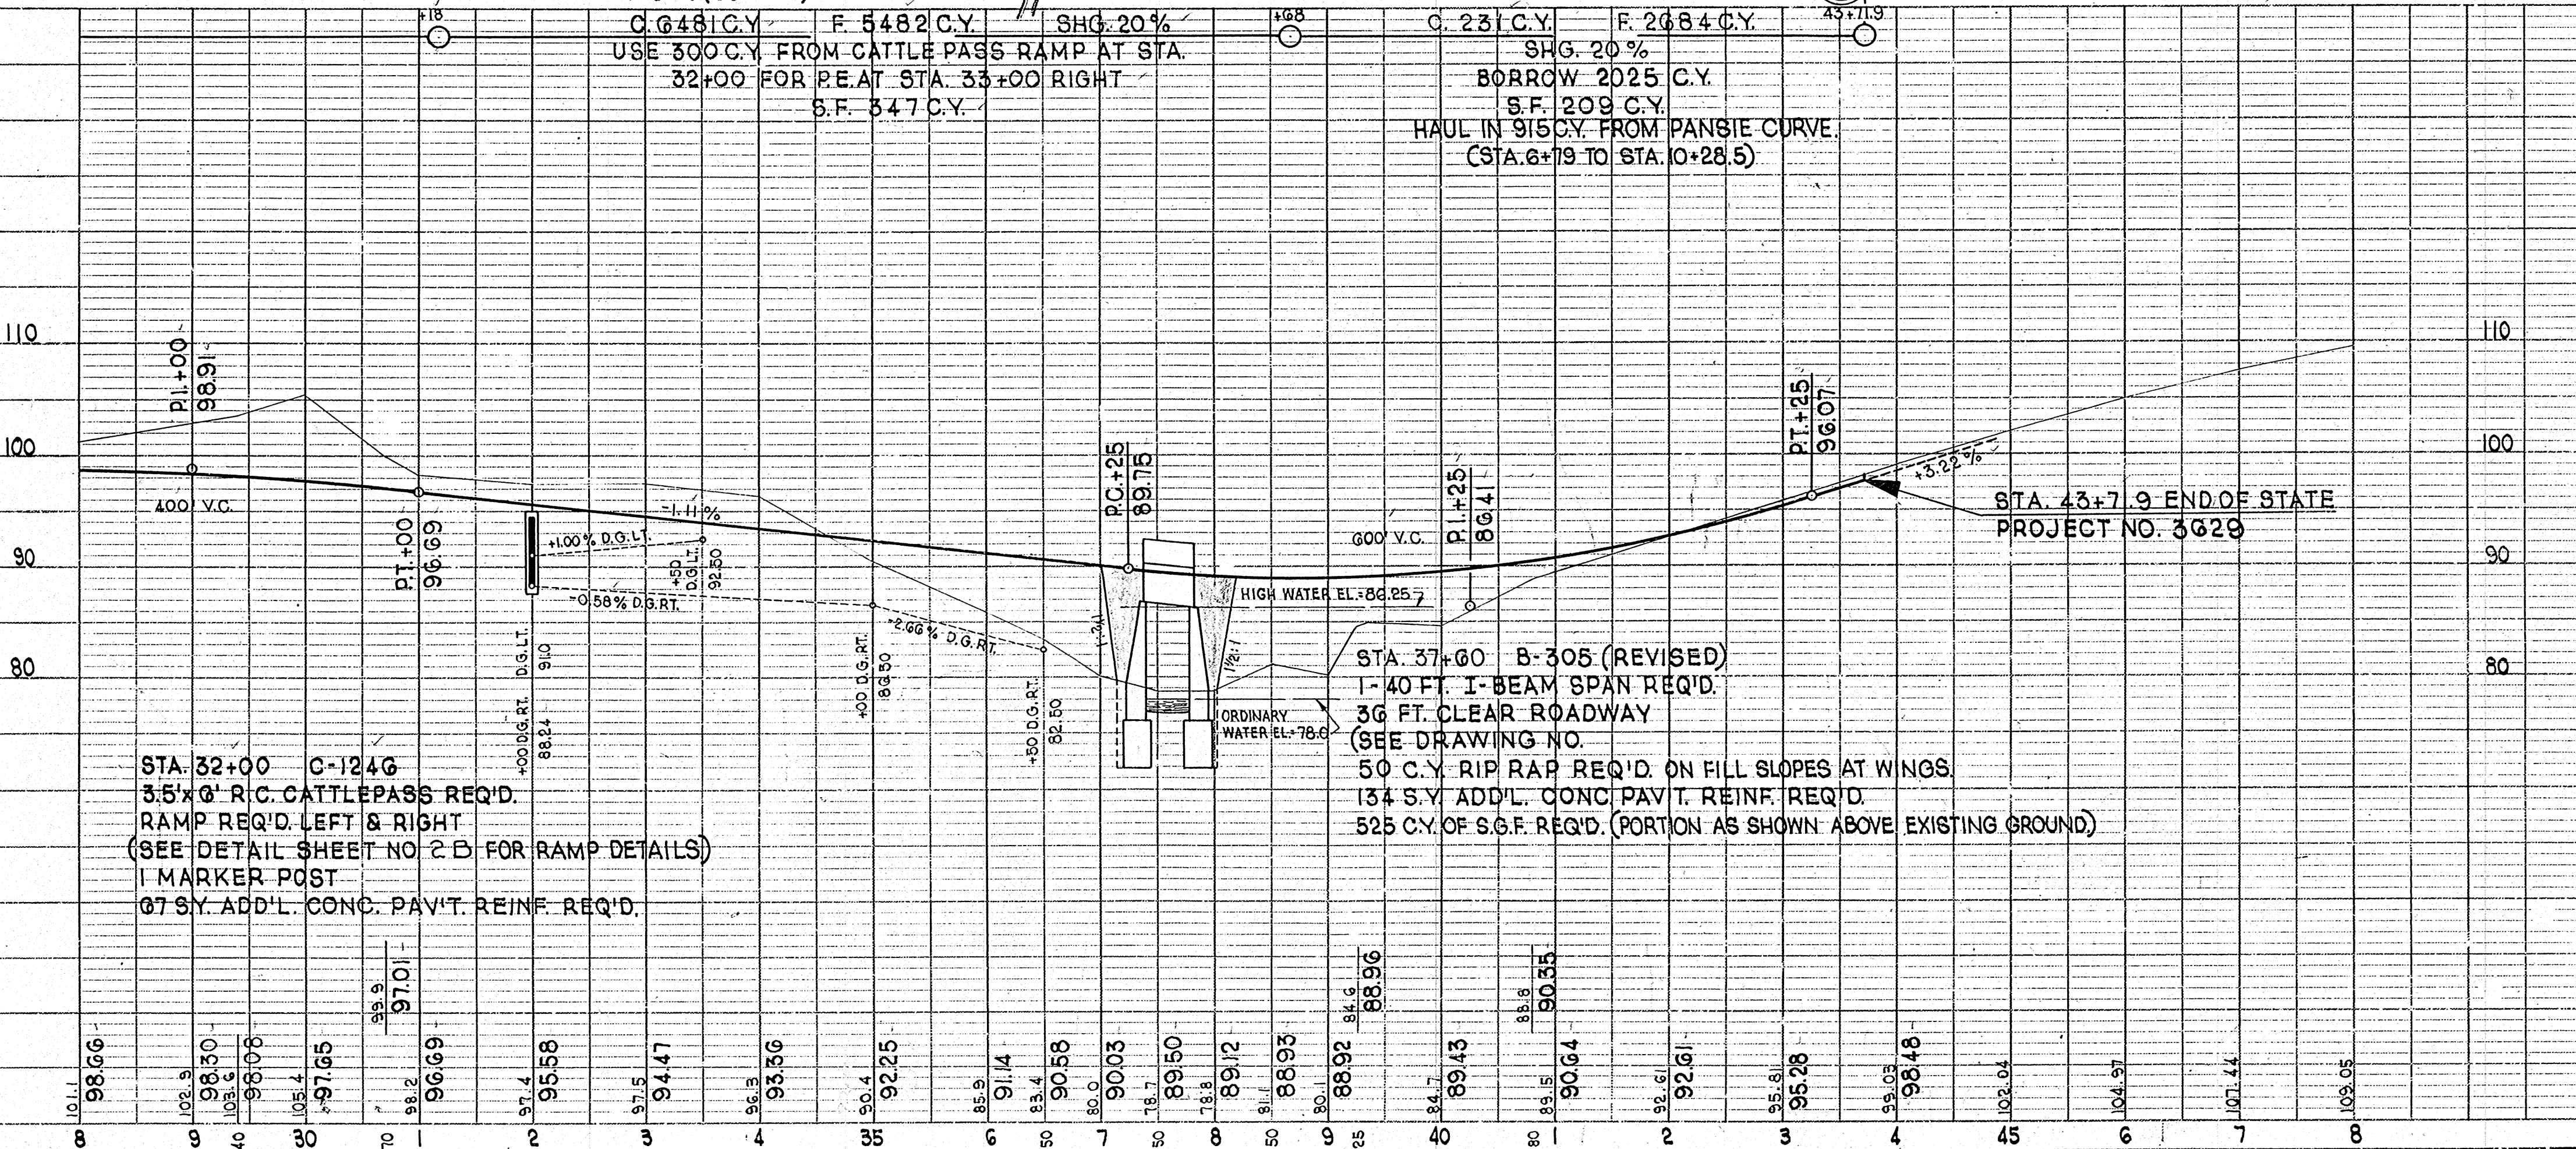

NOTE: CHANNEL EXCAVATION TO BE WASTED IN OLD CHANNEL.

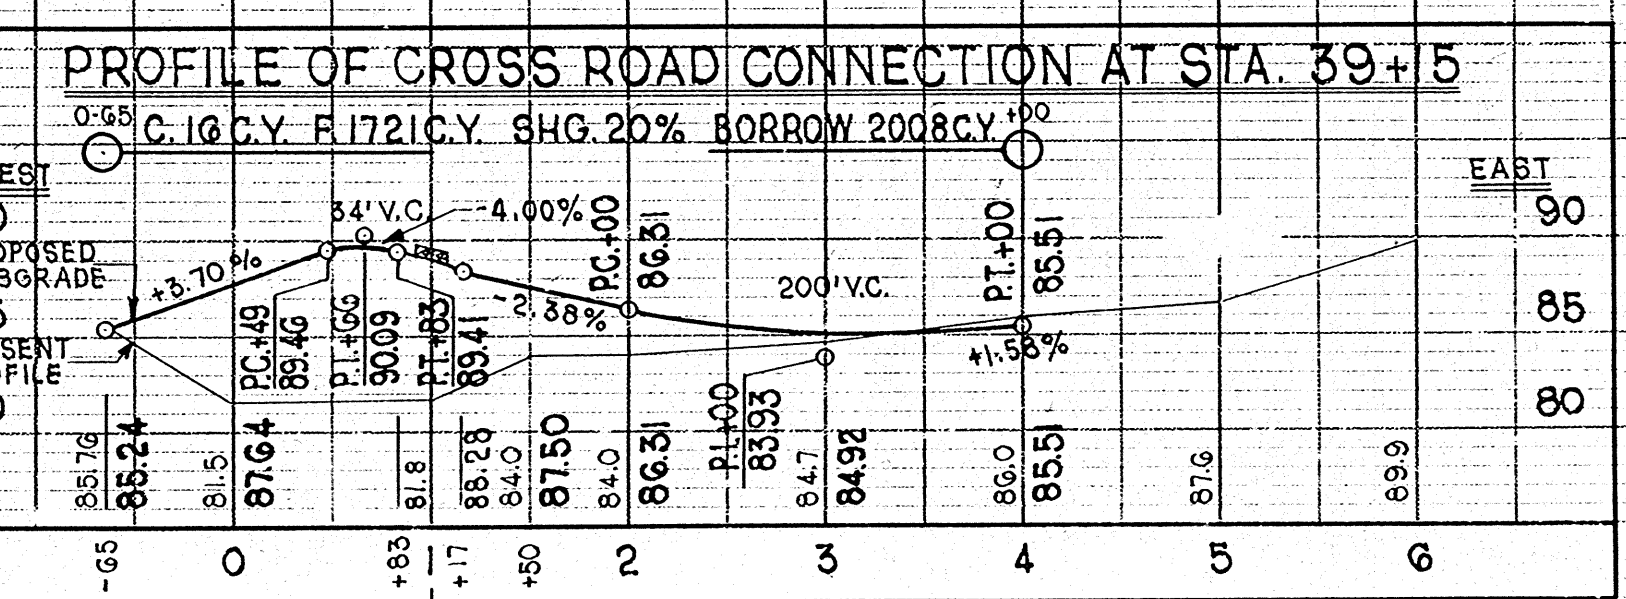

STA. 1+00 CROSS ROAD C.  
 STA. 39+15 HWY. C.

DATE	BY
3-28	M.W.E.
3-28	H.J.G.
3-28	J.T.B.
3-28	L.W.E.
3-28	H.C.A.

STA. 32+00 C-124G  
 3.5x6 R.C. CATTLEPASS REQ'D.  
 RAMP REQ'D. LEFT & RIGHT  
 (SEE DETAIL SHEET NO. 2-D FOR RAMP DETAILS)  
 1 MARKER POST  
 67 SY. ADD'L. CONC. PAV'T. REINF. REQ'D.

STA. 37+60 B-305 (REVISED)  
 1-40 FT. I-BEAM SPAN REQ'D.  
 36 FT. CLEAR ROADWAY  
 (SEE DRAWING NO. B-305)  
 50 C.Y. RIP RAP REQ'D. ON FILL SLOPES AT WINGS  
 134 S.Y. ADD'L. CONC. PAV'T. REINF. REQ'D.  
 525 C.Y. OF S.G.F. REQ'D. (PORTION AS SHOWN ABOVE EXISTING GROUND)



BENCH MARKS			
NO.	STATION	DESCRIPTION	ELEV.
5	33+92	SPIKE IN 16" B. ELDER 20' RT.	94.46
6	42+30	SPIKE IN 10" B. ELDER 28' RT.	88.99

**CONSTR. CURVE**

PI. = 39+59.0  
 $\Delta = 14^\circ-16'$   
 $D = 2^\circ-06'$   
 $T = 341.47$   
 $L = 679.36$   
 $SE = 0.02 \text{ FT./FT.}$

BENCH MARKS			
NO.	STATION	DESCRIPTION	ELEV.
1	3+37	SPIKE IN 6" POPPLE - 32' RT.	100.00
2	10+02	SPIKE IN 10" HICKORY - 31' LT.	91.00



**CONSTR. CURVE**

PI. = 6+15.5  
 $\Delta = 31^\circ-29'$   
 $D = 5^\circ-00'$   
 $T = 323.1$   
 $L = 629.67$   
 $SE = 0.075 \text{ FT.}$

**SURVEY CURVE**  
 $PI. = 6+95.4$   
 $\Delta = 24^\circ-31' \text{ LT.}$   
 $D = 13^\circ-00'$   
 $T = 95.3'$   
 $LC = 187.3'$

FED. ROAD DIST. NO.	STATE	STATE PROJ. NO.	SHEET NO.	TOTAL SHEETS
4	WISC.	3629	7	



STA. 7-50 P.E. LT.  
 $18" \times 28" \text{ C.G.S.M.C.P. REQ'D.}$   
 $8 \text{ C.Y. GVL. SURF.}$   
 $1 \text{ C.Y. MORTAR RUBBLE MASONRY}$

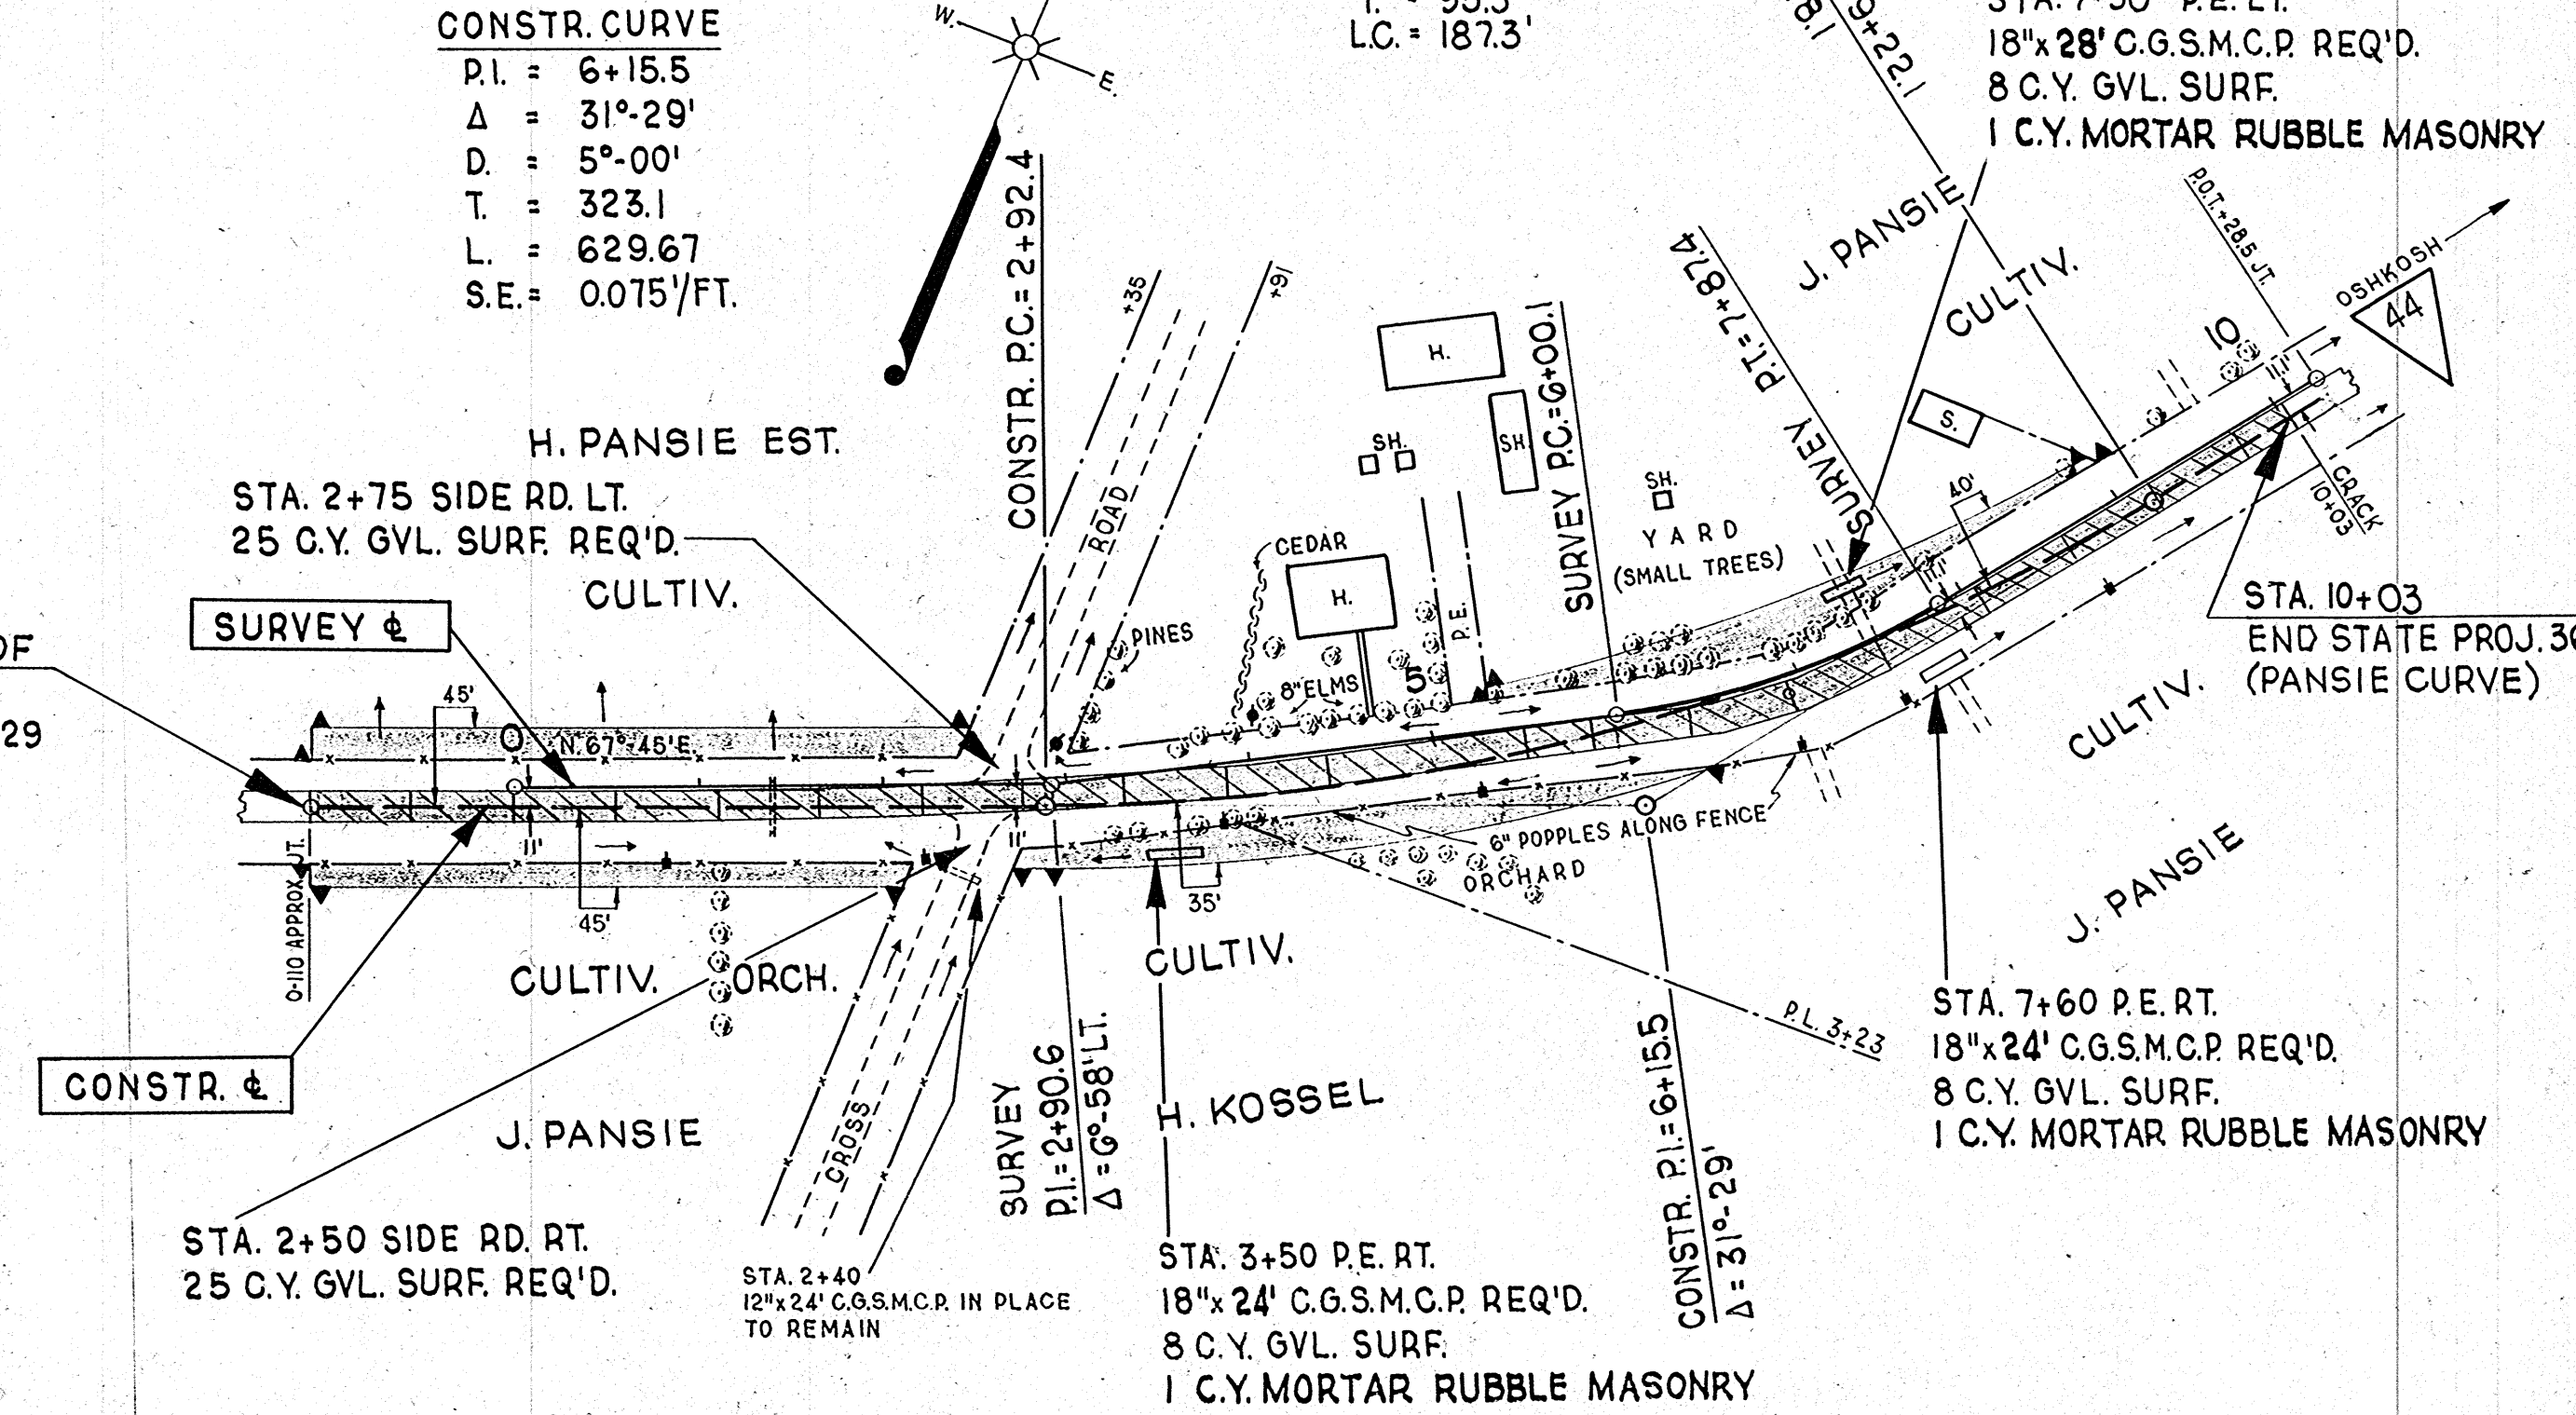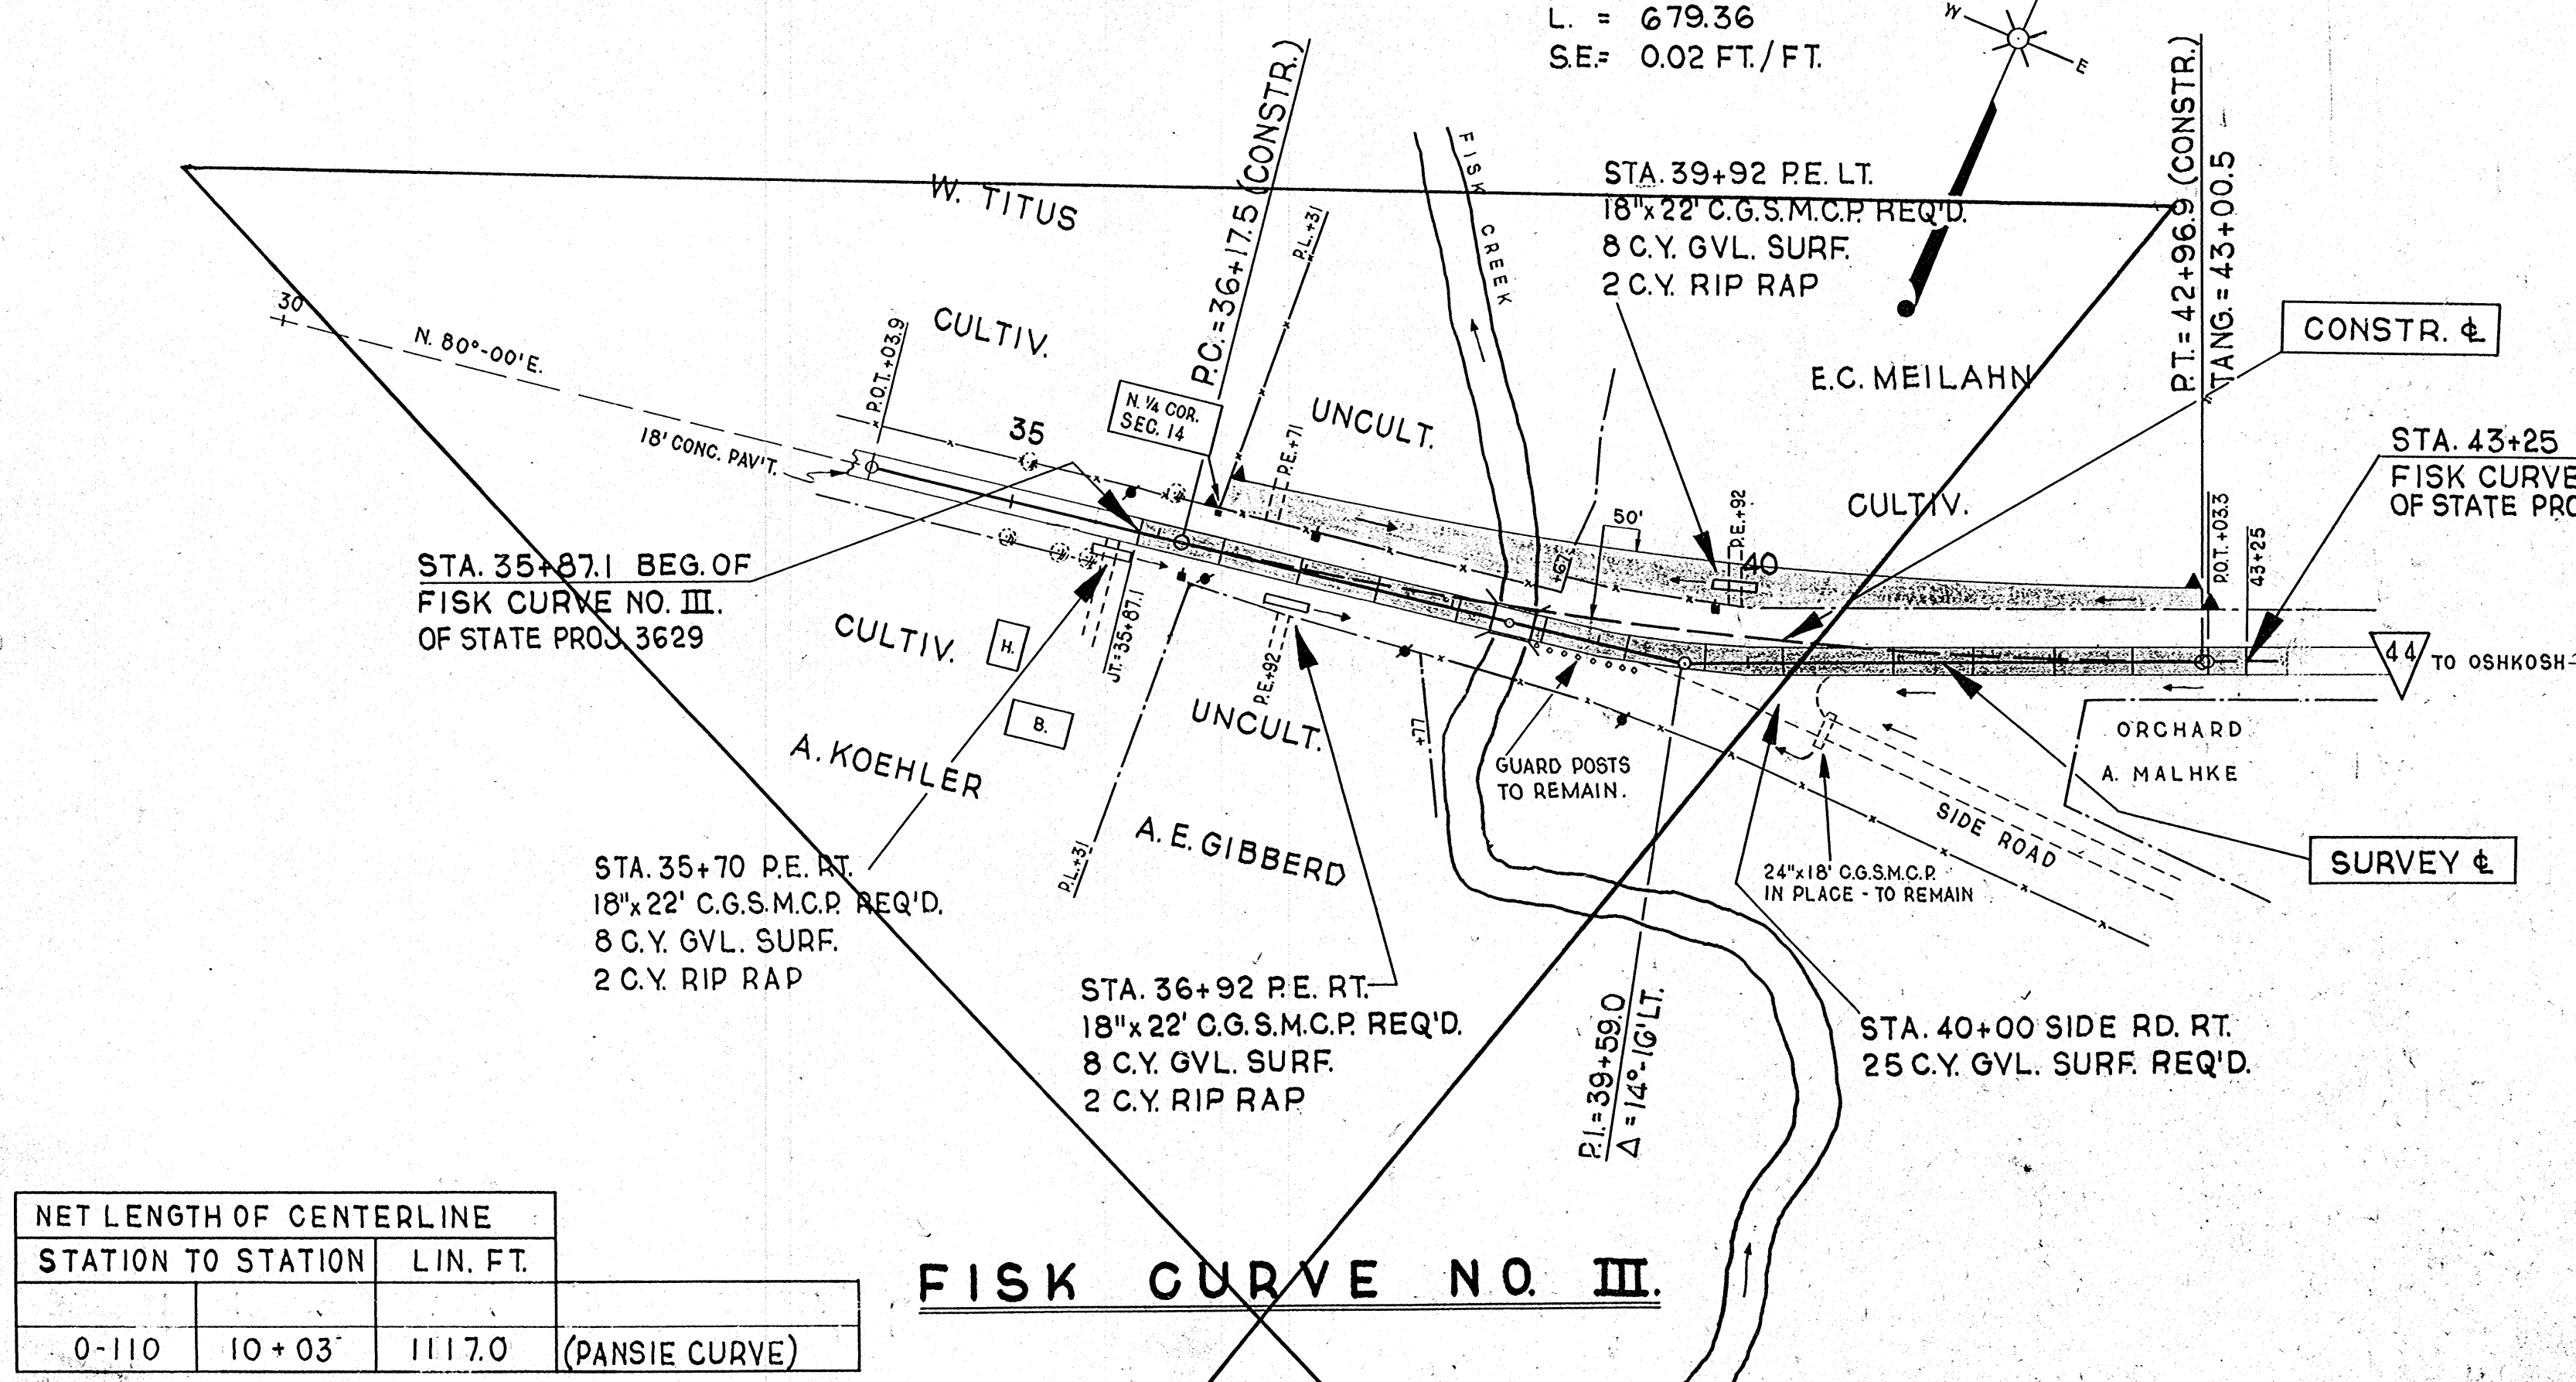

NET LENGTH OF CENTERLINE		
STATION TO STATION	LIN. FT.	
0-110	1117.0	(PANSIE CURVE)

**FISK CURVE NO. III**

**PANSIE CURVE**

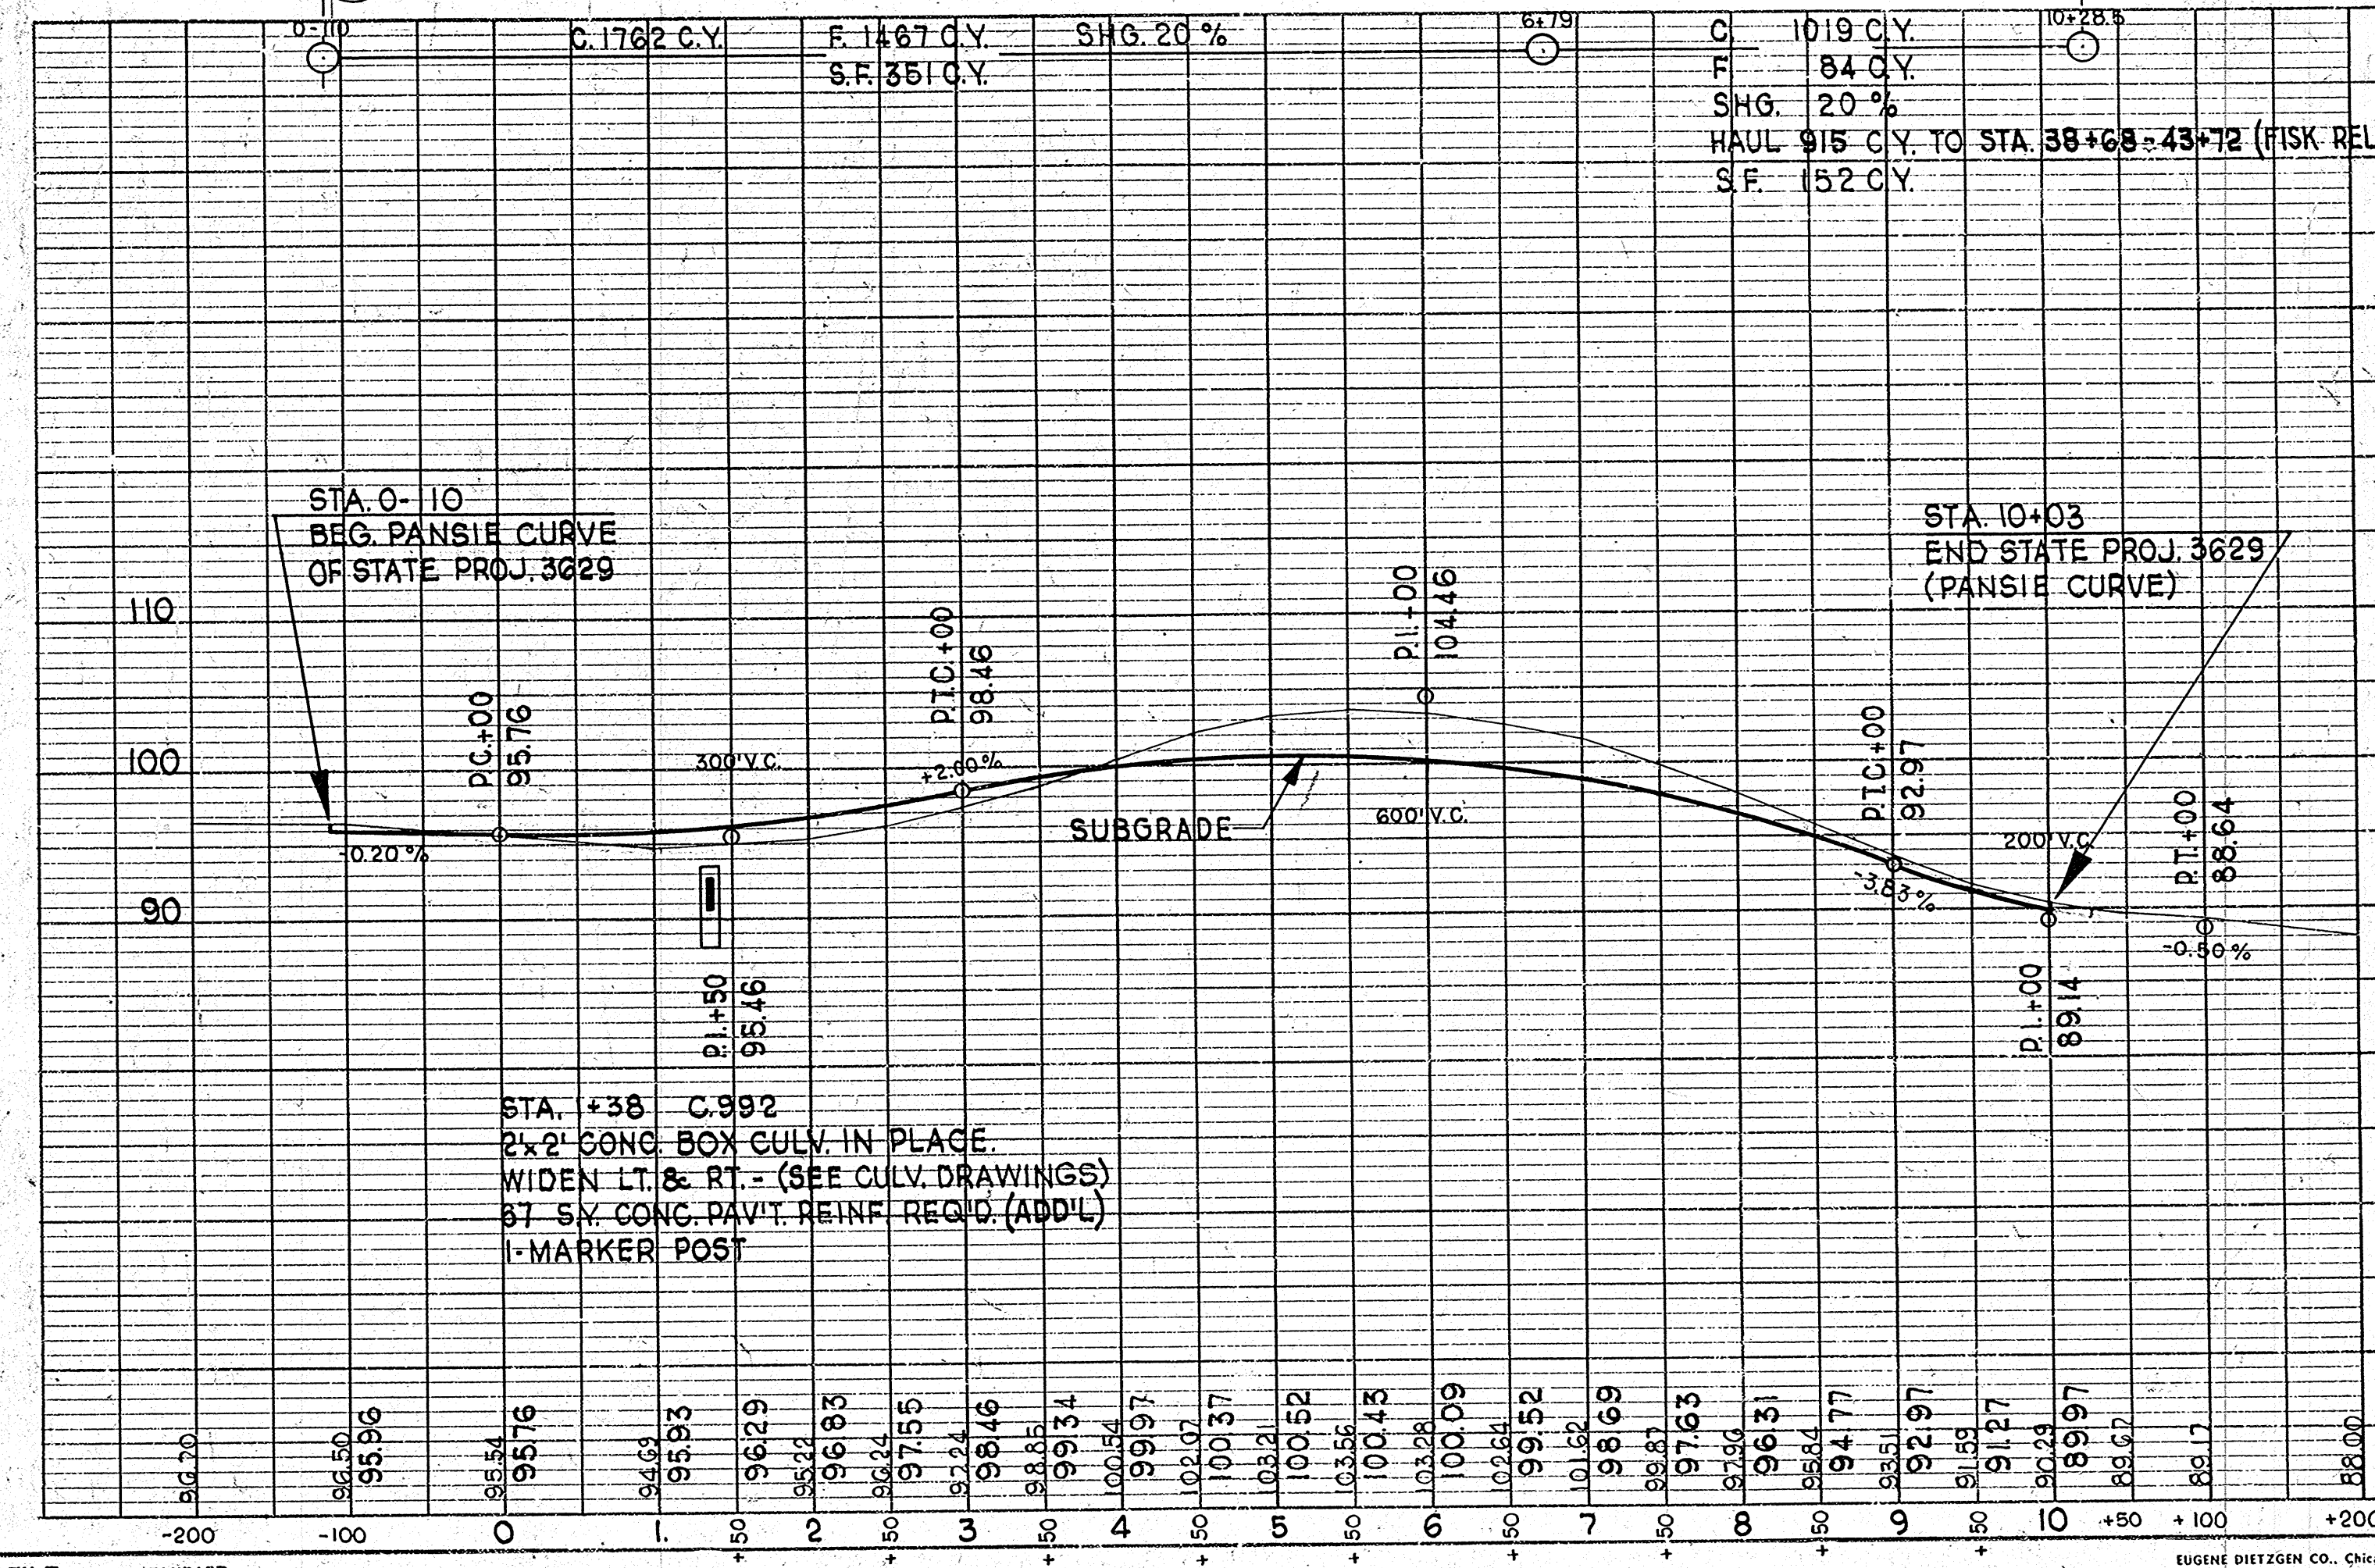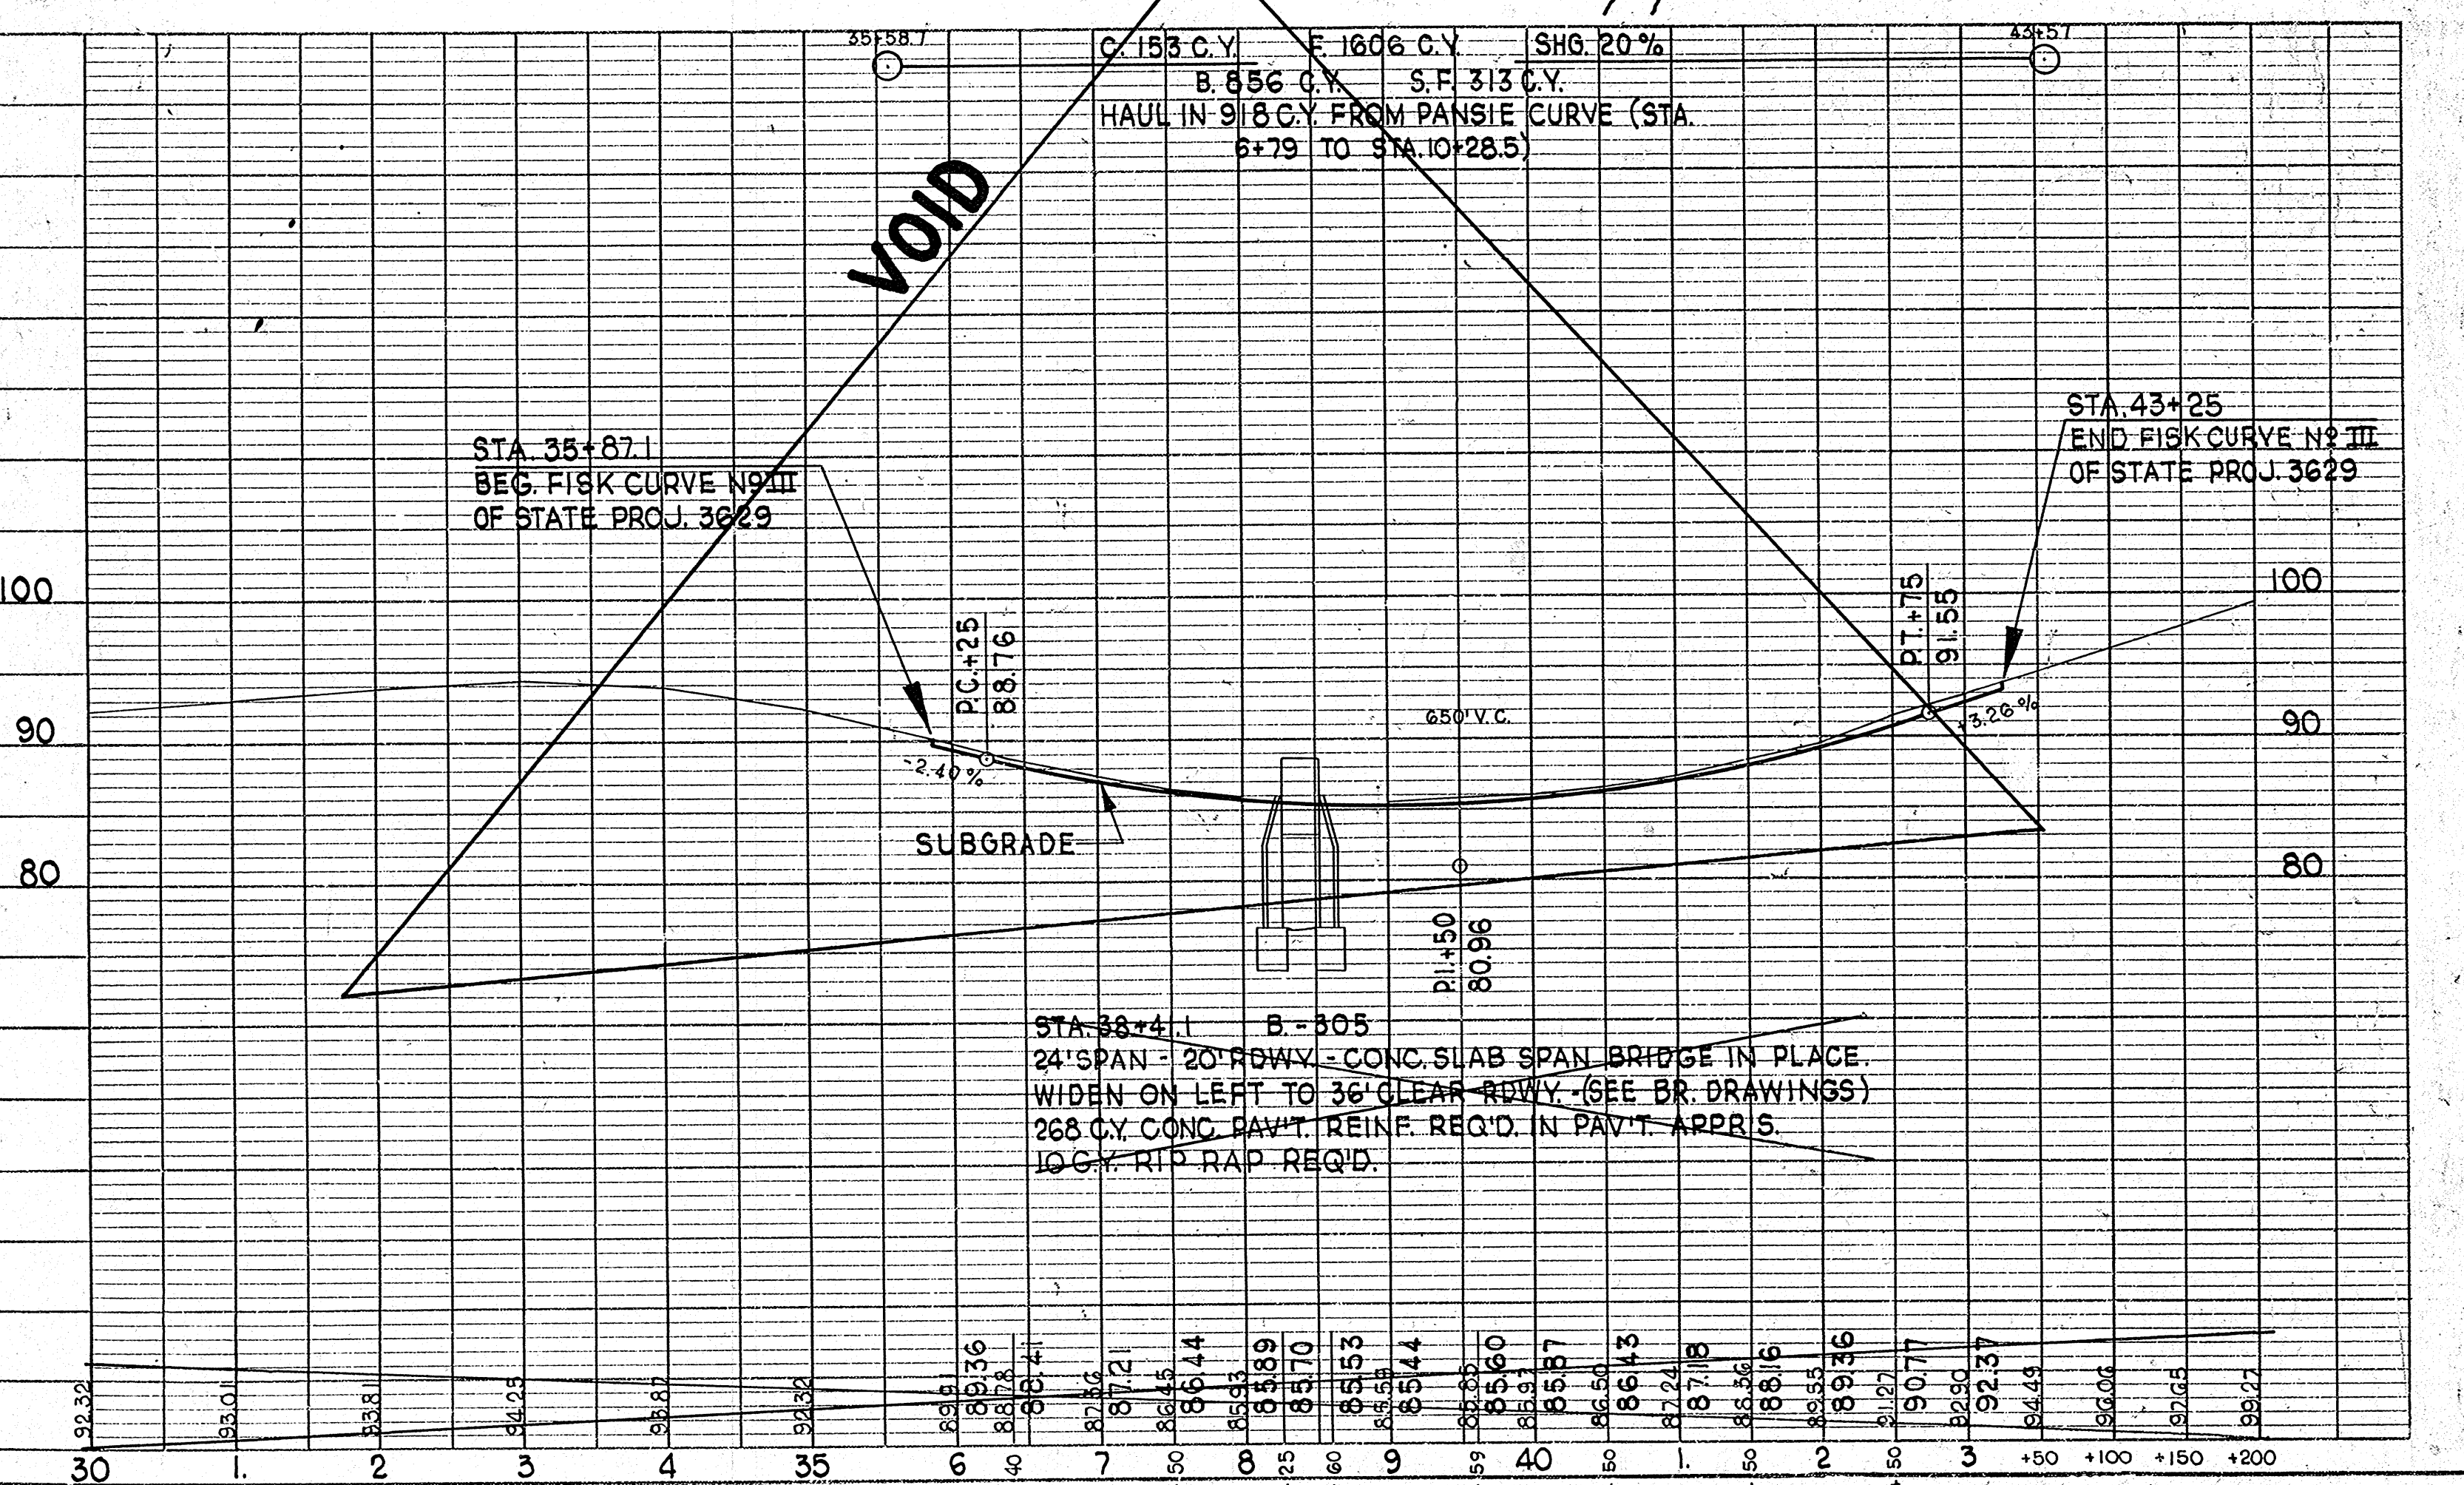


DATE	BY
1-1-37	P.L.J.
1-1-37	E.C.H.
1-1-37	A.J.S.
1-1-37	A.L.P.
1-1-37	J.C.B.

DATE	BY
1-1-37	P.L.J.
1-1-37	E.C.H.
1-1-37	A.J.S.
1-1-37	A.L.P.
1-1-37	J.C.B.



FINAL SURVEY  
 SURVEYED, PLOTTED, TEMPLATE, NO. 240, AREAS CHECKED.

ORIGINAL SURVEY  
 SURVEYED, PLOTTED, TEMPLATE, NO. 240, AREAS CHECKED.

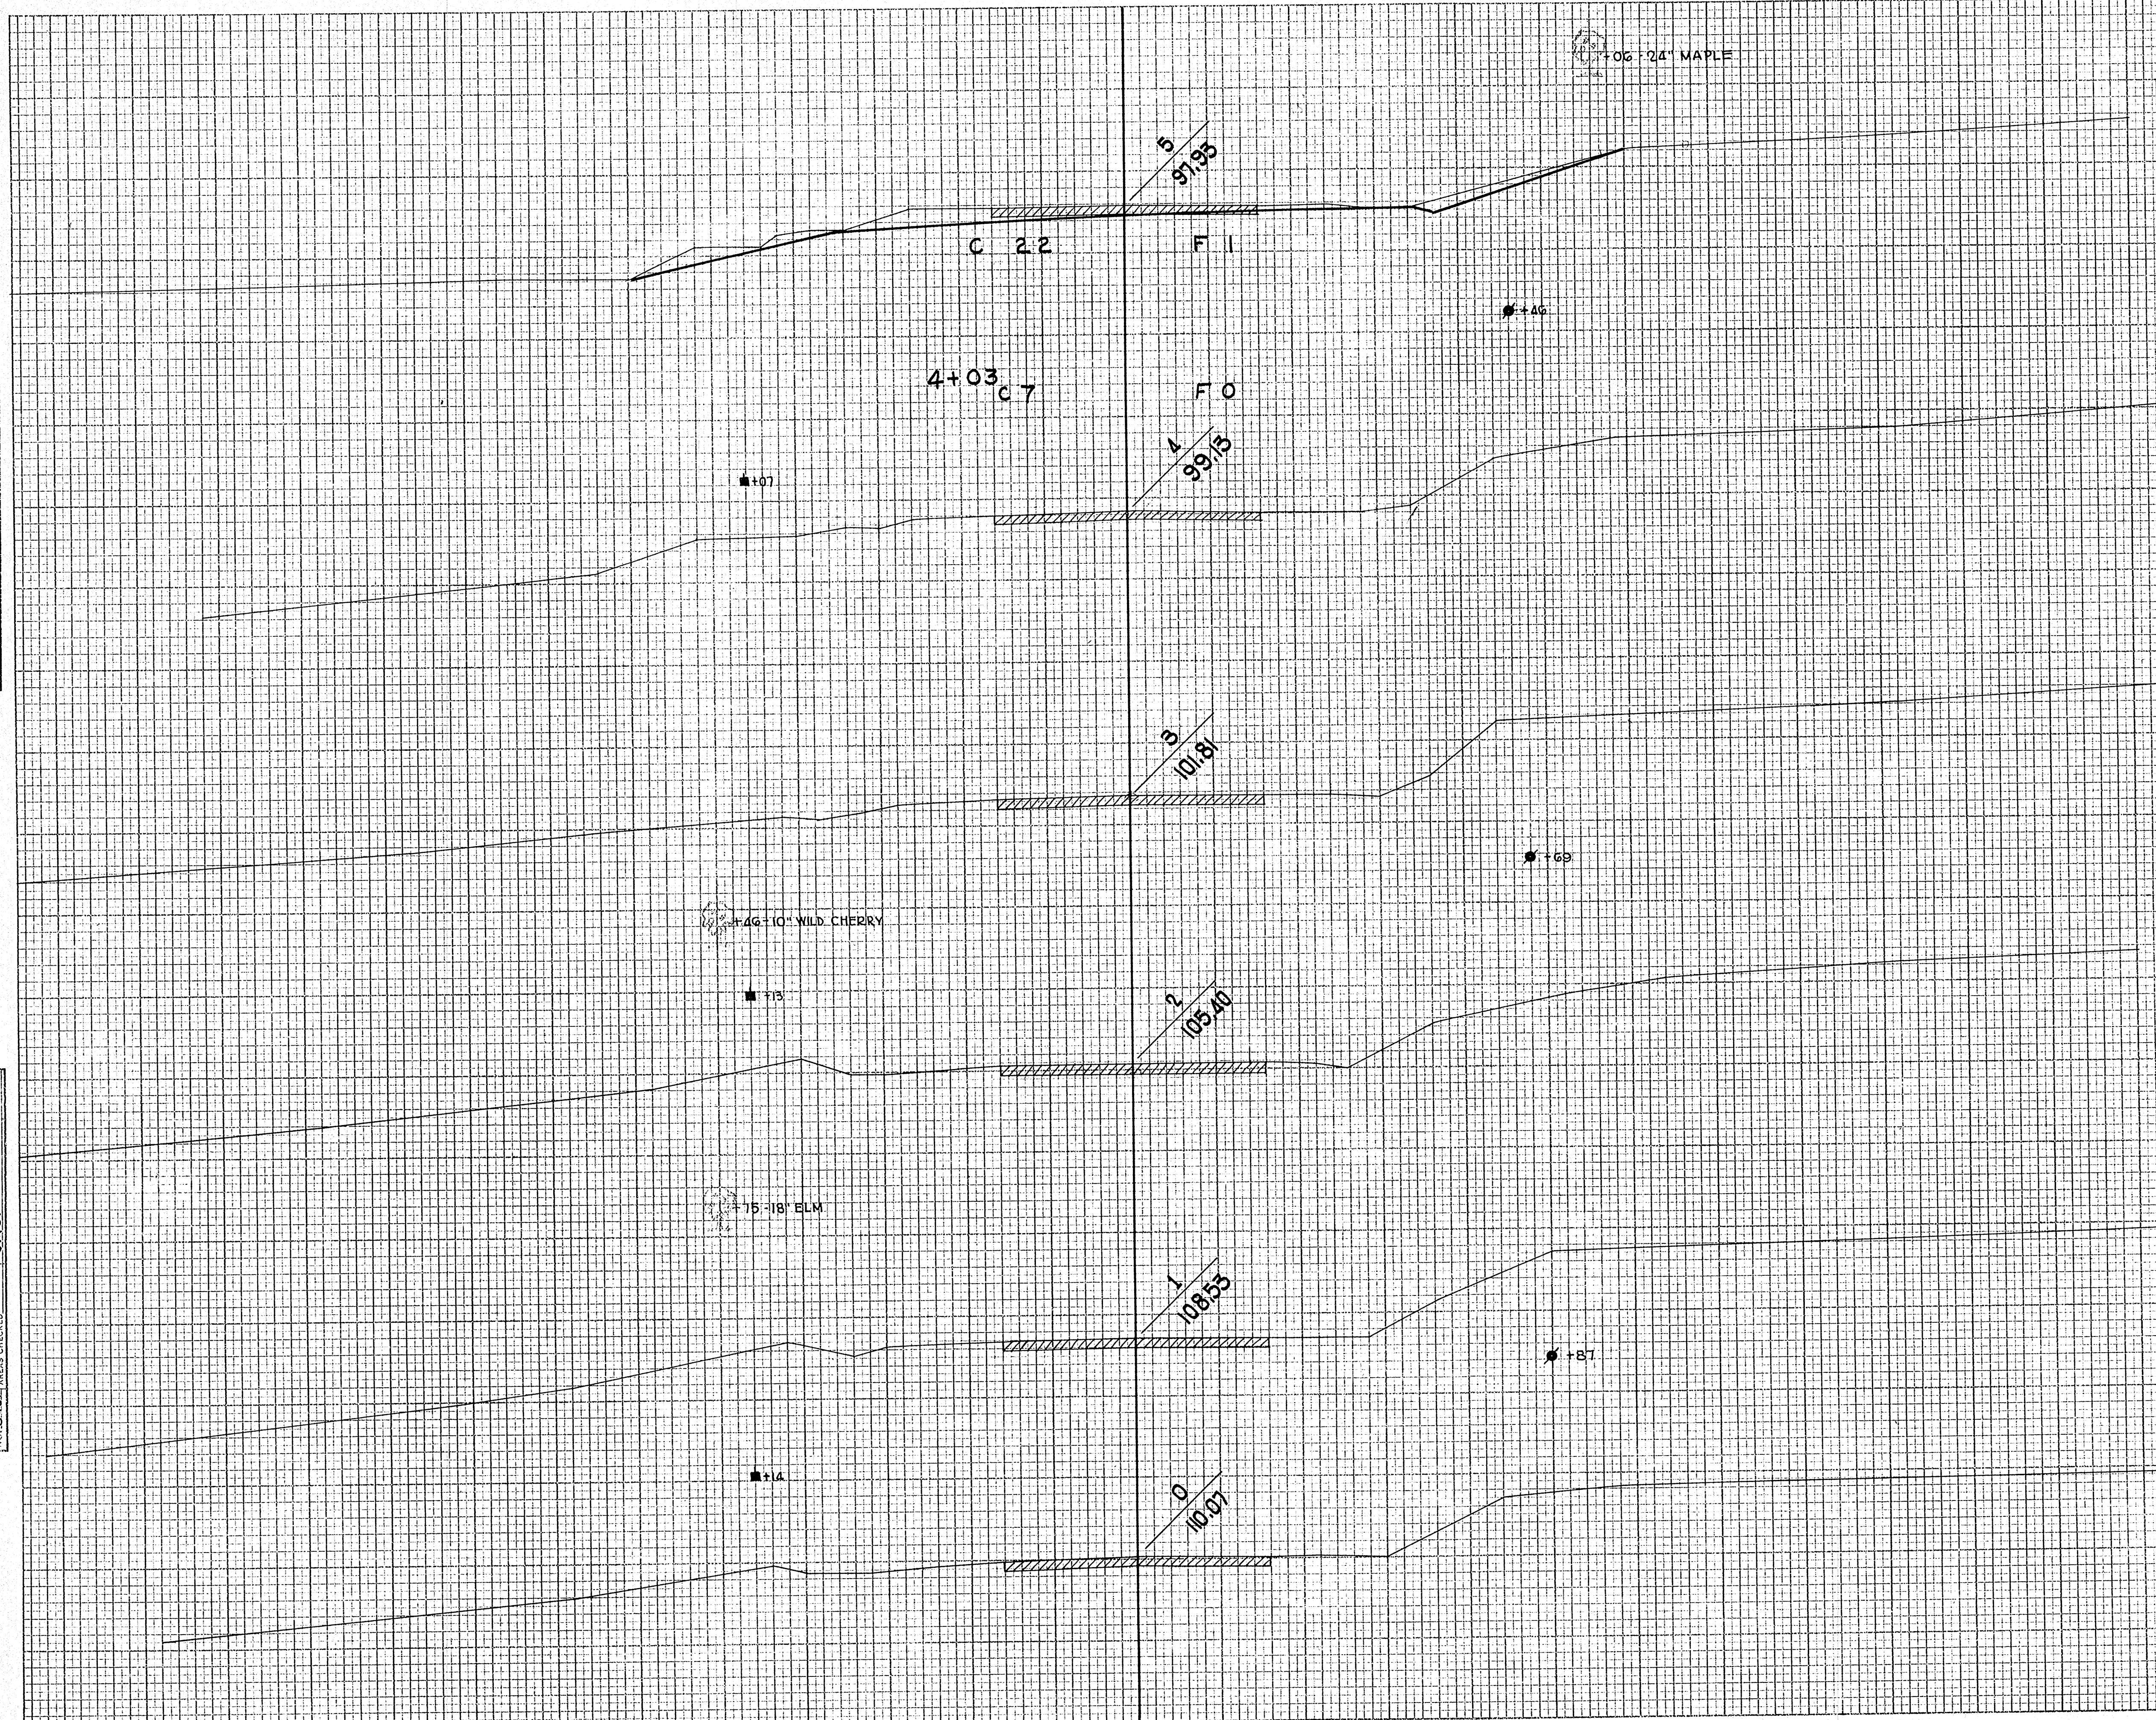

CY	STEP SLOPES	STATION	END AREA			DISTANCE	YARDAGE		
			COMMON	ROCK	FILL		COMMON	ROCK	TOTAL
		4+03	7		0	50		2	
		22			1				
SUB TOTAL-MILE									
SHEET TOTAL						50		2	












FINAL SURVEY SURVEYED, PLOTTED, NOTE BOOK AREAS CHECKED. DATE BY

ORIGINAL SURVEY SURVEYED, PLOTTED, NOTE BOOK AREAS CHECKED. DATE BY M.W.F. C.L.T. R.D.C. A.J.S. J.S.S.

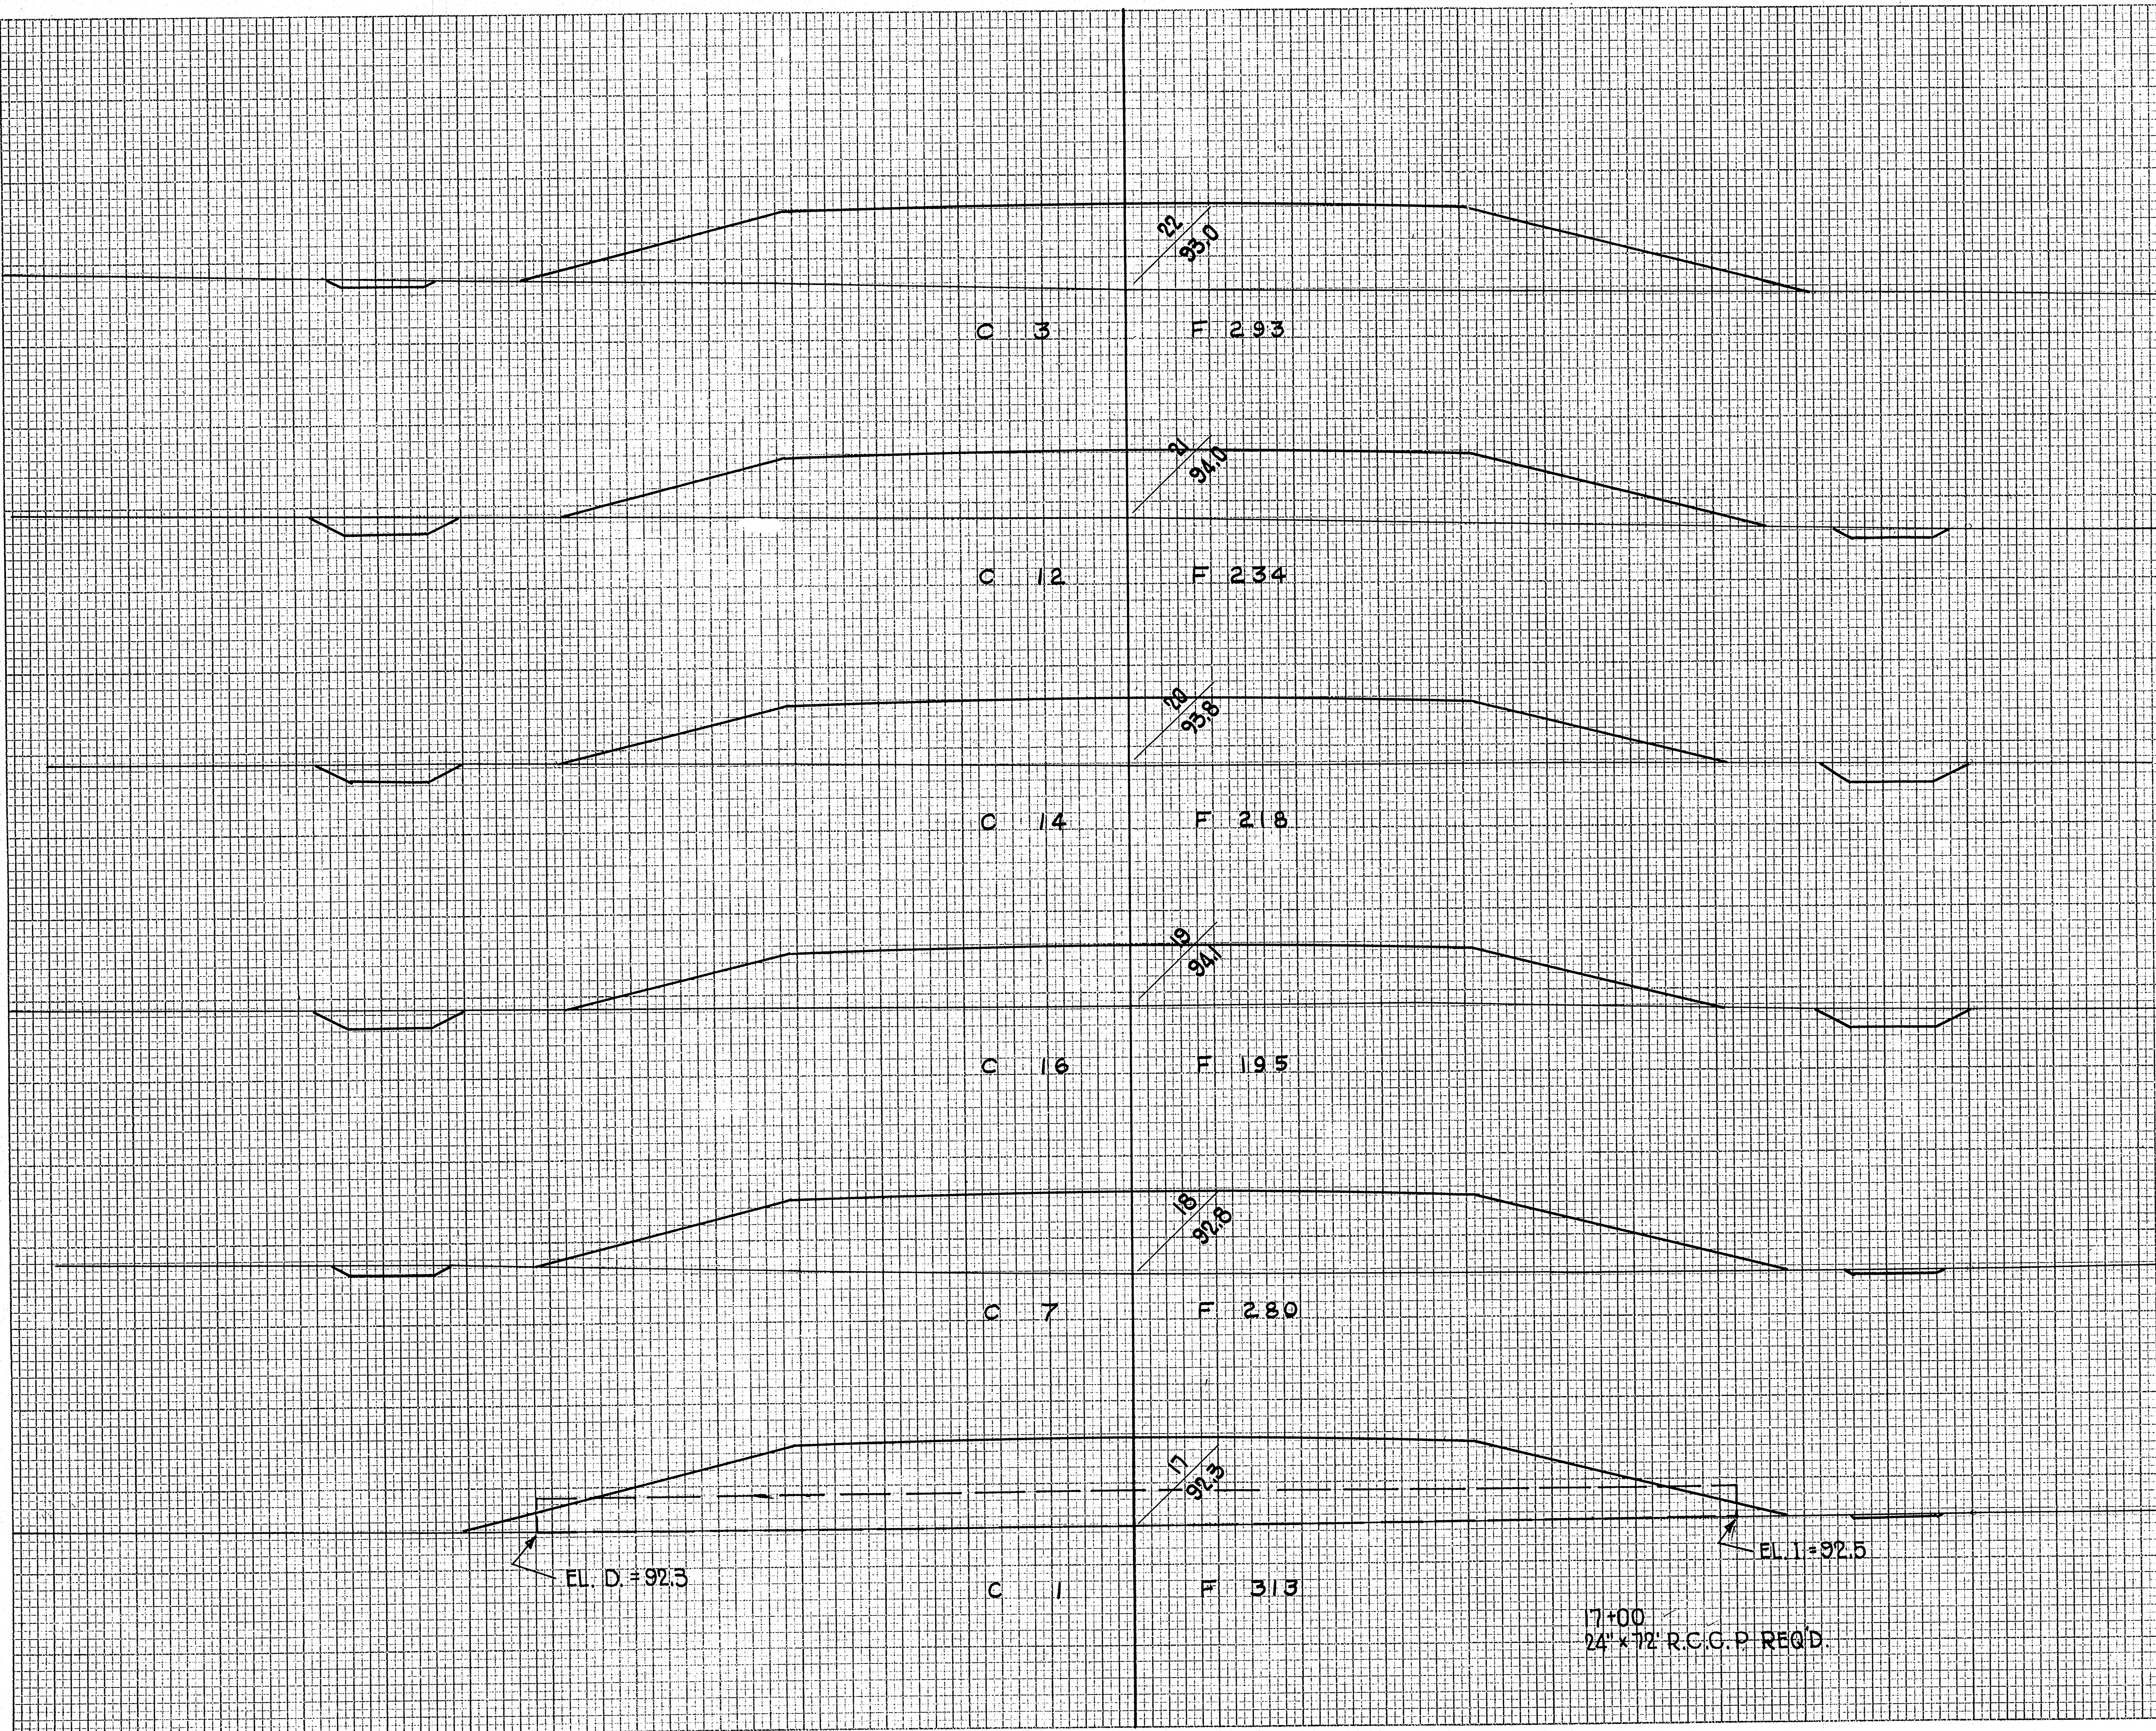

CITY	STEP SLOPES	STATION	END AREA			DISTANCE	YARDAGE			
			EXCAVATION	ROCK	FILL		COMMON	ROCK	TOTAL	TOTAL FILL
		16	0		272					
		17	1		313	2				
		18	7		280	43				
		19	16		195	57				
		20	14		218	48				
		21	12		234	28				
		22	3		293	48				
						276				
						837				
						765				
						879				
						1098				
						1083				
						976				
						5638				

SUB TOTAL MILE \_\_\_\_\_  
SHEET TOTAL \_\_\_\_\_

1.93 5638




















FINAL SURVEY PLOTTED  
NOTE BOOK AREA NO. 3629  
AREA CHECKED

ORIGINAL SURVEY PLOTTED  
NOTE BOOK TEMPLATE NO. 3629  
AREA CHECKED

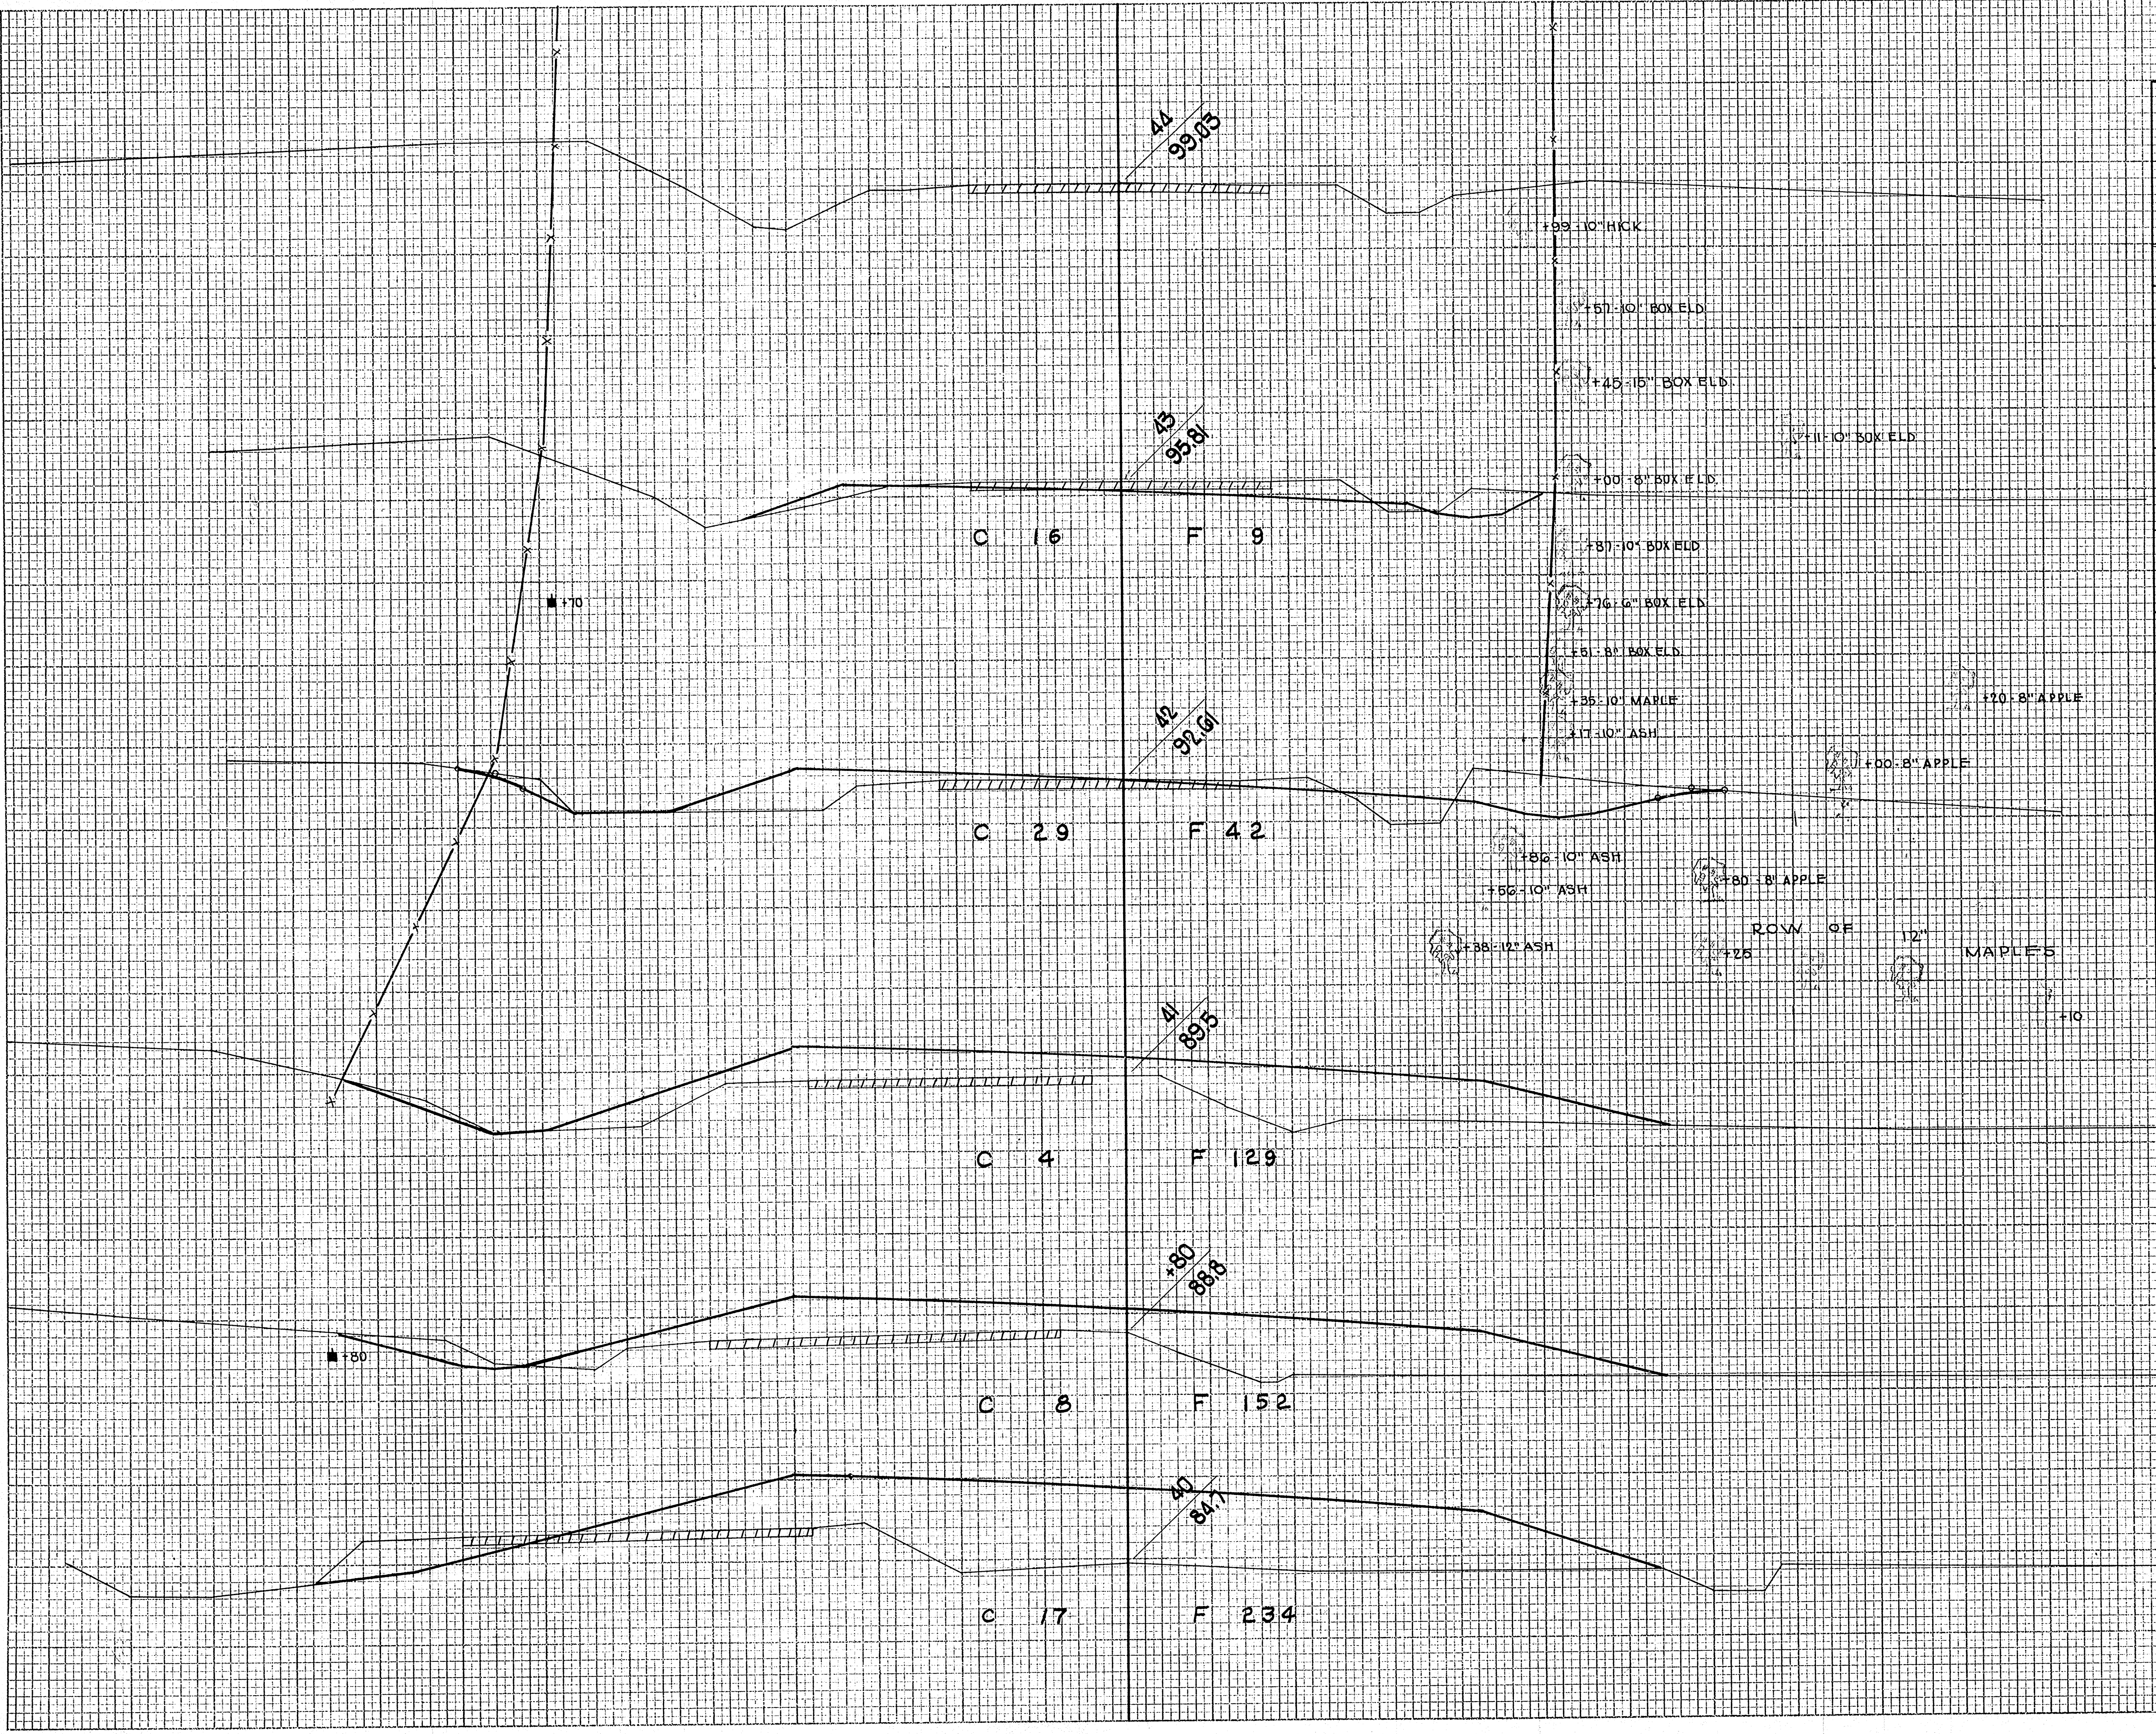

C.Y.	STEP SLOPES	STATION	END AREA			DISTANCE	YARDAGE				
			EXCAVATION		FILL		EXCAVATION			TOTAL FILL	
			COMMON	ROCK			COMMON	ROCK	TOTAL		
		+25	0		285						
		40	17		234			24			720
		+80	8		152			37			
		41	4		129			4			
		42	29		42			61			317
		43	76		9			83			94
		+71.5	0		0			22			11
SUB-TOTAL						231					1819
TOTAL MILE (1)						18361					18270
SUB-TOTAL - MILE											
SHEET TOTAL											








FINAL SURVEYED BY DATE  
 SURVEY PLOTTED  
 NOTE BOOK TEMPLATE NO.  
 AREAS CHECKED

ORIGINAL SURVEYED BY DATE  
 SURVEY PLOTTED M.W.F. 3-38  
 NOTE BOOK TEMPLATE A.J.L. 3-38  
 NO. 8641 AREAS CHECKED B.W.C. 3-38

CROSS ROAD AT 39+15

FED. ROAD DIST. NO.	STATE	STATE PROJ. NO.	SHEET NO.	TOTAL SHEETS
4	WISC.	3629		

DIVISION JOB NO. 3629

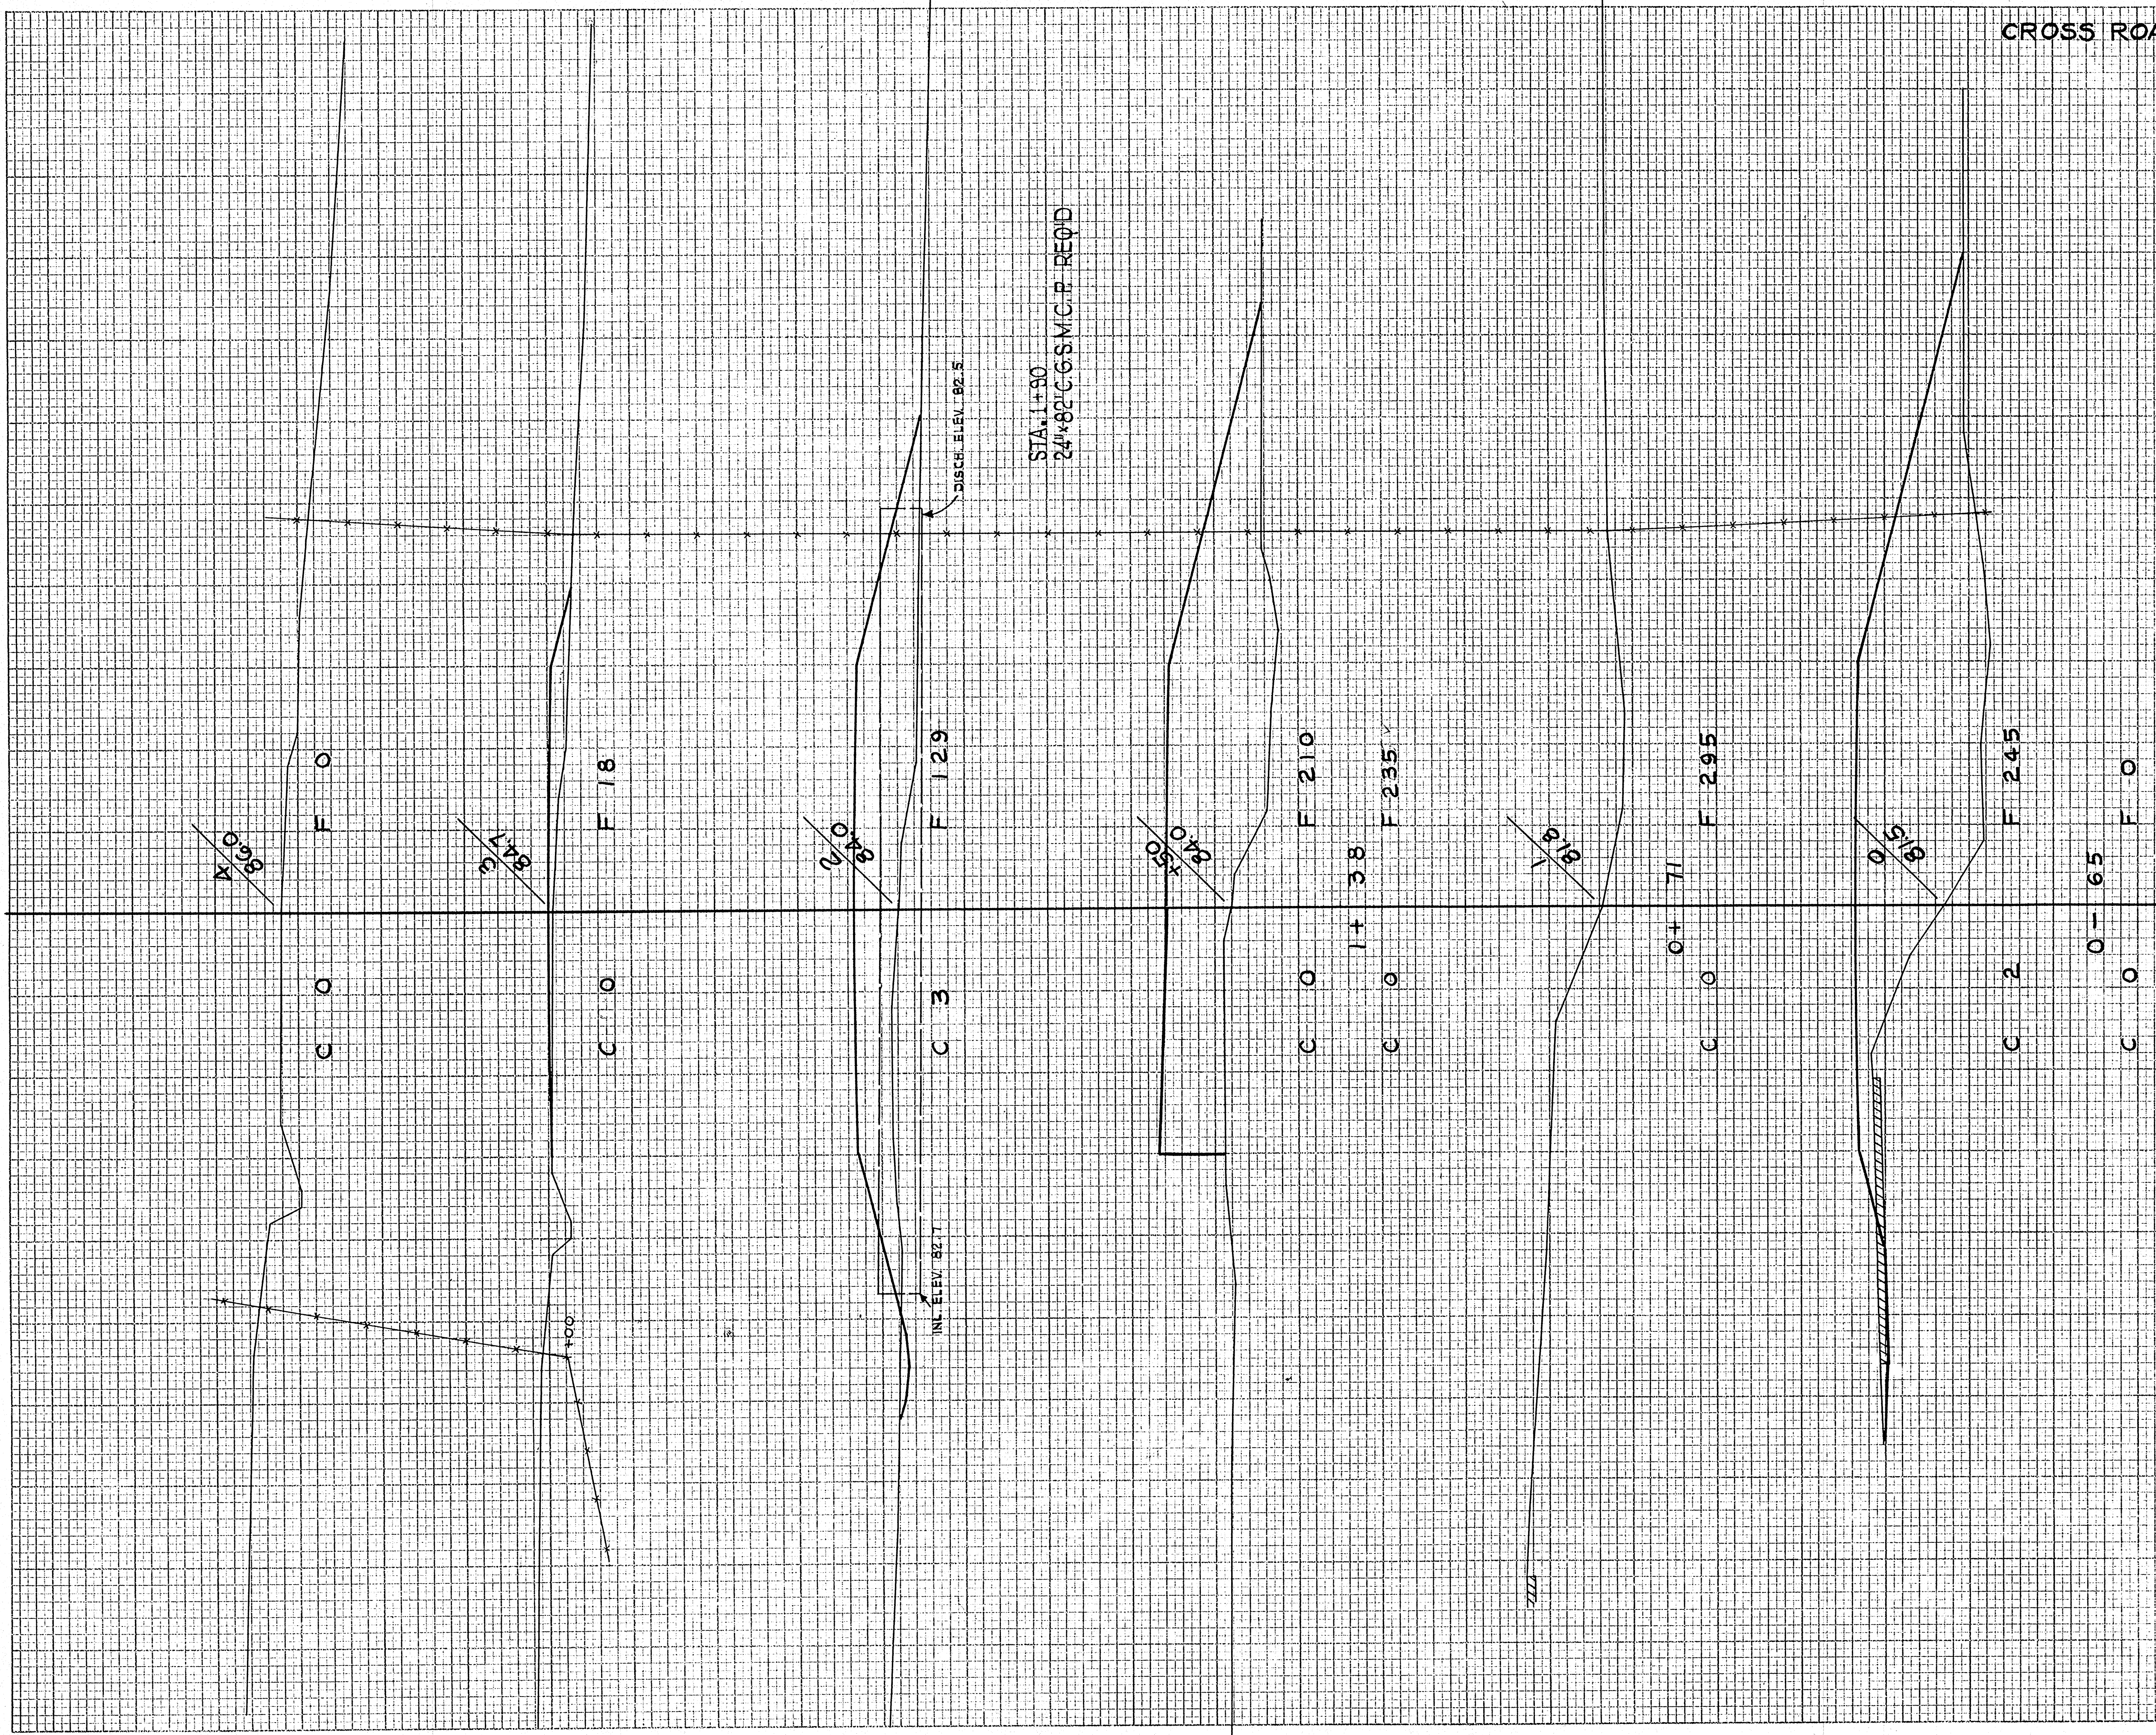

C.Y. STEP SLOPES	STATION	END AREA			DISTANCE	YARDAGE				
		EXCAVATION		FILL		EXCAVATION		TOTAL FILL		
		COMMON	ROCK			COMMON	ROCK		TOTAL	
	0+00	0	0	0						
	1+38	0	0	0						
	2+71	0	0	0						
	4+04	0	0	0						
	5+47	0	0	0						
	6+80	0	0	0						
	8+13	0	0	0						
	64+00	0	0	0						
	65+33	0	0	0						
	66+66	0	0	0						
	68+00	0	0	0						
	69+33	0	0	0						
	70+66	0	0	0						
	72+00	0	0	0						
	73+33	0	0	0						
	74+66	0	0	0						
	76+00	0	0	0						
	77+33	0	0	0						
	78+66	0	0	0						
	80+00	0	0	0						
	81+33	0	0	0						
	82+66	0	0	0						
	84+00	0	0	0						
	85+33	0	0	0						
	86+66	0	0	0						
	88+00	0	0	0						
	89+33	0	0	0						
	90+66	0	0	0						
	92+00	0	0	0						
	93+33	0	0	0						
	94+66	0	0	0						
	96+00	0	0	0						
	97+33	0	0	0						
	98+66	0	0	0						
	100+00	0	0	0						
	TOTAL CROSS ROAD 39+15							16		1721
	TOTAL MILE (1)							18,301		18,270
	TOTAL CHANNEL CHANGE 37+00							2,873		
	TOTAL FISK RELOG,							21,190		19,991

SUB TOTAL - MILE

SHEET TOTAL












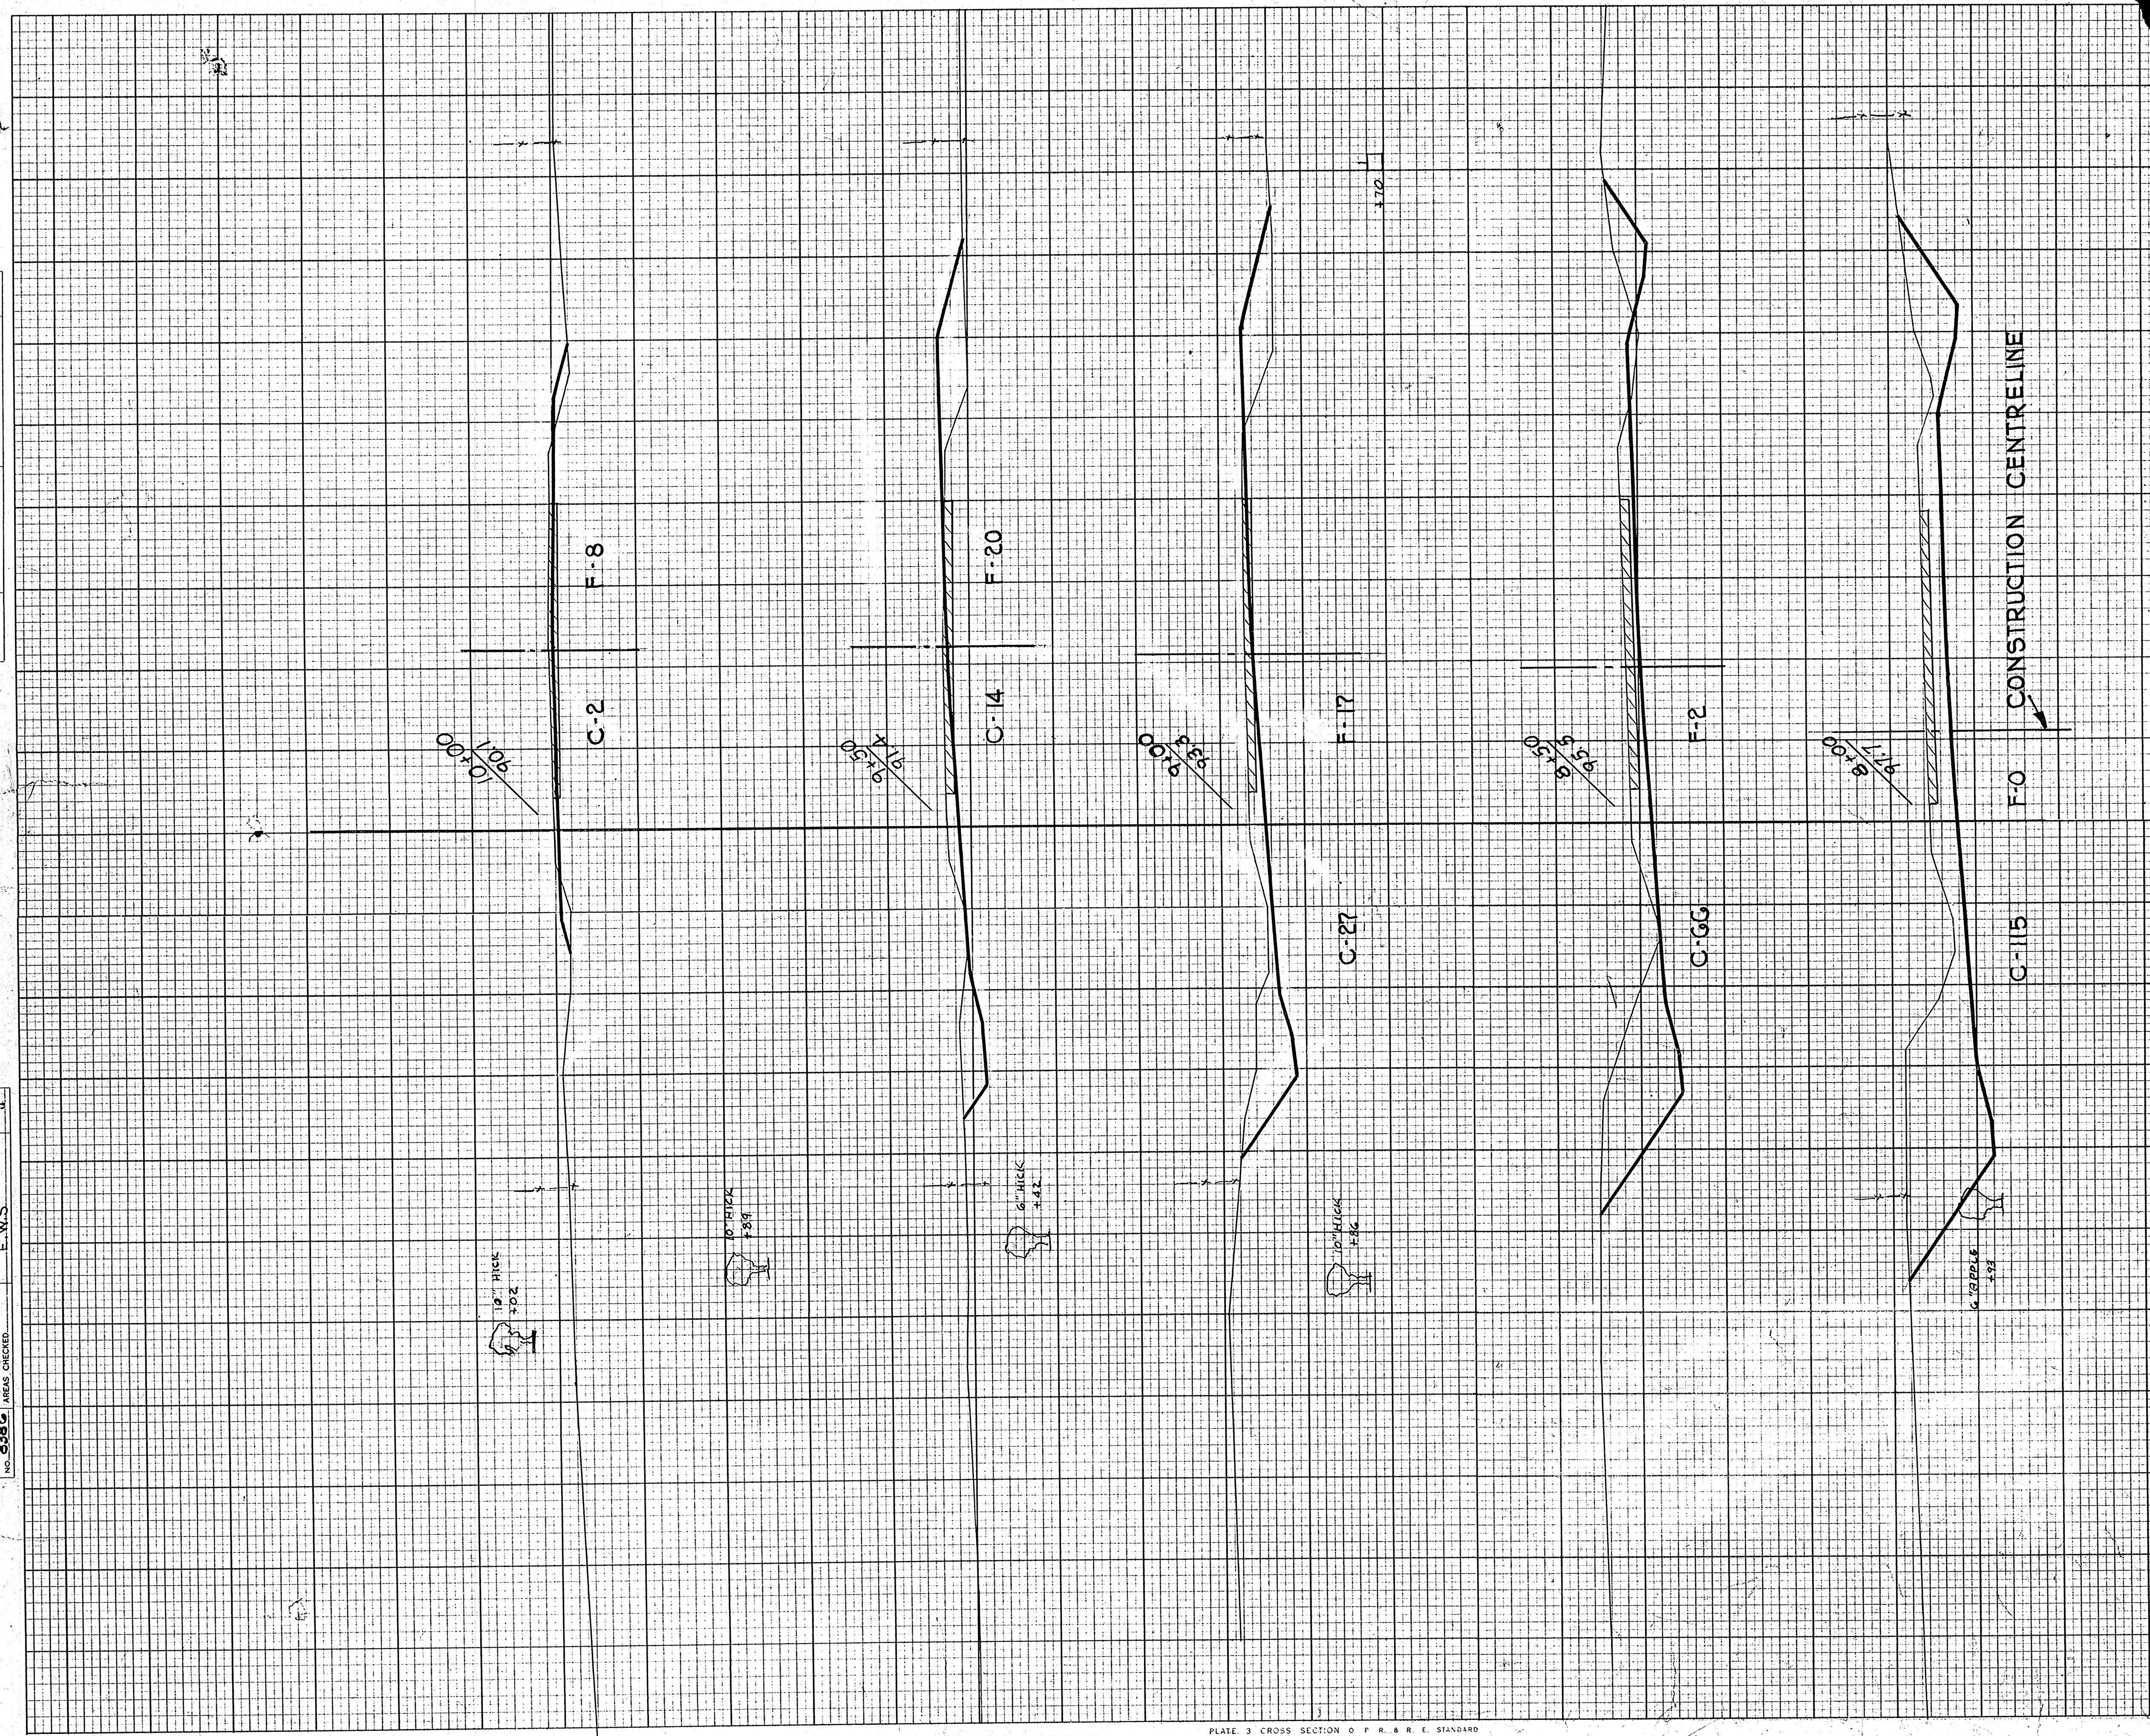

CY	STEP SLOPES	STATION	END AREA			DISTANCE	YARDAGE				
			EXCAVATION	ROCK	FILL		COMMON	ROCK	MARSH	TOTAL	TOTAL FILL
		+28	0	0	0	0	0	0	0	0	0
		10	2	8	8	170	170	0	0	0	0
		+50	14	20	20	37	37	0	0	0	0
		9	27	17	17	87	87	0	0	0	0
		+50	66	27	27	317	317	0	0	0	0
		8	115	2	2	170	170	0	0	0	0
		7+50	128	0	0	317	317	0	0	0	0
		8	128	0	0	317	317	0	0	0	0
		9	115	0	0	170	170	0	0	0	0
		10	2	0	0	170	170	0	0	0	0
		+28	0	0	0	0	0	0	0	0	0
SHEET TOTAL						626	84	0	0	0	0
TOTAL FOR PANSIE CURVE 2781						1551					

**SUMMARY**

25	TOTAL MILE	NO. ①	11890	111	3,901
118	"	NO. ②	5752	111	7,920
26	PANSIE CURVE		2781	111	1,551
163	GRAND TOTAL FOR PROJECT		20,423	111	12,572
26	TOTAL PISK RELOC		21,190		13,991
26	TOTAL PANSIE CURVE		2,781		1,551
26	GRAND TOTAL FOR PROJ.		23,971		15,542

SUB TOTAL - MILE \_\_\_\_\_  
 SHEET TOTAL \_\_\_\_\_

FINAL SURVEY SURVEYED BY DATE  
 NOTE BOOK NO. 8209  
 TEMPLATES AREAS CHECKED

ORIGINAL SURVEY SURVEYED BY DATE  
 P.L.J. 12-36  
 B.S.D. 1-37  
 A.J.S. U.  
 E.W.S. U.  
 NO. 8209  
 AREAS CHECKED